


# GOOD SAMARITAN HOSPITAL

## MRI PRE-ACTION PANEL UPGRADE

### Fire Alarm and Detection System

Equipment Supplied By

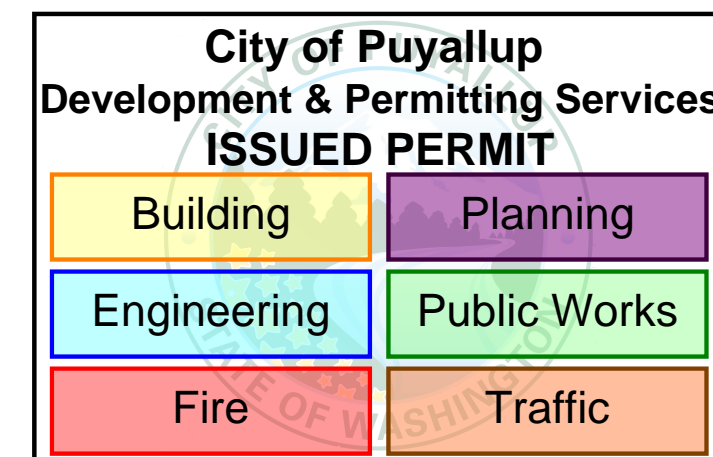

City of Puyallup  
Fire  
REVIEWED  
FOR  
COMPLIANCE

DDrake  
05/15/2023  
8:35:19 AM



THE APPROVED CONSTRUCTION  
PLANS AND ALL ENGINEERING  
MUST BE POSTED ON THE JOB AT  
ALL INSPECTIONS IN A VISIBLE AND  
READILY ACCESSIBLE LOCATION.

Approval of submitted plans is not an  
approval of omissions or oversight by this  
office or noncompliance with any  
applicable regulations of local government.  
The contractor is responsible for making  
sure that the building complies with all  
applicable building codes and regulations of  
the local government.

#### Project Team Contact Information

##### Sales Representative

Paula Goode  
paula.goode@jci.com  
Phone: 206-777-4847

##### Project Coordinator

Bryan Reimer  
bryan.reimer@jci.com  
Phone: 206-777-4933

##### Technician Scheduler

Yvonne Thompson  
yvonne.thompson@jci.com  
Phone: 206-777-4860

##### Project Designer

Eric Beck  
eric.beck@jci.com  
Phone: 206-777-4821  
NICET Fire Alarm System Level III, #148077

DRAWING LIST			
SHEET NAME	DRAWING NAME	ELECTRONIC DRAWING NAME	INCLUDED IN THIS PROJECT
FA-COV-01	TITLE SHEET	FA-COVER	X
FA-COV-02	COVER SHEET	FA-COVER	X
FA-COV-02.1	COVER SHEET	FA-COVER	X
FA-COV-03	COVER SHEET	FA-COVER	
FA-COV-04	COVER SHEET	FA-COVER	
FA-COV-05	COVER SHEET	FA-COVER	
FA-COV-06	PANEL LAYOUT	FA-COVER	
FA-COV-07	PANEL LAYOUT	FA-COVER	
FA-COV-08	PANEL LAYOUT	FA-COVER	
FA-COV-09	SUP. PANEL LAYOUT	FA-COVER	X
FA-RIS-01	RISER SHEET	FA-RISER	X
FA-RIS-02	RISER SHEET	FA-RISER	
FA-DET-01	DETAIL SHEET	FA-COVER	
FA-DET-02	DETAIL SHEET(T.I.)	FA-COVER	X
FA-SCP-01	SMOKE CONTROL PANEL	FA-SCP-01	
FA-LEVA-W	LEVEL A WEST FLOOR PLAN	FA-LEVEL A	
FA-LEVA-E	LEVEL A EAST FLOOR PLAN	FA-LEVEL A	
FA-LEV1-W	LEVEL 1 WEST FLOOR PLAN	FA-LEVEL 1	
FA-LEV1-E	LEVEL 1 EAST FLOOR PLAN	FA-LEVEL 1	
FA-LEV2-W	LEVEL 2 WEST FLOOR PLAN	FA-LEVEL 2	
FA-LEV2-E	LEVEL 2 EAST FLOOR PLAN	FA-LEVEL 2	
FA-LEV3-W-D	LEVEL 3 WEST FLOOR DEMO PLAN	FA-LEVEL 3-D	
FA-LEV3-E-D	LEVEL 3 EAST FLOOR DEMO PLAN	FA-LEVEL 3-D	X
FA-LEV3-W	LEVEL 3 WEST FLOOR PLAN	FA-LEVEL 3	X
FA-LEV3-E	LEVEL 3 EAST FLOOR PLAN	FA-LEVEL 3	X
FA-LEV4-W	LEVEL 4 WEST FLOOR PLAN	FA-LEVEL 4	
FA-LEV4-E	LEVEL 4 EAST FLOOR PLAN	FA-LEVEL 4	
FA-LEV5-W	LEVEL 5 WEST FLOOR PLAN	FA-LEVEL 5	
FA-LEV5-E	LEVEL 5 EAST FLOOR PLAN	FA-LEVEL 5	
FA-LEV6-W	LEVEL 6 WEST FLOOR PLAN	FA-LEVEL 6	
FA-LEV6-E	LEVEL 6 EAST FLOOR PLAN	FA-LEVEL 6	
FA-LEV7-W	LEVEL 7 WEST FLOOR PLAN	FA-LEVEL 7	
FA-LEV7-E	LEVEL 7 EAST FLOOR PLAN	FA-LEVEL 7	
FA-LEV8-W	LEVEL 8 WEST FLOOR PLAN	FA-LEVEL 8	
FA-LEV8-E	LEVEL 8 EAST FLOOR PLAN	FA-LEVEL 8	
FA-ROOF-W	ROOF WEST FLOOR PLAN	FA-ROOF	
FA-ROOF-E	ROOF EAST FLOOR PLAN	FA-ROOF	



NO.	DATE	REVISION DESCRIPTION	DRAWN BY	ENGINEER	PROJECT #
46	6/28/19	PATIENT CARE TOWER 7TH & 6TH FLOOR RECORD DRAWINGS	RSC	RSC	600598222
47	1/23/19	DAILY PHARMACY	RSC	JWB	610318224
47	9/20/19	DAILY PHARMACY RECORD DRAWING	RSC	RSC	610318224
48	9/21/22	EXPRESS DOORS	DAP	BOB	650769145
48	4/12/23	MRI PRE-ACTION PANEL UPGRADE	ABH	BOB	65076924

DRAWINGS REVIEWED BY:  
Eric Beck, CET  
NICET #228984  
Fire Alarm Systems, Level III

FIRE ALARM SYSTEM  
TITLE SHEET  
GOOD SAMARITAN - PATIENT CARE TOWER  
401 15TH AVENUE SE  
PUYALLUP, WA 98371

APPROVED BY:  
C. McCAMMON  
DRAWN BY:  
C. McCAMMON  
DATE:  
8/12/09  
SITE/PROJECT NUMBER:  
458413141/943123501

SHEET NUMBER:  
FA-COV-01

© 2017 JOHNSON CONTROLS  
ALL RIGHTS RESERVED

## GENERAL FIRE ALARM SYSTEM NOTES

- 1) FIRE ALARM SYSTEM IS POWER LIMITED. METALLIC RACEWAY SHALL BE USED IF REQUIRED BY CODE, SPECIFICATIONS AND CONTRACT DOCUMENTS OR AHL.
- 2) ALL RACEWAYS MUST BE FREE OF MOISTURE.
- 3) REFER TO JOHNSON CONTROLS FIRE ALARM DATA SHEETS FOR PROPER TYPE AND SIZES OF REQUIRED DEVICE MOUNTING ELECTRICAL BOXES. ELECTRICAL CONTRACTOR IS RESPONSIBLE FOR PROPER INSTALLATION OF ALL DEVICES.
- 4) AC VOLTAGE IS NOT PERMITTED IN THE SAME RACEWAY AS FIRE ALARM WIRING.
- 5) UNRELATED (NON-FIRE ALARM) WIRING SHALL NOT BE IN THE SAME RACEWAY AS FIRE ALARM WIRING.
- 6) ALL CONTRACTOR FIELD WIRING MUST ENTER ALARM CONTROL PANEL BACKBOX FOLLOWING POWER-LIMITED AND NON-POWER-LIMITED WIRING REQUIREMENTS. REFER TO INSTALLATION INSTRUCTIONS FOR MORE INFORMATION.
- 7) ZONE CIRCUITS AND SIGNAL CIRCUITS ARE ELECTRICALLY SUPERVISED. BRANCH CIRCUITS SHALL BE LOOPED TO MAINTAIN INTEGRITY OF SUPERVISED CIRCUITS—TAPPING OF ZONE CIRCUITS AND SIGNAL CIRCUITS IS NOT PERMITTED.
- 8) REFER TO FACP MODULE DIAGRAMS, INCLUDED WITH FACP, FOR SPECIFICATIONS AND INFORMATION ON INDIVIDUAL PANEL MODULES. VERIFY ALL CONNECTIONS WITH A JOHNSON CONTROLS FIELD TECHNICAL REPRESENTATIVE PRIOR TO TERMINATION.
- 9) ALL FIRE ALARM WIRING SHALL TEST FREE OF OPENS, SHORTS AND GROUNDS.
- 10) ALL WIRING SHALL BE LABELED AND TAGGED.
- 11) ELECTRICAL CONTRACTOR IS RESPONSIBLE FOR INSTALLATION AND MAKING ALL FINAL CONNECTIONS PRIOR TO JOB CHECKOUT AND FINAL TESTING BY A JOHNSON CONTROLS FIELD TECHNICAL REPRESENTATIVE. CALL A MINIMUM OF 5 DAYS IN ADVANCE TO SCHEDULE A JOHNSON CONTROLS TECHNICIAN AT (206) 777-4860.
- 12) ELECTRICAL CONTRACTOR IS RESPONSIBLE FOR MAKING ALL ARRANGEMENTS FOR INSPECTION, TEST AND CERTIFICATION OF THE FIRE ALARM SYSTEM BY ALL APPROPRIATE AUTHORITIES.
- 13) UPON WRITTEN REQUEST, JOHNSON CONTROLS WILL PROVIDE WRITTEN INSTRUCTIONS REGARDING THE APPROPRIATE WIRE/CABLE FOR INSTALLATION OF THE EQUIPMENT(S) IDENTIFIED IN THESE DRAWINGS. JOHNSON CONTROLS SHALL NOT BE RESPONSIBLE FOR PROBLEMS OR DAMAGES RESULTING FROM THE USE OF WIRE/CABLE OTHER THAN THAT WHICH HAS BEEN IDENTIFIED IN WRITING BY JOHNSON CONTROLS FOR A SPECIFIC APPLICATION.
- 14) ALL WIRING SHALL MEET ALL APPLICABLE NATIONAL ELECTRIC CODE ARTICLES FOR FIRE ALARM AND LOW VOLTAGE WIRING.

ARCHITECT: N/A

FIRE ALARM SYSTEM DESIGNED BY: JOHNSON CONTROLS  
SEATTLE, WA

FIRE ALARM SYSTEM INSTALLED BY: GOOD SAMARITAN HOSPITAL  
PUYALLUP, WA

EQUIPMENT FOR FIRE ALARM SYSTEM SUPPLIED BY: JOHNSON CONTROLS  
SEATTLE, WA

WASHINGTON STATE ELECTRICAL CONTRACTORS NUMBER: JOHNSCP831PR

\* THESE DRAWINGS DO NOT SUPERSEDE THE CONTRACT DRAWINGS AND SPECIFICATIONS. THEY ARE INTENDED AS A SUPPLEMENT ONLY AND MUST BE USED IN CONJUNCTION WITH THE CONTRACT DOCUMENTS. THEY DO NOT MODIFY THE CONTRACTORS OBLIGATIONS TO CONFORM TO THE PROJECTS ORIGINAL DESIGN CRITERIA.

Fire Alarm Network

### Fire Alarm Control Panel - N7 (Level 1)

Auxiliary Circuits	Watts
N7AUX(1-2) Not Available	
N7AUX(3) Spare	3.0
N7AUX(4) Auxiliary Power	15.0
N7AUX(5) Not Available	
N7AUX(6) Auxiliary Power	3.0
N7AUX(7) Not Available	
N7AUX(8) Auxiliary Power	21.0
N7AUX(9) Level 1 Door Holders	50.0
N7AUX(10) Level 1 East Link Door Holders	7.5
N7AUX(11-16) Spare	0.0
<b>Total Watts</b>	<b>115.5</b>
<b>Watts Provided</b>	<b>50.0</b>

### Fire Fighter Telephone Circuits

N7SIG(21) Stair 1	
N7SIG(22) Stair 2/3	
N7SIG(23) Elevator 1-3 Lobbies/CAB	
N7SIG(24) Elevator 4-5 Lobbies/CAB	
N7SIG(25) Elevator 6-7 Lobbies/CAB	
N7SIG(26) Elevator 8 Lobbies/CAB	
N7SIG(27) Elevator 9 Lobbies/CAB	
N7SIG(28) Fire Pump Room	
N7SIG(29) Spare	

### Speaker Circuits

Circuit	Watts
N7SIG(30) Level 1 West	15.0
N7SIG(31) Stair	3.0
N7SIG(32) Stair 2/3	3.0
N7SIG(33-35) Not Available	
<b>Total Watts</b>	<b>21.0</b>
<b>Watts Provided</b>	<b>50.0</b>

### IDNET Channel #M1

Level 1 - N7M1-2 to N7M1-32, N7M1-34 to N7M1-60, N7M1-62 to N7M1-75, N7M1-78 to N7M1-139, N7M1-178 to N7M1-179, N7M1-240 to N7M1-245

Level 1 East Link - N7M1-180 to N7M1-170

Level 1 Pharmacy - N7M1-171 to N7M1-178

Stair 1 - N7M1-150 to N7M1-155, N7M1-157 to N7M1-159, N7M1-180 to N7M1-208

Stair 2/3 - N7M1-141 to N7M1-149, N7M1-211 to N7M1-235

0.000 Speaker/Strobe 15cd	
0.004 Speaker/Strobe 30cd	
0.186 Speaker/Strobe 30cd	
0.252 Speaker/Strobe 110cd	
0.000 Strobe 15cd	
0.004 Strobe 30cd	
0.186 Strobe 30cd	
0.252 Strobe 110cd	
0.075 Ceiling Speaker/Strobe 15cd	
0.125 Ceiling Speaker/Strobe 30cd	
0.233 Ceiling Speaker/Strobe 75cd	
0.316 Ceiling Speaker/Strobe 110cd	
0.000 Ceiling Strobe 15cd	
0.000 Weatherproof Bell	

## BATTERY CALCULATIONS - NDU N6 (1st Floor)

Qty	Part #	Description	Standby Current (A)	Total Standby (A)	Alarm Current (A)	Total Alarm (A)
1	4100-9151	Network Display Unit	0.7330	0.7330	0.7980	0.7980
4	4603-9100	LCD Annunciator	0.0300	0.1200	0.1700	0.6800
1	CEF-L-GR-GP6	Smoke Control Panel	0.0168	0.0168	0.3120	0.3120
				0.0000	0.0000	0.0000
Total Standby=			0.8698		1.1700	
Total Alarm=					1.1700	
Total Standby Current Required=			0.8698	X	4.0000	3.4792
Total Alarm Current Required=			1.7900	X	0.0833	0.1491
Total=						3.6283
50% Depletion Factor=						1.8142
Total Amp/Hour Required=						5.4425
Total Amp/Hour Batteries Provided=					(1) set	33.0000

## BATTERY CALCULATIONS - FACP N7 (1st Floor)

Qty	Part #	Description	Standby Current (A)	Total Standby (A)	Alarm Current (A)	Total Alarm (A)
1	4100-9111	Fire Alarm Control Panel	2.1184	2.1184	13.1830	13.1830
34	4906-9153	Speaker/Strobe 15cd	0.0000	0.0000	0.0600	2.0400
3	4906-9153	Speaker/Strobe 30cd	0.0000	0.0000	0.0940	0.2820
6	4906-9153	Speaker/Strobe 75cd	0.0000	0.0000	0.1860	1.1160
2	4906-9153	Speaker/Strobe 110cd	0.0000	0.0000	0.2520	0.5040
23	4906-9103	Strobe 15cd	0.0000	0.0000	0.0600	1.3600
12	4098-9756	TrueAlarm Duct Smoke Sensor	0.0024	0.0288	0.0150	0.1800
12	4098-9843	Duct Detector Relay	0.0000	0.0000	0.0150	0.1800
22	2068-9006	Remote Relay	0.0000	0.0000	0.0150	0.3300
Total Standby=			2.1472		12.1472	14.1950
Total Alarm=					4.0000	19.1950
Total Standby Current Required=			2.1472	X	4.0000	8.5888
Total Alarm Current Required=			19.1950	X	0.0833	1.5989
Total=						10.1877
50% Depletion Factor=						5.0939
Total Amp/Hour Required=						15.2816
Total Amp/Hour Batteries Provided=					(1) set	50.0000

### SCOPE OF WORK:

MODIFY EXISTING FIRE ALARM SYSTEM; EXISTING PRE-ACTION SYSTEM PANEL AND ALL COMPONENTS TO BE DECOMMISSIONED AND REMOVED AS DEPICTED ON DEMO PLAN SHEET. PROVIDE NEW 4007ES PRE-ACTION SYSTEM PANEL AND THE IN-TIE TO EXISTING SIMPLEX 4120 NETWORK. PROVIDE NEW SUPPRESSION PRE-ALARMING APPLIANCE AND PERIPHERALS AND ADDRESSABLE MODULES TO MONITOR PRE-ACTION SPRINKLER POINTS. PROVIDE ADDRESSABLE MODULES TO MONITOR THE EXISTING VESDA SYSTEM SERVING THE PRE-ACTION COVERAGE AREA.

ALL WIRING TO BE CLASS B.

THE EXISTING FIRE ALARM SYSTEM SHALL NOT BE DISCONNECTED OR TAKEN OUT OF SERVICE WITHOUT WRITTEN PERMISSION FROM THE OWNER. IT IS THE CONTRACTOR'S RESPONSIBILITY TO COORDINATE WITH THE OWNER THE TIMING OF ANY EXISTING FIRE ALARM SYSTEM DEMOLITION WORK.

## ELECTRICAL CONTRACTOR

- ELECTRICAL CONTRACTOR IS TO SCHEDULE A PRELIMINARY SITE MEETING WITH A JOHNSON CONTROLS TECHNICAL REPRESENTATIVE. THESE MEETINGS ARE FOR REVIEWING EQUIPMENT LISTS, INSTALLATION PROCEDURES, AND PROVIDING ANSWERS TO QUESTIONS RELATIVE TO SYSTEM INSTALLATION.

- PLEASE ALLOW A MINIMUM OF FIVE WORKING DAYS ADVANCE NOTICE TO SCHEDULE A TECHNICAL REPRESENTATIVE.

- TO SCHEDULE A MEETING PLEASE CONTACT OUR TECHNICIAN SCHEDULER AT (206) 777-4860


- DO NOT USE FIRE ALARM CABINET AS TERMINAL CABINET

## ELECTRICAL CONTRACTOR ASBUILTS

- ELECTRICAL CONTRACTOR IS RESPONSIBLE FOR PROVIDING JOHNSON CONTROLS WITH ACCURATE REDLINED DRAWINGS. DRAWINGS SHALL BE REDLINED AS NECESSARY TO SHOW THE FOLLOWING:

- DEVICE LOCATIONS - ADDS/DELETES.
- CIRCUIT NUMBERS - ADDRESSABLE/SIGNAL/AUXILIARY/ZONE.
- WIRE/CONDUIT - ACCURATE ROUTING.
- WIRE FILL - USING WIRE CODE.
- EOL RESISTOR LOCATIONS.


JOHNSON CONTROLS WILL PROVIDE (UPON REQUEST) A BLANK SET OF FLOOR PLANS TO BE REDLINED. JOHNSON CONTROLS WILL INCORPORATE ALL REDLINED CHANGES INTO THE RECORD AUTOCAD SET OF DRAWINGS.

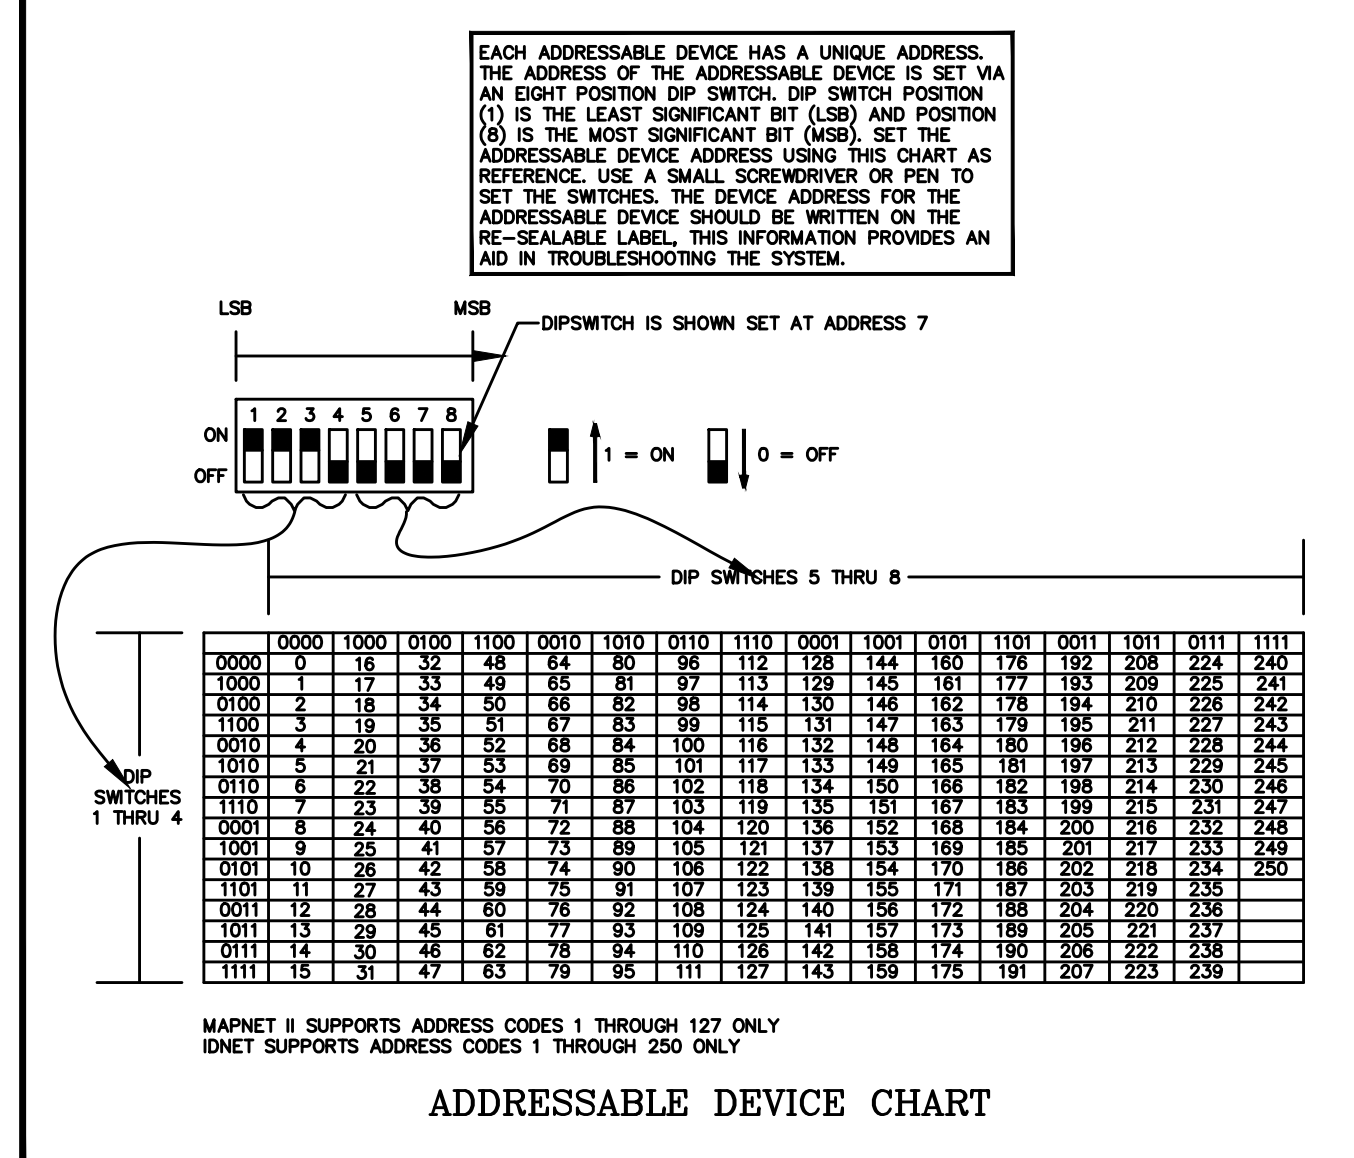


## Supervisory Smoke Detectors

IDNET	Description
N9-M2-177	MT - LVL A STAFF BREAK MA42
N7-M1-125	MT - LVL 1 CLEAN UTILITY/NOURISH M138.1
N7-M1-137	MT - LVL 1 STAFF LOCKERS M184
N7-M1-138	MT - LVL 1 STAFF BREAK/COATS M183
N7-M2-64	MT - LVL 2 OR 6 M287 EAST
N7-M2-65	MT - LVL 2 OR 6 M287 WEST
N7-M2-67	MT - LVL 2 OR 5 M288 EAST
N7-M2-68	MT - LVL 2 OR 5 M288 WEST
N7-M2-73	MT - LVL 2 OR 4 M281 WEST
N7-M2-74	MT - LVL 2 OR 4 M281 EAST
N7-M2-76	MT - LVL 2 OR 3 M282 WEST
N7-M2-77	MT - LVL 2 OR 3 M282 EAST
N7-M2-83	MT - LVL 2 OR 2 M283 WEST
N7-M2-84	MT - LVL 2 OR 2 M283 EAST
N7-M2-91	MT - LVL 2 OR 1 M284 WEST
N7-M2-92	MT - LVL 2 OR 1 M284 EAST
N7-M2-177	MT - LVL 2 BREAKROOM M255
N7-M2-178	MT - LVL 2 BREAKROOM M253
N7-M2-183	MT - LVL 2 CLEAN UTILITY M234.2
N7-M3-33	MT - LVL 3 INTER RADIOLOGY 1 M336 SE
N7-M3-36	MT - LVL 3 INTER RADIOLOGY 2 M337 SE
N7-M3-37	MT - LVL 3 INTER RADIOLOGY 2 M337 NW
N7-M3-40	MT - LVL 3 CATH 1 M333 NW
N7-M3-41	MT - LVL 3 CATH 1 M333 SE
N7-M3-44	MT - LVL 3 CATH2 M332 SW
N7-M3-45	MT - LVL 3 CATH2 M332 NE
N7-M3-51	MT - LVL 3. NOURISHMENT M331.4
N7-M3-76	MT - LVL 3 MRI 365 S
N7-M3-77	MT - LVL 3 MRI 365 S
N7-M3-81	MT - LVL 3 MRI TRANSFER M365.1
N7-M3-164	MT - LVL 3 CONFERENCE M358
N7-M3-179	MT - LVL 3 LOCKERS M392
N7-M3-180	MT - LVL 3 BREAKROOM M325
N7-M3-184	MT - LVL 3 CLEAN UTILITY M374.2
N7-M3-186	MT - LVL 3 CLEAN UTILITY M371
N7-M3-190	MT - LVL 3 CONFERENCE M308.1
N7-M3-193	MT - LVL 3 BREAKROOM M334.7
N7-M3-209	MT - LVL 3 CT-2 M362
N8-M2-36	MT - LVL 5 FOOD PANTRY/NOURISH M587
N8-M2-78	MT - LVL 5 FOOD PANTRY/NOURISH M577
N8-M2-91	MT - LVL 5 STAFF BREAK M557
N8-M2-93	MT - LVL 5 CONFERENCE M556
N8-M3-36	MT - LVL 6 FOOD PANTRY/NOURISH M662
N8-M3-71	MT - LVL 6 FOOD PANTRY/NOURISH M655
N8-M3-91	MT - LVL 6 STAFF BREAK M680
N8-M3-93	MT - LVL 6 CONFERENCE M658

### NDU N6 - LEVEL 1

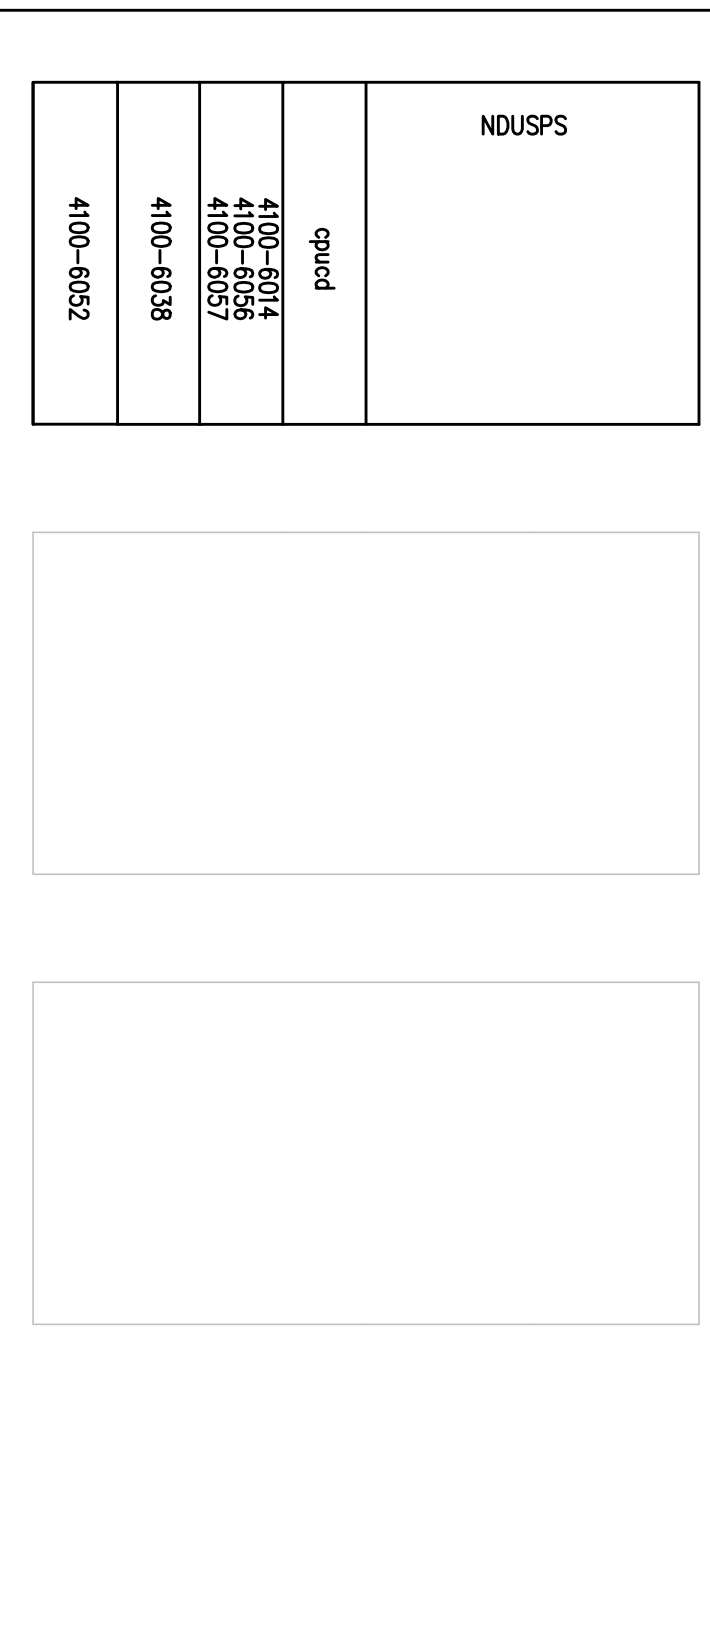

### FACP N7 - LEVEL 1

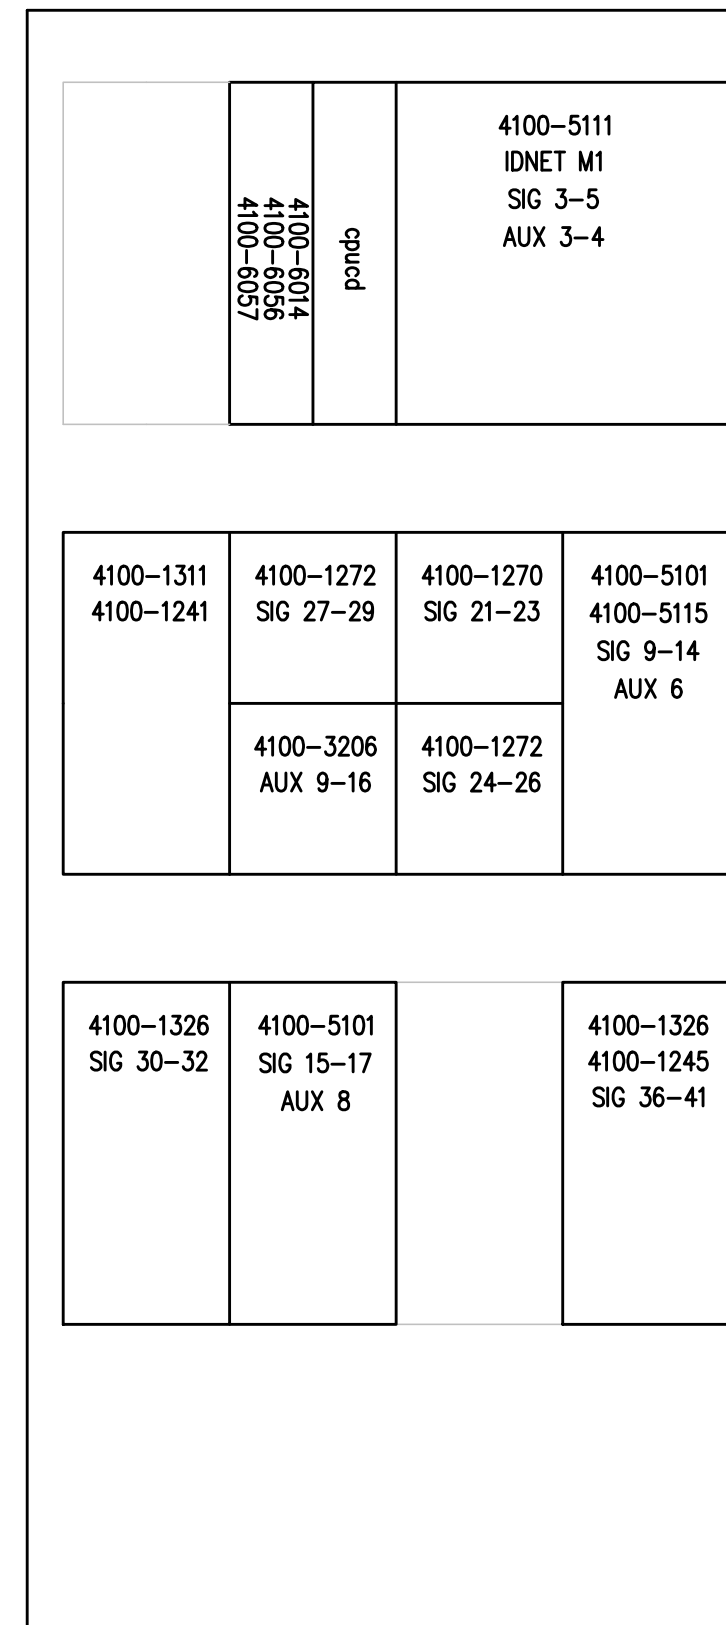


Symbol	Description	Part #	Backbox
□	Multicandela Wall Speaker/Strobe - White	4906-9153	5" sq 2.875" deep w/ ext ring 4"sq adapter by EC
□	Multicandela Ceiling Speaker/Strobe - White	4906-9154	5" sq 2.875" deep w/ ext ring 4"sq adapter by EC
□	Multicandela Wall Strobe - White	4906-9103	4" sq by EC
□	Multicandela Ceiling Strobe - White	4906-9102	4" sq by EC
□	Wall Speaker - White	4902-9717	5" sq 2.875" deep w/ ext ring 4"sq adapter by EC
□	Ceiling Speaker - White	4902-9721	5" sq 2.875" deep w/ ext ring 4"sq adapter by EC
□	Addressable Manual Station	4099-9003 w/ ST11100 Cover	4" sq 2 1/8" deep w/ sg ring by EC
□	Addressable Manual Station Suppression	4099-9015 w/ 4099-9802 Label Kit	4" sq 2 1/8" deep w/ sg ring by EC
□	TrueAlarm Smoke Sensor	4098-9714 w/ 4098-9792 Base	4" od by EC
□	TrueAlarm Heat Sensor	4098-9733 w/ 4098-9792 Base	4" od by EC
□	Heat Detector - 135FT	ED-2638-PL	4" od by EC
□	TrueAlarm Duct Sensor	4098-9756	self-contained
□	Remote LED w/Test	2098-9806	sg by EC
□	Duct Detector Relay	4098-9843	4"sq w/sg & cover by EC
□	Beam Smoke Detector - Transmitter	BEAM1224	Surface Box w/BEAMSK
□	Beam Smoke Detector - Reflector	4090-9101	Surface
□	Supervised IAM	4090-9001	4"sq w/sg & cover by EC
□	Flow Switch	By Others	By Others
□	Pressure Switch	By Others	By Others
□	Low Air Switch	By Others	By Others
□	Tamper Switch	By Others	By Others
□	Post Indicator Valve	By Others	By Others
□	Col Supervision Module	2081-9046	
□	Pre-Action Solenoid	By Others	By Others
□	Door Holders	By Others	
□	Suppression Mech. Disconnect	2080-9060	Included
□	Relay IAM	4090-9002	4"sq 2 1/8" deep w/ 2-gang cover by EC
□	Monitor ZAM	2088-9008	self-contained
□	Remote Relay	2084-9001	sg by EC
□	FFT Cabinet	2084-9026 w/ (10) 2084-9024 handsets	23.5"H x 23.5"W x 4.0"D
□	Smoke Control Panel	CEF-L-GR-GP6	41"H x 29"W x 4.75"D
□	Suppression Releasing Peripheral	4090-9006	8.125"H x 6.125"W x 4"D Surface Mount
□	Printer	4190-9013	Table Top
□	LCD Annunciator	4603-9101	6-gang 3.5"deep by EC or RSA-WP-SA
□	Terminal Cabinet	SSU00661	13"H x 23.5"W x 5.5"D
□	Transponder Panel	4100-9601	56"H x 24"W x 8.375"D 2975-9432
□	Fire Alarm Control Panel	4100-9114	56"H x 24"W x 8.375"D 2975-9426
□	Network Display Unit	4100-9151	56"H x 24"W x 8.375"D 2975-9428
□	4007ES Pre-Action Panel	4007-9101	16.25"H x 13.5"W x 5.75"D

### Wire Code


Letter	Qty	Color/Type	Size	Function
A	2	Black/Orange TFN	16	Zone
C	2	Red/Blue THHN	14	Horn/Strobe
D	4	(2) Red/2) Blue THHN	14	Horn/Strobe Loop
E	2	Brown/Yellow THHN	14	Door Holders
F	2	Orange THHN	14	Fan Shutdown
H	1	WestPerrn D975	18	Serial Communication
J	1	Red/Black THHN	16	Speaker
K	2	WestPerrn 991	16	Speaker Loop
L	1	WestPerrn 5220FZ	16	Local Network Connection**
M	1	WestPerrn 5220FZ	16	Miniplex Transponder**
N	2	WestPerrn D975	18	Network Connection
P	2	Red/Black THHN	14	24VDC Power
R	2	Blue/White TFN	16	Remote LED w/Test
T	2	Pink TFN	16	Fire Fighter Telephone
V	1	WestPerrn D977	18	Printer
X	1	WestPerrn D975	18	Addressable Data Line

\*\* 2-hr cable for survivability

### STROBE AND SPEAKER IDENTIFICATION

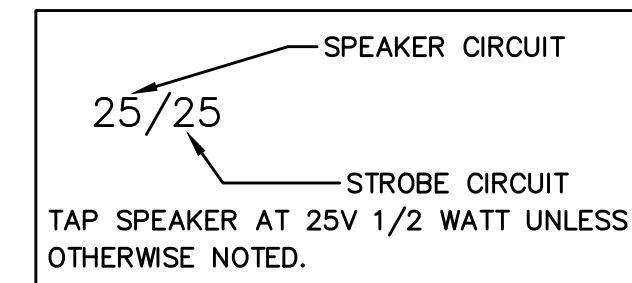

### ADDRESSABLE DETECTOR IDENTIFICATION

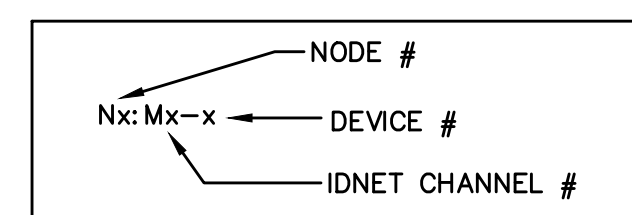

FA-COVER

**Johnson Controls**  
9520 10th Avenue South, Suite 100  
Seattle, WA 98108  
SALES: 206-291-1400  
SERVICE: 206-291-1411

NO.	DATE	REVISION DESCRIPTION	DESIGNER	DRAWER	ENGINEER	PROJECT #	PRODUCT #
46	6/28/19	PATIENT CARE TOWER 7TH & 6TH FLOOR RECORD DRAWINGS	RSC	RSC	JWB	600569222	610318224
47	9/20/19	DAILY PHARMACY RECORD DRAWINGS	RSC	RSC	RWB	610318224	600769145
48	9/21/22	EXRESS DOORS	DAP		ROB		65075924
48	4/12/23	MRI PRE-ACTION PANEL UPGRADE	ABH		ROB		

Sequence of Operation	Manual Station	Smoke Detection	Supervisory Smoke Detection*	Beam Smoke Detection	Corridor Smoke Detection	Anesthetizing Area Smoke Detection	IDF Room Smoke Detection	Primary Recall Elevator Lobbies Smoke Detection	Elev Lobbies Except Primary Recall Smoke Detection	Elevator Mach Rm/Shaft Smoke Detection	Elevator Power Monitor	Duct Smoke Detection Supply Air Handler	Duct Smoke Detection Exhaust Air Handler	Duct Smoke Detection Supply Smoke/Fire Damper	Duct Smoke Detection Exhaust Smoke/Fire Damper	Heat Detection	Clean Agent System Control Panel	Flow Switch	Pressure Switch	High/Low Air Switch	Tamper Switch	Fire Pump	System Trouble	Pre-Action Alarm	Pre-Action Supervisory	Pre-Action Trouble
Activation of Local Alarm at FACP (LCD Display & Audible Indication)	X	X		X	X		X	X	X	X						X	X	X	X					X		
Activation of Local Alarm at Annunciator	X	X		X	X		X	X	X	X						X	X	X	X					X		
Activate Visible Devices Alarm Floor	X	X		X	X		X	X	X	X						X	X	X	X					X		
Activate Audible Devices Alarm Floor/Floor Above/Floor Below	X	X		X	X		X	X	X	X						X	X	X	X					X		
Release Door Holders Within Smoke Zone	X	X		X	X		X	X	X	X						X	X	X	X					X		
Release Door Holders Floor of Alarm	X																							X		
Release Elevator Door Smoke Curtains Local Detection Only		X		X	X		X										X									
Release Stair Door Locks Floor of Alarm	X	X		X	X		X	X	X	X						X	X	X	X					X		
Close Corridor Smoke/Fire Dampers Within Smoke Zone					X																					
Close Smoke/Fire Dampers at Duct Det.														X	X											
Maintain Smoke/Fire Dampers in Anesthetizing Area Ducts in Open Position																										
Shutdown AHU and SAHU Supply Fan												X														
Shutdown EAHU Exhaust Fan													X													
Send Signal to DDC for Shutdown of Associated AHU, SAHU and EAHU Fans												X	X	X	X											
Send Signal to DDC System					X		X					X	X	X	X		X									
Send Signal to DDC System For Smoke Removal Mode																										
Activate Stair Pressurization Fans	X	X		X	X			X	X	X						X	X	X						X		
Open Elevator Hoistway Vent Dampers								X	X	X																
Initiate Primary Elevator Recall									X	X																
Initiate Alternate Elevator Recall								X																		
Activate Elevator Hat Light										X																
Transmit Alarm Signal To Central Station Monitor	X	X		X	X		X	X	X	X						X	X	X	X					X		
Trouble Indication at FACP																										
Trouble Indication at Annunciator																							X			X
Transmit Trouble Signal To Central Station Monitor																							X			X
Supv Indication at FACP			X			X					X	X	X	X	X						X	X	X		X	
Supv Indication at Annunciator			X			X					X	X	X	X	X						X	X	X		X	
Transmit Supv Signal To Central Station Monitor			X			X					X	X	X	X	X						X	X	X		X	

City of Puyallup  
Development & Permitting Services  
ISSUED PERMIT

Building	Planning
Engineering	Public Works
Fire	Traffic

**Johnson Controls**  
9520 10th Avenue South, Suite 100  
Seattle, WA 98108  
SALES: 206-291-1400  
SERVICE: 206-291-1411  
© 2017 JOHNSON CONTROLS. ALL RIGHTS RESERVED.

PROJECT #	60059222
ENGINEER	JWB
DATE	8/23/19
NO.	46
REVISION DESCRIPTION	PATIENT CARE TOWER 7TH & 6TH FLR TI RECORD DRAWINGS
DATE	1/23/19
NO.	47
REVISION DESCRIPTION	DAILY PHARMACY RECORD DRAWINGS
DATE	9/20/19
NO.	48
REVISION DESCRIPTION	DAILY PHARMACY RECORD DRAWINGS
DATE	9/21/22
NO.	49
REVISION DESCRIPTION	REGRESS DOORS
DATE	4/12/23
NO.	50
REVISION DESCRIPTION	MRI PRE-ACTION PANEL UPGRADE

DRAWINGS REVIEWED BY:  
Eric Beck, CET  
NCEI #22884  
Fire Alarm Systems, Level III

FIRE ALARM SYSTEM  
COVER SHEET  
GOOD SAMARITAN - PATIENT CARE TOWER  
401 15TH AVENUE SE  
PUYALLUP, WA 98371

APPROVED BY:  
C. McCAMMON

DRAWN BY:  
C. McCAMMON

DATE:  
8/12/09

SITE/PROJECT NUMBER:  
458413141/943123501

SHEET NUMBER:  
FA-COV-02.1

PROJECT #	ENGINEER	DESIGNER	REVISION DESCRIPTION	DATE	NO.
60059222		RSC	PATIENT CARE TOWER 7TH & 6TH FLR TI RECORD DRAWINGS	8/28/19	46
610318224	JWB	RSC	DAILY PHARMACY	1/23/19	
610318224		RSC	DAILY PHARMACY RECORD DRAWINGS	9/20/19	
650769145	BOB	DAP	EXPRESS DOORS	9/21/22	47
65076924	BOB	ARB	MRI PRE-ACTION PANEL UPGRADE	4/12/23	48

**DRAWINGS REVIEWED BY:**  
 Eric Beck, CET  
 NECT #228584  
 Fire Alarm Systems, Level III

**ELECTRONIC DRAWING NAME**

**FIRE ALARM SYSTEM  
 SUP. PANEL & CALCS**

**GOOD SAMARITAN - PATIENT CARE TOWER**  
 401 15TH AVENUE SE  
 PUYALLUP, WA 98371


**APPROVED BY:**  
 C. McCAMMON

**DRAWN BY:**  
 C. McCAMMON

**DATE:**  
 8/12/09


**SITE/PROJECT NUMBER:**  
 458413141/943123501

**SHEET NUMBER:**  
 FA-COV-09

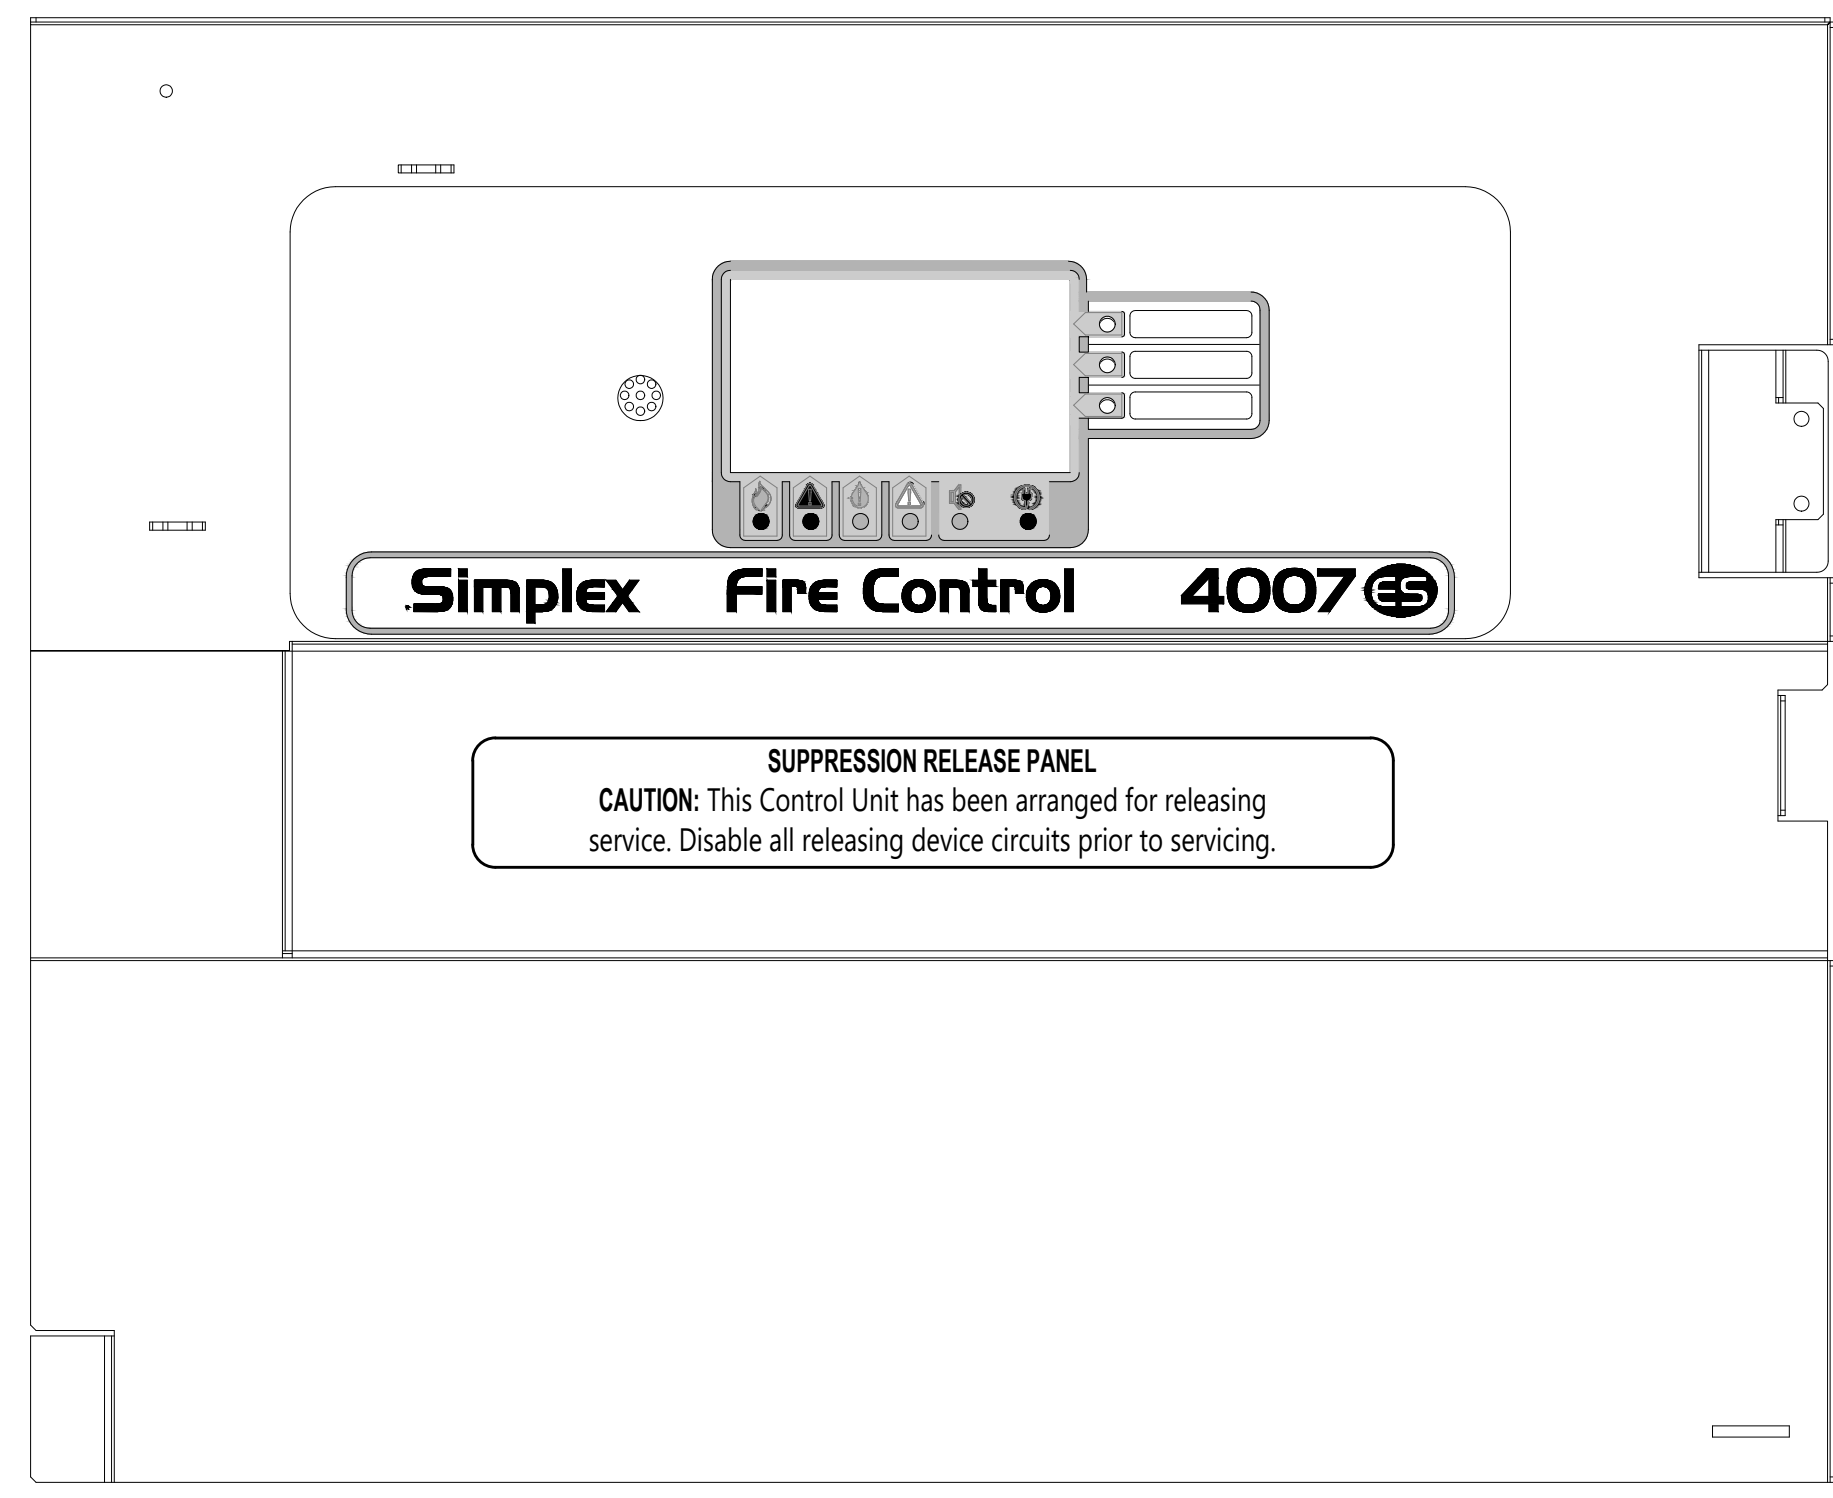

**4007 TERMINATIONS**

CIRCUIT LABEL	CKT DESCRIPTION	WIRE
1	N13:M1 PRE-ACTION IDNET DEVICES	X
2	N13:SIG1 PRE-ACTION SOLENOID CONTROL	C
3	N13:AUX AUX POWER	P

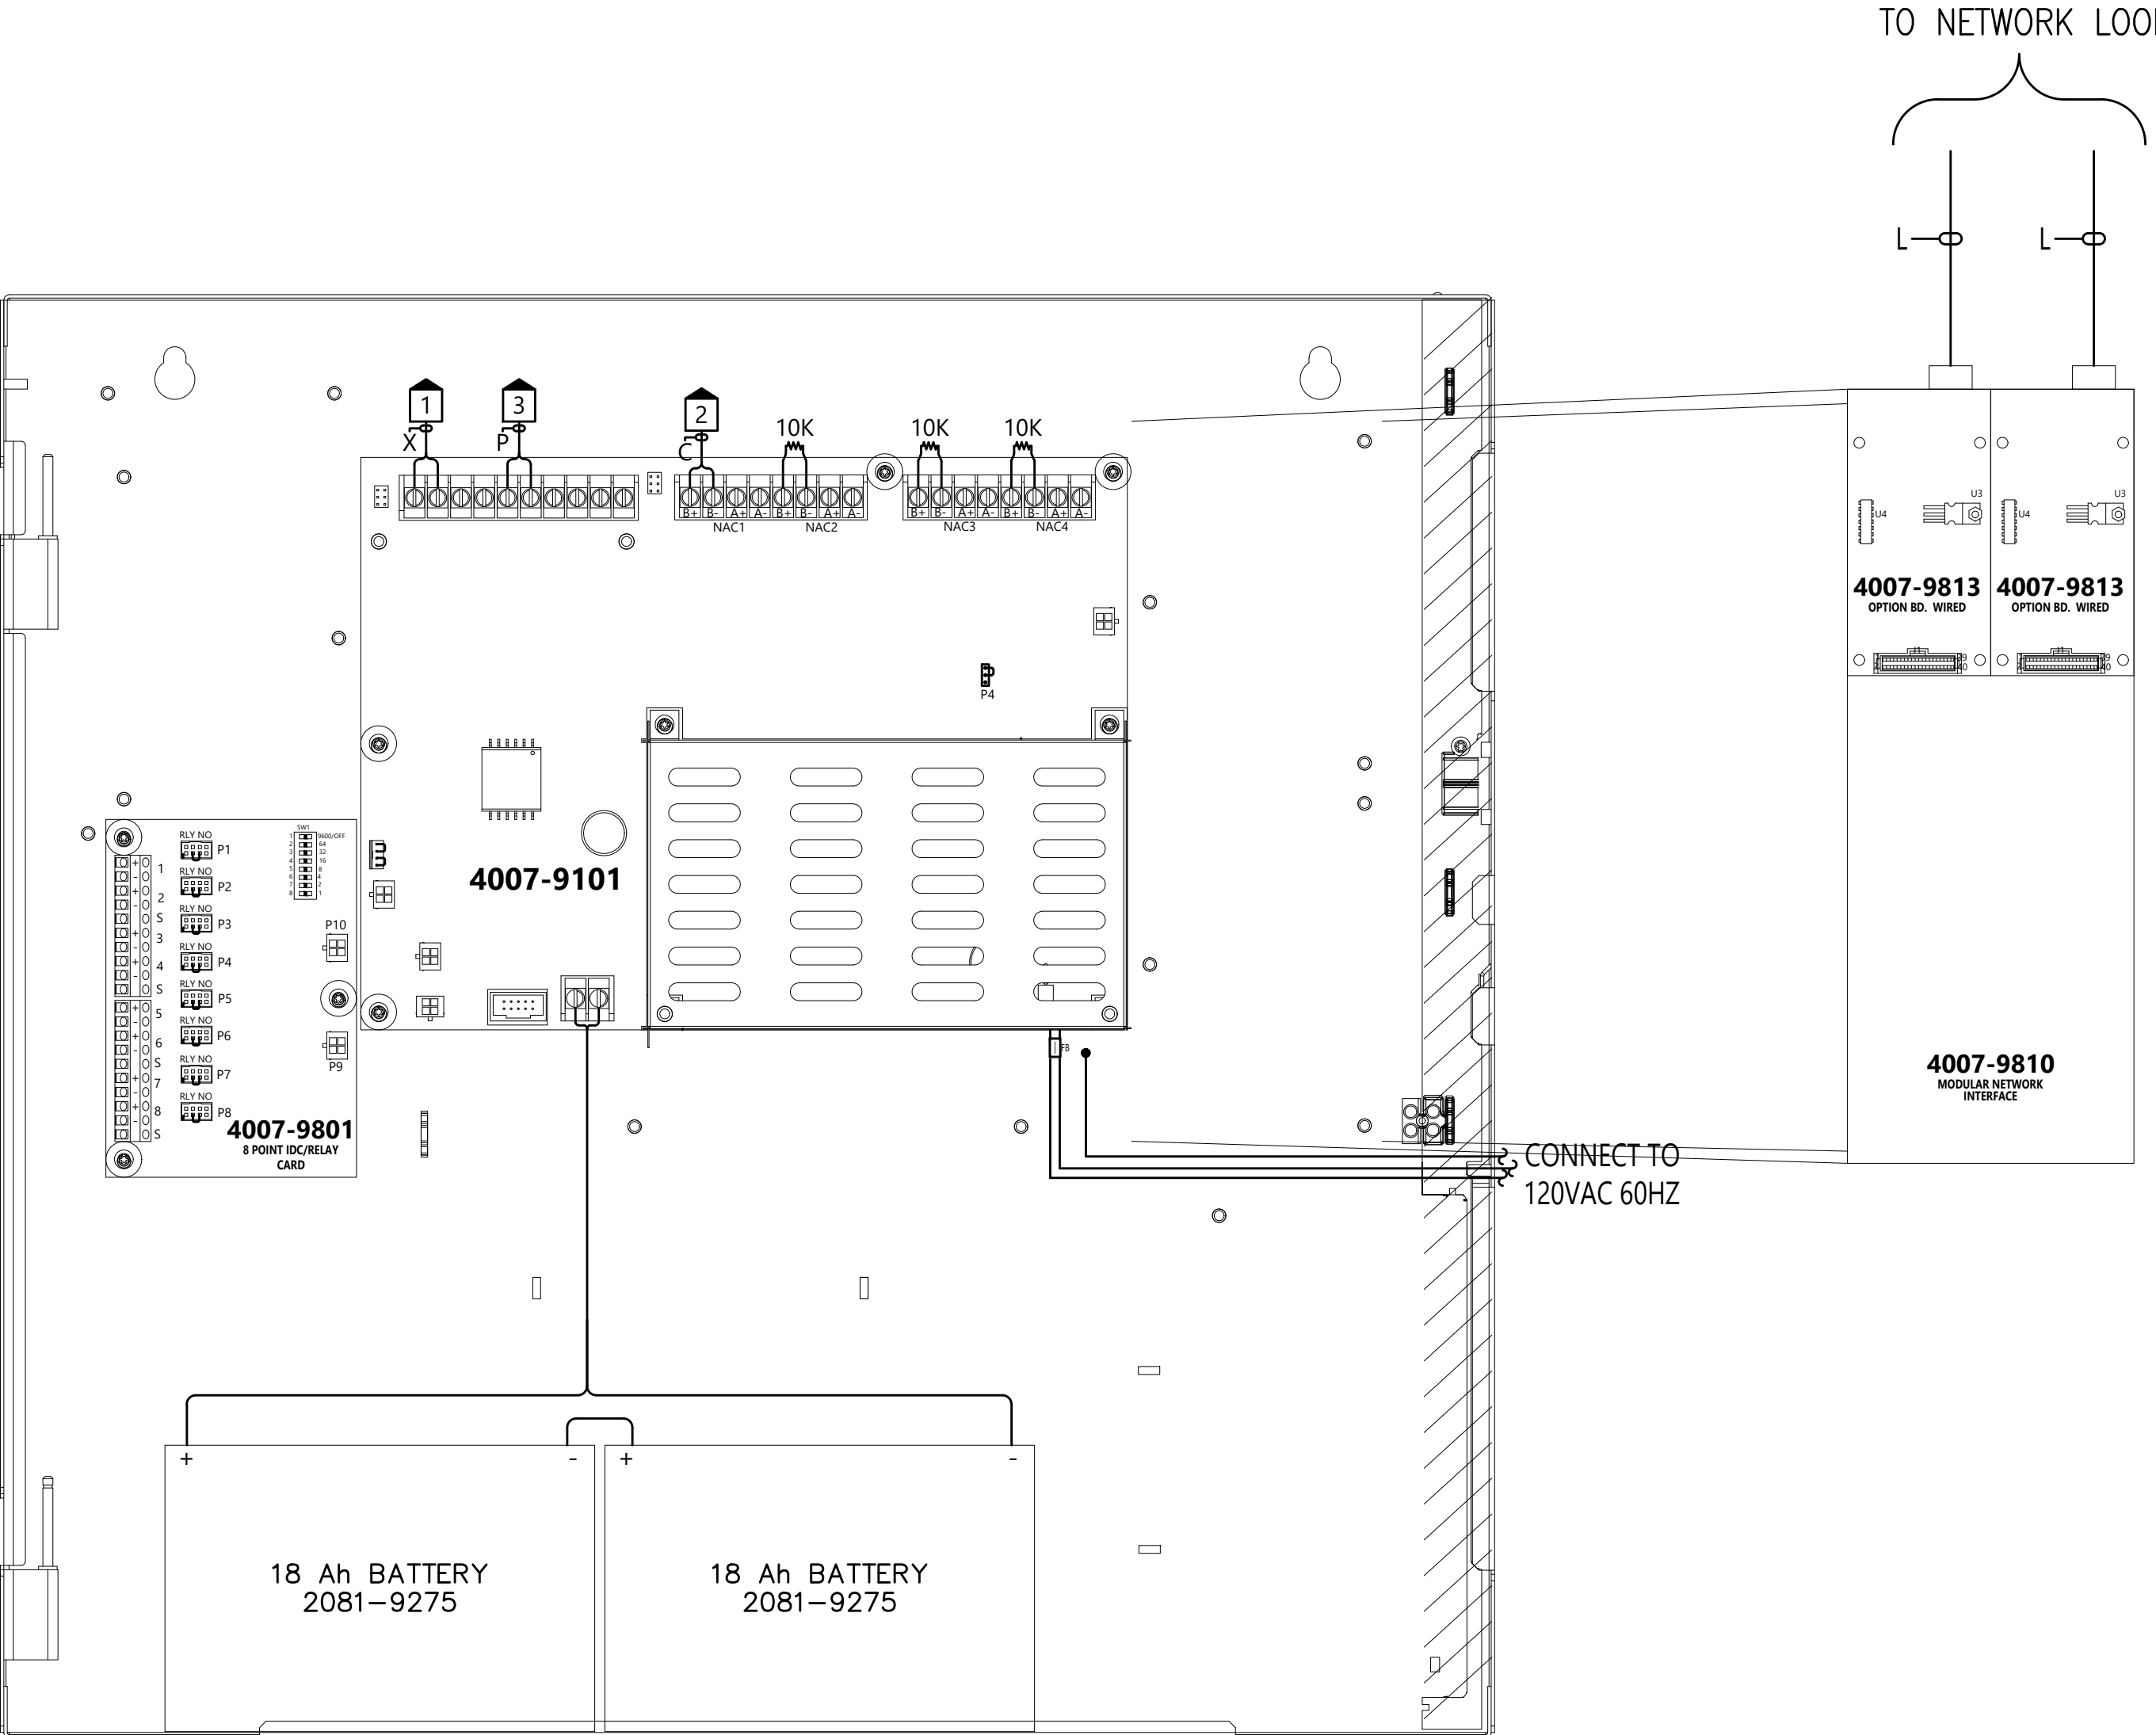

**4007ES SUPPRESSION  
 RELEASING PANEL**

**City of Puyallup  
 Development & Permitting Services  
 ISSUED PERMIT**

Building	Planning
Engineering	Public Works
Fire	Traffic

**MRI Suppression Panel 4007 FACP**

Module	Qty	Description	Standby Current	Total Standby	Alarm Current	Total Alarm
Panel Equipment						
4007-9810	1	NETWORK INTERFACE CARD	0.0300	0.0300	0.0300	0.0300
4007-9813	1	Wired MEDIA MODULE	0.0550	0.0550	0.0550	0.0550
4010-9830	1	SUP RELEASING APPLIQUE KIT	0.0000	0.0000	0.0000	0.0000
4007-9101	1	FIRE ALARM CONTROL PANEL 100 FT ADDRESSABLE - RED	0.1450	0.1450	0.1900	0.1900
<b>Panel Totals</b>			<b>0.2300</b>	<b>0.2300</b>	<b>0.2750</b>	<b>0.2750</b>

**IDNet Addressable Devices (SLC)**

Module	Qty	Description	Standby Current	Total Standby	Alarm Current	Total Alarm
4090-9001	7	IDNET SUPERVISED IWM *				
4090-9006	1	SUP RELEASE PERIPH & ENCLOSURE *				
4090-9114	1	TRULALARM PHOTO SMOKE SENSOR				
4090-9192	1	TRULALARM SENSOR BASE *				
4099-9015	1	ADDRESSABLE PUSH ACTION MANUAL STATION FOR RELEASING *				

**Notification Appliances**

Module	Qty	Description	Standby Current	Total Standby	Alarm Current	Total Alarm
4090-9006	1	SUP RELEASE PERIPH & ENCLOSURE *	0.0000	0.0000	1.7100	1.7100
<b>Address Totals</b>			<b>10 Addresses</b>	<b>0.0000</b>	<b>1.7100</b>	<b>1.7100</b>
<b>System Totals*</b>			<b>Standby</b>	<b>0.2300</b>	<b>Alarm</b>	<b>1.9950</b>

\* Device Address current draw included below (See Additional Current Draws):  
 1. 2-wire detector alarm current is included in the alarm current of the Initiating Device Circuit.

**Battery Set #1 (Cabinet/Charger #1)**

Select ALL Power Supplies on this Battery set:

Category	Value	Standby Current	Standby Total	Alarm Current	Alarm Total
4007			0.2300		1.9950
Sub Total			0.2300		1.9950

**Additional Current Draws:**

Category	Value	Standby Current	Standby Total	Alarm Current	Alarm Total
R/I Connected Peripheral Devices	0 x 0.0035	= 0.0000	x 0.0035 = 0.0000		
MANNET/IDNet Device Address Communication Current	10 x 0.000800	= 0.0080	x 0.001000 = 0.0100		
Sub Total			0.2380		1.9950

**Spare addressable point capacity** 0% 0 x 0.0008 = 0.0000 x 0.001 = 0.0000

**Total** 0.2380 1.9950

Standby Time = 24 Hrs x 0.2380 = 5.7120 Standby Ah  
 Alarm Time = 5 Min 0.08333 x 1.995 = 0.1663 Alarm Ah

**Additional Spare Battery Capacity = 0%**

Battery Discharge Factor = 20%  
 Minimum Battery Required 2081-9274 10AH (2x) 5.8783  
 Battery Supplied 2081-9275 18AH (2x) 7.0639

\* System Totals represent total system current requirements. These currents may be distributed between multiple battery sets or power supplies as shown above.

**MRI Suppression Panel 4007 FACP VOLTAGE DROPS**

WIRE RESISTANCE BASED ON TABLE 8 FROM NATIONAL ELECTRICAL CODE (UNCOATED SOLID COPPER WIRE) @ 75 Celsius

Power Supply	Panel Circuit	Plan Ckt.	Dist. (Ft)	Wire Gauge	Wire Res. / Ft. (R)	Total Alarm (A)	V. Drop (AMPERE)	Volt @ End	% Volt Drop	Min. Device Voltage	Max. Distance	FD Setting
4007	SP3	SP3	15	14ga	0.0031	1.710	0.157	19.343	0.814	Verds	333 Ft.	4090-9006
												0.0000
												1.7100

**NOTIFICATION CIRCUIT DESCRIPTION**

Pre-Action Solenoid Release


NOTE: LUMP SUM METHOD WAS USED TO CALCULATE ALLOWABLE VOLTAGE DROP. THIS METHOD ALLOWS FOR A SMALL MARGIN OF SAFETY, TAKING INTO CONSIDERATION THAT THE ACTUAL INSTALLED CIRCUIT ROUTING MAY DIFFER FROM WHAT IS SHOWN ON THE SHOP DRAWINGS. IF THE ACTUAL CIRCUIT LENGTH IS GOING TO EXCEED THE MAXIMUM ALLOWABLE CIRCUIT LENGTH, CONTACT YOUR LOCAL JOHNSON CONTROLS DISTRICT OFFICE.

	Manual Release Station	Smoke Detection Above Pre-Action	VESDA Alarm Input	VESDA Stage 1/2 Supervisory	VESDA Stage 3 Supervisory	VESDA Trouble	Pre-Action Sprinkler Pressure Switch	Pre-Action Sprinkler Tamper Switch	Pre-Action Sprinkler Low Air Switch	Pre-Action Sprinkler Low Air & VESDA Alarm Input	Maintenance Disconnect Active	Pre-Action Panel Trouble
Activation of Local Alarm at Pre-Action Panel	X	X	X				X			X		
Activation of Local Supervisory at Pre-Action Panel				X	X			X	X		X	
Activation of Local Trouble at Pre-Action Panel						X						X
Actuate Pre-Action Solenoid	X									X		
Transmit General Alarm Over Network	X	X	X				X			X		
Transmit General Supervisory Over Network				X	X			X	X		X	
Transmit General Trouble Over Network						X						X

**Sequence of  
 Operation  
 Pre-Action**

**City of Puyallup**  
Development & Permitting Services  
**ISSUED PERMIT**

Building	Planning
Engineering	Public Works
Fire	Traffic

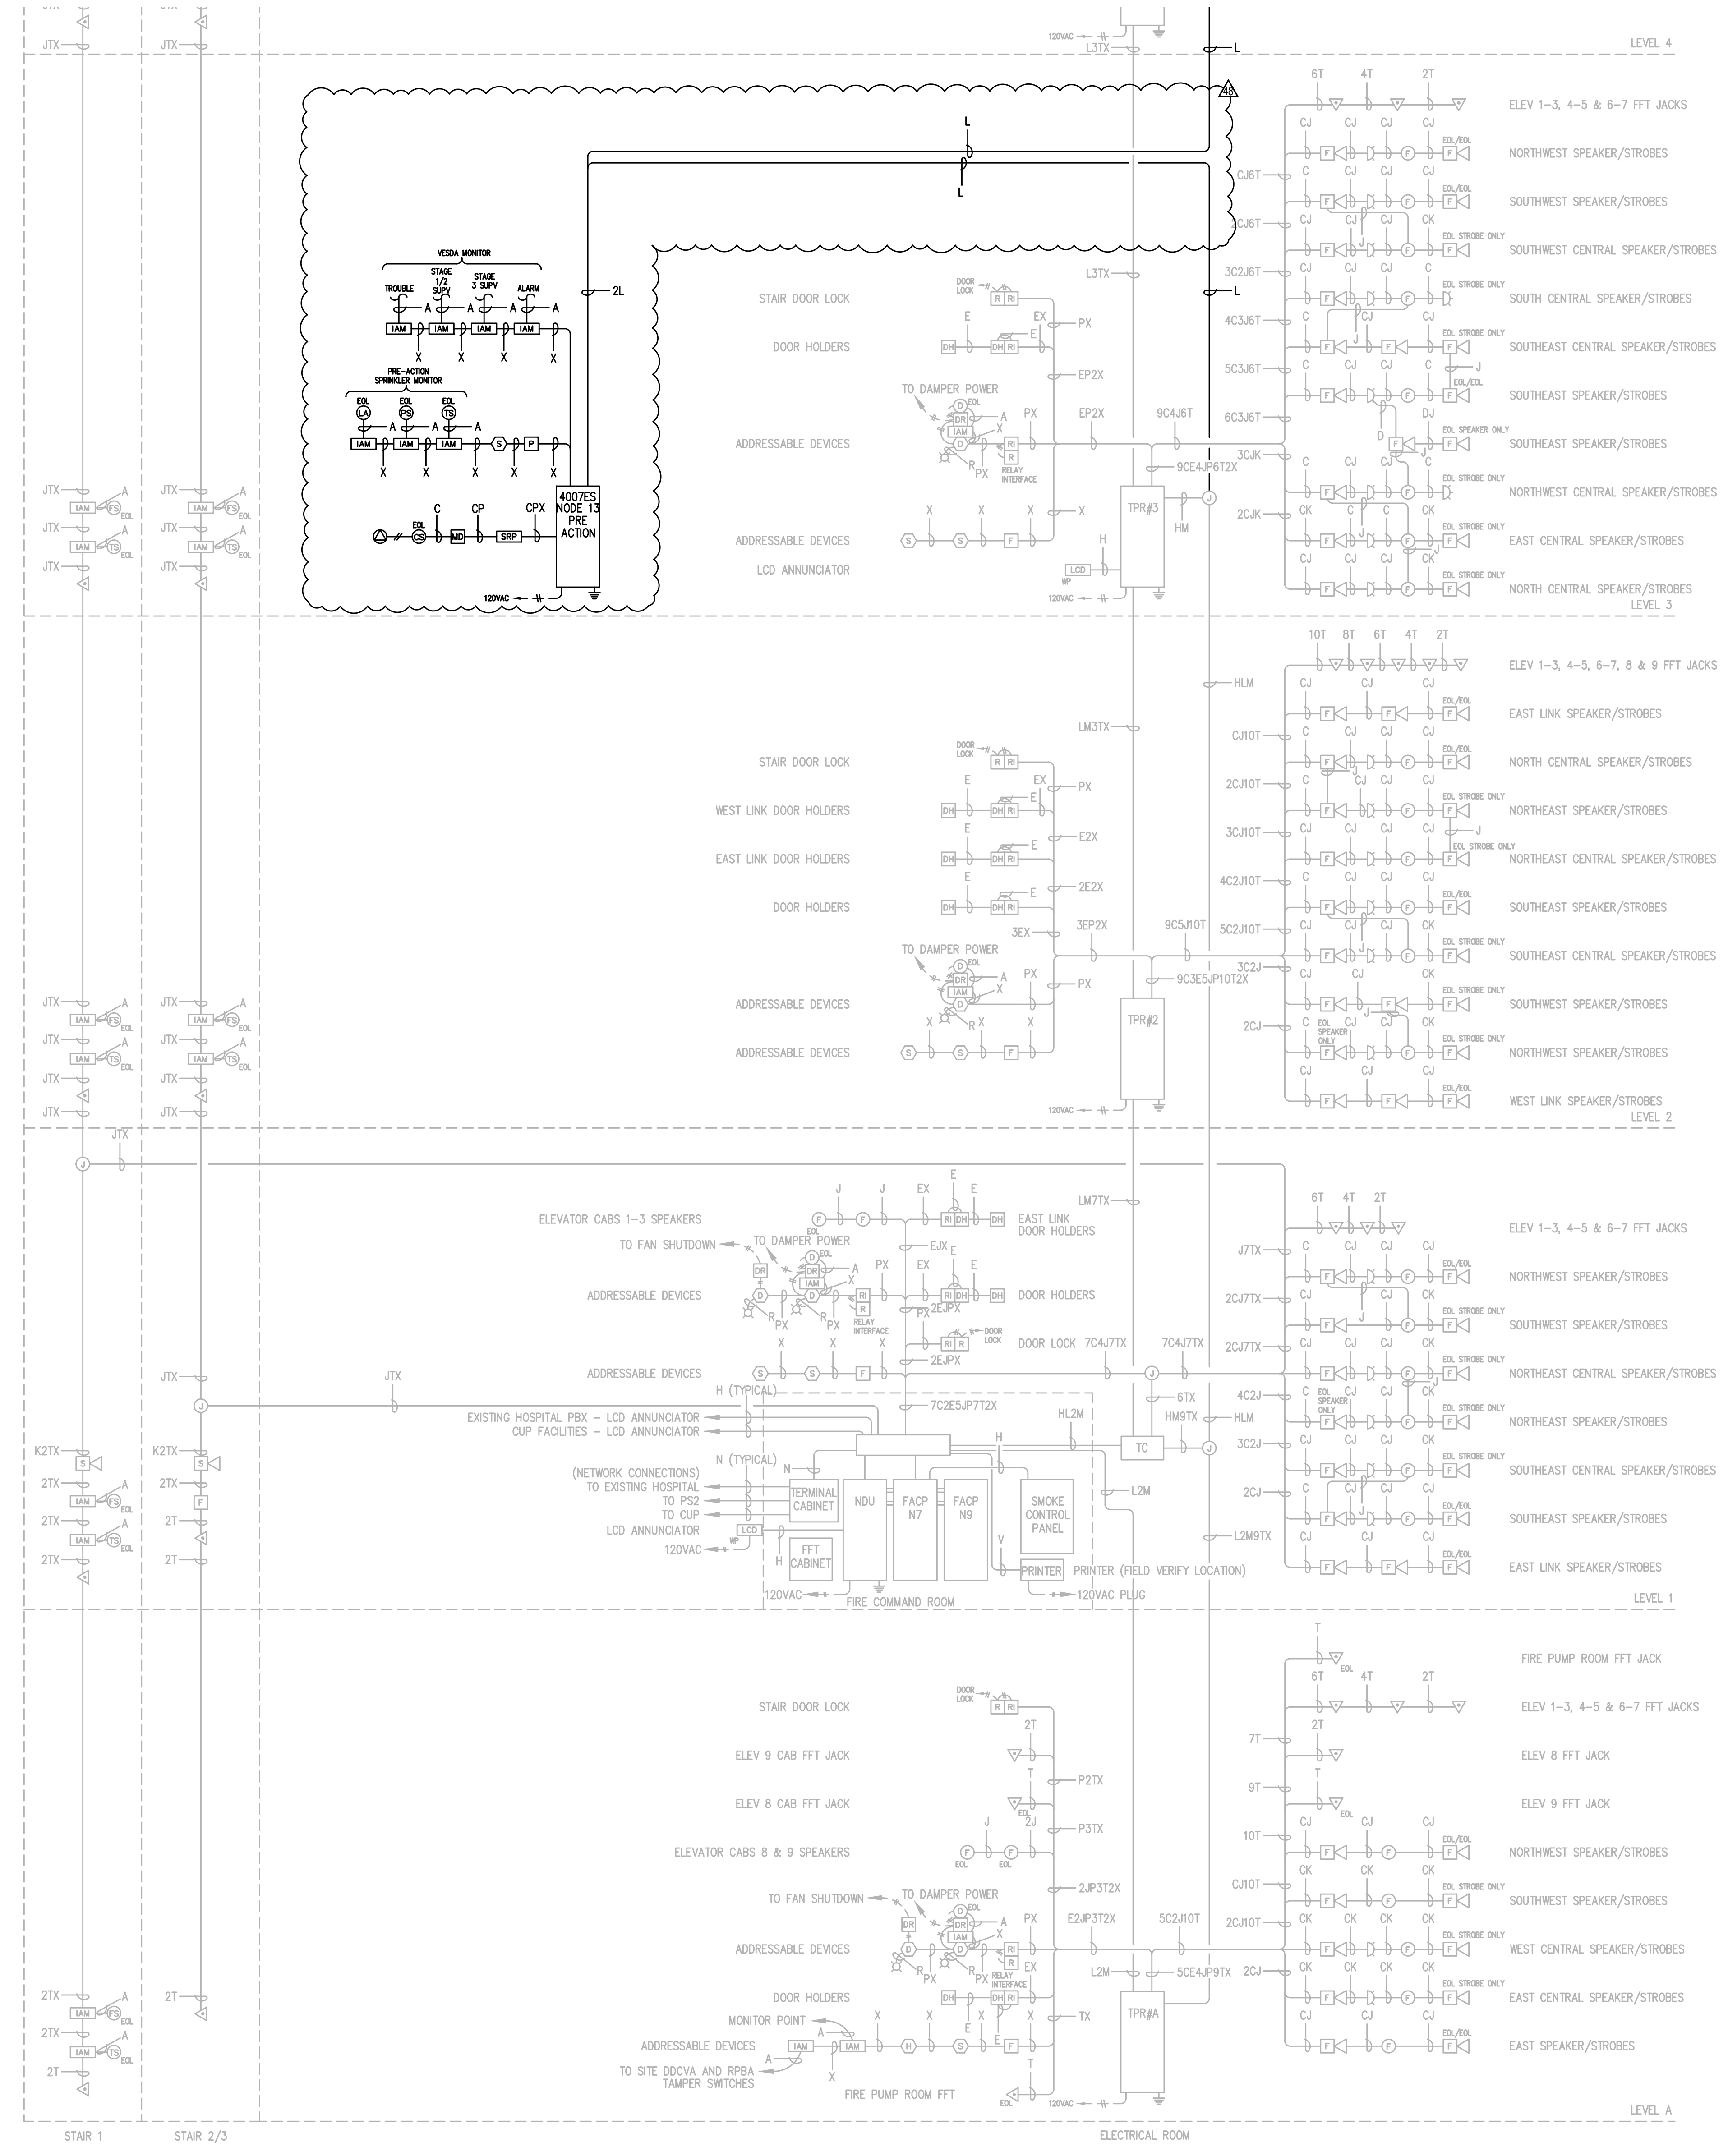


Symbol	Description	Part #	Backbox
[Symbol]	Multicandela Wall Speaker/Strobe - White *subscript indicates circuit # and candela setting	4906-9153	5" sq 2.875" deep w/ ext ring 4"sq adapter by EC
[Symbol]	Multicandela Ceiling Speaker/Strobe - White *subscript indicates circuit # and candela setting	4906-9154	5" sq 2.875" deep w/ ext ring 4"sq adapter by EC
[Symbol]	Multicandela Wall Strobe - White *subscript indicates circuit # and candela setting	4906-9103	4" sq by EC
[Symbol]	Multicandela Ceiling Strobe - White *subscript indicates circuit # and candela setting	4906-9102	4" sq by EC
[Symbol]	Wall Speaker - White *subscript indicates circuit #	4902-9717	5" sq 2.875" deep w/ ext ring 4"sq adapter by EC
[Symbol]	Ceiling Speaker - White *subscript indicates circuit #	4902-9721	5" sq 2.875" deep w/ ext ring 4"sq adapter by EC
[Symbol]	Addressable Manual Station *subscript indicates device address	4099-9003 w/ ST11100 Cover	4" sq 2 1/8" deep w/ sg ring by EC
[Symbol]	Addressable Manual Station Suppression *subscript indicates device address	4099-9015 w/ 4099-9802 Label Kit	4" sq 2 1/8" deep w/ sg ring by EC
[Symbol]	TrueAlarm Smoke Sensor *subscript indicates device address/ SUIPV indicates supervisory device	4098-9714 w/ 4098-9792 Base	4" od by EC
[Symbol]	TrueAlarm Heat Sensor *subscript indicates device address	4098-9733 w/ 4098-9792 Base	4" od by EC
[Symbol]	Heat Detector - 135FT	ED-2638-PL	4" od by EC
[Symbol]	TrueAlarm Duct Sensor *subscript indicates device address and sampling tube size	4098-9756	self-contained
[Symbol]	Remote LED w/Test	2098-9806	sg by EC
[Symbol]	Duct Detector Relay	4098-9843	4"sq w/sg & cover by EC
[Symbol]	Beam Smoke Detector - Transmitter	BEAM1224	Surface Box w/BEAMSK Surface
[Symbol]	Beam Smoke Detector - Reflector	4090-9101	4"sq 2 1/8" deep w/ 2-gang cover by EC
[Symbol]	Monitor ZAM *subscript indicates device address	4090-9001	4"sq w/sg & cover by EC
[Symbol]	Supervised IAM *subscript indicates device address	By Others	By Others
[Symbol]	Flow Switch	By Others	By Others
[Symbol]	Pressure Switch	By Others	By Others
[Symbol]	Low Air Switch	By Others	By Others
[Symbol]	Tamper Switch	By Others	By Others
[Symbol]	Post Indicator Valve	By Others	By Others
[Symbol]	Coil Supervision Module	2081-9046	By Others
[Symbol]	Pre-Action Solenoid	By Others	By Others
[Symbol]	Door Holders	By Others	By Others
[Symbol]	Suppression Mech. Disconnect	2080-9060	Included
[Symbol]	Relay IAM *subscript indicates device address	4090-9002	4"sq 2 1/8" deep w/ 2-gang cover by EC
[Symbol]	Remote Relay	2088-9008	self-contained
[Symbol]	FFT Jack	2084-9001	sg by EC
[Symbol]	FFT Cabinet	2084-9026 w/ (10) 2084-9024 handsets CEF-L-GR-GP6	23.5"H x 23.5"W x 4.0"D
[Symbol]	Smoke Control Panel	4090-9006	41"H x 29"W x 4.75"D
[Symbol]	Suppression Releasing Peripheral	4090-9006	8.125"H x 6.125"W x 4"D Surface Mount
[Symbol]	Printer	4190-9013	Table Top
[Symbol]	LCD Annunciator	4603-9101	6-gang 3.5"deep by EC or RSA-WP-SA 13"H x 23.5"W x 5.5"D
[Symbol]	Terminal Cabinet	SSU00661	56"H x 24"W x 8.375"D
[Symbol]	Transponder Panel	4100-9601	56"H x 24"W x 8.375"D 2975-9432
[Symbol]	Fire Alarm Control Panel	4100-9114	56"H x 24"W x 8.375"D 2975-9426
[Symbol]	Network Display Unit	4100-9151	56"H x 24"W x 8.375"D 2975-9428
[Symbol]	4007ES Pre-Action Panel	4007-9101	16.25"H x 13.5"W x 5.75"D


Letter	Qty	Color/Type	Size	Function
A	2	Black/Orange TFN	16	Zone
C	2	Red/Blue THHN	14	Horn/Strobe
D	4	(2) Red/(2) Blue THHN	14	Horn/Strobe Loop
E	2	Brown/Yellow THHN	14	Door Holders
F	2	Orange THHN	14	Fan Shutdown
H	1	WestPerrn D975	18	Serial Communication
J	1	WestPerrn 991	16	Speaker
K	2	WestPerrn 991	16	Speaker Loop
L	1	WestPerrn 5220FZ	16	Local Network Connection**
M	1	WestPerrn 5220FZ	16	Multiplex Transponder**
N	2	WestPerrn 5120UZ	14	Network Connection
P	2	Red/Black THHN	14	24VDC Power
R	2	Blue/White TFN	16	Remote LED w/Test
T	2	Pink TFN	16	Fire Fighter Telephone
V	1	WestPerrn D977	18	Printer
X	1	WestPerrn D975	18	Addressable Data Line

\*\* 2-hr cable for survivability

**STROBE AND SPEAKER IDENTIFICATION**

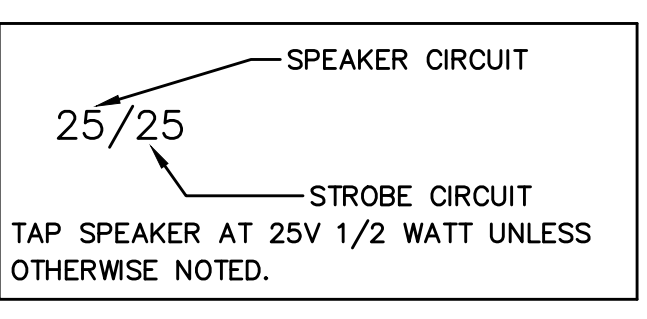

**ADDRESSABLE DETECTOR IDENTIFICATION**

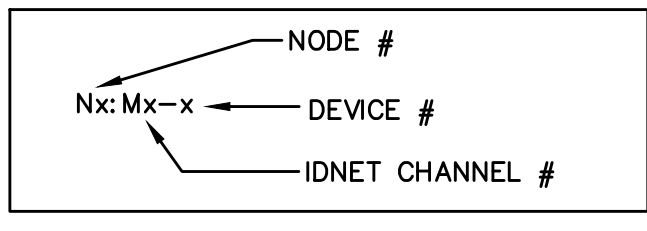

**Johnson Controls**  
9520 10th Avenue South, Suite 100  
Seattle, WA 98108  
SALES: 206-291-1400  
SERVICE: 206-291-1411

NO.	DATE	REVISION DESCRIPTION	DRAWN BY	ENGINEER	PROJECT #
46	9/28/19	PATIENT CARE TOWER 7TH & 6TH FLOOR RECORD DRAWINGS	RSC	RSC	600596222
47	1/23/19	DAILY PHARMACY	RSC	RSC	610318224
48	9/20/19	DAILY PHARMACY RECORD DRAWING#	RSC	RSC	610318224
49	9/21/22	EGRESS DOORS	DAP	ROB	60109145
48	4/12/23	MRI PRE-ACTION PANEL UPGRADE	ABH	ROB	650376924

**DRAWINGS REVIEWED BY:**  
Eric Beck, CET  
NICK K22884  
Fire Alarm Systems, Level III

**FIRE ALARM SYSTEM**  
**FIRE ALARM RISER DIAGRAM**  
**GOOD SAMARITAN - PATIENT CARE TOWER**


APPROVED BY: C. McCAMMON  
DRAWN BY: C. McCAMMON  
DATE: 8/12/09  
SITE/PROJECT NUMBER: 458413141/943123501  
SHEET NUMBER: FA-RIS-01

ELECTRONIC DRAWING NAME: FA-RISER

© 2017 JOHNSON CONTROLS. ALL RIGHTS RESERVED.


## DEVICE MOUNTING HEIGHT REFERENCE

PER NFPA 72

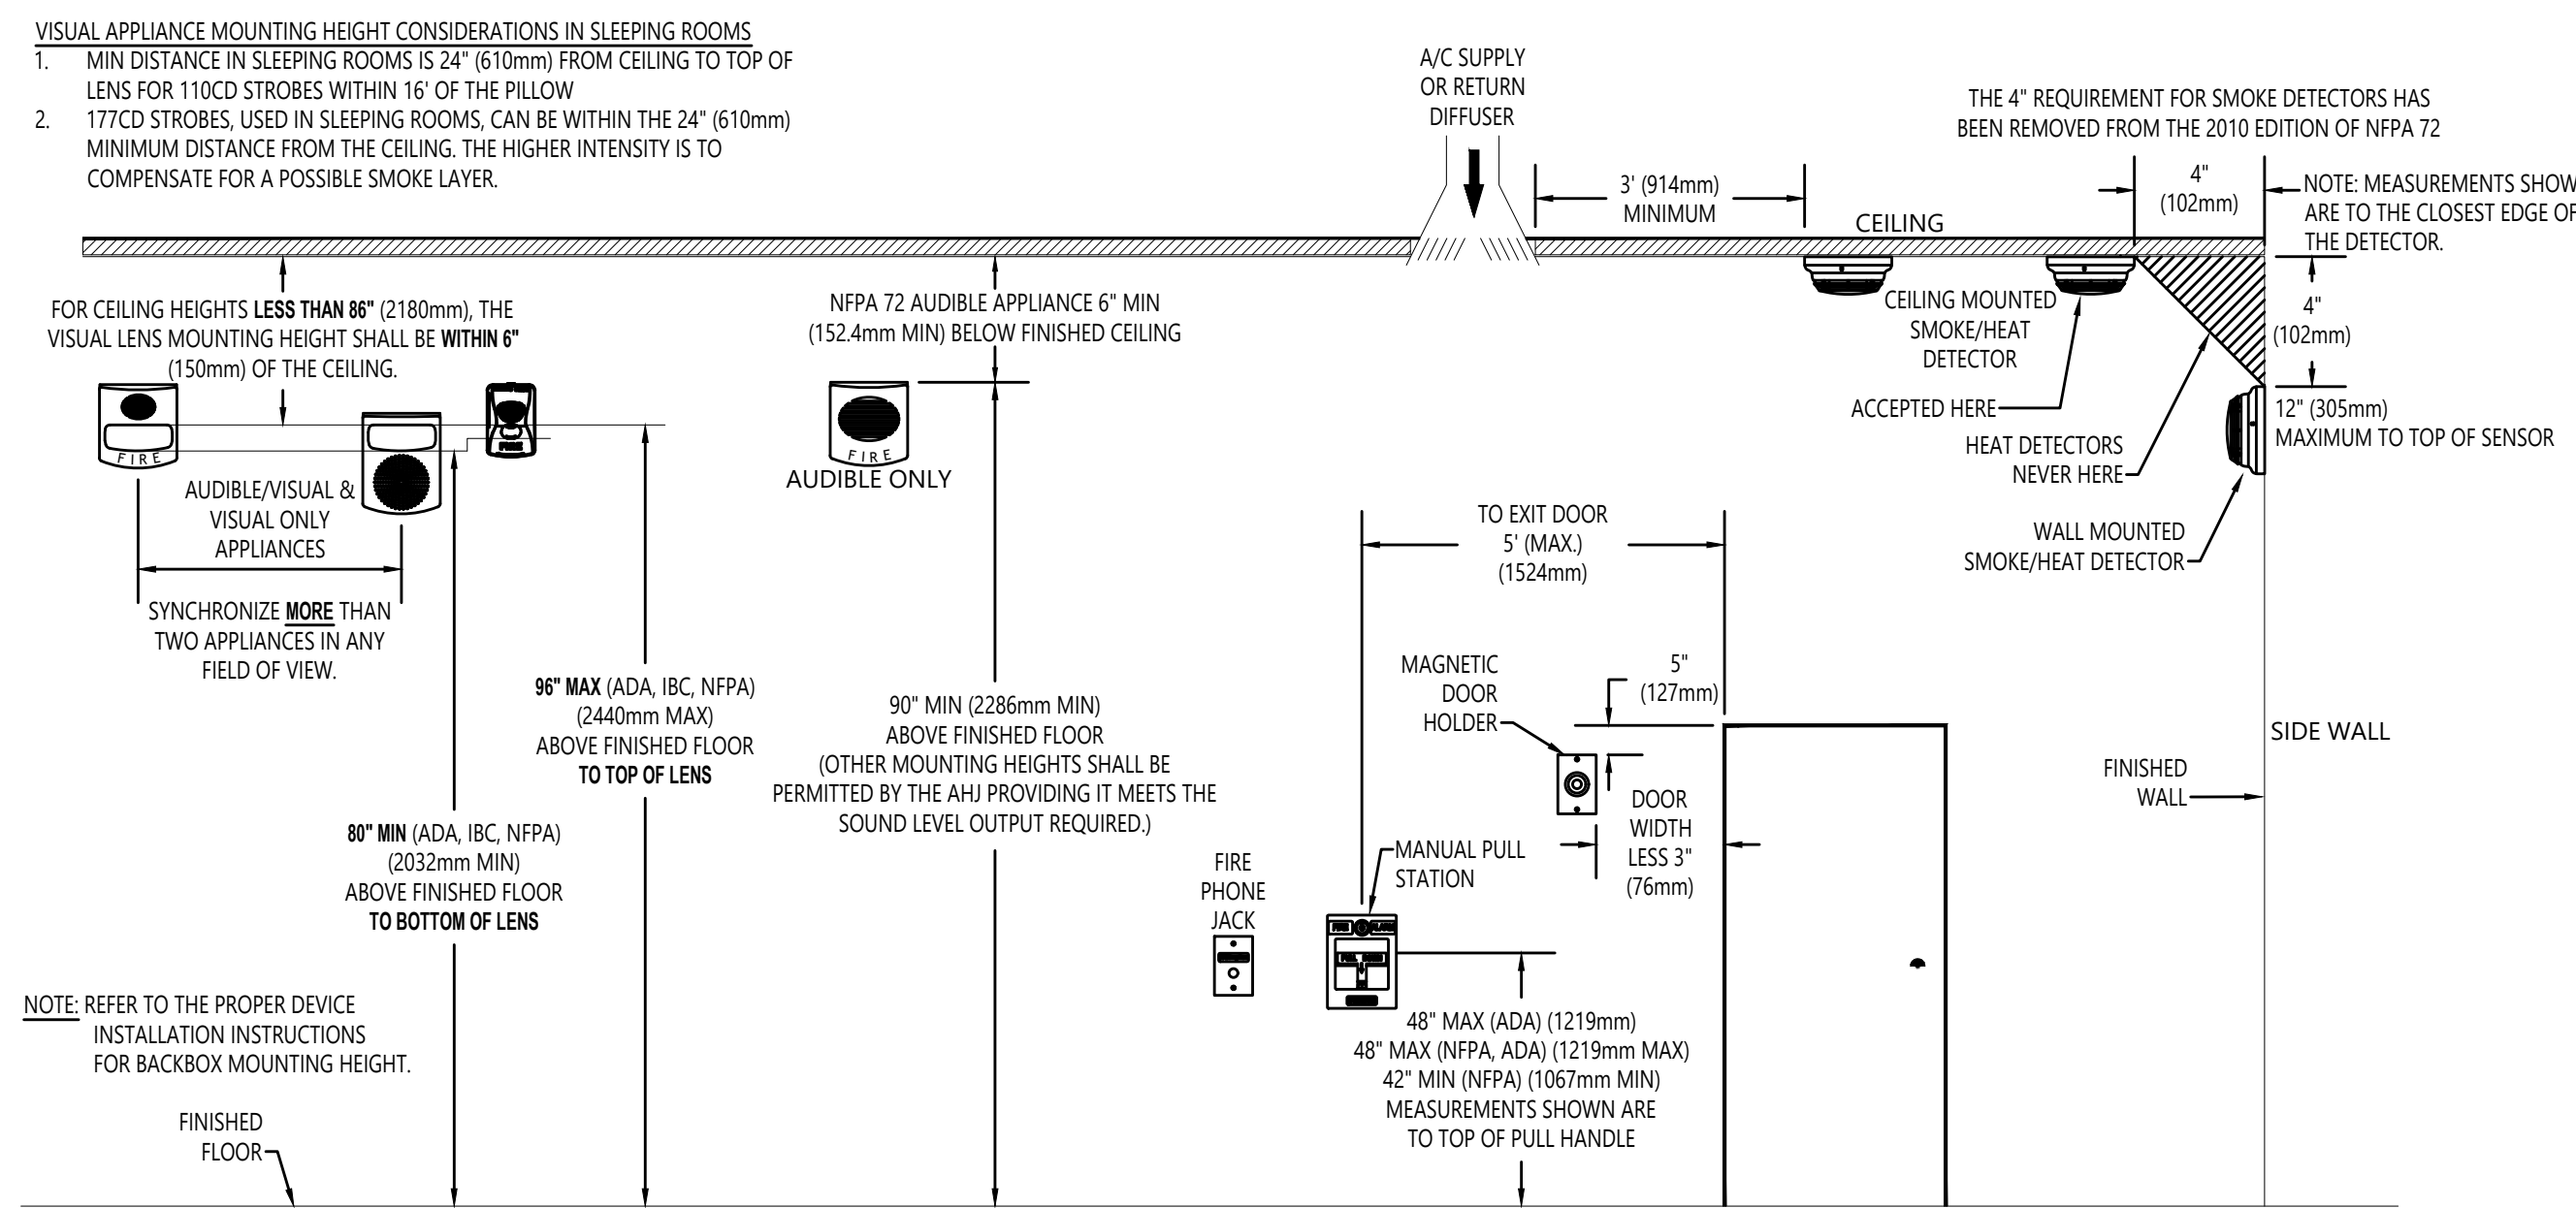

## DIP SWITCH SETTINGS - INITIATING

SIMPLEX IDNet

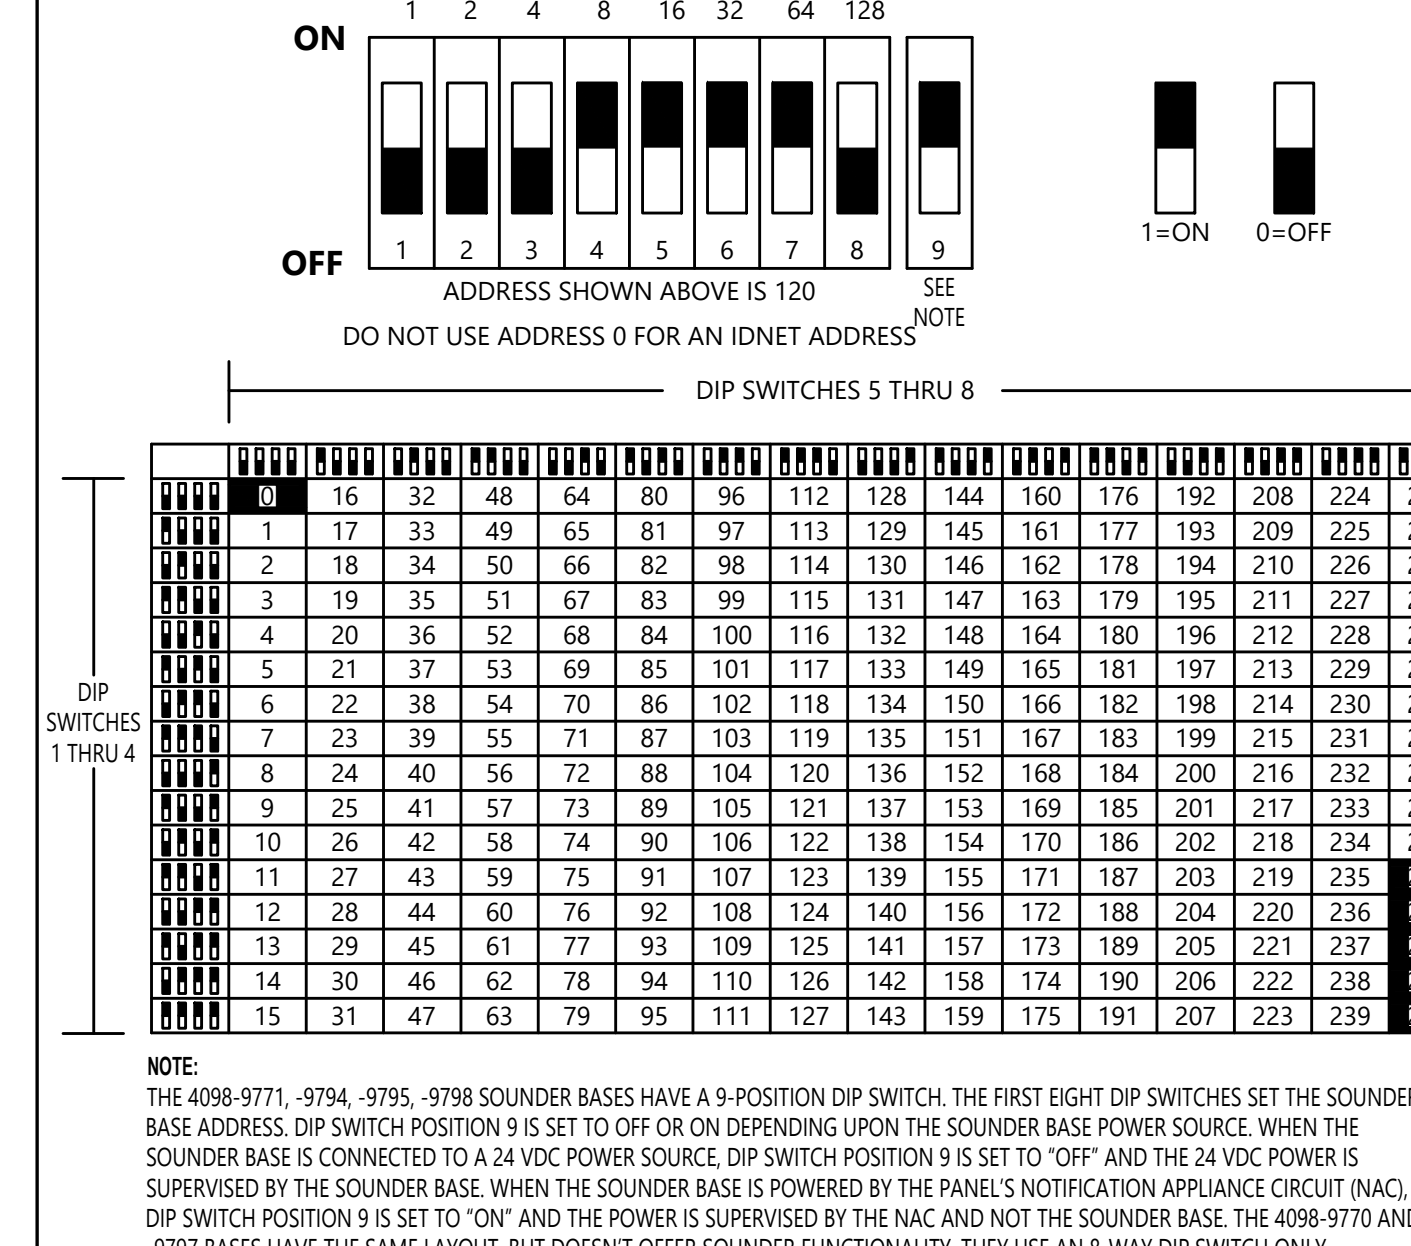


## END OF LINE RESISTOR CODES

MODEL	REF. NUMBER	Ω	BAND NUMBER	WATTS	CIRCUIT TYPE	FIRE ALARM PANEL/MODULE					
4081-9001	733-892	2.2K	RED	RED	GLD	N/A	1/2	ANNUNCIATOR (4300)	4004, 4010 (TROUBLE)		
4081-9002	733-893	3.3K	ORG	ORG	RED	GLD	N/A	1	N.O. INITIATING PULL SMOKE, HEAT, WATERFLOW, TAMPER, ETC. 24 PT. I/O SWITCH SUPV. CURRENT LIMITED N.O. INIT. NOTIFICATION (EOL)	4004*, 400R*, 400C*, 4100, 4120, 4100U, 2AM6 4605-7401, 4100 SERIES 4090 IDNET IAM (EOLR) 2090, 9024	
4081-9003	733-896	4.7K	YLK	YLK	VT	RED	GLD	N/A	1/2		
4081-9004	733-886	6.8K	BLU	GRY	RED	GLD	N/A	1/2			
4081-9005	733-894	1.8K	BRN	GRY	RED	GLD	N/A	1/2	CURRENT LIMITED N.O. INITIATING (IMLINE)	4004, 4005, 4090-9001 IDNET IAM, 2150-3173 MAGNETIC I.P.T. I/O 4-20mA (200T) (TROUBLE)	
4081-9006	733-890	50Ω	GRN	BLU	BRN	GLD	N/A	1	N.C. INITIATING (EOLR)	4090-9001 IDNET IAM	
4081-9007	733-891	1.2K	BRN	BRN	RED	GLD	N/A	1			
4081-9008	733-894	10K	BRN	BLK	ORG	GLD	N/A	1/2	NOTIFICATION	4004, 4005, 4006, 4008, 4009, 4010, 4100, 4100U	
4081-9009	733-912	20Ω	RED	BLK	GLD	N/A	1/2		N.O. INITIATING (EOLR) N.C. INITIATING (EOLR) TO MR-101 RELAY COIL	4004, 4005, 4006, 4008, 4009, 4010, 4100, 4100U	
4081-9010	733-973	1K	BRN	BLK	RED	GLD	N/A	1			
4081-9011	733-974	100Ω	BRN	BLK	BRN	GLD	N/A	1/2	ANNUNCIATOR (N2)	4006, 4008, 4010	
4081-9012	733-885	2.2K	RED	RED	ORG	GLD	N/A	1/2	SPEAKER CIRCUIT	4003	
4081-9013	734-080	4.99K	YEL	WHI	WHI	BRN	BRN	1/2			
4081-9014	734-092	2.4K	RED	YEL	RED	GLD	N/A	1/2			
4081-9015	734-093	1.5K	BRN	GRN	RED	GLD	N/A	1/2	CURRENT LIMITED N.O. INIT. (SECURITY MONITORING EOLR)	4090-9001 IDNET IAM	
4081-9016	734-149	150Ω	BRN	GRN	YEL	GLD	N/A	1/2			
4081-9017	734-171	3.3K	ORG	WHI	RED	GLD	N/A	1			
4081-9018	734-168	1.1K	BRN	BLK	ORG	GLD	N/A	1	70VDC CONSTANT SUPV. NAC	4100, 4120	
4081-9019	734-091	8.2K	GRY	RED	RED	GLD	N/A	1/2	SECURITY MONITORING (EOLR)	4100, 4100U	
4081-9020	734-094	5.1K	GRY	GLD	RED	GLD	N/A	1/2	N.C. SECURITY MON. (SHUNT)	4100, 4100U	
4081-9021	734-095	1.1K	BRN	RED	ORG	GLD	N/A	1/2			

\* USE WITH RETROFIT OR HIGH CURRENT MODULE


## FACP BACKBOX INSTALLATION

SIMPLEX 4007es SERIES

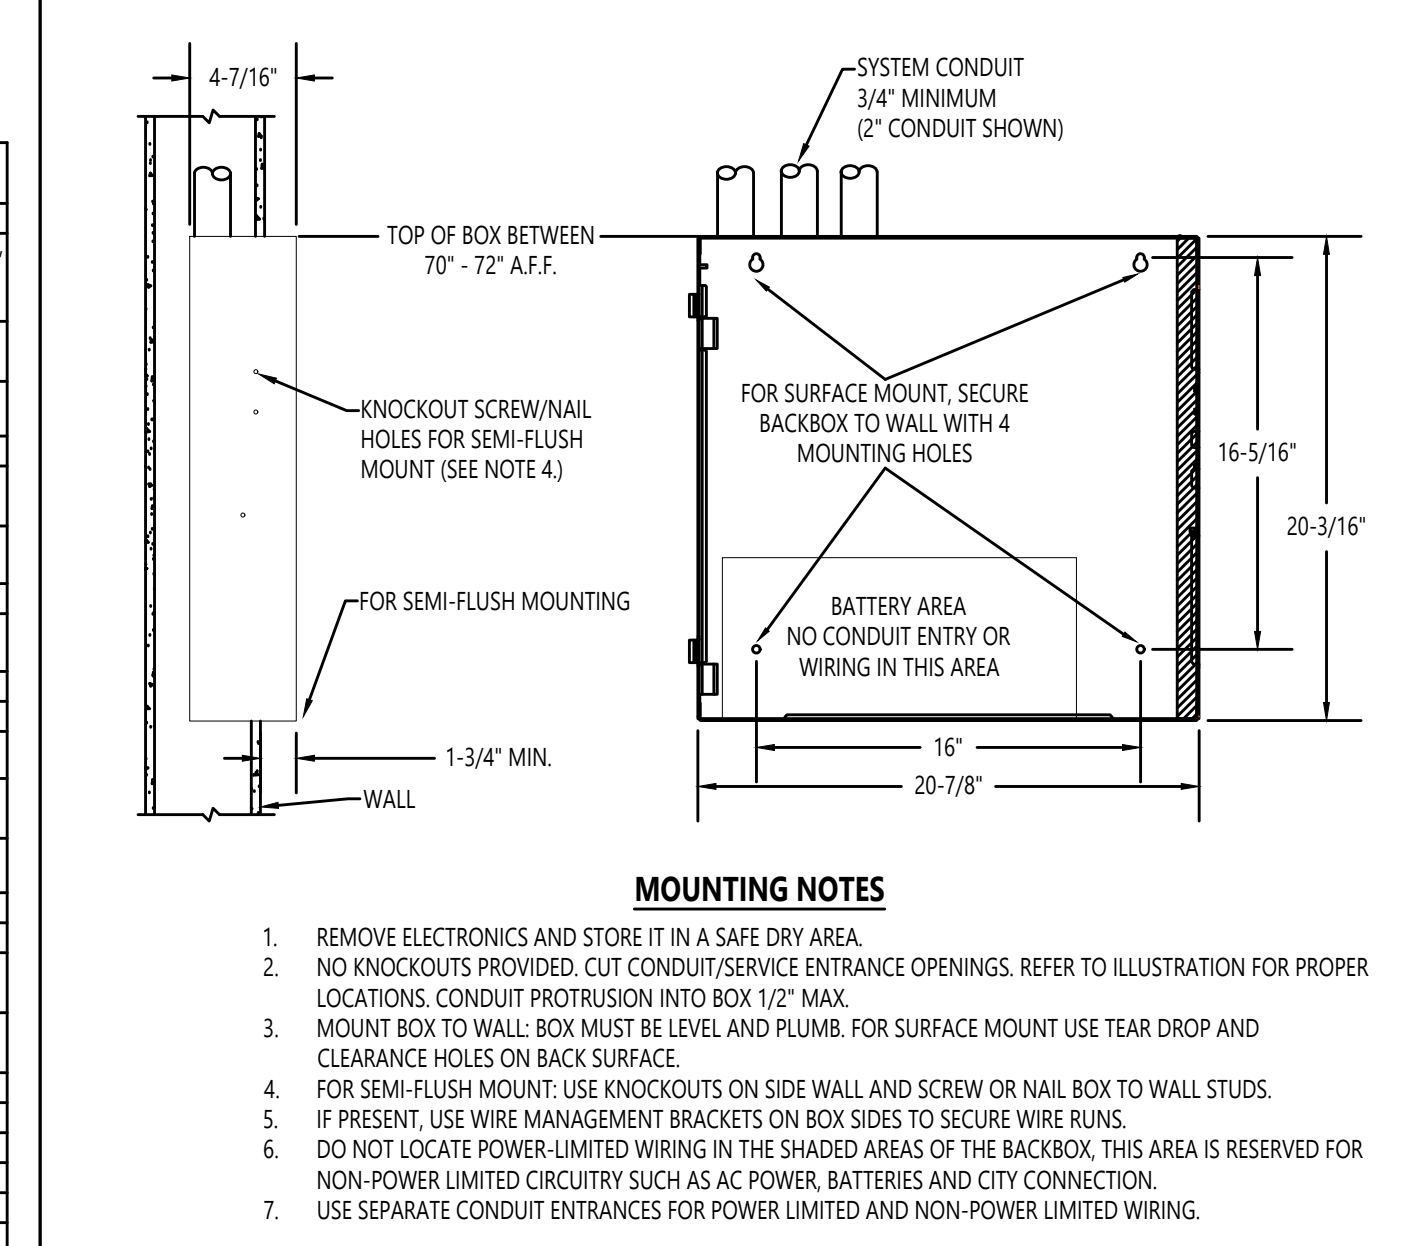

## STANDARD SENSOR BASE

SIMPLEX 4098-9792

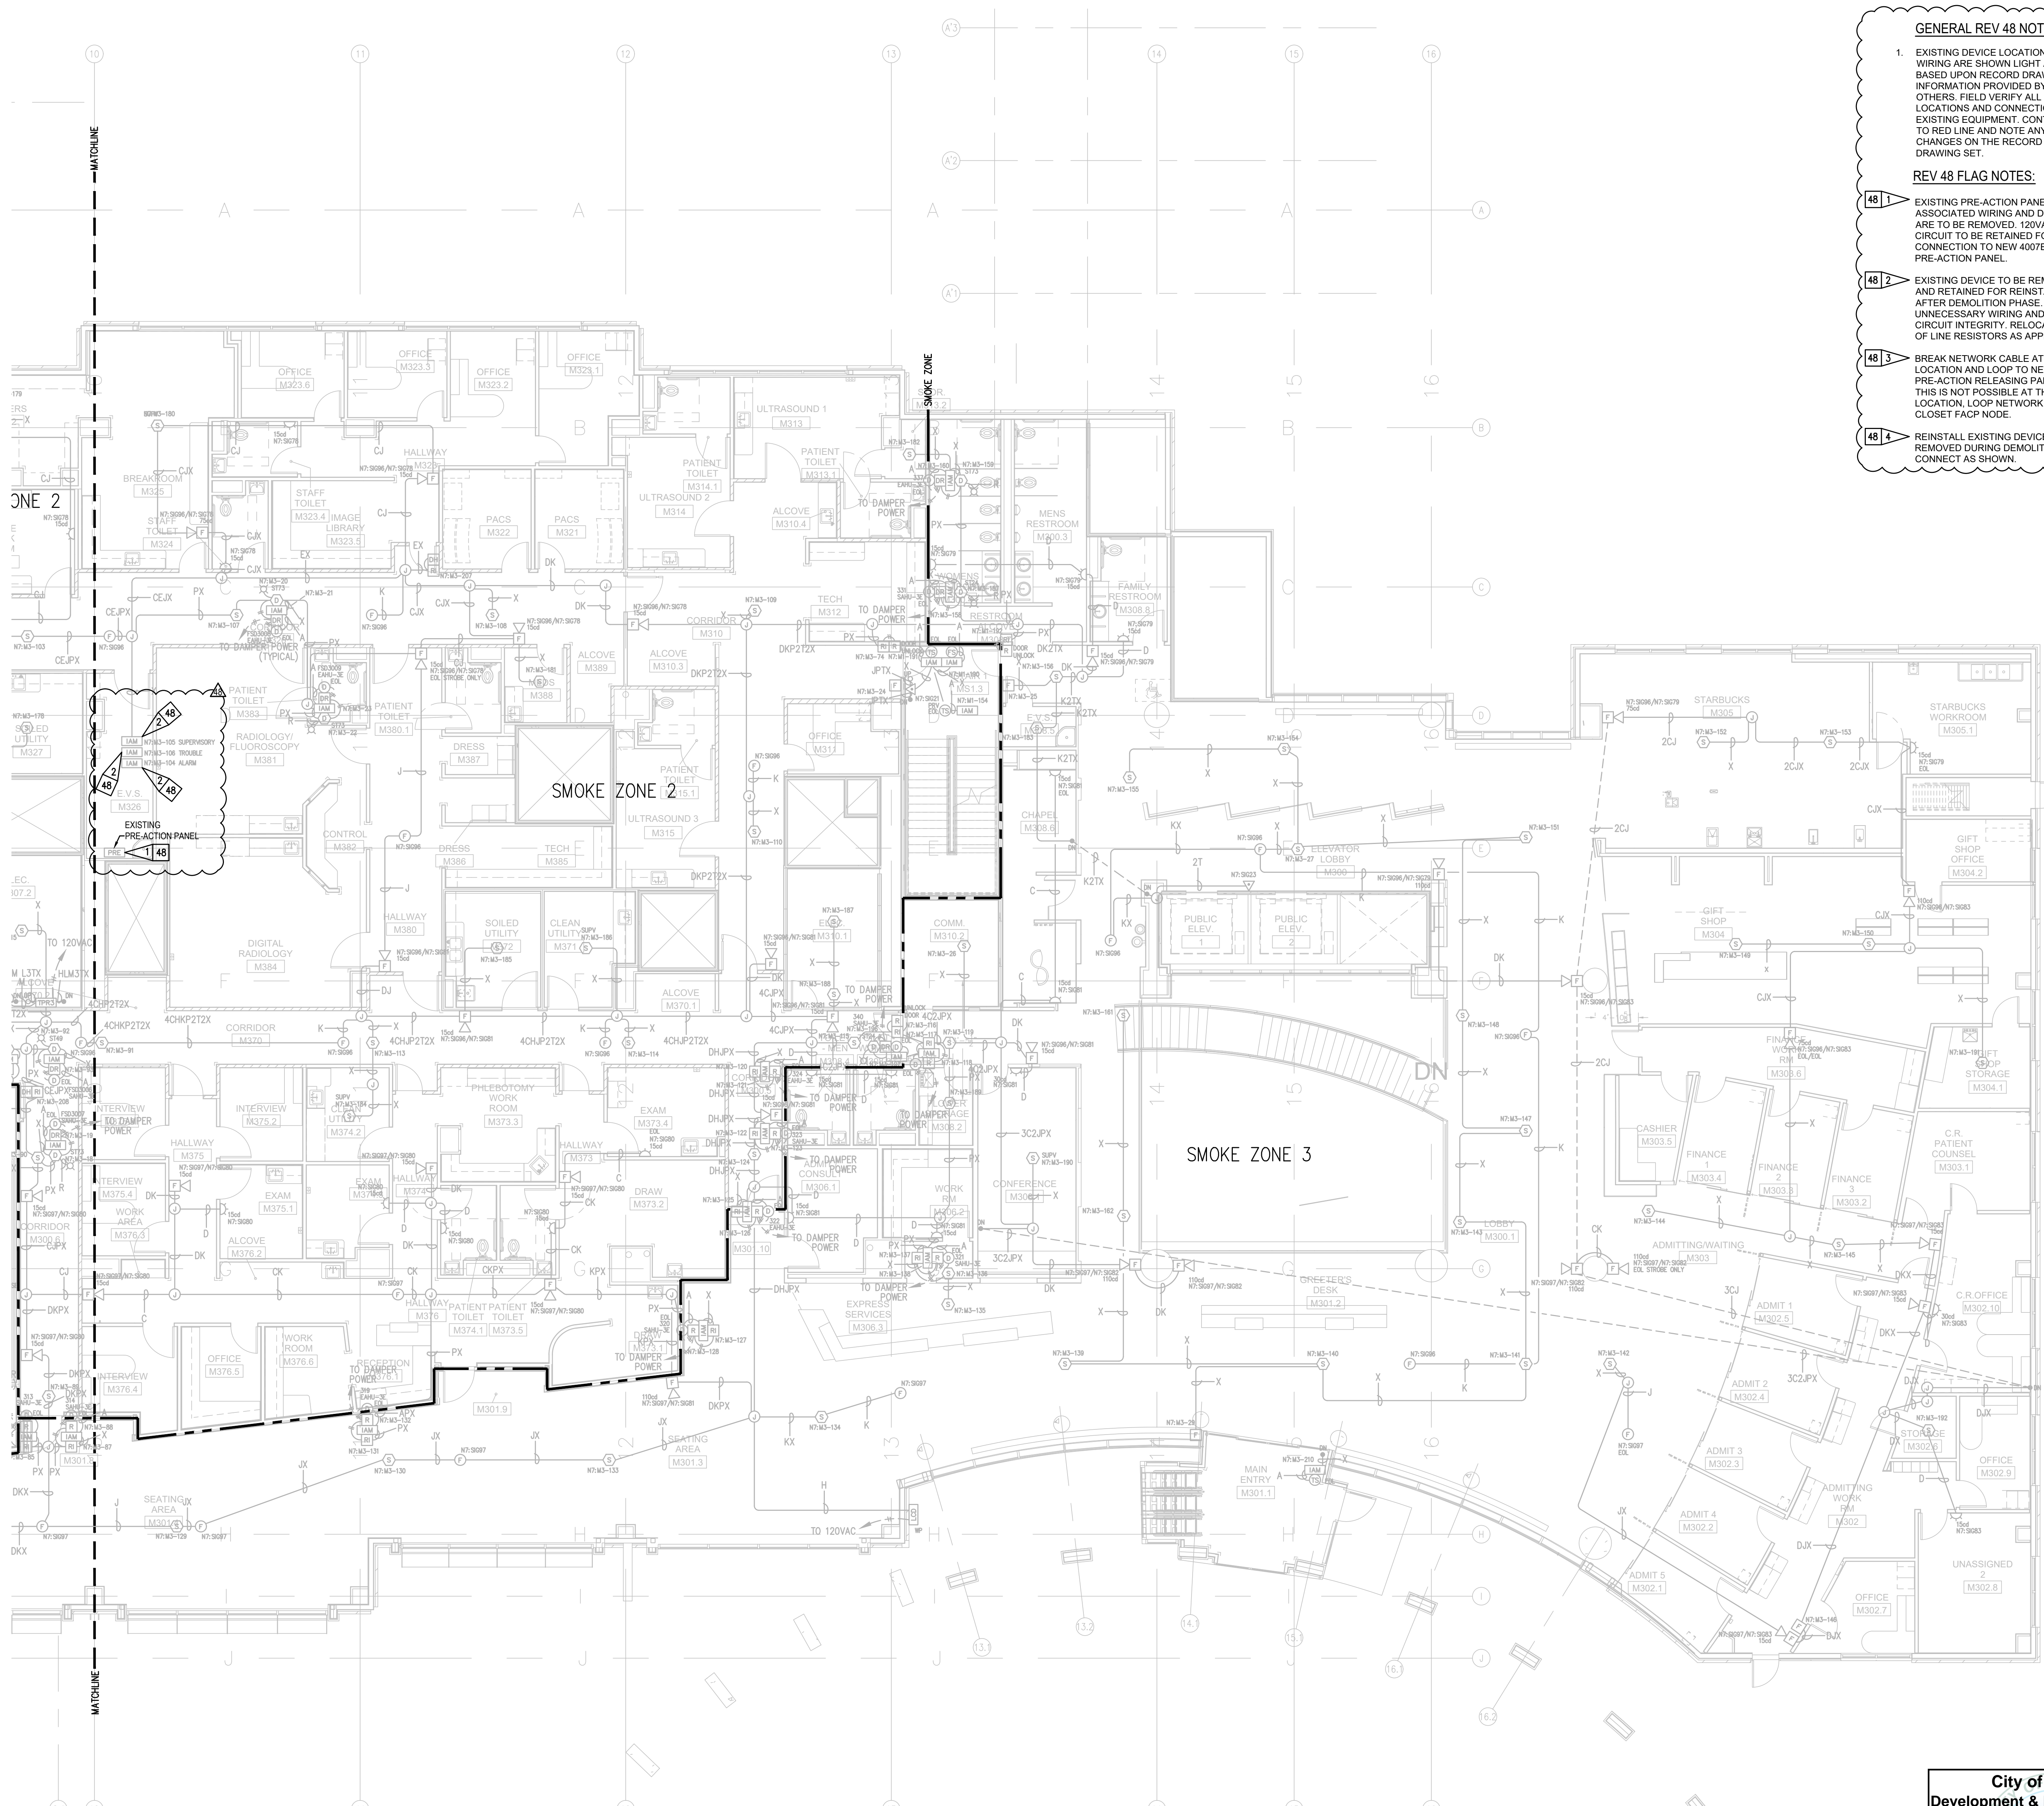

**GENERAL REV 48 NOTES:**

- EXISTING DEVICE LOCATIONS AND WIRING ARE SHOWN LIGHT AND ARE BASED UPON RECORD DRAWING INFORMATION PROVIDED BY OTHERS. FIELD VERIFY ALL LOCATIONS AND CONNECTIONS TO EXISTING EQUIPMENT. CONTRACTOR TO RED LINE AND NOTE ANY AND ALL CHANGES ON THE RECORD DRAWING SET.


**REV 48 FLAG NOTES:**

- 48 1** EXISTING PRE-ACTION PANEL AND ALL ASSOCIATED WIRING AND DEVICES ARE TO BE REMOVED. 120VAC CIRCUIT TO BE RETAINED FOR CONNECTION TO NEW 4007ES PRE-ACTION PANEL.
- 48 2** EXISTING DEVICE TO BE REMOVED AND RETAINED FOR REINSTALLATION AFTER DEMOLITION PHASE. REMOVE UNNECESSARY WIRING AND MAINTAIN CIRCUIT INTEGRITY. RELOCATED END OF LINE RESISTORS AS APPLICABLE.
- 48 3** BREAK NETWORK CABLE AT THIS LOCATION AND LOOP TO NEW 4007ES PRE-ACTION RELEASING PANEL. IF THIS IS NOT POSSIBLE AT THIS LOCATION, LOOP NETWORK CABLE TO CLOSEST FACP NODE.
- 48 4** REINSTALL EXISTING DEVICE REMOVED DURING DEMOLITION. CONNECT AS SHOWN.


Symbol	Description	Part #	Backbox
[Symbol]	Multicandela Wall Speaker/Strobe - White	4906-9153	5" sq 2.875" deep w/ ext ring 4"sq adapter by EC
[Symbol]	Multicandela Ceiling Speaker/Strobe - White	4906-9154	5" sq 2.875" deep w/ ext ring 4"sq adapter by EC
[Symbol]	Multicandela Wall Strobe - White	4906-9103	4" sq by EC
[Symbol]	Multicandela Ceiling Strobe - White	4906-9102	4" sq by EC
[Symbol]	Wall Speaker - White	4902-9717	5" sq 2.875" deep w/ ext ring 4"sq adapter by EC
[Symbol]	Ceiling Speaker - White	4902-9721	5" sq 2.875" deep w/ ext ring 4"sq adapter by EC
[Symbol]	Addressable Manual Station	4099-9003 w/ 5111100 Cover	4" sq 2 1/8" deep w/ sq ring by EC
[Symbol]	Addressable Manual Station Suppression	4099-9015 w/ 4099-9802 Label Kit	4" sq 2 1/8" deep w/ sq ring by EC
[Symbol]	TrueAlarm Smoke Sensor	4098-9714 w/ 4098-9792 Base	4" oct by EC
[Symbol]	TrueAlarm Heat Sensor	4098-9733 w/ 4098-9792 Base	4" oct by EC
[Symbol]	Heat Detector - 135FT	4098-9756	4" self-contained
[Symbol]	TrueAlarm Duct Sensor	4098-9756	self-contained
[Symbol]	Remote LED w/Test	2098-9806	sq by EC
[Symbol]	Duct Detector Relay	4098-9843	4"sq w/sg & cover by EC
[Symbol]	Beam Smoke Detector - Transmitter	BEAM1224	Surface Box w/BEAMSK
[Symbol]	Beam Smoke Detector - Reflector	4090-9101	Surface
[Symbol]	Monitor ZAM	4090-9001	4"sq 2 1/8" deep w/ 2-gang cover by EC
[Symbol]	Supervised IAM	By Others	By Others
[Symbol]	Flow Switch	By Others	By Others
[Symbol]	Pressure Switch	By Others	By Others
[Symbol]	Low Air Switch	By Others	By Others
[Symbol]	Tamper Switch	By Others	By Others
[Symbol]	Post Indicator Valve	By Others	By Others
[Symbol]	Coil Supervision Module	2081-9046	By Others
[Symbol]	Pre-Action Solenoid	By Others	By Others
[Symbol]	Door Holders	By Others	By Others
[Symbol]	Suppression Mech. Disconnect	2080-9060	Included
[Symbol]	Relay IAM	4090-9002	4"sq 2 1/8" deep w/ 2-gang cover by EC
[Symbol]	Remote Relay	2088-9008	self-contained
[Symbol]	FFT Jack	2084-9001	sq by EC
[Symbol]	FFT Cabinet	2084-9026 w/ (10) 2084-9024 handsets	23.5"H x 23.5"W x 4.0"D
[Symbol]	Smoke Control Panel	CEP-L-GR-GP6	41"H x 29"W x 4.75"D
[Symbol]	Suppression Releasing Peripheral	4090-9006	8.125"H x 6.125"W x 4"D Surface Mount
[Symbol]	Printer	4190-9013	Table Top
[Symbol]	LCD Annunciator	4603-9101	6-gang 3.5"deep by EC or RSA-WP-SA
[Symbol]	Terminal Cabinet	SSU00661	13"H x 23.5"W x 5.5"D
[Symbol]	Transponder Panel	4100-9601	56"H x 24"W x 8.375"D 2975-9432
[Symbol]	Fire Alarm Control Panel	4100-9114	56"H x 24"W x 8.375"D
[Symbol]	Network Display Unit	4100-9151	56"H x 24"W x 8.375"D 2975-9426
[Symbol]	4007ES Pre-Action Panel	4007-9101	16.25"H x 13.5"W x 5.75"D

Letter	Qty	Color/Type	Size	Function
A	2	Black/Orange TFN	16	Zone
C	2	Red/Blue THHN	14	Horn/Strobe
D	4	(2) Red/(2) Blue THHN	14	Horn/Strobe Loop
E	2	Brown/Yellow THHN	14	Door Holders
F	2	Orange THHN	14	Fan Shutdown
H	1	WestPenn D975	18	Serial Communication
D	2	Red/Black THHN	14	
J	1	WestPenn 991	16	Speaker
K	2	WestPenn 991	16	Speaker Loop
L	1	WestPenn 5220FZ	16	Local Network Connection**
M	1	WestPenn 5220FZ	16	Multiplex Transponder**
J	1	WestPenn 5220FZ	16	
N	2	WestPenn 5120UZ	14	Network Connection
P	2	Red/Black THHN	14	24VDC Power
R	2	Blue/White TFN	16	Remote LED w/Test
T	2	Pink TFN	16	Fire Fighter Telephone
V	1	WestPenn 991	16	Printer
X	1	WestPenn D975	18	Addressable Data Line

**STROBE AND SPEAKER IDENTIFICATION**

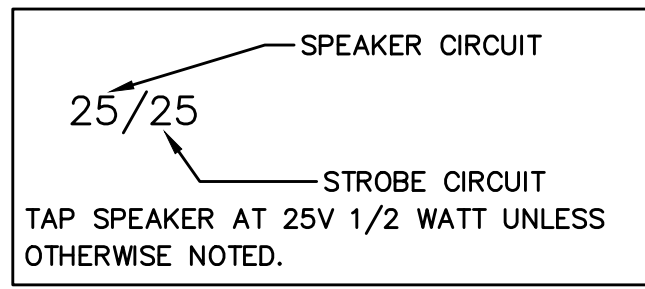

**ADDRESSABLE DETECTOR IDENTIFICATION**

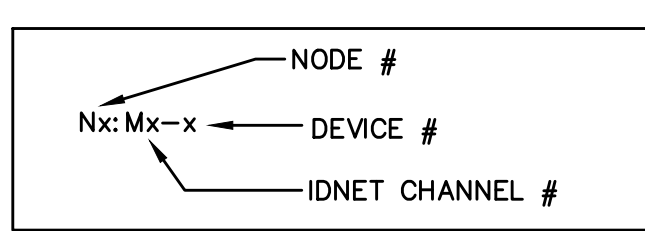

**City of Puyallup**  
Development & Permitting Services  
**ISSUED PERMIT**

Building	Planning
Engineering	Public Works
Fire	Traffic

**LEVEL 3 EAST FLOOR DEMO PLAN**  
SCALE 1/8"=1'-0"

**Johnson Controls**  
9520 10th Avenue South, Suite 100  
Seattle, WA 98108  
SALES: 206-291-1400  
SERVICE: 206-291-1411

NO.	DATE	REVISION DESCRIPTION	DRAWN BY	CHECKED BY	PROJECT #
46	8/28/19	PATIENT CARE TOWER 7TH & 6TH FLOOR RECORD DRAWINGS	RSC	JWB	600592522
47	9/20/19	DAILY PHARMACY RECORD DRAWINGS	RSC	ROB	610318284
48	4/12/23	MRI PRE-ACTION PANEL UPGRADE	DAP	ROB	650769824

**DRAWINGS REVIEWED BY:**  
Eric Beck, CET  
NET 422884  
Fire Alarm Systems, Level III

**FIRE ALARM SYSTEM**  
LEVEL 3 EAST FLOOR DEMO PLAN  
GOOD SAMARITAN - PATIENT CARE TOWER  
401 15TH AVENUE SE  
PUYALLUP, WA 98371


APPROVED BY:  
C. McCAMMON

DRAWN BY:  
C. McCAMMON

DATE:  
8/12/09

SITE/PROJECT NUMBER:  
458413141/943123501

SHEET NUMBER:  
FA-LEV3-E-D

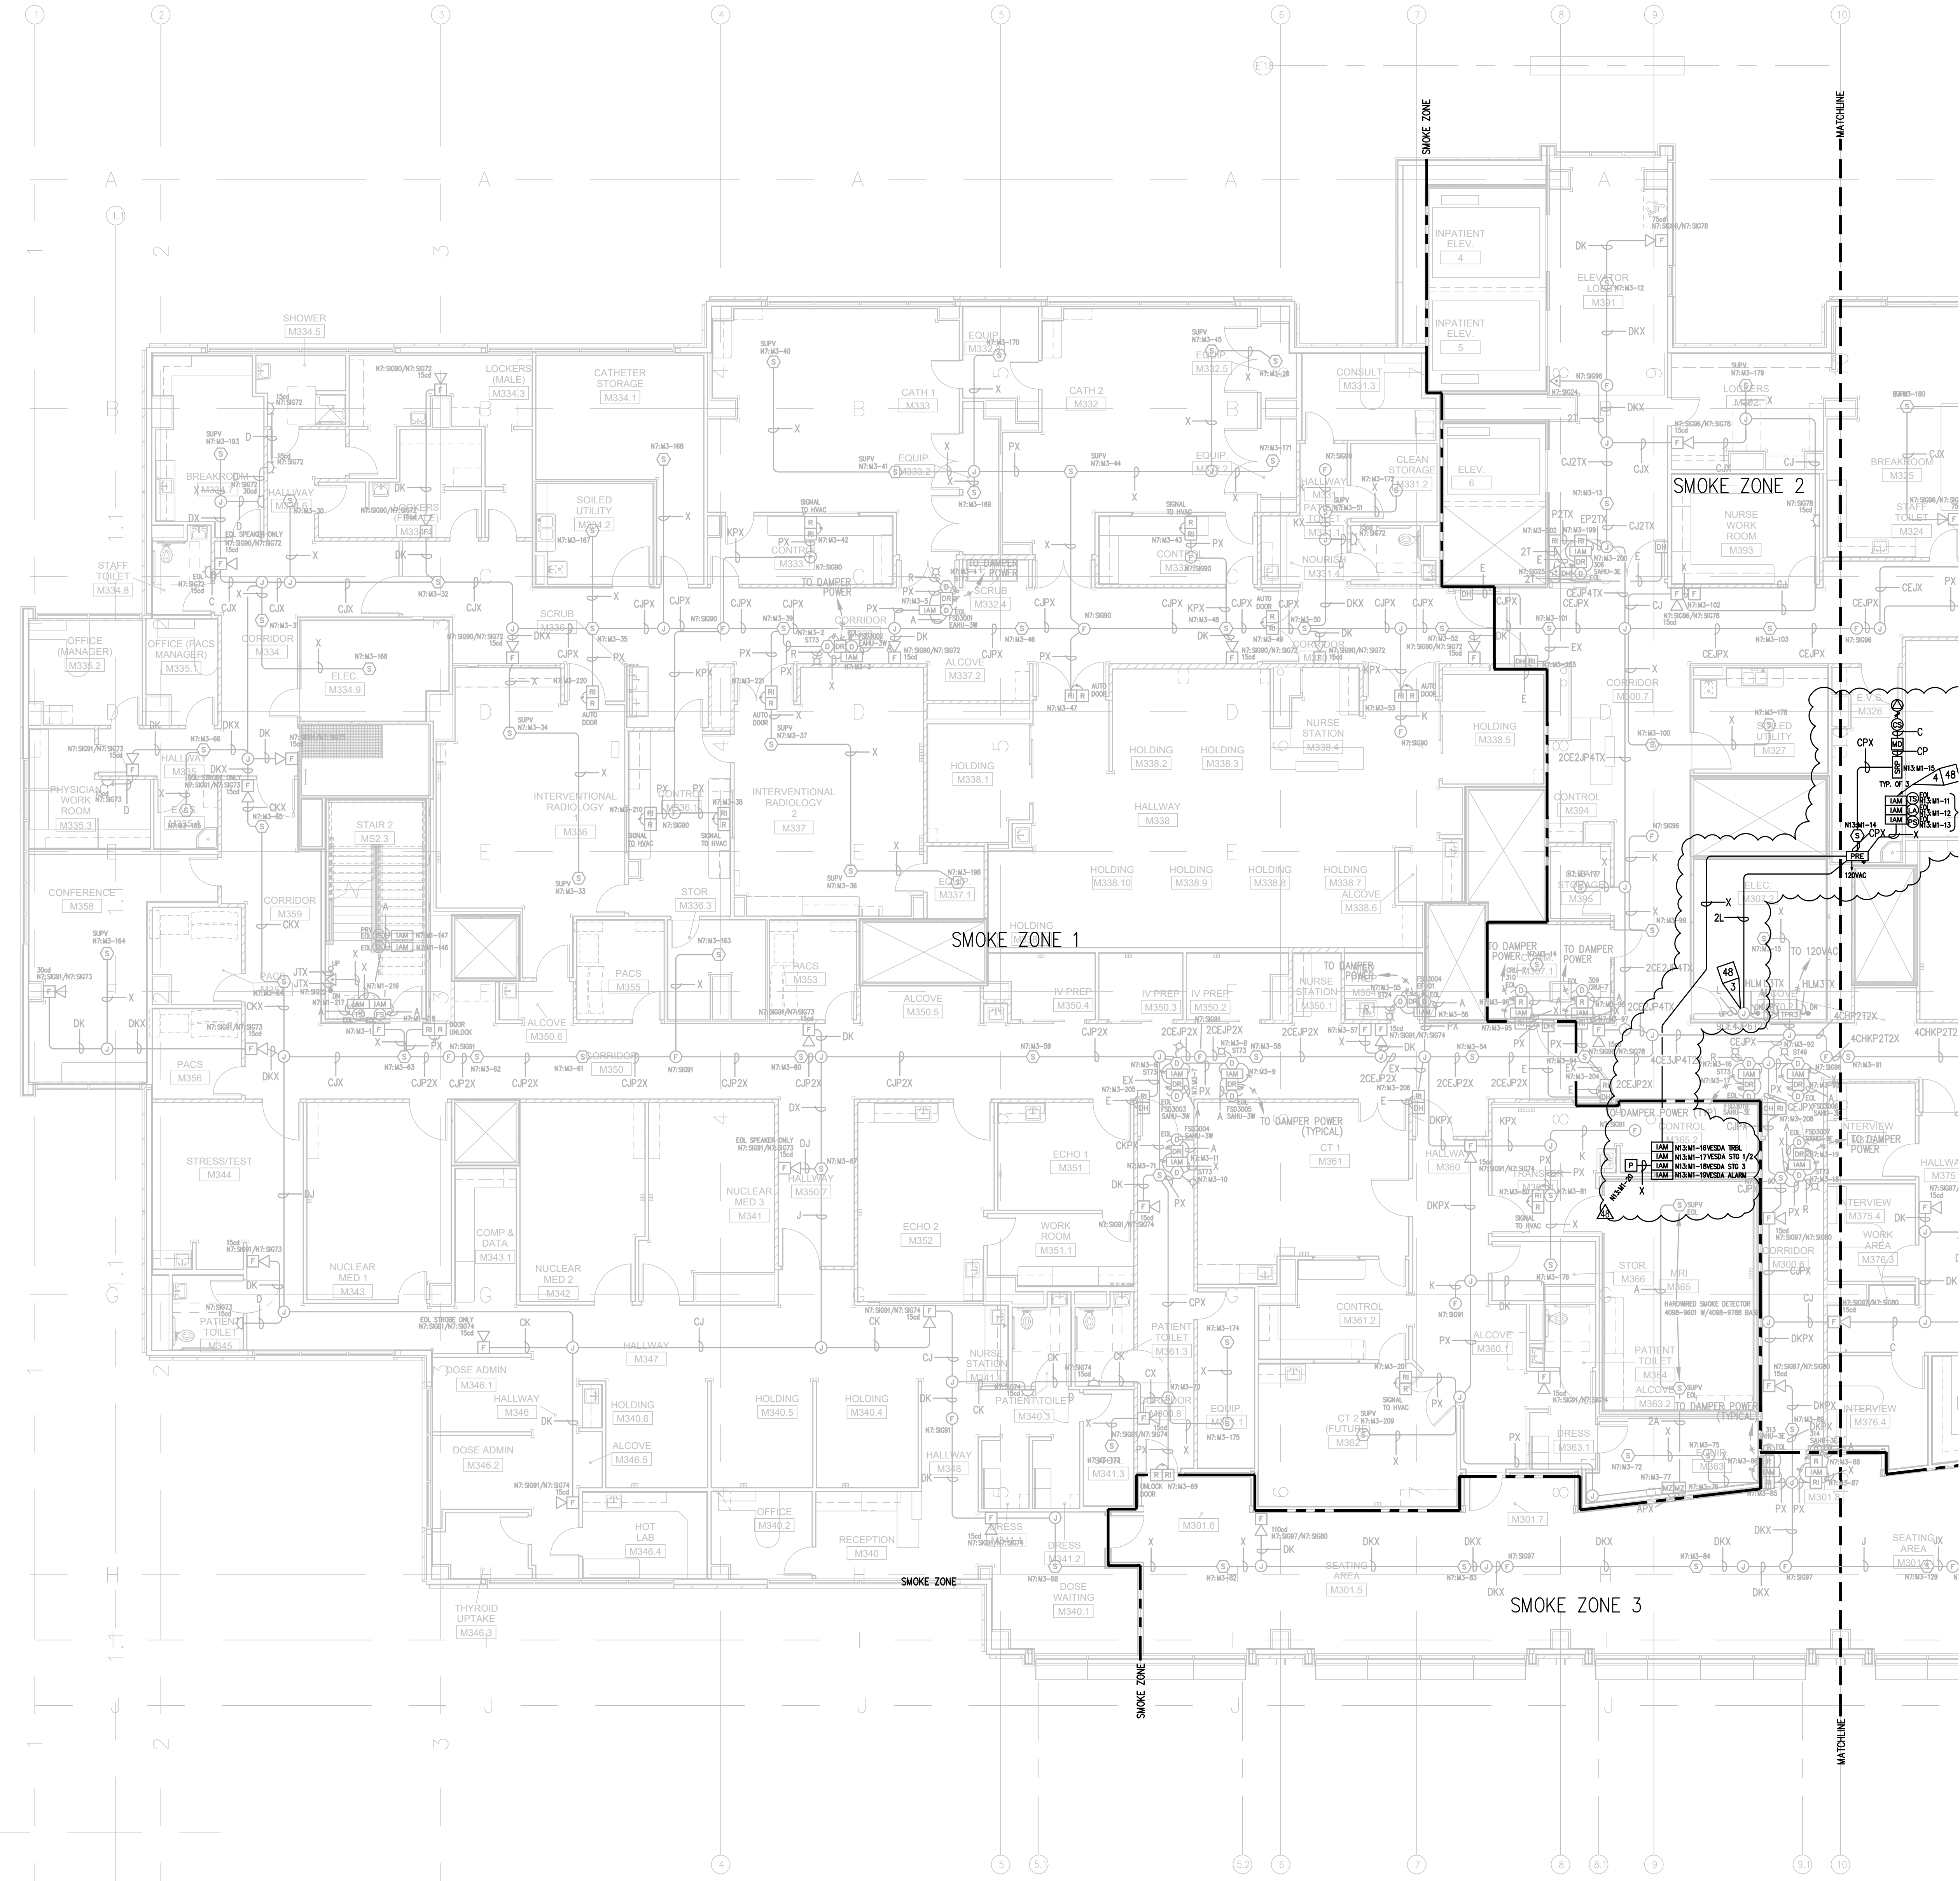

Symbol	Description	Part #	Backbox
[Symbol]	Multicandela Wall Speaker/Strobe - White * subscript indicates circuit # and candela setting	4906-9153	5" sq 2.875" deep w/ ext ring 4" sq adapter by EC
[Symbol]	Multicandela Ceiling Speaker/Strobe - White * subscript indicates circuit # and candela setting	4906-9154	5" sq 2.875" deep w/ ext ring 4" sq adapter by EC
[Symbol]	Multicandela Wall Strobe - White * subscript indicates circuit # and candela setting	4906-9103	4" sq by EC
[Symbol]	Multicandela Ceiling Strobe - White * subscript indicates circuit # and candela setting	4906-9102	4" sq by EC
[Symbol]	Wall Speaker - White * subscript indicates circuit #	4902-9717	5" sq 2.875" deep w/ ext ring 4" sq adapter by EC
[Symbol]	Ceiling Speaker - White * subscript indicates circuit #	4902-9721	5" sq 2.875" deep w/ ext ring 4" sq adapter by EC
[Symbol]	Addressable Manual Station * subscript indicates device address	4099-9003 w/ 5111 100 Cover	4" sq 2 1/8" deep w/ sq ring by EC
[Symbol]	Addressable Manual Station Suppression * subscript indicates device address	4099-9015 w/ 4099-9802 Label Kit	4" sq 2 1/8" deep w/ sq ring by EC
[Symbol]	TrueAlarm Smoke Sensor * subscript indicates device address/ SUIPV indicates supervisory device	4098-9714 w/ 4098-9702 Base	4" oct by EC
[Symbol]	TrueAlarm Heat Sensor * subscript indicates device address	4098-9733 w/ 4098-9702 Base	4" oct by EC
[Symbol]	Heat Detector - 135FT	ED-2838-PL	4" oct by EC
[Symbol]	TrueAlarm Duct Sensor * subscript indicates device address and sampling tube size	4098-9756	self-contained
[Symbol]	Remote LED w/Test	2098-9806	sq by EC
[Symbol]	Duct Detector Relay	4098-9843	4" sq w/sg & cover by EC
[Symbol]	Beam Smoke Detector - Transmitter	BEAM1224	Surface Box w/BEAMSK
[Symbol]	Beam Smoke Detector - Reflector	4090-9101	Surface 4" sq 2 1/8" deep w/ 2-gang cover by EC
[Symbol]	Member ZAM * subscript indicates device address	4090-9001	4" sq w/sg & cover by EC
[Symbol]	Supervised IAM * subscript indicates device address	By Others	By Others
[Symbol]	Flow Switch	By Others	By Others
[Symbol]	Pressure Switch	By Others	By Others
[Symbol]	Low Air Switch	By Others	By Others
[Symbol]	Tamper Switch	By Others	By Others
[Symbol]	Post Indicator Valve	By Others	By Others
[Symbol]	Coil Supervision Module	2081-9046	By Others
[Symbol]	Pre-Action Solenoid	By Others	By Others
[Symbol]	Door Holders	By Others	By Others
[Symbol]	Suppression Mech. Disconnect	2080-9060	Included
[Symbol]	Relay IAM * subscript indicates device address	4090-9002	4" sq 2 1/8" deep w/ 2-gang cover by EC
[Symbol]	Remote Relay	2088-9008	self-contained
[Symbol]	FFT Jack	2084-9001	sg by EC
[Symbol]	FFT Cabinet	2084-9026 w/ (10) 2084-9024 handsets	23.5" H x 23.5" W x 4.0" D
[Symbol]	Smoke Control Panel	CEP-L-GR-GP6	41" H x 29" W x 4.75" D
[Symbol]	Suppression Releasing Peripheral	4090-9006	8.125" H x 6.125" W x 4" D Surface Mount
[Symbol]	Printer	4190-9103	Table Top
[Symbol]	LCI Annunciator	4603-9101	6-gang 3.5" deep by EC or RSA-WP-SA
[Symbol]	Terminal Cabinet	SSU00661	13" H x 23.5" W x 5.5" D
[Symbol]	Transponder Panel	4100-9601	56" H x 24" W x 8.375" D
[Symbol]	Fire Alarm Control Panel	4100-9114	56" H x 24" W x 8.375" D
[Symbol]	Network Display Unit	4100-9115	56" H x 24" W x 8.375" D
[Symbol]	4007ES Pre-Action Panel	4007-9101	16.25" H x 13.5" W x 5.75" D

Wire Code				
Letter	Qty	Color/Type	Size	Function
A	2	Black/Orange THN	16	Zone
C	2	Red/Blue THN	14	Horn/Strobe
D	4	(2) Red/(2) Blue THN	14	Horn/Strobe Loop
E	2	Brown/Yellow THN	14	Door Holders
F	2	Orange THN	14	Fan Shutdown
H	1	WestPenn D975	18	Serial Communication
J	2	Red/Black THN	14	
K	1	WestPenn 991	16	Speaker
L	1	WestPenn 991	16	Speaker Loop
L	1	WestPenn 5220FZ	16	Local Network Connection**
M	1	WestPenn 5220FZ	16	Local Network Connection**
M	1	WestPenn 5220FZ	16	Miniplex Transponder**
N	1	WestPenn 5120UZ	14	
N	2	WestPenn D975	18	Network Connection
P	2	Red/Black THN	14	24VDC Power
R	2	Blue/White THN	16	Remote LED w/Test
T	2	Pink TFN	16	Fire Fighter Telephone
V	1	WestPenn 691	18	Printer
V	1	WestPenn D977	18	Printer
X	1	WestPenn D975	18	Addressable Data Line

\*\* 2-wr cable for survivability

**STROBE AND SPEAKER IDENTIFICATION**

25/25  
 SPEAKER CIRCUIT  
 STROBE CIRCUIT  
 TAP SPEAKER AT 25V 1/2 WATT UNLESS OTHERWISE NOTED.

**ADDRESSABLE DETECTOR IDENTIFICATION**

NODE #  
 Nxx Mxx-x  
 IDNET CHANNEL #

**GENERAL REV 48 NOTES:**

- EXISTING DEVICE LOCATIONS AND WIRING ARE SHOWN LIGHT AND ARE BASED UPON RECORD DRAWING INFORMATION PROVIDED BY OTHERS. FIELD VERIFY ALL LOCATIONS AND CONNECTIONS TO EXISTING EQUIPMENT. CONTRACTOR TO RED LINE AND NOTE ANY AND ALL CHANGES ON THE RECORD DRAWING SET.

**REV 48 FLAG NOTES:**

- EXISTING PRE-ACTION PANEL AND ALL ASSOCIATED WIRING AND DEVICES ARE TO BE REMOVED. 120VAC CIRCUIT TO BE RETAINED FOR CONNECTION TO NEW 4007ES PRE-ACTION PANEL.
- EXISTING DEVICE TO BE REMOVED AND RETAINED FOR REINSTALLATION AFTER DEMOLITION PHASE. REMOVE UNNECESSARY WIRING AND MAINTAIN CIRCUIT INTEGRITY. RELOCATED END OF LINE RESISTORS AS APPLICABLE.
- BREAK NETWORK CABLE AT THIS LOCATION AND LOOP TO NEW 4007ES PRE-ACTION RELEASING PANEL. IF THIS IS NOT POSSIBLE AT THIS LOCATION, LOOP NETWORK CABLE TO CLOSEST FACP NODE.
- REINSTALL EXISTING DEVICE REMOVED DURING DEMOLITION. CONNECT AS SHOWN.

**City of Puyallup**  
 Development & Permitting Services  
**ISSUED PERMIT**

Building	Planning
Engineering	Public Works
Fire	Traffic

**LEVEL 3 WEST FLOOR PLAN**  
 SCALE 1/8"=1'-0"

**Johnson Controls**  
 9520 10th Avenue South, Suite 100  
 Seattle, WA 98108  
 SALES: 206-291-1400  
 SERVICE: 206-291-1411

PROJECT #	ENGINEER	DATE	DESCRIPTION
60059222	RSC	8/28/19	PATIENT CARE TOWER 7TH & 6TH FLOOR RECORD DRAWINGS
61031824	RSC	1/23/19	DAILY PHARMACY
61031824	RSC	9/20/19	DAILY PHARMACY RECORD DRAWINGS
60109145	DAP	9/21/22	EXCESS DOORS
65037694	ARB	4/12/23	MRI PRE-ACTION PANEL UPGRADE

**DRAWINGS REVIEWED BY:**  
 Eric Beck, CET  
 NECT #22884  
 Fire Alarm Systems, Level III

**FIRE ALARM SYSTEM**  
**LEVEL 3 WEST FLOOR PLAN**  
**GOOD SAMARITAN - PATIENT CARE TOWER**

APPROVED BY:  
 C. McCAMMON


DRAWN BY:  
 C. McCAMMON

DATE:  
 8/12/09

SITE/PROJECT NUMBER:  
 458413141/943123501

SHEET NUMBER:  
**FA-LEV3-W**



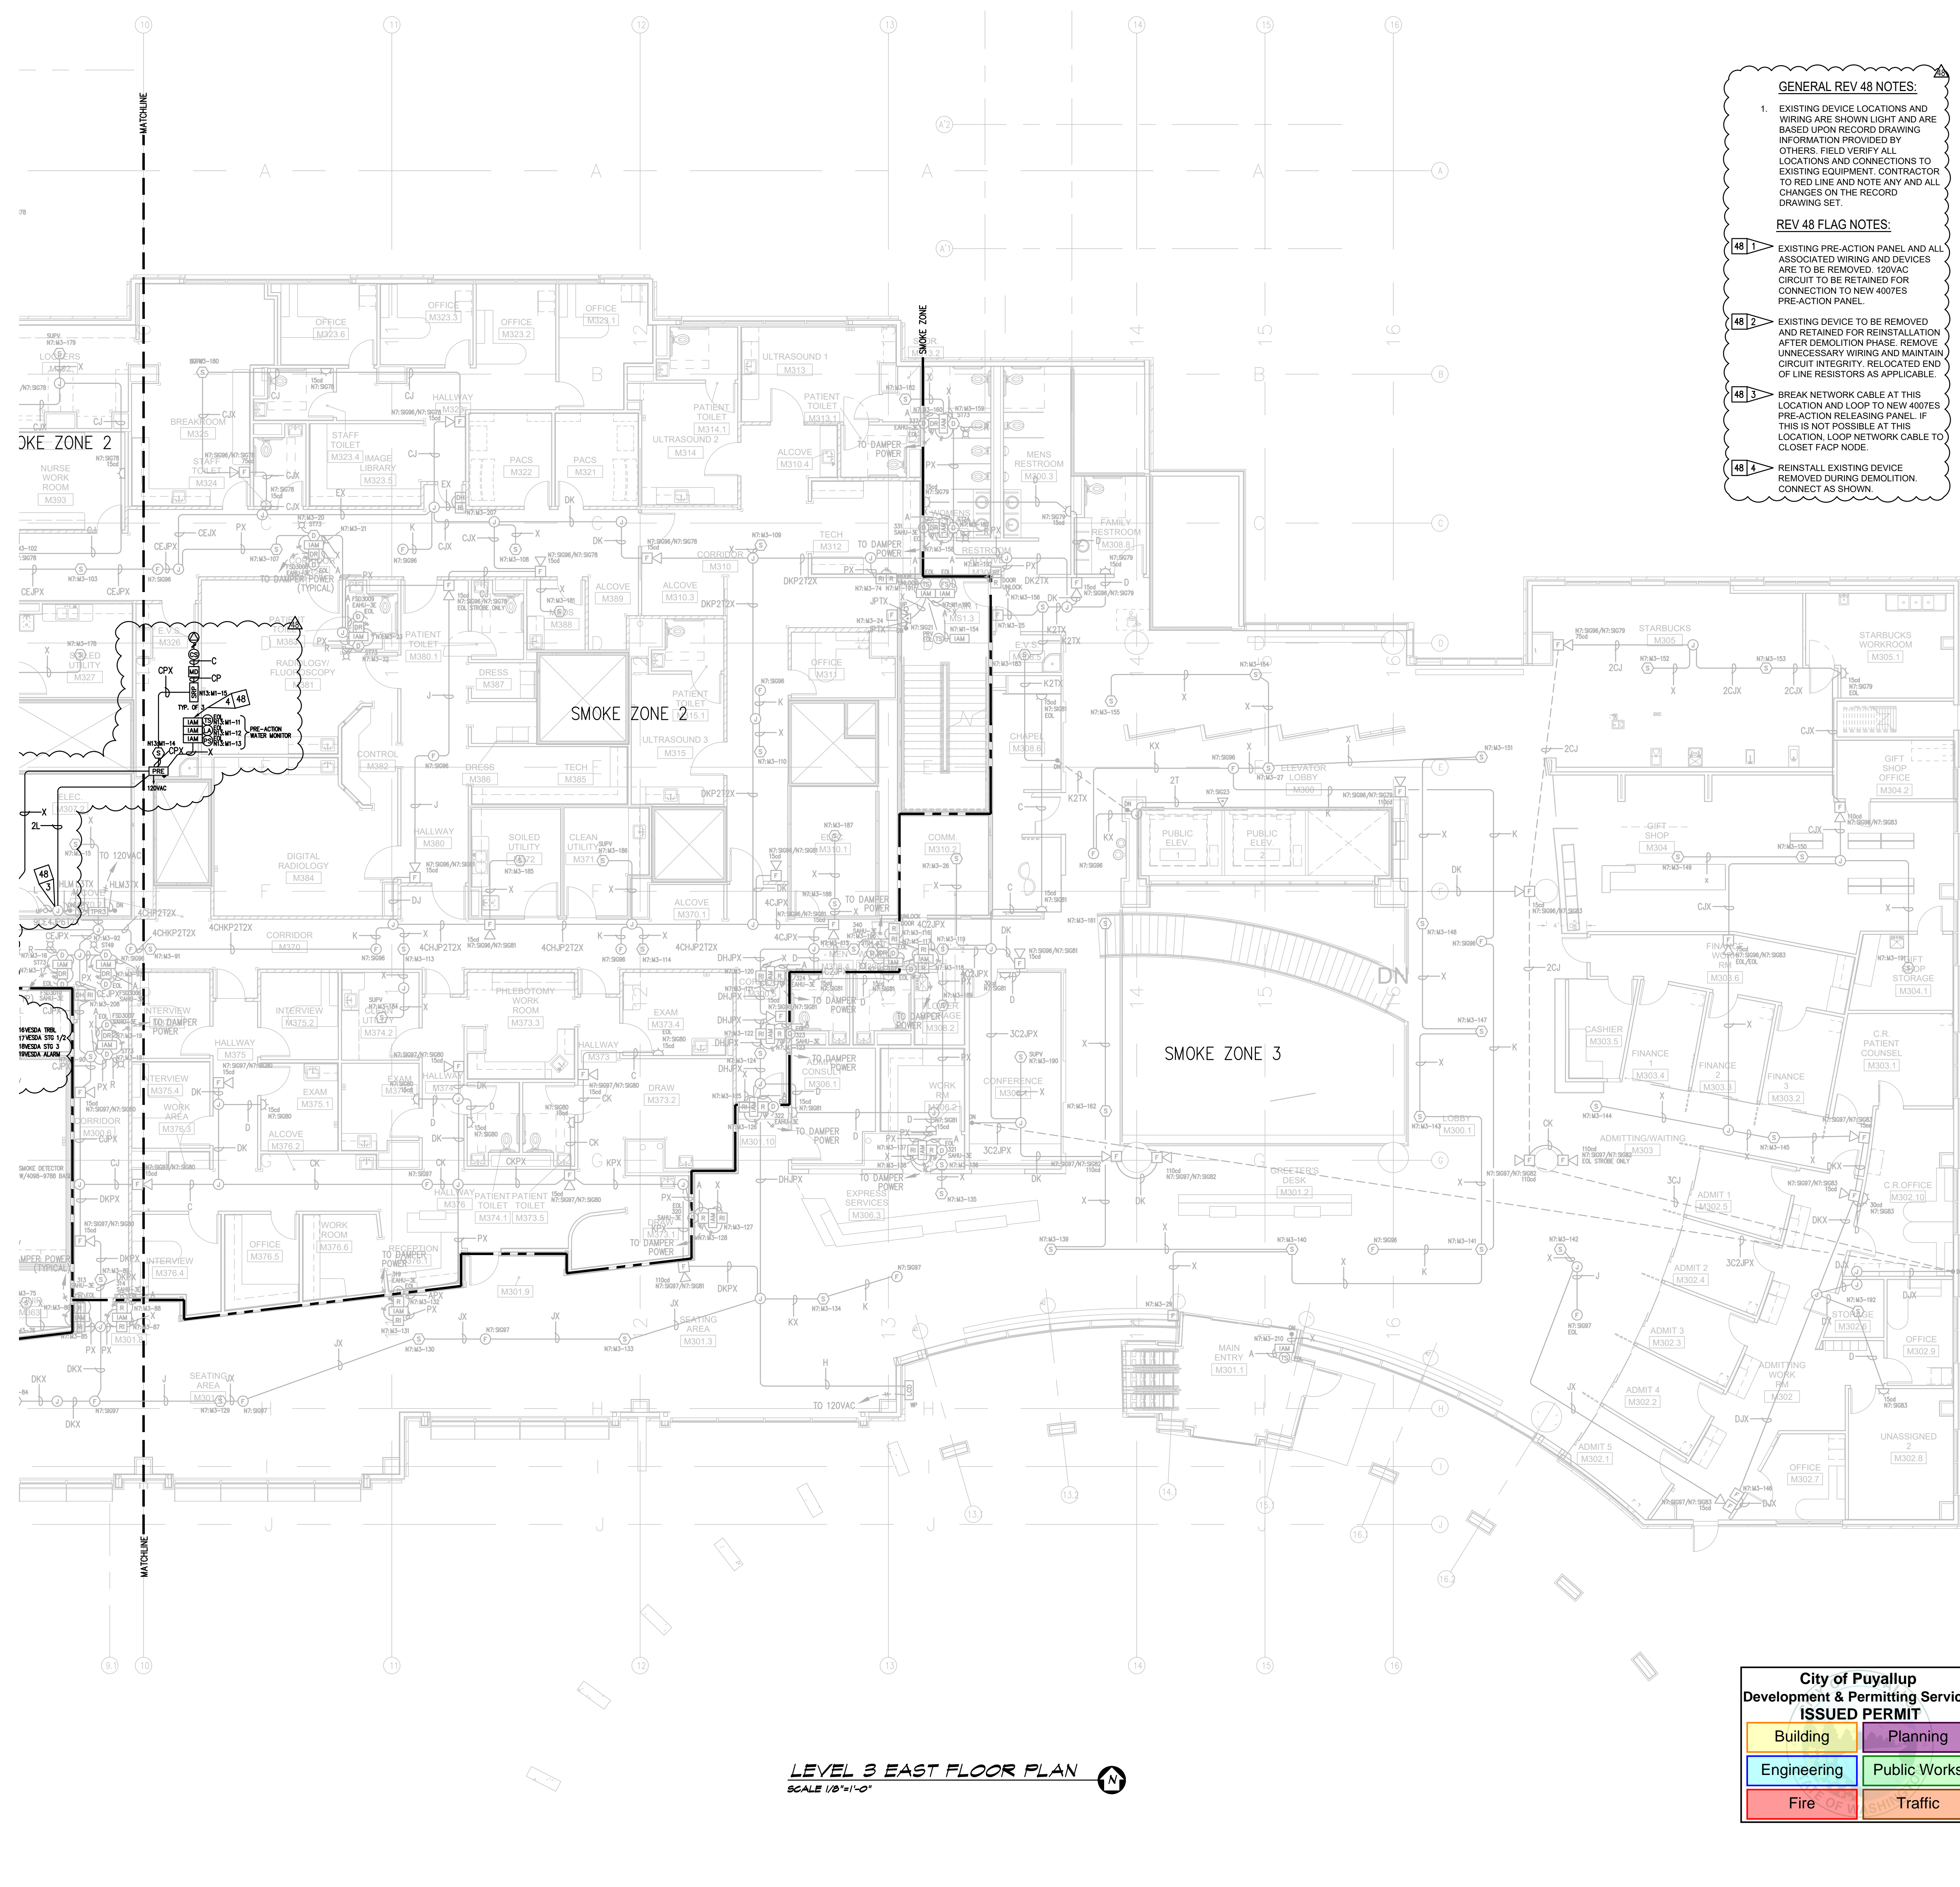

**GENERAL REV 48 NOTES:**

- EXISTING DEVICE LOCATIONS AND WIRING ARE SHOWN LIGHT AND ARE BASED UPON RECORD DRAWING INFORMATION PROVIDED BY OTHERS. FIELD VERIFY ALL LOCATIONS AND CONNECTIONS TO EXISTING EQUIPMENT. CONTRACTOR TO RED LINE AND NOTE ANY AND ALL CHANGES ON THE RECORD DRAWING SET.


**REV 48 FLAG NOTES:**

- 48 EXISTING PRE-ACTION PANEL AND ALL ASSOCIATED WIRING AND DEVICES ARE TO BE REMOVED. 120VAC CIRCUIT TO BE RETAINED FOR CONNECTION TO NEW 4007ES PRE-ACTION PANEL.
- 48 EXISTING DEVICE TO BE REMOVED AND RETAINED FOR REINSTALLATION AFTER DEMOLITION PHASE. REMOVE UNNECESSARY WIRING AND MAINTAIN CIRCUIT INTEGRITY. RELOCATED END OF LINE RESISTORS AS APPLICABLE.
- 48 BREAK NETWORK CABLE AT THIS LOCATION AND LOOP TO NEW 4007ES PRE-ACTION RELEASING PANEL. IF THIS IS NOT POSSIBLE AT THIS LOCATION, LOOP NETWORK CABLE TO CLOSET FACED NODE.
- 48 REINSTALL EXISTING DEVICE REMOVED DURING DEMOLITION. CONNECT AS SHOWN.

Symbol	Description	Part #	Backbox
[Symbol]	Multicandela Wall Speaker/Strobe - White	4906-9153	5" sq 2.875" deep w/ ext ring 4"sq adapter by EC
[Symbol]	Multicandela Ceiling Speaker/Strobe - White	4906-9154	5" sq 2.875" deep w/ ext ring 4"sq adapter by EC
[Symbol]	Multicandela Wall Strobe - White	4906-9103	4" sq by EC
[Symbol]	Multicandela Ceiling Strobe - White	4906-9102	4" sq by EC
[Symbol]	Wall Speaker - White	4902-9717	5" sq 2.875" deep w/ ext ring 4"sq adapter by EC
[Symbol]	Ceiling Speaker - White	4902-9721	5" sq 2.875" deep w/ ext ring 4"sq adapter by EC
[Symbol]	Addressable Manual Station	4099-9003 w/ 5111100 Cover	4" sq 2 1/8" deep w/ sq ring by EC
[Symbol]	Addressable Manual Station Suppression	4099-9015 w/ 4099-9802 Label Kit	4" sq 2 1/8" deep w/ sq ring by EC
[Symbol]	TrueAlarm Smoke Sensor	4098-9714 w/ 4098-9792 Base	4" oct by EC
[Symbol]	TrueAlarm Heat Sensor	4098-9733 w/ 4098-9792 Base	4" oct by EC
[Symbol]	Heat Detector - 135FT	ED-2838-PL	4" self by EC
[Symbol]	TrueAlarm Duct Sensor	4098-9756	self-contained
[Symbol]	Remote LED w/Test	2098-9806	sq by EC
[Symbol]	Duct Detector Relay	4098-9843	4"sq w/sg & cover by EC
[Symbol]	Beam Smoke Detector - Transmitter	BEAM1224	Surface Box w/BEAMSMK Surface
[Symbol]	Monitor ZAM	4090-9101	4"sq 2 1/8" deep w/ 2-gang cover by EC
[Symbol]	Supervised IAM	4090-9001	4"sq w/sg & cover by EC
[Symbol]	Flow Switch	By Others	By Others
[Symbol]	Pressure Switch	By Others	By Others
[Symbol]	Low Air Switch	By Others	By Others
[Symbol]	Tamper Switch	By Others	By Others
[Symbol]	Post Indicator Valve	By Others	By Others
[Symbol]	Co Alarm Supervision Module	2081-9046	By Others
[Symbol]	Pre-Action Solenoid	By Others	By Others
[Symbol]	Door Holders	By Others	By Others
[Symbol]	Suppression Mech. Disconnect	2080-9060	Included
[Symbol]	Relay IAM	4090-9002	4"sq 2 1/8" deep w/ 2-gang cover by EC
[Symbol]	Remote Relay	2088-9008	self-contained
[Symbol]	FFT Jack	2084-9001	sq by EC
[Symbol]	FFT Cabinet	2084-9026 w/ (10) 2084-9024 handsets	23.5" x 23.5" x 4.0" D
[Symbol]	Smoke Control Panel	CEP-L-GR-GP6	41" H x 29" W x 4.75" D
[Symbol]	Suppression Releasing Peripheral	4090-9006	8.125" H x 6.125" W x 4" D
[Symbol]	Printer	4190-9013	Table Top
[Symbol]	LCD Annunciator	4603-9101	6-gang 3.5" deep by EC or RSA-WP-SA
[Symbol]	Terminal Cabinet	SSU00661	13" H x 23.5" W x 5.5" D
[Symbol]	Transponder Panel	4100-9601	56" H x 24" W x 8.375" D
[Symbol]	Fire Alarm Control Panel	4100-9114	2975-9432
[Symbol]	Network Display Unit	4100-9151	56" H x 24" W x 8.375" D
[Symbol]	4007ES Pre-Action Panel	4007-9101	16.25" H x 13.5" W x 5.75" D

Letter	Qty	Color/Type	Size	Function
A	2	Black/Orange TFN	16	Zone
C	2	Red/Blue THHN	14	Horn/Strobe
D	4	(2) Red/(2) Blue THHN	14	Horn/Strobe Loop
E	2	Brown/Yellow THHN	14	Door Holders
F	2	Orange THHN	14	Fan Shutdown
H	1	WestPenn D975	18	Serial Communication
J	1	WestPenn 991	16	Speaker
K	2	WestPenn 991	16	Speaker Loop
L	1	WestPenn 5220FZ	16	Local Network Connection**
M	1	WestPenn 5220FZ	16	Miniplex Transponder**
N	2	WestPenn 5120UZ	14	Network Connection
P	2	Red/Black THHN	14	24VDC Power
R	2	Blue/White TFN	16	Remote LED w/Test
T	1	WestPenn 991	16	Fire Fighter Telephone
V	1	WestPenn D877	18	Printer
X	1	WestPenn D875	18	Addressable Data Line

\*\* 24-cable for survivability

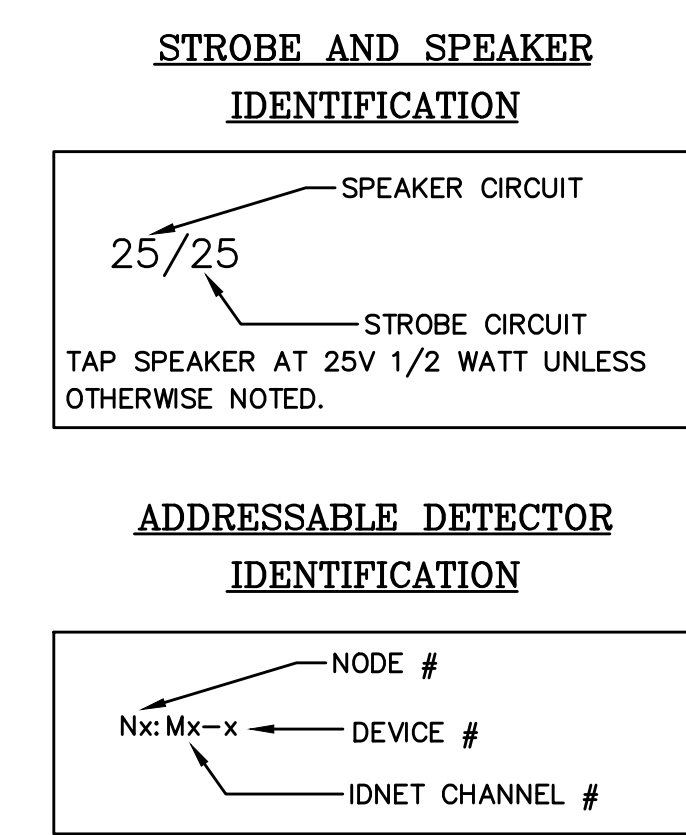

City of Puyallup  
Development & Permitting Services  
**ISSUED PERMIT**

Building	Planning
Engineering	Public Works
Fire	Traffic

**LEVEL 3 EAST FLOOR PLAN**  
SCALE 1/8"=1'-0"

**Johnson Controls**  
9520 10th Avenue South, Suite 100  
Seattle, WA 98108  
SALES: 206-291-1400  
SERVICE: 206-291-1411

**PROJECT #**  
600506222  
61031824  
61031824  
60109145  
65037694

**ENGINEER**  
RSC  
RSC  
RSC  
DAP  
ABH

**REVISION DESCRIPTION**  
PATIENT CARE TOWER 7TH & 6TH FLR TI RECORD DRAWINGS  
DAILY PHARMACY  
DAILY PHARMACY RECORD DRAWINGS  
GRESS DOORS  
MRI PRE-ACTION PANEL UPGRADE

**NO.**  
46  
47  
48

**DATE**  
8/28/19  
1/23/19  
9/20/19  
9/21/22  
4/12/23

**DRAWINGS REVIEWED BY:**  
Eric Beck, CET  
NICK K22884  
Fire Alarm Systems, Level III

**ELECTRONIC DRAWING NAME**  
FA-LEVEL 3

**FIRE ALARM SYSTEM**  
LEVEL 3 EAST FLOOR PLAN  
GOOD SAMARITAN - PATIENT CARE TOWER

APPROVED BY:  
C. McCAMMON

DRAWN BY:  
C. McCAMMON

DATE:  
8/12/09

SITE/PROJECT NUMBER:  
458413141/943123501

SHEET NUMBER:  
FA-LEV3-E