

GOOD SAMARITAN HOSPITAL

HYBRID O.R. #1 TENANT IMPROVEMENT

Fire Alarm and Detection System

Equipment Supplied By



Project Team Contact Information

Sales Representative:	Tim Duggan	timothy.duggan@jci.com	(253) 509-8816
Project Engineer:	Eric Beck	eric.beck@jci.com	(206) 777-4821
Project Coordinator:	Bryan Reimer	bryan.reimer@jci.com	(206) 777-4933
Technician Scheduler:	Yvonne Thompson	yvonne.thompson@jci.com	(206) 777-4860

INCLUDED	SHEET NUMBER	SHEET TITLE
X	FA-COV-01	TITLE SHEET
X	FA-COV-02	GENERAL INFORMATION
	FA-RIS-01	RISER DIAGRAM
	FA-DET-01	WIRING TYPICALS
	FA-DET-02	WIRING TYPICALS
X	FA-DET-03	WIRING TYPICALS
	FA-FG	PARKING
	FA-DO-01	DROP OFF
	FA-B-01	BASEMENT
	FA-G-01W	GROUND WEST
	FA-G-01E	GROUND EAST
	FA-F-01W	LEVEL 1 WEST
	FA-F-01E	LEVEL 1 EAST
X	FA-F-02W-D	LEVEL 2 WEST DEMO
X	FA-F-02W	LEVEL 2 WEST
	FA-F-02E	LEVEL 2 EAST
	FA-R-01	ROOF



12781 Gateway Drive
Tukwila, WA 98166
SALES: 206-291-1400
SERVICE: 206-291-1400

NO.	DATE	REVISION DESCRIPTION	DRAFTER	ENGINEER	PROJECT #
16	8/14/20	GORDON EDU T.I.	SSS	JWB	619230901
17	2/22/21	GORDON EDU T.I.- CUSTOMER CMNT	MAM	JWB	619230901
	06/14/21	GORDON EDU RECORD DRAWINGS	MAM		619230901
	09/02/21	GORDON EDU RECORD DWGS. UPDATES	MAM		619230901
18	5/5/23	HYBRID O.R. #1, T.I.	MAM	EOB	650284615

DRAWINGS REVIEWED BY:
Eric Beck, CET
NICET #228884
Fire Alarm Systems, Level III

**FIRE ALARM SYSTEM
TITLE SHEET**
GOOD SAMARITAN HOSPITAL - WEST WING
407 14TH AVENUE SOUTHEAST
PUYALLUP, WA


APPROVED BY:
K. CHUN
DRAWN BY:
JCP
DATE:
3-1-2000
PROJECT NUMBER:
459-990051
SHEET NUMBER:
FA-COV-01

PROJECT #	ENGINEER	DATE	REVISION DESCRIPTION
619230901	JWB	8/14/20	GORDON EDU T.I.
619230901	JWB	2/22/21	GORDON EDU T.I. - CUSTOMER CMNT
619230901	MAM	06/14/21	GORDON EDU RECORD DRAWINGS
619230901	MAM	09/02/21	GORDON EDU RECORD DWGS. UPDATES
650284615	EOB	5/5/23	HYBRID O.R. #1 T.I.

NO.	DATE	REVISION DESCRIPTION
16	8/14/20	GORDON EDU T.I.
17	2/22/21	GORDON EDU T.I. - CUSTOMER CMNT
18	06/14/21	GORDON EDU RECORD DRAWINGS
18	09/02/21	GORDON EDU RECORD DWGS. UPDATES
18	5/5/23	HYBRID O.R. #1 T.I.

DRAWINGS REVIEWED BY:
 Eric Beck, CET
 NICET #226884
 Fire Alarm Systems, Level III

WORKING DRAWING NAME	APPROVED BY:
FIRE ALARM SYSTEM SECOND FLOOR WEST DEMO PLAN GOOD SAMARITAN HOSPITAL - WEST WING 407 14TH AVENUE SOUTHEAST PUYALLUP, WA	K. CHUN
DATE:	3-1-2000
PROJECT NUMBER:	459-990051
SHEET NUMBER:	FA-F-02W-D

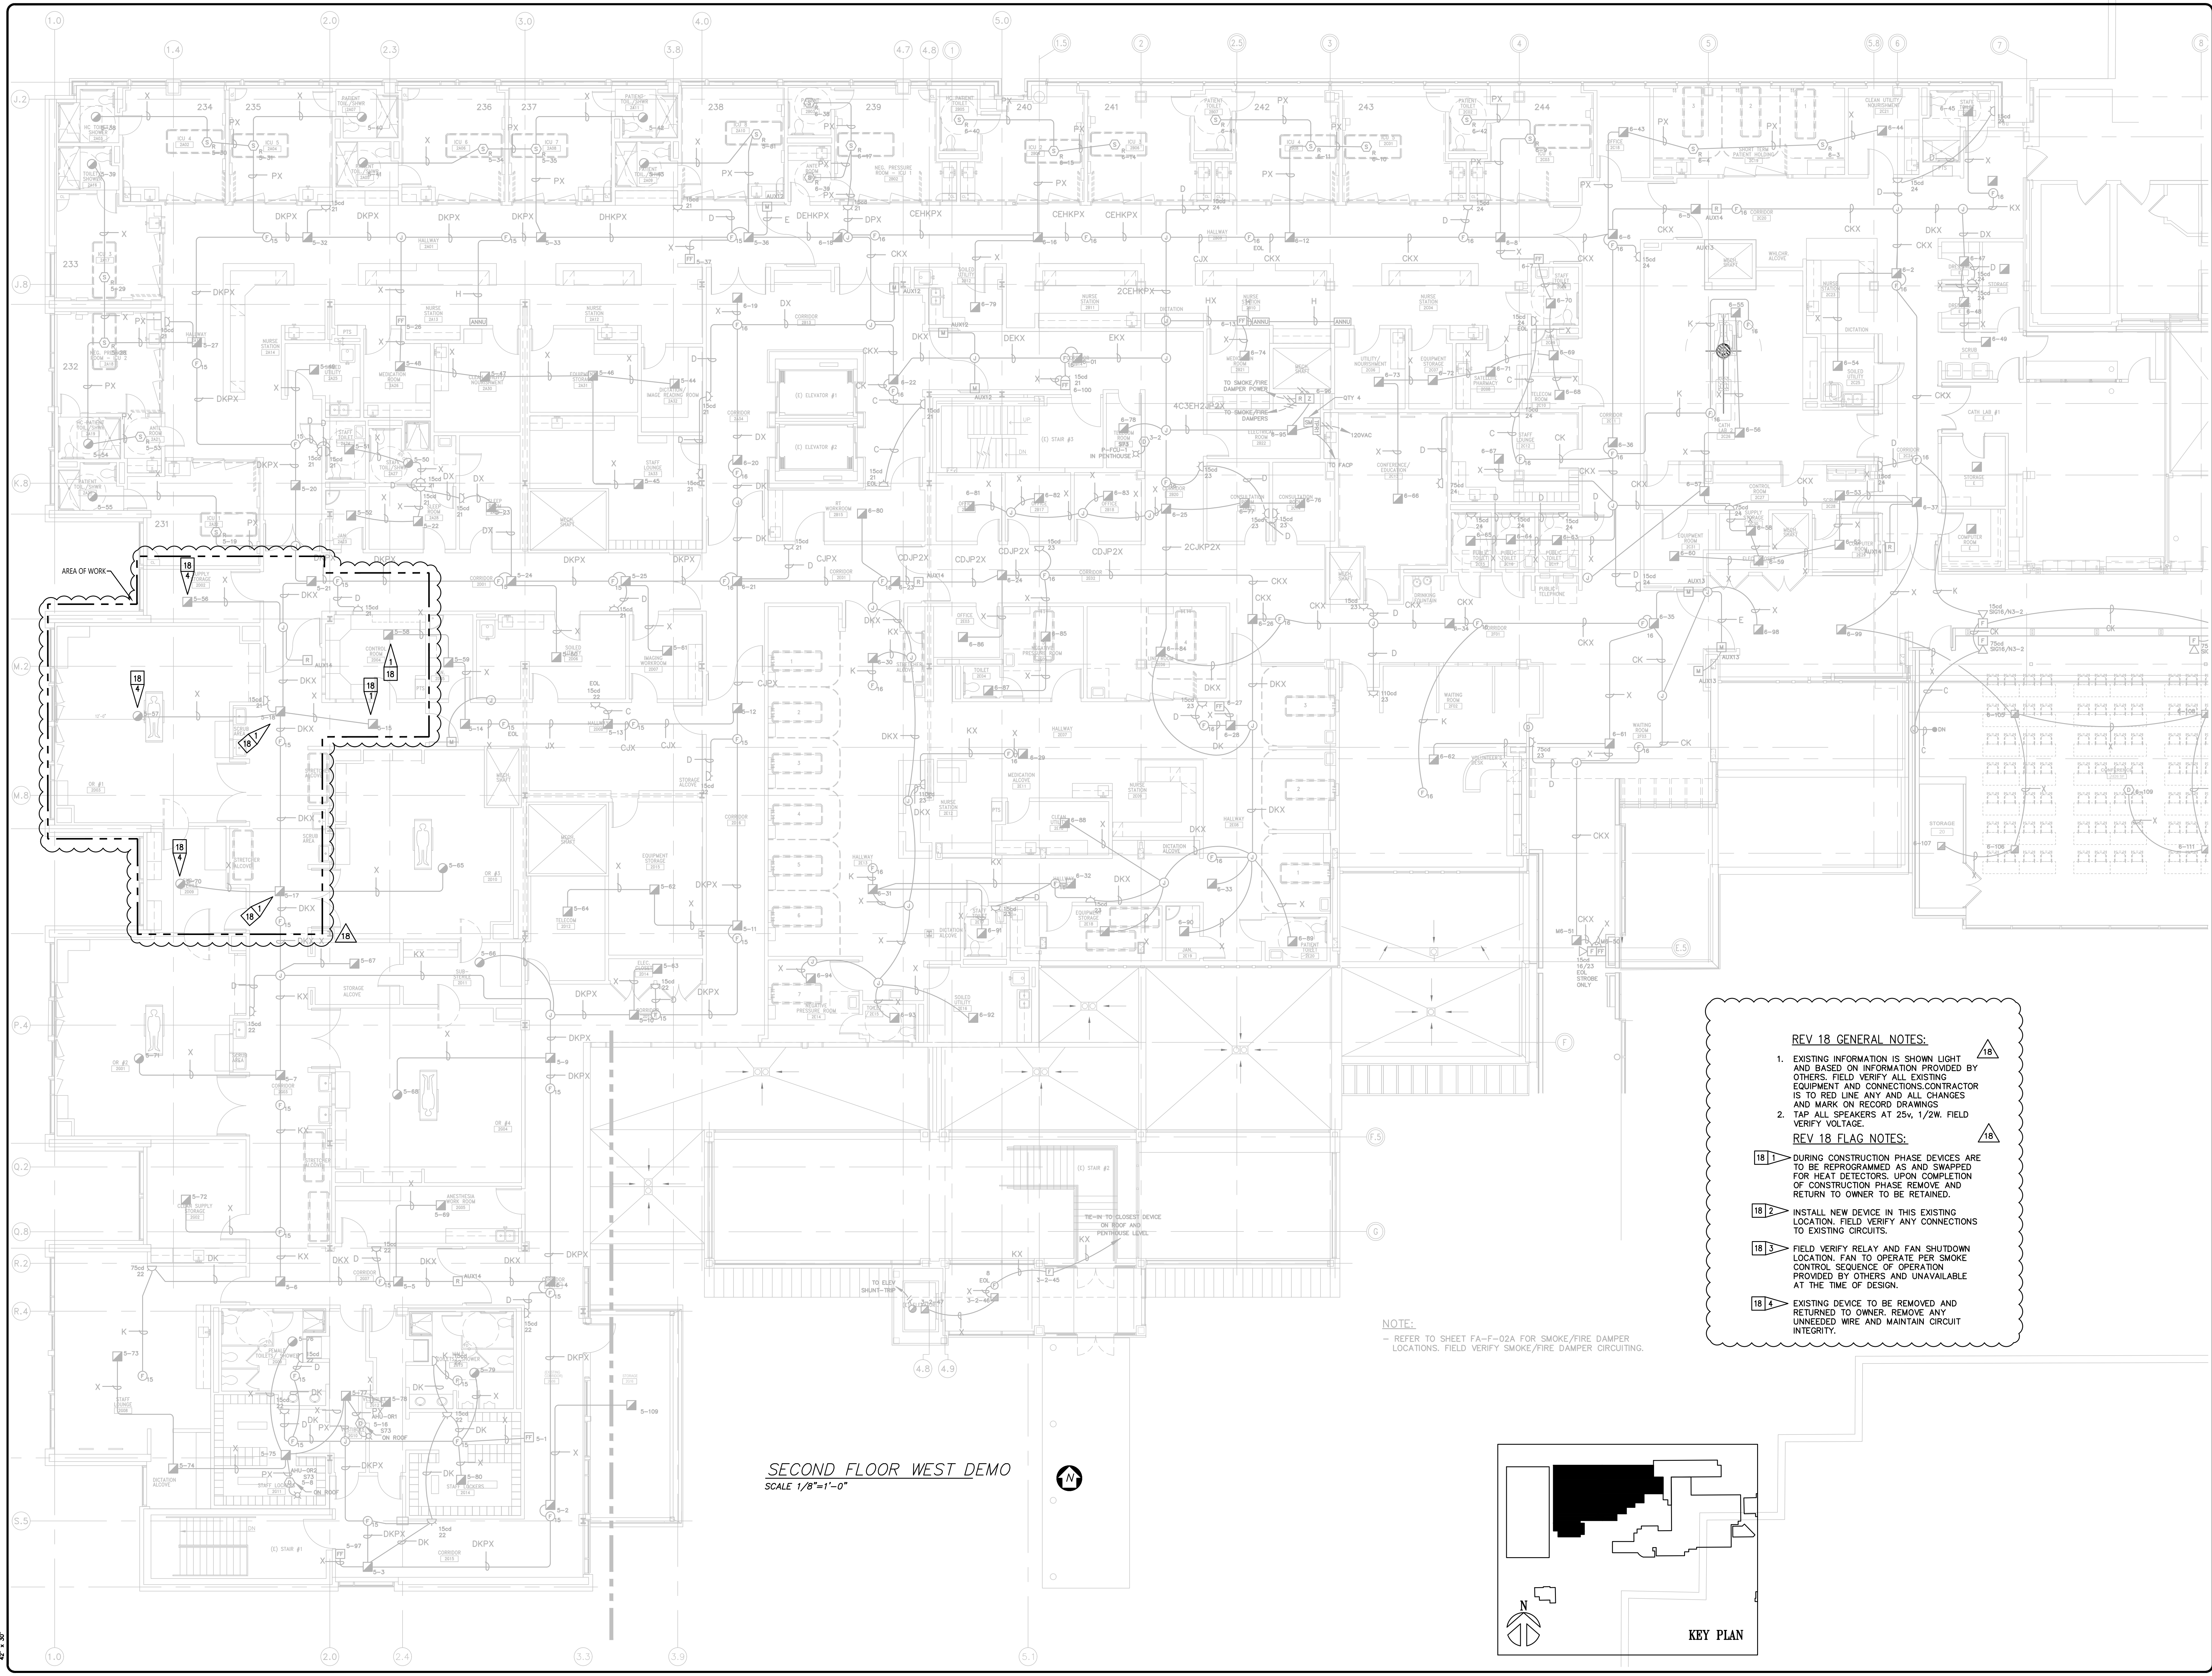

SECOND FLOOR WEST DEMO
SCALE 1/8"=1'-0"


NOTE:
 - REFER TO SHEET FA-F-02A FOR SMOKE/FIRE DAMPER LOCATIONS. FIELD VERIFY SMOKE/FIRE DAMPER CIRCUITING.


REV 18 GENERAL NOTES:

- EXISTING INFORMATION IS SHOWN LIGHT AND BASED ON INFORMATION PROVIDED BY OTHERS. FIELD VERIFY ALL EXISTING EQUIPMENT AND CONNECTIONS. CONTRACTOR IS TO RED LINE ANY AND ALL CHANGES AND MARK ON RECORD DRAWINGS.
- TAP ALL SPEAKERS AT 25V, 1/2W. FIELD VERIFY VOLTAGE.

REV 18 FLAG NOTES:

- 18 1** DURING CONSTRUCTION PHASE DEVICES ARE TO BE REPROGRAMMED AS AND SWAPPED FOR HEAT DETECTORS. UPON COMPLETION OF CONSTRUCTION PHASE REMOVE AND RETURN TO OWNER TO BE RETAINED.
- 18 2** INSTALL NEW DEVICE IN THIS EXISTING LOCATION. FIELD VERIFY ANY CONNECTIONS TO EXISTING CIRCUITS.
- 18 3** FIELD VERIFY RELAY AND FAN SHUTDOWN LOCATION. FAN TO OPERATE PER SMOKE CONTROL SEQUENCE OF OPERATION PROVIDED BY OTHERS AND UNAVAILABLE AT THE TIME OF DESIGN.
- 18 4** EXISTING DEVICE TO BE REMOVED AND RETURNED TO OWNER. REMOVE ANY UNNEEDED WIRE AND MAINTAIN CIRCUIT INTEGRITY.

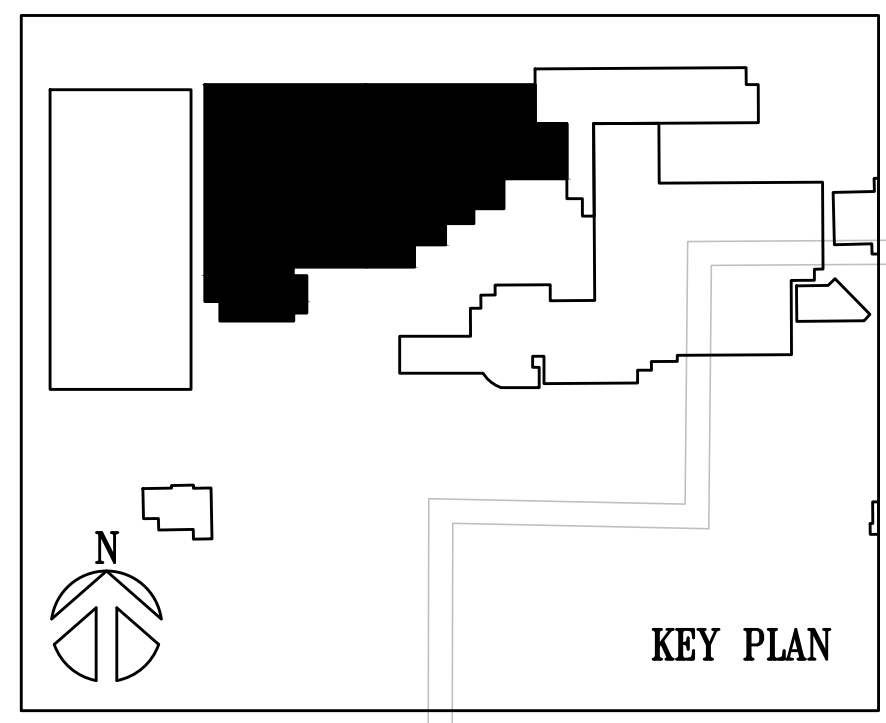

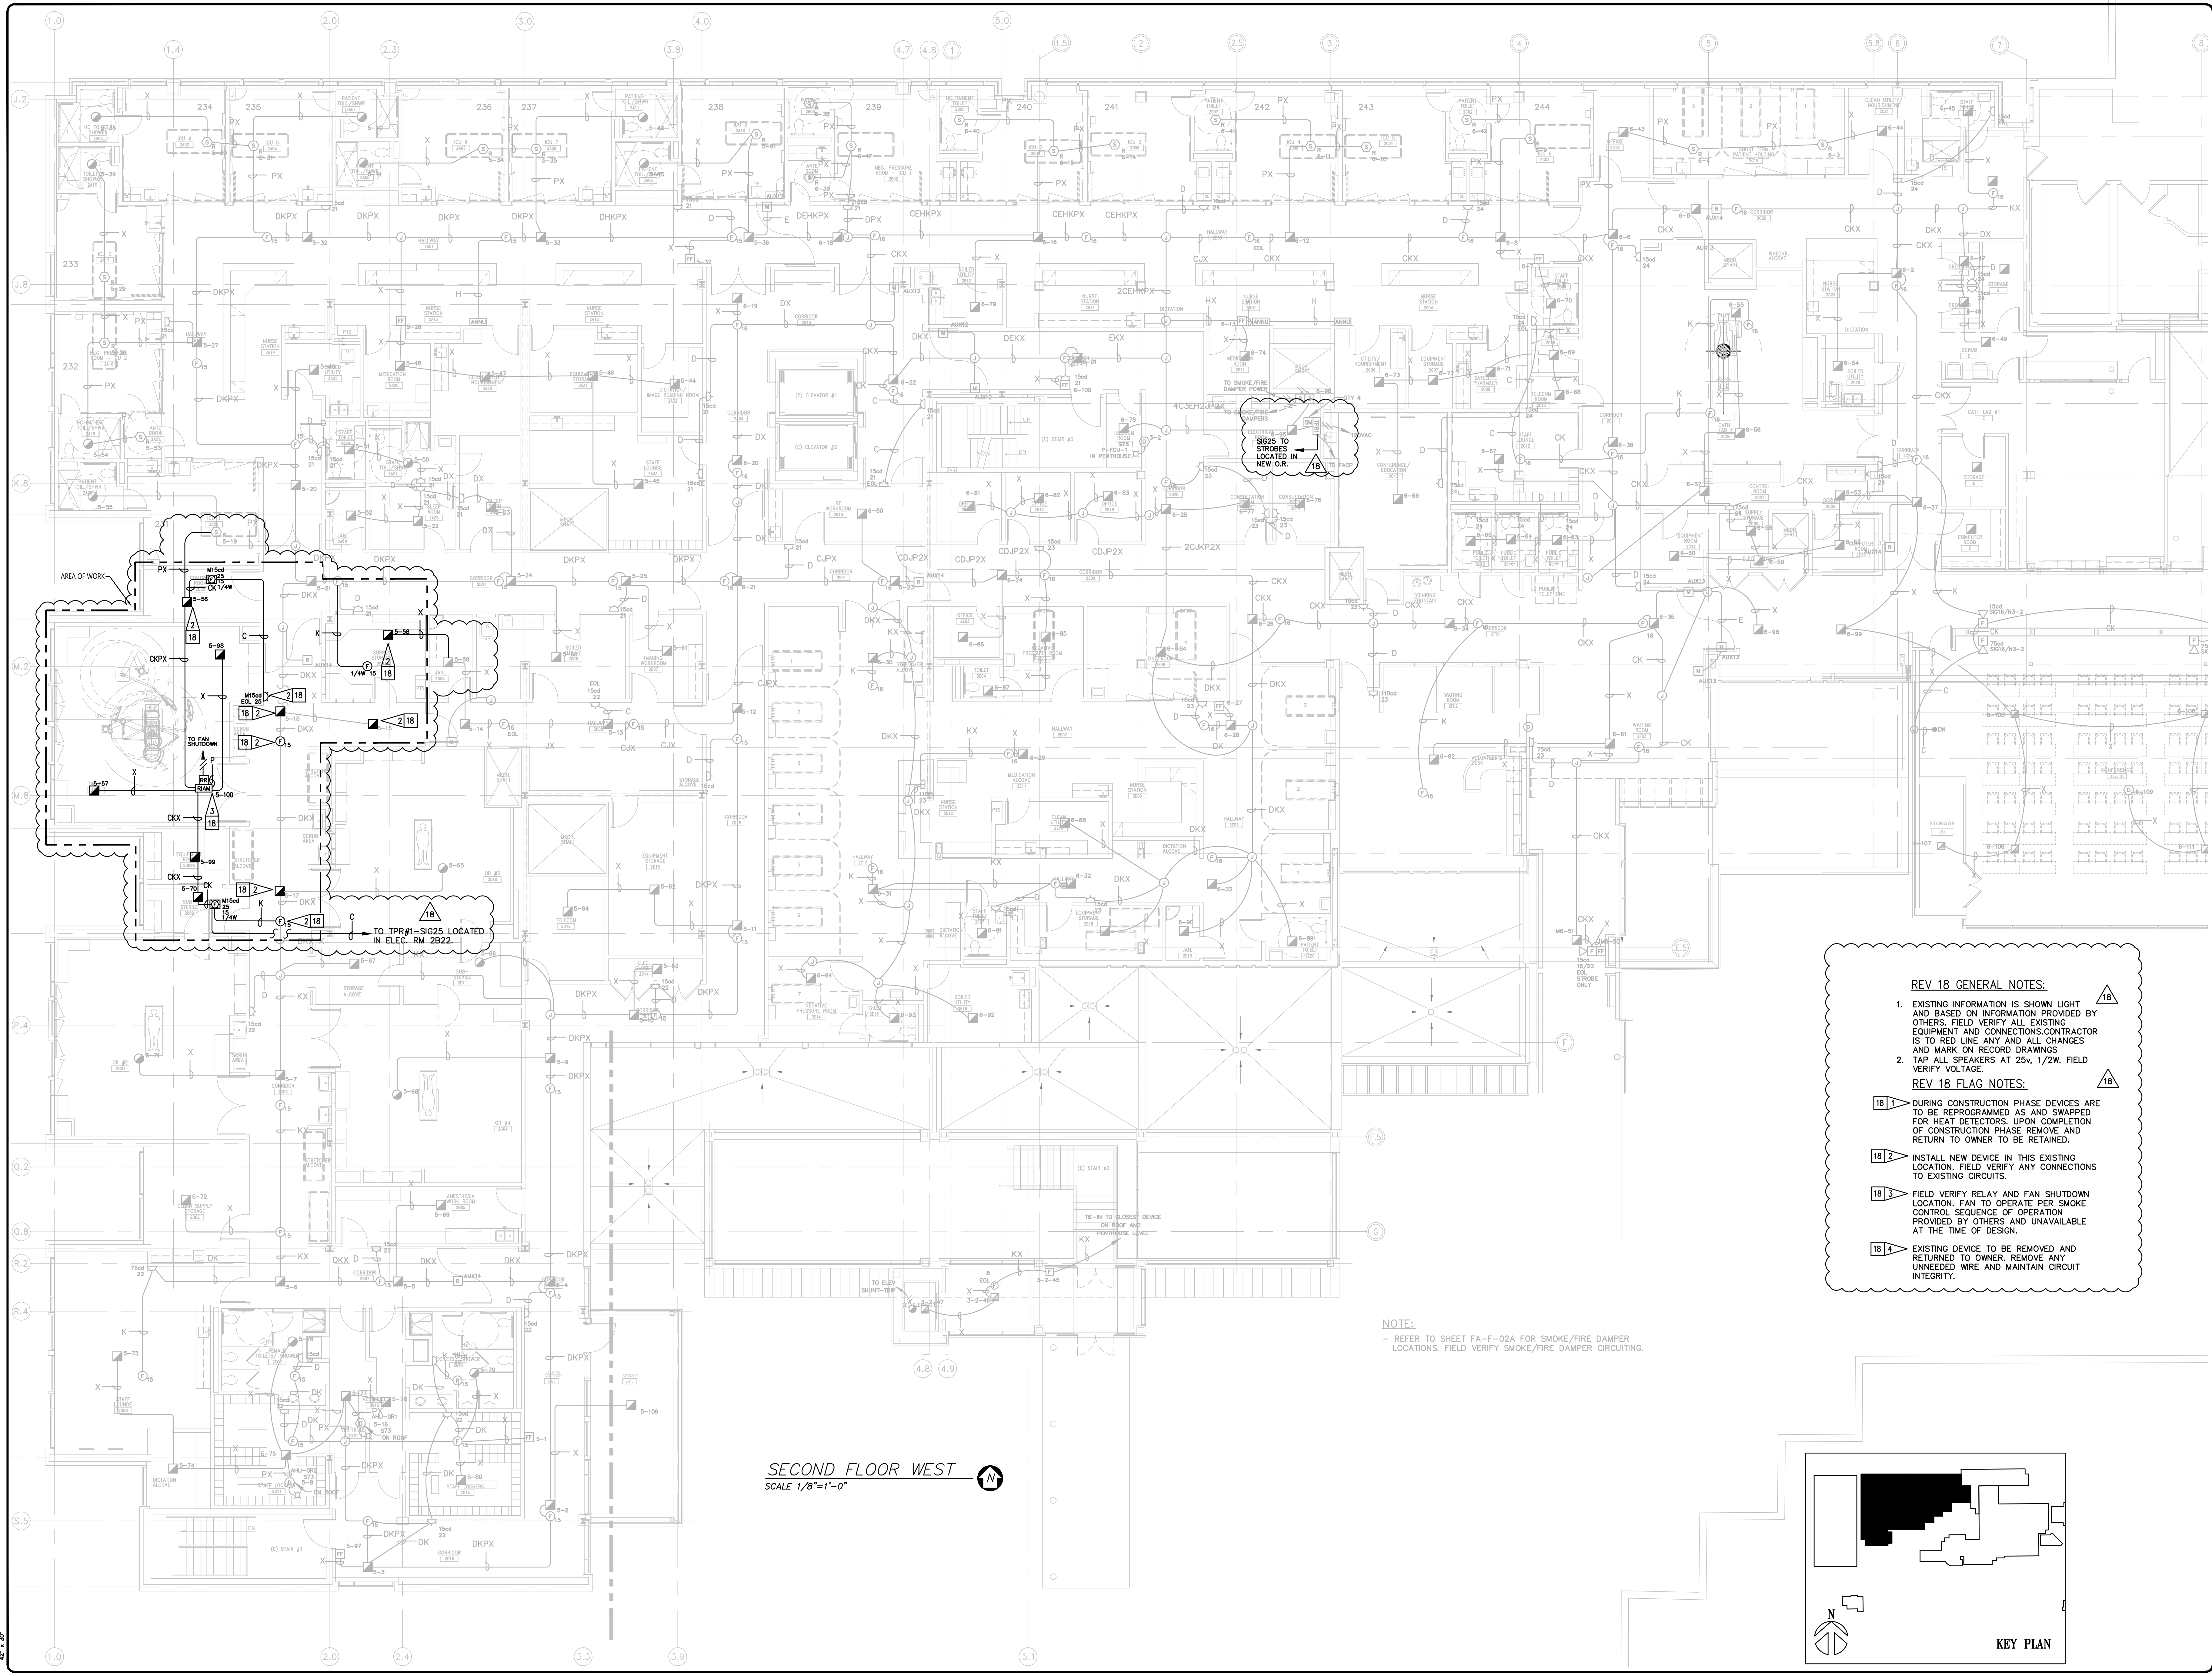

SECOND FLOOR WEST
SCALE 1/8"=1'-0"


REV 18 GENERAL NOTES:

- EXISTING INFORMATION IS SHOWN LIGHT AND BASED ON INFORMATION PROVIDED BY OTHERS. FIELD VERIFY ALL EXISTING EQUIPMENT AND CONNECTIONS. CONTRACTOR IS TO RED LINE ANY AND ALL CHANGES AND MARK ON RECORD DRAWINGS.
- TAP ALL SPEAKERS AT 25V, 1/2W. FIELD VERIFY VOLTAGE.

REV 18 FLAG NOTES:

- 1 DURING CONSTRUCTION PHASE DEVICES ARE TO BE REPROGRAMMED AS AND SWAPPED FOR HEAT DETECTORS. UPON COMPLETION OF CONSTRUCTION PHASE REMOVE AND RETURN TO OWNER TO BE RETAINED.
- 2 INSTALL NEW DEVICE IN THIS EXISTING LOCATION. FIELD VERIFY ANY CONNECTIONS TO EXISTING CIRCUITS.
- 3 FIELD VERIFY RELAY AND FAN SHUTDOWN LOCATION. FAN TO OPERATE PER SMOKE CONTROL SEQUENCE OF OPERATION PROVIDED BY OTHERS AND UNAVAILABLE AT THE TIME OF DESIGN.
- 4 EXISTING DEVICE TO BE REMOVED AND RETURNED TO OWNER. REMOVE ANY UNNEEDED WIRE AND MAINTAIN CIRCUIT INTEGRITY.

NOTE:
- REFER TO SHEET FA-F-02A FOR SMOKE/FIRE DAMPER LOCATIONS. FIELD VERIFY SMOKE/FIRE DAMPER CIRCUITING.

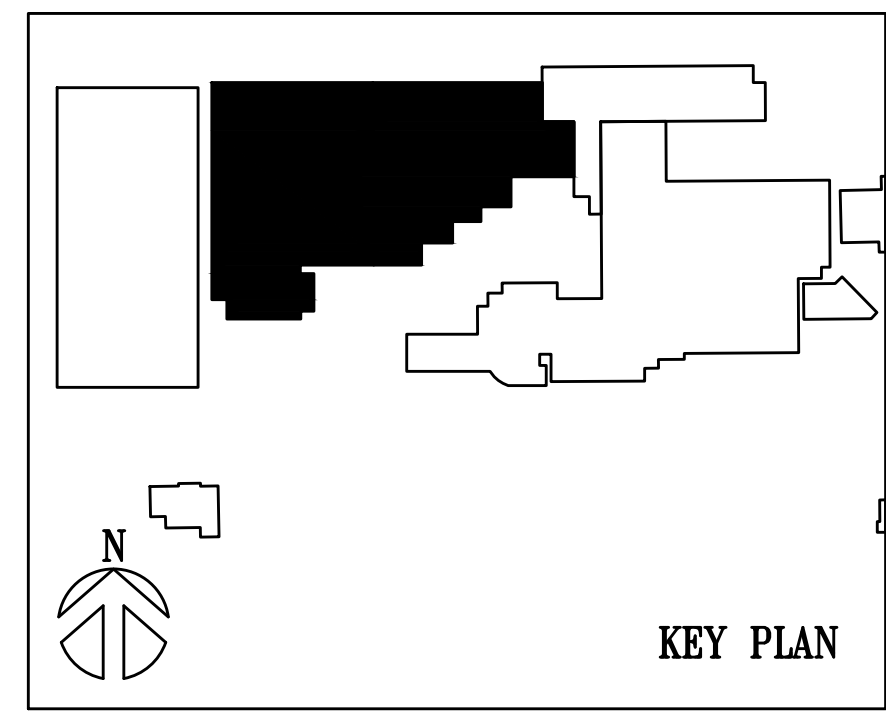

Johnson Controls

17281 Gateway Drive
Tulwina, Wa. 98168
206-291-1400
SALES: 206-291-1400
SERVICE: 206-291-1400

NO.	DATE	REVISION DESCRIPTION	ENGINEER	PROJECT #
16	8/14/20	GORDON EDU T.I.	JWB	619230901
17	2/22/21	GORDON EDU T.I. - CUSTOMER CMNT	JWB	619230901
	06/14/21	GORDON EDU RECORD DRAWINGS	MAM	619230901
	09/02/21	GORDON EDU RECORD DWGS. UPDATES	MAM	619230901
18	5/5/23	HYBRID O.R. #1 T.I.	EOB	650284615

DRAWINGS REVIEWED BY:
Eric Beck, CET
NICET #228884
Fire Alarm Systems, Level III

WORKING DRAWING NAME
**FIRE ALARM SYSTEM
SECOND FLOOR WEST PLAN
GOOD SAMARITAN HOSPITAL - WEST WING**

APPROVED BY:
K. CHUN

DRAWN BY:
JCP

DATE:
3-1-2000

PROJECT NUMBER:
459-990051

SHEET NUMBER:
FA-F-02W