


VICINITY MAP

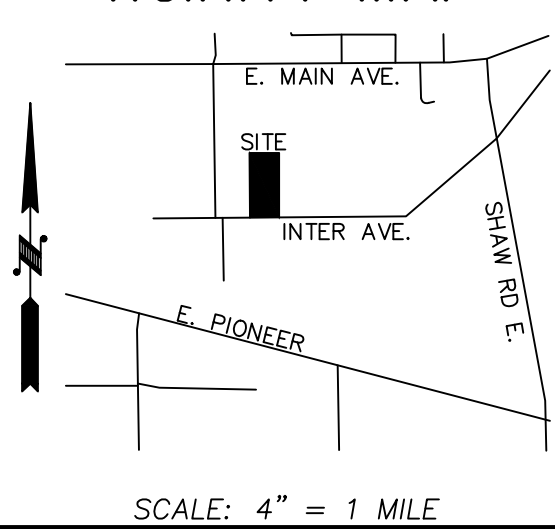

SCALE: 4" = 1 MILE

SHEET INDEX

C0.0	1 OF 7	COVER SHEET
C1.0	2 OF 7	T.E.S.C. & PLAN
C1.1	3 OF 7	T.E.S.C. SPECIFICATIONS
C2.0	4 OF 7	STORM PLAN
C2.1	5 OF 7	DETAILS AND SPECIFICATIONS
C2.2	6 OF 7	DETAILS AND SPECIFICATIONS
C2.3	7 OF 7	DETAILS AND SPECIFICATIONS

PARCEL NUMBER

2105200140

SITE ADDRESS

2315 INTER AVE, PUYALLUP, WA 98372

CIMCO SALES
NE 1/4, SW 1/4, SEC.26, TWN.20 N., RNG. 4 E., W.M.
COVER SHEET

FIRE HYDRANT/FDC LOCATION/ACCESS APPROVED

BY: [Signature]
CITY OF PUYALLUP
FIRE CODE OFFICIAL
10/10/2023
DATE

APPROVED

BY: [Signature]
CITY OF PUYALLUP
ENGINEERING DEPARTMENT
10/10/2023
DATE

NOTE: THIS APPROVAL IS VOID AFTER 180 DAYS FROM APPROVAL DATE. THE CITY WILL NOT BE RESPONSIBLE FOR ERRORS AND/OR OMISSIONS ON THESE PLANS. FIELD CONDITIONS MAY DICTATE CHANGES TO THESE PLANS AS DETERMINED BY THE FIRE CODE OFFICIAL.

NOTE: THIS APPROVAL IS VOID AFTER 180 DAYS FROM APPROVAL DATE. THE CITY WILL NOT BE RESPONSIBLE FOR ERRORS AND/OR OMISSIONS ON THESE PLANS. FIELD CONDITIONS MAY DICTATE CHANGES TO THESE PLANS AS DETERMINED BY THE DEVELOPMENT ENGINEERING MANAGER.

JOB NUMBER	9575
SCALE	1"=40'
HOR.	N/A
VERT.	N/A
DESIGNED JLC	
DRAWN DWN	
CHECKED GJM	

PROPERTY DESCRIPTION

(PER DEED OF TRUST, AFN 201810030016)
LOT 7, ACKERSON'S ADDITION TO PUYALLUP, ACCORDING TO THE PLAT RECORDED IN VOLUME 8 OF PLATS, PAGE 25, RECORDS OF PIERCE COUNTY, WASHINGTON.
SITUATE IN THE COUNTY OF PIERCE, STATE OF WASHINGTON.

CONSTRUCTION NOTES:

- CONTRACTOR TO REMOVE AND RELOCATE FIRE HYDRANT ASSEMBLY AS SHOWN. SEE FIRE HYDRANT ASSEMBLY DETAIL ON SHEET C2.2. CONTRACTOR TO PROVIDE NEW 8"X8"X6" HYDRANT TEE W/ 6" GATE VALVE AND 8" MJ PLUG ON NORTH SIDE OF HYDRANT TEE W/ THRUST BLOCKING. CONTRACTOR TO INSTALL A MINIMUM OF 2 FEET OF 6"DI(CL52) PIPE BEFORE SETTING THE FIRE HYDRANT.
- CONTRACTOR TO CUT OUT EXISTING 8"X8"X6" HYDRANT TEE W/ 6" GATE VALVE AT EXISTING HYDRANT. REPLACE WITH 8"X8"X8" TEE PER CITY OF PUYALLUP REQUIREMENTS.
- CONTRACTOR TO ENSURE 0.5'(MIN) VERTICAL SEPARATION BETWEEN WATER AND STORMWATER LINES.
- CONTRACTOR TO REMOVE AND REPLACE EXISTING FENCING (AS NECESSARY) TO FACILITATE HYDRANT SPOOL EXTENSION & FDC CONNECTION CONSTRUCTION AS SHOWN.
- CONTRACTOR TO INSTALL 90° BEND FITTING IN WATER MAIN WITH THRUST BLOCKING PER CITY OF PUYALLUP REQUIREMENTS.
- CONTRACTOR TO INSTALL POST INDICATOR VALVE (PIV) ON EXISTING FIRE LINE IN FRONT OF THE EXISTING DDCVA FIRE VAULT PER CITY OF PUYALLUP REQUIREMENTS. THE P.I.V. MUST BE INSTALLED A MINIMUM OF 1 FOOT FROM THE EXISTING VAULT. SEE CITY STANDARD ON DETAIL 03.10.03 ON SHEET C2.2.
- CONTRACTOR TO RELOCATE EXISTING FIRE DEPARTMENT CONNECTION (F.D.C.) SO IT IS A MINIMUM OF 10 FEET AND A MAXIMUM OF 15 FEET FROM THE NEW FIRE HYDRANT LOCATION. SEE CITY STANDARD DETAIL 03.10.02 ON SHEET C2.2.
- CONTRACTOR TO "POT HOLE" AND VERIFY WATER MAIN/FIRE LINE LOCATION, DEPTH, PIPE SIZE, CONDITION PRIOR TO CONSTRUCTION AND NOTIFY THE ENGINEER OF ANY DISCREPANCIES.
- CONTRACTOR TO INSTALL 45° BEND FITTING IN WATER MAIN WITH THRUST BLOCKING PER CITY OF PUYALLUP REQUIREMENTS.
- CONTRACTOR TO SAWCUT, REMOVE AND REPLACE WITH EQUAL OR BETTER SECTION AS SHOWN AND PER CITY OF PUYALLUP REQUIREMENTS.

FIRE HYDRANT RELOCATION NOTE:

FIRE HYDRANT CAN ONLY BE RELOCATED AND REUSED IF NEW DEPTH OF BURY MATCHES EXISTING BURY DEPTH.

LANDSCAPE NOTE:

ALL PLANTING AREAS SHALL BE MULCHED WITH A UNIFORM FOUR (4") INCH LAYER OF ORGANIC COMPOST MULCH MATERIAL OR WOOD CHIPS OVER OVER A PROPERLY CLEANED, AMENDED AND GRADE SUBSURFACE.

IMPERVIOUS AREA


TOTAL = 5,931 SF.
BUILDING ROOF (NEW) = 5,355 SF.
"OPEN" STORAGE SHED (REPLACED) = 576 SF.

UTILITY CONFLICT NOTE:


CAUTION:
THE CONTRACTOR SHALL BE FULLY RESPONSIBLE FOR VERIFYING THE LOCATION, AND DEPTH OF ALL EXISTING UTILITIES WHETHER SHOWN ON THESE PLANS OR NOT BY POT-HOLING THE UTILITIES AND SURVEYING THE HORIZONTAL AND VERTICAL LOCATION PRIOR TO CONSTRUCTION. THIS SHALL INCLUDE CALLING UTILITY LOCATE @ 811 AND THEN POT-HOLING ALL OF THE EXISTING UTILITIES AT LOCATIONS OF NEW UTILITY CROSSINGS TO PHYSICALLY VERIFY WHETHER OR NOT CONFLICTS EXIST. LOCATION OF SAID UTILITIES AS SHOWN ON THESE PLANS ARE BASED UPON THE UNVERIFIED PUBLIC INFORMATION AND ARE SUBJECT TO VARIATION. IF CONFLICTS SHOULD OCCUR, THE CONTRACTOR SHALL CONSULT THE PROJECT ENGINEER TO RESOLVE ALL PROBLEMS PRIOR TO PROCEEDING WITH CONSTRUCTION.

CALL BEFORE YOU DIG

THE CONTRACTOR SHALL BE FULLY RESPONSIBLE FOR THE LOCATION AND PROTECTION OF ALL EXISTING UTILITIES. THE CONTRACTOR SHALL VERIFY ALL UTILITY LOCATIONS PRIOR TO CONSTRUCTION BY CALLING THE UNDERGROUND LOCATE LINE AT 811 A MINIMUM OF 48 HOURS PRIOR TO ANY EXCAVATION.

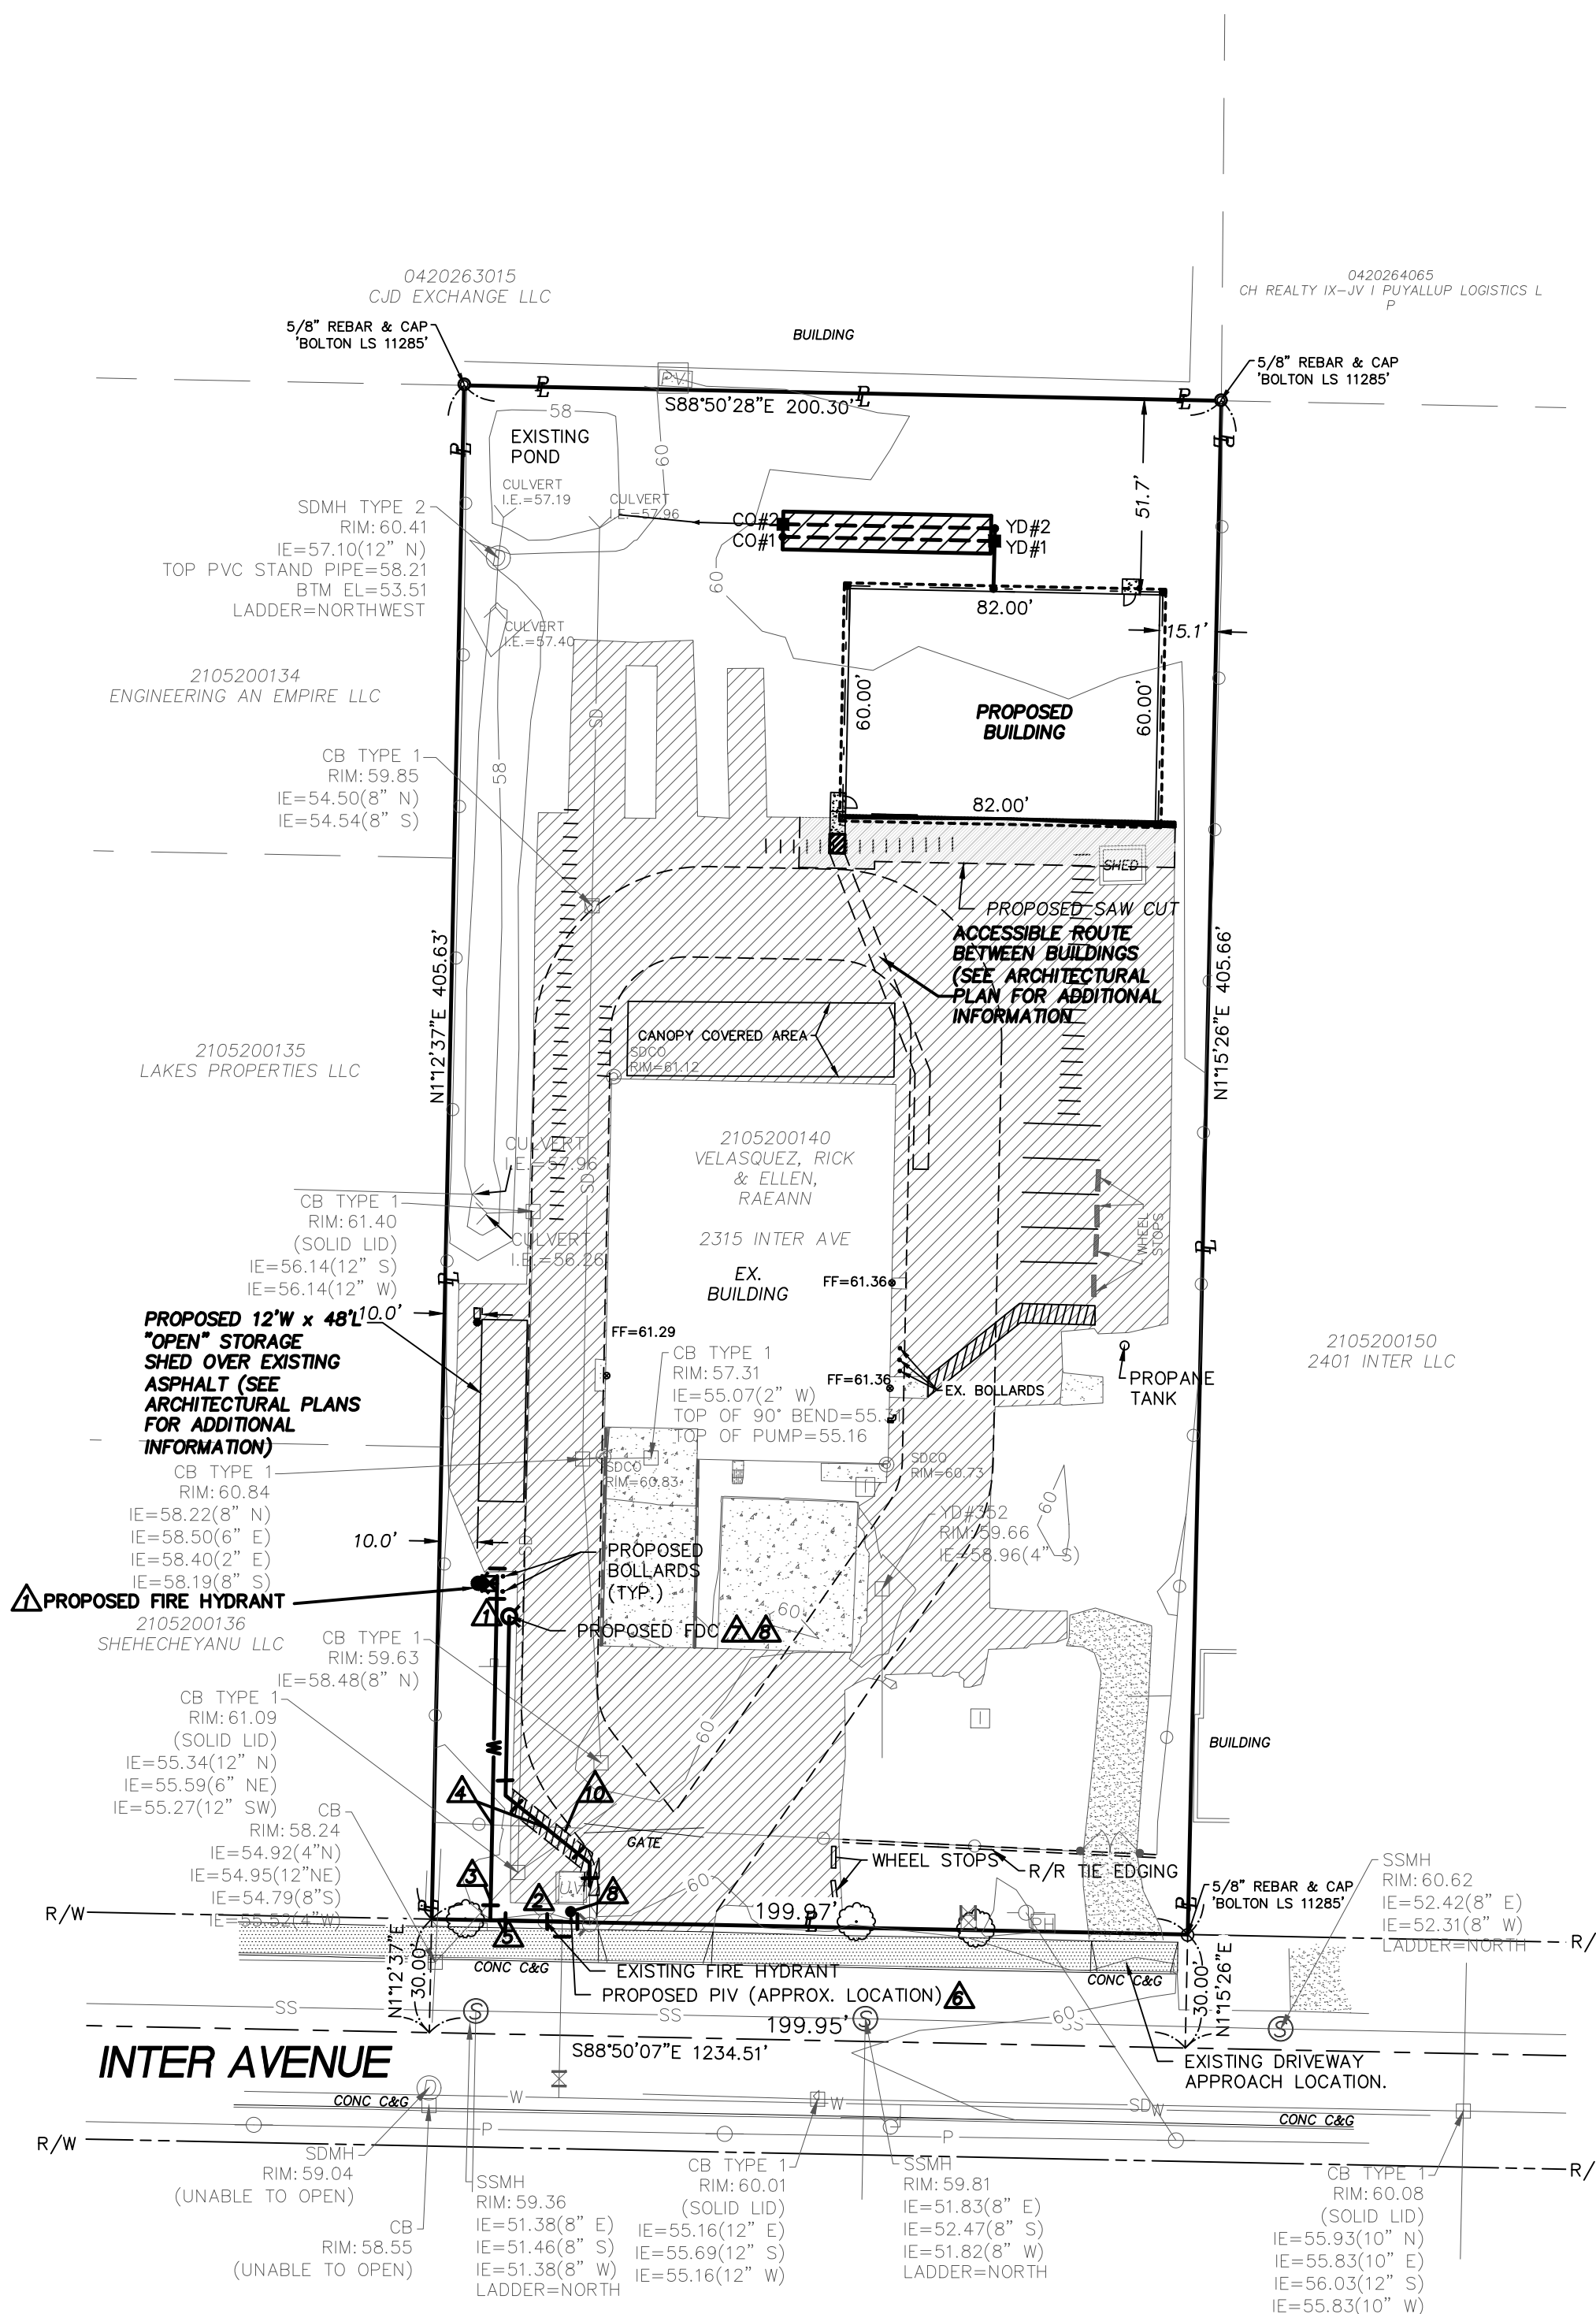


PLAN VIEW
HORIZONTAL SCALE: 1" = 40'

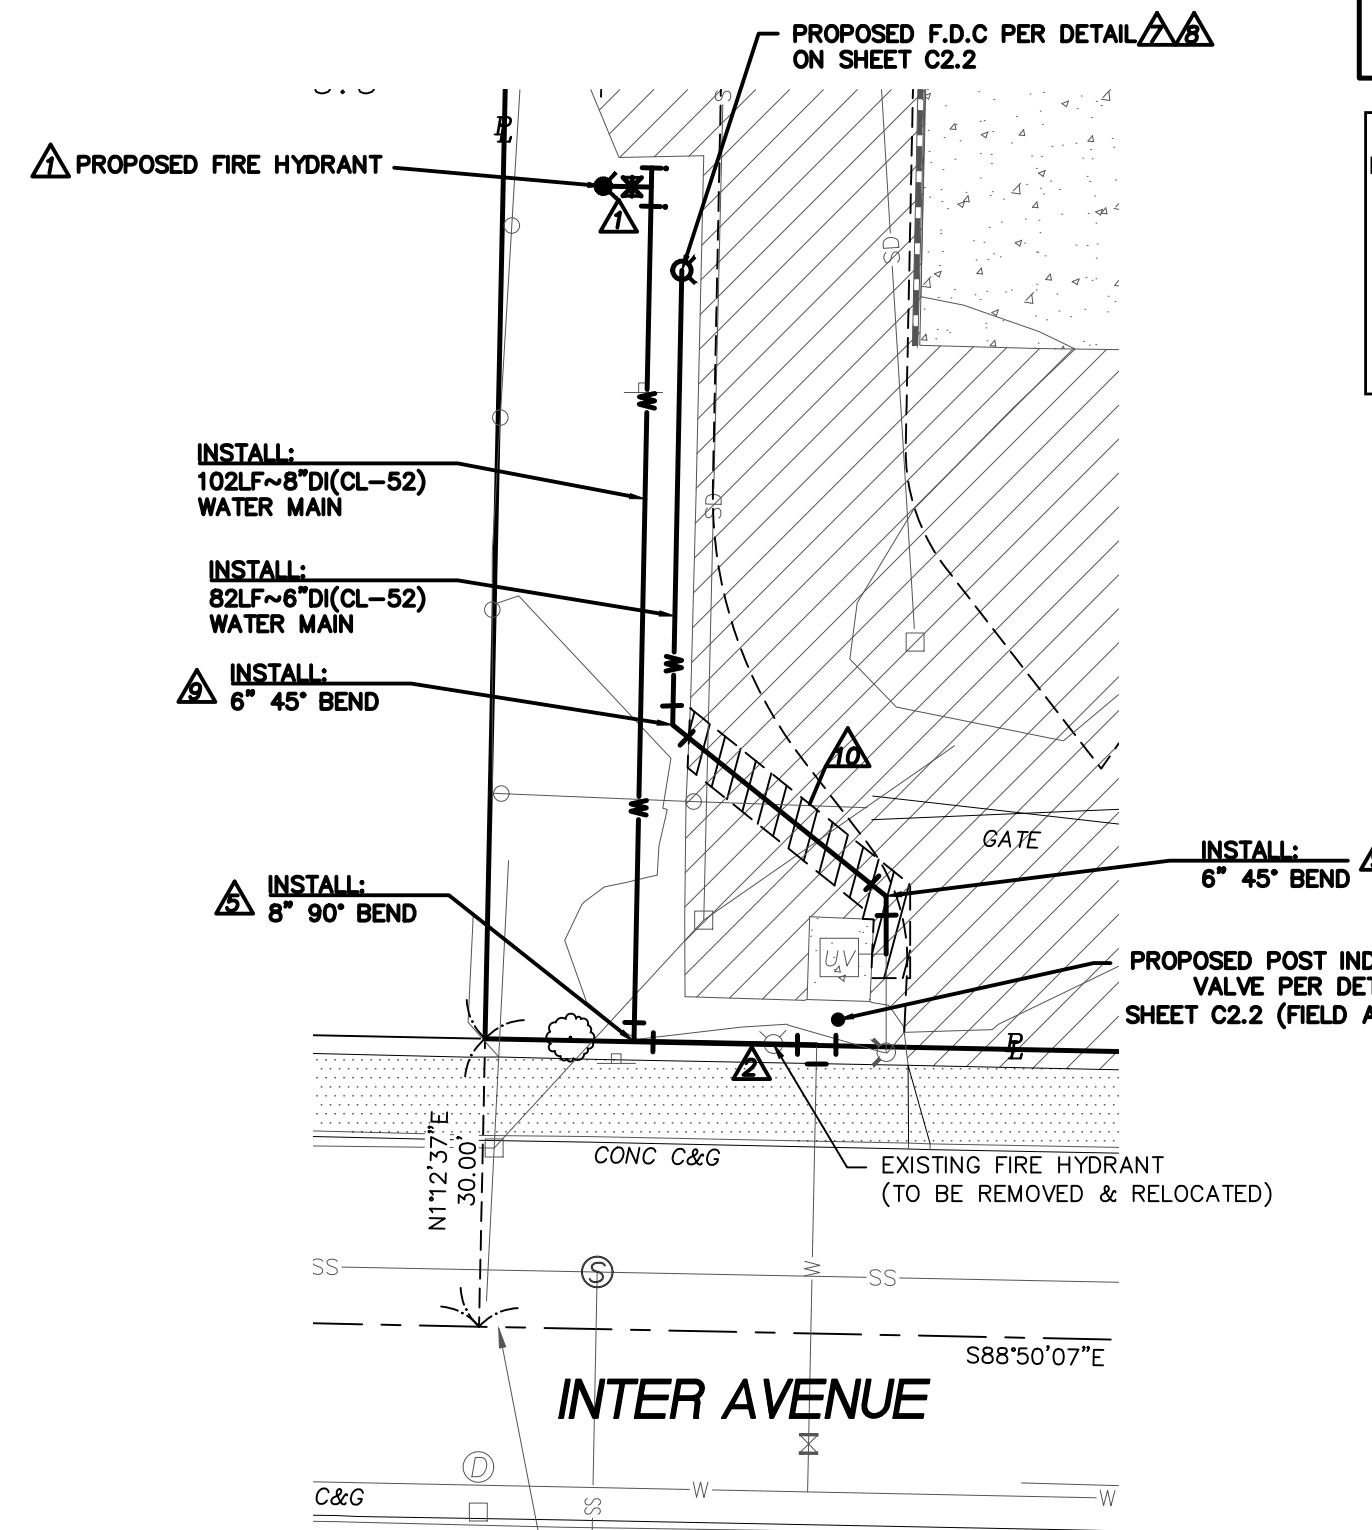

ENLARGED VIEW OF WATER MAIN EXTENSION
PLAN VIEW
HORIZONTAL SCALE: 1" = 20'

City of Puyallup
Development & Permitting Services
ISSUED PERMIT

Building	Planning
Engineering	Public Works
Fire	Traffic

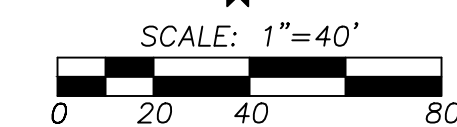

NAVD 88 ESTABLISHED USING GPS RTK ROVER CONSTRAINED TO THE WASHINGTON STATE REFERENCE NETWORK (WSRN) STATIONS
CONTOUR INTERVAL = 1'
TOPOGRAPHY PREPARED BY LARSON & ASSOCIATES
HORIZONTAL DATUM
NAD 83/11 WASHINGTON SOUTH ZONE ESTABLISHED USING GPS RTK ROVER CONSTRAINED TO THE WASHINGTON STATE REFERENCE NETWORK (WSRN) STATIONS
SURVEYOR'S REFERENCES
(P) ACKERSON'S 2ND ADDITION TO PUYALLUP, AFN 215387
(R1) RECORD OF SURVEY, 200801255002


LEGEND

- PROPERTY LINE
- EXISTING CONTOUR
- RIGHT OF WAY
- EXISTING WATER MAIN (APPROX. LOCATION)
- EXISTING SEWER MAIN
- EXISTING STORM MAIN
- EXISTING POWER LINE
- EXISTING WIRE FENCE
- EXISTING CHAINLINK FENCE
- PROPOSED STORM LINE
- PROPOSED WATER LINE
- PROPOSED CATCH BASIN/YARD DRAIN
- PROPOSED CLEAN OUT
- PROPOSED POST INDICATOR VALVE
- PROPOSED F.D.C
- PROPOSED FIRE HYDRANT
- PROPOSED WATER VALVE
- EXISTING WATER METER
- EXISTING F.D.C
- EXISTING IRR. BOX
- EXISTING WATER VALVE
- EXISTING FIRE HYDRANT
- EXISTING DDCVA VAULT
- EXISTING CATCH BASIN
- EXISTING STORM MANHOLE
- EXISTING STORM C/O
- EXISTING SEWER MANHOLE
- EXISTING UTILITY POLE
- EXISTING SIDEWALK
- EXISTING PAVEMENT
- EXISTING CONCRETE
- PROPOSED PAVEMENT GRIND/OVERLAY AREA
- EXISTING TREE

CONTRACTOR / DEVELOPER NOTE:

THE CONTRACTOR AND/OR DEVELOPER SHALL BE RESPONSIBLE FOR COORDINATING ALL REQUIRED MATERIAL TESTING, COMPACTION TESTING, AND APPLICABLE INSPECTIONS AS REQUIRED BY CITY OF PUYALLUP AND PRIVATE ENGINEER. THE CONTRACTOR SHALL SUPPLY CERTIFYING ENGINEER WITH DOCUMENTATION SIGNED BY A PROFESSIONAL SOILS AND/OR MATERIALS ENGINEER SHOWING THAT THE ROAD SECTION WAS BUILT ACCORDING TO THE RECOMMENDATIONS OF THE GEOTECHNICAL REPORT. THE BACKFILL MATERIAL MEETS MINIMUM CITY/STATE REQUIREMENTS, COMPACTION WAS ACHIEVED IN ALL TRENCHES AND ROAD SECTION, AND ALL CONSTRUCTION MATERIALS AND CONSTRUCTION METHODS SHOWN ON THESE PLANS HAVE BEEN FOLLOWED.

REVISION BLOCK			
NO.	DATE	DESCRIPTION	BY
1	8/1/2023	ADDRESS CITY COMMENTS	GJM
		AND ADD NEW "OPEN"	
		STORAGE SHED OVER	
		EXISTING PAVEMENT AS	
		SHOWN.	

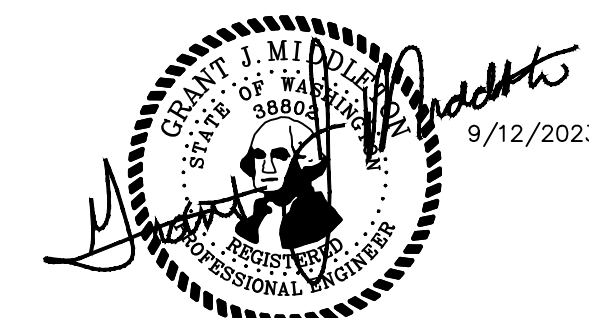

PROPOSEMENT:
RICK VELASQUEZ
13615 122ND ST E
PUYALLUP, WA 98374
PH: (253) 224-4428

LARSON and ASSOCIATES
surveyors, engineers & planners
9027 PACIFIC AVENUE, SUITE 4
TACOMA, WA 98444
(253) 474-3404

COVER SHEET

DATE	9/12/2023
DRAWING NO.	9575BASE
SHEET	1 OF 7

C0.0

CIMCO SALES


NE 1/4, SW 1/4, SEC.26, TWN.20 N., RNG. 4 E., W.M.
T.E.S.C. PLAN

APPROVED

BY *J. Velasquez*
CITY OF PUYALLUP
ENGINEERING DEPARTMENT
DATE 10/10/2023
NOTE: THIS APPROVAL IS VOID AFTER 180 DAYS FROM APPROVAL DATE. THE CITY WILL NOT BE RESPONSIBLE FOR ERRORS AND/OR OMISSIONS ON THESE PLANS. FIELD CONDITIONS MAY DICTATE CHANGES TO THESE PLANS AS DETERMINED BY THE DEVELOPMENT ENGINEERING MANAGER.

JOB NUMBER	9575
SCALE	1"=40'
HOR.	N/A
VERT.	N/A
DESIGNED JLC	
DRAWN	
CHECKED	

City of Puyallup Development & Permitting Services ISSUED PERMIT			
Building	Planning	Engineering	Public Works
Fire	Traffic		

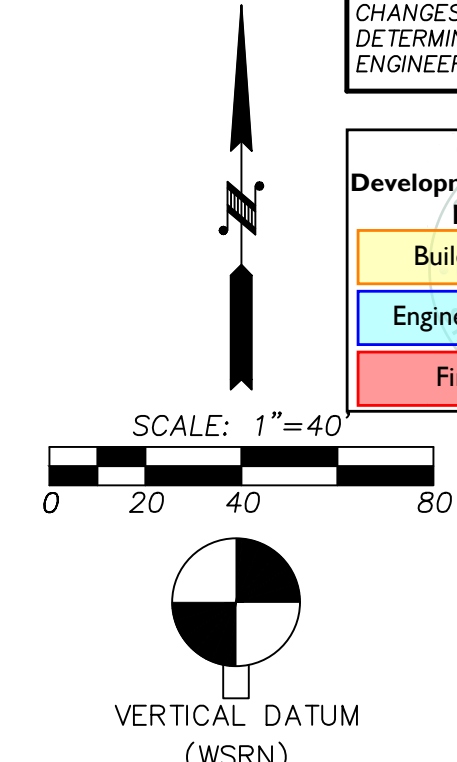

SCALE: 1"=40'
VERTICAL DATUM (WSRN)
NAVD 88 ESTABLISHED USING GPS RTK ROVER CONSTRAINED TO THE WASHINGTON STATE REFERENCE NETWORK (WSRN) STATIONS
CONTOUR INTERVAL=1'
TOPOGRAPHY PREPARED BY LARSON & ASSOCIATES
HORIZONTAL DATUM
NAD 83/11 WASHINGTON SOUTH ZONE
ESTABLISHED USING GPS RTK ROVER CONSTRAINED TO THE WASHINGTON STATE REFERENCE NETWORK (WSRN) STATIONS
SURVEYOR'S REFERENCES
(P) ACKERSON'S 2ND ADDITION TO PUYALLUP, AFN 215387
(R1) RECORD OF SURVEY, 200801255002

CONSTRUCTION NOTES

- CONTRACTOR TO UTILIZE EXISTING ACCESS TO THE PROPERTY FOR CONSTRUCTION.
- CONTRACTOR TO INSTALL MIRAFI SILT FENCE AS SHOWN AND PER DETAIL ON C1.1
- CONTRACTOR TO INSTALL CB INLET PROTECTION AT EXISTING CATCHBASINS AS SHOWN AND PER DETAIL ON SHEET C1.1
- CONTRACTOR TO REMOVE EX. WIRE FENCING TO ALLOW FOR CONSTRUCTION ACTIVITIES.
- CONTRACTOR TO RELOCATE EXISTING SIGN (AS NECESSARY) TO FACILITATE WATER MAIN EXTENSION CONSTRUCTION WORK FOR NEW/RELOCATED FIRE HYDRANT.
- CONTRACTOR TO REMOVE AND REPLACE EXISTING FENCING TO "LIKE KIND" TO ALLOW FOR WATER MAIN EXTENSION CONSTRUCTION WORK AS SHOWN.
- CONTRACTOR TO "POTHOLE" EXISTING STORM LINE TO VERIFY LOCATION PRIOR TO SETTING BUILDING POST FOUNDATIONS TO ENSURE THE BUILDING FOOTPRINT IS POSITIONED OUTSIDE OF THE STORM LINE WHILE ALSO MEETING CITY BUILDING SETBACK REQUIREMENTS FROM PROPERTY LINES.

INSPECTION SCHEDULE


- CONSTRUCTION ENTRANCE SHALL BE INSPECTED WEEKLY & CLEANED AS NEEDED OR NEW SPALLS ADDED AS NEEDED TO MAINTAIN A ROUGH SURFACE.
- THE EXISTING ACCESS ROUTES INTO THE PROJECT SITE SHALL BE INSPECTED EVERY 2 DAYS & SWEEP OR CLEANED ON A WEEKLY BASIS OR MORE FREQUENTLY IF NEEDED.
- ALL CUT & FILL SIDE SLOPES SHALL BE INSPECTED EVERY 2 DAYS AND/OR AFTER EVERY STORM EVENT TO REPAIR ANY EROSION OR SLOPE SCOURING.
- INSPECT CB. INLET PROTECTION ON A WEEKLY BASIS AND AFTER EVERY MAJOR STORM EVENT.

FIRE ACCESS NOTES:

- 26' CLEAR AT THE HYDRANT.
- 20' CLEAR EACH WAY.
- 13.5' GRADE CLEARANCE

CONSTRUCTION SEQUENCE

- HOLD A PRE-CONSTRUCTION MEETING WITH THE CITY AND OBTAIN REQUIRED PERMITS.
- ESTABLISH CLEARING AND GRADING LIMITS.
- UTILIZE EXISTING PAVED ACCESS FOR CONSTRUCTION VEHICLE ACCESS.
- INSTALL CATCH BASIN INLET PROTECTION AND SEDIMENT CONTROL DEVICES IN ALL EXISTING CATCH BASINS WITHIN DIRECT VICINITY OF THE PROJECT.
- SCHEDULE AN EROSION CONTROL INSPECTION WITH THE CITY.
- CLEAR AND GRADE SITE AND CONSTRUCT STORM DRAIN SYSTEM PER APPROVED PLANS.
- PROVIDE C.B. INLET PROTECTION IN NEW CATCH BASINS UNTIL PARKING LOT STORM DRAIN SYSTEM IS COMPLETED AND THE SITE IS COMPLETELY STABILIZED AND PROTECTED FROM EROSION & SEDIMENTATION.
- NOTE: THE BUILDING CONTRACTOR IS RESPONSIBLE FOR MAINTENANCE OF STORM SYSTEM DURING BUILDING AND LANDSCAPE CONSTRUCTION.
- HYDRO SEED AND/OR MULCH SLOPES AND OTHER EXPOSED AREAS IMMEDIATELY AFTER GRADING IS COMPLETED AS OUTLINED IN "EROSION CONTROL NOTES".
- CLEAN OUT AND TEST ALL STORM DRAIN FACILITIES.
- INSPECT AND MAINTAIN ALL EROSION CONTROL FACILITIES (I.E. CB INLET PROTECTION BMPs) AT REGULAR INTERVALS & COMPLETE REQUIRED REPORT. CLEAN AS REQUIRED UNTIL RISK OF SEDIMENTATION HAS PASSED.

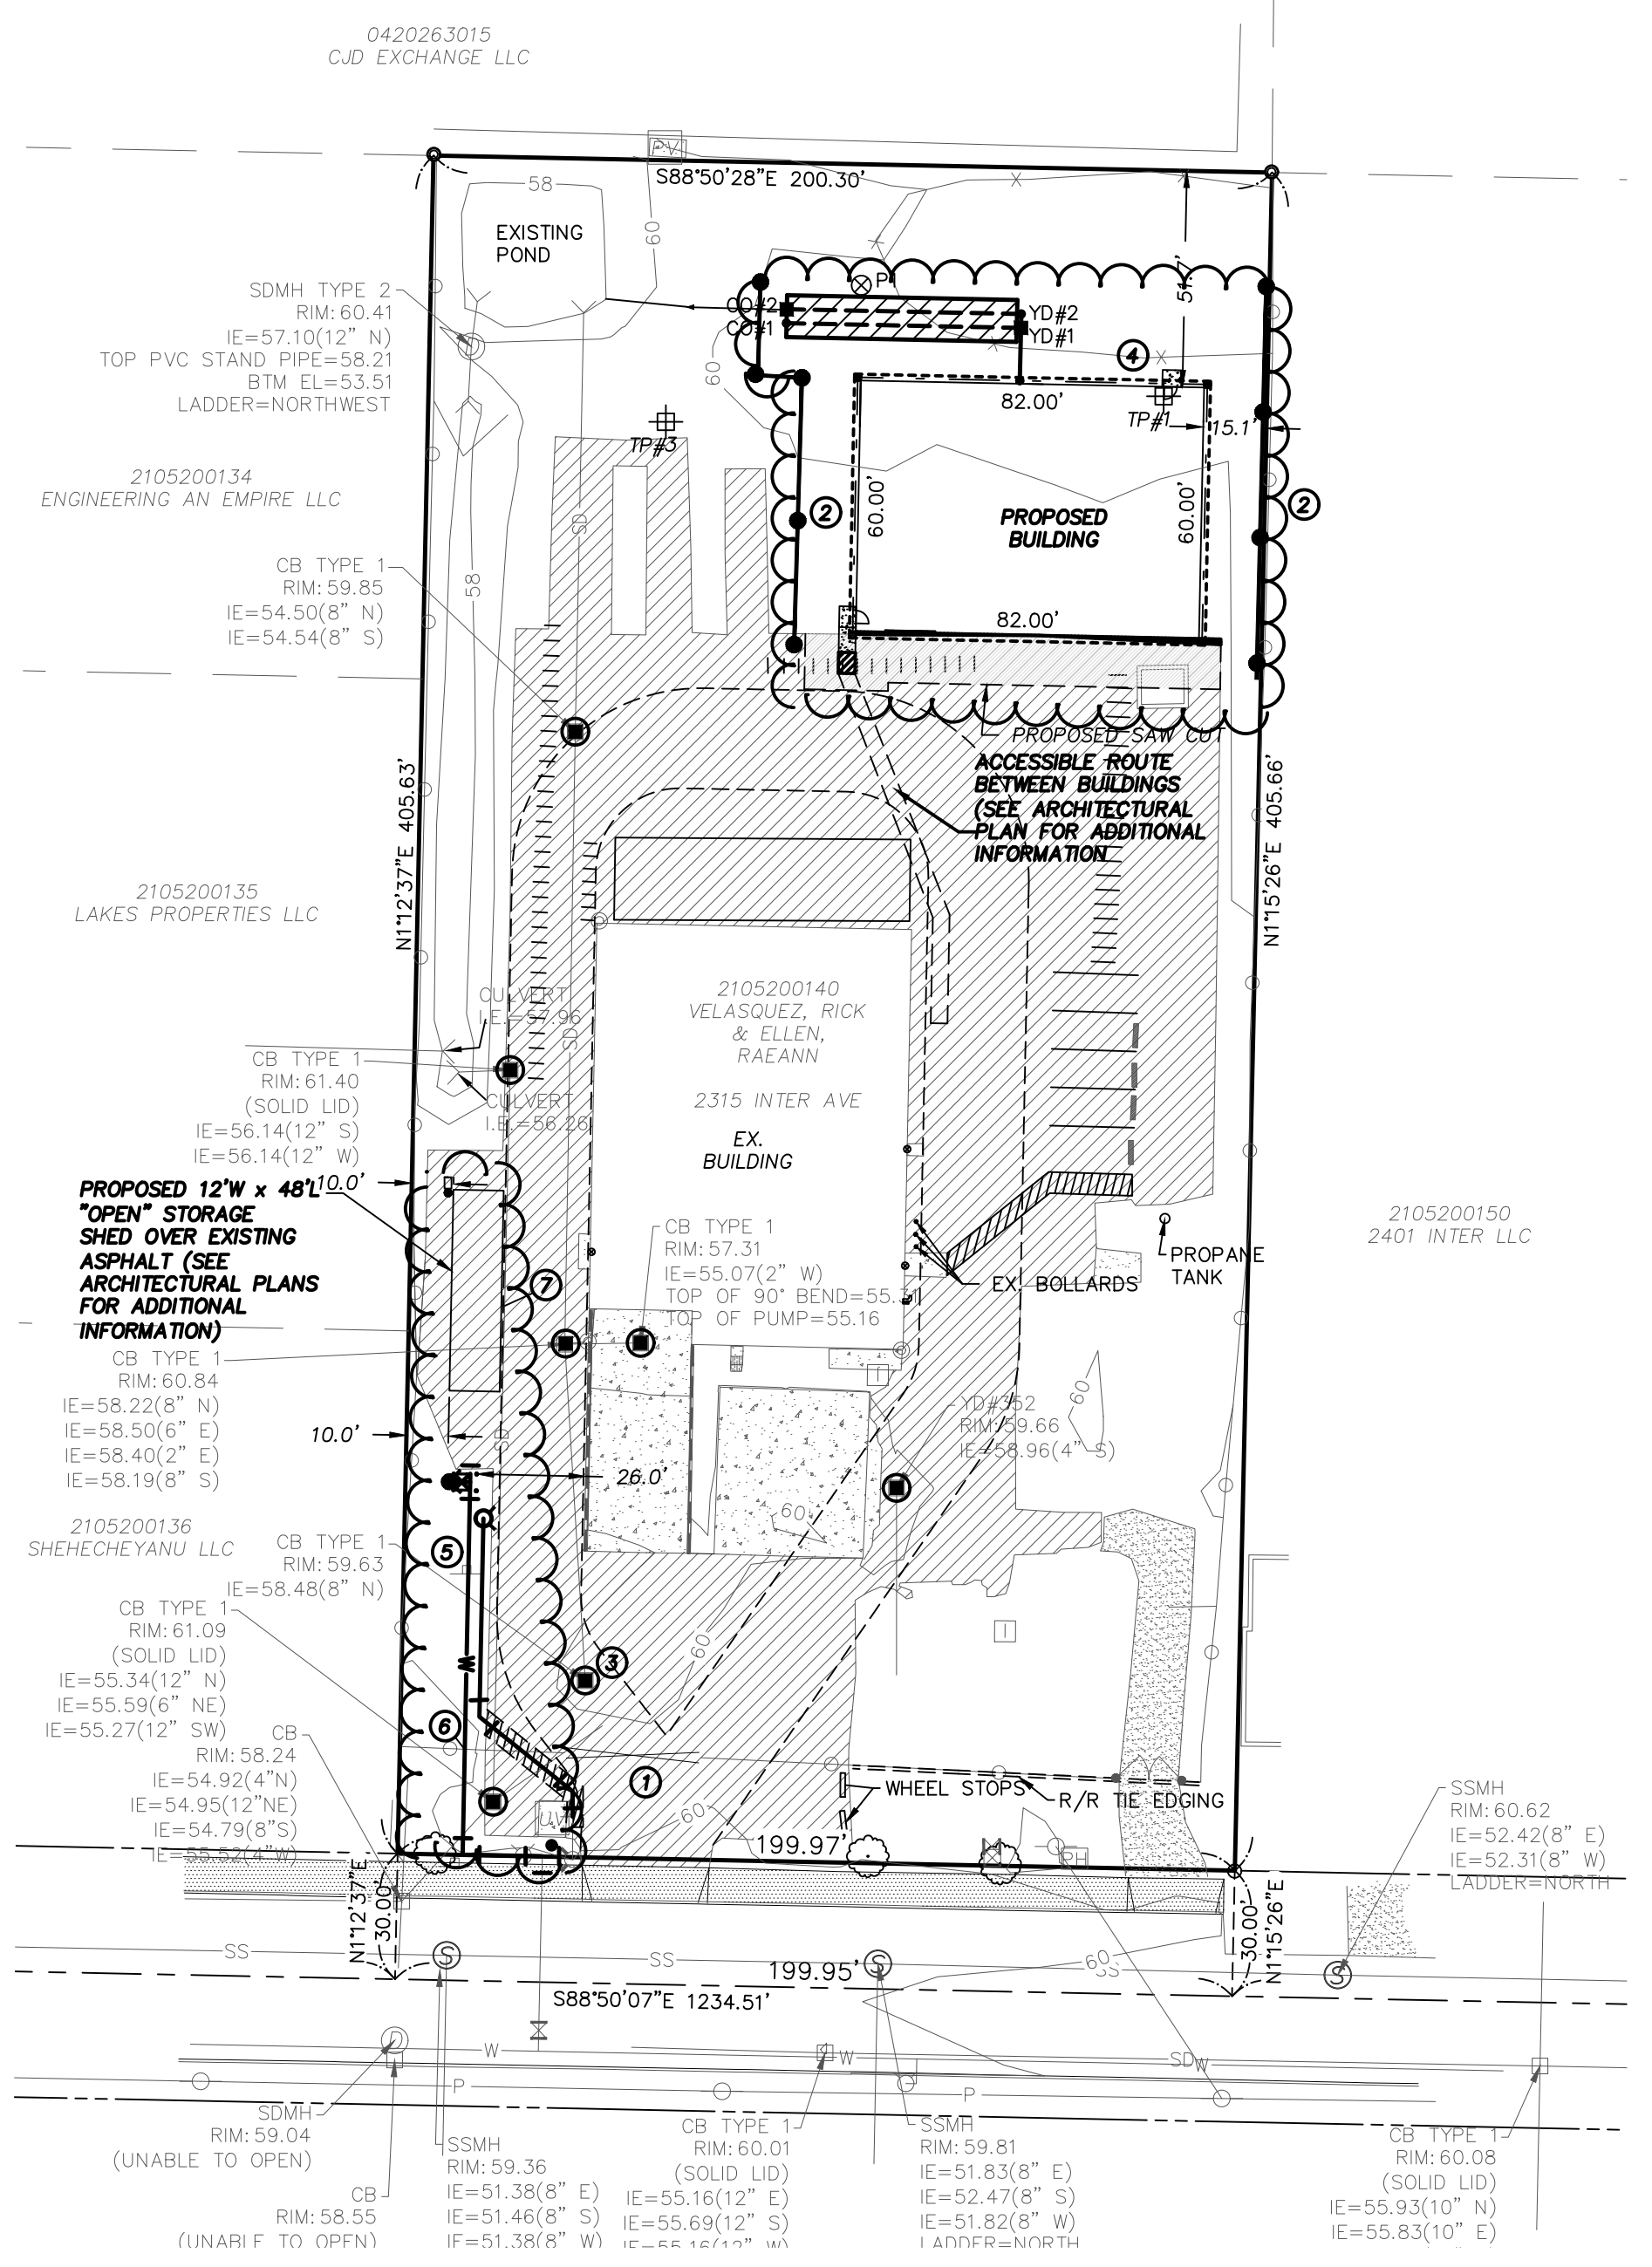

LEGEND

- PROPERTY LINE
- EXISTING CONTOUR
- SILT FENCE
- CLEARING LIMITS
- RIGHT OF WAY
- EXISTING WATER MAIN (APPROX. LOCATION)
- EXISTING SEWER MAIN
- EXISTING STORM MAIN
- EXISTING POWER LINE
- EXISTING WIRE FENCE
- EXISTING CHAINLINK FENCE
- PROPOSED STORM LINE
- PROPOSED WATER LINE
- PROPOSED CATCH BASIN/YARD DRAIN
- PROPOSED CLEAN OUT
- PROPOSED POST INDICATOR VALVE
- PROPOSED F.D.C.
- PROPOSED FIRE HYDRANT
- PROPOSED WATER VALVE
- EXISTING WATER METER
- EXISTING F.D.C.
- EXISTING IRR. BOX
- EXISTING WATER VALVE
- EXISTING FIRE HYDRANT
- EXISTING DDCVA VAULT
- EXISTING CATCH BASIN
- EXISTING STORM MANHOLE
- EXISTING STORM C/O
- EXISTING SEWER MANHOLE
- EXISTING UTILITY POLE
- EXISTING SIDEWALK
- EXISTING PAVEMENT
- EXISTING CONCRETE
- PROPOSED PAVEMENT GRIND/OVERLAY AREA
- EXISTING TREE
- CB INLET PROTECTION
- TEST PIT LOCATION
- SEE GEOTECHNICAL REPORT LOCATED WITHIN THE SSP REPORT FOR ADDITIONAL INFORMATION.
- PILOT INFILTRATION TEST LOCATION
- SEE GEOTECHNICAL REPORT LOCATED WITHIN THE SSP REPORT FOR ADDITIONAL INFORMATION.

NOTES

- ALL FILL SHALL BE CLEAN EARTHEN MATERIAL ONLY, WITH NO CONCRETE, GARBAGE, SOLID WASTE OR ANY OTHER UNACCEPTABLE MASS.
- ALL ASBESTOS ENCOUNTERED MUST BE REMOVED AND DISPOSED OF IN ACCORDANCE WITH PUGET SOUND AIR POLLUTION CONTROL AGENCY (PSAPCA) AND TACOMA-PIERCE COUNTY HEALTH DEPARTMENT REGULATIONS.
- ALL DEMOLITION MATERIAL MUST GO TO A LICENSED SOLID WASTE HANDLING OR DISPOSAL FACILITY.
- ALL SEPTIC TANKS SHALL BE PUMPED BY A CERTIFIED SEPTIC HAULER, FILLED WITH SOIL AND A DECOMMISSIONING APPLICATION COMPLETED PER TACOMA-PIERCE COUNTY HEALTH DEPARTMENT REQUIREMENTS.
- CONTRACTOR SHALL OBTAIN DEMOLITION PERMIT AS REQUIRED PRIOR TO ANY DEMOLITION OR STRUCTURE REMOVAL.
- ALL SLOPES SHALL MAINTAIN MINIMUM SETBACKS IN ACCORDANCE WITH THE GRADING NOTES ON SHEET C1.1.
- THE OWNER'S RETAINED GEOTECHNICAL ENGINEER SHALL TEST ALL FILL MATERIAL & OBTAIN SUFFICIENT COMPACTION TESTS TO VERIFY SOIL STABILITY.
- EROSION CONTROL MEASURES OTHER THAN THOSE SPECIFIED MAY BE NEEDED TO PREVENT MIGRATION OF SEDIMENT. SEE SHEETS C1.1 FOR ADDITIONAL MEASURES.
- CONTRACTOR TO HAVE EQUIPMENT AND MATERIALS I.E.: STRAW, 12" & 18" CMP, QUARRY SPALLS, TEMP RISER STRUCTURES, ETC. ON-SITE DURING CONSTRUCTION FOR EMERGENCY SITUATIONS. CONTRACTOR TO DEVELOP PLAN OF ACTION FOR EROSION MEASURES PRIOR TO STARTING CONSTRUCTION.
- PRIOR TO START OF CONSTRUCTION, A NPDES PERMIT SHALL BE OBTAINED FROM THE DEPARTMENT OF ECOLOGY IF NEEDED.
- PRIOR TO START OF CONSTRUCTION, A FOREST PRACTICE PERMIT SHALL BE OBTAINED FROM THE DEPARTMENT OF NATURAL RESOURCES, IF NEEDED.
- TO LIMIT IMPACTS TO NEIGHBORING PROPERTIES, DUST CONTROL WILL BE REQUIRED.

UTILITY CONFLICT NOTE:

CAUTION:
THE CONTRACTOR SHALL BE FULLY RESPONSIBLE FOR VERIFYING THE LOCATION, AND DEPTH OF ALL EXISTING UTILITIES WHETHER SHOWN ON THESE PLANS OR NOT BY POTHOLES THE UTILITIES AND SURVEYING THE HORIZONTAL AND VERTICAL LOCATION PRIOR TO CONSTRUCTION. THIS SHALL INCLUDE CALLING UTILITY LOCATE @ B11 AND THEN POTHOLES ALL OF THE EXISTING UTILITIES AT LOCATIONS OF NEW UTILITY CROSSINGS TO PHYSICALLY VERIFY WHETHER OR NOT CONFLICTS EXIST. LOCATION OF SAID UTILITIES AS SHOWN ON THESE PLANS ARE BASED UPON THE UNVERIFIED PUBLIC INFORMATION AND ARE SUBJECT TO VARIATION. IF CONFLICTS SHOULD OCCUR, THE CONTRACTOR SHALL CONSULT THE PROJECT ENGINEER TO RESOLVE ALL PROBLEMS PRIOR TO PROCEEDING WITH CONSTRUCTION.

CALL BEFORE YOU DIG
THE CONTRACTOR SHALL BE FULLY RESPONSIBLE FOR THE LOCATION AND PROTECTION OF ALL EXISTING UTILITIES. THE CONTRACTOR SHALL VERIFY ALL UTILITY LOCATIONS PRIOR TO CONSTRUCTION BY CALLING THE UNDERGROUND LOCATE LINE AT B11 A MINIMUM OF 48 HOURS PRIOR TO ANY EXCAVATION.

LARSON and ASSOCIATES
 surveyors, engineers & planners
 9027 PACIFIC AVENUE, SUITE 4
 TACOMA, WA 98444 (253) 474-3404

T.E.S.C. PLAN

DATE	9/12/2023
DRAWING NO.	9575BASE
SHEET	2 OF 2



CIMCO SALES

NE 1/4, SW 1/4, SEC.26, TWN.20 N., RNG. 4 E., W.M.

GRADING, EROSION & SEDIMENT CONTROL NOTES

- ALL WORK IN CITY RIGHT-OF-WAY REQUIRES A PERMIT FROM THE CITY OF PUYALLUP. PRIOR TO ANY WORK COMMENCING, THE GENERAL CONTRACTOR SHALL ARRANGE FOR A PRECONSTRUCTION MEETING AT THE DEVELOPMENT SERVICES CENTER TO BE ATTENDED BY ALL CONTRACTORS THAT WILL PERFORM WORK SHOWN ON THE ENGINEERING PLANS, REPRESENTATIVES FROM ALL APPLICABLE UTILITY COMPANIES, THE PROJECT OWNER AND APPROPRIATE CITY STAFF. CONTACT ENGINEERING SERVICES TO SCHEDULE THE MEETING (253) 841-5568. THE CONTRACTOR IS RESPONSIBLE TO HAVE THEIR OWN APPROVED SET OF PLANS AT THE MEETING.
- AFTER COMPLETION OF ALL ITEMS SHOWN ON THESE PLANS AND BEFORE ACCEPTANCE OF THE PROJECT, THE CONTRACTOR SHALL OBTAIN A "PUNCH LIST" PREPARED BY THE CITY'S INSPECTOR DETAILING REMAINING ITEMS OF WORK TO BE COMPLETED. ALL ITEMS OF WORK SHOWN ON THESE PLANS SHALL BE COMPLETED TO THE SATISFACTION OF THE CITY PRIOR TO ACCEPTANCE OF THE WATER SYSTEM AND PROVISION OF SANITARY SEWER SERVICE.
- ALL MATERIALS AND WORKMANSHIP SHALL CONFORM TO THE STANDARD SPECIFICATIONS FOR ROAD, BRIDGE, AND MUNICIPAL CONSTRUCTION (HEREINAFTER REFERRED TO AS THE "STANDARD SPECIFICATIONS"), WASHINGTON STATE DEPARTMENT OF TRANSPORTATION AND AMERICAN PUBLIC WORKS ASSOCIATION, WASHINGTON STATE CHAPTER, LATEST EDITION, UNLESS SUPERSEDED OR AMENDED BY THE CITY OF PUYALLUP CITY STANDARDS FOR PUBLIC WORKS ENGINEERING AND CONSTRUCTION (HEREINAFTER REFERRED TO AS THE "CITY STANDARDS").
- A COPY OF THESE APPROVED PLANS AND APPLICABLE CITY DEVELOPER SPECIFICATIONS AND DETAILS SHALL BE ON SITE DURING CONSTRUCTION.
- ANY REVISIONS MADE TO THESE PLANS MUST BE REVIEWED AND APPROVED BY THE DEVELOPER'S ENGINEER AND THE CITY ENGINEER PRIOR TO ANY IMPLEMENTATION IN THE FIELD. THE CITY SHALL NOT BE RESPONSIBLE FOR ANY ERRORS AND/OR OMISSIONS ON THESE PLANS.
- THE CONTRACTOR SHALL HAVE ALL UTILITIES VERIFIED ON THE GROUND PRIOR TO ANY CONSTRUCTION. CALL (811) AT LEAST TWO WORKING DAYS HOURS IN ADVANCE. THE OWNER AND HIS/HER ENGINEER SHALL BE CONTACTED IMMEDIATELY IF A CONFLICT EXISTS.
- ALL LIMITS OF CLEARING AND AREAS OF VEGETATION PRESERVATION AS PRESCRIBED ON THE PLANS SHALL BE CLEARLY FLAGGED IN THE FIELD AND OBSERVED DURING CONSTRUCTION.
- ALL REQUIRED SEDIMENTATION AND EROSION CONTROL FACILITIES MUST BE CONSTRUCTED AND IN OPERATION PRIOR TO ANY LAND CLEARING AND/OR OTHER CONSTRUCTION TO ENSURE THAT SEDIMENT LADEN WATER DOES NOT ENTER THE NATURAL DRAINAGE SYSTEM. THE CONTRACTOR SHALL SCHEDULE AN INSPECTION OF THE EROSION CONTROL FACILITIES PRIOR TO ANY LAND CLEARING AND/OR OTHER CONSTRUCTION. ALL EROSION AND SEDIMENT FACILITIES SHALL BE MAINTAINED IN A SATISFACTORY CONDITION AS DETERMINED BY THE CITY, UNTIL SUCH TIME THAT CLEARING AND/OR CONSTRUCTION IS COMPLETED AND THE POTENTIAL FOR ON-SITE EROSION HAS PASSED. THE IMPLEMENTATION, MAINTENANCE, REPLACEMENT, AND ADDITIONS TO THE EROSION AND SEDIMENTATION CONTROL SYSTEMS SHALL BE THE RESPONSIBILITY OF THE PERMITTEE.
- THE EROSION AND SEDIMENTATION CONTROL SYSTEM FACILITIES DEPICTED ON THESE PLANS ARE INTENDED TO BE MINIMUM REQUIREMENTS TO MEET ANTICIPATED SITE CONDITIONS. AS CONSTRUCTION PROGRESSES AND UNEXPECTED OR SEASONAL CONDITIONS DICTATE, FACILITIES WILL BE NECESSARY TO ENSURE COMPLETE SILTATION CONTROL ON THE SITE. DURING THE COURSE OF CONSTRUCTION, IT SHALL BE THE OBLIGATION AND RESPONSIBILITY OF THE PERMITTEE TO ADDRESS ANY NEW CONDITIONS THAT MAY BE CREATED BY HIS ACTIVITIES AND TO PROVIDE ADDITIONAL FACILITIES, OVER AND ABOVE THE MINIMUM REQUIREMENTS, AS MAY BE NEEDED TO PROTECT ADJACENT PROPERTIES, SENSITIVE AREAS, NATURAL WATER COURSES, AND/OR STORM DRAINAGE SYSTEMS.
- APPROVAL OF THESE PLANS IS FOR GRADING, TEMPORARY DRAINAGE, EROSION AND SEDIMENTATION CONTROL ONLY. IT DOES NOT CONSTITUTE AN APPROVAL OF PERMANENT STORM DRAINAGE DESIGN, SIZE OR LOCATION OF PIPES, RESTRICTORS, CHANNELS, OR RETENTION FACILITIES.
- ANY DISTURBED AREA WHICH HAS BEEN STRIPPED OF VEGETATION AND WHERE NO FURTHER WORK IS ANTICIPATED FOR A PERIOD OF 30 DAYS OR MORE, MUST BE IMMEDIATELY STABILIZED WITH MULCHING, GRASS PLANTING, OR OTHER APPROVED EROSION CONTROL TREATMENT APPLICABLE TO THE TIME OF YEAR IN QUESTION. GRASS SEEDING ALONE WILL BE ACCEPTABLE ONLY DURING THE MONTHS OF APRIL THROUGH SEPTEMBER INCLUSIVE. SEEDING MAY PROCEED OUTSIDE THE SPECIFIED TIME PERIOD WHENEVER IT IS IN THE INTEREST OF THE PERMITTEE BUT MUST BE AUGMENTED WITH MULCHING, NETTING, OR OTHER TREATMENT APPROVED BY THE CITY.
- IN CASE EROSION OR SEDIMENTATION OCCURS TO ADJACENT PROPERTIES, ALL CONSTRUCTION WORK WITHIN THE DEVELOPMENT THAT WILL FURTHER AGGRAVATE THE SITUATION MUST CEASE, AND THE OWNER/CONTRACTOR WILL IMMEDIATELY COMMENCE RESTORATION METHODS. RESTORATION ACTIVITY WILL CONTINUE UNTIL SUCH TIME AS THE AFFECTED PROPERTY OWNER IS SATISFIED.
- NO TEMPORARY OR PERMANENT STOCKPILING OF MATERIALS OR EQUIPMENT SHALL OCCUR WITHIN CRITICAL AREAS OR ASSOCIATED BUFFERS, OR THE CRITICAL ROOT ZONE FOR VEGETATION PROPOSED FOR RETENTION.

INLET PROTECTION NOTES

- PLACE CONCRETE BLOCKS LENGTHWISE ON THEIR SIDES IN A SINGLE ROW AROUND THE PERIMETER OF THE INLET, SO THAT THE OPEN END FACE OUTWARD, NOT UPWARD. THE ENDS OF ADJACENT BLOCKS SHALL ABUT. THE HEIGHT OF THE BARRIER CAN BE VARIED, DEPENDING ON DESIGN NEEDS, BY STACKING COMBINATIONS OF BLOCKS THAT ARE 4 INCHES, AND 12 INCHES WIDE. THE ROW OF BLOCKS SHALL BE AT LEAST 12 INCHES BUT NO GREATER THAN 24 INCHES HIGH.
- PLACE WIRE MESH OVER THE OUTSIDE VERTICAL FACE (OPEN END) OF THE CONCRETE BLOCKS TO PREVENT STONE FROM BEING WASHED THROUGH THE BLOCKS. USE HARDWARE CLOTH OR COMPARABLE WIRE MESH WITH 1/2-INCH OPENINGS.
- PILE STONE AGAINST THE WIRE MESH TO THE TOP OF THE BLOCKS. USE 3/4-INCH TO 3-INCH GRAVEL.
- PLACE WIRE MESH OVER THE DROP INLET SO THAT THE WIRE EXTENDS A MINIMUM OF 1 FOOT BEYOND EACH SIDE OF THE INLET STRUCTURE. USE HARDWARE CLOTH OR COMPARABLE WIRE MESH WITH 1/2-INCH OPENINGS. IF MORE THAN ONE STRIP OF MESH IS NECESSARY, OVERLAP THE STRIPS. PLACE FILTER FABRIC OVER WIRE MESH.
- PLACE 3/4 INCH GRAVEL OVER THE WIRE MESH. THE DEPTH OF STONE SHALL BE AT LEAST 12 INCHES OVER THE ENTIRE INLET OPENING. EXTEND THE STONE BEYOND THE INLET OPENING AT LEAST 18 INCHES ON ALL SIDES.
- IF THE STONE FILTER BECOMES CLOGGED WITH SEDIMENT, THE STONES MUST BE PULLED AWAY FROM THE INLET AND CLEANED OR REPLACED.

SEEDING NOTES


- SEED MIXTURE SHALL BE 10% RYE, 40% ANNUAL RYE, 40% CHEWING FESCUE, 10% WHITE DUTCH CLOVER, AND SHALL BE APPLIED AT THE RATE OF 225 LBS. PER ACRE.
- SEED BEDS PLANTED BETWEEN MAY 1 AND OCTOBER 31 WILL REQUIRE IRRIGATION AND OTHER MAINTENANCE AS NECESSARY TO FOSTER AND PROTECT THE ROOT STRUCTURE.
- FOR SEED BEDS PLANTED BETWEEN OCTOBER 31 AND APRIL 30, ARMORING OF THE SEED BED WILL BE NECESSARY. (E.G., GEOTEXTILES, JUTE MAT, CLEAR PLASTIC COVERING).
- BEFORE SEEDING, INSTALL NEEDED SURFACE RUNOFF CONTROL MEASURES SUCH AS GRADIENT TERRACES, INTERCEPTOR DIKES, SWALES, LEVEL SPREADERS AND SEDIMENT BASINS.
- THE SEEDBED SHALL BE FIRM WITH A FAIRLY FINE SURFACE, FOLLOWING SURFACE ROUGHENING. PERFORM ALL OPERATIONS ACROSS OR AT RIGHT ANGLES TO THE SLOPE.
- FERTILIZERS ARE TO BE USED ACCORDING TO SUPPLIERS RECOMMENDATIONS. AMOUNTS USED SHOULD BE MINIMIZED, ESPECIALLY ADJACENT TO WATER BODIES AND WETLANDS.

TOPSOILING NOTES

- APPLY TOPSOIL TO AREAS WITH HIGHLY DENSE OR IMPERMEABLE SOILS.
- APPLY WHERE MULCH AND FERTILIZER ALONE WOULD NOT PROVIDE A SUITABLE GROWTH MEDIUM.
- APPLY WHERE SLOPES DO NOT EXCEED 2:1.
- TOPSOIL SHALL BE FRIABLE AND LOAMY (LOAM, SANDY LOAM, SILT LOAM, SAND CLAY LOAM, CLAY LOAM).
- TOPSOIL SHALL NOT BE PLACED WHILE IN A FROZEN OR MUDDY CONDITION, WHEN THE SUBGRADE IS EXCESSIVELY WET, OR WHEN CONDITIONS EXIST THAT MAY OTHERWISE BE DETRIMENTAL TO PROPER GRADING OR PROPOSED SODDING OR SEEDING.
- PREVIOUSLY ESTABLISHED GRADES ON THE AREAS TO BE TOP SOILED SHALL BE MAINTAINED ACCORDING TO THE APPROVED PLAN.
- STOCKPILES SHALL BE STABILIZED (WITH PLASTIC COVERING OR OTHER APPROVED DEVICE) DAILY BETWEEN NOVEMBER 1 AND MARCH 31.
- IN ANY SEASON, SEDIMENT LEACHING FROM STOCKPILES MUST BE PREVENTED.

SOD NOTES

- SOD SHALL BE MACHINE CUT AT A UNIFORM SOIL THICKNESS OF 3/4-INCH AT THE TIME OF CUTTING. MEASUREMENT FOR THICKNESS SHALL EXCLUDE TOP GROWTH AND THATCH.
- STANDARD SIZE SECTIONS OF SOD SHALL BE STRONG ENOUGH TO SUPPORT THEIR OWN WEIGHT AND RETAIN THEIR SIZE AND SHAPE WHEN SUSPENDED BY THE END OF A 3 FOOT SECTION.
- SOD SHALL NOT BE HARVESTED OR TRANSPLANTED WHEN MOISTURE CONTENT (EXCESSIVELY DRY OR WET) MAY ADVERSELY AFFECT ITS SURVIVAL.
- SOD SHALL BE HARVESTED, DELIVERED AND INSTALLED WITHIN A PERIOD OF 36 HOURS.

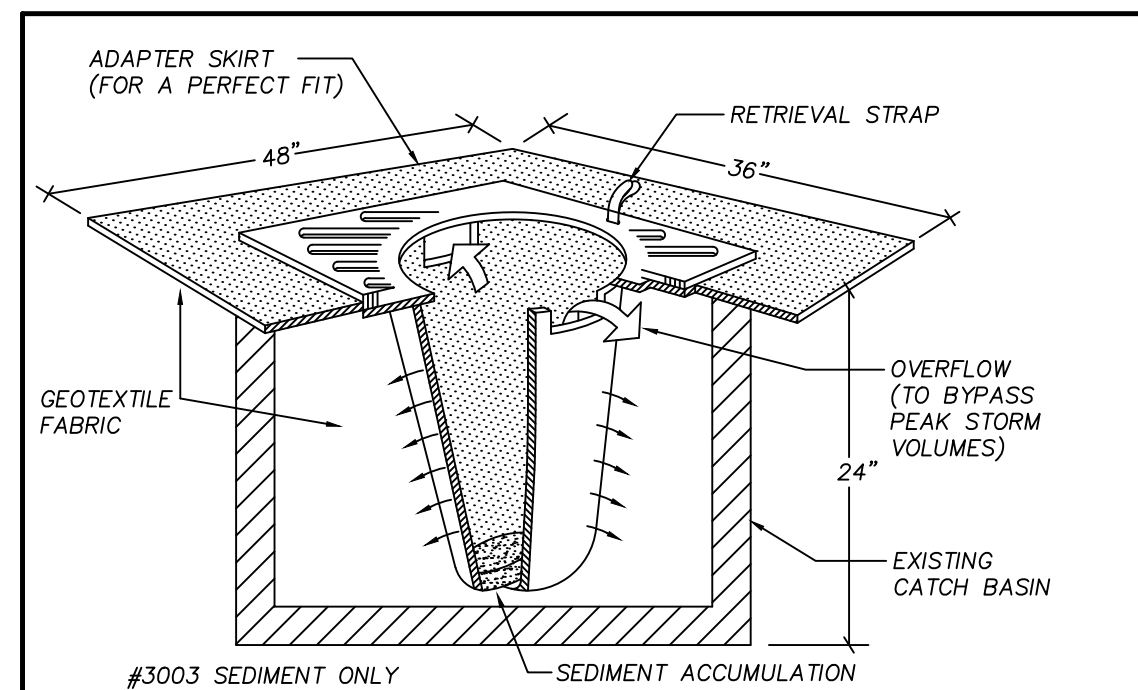

PROVIDE CATCH BASIN SEDIMENT PROTECTION WITH STREAMGUARD BASIN INSERT #3003, FROM FOSS ENVIRONMENTAL 7440 W. MARGINAL WAY S. SEATTLE, WA 98108-4141 PHONE: 1-800-909-3677

INLET SEDIMENT PROTECTION (AFTER PAVING)

NOT TO SCALE

Test Pit TP-1		
Location: West portion of parcel Approximate Elevation: 60' (NAVD88)		
Depth (ft)	Soil Type	Soil Description
0 - 0.5	-	Topsoil
0.5 - 3.0	SM	Brown silty SAND (loose, moist) (alluvium)
3.0 - 5.5	SM/ML	Gray, orange iron oxide stained silty SAND, interbedded gray mottled silt (medium dense/stiff, moist to wet) (alluvium)
5.5 - 6.0	ML	Gray mottled SILT (stiff, wet) (alluvium)
6.0 - 6.5	SP	Gray SAND (medium dense, wet) (alluvium)

Terminated at 3.2 feet below ground surface.
No caving observed.
Slow groundwater seepage observed at 4 feet below existing grades.

Test Pit TP-2		
Location: SW central portion of parcel Approximate Elevation: 60' (NAVD88)		
Depth (ft)	Soil Type	Soil Description
0 - 0.5	-	Topsoil
0.5 - 3.0	SM	Reddish brown silty SAND (loose to medium dense, moist) (alluvium)
3.0 - 3.5	ML	Light gray SILT (medium stiff, moist) (alluvium)
3.5 - 6.0	SP	Gray mottled SAND (medium dense, wet) (alluvium)
6.0 - 7.5	SM	Gray mottled silty SAND (medium dense, wet) (alluvium)
7.5 - 8.0	ML	Gray SILT (stiff, wet) (alluvium)

Terminated at 8.0 feet below ground surface.
No caving observed.
Slow groundwater observed at 4.5 feet below ground surface.

Logged by: AES
Observed on: December 21, 2021


Test Pit Logs	
Proposed Commercial Development 2315 Inter Avenue Puyallup, Washington PN: 2105200140	Doc ID: CIMCO-InterAve.F April 2022 Figure A-2

Pilot Infiltration Test PIT-1		
Location: West portion of parcel Approximate Elevation: 60' (NAVD88)		
Depth (ft)	Soil Type	Soil Description
0 - 0.5	-	Topsoil
0.5 - 2.0	SM	Reddish brown silty SAND (loose to medium dense, moist) (alluvium)
2.0 - 3.0	SM	Gray silty SAND (medium dense, moist) (alluvium)
3.0 - 5.0	SM	Gray mottled silty SAND (medium dense, moist) (alluvium)

Infiltration testing performed at 2 feet below existing grades.
Measured 1 inch per hour.
Overexcavated to 5 feet below existing grades.
No caving observed.
No groundwater seepage observed.


Logged by: AES
Observed on: December 21, 2021

Test Pit Logs	
Proposed Commercial Development 2315 Inter Avenue Puyallup, Washington PN: 2105200140	Doc ID: CIMCO-InterAve.F April 2022 Figure A-3

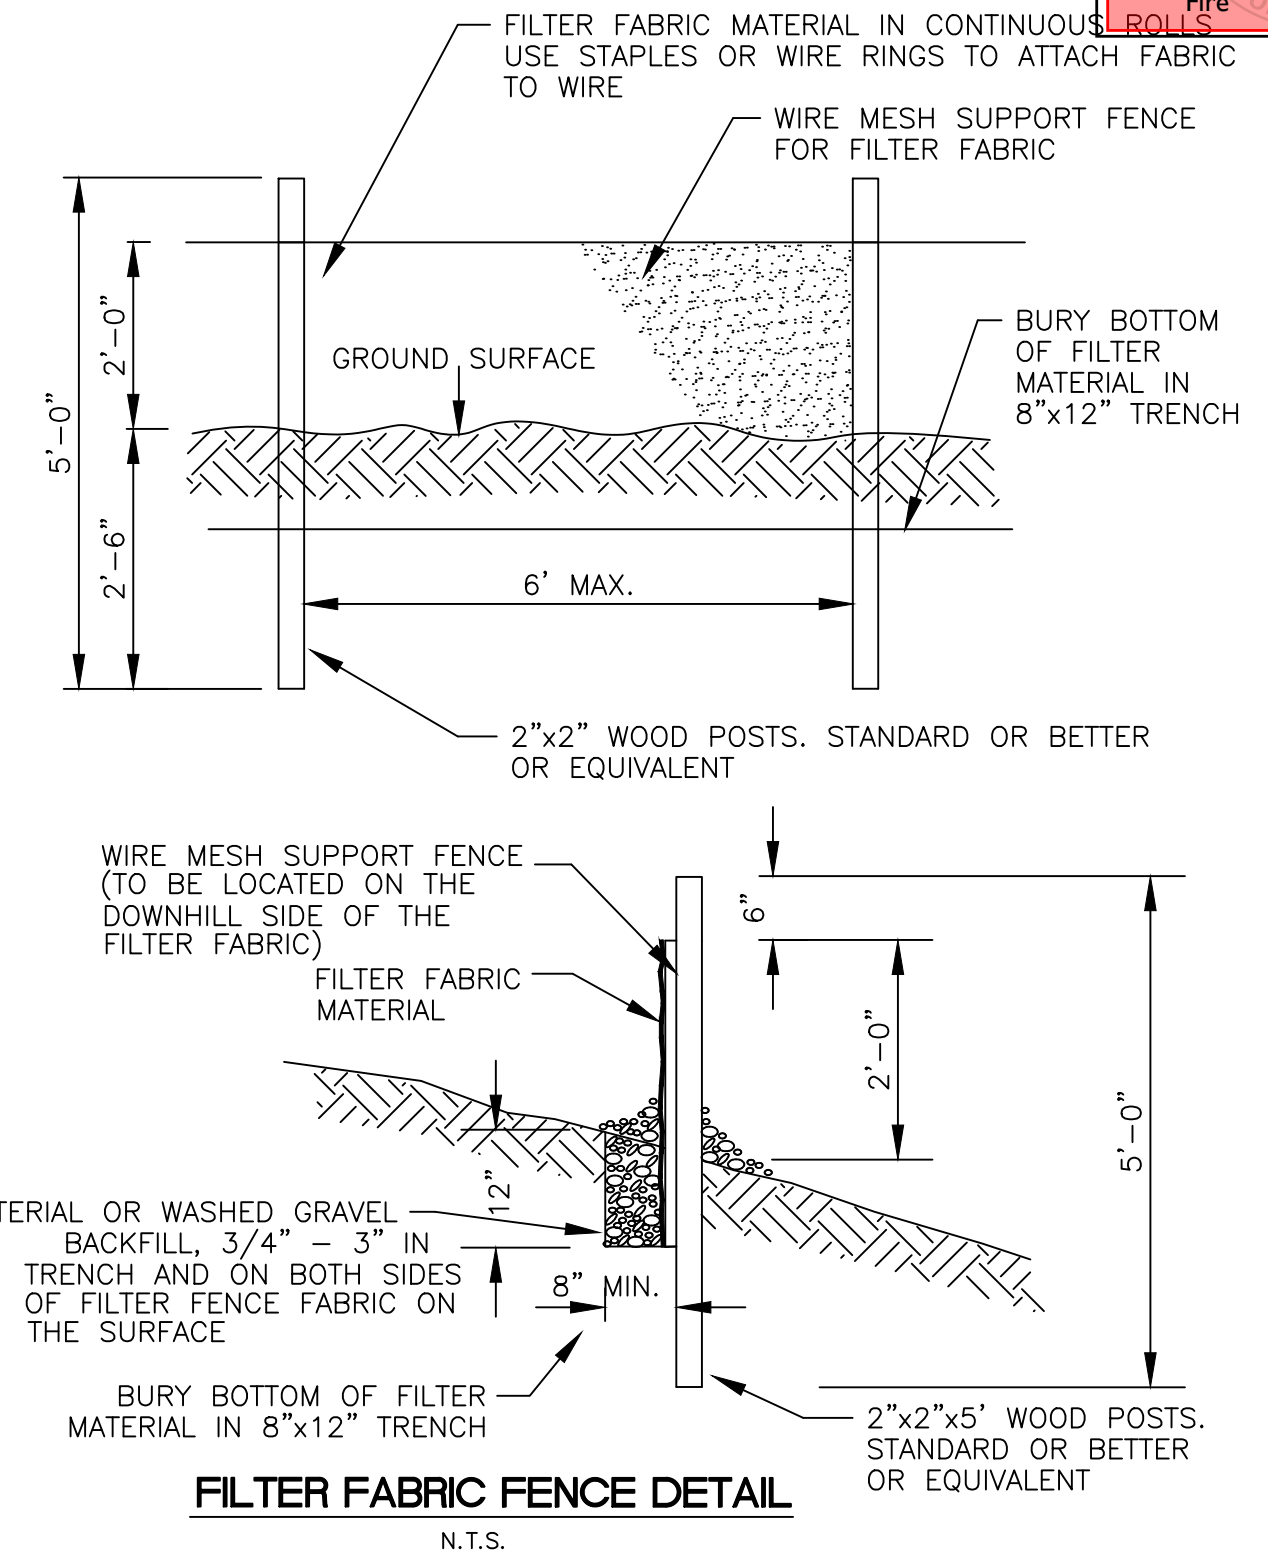

PROVIDE NATIVE MATERIAL OR WASHED GRAVEL BACKFILL, 3/4" - 3" IN TRENCH AND ON BOTH SIDES OF FILTER FABRIC ON THE SURFACE

REVISION BLOCK			
NO.	DATE	DESCRIPTION	BY
1	8/1/2023	ADDRESS CITY COMMENTS	GJM
		AND ADD NEW "OPEN"	
		STORAGE SHED OVER	
		EXISTING PAVEMENT AS SHOWN.	

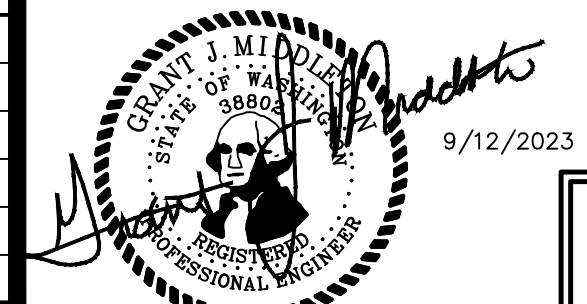

C11

DATE
9/12/2023
DRAWING NO.
9575BASE
SHEET 3 OF 7

APPROVED
BY: [Signature]
CITY OF PUYALLUP
ENGINEERING DEPARTMENT
DATE: 10/10/2023
NOTE: THIS APPROVAL IS VOID AFTER 180 DAYS FROM APPROVAL DATE.
THE CITY WILL NOT BE RESPONSIBLE FOR ERRORS AND/OR OMISSIONS ON THESE PLANS. FIELD CONDITIONS MAY DICTATE CHANGES TO THESE PLANS AS DETERMINED BY THE DEVELOPMENT ENGINEERING MANAGER.

City of Puyallup Development & Permitting Services ISSUED PERMIT			
Building	Planning	Engineering	Public Works
Fire	Traffic		

DESIGNED JLC
DRAWN DWN
CHECKED GJM
SCALE
HOR. N/A
VERT. N/A
JOB NUMBER
9575
PH: (253) 224-4428
PROPOSEN: RICK VELASQUEZ
13615 122ND ST E
PUYALLUP, WA 98374

LARSON AND ASSOCIATES
surveyors, engineers & planners
9027 PACIFIC AVENUE, SUITE 4
TACOMA, WA 98444 (253) 474-3404



T.E.S.C. SPECIFICATIONS

CIMCO SALES

NE 1/4, SW 1/4, SEC.26, TWN.20 N., RNG. 4 E., W.M.
STORM PLAN


CONSTRUCTION NOTES:

- IMMEDIATELY AFTER CONSTRUCTION, CONTRACTOR TO STABILIZE SLOPES BY ANY MEANS NECESSARY (I.E. SEEDING, SODDING, MULCHING, ETC.) PER NOTES LOCATED ON SHEET C1.1.
- 4" DOWNSPOUT TO 6" PVC ROOF DRAIN TIGHTLINE (TYP.)
- CONTRACTOR TO "BUILD UP" BUILDING PAD AREA WITH SUITABLE STRUCTURAL MATERIAL(S) NECESSARY TO ENSURE POSITIVE DRAINAGE AWAY FROM THE BUILDING PAD LOCATIONS.
- CONTRACTOR TO CONSTRUCT 55'L X 10"W X 1.5'D INFILTRATION TRENCH W/ DUAL 6" PVC(SDR35) PERF. PIPES @ 0.00% AS SHOWN AND PER DETAIL ON SHEET C2.1. THE CONTRACTOR SHALL INVITE THE GEOTECHNICAL ENGINEER TO PROVIDE INSPECTION OF SOIL CONDITIONS AT DESIGNED TRENCH LOCATION TO ENSURE PROPER SOIL CONDITIONS AT DEPTH EXIST, MEETING OR EXCEEDING DESIGN ASSUMPTIONS.
- CONTRACTOR TO AMEND DISTURBED SOILS PER 2012 (AMENDED IN 2014) DOE MANUAL, VOLUME V, SECTION 5.3.1 (BMP75.13) AS WELL AS CITY DETAIL 01.02.08A ON SHEET C2.1.
- CONTRACTOR TO PROVIDE GRADED POSITIVE "OVER LAND" RELEASE FROM INFILTRATION TRENCH TO EXISTING STORM POND FROM "BUBBLE UP" EMERGENCY OVERFLOW GRATED INLET (YD#2) TO ALLOW LARGER THAN DESIGN STORM EVENTS TO BE PROPERLY CONVEYED TO THE EXISTING DOWNSIDE DRAINAGE SYSTEM. ENSURE 1.0% (MIN.) GRADED FLOWLINE SWALE TO TOP OF EXISTING POND AS SHOWN.
- CONTRACTOR TO PROVIDE RESIDENTIAL SEDIMENT CONTROL STRUCTURE IN YD#1 PER DETAIL ON SHEET C2.1
- CONTRACTOR TO PROVIDE SINGLE DOWNSPOUT AND SPLASH BLOCK AT NORTHWEST CORNER OF THE PROPOSED OPEN SHED BUILDING AS SHOWN AND PER DETAIL ON SHEET 5.

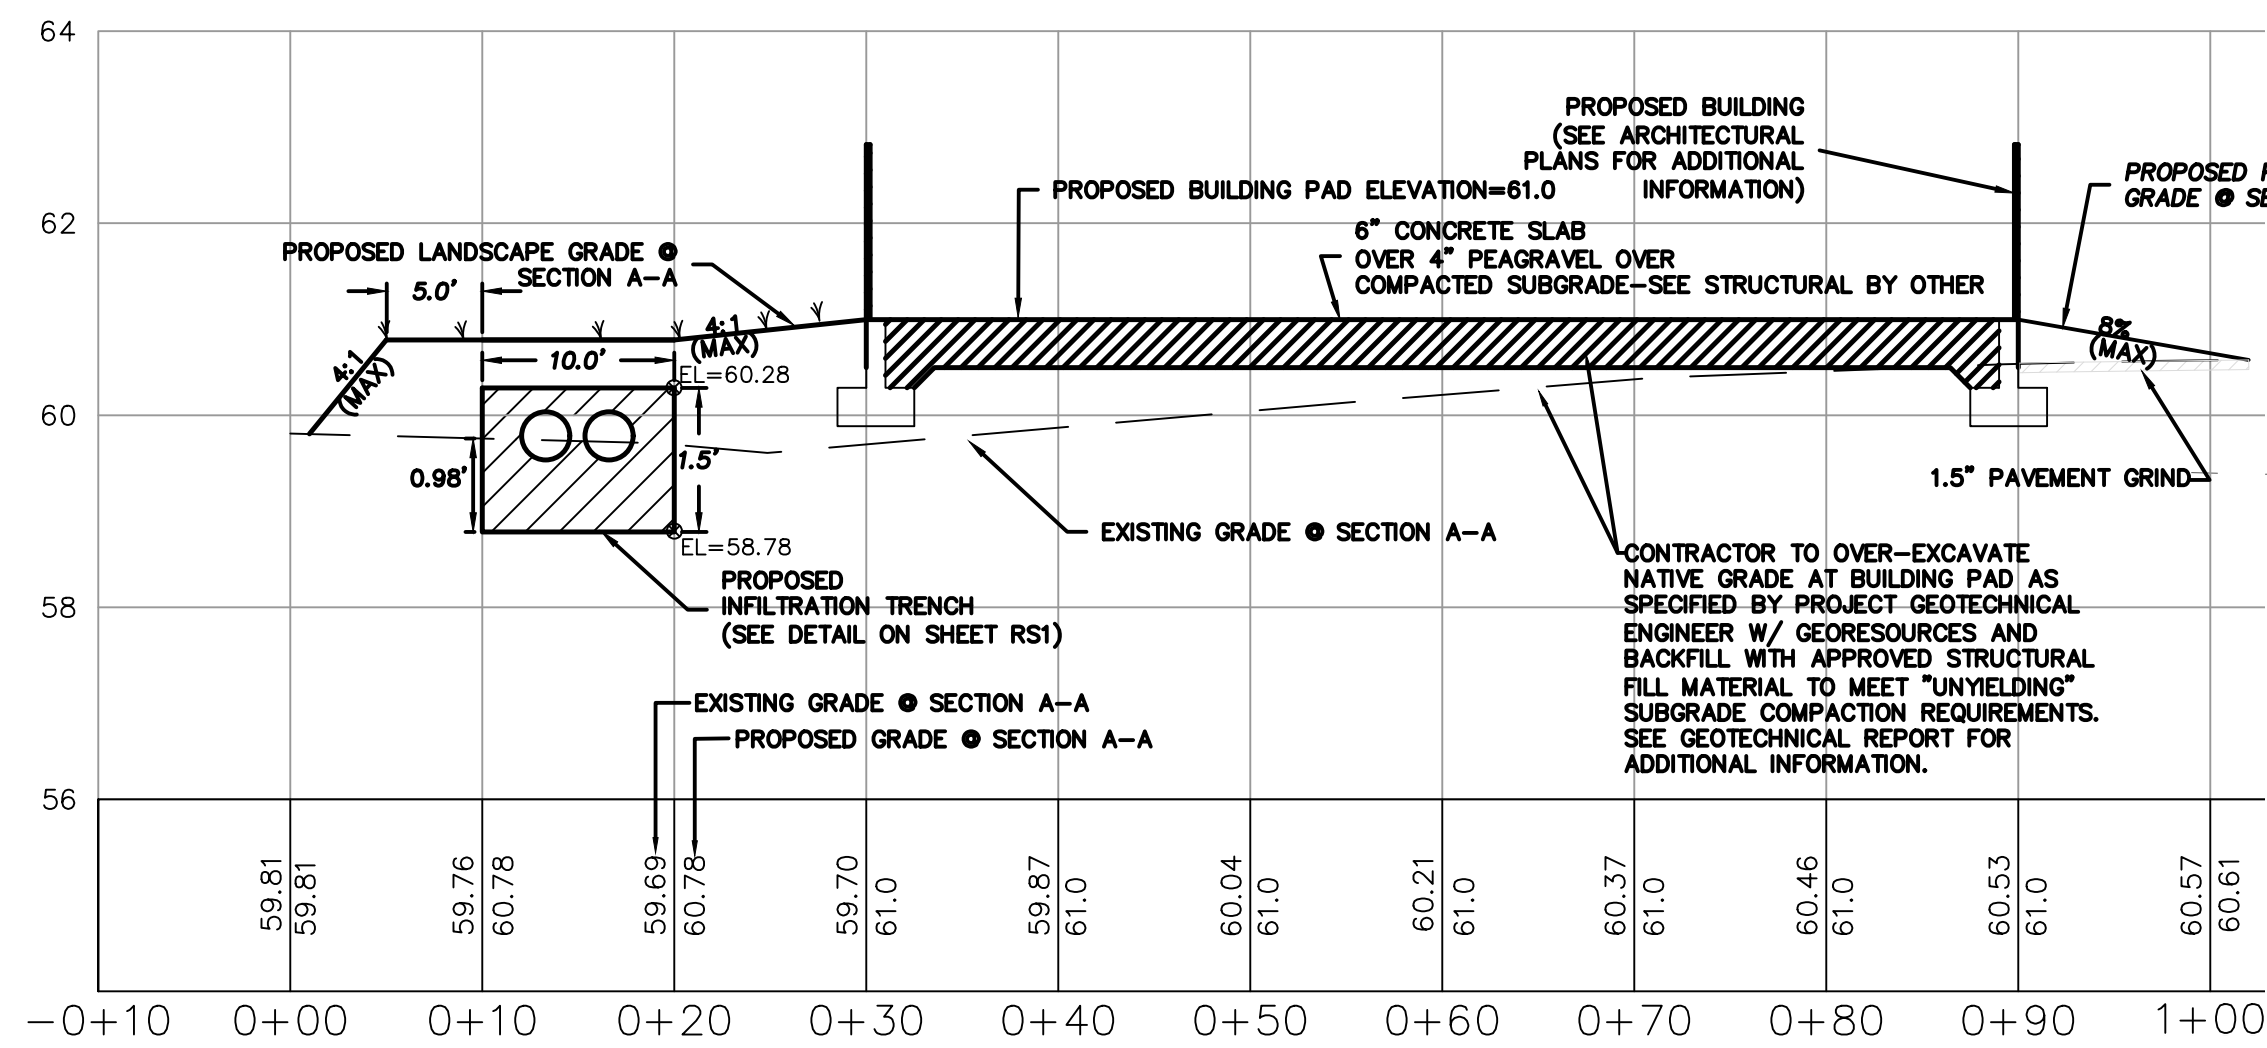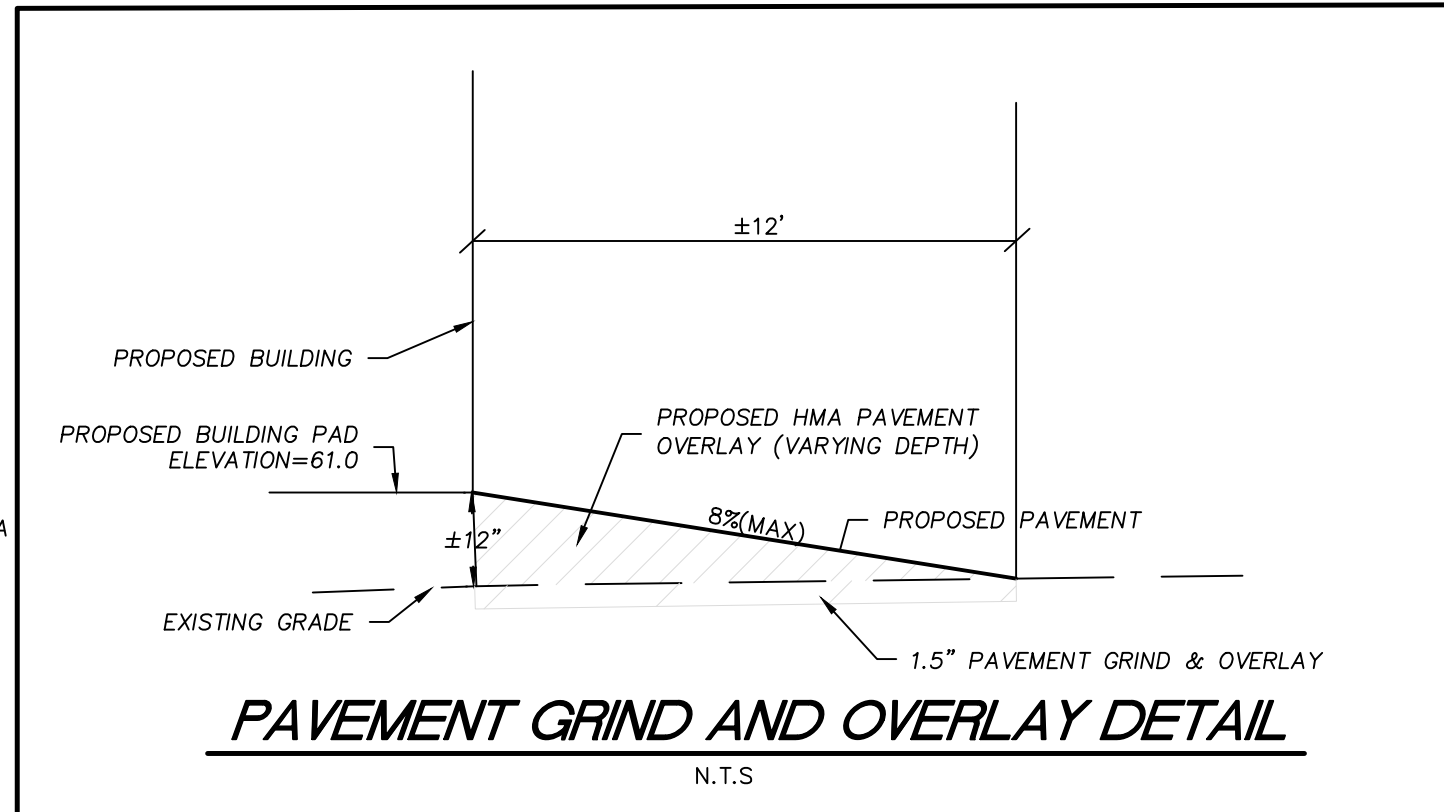

BUILDING SECTION A-A

HORIZONTAL SCALE: 1"=10'
VERTICAL SCALE: 1"=2'

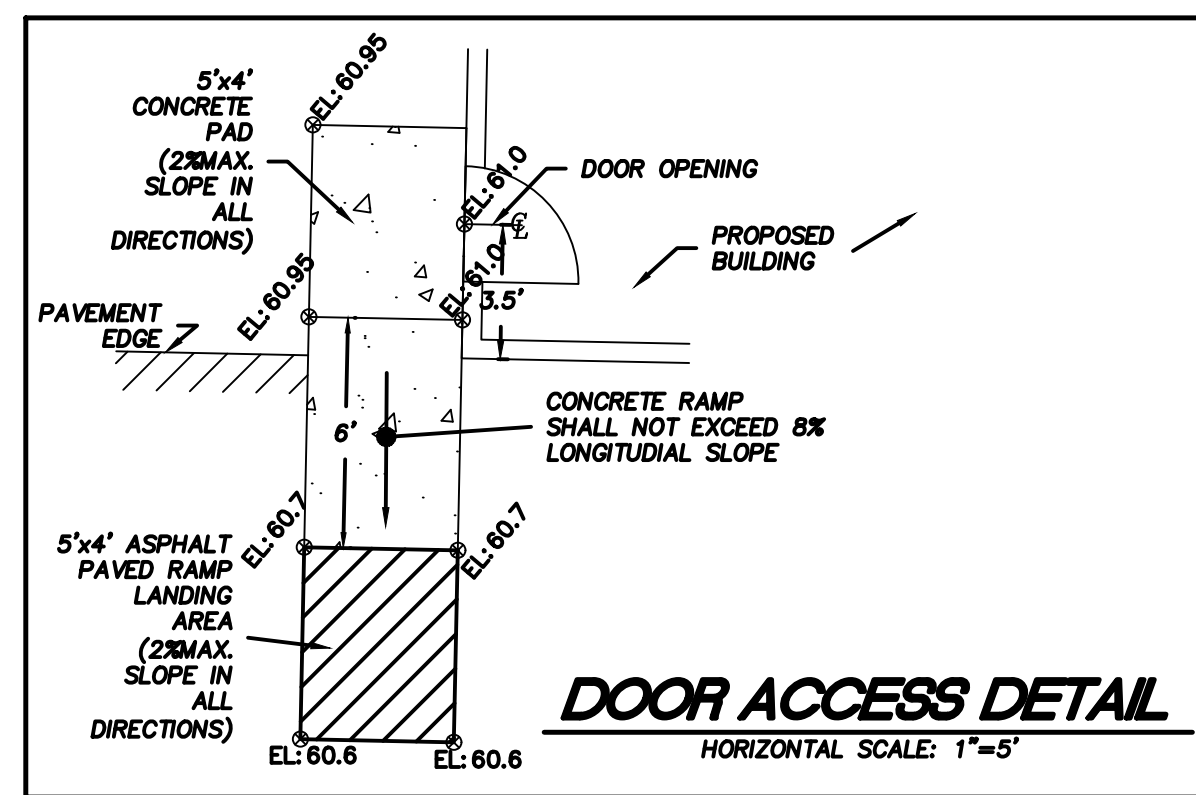

DOOR ACCESS DETAIL

HORIZONTAL SCALE: 1"=5'

UTILITY CONFLICT NOTE:

CAUTION:
THE CONTRACTOR SHALL BE FULLY RESPONSIBLE FOR VERIFYING THE LOCATION, AND DEPTH OF ALL EXISTING UTILITIES WHETHER SHOWN ON THESE PLANS OR NOT BY POT-HOLING THE UTILITIES AND SURVEYING THE HORIZONTAL AND VERTICAL LOCATION PRIOR TO CONSTRUCTION. THIS SHALL INCLUDE CALLING UTILITY LOCATE @ B11 AND THEN POT-HOLING ALL OF THE EXISTING UTILITIES AT LOCATIONS OF NEW UTILITY CROSSINGS TO PHYSICALLY VERIFY WHETHER OR NOT CONFLICTS EXIST. LOCATION OF SAID UTILITIES AS SHOWN ON THESE PLANS ARE BASED UPON THE UNVERIFIED PUBLIC INFORMATION AND ARE SUBJECT TO VARIATION. IF CONFLICTS SHOULD OCCUR, THE CONTRACTOR SHALL CONSULT THE PROJECT ENGINEER TO RESOLVE ALL PROBLEMS PRIOR TO PROCEEDING WITH CONSTRUCTION.

CALL BEFORE YOU DIG



THE CONTRACTOR SHALL BE FULLY RESPONSIBLE FOR THE LOCATION AND PROTECTION OF ALL EXISTING UTILITIES. THE CONTRACTOR SHALL VERIFY ALL UTILITY LOCATIONS PRIOR TO CONSTRUCTION BY CALLING THE UNDERGROUND LOCATE LINE AT B11 A MINIMUM OF 48 HOURS PRIOR TO ANY EXCAVATION.

APPROVED

BY *[Signature]*
CITY OF PUYALLUP
ENGINEERING DEPARTMENT

DATE 10/10/2023

NOTE: THIS APPROVAL IS VOID AFTER 180 DAYS FROM APPROVAL DATE. THE CITY WILL NOT BE RESPONSIBLE FOR ERRORS AND/OR OMISSIONS ON THESE PLANS. FIELD CONDITIONS MAY DICTATE CHANGES TO THESE PLANS AS DETERMINED BY THE DEVELOPMENT ENGINEERING MANAGER.

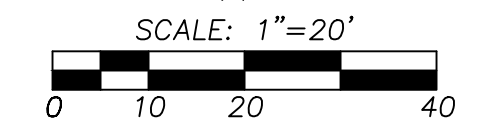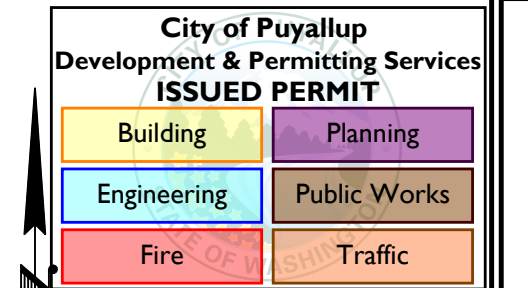

VERTICAL DATUM (WSRN)

NAVD 88 ESTABLISHED USING GPS RTK ROVER CONSTRAINED TO THE WASHINGTON STATE REFERENCE NETWORK (WSRN) STATIONS

CONTOUR INTERVAL=1'

TOPOGRAPHY PREPARED BY LARSON & ASSOCIATES

HORIZONTAL DATUM


NAD 83/11 WASHINGTON SOUTH ZONE
ESTABLISHED USING GPS RTK ROVER CONSTRAINED TO THE WASHINGTON STATE REFERENCE NETWORK (WSRN) STATIONS

SURVEYOR'S REFERENCES

- (P) ACKERSON'S 2ND ADDITION TO PUYALLUP, AFN 215387
- (R1) RECORD OF SURVEY, 200801255002

LEGEND

- P — PROPERTY LINE
- 60 — EXISTING CONTOUR
- SD — EXISTING STORM MAIN
- X — EXISTING WIRE FENCE
- ○ — EXISTING CHAINLINK FENCE
- SD — PROPOSED STORM LINE
- ■ — PROPOSED CATCH BASIN/YARD DRAIN
- □ — PROPOSED CLEAN OUT
- □ — EXISTING CATCH BASIN
- ○ — EXISTING STORM C/O
- ○ — EXISTING POWER VAULT
- ▨ — EXISTING PAVEMENT
- ▨ — PROPOSED PAVEMENT GRIND/OVERLAY AREA
- ▨ — PROPOSED CONC PAD

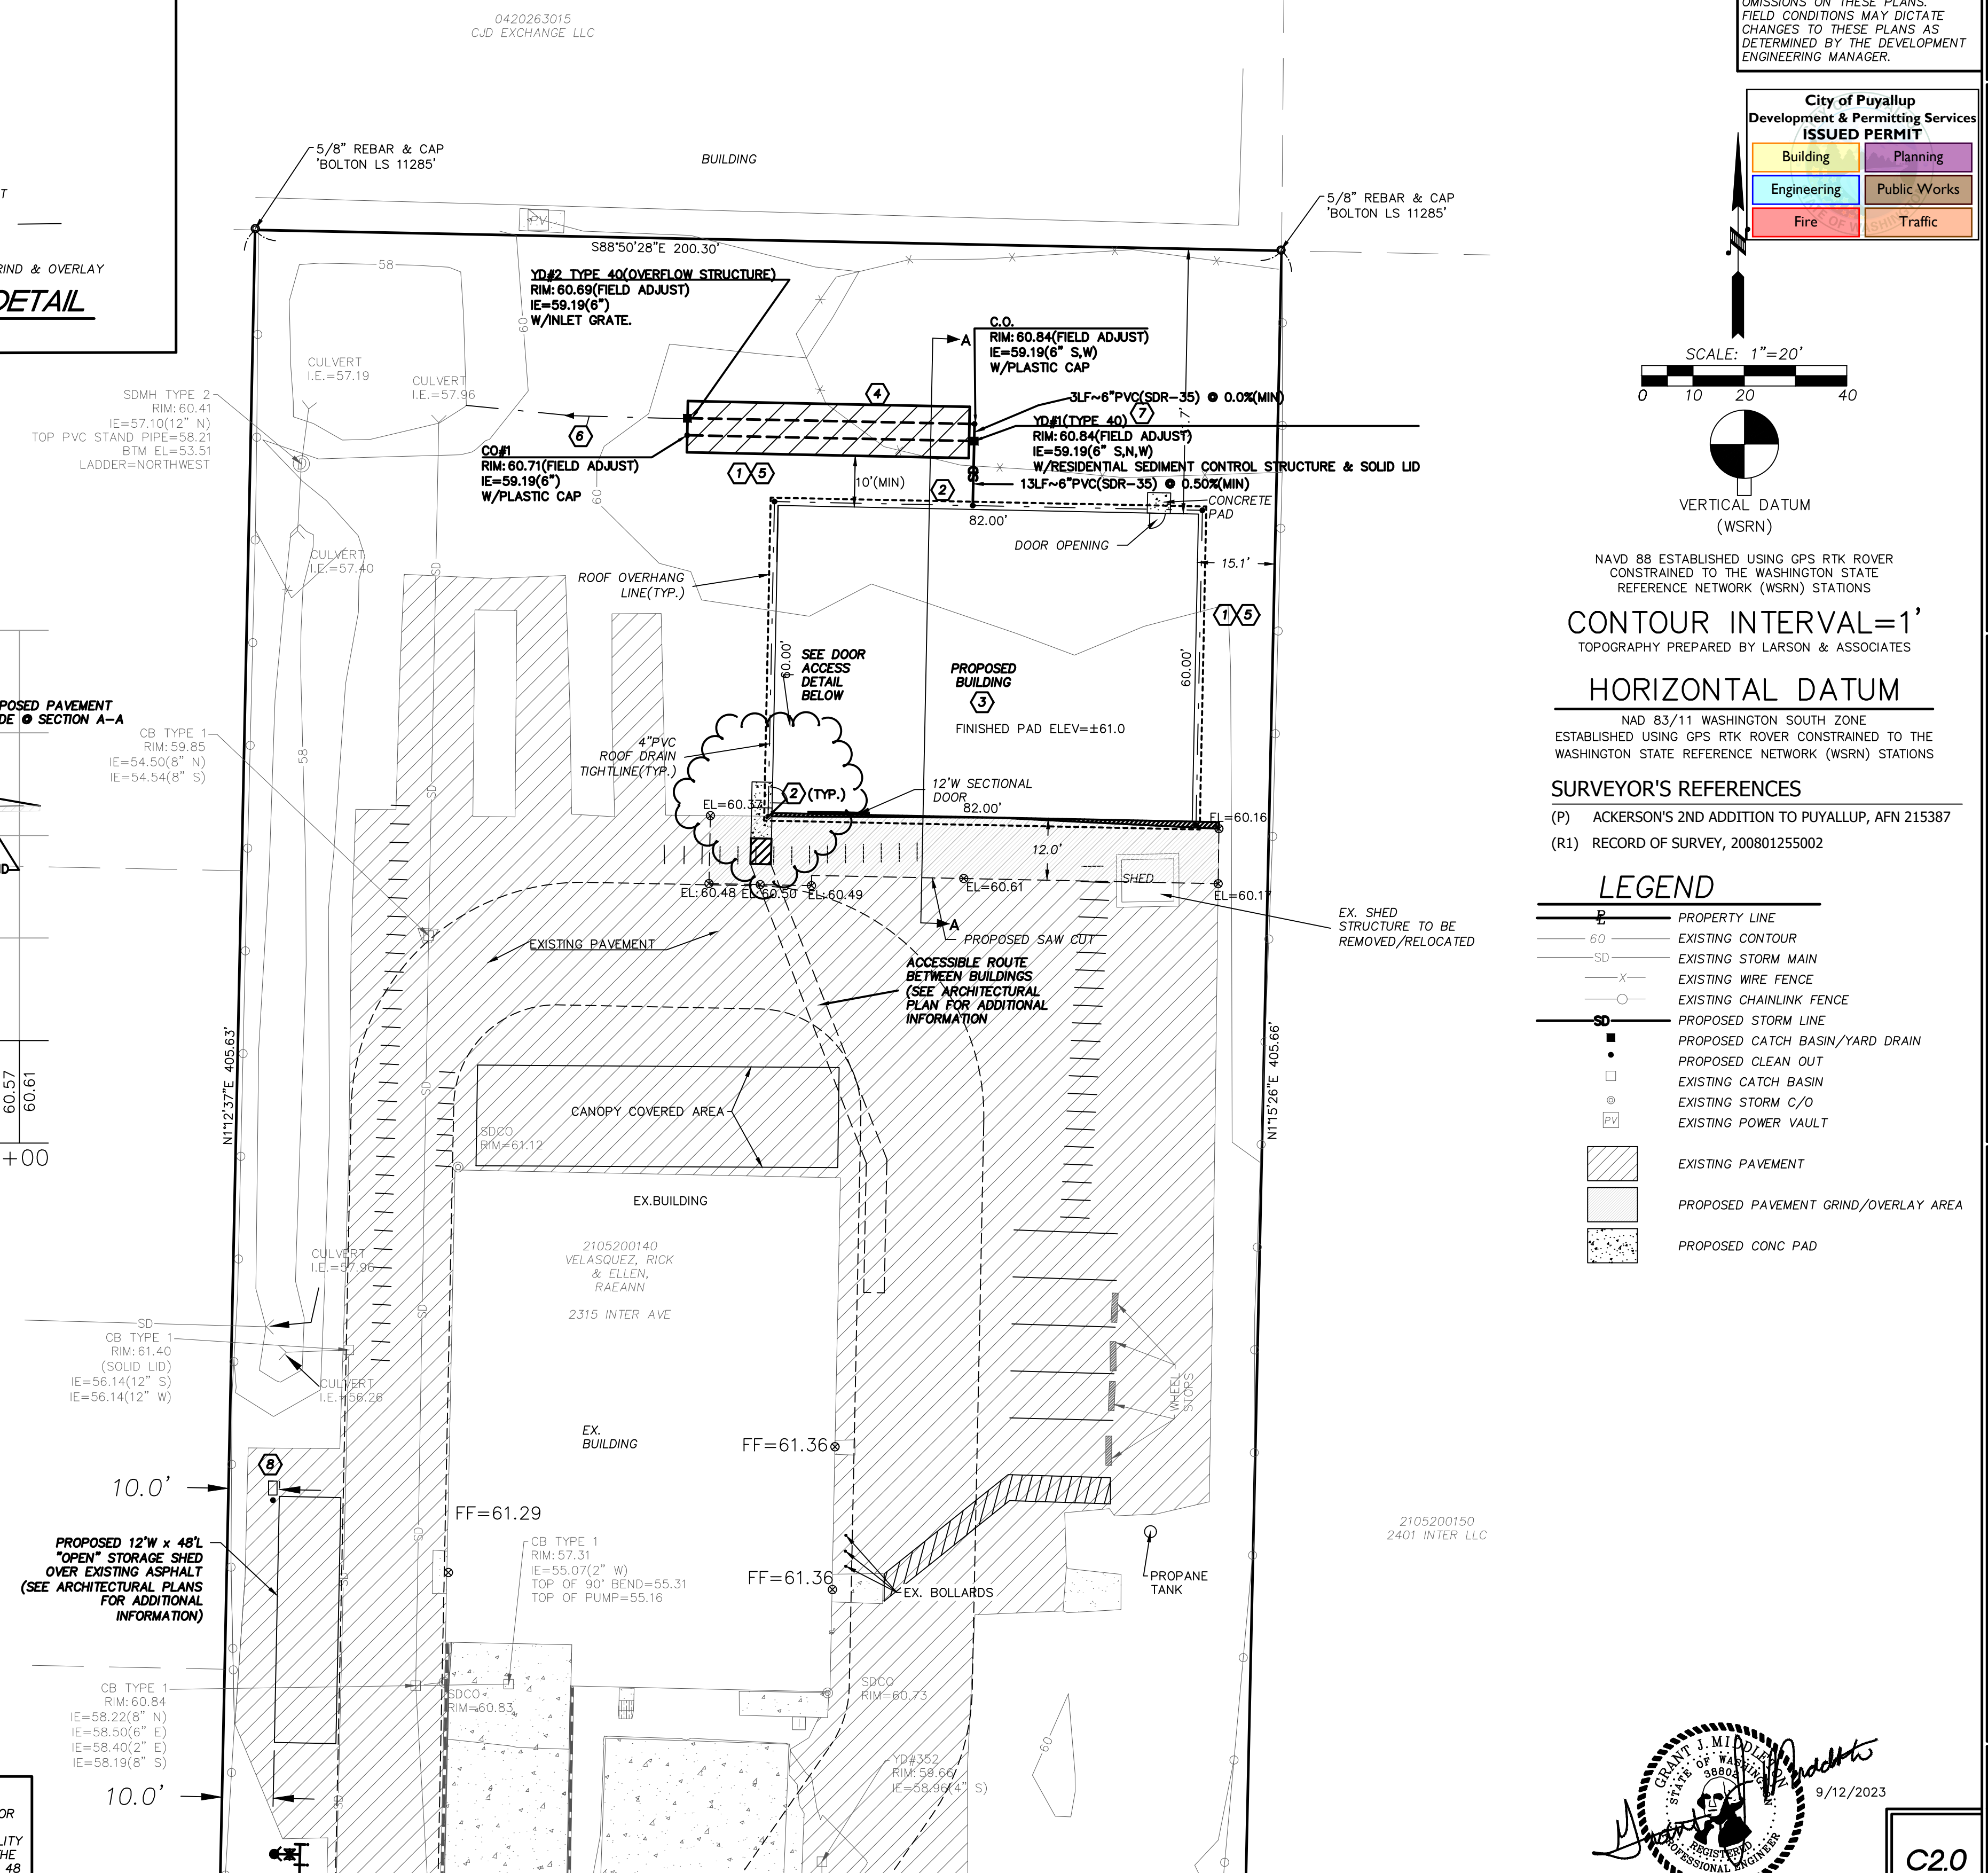

JOB NUMBER: 9575

SCALE: 1"=20'

DESIGNED JLC

DRAWN DWN

CHECKED GJM

PH: (253) 224-4428


PROPOSED BY: RICK VELASQUEZ, 13615 122ND ST E, PUYALLUP, WA 98374

LARSON and ASSOCIATES, engineers & planners, 9027 PACIFIC AVENUE, SUITE 4, TACOMA, WA, 98444 (253) 474-3404

DATE: 9/12/2023

DRAWING NO.: 9575BASE

SHEET 4 OF 7

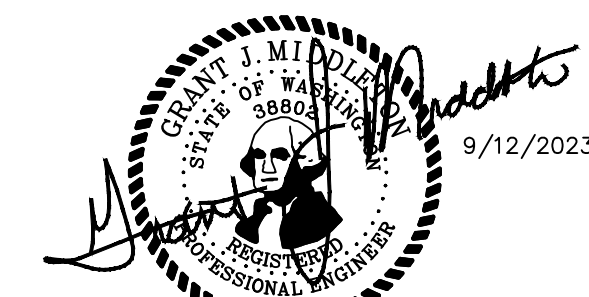

STORM NOTES

- ALL WORK IN CITY RIGHT-OF-WAY REQUIRES A PERMIT FROM THE CITY OF PUYALLUP. PRIOR TO ANY WORK COMMENCING, THE GENERAL CONTRACTOR SHALL ARRANGE FOR A PRECONSTRUCTION MEETING AT THE DEVELOPMENT SERVICES CENTER TO BE ATTENDED BY ALL CONTRACTORS THAT WILL PERFORM WORK SHOWN ON THE ENGINEERING PLANS, REPRESENTATIVES FROM ALL APPLICABLE UTILITY COMPANIES, THE PROJECT OWNER AND APPROPRIATE CITY STAFF. CONTACT ENGINEERING SERVICES TO SCHEDULE THE MEETING (253) 841-5568. THE CONTRACTOR IS RESPONSIBLE TO HAVE THEIR OWN APPROVED SET OF PLANS AT THE MEETING.
- AFTER COMPLETION OF ALL ITEMS SHOWN ON THESE PLANS AND BEFORE ACCEPTANCE OF THE PROJECT, THE CONTRACTOR SHALL OBTAIN A "PUNCH LIST" PREPARED BY THE CITY'S INSPECTOR DETAILING REMAINING ITEMS OF WORK TO BE COMPLETED. ALL ITEMS OF WORK SHOWN ON THESE PLANS SHALL BE COMPLETED TO THE SATISFACTION OF THE CITY PRIOR TO ACCEPTANCE OF THE WATER SYSTEM AND PROVISION OF SANITARY SEWER SERVICE.
- ALL MATERIALS AND WORKMANSHIP SHALL CONFORM TO THE STANDARD SPECIFICATIONS FOR ROAD, BRIDGE, AND MUNICIPAL CONSTRUCTION (HEREINAFTER REFERRED TO AS THE "STANDARD SPECIFICATIONS"), WASHINGTON STATE DEPARTMENT OF TRANSPORTATION AND AMERICAN PUBLIC WORKS ASSOCIATION, WASHINGTON STATE CHAPTER, LATEST EDITION, UNLESS SUPERSEDED OR AMENDED BY THE CITY OF PUYALLUP CITY STANDARDS FOR PUBLIC WORKS ENGINEERING AND CONSTRUCTION (HEREINAFTER REFERRED TO AS THE "CITY STANDARDS").
- A COPY OF THESE APPROVED PLANS AND APPLICABLE CITY DEVELOPER SPECIFICATIONS AND DETAILS SHALL BE ON SITE DURING CONSTRUCTION.
- ANY REVISIONS MADE TO THESE PLANS MUST BE REVIEWED AND APPROVED BY THE DEVELOPER'S ENGINEER AND THE ENGINEERING SERVICES STAFF PRIOR TO ANY IMPLEMENTATION IN THE FIELD. THE CITY SHALL NOT BE RESPONSIBLE FOR ANY ERRORS AND/OR OMISSIONS ON THESE PLANS.
- THE CONTRACTOR SHALL HAVE ALL UTILITIES VERIFIED ON THE GROUND PRIOR TO ANY CONSTRUCTION. CALL AT LEAST TWO WORKING DAYS IN ADVANCE. THE OWNER AND HIS/HER ENGINEER SHALL BE CONTACTED IMMEDIATELY IF A CONFLICT EXISTS.
- ANY STRUCTURE AND/OR OBSTRUCTION WHICH REQUIRE REMOVAL OR RELOCATION RELATING TO THIS PROJECT, SHALL BE DONE SO AT THE DEVELOPER'S EXPENSE.
- DURING CONSTRUCTION, ALL EXISTING AND NEWLY INSTALLED DRAINAGE STRUCTURES SHALL BE PROTECTED FROM SEDIMENTS.
- ALL STORM MANHOLES SHALL CONFORM TO CITY STANDARD DETAIL NO. 02.01.01. FLOW CONTROL MANHOLE/OIL WATER SEPARATOR SHALL CONFORM TO CITY STANDARD DETAIL NO. 02.01.06 AND 02.01.07.
- MANHOLE RING AND COVER SHALL CONFORM TO CITY STANDARD DETAIL 06.01.02.
- CATCH BASINS TYPE I SHALL CONFORM TO CITY STANDARD DETAIL NO.02.01.02 AND 02.01.03 AND SHALL BE USED ONLY FOR DEPTHS LESS THAN 5 FEET FROM TOP OF THE GRATE TO THE INVERT OF THE STORM PIPE.
- CATCH BASINS TYPE II SHALL CONFORM TO CITY STANDARD DETAIL NO.02.01.04 AND SHALL BE USED FOR DEPTHS GREATER THAN 5 FEET FROM TOP OF THE GRATE TO THE INVERT OF THE STORM PIPE.
- CAST IRON OR DUCTILE IRON FRAME AND GRATE SHALL CONFORM TO CITY STANDARD DETAIL NO.02.01.05. GRATE SHALL BE MARKED WITH "DRAINS TO STREAM". SOLID CATCH BASIN LIDS (SQUARE UNLESS NOTED AS ROUND) SHALL CONFORM TO WSDOT STANDARD PLAN B-30.20-04 (OLYMPIC FOUNDRY NO. SM60 OR EQUAL). VANED GRATES SHALL CONFORM TO WSDOT STANDARD PLAN B-30.30-03 (OLYMPIC FOUNDRY NO. SM60V OR EQUAL).
- STORMWATER PIPE SHALL BE ONLY PVC, CONCRETE, DUCTILE IRON, OR DUAL WALLED POLYPROPYLENE PIPE.
 - THE USE OF ANY OTHER TYPE SHALL BE REVIEWED AND APPROVED BY THE ENGINEERING SERVICES STAFF PRIOR TO INSTALLATION.
 - PVC PIPE SHALL BE PER ASTM D3034, SDR 35 FOR PIPE SIZE 15-INCH AND SMALLER AND F679 FOR PIPE SIZES 18 TO 27 INCH. MINIMUM COVER ON PVC PIPE SHALL BE 3.0 FEET.
 - CONCRETE PIPE SHALL CONFORM TO THE WSDOT STANDARD SPECIFICATIONS FOR CONCRETE UNDERDRAIN PIPE. MINIMUM COVER ON CONCRETE PIPE SHALL NOT LESS THAN 3.0 FEET.
 - DUCTILE IRON PIPE SHALL BE CLASS 50, CONFORMING TO AWWA C151. MINIMUM COVER ON DUCTILE IRON PIPE SHALL BE 1.0 FOOT.
 - POLYPROPYLENE PIPE (PP) SHALL BE DUAL WALLED, HAVE A SMOOTH INTERIOR AND EXTERIOR CORRUGATIONS AND MEET WSDOT 9-05.24(1). 12-INCH THROUGH 30-INCH PIPE SHALL MEET OR EXCEED ASTM F2736 AND AASHTO M330, TYPE S, OR TYPE D. 36-INCH THROUGH 60-INCH PIPE SHALL MEET OR EXCEED ASTM F2881 AND AASHTO M330, TYPE S, OR TYPE D. TESTING SHALL BE PER ASTM F1417. MINIMUM COVER OVER POLYPROPYLENE PIPE SHALL BE 3-FEET.
- TRENCHING, BEDDING, AND BACKFILL FOR PIPE SHALL CONFORM TO CITY STANDARD DETAIL NO. 06.01.01.
- STORM PIPE SHALL BE A MINIMUM OF 10 FEET AWAY FROM BUILDING FOUNDATIONS AND/OR ROOF LINES.
- ALL STORM DRAIN MAINS SHALL BE TESTED AND INSPECTED FOR ACCEPTANCE AS OUTLINED IN SECTION 406 OF THE CITY OF PUYALLUP SANITARY SEWER SYSTEM STANDARDS.
- ALL TEMPORARY SEDIMENTATION AND EROSION CONTROL MEASURES, AND PROTECTIVE MEASURES FOR CRITICAL AREAS AND SIGNIFICANT TREES SHALL BE INSTALLED PRIOR TO INITIATING ANY CONSTRUCTION ACTIVITIES.

CIMCO SALES
NE 1/4, SW 1/4, SEC.26, TWN.20 N., RNG. 4 E., W.M.

SOIL AMENDMENT AND DEPTH

1. ALL SOIL AREAS DISTURBED OR COMPACTED DURING CONSTRUCTION, AND NOT COVERED BY BUILDINGS OR PAVEMENT, SHALL BE AMENDED WITH COMPOST AS DESCRIBED BELOW.

2. SUBSOIL SHOULD BE SCARIFIED (LOOSENE) 4 INCHES BELOW AMENDED LAYER, TO PRODUCE 12-INCH DEPTH OF UN-COMPACTED SOIL, EXCEPT WHERE SCARIFICATION WOULD DAMAGE TREE ROOTS OR AS DETERMINED BY THE ENGINEER. SEE NOTE BELOW REGARDING PLANTING STEPS FOR STREET TREES.

3. COMPOST SHALL BE TILLED IN TO 8 INCH DEPTH INTO EXISTING SOIL, OR PLACE 8 INCHES OF COMPOST-AMENDED SOIL, PER SOIL SPECIFICATION.

4. PLANTING BEDS SHALL RECEIVE 3 INCHES OF COMPOST TILLED IN TO 8-INCH DEPTH, OR MAY SUBSTITUTE 8" OF IMPORTED SOIL CONTAINING 35-45% COMPOST BY VOLUME. MULCH AFTER PLANTING, WITH 4 INCHES OF ARBORIST WOOD CHIP MULCH OR APPROVED EQUAL (6" OF LOOSE WOOD CHIPS AT THE TIME OF PLANTING TO ALLOW SETTLING TO 4").

5. STRIPKES TO PREVENT UNEVEN SETTLING, DO NOT COMPOST-AMEND SOILS WITHIN 3 FEET OF UTILITY INFRASTRUCTURES (POLES, WALKS, METERS ETC.). WITHIN ONE FOOT OF PAVEMENT EDGE, CURBS AND SIDEWALKS SOIL SHOULD BE COMPACTED TO APPROXIMATELY 95% PROCTOR TO ENSURE A FIRM SURFACE.

6. SEE SECTION 8.5(B) OF THE IAS FOR SOIL AMENDMENT AND RESTORATION PROCEDURES FOR STREET TREE PLANTER STRIPS. ALL STREET TREE PLANTER STRIPS SHALL RECEIVE 45% COMPOST AMENDED SOIL TO THE FULL DEPTH OF THE STREET TREE ROOTBALL.

CITY OF PUYALLUP
DEVELOPMENT ENGINEERING and PUBLIC WORKS DEPARTMENTS

SOIL AMENDMENT AND DEPTH

DESIGNED BY: LINDA LIAN	CHECKED BY: COLLIN HARRIS	APPROVED BY: COLLEEN HARRIS	DATE APPROVED: 07/29/2023	CITY STANDARD: 01.02.08a
FILE NAME: P:\PROJECTS\2023\20230729\20230729_01A.DWG	DATE APPROVED: 07/29/2023	DATE APPROVED: 07/29/2023	DATE APPROVED: 07/29/2023	DATE APPROVED: 07/29/2023

HOUSE INFILTRATION TRENCH NOTES:

- ALL STORMWATER RUNOFF FROM ROOF AND DRIVEWAY SHALL BE COLLECTED AND TIGHTLINED TO THE INFILTRATION TRENCH.
- TRENCHES SHALL BE INSTALLED ONLY IN UNDISTURBED GROUND WHICH HAS NOT BEEN FILLED OR EXCAVATED.
- TRENCHES SHALL BE PLACED TO RUN PARALLEL WITH NATURAL CONTOURS OF THE LAND.

WASHED ROCK SPECIFICATIONS

100% PASSING 6" SIEVE
80-100% PASSING 4" SIEVE
0-10% PASSING 1.5" SIEVE
0-2% PASSING 1" SIEVE
0-1% PASSING #200 SIEVE

TYPICAL BUILDING INFILTRATION TRENCH.
INSTALL 55' L X 10' W X 1.5' D INFILTRATION TRENCH W/DUAL (2) 6" PERF. PIPES @ S = 0.0% AND FILLED WITH WASHED ROCK. SEE DETAIL BELOW. TO BE INSTALLED AT TIME OF BUILDING CONSTRUCTION. CLEANOUT

INSTALL TEMPORARY MIRAFI SILT FENCE DOWNHILL SIDE OF BUILDING CONSTRUCTION TO PROTECT ROAD & STORM SYSTEMS FROM SEDIMENTATION.

SECTION

GROUND PROFILE
GROUND PROFILE
CLEANOUT (OPTIONAL)
WASHED ROCK
DUAL (2) 6" PERFORATED PIPE @ S=0.0%
SEDIMENT CONTROL STRUCTURE SEE DETAIL THIS SHEET.
NOTE: TRENCH MAY RUN PARALLEL TO BUILDING AS REQUIRED.

LARSON AND ASSOCIATES
LAND SURVEYORS & ENGINEERS, INC.

INFILTRATION TRENCH FOR THE BUILDING

REVISED DATE: 07.29.03 SCALE: N.T.S.
FILE NAME: P:\PROJECTS\LARSON\2023\20230729\20230729_01A.DWG
LARSON STANDARD DETAIL NO. 240

RESIDENTIAL INFILTRATION TRENCH SUMP STRUCTURE

0.5' MIN.
SOLID LOCKING LID
MESH SCREEN 1" X 1" BAND SCREEN TO PIPE
8" DIA. "T" MINIMUM
PIPE SUPPORTS, BAND TO SIDEWALL (2 PLACES, TYP.)
FINE MESH SCREEN 1/2" X 1/2" BAND SCREEN TO PIPE
1' MIN.
1' MIN.

CITY OF PUYALLUP
DEVELOPMENT ENGINEERING and PUBLIC WORKS DEPARTMENTS

RESIDENTIAL INFILTRATION TRENCH SUMP STRUCTURE

DESIGNED BY: LINDA LIAN	CHECKED BY: LINDA LIAN	APPROVED BY: COLLIN HARRIS	DATE APPROVED: 08/10/2023	CITY STANDARD: 02.05.02
FILE NAME: P:\PROJECTS\2023\20230810\20230810_01A.DWG	DATE APPROVED: 08/10/2023	DATE APPROVED: 08/10/2023	DATE APPROVED: 08/10/2023	DATE APPROVED: 08/10/2023

1. ALL LIMITS OF CLEARING AND AREAS OF VEGETATION PRESERVATION AS PRESCRIBED ON THE PLANS SHALL BE CLEARLY FLAGGED IN THE FIELD AND OBSERVED DURING CONSTRUCTION.

2. ALL REQUIRED SEDIMENTATION AND EROSION CONTROL FACILITIES MUST BE CONSTRUCTED AND IN OPERATION PRIOR TO ANY LAND CLEARING AND/OR OTHER CONSTRUCTION TO ENSURE THAT SEDIMENT LADEN WATER DOES NOT ENTER THE NATURAL DRAINAGE SYSTEM. THE CONTRACTOR SHALL SCHEDULE AN INSPECTION OF THE EROSION CONTROL FACILITIES PRIOR TO ANY LAND CLEARING AND/OR CONSTRUCTION. ALL EROSION AND SEDIMENT FACILITIES SHALL BE MAINTAINED IN A SATISFACTORY CONDITION AS DETERMINED BY THE CITY, UNTIL SUCH TIME THAT CLEARING AND/OR CONSTRUCTION IS COMPLETED AND THE POTENTIAL FOR ON-SITE EROSION HAS PASSED. THE IMPLEMENTATION, MAINTENANCE, REPLACEMENT, AND ADDITIONS TO THE EROSION AND SEDIMENTATION CONTROL SYSTEMS SHALL BE THE RESPONSIBILITY OF THE PERMITEE.

3. THE EROSION AND SEDIMENTATION CONTROL SYSTEM FACILITIES DEPICTED ON THESE PLANS ARE INTENDED TO BE MINIMUM REQUIREMENTS TO MEET ANTICIPATED SITE CONDITIONS. AS CONSTRUCTION PROGRESSES AND UNEXPECTED OR SEASONAL CONDITIONS DICTATE, FACILITIES WILL BE NECESSARY TO ENSURE COMPLETE SILTATION CONTROL ON THE SITE. DURING THE COURSE OF CONSTRUCTION, IT SHALL BE THE OBLIGATION AND RESPONSIBILITY OF THE PERMITEE TO ADDRESS ANY NEW CONDITIONS THAT MAY BE CREATED BY HIS ACTIVITIES AND TO PROVIDE ADDITIONAL FACILITIES, OVER AND ABOVE THE MINIMUM REQUIREMENTS, AS MAY BE NEEDED TO PROTECT ADJACENT PROPERTIES, SENSITIVE AREAS, NATURAL WATER COURSES, AND/OR STORM DRAINAGE SYSTEMS.

4. APPROVAL OF THESE PLANS IS FOR GRADING, TEMPORARY DRAINAGE, EROSION AND SEDIMENTATION CONTROL ONLY. IT DOES NOT CONSTITUTE AN APPROVAL OF PERMANENT STORM DRAINAGE DESIGN, SIZE OR LOCATION OF PIPES, RESTRICTORS, CHANNELS, OR RETENTION FACILITIES.

5. ANY DISTURBED AREA WHICH HAS BEEN STRIPPED OF VEGETATION AND WHERE NO FURTHER WORK IS ANTICIPATED FOR A PERIOD OF 30 DAYS OR MORE, MUST BE IMMEDIATELY STABILIZED WITH MULCHING, GRASS PLANTING, OR OTHER APPROVED EROSION CONTROL TREATMENT APPLICABLE TO THE TIME OF YEAR IN QUESTION. GRASS SEEDING ALONE WILL BE ACCEPTABLE ONLY DURING THE MONTHS OF APRIL THROUGH SEPTEMBER INCLUSIVE. SEEDING MAY PROCEED OUTSIDE THE SPECIFIED TIME PERIOD WHENEVER IT IS IN THE INTEREST OF THE PERMITEE BUT MUST BE AUGMENTED WITH MULCHING, NETTING, OR OTHER TREATMENT APPROVED BY THE CITY.

6. IN CASE EROSION OR SEDIMENTATION OCCURS TO ADJACENT PROPERTIES, ALL CONSTRUCTION WORK WITHIN THE DEVELOPMENT THAT WILL FURTHER AGGRAVATE THE SITUATION MUST CEASE, AND THE OWNER/CONTRACTOR WILL IMMEDIATELY COMMENCE RESTORATION METHODS. RESTORATION ACTIVITY WILL CONTINUE UNTIL SUCH TIME AS THE AFFECTED PROPERTY OWNER IS SATISFIED.

7. NO TEMPORARY OR PERMANENT STOCKPILING OF MATERIALS OR EQUIPMENT SHALL OCCUR WITHIN CRITICAL AREAS OR ASSOCIATED BUFFERS, OR THE CRITICAL ROOT ZONE FOR VEGETATION PROPOSED FOR RETENTION.

CITY OF PUYALLUP
DEVELOPMENT ENGINEERING and PUBLIC WORKS DEPARTMENTS

GRADING, EROSION, AND SEDIMENTATION CONTROL NOTES

DESIGNED BY: LINDA LIAN	CHECKED BY: COLLIN HARRIS	APPROVED BY: COLLEEN HARRIS	DATE APPROVED: 07/29/2023	CITY STANDARD: 05.02.01
FILE NAME: P:\PROJECTS\2023\20230729\20230729_01A.DWG	DATE APPROVED: 07/29/2023	DATE APPROVED: 07/29/2023	DATE APPROVED: 07/29/2023	DATE APPROVED: 07/29/2023

DOWNSPOUT SPLASHBLOCK DETAIL
N.T.S.

WALL
ROOF DOWNSPOUT
DOWNSPOUT EXTENSION
SPLASHBLOCK
EXISTING PAVEMENT

REVISION BLOCK

NO.	DATE	DESCRIPTION	BY
1	8/1/2023	ADDRESS CITY COMMENTS AND ADD NEW "OPEN" STORAGE SHED OVER EXISTING PAVEMENT AS SHOWN.	GJM

APPROVED
BY: [Signature]
CITY OF PUYALLUP
ENGINEERING DEPARTMENT
DATE: 10/10/2023

NOTE: THIS APPROVAL IS VOID AFTER 180 DAYS FROM APPROVAL DATE. THE CITY WILL NOT BE RESPONSIBLE FOR ERRORS AND/OR OMISSIONS ON THESE PLANS. FIELD CONDITIONS MAY DICTATE CHANGES TO THESE PLANS AS DETERMINED BY THE DEVELOPMENT ENGINEERING MANAGER.

DESIGNED JLC
DRAWN DWN
CHECKED GJM

SCALE: N/A
HOR: N/A
VERT: N/A

City of Puyallup Development & Permitting Services ISSUED PERMIT

Building Planning
Engineering Public Works
Fire Traffic

JOB NUMBER
9575

PROPOSED BY: RICK VELASQUEZ
13615 122ND ST E
PUYALLUP, WA 98374
PH: (253) 224-4428

LARSON AND ASSOCIATES
surveyors, engineers & planners
9027 PACIFIC AVENUE, SUITE 4
TACOMA, WA 98444 (253) 474-3404

STORM DETAILS AND SPECIFICATIONS

GRANT J. MITCHELL
STATE OF WASHINGTON
LICENSED PROFESSIONAL ENGINEER
9880
9/12/2023

DATE: 9/12/2023
DRAWING NO.: 9575BASE
SHEET 5 OF 7

C21

APPROVED
BY *[Signature]*
CITY OF PUYALLUP
ENGINEERING DEPARTMENT
DATE **10/10/2023**

NOTE: THIS APPROVAL IS VOID AFTER 180 DAYS FROM APPROVAL DATE. THE CITY WILL NOT BE RESPONSIBLE FOR ERRORS AND/OR OMISSIONS ON THESE PLANS. FIELD CONDITIONS MAY DICTATE CHANGES TO THESE PLANS AS DETERMINED BY THE DEVELOPMENT ENGINEERING MANAGER.

JOB NUMBER
9575

SCALE
HOR: N/A
VERT: N/A

DESIGNED JLC
DRAWN DWN
CHECKED GJM

PROPOSER:
RICK VELASQUEZ
13615 122ND ST E
PUYALLUP, WA 98374
PH: (253) 224-4428

**City of Puyallup
Development & Permitting Services
ISSUED PERMIT**

Building	Planning
Engineering	Public Works
Fire	Traffic

WATER MAIN CROSSING OTHER UTILITIES

NOTE: CONTRACTOR SHALL VERIFY LOCATION AND DEPTH OF EXISTING AND/OR PROPOSED UTILITIES.

NOTE: CONTRACTOR SHALL MAINTAIN 2'-0" MINIMUM HORIZONTAL DISTANCE BETWEEN GAS, POWER, AND PHONE MEASURED FROM OUTER EDGE OF PIPE TO OUTER EDGE OF PIPE.

NOTE: CONTRACTOR SHALL MAINTAIN 10'-0" MINIMUM HORIZONTAL DISTANCE BETWEEN WATER AND SEWER MEASURED FROM OUTER EDGE OF PIPE TO OUTER EDGE OF PIPE.

NOTE: CONTRACTOR SHALL MAINTAIN 18" (1.5') MINIMUM VERTICAL CLEARANCE OF WATER ABOVE SEWER MEASURED FROM OUTER EDGE OF PIPE TO OUTER EDGE OF PIPE.

SEE CITY STANDARD 03.01.03-2 FOR ADDITIONAL NOTES FOR THIS DETAIL.

CITY OF PUYALLUP
OFFICE OF THE CITY ENGINEER
APPROVED FOR PUBLICATION
DATE: 2/15/2018
CITY STANDARD 03.01.03-1

NOTE: DRAWINGS DEPICT BLOCK LOCATION, NOT SIZE. FOR SIZE SEE NOTES 3, 4, 5, AND CITY STD. 03.02.01-3

HORIZONTAL THRUST BLOCKING

NOTE: THE FOLLOWING PRECAUTIONS MUST BE OBSERVED WHEN CONSTRUCTING THRUST BLOCKS:

- BLOCKS MUST BE POURED OR PLACED AGAINST UNDISTURBED SOIL.
- THE PIPE FITTING(S) MUST BE ACCESSIBLE. WRAP IN PLASTIC BEFORE POURING CONCRETE BLOCKING.
- CONCRETE SHOULD BE CURED FOR AT LEAST 5 DAYS AND SHOULD HAVE A MINIMUM COMPRESSION STRENGTH OF 3,000 PSI AT 28 DAYS.
- RESTRAINED JOINTS SHALL BE INSTALLED, IN ADDITION TO CONCRETE THRUST BLOCKING.
- BLOCKS MUST BE POSITIONED TO COUNTERACT THE DIRECTION OF THE RESULTANT THRUST FORCE.
- ALL PIPE SHALL BE PROPERLY BEADED. SEE CITY OF PUYALLUP STANDARD BEADING DETAIL NO. 06.01.01.
- CONTRACTOR TO PROVIDE BLOCKING ADEQUATE TO WITHSTAND FULL TEST PRESSURE.
- AREAS SHALL BE ADJUSTED FOR OTHER PRESSURE CONDITIONS.
- NO WATER MAIN SHALL DEAD END AGAINST A MAIN LINE VALVE. DEAD END WATER MAINS SHALL BE BLOCKED AGAINST A RESTRAINED MECHANICAL JOINT (M.J.) PLUG OR CAP.

CITY OF PUYALLUP
OFFICE OF THE CITY ENGINEER
APPROVED FOR PUBLICATION
DATE: 2/15/2018
CITY STANDARD 03.02.01-1

TABLE 2: THRUST AT FITTINGS AT 200 PSI

TEST PRESSURE (PSI)	THRUST FITTINGS AT 200 PSI				
	A	B	C	D	E
4"	3,140	4,440	2,405	1,225	615
6"	7,070	9,995	5,410	2,760	1,385
8"	12,565	17,770	9,820	4,905	2,465
10"	19,635	27,770	15,030	7,660	3,850
12"	28,275	39,885	21,640	11,030	5,545
14"	38,485	54,425	29,455	15,015	7,545
16"	50,285	71,085	38,470	19,615	9,855

TABLE 3: BEARING VALUE OF SOIL

SOIL TYPE	SAFE BEARING LOAD (LBS/FT ²)
MUCK, PEAT, ETC.	0
SOFT CLAY/ALLUVIAL SOIL	1,000
SAND	2,000
SAND AND GRAVEL	3,000
SAND AND GRAVEL CEMENTED WITH CLAY	4,000
HARD SHALE	10,000

SEE CITY STANDARDS 03.02.01-1 AND 03.02.01-2 FOR ADDITIONAL INFORMATION.

THRUST BLOCKING TABLE

CITY OF PUYALLUP
OFFICE OF THE CITY ENGINEER
APPROVED FOR PUBLICATION
DATE: 2/15/2018
CITY STANDARD 03.02.01-3

AUTO SPRINKLER

FIRE DEPARTMENT CONNECTION (FDC)

NOTE: THE FDC SHALL BE A MINIMUM OF 50 FEET FROM THE BUILDING, UNLESS APPROVED BY THE FIRE CODE OFFICIAL, BUT NEVER LESS THAN 5 FEET FROM BUILDING.

IDENTIFICATION PLATECAST DETAIL NOTES:

- IDENTIFICATION PLATECAST SHALL BE BRASS.
- IDENTIFICATION PLATECAST WILL BE 1/4" THICK.
- LETTERS WILL BE ONE INCH HIGH AND RAKED.
- USE TWO (2) 2# 3" U-BOLTS TO AFFIX TO PIPE.

CITY OF PUYALLUP
OFFICE OF THE CITY ENGINEER
APPROVED FOR PUBLICATION
DATE: 2/15/2018
CITY STANDARD 03.10.02

WATER MAIN CROSSING OTHER UTILITIES (NOTES)

NOTE: LOCAL CONDITIONS PREVENT THE SEPARATIONS DESCRIBED ON CITY STANDARD 03.01.03-1, A SEWER MAY BE LAID CLOSER THAN 10'-FEET HORIZONTALLY OR 18-INCHES VERTICALLY TO A WATER LINE, PROVIDED THE GUIDELINES BELOW ARE FOLLOWED:

UNUSUAL CONDITIONS (PARALLEL SYSTEMS)

- SEWER LINE IS LAID IN A SEPARATE TRENCH FROM THE WATER LINE.
- WHEN 18-INCHES VERTICAL SEPARATION CANNOT BE OBTAINED, THE SEWER SHALL BE CONSTRUCTED OF MATERIALS AND JOINTS THAT ARE EQUIVALENT TO WATER MAIN STANDARDS OF CONSTRUCTION AND SHALL BE PRESSURE TESTED TO ENSURE WATER TIGHTNESS PRIOR TO BACKFILLING.
- THE WATER LINE SHALL BE PLACED ON A BENCH OF UNDISTURBED EARTH WITH THE BOTTOM OF THE WATER PIPE AT LEAST 18-INCHES ABOVE THE CROWN OF THE SEWER, AND SHALL HAVE AT LEAST 3'-FEET OF HORIZONTAL SEPARATION AT ALL TIMES. THE CITY RESERVES THE RIGHT TO REQUIRE SUPPLEMENTAL MITIGATION EFFORTS, SUCH AS IMPERMEABLE BARRIERS OR OTHER MEANS, FOR ADDITIONAL PROTECTION.
- THE SEWER SHALL NOT BE INSTALLED IN THE SAME DITCH AS A POTABLE WATER LINE WITHOUT PRIOR WRITTEN APPROVAL BY THE CITY OF PUYALLUP.

UNUSUAL CONDITIONS (PERPENDICULAR SYSTEMS)

CONDITION A - GRAVITY SEWERS PASSING UNDER WATER LINES (ALL OF THE FOLLOWING APPLY)

- ONE FULL SEGMENT (NOT LESS THAN 18'-FEET LONG) OF DUCTILE IRON CLASS 50 WATER PIPE, AND THE LONGEST STANDARD SEWER PIPE LENGTH AVAILABLE FROM THE MANUFACTURER SHALL BE USED WITH THE PIPES CENTERED TO MAXIMIZE JOINT SEPARATION.
- STANDARD GRAVITY-SEWER MATERIAL ENCASED IN CONCRETE OR IN A ONE-QUARTER-INCH THICK CONTINUOUS STEEL, DUCTILE IRON, OR PRESSURE RATED PVC PIPE WITH A DIMENSION RATIO (THE RATIO OF THE OUTSIDE DIAMETER TO THE WALL THICKNESS) OF 18 OR LESS, WITH ALL JOINTS PRESSURE-GRADED WITH SAND-CEMENT GROUT OR BENTONITE.

EXAMPLE OF DIMENSION RATIO (DR): OUTSIDE PIPE DIAMETER DIVIDED BY THE WALL THICKNESS OR DR/7.
FOR 8-INCH SD40 PVC (1-1/4 INCHES), THE DR IS 8.425/0.8125=10.33

CONDITION B - GRAVITY SEWERS PASSING OVER WATER LINES

WATER LINES SHALL BE PROTECTED BY PROVIDING:

- A VERTICAL SEPARATION OF AT LEAST 18-INCHES BETWEEN THE INVERT OF THE SEWER AND THE CROWN OF THE WATER LINE.
- ADEQUATE STRUCTURAL SUPPORT FOR THE SEWER LINE TO PREVENT EXCESSIVE DEFLECTION OF JOINTS AND SETTLING ON AND BREAKING OF THE WATER LINE.
- THE SEWER PIPES SHALL BE THE LONGEST STANDARD SEWER PIPE LENGTH AVAILABLE FROM THE MANUFACTURER WITH THE WATER AND SEWER PIPES CENTERED TO MAXIMIZE JOINT SEPARATION.
- THE SEWER LINE CASING EQUIVALENT TO THAT SPECIFIED IN (A) ABOVE.

CITY OF PUYALLUP
OFFICE OF THE CITY ENGINEER
APPROVED FOR PUBLICATION
DATE: 2/15/2018
CITY STANDARD 03.01.03-2

VERTICAL THRUST BLOCKING

A LENGTH OF 3/8" (MINIMUM - SEE TABLE BELOW) GALVANIZED CHAIN WRAPPED TIGHTLY TWO TIMES AROUND FITTING WITH A #4 BAR PLACED THROUGH THE CHAIN ENDS EMBEDDED INTO THE CONCRETE THRUST BLOCKING.

RESTRAINED JOINTS SHALL BE INSTALLED WITH ALL VERTICAL THRUST BLOCKING.

11'-1/4" TO 45' BEND

11'-1/4" TO 45' BEND

TABLE 1: CONCRETE BLOCKING FOR VERTICAL BENDS

PIPE DIAMETER (INCHES)	TEST PRESSURE (PSI)	BEND ANGLE (DEG)	CONCRETE VOLUME (CY)	CURE SIZE (FEET)	CHAIN SIZE (INCHES)	CHAIN EMBEUREMENT (INCHES)
4"	200	11.25°	6	1.8	3/8"	17"
		22.5°	12	2.3		
		45°	22	2.8		
6"	200	11.25°	14	2.4	3/8"	17"
		22.5°	27	3.0		
		45°	50	3.7		
8"	200	11.25°	25	2.9	3/8"	17"
		22.5°	48	3.6		
		45°	89	4.5		
10"	200	11.25°	38	3.4	3/8"	17"
		22.5°	75	4.2		
		45°	139	5.2		
12"	200	11.25°	55	3.8	3/8"	17"
		22.5°	108	4.8		
		45°	200	5.8		
14"	200	11.25°	75	4.2	3/8"	17"
		22.5°	147	5.3		
		45°	272	6.5		
16"	200	11.25°	98	4.6	3/8"	17"
		22.5°	192	5.8		
		45°	355	7.1		

ALL NOTES ON CITY STANDARD 03.02.01-1 SHALL APPLY TO THIS DETAIL. SEE CITY STANDARD 03.02.01-3 FOR ADDITIONAL INFORMATION.

CITY OF PUYALLUP
OFFICE OF THE CITY ENGINEER
APPROVED FOR PUBLICATION
DATE: 2/15/2018
CITY STANDARD 03.02.01-2

FIRE HYDRANT ASSEMBLY

NOTE: THE TOP OF POST SHALL BE NOT LESS THAN 3 FEET ABOVE GROUND.

NOTE: FOOTING SHALL BE NOT LESS THAN 15" IN DIAMETER AND SHALL CONSIST OF ORDERED COMPACTED ROCK CONFORMING TO NOTE 2, CITY STANDARD 06.01.01, FILED TO WITHIN 4" OF GROUND LEVEL.

NOTE: VALVE BOX SHALL BE INSTALLED AS SPECIFIED IN CITY STANDARD 03.01.01 - WATER VALVES AND MAIN.

NOTE: GATE VALVE SHALL BE INSTALLED AS SPECIFIED IN CITY STANDARD 03.01.01 - WATER VALVES AND MAIN.

NOTE: THE HOLDING SPOOL SHALL BE A MECHANICAL-JOINT (M.J.) HOLDING SPOOL, WITH THE USE OF MEGA-LUG CONNECTORS OR APPROVED EQUAL WITH CLASS 52 DUCTILE IRON PIPE.

NOTE: IF DISTANCE BETWEEN WATER MAIN AND FIRE HYDRANT IS GREATER THAN 17 FEET, RESTRAINED JOINTS ARE REQUIRED ON ANY ADDITIONAL JOINTS. THE MAXIMUM 6-INCH HYDRANT RUN ALLOWED IS 20 FEET. ANY PROPOSED HYDRANT RUN EXCEEDING 20' IN LENGTH SHALL BE SIZED USING AN ENGINEERED HYDRAULIC FIRE FLOW MODEL. ANY HYDRANT RUN EXCEEDING 50 FEET IN LENGTH SHALL BE NO LESS THAN 8-INCHES IN DIAMETER.

NOTE: FIRE HYDRANTS SHALL BE LOCATED A MINIMUM OF 50 FEET FROM A BUILDING OR STRUCTURE.

NOTE: THE CONTRACTOR SHALL PLACE A 6 OZ. GENTLEWEAVE FABRIC AROUND THE WASHED ROCK AREA, ENDS TO OVERLAP.

NOTE: A FLUORESCENT ORANGE BAND MUST COVER AND BE SECURED TO THE FIRE HYDRANT UNTIL APPROVED FOR USE BY CITY ENGINEER.

NOTE: A MINIMUM THREE FOOT (3') RADIUS UNRESTRICTED CLEAR ZONE (WORK AREA) SHALL BE PROVIDED AROUND ALL FIRE HYDRANTS. ADDITIONALLY, NO WOODY LANDSCAPE SHALL BE PLANTED WITHIN TEN FEET (10') OF ANY FIRE HYDRANT. OVERHANGING BRANCHES OF TREES ADJACENT TO HYDRANTS SHALL HAVE A MAINTAINING CLEARANCE OF SEVEN (7) FEET ABOVE FINISHED GRADE OF THE FIRE HYDRANT.

CITY OF PUYALLUP
OFFICE OF THE CITY ENGINEER
APPROVED FOR PUBLICATION
DATE: 11/17/2022
CITY STANDARD 03.05.01

POST INDICATOR VALVE

FIELD ADJUSTMENT INSTRUCTIONS

- REMOVE THE BODY FROM THE TOP OF THE INDICATOR POST ASSEMBLY.
- CUT THE REQUIRED LENGTH OFF THE BOTTOM OF THE STANDPIPE FOR THE GROUND LINE TO MATCH UP WITH STANDPIPE GROUND LINE MARK.
- CUT THE 1" SQ. EXTENSION AT A DISTANCE OF 9" ABOVE THE TOP OF THE STANDPIPE.
- SET THE "OPEN" AND "SHUT" TARGETS FOR THE APPROPRIATE VALVE SIZE.
- RE-ATTACH THE BODY TO THE TOP OF THE INDICATOR POST ASSEMBLY.
- ALL POST INDICATOR VALVES SHALL BE INSTALLED WITH AN ELECTRONIC A.L. LITTED TAMPER SWITCH.
- THESE SHALL BE 3/4" OF UNRESTRICTED CLEARANCE AROUND THE PERIMETER OF ALL POST INDICATOR VALVES.
- POST INDICATOR VALVE SHALL BE LOCATED AT A MINIMUM 5'-R FROM BUILDING.

CITY OF PUYALLUP
OFFICE OF THE CITY ENGINEER
APPROVED FOR PUBLICATION
DATE: 2/15/2018
CITY STANDARD 03.10.03

CITY OF PUYALLUP
OFFICE OF THE CITY ENGINEER
APPROVED FOR PUBLICATION
DATE: 2/15/2018
CITY STANDARD 03.01.03-2

CITY OF PUYALLUP
OFFICE OF THE CITY ENGINEER
APPROVED FOR PUBLICATION
DATE: 2/15/2018
CITY STANDARD 03.02.01-2

CITY OF PUYALLUP
OFFICE OF THE CITY ENGINEER
APPROVED FOR PUBLICATION
DATE: 11/17/2022
CITY STANDARD 03.05.01

REVISION BLOCK			
NO.	DATE	DESCRIPTION	BY
1	8/1/2023	AND ADD NEW "OPEN" STORAGE SHED OVER EXISTING PAVEMENT AS SHOWN.	GJM

DATE
9/12/2023

DRAWING NO.
9575BASE

SHEET 6 OF 7

C2.2

LARSON AND ASSOCIATES
surveyors, engineers & planners
9027 PACIFIC AVENUE, SUITE 4
TACOMA, WA 98444
(253) 474-3404

DETAILS & SPECIFICATIONS

CIMCO SALES


NE 1/4, SW 1/4, SEC.26, TWN.20 N., RNG. 4 E., W.M.

WATER SYSTEM NOTES


- ALL WORK IN CITY RIGHT-OF-WAY REQUIRES A PERMIT FROM THE CITY OF PUYALLUP. PRIOR TO ANY WORK COMMENCING, THE GENERAL CONTRACTOR SHALL ARRANGE FOR A PRECONSTRUCTION MEETING AT THE DEVELOPMENT SERVICES CENTER TO BE ATTENDED BY ALL CONTRACTORS THAT WILL PERFORM WORK SHOWN ON THE ENGINEERING PLANS, REPRESENTATIVES FROM ALL APPLICABLE UTILITY COMPANIES, THE PROJECT OWNER AND APPROPRIATE CITY STAFF. CONTACT ENGINEERING SERVICES TO SCHEDULE THE MEETING 841-5568. THE CONTRACTOR IS RESPONSIBLE TO HAVE THEIR OWN APPROVED SET OF PLANS AT THE MEETING.
- AFTER COMPLETION OF ALL ITEMS SHOWN ON THESE PLANS AND BEFORE ACCEPTANCE OF THE PROJECT, THE CONTRACTOR SHALL OBTAIN A "PUNCH LIST" PREPARED BY THE CITY'S INSPECTOR DETAILING REMAINING ITEMS OF WORK TO BE COMPLETED. ALL ITEMS OF WORK SHOWN ON THESE PLANS SHALL BE COMPLETED TO THE SATISFACTION OF THE CITY PRIOR TO ACCEPTANCE OF THE WATER SYSTEM AND PROVISION OF SANITARY SEWER SERVICE.
- ALL MATERIALS AND WORKMANSHIP SHALL CONFORM TO THE STANDARD SPECIFICATIONS FOR ROAD, BRIDGE, AND MUNICIPAL CONSTRUCTION (HEREINAFTER REFERRED TO AS THE STANDARD SPECIFICATIONS), WASHINGTON STATE DEPARTMENT OF TRANSPORTATION AND AMERICAN PUBLIC WORKS ASSOCIATION, WASHINGTON STATE CHAPTER, LATEST EDITION, UNLESS SUPERSEDED OR AMENDED BY THE CITY OF PUYALLUP CITY STANDARDS FOR PUBLIC WORKS ENGINEERING AND CONSTRUCTION (HEREINAFTER REFERRED TO AS "CITY STANDARDS"), OR AS DIRECTED BY FRUITLAND MUTUAL WATER COMPANY (FMWC), VALLEY WATER (VW), OR TACOMA CITY WATER (TCW) IS THE PURVEYOR.
- A COPY OF THESE APPROVED PLANS AND APPLICABLE CITY DEVELOPER SPECIFICATIONS AND DETAILS SHALL BE ON SITE DURING CONSTRUCTION.
- ANY REVISIONS MADE TO THESE PLANS MUST BE REVIEWED AND APPROVED BY THE DEVELOPER'S ENGINEER, THE ENGINEERING SERVICES STAFF, AND THE FMWC, VW OR TCW WHEN SERVED BY THAT PURVEYOR. PRIOR TO ANY IMPLEMENTATION IN THE FIELD. THE CITY SHALL NOT BE RESPONSIBLE FOR ANY ERRORS AND/OR OMISSIONS ON THESE PLANS.
- THE CONTRACTOR SHALL HAVE ALL UTILITIES VERIFIED ON THE GROUND PRIOR TO ANY CONSTRUCTION. CALL AT LEAST TWO WORKING DAYS IN ADVANCE. THE OWNER AND HIS/HER ENGINEER SHALL BE CONTACTED IMMEDIATELY IF A CONFLICT EXISTS.
- ANY STRUCTURE AND/OR OBSTRUCTION WHICH REQUIRES REMOVAL OR RELOCATION RELATING TO THIS PROJECT SHALL BE DONE SO AT THE DEVELOPER'S EXPENSE.
- BACTERIOLOGICAL (COLIFORM AND IRON BACTERIA) TEST SAMPLES WILL BE TAKEN BY THE CITY (OR FMWC, VW OR TCW WHEN SERVED BY THAT PURVEYOR) AND PAID FOR BY THE CONTRACTOR, EXCEPT FOR CAPITAL IMPROVEMENT PROJECTS (CIP) WHICH SHALL BE PAID FOR BY THE CITY.
- WATER MAINS SHALL HAVE A MINIMUM COVER OF 36 INCHES FROM PAVED FINAL GRADE IN IMPROVED RIGHT-OF-WAY AND IMPROVED EASEMENTS, AND A MINIMUM OF 48 INCHES IN UNIMPROVED RIGHT-OF-WAY AND UNIMPROVED EASEMENTS.
- PIPE FOR WATER MAINS SHALL BE DUCTILE IRON CONFORMING TO SECTION 7-09 OF THE STANDARD SPECIFICATIONS, CLASS 52 WITH TYTON OR APPROVED EQUAL JOINTS. PIPE SHALL BE CEMENT LINED IN ACCORDANCE WITH A.S.A. SPECIFICATION A 21.4-1964.
- CONNECTIONS TO EXISTING WATER MAINS TYPICALLY SHALL BE WET TAPS THROUGH A TAPPING TEE AND TAPPING VALVE AND SHALL BE MADE BY A CITY APPROVED CONTRACTOR. THE TAPPING SLEEVE SHALL BE ROMAC SST ALL STAINLESS STEEL TAPPING SLEEVE OR APPROVED EQUAL. A TWO-PIECE EPOXY COATED OR DUCTILE IRON TAPPING SLEEVE MAY BE USED ON DUCTILE IRON PIPE, WHEN THE TAP IS SMALLER THAN THE WATER MAIN SIZE I.E. 8-INCH TAP ON 8-INCH PIPE. THE CITY (OR FMWC, VW OR TCW WHEN SERVED BY THAT PURVEYOR) SHALL APPROVE THE TIME AND LOCATION FOR THESE CONNECTIONS.
- ALL WATER MAINS AND APPURTENANCES SHALL BE HYDROSTATICALLY TESTED AT 200 PSI IN ACCORDANCE WITH STANDARD SPECIFICATION 7-09.3(23). PRESSURE TESTING SHALL NOT BE PERFORMED UNTIL SATISFACTORY PURITY SAMPLES HAVE BEEN RECEIVED, EXCEPT WHEN NEW WATER MAINS ARE INSTALLED INDEPENDENTLY FROM THE WATER SYSTEM PIPING.
- FIRE HYDRANTS SHALL BE INSTALLED IN ACCORDANCE WITH CITY STANDARD DETAIL 03.05.01 AND AS DIRECTED BY THE CITY OF PUYALLUP FIRE CODE OFFICIAL.
- VALVE MARKER POSTS SHALL BE INSTALLED WHERE VALVE BOXES ARE HIDDEN FROM VIEW OR IN UNPAVED THE INSTALLATION SHALL BE IN ACCORDANCE WITH CITY STANDARD DETAIL 03.01.02.
- RESILIENT SEATED WEDGE GATE VALVES SHALL BE USED FOR 10-INCH MAINS AND SMALLER. BUTTERFLY VALVES SHALL BE USED FOR MAINS GREATER THAN 10 INCHES.
- PIPE FITTING FOR WATER MAINS SHALL BE DUCTILE IRON AND SHALL BE MECHANICAL JOINT CONFORMING TO AWWA SPECIFICATION C111-72.
- WATER MAIN PIPE AND SERVICE CONNECTIONS SHALL BE A MINIMUM OF 10 FEET AWAY FROM BUILDING FOUNDATIONS AND/OR ROOF LINES.
- WHERE A WATER MAIN CROSSES THE NORTHWEST GAS PIPELINE, THE WATER LINE SHALL BE CAVED WITH PVC PIPE A MINIMUM OF 10 FEET BEYOND EACH SIDE OF THE GAS LINE EASEMENT. CONTACT WILLIAMS NORTHWEST PIPELINE BEFORE THE CROSSING IS MADE.
- TRENCHING, BEDDING, AND BACKFILL FOR WATER MAINS SHALL BE INSTALLED IN ACCORDANCE WITH CITY STANDARD DETAIL 06.01.01.
- ALL COMMERCIAL AND INDUSTRIAL DEVELOPMENTS, IRRIGATION SYSTEMS, AND MULTI-FAMILY WATER SERVICE CONNECTIONS SHALL BE PROTECTED BY A DOUBLE CHECK VALVE ASSEMBLY OR A REDUCED PRESSURE BACKFLOW ASSEMBLY AS DIRECTED BY THE CITY (OR FMWC, VW OR TCW WHEN SERVED BY THAT PURVEYOR) CONFORMING TO CITY STANDARD DETAILS 03.04.01, 03.04.02, AND 03.04.03.
- ANY LEAD JOINT FITTING DISTURBED DURING CONSTRUCTION SHALL BE REPLACED WITH A MECHANICAL JOINT FITTING AT THE CONTRACTOR'S EXPENSE.
- WHEN HYDRAULIC FIRE FLOW MODELING IS REQUIRED FOR A PROJECT, THE CITY WILL ISSUE A PERMIT. THE HYDRAULIC MODELING CRITERIA IS BASED ON THE PROJECTED 2030 WATER DEMAND, WHILE MAINTAINING A MINIMUM SYSTEM PRESSURE OF 20 POUNDS PER SQUARE INCH AND A MAXIMUM VELOCITY OF 10 FEET PER SECOND.
- WHEN USING A FIRE HYDRANT FOR NON-FIREFIGHTING PURPOSES, A CITY HYDRANT METER MUST BE USED. COORDINATE THE ACQUISITION OF THE HYDRANT METER WITH THE CITY'S UTILITY BILLING DIVISION AT PUYALLUP CITY HALL. A CITY APPROVED BACKFLOW PROTECTION ASSEMBLY SHALL BE INSTALLED BY THE PERSON REQUESTING USE OF A FIRE HYDRANT. THE ASSEMBLY SHALL BE ACCOMPANIED BY A CURRENT BACKFLOW ASSEMBLY TEST REPORT. THE TEST REPORT SHALL BE AVAILABLE AT THE SITE FOR THE DURATION OF THE HYDRANT USE.
- SHOULD A BREAK OCCUR ON ANY CITY WATER MAIN, THE CONTRACTOR SHALL FOLLOW THE CITY'S ADOPTED WATER MAIN BREAK PROCEDURE ISSUED TO THEM AT THE PRE-CONSTRUCTION MEETING AND NOTIFY THOSE CONNECTED TO THE SYSTEM IN THE IMPACTED AREA AS OUTLINED IN THE PROCEDURE.
- WATER MAIN REPAIRS (REFERENCES: AWWA C651-14 AND WSDOT STANDARD SPECIFICATION SECTION 7-09)
 - NOTE: A PLANNED WATER MAIN REPAIR SHALL BE APPROVED BY THE CITY INSPECTOR AND/OR WATER DIVISION SUPERVISOR PRIOR TO COMMENCING WORK.
 - REPAIR WITHOUT DEPRESSURIZATION - SMALL LEAKS SHALL BE REPAIRED USING REPAIR BANDS WHILE MAINTAINING POSITIVE PRESSURE IN THE WATER MAIN. VALVES SURROUNDING THE LEAK WILL BE PARTIALLY SHUT BY THE CITY WATER DEPARTMENT TO REDUCE THE FLOW AND PRESSURE TO THE AREA. BLOWOFFS AND HYDRANTS IN THE REDUCED PRESSURE AREA MAY BE OPENED AS NEEDED TO FURTHER REDUCE THE PRESSURE. THE WATER MAIN TRENCH SHALL BE OVER-EXCAVATED TO ALLOW WATER IN THE TRENCH TO BE PUMPED OUT AND MAINTAINED BELOW THE LEVEL OF THE WATER MAIN. THE REPAIR SHALL BE COMPLETED WITH THE WATER MAIN PRESSURE REMAINING POSITIVE. AFTER THE REPAIR IS MADE, THE SYSTEM SHALL BE FULLY PRESSURIZED AND A VISUAL LEAK INSPECTION WILL BE COMPLETED. THE WATER MAIN IN THE AFFECTED AREA SHALL BE FLUSHED TO ACHIEVE THREE PIPE VOLUMES PULLED FROM THE PIPE (DISTANCE MEASURED FROM VALVE OPENED FOR FLUSHING TO THE EXIT HYDRANT OR BLOWOFF).
 - REPAIR/CUT-IN WITH DEPRESSURIZATION - TRENCH SHALL BE OVER EXCAVATED AND DEWATERED BELOW THE WATER MAIN. FLUSH WATER FROM PIPE FROM EACH DIRECTION UNTIL IT RUNS CLEAR. IMMEDIATELY PRIOR TO INSTALLATION OF A NEW PIPE SECTION FOR REPAIR OR CUT IN TEE, ALL NEW FITTINGS AND PIPE SPOOLS SHALL BE SWABBED WITH A FIVE PERCENT (5%) CHLORINE SOLUTION (MINIMUM). THE INTERIOR OF THE EXISTING PIPE SHALL BE SWABBED WITH A FIVE PERCENT (5%) CHLORINE SOLUTION AT LEAST 6 FEET IN EACH DIRECTION FROM EXPOSED CUT ENDS. THE WATER MAIN IN THE AFFECTED AREA SHALL BE FLUSHED TO ACHIEVE THREE PIPE VOLUMES PULLED FROM THE PIPE (DISTANCE MEASURED FROM THE VALVE OPENED FOR FLUSHING TO THE EXIT HYDRANT OR BLOWOFF). CUSTOMERS SHALL BE NOTIFIED AFTER THE WATER MAIN IS FLUSHED AND REPAIRS HAVE BEEN COMPLETED, AS OUTLINED IN THE "WATER MAIN BREAK PROCEDURE."

65% Calcium Hypochlorite Addition per Pipe Section


Pipe Diameter (Inches)	Pipe Volume per 18 feet (gal)	5-gram tablets per pipe section	Hypochlorite Grams per 500 feet	Teaspoons per 18 feet	Maximum Fill Rate (gpm)
4	35	1	1.7	0.2	40
6	53	1	3.8	0.4	90
8	70	2	6.7	0.7	150
12	106	4	15.1	1.4	350
16	141	6	27	2.5	600

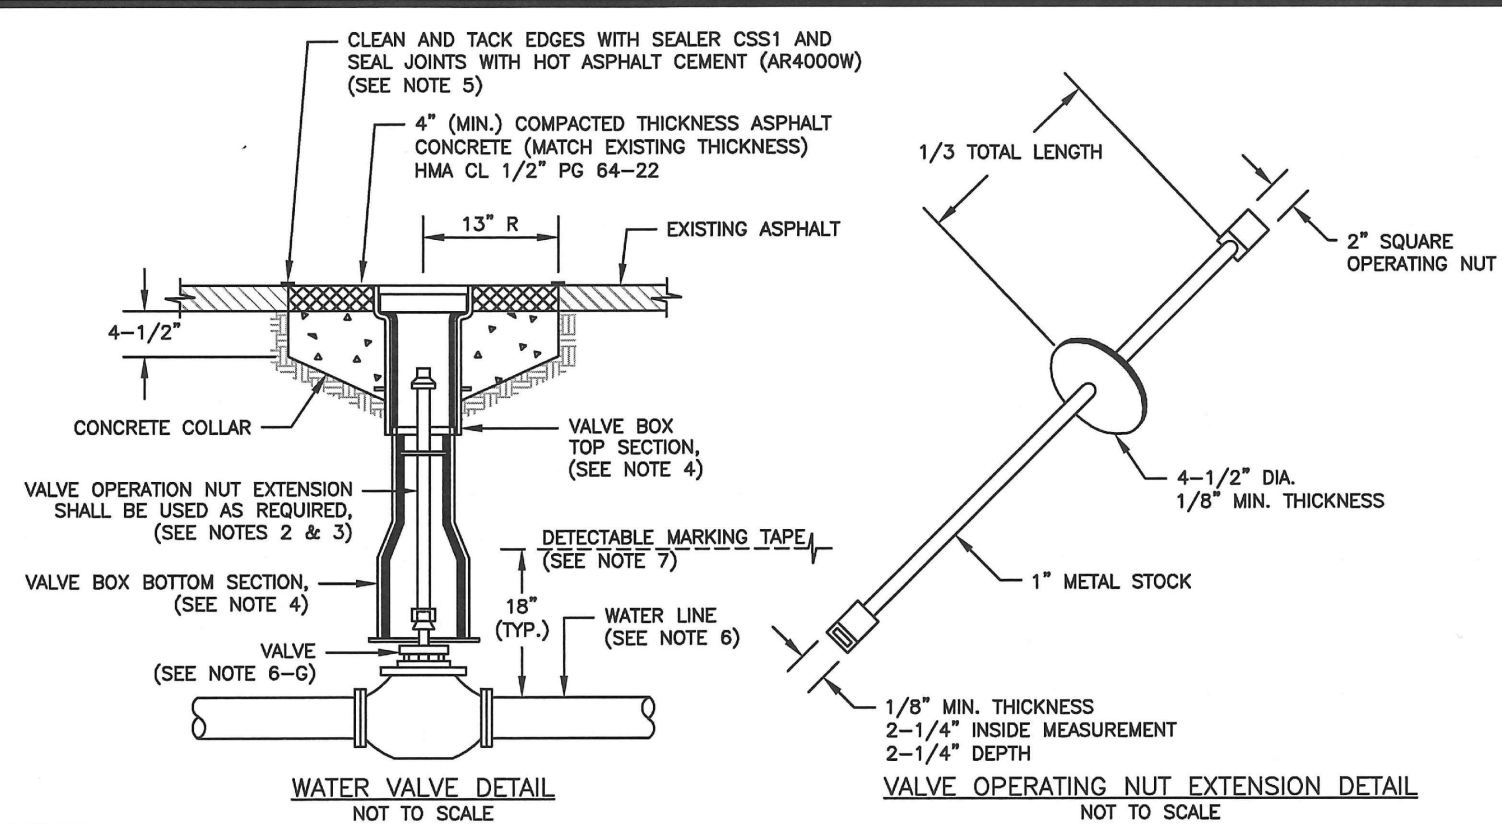

- NOTES:**
- WATER MAINS SHALL HAVE A MINIMUM COVER OF 36" FROM PAVED FINAL GRADE IN IMPROVED RIGHT-OF-WAY AND IMPROVED EASEMENTS, AND A MINIMUM OF 48" IN UNIMPROVED RIGHT-OF-WAY AND UNIMPROVED EASEMENTS.
 - VALVE OPERATING NUT EXTENSIONS ARE REQUIRED WHEN THE VALVE NUT IS MORE THAN FIVE (5) FEET BELOW FINISHED GRADE. EXTENSIONS ARE TO BE A MINIMUM OF TWO (2) FEET LONG, ONLY ONE EXTENSION TO BE USED PER VALVE. TOP OF EXTENSION SHALL BE 2 FEET 6 INCHES TO 3 FEET BELOW FINISHED GRADE.
 - ALL VALVE OPERATING NUT EXTENSIONS ARE TO BE MADE OF STEEL, SIZED AS NOTED, AND PAINTED WITH TWO COATS OF METAL PAINT.
 - VALVE BOXES SHALL BE TWO-PIECE, ADJUSTABLE, CAST IRON WITH EXTENSION PIECES (IF NECESSARY), AS MANUFACTURED BY THE VANRICH #940 SEATTLE OR APPROVED EQUAL. THE WORD "WATER" SHALL BE CAST IN RELIEF ON THE VALVE BOX COVER. VALVE BOX TOPS INSTALLED IN ARTERIAL ROADWAYS SHALL BE MANUFACTURED BY EAST JORDAN (EJ) IRONWORKS MODEL 8555 WITH VALVE BOX COVER MODEL 8600 OR APPROVED EQUAL.
 - NEAT LINE CUTS SHALL BE SEALED WITH A HOT PAVING GRADE ASPHALT AND FACE OF CUT TACKED.
 - WATER MAINS SHALL BE CONSTRUCTED AND TESTED IN ACCORDANCE WITH DIVISION 7 OF THE WSDOT STANDARD SPECIFICATIONS SUPPLEMENTED WITH THE FOLLOWING:
 - DUCTILE IRON PIPE SHALL CONFORM TO AWWA C 151, THICKNESS CLASS 52, AND THE EXTERIOR SHALL BE COATED WITH COAL TAR VARNISH. PIPE AND FITTINGS SHALL BE MORTAR LINED AND SHALL CONFORM TO AWWA C 104. THE THICKNESS OF THE LINING SHALL BE NOT LESS THAN 1/16" THICK FOR 3" TO 12" PIPE, 3/32" THICK FOR 14" TO 24" PIPE, AND 1/8" THICK FOR 30" TO 54" PIPE. THE CEMENT LINING SHALL CONFORM TO THE REQUIREMENTS OF ASTM C 150.
 - JOINTS SHALL BE TYTON PUSH-ON JOINTS, OR APPROVED EQUAL, OR MECHANICAL JOINT TYPE PER AWWA C 111 EXCEPT WHERE FLANGED JOINTS ARE REQUIRED TO CONNECT TO VALVES OR OTHER EQUIPMENT.
 - BOLTS AND NUTS FOR BURIED FLANGES LOCATED OUTDOORS, ABOVE GROUND, OR IN OPEN VAULTS IN STRUCTURES SHALL BE TYPE 316 STAINLESS STEEL CONFORMING TO ASTM A 193, GRADE BM FOR BOLTS, AND ASTM A 194, GRADE BM FOR NUTS. BOLTS AND NUTS LARGER THAN ONE AND ONE-QUARTER (1-1/4) INCHES SHALL BE STEEL, ASTM A 307, GRADE B, WITH CADMIUM PLATING, ASTM A 185, TYPE NS.
 - BOLTS USED IN FLANGE INSTALLATION SETS SHALL CONFORM TO ASTM B 193, GRADE B7. NUTS SHALL COMPLY WITH ASTM A 194, GRADE 2H.
 - PROVIDE A WASHER FOR EACH NUT, WHERE NEEDED. WASHERS SHALL BE OF THE SAME MATERIAL AS THE NUTS.
 - ALL FITTINGS SHALL CONFORM TO THE REQUIREMENTS OF AWWA C 110 AND AWWA C 111.
 - RESILIENT SEATED WEDGE GATE VALVES SHALL BE USED FOR TEN (10) INCH MAINS AND SMALLER. BUTTERFLY VALVES SHALL BE USED FOR MAINS GREATER THAN TEN (10) INCHES.
 - RESILIENT SEATED WEDGE GATE VALVE: GATE VALVES SHALL CONFORM TO THE LATEST AWWA SPECIFICATIONS FOR COLD WATER, DOUBLE-DISK GATE VALVES, 300 PSI WORKING PRESSURE. THEY SHALL BE IRON-BODIED, BRONZE MOUNTED, NON-RISING STEM, WITH TWO (2) INCH SQUARE NUT, COUNTER-CLOCKWISE OPENING, MECHANICAL JOINT AND / OR FLANGED ENDS (6" VALVES ON FIRE HYDRANT LINES WHICH SHALL BE MECHANICAL JOINTS BY FLANGED). VALVE STEMS SHALL BE PROVIDED WITH O-RING SEALS AND SHALL BE AS MANUFACTURED BY THE MUELLER COMPANY OR APPROVED EQUAL.
 - BUTTERFLY VALVES: BUTTERFLY VALVES CONFORMING WITH AWWA C 504, CLASS 150 AND SHALL HAVE STANDARD AWWA TWO (2) INCH SQUARE NUT.
 - DETECTABLE MARKING TAPE SHALL BE INSTALLED 18" ABOVE PIPE, BE BLUE IN COLOR, AND READ "CAUTION WATER LINE BELOW" MEETING WSDOT SPEC. 9-15.18.



CITY OF PUYALLUP
OFFICE OF THE CITY ENGINEER

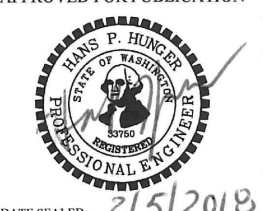


APPROVED FOR PUBLICATION
DATE SEALED: 2/5/2018

WATER VALVES AND MAINS

CITY STANDARD
03.01.01

REVISION BLOCK			
NO.	DATE	DESCRIPTION	BY
1	8/1/2023	ADDRESS CITY COMMENTS	GJM
		AND ADD NEW "OPEN"	
		STORAGE SHED OVER	
		EXISTING PAVEMENT AS	
		SHOWN.	

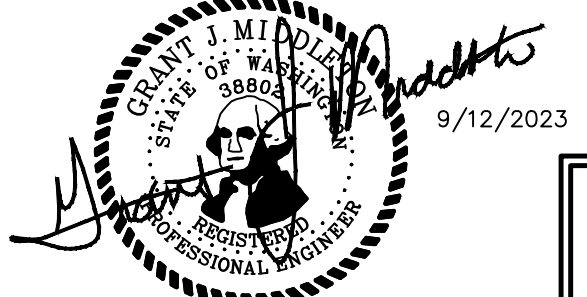

9/12/2023

C2.3

APPROVED
BY: *J. D...*
CITY OF PUYALLUP
ENGINEERING DEPARTMENT
DATE: 10/10/2023

NOTE: THIS APPROVAL IS VOID AFTER 180 DAYS FROM APPROVAL DATE. THE CITY WILL NOT BE RESPONSIBLE FOR ERRORS AND/OR OMISSIONS ON THESE PLANS. FIELD CONDITIONS MAY DICTATE CHANGES TO THESE PLANS AS DETERMINED BY THE DEVELOPMENT ENGINEERING MANAGER.

City of Puyallup Development & Permitting Services ISSUED PERMIT

Building	Planning
Engineering	Public Works
Fire	Traffic

JOB NUMBER	9575
SCALE	N/A
HOR.	N/A
VERT.	N/A
DESIGNED JLC	
DRAWN DWN	
CHECKED JLC	

PROPOSED BY: RICK VELASQUEZ
13615 122ND ST E
PUYALLUP, WA 98374
PH: (253) 224-4428

LARSON AND ASSOCIATES
surveyors, engineers & planners
9027 PACIFIC AVENUE, SUITE 4
TACOMA, WA 98444 (253) 474-3404

WATER DETAILS AND SPECIFICATIONS

DATE	9/12/2023
DRAWING NO.	9575BASE
SHEET	2 OF 2