
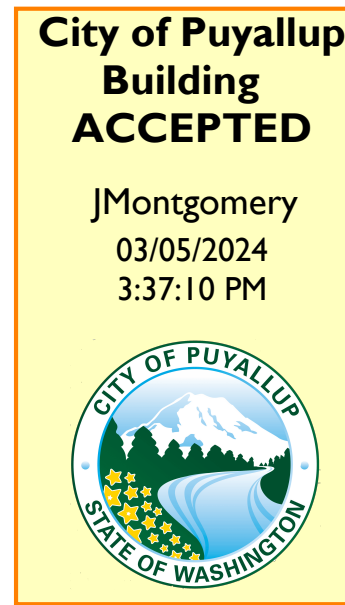


# PUYALLUP HAMPTON INN ADDITION

1515 S. Meridian Street, Puyallup, WA 98371

REVISION 1 OF 2  
(27 PAGES)  
B-20-0078

## VICINITY MAP

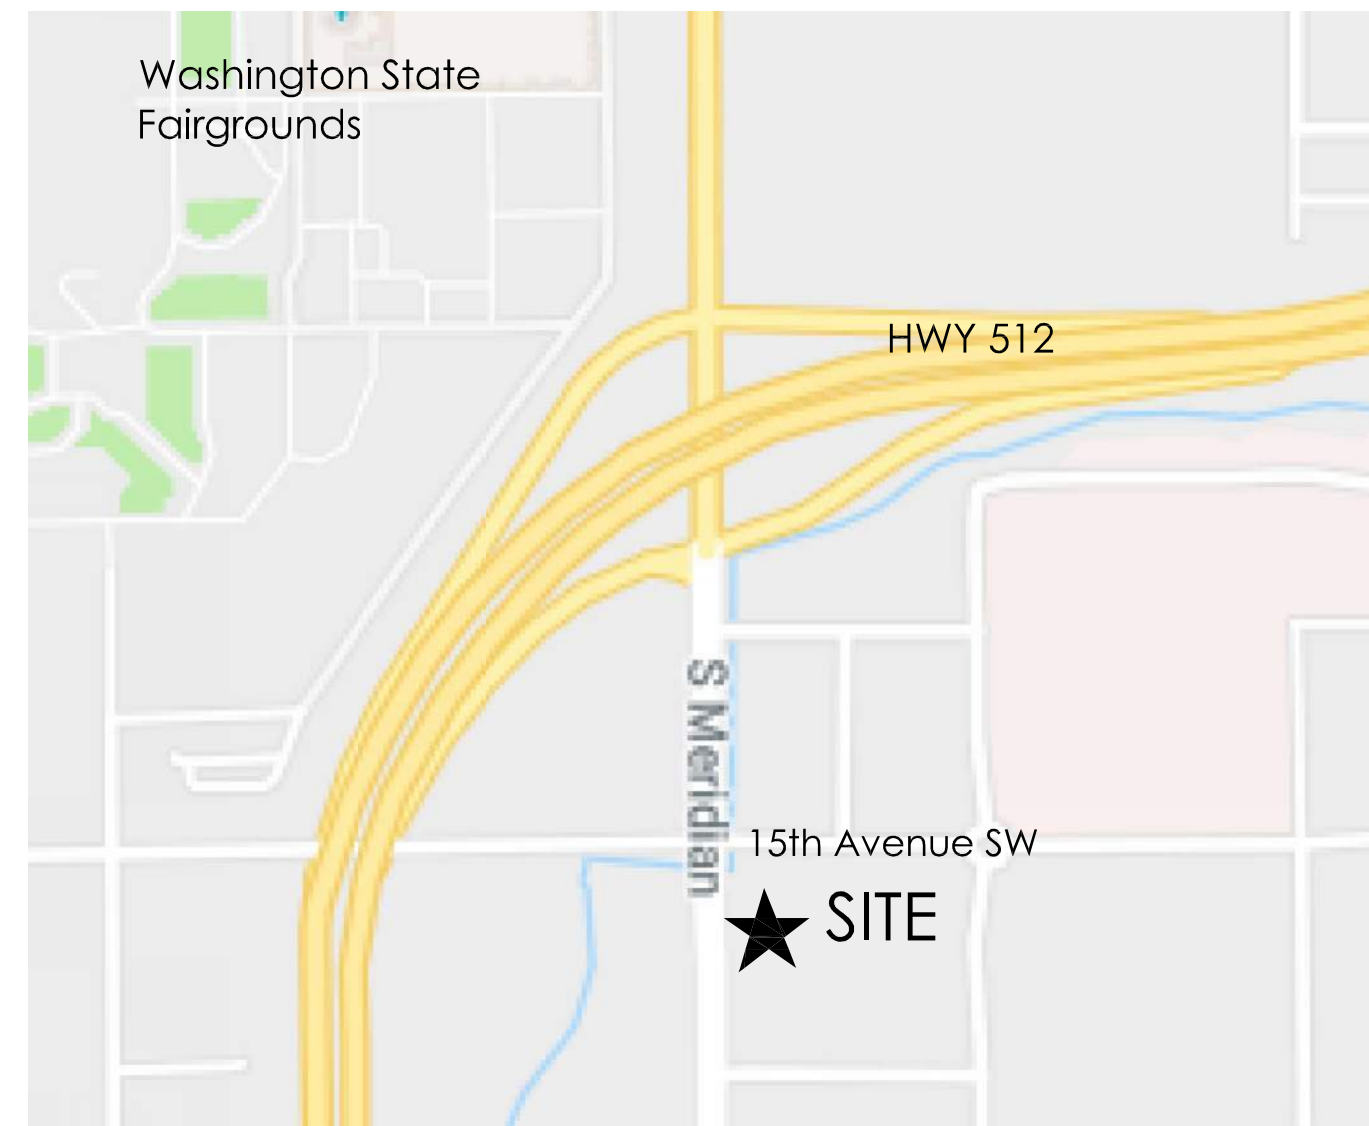


**FULL SIZED LEDGIBLE COLOR PLANS ARE REQUIRED TO BE PROVIDED BY THE PERMITEE ON SITE FOR ALL INSPECTIONS (MIN. PLAN SIZE 24" X 36")**

## ABBREVIATIONS

A.B.	ANCHOR BOLT	L.	LENGTH
A.C.P.	ACOUSTICAL CEILING PANEL	MDF.	MEDIUM DENSITY FIBERBOARD
AFFLR.	ABOVE FINISH FLOOR	MTL.	METAL
ADD. ALT.	ADDITIVE ALTERNATE	N.I.C.	NOT IN CONTRACT
B.F.	BARRIER FREE	N.T.S.	NOT TO SCALE
B.S.	BACK SPLASH	O.C.	ON CENTER
BM.	BEAM	O.H.	OPPOSITE HAND/OVER HANG
C.J.	CONTROL/CONSTRUCTION JOINT	OPT.	OPTIONAL
C.L. or C	CENTERLINE	O.S.B.	ORIENTED STRAND BOARD
CONT.	CONTINUOUS	P.L.B.	PARA LAMINATED BEAM
CPT.	CARPET	P.LAM.	PLASTIC LAMINATED
CRM.	CLASSROOM	PLYWD.	PLYWOOD
C.T.	Ceramic Tile	PR.	PAIR
D.	DEPTH	PT.	PAINT
D.F.	DRINKING FOUNTAIN	P.T.D.	PAPER TOWEL DISPENSER
D.O.	DEDICATED OUTLET	R.B.	RUBBER BASE
D.S.	DOWN SPOUT	R.D.	ROOF DRAIN
E.C.	EXPOSED CONCRETE	R.I.	ROUGH-IN
EXIST.	EXISTING	R.L.	RAIN LEADER
EXP. BOLT	EXPANSION BOLT	R.S.	ROUGH SAWN
FDN.	FOUNDATION	S & V	STAINED & VARNISHED
F.D.	FLOOR DRAIN	S.C.	SOLID CORE
F.E.	FIRE EXTINGUISHER	S.V.	SHEET VINYL
FIN. FLR.	FINISH FLOOR	SHT. MTL.	SHEET METAL
F.O.I.C.	FURNISHED BY OWNER INSTALLED BY GC.	SIM.	SIMILAR
F.O.I.O	FURNISHED BY OWNER INSTALLED BY OWNER	T & G	TONGUE & GROOVE
F.O.P.W	FACE OF PLYWOOD	T.O.C	TOP OF CONCRETE
F.R.P.	FIBERGLASS REINFORCED PANEL	T.O.P.	TOP OF PLATE
G.LAM/GL	GLUE LAMINATED	T.O.W.	TOP OF WALL
GA.	GAUGE OR GAGE	TRT.	TREATED
GALV.	GALVANIZED	T.S.	TUBE STEEL
GWB.	GYPNUM WALL BOARD	T.T.D.	TOILET TISSUE DISPENSER
GYP.	GYPNUM	TYP.	TYPICAL
H.	HEIGHT	U.N.O.	UNLESS NOTED OTHERWISE
H.C.	HOLLOW CORE/HANDICAP	W.O.M.	WALK OFF MAT
H.M.	HOLLOW METAL	W.	WIDE
HDR.	HEADER	W.P.	WATER PROOF
		WD.	WOOD
		WDW.	WINDOW

## SYMBOLS

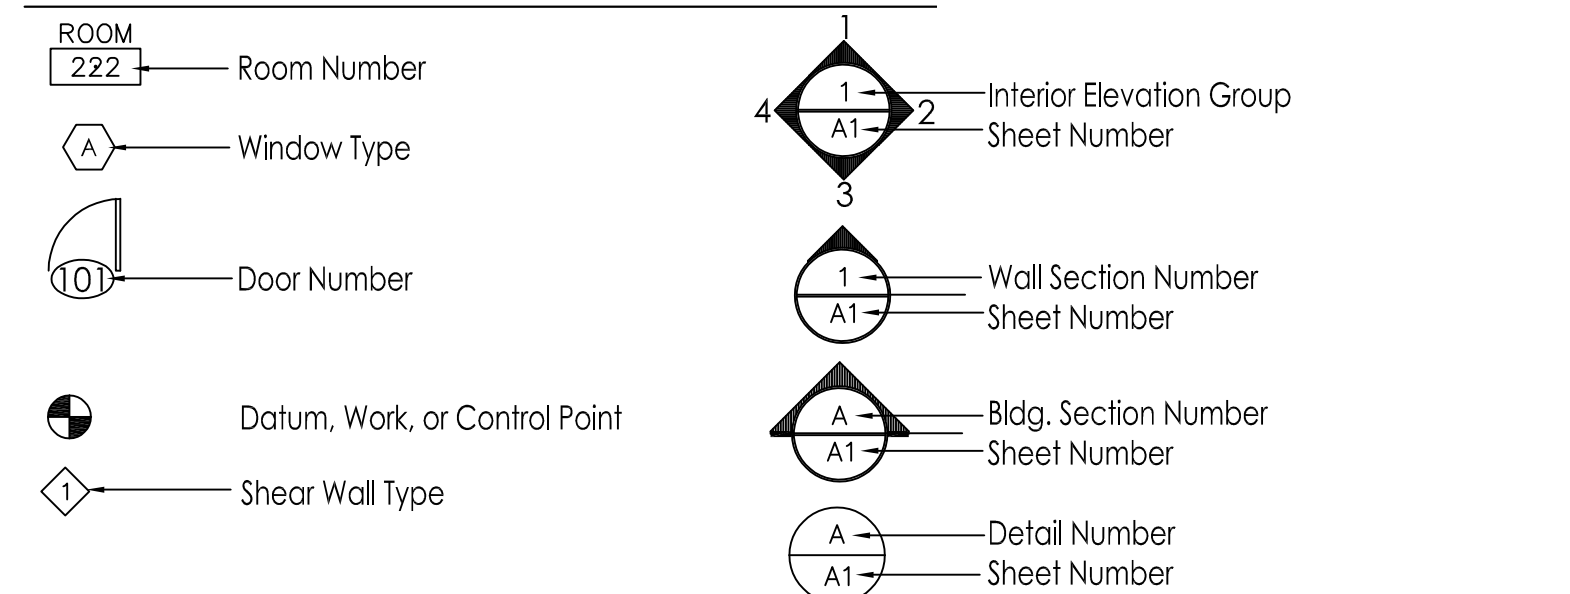

## GENERAL NOTES

- ALL WORK SHALL CONFORM TO APPLICABLE CURRENT FEDERAL, STATE AND LOCAL CODES. THE CONTRACTOR IS TO PROVIDE FOR ALL REQUIRED NOTIFICATION OF AND COORDINATION WITH CITY AND STATE AGENCIES, AND PROVIDE REQUIRED PERMITS. ALL TESTS AND INSPECTIONS ASSOCIATED WITH OBTAINING APPROVALS TO PROCEED WITH AND COMPLETE THE WORK SHALL BE PAID FOR BY THE CONTRACTOR.
- THE CONTRACTOR SHALL COORDINATE ALL OPERATIONS WITH THE OWNER, INCLUDING AREA FOR WORK, MATERIALS STORAGE, AND ACCESS TO AND FROM THE WORK. SPECIAL CONDITIONS OR NOISY WORK, TIMING OF WORK AND INTERRUPTION OF MECHANICAL AND ELECTRICAL SERVICES. NOISY OR DISRUPTIVE WORK SHALL BE SCHEDULED AT LEAST ONE (1) WEEK IN ADVANCE OF THE TIME WORK IS TO COMMENCE.
- ALL WORK SHALL BE PERFORMED IN ACCORDANCE WITH THE HIGHEST STANDARD OF WORKMANSHIP IN GENERAL AND WITH SUCH STANDARDS AS ARE SPECIFIED.
- CONTRACTOR SHALL ADHERE TO ALL BUILDING STANDARDS. ANY CHANGES TO SAME SHALL BE SUBMITTED TO ARCHITECT IN WRITING FOR APPROVAL.
- CONTRACTOR SHALL SUBMIT SAMPLES OF ALL FINISHES OF SUCH SIZE AND NUMBER THAT THEY REPRESENT A REASONABLE DISTRIBUTION OF COLOR RANGES AND PATTERN PRIOR TO INSTALLATION FOR OWNER'S APPROVAL. CONTRACTOR SHALL PROVIDE SHOP DRAWINGS AND PRODUCT DATA FOR ARCHITECT'S APPROVAL ON ALL SPECIAL ITEMS REQUIRING CUSTOM FABRICATION.
- CONTRACTOR IS TO VERIFY ALL DIMENSIONS AND CONDITIONS ON SITE AND NOTIFY ARCHITECT OF ANY DISCREPANCIES. CONTRACTOR IS NOT TO SCALE OFF DRAWINGS.
- CONTRACTOR SHALL PROVIDE BLOCKING/BACKING IN PARTITIONS FOR ALL WALL-MOUNTED FIXTURES AND DEVICES UNLESS INDICATED OTHERWISE ON THE DRAWINGS.
- ALL FLOORS SHOULD BE LEVEL AND NOT VARY MORE THAN 1/4" IN 10'-0". THE CONTRACTOR SHALL NOTIFY ARCHITECT OF ANY CONDITIONS THAT DO NOT MEET THIS STANDARD.
- FLOOR FINISH TRANSITIONS SHALL OCCUR UNDER DOORS, UNLESS SHOWN OR NOTED OTHERWISE.
- MATERIALS, ARTICLES, DEVICES AND PRODUCTS ARE SPECIFIED IN THE DOCUMENTS BY LISTING ACCEPTABLE MANUFACTURERS OR PRODUCTS, BY REQUIRING COMPLIANCE WITH REFERENCED STANDARDS, OR BY PERFORMANCE SPECIFICATIONS. FOR ITEMS SPECIFIED BY NAME, SELECT ANY PRODUCT NAMED. FOR THOSE SPECIFIED BY REFERENCE STANDARDS OR BY PERFORMANCE SPECIFICATIONS SELECT ANY PRODUCT MEETING OR EXCEEDING SPECIFIED CRITERIA. FOR APPROVAL OF AN ITEM NOT SPECIFIED, SUBMIT REQUIRED SUBMITTALS, PROVIDING COMPLETE BACK-UP INFORMATION FOR PURPOSES OF EVALUATION. WHERE BUILDING STANDARD ITEMS ARE CALLED FOR, NO SUBSTITUTE WILL BE ACCEPTED.
- CONTRACTOR SHALL PROVIDE FOR ALL WORK REQUIRED TO MAINTAIN COMPLIANCE WITH LOCAL FIF CODE. PROVIDE FOR ALL REQUIRED SHOP DRAWINGS AND APPROVALS. CONTRACTOR IS RESPONSIBLE FOR PROVIDING FIRE ALARM SYSTEM AUDIBILITY.
- MECHANICAL AND ELECTRICAL FIXTURES, OUTLETS, ETC., WHEN SHOWN ON THE ARCHITECTURAL DRAWINGS, ARE FOR LOCATION INFORMATION ONLY. MECHANICAL AND ELECTRICAL TO BE DESIGNED BY OTHERS. ALL CIRCUITING COORDINATION TO BE BY OTHERS.

## PROJECT TEAM

### OWNER

PVI, LLC  
11010 NE 8th ST SUITE 465  
BELLEVUE, WA 98444  
626-200-5019  
Contact: VICTOR SUNG

### STRUCTURAL ENGINEER

PCS Structural Solutions  
120 Pacific Avenue, Suite 701  
Tacoma, WA 98402  
253.383.2797  
Contact: Jared Plank, Project Eng.

### MECH./ELEC. ENGINEER

Abossein Engineering, Inc.  
18456 NE 68th Street  
Redmond, WA 98052  
425.462.9441  
Elec. Contact: Jay Werner  
Plumbing Contact: Dennis Grovenburg  
Mech. Contact: Gary Womack

### ARCHITECT

KNIT  
909 S. 336th Street, Suite 107  
Federal Way, WA 98003  
253-572-551  
Contact: Rhonda Gillogly, AIA-Project Manager

### CIVIL ENGINEER

Huit-Zollars  
1102 Broadway, #301  
Tacoma, WA 98402  
253.627.9131  
Contact: Darton Riely-Gibbons

### LANDSCAPE ARCHITECT

Aspen Design Group  
P.O. Box 2394  
Issaquah, WA 98027  
425.292.9845  
Contact: Paul Dix

## PROJECT DATA

### SITE ADDRESS:

1515 MERIDIAN S.  
PUYALLUP, WA

### ZONING:

ZONING: CG

### TAX PARCEL NUMBER:

7790000050 AND 7790000024

### SITE AREA:

85,977 SF

### SCOPE OF WORK:

PARKING AREA EXPANSION BELOW NEW GUEST ROOM WING. NEW GUEST ROOM WING ADDITION OF 3 FLOORS. MINOR DEMOLITION OF ONE EXISTING GUEST ROOM ON EACH FLOOR TO PROVIDE ACCESS TO NEW WING.

### APPLICABLE EDITIONS OF BUILDING CODES:

2015 I.B.C. STATE AMENDMENTS AND WAC 51-50  
2015 INTERNATIONAL MECHANICAL CODE, STDS AND AMENDMENTS - WAC 51-52  
2015 INTERNATIONAL FIRE CODE, STDS AND AMENDMENTS - WAC 51-54  
2015 UNIFORM PLUMBING CODE, STDS AND AMENDMENTS - WAC 51-56, 51-57  
2010 ADA STANDARDS FOR ACCESSIBLE DESIGN & I.C.C. A117.1-2009  
2012 NON-RESIDENTIAL ENERGY CODE

### OCCUPANCY CLASSIFICATION:

R1, S1, B, A3

### CONSTRUCTION TYPE:

V-A

### NUMBER OF STORIES:

4

### SPRINKLED

YES

FLOOR	EXISTING AREA	NEW AREA	TOTAL AREA
PARKING GARAGE	15,441 SF	0 SF	15,441 SF
1ST FLOOR	15,189 SF	168 SF	15,357 SF
2ND FLOOR	20,296 SF	4,484 SF	24,780 SF
3RD FLOOR	19,357 SF	4,484 SF	23,841 SF
4TH FLOOR	18,892 SF	4,484 SF	23,376 SF
	89,175 SF	13,620 SF	102,795 SF

## INDEX TO DRAWINGS

A0.1 COVER SHEET AND PROJECT INFORMATION	A7.3 ROOF DETAILS	P9.0 PLUMBING SPECIFICATIONS
CIVIL	A7.4 DETAILS	ELECTRICAL
C1.0 COVER, VICINITY LEGEND & MAP	A7.5 DETAILS	E1.0 GENERAL NOTES, SCHEDULES, AND PLAN INDEX
C1.1 GENERAL NOTES	BE0.0 GENERAL NOTES	E2.0 1ST FLOOR POWER
C1.2 OVERALL SITE PLAN	BE1.1 STEGO SLAB	E2.1 2ND FLOOR POWER
C2.0 DEMOLITION PLAN	BE2.0 TPO ROOFING	E2.2 3RD FLOOR POWER
C3.0 TEMPORARY EROSION AND SEDIMENT CONTROL PLAN	BE2.1 TPO ROOFING	E2.3 4TH FLOOR POWER
C3.1 TESC NOTES AND DETAILS	BE4.0 WINDOW INSTALL	E2.4 1ST FLOOR LIGHTING
C4.0 GRADING CROSS SECTIONS	BE6.1 EIFS	E3.0 1ST FLOOR LIGHTING
C4.1 GRADING CROSS SECTIONS	STRUCTURAL	E3.1 2ND FLOOR LIGHTING
C4.2 GRADING & DRAINAGE PLAN	S1.0 GENERAL NOTES	E3.2 3RD FLOOR LIGHTING
C5.0 SITE PAVING & UTILITY PLAN	S1.1 GENERAL NOTES	E3.3 4TH FLOOR LIGHTING
C5.1 SITE PAVING & UTILITY DETAILS	S1.2 GENERAL NOTES	E4.0 ENLARGED UNIT PLANS ELECTRICAL
C5.2 SITE PAVING & UTILITY DETAILS	S1.3 GENERAL NOTES	E5.0 POWER RISER DIAGRAM LEVELS 1-4
C5.3 SITE PAVING & UTILITY DETAILS	S2.0 FOUNDATION PLAN	E5.1 TELECOMMUNICATION RISER DIAGRAM
C6.0 RIGHT-OF WAY/ FRONTAGE IMPROVEMENTS	S2.1 LEVEL 2 FRAMING PLAN	E6.0 DETAILS
C.1 RIGHT-OF-WAY/ FRONTAGE IMPROVEMENTS DETAILS	S2.1A LEVEL 2 BOTTOM & TOP REINFORCING PLANS	E7.0 PANEL SCHEDULES
S1.0 SURVEY	S2.2 LEVEL 3 FRAMING PLAN	E7.1 PANEL SCHEDULES
LANDSCAPE	S2.3 LEVEL 4 FRAMING PLAN	E8.0 ENERGY CODE FORMS
L1.0 LANDSCAPE PLAN	S2.4 ROOF FRAMING PLAN	E8.1 ENERGY CODE FORMS
L2.0 LANDSCAPED DETAILS	S3.1 FOUNDATION DETAILS	E9.0 MECHANICAL EQUIPMENT SCHEDULES
ARCHITECTURAL	S3.2 FOUNDATION DETAILS	E9.1 FAULT CURRENT & ARC FLASH SCHEDULES
AD1.1 DEMOLITION PLANS	S3.3 FOUNDATION DETAILS	E10.0 SPECIFICATIONS
A0.2 CODE INFORMATION	S3.4 CONCRETE STUD RAIL DETAILS	
A0.3A WALL AND FLOOR-CEILING TYPES	S3.5 FOUNDATION DETAILS	
A0.3B WALL AND FLOOR-CEILING TYPES	S4.0 WOOD FRAMING DETAILS	
A0.4 FIRE RATED PENETRATIONS	S4.1 WOOD FRAMING DETAILS	
A1.1 OVERALL SITE PLAN	S4.2 WOOD FRAMING DETAILS	
A2.1 1ST FLOOR PLAN	S4.3 WOOD FRAMING DETAILS	
A2.2 2ND FLOOR PLAN	S5.0 WOOD FRAMING DETAILS	
A2.3 3RD FLOOR PLAN	S6.0 ROOF FRAMING DETAILS	
A2.4 4TH FLOOR PLAN	MECHANICAL	
A2.5 ROOF PLAN	M1.0 GENERAL NOTES, SCHEDULES AND LEGENDS	
A2.6 1ST FLOOR REFLECTED CEILING PLAN	M1.1 GENERAL NOTES, SCHEDULES AND LEGEND	
A2.7 2ND FLOOR REFLECTED CEILING PLAN	M2.1 1ST LEVEL FLOOR PLAN - HVAC	
A2.8 3RD FLOOR REFLECTED CEILING PLAN	M2.0 2ND LEVEL FLOOR PLAN - HVAC	
A2.9 4TH FLOOR REFLECTED CEILING PLAN	M3.0 3RD LEVEL FLOOR PLAN - HVAC	
A2.11 ENLARGED BATHROOM PLANS	M4.0 4TH LEVEL FLOOR PLAN - HVAC	
A2.12 ENLARGED STAIR PLANS & SECTIONS	M5.0 ROOF PLAN - HVAC	
A3.1 EXTERIOR ELEVATIONS	M6.0 MECHANICAL DETAILS	
A3.2 EXTERIOR ELEVATIONS	M7.0 SPECIFICATIONS	
A4.1 BUILDING SECTIONS	PLUMBING	
A4.2 BUILDING SECTIONS	P1.0 GENERAL NOTES, SCHEDULES AND LEGEND	
A5.1 WALL SECTIONS	P2.0 1ST FLOOR PLAN - PLUMBING	
A6.1 DOOR SCHEDULE	P3.0 2ND FLOOR PLAN - PLUMBING	
A6.2 WINDOW SCHEDULE	P4.0 3RD FLOOR PLAN - PLUMBING	
A7.1 EXTERIOR DETAILS	P5.0 4TH FLOOR PLAN - PLUMBING	
A7.2 DETAILS	P6.0 ROOF PLAN - PLUMBING	
	P7.0 RISER DIAGRAMS PLUMBING	

THESE DOCUMENTS HAVE BEEN PRODUCED AS AN INSTRUMENT OF SERVICE AND ARE INTENDED SOLELY FOR THE PURPOSE OF CONSTRUCTING, USING AND MAINTAINING THE PROJECT. KNIT AS THE ARCHITECT OF RECORD FOR THE PROJECT RETAINS OWNERSHIP OF THESE DOCUMENTS.

ANY USE OF THESE DOCUMENTS OR USE OF THIS DESIGN IDEAS OR CONCEPTS DESCRIBED HEREIN IN WHOLE OR PART BY ANY PERSON WHATSOEVER IS STRICTLY PROHIBITED EXCEPT BY WRITTEN CONSENT OF KNIT.

REPRODUCTION OF THIS DOCUMENT IS STRICTLY PROHIBITED EXCEPT BY WRITTEN CONSENT OF KNIT.

COPYRIGHT 2021 KNIT

ISSUE DATE 09/25/23  
PROGRESS SET

- | REV | DATE       | COMMENT     |
|-----|------------|-------------|
| 1   | 03.03.2023 | AC RESPONSE |
| 2   | 08.14.2023 | CORRECTIONS |
| 3   | 09.25.2023 | CORRECTIONS |
| 4   | 10.17.2023 | CORRECTIONS |
| 5   | 12.21.2023 | CORRECTIONS |

City of Puyallup  
Development & Permitting Services  
ISSUED PERMIT

Building	Planning
Engineering	Public Works
Fire	Traffic

6677 REGISTERED ARCHITECT  
*Rhonda A. Gillogly*  
RHONDA A. GILLOGLY  
STATE OF WASHINGTON  
12/21/2023

COVER SHEET  
ADDITION TO HAMPTON INN  
& SUITES  
1515 S MERIDIAN  
PUYALLUP, WA 98371  
HAMPTON INN & SUITES

TITLE	PROJECT	CLIENT
JOB NO: 210158		

A0.1

**GENERAL NOTES**

A. FIELD VERIFY ALL EXISTING CONDITIONS AND DIMENSIONS. DIMENSIONS ARE TO FACE OF FINISH, TO FACE OF EXISTING WALL, OR TO FACE OF FOUNDATION WALL UNLESS NOTED OTHERWISE.





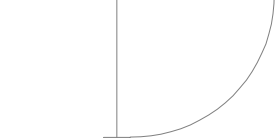
**DEMO FLOOR PLAN KEYED NOTES (1 - 29)**

- 1 REMOVE EXISTING FRAMED INTERIOR WALL AND FINISHES AND LEGALLY DISPOSE, TYPICAL
- 2 REMOVE EXISTING WINDOW AND LEGALLY DISPOSE. REMOVE EXISTING CURTAINS AND RODS AND SALVAGE FOR OWNER.
- 3 EXISTING DOOR, FRAME AND HARDWARE TO BE REMOVED. SALVAGE DOOR HARDWARE FOR OWNER. LEGALLY DISPOSE OF DEMOLISHED ITEMS.
- 4 REMOVE EXISTING LAVATORY, WATER CLOSET, AND BATHTUB/ SHOWER, AND ASSOCIATED PLUMBING PIPING AND ACCESSORIES. COORDINATE EXTENT OF PIPING REMOVAL WITH THE MEP DRAWINGS AND CAP PIPING OR REROUTE AS NEEDED. LEGALLY DISPOSE OF ITEMS THAT ARE NOT SALVAGED. INFILL HOLES IN FLOOR AND CEILING WITH LIKE MATERIALS TO CREATE SEAMLESS LOOK AND MAINTAIN EXISTING FIRE AND SOUND RATINGS.
- 5 REMOVE EXISTING PTAC UNIT AND SALVAGE FOR OWNER.
- 6 REMOVE PORTION OF EXISTING EXTERIOR WALL. (FRAMING, SHEATHING, GYP BOARD, WALL FINISH, EIFS/STUCCO TO CONSTRUCT NEW HALLWAY BETWEEN EXISTING BUILDING AND NEW ADDITION.
- 7 REMOVE EXISTING FLOORING AND BASE. THIS ROOM (CARPET, TILE, SHEET FLOORING). COORDINATE NEW FLOORING WORK WITH NEW FLOOR PLANS.
- 8 COORDINATE REMOVAL OF EXISTING ELECTRICAL, MECHANICAL, AND PLUMBING ITEMS THIS ROOM AREA WITH MEP DRAWINGS.
- 9 REMOVE EXISTING WALL COVERING IN MAIN ROOM AND BATHROOM. PREP TO RECEIVE NEW WALL FINISHES. REFER TO NEW PLANS AND COORDINATE WITH OWNER
- 10 REMOVE EXISTING KITCHENETTE.
- 11 REMOVE, SALVAGE, AND REINSTALL EXISTING FIRE EXTINGUISHER AND FIRE EXTINGUISHER CABINET AT NEW LOCATION.
- 12 REMOVE EXISTING PTAC UNIT. COORDINATE SCOPE OF WORK WITH THE HVAC DRAWINGS
- 13 REMOVE EXISTING EXTERIOR GRILL. PROVIDE WEATHERPROOF BARRIER UNTIL WALL CAN BE PATCHED IN.



**DEMO REFLECTED CEILING PLAN KEYED NOTES (31 - 49)**

- 31 DASHED LINES REPRESENT LOCATIONS OF WHERE EXISTING WALLS ARE BEING REMOVED AND WOULD AFFECT CEILING CONDITIONS. COORDINATE REMOVAL OF MEP ITEMS WITHIN WALLS AND CEILING AREAS WITH MEP DRAWINGS.
- 32 COORDINATE REMOVAL OF PARTIAL FIRE RATED WALL FOR INSERTION OF NEW DUCTWORK, DAMPER AND GRILLES WITH MEP DRAWINGS.
- 33 REMOVE A PORTION OF THE EXISTING ACOUSTICAL CEILING TILE AND GRID AND SALVAGE FOR REINSTALLATION AFTER NEW DUCTWORK IS INSTALLED.
- 34 PROTECT EXISTING SOFFIT WHERE NEW DUCTWORK IS TO BE INSTALLED ABOVE. PATCH WALLS TO MATCH EXISTING IF DAMAGED.
- 35 CONTRACTOR TO REVIEW IF EXISTING SOFFIT CONTAINS ANY DUCTWORK. IF NO, THE CONTRACTOR IS TO REMOVE THE EXISTING SOFFIT AND PATCH CEILING TO MATCH EXISTING. IF THE EXISTING SOFFIT IS FOUND TO CONTAIN DUCTWORK OR OTHER ITEM, THE SCOPE OF SHALL BE REVIEWED WITH THE OWNER.

**LEGEND**

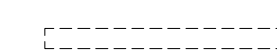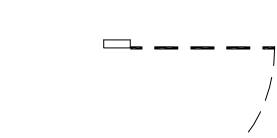
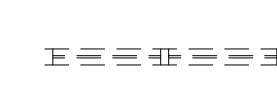
-  EXISTING FRAMED WALL AND GYPSUM BOARD TO BE REMOVED AS SHOWN AND NOTED, AND LEGALLY DISPOSE
-  EXISTING DOOR, FRAME AND HARDWARE TO BE REMOVED. SALVAGE DOOR HARDWARE FOR OWNER. LEGALLY DISPOSE OF DEMOLISHED ITEMS.
-  EXISTING WINDOW TO BE DEMOLISHED, AND LEGALLY DISPOSE
-  EXISTING WALL TO REMAIN
-  EXISTING DOOR TO REMAIN

REMOVE EXISTING WALLPAPER AND GYPSUM BOARD DOWN TO EXISTING FRAMING. REFER TO REVISIONS AND REFER TO NEW FLOOR PLANS. REMOVE EXISTING PTAC UNITS, CURTAINS, WINDOW SILLS, CURTAIN TRACKS, CURTAIN FRAMES AND SALVAGE FOR REINSTALLATION. COORDINATE ADDITIONAL MEP ITEMS WITH MEP DRAWINGS

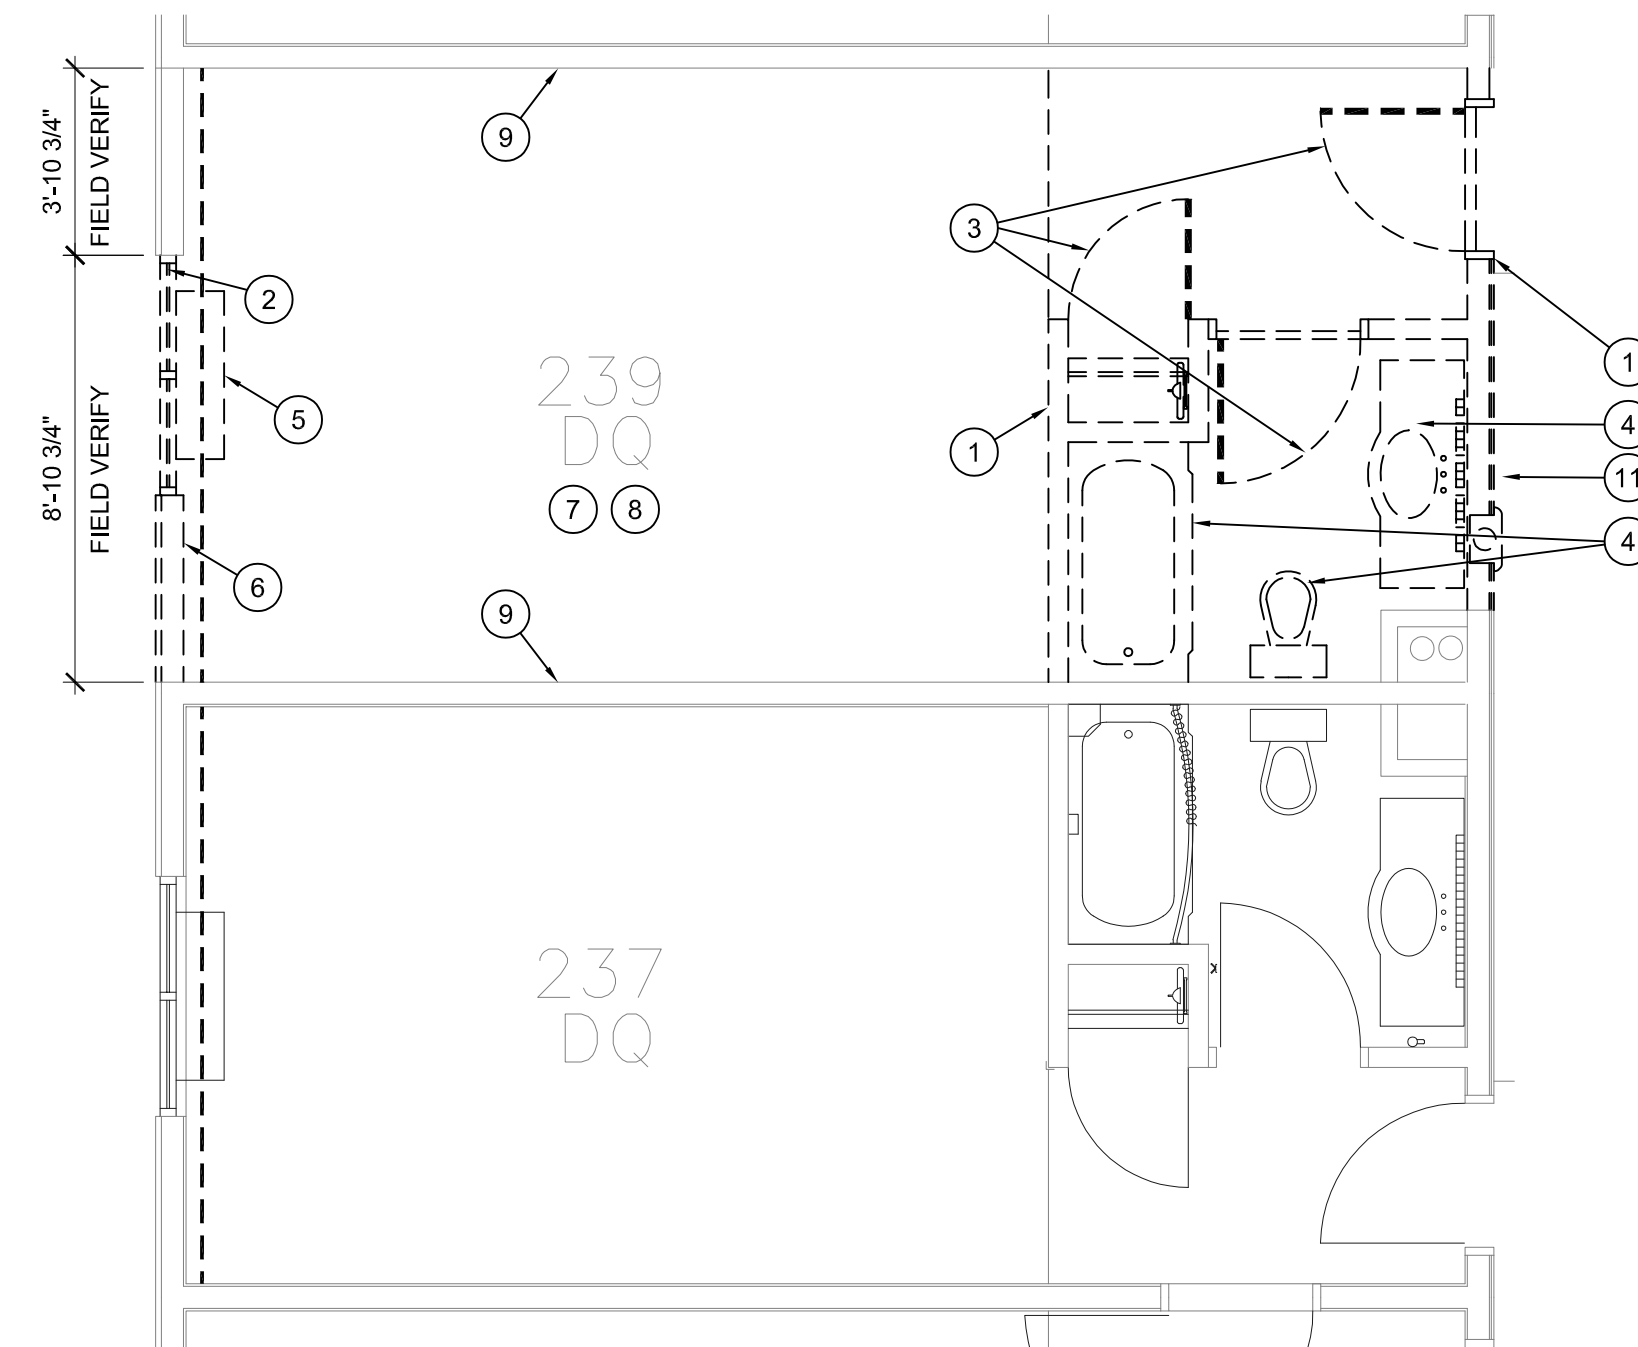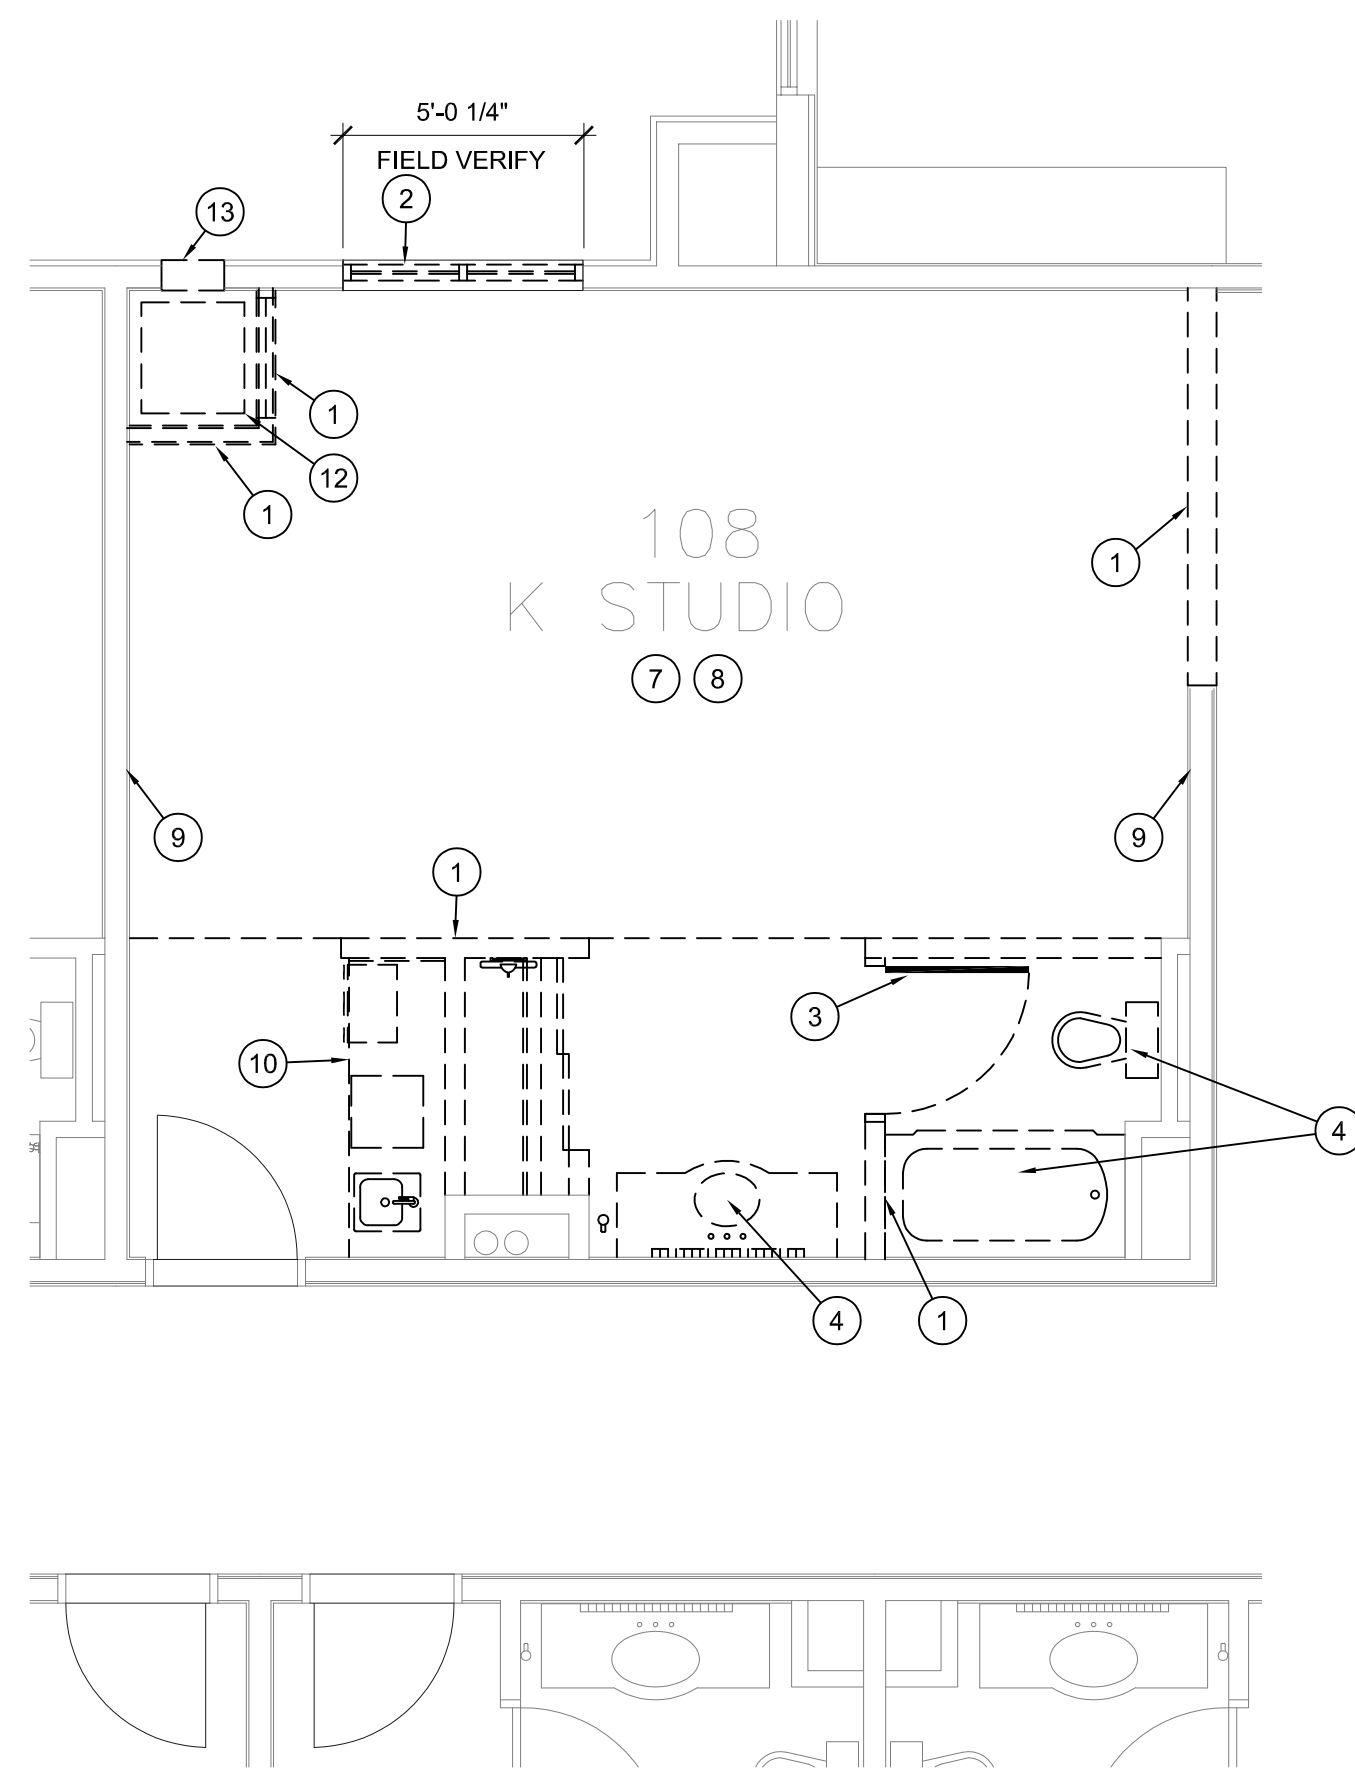

**A PARTIAL SELECTIVE DEMO PLAN - 1ST FLOOR**  
 AD1.1 SCALE: 1/4"=1'-0"

**C PARTIAL SELECTIVE DEMO PLAN - 2ND, 3RD, & 4TH FLOOR**  
 AD1.1 SCALE: 1/4"=1'-0"

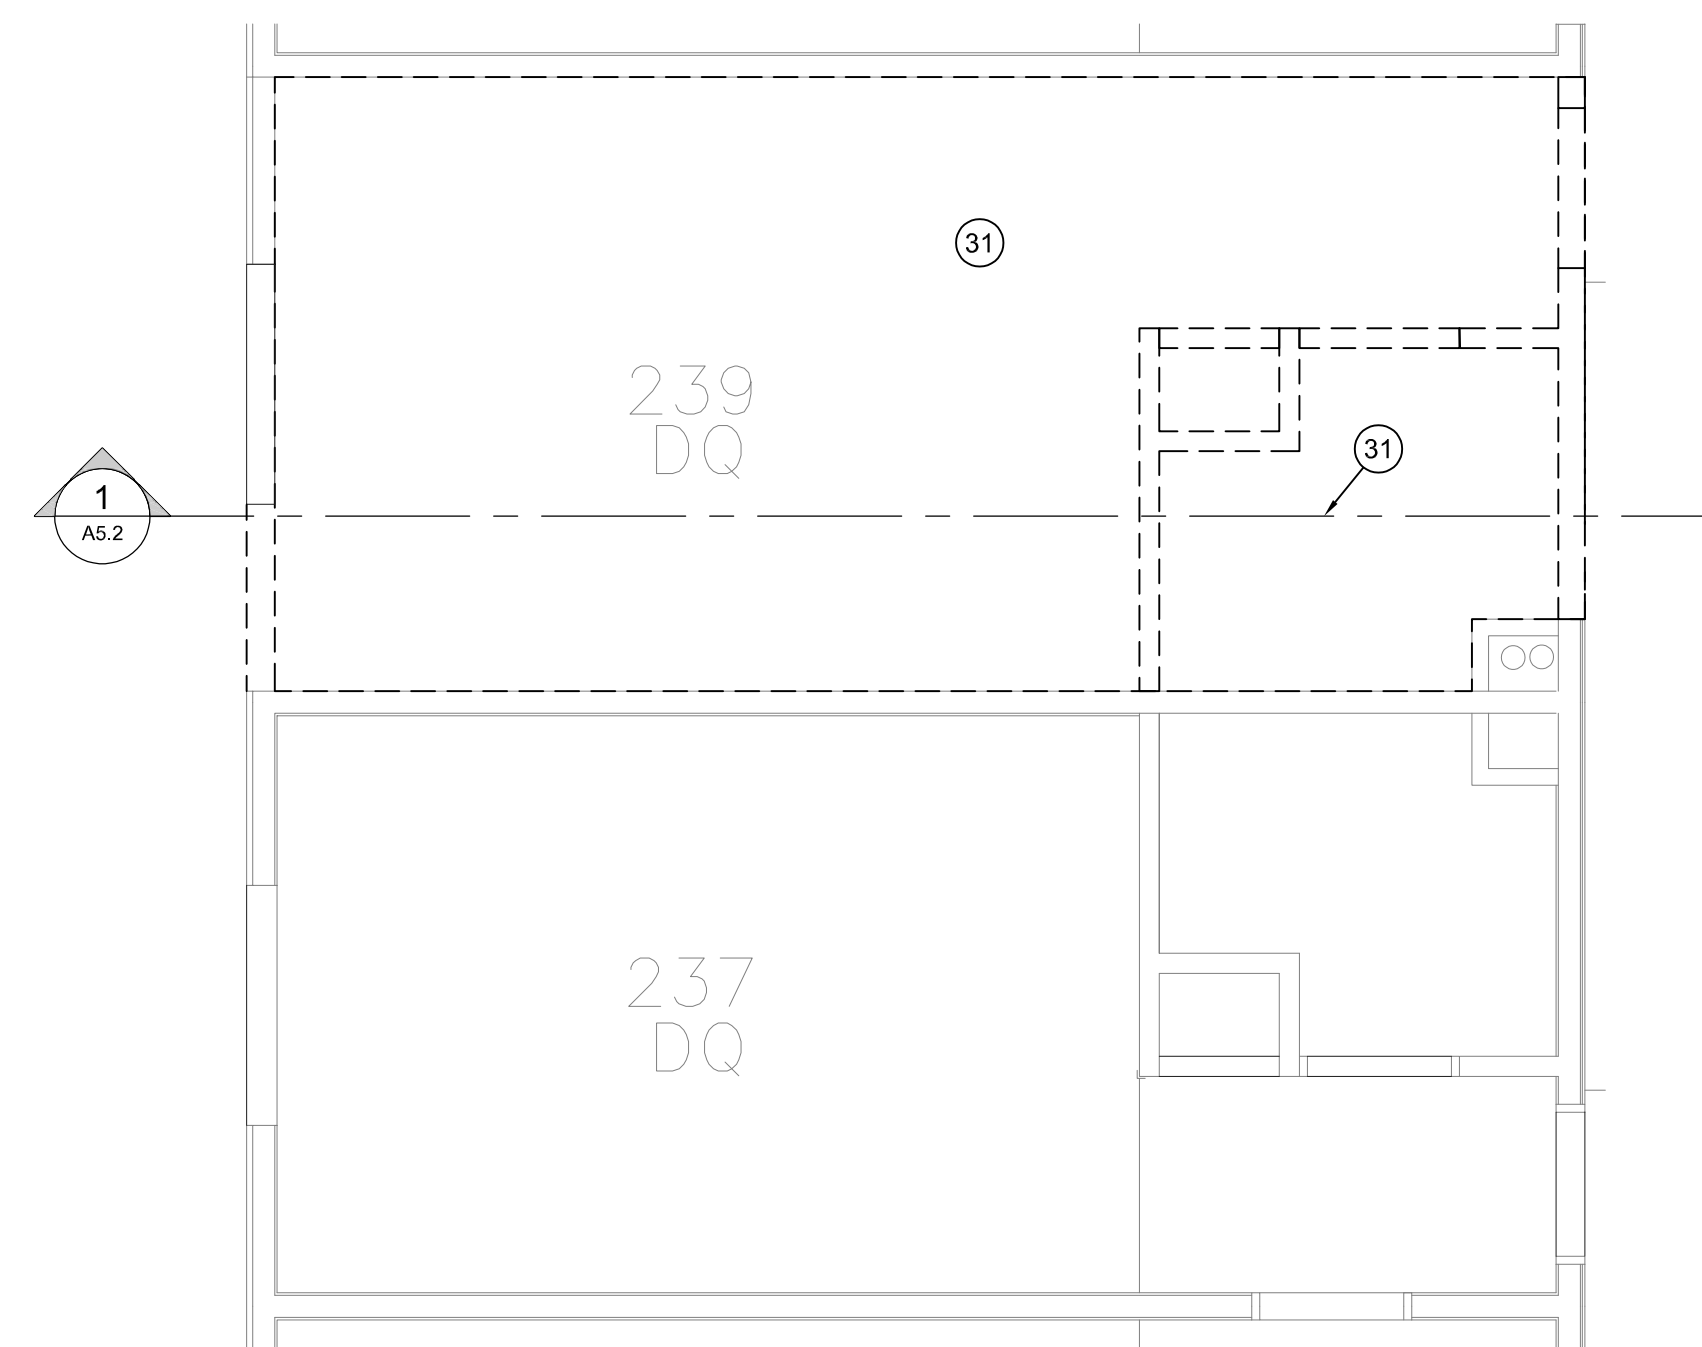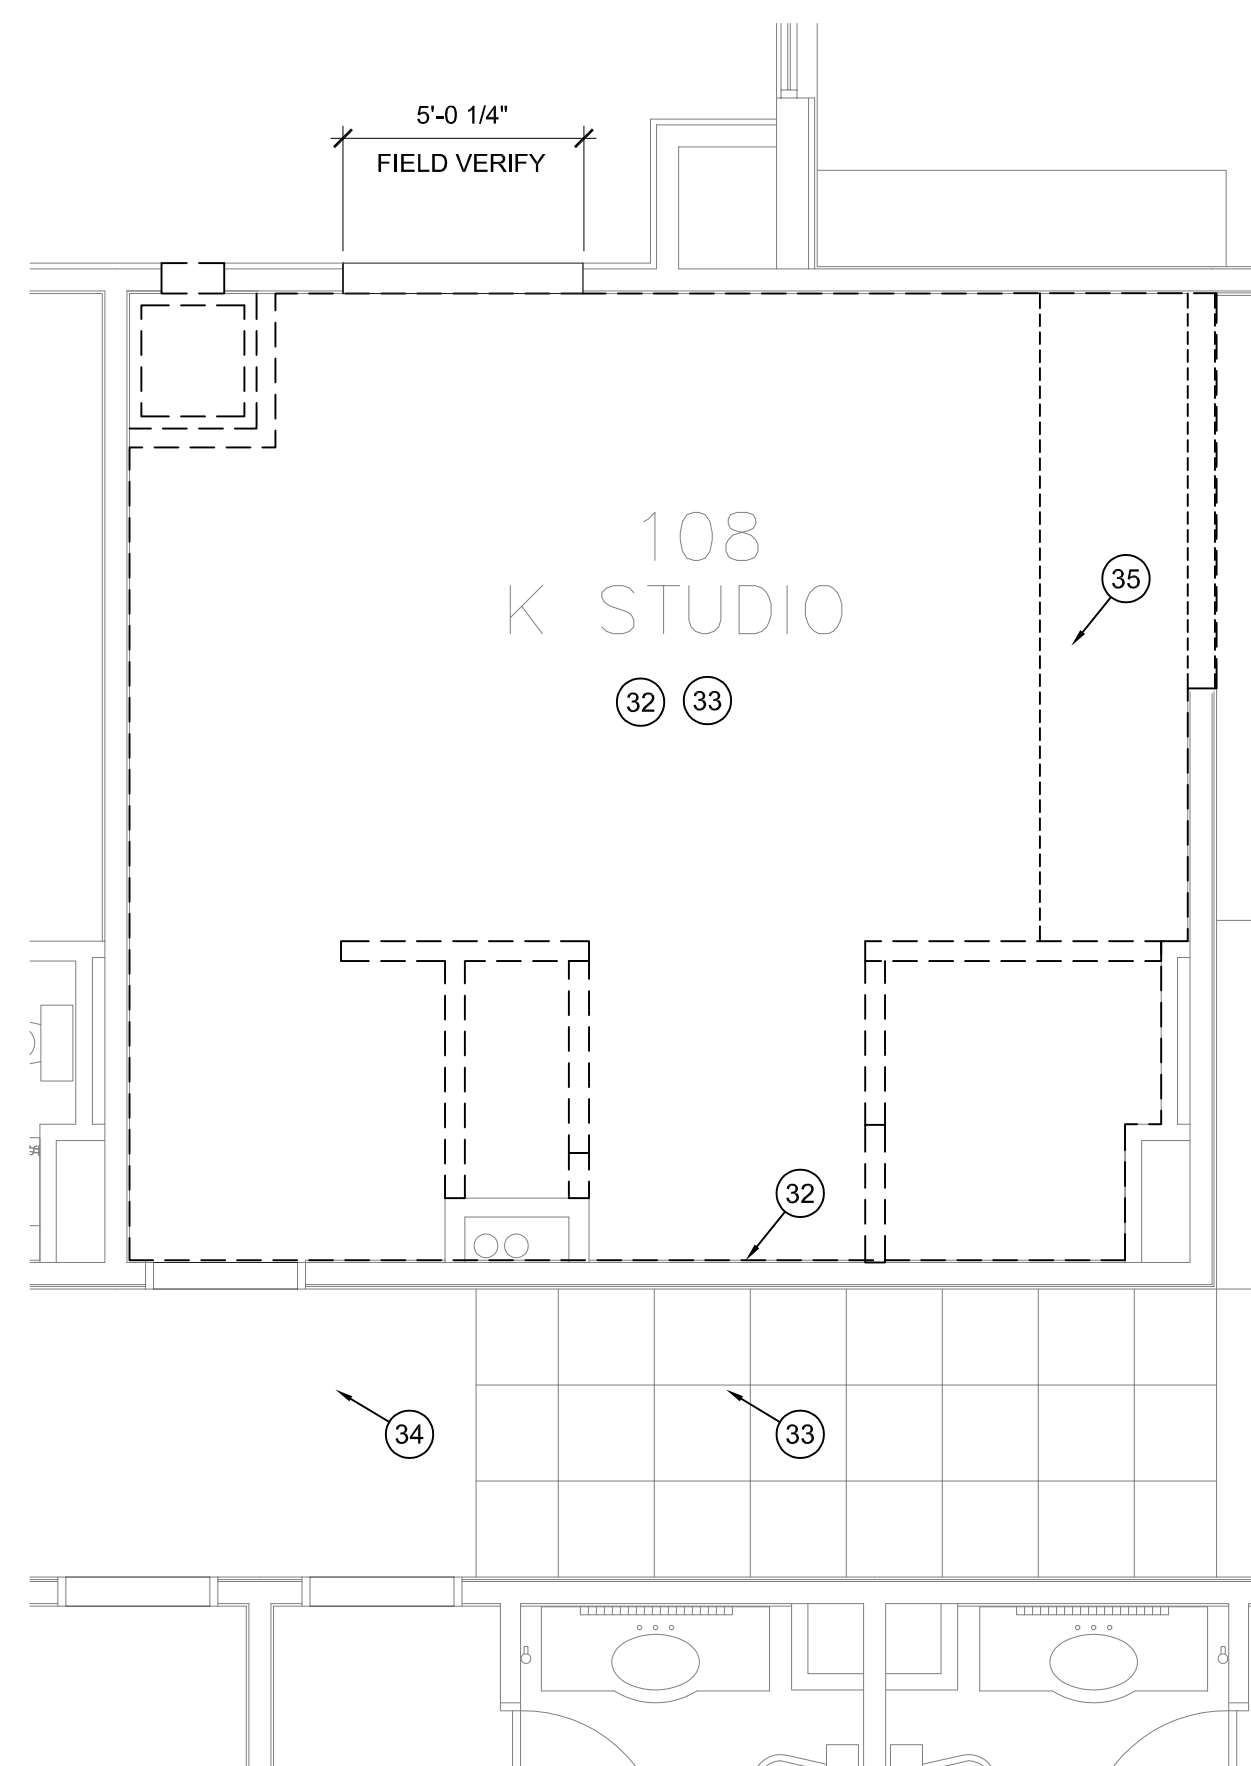

**B PARTIAL SELECTIVE DEMO REFLECTIVE CEILING PLAN - 1ST FLOOR**  
 AD1.1 SCALE: 1/4"=1'-0"

**D SELECTIVE DEMO REFLECTIVE CEILING PLAN - 2ND, 3RD, & 4TH FLOOR**  
 AD1.1 SCALE: 1/4"=1'-0"



**KNIT**  
 909 S. 336TH ST.  
 SUITE 107  
 FEDERAL WAY, WA 98003  
 knitstudios.com


THESE DOCUMENTS HAVE BEEN PRODUCED AS AN INSTRUMENT OF SERVICE AND ARE INTENDED SOLELY FOR THE PURPOSE OF CONSTRUCTION, USING AND WORKING THE PROJECT. KNIT AS THE ARCHITECT OF RECORD FOR THE PROJECT RETAINS OWNERSHIP OF THESE DOCUMENTS.  
 ANY USE OF THESE DOCUMENTS OR USE OF THIS DESIGN IDEAS OR CONCEPTS DESCRIBED HEREIN IN WHOLE OR PART BY ANY PERSON WHATSOEVER IS STRICTLY PROHIBITED EXCEPT BY WRITTEN CONSENT OF KNIT.  
 REPRODUCTION OF THESE DOCUMENTS IS STRICTLY PROHIBITED EXCEPT BY WRITTEN CONSENT OF KNIT.  
 COPYRIGHT 2021 KNIT

ISSUE DATE 09/25/23  
 PROGRESS SET

REV	DATE	COMMENT
1	03.03.2023	AC RESPONSE
2	08.14.2023	CORRECTIONS
3	09.25.2023	CORRECTIONS
4	10.17.2023	CORRECTIONS
5	12.21.2023	CORRECTIONS

City of Puyallup  
 Development & Permitting Services  
**ISSUED PERMIT**


Building	Planning
Engineering	Public Works
Fire	Traffic

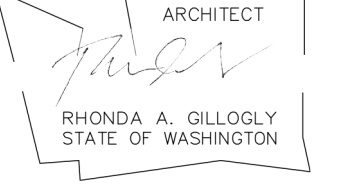8677 REGISTERED ARCHITECT  
  
 RHONDA A. GILLOGLY  
 STATE OF WASHINGTON  
 12/21/2023


**DEMO PLANS**  
**ADDITION TO HAMPTON INN & SUITES**  
 1515 S MERIDIAN  
 PUYALLUP, WA 98371  
 HAMPTON INN & SUITES

TITLE PROJECT CLIENT  
 JOB NO: 210158


**AD1.1**

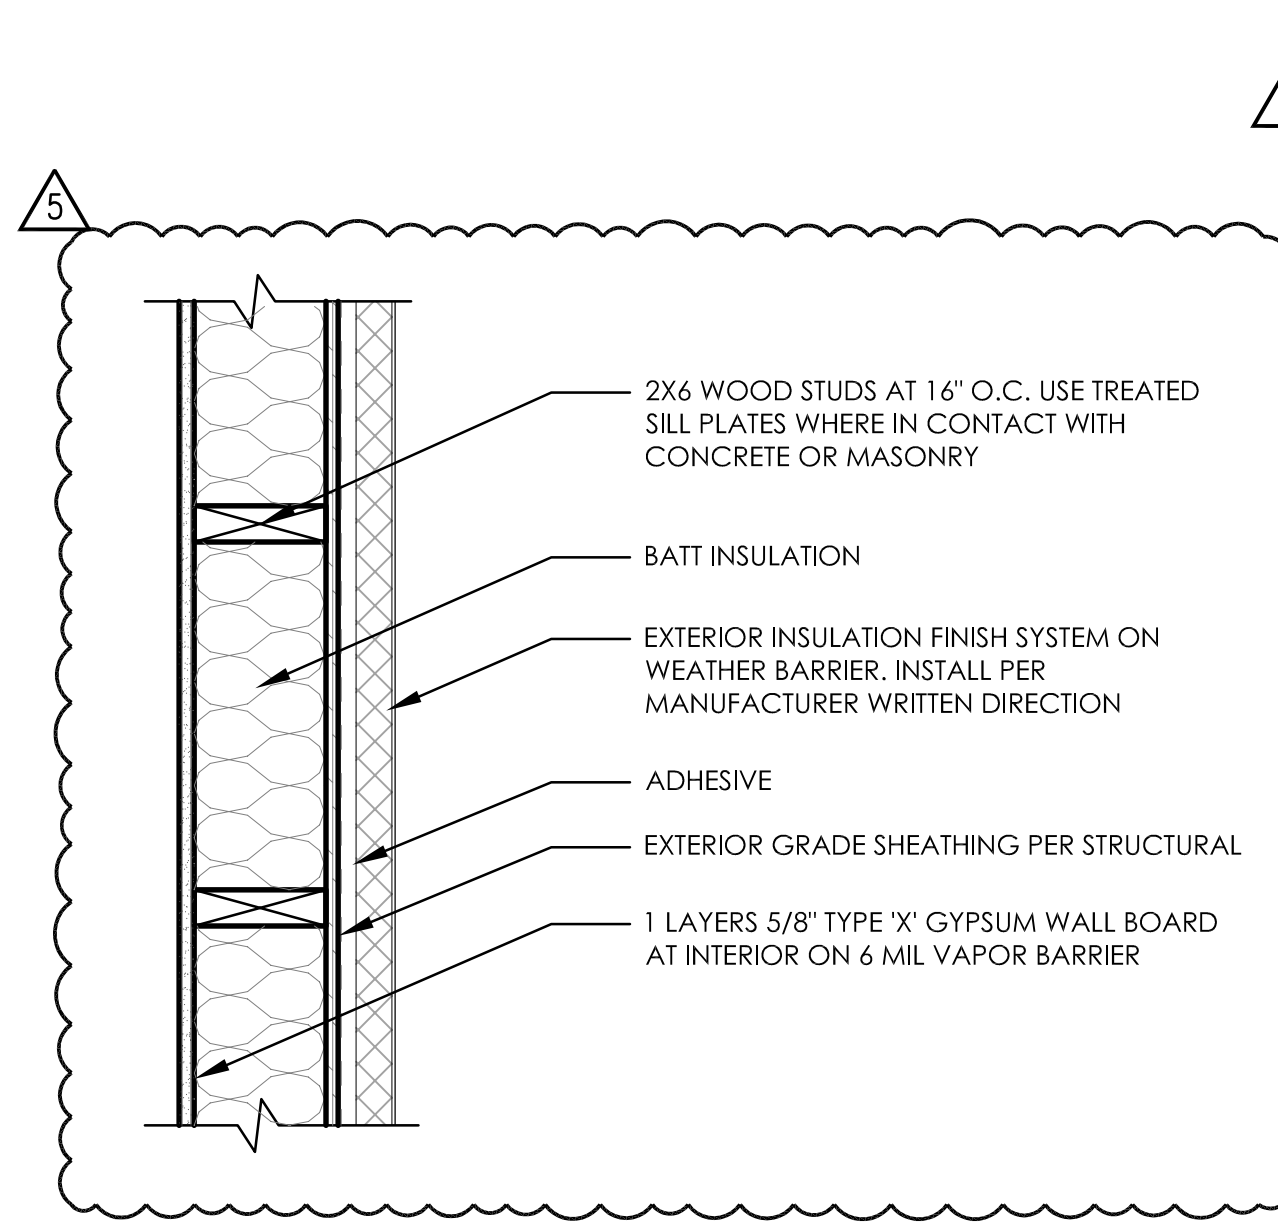


**A** TYPICAL EIFS WALL ASSEMBLIES  
24 x 36 - 1 1/2" = 1'-0"  
12 x 18 - 3/4" = 1'-0"

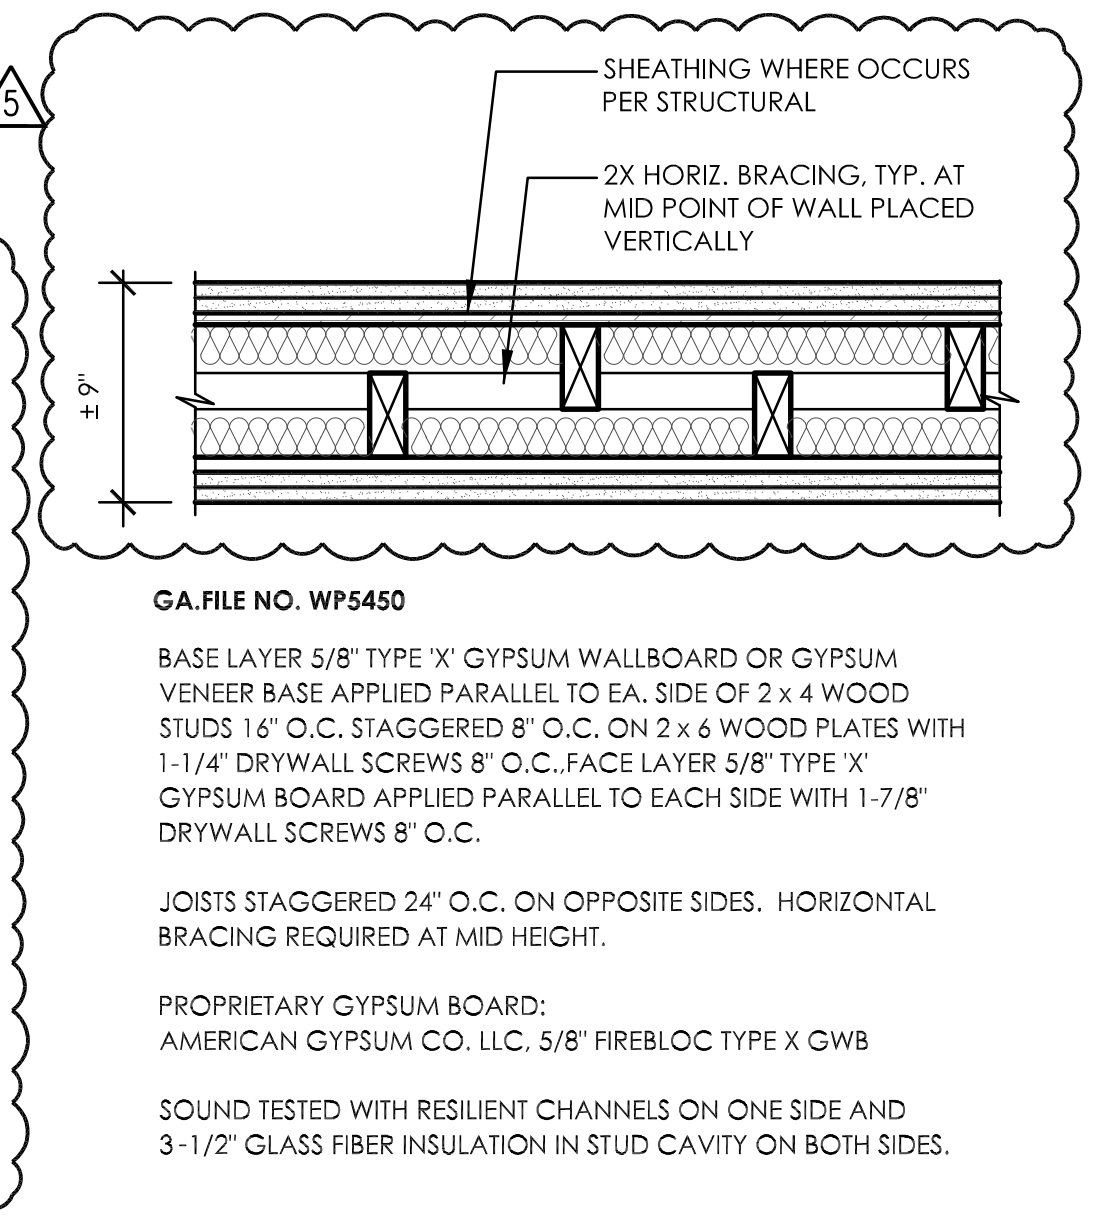


**B** 2 HOUR SOUND WALL  
24 x 36 - 1 1/2" = 1'-0"  
12 x 18 - 3/4" = 1'-0"

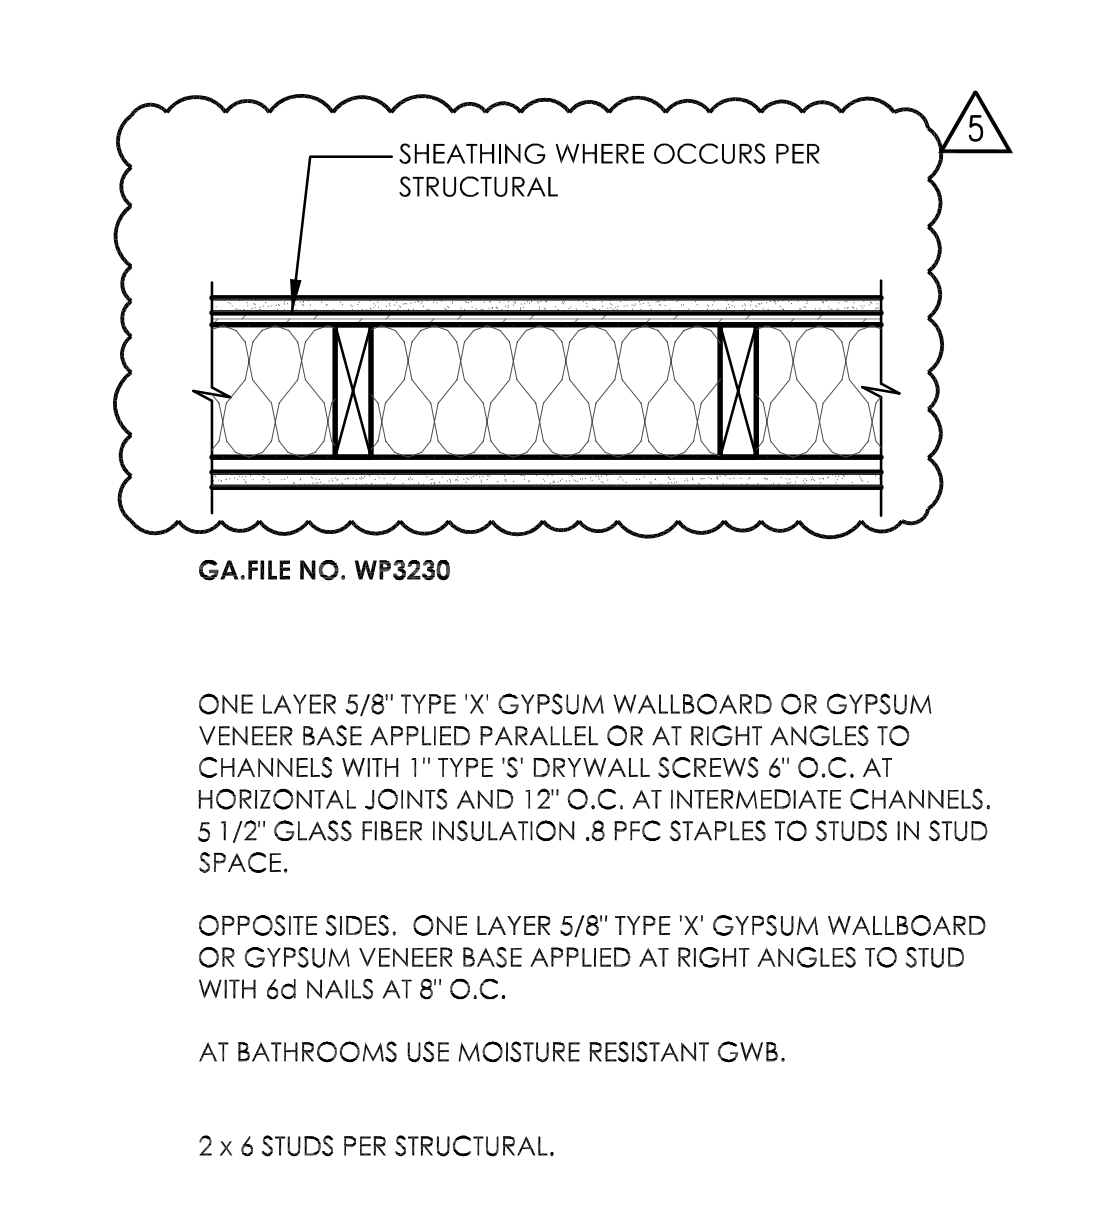


**C** 1 HR TYP. CORRIDOR WALLS  
24 x 36 - 1 1/2" = 1'-0"  
12 x 18 - 3/4" = 1'-0"

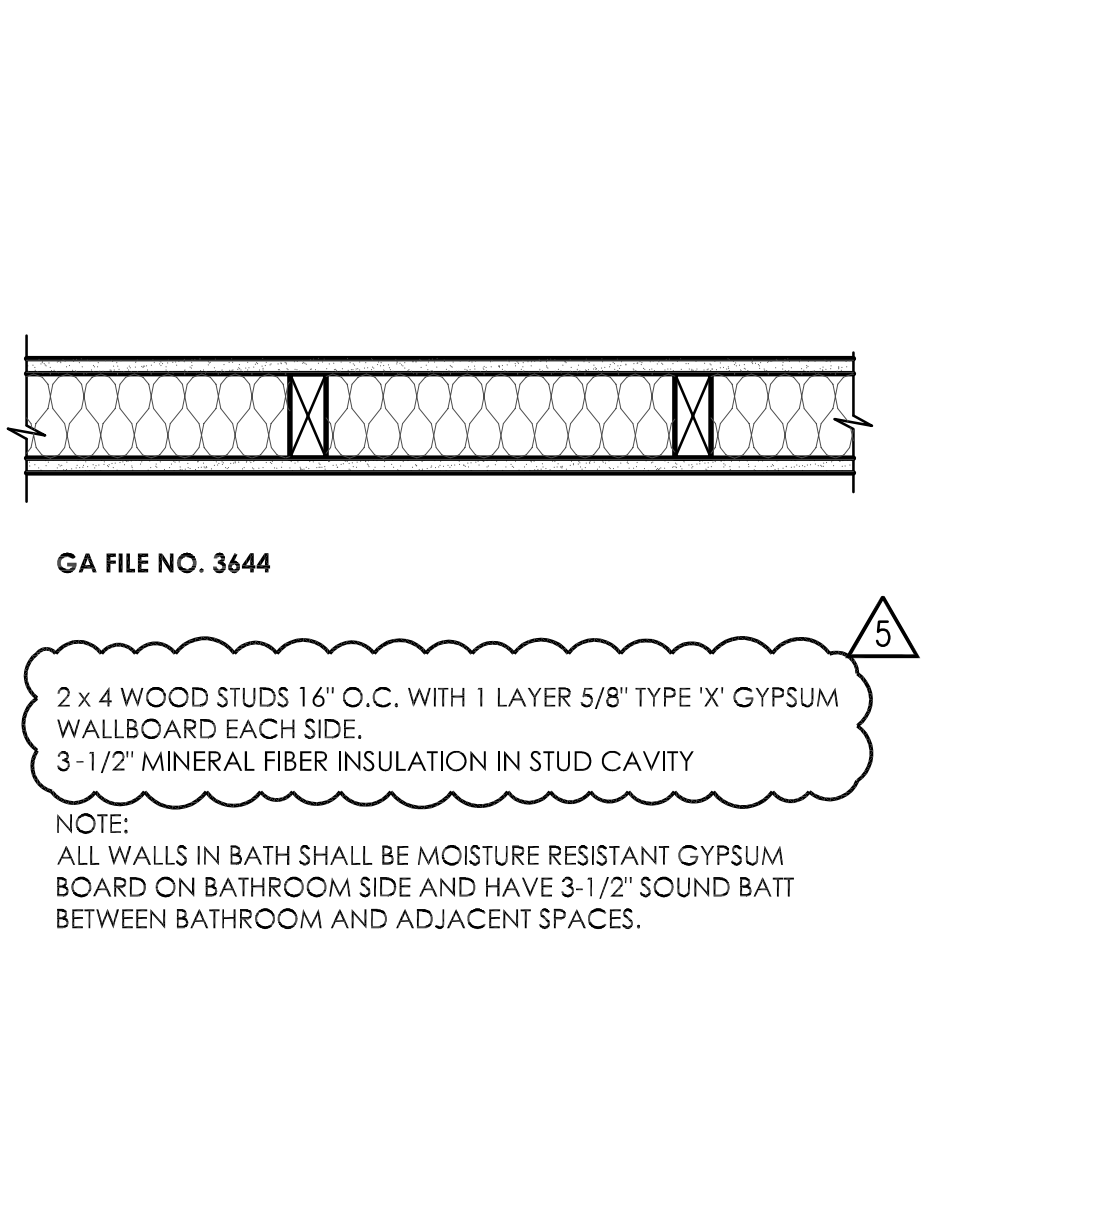


**D** TYP 1 HOUR WALL  
24 x 36 - 1 1/2" = 1'-0"  
12 x 18 - 3/4" = 1'-0"

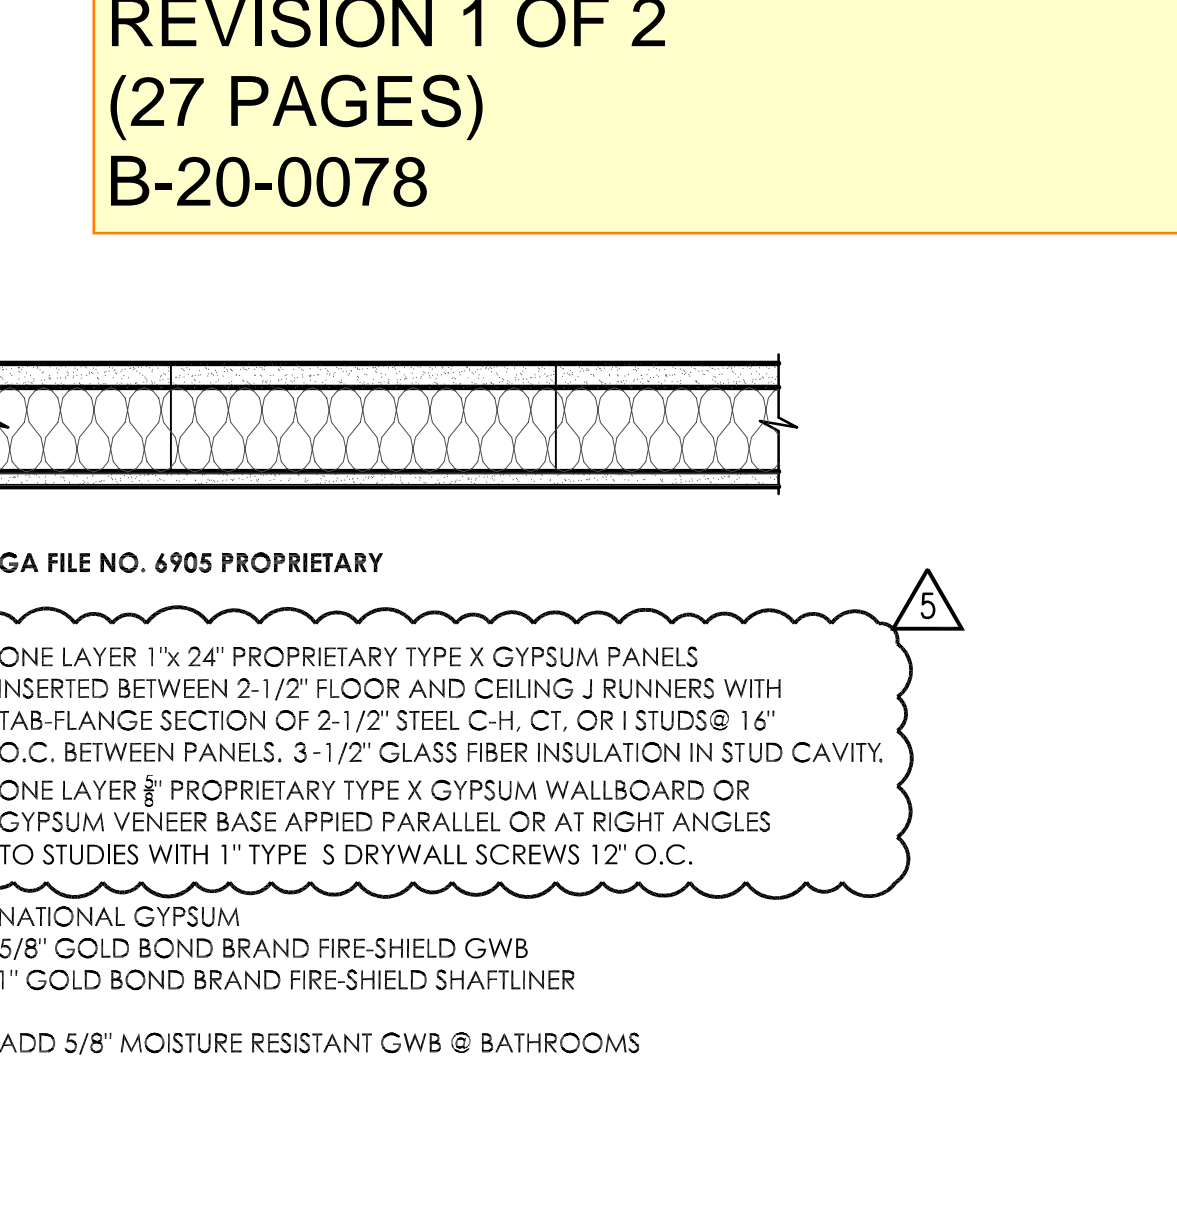


**E** TYP 1 HOUR SHAFT WALL  
24 x 36 - 1 1/2" = 1'-0"  
12 x 18 - 3/4" = 1'-0"

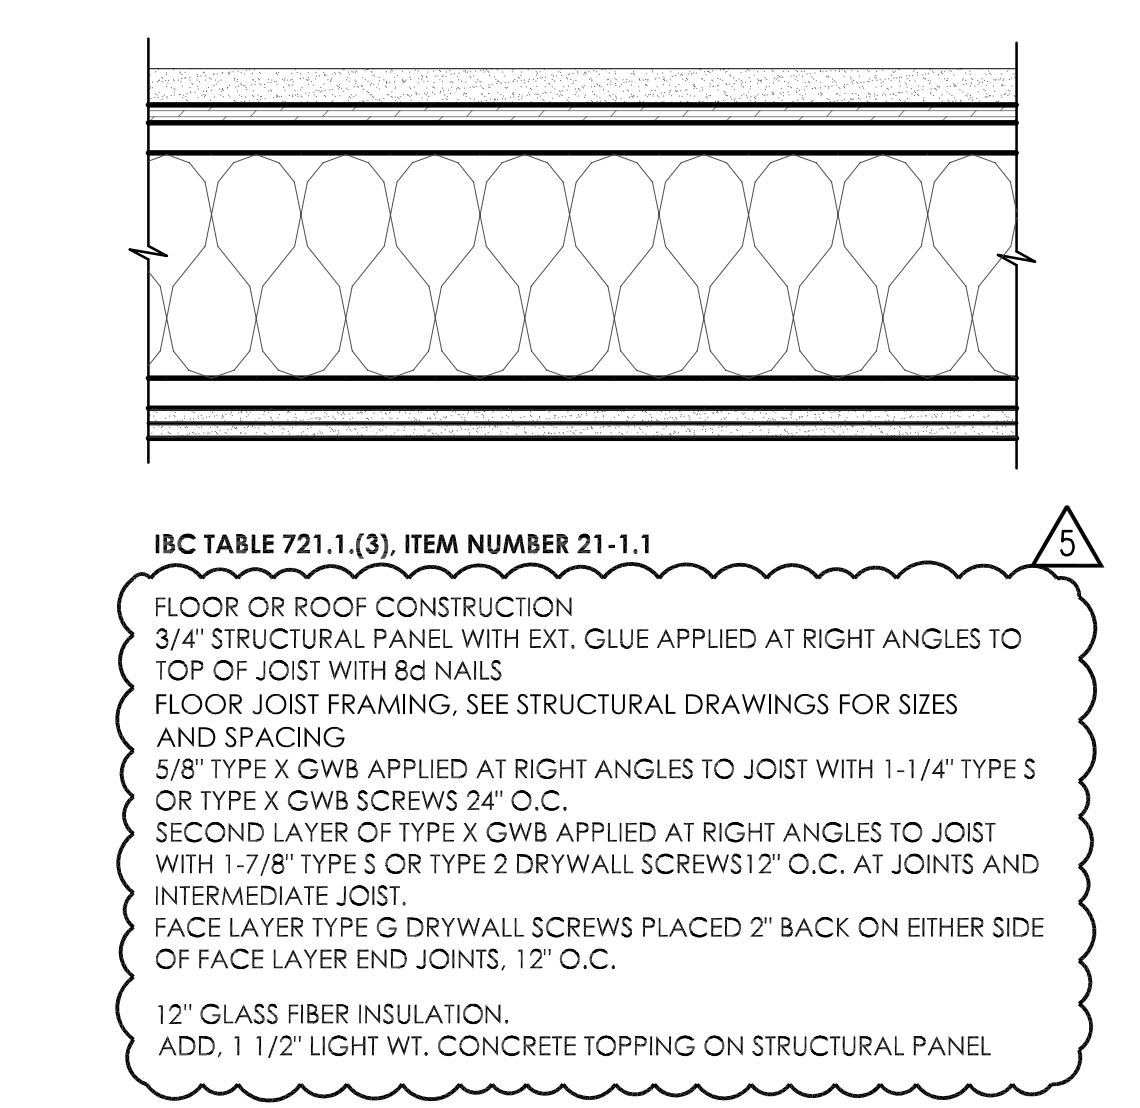


**F** 1 HOUR FLOOR-CLG  
24 x 36 - 1 1/2" = 1'-0"  
12 x 18 - 3/4" = 1'-0"

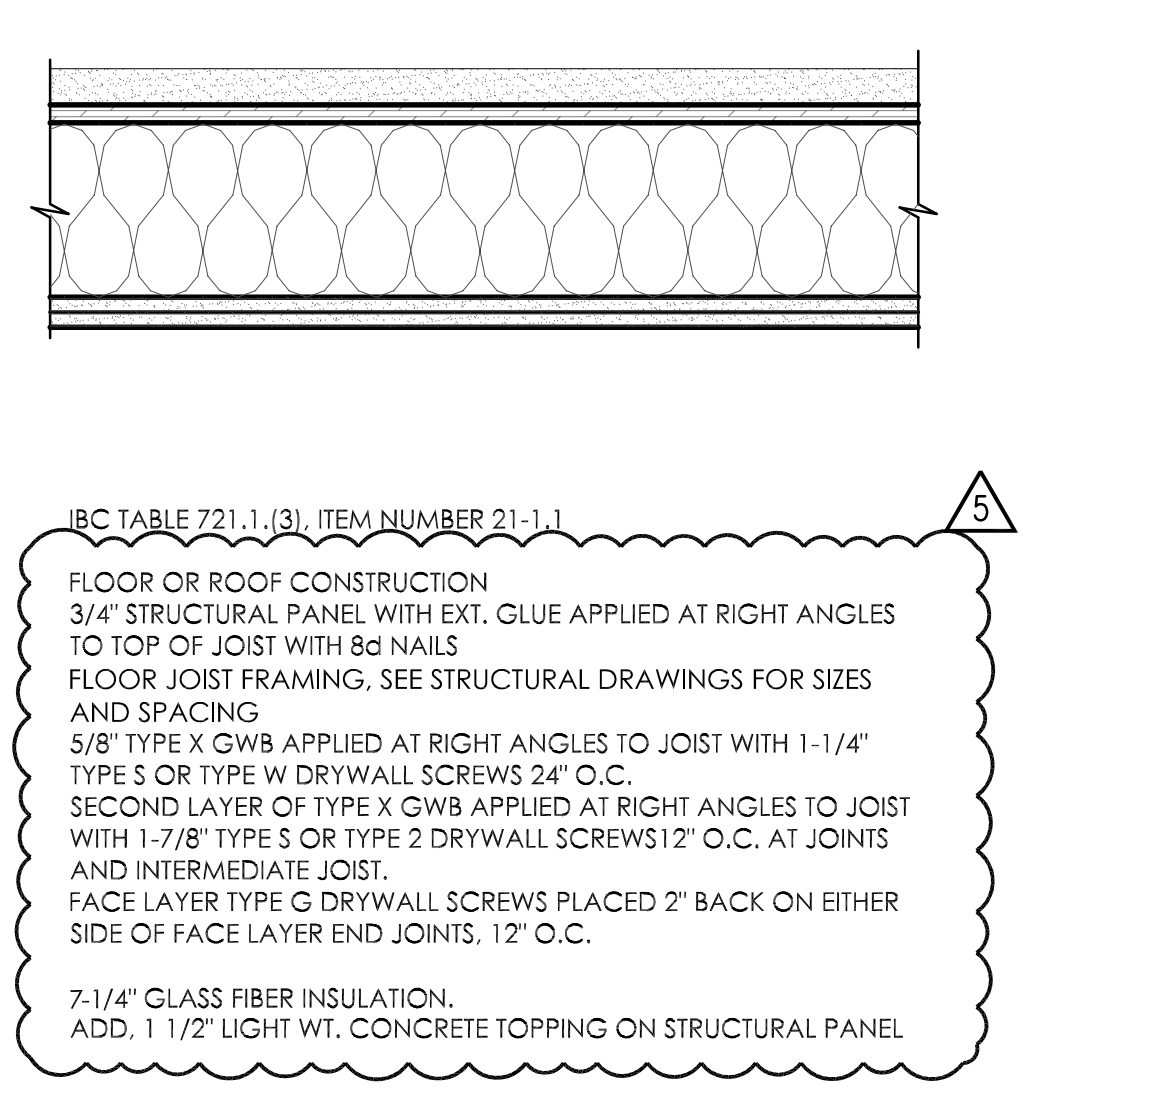


**G** 1 HOUR FLOOR-CLG@CORRIDOR  
24 x 36 - 1 1/2" = 1'-0"  
12 x 18 - 3/4" = 1'-0"

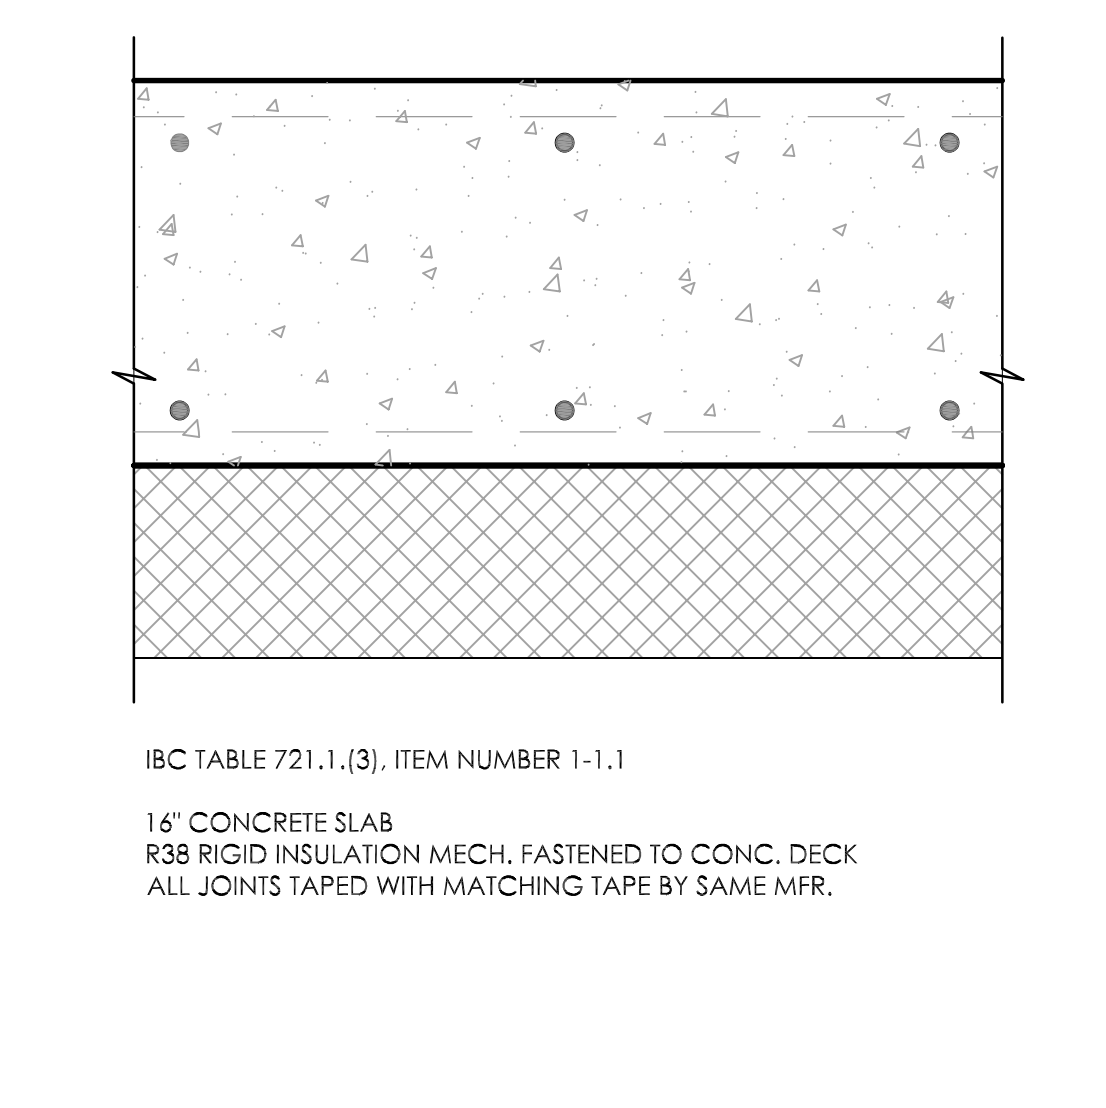


**H** 1 HOUR FLOOR-CLG SEPARATION  
24 x 36 - 1 1/2" = 1'-0"  
12 x 18 - 3/4" = 1'-0"

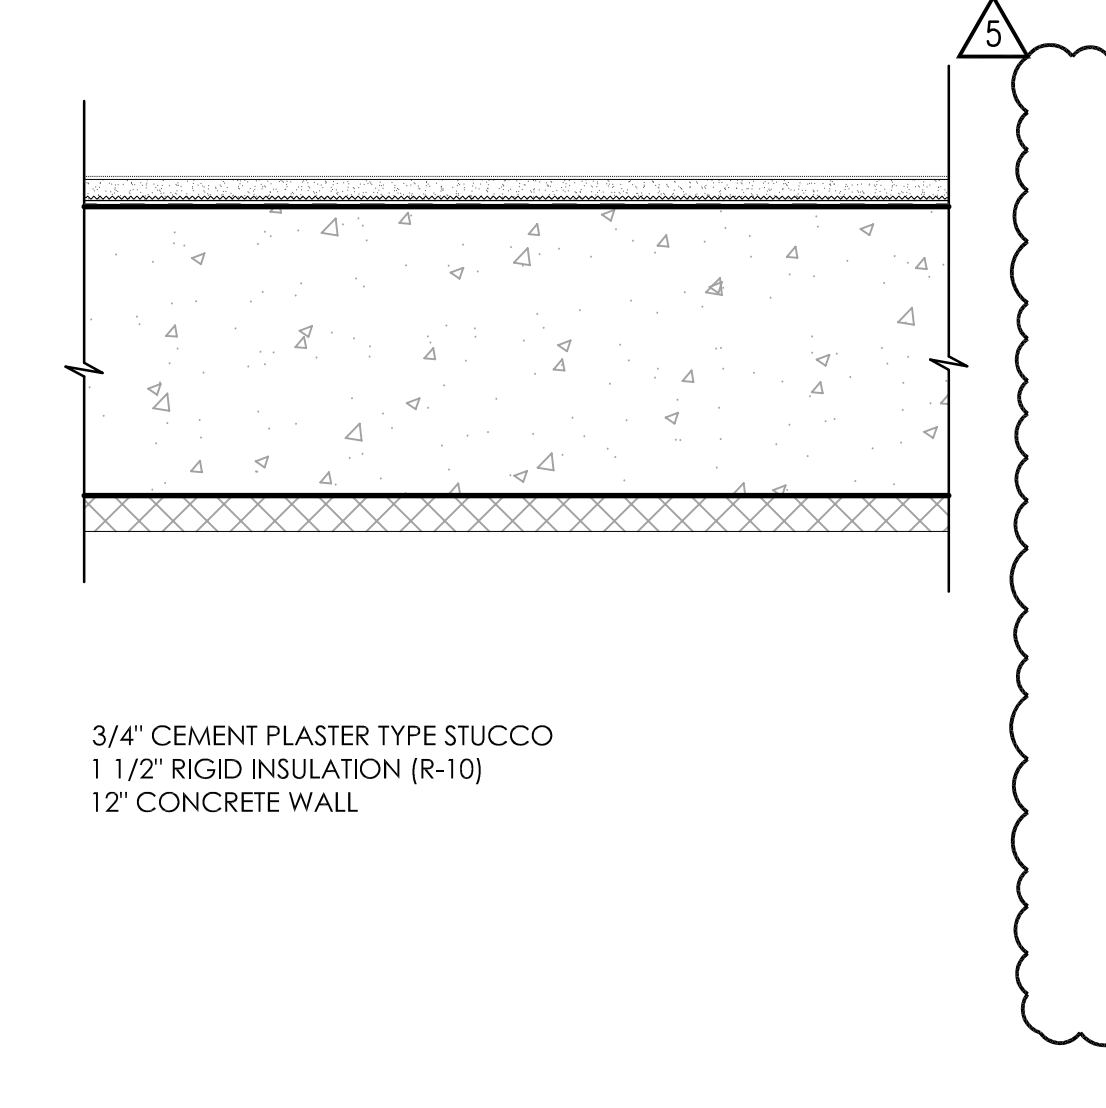


**I** CONCRETE STAIR WALL  
24 x 36 - 1 1/2" = 1'-0"  
12 x 18 - 3/4" = 1'-0"

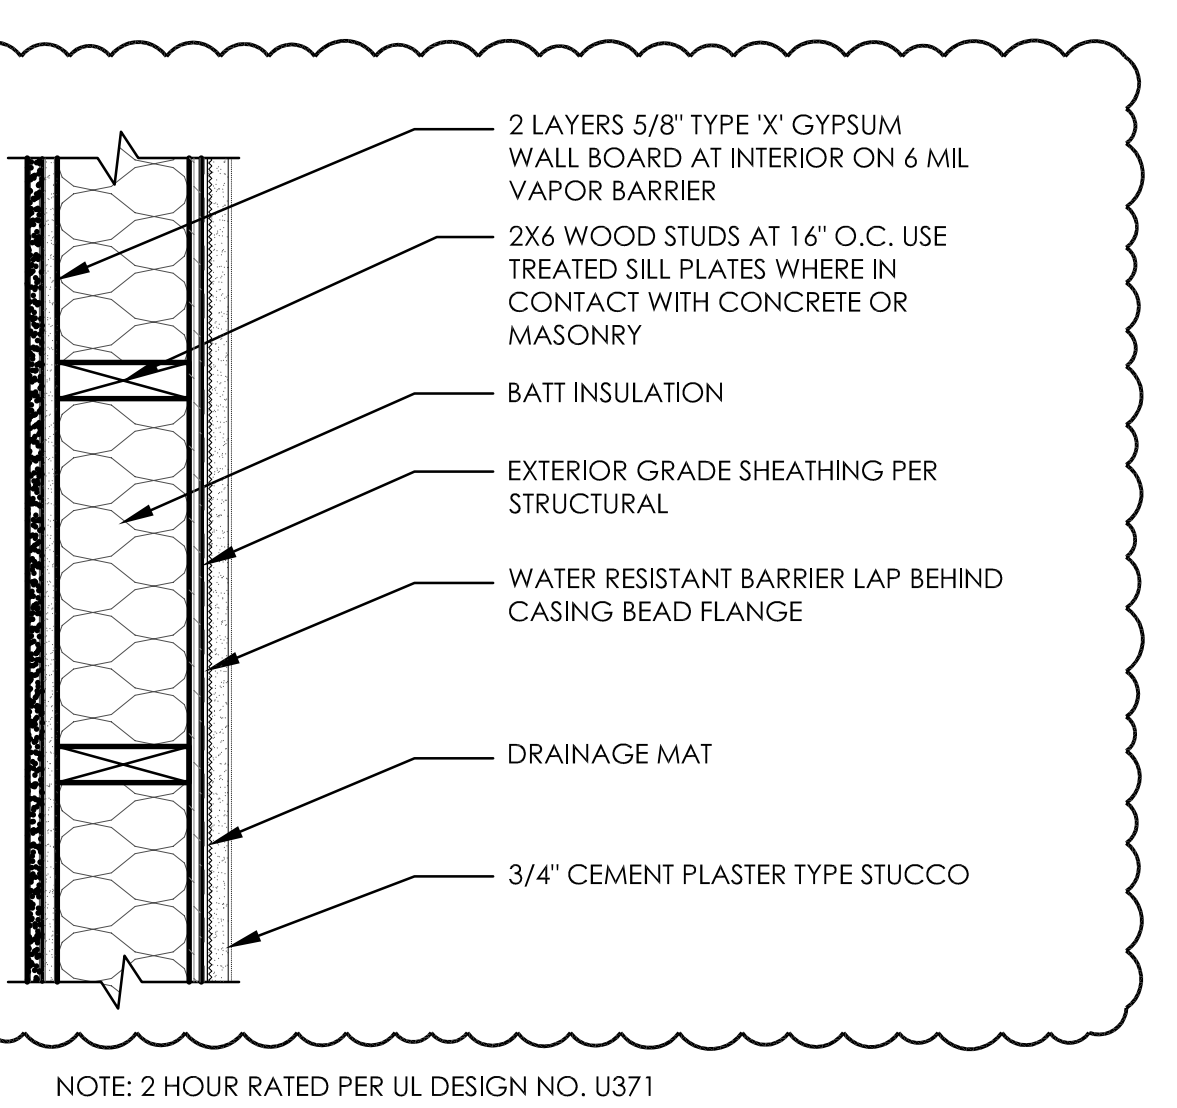


**J** 2 HOUR EXTERIOR STUCCO WALL  
24 x 36 - 1 1/2" = 1'-0"  
12 x 18 - 3/4" = 1'-0"

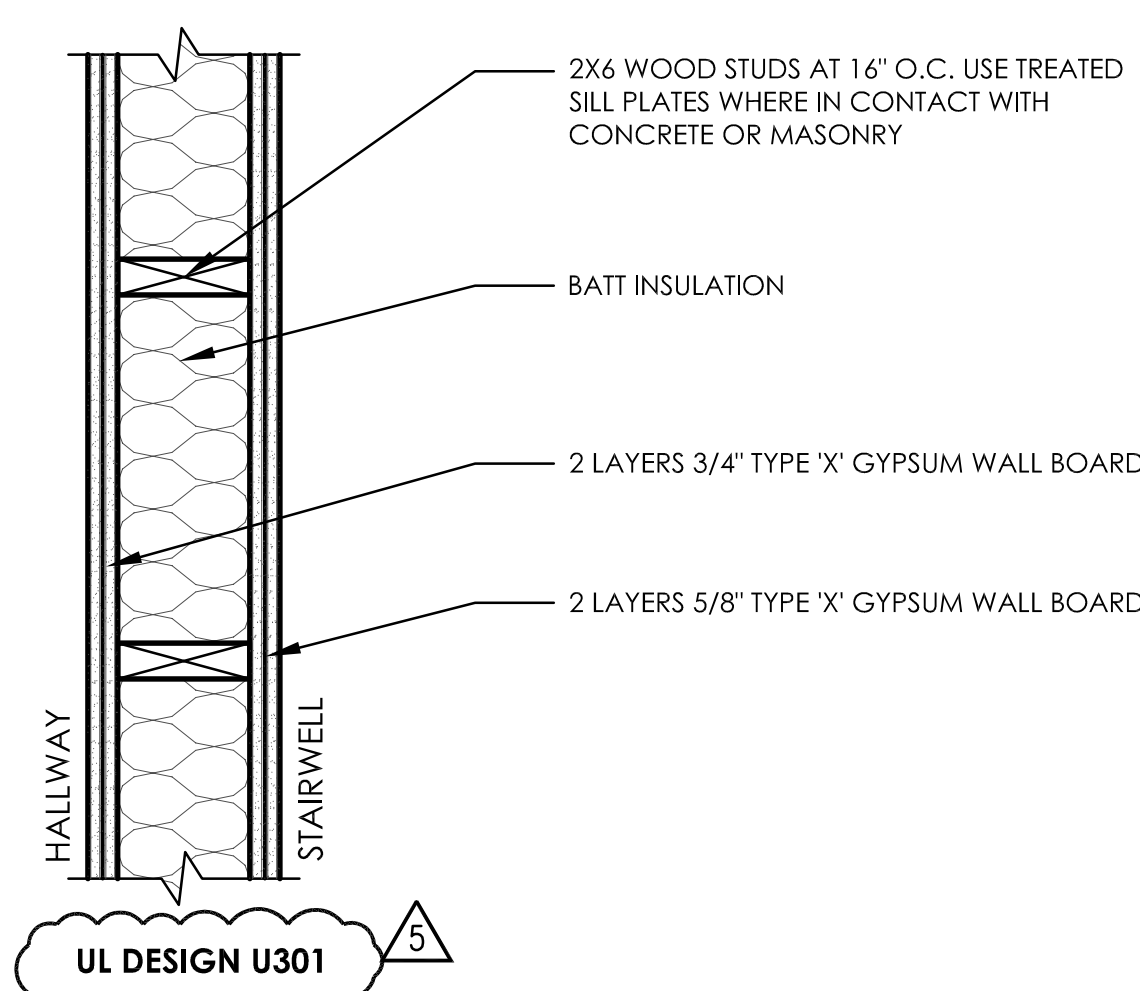


**K** TYP. 2 HR. WALL  
24 x 36 - 1 1/2" = 1'-0"  
12 x 18 - 3/4" = 1'-0"

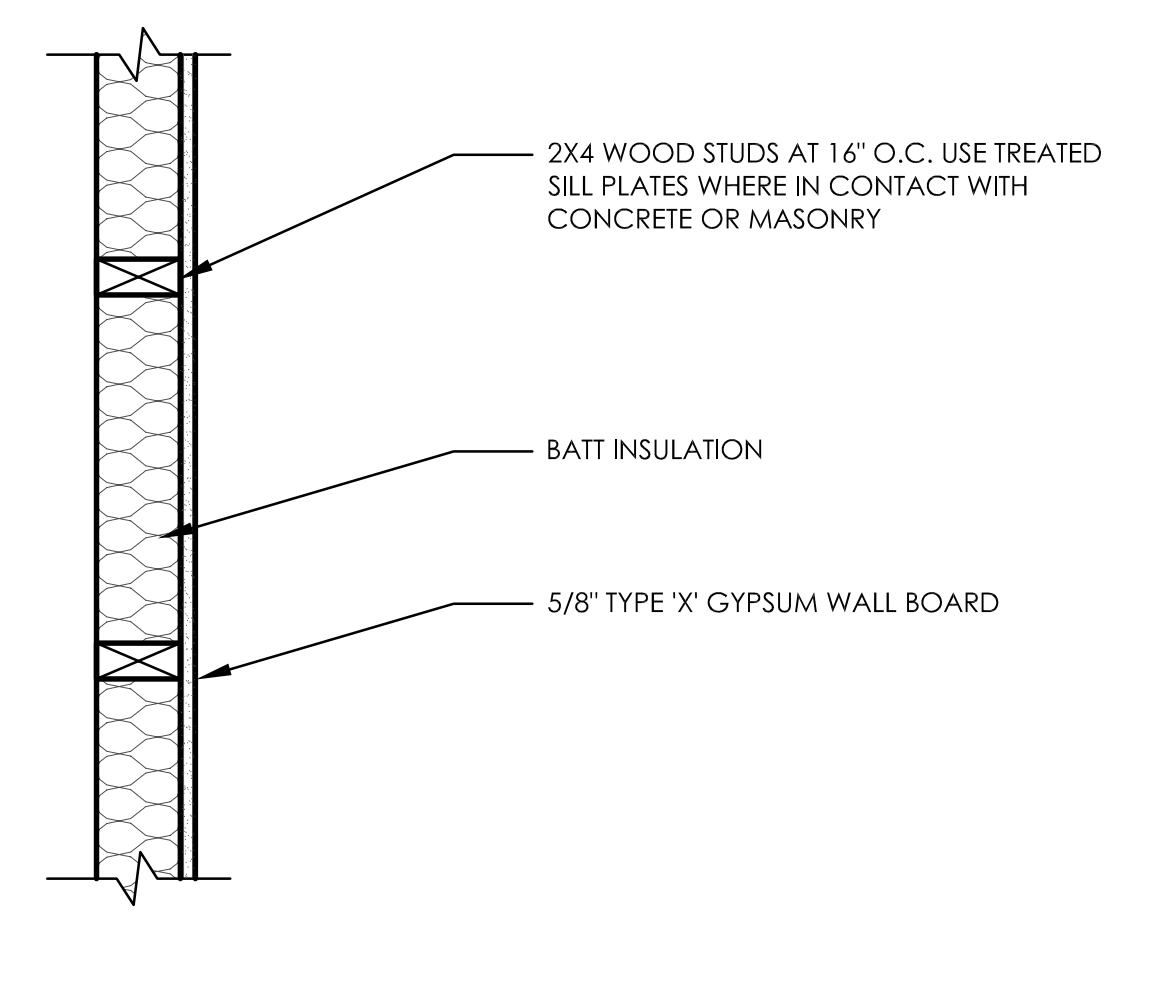


**L** FURRING WALL  
24 x 36 - 1 1/2" = 1'-0"  
12 x 18 - 3/4" = 1'-0"

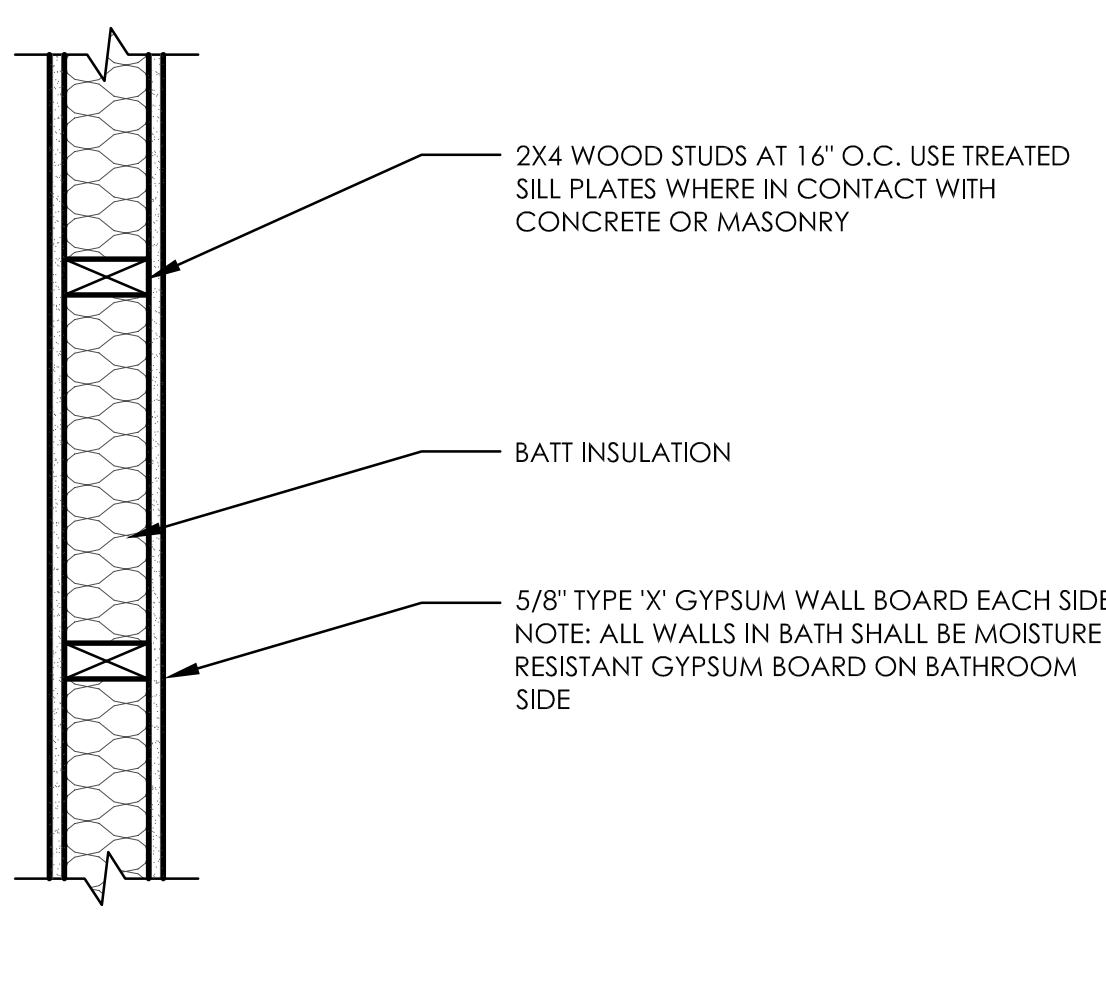

**M** NON-FIRE RATED WALL  
24 x 36 - 1 1/2" = 1'-0"  
12 x 18 - 3/4" = 1'-0"

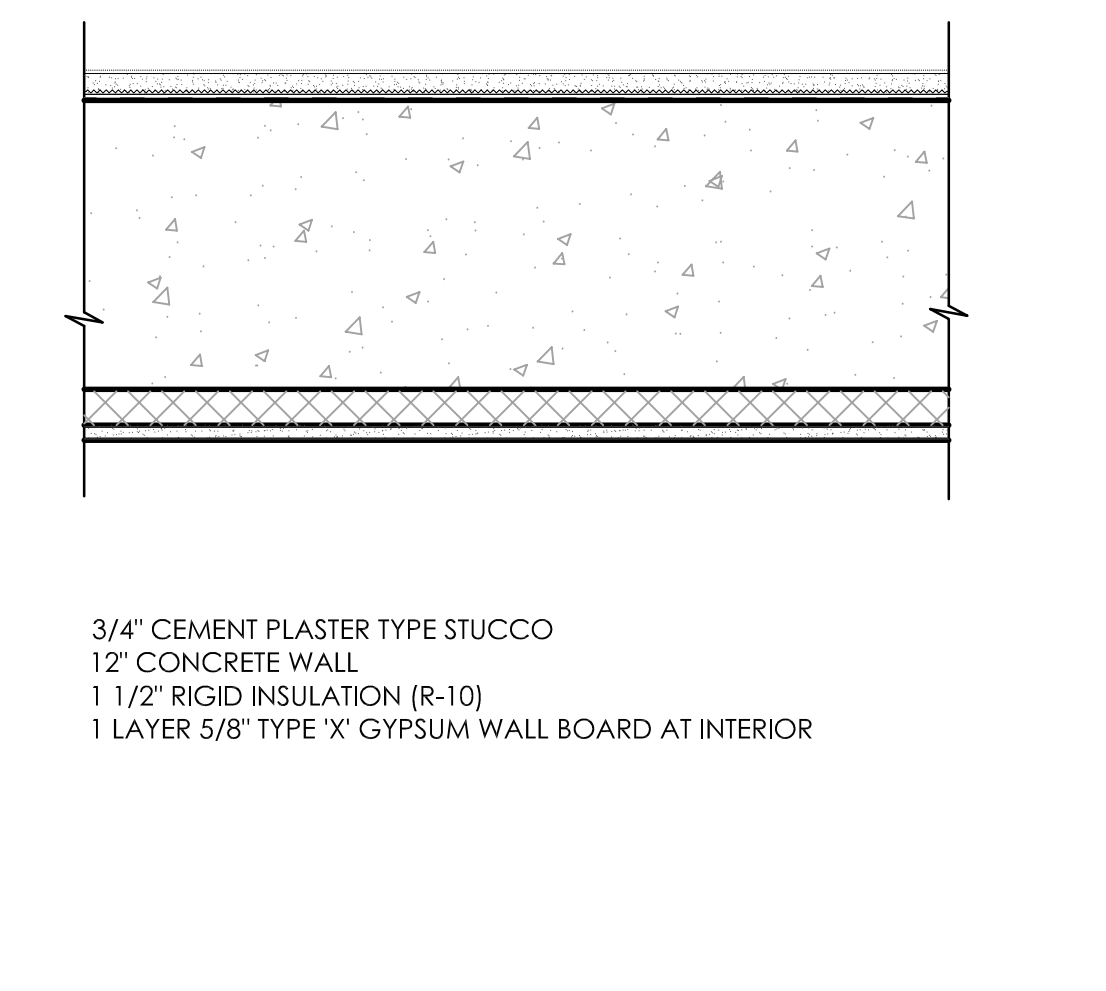

**N** CONCRETE STAIR WALL  
24 x 36 - 1 1/2" = 1'-0"  
12 x 18 - 3/4" = 1'-0"

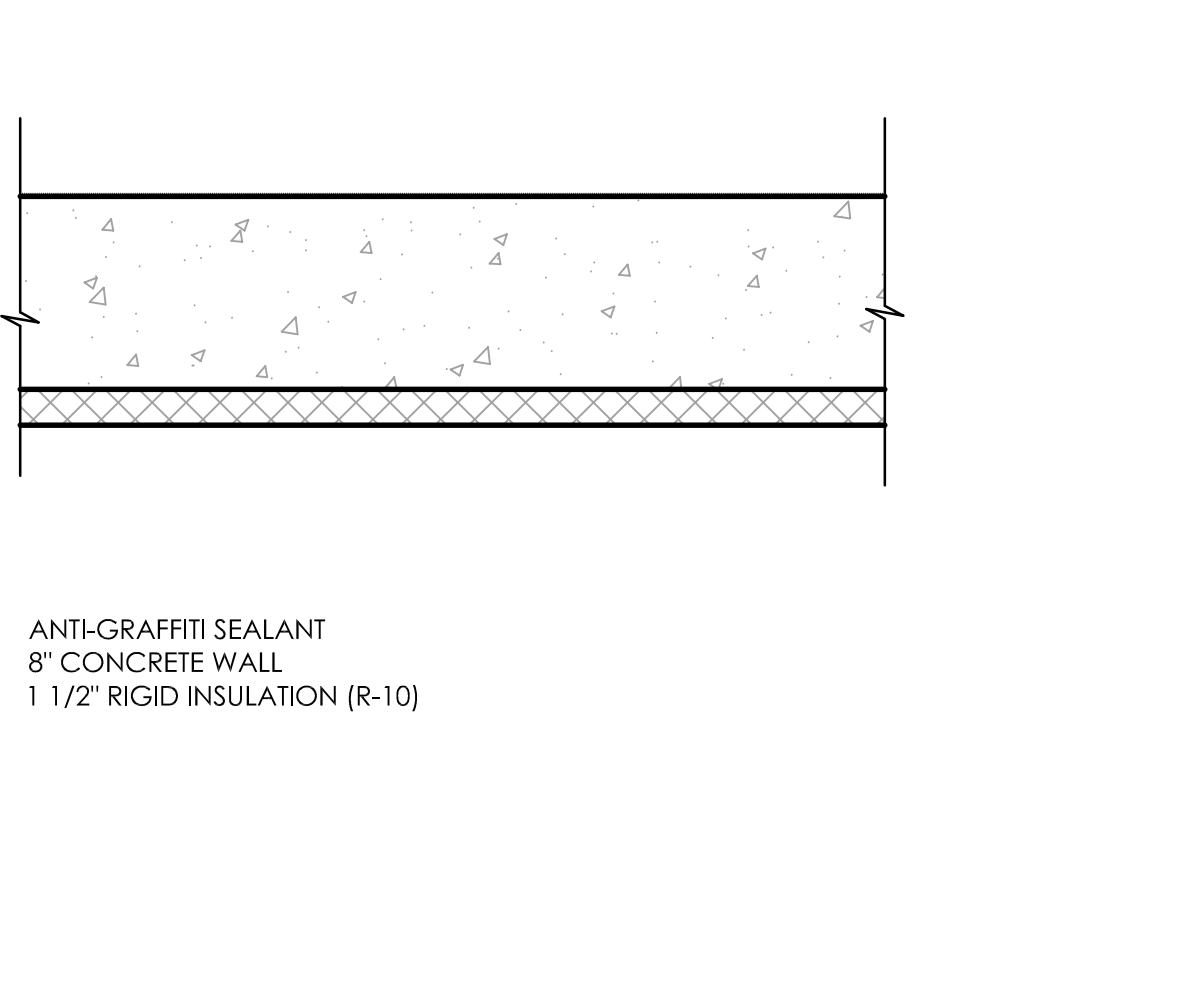

**O** CONCRETE STAIR WALL  
24 x 36 - 1 1/2" = 1'-0"  
12 x 18 - 3/4" = 1'-0"

ISSUE DATE 09/25/23  
PROGRESS SET

REV	DATE	COMMENT
1	03.03.2023	AC RESPONSE
2	08.14.2023	CORRECTIONS
3	09.25.2023	CORRECTIONS
4	10.17.2023	CORRECTIONS
5	12.21.2023	CORRECTIONS

City of Puyallup  
Development & Permitting Services  
ISSUED PERMIT

Building	Planning
Engineering	Public Works
Fire	Traffic

8677 REGISTERED ARCHITECT  
Rhonda A. Gillogly  
STATE OF WASHINGTON  
12/21/2023


WALL AND FLOOR-CLG TYPES

ADDITION TO HAMPTON INN & SUITES


1515 S MERIDIAN  
PUYALLUP, WA 98371  
HAMPTON INN & SUITES

TITLE	PROJECT	CLIENT

JOB NO: 210158

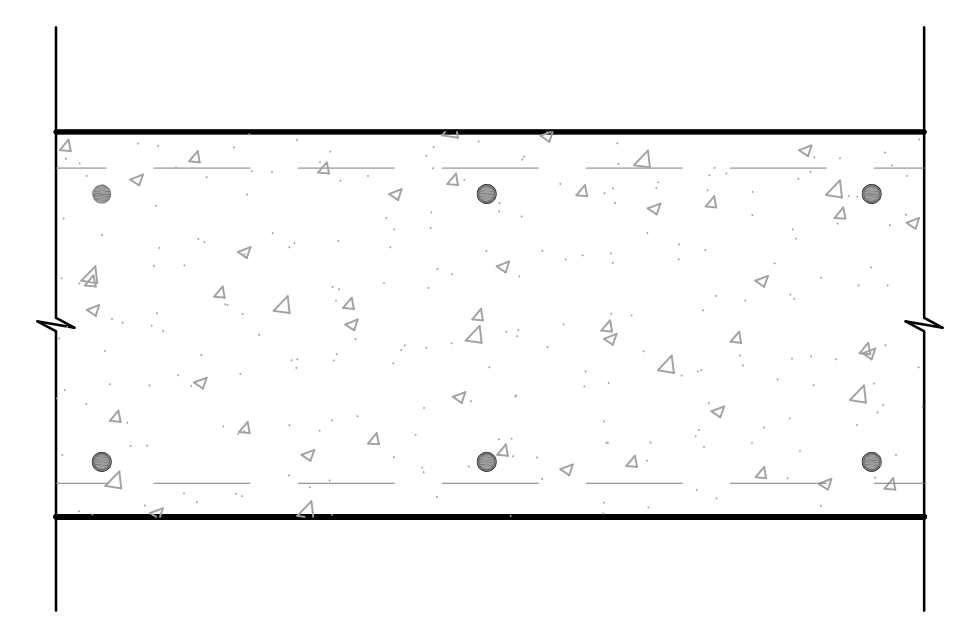

16' REINFORCED CONCRETE SLAB

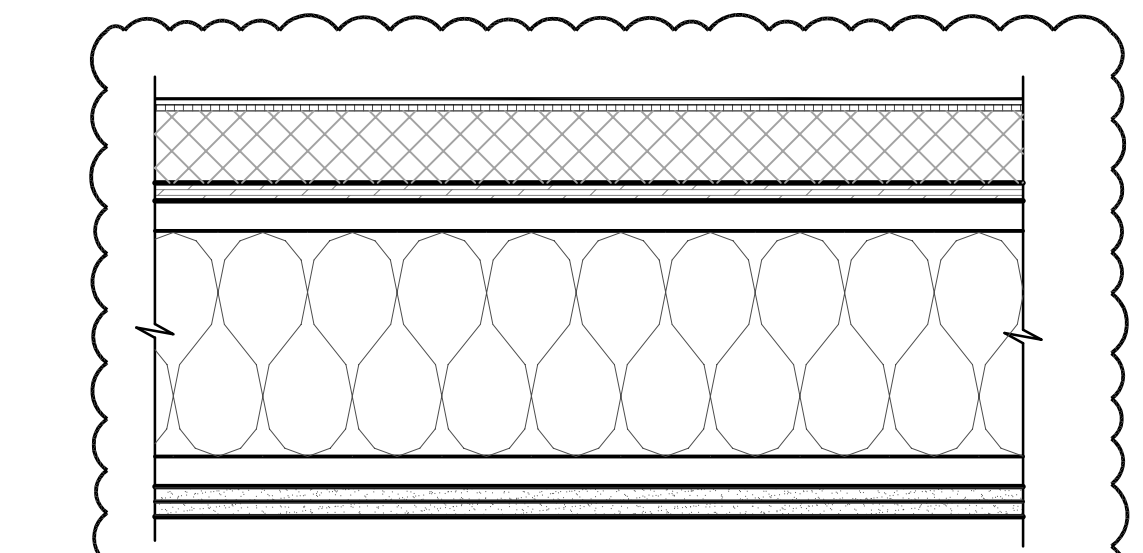


**IBC TABLE 721.1.(3), ITEM NUMBER 21-1.1**

FLOOR OR ROOF CONSTRUCTION  
3/4" STRUCTURAL PANEL WITH EXT. GLUE APPLIED AT RIGHT ANGLES TO TOP OF JOIST WITH 8d NAILS  
FLOOR JOIST FRAMING, SEE STRUCTURAL DRAWINGS FOR SIZES AND SPACING  
5/8" TYPE X GWB APPLIED AT RIGHT ANGLES TO JOIST WITH 1-1/4" TYPE S OR TYPE X GWB SCREWS 24" O.C.  
SECOND LAYER OF TYPE X GWB APPLIED AT RIGHT ANGLES TO JOIST WITH 1-7/8" TYPE S OR TYPE 2 DRYWALL SCREWS 12" O.C. AT JOINTS AND INTERMEDIATE JOIST.  
FACE LAYER TYPE G DRYWALL SCREWS PLACED 2" BACK ON EITHER SIDE OF FACE LAYER END JOINTS, 12" O.C.  
12" GLASS FIBER INSULATION.

MAINTAIN A MINIMUM OF 3" RIGID INSULATION AT ROOF

**Q 1 HOUR ROOF-CLG**  
24 x 36 - 1 1/2" = 1'-0"  
12 x 18 - 3/4" = 1'-0"

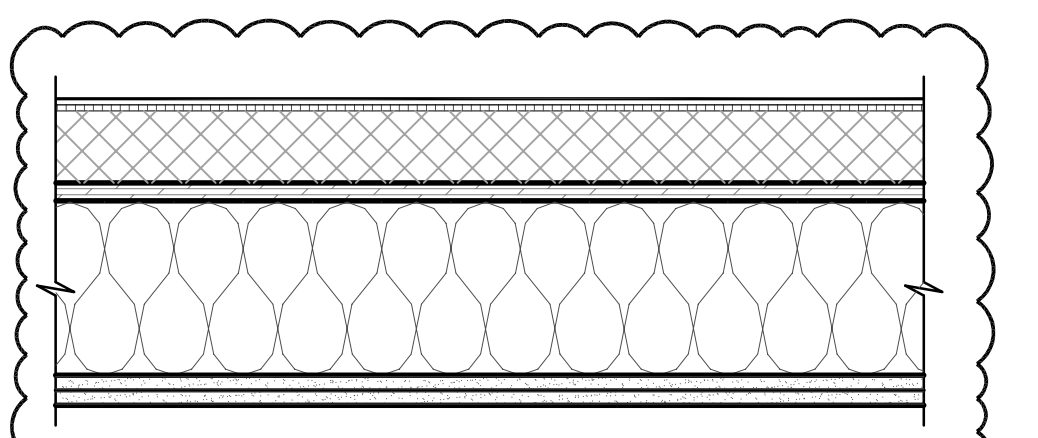


**IBC TABLE 721.1.(3), ITEM NUMBER 21-1.1**

FLOOR OR ROOF CONSTRUCTION  
3/4" STRUCTURAL PANEL WITH EXT. GLUE APPLIED AT RIGHT ANGLES TO TOP OF JOIST WITH 8d NAILS  
FLOOR JOIST FRAMING, SEE STRUCTURAL DRAWINGS FOR SIZES AND SPACING  
5/8" TYPE X GWB APPLIED AT RIGHT ANGLES TO JOIST WITH 1-1/4" TYPE S OR TYPE W DRYWALL SCREWS 24" O.C.  
SECOND LAYER OF TYPE X GWB APPLIED AT RIGHT ANGLES TO JOIST WITH 1-7/8" TYPE S OR TYPE 2 DRYWALL SCREWS 12" O.C. AT JOINTS AND INTERMEDIATE JOIST.  
FACE LAYER TYPE G DRYWALL SCREWS PLACED 2" BACK ON EITHER SIDE OF FACE LAYER END JOINTS, 12" O.C.  
7-1/4" GLASS FIBER INSULATION.

MAINTAIN A MINIMUM OF 3" RIGID INSULATION AT ROOF

**R 1 HOUR ROOF-CLG@CORRIDOR**  
24 x 36 - 1 1/2" = 1'-0"  
12 x 18 - 3/4" = 1'-0"

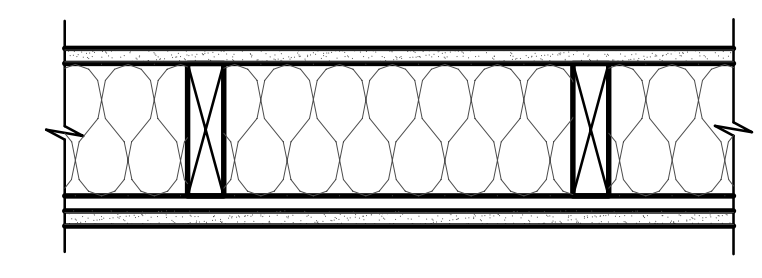

**GA.FILE NO. WP3230**

ONE LAYER 5/8" TYPE 'X' GYPSUM WALLBOARD OR GYPSUM VENEER BASE APPLIED PARALLEL OR AT RIGHT ANGLES TO CHANNELS WITH 1" TYPE 'S' DRYWALL SCREWS 6" O.C. AT HORIZONTAL JOINTS AND 12" O.C. AT INTERMEDIATE CHANNELS, 3 1/2" GLASS FIBER INSULATION .8 PFC STAPLES TO STUDS IN STUD SPACE.


OPPOSITE SIDES. ONE LAYER 5/8" TYPE 'X' GYPSUM WALLBOARD OR GYPSUM VENEER BASE APPLIED AT RIGHT ANGLES TO STUD WITH 6d NAILS AT 8" O.C.

AT BATHROOMS USE MOISTURE RESISTANT GWB.

2 x 8 STUDS PER STRUCTURAL.  
6" GLASS FIBER INSULATION IN STUD CAVITY.


**S 1 HR TYP. CORRIDOR WALLS**  
24 x 36 - 1 1/2" = 1'-0"  
12 x 18 - 3/4" = 1'-0"

**P FLOOR-CLG SEPARATION**  
24 x 36 - 1 1/2" = 1'-0"  
12 x 18 - 3/4" = 1'-0"

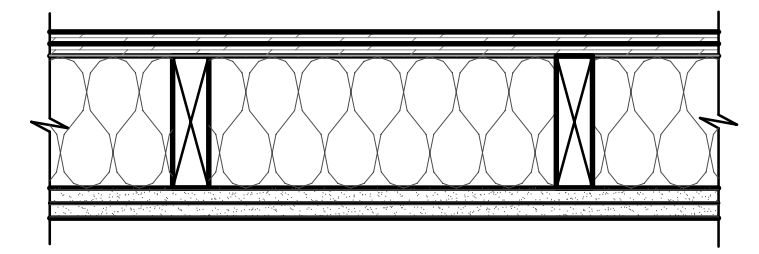


2 LAYERS OF 1/2" PLYWOOD  
2 x 8 WOOD STUDS 12" ON CENTER SEE STRUCTURAL  
6" BATT INSULATION  
2 LAYERS OF 5/8" TYPE 'X' GYPSUM BOARD

**T FLOOR-CLG LANDING**  
24 x 36 - 1 1/2" = 1'-0"  
12 x 18 - 3/4" = 1'-0"

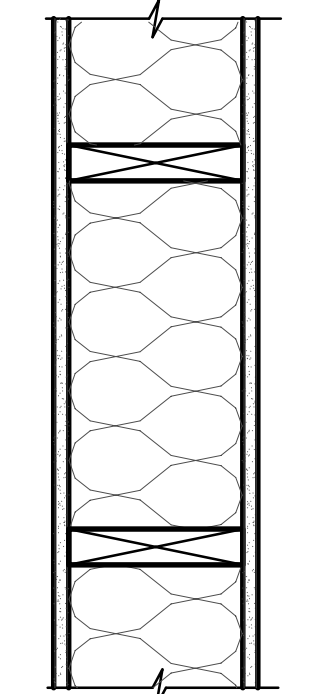


**UL DESIGN U305**

1 LAYER OF 5/8" TYPE 'X' GYPSUM BOARD  
2 x 8 WOOD STUDS 16" ON CENTER SEE STRUCTURAL  
8" BATT INSULATION COMPACTED  
1 LAYER OF 5/8" TYPE 'X' GYPSUM BOARD

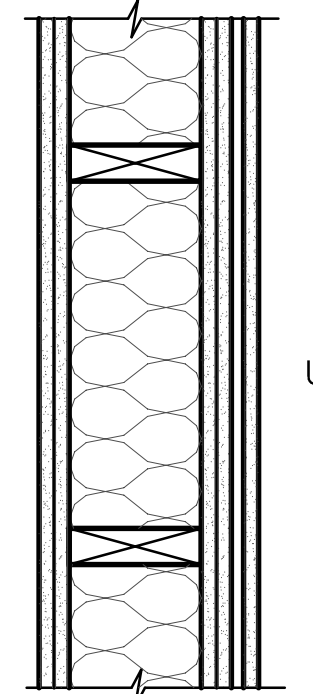

**UL DESIGN U301**

2 LAYERS OF 5/8" TYPE 'X' GYPSUM BOARD  
2 x 6 WOOD STUDS 16" ON CENTER SEE STRUCTURAL  
5 1/2" INSULATION  
2 LAYERS OF 5/8" TYPE 'X' GYPSUM BOARD  
1/2" RESILIENT CHANNEL  
1 LAYER OF 5/8" TYPE 'X' GYPSUM BOARD

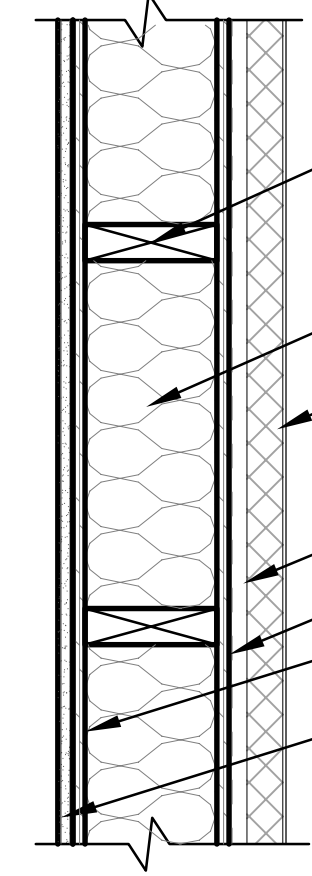

2x6 WOOD STUDS AT 16" O.C. USE TREATED SILL PLATES WHERE IN CONTACT WITH CONCRETE OR MASONRY

BATT INSULATION

EXTERIOR INSULATION FINISH SYSTEM ON WEATHER BARRIER. INSTALL PER MANUFACTURER WRITTEN DIRECTION

ADHESIVE

EXTERIOR GRADE SHEATHING PER STRUCTURAL


NEW PLYWOOD SHEATHING FOR SHEAR WALL PER STRUCTURAL DRAWING

1 LAYERS 5/8" TYPE 'X' GYPSUM WALL BOARD AT INTERIOR ON 6 MIL VAPOR BARRIER

**U 1 HR WALL**  
24 x 36 - 1 1/2" = 1'-0"  
12 x 18 - 3/4" = 1'-0"

**V 2 HOUR SOUND WALL**  
24 x 36 - 1 1/2" = 1'-0"  
12 x 18 - 3/4" = 1'-0"

**W EXT. SHEAR WALL @ EXIST. BLDG**  
24 x 36 - 1 1/2" = 1'-0"  
12 x 18 - 3/4" = 1'-0"

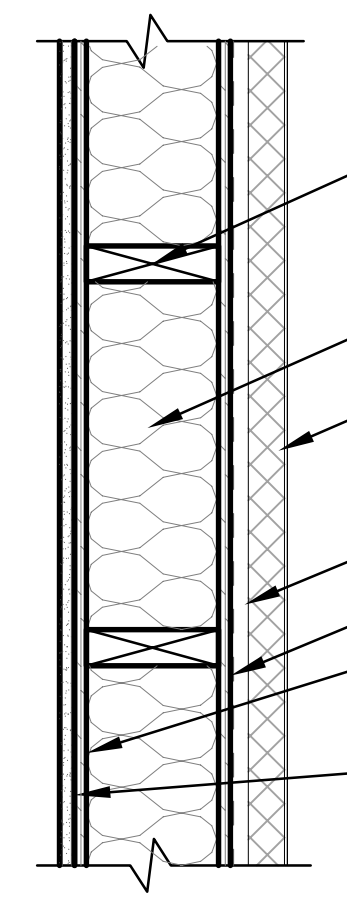

2x6 WOOD STUDS AT 16" O.C. USE TREATED SILL PLATES WHERE IN CONTACT WITH CONCRETE OR MASONRY

EXISTING BATT INSULATION

EXISTING EXTERIOR INSULATION FINISH SYSTEM ON WEATHER BARRIER.

EXISTING ADHESIVE

EXISTING EXTERIOR GRADE SHEATHING PER STRUCTURAL

REMOVE EXISTING INTERIOR GYPSUM AND ADD NEW PLYWOOD SHEATHING FOR SHEAR WALL PER STRUCTURAL DRAWING

1 LAYERS 5/8" TYPE 'X' GYPSUM WALL BOARD AT INTERIOR ON 6 MIL VAPOR BARRIER

**X EXT. SHEAR WALL @ EXIST. BLDG**  
24 x 36 - 1 1/2" = 1'-0"  
12 x 18 - 3/4" = 1'-0"

ISSUE DATE 09/25/23  
PROGRESS SET

REV	DATE	COMMENT
1	03.03.2023	AC RESPONSE
2	08.14.2023	CORRECTIONS
3	09.25.2023	CORRECTIONS
4	10.17.2023	CORRECTIONS
5	12.21.2023	CORRECTIONS

City of Puyallup  
Development & Permitting Services  
ISSUED PERMIT

Building	Planning
Engineering	Public Works
Fire	Traffic

6677 REGISTERED ARCHITECT  
*Rhonda A. Gillogly*  
RHONDA A. GILLOGLY  
STATE OF WASHINGTON  
12/21/2023

WALL AND FLOOR-CLG TYPES

ADDITION TO HAMPTON INN & SUITES

1515 S MERIDIAN  
PUYALLUP, WA 98371  
HAMPTON INN & SUITES

TITLE	PROJECT	CLIENT
JOB NO: 210158		

**REVISION 1 OF 2**  
**(27 PAGES)**  
**B-20-0078**

**GENERAL NOTES**

A. CONTRACTOR TO FIELD VERIFY FRAMING AT ALL DOOR LOCATIONS FOR PROPER OPERATING CLEARANCE WITH VANITY CASEWORK.

B. DIMENSIONS ARE TO FACE OF STUD OR TO CENTERLINE WHERE NOTED.

C. CONTRACTOR TO VERIFY SHEAR WALL LOCATIONS PER STRUCTURAL PLANS.

D. FIELD VERIFY ALL EXISTING CONDITIONS AND DIMENSIONS. DIMENSIONS ARE TO FACE OF FINISH, TO FACE OF EXISTING WALL, OR TO FACE OF FOUNDATION WALL UNLESS NOTED OTHERWISE.



**KNIT**

909 S. 336TH ST.  
 SUITE 107  
 FEDERAL WAY, WA 98003  
 knitstudios.com

THESE DOCUMENTS HAVE BEEN PRODUCED AS AN INSTRUMENT OF SERVICE AND ARE INTENDED SOLELY FOR THE PURPOSE OF CONSTRUCTING, USING AND MAINTAINING THE PROJECT. KNIT AS THE ARCHITECT OF RECORD FOR THE PROJECT RETAINS OWNERSHIP OF THESE DOCUMENTS.

ANY USE OF THESE DOCUMENTS OR USE OF THE DESIGN IDEAS OR CONCEPTS DESCRIBED HEREIN IN WHOLE OR PART BY ANY PERSON WHATSOEVER IS EXPRESSLY PROHIBITED EXCEPT BY WRITTEN CONSENT OF KNIT.

REPRODUCTION OF THESE DOCUMENTS IS STRICTLY PROHIBITED EXCEPT BY WRITTEN CONSENT OF KNIT.

COPYRIGHT 2021 KNIT

- NEW FLOOR PLAN KEYED NOTES**
- 1 INSTALL NEW FLOORING AND RUBBER BASE THIS GENERAL AREA
  - 2 PATCH WALLS WHERE DEMOLITION HAS OCCURRED AND FINISH SEAMLESSLY.
  - 3 ALIGN NEW WALL WITH ADJACENT EXISTING WALLS AND FINISH SEAMLESSLY
  - 4 SUPPORT COLUMNS. SEE STRUCTURAL DRAWINGS FOR MORE INFORMATION
  - 5 SHEAR WALLS. SEE STRUCTURAL DRAWINGS FOR MORE INFORMATION.
  - 6 CONCRETE CURBS. SEE CIVIL DRAWINGS FOR MORE INFORMATION.
  - 7 NEW STOREFRONT ENTRY. SEE DOOR SCHEDULE FOR MORE INFORMATION.
  - 8 (NOT USED)
  - 9 PATCH WALLS WHERE DEMOLITION HAS OCCURRED.
  - 10 ALIGN NEW WALL WITH ADJACENT EXISTING WALLS AND FINISH SEAMLESSLY.
  - 11 (NOT USED)
  - 12 INSTALL NEW CARPETING, COLOR, PATTERN, AND MANUFACTURER TO BE DETERMINED BY OWNER.
  - 13 NEW WALL PAPER TO MATCH EXISTING WALL PAPER IN CORRIDOR ALL INTERIOR WALLS THIS AREA.
  - 14 NEW WALL PAPER TO MATCH EXISTING ROOM WALL PAPER.
  - 15 COORDINATE NEW DUCTWORK AND SUPPLY WITH EXISTING PTAC UNIT AT CORRIDOR AND MEETING ROOM WITH MEP DRAWINGS.
  - 16 PROVIDE NEW TILE BASE TO MATCH EXISTING BASE THIS GENERAL AREA.
  - 17 INFILL EXISTING EXTERIOR WALL WITH LIKE MATERIALS TO MATCH EXISTING AND TO MAINTAIN WATER TIGHTNESS. WALL SURFACES AT INTERIOR AND EXTERIOR SHALL ALIGN AND SHALL BE SEAMLESS. FINISH WITH TEXTURES, PAINT, SHEEN AND COLORS TO MATCH EXISTING.


ISSUE DATE 09/25/23  
 PROGRESS SET

REV	DATE	COMMENT
1	03.03.2023	AC RESPONSE
2	08.14.2023	CORRECTIONS
3	09.25.2023	CORRECTIONS
4	10.17.2023	CORRECTIONS
5	12.21.2023	CORRECTIONS

City of Puyallup  
 Development & Permitting Services  
**ISSUED PERMIT**

Building	Planning
Engineering	Public Works
Fire	Traffic

8677 REGISTERED ARCHITECT

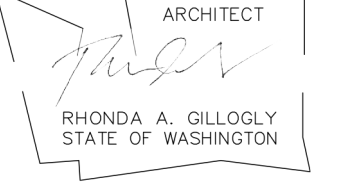

RHONDA A. GILLOGLY  
 STATE OF WASHINGTON

12/21/2023

**1ST FLOOR PLAN**


**ADDITION TO HAMPTON INN & SUITES**

1515 S MERIDIAN  
 PUYALLUP, WA 98371  
 HAMPTON INN & SUITES


TITLE	PROJECT	CLIENT

JOB NO: 210158

**A2.1**

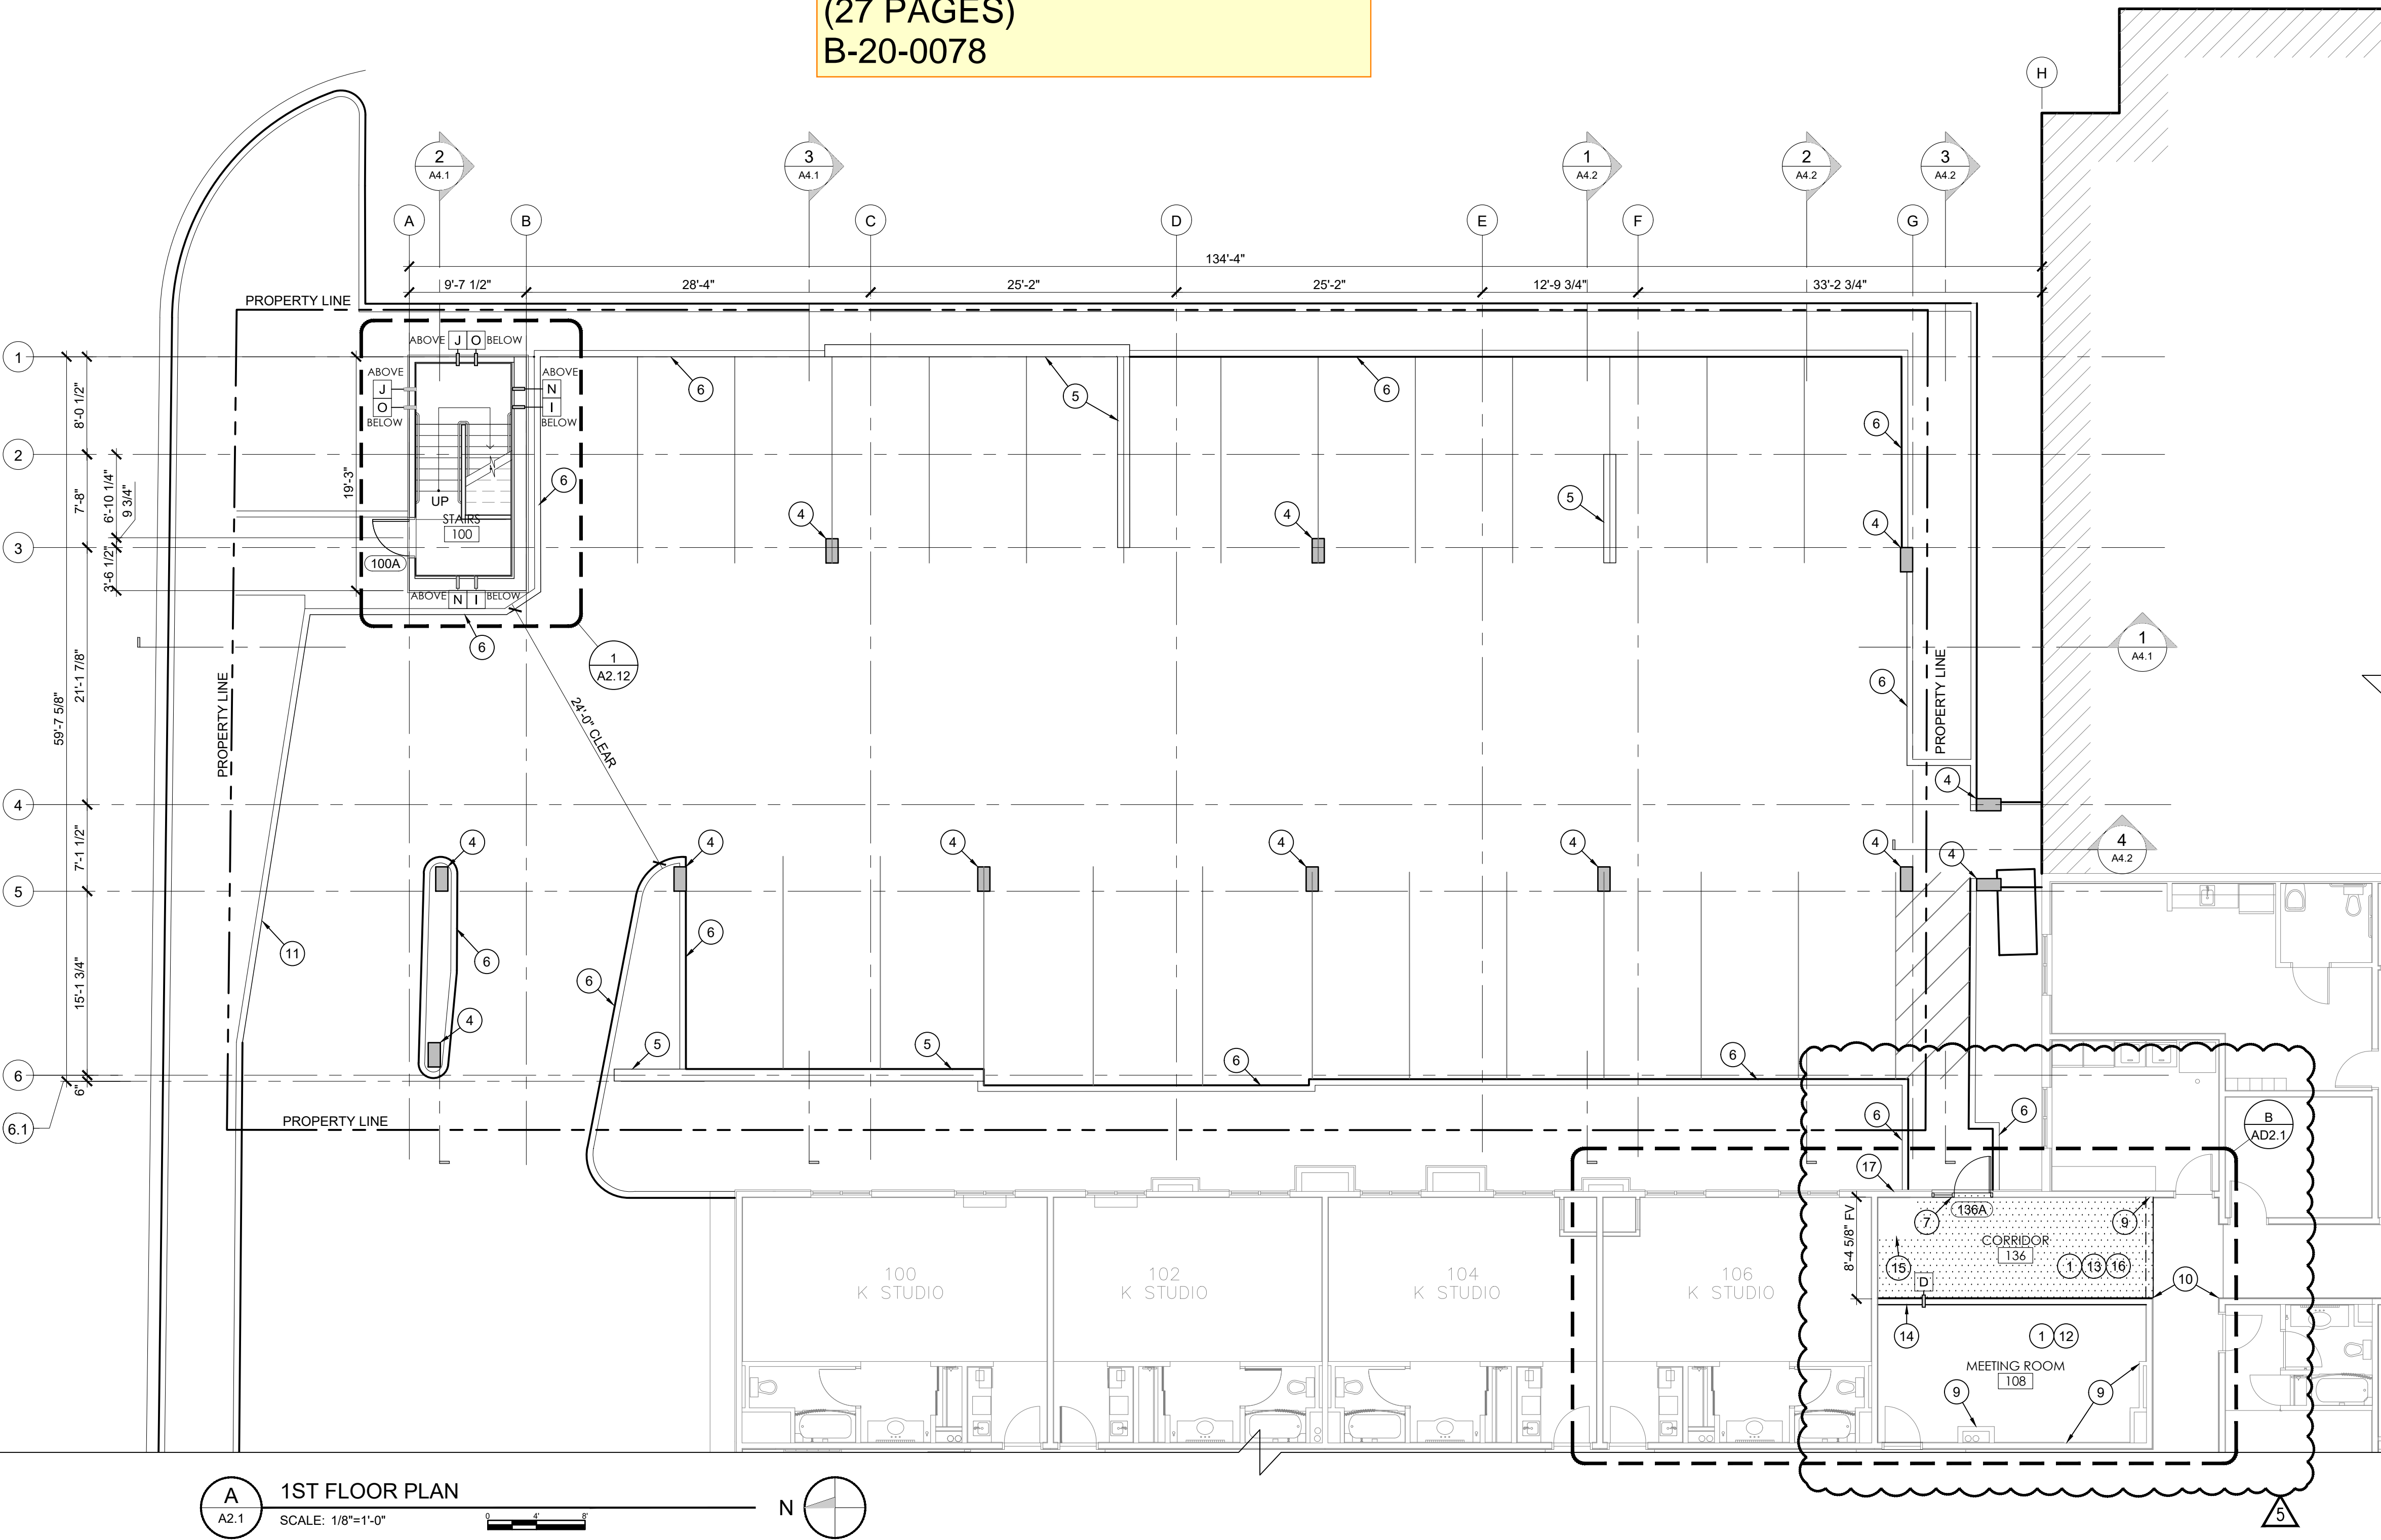

**A** 1ST FLOOR PLAN  
 A2.1 SCALE: 1/8"=1'-0" 

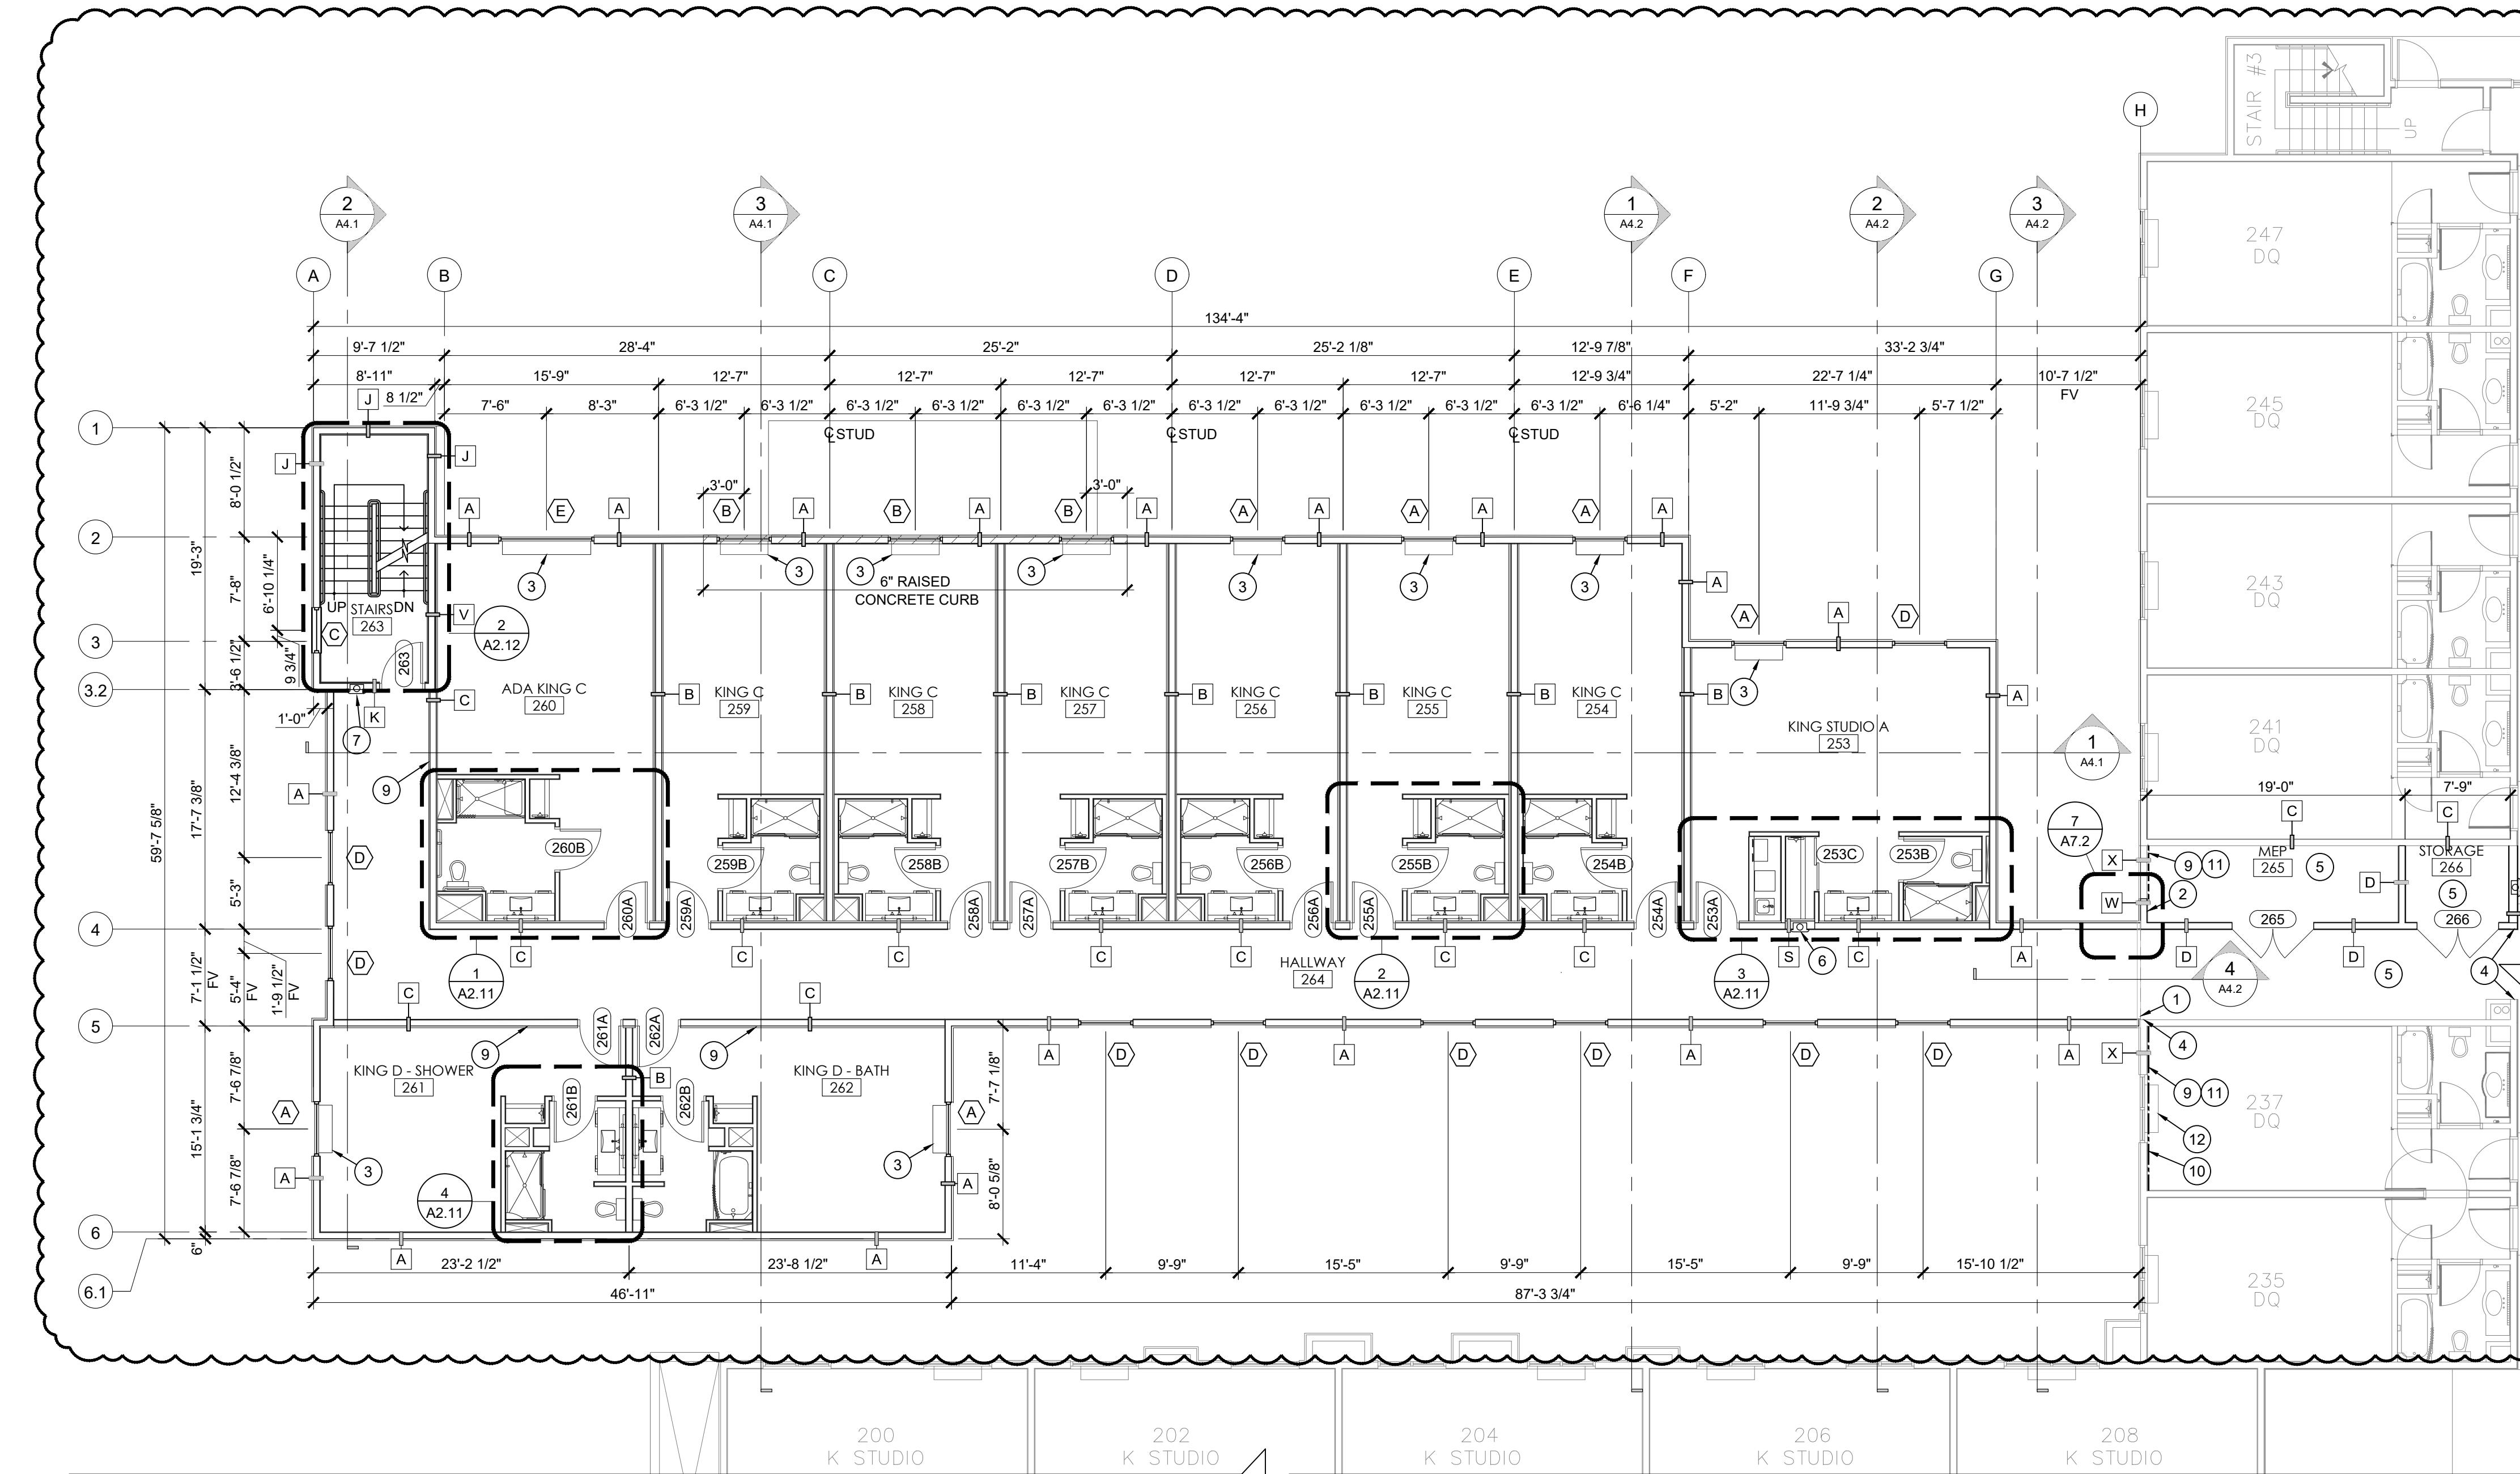

**GENERAL NOTES**

- A. CONTRACTOR TO FIELD VERIFY FRAMING AT ALL DOOR LOCATIONS FOR PROPER OPERATING CLEARANCE WITH VANITY CASEWORK.
- B. DIMENSIONS ARE TO FACE OF STUD OR TO CENTERLINE WHERE NOTED.
- C. CONTRACTOR TO VERIFY SHEAR WALL LOCATIONS PER STRUCTURAL PLANS.
- D. FIELD VERIFY ALL EXISTING CONDITIONS AND DIMENSIONS. DIMENSIONS ARE TO FACE OF FINISH, TO FACE OF EXISTING WALL, OR TO FACE OF FOUNDATION WALL UNLESS NOTED OTHERWISE.

**NEW FLOOR PLAN KEYED NOTES**

- 1 ALIGN NEW WALL WITH EXISTING WALL AND FINISH SEAMLESSLY. COORDINATE WITH EXPANSION JOINT DETAILS.
- 2 NEW WALL INFILL WHERE EXISTING WINDOW AND HVAC UNIT WERE REMOVED.
- 3 NEW HVAC UNITS. SEE MEP DRAWINGS FOR MORE INFORMATION.
- 4 PATCH WALLS WHERE DEMOLITION HAS OCCURRED AND FINISH SEAMLESSLY.
- 5 INSTALL NEW FLOORING AND RUBBER BASE THIS GENERAL AREA.
- 6 FIRE EXTINGUISHER AND CABINET. SEE DETAILS 2/A7.3
- 7 FIRE EXTINGUISHER AND CABINET. SEE DETAILS 3/A7.3
- 8 REINSTALL EXISTING FIRE EXTINGUISHER AND FIRE EXTINGUISHER CABINET. SEE DETAIL 7/A7.3.
- 9 ARROW POINTS AT SHEAR SIDE OF WALL. REFER TO STRUCTURAL SET FOR ALL OTHER SHEAR WALLS.
- 10 PORTION OF EXISTING WALL SHALL BE MODIFIED TO MEET NEW WALL SHEAR WALL THICKNESS. REFER TO STRUCTURAL DRAWINGS AND WALL TYPES.
- 11 INSTALL NEW WALL COVERING TO MATCH EXISTING FROM CORNER TO CORNER AND FROM WALL FLOOR TO CEILING.
- 12 REINSTALL EXISTING PTAC UNIT, WINDOW SILL, CURTAINS, CURTAIN ENCLOSURE, CURTAIN MECHANISM, PLYWOOD BASE FOR CURTAINS, ETC AND WALL BASE.

**LEGEND**

- 6" RAISED CONCRETE CURB
- FIRE EXTINGUISHER AND CABINET. (NEW OR RELOCATED)
- MODIFY EXISTING WALL PER SHEAR WALL MODIFICATIONS NOTED ON STRUCTURAL DRAWINGS
- REMOVE EXISTING GYPSUM WALL BOARD AND REPLACE WITH NEW SHEATHING AND NEW GYPSUM BOARD. COVER WALL FROM JOINT TO JOINT, AND FROM FLOOR TO CEILING WITH NEW WALL COVERING MATERIAL TO MATCH EXISTING

**A 2.2** 2ND FLOOR PLAN  
SCALE: 1/8"=1'-0"  
N

**REVISION 1 OF 2**  
**(27 PAGES)**  
**B-20-0078**

**KNIT**  
909 S. 336TH ST.  
SUITE 107  
FEDERAL WAY, WA 98003  
knitstudios.com

THESE DOCUMENTS HAVE BEEN PRODUCED AS AN INSTRUMENT OF SERVICE AND ARE INTENDED SOLELY FOR THE PURPOSE OF CONSTRUCTING, USING AND MAINTAINING THE PROJECT. KNIT AS THE ARCHITECT OF RECORD FOR THE PROJECT RETAINS OWNERSHIP OF THESE DOCUMENTS.  
ANY USE OF THESE DOCUMENTS OR USE OF THE DESIGN IDEAS OR CONCEPTS DESCRIBED HEREIN IN WHOLE OR PART BY ANY PERSON WHATSOEVER IS EXPRESSLY PROHIBITED EXCEPT BY WRITTEN CONSENT OF KNIT.  
REPRODUCTION OF THESE DOCUMENTS IS STRICTLY PROHIBITED EXCEPT BY WRITTEN CONSENT OF KNIT.  
COPYRIGHT 2021 KNIT

ISSUE DATE 09/25/23  
PROGRESS SET

REV	DATE	COMMENT
1	03.03.2023	AC RESPONSE
2	08.14.2023	CORRECTIONS
3	09.25.2023	CORRECTIONS
4	10.17.2023	CORRECTIONS
5	12.21.2023	CORRECTIONS

City of Puyallup  
Development & Permitting Services  
ISSUED PERMIT

Building	Planning
Engineering	Public Works
Fire	Traffic

6677 REGISTERED ARCHITECT  
RHONDA A. GILLOGLY  
STATE OF WASHINGTON  
12/21/2023

**2ND FLOOR PLAN**  
**ADDITION TO HAMPTON INN & SUITES**  
1515 S MERIDIAN  
PUYALLUP, WA 98371  
HAMPTON INN & SUITES

TITLE	PROJECT	CLIENT
JOB NO: 210158		

**A2.2**

**GENERAL NOTES**


- A. CONTRACTOR TO FIELD VERIFY FRAMING AT ALL DOOR LOCATIONS FOR PROPER OPERATING CLEARANCE WITH VANY CASEWORK.
- B. DIMENSIONS ARE TO FACE OF STUD OR TO CENTERLINE WHERE NOTED.
- C. CONTRACTOR TO VERIFY SHEAR WALL LOCATIONS PER STRUCTURAL PLANS.
- D. FIELD VERIFY ALL EXISTING CONDITIONS AND DIMENSIONS. DIMENSIONS ARE TO FACE OF FINISH, TO FACE OF EXISTING WALL, OR TO FACE OF FOUNDATION WALL UNLESS NOTED OTHERWISE.

**NEW FLOOR PLAN KEYED NOTES**

- 1 ALIGN NEW WALL WITH EXISTING WALL AND FINISH SEAMLESSLY. COORDINATE WITH EXPANSION JOINT DETAILS.
- 2 NEW WALL INFILL WHERE EXISTING WINDOW AND HVAC UNIT WERE REMOVED.
- 3 NEW HVAC UNITS. SEE MEP DRAWINGS FOR MORE INFORMATION.
- 4 PATCH WALLS WHERE DEMOLITION HAS OCCURRED AND FINISH SEAMLESSLY.
- 5 INSTALL NEW FLOORING AND RUBBER BASE THIS GENERAL AREA.
- 6 FIRE EXTINGUISHER AND CABINET. SEE DETAILS 2/A7.3
- 7 FIRE EXTINGUISHER AND CABINET. SEE DETAILS 3/A7.3
- 8 REINSTALL EXISTING FIRE EXTINGUISHER AND FIRE EXTINGUISHER CABINET. SEE DETAIL 7/A7.3.
- 9 **ARROW POINTS AT SHEAR SIDE OF WALL. REFER TO STRUCTURAL SET FOR ALL OTHER SHEAR WALLS.**
- 10 PORTION OF EXISTING WALL SHALL BE MODIFIED TO MEET NEW WALL SHEAR WALL THICKNESS. REFER TO STRUCTURAL DRAWINGS AND WALL TYPES.
- 11 INSTALL NEW WALL COVERING TO MATCH EXISTING FROM CORNER TO CORNER AND FROM WALL FLOOR TO CEILING.
- 12 REINSTALL EXISTING PTAC UNIT, WINDOW SILL, CURTAINS, CURTAIN ENCLOSURE, CURTAIN MECHANISM, PLYWOOD BASE FOR CURTAINS, ETC AND WALL BASE.

**LEGEND**

- (12) FIRE EXTINGUISHER AND CABINET (NEW OR RELOCATED)
- MODIFY EXISTING WALL PER SHEAR WALL MODIFICATIONS NOTED ON STRUCTURAL DRAWINGS
- REMOVE EXISTING GYPSUM WALL BOARD AND REPLACE WITH NEW SHEATHINGS AND NEW GYPSUM BOARD. COVER WALL FROM JOINT TO JOINT, AND FROM FLOOR TO CEILING WITH NEW WALL COVERING MATERIAL TO MATCH EXISTING

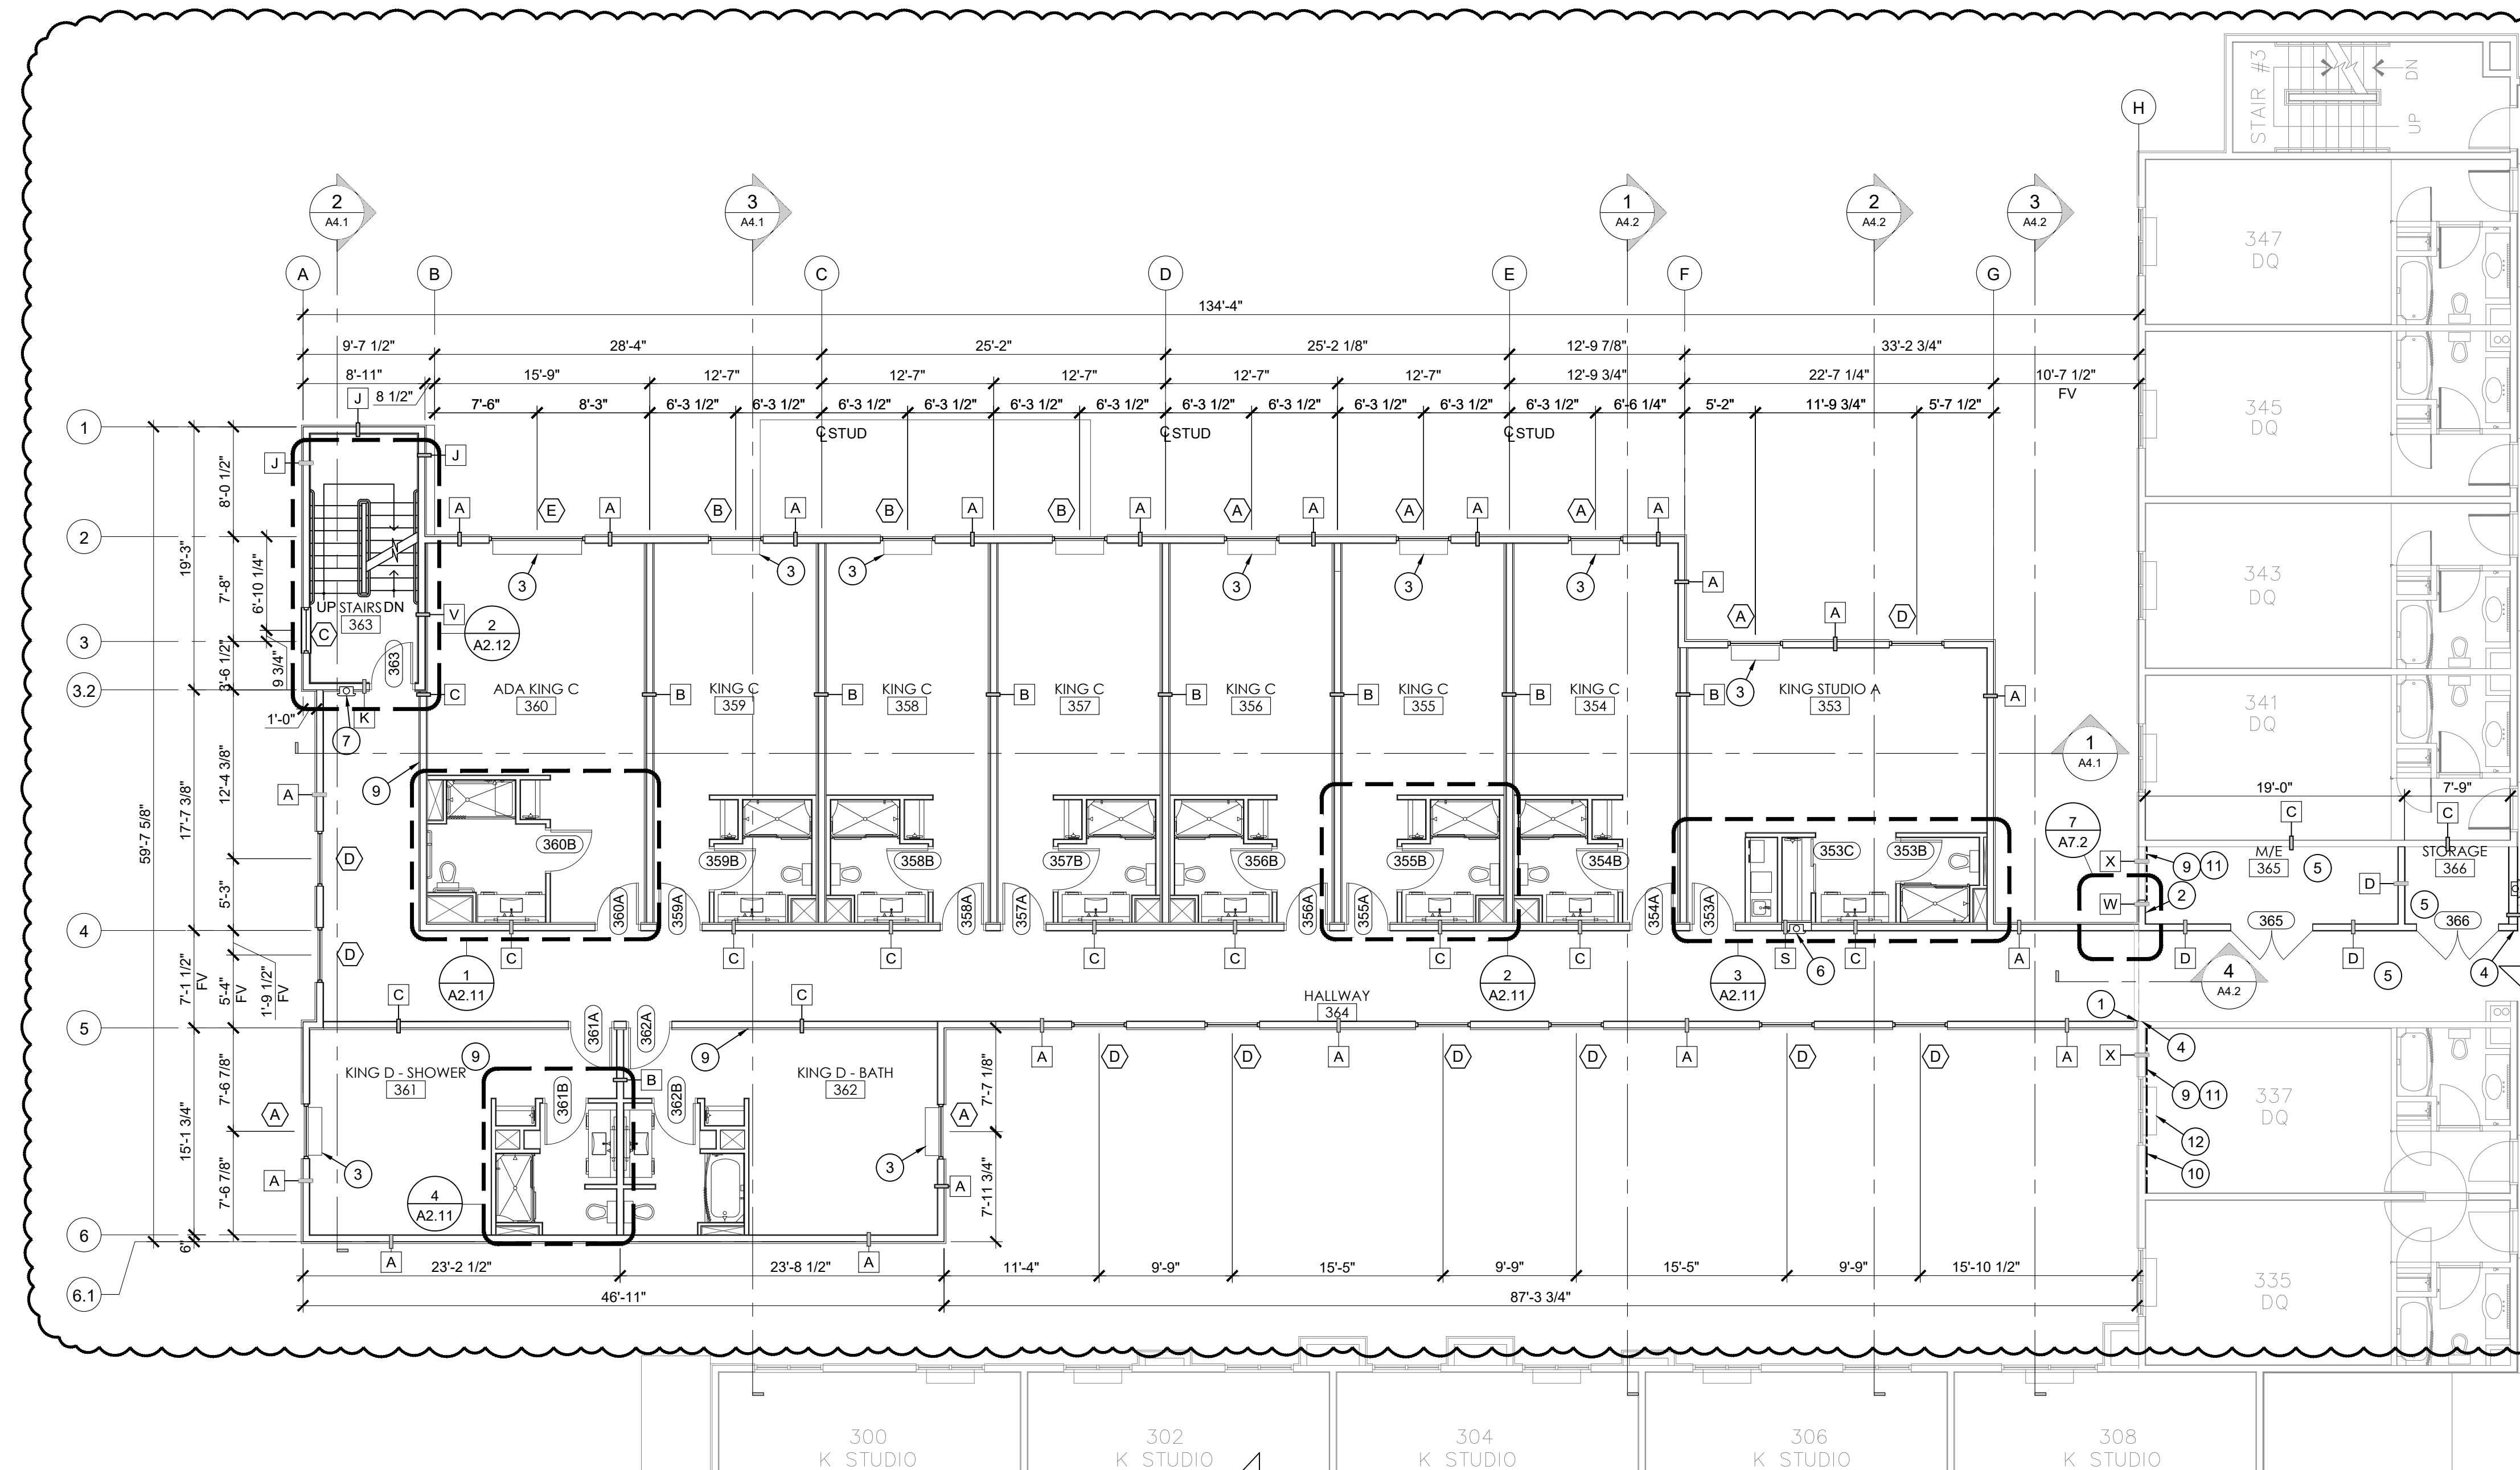

**A 3RD FLOOR PLAN**  
SCALE: 1/8"=1'-0"  
N

**REVISION 1 OF 2**  
**(27 PAGES)**  
**B-20-0078**

**KNIT**  
909 S. 336TH ST.  
SUITE 107  
FEDERAL WAY, WA 98003  
knitstudios.com

THESE DOCUMENTS HAVE BEEN PRODUCED AS AN INSTRUMENT OF SERVICE AND ARE INTENDED SOLELY FOR THE PURPOSE OF CONSTRUCTING, USING AND MAINTAINING THE PROJECT. KNIT AS THE ARCHITECT OF RECORD FOR THE PROJECT RETAINS OWNERSHIP OF THESE DOCUMENTS.  
ANY USE OF THESE DOCUMENTS OR USE OF THE DESIGN IDEAS OR CONCEPTS DESCRIBED HEREIN IN WHOLE OR PART BY ANY PERSON WHATSOEVER IS STRICTLY PROHIBITED EXCEPT BY WRITTEN CONSENT OF KNIT.  
REPRODUCTION OF THESE DOCUMENTS IS STRICTLY PROHIBITED EXCEPT BY WRITTEN CONSENT OF KNIT.  
COPYRIGHT 2021 KNIT

ISSUE DATE 09/25/23  
PROGRESS SET

REV	DATE	COMMENT
1	03.03.2023	AC RESPONSE
2	08.14.2023	CORRECTIONS
3	09.25.2023	CORRECTIONS
4	10.17.2023	CORRECTIONS
5	12.21.2023	CORRECTIONS

City of Puyallup  
Development & Permitting Services  
**ISSUED PERMIT**


Building	Planning
Engineering	Public Works
Fire	Traffic

8677 REGISTERED ARCHITECT  
*Rhonda A. Gillogly*  
RHONDA A. GILLOGLY  
STATE OF WASHINGTON  
12/21/2023

**3RD FLOOR PLAN**  
**ADDITION TO HAMPTON INN & SUITES**  
1515 S MERIDIAN  
PUYALLUP, WA 98371  
HAMPTON INN & SUITES

TITLE	PROJECT	CLIENT
JOB NO: 210158		

**A2.3**

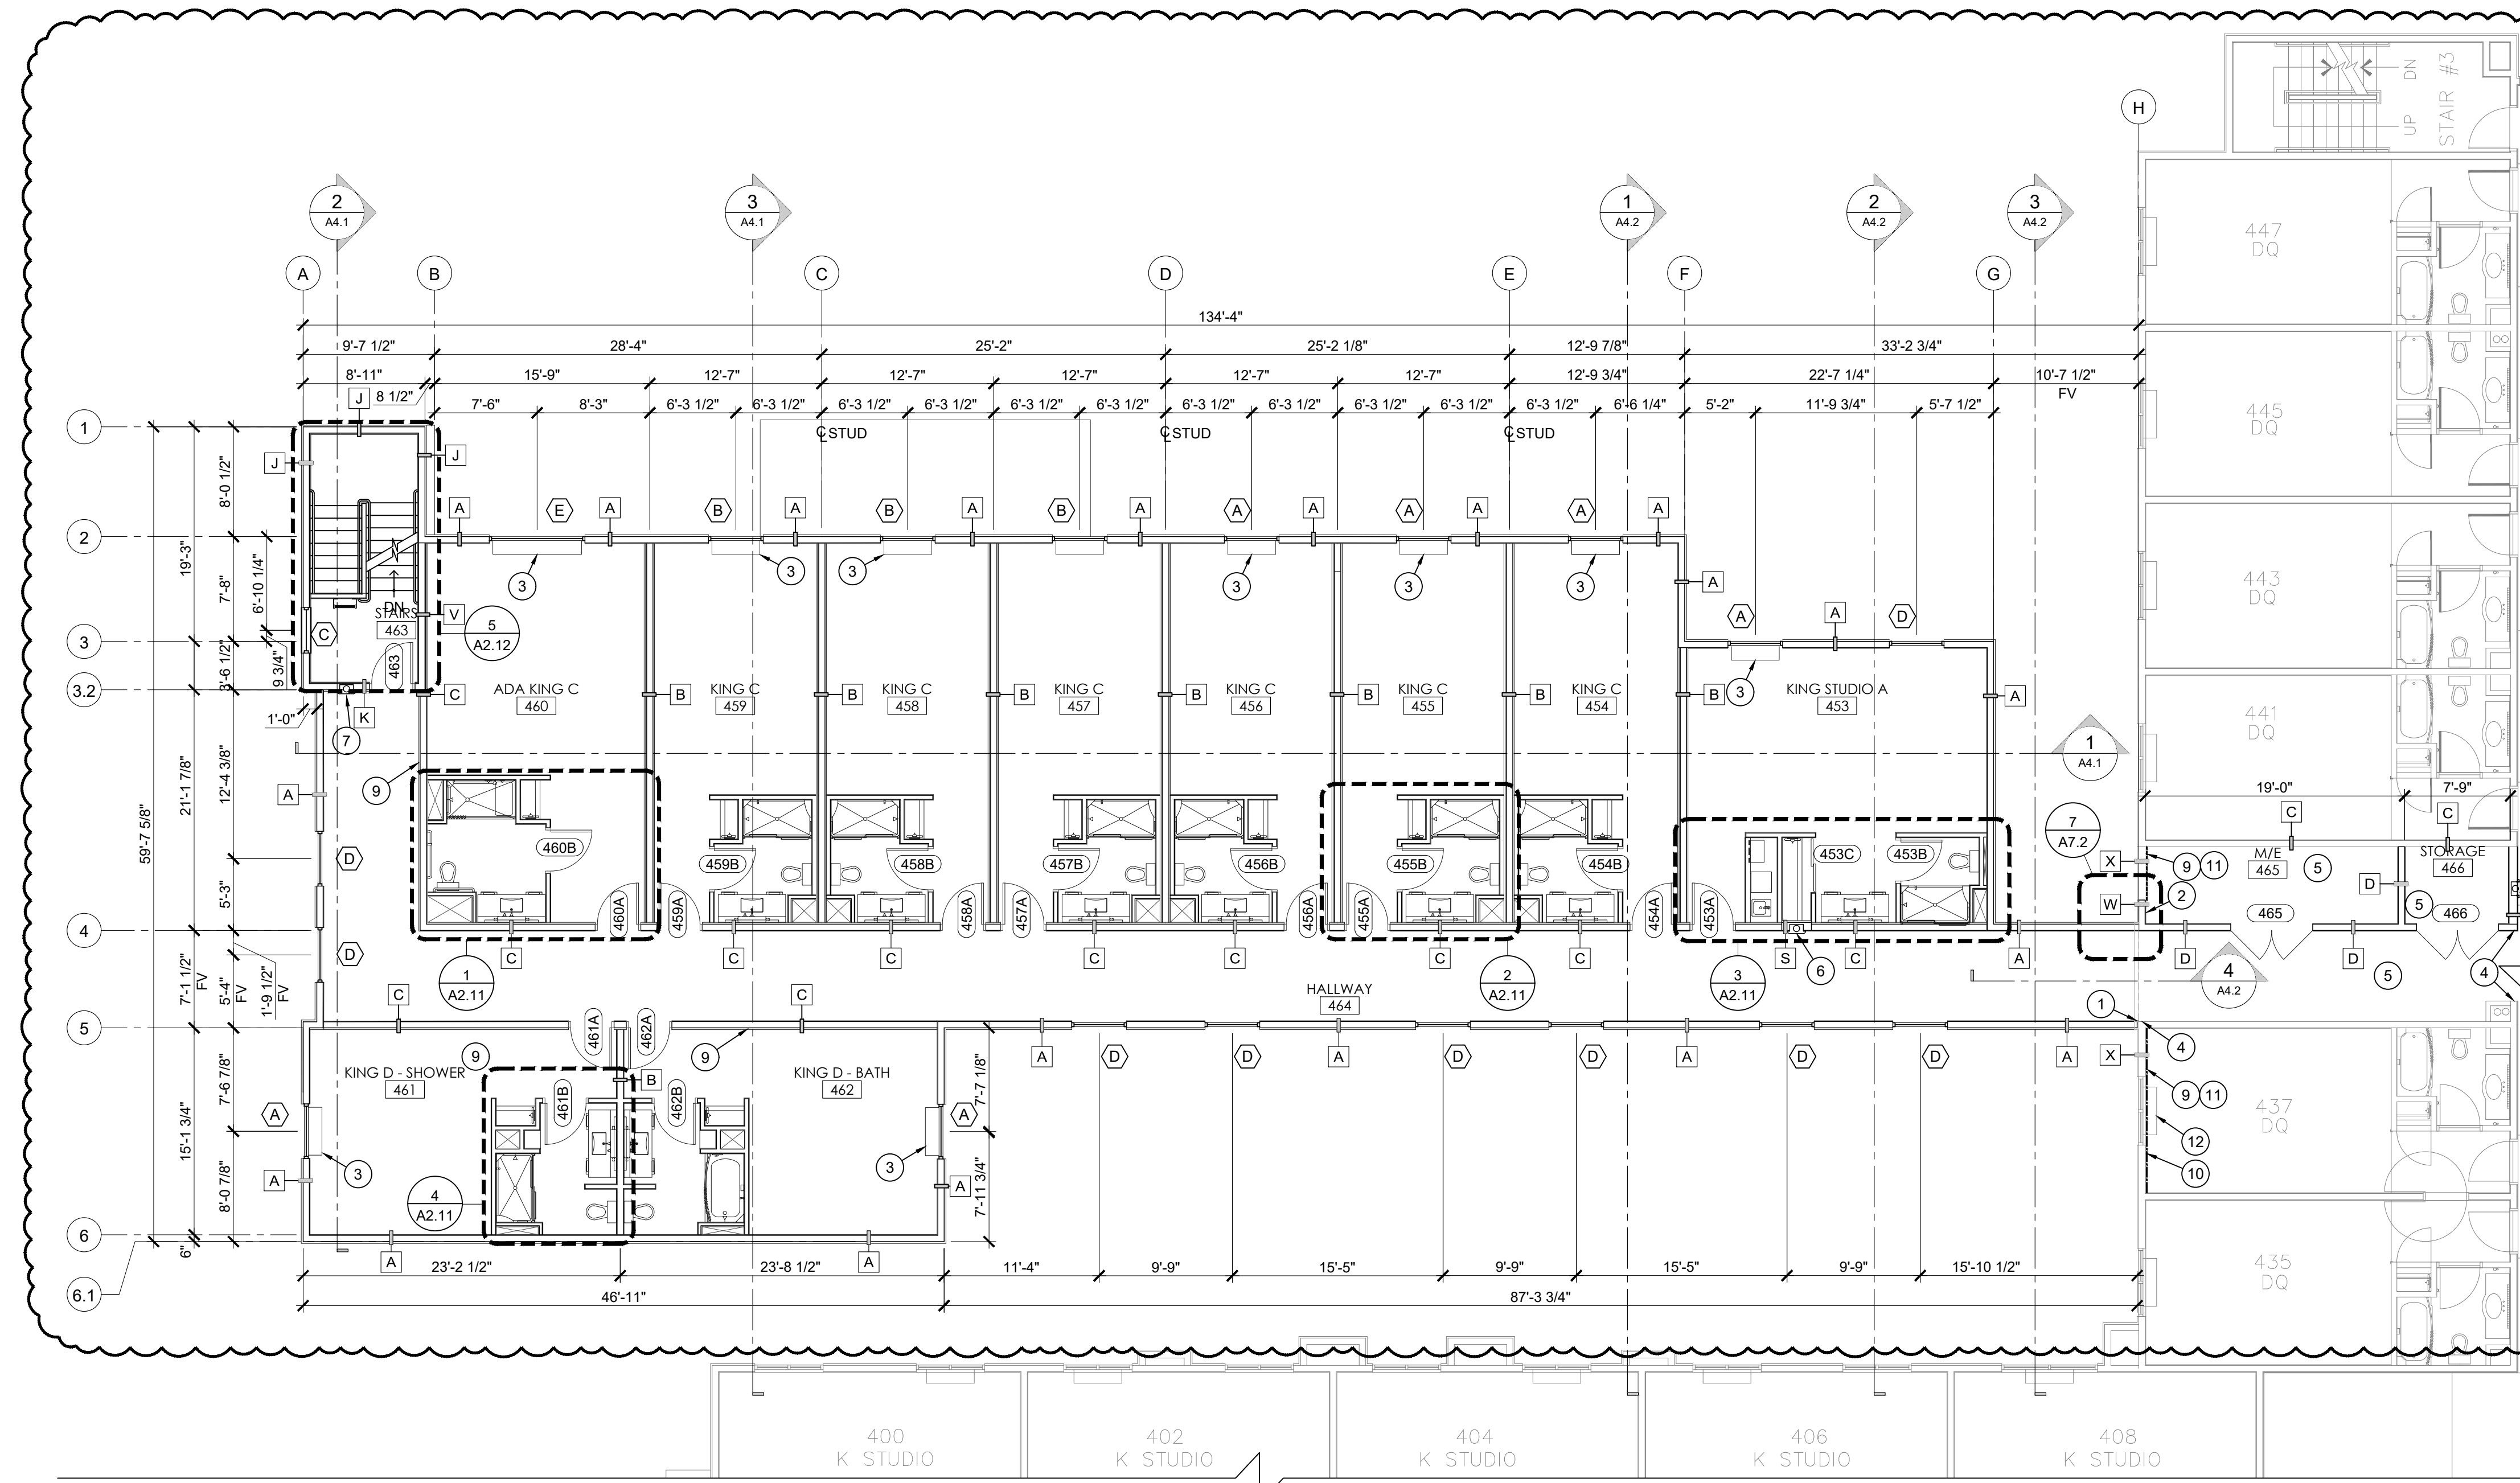

**A** 4TH FLOOR PLAN  
 SCALE: 1/8"=1'-0"  
 N

**GENERAL NOTES**

- A. CONTRACTOR TO FIELD VERIFY FRAMING AT ALL DOOR LOCATIONS FOR PROPER OPERATING CLEARANCE WITH VANITY CASEWORK.
- B. DIMENSIONS ARE TO FACE OF STUD OR TO CENTERLINE WHERE NOTED.
- C. CONTRACTOR TO VERIFY SHEAR WALL LOCATIONS PER STRUCTURAL PLANS.
- D. FIELD VERIFY ALL EXISTING CONDITIONS AND DIMENSIONS. DIMENSIONS ARE TO FACE OF FINISH, TO FACE OF EXISTING WALL, OR TO FACE OF FOUNDATION WALL UNLESS NOTED OTHERWISE.

**NEW FLOOR PLAN KEYED NOTES**

- 1 ALIGN NEW WALL WITH EXISTING WALL AND FINISH SEAMLESSLY. COORDINATE WITH EXPANSION JOINT DETAILS.
- 2 NEW WALL INFILL WHERE EXISTING WINDOW AND HVAC UNIT WERE REMOVED.
- 3 NEW HVAC UNITS. SEE MEP DRAWINGS FOR MORE INFORMATION.
- 4 PATCH WALLS WHERE DEMOLITION HAS OCCURRED AND FINISH SEAMLESSLY.
- 5 INSTALL NEW FLOORING AND RUBBER BASE THIS GENERAL AREA.
- 6 FIRE EXTINGUISHER AND CABINET. SEE DETAILS 2/A7.3.
- 7 FIRE EXTINGUISHER AND CABINET. SEE DETAILS 3/A7.3.
- 8 REINSTALL EXISTING FIRE EXTINGUISHER AND FIRE EXTINGUISHER CABINET. SEE DETAIL 7/A7.3.
- 9 ARROW POINTS AT SHEAR SIDE OF WALL. REFER TO STRUCTURAL SET FOR ALL OTHER SHEAR WALLS.
- 10 PORTION OF EXISTING WALL SHALL BE MODIFIED TO MEET NEW WALL SHEAR WALL THICKNESS. REFER TO STRUCTURAL DRAWINGS AND WALL TYPES.
- 11 INSTALL NEW WALL COVERING TO MATCH EXISTING FROM CORNER TO CORNER AND FROM WALL FLOOR TO CEILING.
- 12 REINSTALL EXISTING PTAC UNIT, WINDOW SILL, CURTAINS, CURTAIN ENCLOSURE, CURTAIN MECHANISM, PLYWOOD BASE FOR CURTAINS, ETC AND WALL BASE.

**LEGEND**

- 1 FIRE EXTINGUISHER AND CABINET (NEW OR RELOCATED)
- 2 MODIFY EXISTING WALL PER SHEAR WALL MODIFICATIONS NOTED ON STRUCTURAL DRAWINGS
- 3 REMOVE EXISTING GYPSUM WALL BOARD AND REPLACE WITH NEW SHEATHINGS AND NEW GYPSUM BOARD. COVER WALL FROM JOINT TO JOINT, AND FROM FLOOR TO CEILING WITH NEW WALL COVERING MATERIAL TO MATCH EXISTING

**REVISION 1 OF 2**  
**(27 PAGES)**  
**B-20-0078**

**KNIT**  
 909 S. 336TH ST.  
 SUITE 107  
 FEDERAL WAY, WA 98003  
 knitstudios.com

THESE DOCUMENTS HAVE BEEN PRODUCED AS AN INSTRUMENT OF SERVICE AND ARE INTENDED SOLELY FOR THE PURPOSE OF CONSTRUCTING, USING AND MAINTAINING THE PROJECT. KNIT AS THE ARCHITECT OF RECORD FOR THE PROJECT RETAINS OWNERSHIP OF THESE DOCUMENTS.  
 ANY USE OF THESE DOCUMENTS OR USE OF THE DESIGN IDEAS OR CONCEPTS DESCRIBED HEREIN IN WHOLE OR PART BY ANY PERSON WHATSOEVER IS EXPRESSLY PROHIBITED EXCEPT BY WRITTEN CONSENT OF KNIT.  
 REPRODUCTION OF THESE DOCUMENTS IS STRICTLY PROHIBITED EXCEPT BY WRITTEN CONSENT OF KNIT.  
 COPYRIGHT 2021 KNIT

ISSUE DATE 09/25/23  
 PROGRESS SET

REV	DATE	COMMENT
1	03.03.2023	AC RESPONSE
2	08.14.2023	CORRECTIONS
3	09.25.2023	CORRECTIONS
4	10.17.2023	CORRECTIONS
5	12.21.2023	CORRECTIONS

City of Puyallup  
 Development & Permitting Services  
**ISSUED PERMIT**

Building	Planning
Engineering	Public Works
Fire	Traffic


8677 REGISTERED ARCHITECT  
  
 RHONDA A. GILLOGLY  
 STATE OF WASHINGTON  
 12/21/2023

4TH FLOOR PLAN  
**ADDITION TO HAMPTON INN & SUITES**  
 1515 S MERIDIAN  
 PUYALLUP, WA 98371  
 HAMPTON INN & SUITES

TITLE	PROJECT	CLIENT
JOB NO: 210158		

**A2.4**



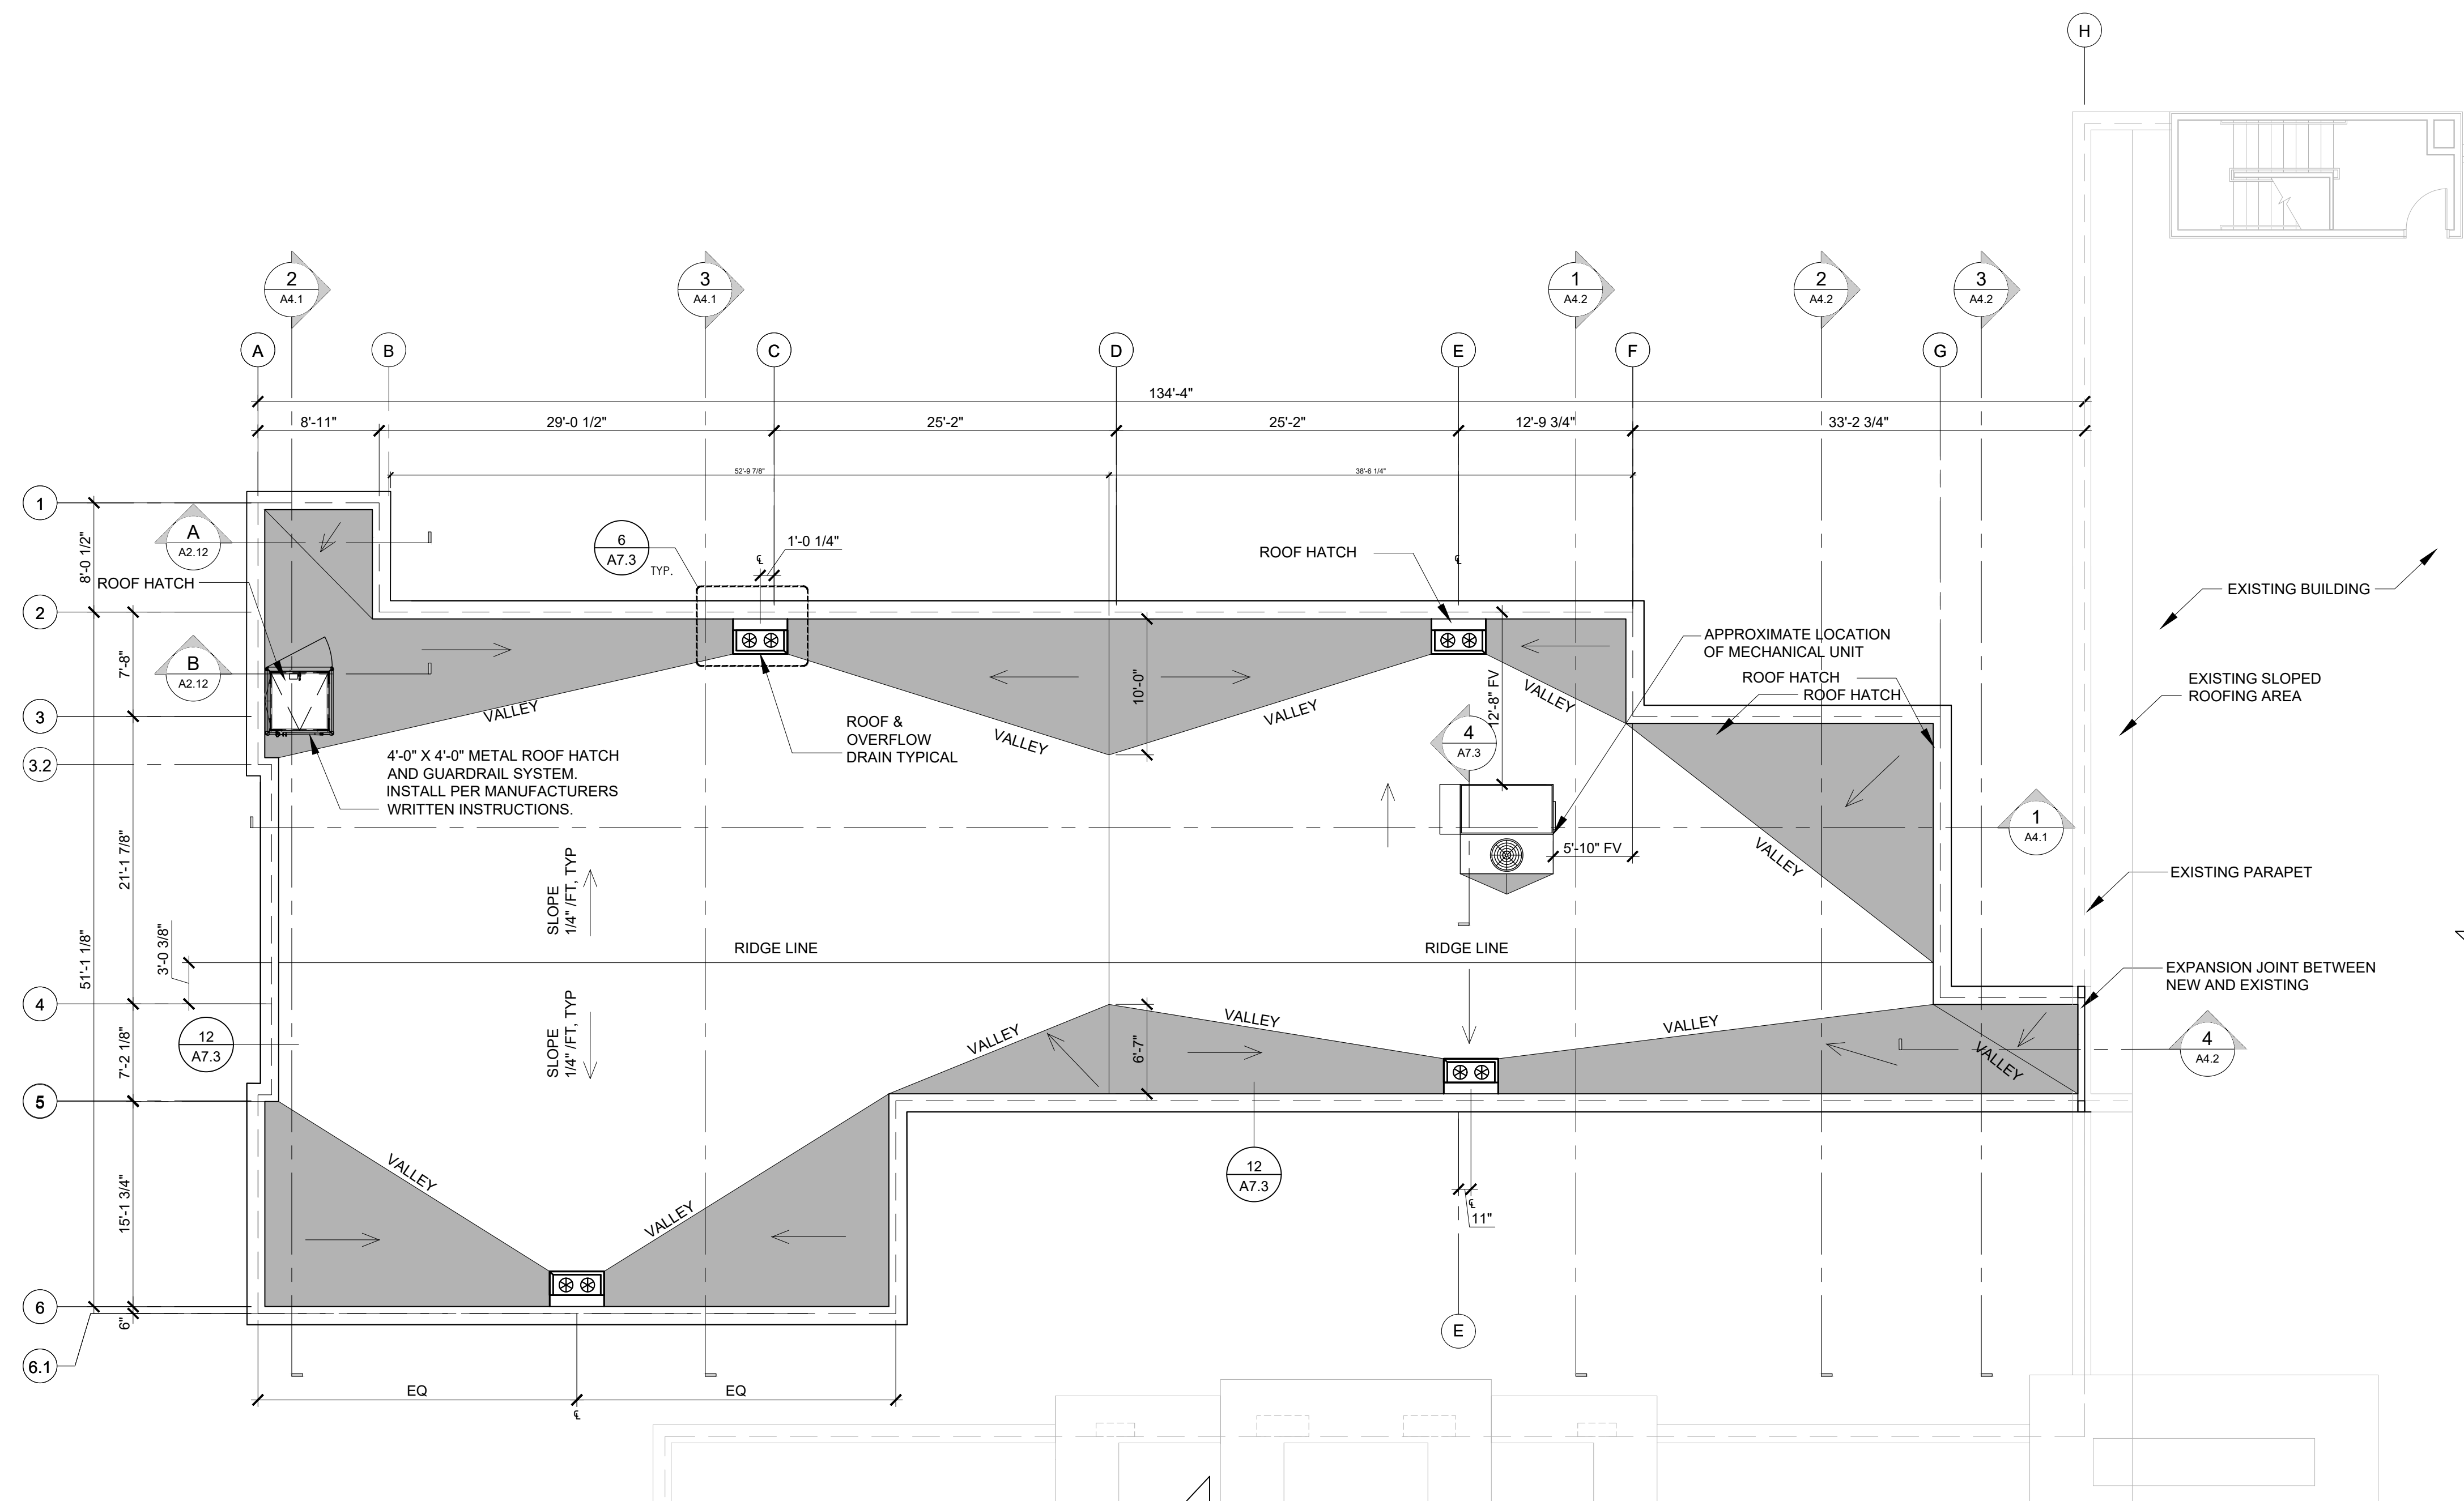

**A** ROOF PLAN  
 A2.5 SCALE: 1/8"=1'-0"

**GENERAL NOTES**

- A. NEW ROOFING IS PVC SINGLE PLY MEMBRANE ON A MINIMUM OF 3" (R=18) POLYISOCYANURATE RIGID INSULATION, WITH RIGID INSULATION CRICKETS (SHOWN SHADED) INSTALL ROOFING AND RIGID INSULATION ACCORDING TO MANUFACTURER'S WRITTEN DIRECTION.  
 NOTE: TOTAL ROOF R VALUE TO EQUAL R-38. (6" COMPACTED BATT = R27 + 2" RIGID = R12 = TOTAL R39)
- B. NOT ALL THRU ROOF MEP PENETRATIONS ARE SHOWN. COORDINATE WORK WITH MEP DRAWINGS AND PROVIDE CRICKETS OR FLASHINGS THAT MEET THE ROOFING MANUFACTURER'S METHOD OF INSTALLATION.

**ROOF DRAINAGE CALCS**

100 YR STORM, 360 S.F. PER IN<sup>2</sup> OF D.S.  
 ROOF AREA 1:  
 1,276/360 = 3.54 IN<sup>2</sup> OF D.S. REQ. PROVIDED 25 IN<sup>2</sup>  
 ROOF AREA 2:  
 1,159/360 = 3.22 IN<sup>2</sup> OF D.S. REQ. PROVIDED 25 IN<sup>2</sup>  
 ROOF AREA 3:  
 1,572/360 = 4.36 IN<sup>2</sup> OF D.S. REQ. PROVIDED 25 IN<sup>2</sup>  
 ROOF AREA 4:  
 930/360 = 2.58 IN<sup>2</sup> OF D.S. REQ. PROVIDED 25 IN<sup>2</sup>

**REVISION 1 OF 2**  
**(27 PAGES)**  
**B-20-0078**

**KNIT**

909 S. 336TH ST,  
 SUITE 107  
 FEDERAL WAY, WA 98003  
 knitstudios.com

THESE DOCUMENTS HAVE BEEN PRODUCED AS AN INSTRUMENT OF SERVICE AND ARE INTENDED SOLELY FOR THE PURPOSE OF CONSTRUCTING, USING AND MAINTAINING THE PROJECT. KNIT AS THE ARCHITECT OF RECORD FOR THE PROJECT RETAINS OWNERSHIP OF THESE DOCUMENTS.  
 ANY USE OF THESE DOCUMENTS OR USE OF THE DESIGN IDEAS OR CONCEPTS DESCRIBED HEREIN IN WHOLE OR PART BY ANY PERSON WHATSOEVER IS STRICTLY PROHIBITED EXCEPT BY WRITTEN CONSENT OF KNIT.  
 REPRODUCTION OF THESE DOCUMENTS IS STRICTLY PROHIBITED EXCEPT BY WRITTEN CONSENT OF KNIT.  
 COPYRIGHT 2021 KNIT

ISSUE DATE 09/25/23  
 PROGRESS SET

REV	DATE	COMMENT
1	03.03.2023	AC RESPONSE
2	08.14.2023	CORRECTIONS
3	09.25.2023	CORRECTIONS
4	10.17.2023	CORRECTIONS
5	12.21.2023	CORRECTIONS

City of Puyallup  
 Development & Permitting Services  
**ISSUED PERMIT**

Building	Planning
Engineering	Public Works
Fire	Traffic

8677 REGISTERED ARCHITECT  
  
 RHONDA A. GILLOGLY  
 STATE OF WASHINGTON  
 12/21/2023


**ROOF PLAN**

**ADDITION TO HAMPTON INN & SUITES**

1515 S MERIDIAN  
 PUYALLUP, WA 98371  
 HAMPTON INN & SUITES

TITLE	PROJECT	CLIENT
JOB NO: 210158		

A2.5

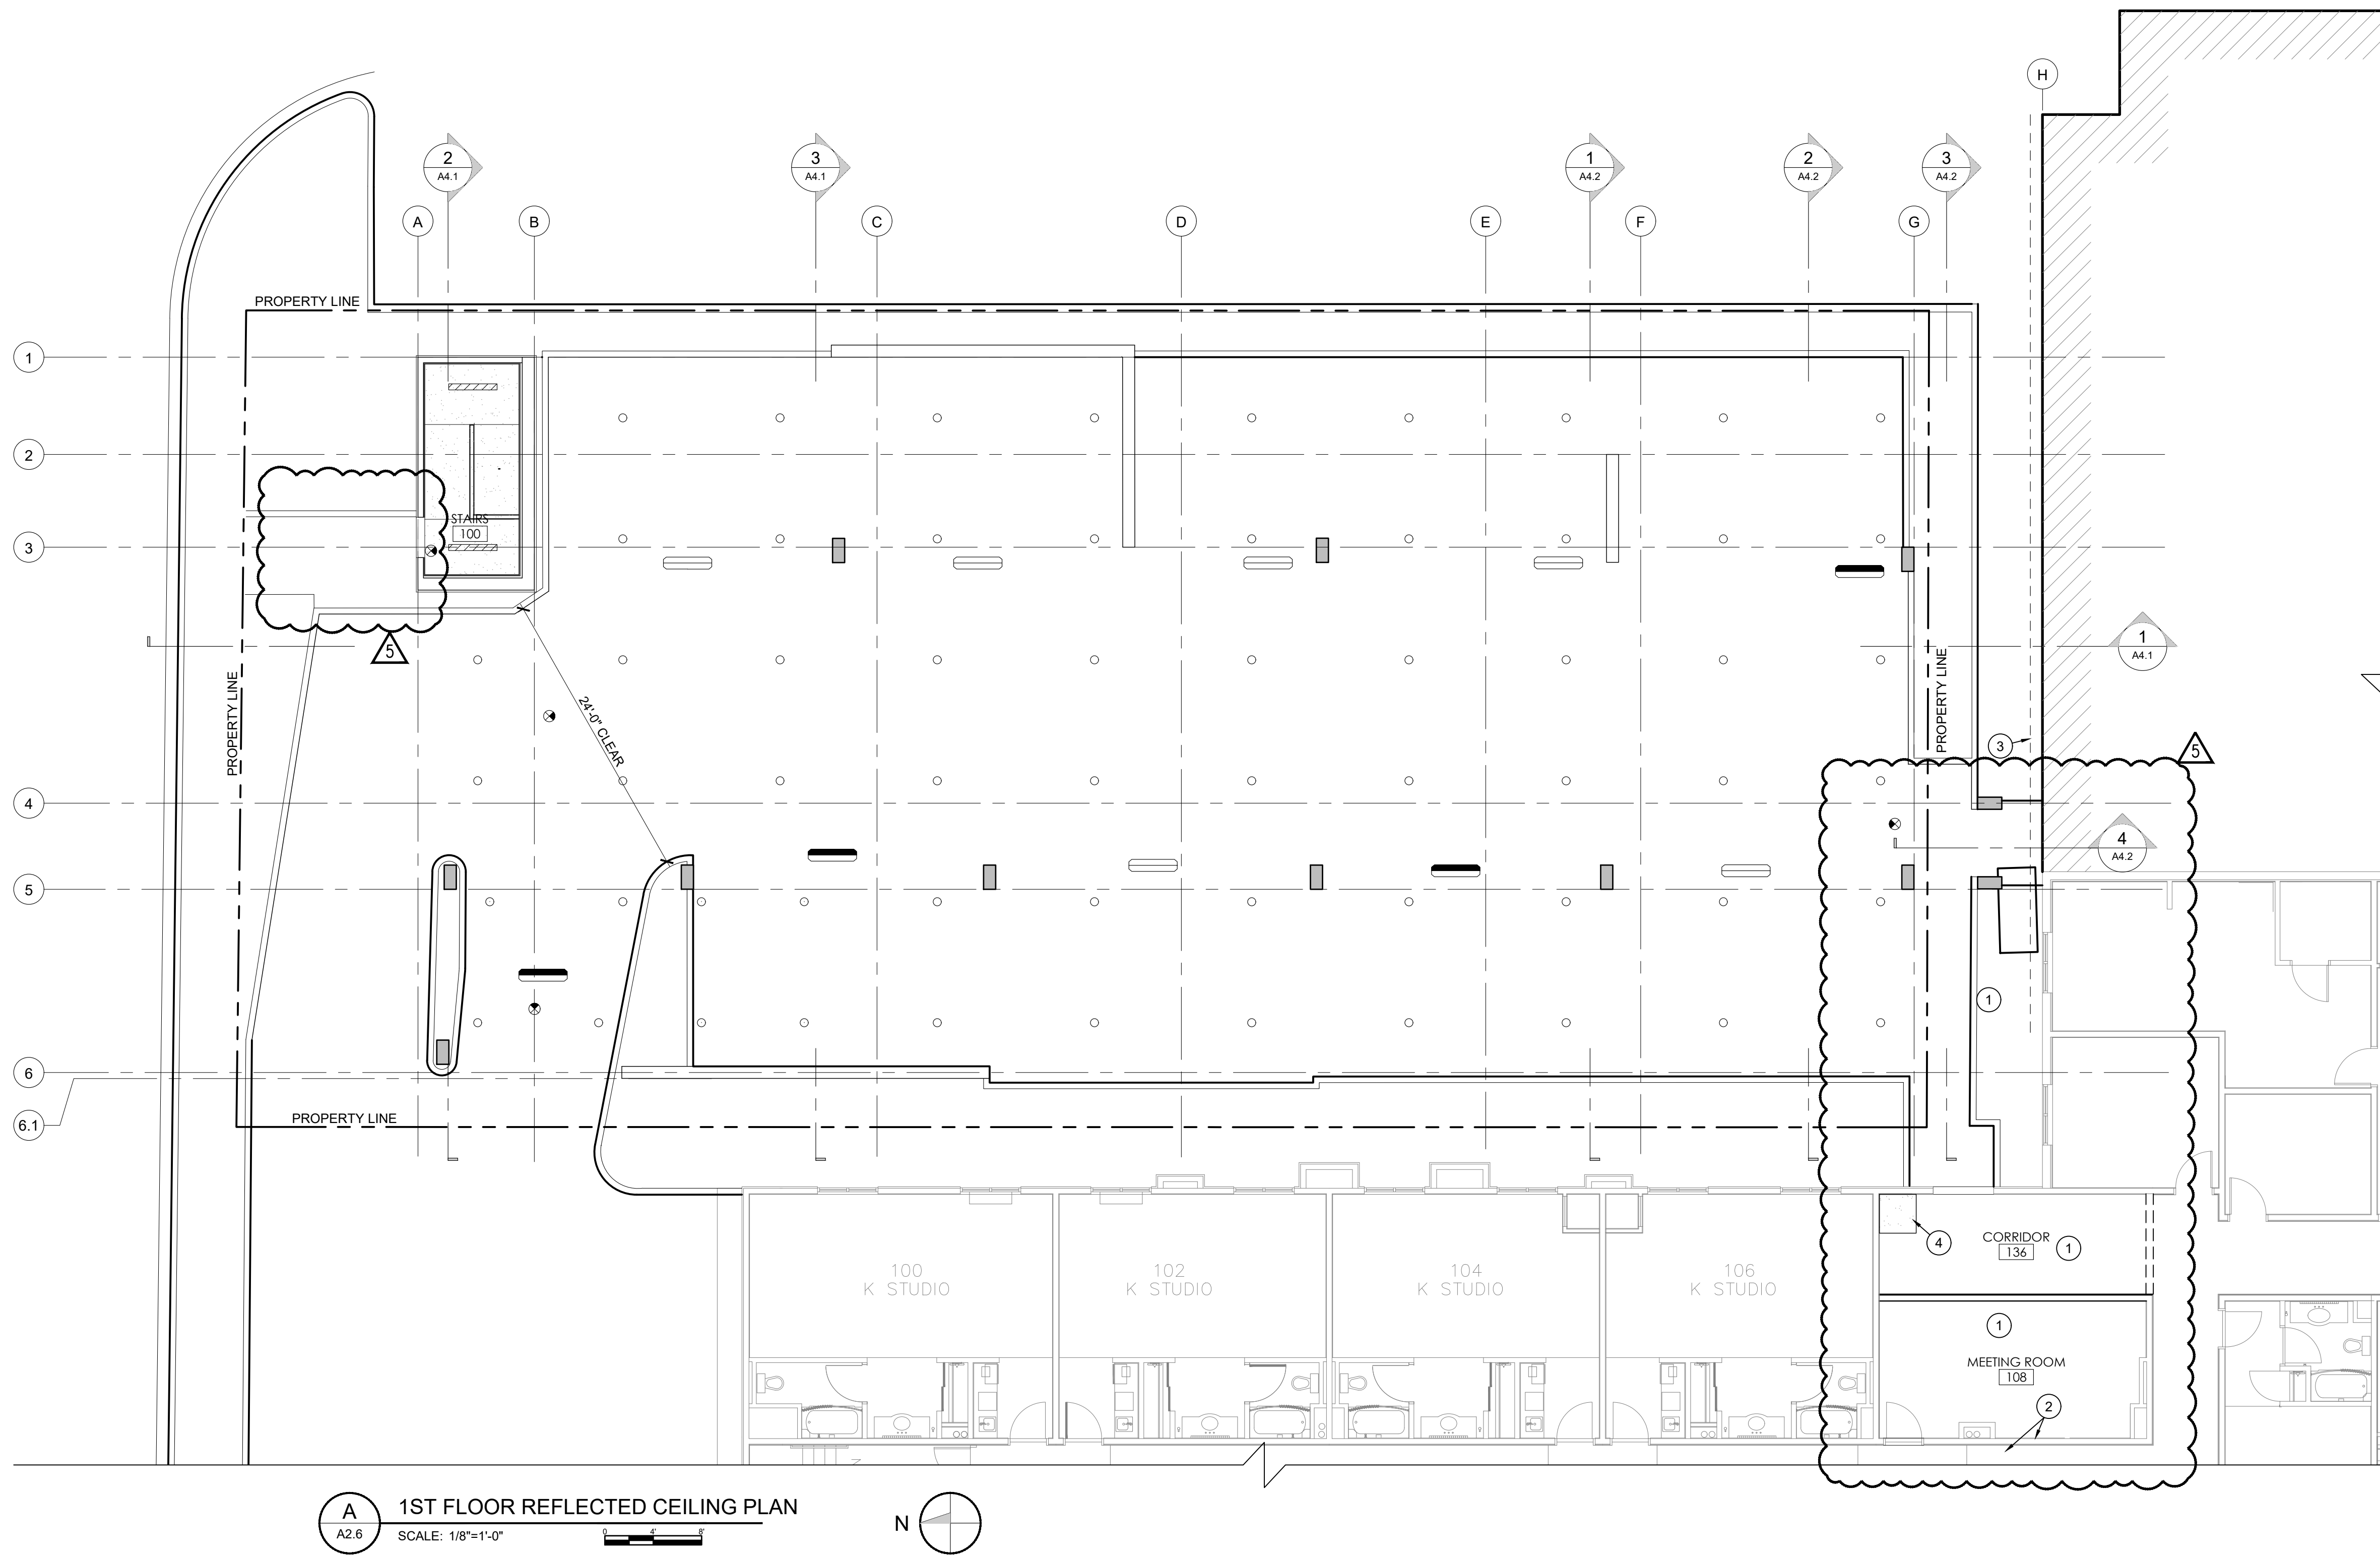

**A** 1ST FLOOR REFLECTED CEILING PLAN  
 A2.6 SCALE: 1/8"=1'-0"  
 N

**GENERAL NOTES**

- A. HEIGHT REFERENCES ARE TAKEN FROM FINISH FLOOR ELEVATIONS. DIMENSIONS ARE CENTERLINE OF FIXTURES.
- B. NOTIFY ARCHITECT OF ANY DISCREPANCIES BETWEEN FINISH SCHEDULE AND CEILING PLAN.
- C. MECHANICAL FIXTURES, LIGHT FIXTURES, AND FIRE SUPPRESSION FIXTURES SHOWN ON THIS DRAWING ARE FOR GENERAL LOCATIONS ONLY. COORDINATE WORK WITH MEP AND FIRE SUPPRESSION DRAWINGS. NOTIFY ARCHITECT OF DISCREPANCIES BETWEEN MECHANICAL AND ELECTRICAL PRIOR TO ORDERING EQUIPMENT.
- D. CENTER ALL FIXTURES IN LAY-IN CEILING TILES.
- E. THE GENERAL CONTRACTOR SHALL COORDINATE FIRE SPRINKLER HEAD LOCATIONS WITH MECHANICAL AND ELECTRICAL ITEMS. ALL HEADS SHALL BE CENTERED IN CEILING TILES, WHERE OCCURS. ALL MEP EQUIPMENT IS SHOWN FOR GENERAL REFERENCE. COORDINATE FIXTURES AND EQUIPMENT WITH MEP DRAWINGS AND SPRINKLER SUBMITTALS.

**NEW REFLECTED CEILING PLAN KEYED NOTES**

- 1 NOT SHOWN FOR CLARITY ARE WHERE EXISTING WALLS AND SOFFITS WERE REMOVED IN THIS GENERAL AREA. CONTRACTOR IS RESPONSIBLE TO PATCH THE EXISTING CEILING TO MATCH EXISTING TEXTURES, AND FINISH TO BE A SEAMLESS AND EVEN APPEARANCE. PAINT THE ENTIRE CEILING FROM CORNER TO CORNER WITH PAINT COLOR AND SHEEN AS IDENTIFIED BY THE OWNER.
- 2 WALL TO RECEIVE NEW THRU WALL HVAC SUPPLY GRILLES. PROVIDE NEW FIRE DAMPERS, FLANGES, SEALANT AND ANY SOUND PROTECTION MEASURES WHERE NEW DUCT WORK PASSES THROUGH EXISTING 1 HOUR FIRE RATED CORRIDOR. REINSTALL EXISTING CEILING TILES IN CORRIDOR AFTER PLACEMENT OF NEW CONNECTING DUCT WORK. PATCH ANY WALLS TO MATCH EXISTING IN TEXTURE, PAINT, (COLOR AND SHEEN), OR PATCH WALL PAPER TO MATCH EXISTING. REPLACE ANY BROKEN CEILING TILES. REFER TO MEP DRAWINGS FOR ADDITIONAL INFORMATION.
- 3 THERE ARE SEVERAL MEP RELATED ITEMS THAT MAY NEED REROUTING, REMOVAL, OR POSSIBLE RELOCATION ALONG THE EXISTING NORTH WALL. COORDINATE EXTENT OF WORK WITH MEP DRAWINGS. WHERE AN ITEM IS REMOVED, PATCH EXISTING WALL TO MATCH EXISTING MATERIALS, THICKNESS, AND PROVIDE WATERTIGHT ASSEMBLY.
- 4 PATCH IN CEILING AFTER REMOVAL OF THE PTAC UNITY TO MATCH EXISTING MATERIALS AND TO MAINTAIN THICKNESS WITH CEILING ADJACENT. MATCH TEXTURE, PAINT, COLOR AND SHEEN.

**CEILING LEGEND**

- TEXTURED AND PAINTED GYPSUM BOARD TO MATCH EXISTING IN TEXTURE, FINISH, PAINT COLOR, TYPE AND SHEEN.
- 

**CEILING FIXTURE LEGEND**

- PARKING GARAGE DOWNLIGHT W/ BUILT-IN OCCUPANCY SENSOR
- PARKING GARAGE DOWNLIGHT W/ EMERGENCY BACKUP AND BUILT IN OCCUPANCY SENSOR
- LED SURFACE MOUNTED LIGHT
- EXIT SIGN
- FIRE SPRINKLER

**REVISION 1 OF 2**  
**(27 PAGES)**  
**B-20-0078**

**KNIT**  
 909 S. 336TH ST.  
 SUITE 107  
 FEDERAL WAY, WA 98003  
 knitstudios.com

THESE DOCUMENTS HAVE BEEN PRODUCED AS AN INSTRUMENT OF SERVICE AND ARE INTENDED SOLELY FOR THE PURPOSE OF CONSTRUCTING, USING AND MAINTAINING THE PROJECT. KNIT AS THE ARCHITECT OF RECORD FOR THE PROJECT RETAINS OWNERSHIP OF THESE DOCUMENTS.

ANY USE OF THESE DOCUMENTS OR USE OF THE DESIGN IDEAS OR CONCEPTS DESCRIBED HEREIN IN WHOLE OR PART BY ANY PERSON WHATSOEVER IS STRICTLY PROHIBITED EXCEPT BY WRITTEN CONSENT OF KNIT.

REPRODUCTION OF THESE DOCUMENTS IS STRICTLY PROHIBITED EXCEPT BY WRITTEN CONSENT OF KNIT.

COPYRIGHT 2021 KNIT

ISSUE DATE 09/25/23  
 PROGRESS SET

REV DATE COMMENT

- 2 08.08.2023 CORRECTIONS #1
- 2 08.14.2023 CORRECTIONS
- 3 09.25.2023 CORRECTIONS
- 4 10.17.2023 CORRECTIONS
- 5 12.21.2023 CORRECTIONS

City of Puyallup  
 Development & Permitting Services  
 ISSUED PERMIT

Building	Planning
Engineering	Public Works
Fire	Traffic


8677 REGISTERED ARCHITECT

RHONDA A. GILLOGLY  
 STATE OF WASHINGTON  
 12/21/2023

1ST FLOOR REFLECTED CEILING PLAN  
 ADDITION TO HAMPTON INN & SUITES

1515 S MERIDIAN  
 PUYALLUP, WA 98371  
 HAMPTON INN & SUITES

TITLE	PROJECT	CLIENT
JOB NO: 210158		
<b>A2.6</b>		

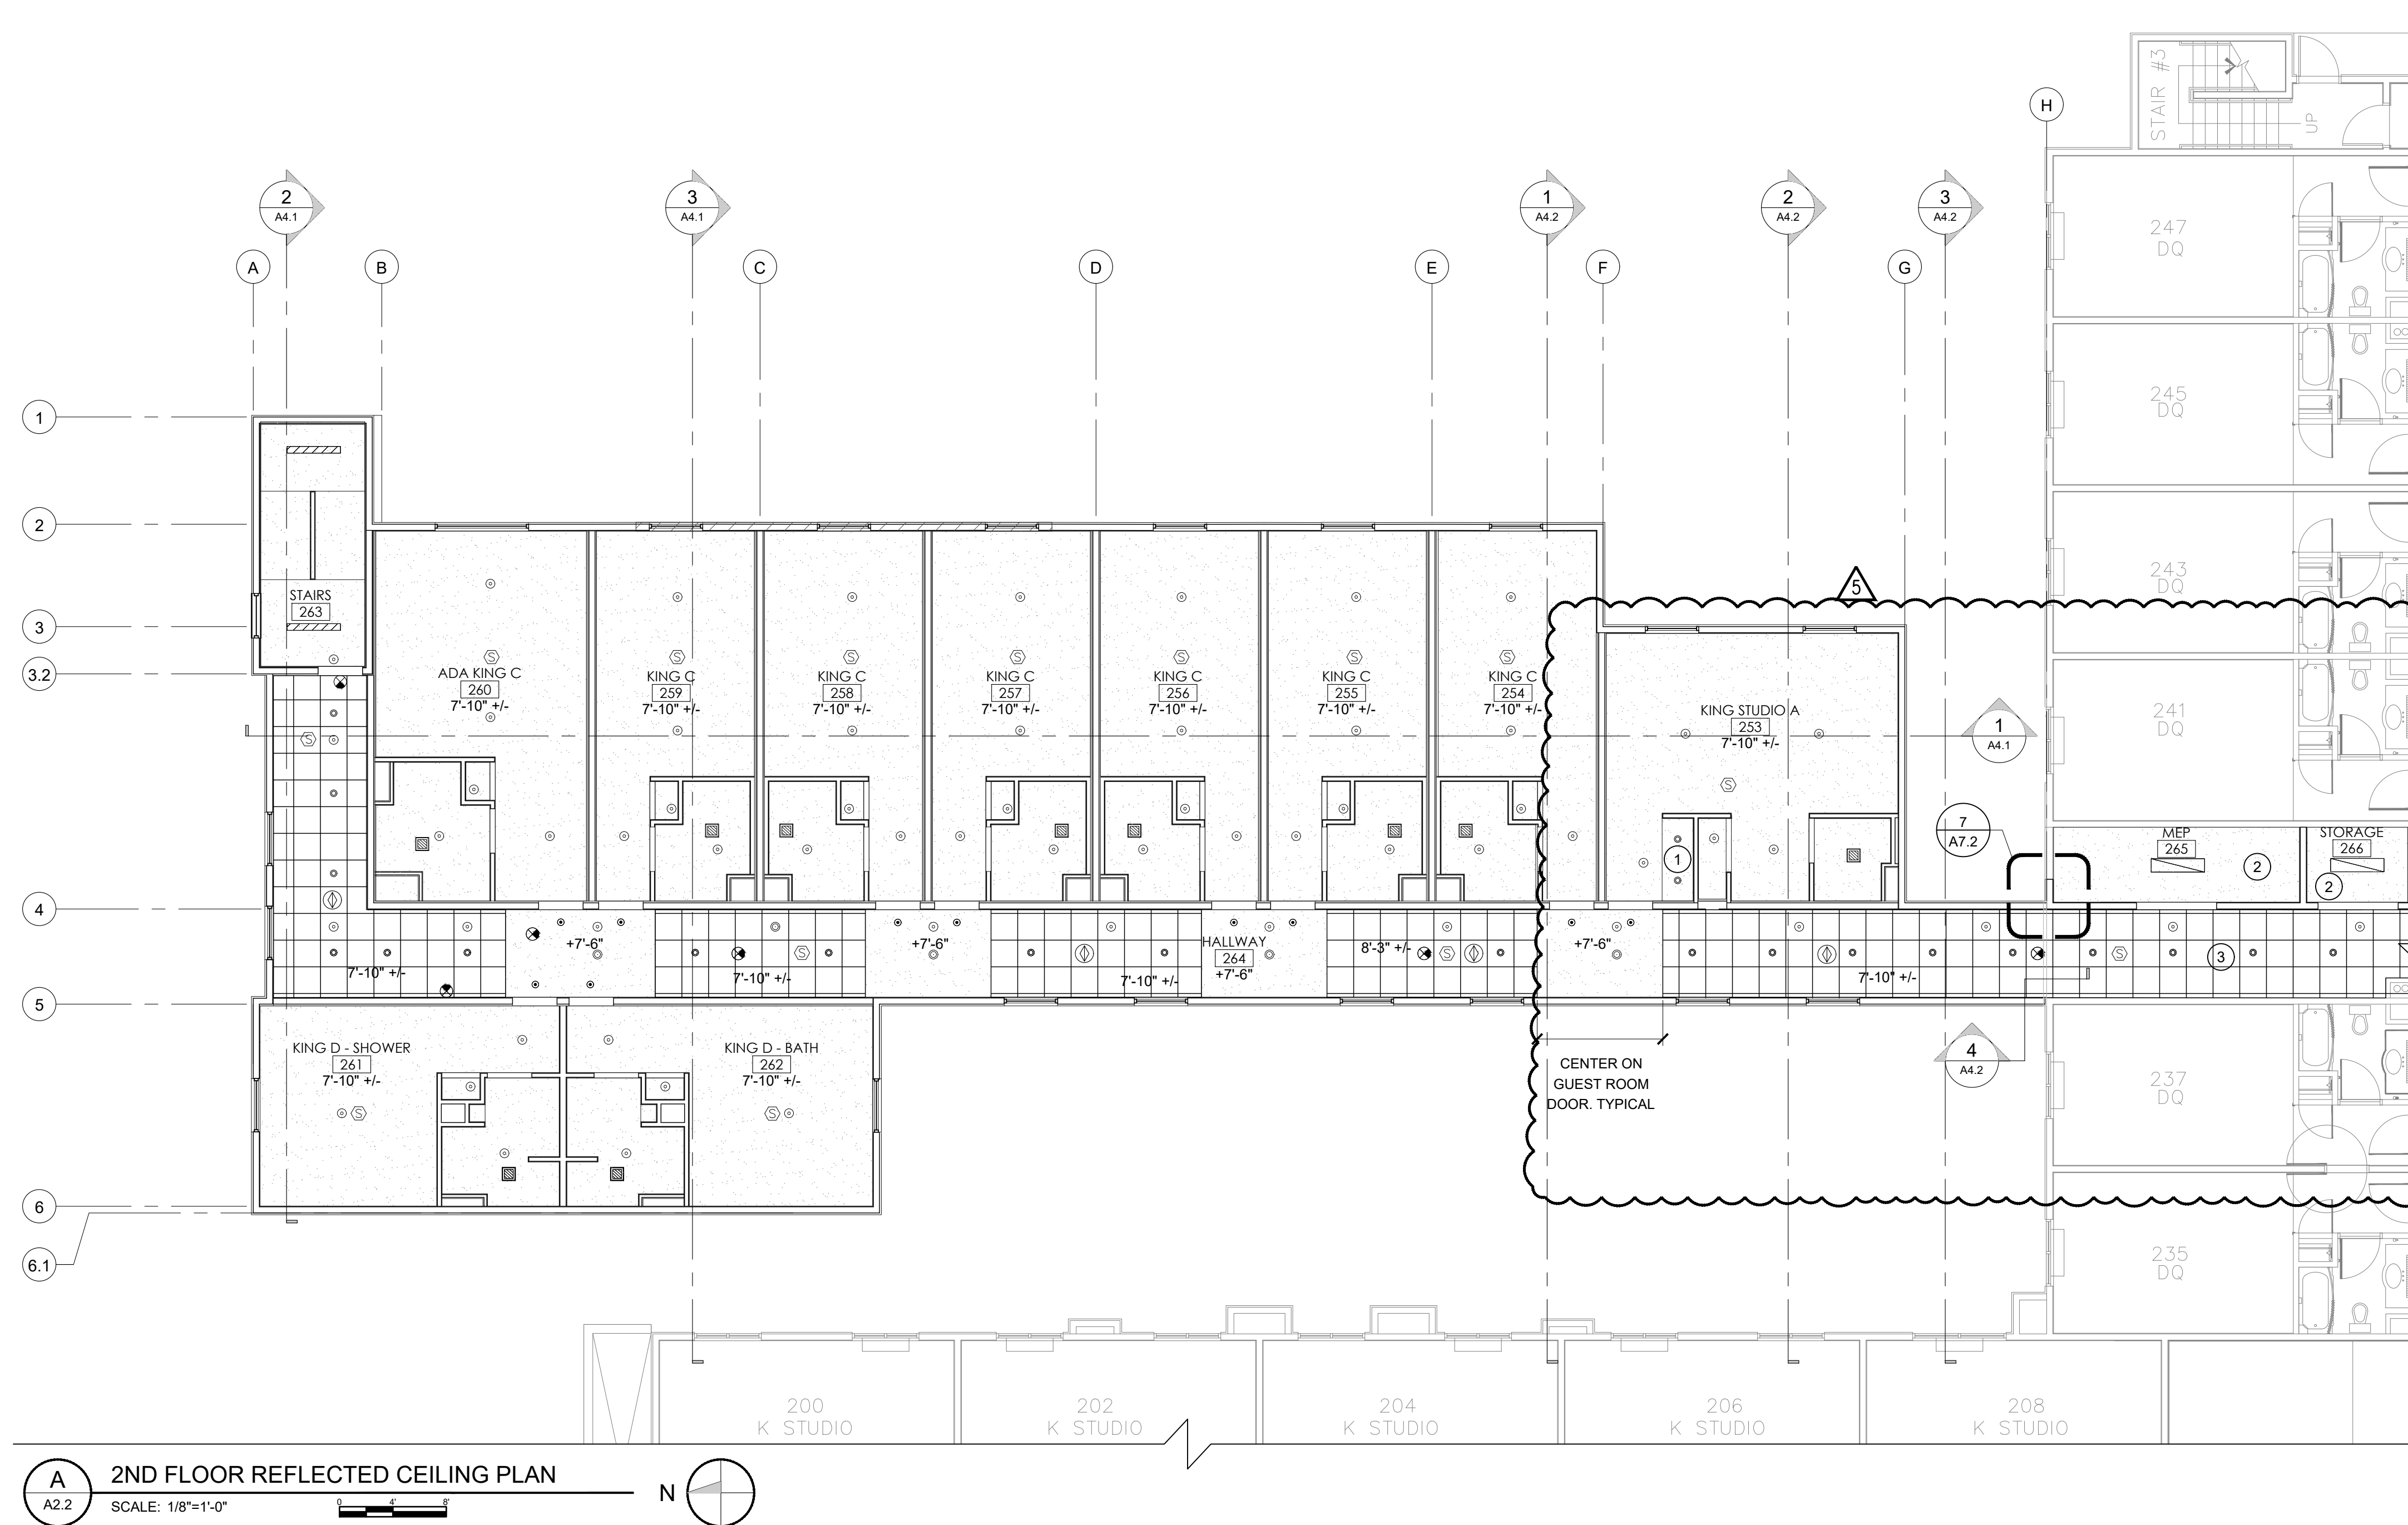

**A**  
A2.2  
**2ND FLOOR REFLECTED CEILING PLAN**  
SCALE: 1/8"=1'-0"  
N

**GENERAL NOTES**

- A. HEIGHT REFERENCES ARE TAKEN FROM FINISH FLOOR ELEVATIONS. DIMENSIONS ARE CENTERLINE OF FIXTURES.
- B. NOTIFY ARCHITECT OF ANY DISCREPANCIES BETWEEN FINISH SCHEDULE AND CEILING PLAN.
- C. MECHANICAL FIXTURES, LIGHT FIXTURES, AND FIRE SUPPRESSION FIXTURES SHOWN ON THIS DRAWING ARE FOR LOCATIONS ONLY. NOTIFY ARCHITECT OF DISCREPANCIES BETWEEN MECHANICAL AND ELECTRICAL PRIOR TO ORDERING EQUIPMENT.
- D. CENTER ALL FIXTURES IN LAY-IN CEILING TILES.
- E. THE GENERAL CONTRACTOR SHALL COORDINATE FIRE SPRINKLER HEAD LOCATIONS WITH MECHANICAL AND ELECTRICAL ITEMS. ALL HEADS SHALL BE CENTERED IN CEILING TILES, WHERE OCCURS. ALL MEP EQUIPMENT IS SHOWN FOR GENERAL REFERENCE. COORDINATE FIXTURES AND EQUIPMENT WITH MEP DRAWINGS AND SPRINKLER SUBMITTALS.
- F. WHERE EXISTING WALLS WERE REMOVED THAT AFFECT 2 DIFFERENT FINISHES, SUCH AS BATHROOM CEILING TO SLEEPING AREA CEILING, THE CEILING SHALL BE PATCHED, TEXTURED, AND PAINTED TO MATCH THE SLEEPING AREA CEILING. PAINT TO MATCH HAMPTON INN STANDARDS.

**NEW REFLECTED CEILING PLAN KEYED NOTES**

- 1 NEW 2x4's @ 16" OC FRAMED SOFFIT WITH 5/8" TYPE 'X' GYPSUM BOARD ON VERTICAL AND CEILING SURFACES. PROVIDE WALL COVERING ON VERTICAL FACES AND TEXTURE AND PAINT CEILING SURFACES.
- 2 PATCH EXISTING GYPSUM BOARD CEILING WHERE EXISTING WALLS OR OTHER EQUIPMENT HAS BEEN REMOVED TO MATCH EXISTING REMAINING CEILING TEXTURE AND FINISH, PAINT, COLOR AND SHEEN. MAINTAIN THE CONTINUITY OF GYPSUM LAYERING TO KEEP EVEN CEILING LEVEL WITHIN THE ROOM.
- 3 EXISTING GYPSUM CEILING ABOVE NEW ACOUSTICAL CEILING AND GRID SHALL BE PATCHED TO MAINTAIN CONTINUITY OF GYPSUM BOARD THICKNESS. THE NEW ACOUSTICAL CEILING TILE AND GRID SHALL MATCH EXISTING IN PROFILE, STYLE AND MANUFACTURER AS EXISTING OR AS DIRECTED WITHIN THE HAMPTON INN DESIGN STANDARDS. NEW CEILING SHALL ALIGN WITH EXISTING.
- 4 NEW 2X FRAMING WITH GYPSUM BOARD ON ALL EXPOSED EDGES TO FORM A HEADER AS A SEPARATION BETWEEN NEW AND EXISTING CEILINGS. IF ACCEPTABLE TO THE OWNER, A CEILING GRID TRANSITION CAN BE USED IN LIEU OF THE HEADER.

**CEILING LEGEND**

- TEXTURED AND PAINTED GYPSUM BOARD TO MATCH EXISTING IN TEXTURE, FINISH, PAINT COLOR, TYPE AND SHEEN.
- 2'-0" x 2'-0" SUSPENDED ACOUSTICAL CEILING TILE AND GRID TO MATCH EXISTING MANUFACTURER AND SYSTEM. INSTALL TO MEET ALL LOCAL ADOPTED BUILDING CODES, INCLUDING SEISMIC INSTALLATION CONDITIONS.

**CEILING FIXTURE LEGEND**

- 1' x 4' SURFACE LIGHT
- LED SURFACE MOUNTED LIGHT
- RECESSED 4" FOCAL LIGHT
- RECESSED 5" DOWNLIGHT
- EXIT SIGN
- PHOTOCELL
- EXHAUST FAN
- SMOKE ALARM
- FIRE SPRINKLER
- FIRE SPRINKLER

**REVISION 1 OF 2**  
**(27 PAGES)**  
**B-20-0078**

**KNIT**  
909 S. 336TH ST.  
SUITE 107  
FEDERAL WAY, WA 98003  
knitstudios.com

THESE DOCUMENTS HAVE BEEN PRODUCED AS AN INSTRUMENT OF SERVICE AND ARE INTENDED SOLELY FOR THE PURPOSE OF CONSTRUCTING, USING AND MAINTAINING THE PROJECT. KNIT AS THE ARCHITECT OF RECORD FOR THE PROJECT RETAINS OWNERSHIP OF THESE DOCUMENTS.

ANY USE OF THESE DOCUMENTS OR USE OF THE DESIGN IDEAS OR CONCEPTS DESCRIBED HEREIN IN WHOLE OR PART BY ANY PERSON WHATSOEVER IS EXPRESSLY PROHIBITED EXCEPT BY WRITTEN CONSENT OF KNIT.

REPRODUCTION OF THESE DOCUMENTS IS STRICTLY PROHIBITED EXCEPT BY WRITTEN CONSENT OF KNIT.

COPYRIGHT 2021 KNIT

ISSUE DATE 09/25/23  
PROGRESS SET

REV	DATE	COMMENT
1	03.03.2023	AC RESPONSE
2	08.14.2023	CORRECTIONS
3	09.25.2023	CORRECTIONS
4	10.17.2023	CORRECTIONS
5	12.21.2023	CORRECTIONS


City of Puyallup  
Development & Permitting Services  
**ISSUED PERMIT**

Building	Planning
Engineering	Public Works
Fire	Traffic

8677 REGISTERED ARCHITECT  
*Rhonda A. Gillogly*  
RHONDA A. GILLOGLY  
STATE OF WASHINGTON  
12/21/2023

**2ND FLOOR REFLECTIVE CEILING PLAN**  
**ADDITION TO HAMPTON INN & SUITES**  
1515 S MERIDIAN  
PUYALLUP, WA 98371  
HAMPTON INN & SUITES

TITLE	PROJECT	CLIENT
JOB NO: 210158		
<b>A2.7</b>		

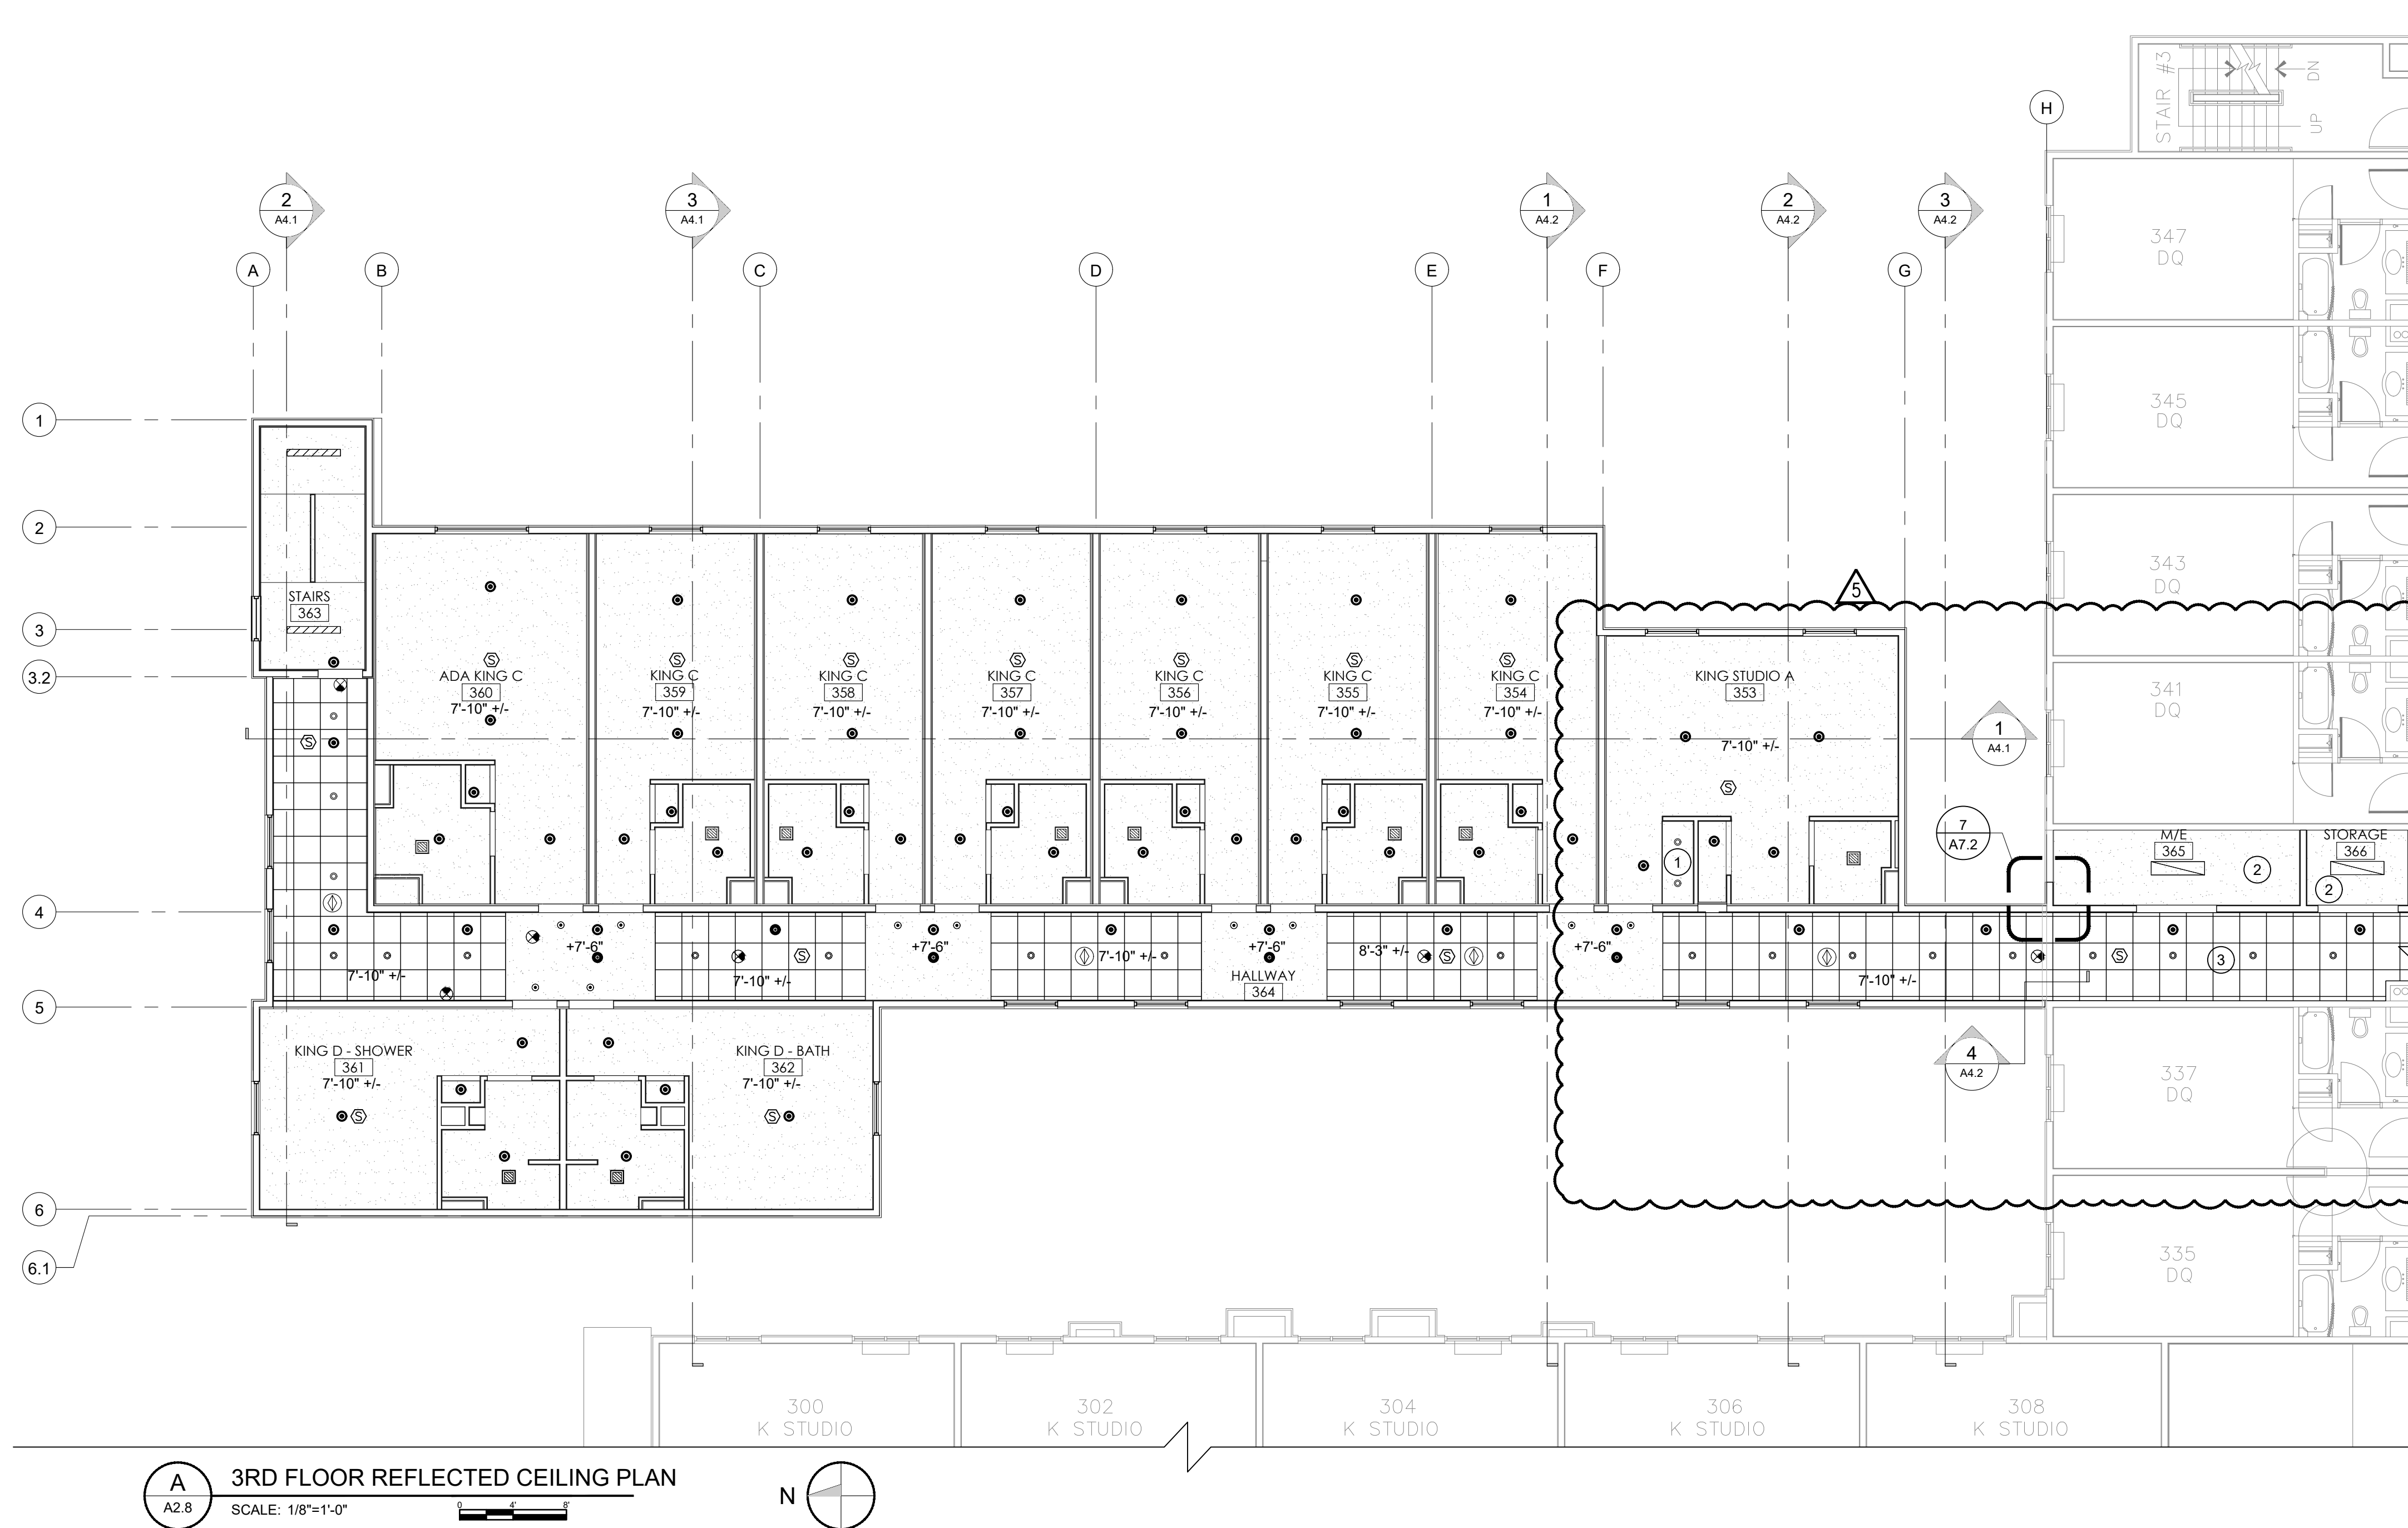

**A** 3RD FLOOR REFLECTED CEILING PLAN  
 A2.8 SCALE: 1/8"=1'-0"

**GENERAL NOTES**

- A. HEIGHT REFERENCES ARE TAKEN FROM FINISH FLOOR ELEVATIONS. DIMENSIONS ARE CENTERLINE OF FIXTURES.
- B. NOTIFY ARCHITECT OF ANY DISCREPANCIES BETWEEN FINISH SCHEDULE AND CEILING PLAN.
- C. MECHANICAL FIXTURES, LIGHT FIXTURES, AND FIRE SUPPRESSION FIXTURES SHOWN ON THIS DRAWING ARE FOR LOCATIONS ONLY. NOTIFY ARCHITECT OF DISCREPANCIES BETWEEN MECHANICAL AND ELECTRICAL PRIOR TO ORDERING EQUIPMENT.
- D. CENTER ALL FIXTURES IN LAY-IN CEILING TILES.
- E. THE GENERAL CONTRACTOR SHALL COORDINATE FIRE SPRINKLER HEAD LOCATIONS WITH MECHANICAL AND ELECTRICAL ITEMS. ALL HEADS SHALL BE CENTERED IN CEILING TILES, WHERE OCCURS. ALL MEP EQUIPMENT IS SHOWN FOR GENERAL REFERENCE. COORDINATE FIXTURES AND EQUIPMENT WITH MEP DRAWINGS AND SPRINKLER SUBMITTALS.
- F. WHERE EXISTING WALLS WERE REMOVED THAT AFFECT 2 DIFFERENT FINISHES, "SUCH AS BATHROOM CEILING TO SLEEPING AREA CEILING", THE CEILING SHALL BE PATCHED, TEXTURED, AND PAINTED TO MATCH THE SLEEPING AREA CEILING. PAINT TO MATCH HAMPTON INN STANDARDS.

**NEW REFLECTED CEILING PLAN KEYED NOTES**

- 1 NEW 2x4's @ 16" OC FRAMED SOFFIT WITH 5/8" TYPE 'X' GYPSUM BOARD ON VERTICAL AND CEILING SURFACES. PROVIDE WALL COVERING ON VERTICAL FACES AND TEXTURE AND PAINT CEILING SURFACES.
- 2 PATCH EXISTING GYPSUM BOARD CEILING WHERE EXISTING WALLS OR OTHER EQUIPMENT HAS BEEN REMOVED TO MATCH EXISTING REMAINING CEILING TEXTURE AND FINISH, PAINT, COLOR AND SHEEN. MAINTAIN THE CONTINUITY OF GYPSUM LAYERING TO KEEP EVEN CEILING LEVEL WITHIN THE ROOM.
- 3 EXISTING GYPSUM CEILING ABOVE NEW ACOUSTICAL CEILING AND GRID SHALL BE PATCHED TO MAINTAIN CONTINUITY OF GYPSUM BOARD THICKNESS. THE NEW ACOUSTICAL CEILING TILE AND GRID SHALL MATCH EXISTING IN PROFILE, STYLE AND MANUFACTURER AS EXISTING OR AS DIRECTED WITHIN THE HAMPTON INN DESIGN STANDARDS. NEW CEILING SHALL ALIGN WITH EXISTING.
- 4 NEW 2X FRAMING WITH GYPSUM BOARD ON ALL EXPOSED EDGES TO FORM A HEADER AS A SEPARATION BETWEEN NEW AND EXISTING CEILINGS. IF ACCEPTABLE TO THE OWNER, A CEILING GRID TRANSITION CAN BE USED IN LIEU OF THE HEADER.

**CEILING LEGEND**

- TEXTURED AND PAINTED GYPSUM BOARD TO MATCH EXISTING IN TEXTURE, FINISH, PAINT COLOR, TYPE AND SHEEN.
- 2'-0" x 2'-0" SUSPENDED ACOUSTICAL CEILING TILE AND GRID TO MATCH EXISTING MANUFACTURER AND SYSTEM. INSTALL TO MEET ALL LOCAL ADOPTED BUILDING CODES, INCLUDING SEISMIC INSTALLATION CONDITIONS.

**CEILING FIXTURE LEGEND**

- 1' x 4' SURFACE LIGHT
- LED SURFACE MOUNTED LIGHT
- RECESSED 4" FOCAL LIGHT
- RECESSED 5" DOWNLIGHT
- EXIT SIGN
- PHOTOCELL
- EXHAUST FAN
- SMOKE ALARM
- FIRE SPRINKLER
- FIRE SPRINKLER

**KNIT**  
 909 S. 336TH ST,  
 SUITE 107  
 FEDERAL WAY, WA 98003  
 knitstudios.com

THESE DOCUMENTS HAVE BEEN PRODUCED AS AN INSTRUMENT OF SERVICE AND ARE INTENDED SOLELY FOR THE PURPOSE OF CONSTRUCTING, USING AND MAINTAINING THE PROJECT. KNIT AS THE ARCHITECT OF RECORD FOR THE PROJECT RETAINS OWNERSHIP OF THESE DOCUMENTS.

ANY USE OF THESE DOCUMENTS OR USE OF THE DESIGN IDEAS OR CONCEPTS DESCRIBED HEREIN IN WHOLE OR PART BY ANY PERSON WHATSOEVER IS EXPRESSLY PROHIBITED EXCEPT BY WRITTEN CONSENT OF KNIT.

REPRODUCTION OF THESE DOCUMENTS IS STRICTLY PROHIBITED EXCEPT BY WRITTEN CONSENT OF KNIT.

COPYRIGHT 2021 KNIT

ISSUE DATE 09/25/23  
 PROGRESS SET

REV	DATE	COMMENT
1	03.03.2023	AC RESPONSE
2	08.14.2023	CORRECTIONS
3	09.25.2023	CORRECTIONS
4	10.17.2023	CORRECTIONS
5	12.21.2023	CORRECTIONS

City of Puyallup  
 Development & Permitting Services  
**ISSUED PERMIT**

Building	Planning
Engineering	Public Works
Fire	Traffic


8677 REGISTERED ARCHITECT  
  
 RHONDA A. GILLOGLY  
 STATE OF WASHINGTON  
 12/21/2023

**3RD FLOOR REFLECTED CEILING PLAN**  
**ADDITION TO HAMPTON INN & SUITES**  
 1515 S MERIDIAN  
 PUYALLUP, WA 98371  
 HAMPTON INN & SUITES

TITLE	PROJECT	CLIENT
JOB NO: 210158		

**A2.8**

**REVISION 1 OF 2**  
**(27 PAGES)**  
**B-20-0078**

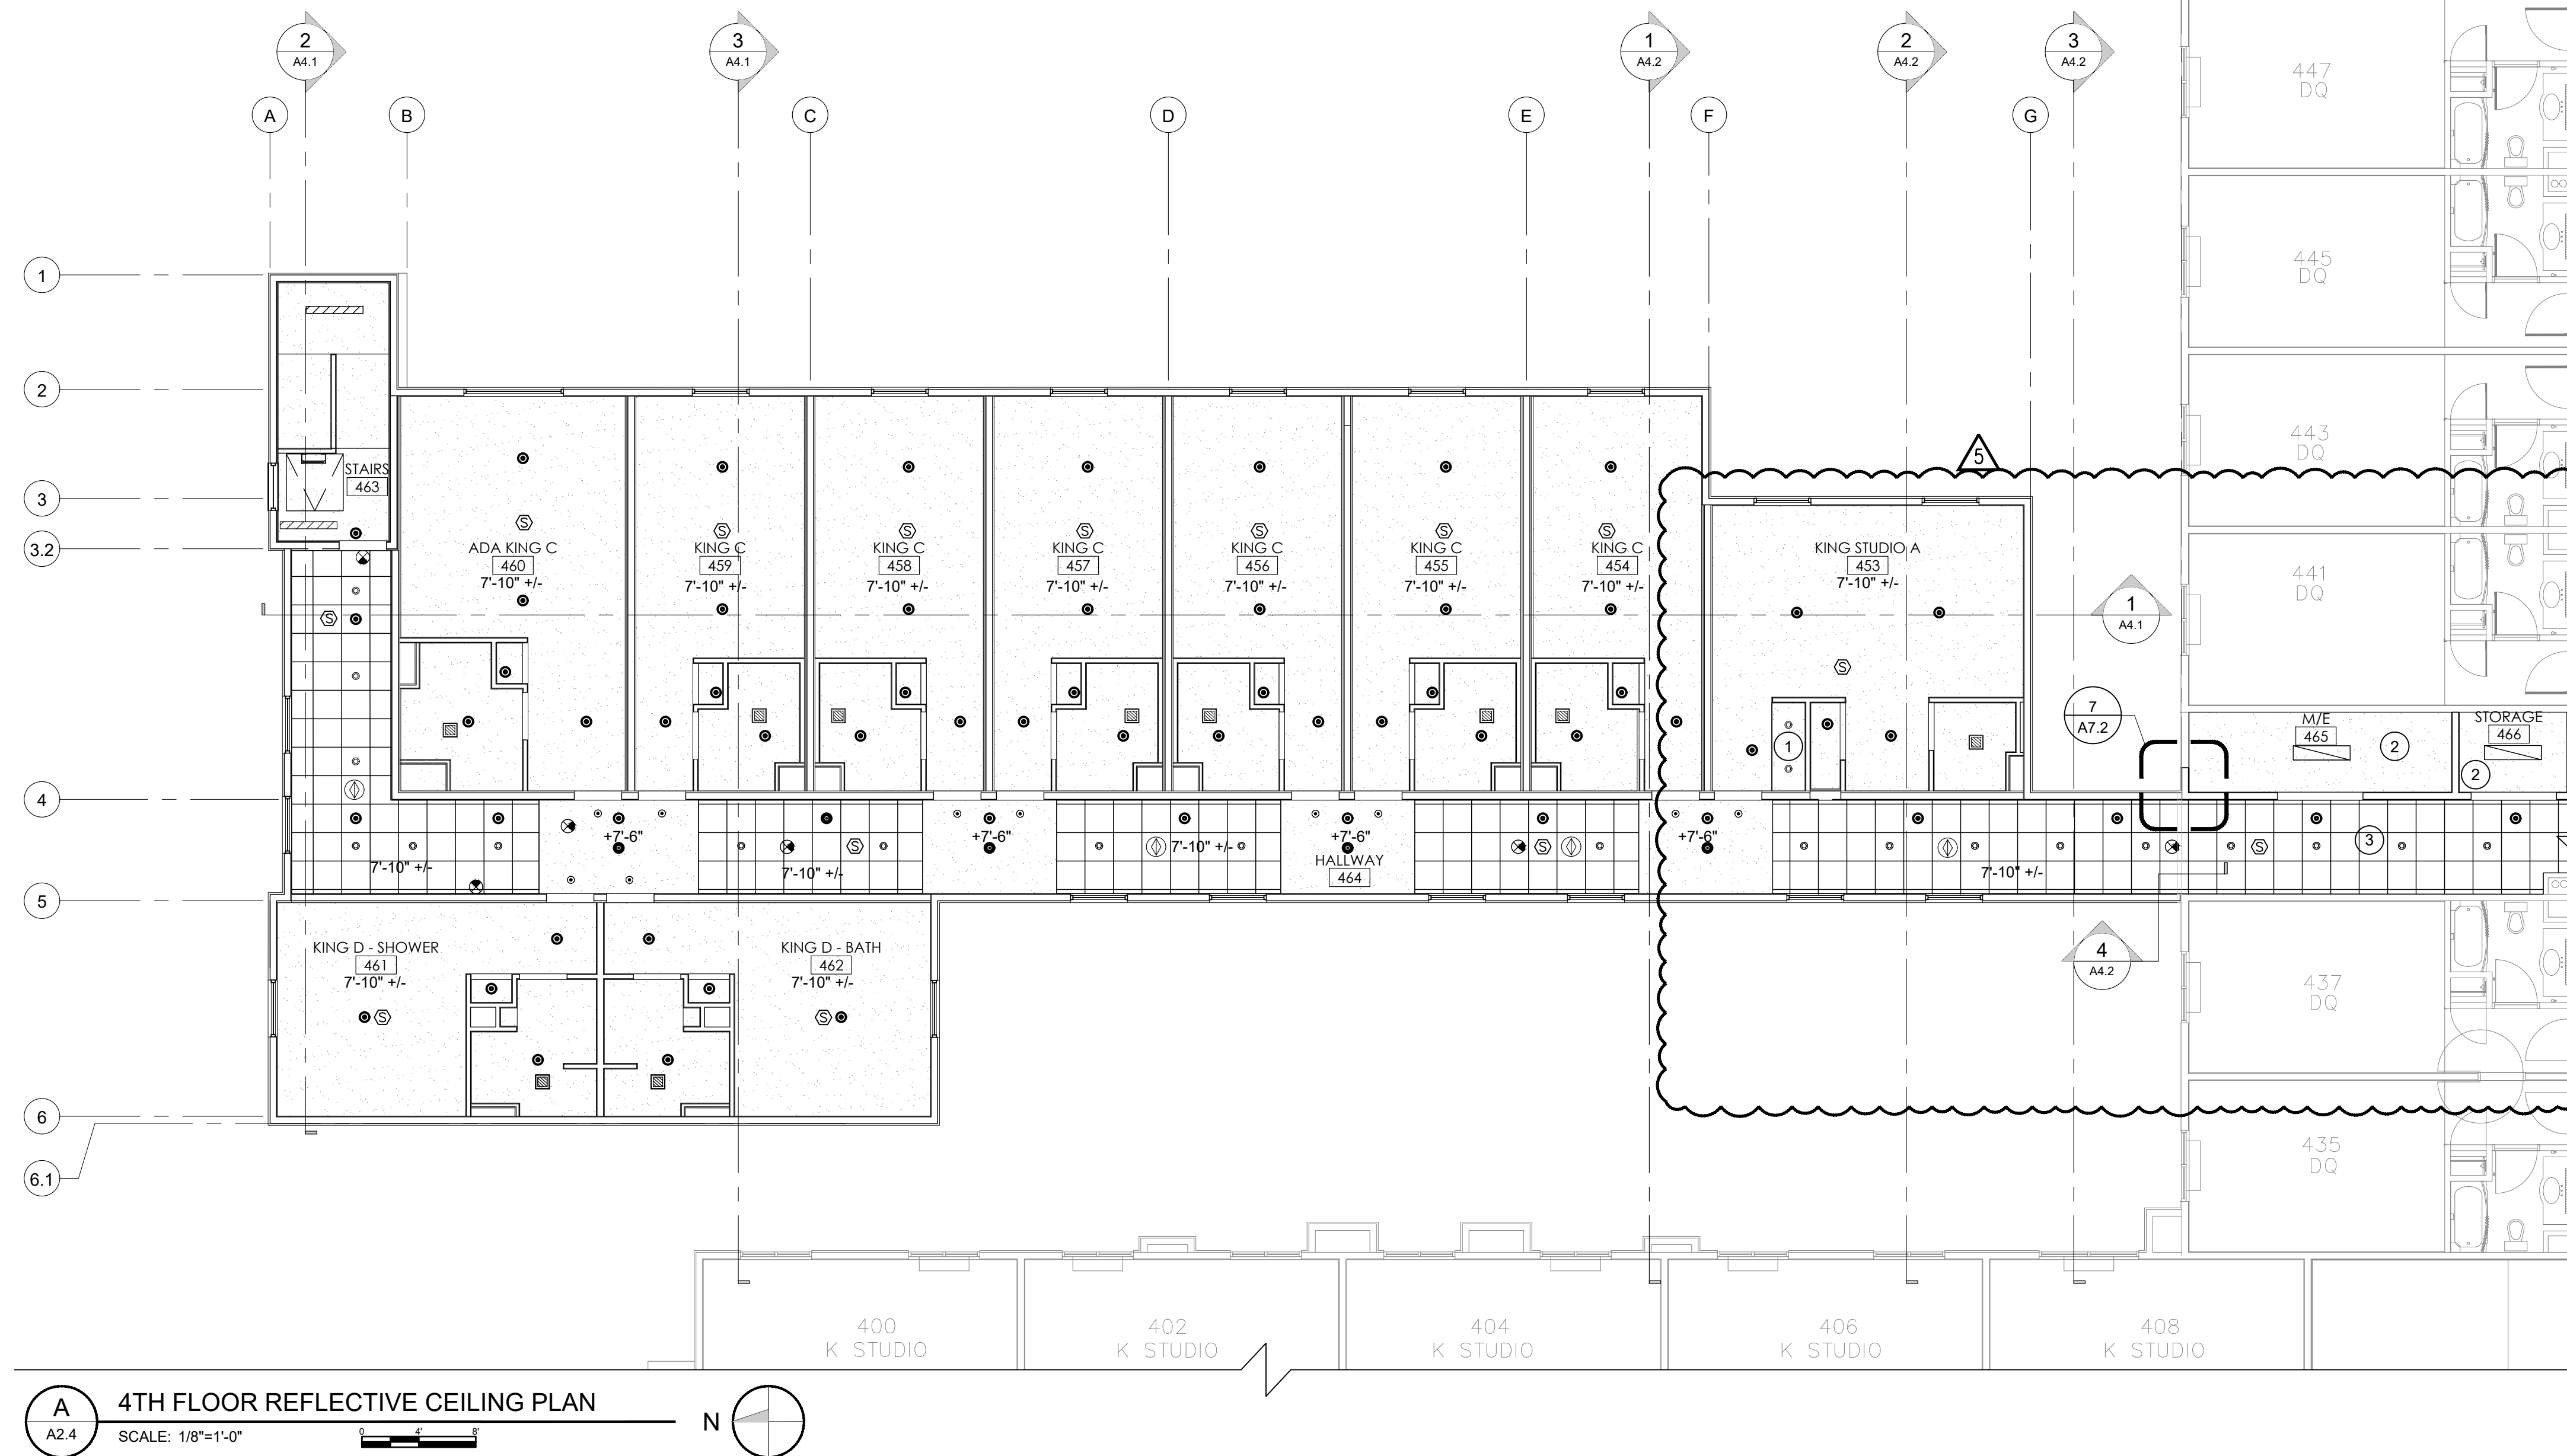

**A**  
A2.4  
4TH FLOOR REFLECTIVE CEILING PLAN  
SCALE: 1/8"=1'-0"  
N

**GENERAL NOTES**

- A. HEIGHT REFERENCES ARE TAKEN FROM FINISH FLOOR ELEVATIONS. DIMENSIONS ARE CENTERLINE OF FIXTURES.
- B. NOTIFY ARCHITECT OF ANY DISCREPANCIES BETWEEN FINISH SCHEDULE AND CEILING PLAN.
- C. MECHANICAL FIXTURES, LIGHT FIXTURES, AND FIRE SUPPRESSION FIXTURES SHOWN ON THIS DRAWING ARE FOR LOCATIONS ONLY. NOTIFY ARCHITECT OF DISCREPANCIES BETWEEN MECHANICAL AND ELECTRICAL PRIOR TO ORDERING EQUIPMENT.
- D. CENTER ALL FIXTURES IN LAY-IN CEILING TILES.
- E. THE GENERAL CONTRACTOR SHALL COORDINATE FIRE SPRINKLER HEAD LOCATIONS WITH MECHANICAL AND ELECTRICAL ITEMS. ALL HEADS SHALL BE CENTERED IN CEILING TILES, WHERE OCCURS. ALL MEP EQUIPMENT IS SHOWN FOR GENERAL REFERENCE. COORDINATE FIXTURES AND EQUIPMENT WITH MEP DRAWINGS AND SPRINKLER SUBMITTALS.
- F. WHERE EXISTING WALLS WERE REMOVED THAT AFFECT 2 DIFFERENT FINISHES, SUCH AS BATHROOM CEILING TO SLEEPING AREA CEILING, THE CEILING SHALL BE PATCHED, TEXTURED, AND PAINTED TO MATCH THE SLEEPING AREA CEILING. PAINT TO MATCH HAMPTON INN STANDARDS.

**NEW REFLECTED CEILING PLAN KEYED NOTES**

- 1 NEW 2x4's @ 16" OC FRAMED SOFFIT WITH 5/8" TYPE 'X' GYPSUM BOARD ON VERTICAL AND CEILING SURFACES. PROVIDE WALL COVERING ON VERTICAL FACES AND TEXTURE AND PAINT CEILING SURFACES.
- 2 PATCH EXISTING GYPSUM BOARD CEILING WHERE EXISTING WALLS OR OTHER EQUIPMENT HAS BEEN REMOVED TO MATCH EXISTING REMAINING CEILING TEXTURE AND FINISH. PAINT, COLOR AND SHEEN. MAINTAIN THE CONTINUITY OF GYPSUM LAYERING TO KEEP EVEN CEILING LEVEL WITHIN THE ROOM.
- 3 EXISTING GYPSUM CEILING ABOVE NEW ACOUSTICAL CEILING AND GRID SHALL BE PATCHED TO MAINTAIN CONTINUITY OF GYPSUM BOARD THICKNESS. THE NEW ACOUSTICAL CEILING TILE AND GRID SHALL MATCH EXISTING IN PROFILE, STYLE AND MANUFACTURER AS EXISTING OR AS DIRECTED WITHIN THE HAMPTON INN DESIGN STANDARDS. NEW CEILING SHALL ALIGN WITH EXISTING.
- 4 NEW 2X FRAMING WITH GYPSUM BOARD ON ALL EXPOSED EDGES TO FORM A HEADER AS A SEPARATION BETWEEN NEW AND EXISTING CEILINGS. IF ACCEPTABLE TO THE OWNER, A CEILING GRID TRANSITION CAN BE USED IN LIEU OF THE HEADER.

**CEILING LEGEND**

- TEXTURED AND PAINTED GYPSUM BOARD TO MATCH EXISTING IN TEXTURE, FINISH, PAINT COLOR, TYPE AND SHEEN.
- 2'-0" x 2'-0" SUSPENDED ACOUSTICAL CEILING TILE AND GRID TO MATCH EXISTING MANUFACTURER AND SYSTEM. INSTALL TO MEET ALL LOCAL ADOPTED BUILDING CODES, INCLUDING SEISMIC INSTALLATION CONDITIONS.

**CEILING FIXTURE LEGEND**

- 1' x 4' SURFACE LIGHT
- LED SURFACE MOUNTED LIGHT
- RECESSED 4" FOCAL LIGHT
- RECESSED 5" DOWNLIGHT
- EXIT SIGN
- PHOTOCELL
- EXHAUST FAN
- SMOKE ALARM
- FIRE SPRINKLER
- FIRE SPRINKLER

**REVISION 1 OF 2  
(27 PAGES)  
B-20-0078**

**KNIT**  
909 S. 336TH ST.  
SUITE 107  
FEDERAL WAY, WA 98003  
knitstudios.com

THESE DOCUMENTS HAVE BEEN PRODUCED AS AN INSTRUMENT OF SERVICE AND ARE INTENDED SOLELY FOR THE PURPOSE OF CONSTRUCTING, USING AND MAINTAINING THE PROJECT. KNIT AS THE ARCHITECT OF RECORD FOR THE PROJECT RETAINS OWNERSHIP OF THESE DOCUMENTS.

ANY USE OF THESE DOCUMENTS OR USE OF THE DESIGN IDEAS OR CONCEPTS DESCRIBED HEREIN IN WHOLE OR PART BY ANY PERSON WHATSOEVER IS EXPRESSLY PROHIBITED EXCEPT BY WRITTEN CONSENT OF KNIT.

REPRODUCTION OF THESE DOCUMENTS IS STRICTLY PROHIBITED EXCEPT BY WRITTEN CONSENT OF KNIT.

COPYRIGHT 2021 KNIT

ISSUE DATE 09/25/23  
PROGRESS SET

REV	DATE	COMMENT
2	08.08.2023	COMMENTS #1
2	08.14.2023	CORRECTIONS
3	09.25.2023	CORRECTIONS
4	10.17.2023	CORRECTIONS
5	12.21.2023	CORRECTIONS


City of Puyallup  
Development & Permitting Services  
**ISSUED PERMIT**

Building	Planning
Engineering	Public Works
Fire	Traffic


8677 REGISTERED ARCHITECT  
*Rhonda A. Gillogly*  
RHONDA A. GILLOGLY  
STATE OF WASHINGTON  
12/21/2023

**4TH FLOOR REFLECTED CEILING PLAN**  
**ADDITION TO HAMPTON INN & SUITES**  
1515 S MERIDIAN  
PUYALLUP, WA 98371  
HAMPTON INN & SUITES


TITLE	PROJECT	CLIENT
JOB NO: 210158		
<b>A2.9</b>		

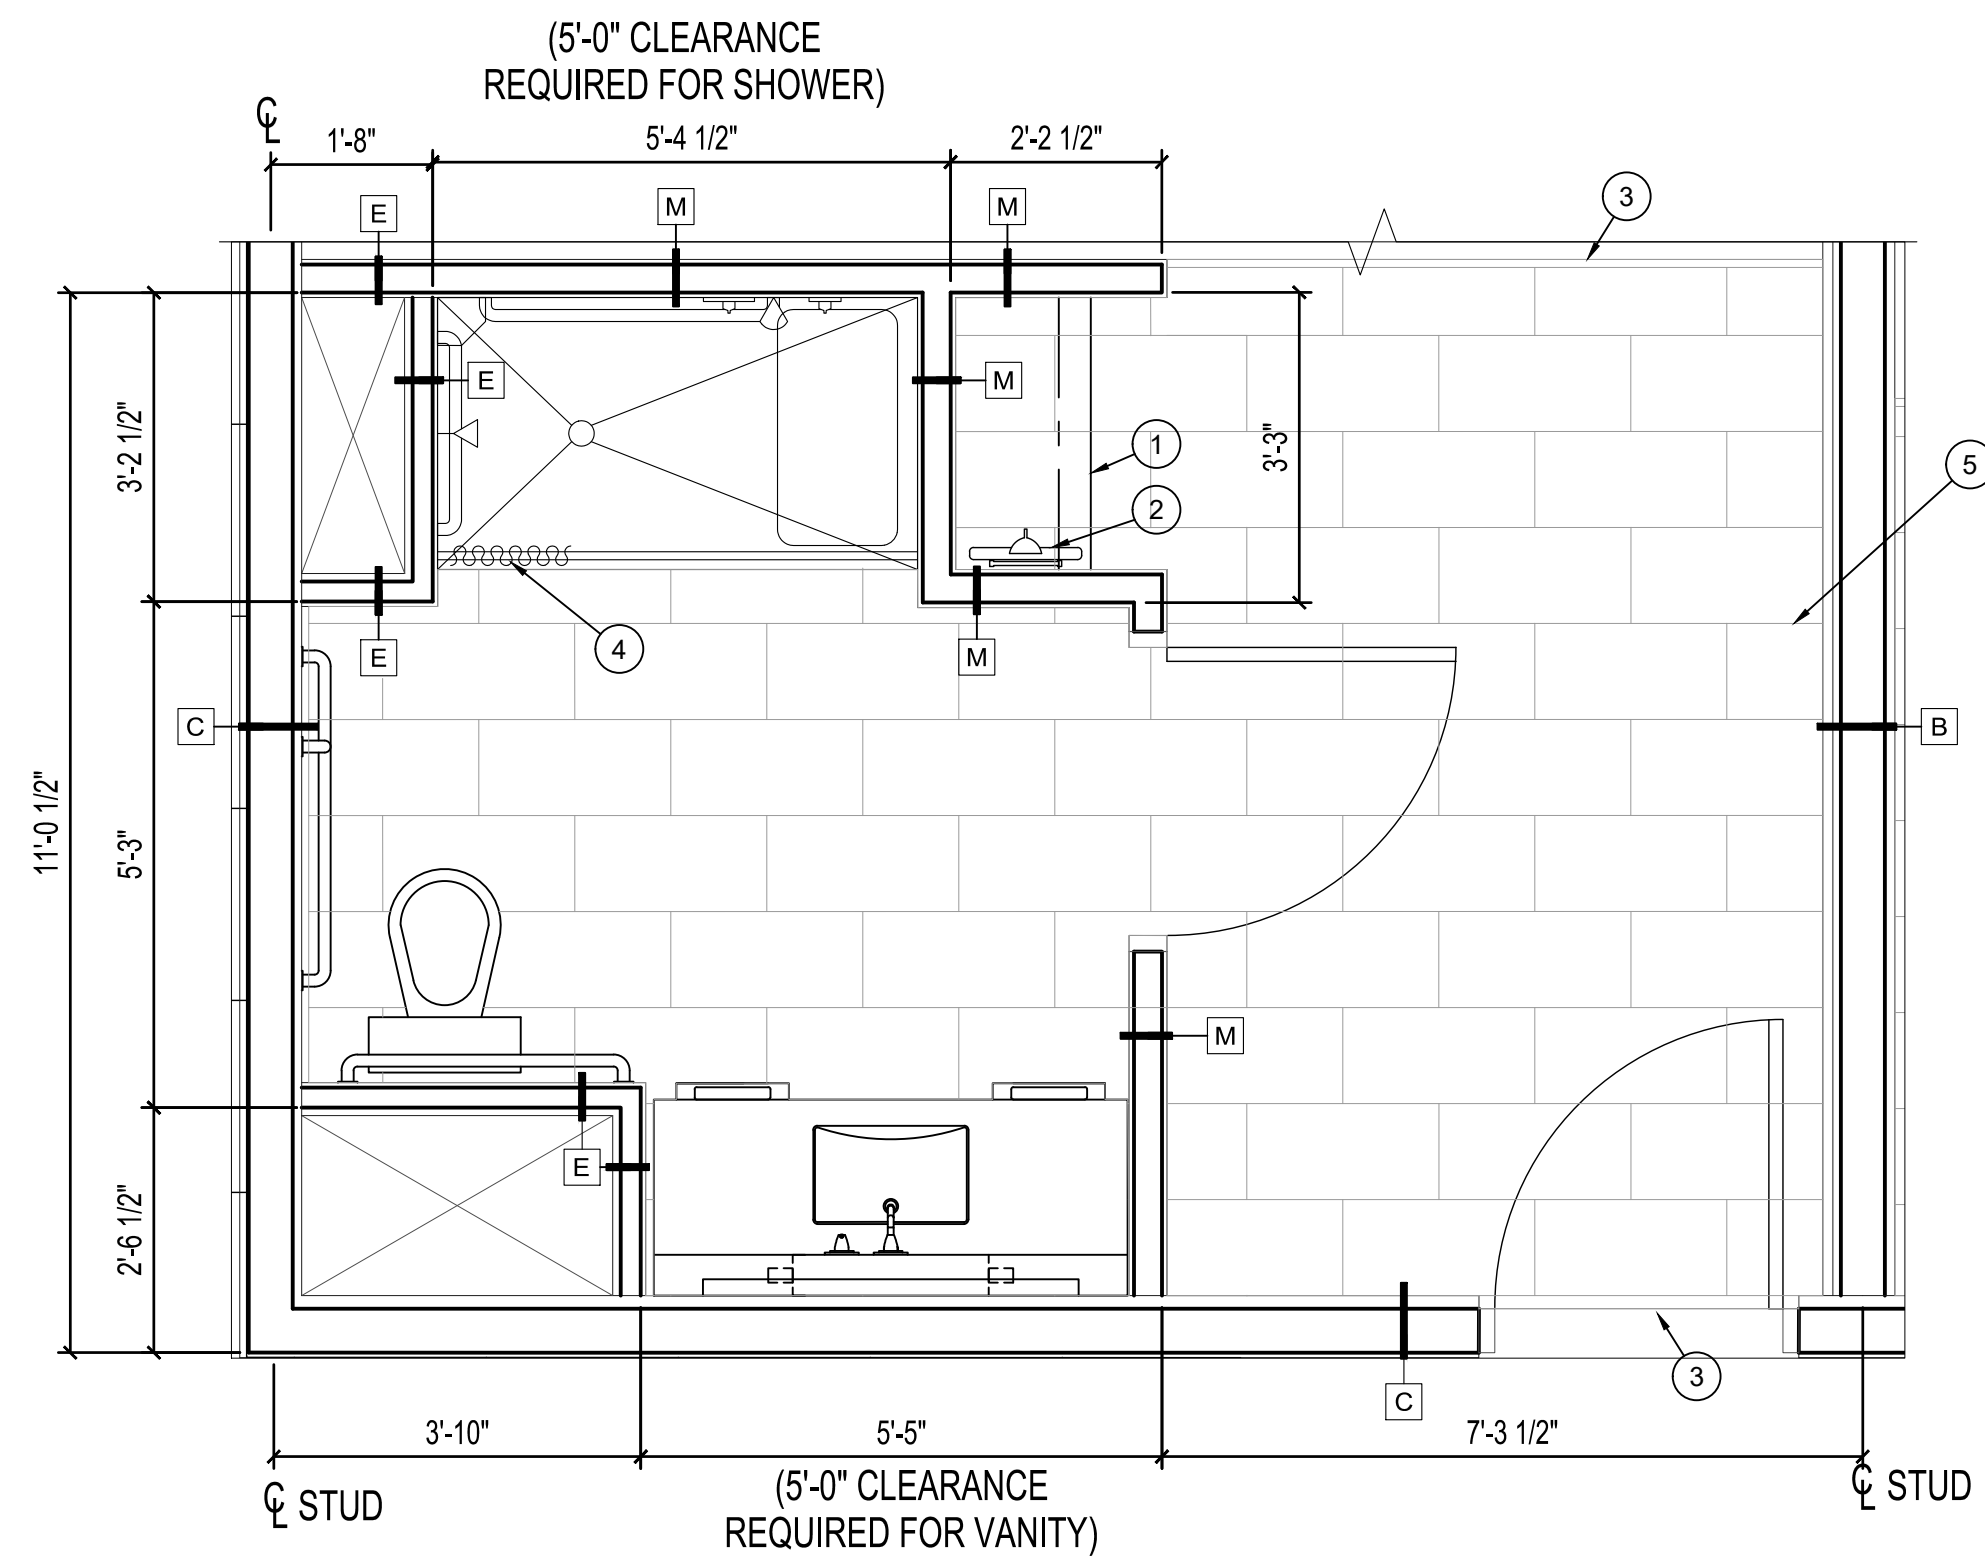


**1 TYPICAL ADA KING C BATH PLAN**  
 24 x 36 - 1/2" = 1'-0"  
 12 x 18 - 1/4" = 1'-0"

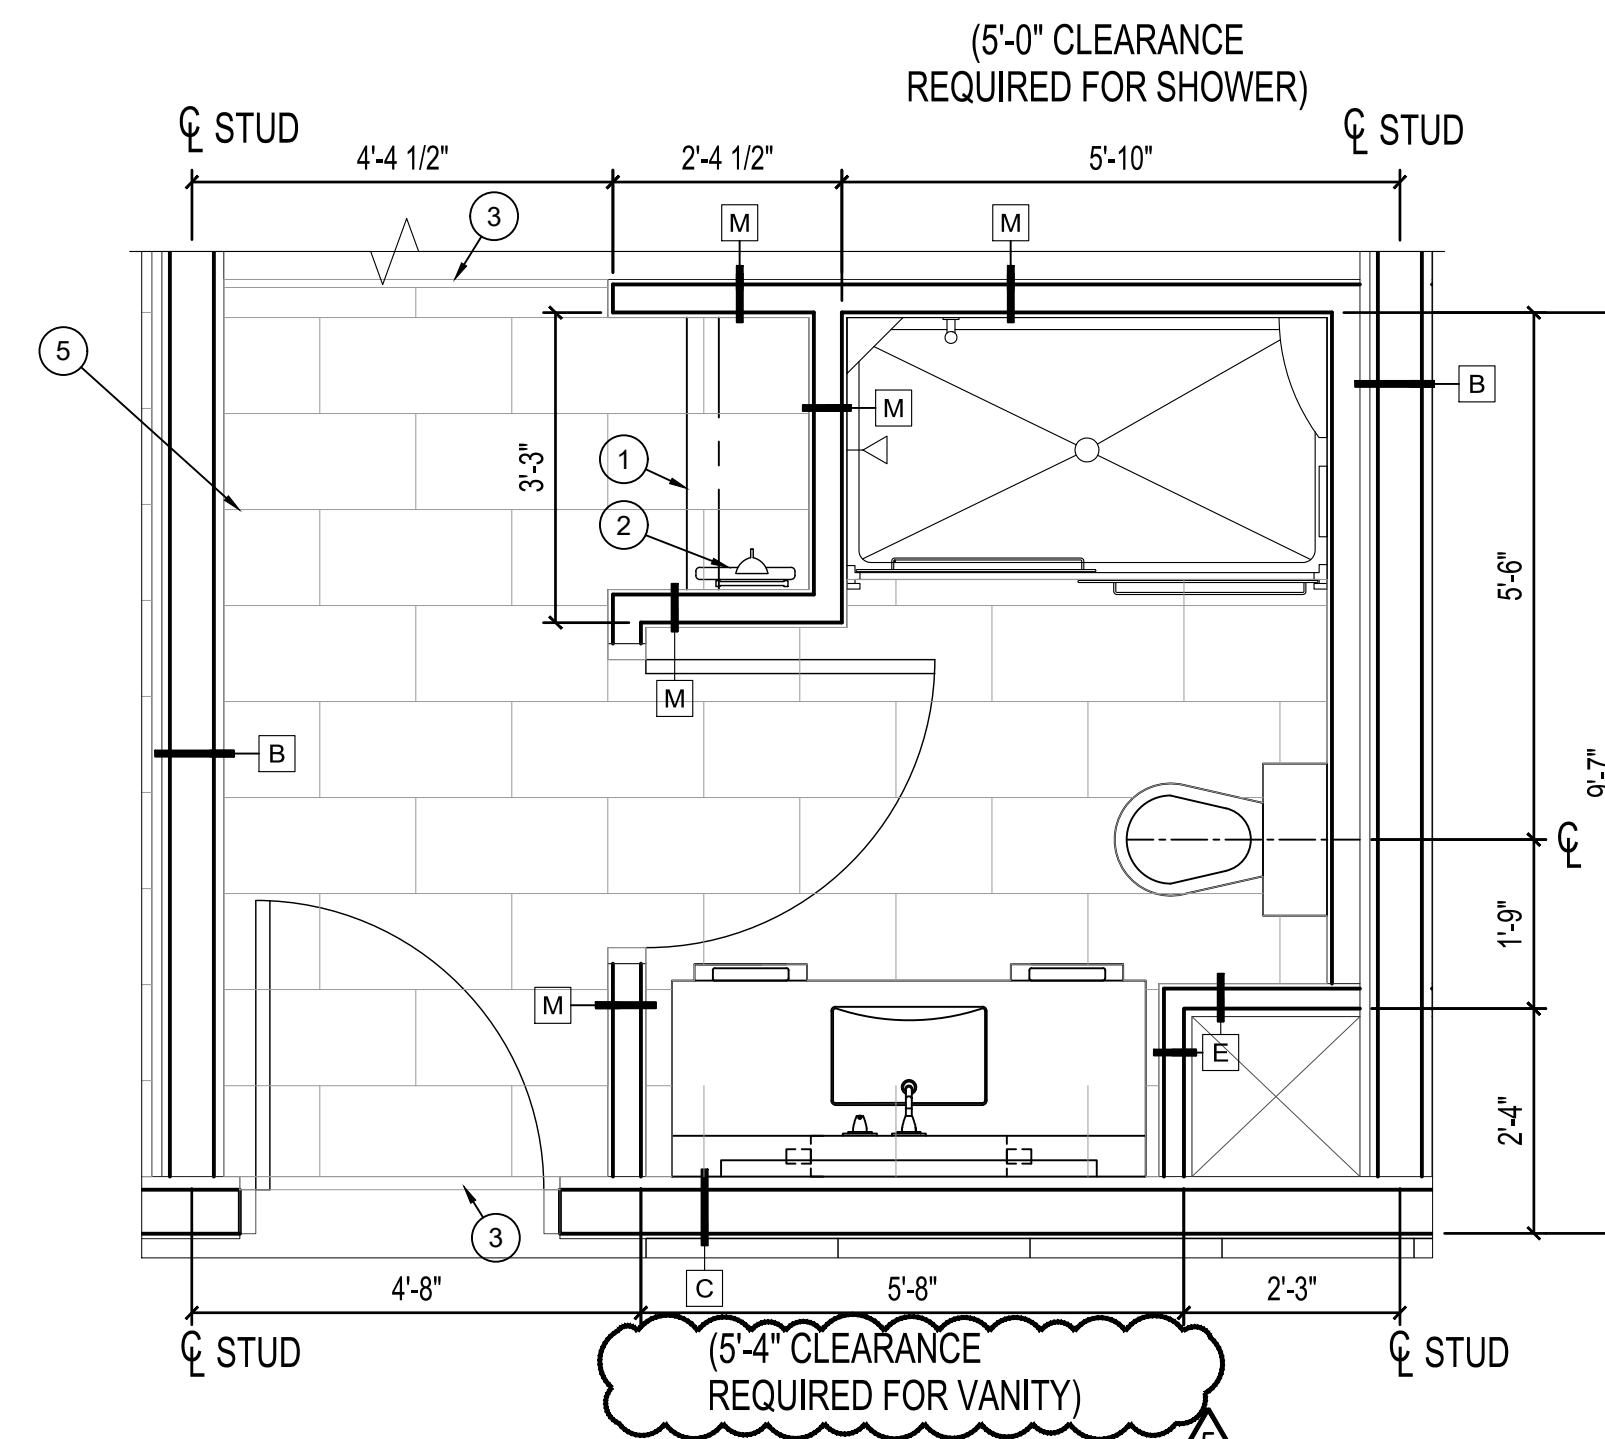

**2 TYPICAL KING C BATH PLAN**  
 24 x 36 - 1/2" = 1'-0"  
 12 x 18 - 1/4" = 1'-0"

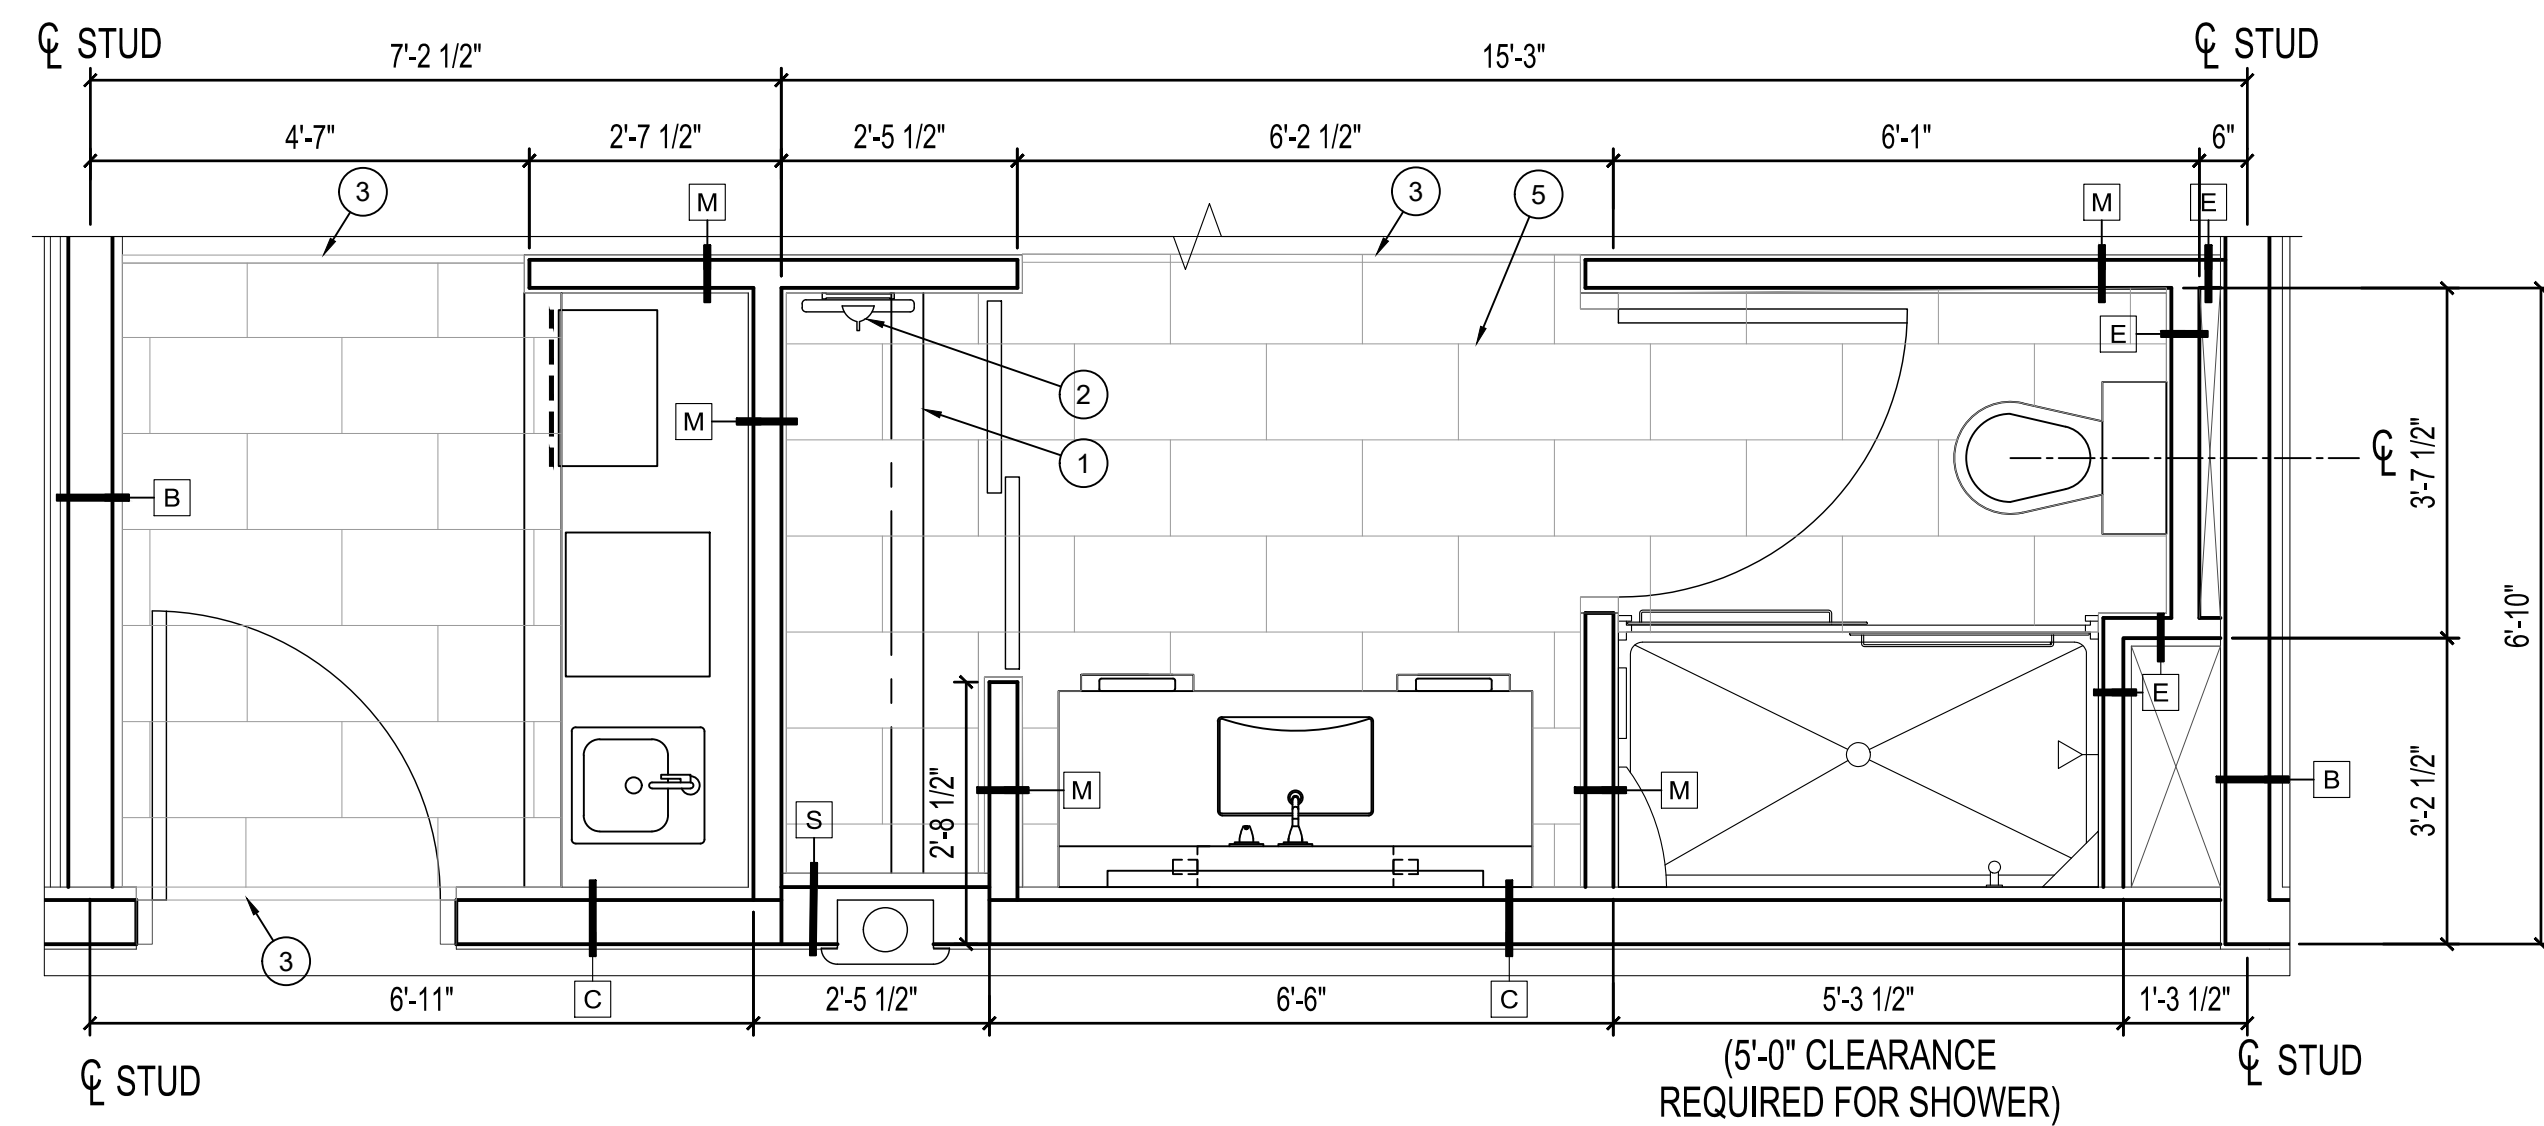

**3 KING STUDIO A BATH PLAN**  
 24 x 36 - 1/2" = 1'-0"  
 12 x 18 - 1/4" = 1'-0"

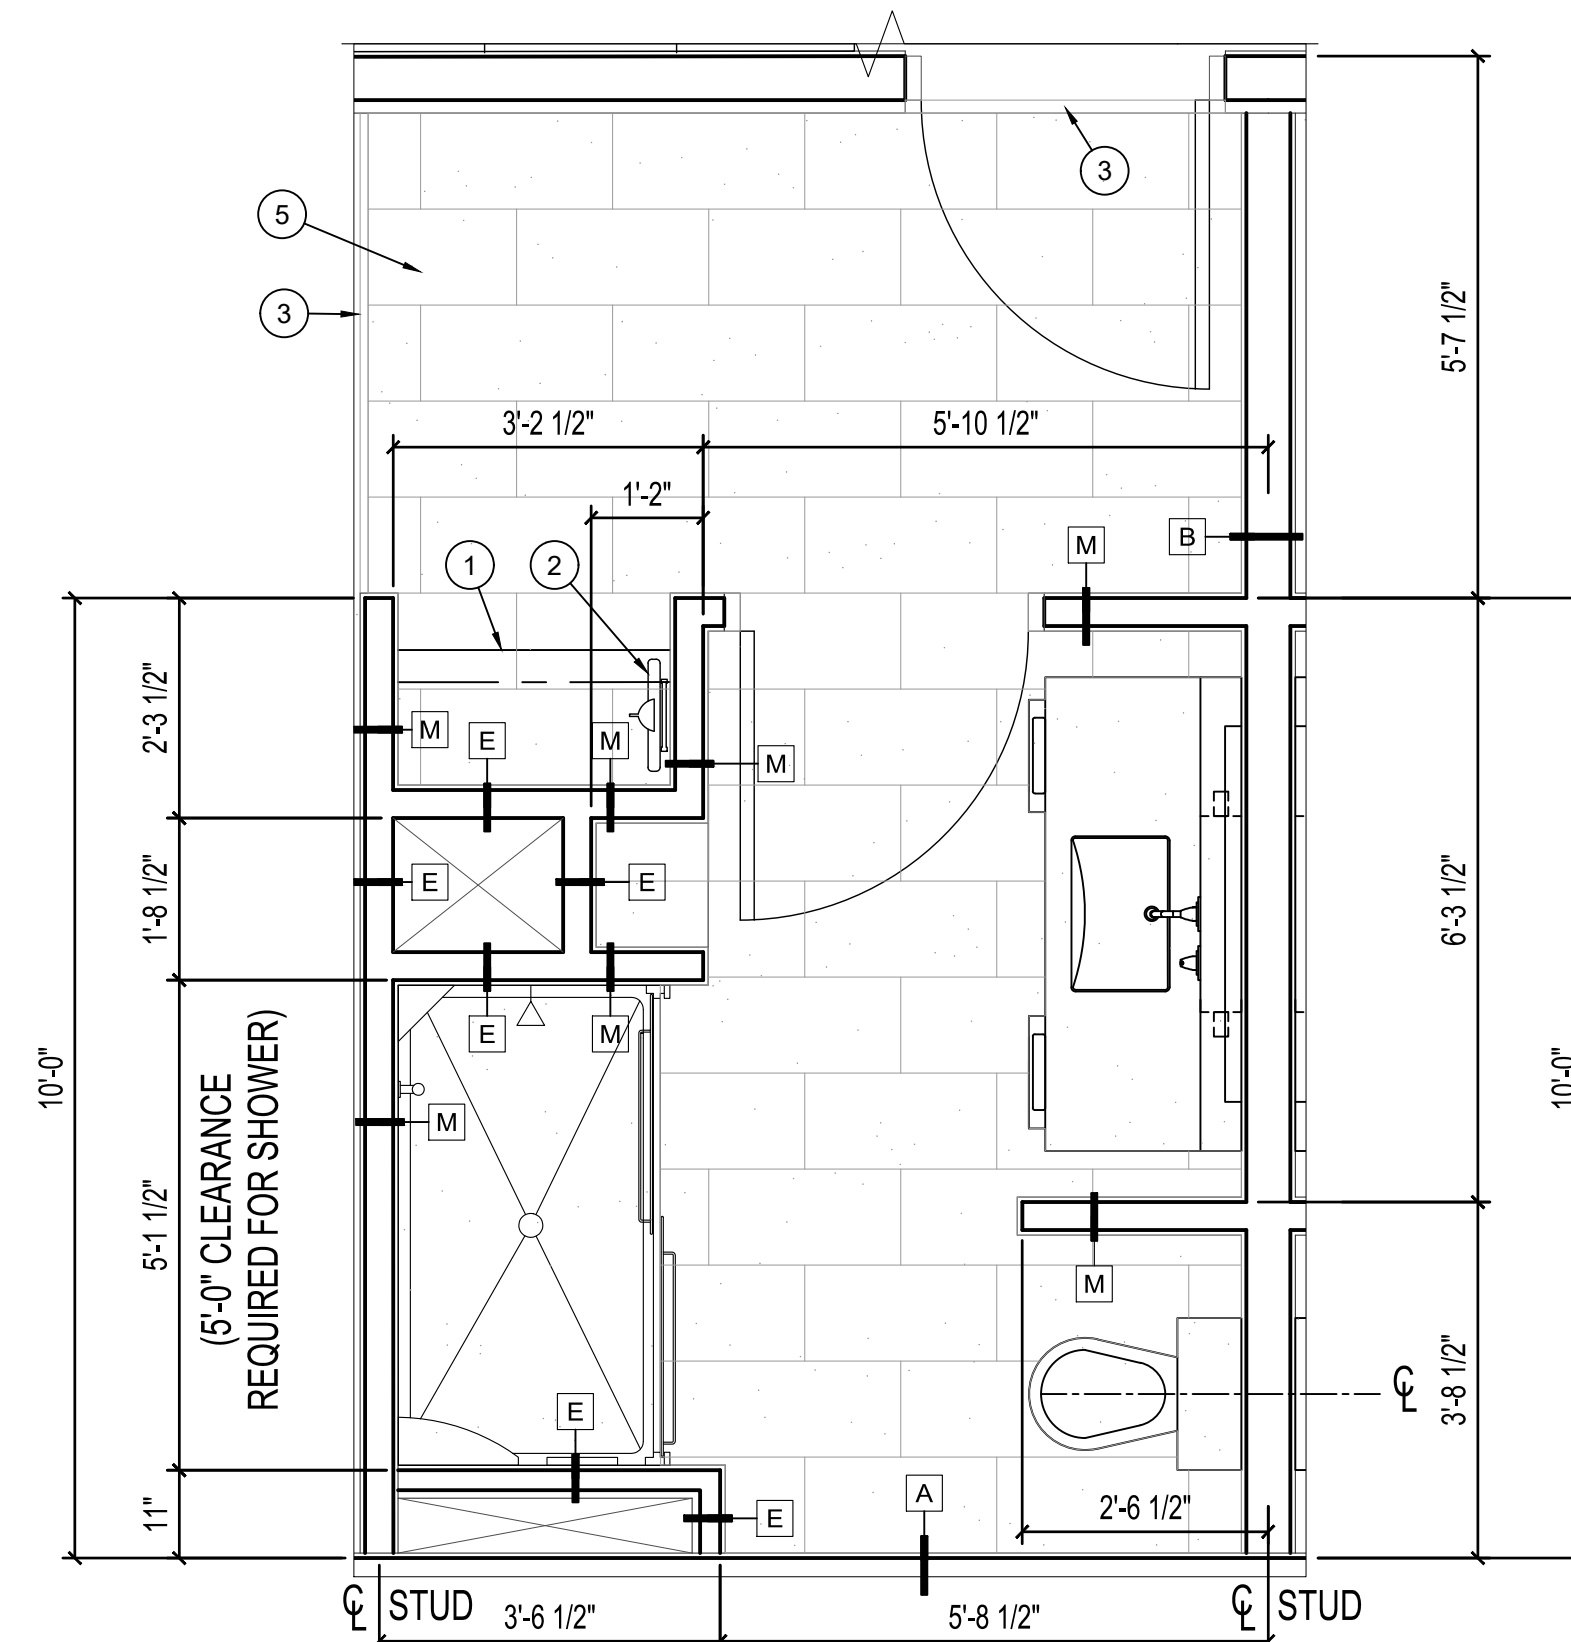

**4 KING D SHOWER PLAN**  
 24 x 36 - 1/2" = 1'-0"  
 12 x 18 - 1/4" = 1'-0"

NOTE: PLAN IS MIRRORED AT 262, 362, AND 462. REFER TO OVERALL FLOOR PLANS. PROVIDE BATHTUBS IN LIEU OF SHOWERS IN THESE SAME ROOMS.

**GENERAL NOTES**

- A. CONTRACTOR TO FIELD VERIFY FRAMING AT ALL DOOR LOCATIONS FOR PROPER OPERATING CLEARANCE WITH VANITY CASEWORK.
- B. DIMENSIONS ARE TO FACE OF STUD OR TO CENTERLINE WHERE NOTED.
- C. CONTRACTOR TO FOLLOW DESIGN GUIDELINES FOR FINISHES AND EQUIPMENT TO PROVIDED WITHIN BATHROOMS. \*PUYALLUP HAMPTON-ADD GR-FFE-SPECS 6-15-2023\*
- D. COORDINATE ALL EQUIPMENT, FURNISHINGS AND FINISHES WITH THE HAMPTON INN STANDARDS

**ENLARGED BATH PLAN KEYED NOTES**

- 1) SHELVING CASEWORK
- 2) IRONING BOARD PER HOTELS STANDARDS
- 3) RUBBER CARPET TO TILE TRANSITION STRIP PER DESIGN STANDARDS
- 4) SHOWER ROD CURTAINS PER HOTEL STANDARDS
- 5) NEW 12" x 24" CERAMIC TILE FLOORING AND GROUT, WITH TILE BASE PER DESIGN STANDARDS

**REVISION 1 OF 2  
 (27 PAGES)  
 B-20-0078**

**KNIT**  
 909 S. 336TH ST.  
 SUITE 107  
 FEDERAL WAY, WA 98003  
 knitstudios.com

THESE DOCUMENTS HAVE BEEN PRODUCED AS AN INSTRUMENT OF SERVICE AND ARE INTENDED SOLELY FOR THE PURPOSE OF CONSTRUCTING, USING AND MAINTAINING THE PROJECT. KNIT AS THE ARCHITECT OF RECORD FOR THE PROJECT RETAINS OWNERSHIP OF THESE DOCUMENTS.

ANY USE OF THESE DOCUMENTS OR USE OF THIS DESIGN IDEAS OR CONCEPTS DESCRIBED HEREIN IN WHOLE OR PART BY ANY PERSON WHATSOEVER IS STRICTLY PROHIBITED EXCEPT BY WRITTEN CONSENT OF KNIT.

REPRODUCTION OF THIS DOCUMENT IS STRICTLY PROHIBITED EXCEPT BY WRITTEN CONSENT OF KNIT.

COPYRIGHT 2021 KNIT

ISSUE DATE 09/25/23  
 PROGRESS SET

REV	DATE	COMMENT
1	03.03.2023	AC RESPONSE
2	08.14.2023	CORRECTIONS
3	09.25.2023	CORRECTIONS
4	10.17.2023	CORRECTIONS
5	12.21.2023	CORRECTIONS

City of Puyallup  
 Development & Permitting Services  
**ISSUED PERMIT**

Building	Planning
Engineering	Public Works
Fire	Traffic

8677 REGISTERED ARCHITECT  
  
 RHONDA A. GILLOGLY  
 STATE OF WASHINGTON  
 12/21/2023

**ENLARGED BATH PLANS**  
**ADDITION TO HAMPTON INN & SUITES**  
 1515 S MERIDIAN  
 PUYALLUP, WA 98371  
 HAMPTON INN & SUITES

TITLE PROJECT CLIENT

JOB NO: 210158

**A2.11**

THESE DOCUMENTS HAVE BEEN PRODUCED AS AN INSTRUMENT OF SERVICE AND ARE INTENDED SOLELY FOR THE PURPOSE OF CONSTRUCTIVE USE AND IMPROVING THE PROJECT. KNIT AS THE ARCHITECT OF RECORD FOR THE PROJECT RETAINS OWNERSHIP OF THESE DOCUMENTS.

ANY USE OF THESE DOCUMENTS OR USE OF THE DESIGN IDEAS OR CONCEPTS DESCRIBED HEREIN IN WHOLE OR PART BY ANY PERSON WHO HAS NOT BEEN STRICTLY PROHIBITED EXCEPT BY WRITTEN CONSENT OF KNIT.

REPRODUCTION OF THESE DOCUMENTS IS STRICTLY PROHIBITED EXCEPT BY WRITTEN CONSENT OF KNIT.


COPYRIGHT 2021 KNIT

ISSUE DATE 09/25/23  
 PROGRESS SET

REV	DATE	COMMENT
1	03.03.2023	AC RESPONSE
2	08.14.2023	CORRECTIONS
3	09.25.2023	CORRECTIONS
4	10.17.2023	CORRECTIONS
5	12.21.2023	CORRECTIONS

City of Puyallup  
 Development & Permitting Services  
**ISSUED PERMIT**


Building	Planning
Engineering	Public Works
Fire	Traffic

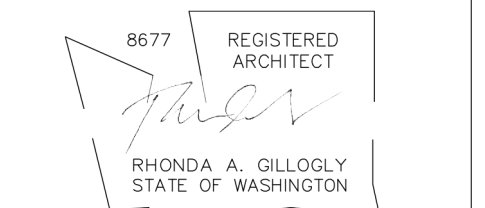8677 REGISTERED ARCHITECT  
  
 RHONDA A. GILLOGLY  
 STATE OF WASHINGTON  
 12/21/2023


**ENLARGED STAIR PLANS & SECTIONS**  
**ADDITION TO HAMPTON INN & SUITES**  
 1515 S MERIDIAN  
 PUYALLUP, WA 98371  
 HAMPTON INN & SUITES

TITLE	PROJECT	CLIENT
JOB NO: 210158		


**A2.12**

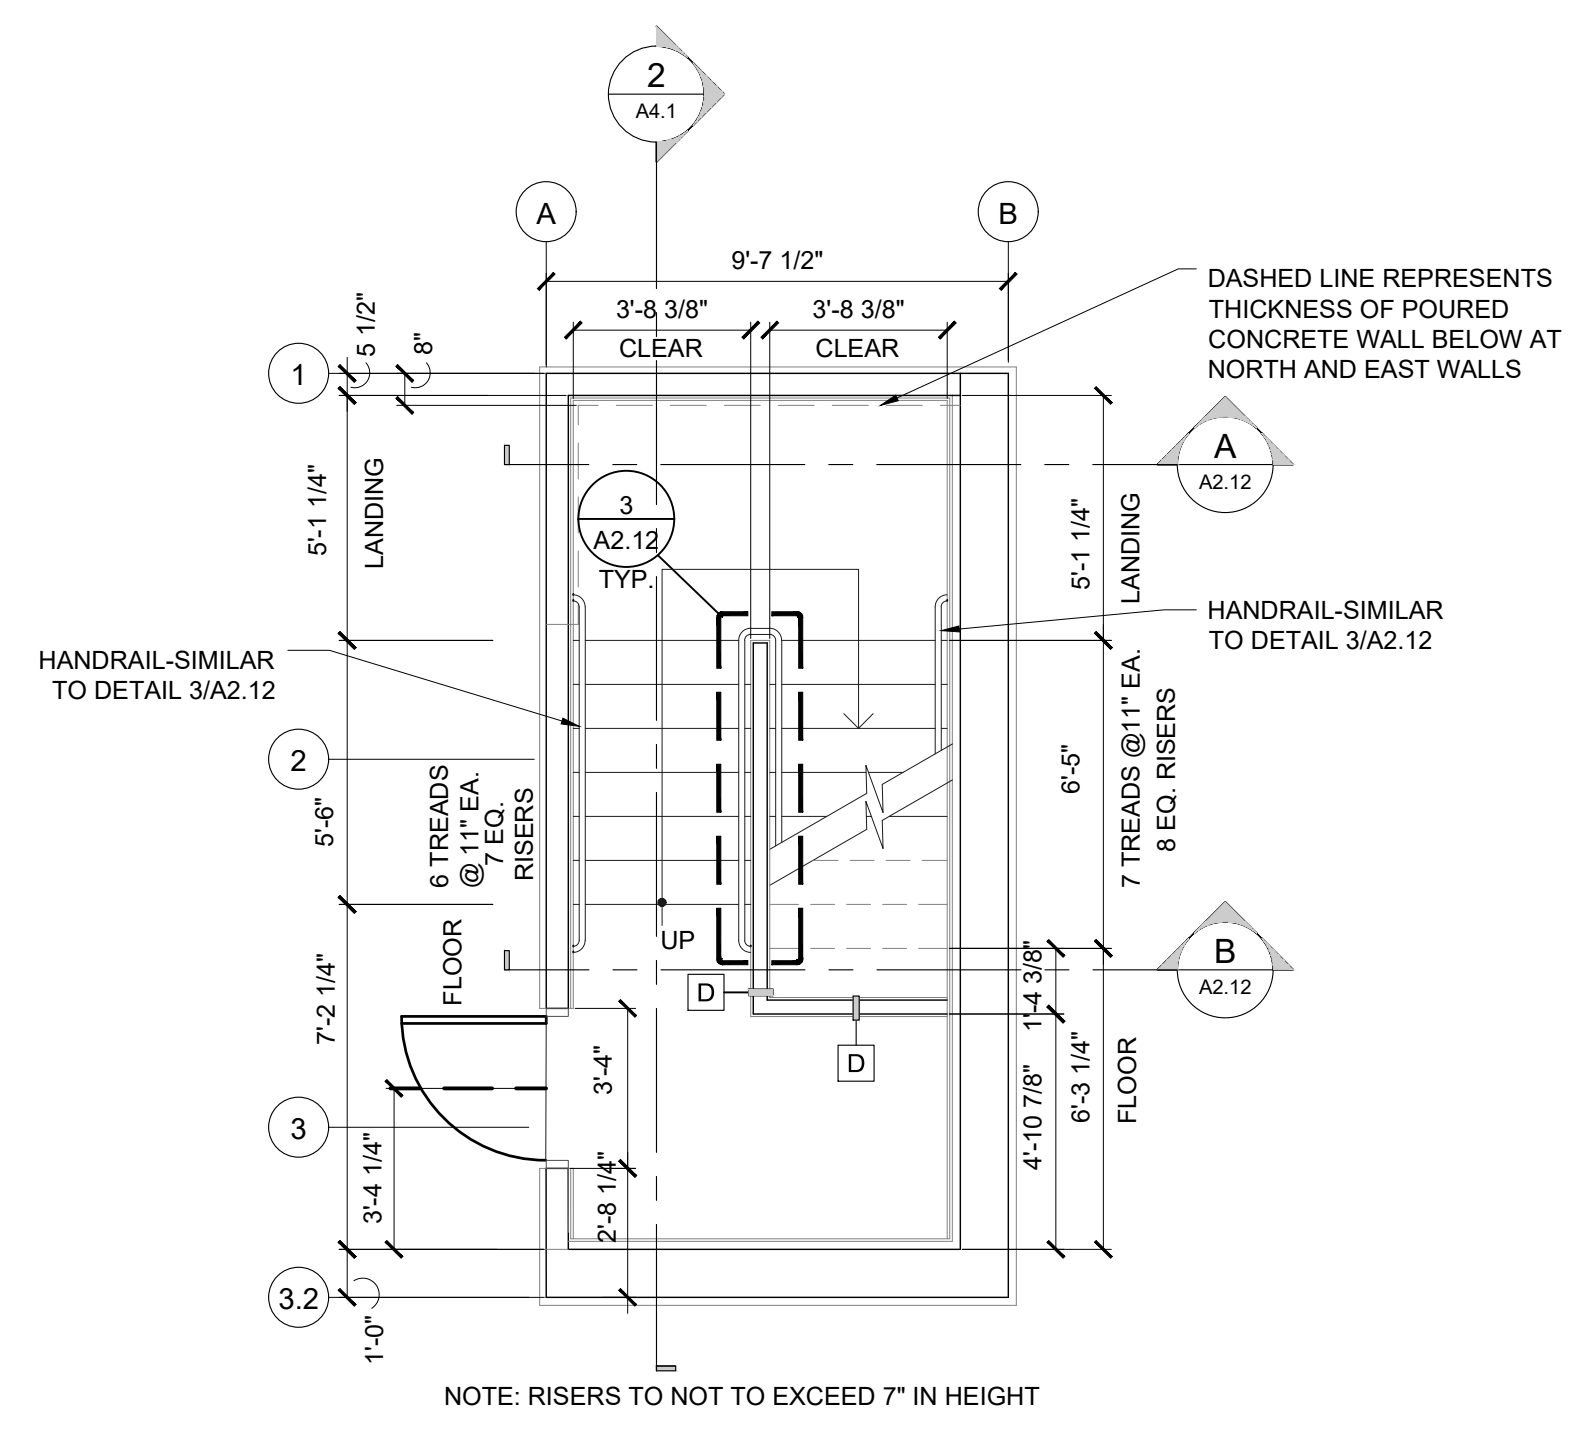


**1 ENLARGED STAIR PLANS - 1ST FLOOR**  
 SCALE: 1/4" = 1'-0"

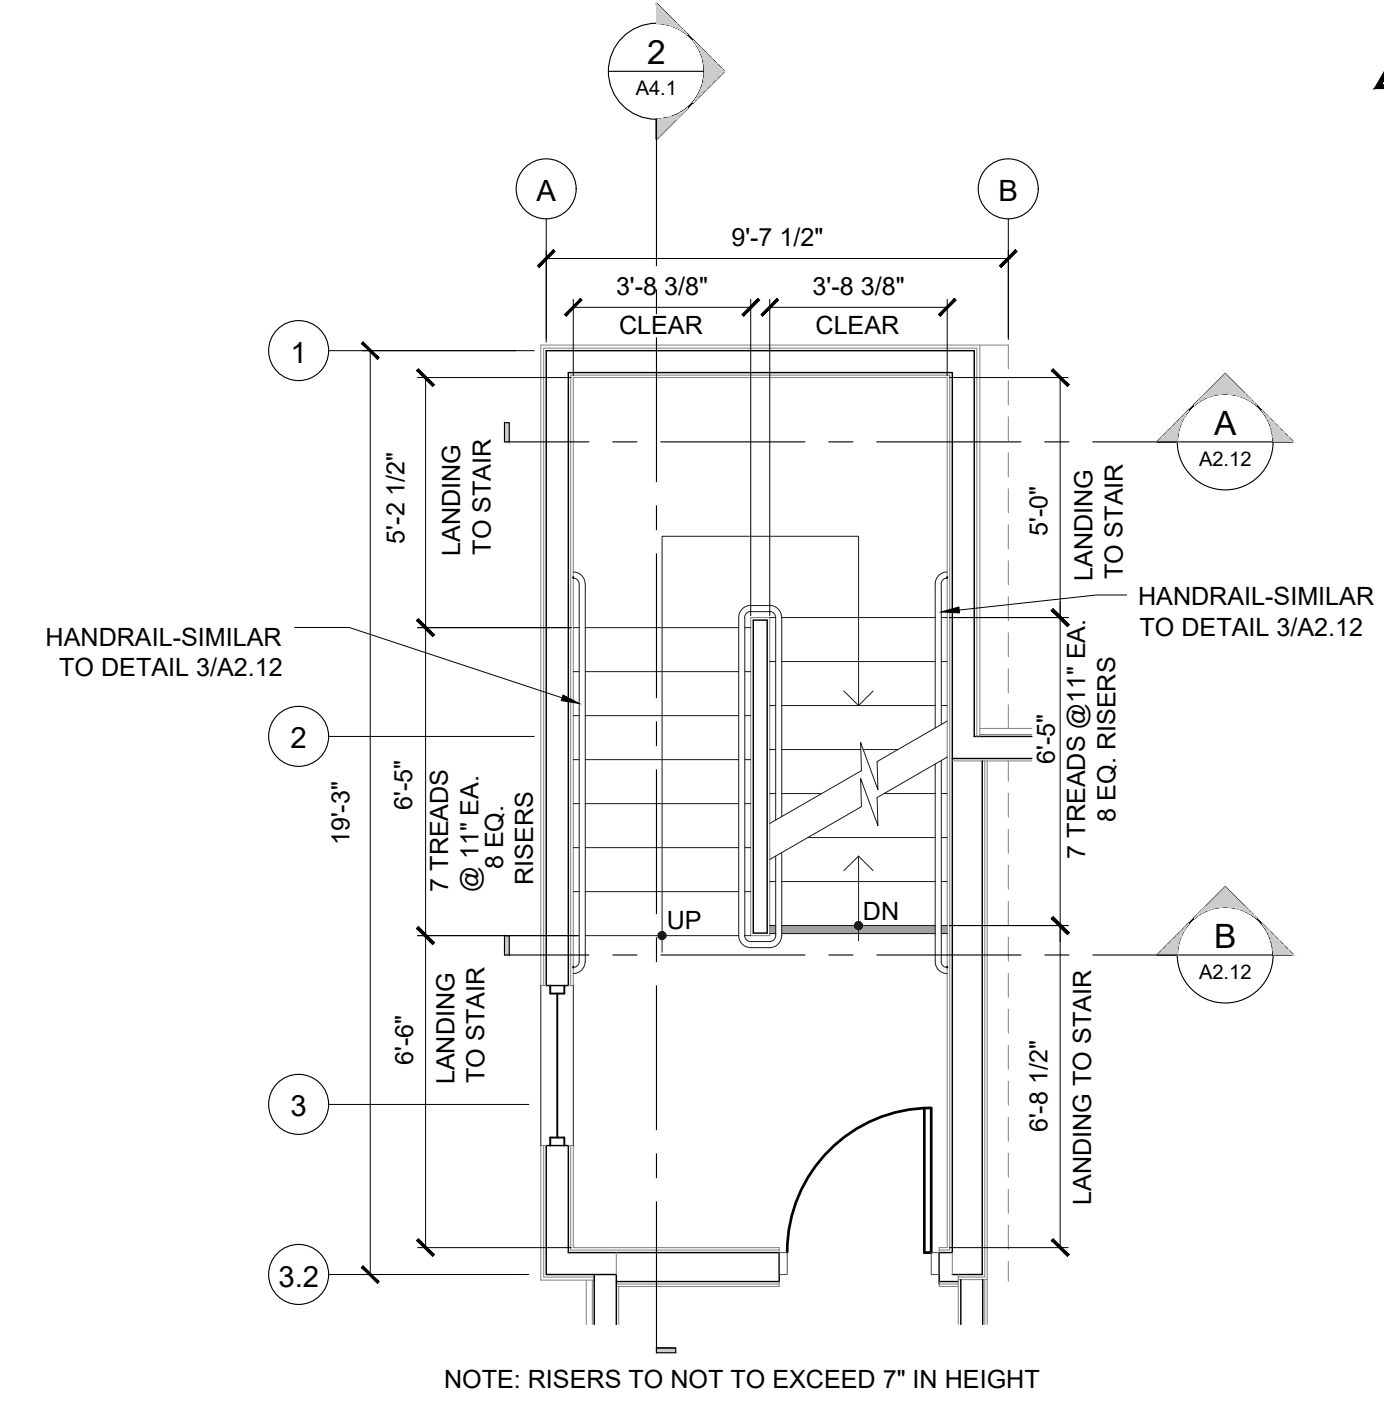


**2 ENLARGED STAIR PLANS - 2ND AND 3RD FLOOR**  
 SCALE: 1/4" = 1'-0"

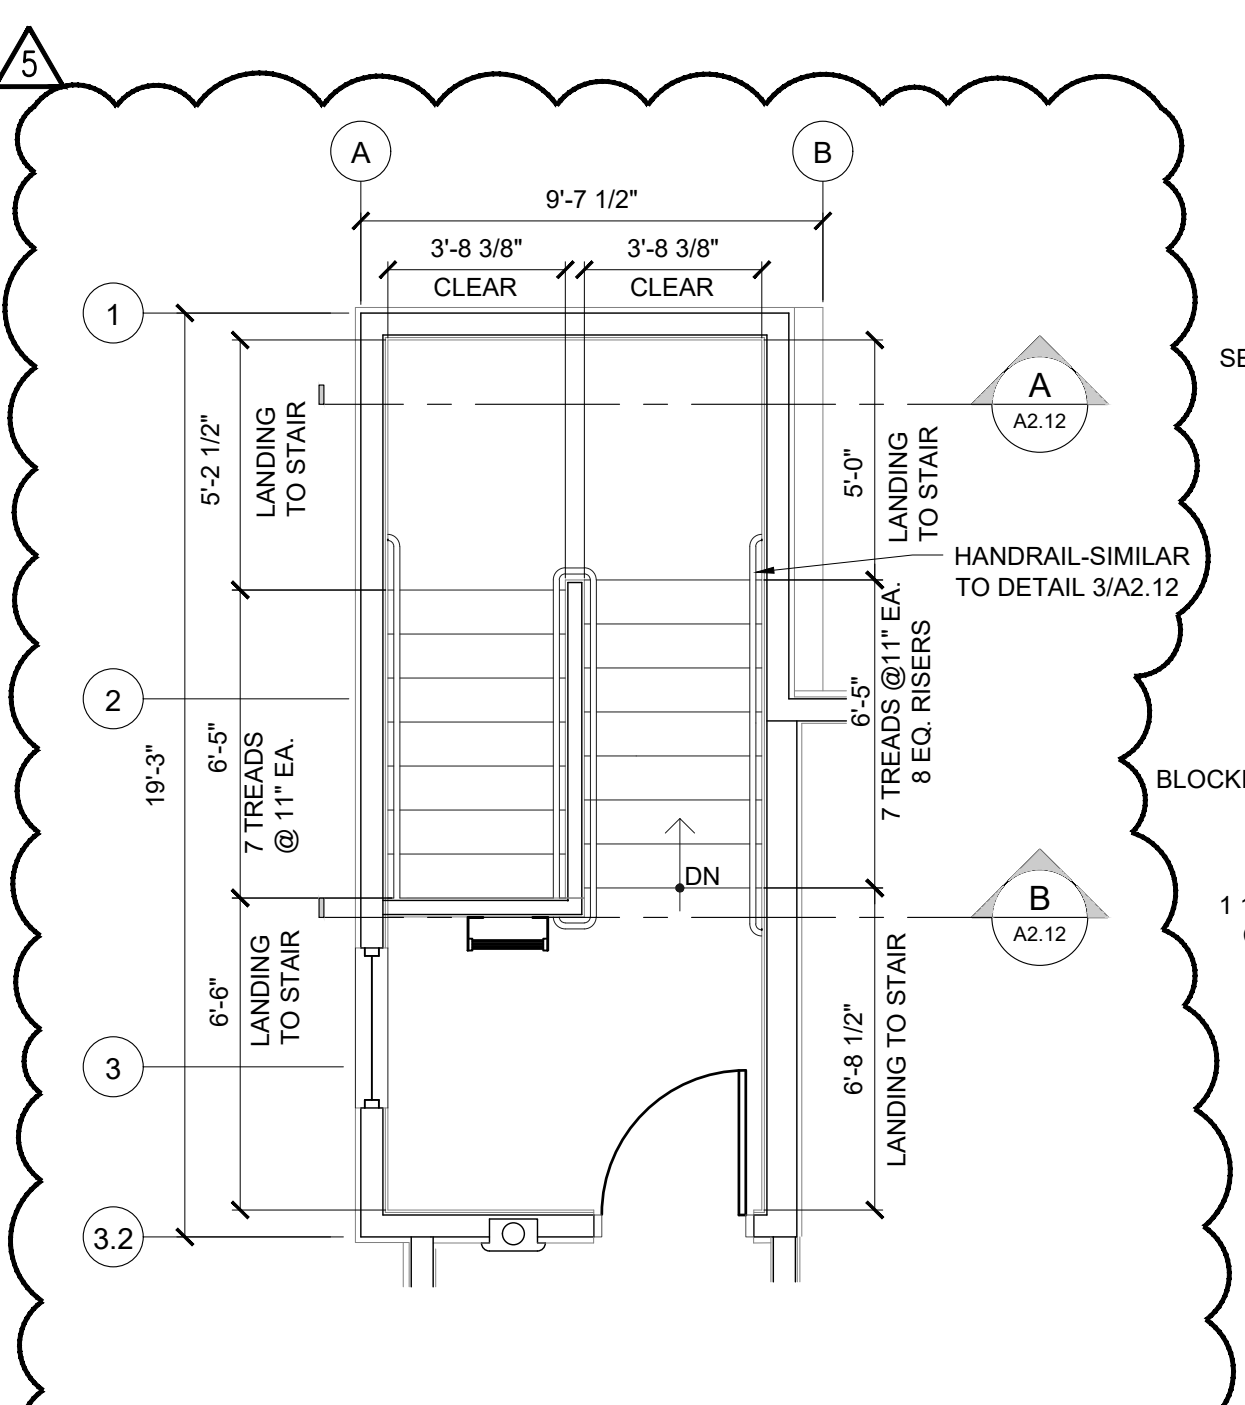


**5 ENLARGED STAIR PLANS - 4TH FLOOR**  
 SCALE: 1/4" = 1'-0"

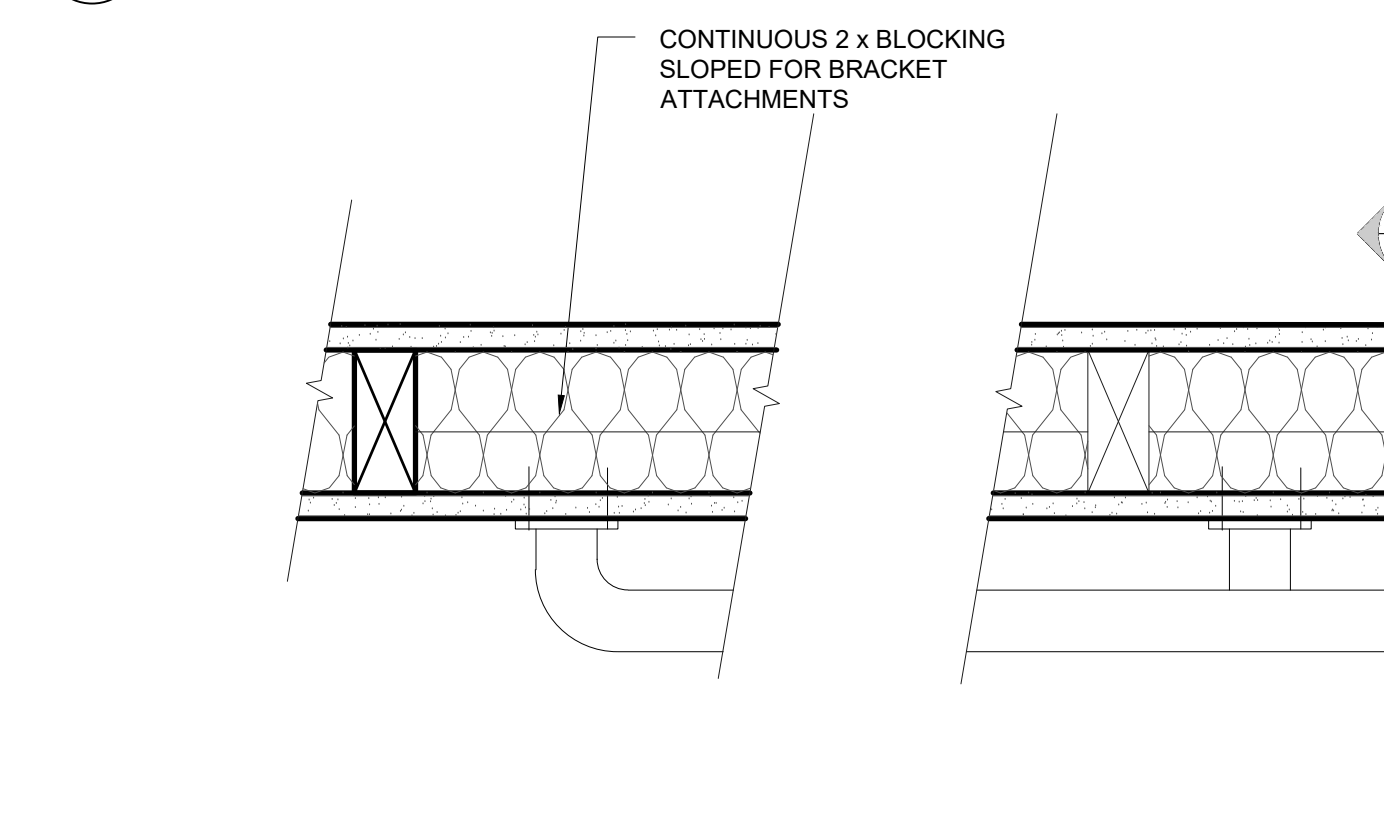

**3 HANDRAIL DETAIL (ROTATED)**  
 SCALE: 3" = 1'-0"

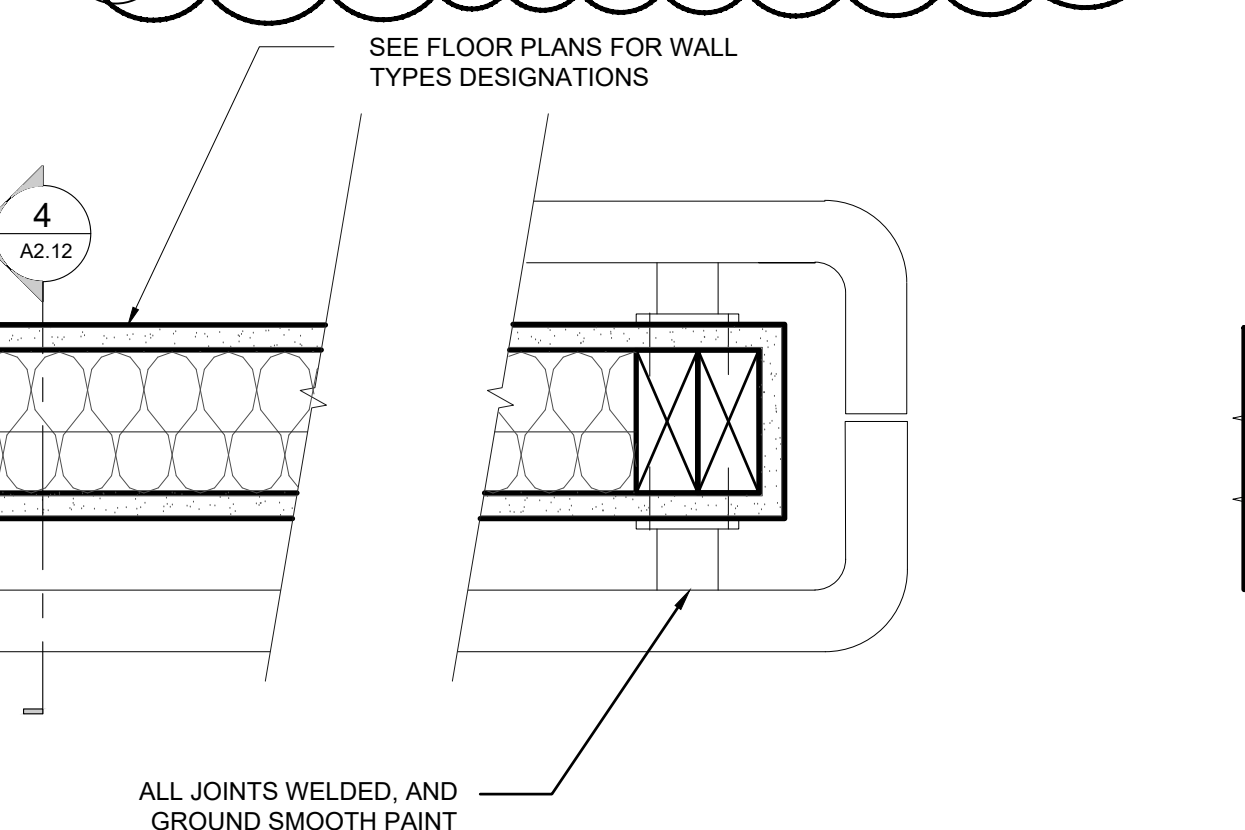


**4 HANDRAIL DETAIL**  
 SCALE: 3" = 1'-0"

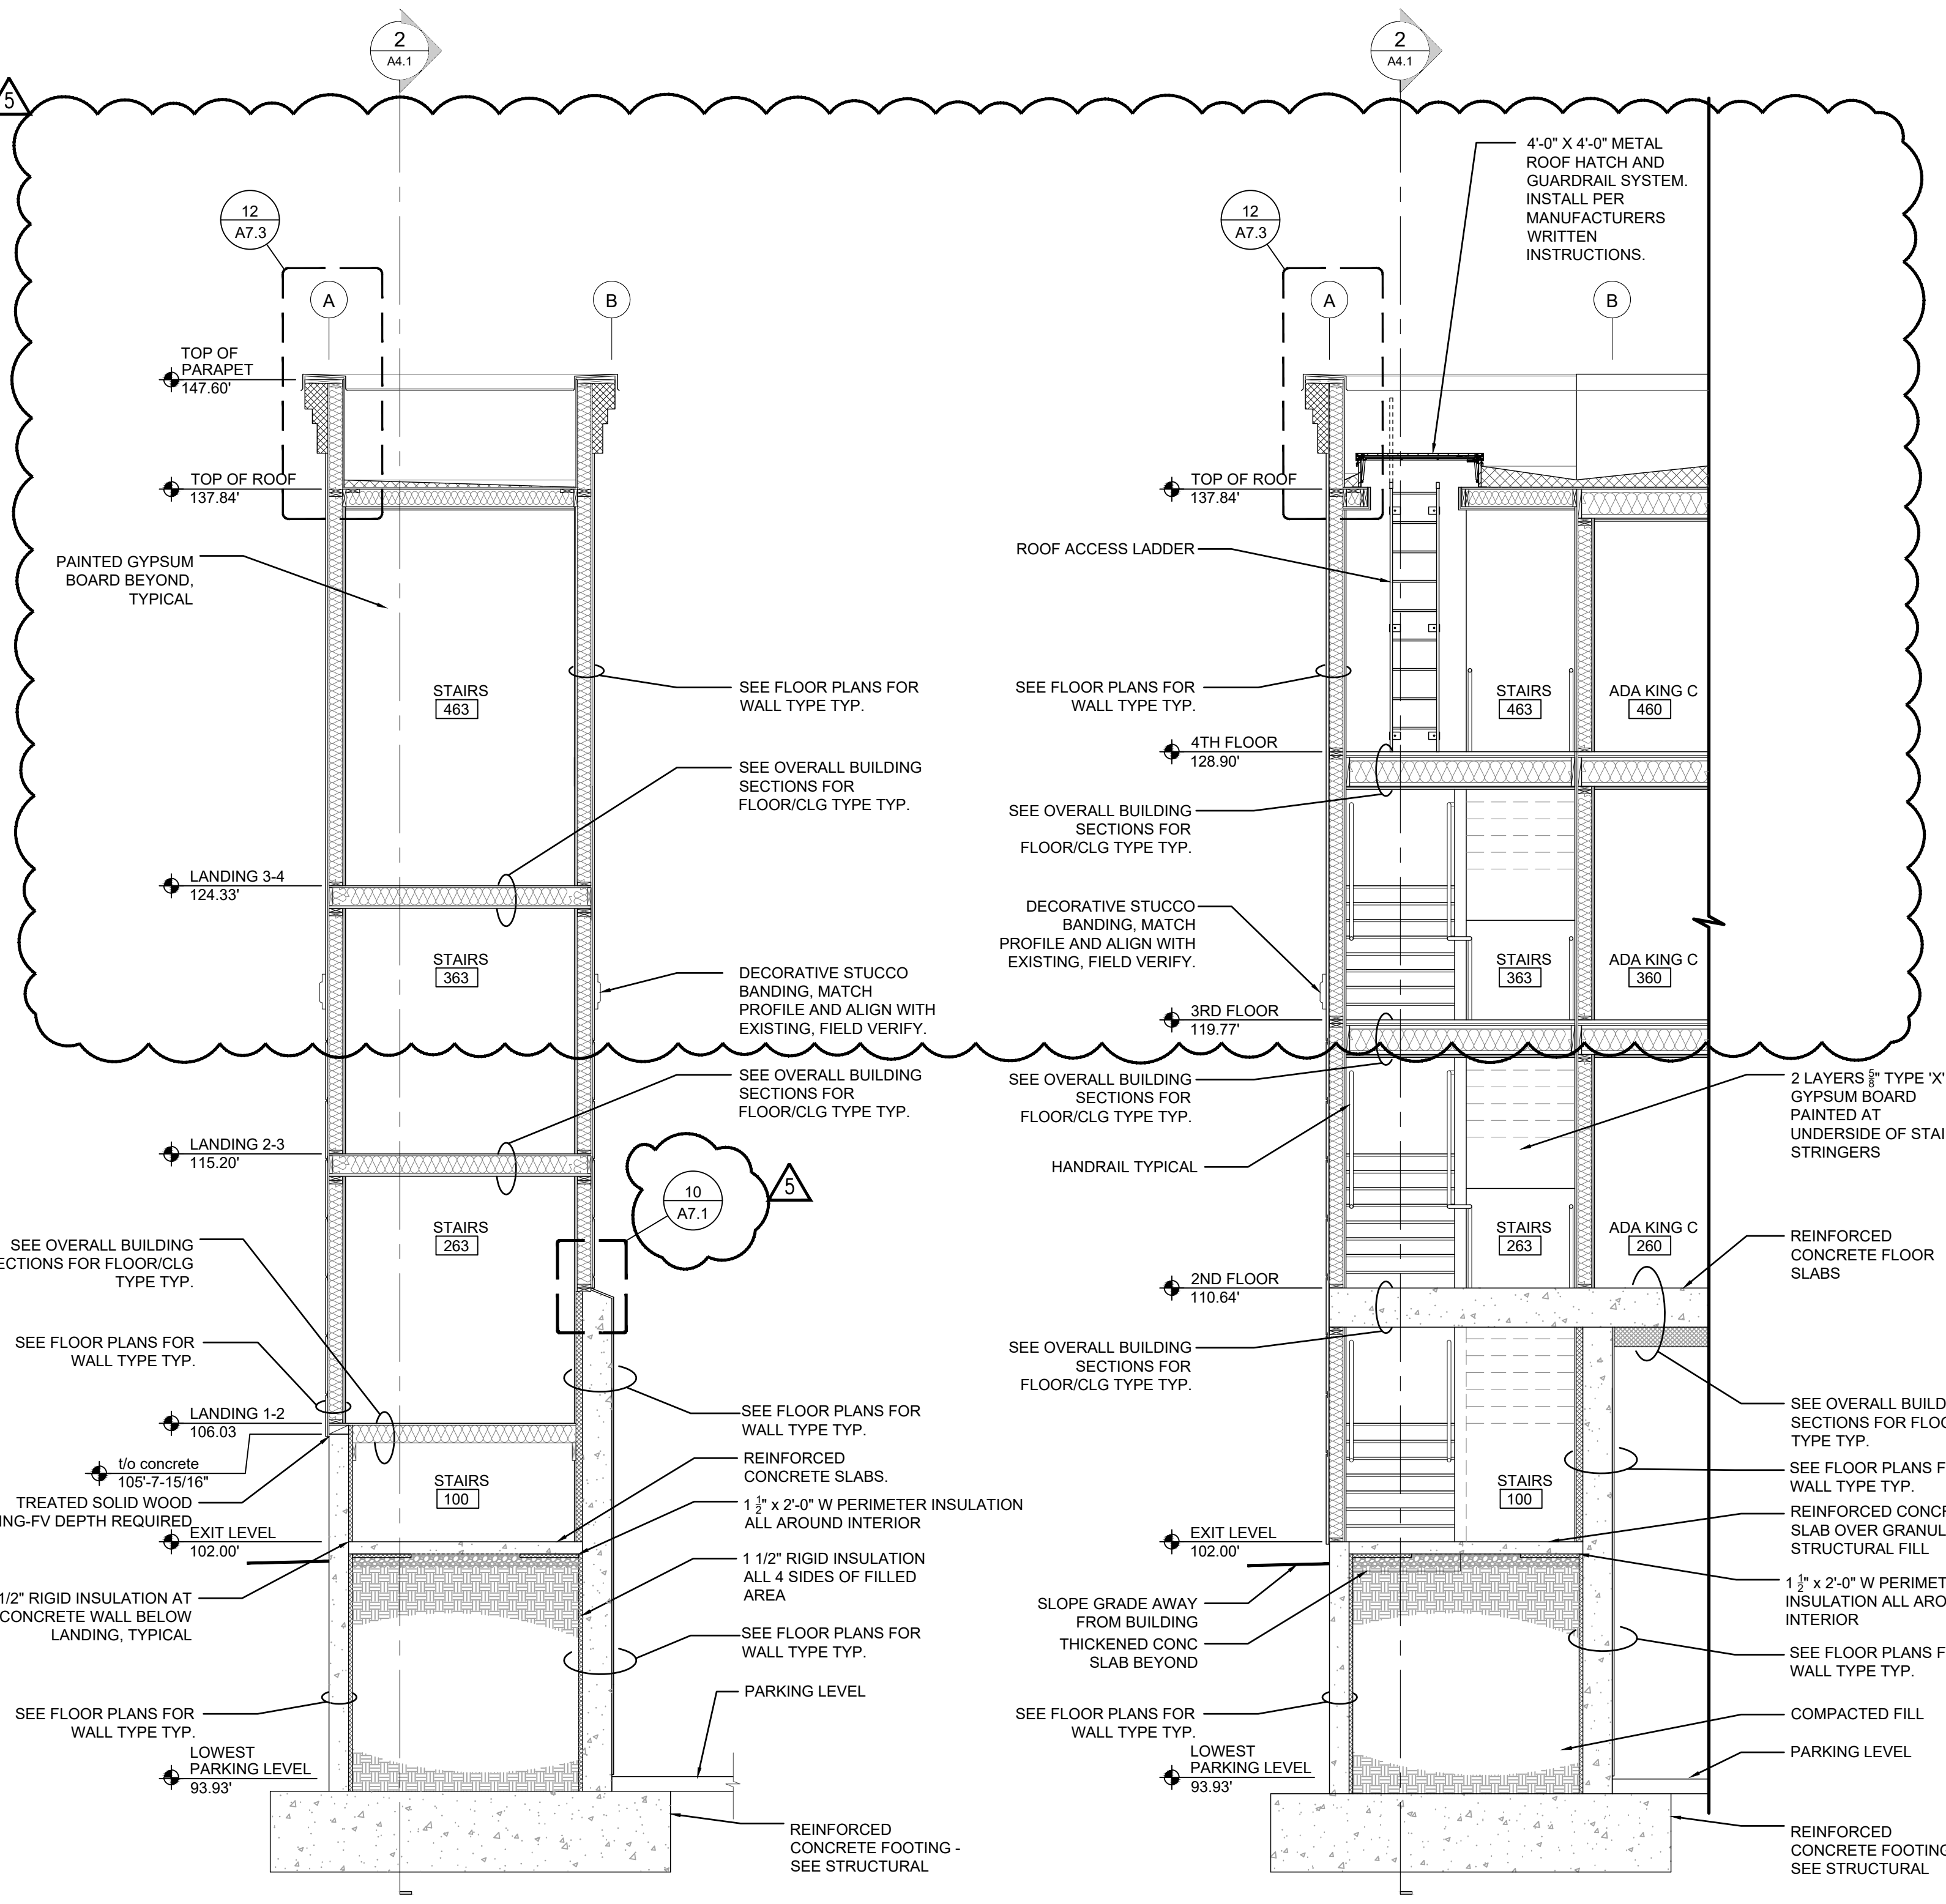

**A STAIR SECTION**  
 SCALE: 1/4" = 1'-0"


**B STAIR SECTION**  
 SCALE: 1/4" = 1'-0"

**REVISION 1 OF 2**  
**(27 PAGES)**  
**B-20-0078**

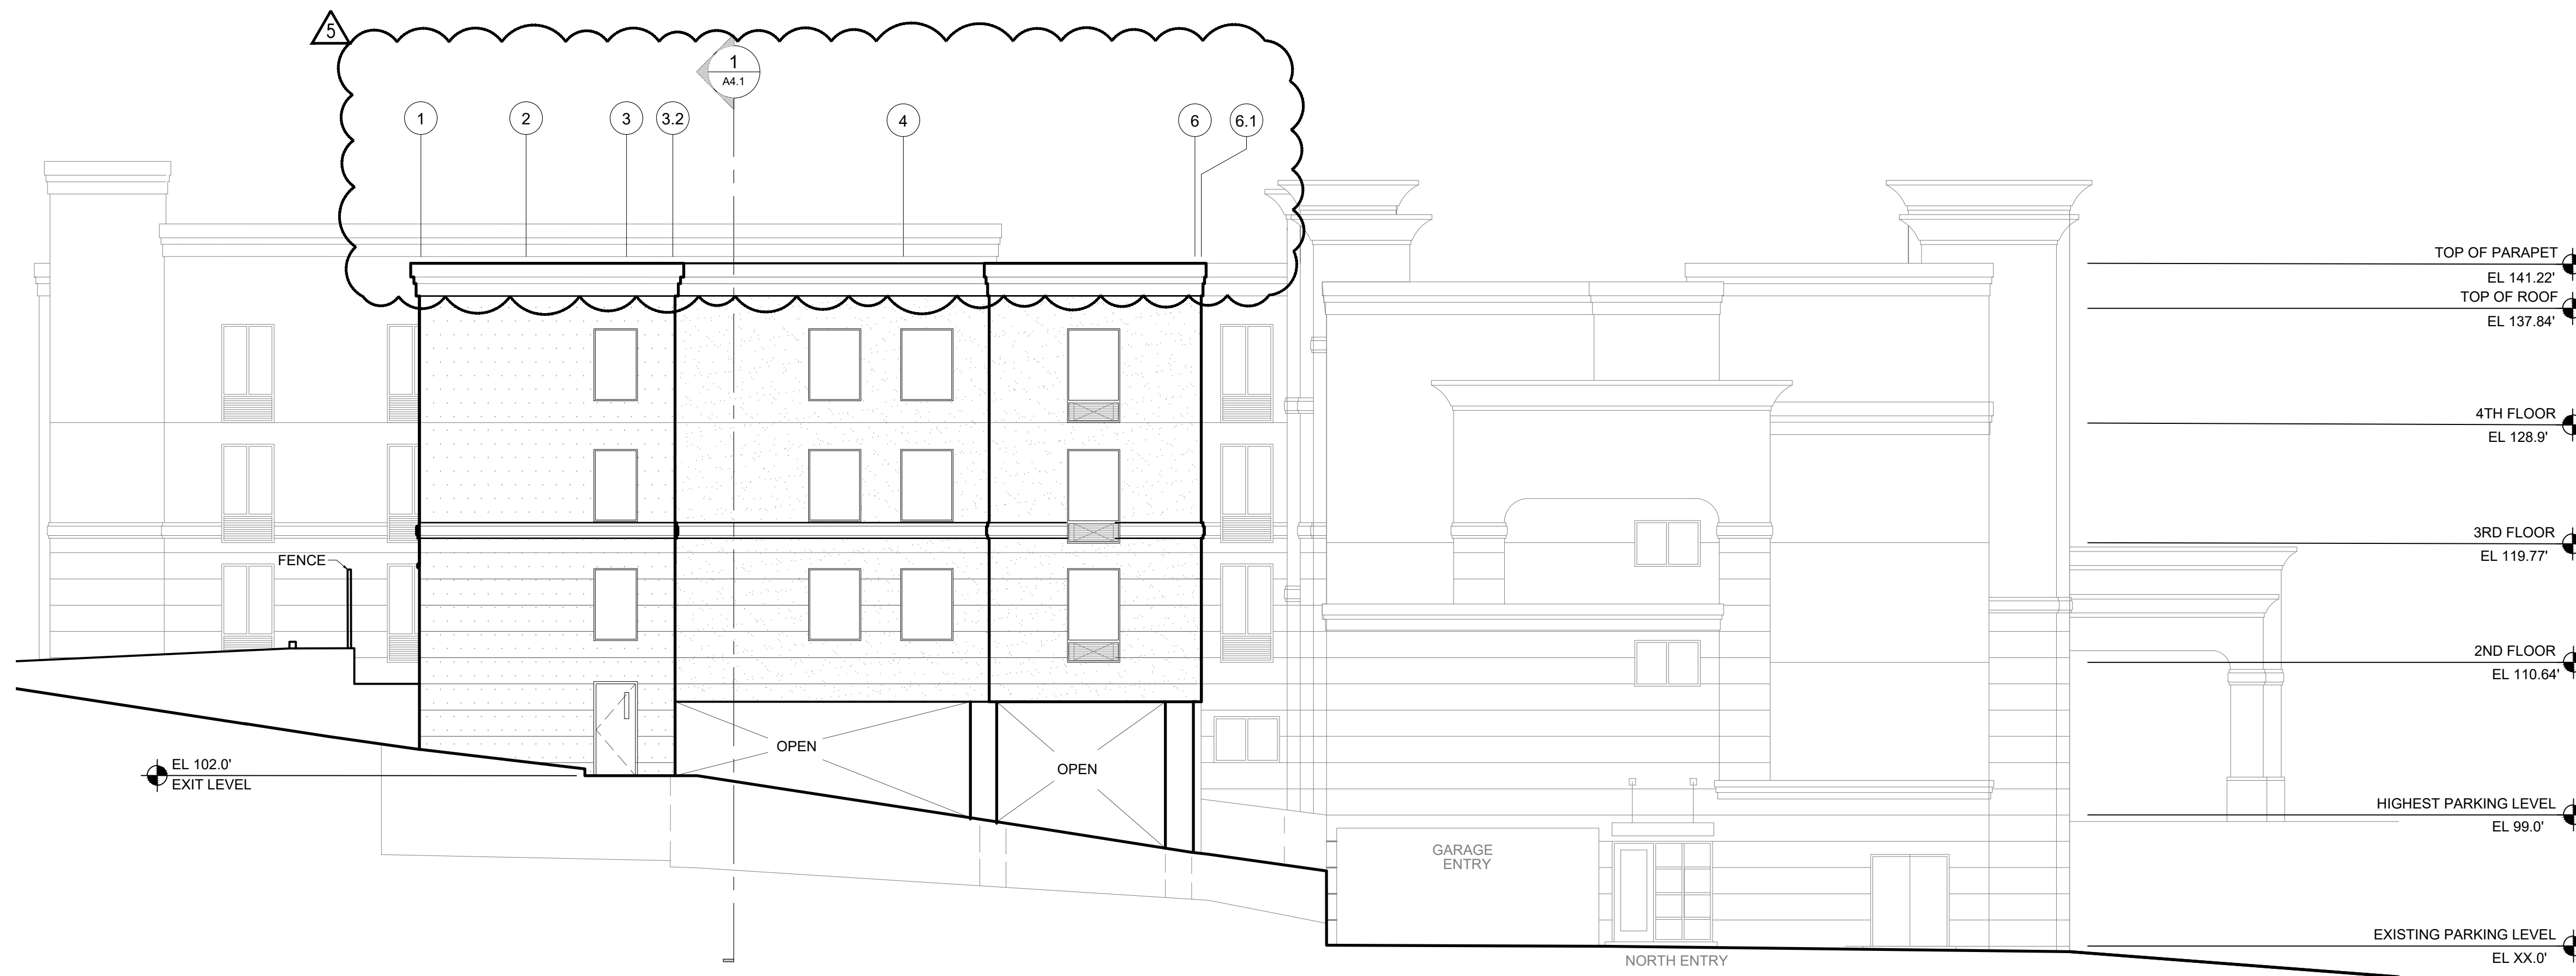

**1 NORTH ELEVATION**

24 x 36 - 1/8" = 1'-0"  
12 x 18 - 1/16" = 1'-0"

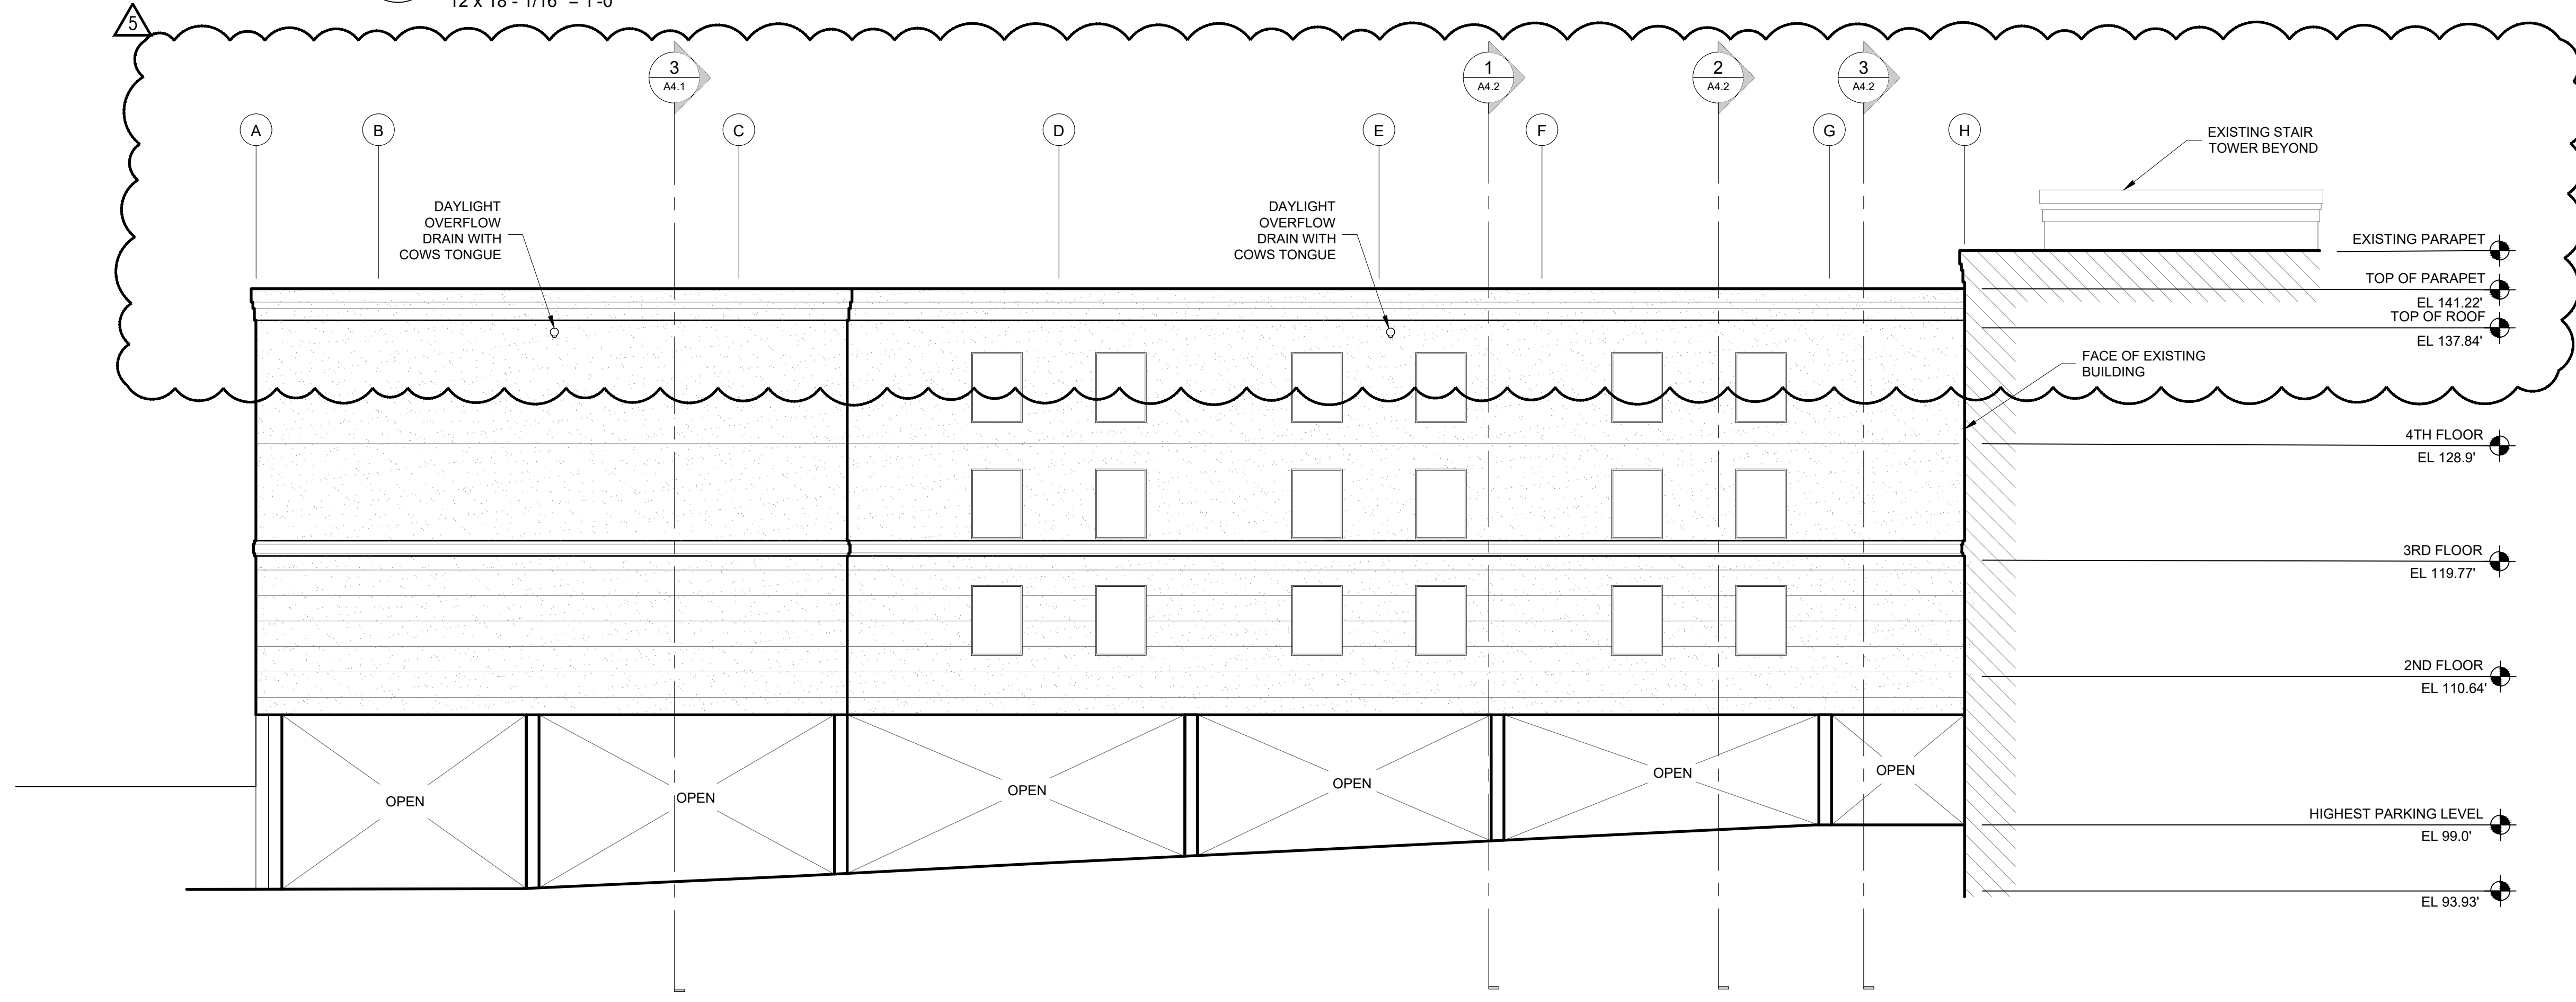

**2 WEST ELEVATION**

24 x 36 - 1/8" = 1'-0"  
12 x 18 - 1/16" = 1'-0"

**GENERAL NOTES**

1. CONTRACTOR SHALL MATCH PARAPET PROFILES AT EXISTING BUILDING AS INDICATED ON THE NEW DRAWINGS.
2. ALIGN ALL DECORATIVE HORIZONTAL JOINTS AT NEW CONSTRUCTION WITH EXISTING.
3. EXTERIOR FINISHES SHALL MATCH EXISTING
4. EXTERIOR COLORS SHALL MATCH EXISTING OR AS SELECTED BY THE OWNER.
5. ALIGN PARAPET NEW PARAPET CAPS WITH EXISTING AS SHOWN OR AS NOTED WITHIN THE CONSTRUCTION DOCUMENTS.
6. FLOOR LINE ELEVATIONS NOTED SHALL BE FIELD VERIFIED TO ALIGN WITH EXISTING FLOOR ELEVATION.

NOTE:  
1ST, 2ND, 3RD AND 4TH FLOOR, AND TOP OF ROOF SHEATHING ELEVATIONS ARE TO ALIGN WITH THE EXISTING ELEVATIONS. THE DESIGNATION NOTED ARE BASED ON AS-BUILT DRAWING NOTATIONS FROM THE EXISTING BUILDING. THE CONTRACTOR SHALL FIELD VERIFY ELEVATIONS PRIOR TO FORMING THE 2ND FLOOR SLAB AND ADDITIONAL LEVEL FRAMING.

**REVISION 1 OF 2  
(27 PAGES)  
B-20-0078**

**KNIT**  
909 S. 336TH ST.  
SUITE 107  
FEDERAL WAY, WA 98003  
knitstudios.com

THESE DOCUMENTS HAVE BEEN PRODUCED AS AN INSTRUMENT OF SERVICE AND ARE INTENDED SOLELY FOR THE PURPOSE OF CONSTRUCTING, USING AND MAINTAINING THE PROJECT. KNIT AS THE ARCHITECT OF RECORD FOR THE PROJECT RETAINS OWNERSHIP OF THESE DOCUMENTS.  
ANY USE OF THESE DOCUMENTS OR USE OF THE DESIGN IDEAS OR CONCEPTS DESCRIBED HEREIN IN WHOLE OR PART BY ANY PERSON WHATSOEVER IS EXPRESSLY PROHIBITED EXCEPT BY WRITTEN CONSENT OF KNIT.  
REPRODUCTION OF THESE DOCUMENTS IS STRICTLY PROHIBITED EXCEPT BY WRITTEN CONSENT OF KNIT.  
COPYRIGHT 2021 KNIT

ISSUE DATE 09/25/23  
PROGRESS SET

REV	DATE	COMMENT
1	03.03.2023	AC RESPONSE
2	08.14.2023	CORRECTIONS
3	09.25.2023	CORRECTIONS
4	10.17.2023	CORRECTIONS
5	12.21.2023	CORRECTIONS

City of Puyallup  
Development & Permitting Services  
**ISSUED PERMIT**

Building	Planning
Engineering	Public Works
Fire	Traffic

8677 REGISTERED ARCHITECT  
*Rhonda A. Gillogly*  
RHONDA A. GILLOGLY  
STATE OF WASHINGTON  
12/21/2023

**EXTERIOR ELEVATIONS**


**ADDITION TO HAMPTON INN & SUITES**

1515 S MERIDIAN  
PUYALLUP, WA 98371  
HAMPTON INN & SUITES


TITLE	PROJECT	CLIENT
JOB NO: 210158		

**A3.1**



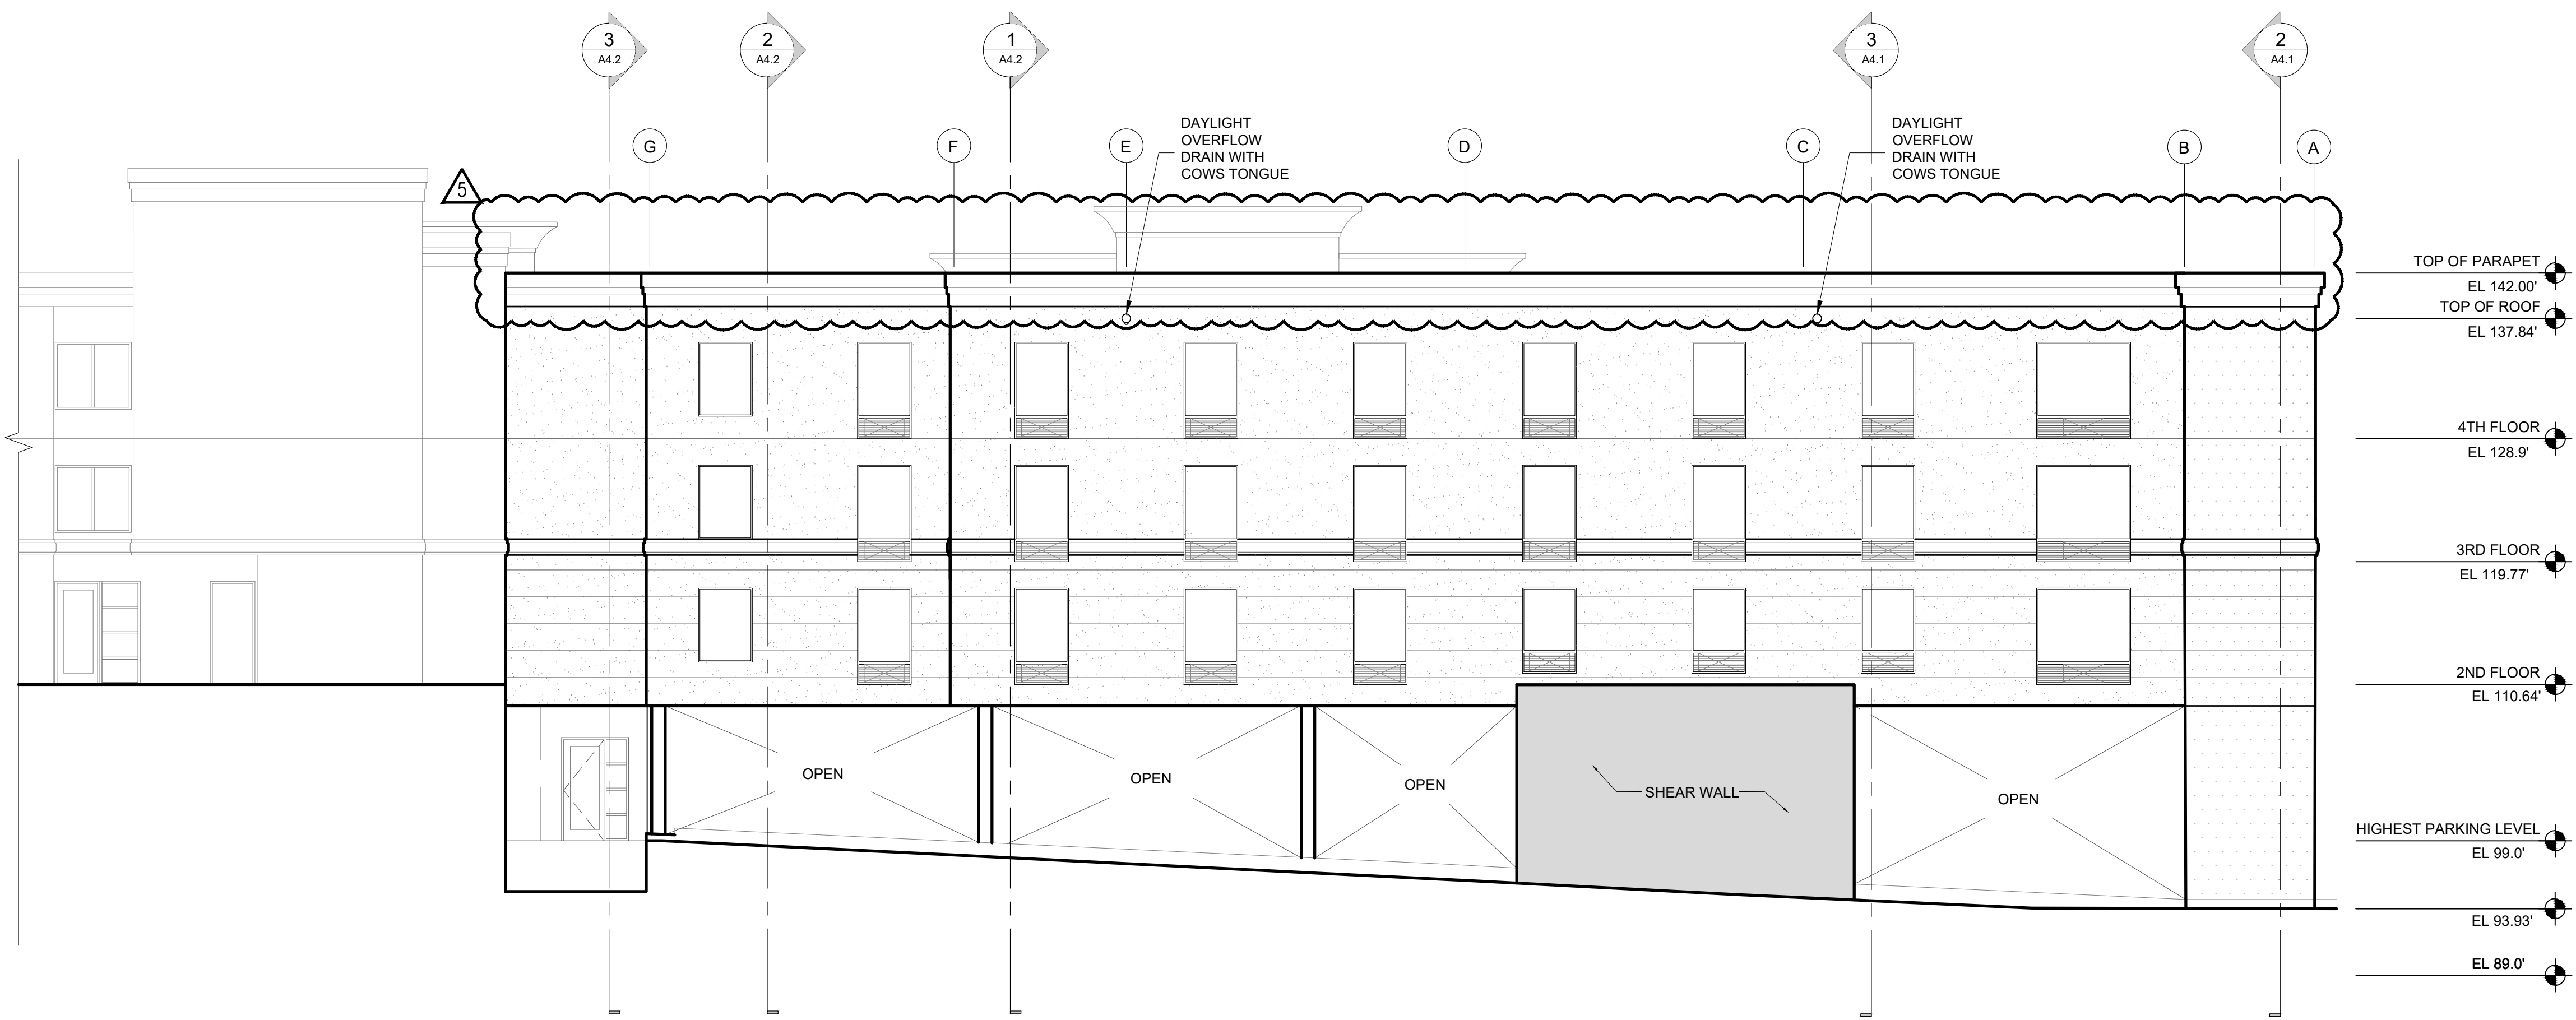

**3 EAST ELEVATION**  
 24 x 36 - 1/8" = 1'-0"  
 12 x 18 - 1/16" = 1'-0"

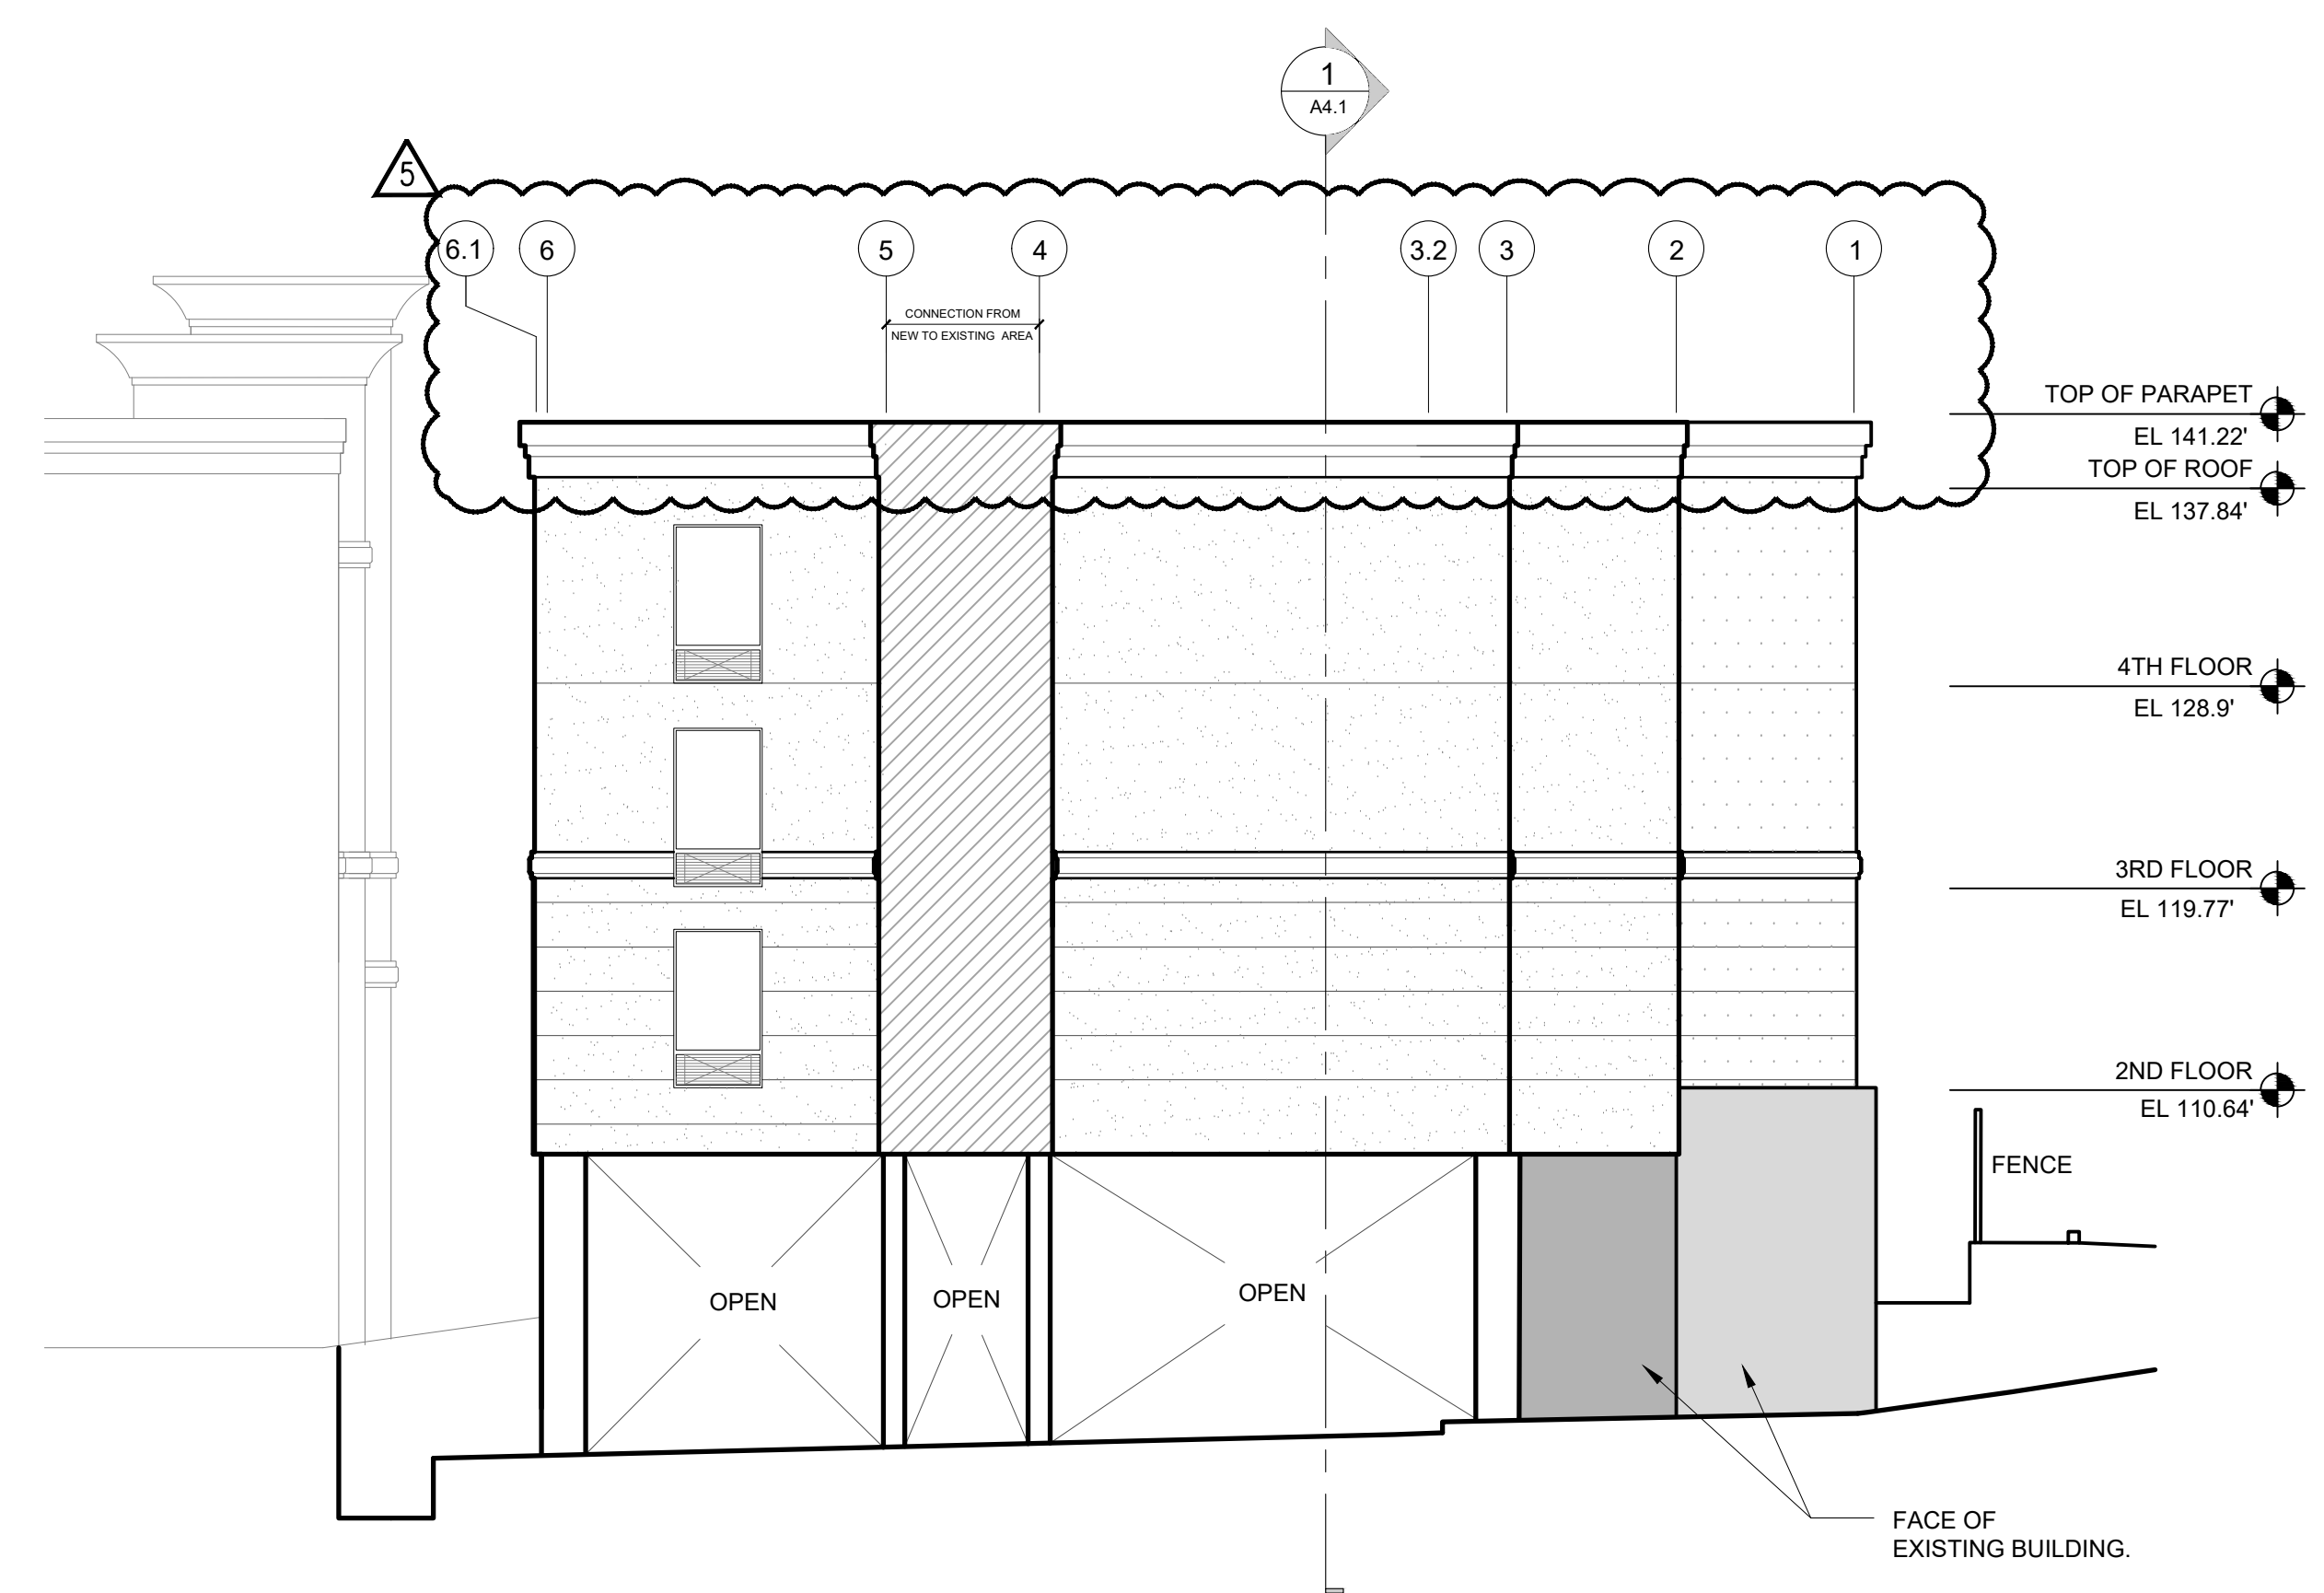

**4 SOUTH ELEVATION**  
 24 x 36 - 1/8" = 1'-0"  
 12 x 18 - 1/16" = 1'-0"

**GENERAL NOTES**

1. CONTRACTOR SHALL MATCH PARAPET PROFILES AT EXISTING BUILDING AS INDICATED ON THE NEW DRAWINGS.
2. ALIGN ALL DECORATIVE HORIZONTAL JOINTS AT NEW CONSTRUCTION WITH EXISTING.
3. EXTERIOR FINISHES SHALL MATCH EXISTING
4. EXTERIOR COLORS SHALL MATCH EXISTING OR AS SELECTED BY THE OWNER.
5. ALIGN PARAPET NEW PARAPET CAPS WITH EXISTING AS SHOWN OR AS NOTED WITHIN THE CONSTRUCTION DOCUMENTS.
6. FLOOR LINE ELEVATIONS NOTED SHALL BE FIELD VERIFIED TO ALIGN WITH EXISTING FLOOR ELEVATION.

**NOTE:**

1ST, 2ND, 3RD AND 4TH FLOOR, AND TOP OF ROOF SHEATHING ELEVATIONS ARE TO ALIGN WITH THE EXISTING ELEVATIONS. THE DESIGNATION NOTED ARE BASED ON AS-BUILT DRAWING NOTATIONS FROM THE EXISTING BUILDING. THE CONTRACTOR SHALL FIELD VERIFY ELEVATIONS PRIOR TO FORMING THE 2ND FLOOR SLAB AND ADDITIONAL LEVEL FRAMING.

**REVISION 1 OF 2**  
**(27 PAGES)**  
**B-20-0078**

THESE DOCUMENTS HAVE BEEN PRODUCED AS AN INSTRUMENT OF SERVICE AND ARE INTENDED SOLELY FOR THE PURPOSE OF CONTRACTING, USING AND MAINTAINING THE PROJECT. KNIT AS THE ARCHITECT OF RECORD FOR THE PROJECT RETAINS OWNERSHIP OF THESE DOCUMENTS.

ANY USE OF THESE DOCUMENTS OR USE OF THIS DESIGN IDEAS OR CONCEPTS DESCRIBED HEREIN IN WHOLE OR PART BY ANY MEANS WHATSOEVER IS STRICTLY PROHIBITED EXCEPT BY WRITTEN CONSENT OF KNIT.

REPRODUCTION OF THESE DOCUMENTS IS STRICTLY PROHIBITED EXCEPT BY WRITTEN CONSENT OF KNIT.

COPYRIGHT 2021 KNIT

ISSUE DATE 09/25/23  
 PROGRESS SET

REV	DATE	COMMENT
1	03.03.2023	AC RESPONSE
2	08.14.2023	CORRECTIONS
3	09.25.2023	CORRECTIONS
4	10.17.2023	CORRECTIONS
5	12.21.2023	CORRECTIONS

City of Puyallup  
 Development & Permitting Services  
 ISSUED PERMIT


Building	Planning
Engineering	Public Works
Fire	Traffic

8677 REGISTERED ARCHITECT  
 RHONDA A. GILLOGLY  
 STATE OF WASHINGTON  
 12/21/2023

EXTERIOR ELEVATIONS  
 ADDITION TO HAMPTON INN & SUITES  
 1515 S MERIDIAN  
 PUYALLUP, WA 98371  
 HAMPTON INN & SUITES

TITLE PROJECT CLIENT  
 JOB NO: 210158

**A3.2**

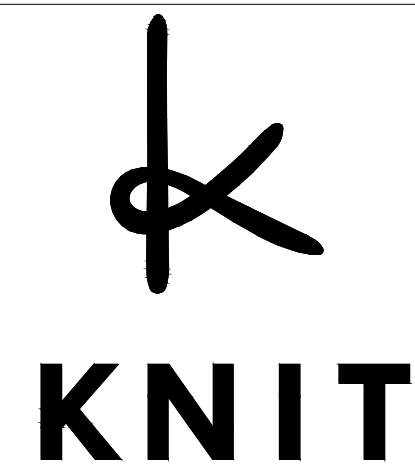

909 S. 336TH ST,  
SUITE 107  
FEDERAL WAY, WA 98003  
knitstudios.com

THESE DOCUMENTS HAVE BEEN PRODUCED AS AN INSTRUMENT OF SERVICE AND ARE INTENDED SOLELY FOR THE PURPOSE OF CONSTRUCTING, USING AND MAINTAINING THE PROJECT. KNIT AS THE ARCHITECT OF RECORD FOR THE PROJECT RETAINS OWNERSHIP OF THESE DOCUMENTS.  
ANY USE OF THESE DOCUMENTS OR USE OF THE DESIGN IDEAS OR CONCEPTS DESCRIBED HEREIN IN WHOLE OR PART BY ANY OTHER PARTY WITHOUT THE WRITTEN CONSENT OF KNIT IS STRICTLY PROHIBITED EXCEPT BY WRITTEN CONSENT OF KNIT.  
REPRODUCTION OF THESE DOCUMENTS IS STRICTLY PROHIBITED EXCEPT BY WRITTEN CONSENT OF KNIT.  
COPYRIGHT 2021 KNIT

ISSUE DATE 09/25/23  
PROGRESS SET

REV	DATE	COMMENT
1	03.03.2023	AC RESPONSE
2	08.14.2023	CORRECTIONS
3	09.25.2023	CORRECTIONS
4	10.17.2023	CORRECTIONS
5	12.21.2023	CORRECTIONS

City of Puyallup  
Development & Permitting Services  
ISSUED PERMIT


Building	Planning
Engineering	Public Works
Fire	Traffic

8677 REGISTERED ARCHITECT  
*Rhonda A. Gillogly*  
RHONDA A. GILLOGLY  
STATE OF WASHINGTON  
12/21/2023

BUILDING SECTIONS  
ADDITION TO HAMPTON INN & SUITES  
1515 S MERIDIAN  
PUYALLUP, WA 98371  
HAMPTON INN & SUITES


TITLE PROJECT CLIENT  
JOB NO: 210158

A4.1

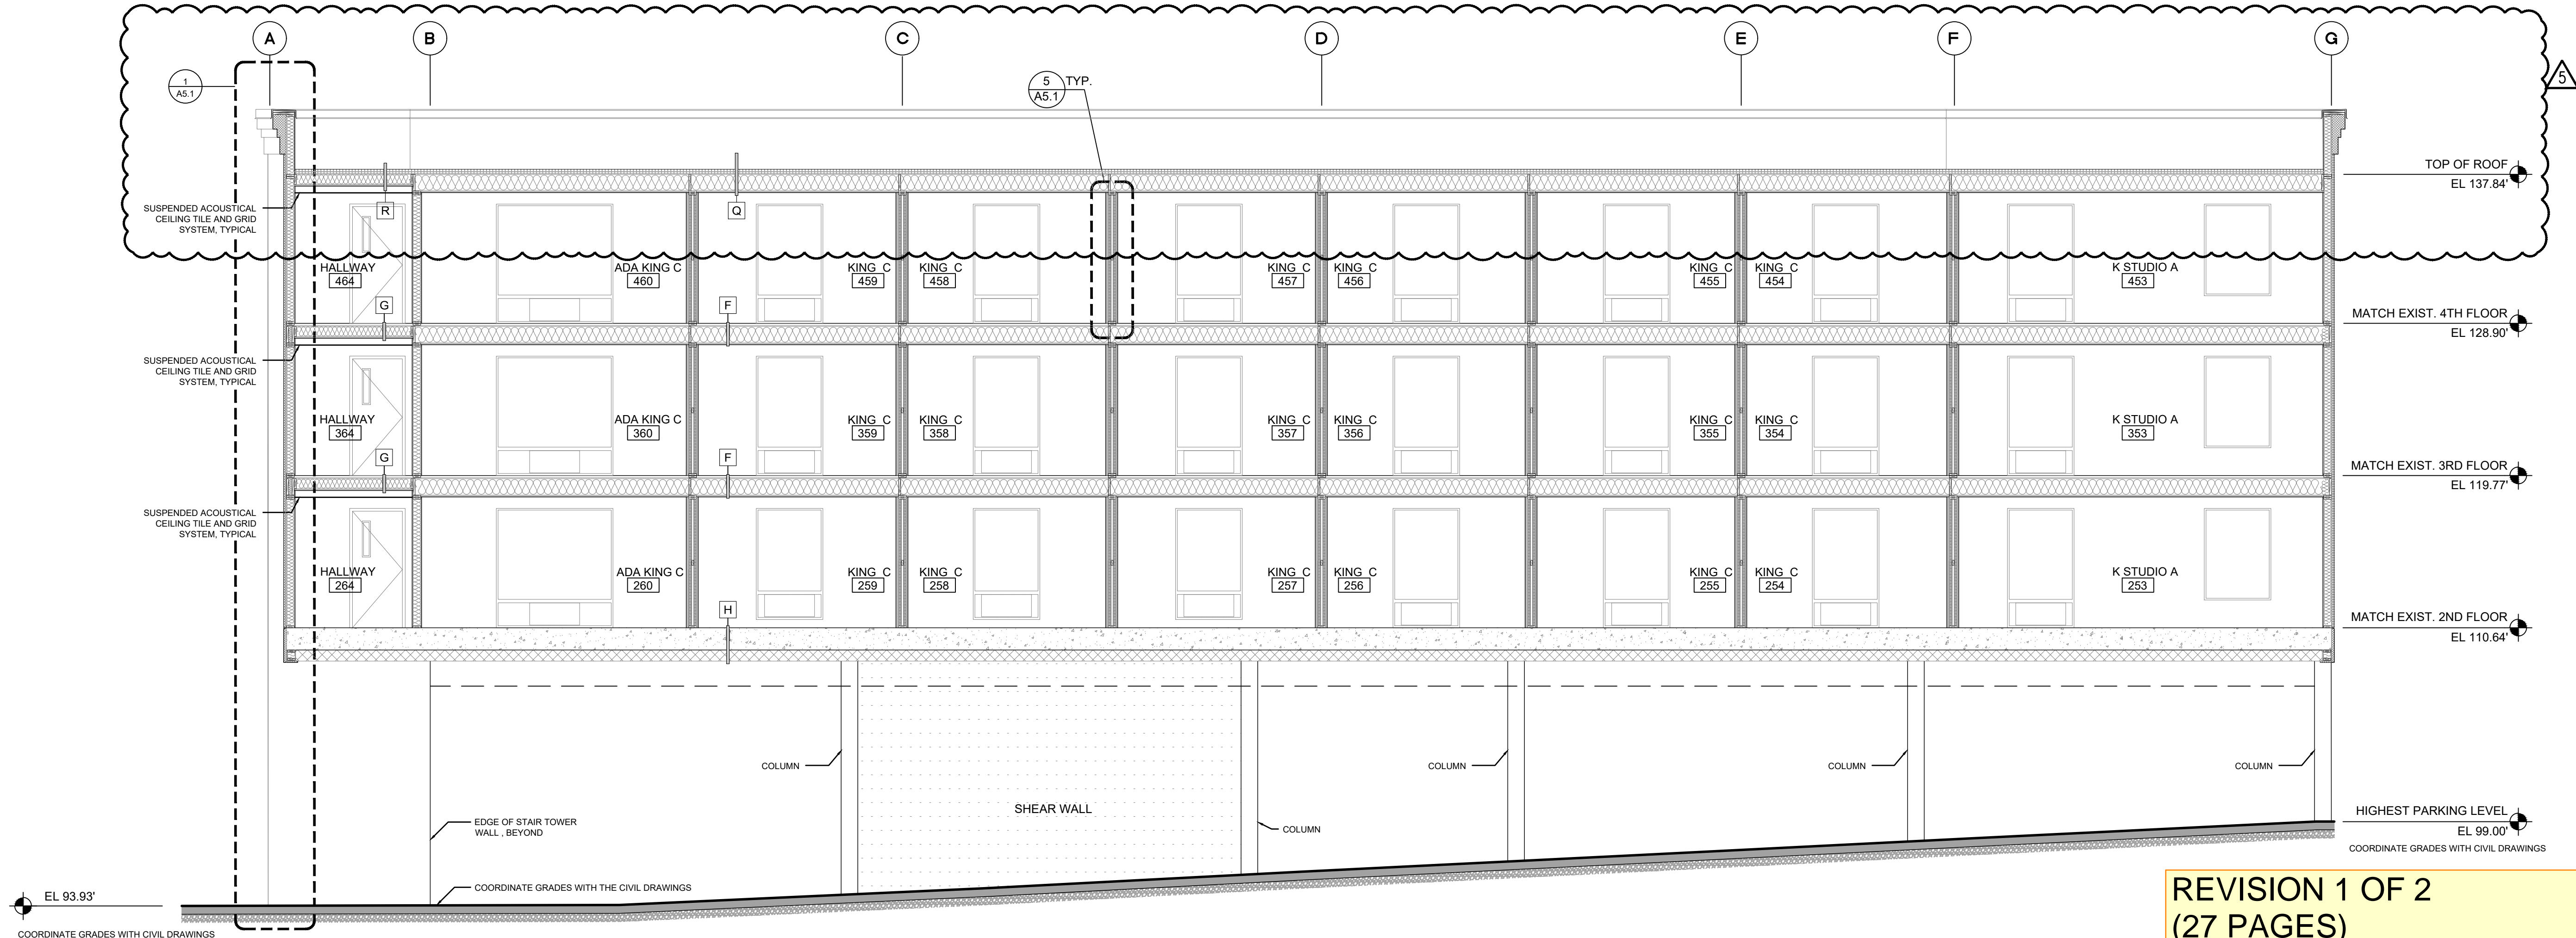


**1 BUILDING SECTION**  
24 x 36 - 3/16" = 1'-0"

REVISION 1 OF 2  
(27 PAGES)  
B-20-0078

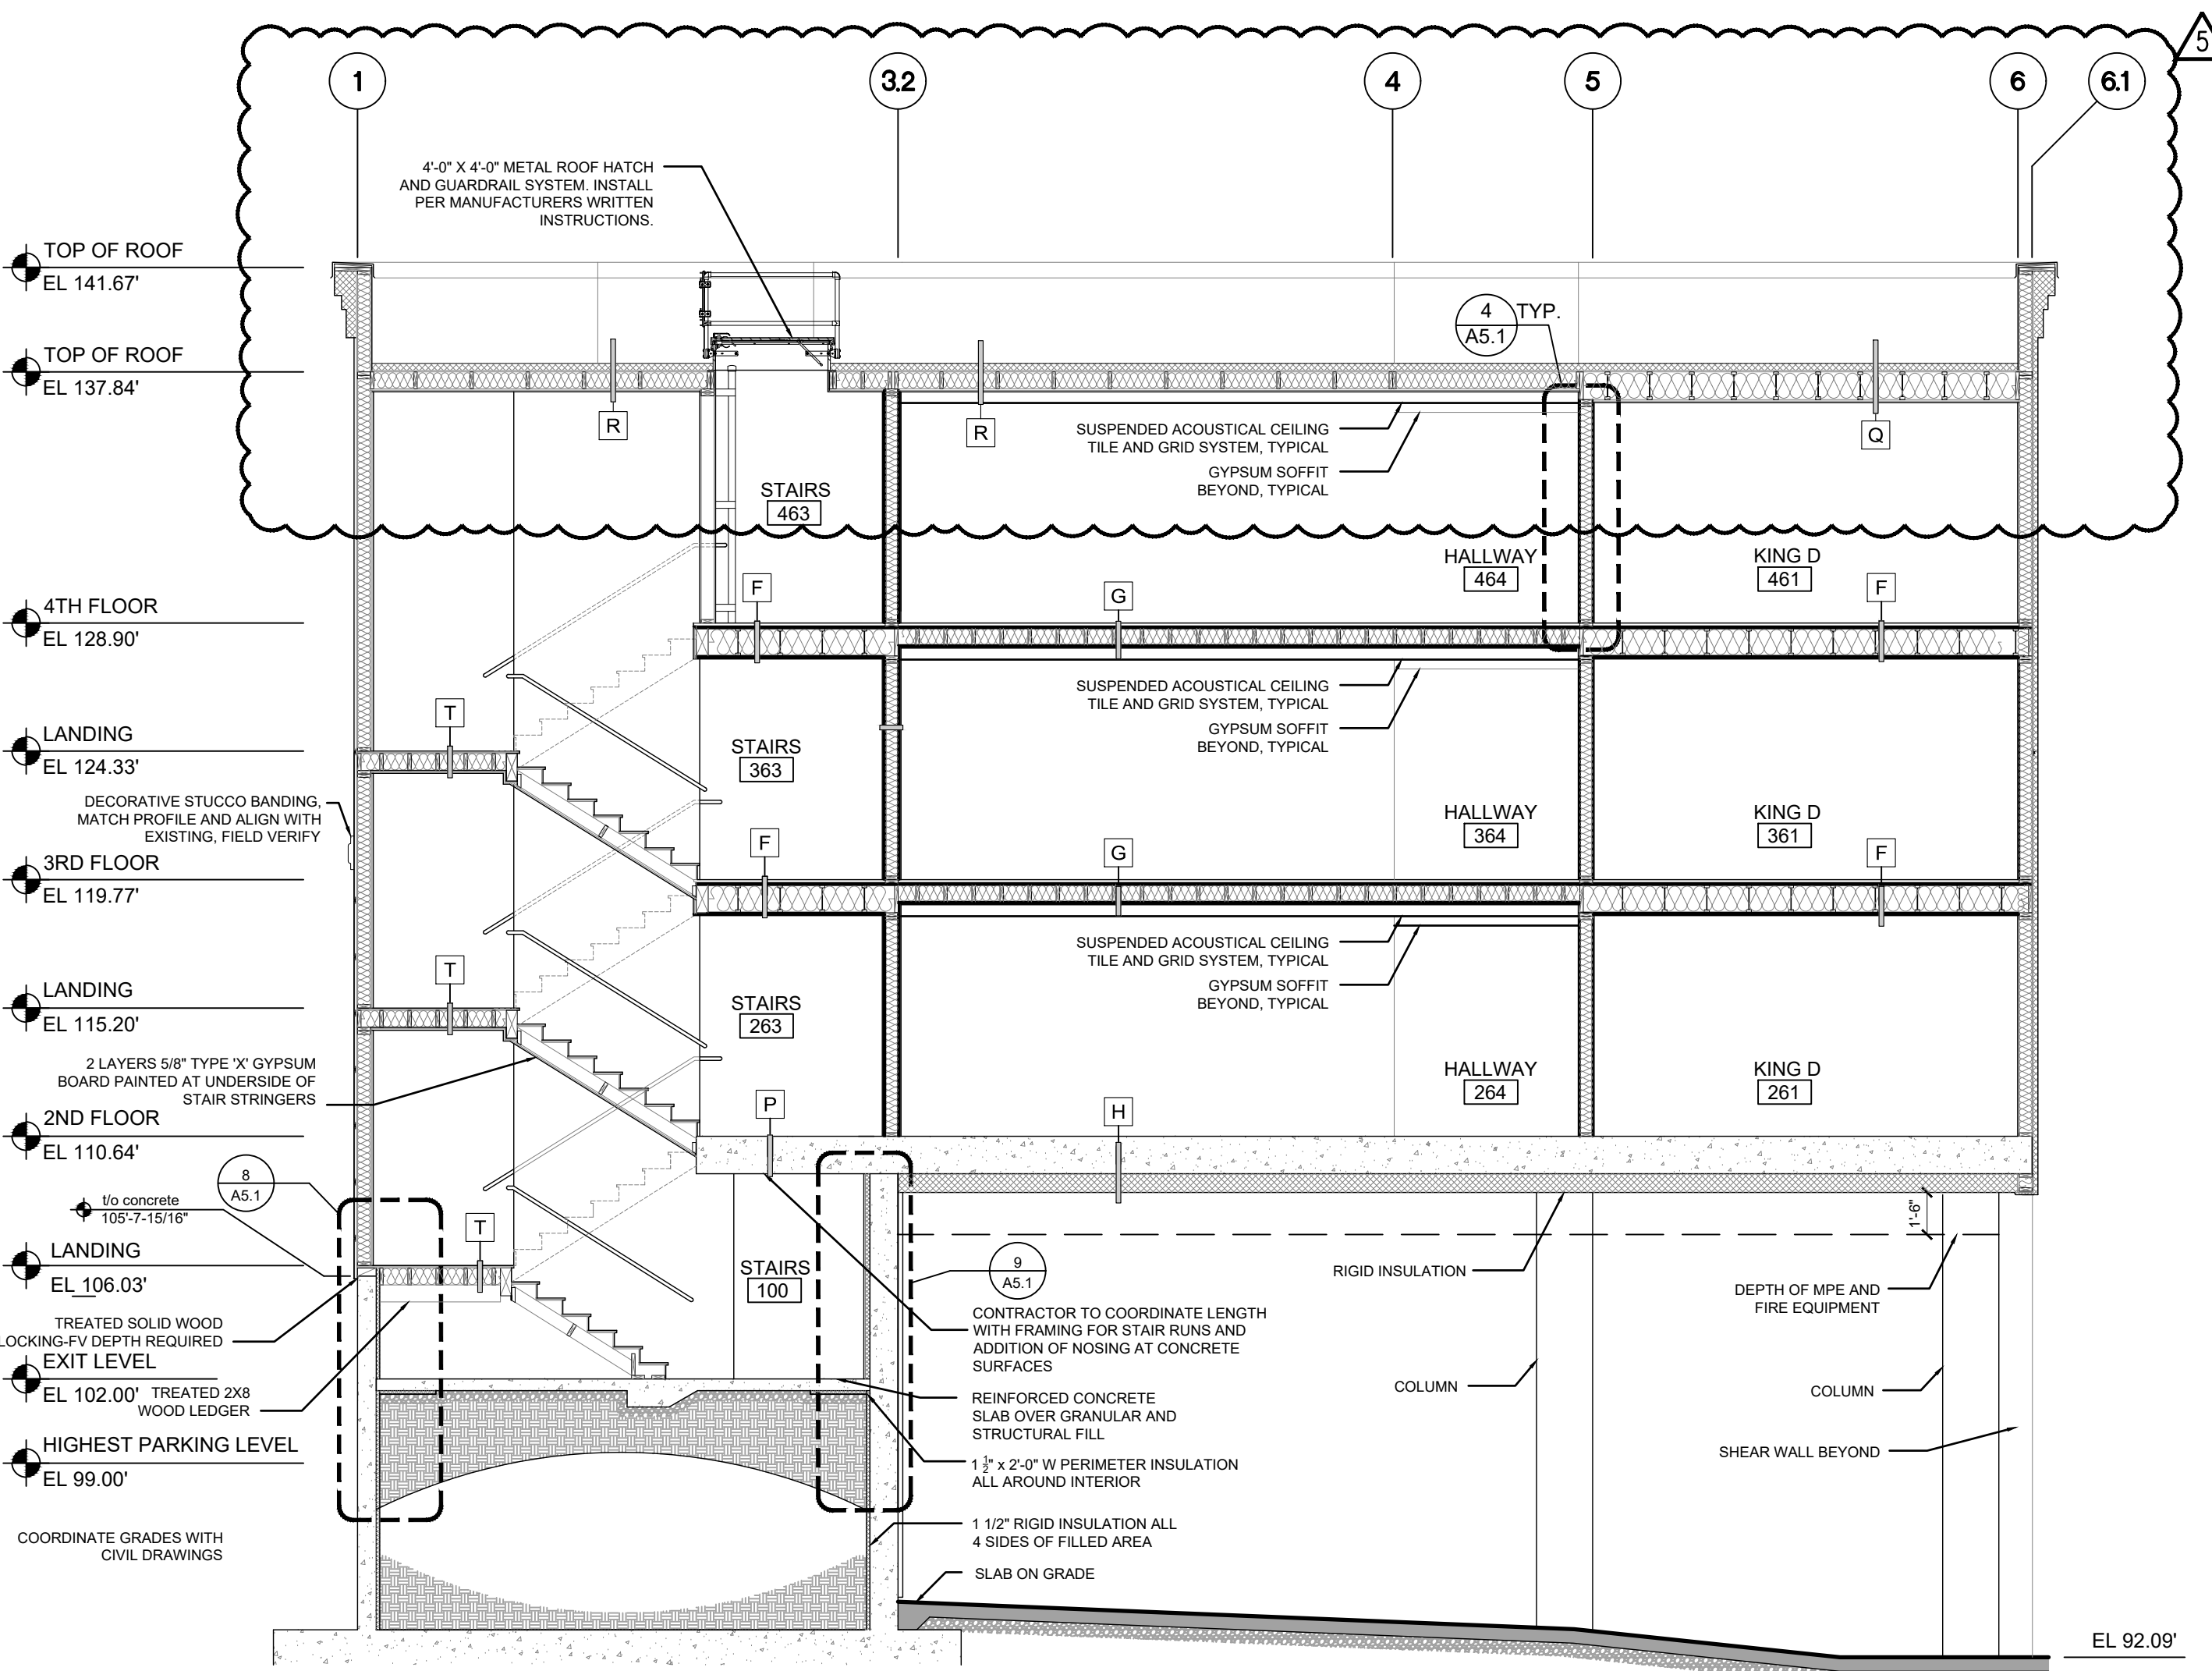


**2 BUILDING SECTION**  
24 x 36 - 3/16" = 1'-0"  
12 x 18 - 3/32" = 1'-0"

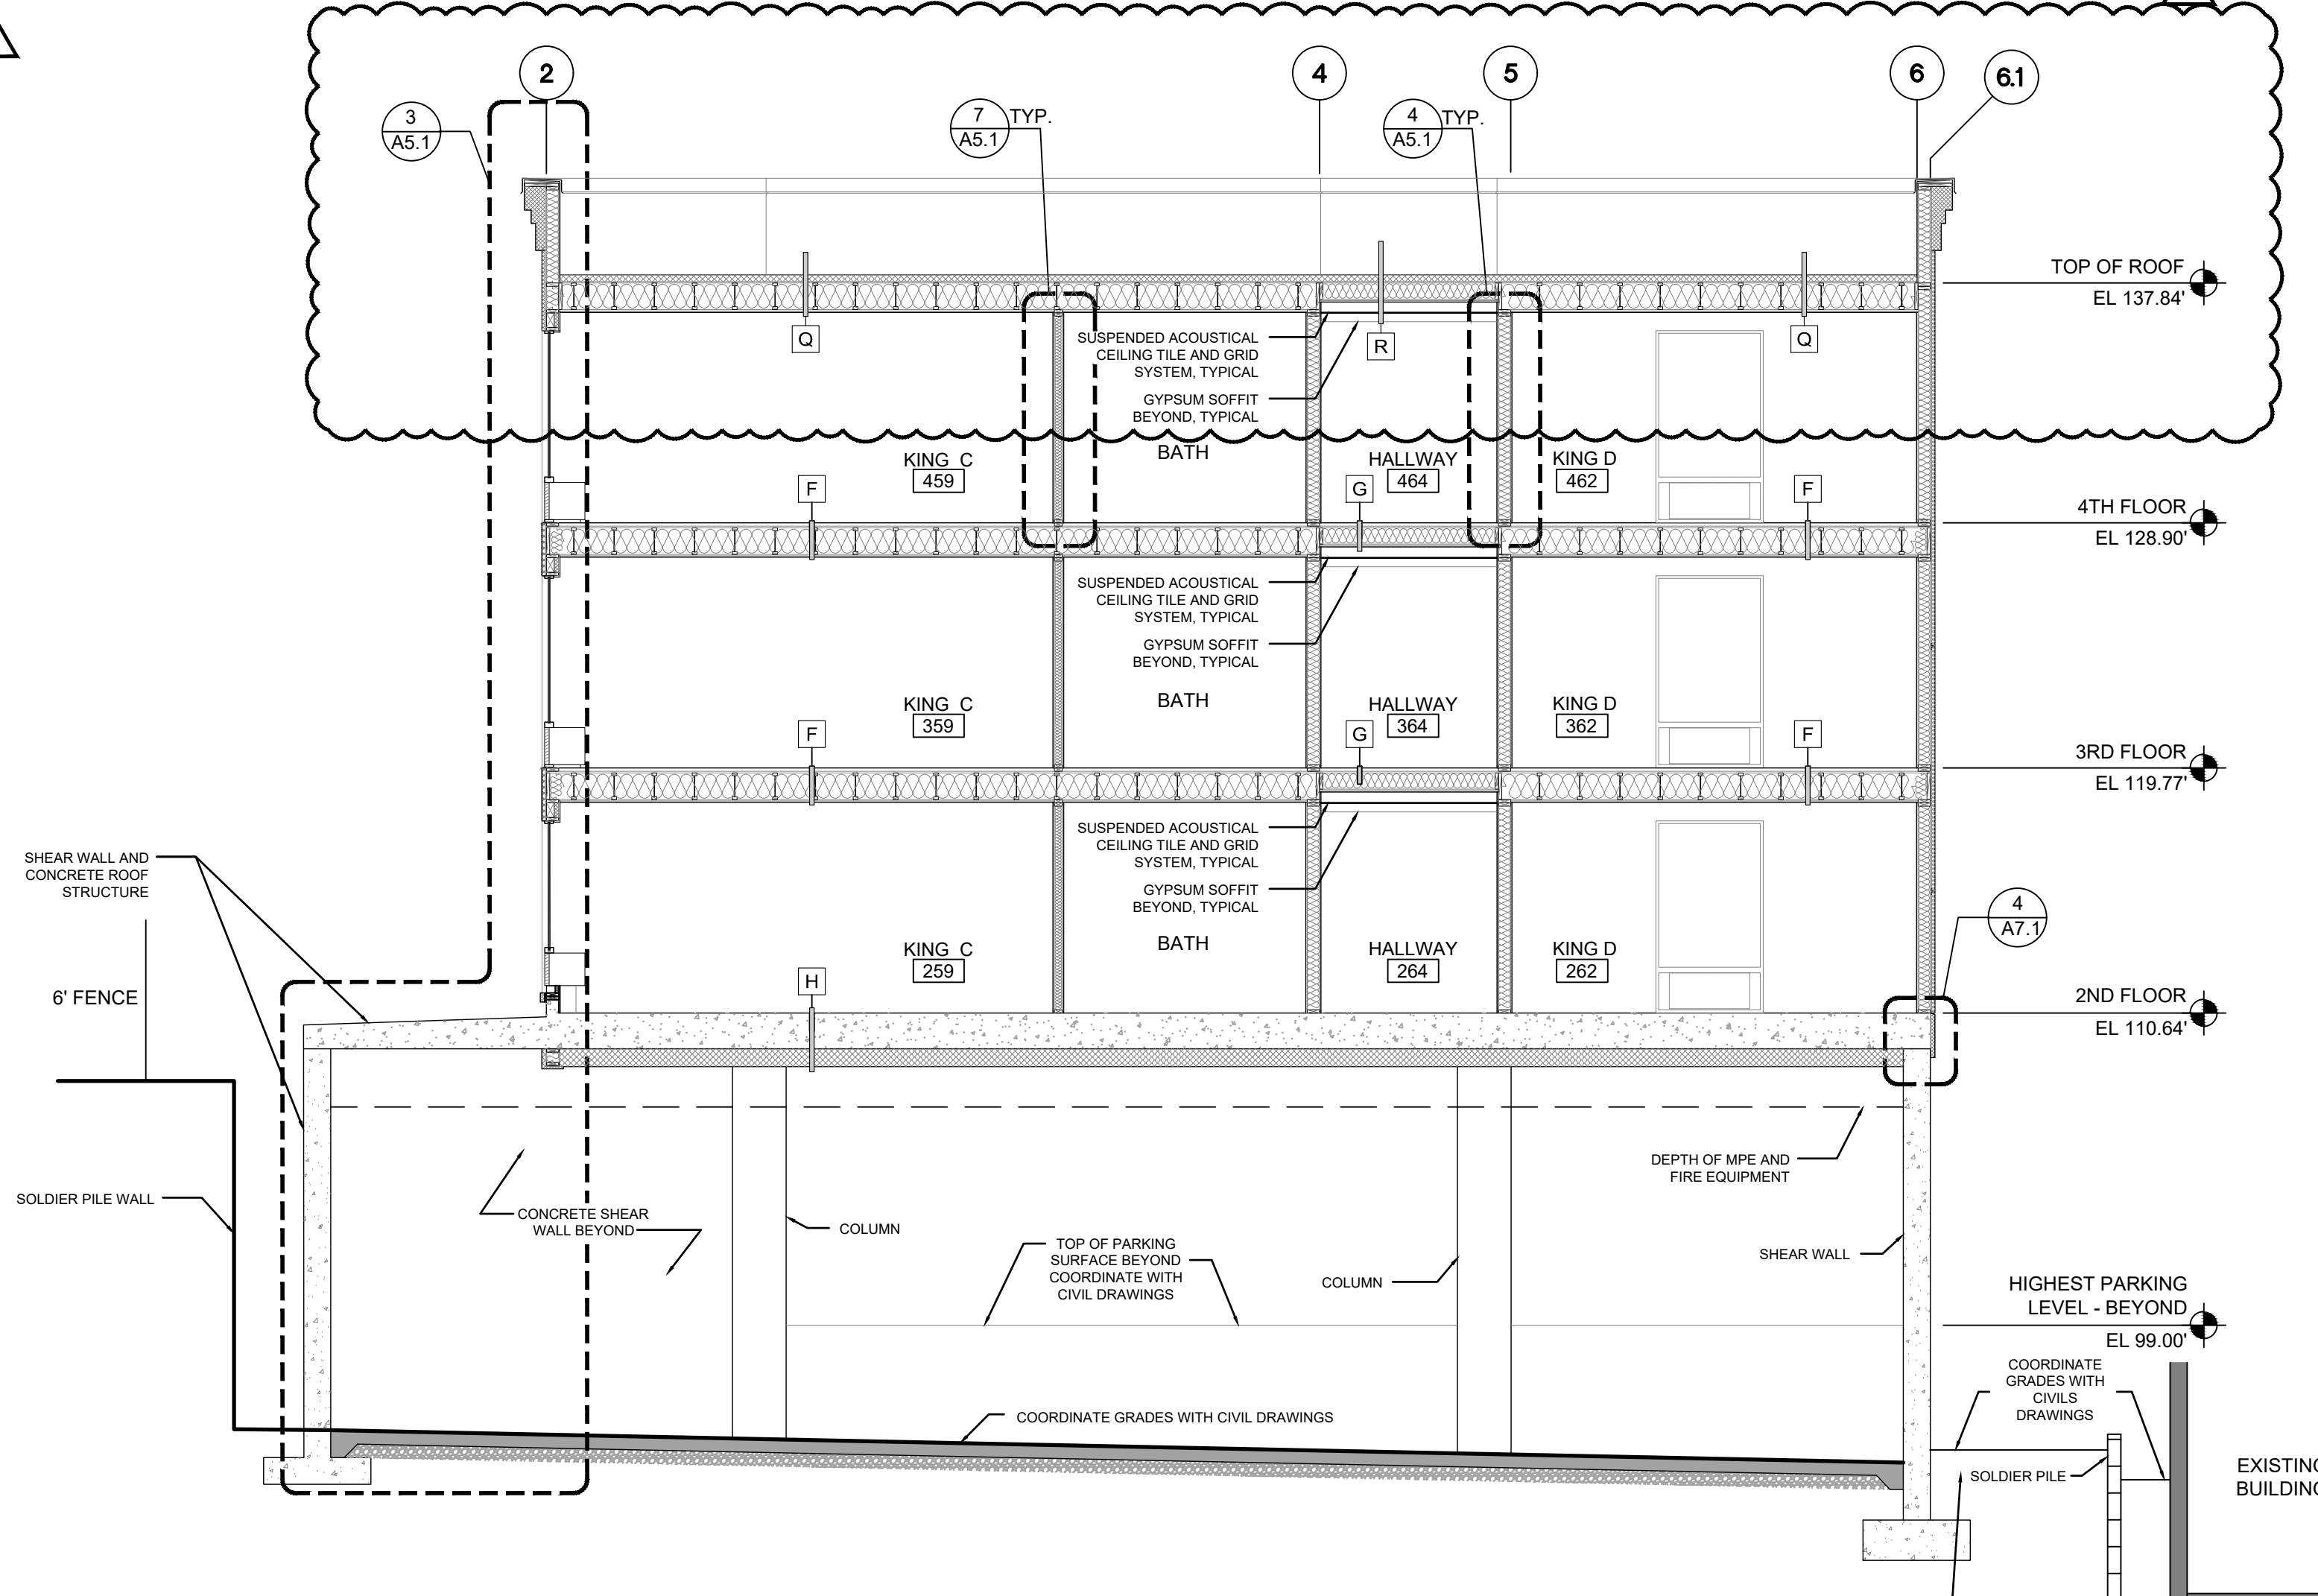


**3 BUILDING SECTION**  
24 x 36 - 3/16" = 1'-0"  
12 x 18 - 3/32" = 1'-0"


REVISION 1 OF 2  
(27 PAGES)  
B-20-0078

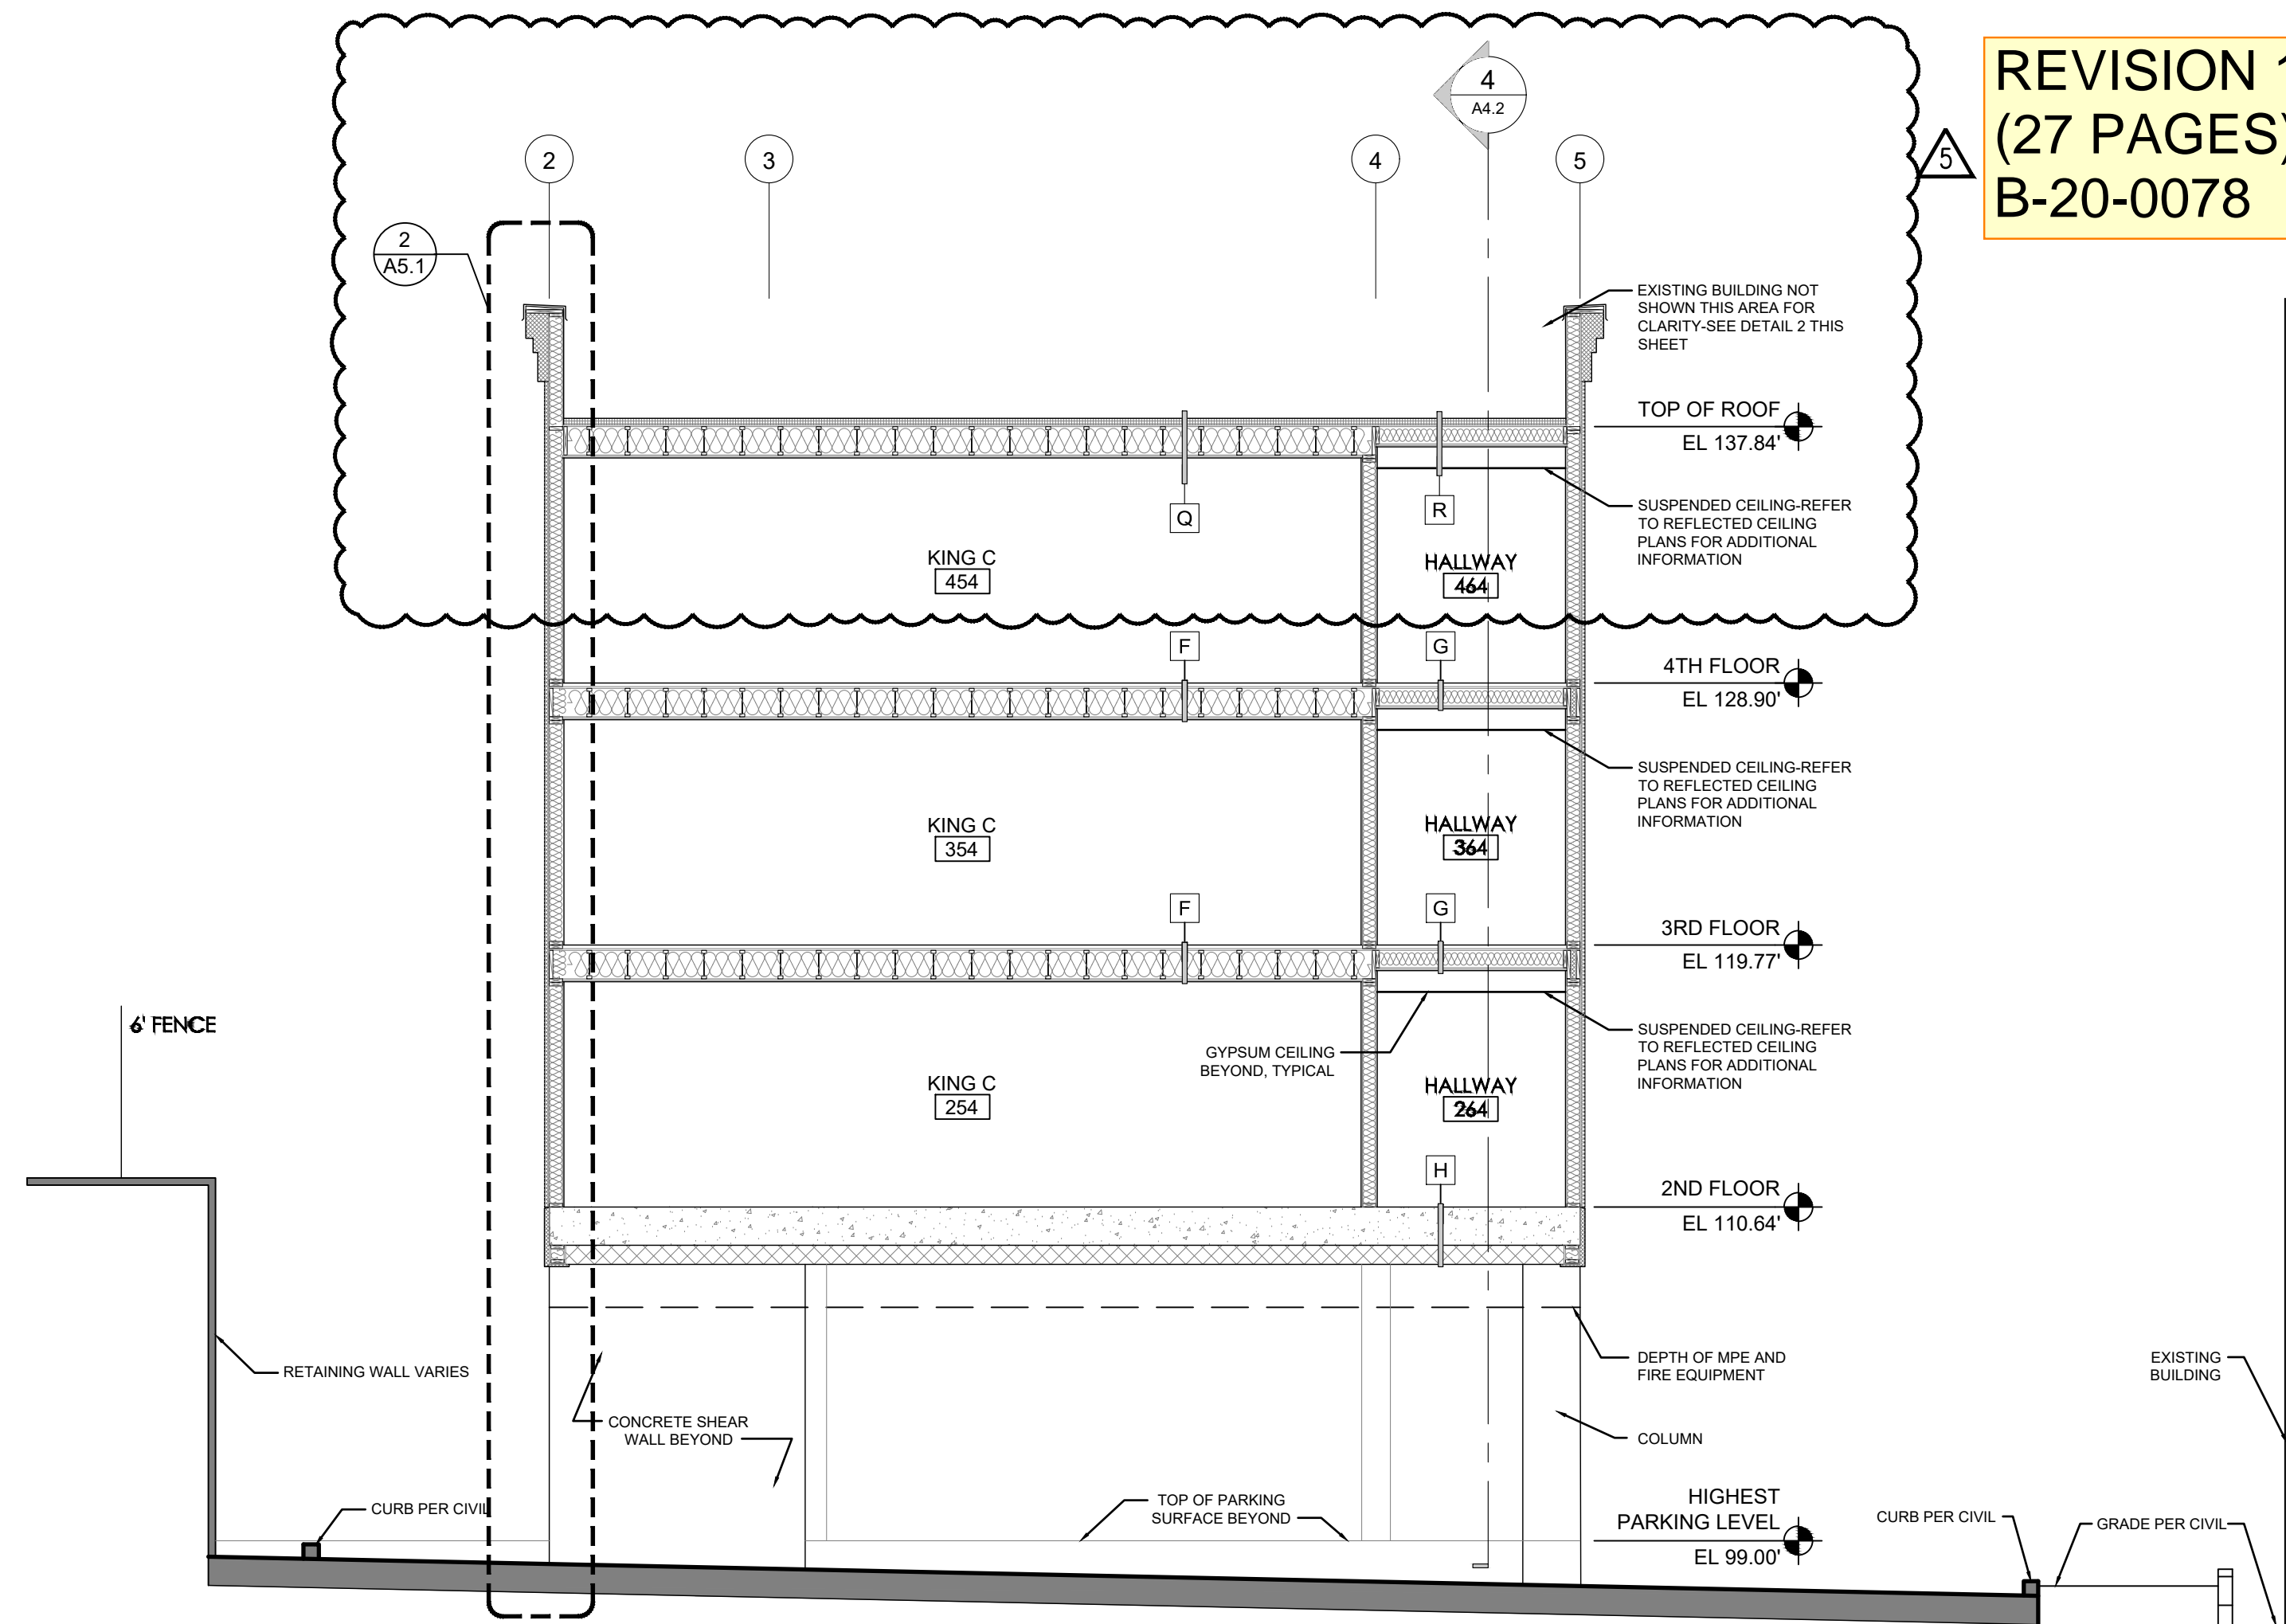


**1 BUILDING SECTION**  
24 x 36 - 3/16" = 1'-0"  
12 x 18 - 3/32" = 1'-0"

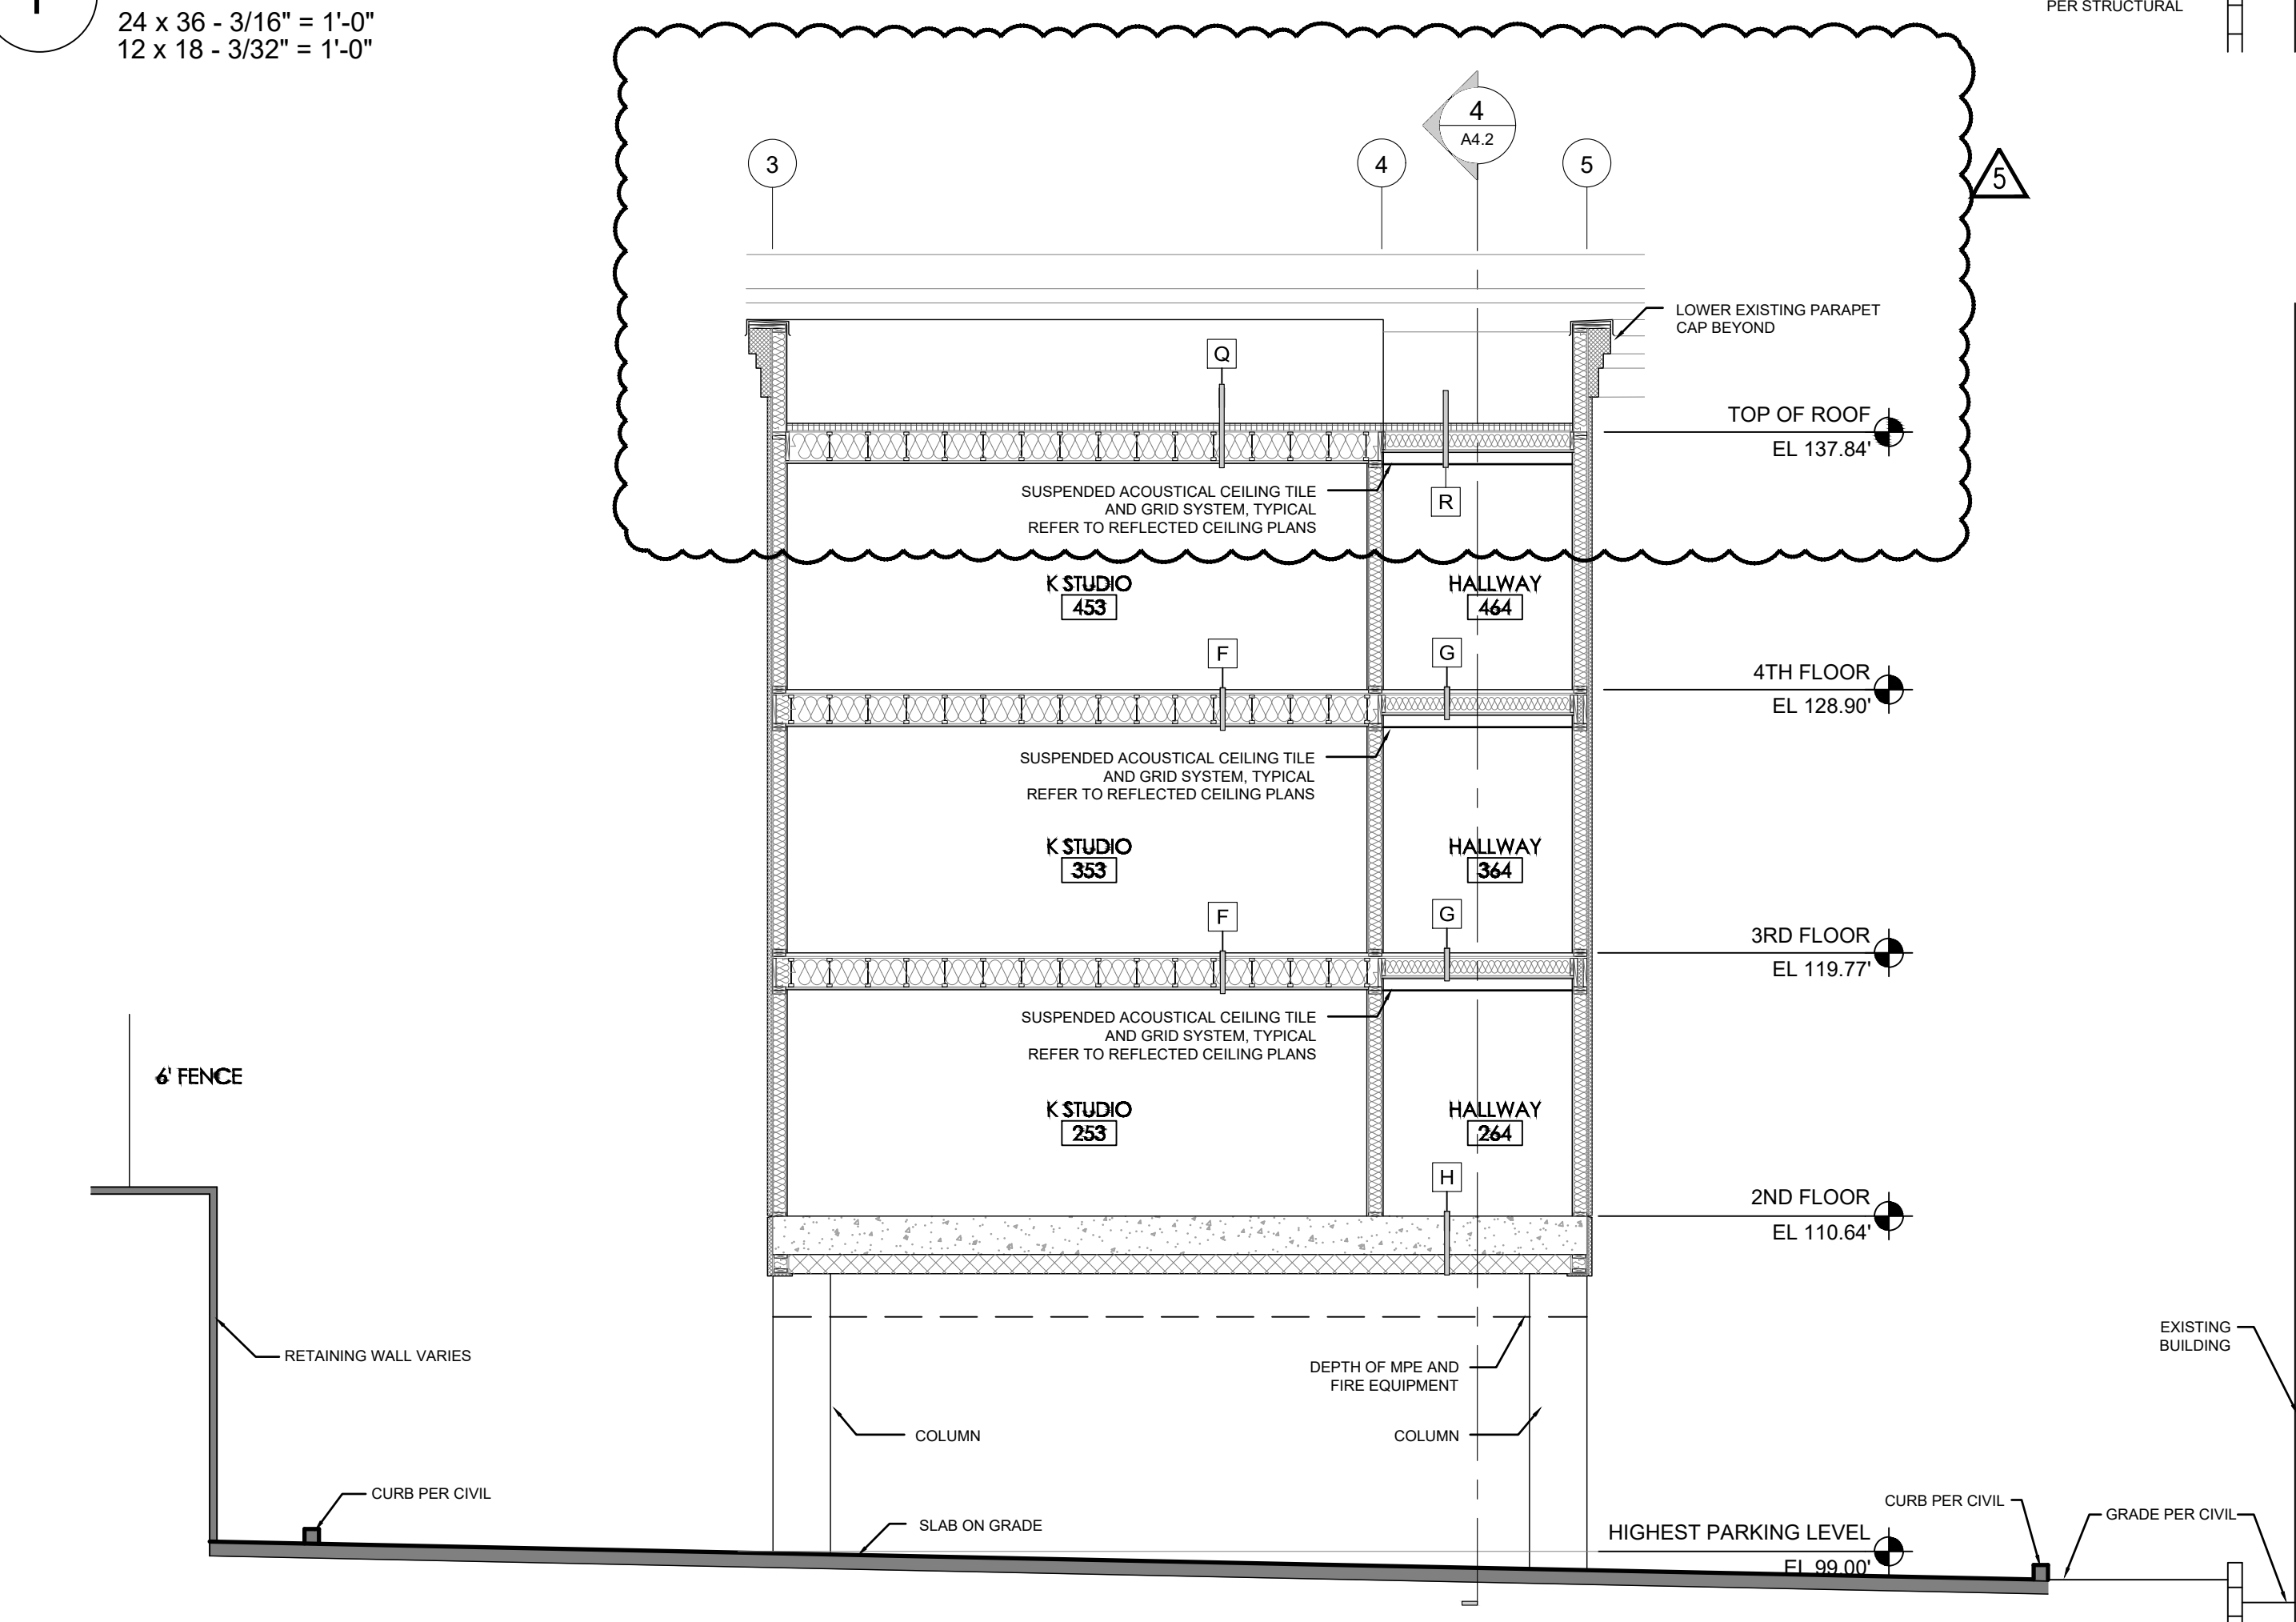

**2 BUILDING SECTION**  
24 x 36 - 3/16" = 1'-0"  
12 x 18 - 3/32" = 1'-0"

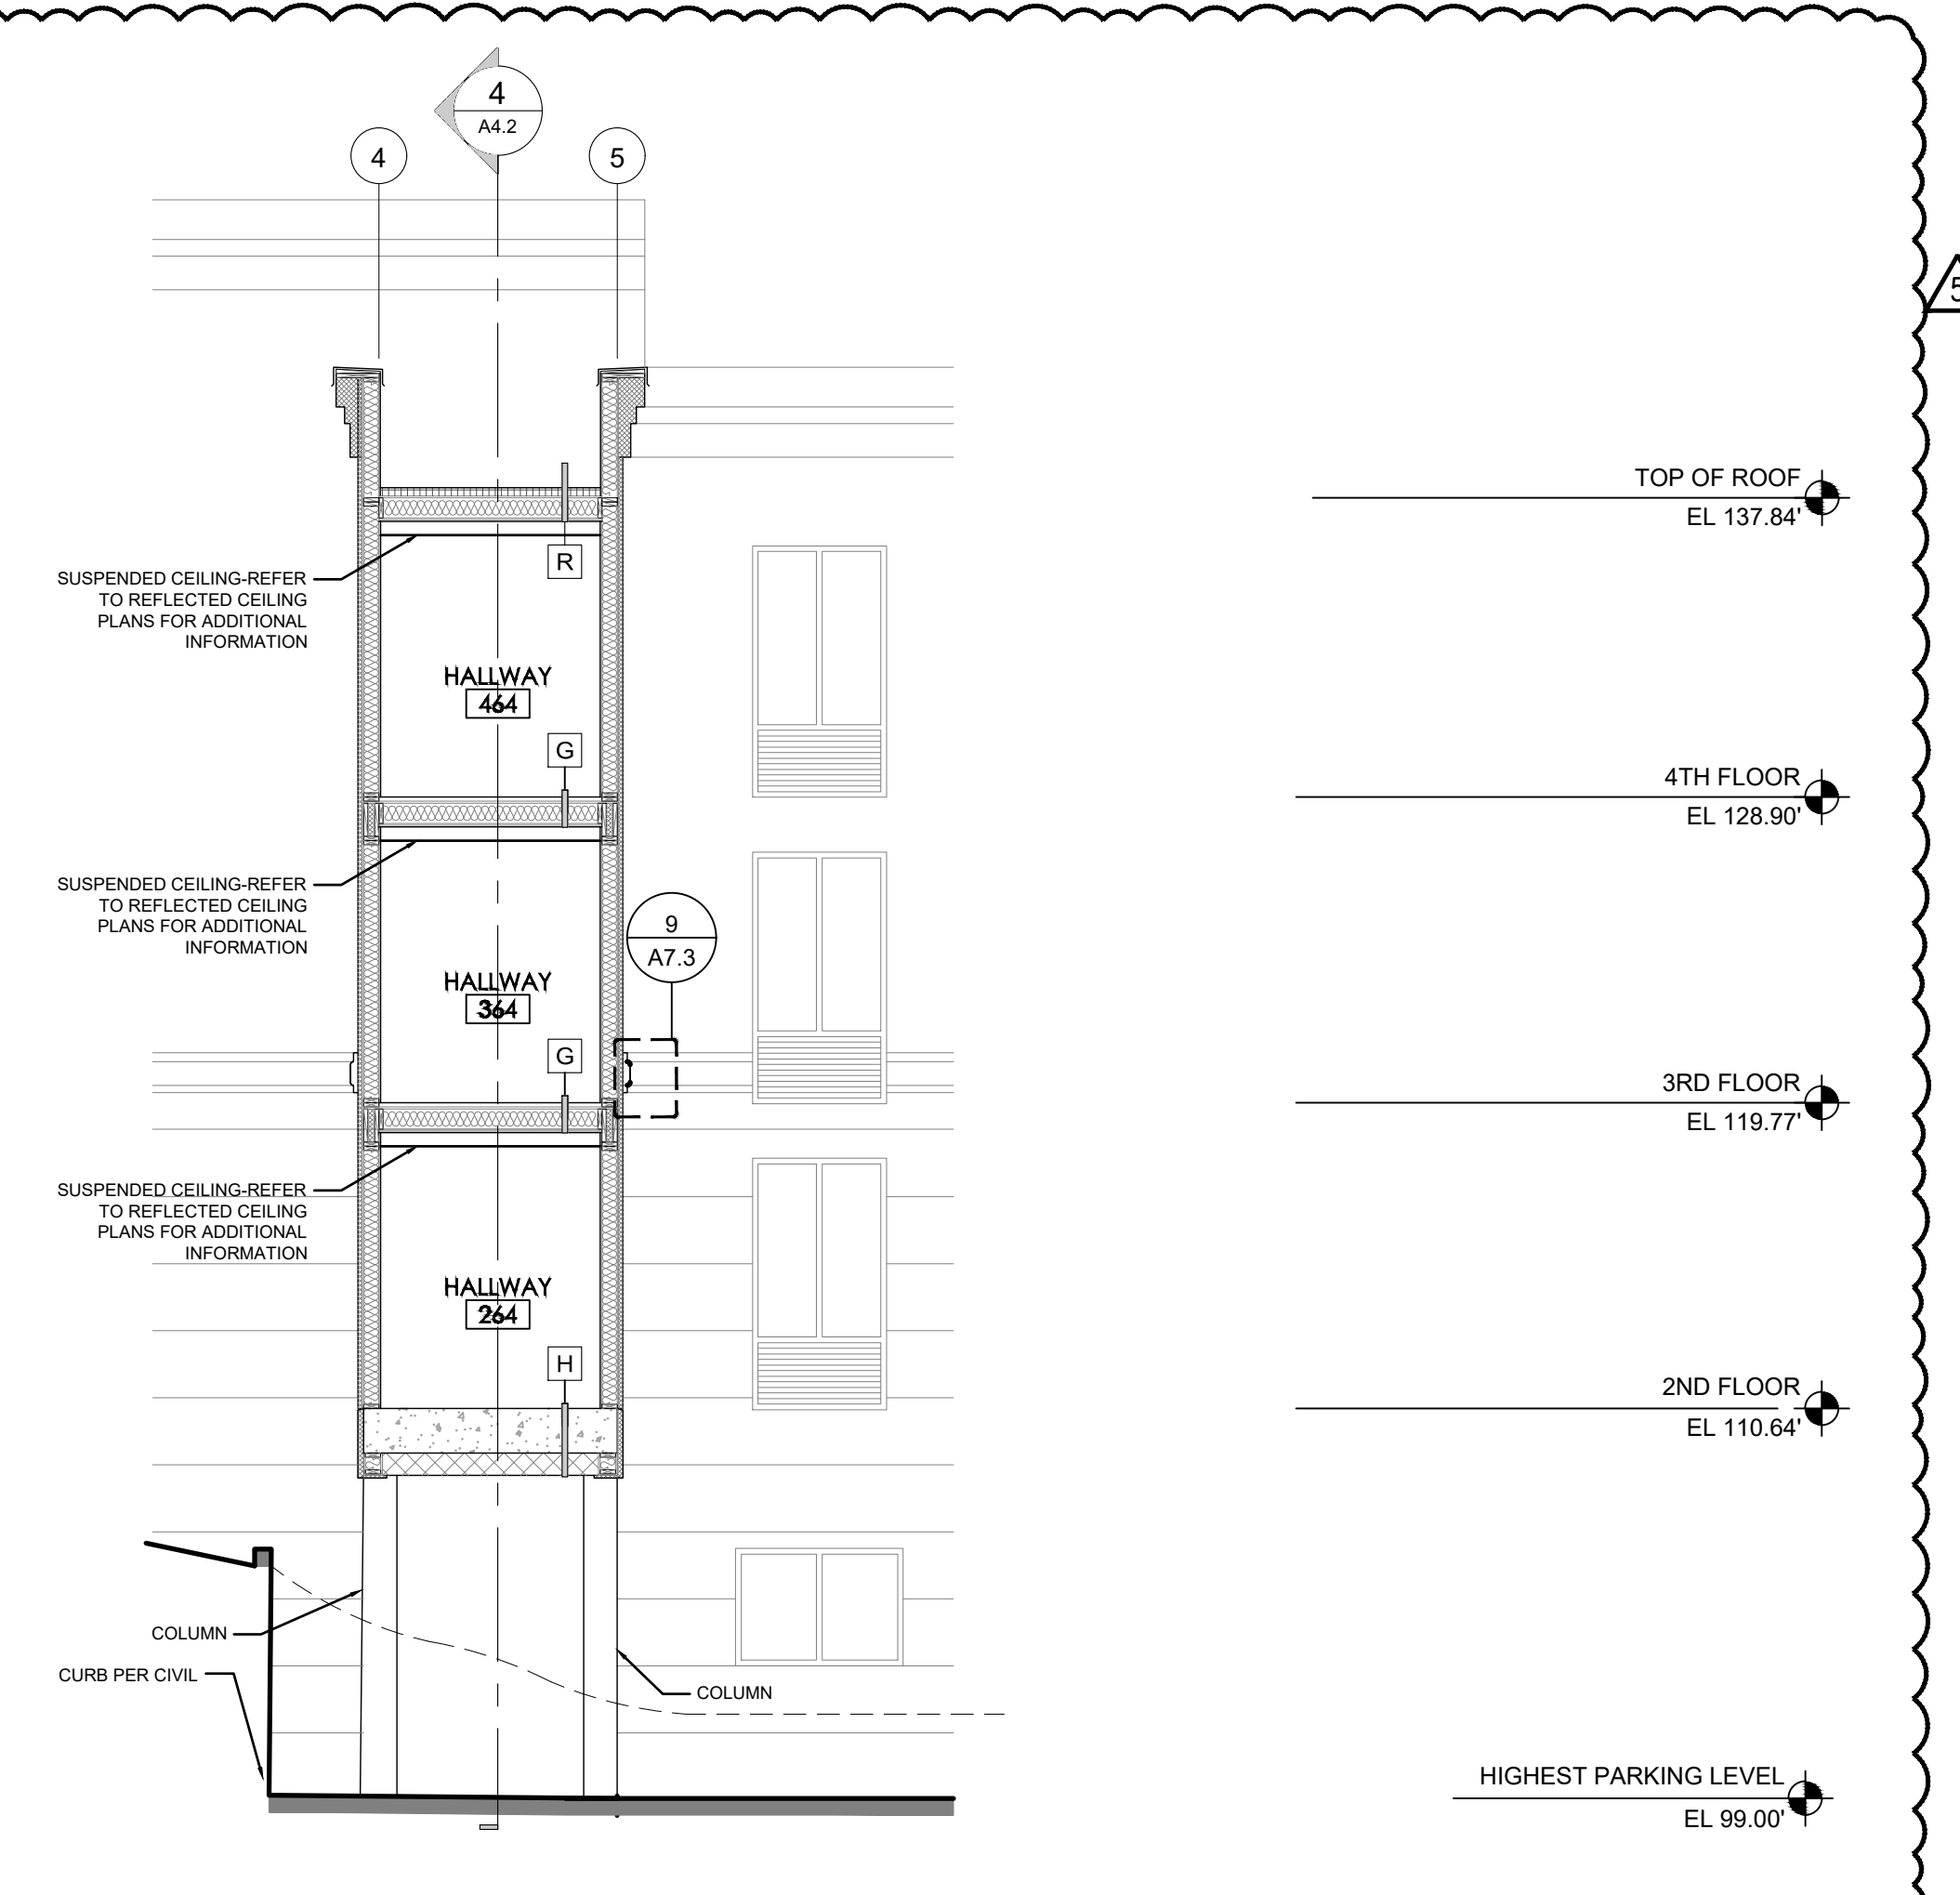

**3 BUILDING SECTION**  
24 x 36 - 3/16" = 1'-0"  
12 x 18 - 3/32" = 1'-0"

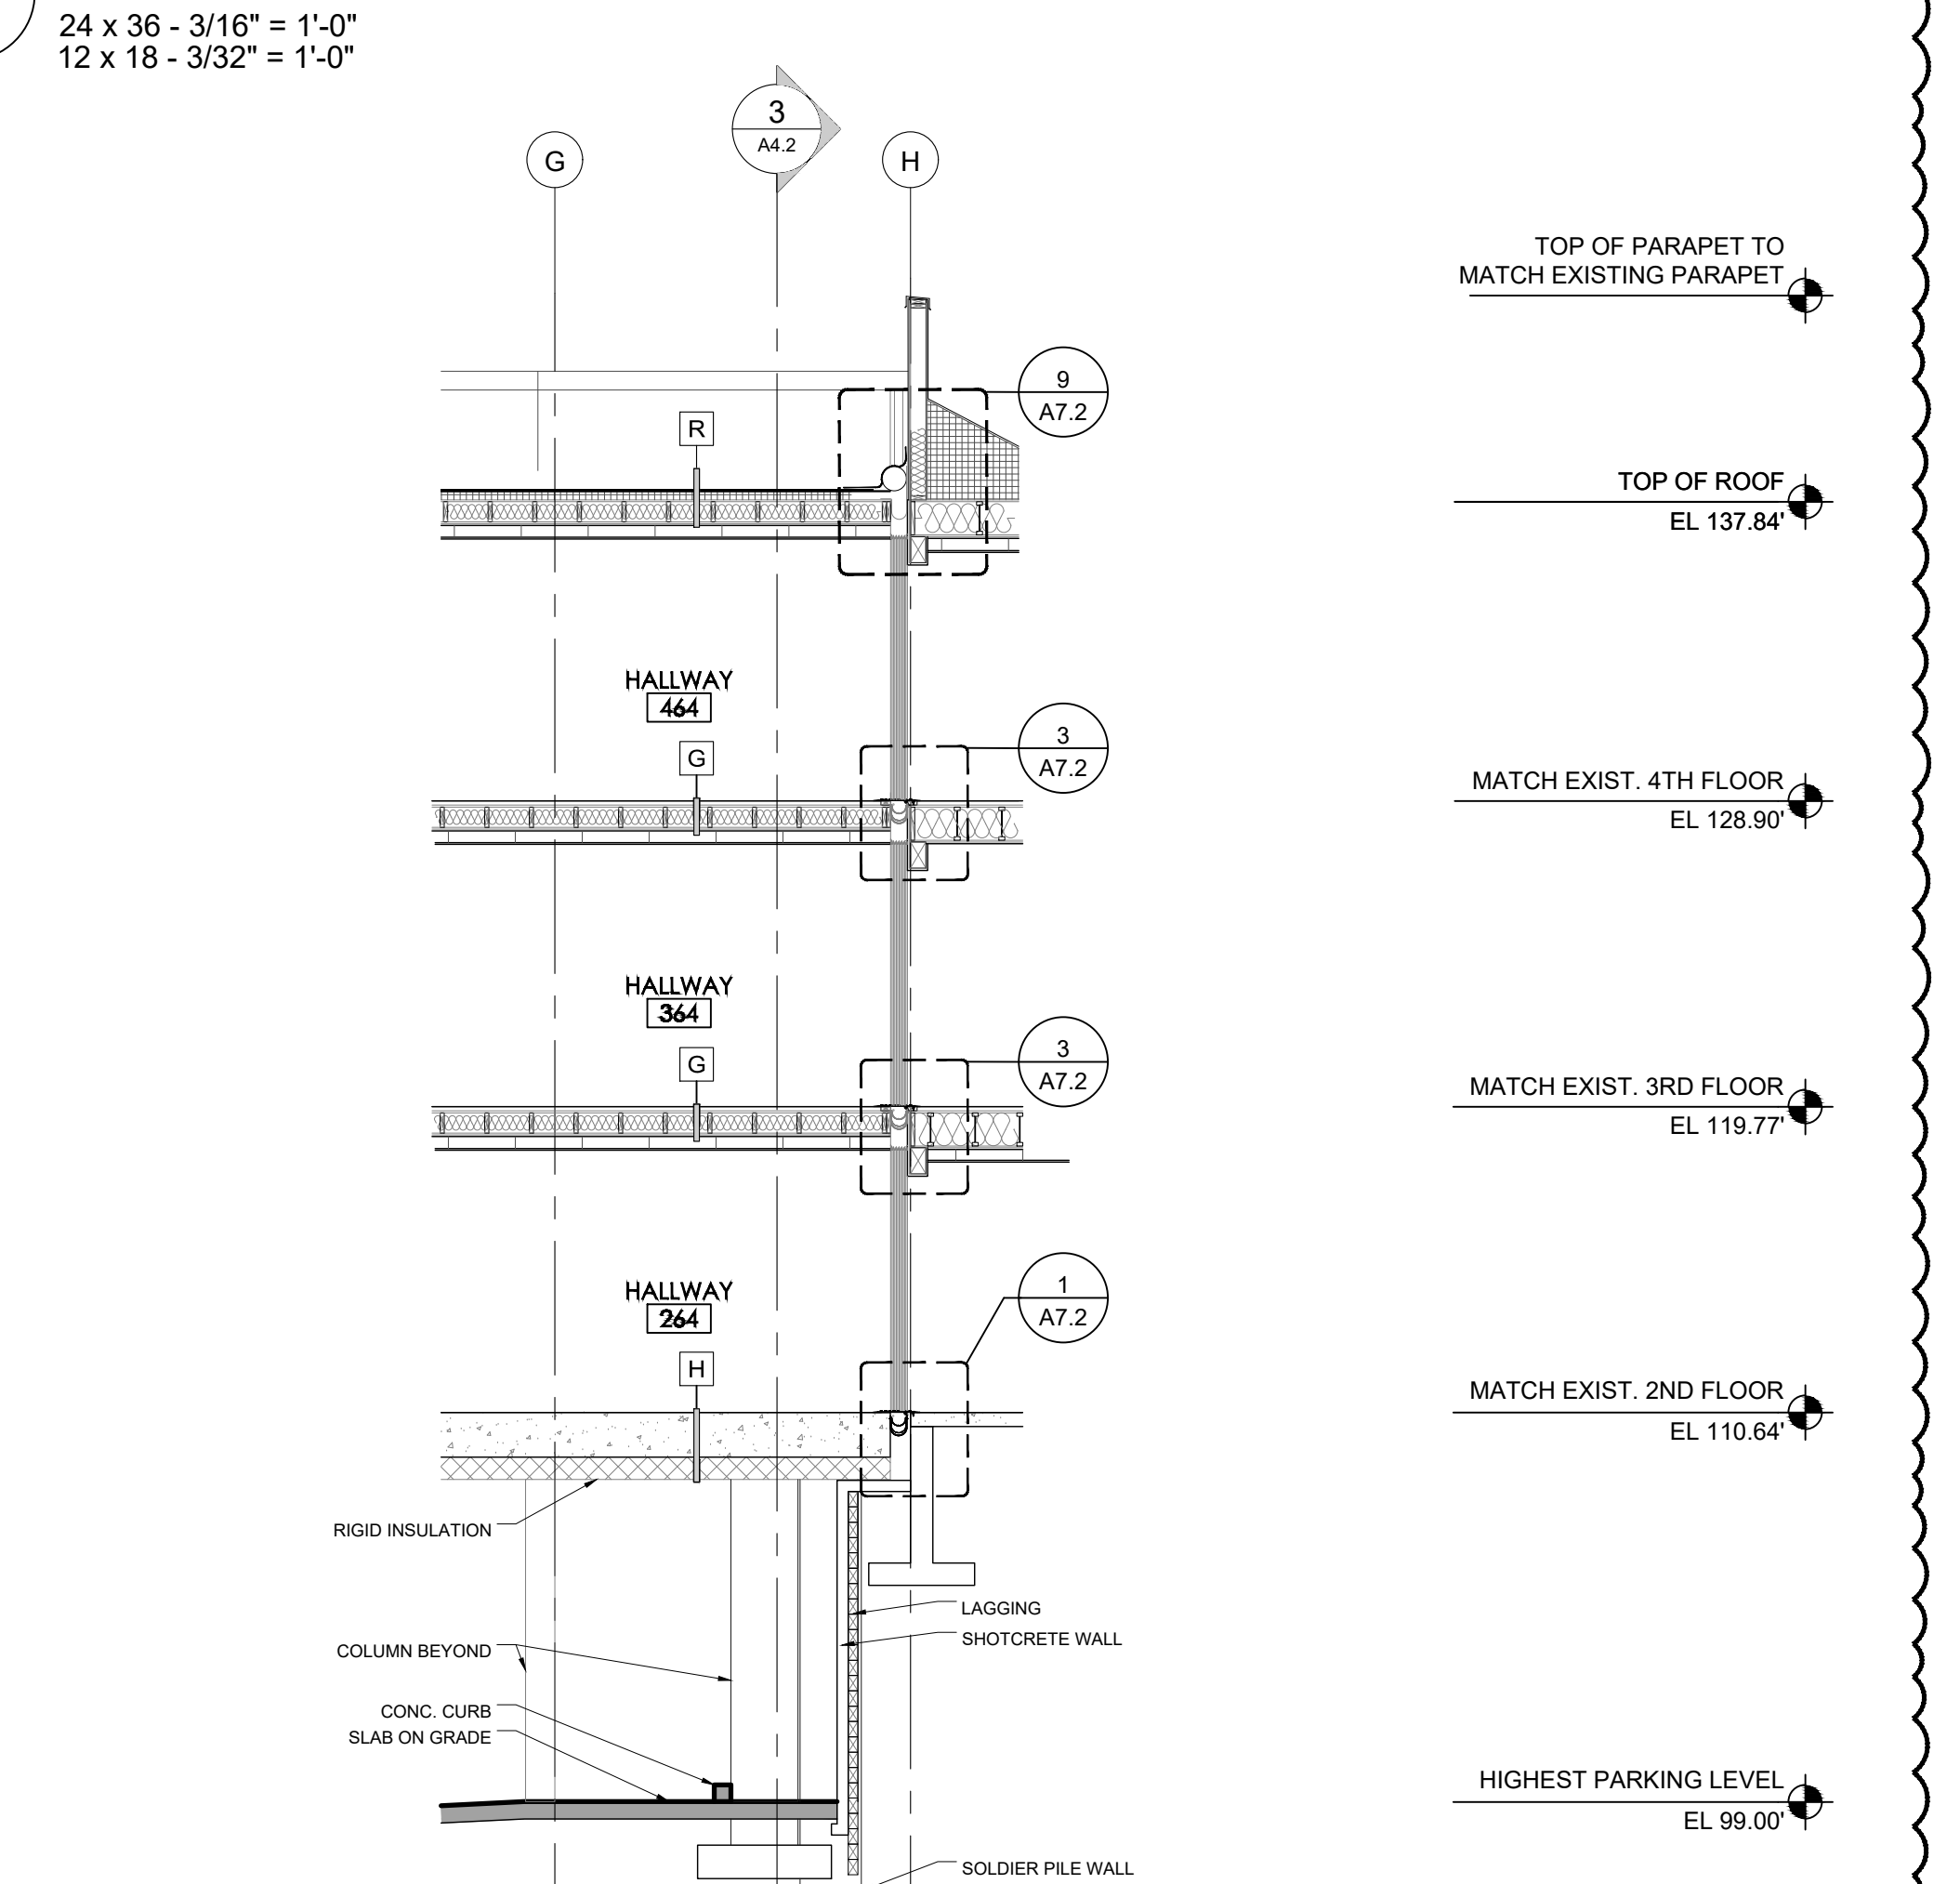

**4 BUILDING SECTION**  
24 x 36 - 3/16" = 1'-0"  
12 x 18 - 3/32" = 1'-0"

**KNIT**  
909 S. 336TH ST.  
SUITE 107  
FEDERAL WAY, WA 98003  
knitstudios.com

THESE DOCUMENTS HAVE BEEN PRODUCED AS AN INSTRUMENT OF SERVICE AND ARE INTENDED SOLELY FOR THE PURPOSE OF CONSTRUCTIVE USE AND IMPROVING THE PROJECT. KNIT AS THE ARCHITECT OF RECORD FOR THE PROJECT RETAINS OWNERSHIP OF THESE DOCUMENTS.

ANY USE OF THESE DOCUMENTS OR USE OF THE DESIGN IDEAS OR CONCEPTS DESCRIBED HEREIN IN WHOLE OR PART BY ANY PERSON WHATSOEVER IS STRICTLY PROHIBITED EXCEPT BY WRITTEN CONSENT OF KNIT.

REPRODUCTION OF THESE DOCUMENTS IS STRICTLY PROHIBITED EXCEPT BY WRITTEN CONSENT OF KNIT.

COPYRIGHT 2021 KNIT

ISSUE DATE 09/25/23  
PROGRESS SET

REV	DATE	COMMENT
1	03.03.2023	AC RESPONSE
2	08.14.2023	CORRECTIONS
3	09.25.2023	CORRECTIONS
4	10.17.2023	CORRECTIONS
5	12.21.2023	CORRECTIONS

City of Puyallup  
Development & Permitting Services  
**ISSUED PERMIT**


Building	Planning
Engineering	Public Works
Fire	Traffic

8677 REGISTERED ARCHITECT  
*Rhonda A. Gillogly*  
RHONDA A. GILLOGLY  
STATE OF WASHINGTON  
12/21/2023


**BUILDING SECTIONS**  
**ADDITION TO HAMPTON INN & SUITES**  
1515 S MERIDIAN  
PUYALLUP, WA 98371  
HAMPTON INN & SUITES

TITLE	PROJECT	CLIENT
JOB NO: 210158		


**A4.2**

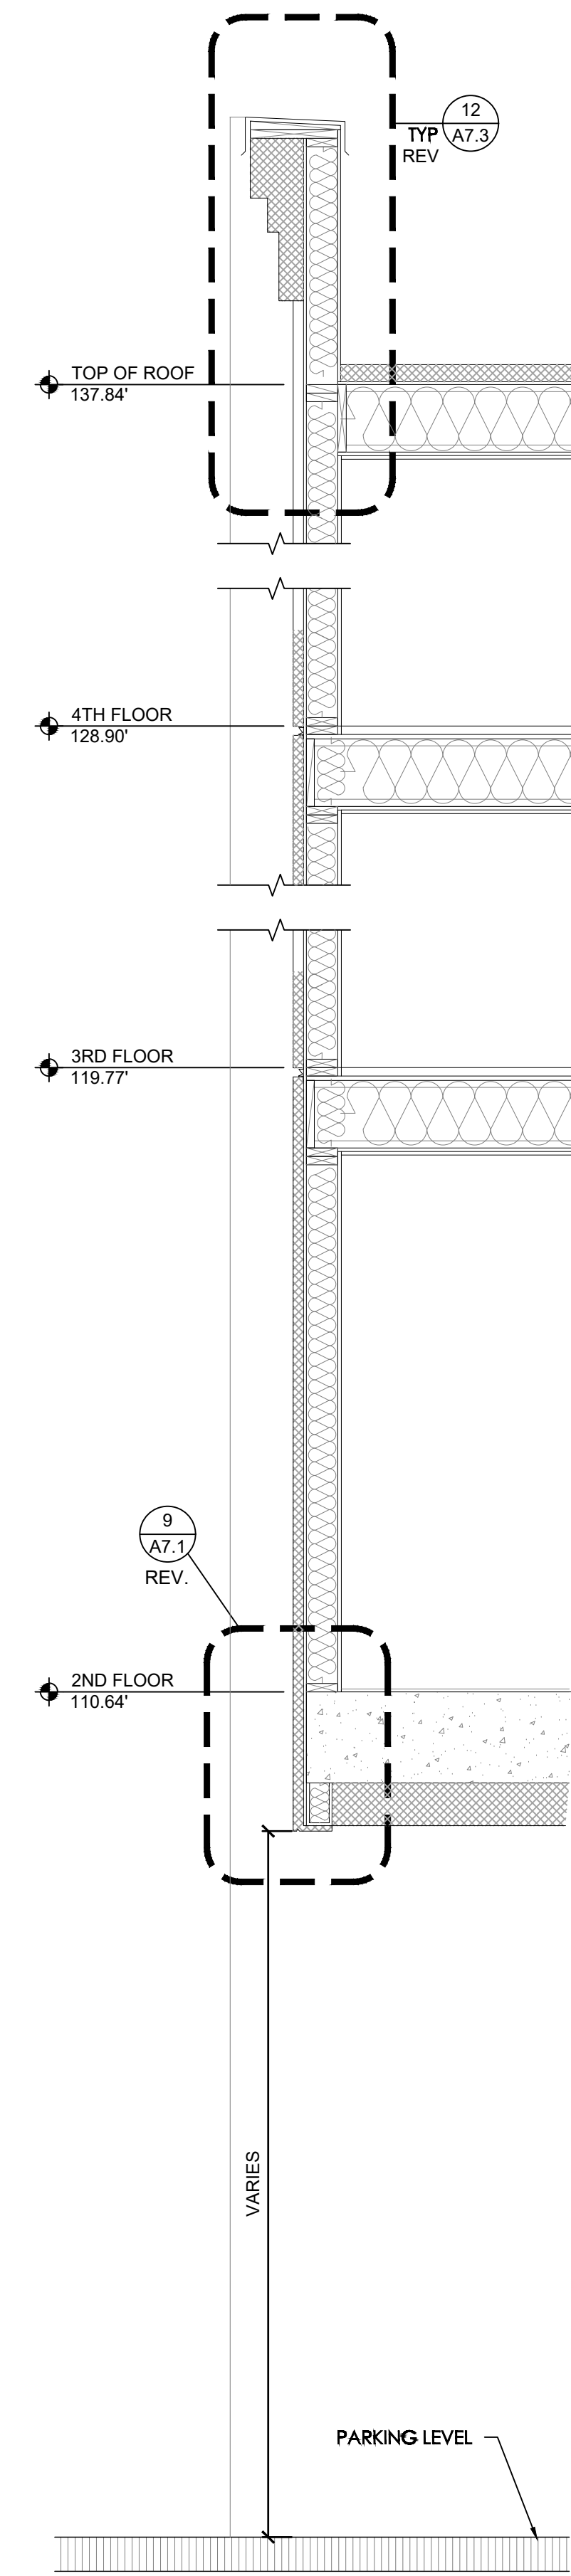


1 TYP. EXT. WALL SECTION  
SCALE: 1/2" = 1'-0"

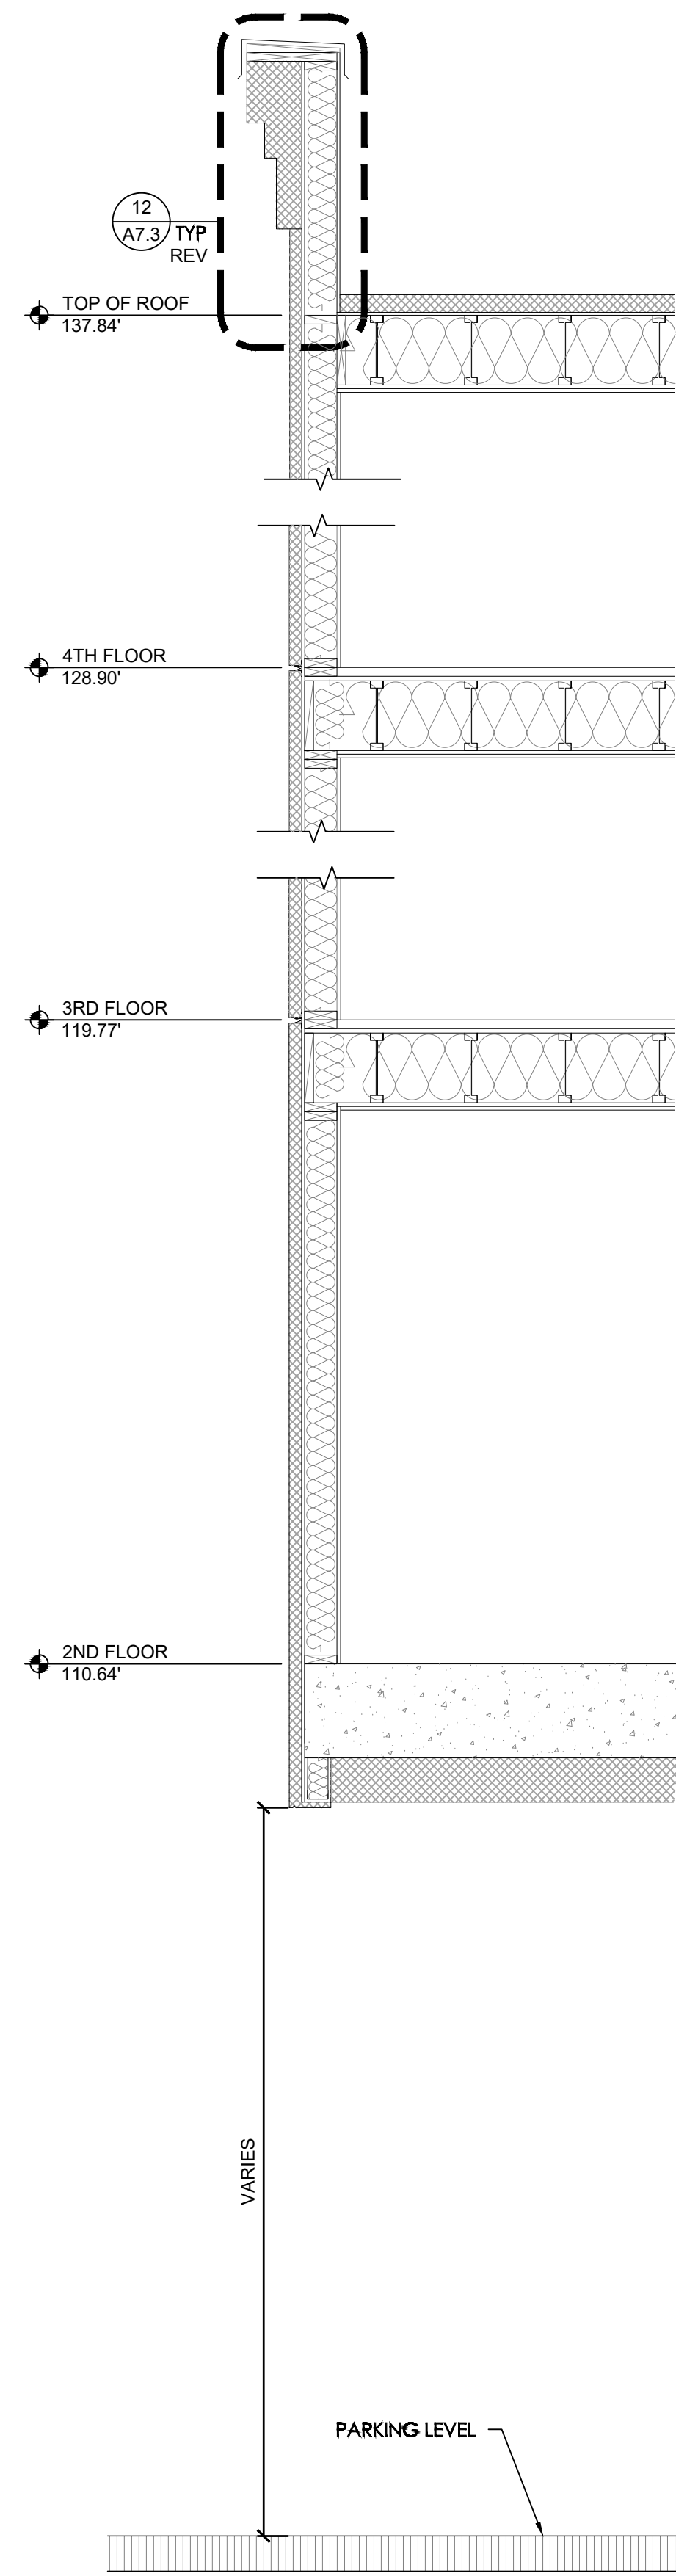


2 TYP. EXT. WALL SECTION  
SCALE: 1/2" = 1'-0"

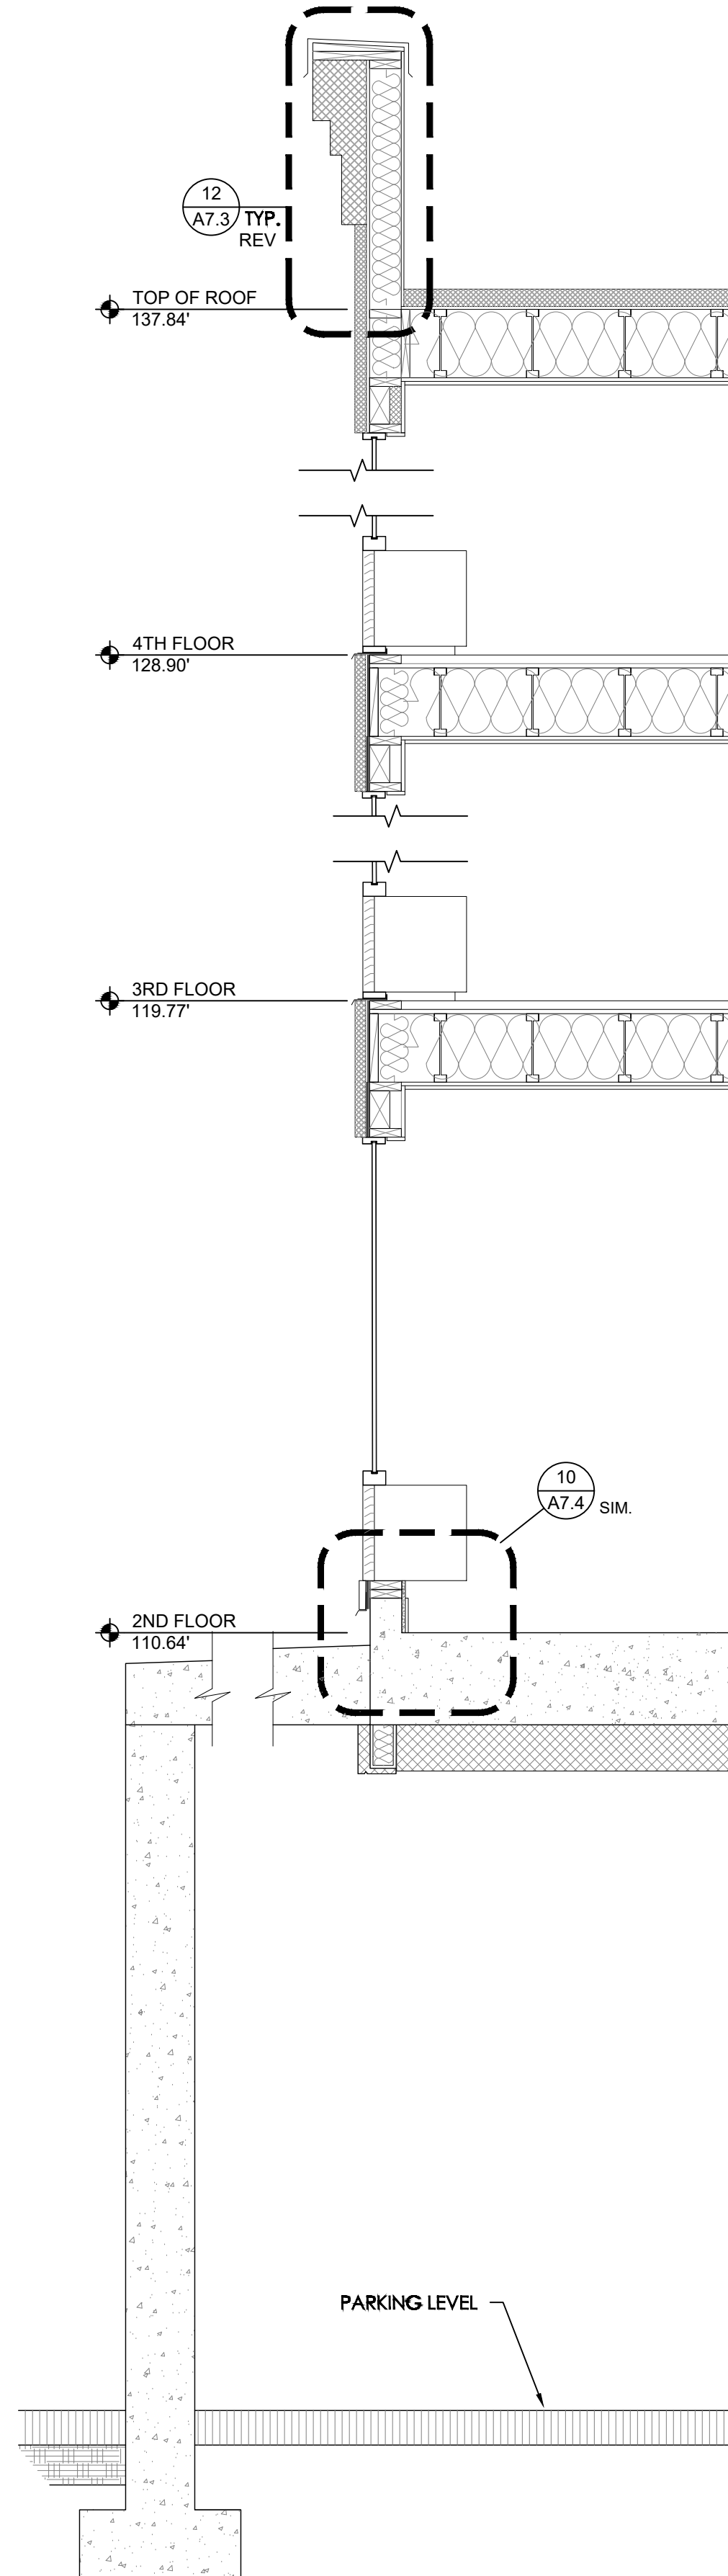

3 WALL SECTION  
SCALE: 3/4" = 1'-0"

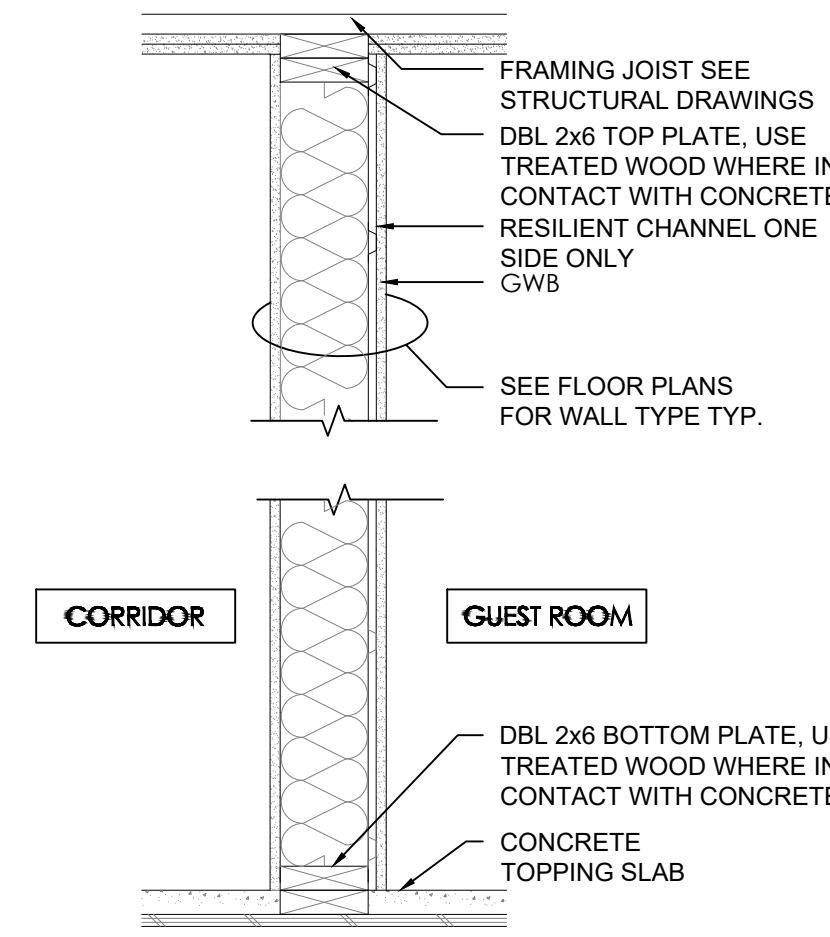


4 WALL SECTION @ CORRIDOR & GUEST  
SCALE: 1" = 1'-0"

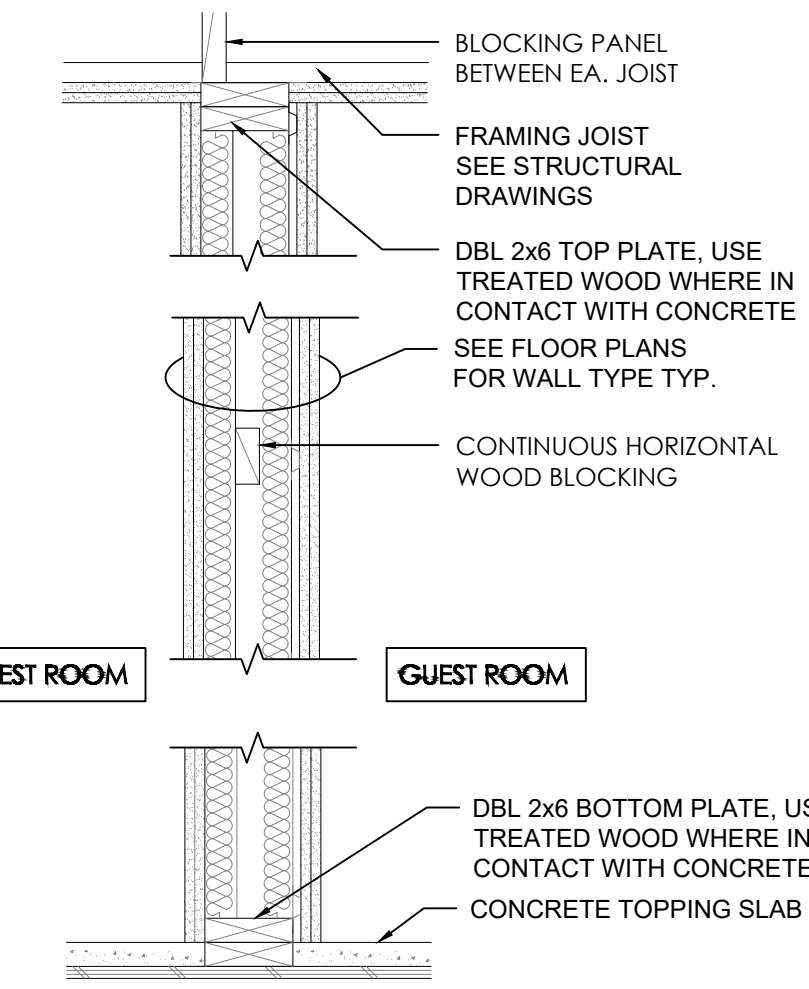


5 WALL SECTION @ GUEST ROOMS  
SCALE: 1" = 1'-0"

DETAIL REMOVED FROM SET

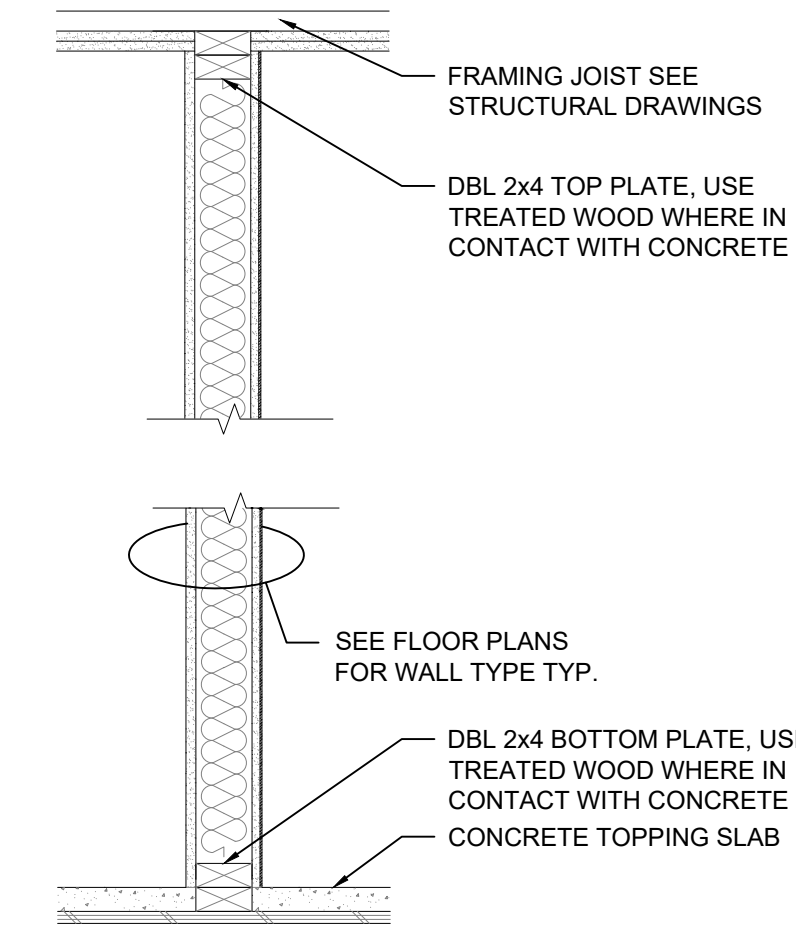


7 WALL SECTION @ BATH & GUEST  
SCALE: 1" = 1'-0"

6 HVAC UNIT SILL DETAIL  
SCALE: 1" = 1'-0"

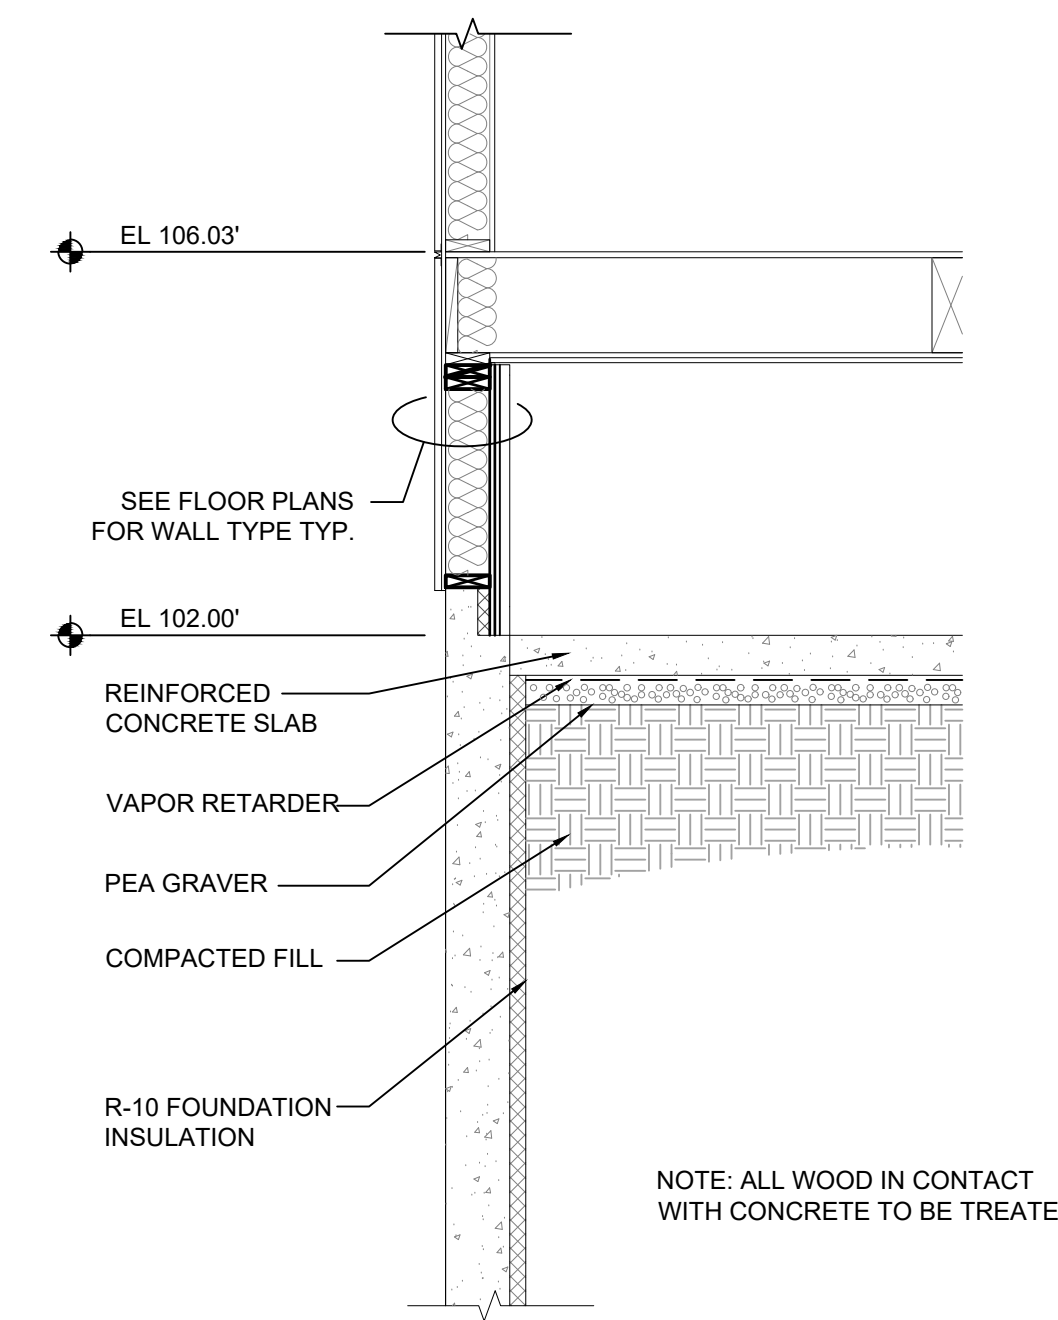

8 SECTION @ STAIR  
SCALE: 1" = 1'-0"

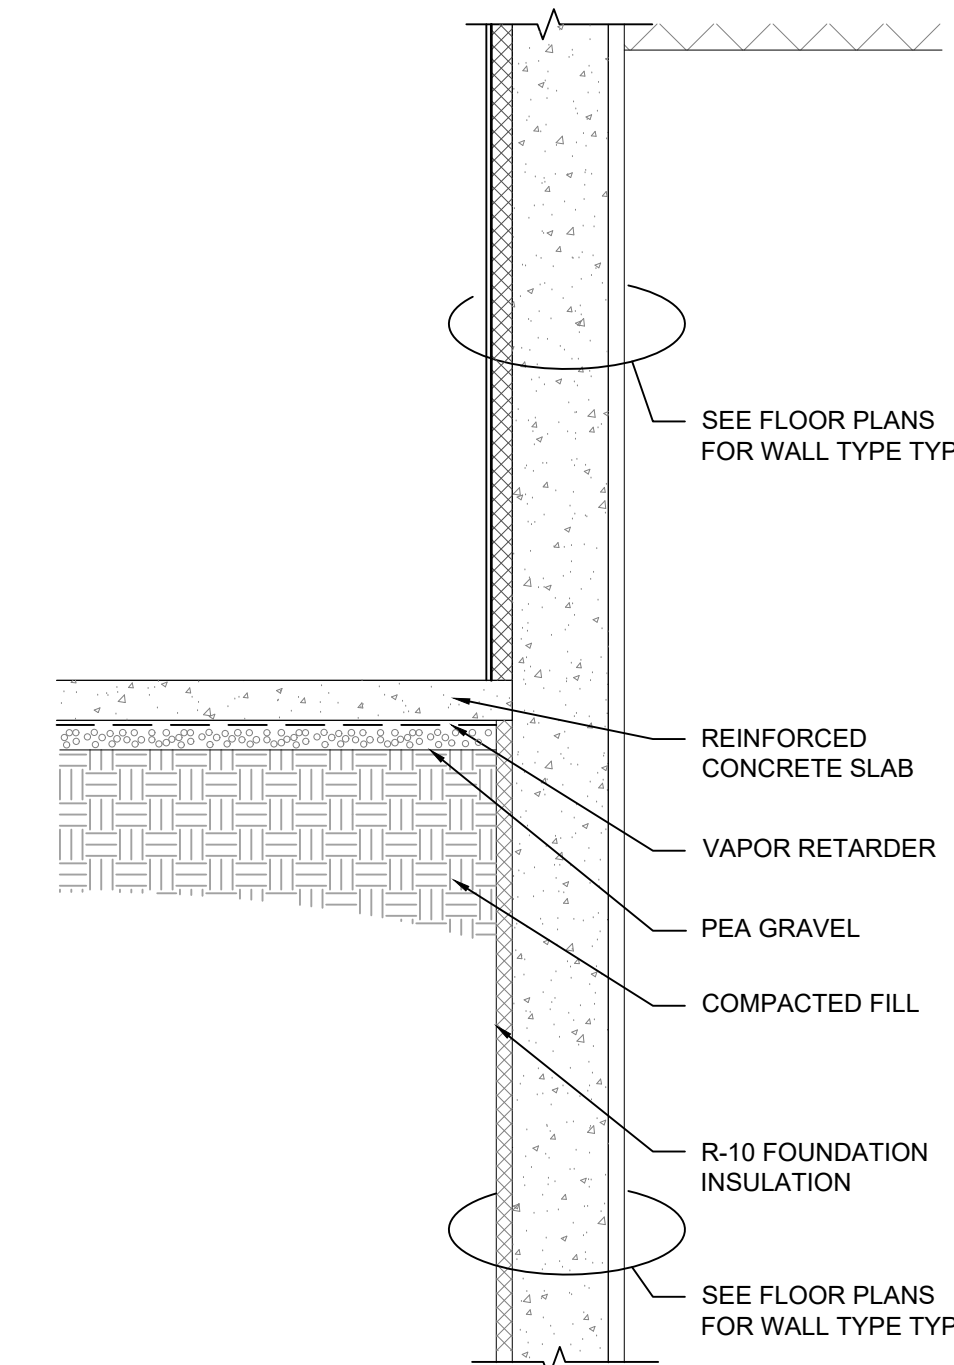

9 SECTION @ STAIR  
SCALE: 1" = 1'-0"

ISSUE DATE 09/25/23  
PROGRESS SET

REV	DATE	COMMENT
1	03.03.2023	AC RESPONSE
2	08.14.2023	CORRECTIONS
3	09.25.2023	CORRECTIONS
4	10.17.2023	CORRECTIONS
5	12.21.2023	CORRECTIONS

City of Puyallup  
Development & Permitting Services  
ISSUED PERMIT

Building	Planning
Engineering	Public Works
Fire	Traffic


8677 REGISTERED ARCHITECT  
RHONDA A. GILLOGLY  
STATE OF WASHINGTON  
12/21/2023

WALL SECTIONS  
ADDITION TO HAMPTON INN & SUITES  
1515 S MERIDIAN  
PUYALLUP, WA 98371  
HAMPTON INN & SUITES

TITLE PROJECT CLIENT

JOB NO: 210158



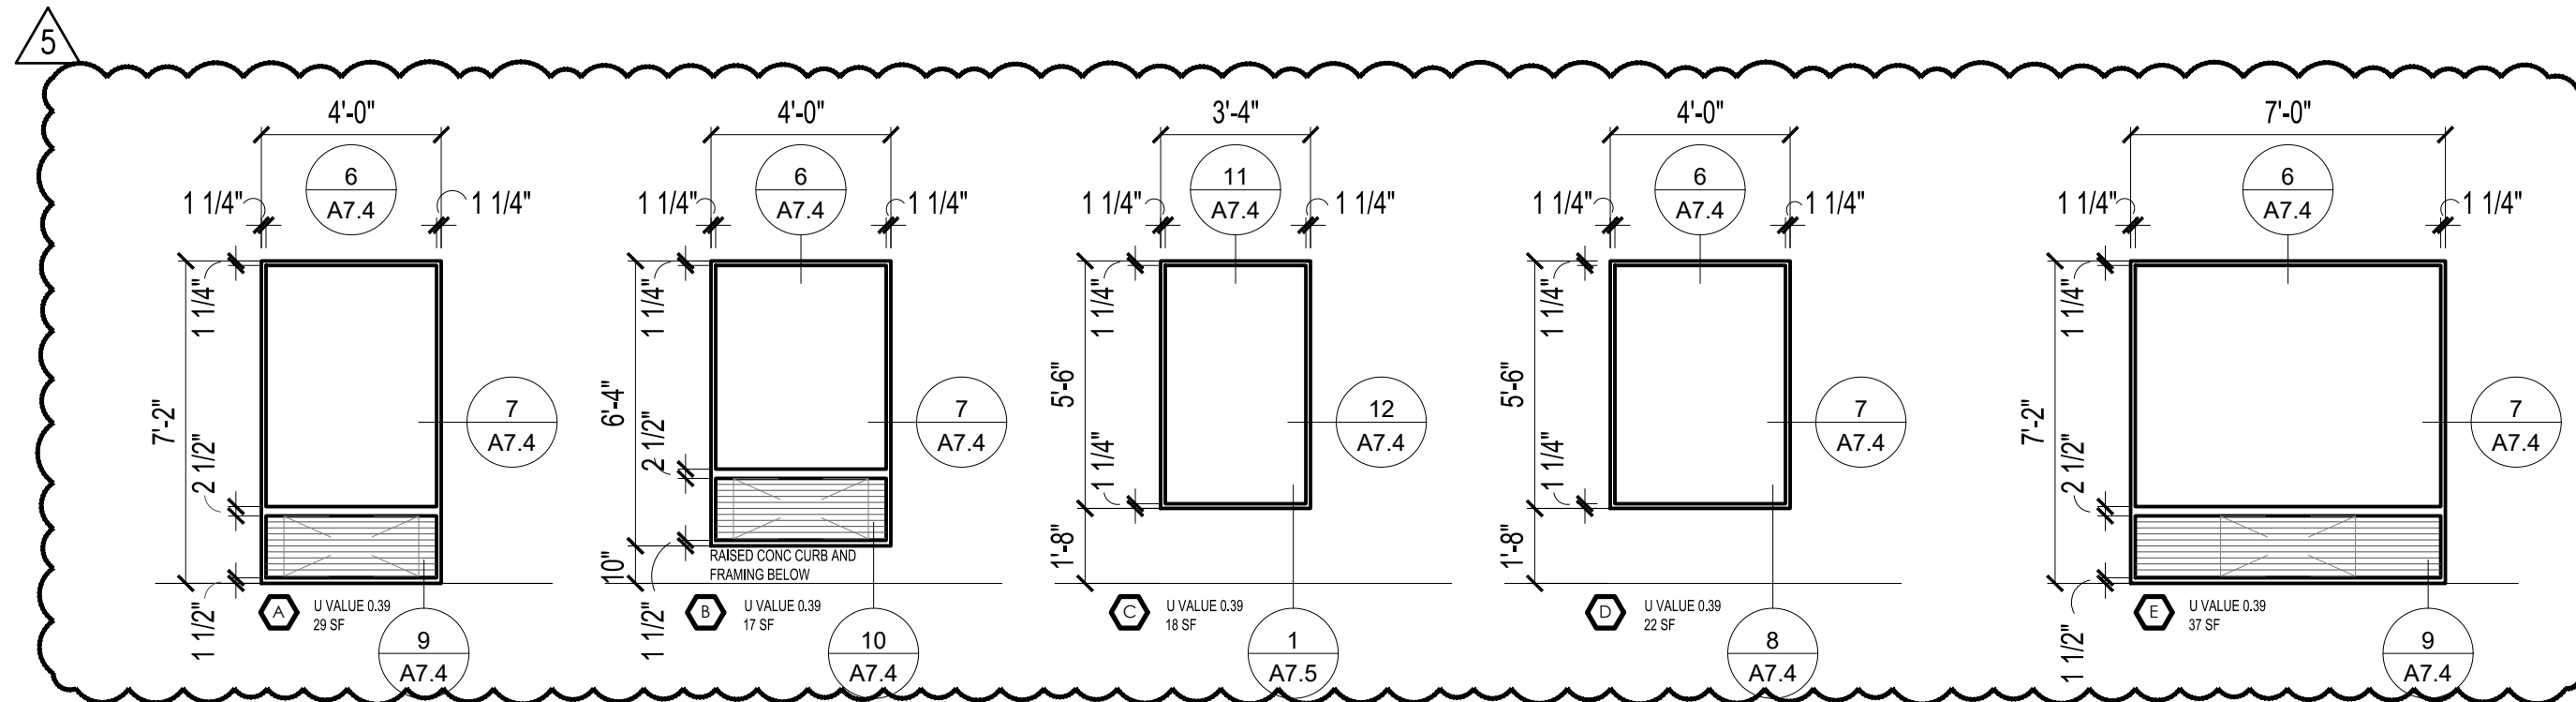

**1 WINDOW TYPES**


24 x 36 - 1/4" = 1'-0"  
12 x 18 - 1/8" = 1'-0"

\*SEE DETAILS ON A7.4

GLAZING			
EXTERIOR WALL AREA:	11,094 S.F.		
VERTICAL + OVERHEAD GLAZING:	1,533 S.F.		
% OF GLAZING	14 %		
PROJECTION FACTOR			
ELEVATION	'A'	'B'	PF
NORTH STAIRWELL	1.58'	14.5'	.109
NORTH	.375'	10.91'/A	.034
SOUTH	.375'	10.91'/A	.034
WEST	.375'	10.91'/A	.034
THESE MEASUREMENTS SHOW THE BEST AVAILABLE PF AT THE 4TH FLOOR. ALL ARE BELOW 0.2 THE NUMBERS DECREASE AT THE 3RD AND 2ND FLOORS.			
FENESTRATION NOTES			
1. ALL WINDOWS TO MEET MINIMUM 0.39 U-VALUE.			
2. ALL WINDOWS TO MEET 40 SHGC.			
3. ALL WINDOWS TO BEAR MANUFACTURER'S CERTIFIED LABEL.			
4. ALL WINDOWS TO BE FILLED WITH ARGON GAS.			
5. ALL WINDOWS TO HAVE AN EMISSIVITY OF .15 TO .08.			
6. ALL WINDOWS WITH TEMPERED GLAZING TO BEAR THE ETCHED LABEL.			

WSEC FENESTRATION REQUIREMENTS									
TYPE	MATERIAL	U-FACTOR	DIRECTION	PROJ. FACTOR	T C402.4 SHGC	T C303.1.3(3) VT CLEAR/TINTED	NO. OF UNITS	AREA	TOTAL AREA
A	ALUM	.39	N	<.20	.53	.60/.30	3	29 SF	87 SF
A	ALUM	.39	E	<.20	.40	.60/.30	18	29 SF	522 SF
A	ALUM	.39	S	<.20	.40	.60/.30	3	29 SF	87 SF
B	ALUM	.39	E	<.20	.40	.60/.30	3	17 SF	81 SF
C	ALUM	.39	N	<.20	.53	.60/.30	3	18 SF	51 SF
D	ALUM	.39	N	<.20	.53	.60/.30	6	22 SF	132 SF
D	ALUM	.39	E	<.20	.40	.60/.30	3	22 SF	66 SF
D	ALUM	.39	W	<.20	.40	.60/.30	18	22 SF	396 SF
E	ALUM	.39	E	<.20	.40	.60/.30	3	37 SF	111 SF
TOTAL								1,533 SF	

**REVISION 1 OF 2  
(27 PAGES)  
B-20-0078**

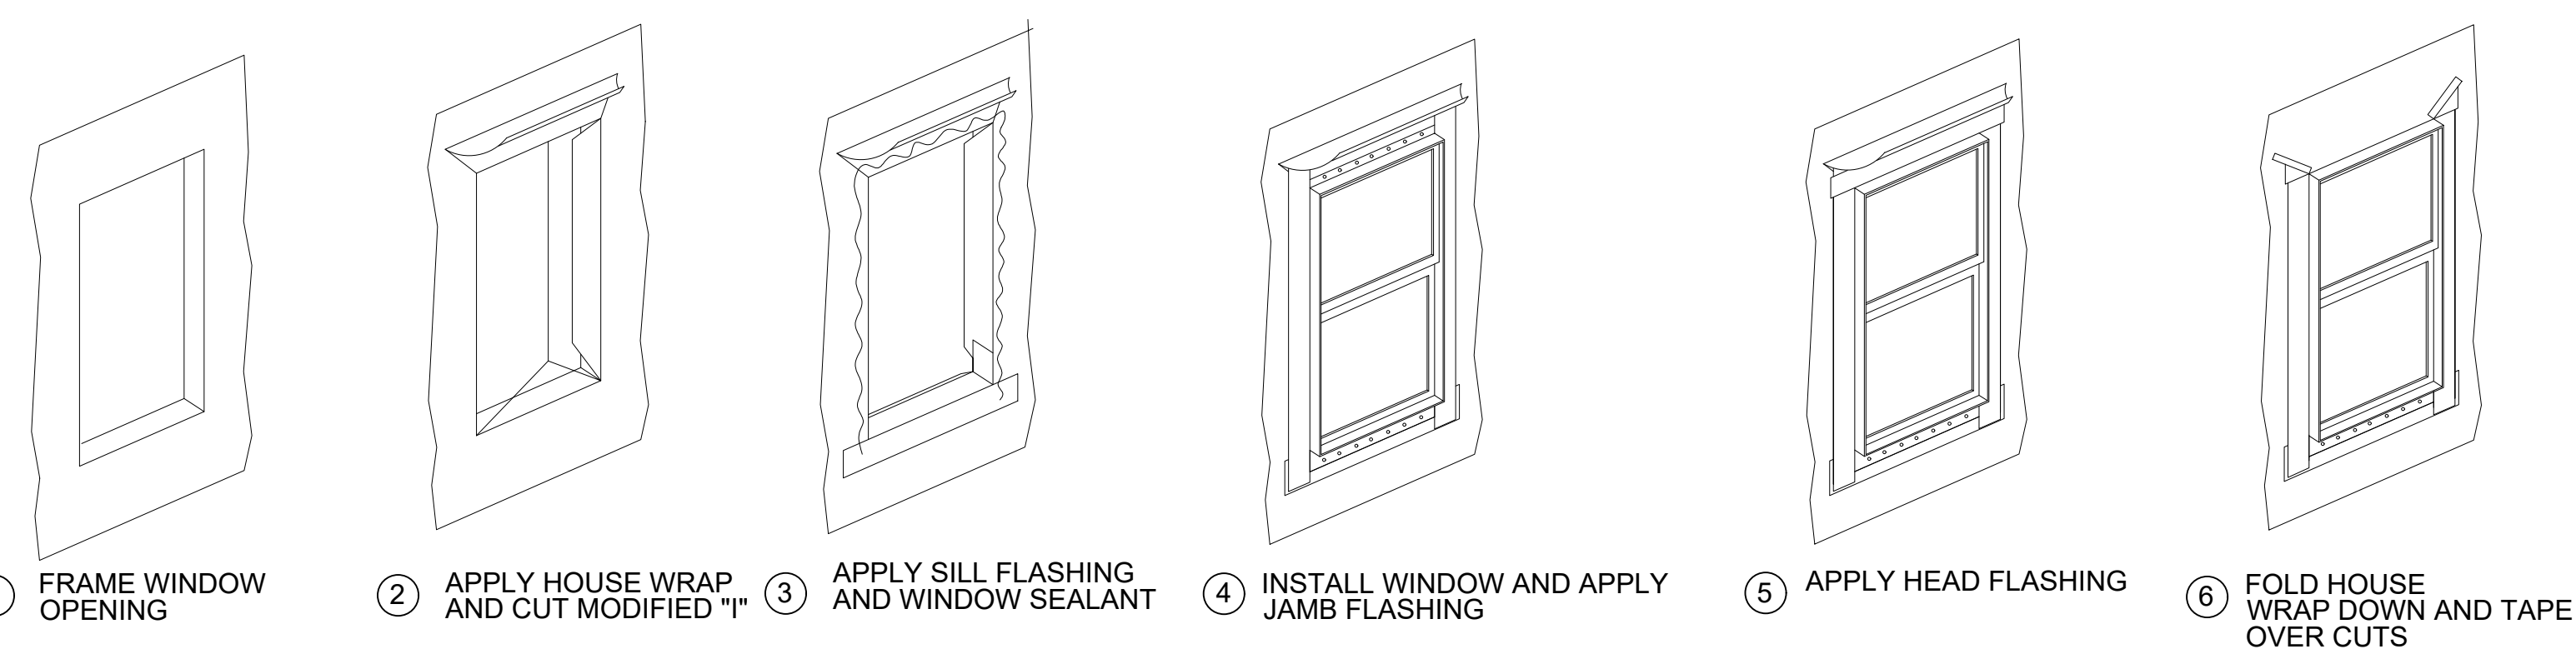

**2 TYP. WINDOW FLASHING APPLICATION FOR STUCCO**

24 x 36 - 1/4" = 1'-0"  
12 x 18 - 1/8" = 1'-0"

\* SEE WEATHERIZATION CONSULTANT SET FOR EIFS FLASHING APPLICATION

DETAILS BEING RELOCATED TO A7 SERIES SHEETS

**KNIT**  
909 S. 336TH ST.  
SUITE 107  
FEDERAL WAY, WA 98003  
knitstudios.com

THESE DOCUMENTS HAVE BEEN PRODUCED AS AN INSTRUMENT OF SERVICE AND ARE INTENDED SOLELY FOR THE PURPOSE OF CONSTRUCTING, USING AND MAINTAINING THE PROJECT. KNIT AS THE ARCHITECT OF RECORD FOR THE PROJECT RETAINS OWNERSHIP OF THESE DOCUMENTS.  
ANY USE OF THESE DOCUMENTS OR USE OF THIS DESIGN BEYOND THE CONCEPTS DESCRIBED HEREIN IN WHOLE OR PART BY ANY MEANS WHATSOEVER IS STRICTLY PROHIBITED EXCEPT BY WRITTEN CONSENT OF KNIT.  
REPRODUCTION OF THIS DOCUMENT IS STRICTLY PROHIBITED EXCEPT BY WRITTEN CONSENT OF KNIT.  
COPYRIGHT 2021 KNIT

ISSUE DATE 09/25/23  
PROGRESS SET

REV	DATE	COMMENT
1	03.03.2023	AC RESPONSE
2	08.14.2023	CORRECTIONS
3	09.25.2023	CORRECTIONS
4	10.17.2023	CORRECTIONS
5	12.21.2023	CORRECTIONS

City of Puyallup  
Development & Permitting Services  
ISSUED PERMIT

Building	Planning
Engineering	Public Works
Fire	Traffic


8677 REGISTERED ARCHITECT  
RHONDA A. GILLOGLY  
STATE OF WASHINGTON  
12/21/2023

WINDOW SCHEDULE


ADDITION TO HAMPTON INN & SUITES

1515 S MERIDIAN  
PUYALLUP, WA 98371  
HAMPTON INN & SUITES


TITLE	PROJECT	CLIENT
JOB NO: 210158		
A6.2		

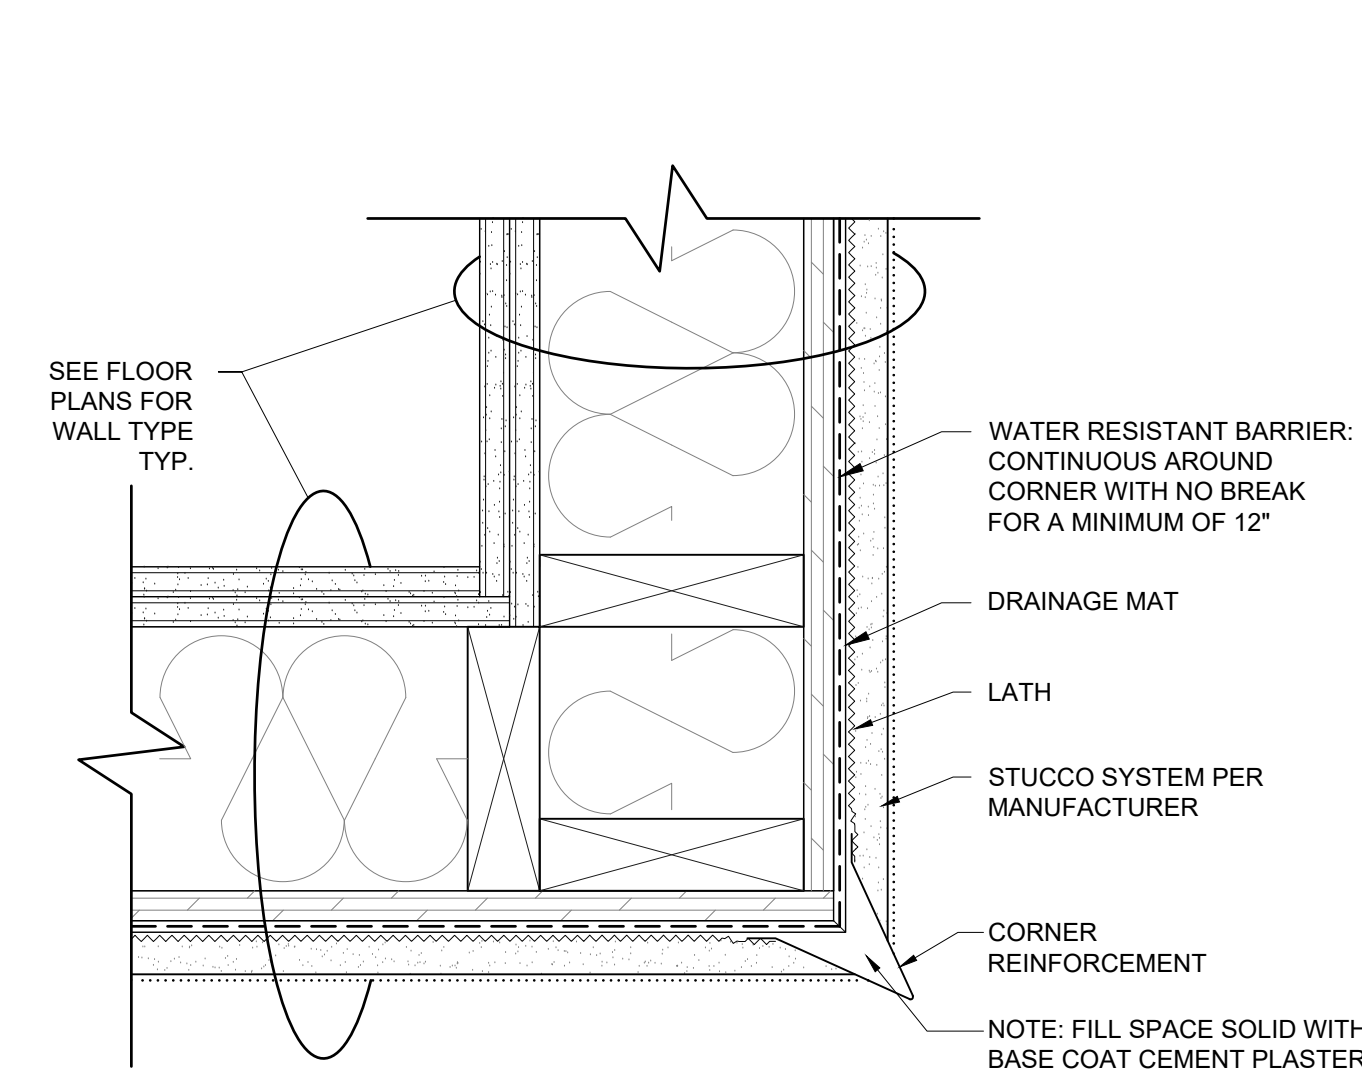


1 STUCCO OUTSIDE CORNER  
SCALE: 3" = 1' - 0"

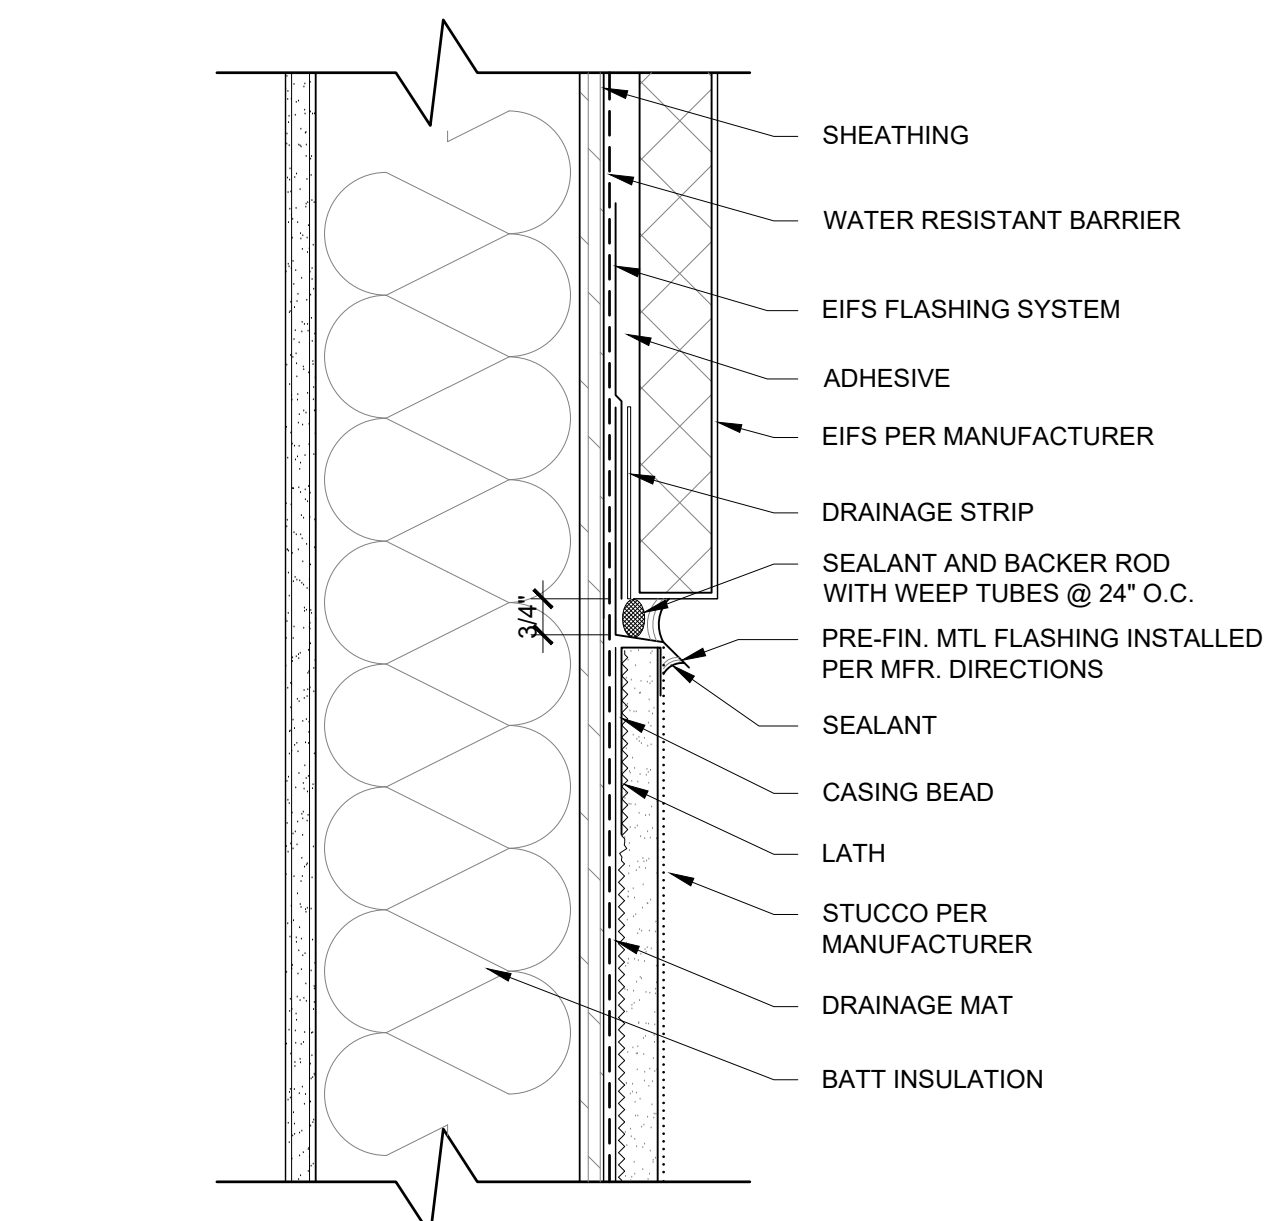


2 STUCCO-EIFS TRANSITION  
SCALE: 3" = 1' - 0"

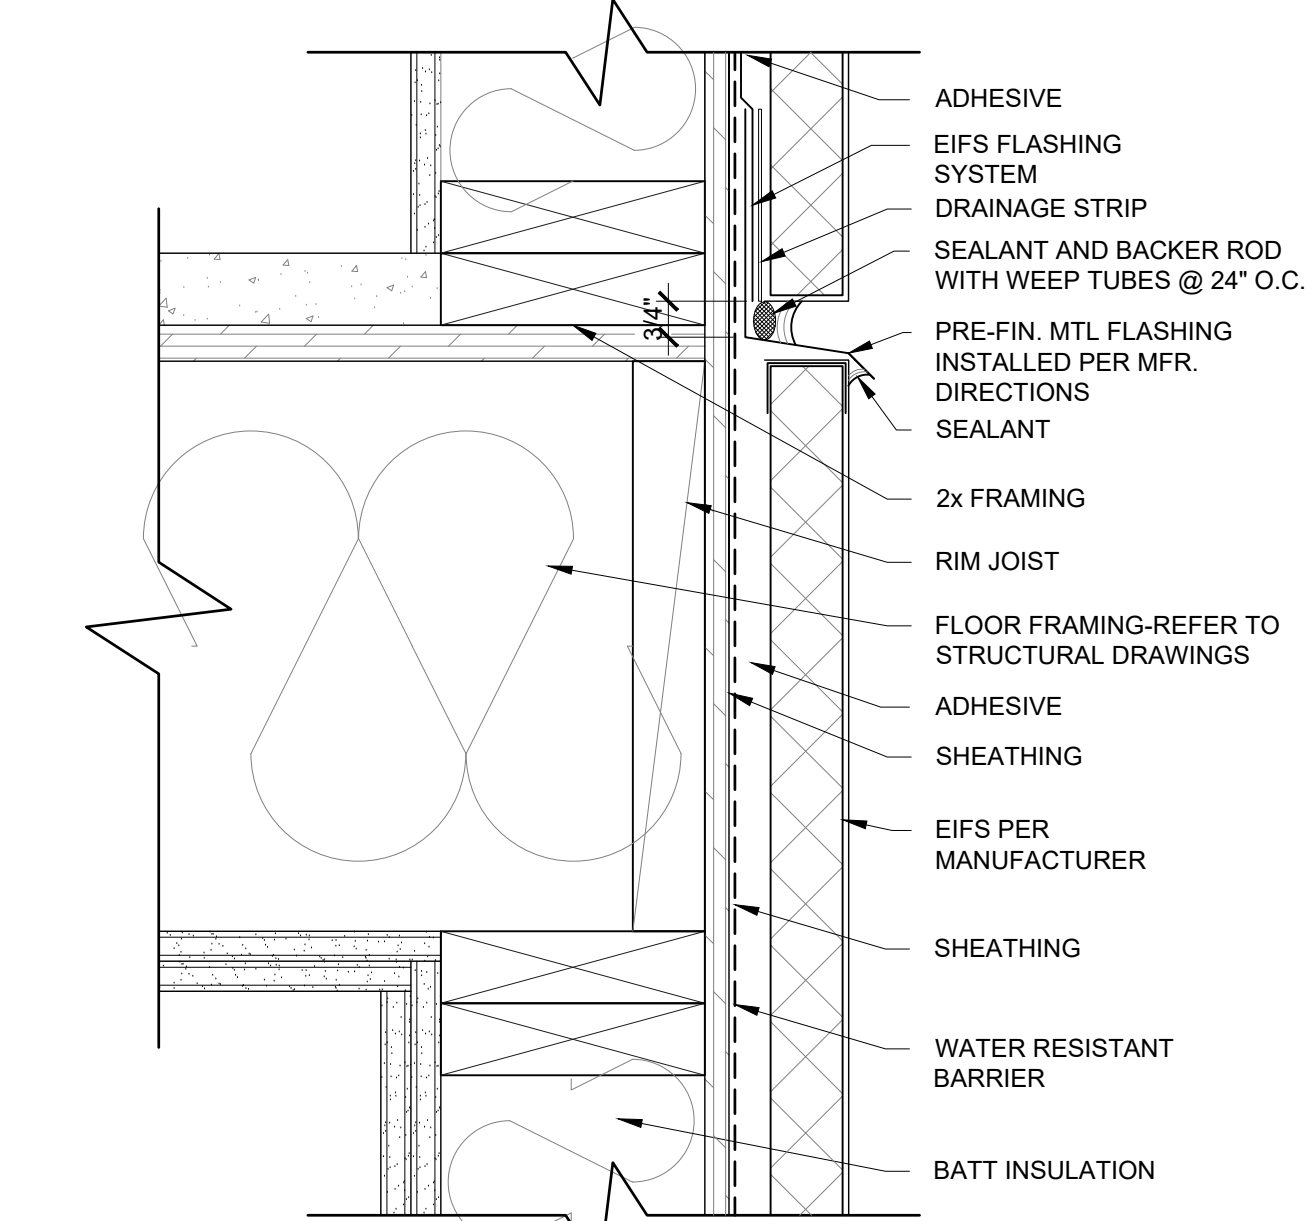


3 EIFS CONTROL JOINT  
SCALE: 3" = 1' - 0"

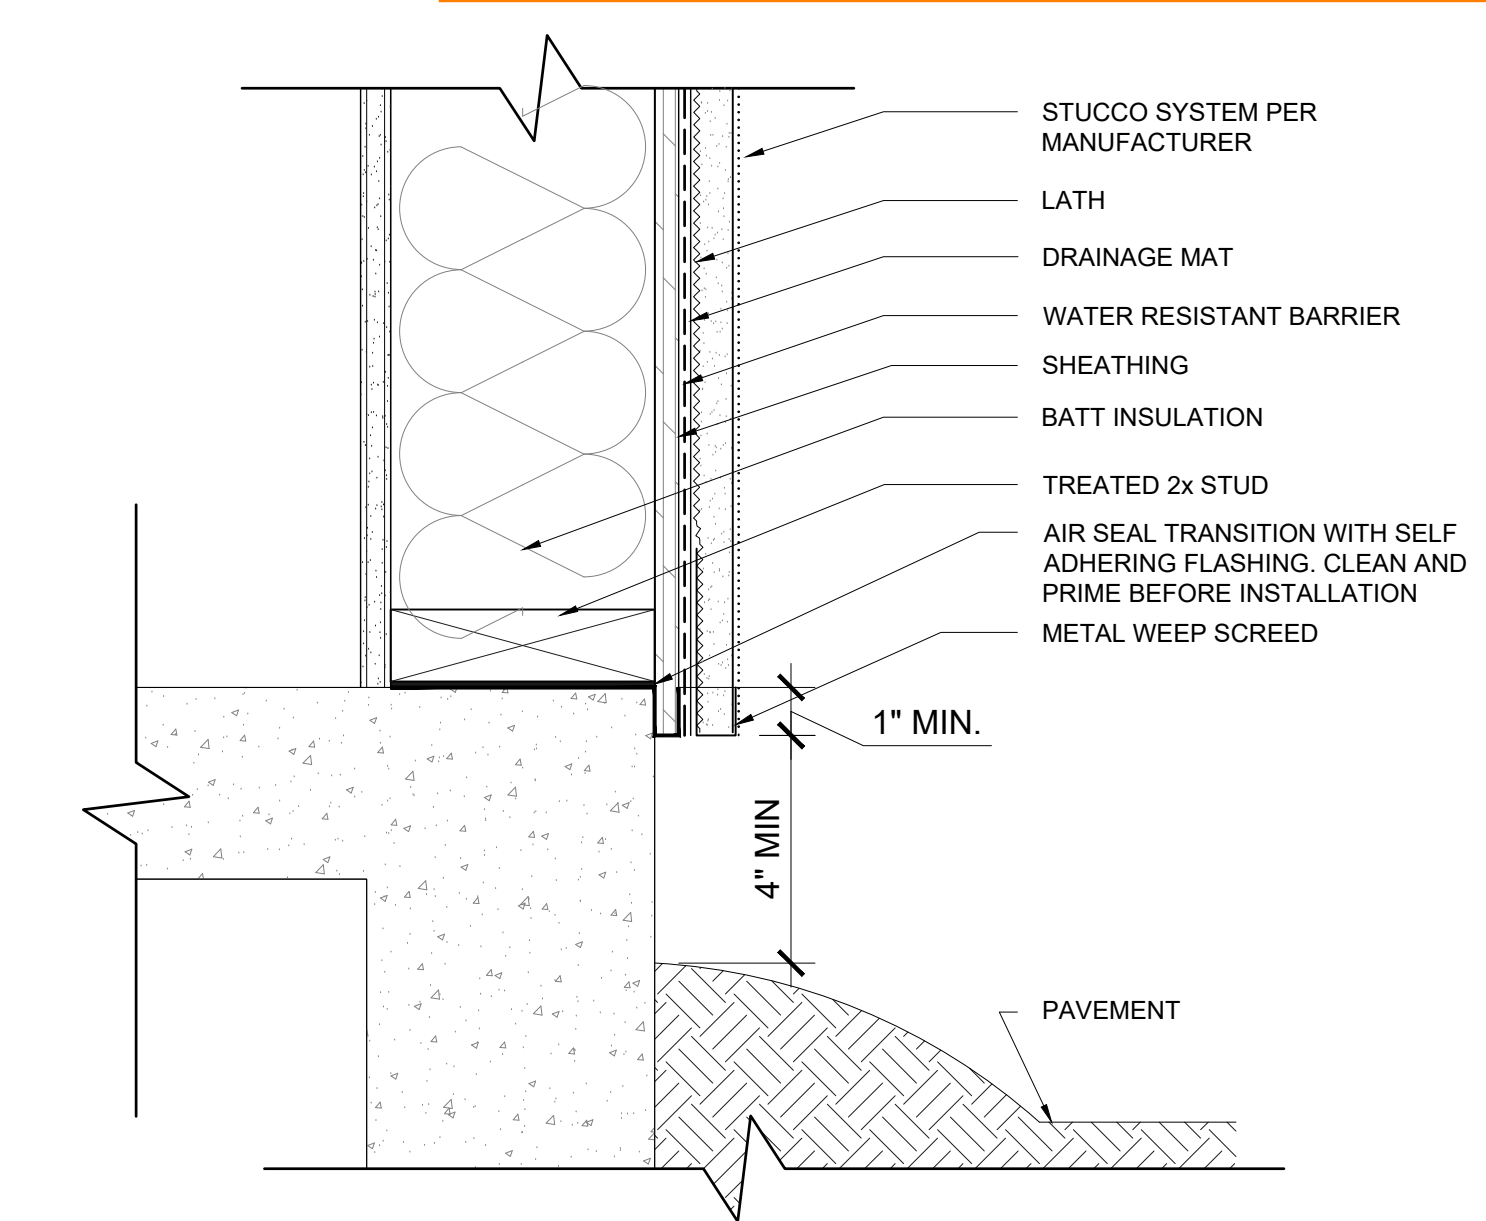


4 STUCCO DRIP TERMINATION  
SCALE: 3" = 1' - 0"

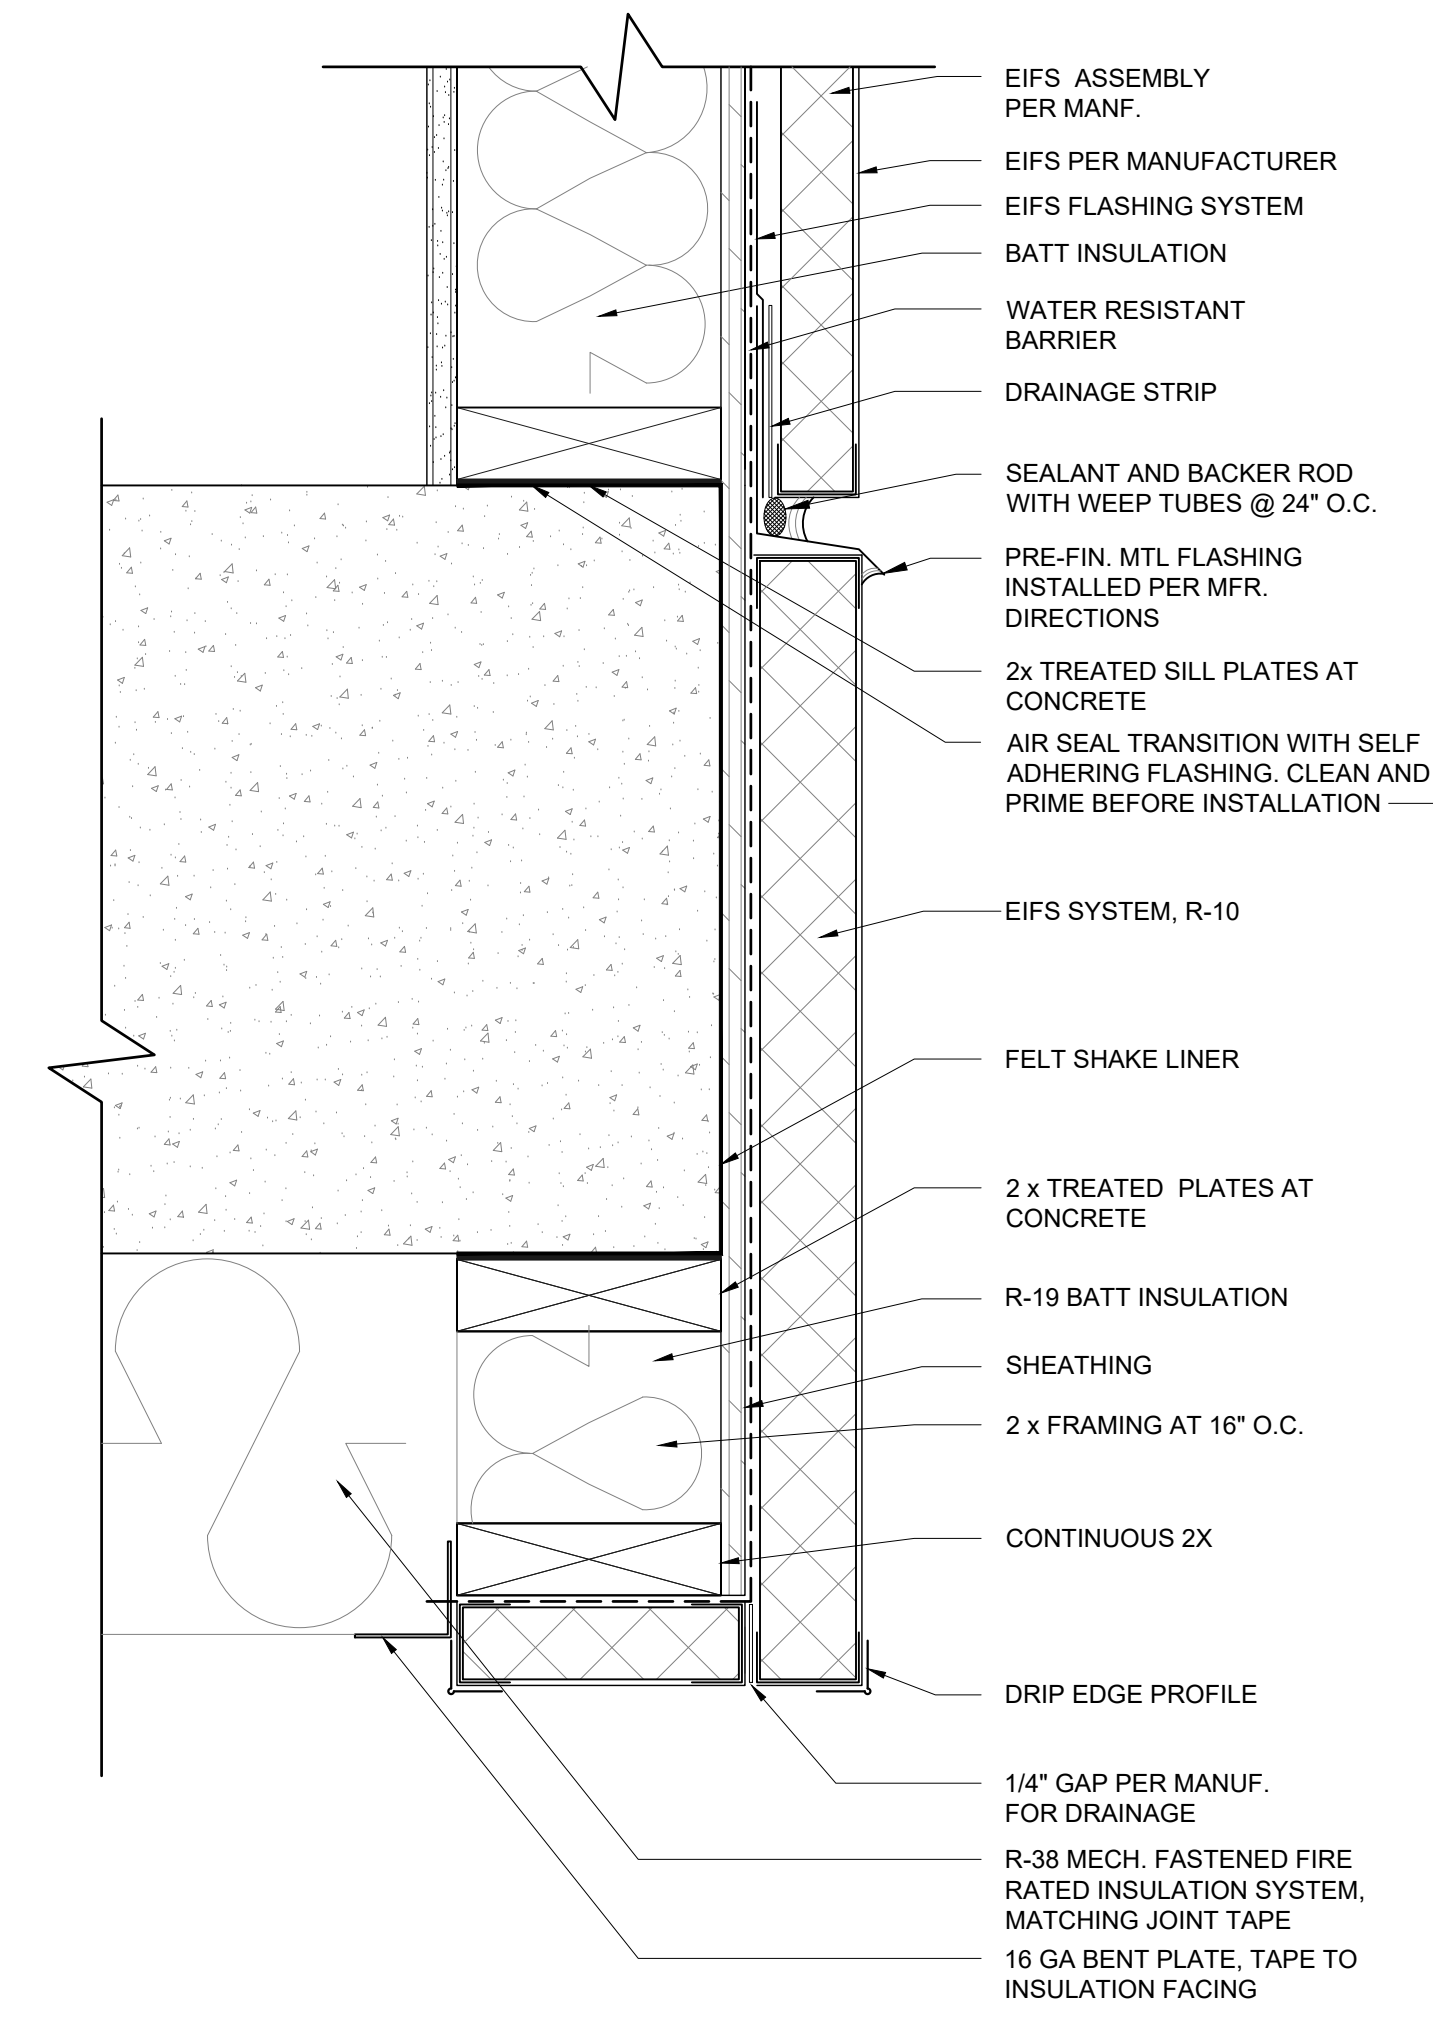

9 EIFS DRIP @ OVER PARKING  
SCALE: 3" = 1' - 0"

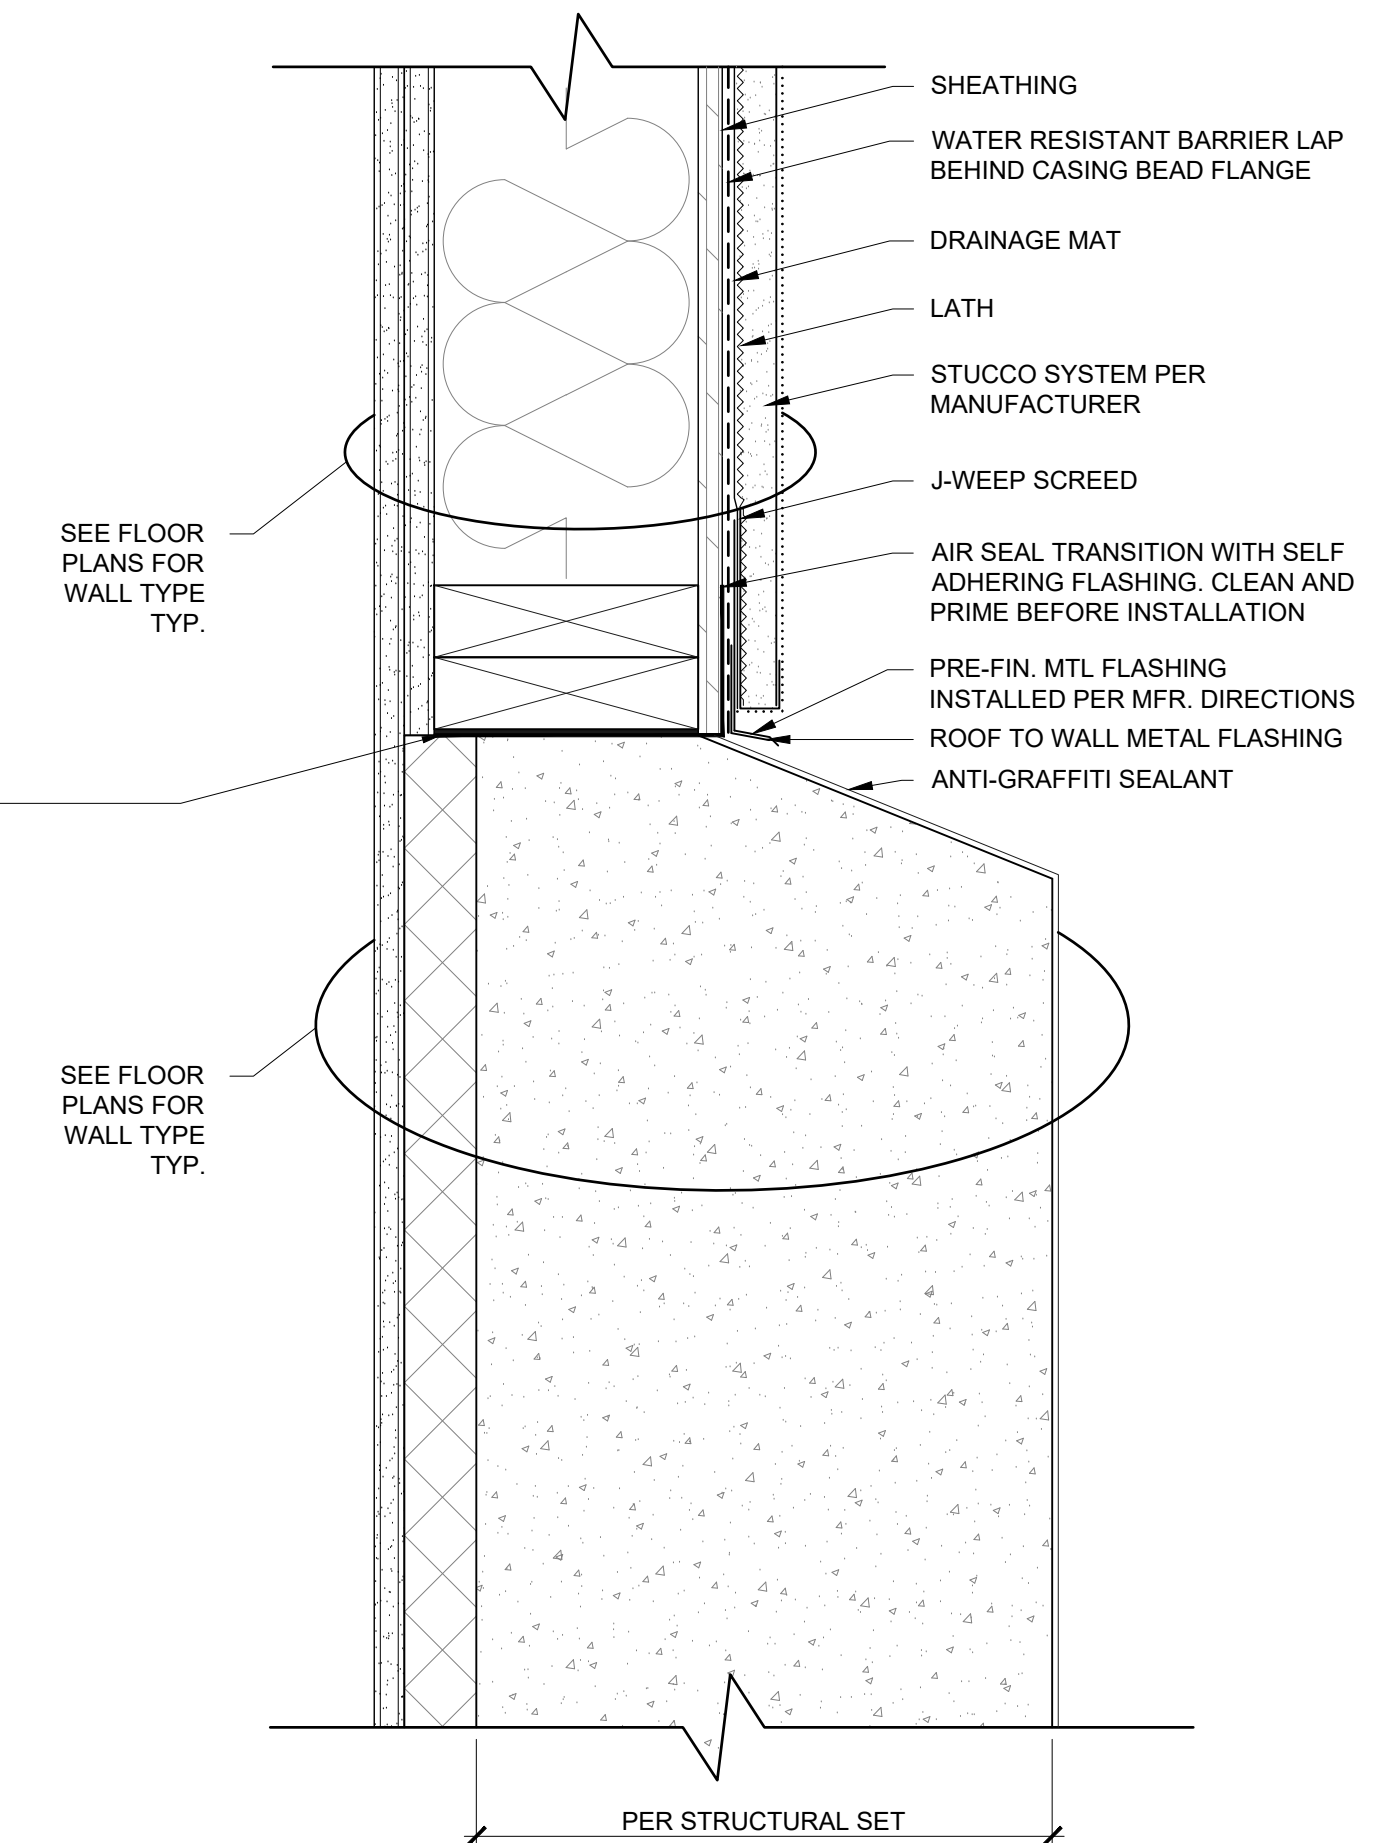

10 STUCCO @ STAIRS  
SCALE: 3" = 1' - 0"

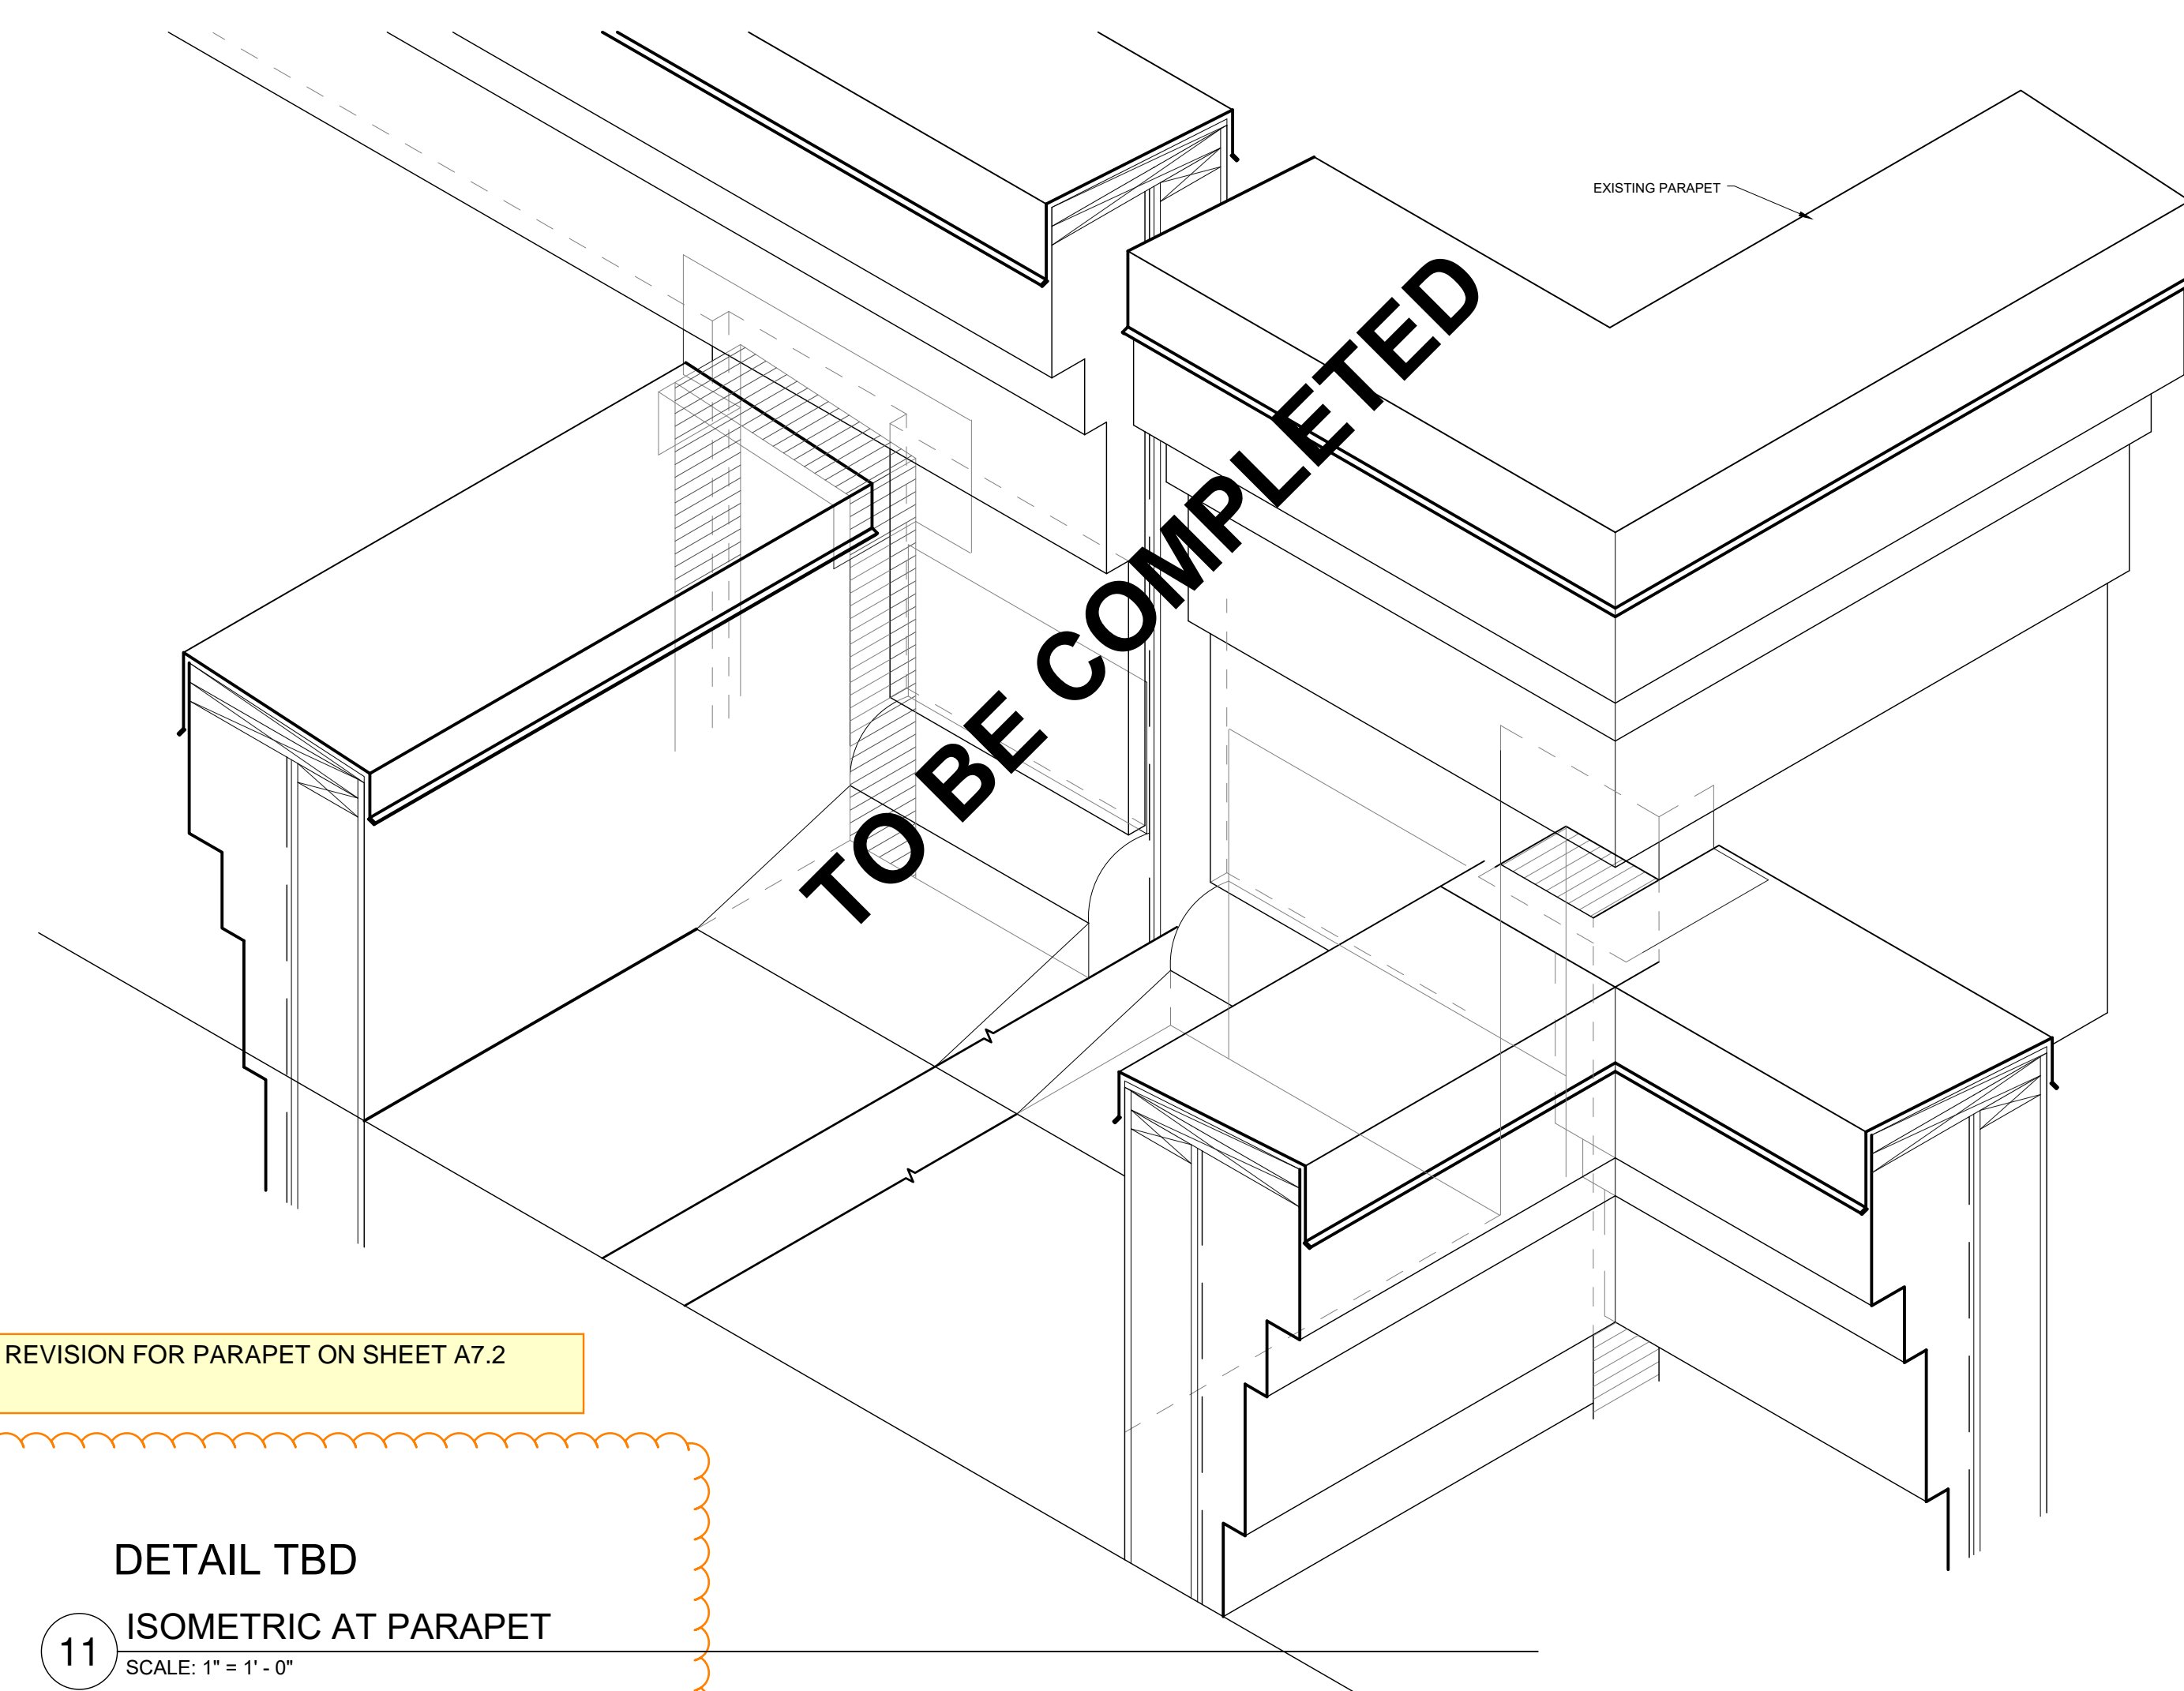

SEE REVISION FOR PARAPET ON SHEET A7.2

11 ISOMETRIC AT PARAPET  
SCALE: 1" = 1' - 0"

ISSUE DATE 09/25/23  
PROGRESS SET

REV	DATE	COMMENT
1	03.03.2023	AC RESPONSE
2	08.14.2023	CORRECTIONS
3	09.25.2023	CORRECTIONS
4	10.17.2023	CORRECTIONS
5	12.21.2023	CORRECTIONS


City of Puyallup  
Development & Permitting Services  
ISSUED PERMIT

Building	Planning
Engineering	Public Works
Fire	Traffic

8677 REGISTERED ARCHITECT  
RHONDA A. GILLOGLY  
STATE OF WASHINGTON  
12/21/2023


EXTERIOR DETAILS  
ADDITION TO HAMPTON INN & SUITES  
1515 S MERIDIAN  
PUYALLUP, WA 98371  
HAMPTON INN & SUITES

TITLE PROJECT CLIENT  
JOB NO: 210158

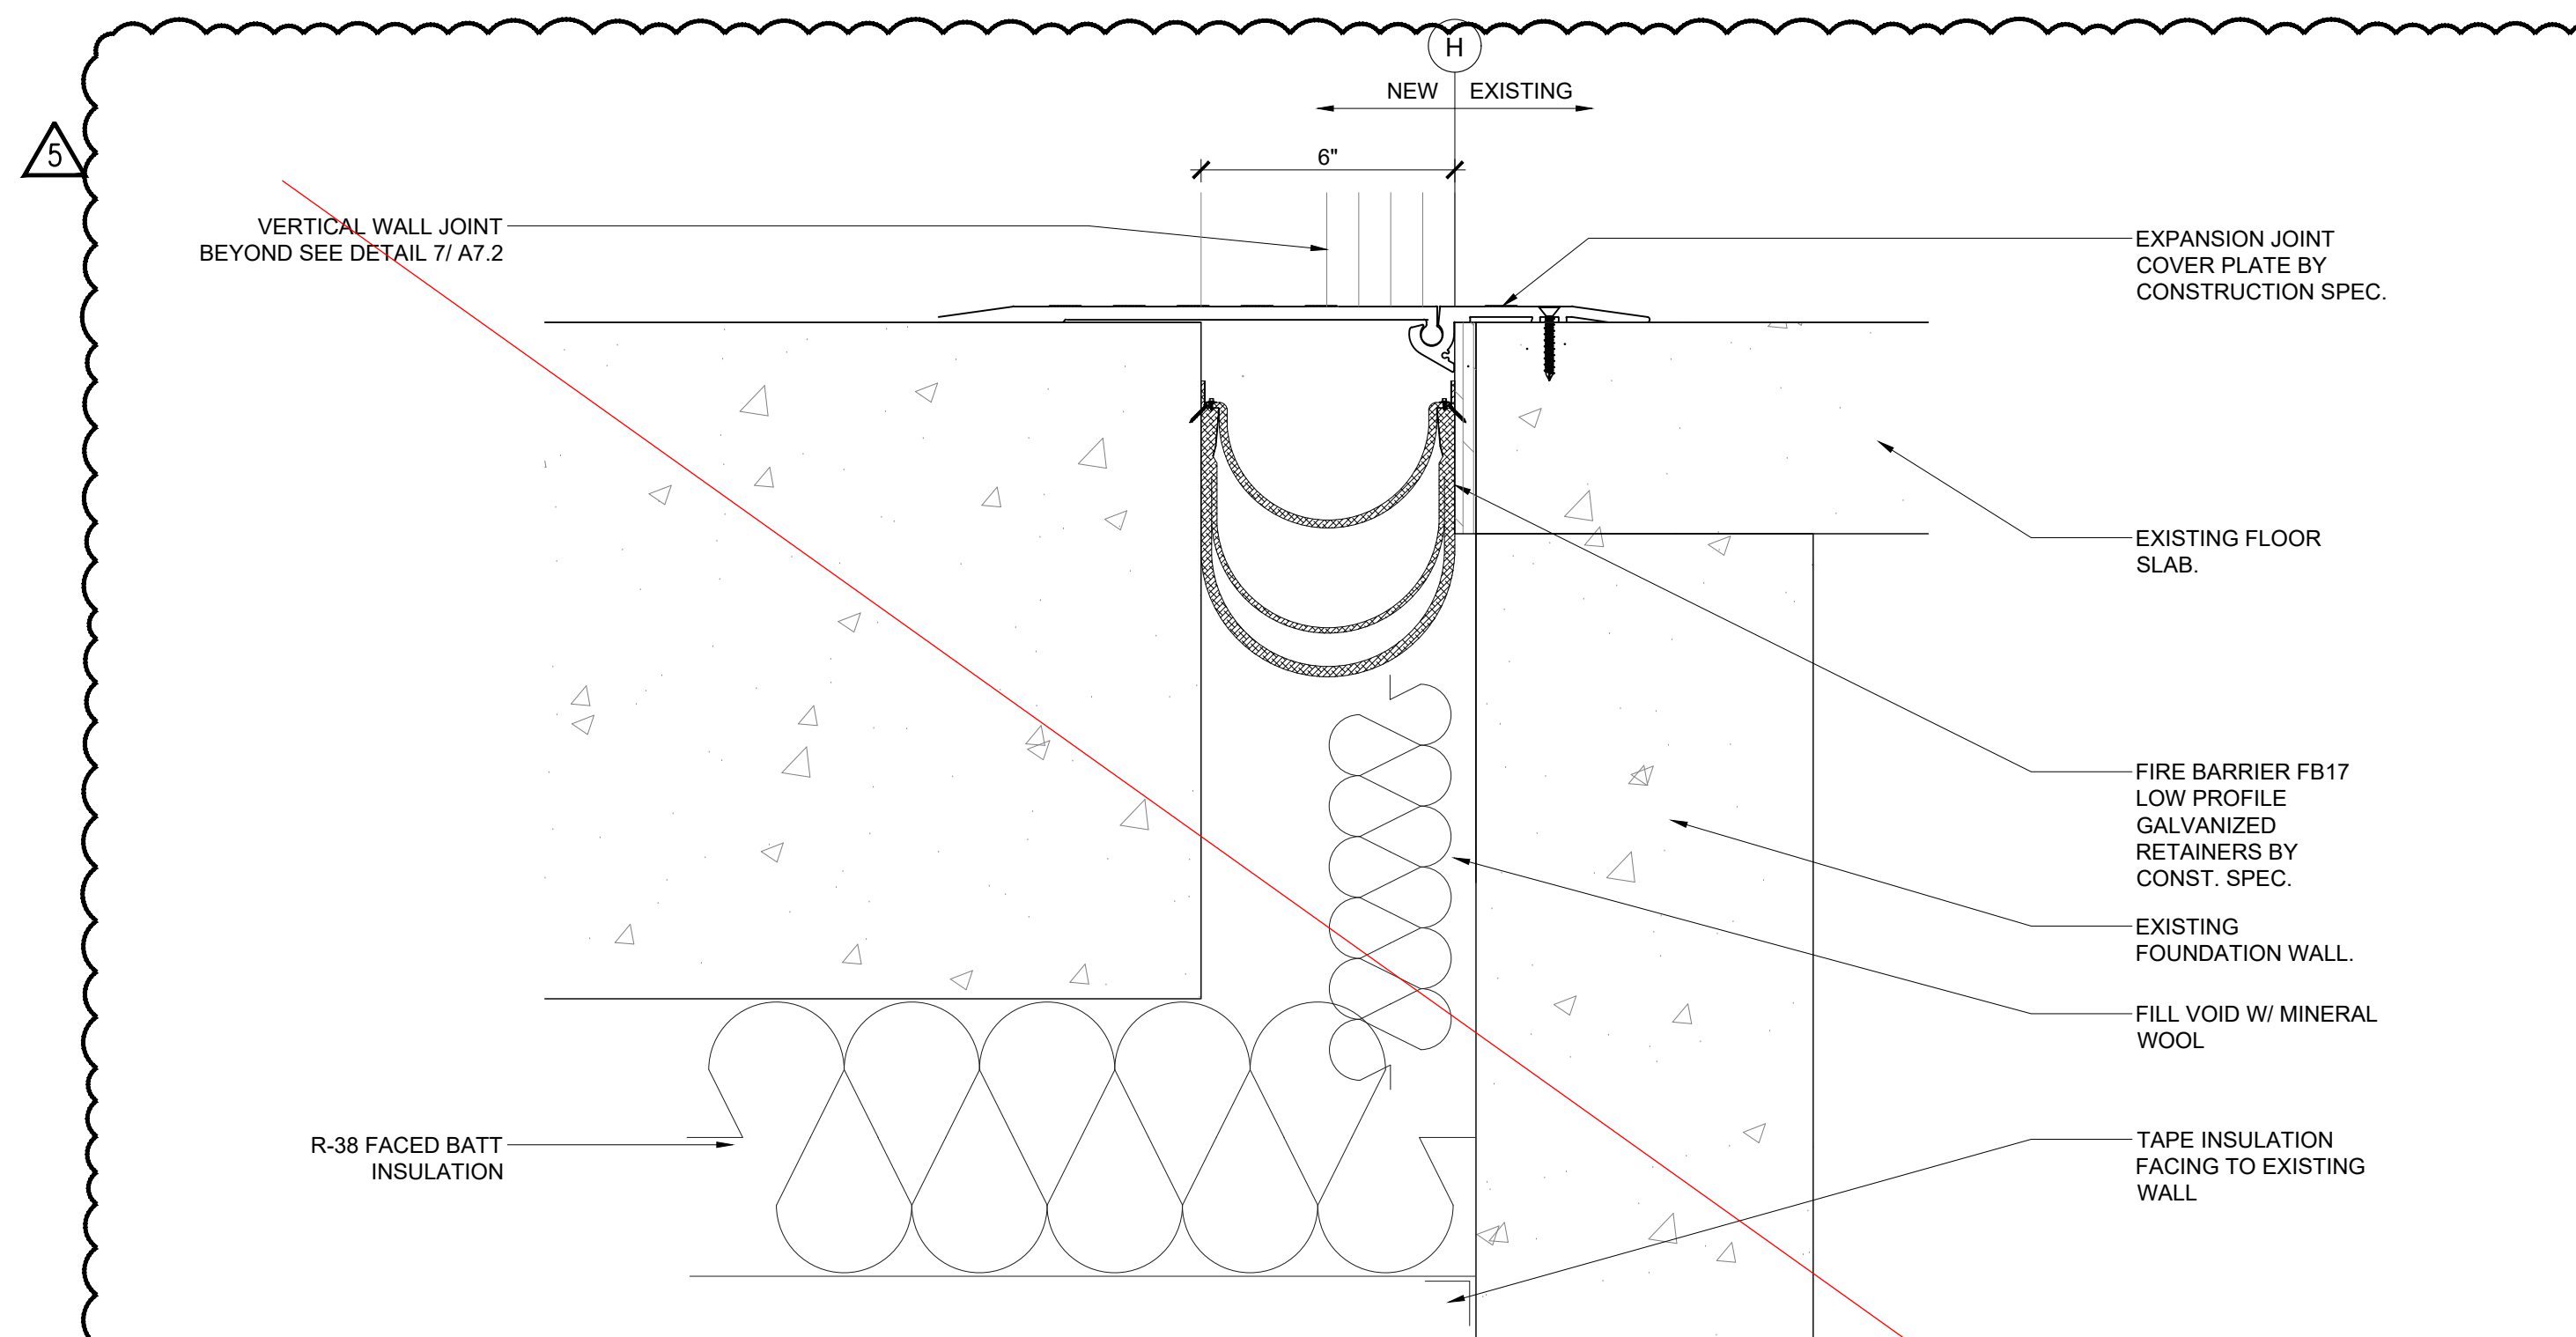

**1** EXPANSION FLOOR JOINT LEVEL 02  
SCALE: 3" = 1'-0"

BASED ON CONSTRUCTION SPECIALTIES

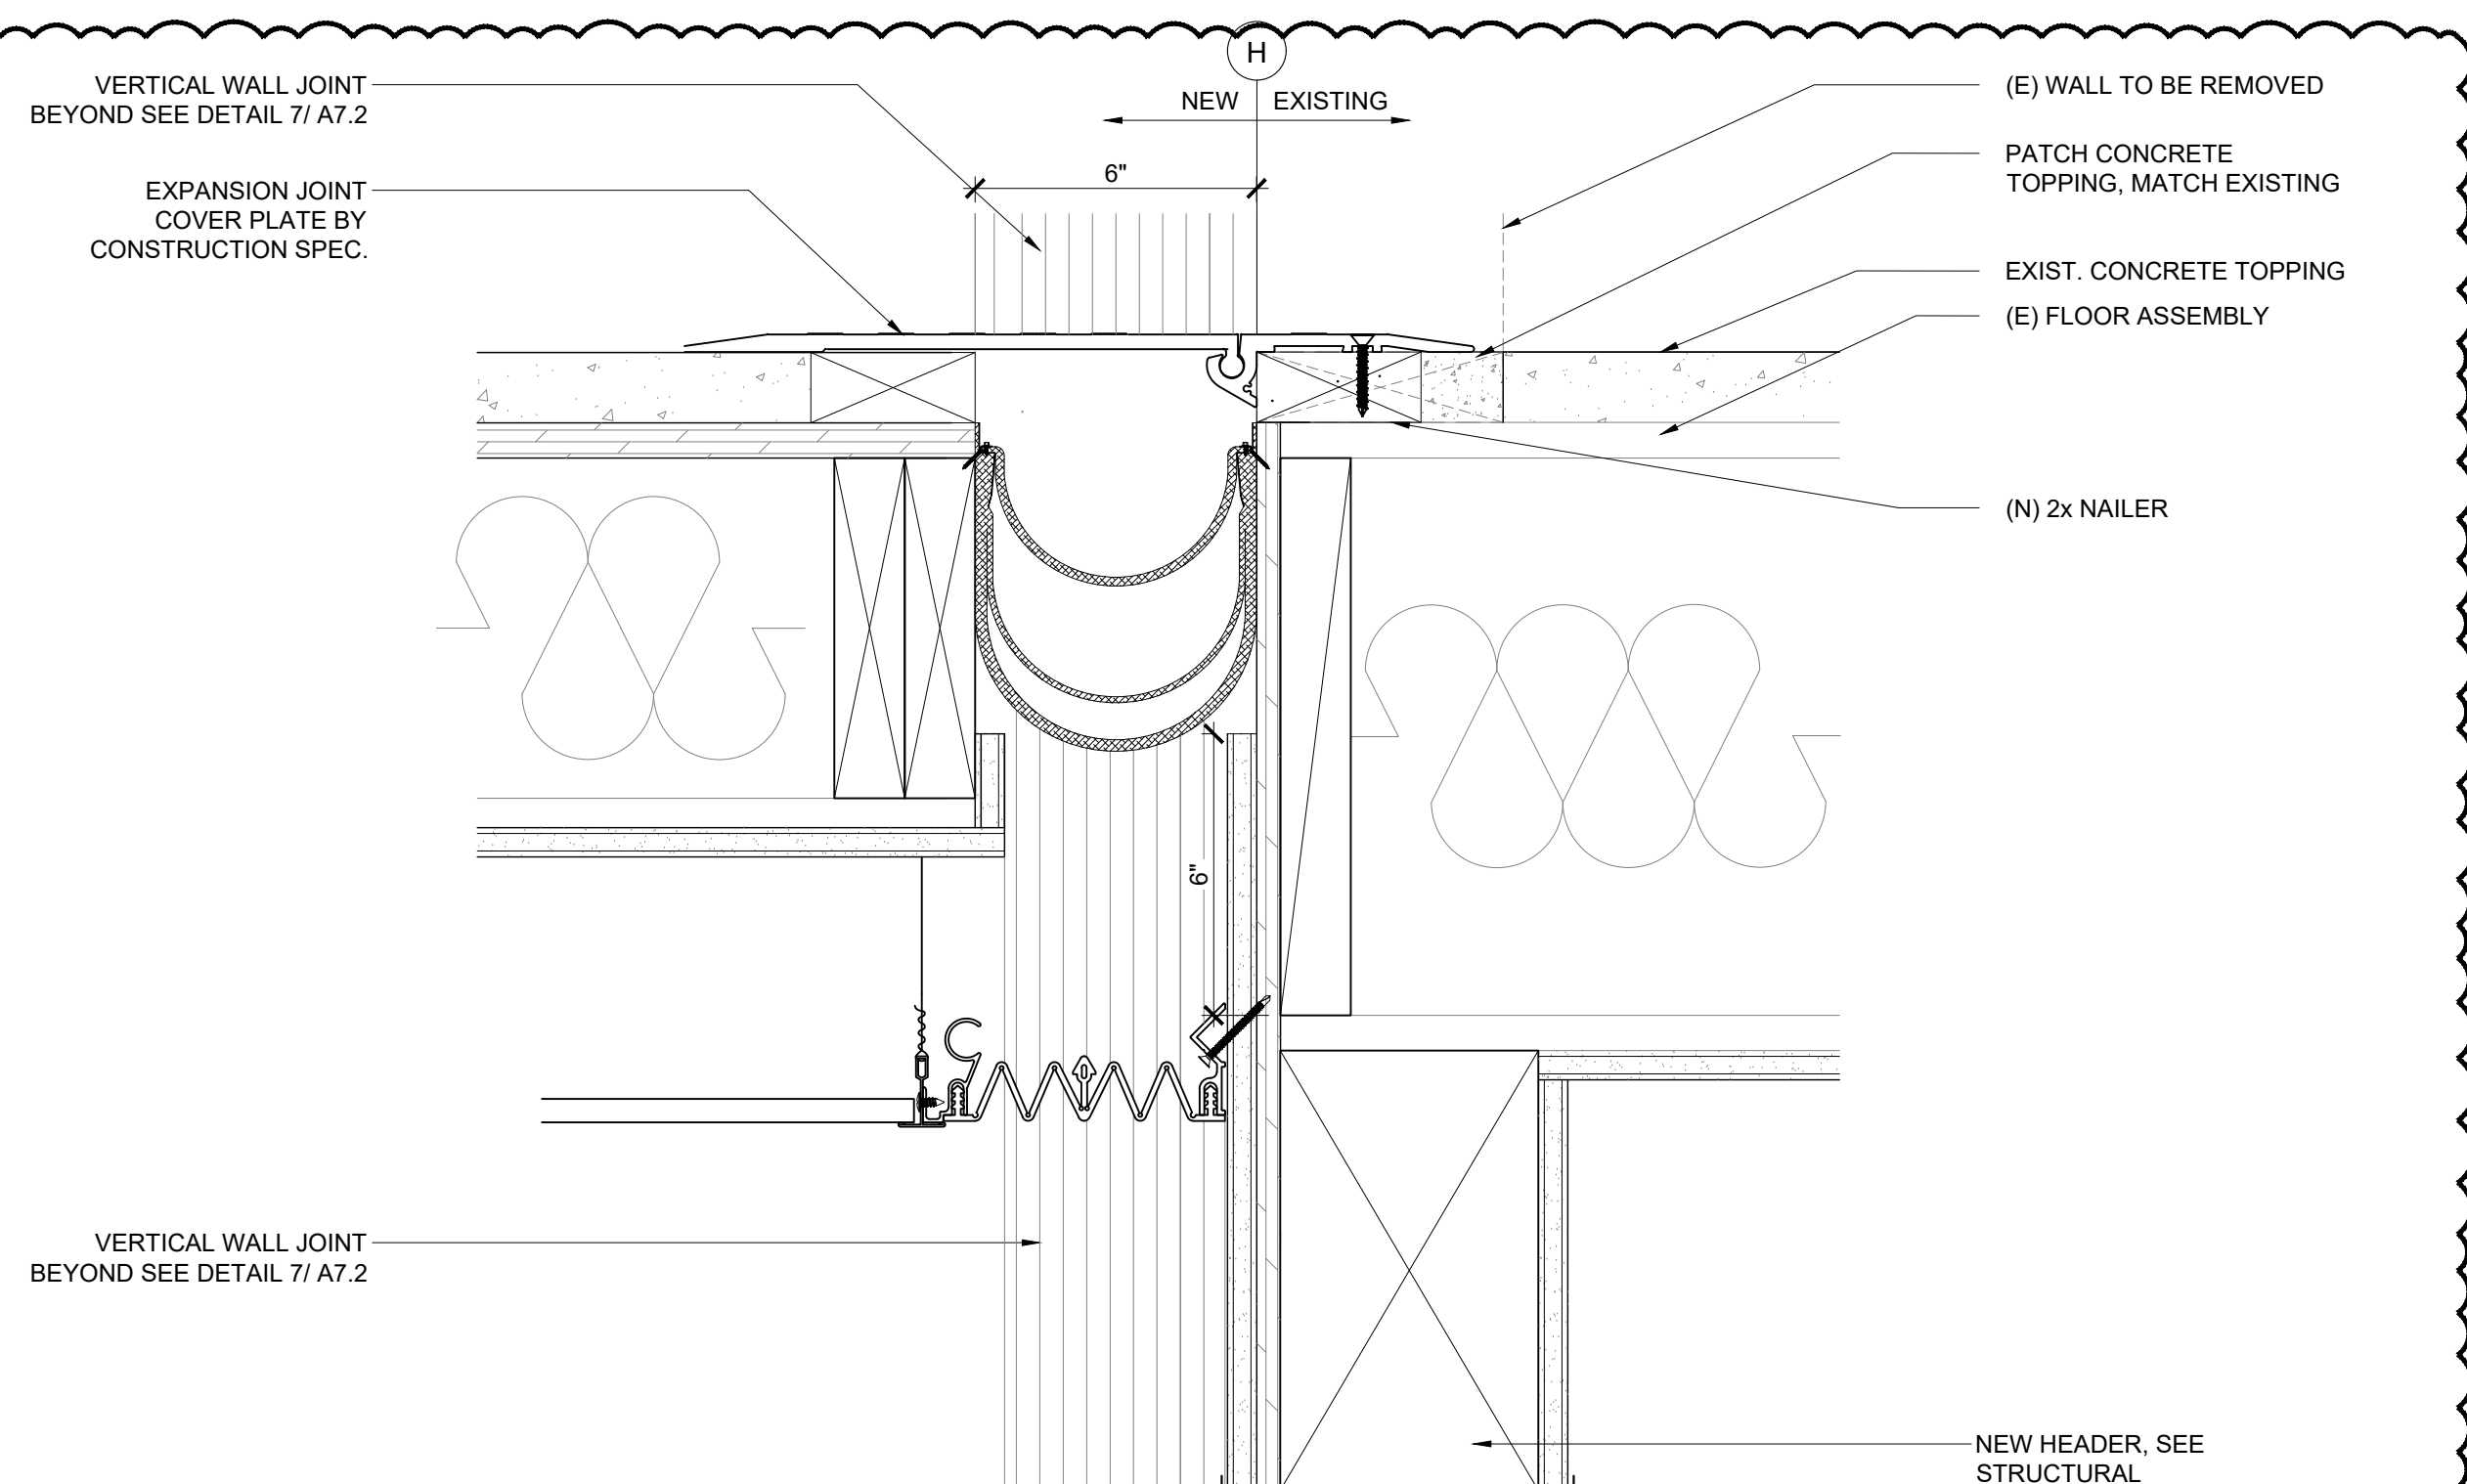


**3** EXPANSION FLOOR JOINT LEVEL 03 & 04  
SCALE: 3" = 1'-0"

BASED ON CONSTRUCTION SPECIALTIES


**TO BE REFINED AS NEEDED**

Required to meet all 2015 building code requirements. Subject to Field Inspection.

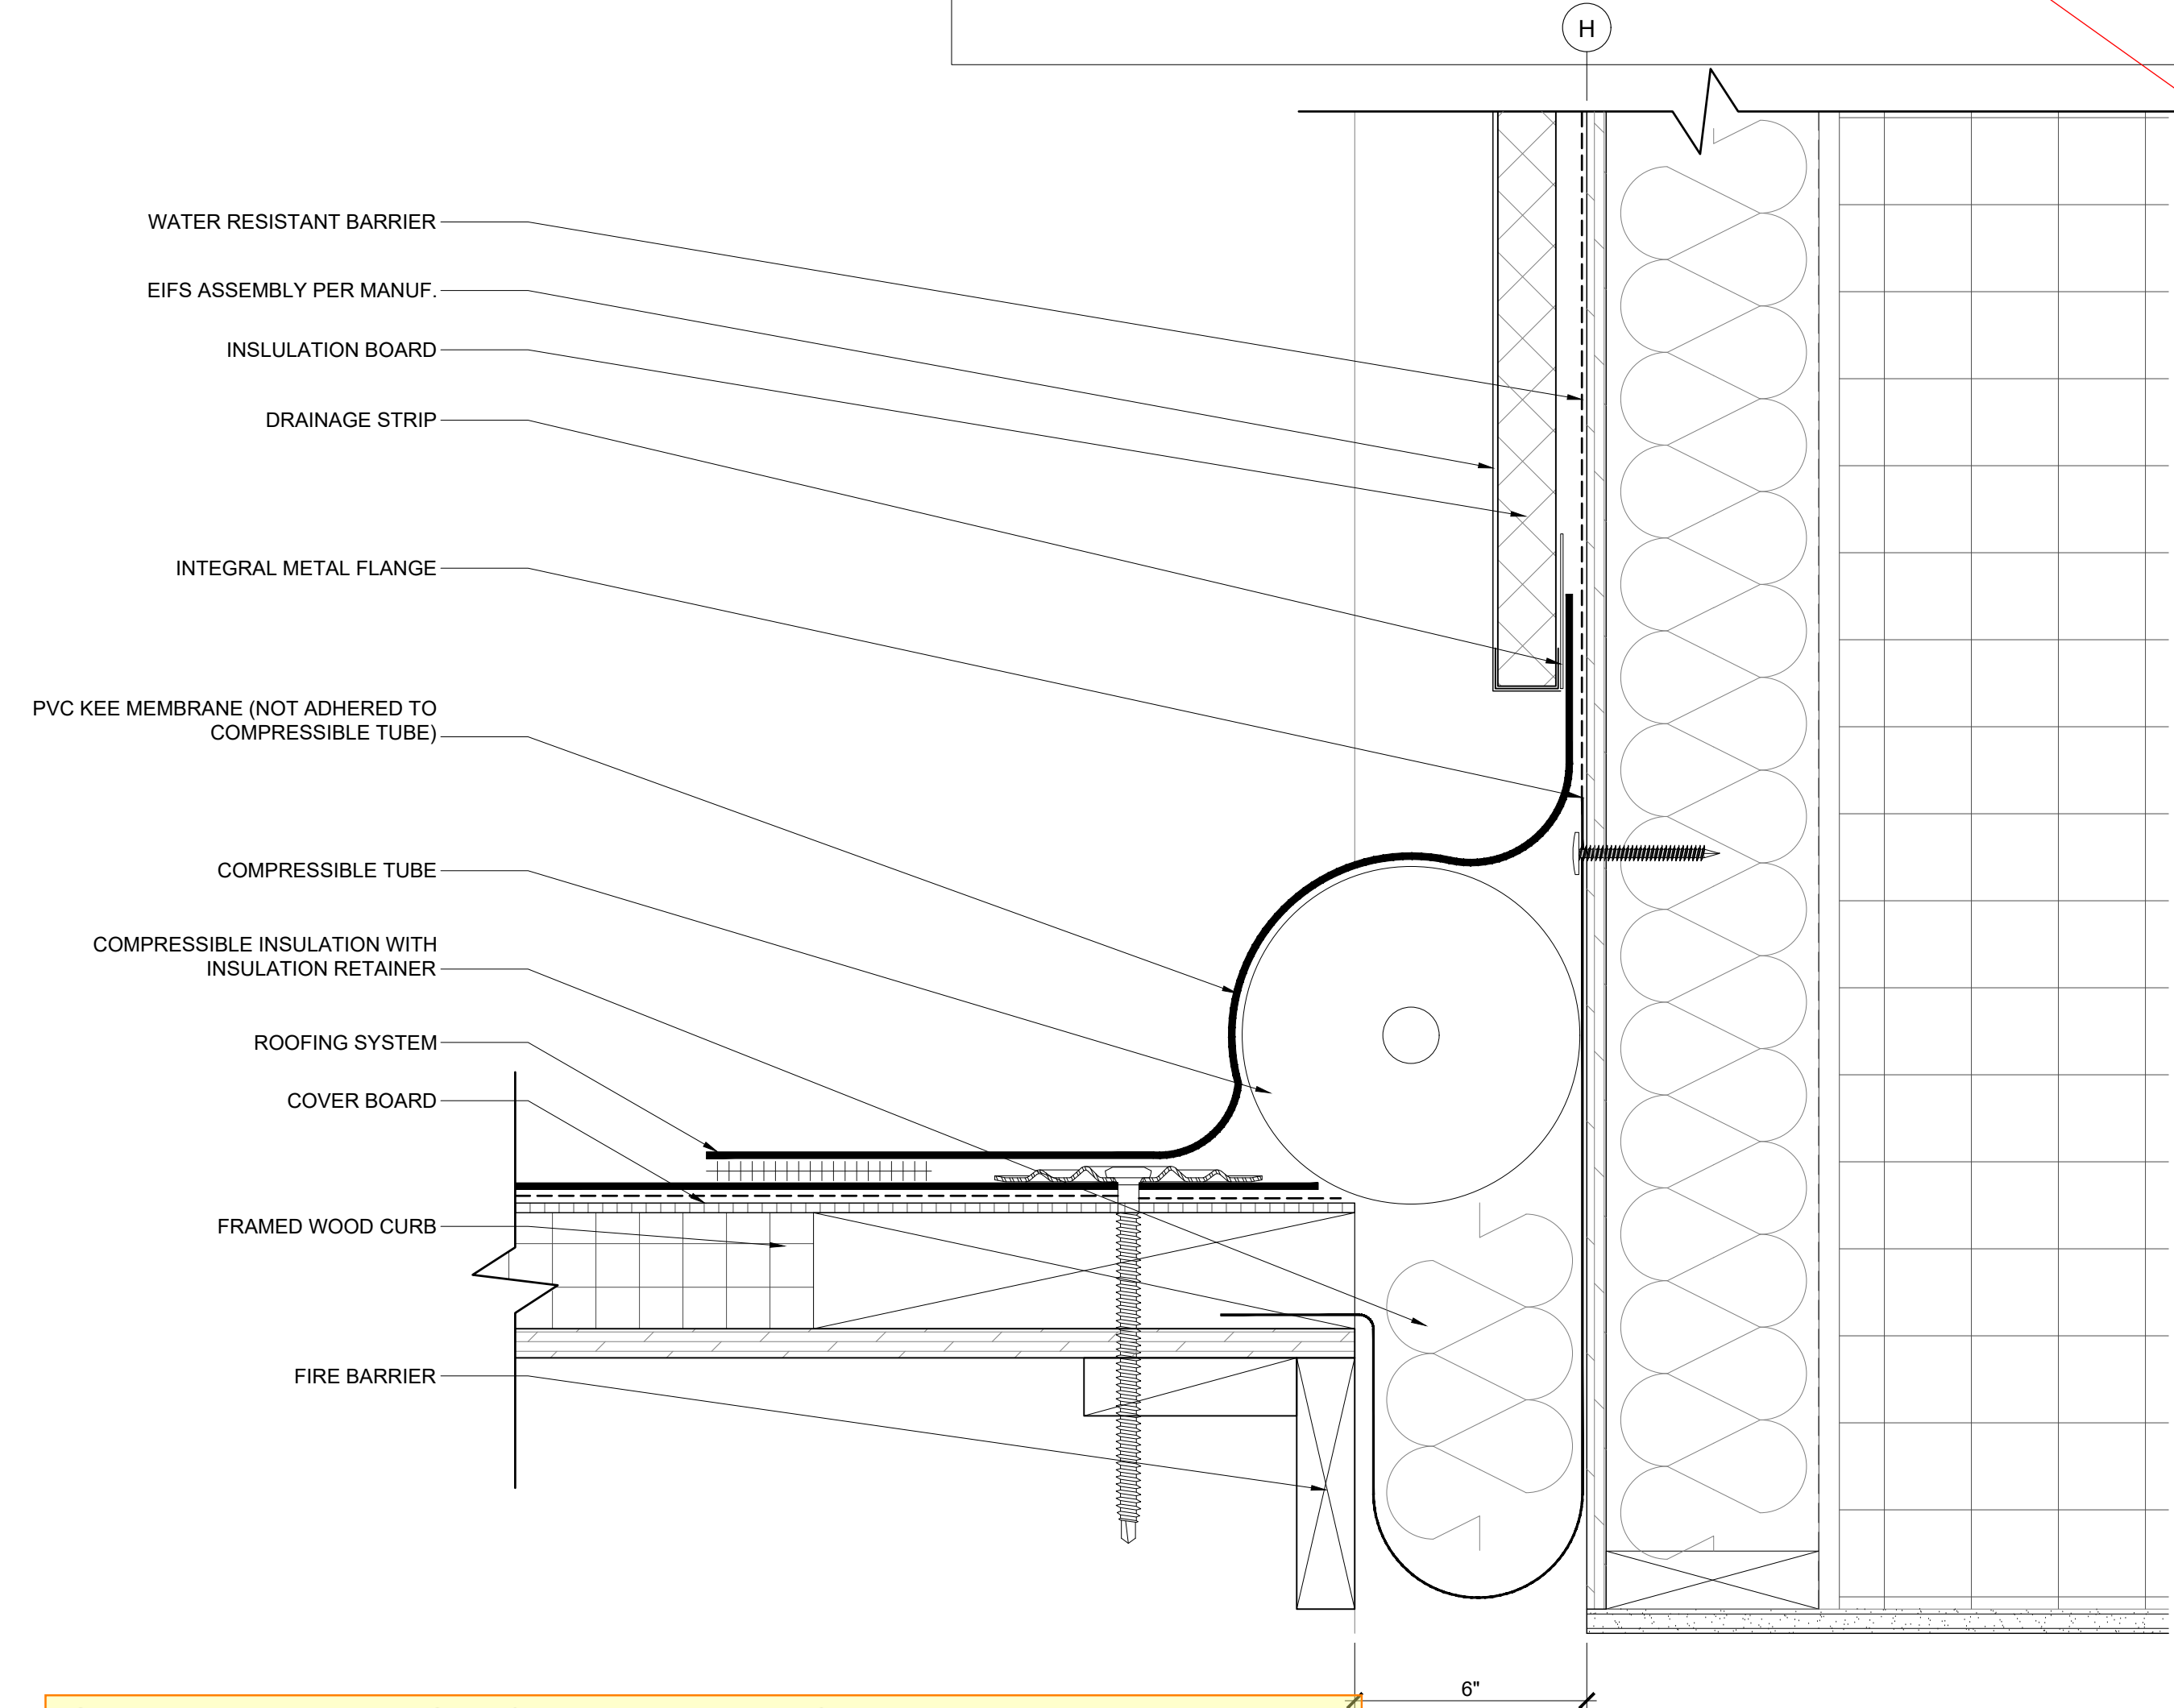


**9** EXPANSION ROOF JOINT AT EXISTING PARAPET  
SCALE: 3" = 1'-0"

BASED ON ELEVATE PVC

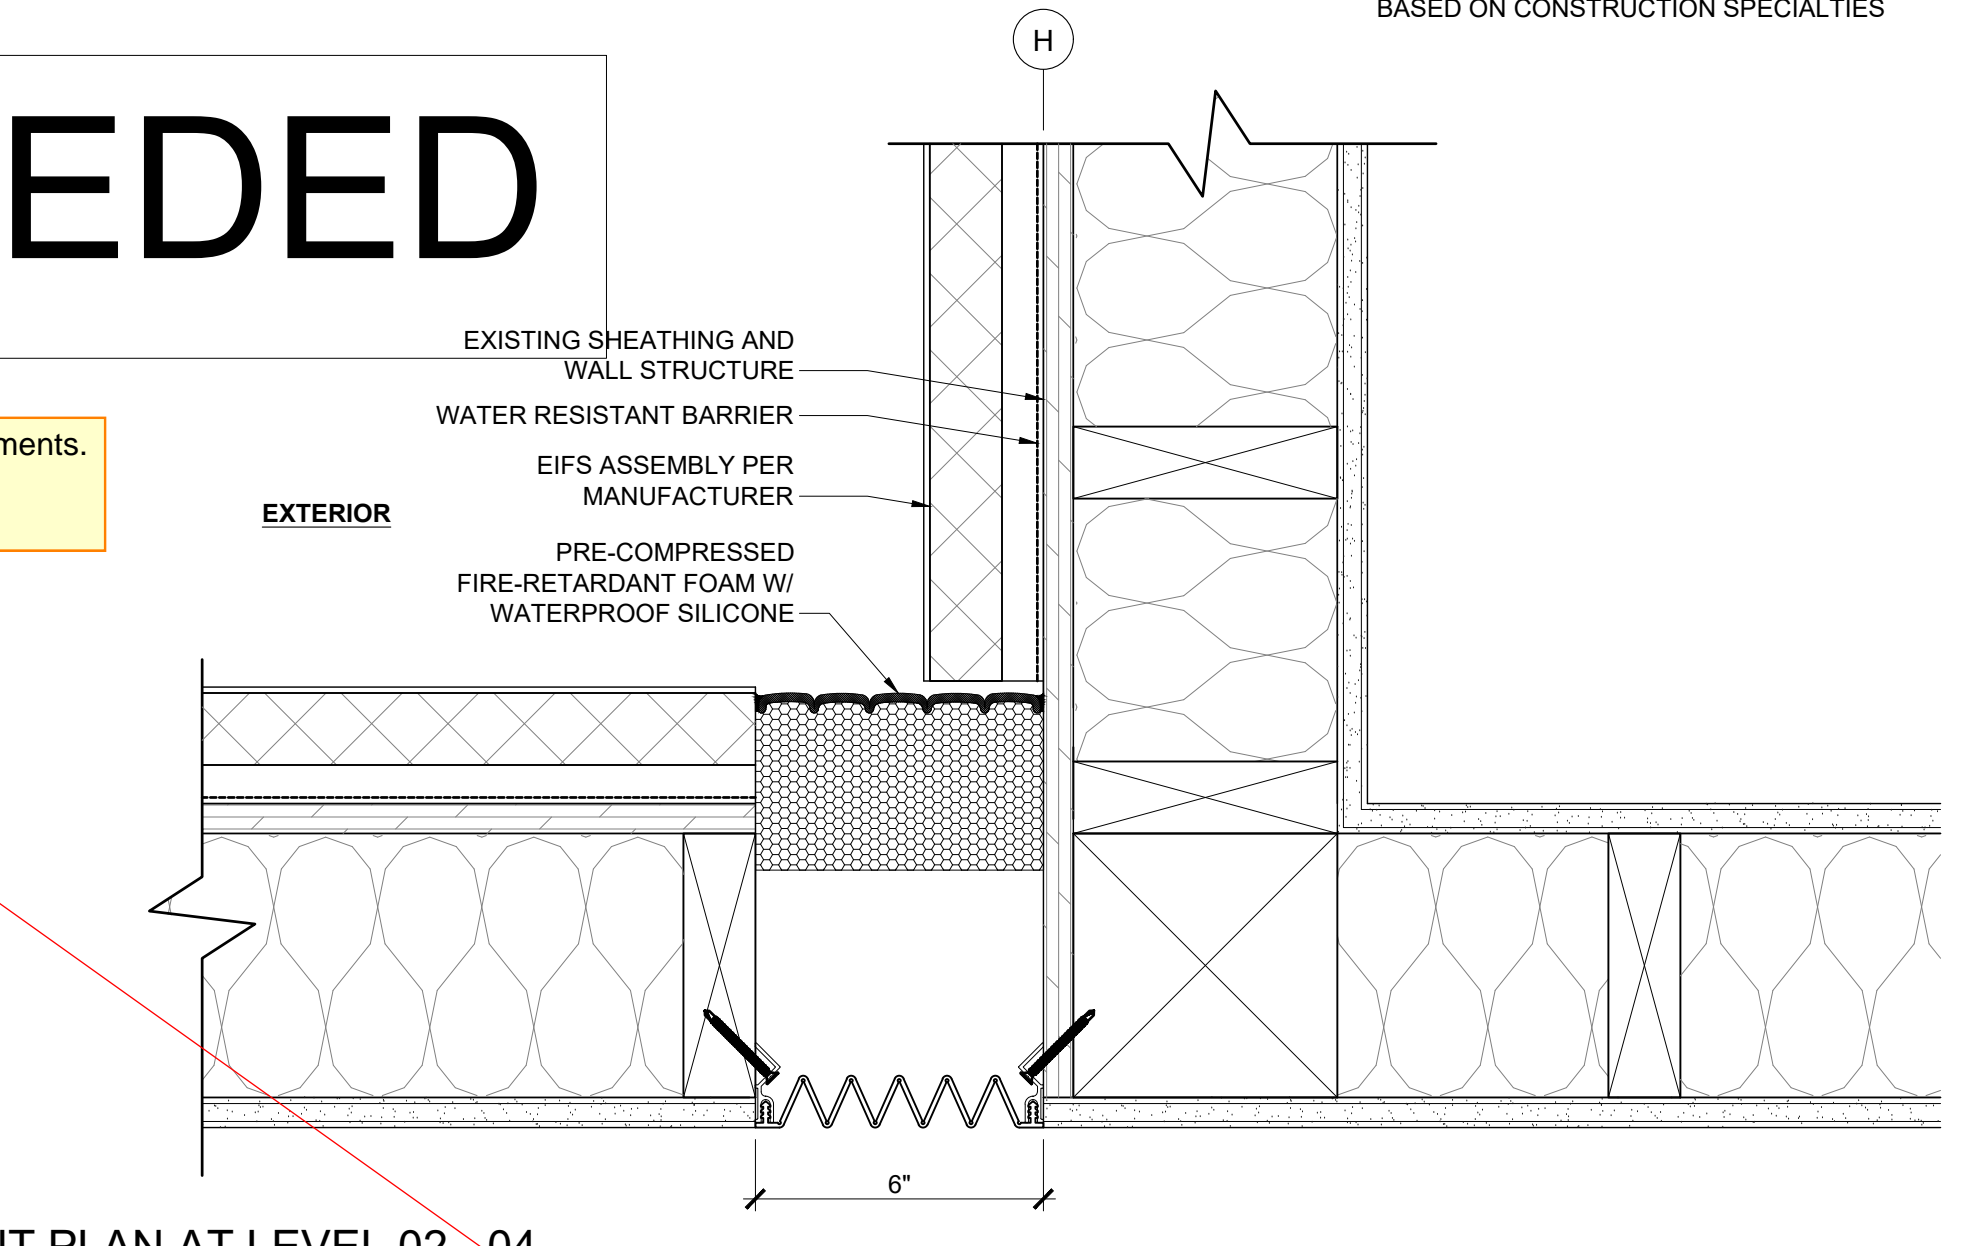

**7** EXPANSION WALL JOINT PLAN AT LEVEL 02 - 04  
SCALE: 3" = 1'-0"

BASED ON CONSTRUCTION SPECIALTIES

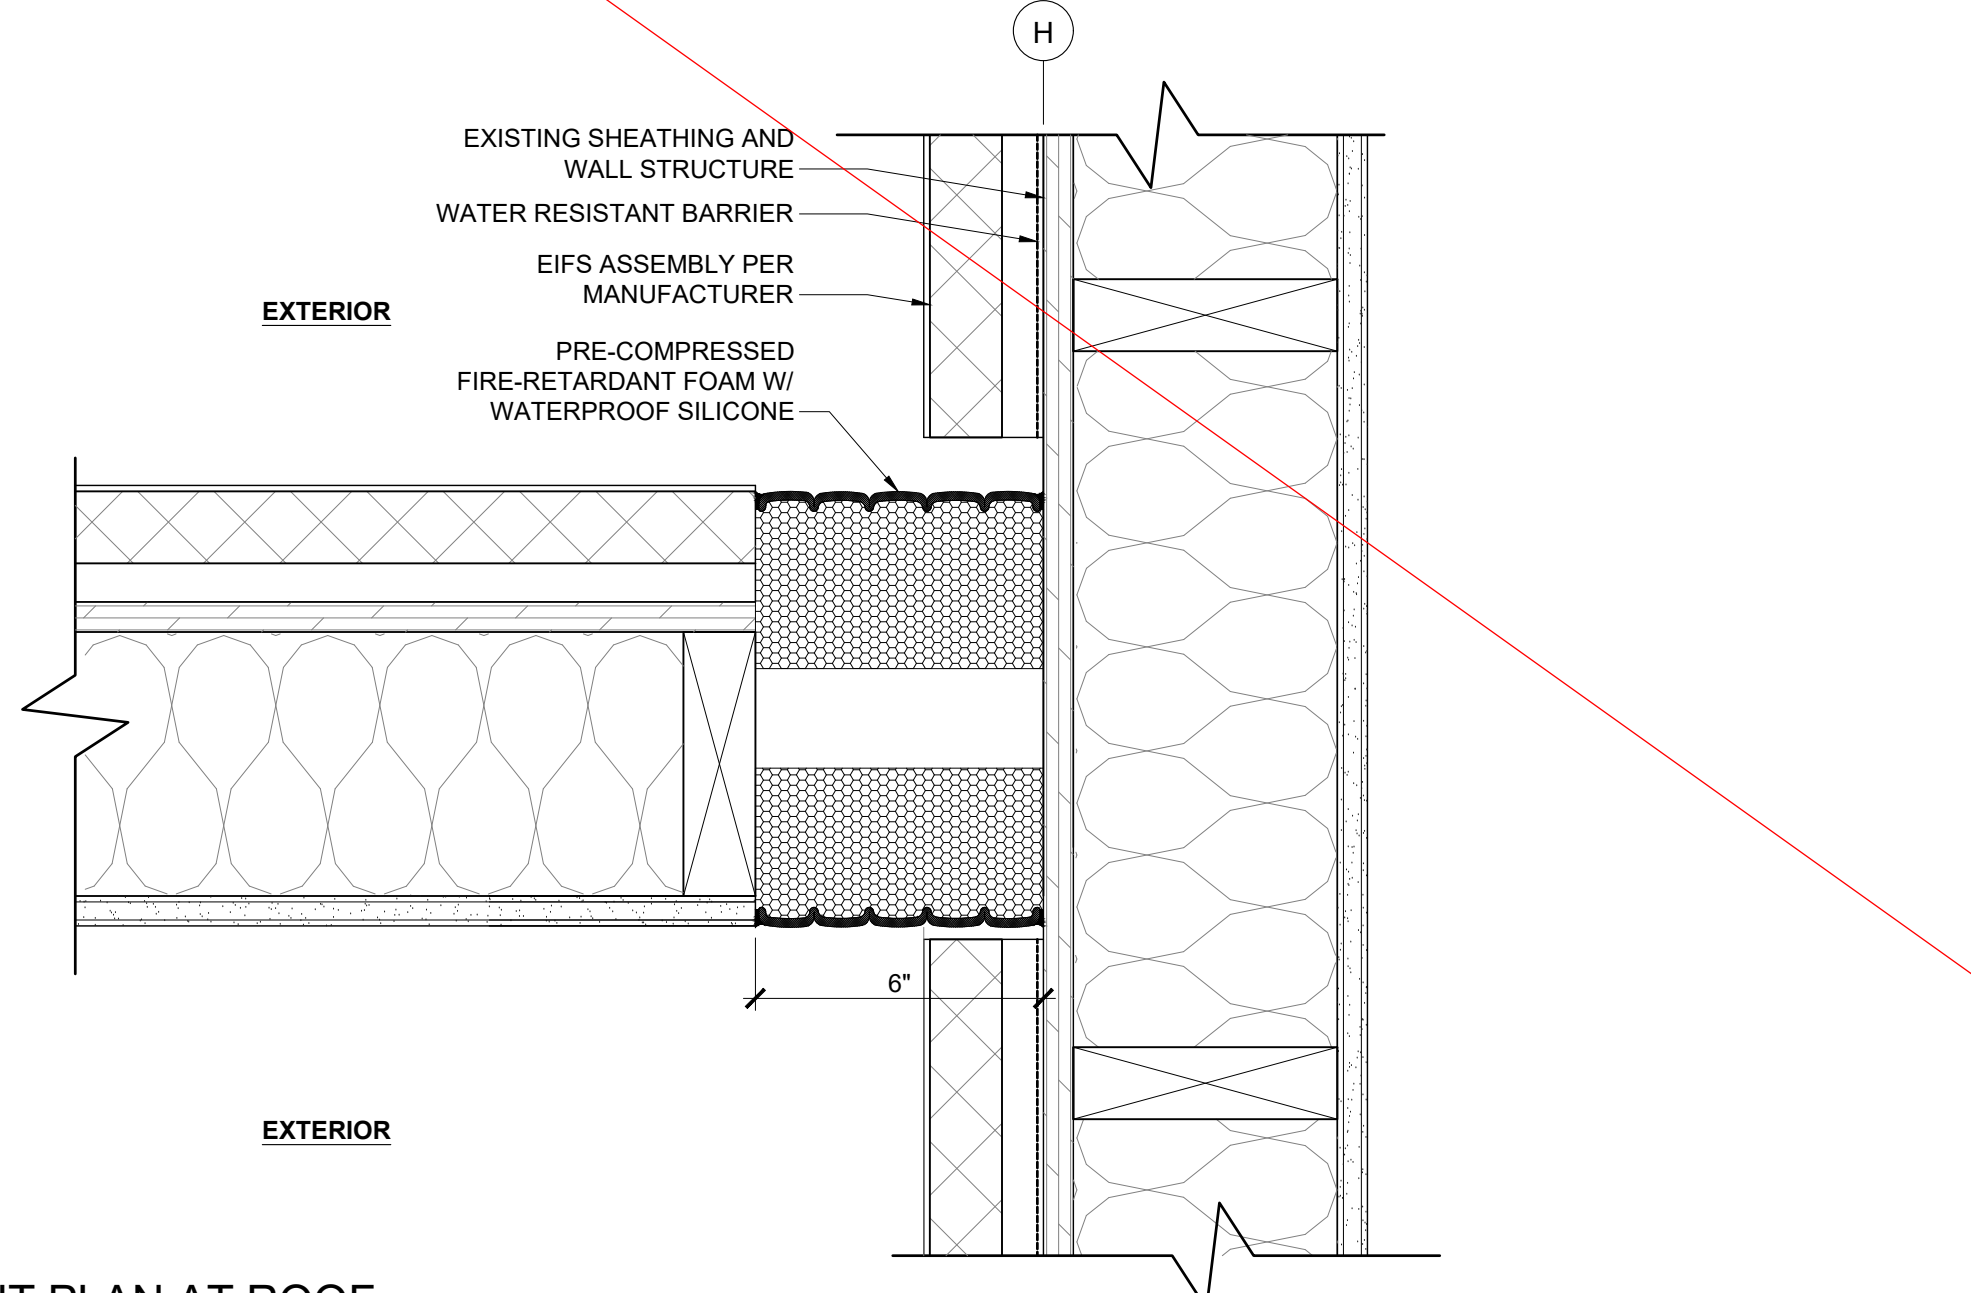

**11** EXPANSION WALL JOINT PLAN AT ROOF  
SCALE: 3" = 1'-0"

BASED ON CONSTRUCTION SPECIALTIES

SEE REVISION 2 PAGE 4 OF 4

**KNIT**  
909 S. 336TH ST.  
SUITE 107  
FEDERAL WAY, WA 98003  
knitstudios.com

THESE DOCUMENTS HAVE BEEN PRODUCED AS AN INSTRUMENT OF SERVICE AND ARE INTENDED SOLELY FOR THE PURPOSE OF CONSTRUCTING, USING AND MAINTAINING THE PROJECT. KNIT AS THE ARCHITECT OF RECORD FOR THE PROJECT RETAINS OWNERSHIP OF THESE DOCUMENTS.

ANY USE OF THESE DOCUMENTS OR USE OF THE DESIGN IDEAS OR CONCEPTS DESCRIBED HEREIN IN WHOLE OR PART BY ANY PERSON WHATSOEVER IS STRICTLY PROHIBITED EXCEPT BY WRITTEN CONSENT OF KNIT.

REPRODUCTION OF THESE DOCUMENTS IS STRICTLY PROHIBITED EXCEPT BY WRITTEN CONSENT OF KNIT.

COPYRIGHT 2021 KNIT

ISSUE DATE 09/25/23  
PROGRESS SET

REV	DATE	COMMENT
1	03.03.2023	AC RESPONSE
2	08.14.2023	CORRECTIONS
3	09.25.2023	CORRECTIONS
4	10.17.2023	CORRECTIONS
5	12.21.2023	CORRECTIONS

City of Puyallup  
Development & Permitting Services  
ISSUED PERMIT

Building	Planning
Engineering	Public Works
Fire	Traffic

6677 REGISTERED ARCHITECT  
*Rhonda A. Gillogly*  
RHONDA A. GILLOGLY  
STATE OF WASHINGTON  
12/21/2023

DETAILS


**ADDITION TO HAMPTON INN & SUITES**  
1515 S MERIDIAN  
PUYALLUP, WA 98371  
HAMPTON INN & SUITES

TITLE	PROJECT	CLIENT


JOB NO: 210158

**A7.2**




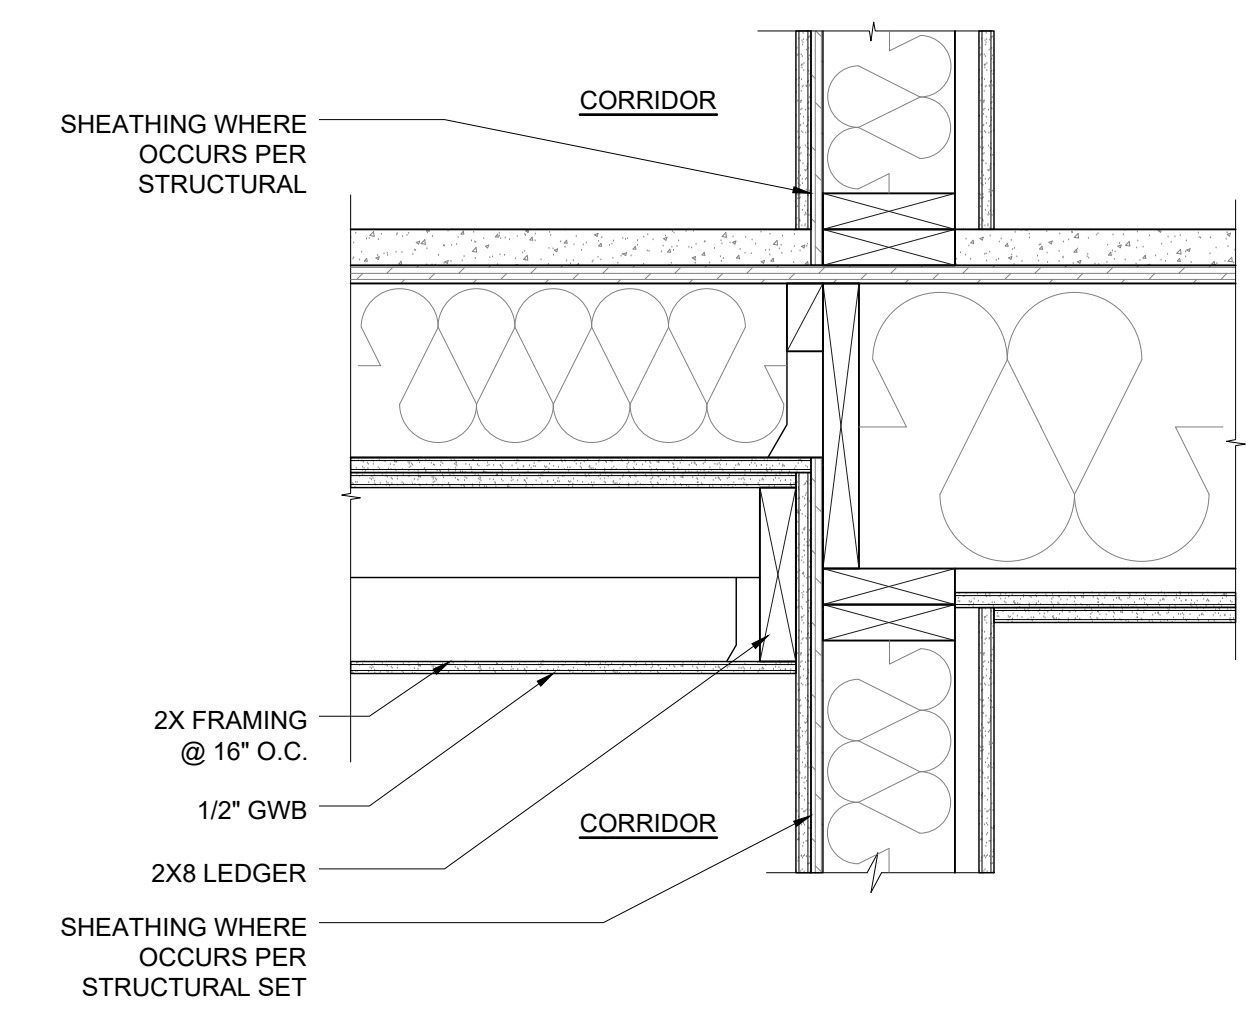


**1 CORRIDOR SOFFIT DETAIL**  
SCALE: 1-1/2" = 1' - 0"

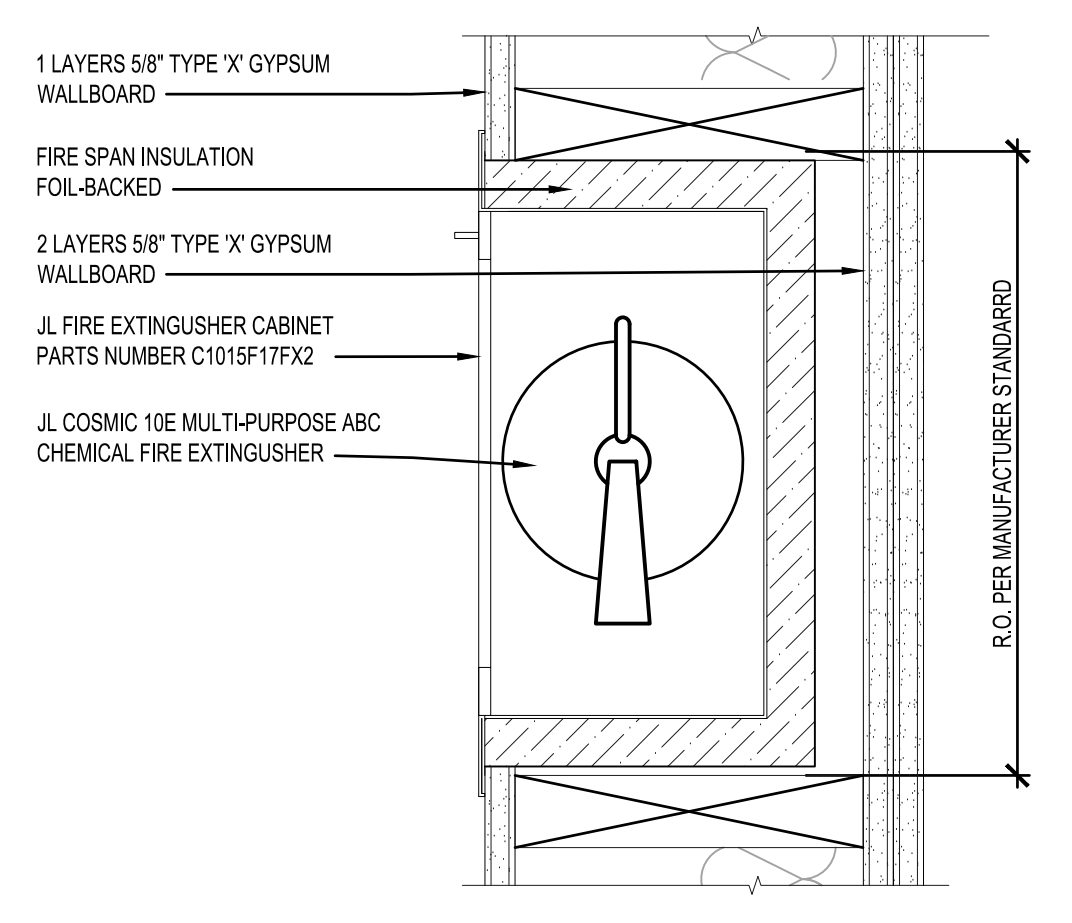

**2 SEMI-RECESSED FIRE EXTINGUISHER CABINET DETAIL**  
SCALE: 3" = 1' - 0"

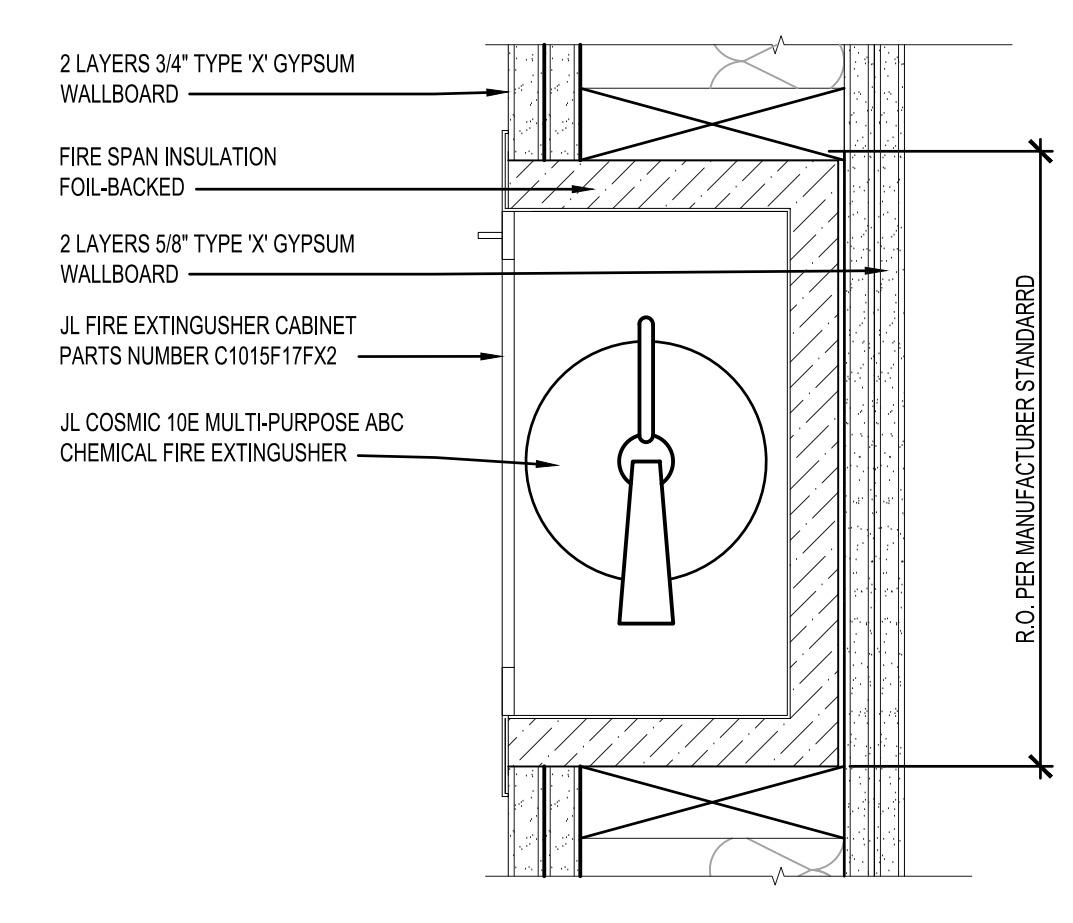


**3 SEMI-RECESSED FIRE EXTINGUISHER CABINET DETAIL**  
SCALE: 3" = 1' - 0"

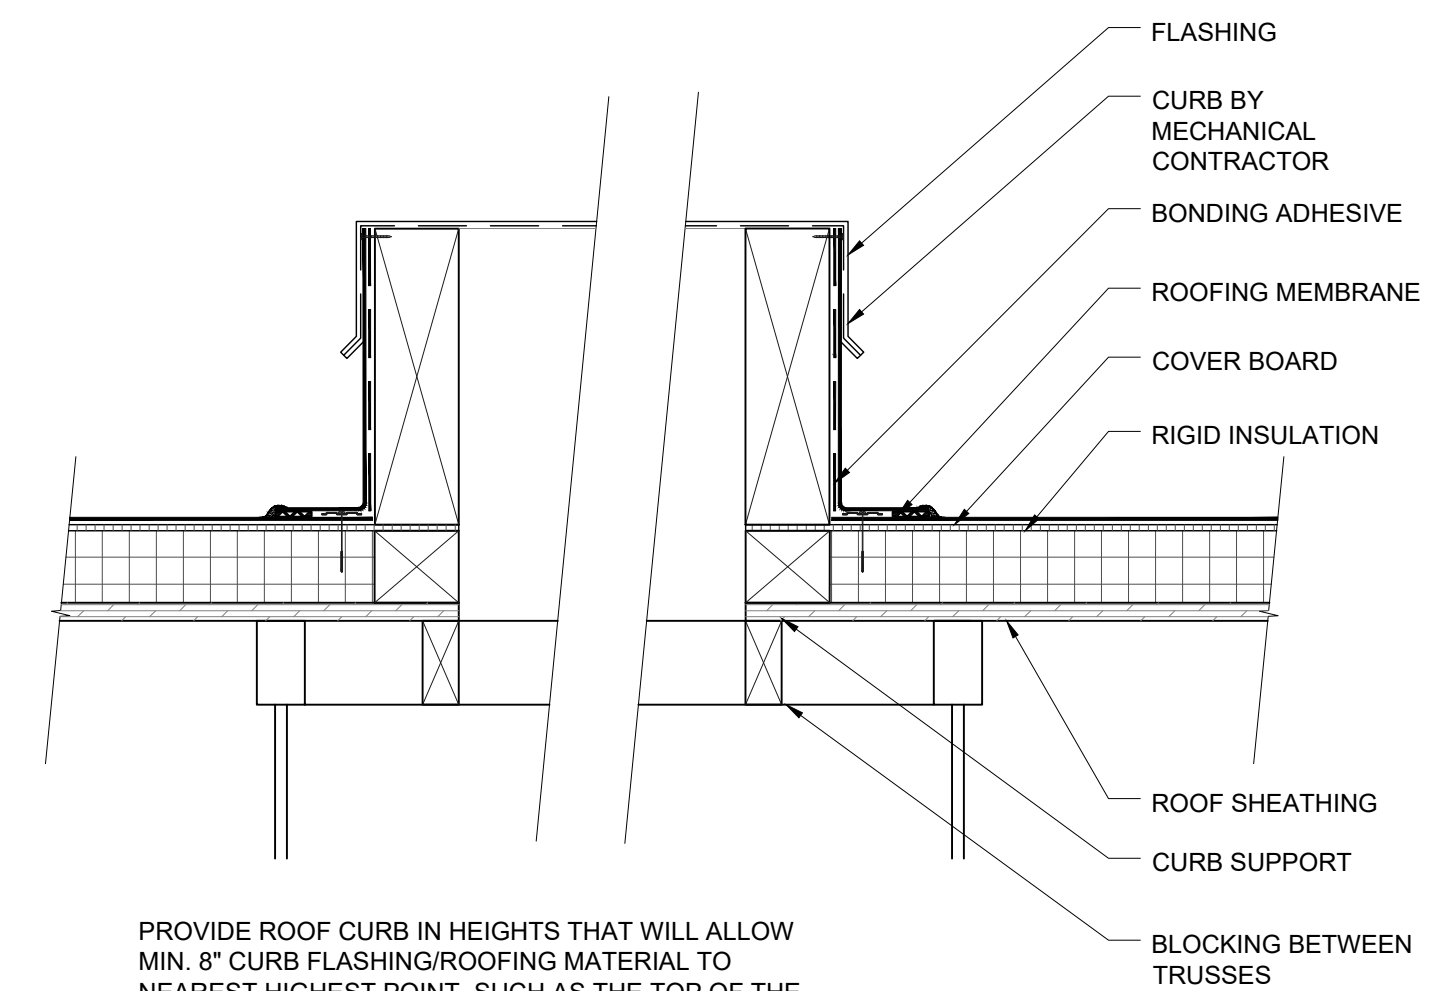


**4 MECH CURB DETAIL**  
SCALE: 1-1/2" = 1' - 0"


PROVIDE ROOF CURB IN HEIGHTS THAT WILL ALLOW MIN. 8" CURB FLASHING/ROOFING MATERIAL TO NEAREST HIGHEST POINT, SUCH AS THE TOP OF THE CRICKET. INSTALL TO MEET ROOFING MATERIAL MANUFACTURER'S STANDARD INSTALLATION DETAILS AND TO MEET WARRANTY TERMS.

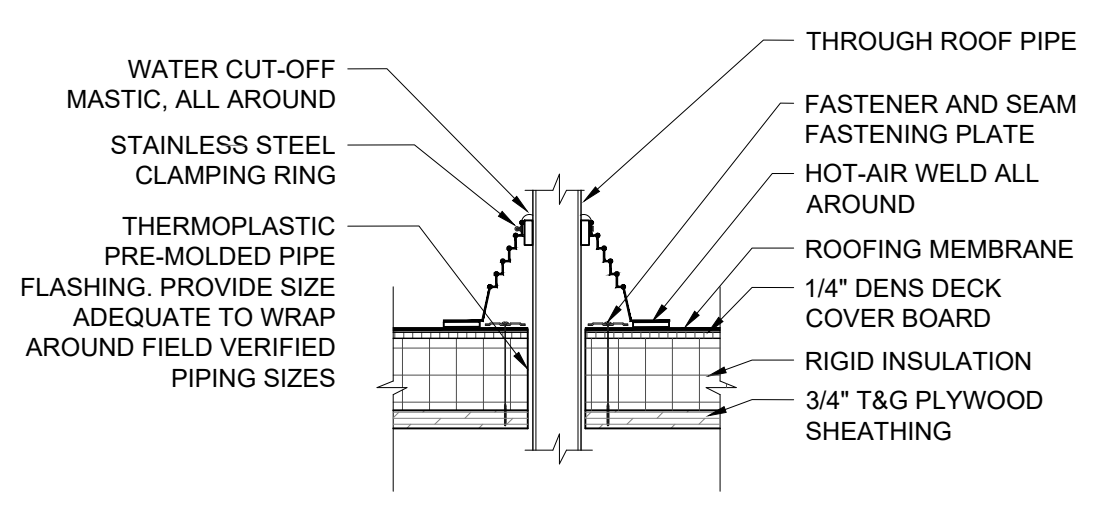


**5 VENT PIPE PENETRATION AT ROOF**  
SCALE: 1-1/2" = 1' - 0"

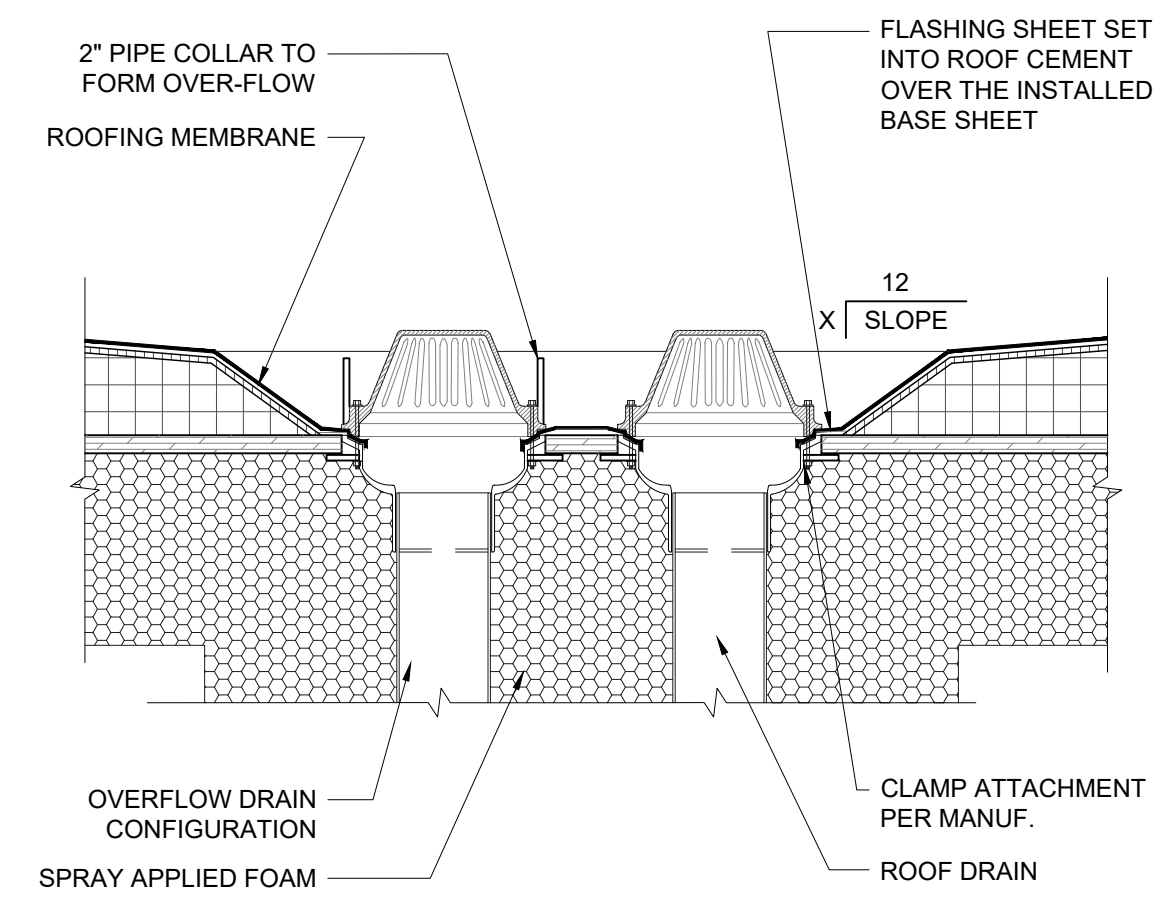


**6 ROOF DRAIN**  
SCALE: 1-1/2" = 1' - 0"

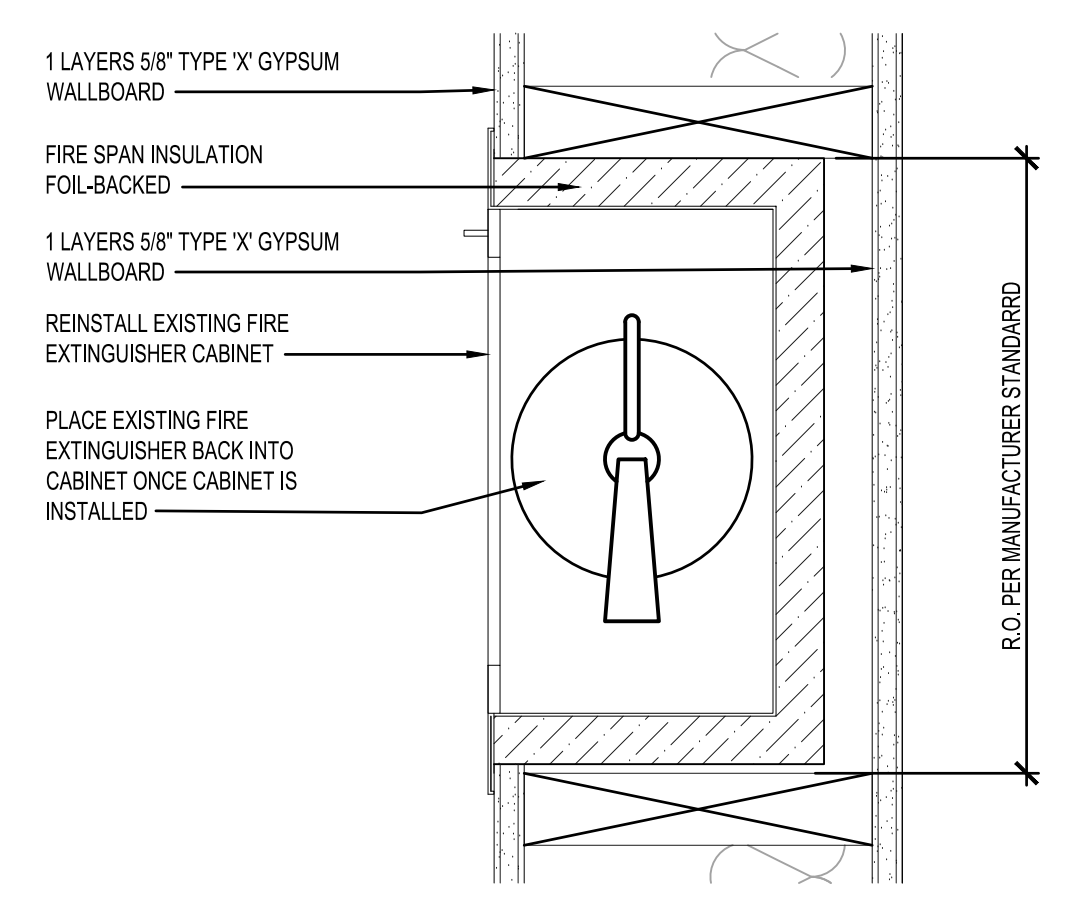

**7 SEMI-RECESSED FIRE EXTINGUISHER CABINET DETAIL**  
SCALE: 3" = 1' - 0"

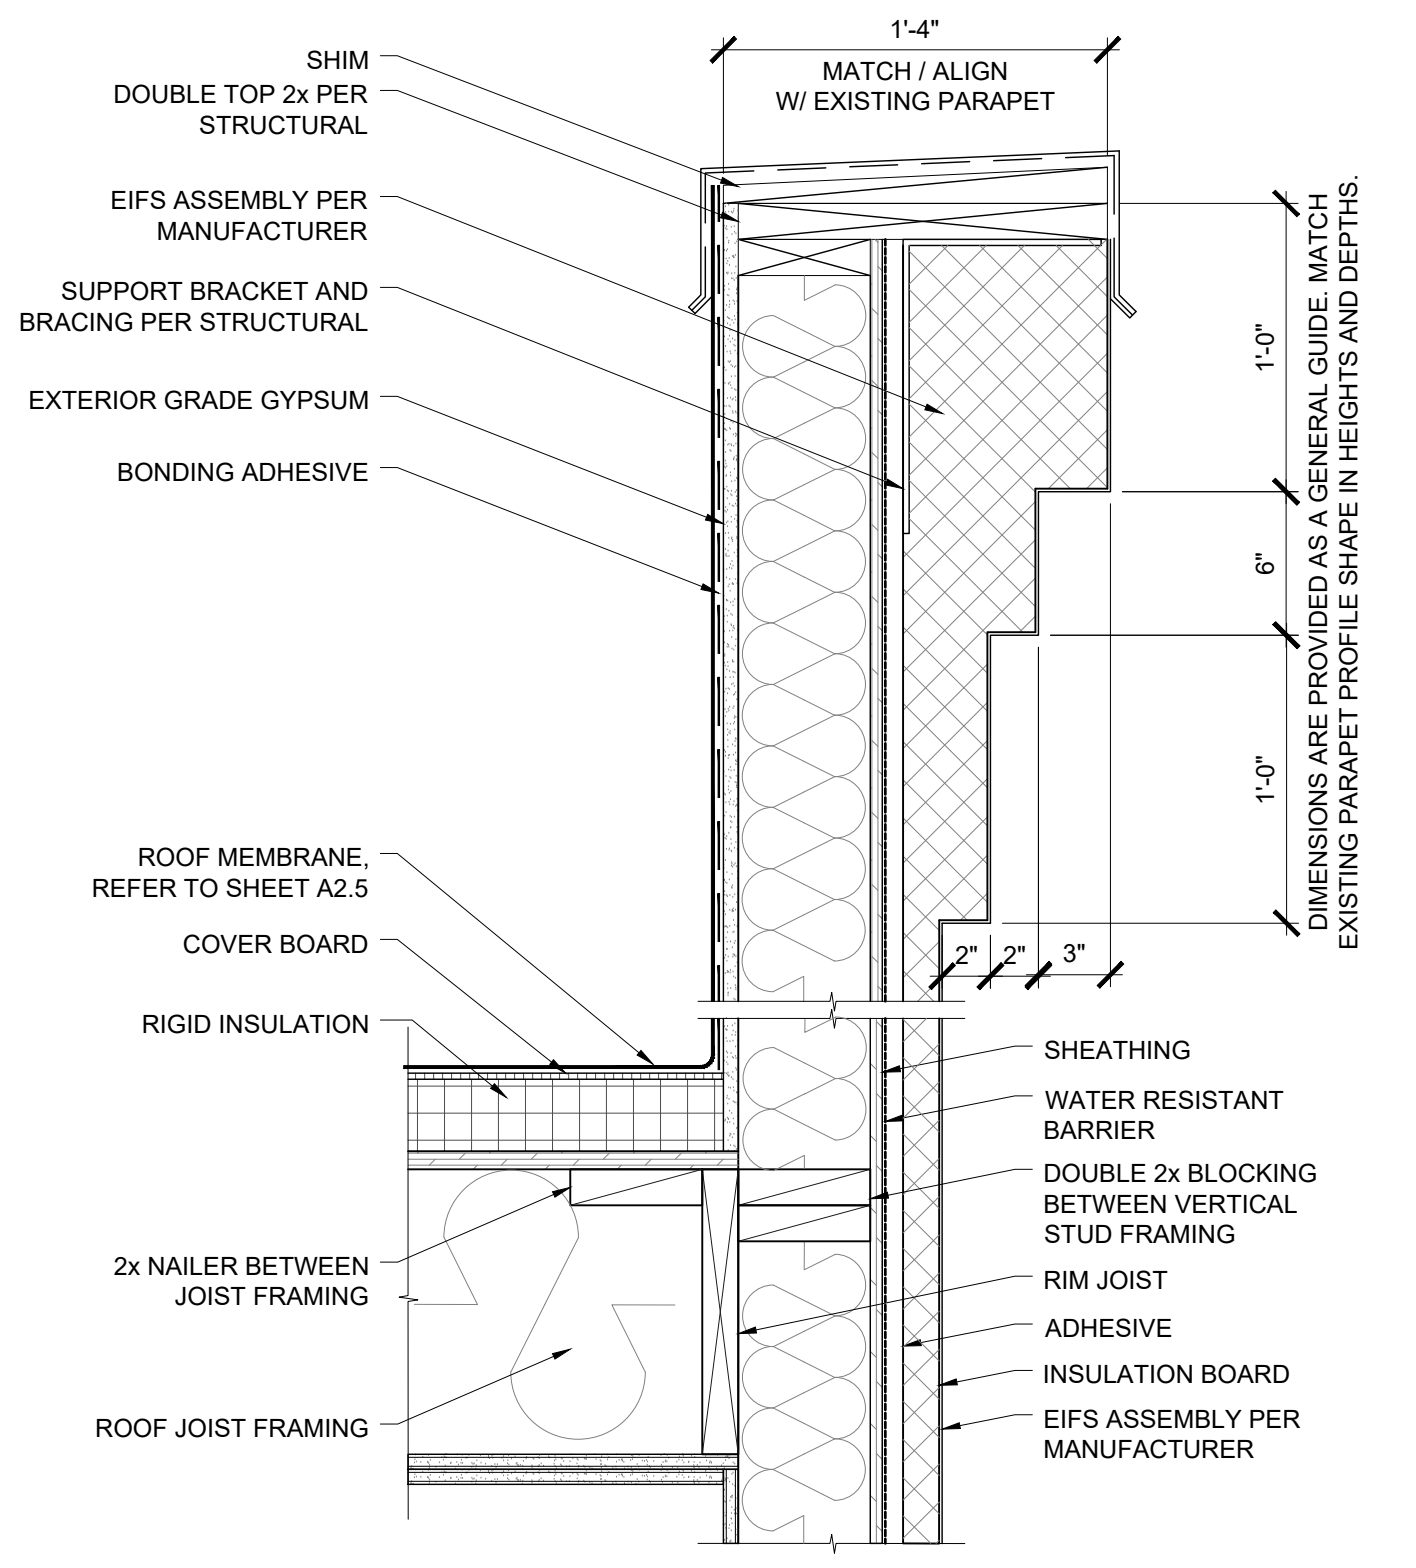

**12 PARAPET DETAIL**  
SCALE: 1-1/2" = 1' - 0"

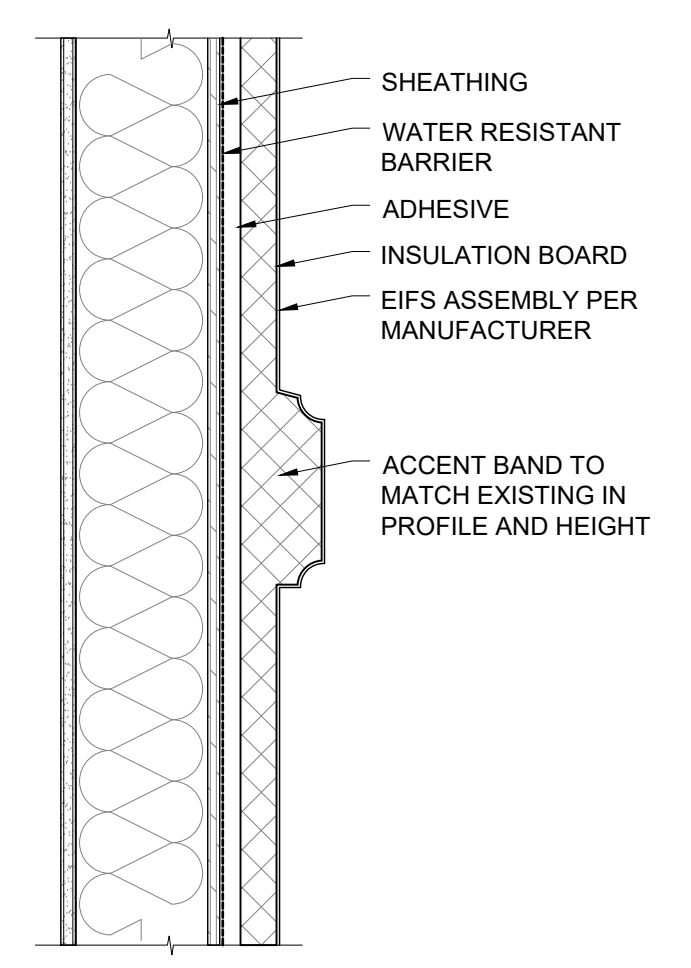

**9 ACCENT BAND**  
SCALE: 1-1/2" = 1' - 0"

ISSUE DATE 09/25/23  
PROGRESS SET

REV	DATE	COMMENT
1	03.03.2023	AC RESPONSE
2	08.14.2023	CORRECTIONS
3	09.25.2023	CORRECTIONS
4	10.17.2023	CORRECTIONS
5	12.21.2023	CORRECTIONS

City of Puyallup  
Development & Permitting Services  
**ISSUED PERMIT**

Building	Planning
Engineering	Public Works
Fire	Traffic


8677 REGISTERED ARCHITECT  
*rhonda*  
RHONDA A. GILLOGLY  
STATE OF WASHINGTON  
12/21/2023

**ROOF DETAILS**

**ADDITION TO HAMPTON INN & SUITES**

1515 S MERIDIAN  
PUYALLUP, WA 98371  
HAMPTON INN & SUITES

TITLE	PROJECT	CLIENT
JOB NO: 210158		


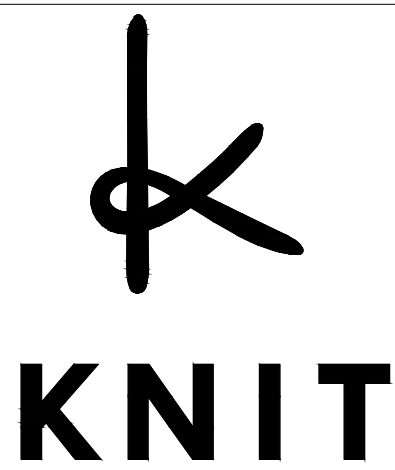


909 S. 336TH ST.  
SUITE 107  
FEDERAL WAY, WA 98003  
knitstudios.com

THESE DOCUMENTS HAVE BEEN PRODUCED AS AN INSTRUMENT OF SERVICE AND ARE INTENDED SOLELY FOR THE PURPOSE OF CONTRACTING, USING AND MAINTAINING THE PROJECT. KNIT AS THE ARCHITECT OF RECORD FOR THE PROJECT RETAINS OWNERSHIP OF THESE DOCUMENTS.  
ANY USE OF THESE DOCUMENTS OR USE OF THE DESIGN IDEAS OR CONCEPTS DESCRIBED HEREIN IN WHOLE OR PART BY ANY PERSON WHATSOEVER IS STRICTLY PROHIBITED EXCEPT BY WRITTEN CONSENT OF KNIT.  
REPRODUCTION OF THESE DOCUMENTS IS STRICTLY PROHIBITED EXCEPT BY WRITTEN CONSENT OF KNIT.  
COPYRIGHT 2021 KNIT

ISSUE DATE 09/25/23  
PROGRESS SET

REV	DATE	COMMENT
1	03.03.2023	AC RESPONSE
2	08.14.2023	CORRECTIONS
3	09.25.2023	CORRECTIONS
4	10.17.2023	CORRECTIONS
5	12.21.2023	CORRECTIONS

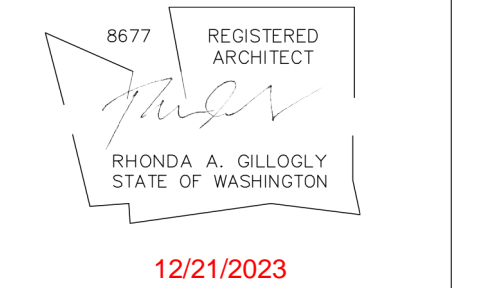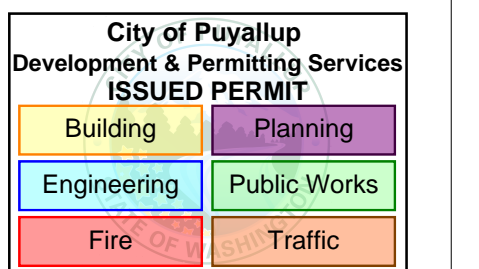


12/21/2023

DETAILS  
ADDITION TO HAMPTON INN & SUITES  
1515 S MERIDIAN  
PUYALLUP, WA 98371  
HAMPTON INN & SUITES


TITLE PROJECT CLIENT

JOB NO: 210158


A7.4

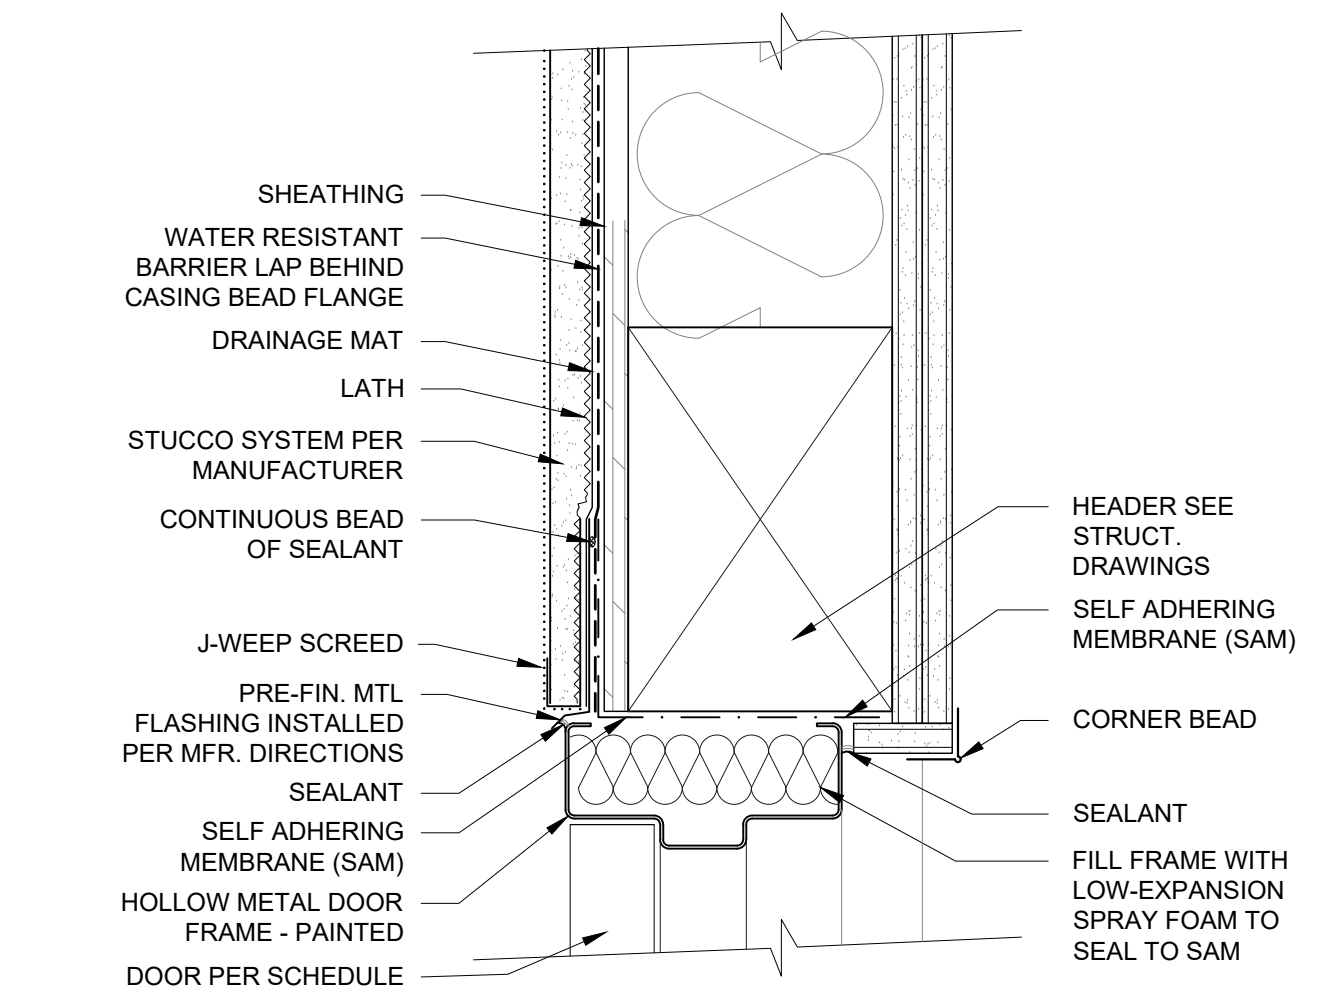


1 100A DOOR HEADER - LEVEL 1  
SCALE: 3" = 1'-0" STUCCO EXTERIOR

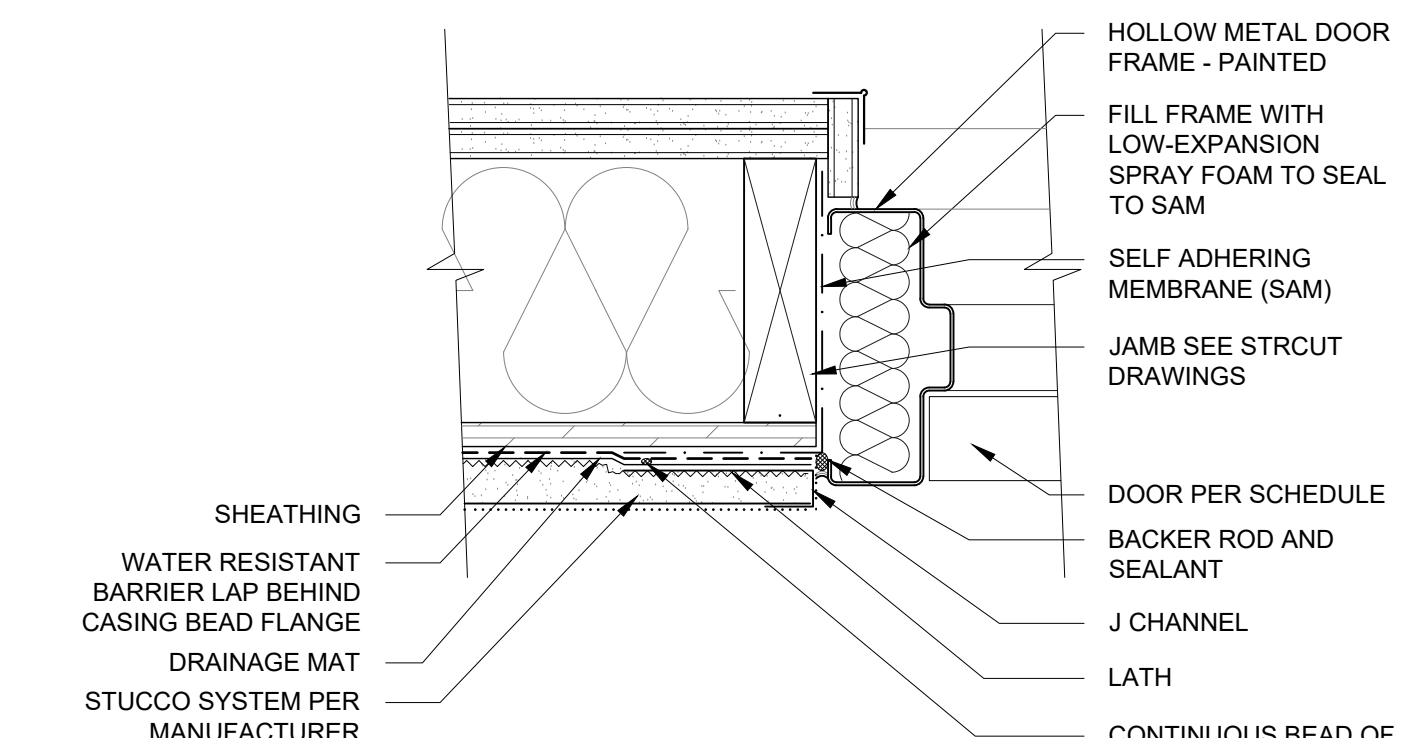


2 100A DOOR JAMB - LEVEL 1  
SCALE: 3" = 1'-0" STUCCO EXTERIOR

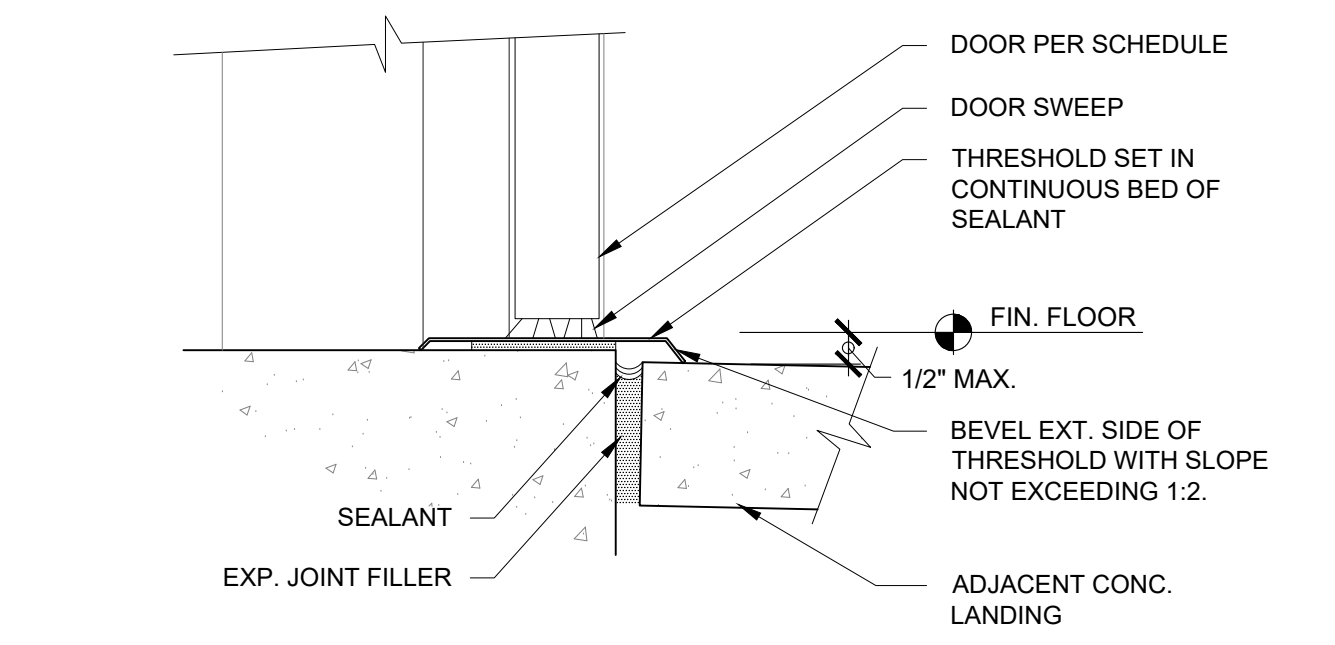


3 100A DOOR THRESHOLD - LEVEL 1  
SCALE: 3" = 1'-0" EXTERIOR

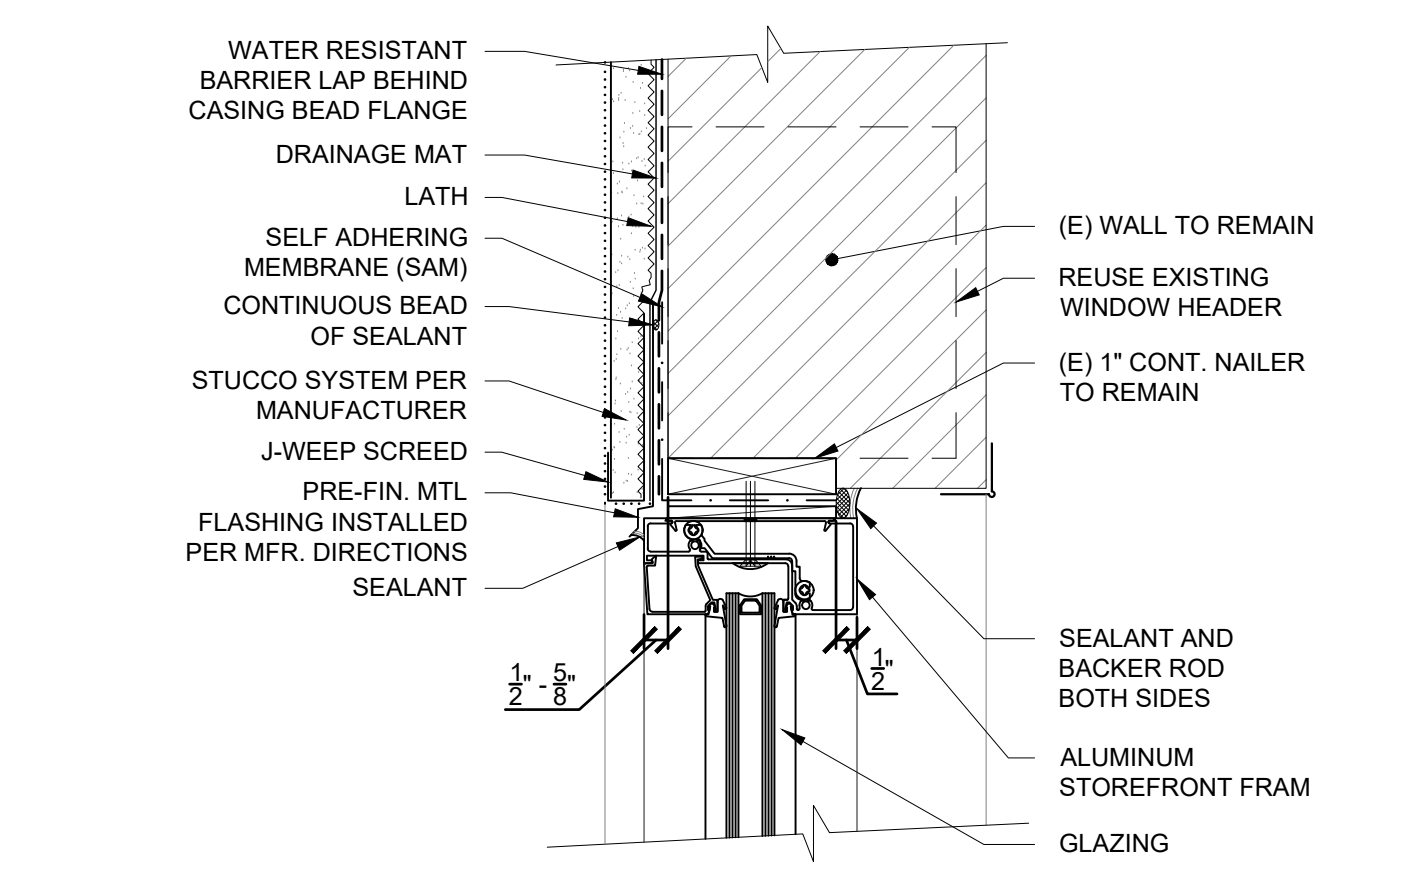


4 STOREFRONT 136A WINDOW HEADER - LEVEL 1  
SCALE: 3" = 1'-0" STUCCO EXTERIOR

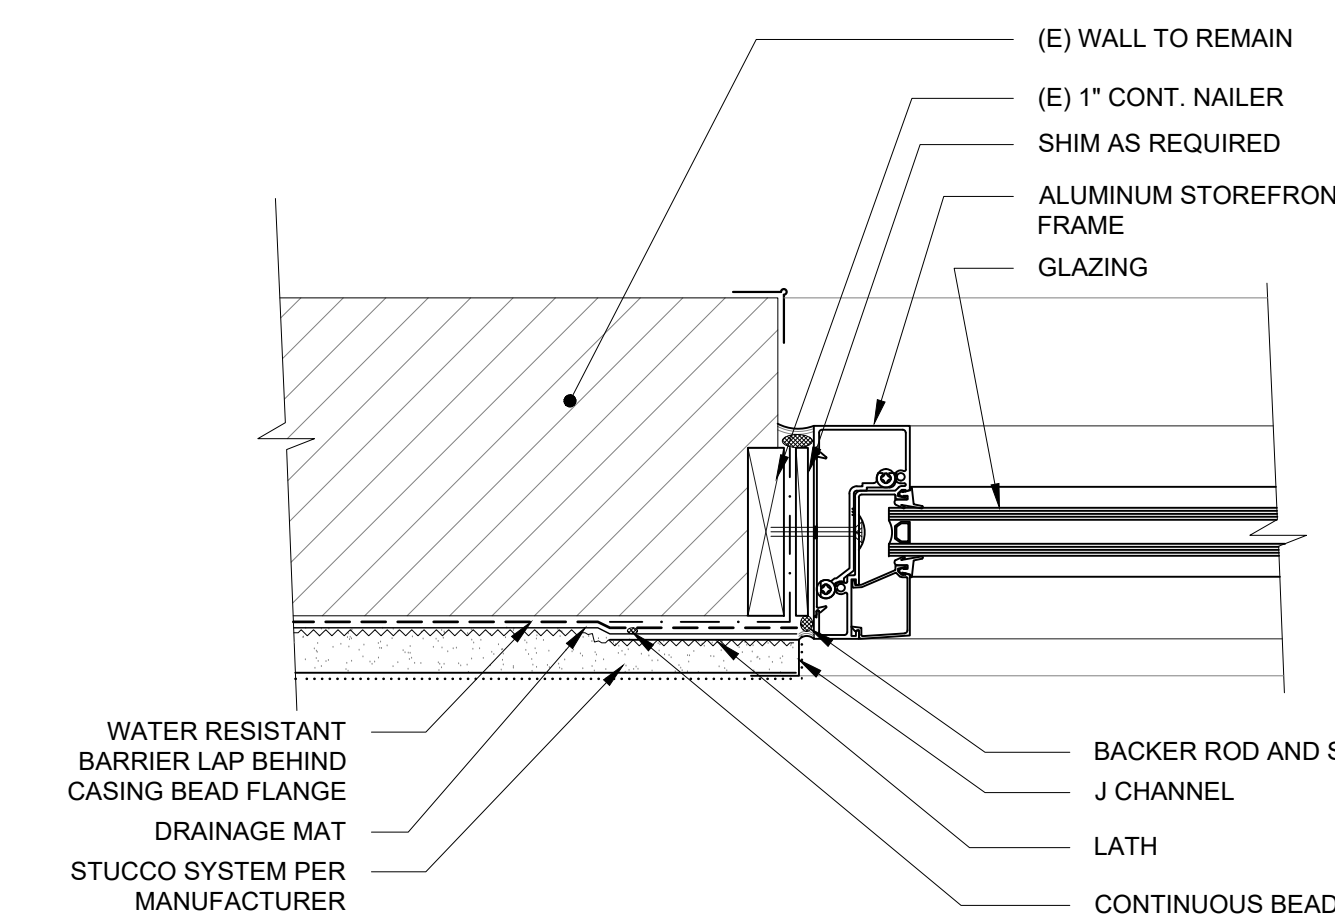


5 STOREFRONT 136A WINDOW JAMB - LEVEL 1 (SILL SIM.)  
SCALE: 3" = 1'-0" STUCCO EXTERIOR

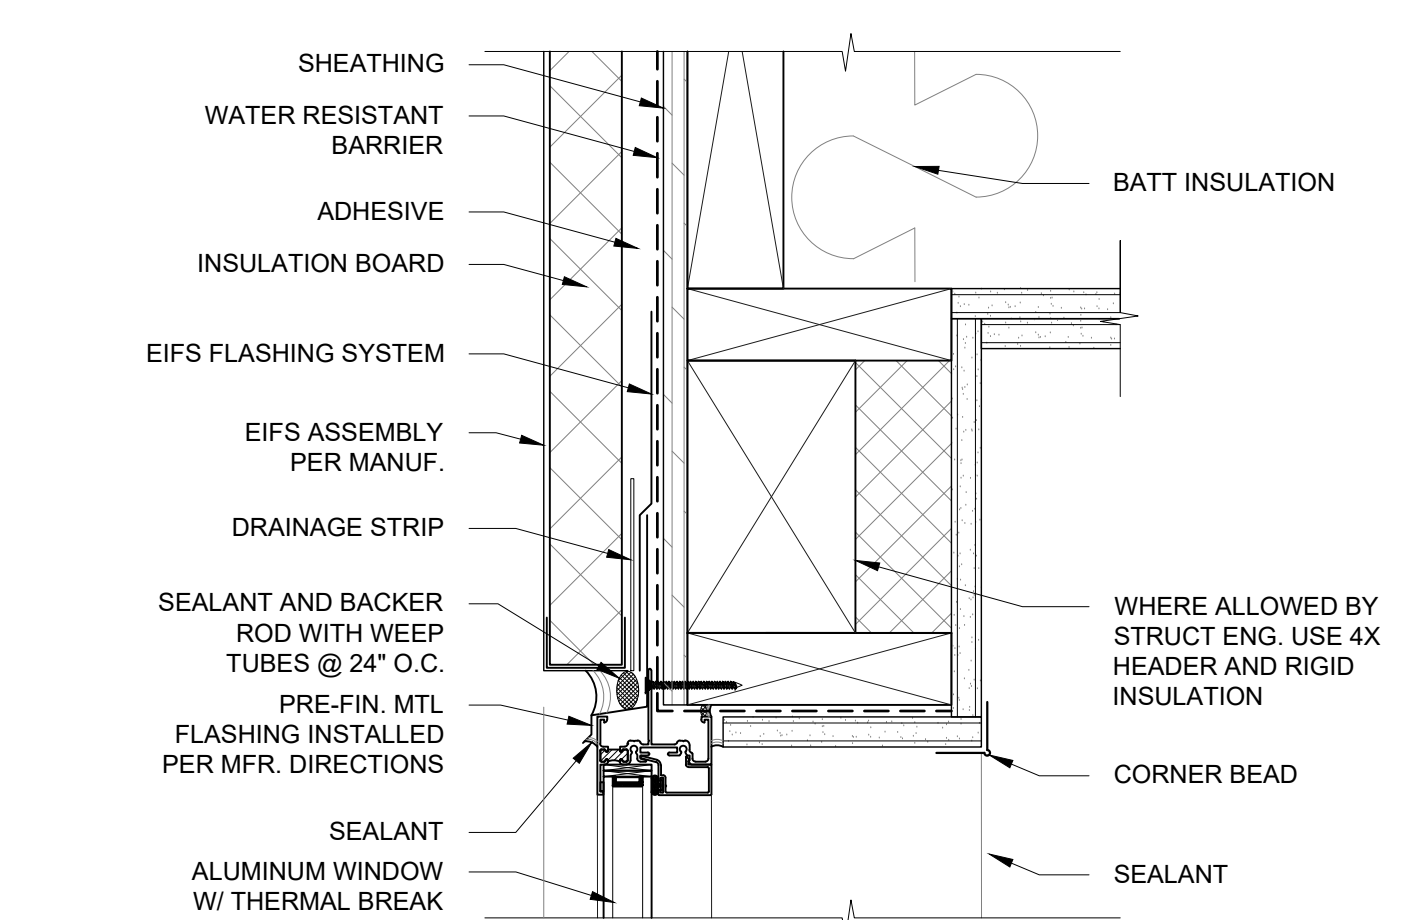


6 UNIT WINDOW HEADER  
SCALE: 3" = 1'-0" EIFS EXTERIOR

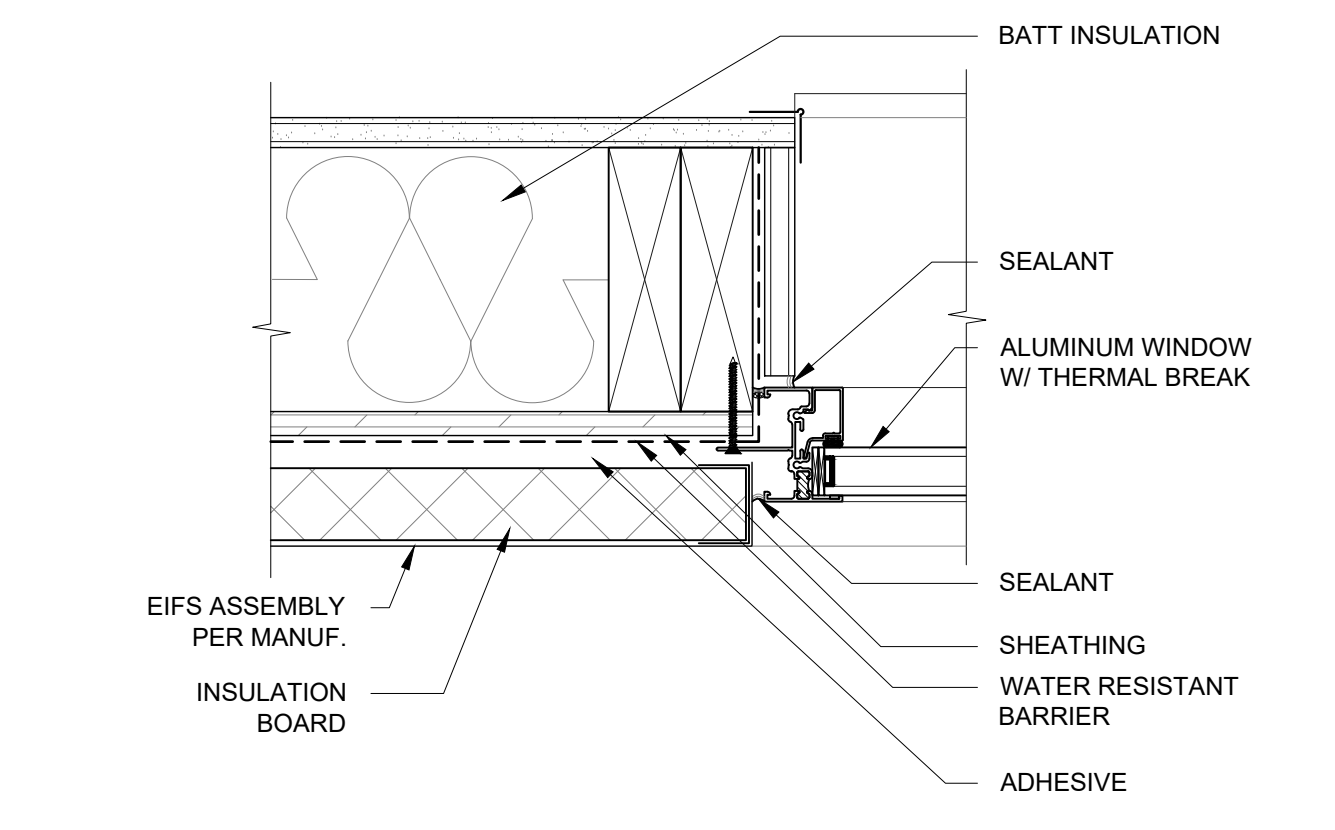


7 UNIT WINDOW JAMB  
SCALE: 3" = 1'-0" EIFS EXTERIOR

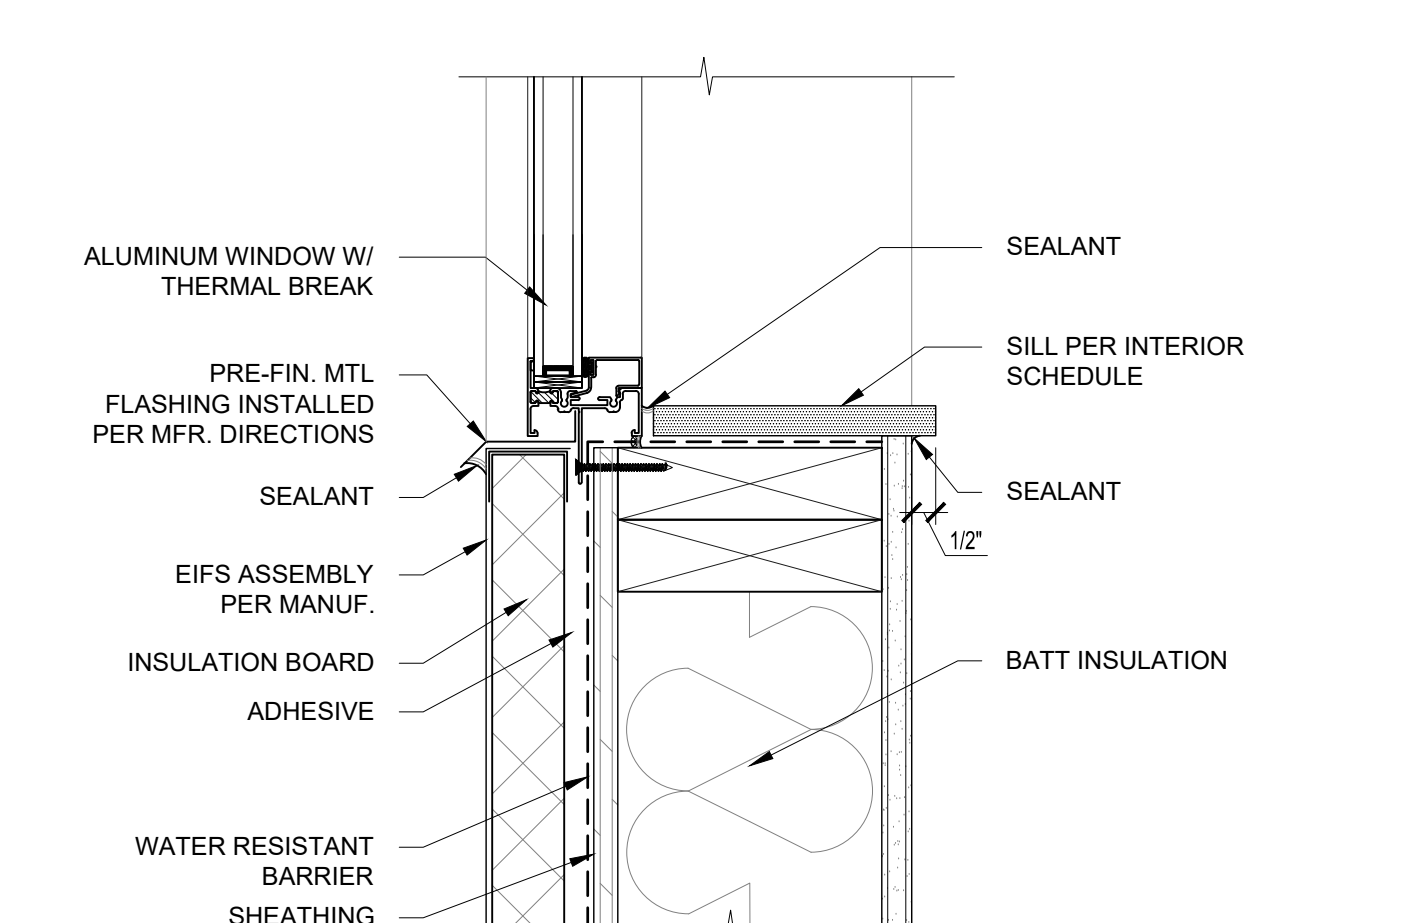


8 UNIT WINDOW SILL  
SCALE: 3" = 1'-0" EIFS EXTERIOR

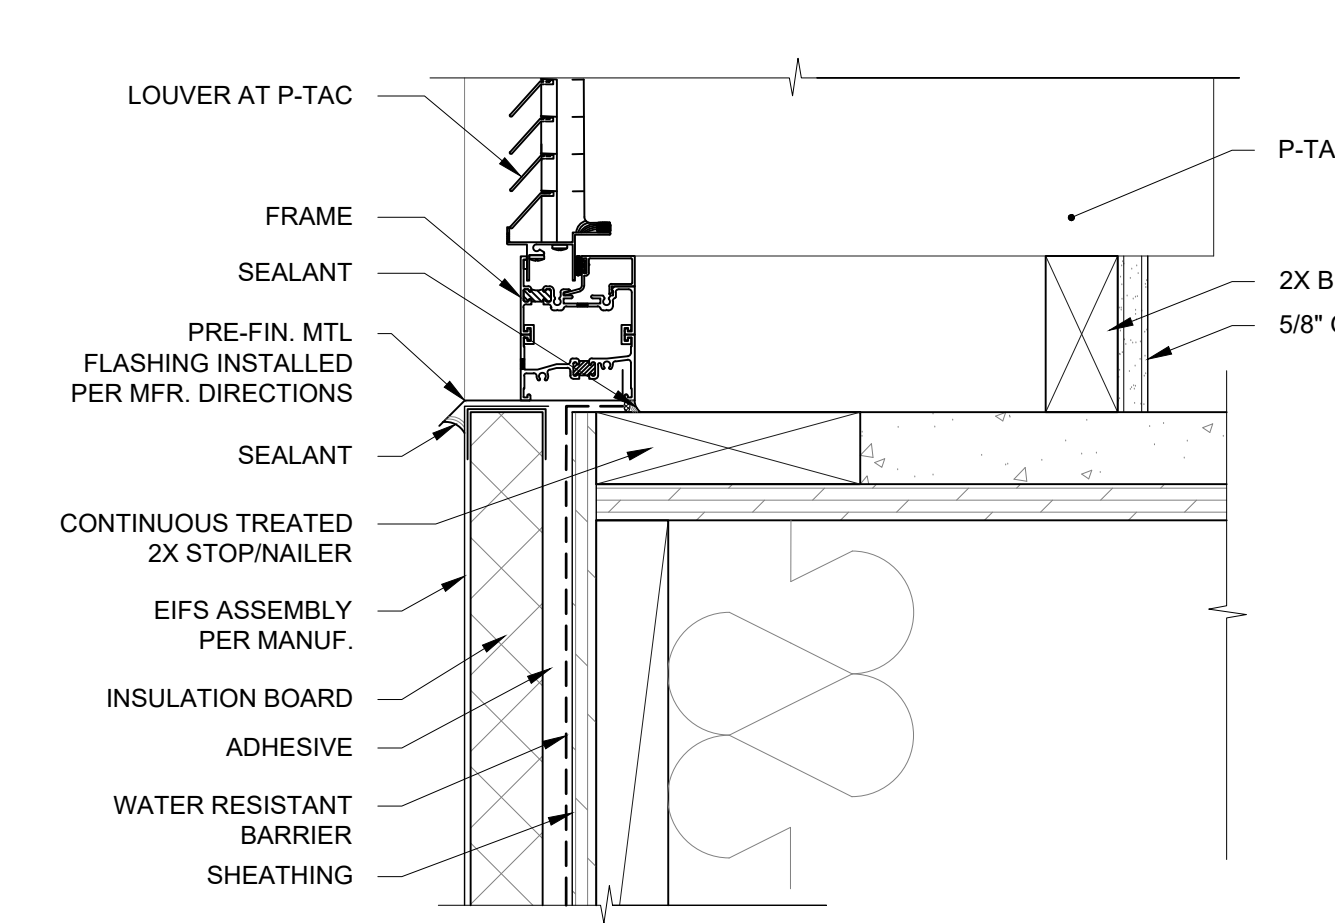


9 WINDOW SILL AT P-TAC  
SCALE: 3" = 1'-0" EIFS EXTERIOR

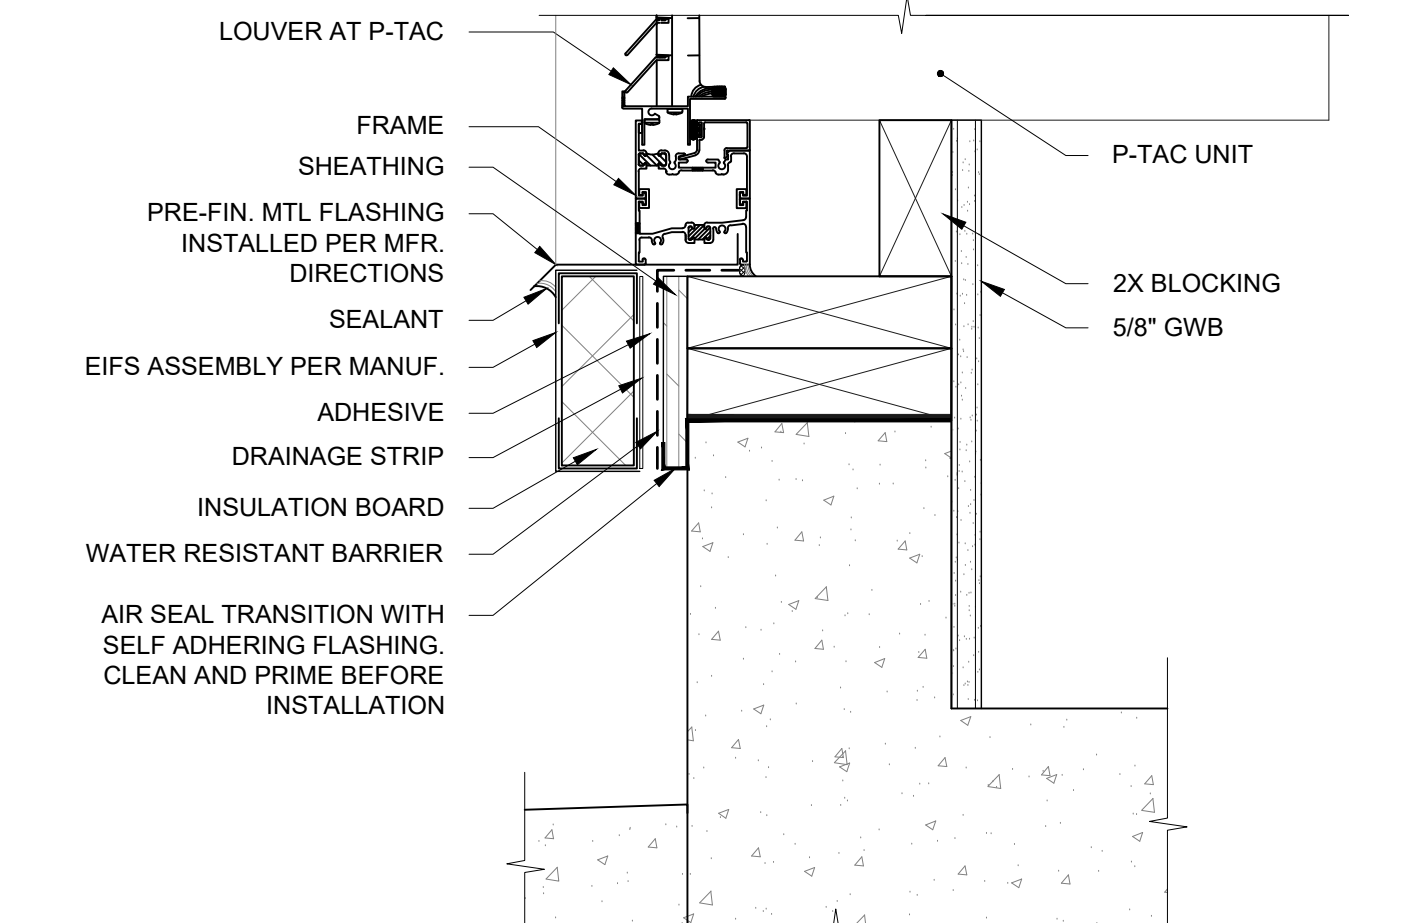


10 UNIT WINDOW MULLION  
SCALE: 3" = 1'-0" EIFS EXTERIOR

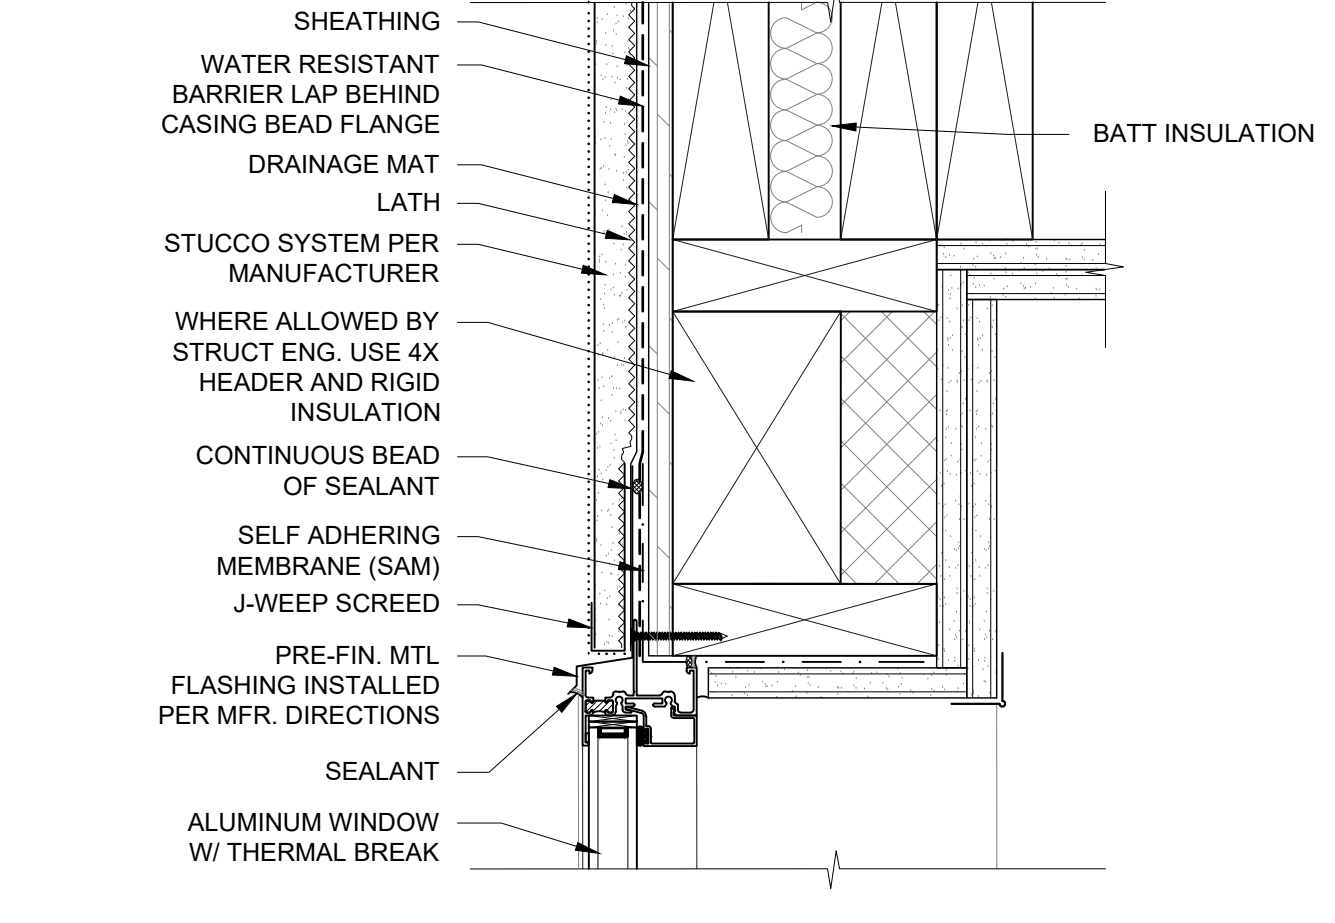


11 UNIT WINDOW HEADER  
SCALE: 3" = 1'-0" STUCCO EXTERIOR

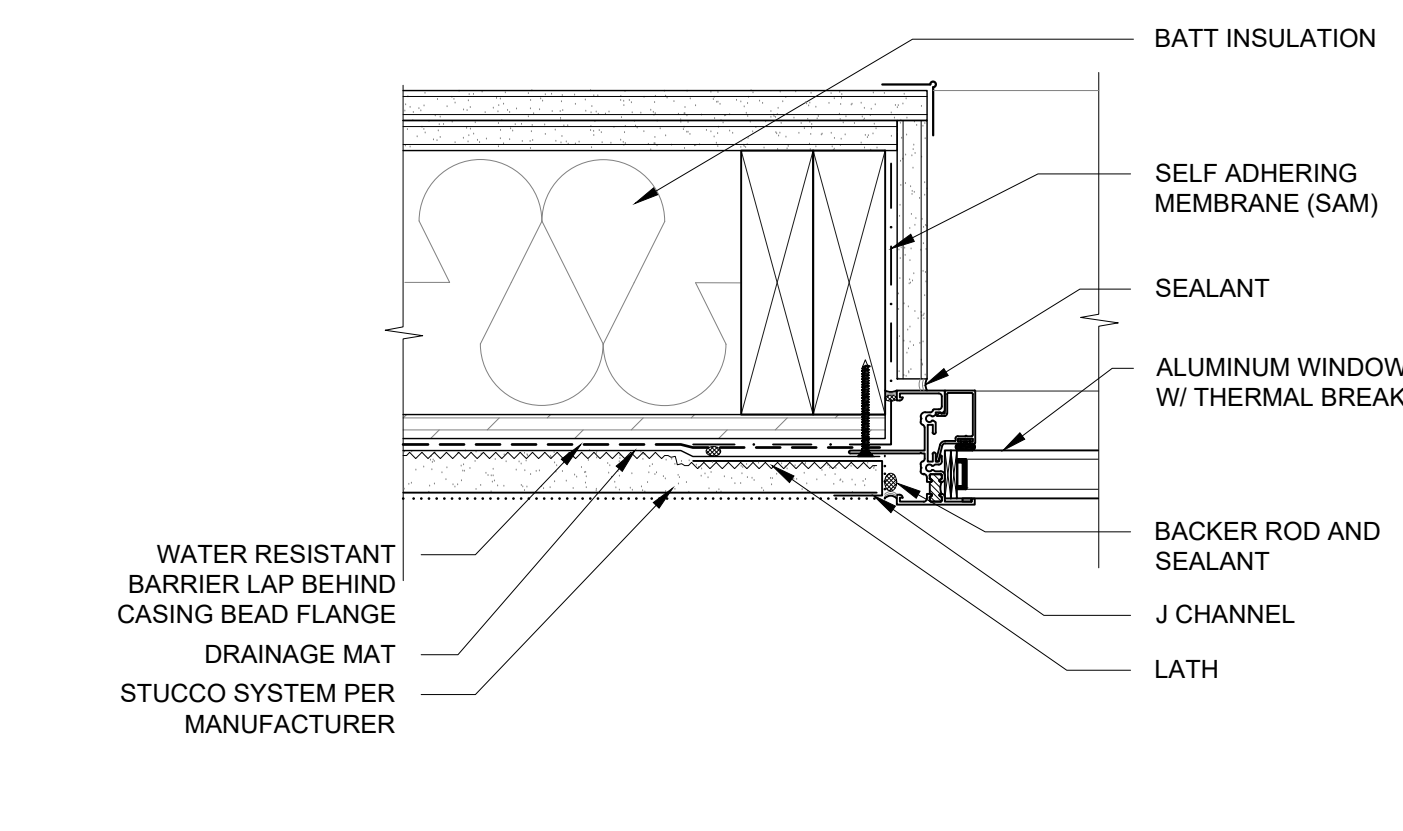


12 UNIT WINDOW JAMB  
SCALE: 3" = 1'-0" STUCCO EXTERIOR

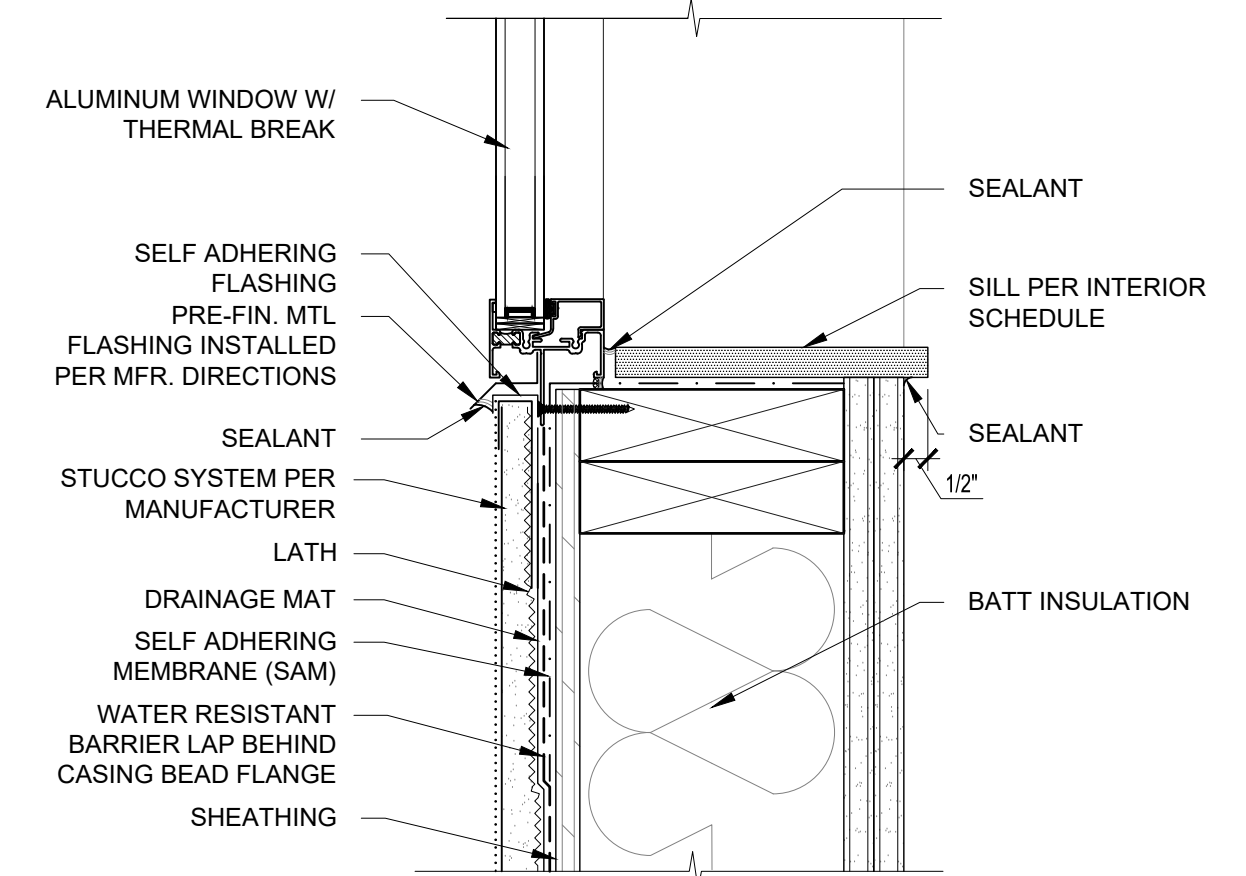


1 UNIT WINDOW SILL  
SCALE: 3" = 1' - 0"  
STUCCO EXTERIOR

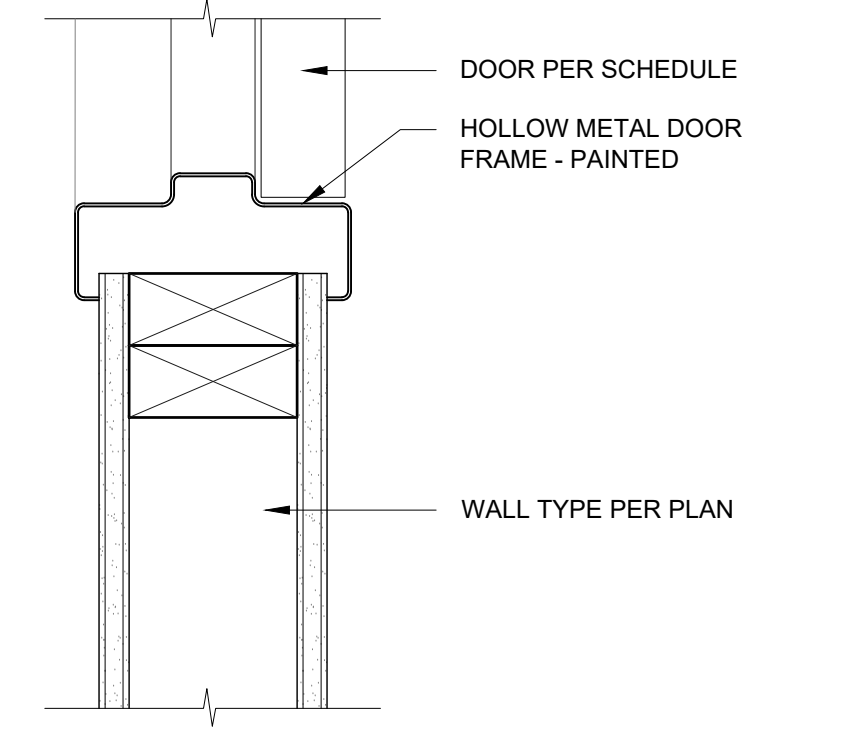


2 INTERIOR HM DOOR JAMB/HEAD SIMILAR  
SCALE: 3" = 1' - 0"  
INTERIOR

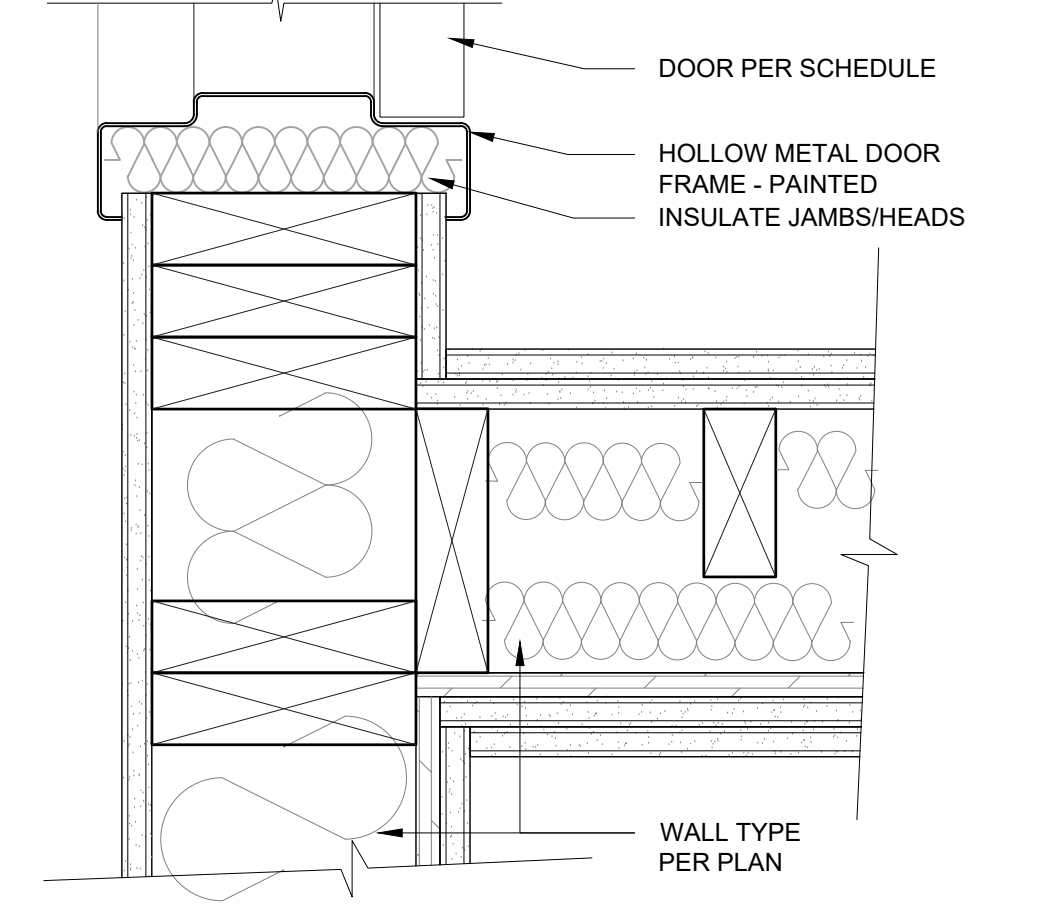

3 INTERIOR HM DOOR JAMB/HEAD SIMILAR AT GUEST ROOM  
SCALE: 3" = 1' - 0"  
INTERIOR

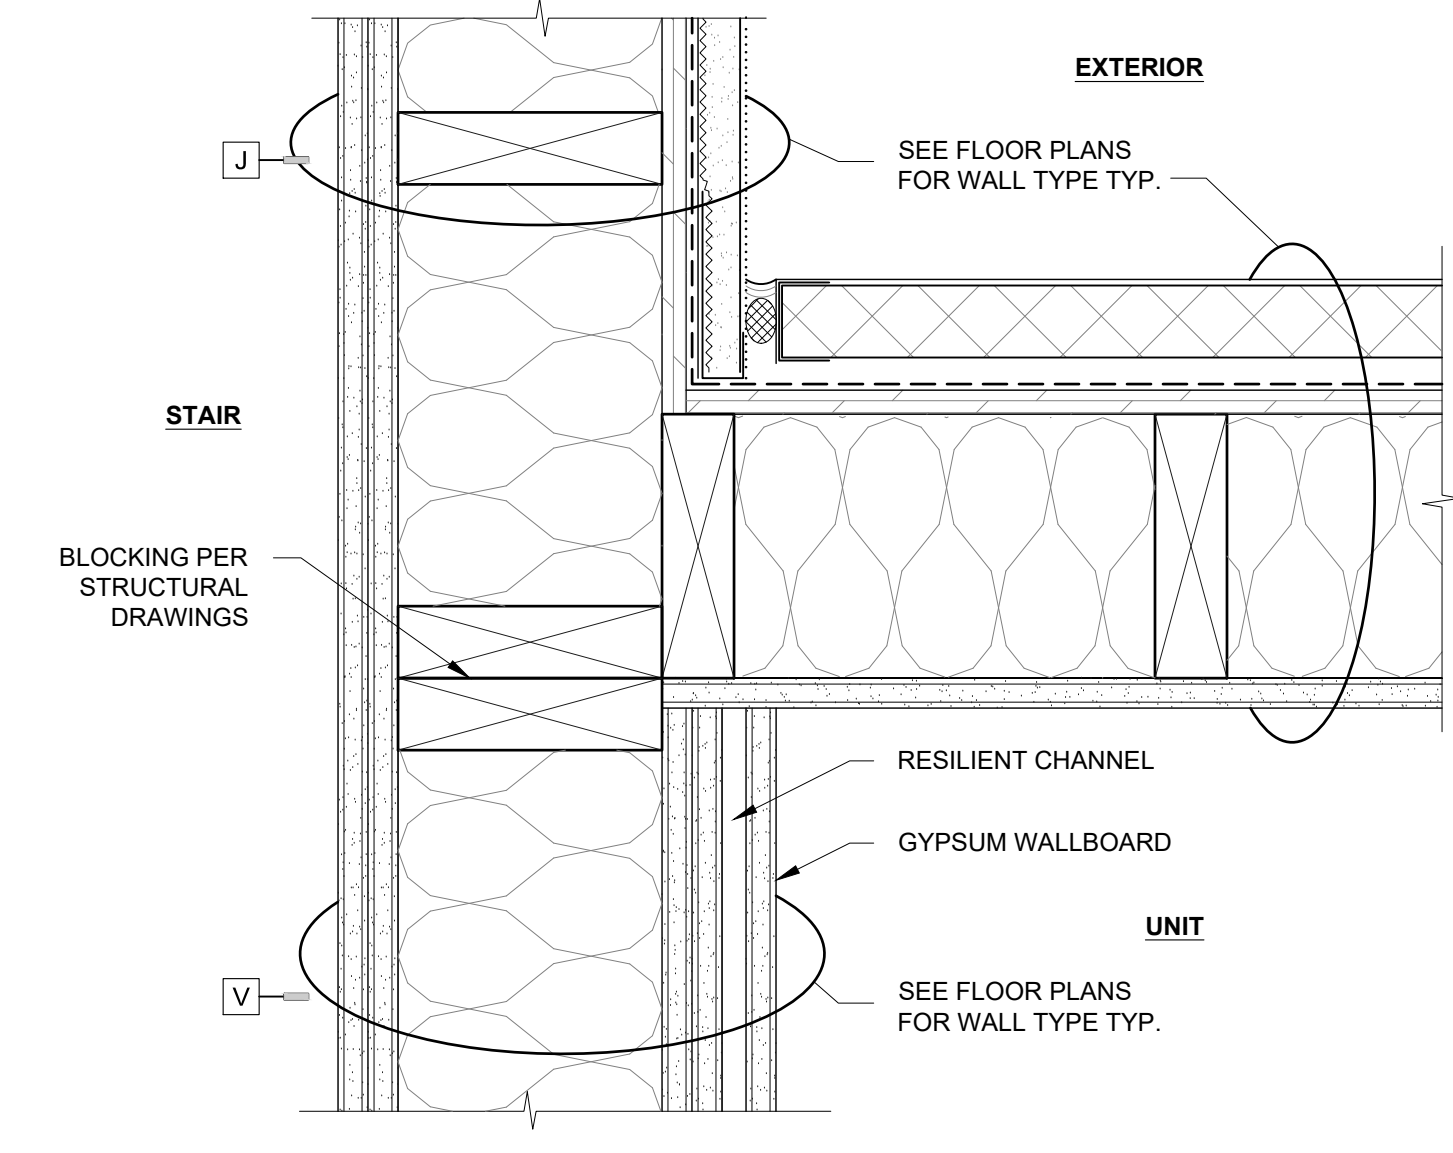

4 WALL DETAIL  
SCALE: 3" = 1' - 0"  
INTERIOR

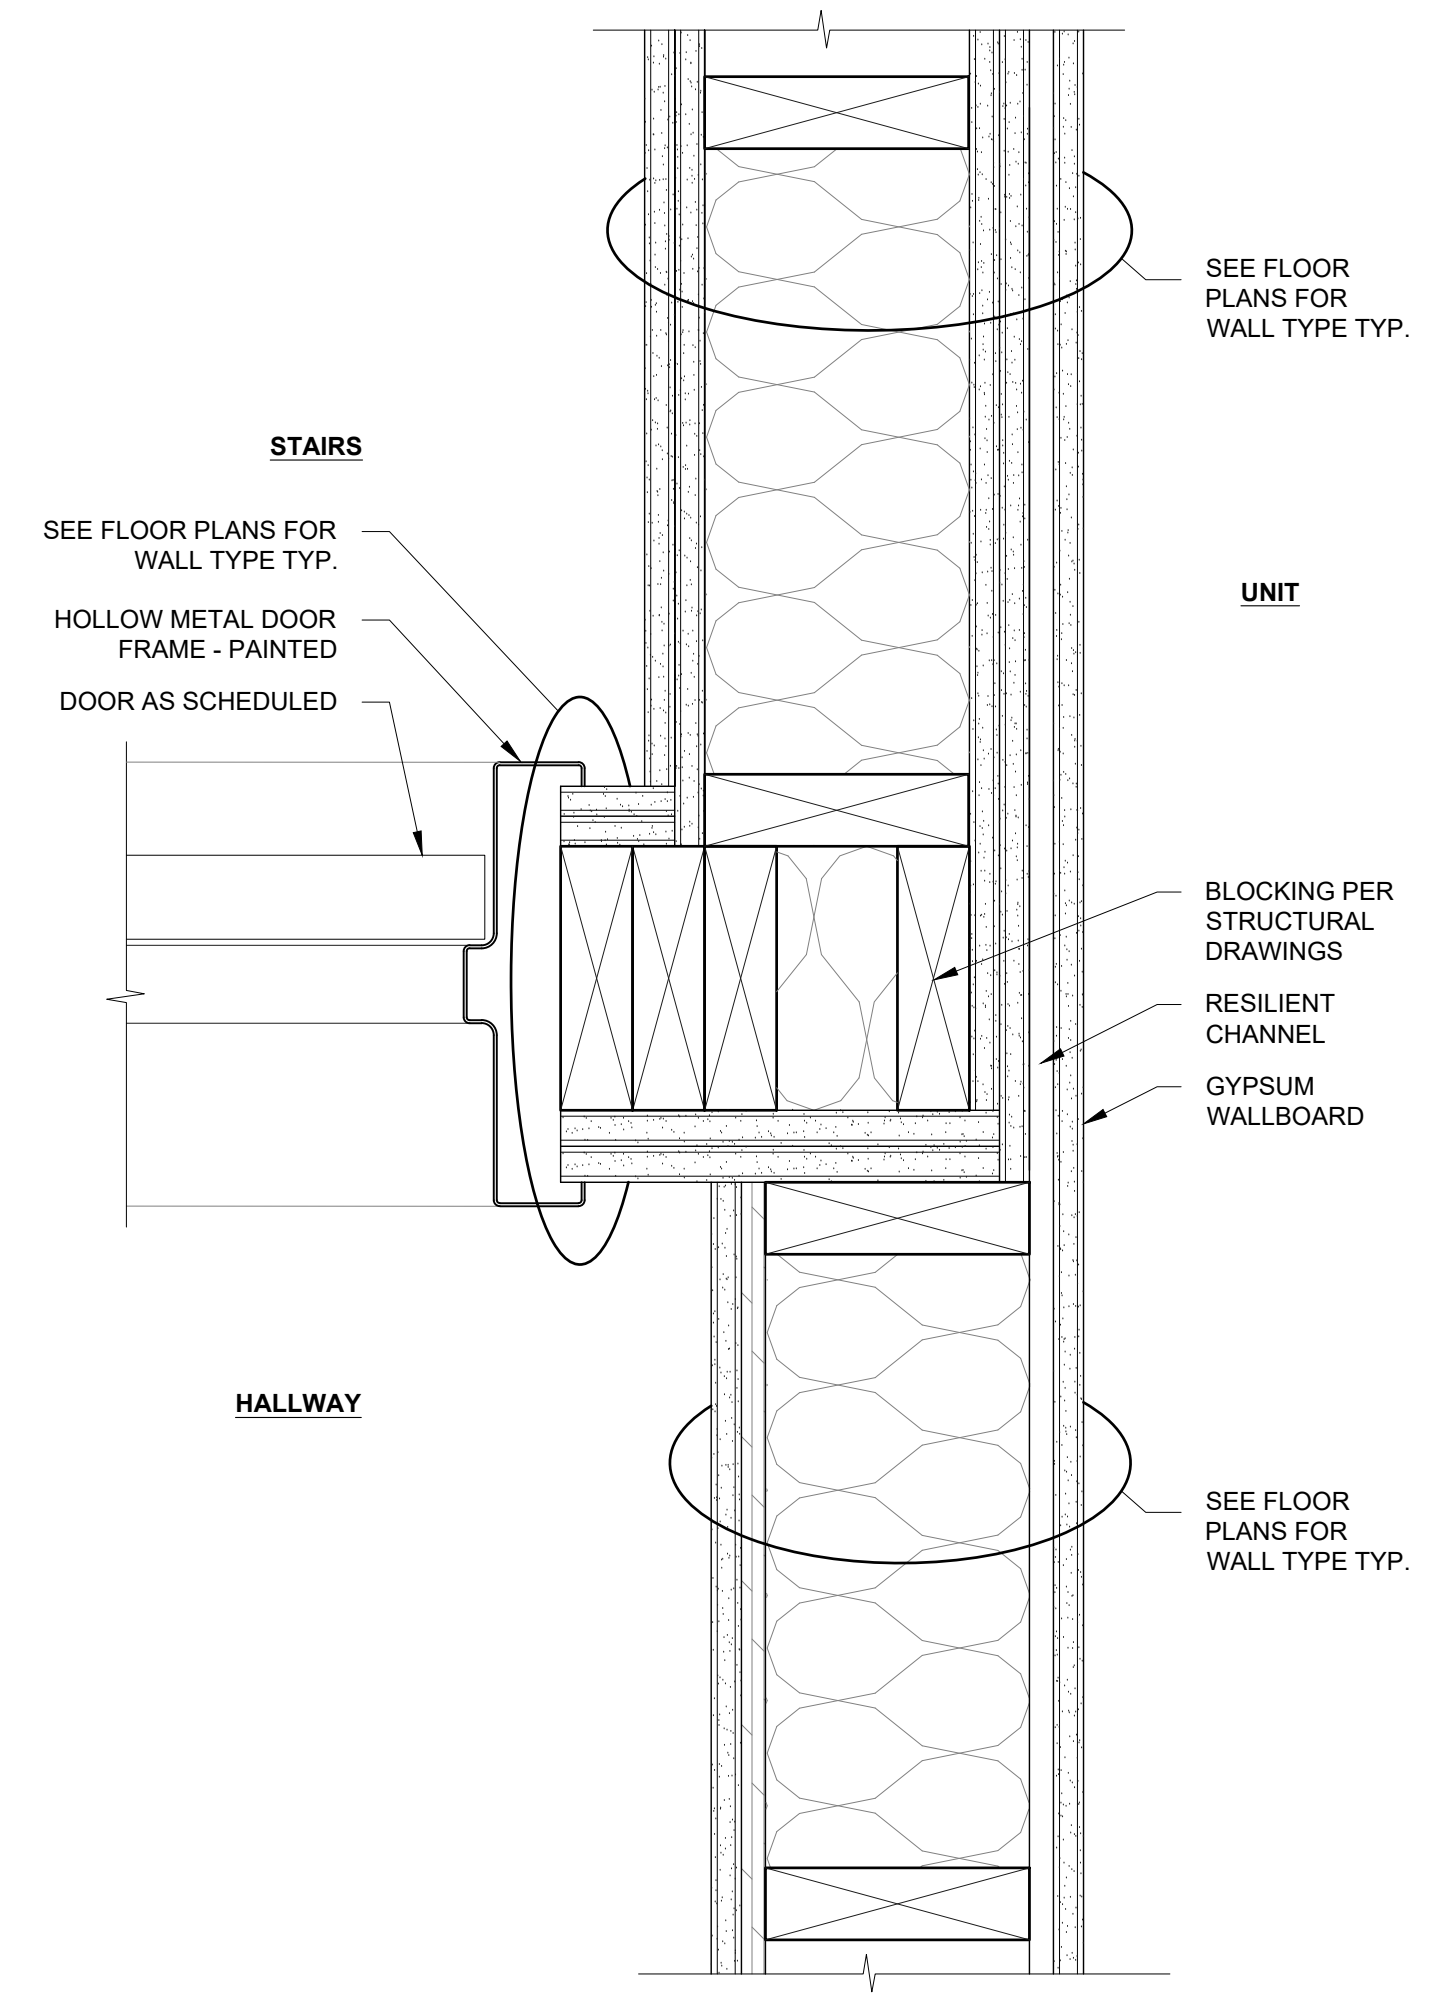

5 WALL DETAIL  
SCALE: 3" = 1' - 0"  
INTERIOR

KNIT  
 909 S. 336TH ST.  
 SUITE 107  
 FEDERAL WAY, WA 98003  
 knitstudios.com

THESE DOCUMENTS HAVE BEEN PRODUCED AS AN INSTRUMENT OF SERVICE AND ARE INTENDED SOLELY FOR THE PURPOSE OF CONSTRUCTING, USING AND MAINTAINING THE PROJECT. KNIT AS THE ARCHITECT OF RECORD FOR THE PROJECT RETAINS OWNERSHIP OF THESE DOCUMENTS.  
 ANY USE OF THESE DOCUMENTS OR USE OF THE DESIGN IDEAS OR CONCEPTS DESCRIBED HEREIN IN WHOLE OR PART BY ANY PERSON WHATSOEVER IS STRICTLY PROHIBITED EXCEPT BY WRITTEN CONSENT OF KNIT.  
 REPRODUCTION OF THESE DOCUMENTS IS STRICTLY PROHIBITED EXCEPT BY WRITTEN CONSENT OF KNIT.  
 COPYRIGHT 2021 KNIT

ISSUE DATE 09/25/23  
 PROGRESS SET

REV	DATE	COMMENT
1	03.03.2023	AC RESPONSE
2	08.14.2023	CORRECTIONS
3	09.25.2023	CORRECTIONS
4	10.17.2023	CORRECTIONS
5	12.21.2023	CORRECTIONS

City of Puyallup  
 Development & Permitting Services  
 ISSUED PERMIT

Building	Planning
Engineering	Public Works
Fire	Traffic

8677 REGISTERED ARCHITECT  
  
 RHONDA A. GILLOGLY  
 STATE OF WASHINGTON  
 12/21/2023

DETAILS  
 ADDITION TO HAMPTON INN & SUITES  
 1515 S MERIDIAN  
 PUYALLUP, WA 98371  
 HAMPTON INN & SUITES

TITLE	PROJECT	CLIENT
JOB NO: 210158		