


16. SCHEDULE THE USE OF THE ELEVATOR WITH BUILDING MANAGEMENT.
17. UPON COMPLETION OF ALL CONSTRUCTION, THE CONTRACTOR SHALL SUPPLY THE LANDLORD WITH ONE SET OF "RECORD" AS-BUILT DRAWINGS.
18. ALL MATERIALS TO BE NEW UON.
19. PATCH ALL DISTURBED AND/OR DAMAGED AREAS AS REQUIRED TO ACCOMPLISH NEW WORK AND AS REQUIRED FOR FINISHED APPEARANCE.
20. GENERAL CONTRACTOR IS RESPONSIBLE FOR PROVIDING ALL NECESSARY BACKING, BLOCKING, AND FRAMING FOR LIGHT FIXTURES, ELECTRICAL FIXTURES, CASEWORK AND ALL OTHER ITEMS REQUIRING IT.
21. CONTRACTOR TO COORDINATE ALL FIRE ALARM WORK WITH BUILDING OWNER.
22. ALL PAINT AND FINISH MATERIAL COLORS SHALL MATCH ARCHITECT'S CONTROL SAMPLES AND REQUIRE ARCHITECT'S REVIEW PRIOR TO INSTALLATION. SUBMIT TO ARCHITECT THREE (3) COPIES FOR REVIEW.
23. CONTRACTOR SHALL FURNISH SHOP DRAWINGS FOR REVIEW ON CABINETWORK, MILLWORK AND ANY OTHER SPECIAL ITEMS REQUIRING CUSTOM SHOP FABRICATION. SUBMIT TO ARCHITECT AT LEAST THREE (3) COPIES FOR REVIEW.
24. REPEITIVE FEATURES NOT FULLY SHOWN OR NOTED ON THE DRAWINGS SHALL BE COMPLETELY PROVIDED AS IF DRAWN.
25. THROUGHOUT THE DRAWINGS ARE ABBREVIATIONS WHICH ARE IN COMMON USE. THE LIST OF ABBREVIATIONS PROVIDED IS NOT INTENDED TO BE A COMPLETE LIST. THE ARCHITECT WILL DEFINE THE INTENT OF ANY IN QUESTION.

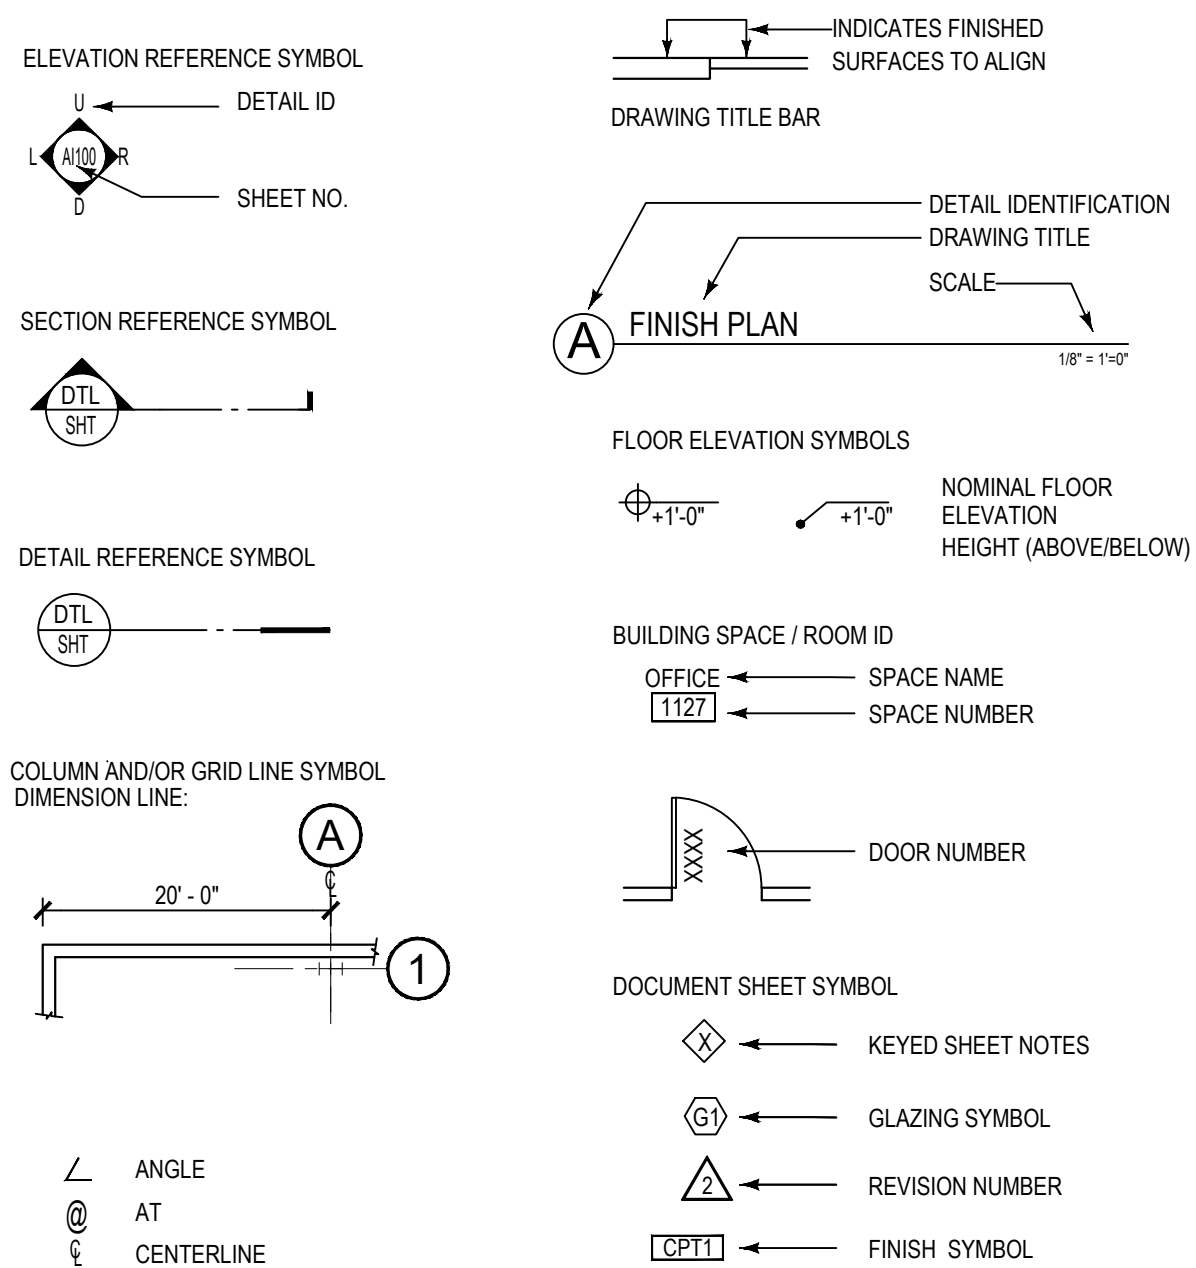

3. MINIMUM DIMENSIONS FOR ACCESSIBILITY CLEARANCES AND BUILDING CODE REQUIREMENTS SHALL BE MAINTAINED.
4. FLOOR ELEVATIONS ARE INDICATED AT THE FACE OF THE STRUCTURAL SLAB, UNLESS OTHERWISE NOTED.
5. VERTICAL DIMENSIONS ARE INDICATED FROM THE FLOOR ELEVATION TO FACE OF FINISHED MATERIAL, UNLESS NOTED ABOVE FINISH FLOOR - "AFF".
6. CEILING HEIGHTS ARE INDICATED FROM THE FLOOR ELEVATION TO THE FACE OF SUSPENDED ACOUSTIC CEILING GRID OR FACE OF FINISH MATERIAL FOR OTHER CEILING TYPES, UNLESS OTHERWISE NOTED.
7. DOCUMENTS ARE DRAWN DIAGMATICALLY, AND SCALED DIMENSIONS SHALL INDICATE REQUIRED SIZE, CLEARANCES, AND RELATIONSHIPS ARE INDICATED BY DIMENSIONS AS NOTED

[illegible]

- PROJECT ADDRESS:  
PROLOGIS PUYALLUP | MAKE READY  
PUYALLUP 1  
1601 INDUSTRIAL PARK WAY, SUITE #100  
PUYALLUP, WA 98371
2. APPLICABLE CODES & ORDINANCES:  
2021 INTERNATIONAL BUILDING CODE WITH STATEWIDE AMENDMENTS  
2021 INTERNATIONAL MECHANICAL CODE WITH STATEWIDE AMENDMENTS  
2021 INTERNATIONAL FUEL GAS CODE  
2021 INTERNATIONAL FIRE CODE WITH STATEWIDE AMENDMENTS  
2021 WASHINGTON STATE COMMERCIAL ENERGY CODE  
2021 UNIFORM PLUMBING CODE WITH STATEWIDE AMENDMENTS  
2021 INTERNATIONAL EXISTING BUILDING CODE WITH STATEWIDE AMENDMENTS  
FOLLOWS PRESCRIPTIVE COMPLIANCE METHOD 301.1 I)  
2009 ICCANSI A117.1 ACCESSIBLE AND USABLE BUILDINGS AND FACILITIES  
2020 NATIONAL ELECTRICAL CODE
- GENERAL BUILDING DESCRIPTION:  
TYPE OF CONSTRUCTION: I-B  
FIRE RESISTIVE SYSTEM: SPRINKLERED WITHOUT QUICK RESPONSE HEADS  
OCCUPANCY TYPE: 'B' OFFICE / 'S-2' WAREHOUSE
- FIRE RESISTIVE CONSTRUCTION REQUIREMENTS:  
SHIRT ENCLOSURES: 2 HOUR  
EXIT STAIR ENCLOSURES: 2 HOUR  
CORRIDORS: NON-RATED PER IBC TABLE 1020.1
5. CODE SUMMARY: REFER TO SHEET G103
- PROJECT DESCRIPTION:  
4.564 SF NON-STRUCTURAL INTERIOR TENANT IMPROVEMENT. WORK INCLUDES ADDING ROOF INSULATION TO UNDERSIDE OF EXISTING ROOF DECK THROUGHOUT OFFICE SUITE TO MEET W-1 COMPLIANCE.  
WALLS AND CEILING EXISTING AND PERIMETER WALL ARE EXISTING. UNDER SEPARATE PERMIT  
NO CHANGE TO EXISTING OCCUPANCY OR EGRESS.

[illegible]

SCALE: NTS

ARCHITECT/DESIGNER: BERNARD INTERIOR ARCHITECTURE 1000 FIFTH AVENUE, SUITE 400 SEATTLE, WASHINGTON 98101 TEL: 206.587.1720 ATTN: SOPHIEAHP@BURGESSPNW.COM EMAIL: SOPHIEAHP@BURGESSPNW.COM	GENERAL CONTRACTOR: TBD - BIDDER DESIGN BUILD BY G.C.  PLUMBING ENGINEER: TBD - BIDDER DESIGN BUILD BY G.C.  MECHANICAL ENGINEER: METRIX ENGINEERS - SCOTT AARON MILLER
BUILDING MANAGER: PROLOGIS 3330 JEFFERSONIAVE/VAE SOUTH, SUITE 100 FEDERAL WAY, WA 98001 TEL: 206.414.7626 ATTN: JAMES BIRCHARD EMAIL: JERICHRCH@PROLOGIS.COM	ELECTRICAL ENGINEER: METRIX ENGINEERS - BENJAMIN C. PREHODA  FIRE/FIFE SAFETY ENGINEER: METRIX ENGINEERS - SCOTT AARON MILLER

FIRE, LIFE SAFETY PERMIT UNDER SEPARATE SUBMITTAL

SHEET NUMBER	SHEET TITLE	SHEET ISSUED	REVISION #	REVISION DATE
G001	COVER SHEET / PROJECT INFORMATION	X	3	03.22.2024
G002	PROJECT NOTES	X	3	03.22.2024
G003	CODE SUMMARY - NO CHANGE, INFORMATION ONLY	X	3	03.22.2024
G004	PROLOGIS CUSTOMER STANDARD FINISH	X	3	03.22.2024
		X	3	03.22.2024

N131	REFLECTED CEILING PLAN - WAREHOUSE	X	3	03.22.2024
N300	SECTIONS / WSEC COMPLIANCE REPORT	X	3	03.22.2024
N500	DETAILS	X	3	03.22.2024

## LEGAL DESCRIPTION / PARCEL NO.

PARCEL NUMBER: 0420212076


ALLEG DESCRIPTION: SECTION 21 TOWNSHIP 20 RANGE 04 QUARTER 21 1 OF 1 DUBLR 2007-02-28 08:00:55 DMS  
 AS BEG AT INTER OF SELLY PUD IN RES L&I AND N OF L VEELE RD N 66 DEG 45 MIN 56 SEC W 381 FT 81 FT TH  
 N 66 DEG 45 MIN 56 SEC W 1249 FT 45 FT S 74 DEG 32 MIN 45 SEC E 280 FT TH N N 65 DEG 38 MIN 56 SEC W 59 37 FT  
 N 66 DEG 21 MIN 54 SEC W 15 FT S 75 DEG 38 MIN 08 SEC E 263 FT TH N 66 DEG 08 MIN 38 SEC W 108 FT  
 N 66 DEG 08 MIN 38 SEC W 108 FT TH N 66 DEG 08 MIN 38 SEC W 108 FT TH N 66 DEG 08 MIN 38 SEC W 108 FT  
 FROM WHICH A TANG L BEARS N 47 DEG 35 MIN 06 SEC E 2331 FT TO A PNT OF TANG N 21 DEG 21 MIN 38 SEC  
 W 70 66 FT TO A PNT OF CONCAVE WLY RAD OF R 307 FT 2 CENTRAL ANGLE OF 25 DEG 34 MIN 46 SEC TH  
 N 130 ALG ARC OF SD C TOL 11 112 FT 11 112 FT N 60 DEG 46 MIN 46 SEC E 299 51 FT TO BEG OF CONCAVE WLY  
 RAD 330 FT TO A CENTRAL ANGLE OF 38 DEG 09 MIN 38 SEC TH NLY ALG ARC OF C TOL 219 73 FT N 38 DEG  
 09 MIN 38 SEC W 1157 36 FT TO POB EXC THAT POR CYO TO CY OF PUYALLUP FOR RW PNT EN 4070920 OUT  
 OF 2072 SEC 2011-06-01 J082095A

## STREET MAP

## KEY PLAN / FLOOR PLATE

SCALE: NTS

## AREA OF WORK

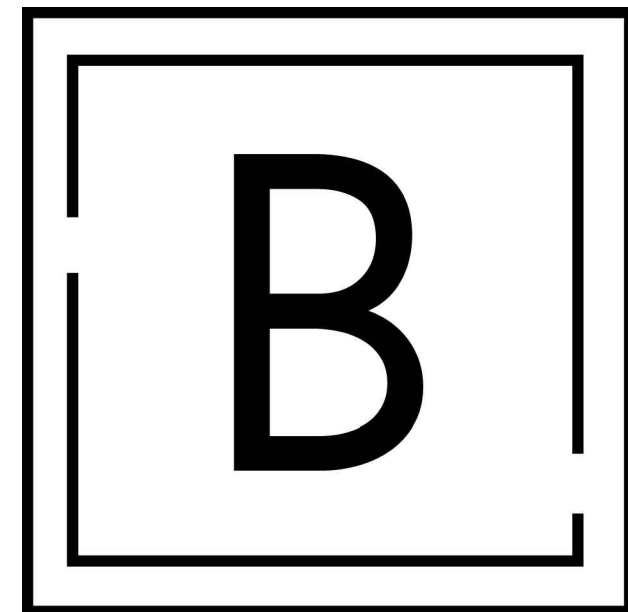

**BURGESS DESIGN**  
INTERIORS + ARCHITECTURE

1200 5th Ave Suite 400 Seattle WA | 206.587.7120




Tenant:  
PROLOGIS PUYALLUP 1  
MAKE READY  
PUYALLUP 1  
1601 INDUSTRIAL PARK #100  
PUYALLUP, WA 98371

CONSTRUCTION WORK SHALL NOT PROCEED UNTIL THE BUILDING OWNER / REPRESENTATIVE AND BUILDING TENANT HAVE GIVEN THEIR APPROVAL TO THESE CONSTRUCTION DOCUMENTS. APPROVAL BY THESE PARTIES SHALL BE INTERPRETED AS APPROVAL OF DRAWINGS FOR CONTENT, FINISH SELECTIONS, SCOPE OF WORK, AND ALL DIMENSIONS REGARDED BY EITHER PARTY AS BEING NECESSARY TO THEIR OPERATIONS, USE OF THE SPACE, FURNISHINGS, AND TENANT EQUIPMENT AND FURNITURE INSTALLATIONS.

CONSTRUCTION AND/OR INITIATION OF CONSTRUCTION, AUTHORIZED BY THE BUILDING OWNER FROM THESE CONSTRUCTION DOCUMENTS, SHALL BE INTERPRETED BY THE DESIGNER AS APPROVAL IN FULL OF THESE CONSTRUCTION DOCUMENTS BY BOTH THE BUILDING OWNER / REPRESENTATIVE AND THE TENANT.

Professional se

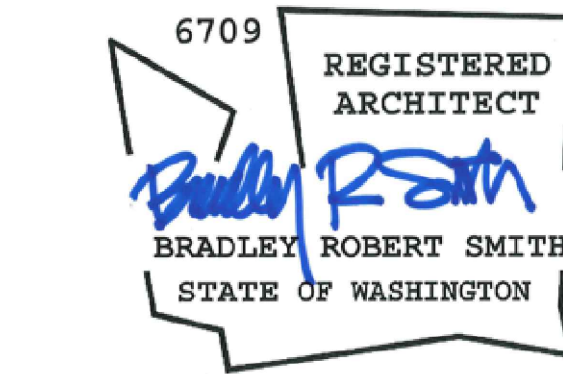

No.	Issue Description	Date
	REVIEW SET	01.06.22
	REVIEW SET	01.30.22
	REVIEW SET	02.17.22
	REVIEW SET	02.27.22
	PERMIT SET	03.10.22
1	CD SET	03.17.22
2	CITY CORRECTION	05.19.22
3	CITY CORRECTION	03.22.22

[illegible]

City Electronic Stamp Location

City Electronic Stamp Location

Drawn by: MK Project Manager: SH  
Project No: 22.0243.00

COVER SHEET/  
PROJECT INFORMATION

Original drawing is 30" x 42". Scale entities accordingly if reduce.

# GI001














<div><div>City of Puyallup Development &amp; Permitting Services ISSUED PERMIT</div><div><div>Building</div><div>Planning</div><div>Engineering</div><div>Public Works</div><div>Fire</div><div>Traffic</div></div></div>	<div><div><div><div>DIVISION 1</div><div>GENERAL REQUIREMENTS</div></div></div></div>	<div><div><div>1.1</div><div>CODES: All construction shall comply with local, state and federal codes and regulations, including all ADA standards.</div></div><div><div>1.1A</div><div>PERMITS: Owner shall reimburse contractor for the cost of the building permit and any impact fees. Contractor shall be responsible for all trade permits and business licenses</div></div><div><div>1.2</div><div><b>INSURANCE: MUST CONFORM WITH Prologis Risk MANAGEMENT REQUIREMENTS</b></div></div><div><div>1.3</div><div><b>BUILDERS RISK INSURANCE:</b> Owner shall provide builders risk insurance to cover the full value of the work being performed</div></div><div><div>1.4</div><div><b>JOB SITE CONDITIONS:</b> All contractors must verify existing job conditions prior to bid.</div></div><div><div>1.5</div><div><b>DOCUMENT CONFLICTS:</b> If there is a conflict in the drawings, or between the written specs and the drawings, the contractor shall be responsible for the more expensive of the options.</div></div><div><div>1.6</div><div><b>CLOSE-OUT DOCUMENTS:</b> Provide O &amp; M manuals and "as-built" drawings for all architectural, structural, plumbing, electrical, HVAC and fire protection work on two (2) flash drives in pdf format. Provide one (1) hard copy and one electronic copy in pdf format of the as-built permit set of drawings. The value of the close-out documents shall be 10% of the value of the respective work.</div></div><div><div>1.7</div><div><b>EXISTING STRUCTURE:</b> Nothing may be suspended from the 2x4 or 2x6 sub-purlins at the roof without the structural engineer's written permission except for warehouse lighting fixtures specified below.</div></div><div><div>1.8</div><div><b>EXISTING CONDITIONS:</b> These finish standards shall be modified to match existing conditions with written approval from the Prologis Project / Property Manager</div></div><div><div>1.9</div><div><b>FLOOR MAINTENANCE:</b> No vehicles except scissor lifts shall be allowed inside the building during construction without written permission from the owner. All scissor lifts shall have non-marking tires and must be diapered to prevent marking and staining of the concrete floor.</div></div><div><div>1.10</div><div><b>SUPERVISION:</b> The general contractor shall provide a highly experienced jobsite superintendent, acceptable to the owner, to manage all the work during the course of construction.</div></div><div><div>1.11</div><div><b>SAFETY:</b> Contractor shall be green flagged in Avetta system prior to beginning any work</div></div><div><div>1.12</div><div><b>WARRANTIES:</b> Contractor shall provide a one year labor and material warranty from project completion on all work performed.</div></div></div>	<div><div><div>DIVISION 3</div><div>CONCRETE</div></div></div>	<div><div><div>3.1</div><div><b>PATCHING:</b> Any removal and replacement of the concrete slab shall meet the requirements of the existing slab. Do not overcut corners when cutting the floor in warehouse areas. Use care when removing concrete to avoid damage to adjacent slabs to remain. Backfill and subgrade shall be compacted to 95% of maximum dry density determined in accordance with ASTM D-1557. Dowel the new concrete patch to the existing slab with 1/2" steel dowels, extending a minimum of 8" into slab at 18" o.c., secured with epoxy. Install two (2) #4 rebar horizontally in all patching trenches. Use 4,000 p.s.i. (at 28 days) concrete for the pour back. All trench patching in the warehouse areas shall have a 1/8 inch radius edge and apply new concrete seal. Prior to pouring concrete, stone the area to be patched with an abrasive brick to approximate a 1/8 inch radius edge. Install vapor barrier if there is existing vapor barrier. Sawcut control joints in new concrete to match existing, and install joint filler to match existing (Metzger McGuire MM80 or equivalent)</div></div><div><div>3.2</div><div><b>BOLT HOLE AND SLAB CRACK REPAIR:</b> All the top of the floor. Utilize a 2-part epoxy to fill the hole and over-apply to the slab surface. Scrape off the excess material once it is dry. Acceptable material: Metzger McGuire MM-80 semi-rigid 2-part epoxy material, or equal. For crack repair: Repair Procedure: Repair Procedure: Chip out spalls to reveal fresh concrete and clean repair area thoroughly. • Repair areas to be at least 1/2" deep and 1/2" wide (on either side of control joint), with vertical repair edges, no feathering) • You'll need to fill any deep cracks with sand to provide a backup rod underneath the patching material so it doesn't sink down below grade after you pour the concrete. Leave 1/2" - 1/2" above sand to be filled with epoxy. Epoxy to be poured so that it's supported directly by firm concrete, with no sand. • Fill area with the 2 part epoxy. Epoxy to be slightly higher than the top of the floor and allow to cure • Sand down the patches so they're smooth and flush with the floor. • When repairing the floor at a warehouse floor joint, it's critical that relief cuts are installed to prevent repair failure.</div></div></div>	<div><div><div>DIVISION 3</div><div>CONCRETE</div></div></div>	<div><div><div>3.1</div><div><b>PATCHING:</b> Any removal and replacement of the concrete slab shall meet the requirements of the existing slab. Do not overcut corners when cutting the floor in warehouse areas. Use care when removing concrete to avoid damage to adjacent slabs to remain. Backfill and subgrade shall be compacted to 95% of maximum dry density determined in accordance with ASTM D-1557. Dowel the new concrete patch to the existing slab with 1/2" steel dowels, extending a minimum of 8" into slab at 18" o.c., secured with epoxy. Install two (2) #4 rebar horizontally in all patching trenches. Use 4,000 p.s.i. (at 28 days) concrete for the pour back. All trench patching in the warehouse areas shall have a 1/8 inch radius edge and apply new concrete seal. Prior to pouring concrete, stone the area to be patched with an abrasive brick to approximate a 1/8 inch radius edge. Install vapor barrier if there is existing vapor barrier. Sawcut control joints in new concrete to match existing, and install joint filler to match existing (Metzger McGuire MM80 or equivalent)</div></div><div><div>3.2</div><div><b>BOLT HOLE AND SLAB CRACK REPAIR:</b> All the top of the floor. Utilize a 2-part epoxy to fill the hole and over-apply to the slab surface. Scrape off the excess material once it is dry. Acceptable material: Metzger McGuire MM-80 semi-rigid 2-part epoxy material, or equal. For crack repair: Repair Procedure: Repair Procedure: Chip out spalls to reveal fresh concrete and clean repair area thoroughly. • Repair areas to be at least 1/2" deep and 1/2" wide (on either side of control joint), with vertical repair edges, no feathering) • You'll need to fill any deep cracks with sand to provide a backup rod underneath the patching material so it doesn't sink down below grade after you pour the concrete. Leave 1/2" - 1/2" above sand to be filled with epoxy. Epoxy to be poured so that it's supported directly by firm concrete, with no sand. • Fill area with the 2 part epoxy. Epoxy to be slightly higher than the top of the floor and allow to cure • Sand down the patches so they're smooth and flush with the floor. • When repairing the floor at a warehouse floor joint, it's critical that relief cuts are installed to prevent repair failure.</div></div></div>	<div><div><div>DIVISION 4</div><div>MASONRY</div></div></div>	<div><div><div>4.1</div><div>MASONRY WALLS: NIC</div></div></div>	<div><div><div>DIVISION 5</div><div>METALS</div></div></div>	<div><div><div>5.1</div><div><b>BOLLARDS:</b> Furnish and install two (2) 6" diameter, concrete filled, thin wall steel, pipe bollards extending 4'-0" A.F.F., set in 3'-0" of concrete at each grouping of electrical transformers and panels and at all sprinkler risers in all warehouse areas and other locations exposed to vehicular traffic. Paint new and existing bollards OSHA "Caution Yellow". Surface mounted bolt down bollards may be acceptable at low traffic areas (verify with Prologis Project / Property Manager). Surface mounted bollards shall be 4" diameter 4'-0" A.F.F. with a one foot square base plate and expansion anchored to the concrete floor with four (4) each 1/2" expansion anchors.</div></div><div><div>5.2</div><div>Framing for roof penetrations and supports for all rooftop equipment must be reviewed, approved and stamped by a structural engineer. See 15.3.6.</div></div><div><div>5.3</div><div><b>EXTERIOR METAL STAIRS:</b> Match existing stairs</div></div></div>	<div><div><div>DIVISION 6</div><div>WOOD AND PLASTICS</div></div></div>	<div><div><div>6.1</div><div><b>CABINETS:</b> Furnish and install a coffee bar and / or lunch room base cabinet. The base cabinets shall be plastic laminate by Wilsonart or approved equal in the manufacturer's standard color on all exposed horizontal and vertical surfaces, including open cabinet interiors, unless otherwise noted. Semi-exposed cabinet interiors and shelves shall be white melamine with .5mm PVC edge binding. Drawers shall be Grass 6036 Zargen System slides or approved equal. The hardware shall be Blum wire pulls, 125dip. Blum concealed hinges or approved equal. The cabinet(s) shall be 6'-0" long minimum and 34" high. Each cabinet shall have one row of drawers over doors. The maximum depth for cabinets and countertop should be 24". If the toe-kick is integrated with the cabinet doors to meet the ADA requirements, use stainless steel toe-kicks for those doors.</div></div><div><div>6.2</div><div><b>COUNTERTOPS:</b> The countertops shall be plastic laminate by Wilsonart or approved equal. The coffee bar tops shall have a 2" bull nosed front edge and top edge with 4" splash and a radius inside and outside corner at the back splash. For SF Bay Area Market, install a solid surface countertop per finish spec provided by Prologis personnel.</div></div><div><div>6.3</div><div><b>LAVATORY COUNTERTOPS:</b> All office toilet rooms with multiple lavatories shall have vanities. The lavatories shall be installed in a plastic laminated countertop with 2" bull nosed front edge, 4" back splash and a radius inside and outside corner at the back splash. Single accommodation toilet rooms and multiple accommodations toilet rooms serving the warehouse shall receive wall mounted lavatories. For SF Bay Area Market, install a solid surface countertop per finish spec provided by Prologis personnel.</div></div><div><div>6.4</div><div><b>MILLWORK QUALITY:</b> Architectural millwork and cabinetry shall be of a construction quality equal to that of the Architectural Woodwork Institute's (AWI) custom grade for floor overlay construction. MDF products shall be made with binder containing no urea-formaldehyde. Wood glued used for fastening shall have a VOC content of 30 g/L or less when calculated according to 40 CFR 59. Subpart D (EPA Method 24). Multipurpose construction adhesives shall have a VOC content of 70 g/L or less when calculated according to 40 CFR 59. Subpart D (EPA Method 24). Contact adhesives shall have a VOC content of 250 g/L or less when calculated according to 40 CFR 59. Subpart D(EPA Method 24)</div></div><div><div>6.5</div><div><b>MILLWORK ADA STANDARDS:</b> All Millwork must meet ADA standard as required by governing agency. Millwork must pass review to properly close out the project.</div></div><div><div>6.6</div><div><b>BLOCKING:</b> Blocking is to be provided as required for installation of wall mounted items and is to meet requirements of IBC 603.1.</div></div></div>	<div><div><div>DIVISION 7</div><div>THERMAL AND MOISTURE PROTECTION</div></div></div>	<div><div><div>7.1</div><div><b>ROOF INSULATION:</b> The roof insulation above conditioned area ceilings shall be R-19 (or as required by the energy compliance calculation). Unfaced fiberglass batts, wire-in place as manufactured by Owens-Corning or equal. Attach the vapor barrier (bbl) to the sub-purlin where required by code or Prologis Managers. For the office where perimeter office walls do not extend to the roof deck, lay insulation on top of the ceiling tiles if code allows.</div></div><div><div>7.2</div><div><b>CEILING INSULATION:</b> Where permitted by code furnish and install R-19 (or as required by the energy compliance calculation), unfaced fiberglass batt insulation on top of the suspended acoustical ceiling at conditioned spaces.</div></div><div><div>7.3</div><div><b>THERMAL WALL INSULATION:</b> Furnish and install R-13 (or as required by the energy compliance calculation) unfaced fiberglass batt insulation from floor to roof in walls between conditioned and unconditioned spaces. Furnish and install R-13 at all turned exterior concrete wall at conditioned spaces. Provide a vapor barrier where required by code. For Seattle market, install R-10 rigid insulation from floor to roof in walls between conditioned and unconditioned spaces.</div></div><div><div>7.4</div><div><b>ACOUSTIC INSULATION:</b> Furnish and install 3 1/2" unfaced fiberglass batt acoustic insulation in all toilet and shower room walls and ceilings, and demising wall at office area. The batt insulation at office demising wall should go to the full height of the wall.</div></div><div><div>7.5</div><div><b>INSULATION FACING:</b> All exposed fiberglass batt insulation shall have a white PSK-25 or approved equivalent facing.</div></div><div><div>7.6</div><div><b>SKYLIGHTS:</b> Existing skylights in conditioned areas shall be sealed if they are vented.</div></div><div><div>7.7</div><div><b>ROOFING:</b> The contractor shall use a roofing contractor certified to install the existing roofing material for patching of all roof penetrations. Prior to the work, contractor should verify with Prologis manager for the qualified roofers. The new roof penetrations shall be made in accordance with the roofing manufacturer's recommendations, such that the existing roofing warranty is maintained. The patch shall also meet all of the requirements stated in the building shield specifications. On built-up roofs, pipe and conduit penetrations at the roof shall receive galvanized pipe flashing with screw clamp and elastic membrane sealant and shall also be hot asphalt patched with 4-ply.</div></div></div>	<div><div><div>DIVISION 8</div><div>DOORS AND WINDOWS</div></div></div>	<div><div><div>8.1</div><div><b>INTERIOR DOORS AND FRAMES:</b> Furnish and install 3'-0" x 7'-0" x 1-3/4", solid core, birch, B-3 stain prefinished doors in "Timely" prefinished black steel frames (clear anodized aluminum frames by ACI, Eclipse or approved equal in the San Francisco Bay Area), with 1-1/2" pairs of Hager BB1279 butts per door U.O.N. All office doors shall receive a 2-0", sightline in the San Francisco Bay and Seattle Areas). Doors receiving doors shall receive ball-bearing butts. Doors and frames shall be 20 minutes rated where required. When working in an existing tenant space, the new doors and frames shall match the existing doors and frames U.O.N. Use metal frame for door backing, wood is not allowed.</div></div></div>	<div><div><div>DIVISION 8</div><div>DOORS AND WINDOWS</div></div></div>	<div><div><div>8.2</div><div><b>NEW EXTERIOR DOORS/FRAMES:</b> 20 gauge, full flush, 1-3/4" thick hollow metal with fibrous honeycomb core or steel stiffened hollow metal. Install overhead rain drip flashing and weather stripping on new hollow metal doors. Frame: 18 gauge with 2" faces and 5/8" stops formed internal corners mitered, welded and ground smooth.</div></div><div><div>8.3</div><div><b>INTERIOR DOOR HARDWARE:</b> Furnish and install Schlage AL105 Saturn passage hardware on all doors except single accommodation toilet rooms which shall receive Schlage AL40S privacy locks. The door hardware shall have a brushed chrome 626 finish U.O.N. Furnish and install weather-stripping, closers, and drop seals at doors between conditioned and non-conditioned areas. Furnish and install closers on all toilet and shower room doors. The closer shall be installed on the toilet room or warehouse side of the door. When working in an existing tenant space, the new door hardware shall match the existing door hardware U.O.N.</div></div><div><div>8.4</div><div><b>EXTERIOR DOOR HARDWARE:</b> Match the existing building hardware. Include door closers, mail slots, and latch guards on all new doors.</div></div><div><div>8.5</div><div><b>KEYS:</b> Owner shall rekey all locking hardware</div></div><div><div>8.6</div><div><b>DOOR SIGNAGE:</b>Include all signage per code (Handicap, Exit, etc.)</div></div><div><div>8.7</div><div><b>OVERHEAD DOORS:</b> Match the existing building overhead doors and door insulation. If no O.H. doors exist, use insulated overhead door Company or equal with 3" track 20 gauge door with self-reinforced bottom rail, with steel plate flush panel sectional. Sawcut at exterior concrete panels must be certified by a licensed structural engineer. No overcuts will be allowed. Protect new overhead door tracks with "Zee Guards". 3/8" thick bent plate, 4 feet long, bolted to the tilt-up wall panel to protect all door overhead door tracks</div></div><div><div>8.8</div><div><b>INTERIOR WINDOW FRAMES/GLASS:</b> Interior windows shall be 1/4" clear tempered glass set in black "Timely" frames (or anodized aluminum frames in the S.F. Bay Area) to match the interior door frames. Glazing height shall match door height, U.O.N; width shall be as indicated on plans.</div></div><div><div>8.9</div><div><b>MIRRORS:</b> Furnish and install 4" high x 14" thick plate glass mirrors with two coats silver and electroplated copper backing, and wiped edges at all lavatory vanities. The mirror shall be the length of the lavatory vanity directly on top of the splash and extending to the underside of the light shelf. If wall mounted lavatories are used, the mirror shall be a Bobsick 2436.</div></div><div><div>8.1</div><div><b>EXTERIOR GLASS:</b> The glass in new storefront doors, and "in-filled" truck door openings shall match the existing building glass. If the building glass is a long lead item, install gray vision glass (tempered if necessary) for temporary use until building standard glass is available.</div></div><div><div>8.11</div><div><b>WINDOW MULLIONS:</b> Where interior drywall partitions meet the exterior window wall, furnish and install aluminum "false" mullions finished to match the existing exterior storefront.</div></div></div>	<div><div><div>DIVISION 9</div><div>FINISHES</div></div></div>	<div><div><div>9.1</div><div><b>FIRE RATED WALLS:</b> All Rated walls and partitions to meet UL U419 listed standards or equal. Metal studs with one layer of 5/8" type "X" gypsum board on each side from the floor to the roof deck. The stud size and spacing shall be per the stud manufacturer's instructions and shall be installed with a transition plate extending 12" minimum into the building if there is no existing steel channel in the dock. Sawcut transition plate into the concrete floor at the leading edge.</div></div><div><div>9.2</div><div><b>FULL HEIGHT DRYWALL PARTITIONS</b> (including tenant demising walls): Metal studs with one layer of 5/8" type "X" gypsum board on each side from the floor to the roof deck with slip track. The stud size and spacing shall be per the stud manufacturer's tables and local code requirements. Drywall installed above an acoustical ceiling shall be fastened and screws spaced.</div></div><div><div>9.3</div><div><b>OFFICE DRYWALL PARTITIONS:</b> All partitions in areas with ceilings shall be underlaid 3-5/8" or 3-1/2" x 25 GA. metal studs at 24" o.c. with 5/8" fire code type "X" gypsum board on each side. The ceiling grid shall be installed first with walls built to the grid. The intersection of the wall at the grid shall be snug and flush. Install 1" metal trim at the top of the wall. Toilet room perimeter walls shall be built to 6" above grid. Fur perimeter concrete walls and interior columns in office areas to 6" above the grid.</div></div><div><div>9.4</div><div><b>OFFICE/TOILET RM. WALL/CEILING FINISH:</b> All office drywall shall receive a light skip trowel textured wall finish. Denver, Salt Lake City, Portland and Seattle area projects shall receive a smooth finish. The work texture shall be the size of a quarter dollar bill. The intersection of the wall at the grid shall be snug and flush. Install 1" metal trim at the top of the wall. Toilet room perimeter walls shall be built to 6" above grid. Fur perimeter concrete walls and interior columns in office areas to 6" above the grid.</div></div><div><div>9.5</div><div><b>WAREHOUSE GYPSUM BOARD WALL FINISH:</b> All drywall in the warehouse shall be fire rated only unless otherwise noted. Spot screws in flatpated areas</div></div><div><div>9.6</div><div><b>END CAPS:</b> Where a partition meets a window mullion, furnish and install aluminum "wall end cap" finished to match the storefront U.O.N. Install rigid 2" x 2" black foam between end cap and storefront glass if end cap does not intersect vertical mullion.</div></div><div><div>9.7</div><div><b>WAINSCOT:</b> Toilet room walls shall have 4" high white FRP or plastic laminated wainscot set 6" A.F.F. U.O.N. Walls behind mop sinks, drinking fountain and laundry sinks shall receive a 4" x 4" wainscot along each side of the sink in contact with the wall. All wet walls shall receive water resistant drywall (greenboard). Walls in showers shall receive cement board backer.</div></div><div><div>9.8</div><div><b>ACOUSTIC CEILING TILE:</b> Furnish and install 24" x 48" x 5/8" USGO Omni non-directional fluted tile or equal, installed at 9'-0" A.F.F., U.O.N. in all office areas except toilet and shower rooms. Use second-look ceiling tile in Seattle market.</div></div><div><div>9.9</div><div><b>ACOUSTIC CEILING TILE SUSPENSION SYSTEM:</b> Furnish and install Class "A" 15'x16" exposed "T" grid system, intermediate duty (heavy duty in seismic design category "D" areas) with 1-1/2" main tees, 1-1/2" cross tees, and 7/8" x 7/8" wall mold as manufactured by Dunn or equal per code. Fire rated grid and tile shall be used where code requires. The grid color shall be white to match the tile exactly.</div></div><div><div>9.10</div><div><b>CARPET:</b> Carpeting shall be Designweave Shaw (such as Lyncbush 26 series) or approved equal, loop graphic, solution dyed 100% nylon, 36" per square yard average yarn weight minimum, 1/10m gauge, color to be selected from manufacturer's standard colors U.O.N. Carpet shall be direct glue down U.O.N. Verify with Prologis Manager for final finish selection. In Seattle Area: Install walk-off mat at all doors from office to either exterior of the building or warehouse. The walk-off mat should be at least 4' wide or the width of the hallway by 3' deep. The product should be Conexus Super No 52 in either roll good or modular tile or equal.</div></div><div><div>9.11</div><div><b>CARPET BORDERS:</b> Carpet insets or borders when specified as a customer upgrade shall be mitered at the corners.</div></div><div><div>9.12</div><div><b>CARPET PAD:</b> Only when specified by the customer as an upgrade, shall be a minimum 3/8" thick, 8lb. dense rebound or slab rubber pad.</div></div><div><div>9.13</div><div><b>VINYL COMPOSITION TILE:</b> Furnish and install 18" gauge, standard gauge, VCT as manufactured by Tarkett, Azrock, or Armstrong. Install VCT in service areas and IT closets. No VCT shall be installed in toilet rooms. Verify with Prologis Manager for final finish selection.</div></div><div><div>9.14</div><div><b>RUBBER BASE:</b> All areas receiving floor covering and new walls except the toilet rooms shall have 4" high topset rubber base as manufactured by Bufile, Rogge, or Tarkett in a standard color. Install the rubber base on a continuously roll, not sectional. Verify with Prologis Manager for final finish selection.</div></div><div><div>9.15</div><div><b>SHEET VINYL:</b> New toilet rooms shall receive sheet vinyl flooring with a 6" integral flashed cove base with brushed aluminum trim on the top edge. All joints shall be heat welded and receive seam sealer. The sheet vinyl shall be Corlon or Mannington Magna, not available, need to specify later installed in all new toilet rooms. Verify with Prologis Manager for final finish selection.</div></div><div><div>9.16</div><div><b>TRANSITION STRIPS:</b> Furnish and install black vinyl transition strips at all changes in flooring material U.O.N.</div></div><div><div>9.17</div><div><b>CERAMIC TILE:</b> (Central Valley area only)</div></div><div><div>9.18</div><div><b>RESTROOMS:</b> Use 2x2 American Olean ceramic tile or equal slip resistant on floors and 4x4 ceramic tile on walls as noted on plans.</div></div><div><div>9.19</div><div><b>ENTRANCES:</b> When specified on plans, 8"x8" American Olean ceramic tile or equal.</div></div><div><div>9.19</div><div><b>GROUT:</b> color to be selected from manufacturer's standard colors. The tile floor shall be cleaned after installation to remove excess mortar and grout. The grout shall be sealed per manufacturer's recommendations. Verify with Prologis Manager for final finish selection.</div></div><div><div>9.18</div><div><b>CONCRETE FLOOR SEALER:</b> All concrete floor patches shall be ressealed to match the existing concrete floor sealer / hardener in warehouse areas.</div></div></div>	<div><div><div>DIVISION 10</div><div>SPECIALTIES</div></div></div>	<div><div><div>10.1</div><div><b>NAPKIN DISPOSALS:</b> Bobsick B-270 sanitary napkin disposals in each women's toilet stall U.O.N.</div></div><div><div>10.2</div><div><b>PAPER TOWEL DISPENSER:</b> Bobsick B-369 (for single accommodation toilet rooms) or a Bobsick B-3944 (for multiple accommodation toilet rooms) recessed paper towel dispenser with a waste receptacle U.O.N.</div></div></div>	<div><div><div>DIVISION 11</div><div>DOCK EQUIPMENT</div></div></div>	<div><div><div>11.1</div><div><b>MANUFACTURER:</b> All dock equipment when required by the customer as an upgrade shall be Arbon, Kelly / Serco, Nordock or Poweramp.</div></div><div><div>11.2</div><div><b>LEVELER PIT:</b> All exposed edges of the dock leveler pit shall be protected with steel corner angles. The existing steel angle or channel at the face of the existing dock pit shall be replaced with new steel integrally tied to the new pit. Do not overcut the corners when sawcutting the concrete slab for the new pit. On the exterior wall, all edges must have a 1/2" chamfer, accomplished by grinding or sawcutting the existing concrete with a 1/2" chamfer and pouring the new concrete with a 1/2" chamfer.</div></div><div><div>11.3</div><div><b>DOCK LEVELERS:</b> Mechanical 6' x 8' 35,000 lb. capacity Arbon, Kelly / Serco, Nordock or Poweramp with recessed pit per manufacturer's detail.</div></div><div><div>11.4</div><div><b>EDGE OF DOCK LEVELERS:</b> 72" wide x 3,000 lb. capacity Arbon, Kelly / Serco, Nordock or Poweramp. The EOD must be mounted per manufacturer's instructions and must be installed with a transition plate extending 12" minimum into the building if there is no existing steel channel in the dock. Sawcut transition plate into the concrete floor at the leading edge.</div></div><div><div>11.5</div><div><b>DOCK SEALS:</b> Rite-Hite PLATF793 (or approved equal) with 22 oz. black vinyl base fabric and 40 oz. vinyl wear pleats with an 6" exposure. The projection shall be 10" standard or 21" at E.O.D.'s including wood block outs.</div></div><div><div>11.6</div><div><b>DOCK SHELTERS:</b> Rite Hite PLE524 dock shelters (or approved equal). The fabric shall be 40 oz black hypalon. The projection shall be 24" standard and 36" at E.O.D.'s.</div></div><div><div>11.7</div><div><b>DOCK LIGHTS:</b> Adjustable dock loading light with 40" extension.</div></div><div><div>11.8</div><div><b>DOCK BUMPERS:</b> Serco or Rite Hite 24" Model B410-24 (or approved equal). Anchor to embed dock angle and anchor bolt per manufacturer's recommendations.</div></div></div>	<div><div><div>DIVISION 12</div><div>FURNISHINGS</div></div></div>	<div><div><div>12.1</div><div><b>BLINDS:</b> All exterior windows, including exterior warehouse windows and windows above any acoustical ceilings, shall receive mini-blinds by Bal' Classic® or approved equal, with a valance, in a color to match the storefront aluminum color U.O.N. The blinds shall be "inside mount" (between the vertical window mullions) flush with the inside face of the mullion. Storefront doors and any interior windows shall not receive blinds. Install blinds at all door sidelights.</div></div></div>	<div><div><div>DIVISION 13</div><div>PLUMBING</div></div></div>	<div><div><div>13.1</div><div><b>DESIGN BUILD:</b> Unless engineered plumbing system drawings are included in the bid documents, the plumbing work shall be performed on a design-build basis. The design-build plumbing contractor shall furnish and install a complete and operative plumbing system to meet all local and state codes.</div></div><div><div>13.2</div><div><b>PLANS:</b> Provide plumbing plans for architect's and owner's review and approval.</div></div><div><div>13.2.A</div><div></div></div><div><div>13.2.B</div><div></div></div><div><div>13.2.C</div><div></div></div><div><div>13.2.D</div><div></div></div><div><div>13.2.E</div><div></div></div><div><div>13.2.F</div><div></div></div><div><div>13.2.G</div><div></div></div><div><div>13.2.H</div><div></div></div><div><div>13.2.I</div><div></div></div><div><div>13.2.J</div><div></div></div><div><div>13.2.K</div><div></div></div><div><div>13.2.L</div><div></div></div><div><div>13.2.M</div><div></div></div><div><div>13.2.N</div><div></div></div><div><div>13.2.O</div><div></div></div><div><div>13.2.P</div><div></div></div><div><div>13.2.Q</div><div></div></div><div><div>13.2.R</div><div></div></div><div><div>13.2.S</div><div></div></div><div><div>13.2.T</div><div></div></div><div><div>13.2.U</div><div></div></div><div><div>13.2.V</div><div></div></div><div><div>13.2.W</div><div></div></div><div><div>13.2.X</div><div></div></div><div><div>13.2.Y</div><div></div></div><div><div>13.2.Z</div><div></div></div><div><div>13.3</div><div><b>SEWER LINES:</b> Sewer, soil and waste lines within the building below the finished floor elevation shall be schedule 40 ABS plastic or schedule 40 PVC plastic pipe. Sewer, soil and waste lines within the building above the finished floor elevation shall be standard weight cast iron pipe. ABS piping may be used above the finished floor if permitted by code and approved by the owner. All lines should be at least a 1% grade of gravity flow. Must ensure that tree roots will not interfere with path of the sewer, soil, and waste lines.</div></div><div><div>13.4</div><div><b>GAS LINES:</b> All gas lines shall be run under the roof above the bottom cord of the trusses perpendicular or parallel to the existing roof structure. All new and existing gas lines within a single tenant space shall be connected to a separate gas meter.</div></div><div><div>13.5</div><div><b>PIPE MATERIAL:</b> All pipe materials shall be subject to the requirements of the City and/or governing body. All domestic water, condensate, and smelly pan drain lines must be copper.</div></div><div><div>13.6</div><div><b>PLUMBING FIXTURES AND TRIM:</b></div></div><div><div>13.6.A</div><div><b>LAVATORY FOR VANITY:</b> American Standard, "Cadet Everclean Oval Countertop Sink", model 0419.444EC, white, left-fitting or equal with a Delta Model 523 FL HDP or Moen L4601 single lever type faucet assembly with a grid strainer and bright chrome finish. Furnish and install a Handy-Shield Drain Cover #3011 White by Plumbers Specialty Products under each lavatory.</div></div><div><div>13.6.B</div><div><b>WALL-HUNG LAVATORY:</b> American Standard, "Lucerne", model 0355.012, white, wall mounted lavatory or equal with a Delta Model 523 FL HDP single lever type faucet assembly with a grid strainer and bright chrome finish. Furnish and install a Handy-Shield Drain Cover #3011 White by Plumbers Specialty Products under each lavatory.</div></div><div><div>13.6.C</div><div><b>WATER CLOSET:</b> American Standard, "Madera Flumix®- Right Height" elongated, flush valve toilet, 17" height, model 3043.001 or approved equal in white, with an Osonite #95 seat and a Flush #111 flush valve</div></div><div><div>13.6.D</div><div><b>WATER CLOSET IF WATER SUPPLY IS NOT SUFFICIENT FOR FLUSH VALVE:</b> American Standard "Cadet" elongated pressure-assisted toilet, Model # 2333.100 (white) with Osonite #64 SST, toilet seat (white) for non-handicapped applications.</div></div><div><div>13.6.E</div><div><b>American Standard "Cadet" Right Height Elongated pressure-assisted toilet, Model # 2377.100 (white) with Osonite #64 SST, toilet seat (white) for ADA applications.</b></div></div><div><div>13.6.F</div><div><b>URNAL:</b> American Standard, "Washbrook Flumix®", model 6590.125, or approved equal, white, with a 3/4" top spud. For Portland Area: American Standard, "Washbrook Flumix®", model 6590.125, or approved equal, white. American Standard model 6590.125 comes with flush valve</div></div><div><div>13.6.G</div><div><b>COFFEE BAR / LUNCH ROOM SINK:</b> Ekay, model LRAD 1918, stainless steel, with a Delta #100 faucet. If the Lunch Room base cabinet is 8'-0" or longer, use Ekay model GECR 2521. Furnish and install a Handy-Shield Drain Cover #3011 White by Plumbers Specialty Products under each sink.</div></div><div><div>13.6.H</div><div><b>LAUNDRY TRAY:</b> When specified as a customer upgrade use Fiat Products, Molded-Stone, model FL-1, with 20 gallon capacity, or Florestone Model FM Utility Sink with a Delta model 2123 laundry tub or equal.</div></div><div><div>13.6.I</div><div><b>SHOWER ENCLOSURE:</b> When specified as a customer upgrade use Florestone, wheelchair accessible fiberglass shower stall, 44-52x white with grab bars, seat, mixing valve and shower curtain rod. Outside the shower pan, be sure to slope floor to drain the water to the floor drain.</div></div><div><div>13.6.J</div><div><b>WATER HEATER:</b> The water heater shall be A.O. Smith, State or approved equal sized to meet the demand. It shall be located on the warehouse floor in a smelly pan draining into a hub drain with a trap rimner. The location shall be as located by the architect or approved by the owner. All plumbing connections shall be made with electric unions. Installing the water heater above the ceiling is not allowed.</div></div><div><div>13.6.K</div><div><b>WATER COOLER:</b> If drinking fountain is specified on the plan use Ekay model EZSTBL8C for the high-low drink fountain. If the local jurisdiction requires the protection for a blind person, use Bobsick model #182996 grab bar; 1 1/2" stainless steel. Install two grab bars, one at each end of the fountain.</div></div><div><div>13.6.L</div><div><b>JANITOR'S HAND SINK:</b> Mustee Utilitub Model # 18F – Floor mount; or Model 18W – wall hung, or equal.</div></div><div><div>13.6.M</div><div><b>Janitor's Mop Service Basin:</b> Mustee Model # 62M 24" x 24" x 8 1/2" with Mustee Service Faucet Part No. 63.600A chrome plated brass service sink faucet, 1/2" pipe eccentric inlet on 8" centers, or equal.</div></div><div><div>13.6.N</div><div><b>CONDENSATE DRAINS:</b> Furnish and install copper condensate drainage lines with proper venting for all HVAC equipment. The lines shall be no smaller than 3/4" diameter and shall be located under the roof unless prohibited by code. PVC condensate lines may not be used. In Reno, provide evaporator pans set in roof mass.</div></div><div><div>13.6.O</div><div><b>SHUT-OFF VALVE:</b> Furnish and install a main water line shut-off valve for the restrooms in the handicapped stall in the men's restroom, not above the ceiling, with an 8" x 8" painted steel access panel. Provide a type labeled "Main Water Valve" on the access panel.</div></div><div><div>13.6.P</div><div><b>MAIN WATER LINE:</b> If a main domestic water line is not existing above the tenant space, furnish and install a 2" diameter copper water line at the roof installed above the bottom cord of the trusses, properly braced to avoid movement. At each future tenant space that the line crosses, install a 2" x 2" with 2" gate valve (one valve per storefront door). Extend the water line through the tenant demising wall into the "downstream" adjacent tenant space with a 2" diameter gate valve. Furnish and install a 2" pressure reducing valve with an access panel at the water service entrance when required.</div></div><div><div>13.6.Q</div><div><b>HOSE BIB:</b> Provide one rooftop hose bib if not existing (freeze proof where required). Vendors to drain water after each use.</div></div><div><div>13.6.R</div><div><b>CLEAN-OUTS:</b> Furnish and install a brass floor clean-out cover at the proper finished elevation as required. If the clean-out is in the warehouse area, furnish and install a cast iron heavy duty traffic rated cover.</div></div><div><div>13.6.S</div><div><b>FLOOR DRAINS:</b> Provide in toilet rooms where required by code.</div></div><div><div>13.6.T</div><div><b>INSULATION:</b> Insulate all water piping (except Florida) with 1" insulation. Use 1 1/2" insulation for piping in exterior walls.</div></div></div>	<div><div><div>DIVISION 14</div><div>FIRE PROTECTION</div></div></div>	<div><div><div>14.1</div><div><b>DESIGN BUILD:</b> The fire protection work shall be performed on a design-build basis. The design-build fire protection contractor shall furnish and install all modifications to the existing fire sprinkler system to meet all applicable local and state fire code requirements. Sprinkler heads shall be dropped into all suspended ceiling areas. Upgrade of existing system shall conform with a class IV occupancy. In buildings with ESFR systems, maintain the necessary clearances from all obstructions.</div></div><div><div>14.2</div><div><b>PIPE MATERIAL:</b> All fire sprinkler piping shall be standard schedule 10 for 6" piping, and schedule 7 for 4" and 2 1/2" piping U.O.N. Schedule 5 pipe may not be used.</div></div></div>	<div><div><div>DIVISION 15</div><div>HVAC</div></div></div>	<div><div><div>15.1</div><div><b>DESIGN BUILD:</b> Unless engineered HVAC system drawings are included in the bid documents, the HVAC work shall be performed on a design-build basis. The design shall be based upon ASHRAE standards, local code, and weather data. Calculations shall be provided upon owner request. The design-build HVAC contractor shall furnish and install a complete and operative HVAC system to meet all local and state codes.</div></div><div><div>15.2</div><div><b>PLANS:</b> Provide HVAC plans for architect's and owner's review and approval.</div></div><div><div>15.3</div><div><b>WARRANTY AND SERVICE:</b> All work shall include a one year parts and labor warranty, a five year compressor parts warranty and a 90 day service contract from the date of project completion.</div></div><div><div>15.3.A</div><div><b>DESIGN TEMPERATURES:</b> The HVAC system shall maintain 75 degrees indoors, on a 100 degree outdoor day or local ASHRAE standards and code requirements, whichever is more stringent.</div></div><div><div>15.3.B</div><div><b>UNITS:</b> The HVAC units shall be gas/electric, bottom discharge, as manufactured by Carrier, Trane, Lennox, or York. Units shall be installed on a leveled, manufactured curb. All rooftop equipment shall be seismically fastened to the structure. Side discharge units may not be used. Commercial grade heat pumps by Carrier (model 50TCQ), or Trane (model WCD) may only be used in the Las Vegas or Phoenix markets. When heat pumps are used, they must be installed with auxiliary supply air heaters and single point air conditioning coils on all units larger than five tons and whenever required by the energy code. For Denver and Salt Lake City areas, provide heat guards on rooftop units.</div></div><div><div>15.3.C</div><div><b>UNIT LOCATIONS:</b> HVAC and evaporative cooler units (when used) shall be located on roof, adjacent to a glulam beam or girder, or at near a structural column, set back from building edge to hide them from sight. Framing for roof penetrations and supports for all rooftop equipment must be reviewed, approved, and stamped by a structural engineer.</div></div><div><div>15.3.D</div><div><b>EVAPORATIVE COOLER:</b> Evaporative coolers when specified as a customer upgrade shall provide a minimum of four air changes per hour U.O.N. The coolers shall be United Metal Products "Slimline" units or approved equals. Provide adequate relief venting to allow air to flow within the tenant space to close properly. The cooler plenums shall be located midway between fire sprinkler lines and fire sprinkler heads in buildings with ESFR systems. The plenums, water supply lines and drain lines shall not encroach into the building's clear space U.O.N.</div></div><div><div>15.3.E</div><div><b>CURBS/SLEEPERS:</b> All mechanical units (HVAC units, evaporative coolers, and relief vents) shall be located on roof and shall be installed with a self-flashing, leveled, factory curb. Furnish and install 4 inch leg cast strips around all curbs. Absolutely no wood or metal sleepers will be used without owner's written approval.</div></div><div><div>15.3.F</div><div><b>CONTROLS:</b> The HVAC system shall be connected to a 7-day digital programmable thermostat. All thermostats shall be mounted at 48" A.F.F. and shall have an automatic change-over feature. All thermostats that are not digital are to be converted to a digital programmable thermostat during Make Ready and Tenant Improvement projects. If freeze protection only is installed in the warehouse, the thermostat controller must be mounted on the fan inside of the unit at the roof top level.</div></div><div><div>15.3.G</div><div><b>EXHAUST FANS:</b> Furnish and install an exhaust fan in each toilet room and shower room (if applicable). Install a supply air grille or a transfer grille from the toilet, shower, or break room ceiling to the adjacent conditioned space. In multi-fixture restrooms, fans shall be rated at 150 CFM minimum.</div></div><div><div>15.3.H</div><div><b>DUCTING:</b> All vertical ducting shall be galvanized spiral, insulated with 1-1/2" wrap and vapor barrier. Horizontal runs shall be galvanized spiral or duct board. Any exposed duct in a conditioned warehouse area must be galvanized spiral sheet metal. Final connections to the registers shall be made with a minimum 5" soft flex duct for sound attenuation, and a maximum of 8' in length. All plenums shall be fabricated from insulated galvanized sheet metal of appropriate gauge for low pressure use. Plenums shall extend from the unit to the level of the horizontal branches. No ducting or plenum drops may be installed over warehouse space, unless approved by owner. If the project is a remodel of an existing system, all abandoned ducting shall be removed.</div></div><div><div>15.3.I</div><div><b>FITTINGS:</b> All five branch fittings shall have volume dampers with locking quadrant in main and branch ducts. The dampers shall be tagged for easy recognition.</div></div><div><div>15.3.J</div><div><b>GRILLES:</b> All conditioned areas shall have a supply register and a ducted return register. Transfer grills are not permitted in the office areas. Supply and return air registers shall be white painted steel with a perforated face, flush mounted. Supply air registers shall have a 4-way directional blade. Restroom registers need to be 1'x2' if there are multiple stalls. Restroom registers may be 1'x1' for one toilet bathroom.</div></div><div><div>15.3.K</div><div><b>FILTERS:</b> Filters shall be located at the unit, not at the return register. Replace all existing filters after the completion of the construction.</div></div><div><div>15.3.L</div><div><b>CONDENSATE DRAINS &amp; PIPING:</b> See section 15.1.7.</div></div><div><div>15.3.M</div><div><b>DUCT SMOKE DETECTORS:</b> Smoke detectors shall be installed in all units 2000 cfm or greater and/or 5 ton or greater, or as required by code.</div></div><div><div>15.3.N</div><div><b>WAREHOUSE HEATERS:</b> NIC</div></div><div><div>15.3.O</div><div><b>DRAFT STOPS:</b> NIC</div></div></div>	<div><div><div>DIVISION 16</div><div>ELECTRICAL</div></div></div>	<div><div><div>16.1</div><div><b>DESIGN BUILD:</b> Unless engineered electrical system drawings are included in the bid documents, the electrical work shall be performed on a design-build</div></div></div>
---	---	---	--	--	--	--	---	---	--	--	---	--	---	--	---	--	---	---	--	--	--	--	---	--	--	---	---	---	--	---	---	---	---	---



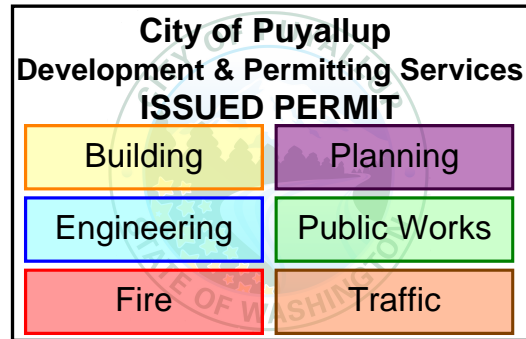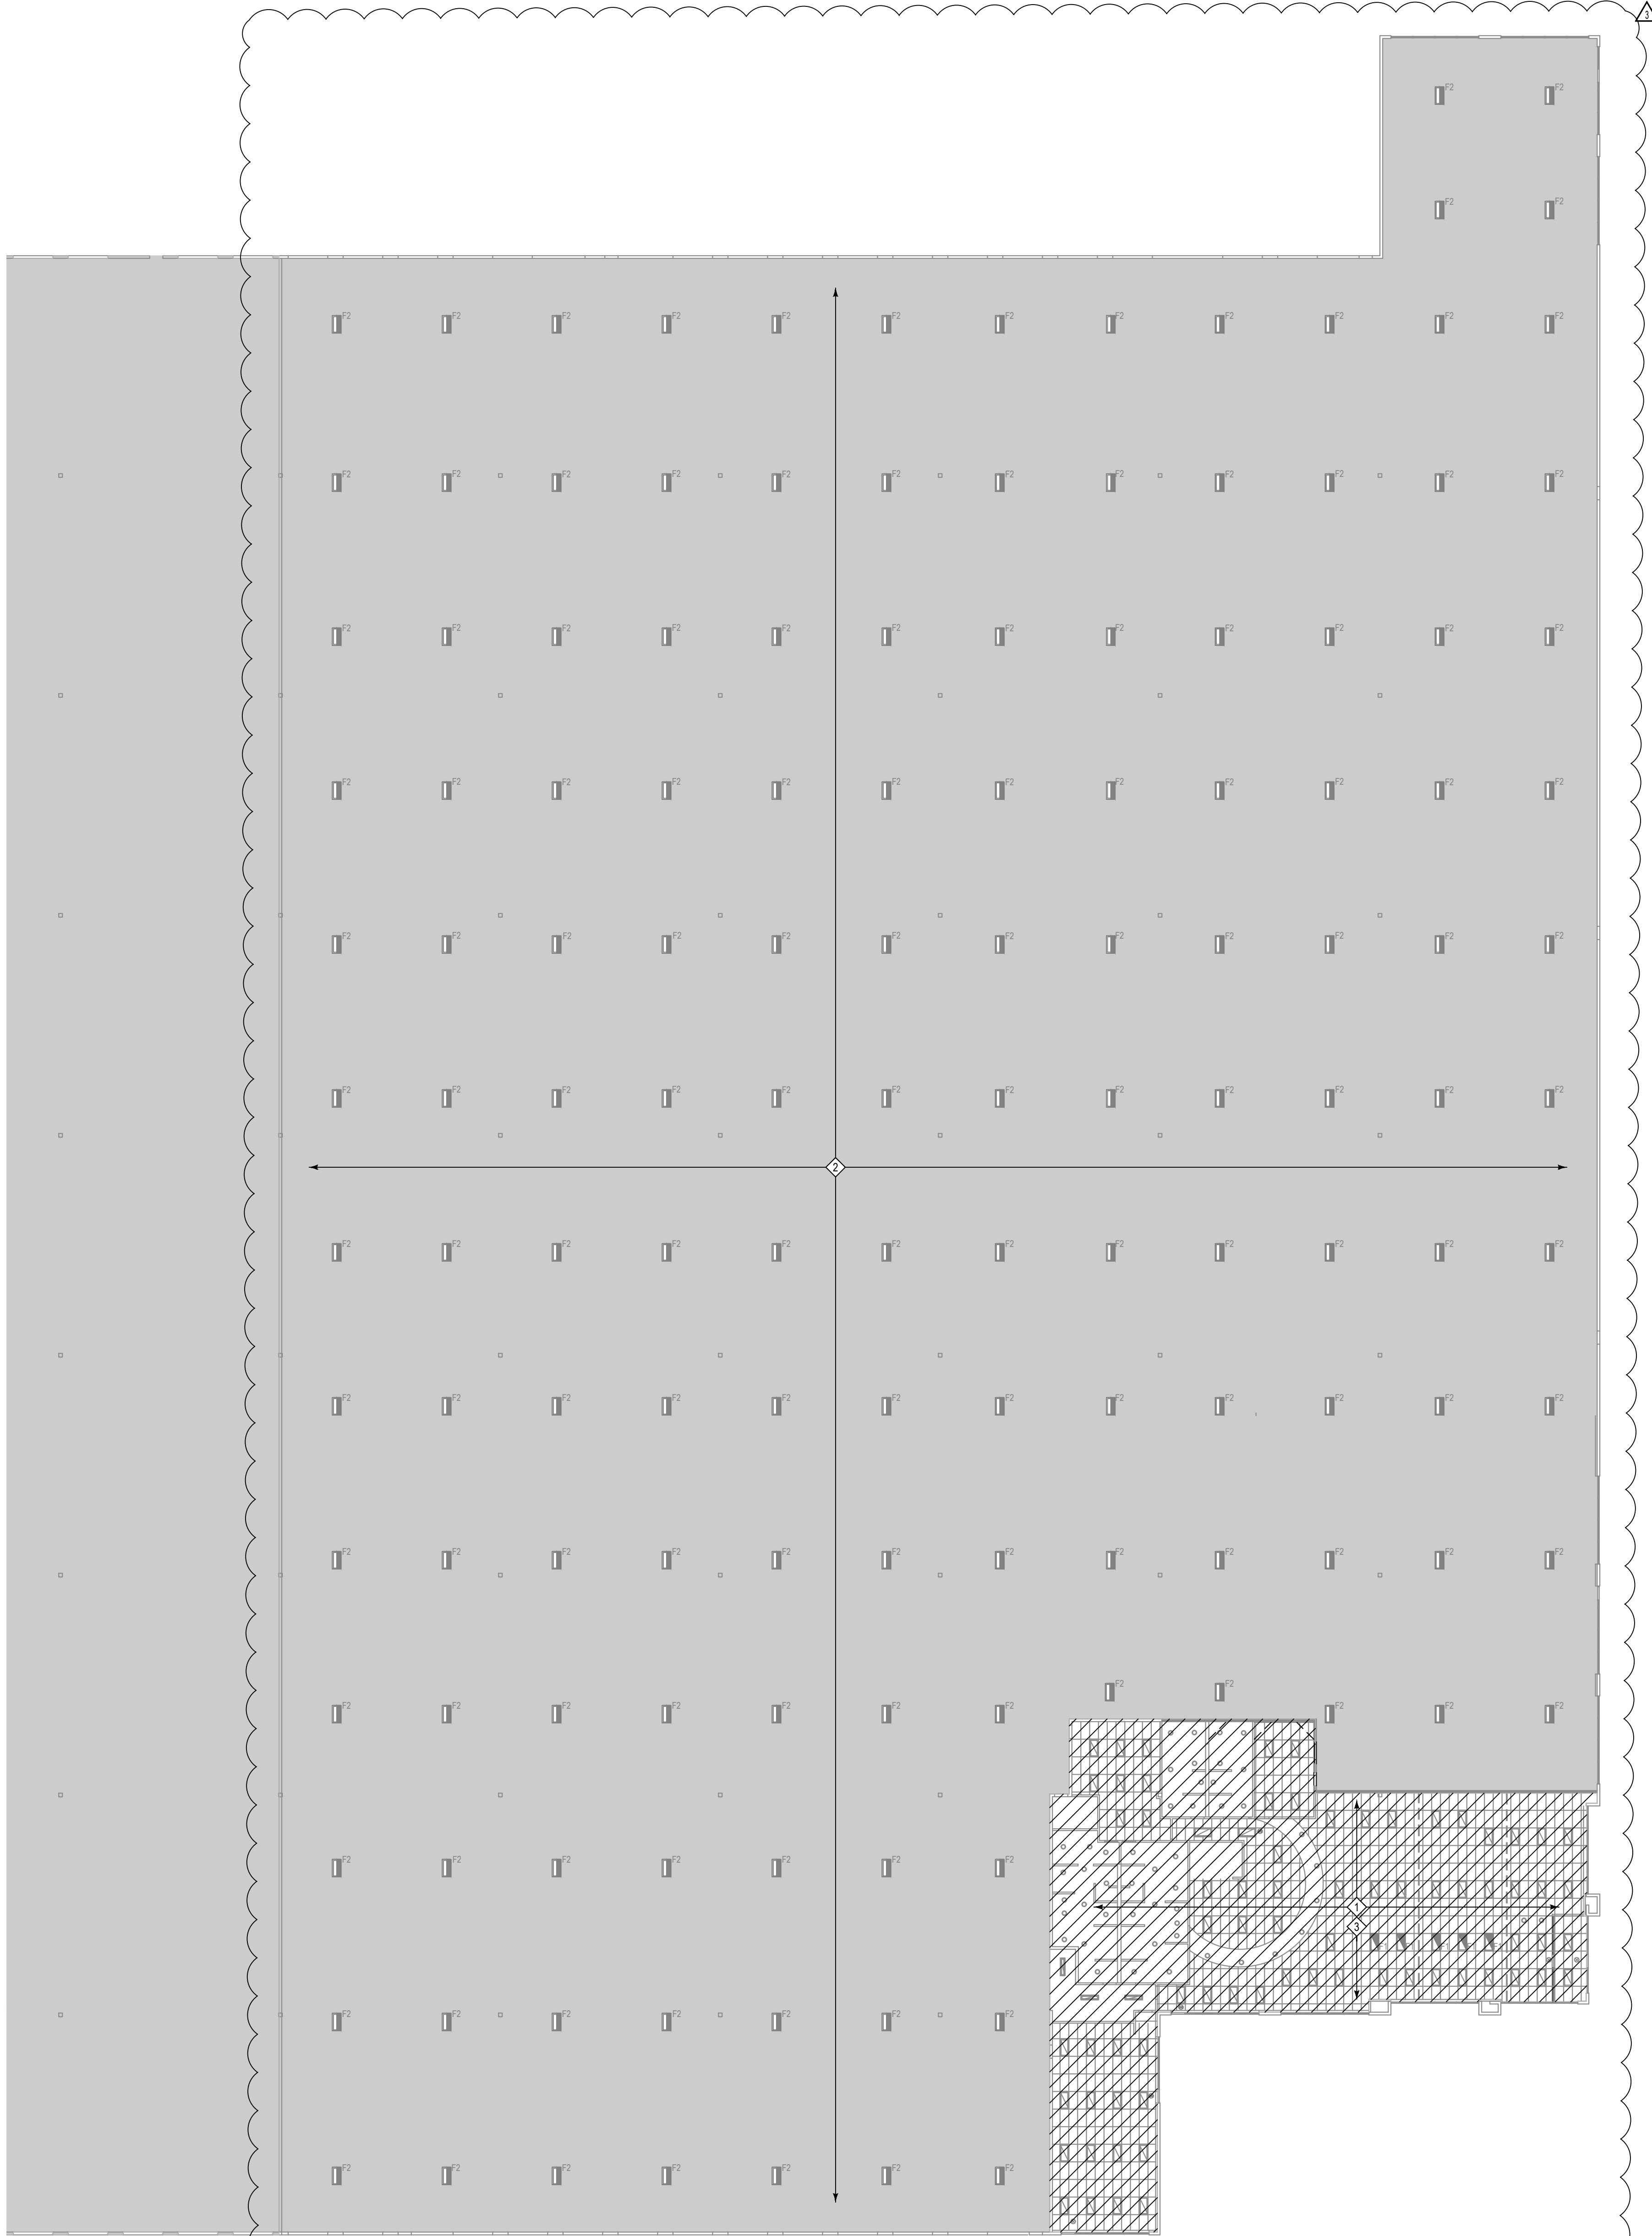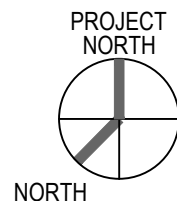

REFLECTED CEILING PLAN LEGEND


FIXTURE / SYMBOL	DESCRIPTION/SPEC
	EXISTING 2' X 4' FLUORESCENT LED FIXTURE TO REMAIN.
	EXISTING 1' X 4' FIXTURE TO REMAIN.
	EXISTING RECESSED DOWNLIGHT FIXTURE TO REMAIN.
	RELOCATED 2' X 4' FIXTURE.
	NEW SUSPENDED HIGH BAY LED LIGHT FIXTURE SPEC: LITHONIA PLD L24 2400LM SEF AFL GND MVOLT G210 50K 80 CRI
	ON/OFF WALL STATION SPEC: ECHO FLEX WIRELESS, OR ARCHITECT APPROVED EQUAL.
	EXISTING EXIT SIGN TO REMAIN. COORDINATE WITH CODE OFFICIAL.
	NEW OR RELOCATED EXIT SIGN. COORDINATE FINAL LOCATION WITH CODE OFFICIAL.
	NOT IN CONTRACT, (NIC)

GENERAL RCP NOTES

- REFER TO PROJECT NOTES FOR CONSTRUCTION REQUIREMENTS.
- ARCHITECTURAL REFLECTED CEILING PLANS INDICATE TYPE AND LOCATION OF LIGHT FIXTURES. REFER TO DESIGN BUILD ELECTRICAL DRAWINGS AND DESIGN BUILD LIFE SAFETY FOR COMPLETE REFLECTED CEILING PLAN DESIGN.
- LIGHT SWITCHES ARE SHOWN FOR LOCATION AND DESIGN INTENT ONLY. REFER TO ELECTRICAL DESIGN BUILD FOR SPECIFIC LOCATION AND SWITCHING DIAGRAMS.
- UNLESS OTHERWISE NOTED, MULTIPLE SWITCHES IN A SINGLE LOCATION SHALL BE GANGED IN A SINGLE BOX AND COVERED WITH A SINGLE COVERPLATE.
- CLEAN, REPAIR OR REPLACE AS REQUIRED ALL EXISTING SUSPENDED CEILING GRID AND TILES EXISTING TO REMAIN.
- HVAC CONTRACTOR TO CLEAN ALL EXISTING SUPPLY/RETURN GRILLS PRIOR TO COMPLETION OF PROJECT.
- ELECTRICAL SUB-CONTRACTOR IS RESPONSIBLE FOR CONFIRMING THE COUNTS OF EXISTING FIXTURES TO BE RELOCATED.
- ELECTRICAL SUB-CONTRACTOR IS RESPONSIBLE FOR PROVIDING CUT SHEETS TO DESIGNER FOR ALL FIXTURES DESIGNATED AS NEW.
- PROVIDE EGRESS ILLUMINATION PER IBC 1008. CONTRACTOR IS RESPONSIBLE FOR DESIGN OF THIS SYSTEM UNDER THE DESIGN BUILD CONTRACT. VERIFY WITH BUILDING MANAGEMENT'S EXISTING SYSTEM AND PROVIDE FULL COMPLIANCE TO NEW TENANT SPACE.
- THE MEANS OF EGRESS ILLUMINATION LEVEL SHALL NOT BE LESS THAN 1 FOOT CANDLE (11 LUX) AT THE WALKING SURFACE.

KEYED RCP SHEET NOTES

- NEW INSULATION ABOVE EXISTING OFFICE SUITE (HATCHED AREA) TO COMPLETE THE WSEC BUILDING ENVELOPE. SEE DETAILS G & Q ON SHEET A1300.
- EXISTING CEILING CONDITIONS SHOWN FOR INFORMATION ONLY - NO CHANGES PROPOSED.
- REMOVE EXISTING ACT CEILING GRID AS NECESSARY TO ALLOW ACCESS FOR INSTALLATION OF THE ROOF INSULATION ABOVE. AFTER NEW ROOF INSULATION INSTALLATION, REINSTALL ACT CEILING GRID AS INDICATED BY DETAIL AND NOTES ON SHEET A1300.

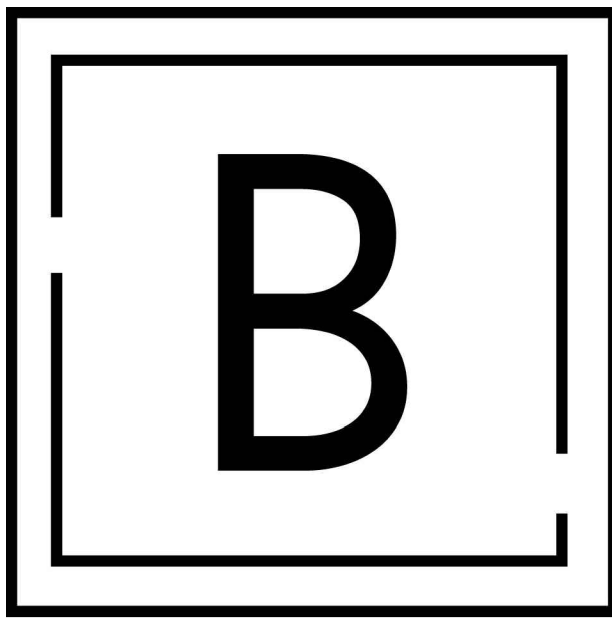


BURGESS DESIGN  
INTERIORS • ARCHITECTURE  
1200 5th Ave Suite 400 Seattle WA | 206.587.7120

PRCT120240469



Tenant:  
PROLOGIS PUYALLUP 1  
MAKE READY  
PUYALLUP 1  
1601 INDUSTRIAL PARK #100  
PUYALLUP, WA 98371

Professional seal

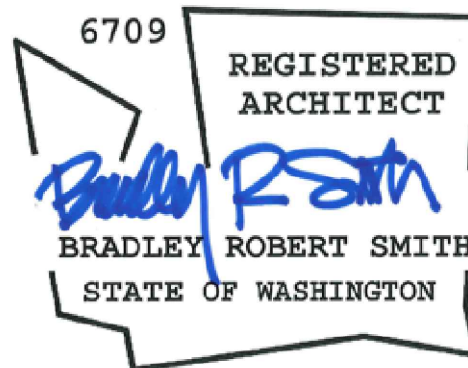

No.	Issue Description	Date
	REVIEW SET	01.06.23
	REVIEW SET	01.30.23
	REVIEW SET	02.17.23
	REVIEW SET	02.27.23
	PERMIT SET	03.10.23
	CD SET	03.17.23
	CITY CORRECTION	05.19.23
	CITY CORRECTION	03.22.24

City Electronic Stamp Location

CLIENT APPROVAL DATE

City Electronic Stamp Location

Drawn by: MK Project Manager: SH


Project No: 22.0243.00

REFLECTED CEILING  
PLAN - WAREHOUSE

Original drawing is 36" x 42". Scale entries accordingly reduced.

A1131



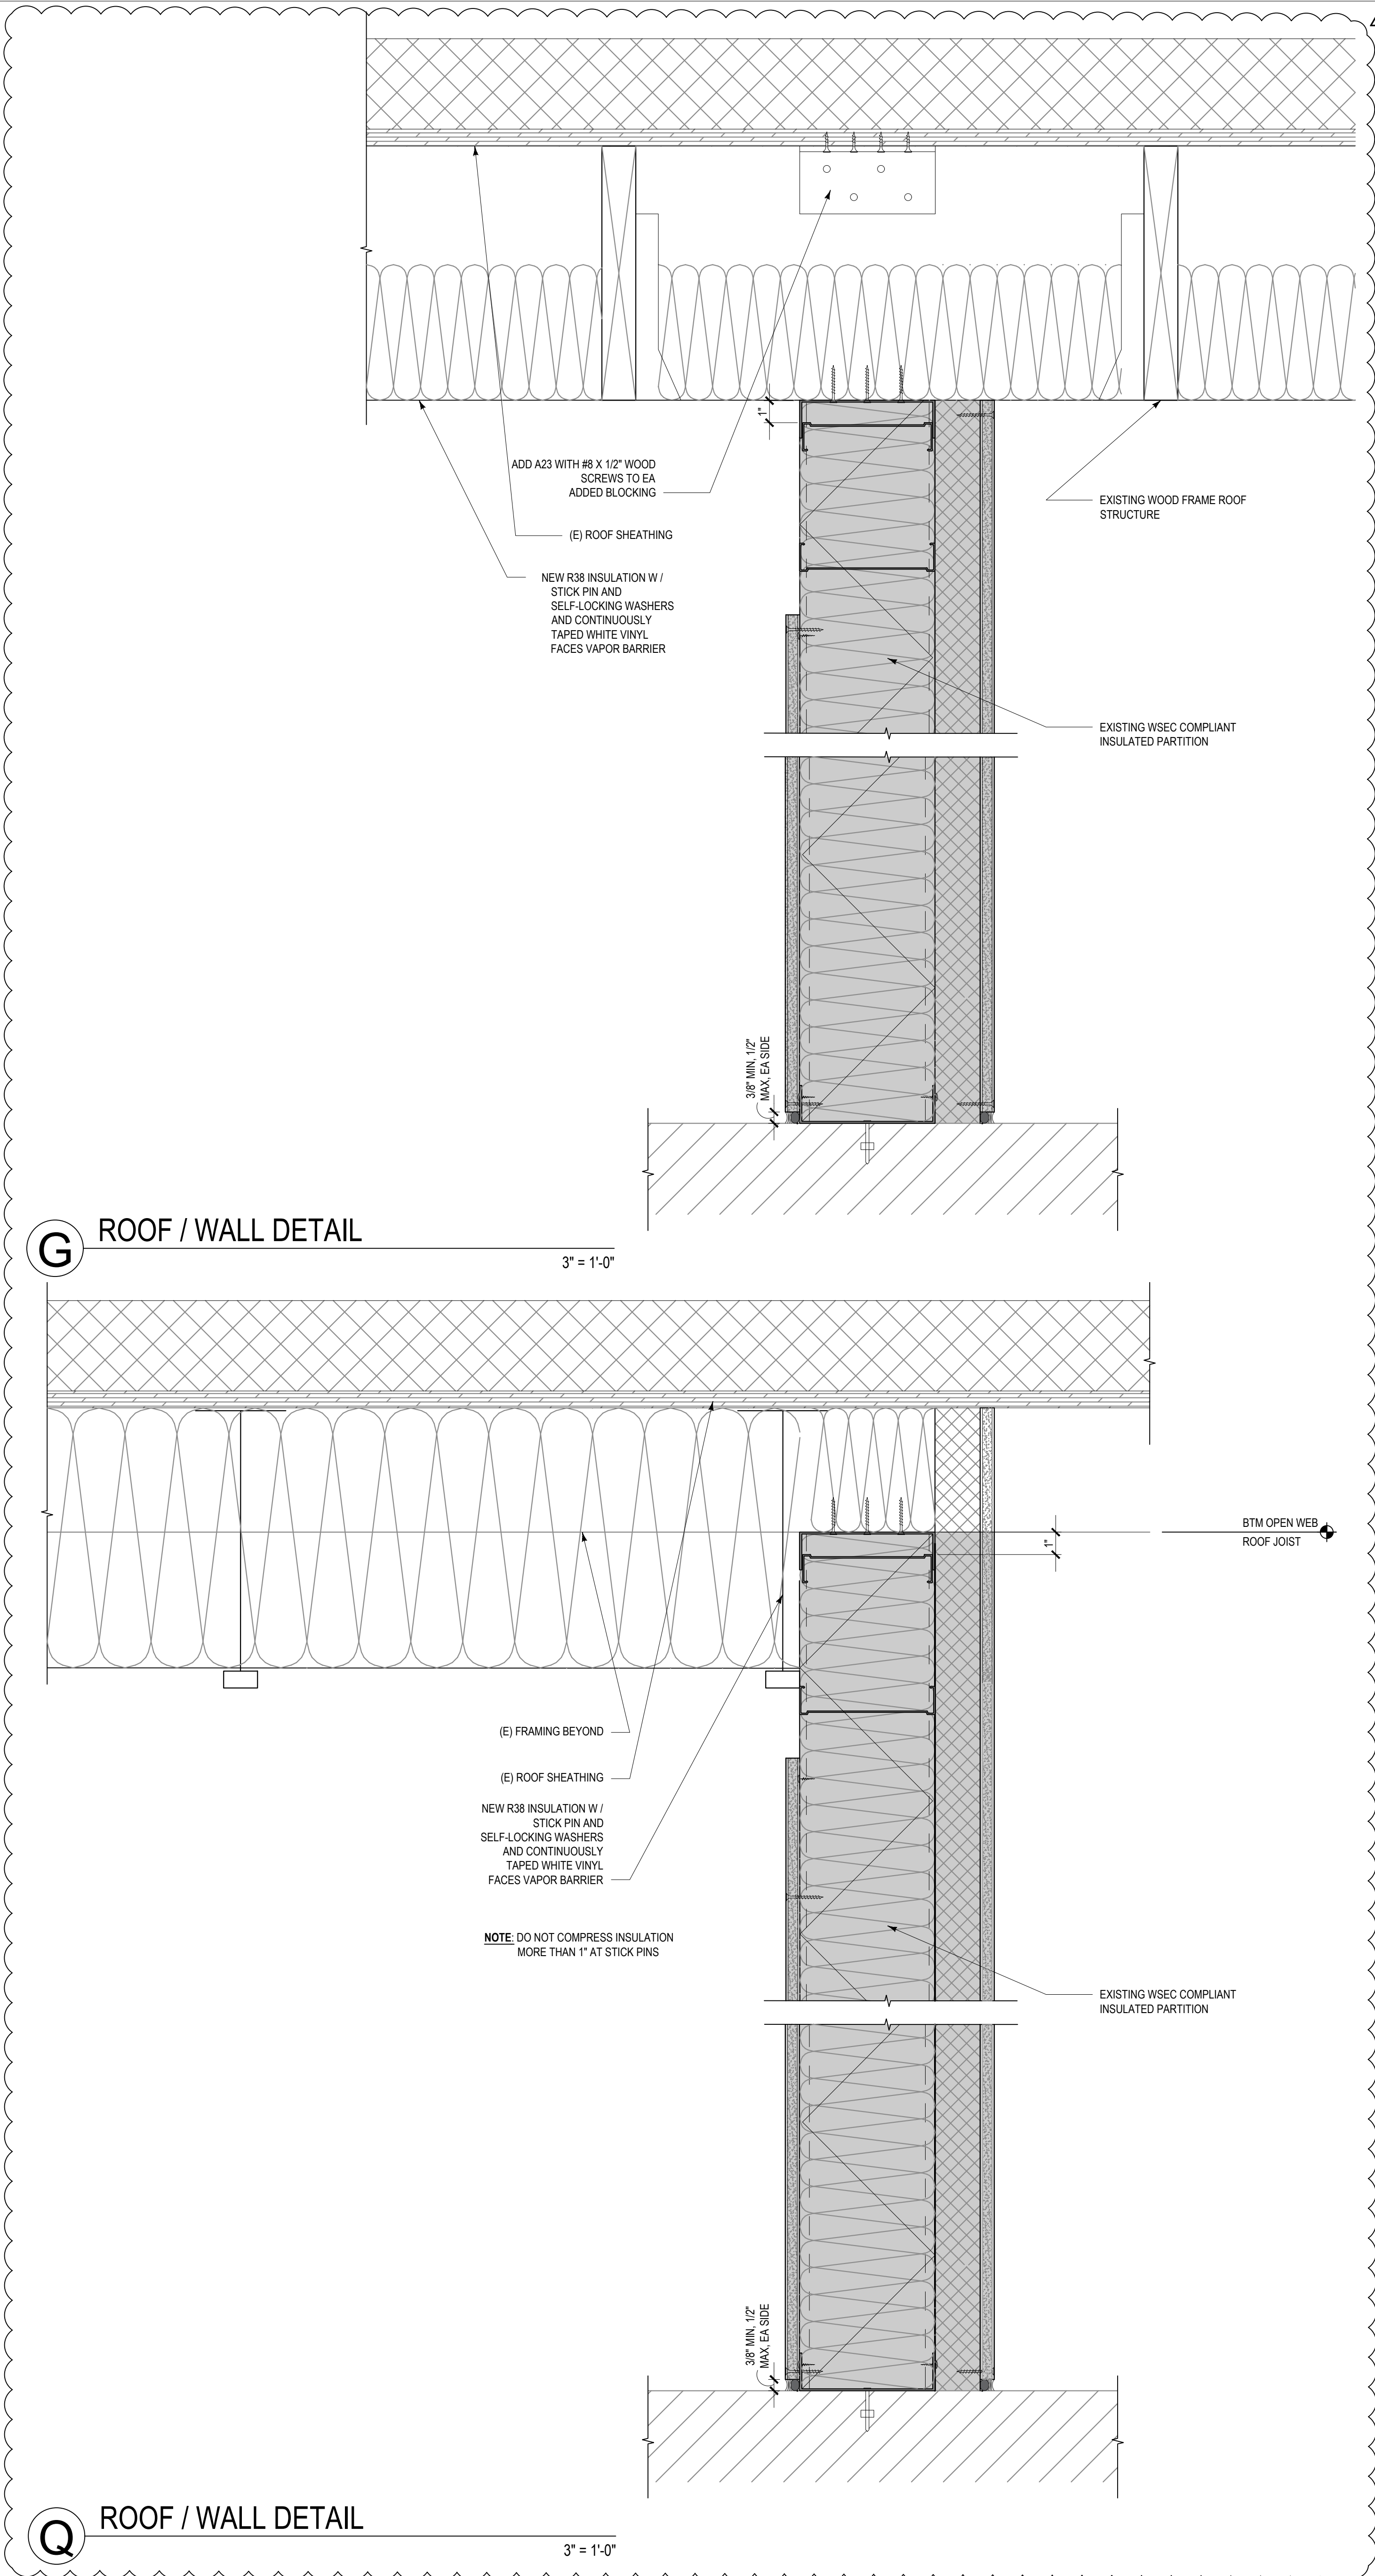

3/19/24, 4:45 PM

waenergycodes.com/print\_project\_summary\_form.php?k=aWQ9MJQ5MzQmZnZpPTI3JnJlc2V0PTEmY3RpPTkx&debug=1

ENVELOPE COMPLIANCE SUMMARY

2021 WSEC Compliance Forms for Commercial Buildings including Group R2, R3 & R4 over 3 stories and all R1

Administered by: ©2024 NEEA, All rights reserved

Project & Applicant Information	Project Title	Prologis Puyallup 1 Roof - 2021 WSEC		For Building Department Use:		Date: Mar 19, 2024
	Project Address	1601 Industrial Park 100 Puyallup, WA 98371				
	Applicant Name	Myles Huddart				
	Applicant Phone	206-683-3236				
	Applicant Email	mylesh@burgessnmw.com				
For questions about this report, contact WSEC Commercial Technical Support at 360-539-5300 or via email at com.techsupport@waenergycodes.com						

General Occupancy	All Commercial	General Building Use Type(s)	Warehouse, Distribution	Building Cond. Floor Area	385,000
Project Scope	Alteration	Space Conditioning Categories	Fully Conditioned	Project Cond. Floor Area	130,912
				Floors Above Grade	1
				Compliance Method	General Prescriptive
Envelope Project Description	NON-STRUCTURAL INTERIOR TENANT IMPROVEMENT: WORK INCLUDES ADDING ROOF INSULATION TO EXISTING ROOF THROUGHOUT THE SUITE.				

Envelope Compliance Scope and Method	Scope	Space Conditioning Category	Compliance Method	WWR/SRR per Category	UA Calculation Adjustment	Fenestration Alternates	Compliance Verification
	Alteration	Fully Conditioned	Prescriptive	0% / 0%	No Calculation Adjustments allowed	No alternates selected	COMPLIES



Additional Energy Efficiency (AEC) Measures Included	No envelope or miscellaneous additional energy efficiency measures included in project	Load Management (LDM) Measures Included	No envelope load management measure credits included in project
Air Barrier Testing	Air barrier testing not included	Air Barrier Comments	Alterations are all on the interior. No changes to exterior building envelope.

Project Title	Prologis Puyallup 1 Roof - 2021 WSEC			Date	Mar 19, 2024
Scope & Space Conditioning	ALTERATION - FULLY CONDITIONED			Compliance Verification	COMPLIES
Window-to-wall Ratio	0%	Skylight-to-roof-ratio	0%	Vertical Fenestration Alternate	No alternates selected

Opaque Envelope Assemblies					
Roof/Ceiling	Location in Documents	Assembly ID	Assembly Location	Insulation R-Values	
Insulation above & below deck	Sheets A1J31 & A1D00	Roof / Wall	Interior partition	Cavity	Continuous (% penetration)
				R-38	R-38 (< 0.04%)
	U-Factor Source: Other U-Factor Source				2nd Layer (MB Roof)
	Roof Framing Type: Standard				U-Factor
	Roof Framing Spacing (OC): 24				Net Area (SF)
Ceiling/Airtic Venting: Unvented					
				U-Factor Source Description:	
				Roof Framing Depth (Inches): 12	
				Roof Framing Material: Wood-framed	
				New, upgraded or unaltered existing?: Upgraded existing assembly	

https://www.waenergycodes.com/print\_project\_summary\_form.php?k=aWQ9MJQ5MzQmZnZpPTI3JnJlc2V0PTEmY3RpPTkx&debug=1

1/1

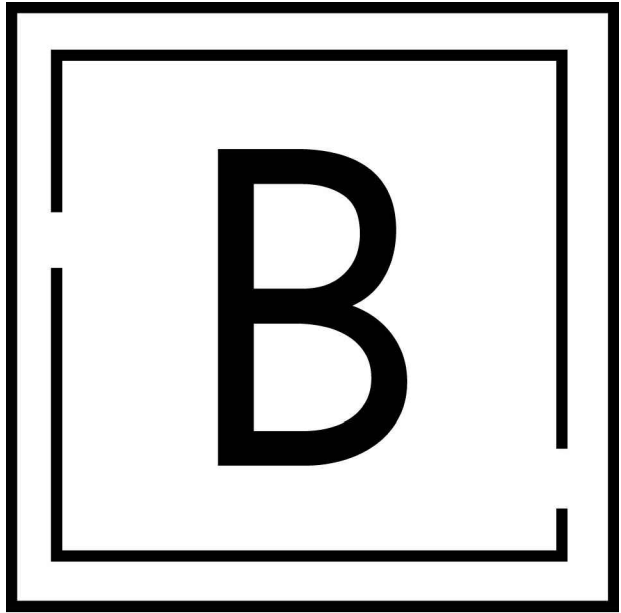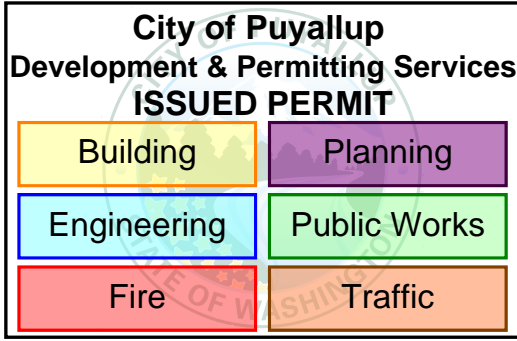


BURGESS DESIGN  
INTERIORS + ARCHITECTURE  
1200 5th Ave Suite 400 Seattle WA | 206.587.7120

PRCTI20240469



Tenant:  
PROLOGIS PUYALLUP 1  
MAKE READY  
PUYALLUP 1  
1601 INDUSTRIAL PARK #100  
PUYALLUP, WA 98371

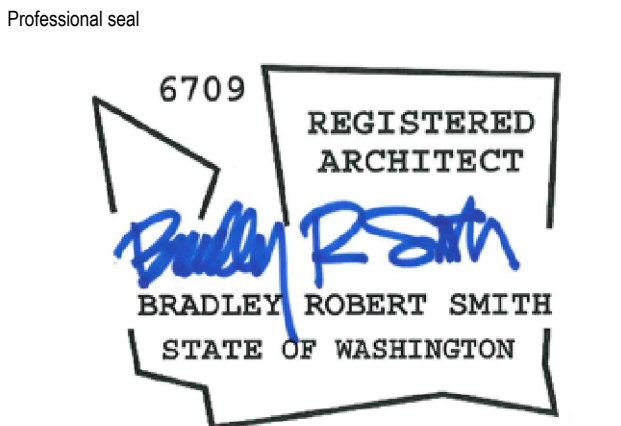

No.	Issue Description	Date
	REVIEW SET	01.06.23
	REVIEW SET	01.30.23
	REVIEW SET	02.17.23
	REVIEW SET	02.27.23
	PERMIT SET	03.10.23
	CD SET	03.17.23
	CITY CORRECTION	05.19.23
	CITY CORRECTION	03.22.24

City Electronic Stamp Location

CLIENT APPROVAL DATE

City Electronic Stamp Location

Drawn by: MK Project Manager: SH



Project No: 22.0243.00

SECTIONS / WSEC  
COMPLIANCE REPORT

Original drawing is 36" x 48". Scale entries accordingly reduced.

A1300



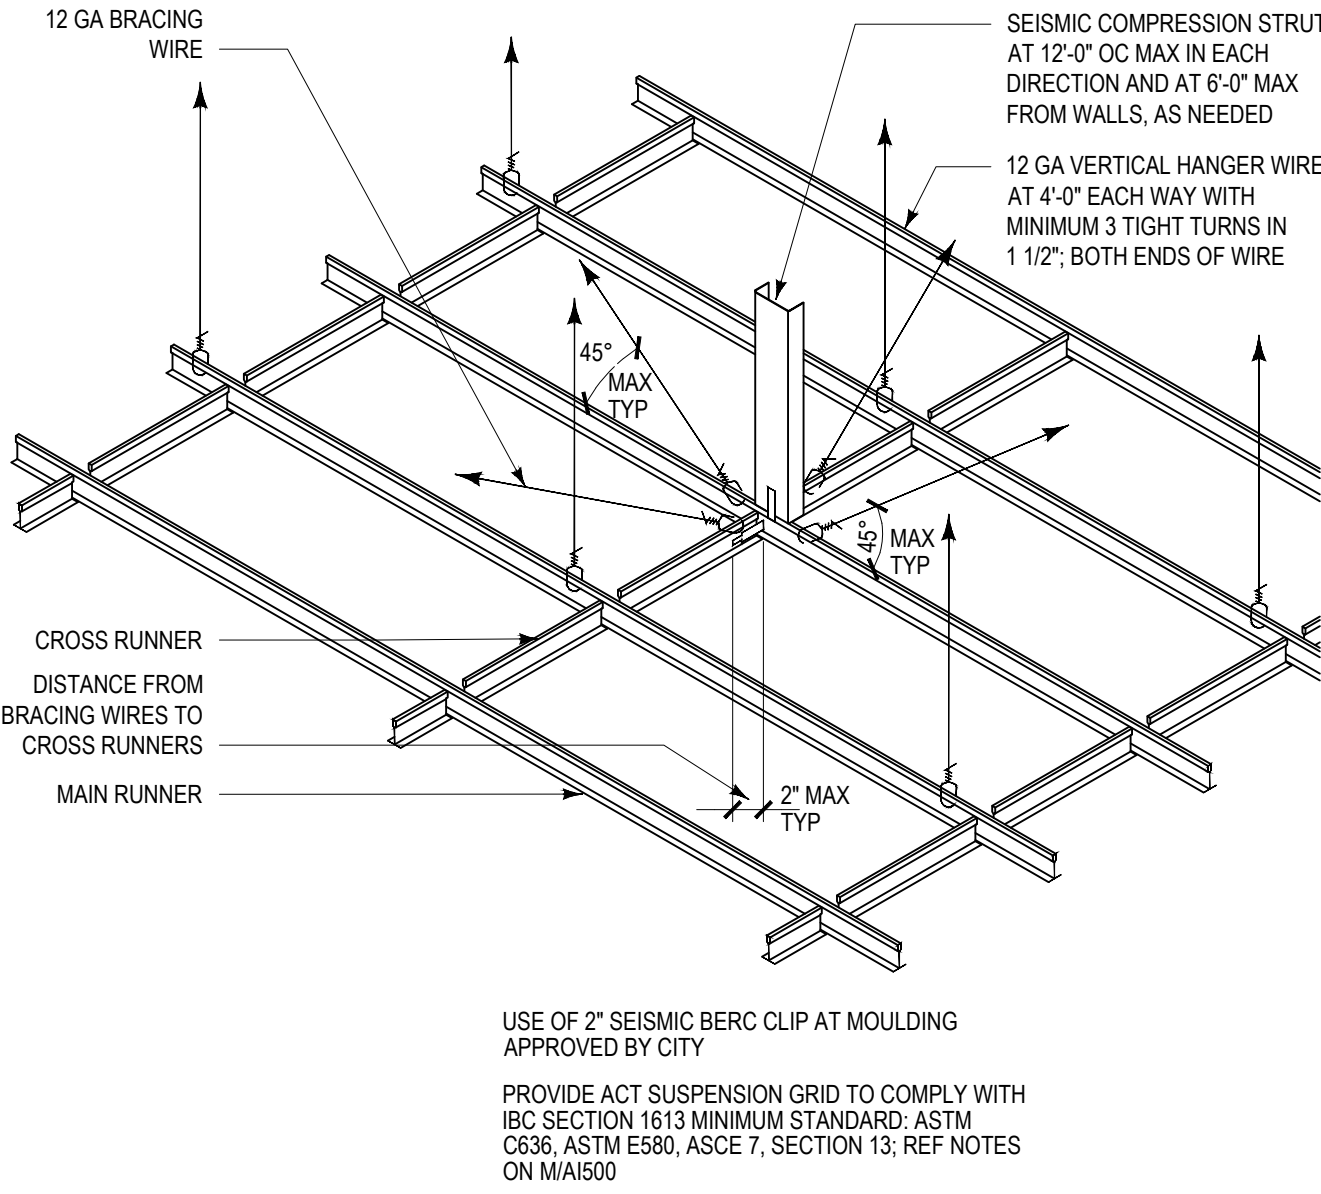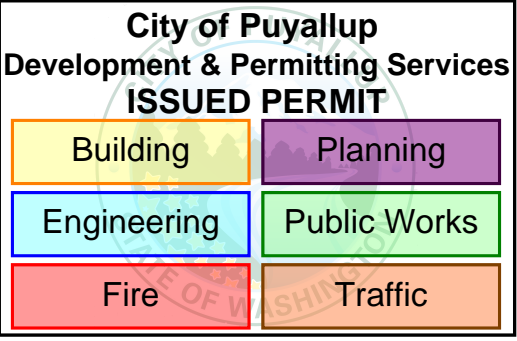

D

ACT SEISMIC SUSPENSION

NOT TO SCALE

VERIFY ALL REQUIREMENTS WITH BUILDING MANAGEMENT

**GENERAL REQUIREMENTS**

REFERENCED SOURCES PER HIERARCHY: IBC (INTERNATIONAL BUILDING CODE), AMERICAN SOCIETY OF TESTING MATERIALS (ASTM C636, C638, E580, M680), AMERICAN SOCIETY OF CIVIL ENGINEERS (ASCE 7, SECTION 13) AND CEILINGS AND INTERIOR SYSTEMS CONSTRUCTION ASSOCIATION (CISCA).

PARTITIONS THAT ARE TIED TO THE CEILING AND ALL PARTITIONS GREATER THAN 6' IN HEIGHT SHALL BE Laterally BRACED TO STRUCTURE. BRACING SHALL BE INDEPENDENT OF CEILING SPLAY BRACING SYSTEM, PER ASCE 7, SECTION 13.

ALL MAIN BEAMS TO BE HEAVY DUTY, PER ASTM E580.

CEILINGS LESS THAN OR EQUAL TO 144 SQ FT AND SURROUNDED BY WALLS CONNECTED TO THE STRUCTURE ABOVE ARE EXEMPT FROM SEISMIC REQUIREMENTS, PER ASTM E580.

THESE REQUIREMENTS ARE INTENDED FOR SUSPENDED CEILINGS AND RELATED COMPONENTS IN AREAS THAT REQUIRE RESISTANCE TO THE EFFECTS OF EARTHQUAKE MOTIONS, PER ASTM E580. ALL WIRES ARE TO BE THREE TIGHT TURNS AROUND ITSELF WITHIN THREE INCHES. PROVIDE TWELVE GAUGE HANGER WIRE SPACED 4" OC, PER ASTM C636, ITEM 2.3.4. CHANGES IN CEILING PLANES WILL REQUIRE POSITIVE BRACINGS, PER ASTM E580.

**LATERAL FORCE BRACING**

CEILINGS CONSTRUCTED OF SCREW OR NAIL ATTACHED GWB ON ONE LEVEL THAT ARE SURROUNDED BY AND CONNECTED TO WALLS OR SOFFITS THAT ARE Laterally BRACED TO THE STRUCTURE ABOVE ARE EXEMPT FROM SEISMIC REQUIREMENTS, PER ASCE 7, SECTION 13.

CEILING AREAS OF 1000 SQ FT OR LESS SHALL BE EXEMPT FROM LATERAL FORCE REQUIREMENTS, PER ASTM E580.

LATERAL FORCE BRACING IS THE USE OF VERTICAL STRUTS (COMPRESSION POSTS) AND SPLAY WIRES.

LATERAL FORCE BRACING SHALL BE 12" OC MAX AND BEGIN NO FARTHER THAN 6" FROM WALLS, PER ASTM E580.

SEISMIC SPLAY WIRES SHALL BE ATTACHED TO THE GRID AND TO THE STRUCTURE IN SUCH A MANNER THAT THEY CAN SUPPORT A DESIGN LOAD OF NOT LESS THAN 200 POUNDS OR THE ACTUAL DESIGN LOAD WITH A SAFETY FACTOR OF 2 WHICHEVER IS GREATER, PER CISCA ZONES 3-4.

POWDER ACTUATED FASTENERS (PAFS) WHEN USED FOR SEISMIC APPLICATIONS AS PART OF THE PRESCRIPTIVE PATH IN SEISMIC DESIGN CATEGORIES D, E SHALL HAVE AN ICC-ED APPROVAL FOR SEISMIC APPLICATIONS AND SHALL REQUIRE SPECIAL INSPECTION IRRESPECTIVE OF THE TYPE OF OCCUPANCY CATEGORY IN WHICH THE STRUCTURE RESIDES. PAF ANCHORS FOR KICKER WIRES ARE EXEMPT FROM THIS REQUIREMENT.

SPLAY WIRES SHALL BE (4) 12 GAUGE ATTACHED TO THE MAIN BEAM. WIRES ARE ARRAYED 90° FROM EACH OTHER AND AT AN ANGLE NOT TO EXCEED 45° FROM THE PLANE OF THE CEILING, PER ASTM E580.

SPLAY WIRES ARE TO BE WITHIN 2" OF THE CONNECTION OF THE VERTICAL STRUT TO SUSPENDED CEILING. RIGID BRACING MAY BE USED IN LIEU OF SPLAY WIRES, PER ASTM E580.

CEILINGS WITH PLENUMS LESS THAN 12" TO STRUCTURE ARE NOT REQUIRED TO HAVE LATERAL FORCE BRACING.

VERTICAL STRUTS MAY BE EMT CONDUIT, METAL STUDS OR PROPRIETARY COMPRESSION POSTS.

VERTICAL STRUTS MUST BE POSITIVELY ATTACHED TO SUSPENSION SYSTEMS AND THE STRUCTURE ABOVE, PER ASTM E580.

**WALL MOLDINGS**

WALL MOLDINGS (PERIMETER CLOSURE ANGLES) ARE REQUIRED TO HAVE A HORIZONTAL FLANGE 2" WIDE. ONE END OF THE CEILING GRID SHALL BE ATTACHED TO THE WALL MOLDING, THE OTHER END SHALL HAVE A 3/4" CLEARANCE FROM THE WALL AND BE FREE TO SLIDE, PER ASTM E580.

WHERE SUBSTANTIATING DOCUMENTATION HAS BEEN PROVIDED TO THE LOCAL JURISDICTION, BERC-2 CLIPS MAY BE USED TO SATISFY THE REQUIREMENTS FOR THE 2" CLOSURE ANGLE.

THE GRID SHALL BE ATTACHED AT TWO ADJACENT WALLS (POP RIVETS OR APPROVED METHOD). SOFFITS EXTENDING TO A POINT AT LEAST LEVEL WITH THE BOTTOM PLANE OF THE GRID AND INDEPENDENTLY SUPPORTED AND Laterally BRACED TO THE STRUCTURE ABOVE, ARE DEEMED TO BE EQUIVALENT TO WALLS, PER ASTM E580.

**SPREADER BARS**

TERMINAL ENDS OF MAIN RUNNERS AND CROSS MEMBERS SHALL BE TIED TOGETHER OR HAVE SOME OTHER APPROVED MEANS TO PREVENT THEIR SPREADING. STABILIZER BARS, CROSS TEES OR OTHER MEANS TO PREVENT SPREADING SHALL OCCUR WITHIN 8" OF EACH WALL, PER ASTM E580.

SPREADER BARS ARE NOT REQUIRED AT PERIMETERS WHERE RUNNERS ARE ATTACHED DIRECTLY TO CLOSURE ANGLES.

SPREADER BARS ARE NOT REQUIRED IF A 90° INTERSECTING CROSS MAIN IS WITHIN 8" OF PERIMETER WALL.

WHERE SUBSTANTIATING DOCUMENTATION HAS BEEN PROVIDED TO THE LOCAL JURISDICTION, BERC-2 CLIPS MAY BE USED TO SATISFY THE REQUIREMENTS FOR THE SPREADER BARS.

**HANGER (SUSPENSION) WIRES**

HANGER AND PERIMETER WIRES MUST BE PLUMB WITHIN 1 IN 8 UNLESS COUNTER SLOPING WIRES ARE PROVIDED, PER ASTM C636.

HANGER WIRES SHALL BE 12 GAUGE AND SPACED 4" OC OR 10 GAUGE SPACE 5" OC, PER ASTM E580.

ANY CONNECTION DEVICE, AT THE SUPPORTING CONSTRUCTION, SHALL BE CAPABLE OF CARRYING NOT LESS THAN 100 POUNDS, PER CISCA ZONES 3-4.

POWDER DRIVEN FASTENERS ARE AN APPROVED METHOD OF ATTACHMENT FOR HANGER WIRE WITH THE MAINTENANCE OF ALL OTHER REQUIREMENTS.

TERMINAL ENDS OF EACH MAIN BEAM AND CROSS TEE MUST BE SUPPORTED WITHIN 8" OF EACH WALL WITH A PERIMETER WIRE, PER ASTM E580.

WIRE SHALL NOT ATTACH TO OR BEND AROUND INTERFERING MATERIAL OR EQUIPMENT. A TRAPEZE OR EQUIVALENT DEVICE SHALL BE USED WHERE OBSTRUCTIONS PRECLUDE DIRECT SUSPENSION. TRAPEZE SUSPENSIONS SHALL BE SIZED TO RESIST THE DEAD LOAD AND LATERAL FORCES APPROPRIATE FOR THE SEISMIC CATEGORY, PER ASTM E580.

**ELECTRICAL FIXTURES**

LIGHT FIXTURES WEIGHING LESS THAN 10 POUNDS SHALL HAVE (1) 12 GAUGE HANGER WIRE CONNECTED FROM THE FIXTURE TO THE STRUCTURE ABOVE. THIS WIRE MAY BE SLACK, PER ASTM E580.

LIGHT FIXTURES WEIGHING MORE THAN 10 POUNDS AND LESS THAN 56 POUNDS SHALL HAVE (2) 12 GAUGE WIRES ATTACHED, AT OPPOSING CORNERS OF THE LIGHT FIXTURE, TO THE STRUCTURE ABOVE. THESE WIRES MAY BE SLACK, PER ASTM E580.

LIGHT FIXTURES WEIGHING MORE THAN 56 POUNDS SHALL BE SUPPORTED DIRECTLY FROM STRUCTURE ABOVE BY APPROVED HANGERS, PER ASTM E580.

PENDANT MOUNTED FIXTURES SHALL BE DIRECTLY SUPPORTED FROM THE STRUCTURE ABOVE USING 9 GAUGE WIRE OR AN APPROVED ALTERNATE SUPPORT WITHOUT USING THE CEILING SUSPENSION SYSTEM FOR DIRECT SUPPORT, PER ASTM E580.

TANDEM FIXTURES MAY UTILIZE COMMON WIRES.

**MECHANICAL SERVICES**

TERMINALS OR SERVICES WEIGHING LESS THAN 20 POUNDS SHALL BE POSITIVELY ATTACHED TO THE CEILING SUSPENSION MAIN RUNNERS OR TO CROSS RUNNERS THAT HAVE THE SAME CARRYING CAPACITY AS THE MAIN RUNNERS, PER ASTM E580 5.4.1.

TERMINALS OR SERVICES WEIGHING 20 POUNDS BUT NOT MORE THAN 56 POUNDS MUST HAVE, IN ADDITION TO 5.4.1, (2) 12 GAUGE WIRES CONNECTING THEM TO THE CEILING SYSTEM HANGERS OR THE STRUCTURE ABOVE. THESE WIRES MAY BE SLACK, PER ASTM E580.

TERMINALS OR SERVICES WEIGHING MORE THAN 56 POUNDS MUST BE SUPPORTED DIRECTLY FORM THE STRUCTURE ABOVE BY APPROVED HANGERS, PER ASCE 7, SECTION 13.

**SEISMIC SEPARATION JOINTS**

FOR CEILING AREAS EXCEEDING 2500 SF, A SEISMIC SEPARATION JOINT OR FULL HEIGHT WALL PARTITION THAT BREAKS THE CEILING SHALL BE PROVIDED UNLESS ANALYSES ARE PERFORMED OF THE CEILING BRACING SYSTEM, CLOSURE ANGLES AND PENETRATIONS TO PROVIDE SUFFICIENT CLEARANCE, PER ASCE 7, SECTION 13.

THE AMOUNT OF FREE MOVEMENT (GAP) SHALL BE A MINIMUM OF 3/4".

IN LIEU OF SEISMIC SEPARATION JOINTS, THE CEILING MAY BE DIVIDED INTO AREAS OF LESS THAN 2,500 SF BY THE USE OF PARTITIONS OR SOFFITS AS FOLLOWS: PARTITIONS SHALL EXTEND A MINIMUM OF 6" ABOVE THE LEVEL OF THE PLANE OF THE GRID AND SHALL BE INDEPENDENTLY BRACED TO THE STRUCTURE ABOVE. SOFFITS SHALL EXTEND TO A POINT AT LEAST LEVEL WITH THE BOTTOM PLANE OF THE GRID AND SHALL BE INDEPENDENTLY SUPPORTED AND Laterally BRACED TO THE STRUCTURE ABOVE, PER ASTM E580.

**SPECIAL INSPECTIONS**


SPECIAL INSPECTIONS SHALL BE SUBJECT TO SPECIAL INSPECTION REQUIREMENTS.

**SPRINKLERS**

FOR CEILINGS WITHOUT RIGID BRACING, SPRINKLER HEAD PENETRATIONS SHALL HAVE A 2" OVERSIZE RING, SLEEVE OR ADAPTER THROUGH THE CEILING TILE TO ALLOW FREE MOVEMENT OF AT LEAST 1" IN ALL HORIZONTAL DIRECTIONS. FLEXIBLE HEAD DESIGN THAT CAN ACCOMMODATE 1" FREE MOVEMENT SHALL BE PERMITTED AS AN ALTERNATE, PER ASTM E580.

Q

ACT SEISMIC BRACING NOTES

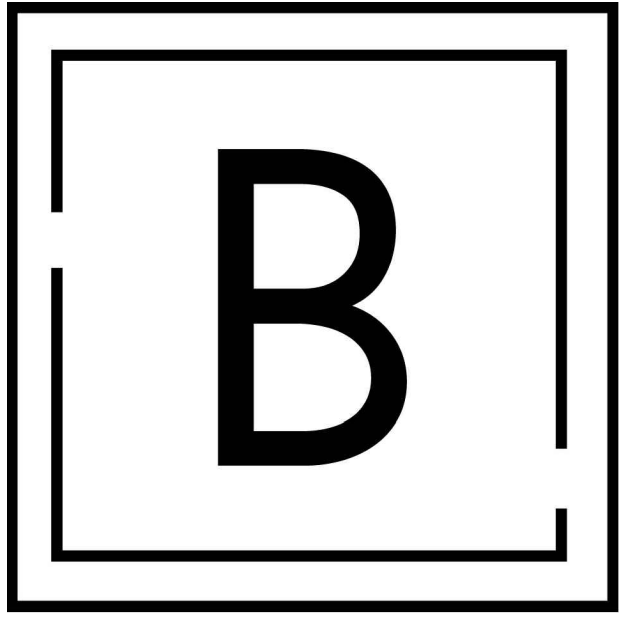


**BURGESS DESIGN**  
INTERIORS + ARCHITECTURE  
1200 5th Ave Suite 400 Seattle WA | 206.587.7120

PRCTI20240469



Tenant:  
**PROLOGIS PUYALLUP 1**  
**MAKE READY**  
PUYALLUP 1  
1601 INDUSTRIAL PARK #100  
PUYALLUP, WA 98371

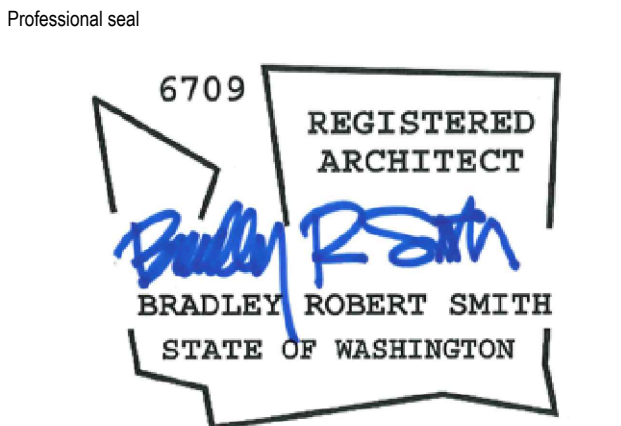

No.	Issue Description	Date
REVIEW SET		01.06.23
REVIEW SET		01.30.23
REVIEW SET		02.17.23
REVIEW SET		02.27.23
PERMIT SET		03.10.23
CD SET		03.17.23
CITY CORRECTION		05.19.23
CITY CORRECTION		03.22.24

City Electronic Stamp Location

CLIENT APPROVAL DATE

City Electronic Stamp Location

Drawn by: MH Project Manager: SH

Project No: 22.0243.00

DETAILS

Original drawing is 36" x 48". Scale entries accordingly reduced.

AI500