

BUILDING SUMMARY

PHASE 2 - BUILDING A

DESCRIPTION: 10 UNIT APARTMENT BUILDING
 APPLICABLE BUILDING CODE: 2018 IBC
 OCCUPANCY: R2
 TYPE OF CONSTRUCTION: VB
 FIRE SPRINKLERS: YES, NFPA 13R PER 903.3.1.2
 FIRE ALARM SYSTEM AND SMOKE ALARM: YES
 ELEVATOR: NO
 NUMBER OF APARTMENT UNITS: 10 (PER BUILDING)
 NUMBER OF (1) BEDROOMS = 8
 NUMBER OF (3) BEDROOMS = 2
 ACCESSIBLE TYPE A UNITS REQUIRED: 1
 ACCESSIBLE TYPE 'B' UNITS REQUIRED: 3

BASE ALLOWABLE BUILDING AREAS, HEIGHT AND STORIES:
 ALLOWABLE AREA: 7,000-sf
 ALLOWABLE MAXIMUM HEIGHT: 60-ft
 ALLOWABLE STORIES: 3

MODIFICATIONS TO THE BASE ALLOWABLE AREA BUILDING G:
 MODIFICATIONS NOT NECESSARY

**FOR SINGLE-OCCUPANCY, MULTI-STORY BUILDING
 **SEE FRONTAGE CALCULATION FOR AREA INCREASE ON SHEET #AG1.2

PROPOSED HEIGHT: 36-ft MAX. PER PMC
 PROPOSED STORIES: 3

TOTAL PROPOSED GROSS AREA ALL LEVELS:
 (INCLUDES DECKS)

| | |
|----------|-----------|
| LEVEL 1: | 3,840-sf |
| LEVEL 2: | 3,824-sf |
| LEVEL 3: | 3,702-sf |
| TOTAL: | 15,206-sf |

OCCUPANT LOAD:
 OCCUPANT LOAD FACTOR: 200 GROSS
 OCCUPANT LOAD PER FLOOR:

| | |
|----------|----|
| LEVEL 1: | 19 |
| LEVEL 2: | 19 |
| LEVEL 3: | 19 |

PHASE 1 - BUILDING B

DESCRIPTION: 24 APARTMENT UNIT BUILDING
 APPLICABLE BUILDING CODE: 2018 IBC
 OCCUPANCY: R2
 TYPE OF CONSTRUCTION: VB
 FIRE SPRINKLERS: YES, NFPA 13R PER 903.3.1.2
 FIRE ALARM SYSTEM AND SMOKE ALARM: YES
 ELEVATOR: NO
 NUMBER OF APARTMENT UNITS: 24
 NUMBER OF (1) BEDROOMS = 0
 NUMBER OF (2) BEDROOMS = 12
 NUMBER OF (3) BEDROOMS = 12
 ACCESSIBLE TYPE A UNITS REQUIRED: 1
 ACCESSIBLE TYPE 'B' UNITS REQUIRED: 7

BASE ALLOWABLE BUILDING AREAS, HEIGHT AND STORIES:
 ALLOWABLE AREA: 7,000-sf
 ALLOWABLE MAXIMUM HEIGHT: 60-ft
 ALLOWABLE STORIES: 3

MODIFICATIONS TO THE BASE ALLOWABLE AREA BUILDING B:
 TOTAL AREA: 36,750-sf
 MAXIMUM AREA PER FLOOR: 12,250-sf

**FOR SINGLE-OCCUPANCY, MULTI-STORY BUILDING
 **SEE FRONTAGE CALCULATION FOR AREA INCREASE ON SHEET #AG1.2

PROPOSED HEIGHT: 36-ft MAX. PER PMC
 PROPOSED STORIES: 3

TOTAL PROPOSED GROSS AREA ALL LEVELS:
 (INCLUDES COVERED DECKS)

| | |
|----------|-----------|
| LEVEL 1: | 10,572-sf |
| LEVEL 2: | 10,571-sf |
| LEVEL 3: | 10,297-sf |
| TOTAL: | 31,440-sf |

OCCUPANT LOAD:
 OCCUPANT LOAD FACTOR: 200 GROSS
 OCCUPANT LOAD PER FLOOR:

| | |
|----------|----|
| LEVEL 1: | 50 |
| LEVEL 2: | 50 |
| LEVEL 3: | 50 |

PHASE 1 - BUILDING C

DESCRIPTION: 24 APARTMENT UNIT BUILDING
 APPLICABLE BUILDING CODE: 2018 IBC
 OCCUPANCY: R2
 TYPE OF CONSTRUCTION: VB
 FIRE SPRINKLERS: YES, NFPA 13R PER 903.3.1.2
 FIRE ALARM SYSTEM AND SMOKE ALARM: YES
 ELEVATOR: NO
 NUMBER OF APARTMENT UNITS: 24
 NUMBER OF (1) BEDROOMS = 0
 NUMBER OF (2) BEDROOMS = 24
 ACCESSIBLE TYPE A UNITS REQUIRED: 1
 ACCESSIBLE TYPE 'B' UNITS REQUIRED: 7

BASE ALLOWABLE BUILDING AREAS, HEIGHT AND STORIES:
 ALLOWABLE AREA: 7,000-sf
 ALLOWABLE MAXIMUM HEIGHT: 60-ft
 ALLOWABLE STORIES: 3

MODIFICATIONS TO THE BASE ALLOWABLE AREA BUILDING C:
 TOTAL AREA: 31,500-sf
 MAXIMUM AREA PER FLOOR: 10,500-sf

**FOR SINGLE-OCCUPANCY, MULTI-STORY BUILDING
 **SEE FRONTAGE CALCULATION FOR AREA INCREASE ON SHEET #AG1.2

PROPOSED HEIGHT: 36-ft MAX. PER PMC
 PROPOSED STORIES: 3

TOTAL PROPOSED GROSS AREA ALL LEVELS:
 (INCLUDES COVERED DECKS)

| | |
|----------|-----------|
| LEVEL 1: | 10,235-sf |
| LEVEL 2: | 9,949-sf |
| LEVEL 3: | 9,893-sf |
| TOTAL: | 30,077-sf |

OCCUPANT LOAD:
 OCCUPANT LOAD FACTOR: 200 GROSS
 OCCUPANT LOAD PER FLOOR:

| | |
|----------|----|
| LEVEL 1: | 50 |
| LEVEL 2: | 50 |
| LEVEL 3: | 50 |

PHASE 1 - BUILDING D

DESCRIPTION: 24 APARTMENT UNIT BUILDING
 APPLICABLE BUILDING CODE: 2018 IBC
 OCCUPANCY: R2
 TYPE OF CONSTRUCTION: VB
 FIRE SPRINKLERS: YES, NFPA 13R PER 903.3.1.2
 FIRE ALARM SYSTEM AND SMOKE ALARM: YES
 ELEVATOR: NO
 NUMBER OF APARTMENT UNITS: 24
 NUMBER OF (1) BEDROOMS = 0
 NUMBER OF (2) BEDROOMS = 24
 ACCESSIBLE TYPE A UNITS REQUIRED: 2
 ACCESSIBLE TYPE 'B' UNITS REQUIRED: 6

BASE ALLOWABLE BUILDING AREAS, HEIGHT AND STORIES:
 ALLOWABLE AREA: 7,000-sf
 ALLOWABLE MAXIMUM HEIGHT: 60-ft
 ALLOWABLE STORIES: 3

MODIFICATIONS TO THE BASE ALLOWABLE AREA BUILDING D:
 TOTAL AREA: 34,650-sf
 MAXIMUM AREA PER FLOOR: 11,550-sf

**FOR SINGLE-OCCUPANCY, MULTI-STORY BUILDING
 **SEE FRONTAGE CALCULATION FOR AREA INCREASE ON SHEET #AG1.2

PROPOSED HEIGHT: 36-ft MAX. PER PMC
 PROPOSED STORIES: 3

TOTAL PROPOSED GROSS AREA ALL LEVELS:
 (INCLUDES COVERED DECKS)

| | |
|----------|-----------|
| LEVEL 1: | 10,180-sf |
| LEVEL 2: | 10,164-sf |
| LEVEL 3: | 9,922-sf |
| TOTAL: | 30,266-sf |

OCCUPANT LOAD:
 OCCUPANT LOAD FACTOR: 200 GROSS
 OCCUPANT LOAD PER FLOOR:

| | |
|----------|----|
| LEVEL 1: | 50 |
| LEVEL 2: | 50 |
| LEVEL 3: | 50 |

PHASE 2 - BUILDING E

DESCRIPTION: 24 APARTMENT UNIT BUILDING
 APPLICABLE BUILDING CODE: 2018 IBC
 OCCUPANCY: R2
 TYPE OF CONSTRUCTION: VB
 FIRE SPRINKLERS: YES, NFPA 13R PER 903.3.1.2
 FIRE ALARM SYSTEM AND SMOKE ALARM: YES
 ELEVATOR: NO
 NUMBER OF APARTMENT UNITS: 24
 NUMBER OF (1) BEDROOMS = 0
 NUMBER OF (2) BEDROOMS = 24
 ACCESSIBLE TYPE A UNITS REQUIRED: 1
 ACCESSIBLE TYPE 'B' UNITS REQUIRED: 7

BASE ALLOWABLE BUILDING AREAS, HEIGHT AND STORIES:
 ALLOWABLE AREA: 7,000-sf
 ALLOWABLE MAXIMUM HEIGHT: 60-ft
 ALLOWABLE STORIES: 3

MODIFICATIONS TO THE BASE ALLOWABLE AREA BUILDING E:
 TOTAL AREA: 33,180-sf
 MAXIMUM AREA PER FLOOR: 11,060-sf

**FOR SINGLE-OCCUPANCY, MULTI-STORY BUILDING
 **SEE FRONTAGE CALCULATION FOR AREA INCREASE ON SHEET #AG1.2

PROPOSED HEIGHT: 36-ft MAX. PER PMC
 PROPOSED STORIES: 3

TOTAL PROPOSED GROSS AREA ALL LEVELS:
 (INCLUDES COVERED DECKS)

| | |
|----------|-----------|
| LEVEL 1: | 9,869-sf |
| LEVEL 2: | 10,138-sf |
| LEVEL 3: | 9,922-sf |
| TOTAL: | 29,929-sf |

OCCUPANT LOAD:
 OCCUPANT LOAD FACTOR: 200 GROSS
 OCCUPANT LOAD PER FLOOR:

| | |
|----------|----|
| LEVEL 1: | 43 |
| LEVEL 2: | 50 |
| LEVEL 3: | 50 |

PHASE 2 - BUILDING F

DESCRIPTION: 24 UNIT APARTMENT BUILDING
 APPLICABLE BUILDING CODE: 2018 IBC
 OCCUPANCY: R2
 TYPE OF CONSTRUCTION: VB
 FIRE SPRINKLERS: YES, NFPA 13R PER 903.3.1.2
 FIRE ALARM SYSTEM AND SMOKE ALARM: YES
 ELEVATOR: NO
 NUMBER OF APARTMENT UNITS: 24 (PER BUILDING)

NUMBER OF (1) BEDROOMS = 12
NUMBER OF (2) BEDROOMS = 12
ACCESSIBLE TYPE A UNITS REQUIRED: 2
ACCESSIBLE TYPE 'B' UNITS REQUIRED: 7

BASE ALLOWABLE BUILDING AREAS, HEIGHT AND STORIES:
 ALLOWABLE AREA: 7,000-sf
 ALLOWABLE MAXIMUM HEIGHT: 60-ft
 ALLOWABLE STORIES: 3

MODIFICATIONS TO THE BASE ALLOWABLE AREA BUILDING F:
 TOTAL AREA: 35,700-sf
 MAXIMUM AREA PER FLOOR: 11,900-sf

**FOR SINGLE-OCCUPANCY, MULTI-STORY BUILDING
 **SEE FRONTAGE CALCULATION FOR AREA INCREASE ON SHEET #AG1.2

PROPOSED HEIGHT: 36-ft MAX. PER PMC
 PROPOSED STORIES: 3

TOTAL PROPOSED GROSS AREA ALL LEVELS:
 (INCLUDES COVERED DECKS)

| | |
|----------|-----------|
| LEVEL 1: | 8,681sf |
| LEVEL 2: | 8,642-sf |
| LEVEL 3: | 8,416-sf |
| TOTAL: | 25,739-sf |

OCCUPANT LOAD:
 OCCUPANT LOAD FACTOR: 200 GROSS
 OCCUPANT LOAD PER FLOOR:

| | |
|----------|----|
| LEVEL 1: | 43 |
| LEVEL 2: | 43 |
| LEVEL 3: | 42 |

APPLICABLE CODES

- INTERNATIONAL BUILDING CODE (2018)
- ANSI 117.1 (2009)
- INTERNATIONAL MECHANICAL CODE (2018)
- INTERNATIONAL FIRE CODE (2018)
- INTERNATIONAL ELECTRICAL CODE (2018)
- UNIFORM PLUMBING CODE (2018)
- WASHINGTON STATE ENERGY CODE (2018)
- INTERNATIONAL FIRE CODE (2018)
- PUYALLUP LAND USE CODE
- WASHINGTON STATE AMENDMENTS (2018)

TOTAL ACCESSIBLE UNITS

DESCRIPTION: 179 UNITS IN 9 BUILDINGS
 ACCESSIBLE TYPE 'A' UNITS REQUIRED: 5% = 179 X .05 = 9
 REMAINING GROUND LEVEL UNITS SHALL BE TYPE 'B'

TYPE 'A' UNITS PROVIDED: 22 > 9 (COMPLIANT)

NUMBER OF UNITS / BEDROOMS SUMMARY

| PHASE 1 | |
|----------|-------------------------|
| BLD'G B: | 12 -TWO BEDROOM UNITS |
| | 12 -THREE BEDROOM UNITS |
| BLD'G C: | 12 -TWO BEDROOM UNITS |
| | 12 -THREE BEDROOM UNITS |
| BLD'G D: | 12 -TWO BEDROOM UNITS |
| | 12 -THREE BEDROOM UNITS |
| BLD'G G: | 12 -ONE BEDROOM UNITS |
| | 12 -TWO BEDROOM UNITS |
| BLD'G H: | 12 -ONE BEDROOM UNITS |
| | 12 -TWO BEDROOM UNITS |

| | |
|----------------------------|------------------|
| TOTAL ONE BEDROOM UNITS: | 24 |
| TOTAL TWO BEDROOM UNITS: | 60 |
| TOTAL THREE BEDROOM UNITS: | 36 |
| TOTAL UNITS: | 120 |
| TOTAL BEDROOMS: | 24+120+108 = 252 |

| PHASE 2 | |
|------------|-------------------------|
| BLD'G A: | 8 -TWO BEDROOM UNITS |
| | 2 -THREE BEDROOM UNITS |
| BLD'G E: | 12 -TWO BEDROOM UNITS |
| | 12 -THREE BEDROOM UNITS |
| BLD'G F: | 6 -ONE BEDROOM UNITS |
| | 12 -TWO BEDROOM UNITS |
| | 6 -THREE BEDROOM UNITS |
| CLUBHOUSE: | 1 -TWO BEDROOM UNIT |


| | |
|----------------------------|---------------|
| TOTAL ONE BEDROOM UNITS: | 6 |
| TOTAL TWO BEDROOM UNITS: | 33 |
| TOTAL THREE BEDROOM UNITS: | 20 |
| TOTAL UNITS: | 59 |
| TOTAL BEDROOMS: | 6+66+60 = 132 |

TOTAL ONE BEDROOM UNITS: 30



SYNTHESIS 9, LLC
 6214 N 31ST
 TACOMA, WA 98403

REUSE OF DOCUMENTS
 THIS DOCUMENT AND THE ORIGINAL DESIGN
 INCORPORATED HEREIN ARE THE PROPERTY OF
 SYNTHESIS 9, LLC AND ARE NOT TO BE USED OR
 REPRODUCED IN WHOLE OR IN PART WITHOUT THE
 WRITTEN AUTHORIZATION OF SYNTHESIS 9, LLC.

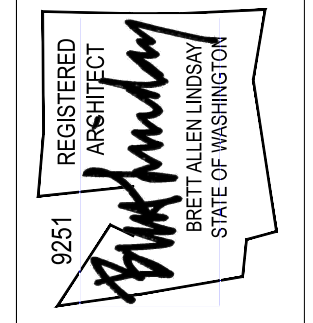

AGENCY REVIEW | 24.03.11

EAST TOWN CROSSING
 BUILDING 'B'
 PIONEER & SHAW PUYALLUP, WA

REVISIONS

REVISIONS

This note references the 2015 IBC.
 [CONSTRUCTION PLAN SET - Bldg B, sheet AG1.1]

PHASE 1 - BUILDING G

DESCRIPTION: 24 UNIT APARTMENT BUILDING
 APPLICABLE BUILDING CODE: 2018 IBC
 OCCUPANCY: R2
 TYPE OF CONSTRUCTION: VB
 FIRE SPRINKLERS: YES, NFPA 13R PER 903.3.1.2
 FIRE ALARM SYSTEM AND SMOKE ALARM: YES
 ELEVATOR: NO
 NUMBER OF APARTMENT UNITS: 24 (PER BUILDING)
 NUMBER OF (1) BEDROOMS = 24
 NUMBER OF (2) BEDROOMS = 0
 ACCESSIBLE TYPE A UNITS REQUIRED: 1
 ACCESSIBLE TYPE 'B' UNITS REQUIRED: 7

BASE ALLOWABLE BUILDING AREAS, HEIGHT AND STORIES:
 ALLOWABLE AREA: 7,000-sf
 ALLOWABLE MAXIMUM HEIGHT: 60-ft
 ALLOWABLE STORIES: 3

MODIFICATIONS TO THE BASE ALLOWABLE AREA BUILDING G:
 TOTAL AREA: 33,180-sf
 MAXIMUM AREA PER FLOOR: 11,060-sf

**FOR SINGLE-OCCUPANCY, MULTI-STORY BUILDING
 **SEE FRONTAGE CALCULATION FOR AREA INCREASE ON SHEET #AG1.2

PROPOSED HEIGHT: 36-ft MAX. PER PMC
 PROPOSED STORIES: 3

TOTAL PROPOSED GROSS AREA ALL LEVELS:
 (INCLUDES COVERED DECKS)

| | |
|----------|-----------|
| LEVEL 1: | 7,385-sf |
| LEVEL 2: | 7,359-sf |
| LEVEL 3: | 7,113-sf |
| TOTAL: | 21,857-sf |

OCCUPANT LOAD:
 OCCUPANT LOAD FACTOR: 200 GROSS
 OCCUPANT LOAD PER FLOOR:

| | |
|----------|----|
| LEVEL 1: | 36 |
| LEVEL 2: | 36 |
| LEVEL 3: | 35 |

PHASE 1 - BUILDING H

DESCRIPTION: 24 UNIT APARTMENT BUILDING
 APPLICABLE BUILDING CODE: 2018 IBC
 OCCUPANCY: R2
 TYPE OF CONSTRUCTION: VB
 FIRE SPRINKLERS: YES, NFPA 13R PER 903.3.1.2
 FIRE ALARM SYSTEM AND SMOKE ALARM: YES
 ELEVATOR: NO
 NUMBER OF APARTMENT UNITS: 24 (PER BUILDING)
 NUMBER OF (1) BEDROOMS = 24
 NUMBER OF (2) BEDROOMS = 0
 ACCESSIBLE TYPE A UNITS REQUIRED: 1
 ACCESSIBLE TYPE 'B' UNITS REQUIRED: 7

BASE ALLOWABLE BUILDING AREAS, HEIGHT AND STORIES:
 ALLOWABLE AREA: 7,000-sf
 ALLOWABLE MAXIMUM HEIGHT: 60-ft
 ALLOWABLE STORIES: 3

MODIFICATIONS TO THE BASE ALLOWABLE AREA BUILDING H:
 TOTAL AREA: 33,180-sf
 MAXIMUM AREA PER FLOOR: 11,060-sf

**FOR SINGLE-OCCUPANCY, MULTI-STORY BUILDING
 **SEE FRONTAGE CALCULATION FOR AREA INCREASE ON SHEET #AG1.2

PROPOSED HEIGHT: 36-ft MAX. PER PMC
 PROPOSED STORIES: 3

TOTAL PROPOSED GROSS AREA ALL LEVELS:
 (INCLUDES COVERED DECKS)

| | |
|----------|-----------|
| LEVEL 1: | 7,367-sf |
| LEVEL 2: | 7,341-sf |
| LEVEL 3: | 7,094-sf |
| TOTAL: | 21,802-sf |

OCCUPANT LOAD:
 OCCUPANT LOAD FACTOR: 200 GROSS
 OCCUPANT LOAD PER FLOOR:

| | |
|---|--|
| LEVEL 1 EXERCISE: (50 gross) | |
| LEVEL 1 UNCONCENTRATED ASSEMBLY: (15 net) | |
| LEVEL 1 ACCESSORY: (300 gross) | |
| LEVEL 2 RESIDENTIAL: (220 gross): | |

PHASE 2 - CLUBHOUSE

DESCRIPTION: 2 APARTMENT UNITS WITH LEASING OFFICE AND MISC. AMENITY SPACES

APPLICABLE BUILDING CODE: 2018 IBC
 FIRE SPRINKLERS: YES, PER IBC 903.3.1.2
 NFPA R13
 FIRE ALARM SYSTEM AND SMOKE ALARM: YES PER 2015 IBC, SECTION 907.2.11.2
 OCCUPANCY: LEVEL 1 = A-3 / B
 LEVEL 2 = R-3

TYPE OF CONSTRUCTION: VB
 NUMBER OF APARTMENT UNITS: 1
 ACCESSIBLE UNITS REQUIRED: N/A

BASE ALLOWABLE BUILDING AREAS, HEIGHT AND STORIES:
 NON-SEPARATED USE - MOST RESTRICTIVE APPLIES

ALLOWABLE AREA PER FLOOR:
 LEVEL 1: B, NS = 9,000 sq ft
 LEVEL 2: R-3, NS = UL
 ALLOWABLE MAXIMUM HEIGHT:
 B, NS = 40-FT
 R, NS = 40-FT
 ALLOWABLE STORIES:
 B, NS = 2
 R-3, NS = 3

TOTAL PROPOSED GROSS AREA ALL LEVELS:
 LEVEL 1 AMENITY : 2,507-sf
 LEVEL 2 RESIDENCE: 1,200-sf
 TOTAL: 3,707-sf

LEVEL 2 DECK: 191-sf

APARTMENT UNIT TO HAVE EMERGENCY ESCAPE AND RESCUE OPENINGS

APARTMENTS BUILDING EGRESS

NUMBER OF EXITS REQUIRED PER FLOOR: 2
 EACH EXIT SERVING NO MORE THAN FOUR UNITS PER TABLE 1006.3.2(1)
 NUMBER OF EXITS PROPOSED PER FLOOR: 2

MAXIMUM ALLOWED EXIT ACCESS TRAVEL DISTANCE WITH SPRINKLERS: 125-LF

NOTE: PER TABLE 1006.3.2(1), EACH HALF OF THE BUILDING IS CONSIDERED A SINGLE EXIT SPACE REQUIRING EACH APARTMENT UNIT TO HAVE EMERGENCY ESCAPE AND RESCUE OPENINGS IN ACCORDANCE WITH SECTION 1030 OF 2015 IBC.

FIRE PROTECTION FOR APARTMENT BUILDINGS

FIRE ALARM SYSTEM AND SMOKE ALARM: YES PER 2015 IBC, SECTION 907.2.9

** A MANUAL FIRE ALARM SYSTEM THAT ACTIVATES THE OCCUPANT NOTIFICATION SYSTEM IN ACCORDANCE WITH SECTION 907.5 IS REQUIRED UNLESS THE AUTOMATIC FIRE SPRINKLER SYSTEM IS INSTALLED IN ACCORDANCE WITH SECTION 903.3.1.1 OR 903.3.1.2 AND THE OCCUPANT NOTIFICATION APPLIANCES AUTOMATICALLY ACTIVATE THROUGHOUT THE NOTIFICATION ZONES UPON A SPRINKLER WATERFLOW.

** SMOKE ALARMS SHALL BE INSTALLED AND MAINTAINED ON THE CEILING OR WALL OUTSIDE EACH SEPARATE SLEEPING AREA AND IN EACH ROOM USED FOR SLEEPING PURPOSES.

FIRE SEPARATION BETWEEN APARTMENT DWELLING UNITS: YES, PER 2015 IBC SECTION 420, 708 AND 711
 SEPARATION WALLS: 1-HR FIRE PARTITION PER 708.3 2015 IBC
 HORIZONTAL SEPARATION: 1-HR HORIZONTAL ASSEMBLY PER 711.3

FIRE-RESISTANCE RATING REQUIREMENTS FOR BUILDING ELEMENTS PER IBC (2015) TABLES 601 AND 602:
 PRIMARY STRUCTURAL FRAME:
 EXTERIOR BEARING WALLS: 0-HR

INTERIOR BEARING WALLS:

PRIVATE DECK FLOOR/CEILING ASSEMBLY



ICC-ES Evaluation Report **ESR-2201**
Reissued May 2014
This report is subject to renewal July 1, 2016.

www.icc-es.org | (800) 423-6587 | (562) 699-0543 A Subsidiary of the International Code Council®

DIVISION: 07 00 00—THERMAL AND MOISTURE PROTECTION
Section: 07 18 13—Pedestrian Traffic Coatings
REPORT HOLDER:
WESTCOAT
 770 GATEWAY CENTER DRIVE
 SAN DIEGO, CALIFORNIA 92102
 (800) 250-4519
www.westcoat.com
EVALUATION SUBJECT:
WESTCOAT ALX STANDARD AND CUSTOM SYSTEMS

1.0 EVALUATION SCOPE
Compliance with the following codes:
 ■ 2012, 2009 and 2006 *International Building Code®* (IBC)
 ■ 2012, 2009 and 2006 *International Residential Code®* (IRC)
Properties evaluated:
 ■ Durability
 ■ Wind resistance
 ■ Fire classification
 ■ Fire resistance

2.0 USES
 WestCoat ALX Standard and Custom Systems are cementitious coating systems for use as walking deck and classified roof covering systems over plywood substrates. The systems, as described in Section 4.4 of this report, provide a Class A roof covering fire classification. The systems, as described in Section 4.5 of this report, are used as a component of a one-hour fire-resistance-rated assembly.

3.0 DESCRIPTION
3.1 General:
 The ALX Standard and Custom Systems are walking deck and roof covering systems applied over plywood. The ALX Standard system consists of the materials described in Section 4.2 and the ALX Custom system consists of the material described in Section 4.3.
3.2 Materials:
3.2.1 Plywood Substrate: Plywood substrates must be exterior grade, 1/2-inch-thick (15.9 mm) plywood complying with U.S. DOC PS-1 or PS-2.

ICC-ES Evaluation Reports are not to be construed as representing aesthetics or any other attributes not specifically addressed, nor are they to be construed as an endorsement of the subject of the report or a recommendation for its use. There is no warranty by ICC Evaluation Service, LLC, express or implied, as to any finding or other matter in this report or as to any product covered by the report.

ESR-2201 | Most Widely Accepted and Trusted **Page 2 of 3**

and pigments, used to stain the TC-2 Smooth Texture Cement. The product is packaged in 1- or 5-gallon pails (3.78 or 18.9 L). Shelf life is three years when stored in dry conditions.
3.2.12 TC-40 Liquid Colorant: TC-40 Liquid Colorant is a proprietary iron oxide slurry formulated with high pigment levels used in the ALX Custom system to integrally color the TC-2 Smooth Texture Cement. The product is packaged in 10-ounce bottles. The shelf life is three years when stored at temperatures between 40°F and 100°F (4.4°C and 37.8°C) in a dry place.
3.2.13 SC-70 Stone Glaze: The SC-70 Stone Glaze is a proprietary acrylic lacquer sealant. The product is packaged in 1- or 5-gallon pails (3.78 or 18.9 L). The shelf life is five years when stored at temperatures between 40°F and 100°F (4.4°C and 37.8°C) in a dry place.

4.0 INSTALLATION
4.1 General:
 Installation of the WestCoat ALX Standard and Custom Systems must be in accordance with the manufacturer's published installation instructions, the applicable code and this report. The manufacturer's installation instructions must be available on the jobsite during application. The system must be installed only when the ambient temperature is between 55°F and 90°F (13°C and 32°C). Materials must not be applied if precipitation is occurring or expected.

4.1.1 Preparation of Plywood Substrate: Plywood must be clean, dry, and free from dirt or foreign materials that may prevent adhesion of the base coat, and must be installed to framing in accordance with the requirements of the applicable code at a maximum framing spacing of 16 inches (406 mm) on center. All plywood edges must be blocked with nominally 2-by-4 wood members, or panel edges must be tongued and grooved. All through-penetrations and terminations of the sheathing must be protected with metal flashing in accordance with the applicable code. Adequate drainage must be provided in accordance with the applicable code.
4.1.2 WP-40 Sheet Membrane: The WP-40 Sheet Membrane must be applied over all plywood joints in 6- or 12-inch-wide (152 or 305 mm) strips or may be applied over the entire plywood deck. When installed in accordance with Section 4.5, installation is limited to use over all plywood joints in 6- or 12-inch-wide (152 or 305 mm) strips.
4.1.3 Metal Lath: The metal lath, as described in Section 3.2.2, must be installed with lath edges parallel to plywood substrate joints and offset from the substrate joints by a minimum of 2 inches (51 mm). The lath must be held back 1/2 inch (12.7 mm) from all deck edges and stapled to the plywood substrate with no less than 16 staples per square foot (174 staples per square meter). Lath must be lapped 1 to 2 inches (25 to 51 mm) at seams and stapled to the plywood substrate every 1 to 2 inches (25.4 to 50.8 mm).
4.1.4 Base Coat: The base coat mixture consists of one 50-pound (22.5 kg) bag of TC-1 Basecoat Cement combined with 1 1/4 gallons (4.73 L) of WP-81 Cement Modifier and up to 1 quart of water (946.4 mL), then mixed until uniform consistency is achieved. The mixture results in a 4.5-gallon (17 L) batch. The base coat mixture must be applied onto the lath at a rate of 40 square feet (3.68 square meters) per 4.5-gallon (17 L) batch. The minimum dry thickness of the base coat must be 0.142 inch (3.6 mm). Prior to the application of the slurry coat, the base coat must be smoothed with a trowel and allowed to cure until firm.

4.1.5 Slurry Coat:
 The slurry coat mixture consists of one bag of TC-1 Basecoat Cement, 1 gallon (3.78 L) of WP-81 Cement Modifier, and up to 1/2 gallon (1.89 L) of water, mixed until uniform consistency is achieved. The slurry coat mixture must be applied onto the cured base coat at a rate of 100 to 150 square feet (9.2 to 13.9 m²) per 4.5-gallon (17.0 L) batch, to result in a minimum dry thickness of the slurry coat of 0.083 inch (1.60 mm). The slurry coat must be smoothed with a trowel and allowed to cure until firm.
4.2 ALX Standard System: Following installation in accordance with Section 4.1.
4.2.1 Texture Coat: The texture coat mixture consists of one bag of TC-3 Medium Texture Cement, 1 gallon (3.78 L) of WP-81 Cement Modifier and 1/2 gallon (1.89 L) of water, mixed until uniform consistency is achieved. The texture coat must be applied with a hopper gun onto the slurry coat at a rate of 150 to 200 square feet (13.9 to 18.6 m²) per batch, to result in a minimum dry thickness of 0.047 inch (1.2 mm). The texture coat must be leveled with a trowel and allowed to cure until firm.
4.2.2 Top Coat: The SC-10 Acrylic TopCoat must be applied over the cured texture coat with a roller in one or two applications, for a total coverage rate of 125 square feet per gallon (3.04 m²), to a minimum thickness of 6 mils (0.152 mm). The coating must be allowed to cure until dry.
4.3 ALX Custom system: Following installation in accordance with Section 4.1.
4.3.1 Grout Coat: The grout coat mixture consists of one 50-pound (22.5 kg) bag of TC-5 Grout Texture Cement combined with 1 gallon (3.78 L) of WP-81, and up to 1/2 gallon (1.89 L) of water, then mixed until uniform consistency is achieved. The mixture results in a 4.5-gallon (3.78 L) batch. The grout coat mixture must be applied onto the slurry coat at a rate of 200 square feet (18.6 m²) per 4.5-gallon (17.0 L) batch. The minimum dry thickness of the grout coat must be 0.047 inch (1.2 mm). The color coat mixture must be applied onto the grout coat at a rate of 175 to 200 square feet (16.3 to 18.6 m²) per 4.5-gallon (3.78 L) batch. The minimum dry thickness of the texture coat must be 0.047 inch (1.2 mm). Prior to the application of the stain, the texture coat must be smoothed with a trowel and allowed to cure until firm.
4.3.2 Texture Coat: The texture coat mixture consists of one bag of TC-2 Smooth Texture Cement combined with 1 gallon (3.78 L) of WP-81 Cement Modifier and up to 1/2 gallon (1.89 L) of water mixed until uniform consistency is achieved. Up to 4 ounces (0.118 L) of TC-40 Liquid Colorant may be added and mixed until color is uniform. The mixture results in a 4.5-gallon (17.0 L) batch. The color coat mixture must be applied onto the grout coat at a rate of 175 to 200 square feet (16.3 to 18.6 m²) per 4.5-gallon (3.78 L) batch. The minimum dry thickness of the texture coat must be 0.047 inch (1.2 mm). Prior to the application of the stain, the texture coat must be smoothed with a trowel and allowed to cure until firm.
4.3.3 Stain: SC-35X Water-Based Stain must be applied over the texture coat with a sprayer, brush, or broom at a coverage rate of 200 to 400 square feet (18.6 to 37.2 m²) per gallon (3.79 L). The SC-35X Water-Based Stain must be allowed to completely dry before application of the next coat.
4.3.4 Top Coat: The top coat consists of SC-70 Stone Glaze that must be applied over the stain with a sprayer, brush, or roller in two applications, for a total coverage rate of 125 square feet (11.6 m²) per gallon (3.79 L). The top coat must be allowed to cure until dry.

4.4 Class A Roof Covering over Plywood Deck:
 When the WestCoat ALX Standard and Custom Systems are applied over a minimum 3/8-inch-thick (15.9 mm) plywood substrate with all edges blocked and installed in accordance with Section 4.0 at a maximum roof slope of 1/4 inch per 1 foot (2% slope), the system provides a Class A roof classification.
4.5 One-hour Fire-resistance-rated Construction:
 When the WestCoat ALX Standard and Custom Systems are installed in accordance Section 4.0, except that the WP-40 Sheet Membrane is only applied over all plywood joints in 6- or 12-inch-wide (152 or 305 mm) strips (see Section 4.1.2), up to 3/8-inch-thick (15.9 mm) exterior-grade plywood complying with PS-1, with nominally 2-by-8 wood joists spaced at a maximum of 16 inches (406 mm) on center, and all plywood joints blocked, the assembly can be recognized as an alternative for the double wood floor described in Item 13 of Table 721.1(3) of the 2009 and 2006 IBC. The design bending stress must be limited to 78 percent of the code-prescribed design values for the wood joist.
4.6 Wind Resistance:
 Installation must be limited to buildings with a maximum height of 40 feet (12.2 m) above grade, in Exposure B areas, with either an ultimate design wind speed of 130 mph (209 km/h) under the 2012 IBC or a maximum 3-second-gust basic wind speed of 100 miles per hour (161 km/h) under the 2009 and 2006 IBC and the 2012, 2009 and 2006 IRC. The plywood and its attachment to support framing must be adequate to resist the required wind load.
4.7 Method of Repair:
 The damaged area must be completely removed, including the base coat and lath. New metal lath must be stapled to the clean, dry substrate, and the system reapplied, as described in Sections 4.1 through 4.6 of this report. If substrate damage occurs, the retention of the strength properties of the system must be investigated.
5.0 CONDITIONS OF USE
 The WestCoat ALX Standard and Custom Systems described in this report comply with, or are suitable

ESR-2201 | Most Widely Accepted and Trusted **Page 3 of 3**

alternatives to what is specified in, those codes listed in Section 1.0 of this report, subject to the following conditions:
5.1 Materials must be manufactured and applied in accordance with this report, the applicable code, and the manufacturer's published installation instructions. In the event of conflict between this report and the manufacturer's installation instructions, this report governs.
5.2 The WP-81 Cement Modifier, TC-1 Basecoat Cement, TC-2 Smooth Texture Cement, TC-3 Medium Texture Cement, TC-5 Grout Texture Cement, SC-10 Acrylic Topcoat, SC-35X Water-Based Stain, TC-40 Liquid Colorant and SC-70 Stone Glaze products are produced under a quality control program with inspections by ICC-ES.

6.0 EVIDENCE SUBMITTED
 Data in accordance with the ICC-ES Acceptance Criteria for Walking Decks (AC39), dated April 2011 (editorially revised October 2012).
7.0 IDENTIFICATION
 The WP-81 Cement Modifier, TC-1 Basecoat Cement, TC-2 Smooth Texture Cement, TC-3 Medium Texture Cement, TC-5 Grout Texture Cement, SC-10 Acrylic Topcoat, SC-35X Water-Based Stain, TC-40 Liquid Colorant and SC-70 Stone Glaze products must be labeled with the WestCoat name and the manufacturing address, the date of manufacture, the shelf life, and the lot number or production number. In addition to the above, the products are labeled with the ICC-ES report number (ESR-2201).

PROPRIETARY GYPSUM COMPONENTS
 United States Gypsum Company... 5/8" Sheetrock® Brand Firecoat® C Gypsum Panels
 LeveRock® Brand Floor Underlayment

GA FILE NO. FC 5112 PROPRIETARY* 1 HOUR FIRE 50 to 54 STC SOUND
WOOD JOISTS, WOOD STRUCTURAL PANELS, GYPSUM FLOOR TOPPING, RESILIENT CHANNELS, INSULATION, GYPSUM PANELS
Fire Design: One layer 5/8" proprietary type X gypsum panel or gypsum veneer base applied at right angles to resilient channels 24" o.c. (16" o.c. when batt insulation is used, 12" o.c. when loose fill insulation is used) with 1" Type S screws 12" o.c. Gypsum panel end joints located midway between continuous channels and attached with screws 8" o.c. to additional pieces of channel 60" long located 3" back on either side of end joint. Resilient channels applied at right angles to studs with 1-1/4" Type S screws. Glass or mineral fiber batt insulation stapled to subfloor or loose fill insulation applied directly over gypsum panel. Wood joists supporting 1/2" wood structural panel subfloor applied at right angles to joists with construction adhesive and 6d ring shank nails 12" o.c. Minimum 1/2" proprietary gypsum floor topping applied over subfloor.
Sound Design: STC and IIC rated with both joists and resilient channels spaced 16" o.c. 3-1/2" glass fiber insulation in joist spaces, 1" proprietary gypsum floor topping poured over 1/4" proprietary sound reduction mat, and with finish flooring of C&P, sheet vinyl, engineered wood laminate, and ceramic tile.
 IIC & Test: RAL IN04-006, 4-22-04; RAL IN04-004, 4-22-04; RAL IN04-007, 4-26-04; RAL IN04-009, 4-26-04; (55 engineered wood laminate)
 United States Gypsum Company... 5/8" Sheetrock® Brand Firecoat® C Gypsum Panels
 LeveRock® Brand Floor Underlayment

GA FILE NO. FC 5529 GENERIC 1 HOUR FIRE
WOOD JOISTS, GYPSUM WALLBOARD
Fire Design: Base layer 5/8" type X gypsum wallboard applied at right angles to 2 x 10 wood joists 24" o.c. with 1-1/4" Type W or S screws 24" o.c. Face layer 5/8" type X gypsum wallboard or gypsum veneer base applied at right angles to joists with 1-7/8" Type W or S screws 12" o.c. at joints and intermediate joists and 1-1/2" Type G screws 12" o.c. placed 2" back on either side of end joints. Wood joists supporting 1/2" plywood with exterior glue applied at right angles to joists with 6d nails.
Approx. Ceiling Weight: 5 psf (Fire)
Fire Test: FM FC 172, 2-29-72; ITS, 8-6-96

GA FILE NO. FC 5529 GENERIC 1 HOUR FIRE
WOOD JOISTS, GYPSUM WALLBOARD
Fire Design: One layer 5/8" type X gypsum wallboard or gypsum veneer base applied at right angles to 2 x 4 wood studs 24" o.c. with 1-1/4" Type W or S screws 24" o.c. Face layer 5/8" type X gypsum wallboard or gypsum veneer base applied at right angles to studs with 1-7/8" Type W or S screws 12" o.c. at joints and intermediate joists and 1-1/2" Type G screws 12" o.c. placed 2" back on either side of end joints. Wood joists supporting 1/2" plywood with exterior glue applied at right angles to joists with 6d nails.
Approx. Ceiling Weight: 5 psf (Fire)
Fire Test: FM FC 172, 2-29-72; ITS, 8-6-96

GA FILE NO. FC 5529 GENERIC 1 HOUR FIRE
WOOD JOISTS, GYPSUM WALLBOARD
Fire Design: One layer 5/8" type X gypsum wallboard or gypsum veneer base applied at right angles to 2 x 4 wood studs 24" o.c. with 1-1/4" Type W or S screws 24" o.c. Face layer 5/8" type X gypsum wallboard or gypsum veneer base applied at right angles to studs with 1-7/8" Type W or S screws 12" o.c. at joints and intermediate joists and 1-1/2" Type G screws 12" o.c. placed 2" back on either side of end joints. Wood joists supporting 1/2" plywood with exterior glue applied at right angles to joists with 6d nails.
Approx. Ceiling Weight: 5 psf (Fire)
Fire Test: FM FC 172, 2-29-72; ITS, 8-6-96

FLOOR/CEILING/ROOF ASSEMBLIES

ROOF-CEILING SYSTEMS

| GA FILE NO. | PROPRIETARY | 1 HOUR FIRE | 50 to 54 STC SOUND |
|-------------|-------------|-------------|--------------------|
| RC 2603 | | | |

WOOD TRUSSES, RESILIENT CHANNELS, INSULATION, DAMPER, GYPSUM BOARD

Fire Design: One layer 5/8" proprietary type X gypsum board or gypsum veneer base applied at right angles to resilient channels 12" o.c. with 1-1/8" Type S screws 8" o.c. Gypsum board end joints attached with screws 8" o.c. to additional pieces of channel 60" long located 3" back on either side of end joint. Resilient channels applied at right angles to bottom chord of pitched wood trusses 24" o.c. with 1-1/4" Type S or W screws. Optional glass fiber or mineral wool batt or loose fill insulation applied directly over gypsum board. Trusses supporting 15/32" plywood or OSB roof sheathing applied at right angles to trusses with construction adhesive and 6d ring shank nails 12" o.c. Optional ceiling damper.

PROPRIETARY GYPSUM BOARD
 National Gypsum Company
 -5/8" Gold Bond® Fire-Shield™ Gypsum Board

Approx. Ceiling Weight: 3 psf (Fire)
Fire Test: UL R3501, 00NK42686, 8-16-01, UL Design P533

FLOOR-CEILING SYSTEMS, WOOD FRAMED

| GA FILE NO. | PROPRIETARY* | 1 HOUR FIRE | 50 to 54 STC SOUND |
|-------------|--------------|-------------|--------------------|
| FC 5112 | | | |

WOOD JOISTS, WOOD STRUCTURAL PANELS, GYPSUM FLOOR TOPPING, RESILIENT CHANNELS, INSULATION, GYPSUM PANELS

Fire Design: One layer 5/8" proprietary type X gypsum panel or gypsum veneer base applied at right angles to resilient channels 24" o.c. (16" o.c. when batt insulation is used, 12" o.c. when loose fill insulation is used) with 1" Type S screws 12" o.c. Gypsum panel end joints located midway between continuous channels and attached with screws 8" o.c. to additional pieces of channel 60" long located 3" back on either side of end joint. Resilient channels applied at right angles to 2 x 10 wood joists spaced a maximum of 24" o.c. with 1-1/4" Type S screws. Glass or mineral fiber batt insulation stapled to subfloor or loose fill insulation applied directly over gypsum panel. Wood joists supporting 1/2" wood structural panel subfloor applied at right angles to joists with construction adhesive and 6d ring shank nails 12" o.c. Minimum 1/2" proprietary gypsum floor topping applied over subfloor.


Sound Design: STC and IIC rated with both joists and resilient channels spaced 16" o.c. 3-1/2" glass fiber insulation in joist spaces, 1" proprietary gypsum floor topping poured over 1/4" proprietary sound reduction mat, and with finish flooring of C&P, sheet vinyl, engineered wood laminate, and ceramic tile.
 IIC & Test: UL R1319, 09W04589; 2-4-05, UL R1319, 02N02986, 3-31-05; UL Design L569; RAL TL04-31 & 32, 2-11-04; RAL TL03-33 & 34, 2-22-04; RAL TL04-67, 3-19-04; (51 generic sheet vinyl); RAL IN04-005, 4-22-04; (54 cushion sheet vinyl); RAL IN04-006, 4-22-04; (55 engineered wood laminate)
 United States Gypsum Company... 5/8" Sheetrock® Brand Firecoat® C Gypsum Panels
 LeveRock® Brand Floor Underlayment

GA FILE NO. FC 5529 GENERIC 1 HOUR FIRE
WOOD JOISTS, GYPSUM WALLBOARD
Fire Design: Base layer 5/8" type X gypsum wallboard applied at right angles to 2 x 10 wood joists 24" o.c. with 1-1/4" Type W or S screws 24" o.c. Face layer 5/8" type X gypsum wallboard or gypsum veneer base applied at right angles to joists with 1-7/8" Type W or S screws 12" o.c. at joints and intermediate joists and 1-1/2" Type G screws 12" o.c. placed 2" back on either side of end joints. Wood joists supporting 1/2" plywood with exterior glue applied at right angles to joists with 6d nails.
Approx. Ceiling Weight: 5 psf (Fire)
Fire Test: FM FC 172, 2-29-72; ITS, 8-6-96

GA FILE NO. FC 5529 GENERIC 1 HOUR FIRE
WOOD JOISTS, GYPSUM WALLBOARD
Fire Design: One layer 5/8" type X gypsum wallboard or gypsum veneer base applied at right angles to 2 x 4 wood studs 24" o.c. with 1-1/4" Type W or S screws 24" o.c. Face layer 5/8" type X gypsum wallboard or gypsum veneer base applied at right angles to studs with 1-7/8" Type W or S screws 12" o.c. at joints and intermediate joists and 1-1/2" Type G screws 12" o.c. placed 2" back on either side of end joints. Wood joists supporting 1/2" plywood with exterior glue applied at right angles to joists with 6d nails.
Approx. Ceiling Weight: 5 psf (Fire)
Fire Test

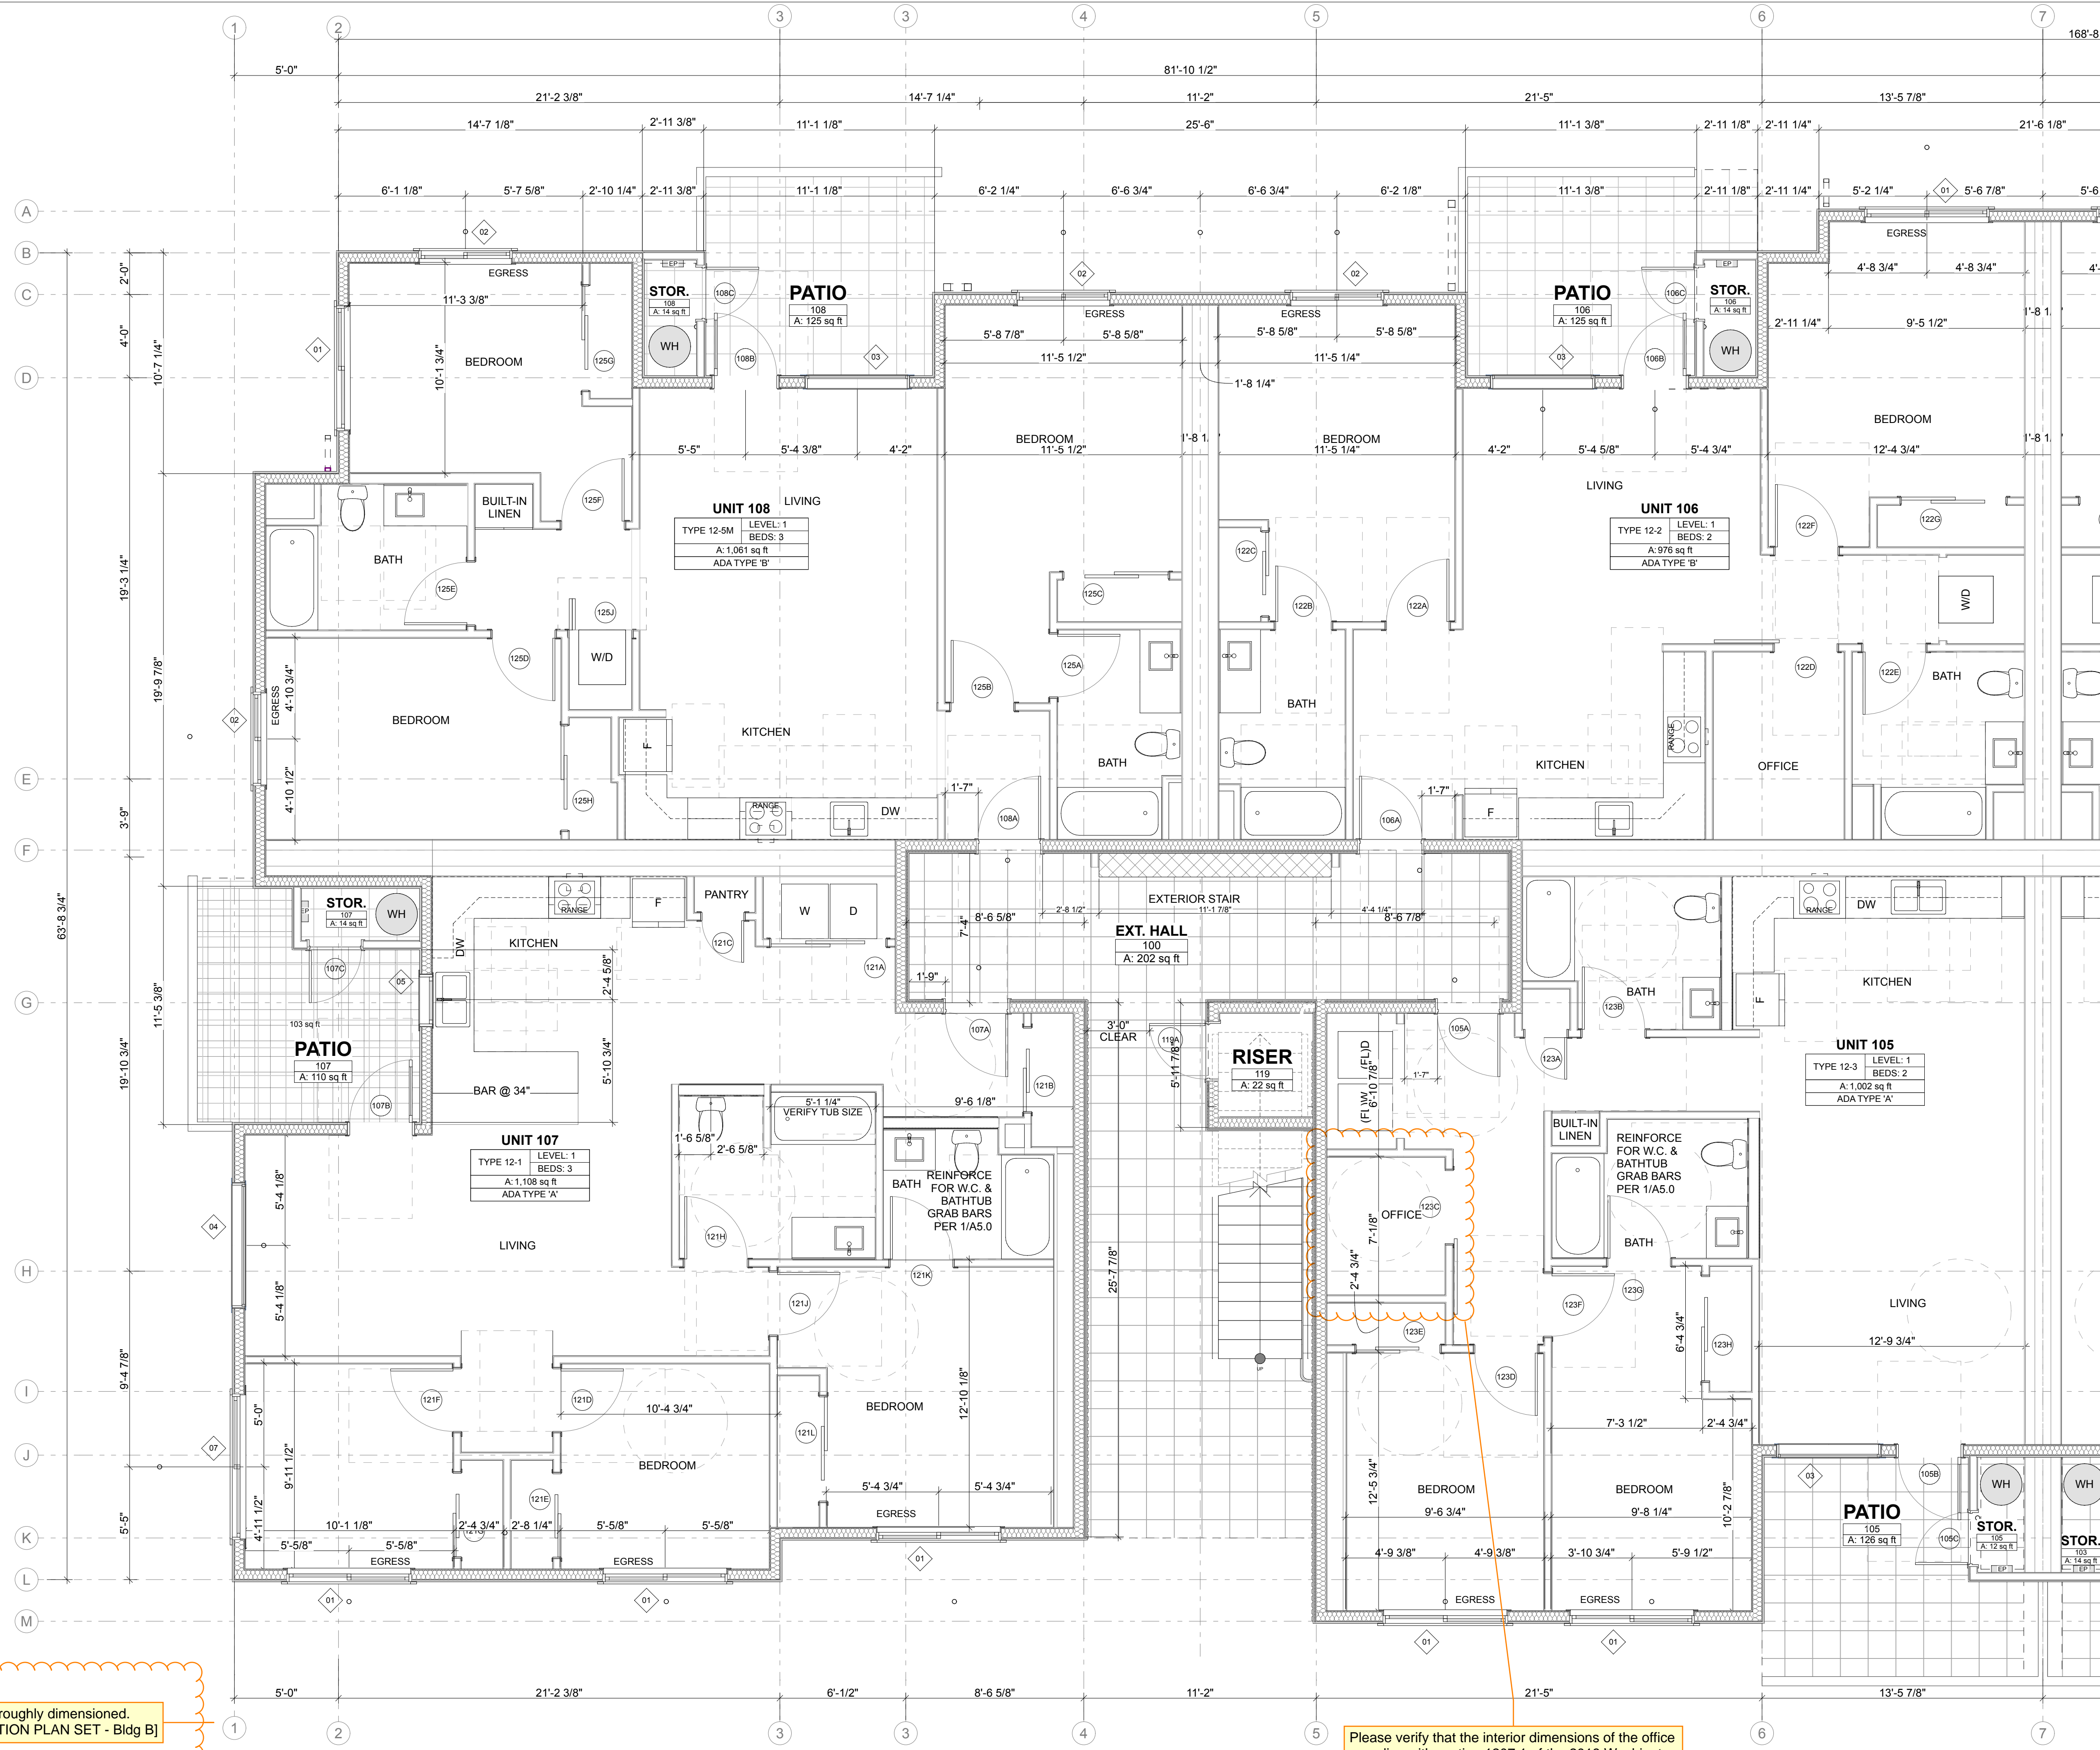

Please ensure the interior space is thoroughly dimensioned.
Typical all plan sheets. [CONSTRUCTION PLAN SET - Bldg B]

Please verify that the interior dimensions of the office
complies with section 1207.1 of the 2018 Washington
State Building Code. Typical at similar.
[CONSTRUCTION PLAN SET - Bldg B]

1 LEVEL 1 PLAN - ENLARGED
SCALE: 1/4" = 1'-0"

EAST TOWN CROSSING
BUILDING 'B'
PIONEER & SHAW PUYALLUP WA


REVISIONS

| NO. | DATE | DESCRIPTION |
|-----|------|-------------|
| | | |
| | | |
| | | |

REVISIONS

| | |
|-------------|-------------------------|
| DRAWN BY: | BL / CM |
| CHECKED BY: | BL |
| DATE: | 24.03.11 |
| TITLE: | LEVEL 1 - ENLARGED LEFT |
| PROJECT #: | 2016 |
| SHEET: | |

AGENCY REVIEW | 24.03.11

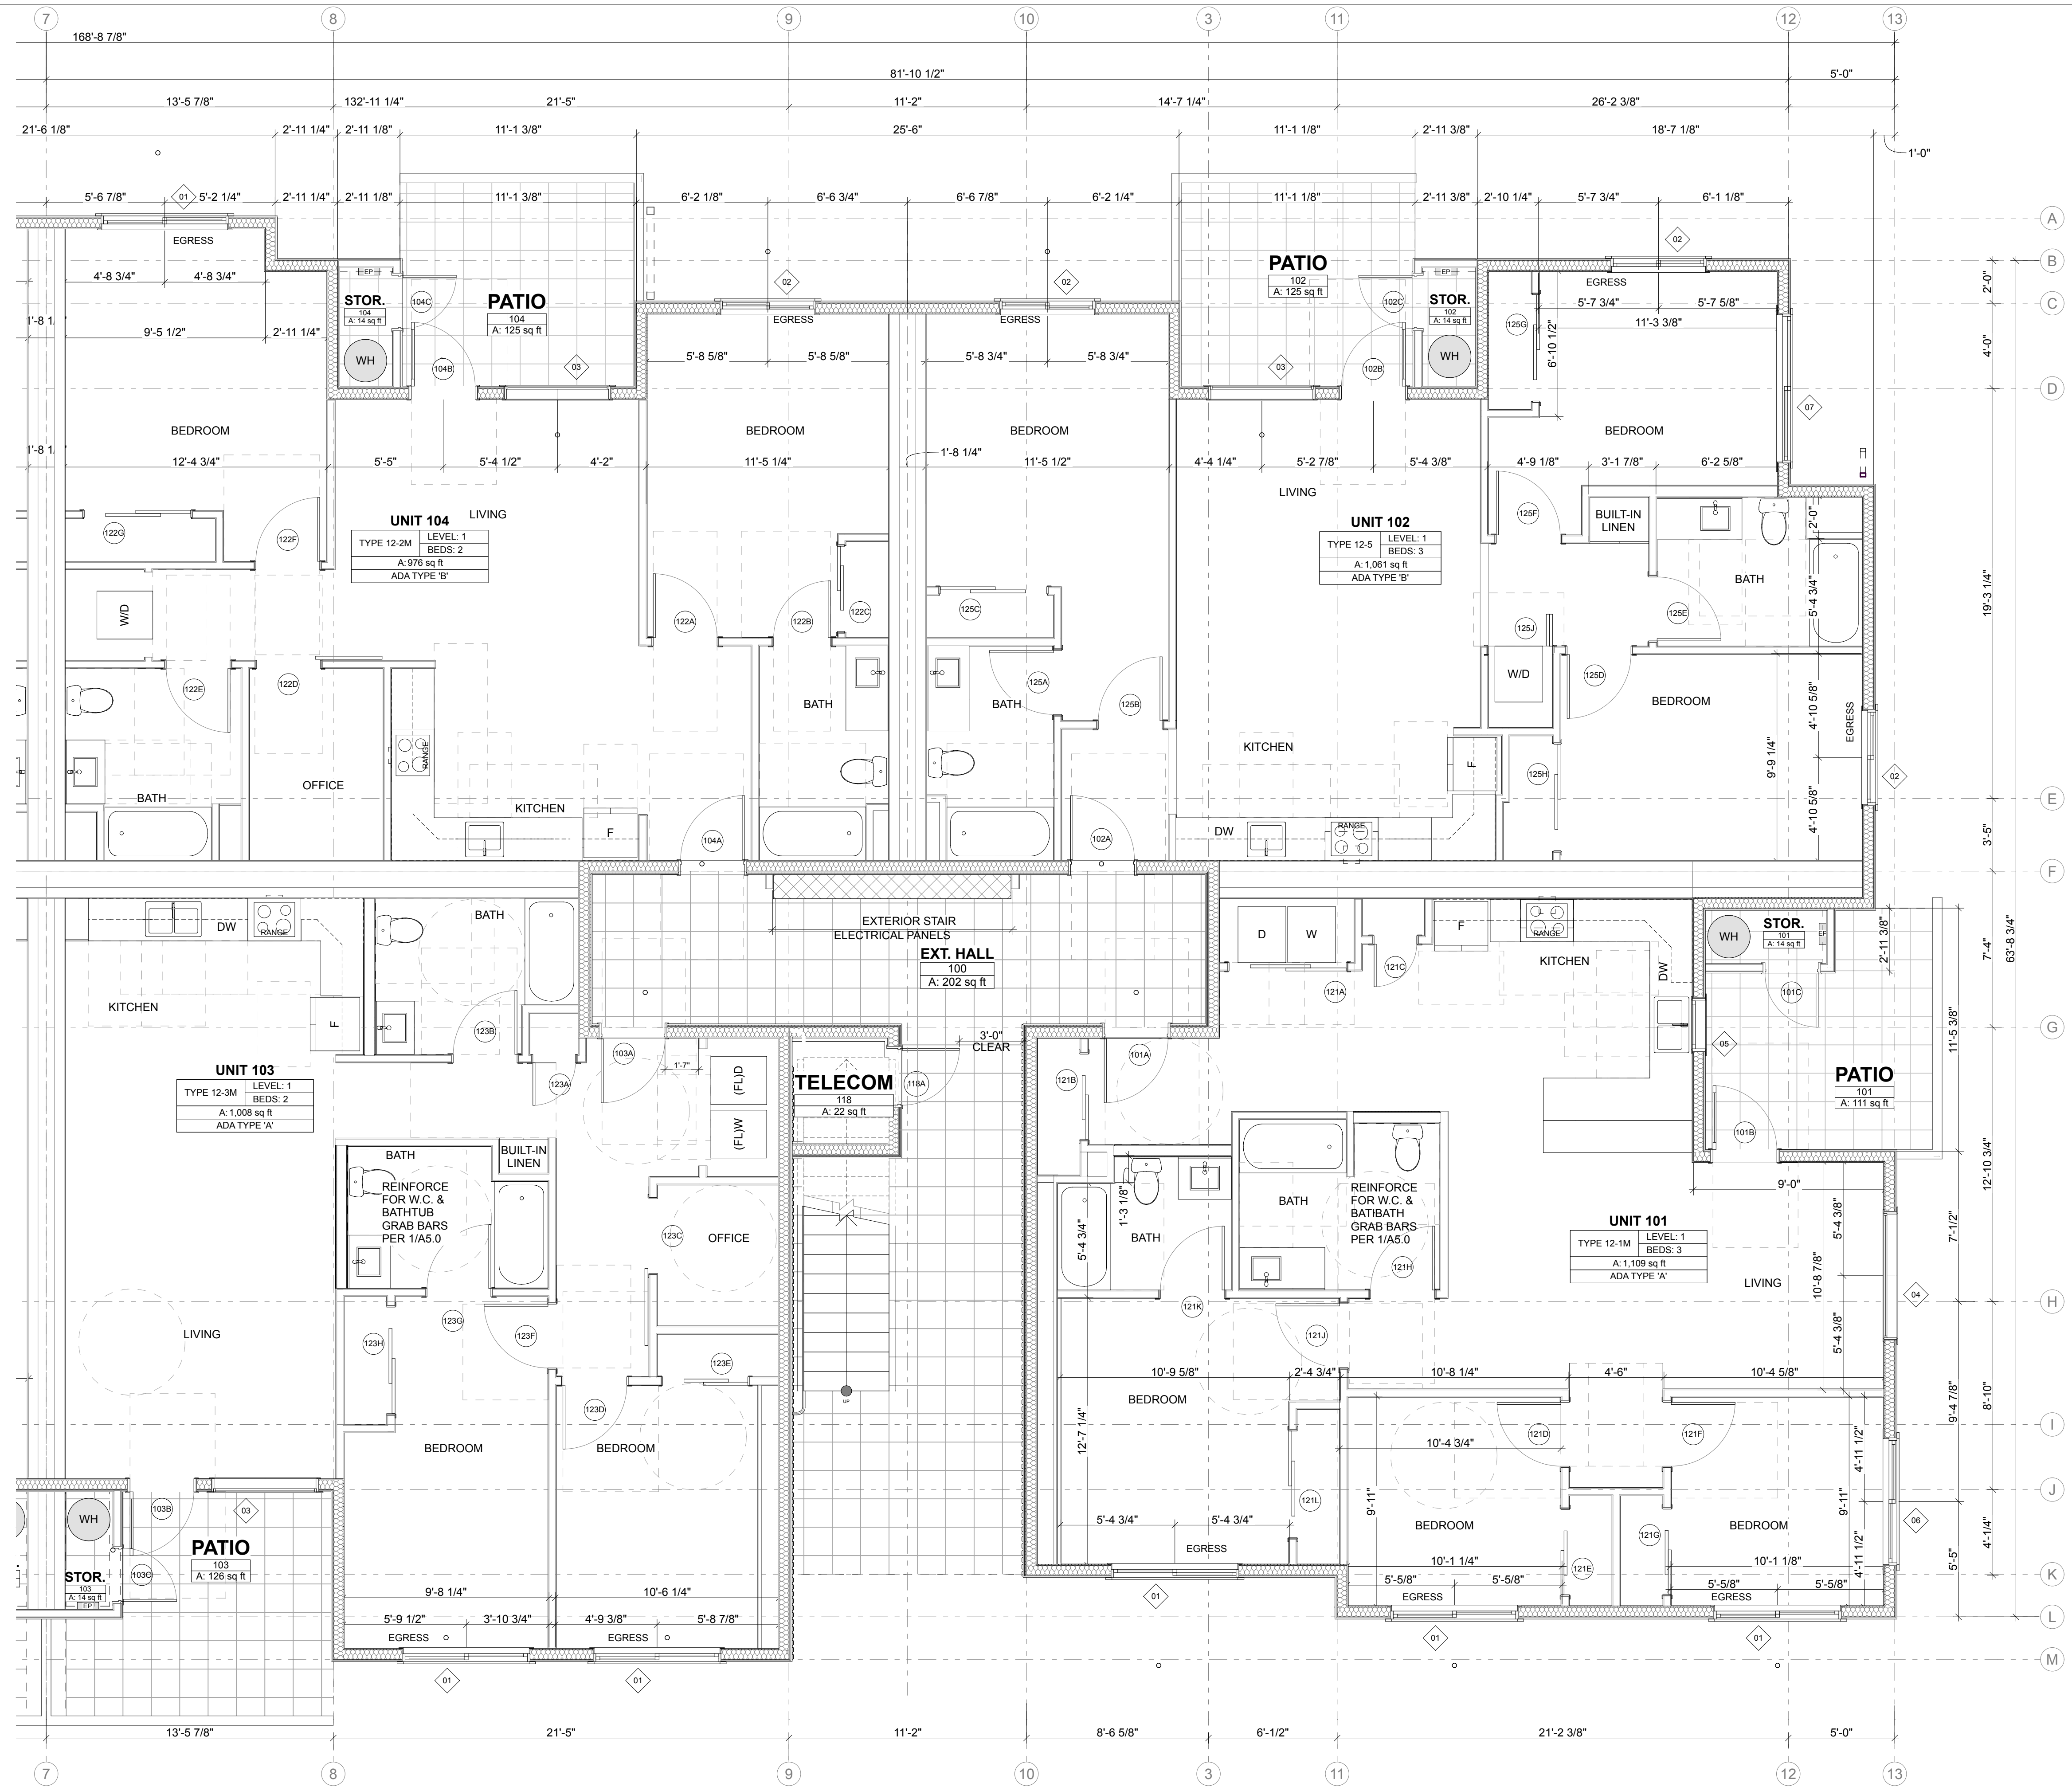


1 LEVEL 1 PLAN - ENLARGED
SCALE: 1/4" = 1'-0"



SYNTHESIS 9, LLC
5214 8TH ST
TACOMA, WA 98403

REUSE OF DOCUMENTS
THIS DOCUMENT AND THE DESIGNATIONS
INCORPORATED HEREIN ARE THE PROPERTY OF
SYNTHESIS 9, LLC AND ARE NOT TO BE USED OR
REPRODUCED IN WHOLE OR IN PART WITHOUT THE
WRITTEN AUTHORIZATION OF SYNTHESIS 9, LLC.

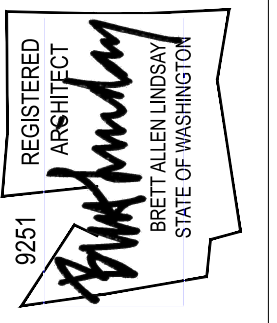

EAST TOWN CROSSING
BUILDING 'B'
PIONEER & SHAW PUYALLUP WA

REVISIONS


| NO. | DATE | DESCRIPTION |
|-----|------|-------------|
| | | |
| | | |
| | | |
| | | |

REVISIONS

DRAWN BY: BL / CM
CHECKED BY: BL
DATE: 24.03.11
TITLE: LEVEL 1 - ENLARGED RIGHT
PROJECT #: 2016
SHEET:

A1.5

AGENCY REVIEW | 24.03.11

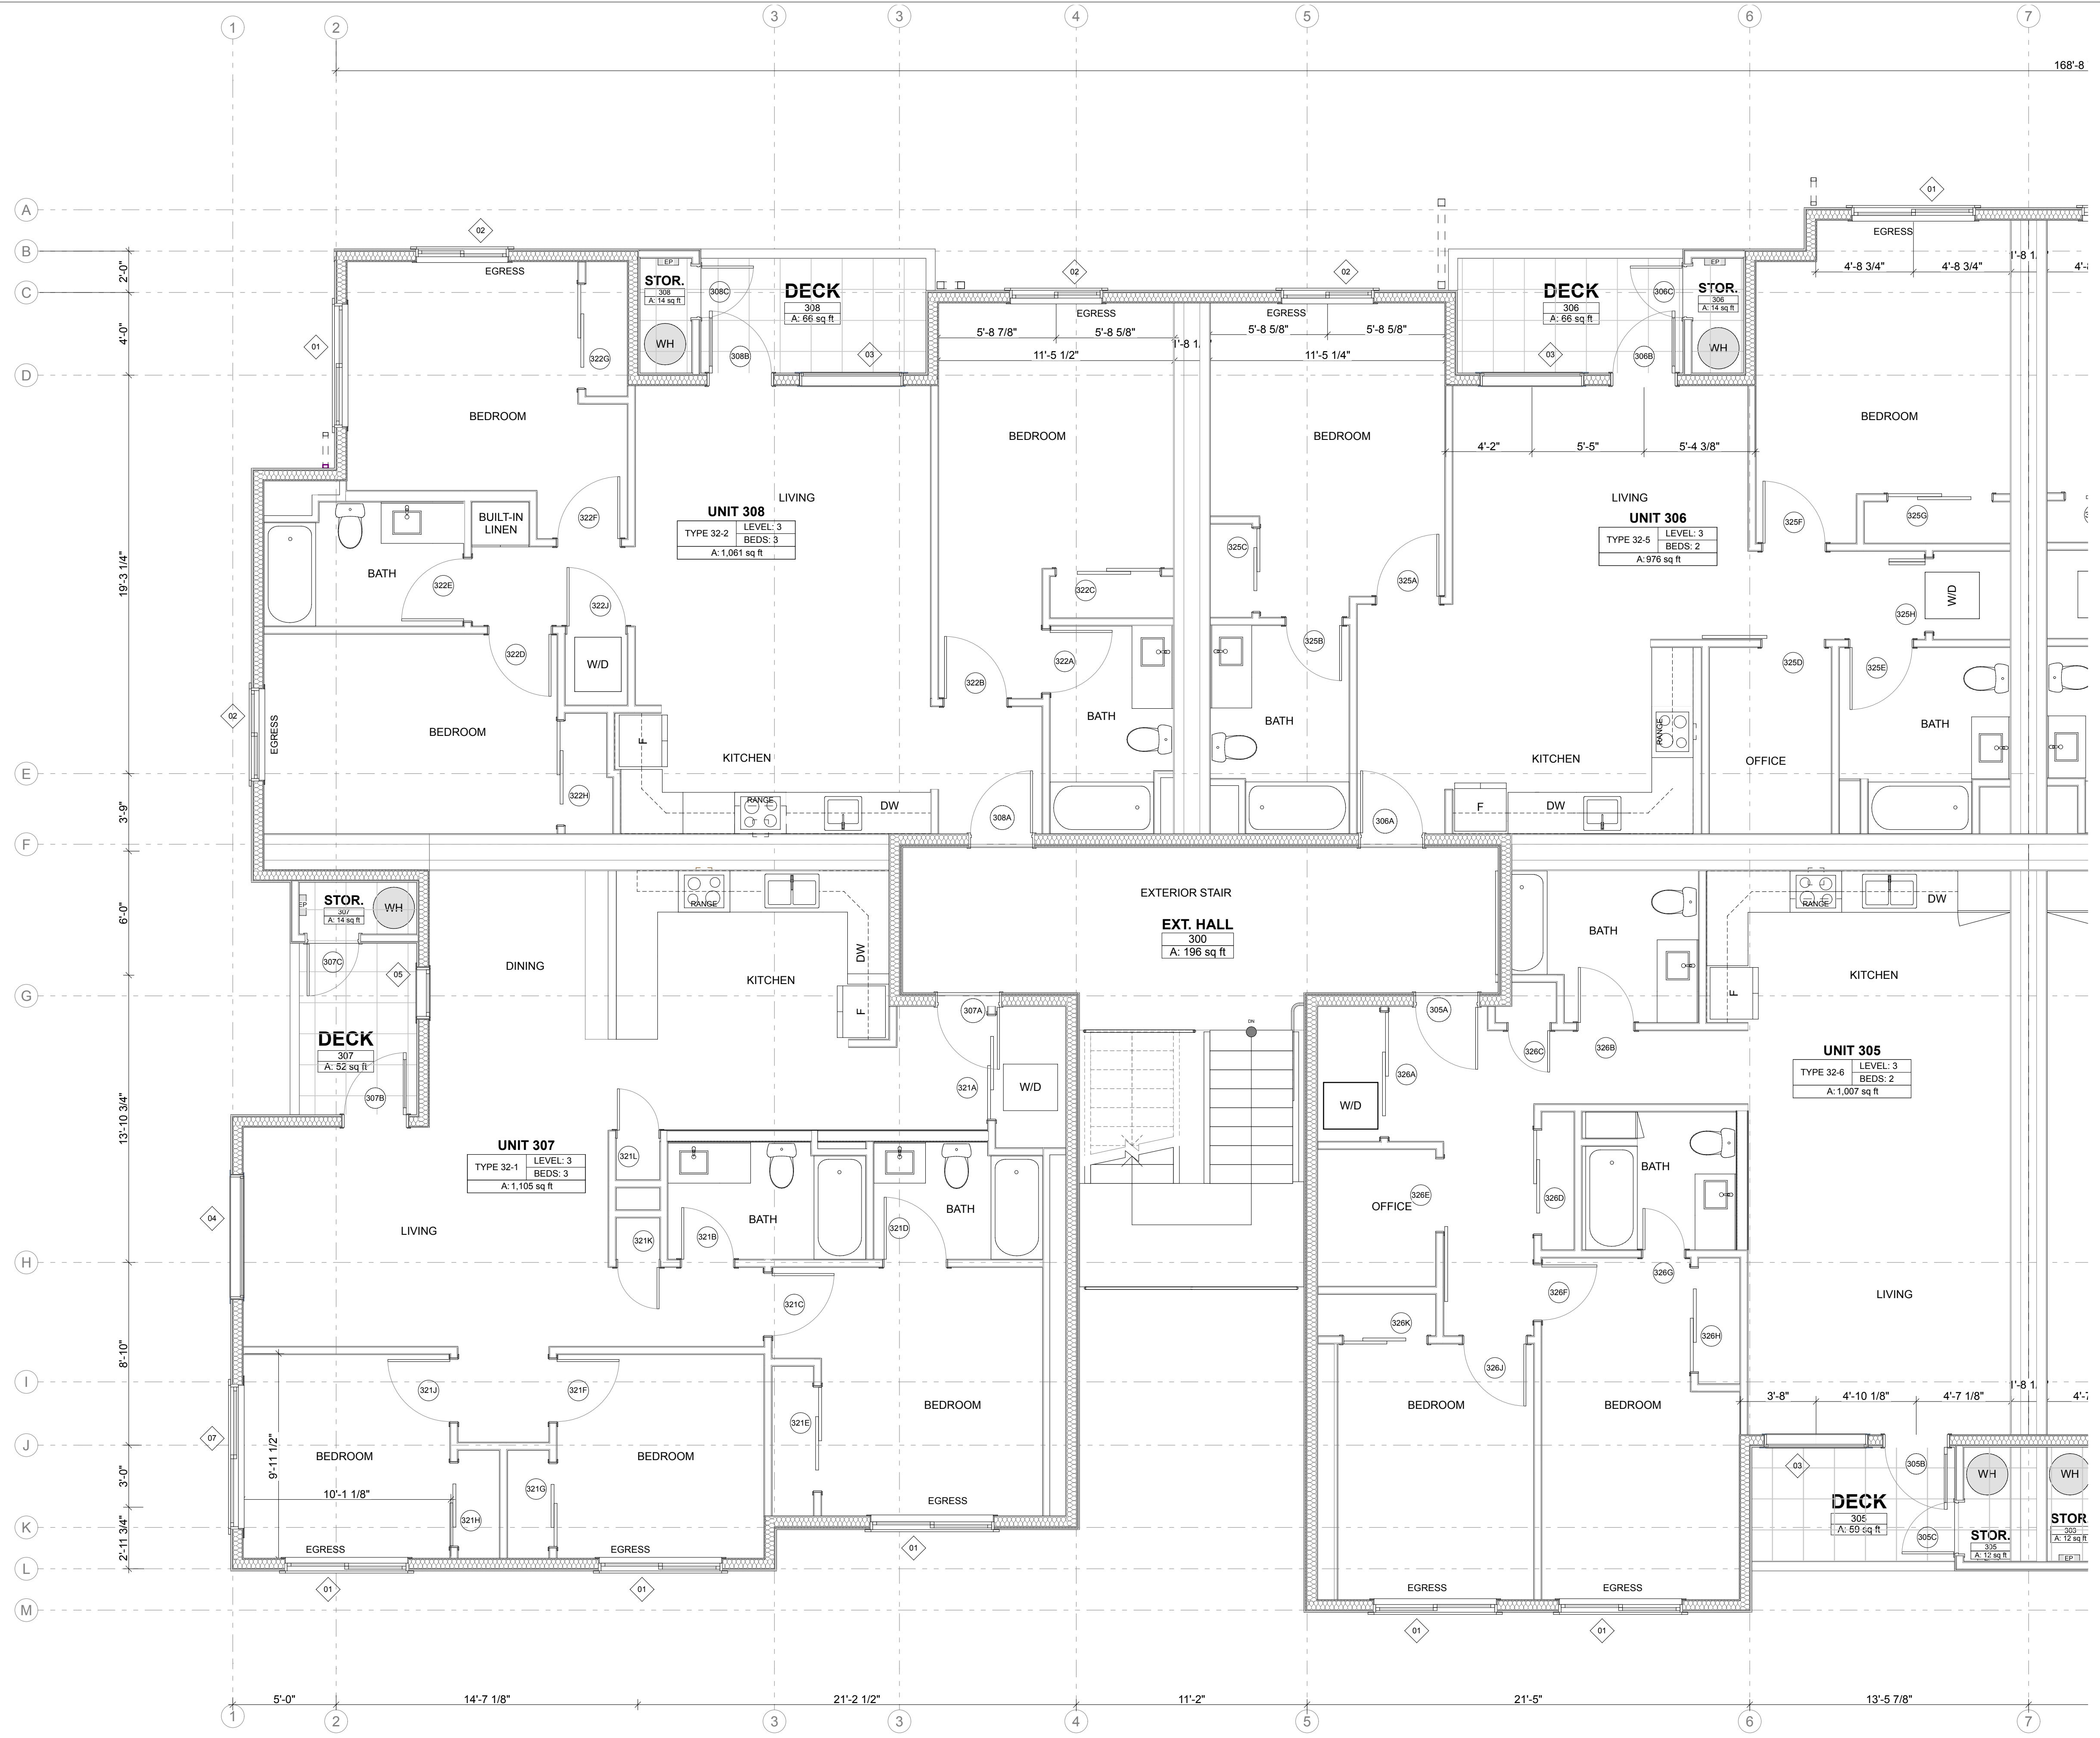


1 LEVEL 3 PLAN - ENLARGED
SCALE: 1/4" = 1'-0"

| NO. | REVISIONS |
|-----|-----------|
| | |
| | |
| NO. | REVISIONS |
|-----|-----------|
| | |
| | |
DRAWN BY: BL / CM
CHECKED BY: BL
DATE: 24.03.11
TITLE: LEVEL 3 - ENLARGED LEFT
PROJECT #: 2016
SHEET:

AGENCY REVIEW | 24.03.11

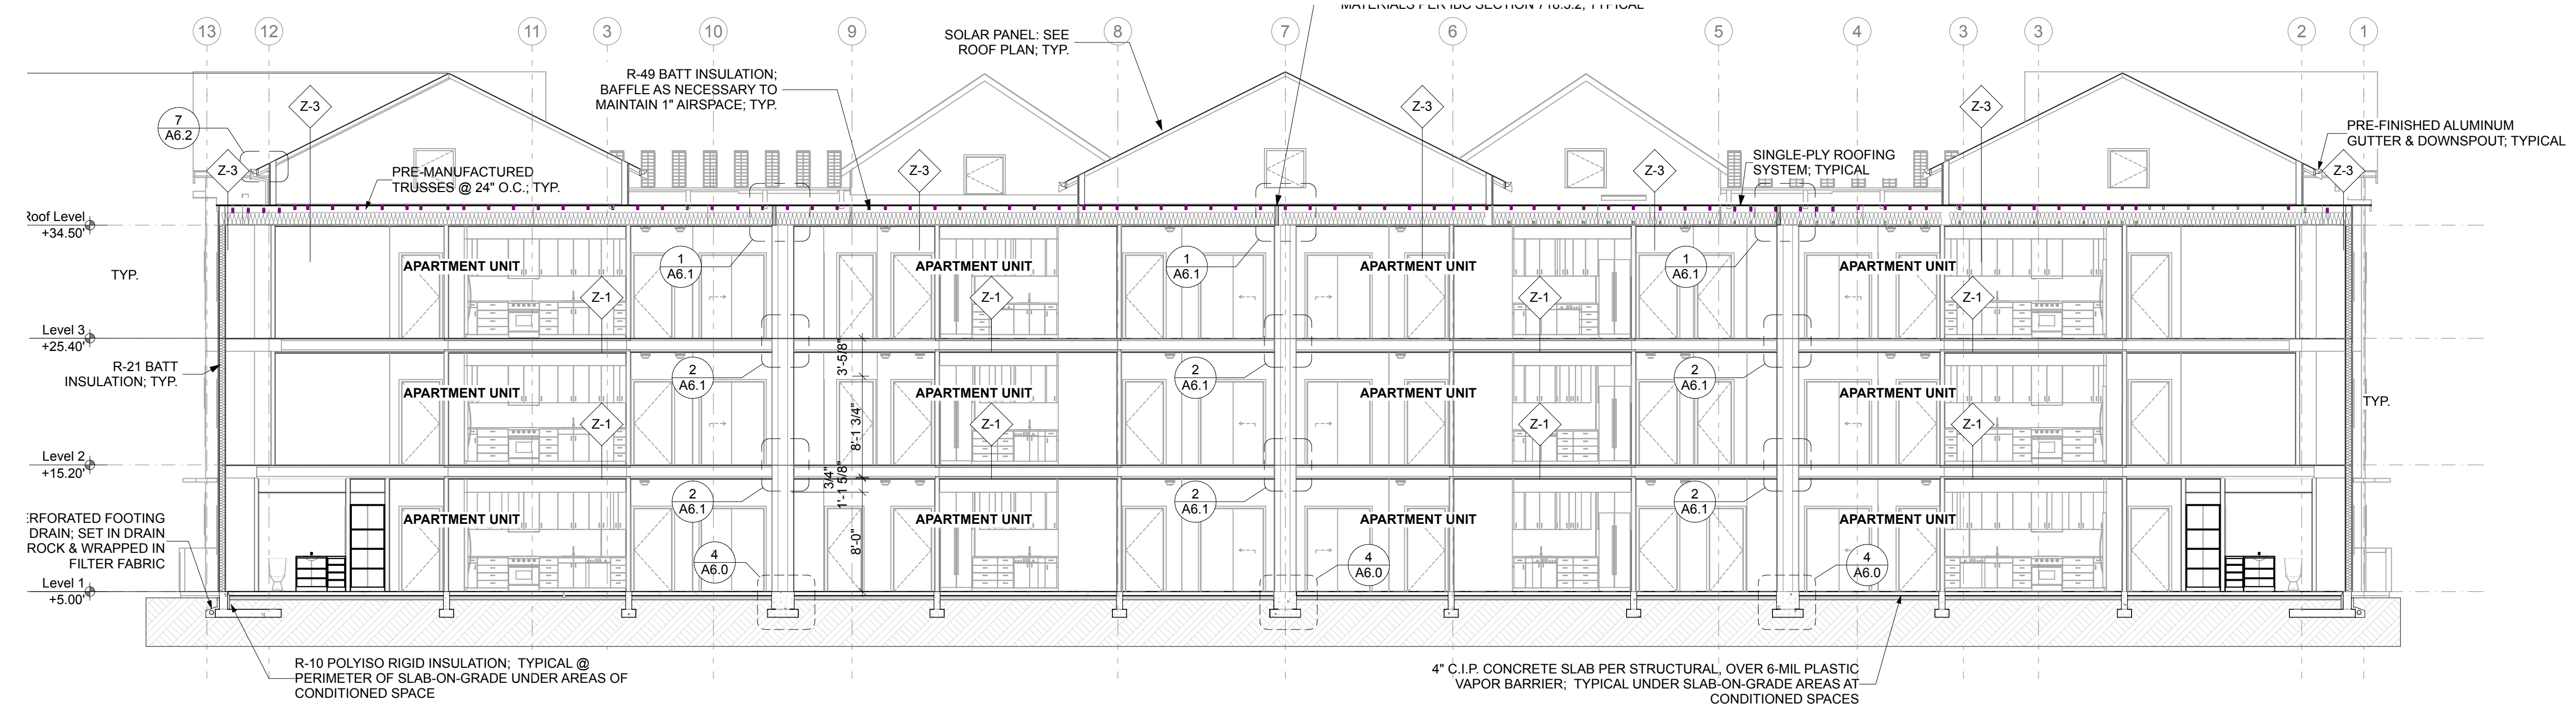

1 BUILDING SECTION 1
SCALE: 1/8" = 1'-0"

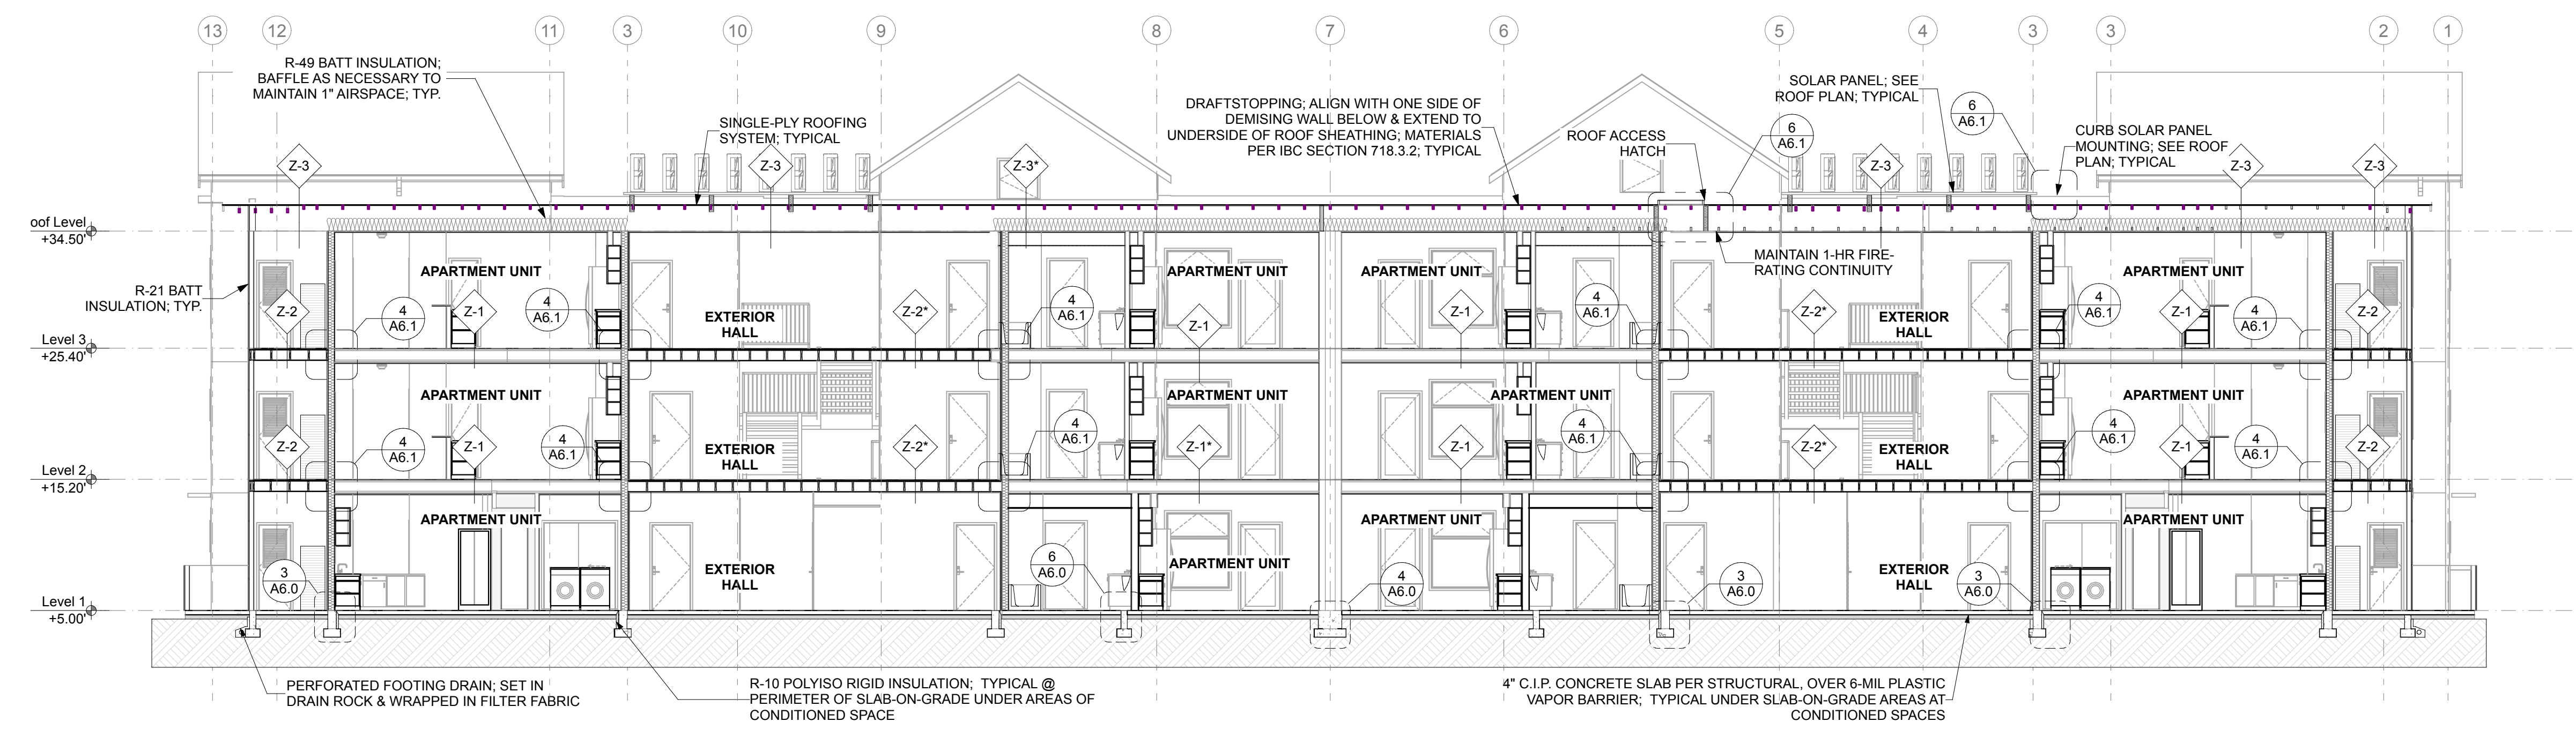


2 BUILDING SECTION 2 **SEE ALL SECTIONS FOR CALL OUTS IN COMMON.
SCALE: 1/8" = 1'-0"

REVISIONS

| NO. | DATE | DESCRIPTION |
|-----|------|-------------|
| | | |
| | | |
REVISIONS

| | |
|-------------|-------------------|
| DRAWN BY: | BL / CM |
| CHECKED BY: | BL |
| DATE: | 24.03.11 |
| TITLE: | BUILDING SECTIONS |
| PROJECT #: | 2016 |
| SHEET: | |

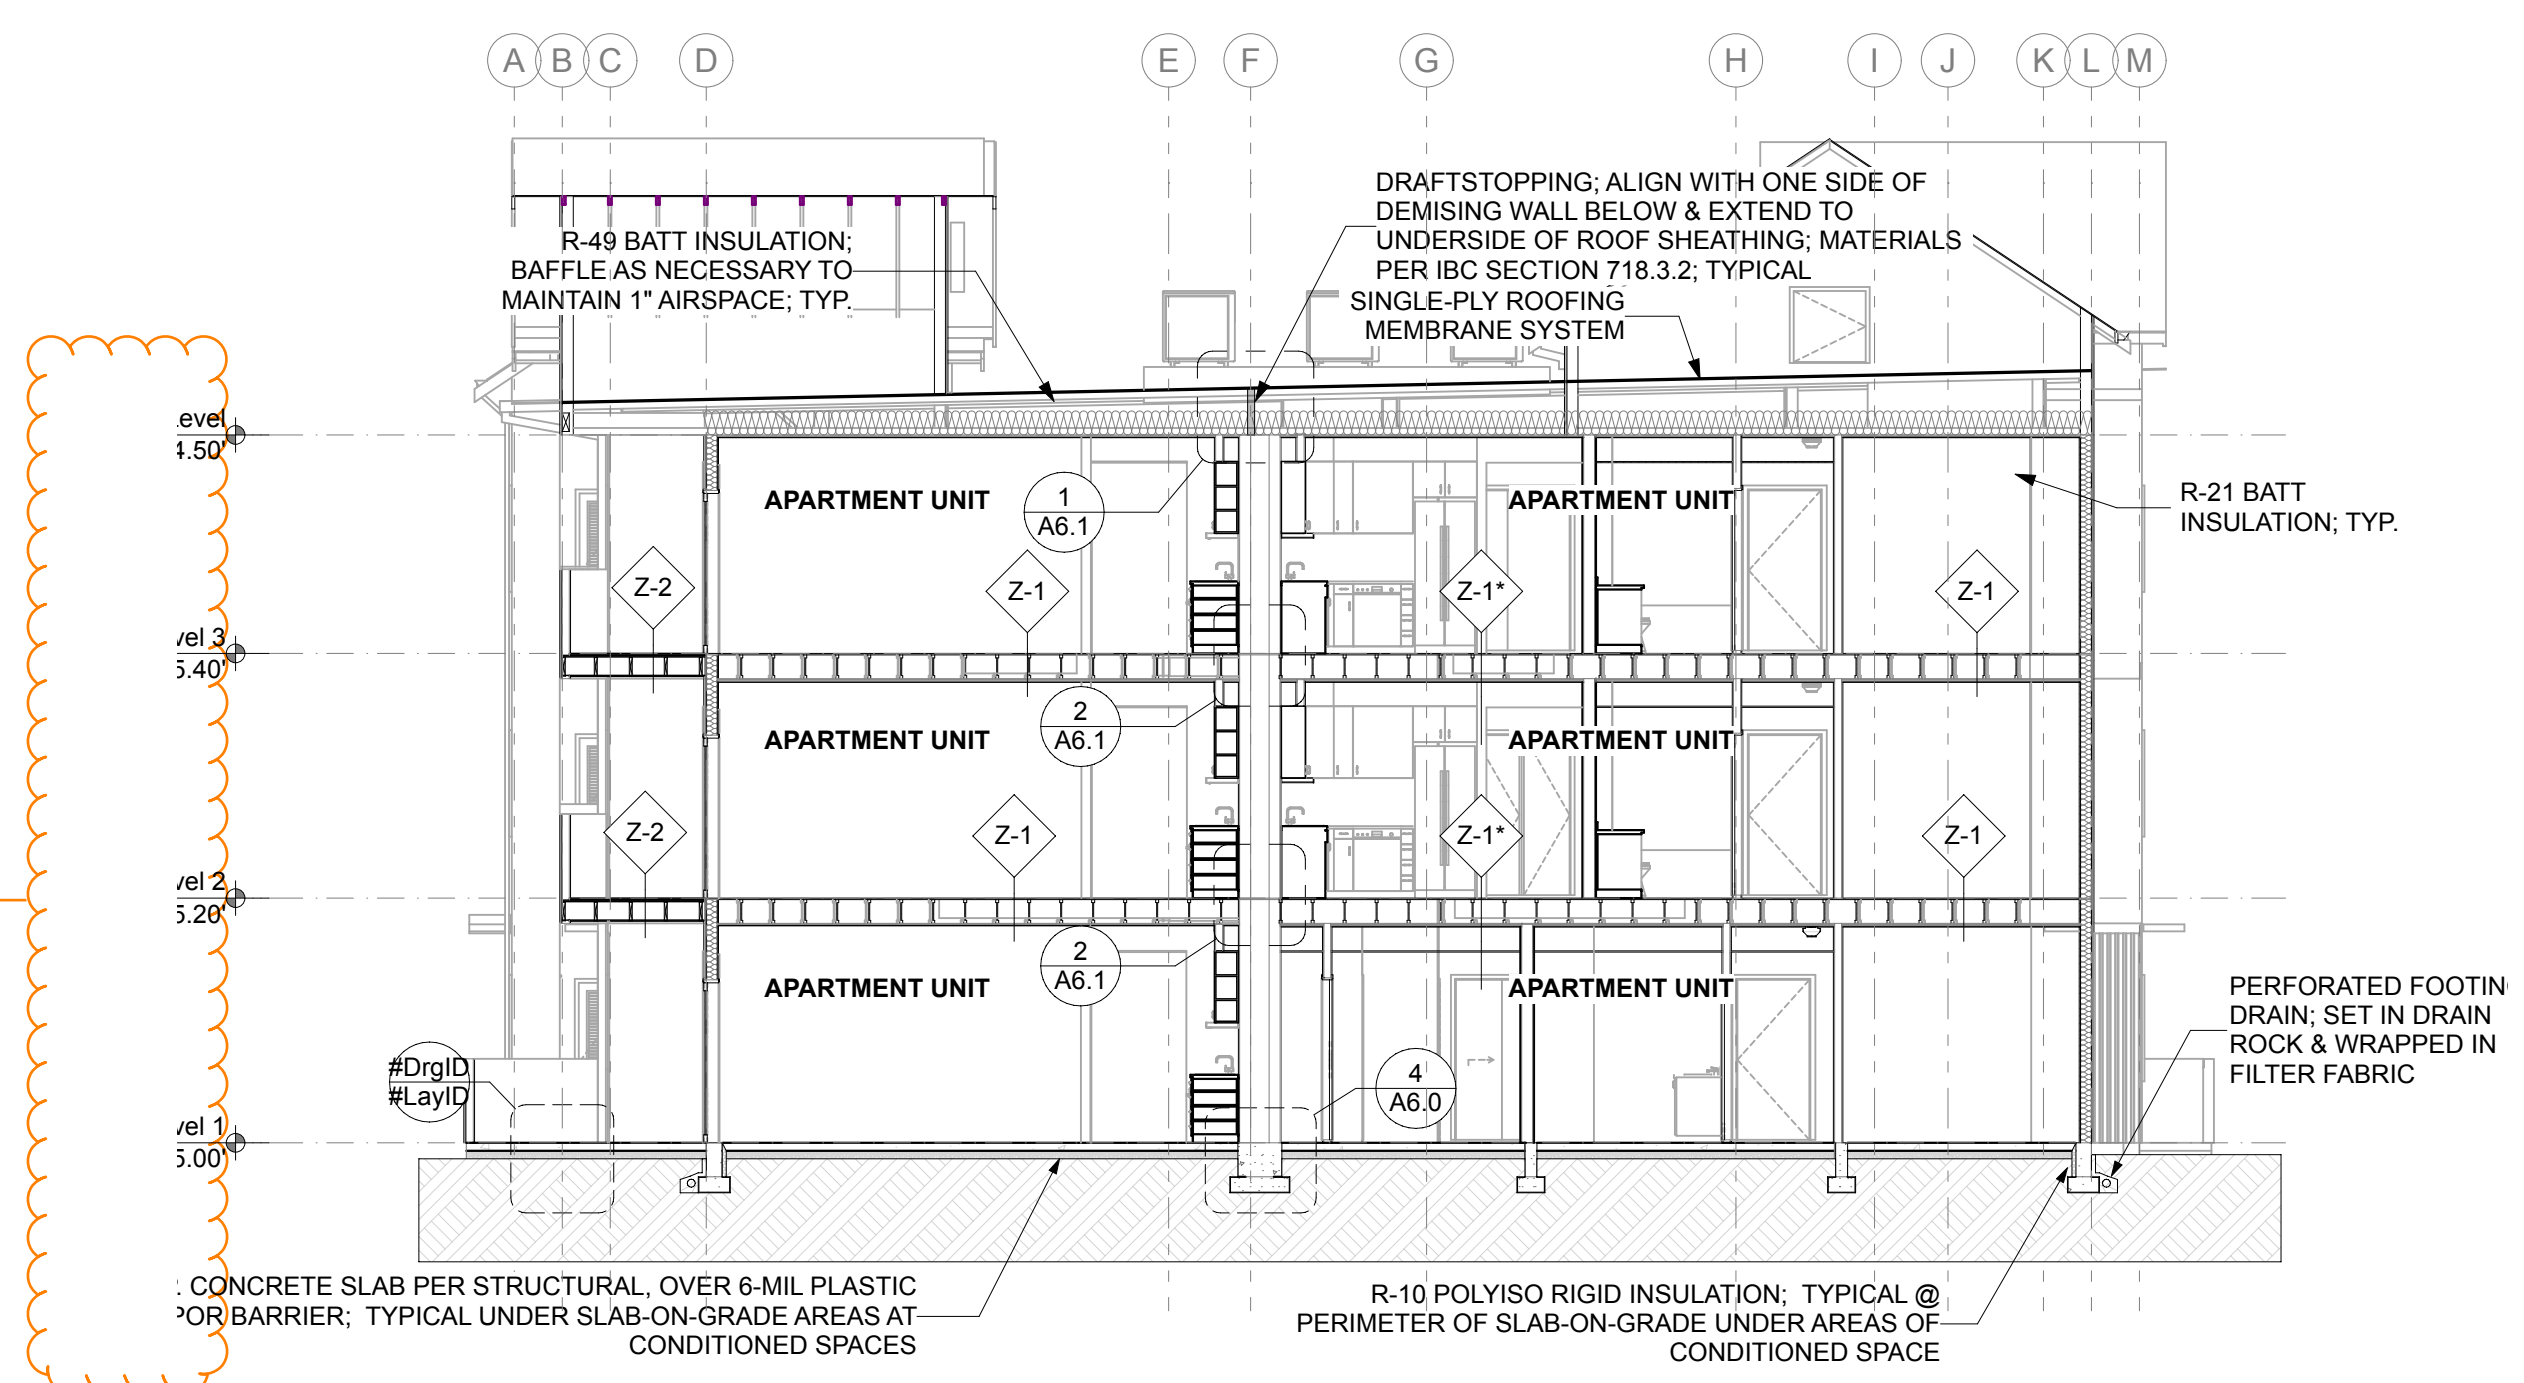

Section 7 is partially cut off.
[CONSTRUCTION PLAN SET - Bldg B, sheet A3.2]

1 BUILDING SECTION 7
SCALE: 1/8" = 1'-0"
**SEE ALL SECTIONS FOR CALL OUTS IN COMMON.

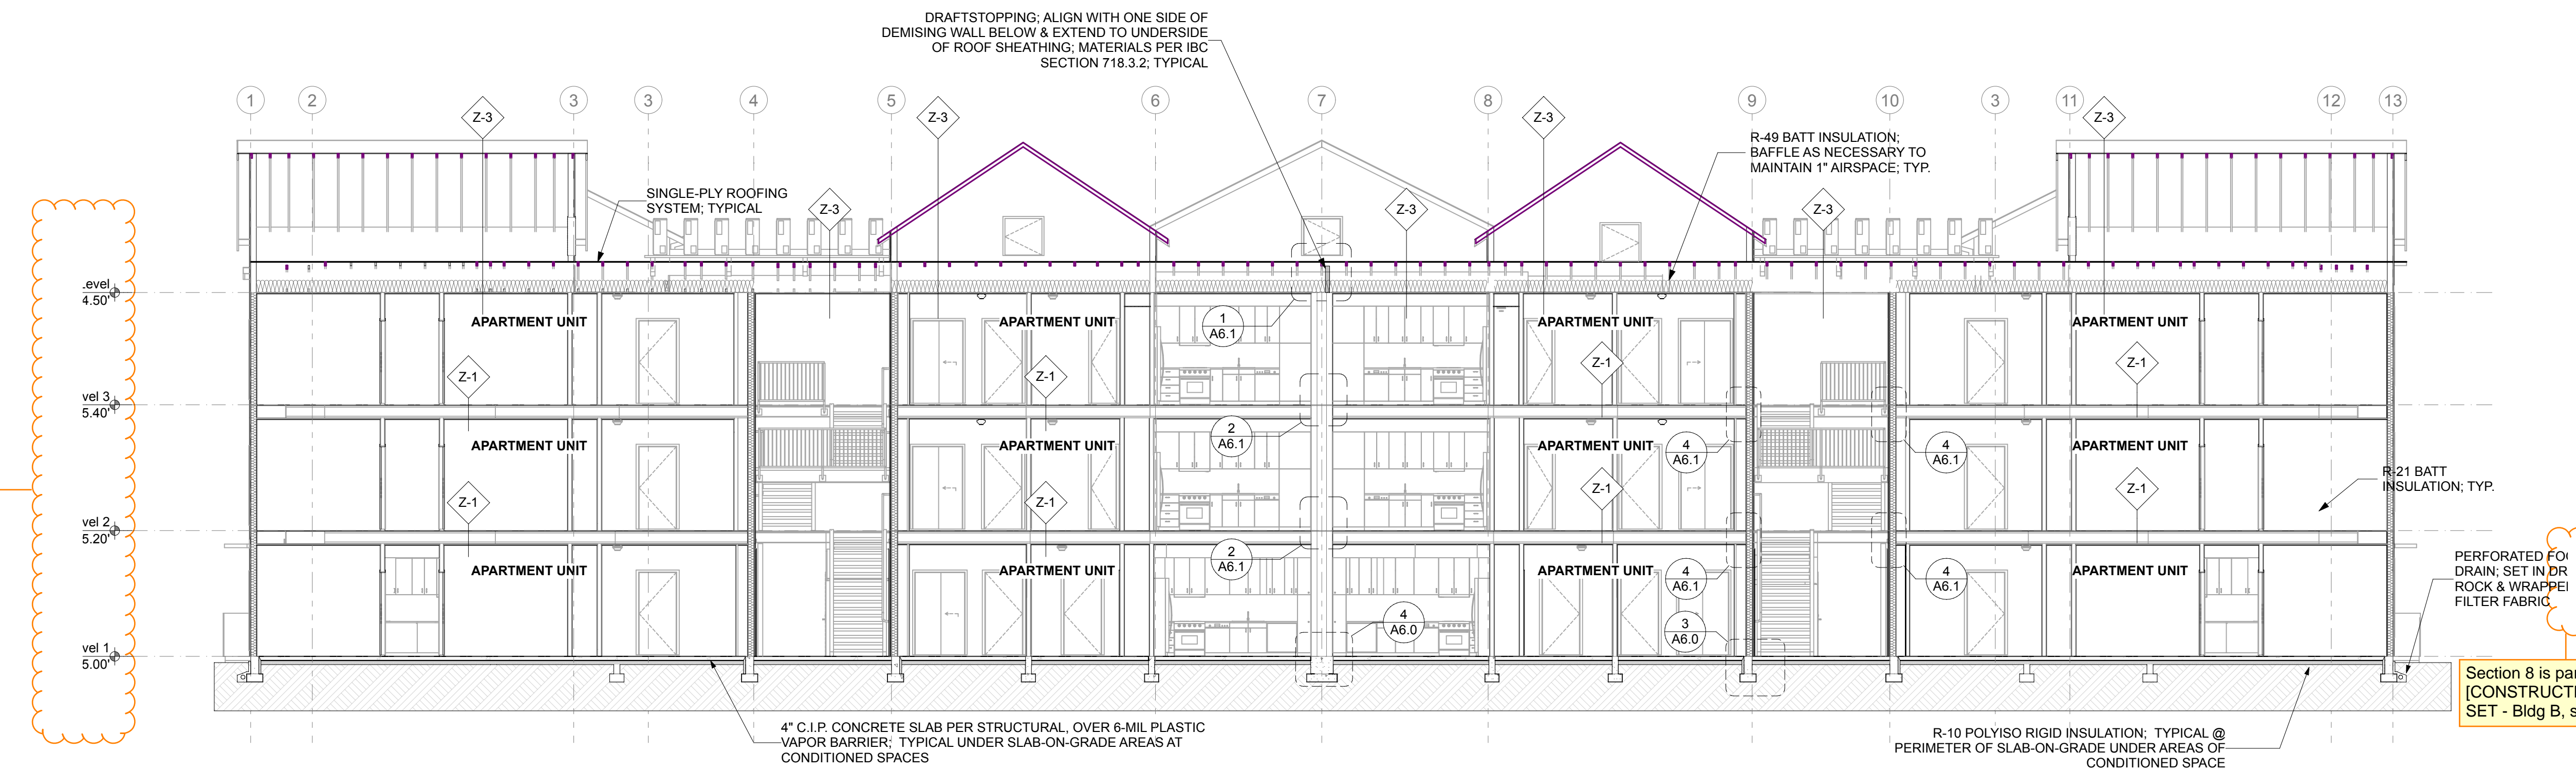

Section 8 is partially cut off.
[CONSTRUCTION PLAN SET - Bldg B, sheet A3.2]

Section 8 is partially cut off.
[CONSTRUCTION PLAN SET - Bldg B, sheet A3.2]

2 BUILDING SECTION 8
SCALE: 1/8" = 1'-0"
**SEE ALL SECTIONS FOR CALL OUTS IN COMMON.

REVISIONS

| NO. | DESCRIPTION |
|-----|-------------|
| | |
| | |
| | |
| | |

REVISIONS

| | |
|-------------|-------------------|
| DRAWN BY: | BL / CM |
| CHECKED BY: | BL |
| DATE: | 24.03.11 |
| TITLE: | BUILDING SECTIONS |
| PROJECT #: | 2016 |
| SHEET: | |

EXTERIOR DOOR SCHEDULE

| DOOR No. | TYPE | ROOM | DOOR W x HT | NOTES |
|----------|------|------------------|-------------|---|
| 101A | A | UNIT 101 | 3'-0"x6'-8" | CLOSER; ACCESSIBLE THRESHOLD; 60-MINUTE RATED |
| 101B | B | UNIT 101 | 3'-0"x6'-8" | |
| 101C | C | UNIT 101 STORAGE | 2'-6"x6'-8" | |
| 102A | A | UNIT 102 | 3'-0"x6'-8" | CLOSER; ACCESSIBLE THRESHOLD; 60-MINUTE RATED |
| 102B | B | UNIT 102 | 3'-0"x6'-8" | |
| 102C | C | UNIT 102 STORAGE | 2'-6"x6'-8" | |
| 103A | A | UNIT 103 | 3'-0"x6'-8" | CLOSER; ACCESSIBLE THRESHOLD; 60-MINUTE RATED |
| 103B | B | UNIT 103 | 3'-0"x6'-8" | |
| 103C | C | UNIT 103 STORAGE | 2'-6"x6'-8" | |
| 104A | A | UNIT 104 | 3'-0"x6'-8" | CLOSER; ACCESSIBLE THRESHOLD; 60-MINUTE RATED |
| 104B | B | UNIT 104 | 3'-0"x6'-8" | |
| 104C | C | UNIT 104 STORAGE | 2'-6"x6'-8" | |
| 105A | A | UNIT 105 | 3'-0"x6'-8" | CLOSER; ACCESSIBLE THRESHOLD; 60-MINUTE RATED |
| 105B | B | UNIT 105 | 3'-0"x6'-8" | |
| 105C | C | UNIT 105 STORAGE | 2'-6"x6'-8" | |
| 106A | A | UNIT 106 | 3'-0"x6'-8" | CLOSER; ACCESSIBLE THRESHOLD; 60-MINUTE RATED |
| 106B | B | UNIT 106 | 3'-0"x6'-8" | |
| 106C | C | UNIT 106 STORAGE | 2'-6"x6'-8" | |
| 107A | A | UNIT 107 | 3'-0"x6'-8" | CLOSER; ACCESSIBLE THRESHOLD; 60-MINUTE RATED |
| 107B | B | UNIT 107 | 3'-0"x6'-8" | |
| 107C | C | UNIT 107 STORAGE | 2'-6"x6'-8" | |
| 108A | A | UNIT 108 | 3'-0"x6'-8" | CLOSER; ACCESSIBLE THRESHOLD; 60-MINUTE RATED |
| 108B | B | UNIT 108 | 3'-0"x6'-8" | |
| 108C | C | UNIT 108 STORAGE | 2'-6"x6'-8" | |
| 118A | J | TELECOM | 2'-8"x6'-8" | CLOSER; ACCESSIBLE THRESHOLD; 60-MINUTE RATED |
| 119A | J | RISER ROOM | 2'-8"x6'-8" | CLOSER; ACCESSIBLE THRESHOLD; 60-MINUTE RATED |
| 201A | A | UNIT 201 | 3'-0"x6'-8" | CLOSER; 60-MINUTE RATED |
| 201B | B | UNIT 201 | 3'-0"x6'-8" | |
| 201C | C | UNIT 201 STORAGE | 2'-6"x6'-8" | |
| 202A | A | UNIT 202 | 3'-0"x6'-8" | CLOSER; 60-MINUTE RATED |
| 202B | B | UNIT 202 | 3'-0"x6'-8" | |
| 202C | C | UNIT 202 STORAGE | 2'-6"x6'-8" | |
| 203A | A | UNIT 203 | 3'-0"x6'-8" | CLOSER; 60-MINUTE RATED |
| 203B | B | UNIT 203 | 3'-0"x6'-8" | |
| 203C | C | UNIT 203 STORAGE | 2'-6"x6'-8" | |
| 204A | A | UNIT 204 | 3'-0"x6'-8" | CLOSER; 60-MINUTE RATED |
| 204B | B | UNIT 204 | 3'-0"x6'-8" | |
| 204C | C | UNIT 204 STORAGE | 2'-6"x6'-8" | |
| 205A | A | UNIT 205 | 3'-0"x6'-8" | CLOSER; 60-MINUTE RATED |
| 205B | B | UNIT 205 | 3'-0"x6'-8" | |
| 205C | C | UNIT 205 STORAGE | 2'-6"x6'-8" | |
| 206A | A | UNIT 206 | 3'-0"x6'-8" | CLOSER; 60-MINUTE RATED |
| 206B | B | UNIT 206 | 3'-0"x6'-8" | |
| 206C | C | UNIT 206 STORAGE | 2'-6"x6'-8" | |
| 207A | A | UNIT 207 | 3'-0"x6'-8" | CLOSER; 60-MINUTE RATED |
| 207B | B | UNIT 207 | 3'-0"x6'-8" | |
| 207C | C | UNIT 207 STORAGE | 2'-6"x6'-8" | |
| 208A | A | UNIT 208 | 3'-0"x6'-8" | CLOSER; 60-MINUTE RATED |
| 208B | B | UNIT 208 | 3'-0"x6'-8" | |
| 208C | C | UNIT 208 STORAGE | 2'-6"x6'-8" | |
| 301A | A | UNIT 301 | 3'-0"x6'-8" | CLOSER; 60-MINUTE RATED |
| 301B | B | UNIT 301 | 3'-0"x6'-8" | |
| 301C | C | UNIT 301 STORAGE | 2'-6"x6'-8" | |

| DOOR No. | TYPE | ROOM | DOOR W x HT | NOTES |
|----------|------|------------------|-------------|-------------------------|
| 302A | A | UNIT 302 | 3'-0"x6'-8" | CLOSER; 60-MINUTE RATED |
| 302B | B | UNIT 302 | 3'-0"x6'-8" | |
| 302C | C | UNIT 302 STORAGE | 2'-6"x6'-8" | |
| 303A | A | UNIT 303 | 3'-0"x6'-8" | CLOSER; 60-MINUTE RATED |
| 303B | B | UNIT 303 | 3'-0"x6'-8" | |
| 303C | C | UNIT 303 STORAGE | 2'-6"x6'-8" | |
| 304A | A | UNIT 304 | 3'-0"x6'-8" | CLOSER; 60-MINUTE RATED |
| 304B | B | UNIT 304 | 3'-0"x6'-8" | |
| 304C | C | UNIT 304 STORAGE | 2'-6"x6'-8" | |
| 305A | A | UNIT 305 | 3'-0"x6'-8" | CLOSER; 60-MINUTE RATED |
| 305B | B | UNIT 305 | 3'-0"x6'-8" | |
| 305C | C | UNIT 305 STORAGE | 2'-6"x6'-8" | |
| 306A | A | UNIT 306 | 3'-0"x6'-8" | CLOSER; 60-MINUTE RATED |
| 306B | B | UNIT 306 | 3'-0"x6'-8" | |
| 306C | C | UNIT 306 STORAGE | 2'-6"x6'-8" | |
| 307A | A | UNIT 307 | 3'-0"x6'-8" | CLOSER; 60-MINUTE RATED |
| 307B | B | UNIT 307 | 3'-0"x6'-8" | |
| 307C | C | UNIT 307 STORAGE | 2'-6"x6'-8" | |
| 308A | A | UNIT 308 | 3'-0"x6'-8" | CLOSER; 60-MINUTE RATED |
| 308B | B | UNIT 308 | 3'-0"x6'-8" | |
| 308C | C | UNIT 308 STORAGE | 2'-6"x6'-8" | |
| R-01 | D | ATTIC ACCESS | 3'-0"x3'-0" | |
| R-02 | D | ATTIC ACCESS | 3'-0"x3'-0" | |
| R-03 | D | ATTIC ACCESS | 3'-0"x3'-0" | |
| R-04 | D | ATTIC ACCESS | 3'-0"x3'-0" | |
| R-05 | D | ATTIC ACCESS | 3'-0"x3'-0" | |
| R-06 | D | ATTIC ACCESS | 3'-0"x3'-0" | |
| R-07 | D | ATTIC ACCESS | 3'-0"x3'-0" | |

DOOR SCHEDULE NOTES

- DOOR OPERATIONS PER 1008.1.9 - EGRESS DOORS SHALL BE READILY OPENABLE FROM THE EGRESS SIDE WITHOUT THE USE OF A KEY OR SPECIAL KNOWLEDGE OR EFFORT.
- DOOR HARDWARE PER 1008.1.9.1 - DOOR HANDLES, PULLS, LATCHES, LOCKS AND OTHER OPERATING DEVICES ON DOORS REQUIRED TO BE ACCESSIBLE BY CHAPTER 11 SHALL NOT REQUIRE TIGHT GRASPING, TIGHT PINCHING OR TWISTING OF THE WRIST TO OPERATE.
- HARDWARE HEIGHT PER 1008.1.9.2 - DOOR HANDLES, PULLS, LATCHES, LOCKS AND OTHER OPERATING DEVICES SHALL BE INSTALLED 34 INCHES MINIMUM AND 48 INCHES MAXIMUM ABOVE THE FINISHED FLOOR. LOCKS USED ONLY FOR SECURITY PURPOSES AND NOT USED FOR NORMAL OPERATION ARE PERMITTED AT ANY HEIGHT.
- ACCESSIBLE THRESHOLDS PER ICC A117.1-2009 SECTION 303 - THRESHOLDS AT DOORWAYS SHALL BE 1/2" MAXIMUM IN HEIGHT.
- DOOR CLOSERS PER ICC A117.1-2009 - DOOR CLOSERS SHALL BE ADJUSTED SO THAT FROM AN OPEN POSITION OF 90 DEGREES, THE TIME REQUIRED TO MOVE THROUGH THE DOOR TO AN OPEN POSITION OF 10 DEGREES SHALL BE 5 SECONDS.
- DOOR-OPENING FORCE PER ICC A117.1-2009 - THE FORCE FOR PUSHING OR PULLING OPEN DOORS SHALL BE 10.0 POUNDS MAXIMUM PER WASHINGTON STATE AMMENDMENT.

DOOR HARDWARE LOCKSETS and DEFINITIONS

SECURITY LOCKSET - THE LATCHBOLT IS RETRACTED BY THE GRIP ON EITHER SIDE UNLESS THE OUTSIDE GRIP IS LOCKED BY THE OUTSIDE KEY. OPERATING THE INSIDE GRIP ALWAYS RETRACTS THE LATCHBOLT.

ACCESSIBLE SECURITY LOCKSET - THE LATCHBOLT IS RETRACTED BY THE GRIP ON EITHER SIDE UNLESS THE OUTSIDE GRIP IS LOCKED BY EITHER THE INSIDE KEY OR THE OUTSIDE KEY. OPERATING THE INSIDE GRIP ALWAYS RETRACTS THE LATCHBOLT. ALL COMPONENTS OF THE DOOR HARDWARE TO MEET ACCESSIBILITY REQUIREMENTS OF SECTION 1008.1.9 OF THE 2012 IBC.

OFFICE LOCKSET - THE LATCHBOLT IS RETRACTED BY THE GRIP ON EITHER SIDE UNLESS THE OUTSIDE GRIP IS LOCKED BY THE TOGGLE OR OUTSIDE KEY. OPERATING THE INSIDE GRIP DOES NOT UNLOCK THE OUTSIDE GRIP.

PASSAGE LOCKSET - THE LATCHBOLT IS ALWAYS RETRACTED BY THE GRIP ON EITHER SIDE. BOTH GRIPS ARE ALWAYS FREE.

PRIVACY LOCKSET - THE LATCHBOLT IS RETRACTED BY THE GRIP ON EITHER SIDE UNLESS THE OUTSIDE GRIP IS LOCKED BY THE INSIDE THUMB-TURN, BUTTON OR KEY. OPERATING THE INSIDE GRIP UNLOCKS THE OUTSIDE GRIP. AN EMERGENCY RELEASE TOOL UNLOCKS THE OUTSIDE GRIP. THE OUTSIDE GRIP IS ALSO UNLOCKED WHEN THE DOOR IS CLOSED. DOOR CAN ONLY BE LOCKED FROM THE INSIDE WHEN THE DOOR IS CLOSED.

PUBLIC RESTROOM LOCKSET - THE LATCHBOLT IS RETRACTED BY THE INSIDE GRIP OR AN OUTSIDE KEY. THE LATCHBOLT IS RETRACTED BY THE OUTSIDE GRIP UNLESS THE GRIP IS LOCKED BY A KEY FROM THE INSIDE. THE LATCHBOLT / OUTSIDE GRIP CANNOT BE LOCKED BY A KEY FROM THE OUTSIDE. ALL COMPONENTS OF THE DOOR HARDWARE GROUP TO MEET ACCESSIBILITY REQUIREMENTS OF SECTION 1008.1.9 OF THE 2012 IBC.

STOREROOM LOCKSET - THE LATCHBOLT IS RETRACTED BY THE INSIDE GRIP OR OUTSIDE KEY.

CLOSET LOCKSET - THE LATCHBOLT IS RETRACTED BY THE OUTSIDE AND THE INSIDE GRIP AND THE GRIP CANNOT BE LOCKED.

GLAZING NOTES

- GLAZING IN A FIXED AND OPERABLE PANELS OF SWINGING, SLIDING AND BIFOLD DOORS SHALL BE CONSIDERED HAZARDOUS LOCATIONS.
- GLAZING IN AN INDIVIDUAL FIXED OR OPERABLE PANEL ADJACENT TO A DOOR WHERE THE NEAREST VERTICAL EDGE OF THE GLAZING IS WITHIN A 24-INCH ARC OF EITHER VERTICAL EDGE OF THE DOOR IN A CLOSED POSITION AND WHERE THE BOTTOM EDGE OF THE GLAZING IS LESS THAN 60 INCHES ABOVE THE WALKING SURFACE SHALL BE CONSIDERED A HAZARDOUS LOCATION.
- GLAZING IN INDIVIDUAL FIXED OR OPERABLE PANEL OF A WINDOW THAT MEETS ALL OF THE FOLLOWING FOUR CONDITIONS SHALL BE CONSIDERED A HAZARDOUS LOCATION: 1. THE EXPOSED AREA OF AN INDIVIDUAL PANE IS GREATER THAN 9 SQUARE FEET, 2. THE BOTTOM EDGE OF THE GLAZING IS LESS THAN 18 INCHES ABOVE THE FLOOR, 3. THE TOP EDGE OF THE GLAZING IS GREATER THAN 36 INCHES ABOVE THE FLOOR, AND 4. ONE OR MORE WALKING SURFACE(S) ARE WITHIN 36 INCHES, MEASURED HORIZONTALLY AND IN A STRAIGHT LINE, OF THE PLANE OF THE GLAZING

DOOR TYPES

| ELEVATION | A | B | C | D | E |
|-----------|-------------------|-------------------|-------------------|-------------------|-------------------|
| | | | | | |
| DOOR TYPE | A | B | C | D | E |
| FUNCTION | EXTERIOR SWINGING | EXTERIOR SWINGING | EXTERIOR SWINGING | EXTERIOR SWINGING | INTERIOR SWINGING |
| PANEL | INSULATED HM DOOR | SAFETY GLAZED | HM DOOR W/ LOUVER | HM DOOR | FLUSH HCW PANEL |
| FRAME | HM FRAME | HM FRAME | HM FRAME | HM FRAME | WOOD FRAME |
| NOTES | UNIT ENTRY | UNIT PATIO | UNIT STORAGE | ATTIC ACCESS | |

| ELEVATION | F | G | H | J |
|-----------|-----------------|------------------|-----------------|-------------------|
| | | | | |
| DOOR TYPE | F | G | H | J |
| FUNCTION | SLIDING CLOSET | BARN DOOR SLIDER | BIFOLD | EXTERIOR SWINGING |
| PANEL | FLUSH HCW PANEL | FLUSH HCW PANEL | FLUSH HCW PANEL | HM DOOR |
| FRAME | WOOD FRAME | WOOD FRAME | WOOD FRAME | HM FRAME |
| NOTES | | | | |

WINDOW TYPES






| ELEVATION | 01 | 02 | 03 |
|--------------|-------------------|-------------------|-------------|
| | | | |
| TYPE | 01 | 02 | 03 |
| SIZE (W x H) | 6'-0"x4'-0" | 4'-6"x3'-6" | 5'-0"x6'-0" |
| QUANTITY | 39 | 24 | 18 |
| NOTES | EGRESS @ BEDROOMS | EGRESS @ BEDROOMS | |

| ELEVATION | 04 | 05 | 06 | 07 |
|--------------|-------------|-------------|-------------|-------------|
| | | | | |
| TYPE | 04 | 05 | 06 | 07 |
| SIZE (W x H) | 6'-0"x6'-0" | 2'-6"x3'-0" | 6'-0"x2'-0" | 7'-0"x2'-0" |
| QUANTITY | 6 | 6 | 5 | 4 |
| NOTES | | | | |

UNIT DOOR SCHEDULE





| DOOR No. | TYPE | ROOM | DOOR W x HT | NOTES |
|----------|------|----------|--------------|-------|
| 121A | F | LAUNDRY | 5'-6"x6'-8" | |
| 121B | F | CLOSET | 4'-0"x6'-8" | |
| 121C | E | CLOSET | 2'-0"x6'-8" | |
| 121D | E | BEDROOM | 3'-0"x6'-8" | |
| 121E | F | CLOSET | 4'-0"x6'-8" | |
| 121F | E | BEDROOM | 3'-0"x6'-8" | |
| 121G | F | CLOSET | 4'-0"x6'-8" | |
| 121H | E | BATHROOM | 3'-0"x6'-8" | |
| 121J | E | BEDROOM | 3'-0"x6'-8" | |
| 121K | E | BATHROOM | 3'-0"x6'-8" | |
| 121L | F | CLOSET | 5'-0"x6'-8" | |
| 122A | E | BEDROOM | 3'-0"x6'-8" | |
| 122B | | | 2'-8"x6'-8" | |
| 122C | F | CLOSET | 4'-0"x6'-8" | |
| 122D | G | OFFICE | 3'-0"x6'-8" | |
| 122E | E | BATHROOM | 3'-0"x6'-8" | |
| 122F | E | BEDROOM | 3'-0"x6'-8" | |
| 122G | F | CLOSET | 5'-0"x6'-8" | |
| 123A | E | CLOSET | 2'-0"x6'-8" | |
| 123B | E | BATHROOM | 3'-0"x6'-8" | |
| 123C | G | OFFICE | 3'-6"x6'-8" | |
| 123D | E | BEDROOM | 3'-0"x6'-8" | |
| 123E | F | CLOSET | 4'-0"x6'-8" | |
| 123F | E | BEDROOM | 3'-0"x6'-8" | |
| 123G | E | BATHROOM | 3'-0"x6'-8" | |
| 123H | F | CLOSET | 5'-0"x6'-8" | |
| 125A | E | BATHROOM | 3'-0"x6'-8" | |
| 125B | E | BEDROOM | 3'-0"x6'-8" | |
| 125C | F | CLOSET | 5'-0"x6'-8" | |
| 125D | E | BEDROOM | 3'-0"x6'-8" | |
| 125E | E | BATHROOM | 3'-0"x6'-8" | |
| 125F | E | BEDROOM | 3'-0"x6'-8" | |
| 125G | F | CLOSET | 5'-0"x6'-8" | |
| 125H | F | CLOSET | 5'-0"x6'-8" | |
| 125J | H | LAUNDRY | 3'-0"x6'-8" | |
| 221A | H | LAUNDRY | 5'-0"x6'-8" | |
| 221B | E | CLOSET | 2'-0"x6'-8" | |
| 221C | E | BEDROOM | 3'-0"x6'-8" | |
| 221D | F | CLOSET | 4'-0"x6'-8" | |
| 221E | E | BEDROOM | 3'-0"x6'-8" | |
| 221F | F | CLOSET | 4'-0"x6'-8" | |
| 221G | E | CLOSET | 2'-0"x6'-8" | |
| 221H | E | BATHROOM | 3'-0"x6'-8" | |
| 221J | E | BEDROOM | 3'-0"x6'-8" | |
| 221K | E | BATHROOM | 3'-0"x6'-8" | |
| 221L | F | CLOSET | 5'-0"x6'-8" | |
| 222A | E | BATHROOM | 3'-0"x6'-8" | |
| 222B | E | BEDROOM | 3'-0"x6'-8" | |
| 222C | F | CLOSET | 5'-0"x6'-8" | |
| 222D | E | BEDROOM | 3'-0"x6'-8" | |
| 222E | E | BATHROOM | 3'-0"x6'-8" | |
| 222F | E | BEDROOM | 3'-0"x6'-8" | |
| 222G | F | CLOSET | 5'-0"x6'-8" | |
| 222H | F | CLOSET | 5'-0"x6'-8" | |
| 222J | E | LAUNDRY | 2'-10"x6'-8" | |
| 225A | E | BEDROOM | 3'-0"x6'-8" | |
| 225B | E | BATHROOM | 2'-8"x6'-8" | |
| 225C | F | CLOSET | 4'-0"x6'-8" | |
| 225D | G | OFFICE | 3'-0"x6'-8" | |
| 225E | E | BATHROOM | 3'-0"x6'-8" | |
| 225F | E | BEDROOM | 3'-0"x6'-8" | |
| 225G | F | CLOSET | 5'-0"x6'-8" | |
| 225H | H | LAUNDRY | 3'-6"x6'-8" | |
| 226A | F | LAUNDRY | 6'-0"x6'-8" | |
| 226B | E | BATHROOM | 2'-8"x6'-8" | |
| 226C | E | CLOSET | 2'-0"x6'-8" | |
| 226D | F | CLOSET | 5'-0"x6'-8" | |
| 226E | G | OFFICE | 3'-6"x6'-8" | |
| 226F | E | BEDROOM | 2'-8"x6'-8" | |
| 226G | F | CLOSET | 4'-0"x6'-8" | |
| 226H | E | BEDROOM | 3'-0"x6'-8" | |

| DOOR No. | TYPE | ROOM | DOOR W x HT | NOTES |
|----------|------|---------|-------------|-------|
| 326J | F | CLOSET | 4'-0"x6'-8" | |
| 326K | F | CLOSET | 4'-0"x6'-8" | |
| 327A | F | CLOSET | 5'-0"x6'-8" | |
| 327B | E | BEDROOM | 3'-0"x6'-8" | |
| 327C | E | BEDROOM | 3'-0"x6'-8" | |
| 327Q | E | BEDROOM | | |

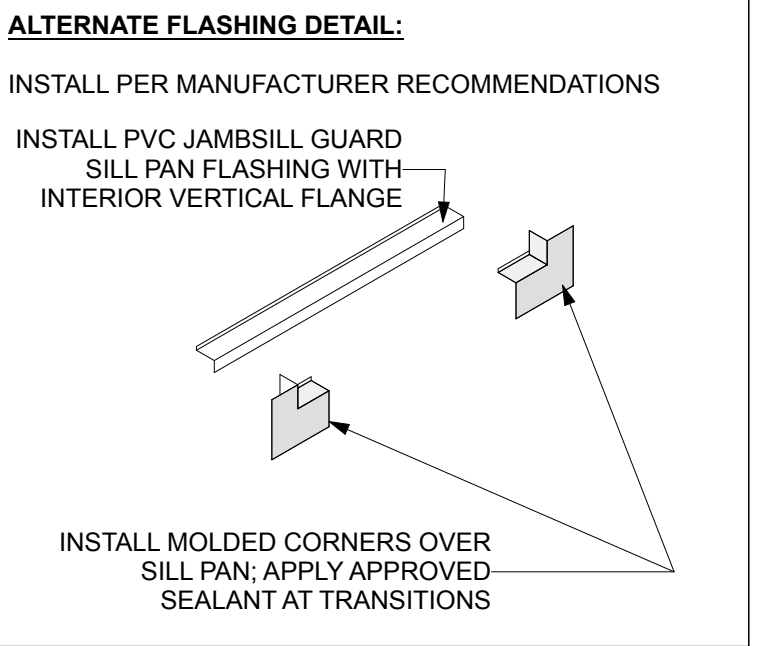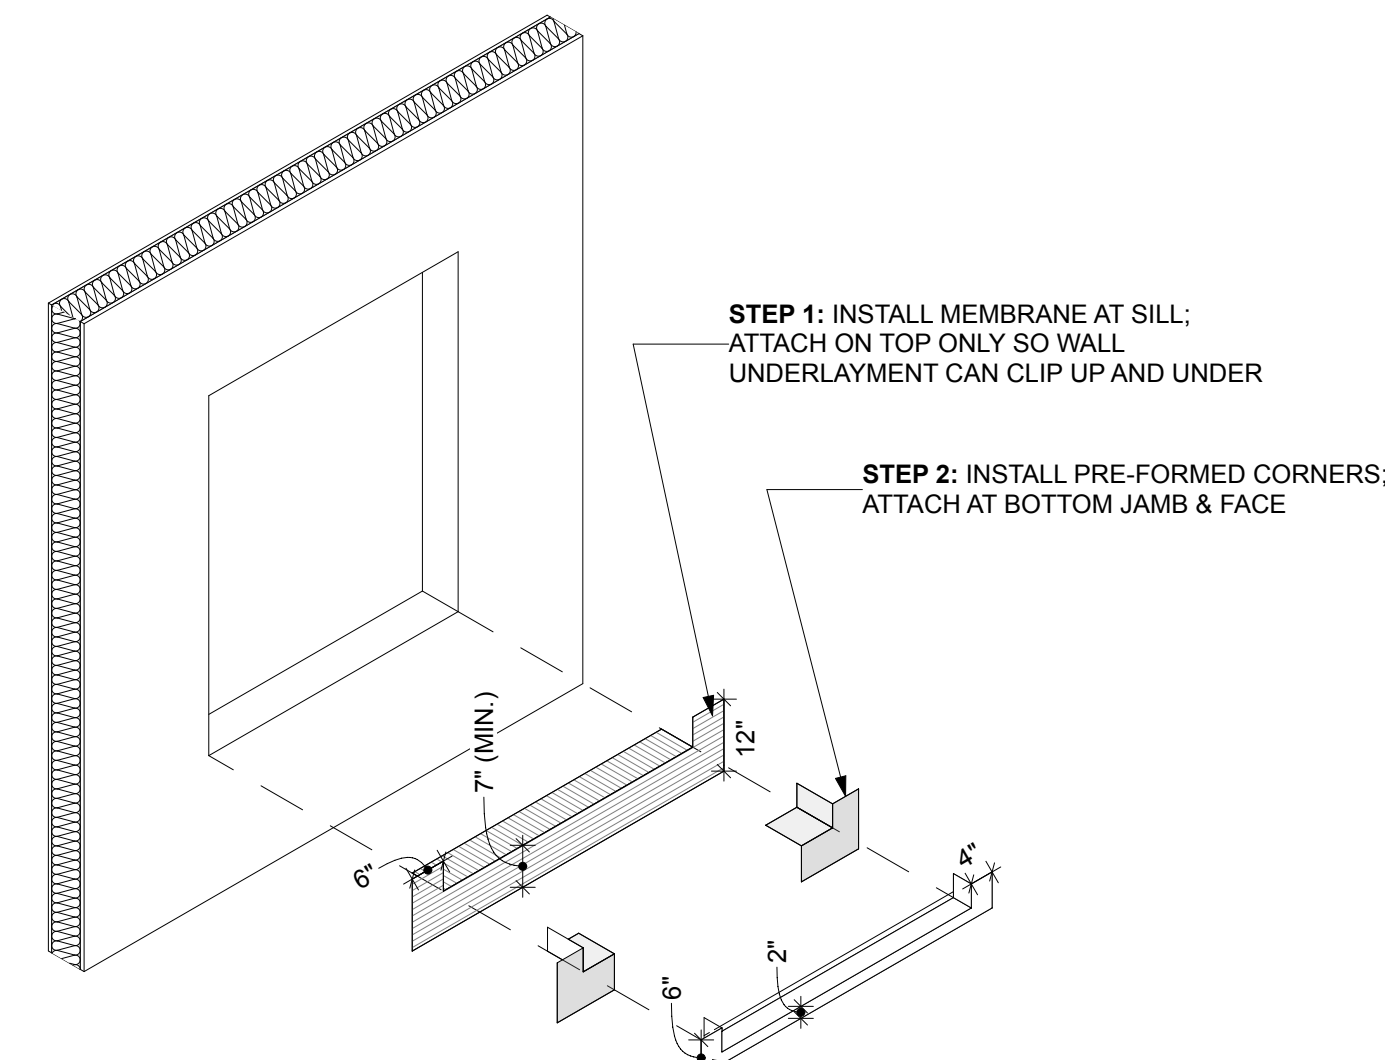
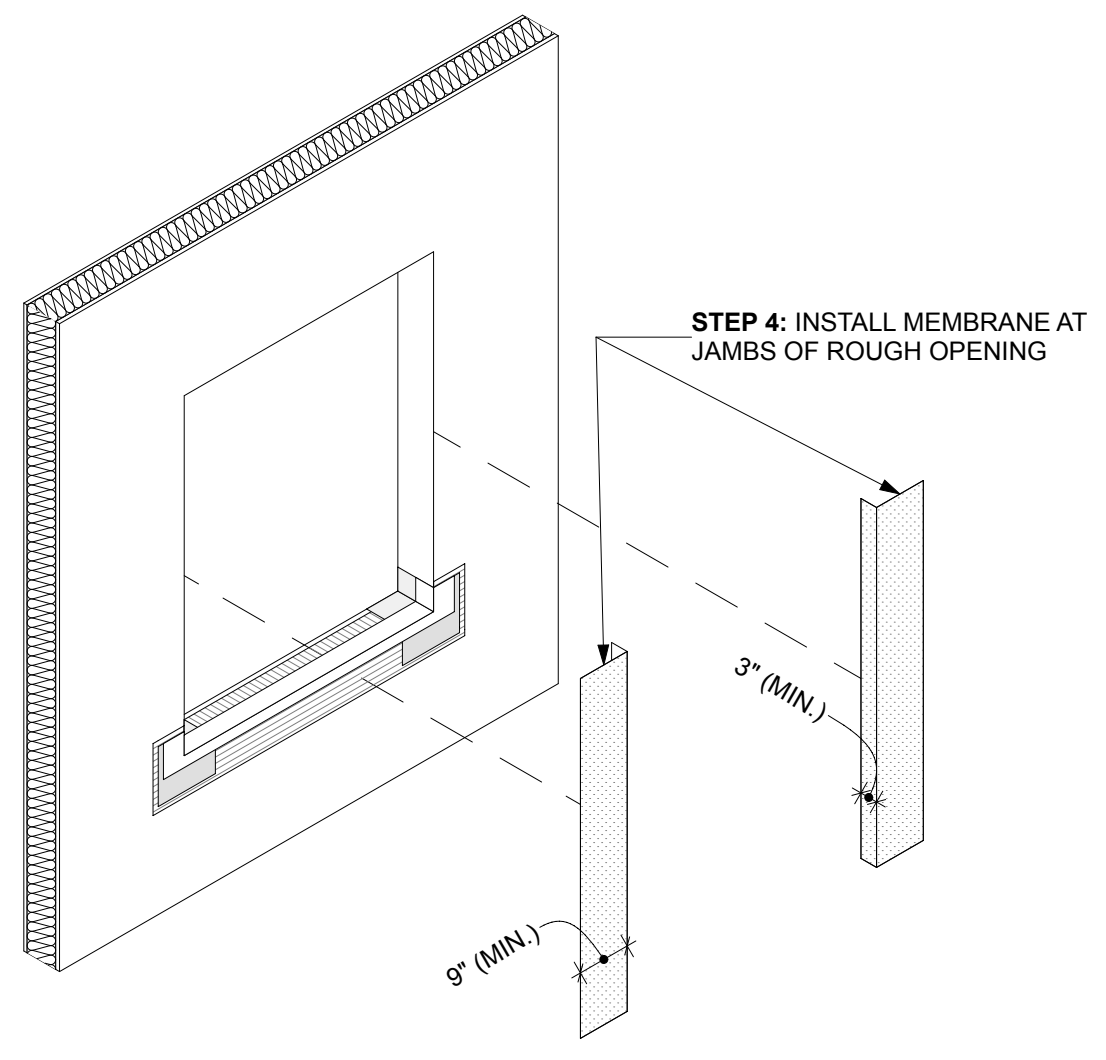
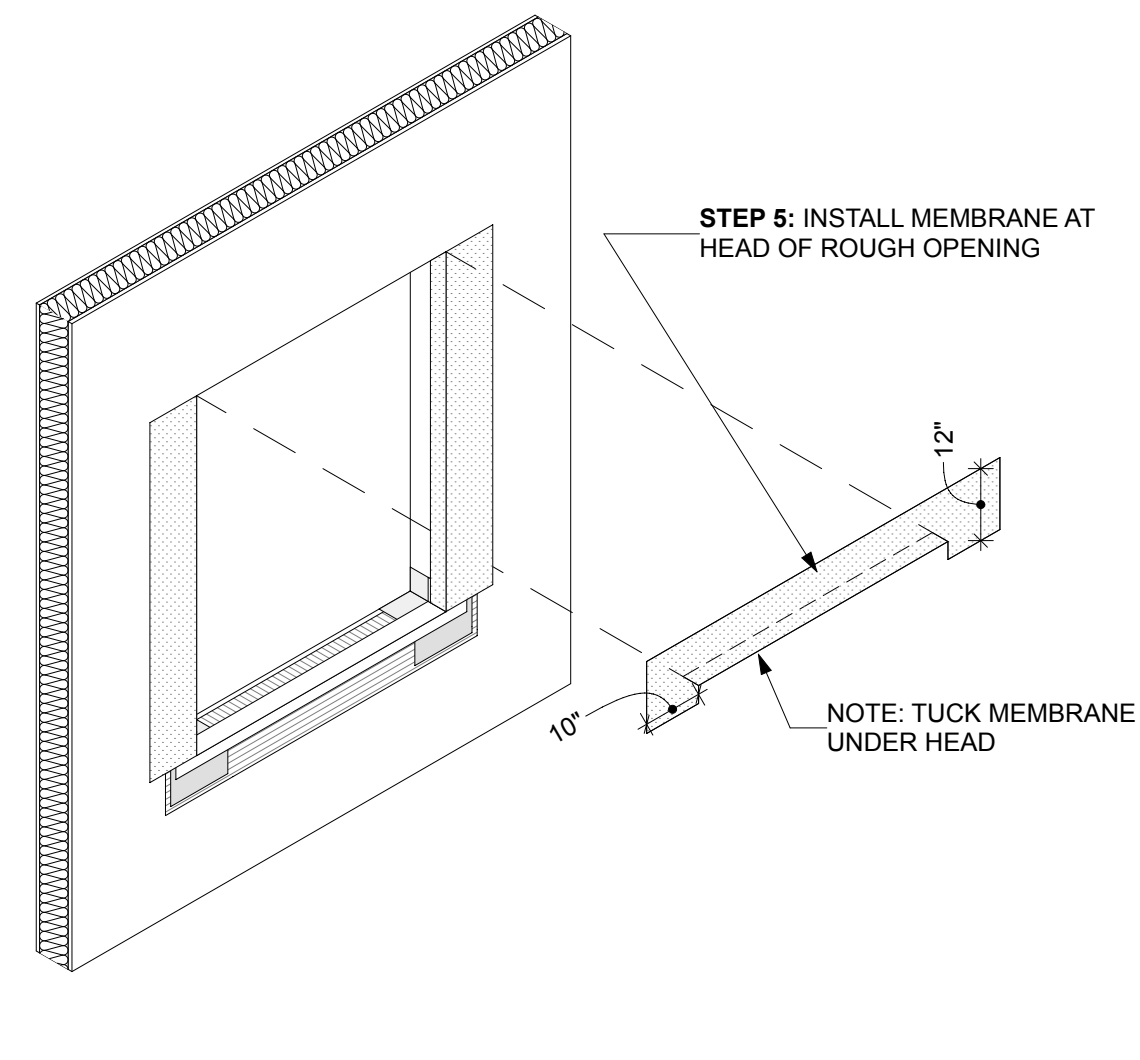
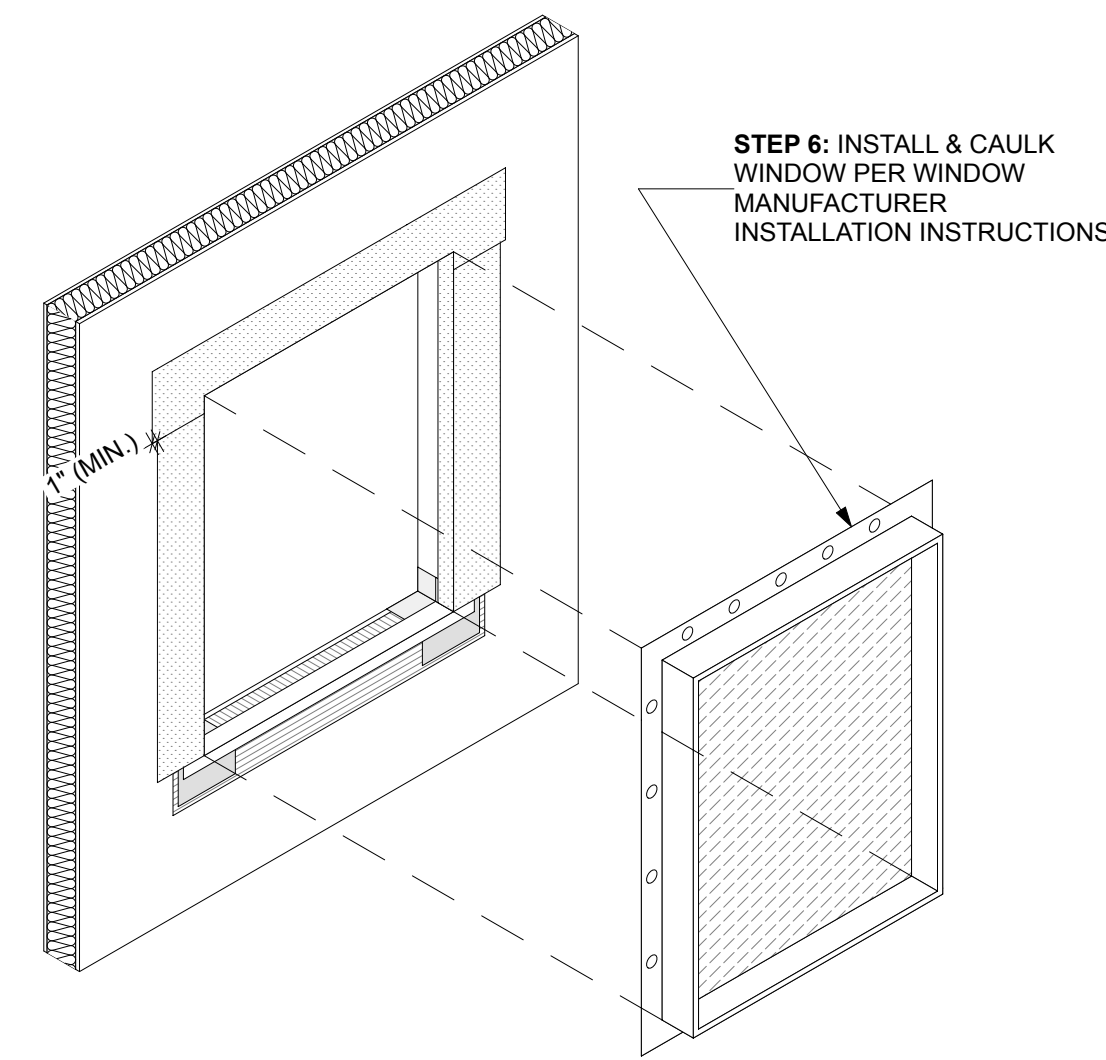


- SILL PLAN NOTES:**
1. ALL PANS AT MASONRY TO BE STAINLESS STEEL OR 24 GA GALV. PRE-FINISHED.
 2. RESIDENTIAL WINDOW WALL SYSTEMS TO HAVE ALUMINUM PANS & FLASHINGS PER DETAILS TO MATCH WINDOW FRAME COLORS.
 3. SEAL OR SOLDER JOINTS AT END- & BACK DAMS TO FORM A WATERTIGHT PAN ASSEMBLY. SEAL BACK TO END DAM TRANSITIONS.
 4. COORDINATE BACK DAM HEIGHT WITH THRESHOLD AND/OR INTERIOR FINISHES PER ARCH PLANS.
 5. PROVIDE HEMMED EDGE AT ALL EXPOSED EDGES.

- WRAP & WRB NOTE:**
1. FASTEN WINDOW / DOOR WRAP & WRB PER WATERPROOFING DETAILS PROVIDED HEREIN WITH STAINLESS STEEL STAPLES WITH 7/16" CROWNS
 2. WHERE STEEL STUD FRAMING OCCURS, USE APPROVED ADHESIVE TO PROPERLY ATTACHED WINDOW / DOOR WRAP THERE TO.
 3. WHERE CONCRETE SURFACES OCCUR, USE VAPROSHIELD SELF-ADHERING MEMBRANE FOR WINDOW / DOOR WRAPS AND WRB.

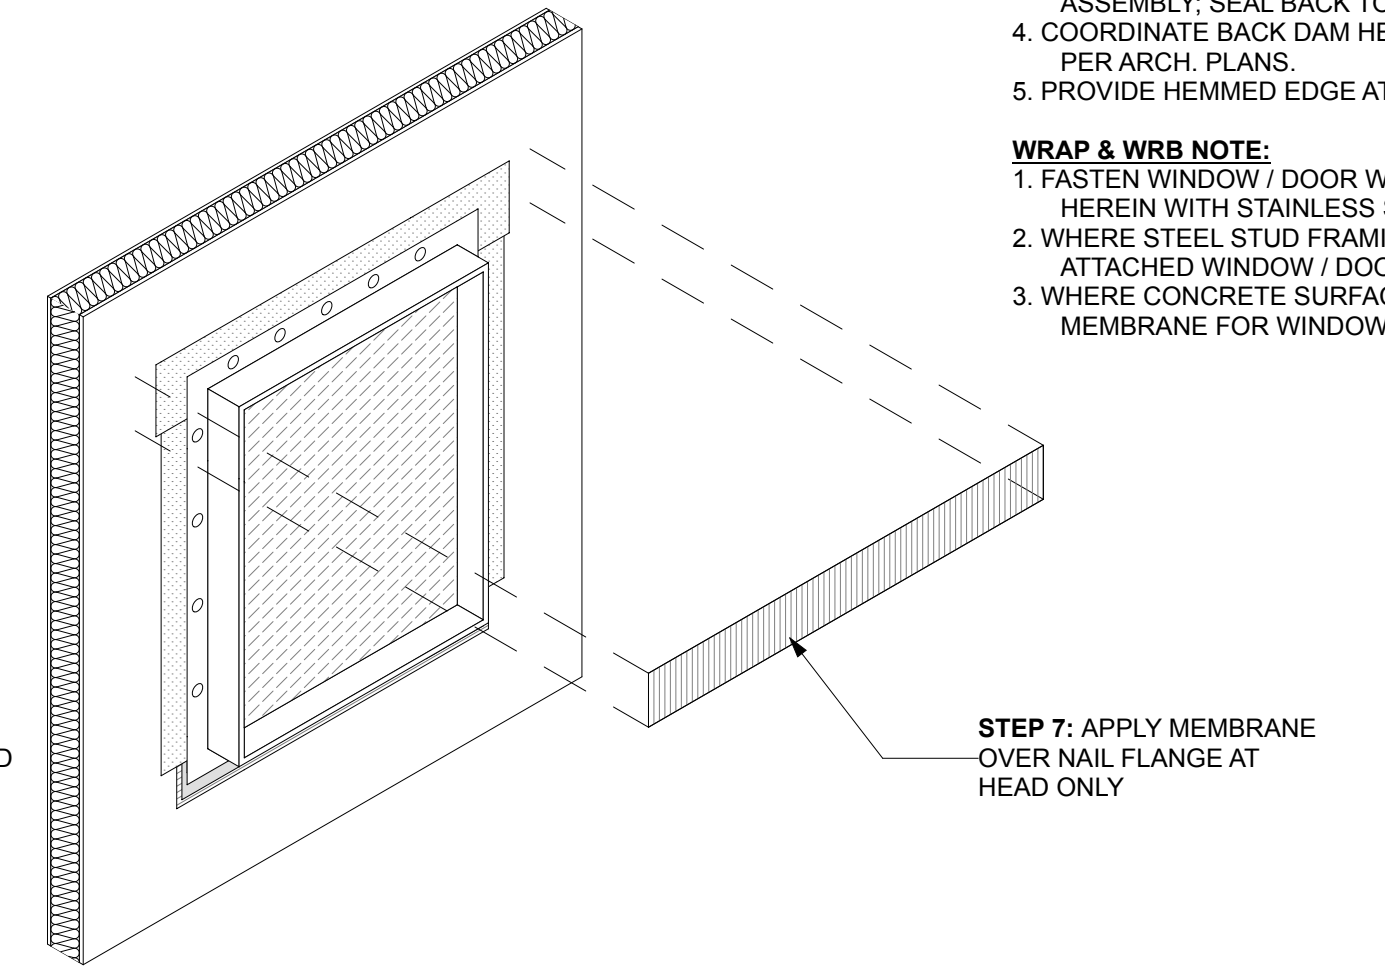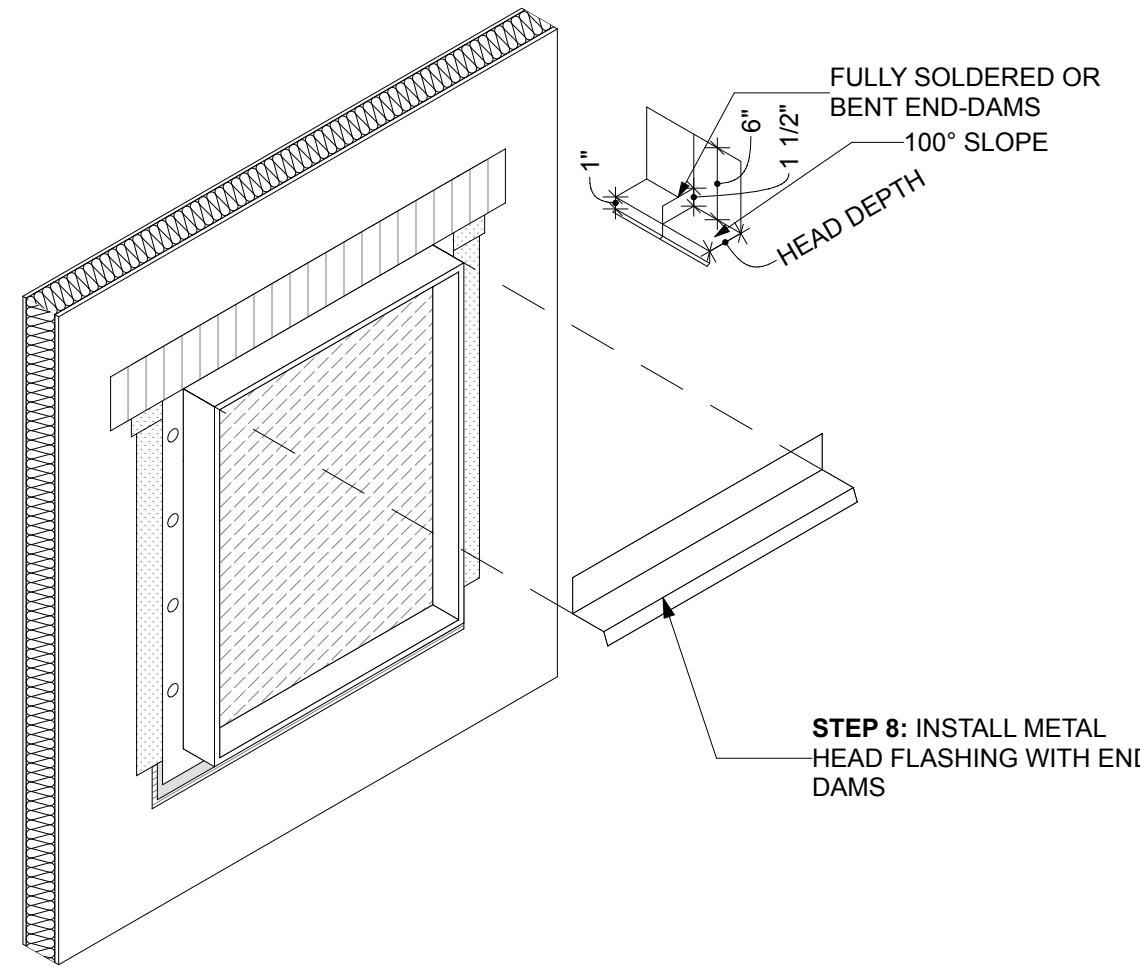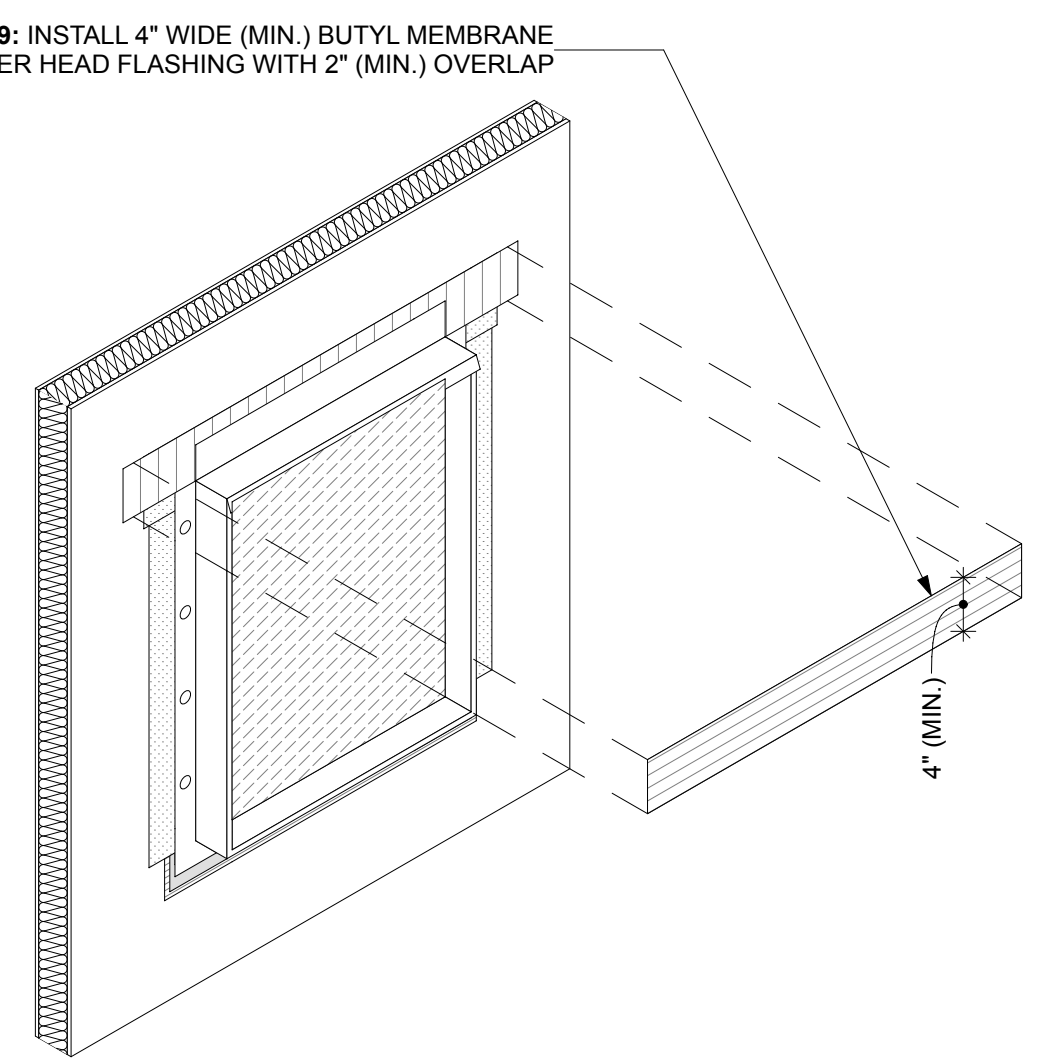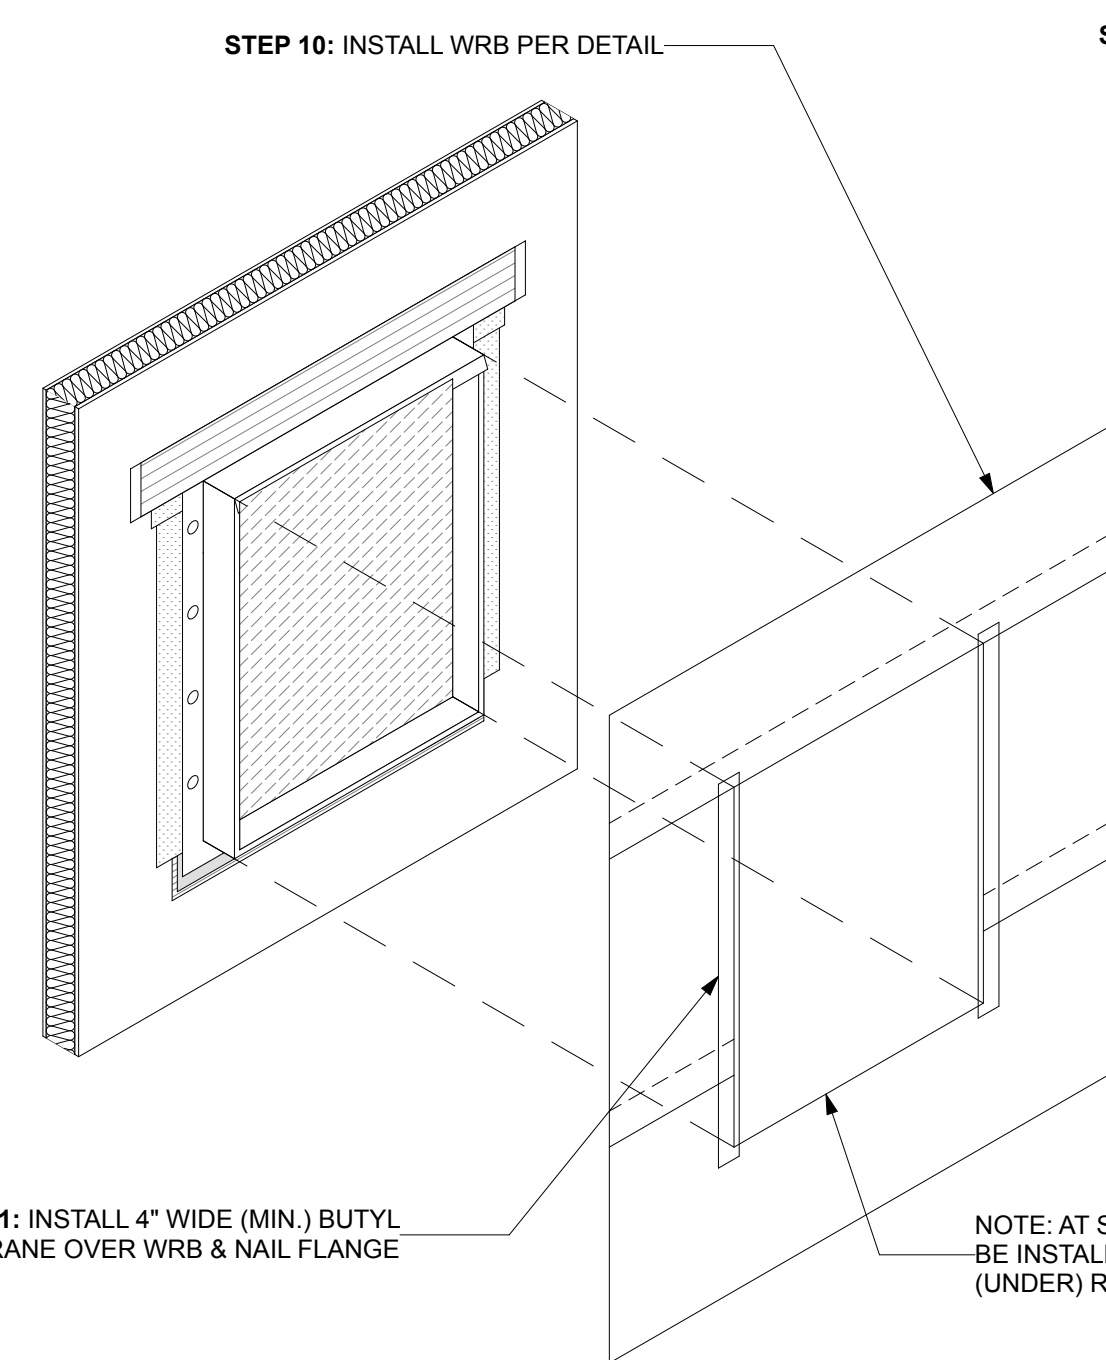


1 FLANGED WINDOW WRAP
 SCALE: 3/8" = 1'-0"

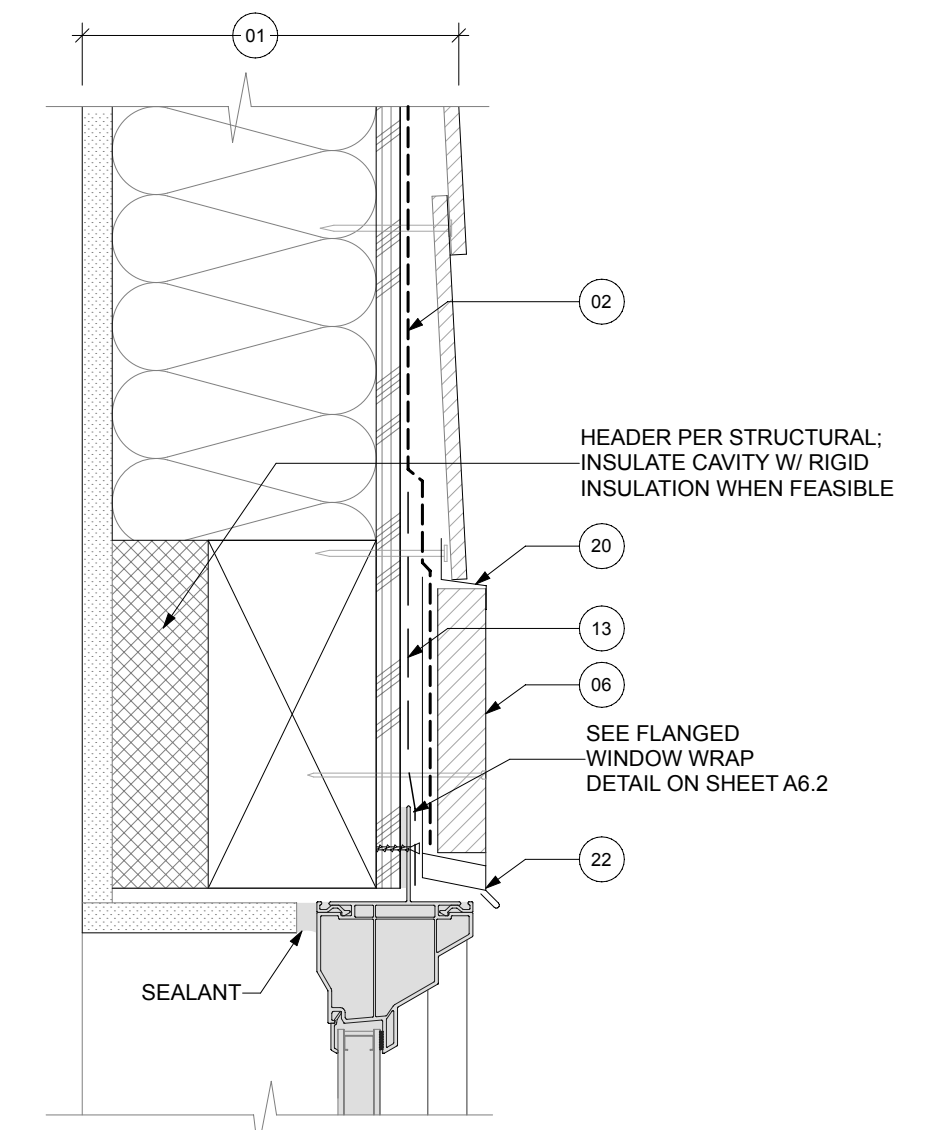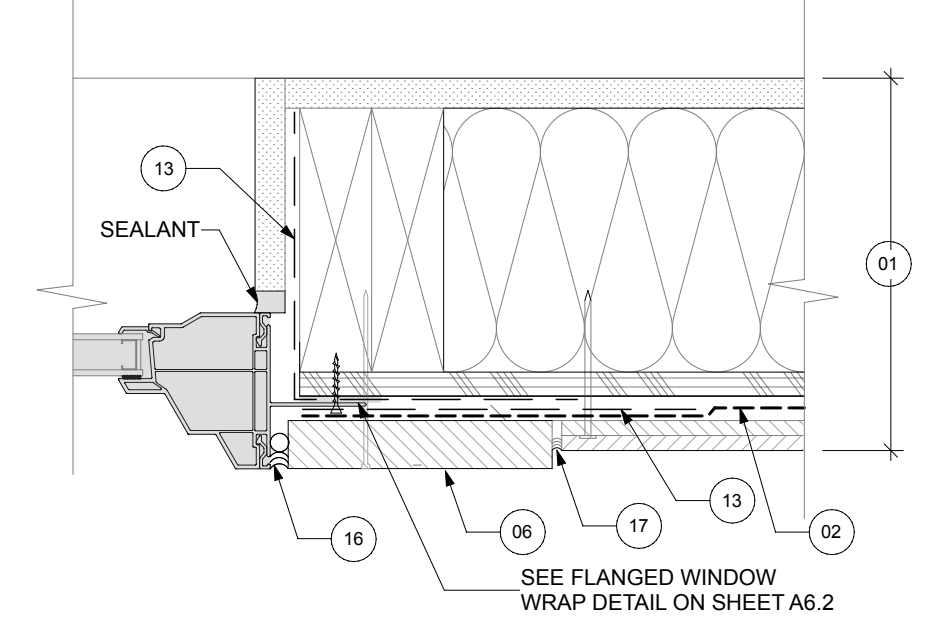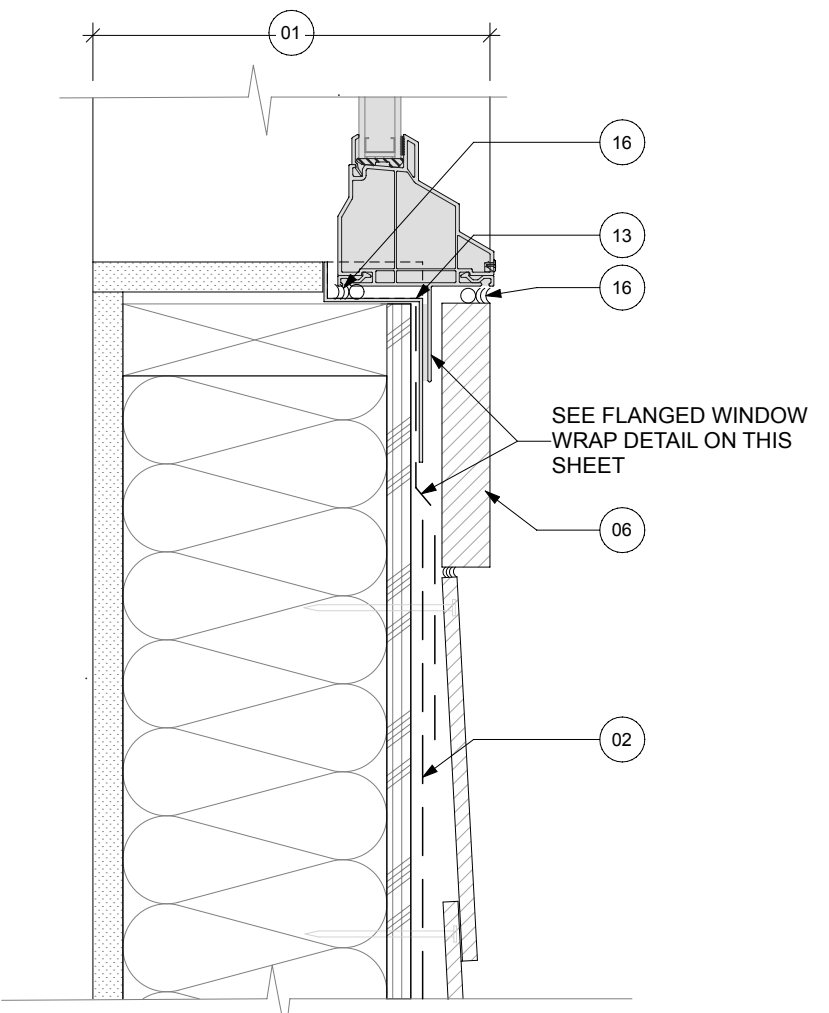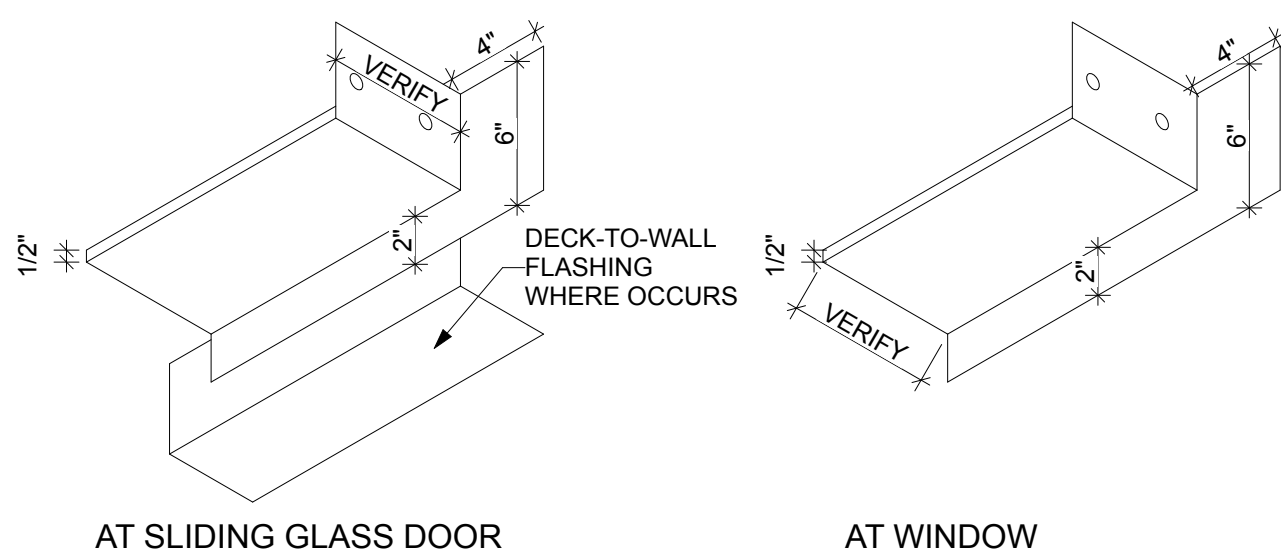

| REVISIONS |
|-----------|
| |
| |
| REVISIONS |
|-----------|
| |
| |
DRAWN BY: BL / CM
 CHECKED BY: BL
 DATE: 24.03.11
 TITLE: DETAILS
 PROJECT #: 2016
 SHEET:

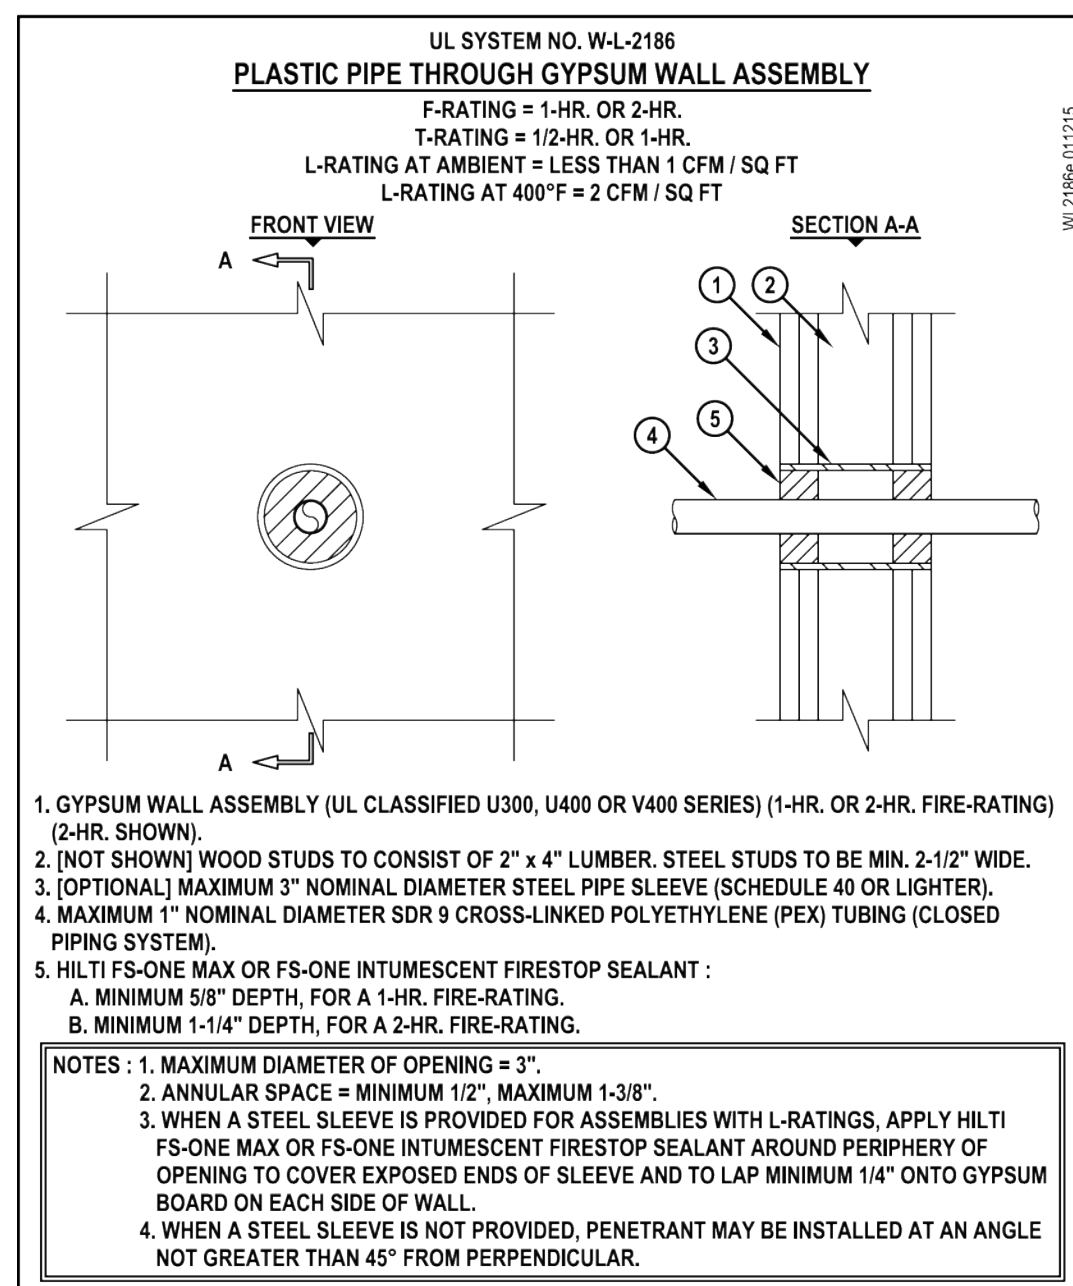


UL SYSTEM NO. WL-2186
PLASTIC PIPE THROUGH GYPSUM WALL ASSEMBLY
 F-RATING = 1-HR. OR 2-HR.
 T-RATING = 1-HR. OR 2-HR.
 L-RATING AT AMBIENT = LESS THAN 1 CFM / SQ FT
 L-RATING AT 400°F = 2 CFM / SQ FT

1. GYPSUM WALL ASSEMBLY (UL CLASSIFIED U300, U400 OR V400 SERIES) (1-HR. OR 2-HR. FIRE-RATING) (2-HR. SHOWN).
 2. [NOT SHOWN] WOOD STUDS TO CONSIST OF NOMINAL 2" x 4" LUMBER. STEEL STUDS TO BE MIN. 2-1/2" WIDE.
 3. [OPTIONAL] MAXIMUM 3" NOMINAL DIAMETER STEEL PIPE SLEEVE (SCHEDULE 40 OR LIGHTER).
 4. MAXIMUM 1" NOMINAL DIAMETER SDR 9 CROSS-LINKED POLYETHYLENE (PEX) TUBING (CLOSED PIPING SYSTEM).
 5. HILTI FS-ONE MAX OR FS-ONE INTUMESCENT FIRESTOP SEALANT:
 A. MINIMUM 5/8" DEPTH FOR A 1-HR. FIRE-RATING.
 B. MINIMUM 1-1/4" DEPTH FOR A 2-HR. FIRE-RATING.

NOTES: 1. MAXIMUM DIAMETER OF OPENING = 3".
 2. ANNULAR SPACE = MINIMUM 1/2", MAXIMUM 1-3/8".
 3. WHEN A STEEL SLEEVE IS PROVIDED FOR ASSEMBLIES WITH L-RATINGS, APPLY HILTI FS-ONE MAX OR FS-ONE INTUMESCENT FIRESTOP SEALANT AROUND PERIPHERY OF OPENING TO COVER EXPOSED ENDS OF SLEEVE AND TO LAP MINIMUM 1/4" ONTO GYPSUM BOARD ON EACH SIDE OF WALL.
 4. WHEN A STEEL SLEEVE IS NOT PROVIDED, PENETRANT MAY BE INSTALLED AT AN ANGLE NOT GREATER THAN 45° FROM PERPENDICULAR.

Hilti Firestop Systems HILTI, Inc. Tulsa, Oklahoma USA (800) 879-8000 Sheet 1 of 1 Scale 3/16" = 1" Drawing No. WL 2186e Date Jan. 12, 2015

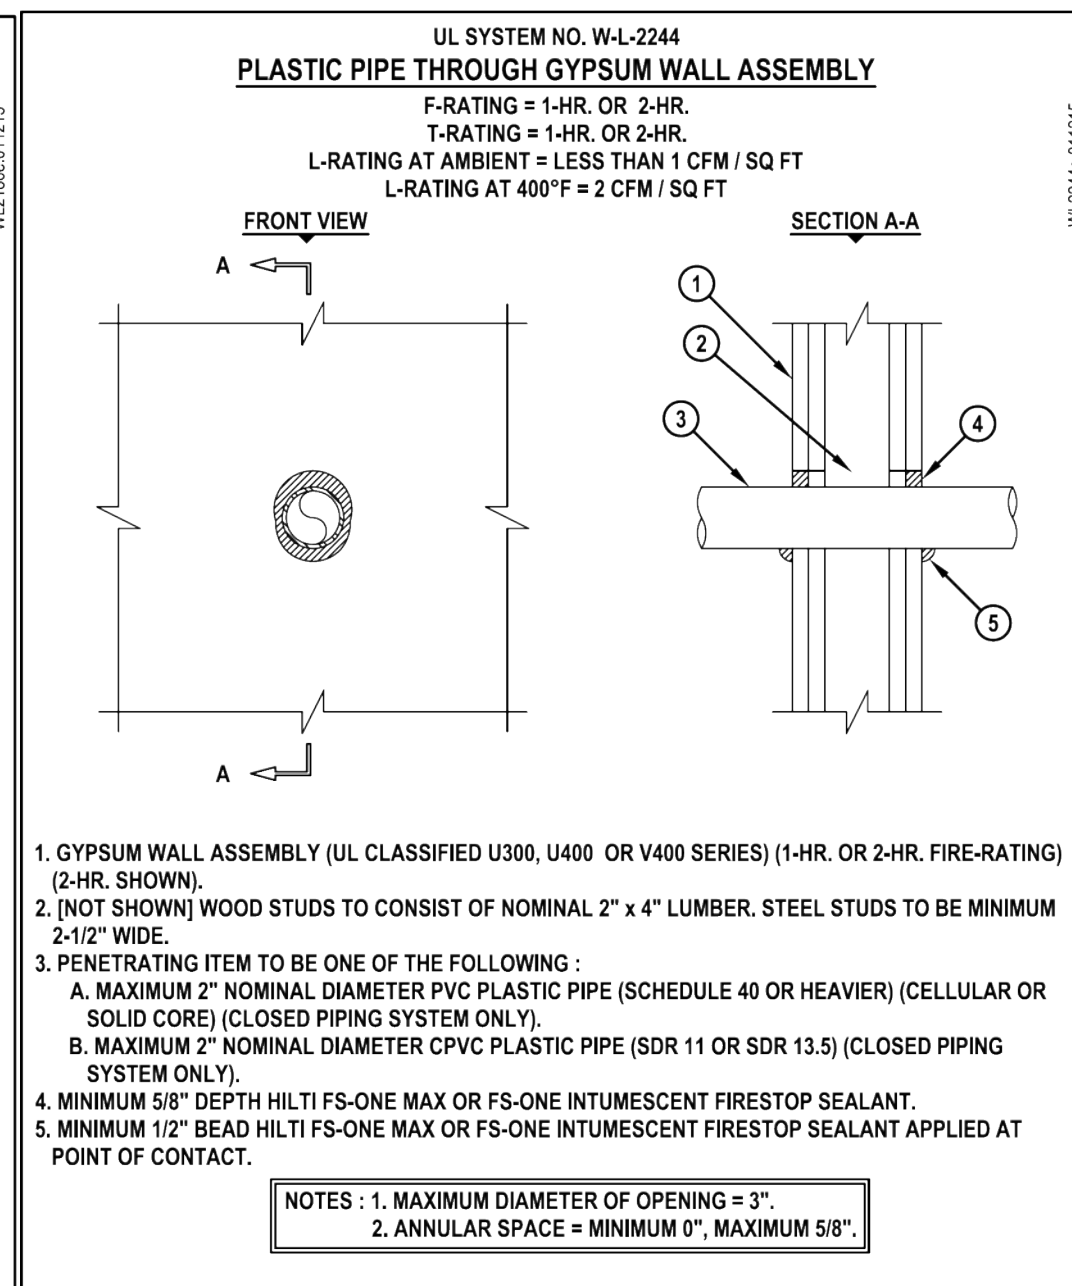


UL SYSTEM NO. WL-2244
PLASTIC PIPE THROUGH GYPSUM WALL ASSEMBLY
 F-RATING = 1-HR. OR 2-HR.
 T-RATING = 1-HR. OR 2-HR.
 L-RATING AT AMBIENT = LESS THAN 1 CFM / SQ FT
 L-RATING AT 400°F = 2 CFM / SQ FT

1. GYPSUM WALL ASSEMBLY (UL CLASSIFIED U300, U400 OR V400 SERIES) (1-HR. OR 2-HR. FIRE-RATING) (2-HR. SHOWN).
 2. [NOT SHOWN] WOOD STUDS TO CONSIST OF NOMINAL 2" x 4" LUMBER. STEEL STUDS TO BE MINIMUM 2-1/2" WIDE.
 3. PENETRATING ITEM TO BE ONE OF THE FOLLOWING:
 A. MAXIMUM 2" NOMINAL DIAMETER PVC PLASTIC PIPE (SCHEDULE 40 OR HEAVIER) (CELLULAR OR SOLID CORE) (CLOSED PIPING SYSTEM ONLY).
 B. MAXIMUM 2" NOMINAL DIAMETER CPVC PLASTIC PIPE (SDR 11 OR SDR 13.5) (CLOSED PIPING SYSTEM ONLY).
 4. MINIMUM 5/8" DEPTH HILTI FS-ONE MAX OR FS-ONE INTUMESCENT FIRESTOP SEALANT.
 5. MINIMUM 1/2" BEAD HILTI FS-ONE MAX OR FS-ONE INTUMESCENT FIRESTOP SEALANT APPLIED AT POINT OF CONTACT.

NOTES: 1. MAXIMUM DIAMETER OF OPENING = 3".
 2. ANNULAR SPACE = MINIMUM 0", MAXIMUM 5/8".

Hilti Firestop Systems HILTI, Inc. Tulsa, Oklahoma USA (800) 879-8000 Sheet 1 of 1 Scale 3/16" = 1" Drawing No. WL 2244e Date Jan. 12, 2015

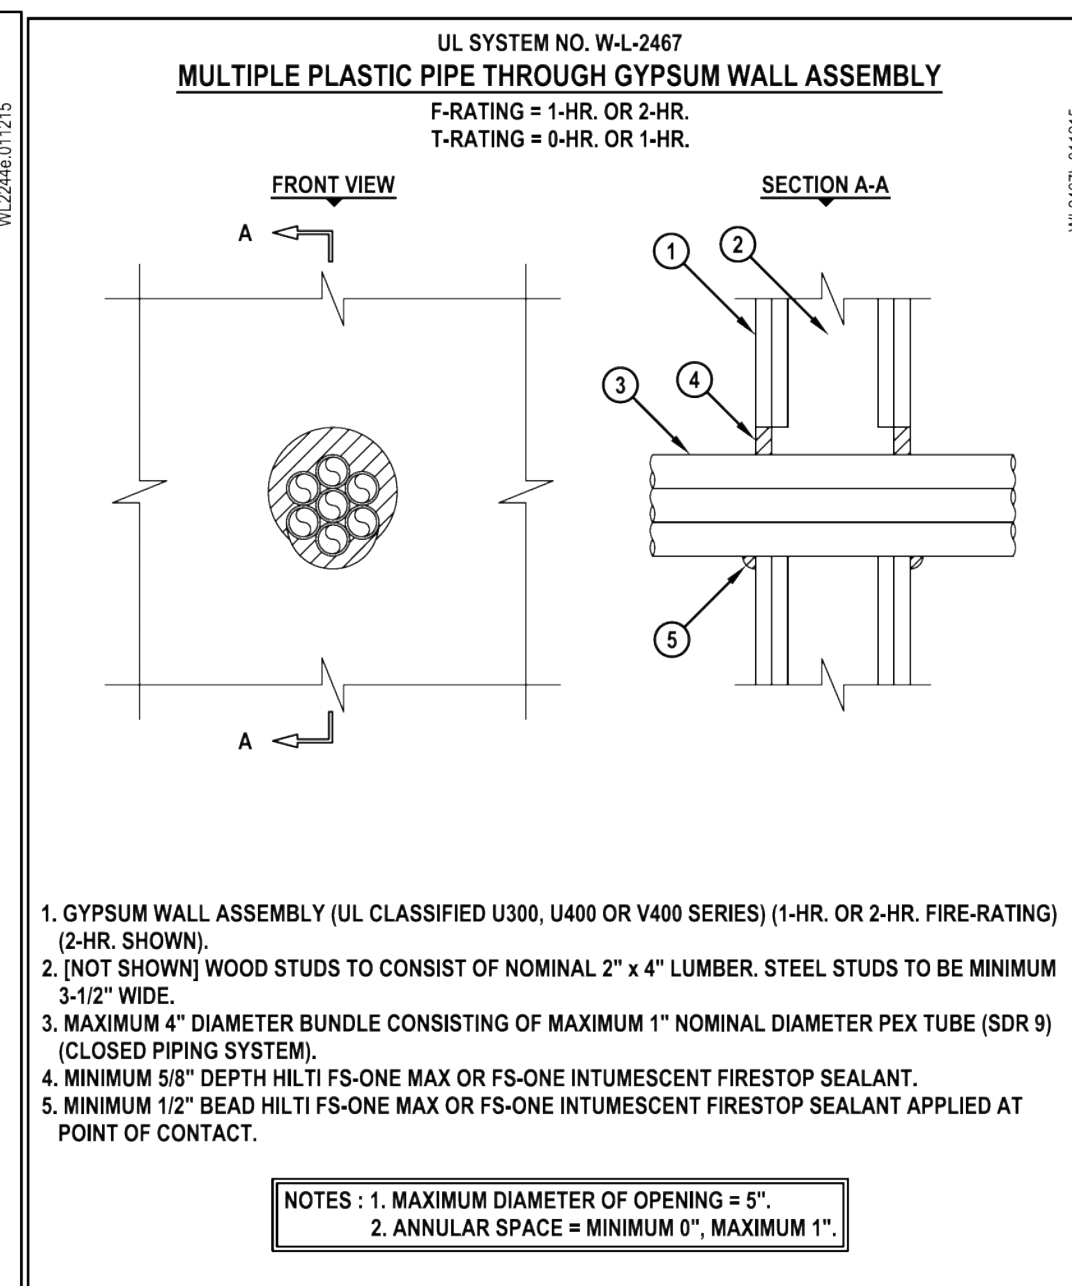


UL SYSTEM NO. WL-2467
MULTIPLE PLASTIC PIPE THROUGH GYPSUM WALL ASSEMBLY
 F-RATING = 1-HR. OR 2-HR.
 T-RATING = 1-HR. OR 2-HR.
 L-RATING AT AMBIENT = LESS THAN 1 CFM / SQ FT
 L-RATING AT 400°F = 4 CFM / SQ FT

1. GYPSUM WALL ASSEMBLY (UL CLASSIFIED U300, U400 OR V400 SERIES) (1-HR. OR 2-HR. FIRE-RATING) (2-HR. SHOWN).
 2. [NOT SHOWN] WOOD STUDS TO CONSIST OF NOMINAL 2" x 4" LUMBER. STEEL STUDS TO BE MINIMUM 3-1/2" WIDE.
 3. MAXIMUM 4" DIAMETER BUNDLE CONSISTING OF MAXIMUM 1" NOMINAL DIAMETER PEX TUBE (SDR 9) (CLOSED PIPING SYSTEM).
 4. MINIMUM 5/8" DEPTH HILTI FS-ONE MAX OR FS-ONE INTUMESCENT FIRESTOP SEALANT.
 5. MINIMUM 1/2" BEAD HILTI FS-ONE MAX OR FS-ONE INTUMESCENT FIRESTOP SEALANT APPLIED AT POINT OF CONTACT.

NOTES: 1. MAXIMUM DIAMETER OF OPENING = 5".
 2. ANNULAR SPACE = MINIMUM 0", MAXIMUM 1".

Hilti Firestop Systems HILTI, Inc. Tulsa, Oklahoma USA (800) 879-8000 Sheet 1 of 1 Scale 3/16" = 1" Drawing No. WL 2467b Date Jan. 12, 2015

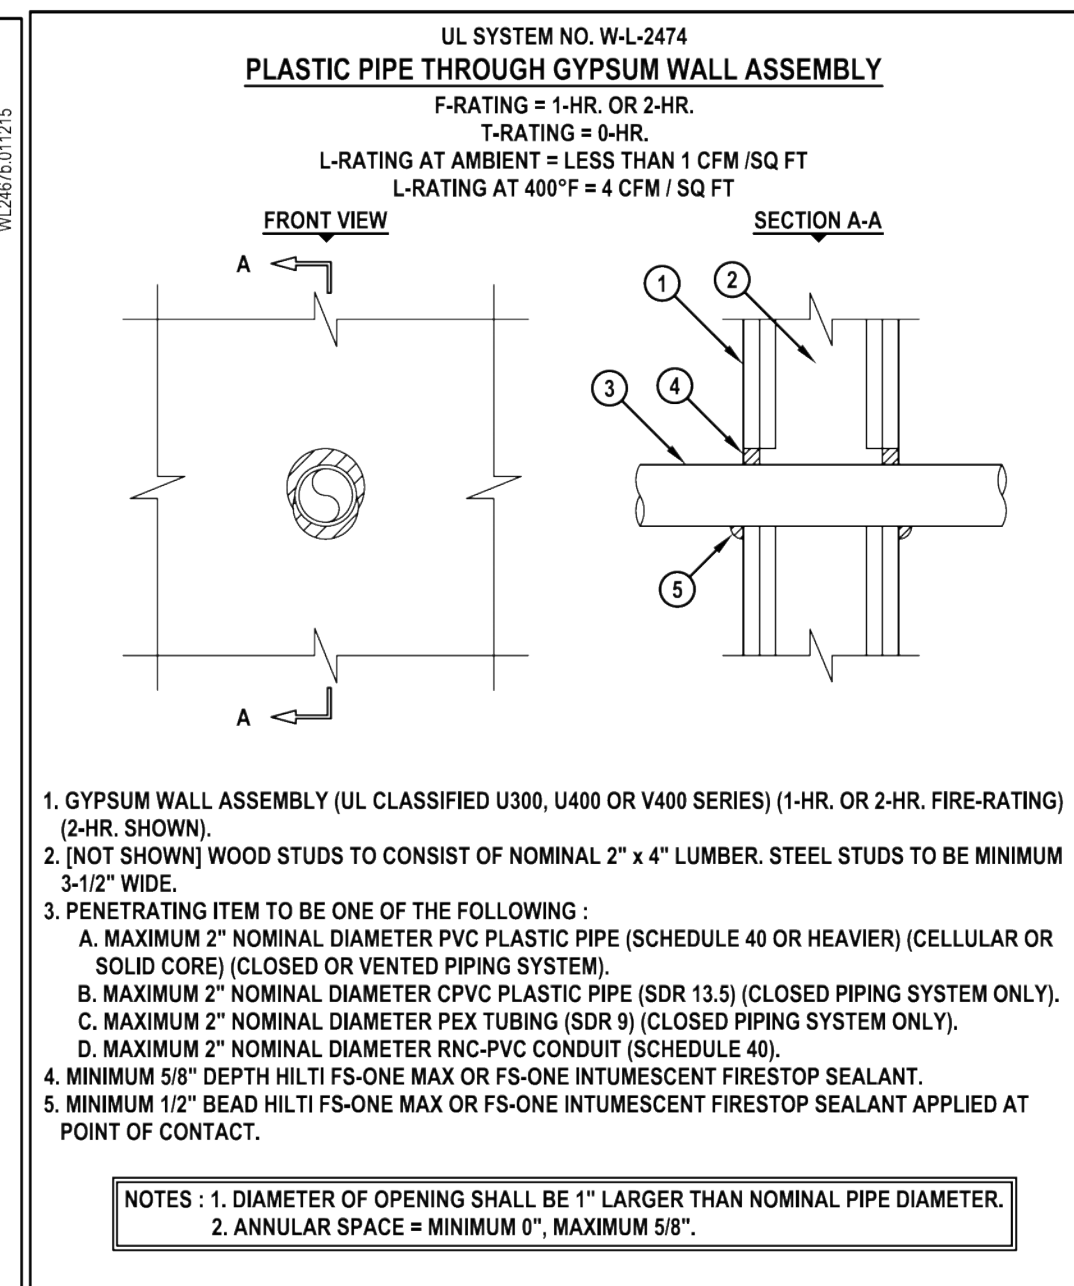


UL SYSTEM NO. WL-2474
PLASTIC PIPE THROUGH GYPSUM WALL ASSEMBLY
 F-RATING = 1-HR. OR 2-HR.
 T-RATING = 1-HR. OR 2-HR.
 L-RATING AT AMBIENT = LESS THAN 1 CFM / SQ FT
 L-RATING AT 400°F = 4 CFM / SQ FT

1. GYPSUM WALL ASSEMBLY (UL CLASSIFIED U300, U400 OR V400 SERIES) (1-HR. OR 2-HR. FIRE-RATING) (2-HR. SHOWN).
 2. [NOT SHOWN] WOOD STUDS TO CONSIST OF NOMINAL 2" x 4" LUMBER. STEEL STUDS TO BE MINIMUM 3-1/2" WIDE.
 3. PENETRATING ITEM TO BE ONE OF THE FOLLOWING:
 A. MAXIMUM 2" NOMINAL DIAMETER PVC PLASTIC PIPE (SCHEDULE 40 OR HEAVIER) (CELLULAR OR SOLID CORE) (CLOSED OR VENTED PIPING SYSTEM).
 B. MAXIMUM 2" NOMINAL DIAMETER CPVC PLASTIC PIPE (SDR 13.5) (CLOSED PIPING SYSTEM ONLY).
 C. MAXIMUM 2" NOMINAL DIAMETER PEX TUBING (SDR 9) (CLOSED PIPING SYSTEM ONLY).
 D. MAXIMUM 2" NOMINAL DIAMETER RNC-PVC CONDUIT (SCHEDULE 40).
 4. MINIMUM 5/8" DEPTH HILTI FS-ONE MAX OR FS-ONE INTUMESCENT FIRESTOP SEALANT.
 5. MINIMUM 1/2" BEAD HILTI FS-ONE MAX OR FS-ONE INTUMESCENT FIRESTOP SEALANT APPLIED AT POINT OF CONTACT.

NOTES: 1. DIAMETER OF OPENING SHALL BE 1" LARGER THAN NOMINAL PIPE DIAMETER.
 2. ANNULAR SPACE = MINIMUM 0", MAXIMUM 5/8".

Hilti Firestop Systems HILTI, Inc. Tulsa, Oklahoma USA (800) 879-8000 Sheet 1 of 1 Scale 3/16" = 1" Drawing No. WL 2474d Date Jan. 12, 2015

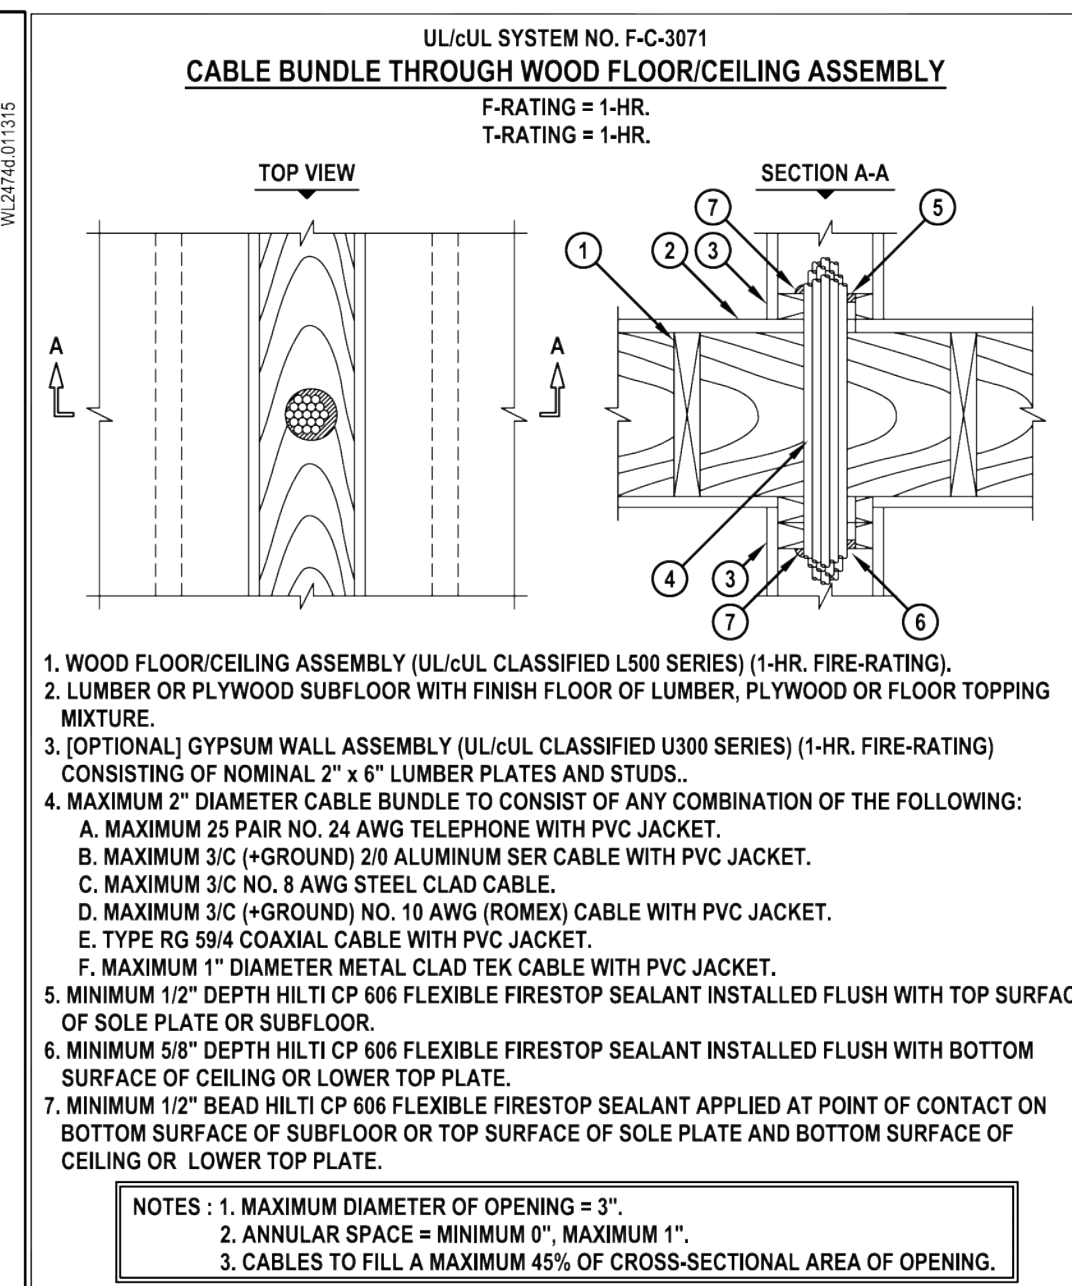


UL/CUL SYSTEM NO. FC-3071
CABLE BUNDLE THROUGH WOOD FLOOR/CEILING ASSEMBLY
 F-RATING = 1-HR.
 T-RATING = 1-HR.

1. WOOD FLOOR/CEILING ASSEMBLY (UL/CUL CLASSIFIED L500 SERIES) (1-HR. FIRE-RATING).
 2. LUMBER OR PLYWOOD SUBFLOOR WITH FINISH FLOOR OF LUMBER, PLYWOOD OR FLOOR TOPPING MIXTURE.
 3. [OPTIONAL] GYPSUM WALL ASSEMBLY (UL/CUL CLASSIFIED U300 SERIES) (1-HR. FIRE-RATING) CONSISTING OF NOMINAL 2" x 4" LUMBER PLATES AND STUDS.
 4. MAXIMUM 2" DIAMETER CABLE BUNDLE TO CONSIST OF ANY COMBINATION OF THE FOLLOWING:
 A. MAXIMUM 25 PAIR NO. 24 AWG TELEPHONE CABLE WITH PVC JACKET.
 B. MAXIMUM 3/C (+GROUND) 20 ALUMINUM SER CABLE WITH PVC JACKET.
 C. MAXIMUM 3/C NO. 8 AWG STEEL CLAD CABLE.
 D. MAXIMUM 3/C (+GROUND) NO. 10 AWG (ROMEX) CABLE WITH PVC JACKET.
 E. TYPE RG 59/4 COAXIAL CABLE WITH PVC JACKET.
 F. MAXIMUM 1" DIAMETER METAL CLAD TEB CABLE WITH PVC JACKET.
 5. MINIMUM 1/2" DEPTH HILTI CP 606 FLEXIBLE FIRESTOP SEALANT INSTALLED FLUSH WITH TOP SURFACE OF SOLE PLATE OR SUBFLOOR.
 6. MINIMUM 5/8" DEPTH HILTI CP 606 FLEXIBLE FIRESTOP SEALANT INSTALLED FLUSH WITH BOTTOM SURFACE OF CEILING OR LOWER TOP PLATE.
 7. MINIMUM 1/2" BEAD HILTI CP 606 FLEXIBLE FIRESTOP SEALANT APPLIED AT POINT OF CONTACT ON BOTTOM SURFACE OF SUBFLOOR OR TOP SURFACE OF SOLE PLATE AND BOTTOM SURFACE OF CEILING OR LOWER TOP PLATE.

NOTES: 1. MAXIMUM DIAMETER OF OPENING = 3".
 2. ANNULAR SPACE = MINIMUM 0", MAXIMUM 1".
 3. CABLES TO FILL A MAXIMUM 45% OF CROSS-SECTIONAL AREA OF OPENING.

Hilti Firestop Systems HILTI, Inc. Tulsa, Oklahoma USA (800) 879-8000 Sheet 1 of 1 Scale 1/8" = 1" Drawing No. FC 3071d Date Sep. 27, 2007

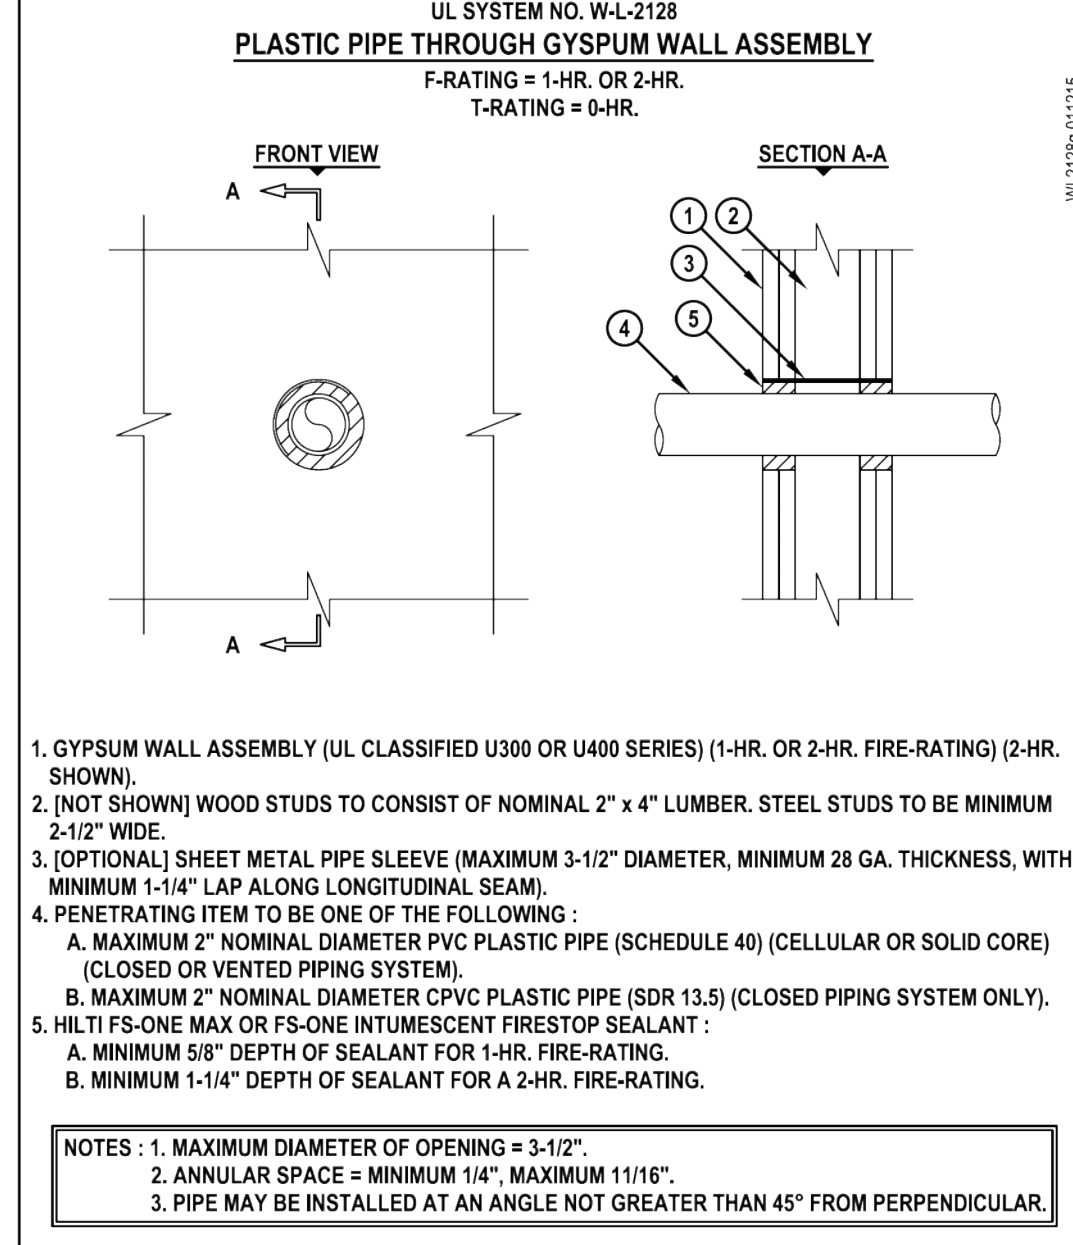


UL SYSTEM NO. WL-2128
PLASTIC PIPE THROUGH GYPSUM WALL ASSEMBLY
 F-RATING = 1-HR. OR 2-HR.
 T-RATING = 1-HR. OR 2-HR.

1. GYPSUM WALL ASSEMBLY (UL CLASSIFIED U300 OR U400 SERIES) (1-HR. OR 2-HR. FIRE-RATING) (2-HR. SHOWN).
 2. [NOT SHOWN] WOOD STUDS TO CONSIST OF NOMINAL 2" x 4" LUMBER. STEEL STUDS TO BE MINIMUM 2-1/2" WIDE.
 3. [OPTIONAL] SHEET METAL PIPE SLEEVE (MAXIMUM 3-1/2" DIAMETER, MINIMUM 28 GA. THICKNESS, WITH MINIMUM 1-1/4" LAP ALONG LONGITUDINAL SEAM).
 4. PENETRATING ITEM TO BE ONE OF THE FOLLOWING:
 A. MAXIMUM 2" NOMINAL DIAMETER PVC PLASTIC PIPE (SCHEDULE 40) (CELLULAR OR SOLID CORE) (CLOSED OR VENTED PIPING SYSTEM).
 B. MAXIMUM 2" NOMINAL DIAMETER CPVC PLASTIC PIPE (SDR 13.5) (CLOSED PIPING SYSTEM ONLY).
 5. HILTI FS-ONE MAX OR FS-ONE INTUMESCENT FIRESTOP SEALANT:
 A. MINIMUM 5/8" DEPTH OF SEALANT FOR 1-HR. FIRE-RATING.
 B. MINIMUM 1-1/4" DEPTH OF SEALANT FOR 2-HR. FIRE-RATING.

NOTES: 1. MAXIMUM DIAMETER OF OPENING = 3-1/2".
 2. ANNULAR SPACE = MINIMUM 1/4", MAXIMUM 11/16".
 3. PIPE MAY BE INSTALLED AT AN ANGLE NOT GREATER THAN 45° FROM PERPENDICULAR.

Hilti Firestop Systems HILTI, Inc. Tulsa, Oklahoma USA (800) 879-8000 Sheet 1 of 1 Scale 3/16" = 1" Drawing No. WL 2128g Date Jan. 12, 2015

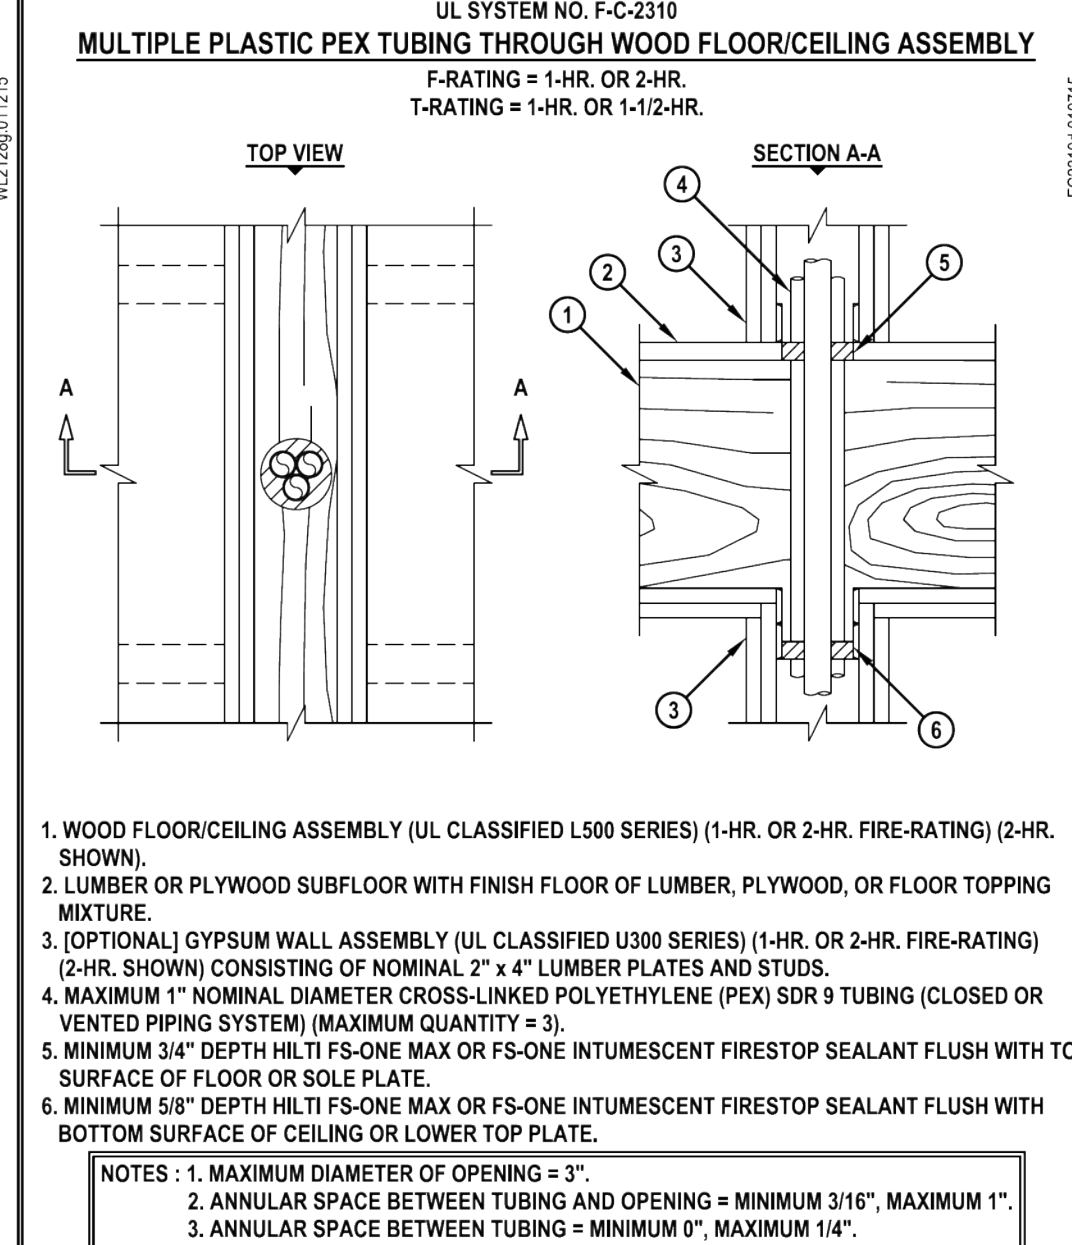


UL SYSTEM NO. FC-2310
MULTIPLE PLASTIC PEX TUBING THROUGH WOOD FLOOR/CEILING ASSEMBLY
 F-RATING = 1-HR. OR 2-HR.
 T-RATING = 1-HR. OR 2-HR.

1. WOOD FLOOR/CEILING ASSEMBLY (UL CLASSIFIED L500 SERIES) (1-HR. OR 2-HR. FIRE-RATING) (2-HR. SHOWN).
 2. LUMBER OR PLYWOOD SUBFLOOR WITH FINISH FLOOR OF LUMBER, PLYWOOD, OR FLOOR TOPPING MIXTURE.
 3. [OPTIONAL] GYPSUM WALL ASSEMBLY (UL CLASSIFIED U300 SERIES) (1-HR. OR 2-HR. FIRE-RATING) (2-HR. SHOWN) CONSISTING OF NOMINAL 2" x 4" LUMBER PLATES AND STUDS.
 4. MAXIMUM 1" NOMINAL DIAMETER CROSS-LINKED POLYETHYLENE (PEX) SDR 9 TUBING (CLOSED OR VENTED PIPING SYSTEM) (MAXIMUM QUANTITY = 3).
 5. MINIMUM 3/4" DEPTH HILTI FS-ONE MAX OR FS-ONE INTUMESCENT FIRESTOP SEALANT FLUSH WITH TOP SURFACE OF FLOOR OR SOLE PLATE.
 6. MINIMUM 5/8" DEPTH HILTI FS-ONE MAX OR FS-ONE INTUMESCENT FIRESTOP SEALANT FLUSH WITH BOTTOM SURFACE OF CEILING OR LOWER TOP PLATE.

NOTES: 1. MAXIMUM DIAMETER OF OPENING = 3".
 2. ANNULAR SPACE BETWEEN TUBING AND OPENING = MINIMUM 3/16", MAXIMUM 1".
 3. ANNULAR SPACE BETWEEN TUBING = MINIMUM 0", MAXIMUM 1/4".

Hilti Firestop Systems HILTI, Inc. Tulsa, Oklahoma USA (800) 879-8000 Sheet 1 of 1 Scale 1/16" = 1" Drawing No. FC 2310d Date Jan. 07, 2015

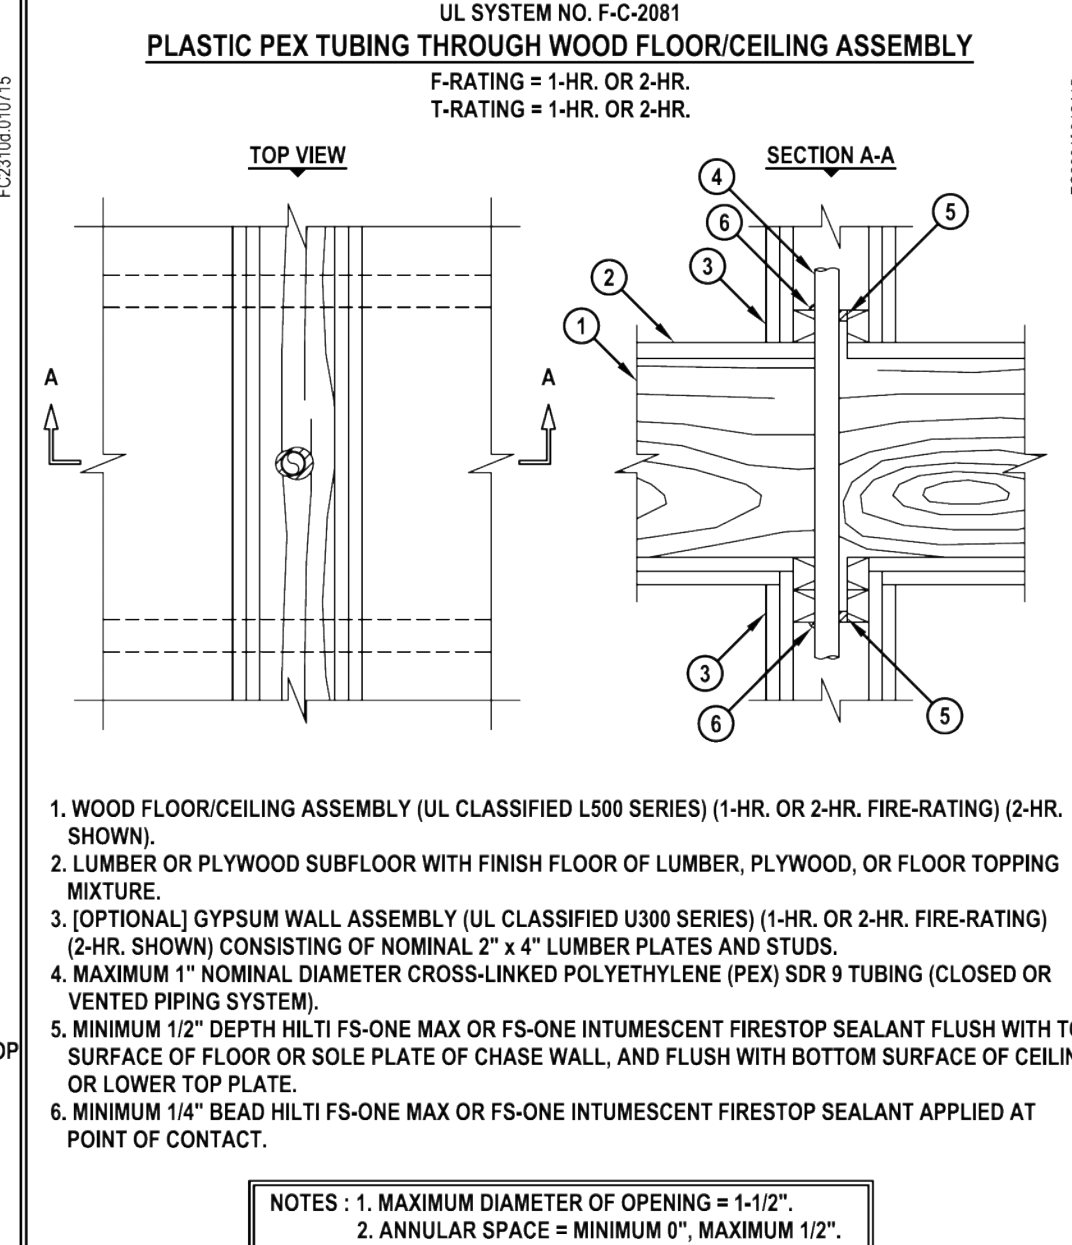

UL SYSTEM NO. FC-2081
PLASTIC PEX TUBING THROUGH WOOD FLOOR/CEILING ASSEMBLY
 F-RATING = 1-HR. OR 2-HR.
 T-RATING = 1-HR. OR 2-HR.

1. WOOD FLOOR/CEILING ASSEMBLY (UL CLASSIFIED L500 SERIES) (1-HR. OR 2-HR. FIRE-RATING) (2-HR. SHOWN).
 2. LUMBER OR PLYWOOD SUBFLOOR WITH FINISH FLOOR OF LUMBER, PLYWOOD, OR FLOOR TOPPING MIXTURE.
 3. [OPTIONAL] GYPSUM WALL ASSEMBLY (UL CLASSIFIED U300 SERIES) (1-HR. OR 2-HR. FIRE-RATING) (2-HR. SHOWN) CONSISTING OF NOMINAL 2" x 4" LUMBER PLATES AND STUDS.
 4. MAXIMUM 1" NOMINAL DIAMETER CROSS-LINKED POLYETHYLENE (PEX) SDR 9 TUBING (CLOSED OR VENTED PIPING SYSTEM).
 5. MINIMUM 1/2" DEPTH HILTI FS-ONE MAX OR FS-ONE INTUMESCENT FIRESTOP SEALANT FLUSH WITH TOP SURFACE OF FLOOR OR SOLE PLATE, AND FLUSH WITH BOTTOM SURFACE OF CEILING OR LOWER TOP PLATE.
 6. MINIMUM 1/4" BEAD HILTI FS-ONE MAX OR FS-ONE INTUMESCENT FIRESTOP SEALANT APPLIED AT POINT OF CONTACT.


NOTES: 1. MAXIMUM DIAMETER OF OPENING = 1-1/2".
 2. ANNULAR SPACE = MINIMUM 0", MAXIMUM 1/2".

Hilti Firestop Systems HILTI, Inc. Tulsa, Oklahoma USA (800) 879-8000 Sheet 1 of 1 Scale 3/16" = 1" Drawing No. FC 2081f Date Jan. 24, 2015

| TYPE OF PENETRANT | F-RATING (HR) | CONCRETE FLOORS | | CONCRETE OR BLOCK WALLS | | GYPSUM WALLS | | WOOD FLOORS | | Hilti Products |
|--|---------------|--|--|---------------------------|--|--|--|---------------------------|--|---|
| | | BASIS OF DESIGN UL SYSTEM | | BASIS OF DESIGN UL SYSTEM | | BASIS OF DESIGN UL SYSTEM | | BASIS OF DESIGN UL SYSTEM | | |
| CIRCULAR BLANK OPENINGS | 1 | F-A-0006, C-AJ-0055, C-AJ-0090 | C-AJ-0055, C-AJ-0090 | | | | | | | CP 680, CP 618, FS One Max, Firestop Block (CFS-Bl) |
| | 2 | F-A-0006, C-AJ-0055, C-AJ-0090 | C-AJ-0055, C-AJ-0090 | | | | | | | |
| | 3 | F-A-0006, C-AJ-0055, C-AJ-0090, F-A-0014 | C-AJ-0055, C-AJ-0090 | | | | | | | |
| METAL PIPES OR CONDUIT | 1 | C-AJ-1226, F-A-1028, F-A-1017 | C-AJ-1226, W-J-1067, W-J-1020 | | | W-L-1054, W-L-1056, W-L-1164, W-L-1506 | F-C-1009, F-C-1059, F-C-1168 | | | CP 680, FS One Max, CP 606, CFS-S, Sil, GG, CFS-D, Mineral Wool |
| | 2 | C-AJ-1226, F-A-1028, F-A-1017 | C-AJ-1226, W-J-1067, W-J-1020, W-J-1248 | | | W-L-1054, W-L-1056, W-L-1164, W-L-1506 | F-C-1009, F-C-1059, F-C-1168 | | | |
| | 3 | C-AJ-1226, F-A-1017 | C-AJ-1226, W-J-1041, W-J-1068 | | | W-L-1110, W-L-1111, W-L-1165 | F-C-2232, F-C-2030, F-C-2160, F-C-2389 | | | |
| | 4 | C-BJ-1037, C-BJ-1034 | C-BJ-1034, C-BJ-1037, W-J-1041, W-J-1042, W-J-1068 | | | W-L-1110, W-L-1111, W-L-1165 | F-C-2232, F-C-2030, F-C-2160, F-C-2389 | | | |
| NON-METALLIC PIPE OR CONDUIT (E.P. PVC, CPVC, ABS, FRP, ENT) | 1 | F-A-2053, F-A-2025, C-AJ-2109, C-AJ-2098, C-AJ-2271, C-AJ-2167, C-BJ-2021, C-AJ-2342 | C-AJ-2109, C-AJ-2098, C-AJ-2167, C-AJ-2342 | | | W-L-2078, W-L-2075, W-L-2128 | F-C-2020, F-C-2030, F-C-2128, C-2189 | | | CP 680, CP 643N, Mineral Wool, CP 644, FS One Max, CFS-S, Sil, GG, CFS-D, Mineral Wool |
| | 2 | F-A-2053, F-A-2025, C-AJ-2109, C-AJ-2098, C-AJ-2271, C-AJ-2167, C-BJ-2021, C-AJ-2342 | C-AJ-2109, C-AJ-2098, C-AJ-2167, C-AJ-2342 | | | W-L-2078, W-L-2075, W-L-2128 | F-C-2020, F-C-2030, F-C-2128, C-2189 | | | |
| | 3 | F-A-2054, C-AJ-2109, C-AJ-2098, C-AJ-2371, C-AJ-2342 | C-AJ-2109, C-AJ-2098, C-AJ-2371, C-AJ-2342 | | | W-L-2198, W-L-2245 | | | | |
| SINGLE OR BUNDLED CABLES | 1 | F-A-3007, C-AJ-3095, C-AJ-3180, C-AJ-3283 | W-J-3036, C-AJ-3095, C-AJ-3180, W-J-3060, W-J-3167 | | | W-L-3065, W-L-3111, W-L-3112, W-L-3334, W-L-3414, W-L-3399 | F-C-3012, F-C-3110, F-C-3044 | | | CP 680, CP 653, FS One Max, CP 618, CP 606, CFS-D, CFS-CC |
| | 2 | F-A-3007, C-AJ-3095, C-AJ-3334, F-A-3060 | W-J-3036, C-AJ-3095, C-AJ-3180, W-J-3060, W-J-3167, W-L-3189 | | | W-L-3065, W-L-3111, W-L-3112, W-L-3334, W-L-3414, W-L-3399 | F-C-3012, F-C-3110 | | | |
| | 3 | F-A-3007, C-AJ-3095, C-AJ-3285 | C-AJ-3095, C-AJ-3180, W-J-3167 | | | W-L-3139, W-L-3334 | | | | |
| | 4 | N/A** | W-J-3050 | | | W-L-3139, W-L-3334 | | | | |
| CABLE TRAY | 1 | C-AJ-4034, C-AJ-4035 | W-J-4027, C-AJ-4034, C-AJ-4035 | | | W-L-4011, W-L-4019, W-L-4081 | | | | Firestop Block (CFS-Bl), FS One Max, Foam (CP 620), CP 618 |
| | 2 | C-AJ-4034, C-AJ-4035 | W-J-4027, C-AJ-4034, C-AJ-4035 | | | W-L-4011, W-L-4019, W-L-4081 | | | | |
| | 3 | C-AJ-4034, C-AJ-4035 | W-L-3385, C-AJ-4035 | | | W-L-3385, W-L-3277 | | | | |
| INSULATED PIPES | 1 | F-A-5015, F-A-5017, C-AJ-5050, C-AJ-5091, C-AJ-5050, C-AJ-5048 | C-AJ-5090, C-AJ-5091, C-AJ-5061, W-J-5042 | | | W-L-5028, W-L-5029, W-L-5047 | F-C-5004, F-C-5037, F-C-5036 | | | CP 680, FS One Max, Mineral Wool |
| | 2 | F-A-5015, F-A-5017, C-AJ-5090, C-AJ-5091, C-AJ-5090 | C-AJ-5090, C-AJ-5091, C-AJ-5061, W-J-5042 | | | W-L-5028, W-L-5029, W-L-5047 | F-C-5004, F-C-5037 | | | |
| | 3 | F-A-5016, C-AJ-5050, F-A-5016 | C-AJ-5090, C-AJ-5091 | | | W-L-5073 | | | | |
| | 4 | C-BJ-5006 | C-BJ-5006, W-J-5028 | | | W-L-5073 | | | | |
| ELECTRICAL BUSWAY | 1 | C-AJ-6036, C-AJ-6017, F-A-6032, C-AJ-6036 | C-AJ-6036, C-AJ-6017, C-AJ-6036 | | | | | | | CP 637, FS One Max, CP 620, Firestop Block (CFS-Bl), Mineral Wool, CFS-S, Sil, GG, CFS-S, Sil, GG |
| | 2 | C-AJ-6036, C-AJ-6017, F-A-6032, C-AJ-6036 | C-AJ-6036, C-AJ-6017, C-AJ-6036 | | | | | | | |
| | 3 | C-AJ-6036, C-AJ-6017 | C-AJ-6036, C-AJ-6017 | | | | | | | |
| MECHANICAL DUCTWORK WITHOUT DAMPERS (NON-INSULATED) | 1 | C-AJ-7046, C-AJ-7051, C-AJ-7094 | C-AJ-7046, C-AJ-7051, W-J-7021, W-J-7022 | | | W-L-7017, W-L-7040, W-L-7042, W-L-7155 | F-C-7013 | | | CFS-S, Sil, GG, CP 606, FS One Max |
| | 2 | C-AJ-7046, C-AJ-7051, C-AJ-7094 | C-AJ-7046, C-AJ-7051, W-J-7021, W-J-7022 | | | W-L-7040, W-L-7042, W-L-7155 | | | | |
| | 3 | C-AJ-7046, C-AJ-7051 | C-AJ-7046, C-AJ-7051 | | | W-L-7059, W-L-7153, W-L-7156, W-L-7151 | | | | |
| MECHANICAL DUCTWORK WITHOUT DAMPERS (INSULATED) | 1 | N/A** | W-J-7029, W-J-7124 | | | W-L-7059, W-L-7153, W-L-7156, W-L-7151 | | | | FS One Max, Mineral Wool |
| | 2 | N/A** | W-J-7091, W-J-7112, W-J-7124 | | | W-L-7059, W-L-7153, W-L-7156, W-L-7151 | | | | |
| | 3 | C-AJ-8099, C-AJ-8056, C-AJ-8143 | C-AJ-8099, C-AJ-8056, W-J-8007, C-AJ-8143 | | | W-L-1095, W-L-1013 | F-C-8009, F-C-8014, F-C-8026 | | | FS One Max, Firestop Block (CFS-Bl), CP 620, CP 618 |
| MIXED PENETRANTS | 1 | C-AJ-8099, C-AJ-8056 | C-AJ-8099, C-AJ-8056, W-J-8007, C-AJ-8099 | | | | | | | |
| | 2 | C-AJ-8099, C-AJ-8056 | C-AJ-8099, C-AJ-8056, W-J-8007, C-AJ-8099 | | | | | | | |
| | 3 | C-AJ-8099, C-AJ-8056 | C-AJ-8099, C-AJ-8056, W-J-8007, C-AJ-8099 | | | W-L-8014 | | | | |

*CONTACT HILTI FOR CURRENT UL CLASSIFIED SYSTEM OR ENGINEER JUDGMENT DRAWING: 800-879-8000

NOTES:
 1. Install conditions of each through-penetration firestop system must meet ALL details of the UL Classified System selected.
 2. If gasket conditions do not match any UL classified systems in the schedules above, contact Hilti for alternative systems or Engineer Judgment Drawings - 800-879-8000
 3. Where more than one applicable UL Classified System is listed in the schedules, choose the UL System which is most economical for each through-penetration firestop system.
 4. Coordinate work with other trades to assure that penetration opening sizes are appropriate for penetrant locations, and vice versa.

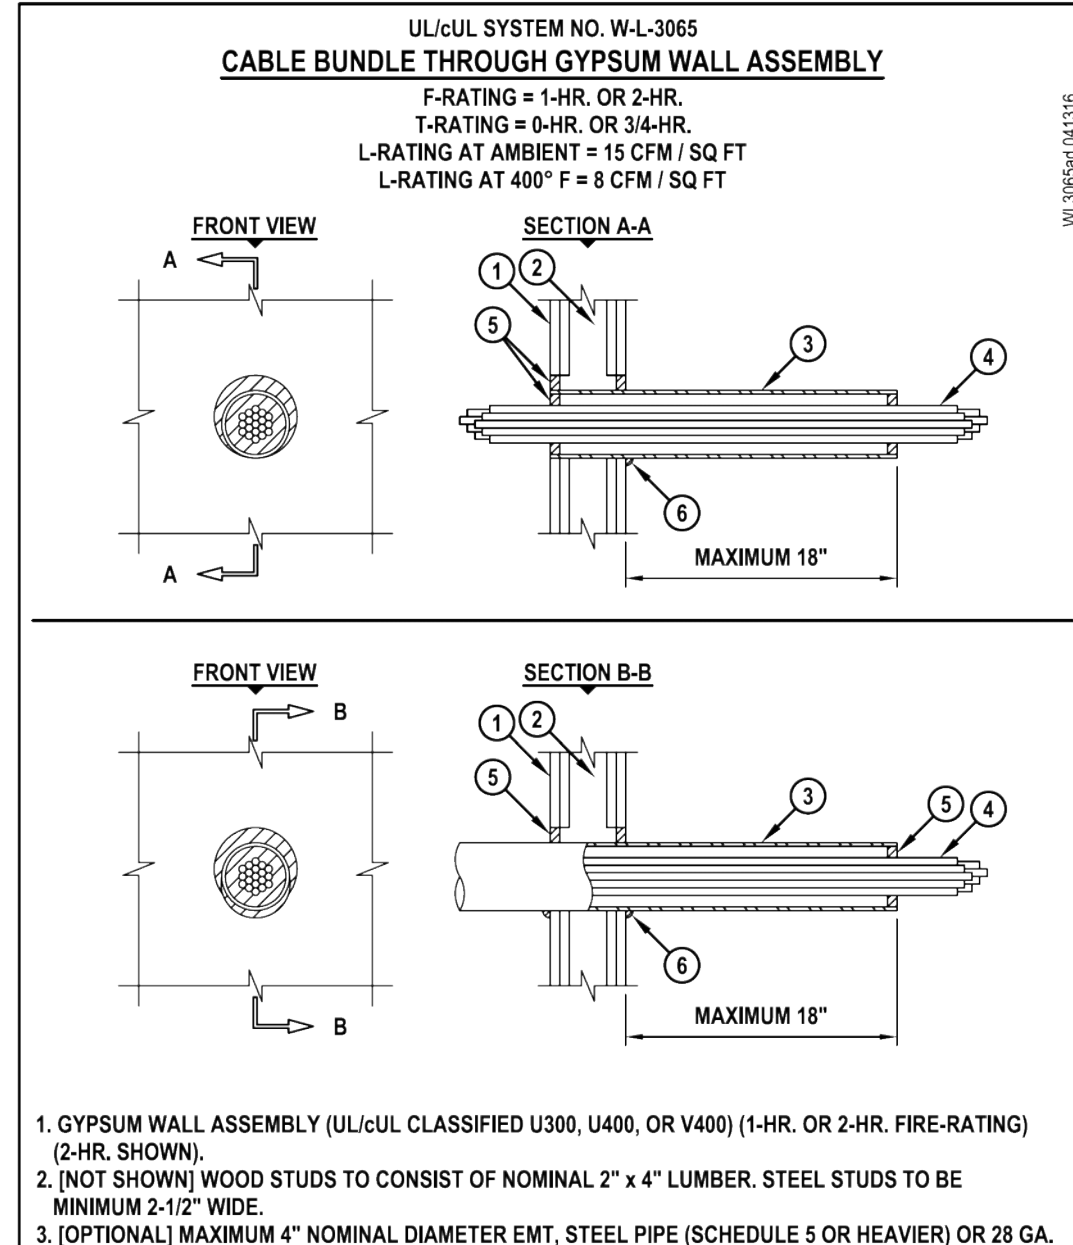

UL/CUL SYSTEM NO. WL-3065
CABLE BUNDLE THROUGH GYPSUM WALL ASSEMBLY
 F-RATING = 1-HR. OR 2-HR.
 T-RATING = 1-HR. OR 2-HR.
 L-RATING AT AMBIENT = 15 CFM / SQ FT
 L-RATING AT 400°F = 8 CFM / SQ FT

1. GYPSUM WALL ASSEMBLY (UL/CUL CLASSIFIED U300, U400, OR V400) (1-HR. OR 2-HR. FIRE-RATING) (2-HR. SHOWN).
 2. [NOT SHOWN] WOOD STUDS TO CONSIST OF NOMINAL 2" x 4" LUMBER. STEEL STUDS TO BE MINIMUM 2-1/2" WIDE.
 3. [OPTIONAL] MAXIMUM 4" NOMINAL DIAMETER ENT, STEEL PIPE (SCHEDULE 5 OR HEAVIER) OR 28 GA. GALVANIZED STEEL SLEEVE (SEE NOTE NO. 6 BELOW).
 4. CABLE BUNDLE TO CONSIST OF ANY COMBINATION OF THE FOLLOWING (SEE NOTE NO. 5 BELOW):
 A. MAXIMUM 7/C NO. 12 AWG POWER CABLE WITH PVC JACKET.
 B. MAXIMUM 25 PAIR NO. 24 AWG TELEPHONE CABLE WITH PVC JACKET.
 C. MAXIMUM 1/2" DIAMETER RGU COAXIAL CABLE WITH PVC JACKET.
 D. MAXIMUM 3/C NO. 8 AWG METAL-CLAD CABLE.
 E. MAXIMUM 3/C (+GROUND) NO. 8 AWG COPPER CONDUCTOR CABLE (ROMEX).
 F. MAXIMUM 5/8" DIAMETER FIBER-OPTIC CABLE WITH PVC JACKET.
 G. MAXIMUM 3/4" DIAMETER COPPER GROUND CABLE WITH OR WITHOUT PVC JACKET.
 H. MAXIMUM 1-1/4" DIAMETER SINGLE OR MULTIPLE CONDUCTOR TYPE MI CABLE (SEE NOTE NO. 4 BELOW).
 I. ANY CABLES, METAL-CLAD CABLES, OR ARMORED CABLES CURRENTLY LISTED UNDER THE THROUGH PENETRATING PRODUCTS CATEGORY.
 J. MAXIMUM 4/C (+GROUND) NO. 300 KCMIL ALUMINUM SER CABLE.
 K. MAXIMUM 4 PAIR NO. 22 AWG CAT 5 OR CAT 6 CABLE.
 L. MAXIMUM RG 6/U COAXIAL CABLE WITH FLUORINATED ETHYLENE JACKET.
 5. MINIMUM 5/8" DEPTH HILTI FS-ONE MAX INTUMESCENT FIRESTOP SEALANT, CP 606 FLEXIBLE FIRESTOP SEALANT, OR CP 618 FIRESTOP PUTTY STICK.
 6. MINIMUM 1/2" BEAD HILTI FS-ONE MAX INTUMESCENT FIRESTOP SEALANT, CP 606 FLEXIBLE FIRESTOP SEALANT, OR CP 618 FIRESTOP PUTTY STICK APPLIED AT WALL/S

DESIGN CRITERIA

BUILDING CODE: 2018 INTERNATIONAL BUILDING CODE (IBC) AS AMENDED BY THE LOCAL JURISDICTION.

| | |
|---------------------------------|---|
| VERTICAL LOADS | |
| ROOF LIVE LOAD: | 25 PSF (SNOW) |
| ROOF DEAD LOAD: | 25 PSF |
| RESIDENTIAL FLOOR LIVE LOAD: | 40 PSF (REDUCIBLE) : 60 PSF (FOR DECKS) |
| STAIRWAY LANDING AREAS: | 150 PSF (INCLUDING $\rho=1.5$) |
| FLOOR DEAD LOAD: | 30 PSF (INCLUDES 1 1/2" GYP TOPPING) |
| SNOW DESIGN DATA (ASCE 7-16) | WIND DESIGN DATA (ASCE 7-16) |
| FLAT SNOW LOAD: N/A | BASIC WIND SPEED (ASD) V= 85MPH |
| SNOW EXPOSURE FACTOR, Ce=1.0, | ULTIMATE WIND SPEED V= 110MPH |
| SNOW IMPORTANCE FACTOR, Is=1.0, | RISK CATEGORY: II EXPOSURE: B |
| THERMAL FACTOR, Ct=1.1 | IMPORTANCE FACTOR, Iw= 1.0 |
| | TOPOGRAPHIC FACTOR, Kzt= 1.0 |

SEISMIC DESIGN DATA (ASCE7-16)
 SEISMIC RESPONSE SYSTEM: WOOD SHEARWALLS
 EQUIVALENT LATERAL FORCE PROCEDURE (ASCE 7-16)
 RISK CATEGORY: II SEISMIC IMPORTANCE FACTOR, Ie= 1.0
 MAPPED SPECTRAL RESPONSE ACCELERATION: Ss=1.24, S1=0.476
 DESIGN SPECTRAL RESPONSE ACCELERATION: Sds=0.831, Sd1=0.476
 SITE CLASS: D SEISMIC DESIGN CATEGORY: D
 SEISMIC RESPONSE COEFFICIENT: Cs= 0.091
 DESIGN BASE SHEAR: 111,513#

SOIL PROPERTIES:
 BEARING CAPACITY: 2,000 PSF
 LATERAL CAPACITY: 250 PSF/FT

Please provide the geotechnical report from Kraزان & Asspcoates that supports the 2,000psf allowable soil bearing capacity. [CONSTRUCTION PLAN SET - Bldg B, sheet S1.0]

GENERAL REQUIREMENTS

- STRUCTURAL DRAWINGS SHALL BE USED IN CONJUNCTION WITH THE SPECIFICATIONS AND OTHER PROJECT DRAWINGS BY OTHER DISCIPLINES. ALL WORK SHALL CONFORM TO THE REQUIREMENTS OF THE CODES LISTED ABOVE.
- CONTRACTOR SHALL VERIFY ALL DIMENSIONS AND ELEVATIONS RELATING TO EXISTING CONDITIONS BY MAKING FIELD SURVEYS AND MEASUREMENTS PRIOR TO COMMENCING FABRICATION OR CONSTRUCTION.
- THE GENERAL CONTRACTOR SHALL ENSURE THAT ALL CONSTRUCTION METHODS USED WILL NOT CAUSE DAMAGE TO ADJACENT BUILDINGS, UTILITIES, OR OTHER PROPERTY. THIS REQUIREMENT IS PARTICULARLY IMPORTANT DURING FOUNDATION INSTALLATION.
- THE GENERAL CONTRACTOR IS ADVISED TO CONSIDER PERFORMING PHOTOGRAPHIC SURVEYS AND OTHER DOCUMENTATION OF THE CONDITION OF ADJACENT BUILDINGS AND OTHER STRUCTURES BEFORE THE START OF CONSTRUCTION.
- THE GENERAL CONTRACTOR SHALL OBTAIN COPIES OF THE LATEST CONTRACT DOCUMENTS, INCLUDING ALL ADDENDA, AND PROVIDE THE RELEVANT PORTIONS TO ALL SUB-CONTRACTORS AND SUPPLIERS PRIOR TO SUBMITTAL OF SHOP DRAWINGS AND FABRICATION AND ERECTION OF STRUCTURAL MEMBERS.
- THE GENERAL CONTRACTOR SHALL COMPARE AND COORDINATE THE DRAWINGS OF ALL DISCIPLINES AND REPORT ANY DISCREPANCIES BETWEEN THE DRAWINGS TO THE ARCHITECT AND ENGINEER.
- DETAILS LABELED "TYPICAL" SHALL APPLY TO ALL SITUATIONS THAT ARE THE SAME OR SIMILAR TO THOSE SPECIFICALLY DETAILED. SEE DETAIL TITLES FOR APPLICABILITY OF A PARTICULAR DETAIL. TYPICAL DETAILS SHALL APPLY WHETHER OR NOT THEY ARE SPECIFICALLY KEYED AT EACH LOCATION. THE ENGINEER SHALL HAVE FINAL AUTHORITY TO DETERMINE APPLICABILITY OF TYPICAL DETAILS.
- WHERE CONFLICTS EXIST BETWEEN STRUCTURAL DOCUMENTS THE STRICTEST REQUIREMENTS, AS INDICATED BY THE STRUCTURAL ENGINEER SHALL GOVERN.
- THE GENERAL CONTRACTOR SHALL REVIEW AND DETERMINE THAT DIMENSIONS ARE COORDINATED BETWEEN ARCHITECTURAL AND STRUCTURAL DRAWINGS PRIOR TO FABRICATION OR START OF CONSTRUCTION.
- NO STRUCTURAL MEMBER SHALL BE CUT OR NOTCHED OR OTHERWISE REDUCED IN STRENGTH UNLESS APPROVED BY THE STRUCTURAL ENGINEER.
- THE GENERAL CONTRACTOR SHALL COORDINATE ARCHITECTURAL, MECHANICAL, ELECTRICAL AND PLUMBING DRAWINGS FOR ANCHORED, EMBEDDED OR SUPPORTED ITEMS. NOTIFY THE ARCHITECT / ENGINEER OF ANY DISCREPANCIES.

CONSTRUCTION RESPONSIBILITY

- THE CONTRACT STRUCTURAL DRAWINGS AND SPECIFICATIONS REPRESENT THE COMPLETED STRUCTURE, AND ARE NOT INTENDED TO INDICATE THE METHOD OR MEANS OF CONSTRUCTION. THE CONTRACTOR SHALL SUPERVISE AND DIRECT THE WORK AND SHALL BE SOLELY RESPONSIBLE FOR ALL CONSTRUCTION MEANS, METHODS, PROCEDURES, TECHNIQUES, SEQUENCES, AND FOR JOB SAFETY.
- THE ENGINEER DOES NOT HAVE CONTROL OR CHARGE OF, AND SHALL NOT BE RESPONSIBLE FOR, CONSTRUCTION MEANS, METHODS, TECHNIQUES, SEQUENCES, OR PROCEDURES, FOR SAFETY PRECAUTIONS AND PROGRAMS IN CONNECTION WITH THE WORK, FOR THE ACTS OR OMISSIONS OF THE CONTRACTOR, SUBCONTRACTOR, OR ANY OTHER PERSONS PERFORMING ANY OF THE WORK, OR FOR THE FAILURE OF ANY OF THEM TO CARRY OUT THE WORK IN ACCORDANCE WITH THE CONTRACT DOCUMENTS.
- PERIODIC SITE OBSERVATION VISITS MAY BE PROVIDED BY THE STRUCTURAL ENGINEER. THE SOLE PURPOSE OF THESE OBSERVATIONS IS TO REVIEW THE GENERAL CONFORMANCE OF THE CONSTRUCTION WITH THE STRUCTURAL CONTRACT DOCUMENTS. THESE LIMITED OBSERVATIONS SHOULD NOT BE CONSTRUED AS CONTINUOUS OR EXHAUSTIVE TO VERIFY THAT ALL CONSTRUCTION IS IN COMPLIANCE WITH THE CONSTRUCTION DOCUMENTS. THE GENERAL CONTRACTOR SHALL BE RESPONSIBLE FOR PERFORMING ALL WORK IN COMPLIANCE WITH THE CONSTRUCTION DOCUMENTS.

ABBREVIATIONS

| | | | |
|--------|----------------------|--------|------------------------|
| A.F.F. | ABOVE FINISHED FLOOR | N.T.S. | NOT TO SCALE |
| CLR. | CLEAR | O.C. | ON CENTER |
| CL | CENTERLINE | PT | PRESSURE TREATED |
| CONC. | CONCRETE | REINF. | REINFORCEMENT |
| CONT. | CONTINUOUS | SIM | SIMILAR |
| C.J. | CONTROL JOINT | SF | SQUARE FEET |
| E.W. | EACH WAY | S.O.G. | SLAB ON GRADE |
| GLB | GLULAM BEAM | STL. | STEEL |
| LBW | LOAD BEARING WALL | T&G | TONGUE AND GROOVE |
| HD | HOLD DOWN | TYP. | TYPICAL |
| MFR. | MANUFACTURER | U.N.O. | UNLESS NOTED OTHERWISE |
| MIN. | MINIMUM | W/ | WITH |
| MTL. | METAL | | |
| N.T.S. | NOT TO SCALE | | |

DEFERRED SUBMITTALS

THE FOLLOWING IS A LIST OF ITEMS THAT ARE NOT INCLUDED IN THIS PLAN AND SHOULD BE PROVIDED BY THE BUILDER AT TIME OF APPLICATION FOR PERMIT OR AS A DEFERRED SUBMITTAL ITEM:

- ALTERNATIVE I-JOIST/BEAM MANUFACTURER PLANS
- PRE-ENGINEERED TRUSS DESIGNS AND LAYOUTS

SITE WORK

PER KRAZAN & ASSOCIATES, INC. REPORT DATED APRIL 11, 2019, FOUNDATION DESIGN IS BASED ON AN ASSUMED AVERAGE SOIL BEARING OF 2,000 PSF. EXTERIOR FOOTINGS SHALL BEAR 18" & INTERIOR FOOTINGS SHALL BEAR 12" (MINIMUM) BELOW FINISHED GRADE. ALL FOOTINGS TO BEAR ON FIRM UNDISTURBED EARTH BELOW ORGANIC SURFACE SOILS OR ON STRUCTURAL FILL PER THE GEOTECHS RECOMMENDATIONS.

CONCRETE

| ITEM | DESIGN f'c (PSI) | MAX. W/C RATIO | MAX. AGGREGATE SIZE | MIN. CEMENT (SACKS/YARD) |
|---------------|------------------|----------------|---------------------|--------------------------|
| FOUNDATIONS | 2,500 @28 DAYS | 0.45 | 3/4" | |
| STEM WALLS | 3,000 @28 DAYS | 0.45 | 3/4" | |
| SLAB ON GRADE | 3,000 @28 DAYS | 0.45 | 3/4" | |

- REINFORCING STEEL SHALL BE ASTM A615 GRADE 40 FOR #4 BARS AND SMALLER AND GRADE 60 FOR #5 BARS AND LARGER.
- MINIMUM SPLICE LENGTHS SHALL BE: 24" FOR #4, 30" FOR #5, 42" FOR #6
- CONCRETE COVER SHALL BE: 3" CAST AGAINST EARTH, 2" EXPOSED TO EARTH/WEATHER, 3/4" NOT EXPOSED TO EARTH/WEATHER.
- CORNER BARS ARE REQUIRED FOR ALL HORIZONTAL BARS IN FOOTINGS AND WALLS.
- ALL CONCRETE HAS BEEN DESIGNED FOR 2,500 PSI CONCRETE SO NO SPECIAL INSPECTION IS REQUIRED.

FRAMING


- ALL NAILING TO COMPLY WITH REQUIREMENTS OF IBC 2303.6 AND FASTENED PER TABLE 2304.10.1.
- ALL WOOD IN CONTACT WITH CONCRETE TO BE PRESSURE TREATED. FIELD CUT ENDS, NOTCHES, AND DRILLED HOLES OF PRESSURE TREATED LUMBER SHALL BE RETREATED IN THE FIELD IN ACCORDANCE WITH AWPA M4.
- FASTENERS FOR PRESSURE PRESERVATIVE AND FIRE RETARDANT TREATED WOOD SHALL BE OF HOT-DIPPED GALVANIZED STEEL, STAINLESS STEEL, SILICON BRONZE OR COPPER.
- MAINTAIN 8" MINIMUM CLEARANCE BETWEEN WOOD AND EARTH.
- MAINTAIN 12" MINIMUM CLEARANCE BETWEEN FLOOR BEAMS AND EARTH.
- MAINTAIN 18" MINIMUM CLEARANCE BETWEEN FLOOR JOISTS AND EARTH.

LUMBER GRADES

FRAMING LUMBER SHALL COMPLY WITH THE LATEST EDITION OF THE GRADING RULES OF THE WESTERN PRODUCTS ASSOCIATION OR THE WEST COAST LUMBER INSPECTION BUREAU. ALL SAWN LUMBER SHALL BE STAMPED WITH THE GRADE MARK OF AN APPROVED LUMBER GRADING AGENCY AND SHALL HAVE THE FOLLOWING UNADJUSTED DESIGN MINIMUM PROPERTIES:

| JOISTS: | WOOD TYPE: |
|---------------|--|
| 2X4 | HF #2 - Fb=850 PSI, FV=75 PSI, Fc=1300 PSI, E=1200000 PSI |
| 2X6 OR LARGER | HF #2 - Fb=850 PSI, Fv=75 PSI, Fc=1300 PSI, E=1200000 PSI |
| BEAMS: | WOOD TYPE: |
| 4X | DF-L#2 - Fb=900 PSI, FV=95 PSI, Fc=1350 PSI, E=1600000 PSI |
| 6X OR LARGER | DF-L #2 - Fb=875 PSI, Fv=85 PSI, Fc=600 PSI, E=1300000 PSI |
| STUDS: | WOOD TYPE: |
| 2X4 | HF #2 - Fb=850 PSI, FV=75 PSI, Fc=1300 PSI, E=1200000 PSI |
| 2X6 OR LARGER | HF #2 - Fb=850 PSI, Fv=75 PSI, Fc=1300 PSI, E=1200000 PSI |
| POSTS: | WOOD TYPE: |
| 4X4 | HF #2 - Fb=900 PSI, FV=95 PSI, Fc=1350 PSI, E=1600000 PSI |
| 4X6 OR LARGER | HF #2 - FB=900 PSI, FV=95 PSI, FC=1350 PSI, E=1600000 PSI |
| 6X6 OR LARGER | DF-L #1 - FB=700 PSI, FV=85 PSI, FC=475 PSI, E=1300000 PSI |
| 6X6 OR LARGER | DF-L #2 - FB=700 PSI, FV=85 PSI, FC=475 PSI, E=1300000 PSI |

SYMBOL LEGEND

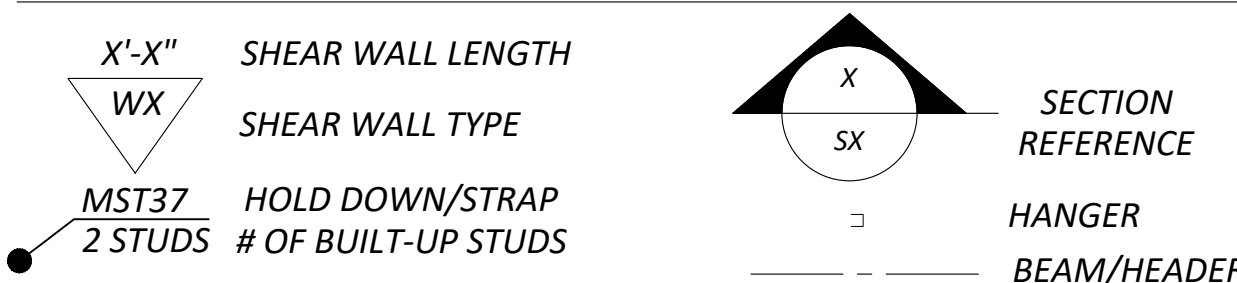

FASTENERS

ALL NAILS SPECIFIED ON THIS PLAN SHALL BE COMMON OR GALVANIZED BOX (UNLESS NOTED OTHERWISE) OF THE DIAMETER AND LENGTH LISTED BELOW OR AS PER APPENDIX L OF THE NATIONAL DESIGN SPECIFICATION FOR WOOD CONSTRUCTION (NDS). ALL FASTENERS PLACE IN PRESSURE TREATED OR FIRE TREATED LUMBER/SHEATHING SHALL BE GALVANIZED.

- 8D COMMON (0.131" DIA., 2-1/2" LENGTH)
- 8D BOX (0.113" DIA., 2-1/2" LENGTH)
- 10D COMMON (0.148" DIA., 3" LENGTH)
- 10D BOX (0.128" DIA., 3" LENGTH)
- 16D COMMON (0.162" DIA., 3-1/2" LENGTH)
- 16D SINKER (0.148" DIA., 3-1/4" LENGTH)
- 5D COOLER (0.086" DIA., 1-5/8" LENGTH)
- 6D COOLER (0.092" DIA., 1-7/8" LENGTH)

SHEATHING

TYPICAL ROOF SHEATHING SHALL BE APA RATED 7/16" SHEATHING WITH A SPAN INDEX OF 24/16. FLOOR SHEATHING SHALL BE APA RATED 3/4" T&G SHEATHING WITH A SPAN INDEX OF 48/24 UNLESS NOTED OTHERWISE. STAGGER END LAPS AT ROOF AND FLOOR SHEATHING. WALL SHEATHING SHALL BE APA RATED 7/16" SHEATHING WITH A SPAN INDEX OF 24/0 UNLESS NOTED OTHERWISE.

GLULAM BEAMS (GLB)

GLULAM BEAMS SHALL BE 24F-V4 FOR SINGLE SPANS AND 24F-V8 FOR CONTINUOUS OR CANTILEVER SPANS WITH THE FOLLOWING MINIMUM PROPERTIES:
 Fb=2400 PSI, Fv=240 PSI, Fc=650 PSI (PERPENDICULAR), E=1,800,000 PSI.

ENGINEERED WOOD BEAMS AND I-JOIST

CONTRACTOR SHALL SUBMIT SHOP DRAWINGS AND SPECIFICATIONS FOR APPROVAL BY BUILDING OFFICIAL. DESIGN, FABRICATION AND ERECTION IN ACCORDANCE WITH THE LATEST ICC EVALUATION REPORT.

BEAMS DESIGNATED AS "PSL" SHALL HAVE THE MINIMUM PROPERTIES:
 Fb=2900 PSI, Fv=290 PSI, Fc=750 PSI (PERPENDICULAR), E=2,000,000 PSI.
 BEAMS DESIGNATED AS "LVL" SHALL HAVE THE MINIMUM PROPERTIES:
 Fb=2600 PSI, Fv=285 PSI, Fc=750 PSI (PERPENDICULAR), E=1,900,000 PSI.
 BEAMS DESIGNATED AS "LSL" SHALL HAVE THE MINIMUM PROPERTIES:
 Fb=1700 PSI, Fv=400 PSI, Fc=680 PSI (PERPENDICULAR), E=1,300,000 PSI.

PRE-ENGINEERED ROOF TRUSSES

PRE-ENGINEERED ROOF TRUSSES IS A DEFERRED SUBMITTAL ITEM AND IS TO BE DESIGNED, FABRICATED AND INSTALLED PER THE LATEST TRUSS PLATE INSTITUTE STANDARDS, AND IBC SECTION 2303.4. PREFABRICATED ITEMS TO BE DESIGNED BY A LICENSED PROFESSIONAL ENGINEER. THE FABRICATOR SHALL PROVIDE ALL CONNECTION DESIGN, DETAILS AND INSTALLATION INSTRUCTIONS, WHICH SHALL BE AVAILABLE ON SITE FOR INSPECTION. WHERE TRUSSES ARE NOT PROVIDED TO COMPLETE THE ROOF SYSTEM, OVERFRAMING MEMBERS AND CONNECTIONS SHALL BE PROVIDED. OVERFRAMING DETAILS SHALL BE INCLUDED IN THE TRUSS SHOP DRAWINGS IN ORDER TO PROVIDE LOADING CONDITIONS CONSISTENT WITH THE MODELING OF THE TRUSSES. THE OVERFRAMING AND RELATED DETAILS SHALL BE DESIGNED BY THE TRUSS ENGINEER. TRUSSES (OR DRAG TRUSSES) ALIGNING WITH SHEAR WALLS SHALL BE SPECIAL TRUSSES THAT HAS BEEN DESIGNED TO TRANSFER THE SPECIFIC WIND AND SEISMIC LOADS SHOWN ON THE PLANS. THE TRUSS SHALL BE DESIGNED TO TRANSFER THE LOAD BETWEEN THE ROOF SHEATHING AND THE SHEAR WALL BELOW. THE TRUSS SHALL BE DESIGNED TO TRANSFER A MINIMUM OF 100 PLF ALONG THE LENGTH OF THE TRUSS. TEMPORARY AND PERMANENT BRACING REQUIRED FOR THE STABILITY OF THE TRUSS ELEMENTS UNDER GRAVITY LOADS AND IN-PLANE WIND OR SEISMIC LOADS SHALL BE DESIGNED BY THE TRUSS ENGINEER WHERE THE TOP CHORD IS NOT DIRECTLY ATTACHED TO THE ROOF SHEATHING. THE TRUSS ENGINEER SHALL DESIGN AND SHOW THE PLACEMENT OF ALL REQUIRED TOP CHORD BRACING AND CONNECTIONS ON THE TRUSS SHOP DRAWINGS. ANY BRACING LOADS TRANSFERRED TO THE MAIN BUILDING SYSTEM SHALL BE IDENTIFIED AND SUBMITTED TO THE ENGINEER OF RECORD FOR REVIEW. DESIGN CALCULATIONS AND SHOP DRAWINGS SHALL BE SUBMITTED FOR REVIEW BY THE ENGINEER OF RECORD PRIOR TO SUBMITTING TO THE BUILDING OFFICIAL FOR APPROVAL. ROOF TRUSS TOP CORD MUST BE HF#2 OR BETTER.

SPECIAL INSPECTIONS

SOILS (PER IBC 1705.6):
 CONTINUOUS SPECIAL INSPECTION SHALL BE REQUIRED FOR MATERIAL, DENSITIES AND LIFT THICKNESS DURING PLACEMENT AND COMPACTION OF COMPACTED STRUCTURAL FILL AND PERIODIC SPECIAL INSPECTION IS REQUIRED TO VERIFY SHALLOW FOUNDATIONS BEARING MATERIAL MEETS DESIGNED BEARING CAPACITY, VERIFYING EXCAVATION ARE EXTENDED TO PROPER DEPTH AND HAVE REACHED PROPER MATERIAL, PERFORM CLASSIFICATION AND TESTING OF COMPACTED FILL MATERIAL AND TO INSPECT SUBGRADE MATERIAL PRIOR TO COMPACTED FILL PLACEMENT TO VERIFY THE SITE HAS BEEN PREPARED PROPERLY.

WOOD CONSTRUCTION (PER IBC 1705.5) AND WIND RESISTANCE (PER IBC 1705.11):
 PERIODIC SPECIAL INSPECTION IS REQUIRED TO VERIFY NAILING, BOLTING, ANCHORING AND OTHER FASTENING OF ELEMENTS OF SHEAR WALLS WITH NAIL SPACING 4" AND LESS, DRAG STRUTS, BRACES AND HOLD DOWNS.

POST-INSTALLED ANCHORS

- POST-INSTALLED ANCHORS SHALL ONLY BE USED WHERE SPECIFIED ON THE DRAWINGS. CONTRACTOR SHALL OBTAIN APPROVAL FROM ENGINEER OF RECORD (EOR) PRIOR TO USING POST-INSTALLED ANCHORS FOR MISSINGS OR MISPLACED ANCHORS.
- CARE SHALL BE GIVEN TO AVOID CONFLICTS WITH EXISTING REINFORCING WHEN DRILLING HOLES. HOLES SHALL BE DRILLED AND CLEANED PER THE MANUFACTURER'S INSTRUCTIONS. ANCHORS SHALL BE INSTALLED PER THE MANUFACTURER'S INSTALLATION INSTRUCTIONS AT NOT LESS THAN MINIMUM EDGE DISTANCES AND/OR SPACING INDICATED IN THE MANUFACTURER'S LITERATURE.
- SPECIAL INSPECTION SHALL BE PROVIDED FOR ALL ADHESIVE AND MECHANICAL ANCHOR INSTALLATIONS AS REQUIRED BY THE EOR. INDEPENDENT ON-SITE PROOF LOAD TESTING SHALL BE PERFORMED AS REQUIRED BY THE EOR. CONTACT EOR FOR NUMBER OF ANCHORS REQUIRED TO BE TESTED AND REQUIRED PROOF LOAD MAGNITUDE.
- UNLESS NOTED OTHERWISE ON DOCUMENTS, ACCEPTABLE PRODUCTS SHALL BE AS LISTED BELOW:
 - MECHANICAL ANCHORS INTO CONCRETE:
 - USE THE FOLLOWING (UNO):
 - SIMPSON TITEN HD (ICC-ES AC193 AND ACI 355.2) FOR CRACKED & UNCRACKED CONCRETE PER (ICC-ES ESR-2713)
 - HILTI KWIK BOLT TZ CARBON AND STAINLESS STEEL ANCHORS (ICC-ES ESR1917)
 - RED HEAD TRUBOLT + WEDGE ANCHORS (ICC-ES ESR2427)
 - SIMPSON STRONG-TIE STRONG-BOLT (STB) (ICC-ES ESR1771)(FL8668)
 - USE THE FOLLOWING ONLY WHERE SPECIFICALLY CALLED OUT ON THE DOCUMENTS:
 - HILTI HDA (ICC-ES ESR1546)
 - HILTI HSL-3 ANCHOR (ICC-ES ESR1545)
 - SIMPSON STRONG-TIE TITEN HD (THD) (ICC-ES ESR2713)(FL2304)
 - MECHANICAL ANCHORS INTO MASONRY LINTELS OR GROUT FILLED CELLS:
 - USE THE FOLLOWING (UNO):
 - SIMPSON TITEN HD (ICC-AC AC106) FOR MASONRY PER (ICC-ES ESR-1056)
 - HILTI KWIK BOLT 3 MASONRY ANCHORS (ICC-ES ESR1385)
 - SIMPSON STRONG-TIE WEDGE-ALL ANCHOR(WA) (IC80-ES ER-3631) (FL5415)
 - USE THE FOLLOWING ONLY WHERE SPECIFICALLY CALLED OUT ON THE DOCUMENTS:
 - HILTI HUS-H SCREW ANCHOR (ICC-ES ESR2369)
 - SIMPSON STRONG-TIE TITEN HD (THD) (ICC-ES ESR1056)(FL2304)
 - ADHESIVE ANCHORS INTO CONCRETE:
 - USE THE FOLLOWING (UNO):
 - HILTI HIT-RE 500-SD ADHESIVE (ICC-ES ESR2322)
 - RED HEAD EPCON G5 ADHESIVE (ICC-ES ESR1137)(FL6582)
 - SIMPSON STRONG-TIE SET-XP EPOXY-TIE ADHESIVE (SETXP) (ICC-ES ESR2508)
 - USE THE FOLLOWING ONLY WHERE SPECIFICALLY CALLED OUT ON THE DOCUMENTS:
 - HILTI HIT HY 150 MAX ADHESIVE (ICC-ES ESR2262)
 - ADHESIVE ANCHORS INTO MASONRY LINTELS OR GROUT FILLED CELLS:
 - USE THE FOLLOWING (UNO):
 - HILTI HIT HY-150 MAX ADHESIVE (ICC-ES ESR1967)
 - SIMPSON STRONG-TIE SET EPOXY-TIE ADHESIVE (SET) (ICC-ES ESR1772)(FL5550)



PIERUCCIONI E&C, LLC
 CHON PIERUCCIONI, PE
 STEIN, BENNETT ST.
 TACOMA, WA 98402

RELEASE OF DOCUMENTS
 THIS DOCUMENT AND THE DESIGN AND/OR CONSTRUCTION THEREOF ARE THE PROPERTY OF PIERUCCIONI ENGINEERING, LLC. ANY REPRODUCTION OR TRANSMISSION OF THIS DOCUMENT IN WHOLE OR IN PART WITHOUT THE WRITTEN PERMISSION OF PIERUCCIONI ENGINEERING, LLC IS PROHIBITED.

EAST TOWN CROSSING
 BUILDING "B"
 PIONEER & SHAW PUYALLUP WA

REVISIONS

| NO. | DATE | DESCRIPTION |
|-----|------|-------------|
| 01 | --- | --- |

REVISIONS

DRAWN BY: CP
 CHECKED BY: CP
 DATE: 2024.01.12
 TITLE: STRUCTURAL NOTES
 PROJECT #: ---
 SHEET:



PIERUCCIONI E&C, LLC
CHON PIERUCCIONI, PE
3701 N. BENNETT ST.
TACOMA, WA 98407

RELEASE OF DOCUMENTS
THIS DOCUMENT IS THE PROPERTY OF
PIERUCCIONI E&C, LLC AND IS NOT TO BE
REPRODUCED OR TRANSMITTED IN ANY
FORM OR BY ANY MEANS, ELECTRONIC
OR MECHANICAL, INCLUDING PHOTOCOPYING,
RECORDING, OR BY ANY INFORMATION
SYSTEMS WITHOUT THE WRITTEN
AUTHORIZATION OF PIERUCCIONI E&C, LLC.

EAST TOWN CROSSING
BUILDING "B"
PIONEER & SHAW PUYALLUP WA

REVISIONS

01

REVISIONS

DRAWN BY: CP

CHECKED BY: CP


DATE: 2024.01.12

TITLE: FOUNDATION PLAN

PROJECT #: ----

SHEET:

S3.1

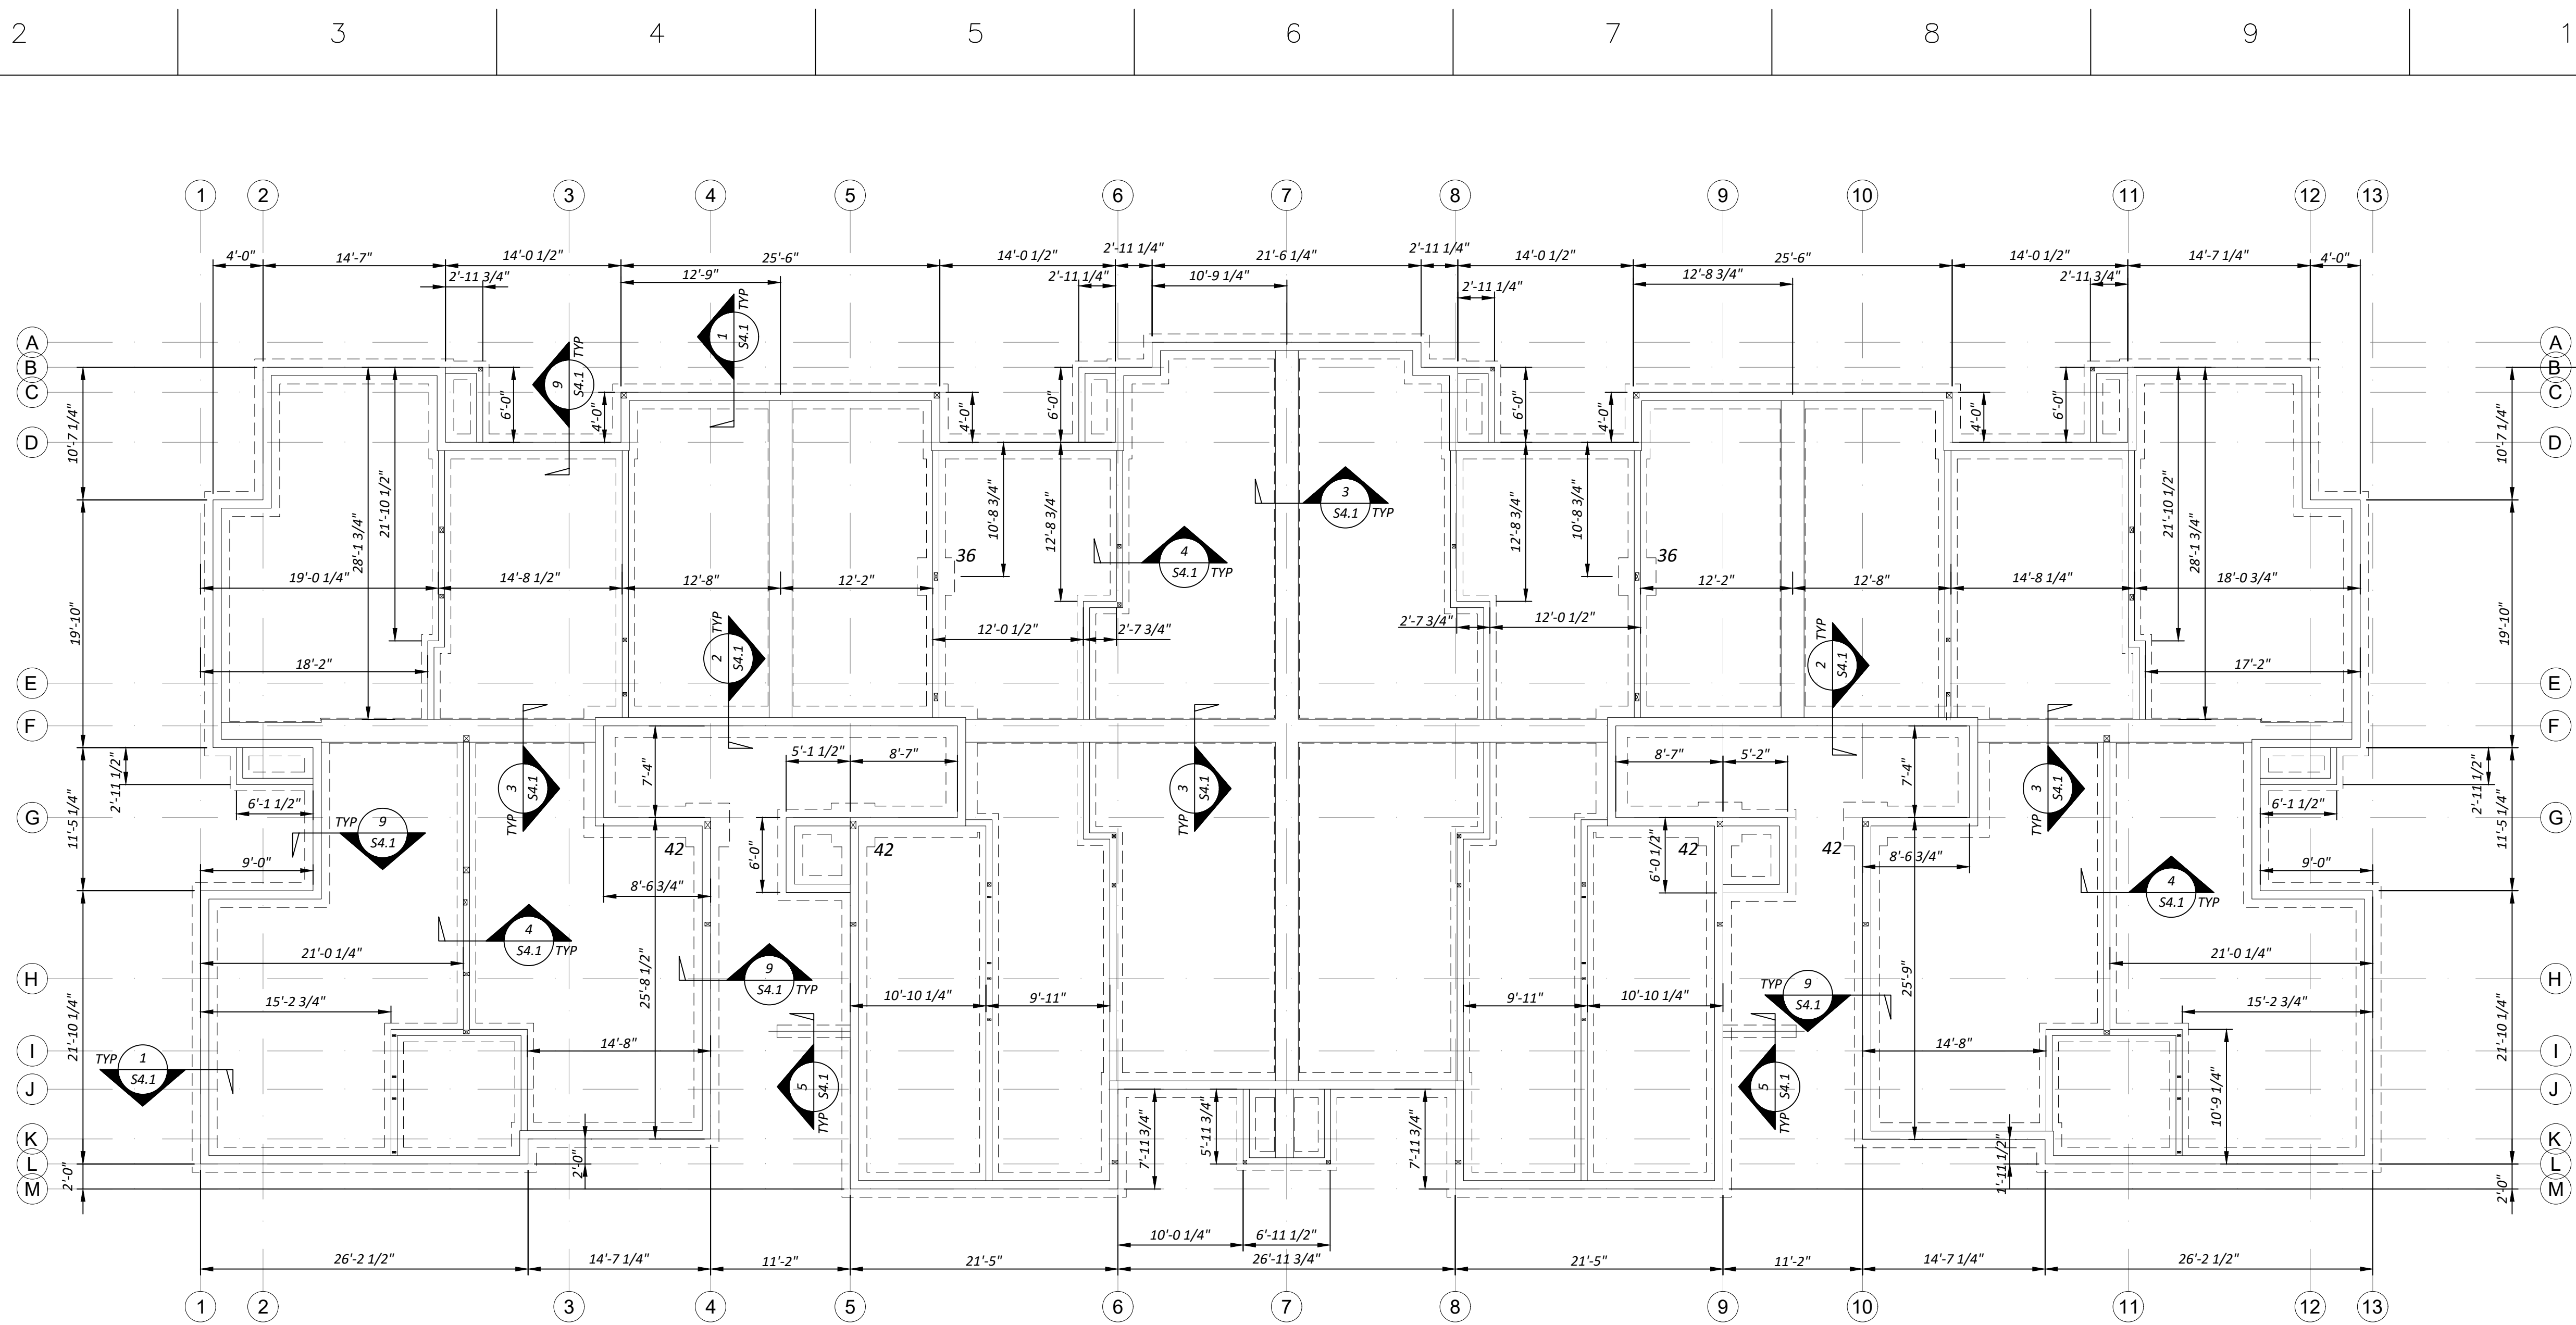

FOOTING SCHEDULE

| | |
|----|---|
| 36 | POST ON 36" SQUARE X 8" THICK CONC. FOOTING W/ 4-#4 BARS E.W. |
| 42 | POST ON 42" SQUARE X 8" THICK CONC. FOOTING W/ 5-#4 BARS E.W. |

NOTES:

1. USE MIN. 6" WIDE POST BELOW BEAM SPLICES
2. USE 4X4 POST BELOW 4X BEAMS, U.N.O.
3. USE 6X6 POST BELOW 6X BEAMS, U.N.O.
4. PT POST SHALL BE USED IN EXTERIOR CONDITIONS

FOUNDATION PLAN
1/8" = 1'-0"

**SPECIAL INSPECTION IS
REQUIRED FOR
FOUNDATION SOIL BEARING**

NOTES:

1. PER KRAZAN & ASSOCIATES, INC. REPORT DATED APRIL 11, 2019, FOUNDATION DESIGN IS BASED ON AN ASSUMED AVERAGE SOIL BEARING OF 2,000 PSF. EXTERIOR FOOTINGS SHALL BEAR 18" & INTERIOR FOOTINGS SHALL BEAR 12" (MINIMUM) BELOW FINISHED GRADE. ALL FOOTINGS TO BEAR ON FIRM UNDISTURBED EARTH BELOW ORGANIC SURFACE SOILS OR ON STRUCTURAL FILL PER THE GEOTECHS RECOMMENDATIONS. IT IS THE CONTRACTORS RESPONSIBILITY TO VERIFY THAT THE SITE SOILS PROVIDE THIS MINIMUM BEARING CAPACITY.
2. EXTERIOR FOOTINGS TO BE A MINIMUM OF 18" BELOW FINISHED GRADE BEARING ON NATIVE UNDISTURBED SOIL OR STRUCTURAL FILL.
3. INTERNAL FOOTINGS TO BE A MINIMUM OF 12" BELOW FINISHED GRADE BEARING ON NATIVE UNDISTURBED SOIL OR STRUCTURAL FILL.
4. INTERIOR S.O.G. SHALL BE 4" THICK SLAB ON GRADE OVER INSULATION (PER ARCH.), OVER VAPOR BARRIER (PER ARCH.) OVER 4" COMPACTED SAND OR GRAVEL. SLAB SHALL BE REINFORCED WITH 6X6 W2.9XW2.9 WELDED WIRE, #3 BARS @ 24" O.C., OR HELIX FABRIC (5# PER CUBIC YARD).
5. EXTERIOR SLAB SHALL BE 4" THICK SLAB ON GRADE SLOPED AT 1% AWAY FROM BUILDING..
6. CONTROL JOISTS SHALL BE 15" O.C. MAX.
7. SEE SHEAR WALL PLAN ON SHEET S4.6 FOR HOLD DOWN AND ANCHOR BOLT LOCATIONS NOT SHOWN HERE.

Shear wall plans are on sheet S3.6, S3.7, an S3.8.
[CONSTRUCTION PLAN SET - Bldg B, sheet S3.1]



PIERUCCIONI E&C, LLC
CHON PIERUCCIONI, PE
3128 N. BENNETT ST.
TACOMA, WA 98407

REUSE OF DOCUMENTS
THIS DOCUMENT HAS THE SIGNATURES OF
PROFESSIONAL PERSONNEL AND IS THE PROPERTY OF
PIERUCCIONI E&C, LLC AND IS NOT TO BE USED OR
REPRODUCED IN WHOLE OR IN PART WITHOUT THE
WRITTEN AUTHORIZATION OF PIERUCCIONI E&C, LLC.

EAST TOWN CROSSING
BUILDING "B"
PIONEER & SHAW PUYALLUP WA


REVISIONS

| | |
|----|-----|
| 01 | --- |
|----|-----|

REVISIONS

| | |
|-------------|--------------|
| DRAWN BY: | CP |
| CHECKED BY: | CP |
| DATE: | 2024.01.12 |
| TITLE: | FRAMING PLAN |
| PROJECT #: | --- |
| SHEET: | --- |

S3.2

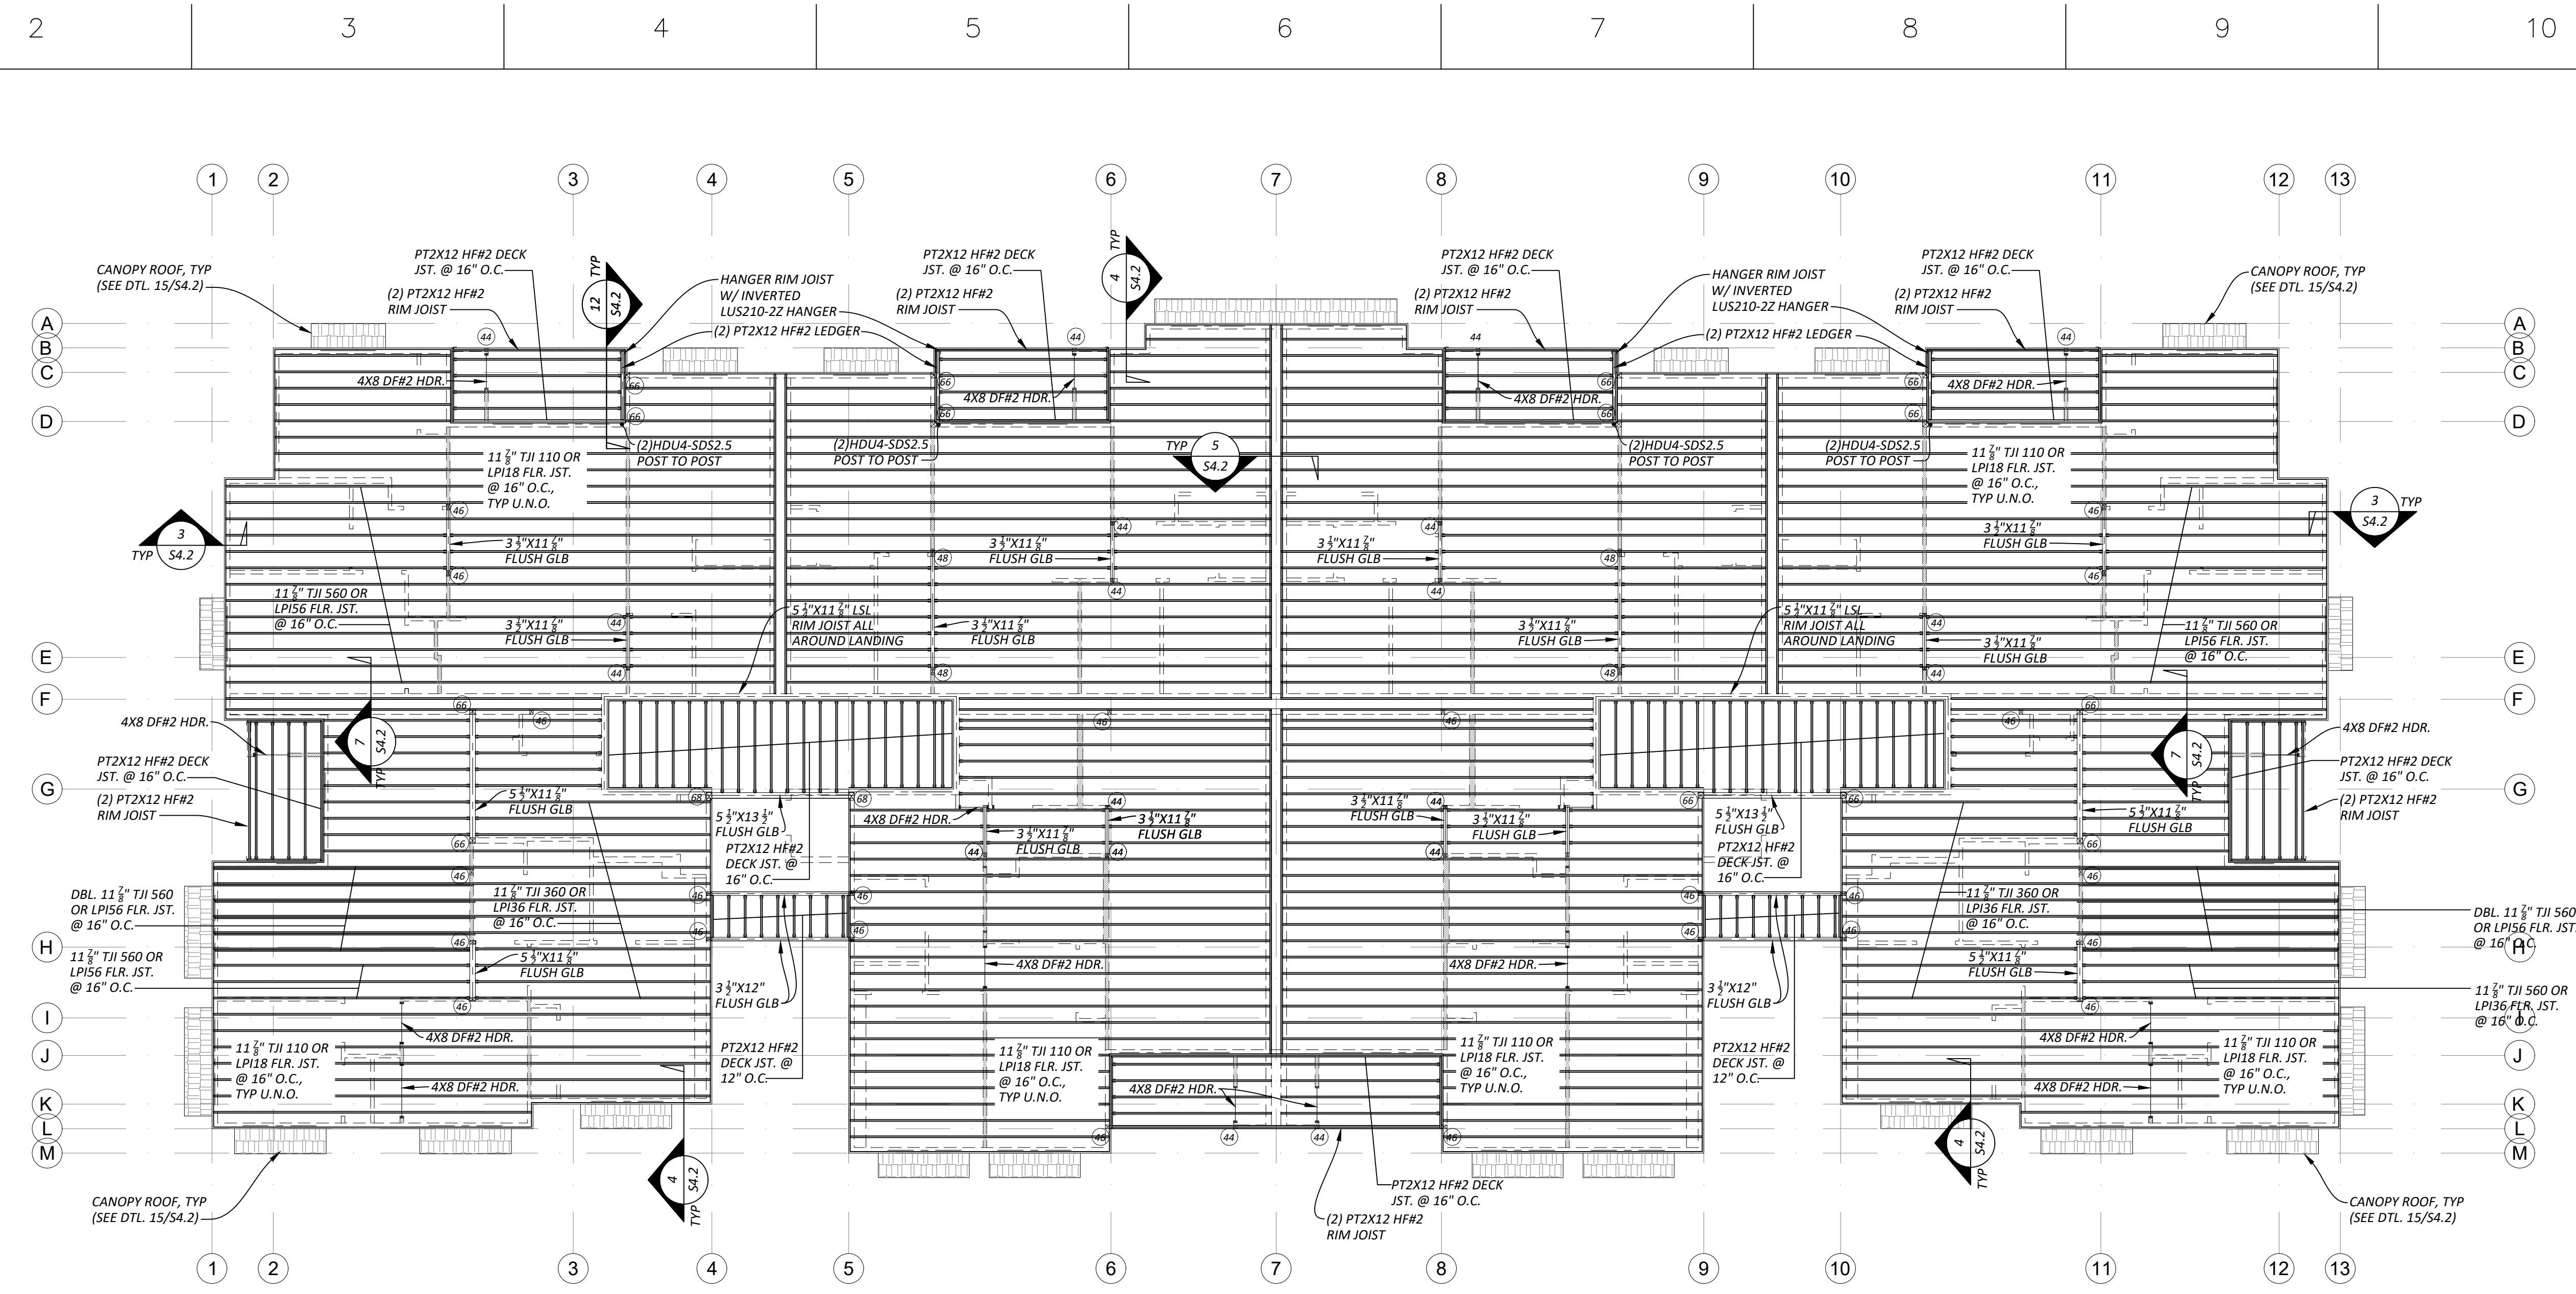

POST SCHEDULE

| POST NUMBER | POST TYPE | ALTERNATIVE BUILT-UP POST |
|-------------|-----------|---------------------------|
| 44 | 4X4 DF#2 | (3) 2X4 DF#2 STUDS |
| 46 | 4X6 DF#2 | (3) 2X6 DF#2 STUDS |
| 48 | 4X8 DF#2 | (5) 2X4 DF#2 STUDS |
| 64 | 4X6 DF#2 | (4) 2X4 DF#2 STUDS |
| 66 | 6X6 DF#2 | (4) 2X6 DF#2 STUDS |
| 68 | 6X8 DF#2 | (5) 2X6 DF#2 STUDS |

- NOTES:
- USE MIN. 6" WIDE POST BELOW BEAM SPLICES
 - USE 4X4 DF#2 POST BELOW 4X BEAMS, U.N.O.
 - USE 6X6 DF#2 POST BELOW 6X BEAMS, U.N.O.

- NOTES:
- ALL COLUMNS NOT SPECIFIED OR OTHERWISE NOTED ON THE PLANS ARE LAMINATED TOGETHER PER "TYPICAL BUILT-UP COLUMN DETAIL" ON SHEET S4.2. SOLID WOOD COLUMNS MAY BE SUBSTITUTED FOR BUILT-UP COLUMNS BY PROVIDING AN EQUIVALENT CROSS SECTIONAL AREA.
 - ALL BEAMS SHALL HAVE A MINIMUM OF 3X BUILT-UP COLUMN WITH CONTINUOUS LOAD PATH TO FOUNDATION.
 - ALL HEADERS UNLESS SPECIFIED ON THE PLANS ARE TO BE 4X10 DF-L #2 WITH AT LEAST ONE CRIPPLE AND ONE STUD FOR EACH END FOR OPENINGS LESS THAN OR EQUAL TO 5'-0" WIDE AND TWO CRIPPLES AND ON KING STUD FOR ALL OTHERS.
 - ALL TJI FLOOR JOIST HUNG FROM FLUSH BEAMS SHALL BE HUNG WITH IUS SERIES HANGERS.
 - ALL RIM JOIST SHALL BE 1 1/2" X 11 1/2" LSL U.N.O. SEE SHEAR WALL TABLE TO AREAS REQUIRING THICKER RIM JOIST.
 - FLOOR SHEATHING SHALL BE 3/4" T&G (48/24) GLUED AND NAILED WITH 10d @ 4" O.C. ALONG PANEL EDGES AND 12" O.C. FIELD. STAGGER END LAPS. NAILS SHALL EMBED 1 1/2" MINIMUM INTO FLOOR JOIST. THIS LEVEL REQUIRES BLOCKING AT ALL SHEATHING PANEL EDGES.
 - SHORT MID LANDING STAIR STRINGERS SHALL BE PT4X12 HF#2.
 - LONG GROUND FLOOR STAIR STRINGERS SHALL BE PT3 1/2"X12" GLB.
 - EXTERIOR WALLS TO BE 2X6 AT 16" O.C., U.N.O.
 - INTERIOR PARTITIONS TO BE 2X4 AT 16" O.C. (2X6 @ PLUMBING WALLS OR PER ARCH.) U.N.O.
 - FLOOR JOISTS AND BEAMS OF EQUAL OR BETTER CAPACITY MAY BE SUBSTITUTED FOR THOSE SHOWN ON THIS PLAN, "EQUAL" IS DEFINED AS HAVING MOMENT CAPACITY, SHEAR CAPACITY, AND STIFFNESS WITHIN 3% OF THE SPECIFIED JOISTS OR BEAMS.

SEE SHEAR WALL PLANS FOR
HOLD DOWN LOCATIONS
THAT REQUIRE DF#2 STUDS

LEVEL 2 FRAMING PLAN
1/8" = 1'-0"



PIERUCCIONI E&C, LLC
CHON PIERUCCIONI, PE
378 N. BENNETT ST.
TACOMA, WA 98407

REUSE OF DOCUMENTS
THIS DOCUMENT HAS BEEN REUSED BY THE DESIGN PROFESSIONAL SERVICE, AND THE PROPERTY OF PIERUCCIONI E&C, LLC AND IS NOT TO BE USED OR REPRODUCED IN WHOLE OR IN PART WITHOUT THE WRITTEN AUTHORIZATION OF PIERUCCIONI E&C, LLC.

EAST TOWN CROSSING
BUILDING "B"
PIONEER & SHAW PUYALLUP WA

REVISIONS

01

REVISIONS

DRAWN BY: CP

CHECKED BY: CP


DATE: 2024.01.12

TITLE: FRAMING PLAN

PROJECT #: ---

SHEET:

S3.3

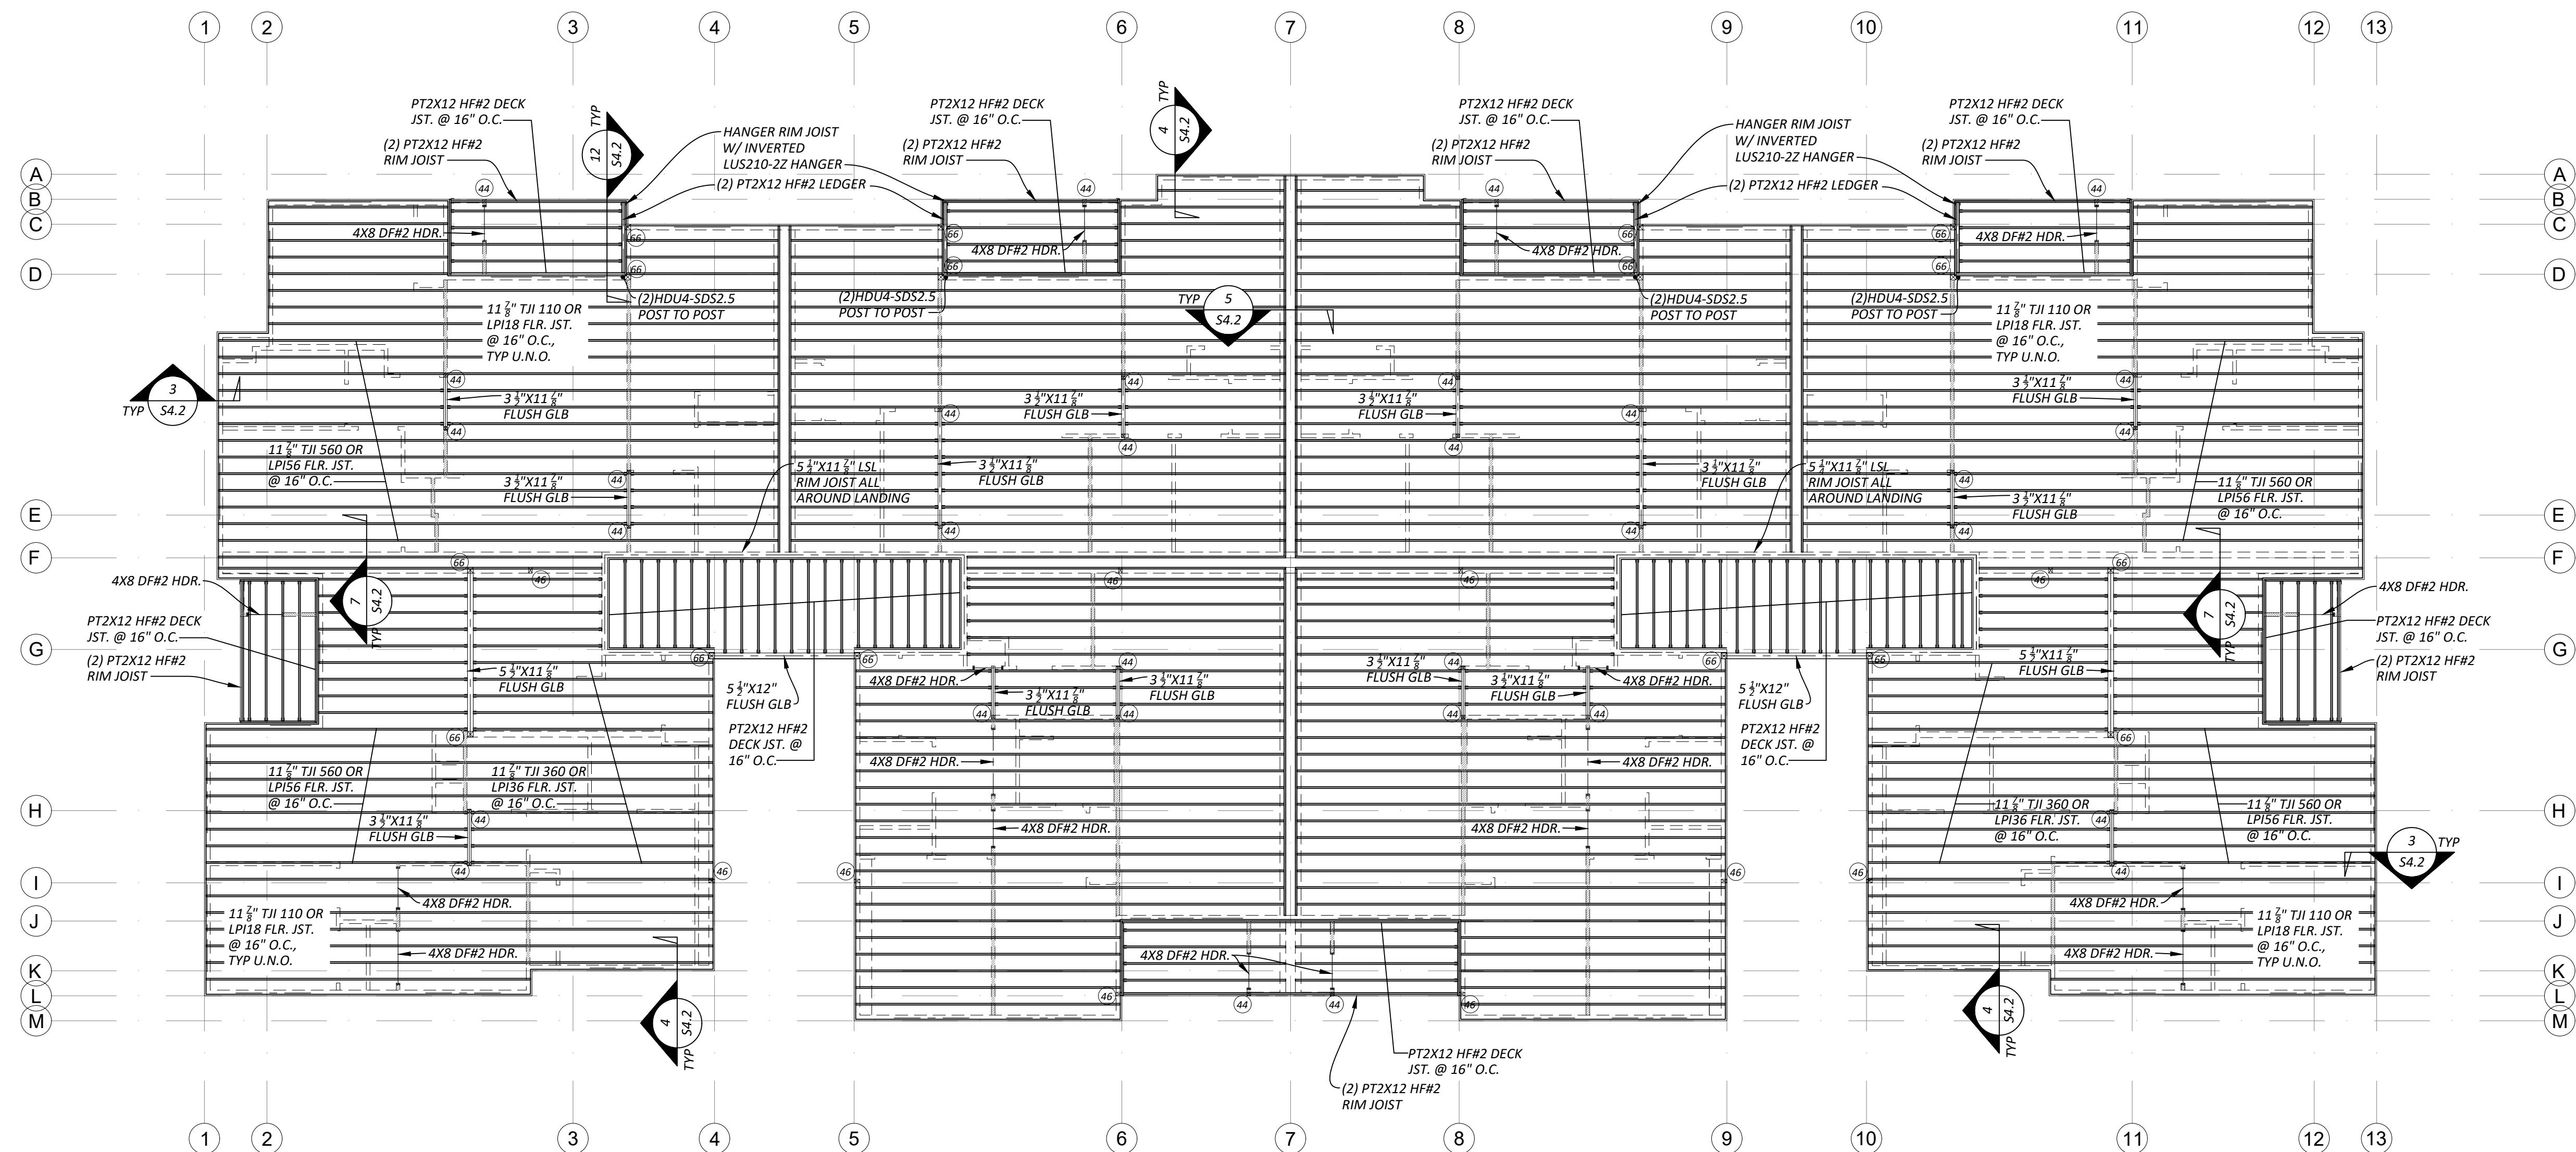


POST SCHEDULE

| POST NUMBER | POST TYPE | ALTERNATIVE BUILT-UP POST |
|-------------|-----------|---------------------------|
| 44 | 4X4 DF#2 | (3) 2X4 DF#2 STUDS |
| 46 | 4X6 DF#2 | (3) 2X6 DF#2 STUDS |
| 64 | 4X6 DF#2 | (4) 2X4 DF#2 STUDS |
| 66 | 6X6 DF#2 | (4) 2X6 DF#2 STUDS |
| 68 | 6X8 DF#2 | (5) 2X6 DF#2 STUDS |

- NOTES:**
- USE MIN. 6" WIDE POST BELOW BEAM SPLICES
 - USE 4X4 DF#2 POST BELOW 4X BEAMS, U.N.O.
 - USE 6X6 DF#2 POST BELOW 6X BEAMS, U.N.O.

- NOTES:**
- ALL COLUMNS NOT SPECIFIED OR OTHERWISE NOTED ON THE PLANS ARE LAMINATED TOGETHER PER "TYPICAL BUILT-UP COLUMN DETAIL" ON SHEET S4.2. SOLID WOOD COLUMNS MAY BE SUBSTITUTED FOR BUILT-UP COLUMNS BY PROVIDING AN EQUIVALENT CROSS SECTIONAL AREA.
 - ALL BEAMS SHALL HAVE A MINIMUM OF 3X BUILT-UP COLUMN WITH CONTINUOUS LOAD PATH TO FOUNDATION.
 - ALL HEADERS UNLESS SPECIFIED ON THE PLANS ARE TO BE 4X10 DF-L #2 WITH AT LEAST ONE CRIPPLE AND ONE STUD FOR EACH END FOR OPENINGS LESS THAN OR EQUAL TO 5'-0" WIDE AND TWO CRIPPLES AND ON KING STUD FOR ALL OTHERS.
 - ALL TJI FLOOR JOIST HUNG FROM FLUSH BEAMS SHALL BE HUNG WITH IUS SERIES HANGERS.
 - ALL RIM JOIST SHALL BE 1 1/4" X 11 3/4" LSL U.N.O. SEE SHEAR WALL TABLE TO AREAS REQUIRING THICKER RIM JOIST.
 - FLOOR SHEATHING SHALL BE 3/8" T&G (48/24) GLUED AND NAILED WITH 10d @ 6" O.C. ALONG PANEL EDGES AND 12" O.C. FIELD. STAGGER END LAPS. NAILS SHALL EMBED 1 1/2" MINIMUM INTO FLOOR JOIST.
 - SHORT MID LANDING STAIR STRINGERS SHALL BE PT4X12 HF#2.
 - LONG GROUND FLOOR STAIR STRINGERS SHALL BE PT3 1/2" X 12" GLB.
 - EXTERIOR WALLS TO BE 2X6 AT 16" O.C., U.N.O.
 - INTERIOR PARTITIONS TO BE 2X4 AT 16" O.C. (2X6 @ PLUMBING WALLS OR PER ARCH.) U.N.O.
 - FLOOR JOISTS AND BEAMS OF EQUAL OR BETTER CAPACITY MAY BE SUBSTITUTED FOR THOSE SHOWN ON THIS PLAN, "EQUAL" IS DEFINED AS HAVING MOMENT CAPACITY, SHEAR CAPACITY, AND STIFFNESS WITHIN 3% OF THE SPECIFIED JOISTS OR BEAMS.

LEVEL 3 FRAMING PLAN
1/8" = 1'-0"

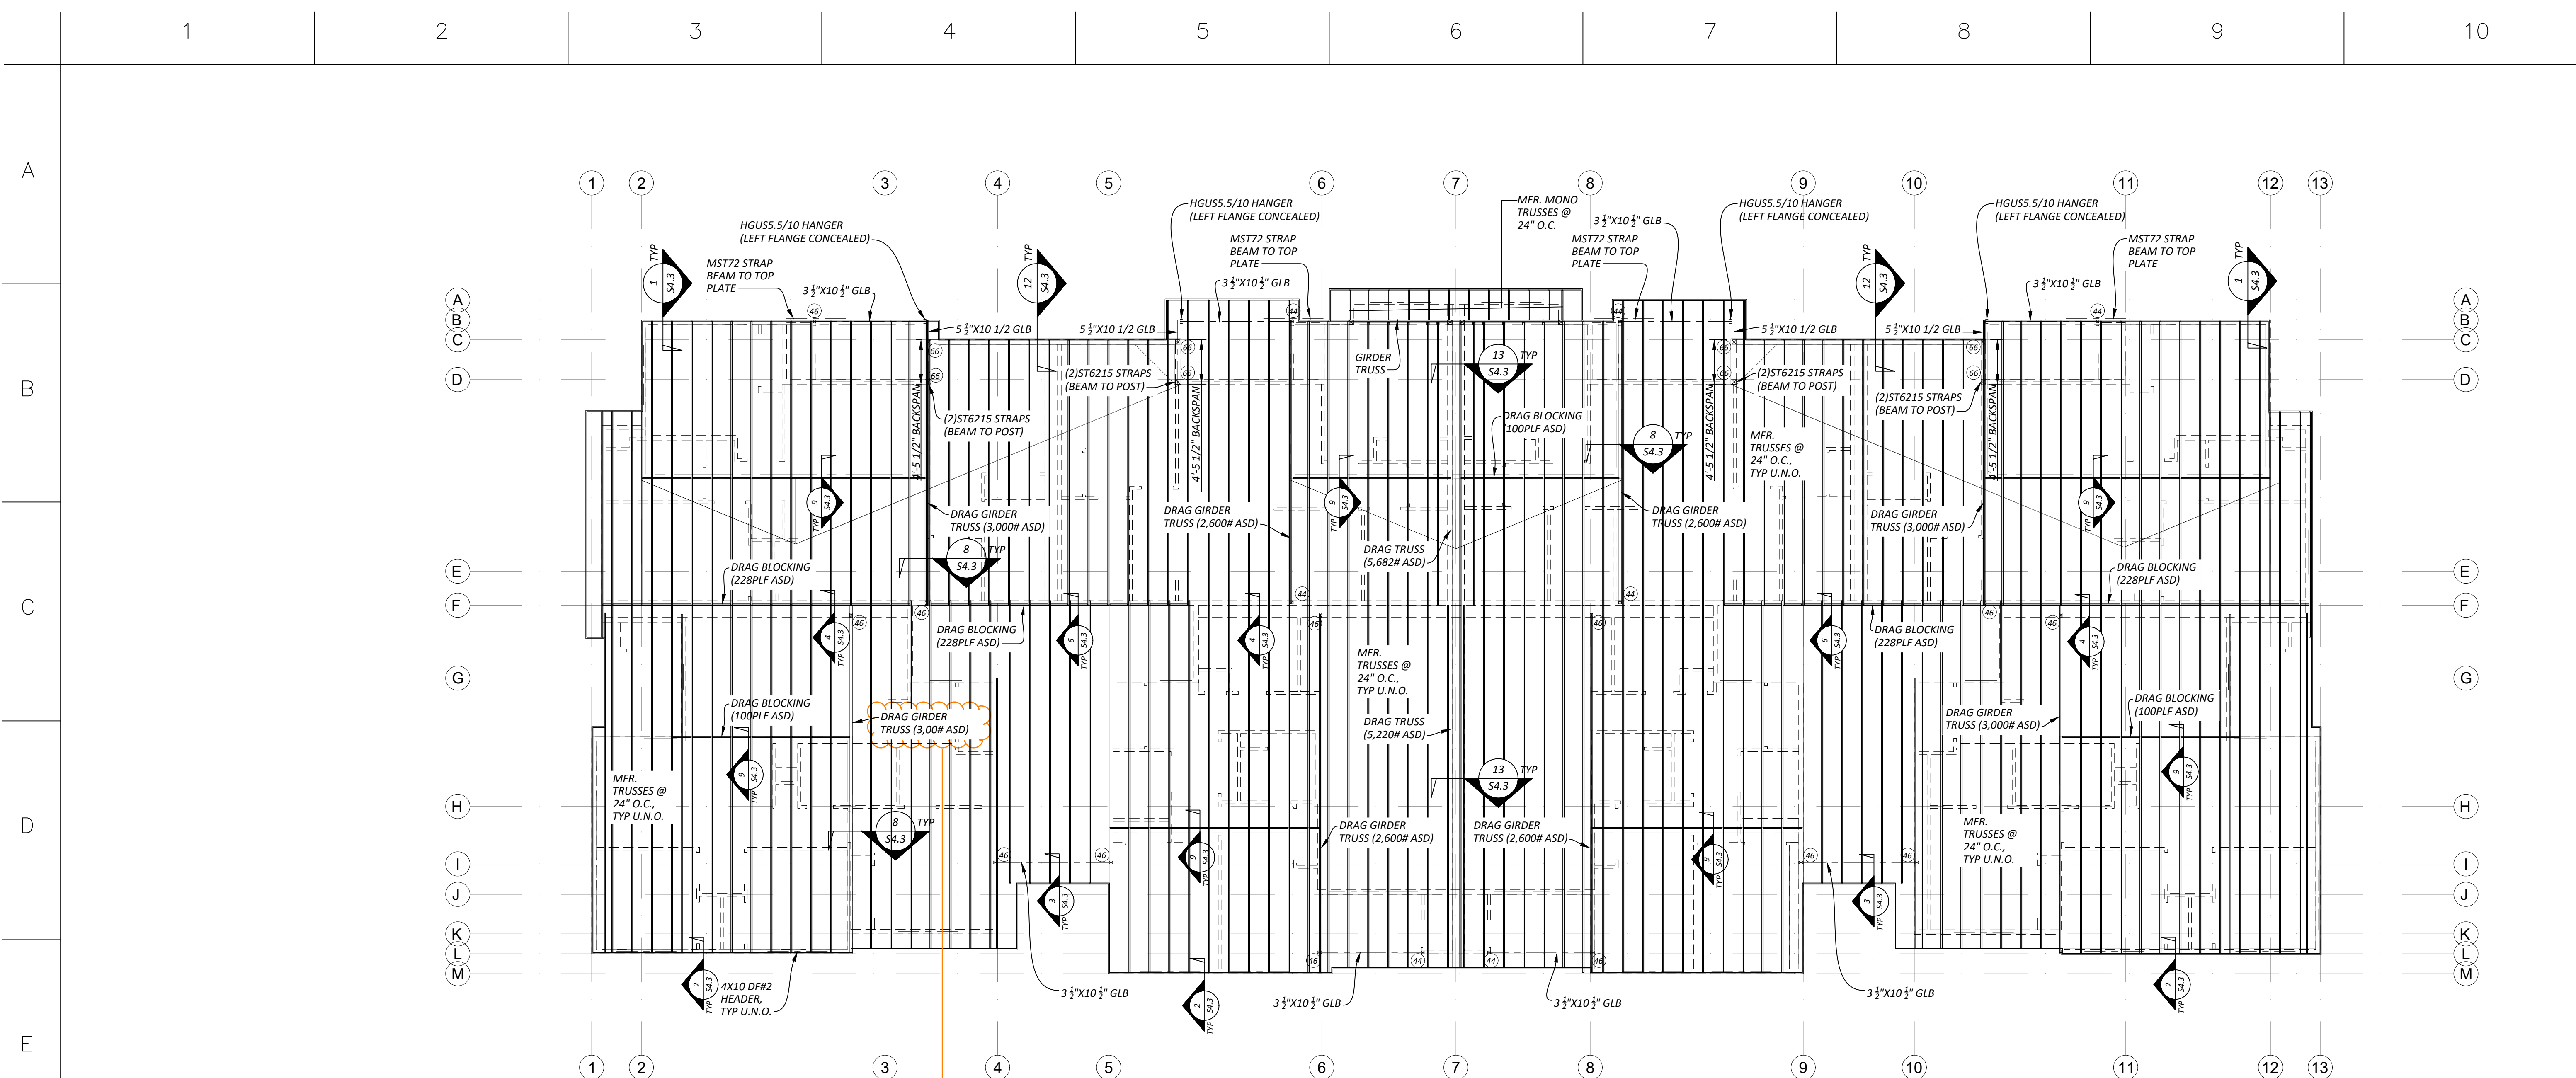

POST SCHEDULE

| POST NUMBER | POST TYPE | ALTERNATIVE BUILT-UP POST |
|-------------|-----------|---------------------------|
| 44 | 4X4 DF#2 | (3) 2X4 DF#2 STUDS |
| 46 | 4X6 DF#2 | (3) 2X6 DF#2 STUDS |
| 64 | 4X6 DF#2 | (4) 2X4 DF#2 STUDS |
| 66 | 6X6 DF#2 | (4) 2X6 DF#2 STUDS |
| 68 | 6X8 DF#2 | (5) 2X6 DF#2 STUDS |

- NOTES:
- USE MIN. 6" WIDE POST BELOW BEAM SPLICES
 - USE 4X4 DF#2 POST BELOW 4X BEAMS, U.N.O.
 - USE 6X6 DF#2 POST BELOW 6X BEAMS, U.N.O.

- NOTES:
- ALL COLUMNS NOT SPECIFIED OR OTHERWISE NOTED ON THE PLANS ARE LAMINATED TOGETHER PER "TYPICAL BUILT-COLUMN DETAIL" ON SHEET S4.2. SOLID WOOD COLUMNS MAY BE SUBSTITUTED FOR BUILT-UP COLUMNS BY PROVIDING AN EQUIVALENT CROSS SECTIONAL AREA.
 - ALL HEADERS UNLESS SPECIFIED ON THE PLANS ARE TO BE 4X10 DF-L #2 WITH AT LEAST ONE CRIPPLE AND ONE STUD FOR EACH END FOR OPENINGS LESS THAN OR EQUAL TO 5'-0" WIDE AND TWO CRIPPLES AND ON KING STUD FOR ALL OTHERS.
 - ROOF SHEATHING SHALL BE 1/2" CDX OR 7/16" OSB NAILED WITH 8d @ 6" O.C. ALONG PANEL EDGES, AND 12" O.C. FIELD. SPAN INDEX SHALL BE 24/0. STAGGER END LAPS. NAILS SHALL MINIMUM 1 1/2" EMBED INTO ROOF STRUCTURE BELOW.
 - BEARING WALLS ARE INDICATED AS SHADED WALLS
 - PROVIDE VENTED BLOCKING AT REQUIRED TRUSS/RAFTER BAYS
 - SHADED AREAS INDICATE OVERFRAMING. ROOF OVER FRAMING (IRC SECTION R802.3): RAFTERS SHALL BE FRAMED TO 2X RIDGE BOARD PER PLAN. RIDGE BOARD SHALL NOT BE LESS IN DEPTH THAN THE CUT END OF THE RAFTER. AT ALL VALLEYS AND HIPS THERE SHALL BE A 2X VALLEY OR HIP RAFTER AND NOT LESS IN DEPTH THAN THE CUT END OR THE RAFTER. (FULL COVERAGE AT RIDGE, HIPS AND VALLEYS).
 - ALL MANUFACTURED TRUSSES:
 - * SHALL NOT BE FIELD ALTERED WITHOUT ENGINEER'S APPROVAL
 - * SHALL HAVE DESIGN DETAILS AND DRAWINGS ON SITE FOR FRAMING INSPECTION
 - * SHALL BE INSTALLED AND BRACED TO MANUFACTURER'S SPECIFICATION
 - * SHALL CARRY MANUFACTURER'S STAMP ON EACH TRUSS
 - IF AN ENGINEERED ROOF FRAMING LAYOUT IS PROVIDED BY THE TRUSS SUPPLIER, THAT TRUSS LAYOUT SHALL SUPERCEDE THE TRUSS LAYOUT INDICATED IN THE PLANS. PROVIDE TRUSS LAYOUT AND SPECS ON SITE FOR INSPECTION.
 - PROVIDE SOLID FRAMING EQUAL TO THE WIDTH OF THE MEMBER BEING SUPPORTED (U.N.O.)

LOWER ROOF FRAMING PLAN
1/8" = 1'-0"



PIERUCCIONI E&C, LLC
CHON PIERUCCIONI, PE
378 N. BENNETT ST.
TACOMA, WA 98407

REUSE OF DOCUMENTS
THIS DOCUMENT IS THE PROPERTY OF
PIERUCCIONI E&C, LLC. IT IS TO BE USED
ONLY FOR THE PROJECT AND SITE SPECIFICALLY
IDENTIFIED IN THE TITLE. ANY REUSE OF THIS
DOCUMENT WITHOUT THE WRITTEN PERMISSION OF
PIERUCCIONI E&C, LLC IS PROHIBITED.

EAST TOWN CROSSING
BUILDING "B"
PIONEER & SHAW PUYALLUP WA

REVISIONS

| NO. | DATE | DESCRIPTION |
|-----|------|-------------|
| 01 | --- | --- |

| REVISIONS | |
|-------------|--------------|
| DRAWN BY: | CP |
| CHECKED BY: | CP |
| DATE: | 2024.01.12 |
| TITLE: | FRAMING PLAN |
| PROJECT #: | --- |
| SHEET: | --- |

S3.4



PIERUCCIONI E&C, LLC
CHON PIERUCCIONI, PE
3726 N. BENNETT ST.
TACOMA, WA 98407

REUSE OF DOCUMENTS
THIS DOCUMENT IS THE PROPERTY OF PIERUCCIONI E&C, LLC AND IS NOT TO BE REPRODUCED OR TRANSMITTED IN ANY FORM OR BY ANY MEANS, ELECTRONIC OR MECHANICAL, INCLUDING PHOTOCOPYING, RECORDING, OR BY ANY INFORMATION STORAGE AND RETRIEVAL SYSTEM, WITHOUT THE WRITTEN PERMISSION OF PIERUCCIONI E&C, LLC.

EAST TOWN CROSSING
BUILDING "B"
PIONEER & SHAW PUYALLUP WA


REVISIONS

| NO. | DESCRIPTION |
|-----|-------------|
| 01 | --- |
| | |
| | |
REVISIONS

| | |
|-------------|--------------|
| DRAWN BY: | CP |
| CHECKED BY: | CP |
| DATE: | 2024.01.12 |
| TITLE: | FRAMING PLAN |
| PROJECT #: | --- |
| SHEET: | --- |

S3.5

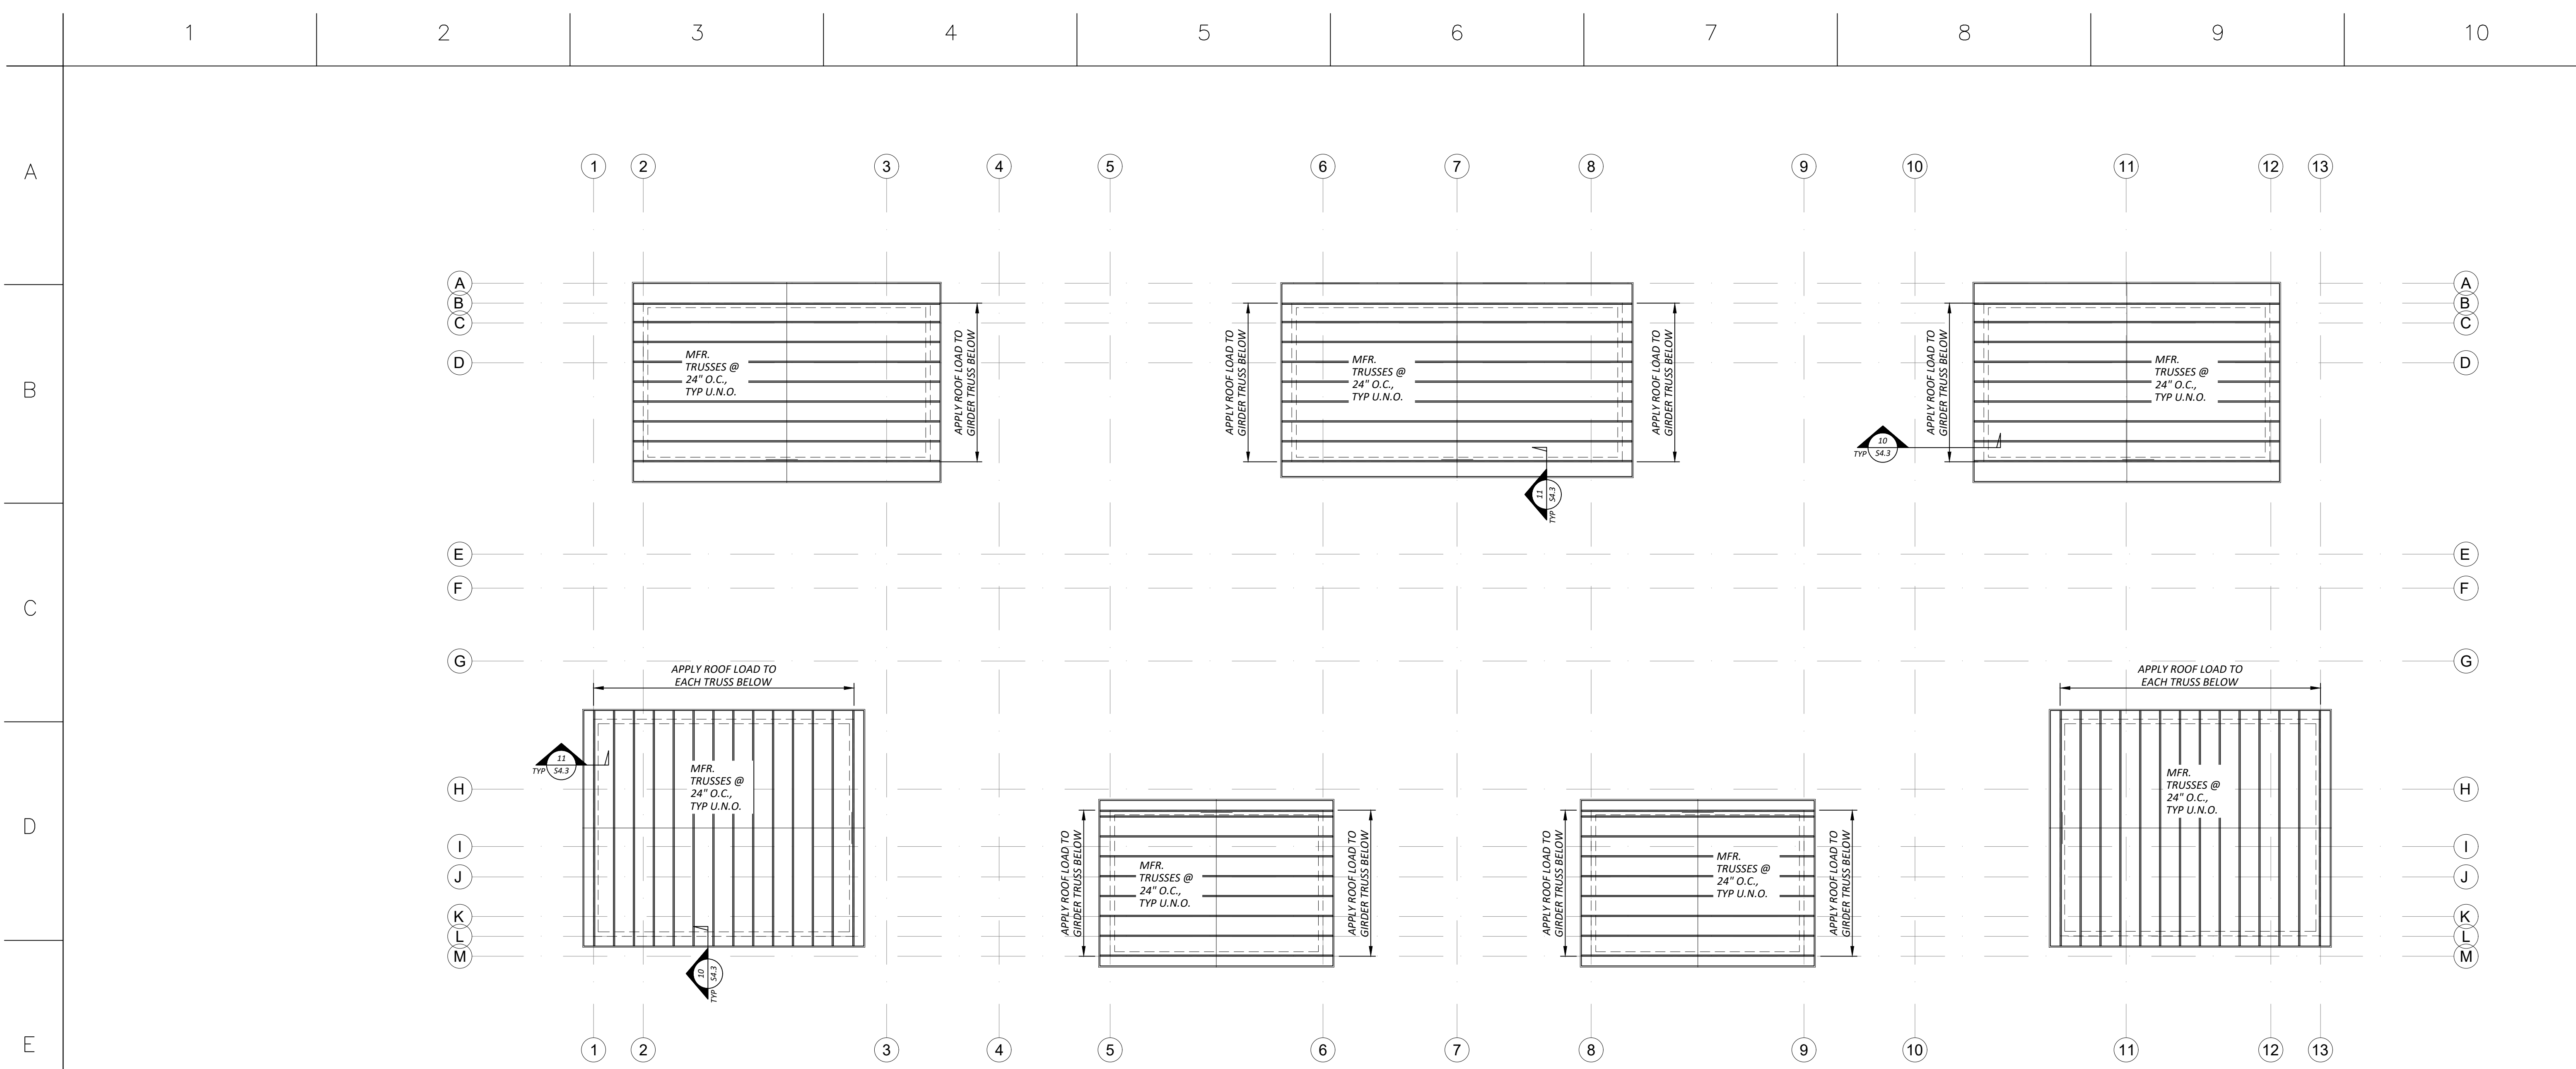

UPPER ROOF FRAMING PLAN
1/8" = 1'-0"


- NOTES:
- ALL COLUMNS NOT SPECIFIED OR OTHERWISE NOTED ON THE PLANS ARE LAMINATED TOGETHER PER "TYPICAL BUILT-COLUMN DETAIL" ON SHEET S4.2. SOLID WOOD COLUMNS MAY BE SUBSTITUTED FOR BUILT-UP COLUMNS BY PROVIDING AN EQUIVALENT CROSS SECTIONAL AREA.
 - ALL HEADERS UNLESS SPECIFIED ON THE PLANS ARE TO BE 4X10 DF-L #2 WITH AT LEAST ONE CRIPPLE AND ONE STUD FOR EACH END FOR OPENINGS LESS THAN OR EQUAL TO 5'-0" WIDE AND TWO CRIPPLES AND ON KING STUD FOR ALL OTHERS.
 - ROOF SHEATHING SHALL BE 1/2" CDX OR 7/16" OSB NAILED WITH 8d @ 6" O.C. ALONG PANEL EDGES, AND 12" O.C. FIELD. SPAN INDEX SHALL BE 24/0. STAGGER END LAPS. NAILS SHALL MINIMUM 1 1/2" EMBED INTO ROOF STRUCTURE BELOW.
 - BEARING WALLS ARE INDICATED AS SHADED WALLS
 - PROVIDE VENTED BLOCKING AT REQUIRED TRUSS/RAFTER BAYS
 - ALL MANUFACTURED TRUSSES:
 - * SHALL NOT BE FIELD ALTERED WITHOUT ENGINEER'S APPROVAL
 - * SHALL HAVE DESIGN DETAILS AND DRAWINGS ON SITE FOR FRAMING INSPECTION
 - * SHALL BE INSTALLED AND BRACED TO MANUFACTURER'S SPECIFICATION
 - * SHALL CARRY MANUFACTURER'S STAMP ON EACH TRUSS
 - IF AN ENGINEERED ROOF FRAMING LAYOUT IS PROVIDED BY THE TRUSS SUPPLIER, THAT TRUSS LAYOUT SHALL SUPERCEDE THE TRUSS LAYOUT INDICATED IN THE PLANS. PROVIDE TRUSS LAYOUT AND SPECS ON SITE FOR INSPECTION.
 - PROVIDE SOLID FRAMING EQUAL TO THE WIDTH OF THE MEMBER BEING SUPPORTED (U.N.O.)



PIERUCCIONI E&C, LLC
CHON PIERUCCIONI, PE
378 N. BENNETT ST.
TACOMA, WA 98402

REUSE OF DOCUMENTS
THIS DOCUMENT HAS BEEN REPRODUCED FROM THE ORIGINAL DOCUMENT OF PIERUCCIONI E&C, LLC. THE REPRODUCED DOCUMENT IS THE PROPERTY OF PIERUCCIONI E&C, LLC AND IS NOT TO BE REPRODUCED OR TRANSMITTED IN ANY FORM OR BY ANY MEANS, ELECTRONIC OR MECHANICAL, INCLUDING PHOTOCOPYING, RECORDING, OR BY ANY INFORMATION STORAGE AND RETRIEVAL SYSTEM, WITHOUT THE WRITTEN PERMISSION OF PIERUCCIONI E&C, LLC.

EAST TOWN CROSSING
BUILDING "B"
PIONEER & SHAW PUYALLUP WA

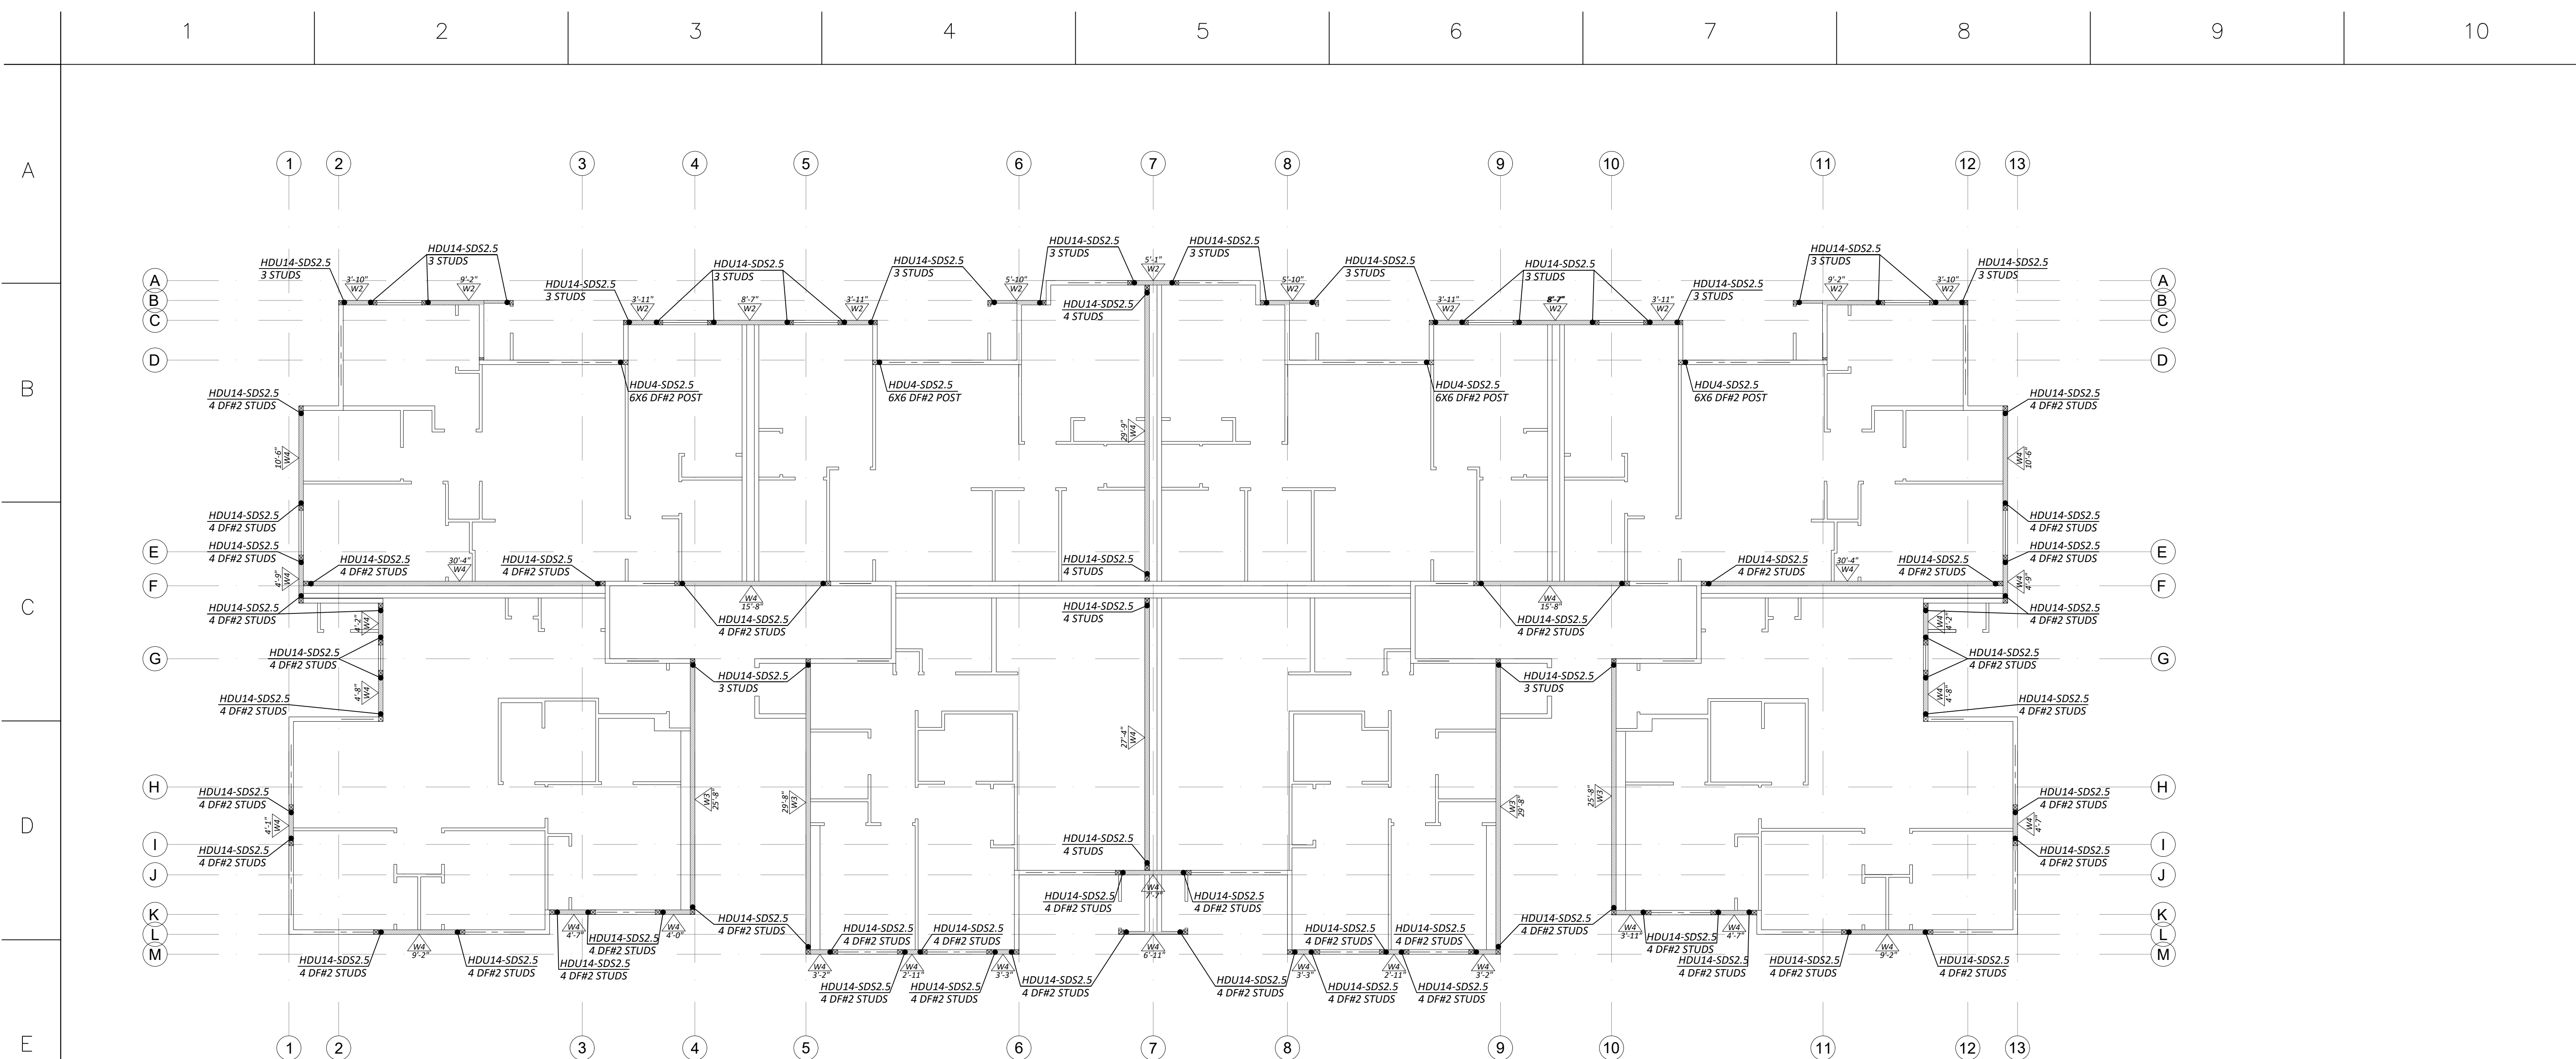

SPECIAL INSPECTIONS ARE REQUIRED FOR SHEAR WALLS: $\triangle W2$ $\triangle W3$ $\triangle W4$

LEVEL 1 SHEAR WALL PLAN
1/8" = 1'-0"

- NOTES:
1. ALL EXTERIOR WALL SHALL BE SHEAR WALL TYPE W1 UNLESS NOTED OTHERWISE.

HOLD DOWN SCHEDULE

| SIMPSON PRODUCT | FASTENERS | | ANCHOR BOLTS |
|-----------------|---|-------|------------------------|
| | SCREWS OR BOLTS | NAILS | |
| HDU4-SDS2.5 | (10) 3/4" X 2 3/4" SDS INTO POST PER PLAN | -- | SB 3/4"x24 (18" EMBED) |
| HDU14-SDS2.5 | (36) 3/4" X 2 3/4" SDS INTO POST PER PLAN | -- | SB 1X30 (24" EMBED) |

SHEAR WALL AND ANCHOR TABLE

| WALL TYPE | APA RATED SHEATHING (b), (c) | MINIMUM NOMINAL THICKNESS (IN) (j) | MINIMUM NAIL PENETRATION IN FRAMING (IN) (i) | STUD & BLOCKING SIZE @ ADJOINING EDGES (k) | REQUIRED RIM JOIST THICKNESS | EDGE NAIL SIZE AND SPACING, COMMON OR GALV. BOX (d) | RIM JOIST OR BLOCK CONNECTION TO TOP PLATE (e), (f) | 2x BOTTOM PLATE ATTACHMENT TO WOOD BELOW (g), (i) | ANCHOR BOLT SILL PLATE ATTACHMENT TO CONCRETE BELOW (h) | CAPACITY (PLF) SEISMIC/WIND |
|-----------|------------------------------|------------------------------------|--|--|------------------------------|---|---|---|---|-----------------------------|
| W1 | OSB | 7/16 (j) | 1 3/8 | 2x | 2x OR 1 1/4" LSL | 8d@6" O.C. EDGE 8d@12" O.C. FIELD | LTP4 @ 20" O.C. OR A35 @ 16" O.C. | (1) 16d @ 8" O.C. | 3/8" @ 48" O.C. | 242/339 |
| W2 | OSB | 7/16 (j) | 1 3/8 | 2x | 2x OR 1 1/4" LSL | 8d@4" O.C. EDGE 8d@12" O.C. FIELD | LTP4 @ 14" O.C. OR A35 @ 11" O.C. | (1) 16d @ 6" O.C. | 3/8" @ 36" O.C. | 353/495 |
| W3 | OSB | 7/16 (j) | 1 3/8 | 2x | 2x OR 1 1/4" LSL | 8d@3" O.C. EDGE 8d@12" O.C. FIELD | LTP4 @ 11" O.C. OR A35 @ 8" O.C. | (1) 16d @ 4" O.C. | 3/8" @ 24" O.C. | 456/637 |
| W4 (a) | OSB | 7/16 (j) | 1 3/8 | 3x | 3x OR 1 3/4" LSL | 8d@2" O.C. EDGE 8d@12" O.C. FIELD | LTP4 @ 8" O.C. OR A35 @ 6" O.C. | (2) 16d @ 6" O.C. | 3/8" @ 24" O.C. | 595/832 |

- (a) FRAMING AT ADJACENT PANELS SHALL BE 3" NOMINAL OR GREATER AND NAILS SHALL BE STAGGERED.
 (b) WHERE SHEATHING IS APPLIED ON BOTH SIDES OF WALL, PANEL EDGE JOINTS ON 2x FRAMING SHALL BE STAGGERED SO THAT JOINTS ON THE OPPOSITE SIDE ARE NOT LOCATED ON THE SAME STUDS.
 (c) BLOCKING IS REQUIRED AT ALL PANEL EDGES
 (d) PROVIDE SHEAR WALL SHEATHING AND NAILING FOR THE ENTIRE LENGTH OF THE WALLS INDICATED ON THE PLANS. ENDS OF FULL HEIGHT WALLS ARE DESIGNATED BY EXTERIOR OF THE BUILDING, CORRIDORS, WINDOW, OR DOORWAYS OR AS DESIGNATED ON THE PLANS. SEE PLANS FOR HOLD DOWN POSTS. SHEATHING EDGE NAILING IS REQUIRED AT ALL HOLD DOWN POSTS. EDGE NAILING MAY ALSO BE REQUIRED TO EACH STUD USED IN BUILT-UP HOLD DOWN POSTS.
 (e) BASED ON 0.131X 1 1/4" LONG NAILS USED TO ATTACH FRAMING CLIPS DIRECTLY TO FRAMING. USE 0.131X 2 3/4" NAILS WHERE INSTALLED OVER SHEATHING. USE A35 OR RBC CLIPS IN LIEU OF LTP'S FOR ROOF BLOCKING TO TOP PLATE.
 (f) LTP4'S ARE NOT REQUIRED WHERE THE LOWER WALL SHEATHING IS OVERLAPPED ONTO THE RIM JOIST A MINIMUM OF 1 1/2" AND NAILED TO THE RIM JOIST PER THE SHEAR WALL PERIMETER NAIL SPACING. LTP4'S MAY BE SUBSTITUTED W/ A35'S.
 (g) CONTINUOUS SHEATHING IS REQUIRED OVER THE BOTTOM PLATE TO THE BOTTOM OF THE RIM JOIST OR SILL PLATE WITH EDGE NAILING AT EACH. WHERE TWO ROWS OF NAILING ARE REQUIRED AT RAISED FLOORS, PROVIDE BLOCKING PER PLAN, AND ATTACH WITH LTP4 PER SCHEDULE.
 (h) ANCHOR BOLTS SHALL BE PROVIDED WITH STEEL PLATE WASHERS 0.229"x3"x3". EMBED ANCHOR BOLTS MINIMUM 7" INTO THE CONCRETE. PLATE WASHERS SHALL EXTEND TO WITHIN 1" OF THE SILL PLATE EDGE ON THE SHEATHED WALL FACE.
 (i) PRESSURE TREATED MATERIALS CAN CAUSE EXCESSIVE CORROSION IN THE FASTENERS. PROVIDE HOT-DIPPED GALVANIZED (ELECTROPLATING IS NOT ACCEPTABLE) NAILS AND CONNECTOR PLATES (FRAMING ANGLES, ETC.) FOR ALL CONNECTORS IN CONTACT WITH PRESSURE TREATED FRAMING MEMBERS.
 (j) ALL SHEAR WALL STUDS MUST BE SPACED NO MORE THAN 16" O.C.
 (k) 3x MEMBERS MAY BE SUBSTITUTED WITH 2 STUDS NAILED TOGETHER PER TYPICAL BUILT-UP COLUMN DETAIL (SEE DETAILS).

REVISIONS

| NO. | DESCRIPTION |
|-----|-------------|
| 01 | --- |

DRAWN BY: CP
 CHECKED BY: CP
 DATE: 2024.01.12
 TITLE: SHEAR WALL PLAN
 PROJECT #: ---
 SHEET:


S3.6



PIERUCCIONI E&C, LLC
CHON PIERUCCIONI, PE
3726 N. BENNETT ST.
TACOMA, WA 98407

REUSE OF DOCUMENTS
THIS DOCUMENT AND THE DESIGN AND CONSTRUCTION OF THE PROJECT ARE THE PROPERTY OF PIERUCCIONI E&C, LLC AND ARE TO BE USED ONLY FOR THE PROJECT AND NOT TO BE REPRODUCED OR IN ANY MANNER WITHOUT THE WRITTEN PERMISSION OF PIERUCCIONI E&C, LLC.

EAST TOWN CROSSING
BUILDING "B"
PIONEER & SHAW PUYALLUP WA

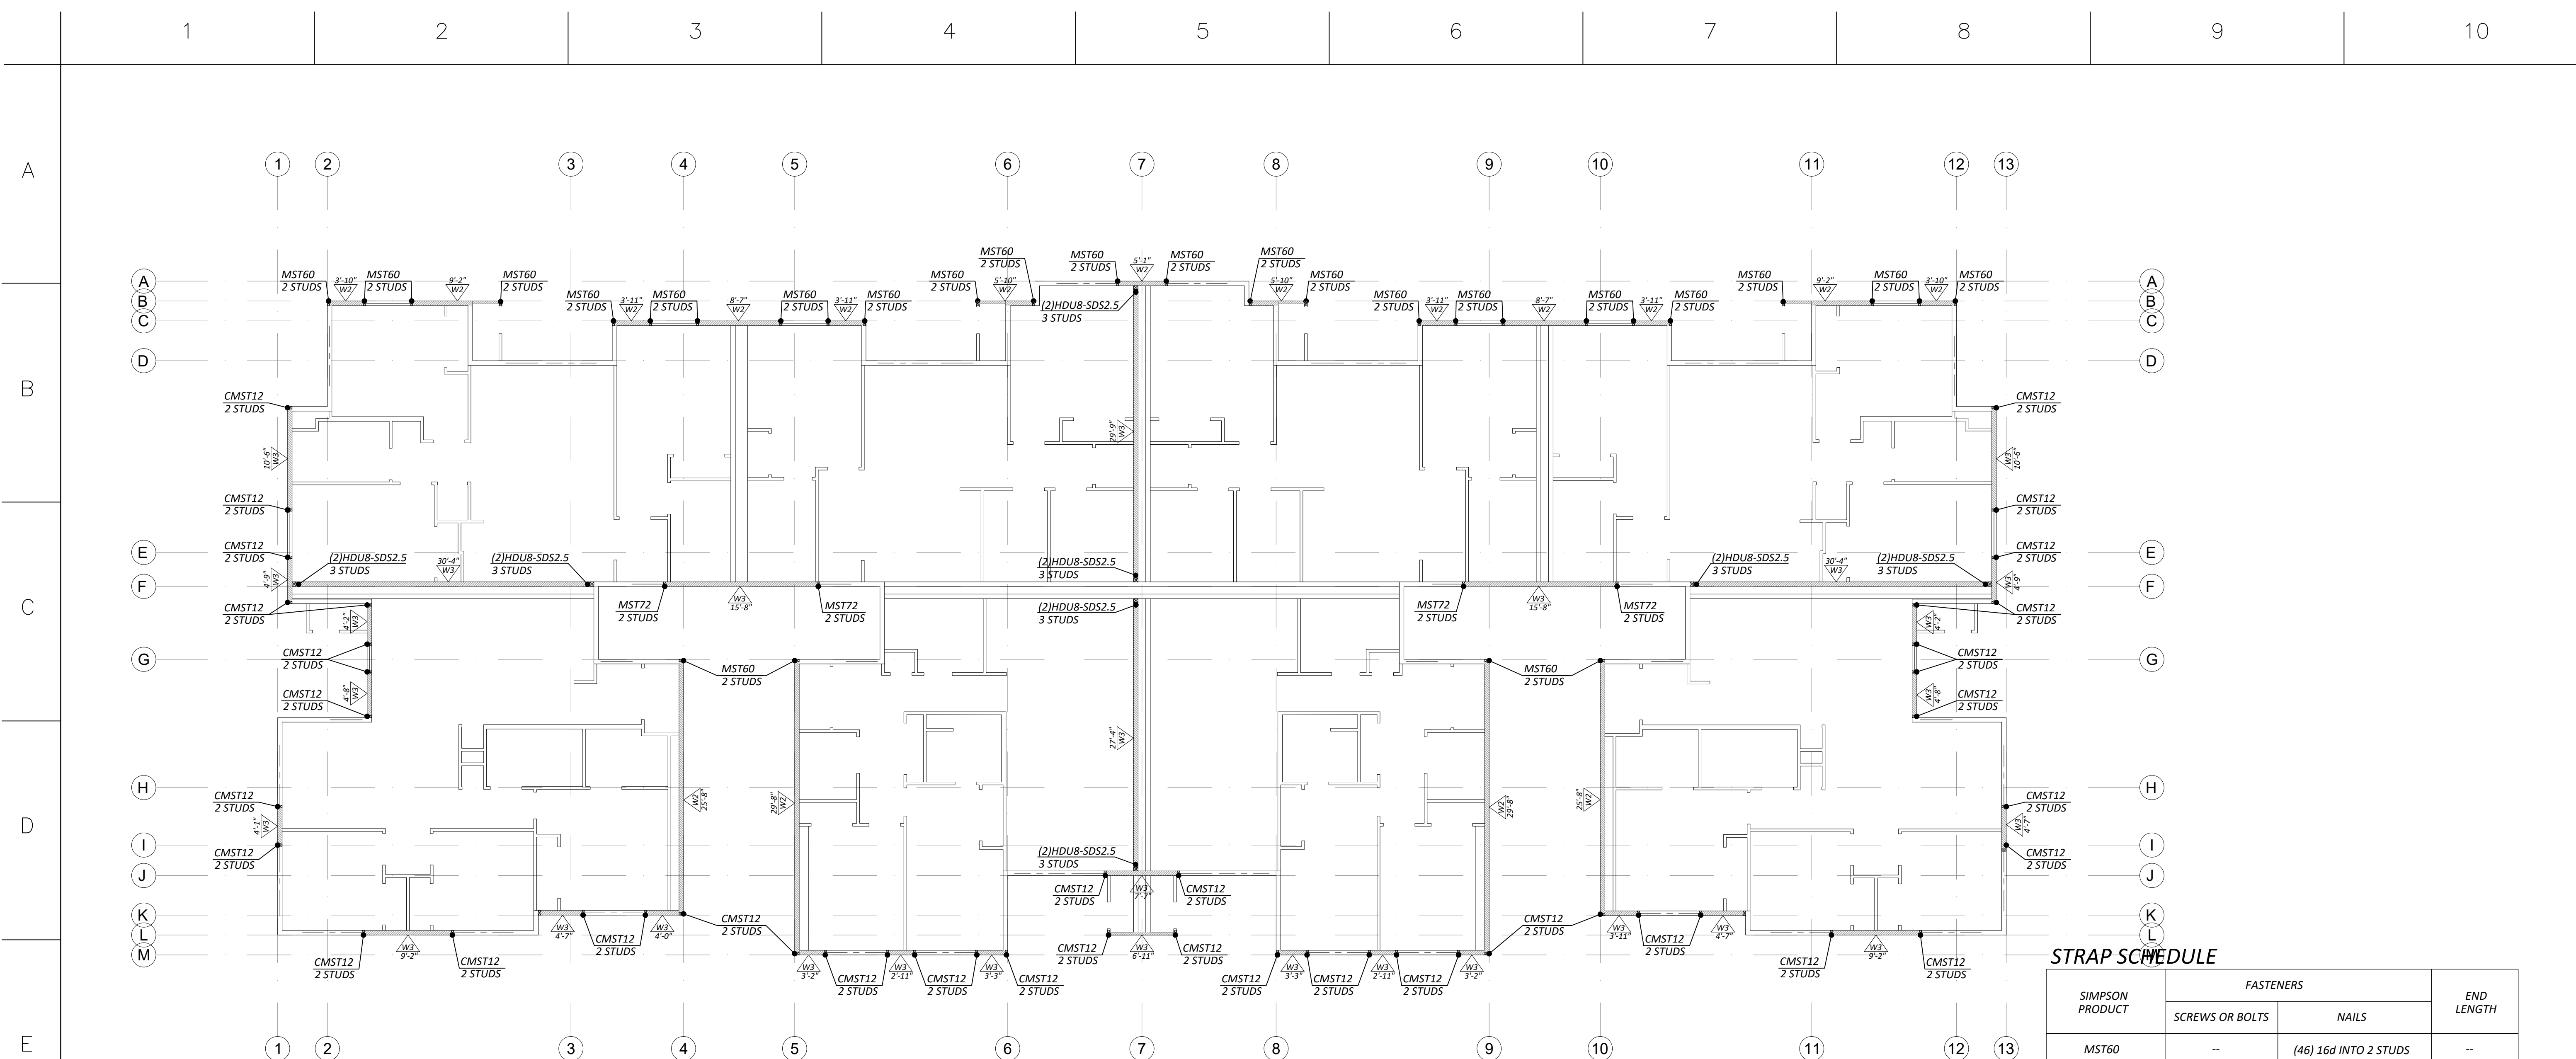

STRAP SCHEDULE

| SIMPSON PRODUCT | FASTENERS | | END LENGTH |
|-----------------|-----------------|-----------------------|------------|
| | SCREWS OR BOLTS | NAILS | |
| MST60 | -- | (46) 16d INTO 2 STUDS | -- |
| MST72 | -- | (62) 16d INTO 2 STUDS | -- |
| CMST12 | -- | (84) 10d INTO 2 STUDS | 38" |

THRU FLOOR HOLD DOWN SCHEDULE

| SIMPSON PRODUCT | FASTENERS | | ANCHOR BOLTS |
|-----------------|---|-------|-------------------|
| | SCREWS OR BOLTS | NAILS | |
| (2) HDU8-SDS2.5 | (20) 1/4" X 2 1/2" SDS INTO POST PER PLAN | -- | 5/8" THREADED ROD |

(a) THESE HOLD DOWNS ARE THRU FLOOR HOLD DOWN. TOTAL OF 2 HOLD DOWNS ARE REQUIRED (SEE DETAIL 2/S4.2).

SHEAR WALL AND ANCHOR TABLE

| WALL TYPE | APA RATED SHEATHING (b), (c) | MINIMUM NOMINAL THICKNESS (IN) (j) | MINIMUM NAIL PENETRATION IN FRAMING (IN) (i) | STUD & BLOCKING SIZE @ ADJOINING EDGES (k) | REQUIRED RIM JOIST THICKNESS | EDGE NAIL SIZE AND SPACING, COMMON OR GALV. BOX (d) | RIM JOIST OR BLOCK CONNECTION TO TOP PLATE (e), (f) | 2x BOTTOM PLATE ATTACHMENT TO WOOD BELOW (g), (l) | ANCHOR BOLT SILL PLATE ATTACHMENT TO CONCRETE BELOW (h) | CAPACITY (PLF) SEISMIC/WIND |
|-----------|------------------------------|------------------------------------|--|--|------------------------------|---|---|---|---|-----------------------------|
| W1 | OSB | 7/16 (j) | 1 3/8 | 2x | 2x OR 1 1/2" LSL | 8d @ 6" O.C. EDGE 8d @ 12" O.C. FIELD | LTP4 @ 20" O.C. OR A35 @ 16" O.C. | (1) 16d @ 8" O.C. | 5/8" @ 48" O.C. | 242/339 |
| W2 | OSB | 7/16 (j) | 1 3/8 | 2x | 2x OR 1 1/2" LSL | 8d @ 4" O.C. EDGE 8d @ 12" O.C. FIELD | LTP4 @ 14" O.C. OR A35 @ 11" O.C. | (1) 16d @ 6" O.C. | 5/8" @ 36" O.C. | 353/495 |
| W3 | OSB | 7/16 (j) | 1 3/8 | 2x | 2x OR 1 1/2" LSL | 8d @ 3" O.C. EDGE 8d @ 12" O.C. FIELD | LTP4 @ 11" O.C. OR A35 @ 8" O.C. | (1) 16d @ 4" O.C. | 5/8" @ 24" O.C. | 456/637 |

- FRAMING AT ADJACENT PANELS SHALL BE 3" NOMINAL OR GREATER AND NAILS SHALL BE STAGGERED.
- WHERE SHEATHING IS APPLIED ON BOTH SIDES OF WALL, PANEL EDGE JOINTS ON 2x FRAMING SHALL BE STAGGERED SO THAT JOINTS ON THE OPPOSITE SIDE ARE NOT LOCATED ON THE SAME STUDS.
- BLOCKING IS REQUIRED AT ALL PANEL EDGES.
- PROVIDE SHEAR WALL SHEATHING AND NAILING FOR THE ENTIRE LENGTH OF THE WALLS INDICATED ON THE PLANS. ENDS OF FULL HEIGHT WALLS ARE DESIGNATED BY EXTERIOR OF THE BUILDING, CORRIDORS, WINDOW, OR DOORWAYS OR AS DESIGNATED ON THE PLANS. SEE PLANS FOR HOLD DOWN POSTS. SHEATHING EDGE NAILING IS REQUIRED AT ALL HOLD DOWN POSTS. EDGE NAILING MAY ALSO BE REQUIRED TO EACH STUD USED IN BUILT-UP HOLD DOWN POSTS.
- BASED ON 0.131X 1 1/2" LONG NAILS USED TO ATTACH FRAMING CLIPS DIRECTLY TO FRAMING. USE 0.131X 2 1/2" NAILS WHERE INSTALLED OVER SHEATHING. USE A35 OR RBC CLIPS IN LIEU OF LTP'S FOR ROOF BLOCKING TO TOP PLATE.
- LTP4'S ARE NOT REQUIRED WHERE THE LOWER WALL SHEATHING IS OVERLAPPED ONTO THE RIM JOIST A MINIMUM OF 1 1/2" AND NAILED TO THE RIM JOIST PER THE SHEAR WALL PERIMETER NAIL SPACING. LTP4'S MAY BE SUBSTITUTED W/ A35'S.
- CONTINUOUS SHEATHING IS REQUIRED OVER THE BOTTOM PLATE TO THE BOTTOM OF THE RIM JOIST OR SILL PLATE WITH EDGE NAILING AT EACH. WHERE TWO ROWS OF NAILING ARE REQUIRED AT RAISED FLOORS, PROVIDE BLOCKING PER PLAN, AND ATTACH WITH LTP4 PER SCHEDULE.
- ANCHOR BOLTS SHALL BE PROVIDED WITH STEEL PLATE WASHERS 0.229"x3"x3". EMBED ANCHOR BOLTS MINIMUM 7" INTO THE CONCRETE. PLATE WASHERS SHALL EXTEND TO WITHIN 1/2" OF THE SILL PLATE EDGE ON THE SHEATHED WALL FACE.
- PRESSURE TREATED MATERIALS CAN CAUSE EXCESSIVE CORROSION IN THE FASTENERS. PROVIDE HOT-DIPPED GALVANIZED (ELECTROPLATING IS NOT ACCEPTABLE) NAILS AND CONNECTOR PLATES (FRAMING ANGLES, ETC.) FOR ALL CONNECTORS IN CONTACT WITH PRESSURE TREATED FRAMING MEMBERS.
- ALL SHEAR WALL STUDS MUST BE SPACED NO MORE THAN 16" O.C.
- 3X MEMBERS MAY BE SUBSTITUTED WITH 2 STUDS NAILED TOGETHER PER TYPICAL BUILT-UP COLUMN DETAIL (SEE DETAILS).

SPECIAL INSPECTIONS ARE REQUIRED FOR SHEAR WALLS:

LEVEL 2 SHEAR WALL PLAN
1/8" = 1'-0"

- NOTES:
1. ALL EXTERIOR WALL SHALL BE SHEAR WALL TYPE W1 UNLESS NOTED OTHERWISE.

REVISIONS

| NO. | DESCRIPTION |
|-----|-------------|
| 01 | --- |


DRAWN BY: CP
CHECKED BY: CP
DATE: 2024.01.12
TITLE: SHEAR WALL PLAN
PROJECT #: ---
SHEET:



PIERUCCIONI E&C, LLC
CHON PIERUCCIONI, PE
378 N. BENNETT ST.
TACOMA, WA 98407

REUSE OF DOCUMENTS
THIS DOCUMENT HAS BEEN REDESIGNED OR
MODIFIED BY THE ORIGINAL DESIGNER OR
PROFESSIONAL LICENSEE, AND THE PROPERTY OF
PIERUCCIONI E&C, LLC. ANY REUSE OF THIS
DOCUMENT IN WHOLE OR IN PART WITHOUT THE
WRITTEN PERMISSION OF PIERUCCIONI E&C, LLC

EAST TOWN CROSSING
BUILDING "B"
PIONEER & SHAW PUYALLUP WA

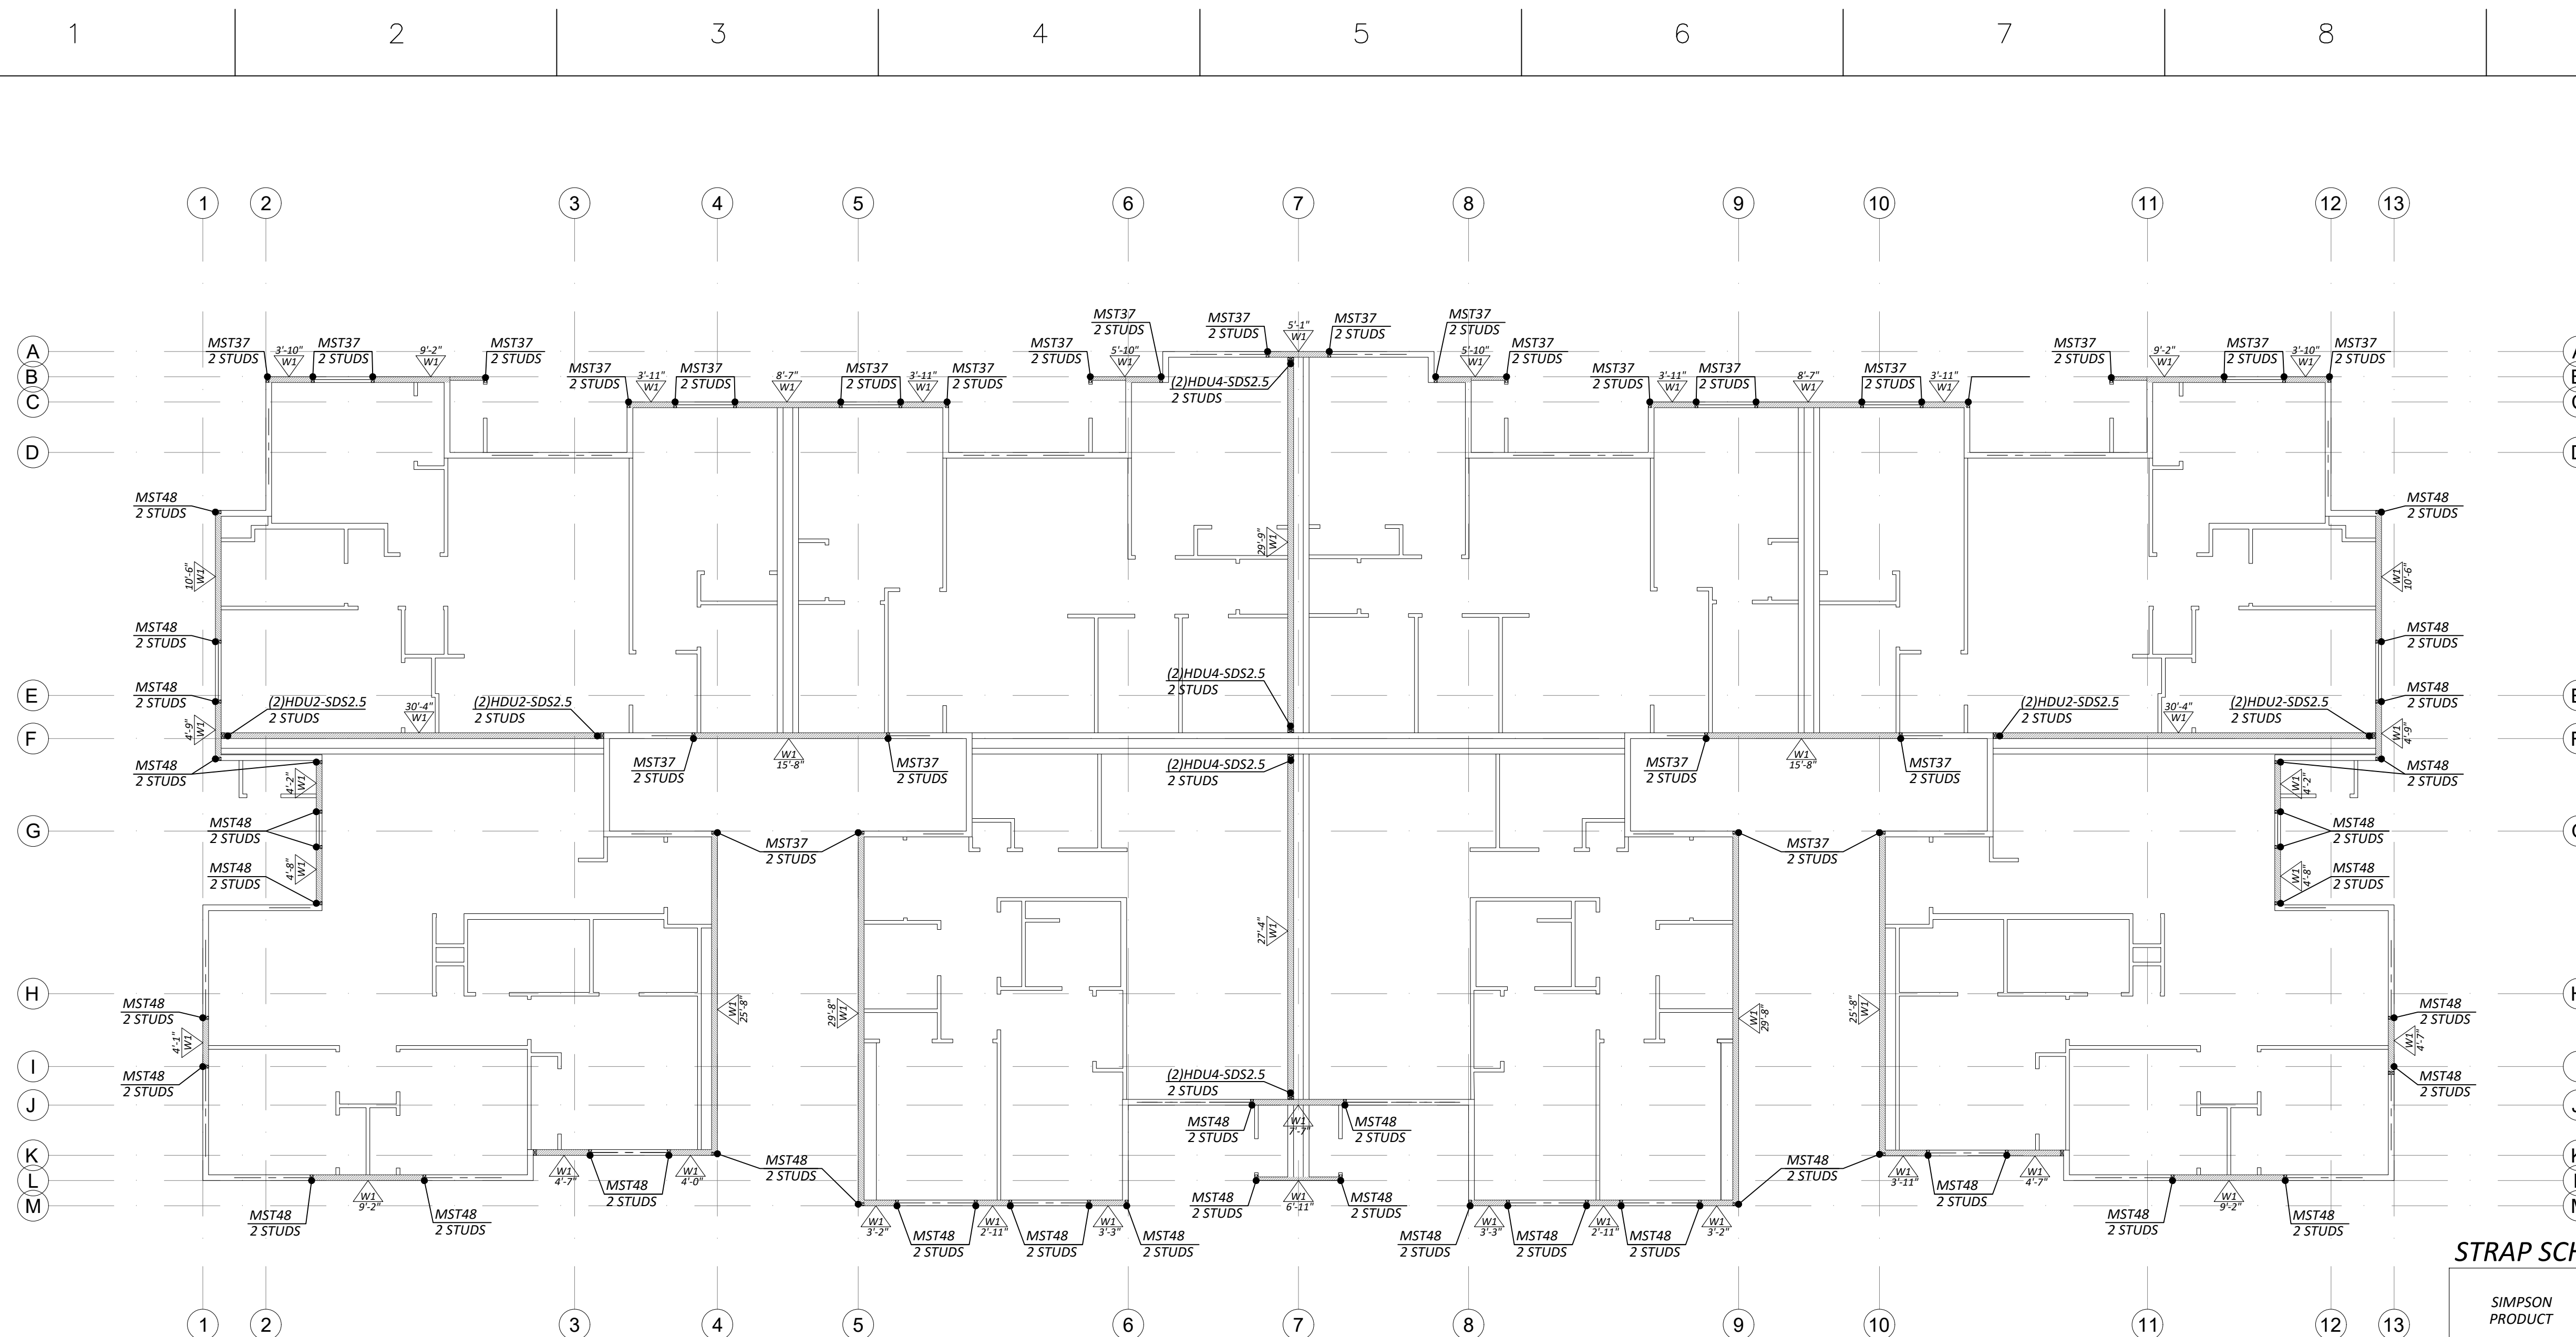

LEVEL 3 SHEAR WALL PLAN
1/8" = 1'-0"

- NOTES:
1. ALL EXTERIOR WALL SHALL BE SHEAR WALL TYPE W1 UNLESS NOTED OTHERWISE.

STRAP SCHEDULE

| SIMPSON PRODUCT | FASTENERS | | END LENGTH |
|-----------------|-----------------|-----------------------|------------|
| | SCREWS OR BOLTS | NAILS | |
| MST37 | -- | (22) 16d INTO 2 STUDS | -- |
| MST48 | -- | (34) 16d INTO 2 STUDS | -- |

THRU FLOOR HOLD DOWN SCHEDULE

| SIMPSON PRODUCT | FASTENERS | | ANCHOR BOLTS |
|---------------------|---|-------|-------------------|
| | SCREWS OR BOLTS | NAILS | |
| (2) HDU2-SDS2.5 (a) | (6) 1/4" X 2 1/2" SDS INTO POST PER PLAN | -- | 5/8" THREADED ROD |
| (2) HDU4-SDS2.5 (a) | (10) 1/4" X 2 1/2" SDS INTO POST PER PLAN | -- | 5/8" THREADED ROD |

(a) THESE HOLD DOWNS ARE THRU FLOOR HOLD DOWN. TOTAL OF 2 HOLD DOWNS ARE REQUIRED (SEE DETAIL 2/S4.2).

SHEAR WALL AND ANCHOR TABLE

| WALL TYPE | APA RATED SHEATHING (b), (c) | MINIMUM NOMINAL THICKNESS (IN) (j) | MINIMUM NAIL PENETRATION IN FRAMING (IN) (i) | STUD & BLOCKING SIZE @ ADJOINING EDGES (k) | REQUIRED RIM JOIST THICKNESS | EDGE NAIL SIZE AND SPACING, COMMON OR GALV. BOX (d) | RIM JOIST OR BLOCK CONNECTION TO TOP PLATE (e), (f) | 2x BOTTOM PLATE ATTACHMENT TO WOOD BELOW (g), (i) | ANCHOR BOLT SILL PLATE ATTACHMENT TO CONCRETE BELOW (h) | CAPACITY (PLF) SEISMIC/WIND |
|-----------|------------------------------|------------------------------------|--|--|------------------------------|---|---|---|---|-----------------------------|
| W1 | OSB | 7/16 (j) | 1 3/8 | 2x | 2x OR 1 1/4" LSL | 8d@6" O.C. EDGE 8d@12" O.C. FIELD | LTP4 @ 20" O.C. OR A35 @ 16" O.C. | (1) 16d @ 8" O.C. | 5/8" @ 48" O.C. | 242/339 |

FRAMING AT ADJACENT PANELS SHALL BE 3" NOMINAL OR GREATER AND NAILS SHALL BE STAGGERED. WHERE SHEATHING IS APPLIED ON BOTH SIDES OF WALL, PANEL EDGE JOINTS ON 2x FRAMING SHALL BE STAGGERED SO THAT JOINTS ON THE OPPOSITE SIDE ARE NOT LOCATED ON THE SAME STUDS.
BLOCKING IS REQUIRED AT ALL PANEL EDGES
PROVIDE SHEAR WALL SHEATHING AND NAILING FOR THE ENTIRE LENGTH OF THE WALLS INDICATED ON THE PLANS. ENDS OF FULL HEIGHT WALLS ARE DESIGNATED BY EXTERIOR OF THE BUILDING, CORRIDORS, WINDOW, OR DOORWAYS OR AS DESIGNATED ON THE PLANS. SEE PLANS FOR HOLD DOWN POSTS. SHEATHING EDGE NAILING IS REQUIRED AT ALL HOLD DOWN POSTS. EDGE NAILING MAY ALSO BE REQUIRED TO EACH STUD USED IN BUILT-UP HOLD DOWN POSTS.
BASED ON 0.131X 1 1/4" LONG NAILS USED TO ATTACH FRAMING CLIPS DIRECTLY TO FRAMING. USE 0.131X 2 1/2" NAILS WHERE INSTALLED OVER SHEATHING. USE A35 OR RBC CLIPS IN LIEU OF LTP'S FOR ROOF BLOCKING TO TOP PLATE.
LTP4'S ARE NOT REQUIRED WHERE THE LOWER WALL SHEATHING IS OVERLAPPED ONTO THE RIM JOIST A MINIMUM OF 1 1/4" AND NAILED TO THE RIM JOIST PER THE SHEAR WALL PERIMETER NAIL SPACING. LTP4'S MAY BE SUBSTITUTED W/ A35'S.
CONTINUOUS SHEATHING IS REQUIRED OVER THE BOTTOM PLATE TO THE BOTTOM OF THE RIM JOIST OR SILL PLATE WITH EDGE NAILING AT EACH. WHERE TWO ROWS OF NAILING ARE REQUIRED AT RAISED FLOORS, PROVIDE BLOCKING PER PLAN, AND ATTACH WITH LTP4 PER SCHEDULE.
ANCHOR BOLTS SHALL BE PROVIDED WITH STEEL PLATE WASHERS 0.229"x3"x3". EMBED ANCHOR BOLTS MINIMUM 7" INTO THE CONCRETE. PLATE WASHERS SHALL EXTEND TO WITHIN 1/2" OF THE SILL PLATE EDGE ON THE SHEATHED WALL FACE.
PRESSURE TREATED MATERIALS CAN CAUSE EXCESSIVE CORROSION IN THE FASTENERS. PROVIDE HOT-DIPPED GALVANIZED (ELECTROPLATING IS NOT ACCEPTABLE) NAILS AND CONNECTOR PLATES (FRAMING ANGLES, ETC.) FOR ALL CONNECTORS IN CONTACT WITH PRESSURE TREATED FRAMING MEMBERS.
ALL SHEAR WALL STUDS MUST BE SPACED NO MORE THAN 16" O.C.
3X MEMBERS MAY BE SUBSTITUTED WITH 2 STUDS NAILED TOGETHER PER TYPICAL BUILT-UP COLUMN DETAIL. (SEE DETAILS).

REVISIONS

01

REVISIONS

DRAWN BY: CP

CHECKED BY: CP

DATE: 2024.01.12

TITLE: SHEAR WALL PLAN

PROJECT #: ---

SHEET:

S3.8



PIERUCCI E&C, LLC
CHON PIERUCCI, PE
3720 N. BENNETT ST.
TACOMA, WA 98407

REUSE OF DOCUMENTS
THIS DOCUMENT AND THE DESIGNATIONS OF PROFESSIONAL LICENSE ARE THE PROPERTY OF PIERUCCI E&C, LLC AND ARE NOT TO BE REPRODUCED IN WHOLE OR IN PART WITHOUT THE WRITTEN APPROVAL OF PIERUCCI E&C, LLC.

EAST TOWN CROSSING
BUILDING "B"
PIONEER & SHAW PUYALLUP WA


REVISIONS

| | |
|----|-----|
| 01 | --- |
|----|-----|

REVISIONS

| | |
|-------------|--------------------|
| DRAWN BY: | CP |
| CHECKED BY: | CP |
| DATE: | 2024.01.12 |
| TITLE: | FOUNDATION DETAILS |
| PROJECT #: | --- |
| SHEET: | |

S4.1

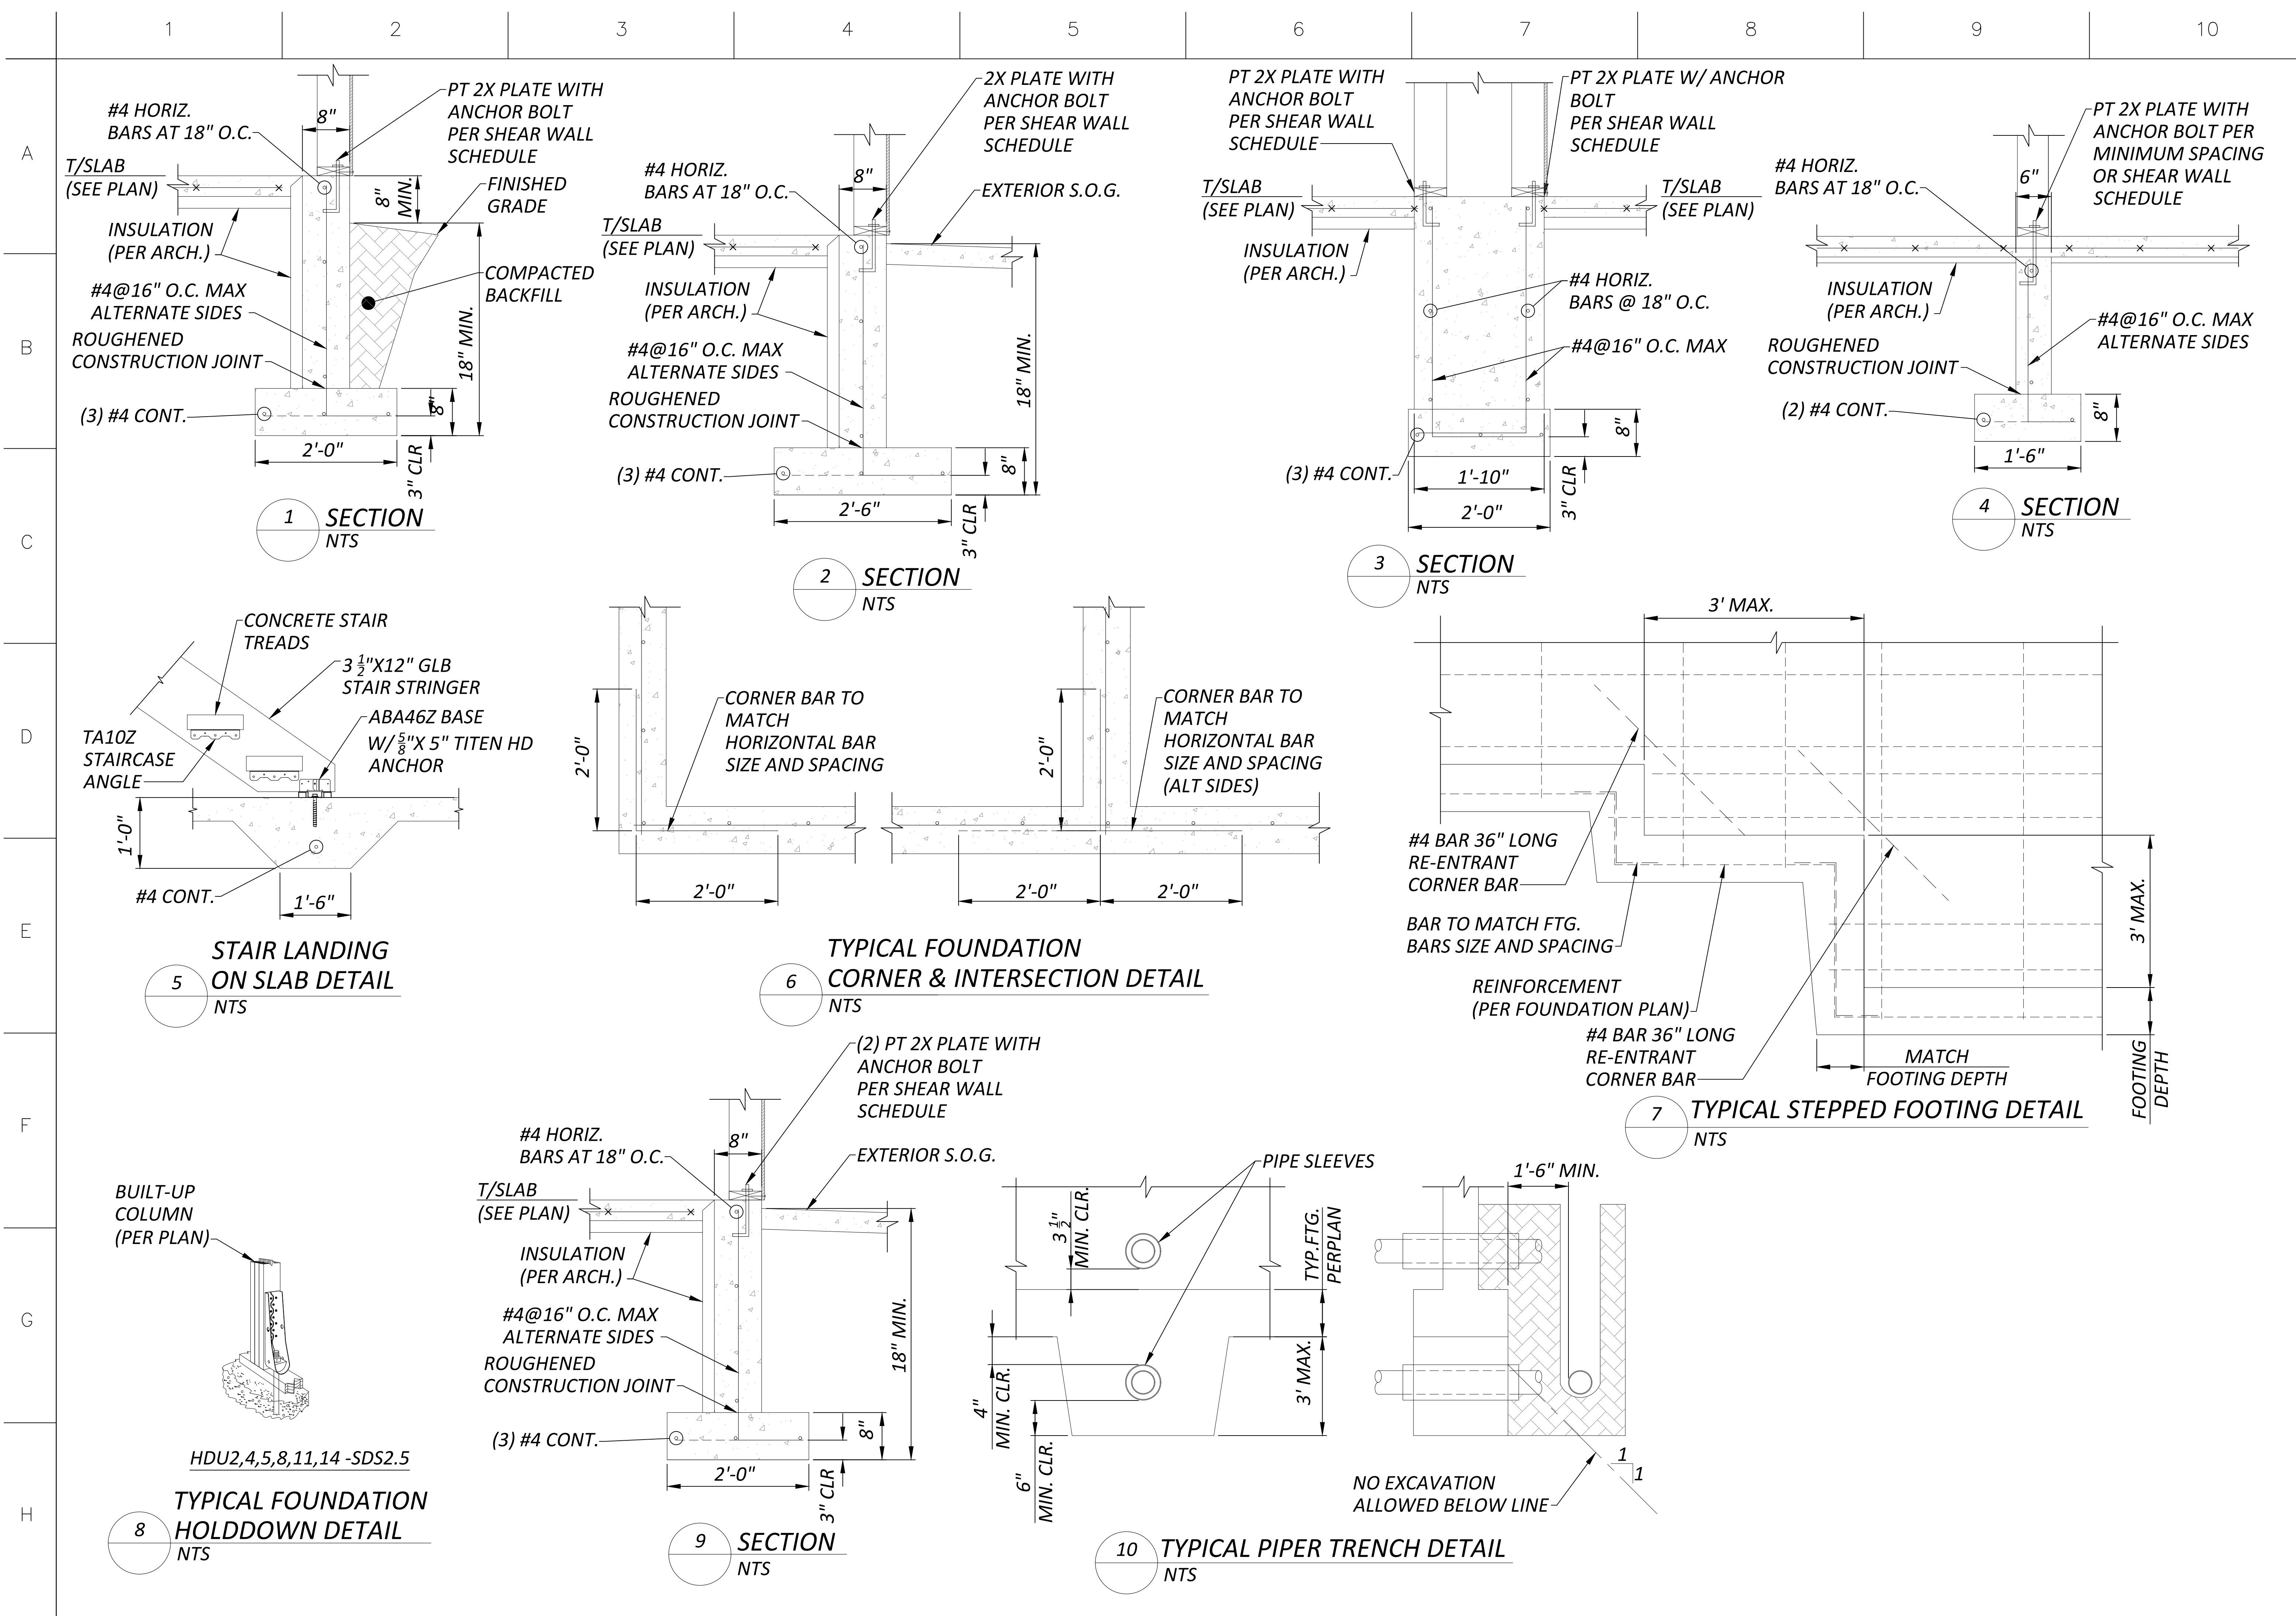



PIERUCCIONI E&C, LLC
CHON PIERUCCIONI, PE
378 N. BENNETT ST.
TACOMA, WA 98407

RELEASE OF DOCUMENTS
THIS DOCUMENT IS THE SOLE PROPERTY OF
PIERUCCIONI E&C, LLC. THE PROPERTY OF
ANY OTHER PARTY IS HEREBY DENIED. THE USE OF
THIS DOCUMENT IN WHOLE OR IN PART WITHOUT THE
WRITTEN AUTHORIZATION OF PIERUCCIONI E&C, LLC IS
PROHIBITED.

EAST TOWN CROSSING
BUILDING "B"
PIONEER & SHAW PUYALLUP WA

REVISIONS

01

REVISIONS

DRAWN BY: CP

CHECKED BY: CP


DATE: 2024.01.12

TITLE: FRAMING DETAILS


PROJECT #: ----

SHEET:


S4.2

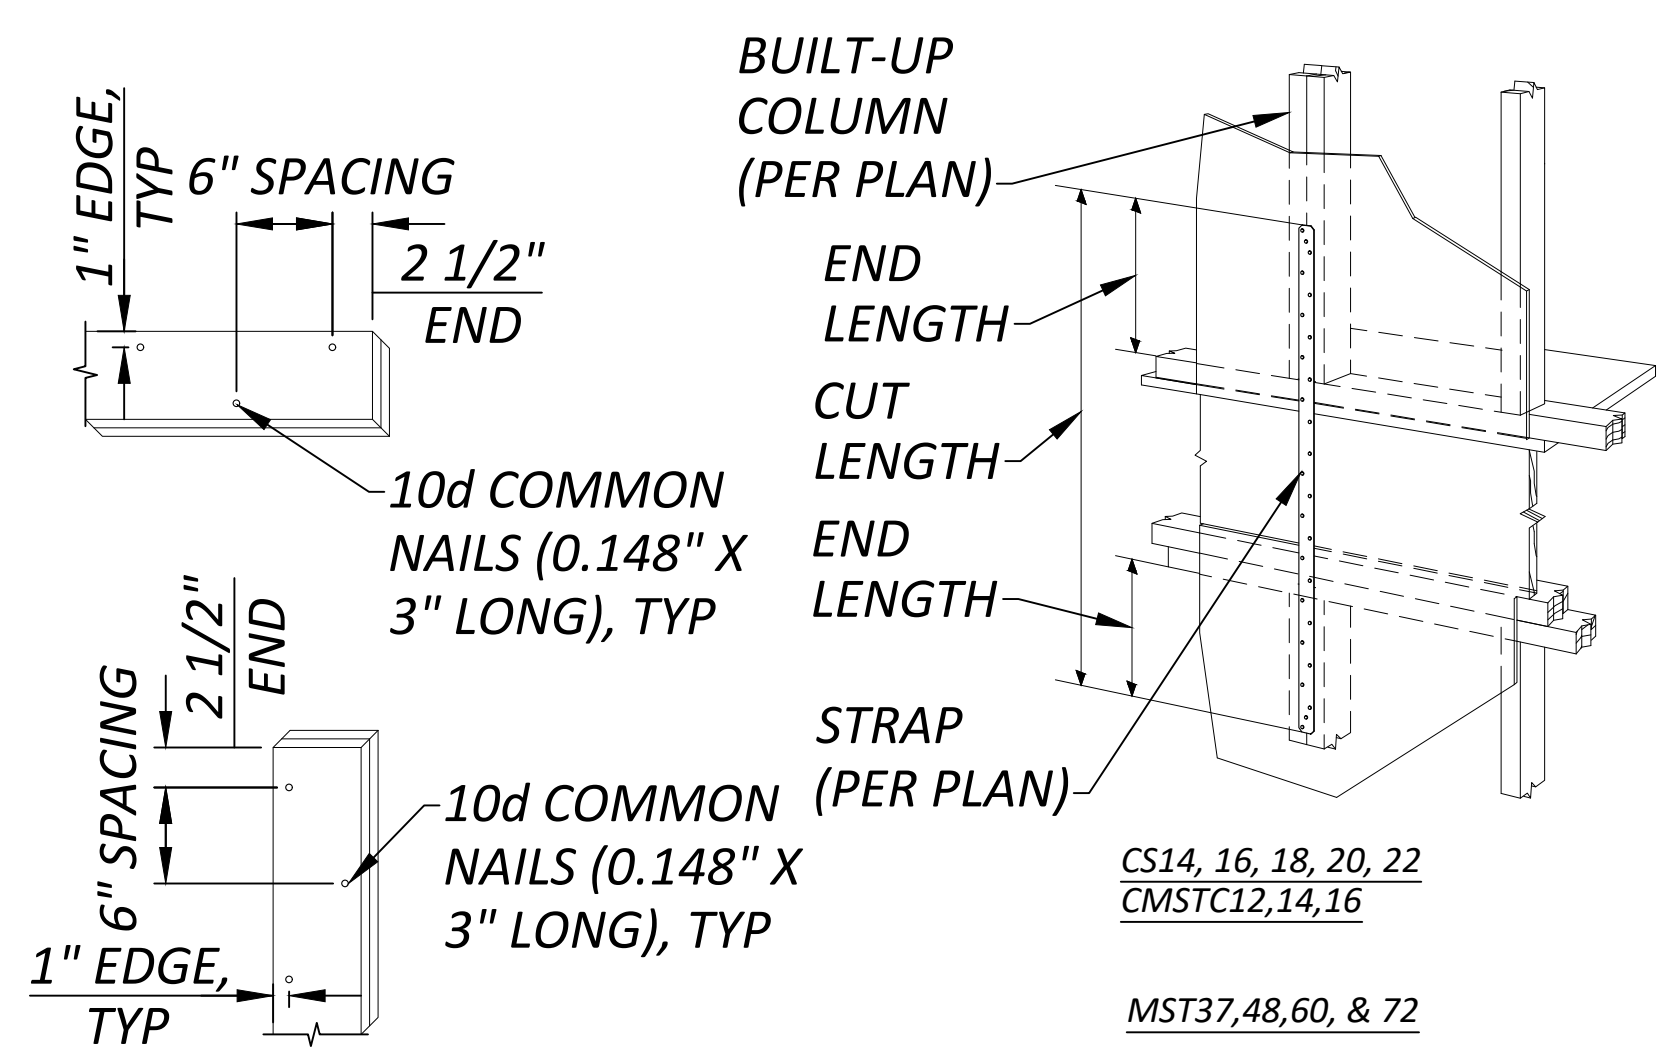


1 TYPICAL BUILT-UP BEAM/COLUMN DETAIL NTS

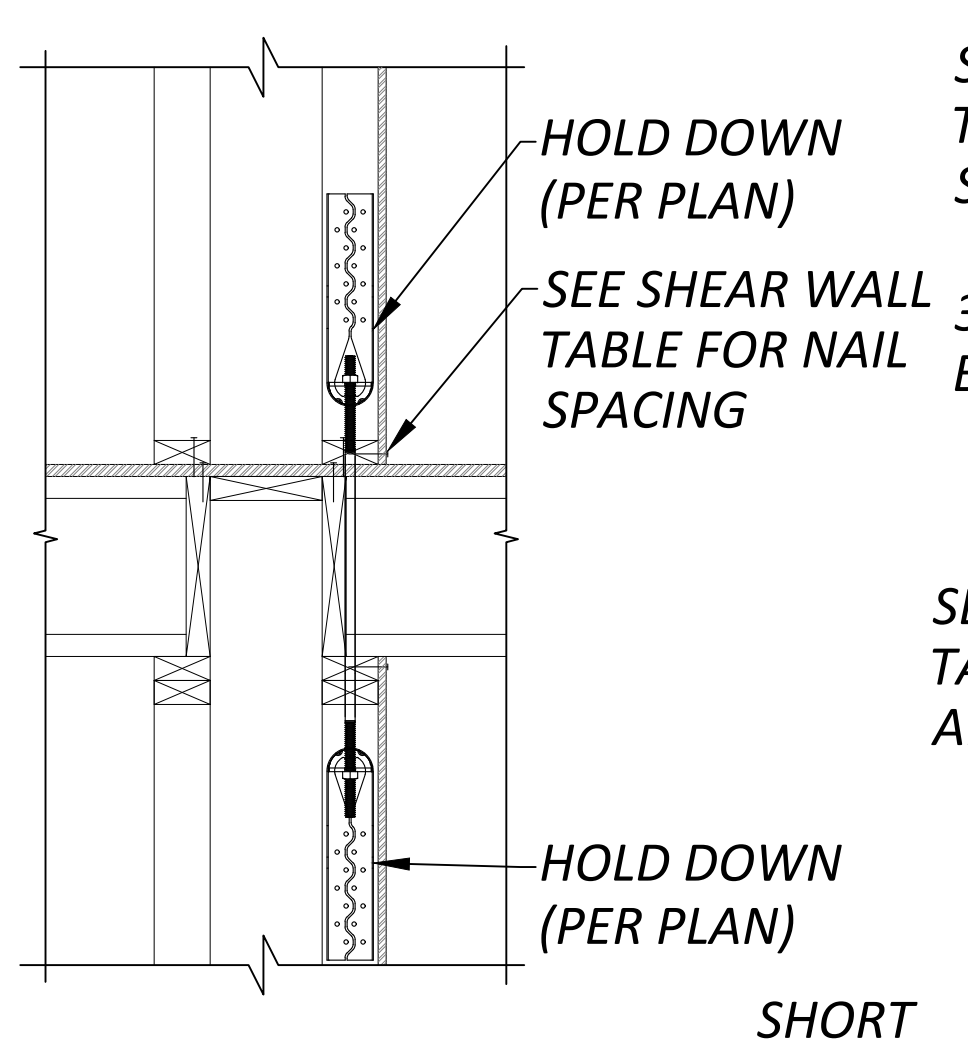











2 TYPICAL STRAP/THRU FLOOR HOLDDOWN DETAIL NTS

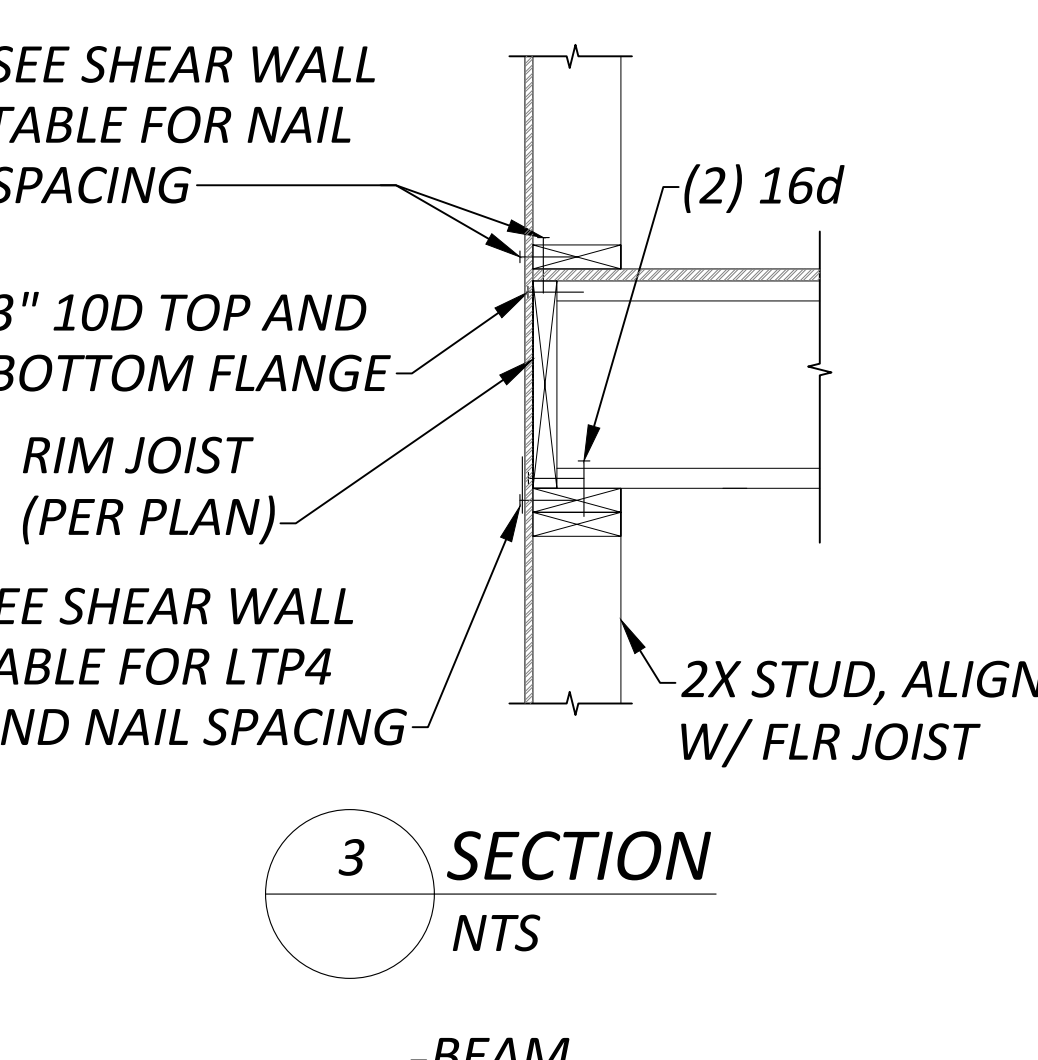

3 TYPICAL STAIR LANDING DETAIL NTS

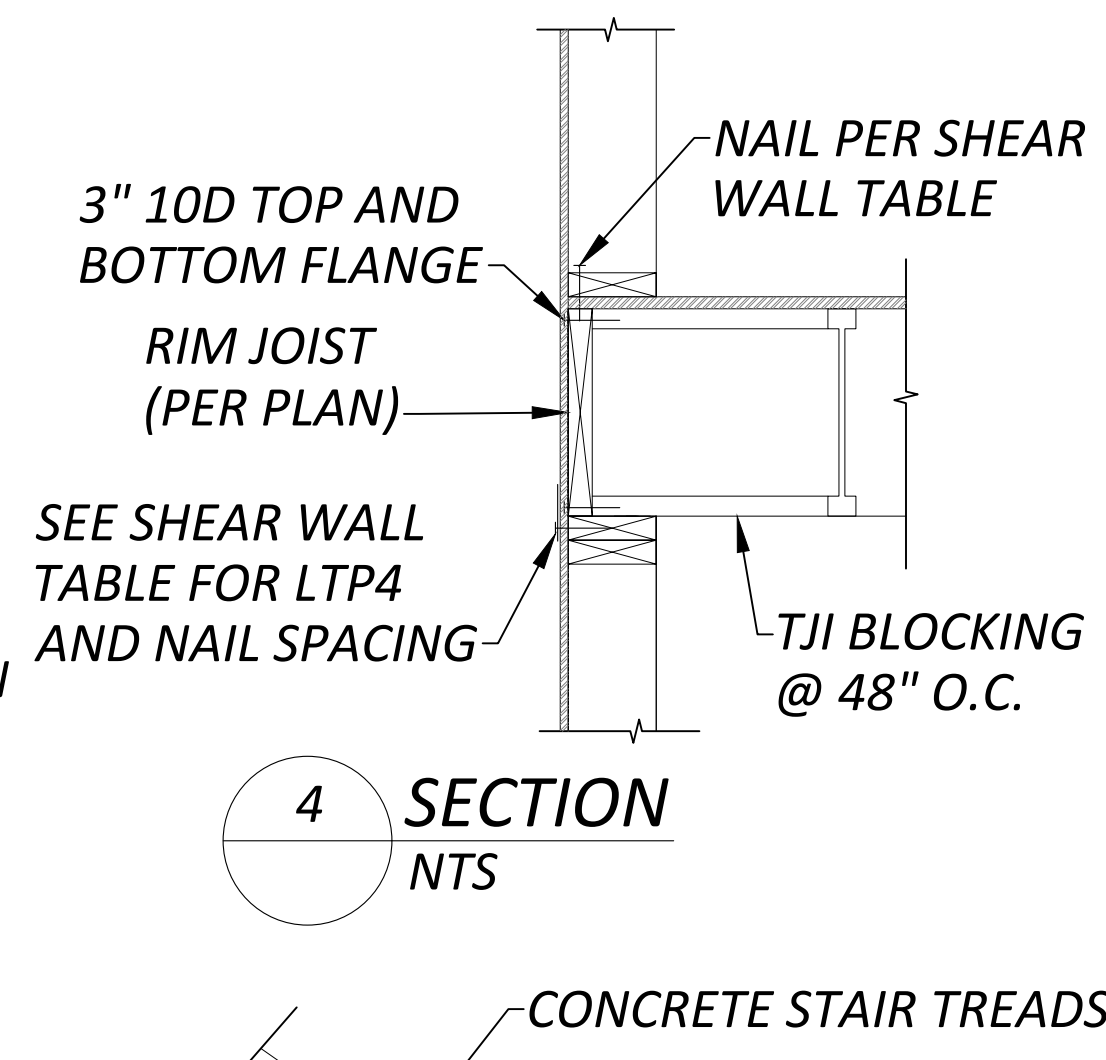

4 SECTION NTS

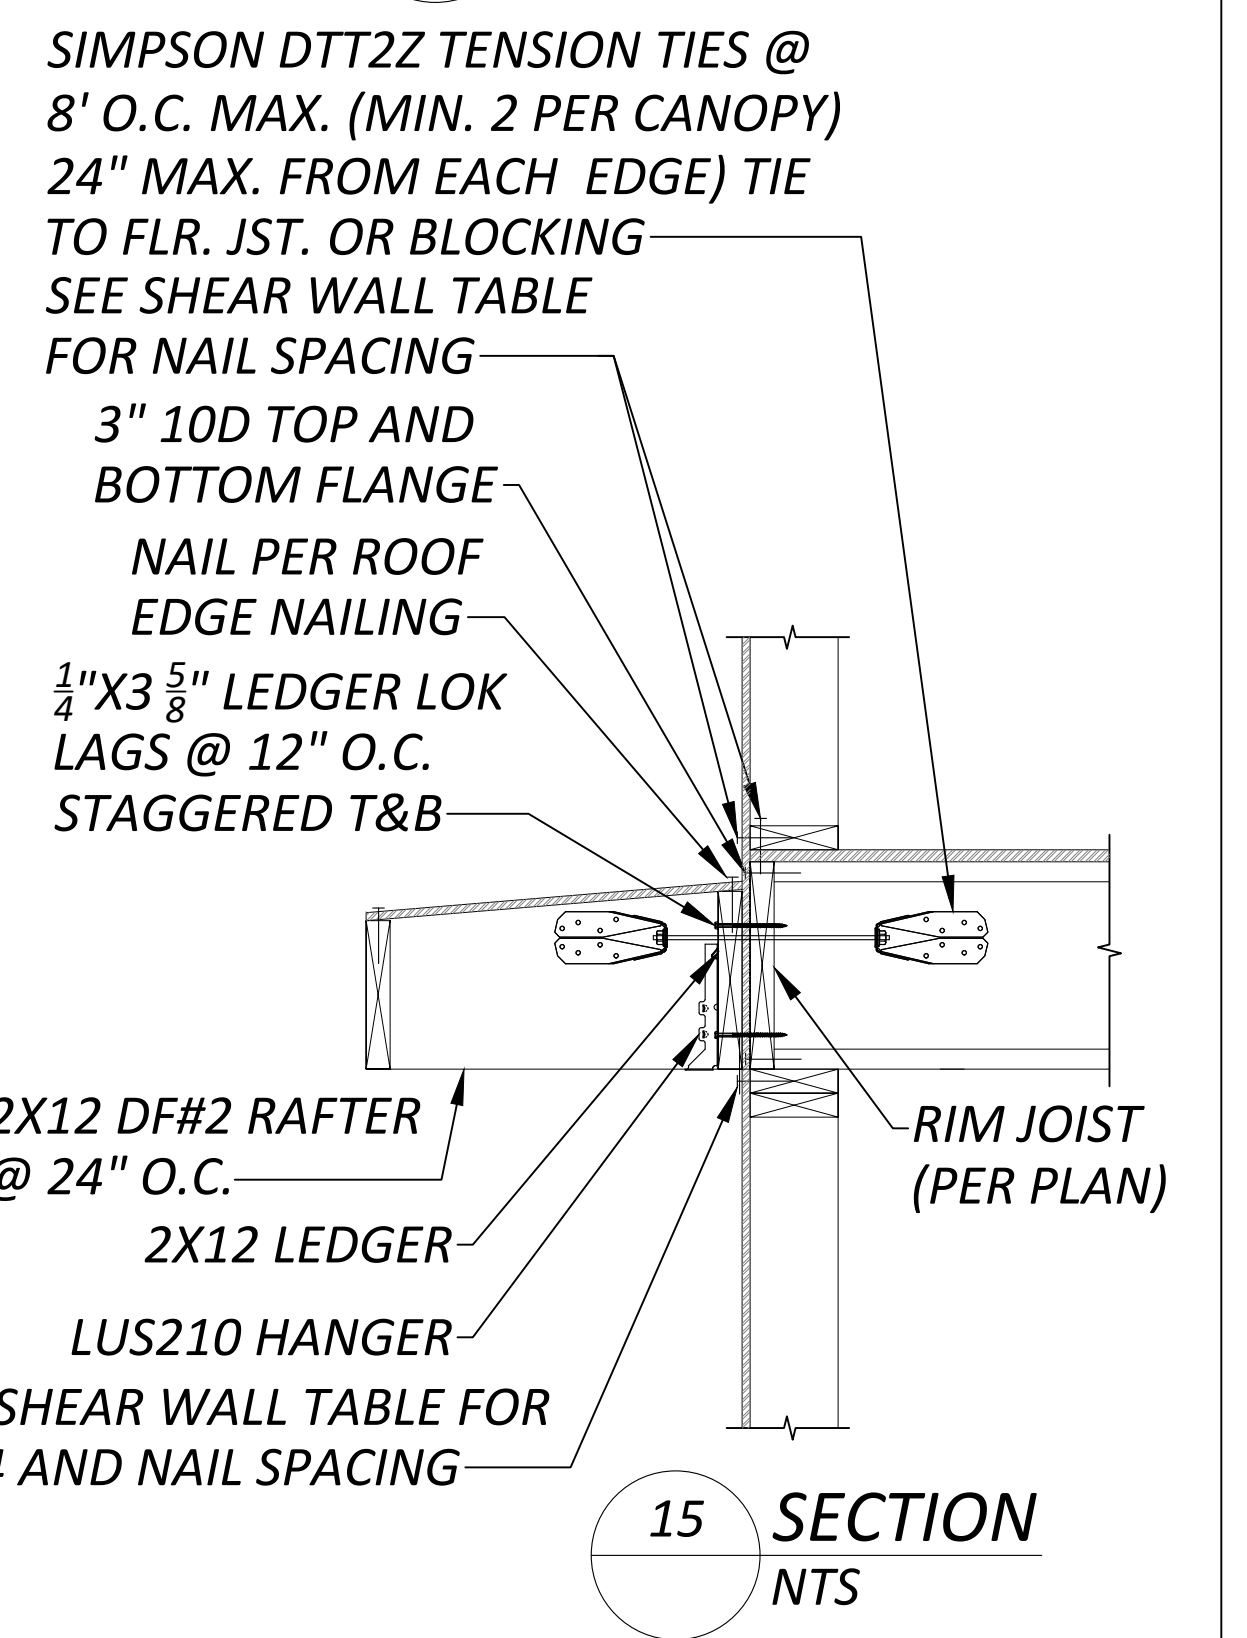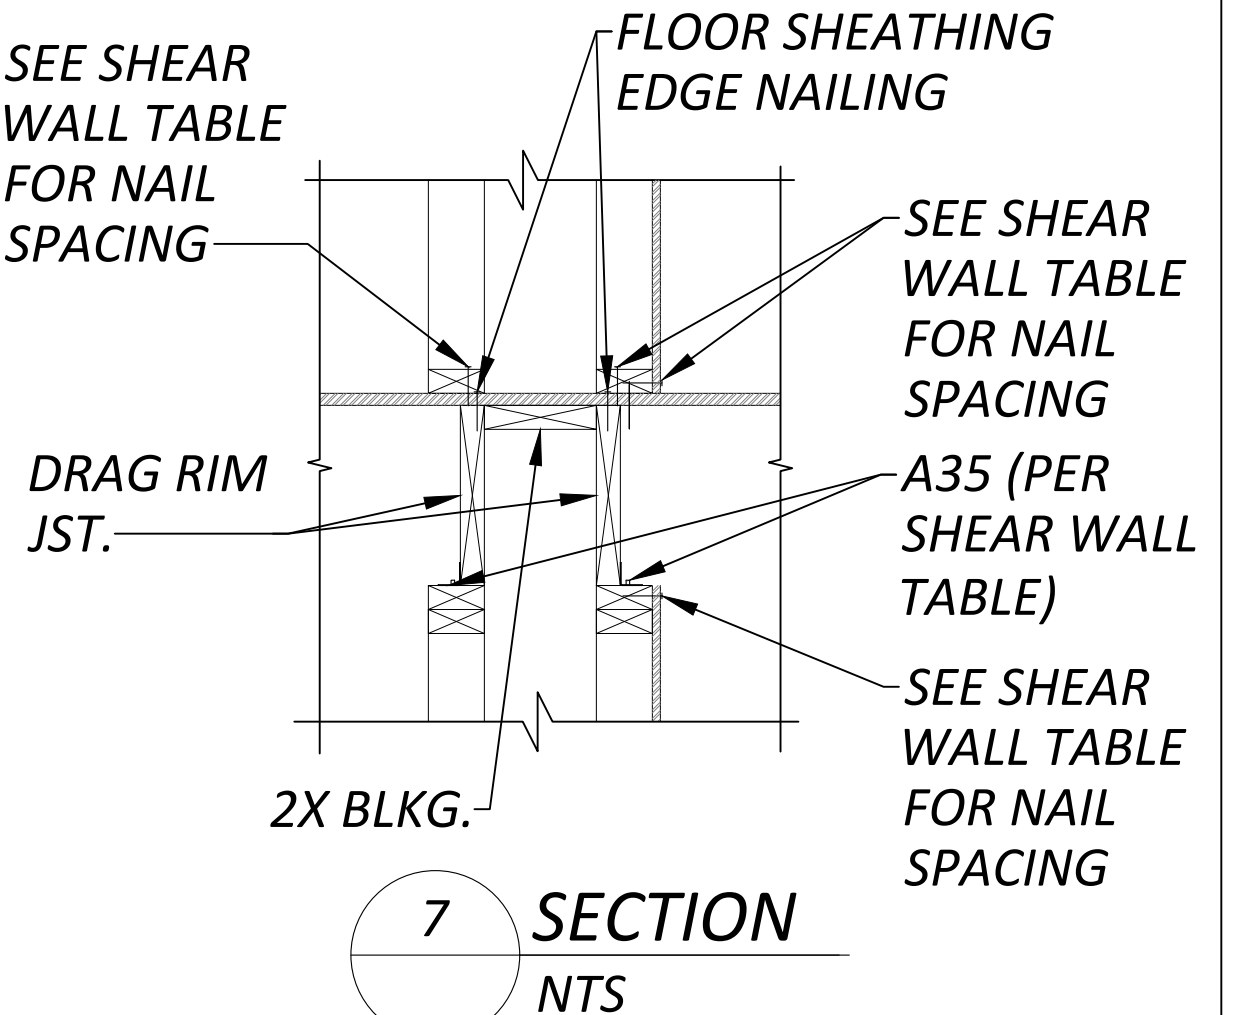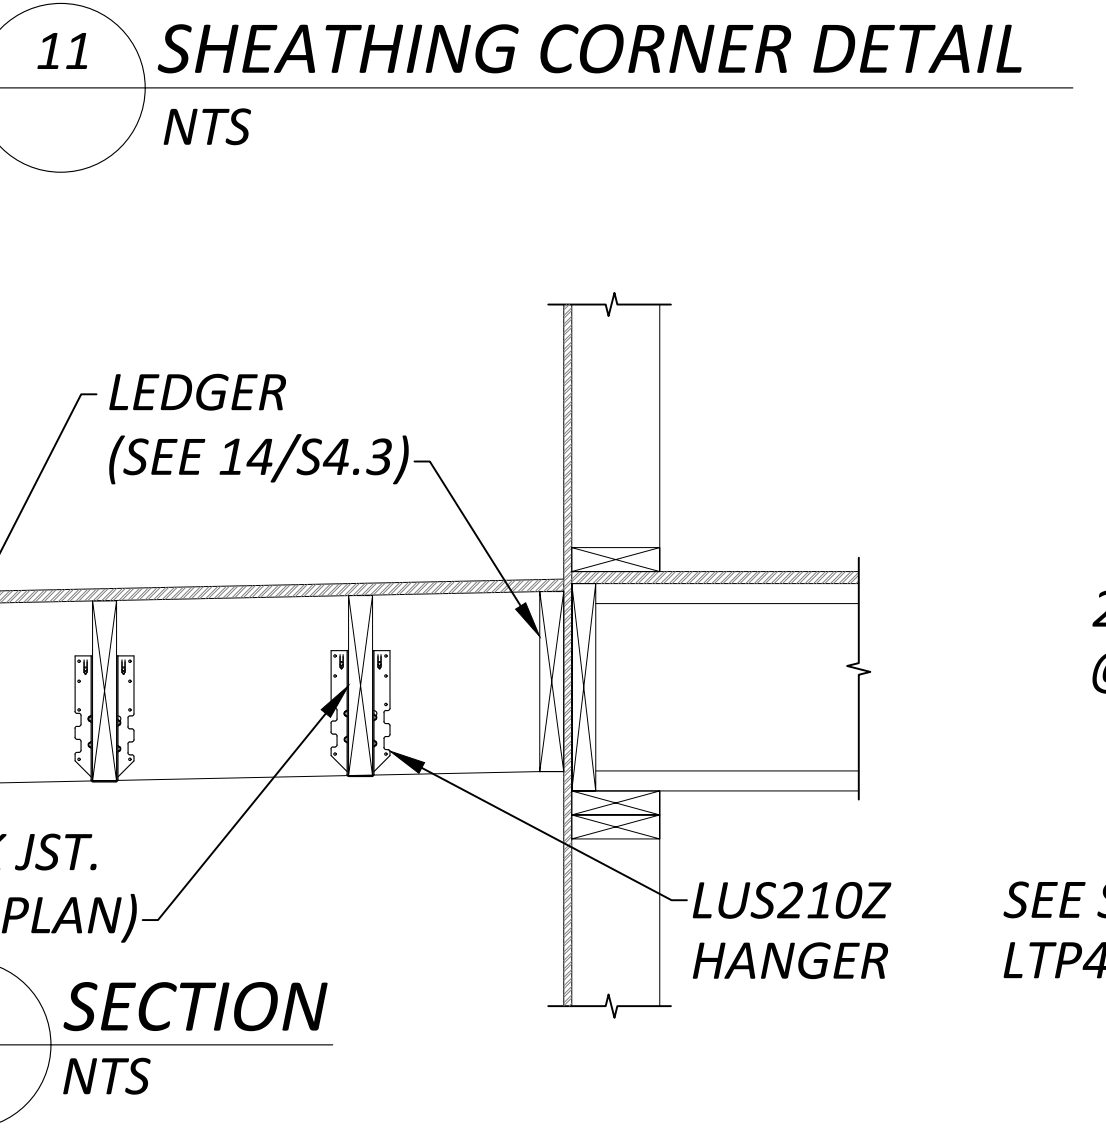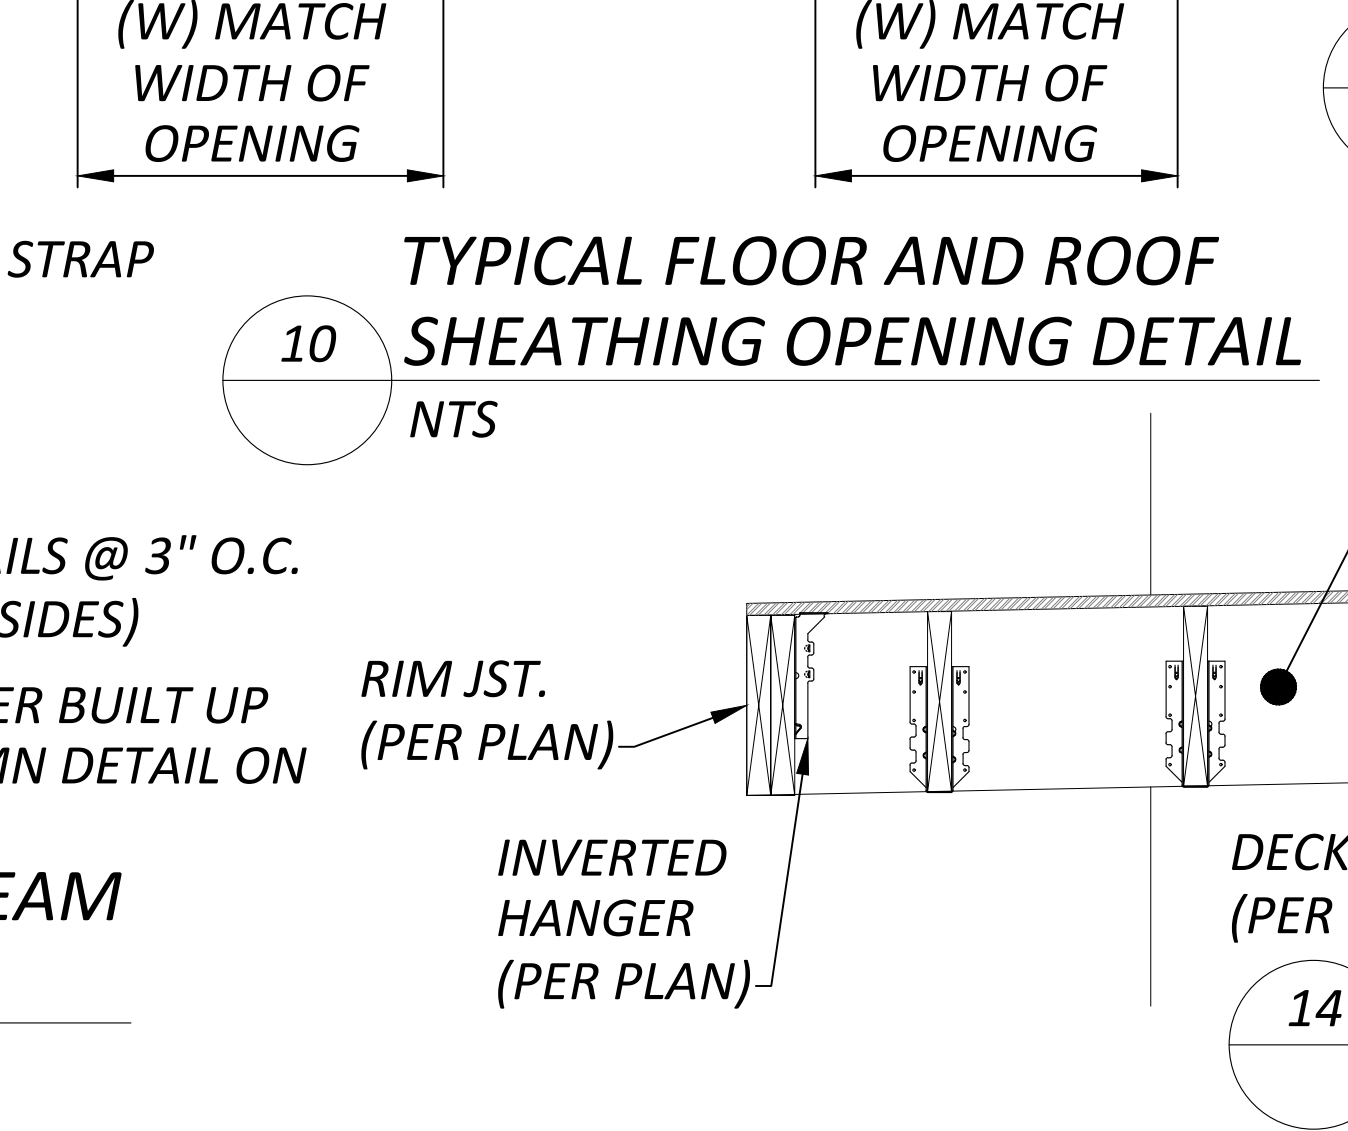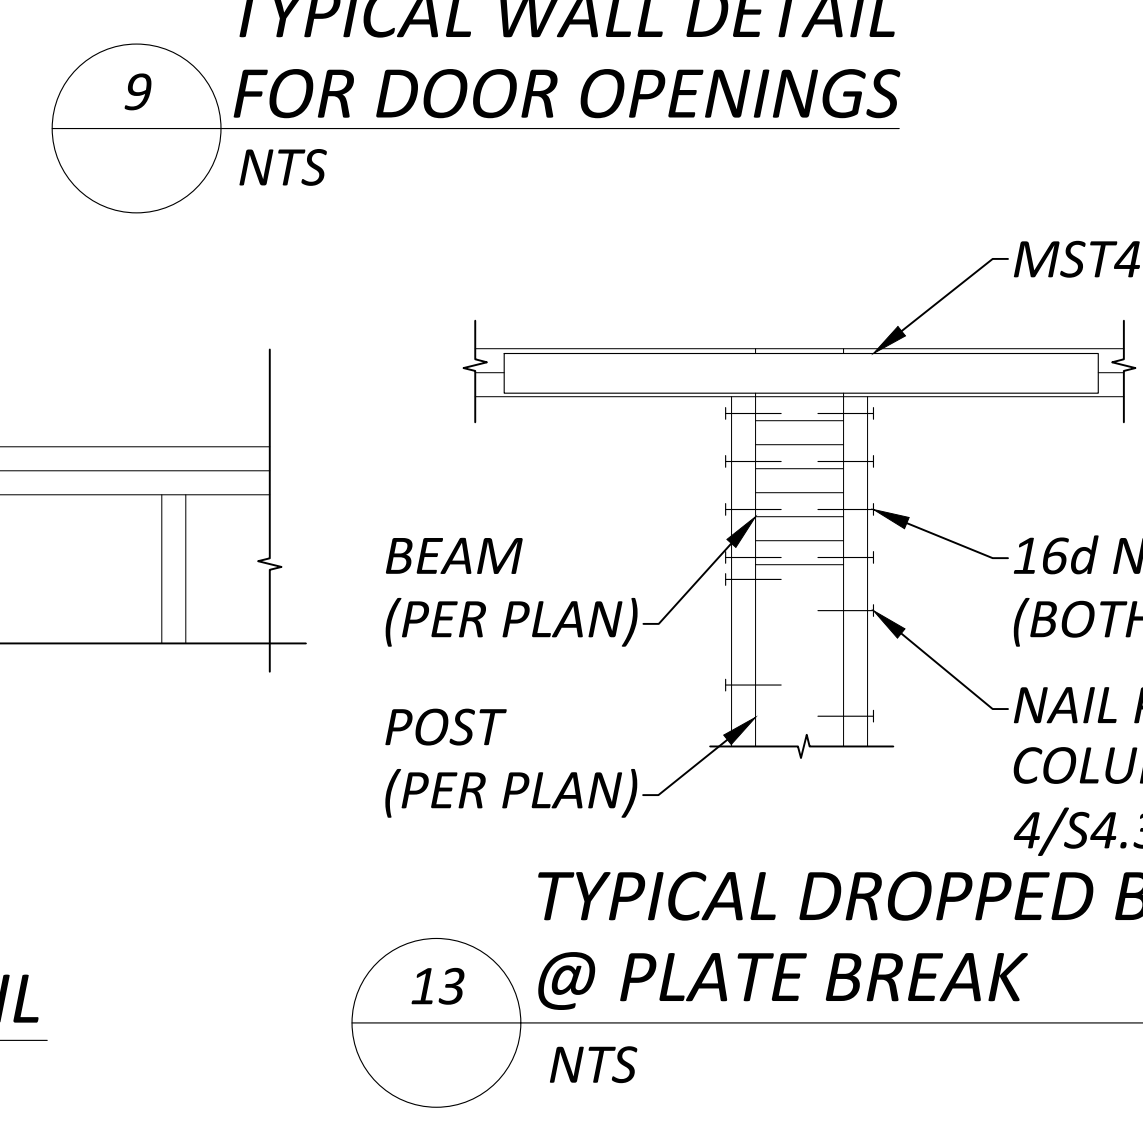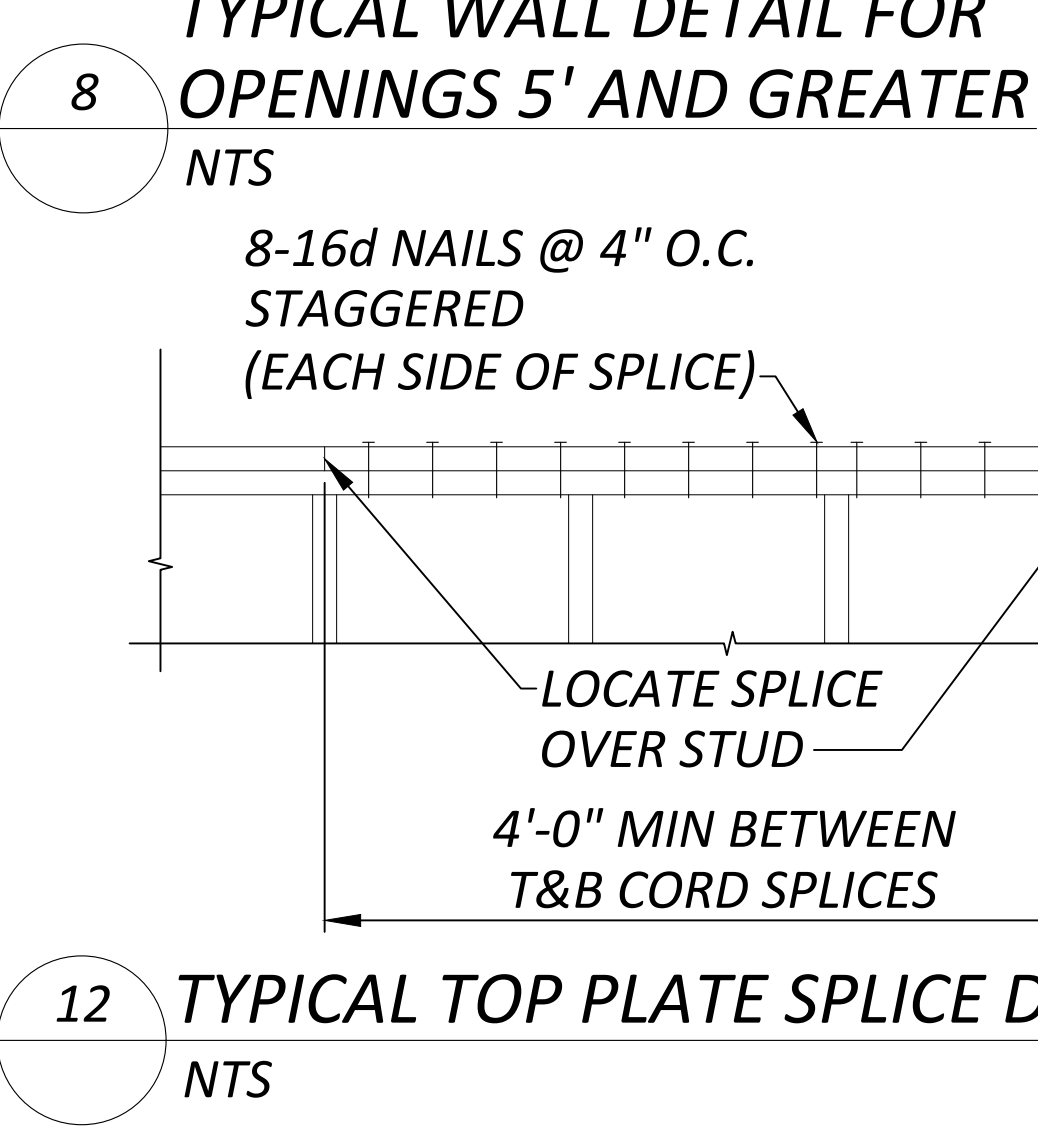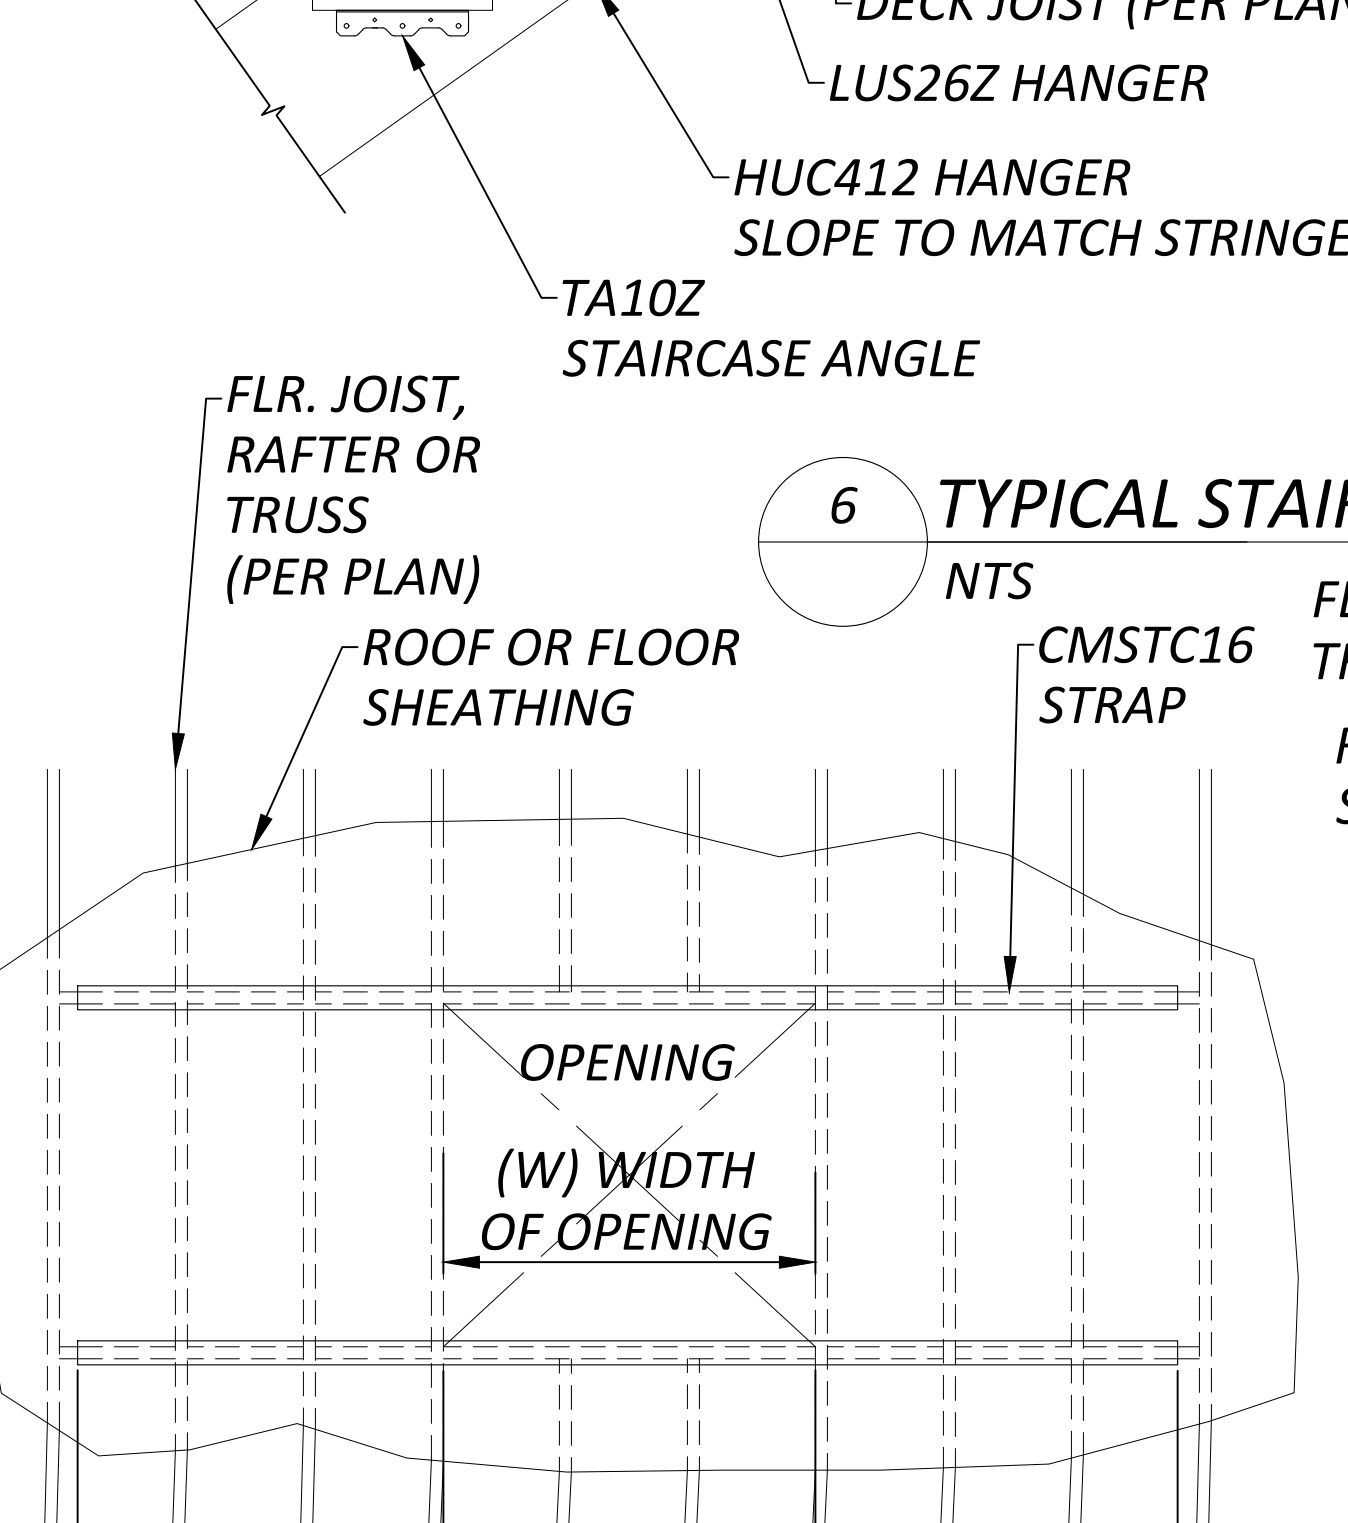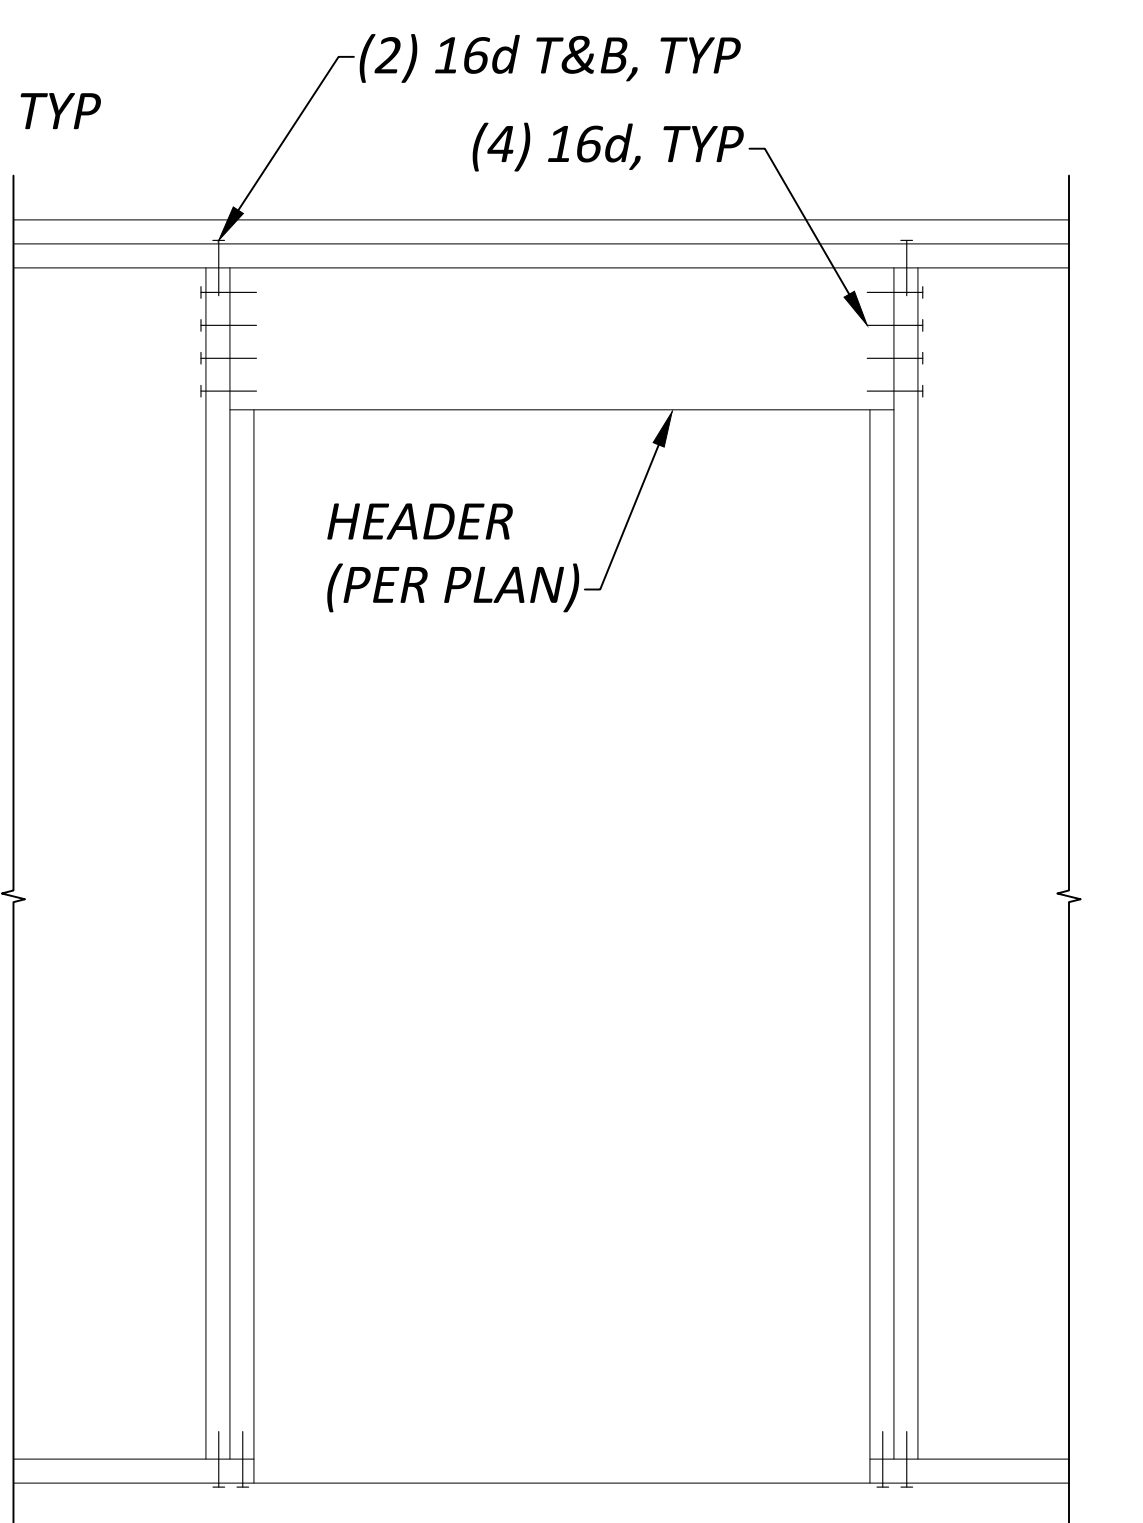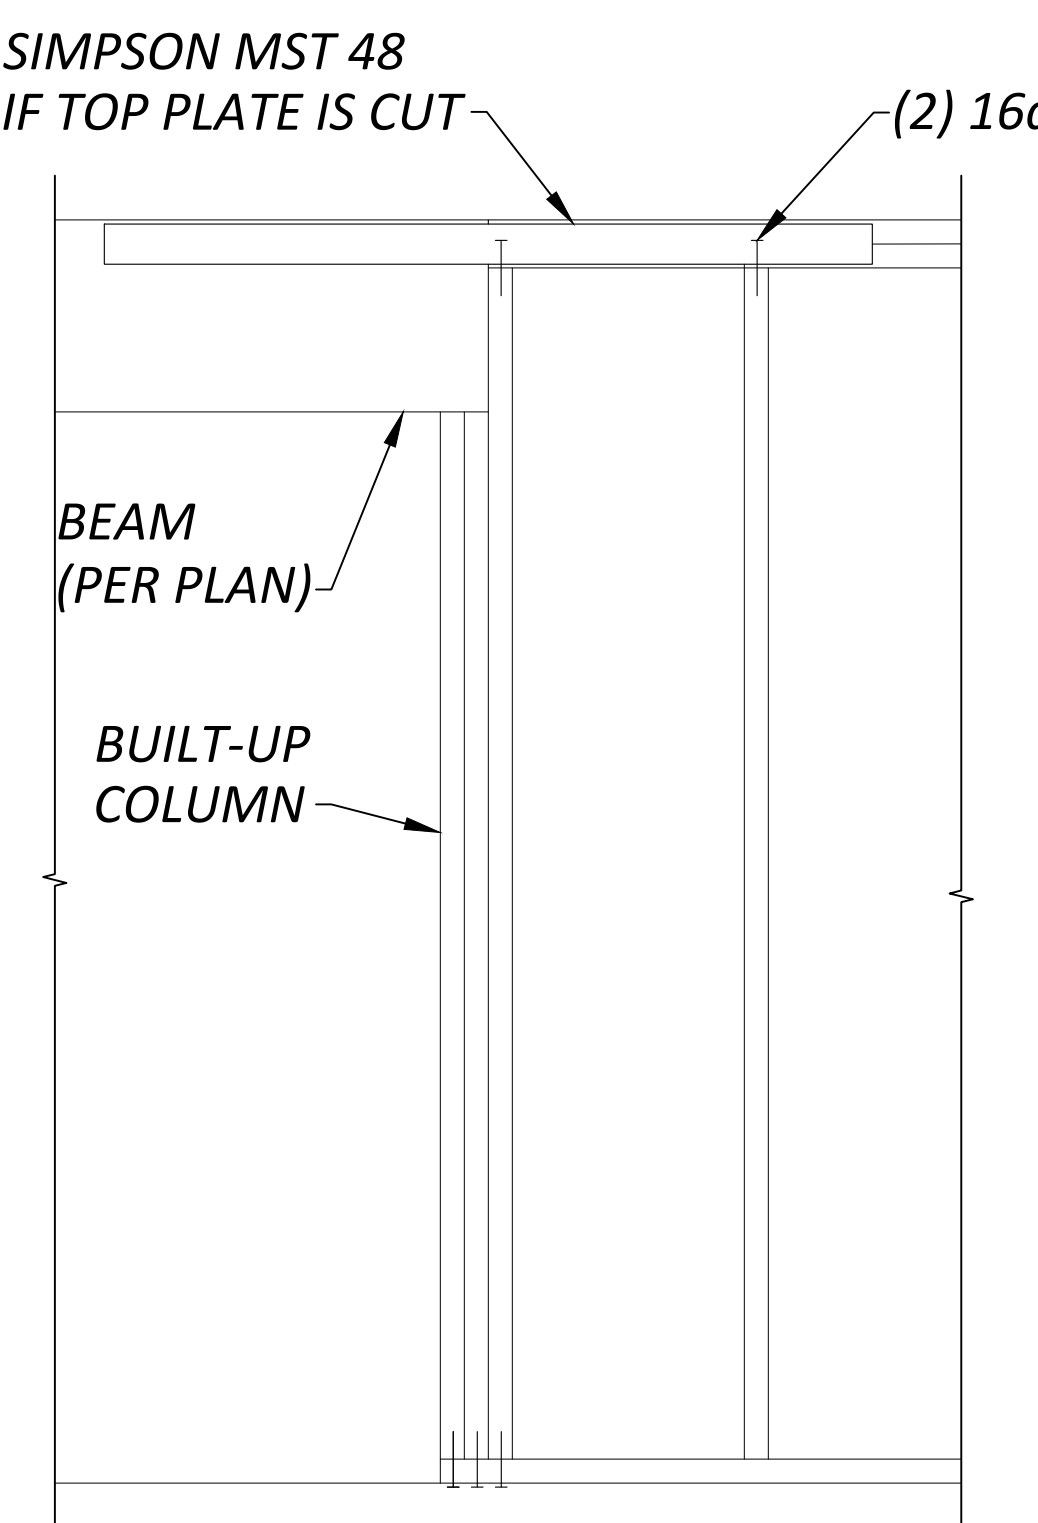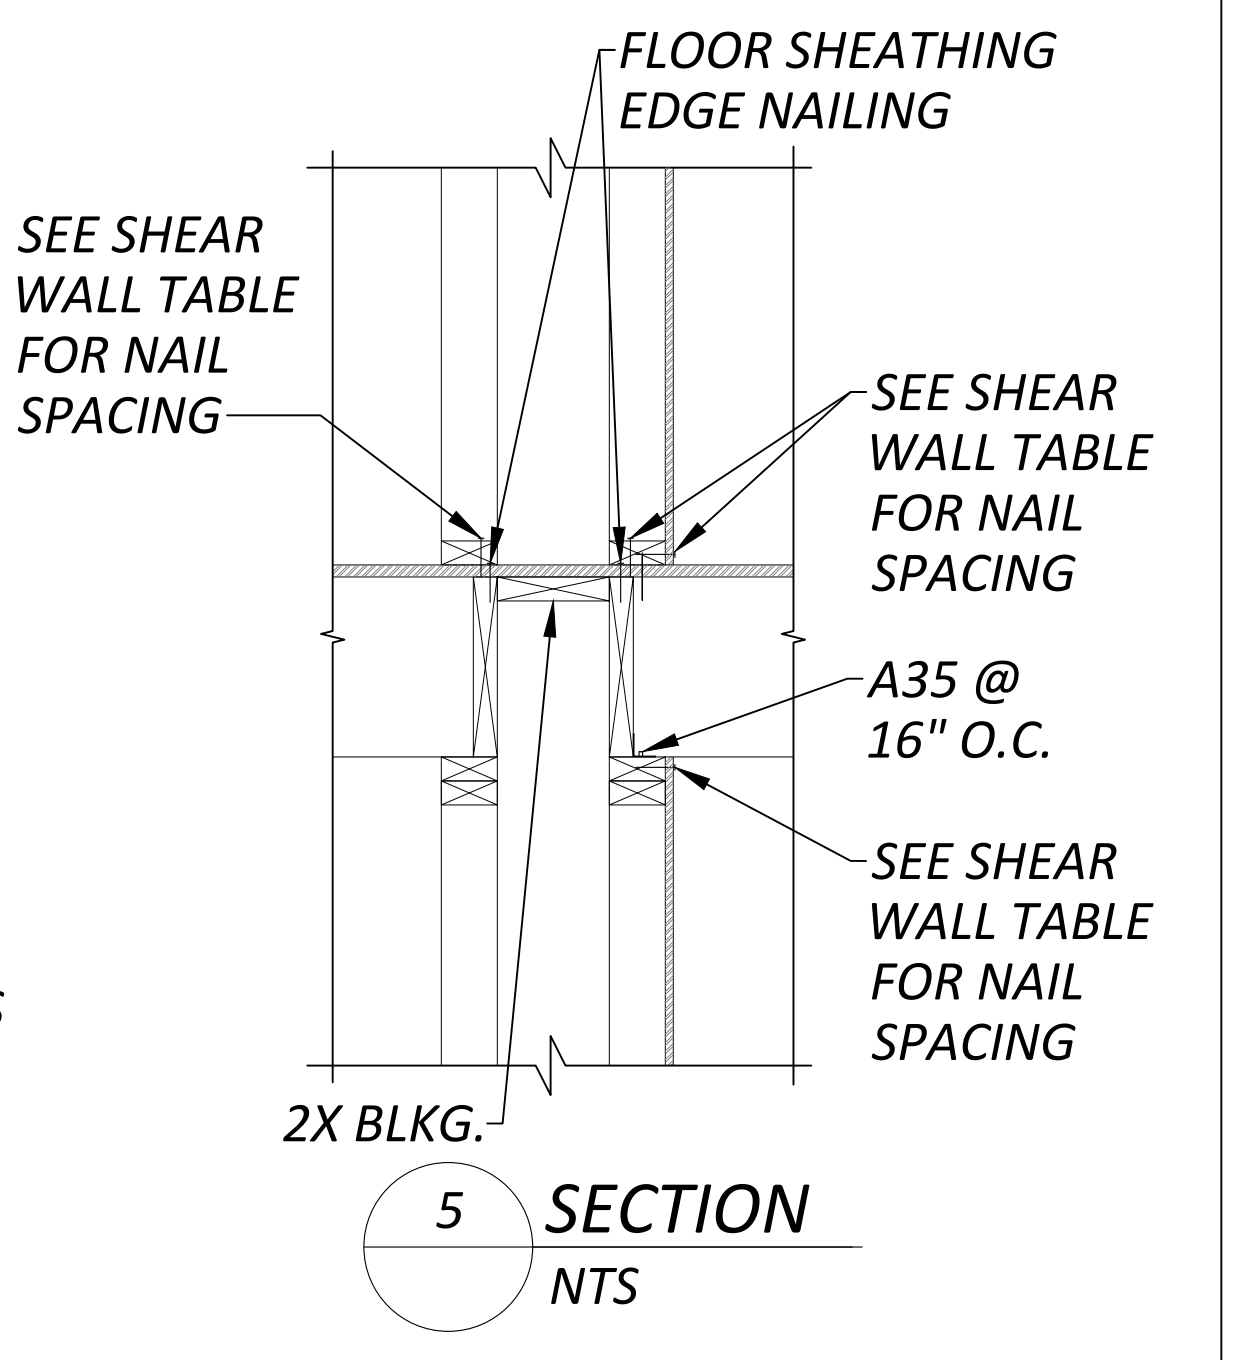

15 SECTION NTS

GENERAL NOTES

GENERAL NOTES – MECHANICAL

- REFERENCE TO RELATED WORK: "REF" INDICATIONS DENOTE WORK COVERED ELSEWHERE (ARCHITECTURAL, STRUCTURAL, CIVIL, ELECTRICAL, LANDSCAPE, OR KITCHEN), OR ITEM BASED ON A SPECIFIC MANUFACTURER'S DIMENSIONS (VERIFY).
- ELECTRICAL CHARACTERISTICS: REFER TO ELECTRICAL DRAWINGS FOR ELECTRICAL CHARACTERISTICS (VOLTAGES, ETC. OF MECHANICAL EQUIPMENT, UNLESS OTHERWISE INDICATED).
- CODES: COMPLETE INSTALLATION OF THE MECHANICAL SYSTEM SHALL BE PER THE APPLICABLE BUILDING, MECHANICAL, ENERGY, PLUMBING, FIRE, AND HEALTH CODES AND REGULATIONS AS ADOPTED BY THE LOCAL AHJ.
- PREPARE AND SUBMIT FOR REVIEW A SHOP DRAWING BASED ON FINAL STRUCTURAL SHOP DRAWINGS FOR LOCATING AND ROUTING ALL DUCTWORK, DAMPERS, EQUIPMENT, PIPING, ETC.
 - COORDINATE FLOOR AND BEAM PENETRATIONS WITH STRUCTURAL.
 - COORDINATE FINAL LOCATION AND ROUTING WITH CEILING, LIGHTS, WALLS, FIRE SPRINKLER PIPING, AND OTHER TRADES WORK.
 - INCLUDE ADDITIONAL OFFSETS, ELBOWS, ROUTING, EQUIVALENT DUCT SIZING EXCHANGE, RELOCATING, ETC. AS REQUIRED FOR A COMPLETE OPERATING MECHANICAL SYSTEM.
 - PROVIDE SHOP DRAWINGS AT NO ADDITIONAL COST TO THE OWNER.
- MECHANICAL CONTRACTOR SHALL LOCATE AND COORDINATE EXACT LOCATION OF ALL MECHANICAL EQUIPMENT WITHIN THE STRUCTURE.
- ACCESS DOORS: COORDINATE WITH ARCHITECT AND LOCATE ALL ACCESS DOORS ON SHOP DRAWINGS PRIOR TO BEGINNING OF CONSTRUCTION. ACCESS DOORS IN FIRE RATED STRUCTURE SHALL BE FIRE RATED. VERIFY ACCESS DOOR LOCATIONS WITH GENERAL CONTRACTOR PRIOR TO BIDDING.
- RATED PENETRATION: DUCT PENETRATIONS THROUGH RATED ENCLOSURES SHALL BE FIRE/SMOKE DAMPERED PER THE LATEST EDITION OF THE UNDERWRITERS LABORATORIES(UL) FIRE RESISTANCE WITH HOURLY RATINGS FOR THROUGH-PENETRATION FIRE STOPS SYSTEM VOLUME #2, OR SHALL BE INSTALLED IN STRICT ACCORDANCE WITH THE MANUFACTURER'S UL LISTINGS (3M OR EQUIVALENT). DETERMINE REQUIREMENTS WITH GENERAL CONTRACTOR PRIOR TO BID.
- EXHAUST OUTLETS: SOURCE-SPECIFIC FANS SHALL BE VENTED TO OUTDOORS WITH A MINIMUM 3' CLEARANCE BETWEEN VENT OUTLETS AND BUILDING OPENINGS, AND 10' MINIMUM BETWEEN VENT OUTLETS AND MECHANICAL AIR INTAKES.
- ROOF PENETRATIONS: SEE ARCHITECTURAL DRAWINGS FOR ROOF CAP, ROOF CURB, ROOF DRAIN, AND VTR DETAILS.
- EXPOSED PIPING: PROVIDE CHROME PLATING FOR EXPOSED PIPING IN FINISHED ROOMS.
- PENETRATIONS: PROVIDE ESCUTCHEON PLATES FOR EXPOSED PIPING PENETRATIONS AND SHEET METAL FLASHING FOR EXPOSED DUCTWORK PENETRATIONS.
- SHAFT AND PLENUM CONNECTIONS: SEAL CONNECTIONS TO AIR SHAFTS AIRTIGHT. PROVIDE AIRTIGHT SEAL AROUND PENETRATIONS IN AIR PLENUMS.
- LIGHT FIXTURE CLEARANCE: COORDINATE LOCATIONS OF MECHANICAL WORK TO PROVIDE CLEARANCES OVER LIGHTING FIXTURES FOR REMOVAL AND REPLACEMENT.
- MOTORS: COMPLY WITH ENERGY CODE ENFORCED BY AHJ FOR MINIMUM EFFICIENCIES UNDER FULL LOAD.
- ACCESS CLEARANCES FOR MAINTENANCE AND REPLACEMENT: VERIFY PHYSICAL DIMENSIONS OF EQUIPMENT TO ENSURE THAT ACCESS CLEARANCES CAN BE MET. COORDINATE LOCATIONS OF MECHANICAL WORK AND WORK OF OTHER TRADES TO PROVIDE ACCESS CLEARANCES FOR SERVICE AND MAINTENANCE.

COORDINATION REQUIREMENTS

- PIPING: COORDINATE WITH STRUCTURAL FOR EXACT LOCATION OF ALL STRUCTURAL FRAMING AND FOOTINGS AND FINALIZE THE EXACT ROUTING OF ALL PIPES WITH STRUCTURAL AND AT THE SITE PRIOR AND DURING THE CONSTRUCTION.
- DUCTWORK: LOCATE AND COORDINATE THE EXACT LOCATION OF DUCTWORK WITH STRUCTURAL PLANS AND WITH THE GENERAL CONTRACTOR PRIOR TO INSTALLATION OF ANY STRUCTURE OR EQUIPMENT. COORDINATE WITH FRAMING CONTRACTOR TO ASSURE JOIST SPACES LINE UP WHEN DUCTWORK MUST PASS THROUGH DIFFERENT JOIST SPACES.
- ADJUSTMENTS: ALL EQUIPMENT, MOTORS, FANS GAS BURNERS, IGNITION DEVICES, DRIVES, ETC. SHALL BE ADJUSTED AND BALANCED TO OPERATE AT SPECIFIED RATINGS AS REQUIRED FOR THIS PROJECT SITE AND ACCOUNTING FOR ELEVATION ABOVE SEA LEVEL.
- APPROVALS: MECHANICAL AND PLUMBING EQUIPMENT SHALL BE APPROVED FOR INSTALLATION IN THE PROJECT LOCATION AND SHALL HAVE ALL CERTIFICATIONS AND RATINGS TO MEET ALL ENERGY, POLLUTION, ENVIRONMENTAL, SEISMIC, ETC. CODES AND REGULATIONS. THE CONTRACTOR SHALL COORDINATE WITH HIS MANUFACTURE SUPPLIERS AND SHALL INCLUDE ALL COSTS REQUIRED TO MEET THESE REQUIREMENTS IN HIS BID.
- FIRE PROTECTION: CONTRACTOR SHALL PROVIDE A FULLY DESIGNED FIRE PROTECTION SPRINKLER SYSTEM IN COMPLIANCE WITH NFPA AND LOCAL CODES. PROVIDE DESIGN, PERMITS, MATERIALS, INSTALLATION, TESTING AND ALL OTHER FOR A FULLY OPERATIONAL SYSTEM. LOCATION OF ALL PIPING TO BE COORDINATED WITH OTHER TRADES.

PIPING NOTES

- DISASSEMBLY PROVISIONS: PROVIDE UNIONS OR FLANGES AT PIPING CONNECTIONS TO EQUIPMENT, COILS, TRAPS, CONTROL VALVES, AND OTHER COMPONENTS TO ALLOW DISASSEMBLY FOR MAINTENANCE.
- REDUCERS: PROVIDE AS REQUIRED FROM LINE PIPE SIZE TO EQUIPMENT, TRAP, COIL, AND CONTROL VALVE CONNECTION SIZES.
- OFFSETS: PROVIDE FOR BRANCH LINES TO EQUIPMENT.
- DISSIMILAR UNIONS: PROVIDE AT CONNECTIONS OF DISSIMILAR PIPE.
- REFRIGERANT PIPING: PROVIDE SIZING & INSTALLATION IN STRICT ACCORDANCE WITH MANUFACTURER'S INSTRUCTIONS.
- CONDENSATE DRAIN: PROVIDE A P-TRAP FOR EACH HVAC UNIT CONDENSATE PAN WITH PLUG TEES FOR CLEANING. CONDENSATE DRAINS SHALL BE DISCHARGED TO AN INDIRECT WASTE OR OUTSIDE.

INSULATION/LINING NOTES

- ENERGY CODE: AS A MINIMUM, COMPLY WITH THICKNESSES AND TYPES LISTED IN ENERGY CODE ENFORCED BY AHJ.
- EXTENT OF INTERNAL DUCT LINING:
 - GRILLE AND DIFFUSER BOXES AND BOOTS.
 - TRANSFER DUCTS.
 - THE FIRST 10 FEET OF SUPPLY AND RETURN DUCTWORK FROM THE AIR HANDLER.
- EXTENT OF EXTERNAL DUCT INSULATION:
 - SUPPLY AND RETURN AIR IN UNCONDITIONED SPACES, MECHANICAL ROOMS, ELECTRICAL ROOMS, AND EQUIPMENT ROOMS NOT SPECIFIED TO BE INTERNALLY LINED.
 - SUPPLY AIR ABOVE CEILING OR EXPOSED NOT SPECIFIED TO BE INTERNALLY LINED.
 - OUTDOOR AIR INTAKE.
- MISCELLANEOUS DUCT FITTINGS (CONICAL TAKEOFFS, ETC.): WRAP WITH INSULATION FOR CONDENSATION CONTROL.

PLAN NOTES

- DUCTWORK SHALL BE METALLIC DUCTWORK
- TEST AND BALANCE WORK SHALL BE PERFORMED BY AN INDEPENDENT TEST AND BALANCE AGENCY. PROVIDE (3) COPIES OF TEST AND BALANCE REPORT TO OWNER.
- COORDINATE DUCTWORK WITH MISCELLANEOUS OBSTRUCTIONS IN CEILING SPACE.
- RESTROOM EXHAUST SHALL BE A MINIMUM OF 10' FROM ANY MECHANICAL OUTSIDE AIR INTAKES.
- ROUTE DUCTWORK UNDERNEATH JOISTS UON.
- TRANSITION DUCT UNDER BEAMS AND DUCTS. FIELD VERIFY AVAILABLE CEILING CAVITY DIMENSIONS.
- COORDINATE MOUNTING HEIGHT OF DIFFUSERS WITH ARCHITECTURAL PLANS.

SHEET METAL NOTES

- REFERENCE: SMACNA HVAC DUCT CONSTRUCTION STANDARDS, METAL AND FLEXIBLE, CURRENT EDITION.
- CLEARANCE: COORDINATE DUCTWORK WITH MISCELLANEOUS OBSTRUCTIONS IN CEILING SPACE.
- ROUND ELBOWS AND OFFSETS: FULL RADIUS (R/D = 1.5), 5-PIECE SEGMENTED OR STAMPED. REFER TO SMACNA HVAC FIG 2-7, 3-3. DO NOT USE ANGLED OFFSET (TYPE 1). MITERED OFFSET (TYPE 2) MAY BE USED UP TO 30 DEGREE OFFSET ANGLE.
- ROUND TEES AND LATERALS: CONICAL TEE PER SMACNA HVAC FIG 3-5; DO NOT USE STRAIGHT TEE. DO NOT USE CONICAL SADDLE TAP FOR EXPOSED DUCTWORK IN FINISHED SPACES. 90-DEGREE TEE WITH OVAL TO ROUND TAP, LATERAL, AND 45-DEGREE RECTANGULAR LEAD-IN PER SMACNA HVAC FIG 3-4.
- RECTANGULAR ELBOWS AND OFFSETS: FULL RADIUS WHERE SPACE PERMITS, R/W = 1.5; OTHERWISE USE SQUARE CORNER ELBOW WITH TURNING VANES.
- RECTANGULAR DIVIDED FLOW FITTINGS: USE GENERALLY, EXCEPT BRANCHES TO TERMINALS; SMACNA HVAC FIG 2-5, TYPES 1, 2, 4A, AND 4B. DO NOT USE TYPE 3.
- TURNING VANES: H.E.P. MANUFACTURER OR APPROVED HIGH EFFICIENCY PROFILE AIRFOIL TYPE FOR RECTANGULAR SQUARE THROAT ELBOWS. ACOUSTICAL TYPE FOR RETURN AIR MITERED ELBOWS.
- TAKEOFFS TO OPENINGS: CONICAL TYPE WITH VOLUME DAMPER FOR ROUND DUCT BRANES PER SMACNA HVAC FIG 2-6, MINIMUM INLET DIAMETER 2 INCHES LARGER THAN DUCT SIZE. 45 DEGREE ENTRY FITTING FOR RECTANGULAR DUCT BRANCHES PER SMACNA HVAC FIG 2-6.
- FLEXIBLE CONNECTIONS: PROVIDE AT EACH DUCT CONNECTION TO FANS, PACKAGED HVAC EQUIPMENT, EXTERNALLY ISOLATED AIR HANDLING UNITS, FAN COIL UNITS, AND SIMILAR EQUIPMENT. EXCEPTION: EQUIPMENT IN CORRIDOR CEILING SPACES WHERE FIRE RATING IS REQUIRED.
- ALL DUCT WORK SHALL BE CLASSIFIED FOR LOW PRESSURE SYSTEMS PER IMC SECTION 603.
- ALL DUCTS AND JOINTS SHALL BE SEALED PER IMC SECTION 603.

HVAC NOTES

- ATTACHMENTS: AIR DISTRIBUTION OUTLETS AND LOUVERS

- SHALL HAVE ALL REQUIRED ACCESSORIES AND ATTACHMENTS FOR A COMPLETE CONNECTION TO THE SPECIFIC TYPE OF STRUCTURE THAT THEY ARE BEING ATTACHED TO. THIS INCLUDES, BUT IS NOT LIMITED TO, EXTERIOR BRICKS, GWB WALLS, GWB CEILING, ETC.
- DUCTWORK: DUCTWORK SHALL BE SMOOTH SHEET METAL (CLASS-1). DUCTWORK THROUGH FIRE RATED STRUCTURE AND FLOOR SHALL BE MIN. 26 GA. STEEL. MAXIMUM LENGTH OF FLEXIBLE DUCTS SHALL BE 5'-0", UNLESS OTHERWISE NOTED ON DRAWINGS. DUCTWORK SIZES SHOWN ARE INSIDE CLEAR DIMENSIONS.
 - SEISMIC: PROVIDE SEISMIC RESTRAINTS FOR MECHANICAL EQUIPMENT, PIPING, AND DUCTWORK PER SMACNA AND LOCAL REGULATIONS.
 - FILTER CLEARANCE: PROVIDE ADEQUATE CLEARANCE FOR CHANGING AIR FILTERS.
 - DUCTWORK AND PIPING OUTSIDE OF MECHANICAL ROOMS SHALL BE CONCEALED, COORDINATE WITH THE GENERAL CONTRACTOR TO FUR-OUT AS REQUIRED.
 - FIRE RATINGS: RATED FLOOR/CEILING JOINT SPACES HAVING DUCTWORK INSIDE THEM SHALL BE FIRE/SMOKE PROTECTED TO MAINTAIN THE 1-HOUR FLOOR/CEILING RATING PER LOCAL JURISDICTIONS. EXHAUST DUCTWORK PENETRATING THE 1-HOUR ROOF/CEILING OR FLOOR/CEILING ASSEMBLY SHALL HAVE ACCESSIBLE CEILING FIRE DAMPERS. ALTERNATIVELY, THE EXHAUST DUCTWORK SHALL BE ROUTED INSIDE A RATED SHAFT TO PROTECT THE CEILING/ROOF RATING PER THE LOCAL JURISDICTIONS.
 - FIRESTOP: PIPE, DUCT AND CONDUIT PENETRATIONS THROUGH RATED ASSEMBLIES SHALL BE FIRE AND SMOKE STOPPED PER CODE.
 - DUCTWORK: DUCTWORK SHALL BE SMOOTH SHEET METAL (CLASS-1). DUCTWORK THROUGH FIRE RATED STRUCTURE AND FLOOR SHALL BE MIN. 26 GA. STEEL. MAXIMUM LENGTH OF FLEXIBLE DUCTS SHALL BE 5'-0" UNLESS OTHERWISE NOTED ON DRAWINGS. DUCTWORK SIZES SHOWN ARE INSIDE CLEAR DIMENSIONS.
 - VOLUME DAMPERS: PROVIDE AN ACCESSIBLE MANUAL VOLUME DAMPER FOR EACH SUPPLY, RETURN, OSA AND EXHAUST OPENING, LOCATED AS FAR UPSTREAM AS POSSIBLE FROM THE OPENING. PROVIDE A MANUAL VOLUME DAMPER FOR BRANCH MAINS SERVING MORE THAN ONE OPENING. VOLUME DAMPERS IN NON-ACCESSIBLE CEILING SHALL HAVE A CONTROL ARM EXTENDED TO AN ACCESSIBLE LOCATION. PROVIDE "YOUNG" REGULATOR OR EQUAL. EXACT LOCATION OF CONTROL DEVICES VISIBLE IN FINISHED SPACES SHALL BE COORDINATED WITH THE ARCHITECT.
 - CORRIDOR THERMOSTAT: PROVIDE TAMPERPROOF THERMOSTATS IN CORRIDORS. DO NOT PROVIDE PLASTIC GUARDS TO MAKE THE THERMOSTATS TAMPERPROOF. PROVIDE BLANK SECURABLE THERMOSTAT COVERS.

APPLICABLE CODE

BUILDING CODE:

- 2018 WASHINGTON STATE ENERGY CODE-RESIDENTIAL BY WASHINGTON ADMINISTRATIVE CODE CHAP 51-50 (WSEC)
- 2018 INTERNATIONAL RESIDENTIAL CODE WITH ADMINISTRATIVE CODE CHAP 51-51 (WSRC)
- 2018 INTERNATIONAL MECHANICAL CODE WITH ADMINISTRATIVE CODE CHAP 51-52 (WSMC)

DRAWINGS ARE DIAGRAMMATIC, SHOWING THE GENERAL LOCATION, TYPE, LAYOUT, AND EQUIPMENT REQUIRED. THE DRAWINGS SHALL NOT BE SCALED FOR EXACT MEASUREMENT. REFER TO ARCHITECTURAL DRAWINGS FOR DIMENSIONS. REFER TO MANUFACTURER'S STANDARD INSTALLATION DRAWINGS FOR EQUIPMENT CONNECTIONS AND INSTALLATION REQUIREMENTS. PROVIDE DUCTWORK, CONNECTIONS, ACCESSORIES, OFFSETS, AND MATERIALS NECESSARY FOR A COMPLETE SYSTEM.

PRE-CON MEETING NOTES

CONTRACTORS SHALL ATTEND A PRE-CONSTRUCTION MEETING WITH THE ENGINEER FOR THE PURPOSE OF REVIEWING THE WORK PRIOR TO ORDERING ANY EQUIPMENT OR PERFORMING ANY WORK. THE MEETING SHALL BE LOCATED AT THE PROJECT SITE ON A DATE AND TIME TO BE MUTUALLY AGREED. THE MEETING WILL BE A WORKING SESSION. THE MEETING WILL BE FACILITATED BY THE ENGINEER AND THE AGENDA WILL INCLUDE A DETAILED REVIEW OF THE PLANS AND SPECIFICATIONS, CROSS CHECK WITH OTHER TRADES FOR COORDINATION ISSUES, REVIEW OF PROPOSED PRODUCTS, REVIEW OF PLANNED MEANS AND METHODS, AND ON-SITE INVESTIGATION OF FIELD CONDITIONS RELATIVE TO EXISTING CONDITIONS THAT COULD AFFECT THE WORK. PERSONS ATTENDING THE MEETING SHALL BE KNOWLEDGEABLE OF THE PROJECT AND SHALL BE THE SPECIFIC PERSONS INTENDED TO CONTINUE WITH THE PROJECT THROUGH TO COMPLETION. IF REQUIRED, REVISED PLANS WILL BE ISSUED THROUGH OFFICIAL CHANNELS. CHANGES IN THE BID PRICE WILL BE DISCUSSED, BUT NO CHANGE ORDERS WILL BE ISSUED UNLESS PROCESSED THROUGH OFFICIAL CHANNELS. IT SHALL BE UNDERSTOOD THAT THE ENGINEER HAS NO AUTHORITY TO ISSUE CHANGE ORDERS.










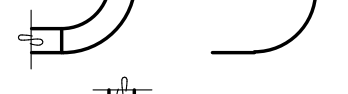

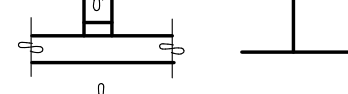
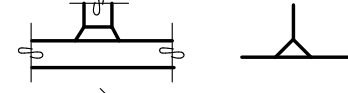
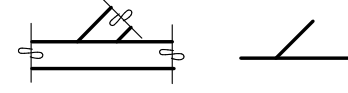
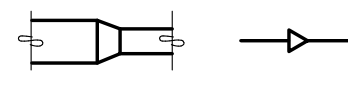








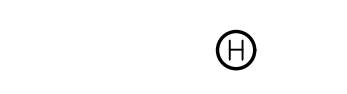
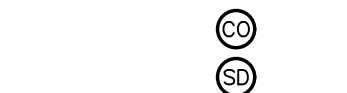
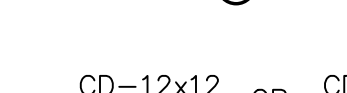
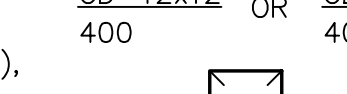

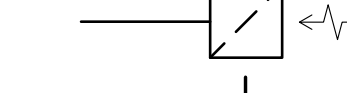
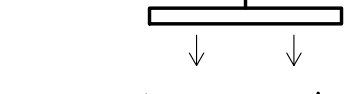
THE FOLLOWING TRADES SHALL BE REPRESENTED FOR THE MINIMUM TIME INDICATED:

| | |
|------------------------|--------------|
| MECHANICAL SHEET METAL | 4 HOURS |
| PLUMBING/PIPING | 4 HOURS |
| ELECTRICAL | 4 HOURS |
| SPRINKLER | 2 HOURS |
| GENERAL CONTRACTOR | ALL SESSIONS |

ANNOTATIONS

- ACU AIR CONDITIONING UNIT
- AFF ABOVE FINISHED FLOOR
- AHJ AUTHORITY HAVING JURISDICTION
- AHU AIR HANDLING UNIT
- BDD BACKDRAFT DAMPER
- BHP BRAKE HORSEPOWER
- BTUH BRITISH THERMAL UNIT PER HOUR
- C COMMON
- CAP CAPACITY
- CC COOLING COIL
- CD CEILING DIFFUSER
- CFM CUBIC FEET PER MINUTE
- CLG CEILING, COOLING
- CO CLEANOUT
- COMB COMBUSTION
- CONT CONTINUE, CONTROL
- CONTR CONTRACTOR
- COP COEFFICIENT OF PERFORMANCE
- CWS CHILLED WATER SUPPLY
- CWR CHILLED WATER RETURN
- D DIAMETER
- DB DRY BULB, DECIBEL
- DEG DEGREE
- DM DIMENSION
- DISCH DISCHARGE
- DN DOWN
- EA EXHAUST AIR
- EAT ENTERING AIR TEMPERATURE
- EER ENERGY EFFICIENCY RATIO
- EF EXHAUST FAN
- EFF EFFICIENCY
- EG EXHAUST GRILLE, ENGINE GENERATOR
- ELEC ELECTRIC
- EQUIV EQUIVALENT
- ESP EXTERNAL STATIC PRESSURE
- EXH EXHAUST
- EXT EXTERIOR, EXTERNAL
- F FAHRENHEIT
- FD FAN DAMPER
- FCU FAN COIL UNIT
- FLR FLOOR
- FPM FEET PER MINUTE
- FPS FEET PER SECOND
- FSD FIRE/SMOKE DAMPER
- G GAS
- GRD GRILLES, REGISTERS, AND DIFFUSERS
- GWB GYPSUM WALLBOARD
- HORIZ HORIZONTAL
- HP HORSEPOWER, HEAT PUMP
- HRU HEAT RECOVERY UNIT
- HVAC HEATING, VENTILATING, AND AIR CONDITIONING
- HVU HEATING AND VENTILATION UNIT
- HWR HIGH WALL RETURN, HOT WATER RETURN
- HWS HIGH WALL SUPPLY, HOT WATER SUPPLY
- HX HEAT EXCHANGER
- ID INDIRECT DRAIN, INSIDE DIAMETER
- IN INCH
- KW KILOWATT
- L LONG, LENGTH
- LB POUND
- LWR LOW WALL RETURN
- LWS LOW WALL SUPPLY
- MBH THOUSAND BTU PER HOUR
- MECH MECHANICAL
- MCA MINIMUM CIRCUIT AMPACITY
- MOCP MAXIMUM OVER CURRENT PROTECTION
- MOUNTED MOUNTED
- MTD OUTDOOR AIR
- OSD OPPOSED BLADE DAMPER
- OD OPENING
- OPNG OPENING
- P PUMP
- PD PRESSURE DROP
- POC POINT OF CONNECTION
- PRV PRESSURE REDUCING VALVE
- PSIG POUNDS PER SQUARE INCH GAUGE
- RA RETURN AIR
- REF REFERENCE
- RF RELIEF FAN
- RG RETURN GRILLE
- RPM REVOLUTIONS PER MINUTE
- SA SUPPLY AIR
- SCH SCHEDULE
- SF SUPPLY FAN, SQUARE FOOT
- SENS SENSIBLE
- SG SUPPLY GRILLE
- SMACNA SHEET METAL AND AIR CONDITIONING CONTRACTORS NATIONAL ASSOCIATION
- SO SCREENED OPENING
- SP STATIC PRESSURE
- SS STAINLESS STEEL, SANITARY
- SQ SQUARE
- TG TRANSFER GRILLE
- TP TYPICAL
- UH UNIT HEATER
- UON UNLESS OTHERWISE NOTED
- V VENT
- VENT VENTILATION, VENTILATOR
- VTR VENT THRU ROOF
- W WASTE, WATT, WIDE
- WB WET BULB (TEMPERATURE)

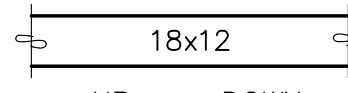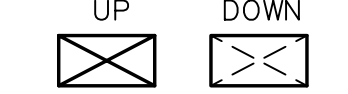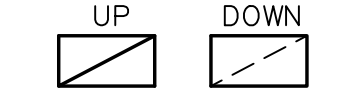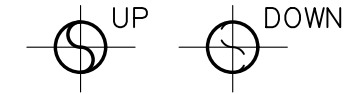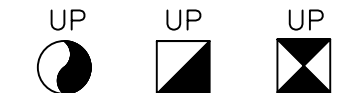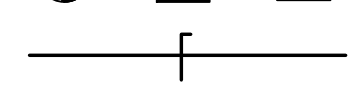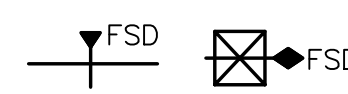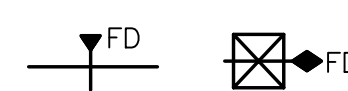
SYMBOLS
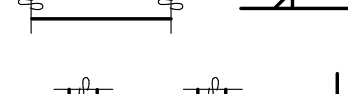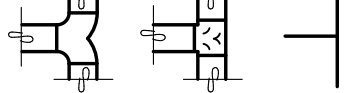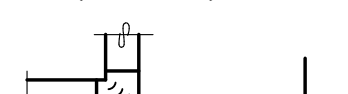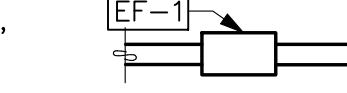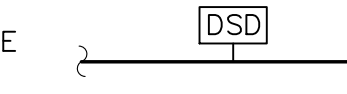
| | |
|--|---|
| <p>DUCTWORK</p>  <p>DUCT (1ST FIGURE = SIDE SHOWN, 2ND FIGURE = SIDE NOT SHOWN)</p>  <p>DUCT SECTION, POSITIVE PRESSURE</p>  <p>DUCT SECTION, NEGATIVE PRESSURE</p>  <p>ROUND DUCT SECTION</p>  <p>DUCT PENETRATION THRU FLOOR OR ROOF</p>  <p>VOLUME DAMPER</p>  <p>FIRE/SMOKE DAMPER (--- = HORIZ DUCT, --◇ = VERT DUCT), 2-HR RATED, UON</p>  <p>FIRE DAMPER (--- = HORIZ DUCT, ---◇ = VERT DUCT), 2-HR RATED, UON</p>  <p>90° ELBOW, R/D OR R/W=1.5</p>  <p>SQUARE CORNER ELBOW WITH TURNING VANES</p>  <p>90° TAKE-OFF OR TEE</p>  <p>90° CONICAL TAKE-OFF</p>  <p>45° LATERAL TAKE-OFF</p>  <p>TRANSITION OR REDUCER (FOT = FLAT ON TOP, FOB = FLAT ON BOTTOM)</p>  <p>WYE FITTING</p>  <p>90° RECTANGULAR TAKE-OFF WITH 45° TAPER</p>  <p>90° DIVERGING RECTANGULAR TEE, EITHER RADIUS OR TURNING VANES</p>  <p>PARALLEL FLOW BRANCH CONNECTION, EITHER RADIUS OR TURNING VANES</p>  <p>FLEXIBLE DUCT</p>  <p>ROUND DUCT INDICATOR</p> | <p>EQUIPMENT</p> <p>TYPICAL EQUIPMENT DESIGNATION (EXHAUST FAN SHOWN)</p>  <p>DUCT SMOKE DETECTOR</p>  <p>ROOM THERMOSTAT OR TEMPERATURE TRANSMITTER</p>  <p>ROOM HUMIDISTAT OR HUMIDITY TRANSMITTER</p>  <p>CARBON MONOXIDE SENSOR</p>  <p>SMOKE DETECTOR</p> <p>TERMINALS</p> <p>DIFFUSER/GRILLE TYPE, AND NUMBER OR SIZE</p> <p>DESIGN CFM (WHERE APPLICABLE) CEILING DIFFUSER (FLOW ARROWS SHOWN FOR NON SYMMETRICAL AIRFLOW)</p>  <p>CEILING RETURN/EXHAUST GRILLE</p> <p>LINEAR DIFFUSER, CEILING OR WALL MOUNTED (FLOW ARROWS SHOWN FOR NON SYMMETRICAL AIRFLOW)</p>  <p>WALL SUPPLY GRILLE (SG)</p>  <p>WALL RETURN/EXHAUST GRILLE (RG, EG)</p>  <p>TRANSFER GRILLE (TG), DUCT CONNECTED, WALL MOUNTED W/ OPTIONAL CFM SHOWN</p>  <p>TRANSFER GRILLE, CEILING MOUNTED WITH FULL-SIZED LINED DUCT CONNECTION</p> |
|--|---|

DRAWING INDEX

| Sheet Number | Sheet Title | PERMIT SET | DATE | BY | CHECKED | DATE | BY |
|--------------|--|------------|-----------|----|---------|------|----|
| M0.0 | LEGEND, GENERAL NOTES, & DRAWING INDEX | X | 1/22/2024 | | | | |
| M0.1 | PROJECT NOTES | X | | | | | |
| M0.2 | TABLES & CALCULATIONS | X | | | | | |
| M0.3 | MECHANICAL SCHEDULES | X | | | | | |
| M0.4 | WSEC FORMS | X | | | | | |
| M1.0 | SITE PLAN | X | | | | | |
| M2.0 | HVAC PLAN - LEVEL 1 | X | | | | | |
| M2.1 | HVAC PLANS - LEVEL 2 | X | | | | | |
| M2.2 | HVAC PLANS - LEVEL 3 | X | | | | | |
| M2.3 | HVAC PLANS - ROOF | X | | | | | |
| M3.0 | HVAC ENLARGED PLANS | X | | | | | |
| M3.1 | HVAC ENLARGED PLANS | X | | | | | |
| M4.0 | DETAILS & DIAGRAMS | X | | | | | |
| M4.1 | DETAILS & DIAGRAMS | X | | | | | |


| REVISED | DESCRIPTION | DATE | |
|---------|-------------|------|----|
| | | NO. | BY |
| | | | |
| | | | |
| | | | |

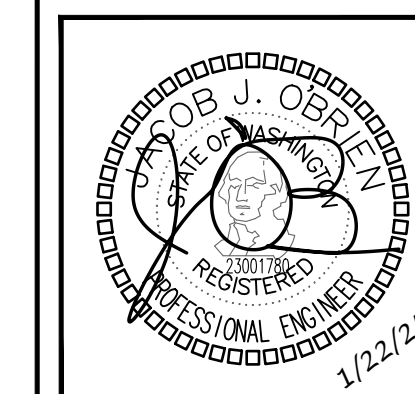

| | | |
|---------------|-------------|---------------|
| DRAWN: ABE | OF | APPROVED: JMR |
| DESIGNED: ABE | CHECKED: PR | |

EAST TOWN CROSSING BUILDING B
MULTIFAMILY DEVELOPMENT
PIONEER WAY & SHAW RD. PUYALLUP, WA

19401 40TH AVE W, SUITE 302
LYNNWOOD, WA 98036
PHONE: 206/864-3343
REPROJECT NO.: 810010
CONTACT: ARK.ESPINELLI

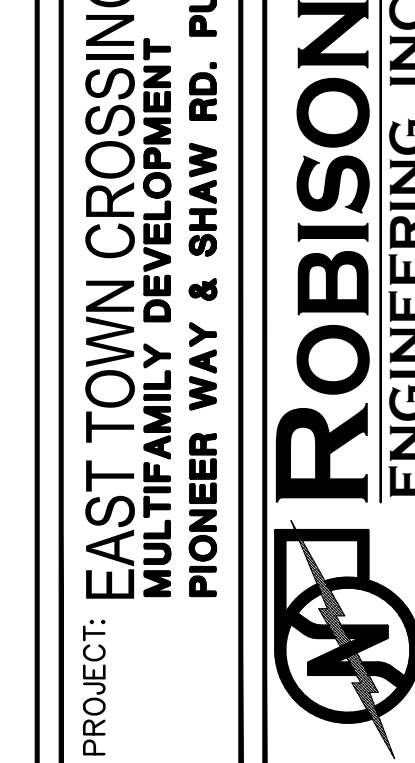

DATE:
1/22/2024

SHEET TITLE:
LEGEND,
GENERAL NOTES,
& DRAWING INDEX

SHEET NO.
M0.0

ENERGY CODE NOTES

WSEC SECTION R406: ADDITIONAL ENERGY EFFICIENCY REQUIREMENTS

EACH DWELLING UNIT IN A RESIDENTIAL BUILDING SHALL COMPLY WITH SUFFICIENT CREDIT OPTIONS FROM SECTION R406. CREDIT FROM BOTH SECTIONS R406.2 AND R406.3 ARE REQUIRED:

- #1. SMALL DWELLING UNIT: 3.0 CREDITS
DWELLING UNITS LESS THAN 1500 SQUARE FEET IN CONDITIONED FLOOR AREA WITH LESS THAN 300 SQUARE FEET OF FENESTRATION AREA. ADDITIONS TO EXISTING BUILDING THAT ARE GREATER THAN 500 SQUARE FEET OF HEATED FLOOR AREA BUT LESS THAN 1500 SQUARE FEET.
- #2. MEDIUM DWELLING UNIT: 6.0 CREDITS
ALL DWELLING UNITS THAT ARE NOT INCLUDED IN #1, #3 OR #4.
- #3. LARGE DWELLING UNIT: 7.0 CREDITS
DWELLING UNITS EXCEEDING 5000 SQUARE FEET OF CONDITIONED FLOOR AREA.
- #4. DWELLING UNITS SERVING R-2 OCCUPANCIES: 4.5 CREDITS
- #5. ADDITIONS LESS THAN 500 SQUARE FEET: 1.5 CREDITS

TABLE R406.2 FUEL NORMALIZATION CREDITS

| SYSTEM TYPE | DESCRIPTION | CREDITS | CREDIT TAKEN |
|---------------|--|---------|--------------|
| 1 | COMBUSTION HEATING EQUIPMENT MEETING MINIMUM FEDERAL EFFICIENCY STANDARDS FOR THE EQUIPMENT LISTED IN TABLE C403.3.2(4) OR C403.3.2(5) | 0.0 | - |
| 2 | FOR AN INITIAL HEATING SYSTEM USING A HEAT PUMP THAT MEETS FEDERAL STANDARDS FOR EQUIPMENT LISTED IN TABLE C403.3.2(2)C OR C403.3.2(2) OR AIR TO WATER HEAT PUMP UNITS THAT ARE CONFIGURED TO PROVIDE BOTH HEATING AND COOLING AND ARE RATED IN ACCORDANCE WITH AHRI 550 / 590 | 1.0 | 1.0 |
| 3 | FOR HEATING SYSTEM BASED ON ELECTRIC RESISTANCE ONLY (EITHER FORCED AIR OR ZONAL) | -1.0 | - |
| 4 | FOR HEATING SYSTEM BASED ON ELECTRIC RESISTANCE WITH A DUCTLESS MINI-SPLIT HEAT PUMP SYSTEM IN ACCORDANCE WITH SECTION R403.7.1 INCLUDING THE EXCEPTION | N/A | - |
| 5 | ALL OTHER HEATING SYSTEMS | -1.0 | - |
| TOTAL CREDITS | | | 1.0 |

TABLE R406.3 ENERGY CREDITS

| OPTION | DESCRIPTION | CREDITS | CREDIT TAKEN |
|---|---------------------------------|---------|--------------|
| EFFICIENT BUILDING ENVELOPE OPTIONS | | | |
| 1 | OPTION 1.1 | 0.5 | - |
| | OPTION 1.2 | 1.0 | - |
| | OPTION 1.3 | N/A | - |
| | OPTION 1.4 | 1.0 | - |
| | OPTION 1.5 | 1.5 | - |
| | OPTION 1.6 | 2.0 | - |
| | OPTION 1.7 | 0.5 | - |
| AIR LEAKAGE CONTROL AND EFFICIENT VENTILATION OPTIONS | | | |
| 2 | OPTION 2.1 | 1.0 | - |
| | OPTION 2.2 | 1.5 | - |
| | OPTION 2.3 | 2.0 | - |
| | OPTION 2.4 | 2.5 | - |
| HIGH EFFICIENCY HVAC EQUIPMENT OPTIONS | | | |
| 3 | OPTION 3.1 | 1.0 | - |
| | OPTION 3.2 | N/A | - |
| | OPTION 3.3 | 1.0 | - |
| | OPTION 3.4 | 2.0 | - |
| | OPTION 3.5 | N/A | - |
| | OPTION 3.6 | 3.0 | 3.0 |
| HIGH EFFICIENCY HVAC DISTRIBUTION SYSTEM OPTIONS | | | |
| 4 | OPTION 4.1 | 0.5 | - |
| | OPTION 4.2 | N/A | - |
| EFFICIENT WATER HEATING OPTIONS | | | |
| 5 | OPTION 5.1 | 0.5 | - |
| | OPTION 5.2 | 0.5 | - |
| | OPTION 5.3 | 1.0 | - |
| | OPTION 5.4 | 2.0 | - |
| | OPTION 5.5 | 2.5 | 2.5 |
| | OPTION 5.6 | 3.0 | - |
| RENEWABLE ELECTRIC ENERGY OPTION | | | |
| 6 | OPTION 6.1 | 1.0 | - |
| | APPLIANCE PACKAGE OPTION | | |
| 7 | OPTION 7.1 | 1.5 | - |
| | TOTAL CREDITS FROM TABLE R406.3 | | |
| TOTAL CREDITS FROM TABLE R406.2 | | | 1.0 |
| TOTAL CREDITS | | | 6.5 |

WHOLE HOUSE VENTILATION NOTES

EACH DWELLING UNIT OR SLEEPING UNIT SHALL BE EQUIPPED WITH A WHOLE-HOUSE MECHANICAL VENTILATION SYSTEM THAT COMPLIES WITH SECTIONS 403.4.1 THROUGH 403.4.6. EACH DWELLING UNIT OR SLEEPING UNIT SHALL BE EQUIPPED WITH LOCAL EXHAUST COMPLYING WITH SECTION 403.4.7. ALL OCCUPIED SPACES, INCLUDING PUBLIC CORRIDORS, OTHER THAN GROUP R DWELLING UNITS AND/OR SLEEPING UNITS, THAT SUPPORT THESE GROUP R OCCUPANCIES, SHALL MEET THE VENTILATION REQUIREMENTS OF SECTION 402 OR THE MECHANICAL VENTILATION REQUIREMENTS OF SECTIONS 403.1 THROUGH 403.3.

THE WHOLE HOUSE VENTILATION SYSTEM SHALL CONSIST OF ONE OR MORE SUPPLY FANS, ONE OR MORE EXHAUST FANS, OR AN ERV/HRV WITH INTEGRAL FANS; AND THE ASSOCIATED DUCTS AND CONTROLS. LOCAL EXHAUST FANS SHALL BE PERMITTED TO SERVE AS PART OF THE WHOLE-HOUSE VENTILATION SYSTEM WHEN PROVIDED WITH THE PROPER CONTROLS IN ACCORDANCE WITH SECTION 403.4.5. THE SYSTEMS SHALL BE DESIGNED AND INSTALLED TO SUPPLY AND EXHAUST THE MINIMUM OUTDOOR AIRFLOW RATES PER SECTION 403.4.2 AS CORRECTED BY THE BALANCED AND/OR DISTRIBUTED WHOLE-HOUSE VENTILATION SYSTEM COEFFICIENTS IN ACCORDANCE WITH SECTION 403.4.3 WHERE APPLICABLE.

THE DWELLING UNIT WHOLE-HOUSE MECHANICAL VENTILATION MINIMUM OUTDOOR AIRFLOW RATE SHALL BE DETERMINED IN ACCORDANCE WITH EQUATION 4-10 OR TABLE 403.4.2.

RESIDENTIAL DWELLING AND SLEEPING UNITS IN GROUP R-2 OCCUPANCIES SYSTEM SHALL INCLUDE SUPPLY AND EXHAUST FANS AND BE A BALANCED WHOLE-HOUSE VENTILATION SYSTEM IN ACCORDANCE WITH SECTION 403.4.6.3. THE SYSTEM SHALL INCLUDE A HEAT OR ENERGY RECOVERY VENTILATOR WITH A SENSIBLE HEAT RECOVERY EFFECTIVENESS AS PRESCRIBED IN SECTION C403.3.6 OF THE WASHINGTON STATE ENERGY CODE. THE WHOLE-HOUSE VENTILATION SYSTEM SHALL OPERATE CONTINUOUSLY AT THE MINIMUM VENTILATION RATE DETERMINED IN ACCORDANCE WITH SECTION 403.4. THE WHOLE-HOUSE SUPPLY FAN SHALL PROVIDE DUCTED OUTDOOR VENTILATION AIR TO EACH HABITABLE SPACE WITHIN THE RESIDENTIAL UNIT.

CONTROLS FOR THE WHOLE-HOUSE VENTILATION SYSTEM SHALL COMPLY WITH THE FOLLOWING:

- THE WHOLE-HOUSE VENTILATION SYSTEM SHALL BE CONTROLLED WITH MANUAL SWITCHES, TIMERS OR OTHER MEANS THAT PROVIDE FOR AUTOMATIC OPERATION OF THE VENTILATION SYSTEM THAT HAVE READY ACCESS FOR THE OCCUPANT.
- THE WHOLE-HOUSE MECHANICAL VENTILATION SYSTEM SHALL BE PROVIDED WITH CONTROLS THAT ENABLE MANUAL OVERRIDE OFF OF THE SYSTEM BY THE OCCUPANT DURING PERIODS OF POOR OUTDOOR AIR QUALITY. CONTROLS SHALL INCLUDE PERMANENT TEXT OR A SYMBOL INDICATING THEIR FUNCTION. RECOMMENDED CONTROL PERMANENT LABELING TO INCLUDE TEXT SIMILAR TO THE FOLLOWING; "LEAVE ON UNLESS OUTDOOR AIR QUALITY IS VERY POOR." MANUAL CONTROLS SHALL HAVE READY ACCESS FOR THE OCCUPANT.
- WHOLE-HOUSE VENTILATION SYSTEMS SHALL BE CONFIGURED TO OPERATE CONTINUOUSLY EXCEPT WHERE INTERMITTENT OFF CONTROLS ARE PROVIDED IN ACCORDANCE WITH SECTION 403.4.6.5 AND ALLOWED BY SECTION 403.4.4.2.

WHOLE HOUSE VENTILATION SUPPLY AND EXHAUST FANS SPECIFIED IN THIS SECTION SHALL HAVE A MINIMUM EFFICACY AS PRESCRIBED IN THE WASHINGTON STATE ENERGY CODE. THE FANS SHALL BE RATED FOR SOUND AT A MAXIMUM OF 1.0 SOME AT DESIGN AIRFLOW AND STATIC PRESSURE CONDITIONS. DESIGN AND INSTALLATION OF THE SYSTEM OR EQUIPMENT SHALL BE CARRIED OUT IN ACCORDANCE WITH MANUFACTURERS' INSTALLATION INSTRUCTIONS

A BALANCED WHOLE HOUSE VENTILATION SYSTEM SHALL INCLUDE BOTH SUPPLY AND EXHAUST FANS. THE SUPPLY AND EXHAUST FANS SHALL HAVE AIRFLOW THAT IS WITHIN 10 PERCENT OF EACH OTHER. THE TESTED AND BALANCED TOTAL MECHANICAL EXHAUST AIRFLOW RATE IS WITHIN 10 PERCENT OR 5 CFM, WHICHEVER IS GREATER, OF THE TOTAL MECHANICAL SUPPLY AIRFLOW RATE. THE FLOW RATE TEST RESULTS SHALL BE SUBMITTED AND POSTED IN ACCORDANCE WITH SECTION 403.4.6.6. THE EXHAUST FAN SHALL MEET THE REQUIREMENTS OF SECTION 403.4.6.2. THE SUPPLY FAN SHALL MEET THE REQUIREMENTS OF SECTION 403.4.6.3. FOR R-2 DWELLING AND SLEEPING UNITS, THE SYSTEM IS REQUIRED TO HAVE BALANCED WHOLE-HOUSE VENTILATION BUT IS NOT REQUIRED TO HAVE DISTRIBUTED WHOLE-HOUSE VENTILATION WHERE THE NOT DISTRIBUTED SYSTEM COEFFICIENT FROM TABLE 403.4.3 IS UTILIZED TO CORRECT THE WHOLE-HOUSE MECHANICAL VENTILATION RATE. THE SYSTEM SHALL BE DESIGNED AND BALANCED TO MEET THE PRESSURE EQUALIZATION REQUIREMENTS OF SECTION 501.4. INTERMITTENT DRYER EXHAUST, INTERMITTENT RANGE HOOD EXHAUST, AND INTERMITTENT TOILET ROOM EXHAUST AIRFLOW RATES ABOVE THE RESIDENTIAL DWELLING OR SLEEPING UNIT MINIMUM VENTILATION RATE ARE EXEMPT FROM THE BALANCED AIRFLOW CALCULATION.

FACTORY-BUILT INTAKE/EXHAUST COMBINATION TERMINATIONS


PER 2018 IMC 401.4.3, ITEM 3, EXCEPTION, SEPARATION IS NOT REQUIRED BETWEEN INTAKE AIR OPENINGS AND LIVING SPACE RELIEF AIR EXHAUST AIR OPENINGS OF AN INDIVIDUAL DWELLING UNIT OR SLEEPING UNIT, NOT TO INCLUDE COMMON AREAS OUTSIDE OF THE DWELLING OR SLEEPING UNIT, WHERE A FACTORY-BUILT INTAKE/EXHAUST COMBINATION TERMINATION FITTING, LISTED AND INSTALLED IN ACCORDANCE WITH THE MANUFACTURER'S INSTRUCTIONS, IS USED TO SEPARATE THE AIR STREAMS. A MINIMUM OF 5 FEET HORIZONTAL SEPARATION BETWEEN OTHER ENVIRONMENTAL AIR EXHAUST OUTLETS AND OTHER DWELLING OR SLEEPING UNIT FACTORY-BUILT INTAKE/EXHAUST COMBINATION TERMINATION FITTINGS SHALL BE MAINTAINED.

CALCULATIONS

| RESIDENTIAL VENTILATION CALCULATIONS | | | | | | |
|--------------------------------------|---|--------------------|-----------------------|--------------------|------------------|--|
| UNIT TYPE | UNIT SQUARE FOOTAGE PER ARCHITECTURAL PLANS | NUMBER OF BEDROOMS | 2015 IMC CRITERIA (1) | | | TOTAL CFM PROVIDED BY WHOLE HOUSE VENTILATION SYSTEM |
| | | | FLOOR AREA, SQFT | NUMBER OF BEDROOMS | REQUIRED CFM (2) | |
| 11-3/21-3 | 634 | 1 | 501-1,000 | 0-1 | 30 | 50 |
| 11-7/21-9/31-9 | 659 | 1 | 501-1,000 | 0-1 | 30 | 50 |
| 11-8/21-4/31-4 | 679 | 2 | 501-1,000 | 2 | 35 | 50 |
| 21-2/31-2 | 958 | 2 | 501-1,000 | 2 | 35 | 50 |
| 12-1 | 1,021 | 2 | 1,001-1,500 | 2 | 40 | 50 |
| 12-3 | 1,000 | 2 | 501-1,000 | 2 | 35 | 50 |
| 12-5 | 957 | 2 | 501-1,000 | 2 | 35 | 50 |
| 22-1/32-1 | 1,022 | 2 | 1,001-1,500 | 2 | 40 | 50 |
| 22-2/32-2 | 958 | 2 | 501-1,000 | 2 | 35 | 50 |
| 22-5/32-5 | 958 | 2 | 501-1,000 | 2 | 35 | 50 |
| 22-6/32-6 | 1,000 | 2 | 501-1,000 | 2 | 35 | 50 |
| 31-3 | 645 | 1 | 501-1,000 | 0-1 | 30 | 50 |

NOTE: (1) VENTILATION CRITERIA IS PER THE 2018 IRC, TABLE 1505.4.3(1).
(2) MINIMUM OSA FOR CONTINUOUSLY OPERATING FAN(S).

| NO. | DATE | DESCRIPTION |
|-----|------|-------------|
| | | |
| | | |
| | | |

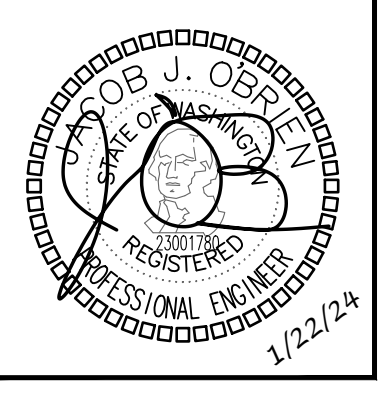

| | |
|-----------|-----|
| DRAWN: | OF |
| DESIGNED: | ABE |
| CHECKED: | PR |
| APPROVED: | JMR |

PROJECT: EAST TOWN CROSSING BUILDING B
MULTIFAMILY DEVELOPMENT
PIONEER WAY & SHAW RD. PUYALLUP, WA

19401 40TH AVE W, SUITE 302
LYNNWOOD, WA 98036
PHONE: (206) 864-3343
REPROJECT NO.: 810010
CONTACT: ARK@ESPINELI

ROBISON ENGINEERING, INC.

DATE:
1/22/2024

SHEET TITLE:
TABLES & CALCULATIONS

SHEET NO.
M0.2

SCHEDULES

ENERGY RECOVERY VENTILATOR

| EQUIP NO. | SERVICE | MOUNTING/ DISCHARGE | FAN | | ELECTRICAL | | | SENSIBLE HEAT RECOVERY EFFICIENCY | BASIS OF DESIGN (1)(2)(3) |
|-----------|------------------|------------------------|--------------|------------|------------|------|------|--------------------------------------|---------------------------|
| | | | AIRFLOW, CFM | ESP. IN WG | VOLTAGE | AMPS | MOCP | | |
| ERV-1 | RESIDENTIAL UNIT | HORIZONTAL | PER PLANS | 0.4 | 120V/1P | 1.1 | 15 | 0.69 | ALDES E130-HF-N (4) |
| ERV-2 | RESIDENTIAL UNIT | HORIZONTAL | PER PLANS | 0.4 | 120V/1P | 1.1 | 15 | 0.69 | ALDES E130-HF-N-M (4) |

- NOTES:
- (1) INSTALL IN ACCORDANCE WITH MANUFACTURER'S INSTALLATION REQUIREMENTS.
 - (2) UNIT SHALL RUN CONTINUOUSLY.
 - (3) UNIT SHALL HAVE A MINIMUM MERV 8 FILTER.
 - (4) PROVIDE MANUFACTURER'S OPTIONAL WALL MOUNT SPEED CONTROLLER, PART NUMBER 611229. SPEED CONTROLLER SHALL BE MOUNTED NEXT TO THE LIGHT SWITCH FOR THE BATHROOM.

FAN SCHEDULE

| EQUIP NO. | SERVICE | TYPE | AIRFLOW, CFM | ESP. IN WG | ELECTRICAL | | OPERATION | WEIGHT, LBS | BASIS OF DESIGN (1) |
|-----------|--------------|-----------------|-----------------|------------|------------|-------|-----------|-------------|--------------------------|
| | | | | | VOLTAGE | HP | | | |
| BEF-1 | BATHROOM | CEILING MOUNTED | 50 | 0.25 | 115V/1P | FHP | (2) | 10 | PANASONIC FV-0511VQ1 (3) |
| TF-1 | TRANSFER FAN | IN WALL | 50 | 0.1 | 120V/1P | [4.4] | (5) | 8.82 | PANASONIC FV-0510V51 (4) |
| TF-2 | TRANSFER FAN | CEILING MOUNTED | 50 | 0.1 | 120V/1P | [4.4] | (5) | 8.82 | PANASONIC FV-0510V51 (4) |

- NOTES:
- (1) PROVIDE BACKDRAFT DAMPERS ON EXHAUST FANS.
 - (2) FAN SHALL BE ACTIVATED VIA WALL SWITCH.
 - (3) PROVIDE MANUFACTURER'S OPTIONAL CEILING RADIATION DAMPER.
 - (4) PROVIDE TRANSFER REGISTER BOX. BOD PANASONIC FV-JD
 - (5) FAN TO BE CONTROLLED BY WALL MOUNTED THERMOSTAT.

DIFFUSER SCHEDULE

| CALLOUT | DESCRIPTION | AIRFLOW RANGE, CFM | FACE SIZE, IN | BASIS OF DESIGN |
|---------|------------------------|--------------------|---------------|-----------------|
| HRG-1 | HARD LID RETURN GRILLE | 0-700 | 12X12 | TITUS 350ZRL |
| SSG-1 | SIDEWALL SUPPLY GRILLE | 0-150 | 10X4 | SHOEMAKER 950 |
| HSM-1 | HARD LID SUPPLY GRILLE | 0-150 | 10X4 | SHOEMAKER 950 |

ELECTRIC HEATERS

| EQUIP NO. | SERVICE | MOUNTING/ DISCHARGE | HEATING | | ELECTRICAL | | BASIS OF DESIGN (3) |
|-----------|-----------|------------------------|---------|---------|------------|--|---------------------|
| | | | KW | VOLTAGE | VOLTAGE | | |
| EWH-0.5 | PER PLANS | WALL | 0.5 | 208V/1P | 208V/1P | | (1)(2) |
| EWH-0.75 | PER PLANS | WALL | 0.75 | 208V/1P | 208V/1P | | (1)(2) |
| EWH-1.0 | PER PLANS | WALL | 1.0 | 208V/1P | 208V/1P | | (1)(2) |
| EWH-1.5 | PER PLANS | WALL | 1.5 | 208V/1P | 208V/1P | | (1)(2) |
| EWH-2.0 | PER PLANS | WALL | 2.0 | 208V/1P | 208V/1P | | (1)(2) |

- NOTES: (1) BROAN, KING, CADET OR EQUIVALENT.
 (2) PROVIDE INTEGRAL THERMOSTAT.
 (3) ALL ELECTRIC HEATERS TO BE FURNISHED AND INSTALLED BY ELECTRICAL CONTRACTOR.

SPLIT SYSTEM HEAT PUMP SCHEDULE - INDOOR UNIT

| EQUIP NO. | SERVICE | MOUNTING/ DISCHARGE | FAN | | ELECTRICAL | | | BASIS OF DESIGN (1)(2)(4) | CONNECTED OUTDOOR UNIT |
|-----------|-----------|------------------------|-----------------|------------|------------|-----|------|------------------------------|---------------------------|
| | | | AIRFLOW, CFM | ESP. IN WG | VOLTAGE | MCA | MOCP | | |
| FCU-X | RES. UNIT | HIGH WALL | 716 | N/A | (3) | (3) | (3) | DAIKIN FTXB18BXVJU | HP-1 |


- NOTES:
- (1) INSTALL IN ACCORDANCE WITH MANUFACTURER'S INSTALLATION REQUIREMENTS.
 - (2) PROVIDE MANUFACTURER'S OPTIONAL CONDENSATE PUMP WITH RESERVOIR AND SENSOR.
 - (3) INDOOR UNIT POWERED FROM OUTDOOR UNIT.
 - (4) "X" DENOTES THE UNIT BEING SERVED.

SPLIT SYSTEM HEAT PUMP SCHEDULE - OUTDOOR UNIT

| EQUIP NO. | SERVICE | CAPACITY, TONS | TOTAL COOLING CAPACITY, BTUH | SEER | TOTAL HEATING CAPACITY, BTUH | HSPF | ELECTRICAL | | | DIMENSIONS, INCHES | | | WEIGHT, LBS | BASIS OF DESIGN (1)(2)(3)(4)(5)(6) | CONNECTED FAN COIL UNIT |
|-----------|-----------|-------------------|---------------------------------|------|---------------------------------|------|------------|-------|------|----------------------------------|--------------------------------|--------------------------------|----------------|---------------------------------------|----------------------------|
| | | | | | | | VOLTAGE | MCA | MOCP | H | W | D | | | |
| HP-1 | RES. UNIT | 1.5 | 18,000 | 18.8 | 17,900 | 10.0 | 208V/1P | 16.55 | 20 | 27 ¹¹ / ₁₆ | 36 ⁷ / ₈ | 13 ¹ / ₂ | 97 | DAIKIN RXB18BXVJU | FCU-1 |

- NOTES:
- (1) INSTALL IN ACCORDANCE WITH MANUFACTURER'S INSTALLATION REQUIREMENTS.
 - (2) ARI LISTED WITH ALL STANDARD FEATURES. INSTALLATION ACCESSORIES AND COMPRESSOR SHORT CYCLING PROTECTION, FILTER DRIVER, REFRIGERANT LINE FILTER, LIQUID SOLENOID VALVE, AND SAFETY PRESSURE SWITCHES. INSTALL REFRIGERANT TUBING AND LENGTH IN STRICT ACCORDANCE WITH MANUFACTURER'S RECOMMENDATIONS.
 - (3) PROVIDE ALL REQUIRED ACCESSORIES FOR LOW-AMBIENT.
 - (4) ROUTING OF REFRIGERANT LINES FROM INDOOR TO OUTDOOR UNITS NOT SHOWN ON PLANS. CONTRACTOR TO FIELD COORDINATE ROUTING.
 - (5) REFRIGERANT SHALL BE R-410A.
 - (6) "X" DENOTES THE UNIT BEING SERVED.

| NO. | DATE | DESCRIPTION |
|-----|------|-------------|
| | | |
| | | |
| | | |

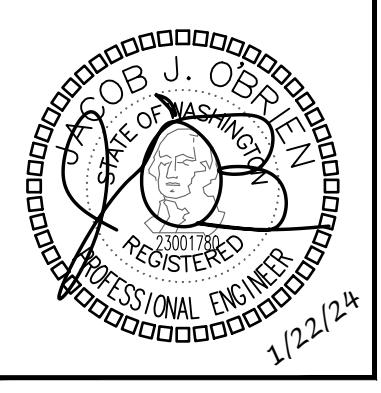

| | | | |
|-----------|---------------|-------------|---------------|
| DRAWN: OP | DESIGNED: ABE | CHECKED: PR | APPROVED: JMR |
|-----------|---------------|-------------|---------------|

PROJECT: EAST TOWN CROSSING BUILDING B
 MULTIFAMILY DEVELOPMENT
 PIONEER WAY & SHAW RD. PUYALLUP, WA

19401 40TH AVE W, SUITE 302
 LYNNWOOD, WA 98036
 PHONE: (206) 364-3343
 RE: PROJECT NO.: 810010
 CONTACT: ARK/ESP/INELI

DATE:
1/22/2024

SHEET TITLE:
MECHANICAL
SCHEDULES

SHEET NO.
M0.3

WSEC FORMS

2/26/24, 3:00 PM waenergycodes.com/print_project_summary_form.php?k=aWQ9MjMyNDAmZnZpPTE3JmN0aT00Ng==&print=1

| System/Equip ID | Area(s) Served | Location In Project Documents - Plan/Detail # |
|---|----------------------|---|
| HP-1 | APARTMENT UNITS M0.3 | M0.3 |
| System/Equip ID for a single or multiple items? Multiple items w/ identical heating & cooling capacity | | |
| Heating Section/Auxiliary Heating Type: Electric resistance (or None) | | |
| Air-side economizer exception applied: Exp 5(2) - Group R cooling units ≥ 20,000 < 54,000 Btu/h (Note equip location limitations) | | |
| Proposed Low OSA Temp Efficiency: | | |
| WSEC Equip Efficiency Reference Table - Heating: Table C403.3.2(2) - Unitary and Applied Heat Pumps | | |
| Economizer Compliance Method: Applying air-side economizer exception | | |
| WSEC Equip Efficiency Reference Table - Cooling: Table C403.3.2(2) - Unitary and Applied Heat Pumps | | |
| LTI Units: COP | | |

2/26/24, 2:59 PM waenergycodes.com/print_project_summary_form.php?k=aWQ9MjMyNDAmZnZpPTE3JmN0aT00Ng==&print=1

| MECHANICAL COMPLIANCE SUMMARY | | | |
|--|--|---|--|
| 2018 WSEC Compliance Forms for Commercial Buildings including Group R2, R3 & R4 over 3 stories and all R1 | | | |
| Project Title | | East Town Crossing Building B - 2018 WSEC | |
| Project Address | | Pioneer & Shaw Puyallup, WA 98372 | |
| Applicant Name | | Ark Espineli | |
| Applicant Phone | | 206-364-3343 | |
| Applicant Email | | aespineli@robisonengineering.com | |
| For questions about this report, contact WSEC Commercial Technical Support at 360-539-5300 or via email at com.techsupport@waenergycodes.com | | | |
| General Occupancy | | All Group R - R2, R3 & R4 over 3 stories and all R1 | |
| General Building Use Type | | Multifamily/Residential | |
| Building Cond. Floor Area | | 27,753 | |
| Project Cond. Floor Area | | 27,753 | |
| Floors Above Grade | | 3 | |
| Compliance Method | | Compliance Method 1 - General | |

| General Project Types | New Building | New Building or Addition Mechanical Scope | Single Zone Systems & Equipment | Alteration Mechanical Scope | Building Cond. Floor Area | Project Cond. Floor Area | Floors Above Grade | Compliance Method |
|-----------------------|--------------|---|---------------------------------|-----------------------------|---------------------------|--------------------------|--------------------|-------------------------------|
| | | | | | 27,753 | 27,753 | 3 | Compliance Method 1 - General |

| Mechanical Compliance Scope and Method | Project Type | Mechanical Scope | Economizer Exception(s) Applied? | DOAS Ventilation Provided? | Higher Equipment Efficiency Option Applied? | Equipment Efficiency Compliance Verification |
|--|--------------|---------------------------------|----------------------------------|----------------------------|---|--|
| | New Building | Single Zone Systems & Equipment | Yes | Yes | Yes | COMPLIES |

| Additional Efficiency Credits Included (AEC) | Higher equipment efficiency and fan FEG | Does project include DOAS equipment? | Yes |
|---|---|--|-----|
| Does building include occupancy classifications requiring DOAS? | No | Does project include DOAS equipment? | Yes |
| Based on project scope do TSPR requirements apply? | No | Do all systems comply with Appendix D standard reference design or qualify for an exception to TSPR? | No |

| Scope & Space Conditioning | NEW BUILDING - SINGLE ZONE SYSTEMS & EQUIPMENT | Compliance Verification | COMPLIES |
|--|--|-------------------------|----------|
| Single Zone Air Systems Category - Heat pump, unitary, thru-wall, SDHV | | | |


| System/Equip ID | Quantity of Items | Supply Airflow Control | Ventilation Standard | Ventilation CFM (Total if Multiple Items) | Ventilation Air Source | Paired with DOAS | Ventilation energy recovery | Energy Recovery Efficiency (%) |
|-----------------|-------------------|------------------------|----------------------|---|------------------------|------------------|-----------------------------|--------------------------------|
| HP-1 | 36 | Constant volume | IMC Ventilation | | Other System | | Provided but not required | 69 |

| System/Equip ID | Cooling System/Equip Type | Specific Type | Cooling Capacity per Item (Btu/h) | AEC Efficiency Multiplier | Econo Exception Multiplier (E1 & PL) | Combined Efficiency Multiplier (AEC & Econo) | Proposed Cooling Efficiency | CE Units | Proposed Part Load Efficiency | PL Units | Efficiency Compliance Verification |
|-----------------|---------------------------|---------------|-----------------------------------|---------------------------|--------------------------------------|--|-----------------------------|----------|-------------------------------|----------|------------------------------------|
| HP-1 | Heat pump, air cooled | Split system | 18,000 | 1.15 | 1.15 | 1.3225 | 18.8 | SEER | | HEER | COMP_EES |

| System/Equip ID | Heating System/Equip Type | Specific Type | Heat Pump Heating Capacity (Btu/h) | Cooling Capacity (Btu/h) | AEC Efficiency Multiplier | Proposed Heat Pump Heating Efficiency | HSPF Units | Proposed Low OSA Temp Efficiency | LTH Units | Efficiency Compliance Verification |
|-----------------|--------------------------------|---------------|------------------------------------|--------------------------|---------------------------|---------------------------------------|------------|----------------------------------|-----------|------------------------------------|
| HP-1 | Heat pump, air cooled, heating | Split system | 17,900 | 18,000 | 1.15 | 10.0 | HSPF | | COP | COMPLIES |

| Air Systems & Equipment Details | | | | | | | | | | | |
|---------------------------------|--|--|--|--|--|--|--|--|--|--|--|
|---------------------------------|--|--|--|--|--|--|--|--|--|--|--|

| NO. | DATE | DESCRIPTION |
|-----|------|-------------|
| | | |
| | | |
| | | |

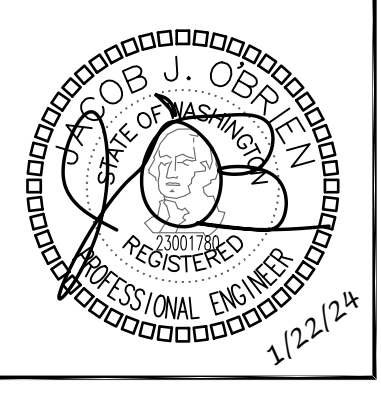

| | |
|-----------|-----|
| DRAWN: | OP |
| DESIGNED: | ABE |
| CHECKED: | PR |
| APPROVED: | JMR |


PROJECT: EAST TOWN CROSSING BUILDING B
MULTIFAMILY DEVELOPMENT
PIONEER WAY & SHAW RD. PUYALLUP, WA

19401 40TH AVE W, SUITE 302
LYNNWOOD, WA 98036
PHONE: (206) 364-3343
REI PROJECT NO.: 810010
CONTACT: ARK.ESPINELI

DATE:
1/22/2024

SHEET TITLE:
WSEC FORMS

SHEET NO.
M0.4

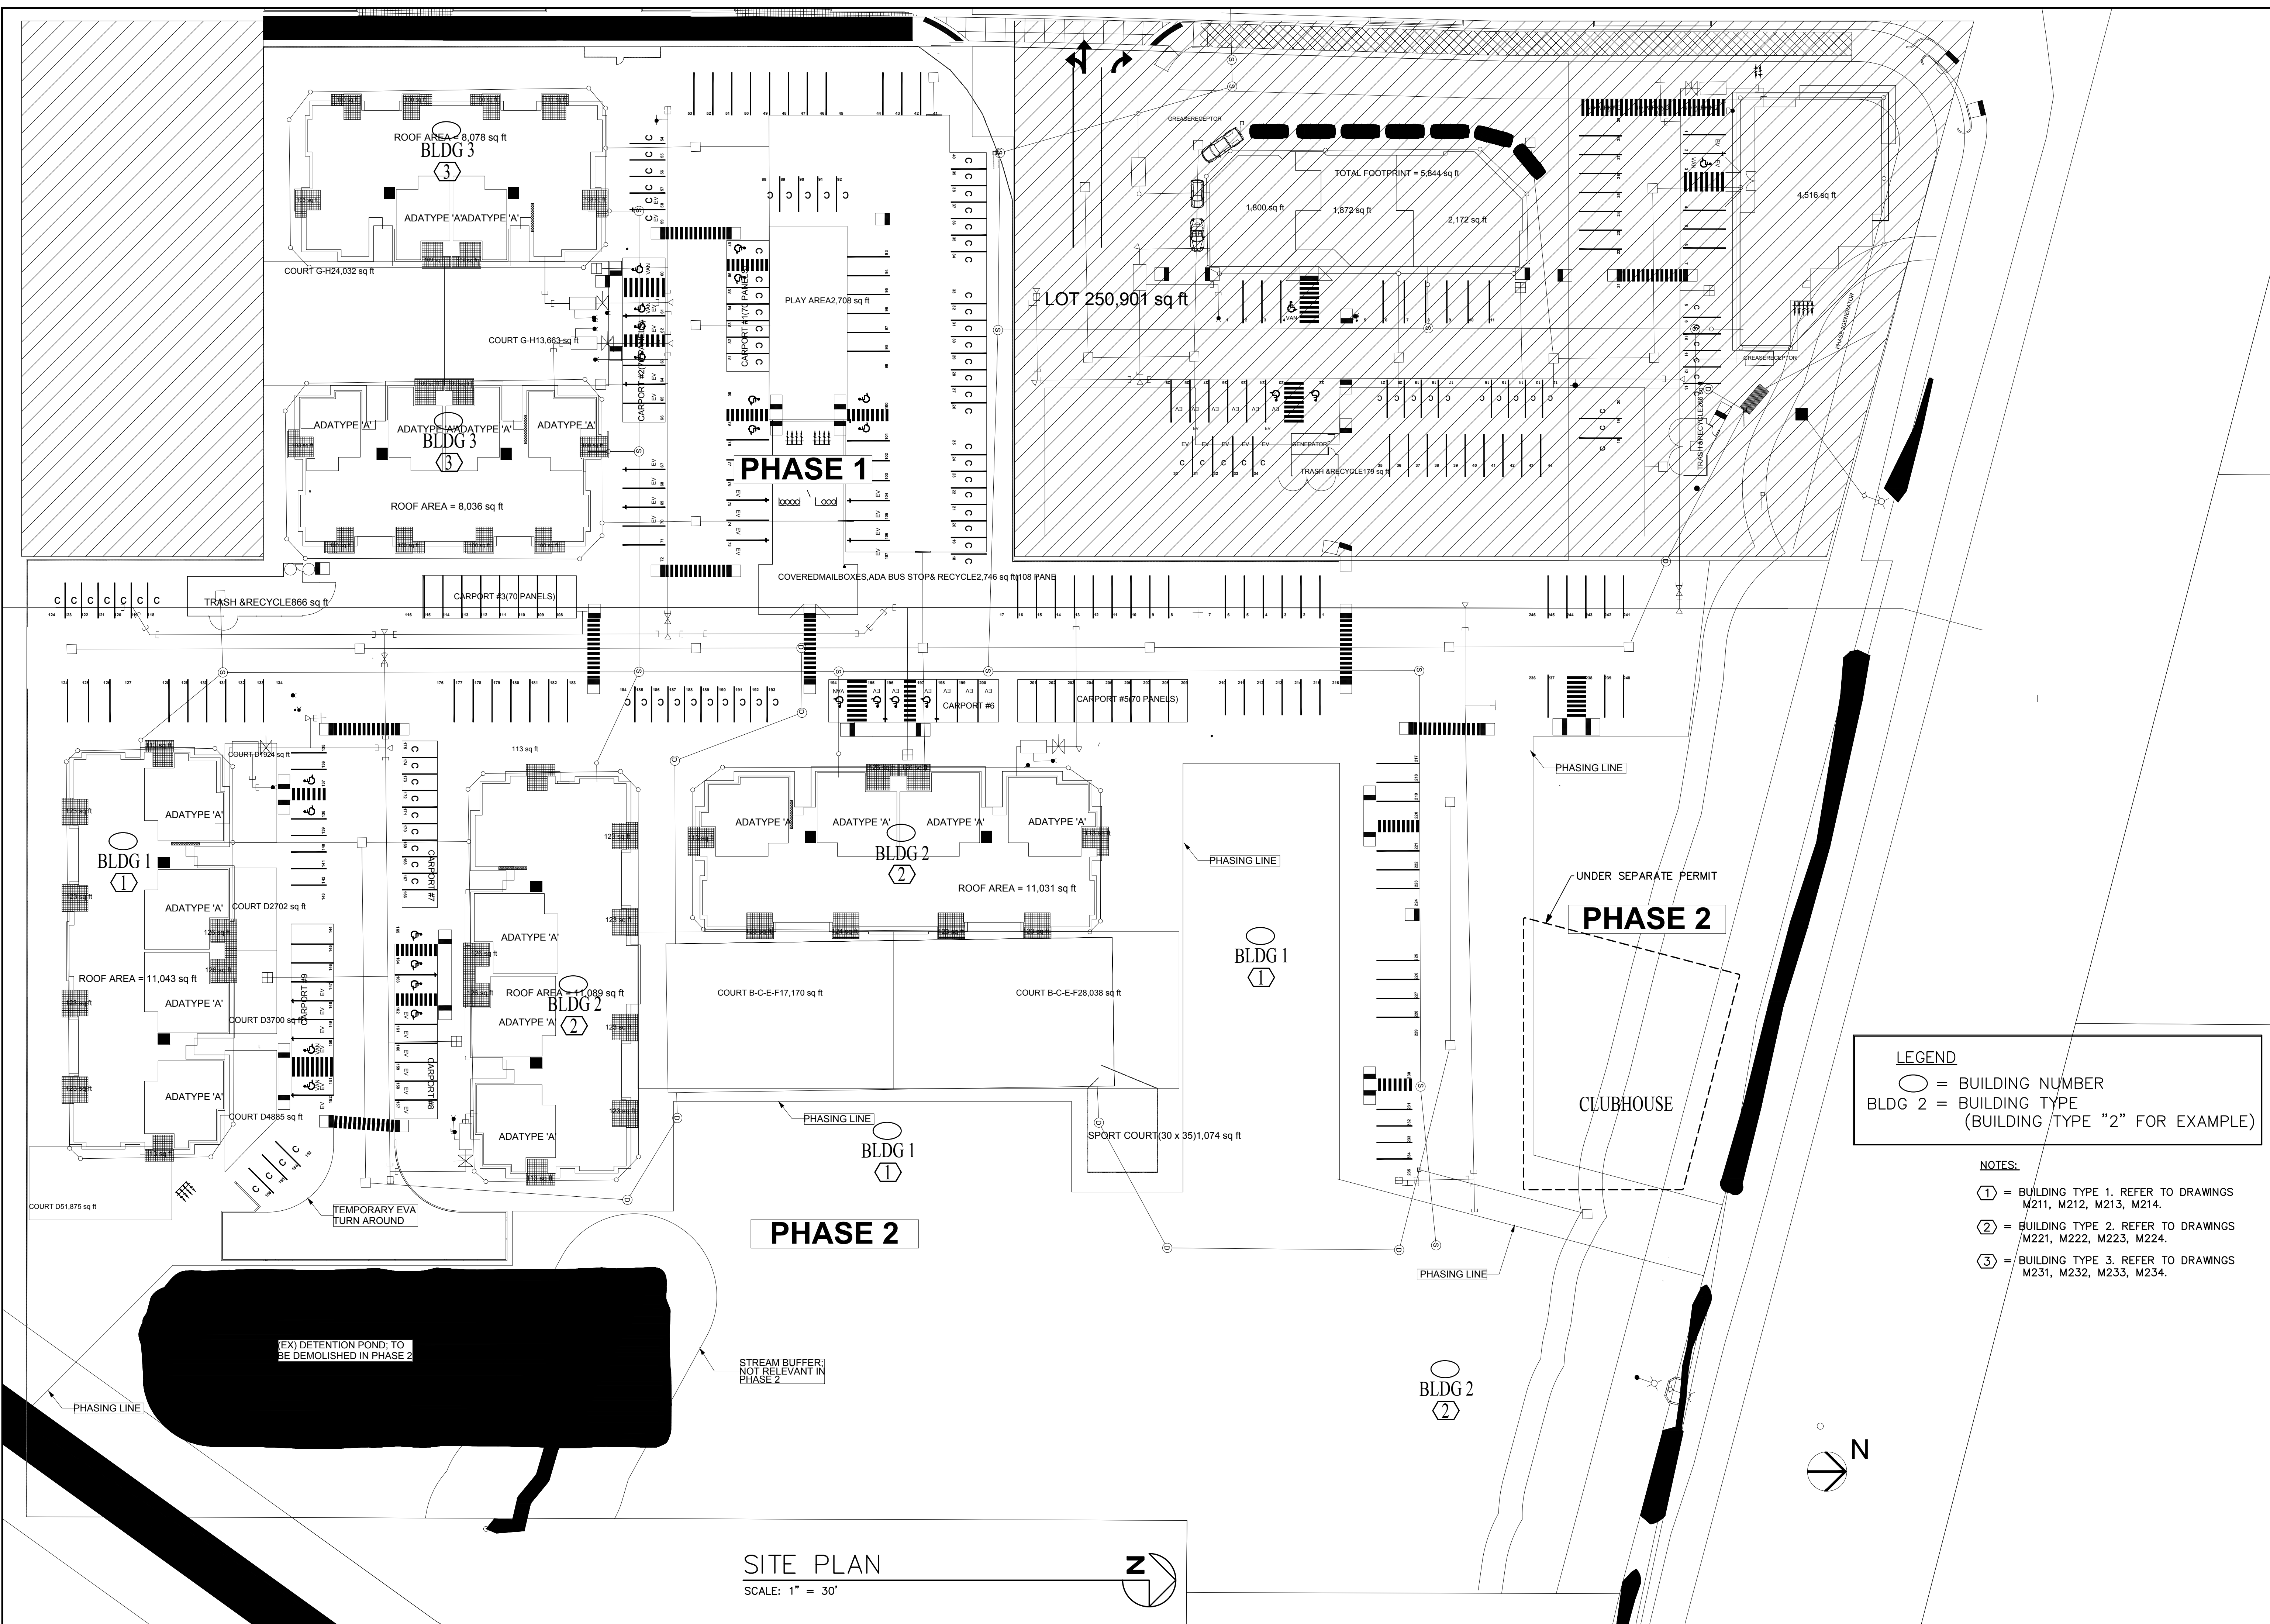

PHASE 2


PHASE 2

LEGEND
 ○ = BUILDING NUMBER
 BLDG 2 = BUILDING TYPE
 (BUILDING TYPE "2" FOR EXAMPLE)

NOTES:
 ① = BUILDING TYPE 1. REFER TO DRAWINGS M211, M212, M213, M214.
 ② = BUILDING TYPE 2. REFER TO DRAWINGS M221, M222, M223, M224.
 ③ = BUILDING TYPE 3. REFER TO DRAWINGS M231, M232, M233, M234.

SITE PLAN
 SCALE: 1" = 30'

| NO. | DATE | DESCRIPTION |
|-----|------|-------------|
| | | |
| | | |
| | | |

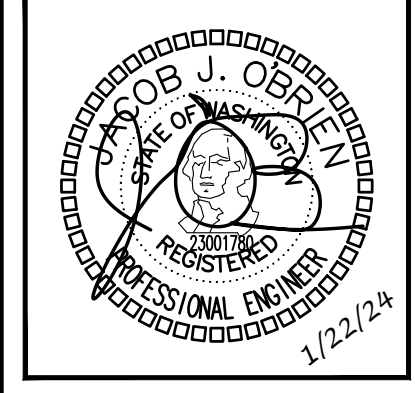

| | |
|---------------|---------------|
| DRAWN: OP | CHECKED: JMR |
| DESIGNED: ABE | APPROVED: JMR |


PROJECT: EAST TOWN CROSSING BUILDING B
 MULTIFAMILY DEVELOPMENT
 PIONEER WAY & SHAW RD. PUYALLUP, WA

CONTACT: ARK(ESPINEL)

DATE: 1/22/2024

SHEET TITLE: SITE PLAN

SHEET NO. M1.0

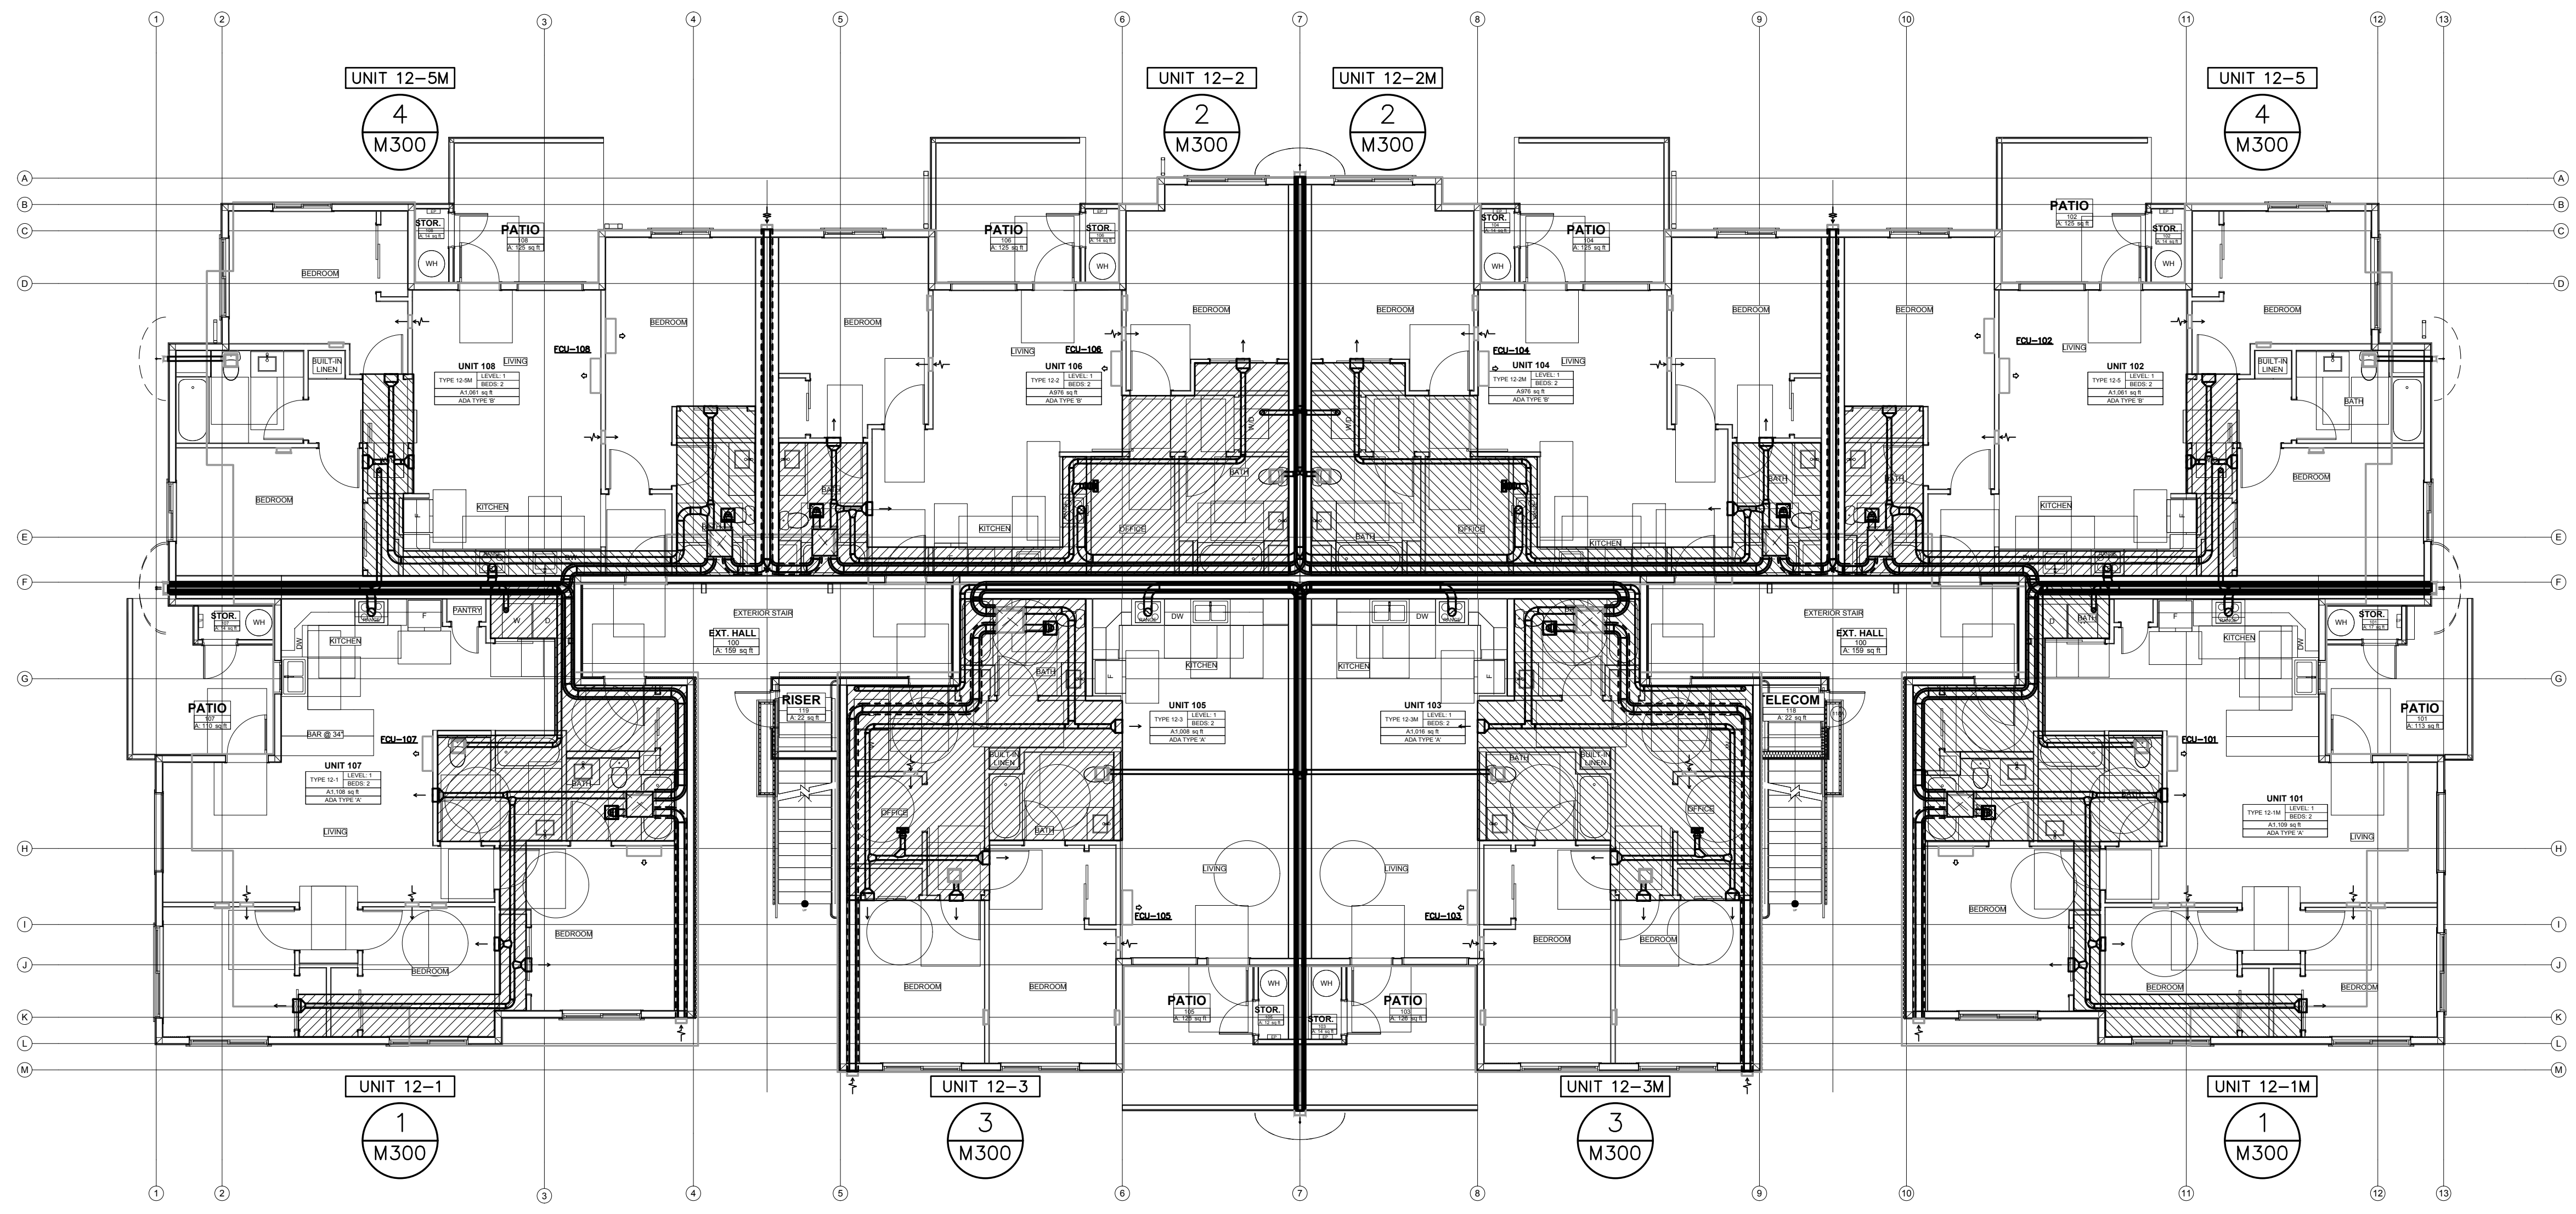



RESIDENTIAL UNIT NOTES:

UNIT A = UNIT TYPE A (FOR EXAMPLE)
 REFER TO DWG M300,
 DETAIL 1.

FOR DUCT SIZES WITHIN THE RESIDENTIAL
 UNITS, REFER TO THE ENLARGED UNIT
 PLANS ON DWGS M300-M303.

BUILDING TYPE 1
 LEVEL 1 FLOOR PLAN
 SCALE: 1/8" = 1'-0"

| NO. | DATE | REVISIONS DESCRIPTION |
|-----|------|-----------------------|
| | | |
| | | |
| | | |

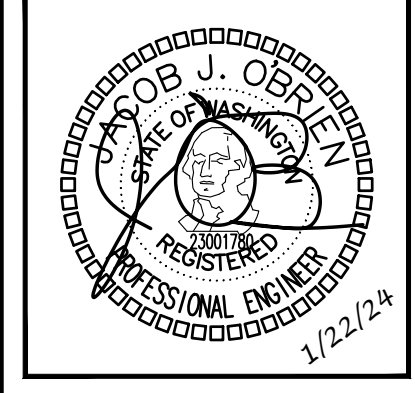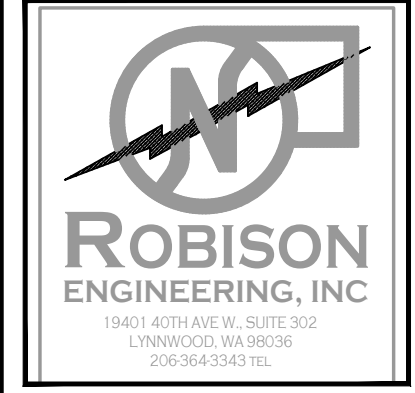

| | |
|-----------|-----|
| DRAWN: | OP |
| DESIGNED: | ABE |
| CHECKED: | PR |
| APPROVED: | JMR |


PROJECT: EAST TOWN CROSSING BUILDING B
 MULTIFAMILY DEVELOPMENT
 PIONEER WAY & SHAW RD. PUYALLUP, WA

19401 40TH AVE W, SUITE 302
 LYNNWOOD, WA 98036
 PHONE: (206) 364-3343
 RE: PROJECT NO. 810010
 CONTACT: ARK ESPINELLI

DATE:
 1/22/2024

SHEET TITLE:
 HVAC PLAN -
 LEVEL 1

SHEET NO.
M2.0

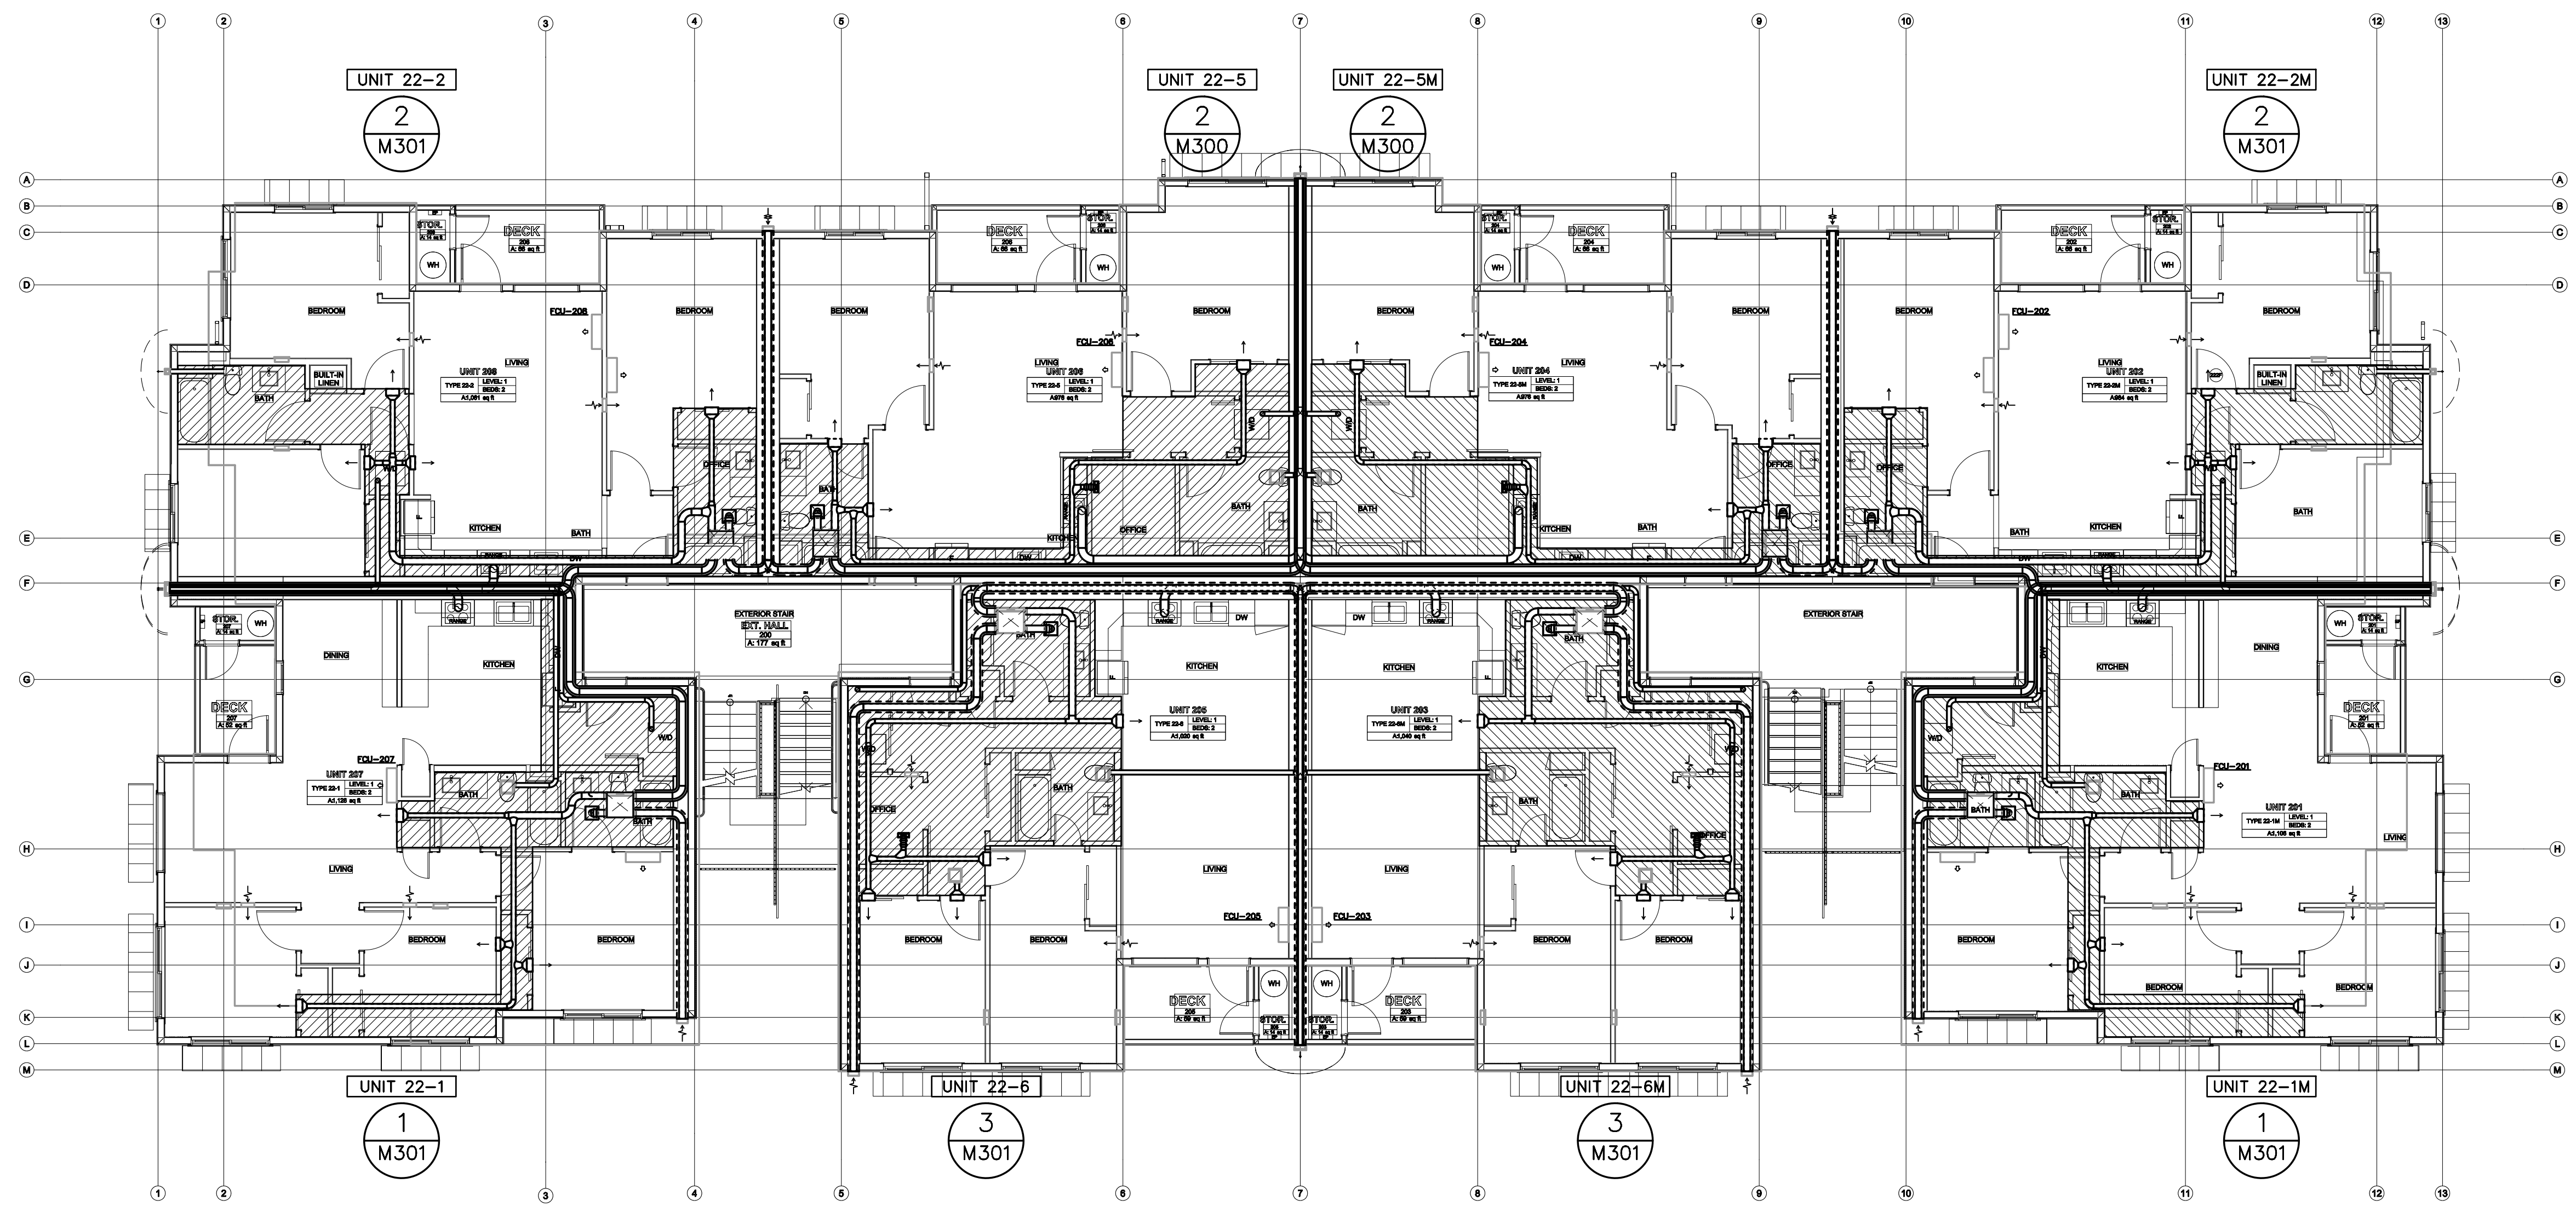


RESIDENTIAL UNIT NOTES:

UNIT A = UNIT TYPE A (FOR EXAMPLE)
 REFER TO DWG M300,
 DETAIL 1.

FOR DUCT SIZES WITHIN THE RESIDENTIAL
 UNITS, REFER TO THE ENLARGED UNIT
 PLANS ON DWGS M300-M303.

BUILDING TYPE 1
 LEVEL 2 FLOOR PLAN
 SCALE: 1/8" = 1'-0"

| NO. | DATE | REVISIONS DESCRIPTION |
|-----|------|-----------------------|
| | | |
| | | |
| | | |

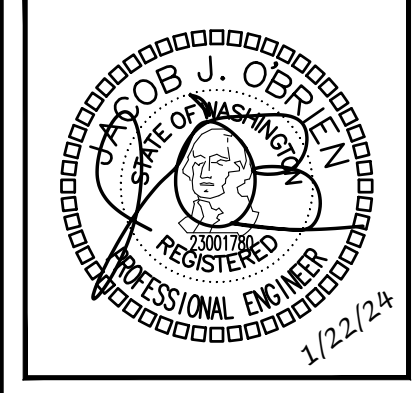

| | | | |
|-----------|---------------|-------------|---------------|
| DRAWN: OP | DESIGNED: ABE | CHECKED: PR | APPROVED: JMR |
|-----------|---------------|-------------|---------------|


PROJECT: EAST TOWN CROSSING BUILDING B
 MULTIFAMILY DEVELOPMENT
 PIONEER WAY & SHAW RD. PUYALLUP, WA

19401 40TH AVE W, SUITE 302
 LYNNWOOD, WA 98036
 PHONE: (206) 964-3343
 RE: PROJECT NO. 810010
 CONTACT: ARK@ESPINELI.COM

DATE:
1/22/2024

SHEET TITLE:
HVAC PLANS -
LEVEL 2

SHEET NO.
M2.1

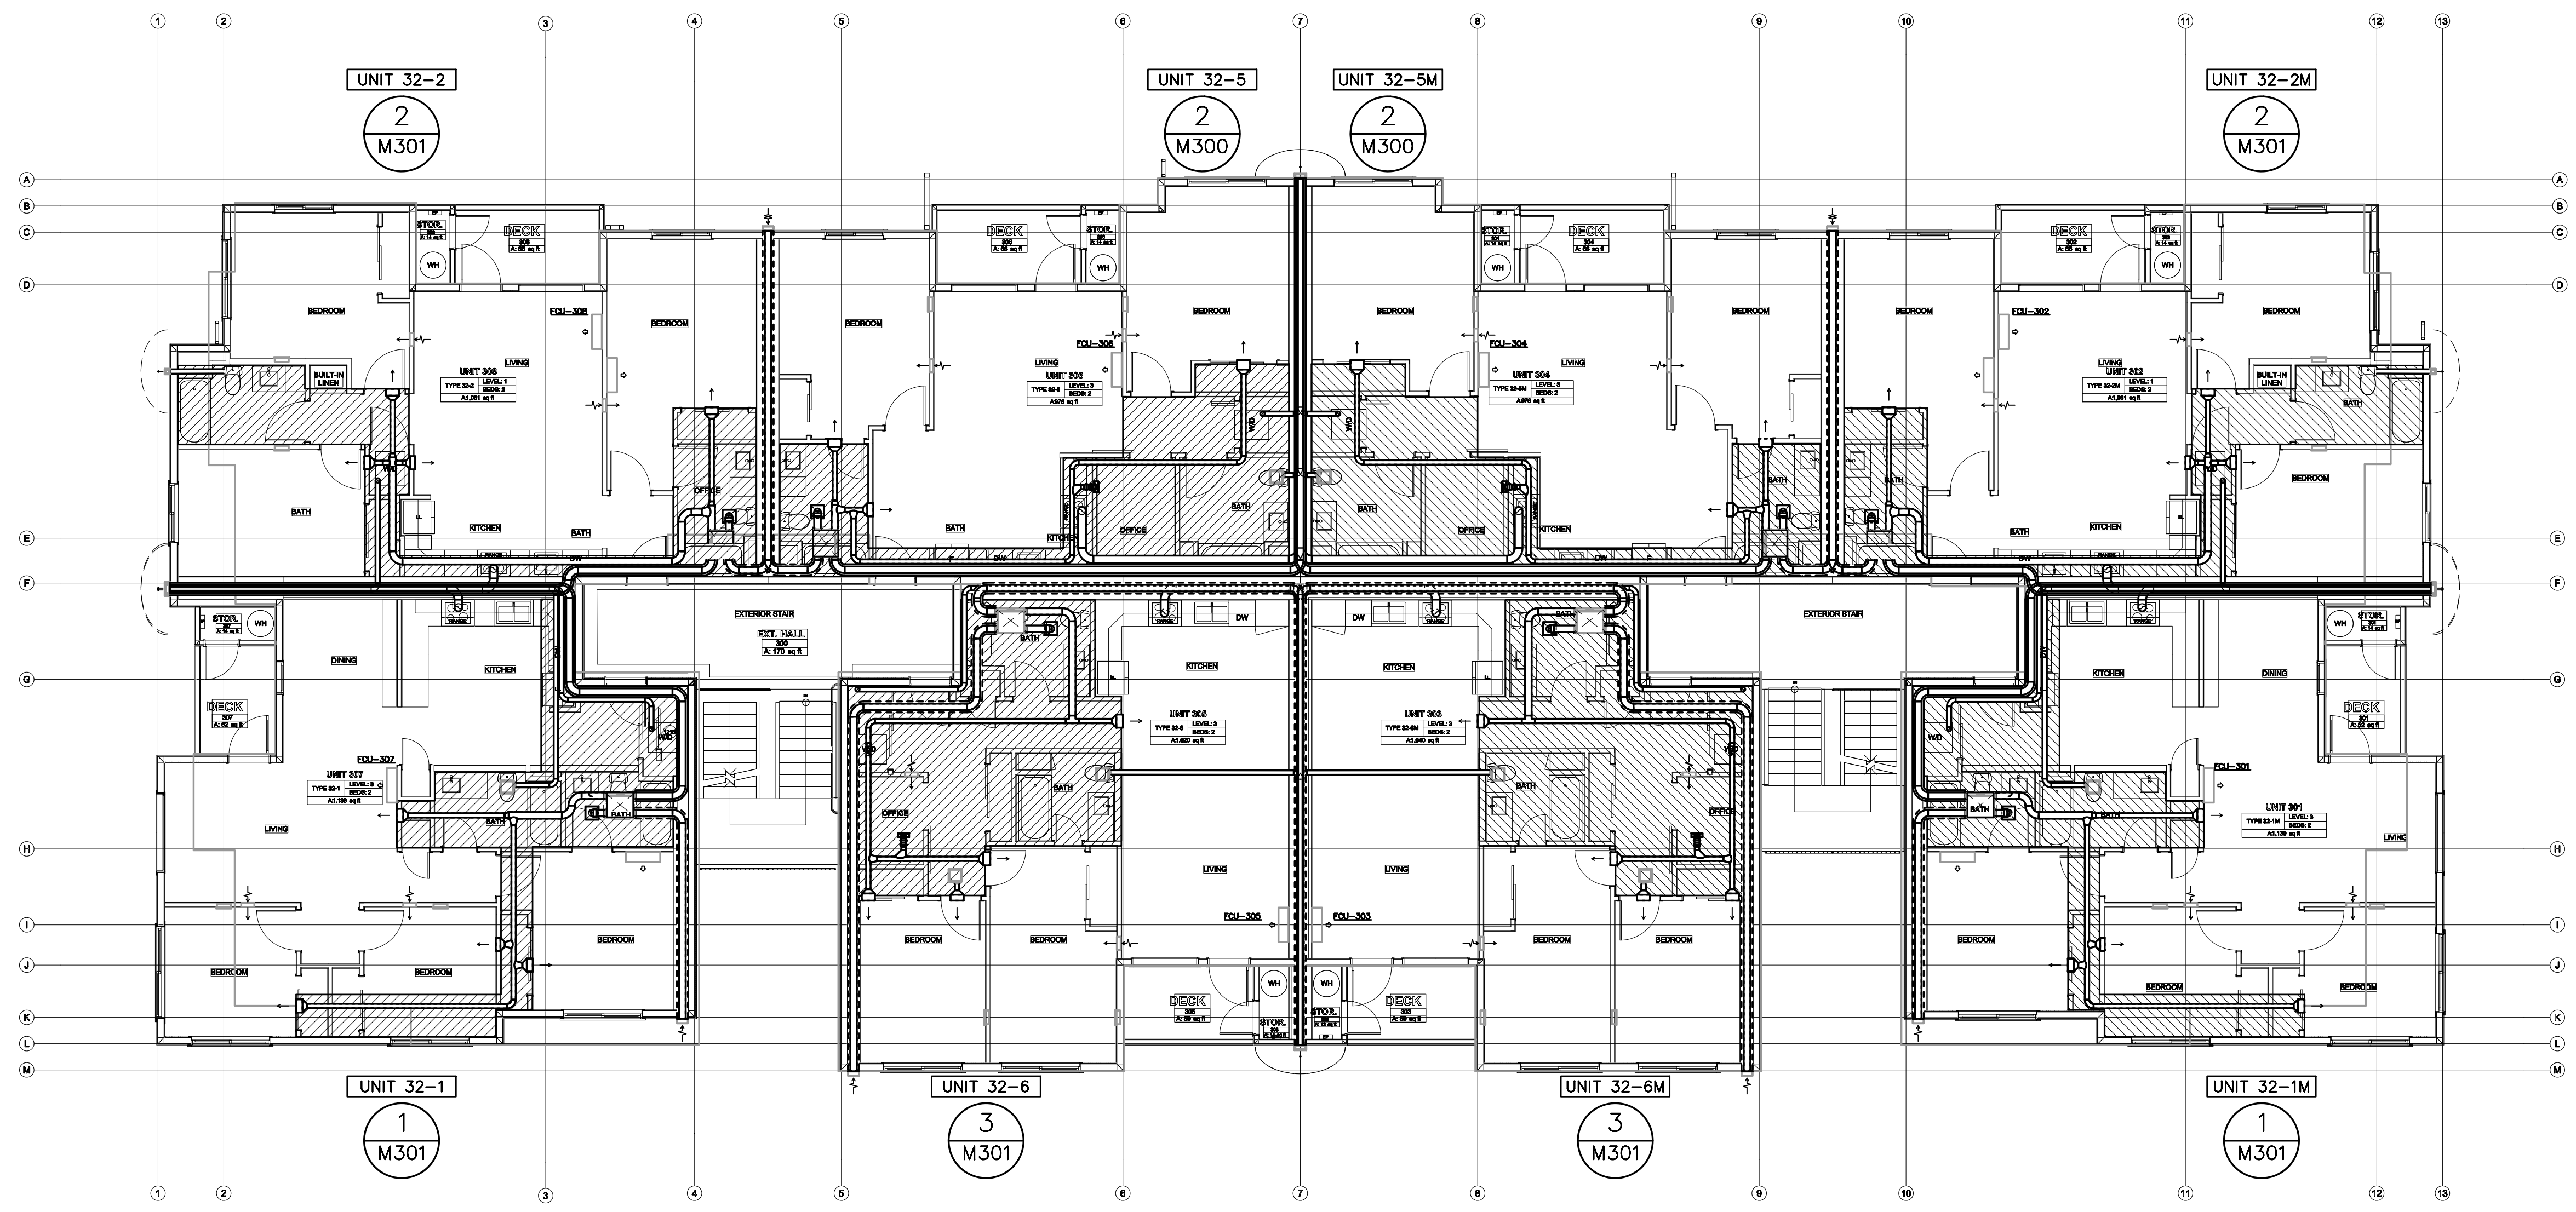



RESIDENTIAL UNIT NOTES:

UNIT A = UNIT TYPE A (FOR EXAMPLE)
 REFER TO DWG M300,
 DETAIL 1.

FOR DUCT SIZES WITHIN THE RESIDENTIAL
 UNITS, REFER TO THE ENLARGED UNIT
 PLANS ON DWGS M300-M303.

BUILDING TYPE 1
 LEVEL 3 FLOOR PLAN
 SCALE: 1/8" = 1'-0"

| NO. | DATE | DESCRIPTION |
|-----|------|-------------|
| | | |
| | | |
| | | |

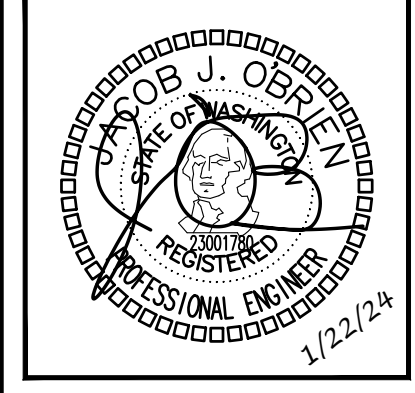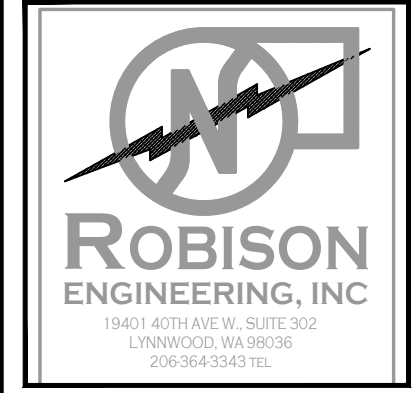

| | | | |
|-----------|---------------|-------------|---------------|
| DRAWN: OP | DESIGNED: ABE | CHECKED: PR | APPROVED: JMR |
|-----------|---------------|-------------|---------------|


PROJECT: EAST TOWN CROSSING BUILDING B
 MULTIFAMILY DEVELOPMENT
 PIONEER WAY & SHAW RD. PUYALLUP, WA

19401 40TH AVE W. SUITE 302
 LYNNWOOD, WA 98036
 PHONE: (206) 964-3343
 RE: PROJECT NO. 810010
 CONTACT: ARK.ESPINELLI



DATE:
 1/22/2024

SHEET TITLE:
 HVAC PLANS -
 LEVEL 3

SHEET NO.
M2.2

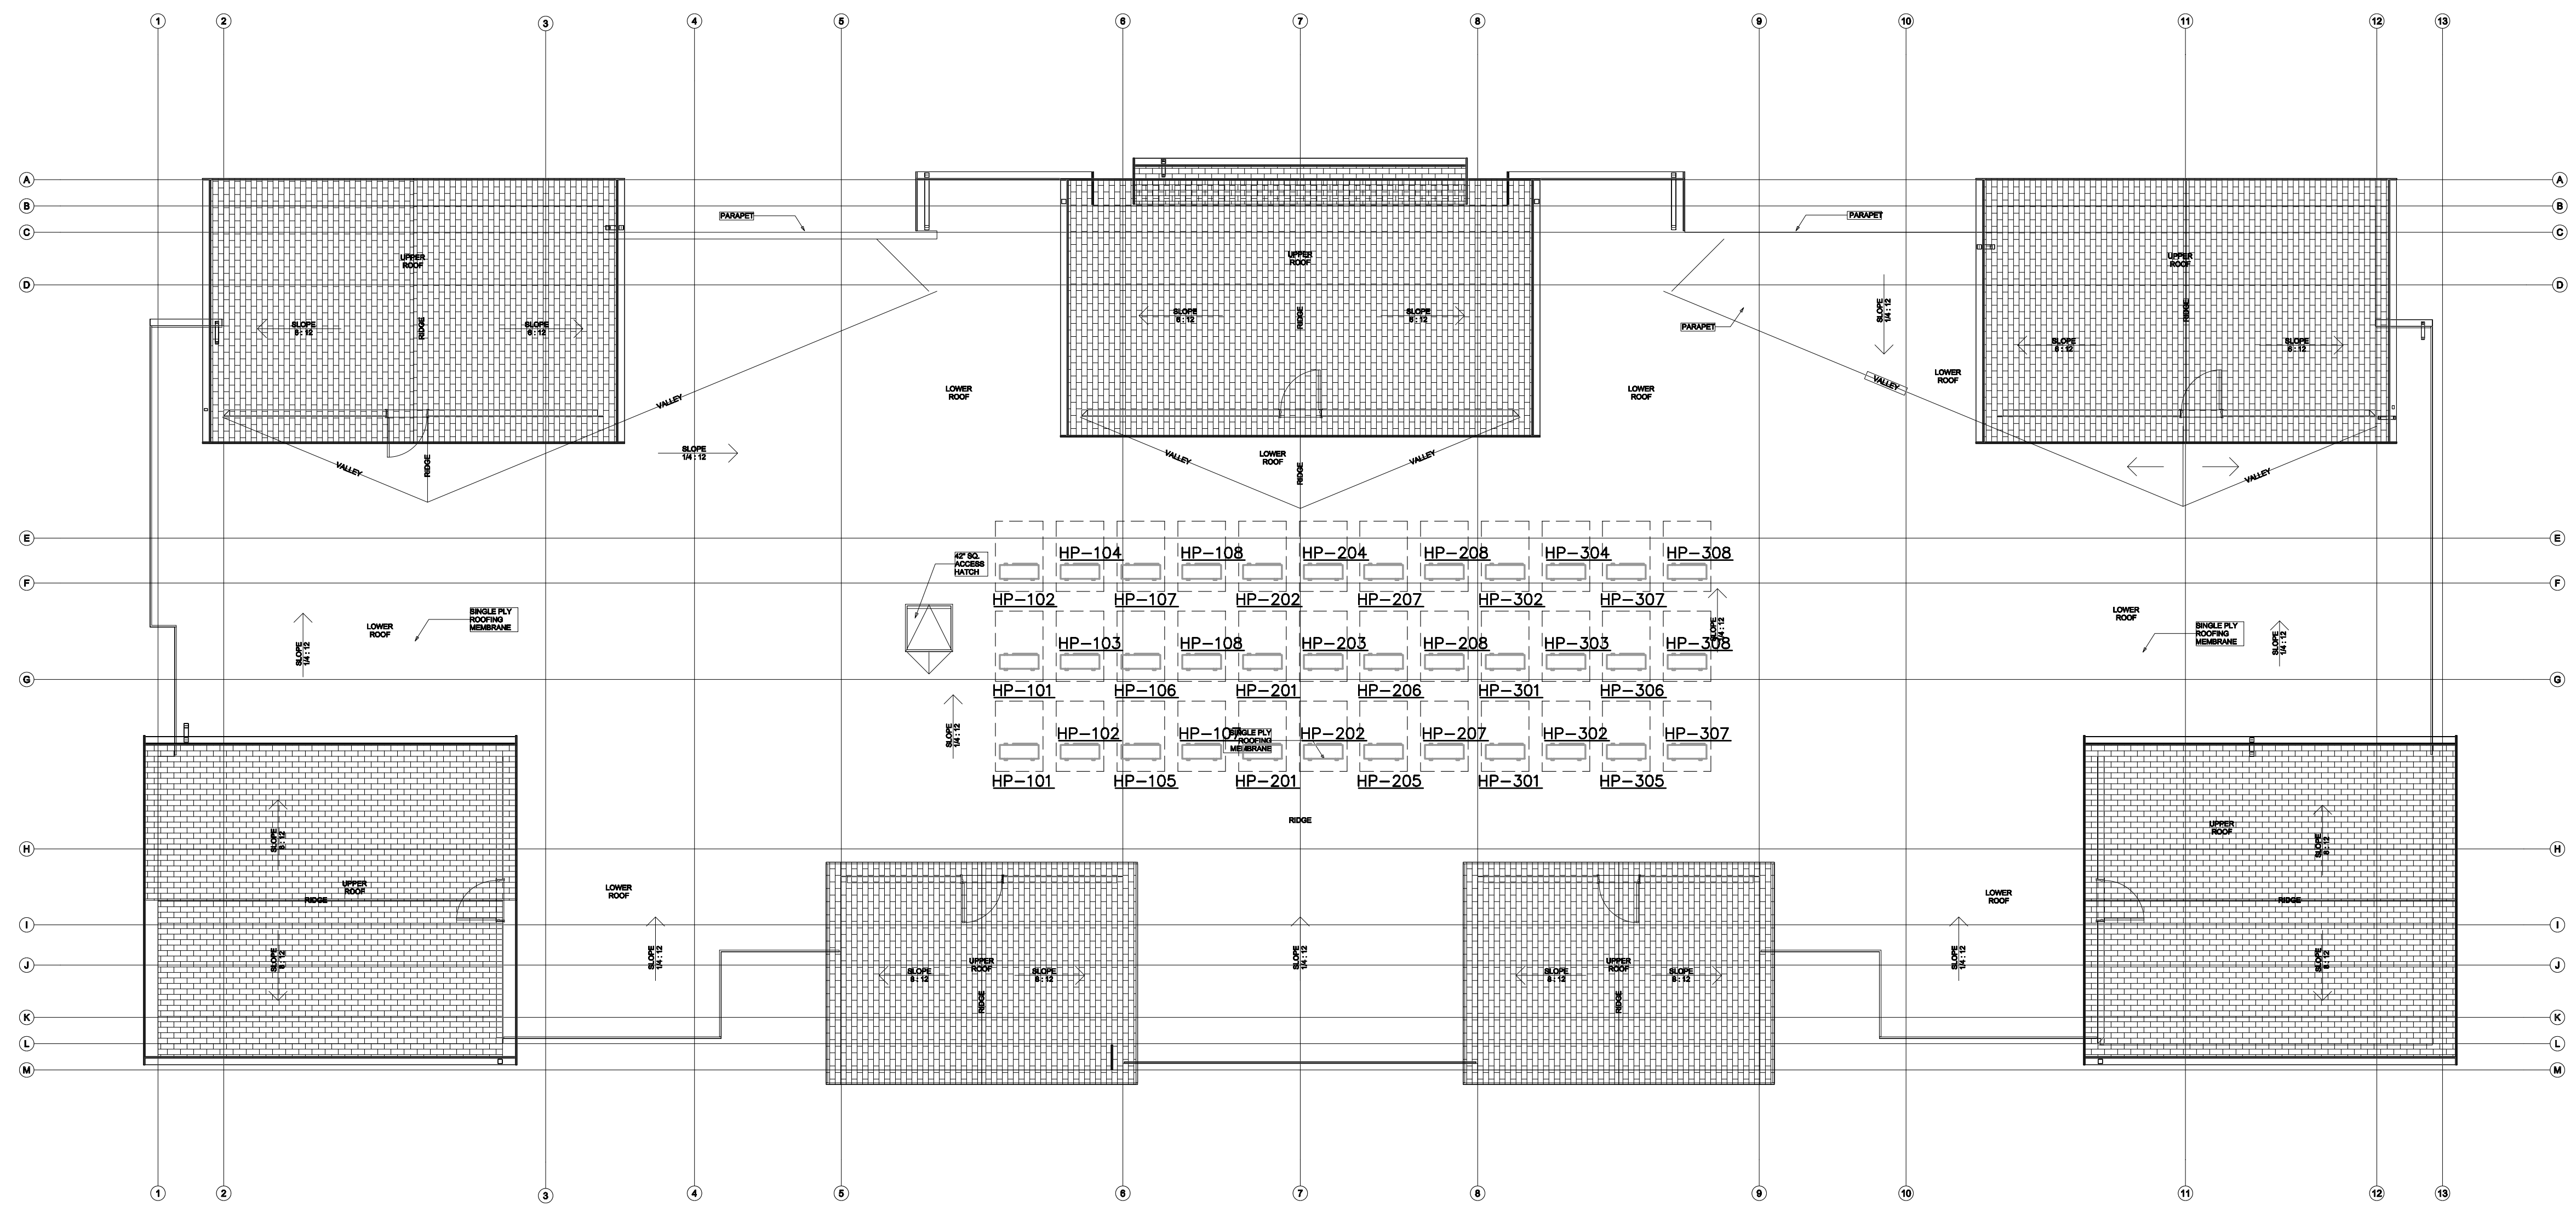

| NO. | DATE | DESCRIPTION |
|-----|------|-------------|
| | | |
| | | |
| | | |
| | | |

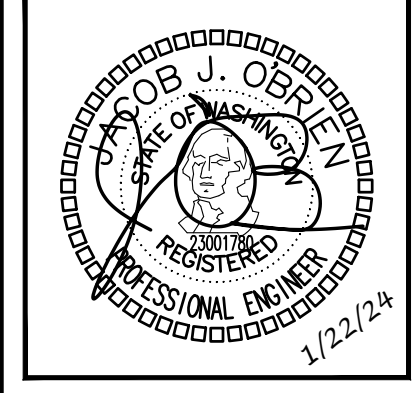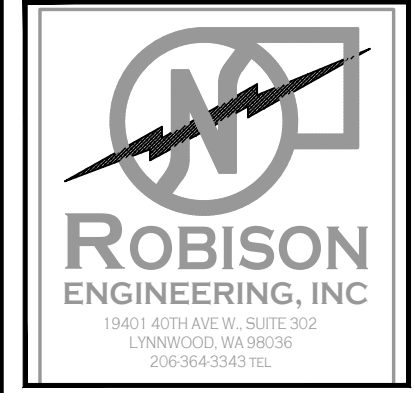

| | |
|-----------|-----|
| DRAWN: | OP |
| DESIGNED: | ABE |
| CHECKED: | PR |
| APPROVED: | JMR |

PROJECT: EAST TOWN CROSSING BUILDING B
 MULTIFAMILY DEVELOPMENT
 PIONEER WAY & SHAW RD. PUYALLUP, WA


19401 40TH AVE W, SUITE 302
 LYNNWOOD, WA 98036
 PHONE: (206) 964-3343
 RE: PROJECT NO. 810010
 CONTACT: ARK@ESPINELI.COM

DATE:
1/22/2024

SHEET TITLE:
HVAC PLANS -
ROOF

SHEET NO.
M2.3


BUILDING TYPE 1
 ROOF
 SCALE: 1/8" = 1'-0"

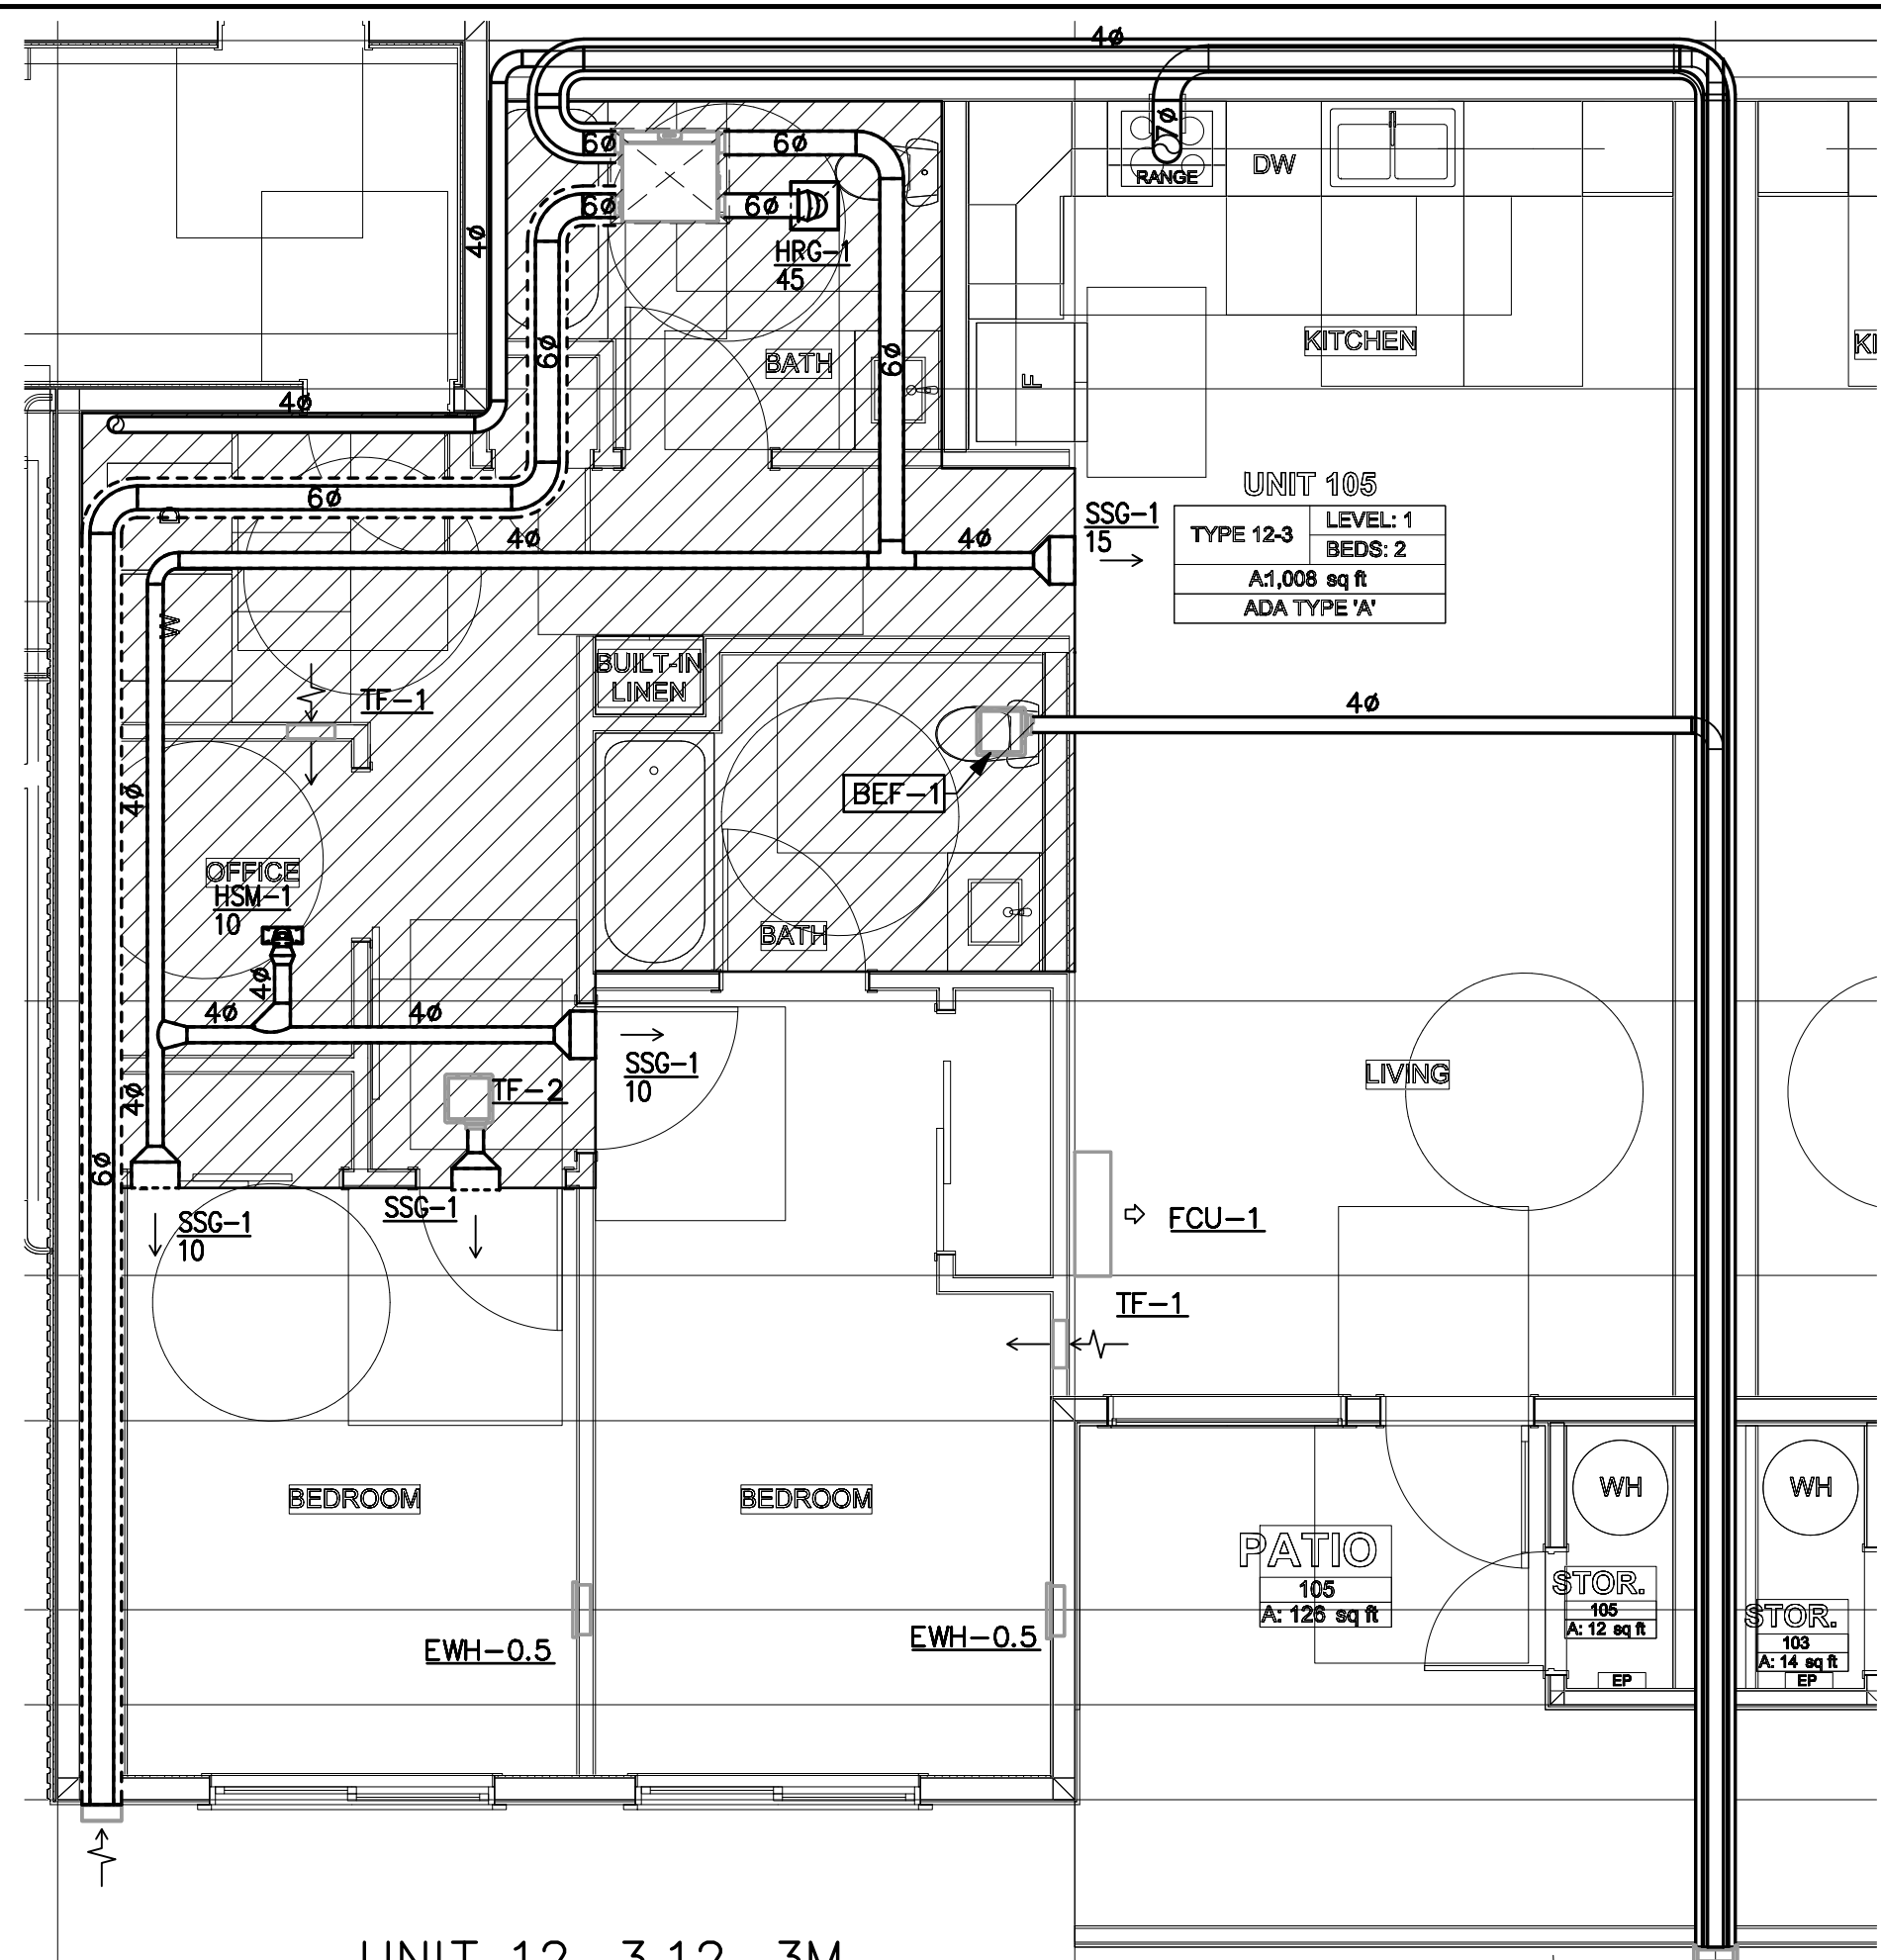

UNIT 106
TYPE 12-3 LEVEL: 1
BEDS: 2
A: 1,008 sq ft
ADA TYPE 'A'

UNIT 12-3,12-3M
ENLARGED PLAN
SCALE: 1/4" = 1'-0"


3
M3.0

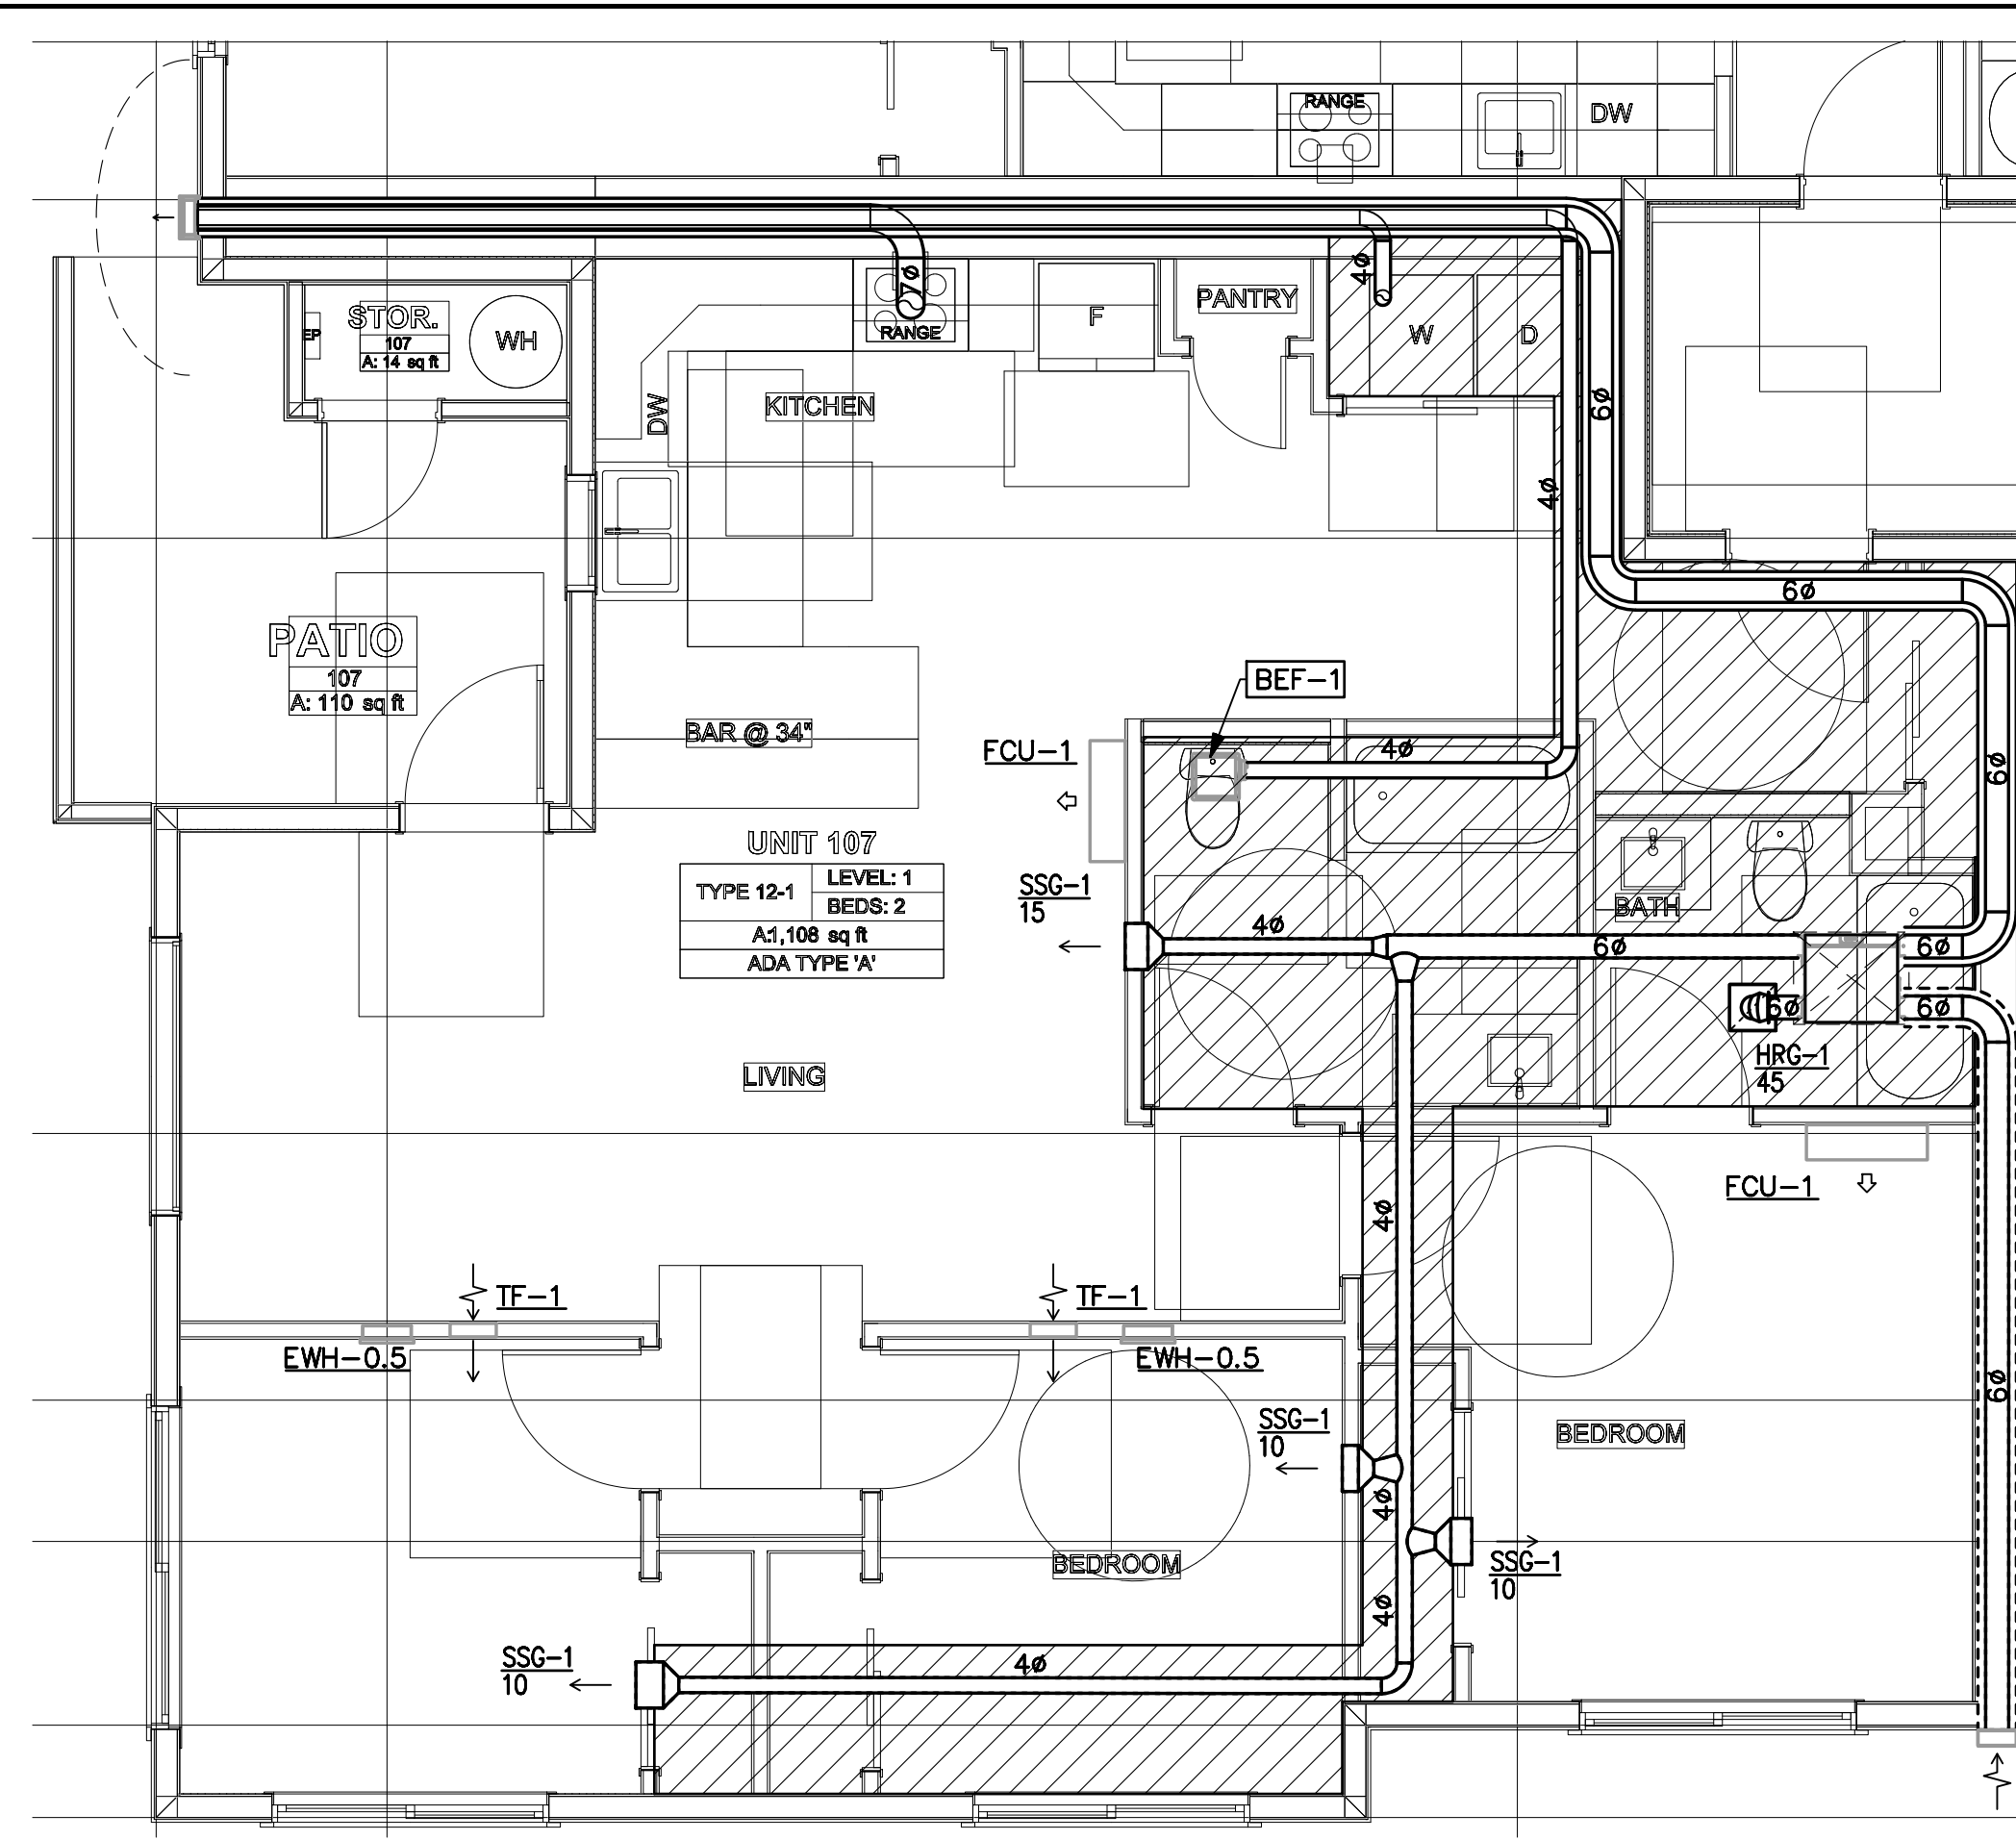

UNIT 107
TYPE 12-1 LEVEL: 1
BEDS: 2
A: 1,108 sq ft
ADA TYPE 'A'

UNIT 12-1,12-1M
ENLARGED PLAN
SCALE: 1/4" = 1'-0"


1
M3.0

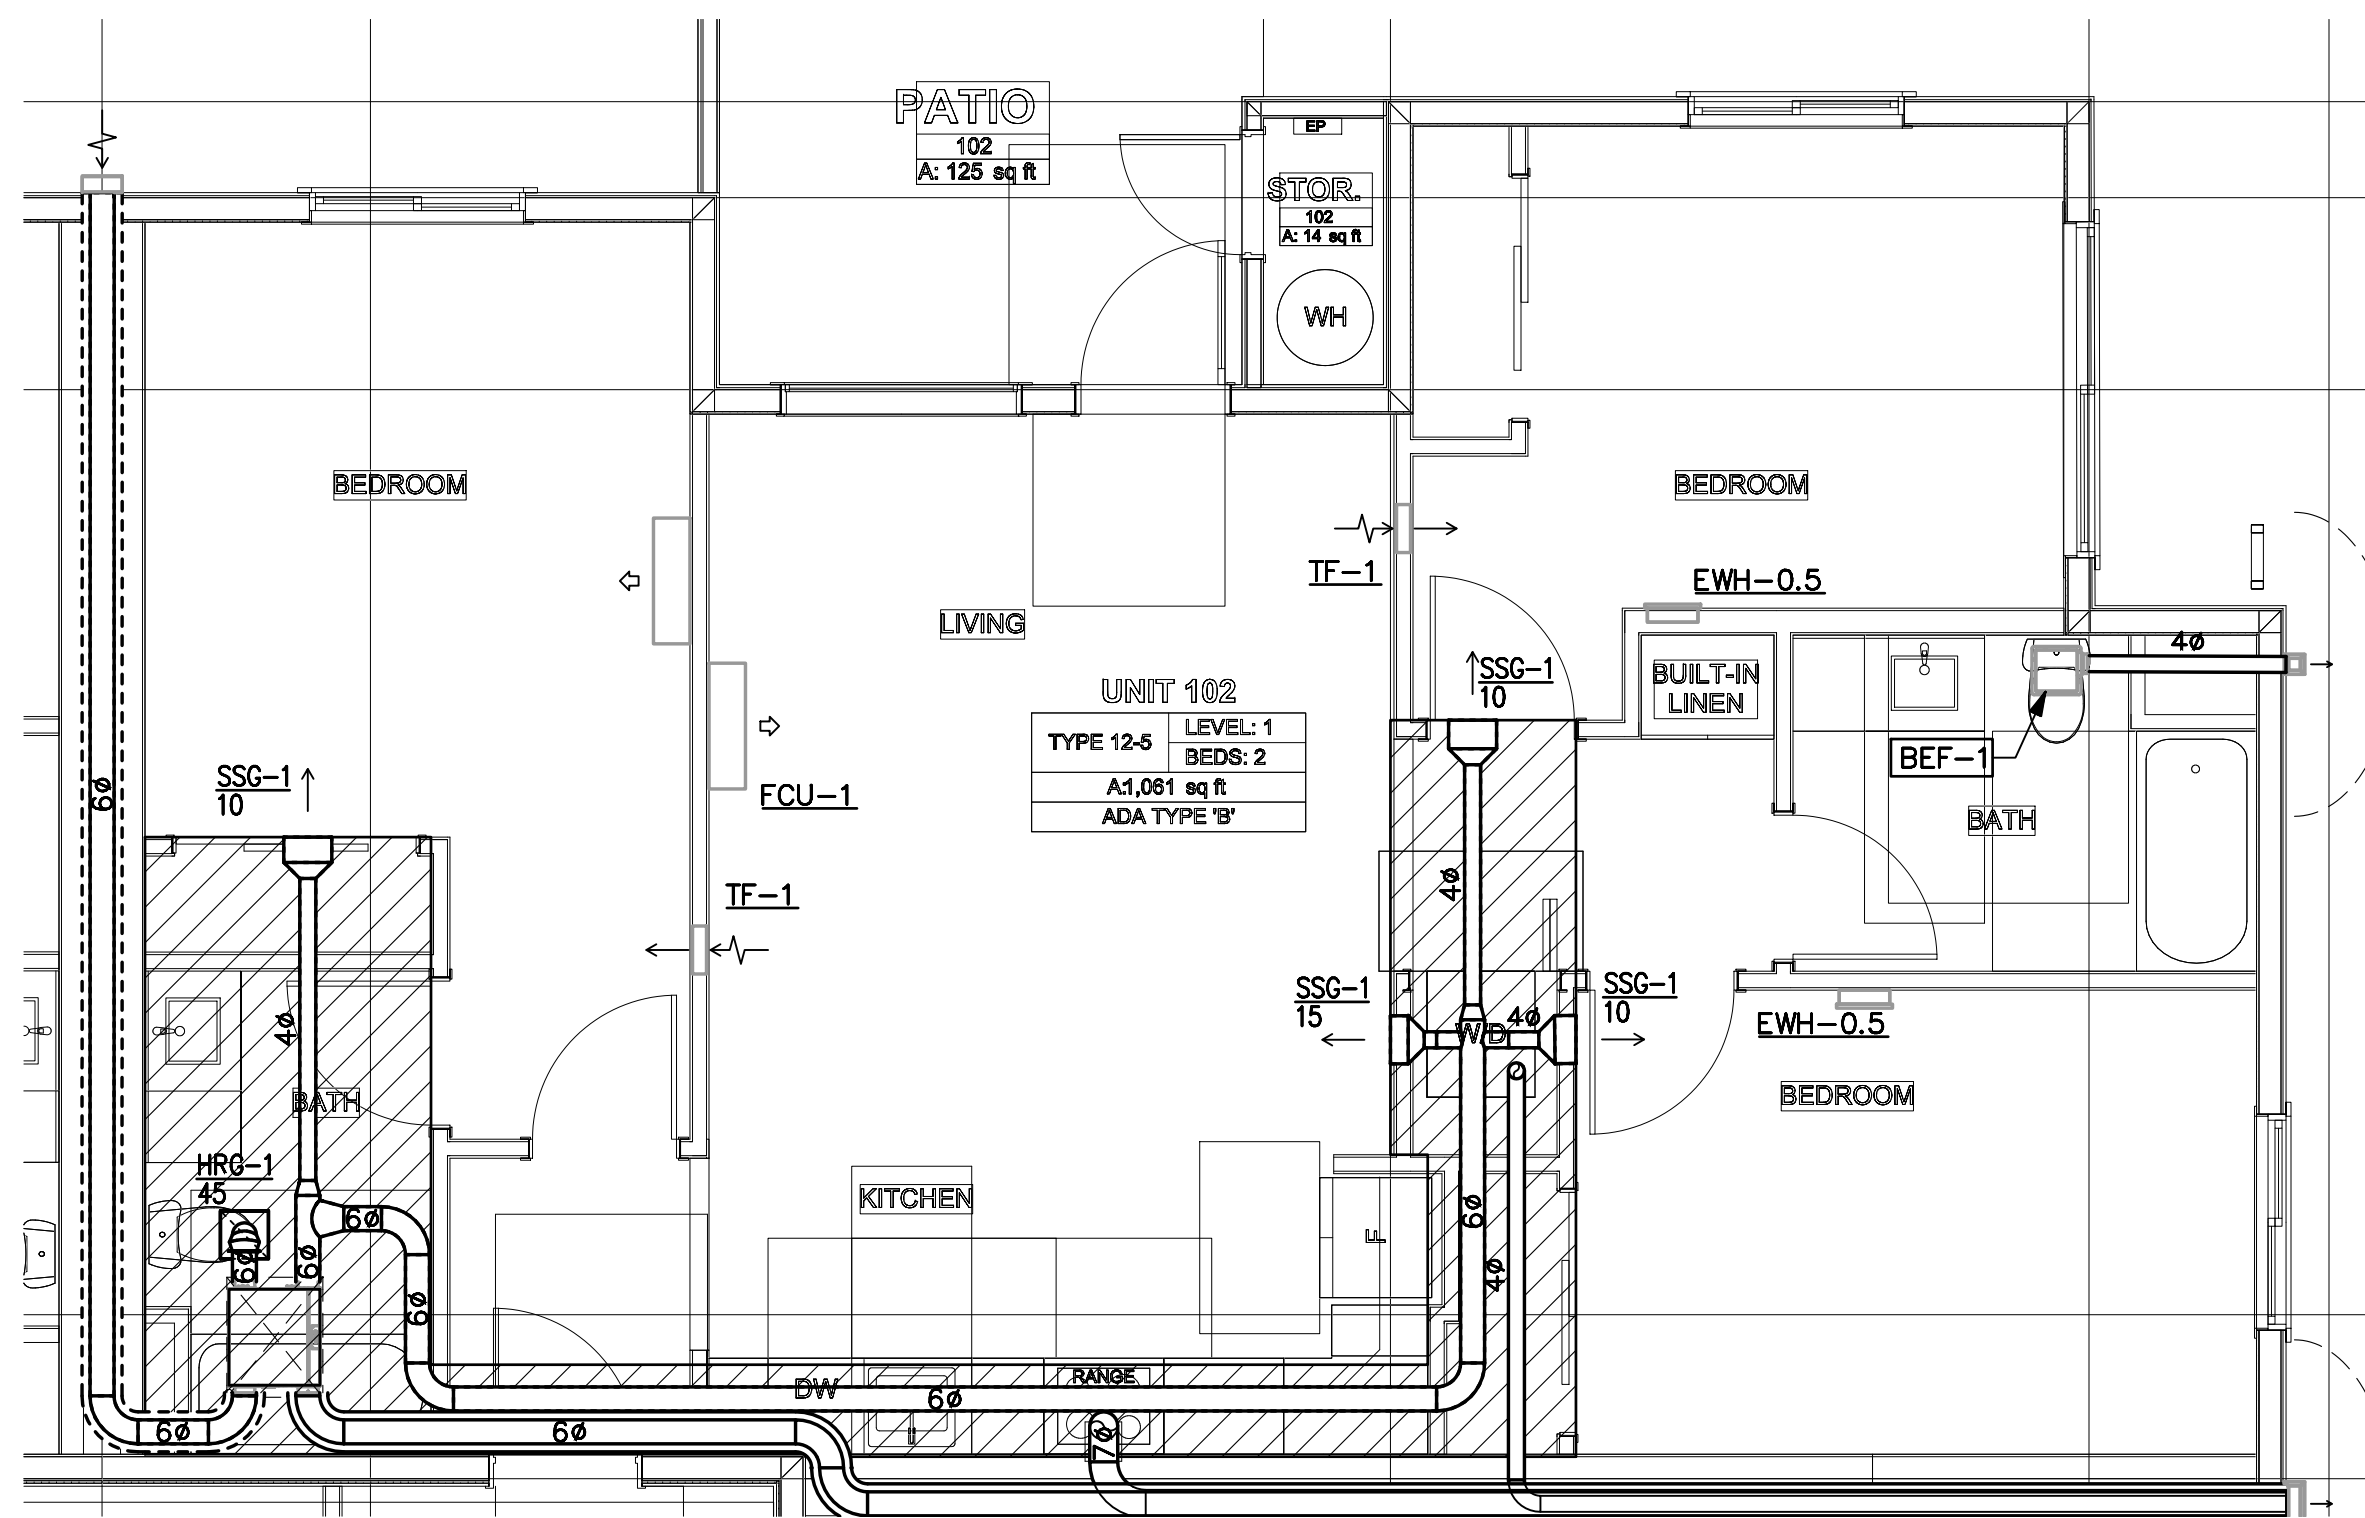

UNIT 102
TYPE 12-5 LEVEL: 1
BEDS: 2
A: 1,081 sq ft
ADA TYPE 'B'

UNIT 12-5,12-5M
ENLARGED PLAN
SCALE: 1/4" = 1'-0"

4
M3.0

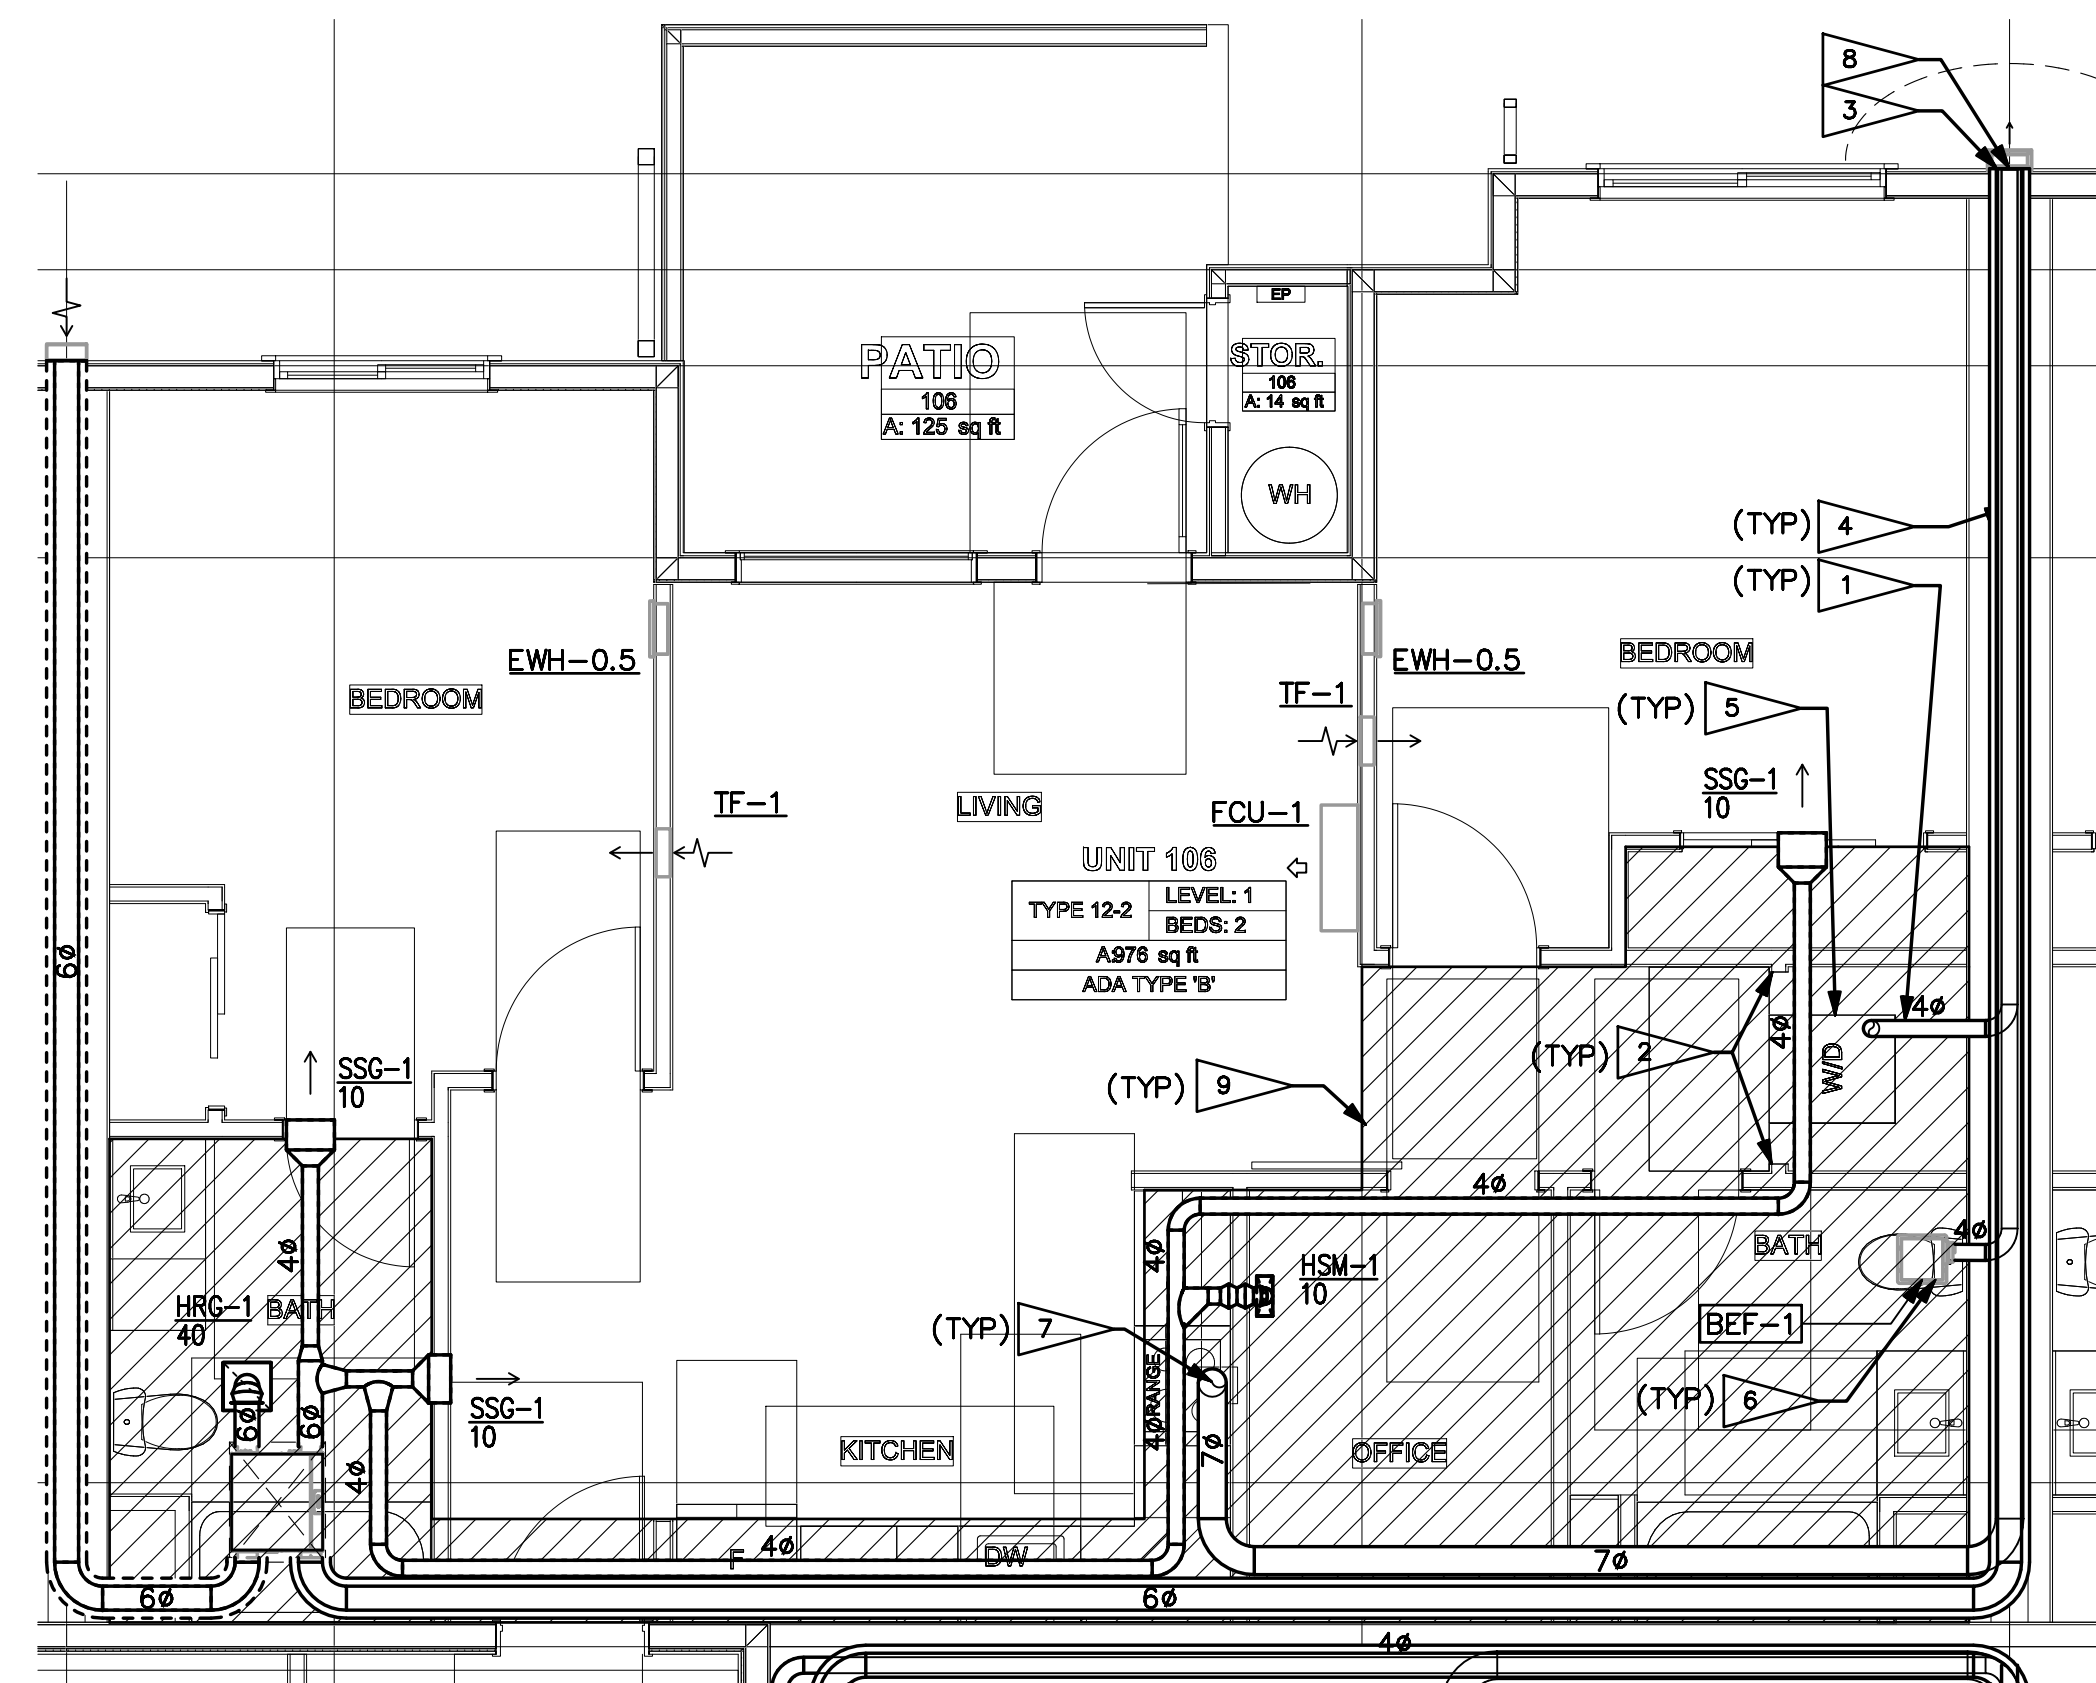

UNIT 108
TYPE 12-2 LEVEL: 1
BEDS: 2
A: 878 sq ft
ADA TYPE 'B'

UNIT 12-2, 12-2M, 22-5, 22-5M, 32-5, 32-5M
ENLARGED PLAN
SCALE: 1/4" = 1'-0"

2
M3.0

RESIDENTIAL UNIT NOTES:

- PENETRATIONS OF THE RATED WALL ASSEMBLIES SHALL BE PROTECTED IN ACCORDANCE WITH IBC SECTION 717. REFER TO ARCHITECTURAL PLANS FOR PENETRATION DETAILS.
- PER OWNER, THE FOLLOWING RANGE HOODS ARE BEING INSTALLED: STANDARD UNITS (MICRO/HOOD COMBO): FRIGIDAIRE LFMV1846VF ADA UNITS (HOOD ONLY): GE JX3240DJWW PER THE MANUFACTURER'S INSTALLATION INSTRUCTIONS, DUCT CONNECTION TO HOODS ARE 6". MINIMUM SIZE ROUND DUCT FOR HOOD VENTING SHALL BE 7".
- EXHAUST FAN EF-1 SHALL SERVE AS THE WHOLE HOUSE VENTILATION FAN. REFER TO M003 FOR REQUIREMENTS.
- DRYER VENTING: PER THE MANUFACTURER'S INSTALLATION INSTRUCTIONS, THE MAXIMUM LENGTH OF THE DRYER VENTS IS AS FOLLOWS (REFER TO DWG M400, DETAIL 1):

STANDARD DRYER:
GE GUV27ESSM

| NUMBER OF 90° ELBOWS OR TURNS | MAXIMUM LENGTH (FT) |
|-------------------------------|---------------------|
| 0 | 200 |
| 1 | 185 |
| 2 | 175 |
| 3 | 165 |
| 4 | 155 |
| 5 | 145 |


ADA DRYER:
GE GFV55ESSN

| NUMBER OF 90° ELBOWS OR TURNS | MAXIMUM LENGTH (FT) |
|-------------------------------|---------------------|
| 0 | 200 |
| 1 | 185 |
| 2 | 175 |
| 3 | 165 |
| 4 | 155 |

FLAG NOTES: \triangle

- 4" POC TO DRYER. PROVIDE METAL DRYER BOX WHERE DUCT IS ROUTED IN 2X6 FRAMED WALL. REFER TO MANUFACTURER'S INSTALLATION INSTRUCTIONS AND WSMC 504.8.4.1 FOR THE MAXIMUM ALLOWED LENGTH OF THE DRYER VENT. PROVIDE PERMANENT PLACARD OF TYPE PLAC34 SHOWING NET EQUIVALENT LENGTH. DUCT SHALL REMAIN SEPARATE FROM OTHER EXHAUST SYSTEMS UP TO TERMINATION.
- LOUVERED DOOR. REFER TO ARCHITECTURAL PLANS FOR DETAILS.
- DRYER EXHAUST VENT SHALL BE PROTECTED WITH FIRE WRAP FROM DRYER TO EXTERIOR WALL TERMINATION POINT. REFER TO DWG M401, DETAIL 1 FOR FIRE WRAP DETAILS. FIRE WRAP SHALL BE UNIFRAX FYREWRAPE DPS.
- DUCT ROUTED IN LINED JOIST BAY
- CLOSETS CONTAINING DRYERS SHALL BE PROVIDED WITH LOUVERED DOOR OR 100 SQ. IN FREE-AREA OPENING ABOVE DOOR. OPENING PROVIDES PATH FOR EXHAUST AIR DURING WASHER OPERATION PER WSMC TABLE 403.3.1.1 NOTE (I) AND MAKEUP AIR DURING DRYER OPERATION PER 504.6.
- 4" DRYER EXHAUST TERMINATION WALL CAP. PROVIDE BACKDRAFT DAMPER AT TERMINATION. DO NOT INSTALL SCREENS ON DRYER EXHAUST TERMINATIONS. CLEARANCES PER GENERAL NOTE 1.
- POC TO DOMESTIC KITCHEN RANGE HOOD. SEE PLANS FOR SIZE. DUCT SHALL REMAIN SEPARATE FROM OTHER EXHAUST SYSTEMS UP TO TERMINATION.
- DOMESTIC KITCHEN RANGE HOOD EXHAUST TERMINATION WALL CAP WITH SCREEN. PROVIDE BACKDRAFT DAMPER AT TERMINATION. CLEARANCES PER GENERAL NOTE 1.
- LOWERED SOFFIT FOR MECHANICAL EQUIPMENT.

| NO. | DATE | DESCRIPTION |
|-----|------|-------------|
| | | |
| | | |
| | | |

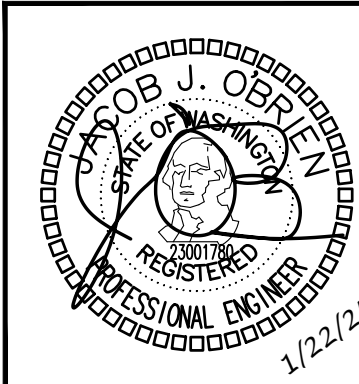

| | | | |
|-----------|---------------|-------------|---------------|
| DRAWN: OP | DESIGNED: ABE | CHECKED: PR | APPROVED: JMR |
|-----------|---------------|-------------|---------------|

PROJECT: EAST TOWN CROSSING BUILDING B
MULTIFAMILY DEVELOPMENT
PIONEER WAY & SHAW RD. PUYALLUP, WA


19401 ACOTWAYE W. SUITE 302
LYNNWOOD, WA 98036
PHONE: (206) 964-3343
REPROJECT NO.: 810010
CONTACT: ARK.ESPINELLI

ROBISON ENGINEERING, INC.

DATE: 1/22/2024


SHEET TITLE:
HVAC ENLARGED PLANS

SHEET NO.
M3.0

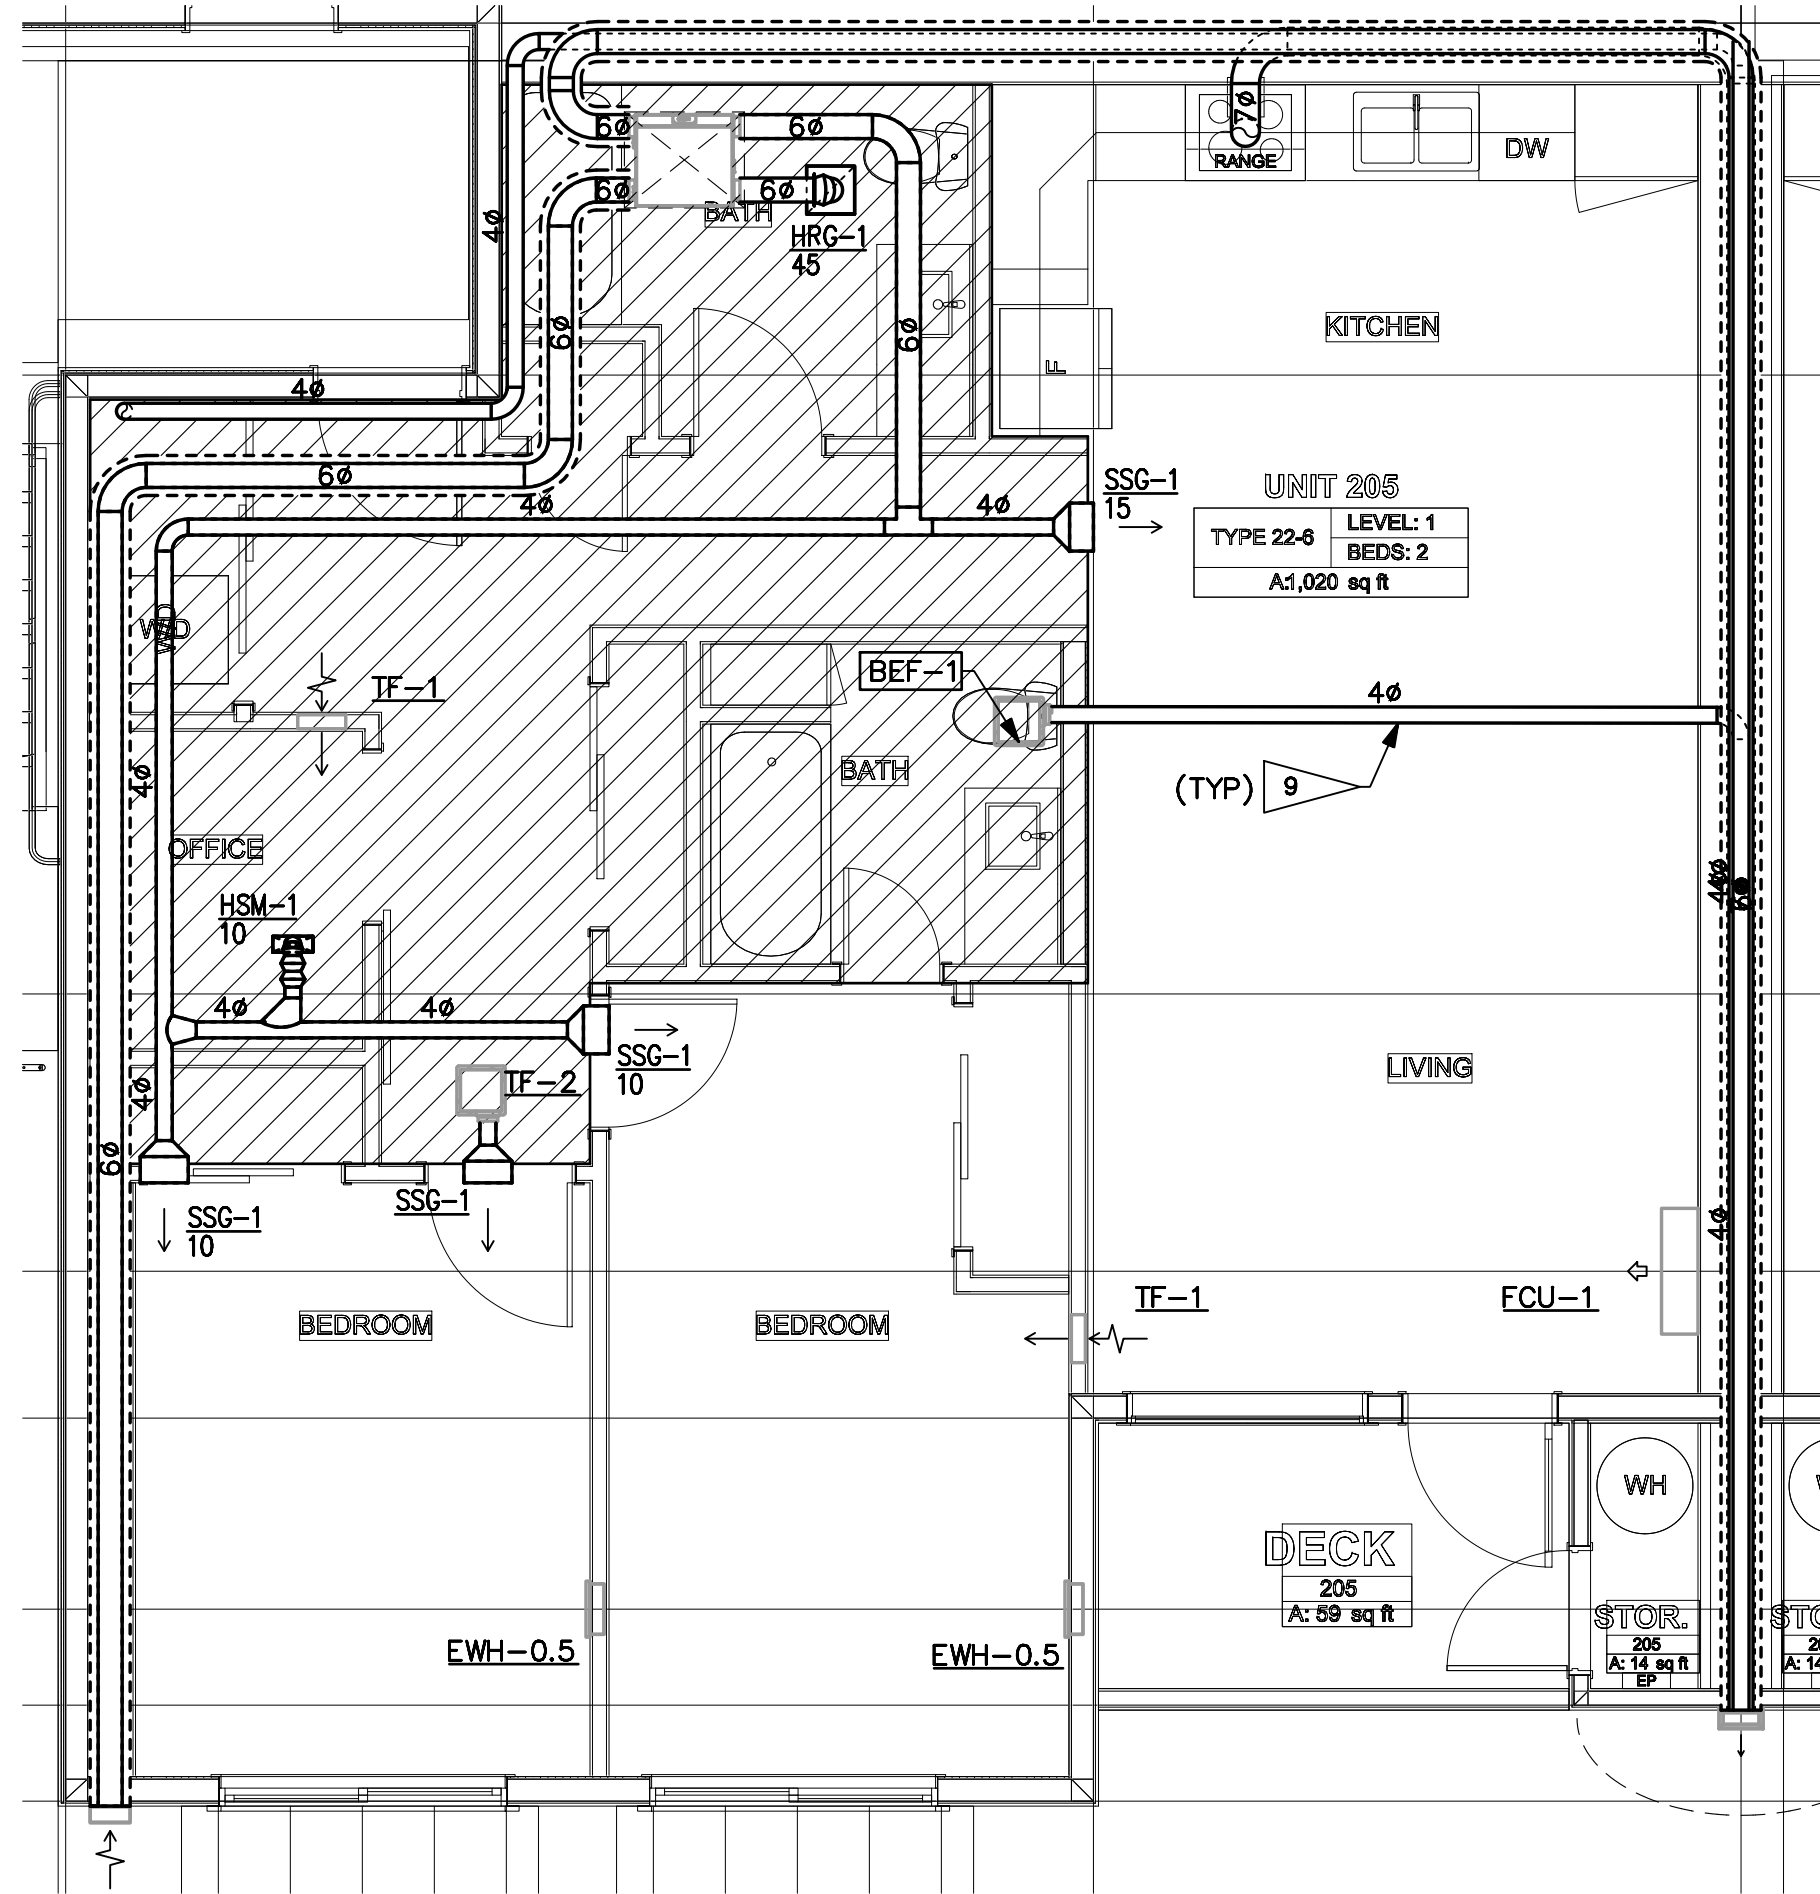


UNIT 22-6, 22-6M, 32-6, 32-6M
ENLARGED PLAN
SCALE: 1/4" = 1'-0"

3
M3.1

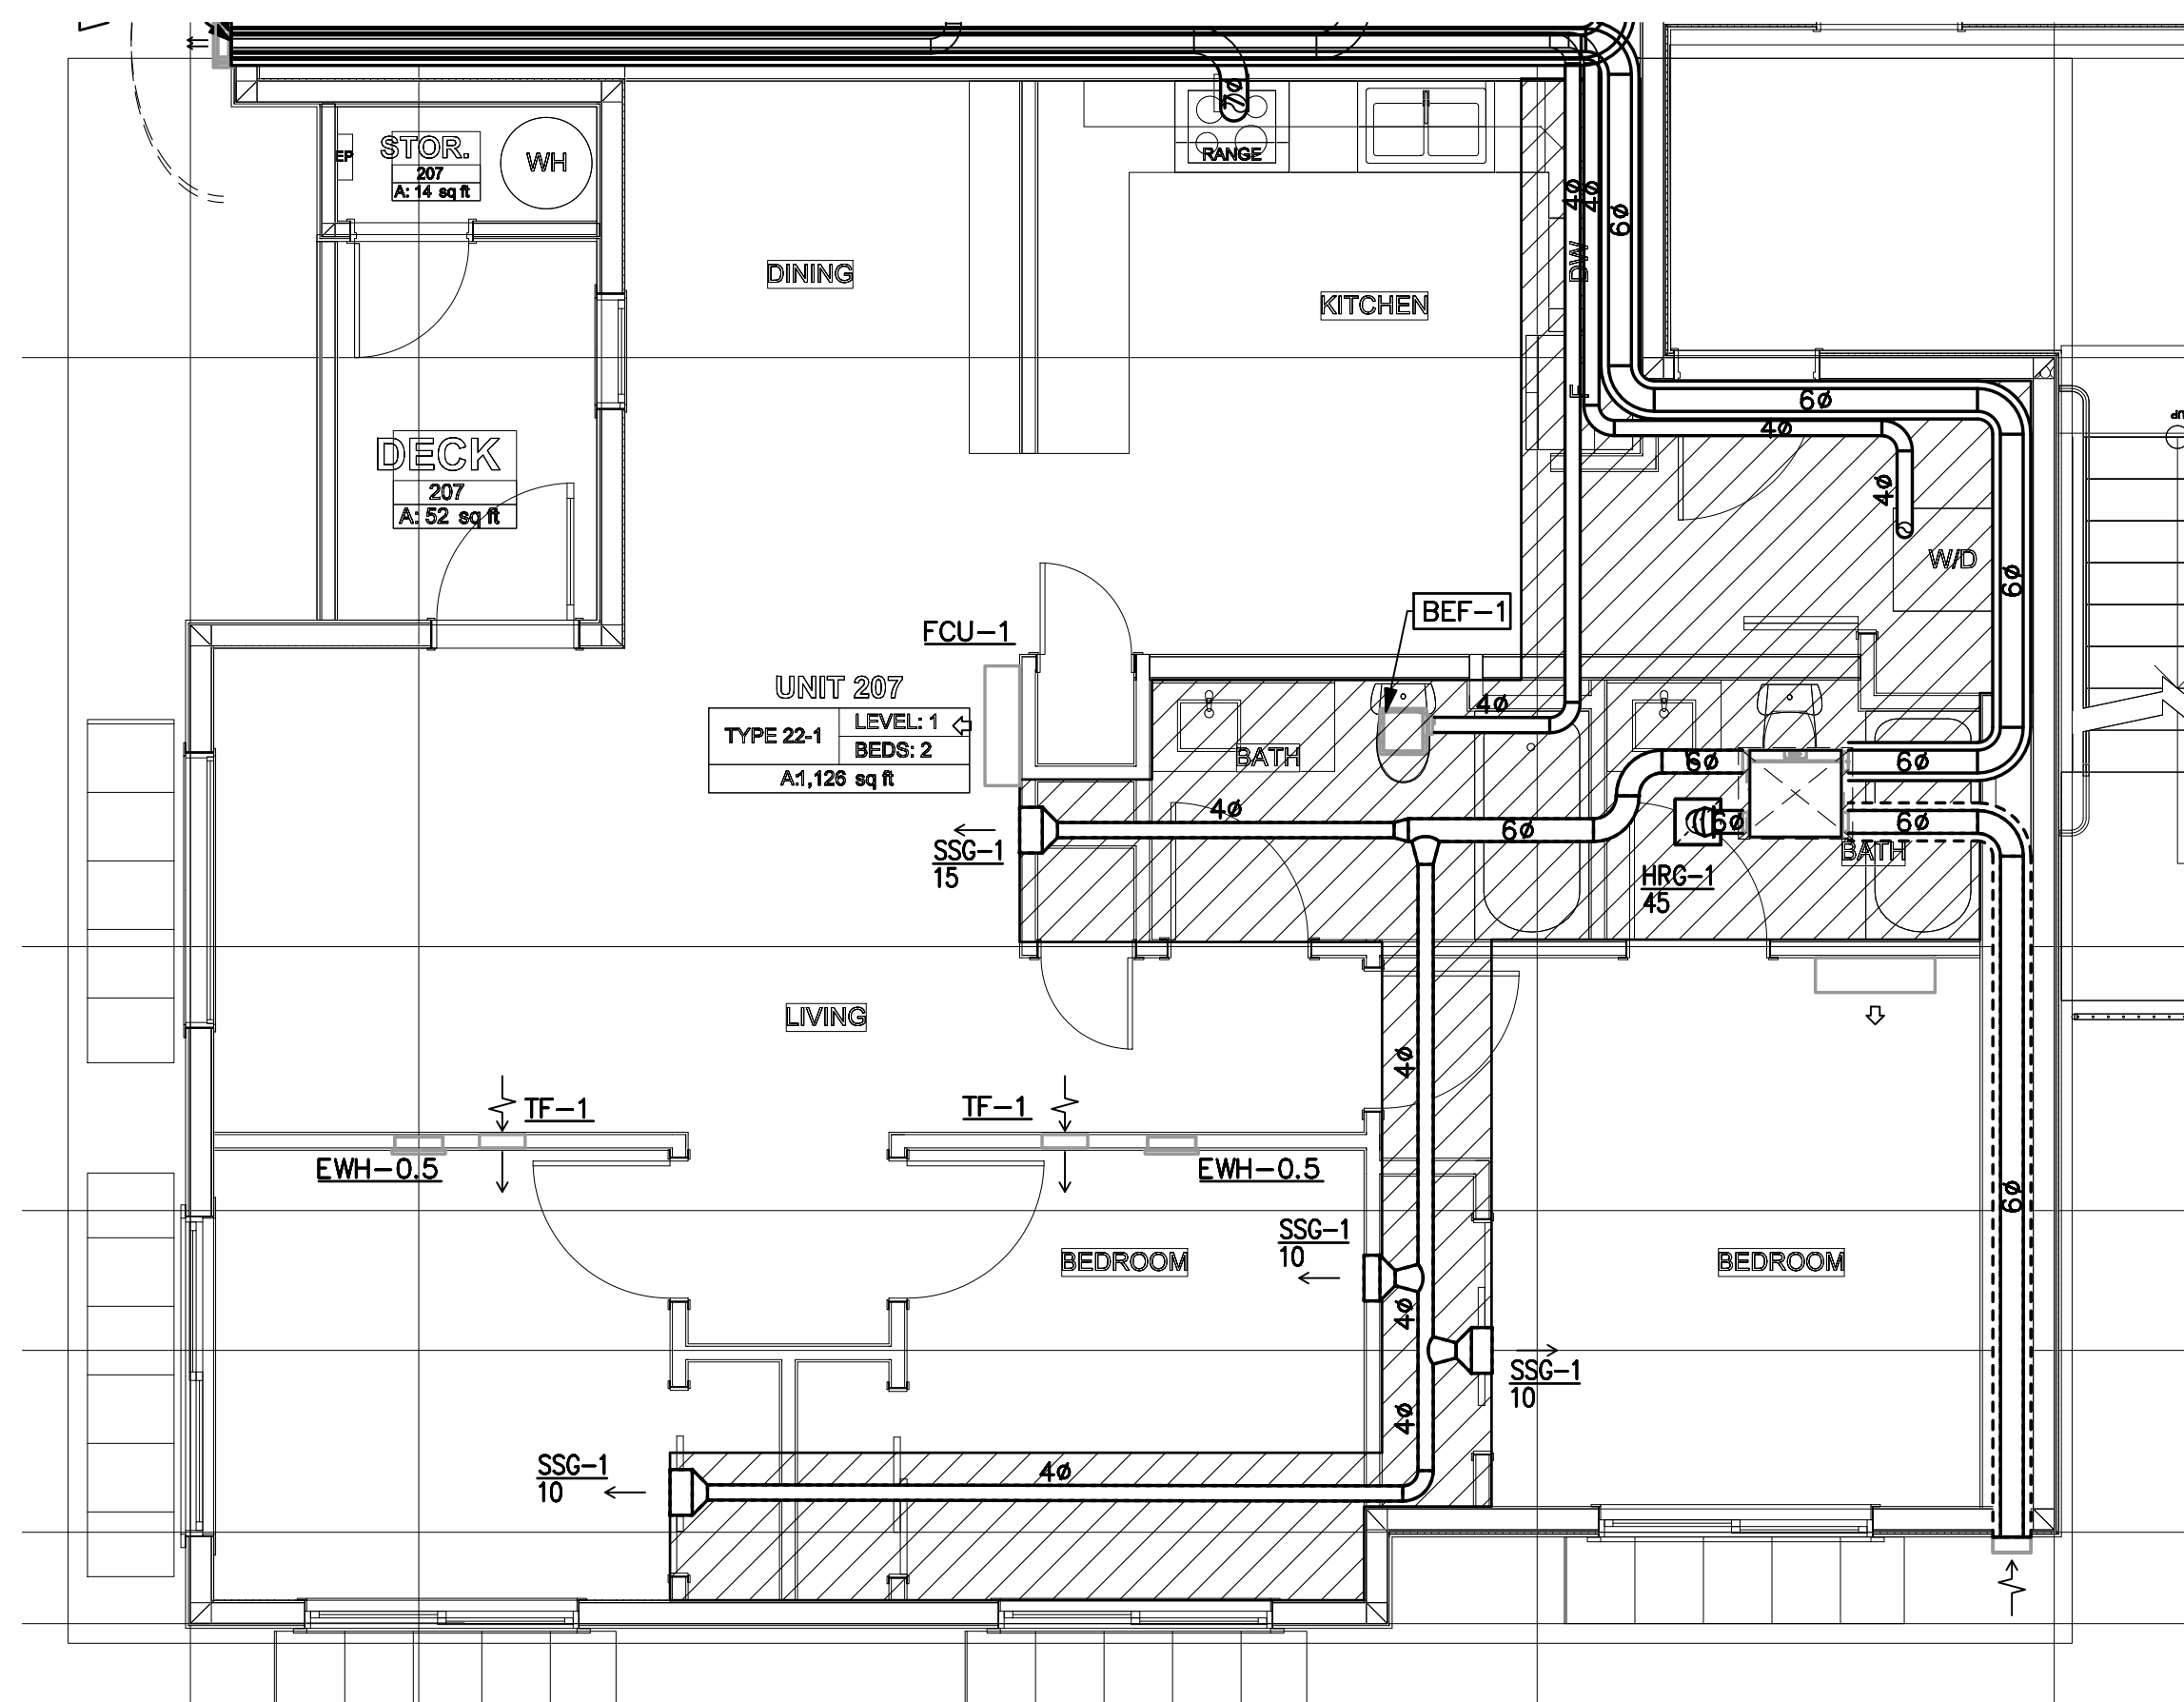

UNIT 22-1, 22-1M, 32-1, 32-1M
ENLARGED PLAN
SCALE: 1/4" = 1'-0"

1
M3.1

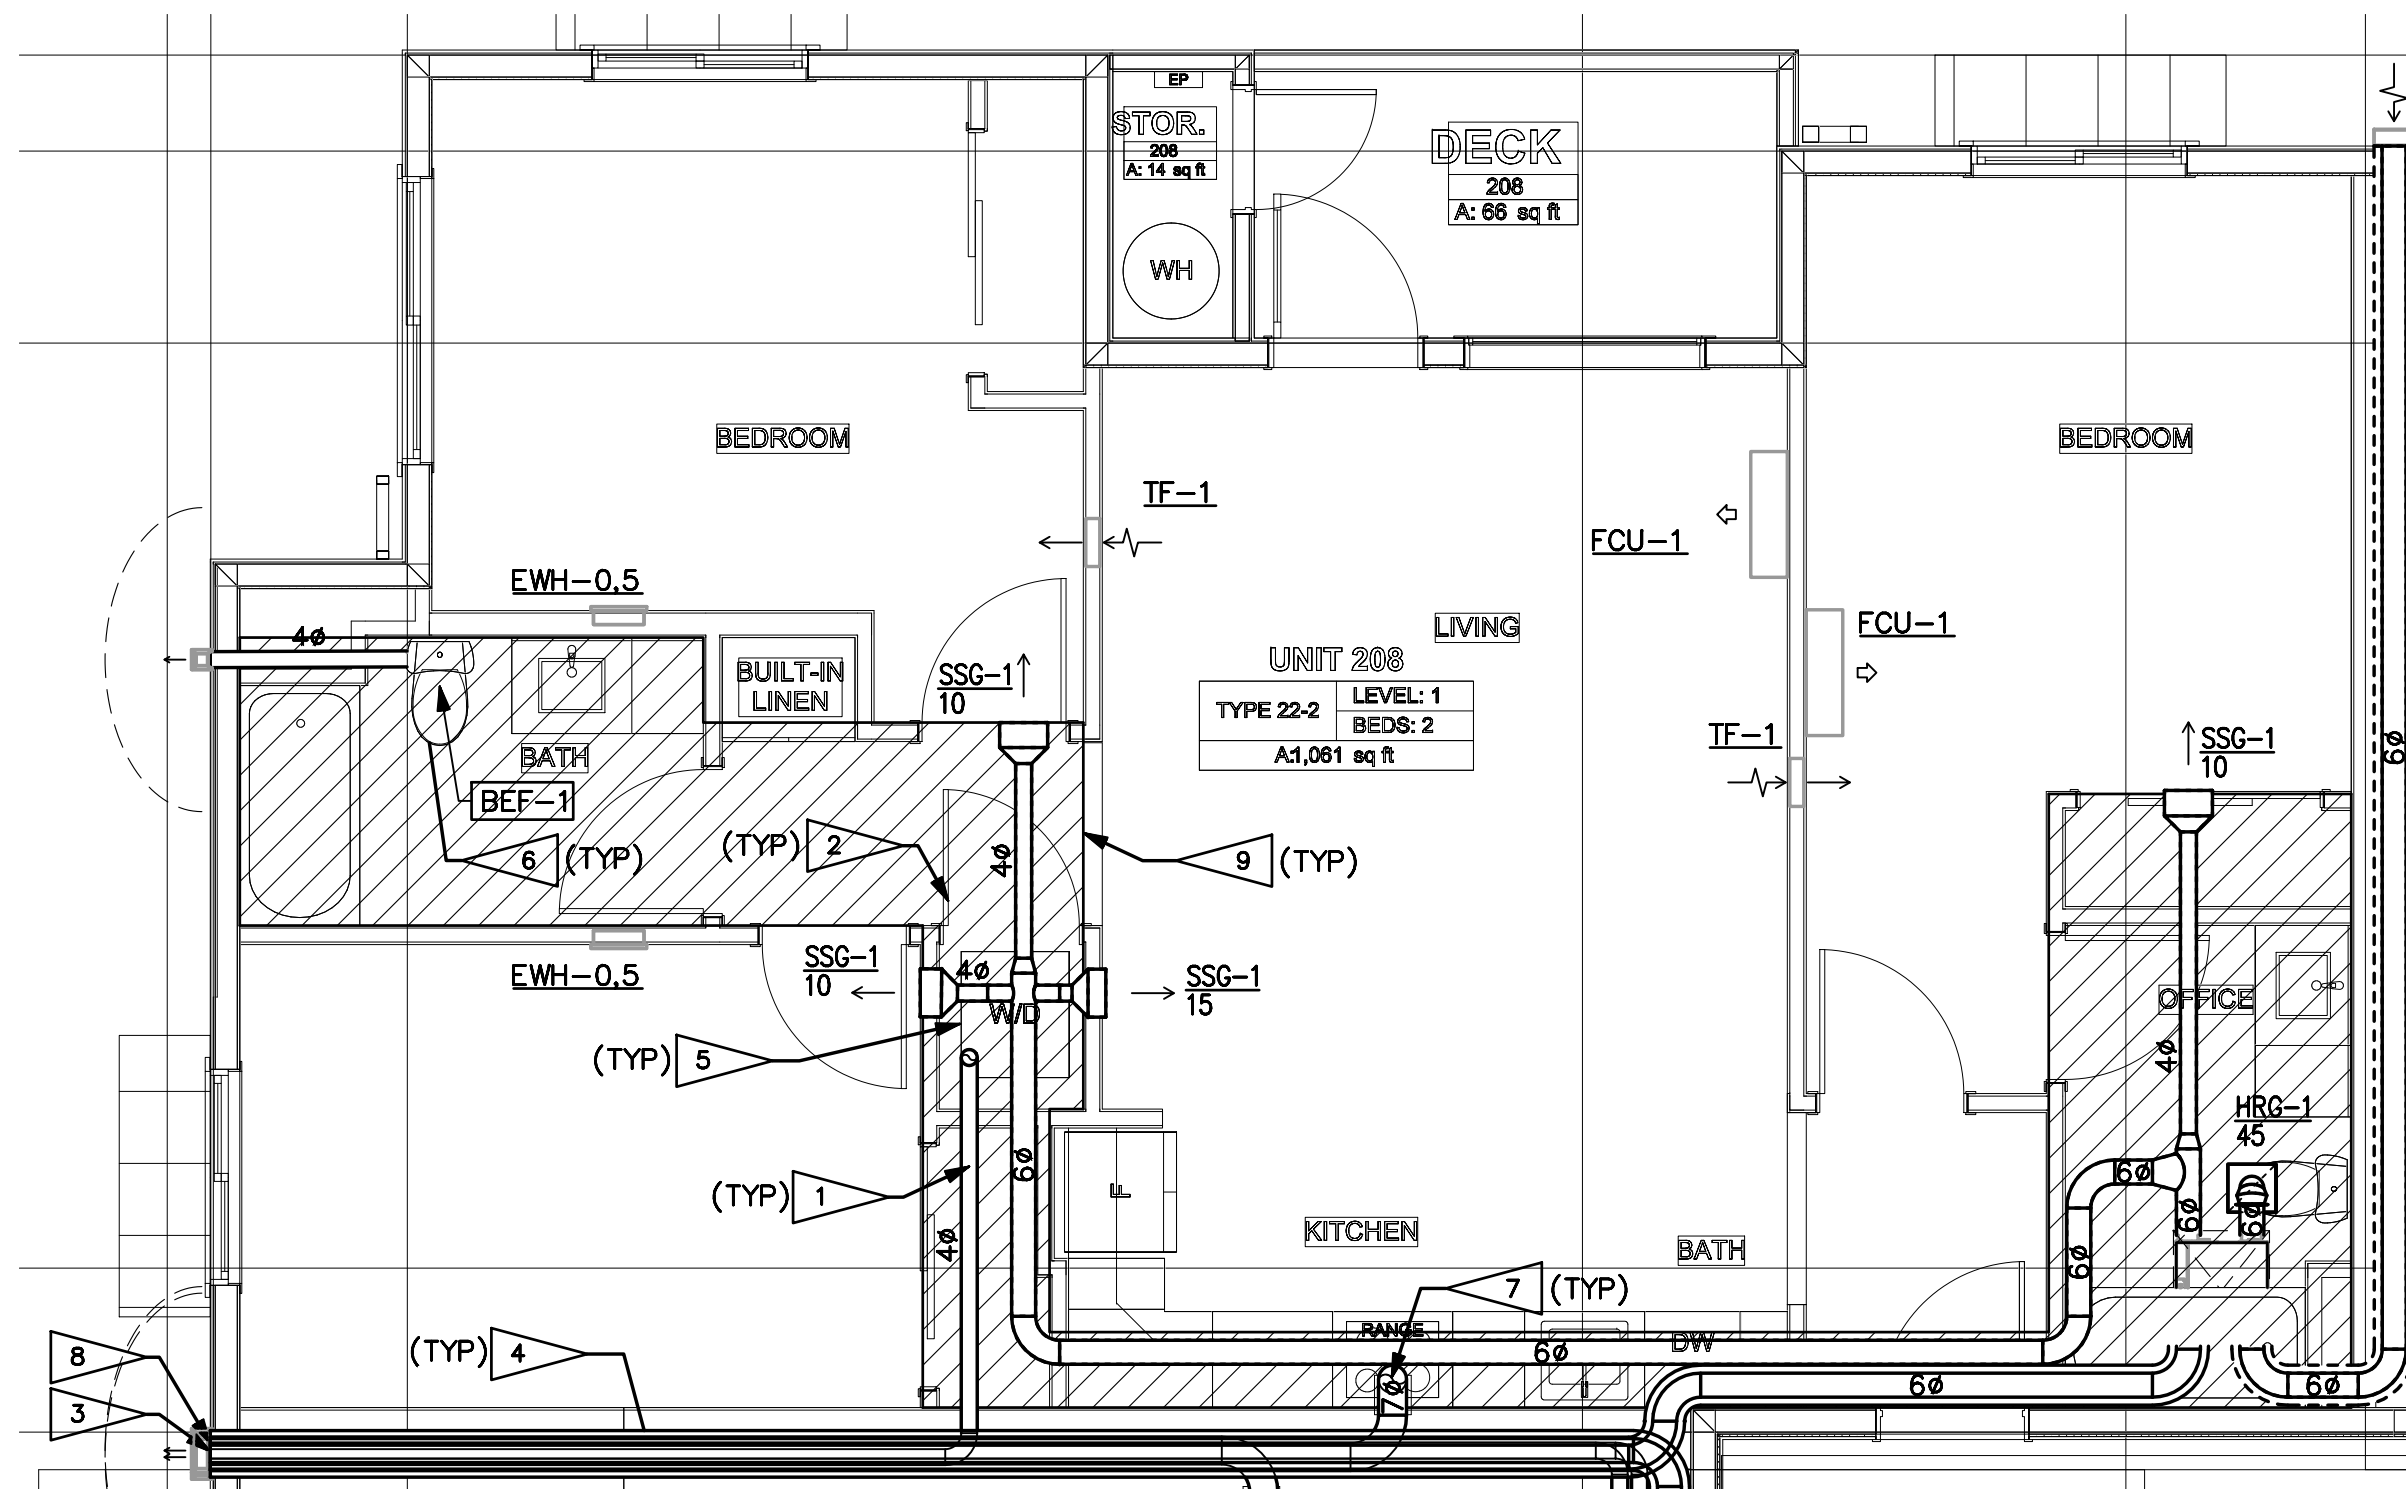

UNIT 22-2, 22-2M, 32-2, 32-2M
ENLARGED PLAN
SCALE: 1/4" = 1'-0"

2
M3.1

RESIDENTIAL UNIT NOTES:

1. PENETRATIONS OF THE RATED WALL ASSEMBLIES SHALL BE PROTECTED IN ACCORDANCE WITH IBC SECTION 717. REFER TO ARCHITECTURAL PLANS FOR PENETRATION DETAILS.
2. PER OWNER, THE FOLLOWING RANGE HOODS ARE BEING INSTALLED: STANDARD UNITS (MICRO/HOOD COMBO): FRIGIDAIRE LFMV1846VF ADA UNITS (HOOD ONLY): GE JX3240DJWW PER THE MANUFACTURER'S INSTALLATION INSTRUCTIONS, DUCT CONNECTION TO HOODS ARE 6". MINIMUM SIZE ROUND DUCT FOR HOOD VENTING SHALL BE 7".
3. EXHAUST FAN EF-1 SHALL SERVE AS THE WHOLE HOUSE VENTILATION FAN. REFER TO M003 FOR REQUIREMENTS.
4. DRYER VENTING: PER THE MANUFACTURER'S INSTALLATION INSTRUCTIONS, THE MAXIMUM LENGTH OF THE DRYER VENTS IS AS FOLLOWS (REFER TO DWG M400, DETAIL 1):



| STANDARD DRYER: GE GUV27ESSM | |
|---------------------------------|---------------------|
| NUMBER OF 90° ELBOWS OR TURNS | MAXIMUM LENGTH (FT) |
| 0 | 200 |
| 1 | 185 |
| 2 | 175 |
| 3 | 165 |
| 4 | 155 |
| 5 | 145 |

| ADA DRYER: GE GFV55ESSN | |
|-------------------------------|---------------------|
| NUMBER OF 90° ELBOWS OR TURNS | MAXIMUM LENGTH (FT) |
| 0 | 200 |
| 1 | 185 |
| 2 | 175 |
| 3 | 165 |
| 4 | 155 |

FLAG NOTES: #

1. 4" POC TO DRYER. PROVIDE METAL DRYER BOX WHERE DUCT IS ROUTED IN 2X6 FRAMED WALL. REFER TO MANUFACTURER'S INSTALLATION INSTRUCTIONS AND WSMC 504.8.4.1 FOR THE MAXIMUM ALLOWED LENGTH OF THE DRYER VENT. PROVIDE PERMANENT PLACARD OF TYPE PLAC34 SHOWING NET EQUIVALENT LENGTH. DUCT SHALL REMAIN SEPARATE FROM OTHER EXHAUST SYSTEMS UP TO TERMINATION.
2. LOUVERED DOOR. REFER TO ARCHITECTURAL PLANS FOR DETAILS.
3. DRYER EXHAUST VENT SHALL BE PROTECTED WITH FIRE WRAP FROM DRYER TO EXTERIOR WALL TERMINATION POINT. REFER TO DWG M401, DETAIL 1 FOR FIRE WRAP DETAILS. FIRE WRAP SHALL BE UNIFRAX FYREWRAPE DPS.
4. DUCT ROUTED IN LINED JOIST BAY
5. CLOSETS CONTAINING DRYERS SHALL BE PROVIDED WITH LOUVERED DOOR OR 100 SQ. IN FREE-AREA OPENING ABOVE DOOR. OPENING PROVIDES PATH FOR EXHAUST AIR DURING WASHER OPERATION PER WSMC TABLE 403.3.1.1 NOTE (1) AND MAKEUP AIR DURING DRYER OPERATION PER 504.6.
6. 4" DRYER EXHAUST TERMINATION WALL CAP. PROVIDE BACKDRAFT DAMPER AT TERMINATION. DO NOT INSTALL SCREENS ON DRYER EXHAUST TERMINATIONS. CLEARANCES PER GENERAL NOTE 1.
7. POC TO DOMESTIC KITCHEN RANGE HOOD. SEE PLANS FOR SIZE. DUCT SHALL REMAIN SEPARATE FROM OTHER EXHAUST SYSTEMS UP TO TERMINATION.
8. DOMESTIC KITCHEN RANGE HOOD EXHAUST TERMINATION WALL CAP WITH SCREEN. PROVIDE BACKDRAFT DAMPER AT TERMINATION. CLEARANCES PER GENERAL NOTE 1.
9. LOWERED SOFFIT FOR MECHANICAL EQUIPMENT.

| NO. | DATE | DESCRIPTION |
|-----|------|-------------|
| | | |
| | | |
| | | |

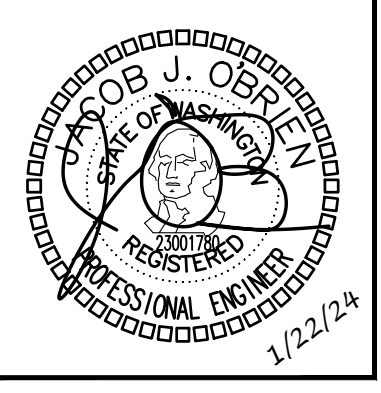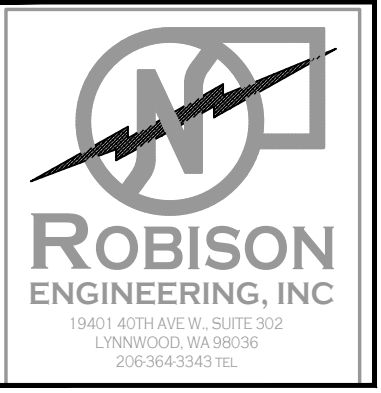

| | | | |
|--------|-----------|----------|-----------|
| OP | ABE | PR | JMR |
| DRAWN: | DESIGNED: | CHECKED: | APPROVED: |

PROJECT: EAST TOWN CROSSING BUILDING B
MULTIFAMILY DEVELOPMENT
PIONEER WAY & SHAW RD. PUYALLUP, WA

19401 ACOTWAYE W. SUITE 302
LYNNWOOD, WA 98036
PHONE: (206) 964-3343
REPROJECT NO.: 810010
CONTACT: ARK.ESPINELLI

ROBISON ENGINEERING, INC.

DATE:
1/22/2024

SHEET TITLE:
HVAC ENLARGED PLANS

SHEET NO.
M3.1

ADA DRYER

GFV55ESSN

GE® Long Vent 7.8 cu. ft. Capacity Front Load Electric Dryer

DIMENSIONS AND INSTALLATION INFORMATION (IN INCHES)


| ELECTRIC DRYER RATING | |
|-----------------------|------------------|
| 120V/240V | 5600W, 25A, 60Hz |
| 120V/208V | 4300W, 23A, 60Hz |

EXHAUST OPTIONS: 4-way via rear, right, left and bottom.

CIRCUIT REQUIREMENTS: An individual, properly grounded branch circuit, protected by a 30-amp circuit breaker or a time-delay fuse, is required.

NOTE: Dryer wall outlet must be located within 36" of service cord entry and accessible when dryer is mounted in position.

INSTALLATION INFORMATION: For complete information, see installation instructions packed with your dryer.

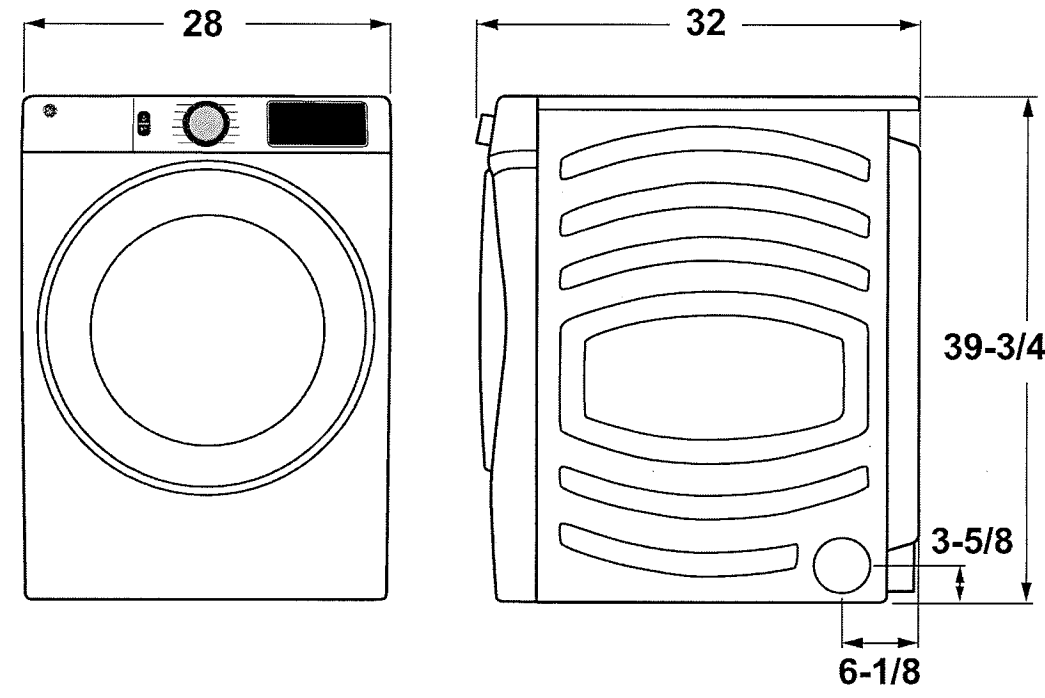

For answers to your Monogram, GE Café® Series, GE Profile® Series or GE Appliances product questions, visit our website at geappliances.com or call GE Answer Center® Service, 800.626.2000.



Specification Revised 11/19

GFV55ESSN

GE® Long Vent 7.8 cu. ft. Capacity Front Load Electric Dryer

DRYER EXHAUSTING INFORMATION - METAL DUCT ONLY

For complete information, see installation instructions packed with your dryer.

DUCTING MATERIALS: For best performance, this dryer should be vented with 4" diameter all rigid metal exhaust duct. If rigid metal duct cannot be used, then UL-listed flexible metal (semi-rigid) ducting can be used (Kit WX08X10077). In special installations, it may be necessary to connect the dryer to the house vent using a flexible metal (foil-type) duct. A UL-listed flexible metal (foil-type) duct may be used ONLY in installations where rigid metal or flexible metal (semi-rigid) ducting cannot be used AND where a 4" diameter can be maintained throughout the entire length of the transition duct. Please see installation instruction packed with your dryer for complete instructions when using flexible metal (foil type) ducting.

EXHAUST LENGTH CALCULATION:

- Determine the number of 90° turns needed for your installation. If you exhaust to the side or bottom of dryer, add one turn.
- The maximum length of 4" rigid (aluminum or galvanized) duct which can be tolerated is shown in the table.

A turn of 45° or less may be ignored. Two 45° turns within the duct length should be treated as a 90° elbow.


A turn over 45° should be treated as a 90° elbow. Dryers must be exhausted to the outside.

CAUTION: For personal safety do not terminate exhaust into a chimney, under any enclosed house floor (crawl space), or into an attic, since the accumulated lint could create a fire hazard or moisture could cause damage. Never terminate the exhaust into a common duct or plenum with a kitchen exhaust, since the combination of lint and grease could create a fire hazard.

Exhaust ducts should be terminated in a dampered wall cap to prevent back drafts, bird nesting, etc. The wall cap must also be located at least 12" above the ground or any other obstruction with the opening pointed down.

FOR MORE INFORMATION ON VENTING KITS AND ACCESSORIES, PLEASE CALL 1-800-GE-CARES.

| Domestic dryer models | Number of 90° turns | Best performance Maximum length of 4" dia. rigid metal duct Exhaust hood type | |
|-----------------------|---------------------|---|------------------|
| | | A 4" opening | B 2-1/2" opening |
| | 0 | 200 ft. | 175 ft. |
| | 1 | 185 ft. | 165 ft. |
| | 2 | 175 ft. | 155 ft. |
| | 3 | 165 ft. | 145 ft. |
| | 4 | 155 ft. | 135 ft. |

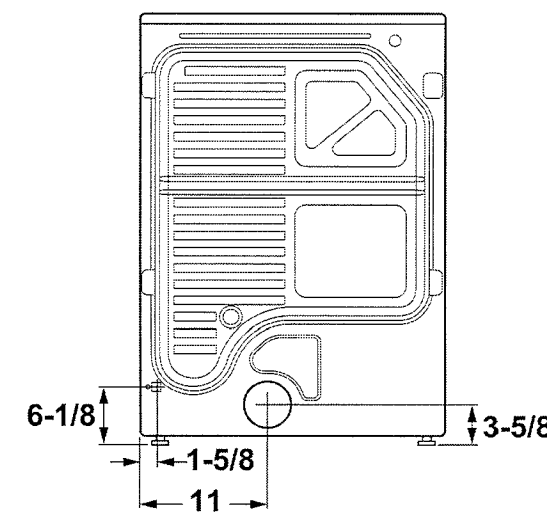

For answers to your Monogram, GE Café® Series, GE Profile® Series or GE Appliances product questions, visit our website at geappliances.com or call GE Answer Center® Service, 800.626.2000.



Specification Revised 11/19

STANDARD DRYER

GUV27ESSM

GE® Unitized Spacemaker® 3.8 DOE Cu. Ft. Stainless Steel Washer and 5.9 Cu. Ft. Long Vent Electric Dryer


DIMENSIONS AND INSTALLATION INFORMATION (IN INCHES)

ELECTRICAL REQUIREMENTS: This appliance should be connected to an individual, properly-grounded branch circuit with 120/240V or 120/208V single-phase 60 Hz electrical service and should be protected by 30-amp time-delay fuses or circuit breakers KW Rating per voltage (240/208). This appliance is manufactured with neutral connected to the frame. Power cord should be purchased separately. Dryers must be exhausted to the outside.

INSTALLATION INFORMATION: For complete information, see installation instructions packed with the product.

Installation Instructions

27" NOMINAL PRODUCT DIMENSIONS

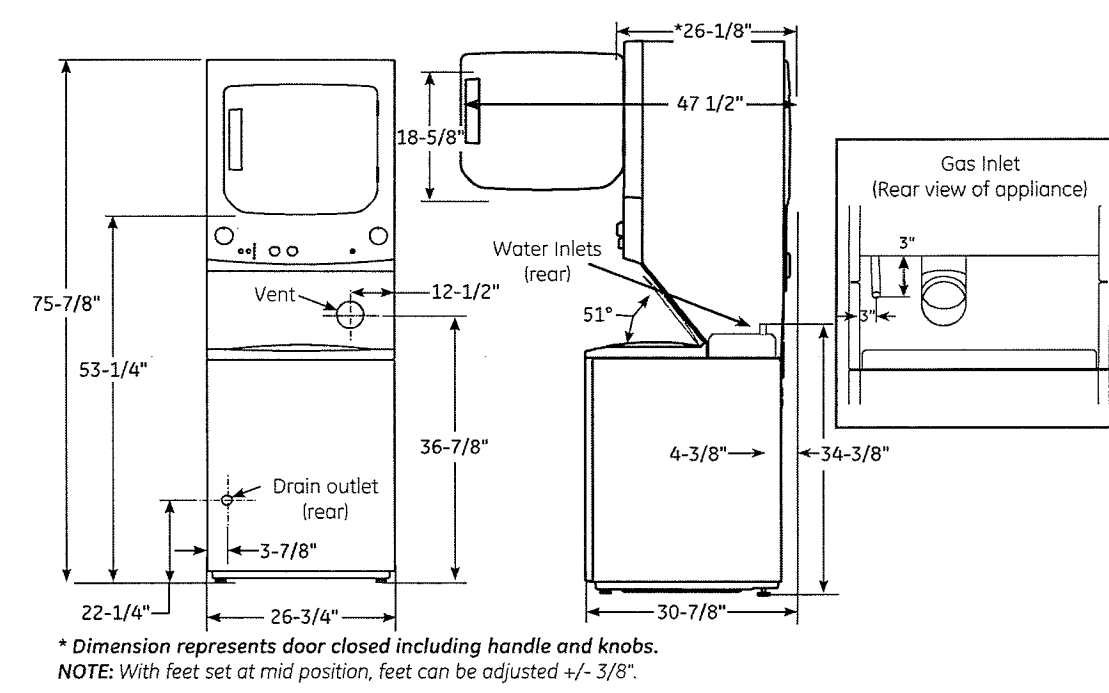

* Dimension represents door closed including handle and knobs. NOTE: With feet set at mid position, feet can be adjusted +/- 3/8".



For answers to your Monogram, GE Café® Series, GE Profile® Series or GE Appliances product questions, visit our website at geappliances.com or call GE Answer Center® Service, 800.626.2000.



Specification Revised 11/17

GUV27ESSM

GE® Unitized Spacemaker® 3.8 DOE Cu. Ft. Stainless Steel Washer and 5.9 Cu. Ft. Long Vent Electric Dryer

DIMENSIONS AND INSTALLATION INFORMATION (IN INCHES)

For complete information, see installation instructions packed with your dryer.

DUCTING MATERIALS:

For best performance, this dryer should be vented with 4" diameter all rigid metal exhaust duct. If rigid metal duct cannot be used, then UL-listed flexible metal (semi-rigid) ducting can be used (Kit WX08X10077). In special installations, it may be necessary to connect the dryer to the house vent using a flexible metal (foil-type) duct. A UL-listed flexible metal (foil-type) duct may be used ONLY in installations where rigid metal or flexible metal (semi-rigid) ducting cannot be used AND where a 4" diameter can be maintained throughout the entire length of the transition duct. Please see installation instruction packed with your dryer for complete instructions when using flexible metal (foil type) ducting.

EXHAUST LENGTH CALCULATION:

- Determine the number of 90° turns needed for your installation. If you exhaust to the side or bottom of dryer, add one turn.
- The maximum length of 4" rigid (aluminum or galvanized) duct which can be tolerated is shown in the table.

For every extra 90° elbow, reduce the allowable vent system length by 10 ft. Two 45° elbows will be treated like one 90° elbow. For the side exhaust installations, add one 90° elbow to the chart. The total vent system length includes all the straight portions and elbows of the system (transition duct included).

Dryers must be exhausted to the outside.

CAUTION: For personal safety do not terminate exhaust into a chimney, under any enclosed house floor (crawl space), or into an attic, since the accumulated lint could create a fire hazard or moisture could cause damage. Never terminate the exhaust into a common duct or plenum with a kitchen exhaust, since the combination of lint and grease could create a fire hazard.

Exhaust ducts should be terminated in a dampered wall cap to prevent back drafts, bird nesting, etc. The wall cap must also be located at least 12" above the ground or any other obstruction with the opening pointed down.

GUV27 DRYER EXHAUST LENGTH

| No. of 90° Elbows | RECOMMENDED MAXIMUM LENGTH | |
|-------------------|----------------------------|-------------|
| | Rigid Metal | Rigid Metal |
| 0 | 200 Feet | 175 Feet |
| 1 | 185 Feet | 165 Feet |
| 2 | 175 Feet | 155 Feet |
| 3 | 165 Feet | 145 Feet |
| 4 | 155 Feet | 135 Feet |
| 5 | 145 Feet | 125 Feet |



For answers to your Monogram, GE Café® Series, GE Profile® Series or GE Appliances product questions, visit our website at geappliances.com or call GE Answer Center® Service, 800.626.2000.



Specification Revised 11/17

SAMPLE LABEL

RISK OF FIRE

THE NET EQUIVALENT LENGTH OF DRYER DUCT FROM THIS LOCATION IS _____ FEET

The maximum allowable exhaust duct length stated in the clothes dryer's installation instructions shall be equal to or greater than the posted equivalent length indicated on this placard.

DO NOT REMOVE OR DEFACE THIS PLACARD

Equivalent length Punch-outs
10's 00 10 20 30 40 50 60 70 80 90 100

Permanently identify length by removing the corresponding 10's and units placed with a hole punch

Units: 00 01 02 03 04 05 06 07 08 09

Dryer Placard ver. 4 - 407
Complies with UL 552 Marking Systems

NOTE:

DRYER MAKE AND MODEL SHOWN ARE THE BASIS OF DESIGN FOR DETERMINING MAXIMUM DRYER VENT LENGTHS. IF A DIFFERENT MAKE/MODEL IS USED, NOTIFY THE ENGINEER AND ARCHITECT IMMEDIATELY TO VERIFY VENT LENGTHS AND TO DETERMINE IF DRYER BOOSTER FANS WILL BE NECESSARY.


PER IMC 504.8.5, CONTRACTOR SHALL PROVIDE A LABEL OR PLACARD WITHIN 6 FEET OF THE EXHAUST DUCT CONNECTION THAT LISTS THE EQUIVALENT LENGTH OF THE DRYER EXHAUST DUCT. SEE SAMPLE LABEL FOR DETAILS.

BASIS OF DESIGN FOR DRYER VENTING

DETAIL

SCALE: NONE

| REVISIONS | DATE | DESCRIPTION |
|-----------|------|-------------|
| NO. | | |

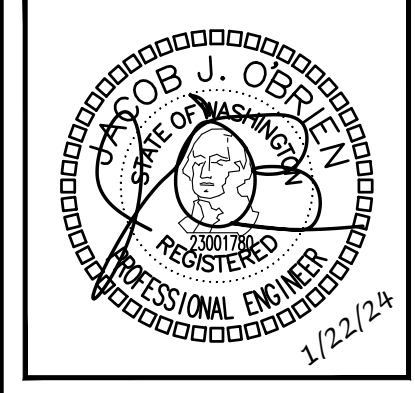

| DRAWN: | OP |
|-----------|-----|
| DESIGNED: | ABE |
| CHECKED: | PR |
| APPROVED: | JMR |


PROJECT: EAST TOWN CROSSING BUILDING B MULTIFAMILY DEVELOPMENT PIONEER WAY & SHAW RD. PUYALLUP, WA

19401 ACOTIAVE W. SUITE 302 LYNNWOOD, WA 98036 PHONE: (206) 964-3343 RE/PROJECT NO.: 810010 CONTACT: ARK@ESPINELI

DATE: 1/22/2024

SHEET TITLE: DETAILS & DIAGRAMS

SHEET NO. M4.0

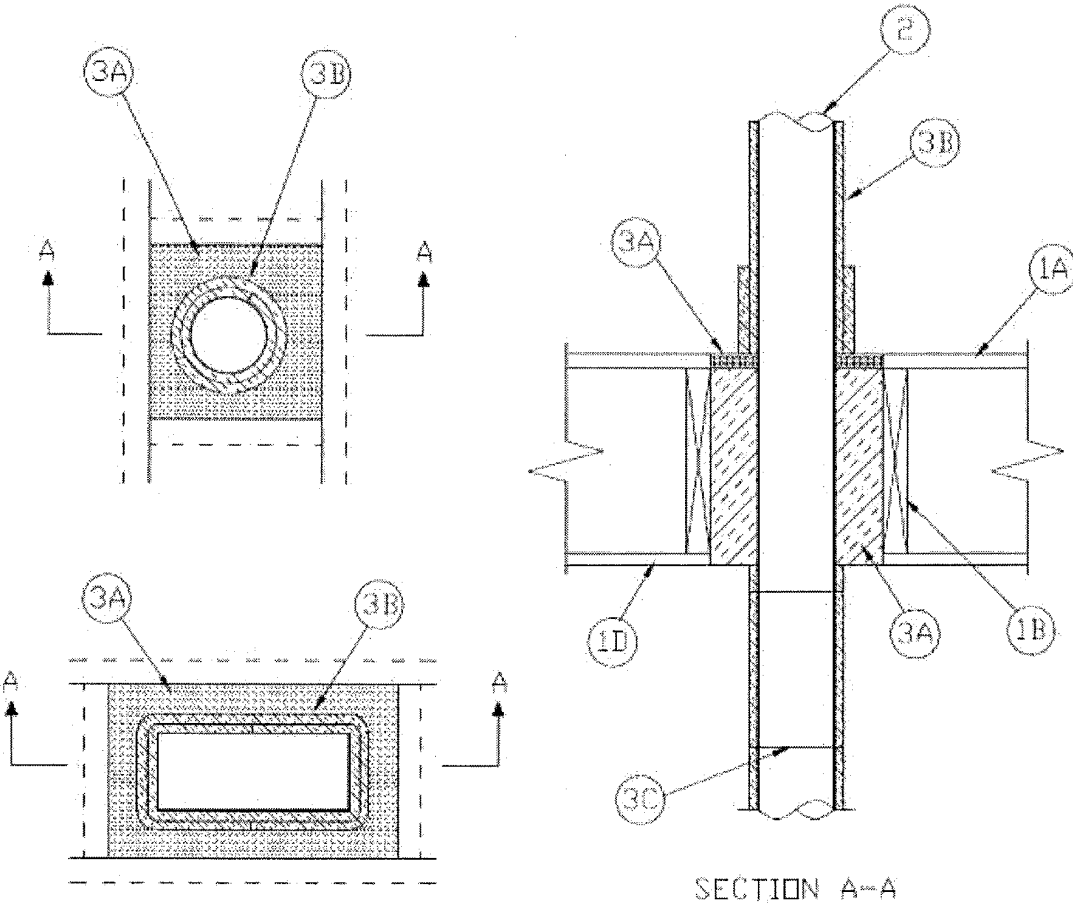

1. **Floor-Ceiling Assembly** – The 1 hr fire-rated solid or trussed lumber joist floor-ceiling assembly shall be constructed of the materials and in the manner specified in the individual 1500 Series Floor-Ceiling Designs in the UL Fire Resistance Directory. The general construction details of the floor-ceiling assembly are summarized below:

- A. **Flooring System** – Lumber or plywood subfloor with finish floor of lumber, plywood or **Floor Topping Mixture** as specified in the individual Floor-Ceiling Design. Max area of floor opening is 150 in.2 (0.98 m²) with a max 1.5 in. (38 mm) annular space between wrapped duct and framing members.
 - B. **Wood Joists** – Nom 10 in. (254 mm) deep (or deeper) lumber, steel or combination lumber and steel joists, trusses or **Structural Wood Members** with bridging as required and with ends firestopped. Additional framing members installed to form a square enclosure around the perimeter of the opening in the floor and ceiling.
 - C. **Furring Channels** – (Where required - not shown) - Resilient galv steel furring installed perpendicular to wood joists between gypsum board and wood joists as specified in the individual Floor-Ceiling Design. Furring channels spaced max 24 in. (610 mm) OC. If furring channels are used within the assembly, additional furring channels to be installed around the periphery of the opening.
 - D. **Gypsum Board*** – Nom 4 ft (1.2 m) wide by 5/8 in. (15.9 mm) thick as specified in the individual Floor-Ceiling Design. Gypsum board secured to wood joists or furring channels as specified in the individual Floor-Ceiling Design. Max area of ceiling opening is 150 in.2 (0.98 m²) with a max 1.5 in. (38 mm) annular space between duct and framing members.
2. **Steel Air Duct** – Max 7 in. (178 mm) diam by min 0.0157 in. (No. 30 gauge or 0.40 mm) thick galv steel air duct to be centered within the firestop system. Max one steel air duct to be installed within opening. Steel duct to be rigidly supported on top side of floor-ceiling assembly.
- 2A. **Steel Air Duct** – Max 10 x 4 in. (254 x 102 mm) rectangular by min 0.022 in. (no. 26 gauge or 0.56 mm) thick galv steel air duct to be centered within the firestop system. Max one steel air duct to be installed within opening. Steel duct to be rigidly supported on top side of floor-ceiling assembly.
3. **Fire-resistive System** – The fire resistive system shall consist of the following:
- A. **Firestop System** – When the ventilation duct passes through a fire rated floor assembly, the through openings shall be firestopped in accordance with System No. F-C-7057.
 - B. **Batts and Blankets*** – 1/2 in. (13 mm) thick, 8 pcf (128 kg/m³) or nom 1-1/2 in.

(38 mm) thick, 6 pcf (96 kg/m³) with foil-scrim facers. The steel duct shall be wrapped with one layer of duct wrap installed with 1 in. (25 mm) transverse and longitudinal overlaps or tightly butted compression joints in accordance with the manufacturer's installation instructions A min 12 in. high collar consisting of an additional layer of 1/2 in. (13 mm) thick, 8 pcf (128 kg/m³) or nom 1-1/2 in. (38 mm) thick, 6 pcf (96 kg/m³) duct wrap, installed over the duct wrap flush with the top surface of the floor and extending upward. All seams and edges shall be sealed with min 3 in. (76 mm) wide pressure sensitive aluminum foil tape.

UNIFRAX I LLC – FyreWrap® DPS or FyreWrap® Elite 1.5

C. **Steel Tie Wire** – Min No. 18 Gauge (0.040 in. or 1 mm) galvanized steel wire formed into a loop on one end, with the other end passed through the loop, pulled hand tight and bent over. Tie wires spaced a max 12 in. (305 mm) OC.

*Bearing the UL Classification Mark

Last Updated on 2013-10-29

Questions? Print this page Terms of Use Page Top

© 2013 UL LLC

When the UL Leaf Mark is on the product, or when the word "Environment" is included in the UL Mark, please search the [UL Environment database](#) for additional information regarding this product's certification.

The appearance of a company's name or product in this database does not in itself assure that products so identified have been manufactured under UL's Follow-Up Service. Only those products bearing the UL Mark should be considered to be Certified and covered under UL's Follow-Up Service. Always look for the Mark on the product.

UL permits the reproduction of the material contained in the Online Certification Directory subject to the following conditions: 1. The Guide Information, Assemblies, Constructions, Designs, Systems, and/or Certifications (files) must be presented in their entirety and in a non-misleading manner, without any manipulation of the data (or drawings); 2. The statement "Reprinted from the Online Certification Directory with permission from UL" must appear adjacent to the extracted material. In addition, the reprinted material must include a copyright notice in the following format: "© 2013 UL LLC".

UL ONLINE CERTIFICATIONS DIRECTORY

Assembly No. V-32
HNLJ-V-32
Ventilation Duct Assemblies

Page Bottom

Design/System/Construction/Assembly Usage Disclaimer

- Authorities Having Jurisdiction should be consulted in all cases as to the particular requirements covering the installation and use of UL Certified products, equipment, system, devices, and materials.
- Authorities Having Jurisdiction should be consulted before construction.
- Fire resistance assemblies and products are developed by the design submitter and have been investigated by UL for compliance with applicable requirements. The published information cannot always address every construction nuance encountered in the field.
- When field issues arise, it is recommended the first contact for assistance be the technical service staff provided by the product manufacturer noted for the design. Users of fire resistance assemblies are advised to consult the general Guide Information for each product category and each group of assemblies. The Guide Information includes specifics concerning alternate materials and alternate methods of construction.
- Only products which bear UL's Mark are considered Certified.

Ventilation Duct Assemblies

See General Information for Ventilation Duct Assemblies

Assembly No. V-32
October 29, 2013

| Duct A | Fire Resistance Rating |
|--------|------------------------|
| | 1 Hr |

UL ONLINE CERTIFICATIONS DIRECTORY

UL Product iQ
UL'S NEXT GENERATION CERTIFICATIONS SEARCH
The same trusted data in a modern search engine. **NOW AVAILABLE** [LEARN MORE](#)

System No. F-C-7057
XHEZ-F-C-7057
Through-penetration Firestop Systems

Page Bottom

Design/System/Construction/Assembly Usage Disclaimer

- Authorities Having Jurisdiction should be consulted in all cases as to the particular requirements covering the installation and use of UL Certified products, equipment, system, devices, and materials.
- Authorities Having Jurisdiction should be consulted before construction.
- Fire resistance assemblies and products are developed by the design submitter and have been investigated by UL for compliance with applicable requirements. The published information cannot always address every construction nuance encountered in the field.
- When field issues arise, it is recommended the first contact for assistance be the technical service staff provided by the product manufacturer noted for the design. Users of fire resistance assemblies are advised to consult the general Guide Information for each product category and each group of assemblies. The Guide Information includes specifics concerning alternate materials and alternate methods of construction.
- Only products which bear UL's Mark are considered Certified.

XHEZ - Through-penetration Firestop Systems

XHEZ7 - Through-penetration Firestop Systems Certified for Canada

See General Information for Through-penetration Firestop Systems

See General Information for Through-penetration Firestop Systems Certified for Canada

System No. F-C-7057
March 27, 2017

| ANSI/UL1479 (ASTM E814) | CAN/ULC S115 |
|-------------------------|-------------------|
| F Rating – 1 Hr | F Rating – 1 Hr |
| T Rating – 1 Hr | FT Rating – 1 Hr |
| | FH Rating – 1 Hr |
| | FTH Rating – 1 Hr |

UNIFRAX Product Information Sheet

FyreWrap® DPS Insulation
Dryer Protection System

Introduction
Unifrax's FyreWrap® DPS Insulation is a high-temperature insulation blanket specifically designed, UL tested and certified to provide a single layer, one-hour rated flexible enclosure around dryer and residential kitchen exhaust ductwork.

Dryer Exhaust Applications
FyreWrap DPS is an innovative product that provides a safe and cost-effective means to achieve a one-hour fire resistance rated zero clearance enclosure for routing dryer ductwork, from start to finish, through rated wood truss/joist construction as prescribed by the International Building and Mechanical Codes.

FyreWrap DPS Insulation offers the following product features:

- Lightweight, flexible product form
- Scrim encapsulated
- Easy to cut, fabricate, wrap around ducts, pipes or cables
- Thin, single-layer design
- High-temperature, low bioperisability fiber

Product Components
Core Material: FyreWrap DPS Insulation incorporates Insulfrax® Thermal Insulation as its core material. Insulfrax is a high-temperature insulation made from a calcia, magnesia, silica chemistry designed to enhance bioperisability. It provides excellent insulation in a noncombustible blanket product form.

Typical System Properties

| | |
|------------------------------------|---|
| ISO 6944 | UL Assembly No. V-32, ULC Assembly No. FRD-29 |
| UL 1479 (ASTM E814), CAN/ULC S115 | UL Assembly Nos. F-C-7057, F-C-7058 |
| Intertek Laboratories (CPL) Listed | Applied Fire Protection, File 16341-3 |
| ASTM E136 Noncombustibility Test | Passes |
| ASTM E84, UL 723, ULC S102.2 | UL File No. R14514 |
| Flame Spread Rating: | Unfaced Blanket |
| Smoke Developed Rating: | Encapsulated |
| | Zero |
| | <25 |
| | Zero |
| | <50 |

Encapsulating Material: The core insulation blanket is completely encapsulated in an aluminum foil, fiberglass reinforced scrim covering. This scrim provides additional handling strength as well as protection from moisture absorption and tearing.

Typical Product Parameters

| | |
|----------------------|--------------|
| Thickness | 1/2" |
| Density | 8pcf |
| Scrim Encapsulated | |
| Covering | 16" w x 25LF |
| Product Availability | 24" w x 25LF |
| | 26" w x 25LF |
| | 48" w x 25LF |

Typical System Properties

| | |
|-------------------------|------|
| Flame Spread Rating: | Zero |
| Smoke Developed Rating: | Zero |

Refer to the product Safety Data Sheet (SDS) No. M0456 for recommended work practices and other product safety information.

FyreWrap

Installation
FyreWrap DPS Insulation consists of a single-layer system applied directly on to the surface of the duct or combustible item.

Dryer Applications
Install the insulation around the duct to provide a 1" longitudinal compression joint or overlap. Adjacent pieces of insulation should be installed with a 1" perimeter compression joint or material overlap. The 16" wide DPS product facilitates linear installation around 4" diameter dryer ductwork without material cutting or scrap. The same technique can be used with wrapping 26" wide FyreWrap DPS on 7" diameter dryer ductwork. To temporarily secure the insulation, optional use of foil tape is permitted. Seal all cut edges with aluminum foil tape to ensure there is no exposed fiber. 18 gauge steel tie wire should be utilized for permanent attachment. Locate the wire 1/2" from the blank edge and on maximum 12" centers. Twist tension the wire to firmly hold the wrap system in place, but not so tight as to cut or damage the blanket. Installation details are provided below for additional illustration.

Unifrax has a wide range of FyreWrap fire protection materials available to provide passive fire protection solutions in a variety of applications in the commercial building, industrial facility and transportation industries.

For additional information about product performance or for assistance identifying the recommended product for your fire protection application, please contact Unifrax at 716-768-6500 and ask for Fire Protection Application Engineering.

FyreWrap® DPS – Dryer Protection System FP-950

Figure 1: Max. 7" Dryer Duct, 1-Hour Enclosure

Figure 2: UL Tested 1-Hour Membrane Penetration

Figure 3: UL Tested 1-Hour Dryer Duct System

From C-4055 Effective 6/16 © 2013 Unifrax I LLC All Rights Reserved Printed in USA Page 2 of 2

The following are registered trademarks of Unifrax: FyreWrap, Insulfrax.



The test data shown are average results of tests conducted under standard procedures and are subject to variation. Results should not be used for specification purposes.

Product information sheets are periodically updated by Unifrax. Before relying on any data or other information in this Product Information Sheet, you should confirm that it is still current and has not been superseded. A Product Information Sheet that has been superseded may contain incorrect, obsolete and/or irrelevant data and other information.

Unifrax I LLC
Corporate Headquarters
600 Riverwalk Parkway
Suite 120
Babylon, NY 11550
Telephone: 716-768-6500
Canada: 1-800-635-4464
Internet: www.unifrax.com
Email: info@unifrax.com

DUCT FIRE WRAP
DETAIL
SCALE: NONE

| REVISIONS | DESCRIPTION | DATE |
|-----------|-------------|------|
| NO. | | |

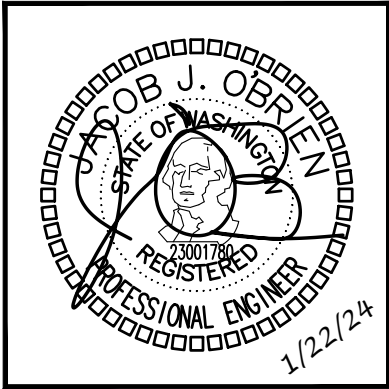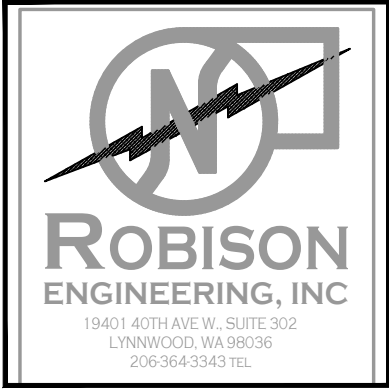

| | |
|-----------|-----|
| DRAWN: | OP |
| DESIGNED: | ABE |
| CHECKED: | PR |
| APPROVED: | JMR |

PROJECT: EAST TOWN CROSSING BUILDING B
MULTIFAMILY DEVELOPMENT
PIONEER WAY & SHAW RD. PUVALUP, WA

19401 ACOTIAVE W. SUITE 302
LYNNWOOD, WA 98036
PHONE: (206) 964-3343
REPROJECT NO.: 810010
CONTACT: ARK@ESPINELI

ROBISON ENGINEERING, INC.

DATE:
1/22/2024

SHEET TITLE:
DETAILS & DIAGRAMS

SHEET NO.
M4.1

GENERAL NOTES

- REFERENCE TO RELATED WORK: "REF" INDICATIONS DENOTE WORK COVERED ELSEWHERE (ARCHITECTURAL, STRUCTURAL, CIVIL, ELECTRICAL, LANDSCAPE, OR KITCHEN), OR ITEM BASED ON A SPECIFIC MANUFACTURER'S DIMENSIONS (VERIFY).
- ELECTRICAL CHARACTERISTICS: REFER TO ELECTRICAL DRAWINGS FOR ELECTRICAL CHARACTERISTICS (VOLTAGES, ETC. OF MECHANICAL EQUIPMENT, UNLESS OTHERWISE INDICATED).
- CODES: COMPLETE INSTALLATION OF THE PLUMBING SYSTEM SHALL BE PER THE APPLICABLE BUILDING, MECHANICAL, ENERGY, PLUMBING, FIRE, AND HEALTH CODES AND REGULATIONS AS ADOPTED BY THE LOCAL AHJ.
- PREPARE AND SUBMIT FOR REVIEW A SHOP DRAWING BASED ON FINAL STRUCTURAL SHOP DRAWINGS FOR LOCATING AND ROUTING ALL EQUIPMENT, PIPING, ETC.
 - COORDINATE FLOOR AND BEAM PENETRATIONS WITH STRUCTURAL.
 - COORDINATE FINAL LOCATION AND ROUTING WITH CEILING, LIGHTS, WALLS, FIRE SPRINKLER PIPING, AND OTHER TRADES WORK.
 - INCLUDE ADDITIONAL OFFSETS, ELBOWS, ROUTING, EQUIVALENT DUCT SIZING EXCHANGE, RELOCATING, ETC. AS REQUIRED FOR A COMPLETE OPERATING MECHANICAL SYSTEM.
 - PROVIDE SHOP DRAWINGS AT NO ADDITIONAL COST TO THE OWNER.
- PLUMBING CONTRACTOR SHALL LOCATE AND COORDINATE EXACT LOCATION OF ALL PLUMBING EQUIPMENT WITHIN THE STRUCTURE.
- ACCESS DOORS: COORDINATE WITH ARCHITECT AND LOCATE ALL ACCESS DOORS ON SHOP DRAWINGS PRIOR TO BEGINNING OF CONSTRUCTION. ACCESS DOORS IN FIRE RATED STRUCTURE SHALL BE FIRE RATED. VERIFY ACCESS DOOR LOCATIONS WITH GENERAL CONTRACTOR PRIOR TO BIDDING.
- ROOF PENETRATIONS: SEE ARCHITECTURAL DRAWINGS FOR ROOF CAP, ROOF CURB, ROOF DRAIN, OVERFLOW DRAINS AND VTR DETAILS.
- EXPOSED PIPING: PROVIDE CHROME PLATING FOR EXPOSED PIPING IN FINISHED ROOMS.
- PENETRATIONS: PROVIDE ESCUTCHEON PLATES FOR EXPOSED PIPING PENETRATIONS AND SHEET METAL FLASHING FOR EXPOSED DUCTWORK PENETRATIONS.
- SHAFT AND PLENUM CONNECTIONS: SEAL CONNECTIONS TO AIR SHAFTS AIRTIGHT. PROVIDE AIRTIGHT SEAL AROUND PENETRATIONS IN AIR PLENUMS.
- LIGHT FIXTURE CLEARANCE: COORDINATE LOCATIONS OF MECHANICAL WORK TO PROVIDE CLEARANCES OVER LIGHTING FIXTURES FOR REMOVAL AND REPLACEMENT.
- CABLE TRAYS: PIPING INSTALLED ADJACENT TO ELECTRICAL CABLE TRAYS SHALL ALLOW MINIMUM ACCESS OF 6" ABOVE AND TO THE SIDE OF CABLE TRAYS.
- MOTORS: COMPLY WITH ENERGY CODE ENFORCED BY AHJ FOR MINIMUM EFFICIENCIES UNDER FULL LOAD.
- ACCESS CLEARANCES FOR MAINTENANCE AND REPLACEMENT: VERIFY PHYSICAL DIMENSIONS OF EQUIPMENT TO ENSURE THAT ACCESS CLEARANCES CAN BE MET. COORDINATE LOCATIONS OF MECHANICAL WORK AND WORK OF OTHER TRADES TO PROVIDE ACCESS CLEARANCES FOR SERVICE AND MAINTENANCE.

COORDINATION REQUIREMENTS

- IRRIGATION SYSTEM: COORDINATE IRRIGATION WATER DEMAND, MINIMUM WATER PRESSURE REQUIREMENTS & CONTROL CABINET LOCATIONS WITH IRRIGATION CONTRACTOR.
- GAS: CONTRACTOR/GAS COMPANY SHALL FINALIZE GAS METER AND GAS SERVICE LOCATIONS. INSTALL SEISMIC GAS SHUT OFF VALVE PER GAS COMPANY REGULATIONS.
- UTILITIES: COORDINATE WITH SITE UTILITY CONTRACTOR AND CIVIL DRAWINGS FOR UTILITY CONNECTIONS AND EXTENSIONS.
- ROOF DRAINAGE: COORDINATE WITH GENERAL CONTRACTOR FOR ROOF DRAIN AND OVERFLOWS, SCUPPER DRAINS, AND CONDENSATE DRAINS.
- PLUMBING FIXTURES & EQUIPMENT: COORDINATE EXACT LOCATION OF ALL PLUMBING FIXTURES & EQUIPMENT WITH ARCHITECTURAL AND OTHER TRADES DOCUMENTS.
- PIPING: COORDINATE EXACT LOCATION OF ALL STRUCTURAL FRAMING & FOOTINGS AND FINALIZE THE EXACT ROUTING OF ALL PIPES WITH STRUCTURAL ENGINEER AT THE SITE PRIOR TO AND DURING THE CONSTRUCTION. COORDINATE UNDER GRADE PIPING & FOUNDATION DRAINAGE PIPING WITH CIVIL ENGINEER.
- ADJUSTMENTS: ALL EQUIPMENT, MOTORS, FANS GAS BURNERS, IGNITION DEVICES, DRIVES, ETC. SHALL BE ADJUSTED AND BALANCED TO OPERATE AT SPECIFIED RATINGS AS REQUIRED FOR THIS PROJECT SITE AND ACCOUNTING FOR ELEVATION ABOVE SEA LEVEL.
- APPROVALS: MECHANICAL AND PLUMBING EQUIPMENT SHALL BE APPROVED FOR INSTALLATION IN THE PROJECT LOCATION AND SHALL HAVE ALL CERTIFICATIONS AND RATINGS TO MEET ALL ENERGY, POLLUTION, ENVIRONMENTAL, SEISMIC, APPLICABLE CODES AND REGULATIONS. THE CONTRACTOR SHALL COORDINATE WITH MANUFACTURE SUPPLIERS AND SHALL INCLUDE ALL COSTS REQUIRED TO MEET THE BID DOCUMENTS.
- FIRE PROTECTION: CONTRACTOR SHALL PROVIDE A FULLY DESIGNED FIRE PROTECTION SPRINKLER SYSTEM IN COMPLIANCE WITH NFPA AND LOCAL CODES. PROVIDE DESIGN, PERMITS, MATERIALS, INSTALLATION, TESTING AND ALL OTHER FOR A FULLY OPERATIONAL SYSTEM. LOCATION OF ALL PIPING TO BE COORDINATED WITH OTHER TRADES.
- PRIOR TO PIPING INSTALLATION: PLUMBING CONTRACTOR TO COORDINATE PIPING LAYOUT WITH ALL OTHER TRADES.
- ACCESS: COORDINATE ALL ACCESS LOCATIONS WITH GENERAL CONTRACTOR AND ARCHITECT TO ENSURE ALL REQUIRED ACCESS HATCHES, ACCESS PANELS & ACCESS COVERS ARE PROVIDED.
- PROVIDE WATER TIGHT SEALS FOR ANY PIPING PENETRATING THE EXTERIOR FOUNDATION WALLS OR SLABS.
- ANY DISCREPANCIES SHOULD BE REPORTED TO THE ARCHITECT IMMEDIATELY.
- PROVIDE FIRE PROOFING FOR ALL PIPING PENETRATING FIRE BARRIER WALLS OR FLOOR SLABS.

SYMBOLS

| GENERAL | | SECTION IDENTIFICATION | | DETAIL IDENTIFICATION | | EQUIPMENT | | PIPING | | PIPE SYMBOLS | | | | | | | | | | | | | | | | | | | | | | | | | | | | | | | | | | | | | | | | | | | | | |
|---|
| | ARCHITECTURAL BACKGROUND (THIN LINE) | | NEW PIPING (HEAVY LINE) | | EXISTING PIPING (THIN LINE) | | EXISTING WORK TO BE REMOVED | | MATCHLINE OR PROPERTY LINE | | CONNECTION TO EXISTING | |
| | INDICATES DIRECTION OF CUTTING PLANE | | LETTER INDICATES SECTION (NO. INDICATES DETAIL) | | SHEET NUMBER WHERE SECTION IS DRAWN | | SHEET NUMBER WHERE SECTION IS TAKEN | | DETAIL NUMBER | | DRAWING/SHEET NUMBER | |
| | TYPICAL EQUIPMENT DESIGNATION | | WASTE BELOW GRADE | | WASTE ABOVE GRADE | | PUMPED WASTE | | INDIRECT WASTE | | SANITARY SEWER BELOW GRADE | | SANITARY SEWER ABOVE GRADE | | PUMPED SANITARY SEWER | | VENT | | STORM DRAIN | | OVERFLOW STORM DRAIN | | PUMPED STORM DRAIN | | CONDENSATE DRAIN | | PUMPED CONDENSATE DRAIN | | COLD WATER (CW) | | HOT WATER (HW), POTABLE, 120°F | | HOT WATER, POTABLE, TEMPERATURE OTHER THAN 120°F | | HOT WATER CIRCULATING (HWC), POTABLE, 120°F | | HOT WATER CIRCULATING, POTABLE, TEMPERATURE OTHER THAN 120°F | | FUEL OIL FILL | | FUEL OIL SUPPLY | | FUEL OIL RETURN | | FUEL OIL VENT | | RELIEF VENT | | LOW PRESSURE NATURAL GAS | | MEDIUM PRESSURE NATURAL GAS | | IRRIGATION (NON POTABLE) | | FIRE MAIN |
| | TOP PIPE CONNECTION | | BOTTOM PIPE CONNECTION | | PIPE TURNING UP | | PIPE TURNING DOWN/DROP | | PIPE CAP | | PIPE PLUG | | UNION | | FLANGE | | WYE STRAINER | | WYE STRAINER WITH CAPPED HOSE END BLOWDOWN VALVE | | BALL VALVE | | 
NOTE TO CONTRACTOR

DRAWINGS ARE DIAGRAMMATIC, SHOWING THE GENERAL LOCATION, TYPE, LAYOUT, AND EQUIPMENT REQUIRED. THE DRAWINGS SHALL NOT BE SCALED FOR EXACT MEASUREMENT. REFER TO ARCHITECTURAL DRAWINGS FOR DIMENSIONS. REFER TO MANUFACTURER'S STANDARD INSTALLATION DRAWINGS FOR EQUIPMENT CONNECTIONS AND INSTALLATION REQUIREMENTS. PROVIDE DUCTWORK, CONNECTIONS, ACCESSORIES, OFFSETS, AND MATERIALS NECESSARY FOR A COMPLETE SYSTEM.

ABBREVIATIONS

| | | | | | |
|-------|-------------------------------|-------|---------------------------------|------|-------------------------------------|
| ABV | ABOVE AREA DRAIN | FLR | FLOOR | OPD | OVER PRESSURE DEVICE |
| AD | AREA DRAIN | FPM | FEET PER MINUTE | OPNG | OPENING |
| AFF | ABOVE FINISHED FLOOR | FPS | FEET PER SECOND | P | PUMP |
| AHJ | AUTHORITY HAVING JURISDICTION | FS | FLOOR SINK | PD | PRESSURE DROP, PLANTER DRAIN |
| BFF | BELOW FINISHED FLOOR | FT | FEET | POC | POINT OF CONNECTION |
| BFP | BACKFLOW PREVENTER | FU | FIXTURE UNITS | PRV | PRESSURE REDUCING VALVE |
| BOH | BACK OF HOUSE | G | GAS (LOW PRESSURE) | PS | PRESSURE RELIEF VALVE |
| BP | BOOSTER PUMP | GAL | GALLONS | PSIG | PUMPED STORM DRAINAGE |
| BT | BATHTUB | GD | GARAGE DRAIN | PSIG | POUNDS PER SQUARE INCH GAUGE |
| BTUH | BRITISH THERMAL UNIT PER HOUR | GM | GAS METER | PSD | PUMPED STORM DRAINAGE |
| BV | BALANCING VALVE | GPG | GRAINS PER GALLON | PSS | PUMPED SANITARY SEWER |
| C | COMMON | GPM | GALLONS PER MINUTE | PSW | PUMPED SANITARY WASTE |
| CAP | CAPACITY | GV | GATE VALVE | PW | PUMPED WASTE |
| CB | CATCH BASIN | GW | GAS WATER HEATER | RD | ROOF DRAIN |
| CD | CONDENSATE DRAIN | HB | HOSE BIBB | REF | REFERENCE |
| CFF | CAPPED FOR FUTURE | HD | HEAD | RPBP | REDUCED PRESSURE BACKFLOW PREVENTER |
| CFM | CUBIC FEET PER MINUTE | HDR | HUB DRAIN | RPM | REVOLUTIONS PER MINUTE |
| CI | CAST IRON | HEDV | HOSE END DRAIN VALVE | S | SINK |
| CLG | CEILING, COOLING | HORIZ | HORIZONTAL | SCH | SCHEDULE |
| CLW | CLOTHES WASHER | HP | HORSEPOWER | SCW | SOFTENED COLD WATER |
| CO | CLEANOUTS | HPCW | HIGH PRESSURE COLD WATER | SD | STORM DRAIN |
| COMB | COMBUSTION | HW | HOT WATER | SEP | SEWAGE EJECTOR PUMP |
| CONT | CONTINUE, CONTROL | HWC | HOT WATER RE-CIRCULATION | SF | SQUARE FOOT |
| CONTR | CONTRACTOR | HWCP | HOT WATER CIRCULATION PUMP | SGSV | SEISMIC GAS SHUT-OFF VALVE |
| COTG | CLEANOUTS TO GRADE | HWR | HOT WATER RETURN | SH | SHOWER |
| CP | CIRCULATING PUMP | HWST | HOT WATER STORAGE TANK | SO | STORM OVERFLOW |
| CV | CHECK VALVE | HX | HEAT EXCHANGER | SP | STATIC PRESSURE/SUMP PUMP |
| CW | COLD WATER | ICW | INDUSTRIAL COLD WATER | SUDS | SUDS RELIEF |
| D | DIAMETER | ID | INDIRECT DRAIN, INSIDE DIAMETER | SR | STAINLESS STEEL/SANITARY SEWER |
| DB | DRY BULB, DECIBEL | IE | INVERT ELEVATION | SS | STAINLESS STEEL/SANITARY SEWER |
| DF | DRINKING FOUNTAIN | IHW | INDUSTRIAL HOT WATER | SSS | SIDE SANITARY SEWER |
| DFU | DRAIN FIXTURE UNITS | IN | INCH | STD | STANDARD |
| DI | DUCTILE IRON | KS | KITCHEN SINK | SQ | SQUARE |
| DIM | DIMENSION | KW | KILOWATT | TD | TRENCH DRAIN |
| DN | DOWN | L | LONG, LENGTH | TMV | THERMOSTATIC MIXING VALVE |
| DS | DOWN SPOUT | LAV | LAVATORY | TP | TRAP PRIMER |
| DWG | DRAWING | LB | POUND | TYP | TYPICAL |
| (E) | EXISTING | M | METER | UH | UNIT HEATER |
| EFF | EFFICIENCY | MBH | THOUSAND BTU PER HOUR | UON | UNLESS OTHERWISE NOTED |
| ELEC | ELECTRIC | MECH | MECHANICAL | UR | URINAL |
| EQUIV | EQUIVALENT | MCA | MIN. CIRCUIT AMPACITY | V | VENT |
| EWC | ELECTRIC WATER COOLER | MOC | MAX. OVER CURRENT PROTECTION | VTR | VENT THRU ROOF |
| EW | ELECTRIC WATER HEATER | MPG | MEDIUM PRESSURE GAS | W | WASTE, WATT, WIDE |
| EXT | EXTERIOR, EXTERNAL | MTD | MOUNTED | WC | WATER CLOSET |
| F | FAHRENHEIT | (N) | NEW | WCO | WALL CLEANOUTS |
| FCO | FLOOR CLEANOUTS | NC | NORMALLY CLOSED | WHD | WALL HYDRANT |
| FD | FLOOR DRAIN | NO | NORMALLY OPEN | WM | WASHING MACHINE |
| FDC | FIRE DEPARTMENT CONNECTION | OD | OUTSIDE DIMENSION/DIAMETER | WSFU | WATER SUPPLY FIXTURE UNITS |
| FF | FINISHED FLOOR | | OVERFLOW DRAIN/DECK DRAIN | | |

DRAWING INDEX

| DWG | DESCRIPTION | INCLUDED IN SET |
|-------|--|-----------------|
| P0.00 | LEGEND, GENERAL NOTES, AND DRAWING INDEX | X |
| P0.01 | PLUMBING NOTES, TABLES AND CODES | X |
| P0.02 | PLUMBING FIXTURE UNIT COUNTS AND FIXTURE/RAIN SCHEDULES | X |
| P0.03 | PLUMBING EQUIPMENT SCHEDULES, PIPE SIZING TABLES AND PRESSURE CALCULATIONS | X |
| P2.B0 | BUILDING B - UNDERSLAB AND LEVEL 1 PLUMBING PLANS | X |
| P2.B1 | BUILDING B - LEVEL 1 AND LEVEL 2 PLUMBING PLANS | X |
| P2.B2 | BUILDING B - ROOF PLUMBING PLAN | X |
| P3.00 | ENLARGED UNIT PLANS | X |
| P4.00 | DETAILS | X |
| P4.01 | DETAILS | X |
| P4.02 | DETAILS | X |
| P6.B0 | BUILDING B - WASTE DIAGRAMS | X |
| P6.B1 | BUILDING B - WASTE DIAGRAMS | X |

| NO. | DATE | DESCRIPTION |
|-----|------|-------------|
| | | |
| | | |
| | | |



| | | | | | | | |
|--------|----|-----------|----|----------|----|-----------|----|
| DRAWN: | JD | DESIGNED: | JD | CHECKED: | RJ | APPROVED: | RJ |
|--------|----|-----------|----|----------|----|-----------|----|

PROJECT: **EAST TOWN CROSSING**
MULTIFAMILY DEVELOPMENT
PIONEER WAY & SHAW RD. PUYALLUP, WA

19401 40TH AVE W, SUITE 302
LYNNWOOD, WA 98036
PHONE: 206-864-3343

ROBISON ENGINEERING, INC.

PERMIT PLANS
01/22/2024

SHEET TITLE:
LEGEND, GENERAL
NOTES, &
DRAWING INDEX

SHEET NO.
P0.00

PLUMBING TABLES

PIPE INSULATION SCHEDULE

| SERVICE | OPTION 1 | | OPTION 2 | | VAPOR RETARDER REQUIRED | NOTES |
|---|---|---|----------|---|-------------------------|--------|
| | MATERIAL | THICKNESS | MATERIAL | THICKNESS | | |
| DOMESTIC COLD WATER, IRRIGATION WATER, CONDENSATE DRAINS, STORM DRAIN (IN CONDITIONED SPACE) | MINERAL-FIBER WITH JACKET | ALL SIZES: 1/2" | PVC/NBR | ALL SIZES: 3/8" | YES | 12,13 |
| DOMESTIC COLD WATER, IRRIGATION WATER, CONDENSATE DRAINS, WASTE (OUTSIDE THE CONDITIONED SPACE) | MINERAL-FIBER WITH JACKET | (R-3) 1/2" PIPE: 1/2" ALL OTHER SIZES: 1" | PVC/NBR | (R-3) 1/2" PIPE: 1/2" ALL OTHER SIZES: 3/4" | YES | 7,8,10 |
| ROOF DRAIN BODIES | MINERAL-FIBER OR CELLULAR GLASS WITH JACKET | 1" | PVC/NBR | 1" | YES | 12 |
| DOMESTIC HOT WATER AND RECIRCULATED HOT WATER (RESIDENTIAL) | MINERAL-FIBER WITH JACKET | (R-3) 1/2" PIPE: 1/2" ALL OTHER SIZES: 1" | PVC/NBR | (R-3) 1/2" PIPE: 1/2" ALL OTHER SIZES: 3/4" | NO | 2,10 |
| DOMESTIC HOT WATER AND RECIRCULATED HOT WATER (NONRESIDENTIAL) | MINERAL-FIBER WITH JACKET | 1/2"-1 1/4" PIPE: 1" 1 1/2"-4" PIPE: 1.5" | PVC/NBR | 1/2"-1 1/4" PIPE: 1" 1 1/2"-4" PIPE: 1.5" | NO | 3,9 |
| EXPOSED SANITARY DRAINS AND DOMESTIC WATER SUPPLIES AND STOPS FOR ADA FIXTURES. | TRUEBRO LAV-GUARD | N/A | N/A | N/A | NO | 11 |

NOTES:

- PIPING INSULATION EXPOSED TO THE WEATHER SHALL BE PROTECTED FROM DAMAGE. CONTRACTOR SHALL PROVIDE SHIELDING FROM SOLAR RADIATION THAT CAN CAUSE DEGRADATION OF THE MATERIAL. ADHESIVE TAPE SHALL NOT BE PERMITTED.
- PER 2015 WSEC SECTION R403.5.3 (RESIDENTIAL) INSULATION FOR HOT WATER PIPE SHALL HAVE A MINIMUM R-VALUE OF R-3.
- PIPING FROM WATER HEATER TO THE TERMINATION OF HEATED WATER SUPPLY PIPE SHALL BE INSULATED IN ACCORDANCE WITH TABLE C403.2.9.
- ON BOTH THE INLET AND OUTLET PIPING OF A STORAGE HOT WATER HEATER, THE FIRST 8 FEET OF PIPING OR PIPING FROM WATER HEATER TO HEAT TRAP SHALL BE INSULATED.
- HEAT TRACED PIPING SHALL BE INSULATED IN THE SAME MANNER AS NON HEAT TRACED PIPING OR PER THE HEAT TRACE MANUFACTURER'S INSTRUCTIONS.
- TUBULAR PIPING INSULATION SHALL NOT BE REQUIRED FOR THE FOLLOWING:
 - THE TUBING FROM THE CONNECTION AT THE TERMINATION OF THE FIXTURE SUPPLY PIPING TO A PLUMBING FIXTURE OR PLUMBING APPLIANCE.
 - VALVES, PUMPS, STRAINERS, AND THREADED UNIONS IN PIPING THAT IS 1 INCH OR LESS IN NOMINAL DIAMETER.
 - PIPING FROM USER-CONTROLLED SHOWER AND BATH MIXING VALVES TO THE WATER OUTLETS.
 - COLD WATER PIPING OF A DEMAND RECIRCULATION WATER SYSTEM.
 - TUBING FROM A HOT DRINKING-WATER HEATING UNIT TO THE WATER OUTLET.
 - PIPING AT LOCATIONS WHERE A VERTICAL SUPPORT OF THE PIPING IS INSTALLED.
 - PIPING SURROUNDED BY BUILDING INSULATION WITH A THERMAL RESISTANCE (R-VALUE) OF NOT LESS THAN R-3.
 - HOT WATER PIPING THAT IS PART OF THE FINAL PIPE RUN TO THE PLUMBING FIXTURE AND IS NOT PART OF THE HEATED-WATER CIRCULATION SYSTEM CIRCULATION PATH IS NOT REQUIRED TO MEET THE MINIMUM INSULATION REQUIREMENTS OF C404.6.
- PER 2015 UPC SECTION 312.6 NO WATER, SOIL, OR WASTE PIPE SHALL BE INSTALLED OR PERMITTED OUTSIDE OF A BUILDING, IN ATTICS OR CRAWL SPACES, OR IN AN EXTERIOR WALL UNLESS, WHERE NECESSARY, ADEQUATE PROVISION IS MADE TO PROTECT SUCH PIPE FROM FREEZING. ALL HOT AND COLD WATER PIPES OUTSIDE THE CONDITIONED SPACE SHALL BE PROVIDED WITH INSULATION WITH A MINIMUM R-VALUE OF R-3.
- HEAT TRACING SHALL BE PROVIDED FOR COLD WATER AND IRRIGATION WATER IN UNCONDITIONED SPACES. CONTACT ENGINEERING IF NECESSARY. PER 2015 WSEC SECTION C403.12.3 FREEZE PROTECTION SYSTEMS, SUCH AS HEAT TRACING OF OUTDOOR PIPING, SHALL INCLUDE AUTOMATIC CONTROLS CONFIGURED TO SHUT OFF THE SYSTEMS WHEN OUTDOOR AIR TEMPERATURES ARE ABOVE 40°F.
- PER 2015 WSEC TABLE C403.2.9 INSULATION FOR HOT WATER AND HOT WATER RECIRCULATION SHALL HAVE A THERMAL CONDUCTIVITY OF 0.21-0.28 (BTU·IN/H·FT²·°F) AT OPERATING TEMPERATURE.
- INSULATION R-VALUE SHALL MEET THE MINIMUM REQUIREMENT. THICKNESS IS BASED ON GRAINGER SAMPLE DATA FOR K-FLEX(PVC/NBR) AND OWENS CORNING(FIBER GLASS).
- ALL ADA P-TRAPS, HOT WATER SUPPLY TUBING, AND SHUT-OFF COCKS SHALL BE PROTECTED WITH APPROVED COVERS TO PREVENT SCALDING.
- REQUIRED BY ENGINEERING BASED ON BEST PRACTICE.
- INSULATION IS NOT REQUIRED ON PLASTIC COLD WATER PIPING.

Please revise this sheet and associates notes and sheets to conform to the 2018 Washington State Codes. [CONSTRUCTION PLAN SET - Bldg B, sheet P0.01]

WASHINGTON STATE-COMMERCIAL ENERGY CODE EFFICIENT HEATED WATER SUPPLY PIPING

| NOMINAL PIPE SIZE (IN) | METHOD #1 - PIPE LENGTH (RECOMMENDED) | | METHOD #2 - PIPE VOLUME | | | NOTES |
|------------------------|---------------------------------------|----------------|-------------------------------|--------------------------------------|----------------|-------|
| | MAXIMUM ALLOWABLE PIPING LENGTH (FT) | | PIPE VOLUME (FLUID OZ / FEET) | MAXIMUM ALLOWABLE PIPING LENGTH (FT) | | |
| | PUBLIC LAVATORY FAUCET | OTHER FIXTURES | | PUBLIC LAVATORY FAUCET | OTHER FIXTURES | |
| 3/8 | 3 | 50 | 0.75 | 2.67 | 85 | 1-8 |
| 1/2 | 2 | 43 | 1.5 | 1.33 | 43 | |
| 5/8 | 1 | 32 | 2 | 1.00 | 32 | |
| 3/4 | 0.5 | 21 | 3 | 0.67 | 21 | |
| 7/8 | 0.5 | 16 | 4 | 0.50 | 16 | |
| 1 | 0.5 | 13 | 5 | 0.40 | 13 | |
| 1-1/4 | 0.5 | 8 | 8 | 0.25 | 8 | |
| 1-1/2 | 0.5 | 6 | 11 | 0.18 | 6 | |
| 2 OR LARGER | 0.5 | 4 | 18 | 0.11 | 4 | |

NOTES:

- CONTRACTOR MAY USE METHOD 1 OR 2 TO DETERMINE MAXIMUM ALLOWABLE PIPING LENGTH FROM SOURCE OF HEATED WATER.
- PER 2015 WSEC SECTION C404.3 WATER HEATER, CIRCULATING WATER SYSTEM & HEAT TRACE TEMPERATURE MAINTENANCE SHALL BE CONSIDERED SOURCE OF HEATED WATER.
- THIS TABLE IS BASED ON MINIMUM CODE REQUIREMENTS. CONTRACTOR SHALL FOLLOW OWNERSHIP/DEVELOPER REQUIREMENT AND/OR BRAND STANDARD REGARDING MAXIMUM WAITING TIME FOR HOT WATER DELIVERY [OR ALLOWABLE NON-CIRCULATING HOT WATER PIPING LENGTH] AS LONG AS IT IS STRICTER THAN CODE MINIMUM. CONTACT ENGINEERING AS NECESSARY.
- PIPE LENGTH METHOD ONLY: WHERE THE PIPING CONTAINS MORE THAN ONE SIZE OF PIPE, THE LARGEST SIZE OF PIPE SHALL BE USED FOR DETERMINING THE MAXIMUM ALLOWABLE LENGTH OF PIPING.
- PIPE LENGTH METHOD ONLY: PER WSEC TABLE C404.3.1
- PIPE VOLUME METHOD ONLY: PER WSEC SECTION C404.3.2 THE VOLUME FROM HEATED WATER TO THE TERMINATION OF FIXTURE SUPPLY PIPE SHALL NOT EXCEED 2 FLUID OUNCES FOR PUBLIC LAVATORIES AND 0.5 GALLON (64 FLUID OUNCES) FOR OTHER FIXTURES.
- PIPE VOLUME METHOD ONLY: PER C404.3.2.1 WATER VOLUME SHALL BE THE SUM OF INTERNAL VOLUMES OF PIPE, VALVES, METERS AND MANIFOLD BETWEEN THE NEAREST SOURCE OF HEATED WATER AND TERMINATION OF THE FIXTURE SUPPLY PIPE. PROVIDED CALCULATION DOES NOT INCLUDE VALVES, METERS, MANIFOLDS.
- REFER TO MANUFACTURER RECOMMENDATIONS AND PLUMBING FIXTURE SCHEDULE IN COMPLIANCE WITH 2015 UPC SECTION A106 AND TABLES 610.3 & A103.1 FOR MINIMUM BRANCH PIPE SIZES.

PIPING SUPPORTS (SUPPLY)

ALL SUSPENDED WATER SUPPLY PIPE SHALL BE SUPPORTED AS FOLLOWS PER 2015 UPC TABLE 313.3:

| | MAX. HORIZONTAL SPACING | MAX. VERTICAL SPACING |
|-----------------------|-------------------------|-----------------------|
| COPPER PIPE <1 1/2" | 6 FT. | 10 FT. |
| COPPER PIPE >2" | 10 FT. | 10 FT. |
| COPPER TUBING <1 1/2" | 6 FT. | 10 FT. |
| COPPER TUBING >2" | 10 FT. | 10 FT. |
| CPVC < 1" | 3 FT. | 10 FT. |
| CPVC > 1 1/4" | 4 FT. | 10 FT. |

PIPING SUPPORTS (WASTE)

ALL SUSPENDED SANITARY AND VENT PIPE SHALL BE SUPPORTED AS FOLLOWS PER 2015 UPC TABLE 313.3:

| | MAX. HORIZ. SPACING | MAX. VERT. SPACING |
|----------------------------------|---------------------|--------------------|
| ABS | 4 FT. | 10 FT. |
| PVC (TYPE DWV) | 4 FT. | 10 FT. |
| CAST-IRON (<10 FT PIPE SECTIONS) | 5 FT. | 15 FT. |
| CAST-IRON (10 FT PIPE SECTIONS) | 10 FT. | 15 FT. |

PRE-CONSTRUCTION MEETING NOTES

CONTRACTORS SHALL ATTEND A PRE-CONSTRUCTION MEETING WITH THE ENGINEER FOR THE PURPOSE OF REVIEWING THE WORK PRIOR TO ORDERING ANY EQUIPMENT OR PERFORMING ANY WORK. THE MEETING SHALL BE LOCATED AT THE PROJECT SITE ON A DATE AND TIME TO BE MUTUALLY AGREED. THE MEETING WILL BE A WORKING SESSION. THE MEETING WILL BE FACILITATED BY THE ENGINEER AND THE AGENDA WILL INCLUDE A DETAILED REVIEW OF THE PLANS AND SPECIFICATIONS, CROSS CHECK WITH OTHER TRADES FOR COORDINATION ISSUES, REVIEW OF PROPOSED PRODUCTS, REVIEW OF PLANNED MEANS AND METHODS, AND ON-SITE INVESTIGATION OF FIELD CONDITIONS RELATIVE TO EXISTING CONDITIONS THAT COULD AFFECT THE WORK. PERSONS ATTENDING THE MEETING SHALL BE KNOWLEDGEABLE OF THE PROJECT AND SHALL BE THE SPECIFIC PERSONS INTENDED TO CONTINUE WITH THE PROJECT THROUGH TO COMPLETION. IF REQUIRED, REVISED PLANS WILL BE ISSUED THROUGH OFFICIAL CHANNELS. CHANGES IN THE BID PRICE WILL BE DISCUSSED, BUT NO CHANGE ORDERS WILL BE ISSUED UNLESS PROCESSED THROUGH OFFICIAL CHANNELS. IT SHALL BE UNDERSTOOD THAT THE ENGINEER HAS NO AUTHORITY TO ISSUE CHANGE ORDERS.

THE FOLLOWING TRADES SHALL BE REPRESENTED FOR THE MINIMUM TIME INDICATED:

| | |
|------------------------|--------------|
| MECHANICAL SHEET METAL | 4 HOURS |
| PLUMBING/PIPING | 4 HOURS |
| ELECTRICAL | 4 HOURS |
| SPRINKLER | 2 HOURS |
| GENERAL CONTRACTOR | ALL SESSIONS |

PLUMBING NOTES

- CONNECTIONS: PROVIDE PLUMBING FIXTURE CONNECTIONS TO BUILDING WASTE, VENT, COLD WATER, AND HOT WATER SYSTEM IN ACCORDANCE WITH DRAWINGS, MANUFACTURER'S RECOMMENDATIONS, AND LOCAL CODES. CONNECT TO EACH FIXTURE, EQUIPMENT, ETC. WITH ALL ACCESSORIES, VALVES, VACUUM BREAKERS, REGULATORS, UNIONS, ETC. AS REQUIRED AND AS RECOMMENDED BY THE MANUFACTURERS. REFER TO PLUMBING FIXTURE CONNECTION SCHEDULE ON PLANS.
- HOT AND COLD: WATER PIPING CONNECTION TO EACH FIXTURE SHALL BE COLD WATER ON THE RIGHT HAND SIDE AND HOT WATER ON THE LEFT HAND SIDE.
- HOT WATER: NON-CIRCULATING HOT WATER PIPE SHALL NOT EXCEED 10' UNLESS OTHERWISE SHOWN ON DRAWINGS.
- VENT STACKS: COORDINATE VENT STACK WITH HVAC EQUIPMENT TO MAINTAIN MINIMUM 10' CLEARANCE FROM OUTSIDE AIR INTAKES.
- CLEANOUTS: PROVIDE CLEANOUTS PER CURRENT UPC AND AS REQUIRED BY LOCAL JURISDICTIONS. CLEANOUTS SHALL BE LOCATED IN WALLS/FLOORS WHERE THEY ARE NOT HIGHLY VISIBLE. FLOOR CLEANOUTS IN CARPETED AREAS TO BE FITTED WITH CARPET INSERTS. LOCATIONS SHALL BE SUBMITTED TO ARCHITECT FOR APPROVAL. NOTE: NOT ALL CLEANOUTS ARE SHOWN ON THE PLUMBING DRAWINGS.
- SUDS RELIEF: PROVIDE SUDS RELIEF IN ACCORDANCE WITH 2015 UPC SECTION 711.0, STATE AND LOCAL CODES.
- SHUT-OFFS: PROVIDE 1/4 TURN BALL VALVE ANGLE STOP SHUT-OFF VALVES AND BRAIDED STAINLESS STEEL FLEX CONNECTORS AT HOT AND COLD WATER SUPPLY TO EACH FIXTURE. EXCEPTION: PROVIDE SCREWDRIVER STOPS AT BATH/SHOWERS.
- TUB SPOUTS SHALL BE THREADED (NO PUSH-ON FITTINGS).
- TRAP ARMS: PROVIDE TRAP ARMS SUCH THAT THE MAXIMUM LENGTH WILL NOT EXCEED CODE REQUIREMENTS.
- ADA INSULATION: AT PLUMBING PIPING EXPOSED UNDER LAVATORIES, INSULATE THE EXPOSED PIPING AND TRAPS WITH PRODUCT SPECIFICALLY DESIGNED FOR THIS APPLICATION MEETING ADA REQUIREMENTS. PROVIDE HANDI-LAV GUARD OR EQUIVALENT. OFFSET P-TRAPS TO CLEAR WHEELCHAIR ACCESS.
- GAS EQUIPMENT: GAS EQUIPMENT SHALL BE INSTALLED PER EQUIPMENT LISTINGS, APPLICABLE IFGC, UPC, LOCAL CODES & NFPA STANDARDS.
- GAS CONNECTIONS: INSTALL FLEXIBLE QUICK DISCONNECT ASSEMBLIES FOR ALL GAS FIRED KITCHEN EQUIPMENT PER APPLICABLE IFGC, UPC, LOCAL CODES & NFPA STANDARDS. PROVIDE LOCKABLE GAS SHUT-OFF VALVES FOR FIREPLACES & BBQS IN UNATTENDED PUBLIC LOCATIONS IN THE BUILDING.
- WATER HAMMER ARRESTORS: PROVIDE AT THE END OF HOT AND COLD WATER LINES SERVING TWO OR MORE FIXTURES; SIZE IN ACCORDANCE WITH PLUMBING AND DRAINAGE INSTITUTE (PDI) REQUIREMENTS. WATER HAMMER ARRESTORS ARE REQUIRED FOR QUICK CLOSING VALVES, SUCH AS LAUNDRY WASHERS, FLUSH VALVES (PUBLIC TOILETS), ETC.
- TRAP PRIMERS AS SPECIFIED: PROVIDE TRAP PRIMERS AND PIPING FOR FLOOR DRAINS, FLOOR SINKS, AREA DRAINS & HUB DRAINS. ARRANGE PIPING TO ACHIEVE EQUAL FLOW TO EACH DRAIN AND FLOOR SINK FOR TRAP PRIMERS SERVING MULTIPLE DRAINS AND FLOOR SINKS. COORDINATE EXACT LOCATIONS WITH ARCHITECT & ELECTRICAL ENGINEER.
- P-TRAPS: ALL EXPOSED P-TRAPS SHALL BE CHROME-PLATED BRASS. P-TRAPS SERVING HANDICAPPED COUNTER TOP LAVATORIES SHALL BE INSULATED.
- THROUGHOUT THE PROJECT PROVIDE BALL VALVES. GATE VALVES SHALL NOT BE USED. NO EXCEPTIONS.
- HOT WATER RECIRCULATING BALANCING VALVES SHOULD BE BELL & GOSSETT CIRCUIT SETTER (WATTS OR EQUAL) WITH INTEGRAL READOUT PORTS, ADJUSTMENT KNOB, DRAIN CONNECTION, AND POSITIVE SHUTOFF.
- DISASSEMBLY PROVISIONS: PROVIDE UNIONS OR FLANGES AT PIPING CONNECTIONS TO EQUIPMENT, COILS, TRAPS, CONTROL VALVES, AND OTHER COMPONENTS TO ALLOW DISASSEMBLY FOR MAINTENANCE.
- REDUCERS: PROVIDE AS REQUIRED FROM LINE PIPE SIZE TO EQUIPMENT, TRAP, COIL, AND CONTROL VALVE CONNECTION SIZES.
- VALVE TAGS: PROVIDE VALVE TAGS PER SPECIFICATIONS TO IDENTIFY VALVE AND THE AREA IT SERVES.
- OFFSETS: PROVIDE FOR BRANCH LINES TO EQUIPMENT.
- ALL TEMPERATURE MIXING VALVES SHALL COMPLY WITH ASSE-1070 SAFETY STANDARDS.
- PROVIDE PIPE MARKER WITH DIRECTION OF FLOW. LABEL "NON-POTABLE WATER DO NOT DRINK" CLEARLY ON NON-POTABLE WATER PIPING.
- PROVIDE EXPANSION LOOPS/EXPANSION JOINTS IN PIPING PER 2015 UPC TABLE 313.3 AND MANUFACTURER INSTALLATION INSTRUCTIONS.
- PROVIDE APPROVED PIPE HANGERS & PIPE SUPPORTS IN ACCORDANCE WITH MANUFACTURER'S INSTALLATION INSTRUCTIONS AND 2015 UPC TABLES 313.3 & 313.6. SUBMIT FOR APPROVAL.
- DIELECTRIC UNIONS: PROVIDE AT CONNECTIONS OF DISSIMILAR PIPE.
- REFRIGERANT PIPING: PROVIDE SIZING & INSTALLATION IN STRICT ACCORDANCE WITH MANUFACTURER'S INSTRUCTIONS.
- CONDENSATE DRAIN: PROVIDE A P-TRAP FOR EACH HVAC UNIT CONDENSATE PAN WITH PLUG TEES FOR CLEANING. CONDENSATE DRAINS SHALL BE DISCHARGED TO AN INDIRECT WASTE OR OUTSIDE.
- PROVIDE VIBRATION, SEISMIC ISOLATIONS & CONTROLS IN ACCORDANCE WITH SPEC SECTION 230548.
- PIPING & EQUIPMENT SUPPORTS/HANGERS & SEISMIC RESTRAINTS TO BE DESIGNED BY DESIGN BUILT CONTRACTOR.
- IF NEEDED, PROVIDE VACUUM BREAKERS AT ALL HOSE BIBBS.
- FLOOR DRAINS OR SIMILAR TRAPS DIRECTLY CONNECTED TO THE DRAINAGE AND SUBJECT TO INFREQUENT USE SHALL BE PROVIDED WITH AN APPROVED AUTOMATIC MEANS OF MAINTAINING THEIR WATER SEALS IN ACCORDANCE WITH 2015 UPC 1007.0.
- INSULATION MATERIAL SHALL MEET CITY OF PUYALLUP QUALITY STANDARDS.
- ALL PIPING AND DUCTWORK SHALL BE INSULATED CONSISTENT WITH THE 2015 WASHINGTON STATE ENERGY CODE.
- BUILDING DRAIN AND VENT PIPING MATERIALS SHALL COMPLY WITH 2015 UPC 701.0 AND 903.0.
- ALL SANITARY SYSTEM MATERIAL SHALL BE LISTED BY AN APPROVED LISTING AGENCY.
- ALL STORAGE WATER HEATING EQUIPMENT SHALL BE PROVIDED WITH AN APPROVED, LISTED EXPANSION TANK OR OTHER DEVICE DESIGNED FOR INTERMITTENT OPERATION FOR THERMAL EXPANSION CONTROL PER 2015 UPC 608.3.
- WATER HEATERS SHALL BE ANCHORED OR STRAPPED TO RESIST HORIZONTAL DISPLACEMENTS DUE TO SEISMIC MOTION PER 2015 UPC 507.2.
- MATERIAL EXPOSED WITHIN A DUCT OR PLENUM SHALL COMPLY WITH 2015 IMC 602.2.1.
- HVAC EQUIPMENT AND WATER HEATERS SHALL COMPLY WITH 2015 IMC CHAPTER 3.
- BOILERS SHALL COMPLY WITH ALL THE REQUIREMENTS OF 2015 IMC CHAPTER 10.
- PROVIDE EXPANSION TANKS FOR BOILERS PER 2015 IMC SECTION 1009.0.
- SHOWERS AND TUB/SHOWER COMBINATIONS SHALL BE PROVIDED WITH MIXING VALVES PER 2015 UPC 408.0.
- PLUMBING FIXTURES AND FITTINGS SHALL COMPLY WITH CITY OF PUYALLUP WATER CONSERVATION STANDARDS.
- CONTRACTOR SHALL PROVIDE FIRESTOPPING AT PENETRATIONS AS NECESSARY TO RETAIN THE FIRE RATING OF ALL ASSEMBLIES. ALL WORK SHALL BE IN COMPLIANCE WITH CODE REQUIREMENTS FOR THE BUILDING CONSTRUCTION TYPE.
- ALL GARAGE DRAINS, TRASH ROOMS DRAINS & GARAGE TRENCH DRAINS SHALL BE TAKEN TO SAND/OIL INTERCEPTOR(S) BEFORE CONNECTING TO THE SANITARY SEWER SYSTEM.
- PLUMBING CONTRACTOR SHALL PROVIDE REDUCED PRESSURE BACKFLOW PREVENTERS OR OTHER APPROVED BACKFLOW PREVENTION DEVICE WHERE REQUIRED BY HEALTH AUTHORITIES, FOOD SERVICE DRAWINGS, APPLIANCE MANUFACTURER INSTRUCTIONS AND BY CODE.

- PROVIDE REQUIRED & PROPER BACK FLOW PREVENTERS AS SPECIFIED FOR THE APPLIANCES INCLUDING, BUT NOT LIMITED TO THE FOLLOWING:
- ICE MACHINES AND ICE MAKERS
 - CARBONATED BEVERAGE DISPENSING SYSTEMS
 - COFFEE BREWERS
 - ESPRESSO MACHINES
 - WATER FILTERS
 - STEAM OR HOT WATER BOILERS
 - IRRIGATION SYSTEM
 - FIRE PROTECTION SYSTEM
 - CHEMICAL TREATMENT SYSTEM
 - SOAP/CHEMICAL DISPENSER SYSTEM
 - COMMERCIAL WASHER

APPLICABLE CODES


THE FOLLOWING PROJECT DESIGN IS BASED ON THE FOLLOWING CODES:

- 2015 INTERNATIONAL BUILDING CODE (IBC) & WASHINGTON STATE AMENDMENTS
- 2015 INTERNATIONAL MECHANICAL CODE (IMC) & WASHINGTON STATE AMENDMENTS
- 2015 UNIFORM PLUMBING CODE (UPC) & WASHINGTON STATE AMENDMENTS
- 2018 WASHINGTON STATE ENERGY CONSERVATION CODE (WSEC)
- 2015 INTERNATIONAL FUEL GAS CODE (IFGC) & WASHINGTON STATE AMENDMENTS

CONTRACTOR SUBSTITUTIONS & REVISIONS

PLEASE SUBMIT PROPOSALS FOR SUBSTITUTIONS OR REVISIONS FOR REVIEW AND APPROVAL PRIOR TO ORDERING MATERIAL OR DOING WORK. FOR EQUIPMENT THAT IS SCHEDULED BY MANUFACTURER'S NAME AND CATALOG DESIGNATIONS, THE MANUFACTURER'S PUBLISHED DATA AND/OR SPECIFICATION FOR THAT ITEM ARE CONSIDERED PART OF SPECIFICATION. ENGINEERING COSTS FOR REVISING MEP PLANS SHALL BE ADDRESSED IN THE COST ANALYSIS OF THE SUBSTITUTION PROPOSAL. CONTRACTOR TO COORDINATE WITH ENGINEER AND DETERMINE ASSOCIATED DESIGN AND PERMITTING COSTS. CONTRACTOR SHALL BE RESPONSIBLE FOR OTHER COSTS ASSOCIATED WITH UNFORESEEN ISSUES RESULTING FROM SUBSTITUTIONS OR REVISIONS.

| NO. | DATE | DESCRIPTION |
|-----|------|-------------|
| | | |
| | | |
| | | |

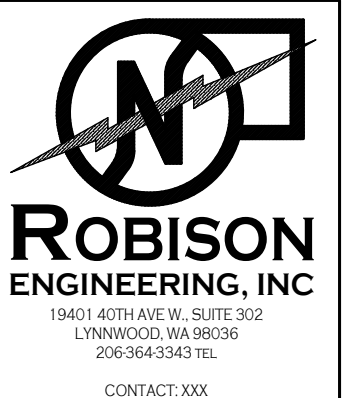

| | | | |
|-----------|--------------|-------------|--------------|
| DRAWN: JD | DESIGNED: JD | CHECKED: RJ | APPROVED: RJ |
|-----------|--------------|-------------|--------------|

PROJECT: EAST TOWN CROSSING MULTIFAMILY DEVELOPMENT PIONEER WAY & SHAW RD. PUYALLUP, WA

PERMIT PLANS

01/22/2024

SHEET TITLE: PLUMBING NOTES, TABLES AND CODES

SHEET NO. P0.01

19401 40TH AVE W, SUITE 302
LYNNWOOD, WA 98036
PHONE: 206-844-3413

ROBISON ENGINEERING, INC

PLUMBING FIXTURE UNIT COUNTS AND FIXTURE / DRAIN SCHEDULES

| FIXTURE SCHEDULE | | | | | | | | | | | |
|------------------|---------------|-----------------------|-----|-------|-------------------|-------------------|-----------------|------------------|-----------------------|----------------|---------|
| PLAN MARK | FIXTURE TYPE | SERVICE SIZE - INCHES | | | | LOCATION | FINISH | MANUFACTURER | BASIS OF DESIGN MODEL | FLOW RATE, GPM | NOTES |
| | | CW | HW | W | V | | | | | | |
| BT-1 | BATH-TUB | 1/2 | 1/2 | 2 | 1-1/2 | TYPICAL APARTMENT | WHITE | AQUATIC | 6030SM | 1.75 GPM | 1-5.7 |
| | IN-WALL VALVE | | | | | | N/A | 45312 | | | |
| | TRIM KIT | | | | | | CHROME | CFG | 40311CGR | | |
| LV-1 | LAVATORY | 1/2 | 1/2 | 1-1/2 | TYPICAL APARTMENT | WHITE | CASCADIAN | L1560 | 1.2 GPM | 1-5 | |
| | FAUCET | | | | | CHROME | PFISTER | LG1420600C | | | |
| KS-1 | KITCHEN SINK | 1/2 | 1/2 | 2 | TYPICAL APARTMENT | STAINLESS | MOEN | G20193 | 1.8 GPM | 1-5 | |
| | FAUCET | | | | | CHROME | PEERLESS | P188152LF | | | |
| WC-1 | WATER CLOSET | 1/2 | --- | 3 | TYPICAL APARTMENT | WHITE | WESTERN POTTERY | B832, -T8ULF -HP | 1.28 GPF | 1-6 | |
| | SEAT | | | | | WHITE | COMFORT SEATS | C014WD | | | |
| WB-1 | WASHER BOX | 3/4 | 3/4 | 2 | 1-1/2 | TYPICAL APARTMENT | WHITE | SIoux CHIEF | 696-2313 | N/A | 1-5 |
| HB-1 | WALL HYDRANT | 3/4 | --- | --- | --- | PER DWGS. | N/A | WOODFORD | B65 | N/A | 1-3,5,8 |

NOTES:

- REFER TO ARCH PLANS FOR MOUNTING HEIGHT.
- CONTRACTOR SHALL CONFIRM MAKE, MODEL, AND FINISH OF ALL FIXTURES WITH OWNER, ARCHITECT, AND INTERIOR DESIGNER PRIOR TO ORDERING.
- PROVIDE RED/HOT AND BLUE/COLD WATER INDICATORS TO ALL FIXTURES.
- ALL FIXTURE P-TRAPS SHALL BE CHROME-PLATED BRASS.
- PROVIDE DAHL 1/4-TURN BALL VALVE ANGLE STOPS WITH BRAIDED STAINLESS STEEL FLEX CONNECTORS AT HOT AND COLD WATER SUPPLY TO EACH FIXTURE EXCEPT SHOWERS AND BATHS. PROVIDE SCREWDRIVER STOPS AT SHOWERS AND BATHS.
- FLUSH TRIGGER SHALL BE ON WIDE SIDE OF ROOM.
- SHOWERS AND TUB-SHOWER COMBINATIONS SHALL BE PROVIDED WITH MIXING VALVES PER UPC SECTION 408.3.
- PROVIDE LOCKABLE BOX.

| DRAINS & CLEANOUTS SCHEDULE | | | | | | | | |
|-----------------------------|----------------|-----------------------|-------|-----------|-----------|--------------|-----------------------|-------|
| PLAN MARK | FIXTURE TYPE | SERVICE SIZE - INCHES | | LOCATION | FINISH | MANUFACTURER | BASIS OF DESIGN MODEL | NOTES |
| | | W | V | | | | | |
| FD-1 | FLOOR DRAIN | 4 | 2 | PER DWGS. | CAST IRON | JR SMITH | 2010 | 1 |
| FS-1 | FLOOR SINK | 4 | 2 | PER DWGS. | N/A | JR SMITH | 3140 | 1 |
| HD-1 | HUB DRAIN | 2 | 1-1/2 | PER DWGS. | STAINLESS | JR SMITH | 9654 | 1 |
| FCO | FLOOR CLEANOUT | PER PLANS | N/A | PER DWGS. | CAST IRON | WADE | 6000 | 1 |
| WCO | WALL CLEANOUT | PER PLANS | N/A | PER DWGS. | CAST IRON | WADE | 8560 | 1 |

NOTES:

- CONTRACTOR SHALL CONFIRM MAKE, MODEL, AND FINISH OF ALL FIXTURES WITH OWNER, ARCHITECT, AND INTERIOR DESIGNER PRIOR TO ORDERING.

| FIXTURE UNIT CALCULATIONS - BUILDING B,C,D | | | | | | | | | | | | | | | | | | | | | | | | | | | | | | | | | | | | | | | | | | | | | | | | | | | | | | | | | |
|---|
| CALCULATIONS BASED ON 2015 UPC TABLES A103.1 AND 702.1. | | | | | | | | | | | | | | | | | | | | | | | | | | | | | | | | | | | | | | | | | | | | | | | | | | | | | | | | | |
| APARTMENTS | | | | | | | | | | | | | | | | | | | | | | | | | | | | | | | | | | | | | | | | | | | | | | | | | | | | | | | | | |
| FIXTURE | FIXTURE UNITS | | | | FLOOR | | | | TOTAL QTY OF FIXTURES | TOTAL FIXTURE UNITS | | | | | | | | | | | | | | | | | | | | | | | | | | | | | | | | | | | | | | | | | | | | | | | |
| | TOTAL | CW | HW | W/V | 1 | 2 | 3 | R | | SERVICE | CW ONLY | HW ONLY | W/V ONLY | | | | | | | | | | | | | | | | | | | | | | | | | | | | | | | | | | | | | | | | | | | | |
| LAVATORY (PRIVATE) | 1 | 0.75 | 0.75 | 1 | 16 | 16 | 16 | | 48 | 48 | 36 | 36 | 48 | | | | | | | | | | | | | | | | | | | | | | | | | | | | | | | | | | | | | | | | | | | | |
| WATER CLOSET (PRIVATE, TANK) | 2.5 | 2.5 | 0 | 3 | 16 | 16 | 16 | | 48 | 120 | 120 | 0 | 144 | | | | | | | | | | | | | | | | | | | | | | | | | | | | | | | | | | | | | | | | | | | | |
| BATH-TUB (PRIVATE) | 4 | 3 | 3 | 2 | 16 | 16 | 16 | | 48 | 192 | 144 | 144 | 96 | | | | | | | | | | | | | | | | | | | | | | | | | | | | | | | | | | | | | | | | | | | | |
| KITCHEN SINK (PRIVATE) | 1.5 | 1.125 | 1.125 | 2 | 8 | 8 | 8 | | 24 | 36 | 27 | 27 | 48 | | | | | | | | | | | | | | | | | | | | | | | | | | | | | | | | | | | | | | | | | | | | |
| DISHWASHER | 1.5 | 0 | 1.5 | 0 | 8 | 8 | 8 | | 24 | 36 | 0 | 36 | 0 | | | | | | | | | | | | | | | | | | | | | | | | | | | | | | | | | | | | | | | | | | | | |
| CLOTHES WASHER | 4 | 3 | 3 | 3 | 8 | 8 | 8 | | 24 | 96 | 72 | 72 | 72 | | | | | | | | | | | | | | | | | | | | | | | | | | | | | | | | | | | | | | | | | | | | |
| | | | | | | | | | | 528 | 399 | 315 | 408 | | | | | | | | | | | | | | | | | | | | | | | | | | | | | | | | | | | | | | | | | | | | |
| PUBLIC SPACES / MISC. | | | | | | | | | | | | | | | | | | | | | | | | | | | | | | | | | | | | | | | | | | | | | | | | | | | | | | | | | |
| FIXTURE | FIXTURE UNITS | | | | FLOOR | | | | TOTAL QTY OF FIXTURES | TOTAL FIXTURE UNITS | | | | | | | | | | | | | | | | | | | | | | | | | | | | | | | | | | | | | | | | | | | | | | | |
| | TOTAL | CW | HW | W/V | 1 | 2 | 3 | R | | SERVICE | CW ONLY | HW ONLY | W/V ONLY | | | | | | | | | | | | | | | | | | | | | | | | | | | | | | | | | | | | | | | | | | | | |
| FLOOR DRAIN (2") | 0 | 0 | 0 | 2 | 2 | | | | 2 | 0 | 0 | 0 | 4 | | | | | | | | | | | | | | | | | | | | | | | | | | | | | | | | | | | | | | | | | | | | |
| HOSE BIB | 2.5/1 | 2.5/1 | 0 | 0 | 2 | | | | 2 | 3.5 | 3.5 | 0 | 0 | | | | | | | | | | | | | | | | | | | | | | | | | | | | | | | | | | | | | | | | | | | | |
| | | | | | | | | | | 3.5 | 3.5 | 0 | 4 | | | | | | | | | | | | | | | | | | | | | | | | | | | | | | | | | | | | | | | | | | | | |
| <table style="width: 100%; border: none;"> <tr> <td style="width: 15%;">TOTAL</td> <td style="width: 15%;">CW</td> <td style="width: 15%;">HW</td> <td style="width: 15%;">W/V</td> <td colspan="10"></td> </tr> <tr> <td>TOTAL FIXTURE UNITS:</td> <td>531.5</td> <td>402.5</td> <td>315</td> <td>412</td> <td colspan="10"></td> </tr> <tr> <td>DOMESTIC WATER PEAK FLOW:</td> <td>103 GPM</td> <td colspan="13"></td> </tr> </table> | | | | | | | | | | | | | | TOTAL | CW | HW | W/V | | | | | | | | | | | TOTAL FIXTURE UNITS: | 531.5 | 402.5 | 315 | 412 | | | | | | | | | | | DOMESTIC WATER PEAK FLOW: | 103 GPM | | | | | | | | | | | | | |
| TOTAL | CW | HW | W/V | | | | | | | | | | | | | | | | | | | | | | | | | | | | | | | | | | | | | | | | | | | | | | | | | | | | | | |
| TOTAL FIXTURE UNITS: | 531.5 | 402.5 | 315 | 412 | | | | | | | | | | | | | | | | | | | | | | | | | | | | | | | | | | | | | | | | | | | | | | | | | | | | | |
| DOMESTIC WATER PEAK FLOW: | 103 GPM | | | | | | | | | | | | | | | | | | | | | | | | | | | | | | | | | | | | | | | | | | | | | | | | | | | | | | | | |
| <table style="width: 100%; border: none;"> <tr> <td style="width: 30%;">REQUIRED SERVICE SIZES IN BUILDING:</td> <td style="width: 30%;">DOMESTIC WATER</td> <td style="width: 30%;">SEWER SIZE</td> <td colspan="3"></td> </tr> <tr> <td></td> <td>SERVICE SIZE: 3"</td> <td>6"</td> <td colspan="3">14" PER FT</td> </tr> </table> | | | | | | | | | | | | | | REQUIRED SERVICE SIZES IN BUILDING: | DOMESTIC WATER | SEWER SIZE | | | | | SERVICE SIZE: 3" | 6" | 14" PER FT | | | REQUIRED SERVICE SIZES IN BUILDING: | DOMESTIC WATER | SEWER SIZE | |
| | SERVICE SIZE: 3" | 6" | 14" PER FT | | | | | | | | | | | | | | | | | | | | | | | | | | | | | | | | | | | | | | | | | | | | | | | | | | | | | | |

| PLUMBING FIXTURE FLOW RATES PER 2015 UPC CH. 4 | | |
|--|-------------------|-------|
| FIXTURE TYPE | FLOW RATE | NOTES |
| SHOWERHEADS | 2.5 GPM @ 80 PSI | |
| LAVATORY FAUCETS, RESIDENTIAL | 2.2 GPM @ 60 PSI | 1 |
| LAVATORY FAUCETS, NON-RESIDENTIAL | 0.5 GPM @ 60 PSI | 2 |
| KITCHEN FAUCETS | 2.2 GPM @ 60 PSI | 3 |
| GRAVITY TANK-TYPE WATER CLOSETS | 1.6 GALLONS/FLUSH | 4 |
| FLUSHOMETER TANK WATER CLOSETS | 1.6 GALLONS/FLUSH | 4 |
| FLUSHOMETER VALVE WATER CLOSETS | 1.6 GALLONS/FLUSH | 4 |
| ELECTROMECHANICAL HYDRAULIC WATER CLOSETS | 1.6 GALLONS/FLUSH | 4 |
| URINALS | 1.0 GALLONS/FLUSH | |

NOTES:

- LAVATORY FAUCETS SHALL NOT HAVE A FLOW RATE LESS THAN 0.8 GPM AT 20 PSI.
- WHERE COMPLYING FAUCETS ARE UNAVAILABLE, AERATORS RATED AT 0.35 GPM OR OTHER MEANS MAY BE USED TO ACHIEVE REDUCTION.
- KITCHEN FAUCETS MAY TEMPORARILY INCREASE FLOW ABOVE THE MAXIMUM RATE, BUT NOT ABOVE 2.2 GPM @ 60 PSI AND MUST DEFAULT TO A MAXIMUM FLOW RATE OF 1.8 GPM @ 60 PSI.
- INCLUDES SINGLE AND DUAL FLUSH WATER CLOSETS WITH AN EFFECTIVE FLUSH OF 1.6 GALLONS OR LESS. SINGLE FLUSH TOILETS - THE EFFECTIVE FLUSH VOLUME SHALL NOT EXCEED 1.6 GALLONS. THE EFFECTIVE FLUSH VOLUME IS THE AVERAGE FLUSH VOLUME WHEN TESTED IN ACCORDANCE WITH ASME A112.19.2 DUAL FLUSH TOILETS - THE EFFECTIVE FLUSH VOLUME SHALL NOT EXCEED 1.6 GALLONS. THE EFFECTIVE FLUSH VOLUME IS DEFINED AS THE COMPOSITE, AVERAGE FLUSH VOLUME OF TWO REDUCED FLUSHES AND ONE FULL FLUSH. FLUSH VOLUMES WILL BE TESTED IN ACCORDANCE WITH ASME A112.19.2 AND ASME A112.19.14.

| NO. | DATE | DESCRIPTION |
|-----|------|-------------|
| | | |
| | | |
| | | |



| | | | |
|-----------|--------------|-------------|--------------|
| DRAWN: JD | DESIGNED: JD | CHECKED: RJ | APPROVED: RJ |
|-----------|--------------|-------------|--------------|

PROJECT: EAST TOWN CROSSING
 MULTIFAMILY DEVELOPMENT
 PIONEER WAY & SHAW RD. PUYALLUP, WA
 19401 40TH AVE W, SUITE 302
 LYNNWOOD, WA 98036
 PHONE: 206-964-3343
ROBISON ENGINEERING, INC.

PERMIT PLANS
01/22/2024

SHEET TITLE:
PLUMBING FIXTURE
UNIT COUNTS AND
FIXTURE/DRAIN
SCHEDULE

SHEET NO.
P0.02

WATER SUPPLY PIPE SIZING CALCULATIONS

TYPE L COPPER SERVICE PIPING

Robison Engineering, Inc.
19401 40th AVE W. Suite 302
Lynnwood, WA 98087

Project Name: EAST TOWN CROSSING
Project Number: 810-010
Edited By: JD
Edit Date: 1/22/2024

SIZING IS PER 2015 UPC APPENDIX A

WATER SUPPLY PIPE SIZING CALCULATION FORM

UTILITY SUPPLY WATER PRESSURE: 55 PSI STATIC PRESSURE
ASSUMING BUILDING PRESSURE

BOOSTER PUMP: 70 PSI
OUTLET PRESSURE

WATER SOFTENER LOSS: 0 PSI
TYPICALLY 5-20 PSI, IF NO SOFTENER ENTER "0".

STATIC LIFT: 30 FEET = 13.0 PSI

THERMOSTATIC MIXING VALVE LOSS: 0 PSI

REQUIRED MINIMUM PRESSURE AT FURTHEST PLUMBING FIXTURE: 25 PSI

PRESSURE AVAILABLE TO OFFSET FRICTION LOSSES: 32.0 PSI

PIPING SYSTEM LENGTH FROM SERVICE TO FURTHEST FIXTURE: 200 FEET
FITTING ALLOWANCE: 66.6667 FEET

MAXIMUM FRICTION LOSS FACTOR: 12.0 PSI/100 FT

SELECTED FRICTION LOSS FACTOR: 12.0 PSI/100 FT
MAX CW VELOCITY 8 FPS, MAX HW VELOCITY 5 FPS.

| SUPPLY PIPE SIZING SCHEDULE | | | | | | Copper Type: Type L | |
|-----------------------------|-----------|----------|---------------|-----------|----------|---------------------|---------------|
| FLUSH TANK CW | | | HOT WATER | | | FLUSH VALVE CW | |
| PIPE SIZE | FLOW, GPM | VEL, FPS | FIXTURE UNITS | FLOW, GPM | VEL, FPS | FIXTURE UNITS | FIXTURE UNITS |
| 2-1/2" | 116.0 | 8.0 | 440.0 | 72.0 | 5.0 | 215.0 | 116.0 |
| 3" | 160.0 | 8.0 | 750.0 | 100.0 | 5.0 | 350.0 | 160.0 |
| 4" | 280.0 | 8.0 | 1600.0 | 175.0 | 5.0 | 800.0 | 280.0 |
| 6" | 650.0 | 8.0 | 5250.0 | 400.0 | 5.0 | 2750.0 | 650.0 |

PEX PIPING

Robison Engineering, Inc.
19401 40th Ave. W. Suite 302
Lynnwood, WA 98036

Project Name: East Town Crossing
Project Number: 810-010
Edited By: JD
Edit Date: 1/22/24

SIZING IS PER 2015 UPC APPENDIX A

WATER SUPPLY PIPE SIZING CALCULATION FORM

AVAILABLE PRESSURE BEFORE BOOSTER PUMP: 55 PSI

AVAILABLE PRESSURE AFTER BOOSTER PUMP: 70 PSI

STATIC LIFT TO HIGHEST FIXTURE: 30 FEET = 13.0 PSI

REQUIRED MINIMUM PRESSURE AT FURTHEST PLUMBING FIXTURE: 25 PSI

PRESSURE AVAILABLE TO OFFSET FRICTION LOSSES: 32.0 PSI

PIPING SYSTEM LENGTH FROM SERVICE TO FURTHEST FIXTURE: 200 FEET
FITTING ALLOWANCE: 66 FEET

MAXIMUM FRICTION LOSS FACTOR: 12.0 PSI/100 FT

SELECTED FRICTION LOSS FACTOR: 12.0 PSI/100 FT
MAX HW & CW VELOCITY 8 FPS

| SUPPLY PIPE SIZING SCHEDULE | | | | PIPE MATERIAL |
|-----------------------------|-----------|--------------|---------------|---------------|
| PIPE SIZE | FLOW, GPM | VELOCITY FPS | FIXTURE UNITS | |
| 1/2" | 3.5 | 8.00 | 3.0 | PEX |
| 3/4" | 7.9 | 8.00 | 9.0 | PEX |
| 1" | 14.6 | 8.00 | 20.0 | PEX |
| 1-1/4" | 27.8 | 8.00 | 33.0 | PEX |
| 1-1/2" | 30.3 | 8.00 | 54.0 | PEX |
| 2" | 52.0 | 8.00 | 134.0 | PEX |
| 2-1/2" | 79.2 | 8.00 | 270.0 | PEX |
| 3" | 112.6 | 8.00 | 440.0 | PEX |

Please revise this sheet and associates notes and sheets to conform to the 2018 Washington State Codes. [CONSTRUCTION PLAN SET - Bldg B, sheet P0.03]

PLUMBING EQUIPMENT SCHEDULES

PIPE MATERIALS

| PIPE TYPE | MATERIAL | JOINT | NOTES |
|---|-----------------------------------|--------------------------------------|-------|
| UNDERGROUND WATER SERVICE ENTRANCE PIPING | PVC | SOLVENT CEMENT | |
| WATER DISTRIBUTION PIPING – MAINS ADN RISERS | SCHEDULE 80 CPVC | SOLVENT CEMENT | |
| WATER DISTRIBUTION PIPING – UNIT FIXTURE RUN-OUTS | PEX | EXPANSION FITTINGS | 3 |
| WASTE & VENT PIPING | SCHEDULE 40 SOLID CORE PVC OR ABS | SOLVENT CEMENT | 4 |
| STORM PIPING | SCHEDULE 40 SOLID CORE PVC OR ABS | SOLVENT CEMENT | |
| CONDENSATE DRAIN PIPING | CPVC OR PEX | SOLVENT CEMENT OR EXPANSION FITTINGS | |

NOTES:

- ALL SANITARY SYSTEM MATERIALS SHALL BE LISTED BY AN APPROVED LISTING AGENCY.
- NOT USED
- PROVIDE THERMAL EXPANSION LOOPS FOR ALL CPVC PIPING PER MANUFACTURER REQUIREMENTS.
- NOT TO BE USED WHERE EXPOSED IN RETURN AIR PLENUM (METAL PIPING REQUIRED IN RETURN AIR PLENUMS.) USE CAST IRON FOR PIPING IN PLENUM.

WATER HEATER SCHEDULE - ELECTRIC

| EQUIP. TAG | LOCATION | SERVICE | HEAT RECOVERY | STORAGE CAPACITY, GAL | INLET/OUTLET CONNECTION | HEATER, KW | OPERATING WEIGHT (LBS) | ELECTRICAL | BOD ENERGY FACTOR | BASIS OF DESIGN | NOTES |
|------------|-----------|-------------------------------|------------------|-----------------------|-------------------------|------------|------------------------|------------|-------------------|---------------------------|---------|
| WH-1 | APARTMENT | DOMESTIC HOT WATER (EA. UNIT) | 21 GPH @ 90°F TR | 30 | 3/4" | 4.5 | 360 | 240V/1P | 0.94 | AMERICAN STANDARD EN30T-6 | 1,2,3,4 |

NOTES:

- WATER HEATER RECOVERY AND POWER REQUIREMENT ARE BASED ON NON-SIMULTANEOUS OPERATION.
- FOR WATER HEATER PIPING, SEE PIPING DIAGRAM DETAIL 1 ON P7.00.
- PROVIDE DRAIN PAN FOR WATER HEATER.

Sheet P7.00 was not included in the plan set. [CONSTRUCTION PLAN SET - Bldg B, sheet P0.03]

EXPANSION TANK

| EQUIP. TAG | LOCATION | SERVICE | CAPACITY GAL. | TANK SIZE, IN | | OPERATING WEIGHT, LBS | BASIS OF DESIGN | NOTES |
|------------|-----------|-------------------------------|---------------|---------------|--------|-----------------------|-----------------|-------|
| | | | | DIAMETER | HEIGHT | | | |
| ET-1 | APARTMENT | DOMESTIC HOT WATER (EA. UNIT) | 2 | 8 | 13 | 25 | AMTROL ST-5 | 1,2 |

NOTES:

- INSTALL ACCORDING TO MANUFACTURER'S REQUIREMENTS
- EXPANSION TANK PRE-CHARGE PRESSURE SHALL BE SET TO INLET WATER STATIC PRESSURE AT INSTALLATION.

REDUCED PRESSURE BACKFLOW ASSEMBLY

| EQUIP. TAG | SERVICE | INLET/OUTLET SIZE | DESIGN FLOW, GPM | PRESSURE DROP, PSI | MAX WATER PRESSURE, PSI | BASIS OF DESIGN | NOTES |
|------------|----------------|-------------------|------------------|--------------------|-------------------------|-----------------|-------|
| RPBA-1 | DOMESTIC WATER | 3" | 105 | 15 | 175 | ZURN 3750SY | 1,2 |

NOTES:

- COMPLIES WITH AWWA C551-92 STANDARDS.
- PROVIDE DRAIN TO NEAREST INDIRECT WASTE RECEPTOR.

PACKAGED BOOSTER PUMP SCHEDULE

| EQUIP NO. | SERVICE | TYPE | TOTAL FLOW, GPM | PRESSURE RISE (INLET/OUTLET) PSIG | MOTOR HP (EACH) | ELECTRICAL | FLA (AMPS) | WEIGHT, LBS | BASIS OF DESIGN |
|-----------|----------------|--------|-----------------|-----------------------------------|-----------------|------------|------------|-------------|------------------------------|
| BP-1 | DOMESTIC WATER | DUPLEX | 103 | 30 (40/70) | 2 | 208V/3P | 13.3 | 730 | FLOWTHERM FMV2-3LH (1)(2)(3) |

NOTES:

- SINGLE POINT POWER CONNECTION.
- PROVIDE ALL REQUIRED VALVES, PIPING, CONTROLS, ETC. FOR A COMPLETE SYSTEM.
- PROVIDE VFD'S FOR EACH PUMP.

| NO. | DATE | DESCRIPTION |
|-----|------|-------------|
| | | |
| | | |
| | | |



| | | | |
|-----------|--------------|-------------|--------------|
| DRAWN: JD | DESIGNED: JD | CHECKED: RJ | APPROVED: RJ |
|-----------|--------------|-------------|--------------|

PROJECT: EAST TOWN CROSSING
MULTIFAMILY DEVELOPMENT
PIONEER WAY & SHAW RD. PUYALLUP, WA

19401 40TH AVE W. SUITE 302
LYNNWOOD, WA 98036
PHONE: 206-964-3343


ROBISON ENGINEERING, INC.

PERMIT PLANS
01/22/2024


SHEET TITLE:
PLUMBING EQUIPMENT SCHEDULES, PIPE SIZING TABLES AND PRESSURE CALCULATIONS

SHEET NO.
P0.03

| NO. | DATE | DESCRIPTION |
|-----|------|-------------|
| | | |
| | | |
| | | |

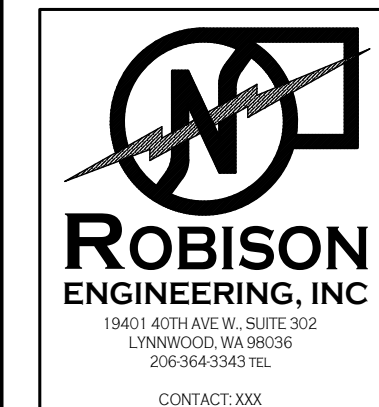

| | |
|-----------|----|
| DRAWN: | JD |
| DESIGNED: | JD |
| CHECKED: | RJ |
| APPROVED: | RJ |

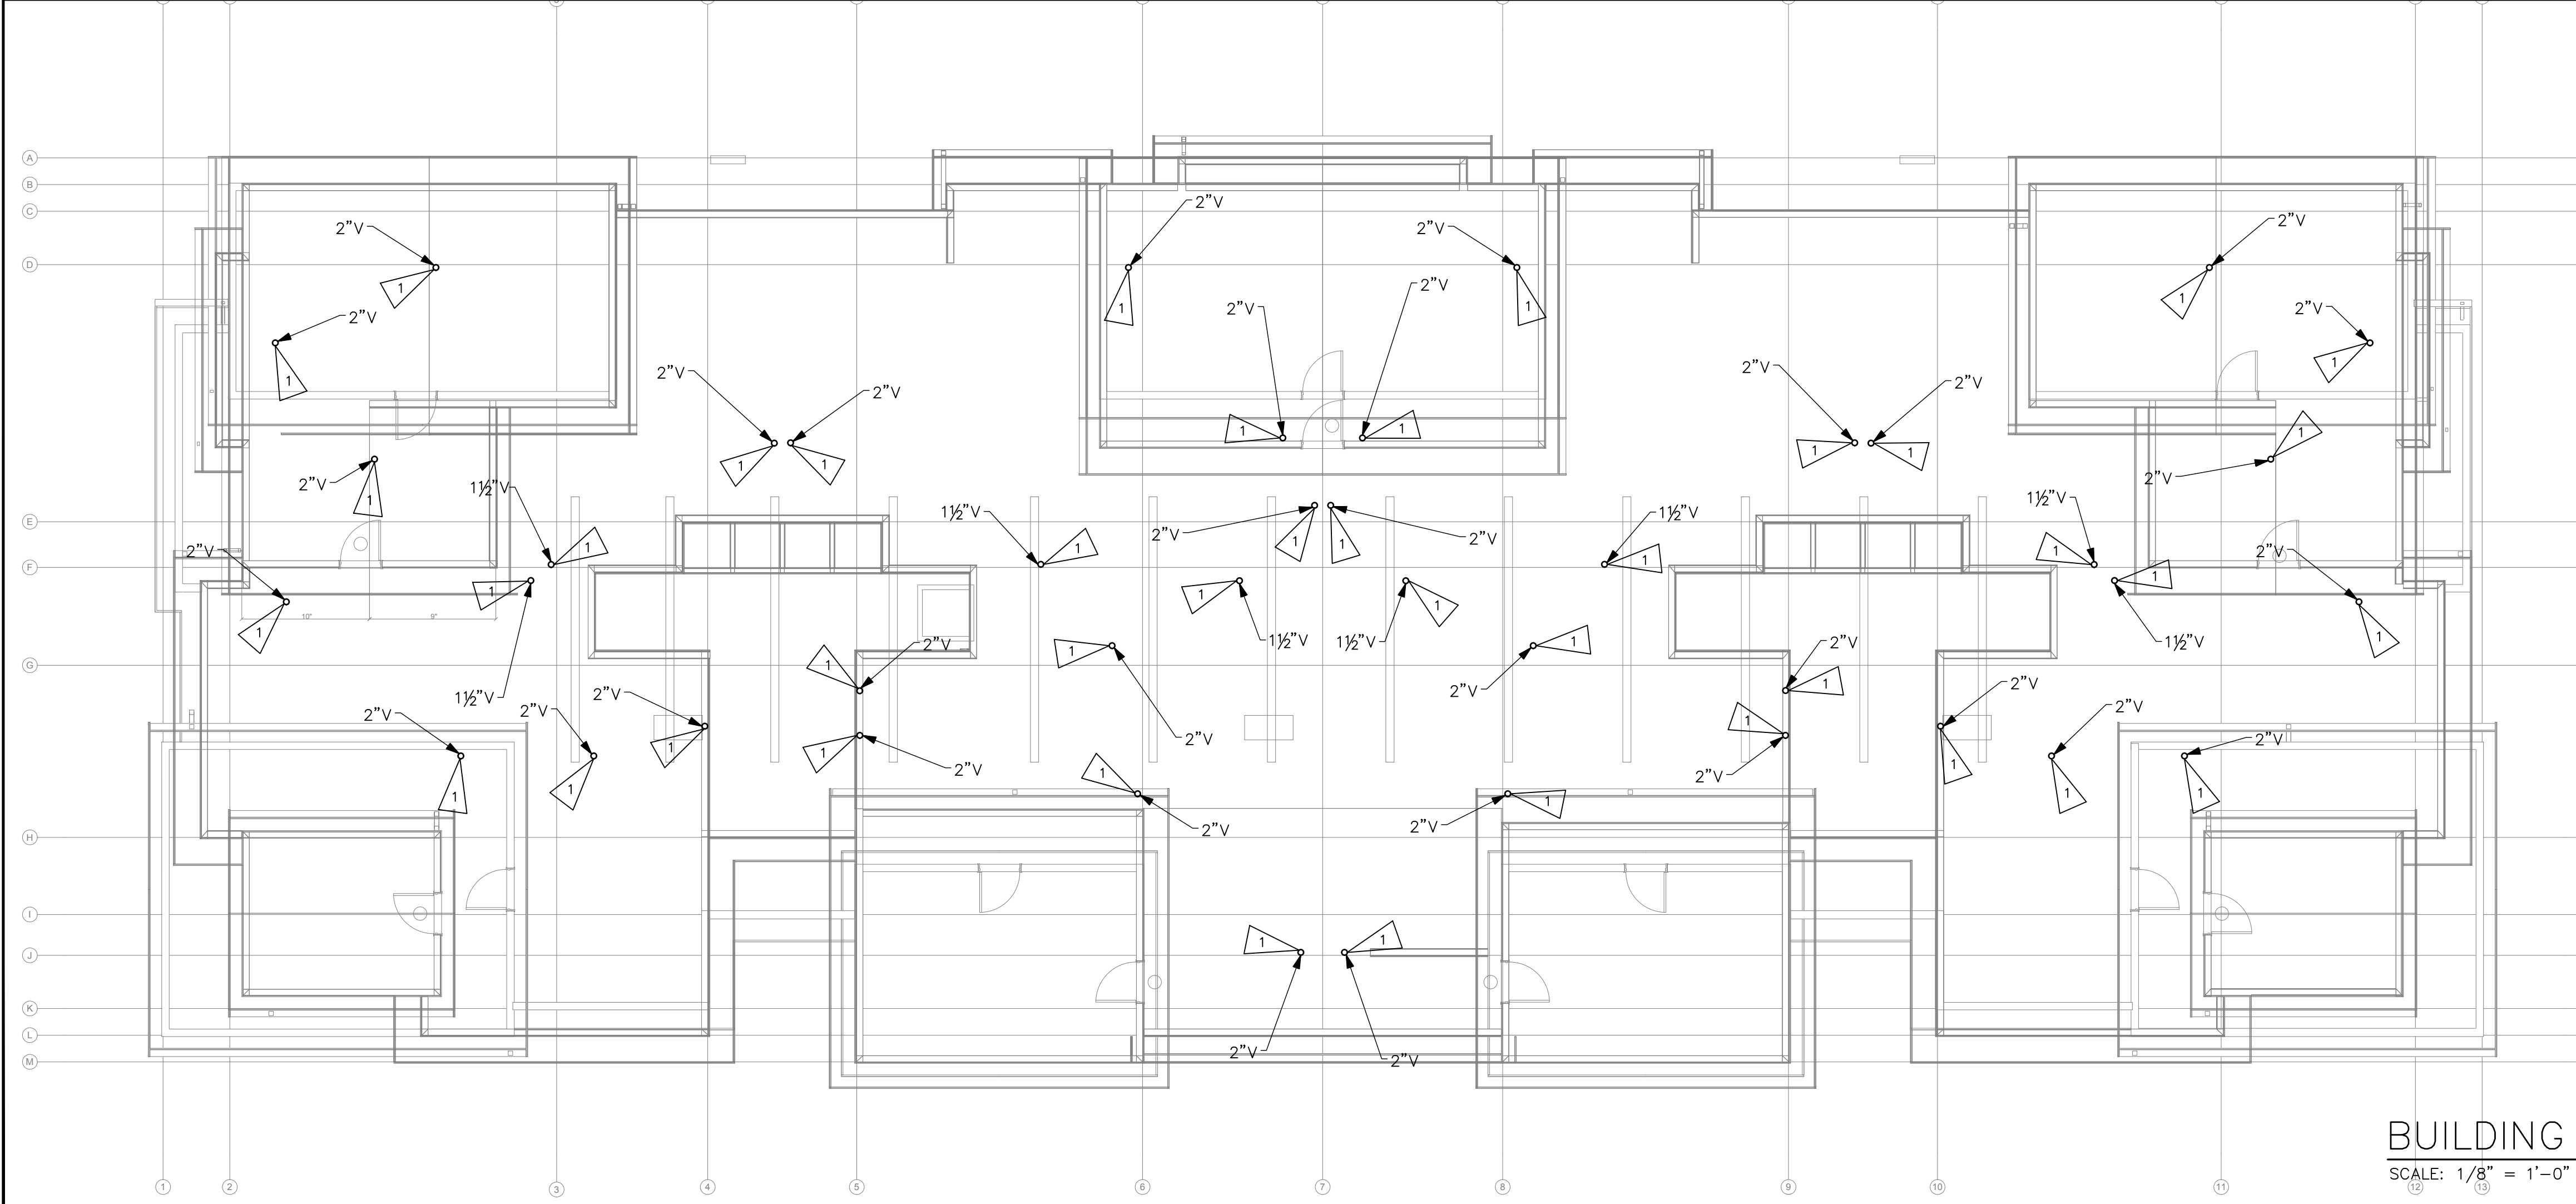

- NOTES:**
- WASTE & VENT SIZING: WASTE & VENT PIPING SIZED PER 2018 UPC CHAPTER 7. WASTE PIPING SHALL BE SLOPED AT 1/4" PER FOOT:
- | PIPE SIZE | VERT. | HORIZ. | VENT |
|-----------|-----------|-----------|-----------|
| 1 1/2" | 2 DFU | 1 DFU | 8 DFU |
| 2" | 16 DFU | 8 DFU | 24 DFU |
| 3" | 48 DFU | 35 DFU | 84 DFU |
| 4" | 256 DFU | 216 DFU | 256 DFU |
| 6" | 1,380 DFU | 720 DFU | 1,380 DFU |
| 8" | 3,600 DFU | 2,640 DFU | 3,600 DFU |
- PROVIDE TRAP PRIMERS FOR ALL FLOOR DRAINS. SEE DETAIL 2, P9.00.
 - STORM DRAINAGE: ROOF IS SLOPED AND DRAINAGE IS VIA GUTTERS AND DOWNSPOUTS. REFER TO ARCHITECTURAL PLANS FOR DOWNSPOUTS LOCATIONS.

- FLAG NOTES:**
- VENT TO ROOF. VENT TO BE 10' MINIMUM FROM ANY FRESH AIR INTAKE.

BUILDING B ROOF - PLUMBING PLAN
SCALE: 1/8" = 1'-0"
0' 4' 8' 16'

PROJECT: EAST TOWN CROSSING
MULTIFAMILY DEVELOPMENT
PIONEER WAY & SHAW RD. PUYALLUP, WA

19401 40TH AVE W, SUITE 302
LYNNWOOD, WA 98036
PHONE: 206-864-3343


ROBISON ENGINEERING, INC.

PERMIT PLANS
01/22/2024

SHEET TITLE:
BUILDING B -
ROOF PLUMBING
PLAN

SHEET NO.
P2.B2

| NO. | DATE | DESCRIPTION |
|-----|------|-------------|
| | | |
| | | |
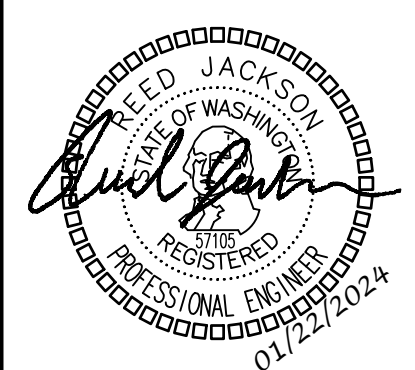

| | |
|-----------|----|
| DRAWN: | JD |
| DESIGNED: | JD |
| CHECKED: | RJ |
| APPROVED: | RJ |

PROJECT: **EAST TOWN CROSSING**
 MULTIFAMILY DEVELOPMENT
 PIONEER WAY & SHAW RD. PUYALLUP, WA

19401 40TH AVE W, SUITE 302
 LYNNWOOD, WA 98036
 PHONE: 206-844-1343

ROBISON ENGINEERING, INC.

PERMIT PLANS
 01/22/2024

SHEET TITLE:
 ENLARGED UNIT PLANS


SHEET NO.
 P3.00

FLAG NOTES:

1. COLD WATER PIPE. REFER TO FLOOR PLANS FOR CONTINUATION.
2. HOT & COLD WATER PIPING MANIFOLD. VIEGA MANABLOC MODEL V5030.5 OR EQUAL. MANIFOLD SHALL BE NSF/ANSI 61 @ 372 CERTIFIED.
3. ACCESS PANEL.


ABBREVIATION LEGEND / FIXTURE UNIT VALUES:

| | |
|-----------------------------------|------------|
| LV = LAVATORY | (1 WSFU) |
| BT = BATHTUB/SHOWER COMBO | (4 WSFU) |
| KS = KITCHEN SINK WITH DISHWASHER | (1.5 WSFU) |
| WB = WASHER BOX | (4 WSFU) |
| WC = WATER CLOSET | (2.5 WSFU) |

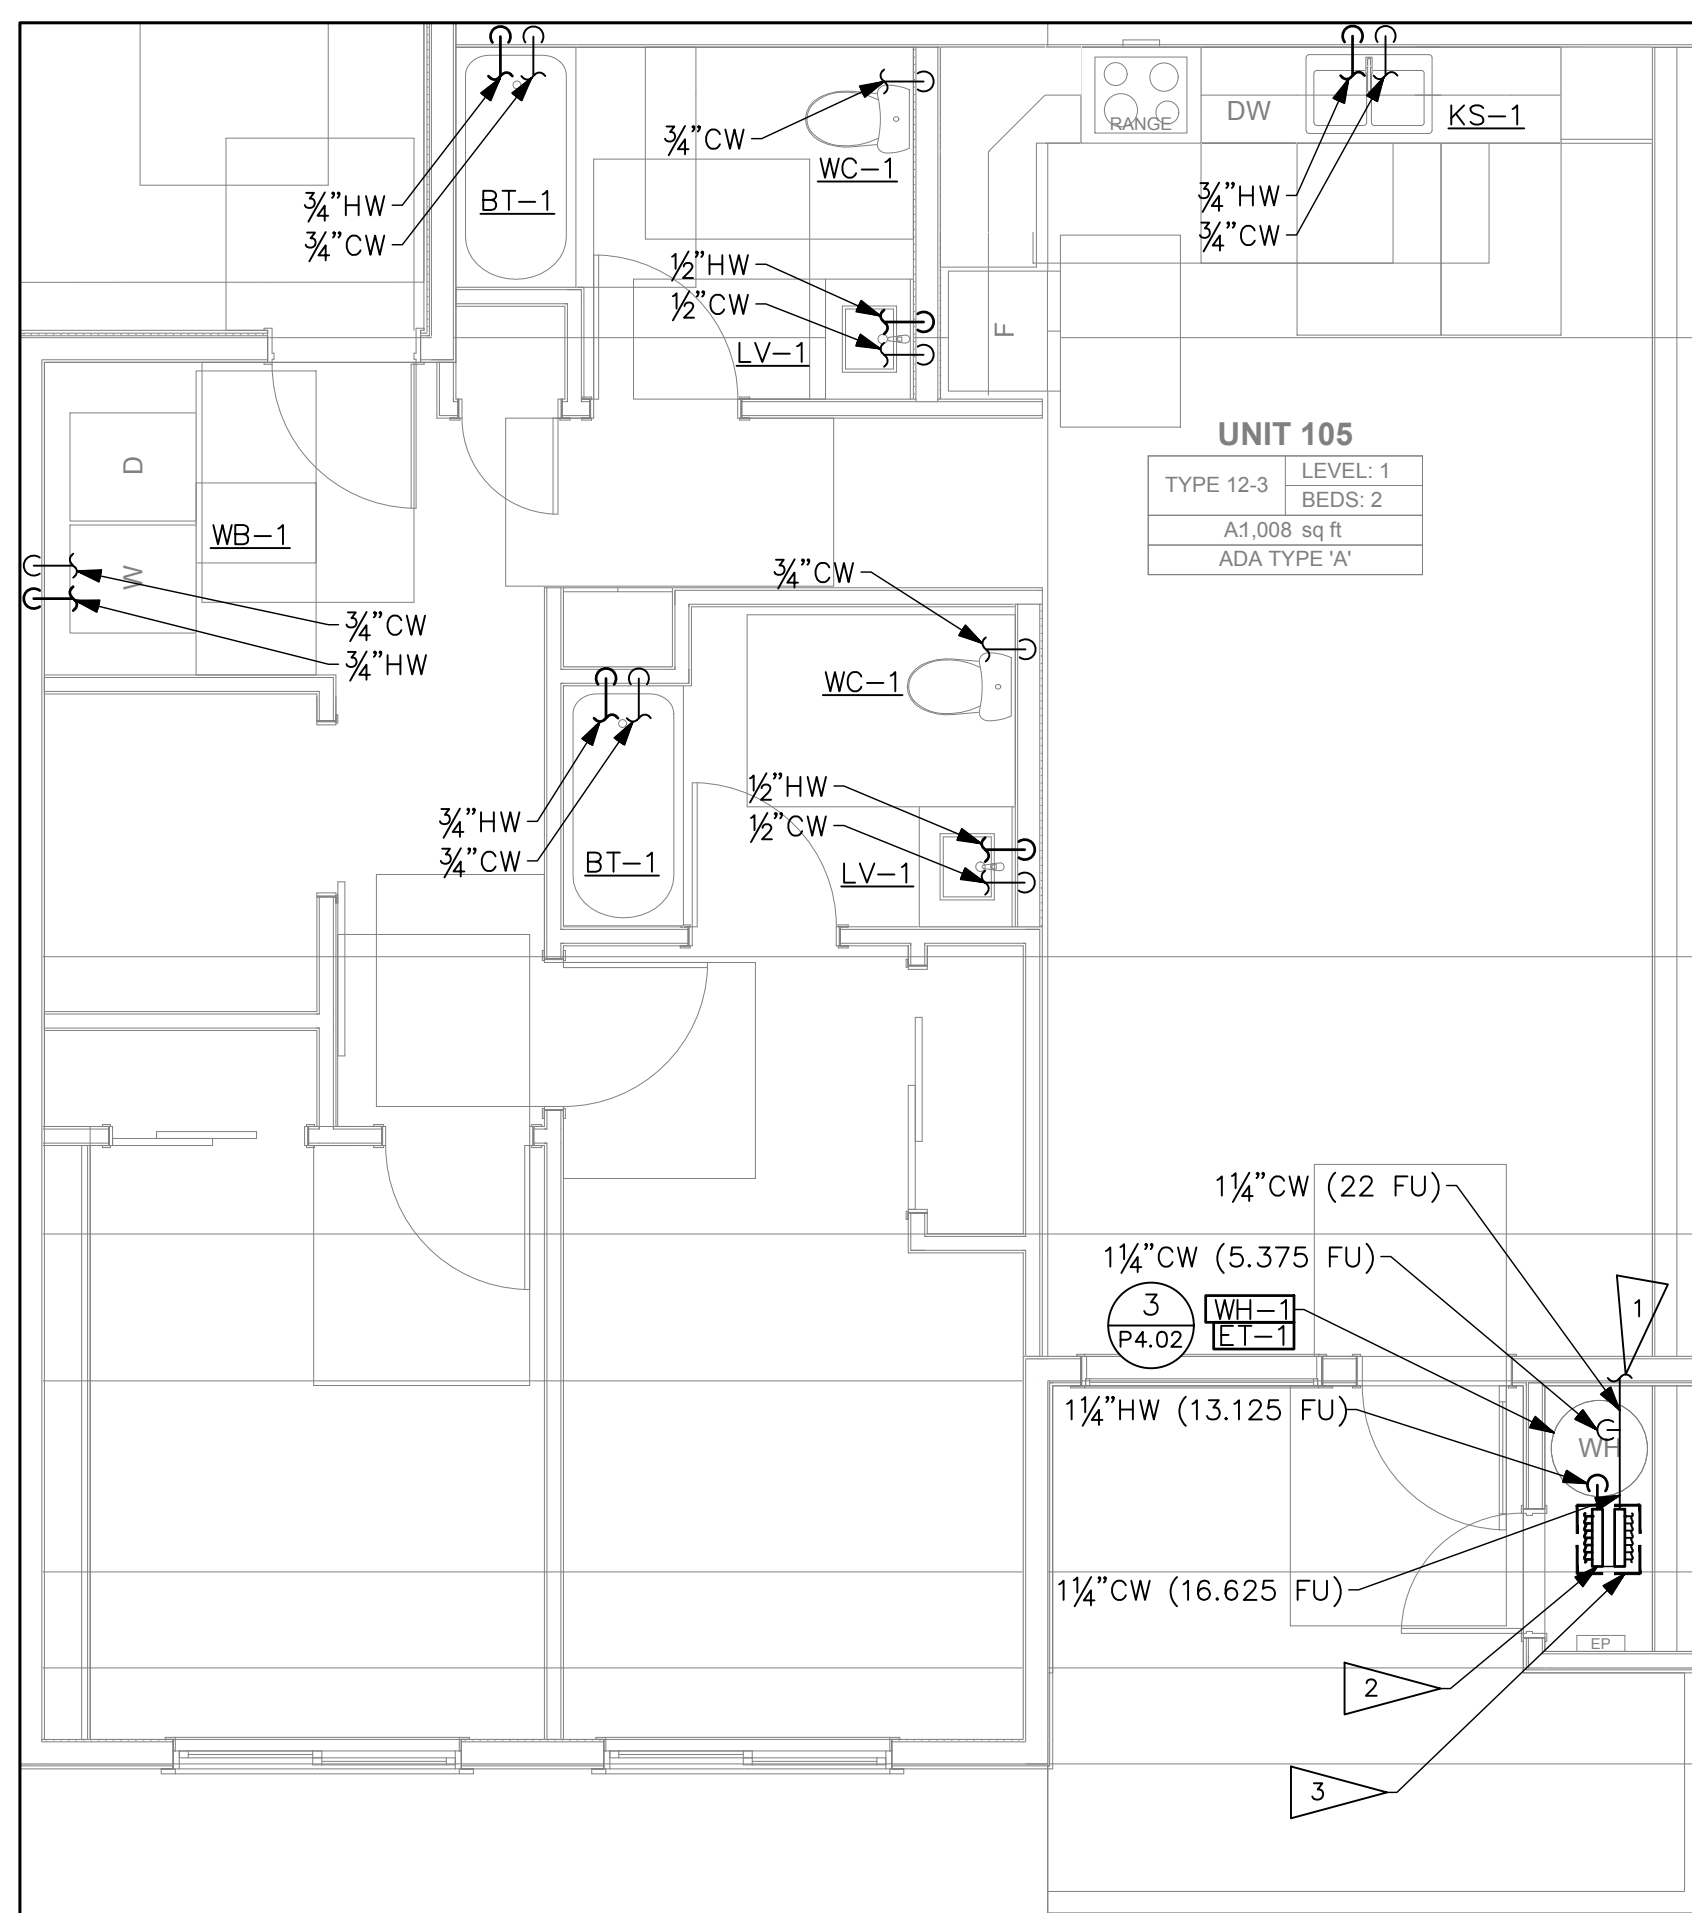


TYPICAL ENLARGED
 ADA 2 BATHROOM UNIT
 SCALE: 1/4" = 1'-0"

S2
 P5.B0

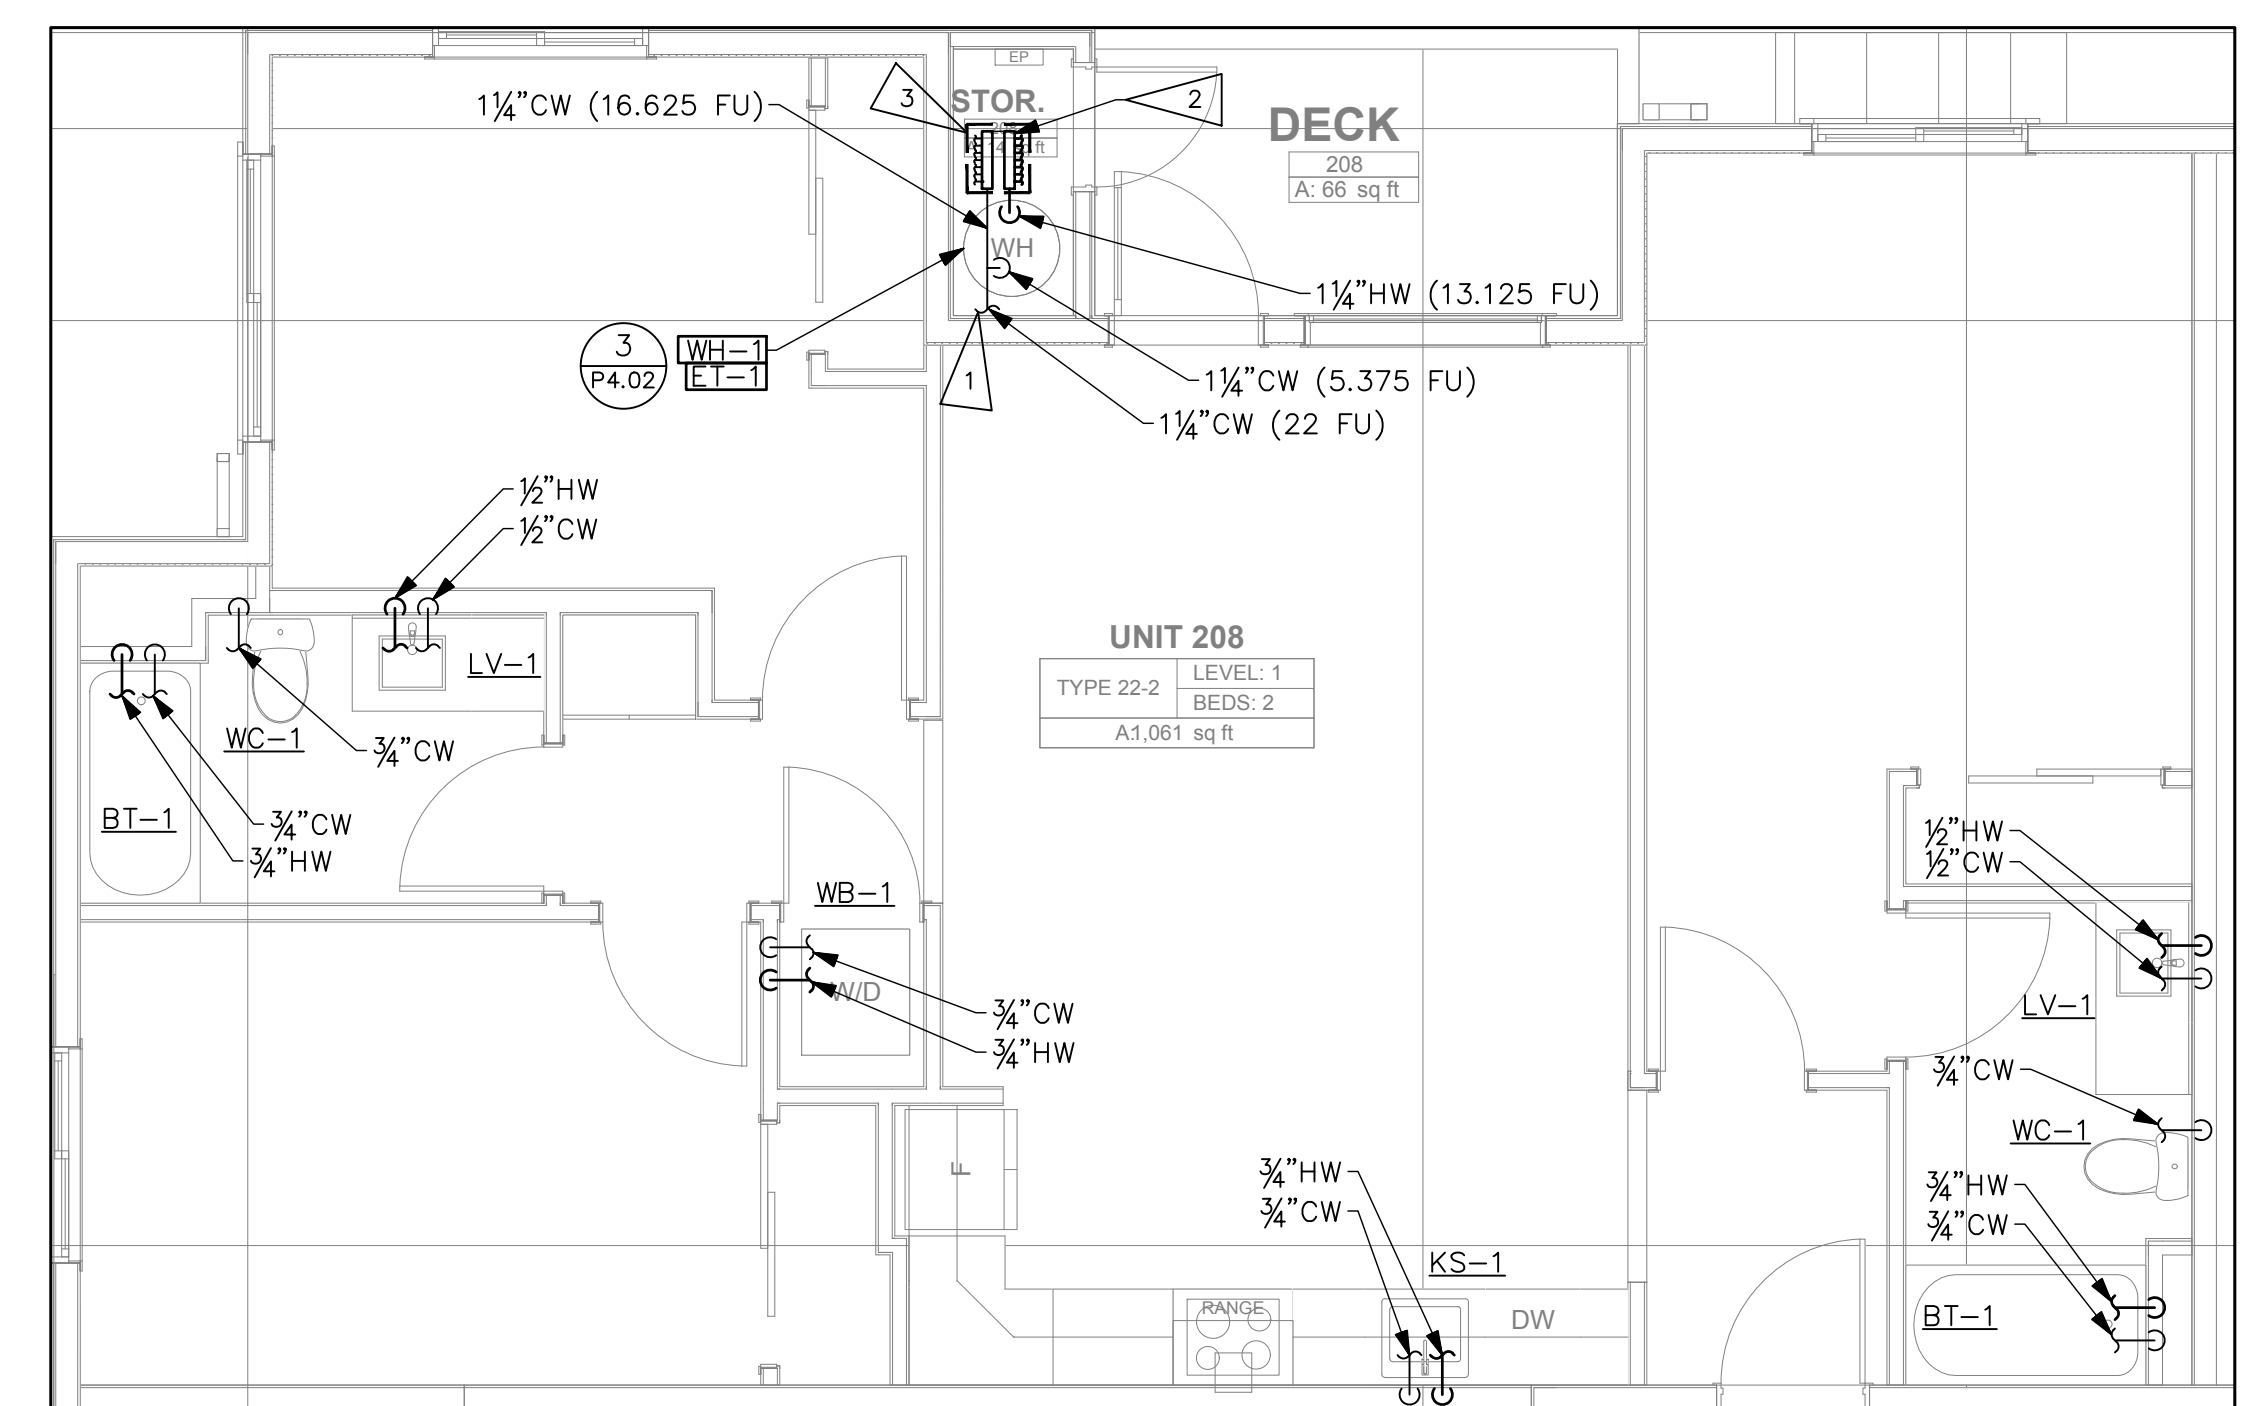


TYPICAL ENLARGED
 2 BATHROOM UNIT
 SCALE: 1/4" = 1'-0"

S1
 P5.B0

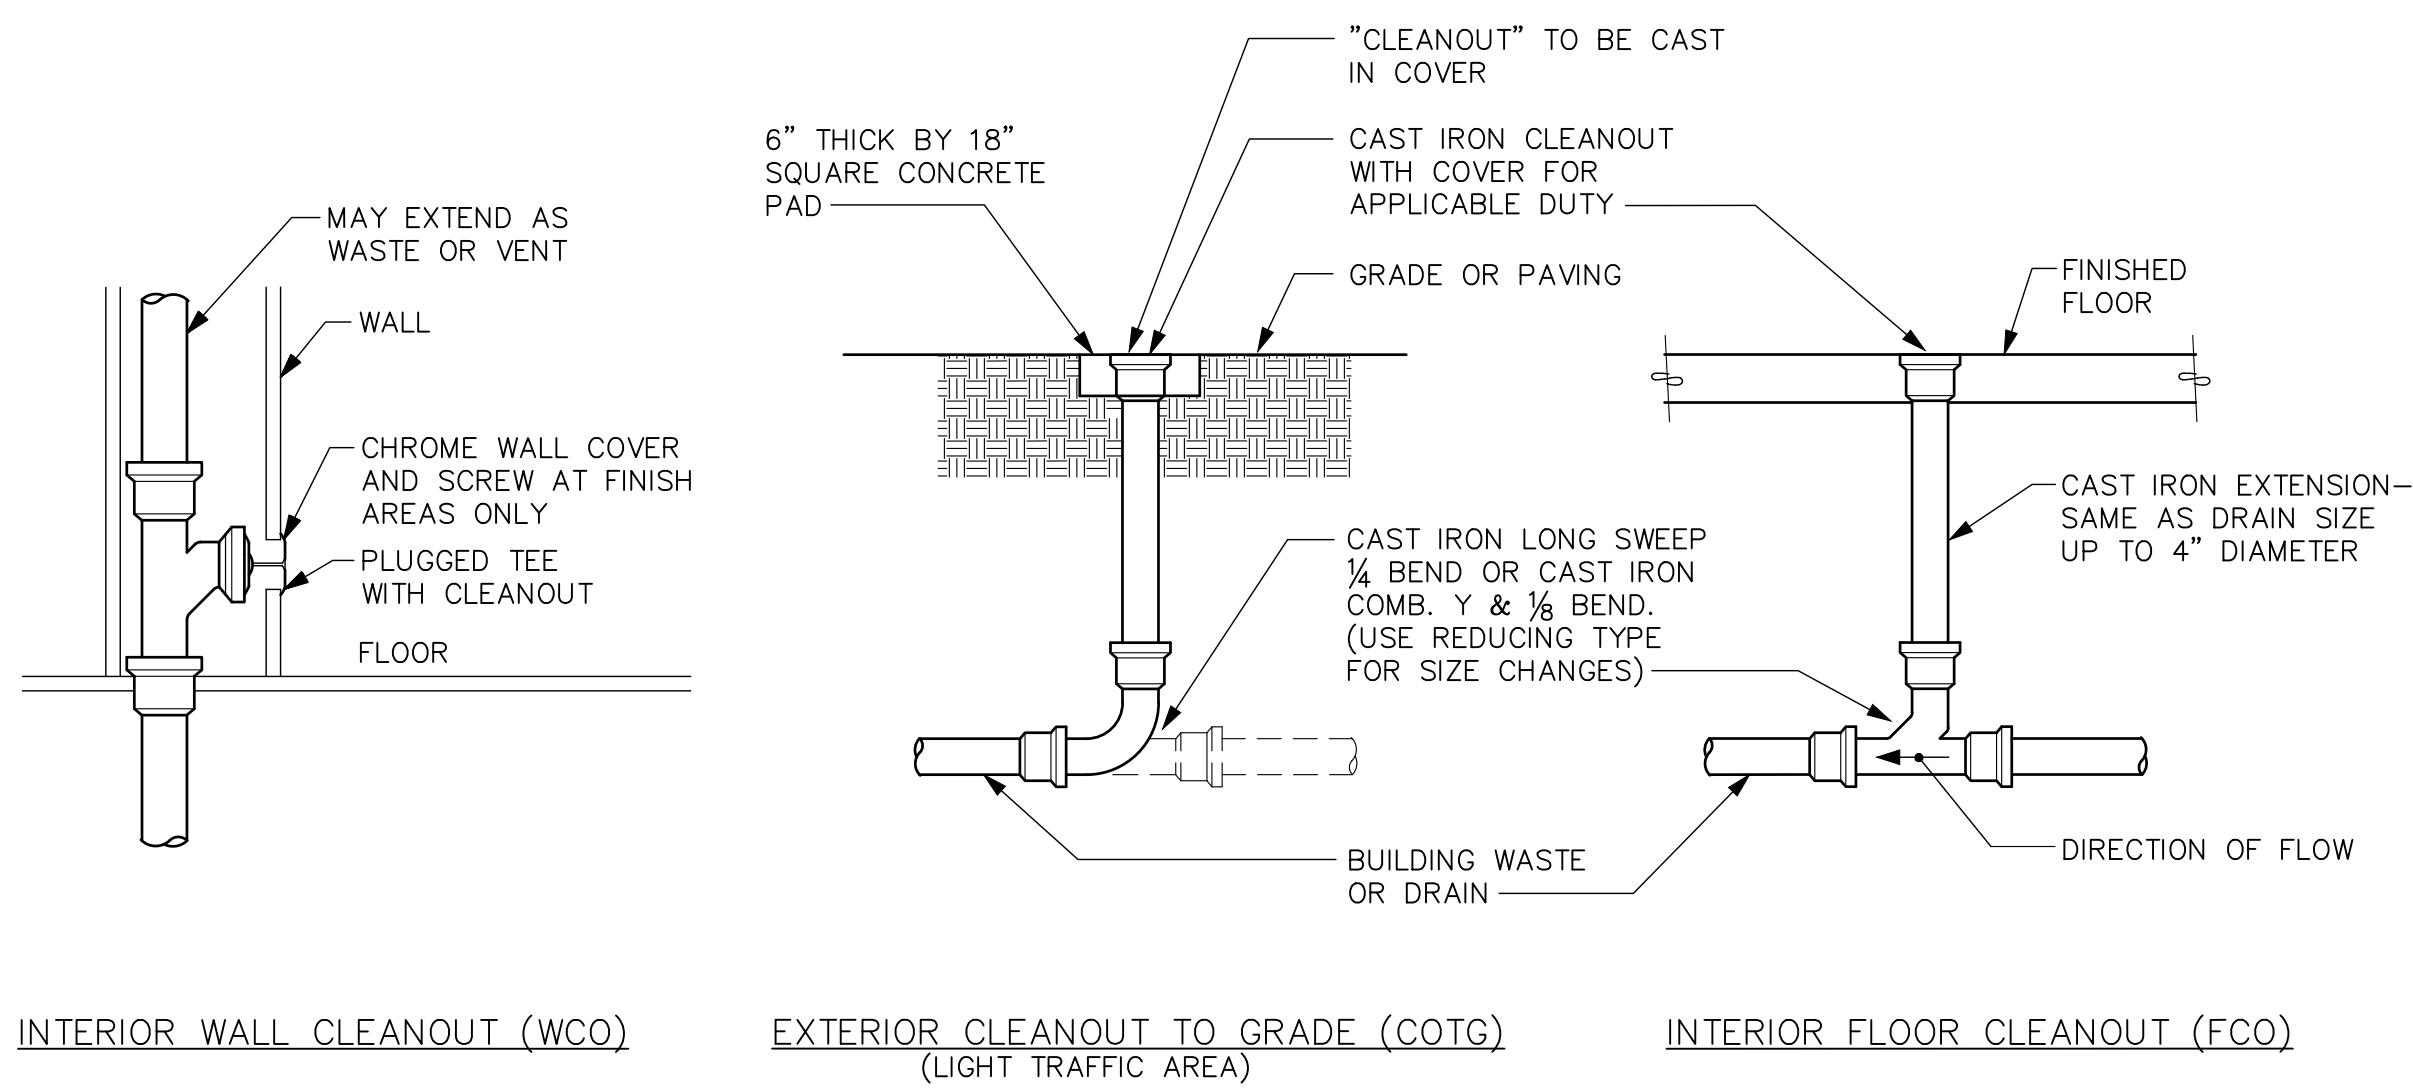


CLEANOUTS
DETAIL
SCALE: NONE

6
P4.00

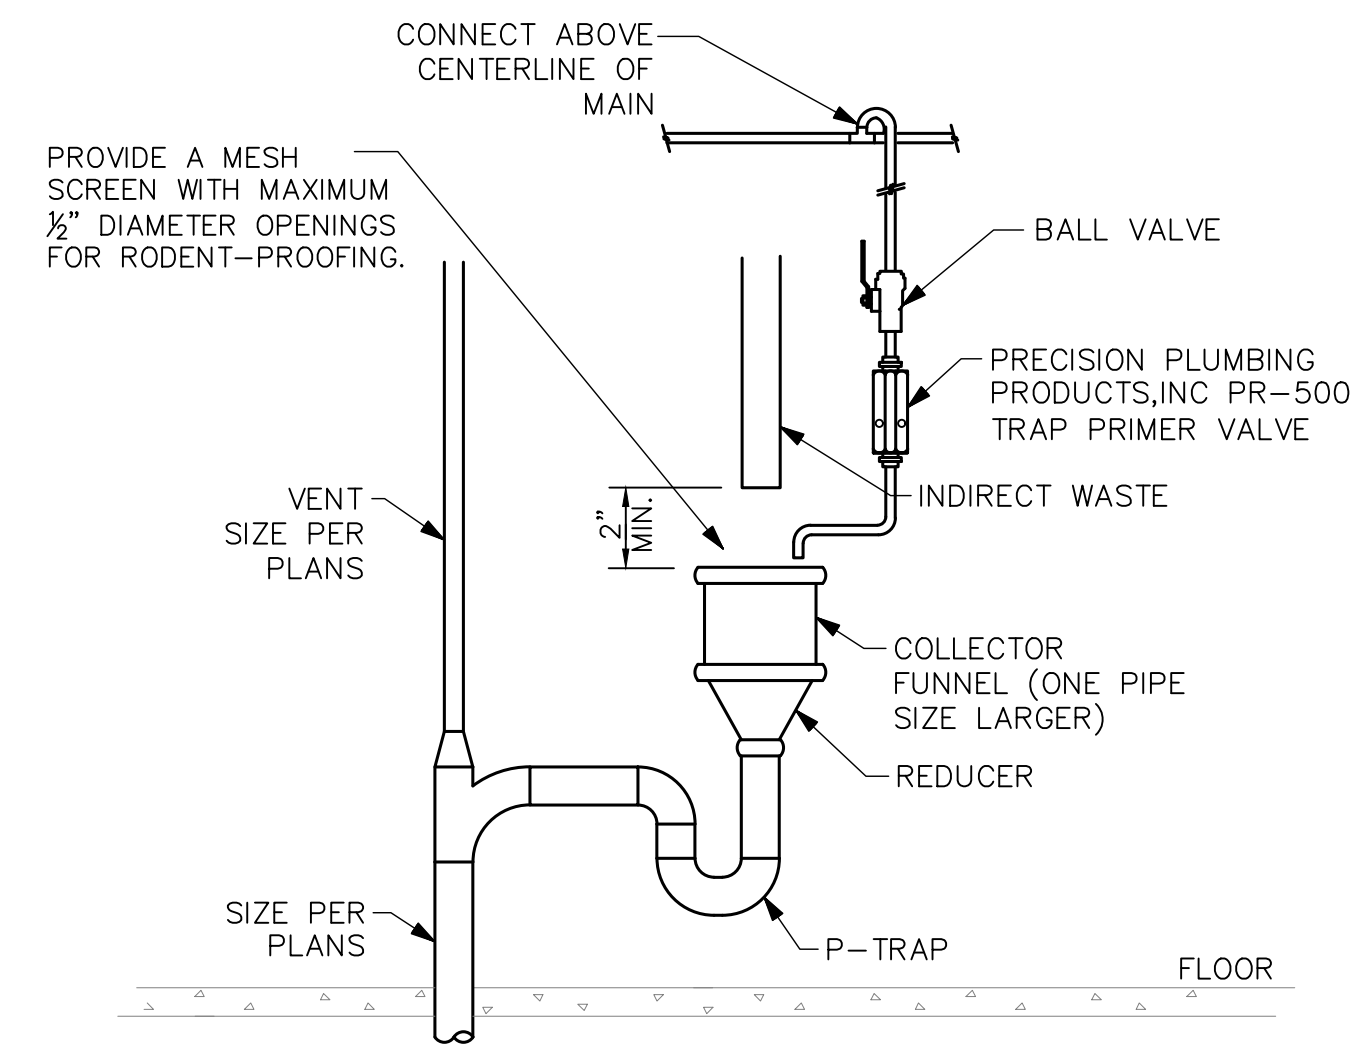


HUB DRAIN
DETAIL
SCALE: NONE

5
P4.00

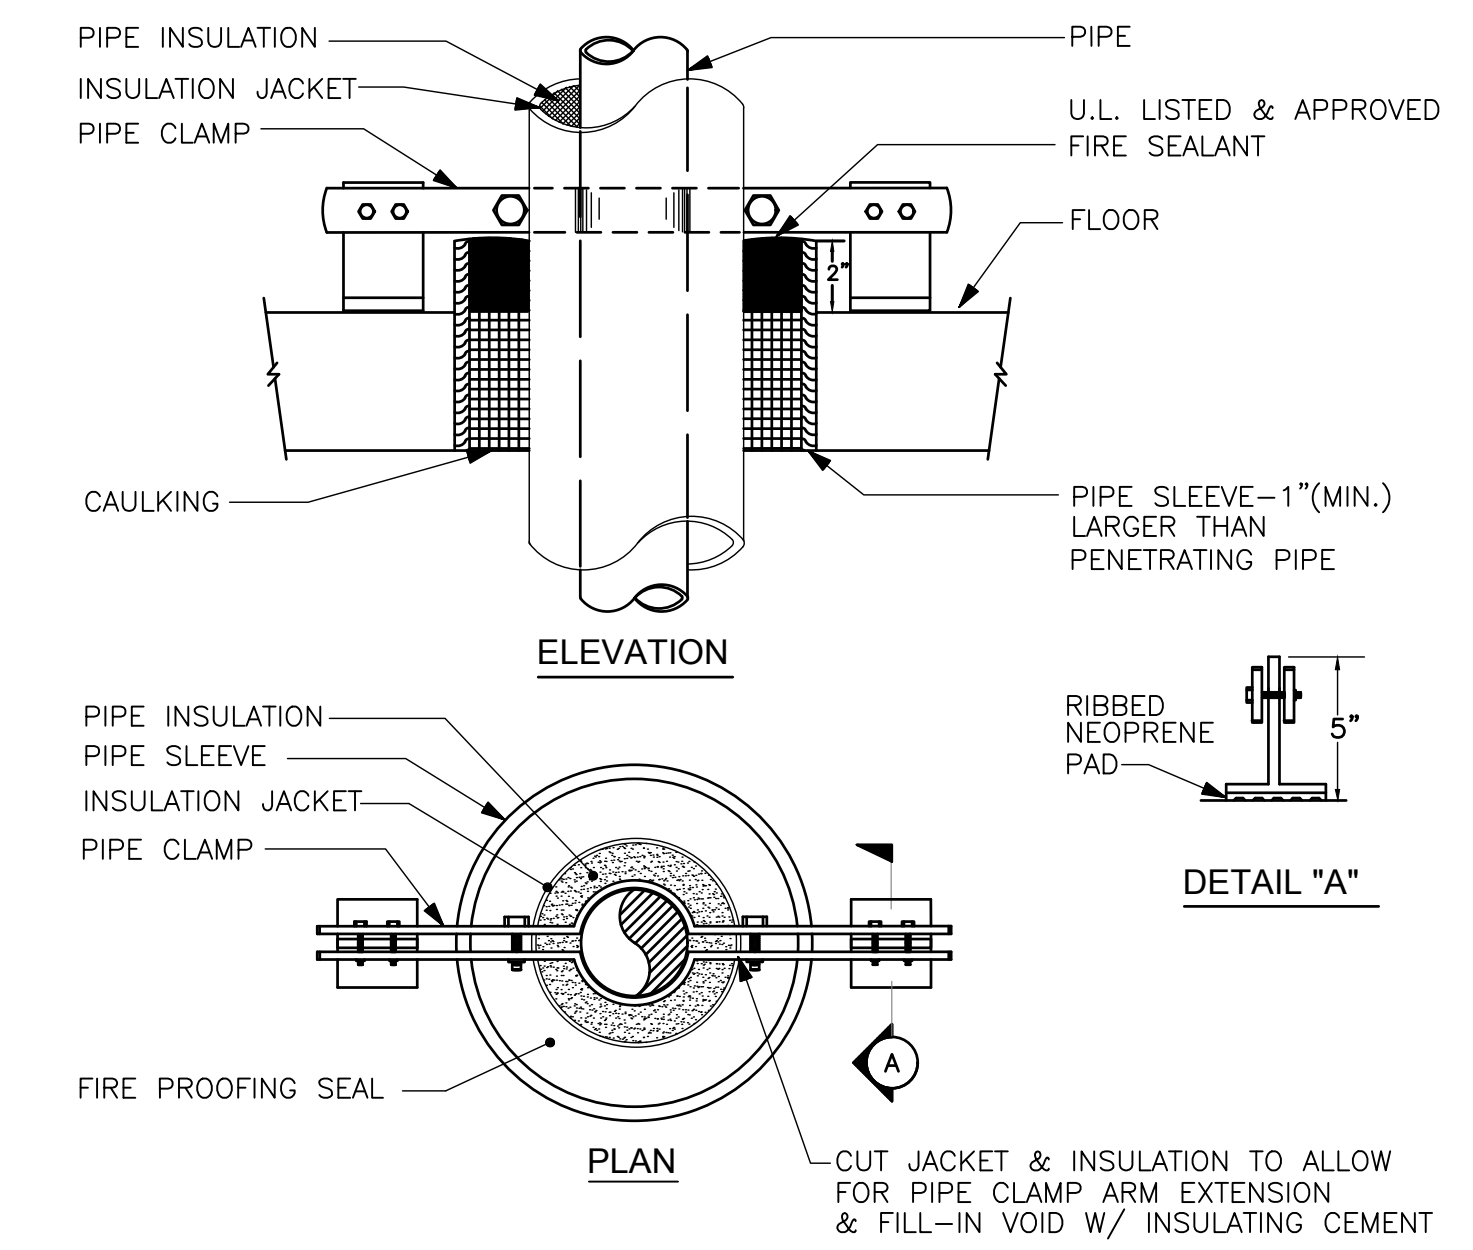


RISER PIPE SUPPORT
DETAIL
SCALE: NONE

4
P4.00

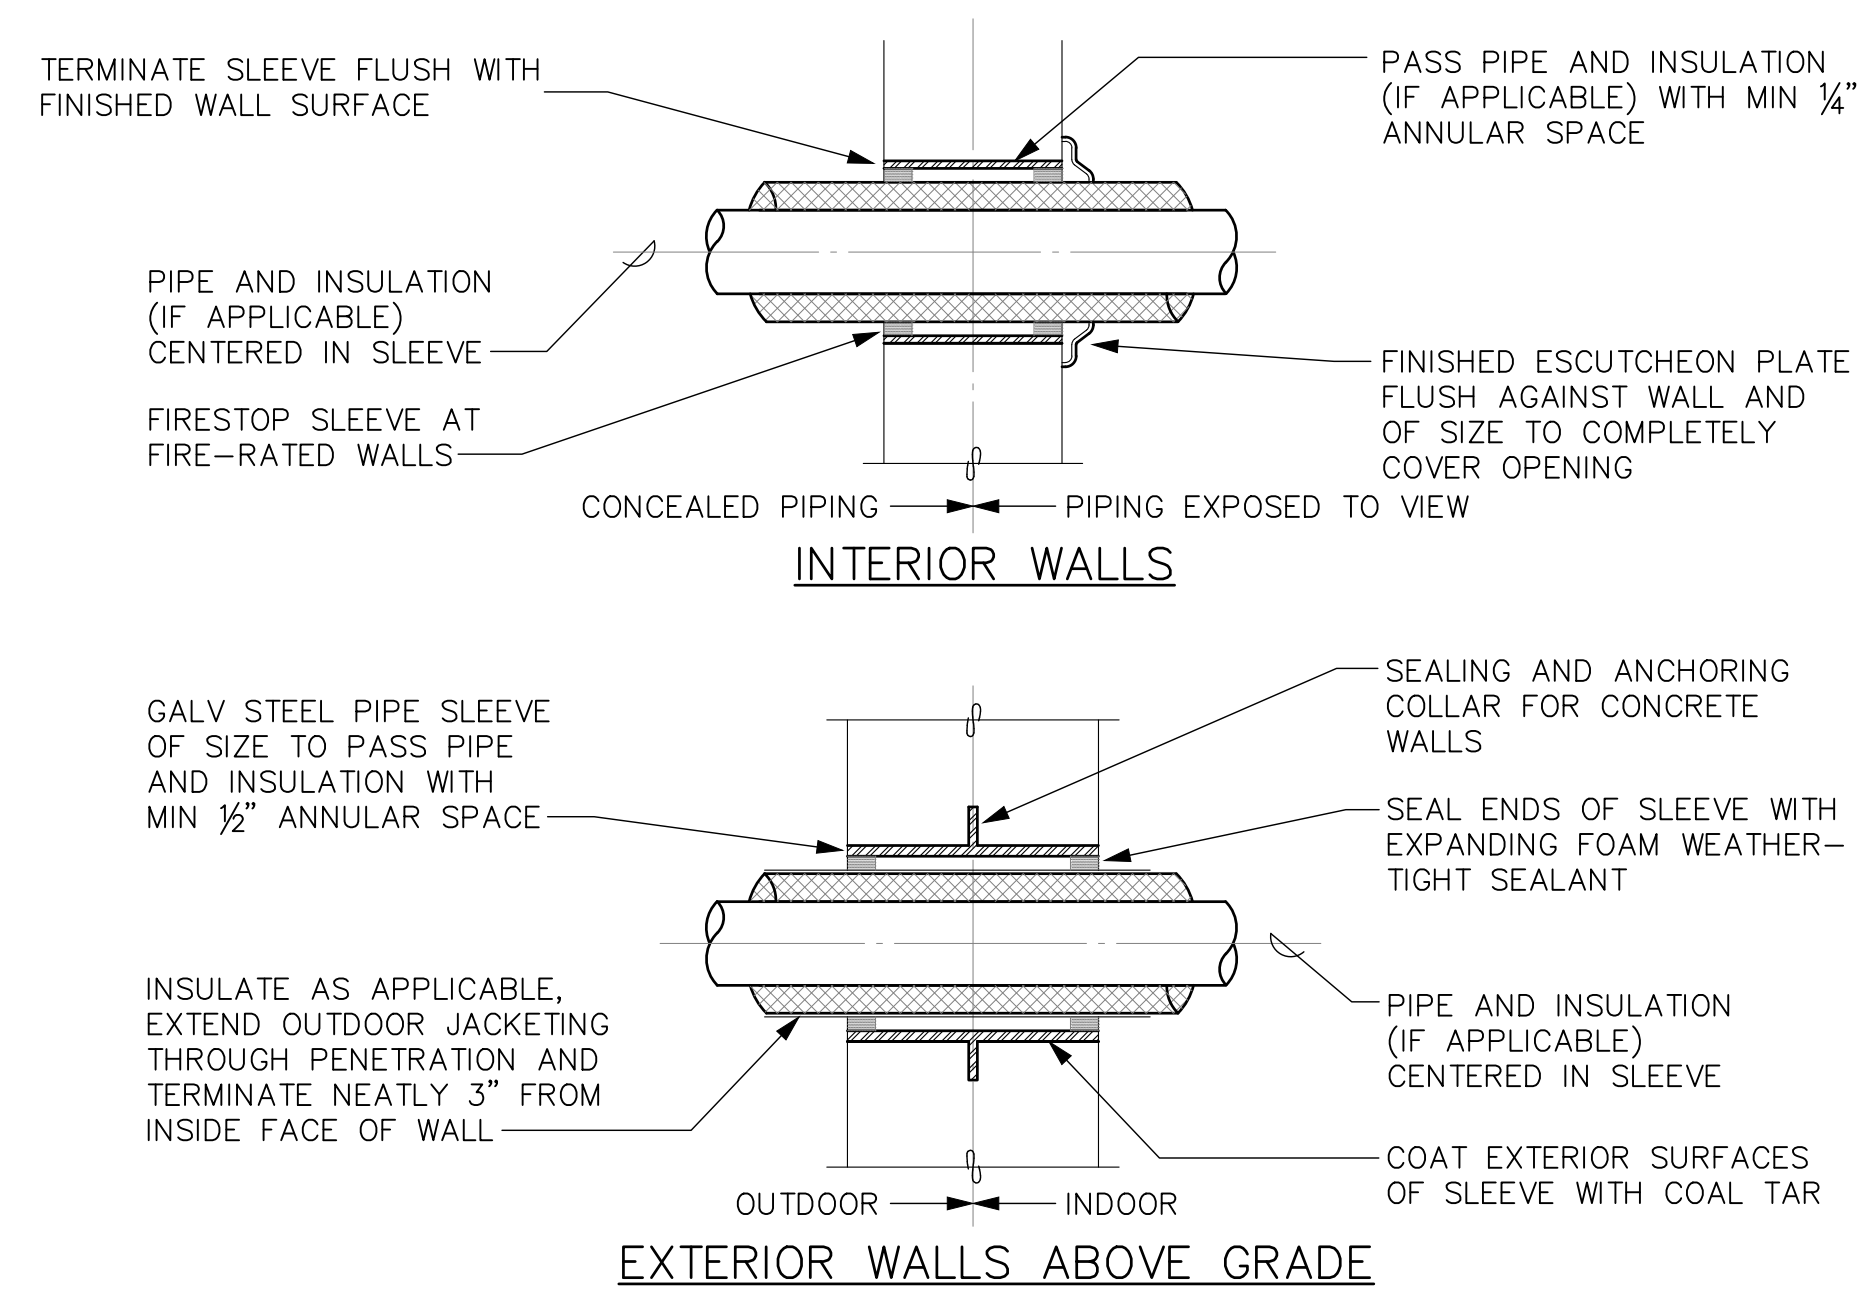


PIPE SLEEVES THROUGH WALLS
DETAIL
SCALE: NONE

3
P4.00

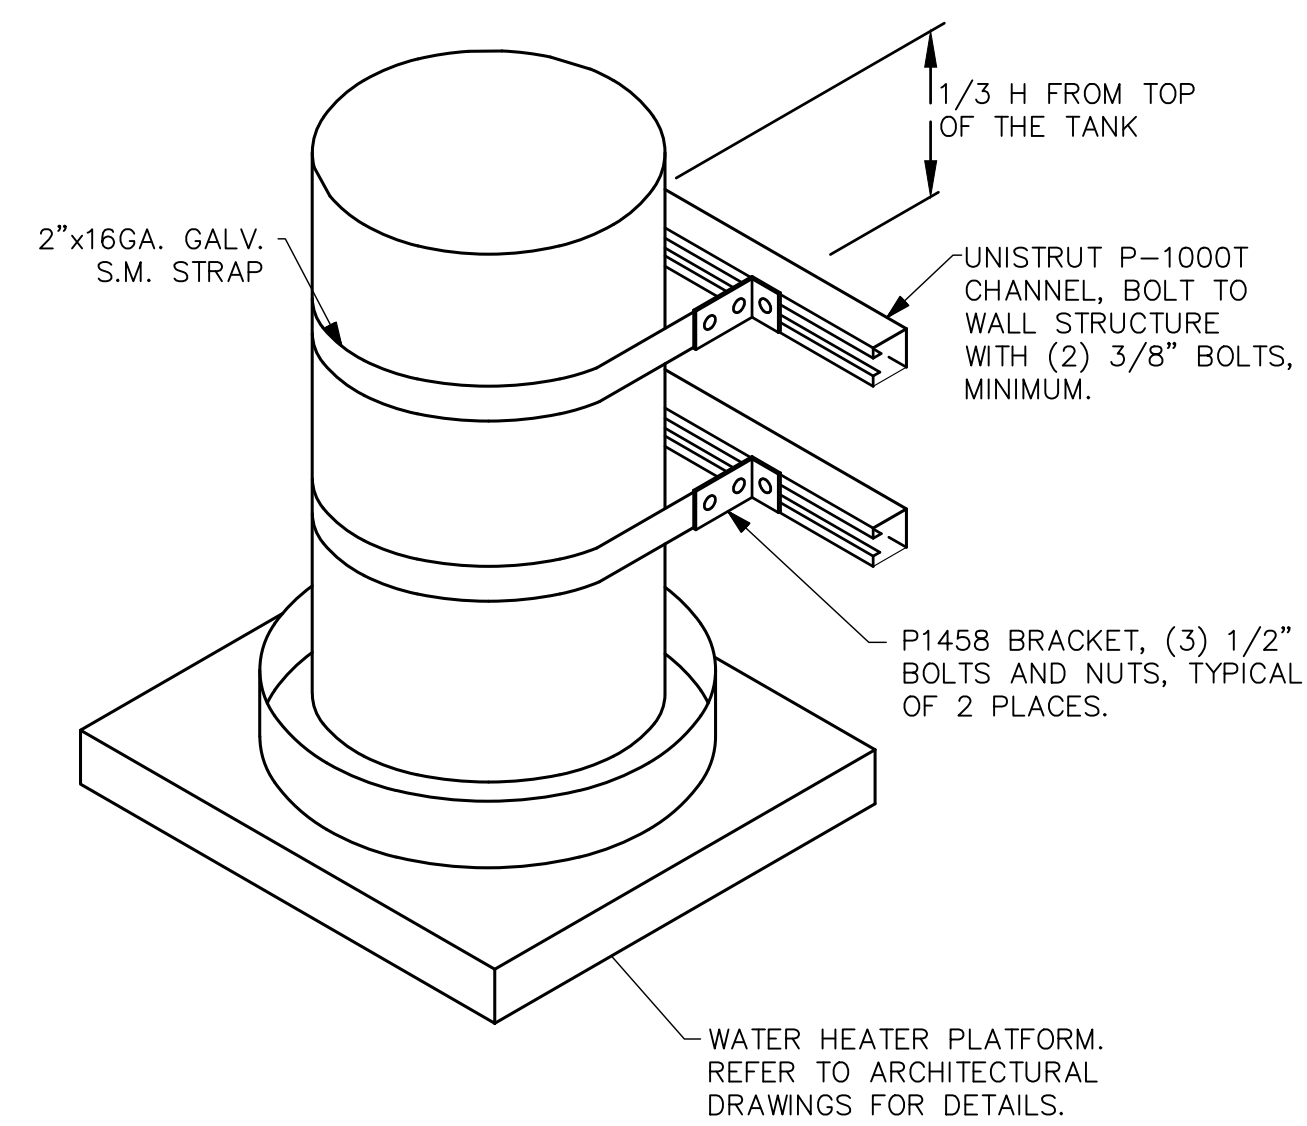

WATER HEATER SEISMIC STRAPPING
DETAIL
SCALE: NONE

2
P4.00

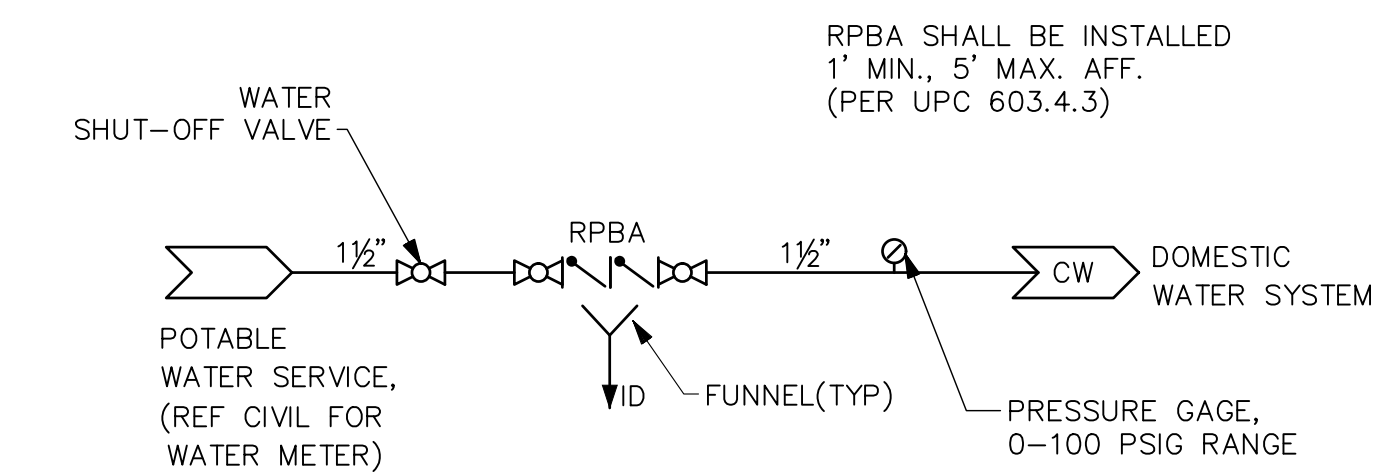

WATER SERVICE
PIPING DIAGRAM
SCALE: NONE

1
P4.00

| REVISIONS | DESCRIPTION | DATE |
|-----------|-------------|------|
| NO. | | |



| | | | |
|-----------|--------------|-------------|--------------|
| DRAWN: JD | DESIGNED: JD | CHECKED: RJ | APPROVED: RJ |
|-----------|--------------|-------------|--------------|

PROJECT: EAST TOWN CROSSING
MULTIFAMILY DEVELOPMENT
PIONEER WAY & SHAW RD. PUYALLUP, WA


19401 40TH AVE W, SUITE 302
LYNNWOOD, WA 98036
PHONE: 206-864-3343

ROBISON ENGINEERING, INC.

PERMIT PLANS
01/22/2024


SHEET TITLE:
DETAILS

SHEET NO.
P4.00

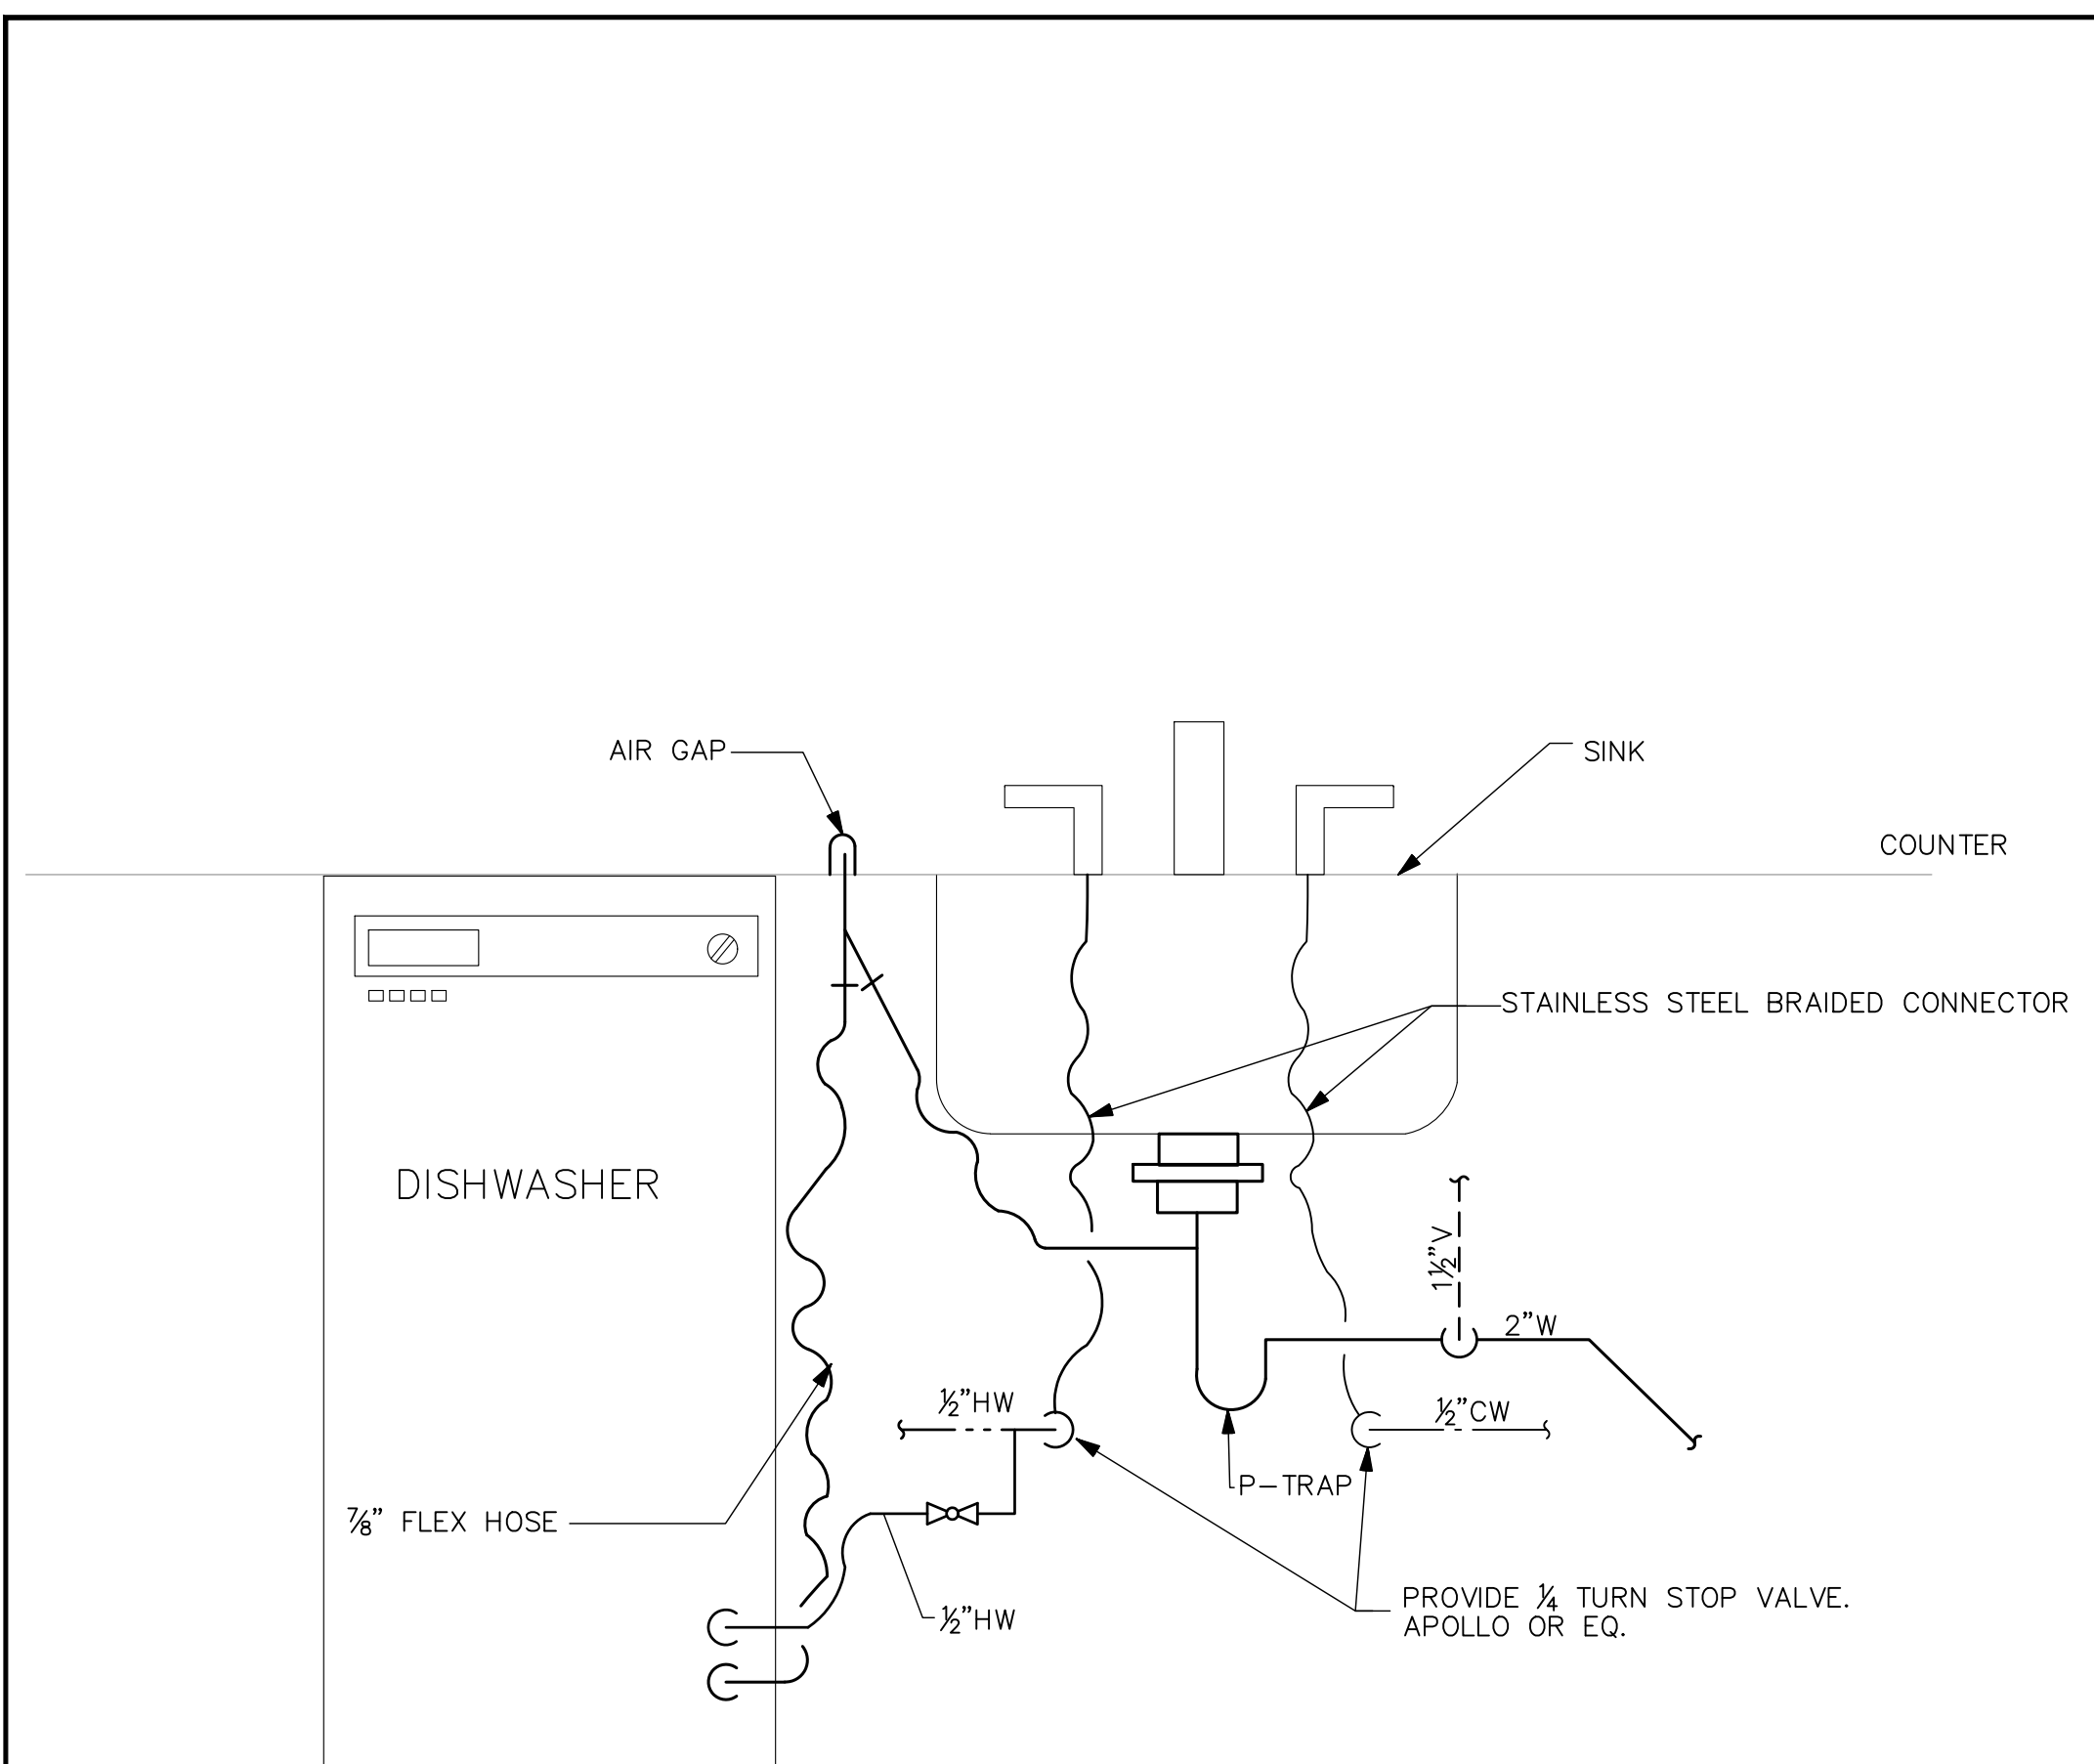


**RESIDENTIAL DISHWASHER CONNECTION
DETAIL**
SCALE: NONE

6
P4.01

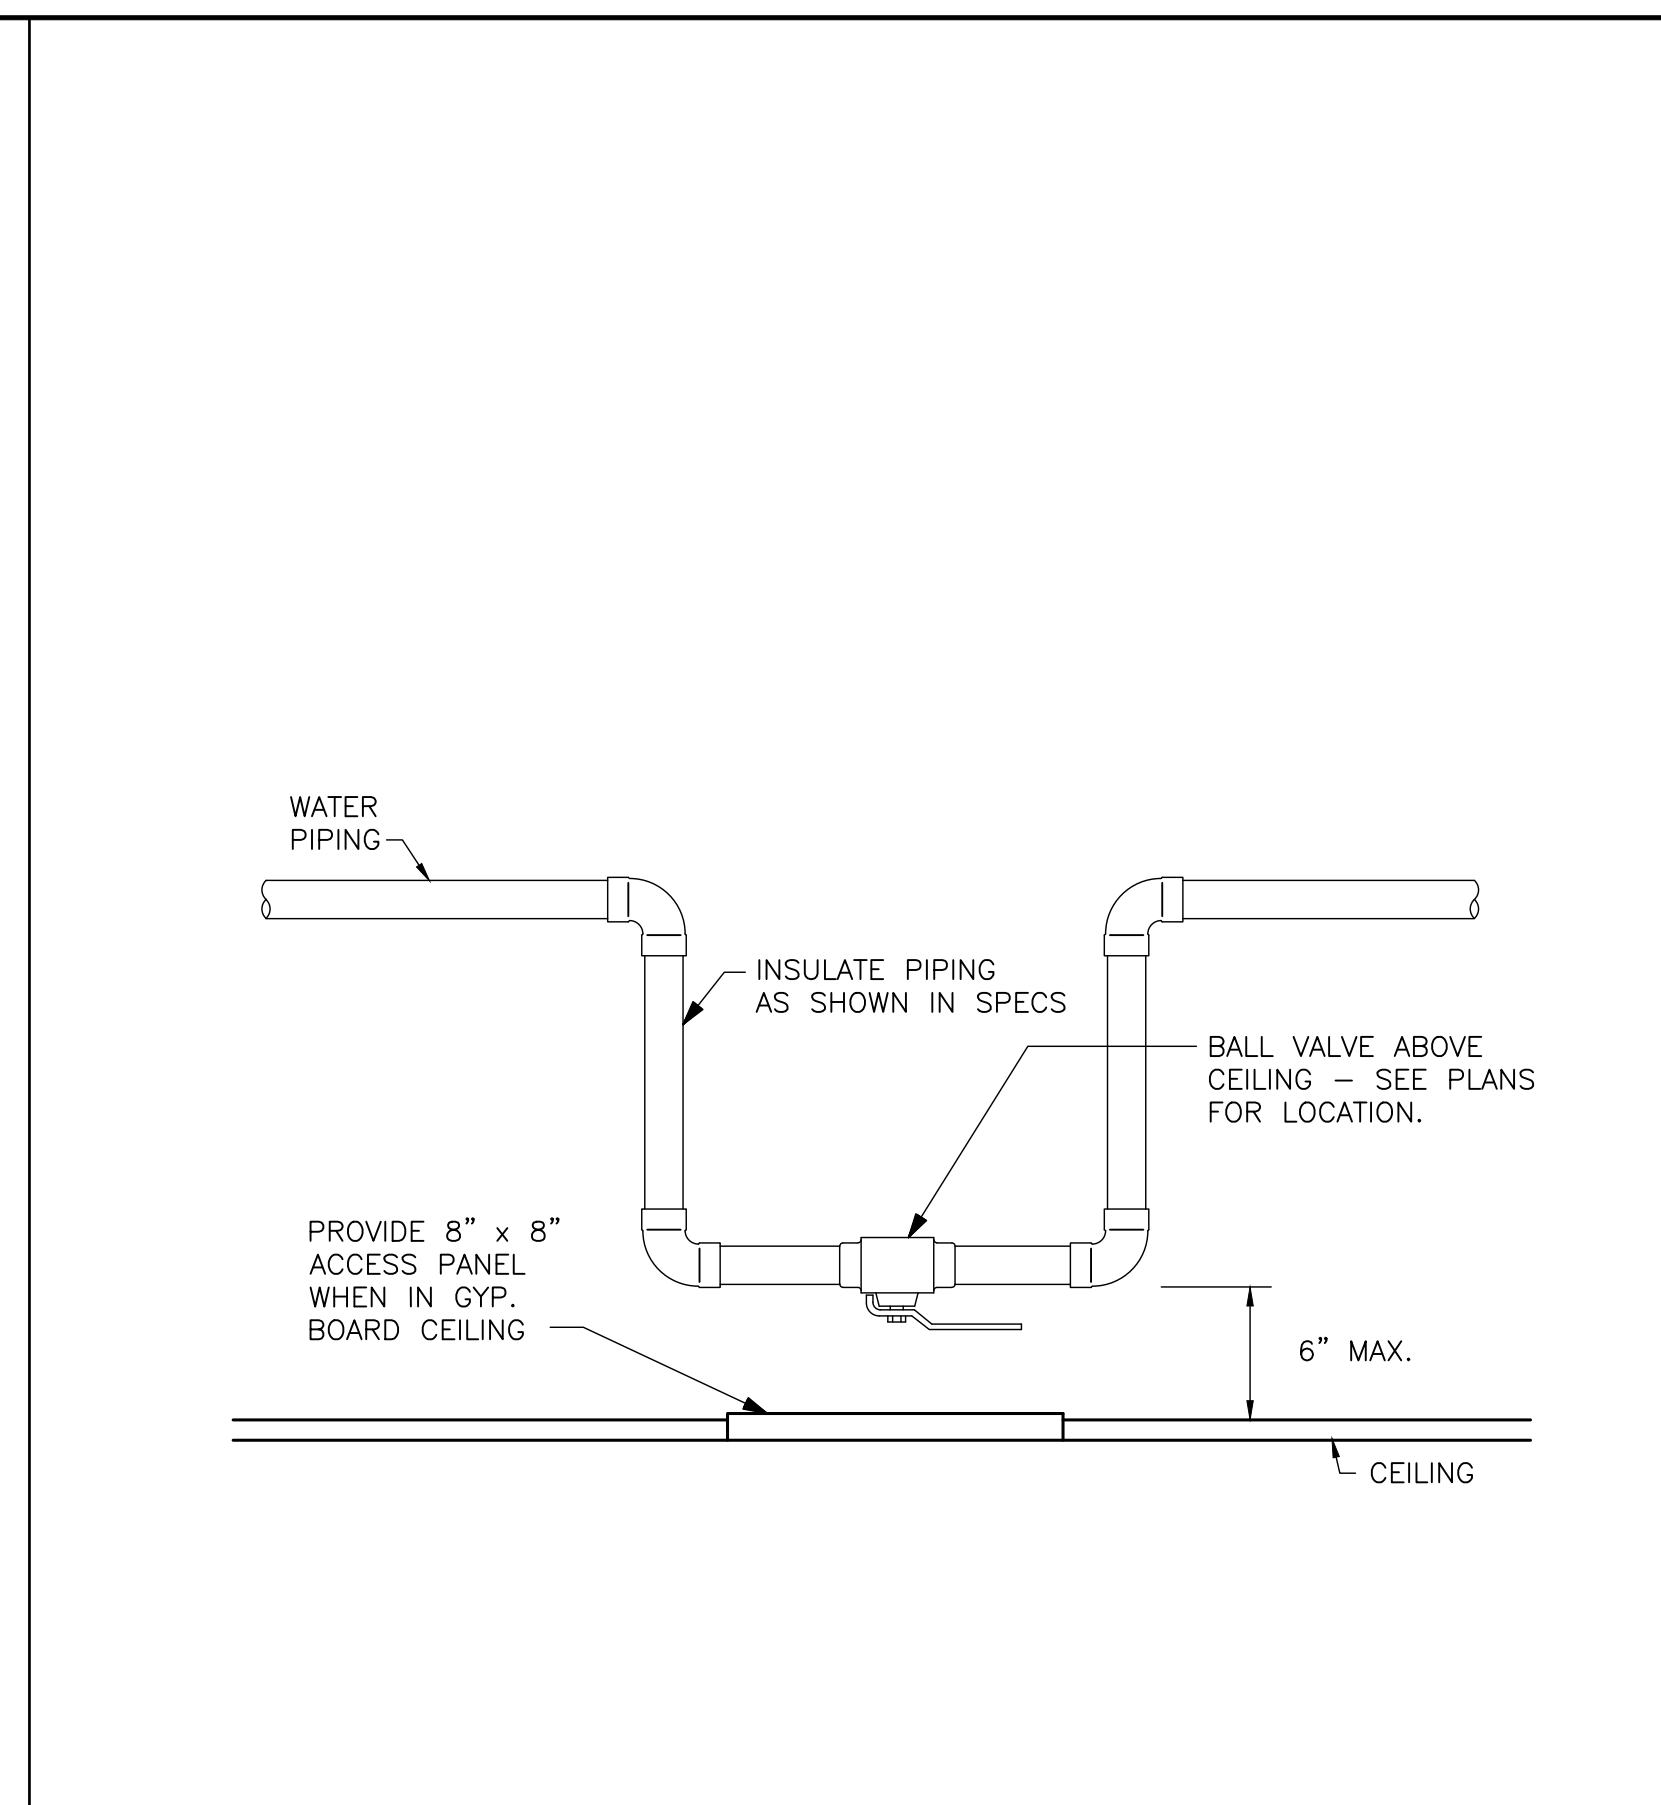

**TYPICAL VALVE PLACEMENT
DETAIL**
SCALE: NONE

5
P4.01

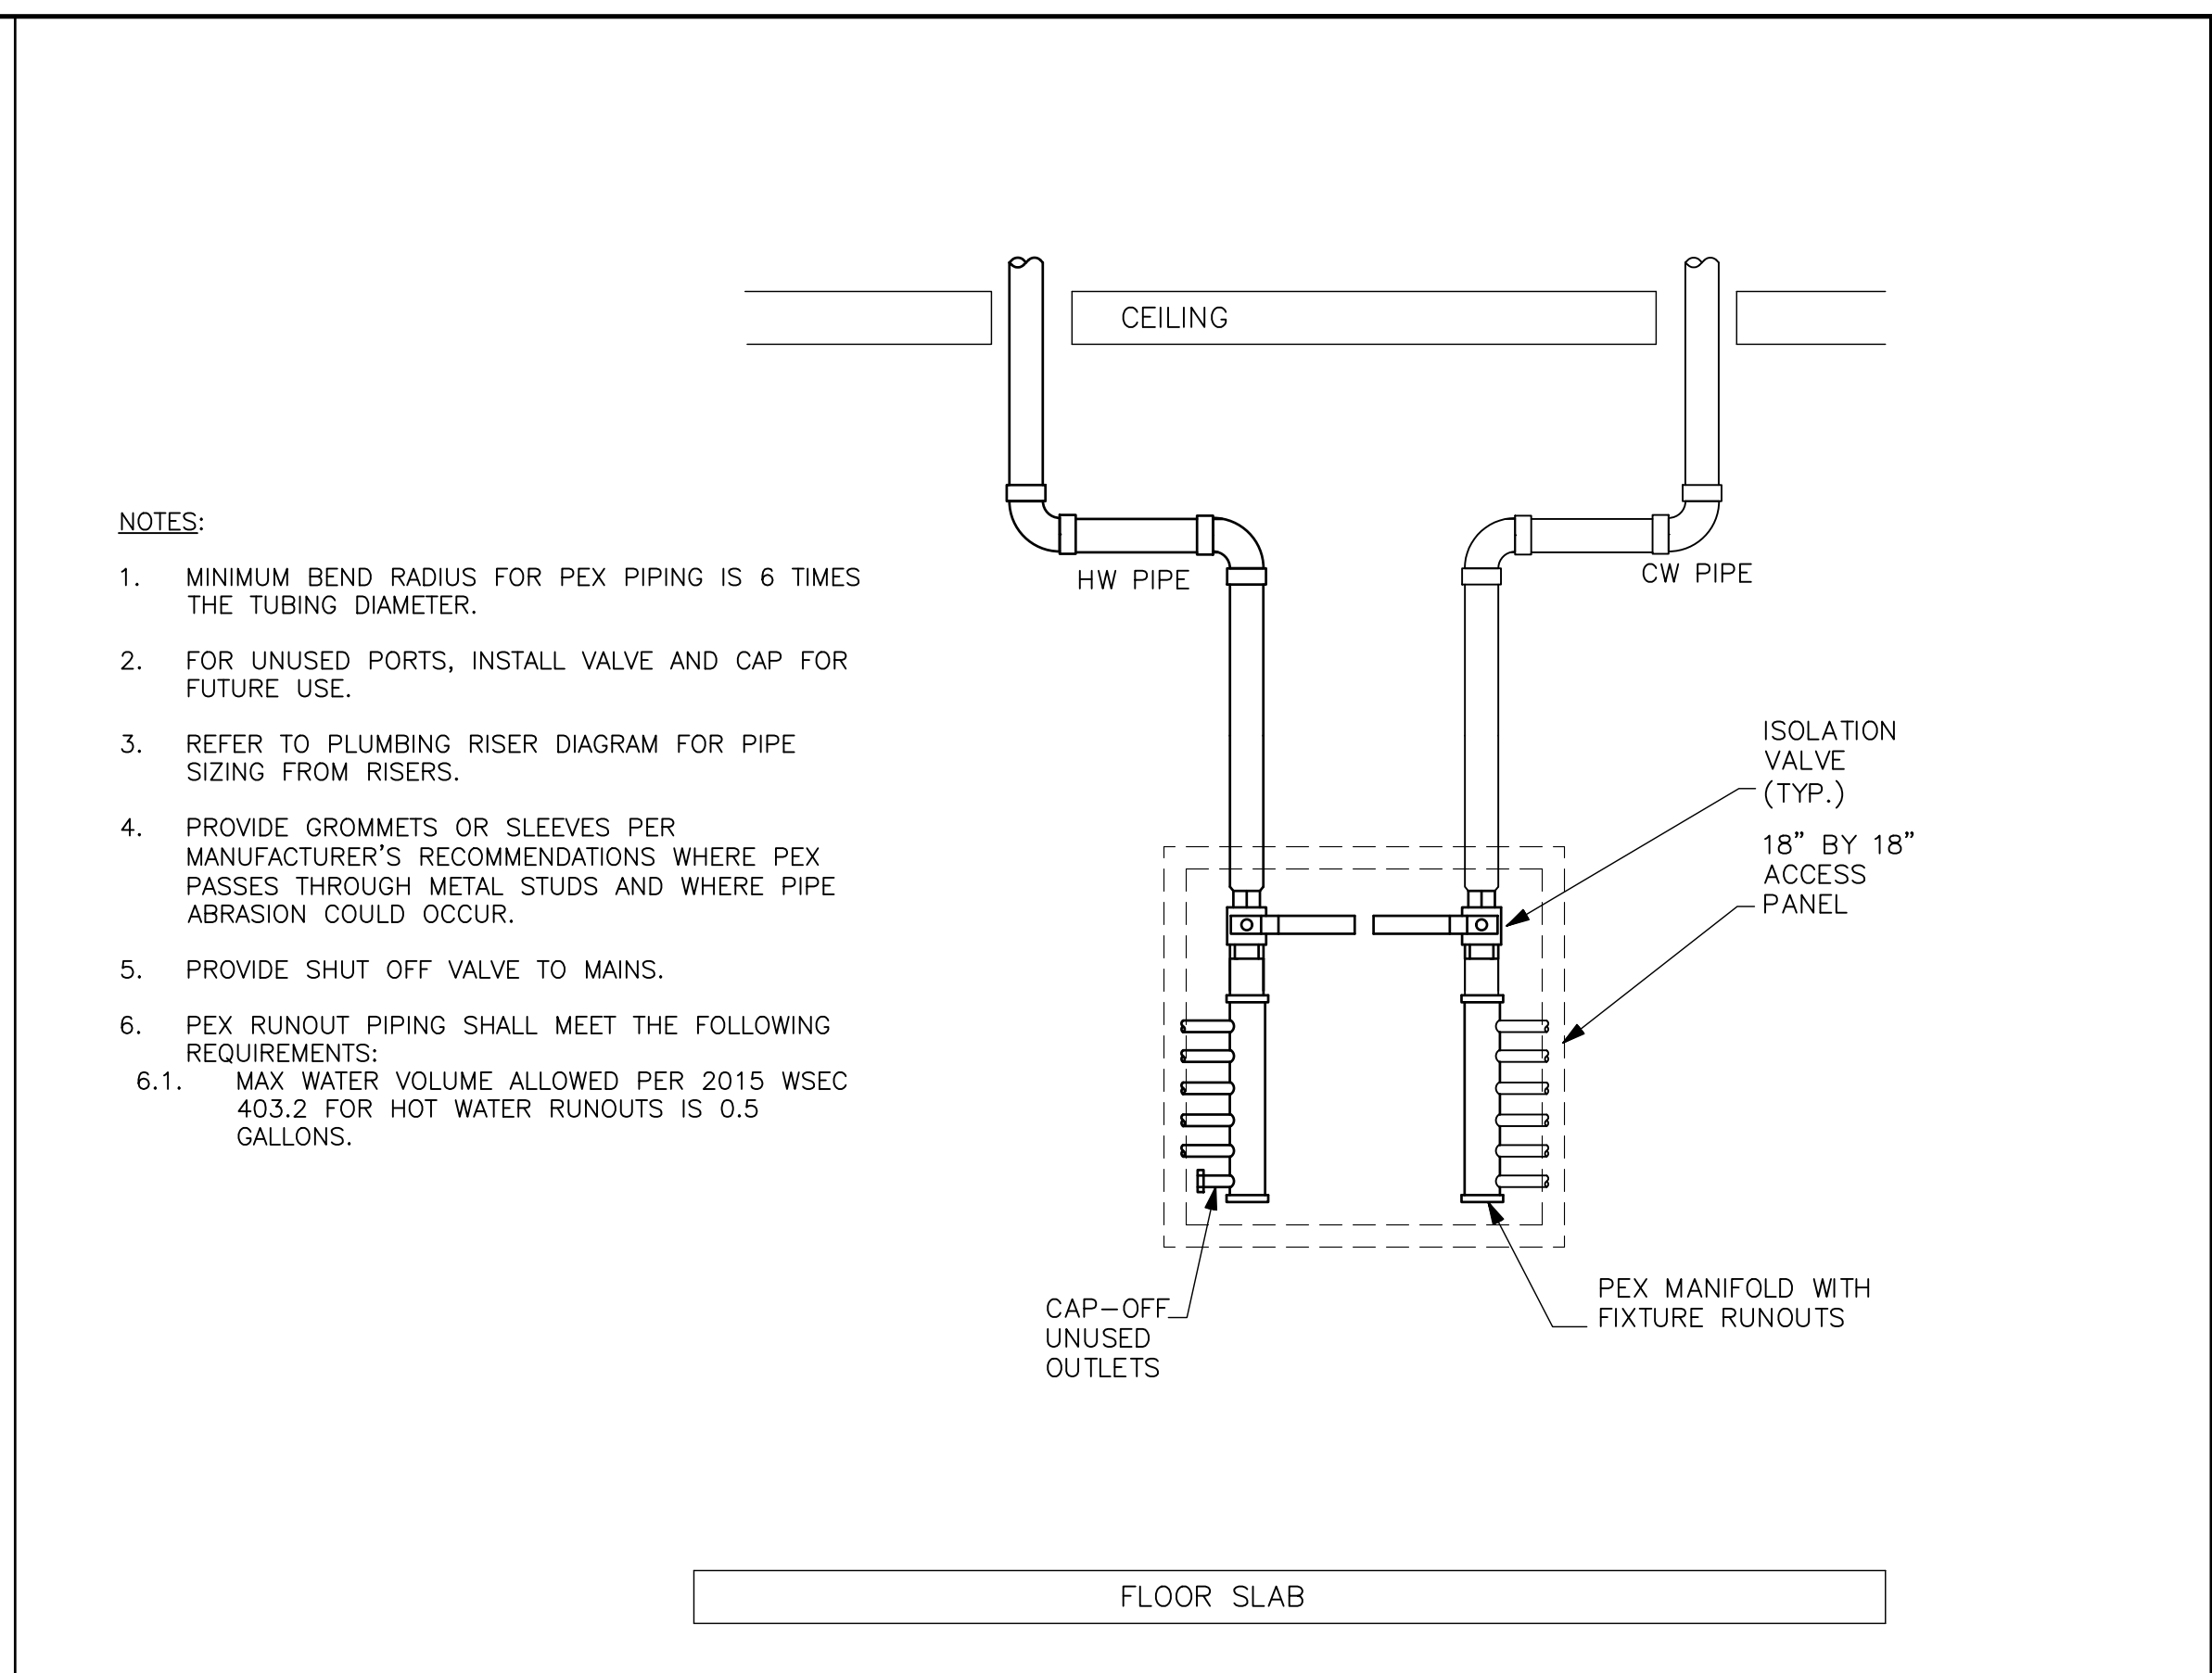


**PEX MANIFOLD
DETAIL**
SCALE: NONE

4
P4.01


NOTES:

1. MINIMUM BEND RADIUS FOR PEX PIPING IS 6 TIMES THE TUBING DIAMETER.
2. FOR UNUSED PORTS, INSTALL VALVE AND CAP FOR FUTURE USE.
3. REFER TO PLUMBING RISER DIAGRAM FOR PIPE SIZING FROM RISERS.
4. PROVIDE GROMMETS OR SLEEVES PER MANUFACTURER'S RECOMMENDATIONS WHERE PEX PASSES THROUGH METAL STUDS AND WHERE PIPE ABRASION COULD OCCUR.
5. PROVIDE SHUT OFF VALVE TO MAINS.
6. PEX RUNOUT PIPING SHALL MEET THE FOLLOWING REQUIREMENTS:
 - 6.1. MAX WATER VOLUME ALLOWED PER 2015 WSEC 403.2 FOR HOT WATER RUNOUTS IS 0.5 GALLONS.

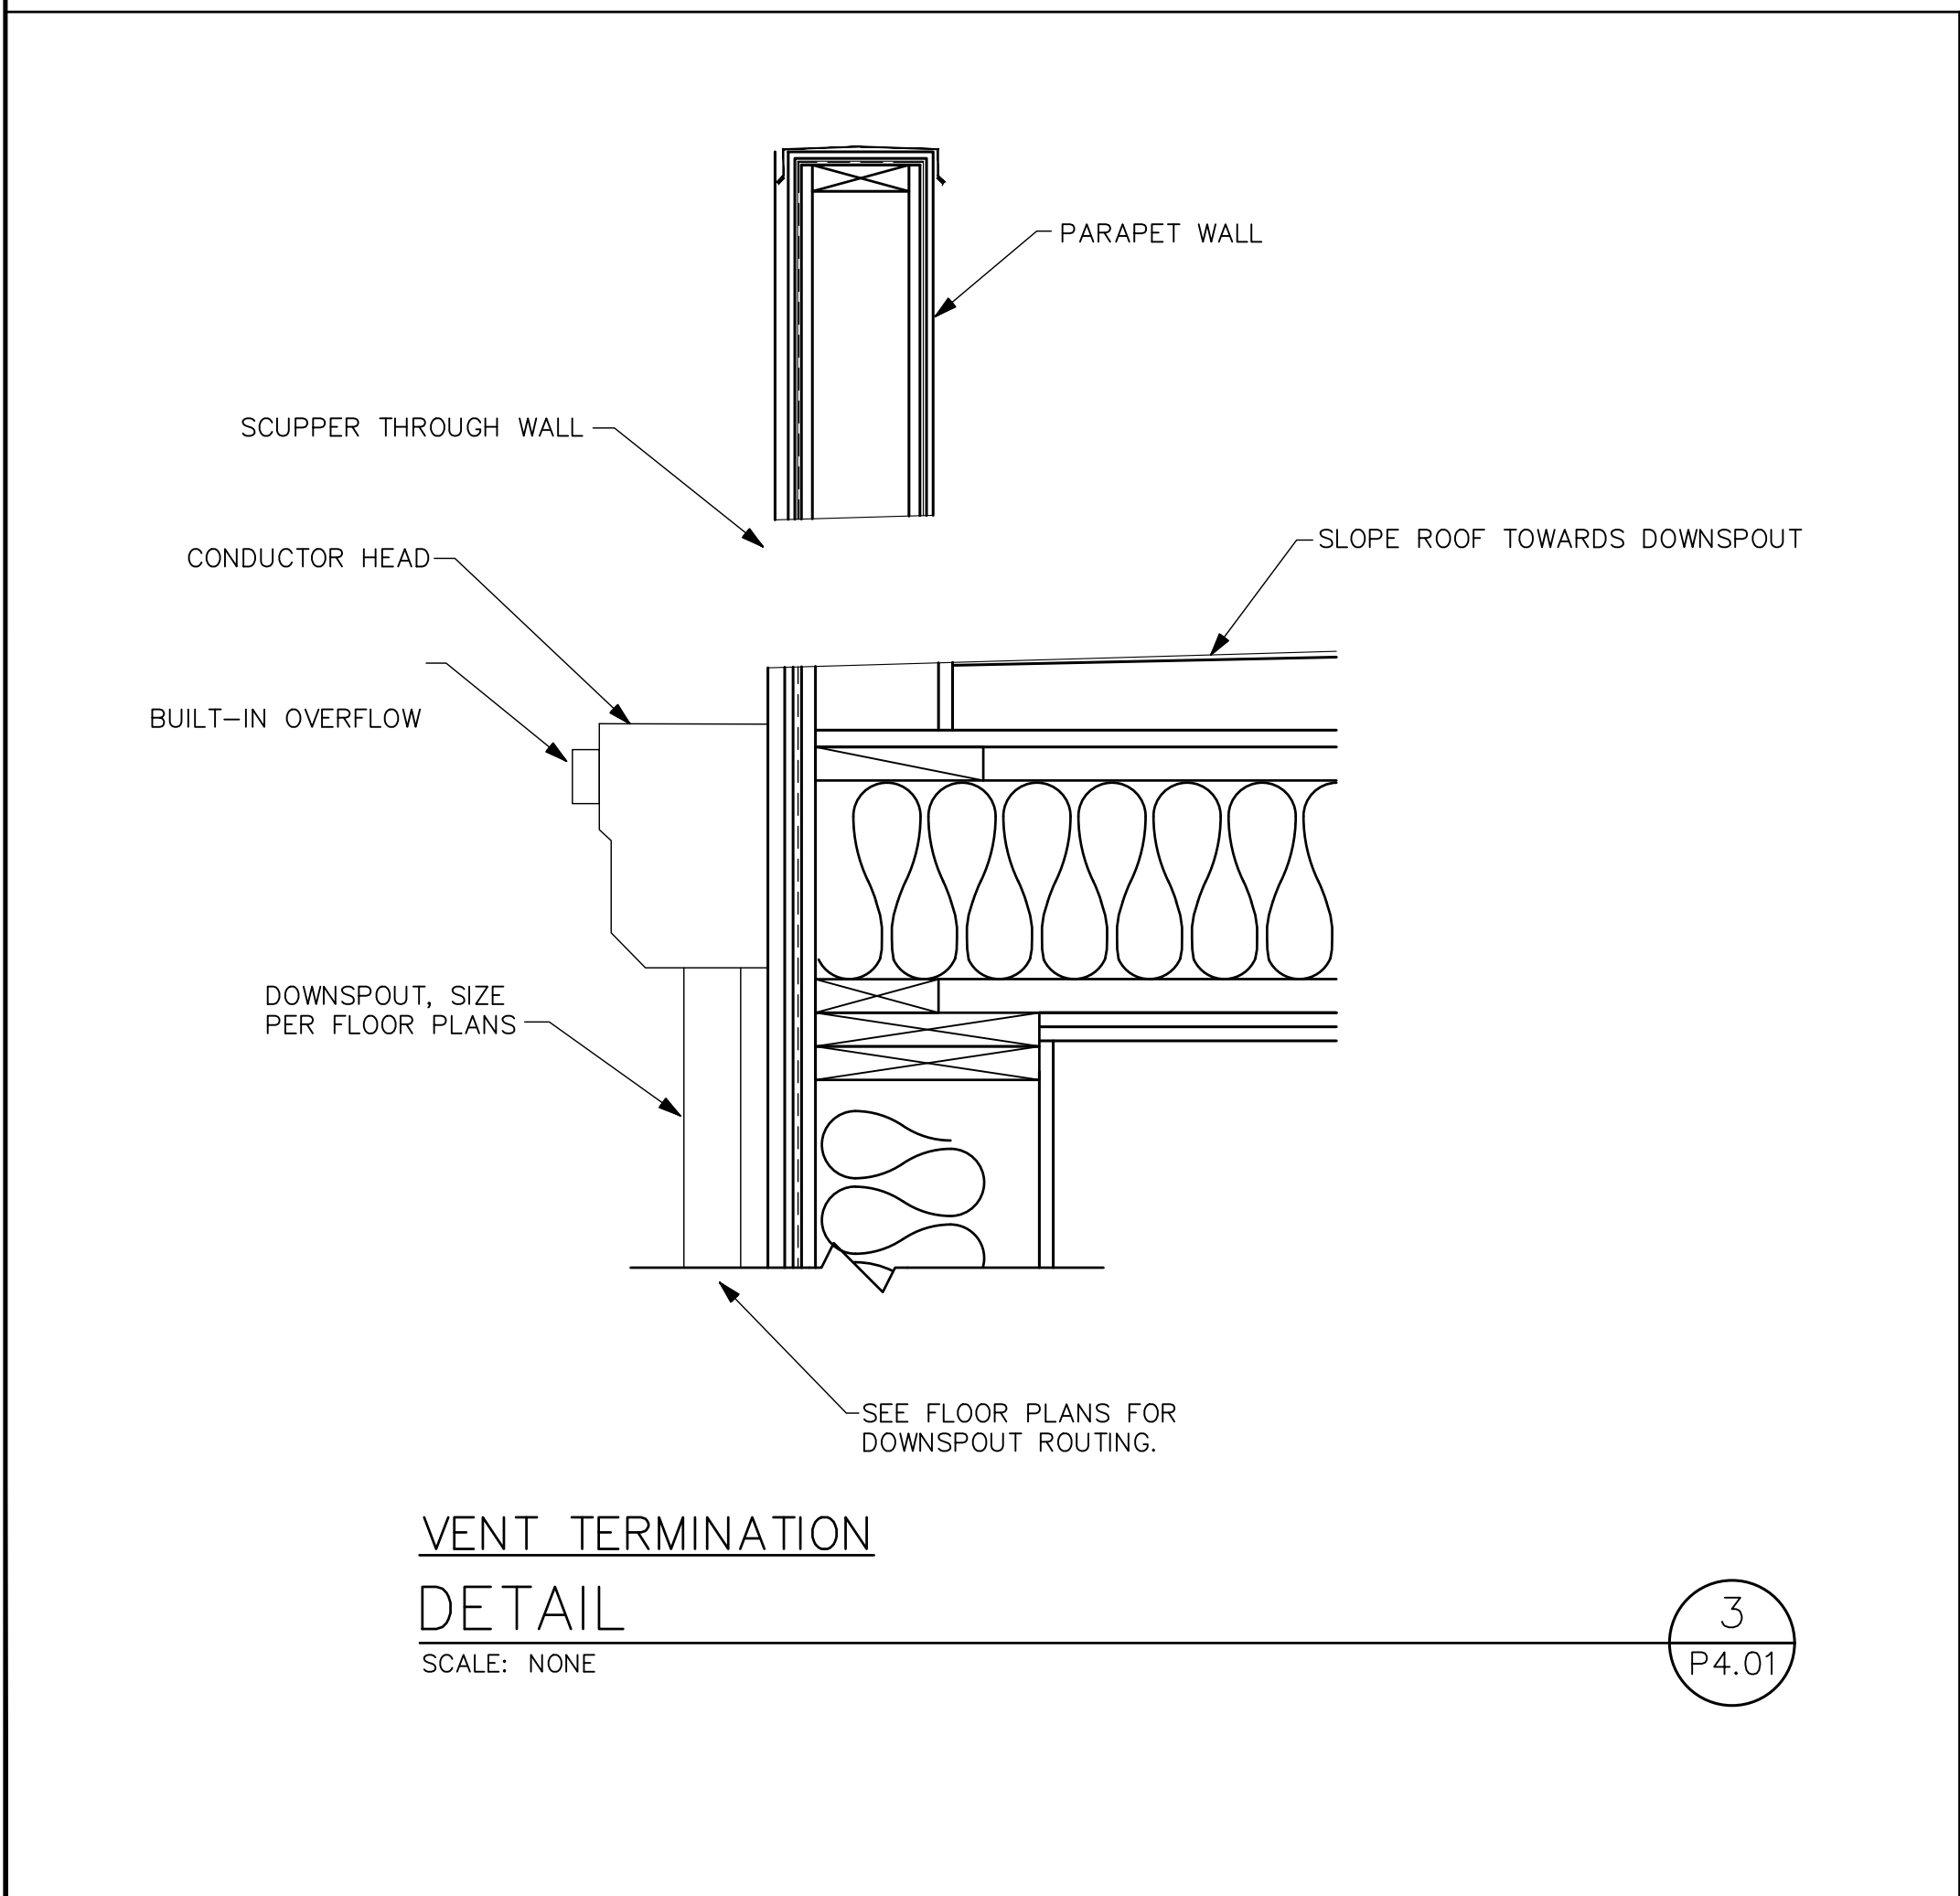


**VENT TERMINATION
DETAIL**
SCALE: NONE

3
P4.01

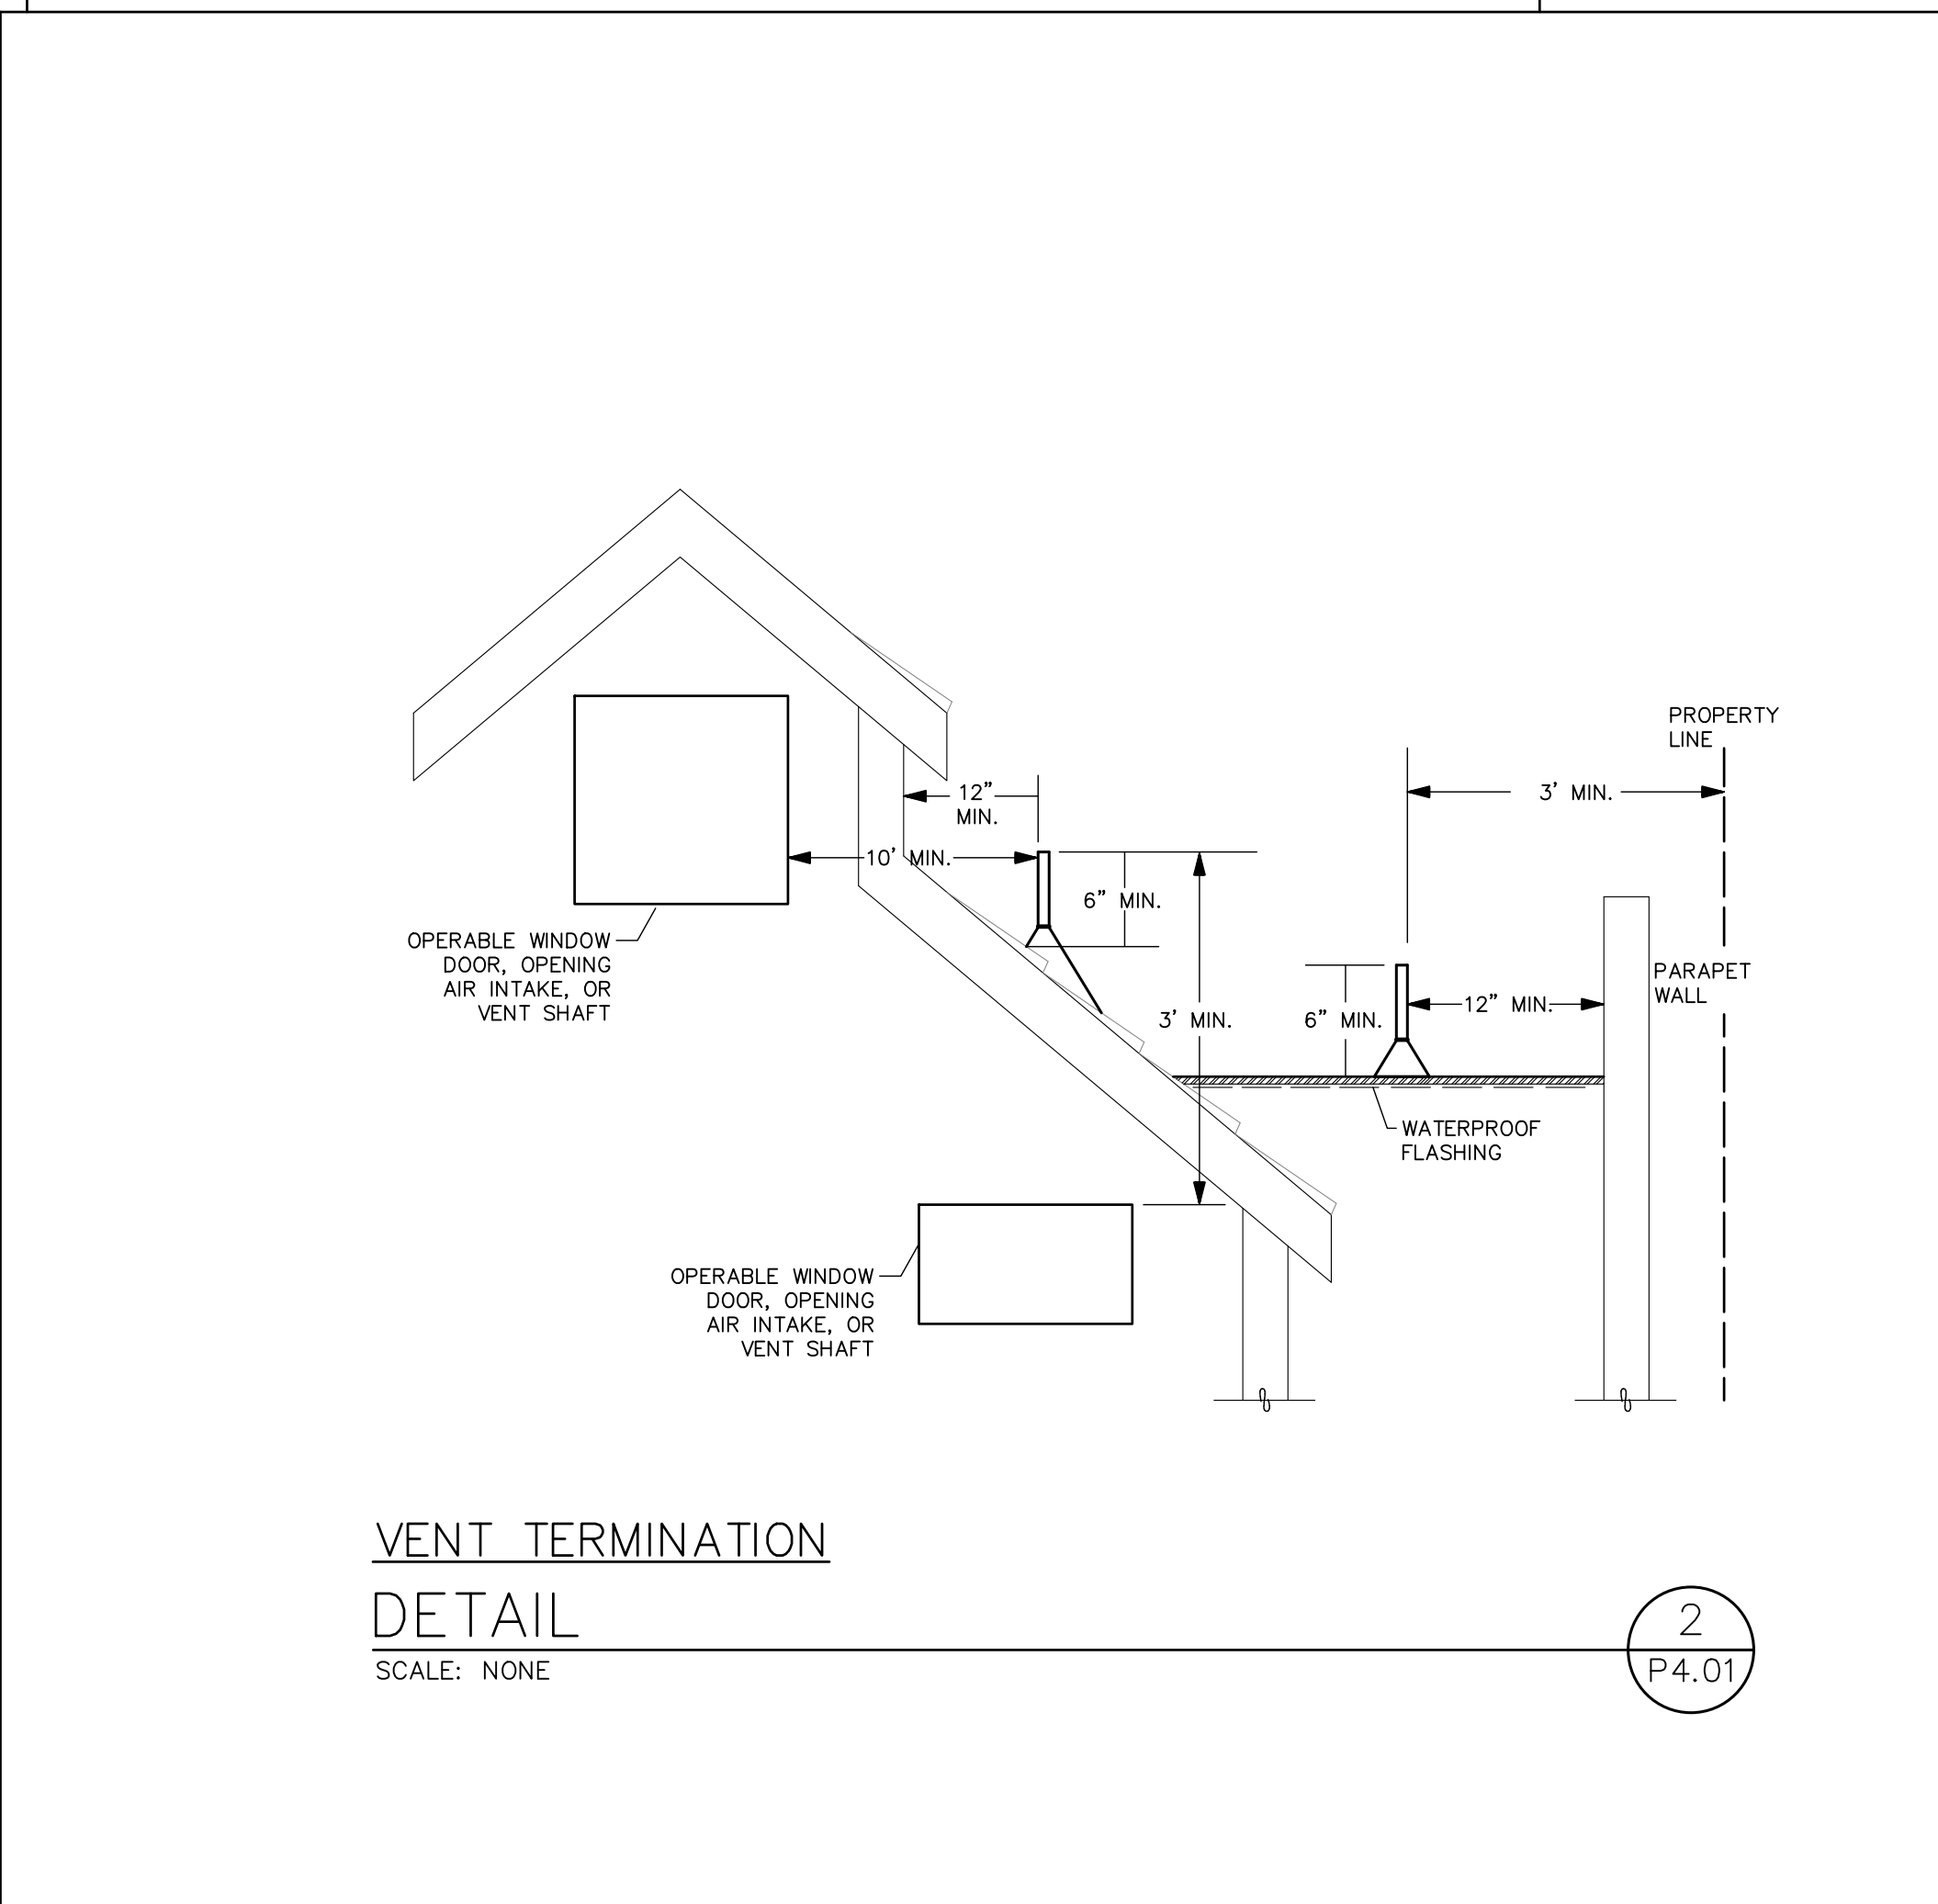

**VENT TERMINATION
DETAIL**
SCALE: NONE

2
P4.01

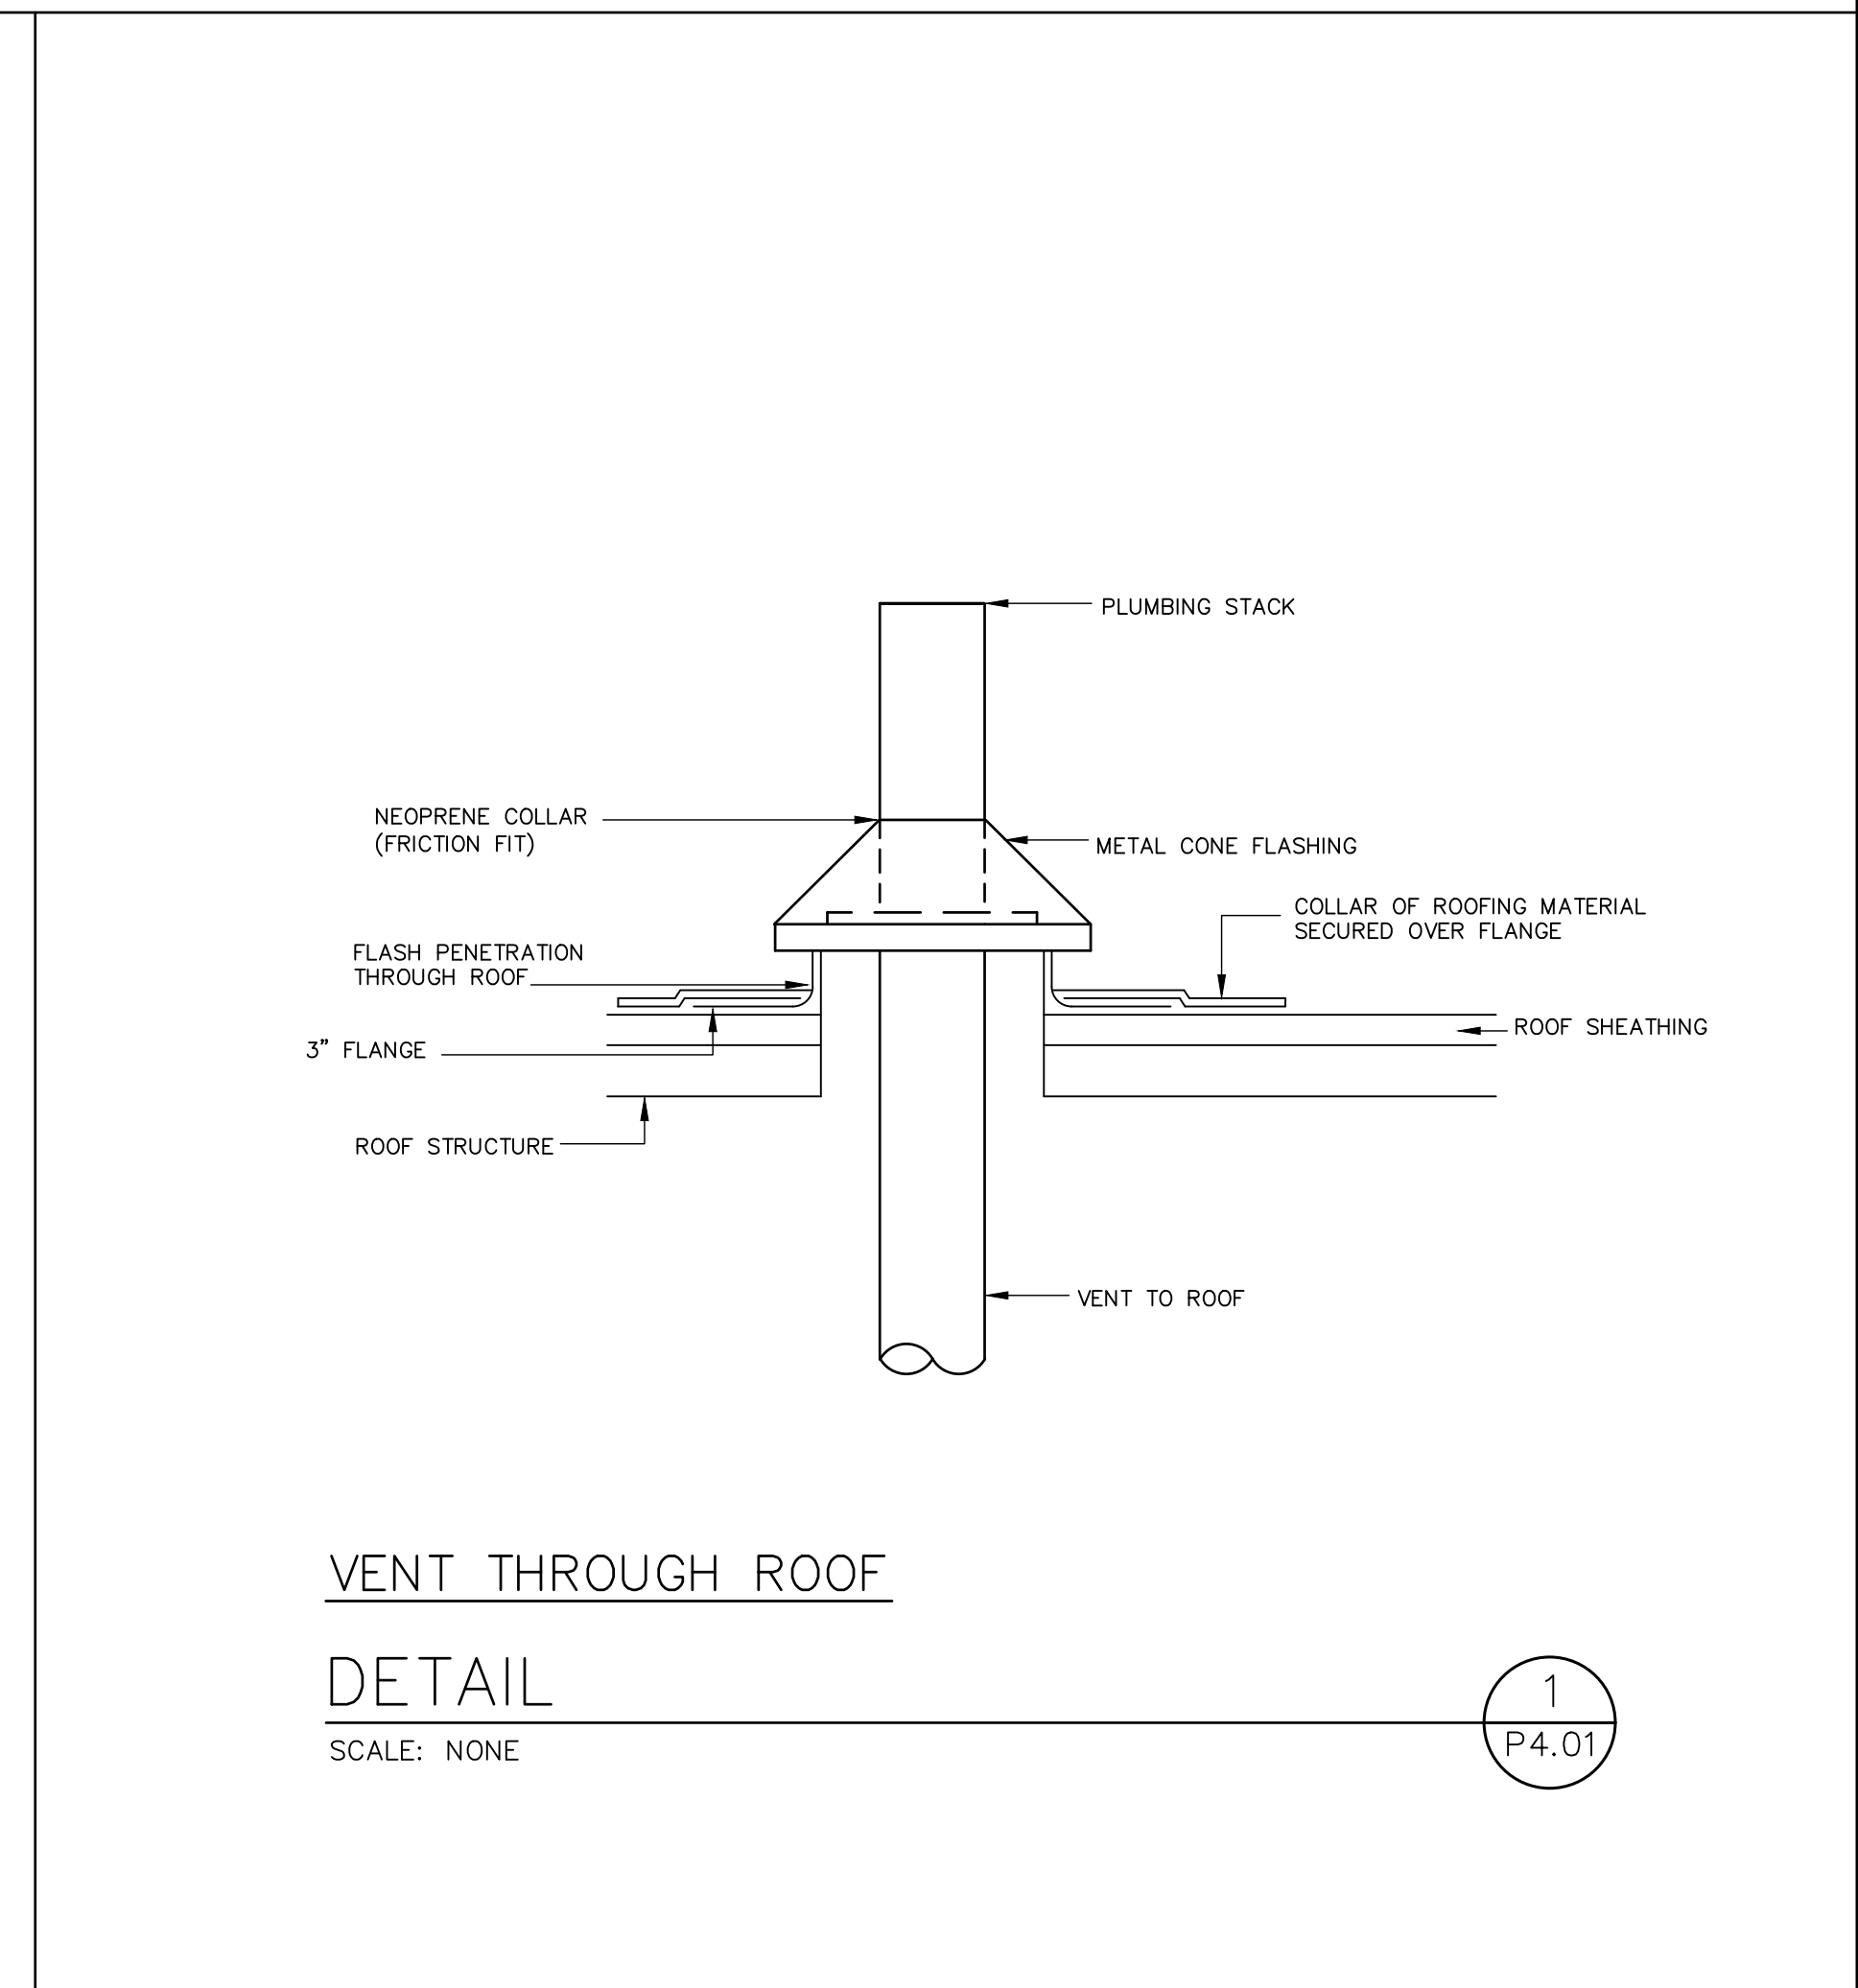

**VENT THROUGH ROOF
DETAIL**
SCALE: NONE

1
P4.01

| REVISIONS | DESCRIPTION | DATE |
|-----------|-------------|------|
| NO. | | |

ROBISON ENGINEERING, INC
19401 40TH AVE W, SUITE 302
LYNNWOOD, WA 98036
206-864-3343
CONTACT: XXXX

PROFESSIONAL ENGINEER
JACOB J. JACOBSON
REGISTERED
01/22/2024

| | | | |
|-----------|--------------|-------------|--------------|
| DRAWN: JD | DESIGNED: JD | CHECKED: RJ | APPROVED: RJ |
|-----------|--------------|-------------|--------------|

PROJECT: EAST TOWN CROSSING
MULTIFAMILY DEVELOPMENT
PIONEER WAY & SHAW RD. PUYALLUP, WA

19401 40TH AVE W, SUITE 302
LYNNWOOD, WA 98036
PHONE: 206-864-3343


ROBISON ENGINEERING, INC

PERMIT PLANS
01/22/2024

SHEET TITLE:
DETAILS

SHEET NO.
P4.01

| NO. | DATE | DESCRIPTION |
|-----|------|-------------|
| | | |
| | | |
| | | |

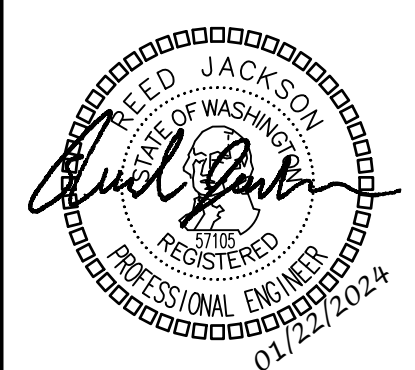

| | |
|-----------|----|
| DRAWN: | JD |
| DESIGNED: | JD |
| CHECKED: | RJ |
| APPROVED: | RJ |

PROJECT: **EAST TOWN CROSSING**
 MULTIFAMILY DEVELOPMENT
 PIONEER WAY & SHAW RD. PUYALLUP, WA

19401 40TH AVE W, SUITE 302
 LYNNWOOD, WA 98036
 PHONE: 206-864-5242


ROBISON ENGINEERING, INC.

PERMIT PLANS
 01/22/2024

SHEET TITLE:
 DETAILS

SHEET NO.
 P4.02


NOTE: THE SEISMIC STRAPS SHALL BE AT POINTS WITHIN THE UPPER 1/3 AND LOWER 1/3 OF THE WATER HEATER. AT THE LOWER POINT A MINIMUM OF 4" SHALL BE MAINTAINED ABOVE THE CONTROLS WITH THE STRAP.

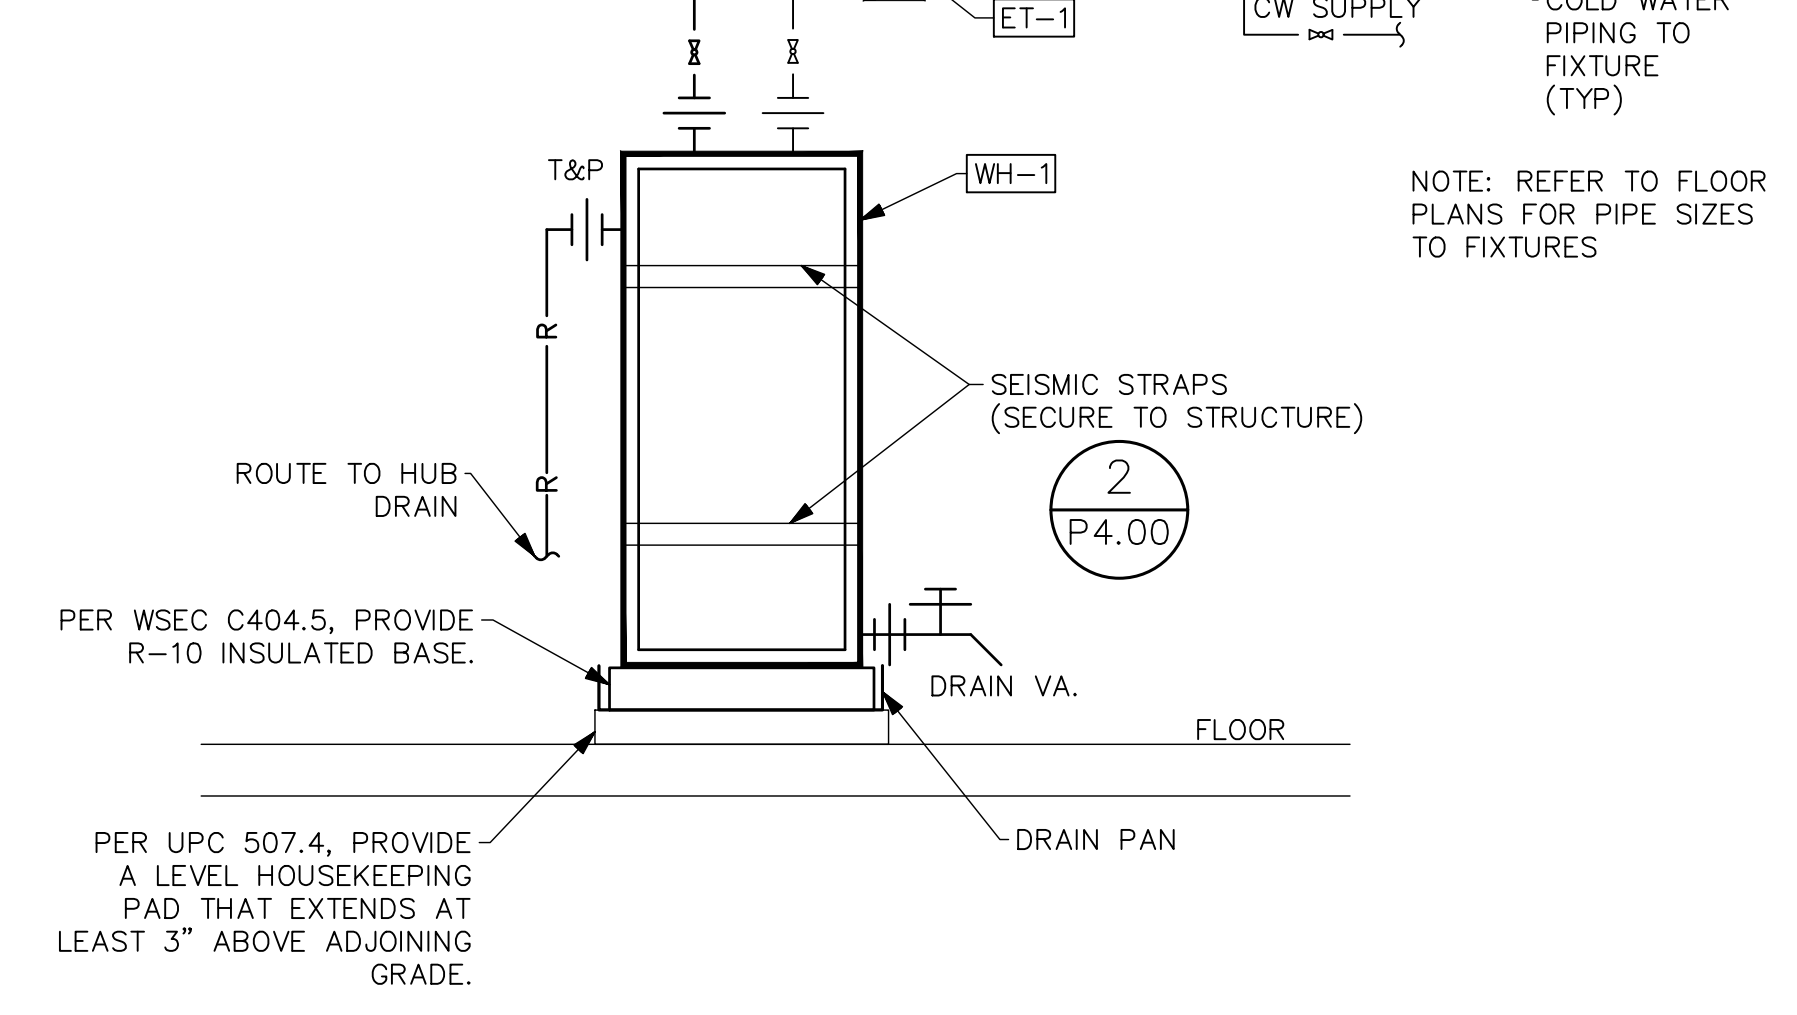

NOTE: REFER TO FLOOR PLANS FOR PIPE SIZES TO FIXTURES

WATER HEATER
DETAIL
 SCALE: NONE


4
 P4.02

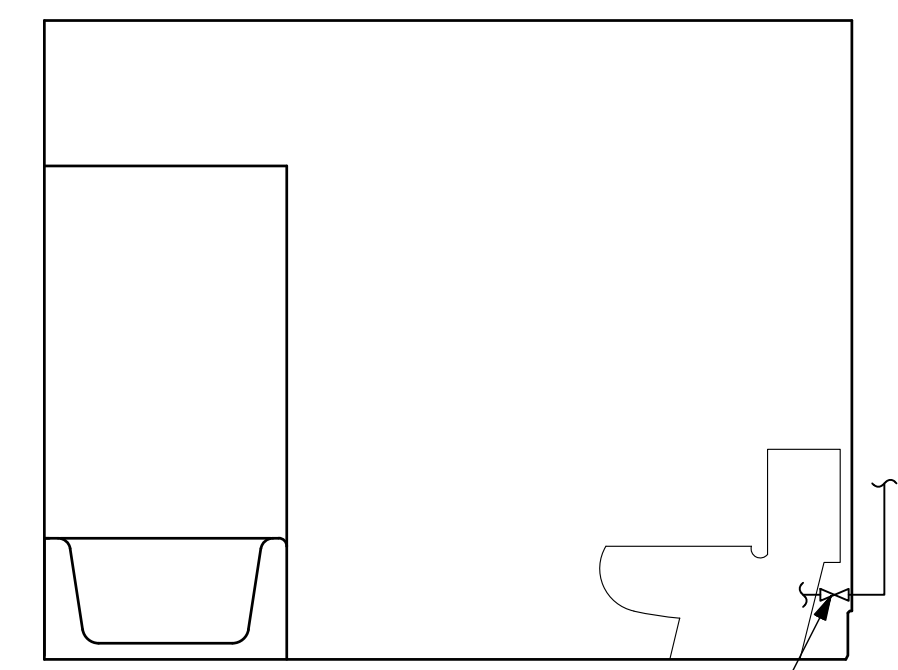

INSTALL CW ROUGH-IN APPROXIMATELY 8" AFF (CONFIRM ELEVATION WITH ARCH PLANS).

WATER CLOSET CW SUPPLY
DETAIL
 SCALE: NONE


3
 P4.02

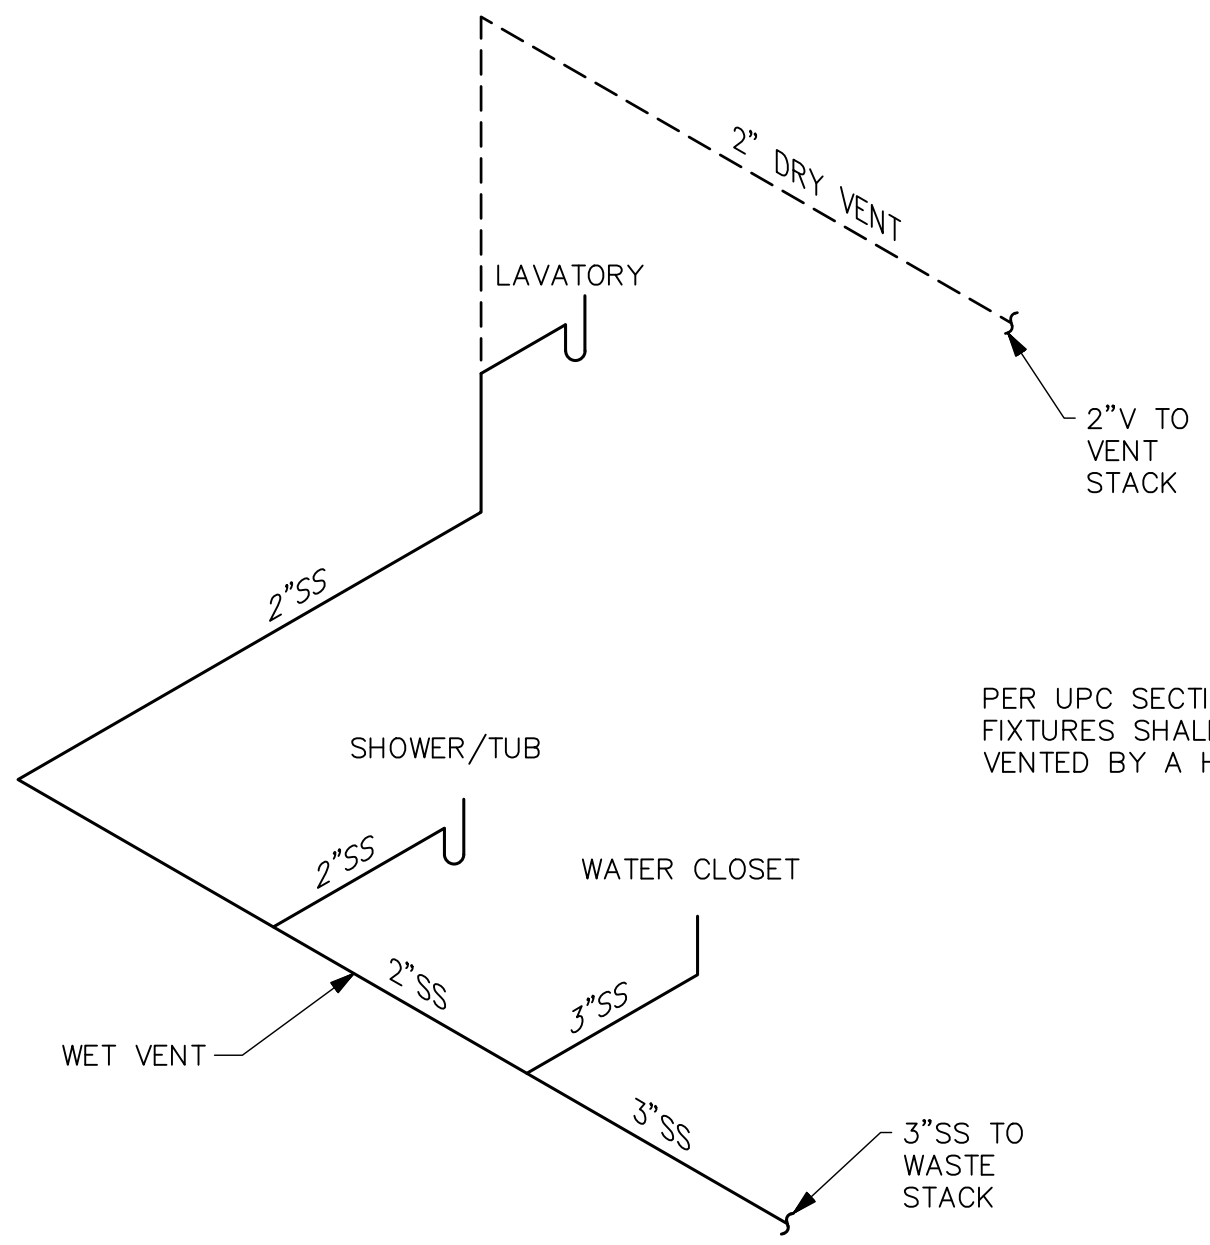

PER UPC SECTION 908, BATHROOM GROUP FIXTURES SHALL BE PERMITTED TO BE VENTED BY A HORIZONTAL WET VENT.

PRIVATE BATHROOM WET VENTING
DETAIL
 SCALE: NONE

2
 P4.02

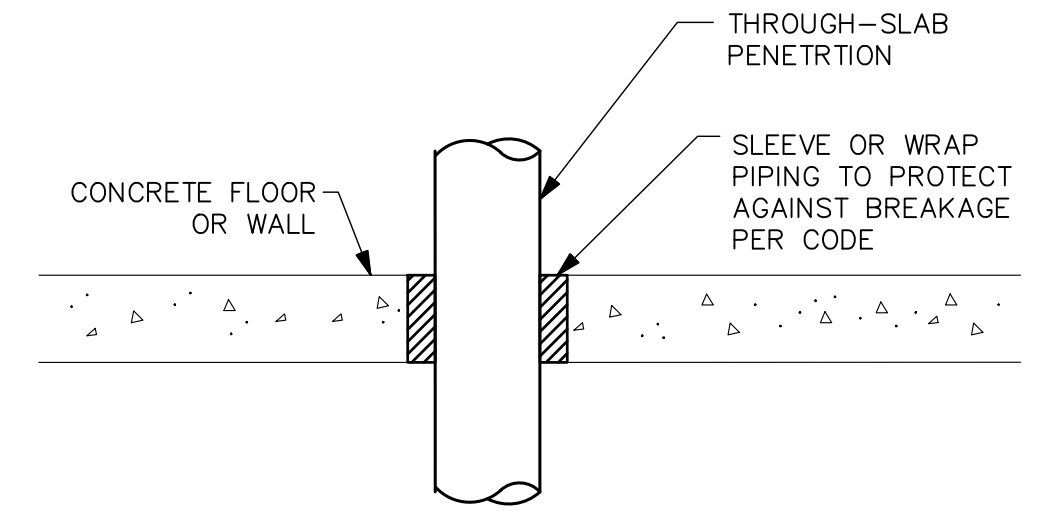

PIPE SLAB PENETRATION
DETAIL
 SCALE: NONE

1
 P4.02


SYMBOLS

GENERAL

LIGHT LINE INDICATES NON-ELECTRICAL OR BACKGROUND (THIS IS NOT CONTRACTUAL DEFINITION OF WORK)
HEAVY LINE INDICATES NEW WORK (THIS IS NOT CONTRACTUAL DEFINITION OF WORK)

DETAIL IDENTIFICATION


SYMBOL

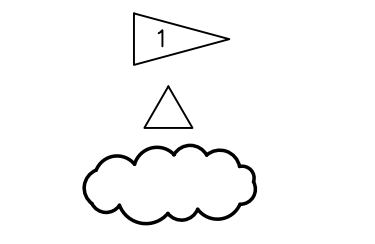

NAME

FLAG NOTE


REVISION DEFINITION

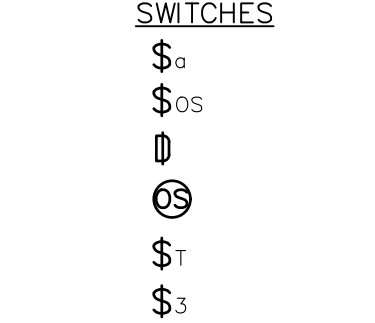

REVISION NOTE


REVISION DEFINITION, AREA ENCLOSED CONTAINS DRAWING CHANGES MADE SUBSEQUENT TO PREVIOUS ISSUE

SWITCHES

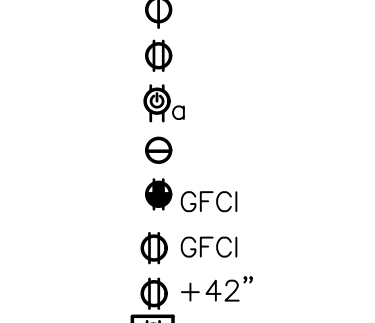


SWITCH, SINGLE POLE; WITH SWITCHING SUBSCRIPT
OCCUPANCY SENSOR SWITCH
SWITCH, SINGLE POLE; WITH SWITCHING SUBSCRIPT "D" INDICATES WALLBOX DIMMER
CEILING MOUNTED OCCUPANCY SENSOR
SWITCH, TIMER.
SWITCH, THREE WAY.

RECEPTACLES

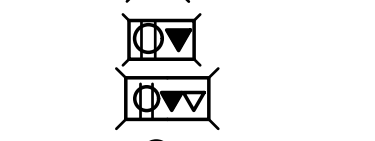


SINGLE RECEPTACLE
DUPLEX RECEPTACLE: WALL MOUNTED, +18" AFF
CONTROLLED AND NON CONTROLLED DUPLEX RECEPTACLE (SPLIT WIRED RECEPTACLE)
DUPLEX RECEPTACLE - ABOVE COUNTER
DUPLEX GFCI ABOVE COUNTER
DUPLEX GFCI
DUPLEX RECEPTACLE, WITH HEIGHT ABOVE FINISHED FLOOR INDICATED
CEILING MOUNTED DUPLEX RECEPTACLE
DOUBLE DUPLEX RECEPTACLE: WALL MOUNTED, +18" AFF
FLOOR BOX ONE DUPLEX RECEPTACLE
FLOOR BOX ONE DUPLEX RECEPTACLE + ONE DATA
FLOOR BOX ONE DUPLEX RECEPTACLE + ONE DATA + ONE VOICE
SPECIAL PURPOSE RECEPTACLE, AS NOTED

MISCELLANEOUS

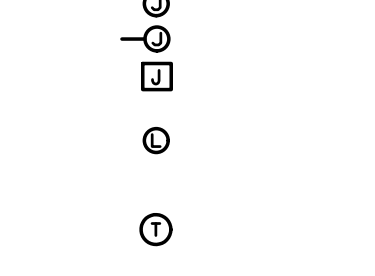


JUNCTION BOX: 4SQ MOUNTED
JUNCTION BOX: 4SQ WALL MOUNTED
JUNCTION BOX: 4SQ TRACK
CONNECTION FOR LIGHTED MIRROR COORDINATE LOCATION AND ELEVATION WITH ARCHITECT PRIOR TO ROUGH-IN
THERMOSTAT

SIGNAL/COMMUNICATION

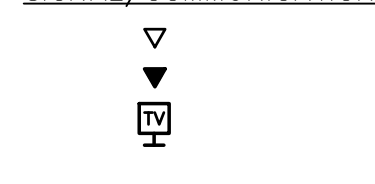


DATA OUTLET: WALL MOUNTED @ +18" AFF U.O.N.
TELEPHONE/DATA OUTLET: WALL MOUNTED @ +18" AFF U.O.N.
TELEVISION OUTLET: WALL MOUNTED @ +18" AFF U.O.N.

POWER

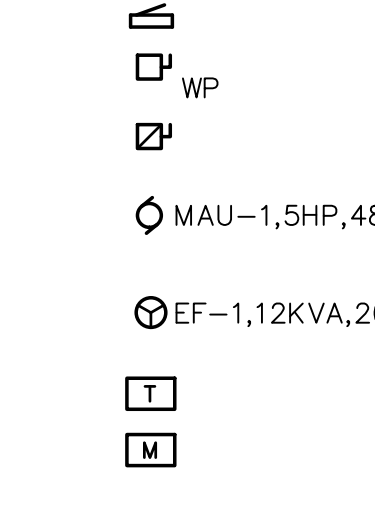

PANELBOARD
NON-FUSED DISCONNECT SWITCH (WP = NEMA 3R WHERE APPROPRIATE)
FUSED DISCONNECT SWITCH
MOTOR CONNECTION (EQUIPMENT NAME, HORSEPOWER, VOLTAGE, AND PHASE INDICATED)
EQUIPMENT CONNECTION (EQUIPMENT NAME, LOAD, VOLTAGE, AND PHASE INDICATED)
TRANSFORMER, DRY TYPE, SHOWN TO SCALE
KW METER AND BASE

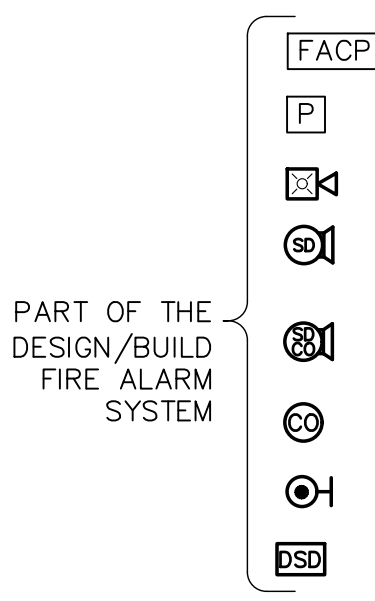

FIRE ALARM SYSTEM CONTROL PANEL
FIRE ALARM SYSTEM PULL STATION
FIRE ALARM SYSTEM STROBE/SPEAKER
FIRE ALARM PHOTOELECTRIC SMOKE DETECTOR AND SPEAKER.
FIRE ALARM COMBINATION PHOTOELECTRIC SMOKE DETECTOR, CARBON MONOXIDE DETECTOR, AND SPEAKER, GUESTROOM.
CARBON MONOXIDE DETECTOR.
ELECTRO-MAGNETIC DOOR HOLDER
DUCT SMOKE DETECTOR

ABBREVIATIONS

Table listing abbreviations for electrical components such as AMPERE, ALUMINUM, BREAKER, CONDUIT, COPPER, DIMMER, etc.

GENERAL NOTES

GENERAL

- 1. PROVIDE ELECTRICAL INSTALLATION IN ACCORDANCE WITH THE GOVERNING ELECTRICAL CODE, LOCAL CODES, ORDINANCES AND REQUIREMENTS OF UTILITY COMPANIES FURNISHING SERVICES TO INSTALLATION.
2. PROVIDE ALL WORK AND ITEMS NECESSARY FOR COMPLETE AND FUNCTIONAL ELECTRICAL SYSTEMS. THE ELECTRICAL DRAWINGS ARE DIAGRAMMATIC AND DO NOT NECESSARILY SHOW EVERY CONDUIT, BOX, CONDUCTOR OR SIMILAR ITEMS FOR A COMPLETE INSTALLATION.
3. THE CONTRACTOR SHALL VISIT THE SITE PRIOR TO BID AND DETERMINE CONDITIONS WHICH MAY AFFECT BID. ANY ITEMS NOT FULLY UNDERSTOOD SHALL BE BROUGHT TO THE ATTENTION OF THE ARCHITECT PRIOR TO BIDDING.
4. "REF" INDICATIONS DENOTE WORK COVERED ELSEWHERE (ARCHITECTURAL, STRUCTURAL, OR MECHANICAL).
5. REFERENCE ARCHITECTURAL DRAWING FOR EXACT LOCATION OF DEVICES. QUESTIONS CONCERNING THE LOCATION OF DEVICES AND EQUIPMENT SHALL BE DIRECTED TO THE ARCHITECT. FAILURE TO COORDINATE REQUIREMENTS SHALL IN NO WAY RESULT IN ADDITIONAL COMPENSATION BEING PROVIDED TO THE CONTRACTOR.
6. WHEREVER THE WORD "PROVIDE" IS USED, IT MEANS, "FURNISH AND INSTALL COMPLETE AND READY FOR USE."
7. COORDINATE LOCATION OF ELECTRICAL WITH OTHER TRADES.
8. REFER TO EQUIPMENT DRAWINGS FOR MECHANICAL CHARACTERISTICS (SIZE, LOCATION, ETC.) OF MECHANICAL EQUIPMENT, UNLESS OTHERWISE INDICATED. COORDINATE INSTALLATION AND LOCATION OF ALL EQUIPMENT WITH MECHANICAL CONTRACTOR. VERIFY ALL FUSE RATINGS, WIRE SIZES AND DISCONNECT SIZES PRIOR TO INSTALLATION.

- 7. WIRING: PROVIDE MINIMUM #10 AWG COPPER CONDUCTOR SIZE IN 120V BRANCH CIRCUIT RUNS OVER 75' IN LENGTH.

SITE ELECTRICAL

- 1. TRENCHING: COORDINATE ALL TRENCHING WORK WITH OTHER UTILITY LOCATIONS AND DRAINAGE TRENCHES.
2. UNDERGROUND CONDUITS: PROVIDE PVC, SCHEDULE 40, 3/4" MINIMUM. PROVIDE GRC CONDUIT TRANSITION ELBOW WHEN TURNING UP TO ABOVE GRADE.
3. DIRECT-BURIED CONDUITS: CONDUIT FOR BRANCH CIRCUITS OUTSIDE BUILDINGS NOT BENEATH DRIVEWAYS OR PARKING AREAS SHALL BE DIRECTLY BURIED WITHOUT CONCRETE ENCASEMENT. THE DEPTH TO THE TOP OF BURIED CONDUITS SHALL BE 36". PROVIDE MARKER TAPE 12" BELOW GRADE.
4. BELOW SLAB: CONDUIT ROUTED BELOW ON-GRADE FLOOR SLABS SHALL BE INSTALLED PRIOR TO FLOOR SLAB POUR. ROUTE CONDUITS BELOW SLAB AS STRAIGHT AS POSSIBLE TO MINIMIZE BENDS.
5. ALL CONDUITS PENETRATING THE BUILDING ENVELOPE BELOW GRADE SHALL FOLLOW WATERPROOFING REQUIREMENTS IN THE ARCHITECTURAL DRAWINGS.

NEUTRALS

- 1. AT CONTRACTORS OPTION, NEUTRALS MAY BE SHARED ON COMBINED HOMERUNS UNLESS THE CIRCUIT HAS A GFCI BREAKER, AN ISOLATED GROUND, OR IS FROM A PANEL WITH TVSS PROTECTION. ANY NEUTRAL DOWNSTREAM FROM A DIMMER SHALL BE DEDICATED TO THE DIMMED LOAD.
2. NEUTRAL WIRES SHOWN FOR TWO AND THREE POLE MECHANICAL AND KITCHEN EQUIPMENT MAY BE OMITTED UPON VERIFICATION THAT THEY ARE NOT REQUIRED EITHER FOR OPERATION OR CONTROL CIRCUITS PER MANUFACTURER'S SPECIFICATIONS.

LIGHTING

- 1. PROVIDE LIGHT FIXTURES WITH PROPER FITTING FLANGES, MOUNTING SUPPORTS, AND ACCESSORY ITEMS, UL LISTED FOR CONDITIONS OF USE.

LOW VOLTAGE LIGHTING

- 1. PROVIDE LOW VOLTAGE TRANSFORMERS IN NEARBY ACCESSIBLE CEILING SPACE.
2. PROVIDE LOW VOLTAGE CONDUCTORS SIZED PER MANUFACTURER'S GUIDELINES TO MINIMIZE VOLTAGE DROP.

LIGHTING CONTROL

- 1. THE MAXIMUM LIGHTING POWER THAT MAY BE CONTROLLED FROM A SINGLE SWITCH OR AUTOMATIC CONTROL SHALL NOT EXCEED THAT WHICH IS PROVIDED BY A TWENTY AMPERE CIRCUIT LOADED TO NOT MORE THAN EIGHTY PERCENT. A MASTER CONTROL MAY BE INSTALLED PROVIDED THE INDIVIDUAL SWITCHES RETAIN THEIR CAPABILITY TO FUNCTION INDEPENDENTLY.
2. EMERGENCY FIXTURES: EMERGENCY BATTERY/CHARGER SHALL BE CONNECTED TO AN UNSWITCHED LEG OF THE DESIGNATED CIRCUIT.

MATERIALS AND METHODS

- 1. PROVIDE RACEWAY AND WIRING ROUTED CONCEALED WITHIN BUILDING STRUCTURE WHERE POSSIBLE. WHERE RACEWAY CANNOT BE CONCEALED, IT SHALL BE INSTALLED PER PROJECT MANAGER'S DIRECTION. ALL CONDUIT SHALL BE INSTALLED IN NEAT SYMMETRICAL LINES HORIZONTAL OR PERPENDICULAR TO BUILDING COLUMNS AND ROOF LINES. CONDUITS SHALL BE GROUPED ON COMMON SUPPORTS WHEREVER POSSIBLE.
2. EXPOSED CONDUIT ROUTING: CONDUITS MAY BE ROUTED EXPOSED IN MECHANICAL AND ELECTRICAL ROOMS ONLY. EXPOSED CONDUITS SHALL BE SECURED A MINIMUM OF 6" ABOVE FLOOR.
3. OUTDOOR EXPOSED CONDUIT ROUTING: CONDUITS ROUTED ON ROOF OR EXPOSED TO WEATHER SHALL BE GRC, PVC OR LIQUID-TIGHT FLEX. PROVIDE WATER-TIGHT CONNECTIONS AND FITTINGS.
4. CLEARANCES: VERIFY PHYSICAL DIMENSIONS OF EQUIPMENT TO ENSURE THAT ACCESS CLEARANCES CAN BE MET.
5. CONNECTIONS: PROVIDE GRS, METALLIC FLEX, OR LIQUIDTITE FLEX CONDUITS FOR CONNECTIONS TO MOTORS OR MOTORIZED EQUIPMENT.
6. WIRING: PROVIDE MINIMUM #12 AWG WIRE SIZE. IF CONDUIT IS TO BE USED MINIMUM IS TO BE 1/2". FLEXIBLE CONDUIT AND FLEXIBLE CABLE IS PERMISSIBLE THROUGHOUT THE BUILDING.

GENERAL REQUIREMENTS

- 1. DRAWINGS ARE DIAGRAMMATIC, SHOWING THE GENERAL LOCATION, TYPE, LAYOUT, AND EQUIPMENT REQUIRED.
2. THE DRAWINGS SHALL NOT BE SCALED FOR EXACT MEASUREMENT.
3. REFER TO ARCHITECTURAL DRAWINGS FOR DIMENSIONS.
4. REFER TO MANUFACTURER'S STANDARD INSTALLATION DRAWINGS FOR EQUIPMENT CONNECTIONS AND INSTALLATION REQUIREMENTS.
5. PROVIDE CONNECTIONS, ACCESSORIES, OFFSETS, AND MATERIALS NECESSARY FOR A COMPLETE SYSTEM.

CONTRACTOR SUBSTITUTIONS & REVISIONS

- 1. PLEASE SUBMIT PROPOSALS FOR SUBSTITUTIONS OR REVISIONS FOR REVIEW AND APPROVAL PRIOR TO ORDERING MATERIAL OR DOING WORK.
2. FOR EQUIPMENT THAT IS SCHEDULED BY MANUFACTURER'S NAME AND CATALOG DESIGNATIONS, THE MANUFACTURER'S PUBLISHED DATA AND/OR SPECIFICATION FOR THAT ITEM ARE CONSIDERED PART OF SPECIFICATION.
3. ENGINEERING COSTS FOR REVISING MEP PLANS SHALL BE ADDRESSED IN THE COST ANALYSIS OF THE SUBSTITUTION PROPOSAL.
4. CONTRACTOR TO COORDINATE WITH ENGINEER AND DETERMINE ASSOCIATED DESIGN AND PERMITTING COSTS. CONTRACTOR SHALL BE RESPONSIBLE FOR OTHER COSTS ASSOCIATED WITH UNFORESEEN ISSUES RESULTING FROM SUBSTITUTIONS OR REVISIONS.

PRE-CON MEETING NOTES

CONTRACTORS SHALL ATTEND A PRE-CONSTRUCTION MEETING WITH THE ENGINEER FOR THE PURPOSE OF REVIEWING THE WORK PRIOR TO ORDERING ANY EQUIPMENT OR PERFORMING ANY WORK. THE MEETING SHALL BE LOCATED AT THE PROJECT SITE ON A DATE AND TIME TO BE MUTUALLY AGREED. THE MEETING WILL BE A WORKING SESSION. THE MEETING WILL BE FACILITATED BY THE ENGINEER AND THE AGENDA WILL INCLUDE A DETAILED REVIEW OF THE PLANS AND SPECIFICATIONS, CROSS CHECK WITH OTHER TRADES FOR COORDINATION ISSUES, REVIEW OF PROPOSED PRODUCTS, REVIEW OF PLANNED MEANS AND METHODS, AND ON-SITE INVESTIGATION OF FIELD CONDITIONS RELATIVE TO EXISTING CONDITIONS THAT COULD AFFECT THE WORK. PERSONS ATTENDING THE MEETING SHALL BE KNOWLEDGEABLE OF THE PROJECT AND SHALL BE THE SPECIFIC PERSONS INTENDED TO CONTINUE WITH THE PROJECT THROUGH TO COMPLETION. IF REQUIRED, REVISED PLANS WILL BE ISSUED THROUGH OFFICIAL CHANNELS. CHANGES IN THE BID PRICE WILL BE DISCUSSED, BUT NO CHANGE ORDERS WILL BE ISSUED UNLESS PROCESSED THROUGH OFFICIAL CHANNELS. IT SHALL BE UNDERSTOOD THAT THE ENGINEER HAS NO AUTHORITY TO ISSUE CHANGE ORDERS.

Table showing minimum time requirements for trades: MECHANICAL SHEET METAL (4 HOURS), PLUMBING/PIPING (4 HOURS), ELECTRICAL (4 HOURS), SPRINKLER (2 HOURS), GENERAL CONTRACTOR (ALL SESSIONS).

DRAWING INDEX

Table with columns for DWG, DESCRIPTION, PERMIT SET, and INCLUDED IN SET. Lists drawings such as LEGEND, GENERAL NOTES, DRAWING INDEX, SITE POWER PLAN, SITE LIGHTING PLAN, LIGHTING PLAN - LEVEL 1, etc.

Separate Electrical Permit is required with the Washington State Department of Labor & Industries. https://lni.wa.gov/licensing-permits/electrical/electrical-permits-fees-and-inspections or call for Licensing Information: 1-800-647-0982

Table for REVISIONS and DATE tracking.




Table for project approvals: DRAWN: LYSAK K., DESIGNED: LYSAK K., CHECKED: STEINKE M., APPROVED: STEINKE M.

PROJECT: EAST TOWN CROSSING MULTIFAMILY DEVELOPMENT PIONEER WAY & SHAW RD. PUYALLUP, WA. Includes Robison Engineering, Inc. logo and contact info.


PERMIT SET 01/22/2024

SHEET TITLE: LEGEND, GENERAL NOTES, DRAWING INDEX

SHEET NO. E0.00

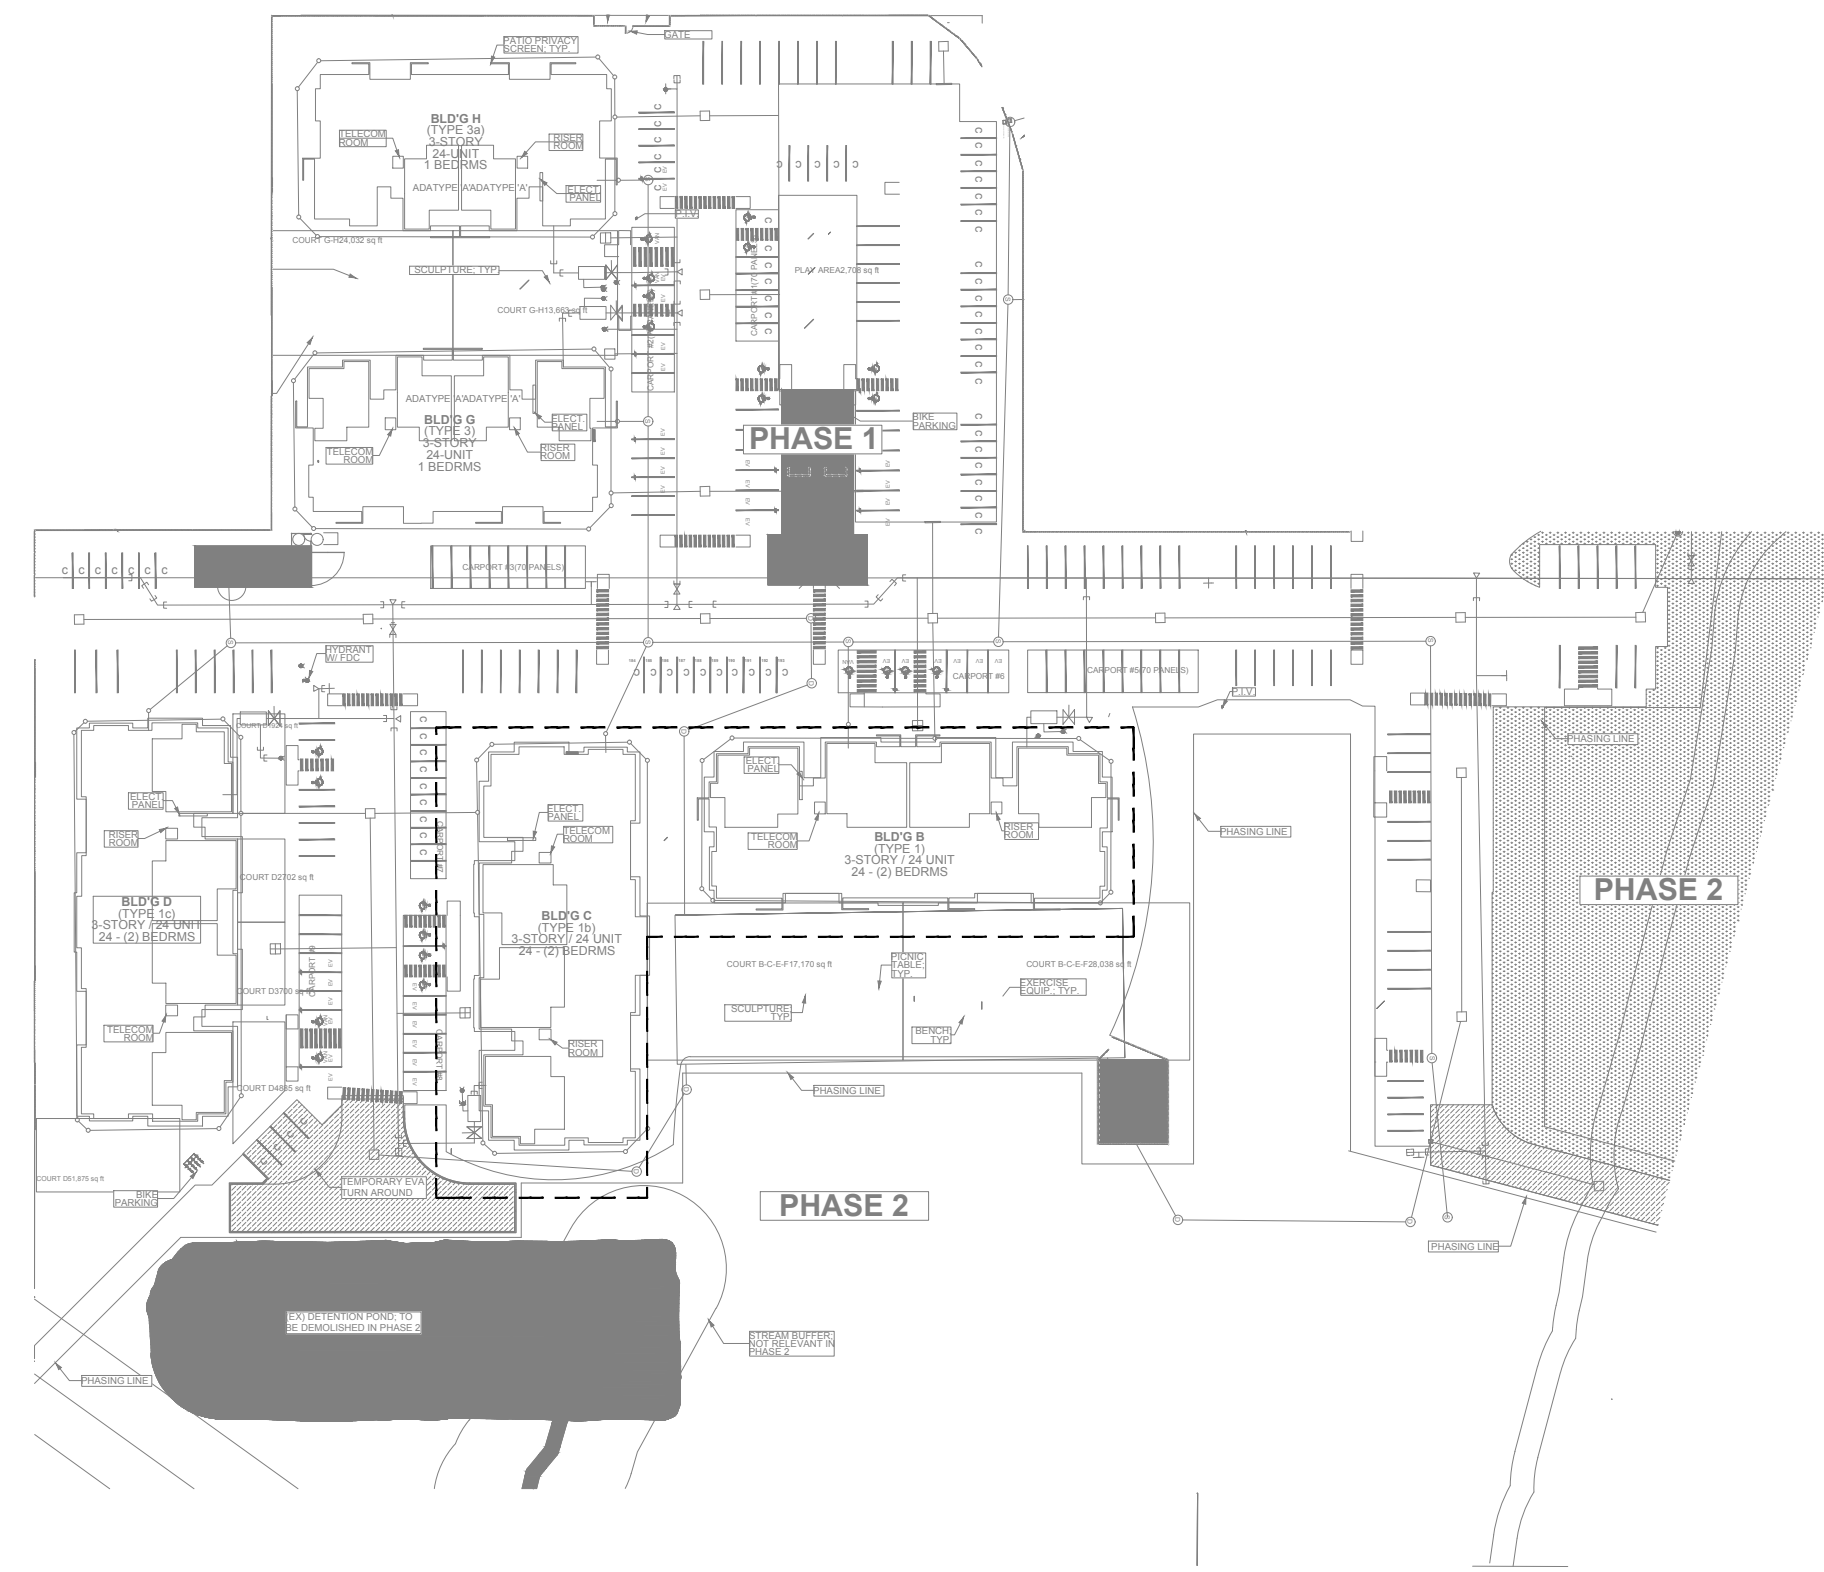


VICINITY MAP

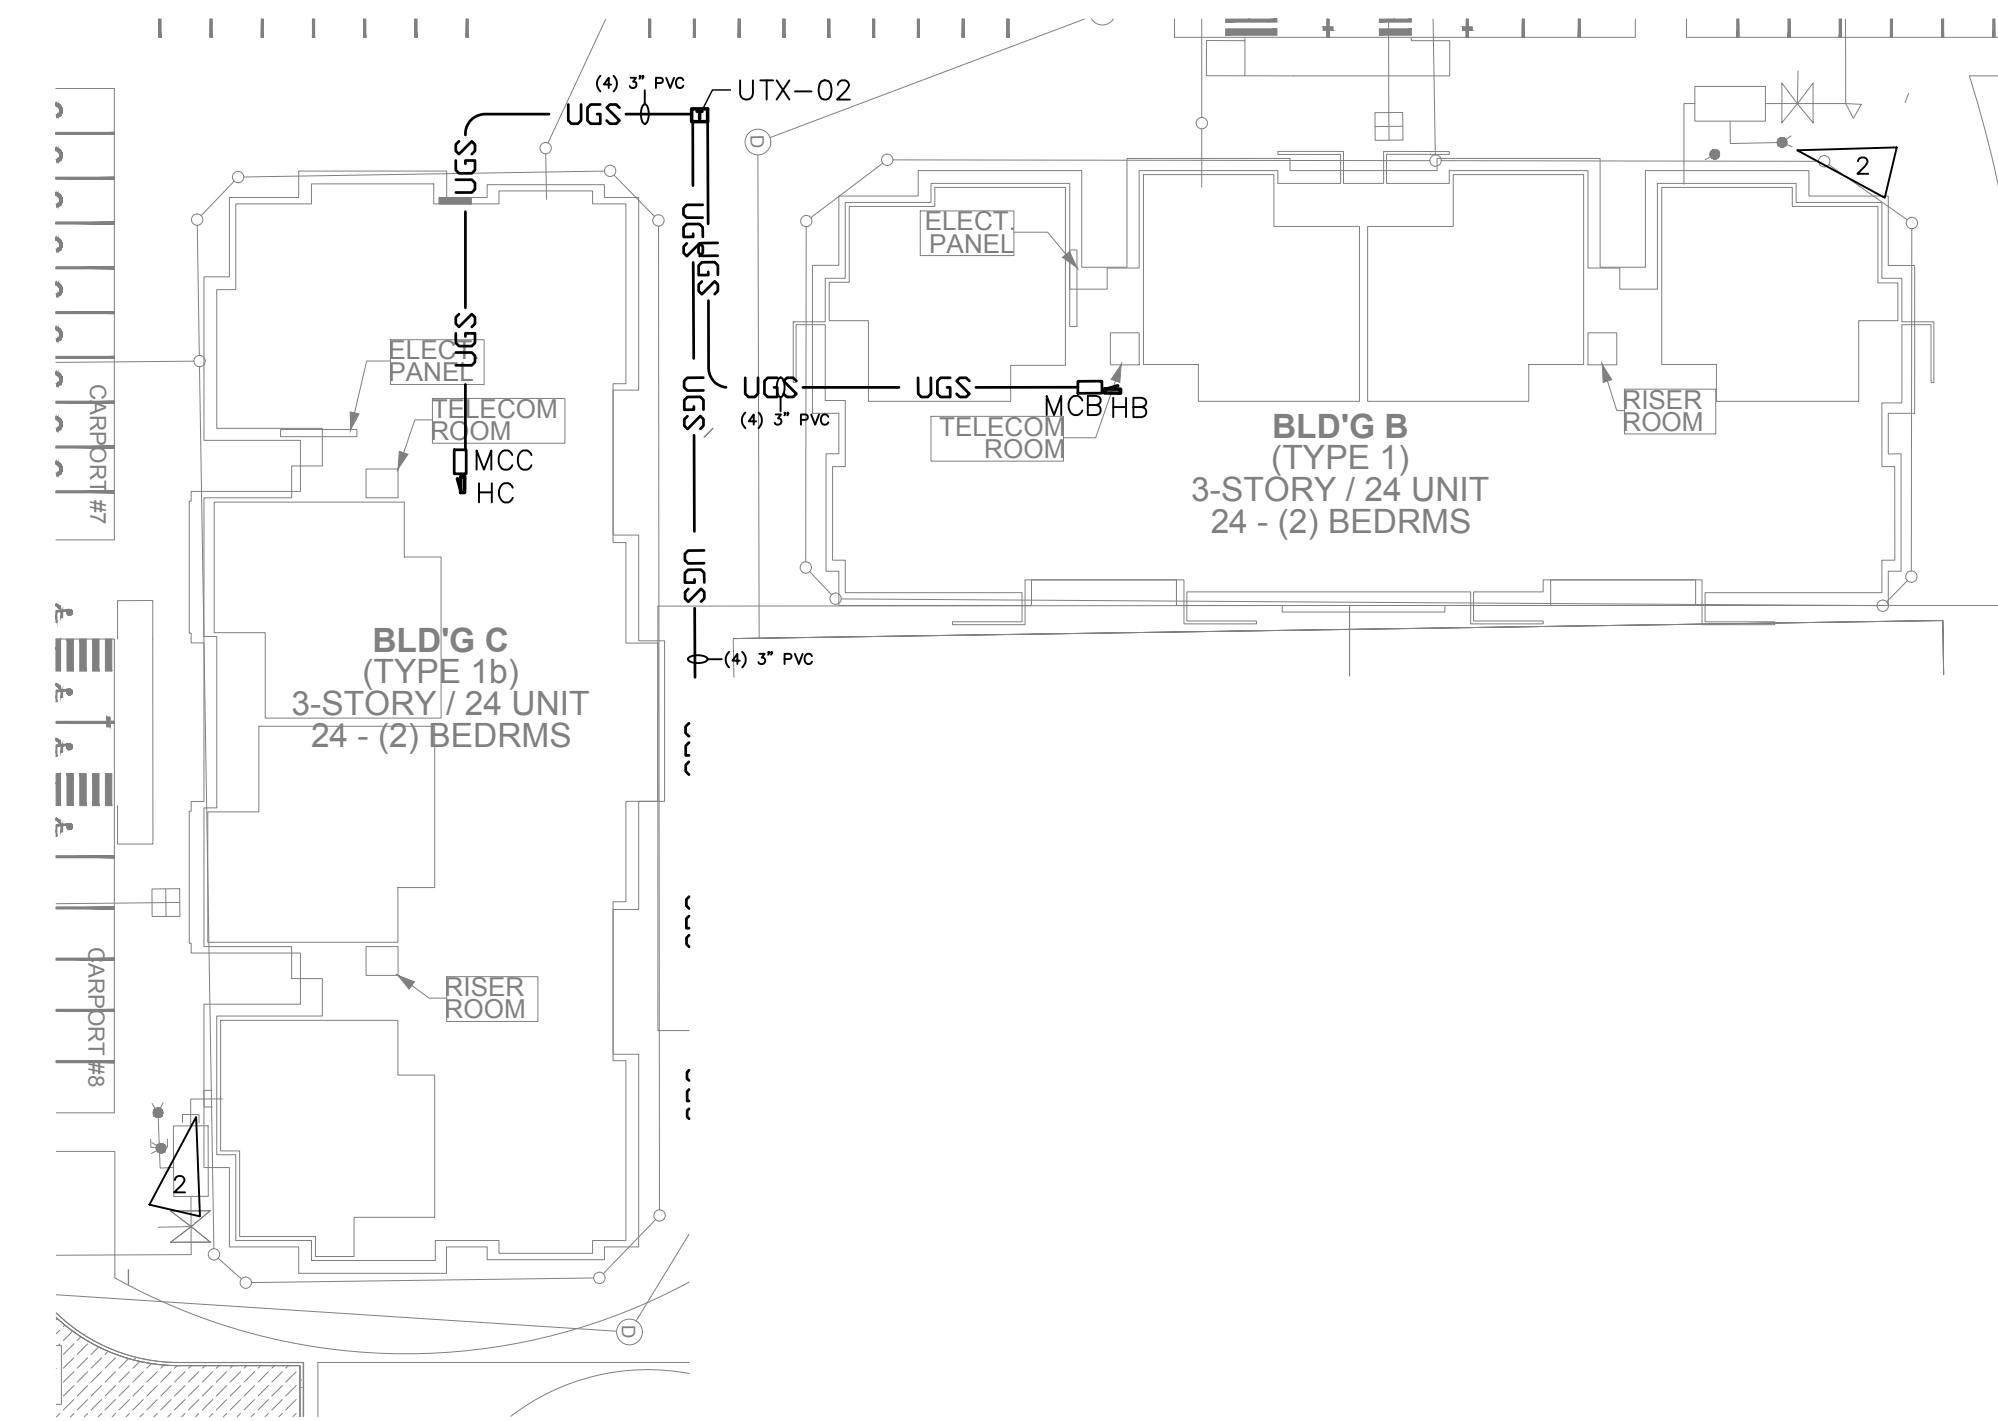

BUILDING C & B SITE PLAN - POWER

SCALE: 1" = 30'

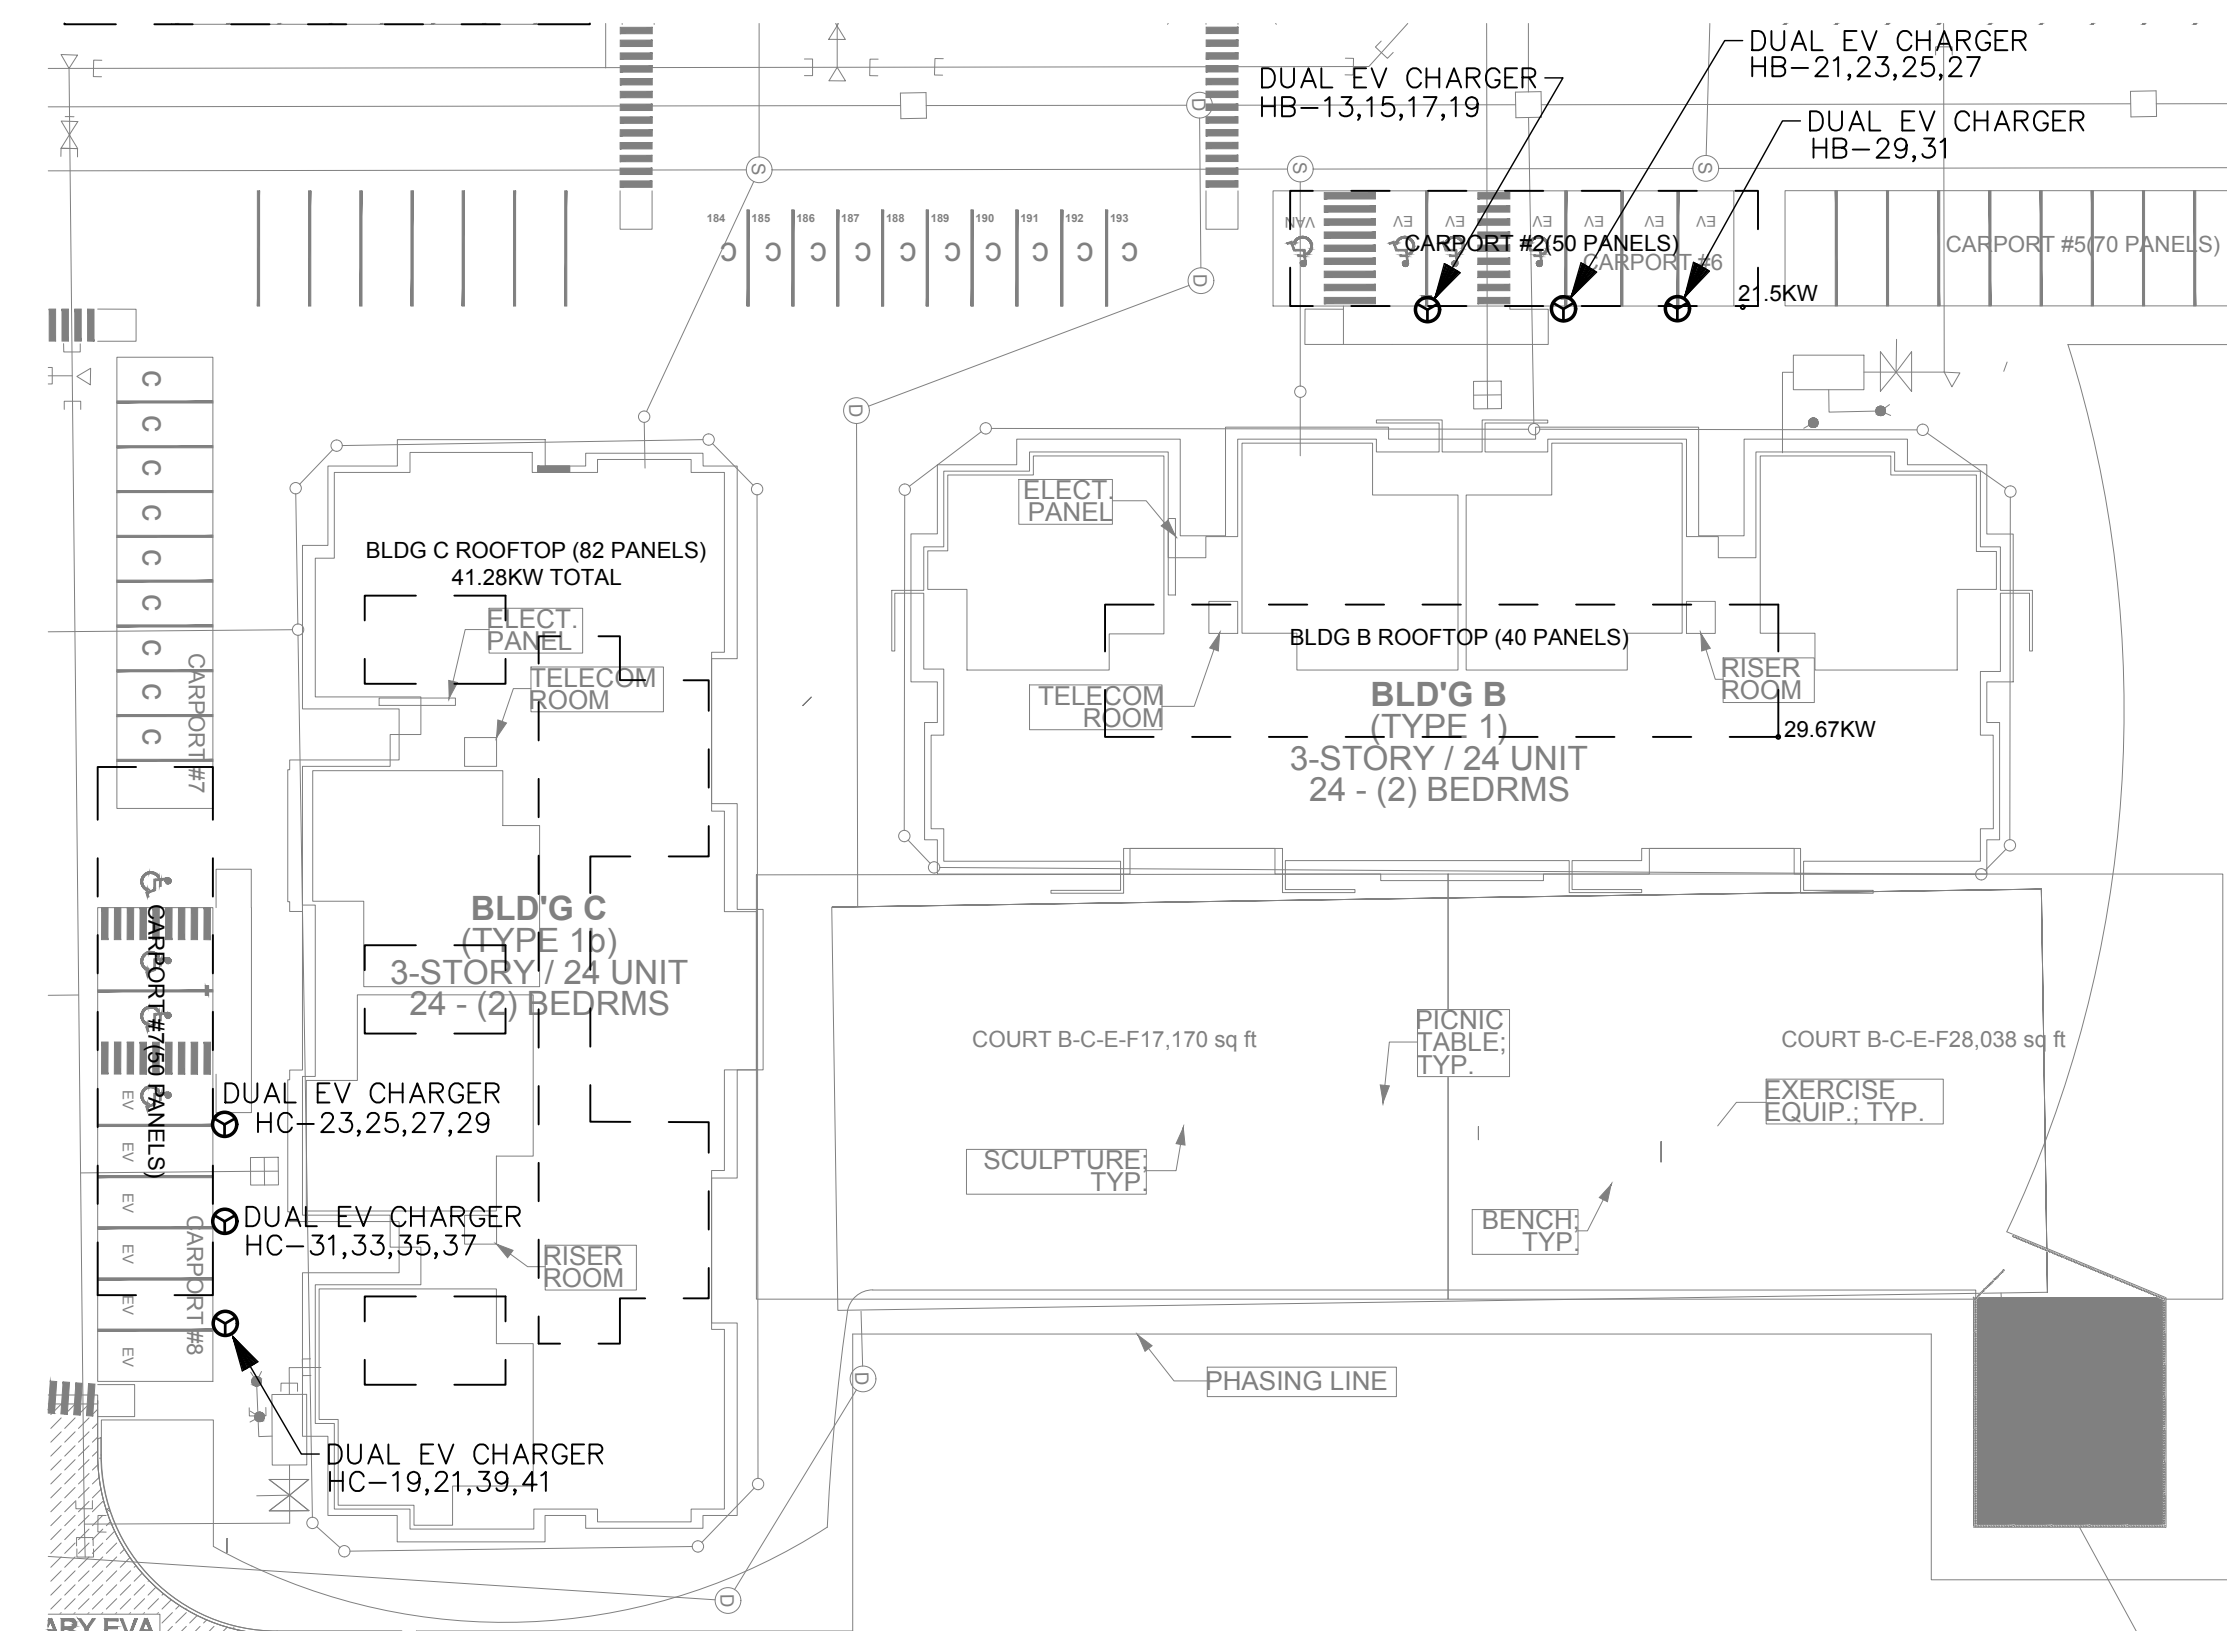

BUILDING C&B SITE PLAN - EV & SOLAR LAYOUT

SCALE: 1" = 30'

| NO. | DATE | DESCRIPTION |
|-----|------|-------------|
| | | |
| | | |
| | | |



| | | | |
|--------|-----------|----------|-----------|
| DRAWN: | DESIGNED: | CHECKED: | APPROVED: |
|--------|-----------|----------|-----------|

PROJECT: **EAST TOWN CROSSING**
MULTIFAMILY DEVELOPMENT
PIONEER WAY & SHAW RD. PUYALLUP, WA


19401 40TH AVE W, SUITE 302
LYNNWOOD, WA 98036
PHONE: 206-364-3343

ROBISON ENGINEERING, INC.



DATE:
12-06-2023

SHEET TITLE:
SITE PLAN

SHEET NO.
E0.02

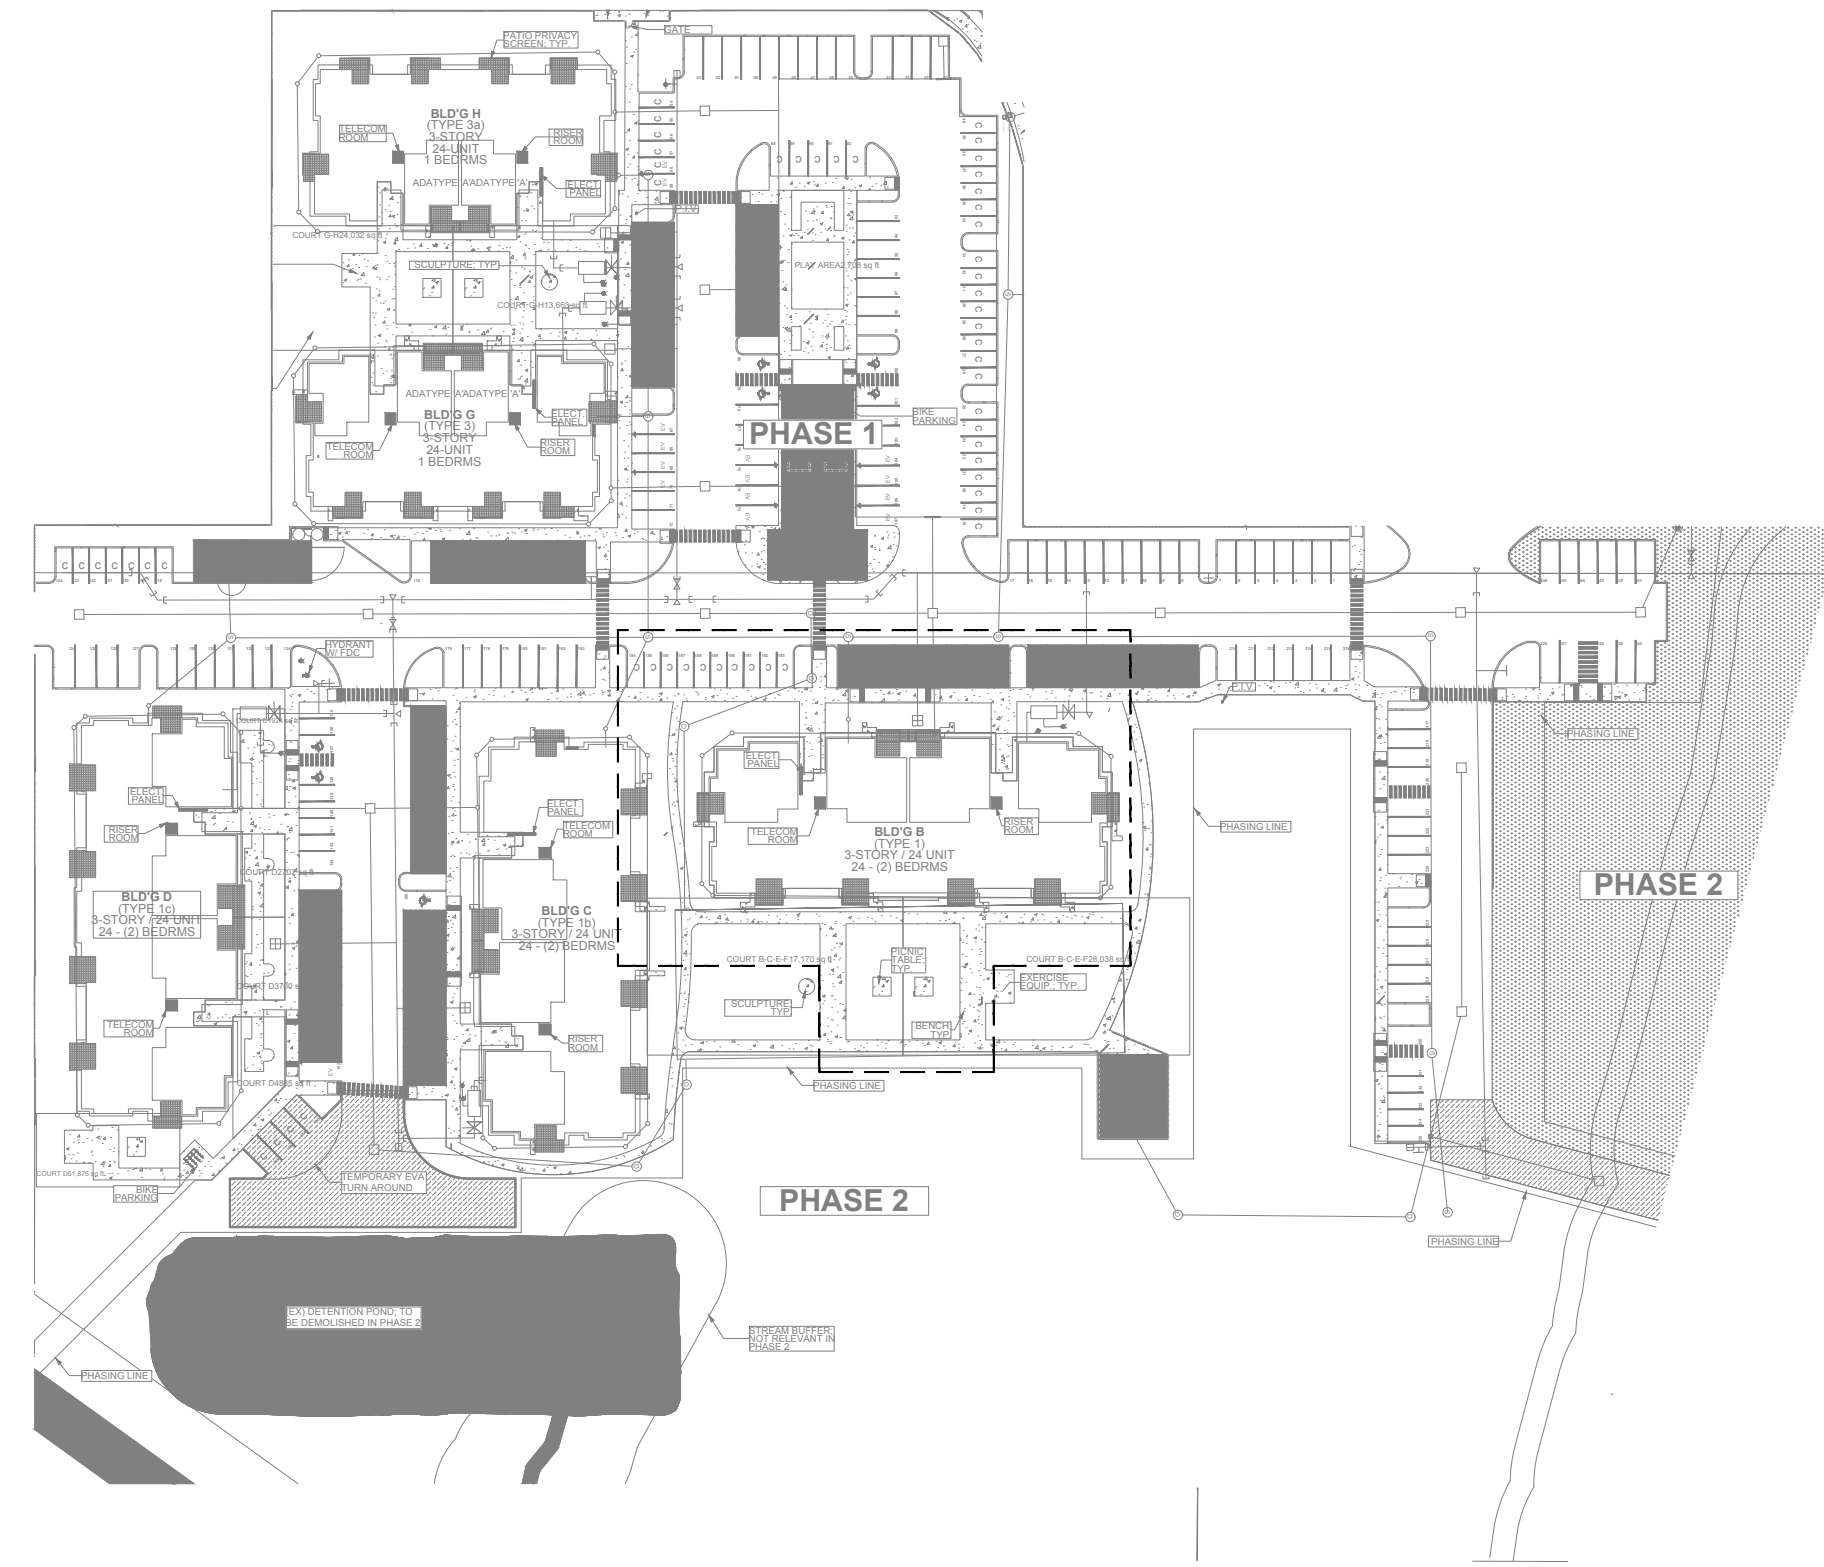


VICINITY MAP

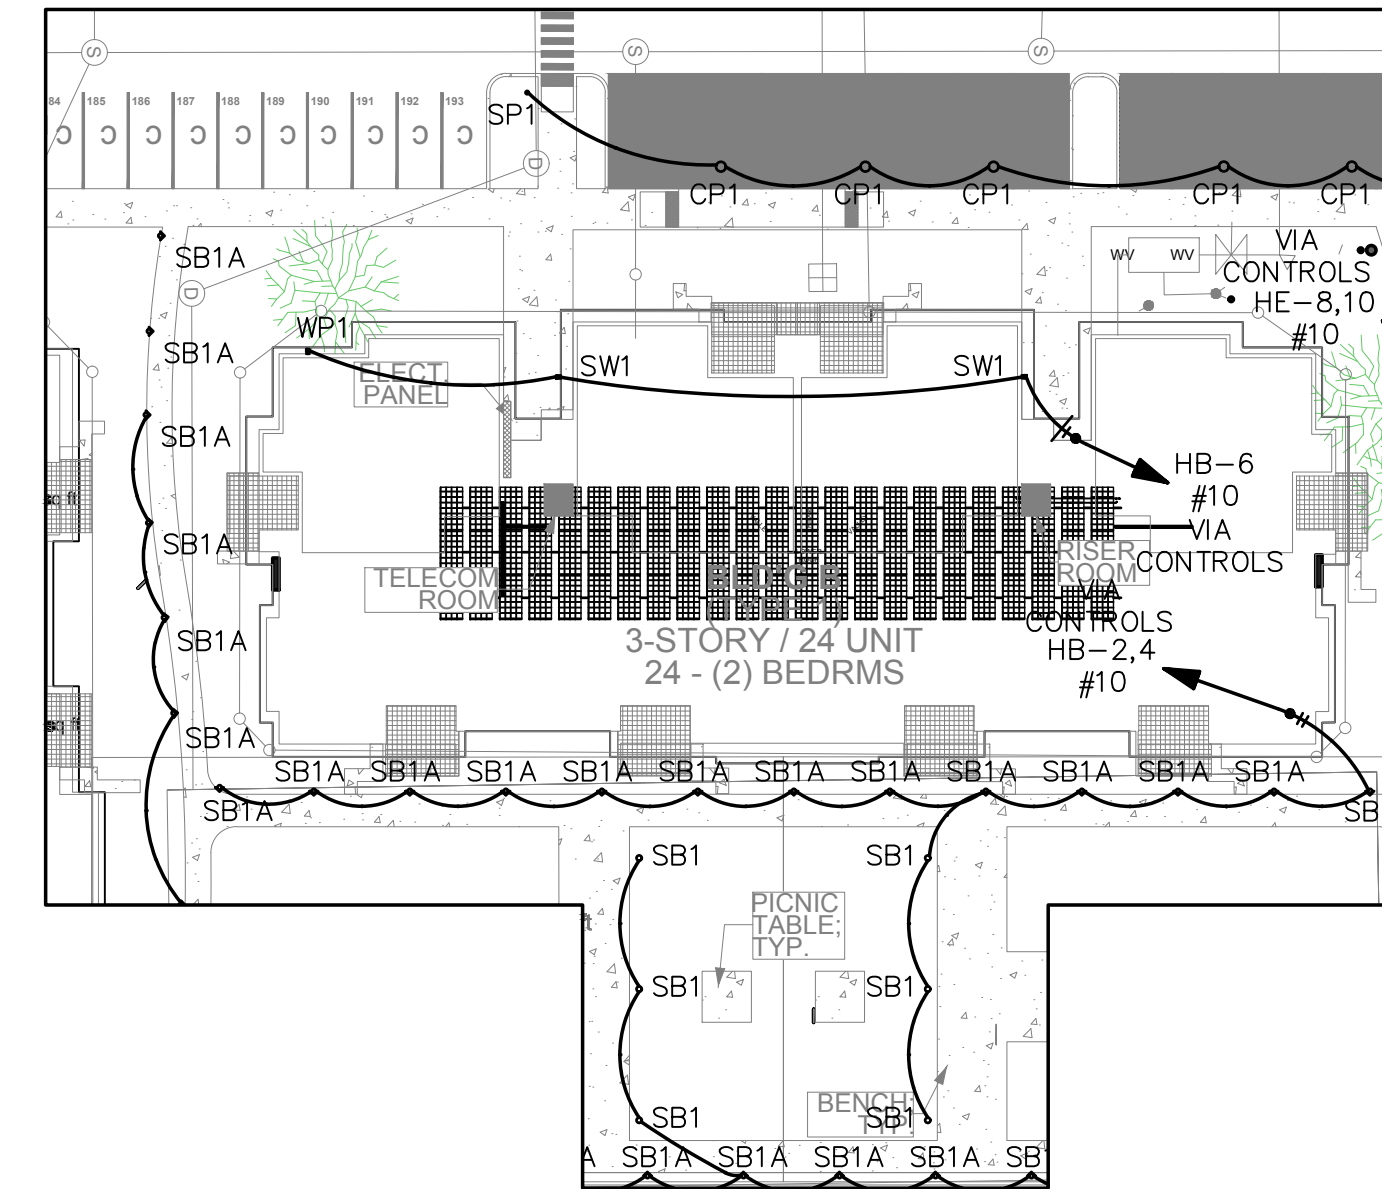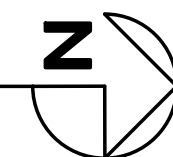


BUILDING B SITE LIGHTING PLAN – POWER

SCALE: 1" = 30'

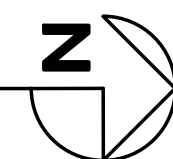

| NO. | DATE | DESCRIPTION |
|-----|------|-------------|
| | | |
| | | |
| | | |
| | | |

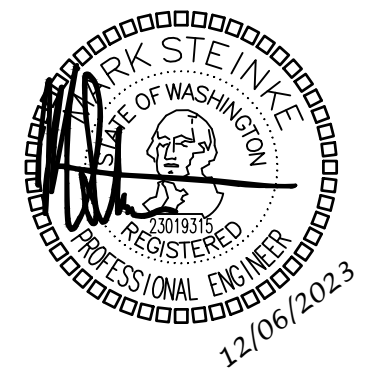

| | | | |
|--------|-----------|----------|-----------|
| DRAWN: | DESIGNED: | CHECKED: | APPROVED: |
| | | | |

PROJECT: **EAST TOWN CROSSING**
 MULTIFAMILY DEVELOPMENT
 PIONEER WAY & SHAW RD. PUYALLUP, WA

19401 40TH AVE W, SUITE 302
 LYNNWOOD, WA 98036
 PHONE: 206-364-3343

ROBISON
 ENGINEERING, INC.


DATE:
12-06-2023

SHEET TITLE:
LIGHTING PLAN

SHEET NO.
E0.03

GENERAL NOTES

- 1. MOUNTING HEIGHT (MH) LISTED IN LUMINAIRE SCHEDULE SHALL BE FROM ABOVE GRADE TO BOTTOM OF COMPLETE EXPOSED FIXTURE.
- 2. ALL EXTERIOR MOUNTED LIGHTING SHALL BE CONTROLLED BY PHOTOCONTROL OR ASTRONOMIC TIME-CLOCK SCHEDULING PER CALIFORNIA ENERGY CODE (CENC) REQUIREMENTS 160.5(c)2. PROVIDE MOTION SENSING CONTROLS FOR LUMINAIRES OVER 40 WATTS MOUNTED LESS THAN 24' ABOVE GRADE AND WALL MOUNTED LUMINAIRES MORE THAN 24' ABOVE GRADE.
- 3. ALL EXTERIOR MOUNTED LUMINAIRES SHALL FOLLOW MAXIMUM ALLOWABLE BACKLIGHT, UPLIGHT AND GLARE (BUG) RATINGS FOUND IN CALIFORNIA GREEN BUILDING STANDARDS CODE TABLE 5.106.8.
- 4. DURING EMERGENCY CONDITIONS EMERGENCY LIGHTING CIRCUITS SHALL BYPASS ALL LIGHTING CONTROLS IN ORDER TO ENERGIZE ALL CONNECTED LUMINAIRES AT FULL CAPACITY. PROVIDE UL924 RELAYS AS REQUIRED TO BYPASS AREA CONTROLS.
 - 4.1. EMERGENCY PATHWAY EGRESS LIGHTING: EMERGENCY LIGHTING FACILITIES SHALL BE ARRANGED TO PROVIDE INITIAL ILLUMINATION THAT IS NOT LESS THAN AN AVERAGE OF 1 FOOTCANDLE. (CBC 1008.3.5)

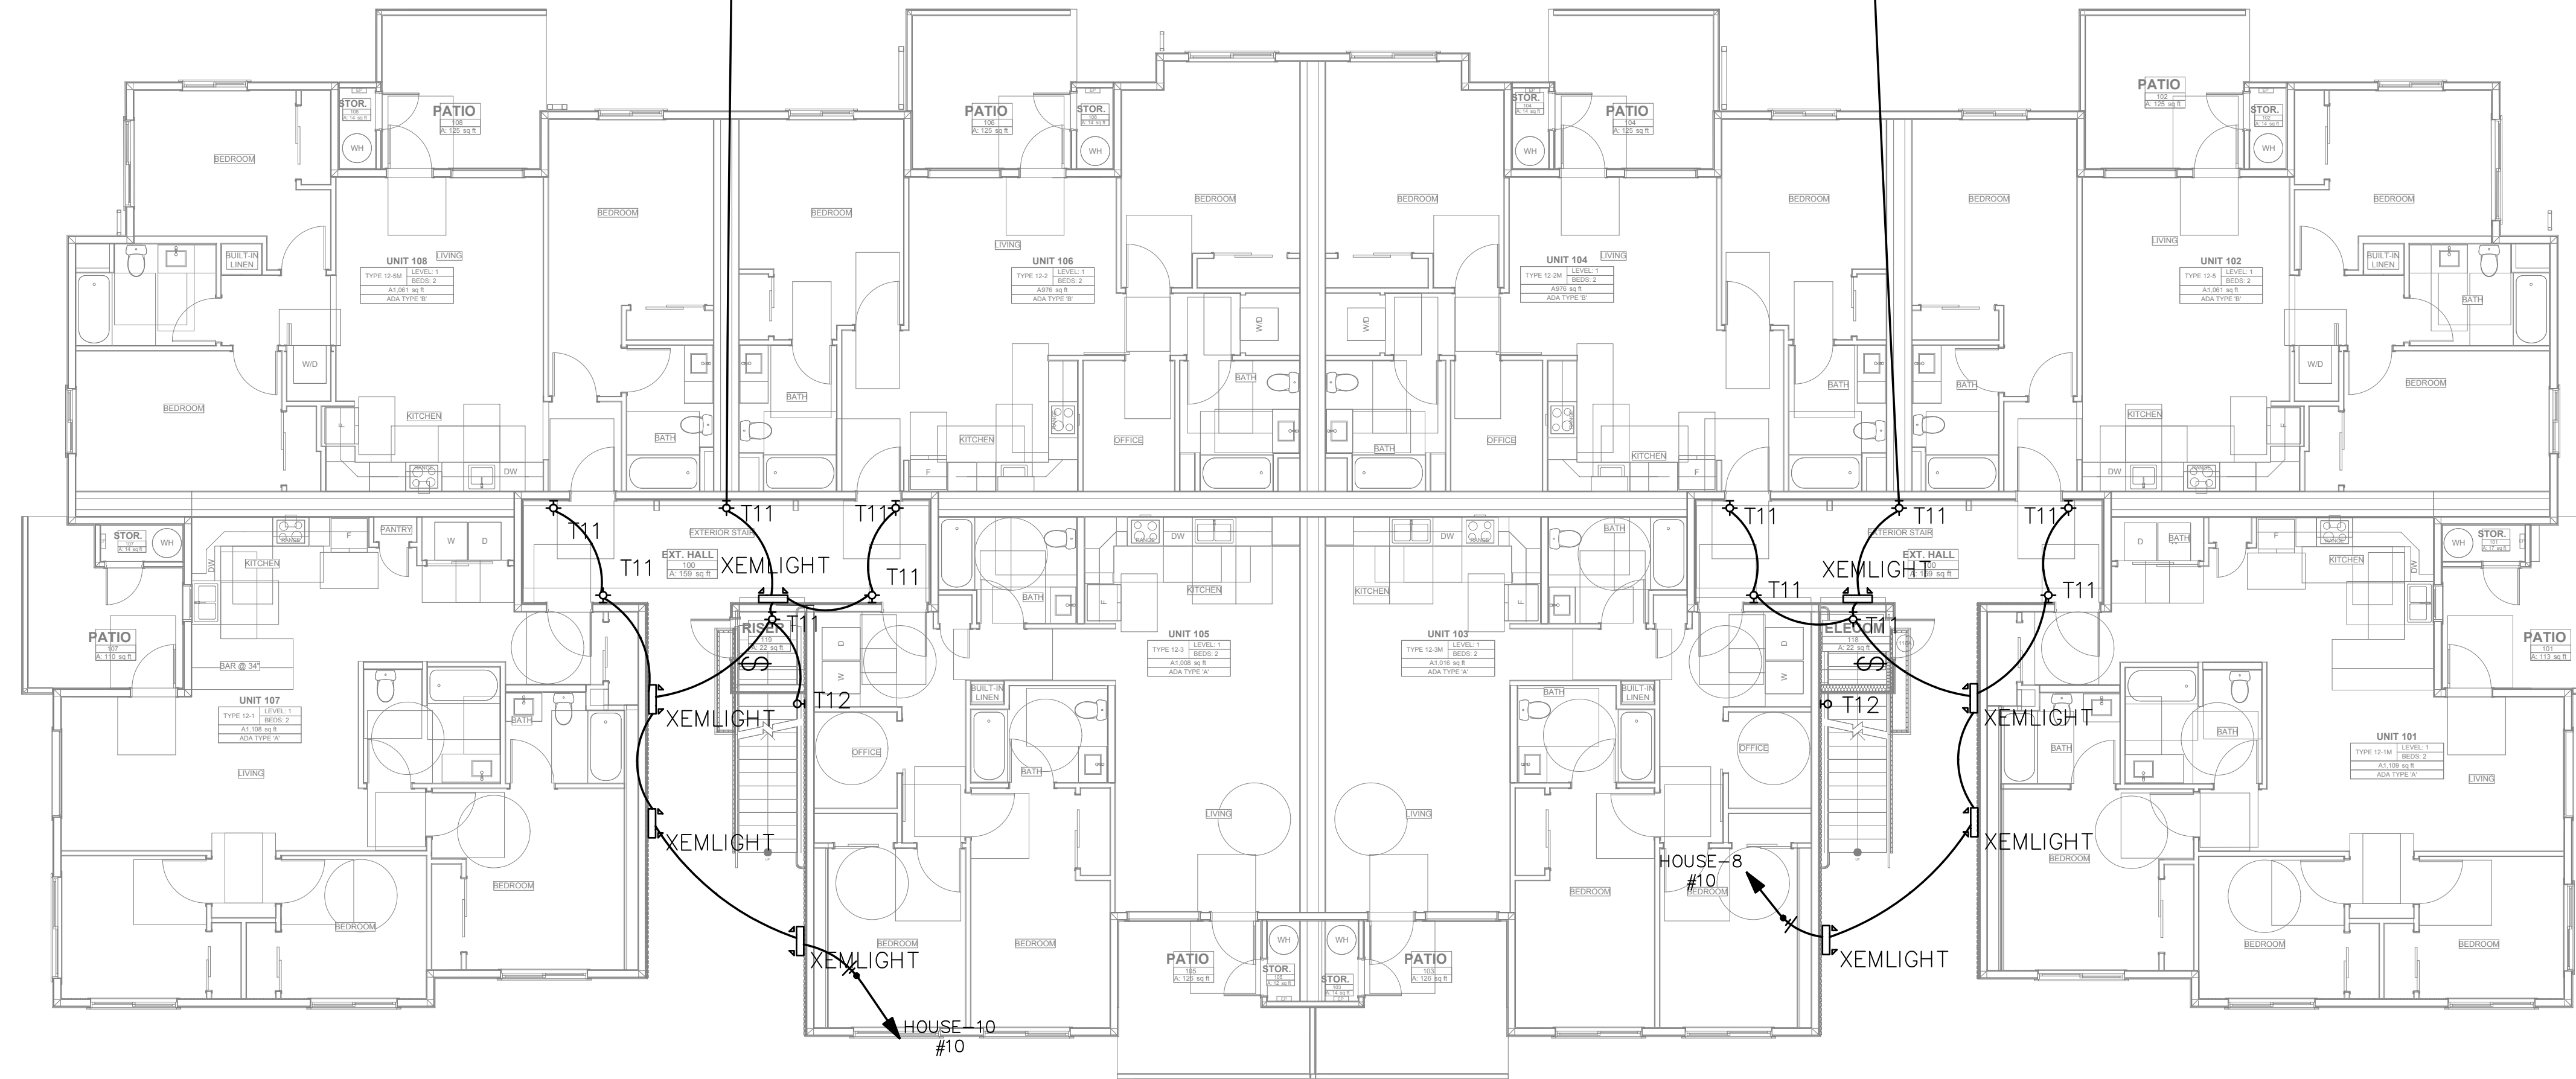

PHOTOM ARROW

| NO. | DATE | REVISIONS DESCRIPTION |
|-----|------|-----------------------|
| | | |
| | | |
| | | |



| | | | |
|-----------------|--------------------|---------------------|----------------------|
| DRAWN: LYSAK K. | DESIGNED: LYSAK K. | CHECKED: STEINKE M. | APPROVED: STEINKE M. |
|-----------------|--------------------|---------------------|----------------------|

PROJECT: **EAST TOWN CROSSING**
 MULTIFAMILY DEVELOPMENT
 PIONEER WAY & SHAW RD. PUYALLUP, WA

19401 40TH AVE W, SUITE 302
 LYNNWOOD, WA 98036
 PHONE: 206-864-3343

ROBISON ENGINEERING, INC.


PERMIT SET
 01/22/2024

SHEET TITLE:
 LIGHTING PLAN - LEVEL 1

SHEET NO.
 E1.01


LIGHTING PLAN - LEVEL 1

SCALE: 1/8" = 1'-0" 0' 4' 8' 16'

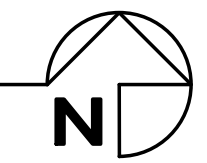

GENERAL NOTES

1. MOUNTING HEIGHT (MH) LISTED IN LUMINAIRE SCHEDULE SHALL BE FROM ABOVE GRADE TO BOTTOM OF COMPLETE EXPOSED FIXTURE.
2. ALL EXTERIOR MOUNTED LIGHTING SHALL BE CONTROLLED BY PHOTOCONTROL OR ASTRONOMIC TIME-CLOCK SCHEDULING PER CALIFORNIA ENERGY CODE (CEC) REQUIREMENTS 160.5(c)2. PROVIDE MOTION SENSING CONTROLS FOR LUMINAIRES OVER 40 WATTS MOUNTED LESS THAN 24' ABOVE GRADE AND WALL MOUNTED LUMINAIRES MORE THAN 24' ABOVE GRADE.
3. ALL EXTERIOR MOUNTED LUMINAIRES SHALL FOLLOW MAXIMUM ALLOWABLE BACKLIGHT, UPLIGHT AND GLARE (BUG) RATINGS FOUND IN CALIFORNIA GREEN BUILDING STANDARDS CODE TABLE 5.106.8.
4. DURING EMERGENCY CONDITIONS EMERGENCY LIGHTING CIRCUITS SHALL BYPASS ALL LIGHTING CONTROLS IN ORDER TO ENERGIZE ALL CONNECTED LUMINAIRES AT FULL CAPACITY. PROVIDE UL924 RELAYS AS REQUIRED TO BYPASS AREA CONTROLS.
 - 4.1. EMERGENCY PATHWAY EGRESS LIGHTING: EMERGENCY LIGHTING FACILITIES SHALL BE ARRANGED TO PROVIDE INITIAL ILLUMINATION THAT IS NOT LESS THAN AN AVERAGE OF 1 FOOTCANDLE. (CBC 1008.3.5)

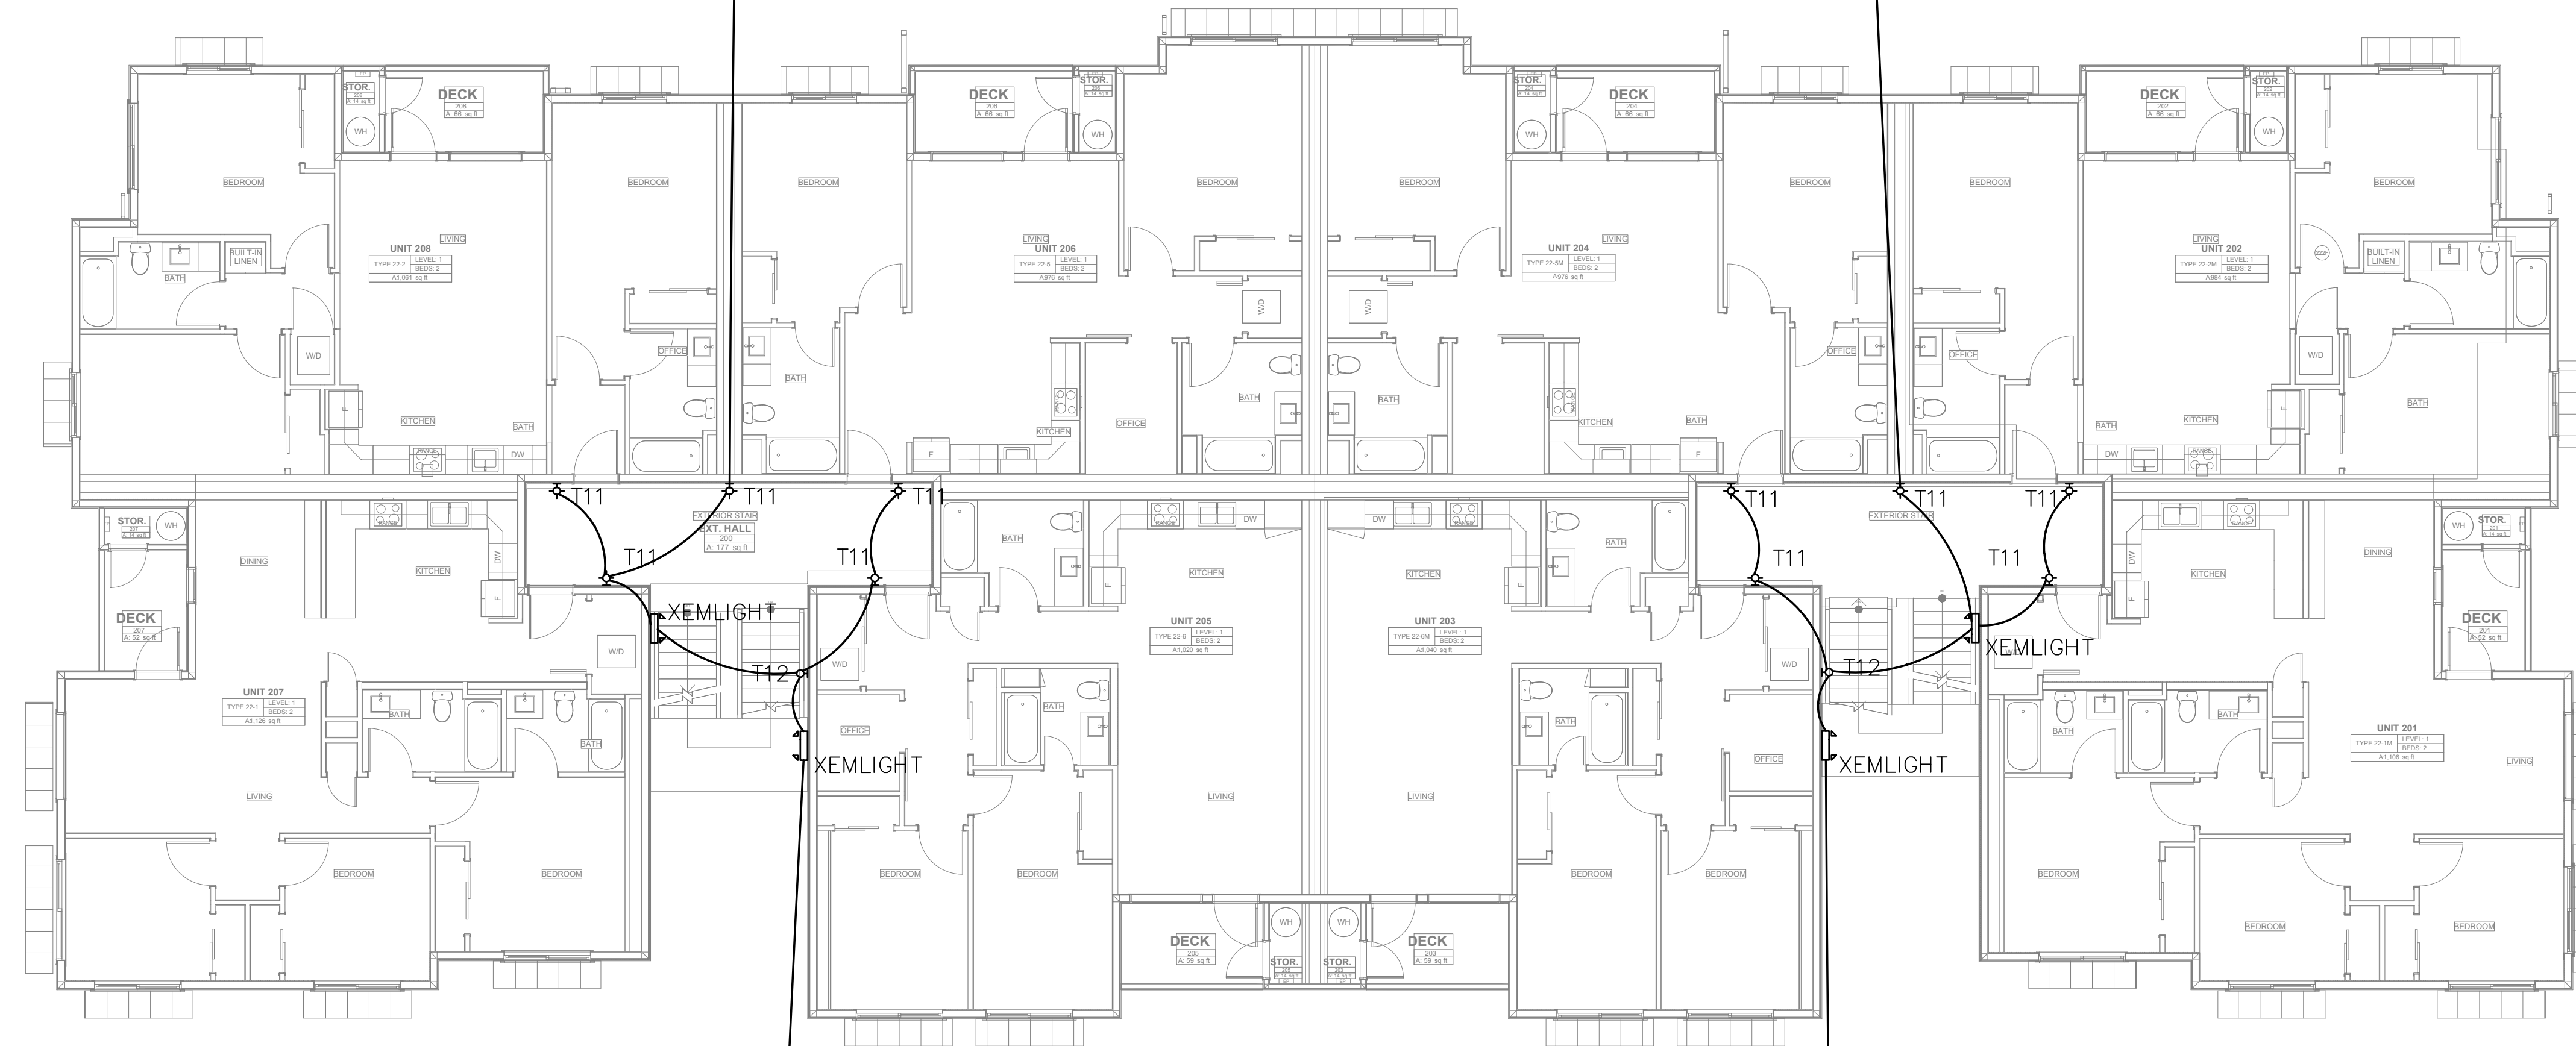

| NO. | DATE | REVISIONS DESCRIPTION |
|-----|------|-----------------------|
| | | |
| | | |
| | | |



| | | | |
|-----------------|--------------------|---------------------|----------------------|
| DRAWN: LYSAK K. | DESIGNED: LYSAK K. | CHECKED: STEINKE M. | APPROVED: STEINKE M. |
|-----------------|--------------------|---------------------|----------------------|

PROJECT: **EAST TOWN CROSSING**
 MULTIFAMILY DEVELOPMENT
 PIONEER WAY & SHAW RD. PUYALLUP, WA

19401 40TH AVE W, SUITE 302
 LYNNWOOD, WA 98036
 PHONE: 206-864-3343

ROBISON ENGINEERING, INC

PERMIT SET
 01/22/2024

SHEET TITLE:
 LIGHTING PLAN -
 LEVEL 2


SHEET NO.
 E1.02

LIGHTING PLAN - LEVEL 2
 SCALE: 1/8" = 1'-0" 0' 4' 8' 16'




GENERAL NOTES

1. MOUNTING HEIGHT (MH) LISTED IN LUMINAIRE SCHEDULE SHALL BE FROM ABOVE GRADE TO BOTTOM OF COMPLETE EXPOSED FIXTURE.
2. ALL EXTERIOR MOUNTED LIGHTING SHALL BE CONTROLLED BY PHOTOCONTROL OR ASTRONOMIC TIME-CLOCK SCHEDULING PER CALIFORNIA ENERGY CODE (CEC) REQUIREMENTS 160.5(c)2. PROVIDE MOTION SENSING CONTROLS FOR LUMINAIRES OVER 40 WATTS MOUNTED LESS THAN 24' ABOVE GRADE AND WALL MOUNTED LUMINAIRES MORE THAN 24' ABOVE GRADE.
3. ALL EXTERIOR MOUNTED LUMINAIRES SHALL FOLLOW MAXIMUM ALLOWABLE BACKLIGHT, UPLIGHT AND GLARE (BUG) RATINGS FOUND IN CALIFORNIA GREEN BUILDING STANDARDS CODE TABLE 5.106.8.
4. DURING EMERGENCY CONDITIONS EMERGENCY LIGHTING CIRCUITS SHALL BYPASS ALL LIGHTING CONTROLS IN ORDER TO ENERGIZE ALL CONNECTED LUMINAIRES AT FULL CAPACITY. PROVIDE UL924 RELAYS AS REQUIRED TO BYPASS AREA CONTROLS.
 - 4.1. EMERGENCY PATHWAY EGRESS LIGHTING: EMERGENCY LIGHTING FACILITIES SHALL BE ARRANGED TO PROVIDE INITIAL ILLUMINATION THAT IS NOT LESS THAN AN AVERAGE OF 1 FOOTCANDLE. (CBC 1008.3.5)

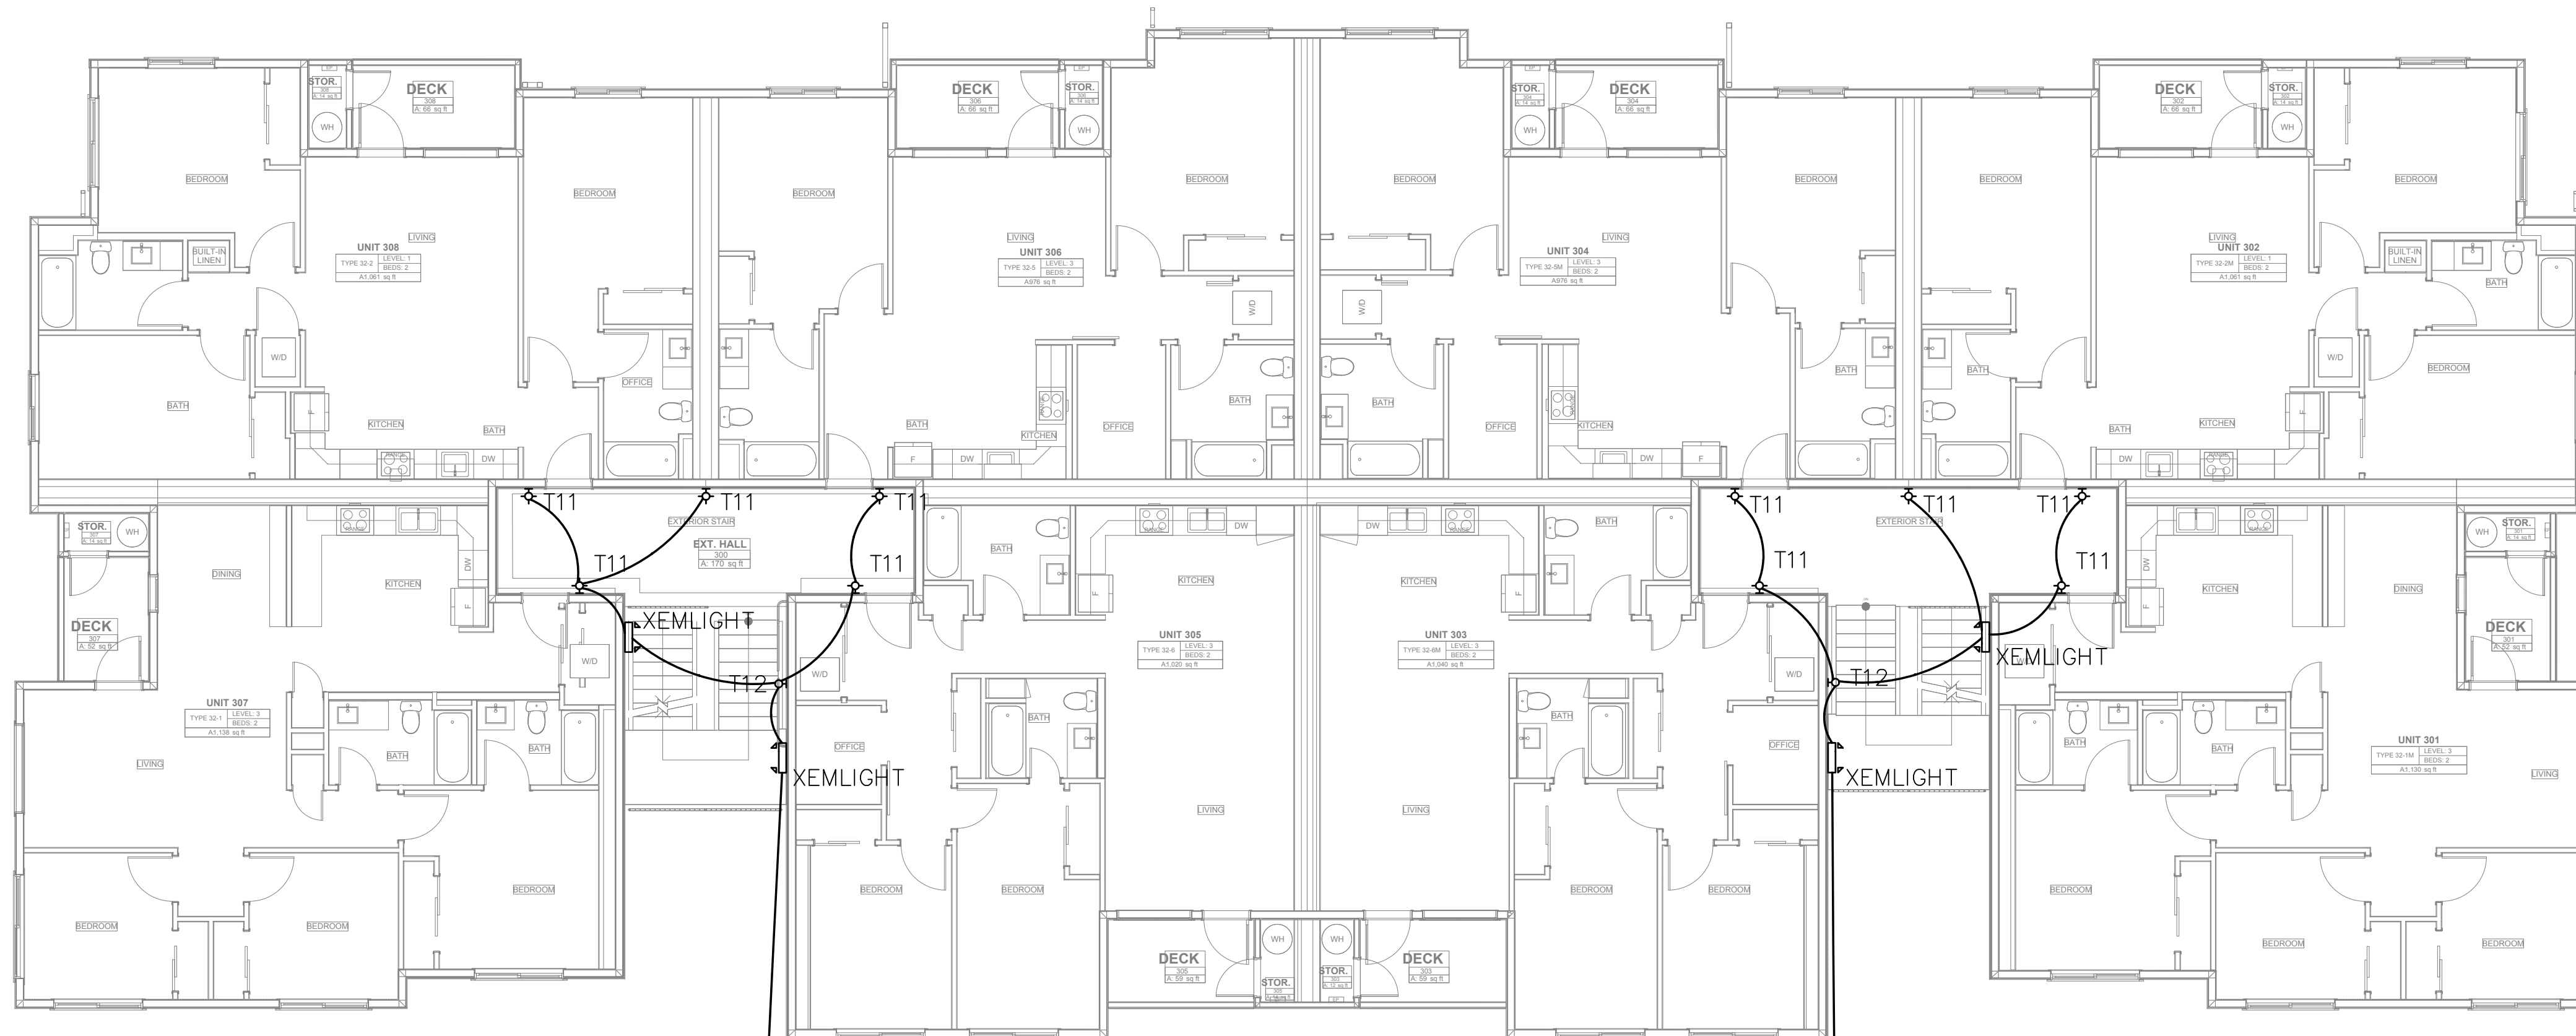

| NO. | DATE | REVISIONS DESCRIPTION |
|-----|------|-----------------------|
| | | |
| | | |

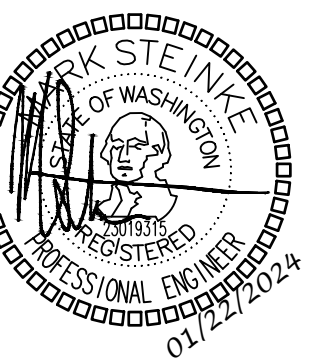

| | | | |
|-----------------|--------------------|---------------------|----------------------|
| DRAWN: LYSAK K. | DESIGNED: LYSAK K. | CHECKED: STEINKE M. | APPROVED: STEINKE M. |
|-----------------|--------------------|---------------------|----------------------|

PROJECT: **EAST TOWN CROSSING**
 MULTIFAMILY DEVELOPMENT
 PIONEER WAY & SHAW RD. PUYALLUP, WA

19401 40TH AVE W, SUITE 302
 LYNNWOOD, WA 98036
 PHONE: (206) 364-3343

ROBISON ENGINEERING, INC.

| |
|-------------------------|
| PERMIT SET |
| 01/22/2024 |
| SHEET TITLE: |
| LIGHTING PLAN - LEVEL 3 |
| SHEET NO. |
| E1.03 |

LIGHTING PLAN - LEVEL 3
 SCALE: 1/8" = 1'-0" 0' 4' 8' 16'



EXTERIOR & SITE LUMINAIRE SCHEDULE

| CALLOUT | SYMBOL | MOUNTING | DESCRIPTION | MODEL | VOLTAGE | TYPE | CRI / CCT | LAMPING | WATTAGE |
|---------|--------|------------|--|---|----------|------------------------------|------------|-------------|---------|
| CP1 | ○ | SURFACE | CARPORT LIGHT - TYPE 5 - B1 U0 G1 | GARDCO: SVPG A01 830 5CD [MOUNTING] UNV | MULTIPLE | 0-10V DIMMING | 80 / 3000K | (1) 21W LED | 21 |
| SB1 | ○ | 3' BOLLARD | BOLLARD - TYPE 5 - B1 U0 G0 | GARDCO: PUREFORM BOLLARD / PBL 36 14L 100 WW-G2 5 UNV | MULTIPLE | 0-10V DIMMING | 70 / 3000K | (1) 6W LED | 6 |
| SB1A | ⊕ | 3' BOLLARD | BOLLARD - TYPE 3 - B0 U0 G0 | GARDCO: PUREFORM BOLLARD / PBL 36 14L 100 WW-G2 3 UNV | MULTIPLE | 0-10V DIMMING | 70 / 3000K | (1) 6W LED | 6 |
| SF1 | ⊕ | SURFACE | MONUMENT SIGN FLOOD LIGHT | TBD | 120 | TBD | | (1) 15W LED | 15 |
| SP1 | ○ | 16' POLE | POST TOP LIGHT - TYPE 5 - B2 U3 G2 | WE-EF: ZFT434LED / 115-1283 | MULTIPLE | 0-10V DIMMING | 80 / 3000K | (1) 42W LED | 42 |
| SP2 | ○ | 16' POLE | POLE LIGHT - SPORT COURT - B1 U0 G2 - TYPE 3 | SIGNIFY - GARDCO: P15 P A03 730 T3M AR1 UNV PCB [FINISH] | MULTIPLE | 0-10V DIMMING | 80 / 3000K | (1) 45W LED | 45 |
| SU1 | ⊕ | TREE BAND | UPLIGHT - ACCENT | HK LIGHTING: ZX1161 120V 5W 30K 010 / TMS120 TS - WATER TIGHT FITTING - CORD & PLUG BY ELECTRICAL | 120 | 0-10V DIMMING | | (1) 10W LED | 10 |
| SW1 | ⊕ | SURFACE | EXTERIOR SCONCE - STAIRS - NB UP / TYPE II DOWN - MH 10' | PERFORMANCE IN LIGHTING: AMON / 070274 | MULTIPLE | 0-10V DIMMING | 80 / 3000K | (1) 37W LED | 37 |
| SW2 | ⊕ | SURFACE | SECURITY LIGHT - TRASH ENCLOSURES | STONCO: SL20 SCT G1 8 BK | MULTIPLE | INTEGRAL MOTION & PHOTOCCELL | 70 / 3000K | (1) 20W LED | 20 |
| WP1 | ⊕ | SURFACE | WALL PACK - PARKING - TYPE III - B2 U0 G2 - MH 18' | GARDCO: PUREFORM COMFORT OPTICS / PWS 140L 1150 WW-G2 3 X UNV | MULTIPLE | AS NEEDED | 70 / 3000K | (1) 52W LED | 52 |
| WP2 | ⊕ | SURFACE | WALL PACK - POOL - TYPE IV - B3 U0 G3 - MH 14' | GARDCO: PUREFORM COMFORT OPTICS / PWS 140L 1675 WW-G2 4 UNV | MULTIPLE | AS NEEDED | | (1) 76W LED | 76 |

- CONTRACTOR TO FURNISH AND INSTALL ALL FIXTURES.
- FIXTURE FINISHES TO BE COORDINATED WITH ARCHITECT/ID.

DWELLING UNIT LUMINAIRE SCHEDULE

| CALLOUT | SYMBOL | LAMP | MOUNTING | DESCRIPTION | MODEL | VOLTAGE | WATTAGE | NOTES |
|---------|--------|------|----------|-------------------------------|---------------------------|------------|---------|--|
| T1 | ⊕ | (1) | CEILING | SURFACE MOUNT LED LIGHT | OSTW: OW-LFMDR-14D2130-NK | 120V 1P 2W | 21 | |
| T2 | ⊕ | (1) | CEILING | SURFACE MOUNT LED | OSTW: OW-LDS01-6D1530N | 120V 1P 2W | 15 | |
| T3 | ○ | (1) | CEILING | FAN/LIGHT COMBO | KICHLER: 330017NI | 120V 1P 2W | 52 | PROVIDE DIVA: DVFSQ-LF CONTROLLER IN UNITS DESIGNATED AS ACCESSIBLE PER ARCHITECTUAL |
| T4 | ⊕ | (1) | PENDANT | LED CHANDELIER | OSTW: OW-LSFDR-12D1530-NK | 120V 1P 2W | 15 | |
| T5 | ● | (1) | CEILING | LAUNDRY LIGHT/HOUSE FAN COMBO | BROAN: LP50100DC | 120V 1P 2W | 45 | |
| T6 | ● | (1) | CEILING | BATH FAN/LIGHT COMBO | ORB: OSP70L | 120V 1P 2W | 45 | |
| T7 | ⊕ | (1) | WALL | LED VANITY LIGHT | KICHLER: 5337NIS | 120V 1P 2W | 27 | (3) BULBRITE 9W LED BULBS: ITEM #774006 |
| T8 | ⊕ | (1) | WALL | EXT. LED SCONCE | | 120V 1P 2W | 20 | |
| T9 | ○ | (1) | CEILING | SURFACE MOUNT LED | OSTW: OW-LDS0B-6D1830W | 120V 1P 2W | 18 | |
| T13 | □ | (1) | CEILING | 1.4 LED TROFFER | TBD | 120V 1P 2W | 40 | |

- CONTRACTOR TO FURNISH AND INSTALL ALL FIXTURES.
- FIXTURE FINISHES TO BE COORDINATED WITH ARCHITECT/ID.

GENERAL LIGHTING NOTES

- LIGHTING CONTROLS SHALL BE INSTALLED WHICH MEET ALL REQUIREMENTS OF LOCAL ENERGY CODES.
- EMERGENCY LIGHT FIXTURES: PROVIDE UNSWITCHED HOT FOR BATTERY CHARGER.
- LOCATIONS OF OCCUPANCY SENSORS, PHOTO SENSORS, DIMMERS, AND SWITCHES ARE DIAGRAMMATIC. CONTRACTOR TO FIELD-IDENTIFY OPTIMAL LOCATIONS AND QUANTITIES.
- ASSURE COMPATIBILITY OF DIMMERS WITH CONTROLLED LUMINAIRES PRIOR TO PURCHASING.
- AUTOMATIC LIGHTING SHUT-OFF CONTROLS SHALL BE PROVIDED BY LOCAL OCCUPANCY SENSORS AND/OR ASTRONOMIC TIME CLOCK UNLESS OTHERWISE NOTED.
- DAYLIGHT ZONES ARE REFERRED TO AS 'PRIMARY' AND 'SECONDARY' ON PLANS AND DENOTED BY DASHED LINES.
- FOR CUSTOM FF&E FIXTURES, IT IS THE MANUFACTURER'S RESPONSIBILITY TO FURNISH PRODUCTS WHICH ARE COMPLIANT WITH ALL REQUIREMENTS OF LOCAL ENERGY CODES, AS WELL AS MATCH THE ELECTRICAL SPECIFICATIONS PROVIDED IN THE LUMINAIRE SCHEDULES. PROVIDE SUBMITTAL SHOP DRAWINGS WITHIN 30 DAYS OF RECEIVING FIXTURE ORDER. SUBMITTALS SHALL CLEARLY INDICATE LAMPING AND MAXIMUM WATTAGE RATING OF LAMP SOCKETS. NON-COMPLIANT FIXTURES REJECTED BY ELECTRICAL INSPECTOR SHALL BE RETURNED TO THE MANUFACTURER FOR REWORKING AND/OR RE-LABELING.
- EMERGENCY EGRESS LIGHTING TO BE CONFIRMED AS INTENDED EGRESS DESIGN PRIOR TO PERMITTING

EXIT SIGN NOTES

DURING CONSTRUCTION, UPON COMPLETION OF A TYPICAL FLOOR FRAMING AND BEFORE WALL COVER, ELECTRICAL CONTRACTOR SHALL WALK THE EGRESS PATHS WITH THE LOCAL INSPECTOR (AHJ) TO CONFIRM THAT ALL THE EXIT SIGNS ARE LOCATED PER THE AHJ'S SATISFACTION AND IDENTIFY ANY ADDITIONAL EXIT SIGNS THAT THE AHJ WISHES TO BE INSTALLED. CONTRACTOR SHALL INCLUDE IN THEIR BASE BID UP TO 10% ADDITIONAL EXIT SIGNS (HIGH & LOW) AT NO ADDITIONAL COST. INCLUDE COST OF FIXTURES AND ASSOCIATED WIRING AND INSTALLATION.

LIGHTING CONTROL SYSTEM REQUIREMENTS

- CONTRACTOR TO PROVIDE A FULLY OPERATIONAL LIGHTING CONTROL SYSTEM.
- ELECTRICAL CONTRACTOR SHALL COORDINATE WITH A LIGHTING CONTROLS VENDOR TO OBTAIN LIGHTING CONTROL SYSTEM PACKAGE COMPLETE WITH DEVICES, WIRING DIAGRAMS, ANNOTATED PLANS INDICATING WHICH DEVICE TO BE USED IN EACH LOCATION, CONNECTION REQUIREMENTS, SET UP INSTRUCTIONS, COMMISSIONING AND CHECK-OUT FOLLOWING COMPLETION. PROVIDE ALL LOW VOLTAGE WIRING AS REQUIRED FOR CONTROL DEVICE INTERCONNECTIONS.
- INSTALLER QUALIFICATIONS: TECHNICIAN INSTALLING AND WIRING THE LIGHTING CONTROL SYSTEM SHALL HAVE INSTALLED THIS SAME SYSTEM AT LEAST ONCE PREVIOUSLY. TECHNICIAN SHALL HAVE RECEIVED TRAINING BY FACTORY REPRESENTATIVE ON THE SYSTEM BEING INSTALLED.
- PROVIDE LIGHTING CONTROL SYSTEM TO PERFORM THE FUNCTIONS DESCRIBED BELOW AND WHERE INDICATED ON PLANS. NOT ALL FEATURES ARE REQUIRED.
 - CONTROL EXTERIOR LIGHTING BASED ON ASTRONOMIC TIME-CLOCK SCHEDULING.
 - INTERIOR PRIMARY AND SECONDARY DAYLIGHT HARVESTING CONTROL PER ENERGY CODE REQUIREMENTS.
 - PROVIDE SEPARATE SWITCHING AND DIMMING CONTROL FOR LIGHTING ZONES AS INDICATED IN LIGHTING DIMMING SCHEDULE.
- DURING EMERGENCY CONDITIONS EMERGENCY LIGHTING CIRCUITS SHALL BYPASS ALL LIGHTING CONTROLS IN ORDER TO ENERGIZE ALL CONNECTED LUMINAIRES AT FULL CAPACITY. PROVIDE UL924 RELAYS AS REQUIRED TO BYPASS AREA CONTROLS.

LIGHTING CONTROLS LEGEND

| | |
|-------|---|
| ⊕ ⊕ | TOGGLE SWITCH FOR MANUAL ON/OFF LIGHTING CONTROL. SUBSCRIPT INDICATES WHICH FIXTURES ARE TO BE CONTROLLED BY WHICH SWITCH. |
| ⊕ ⊕ | DIMMER SWITCH FOR MANUAL MULTI-LEVEL LIGHTING CONTROL. SWITCH SHALL ALSO HAVE MANUAL ON/OFF FUNCTIONALITY. SUBSCRIPT INDICATES WHICH FIXTURES ARE TO BE CONTROLLED BY WHICH DIMMER. |
| OS OS | SWITCHES LABELED 'OS' SHALL TURN OFF ALL CONNECTED LUMINAIRES WITHIN 30 MINUTES OF SPACE BEING VACANT. |
| ⊕ | OCCUPANCY SENSOR SHALL AUTOMATICALLY TURN OFF ALL CONNECTED LUMINAIRES WITHIN 30 MINUTES OF SPACE BEING VACANT. |
| ⊕ | PHOTOSENSOR FOR DAYLIGHT ZONE CONTROL SHALL AUTOMATICALLY ADJUST THE LIGHT OUTPUT OF ALL CONNECTED LUMINAIRES BASED ON THE DAYLIGHT LEVEL IN THE SPACE. |

| NO. | DATE | DESCRIPTION |
|-----|------|-------------|
| | | |
| | | |
| | | |



| | | | |
|-----------------|--------------------|---------------------|----------------------|
| DRAWN: LYSAK K. | DESIGNED: LYSAK K. | CHECKED: STEINKE M. | APPROVED: STEINKE M. |
|-----------------|--------------------|---------------------|----------------------|

PROJECT: **EAST TOWN CROSSING**
MULTIFAMILY DEVELOPMENT
PIONEER WAY & SHAW RD. PUYALLUP, WA


19401 40TH AVE W, SUITE 302
LYNNWOOD, WA 98036
PHONE: 206/864-5362

ROBISON ENGINEERING, INC.

PERMIT SET
01/22/2024

SHEET TITLE:
LIGHTING NOTES
& LUMINAIRE
SCHEDULE

SHEET NO.
E1.50

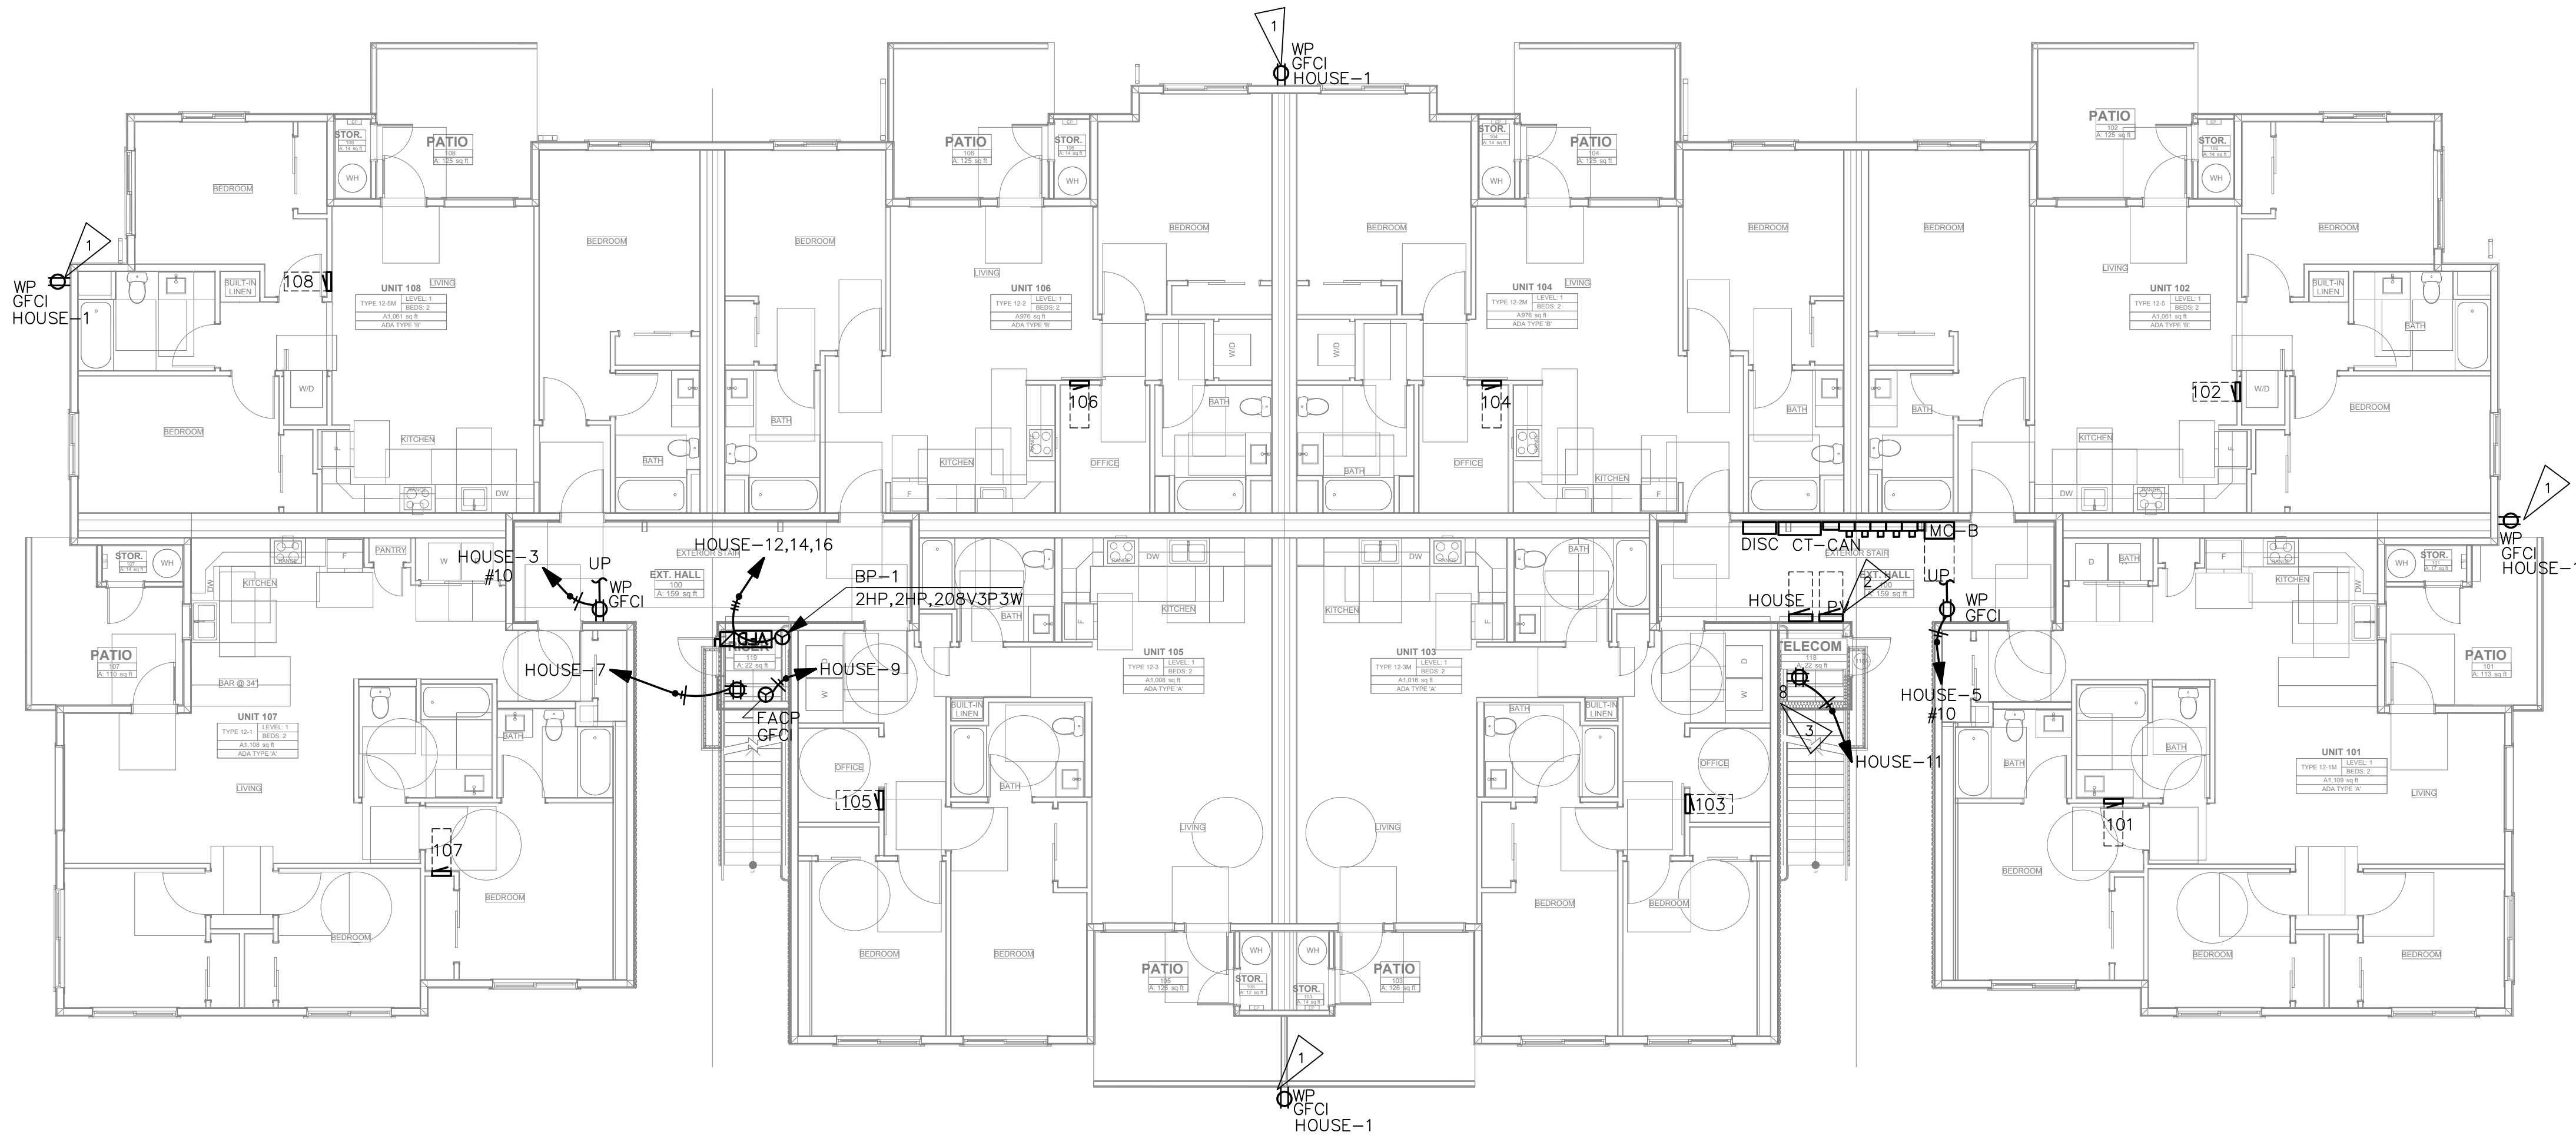

UTIL
T TBD LOCATION

SHEET NOTES:

1. PROVIDE CONDUITS WITH PULL WIRE FROM DEMARCATION OR MDF TO IDF CLOSETS FOR ALL SYSTEMS INCLUDING VOICE, DATA, TV AND SECURITY. QUANTITY AND SIZE AS DETERMINED BY LOW VOLTAGE CONSULTANT. PROVIDE SLEEVES WITH BUSHINGS AT BOTH ENDS PER LOW VOLTAGE CONSULTANT. FIRE STOP AS REQUIRED BY AHJ
2. PROVIDE CONDUIT, WIRING, CIRCUITS AND CONNECTIONS AS COORDINATED WITH SECURITY VENDOR FOR FULLY FUNCTIONING SECURITY AND ACCESS CONTROL SYSTEM. COORDINATE WITH SECURITY CONSTRUCTION DOCUMENTS TO IDENTIFY ALL CAMERA LOCATIONS, AT ALL DOORS CALLED OUT BY OWNER, AS WELL AS ROLL UP GARAGE DOORS FOR GARAGE ACCESS.
3. AMENITY SPACES, OFFICES AND PUBLIC AREAS: ROUGH-IN FOR EQUIPMENT, OUTLETS AND APPLIANCES IN AMENITY SPACES TO BE COORDINATED WITH ARCHITECT. REFER TO ARCHITECTS DRAWINGS AND ELEVATIONS.
4. WIRING METHOD FOR APARTMENT FEEDERS MUST BE SUITABLE FOR THE TYPE OF CONSTRUCTION. SEE NEC 334.10
5. CONTRACTOR TO COORDINATE DOOR CONTROLS AND CONNECTIONS WITH DOOR VENDOR. PROVIDE RACEWAY, CONDUCTORS, POWER SUPPLY AND TERMINATIONS FOR A FULLY FUNCTIONING SYSTEM. COORDINATE WITH SECURITY VENDOR FOR MONITORING AND CONTROL AS NEEDED.
6. ELECTRICAL CONTRACTOR (EC) TO PROVIDE J-BOX/PULL BOX SO NUMBER OF BENDS IN CONDUIT DOES NOT EXCEED CODE REQUIREMENT (360 MAX TOTAL). EC TO FIELD VERIFY LOCATION OF J-BOX/PULL BOX. COORDINATE WITH ARCHITECT WHERE ACCESS PANEL IS REQUIRED.
7. PROVIDE BLOCKOUTS AND SLEEVES AS REQUIRED FOR ALL FEEDERS AND RISERS SHOWN ON 1-LINE. COORDINATE WITH STRUCTURAL. PROVIDE SUPPORT FOR VERTICAL FEEDERS AS REQUIRED BY NEC 300.19. ANY SLEEVE LOCATIONS SHOWN ARE DIAGRAMMATIC ONLY. ELECTRICAL PLANS DO NOT SHOW BRANCH CIRCUIT OR SMALL FEEDER CONDUIT RUNS. LAYOUT PER EC. FINAL VERIFICATION OF NUMBER AND LOCATION OF ALL FLOOR PENETRATIONS BY EC.

FLAG NOTES: (NOT EVERY FLAG IS USED ON EVERY SHEET)

1. PROVIDE LOCKING COVER FOR EXTERIOR & CORRIDOR RECEPTACLES. TYP.
2. LEAVE 2" OF OPEN WALL SPACE ADJACENT TO HOUSE PANEL FOR FUTURE EV PANEL.
3. PROVIDE (1) 2" CONDUIT FROM TELEPHONE VAULT AND (1) 2" CONDUIT FROM THE CABLE TV VAULT. COORDINATE WITH TELECOM UTILITY FOR TELEPHONE & CABLE TV VAULT LOCATIONS.

POWER PLAN — LEVEL 1
SCALE: 1/8" = 1'-0"

| NO. | DATE | DESCRIPTION |
|-----|------|-------------|
| | | |
| | | |
| | | |



| | | | |
|-----------------|--------------------|---------------------|----------------------|
| DRAWN: LYSAK K. | DESIGNED: LYSAK K. | CHECKED: STEINKE M. | APPROVED: STEINKE M. |
|-----------------|--------------------|---------------------|----------------------|


PROJECT: **EAST TOWN CROSSING**
MULTIFAMILY DEVELOPMENT
PIONEER WAY & SHAW RD. PUYALLUP, WA

ROBISON ENGINEERING, INC.
19401 40TH AVE W, SUITE 302
LYNNWOOD, WA 98036
PHONE: 206-834-3316

PERMIT SET
01/22/2024

SHEET TITLE:
POWER PLAN — LEVEL 1

SHEET NO.
E3.00

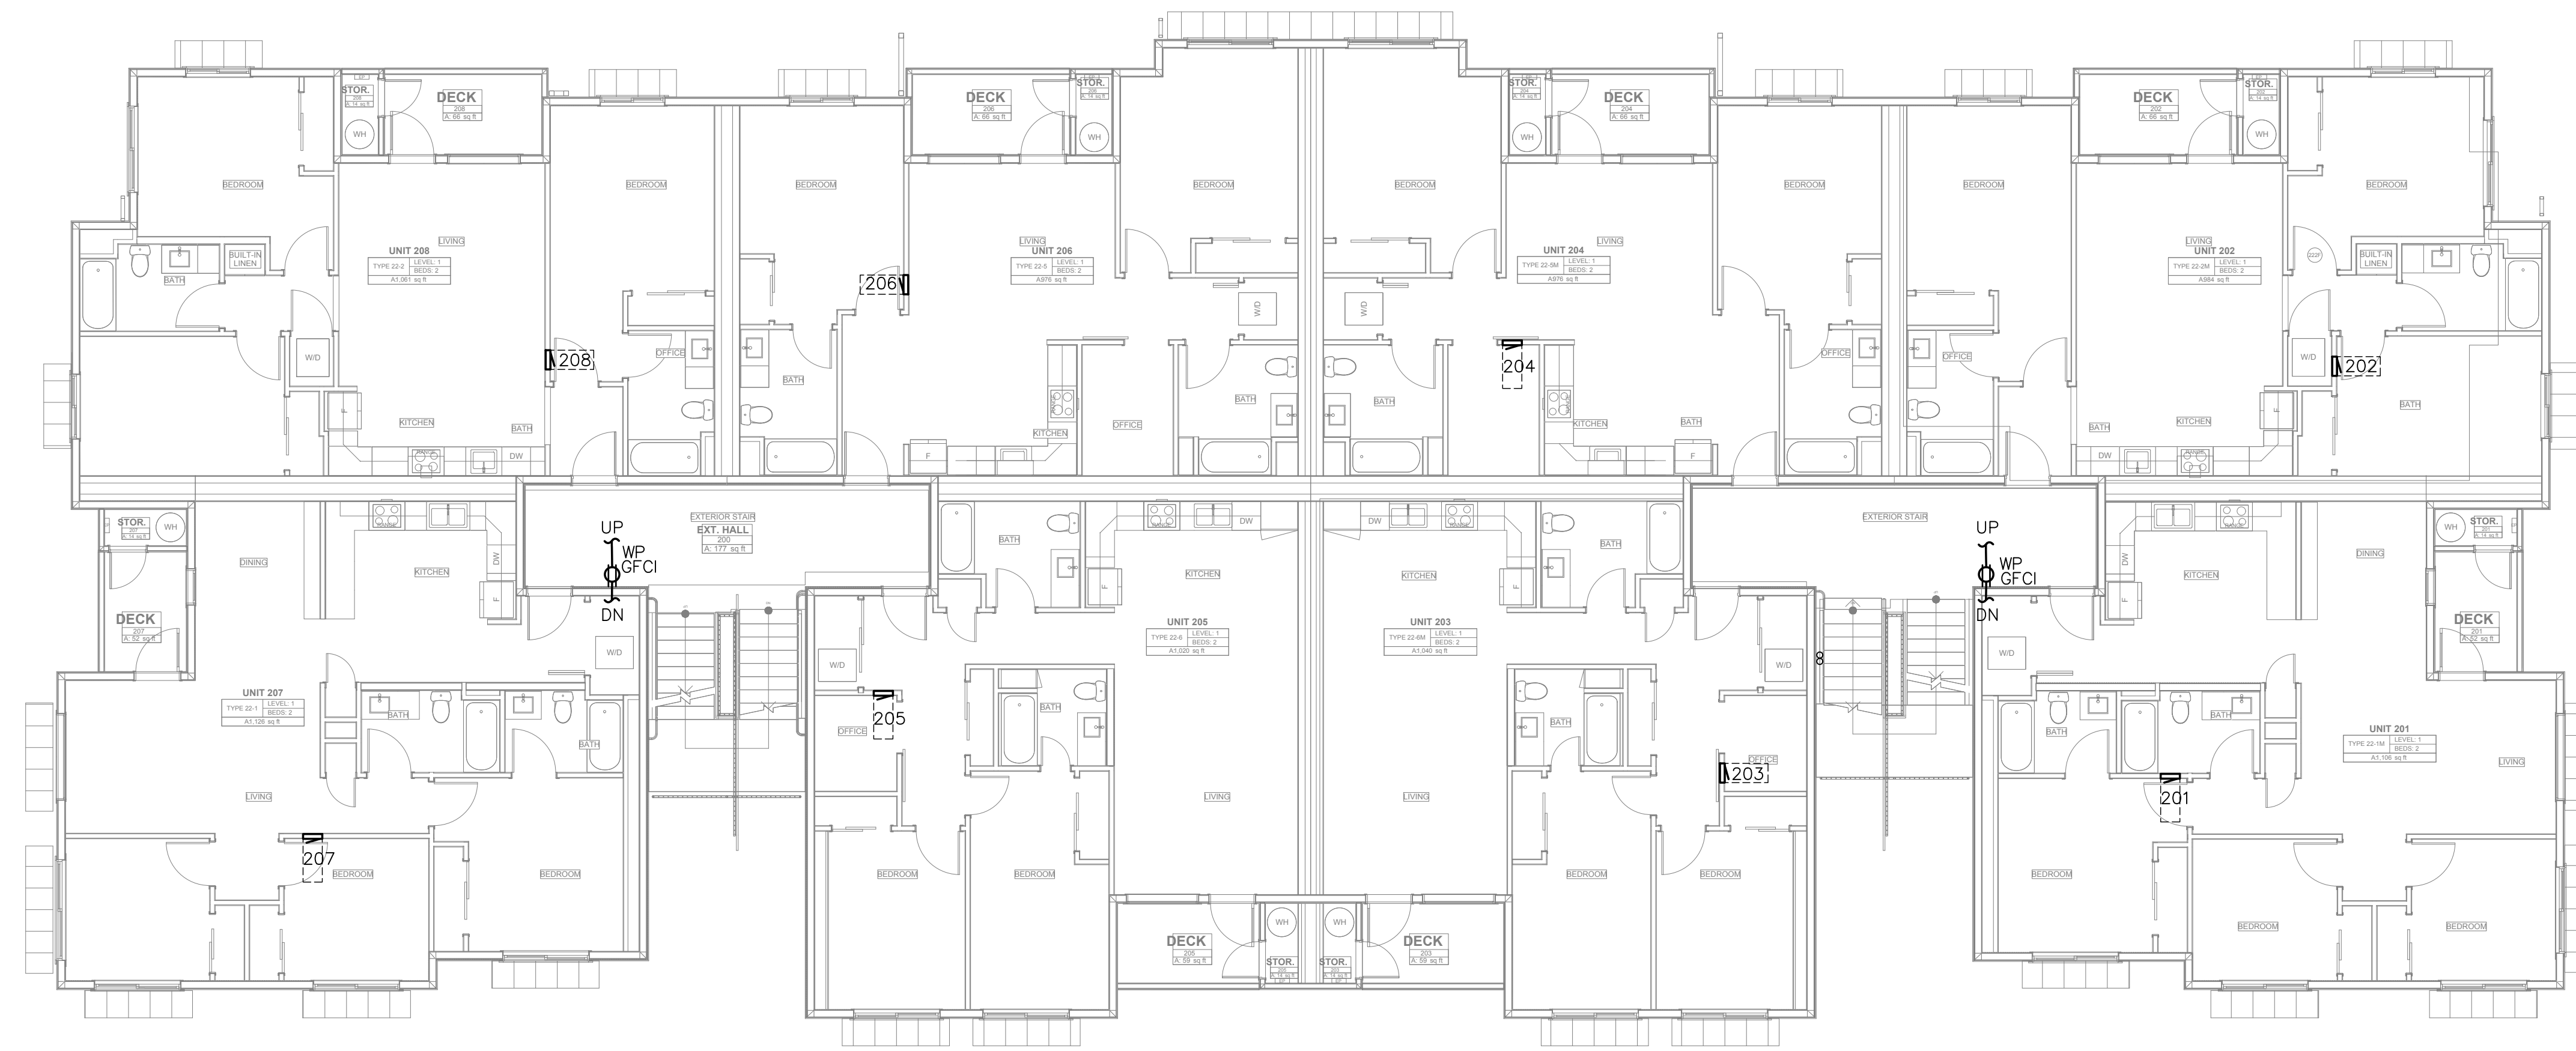

SHEET NOTES:

1. PROVIDE CONDUITS WITH PULL WIRE FROM DEMARCATION OR MDF TO IDF CLOSETS FOR ALL SYSTEMS INCLUDING VOICE, DATA, TV AND SECURITY. QUANTITY AND SIZE AS DETERMINED BY LOW VOLTAGE CONSULTANT. PROVIDE SLEEVES WITH BUSHINGS AT BOTH ENDS PER LOW VOLTAGE CONSULTANT. FIRE STOP AS REQUIRED BY AHJ
2. PROVIDE CONDUIT, WIRING, CIRCUITS AND CONNECTIONS AS COORDINATED WITH SECURITY VENDOR FOR FULLY FUNCTIONING SECURITY AND ACCESS CONTROL SYSTEM. COORDINATE WITH SECURITY CONSTRUCTION DOCUMENTS TO IDENTIFY ALL CAMERA LOCATIONS, AT ALL DOORS CALLED OUT BY OWNER, AS WELL AS ROLL UP GARAGE DOORS FOR GARAGE ACCESS.
3. AMENITY SPACES, OFFICES AND PUBLIC AREAS: ROUGH-IN FOR EQUIPMENT, OUTLETS AND APPLIANCES IN AMENITY SPACES TO BE COORDINATED WITH ARCHITECT. REFER TO ARCHITECTS DRAWINGS AND ELEVATIONS.
4. WIRING METHOD FOR APARTMENT FEEDERS MUST BE SUITABLE FOR THE TYPE OF CONSTRUCTION. SEE NEC 334.10
5. CONTRACTOR TO COORDINATE DOOR CONTROLS AND CONNECTIONS WITH DOOR VENDOR. PROVIDE RACEWAY, CONDUCTORS, POWER SUPPLY AND TERMINATIONS FOR A FULLY FUNCTIONING SYSTEM. COORDINATE WITH SECURITY VENDOR FOR MONITORING AND CONTROL AS NEEDED.
6. ELECTRICAL CONTRACTOR (EC) TO PROVIDE J-BOX/PULL BOX SO NUMBER OF BENDS IN CONDUIT DOES NOT EXCEED CODE REQUIREMENT (360 MAX TOTAL). EC TO FIELD VERIFY LOCATION OF J-BOX/PULL BOX. COORDINATE WITH ARCHITECT WHERE ACCESS PANEL IS REQUIRED.
7. PROVIDE BLOCKOUTS AND SLEEVES AS REQUIRED FOR ALL FEEDERS AND RISERS SHOWN ON 1-LINE. COORDINATE WITH STRUCTURAL. PROVIDE SUPPORT FOR VERTICAL FEEDERS AS REQUIRED BY NEC 300.19. ANY SLEEVE LOCATIONS SHOWN ARE DIAGRAMMATIC ONLY. ELECTRICAL PLANS DO NOT SHOW BRANCH CIRCUIT OR SMALL FEEDER CONDUIT RUNS. LAYOUT PER EC. FINAL VERIFICATION OF NUMBER AND LOCATION OF ALL FLOOR PENETRATIONS BY EC.

FLAG NOTES: (NOT EVERY FLAG IS USED ON EVERY SHEET)

1. PROVIDE LOCKING COVER FOR EXTERIOR & CORRIDOR RECEPTACLES. TYP.
2. LEAVE 2" OF OPEN WALL SPACE ADJACENT TO HOUSE PANEL FOR FUTURE EV PANEL.
3. PROVIDE (1) 2" CONDUIT FROM TELEPHONE VAULT AND (1) 2" CONDUIT FROM THE CABLE TV VAULT. COORDINATE WITH TELECOM UTILITY FOR TELEPHONE & CABLE TV VAULT LOCATIONS.

| NO. | DATE | DESCRIPTION |
|-----|------|-------------|
| | | |
| | | |
| | | | |
|-----------------|--------------------|---------------------|----------------------|
| DRAWN: LYSAK K. | DESIGNED: LYSAK K. | CHECKED: STEINKE M. | APPROVED: STEINKE M. |
|-----------------|--------------------|---------------------|----------------------|

PROJECT: **EAST TOWN CROSSING**
 MULTIFAMILY DEVELOPMENT
 PIONEER WAY & SHAW RD. PUYALLUP, WA


19401 40TH AVE W. SUITE 302
 LYNNWOOD, WA 98036
 PHONE: (206) 964-3343

ROBISON ENGINEERING, INC.

PERMIT SET
 01/22/2024


SHEET TITLE:
 POWER PLAN -
 LEVEL 2

SHEET NO.
 E3.01

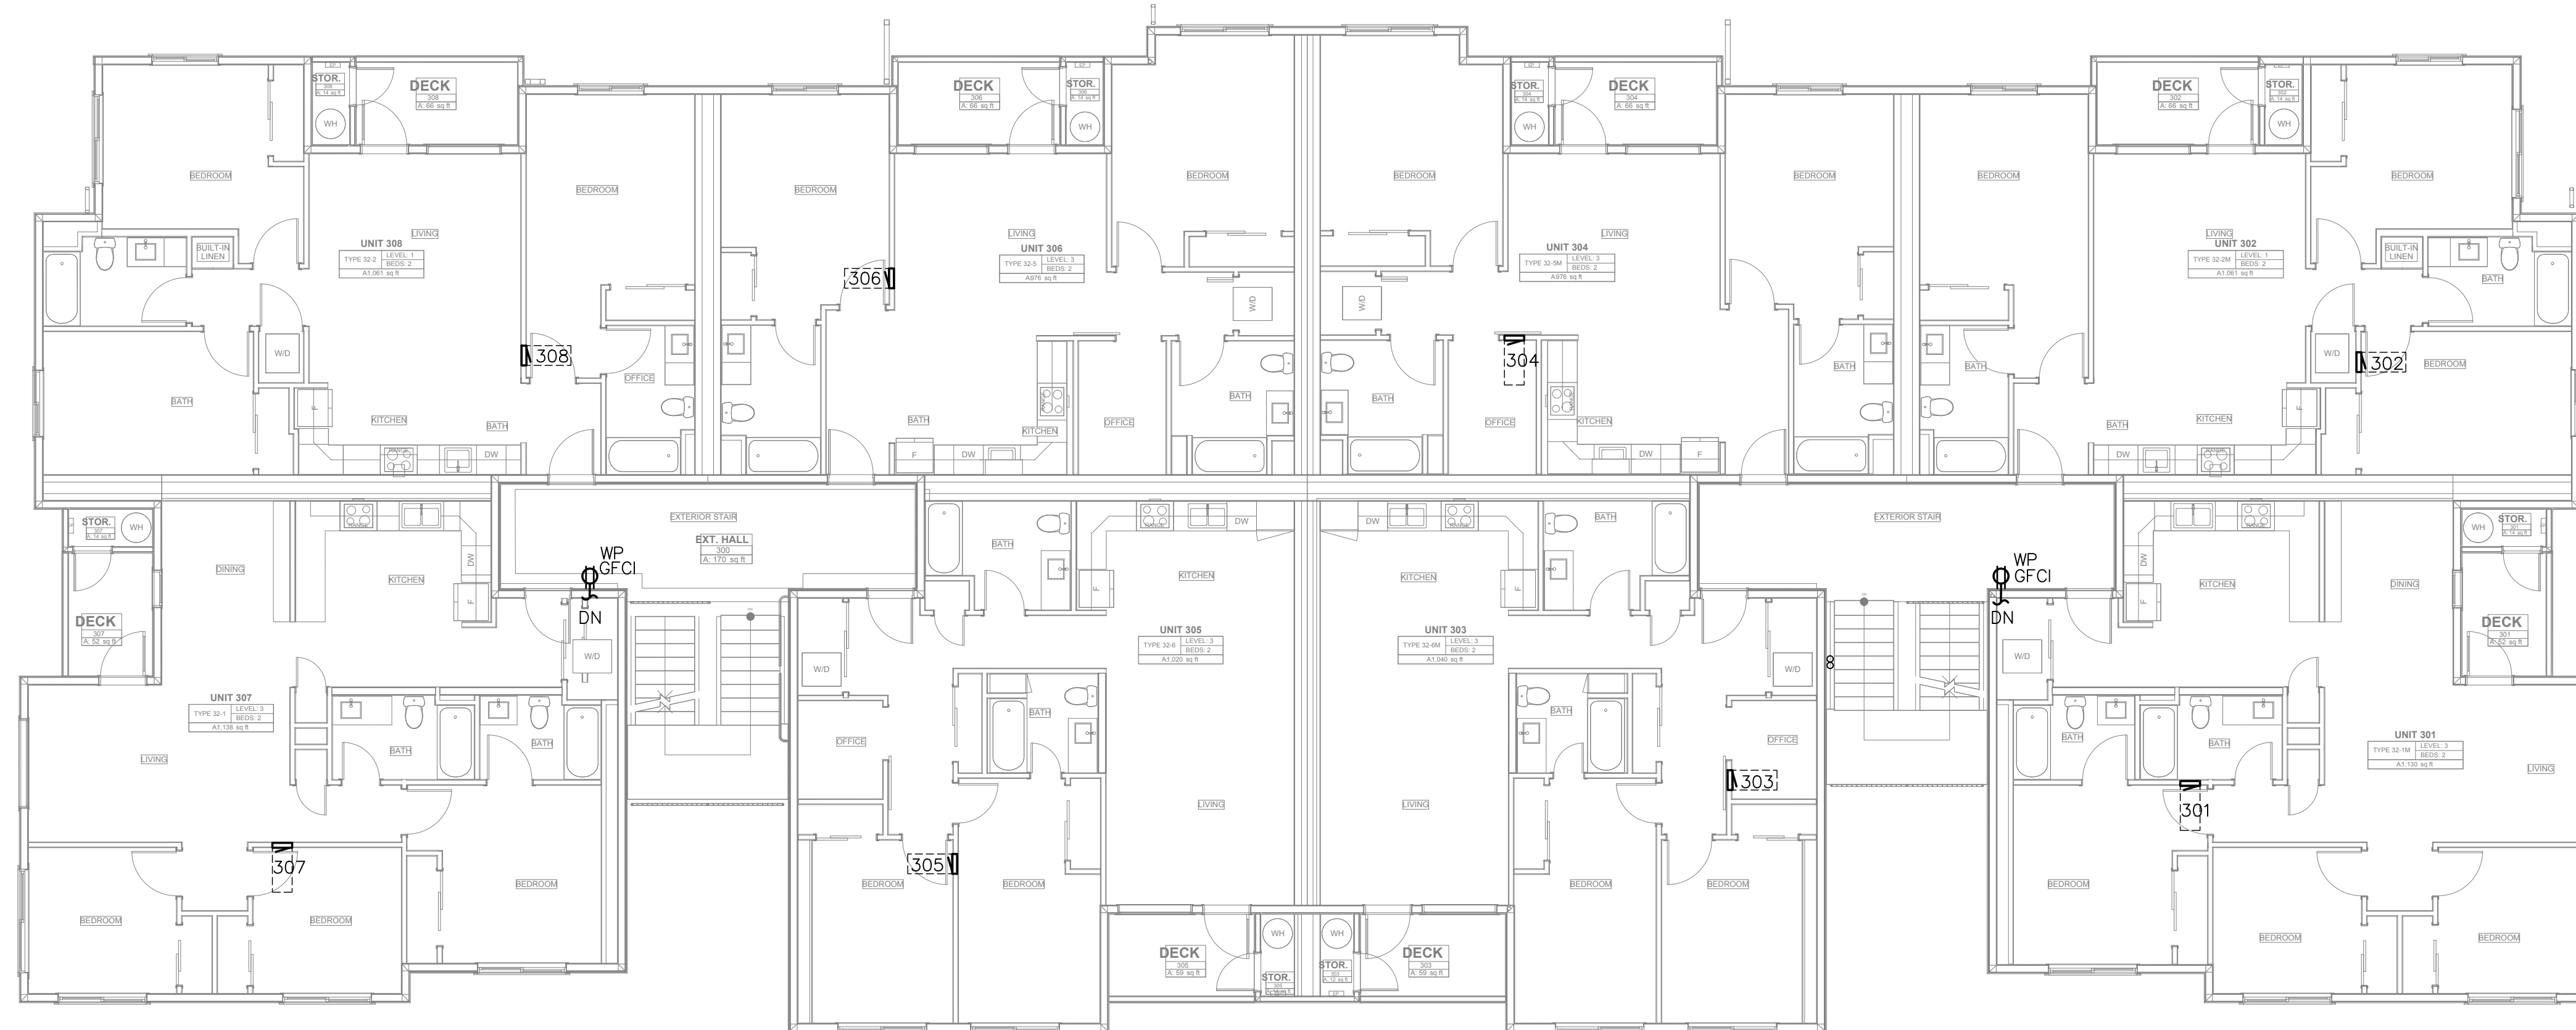

SHEET NOTES:

1. PROVIDE CONDUITS WITH PULL WIRE FROM DEMARCATION OR MDF TO IDF CLOSETS FOR ALL SYSTEMS INCLUDING VOICE, DATA, TV AND SECURITY. QUANTITY AND SIZE AS DETERMINED BY LOW VOLTAGE CONSULTANT. PROVIDE SLEEVES WITH BUSHINGS AT BOTH ENDS PER LOW VOLTAGE CONSULTANT. FIRE STOP AS REQUIRED BY AHJ
2. PROVIDE CONDUIT, WIRING, CIRCUITS AND CONNECTIONS AS COORDINATED WITH SECURITY VENDOR FOR FULLY FUNCTIONING SECURITY AND ACCESS CONTROL SYSTEM. COORDINATE WITH SECURITY CONSTRUCTION DOCUMENTS TO IDENTIFY ALL CAMERA LOCATIONS, AT ALL DOORS CALLED OUT BY OWNER, AS WELL AS ROLL UP GARAGE DOORS FOR GARAGE ACCESS.
3. AMENITY SPACES, OFFICES AND PUBLIC AREAS: ROUGH-IN FOR EQUIPMENT, OUTLETS AND APPLIANCES IN AMENITY SPACES TO BE COORDINATED WITH ARCHITECT. REFER TO ARCHITECTS DRAWINGS AND ELEVATIONS.
4. WIRING METHOD FOR APARTMENT FEEDERS MUST BE SUITABLE FOR THE TYPE OF CONSTRUCTION. SEE NEC 334.10
5. CONTRACTOR TO COORDINATE DOOR CONTROLS AND CONNECTIONS WITH DOOR VENDOR. PROVIDE RACEWAY, CONDUCTORS, POWER SUPPLY AND TERMINATIONS FOR A FULLY FUNCTIONING SYSTEM. COORDINATE WITH SECURITY VENDOR FOR MONITORING AND CONTROL AS NEEDED.
6. ELECTRICAL CONTRACTOR (EC) TO PROVIDE J-BOX/PULL BOX SO NUMBER OF BENDS IN CONDUIT DOES NOT EXCEED CODE REQUIREMENT (360 MAX TOTAL). EC TO FIELD VERIFY LOCATION OF J-BOX/PULL BOX. COORDINATE WITH ARCHITECT WHERE ACCESS PANEL IS REQUIRED.
7. PROVIDE BLOCKOUTS AND SLEEVES AS REQUIRED FOR ALL FEEDERS AND RISERS SHOWN ON 1-LINE. COORDINATE WITH STRUCTURAL. PROVIDE SUPPORT FOR VERTICAL FEEDERS AS REQUIRED BY NEC 300.19. ANY SLEEVE LOCATIONS SHOWN ARE DIAGRAMMATIC ONLY. ELECTRICAL PLANS DO NOT SHOW BRANCH CIRCUIT OR SMALL FEEDER CONDUIT RUNS. LAYOUT PER EC. FINAL VERIFICATION OF NUMBER AND LOCATION OF ALL FLOOR PENETRATIONS BY EC.

FLAG NOTES:  (NOT EVERY FLAG IS USED ON EVERY SHEET)

1. PROVIDE LOCKING COVER FOR EXTERIOR & CORRIDOR RECEPTACLES. TYP.
2. LEAVE 2" OF OPEN WALL SPACE ADJACENT TO HOUSE PANEL FOR FUTURE EV PANEL.
3. PROVIDE (1) 2" CONDUIT FROM TELEPHONE VAULT AND (1) 2" CONDUIT FROM THE CABLE TV VAULT. COORDINATE WITH TELECOM UTILITY FOR TELEPHONE & CABLE TV VAULT LOCATIONS.

| NO. | DATE | DESCRIPTION |
|-----|------|-------------|
| | | |
| | | |
| | | |



| | | | |
|-----------------|--------------------|---------------------|----------------------|
| DRAWN: LYSAK K. | DESIGNED: LYSAK K. | CHECKED: STEINKE M. | APPROVED: STEINKE M. |
|-----------------|--------------------|---------------------|----------------------|

PROJECT: **EAST TOWN CROSSING**
 MULTIFAMILY DEVELOPMENT
 PIONEER WAY & SHAW RD. PUYALLUP, WA


19401 40TH AVE W. SUITE 302
 LYNNWOOD, WA 98036
 PHONE: (206) 964-3343

ROBISON ENGINEERING, INC.

PERMIT SET
 01/22/2024

SHEET TITLE:
 POWER PLAN -
 LEVEL 3


SHEET NO.
 E3.02

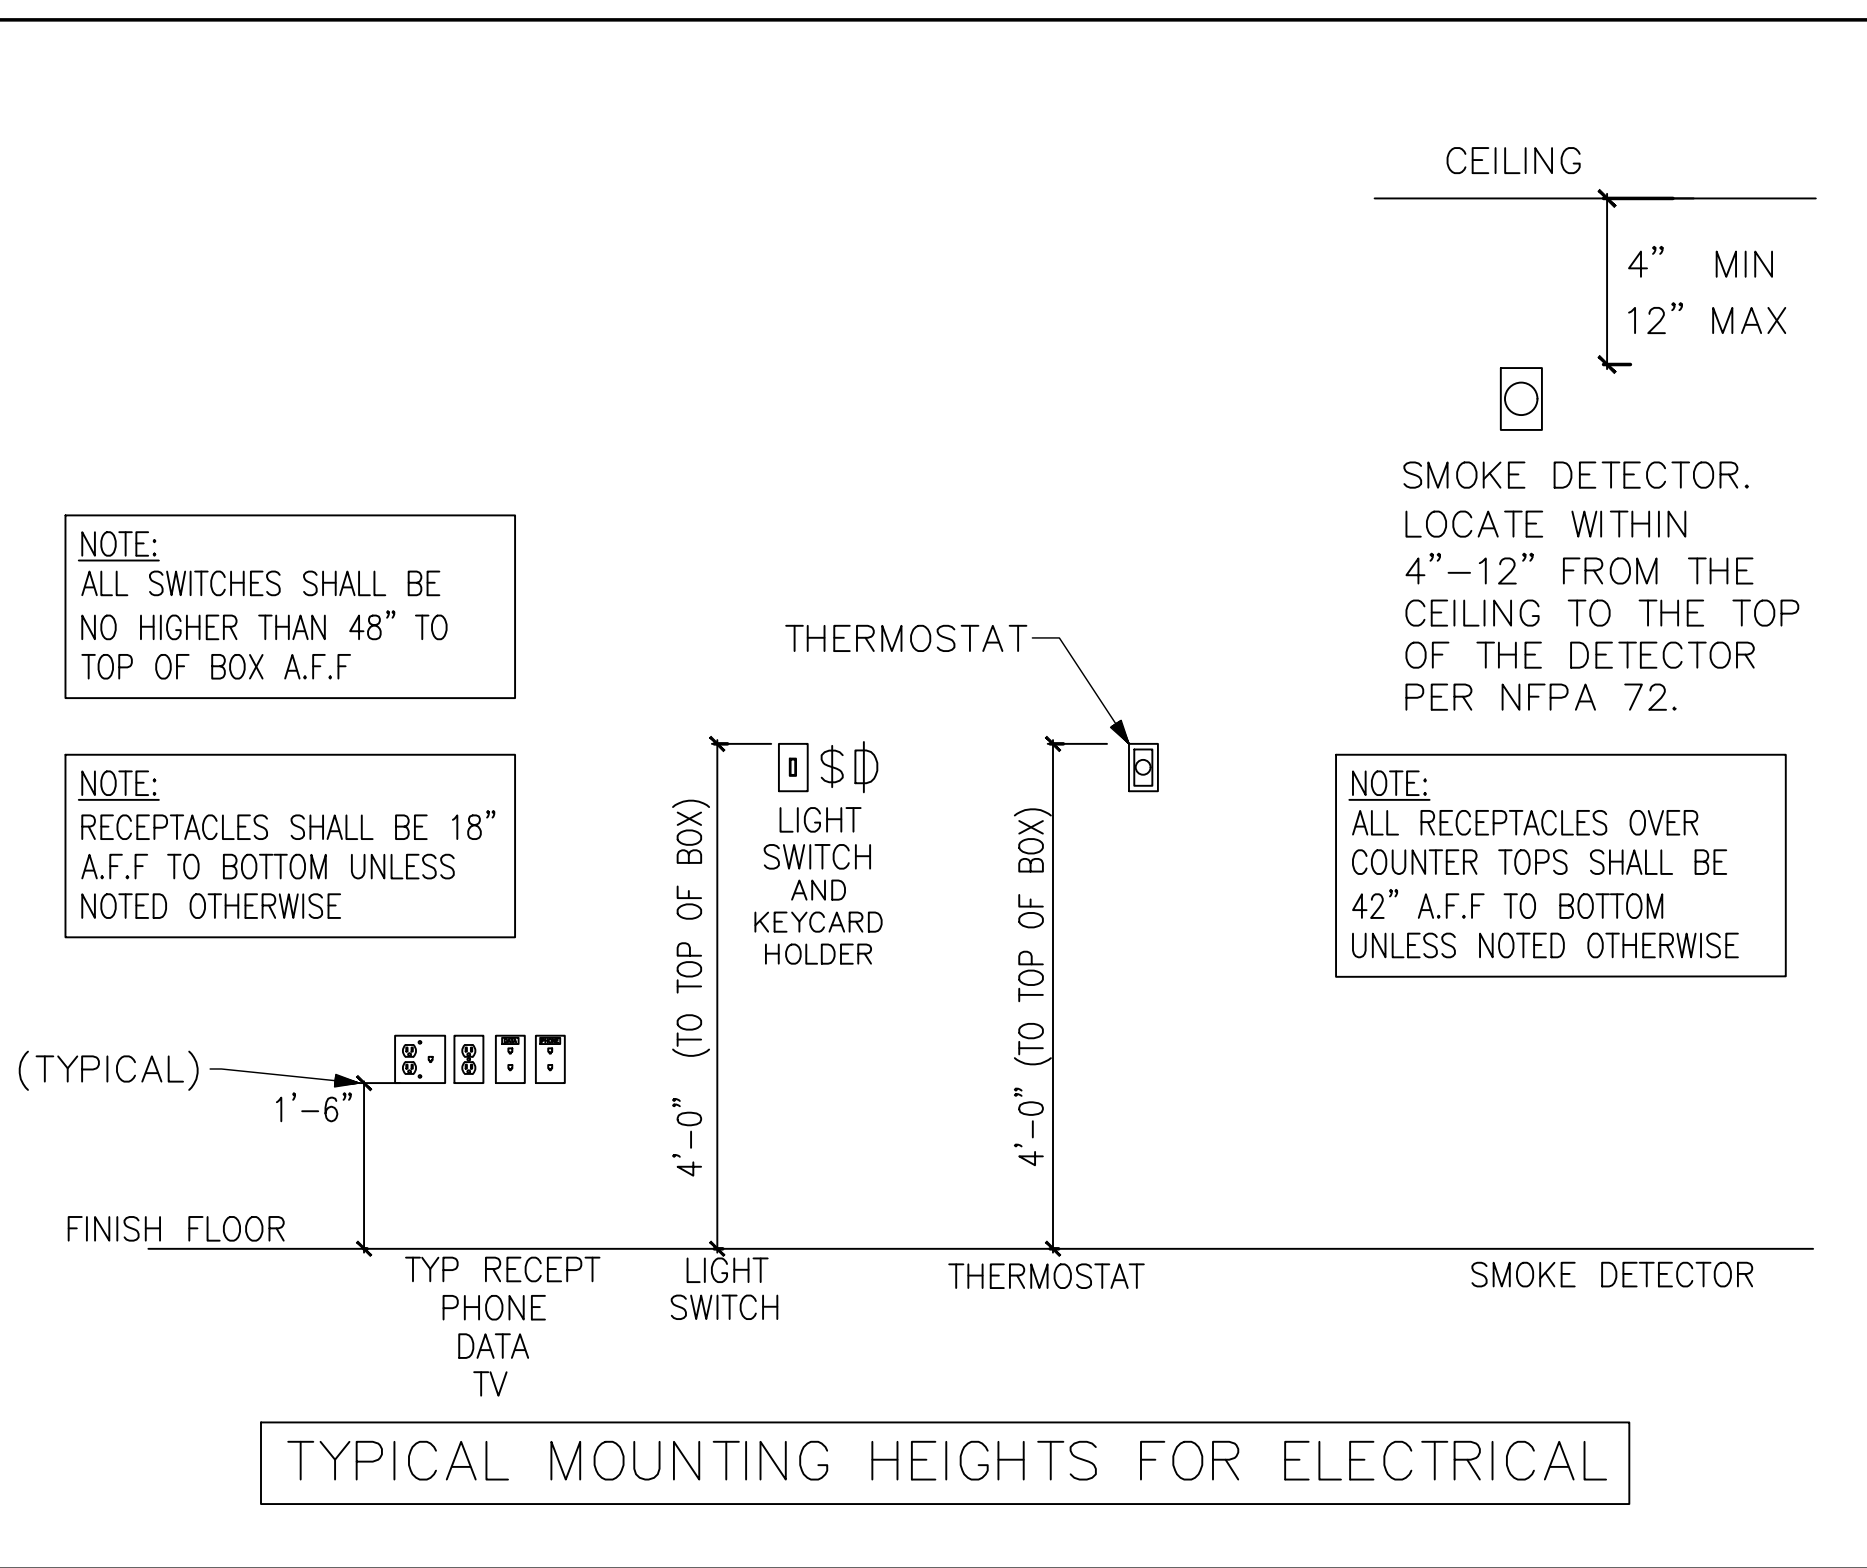

APARTMENT ELECTRICAL DEVICE SCHEDULE

| SYMBOL | DEVICE | NOTES |
|------------------|---|--|
| ⊕ | RECEPTACLE, SIMPLEX | PROVIDE WHERE INDICATED. |
| ⊕ | RECEPTACLE, SIMPLEX, FLOOR MOUNT | PROVIDE WHERE INDICATED. |
| ⊕ | RECEPTACLE, DUPLEX, FLOOR MOUNT | PROVIDE WHERE INDICATED. |
| ⊕ | RECEPTACLE, DUPLEX | PROVIDE WHERE INDICATED. |
| ⊕ | RECEPTACLE, DUPLEX, SPLIT-WIRED | PROVIDE WHERE INDICATED. LOWER OUTLET CONTROLLED BY WALL SWITCH |
| ⊕ | RECEPTACLE, QUAD + TELEVISION CABLE OUTLET | PROVIDE WHERE INDICATED. |
| ⊕ | RECEPTACLE, QUAD | PROVIDE WHERE INDICATED. |
| ▽ | TELEPHONE WALL OUTLET | REFER TO LOW VOLTAGE PLANS |
| ▽ | COMM/DATA WALL OUTLET | REFER TO LOW VOLTAGE PLANS |
| ⊕ | TELEVISION CABLE OUTLET | REFER TO LOW VOLTAGE PLANS |
| \$ | WALL SWITCH | PROVIDE WHERE INDICATED. |
| \$ _{vs} | WALL SWITCH VACANCY SENSOR | PROVIDE WHERE INDICATED. |
| \$ _{sw} | WALL SWITCH (3-WAY) | PROVIDE WHERE INDICATED. |
| ⊕ | WALL SWITCH DIMMER | PROVIDE WHERE INDICATED. |
| ⊕ | FAN CONTROL | PROVIDE WHERE INDICATED. |
| \$ _{AT} | SWITCH ASTRONOMICAL TIME CLOCK CONTROL | PROVIDE WHERE INDICATED. |
| ⊕ | LIGHT FIXTURE, WALL MOUNTED SCNCE | PROVIDE ROUGH IN WHERE INDICATED REFER TO LUMINAIRE SCHEDULE |
| ⊕ | LIGHT FIXTURE, CEILING MOUNTED | PROVIDE ROUGH IN WHERE INDICATED REFER TO LUMINAIRE SCHEDULE |
| ⊕ | PENDANT LIGHT FIXTURE, CEILING MOUNTED | PROVIDE ROUGH IN WHERE INDICATED REFER TO LUMINAIRE SCHEDULE |
| ⊕ | LIGHT FIXTURE, WALL MOUNTED | PROVIDE ROUGH IN WHERE INDICATED REFER TO LUMINAIRE SCHEDULE |
| ⊕ | FAN, CEILING MOUNTED. | FURNISHED & INSTALLED BY MECH, WIRED BY ELECTRICAL CONTRACTOR |
| ⊕ | THERMOSTAT | FURNISHED & INSTALLED BY MECH |
| ⊕ | SMOKE DETECTOR & CARBON MONOXIDE DETECTOR | PART OF DESIGN/BUILD FIRE ALARM SYSTEM. SMOKE/CO DETECTORS TO BE WIRED TO FIRE ALARM SYSTEM. |
| ⊕ | DOOR BELL BUTTON | PROVIDE WHERE INDICATED. |
| ⊕ | DOOR BELL CHIMES | PROVIDE WHERE INDICATED. |
| ⊕ | DOOR BELL TRANSFORMER | PROVIDE WHERE INDICATED. |
| ⊕ | MULTIMEDIA BOX | PROVIDE WHERE INDICATED. |
| ⊕ | FAN COIL UNIT | FURNISHED & INSTALLED BY MECH (ELECTRICAL PROVIDE POWER TO THE UNIT PER NEC) |
| ⊕ | PHOTOCELL | EXTERIOR WEATHERPROOF PHOTOCELL CONTROL FOR DUSK TO DAWN OPERATION |
| ⊕ | WALL SWITCH, LOW VOLTAGE BATHROOM FAN SPEED CONTROL | FURNISHED & INSTALLED BY ELEC |

NOTE: NOT ALL ITEMS USED ON PROJECT.

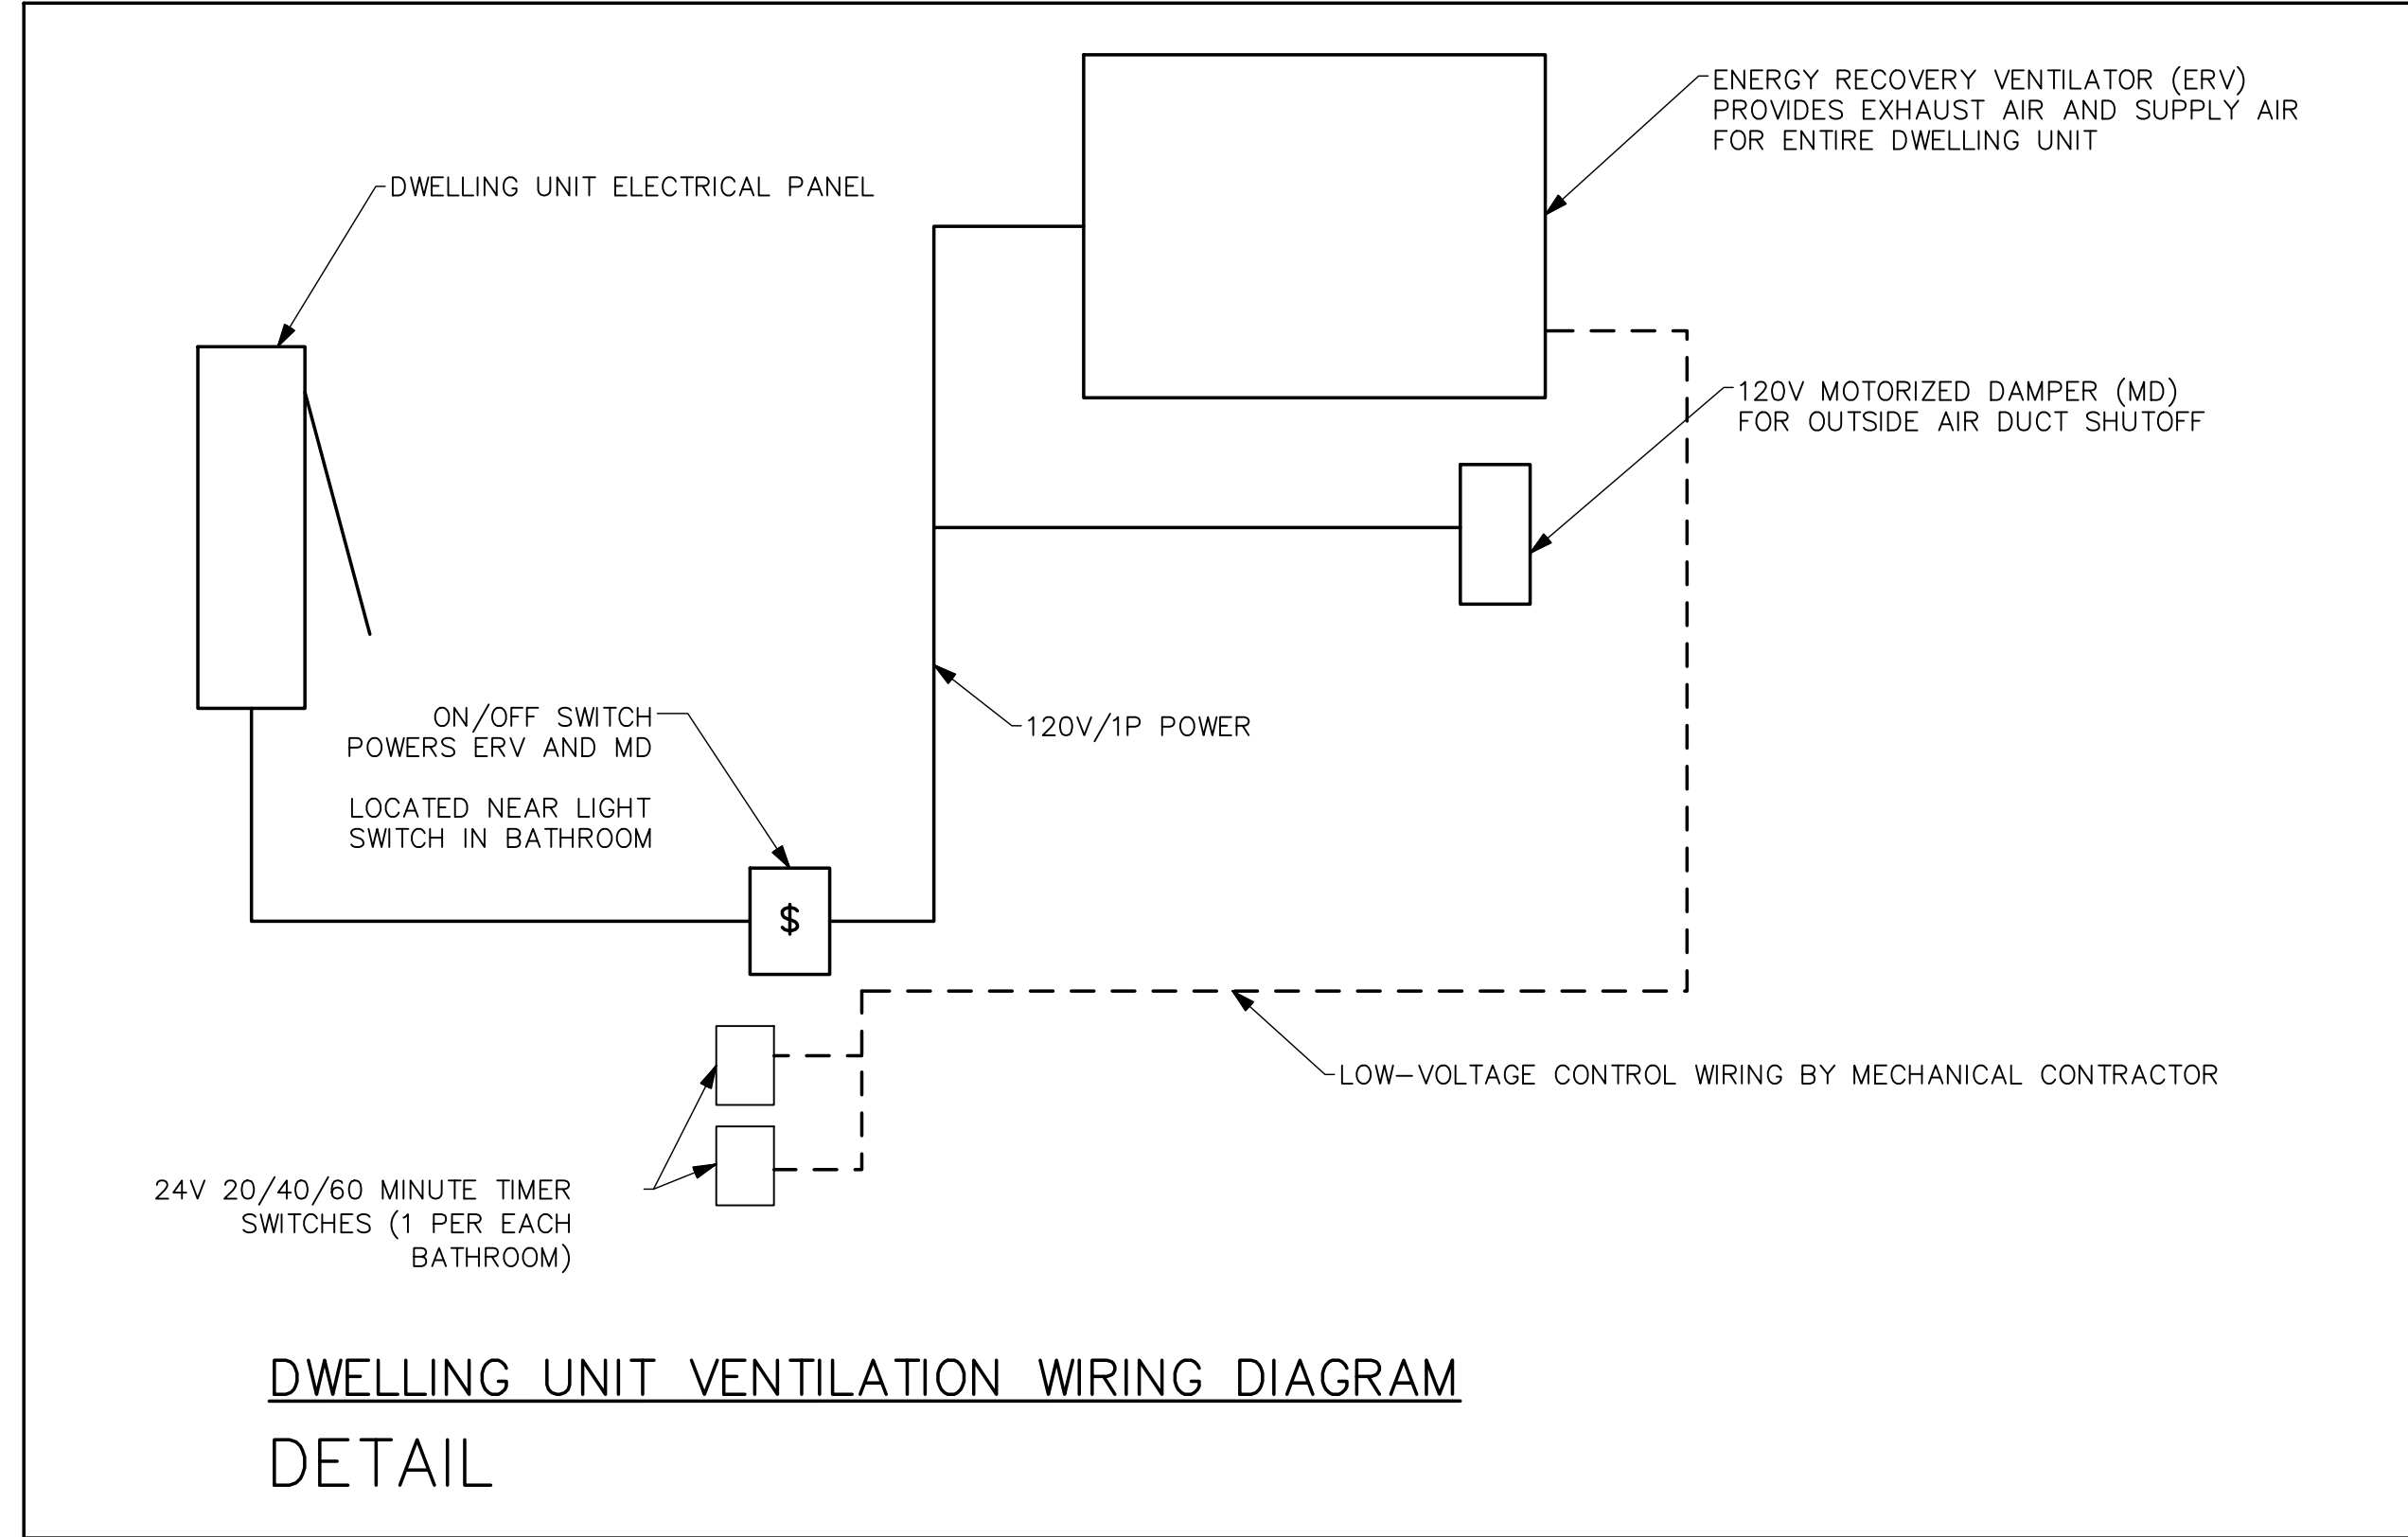

| ELECTRIC HEATERS | | | | | |
|------------------|-------------|------------------------|---------|------------|-----------------|
| EQUIP NO. | SERVICE | MOUNTING/ DISCHARGE | HEATING | ELECTRICAL | BASIS OF DESIGN |
| | | | KW | VOLTAGE | |
| EWH-1 | BEDROOM | WALL | 1 | 208V/1P | KING WHF |
| EWH-2 | LIVING ROOM | WALL | 2 | 208V/1P | KING WHF |
| EWH-0.5 | BATHROOM | WALL | 0.5 | 208V/1P | KING WHF |

NOTES:
(1) BROAN, CADET OR EQUIVALENT.
(2) PROVIDE REMOTE THERMOSTAT.

APARTMENT NOTES:

- ALL ELECTRICAL WORK SHALL COMPLY WITH ALL LOCAL AND NATIONAL CODES.
- DEVICE BOXES ON OPPOSITE SIDES OF DEMISING WALLS SHALL BE IN SEPARATE STUD BAYS. PROVIDE BACKING EQUIVALENT TO LOWRY'S OUTLET BOX PADS. CONDUIT FROM ONE UNIT SHALL NOT PASS THROUGH STUDS OF A SHARED WALL(DOUBLE STUDS) FROM AN ADJACENT UNIT(BRIDGING).
- PROVIDE ARC-FAULT PROTECTION, TAMPER PROOF AND GFCI RECEPTACLES AS REQUIRED BY CODE AND LOCAL AHJ. ARC-FAULT PROTECTION MUST BE PROVIDED FOR CIRCUITS IN THE AREAS LISTED IN NEC 210.12(A).
- PROVIDE SUFFICIENT DUPLEX RECEPTACLES TO MEET NEC 210.52.
- THERMOSTATS SHALL NOT INTERFERE WITH DOOR SWINGS.
- ELECTRICAL CONTRACTOR SHALL MAKE ALL FINAL CONNECTIONS FOR KITCHEN APPLIANCES. COORDINATE ALL J-BOX LOCATIONS WITH APPLIANCE INSTALLATION INSTRUCTIONS PRIOR TO ROUGH-IN.
- ELECTRICAL CONTRACTOR SHALL FURNISH AND INSTALL CORD AND PLUG ASSEMBLY FOR EACH DISPOSER.
- PROVIDE A DEDICATED 20 AMP CIRCUIT TO EACH UNIT BATHROOM RECEPTACLE. BATHROOM LIGHTS, FAN TO BE ON SAME CIRCUIT PER 210.11(C)(3) EXCEPTION.
- HOME RUNS AND LOOPS CONNECTING LIGHT FIXTURES, WIRING DEVICES, AND HVAC EQUIPMENT ON PLANS INDICATE CIRCUITING SCHEME. SEE TYPICAL PANEL SCHEDULES FOR ACTUAL CIRCUIT NUMBERS FOR TYPICAL APARTMENT.
- LIGHTS WITHIN 3' HORIZONTAL OF SHOWER OR TUB TO BE WET LOCATION RATED AND HAVE FULLY ENCLOSED TRIMS. PROVIDE GFCI PROTECTION IF THE LUMINAIRE INSTALLATION MANUAL STATES IT IS REQUIRED.
- PROVIDE SMOKE DETECTORS AND CO ALARMS AS REQUIRED. DETECTORS AND ALARMS TO BE HARDWIRED AND PROVIDED WITH BATTERY BACKUP.
- ELECTRICAL CONTRACTOR SHALL INSTALL RECEPTACLES AND TV, DATA/PHONE OUTLETS UNDER COMMON COVER PLATE WHERE POSSIBLE. PROVIDE AND INSTALL DIVIDERS AS REQUIRED FOR CABLE/POWER SEPARATION.
- SEE ARCHITECTURAL DRAWINGS FOR DIMENSIONS AND LAYOUTS OF ALL DEVICES.
- ALL WALL PENETRATIONS SHALL BE CAULKED WITH APPROVED MATERIAL TO MAINTAIN THE FIRE RATING OF ALL WALLS AND FLOORS.
- ALL CONDUIT SHALL BE INSTALLED IN NEAT SYMMETRICAL LINES HORIZONTAL OR PERPENDICULAR TO BUILDING COLUMNS AND ROOF LINES. CONDUITS SHALL BE GROUPED ON COMMON SUPPORTS WHEREVER POSSIBLE.
- REFERENCE MECHANICAL DRAWINGS FOR EXACT LOCATION OF ALL MECHANICAL EQUIPMENT.
- ELECTRICAL CONTRACTOR SHALL VERIFY ALL FUSE RATING WIRE SIZES AND DISCONNECT SIZES WITH EQUIPMENT SERVED ON THE JOB PRIOR TO INSTALLATION.
- SEE ARCHITECTURAL DRAWINGS AND ELEVATIONS FOR ADDITIONAL DETAILS AND CASEWORK DIMENSIONS.
- DEVICE LOCATIONS IN 1ST DWELLING/RESIDENT UNIT SHALL BE REVIEWED AND APPROVED BY OWNER PRIOR TO ROUGH-IN OF REMAINING UNITS
- CONFIRM FINAL LOCATION OF HEATERS AND THERMOSTATS IN FIELD PRIOR TO ROUGH-IN

ACCESSIBILITY NOTES:

- ALL SWITCHES AND CONTROLS - 15" MIN; 48" MAX TO CONTROL.
- GENERAL OUTLETS MIN 18" AFF.
- ALL SWITCHES/CONTROLS ABOVE COUNTERTOPS 48" MAX.
- ELECTRICAL SUB-PANELS IN UNITS MUST COMPLY WITH ABOVE REACH RANGES.
- SWITCHES FOR EXHAUST HOODS AND GARBAGE DISPOSALS MUST COMPLY WITH ABOVE REACH RANGES. INSTALL SWITCHES ON FACE OF CABINETS IF REQUIRED TO COMPLY.

| REVISIONS | DESCRIPTION | DATE |
|-----------|-------------|------|
| NO. | | |



| | | | |
|-----------------|--------------------|---------------------|----------------------|
| DRAWN: LYSAK K. | DESIGNED: LYSAK K. | CHECKED: STEINKE M. | APPROVED: STEINKE M. |
|-----------------|--------------------|---------------------|----------------------|

PROJECT: **EAST TOWN CROSSING**
MULTIFAMILY DEVELOPMENT
PIONEER WAY & SHAW RD. PUYALLUP, WA


19401 40TH AVE W, SUITE 302
LYNNWOOD, WA 98036
PHONE: 206-844-3343

ROBISON ENGINEERING, INC


PERMIT SET
01/22/2024

SHEET TITLE:
UNIT PLANS
NOTES


SHEET NO.
E5.00

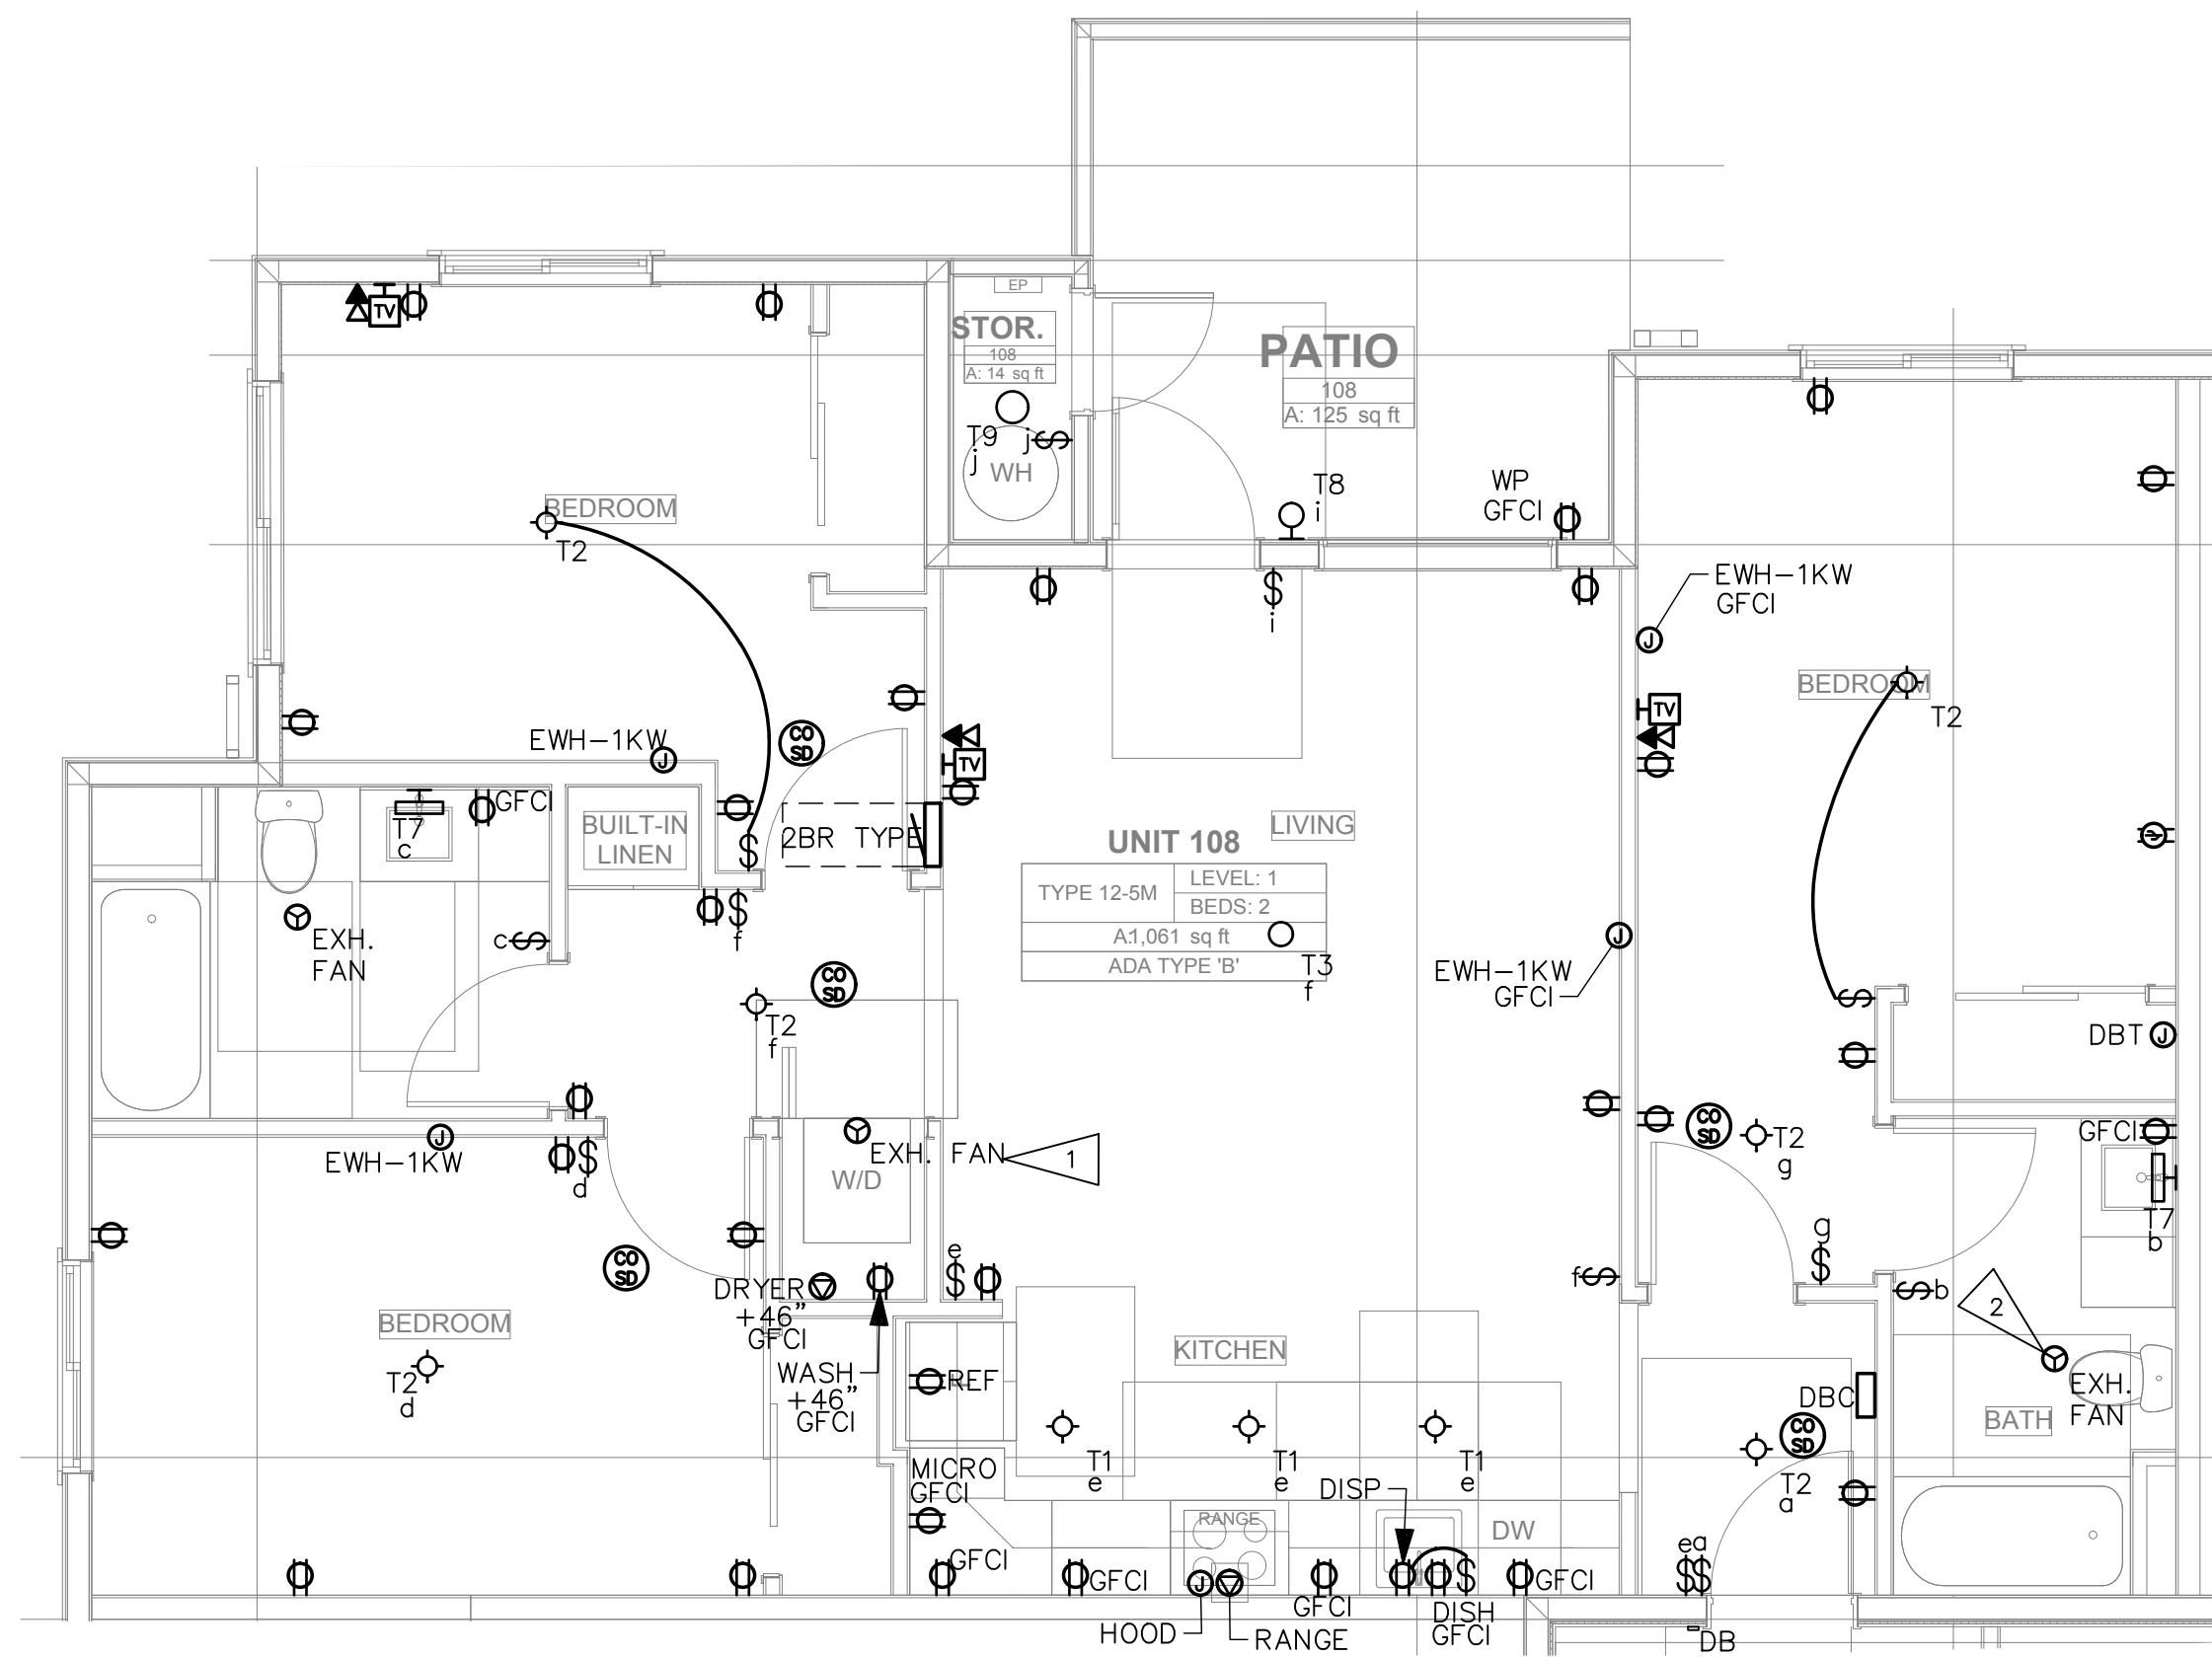


UNIT TYPICALS
 TYPE 12-5 2BR
 SCALE: 1/4" = 1'-0"

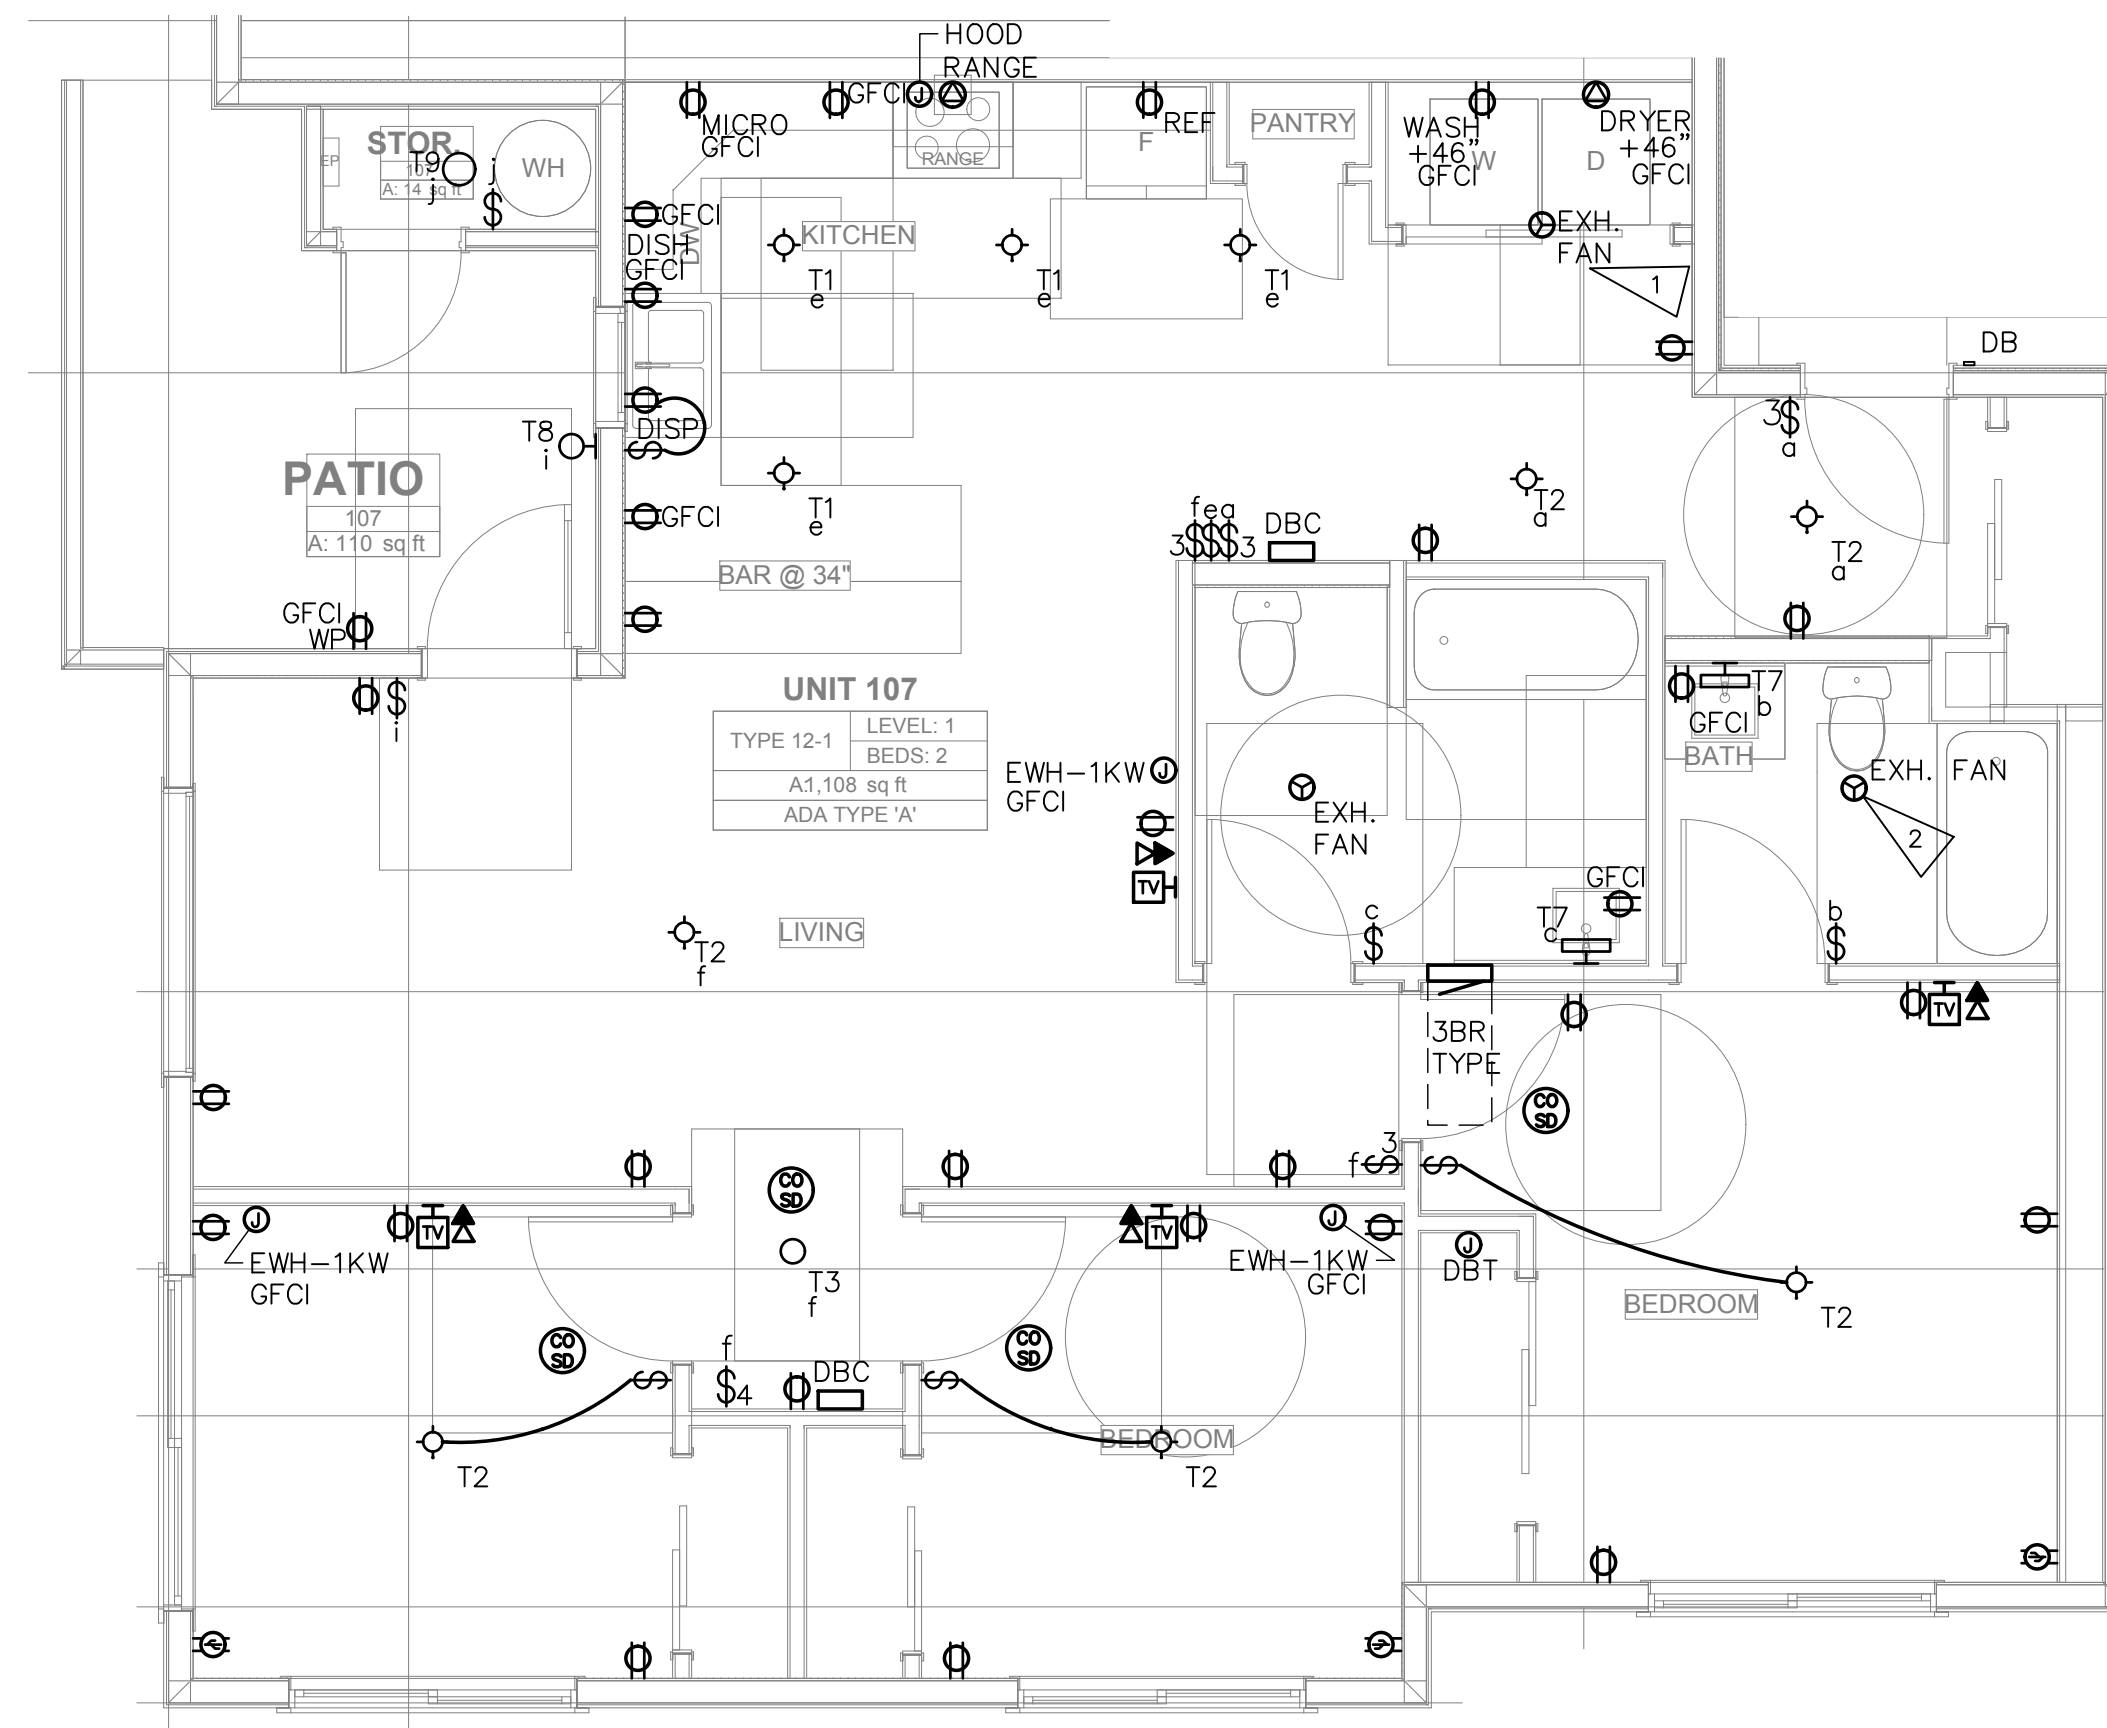

UNIT TYPICALS
 TYPE 12-1 3BR
 SCALE: 1/4" = 1'-0"

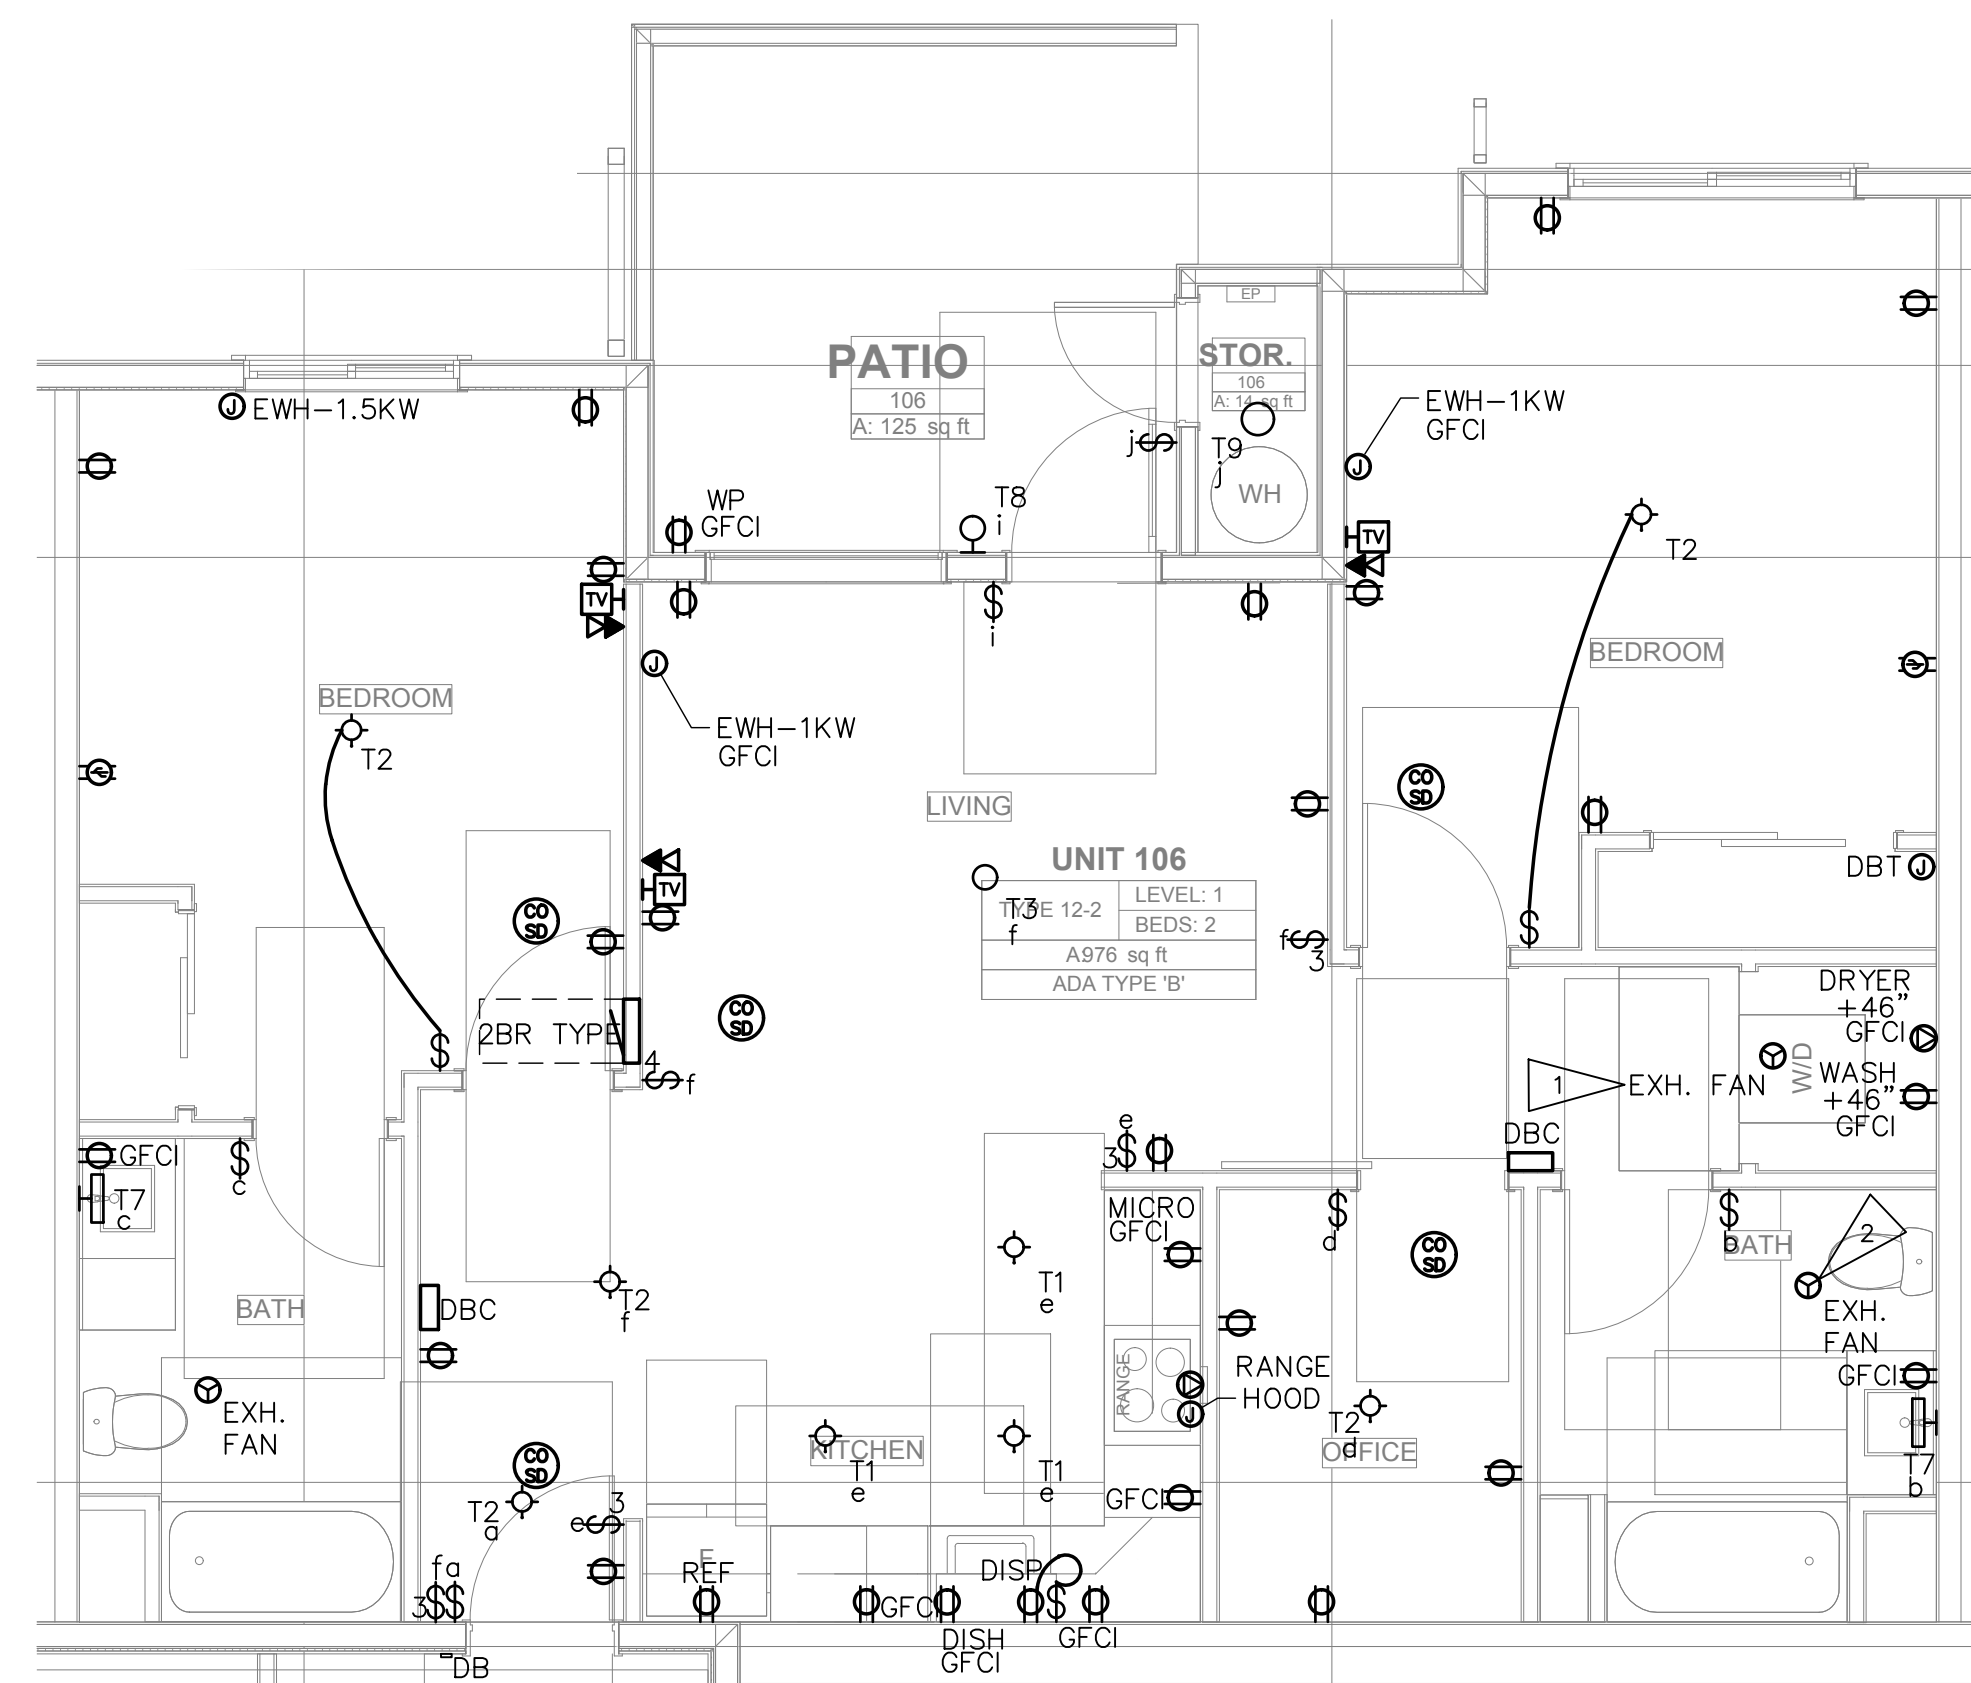

UNIT TYPICALS
 TYPE 12-2 2BR
 SCALE: 1/4" = 1'-0"

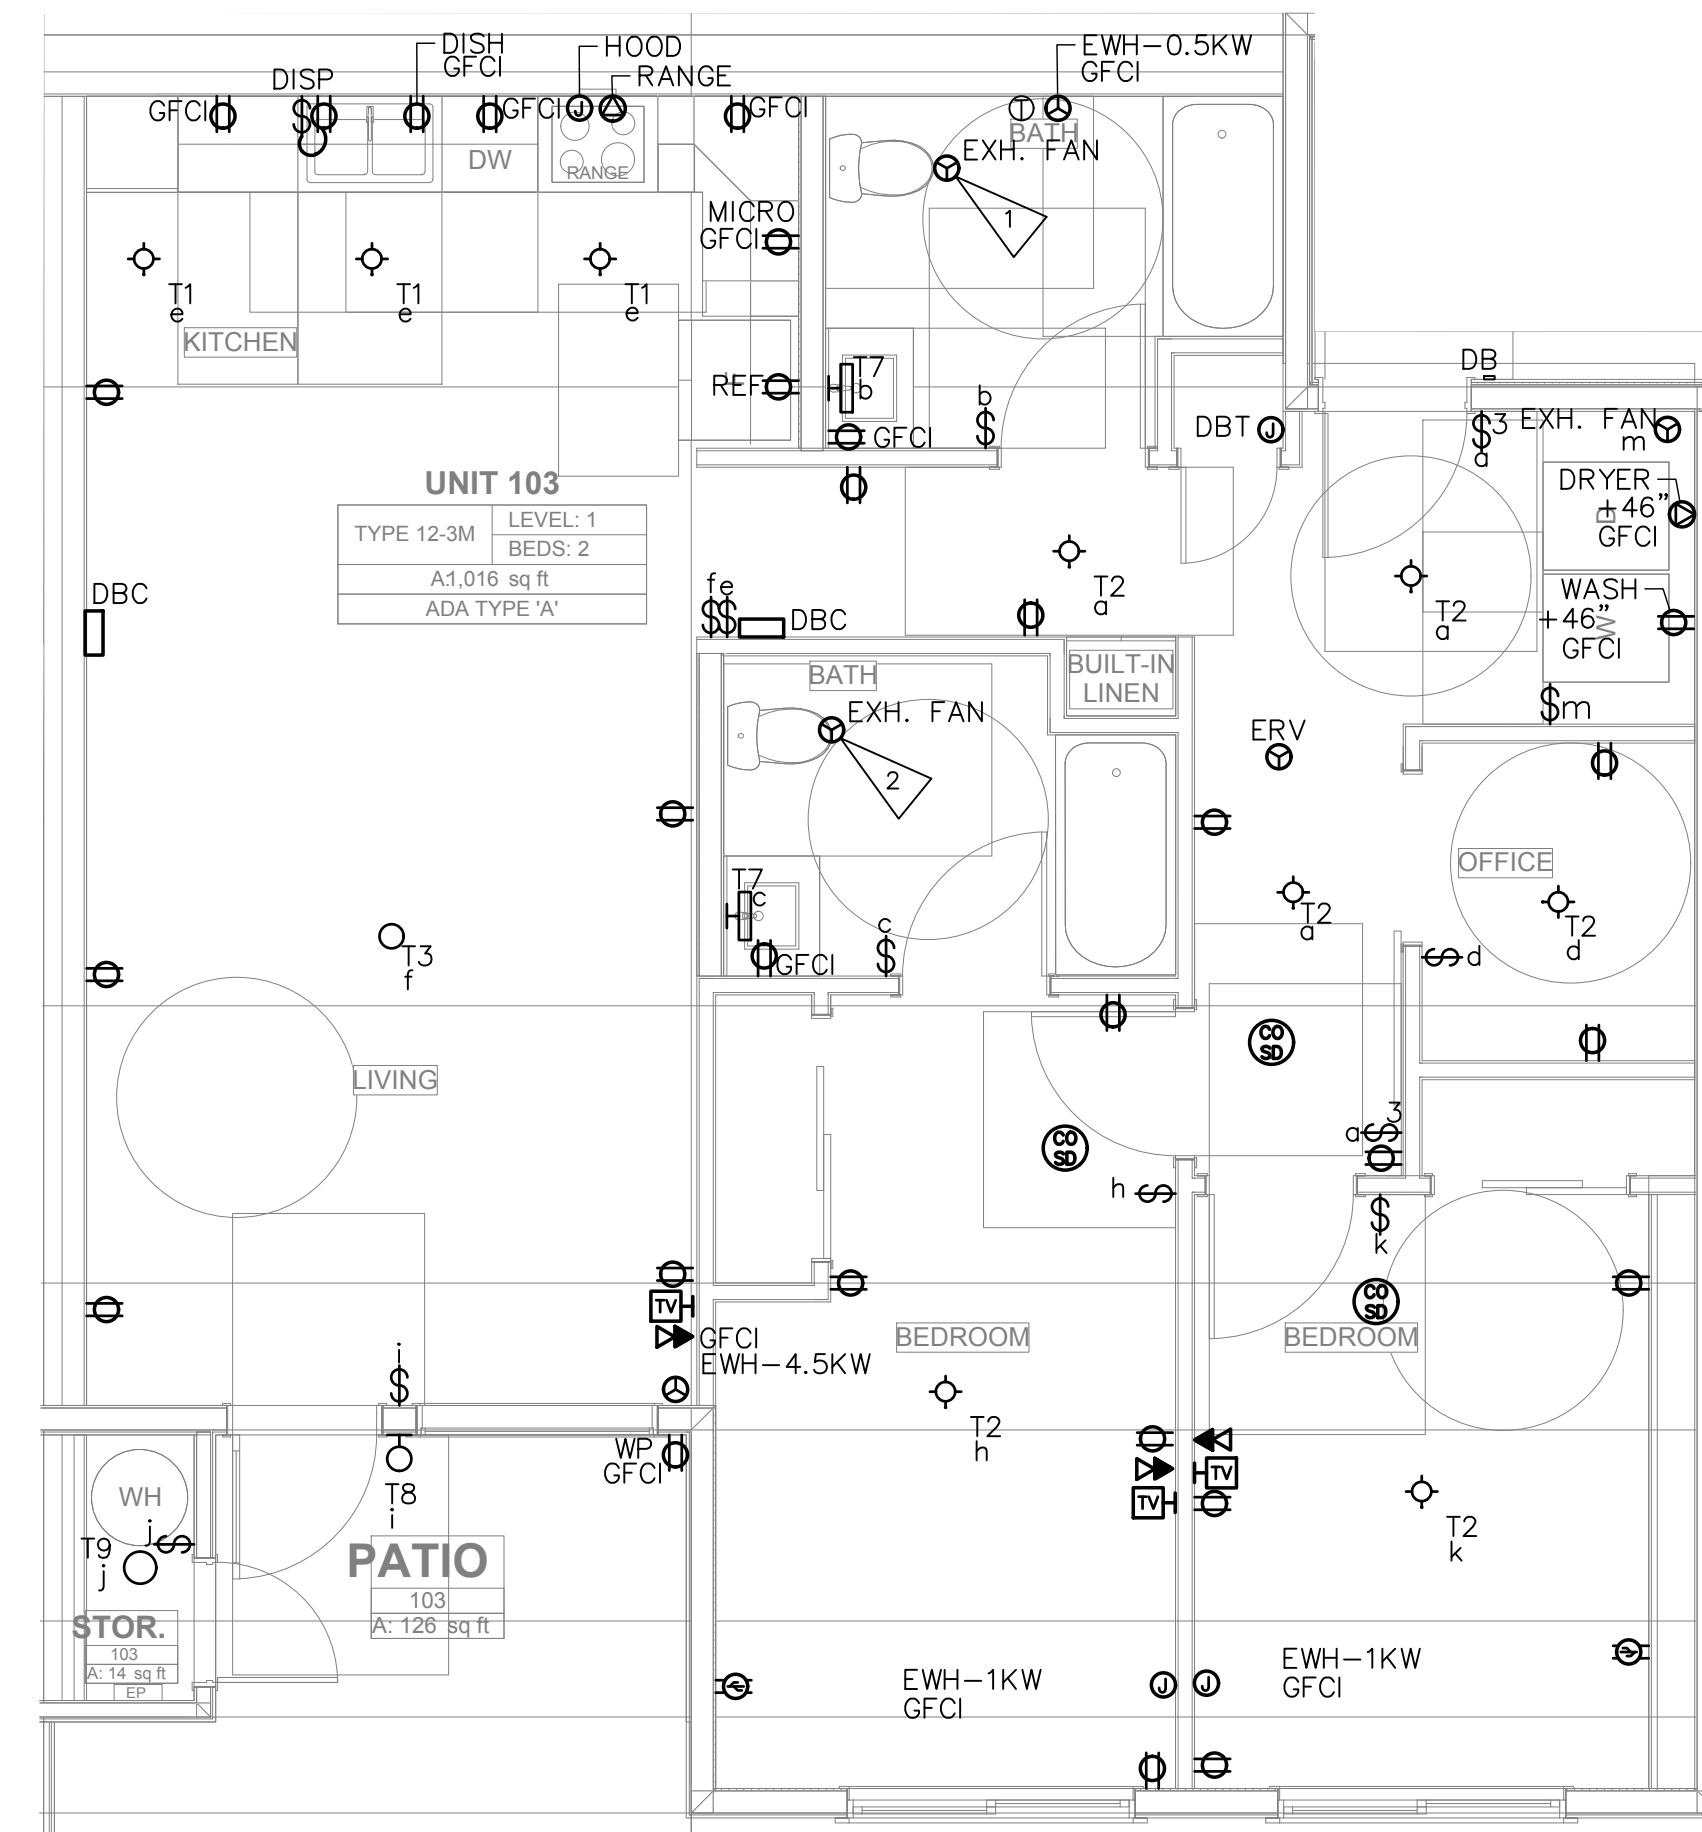

UNIT TYPICALS
 TYPE 12-3 3BR
 SCALE: 1/4" = 1'-0"

GENERAL NOTES:

1. PROVIDE AFCI BREAKERS PER NEC 210.12.
2. PROVIDE TAMPER RESISTANT RECEPTACLES PER NEC 406.12.
3. PROVIDE ADA COMPLIANT CONTROLS FOR RANGE HOODS & CEILING FANS IN UNITS DESIGNATED AS 'ACCESSIBLE' PER ARCHITECTURAL.

FLAG NOTES

1. LAUNDRY EXHAUST FAN CONTROLLED BY INTEGRAL HUMIDISTAT. PROVIDE UNSWITCHED HOT.
2. TWO-SPEED WHOLE HOUSE FAN CONTROLLED BY INTEGRAL OCCUPANCY SENSOR. HIGH SPEED OPERATION WHEN OCCUPIED, LOW SPEED OPERATION OTHERWISE. PROVIDE UNSWITCHED HOT.

| NO. | DATE | REVISIONS DESCRIPTION |
|-----|------|-----------------------|
| | | |
| | | |
| | | |



| | | | |
|-----------------|--------------------|---------------------|----------------------|
| DRAWN: LYSAK K. | DESIGNED: LYSAK K. | CHECKED: STEINKE M. | APPROVED: STEINKE M. |
|-----------------|--------------------|---------------------|----------------------|

PROJECT: EAST TOWN CROSSING
 MULTIFAMILY DEVELOPMENT
 PIONEER WAY & SHAW RD. PUYALLUP, WA


19401 40TH AVE W, SUITE 302
 LYNNWOOD, WA 98036
 PHONE: 206-844-3343

ROBISON ENGINEERING, INC.

PERMIT SET
 01/22/2024

SHEET TITLE:
 UNIT PLANS

SHEET NO.
 E5.01

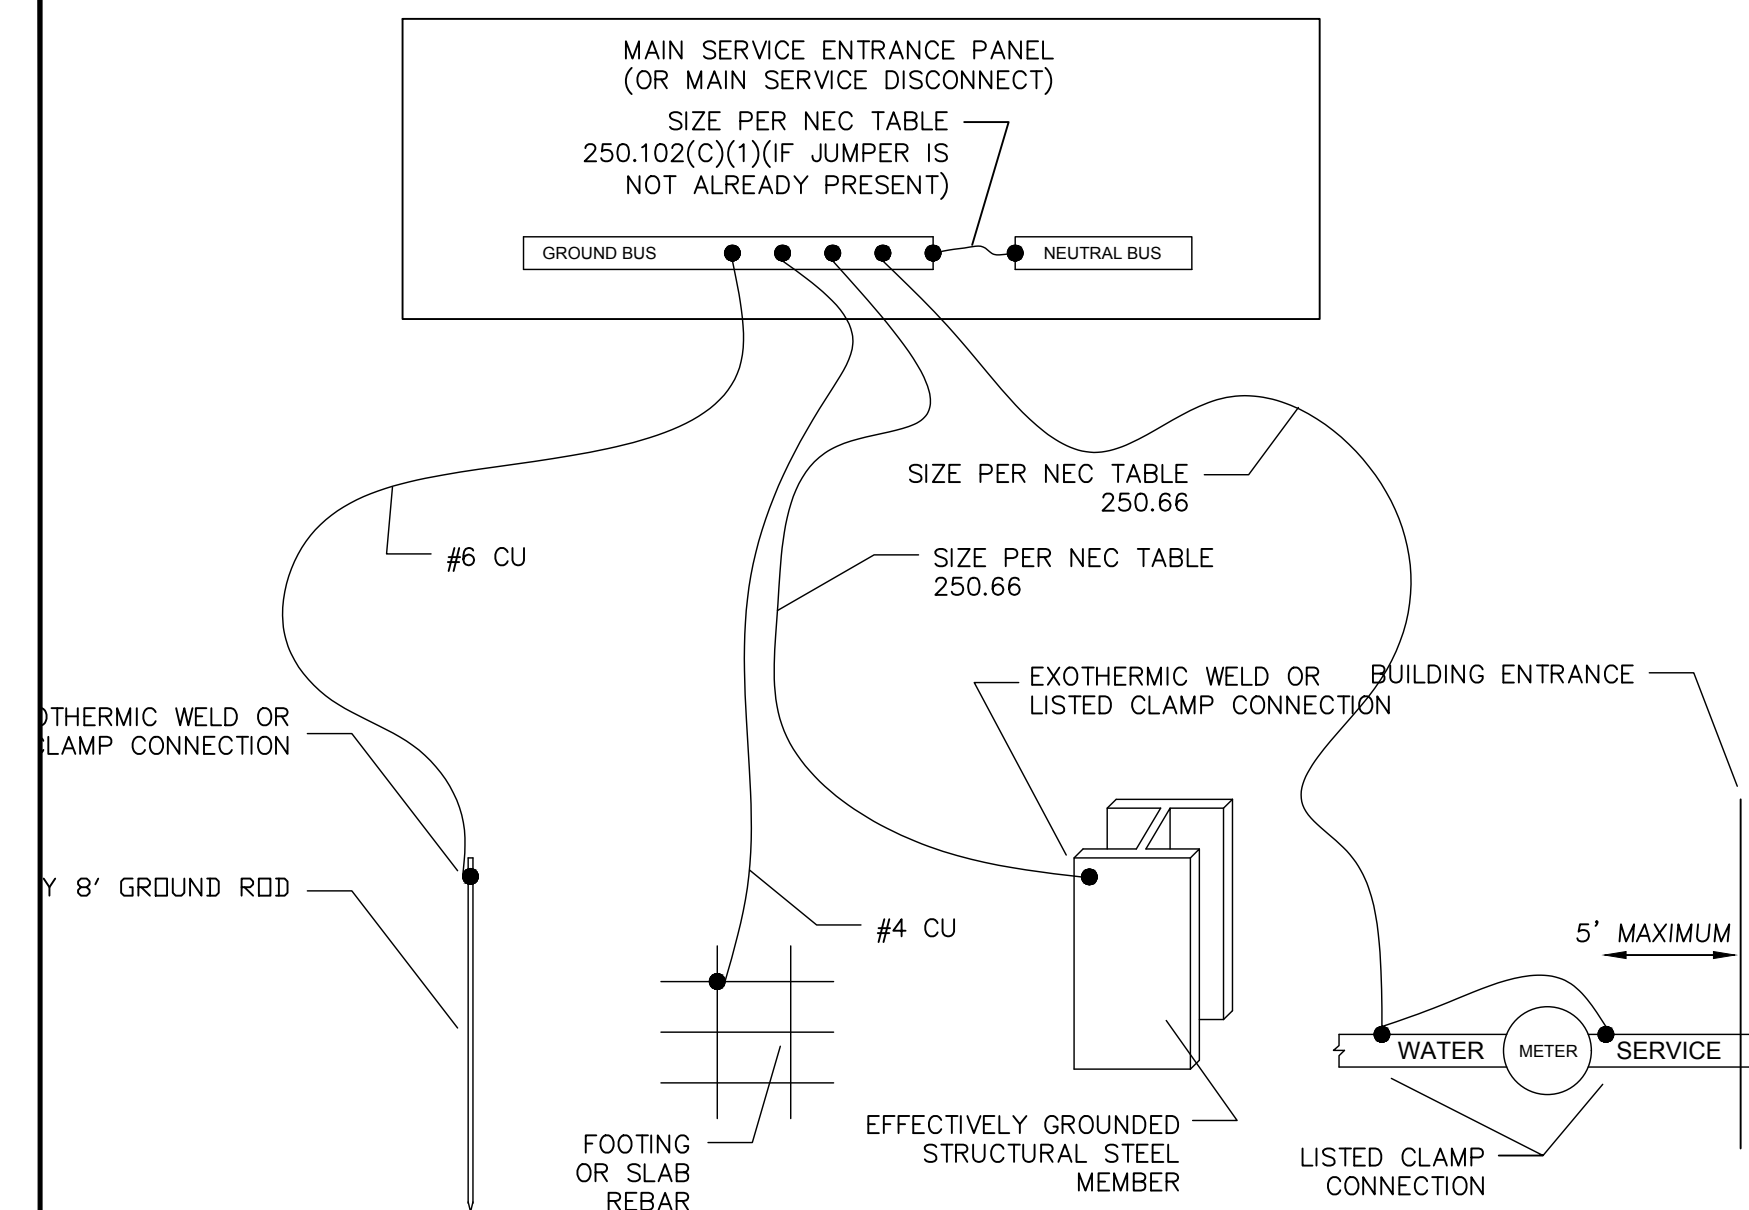

GEC DIAGRAM

| ID | FEEDER AMPS | CONDUIT AND FEEDER | FEEDING THESE DEVICES |
|----|-------------|--|--|
| 1 | 125 | 1-1/2" C, 2#2/0 AL, #2/0 AL N, #4 AL G | 101, 102, 103, 104, 105, 106, 107, 108, 201, 202, 203, 204, 205, 206, 207, 208, 301, 302, 303, 304, 305, 306, 307, 308 |
| 10 | 800 | (3) 3" C, 3#400kcmil AL, #400kcmil AL N, #4/0 AL G | UTIL |
| 11 | 400 | (2) 2-1/2" C, 3#250kcmil AL, #250kcmil AL N, #1 AL G | HOUSE |
| 12 | 1000 | (4) 3" C, 3#350kcmil AL, #350kcmil AL N, #4/0 AL G | MC |
| 14 | 300 | 3" C, 3#350kcmil, #350kcmil N, #4G | PV |

SIZING METHOD: COPPER, 60°C #12 THROUGH #1, 75°C 1/0 AND ABOVE

FEEDER SCHEDULE NOTES:

CONDUIT FILL:

- * FOR CONDUIT SIZES 1-1/2" AND BELOW, FILL IS BASED ON EMT.
- * FOR CONDUIT SIZES 2" AND ABOVE, FILL IS BASED ON SCHEDULE 40 PVC.

IN LOCATIONS APPROVED FOR THE PURPOSE, CONTRACTOR MAY USE MC CABLE. IN LOCATIONS APPROVED FOR THE PURPOSE CONTRACTOR MAY USE OTHER CONDUIT TYPES, INCLUDING RMC, FMC AND LFMC. CONTRACTOR REQUIRED TO ENSURE CONDUIT FILL DOES NOT EXCEED 40%.

CONTRACTOR RESPONSIBLE TO ENSURE TERMINATION/LUG CAPACITY FOR ALL SCHEDULED FEEDERS.

XHHW/THHN/THWN SHALL BE USED FOR INSULATION OF THE CONDUCTOR.

| PHASE 1 EV BREAKDOWN: 290 PARKING SPACES * 0.2 = 58 EV CHARGERS | | | | | |
|---|---------------|---------------------|-----------------------|--|--|
| Bldg | # EV chargers | 208V 1PH load (KVA) | 208/120V 3PH load (A) | 50% load management infrastructure (KVA) | 50% load management infrastructure (A) |
| B | 6 | 49.92 | 138.57 | 24.96 | 69.29 |
| C | 6 | 49.92 | 138.57 | 24.96 | 69.29 |
| D | 6 | 49.92 | 138.57 | 24.96 | 69.29 |
| G | 20 | 166.4 | 461.9 | 83.2 | 230.95 |
| H | 4 | 33.28 | 92.38 | 16.64 | 46.19 |
| TI.1 | 3 | 24.96 | 69.29 | 12.48 | 34.65 |
| TI.2-4 | 13 | 108.16 | 300.24 | 54.08 | 150.12 |
| Total | 58 | 482.56 | 1339.5 | 241.28 | 669.75 |

REQUIRED ELECTRIC VEHICLE CHARGING INFRASTRUCTURE WAC 51-50-0429:

- WHERE PARKING IS PROVIDED, TEN PERCENT OF PARKING SPACES SHALL BE PROVIDED WITH ELECTRIC VEHICLE CHARGING INFRASTRUCTURE.
- ELECTRICAL ROOM(S) SERVING PARKING AREAS SHALL BE DESIGNED TO ACCOMMODATE THE ELECTRICAL EQUIPMENT AND DISTRIBUTION REQUIRED TO SERVE A MINIMUM OF 20 PERCENT OF THE TOTAL PARKING SPACES WITH 208/240 V 40-AMP ELECTRIC VEHICLE CHARGING INFRASTRUCTURE.
- MINIMUM ONE ACCESSIBLE PARKING SPACE SHALL BE SERVED BY ELECTRIC VEHICLE CHARGING INFRASTRUCTURE.

TOTAL NUMBER OF PARKING SPACES = 458; 458 x 0.2 = CAPACITY FOR 92 EV CHARGERS
 92 CHARGERS x 208V/1PH x 40A = 765.44 KVA = 2,126.22 A 3 PHASE POWER @ 120/208V



UTILIZING LOAD MANAGEMENT INFRASTRUCTURE, EV LOAD CAN BE REDUCED BY 50%. 2,126.22A/2 = 382.72 KVA (1,063.11 A) @ 208V 3 PHASE.

PER WAC 427, ELECTRICAL INFRASTRUCTURE SHALL BE DESIGNED TO ACCOMMODATE AN ADDITIONAL 1,064 AMPS OF ELECTRICAL LOAD.

FAULT CURRENT SCHEDULE

| DEVICE | FAULT | AIC RATING | L-N VOLTS | UTILITY FAULT | FED FROM | | FEEDER | | TOTAL MOTOR FAULT |
|--------|--------|------------|-----------|---------------|----------|--------|-----------------|--------|-------------------|
| | | | | | DEVICE | FAULT | SIZE | LENGTH | |
| UTIL | 29,711 | NA | 120V | 29,100 | | | | | 611 |
| MC-B | 21,901 | 42,000 | 120V | 21,286 | UTIL | 29,100 | (4)#350kcmil AL | 105' | 615 |
| HOUSE | 17,917 | 42,000 | 120V | 17,483 | MC-B | 21,286 | (2)#250kcmil AL | 29' | 434 |
| PV | 16,302 | 22,000 | 120V | 15,944 | HOUSE | 17,483 | #350kcmil | 12' | 358 |
| 101 | 10,709 | 22,000 | 120V | 10,549 | MC-B | 21,286 | #2/0 AL | 42' | 160 |
| 102 | 11,121 | 22,000 | 120V | 10,949 | MC-B | 21,286 | #2/0 AL | 39' | 172 |
| 103 | 9,799 | 22,000 | 120V | 9,662 | MC-B | 21,286 | #2/0 AL | 48' | 137 |
| 104 | 9,351 | 22,000 | 120V | 9,225 | MC-B | 21,286 | #2/0 AL | 52' | 126 |
| 105 | 5,597 | 22,000 | 120V | 5,539 | MC-B | 21,286 | #2/0 AL | 106' | 58 |
| 106 | 6,879 | 22,000 | 120V | 6,802 | MC-B | 21,286 | #2/0 AL | 81' | 77 |
| 107 | 4,386 | 22,000 | 120V | 4,342 | MC-B | 21,286 | #2/0 AL | 143' | 44 |
| 108 | 4,426 | 22,000 | 120V | 4,381 | MC-B | 21,286 | #2/0 AL | 141' | 45 |
| 201 | 9,257 | 22,000 | 120V | 9,133 | MC-B | 21,286 | #2/0 AL | 53' | 124 |
| 202 | 9,316 | 22,000 | 120V | 9,191 | MC-B | 21,286 | #2/0 AL | 52' | 125 |
| 203 | 8,690 | 22,000 | 120V | 8,578 | MC-B | 21,286 | #2/0 AL | 58' | 112 |
| 204 | 8,266 | 22,000 | 120V | 8,164 | MC-B | 21,286 | #2/0 AL | 63' | 102 |
| 205 | 5,413 | 22,000 | 120V | 5,358 | MC-B | 21,286 | #2/0 AL | 111' | 55 |
| 206 | 5,496 | 22,000 | 120V | 5,439 | MC-B | 21,286 | #2/0 AL | 109' | 57 |
| 207 | 3,976 | 22,000 | 120V | 3,936 | MC-B | 21,286 | #2/0 AL | 160' | 40 |
| 208 | 4,749 | 22,000 | 120V | 4,701 | MC-B | 21,286 | #2/0 AL | 130' | 48 |
| 301 | 8,258 | 22,000 | 120V | 8,155 | MC-B | 21,286 | #2/0 AL | 63' | 103 |
| 302 | 8,305 | 22,000 | 120V | 8,202 | MC-B | 21,286 | #2/0 AL | 62' | 103 |
| 303 | 7,798 | 22,000 | 120V | 7,705 | MC-B | 21,286 | #2/0 AL | 68' | 93 |
| 304 | 7,453 | 22,000 | 120V | 7,366 | MC-B | 21,286 | #2/0 AL | 73' | 87 |
| 305 | 4,826 | 22,000 | 120V | 4,778 | MC-B | 21,286 | #2/0 AL | 127' | 48 |
| 306 | 5,118 | 22,000 | 120V | 5,066 | MC-B | 21,286 | #2/0 AL | 119' | 52 |
| 307 | 3,773 | 22,000 | 120V | 3,735 | MC-B | 21,286 | #2/0 AL | 170' | 38 |
| 308 | 4,463 | 22,000 | 120V | 4,418 | MC-B | 21,286 | #2/0 AL | 140' | 45 |

208Y/120V 3P 4W
 225 KVA
 FC 29,649

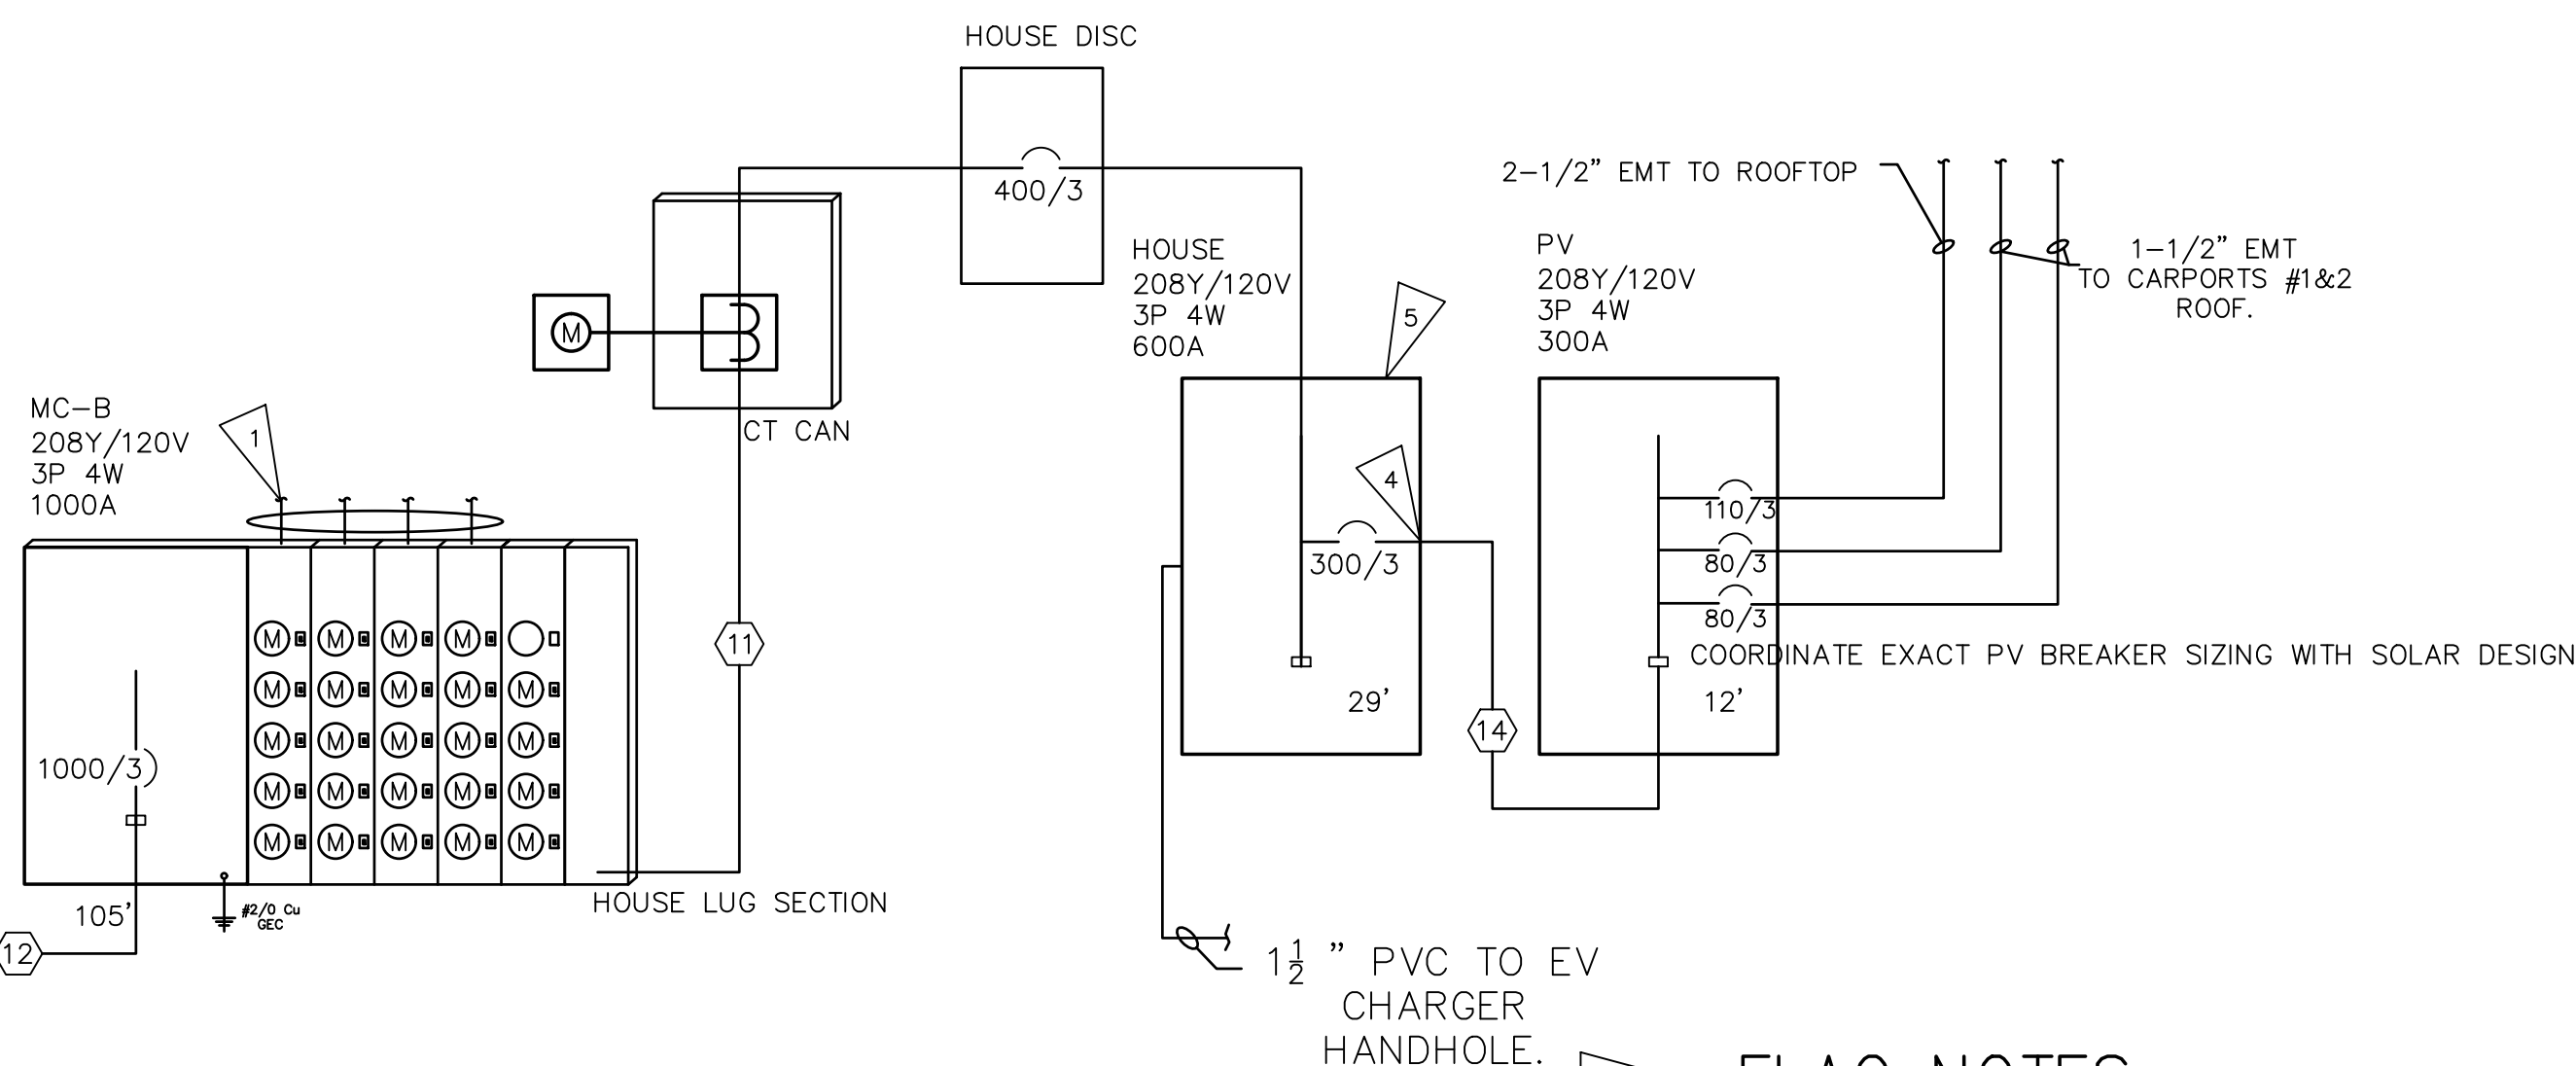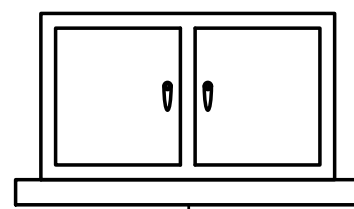

FLAG NOTES

- UNIT FEEDERS: REFER TO METER CENTER PANEL SCHEDULE ON THIS SHEET FOR UNIT FEEDER SIZE & TYPE. TYP.
- CONTRACTOR SHALL VERIFY AVAILABLE FAULT CURRENT WITH PSE SERVICE LETTER PRIOR TO ORDERING EQUIPMENT.
- HOUSE PANEL METER AND MAIN BREAKER.
- PROVISIONAL BREAKER SPACE AND CONDUIT FOR FUTURE PV SYSTEM. LOCATE BREAKER SPACE AT
- BUSBAR SIZED PER NEC 705.12(B)(2).

ONE-LINE DIAGRAM

SCALE: NONE

| REVISIONS | DESCRIPTION | DATE |
|-----------|-------------|------|
| NO. | | |



| | | | |
|-----------------|--------------------|---------------------|----------------------|
| DRAWN: LYSAK K. | DESIGNED: LYSAK K. | CHECKED: STEINKE M. | APPROVED: STEINKE M. |
|-----------------|--------------------|---------------------|----------------------|

PROJECT: **EAST TOWN CROSSING**
 MULTIFAMILY DEVELOPMENT
 PIONEER WAY & SHAW RD. PUYALLUP, WA

19401 40TH AVE W, SUITE 302
 LYNNWOOD, WA 98036
 PHONE: 206-864-3343

ROBISON ENGINEERING, INC.

PERMIT SET
 01/22/2024

SHEET TITLE:
ONE-LINE DIAGRAM & PANELS SCHEDULES

SHEET NO.
 E6.00

| MC-B | | ROOM MOUNTING FLUSH | | VOLTS 208Y/120V 3P 4W | | AIC 42,000 | |
|--|--------------------|---------------------|-----------------------|-----------------------|------|---|----------|
| FED FROM UTIL | | BUS AMPS 1000 | | NEUTRAL 100% | | MAIN BKR MLO LUGS STANDARD | |
| CKT # | BREAKER TRIP/POLES | CIRCUIT DESCRIPTION | LOAD KVA | | | FEEDER RACEWAY AND CONDUCTORS | |
| | | | A | B | C | | |
| 1 | 125/2 | PANEL 101 | 18.2 | 18.3 | | 1-1/2"C,2#2/0 AL,#2/0 AL,N,#4 AL G | |
| 2 | 125/2 | PANEL 102 | 18.2 | 18.3 | | 1-1/2"C,2#2/0 AL,#2/0 AL,N,#4 AL G | |
| 3 | 125/2 | PANEL 103 | 17.8 | 17.7 | | 1-1/2"C,2#2/0 AL,#2/0 AL,N,#4 AL G | |
| 4 | 125/2 | PANEL 104 | 17.7 | 17.8 | | 1-1/2"C,2#2/0 AL,#2/0 AL,N,#4 AL G | |
| 5 | 125/2 | PANEL 105 | 17.7 | 17.8 | | 1-1/2"C,2#2/0 AL,#2/0 AL,N,#4 AL G | |
| 6 | 125/2 | PANEL 106 | 17.8 | 17.7 | | 1-1/2"C,2#2/0 AL,#2/0 AL,N,#4 AL G | |
| 7 | 125/2 | PANEL 107 | 18.2 | 18.3 | | 1-1/2"C,2#2/0 AL,#2/0 AL,N,#4 AL G | |
| 8 | 125/2 | PANEL 108 | 18.2 | 18.3 | | 1-1/2"C,2#2/0 AL,#2/0 AL,N,#4 AL G | |
| 9 | 125/2 | PANEL 201 | 18.3 | 18.2 | | 1-1/2"C,2#2/0 AL,#2/0 AL,N,#4 AL G | |
| 10 | 125/2 | PANEL 202 | 17.7 | 17.8 | | 1-1/2"C,2#2/0 AL,#2/0 AL,N,#4 AL G | |
| 11 | 125/2 | PANEL 203 | 17.7 | 17.8 | | 1-1/2"C,2#2/0 AL,#2/0 AL,N,#4 AL G | |
| 12 | 125/2 | PANEL 204 | 17.8 | 17.7 | | 1-1/2"C,2#2/0 AL,#2/0 AL,N,#4 AL G | |
| 23 | 125/2 | PANEL 307 | 18.2 | 18.3 | | 1-1/2"C,2#2/0 AL,#2/0 AL,N,#4 AL G | |
| 24 | 125/2 | PANEL 308 | 18.3 | 18.2 | | 1-1/2"C,2#2/0 AL,#2/0 AL,N,#4 AL G | |
| 25 | 400/3 | PANEL HOUSE | 42.2 | 41.9 | | (2)2-1/2"C,3#250kcmil AL,#250kcmil AL,N,#1 AL G | |
| 26 | -/2 | SPACE | 0 | 0 | | | |
| TOTAL CONNECTED KVA BY PHASE | | | 329 | 329 | 329 | | |
| OPTIONAL MULTIFAMILY DWELLING CALCULATION (NEC 220.84) | | | | | | | |
| DWELLING UNIT LOADS | | | | | | | |
| KVA | | | | KVA | | | |
| LIGHTING AND RECEPTACLES | 77.9 | 25,950 SF (3 VA/SF) | CONNECTED LOAD | 794 | | | |
| SMALL-APPLIANCE | 72 | | DWELLING UNITS | 24 | | | |
| LAUNDRY | 36 | | DEMAND FACTOR | (35%) | | | |
| APPLIANCES | 290 | | CALCULATED LOAD | 278 | | | |
| ELECTRIC COOKING | 194 | | | | | | |
| MOTORS | 28.8 | | | | | | |
| HEATING | 95 | (100%) | | | | | |
| HOUSE LOADS | | | | | | | |
| CONN KVA | | CALC KVA | | CONN KVA | | CALC KVA | |
| LIGHTING | 0.658 | 0.823 | (125%) | RECEPTACLES | 2.7 | 2.7 | (50%>10) |
| LARGEST MOTOR | 2.83 | 0.707 | (25%) | EV LOAD | 39.6 | 49.5 | (125%) |
| MOTORS | 5.65 | 5.65 | (100%) | PV LOAD | 77.4 | 0 | (0%) |
| TOTAL HOUSE LOAD | | | | 59.4 | | | |
| TOTAL LOAD | | | | | | | |
| KVA | | | | KVA | | | |
| TOTAL DWELLING UNIT LOAD | 278 | | TOTAL LOAD | 337 | | | |
| TOTAL HOUSE LOAD | 59.4 | | BALANCED 3-PHASE LOAD | 93.7 A | | | |

| HOUSE | | ROOM MOUNTING FLUSH | | VOLTS 208Y/120V 3P 4W | | AIC 42,000 | |
|-----------------------|---------|---------------------|---------------------|-----------------------|---------|----------------------------|---------------------|
| FED FROM MC-B | | BUS AMPS 600 | | NEUTRAL 100% | | MAIN BKR MLO LUGS STANDARD | |
| CKT # | CKT BKR | LOAD KVA | CIRCUIT DESCRIPTION | CKT # | CKT BKR | LOAD KVA | CIRCUIT DESCRIPTION |
| | | | | | | | |
| 1 | 20/1 | 0.72 | RECEPTACLE | a 2 | 20/2 | 0.1 | COURTYARD LIGHTING |
| 3 | 20/1 | 0.54 | RECEPTACLE | b 4 | | | |
| 5 | 20/1 | 0.54 | RECEPTACLE | c 6 | 20/1 | 0.1 | SITE LIGHTING |
| 7 | 20/1 | 0.36 | RECEPTACLE | a 8 | 20/1 | 0.22 | LIGHTING |
| 9 | 20/1 | 0.18 | FACP | b 10 | 20/1 | 0.238 | LIGHTING |
| 11 | 20/1 | 0.36 | RECEPTACLE | c 12 | 20/3 | 5.65 | BP-1 |
| 13 | 40/2 | 6.6 | DUAL EV CHARGER | a 14 | | | |
| 15 | | | | b 16 | | | |
| 17 | 40/2 | 6.6 | DUAL EV CHARGER | c 18 | -/1 | 0 | SPACE |
| 19 | | | | a 20 | -/1 | 0 | SPACE |
| 21 | 40/2 | 6.6 | DUAL EV CHARGER | b 22 | -/1 | 0 | SPACE |
| 23 | | | | c 24 | -/1 | 0 | SPACE |
| 25 | 40/2 | 6.6 | DUAL EV CHARGER | a 26 | -/1 | 0 | SPACE |
| 27 | | | | b 28 | -/1 | 0 | SPACE |
| 29 | 40/2 | 6.6 | DUAL EV CHARGER | c 30 | -/1 | 0 | SPACE |
| 31 | | | | a 32 | -/1 | 0 | SPACE |
| 33 | 40/2 | 6.6 | DUAL EV CHARGER | b 34 | -/1 | 0 | SPACE |
| 35 | | | | c 36 | -/1 | 0 | SPACE |
| 37 | -/1 | 0 | SPACE | a 38 | 300/3 | 77.4 | PANEL PV |
| 39 | -/2 | 0 | SPACE | b 40 | | | |
| 41 | | | | c 42 | | | |
| CONN KVA | | | | CONN KVA | | | |
| CALC KVA | | CALC KVA | | CALC KVA | | CALC KVA | |
| LIGHTING | 0.658 | 0.823 | (125%) | MOTORS | 5.65 | 5.65 | (100%) |
| LARGEST MOTOR | 2.83 | 0.707 | (25%) | RECEPTACLES | 2.7 | 2.7 | (50%>10) |
| | | | | EV LOAD | 39.6 | 49.5 | (125%) |
| | | | | PV LOAD | 77.4 | 0 | (0%) |
| TOTAL LOAD | | | | 59.4 | | | |
| BALANCED 3-PHASE LOAD | | | | 165 A | | | |
| PHASE A | | | | 101% | | | |
| PHASE B | | | | 99.7% | | | |
| PHASE C | | | | 99.7% | | | |

| 2 BED | | ROOM MOUNTING FLUSH | | VOLTS 208/120V 2P 3W | | AIC 22,000 | |
|---|---------|---------------------|------------------------|----------------------|---------|----------------------------|----------------------|
| FED FROM MC-B | | BUS AMPS 125 | | NEUTRAL 100% | | MAIN BKR MLO LUGS STANDARD | |
| CKT # | CKT BKR | LOAD KVA | CIRCUIT DESCRIPTION | CKT # | CKT BKR | LOAD KVA | CIRCUIT DESCRIPTION |
| | | | | | | | |
| 1 | 15/1 | 1 | LVG RM R/L, SD/CO | a 2 | 20/1 | 1.5 | SML APPLIANCE/REF |
| 3 | 15/1 | 1 | OFFICE R/L | b 4 | 20/1 | 1.5 | SML APPLIANCE/DINING |
| 5 | 15/1 | 1 | BED RM R/L | a 6 | 20/1 | 0.8 | DISHWASHER |
| 7 | 15/1 | 1 | BED RM R/L | b 8 | 20/1 | 1.2 | DISPOSAL |
| 9 | 20/1 | 1 | BATHROOM REC/LTG | a 10 | 40/2 | 8.1 | RANGE |
| 11 | 20/1 | 1 | BATHROOM REC/LTG | b 12 | | | |
| 13 | 20/2 | 1.5 | WALL HEATER BED | a 14 | 20/1 | 1.8 | MICRO/HOOD |
| 15 | | | | b 16 | 30/2 | 5 | DRYER |
| 17 | 20/2 | 2 | WALL HEATER LVG | a 18 | | | |
| 19 | | | | b 20 | 20/1 | 1.5 | WASHER |
| 21 | 30/2 | 4.5 | ELEC WATER HEATER | a 22 | -/1 | 0 | SPACE |
| 23 | | | | b 24 | -/1 | 0 | SPACE |
| 25 | -/1 | 0 | SPACE | a 26 | -/1 | 0 | SPACE |
| 27 | -/1 | 0 | SPACE | b 28 | -/1 | 0 | SPACE |
| 29 | -/1 | 0 | SPACE | a 30 | -/1 | 0 | SPACE |
| OPTIONAL DWELLING UNIT CALCULATION (NEC 220.82) | | | | | | | |
| CONN KVA | | | | CONN KVA | | | |
| CALC KVA | | CALC KVA | | CALC KVA | | CALC KVA | |
| LIGHTING AND RECEPTACLES | 3.12 | 1,040 SF (3 VA/SF) | GENERAL LOAD | 10 | 10 | (100%) | |
| SMALL-APPLIANCE | 3 | | UP TO 10 KVA | | | | |
| LAUNDRY | 1.5 | | OVER 10 KVA | 19 | 7.61 | (40%) | |
| APPLIANCES | 12.1 | | | | | | |
| ELECTRIC COOKING | 8.1 | | MAX HEATING OR COOLING | | 2.28 | (220.82(C)(4)) | |
| MOTORS | 1.2 | | | | | | |
| TOTAL GENERAL LOAD | | | | 19.9 | | | |
| TOTAL LOAD | | | | 95.6 A | | | |
| PHASE A | | | | 99.7% | | | |
| PHASE B | | | | 100% | | | |

| PV | | ROOM MOUNTING FLUSH | | VOLTS 208Y/120V 3P 4W | | AIC 22,000 | |
|-----------------------|---------|---------------------|-----------------------|-----------------------|---------|----------------------------|---------------------|
| FED FROM HOUSE | | BUS AMPS 300 | | NEUTRAL 100% | | MAIN BKR MLO LUGS STANDARD | |
| CKT # | CKT BKR | LOAD KVA | CIRCUIT DESCRIPTION | CKT # | CKT BKR | LOAD KVA | CIRCUIT DESCRIPTION |
| | | | | | | | |
| 1 | 150/3 | 40.2 | BTPO ARRAY 82 PANELS | a 2 | -/1 | 0 | SPACE |
| 3 | | | | b 4 | -/1 | 0 | SPACE |
| 5 | | | | c 6 | -/1 | 0 | SPACE |
| 7 | 30/3 | 5.88 | SOUTH ARRAY 12 PANELS | a 8 | -/1 | 0 | SPACE |
| 9 | | | | b 10 | -/1 | 0 | SPACE |
| 11 | | | | c 12 | -/1 | 0 | SPACE |
| 13 | 20/3 | 3.92 | SOUTH ARRAY 8 PANELS | a 14 | -/1 | 0 | SPACE |
| 15 | | | | b 16 | -/1 | 0 | SPACE |
| 17 | | | | c 18 | -/1 | 0 | SPACE |
| 19 | 30/3 | 5.88 | EAST ARRAY 12 PANEL | a 20 | -/1 | 0 | SPACE |
| 21 | | | | b 22 | -/1 | 0 | SPACE |
| 23 | | | | c 24 | -/1 | 0 | SPACE |
| 25 | 80/3 | 21.5 | CARPORT 1 50 PANELS | a 26 | -/1 | 0 | SPACE |
| 27 | | | | b 28 | -/1 | 0 | SPACE |
| 29 | | | | c 30 | -/1 | 0 | SPACE |
| 31 | -/1 | 0 | SPACE | a 32 | -/1 | 0 | SPACE |
| 33 | -/1 | 0 | SPACE | b 34 | -/1 | 0 | SPACE |
| 35 | -/1 | 0 | SPACE | c 36 | -/1 | 0 | SPACE |
| 37 | -/1 | 0 | SPACE | a 38 | -/1 | 0 | SPACE |
| 39 | -/1 | 0 | SPACE | b 40 | -/1 | 0 | SPACE |
| 41 | -/1 | 0 | SPACE | c 42 | -/1 | 0 | SPACE |
| CONN KVA | | | | CONN KVA | | | |
| CALC KVA | | CALC KVA | | CALC KVA | | CALC KVA | |
| PV LOAD | 77.4 | 0 | (0%) | TOTAL LOAD | 0 | | |
| BALANCED 3-PHASE LOAD | | | | 0 A | | | |
| PHASE A | | | | 100% | | | |
| PHASE B | | | | 100% | | | |
| PHASE C | | | | 100% | | | |

| 3 BED | | ROOM MOUNTING FLUSH | | VOLTS 208/120V 2P 3W | | AIC 22,000 | |
|---|---------|---------------------|------------------------|----------------------|---------|----------------------------|----------------------|
| FED FROM MC-B | | BUS AMPS 125 | | NEUTRAL 100% | | MAIN BKR MLO LUGS STANDARD | |
| CKT # | CKT BKR | LOAD KVA | CIRCUIT DESCRIPTION | CKT # | CKT BKR | LOAD KVA | CIRCUIT DESCRIPTION |
| | | | | | | | |
| 1 | 15/1 | 1 | LVG RM R/L, SD/CO | a 2 | 20/1 | 1.5 | SML APPLIANCE/REF |
| 3 | 15/1 | 1 | BED RM R/L | b 4 | 20/1 | 1.5 | SML APPLIANCE/DINING |
| 5 | 15/1 | 1 | BED RM R/L | a 6 | 20/1 | 0.8 | DISHWASHER |
| 7 | 15/1 | 1 | BED RM R/L | b 8 | 20/1 | 1.2 | DISPOSAL |
| 9 | 20/1 | 1 | BATHROOM REC/LTG | a 10 | 40/2 | 8.1 | RANGE |
| 11 | 20/1 | 1 | BATHROOM REC/LTG | b 12 | | | |
| 13 | 20/2 | 1.5 | WALL HEATER BED | a 14 | 20/1 | 1.8 | MICRO/HOOD |
| 15 | | | | b 16 | 30/2 | 5 | DRYER |
| 17 | 20/2 | 1.5 | WALL HEATER BED/BATH | a 18 | | | |
| 19 | | | | b 20 | 20/1 | 1.5 | WASHER |
| 21 | 20/2 | 1.5 | WALL HEATER LVG | a 22 | -/1 | 0 | SPACE |
| 23 | | | | b 24 | -/1 | 0 | SPACE |
| 25 | 30/2 | 4.5 | ELEC WATER HEATER | a 26 | -/1 | 0 | SPACE |
| 27 | | | | b 28 | -/1 | 0 | SPACE |
| 29 | -/1 | 0 | SPACE | a 30 | -/1 | 0 | SPACE |
| OPTIONAL DWELLING UNIT CALCULATION (NEC 220.82) | | | | | | | |
| CONN KVA | | | | CONN KVA | | | |
| CALC KVA | | CALC KVA | | CALC KVA | | CALC KVA | |
| LIGHTING AND RECEPTACLES | 3.39 | 1,130 SF (3 VA/SF) | GENERAL LOAD | 10 | 10 | (100%) | |
| SMALL-APPLIANCE | 3 | | UP TO 10 KVA | | | | |
| LAUNDRY | 1.5 | | OVER 10 KVA | 19.3 | 7.72 | (40%) | |
| APPLIANCES | 12.1 | | | | | | |
| ELECTRIC COOKING | 8.1 | | MAX HEATING OR COOLING | | 2.93 | (220.82(C)(4)) | |
| MOTORS | 1.2 | | | | | | |
| TOTAL GENERAL LOAD | | | | 20.6 | | | |
| TOTAL LOAD | | | | 99.2 A | | | |
| PHASE A | | | | 99.8% | | | |
| PHASE B | | | | 100% | | | |

| NO. |
|-----|
|-----|