EAST TOWN CROSSING FRONTAGE IMPROVEMENTS SEC. 26,35/ TWP. 20 N./ RGE. 4 E., W.M. EXISTING STORMDRAIN MANHOLE Revise per comments on Sht R6.3. [Plans; Sht 1 of 21] **IMPROVEMENTS** 6026470071 6026470061 EXISTING STORMDRAIN CATCHBASIN 0420351074 EXISTING SANITARY SEWER MANHOLE SHAW ROAD E →100.00 EXISTING ROW **GRAPHIC SCALE** EXISTING WATER VAULT _____ EXISTING WATER METER EXISTING WATER VALVE

ONSITE IMPROVEMENTS

REVIEWED AND PERMITTED

BY CITY OF PUYALLUP

0420264053

BLDG F

0420264054

BLDG G

0420351066

PRIOR TO PERMIT ISSUANCE. RIGHT-OF-WAY DEDICATION ALONG SHAW ROAD SHALL BE APPROVED AND

RECORDED. RIGHT-OF-WAY ALONG EAST PIONEER SHALL BE APPROVED AND RECORDED PRIOR TO ISSUANCE OF

PRIOR TO PERMIT ISSUANCE, THE APPLICANT SHALL CLARIFY WHETHER IT IS THE PROJECT'S INTENT TO DEDICATE

ALL PRIVATE STORM DRAINAGE FACILITIES SHALL BE COVERED BY A MAINTENANCE AGREEMENT PROVIDED BY

CITY AND RECORDED WITH PIERCE COUNTY. UNDER THIS AGREEMENT, IF THE OWNER FAILS TO PROPERLY MAINTAIN THE FACILITIES, THE CITY, AFTER GIVING THE OWNER NOTICE, MAY PERFORM NECESSARY MAINTENANC

AT THE OWNER'S EXPENSE. PRIOR TO OCCUPANCY THE AGREEMENT SHALL BE APPROVED AND RECORDED.

PRIOR TO OCCUPANCY, A STREET MAINTENANCE COVENANT WILL BE REQUIRED TO ENSURE THAT PAVEMENT

AS MENTIONED DURING THE LAND USE APPLICATION (P-21-0034). THE EXISTING STORMWATER FACILITY SERVING

THE OFFSITE PROPERTIES SOUTH OF THE PROJECT IS CURRENTLY IN VIOLATION OF NPDES REGULATIONS AND THE

PUYALLUP MUNICIPAL CODE DUE TO LACK OF MAINTENANCE, BREACHING OF THE POND BERM, AND PASS-THROUGH

OF A REGULATED STREAM THROUGH THE CONTROL STRUCTURE. HOWEVER, THE CITY IS WILLING TO ALLOW THE

POND REMEDIATION TO OCCUR DURING PHASE 2, PROVIDED THE REMEDIATION IS ACCOMPLISH PRIOR TO ANY

MARKINGS LOCATED ON PRIVATE PROPERTY AT THE DRIVE ENTRANCES WILL BE MAINTAINED.

RIGHT-OF-WAY OR GRANT AN EASEMENT FOR MAINTENANCE AND OPERATION OF THE SHAW ROAD TRAFFIC SIGNAL

TRASH ENCLOSURE

0420355026

0420351000

AND EQUIPMENT

40249900-T35

CONDITIONS:

LEGAL DESCRIPTION

DATED JANUARY 22, 2021 AT 8:00 A.M.

AUDITOR'S FILE NO. 9308310480

THENCE EAST 258.35 FEET

EAST OF "POINT A":

40249901-T35

JARANTY COMPANY SUBDIVISION GUARANTEE ORDER NO.

TOWNSHIP 20 NORTH, RANGE 4 EAST, W.M., IN PIERCE COUNTY,

HENCE NORTH TO THE SOUTHERLY LINE OF THE COUNTY ROAD;

THENCE NORTHWESTERLY ALONG SAID SOUTHERLY LINE OF COUNTY

THENCE SOUTH ALONG SAID 1/16TH LINE TO THE POINT OF BEGINNING;

EXCEPT THE WEST 30 FEET THEREOF CONVEYED TO PIERCE COUNTY

BY DEED RECORDED UNDER RECORDING NO. 1618885 FOR SHAW

ALSO EXCEPT THEREFROM THAT PORTION CONVEYED TO THE CITY

PUYALLUP BY INSTRUMENT RECORDED UNDER AUDITOR'S FILE NO.

AND ALSO EXCEPT ANY PORTION THEREOF LYING SOUTHERLY AND

THENCE SOUTH TO A POINT 495.4 FEET SOUTH OF AND 258.35 FEET

FERMINUS OF SAID LINE, SAID POINT ALSO BEING DESCRIBED AS THE

THENCE EAST TO THE EAST LINE OF SAID PREMISES AND THE

SITUATE IN THE CITY PUYALLUP, COUNTY OF PIERCE STATE OF

TAX PARCEL NO. 0420264053: PER CW TITLE TITLE RESOURCES

THAT PORTION OF THE NORTHEAST QUARTER OF THE NORTHEAST

SOUTHEAST QUARTER OF SECTION 26, TOWNSHIP 20 NORTH, RANGE 4

QUARTER OF SECTION 35. AND THE SOUTHEAST QUARTER OF THE

EAST, WM.M., IN PIERCE COUNTY, WASHINGTON, DESCRIBED AS

COMMENCING AT THE NORTHEAST CORNER OF THE WEST HALF OF

THE NORTHEAST QUARTER OF THE NORTHEAST QUARTER OF SAID

SECTION 35 WHICH POINT BEARS NORTH 88°32'51" WEST, 640.11 FEET

FROM A BRASS IN CONCRETE MONUMENT MARKING THE NORTHEAST

THENCE ALONG THE EAST LINE OF SAID WEST HALF, SOUTH 01°15'04"

THENCE ALONG THE EAST LINE OF SAID WEST HALF, SOUTH 01°15'04"

272.98 FEET TO A LINE LYING 263.84 FEET EAST OF AND PARALLEL

THE NORTHERLY EXTENSION OF THE EAST LINE OF SAID LOT 2;

THENCE ALONG SAID PARALLEL LINE, SOUTH 01°06'30" WEST, 282.06

WEST, 54.00 FEET TO THE TRUE POINT OF BEGINNING;

SOUTHWEST CORNER OF LOT 3 OF BOUNDARY LINE ADJUSTMENT

9408230215, BEING A RE-RECORD OF INSTRUMENT RECORDED UNDER

WESTERLY OF A LINE DESCRIBED AS BEGINNING AT THE NORTHWEST

CORNER OF THE NORTHEAST QUARTER OF THE NORTHEAST QUARTER

THENCE SOUTH ALONG THE 1/16TH LINE 95.4 FEET TO THE TRUE POINT

WASHINGTON. WITH THE EAST 1/16TH LINE OF SAID SECTION:

NORTH, RANGE 4 EAST, W.M., A DISTANCE OF 95.4 FEET;

OF SAID SECTION 35 HEREINAFTER CALLED "POINT A"-

RECORDED LINDER AUDITOR'S FILE NO. 200303315001

DATED JANUARY 22, 2021 AT 8:00 A.M.

CORNER OF SAID SECTION 35:

WEST, 437,43 FEET TO POINT LYING

OF BEGINNING OF THE LINE TO BE DESCRIBED;

ROAD TO THE EAST 1/16TH LINE OF SECTION 26:

BEGINNING AT THE INTERSECTION OF THE SOUTH LINE OF SECTION 26

FLOOD PLAIN NOTE

THE FLOOD PLAIN INFORMATION SHOWN IN THE PLAN SET IS BASED ON THE REVISED PANEL 342 OF 1375 OF MAP 53053C0342E THAT WAS PART OF THE 09/08/22 LOMR. THE FLOOD ZONES AND BFE's SHOWN IN THE PLAN SET ARE DRAWN FROM A COMBINATION OF THE PDF MAP PANEL AND GIS DATA. THE INFORMATION SHOWN IN THE REVISED PANEL IS BASED ON AN ASSUMED RELOCATED STREAM LOCATION. ACTUAL FLOOD ZONE AND BFE's WILL BE BASED FINAL LOCATION AND ELEVATION OF RELOCATED STREAM.

CITY OF PUYALLUP DEVELOPMENT ENGINEERING

NOTE: THIS APPROVAL IS VOID AFTER 180 DAYS FROM APPROVA

THE CITY WILL NOT BE RESPONSIBLE FOR ERRORS AND/OR OMISSIONS ON THESE FIELD CONDITIONS MAY DICTATE

APPROVED

1st Review PRCCP20240569 June 2024

> CHANGES TO THESE PLANS AS DETERMINED BY THE 2215 North 30th Street, Suite 300, Tacoma, WA 98403 DEVELOPMENT ENGINEERING 253.383.2422 TEL 253.383.2572 FAX www.ahbl.com WEB

> > <u>Project Title:</u>

Project No.

Issue Set & Date:

FRONTAGE

IMPROVEMENTS

ASH DEVELOPMENT

GREG HELLE

GREG.HELLE@ASHNW.COM

2230752

PERMIT SUBMITTAL

04/03/2024

EAST TOWN CROSSING

rovide DRAFT ROW dedication deed along Pioneer

Plans: Sht R0.0 of 211

/ay frontage, including sketch, on City Form. 34ft road vidth from centerline, 10ft planter, and 8ft sidewalk. Once approved, record with the Pierce County Auditor.

SYNTHESIS 9, LLC CONTACT: BRETT LINDSAY

523 N. D. ST **TACOMA. WA 98403** OFFICE: 253-468-4117

ARCHITECT

ADDRESS: 2902 E PIONEER

0420351066, 0420351030, 0420351029, 0420351026 PUYALLUP, WA 98372

ZONING: CG AND RM-20

. HORIZONTAL DATUM: BASIS OF BEARING AND SURVEY DATA PER

BASIS OF BEARING: HELD S 01° 21' 28" W OBSERVED ALONG THE EAST

LINE OF THE NORTHEAST QUARTER OF SEC. 35, T. 20 N. R. 4 E. BETWEEN THE NORTHEAST CORNER OF THE NORTHEAST QUARTER MONUMENT AND THE SOUTHEAST CORNER OF THE NORTHEAST QUARTER MONUMENT OF THE SAID SECTION AS SHOWN HEREON.

PID: DL2774

DESCRIPTION: ENCASED STEEL ROD LOCATED IN EASTERLY GRAVEL

4. ALL UTILITY LOCATES HAVE BEEN DETERMINED BY SURFACE LOCATION ONLY EITHER BY PHYSICAL STRUCTURES OR PAINT MARKINGS AS DETERMINED BY UNDERGROUND + UTILITY LOCATE, INC. AND/OR UTILITY COMPANY. GAS PIPE LOCATION WITH IN THE PROPERTY DETERMINED BY MAP PROVIDE BY PUGET SOUND ENERGY, INC. ACTUAL UNDERGROUND LOCATION MAY VARY. EXISTING UTILITIES AS SHOWN MAY NOT BE THE SAME AFTER THIS DATE AS MAJOR CONSTRUCTION IS IN PROGRESS

Sheet List Table Sheet Number | Sheet Title **COVER SHEET** SHAW ROAD E TESC AND DEMOLITION PLAN SHAW ROAD E TESC AND DEMOLITION PLAN SHAW ROAD E IMPROVEMENTS - STA. 9+00 - 12+80 SHAW ROAD E IMPROVEMENTS - STA. 12+80-17+25 PIONEER WAY E TESC AND DEMOLITION PLAN PIONEER WAY E TESC AND DEMOLITION PLAN PIONEER WAY E IMPROVEMENTS STA. 43+50 - 48+0 PIONEER WAY E IMPROVEMENTS STA. 48+00 - 52+00 PIONEER WAY E CHANNELIZATION PLAN TESC DETAILS AND NOTES ADA DETAILS AND NOTES STORM DETAILS AND NOTES CROSS SECTIONS CHANNELIZATION NOTES AND DETAILS PAVING NOTES AND DETAILS LANDSCAPE PLAN STREET LIGHTING STREET LIGHTING - DETAILS STREET LIGHTING - DETAILS

STREET LIGHTING - DETAILS



SURVEYOR

MCINNIS ENGINEERING CONTACT: LARRY WALKER TACOMA, WA 98404 OFFICE: 253-414-1992

EMAIL: TSAWIN@AHBL.COM

RELOCATION

Revise floodplain delineation

based on approved LOMR.

FEMA BASE FLOOD

ELEVATION

0420264006

PIONEER WAY E ROW

0420264023

DEDICATION TO BE COMPLETED AS

PART OF PHASE 2

CONSTRUCTION SEQUENCE

2. STABILIZE ALL AREAS WITHIN SEVEN DAYS OF REACHING FINAL GRADE.

WASHINGTON.

APPROPRIATE LIPON APPROVAL OF THE CITY OF PLIYALLUP

SCHEDULE EROSION CONTROL INSPECTION W/ CITY

TWO DAYS DURING THE WET SEASON

I. INSTALL SURFACE IMPROVEMENTS

FLAG CLEARING LIMITS

GENERAL PERMIT

). INSTALL UTILITIES

OBTAIN REQUIRED PERMITS AND HOLD A PRE-CONSTRUCTION MEETING WITH THE CITY

POTHOLE ANY EXISTING UTILITIES FOR VERIFICATION OF DEPTH AND LOCATION. SEE VERIFICATION NOTE

COVER ALL AREAS THAT WILL BE UNWORKED FOR MORE THAN FIVE DAYS DURING THE DRY SEASON OR

MAINTAIN EROSION CONTROL MEASURE AND RELOCATE SURFACEWATER CONTROLS AS NEEDED IN

ACCORDANCE WITH CITY OF PUYALLUP REQUIREMENTS AND NPDES CONSTRUCTION STORMWATER

I. STABILIZE ALL DISTURBED AREAS AND REMOVES BMP'S AND EROSION CONTROL MEASURES AS

CIVIL ENGINEER SITE INFORMATION PARCEL: 0420264021 0420264054 0420264053

2215 NORTH 30TH STREET, SUITE 300 **TACOMA, WA 98403** PHONE: (253) 383-2422 - PHASE 2 STREAM CONTACT: TODD SAWIN

SURVEYOR'S NOTES

PLANE COORDINATE SYSTEM, SOUTH ZONE.

HOULDER AT THE INTERSECTION OF PIONEER WAY AND 134TH AVE. E.

5. REFERENCE SURVEYS 1. 200303315001 2. SP 9303315001 3. ROS 821004020

6. METHOD OF SURVEYING WAS: 1. CONVENTIONAL TRAVERSE USING A TOPCON 800A TOTAL STATION. 2. MONUMENTS FOUND MARCH 2008

VICINITY MAP

2902 E PIONEER WAY

COVER SHEET

1 of 21 Sheets

EXISTING FIRE HYDRANT EXISTING IRRIGATION CONTROL VALVE EXISTING NATURAL GAS METER EXISTING LUMINAIRE ON CONCRETE BASE EXISTING FENCE GATE POST SECTIONAL SUBDIVISIONAL LINE SUBJECT PARCELS DEED LINE EXISTING 1 FOOT MAJOR CONTOUR INTERVAL EASEMENT 1 FOOT MINOR CONTOUR INTERVAL EXISTING CONCRETE SURFACE EXISTING ASPHALT SURFACE EXISTING GRAVEL SURFACE PUGET SOUND LIDAR CONSORTIUM G(REC) ————— GAS LINE (PLOTTED FROM RECORD DRAWING) —— FO —— FO —— *FIBER OPTIC LINE* Please remove Notes 2 and 5 (not elevant to this permit application). [Plans; Sht R0.0 of 21] P(REC) POWER LINE (PLOTTED FROM RECORD DRAWING) ---- SS ----- SS ---- SANITARY SEWER

TOPOGRAPHIC NOTE

THE EXISTING CULTURAL AND TOPOGRAPHICAL DATA SHOWN ON THESE DRAWINGS HAS BEEN PREPARED, IN PART, BASED UPON INFORMATION FURNISHED BY OTHERS. WHILE THIS INFORMATION IS BELIEVED TO BE RELIABLE, AHBL ENGINEERING CANNOT ENSURE ACCURACY AND THUS IS NOT RESPONSIBLE FOR THE ACCURACY OF THAT INFORMATION OR FOR ANY ERRORS OR OMISSIONS WHICH MAY HAVE BEEN INCORPORATED INTO THESE DRAWINGS AS A RESULT.

T(REC) TELEPHONE LINE (PLOTTED FROM RECORD DRAWING)

FILL SPECIFICATIONS

FILL MATERIAL SHALL NOT CONTAIN PETROLEUM PRODUCTS, OR SUBSTANCES WHICH ARE HAZARDOUS, DANGEROUS, TOXIC, OR WHICH OTHERWISE VIOLATE ANY STATE, FEDERAL. OR LOCAL LAW, ORDINANCE, CODE, REGULATION, RULE, ORDER, OR

VERIFICATION NOTE

ALL EXISTING UTILITIES IN THE CONSTRUCTION AREA SHALL BE IDENTIFIED AND VERIFIED FOR DEPTH AND LOCATION PRIOR TO ANY CONSTRUCTION ACTIVITIES SO TO IDENTIFY ANY POTENTIAL CONFLICTS WITH PROPOSED CONSTRICTION. CONTACT PROJECT ENGINEER IMMEDIATELY IF ANY CONFLICTS ARE

PRIOR TO ANY CONSTRUCTION ACTIVITIES, VERIFY EXISTING TOPOGRAPHY IS CONSISTENT WITH WHAT IS SHOWN ON PLANS AND IF THERE ARE ANY POTENTIAL CONFLICTS WITH PROPOSED CONSTRUCTION ACTIVITIES. CONTACT PROJECT ENGINEER IMMEDIATELY IF ANY CONFLICTS ARE IDENTIFIED.

TRENCH NOTES

IF WORKERS ENTER ANY TRENCH OR OTHER EXCAVATION FOUR OR MORE FEET IN DEPTH THAT DOES NOT MEET THE OPEN PIT REQUIREMENTS OF WSDOT SECTION 2-09 FOR WORKER SAFETY. ALL TRENCH SAFETY SYSTEMS SHALL MEET THE REQUIREMENTS OF THE WASHINGTON INDUSTRIAL SAFETY AND HEALTH ACT, CHAPTER 49.17 RCW.



CUT AND FILL ESTIMATES

NET IMPORT: 252 CY

SOUTH 88°53'30" EAST, 405.26 FEET OF THE EASTERLY EXTENSION OF THE NORTH LINE OF LOT 2 OF PIERCE COUNTY SHORT PLAT NO. THENCE ALONG THE NORTHERLY EXTENSION OF THE EAST LINE OF SAID LOT 2, NORTH 01°06'30" EAST, 789.89 FEET TO THE SOUTHERLY MARGIN OF PIONEER WAY: THENCE ALONG SAID SOUTHERLY MARGIN. SOUTH 74°08'09" EAST.

FEET TO A LINE 54.00 FEET SOUTH OF AND PARALLEL WITH THE NORTH LINE OF SECTION 35: THENCE ALONG SAID PARALLEL LINE, SOUTH 88°32'51" EAST, 142.38 FEET TO THE TRUE POINT OF BEGINNING EXCEPT THE SOUTH 145.00 FEET THEREOF (ALSO KNOWN AS LOT 3 OF RECORD OF SURVEY FOR BOUNDARY LINE

BLDG T.I.

0420264021

HOUSE

ADJUSTMENT RECORDED MARCH 31, 2003 UNDER RECORDING NO. THENCE SOUTH ALONG THE 1/16TH LINE OF SECTION 35, TOWNSHIP 20 SITUATE IN THE CITY OF PUYALLUP, COUNTY OF PIERCE, STATE OF

TAX PARCEL NO. 0420264054: PER CW TITLE TITLE RESOURCES 40249902-T35

DATED JANUARY 22, 2021 AT 8:00 A.M. THAT PORTION OF THE NORTHEAST QUARTER OF THE NORTHEAST QUARTER OF SECTION 35, AND THE SOUTHEAST QUARTER OF THE SOUTHEAST QUARTER OF SECTION 26, TOWNSHIP 20 NORTH, RANGE 4 EAST, WM.M., IN PIERCE COUNTY, WASHINGTON, DESCRIBED AS BEGINNING AT THE NORTHEAST CORNER OF THE WEST HAI F OF THE NORTHEAST QUARTER OF THE NORTHEAST QUARTER OF SECTION 35 WHICH POINT BEARS NORTH 88°32'51" WEST, 640.11 FEET FROM A BRASS IN CONCRETE MONUMENT MARKING THE NORTHEAST CORNER

SAID SECTION 35: THENCE ALONG THE EAST LINE OF SAID WEST HALF, SOUTH 01°15'04" WEST, 54.00 FEET; THENCE ALONG A LINE PARALLEL WITH THE NORTH LINE OF SAID SECTION 35, NORTH 88°32'51" WEST, 142.38 FEET; THENCE NORTH 01°06'30" EAST, 282.08 FEET TO THE SOUTHERLY

MARGIN OF PIONEER WAY THENCE ALONG SAID SOUTHERLY MARGIN, SOUTH 74°08'09" EAST, 179.36 FEET TO A LINE LYING 30.48 FEET EAST OF AND PARALLEL WITH EAST LINE OF THE WEST HALF OF THE NORTH EAST QUARTER OF THE NORTHEAST QUARTER OF SAID SECTION 35; THENCE ALONG SAID PARALLEL LINE, SOUTH 01°15'04" WEST, 183.43 FEET TO THE NORTH LINE OF SAID SECTION 35: THENCE ALONG SAID NORTH LINE. NORTH 88°32'51" WEST. 30.48 FEET TO THE POINT OF BEGINNING (ALSO KNOWN AS LOT 5 OF RECORD OF SURVEY FOR BOUNDARY LINE ADJUSTMENT RECORDED MARCH 31, 2003 UNDER RECORDING NO.

SITUATE IN THE CITY OF PUYALLUP, COUNTY OF PIERCE, STATE OF

TAX PARCEL NO. 0420351066: PER CW TITLE TITLE RESOURCES GUARANTY COMPANY SUBDIVISION GUARANTEE ORDER NO.

DATED JANUARY 22, 2021 AT 8:00 A.M. COMMENCING AT THE NORTHEAST CORNER OF THE WEST HALF OF THE NORTHEAST QUARTER OF THE NORTHEAST QUARTER OF SAID SECTION 35 WHICH POINT BEARS NORTH 88°32'51" WEST, 640.11 FEET FROM A BRASS IN CONCRETE MONUMENT MARKING THE NORTHEAST CORNER OF SAID SECTION 35: THENCE ALONG THE EAST LINE OF SAID WEST HALF, SOUTH 01°15'04"

WEST, 491.43 FEET TO A POINT LYING

SOUTH 88°53'30" EAST, 405.26 FEET TO THE EASTERLY EXTENSION OF THE NORTH LINE OF LOT 2 OF THE PIERCE COUNTY SHORT PLAT NO. 9303010321 AND THE TRUE POINT OF BEGINNING THENCE ALONG SAID NORTH LINE, NORTH 88°53'30" WEST, 405.26 TO THE NORTHEAST CORNER OF SAID LOT 2; THENCE ALONG THE NORTHERLY EXTENSION OF THE EAST LINE OF SAID LOT 2 NORTH 01°06'30" FAST 145 00 FFFT THENCE SOUTH 88°53'30" EAST 405.62 FEET TO THE EAST LINE OF THE

WEST HALF OF THE NORTHEAST QUARTER OF THE NORTHEAST

THENCE ALONG SAID EAST LINE SOUTH 01°15'04" WEST, 145.00 FEET TO THE TRUE POINT OF BEGINNING (ALSO KNOWN AS LOT 3 OF RECORD OF SURVEY FOR BOUNDARY LINE ADJUSTMENT RECORDED MARCH 31, 2003 UNDER RECORDING NO. SITUATE IN THE CITY OF PUYALLUP, COUNTY OF PIERCE, STATE OF

TAX PARCEL NO. 0420351030: PER CW TITLE TITLE RESOURCES GUARANTY COMPANY SUBDIVISION GUARANTEE ORDER NO.

40249904-T35 DATED JANUARY 22, 2021 AT 8:00 A.M. BEGINNING AT THE SIXTEENTH SECTION CORNER OF SECTION 35, TOWNSHIP 20 NORTH, RANGE 4 EAST OF THE WILLAMETTE MERIDIAN, 1321.48 FEET WEST OF THE CORNER COMMON TO SECTIONS 25, 26, 35 THENCE SOUTH ALONG THE SIXTEENTH SECTION 95.4 FEET TO THE TRUE POINT OF BEGINNING;

THENCE EAST 258.26 FEET THENCE SOUTH 100 FEET THENCE WEST 258.26 FEET THENCE NORTH 100 FEET TO THE TRUE POINT OF BEGINNING, IN PIERCE COUNTY, WASHINGTON.

EXCEPT SHAW COUNTY ROAD. SITUATE IN THE CITY OF PUYALLUP, COUNTY OF PIERCE, STATE OF

TAX PARCEL NO. 0420351029: PER CW TITLE TITLE RESOURCES GUARANTY COMPANY SUBDIVISION GUARANTEE ORDER NO. 40249905-1-F DATED JANUARY 22, 2021 AT 8:00 A.M.

BEGINNING AT THE 1/16 SECTION CORNER, 1321.48 FEET WEST OF COMMON TO SECTIONS 25, 26, 35 AND 36 IN TOWNSHIP 20 NORTH, RANGE 4 EAST,

MONUMENT COMMON TO SECTIONS 25, 26, 35 AND 36 IN TOWNSHIP 20 NORTH, RANGE 4 EAST, WILLAMETTE MERIDIAN, IN PIERCE COUNTY, WASHINGTON: THENCE SOUTH ALONG THE 1/16 SECTION LINE 294.5 FEET TO THE TRUE POINT OF BEGINNING;


THENCE SOUTH 100 FEET THENCE WEST 258 35 FEET THENCE NORTH 100 FEET TO THE TRUE POINT OF BEGINNING, IN PIERCE COUNTY, WASHINGTON

CORNER MONUMENT WILLAMETTE MERIDIAN, IN PIERCE COUNTY, WASHINGTON; THENCE SOUTH ALONG THE 1/16 SECTION LINE 195.4 FEET TO THE TRUE POINT OF THENCE SOUTH 100 FEET THENCE WEST 258.26 FEET THENCE NORTH 100 FEET TO TRUE POINT OF BEGINNING. EXCEPT THE WEST 30 FEET THEREOF FOR ROAD. SITUATE IN THE COUNTY OF PIERCE, STATE OF WASHINGTON. TAX PARCEL NO. 0420351026: PER CW TITLE TITLE RESOURCES

40249906-T35 DATED JANUARY 22, 2021 AT 8:00 A.M.


BEGINNING AT THE 1/16 CORNER 1321.48 FEET WEST OF THE CORNER

EXCEPT SHAW COUNTY ROAD. SITUATE IN THE CITY OF PUYALLUP, COUNTY OF PIERCE, STATE OF

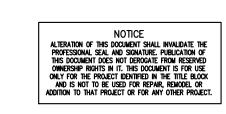

Sheet Title:

EAST TOWN CROSSING SHAW ROAD IMPROVEMENTS SEC. 26,35/ TWP. 20 N./ RGE. 4 E., W.M.

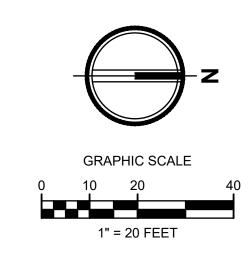

APPROVED

CITY OF PUYALLUP DEVELOPMENT ENGINEERING

NOTE: THIS APPROVAL IS VOID AFTER 180 DAYS FROM APPROVAL THE CITY WILL NOT BE RESPONSIBLE FOR ERRORS

AND/OR OMISSIONS ON THESE FIELD CONDITIONS MAY DICTATE CHANGES TO THESE PLANS AS DETERMINED BY THE 2215 North 30th Street, Suite 300, Tacoma, WA 98403 DEVELOPMENT ENGINEERING 253.383.2422 TEL 253.383.2572 FAX www.ahbl.com WEB

Project Title:

EAST TOWN CROSSING FRONTAGE IMPROVEMENTS

ASH DEVELOPMENT

GREG HELLE

GREG.HELLE@ASHNW.COM

<u>Project No.</u>


2230752

Issue Set & Date:

PERMIT SUBMITTAL

04/03/2024



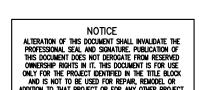

Revisions:


Sheet Title:

SHAW ROAD E TESC AND DEMOLITION **PLAN**

Designed by: Drawn by: Checked by:

Sheet No.

2 of 21 Sheets

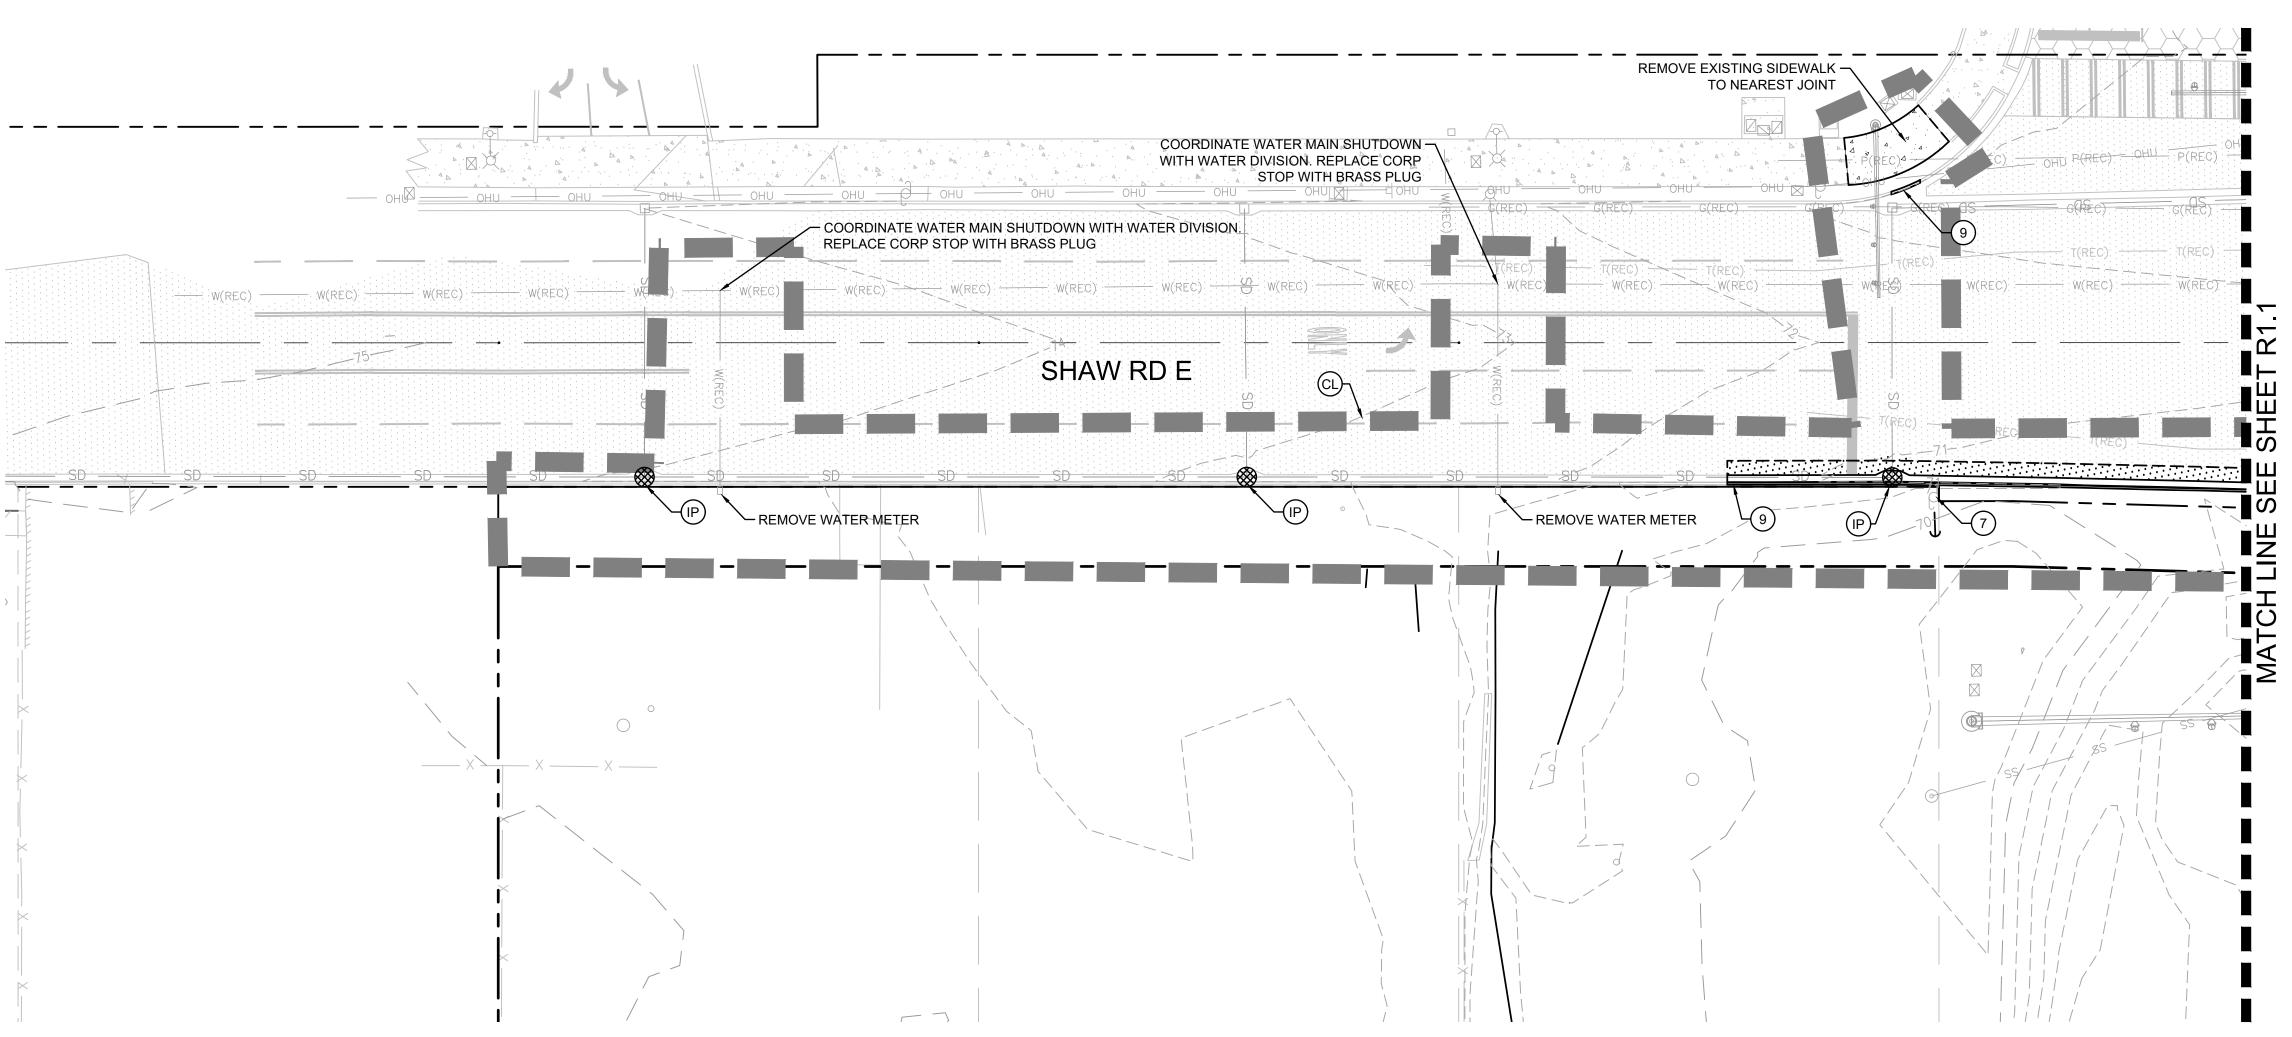

LEGEND

REMOVE EXISTING ASPHALT REMOVE EXISTING CONCRETE REMOVE EXISTING TREE

NOTES

1. CONTRACTOR SHALL REMOVE AND DISPOSE OF ALL DEBRIS AND

EXISTING TREE TO REMAIN

2. ALL CURB AND GUTTER TO BE REMOVED TO NEAREST JOINT

-Existing public utilities that are in conflict with proposed frontage improvements shall be relocated as necessary to meet all applicable City, State, and Federal requirements. maintained right-of way and utilities shall be relocated outside of the travelled road section, i.e., behind the curb under the sidewalk area or other location as approved by the City.


KEYNOTES

- 1) REMOVE EXISTING ASPHALT PAVEMENT.
- 2 PROTECT EXISTING SIGN TO REMAIN
- 3 EXISTING CULVERT TO BE REPLACED. SEE NOTE 4 THIS SHEET.
- 4) PROTECT EXISTING POWER POLE
- SWEEP STREET AS NECESSARY TO REMOVE DIRT LEAVING CONSTRUCTION SITE.
- 6 REMOVE AND RELOCATE SIGN SEE SHEETS R2.0 R2.1 FOR LOCATION
- 7 REMOVE AND RELOCATE POWER POLE SEE SHEETS R2.0 R2.1 FOR LOCATION
- 8 PROPOSED CONSTRUCTION ENTRANCE FOR ONSITE PERMITING WORK. EXISTING CULVERT TO BE MAINTAINED
- 9 REMOVE EXISTING CONCRETE CURB
- 10) PROTECT EXISTING UTILITY

Know what's below. Call before you dig.

EAST TOWN CROSSING SHAW ROAD IMPROVEMENTS

SEC. 26,35/ TWP. 20 N./ RGE. 4 E., W.M.

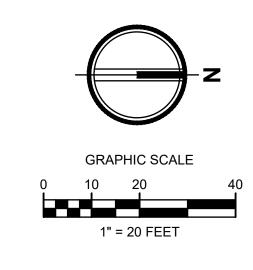

APPROVED

CITY OF PUYALLUP DEVELOPMENT ENGINEERING

NOTE: THIS APPROVAL IS VOID AFTER 180 DAYS FROM APPROVAL THE CITY WILL NOT BE RESPONSIBLE FOR ERRORS

AND/OR OMISSIONS ON THESE FIELD CONDITIONS MAY DICTATE CHANGES TO THESE PLANS AS DETERMINED BY THE DEVELOPMENT ENGINEERING

2215 North 30th Street, Suite 300, Tacoma, WA 98403

Project Title:

EAST TOWN CROSSING FRONTAGE IMPROVEMENTS

253.383.2422 TEL 253.383.2572 FAX www.ahbl.com WEB

ASH DEVELOPMENT

GREG HELLE

GREG.HELLE@ASHNW.COM

2230752


Project No.

Issue Set & Date:

PERMIT SUBMITTAL

04/03/2024



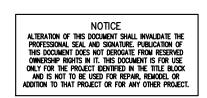

LEGEND

REMOVE EXISTING ASPHALT REMOVE EXISTING CONCRETE REMOVE EXISTING TREE

NOTES

EXISTING TREE TO REMAIN

ocated as necessary to meet all applicable City, State, and Federal requirements. aintained right-of way and utilities shall be relocated outside of the travelled road section,

KEYNOTES

- 1) REMOVE EXISTING ASPHALT PAVEMENT.
- 2 PROTECT EXISTING SIGN TO REMAIN
- (3) EXISTING CULVERT TO BE REPLACED. SEE NOTE 4 THIS SHEET.
- 4 PROTECT EXISTING POWER POLE
- 5 SWEEP STREET AS NECESSARY TO REMOVE DIRT LEAVING CONSTRUCTION SITE.
- 6 REMOVE AND RELOCATE SIGN SEE SHEETS R2.0 R2.1 FOR LOCATION
- 7 REMOVE AND RELOCATE POWER POLE SEE SHEETS R2.0 R2.1 FOR LOCATION
- 8 PROPOSED CONSTRUCTION ENTRANCE FOR ONSITE PERMITING WORK. EXISTING CULVERT TO BE MAINTAINED
- 9 REMOVE EXISTING CONCRETE CURB
- (10) PROTECT EXISTING UTILITY


Revisions:

Sheet Title:


SHAW ROAD E TESC AND DEMOLITION **PLAN**

Designed by: Drawn by: Checked by:

Sheet No.

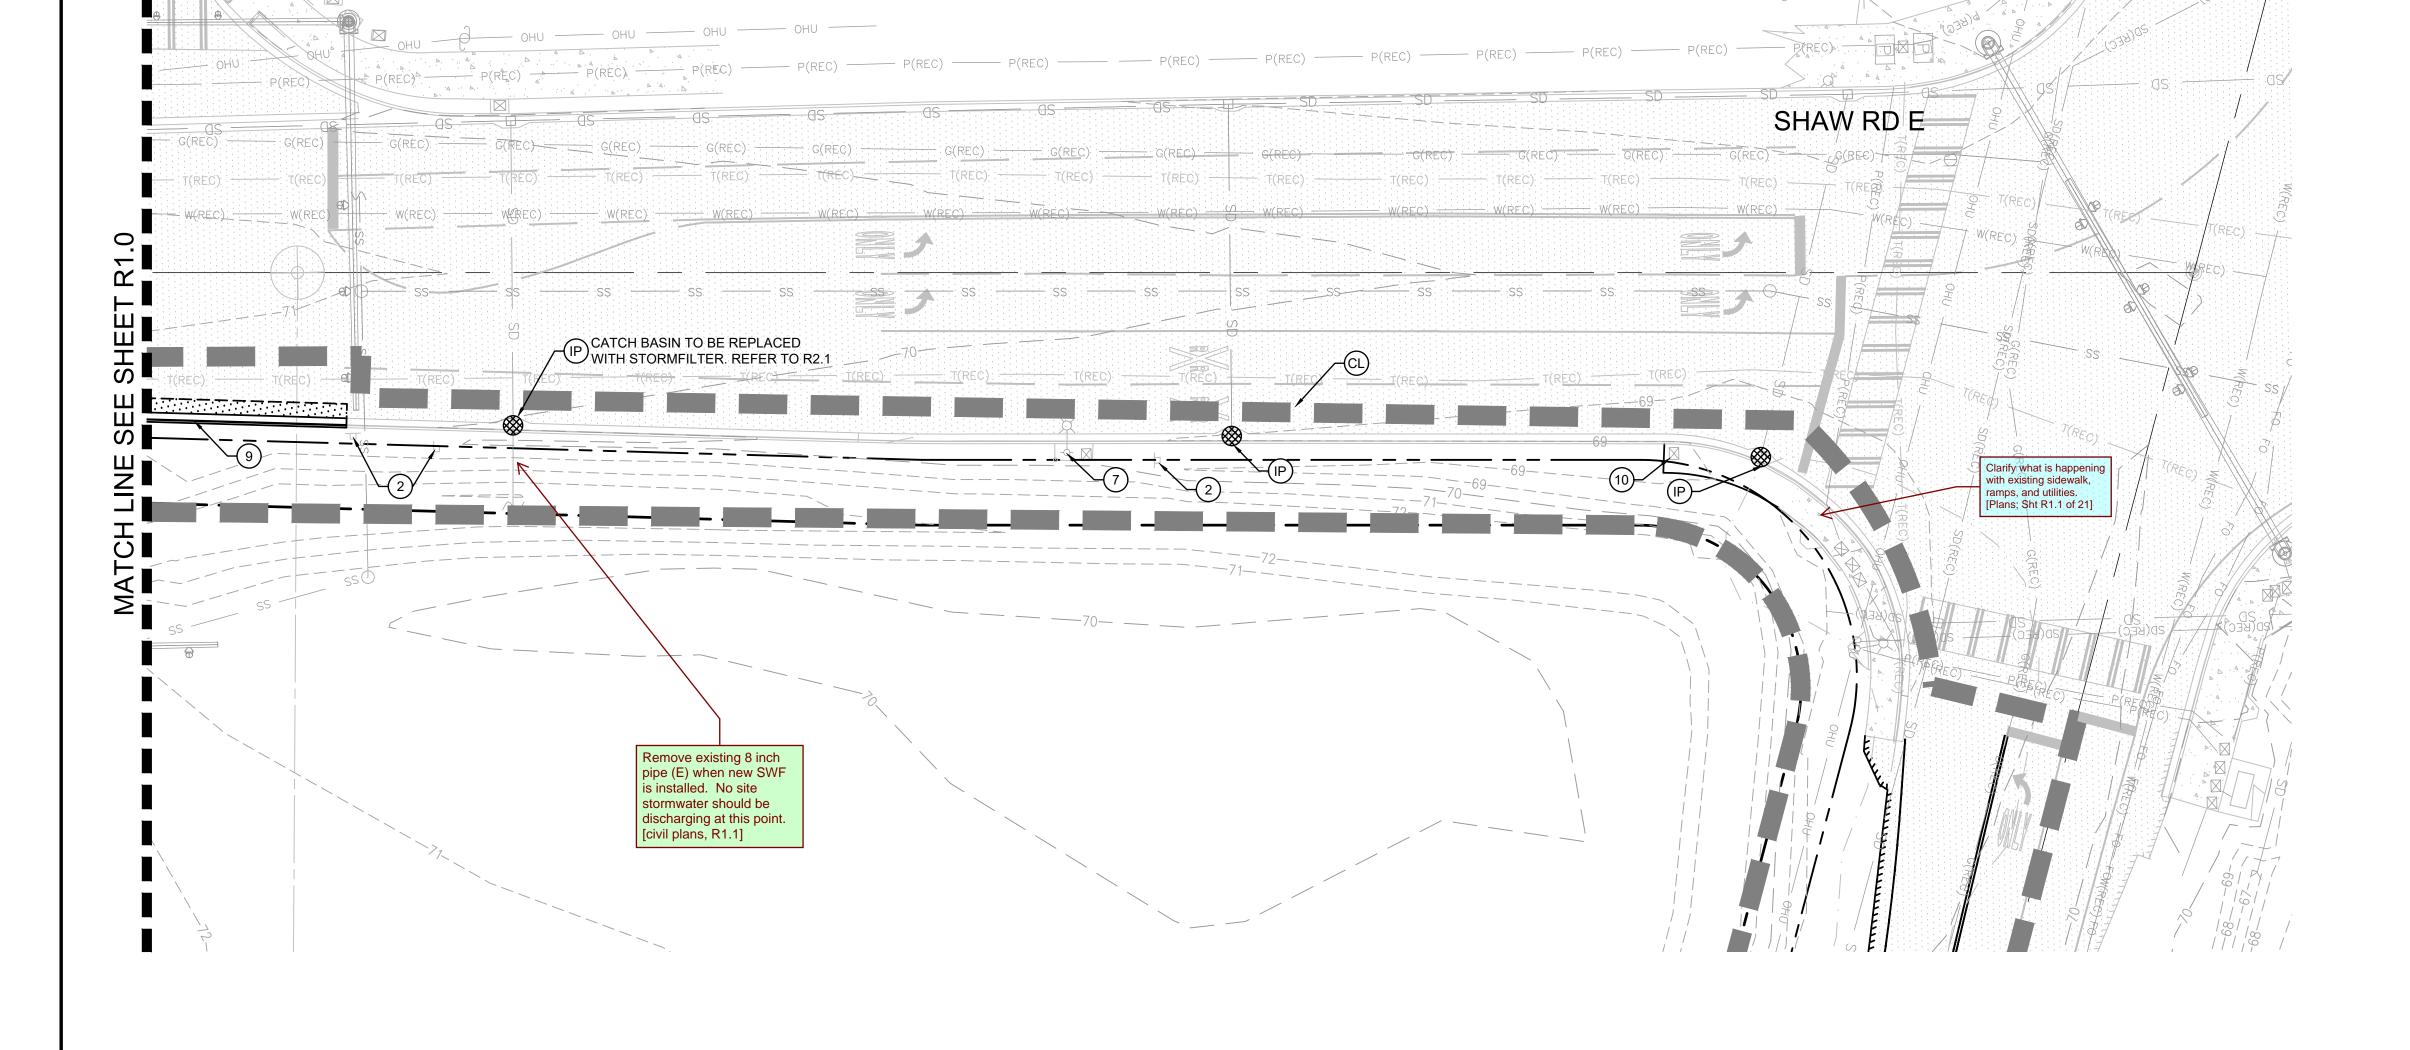



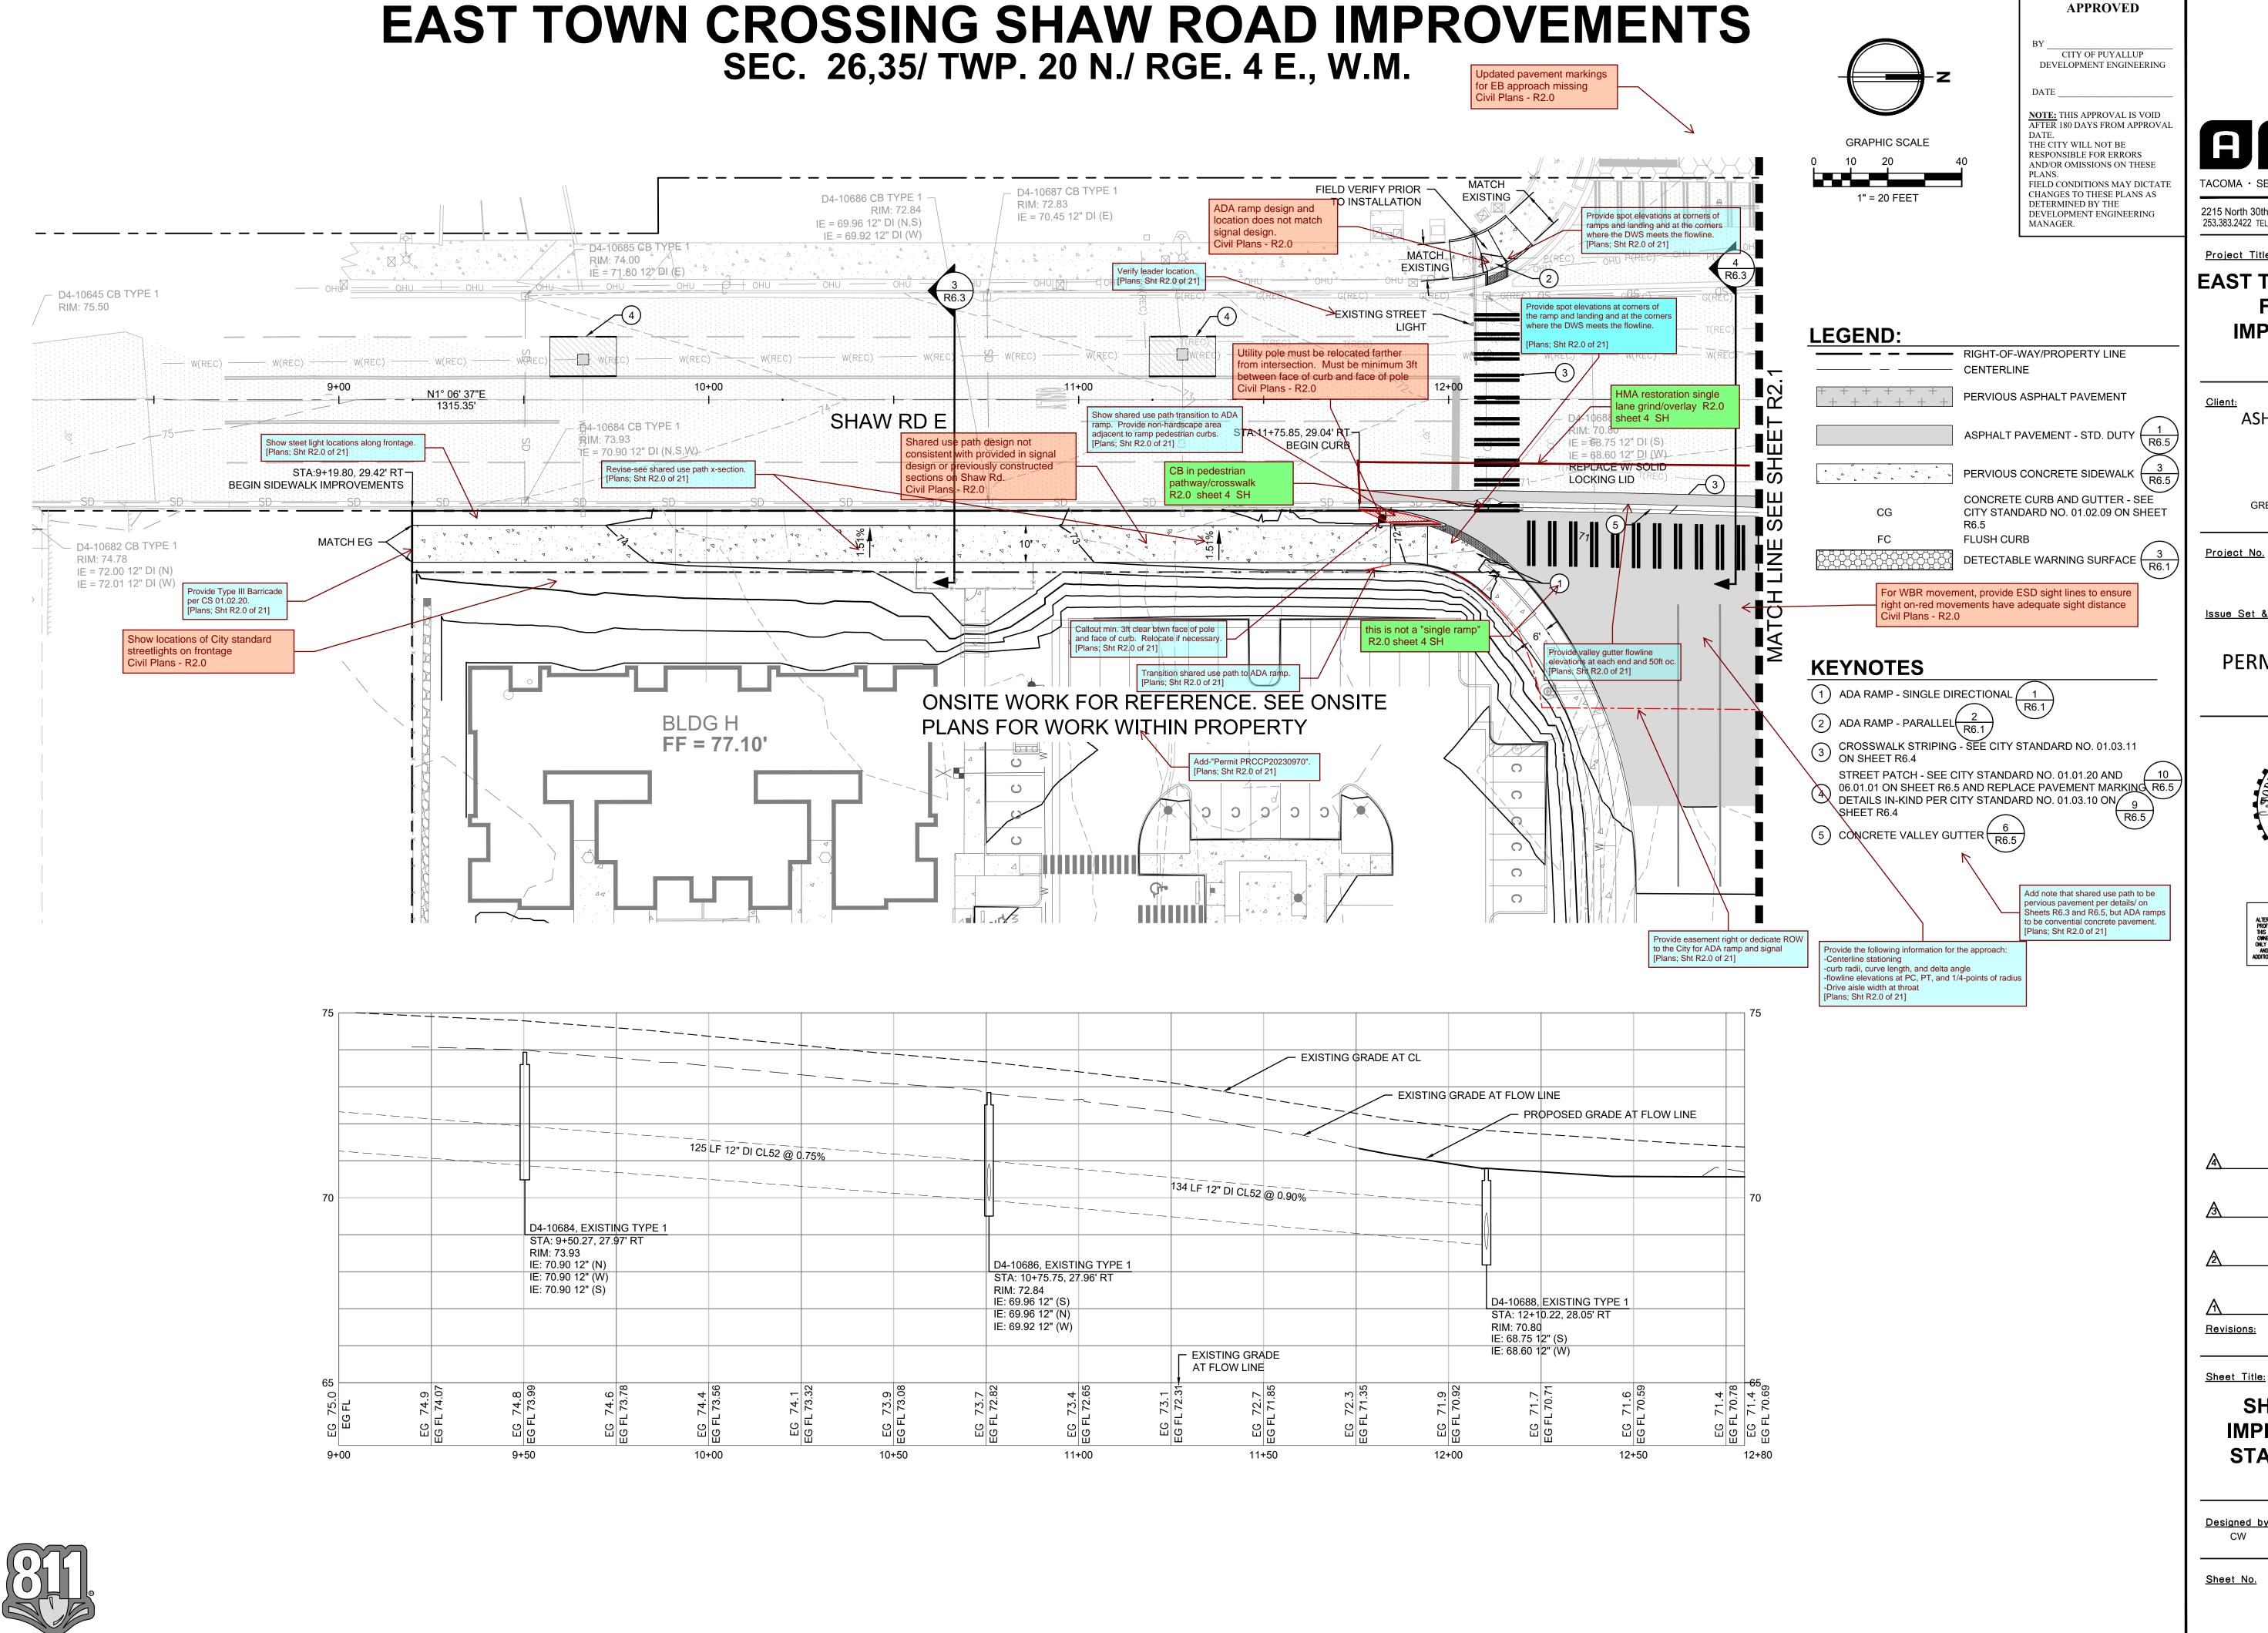

2215 North 30th Street, Suite 300, Tacoma, WA 98403 253.383.2422 TEL 253.383.2572 FAX www.ahbl.com WEB

Project Title:

EAST TOWN CROSSING FRONTAGE IMPROVEMENTS

ASH DEVELOPMENT

GREG HELLE

GREG.HELLE@ASHNW.COM


2230752

Issue Set & Date:

PERMIT SUBMITTAL

04/03/2024



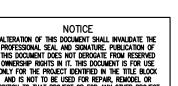


Sheet Title:


SHAW ROAD E **IMPROVEMENTS -**STA. 9+00 - 12+80

Designed by: Drawn by: Checked by:

Know what's below.

Call before you dig.

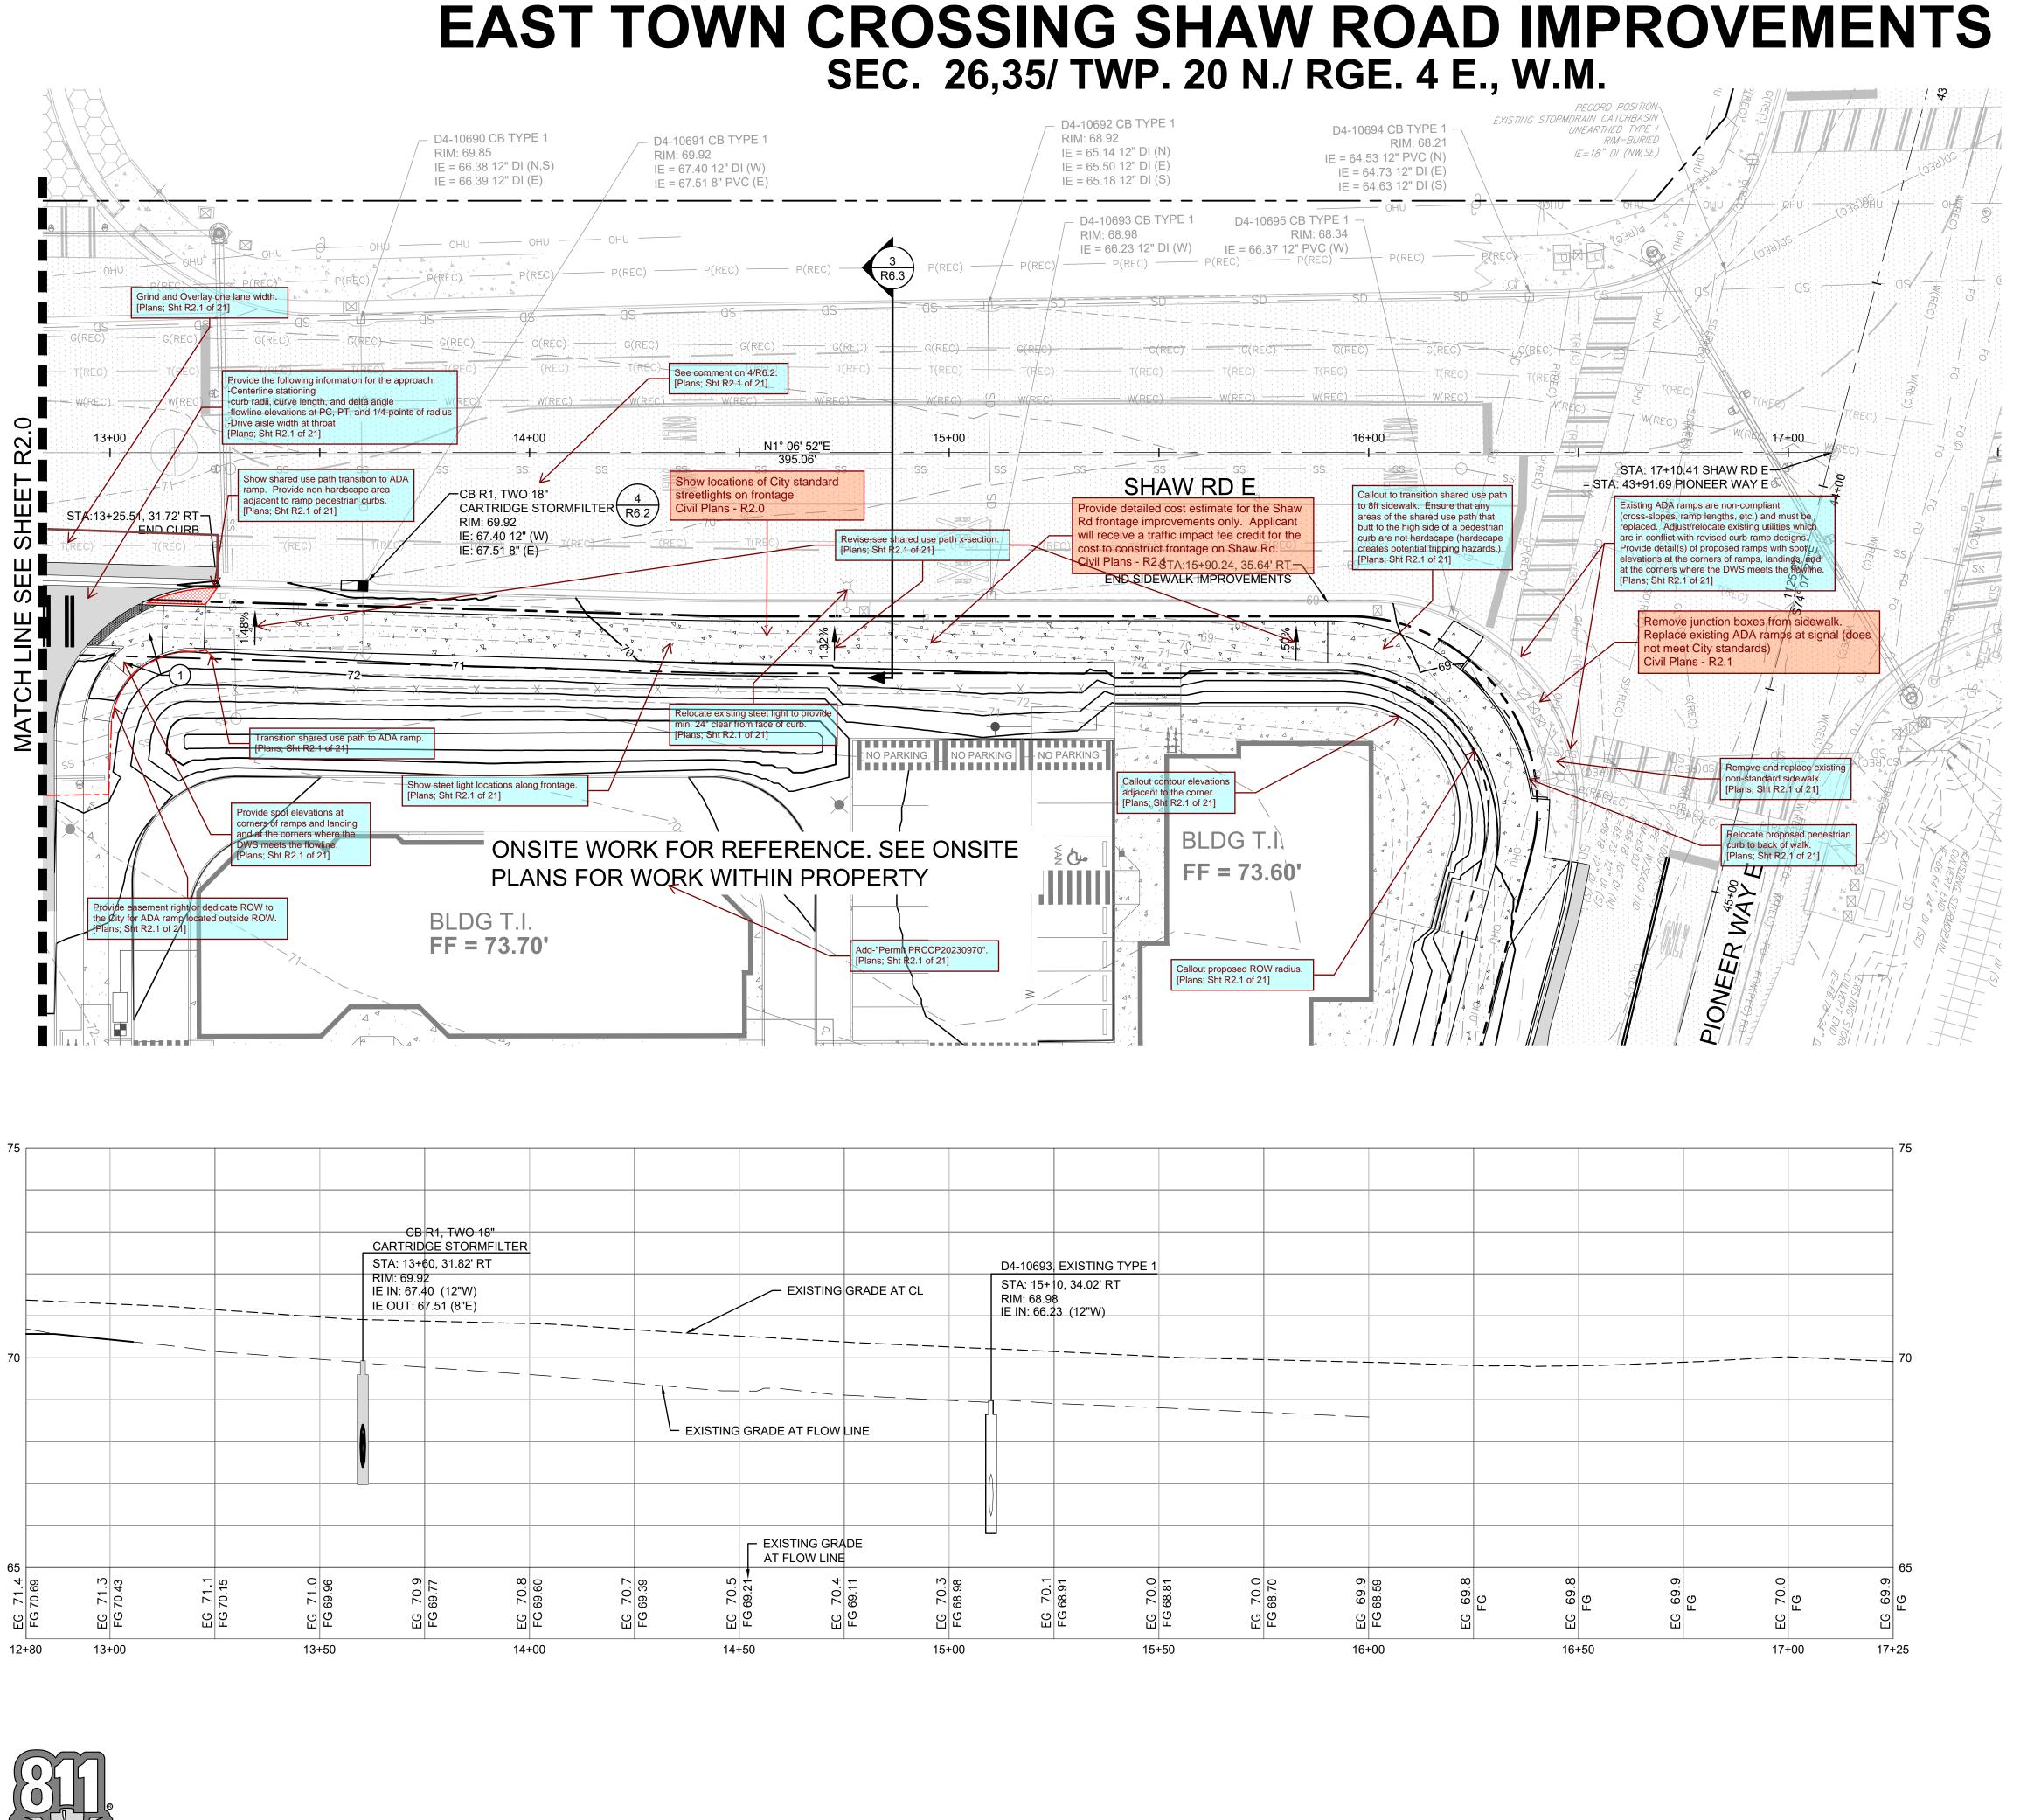

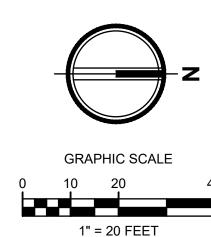


CITY OF PUYALLUP DEVELOPMENT ENGINEERING

APPROVED

NOTE: THIS APPROVAL IS VOID AFTER 180 DAYS FROM APPROVAL THE CITY WILL NOT BE RESPONSIBLE FOR ERRORS AND/OR OMISSIONS ON THESE

FIELD CONDITIONS MAY DICTATE CHANGES TO THESE PLANS AS DETERMINED BY THE DEVELOPMENT ENGINEERING 253.383.2422 TEL 253.383.2572 FAX www.ahbl.com WEB

LEGEND:

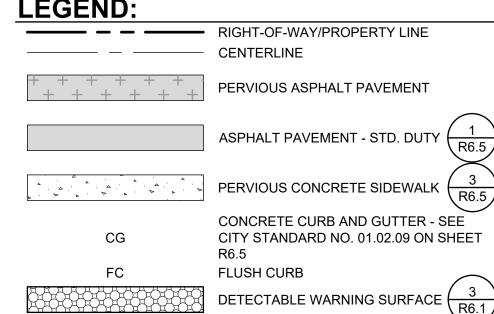


KEYNOTES

1 ADA RAMP - SINGLE DIRECTIONAL 1



- 3 CROSSWALK STRIPING SEE CITY STANDARD NO. 01.03.11 ON SHEET R6.4
- STREET PATCH SEE CITY STANDARD NO. 01.01.20 AND 06.01.01 ON SHEET R6.5 AND REPLACE PAVEMENT MARKING R6.5 DETAILS IN-KIND PER CITY STANDARD NO. 01.03.10 ON

(5) CONCRETE VALLEY GUTTER $\frac{6}{86.5}$

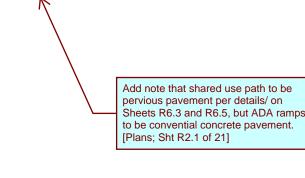



2215 North 30th Street, Suite 300, Tacoma, WA 98403

Project Title:

EAST TOWN CROSSING FRONTAGE IMPROVEMENTS

ASH DEVELOPMENT

GREG HELLE

GREG.HELLE@ASHNW.COM

<u>Project No.</u>


Issue Set & Date:

PERMIT SUBMITTAL

2230752

04/03/2024



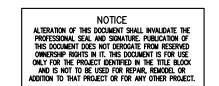

<u> </u>		
<u>A</u>		
A		
/2\		

Sheet Title:


SHAW ROAD E **IMPROVEMENTS -**STA. 12+80-17+25

Designed by: Drawn by: Checked by:

Sheet No.

5 of 21 Sheets

Know what's below.

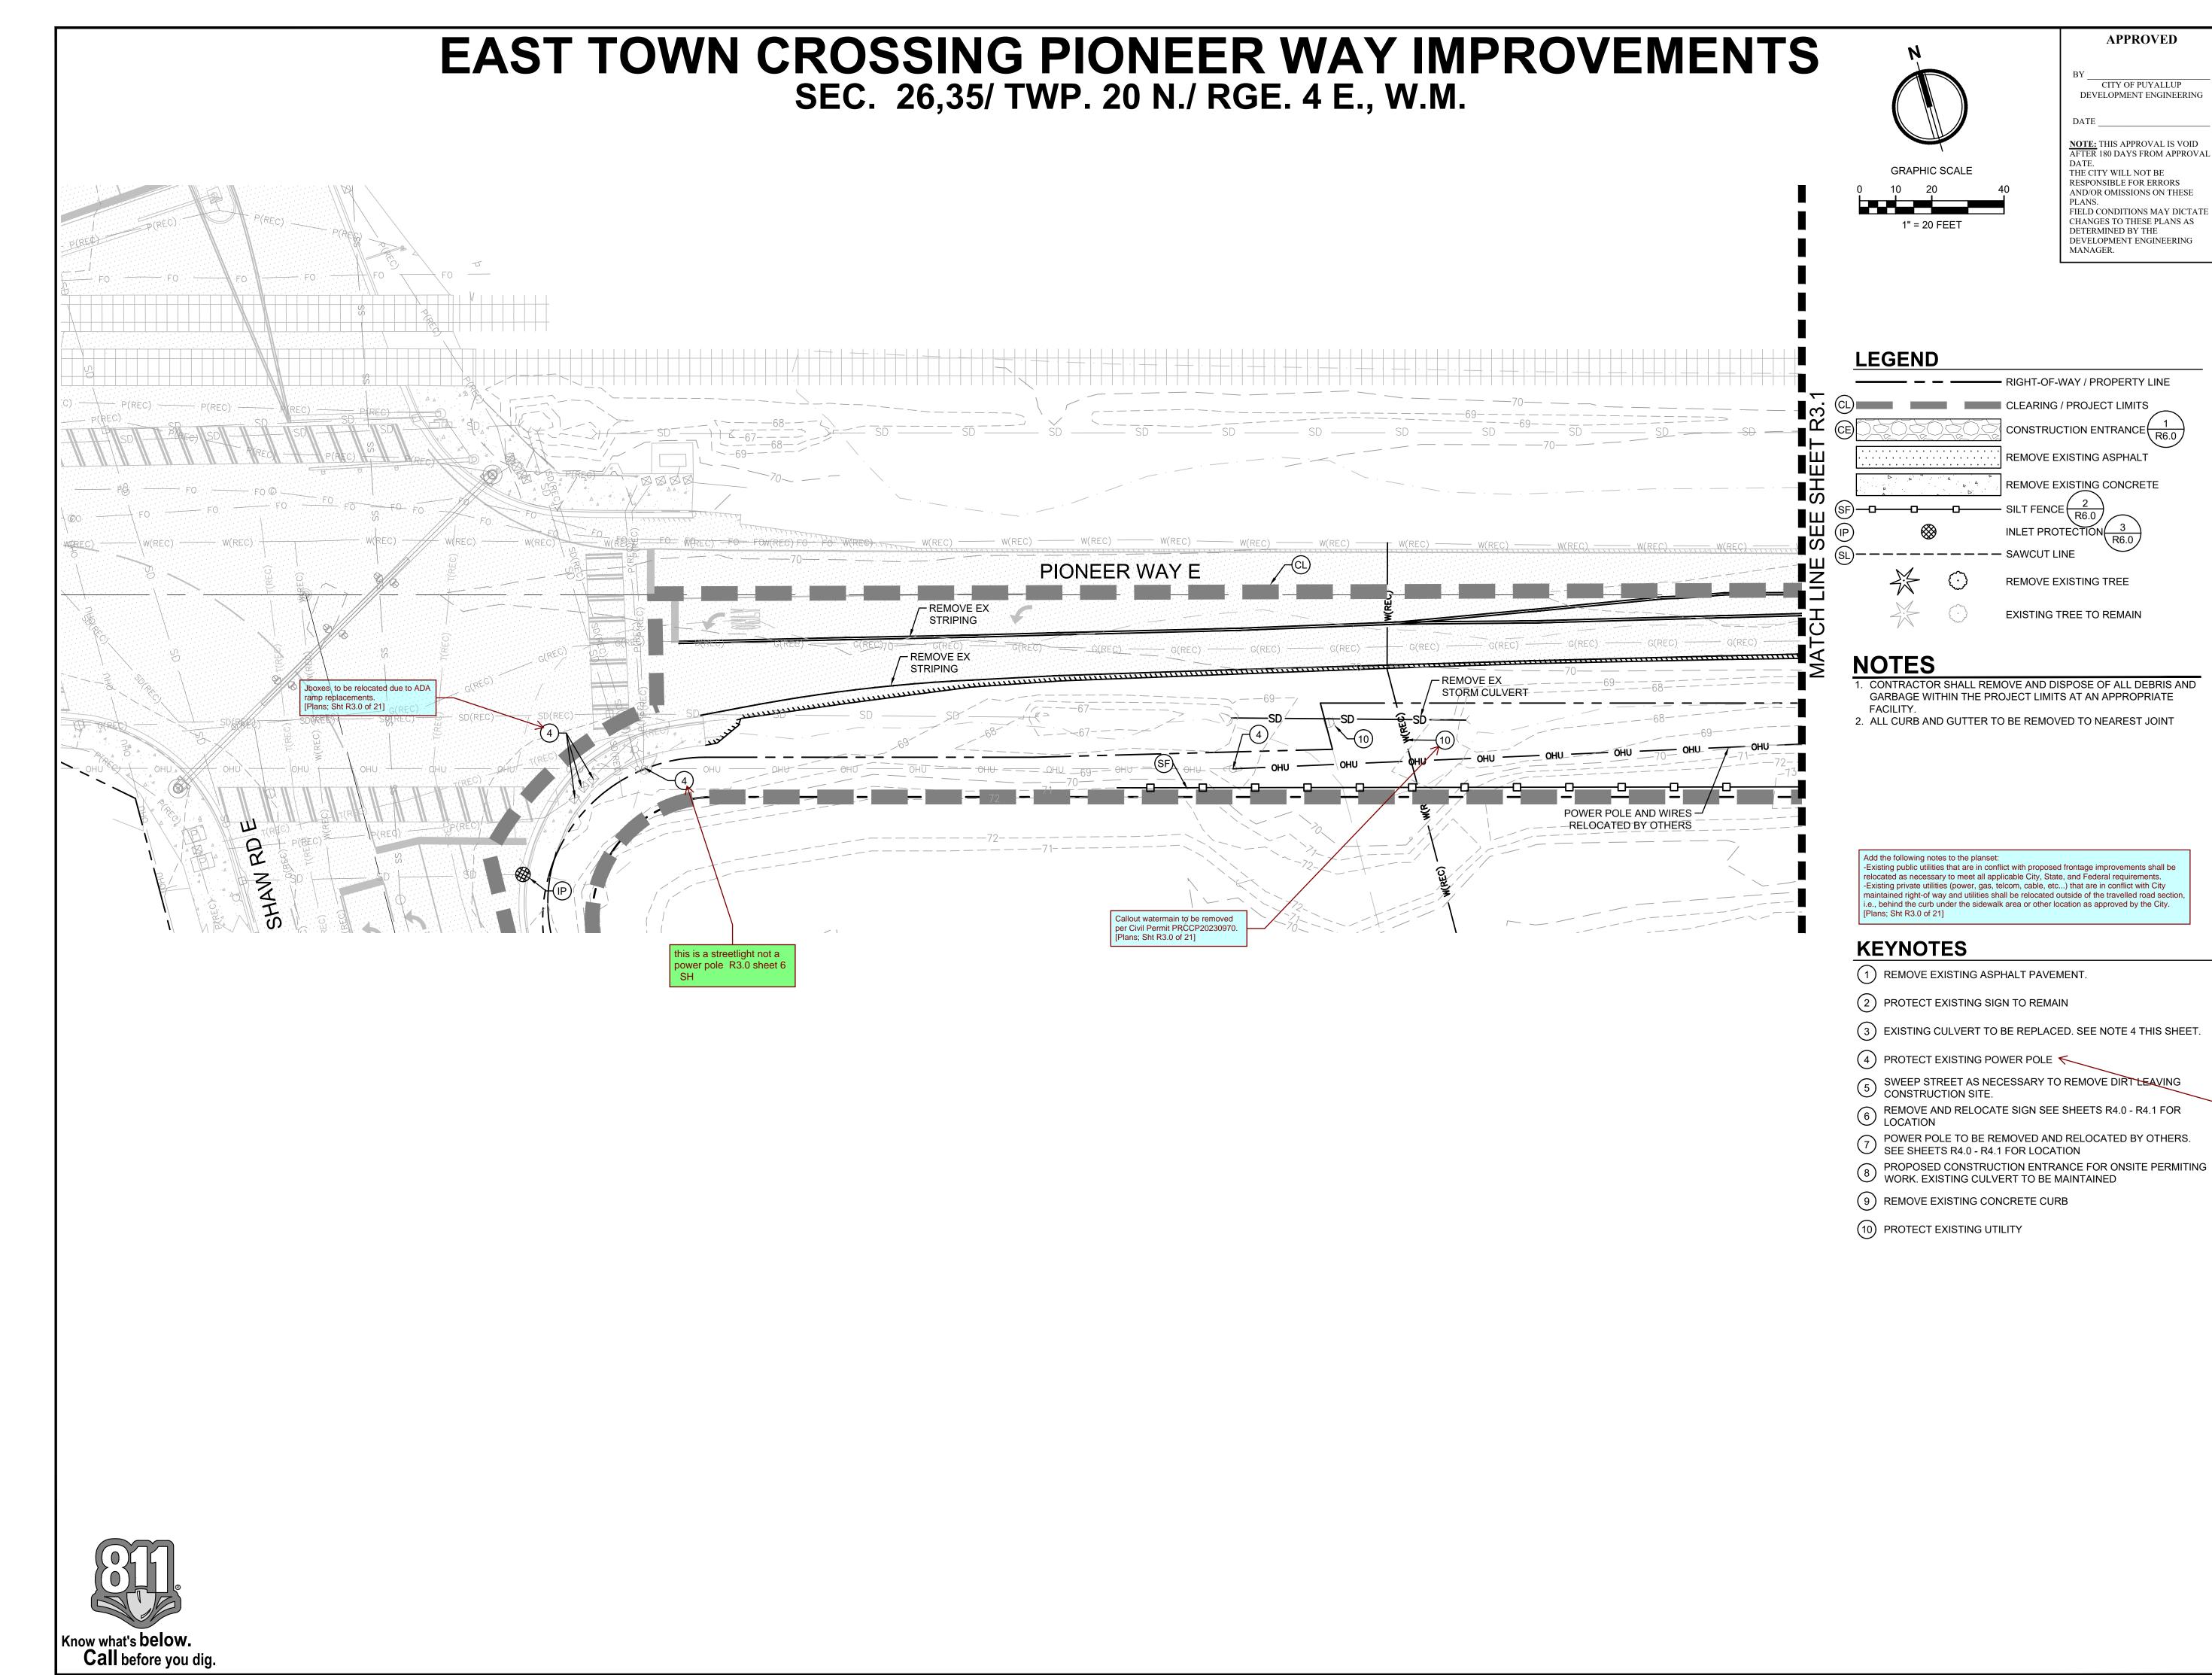

APPROVED

CITY OF PUYALLUP DEVELOPMENT ENGINEERING

NOTE: THIS APPROVAL IS VOID AFTER 180 DAYS FROM APPROVA

THE CITY WILL NOT BE RESPONSIBLE FOR ERRORS AND/OR OMISSIONS ON THESE CHANGES TO THESE PLANS AS

REMOVE EXISTING TREE



Project Title:

EAST TOWN CROSSING FRONTAGE IMPROVEMENTS

ASH DEVELOPMENT


GREG HELLE

<u>Project No.</u>

Issue Set & Date:

PERMIT SUBMITTAL



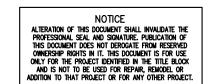

Clarify-Keynote 4 is also being used for existing light standard and j-boxes at the intersection. [Plans; Sht R3.0 of 21]

4		

Revisions:

Sheet Title:

PIONEER WAY E TESC AND DEMOLITION **PLAN**

Designed by: Drawn by: Checked by:

Sheet No.

EAST TOWN CROSSING PIONEER WAY IMPROVEMENTS SEC. 26,35/ TWP. 20 N./ RGE. 4 E., W.M. **LEGEND** PIONEER WAY E **NOTES** 1. CONTRACTOR SHALL REMOVE AND DISPOSE OF ALL DEBRIS AND treetlight to be removed. Lighting to be Civil Plans - R3.1 streetlight removed & relocated by others, who s others R3.1 sheet 7 SH **KEYNOTES** 1) REMOVE EXISTING ASPHALT PAVEMENT 2 PROTECT EXISTING SIGN TO REMAIN 3 EXISTING CULVERT TO BE REPLACED. SEE NOTE 4 THIS SHEET. 4 PROTECT EXISTING POWER POLE 5 SWEEP STREET AS NECESSARY TO REMOVE DIRT LEAVING CONSTRUCTION SITE. 6 REMOVE AND RELOCATE SIGN SEE SHEETS R4.0 - R4.1 FOR LOCATION 7 POWER POLE TO BE REMOVED AND RELOCATED BY OTHERS. SEE SHEETS R4.0 - R4.1 FOR LOCATION 8 PROPOSED CONSTRUCTION ENTRANCE FOR ONSITE PERMITING WORK. EXISTING CULVERT TO BE MAINTAINED 9 REMOVE EXISTING CONCRETE CURB 10) PROTECT EXISTING UTILITY

APPROVED

REMOVE EXISTING ASPHALT

REMOVE EXISTING TREE

EXISTING TREE TO REMAIN

Existing public utilities that are in conflict with proposed frontage improvements shall be cated as necessary to meet all applicable City, State, and Federal requirements.

Verify "Note 4" reference. [Plans; Sht R3.1 of 21]

CITY OF PUYALLUP DEVELOPMENT ENGINEERING

NOTE: THIS APPROVAL IS VOID AFTER 180 DAYS FROM APPROVAL

THE CITY WILL NOT BE RESPONSIBLE FOR ERRORS AND/OR OMISSIONS ON THESE CHANGES TO THESE PLANS AS DETERMINED BY THE

Project Title:

EAST TOWN CROSSING FRONTAGE IMPROVEMENTS

ASH DEVELOPMENT

GREG HELLE

<u>Project No.</u>


2230752

Issue Set & Date:

PERMIT SUBMITTAL

04/03/2024



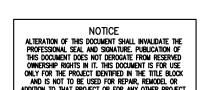

Revisions:

Sheet Title:

PIONEER WAY E TESC AND DEMOLITION **PLAN**


Designed by: Drawn by: Checked by:


Sheet No.

7 of 21 Sheets

Know what's below.

Call before you dig.

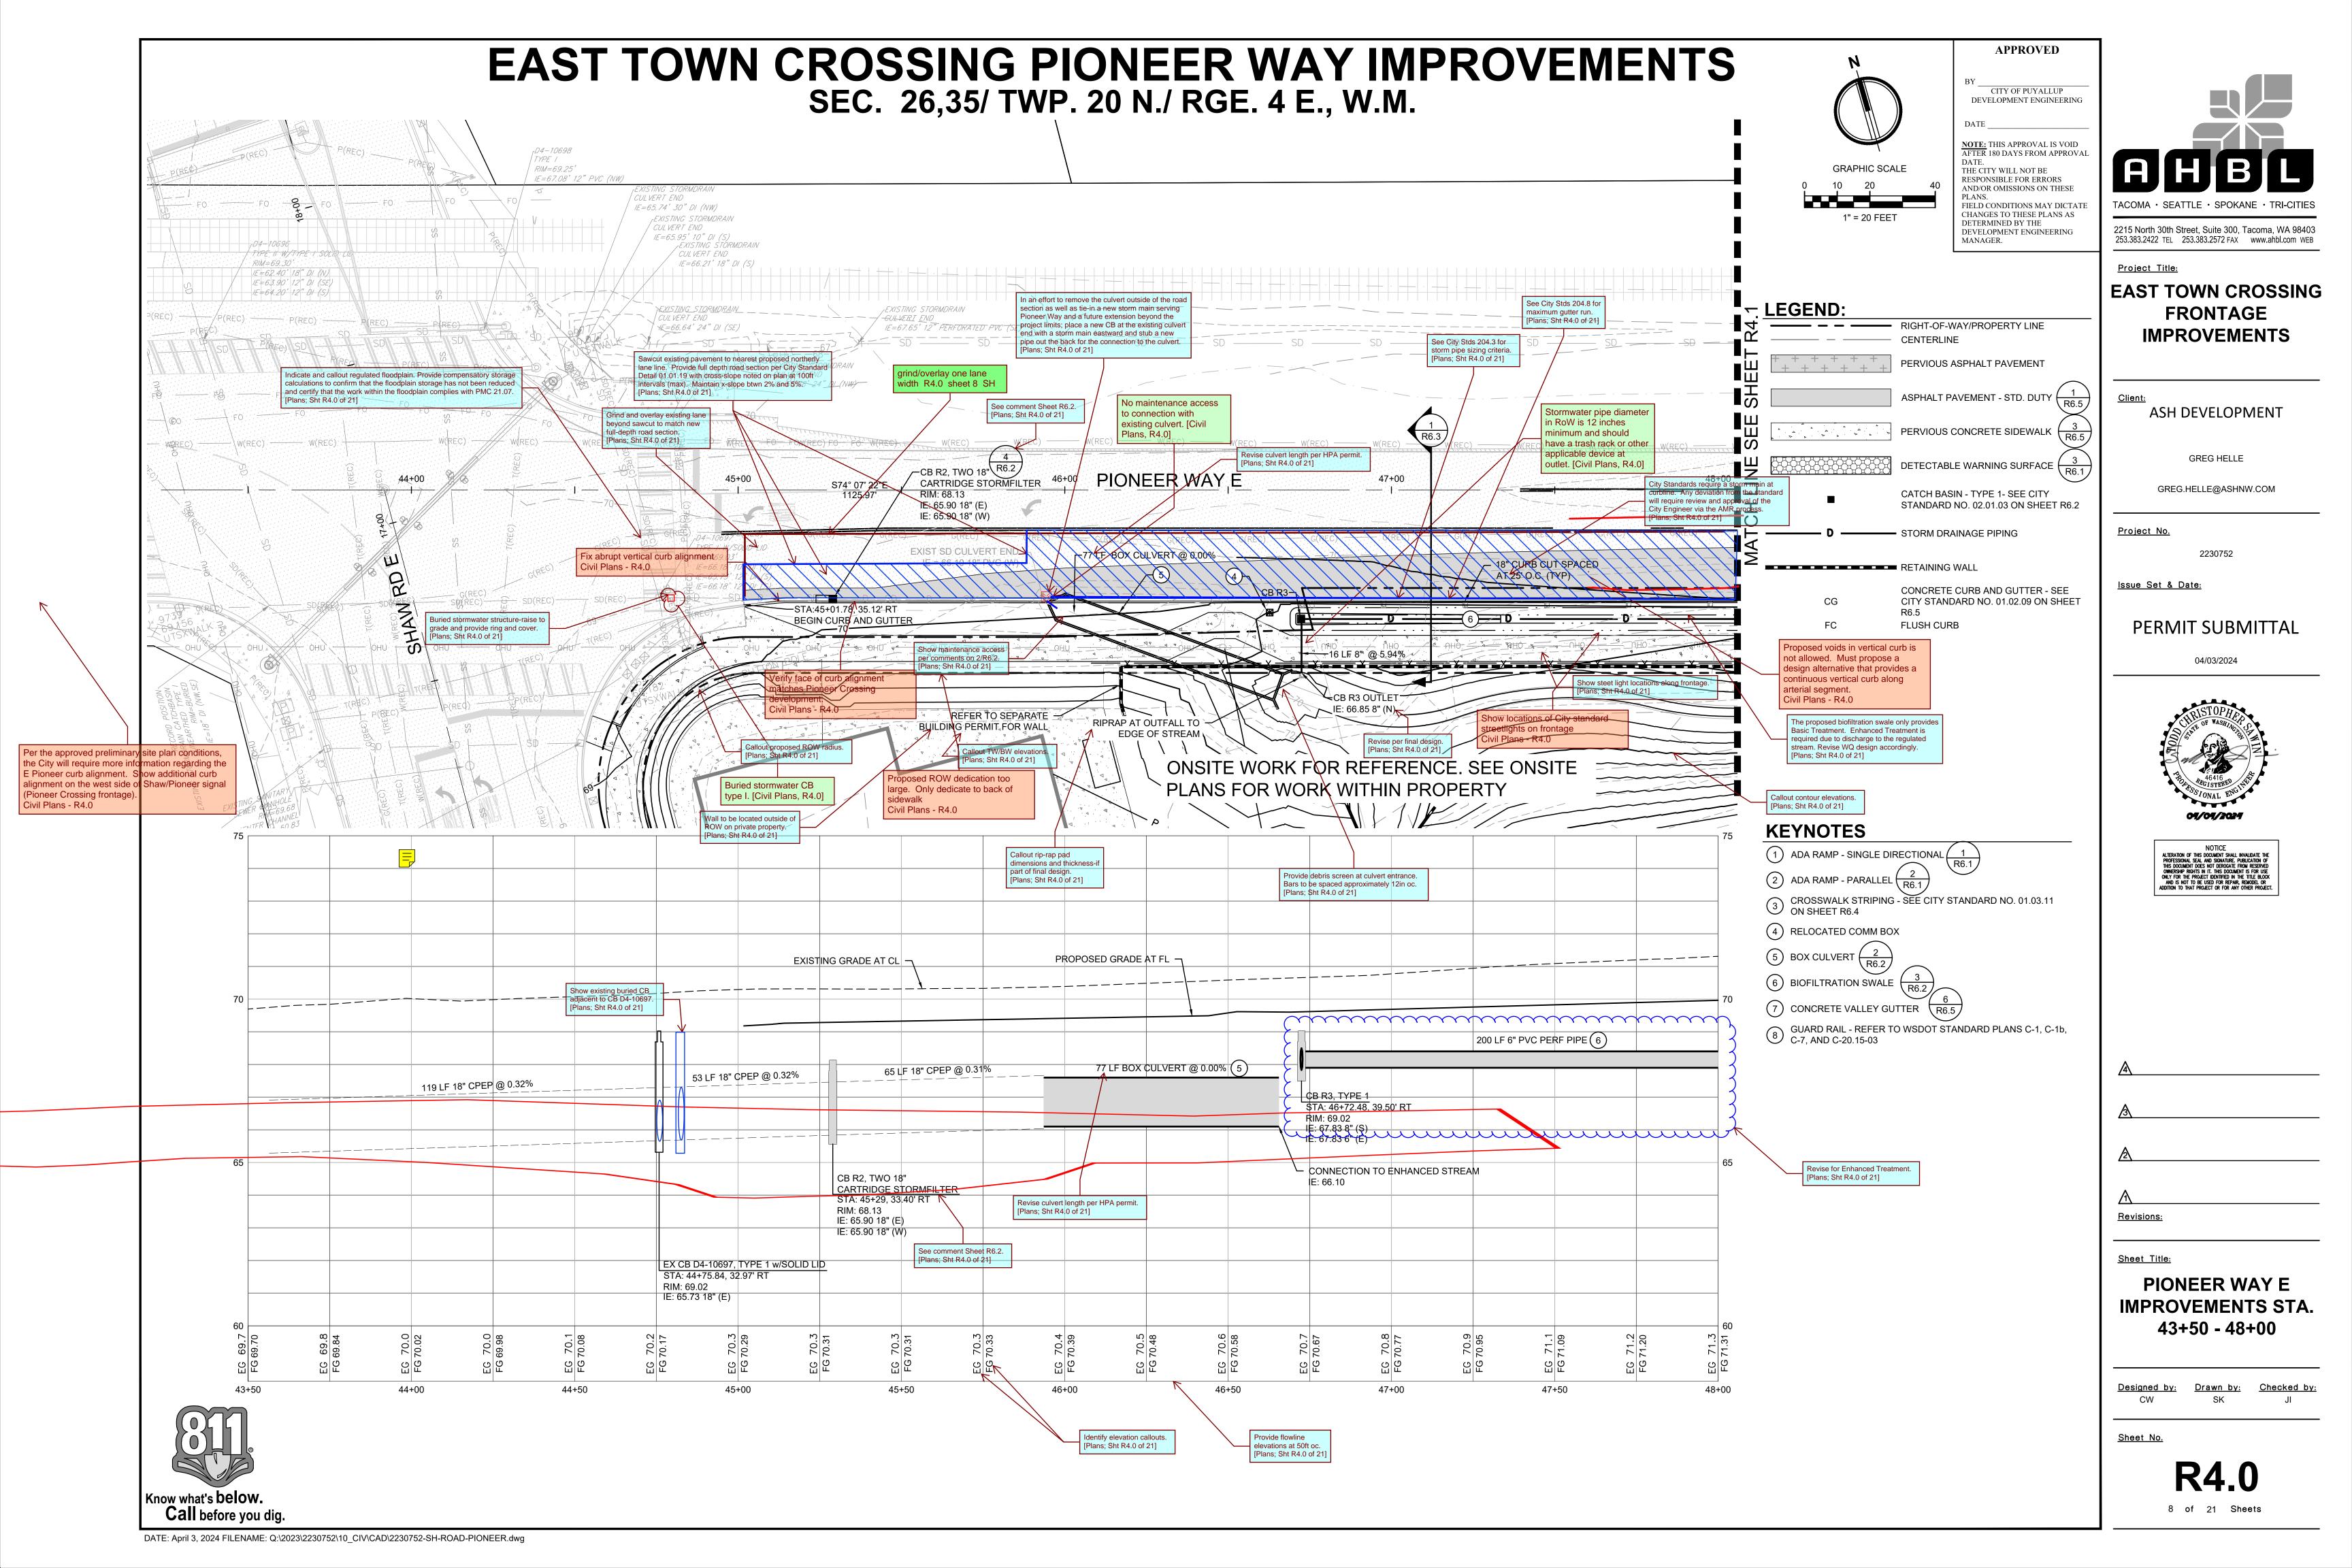

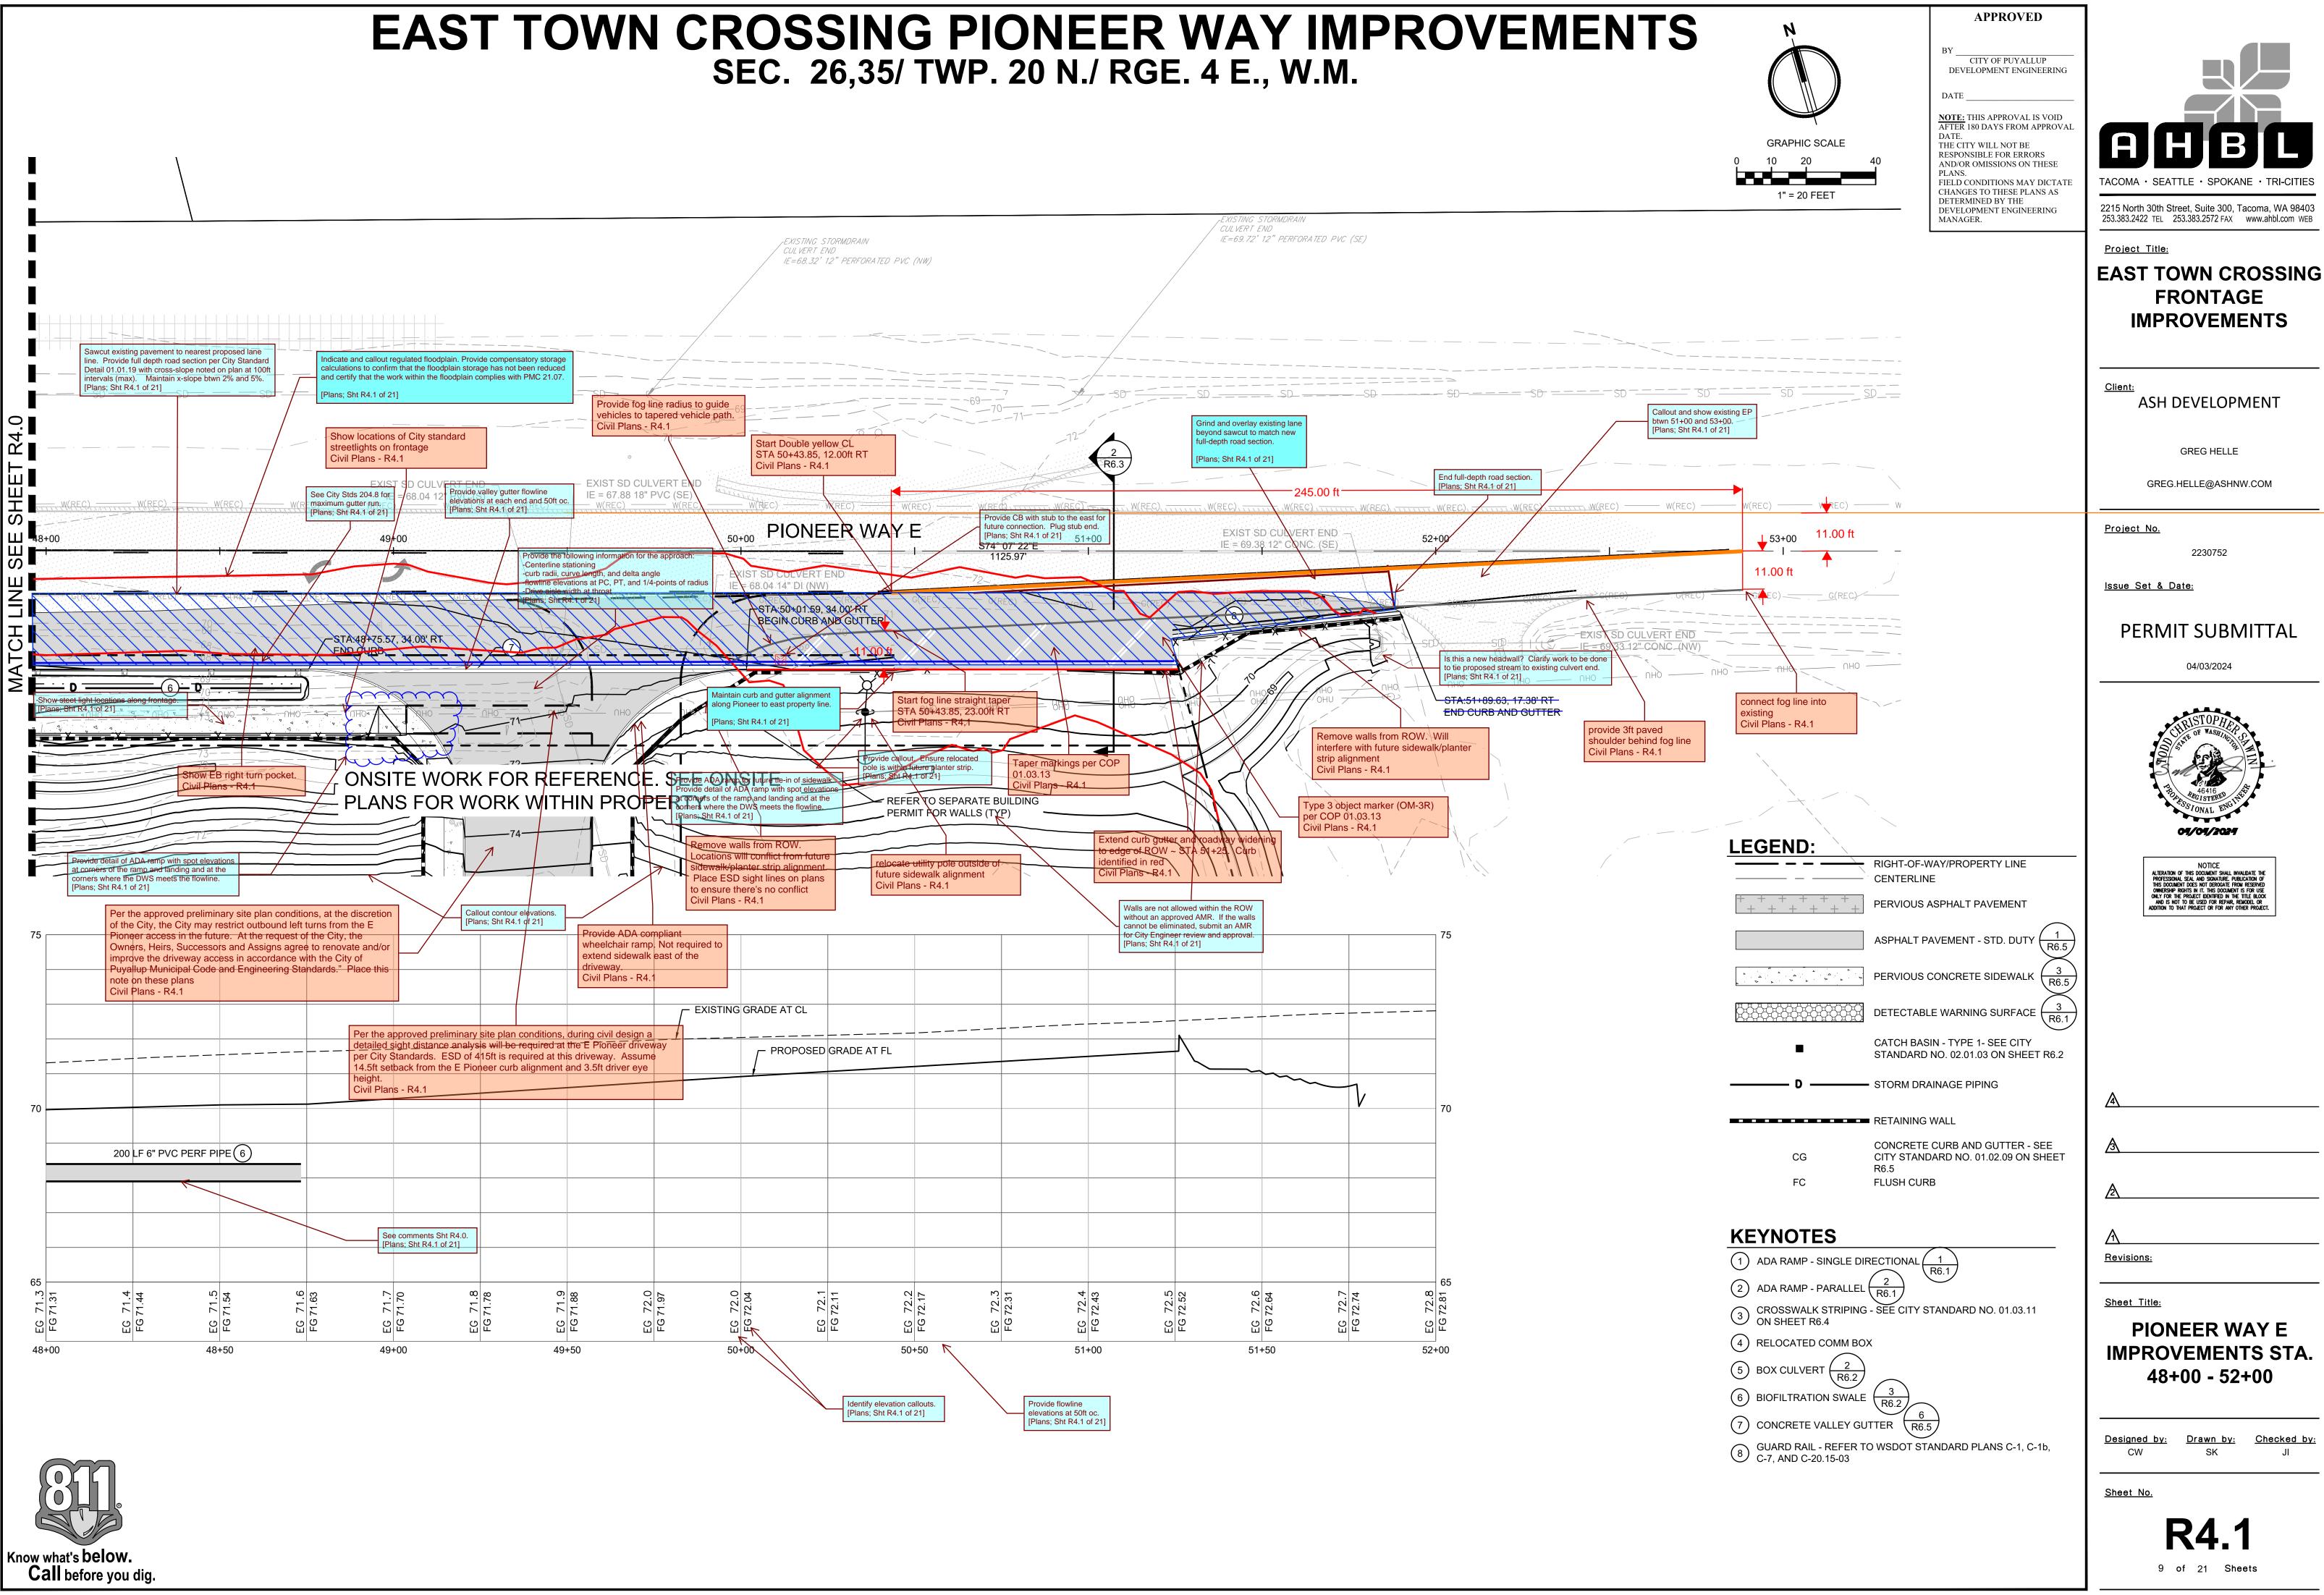

EAST TOWN CROSSING PIONEER WAY IMPROVEMENTS **APPROVED** SEC. 26,35/ TWP. 20 N./ RGE. 4 E., W.M. CITY OF PUYALLUP DEVELOPMENT ENGINEERING NOTE: THIS APPROVAL IS VOID AFTER 180 DAYS FROM APPROVAL **GRAPHIC SCALE** THE CITY WILL NOT BE RESPONSIBLE FOR ERRORS AND/OR OMISSIONS ON THESE Per approved preliminary site plan conditions, civil plan set shall provide a detailed channelization FIELD CONDITIONS MAY DICTATE plan for all striping & pavement markings in within ROW. All proposed striping shall meet City and CHANGES TO THESE PLANS AS 1" = 30 FEET MUTCD requirements. Plan shall include signage located in ROW. All City standard details DETERMINED BY THE related to pavement markings, striping, sign placement must be provided. DEVELOPMENT ENGINEERING Remove curvature Civil Plans - R5.0 marking removal should be on this Turn pocket markings do not meet City standards. New thermoplastic Per the approved preliminary site plan pavement markings required ASH DEVELOPMENT conditions, striping/paveme Civil Plan - R5.0 modifications required at Shaw/Pionee signal. With proposed improvements, EB approach will allow two lanes thru. Civil Plans - R5.0 STA:47+39.42, 0.00' STA:52+84.42, 0.00'¬ END DOUBLE YELLOW TAPER BEGIN YELLOW SOLID AND SKIP STA:50+39.42, 12.00' RT STA:47+49.42, 12.00' RT-END YELLOW SOLID AND SKIP LINE END DOUBLE YELLOW STA:48+89.42, 5.80' RT-BEGIN DOUBLE YELLOW TAPER BEGIN YELLOW SOLID AND SKIP LINE 2 LEFT TURN ARROW <u>Project No.</u> 49+00 PIONEER WAY E 50+00 51+00 BEGIN DOUBLE YELLOW -STA:50+45.31, 30.50' RT STA:52+40.41, 11.41' RT-END FOG LINE TAPER BEGIN FOG LINE TAPER Verify lane striping alignment with existing Provide short interval white skip **CHANNELIZATION NOTES:** striping on the vest side of signal. Civil Plans - R5 0 stripe in advance of solid white gore for right turn pocket FOR PAVEMENT MARKING DIMENSIONS SEE CITY STANDARD DETAIL 01.03.10 ON SHEET R6.4 Civil Plans - R5.0 rovide right turn pocket striping + 2. FOR TWO-WAY LEFT TURN REQUIREMENTS SEE CITY STANDARD DETAIL 01.03.07, 01.03.08 AND 01.03.09 ON SHEET R6.4 Channelization? Civil Plans - R5.0 Two EB lane striping not provided Provide MUTCD compliant "RIGHT Prior to Occupancy, execute and record LANE MUST TURN RIGHT" maintenance of private striping within the signage Civil Plans - R5.0 Provide stiping info for the approach. ROW) on form approved by the City Attorney. [Plans; Sht R5.0 of 21] Revisions: Sheet No. Know what's below. Call before you dig.



2215 North 30th Street, Suite 300, Tacoma, WA 98403 253.383.2422 TEL 253.383.2572 FAX www.ahbl.com WEB

Project Title:

EAST TOWN CROSSING FRONTAGE IMPROVEMENTS

GREG HELLE

GREG.HELLE@ASHNW.COM


2230752

Issue Set & Date:

PERMIT SUBMITTAL

04/03/2024



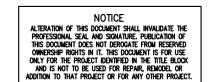

Sheet Title:

PIONEER WAY E CHANNELIZATION

PLAN

Designed by: Drawn by: Checked by:

EAST TOWN CROSSING FRONTAGE IMPROVEMENTS SEC. 26,35/ TWP. 20 N./ RGE. 4 E., W.M.

TESC INSPECTION NOTES:


- INSPECT ALL INLET PROTECTION ON CATCH BASINS. CLEAN OR REPLACE IF FULL OF SEDIMENT /DEBRIS AND REPAIR/REPLACE AS NEEDED IF DAMAGED TO MAINTAIN PROTECTION.
- INSPECT ALL PERMANENT AND TEMPORARY STABILIZED SLOPES. REPAIR ANY DAMAGED SECTIONS AND RE-VEGETATE AS NEEDED TO ENSURE THE ESTABLISHMENT OF VEGETATION AND THAT NO EROSION OF THE SLOPES OCCUR.
- INSPECT ALL FILTER FABRIC FENCING FOR SIGNS OF EROSION, DAMAGE OR FAILURES. REPAIR AND/OR REPLACE AS NEEDED. SEE FILTER FABRIC NOTES. SEDIMENT BUILD-UP ALONG FENCE SHALL BE REMOVED WHEN REACHES 1/3 THE FENCE HEIGHT. IF EROSION IS OCCURRING. CONTRACTOR SHALL INSTALL ADDITIONAL EROSION
- ANY FILL/CUT SLOPES SHALL BE INSPECTED FOR EROSION. IF SIGNS OF EROSION ARE PRESENT, INSTALL
- APPROPRIATE BMPS AS NEEDED TO STOP EROSION AND STABILIZE SLOPES. TESC LEAD RESPONSIBLE FOR NOTIFYING ENGINEER IF ADDITIONAL MEASURES ARE WARRANTED

PERMANENT STABILIZATION NOTES:

- 1. ALL EXPOSED SOILS AND SLOPES SHALL BE SEEDED OR OTHERWISE STABILIZED IMMEDIATELY AFTER CONSTRUCTION AND GRADING ACTIVITIES HAVE BEEN COMPLETED. 2. SILT FENCE, IF DEEMED APPROPRIATE, SHALL REMAIN FOR A MINIMUM OF 30 DAYS AFTER THE FINAL STABILIZATION OF
- 3. ALL TEMPORARY EROSION CONTROL BMP'S SHALL BE REMOVED 30 DAYS AFTER FINAL STABILIZATION HAS OCCURRED
- AS DIRECTED BY CITY OR COUNTY INSPECTOR. 4. CONTRACTOR SHALL REFER TO THE CONSTRUCTION SWPP FOR APPLICABLE BMPS

CONSTRUCTION ENTRANCE NOTES:


- 1. MATERIAL SHALL BE 4" TO 8" QUARRY SPALLS (4 TO 6 INCH FOR RESIDENTIAL SINGLE FAMILY LOTS) AND MAY BE
- 2. THE ROCK PAD SHALL BE AT LEAST 12" THICK AND 100' LONG (REDUCED TO 20 FEET FOR SITES LESS THAN 1 ACRE OF DISTURBED SOIL) WIDTH SHALL BE FULL WIDTH OF INGRESS AND EGRESS AREA. SMALLER PADS MAY BE APPROVED FOR SINGLE-FAMILY RESIDENTIAL AND COMMERCIAL SITES.
- 3. ADDITIONAL ROCK SHALL BE ADDED PERIODICALLY TO MAINTAIN FUNCTION OF THE PAD.
- 4. IF THE PAD DOES NOT ADEQUATELY REMOVE MUD FROM THE VEHICLE WHEELS, THE WHEELS SHALL BE HOSED OFF BEFORE THE VEHICLE ENTERS A PAVED STREET.THE WASHING SHALL BE DONE ON AN AREA COVERED WITH CRUSHED
- ROCK AND WASH WATER SHALL DRAIN TO A SEDIMENT RETENTION FACILITY OR THROUGH A SILT FENCE. CONSTRUCTION ACCESS IS FORBIDDEN ALONG SHAW ROAD FOR THE DURATION OF CONSTRUCTION.

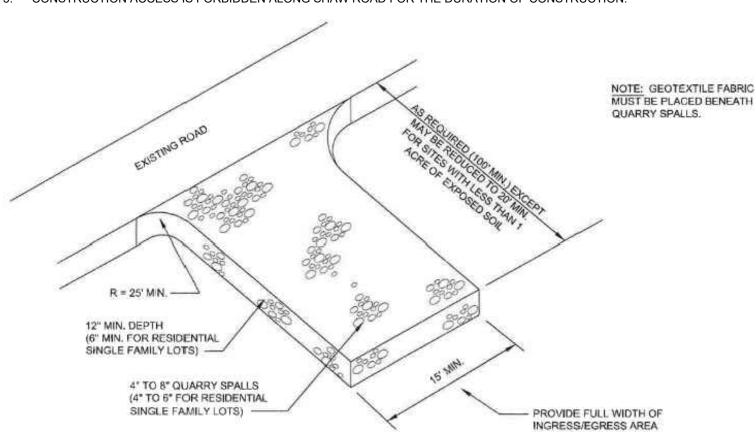

CONSTRUCTION ENTRANCE

FILTER FABRIC FENCE NOTES

- SUPPORT POST, WITH A MINIMUM 6-INCH OVERLAP. AND SECURELY FASTENED AT BOTH ENDS TO POSTS.
- POSTS SHALL BE SPACED A MAXIMUM OF 6 FEET APART AND DRIVEN SECURELY INTO THE GROUND (MINIMUM OF 30
- A TRENCH SHALL BE EXCAVATED APPROXIMATELY 8 INCHES WIDE AND 12 INCHES DEEP ALONG THE LINE OF POSTS AND UPSLOPE FROM THE BARRIER. THIS TRENCH SHALL BE BACKFILLED WITH WASHED GRAVEL.
- WHEN STANDARD STRENGTH FILTER FABRIC IS USED, A WIRE MESH SUPPORT FENCE SHALL BE FASTENED SECURELY TO THE UPSLOPE SIDE OF THE POSTS USING HEAVY-DUTY WIRE STAPLES AT LEAST 1 INCH LONG, TIE WIRES OR HOG RINGS. THE WIRE SHALL EXTEND INTO THE TRENCH A MINIMUM OF 4 INCHES AND SHALL NOT EXTEND MORE THAN 24 INCHES ABOVE
- THE ORIGINAL GROUND SURFACE. THE STANDARD STRENGTH FILTER FABRIC SHALL BE STAPLED OR WIRED TO THE FENCE, AND 20 INCHES OF THE FABRIC SHALL BE EXTENDED INTO THE TRENCH. THE FABRIC SHALL NOT EXTEND MORE THAN 24 INCHES ABOVE THE ORIGINAL GROUND SURFACE. FILTER FABRIC SHALL NOT BE STAPLED TO EXISTING TREES.
- WHEN EXTRA-STRENGTH FILTER FABRIC AND CLOSER POST SPACING IS USED, THE WIRE MESH SUPPORT FENCE MAY BE ELIMINATED. IN SUCH A CASE, THE FILTER FABRIC IS STAPLED OR WIRED DIRECTLY TO THE POSTS WITH ALL OTHER PROVISIONS OF ABOVE NOTES APPLYING
- FILTER FABRIC FENCES SHALL NOT BE REMOVED BEFORE THE UPSLOPE AREA HAS BEEN PERMANENTLY STABILIZED. FILTER FABRIC FENCES SHALL BE INSPECTED IMMEDIATELY AFTER EACH RAINFALL AND AT LEAST DAILY DURING
- PROLONGED RAINFALL. ANY REQUIRED REPAIRS SHALL BE MADE IMMEDIATELY. SILT FENCES WILL BE INSTALLED PARALLEL TO ANY SLOPE CONTOURS.
- CONTRIBUTING LENGTH TO FENCE WILL NOT BE GREATER THAN 100 FEET.
- DO NOT INSTALL BELOW AN OUTLET PIPE OR WEIR.
- INSTALL DOWNSLOPE OF EXPOSED AREAS. DO NOT DRIVE OVER OR FILL OVER SILT FENCES

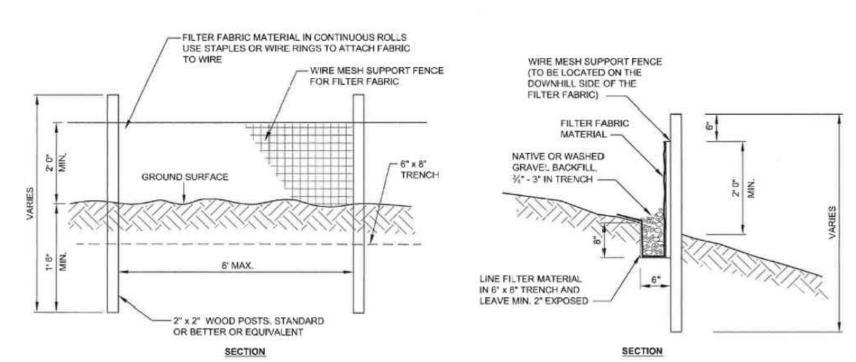

AMENDED SOILS NOTES:

- SOIL AMENDMENTS ARE REQUIRED FOR ALL DISTURBED AREAS IN ACCORDANCE WITH BMP L613: POST-CONSTRUCTION SOIL QUALITY AND DEPTH OF THE 2021 SURFACE WATER MANAGEMENT MANUAL
- AMENDED SOILS SHALL BE A MINIMUM OF 8" (NON-COMPACTED) WITH SUBSOILS SCARIFIED AT LEAST 4" WITH INCORPORATION OF THE UPPER MATERIAL TO AVOID STRATIFIED LAYERS, WHERE FEASIBLE.
- QUALITY OF COMPOST AND OTHER MATERIALS USED TO MEET THE ORGANIC CONTENT REQUIREMENTS ARE AS FOLLOWS:
- a. THE ORGANIC CONTENT FOR "PRE-APPROVED" AMENDMENT RATES CAN BE MET ONLY USING COMPOST THAT MEETS THE DEFINITION OF "COMPOSTED MATERIALS" IN WAC 173-350-220. THE WAC IS AVAILABLE ONLINE AT: HTTP://WWW.ECY.WA.GOV/PROGRAMS/SWFA/FACILITIES/350.HTML THE COMPOST MUST ALSO HAVE AN ORGANIC MATTER CONTENT OF 35% TO 65%, AND A CARBON TO NITROGEN RATIO BELOW 25:1. THE CARBON TO NITROGEN RATIO MAY BE AS
- HIGH AS 35: 1 FOR PLANTINGS COMPOSED ENTIRELY OF PLANTS NATIVE TO THE PUGET SOUND LOWLANDS REGION. CALCULATED AMENDMENT RATES MAY BE MET THROUGH USE OF COMPOSTED MATERIALS AS DEFINED ABOVE; OR OTHER ORGANIC MATERIALS AMENDED TO MEET THE CARBON TO NITROGEN RATIO REQUIREMENTS. AND MEETING THE CONTAMINANT STANDARDS OF GRADE A COMPOST
- USE ONE OF THE FOLLOWING OPTIONS TO MEET THE POST CONSTRUCTION SOIL QUALITY AND DEPTH REQUIREMENTS. USE THE MOST RECENT VERSION OF "GUIDELINES FOR RESOURCES FOR IMPLEMENTING SOIL QUALITY AND DEPTH BMP T5.13" TO MEET THE REQUIREMENTS OF THIS BMP. THIS GUIDANCE CAN BE FOUND ONLINE AT:WWW.SOILSFORSALMON.ORG LEAVE NATIVE VEGETATION AND SOIL UNDISTURBED, AND PROTECT FROM COMPACTION DURING CONSTRUCTION
- AMEND EXISTING SITE TOPSOIL OR SUBSOIL EITHER AT DEFAULT "PRE-APPROVED" RATES, OR AT CUSTOM CALCULATED RA TES BASED ON SPECIFIC TESTS OF THE SOIL AND AMENDMENT
- STOCKPILE EXISTING TOPSOIL DURING GRADING, AND REPLACE IT PRIOR TO PLANTING. STOCKPILED TOPSOIL MUST ALSO BE AMENDED IF NEEDED TO MEET THE ORGANIC MATTER OR DEPTH REQUIREMENTS, EITHER AT A DEFAULT "PRE-APPROVED" RATE OR AT A CUSTOM CALCULATED RATE
- IMPORT TOPSOIL MIX OF SUFFICIENT ORGANIC CONTENT AND DEPTH TO MEET THE REQUIREMENTS. MORE THAN ONE METHOD MAY BE USED ON DIFFERENT PORTIONS OF THE SAME SITE. SOIL THAT ALREADY MEETS THE DEPTH AND ORGANIC MATTER QUALITY STANDARDS, AND IS NOT COMPACTED, DOES NOT NEED TO BE AMENDED.
- AMENDED SOILS SHALL BE MAINTAINED AS FOLLOWS SOIL QUALITY AND DEPTH SHOULD BE ESTABLISHED TOWARD THE END OF CONSTRUCTION AND ONCE ESTABLISHED,
- SHOULD BE PROTECTED FROM COMPACTION, SUCH AS FROM LARGE MACHINERY USE, AND FROM EROSION.
- SOIL SHOULD BE PLANTED AND MULCHED AFTER INSTALLATION.
- PLANT DEBRIS OR ITS EQUIVALENT SHOULD BE LEFT ON THE SOIL SURFACE TO REPLENISH ORGANIC MA TIER. d. IT SHOULD BE POSSIBLE TO REDUCE USE OF IRRIGATION, FERTILIZERS, HERBICIDES AND PESTICIDES. THESE ACTIVITIES
- SHOULD BE ADJUSTED WHERE POSSIBLE, RATHER THAN CONTINUING TO IMPLEMENT FORMERLY ESTABLISHED PRACTICES
- SEE PROJECT CONSTRUCTION SWPPP FOR ADDITIONAL INFORMATION OR SECTION 2.2.1.4 OF CHAPTER 2 OF VOLUME 6 OF THE 2021 SURFACE WATER MANAGEMENT MANUAL

MULCHING NOTES:

- MULCH MATERIALS USED SHALL BE STRAW OR HAY, AND SHALL BE APPLIED AT THE RATE OF 75-100 POUNDS PER 1000
- MULCH SHALL BE APPLIED IN ALL AREAS WITH EXPOSED SLOPES GREATER THAN 2: 1.
- MULCHING SHALL BE USED IMMEDIATELY AFTER SEEDING OR IN AREAS WHICH CANNOT BE SEEDED BECAUSE OF THE
- 4. ALL AREAS NEEDING MULCH SHALL BE COVERED BY NOVEMBER 1

CONTRACTOR NOTES

- INLET PROTECTION SHALL BE INSTALLED IN ALL NEWLY CONSTRUCTED CATCH BASINS AND ALONG ALL IMPACTED FRONTAGE AND OFFSITE AREAS PER THE REQUIREMENTS OF THE COUNTY INSPECTOR PER DETAIL 5 ON THIS SHEET 5 CONSTRUCTION FENCE CAN BE UTILIZED IN PLACE OF FILTER FABRIC FENCE ONLY IN AREAS WHERE THE GRADES DO
- NOT ALLOW THE POTENTIAL FOR ANY STORMWATER TO LEAVE THE SITE. ALL DEMOLISHED MATERIALS SHALL BE REMOVED FROM THE SITE AND DISPOSED OF AT A CITY APPROVED LOCATION
- AND IN A MANNER CONSISTENT WITH CURRENT REGULATIONS AND REQUIREMENTS. 4. ALL AREAS THAT WILL BE UNWORKED FOR MORE THAN SEVEN (7) DAYS DURING THE DRY SEASON OR TWO (2) DAYS DURING THE WET SEASON, SHALL BE COVERED WITH STRAW, WOOD FIBER MULCH, COMPOST, PLASTIC SHEETING, OR OTHER EQUIVALENT PER CURRENT CITY OR COUNTY STANDARDS. SEE SEEDING NOTES AND MULCHING NOTES ON THIS
- CONTRACTOR SHALL DESIGNATE A WASHINGTON DEPT OF ECOLOGY CERTIFIED EROSION CONTROL LEAD PERSON, AND SHALL COMPLY WITH THE CONSTRUCTION STORMWATER POLLUTION PREVENTION PLAN (SWPPP) PREPARED FOR
- 6. AT ANY TIME DURING CONSTRUCTION IT IS DETERMINED BY THE CITY OR COUNTY THAT MUD AND DEBRIS ARE BEING TRACKED ONTO PUBLIC STREETS WITH INSUFFICIENT CLEANUP, ALL WORK SHALL CEASE ON THE PROJECT UNTIL THIS CONDITION IS CORRECTED. THE CONTRACTOR AND/OR THE OWNER SHALL IMMEDIATELY TAKE ALL STEPS NECESSARY TO PREVENT FUTURE TRACKING OF MUD AND DEBRIS INTO THE PUBLIC ROW, WHICH MAY INCLUDE THE INSTALLATION
- OF A WHEEL WASH FACILITY ON-SITE. 7. SEDIMENT LADEN RUNOFF SHALL NOT BE ALLOWED TO DISCHARGE BEYOND THE LIMITS OF THE IMPROVEMENTS.
- ADDITIONAL MEASURES SHALL BE INSTALLED AS NEEDED. SAND BAGS SHALL BE SECURELY PLACED AROUND INSTALLED CATCH BASINS WITH INLET PROTECTION AS FIELD AND WEATHER CONDITIONS WARRANT SO TO PROTECT ALL DISPERSION AND INFILTRATION TRENCHES SEDIMENT LADEN
- TREES WITHIN WORKING LIMITS TO BE SAVED, SHALL BE MARKED AS SUCH ON SITE AND PROTECTION FENCE PLACED AROUND EACH TREE.

SEEDING NOTES

THE FOLLOWING SEED MIXTURE SHALL BE AS BELOW AND SHALL BE APPLIED AT THE RATE RECOMMENDED BY THE

TABLE D.3.2.B TEI	MPORARY EROSI	ON CONTROL SE	ED MIX
	% WEIGHT	% PURITY	% GERMINATION
CHEWINGS OR RED FESCUE FESTUCA RUBRA VAR. COMMUTATA OR FESTUCA RUBRA	40	98	90
ANNUAL OR PERENNIAL RYE LOLIUM MULTIFLORUM OR LOLIUM PERENNE	40	98	90
REDTOP OR COLONIAL BENTGRASS AGROSTIS ALBA OR AGROSTIS TENUIS	10	92	85
WHITE DUTCH CLOVER TRIFOLIUM REPENS	10	98	90

- SEED BEDS PLANTED BETWEEN MAY 1 AND OCTOBER 31 WILL REQUIRE IRRIGATION AND OTHER MAINTENANCE AS
- NECESSARY TO FOSTER AND PROTECT THE ROOT STRUCTURE. FOR SEED BEDS PLANTED BETWEEN OCTOBER 31 AND APRIL 30, ARMORING OF THE SEED BED WILL BE NECESSARY. (E.G., GEOTEXTILES, JUTE MAT, CLEAR PLASTIC COVERING), BEFORE SEEDING, INSTALL NEEDED SURFACE RUNOFF CONTROL MEASURES SUCH AS GRADIENT TERRACES,
- INTERCEPTOR DIKES, SWALES, LEVEL SPREADERS AND SEDIMENT BASINS. THE SEEDBED SHALL BE FIRM WITH A FAIRLY FINE SURFACE, FOLLOWING SURFACE ROUGHENING. PERFORM ALL
- OPERATIONS ACROSS OR AT RIGHT ANGLES TO THE SLOPE. 6. FERTILIZERS ARE TO BE USED ACCORDING TO SUPPLIER'S RECOMMENDATIONS. AMOUNTS USED SHOULD BE
- MINIMIZED, ESPECIALLY ADJACENT TO WATER BODIES AND WETLANDS.



CITY OF PUYALLUP DEVELOPMENT ENGINEERING

NOTE: THIS APPROVAL IS VOID AFTER 180 DAYS FROM APPROVAL

WASHED GRAVEL

THE CITY WILL NOT BE RESPONSIBLE FOR ERRORS AND/OR OMISSIONS ON THESE FIELD CONDITIONS MAY DICTATE CHANGES TO THESE PLANS AS DETERMINED BY THE DEVELOPMENT ENGINEERING

Project Title: **EAST TOWN CROSSING FRONTAGE IMPROVEMENTS**

2215 North 30th Street, Suite 300, Tacoma, WA 98403

253.383.2422 TEL 253.383.2572 FAX www.ahbl.com WEB

ASH DEVELOPMENT

GREG HELLE

GREG.HELLE@ASHNW.COM


<u>Project No.</u>


2230752

Issue Set & Date:

PERMIT SUBMITTAL

04/03/2024

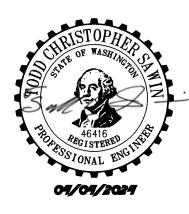

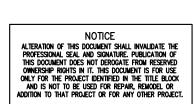

INLET PROTECTION WITH FILTER **FABRIC FENCE OR FILTER SOCK**

FABRIC

STAKES -

NOTE: ALL FILTER FABRIC SHALL

WOOD STAKE

FILTER FABRIC -

BURIED FILTER

BYPASS PEAK

SEDIMENT ACCUMULATION

1. FILTERS SHALL BE INSPECTED AFTER EACH STORM EVENT AND

2. INSTALL INLET PROTECTION IN ALL NEW STORM STRUCTURES

THAT WILL COLLECT STORMWATER AS THEY ARE INSTALLED.

CLEANED OR REPLACED WHEN 1/3 FULL.

STORM VOLUMES)

—EXISTING CATCH BASIN

FABRIC -

RUNOFF WATER

WITH SEDIMENT

E MIRAFI 140NS OR EQUAL

FILTER

<u> </u>
<u> </u>
A
lack

Sheet Title:

<u>Revisions:</u>

TESC DETAILS AND NOTES

<u>Drawn by:</u>


Sheet No.


11 of 21 Sheets

Know what's below. Call before you dig. FILTER FABRIC FENCE

EAST TOWN CROSSING FRONTAGE IMPROVEMENTS

SEC. 26,35/ TWP. 20 N./ RGE. 4 E., W.M.

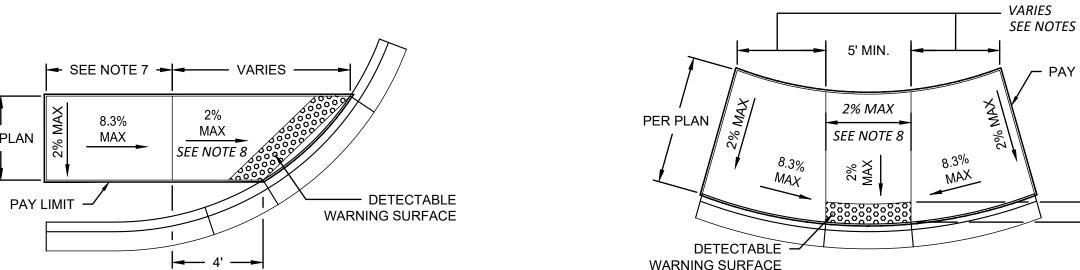


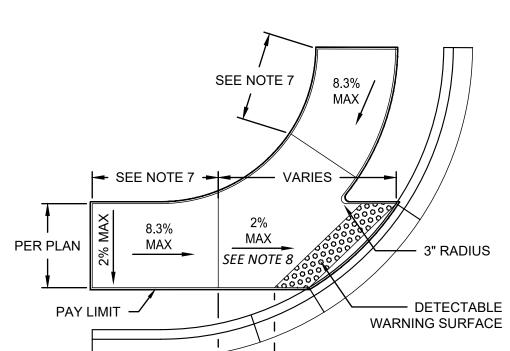

SINGLE DIRECTION CURB RAMP

SEE NOTES WARNING SURFACE

PARALLEL CURB RAMP

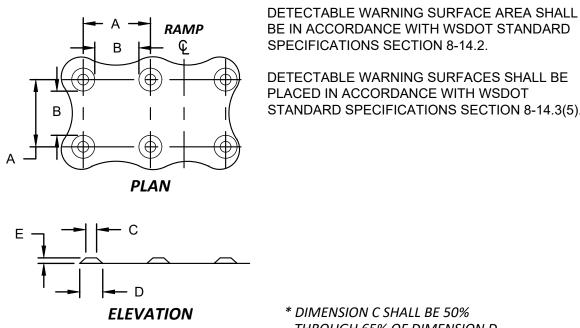

DETECTABLE WARNING SURFACES SHALL BE PLACED IN ACCORDANCE WITH WSDOT STANDARD SPECIFICATIONS SECTION 8-14.3(5).

DETECTABLE WARNING SURFACE DETAIL

CURB RAMP NOTES:


- 1. CURB RAMPS ARE TYPICALLY CENTERED AT THE 1/4 RADIUS POINTS.
- 2. CURB TO BE FLUSH WITH ADJACENT ROADWAY SURFACE. THE BID ITEM DOES NOT INCLUDE THE CURB AND GUTTER.
- 3. PERPENDICULAR RAMP LENGTH IS MEASURED FROM BACK OF CURB.
- 4. PARALLEL RAMP LENGTHS VARY FROM 6' MIN. TO 15' MAX.
- 5. IF SIGNAL POLE EXISTS, PARALLEL CURB RAMP SHALL INCLUDE THE CONCRETE AREA AROUND THE SIGNAL POLE. SIDEWALK DEPTH SHALL BE 6" FROM PC TO PT. SEE STANDARD DRAWING PC.J1.2 FOR ADDITIONAL DETAILS.
- ADJUST RAMP LENGTHS TO MEET ADA REQUIREMENTS 8.3% MAX GRADE, 15' MAX LENGTH.
- 7. SEE WSDOT STANDARD PLAN F-40.16-03 NOTE 8.
- 8. LANDINGS SHALL HAVE A 2% MAX. GRADE IN EACH DIRECTION, EXCEPT AT MIDBLOCK CROSSINGS WHERE THEY MAY MATCH THE GRADE OF
- 9. PERPENDICULAR CURB RAMPS SHALL HAVE A 2% MAX. CROSS SLOPE, EXCEPT AT MIDBLOCK CROSSINGS WHERE IT MAY MATCH THE GRADE
- 10. THE ROWS OF TRUNCATED DOMES IN DETECTABLE WARNING SURFACES SHALL BE ALIGNED PERPENDICULAR TO THE GRADE BREAK AT THE
- 11. CURB RAMPS CANNOT BE PERVIOUS MATERIAL
- 12. SEE THE CURRENT EDITION OF WSDOT STANDARD PLAN F-10.12 FOR PEDESTRIAN CURB DETAILS.
- 13. FOR RESIDENTIAL DRIVEWAY APPROACHES PARALLEL CURB RAMPS SHALL BE 2' MIN. FROM THE DRIVEWAY APPROACH.
- 14. TO AVOID OBSTACLES, CURB RAMPS OPPOSITE THE RETURNED CURBS AT "T" INTERSECTIONS MAY BE PLACED AT A SKEW OF 5° MAX FROM AN ALIGNMENT PERPENDICULAR TO THE CENTERLINE

Notes 13 and 14 aren't applicable to this project.

Remove reference to Pierce County standard.

[Plans; Sht R6.1 of 21]


PAY LIMIT

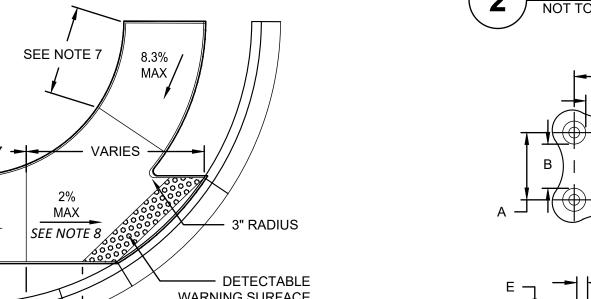

THROUGH 65% OF DIMENSION D

Examples of curb ramp designs with spot

[Plans; Sht R6.1 of 21] FL 66.07 FL 66.09 FL 66.14 STA 105+64.02 EASEMENT FOR PORTIONS OF RAMP OUTSIDE RIGHT-OF-WAY NW DRIVEWAY

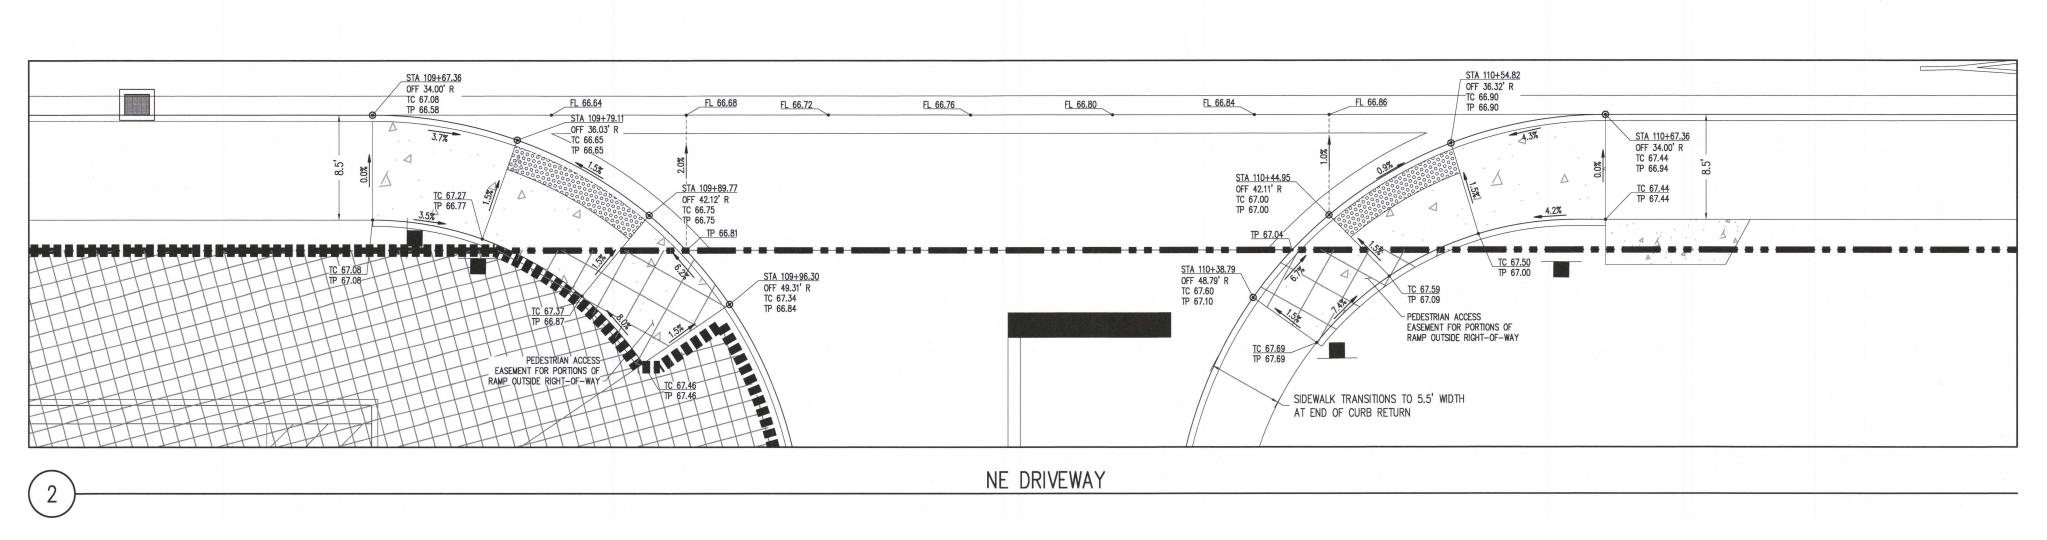

Know what's below. Call before you dig. **APPROVED**

CITY OF PUYALLUP DEVELOPMENT ENGINEERING

NOTE: THIS APPROVAL IS VOID AFTER 180 DAYS FROM APPROVA THE CITY WILL NOT BE RESPONSIBLE FOR ERRORS AND/OR OMISSIONS ON THESE

FIELD CONDITIONS MAY DICTATE CHANGES TO THESE PLANS AS DETERMINED BY THE 2215 North 30th Street, Suite 300, Tacoma, WA 98403 DEVELOPMENT ENGINEERING



253.383.2422 TEL 253.383.2572 FAX www.ahbl.com WEB Project Title:

EAST TOWN CROSSING FRONTAGE IMPROVEMENTS

ASH DEVELOPMENT

GREG HELLE

GREG.HELLE@ASHNW.COM

<u>Project No.</u>


2230752

Issue Set & Date:

PERMIT SUBMITTAL

04/03/2024



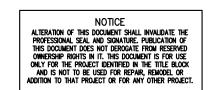


Revisions:

Sheet Title:

ADA DETAILS AND NOTES

<u>Drawn by:</u> <u>Checked by:</u>

Sheet No.

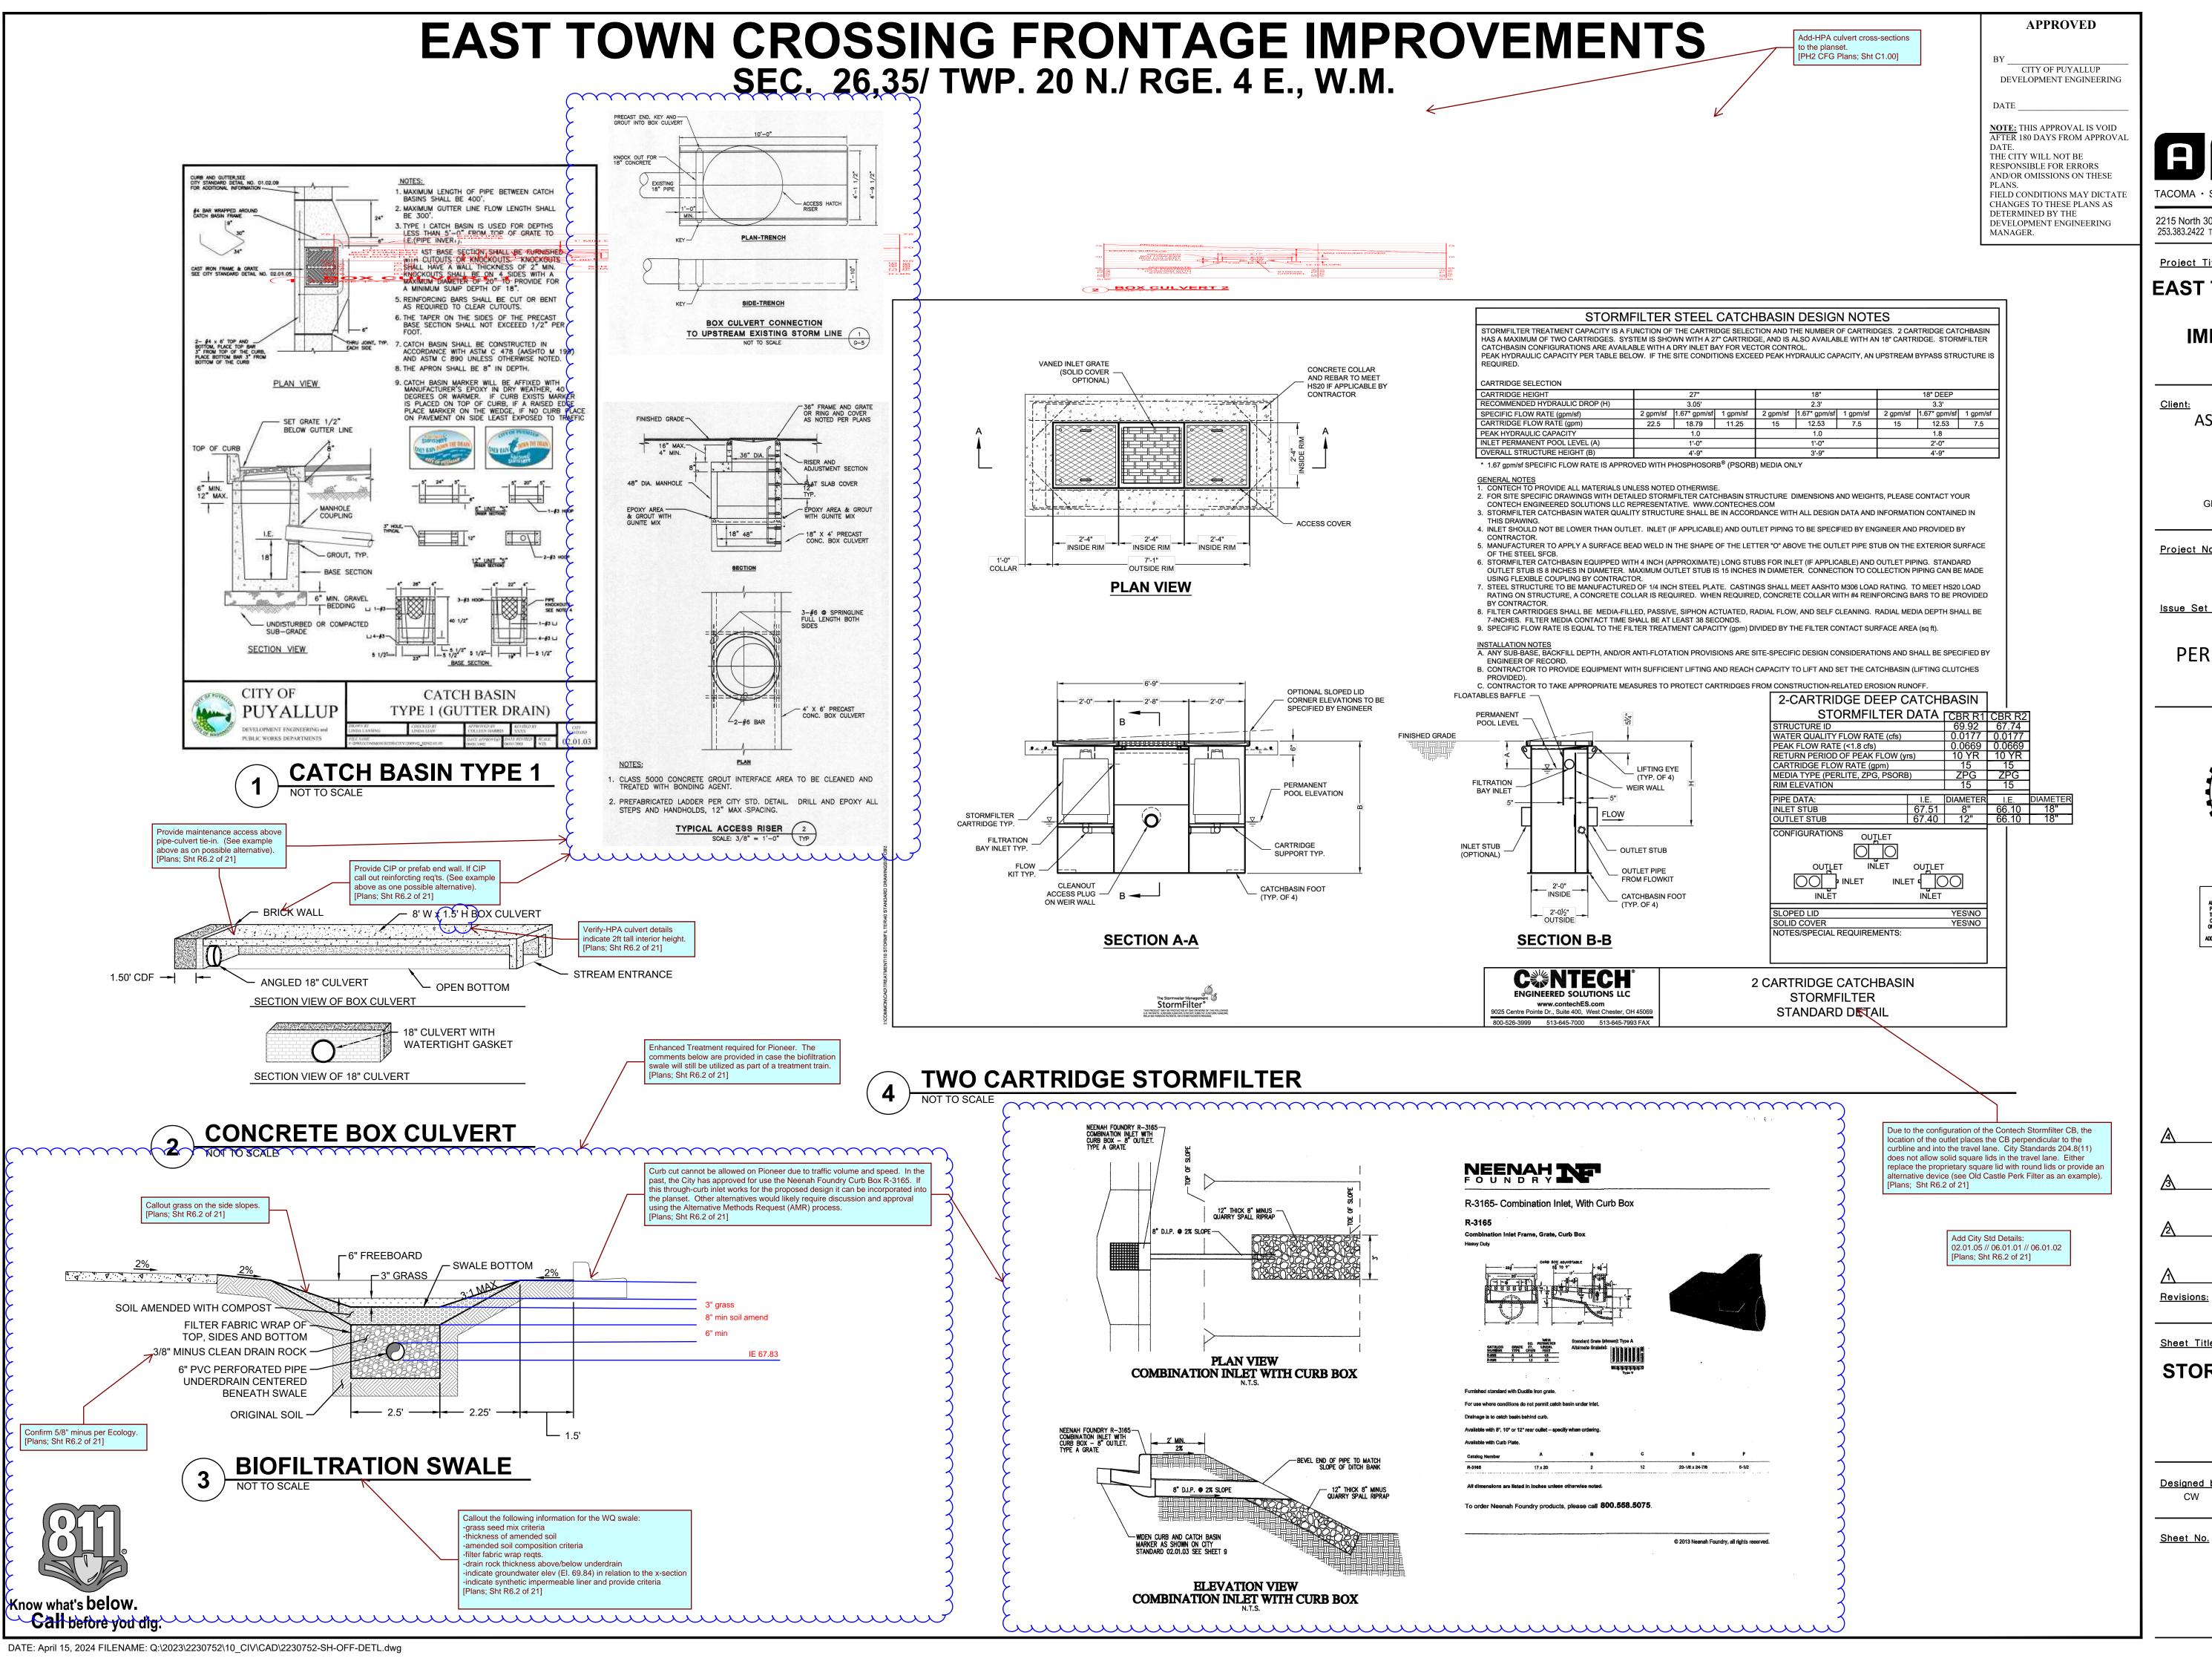

2215 North 30th Street, Suite 300, Tacoma, WA 98403 253.383.2422 TEL 253.383.2572 FAX www.ahbl.com WEB

Project Title:

EAST TOWN CROSSING FRONTAGE IMPROVEMENTS

ASH DEVELOPMENT

GREG HELLE

GREG.HELLE@ASHNW.COM

Project No.


2230752

Issue Set & Date:

PERMIT SUBMITTAL

04/03/2024



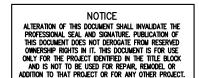


Revisions:

Sheet Title:

STORM DETAILS AND **NOTES**

Drawn by: Checked by:

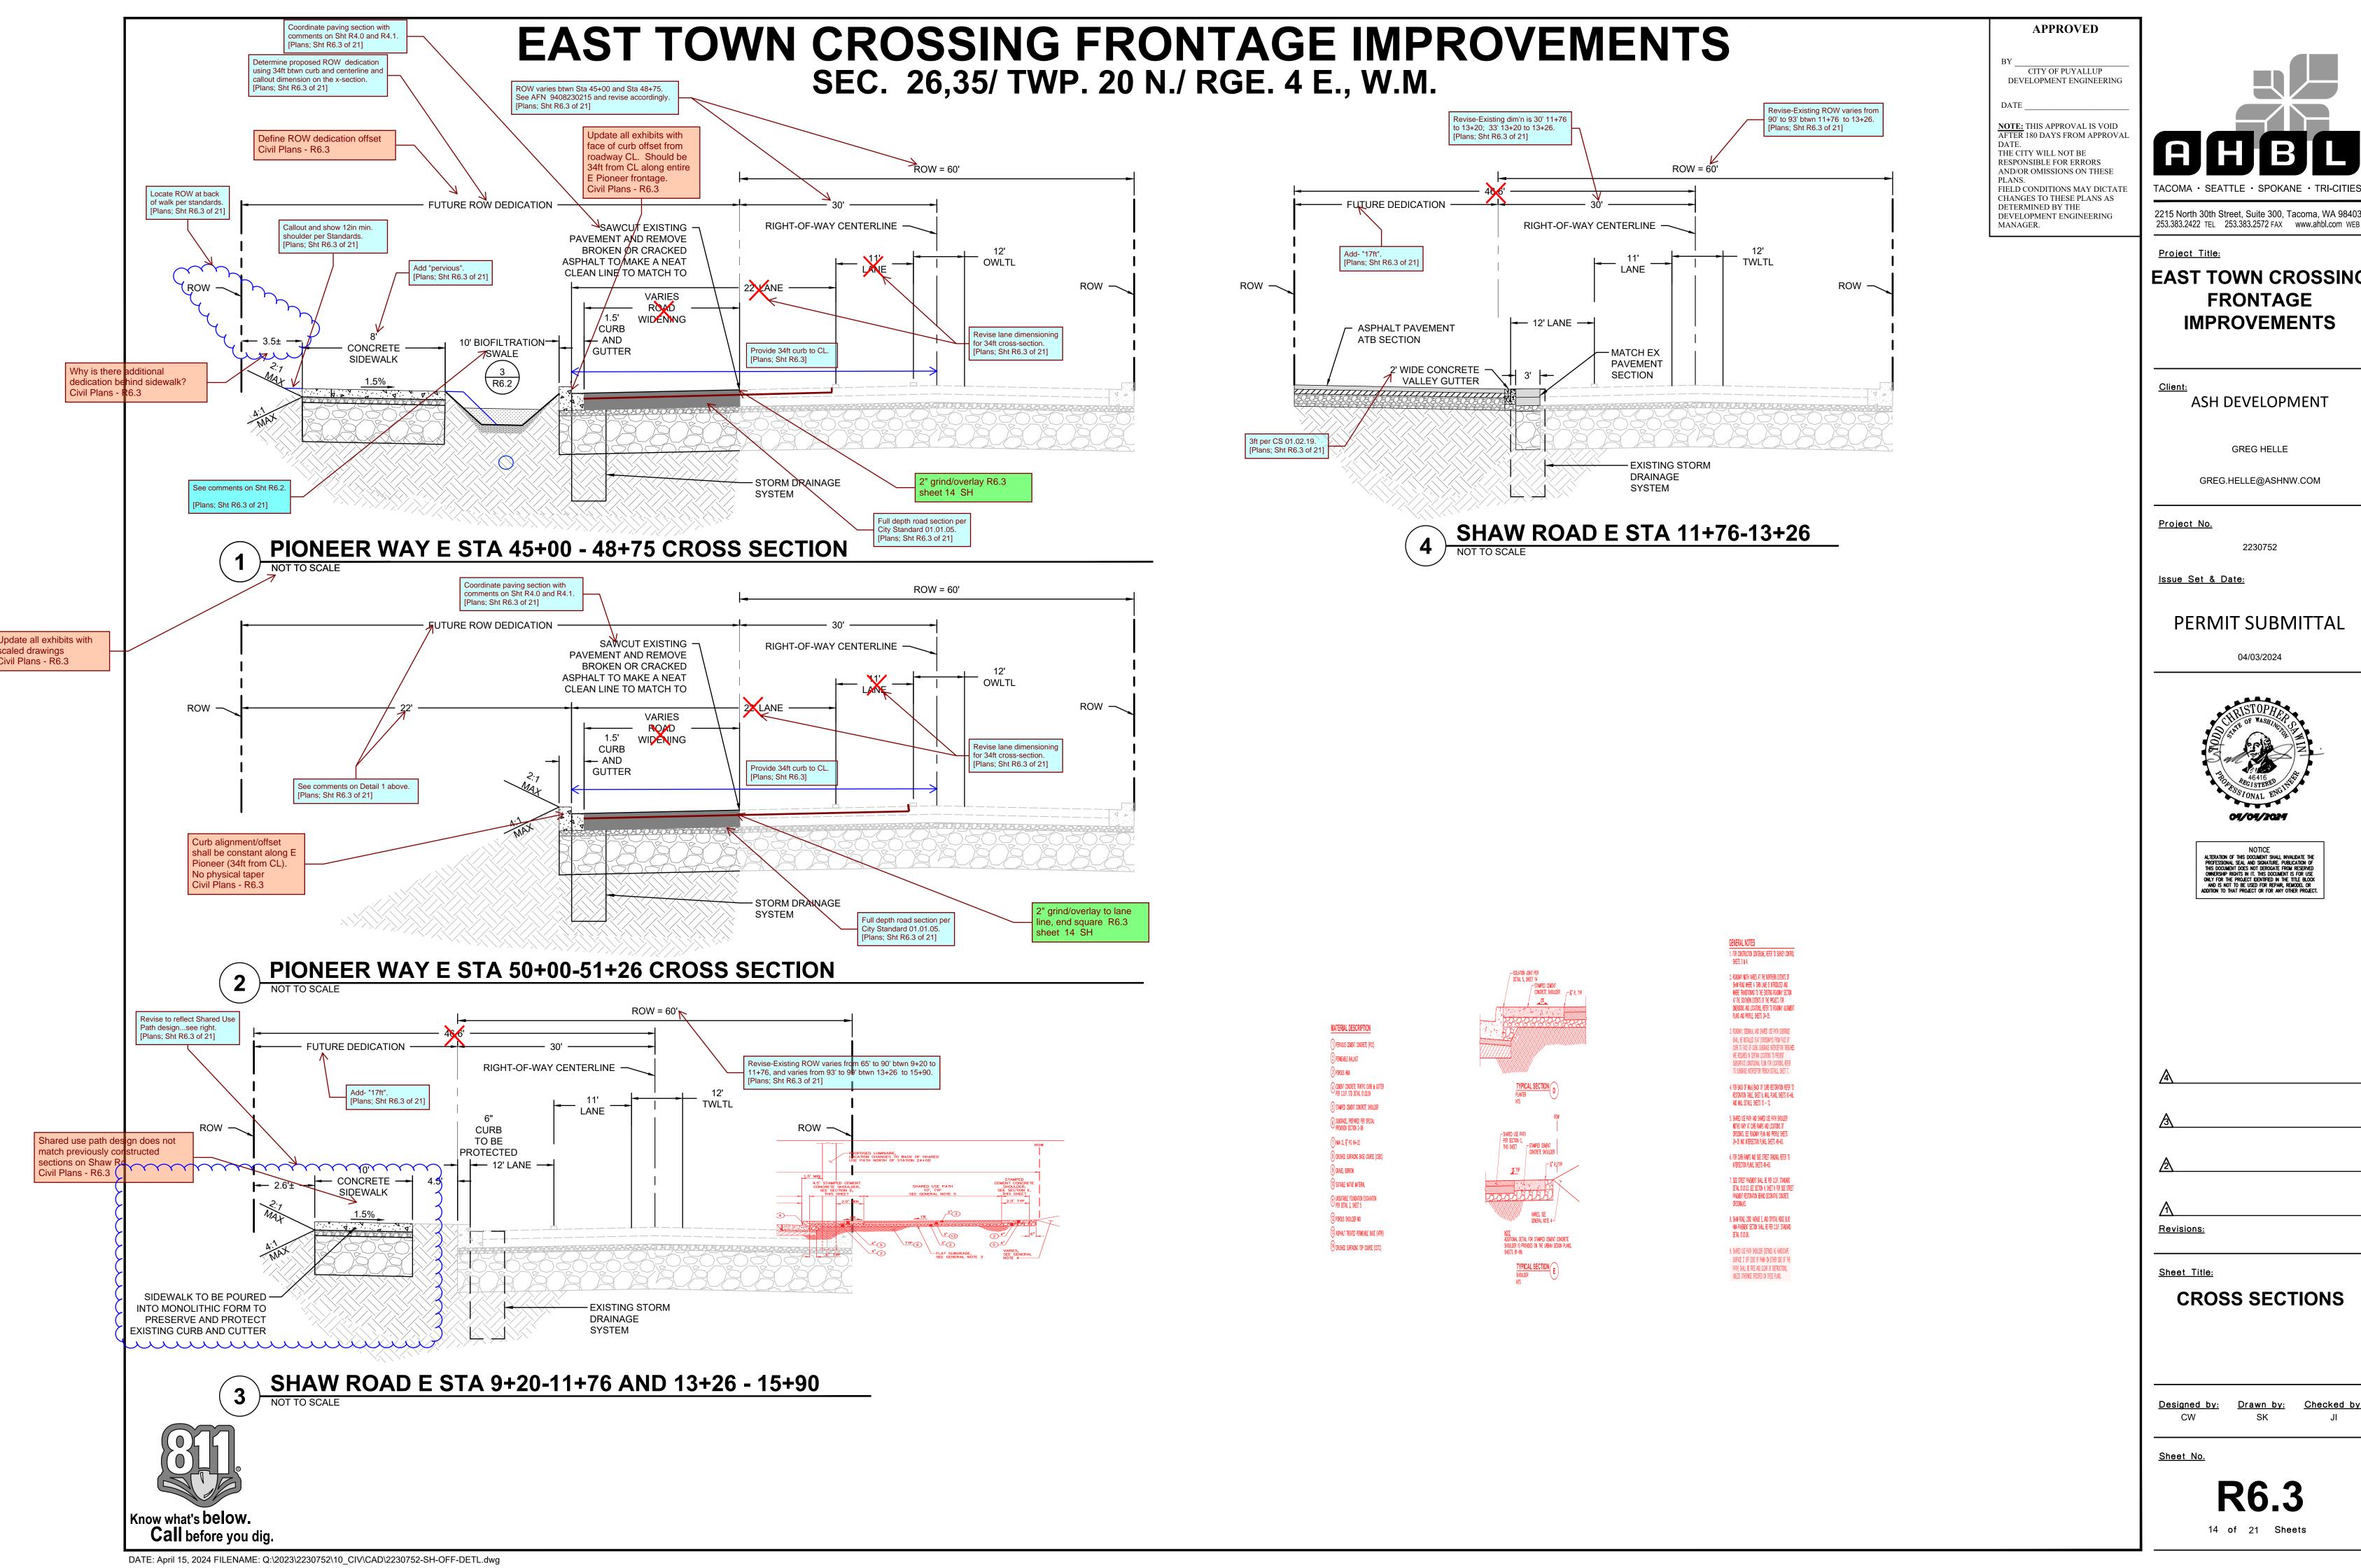


2215 North 30th Street, Suite 300, Tacoma, WA 98403

EAST TOWN CROSSING FRONTAGE IMPROVEMENTS

GREG.HELLE@ASHNW.COM

PERMIT SUBMITTAL




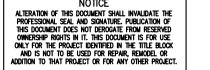



Drawn by: Checked by:


EAST TOWN CROSSING FRONTAGE IMPROVEMENTS


SEC. 26,35/ TWP. 20 N./ RGE. 4 E., W.M.

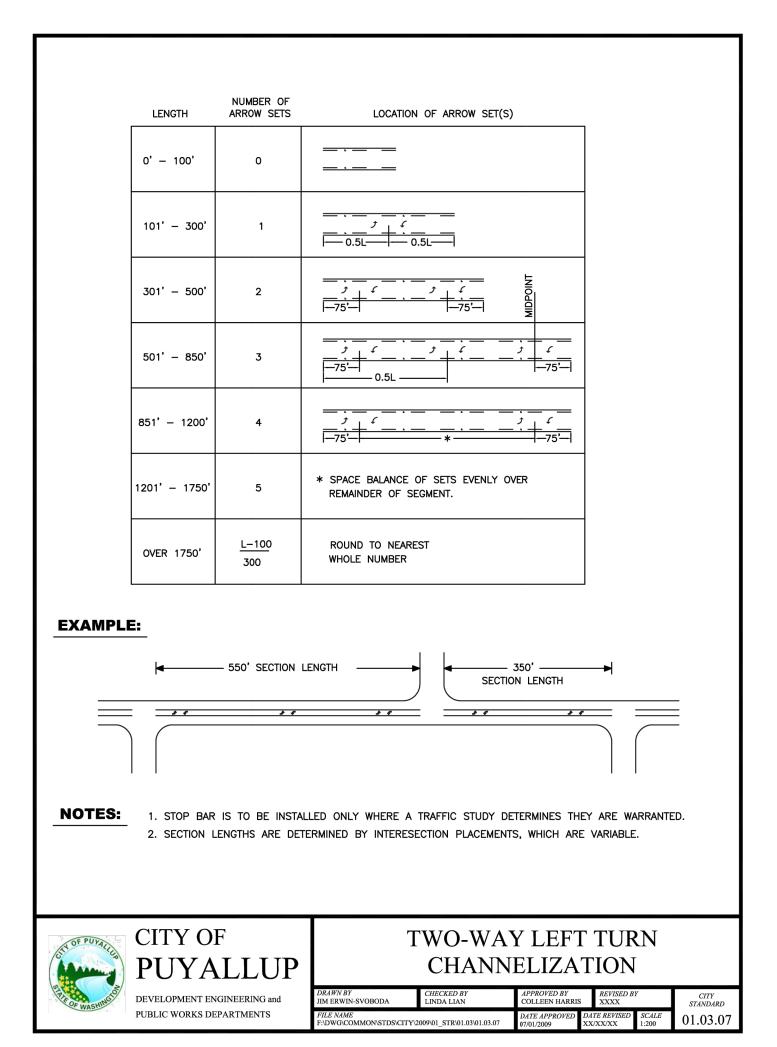

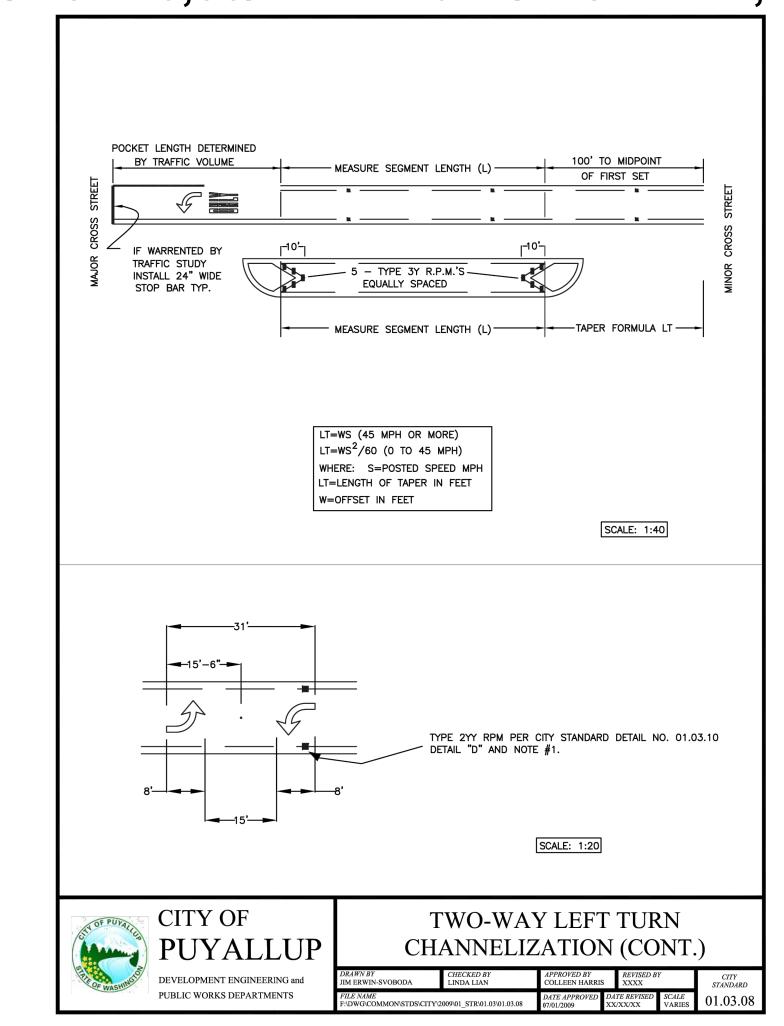

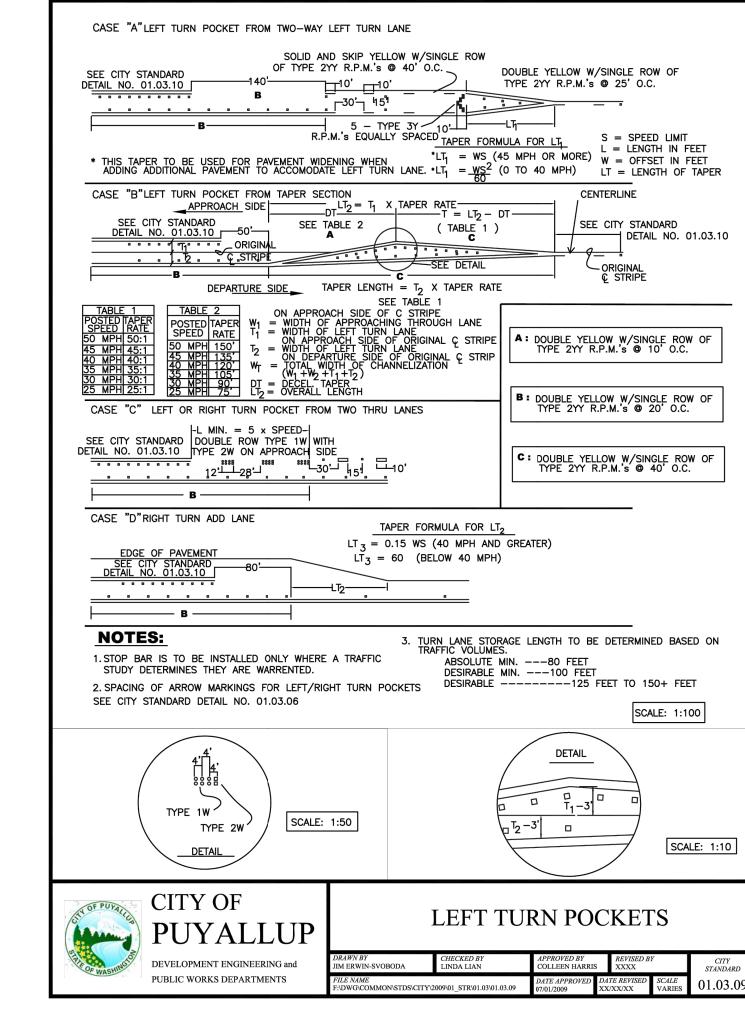

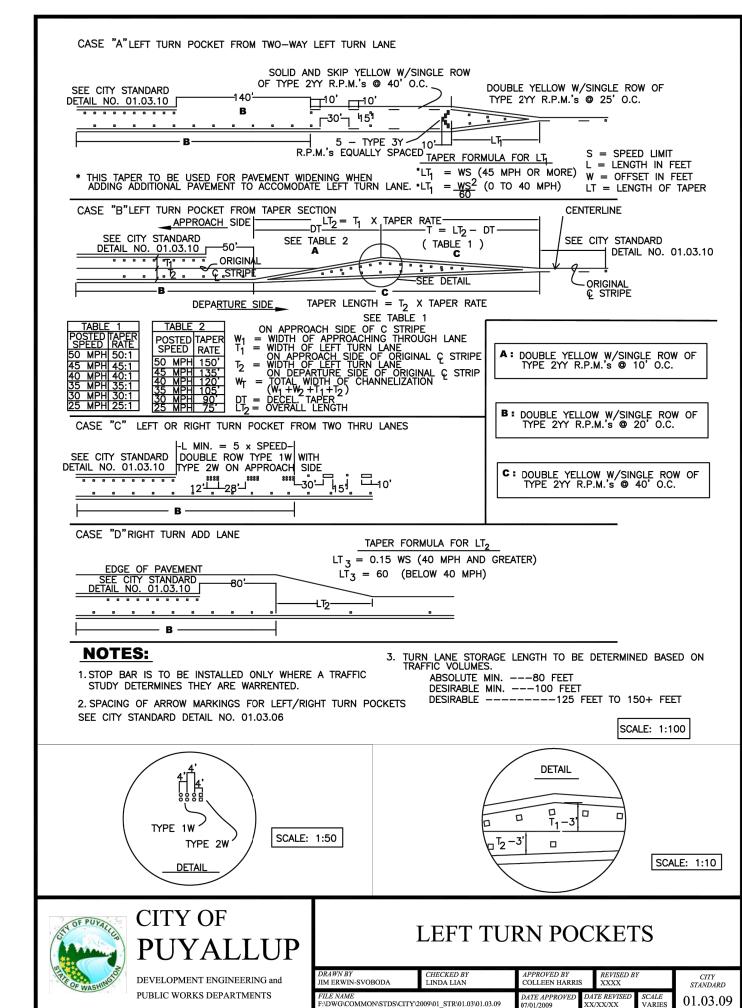

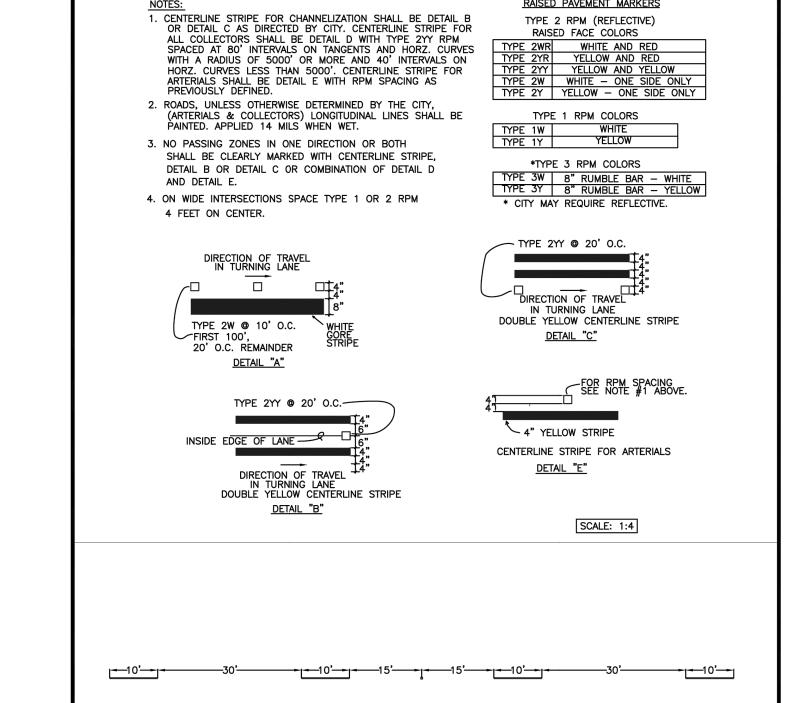

SKIP STRIPE PATTERN FOR

<u>DETAIL "D"</u>


CENTERLINES AND LANE LINES.

RAISED PAVEMENT MARKERS


SCALE: 1:20

01.03.10

PAVEMENT MARKING DETAILS

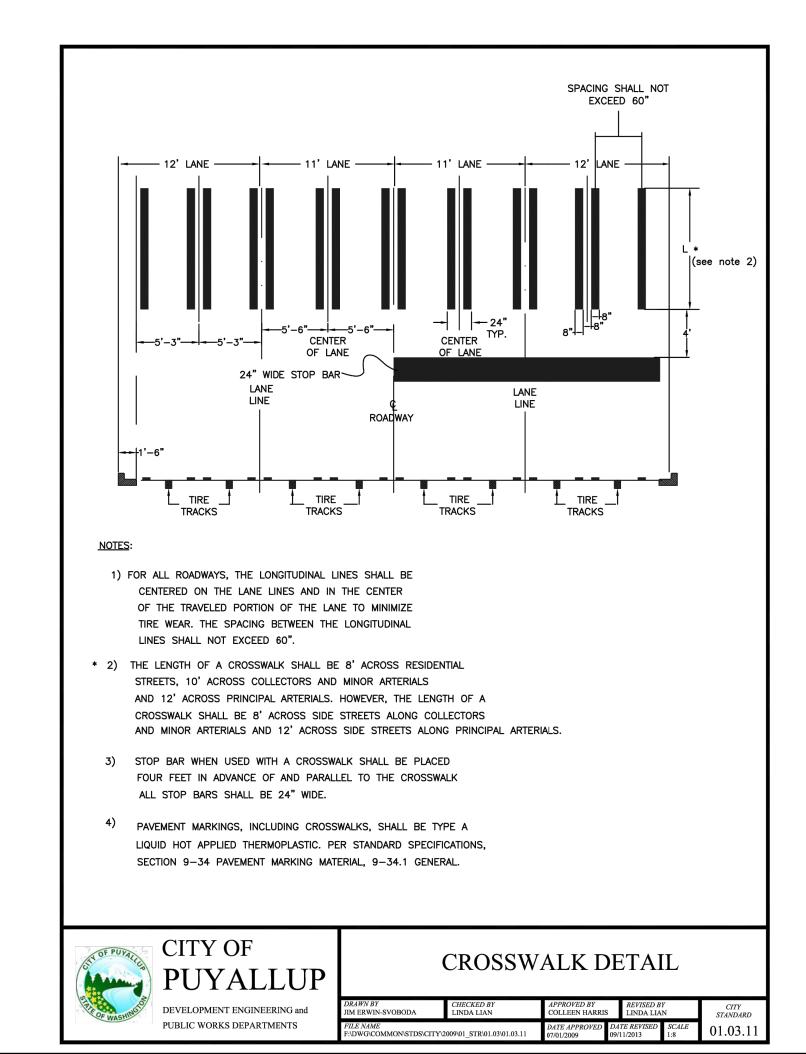

Add City Std Details: 01.01.05 // 01.01.11 // 01.01.18 // 01.02.02 (strike Note 7 due to pervious concrete) // 01.02.03 // 01.02.08a // 01.02.16 // 01.02.19 // 01.02.20 // 01.03.06 // 01.03.13 // 01.03.14 // 01.03.15 // 01.04.01 // 01.04.02

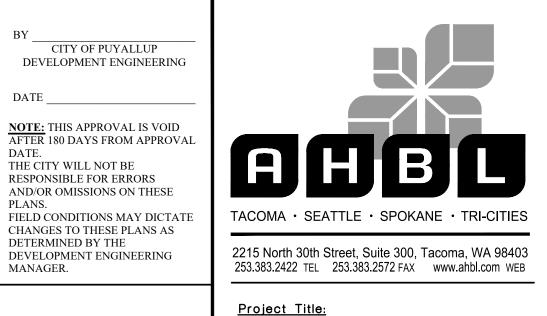

APPROVED

THE CITY WILL NOT BE

DETERMINED BY THE

PLANS.

EAST TOWN CROSSING FRONTAGE IMPROVEMENTS

ASH DEVELOPMENT

GREG HELLE

GREG.HELLE@ASHNW.COM

Project No.


2230752

Issue Set & Date:

PERMIT SUBMITTAL

04/03/2024



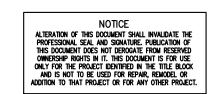

<u> </u>
A
A
/2\
<u> </u>

<u>Revisions:</u>

Sheet Title:

CHANNELIZATION NOTES AND DETAILS

Designed by: Drawn by: Checked by:

<u>Sheet No.</u>


15 of 21 Sheets



PUYALLUP

DEVELOPMENT ENGINEERING and

PUBLIC WORKS DEPARTMENTS

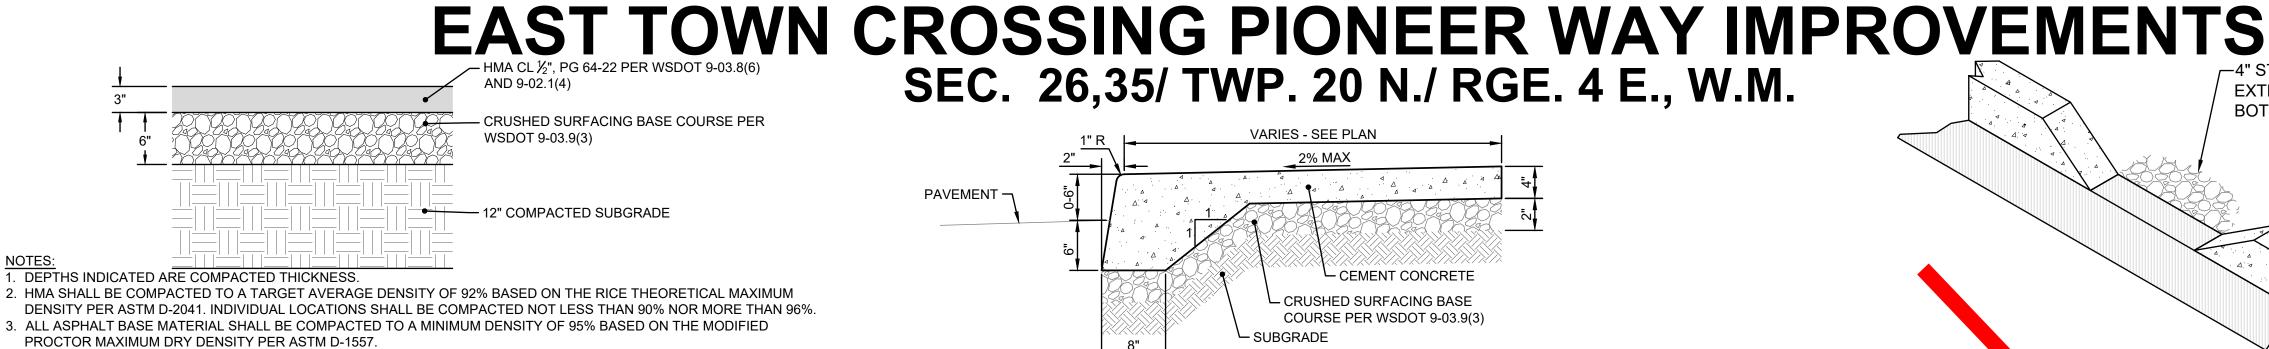

2. HMA SHALL BE COMPACTED TO A TARGET AVERAGE DENSITY OF 92% BASED ON THE RICE THEORETICAL MAXIMUM DENSITY PER ASTM D-2041, INDIVIDUAL LOCATIONS SHALL BE COMPACTED NOT LESS THAN 90% NOR MORE THAN 96%.

4. SUBGRADE SHALL BE COMPACTED TO A FIRM AND UNYIELDING CONDITION PRIOR TO PLACEMENT OF ANY PAVEMENT LAYERS. ANY LOCALIZED ZONES OF SOFT, ORGANIC-RICH, OR DEBRIS-LADEN SOILS SHOULD BE OVEREXCAVATED AND REPLACED WITH STRUCTURAL FILL MATERIAL

5. SEAL JOINTS WITH EMULSIFIED ASPHALT PER PROJECT SPECIFICATIONS.


ASPHALT PAVEMENT - STANDARD DUTY

HMA CL ½", PG 64-22 PER WSDOT 9-03.8(6) — CRUSHED SURFACING BASE COURSE PER WSDOT 9-03.9(3)

1. DEPTHS INDICATED ARE COMPACTED THICKNESS.

- 2. HMA SHALL BE COMPACTED TO A TARGET AVERAGE DENSITY OF 92% BASED ON THE RICE THEORETICAL MAXIMUM
- DENSITY PER ASTM D-2041. INDIVIDUAL LOCATIONS SHALL BE COMPACTED NOT LESS THAN 90% NOR MORE THAN 96%. 3. ALL ASPHALT BASE MATERIAL SHALL BE COMPACTED TO A MINIMUM DENSITY OF 95% BASED ON THE MODIFIED PROCTOR MAXIMUM DRY DENSITY PER ASTM D-1557
- 4. SUBGRADE SHALL BE COMPACTED TO A FIRM AND UNYIELDING CONDITION PRIOR TO PLACEMENT OF ANY PAVEMENT LAYERS. ANY LOCALIZED ZONES OF SOFT, ORGANIC-RICH, OR DEBRIS-LADEN SOILS SHOULD BE OVEREXCAVATED AND REPLACED WITH STRUCTURAL FILL MATERIAL
- 5. SEAL JOINTS WITH EMULSIFIED ASPHALT PER PROJECT SPECIFICATIONS

ASPHALT PAVEMENT - ATB

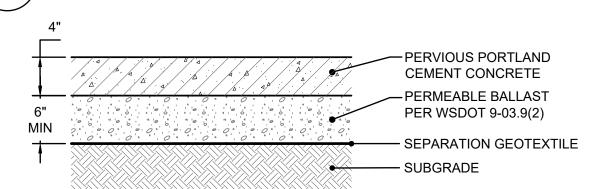

- UNIT WEIGHT: 120 TO 130 POUNDS PER CUBIC FOOT (PERMEABLE CONCRETE IS APPROXIMATELY 70 TO 80 PERCENT OF THE UNIT WEIGHT OF CONVENTIONAL CONCRETE) (FCPA, N.D.)
- VOID SPACE: 15 TO 21 PERCENT ACCORDING TO ASTM C 138.
- WATER CEMENT RATIO: 0.27 TO 0.35. AGGREGATE TO CEMENT RATIO: 4:1 TO 4.5:1


REDUCING/RETARDING ADMIXTURE

- AGGREGATE: USE EITHER:
 - 3/8 INCH TO NO. 16 WASHED CRUSHED OR ROUND PER ASTM C 35 OR 3/8 - INCH TO NO. 50 WASHED CRUSHED OR ROUND PER ASTM D 448.

PORTLAND CEMENT: TYPE I OR II CONFORMING TO ASTM C 150 OR TYPE IP OR IS CONFORMING TO

- ASTM C 595. • ADMIXTURES: CAN BE USED TO INCREASE WORKING TIME AND INCLUDE: WATER
- IN CONFORMANCE WITH ASTM C 494 TYPE D AND HYDRATION STABILIZER IN CONFORMANCE WITH ASTM C494 TYPE B.
- WATER: USE POTABLE WATER.
- FIBER MESH CAN BE INCORPORATED INTO THE CEMENT MIX FOR ADDED STRENGTH.
- PROVIDE JOINTS AT 15' O.C. PROVIDE DOWEL BARS 1 1/8" x 18" LONG ON 18" CENTERS ON TRANSVERSE JOINTS AND #5 TIE BARS x 30" LONG ON 36" CENTERS ON LONGITUDINAL JOINTS


PERVIOUS CEMENT CONCRETE

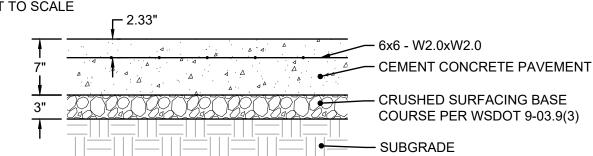


- DEPTHS INDICATED ARE COMPACTED THICKNESSES. 2. CEMENT CONCRETE PAVEMENT SHALL CONSIST OF PORTLAND CEMENT CONCRETE WITH A
- MINIMUM COMPRESSIVE STRENGTH OF 4000 PSI AND A MINIMUM RUPTURE MODULUS OF 580 PSI. 3. GRANULAR SUBBASE SHALL CONSIST OF "BALLAST" PER WSDOT 9-03.9(1), "GRAVEL BORROW" PER WSDOT 9-03.14, OR CRUSHED RECYCLED CONCRETE PROVIDED THAT IT MEETS THE SAME
- TEXTURAL CRITERIA AS "BALLAST" OR "GRAVEL BORROW. 4. ALL BASE MATERIAL SHALL BE COMPACTED TO A MINIMUM DENSITY OF 95% BASED ON THE
- MODIFIED PROCTOR MAXIMUM DRY DENSITY PER ASTM D-1557. 5. SUBGRADE SHALL BE COMPACTED TO A FIRM AND UNYIELDING CONDITION PRIOR TO PLACEMENT OF ANY PAVEMENT LAYERS. ANY LOCALIZED ZONES OF SOFT, ORGANIC-RICH, OR DEBRIS-LADEN SOILS SHOULD BE OVEREXCAVATED AND REPLACED WITH STRUCTURAL FILL MATERIAL

CEMENT CONCRETE - HEAVY DUTY




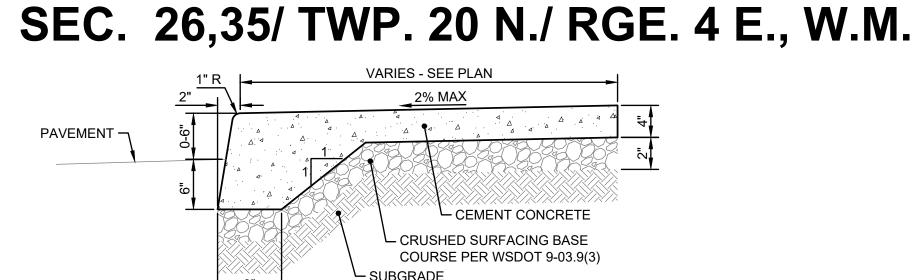

- DEPTHS INDICATED ARE COMPACTED THICKNESSES.
- 2. CEMENT CONCRETE PAVEMENT SHALL CONSIST OF PORTLAND CEMENT CONCRETE WITH A MINIMUM COMPRESSIVE STRENGTH OF 4000 PSI AND A MINIMUM RUPTURE MODULUS OF 580 PSI
- 3. ALL BASE MATERIAL SHALL BE COMPACTED TO A MINIMUM DENSITY OF 95% BASED ON THE MODIFIED PROCTOR MAXIMUM DRY DENSITY PER ASTM D-1557.
- 4. SUBGRADE SHALL BE COMPACTED TO A FIRM AND UNYIELDING CONDITION PRIOR TO PLACEMENT OF ANY PAVEMENT LAYERS. ANY LOCALIZED ZONES OF SOFT, ORGANIC-RICH, OR DEBRIS-LADEN SOILS SHOULD BE OVEREXCAVATED AND REPLACED WITH STRUCTURAL FILL MATERIAL.
- 5. EXPANSION JOINTS SHALL BE AT 10' INTERVALS OR AS SHOWN ON THE ARCHITECTURAL PLANS. 6. RECYCLED CONCRETE IS NOT ACCEPTABLE.

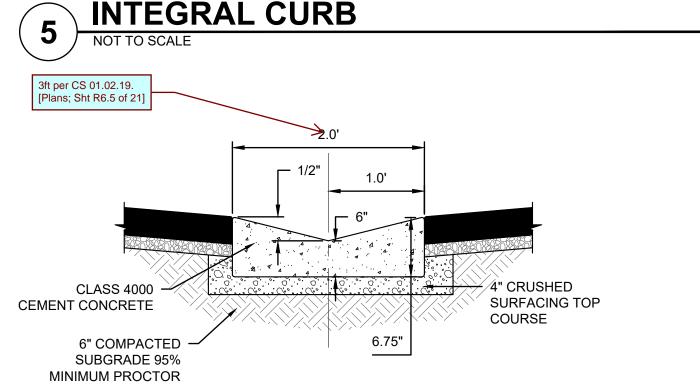

VALLEY GUTTER

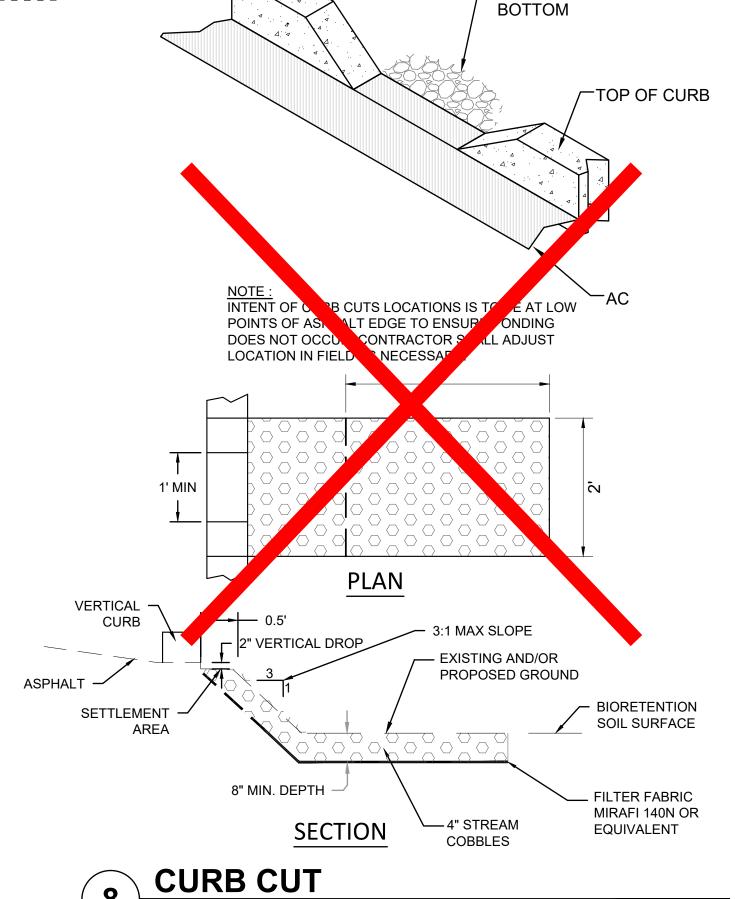

-4" STREAM COBBLES,

EXTEND TO BIORETENTION

WATERTIGHT 12" THICK BENTONITE,

APPROVED BY THE CITY ENGINEER.

CDF, OR OTHER MATERIAL AS

SEE NOTE 3

-12" MIN BEYOND PIPE


_ 4" CSBC OR GRAVEL BASE COMPACTED AT 95% SUITABLE NATIVE SOIL COMPACTED AT 95%


TRENCH BACKFILL -


PIPE BEDDING ZONE -

UTILITY PIPE/CONDUIT


- 1. CONTRACTION JOINTS SHALL BE 3/8" x 2 1/4" ASPHALT SATURATED FELT PLACED IN ALL EXPOSED SURFACES OF CURB AND GUTTER AND SPACED AT 15' MAX. 10' MIN. O.C.
- 2. THRU JOINTS SHALL BE 3/8" ASPHALT SATURATED FELT PLACED AT POINTS OF TANGENCY ON CURVES, AT CATCH BASINS, AND AT EDGES OF ALLEY AND DRIVEWAYS. THE MAXIMUM DISTANCE BETWEEN THRU JOINTS SHALL BE 100'.
- CONCRETE SHALL BE CLASS 3000 COMMERCIAL CONCRETE, 5.5 SACK MINIMUM, AASHTO GRADING 467 COARSE AGGREGATE, NO FLY ASH.
- FORMS SHALL BE STEEL UNLESS PRIOR APPROVAL IS GIVEN BY THE CITY ENGINEER. FORMS SHALL BE SET TRUE TO LINE AND GRADE AND SECURELY STAKED PRIOR TO CONCRETE PLACEMENT. FULL DEPTH DIVISION PLATES ARE ONLY TO BE USED WHERE THRU JOINTS ARE TO BE PLACED.
- 5. THE 1" RADIUS ON THE UPPER FACE OF THE CURB MAY BE FORMED BY AN EDGER TOOL OR BUILT INTO THE FACE FORM. THE 1" RADIUS AT THE BOTTOM FACE OF THE CURB SHALL BE

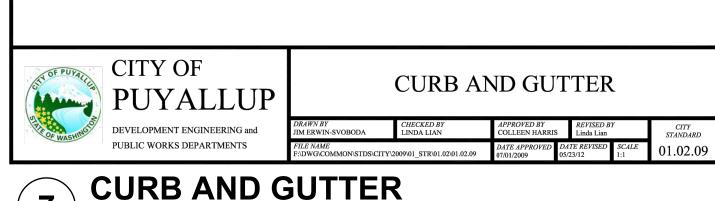

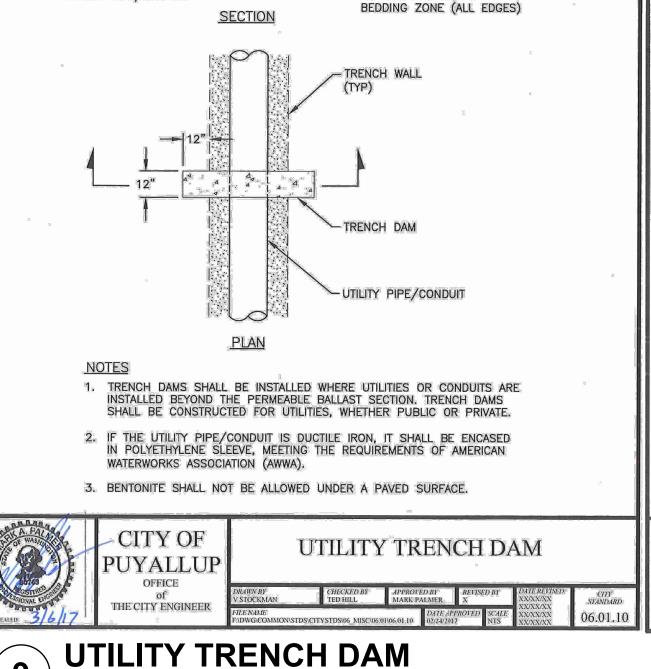


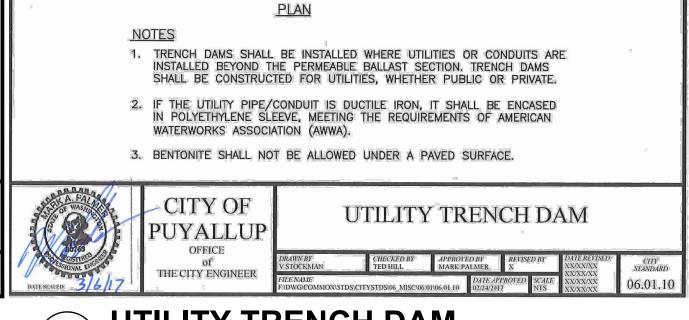

UTILITY TRENCH DAM

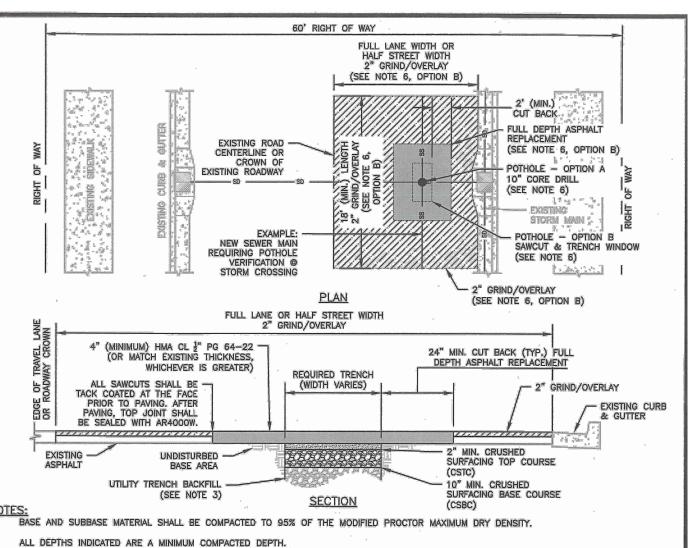

- INITIAL BACKFILLING SHALL BE PERFORMED ONLY AFTER INSPECTION AND APPROVAL OF THE INSTALLED PIPE OR STRUCTURE. THE TRENCH BACKFILL MATERIAL SHALL BE IN ACCORDANCE WITH CITY STANDARD DETAIL NO. 06.01.01.
- ALL BACKFILL FOR PIPE TRENCHES SHALL BE MECHANICALLY COMPACTED BY A POWER-OPERATED MECHANICAL TAMPER(S) AS SPECIFIED IN WSDOT STANDARD SPEC. 2-03.3 (14)C, COMPACTING EARTH EMBANKMENTS, METHOD C OF THE WSDOT STANDARD SPECIFICATIONS. IF PAVING SURFACES ADJACENT TO THE TRENCH OPENING MAY BE DAMAGED WHERE TRENCHES ARE MADE PARALLEL TO THE STREET, OR WHERE A NUMBER OF CROSS TRENCHES ARE LAID IN CLOSE PROXIMITY TO ONE ANOTHER OR WHERE THE EQUIPMENT USED MAY CAUSE SUCH DAMAGE, THE CITY ENGINEER MAY REQUIRE A NEGOTIATED CONTRIBUTION FROM THE PERMITTEE FOR RESURFACING IN LIEU OF PATCHING.
- IF THE TOTAL AREA OF THE PROPOSED PATCH OR PROBABLE DAMAGED AREA EXCEEDS 25 PERCENT OF THE TOTAL PAVEMENT SURFACING BETWEEN CURB FACES OR BETWEEN CONCRETE GUTTER EDGES IN ANY BLOCK, SUCH NEGOTIATIONS SHALL BE CARRIED ON AND CONTRIBUTIONS AGREED UPON PRIOR TO ISSUANCE OF A PERMIT. SUCH CONTRIBUTIONS SHALL BE IN ADDITION TO THE STANDARD PERMIT FEE.
- OPTION A UP TO A 10" DIAMETER CORE DRILL IS ALLOWED. CORE HOLES MADE DURING UTILITY POTHOLES SHALL BE BACKFILLED WITH CDF TO WITHIN 4" OF FINISHED GRADE, 4" OF HMA SHALL THEN BE PLACED AND COMPACTED, FLUSH WITH EXISTING GRADE,
- OPTION B FOR POTHOLE WINDOWS LARGER THAN 10" IN DIAMETER OR TRENCHING COMPLETED IN EXISTING ROADWAY, THE CONTRACTOR SHALL MEET CITY STANDARD 06.01.01 FOR PIPE BEDDING AND BACKFILL REQUIREMENTS, PAVEMENT RESTORATION SHALL BE ACCOMPLISHED BY INSTALLING THE TRENCH PATCH, AS SHOWN HEREIN, AND THEN GRINDING/OVERLAYING TO A MINIMUM DEPTH OF 2". THE LIMITS OF THE REQUIRED GRIND/OVERLAY SHALL BE TO THE NEAREST LANE LINE, OR HALF STREET, AND SHALL BE A MINIMUM OF 18 FEET LONG (LONGITUDINALLY ALONG ROADWAY) CENTERED AT LOCATION OF PATCH. NOTE: IF EXISTING ASPHALT THICKNESS IS LESS THAN 3", FULL DEPTH PAVEMENT REPLACEMENT, IN LIEU OF GRIND/OVERLAY, TO MEET A MINIMUM ASPHALT THICKNESS OF 4" WILL BE REQUIRED. WHERE LOCATION OF TRENCH OR POTHOLE WINDOW INTERSECTS ROAD CENTERLINE, A MINIMUM GRIND AND OVERLAY OF ONE FULL LANE WIDTH
- (12') IS REQUIRED CENTERED ON ROADWAY. NO LONGITUDINAL JOINTS WILL BE ALLOWED IN THE WHEEL PATH. ALL MANHOLE FRAMES, VALVE FRAMES AND MONUMENT COVERS SHALL BE INSTALLED AFTER PLACEMENT OF ASPHALT. IF MORE THAN ONE LIFT IS NECESSARY, FRAMES AND LIDS WILL BE ADJUSTED TO FINISH GRADE AT FIRST LIFT AS DIRECTED BY THE CITY.

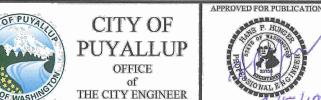

STREET PATCH

STREET PATCH

01.01.20

Sheet No.

R6.5



2215 North 30th Street, Suite 300, Tacoma, WA 98403 253.383.2422 TEL 253.383.2572 FAX www.ahbl.com WEB

Project Title:

APPROVED

CITY OF PUYALLUP

NOTE: THIS APPROVAL IS VOID AFTER 180 DAYS FROM APPROVA

THE CITY WILL NOT BE

DETERMINED BY THE

RESPONSIBLE FOR ERRORS

AND/OR OMISSIONS ON THESE FIELD CONDITIONS MAY DICTATE CHANGES TO THESE PLANS AS

DEVELOPMENT ENGINEERING

DEVELOPMENT ENGINEERING

EAST TOWN CROSSING FRONTAGE IMPROVEMENTS

ASH DEVELOPMENT

GREG HELLE

GREG.HELLE@ASHNW.COM


Project No.


2230752

Issue Set & Date:

PERMIT SUBMITTAL

04/03/2024

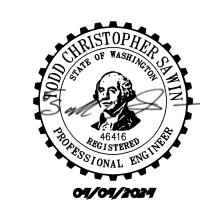

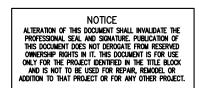



Revisions:


Sheet Title:


PAVING NOTES AND DETAILS


<u>Drawn by:</u> <u>Checked by:</u>

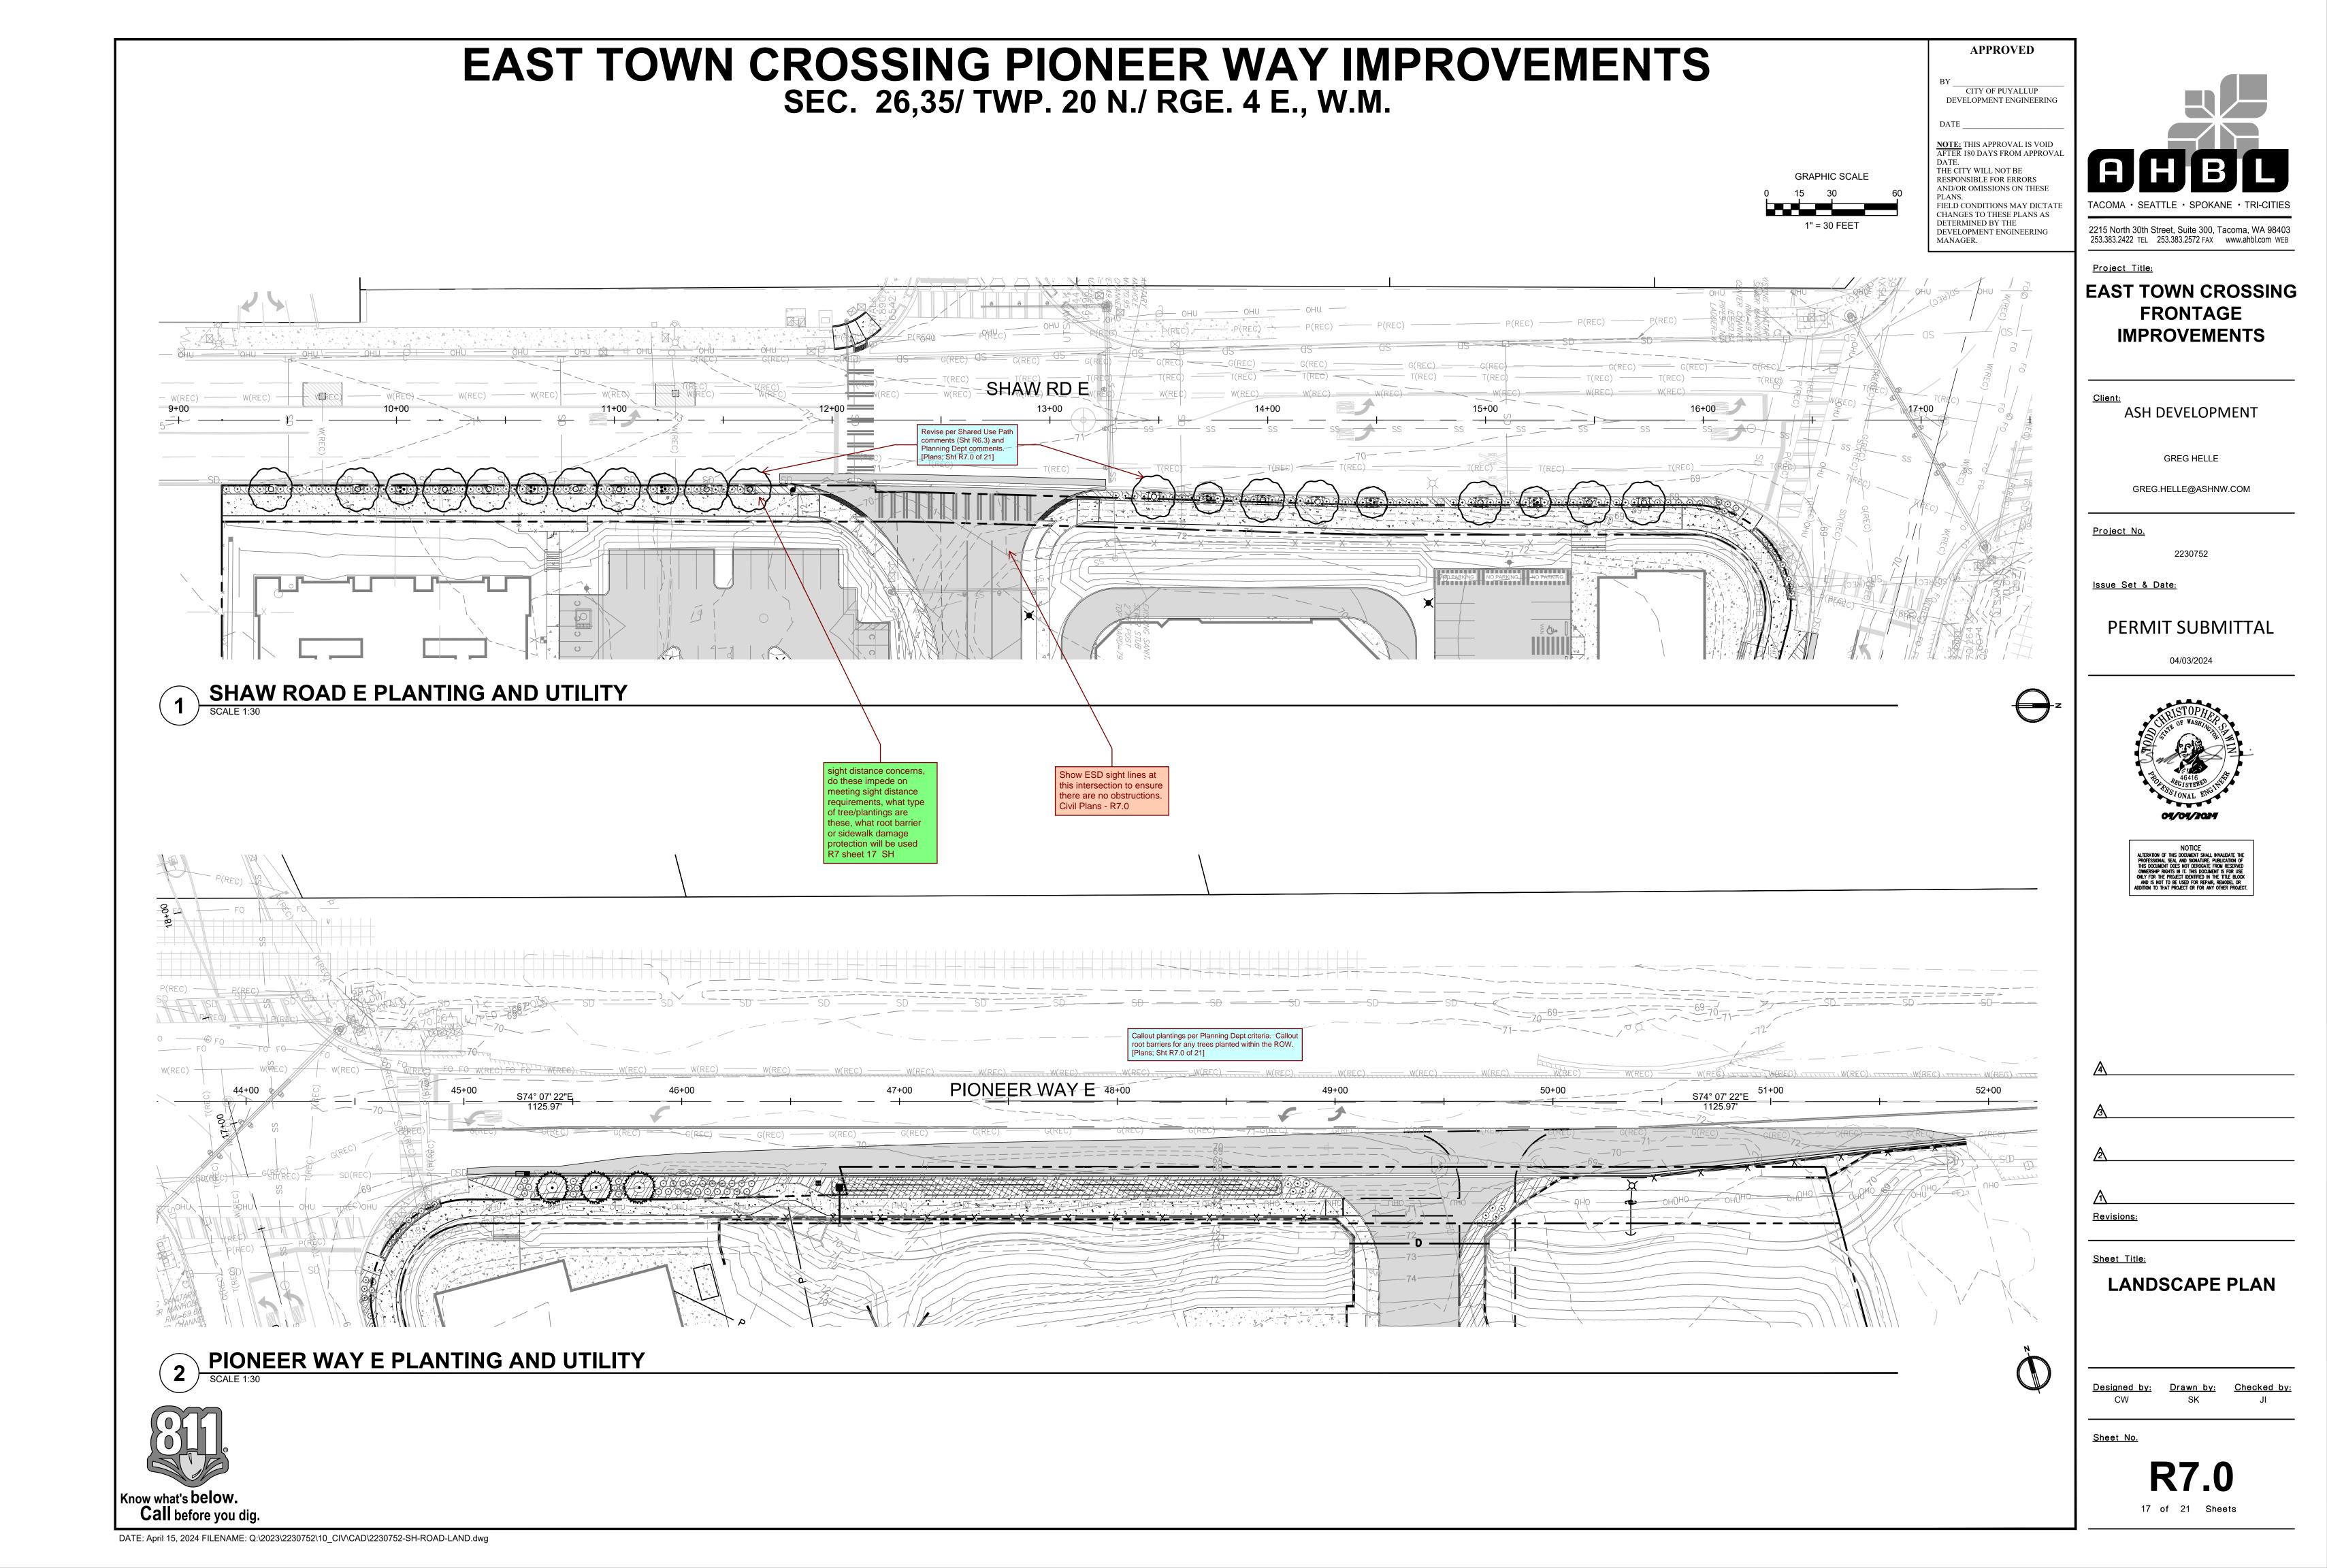


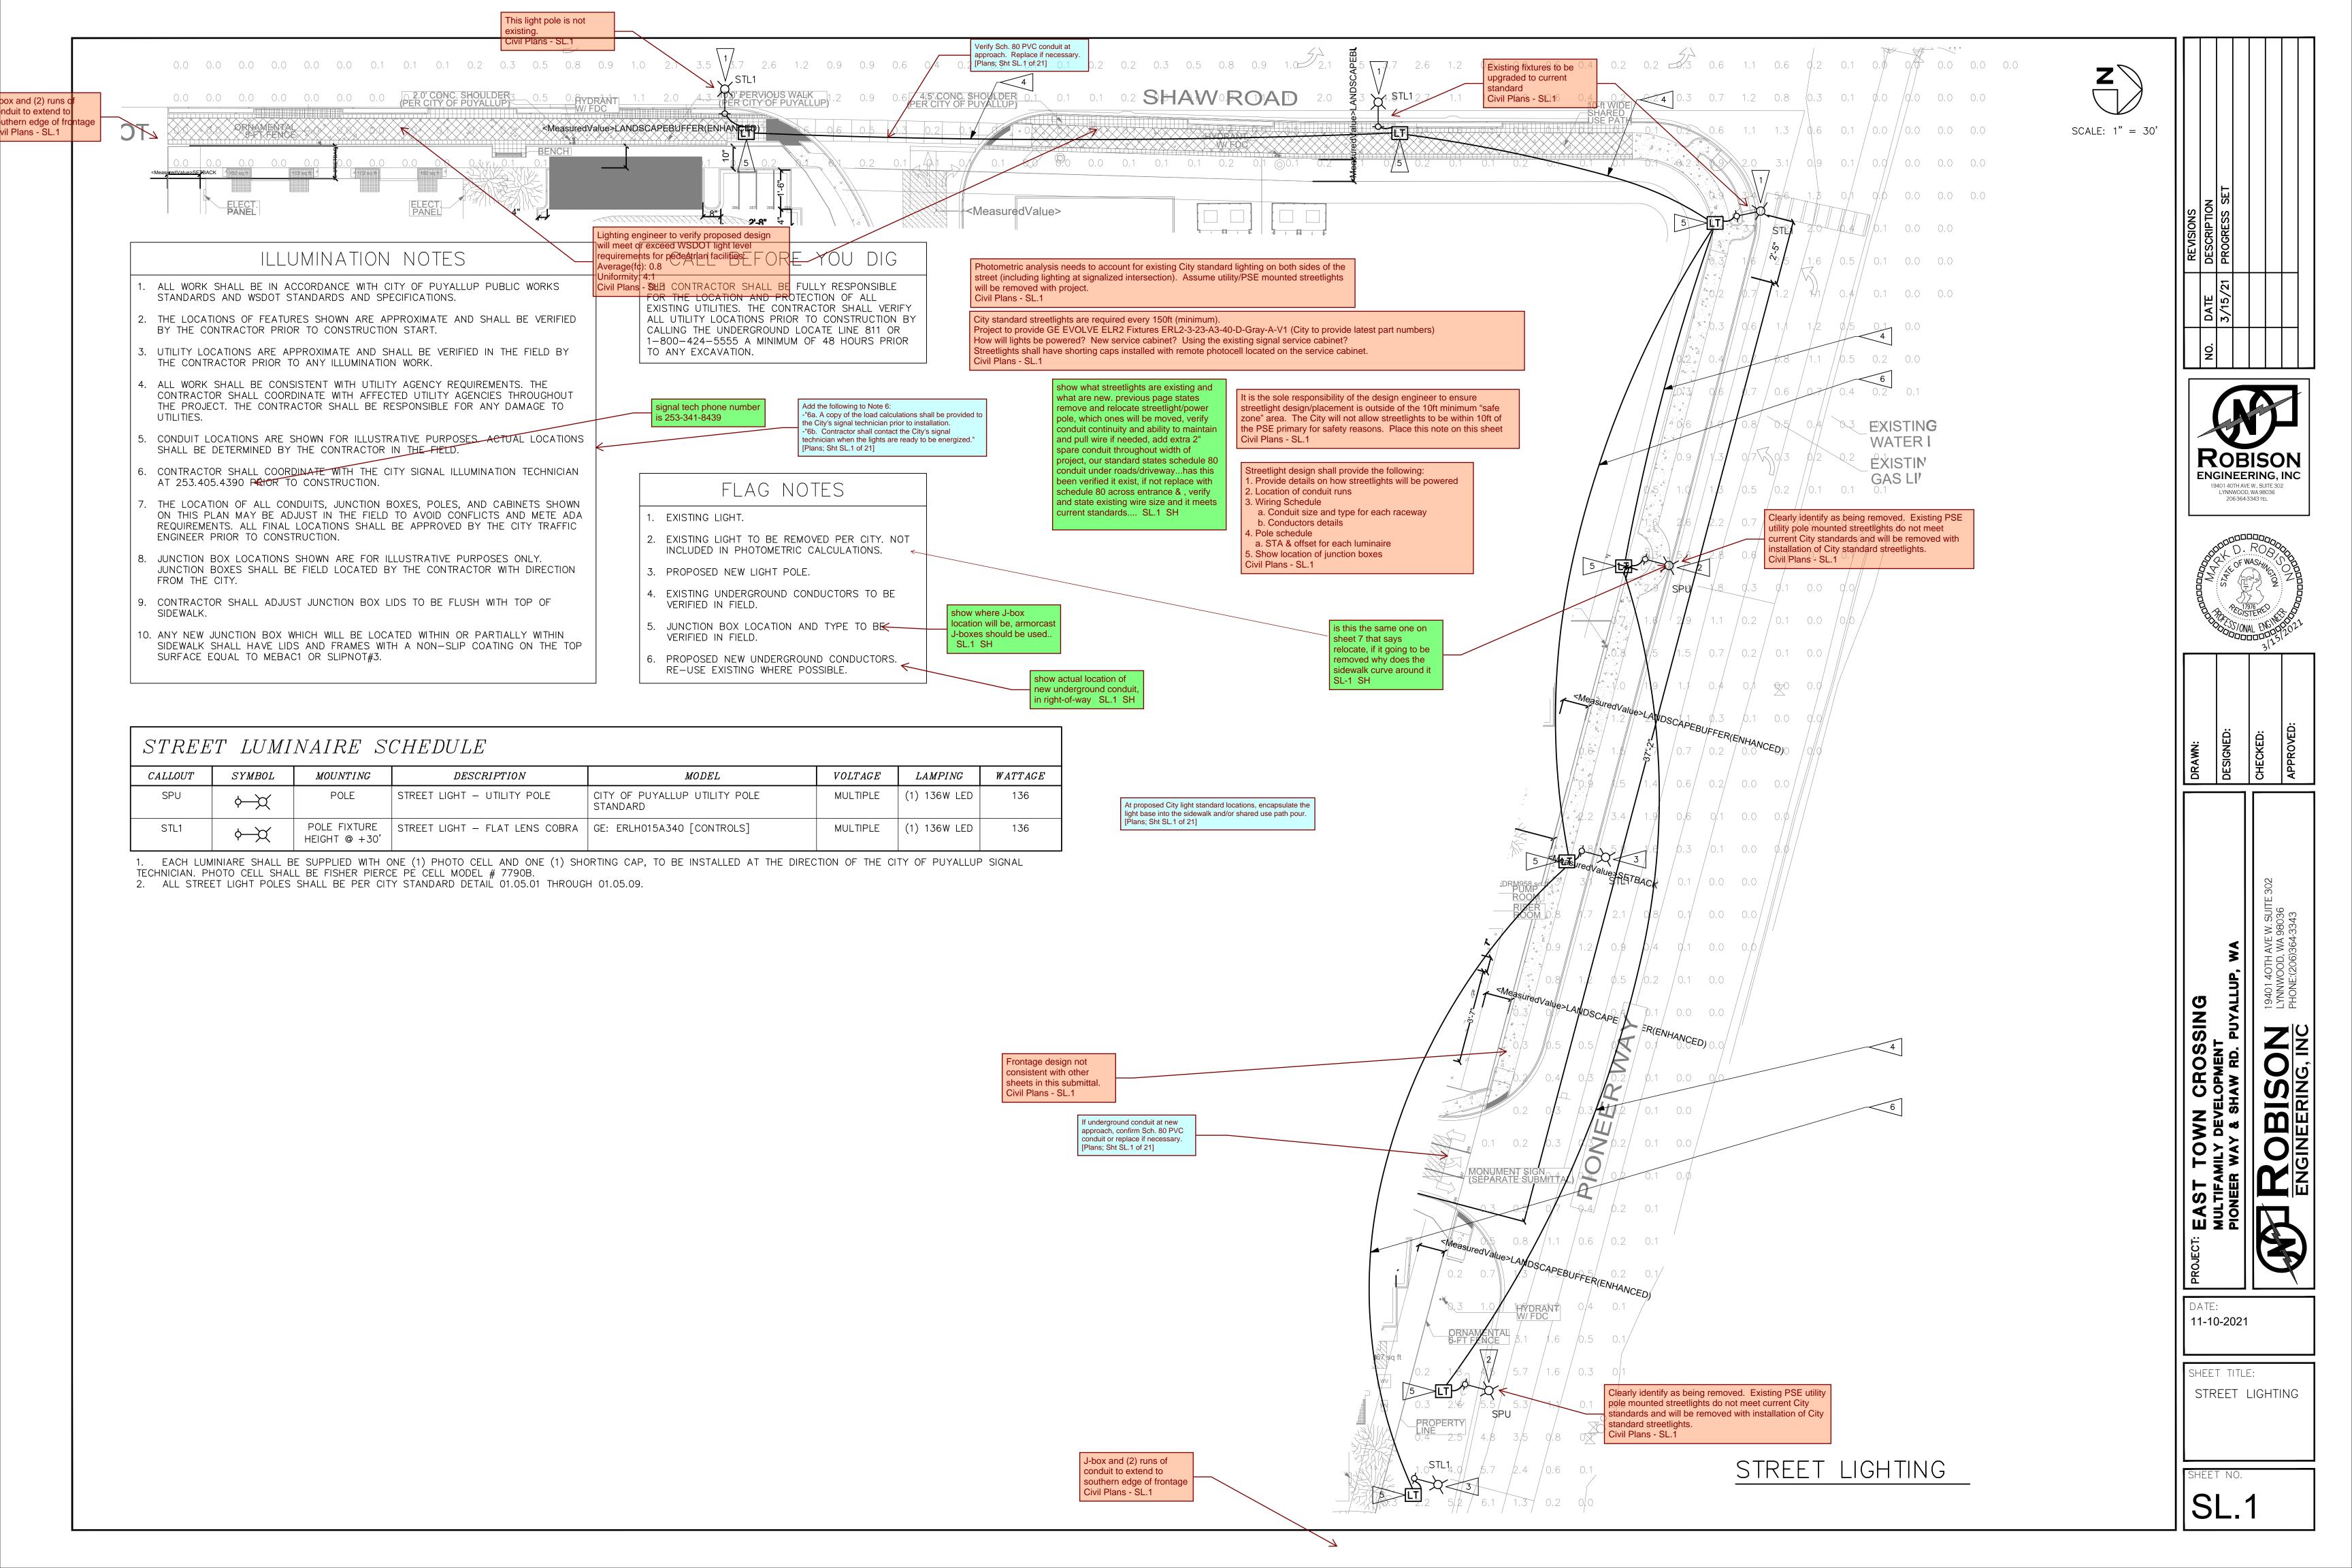

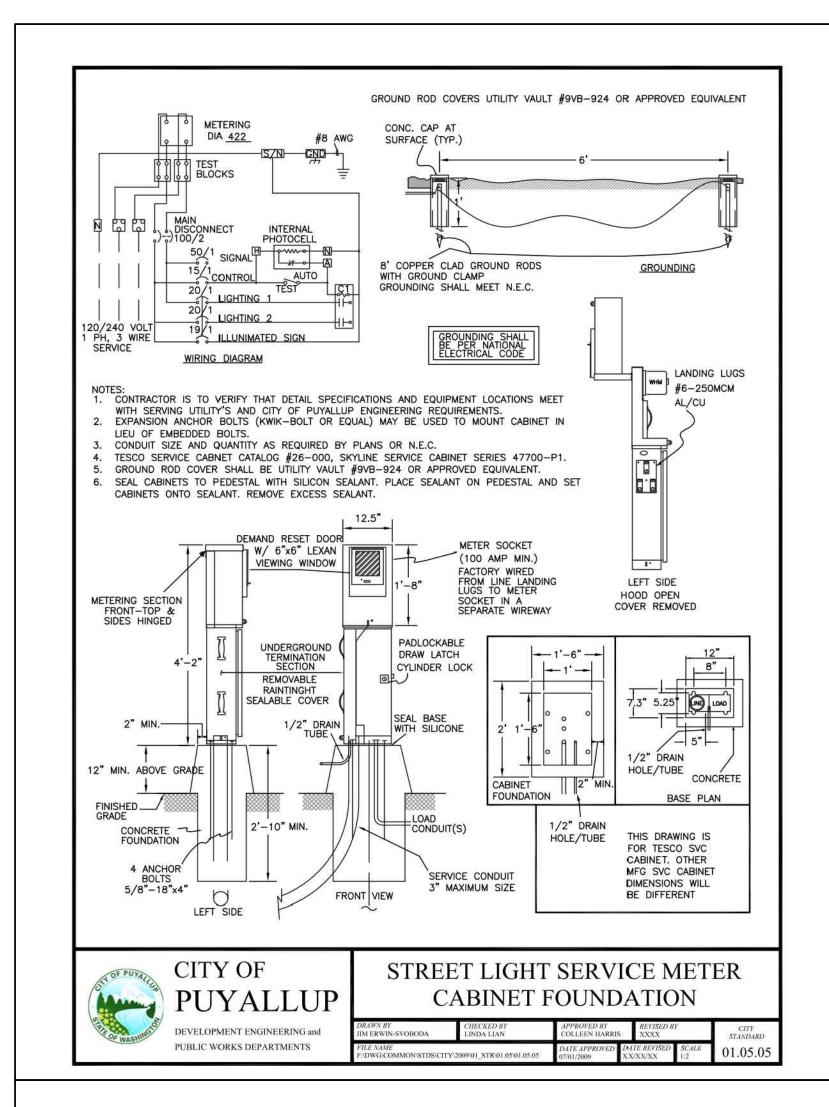

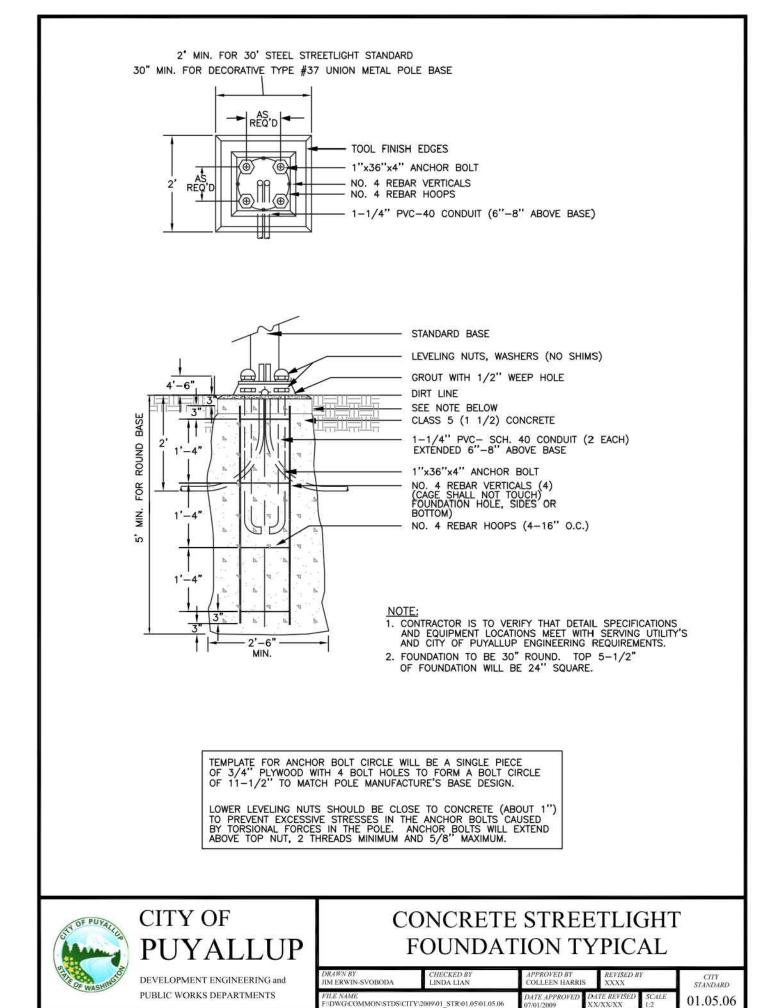

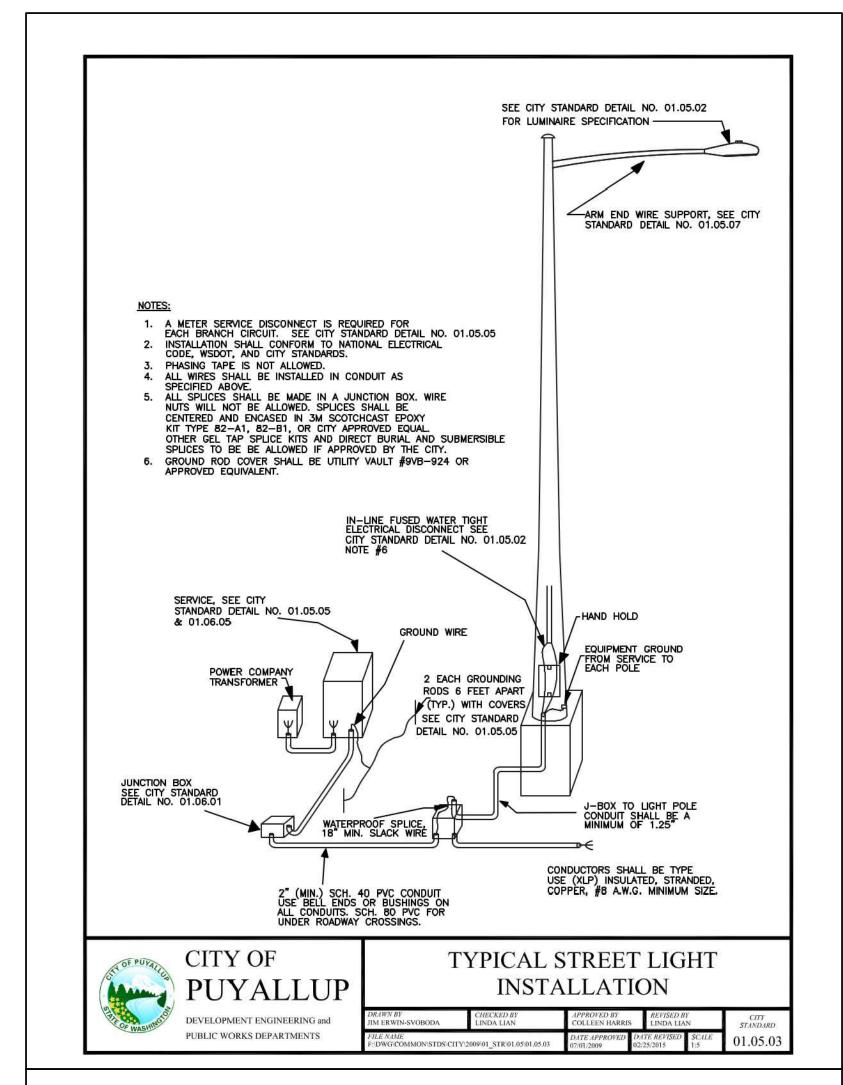

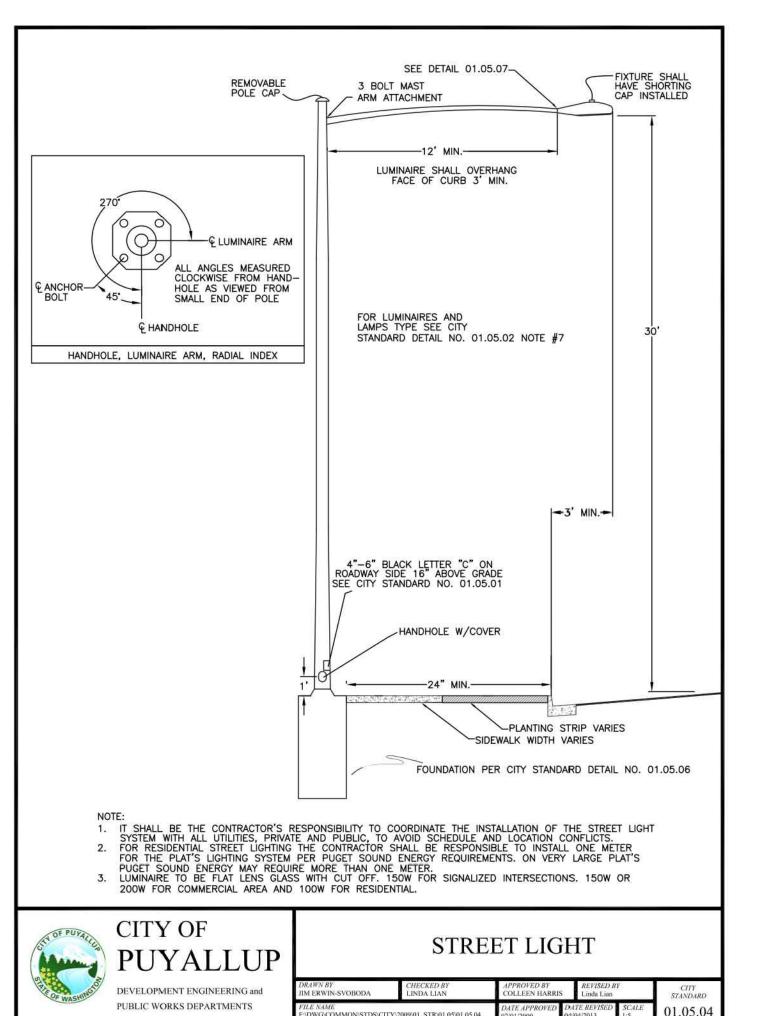

STREET LIGHTING SPECIFICATIONS

30-FOOT STEEL STREETLIGHT STANDARD

STREETLIGHT STANDARDS SHALL PROVIDE A FIXTURE MOUNTING HEIGHT OF 30'0" PLUS OR MINUS 6" WITH A TYPICAL 12 FOOT MAST ARM WITH A THREE FOOT OVERHANG.

BASE PLATE SHALL HAVE SLOTTED HOLES TO ACCOMMODATE 1-INCH ANCHOR BOLTS, AND 11 1/2" BOLT CIRCLE WITH MINIMUM CLEARANCE OF 1" BETWEEN BOLT AND POLE.

HANDHOLE CENTER SHALL BE LOCATED APPROXIMATELY 12 INCHES FROM THE BASE PLATE, ROTATED 270 DEGREES FROM MAST ARM SO AS THE HANDHOLE IS LOCATED ON THE SIDE OPPOSING ONCOMING TRAFFIC.

POLES SHALL MEET ALL STRENGTH REQUIREMENTS OF AASHTO FOR 90 MPH ISOTACH WHEN USED WITH A LUMINAIRE WEIGHING 48 POUNDS WITH A E.P.A. OF 1.1 SQUARE FEET. ALL ATTACHING BOLTS AND SCREWS THAT ARE NOT GALVANIZED SHALL BE STAINLESS STEEL.

THE POLES AND ALL HARDWARE SAHALL BE HOT DIPPED GALVANIZED, MINIMUM 3 MIL THICKNESS.

- d. MAST ARM ATTACHMENT SHALL BE SECURED BY 3 BOLTS.
- e. EACH POLE SHALL HAVE HANDHOLE (WITH COVER), GROUND LUG AND REMOVABLE POLE CAP.
- f. EACH CITY POLE SHALL HAVE A BLACK 4" TO 6" LETTER C STENCILED ON ROADWAY SIDE OF POLE 16" ABOVE GRADE.

ANCHORAGE

- a. POLES SHALL BE ANCHORED WITH 4 BOLTS, 1"X36"X4" #BUNC WITH HOT DIPPED GALVANIZING AFTER THREADS ARE CUT. GALVANIZED AREA SHALL EXTEND FROM THREADED END FOR A MINIMUM OF 12 INCHES. BOLTS SHALL BE PROVIDED WITH 2 GALVANIZED NUTS AND FLAT WASHERS FOR LEVELING. SHIMS WILL NOT BE USED.
- b. A NON-SHRINKING GROUT SHALL BE INSTALLED WITH ONE 1/2" DRAIN HOLE UNDER THE BASE PLATE AFTER THE ENGINEER HAS APPROVED THE POLE INSTALLATION.

ALL CONDUIT SHALL BE BURIED A MINIMUM OF 24 INCHES DEEP. ALL ROADWAY CROSSINGS SHALL BE RIGID METALLIC OR SCHEDULE 80 PVC. CONDUIT SHALL CONFORM TO SECTION 9-29 OF WSDOT STANDARD SPECIFICATIONS. SCHEDULE 80 PVC MAY BE USED IN LOCATIONS OTHER THAN ROADWAY CROSSINGS.



CITY OF

PUBLIC WORKS DEPARTMENTS

DEVELOPMENT ENGINEERING and

SPECIFICATIONS 01.05.01

STREET LIGHT

(STR LIGHT SPECS CONTINUED)

4. JUNCTION BOXES (WHEN REQUIRED) JUNCTION BOXES SHALL BE INSTALLED AT LOCATIONS AS SHOWN ON THE PLANS. THEY WILL CONFORM TO WSDOT STANDARD PLAN J-40.10-02, TYPE 1. THEY SHALL BE LEVEL WITH THE SIDEWALK GRADE AND FIRMLY BEDDED TO PREVENT FUTURE SETTLING. JUNCTION BOXES ARE PREFERRED NOT TO BE INSTALLED IN THE SIDEWALK. THE COVER SHALL BE GALVANIZED AND GROUNDED. THE LETTERS "LT" SHALL BE ETCHED ON THE COVER. (SEE CITY STANDARD DETAIL NO. 01.06.01). IF THE JUNCTION BOX IS NOT IN THE SIDEWALK THEN IT SHALL HAVE A CONCRETE COLLAR. IF THE JUNCTION BOX IS IN THE SIDEWALK THEN IT SHALL HAVE A NON-SLIP SURFACE TREATMENT. SEE CITY STANDARD DETAIL NO. 01.06.01.

CONDUCTORS, WIRES, ETC.

WIRE CONDUCTORS FOR UNDERGROUND FEEDER RUNS AND FOR CIRCUITRY FROM THE IN-LINE FUSE IN THE POLES TO THE JUNCTION BOX SHALL BE 600 VOLT. SINGLE CONDUCTOR STRANDED COPPER AND INSULATED WITH USE GRADE POLYVINYL CHLORIDE COMPOUND (XLP) OR APPROVED EQUAL IN ACCORDANCE WITH THE INSULATED POWER CABLE ENGINEER'S ASSOCIATION SPECIFICATIONS. AN AWG NO. 8 GREEN INSULATED STRANDED COPPER WIRE WILL BE RUN TO THE SERVICE GROUND LUG ON EACH POLE. FEEDERS SHALL BE SIZED IN ACCORDANCE WITH THE NATIONAL ELECTRICAL CODE. WIRES INSIDE THE POLE BETWEEN BALLAST AND IN-LINE FUSES SHALL BE ROME 2C AWG 10 STRANDED POLE AND BRACKET WIRE OR APPROVED EQUAL. SPLICES WILL BE ALLOWED IN JUNCTION BOXES AND POLE BASES ONLY. NO MORE THAN 2 CONDUITS WILL BE ALLOWED INSIDE THE STREET POLE.

LUMINARE FUSING AND ELECTRICAL CONNECTIONS AT LIGHT STANDARD BASES SPECIFICATIONS AND AS SHOWN ON THE UNIFORM LUMINARE WIRING DETAIL IN THE APPENDIX. IN-LINE FUSE HOLDERS SHALL BE SEC MODEL 1791-SF WITH FNM-5 FUSES OR APPROVED EQUAL. (REFER TO CITY STANDARD DETAIL NO. 01.06.01)

LUMINAIRES AND LAMPS

RESIDENTIAL STREETS AND NEIGHBORHOOD COLLECTORS: LEOTEK LED GC1-40E-MV-NW-2-530 (67 WATT LED)

ARTERIALS AND COMMERCIAL COLLECTORS: GE EVOLVE LED ERS2-E-0-HX-EX-5-40 (130 WATT LED)

THE CITY WILL ENERGIZE THE STREET LIGHTS WHEN A HOME IS OCCUPIED ADJACENT TO A STREET LIGHT OR IMMEDIATELY ACROSS THE STREET. AT THE DEVELOPER'S REQUEST, STREET LIGHTS MAY BE ENERGIZED PRIOR TO OCCUPANCY OF HOMES. HOWEVER, THE DEVELOPER OR BUILDER SHALL ASSUME FULL RESPONSIBILITY FOR ELECTRICAL POWER COSTS AND REPAIR COSTS DUE TO VANDALISM, THEFT, OR CONSTRUCTION.

8. SAFE WIRING LABELS

THE CONTRACTOR IS ADVISED THAT SAFE WIRING LABELS REQUIRED BY LABOR AND INDUSTRIES SHALL APPLY ON THIS PROJECT. (ELECTRICAL INSPECTION STICKER)

THE CONTRACTOR SHALL SURRENDER TO THE CITY OF PUYALLUP ANY GUARANTEE OR WARRANTY ACQUIRED BY HIM AS A NORMAL TRADE PRACTICE IN CONNECTION WITH THE PURCHASE OF ANY MATERIALS OR ITEMS USED IN THE CONSTRUCTION OF THE ILLUMINATION.


10. LOCATION


SEE CITY STANDARD SECTION 01.01 ROADWAY DESIGN.



STREET LIGHT	
ECIFICATIONS (CONT.)	

01.05.02

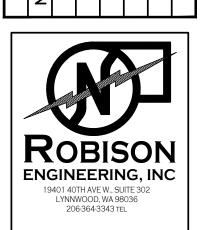

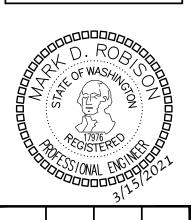

X X

SING

S


S


11-10-2021


SHEET TITLE: STREET LIGHTING


DETAILS

SL.2

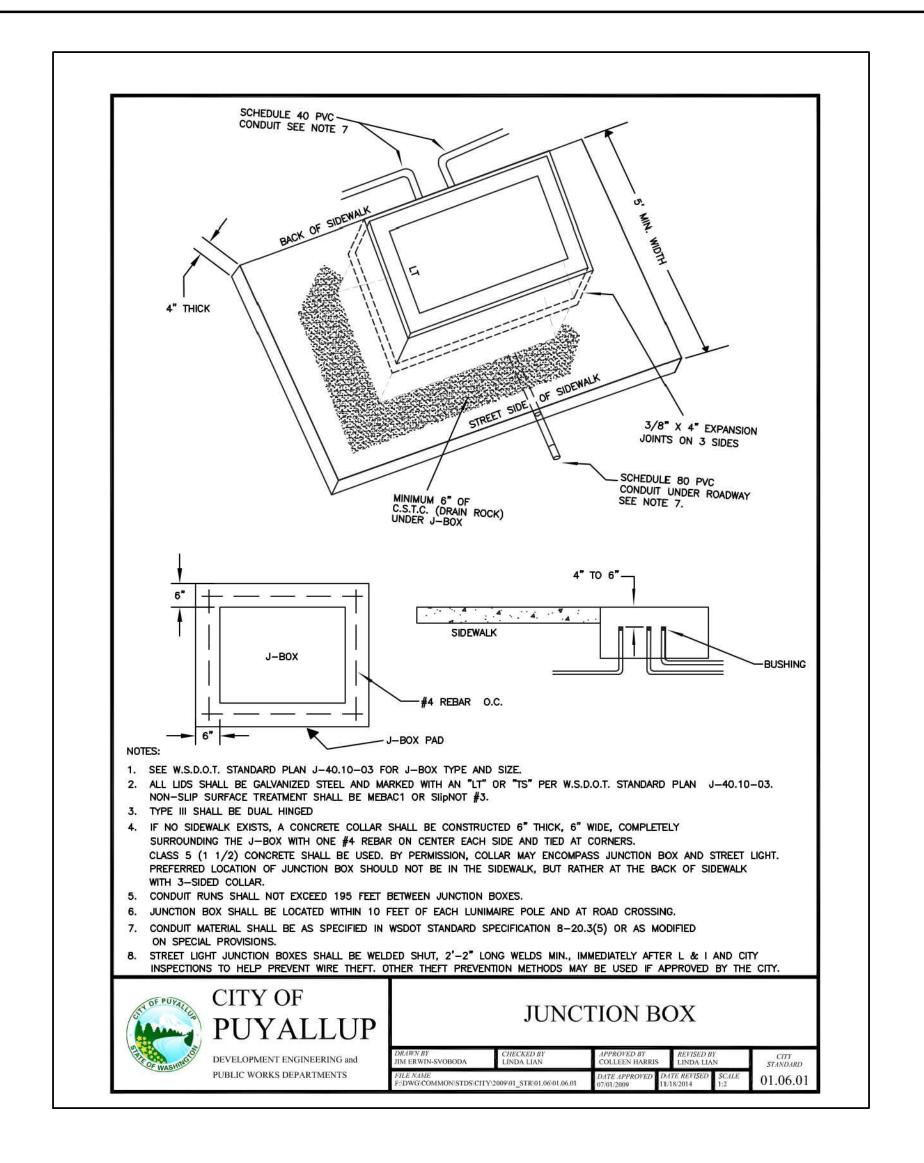


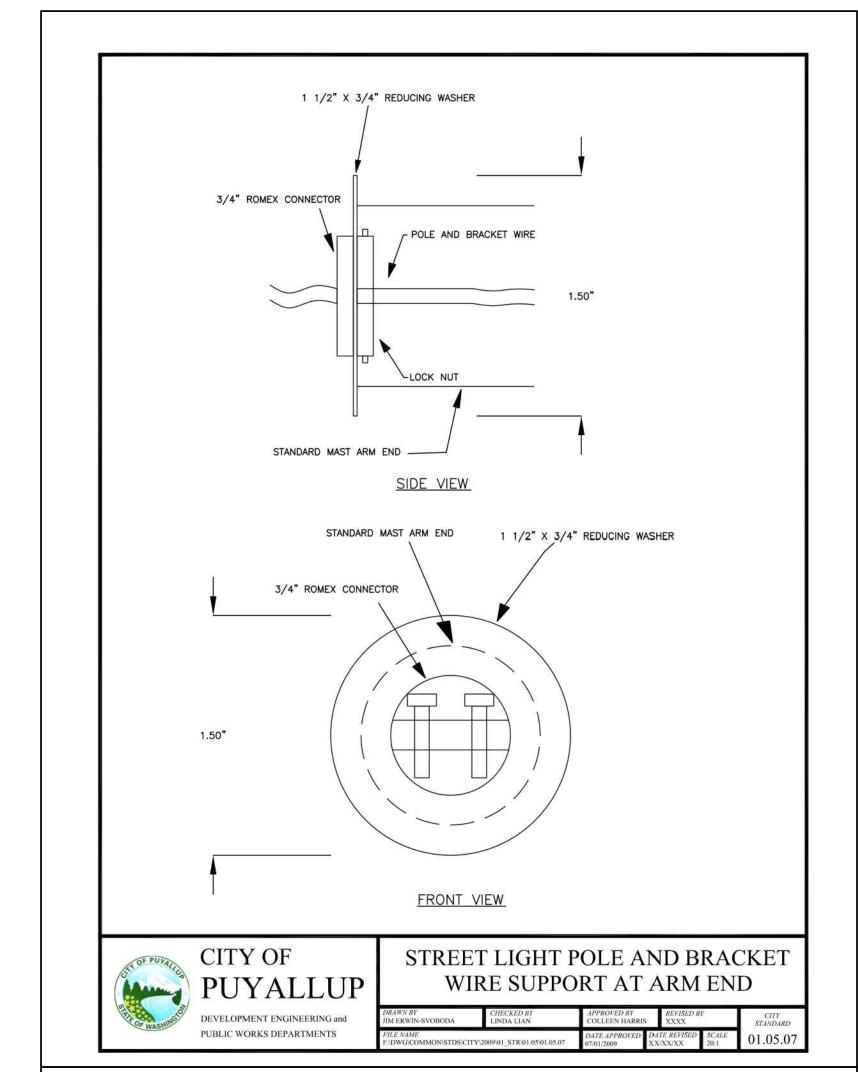

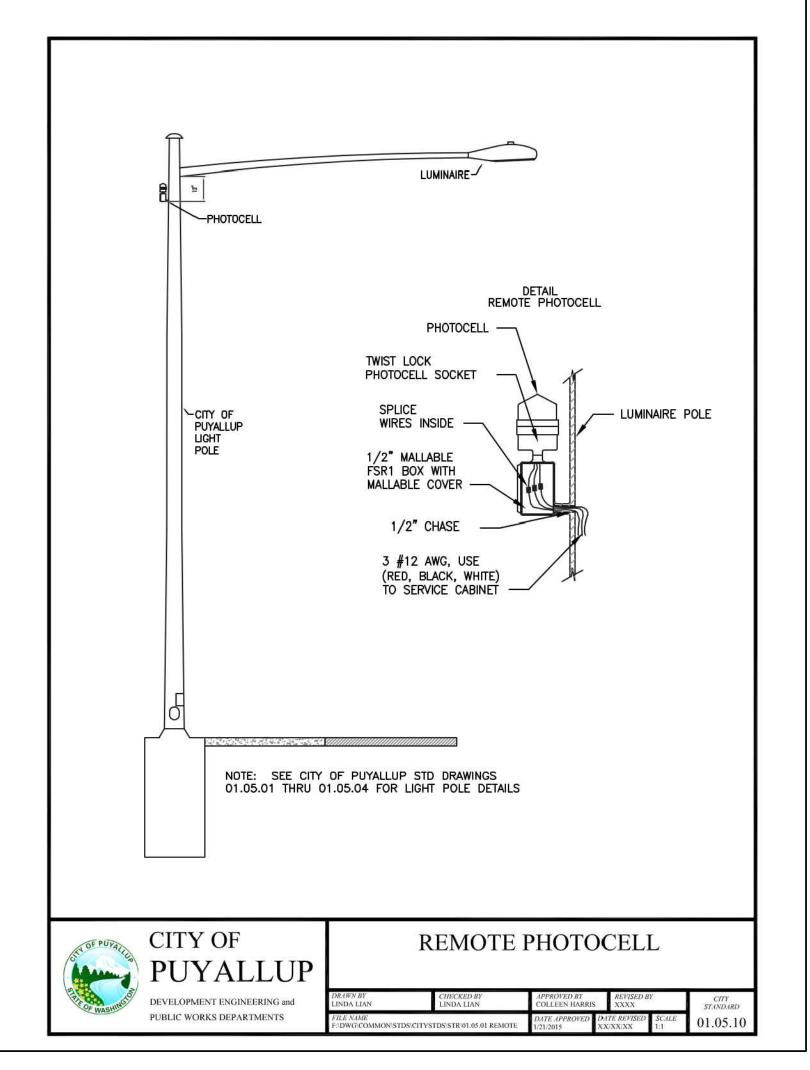

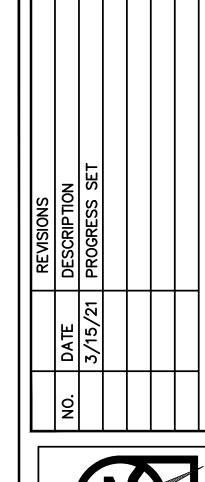



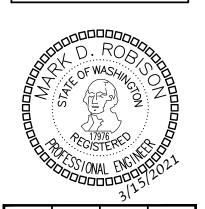


CROSSING ELOPMENT HAW RD. PUYALLUP, V

11-10-2021


SHEET TITLE: STREET LIGHTING - DETAILS

|SL.3

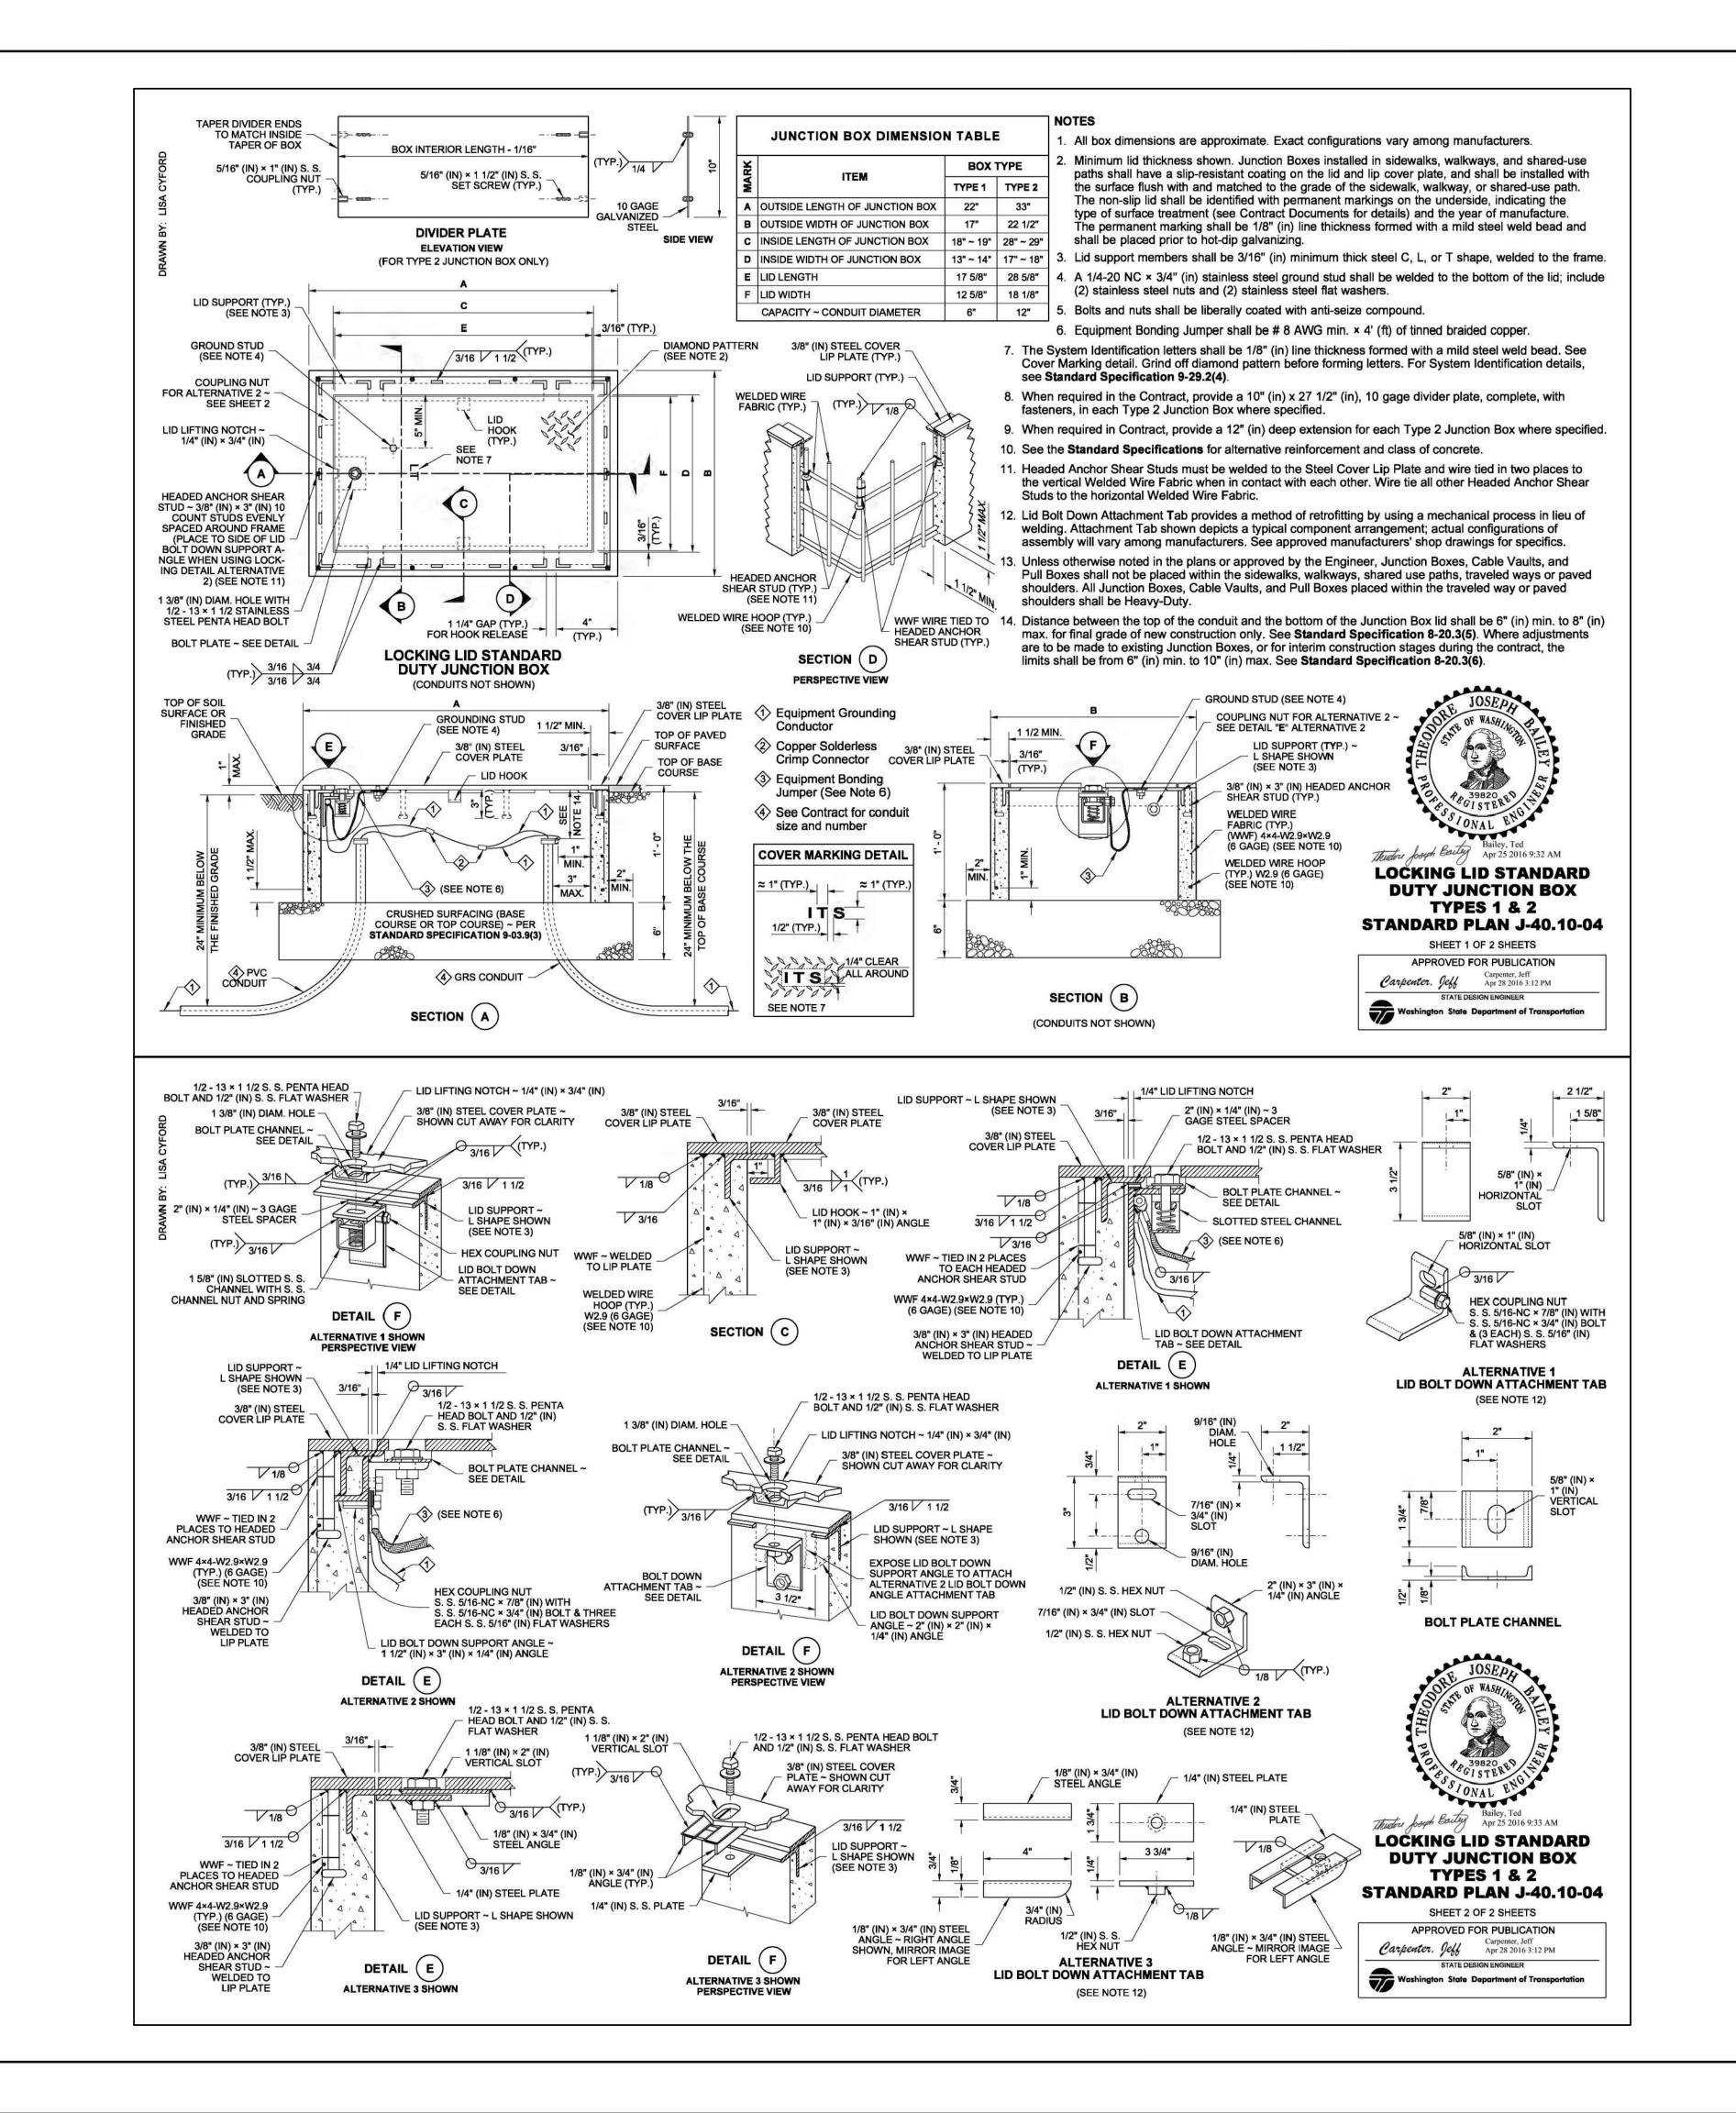

NO. DATE DESCRIPTION
3/15/21 PROGRESS SET



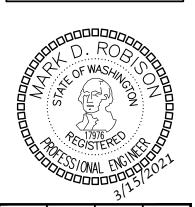

DESIGNED:
CHECKED:
APPROVED:

JP, WA

40TH AVE W. SUITE 302
WOOD, WA 98036
F:(206)364-3343

NAY & SHAW RD. PUYALLU
OBISON
LYNN
LYNN
PHON

NIS

り

ROJECT: EAST TON MULTIFAMILY PIONEER WAY

DATE: 11-10-2021

SHEET TITLE:

STREET LIGHTING

— DETAILS

SHEET NO.

SL.4