


SECTION 26, TOWNSHIP 20 N, RANGE 4 E, W.M.

1st Review
PRCCP20240569
June 2024

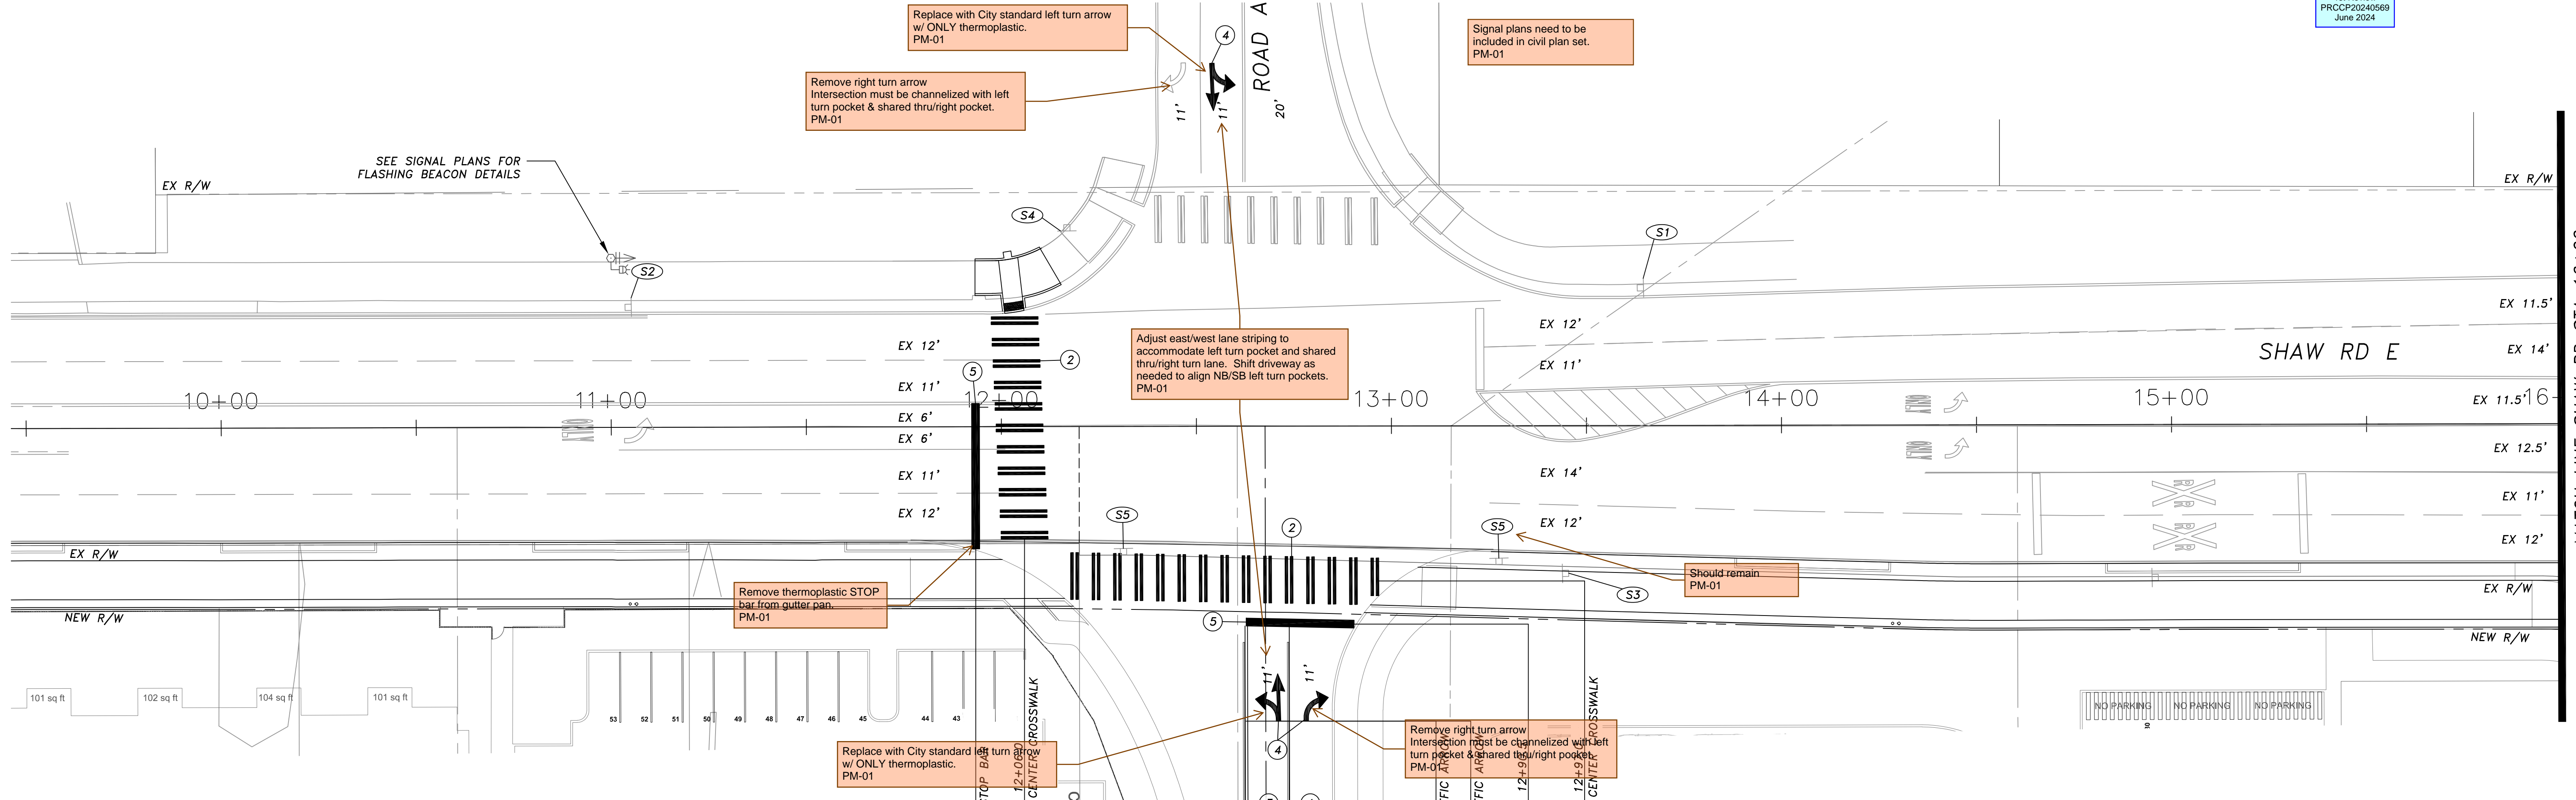

MATCH LINE SHAW RD STA 16+00
SEE SHEET PHASE 2 SET

PAVEMENT MARKING CONSTRUCTION NOTES

- ① INSTALL 8" WHITE PAINTED GORE STRIPE WITH TYPE 2W RPM'S AT 10' O.C. PER CITY OF PUYALLUP STANDARD 01.03.06 AND 01.03.10, DETAIL A.
- ② INSTALL WHITE THERMOPLASTIC CROSSWALK PER CITY OF PUYALLUP STANDARD 01.03.11.
- ③ INSTALL PAINTED DOUBLE YELLOW CENTERLINE (DYC) STRIPE WITH TYPE 2YY RPM'S 20' O.C. PER CITY OF PUYALLUP STANDARD 01.03.10, DETAIL B.
- ④ INSTALL WHITE THERMOPLASTIC TRAFFIC ARROW PER CITY OF PUYALLUP STANDARDS 01.03.06 AND 01.03.14 AND WSDOT STANDARD PLAN M-24.40. CENTER IN LANE AT THE STATION SHOWN.
- ⑤ INSTALL 24" WIDE WHITE THERMOPLASTIC STOP BAR PER CITY OF PUYALLUP STANDARD 01.03.06 AND 01.03.11.


PAVEMENT MARKING GENERAL NOTES

1. ALL PAVEMENT MARKINGS SHALL BE LAID OUT WITH SPRAY PAINT AND APPROVED BY CITY OF PUYALLUP (COP) TRAFFIC OPERATIONS PRIOR TO INSTALLATION. CONTRACTOR SHALL COORDINATE COP TRAFFIC OPERATIONS APPROVAL THROUGH THE COP INSPECTOR.
2. ALL CROSSWALK MARKINGS SHALL BE CENTERED WITHIN THE ADJACENT ADA RAMPS UNLESS OTHERWISE DIRECTED BY THE COP INSPECTOR.
3. COORDINATE WITH CITY STRIPING TECHNICIAN AT 253.405.4389 PRIOR TO INSTALLATION.
4. CONTRACTOR SHALL COORDINATE WITH CITY SIGN SPECIALIST, ~~TED SCHUMAN, (253.405.4389)~~ PRIOR TO SIGN INSTALLATIONS.
5. THE CONTRACTOR IS RESPONSIBLE FOR INSTALLING ALL SIGNS AND CHANNELIZATION PER CITY OF PUYALLUP STANDARDS. CONTRACTOR SHALL LAYOUT OUT ALL SIGNS AND CHANNELIZATION, AND THEN CONTACT PUYALLUP, AT 253.405.4389, 48-HOURS IN ADVANCE OF INSTALLATION TO VERIFY LAYOUT.
6. INSTALL ALL SIGNS IN CONCRETE/ASPHALT PER CITY OF PUYALLUP STANDARD 01.04.01.
7. CONTRACTOR SHALL PRUNE ALL VEGETATION IN CONFLICT WITH SIGNS TO ENSURE UNOBSTRUCTED VISIBILITY TO DRIVERS AND PEDESTRIANS.
8. UNLESS OTHERWISE NOTED, INSTALL ALL SIGNS, PER CITY OF PUYALLUP STANDARD DETAIL 01.04.01, AT 7" ABOVE FINISHED GRADE, AS MEASURED TO THE BOTTOM OF SIGN. ON THE SAME POST, THE LOWEST SIGN SHALL BE 7" ABOVE FINISHED GRADE, AS MEASURED TO THE BOTTOM OF THE SIGN.

PAVEMENT MARKING REMOVAL NOTE

1. REMOVE EXISTING CONFLICTING STRIPING AS NECESSARY TO ACCOMMODATE NEW STRIPING. CONTRACTOR TO COORDINATE STRIPING REMOVAL WITH ASPHALT RESTORATION WORK.

Jason Rogge
253-841-5471
PM-01

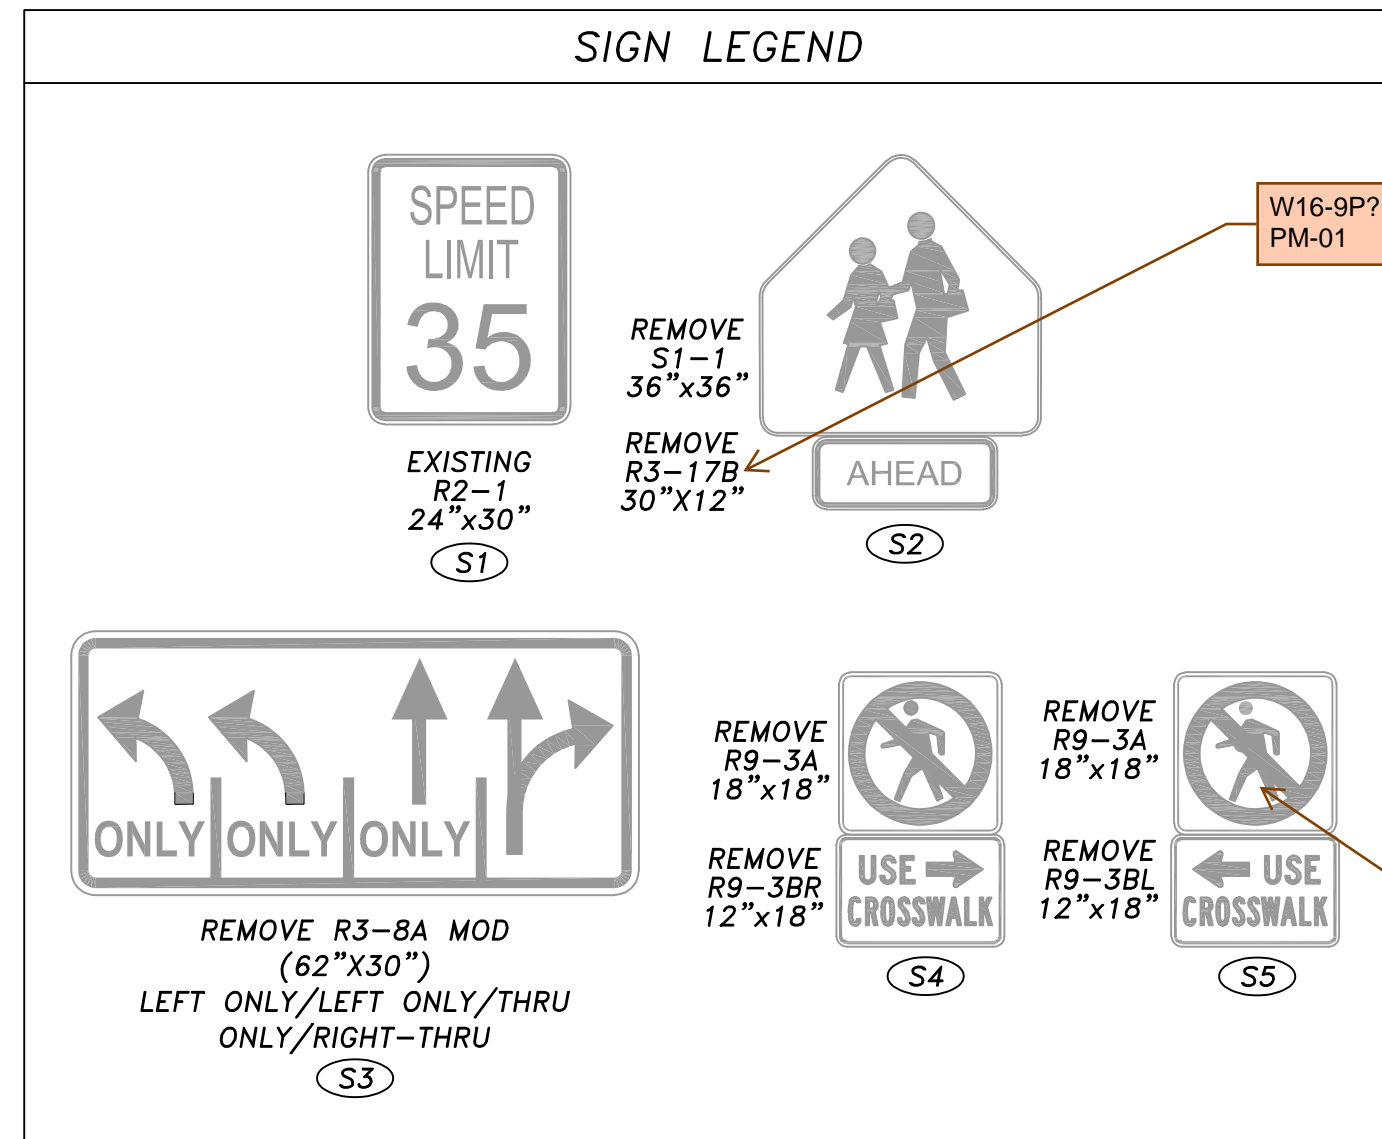


SIGNING CONSTRUCTION NOTES

- ① EXISTING R2-1 "SPEED LIMIT" SIGN AND EXISTING POST TO REMAIN. PROTECT DURING CONSTRUCTION.
- ② REMOVE EXISTING S1-1 AND R3-17B SIGNS AND POST AND RETURN TO CITY. RESTORE AREA TO MATCH SURROUNDING.
- ③ REMOVE EXISTING R3-8A MOD SIGN AND POST AND RETURN TO CITY. RESTORE AREA TO MATCH SURROUNDING.
- ④ REMOVE EXISTING R9-3A SIGN AND R9-3BR SIGN AND RETURN TO CITY.
- ⑤ ~~REMOVE EXISTING R9-3A SIGN AND R9-3BL SIGN AND RETURN TO CITY.~~

remain and point to southern leg of this intersection. PM-01

Should Remain PM-01

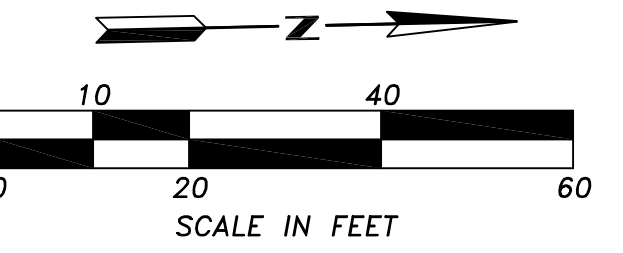

LEGEND

○	PAVEMENT MARKING NOTE
○	SIGNING NOTE
■	SIGN (NEW)
□	SIGN (EXISTING)

APPROVED

BY: _____
CITY OF PUYALLUP
ENGINEERING SERVICES

DATE: _____

NOTE: THIS APPROVAL IS VOID AFTER 1 YEAR FROM APPROVAL DATE.
THE CITY WILL NOT BE RESPONSIBLE FOR ERRORS AND/OR OMISSIONS ON THESE PLANS. FIELD CONDITIONS MAY DICTATE CHANGES TO THESE PLANS AS DETERMINED BY THE ENGINEERING SERVICES MANAGER.

SEE SHEET PM-02 TO PM-03 FOR:
• STANDARD PLAN DETAILS

No.	Date	By	Revision Description

Designed By:	Issue Date:
LAB	09/29/2023
Drawn By:	PERMIT
LAB	
Checked By:	Project No.:
GRL	2022-295



TENW
Transportation Engineering NorthWest

Transportation Planning | Design | Traffic Impact & Operations
11400 36th Street, Suite 200, Bellevue, WA 98004 | Office (425) 889-6747
Project Contact: Trevor Tokara, P.E.
Phone: 206-914-3843

ASH DEVELOPMENT, LLC
EAST TOWN CROSSING
PUYALLUP, WA

PAVEMENT MARKING &
SIGNING PLANS - PHASE 1

PM-01
SHEET:
OF

SECTION 26, TOWNSHIP 20 N, RANGE 4 E, W.M.

CASE 1
WHEN LEFT TURN POCKET IS 100' OR LESS

CASE 2
WHEN LEFT TURN POCKET IS 101' - 200'

CASE 3
WHEN LEFT TURN POCKET IS 201' - 275'

NOTES:

- THE PLACEMENT AND NUMBER OF ARROW/ONLY MARKINGS FOR LANES EXCEEDING 275' WILL BE APPROVED ON AN INDIVIDUAL BASIS BY THE CITY OF PUYALLUP.
- DISTANCES SHALL BE EQUAL WHEN LESS THAN 100'
- PAINT FOR LANES STRIPES SHALL COMPLY WITH SPECIFICATIONS FOR NO HEAT, INSTANT DRY PAVEMENT MARKING. GLASS BEADS SHALL COMPLY WITH SPECIFICATIONS FOR TYPE 1 WATERPROOF OVERLAY GLASS SPHERES. INSTALLATION SHALL MEET CONSTRUCTION REQUIREMENTS 8-22.3 OF 2002 STANDARD SPECIFICATIONS FOR ROAD, BRIDGE AND MUNICIPAL CONSTRUCTION. SEE PAVEMENT MARKING DETAILS FOR EXCEPTIONS WHEN PAINT CAN NOT BE USED.
- PAVEMENT MARKINGS SHALL BE TYPE A - LIQUID HOT APPLIED THERMOPLASTIC PER STANDARD SPECIFICATIONS, SECTION 9-34 PAVEMENT MARKING MATERIAL, 9-34.1 GENERAL.
- STOP BAR IS TO BE INSTALLED ONLY WHERE A TRAFFIC STUDY DETERMINES THEY ARE WARRANTED.

CITY OF PUYALLUP
DEVELOPMENT ENGINEERING and PUBLIC WORKS DEPARTMENTS

LEFT/RIGHT TURN POCKET ARROW AND ONLY LAYOUT

01.03.06

LENGTH	NUMBER OF ARROW SETS	LOCATION OF ARROW SETS
0' - 100'	0	
101' - 300'	1	
301' - 500'	2	
501' - 850'	3	
851' - 1200'	4	
1201' - 1750'	5	* SPACE BALANCE OF SETS EVENLY OVER REMAINDER OF SEGMENT.
OVER 1750'	L=100 300	ROUND TO NEAREST WHOLE NUMBER

EXAMPLE:

NOTES:

- STOP BAR IS TO BE INSTALLED ONLY WHERE A TRAFFIC STUDY DETERMINES THEY ARE WARRANTED.
- SECTION LENGTHS ARE DETERMINED BY INTERSECTION PLACEMENTS, WHICH ARE VARIABLE.

CITY OF PUYALLUP
DEVELOPMENT ENGINEERING and PUBLIC WORKS DEPARTMENTS

TWO-WAY LEFT TURN CHANNELIZATION

01.03.07

NOTES:

- POCKET LENGTH DETERMINED BY TRAFFIC VOLUME.
- MEASURE SEGMENT LENGTH (L).
- 100' TO MIDPOINT OF FIRST SET.
- IF WARRANTED BY TRAFFIC STUDY, INSTALL 24" WIDE STOP BAR TYP.
- MEASURE SEGMENT LENGTH (L).
- TAPER FORMULA $LT = \frac{L}{T}$
- TYPE 2Y R.P.M.'S EQUALLY SPACED.
- TYPE 3Y R.P.M.'S EQUALLY SPACED.
- SCALE: 1:40
- SCALE: 1:20
- SCALE: 1:50
- SCALE: 1:10

CITY OF PUYALLUP
DEVELOPMENT ENGINEERING and PUBLIC WORKS DEPARTMENTS

TWO-WAY LEFT TURN CHANNELIZATION (CONT.)

01.03.08

CASE "A" LEFT TURN POCKET FROM TWO-WAY LEFT TURN LANE

CASE "B" LEFT TURN POCKET FROM TAPER SECTION

CASE "C" LEFT OR RIGHT TURN POCKET FROM TWO THRU LANES

CASE "D" RIGHT TURN ADD LANE

NOTES:

- STOP BAR IS TO BE INSTALLED ONLY WHERE A TRAFFIC STUDY DETERMINES THEY ARE WARRANTED.
- SPACING OF ARROW MARKINGS FOR LEFT/RIGHT TURN POCKETS DESIRABLE --- 125 FEET TO 150+ FEET
- TURN LANE STORAGE LENGTH TO BE DETERMINED BASED ON TRAFFIC VOLUMES. ABSOLUTE MIN. --- 80 FEET DESIRABLE --- 100 FEET

CITY OF PUYALLUP
DEVELOPMENT ENGINEERING and PUBLIC WORKS DEPARTMENTS

LEFT TURN POCKETS

01.03.09

NOTES:

- CENTERLINE STRIPE FOR CHANNELIZATION SHALL BE DETAIL B OR DETAIL C AS DIRECTED BY CITY. CENTERLINE STRIPE FOR ALL COLLECTORS SHALL BE DETAIL D WITH TYPE 2Y R.P.M. SPACED AT 40' INTERVALS ON TANGENTS AND HORIZ. CURVES WITH A RADIUS OF 500' OR MORE AND 40' INTERVALS ON HORIZ. CURVES LESS THAN 500'. CENTERLINE STRIPE FOR ARTERIALS SHALL BE DETAIL E WITH RPM SPACING AS PREVIOUSLY DEFINED.
- ROADS, UNLESS OTHERWISE DETERMINED BY THE CITY, (ARTERIALS & COLLECTORS) LONGITUDINAL LINES SHALL BE PAINTED, APPLIED 14 MILS WHEN WET.
- NO PASSING ZONES IN ONE DIRECTION OR BOTH SHALL BE CLEARLY MARKED WITH CENTERLINE STRIPE, DETAIL B OR DETAIL C OR COMBINATION OF DETAIL D AND DETAIL E.
- ON WIDE INTERSECTIONS SPACE TYPE 1 OR 2 RPM 4 FEET ON CENTER.

RAISED PAVEMENT MARKINGS

TYPE 2 RPM (REFLECTIVE)

TYPE 2R1 WHITE AND RED

TYPE 2R2 YELLOW AND RED

TYPE 2Y1 YELLOW AND YELLOW

TYPE 2W WHITE - ONE SIDE ONLY

TYPE 2Y YELLOW - ONE SIDE ONLY

TYPE 1 RPM COLORS

TYPE 1W WHITE

TYPE 1Y YELLOW

***TYPE 3 RPM COLORS**

TYPE 3W 8" RUMBLE BAR - WHITE

TYPE 3Y 8" RUMBLE BAR - YELLOW

* CITY MAY REQUIRE REFLECTIVE.

CITY OF PUYALLUP
DEVELOPMENT ENGINEERING and PUBLIC WORKS DEPARTMENTS

PAVEMENT MARKING DETAILS

01.03.10

NOTES:

- FOR ALL ROADWAYS, THE LONGITUDINAL LINES SHALL BE CENTERED ON THE LANE LINES AND IN THE CENTER OF THE TRAVELED PORTION OF THE LANE TO MINIMIZE TIRE WEAR. THE SPACING BETWEEN THE LONGITUDINAL LINES SHALL NOT EXCEED 60".
- THE LENGTH OF A CROSSWALK SHALL BE 8' ACROSS RESIDENTIAL STREETS, 10' ACROSS COLLECTORS AND MINOR ARTERIALS AND 12' ACROSS PRINCIPAL ARTERIALS. HOWEVER, THE LENGTH OF A CROSSWALK SHALL BE 8' ACROSS SIDE STREETS ALONG COLLECTORS AND MINOR ARTERIALS AND 12' ACROSS SIDE STREETS ALONG PRINCIPAL ARTERIALS.
- STOP BAR WHEN USED WITH A CROSSWALK SHALL BE PLACED FOUR FEET IN ADVANCE OF AND PARALLEL TO THE CROSSWALK ALL STOP BARS SHALL BE 24" WIDE.
- PAVEMENT MARKINGS, INCLUDING CROSSWALKS, SHALL BE TYPE A LIQUID HOT APPLIED THERMOPLASTIC PER STANDARD SPECIFICATIONS, SECTION 9-34 PAVEMENT MARKING MATERIAL, 9-34.1 GENERAL.

CITY OF PUYALLUP
DEVELOPMENT ENGINEERING and PUBLIC WORKS DEPARTMENTS

CROSSWALK DETAIL

01.03.11

RPM LAYOUT

MPH	SET SPACING
20 MPH	15 FEET
25 MPH	20 FEET
30 MPH	25 FEET
35 MPH	30 FEET
40 MPH	35 FEET

NOTES:

- TAPER LINE USAGE DETERMINED BY TRAFFIC ENGINEER
- RPM USAGE DETERMINED BY TRAFFIC ENGINEER
- OBJECT MARKER USAGE DETERMINED BY TRAFFIC ENGINEER
- SIGN SHALL BE TYPE 4 PRISMATIC SHEETING

TYPE 3 OBJECT MARKERS

OM-SL
OM-SR

CITY OF PUYALLUP
DEVELOPMENT ENGINEERING and PUBLIC WORKS DEPARTMENTS

TAPER MARKING LAYOUTS

01.03.13

PER WSDOT STANDARD PLAN M-24.20.01

NOTE: PAVEMENT MARKINGS, INCLUDING CROSSWALKS, SHALL BE TYPE A LIQUID HOT APPLIED THERMOPLASTIC PER STANDARD SPECIFICATIONS, SECTION 9-34 PAVEMENT MARKING MATERIAL, 9-34.1 GENERAL.

CITY OF PUYALLUP
DEVELOPMENT ENGINEERING and PUBLIC WORKS DEPARTMENTS

PAVEMENT ARROWS

01.03.14

APPROVED

BY: _____ CITY OF PUYALLUP ENGINEERING SERVICES

DATE: _____

NOTE: THIS APPROVAL IS VOID AFTER 1 YEAR FROM APPROVAL DATE. THE CITY WILL NOT BE RESPONSIBLE FOR ERRORS AND/OR OMISSIONS ON THESE PLANS. FIELD CONDITIONS MAY Dictate CHANGES TO THESE PLANS AS DETERMINED BY THE ENGINEERING SERVICES MANAGER.

No.	Date	By	Revision Description

Designed By:	Issue Date:
LAB	09/29/2023
Drawn By:	PERMIT
LAB	
Checked By:	Project No.:
GRL	2022-295



TENW
Transportation Engineering NorthWest


Transportation Planning | Design | Traffic Impact & Operations
11400 SE 8th Street, Suite 200, Bellevue, WA 98004 | Office (425) 889-6747
Project Contact: Trevor Tokara, P.E.
Phone: 206-914-3843

ASH DEVELOPMENT, LLC
EAST TOWN CROSSING
PUYALLUP, WA

PAVEMENT MARKING & SIGNING PLANS
STANDARD DETAILS - PHASE 1

PM-02
SHEET:
OF

SECTION 26, TOWNSHIP 20 N, RANGE 4 E, W.M.

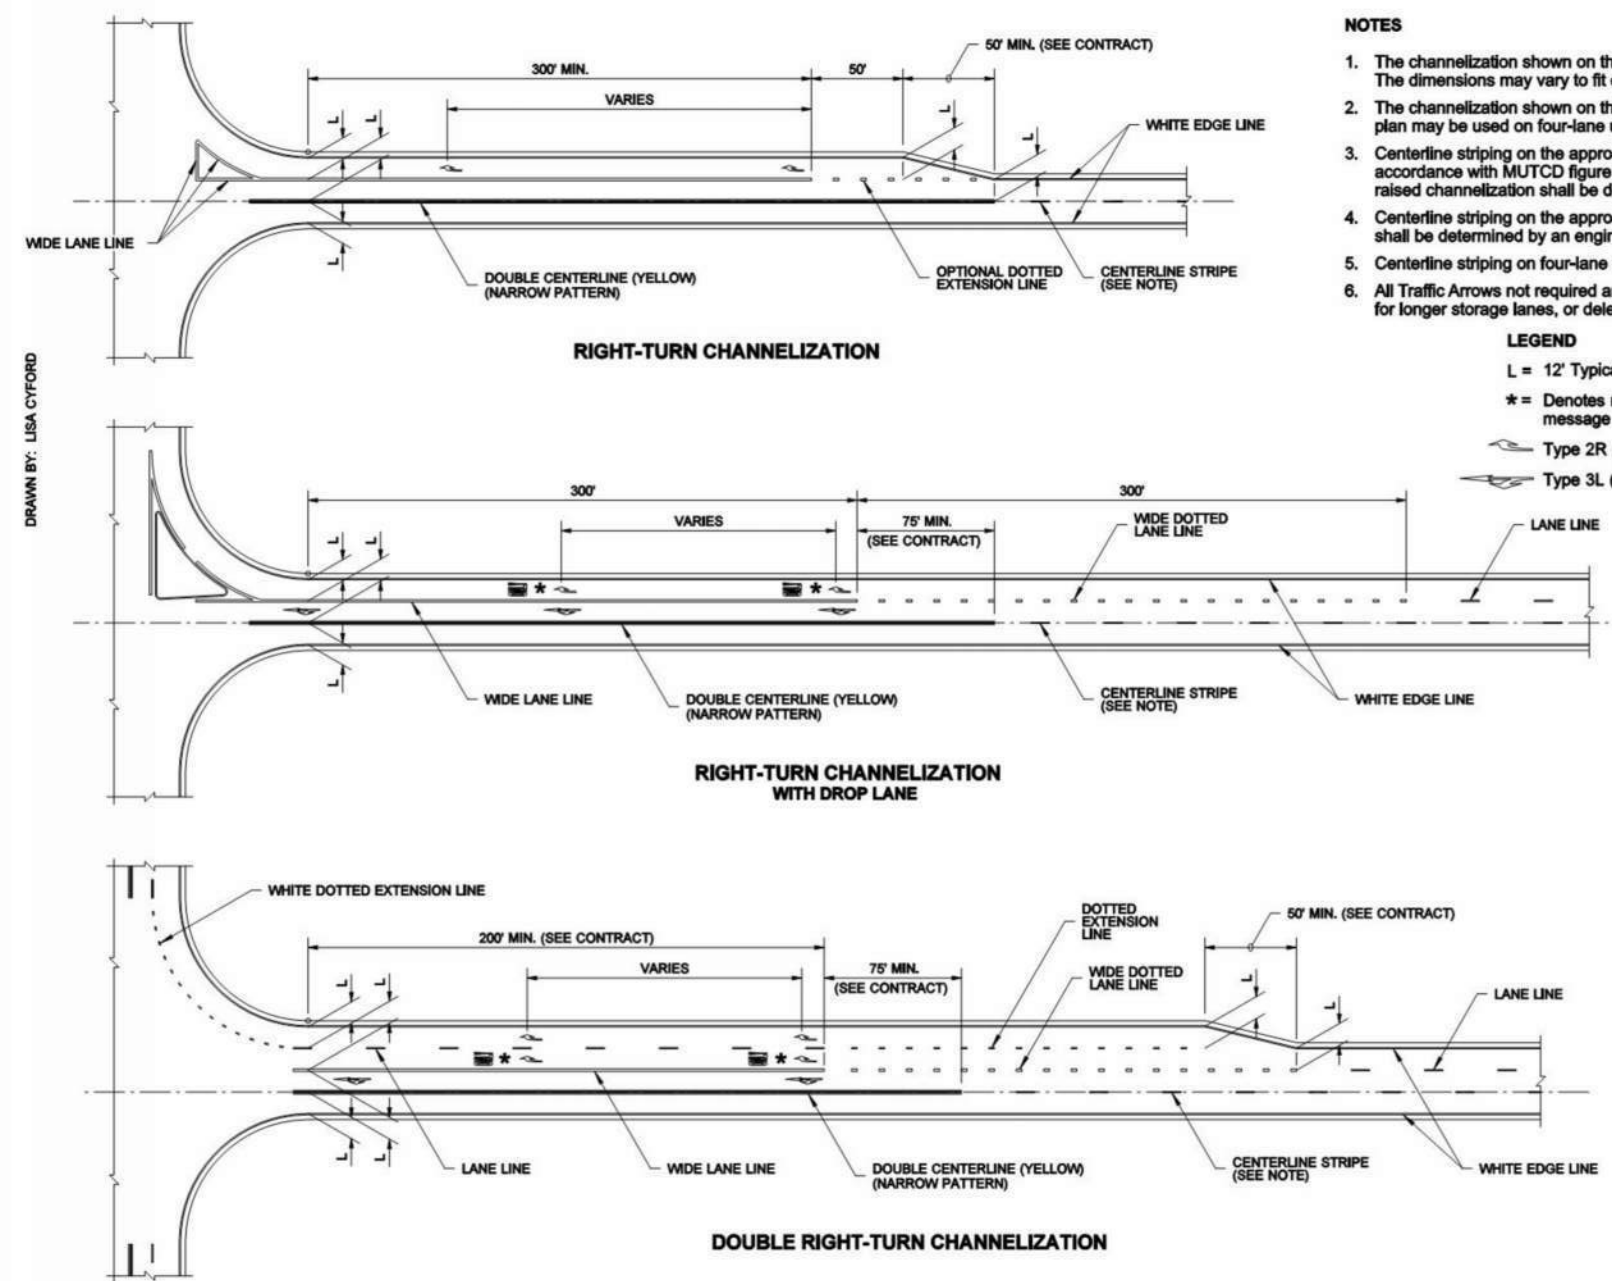

- NOTES**
- The channelization shown on this plan assumes optimal roadway geometric design. The dimensions may vary to fit existing conditions. See Contract.
 - The channelization shown on this plan is for a two-lane highway. The channelization plan may be used on four-lane undivided highways with the appropriate considerations.
 - Centerline striping on the approach to raised channelization shall be No Pass in accordance with MUTCD Figure 3B-15. Centerline striping on the departure from raised channelization shall be determined by an engineering study.
 - Centerline striping on the approach to and departure from painted channelization shall be determined by an engineering study.
 - Centerline striping on four-lane undivided highways shall be a double center line.
 - All Traffic Arrows not required are optional, but recommended. Arrows may be added for longer storage lanes, or deleted for shorter storage lanes. See Contract Plans.

LEGEND

L = 12' Typical Lane Width. See Contract for specified lane widths.


• = Devices required traffic arrow. Accompanying ONLY word message optional. See Standard Plan M-24.40-02 for spacing.

Type 2R (SR) Traffic Arrow

Type 3L (SL) Traffic Arrow




RIGHT-TURN CHANNELIZATION
STANDARD PLAN M-5.10-02
SHEET 1 OF 1 SHEET
APPROVED FOR PUBLICATION
Pasco Balotich III 06-03-11
Washington State Department of Transportation

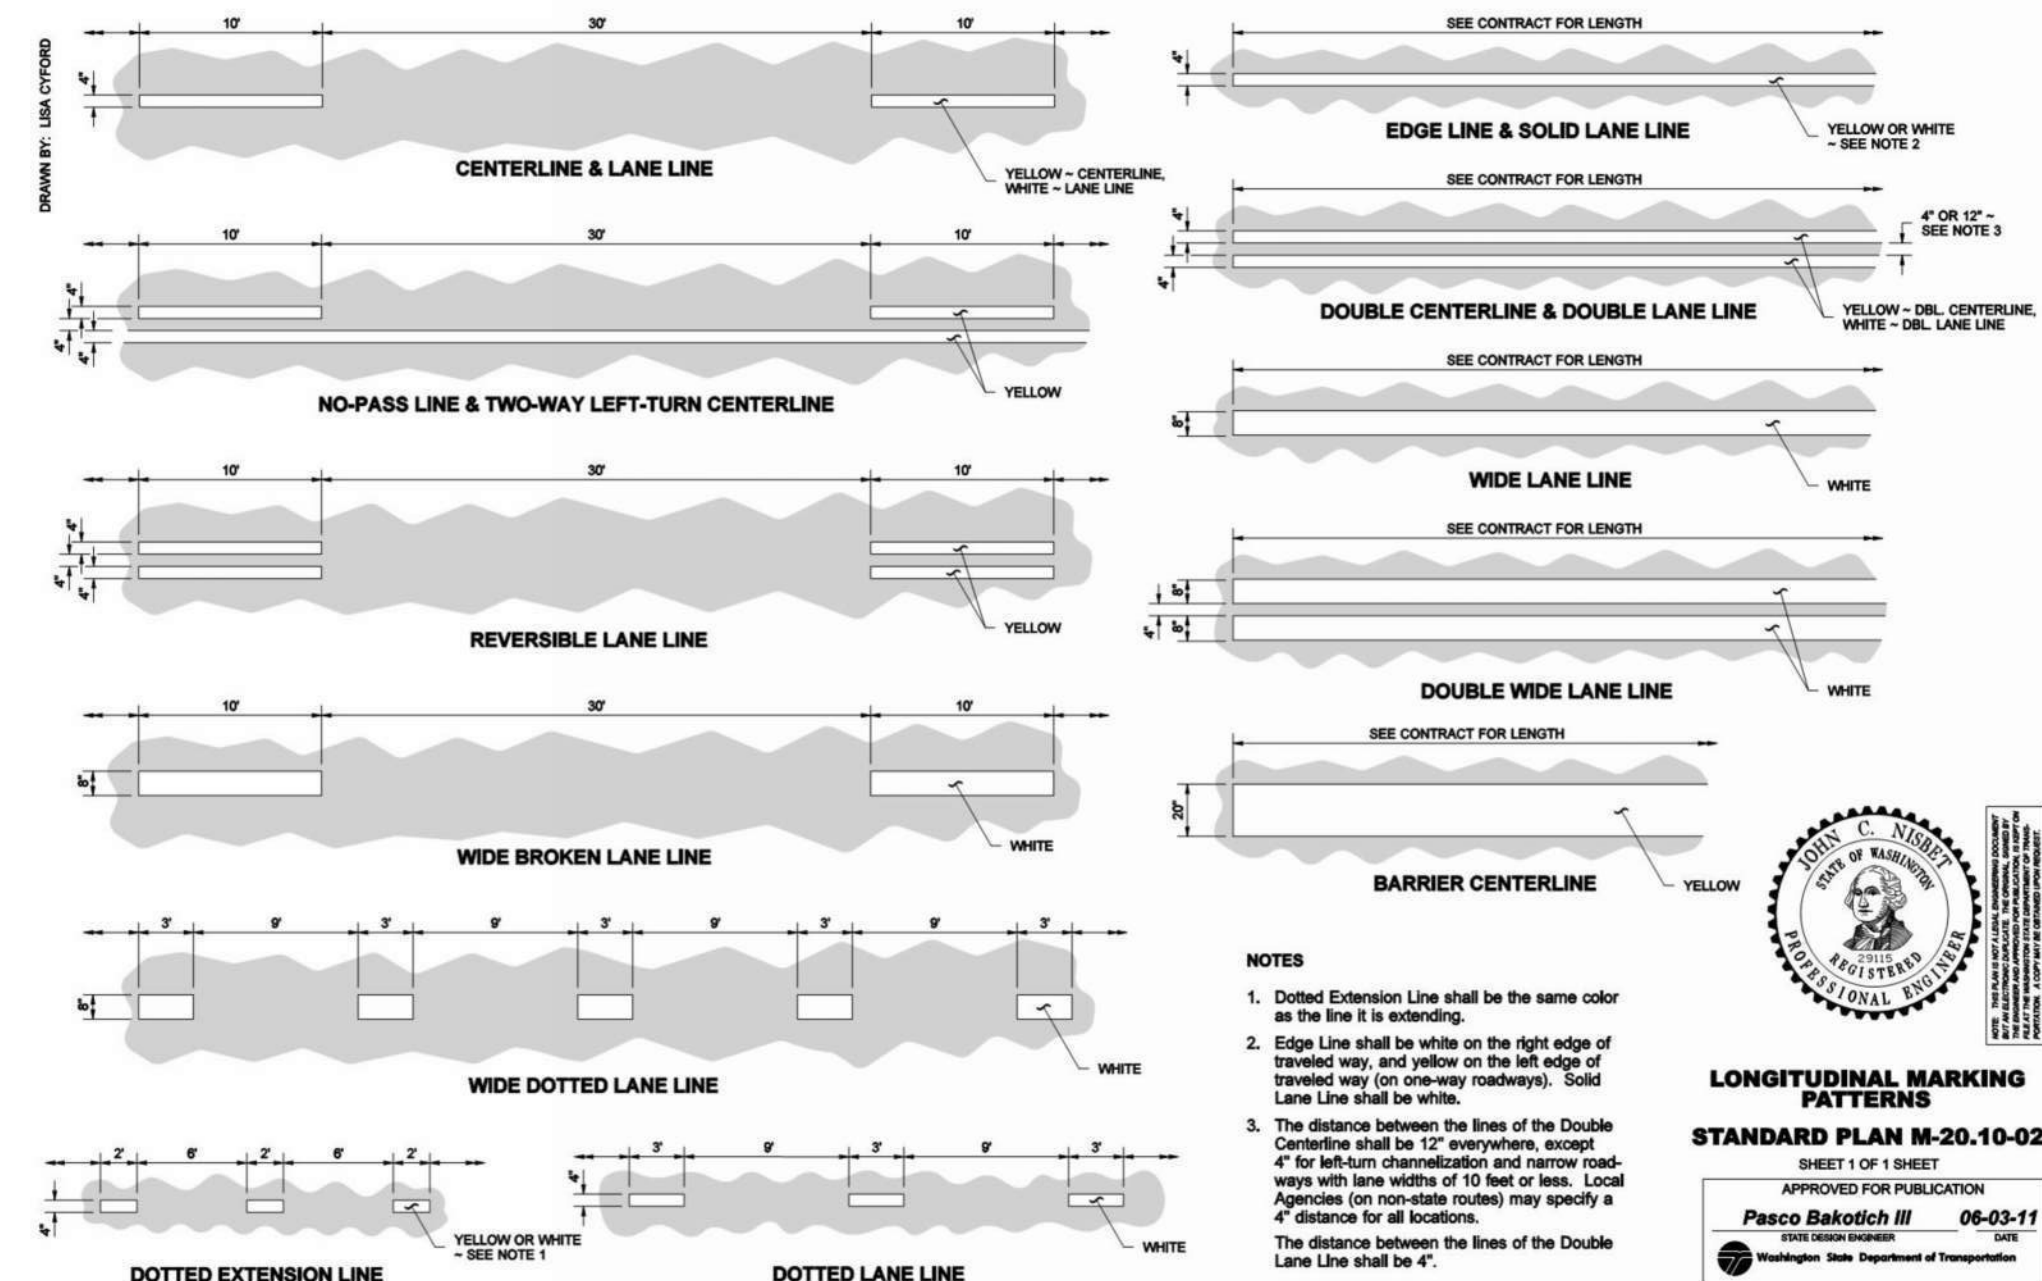


- NOTES**
- Dotted Extension Line shall be the same color as the line it is extending.
 - Edge Line shall be white on the left edge of traveled way, and yellow on the right edge of traveled way (on one-way roadways). Solid Lane Line shall be white.
 - The distance between the lines of the Double Centerline shall be 12' everywhere, except 4' for left-turn channelization and narrow roadway with lane width of 10 feet or less. Local Agencies (on non-state routes) may specify a 4' distance for all locations. The distance between the lines of the Double Lane Line shall be 4'.




LONGITUDINAL MARKING PATTERNS
STANDARD PLAN M-20.10-02
SHEET 1 OF 1 SHEET
APPROVED FOR PUBLICATION
Pasco Balotich III 06-03-11
Washington State Department of Transportation

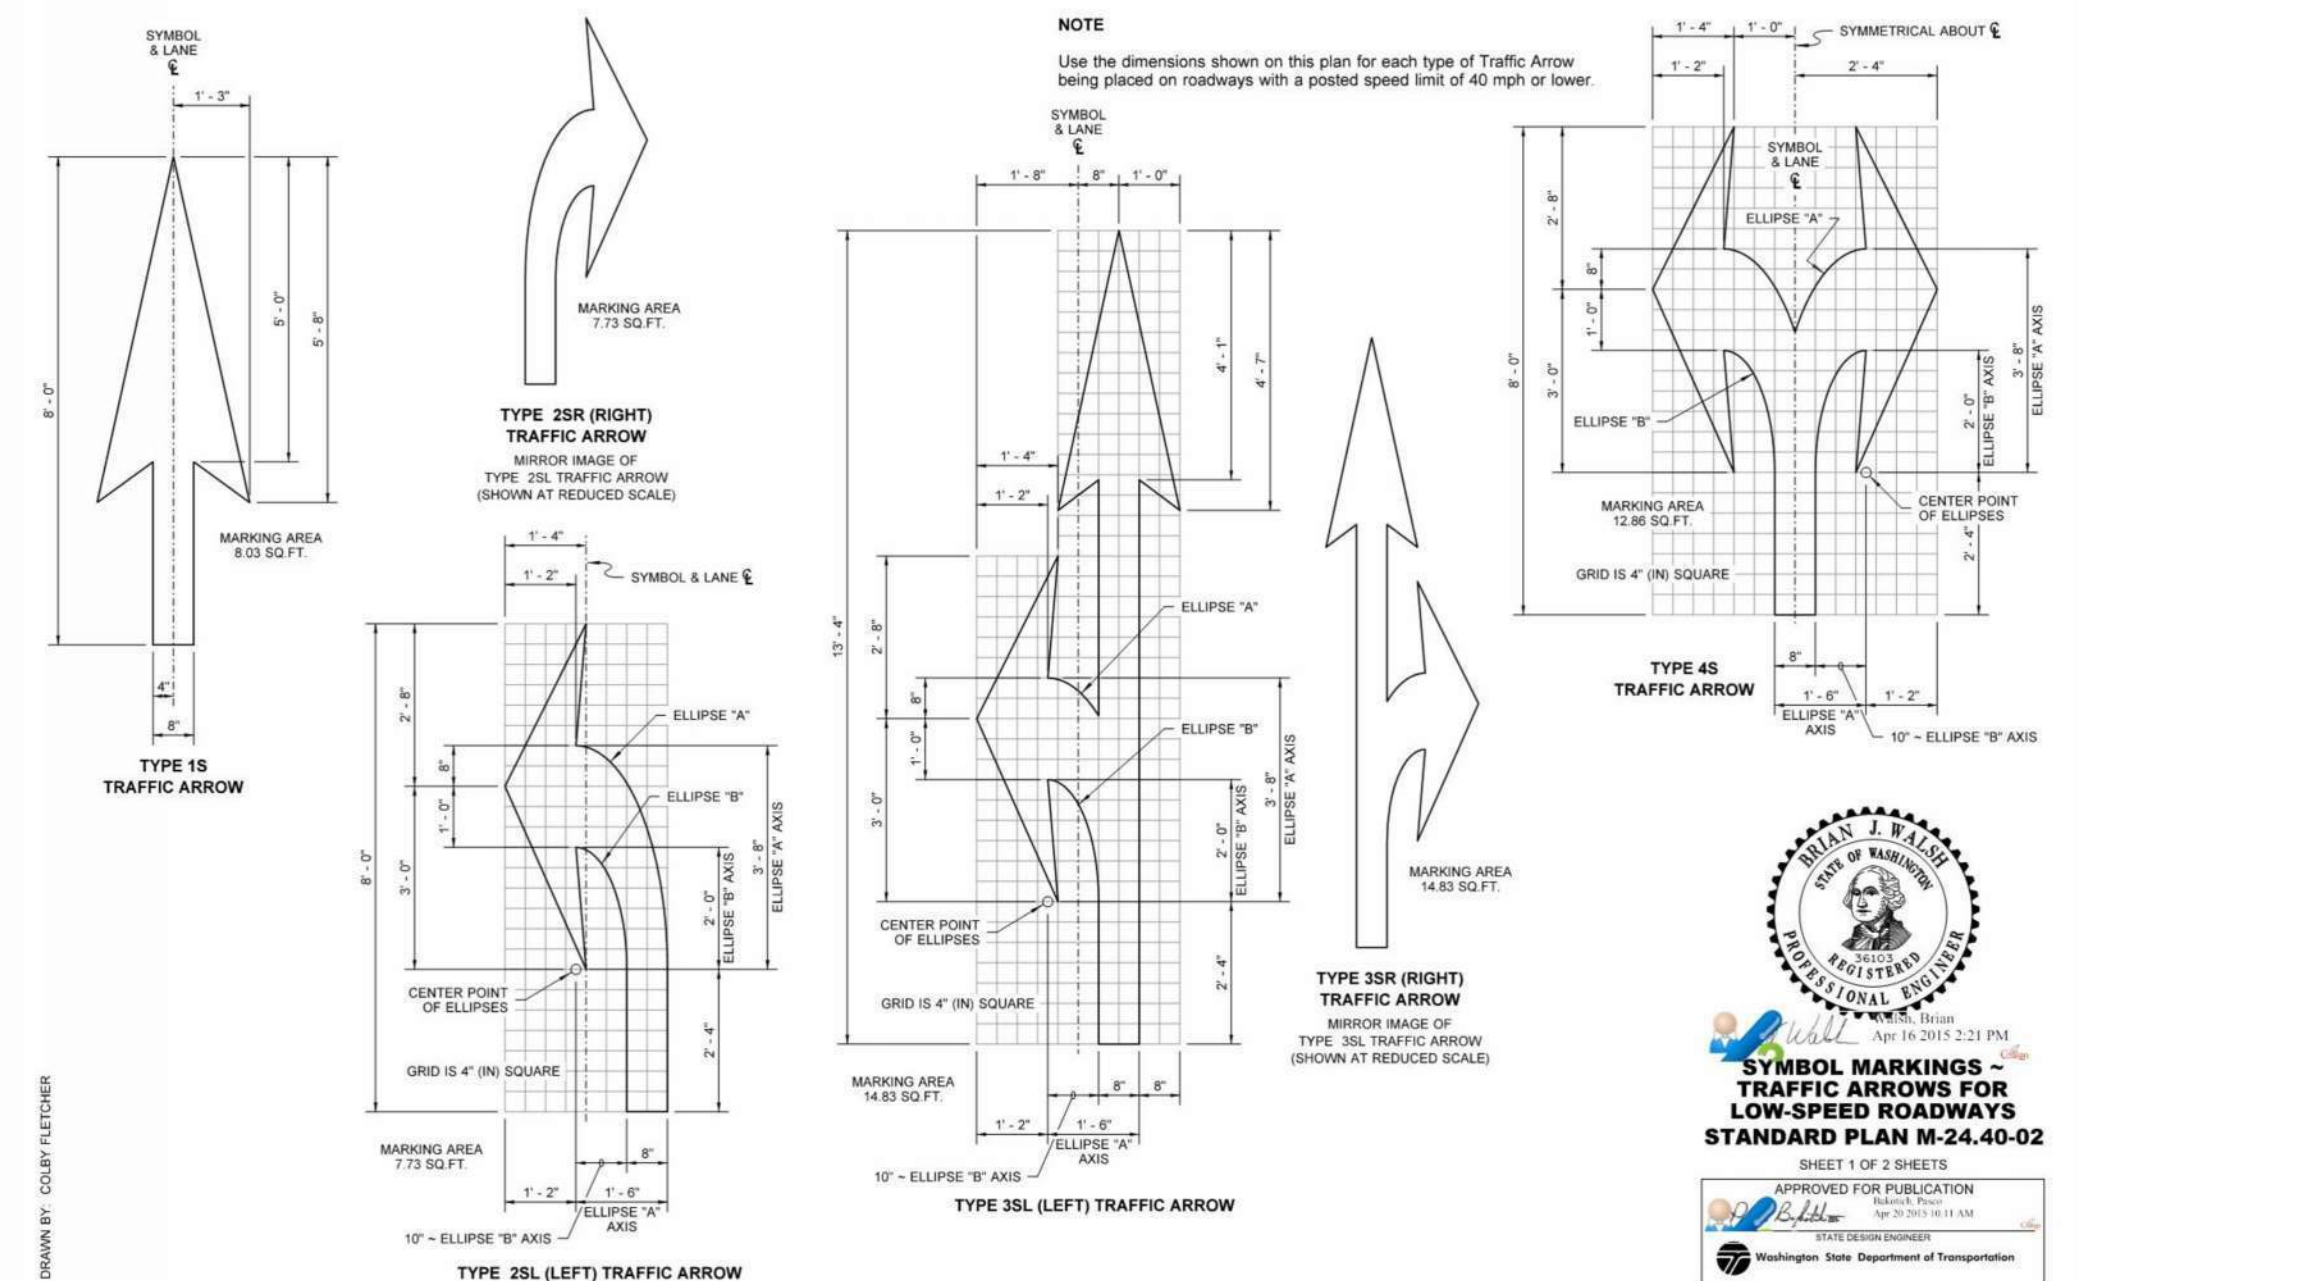


SYMBOL MARKINGS - TRAFFIC ARROWS FOR LOW-SPEED ROADWAYS
STANDARD PLAN M-24.40-02
SHEET 1 OF 2 SHEETS
APPROVED FOR PUBLICATION
Pasco Balotich III 06-03-11
Washington State Department of Transportation

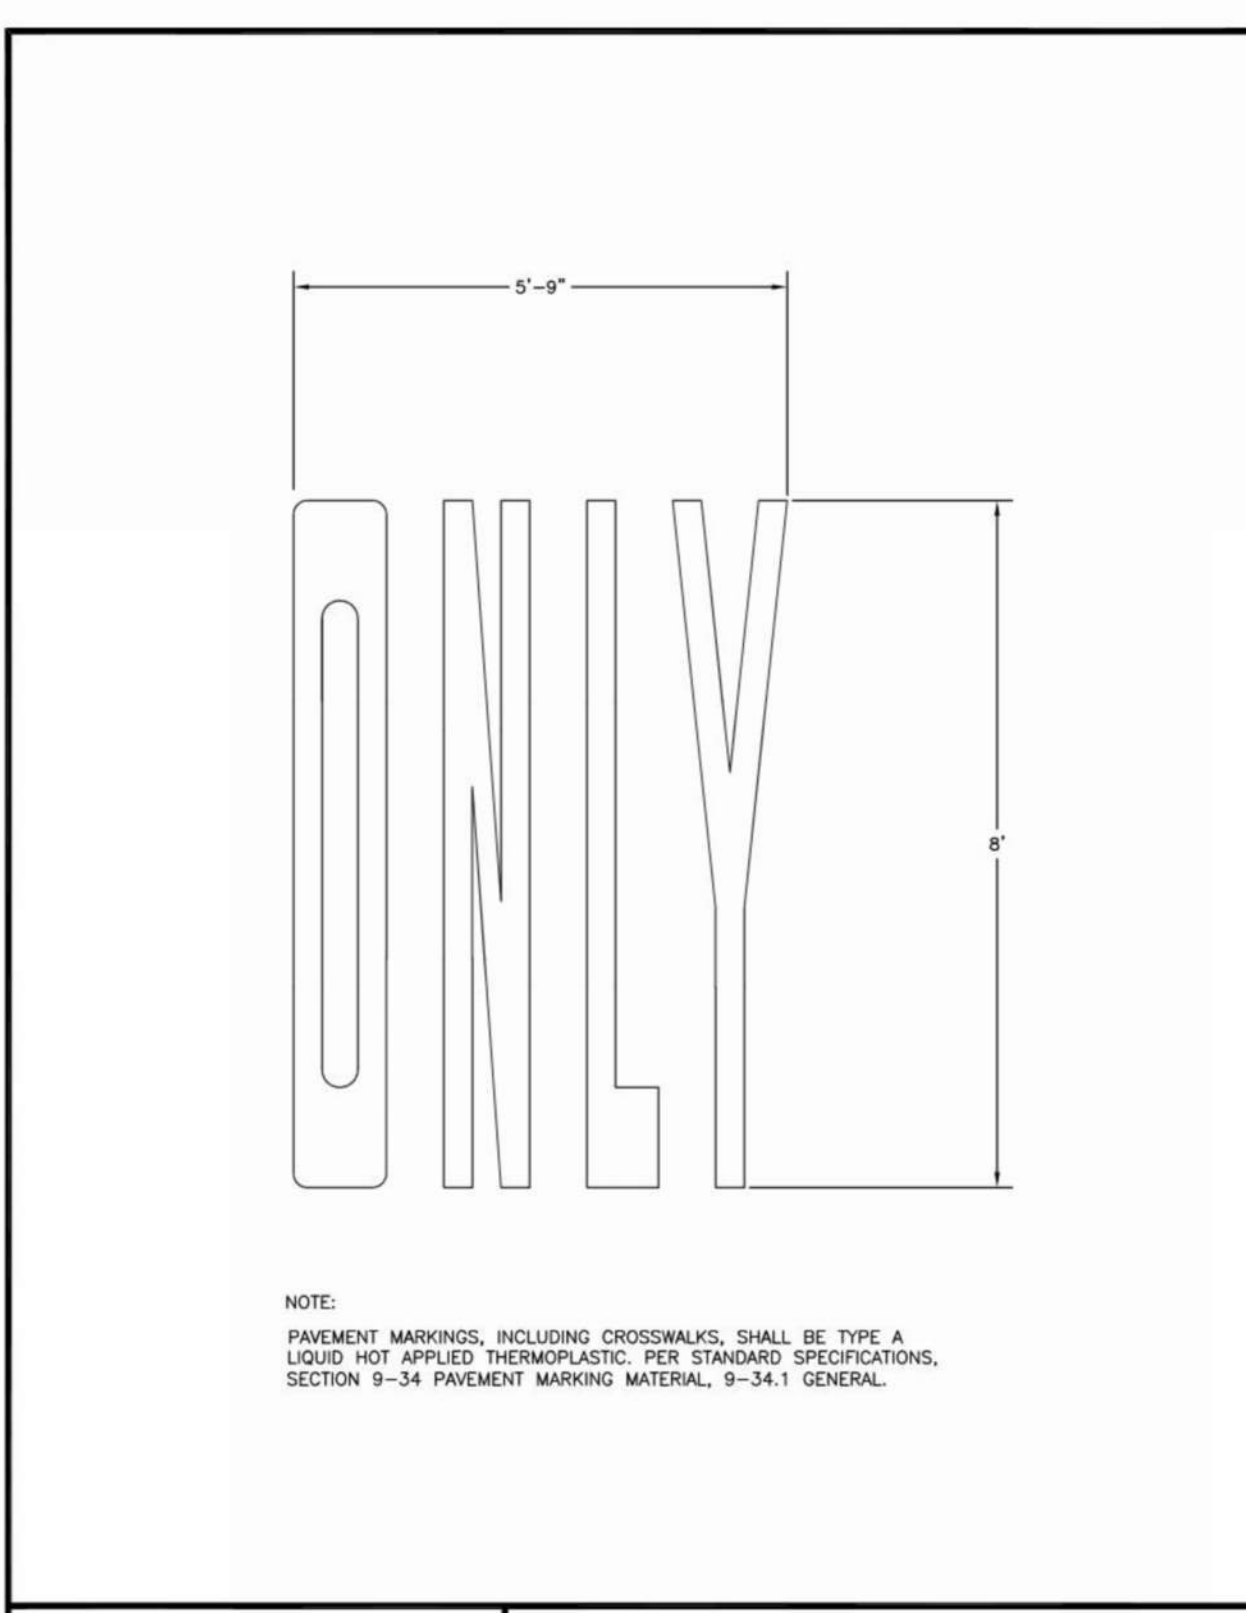


CITY OF PUYALLUP
DEVELOPMENT ENGINEERING and PUBLIC WORKS DEPARTMENTS
PAVEMENT MARKER "ONLY"
SHEET 1 OF 1 SHEET
APPROVED FOR PUBLICATION
01.03.15

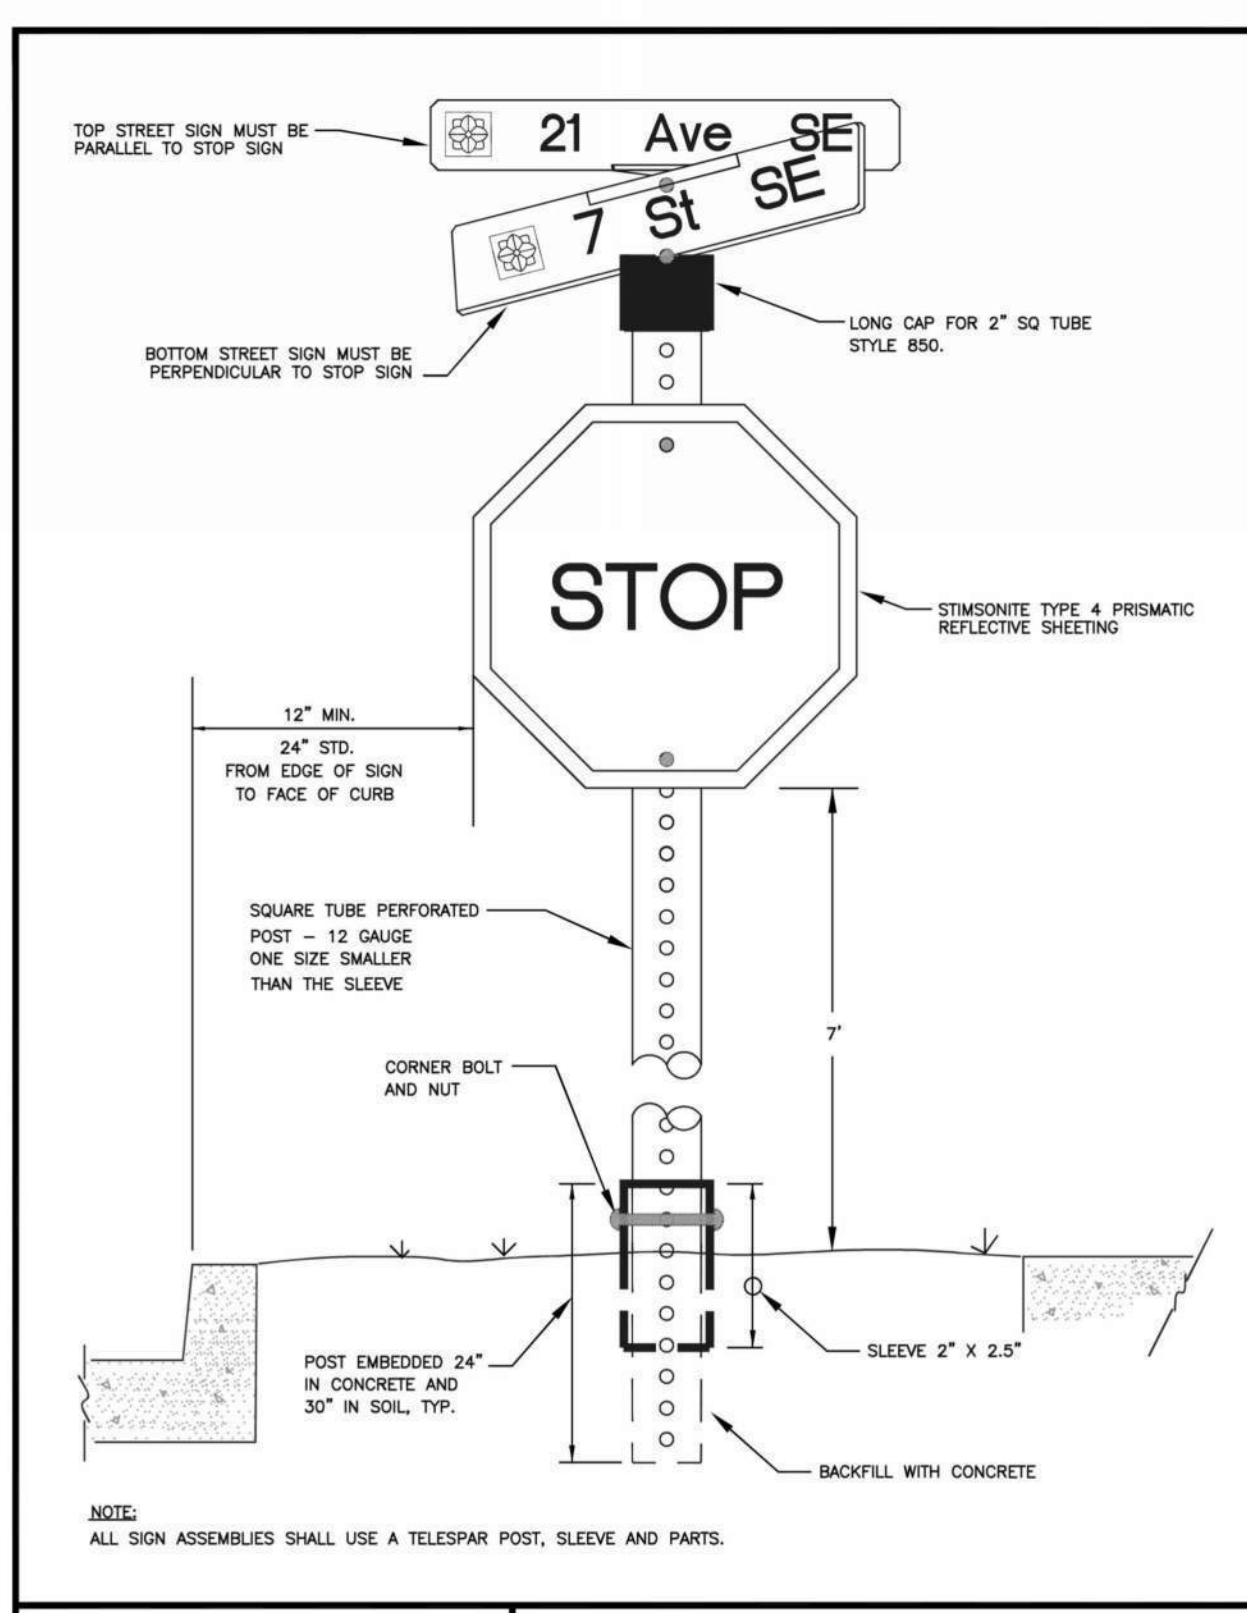

CITY OF PUYALLUP
DEVELOPMENT ENGINEERING and PUBLIC WORKS DEPARTMENTS
STREET SIGN DETAIL
SHEET 1 OF 1 SHEET
APPROVED FOR PUBLICATION
01.04.01

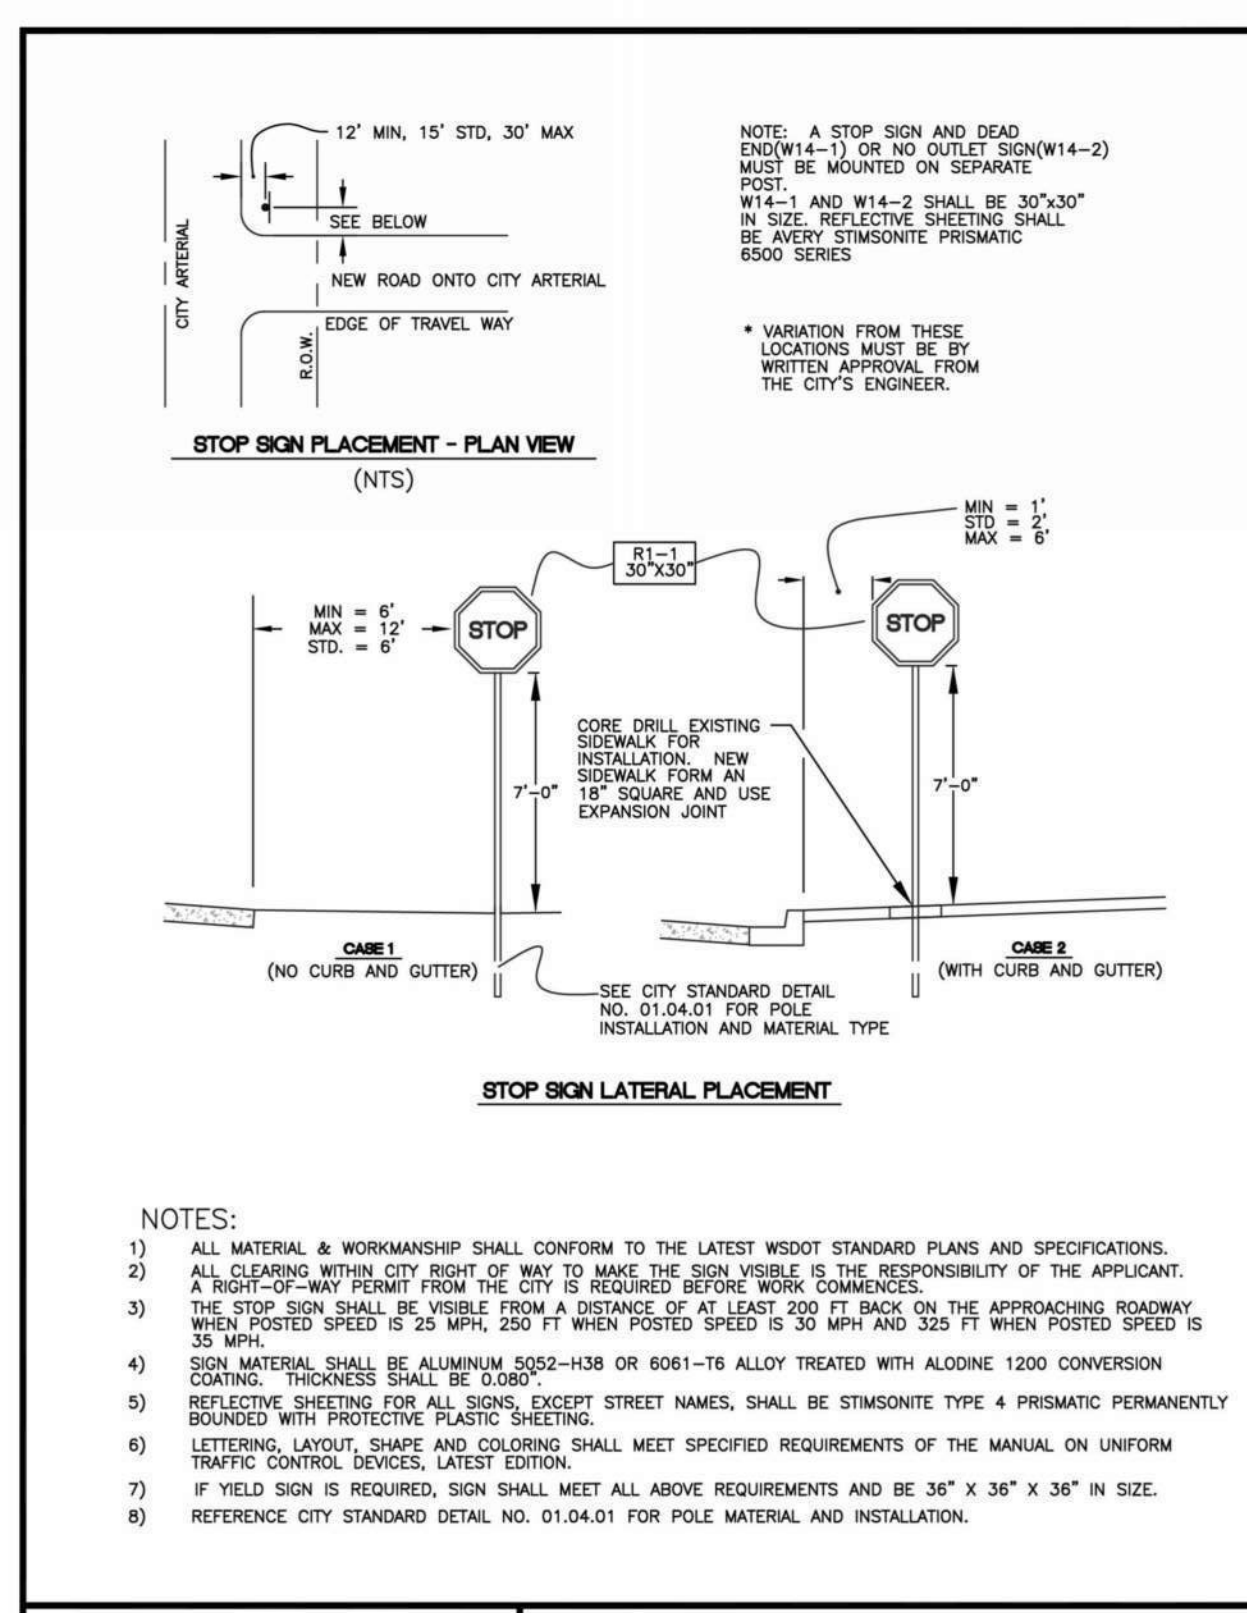

CITY OF PUYALLUP
DEVELOPMENT ENGINEERING and PUBLIC WORKS DEPARTMENTS
STOP SIGN DETAIL
SHEET 1 OF 1 SHEET
APPROVED FOR PUBLICATION
01.04.02

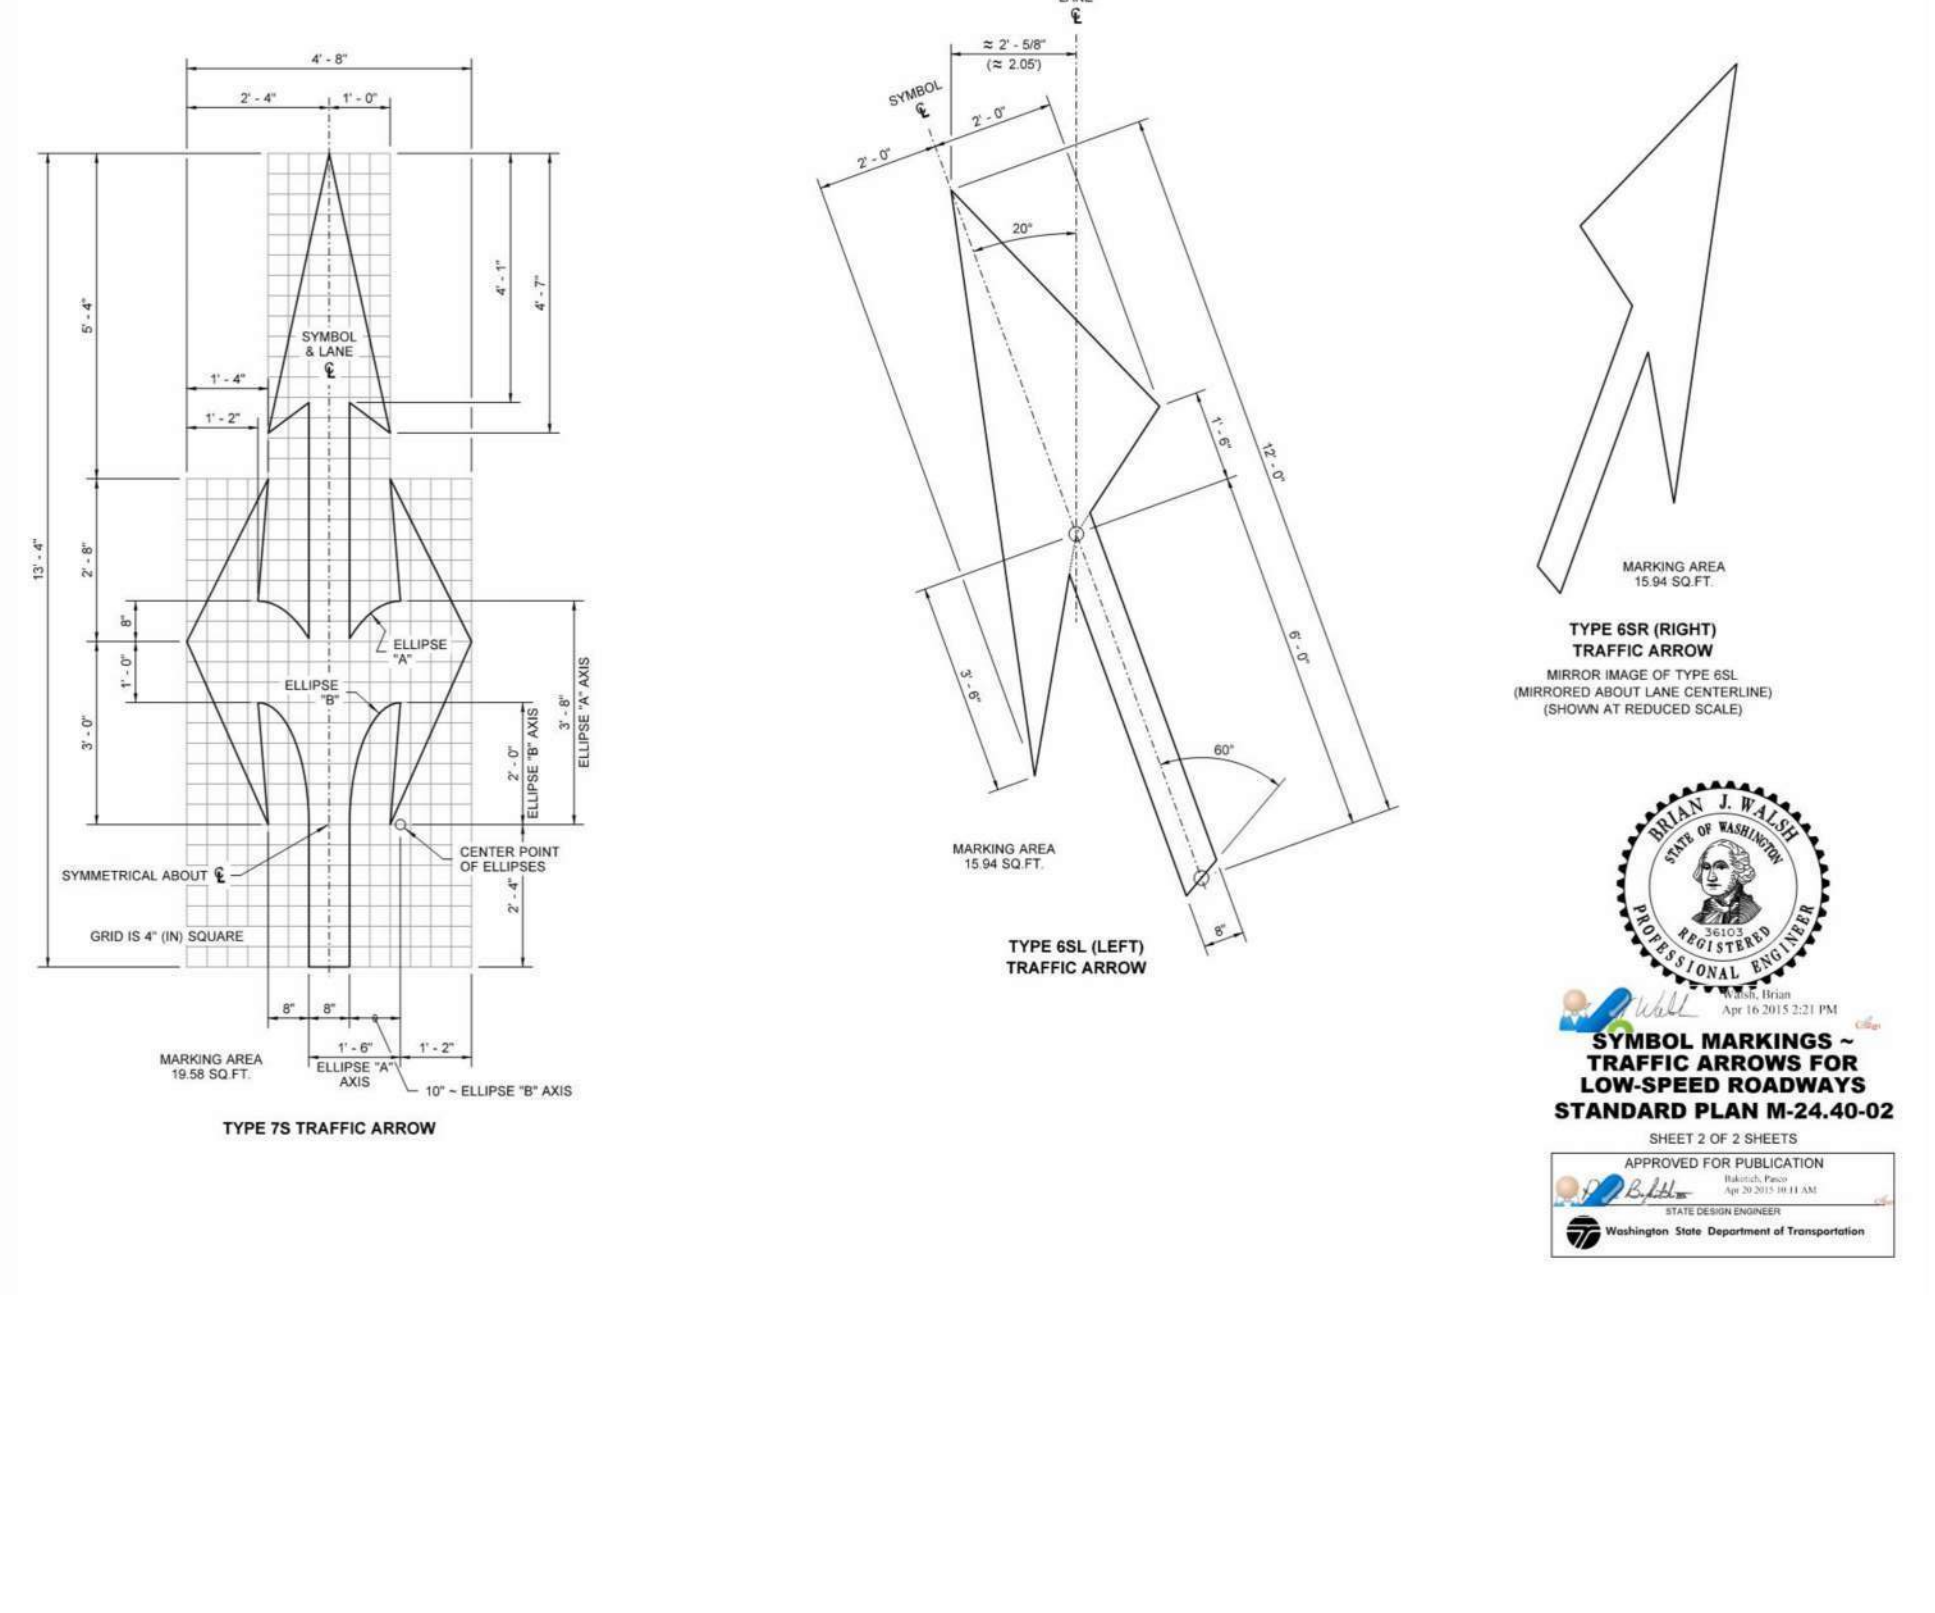

SYMBOL MARKINGS - TRAFFIC ARROWS FOR LOW-SPEED ROADWAYS
STANDARD PLAN M-24.40-02
SHEET 2 OF 2 SHEETS
APPROVED FOR PUBLICATION
Pasco Balotich III 06-03-11
Washington State Department of Transportation

APPROVED

BY: CITY OF PUYALLUP ENGINEERING SERVICES

DATE: _____

NOTE: THIS APPROVAL IS VOID AFTER 1 YEAR FROM APPROVAL DATE.

THE CITY WILL NOT BE RESPONSIBLE FOR ERRORS AND/OR OMISSIONS ON THESE PLANS. FIELD CONDITIONS MAY DICTATE CHANGES TO THESE PLANS AS DETERMINED BY THE ENGINEERING SERVICES MANAGER.

No.	Date	By	Revision Description

Designed By:	Issue Date:
LAB	09/29/2023
Drawn By:	PERMIT
LAB	
Checked By:	Project No.:
GRL	2022-295




TENW
Transportation Engineering NorthWest
Transportation Planning | Design | Traffic Impact & Operations
11400 36th Street, Suite 200, Bellevue, WA 98004 | Office (425) 889-6747
Project Contact: Trevor Takara, P.E.
Phone: 206-914-3843

ASH DEVELOPMENT, LLC
EAST TOWN CROSSING
PUYALLUP, WA

PAVEMENT MARKING & SIGNING PLANS
STANDARD DETAILS - PHASE 1
PM-03
SHEET: _____ OF _____



SECTION 26, TOWNSHIP 20 N, RANGE 4 E, W.M.

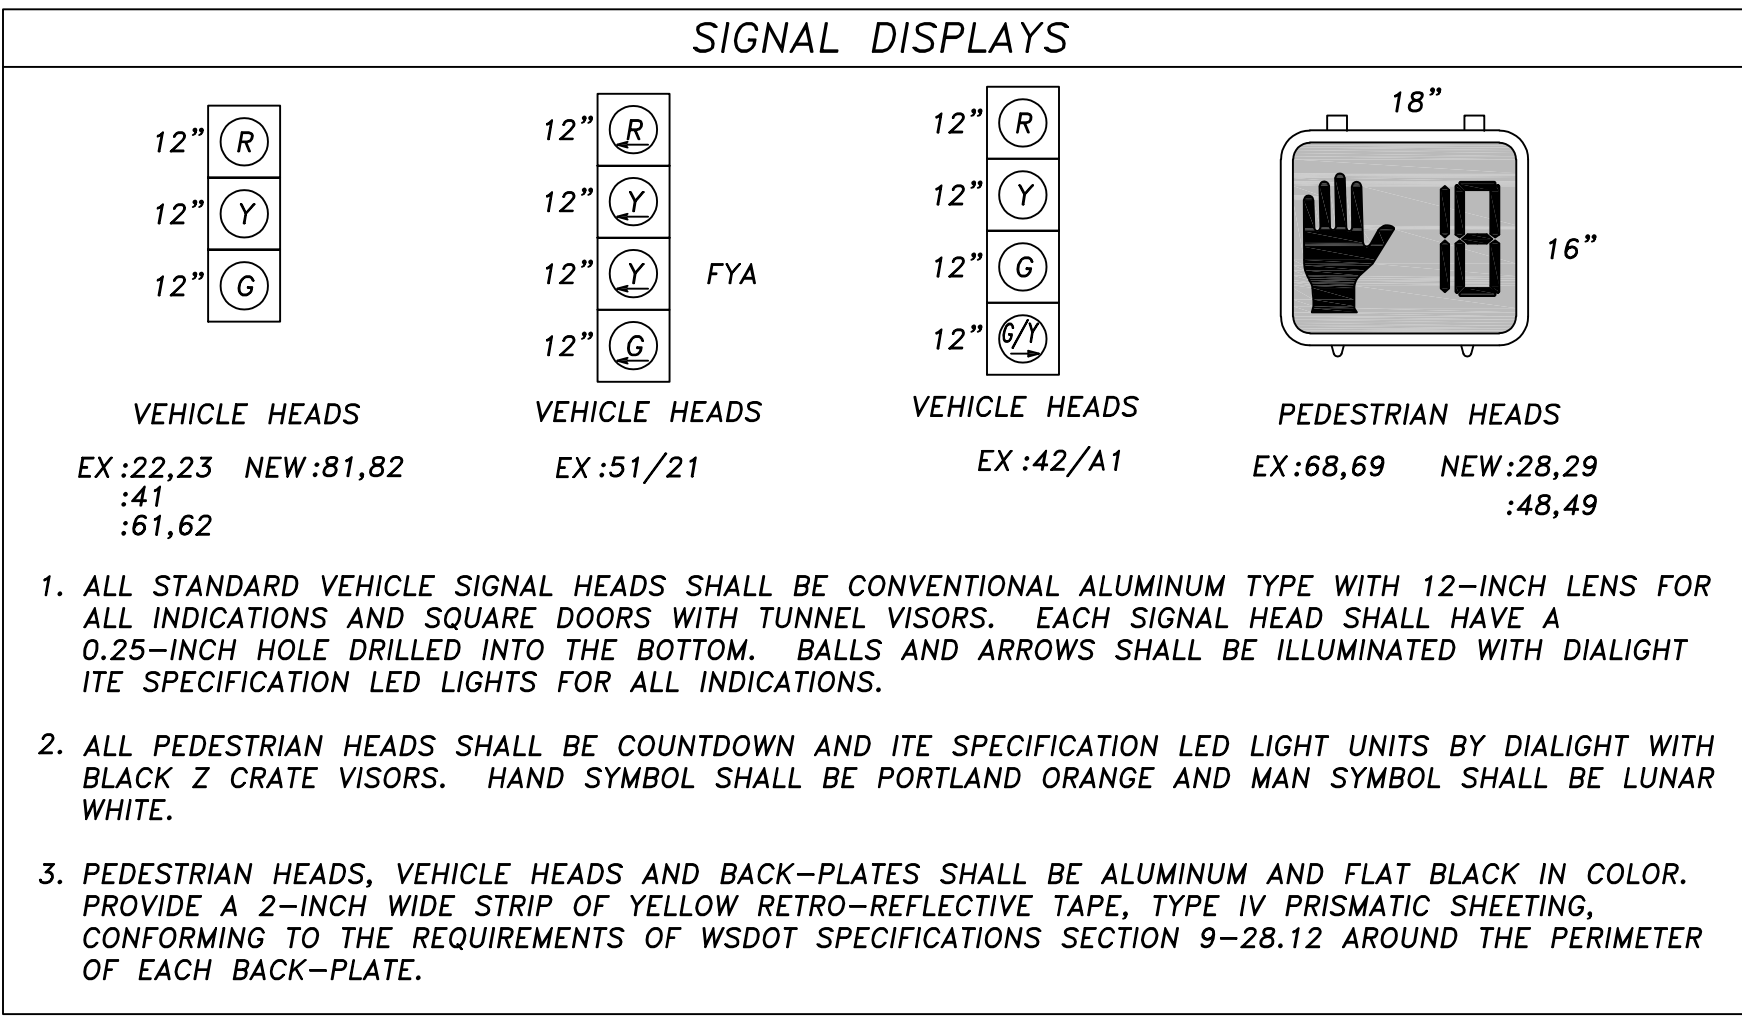

As condition with the preliminary site plan approval, the required signal/intersection modifications must be fully configured and operational no less than 2 weeks prior to receiving occupancy for any building on-site. Adaptive signal contractor (Rhythm Engineering) will be required to configure the adaptive system on-site. Adaptive contractor will provide setup/configuration/optimization (not completed by the City). Place this condition on the plans. TS-01

JUNCTION BOX SCHEDULE


BOX	TYPE	ROADWAY REFERENCE	STATION	OFFSET	FUNCTION	NOTES
A	2	SHAW RD E	12+92.0	60.0' RT	SIGNAL	ENCAPSULATE IN CONCRETE

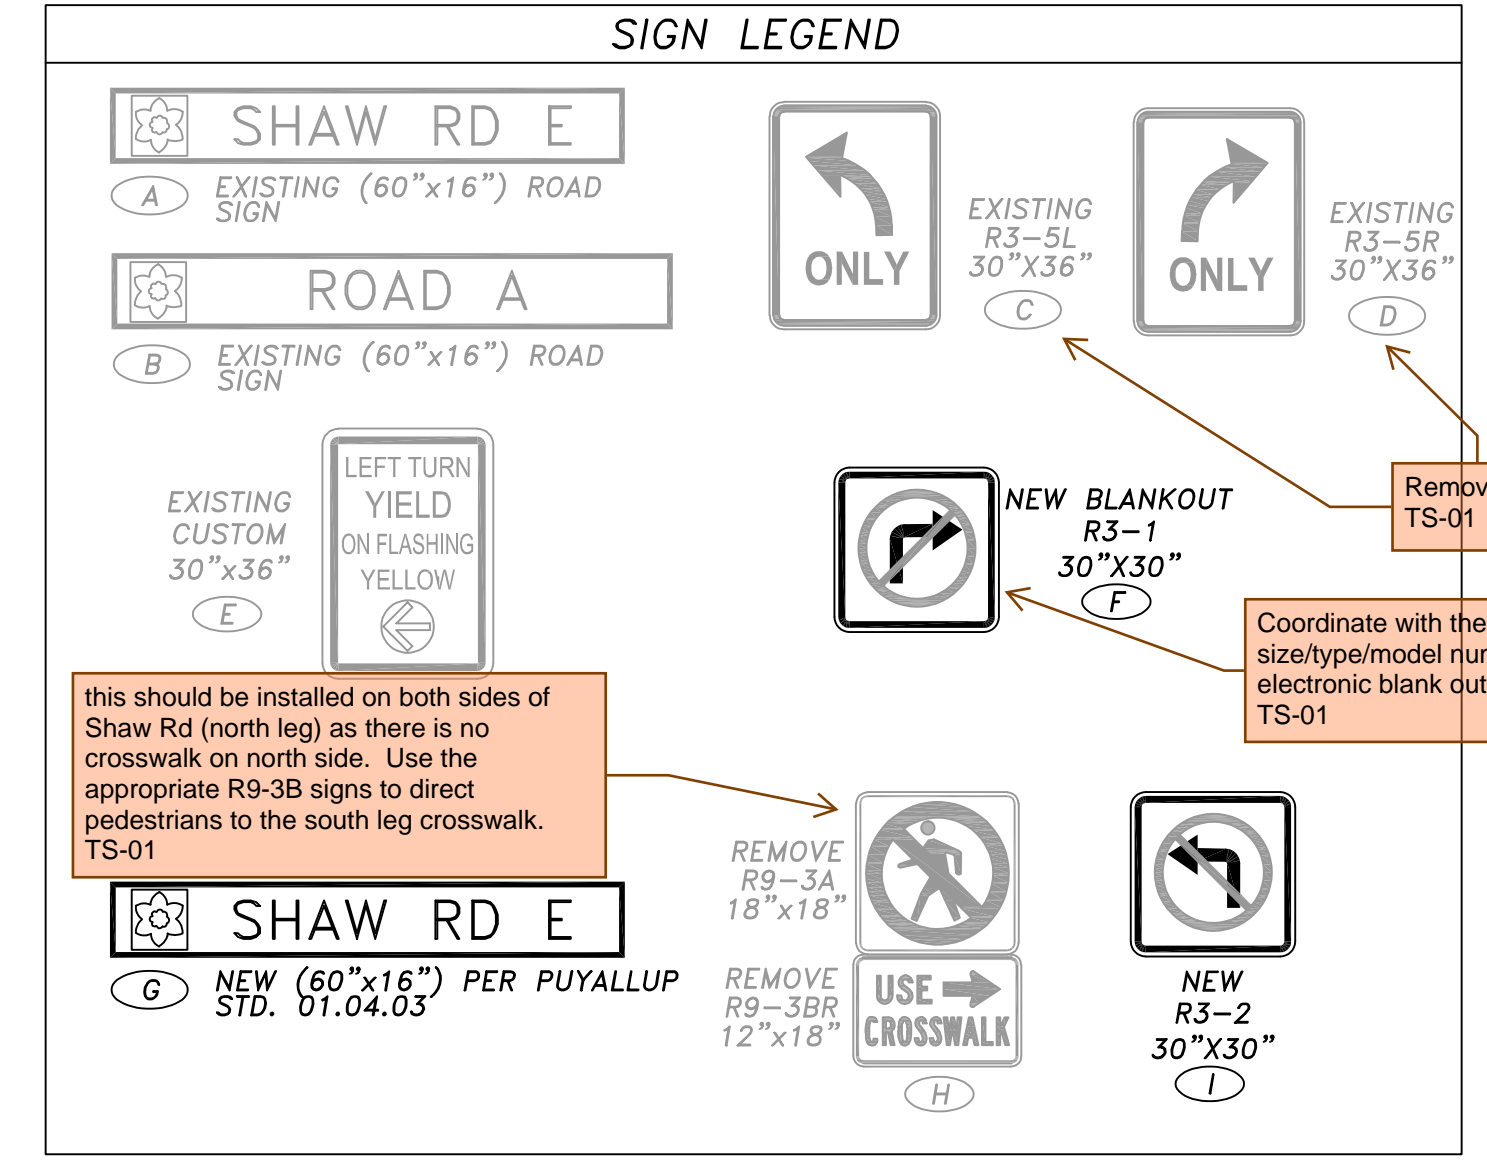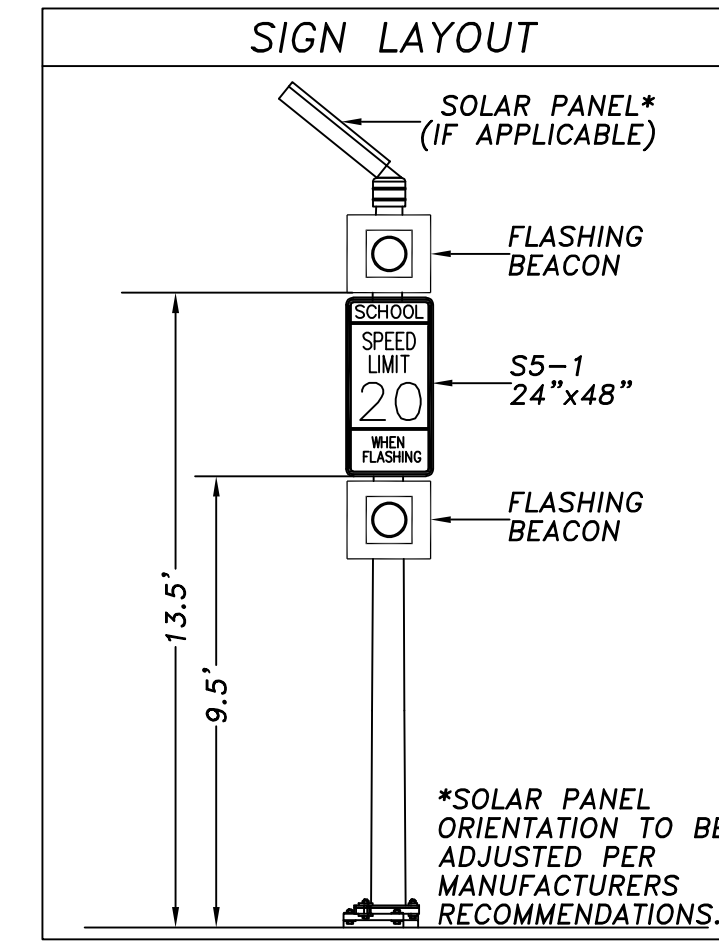

Adjust east/west lane striping to accommodate left turn pocket and shared thru/right turn lane. To accommodate this phasing, the EBR overlap must be removed TS-01



As condition with the preliminary site plan approval, Flashing yellow arrows with PT/PM phasing required for EB/WB left turns. Modify phasing as needed TS-01

Per the approved preliminary site plan conditions, provide details on overhead fiber connection and how it will be spliced/connected to cabinet. TS-01

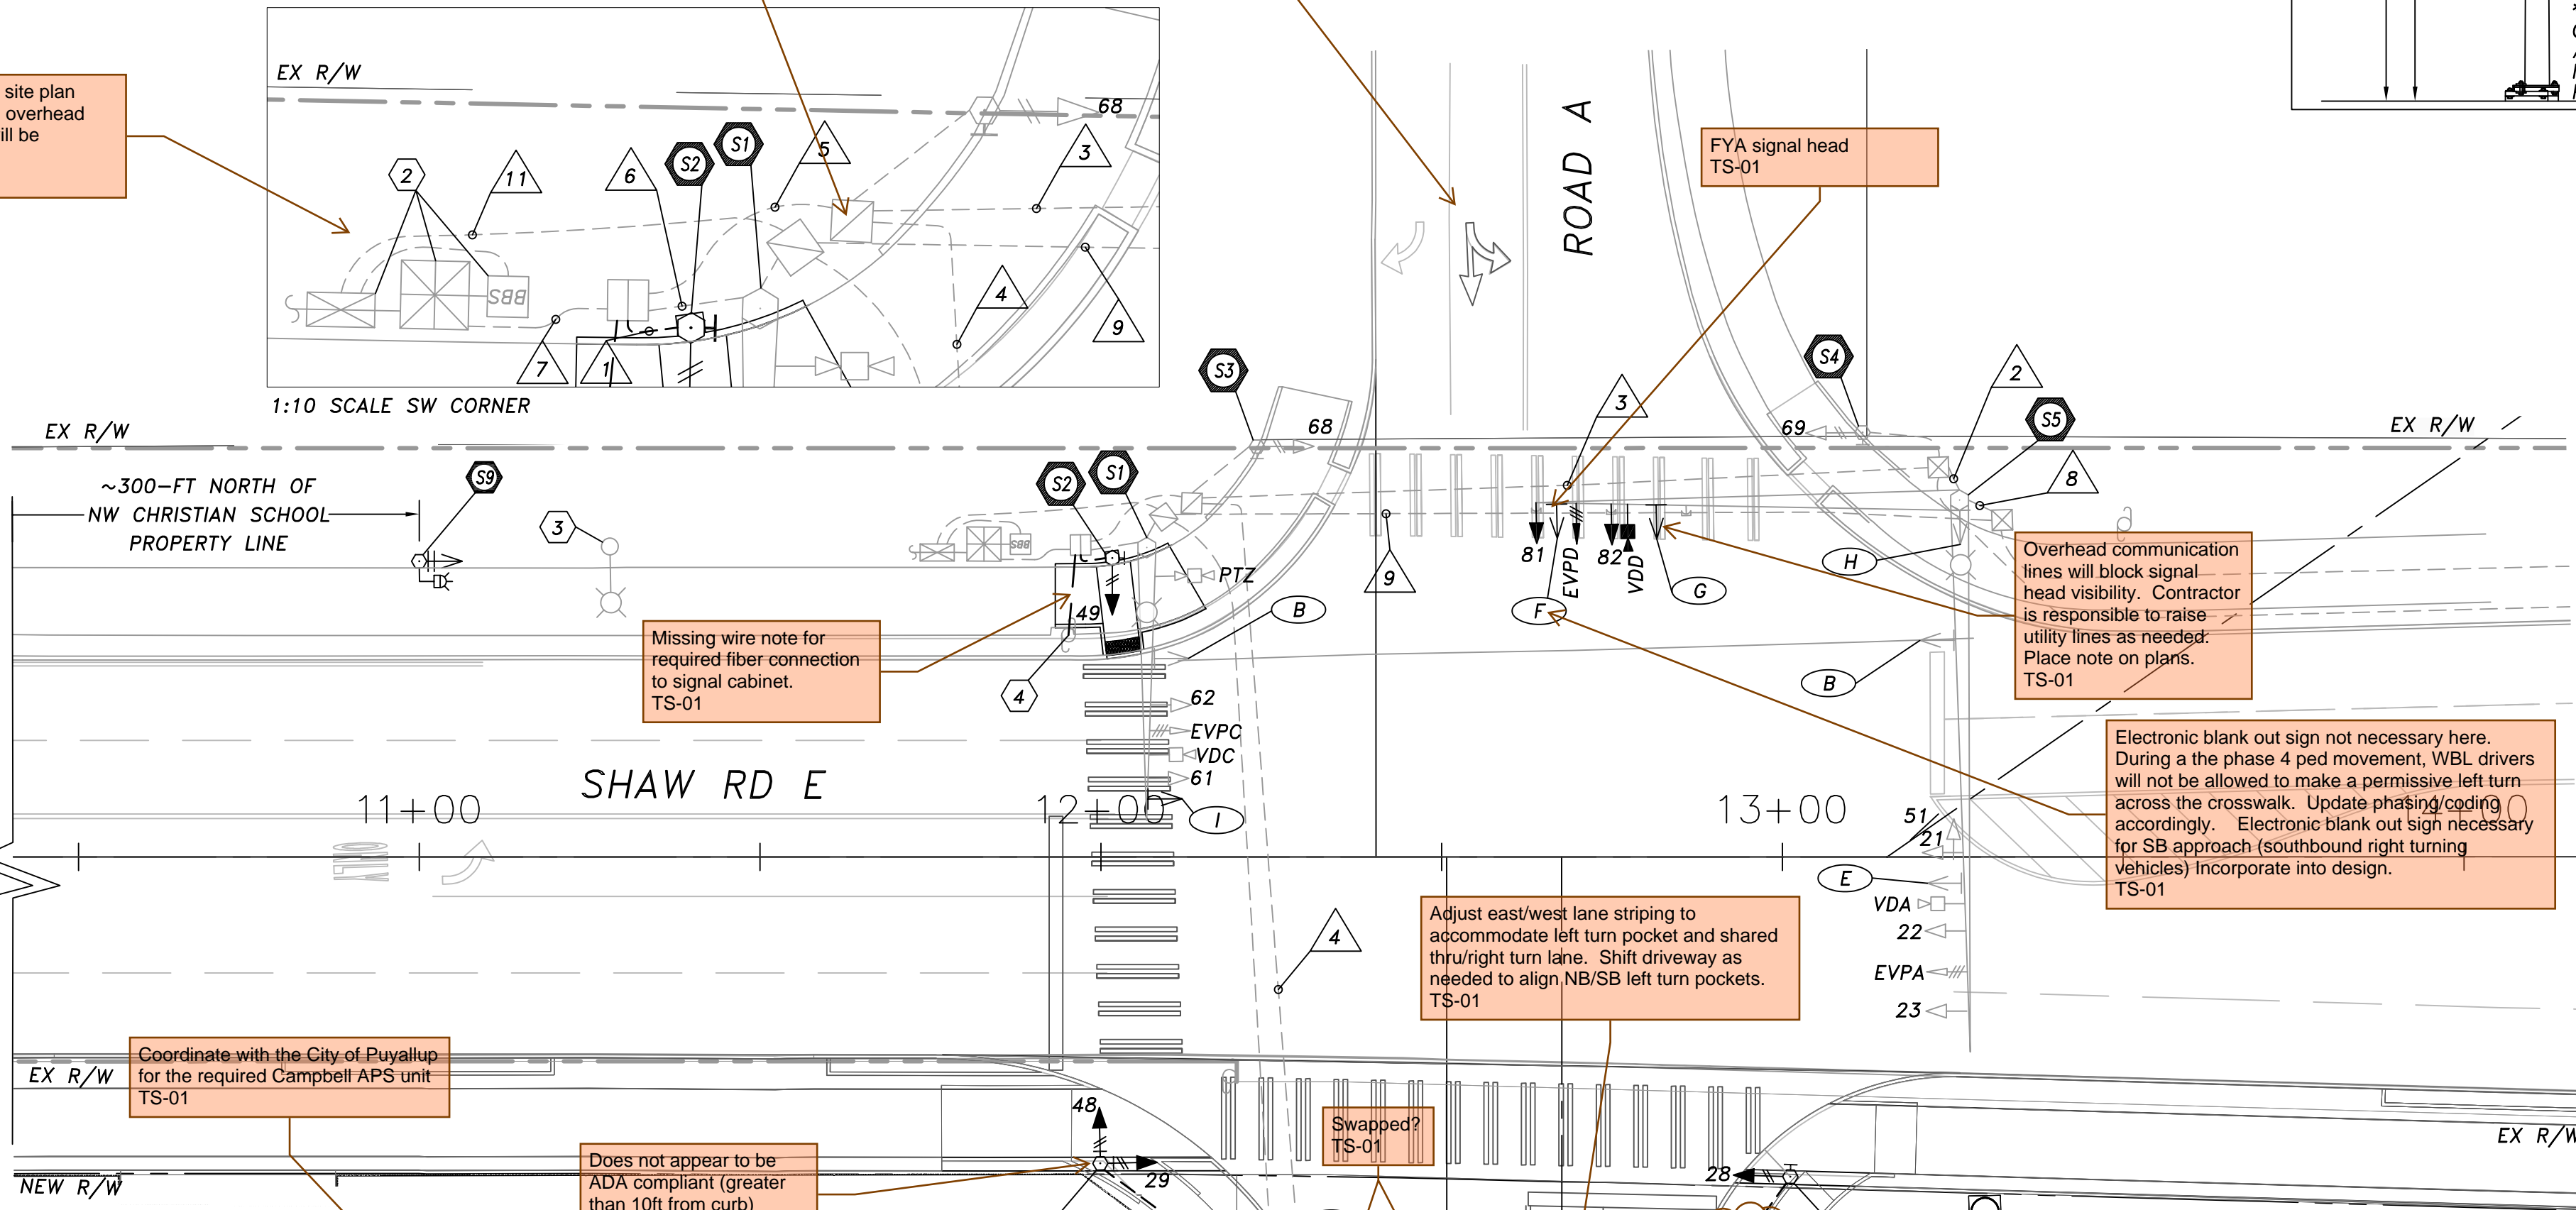

Update phasing diagram to reflect PT/PM FYA operation for EB/WB. TS-01



To accommodate required channelization (left turn pocket and shared thru/right turn lane), EBR overlap must be removed TS-01

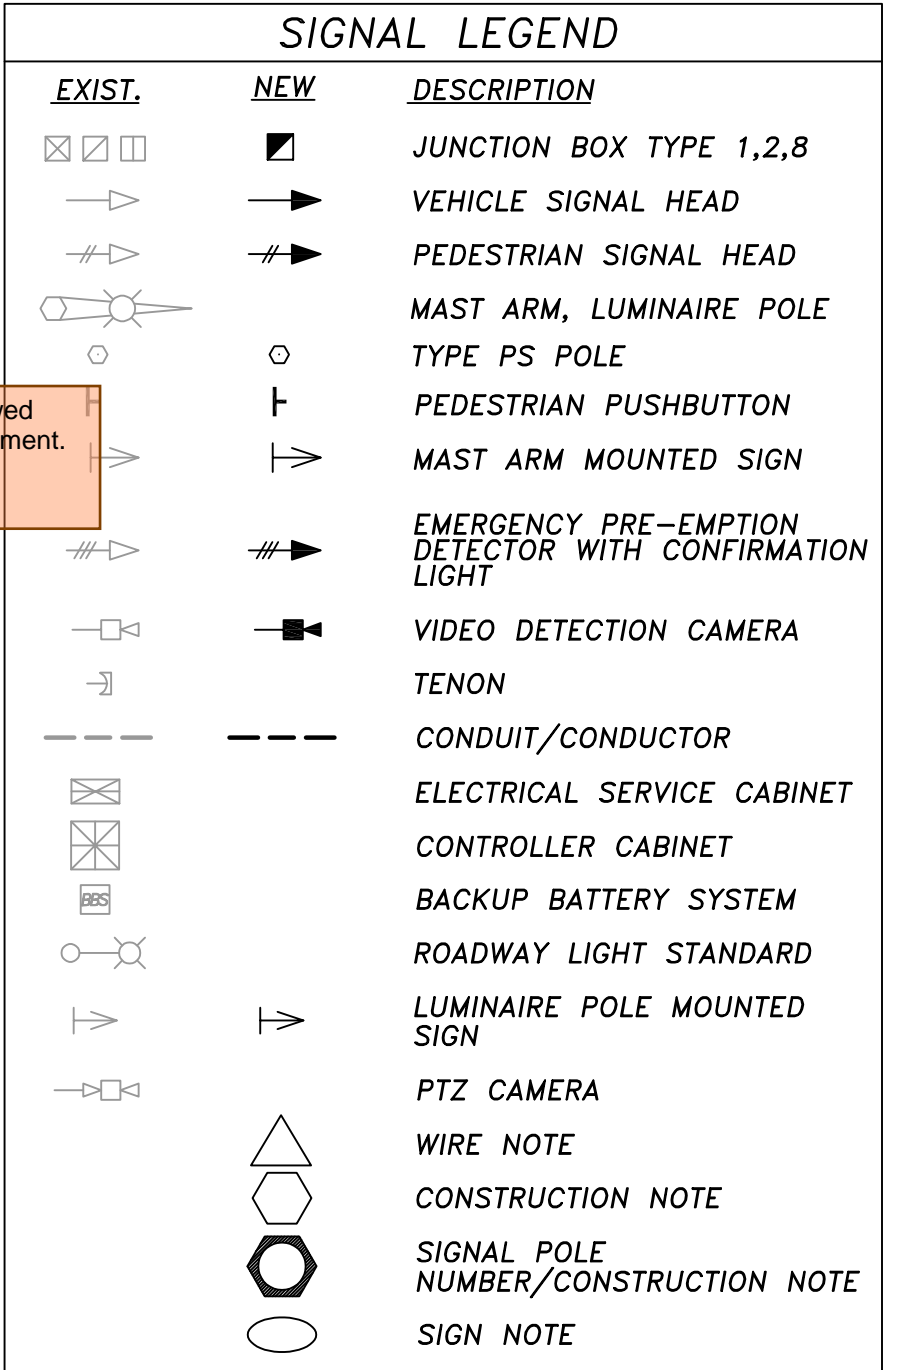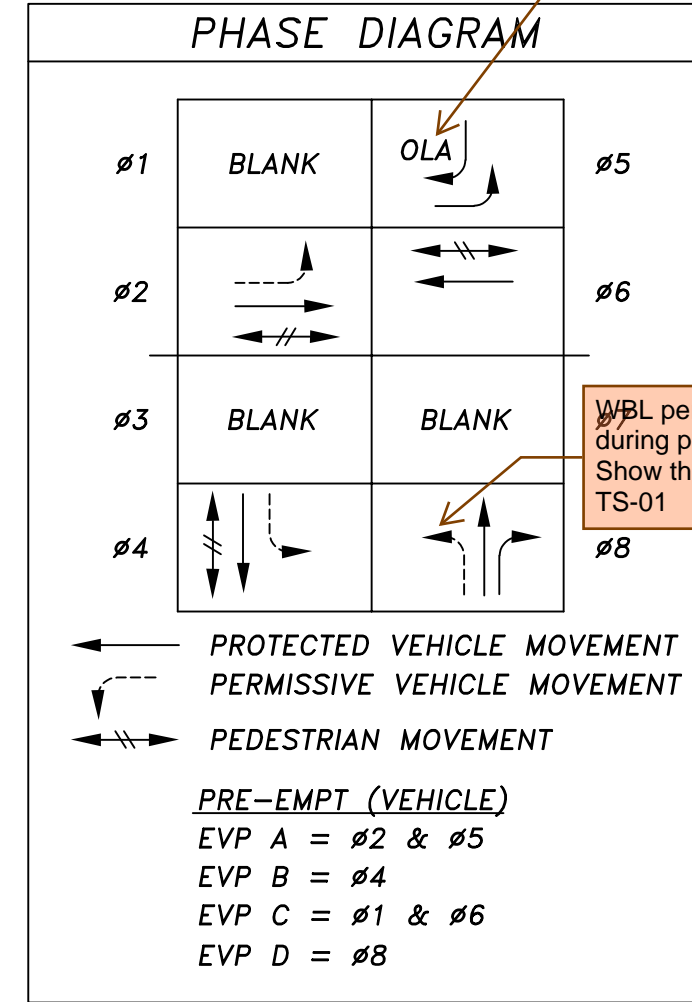

RSSZ flasher
-Coordinate with the City for required hardware & wireless interconnect
-Show conduit/j-box/power source/etc.
-Reference applicable WAC with placement/design justification.
-MUTCD compliant advanced signage/pavement markings missing from design TS-01

SIGNAL CONSTRUCTION NOTES:

- EXISTING TYPE III SIGNAL POLE AND ASSOCIATED EQUIPMENT TO REMAIN. INSTALL ONE NEW R3-2 SIGN.
- CONSTRUCT FOUNDATION PER WSDOT STANDARD PLAN J-21.10, POLE SCHEDULE, SHEET TS-04, AND POLE DETAIL, THIS SHEET. FURNISH AND INSTALL TYPE PS POLE WITH ONE NEW PEDESTRIAN SIGNAL HEAD 48 AND ONE NEW CAMPBELL APS PUSHBUTTON 49. PEDESTRIAN PUSHBUTTON SHALL FACE NORTH PARALLEL TO CROSSWALK.
- EXISTING PS POLE AND ASSOCIATED EQUIPMENT TO REMAIN. PROTECT DURING CONSTRUCTION.
- EXISTING PS POLE AND ASSOCIATED EQUIPMENT TO REMAIN. PROTECT DURING CONSTRUCTION.
- EXISTING TYPE SD SIGNAL POLE AND ASSOCIATED EQUIPMENT TO REMAIN. REMOVE EXISTING SIGNS R9-3A & R9-3BR AND RETURN TO CITY. FURNISH AND INSTALL TWO NEW VEHICLE SIGNAL HEADS 81 AND 82, ONE NEW OPTICOM EMERGENCY VEHICLE PREEMPTION DETECTOR WITH CONFIRMATION LIGHT, ONE NEW INSYNC VIDEO DETECTION CAMERA, AND ONE NEW ILLUMINATED STREET NAME SIGN ON WESTBOUND MAST ARM.
- CONSTRUCT FOUNDATION PER WSDOT STANDARD PLAN J-21.10, POLE SCHEDULE, SHEET TS-04, AND POLE DETAIL, THIS SHEET. FURNISH AND INSTALL TYPE PS POLE WITH ONE NEW PEDESTRIAN SIGNAL HEAD 28 AND ONE NEW CAMPBELL APS PUSHBUTTON 28. PEDESTRIAN PUSHBUTTON SHALL FACE WEST PARALLEL TO CROSSWALK.
- EXISTING TYPE III SIGNAL POLE AND ASSOCIATED EQUIPMENT TO REMAIN. INSTALL NEW BLANK OUT SIGN PER POLE SCHEDULE, SHEET PM-04, AND ALL ASSOCIATED WIRING BACK TO CONTROLLER CABINET USING EXISTING CONDUIT.
- CONSTRUCT FOUNDATION PER WSDOT STANDARD PLAN J-21.10, POLE SCHEDULE, SHEET TS-04, AND POLE DETAIL, THIS SHEET. FURNISH AND INSTALL TYPE PS POLE WITH TWO NEW PEDESTRIAN SIGNAL HEAD 48 & 29 AND TWO NEW CAMPBELL APS PUSHBUTTON 48 & 29. PEDESTRIAN PUSHBUTTON 48 SHALL FACE NORTH PARALLEL TO CROSSWALK. PEDESTRIAN PUSHBUTTON 29 SHALL FACE WEST PARALLEL TO CROSSWALK.
- CONSTRUCT FOUNDATION PER WSDOT STANDARD PLAN J-21.10. LOCATION SHALL BE FIELD VERIFIED BY CITY OF PUYALLUP ENGINEER. FURNISH AND INSTALL TYPE FB POLE PER WSDOT STANDARD PLAN J-21.16 WITH TWO FLASHING BEACONS, AND ONE MUTCD SCHOOL SPEED LIMIT WHEN FLASHING SIGN (SS-1) ON POLE PER DETAIL, THIS SHEET, AND CITY OF PUYALLUP STANDARD PLANS 01.07.03, 01.07.04, AND 01.07.05.
- CONSTRUCT FOUNDATION PER WSDOT STANDARD PLAN J-21.10. LOCATION SHALL BE FIELD VERIFIED BY CITY OF PUYALLUP ENGINEER. FURNISH AND INSTALL TYPE FB POLE PER WSDOT STANDARD PLAN J-21.16 WITH TWO FLASHING BEACONS, AND ONE MUTCD SCHOOL SPEED LIMIT WHEN FLASHING SIGN (SS-1) ON POLE PER DETAIL, THIS SHEET, AND CITY OF PUYALLUP STANDARD PLANS 01.07.03, 01.07.04, AND 01.07.05.
- FURNISH AND INSTALL NEW TYPE 2 JUNCTION BOX PER CITY OF PUYALLUP STANDARD 01.06.01.
- EXISTING COMBINATION CONTROLLER/SERVICE/BBS CABINET TO REMAIN. PROTECT DURING CONSTRUCTION.
- EXISTING STREET LIGHT AND EQUIPMENT TO REMAIN. PROTECT DURING CONSTRUCTION.
- CONTRACTOR SHALL COORDINATE WITH CITY TO INTERCEPT EXISTING FIBER AND ROUTE DOWN EXISTING UTILITY POLE. CONTRACTOR SHALL INSTALL NEW CONDUIT/RISER TO EXISTING JUNCTION BOX AND SPLICE EXISTING FIBER INTO EXISTING CONTROLLER CABINET. IF SUFFICIENT SLACK IS NOT AVAILABLE, CONTRACTOR SHALL PULL NEW FIBER FROM NEAREST SPLICE POINT.

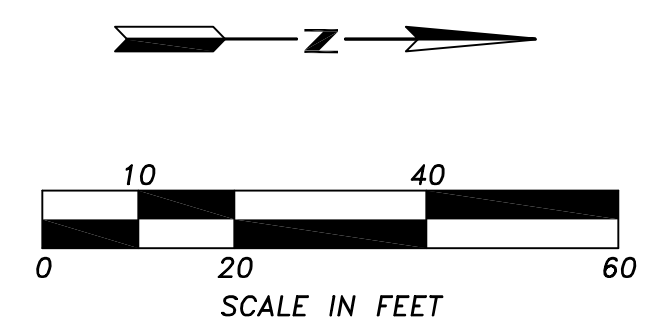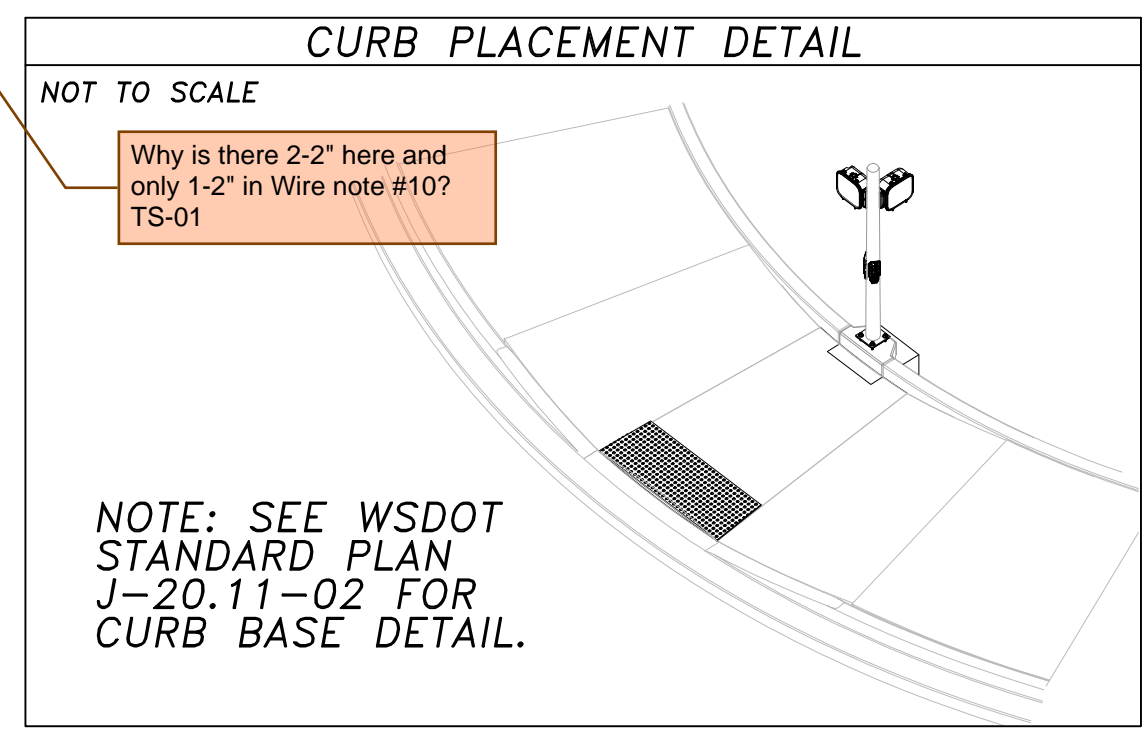

APPROVED

BY: _____
CITY OF PUYALLUP
ENGINEERING SERVICES

DATE: _____

NOTE: THIS APPROVAL IS VOID AFTER 1 YEAR FROM APPROVAL DATE.

THE CITY WILL NOT BE RESPONSIBLE FOR ERRORS AND/OR OMISSIONS ON THESE PLANS. FIELD CONDITIONS MAY DICTATE CHANGES TO THESE PLANS AS DETERMINED BY THE ENGINEERING SERVICES MANAGER.

No.	Date	By	Revision Description
1			

Designed By:	LAB	Issue Date:	09/29/2023
Drawn By:	LAB		PERMIT
Checked By:	GRL	Project No.:	2022-295



TENW
Transportation Engineering NorthWest

Transportation Planning | Design | Traffic Impact & Operations
11400 SE 8th Street, Suite 200, Bellevue, WA 98004 | Office (425) 889-6747
Project Contact: Trevor Takara, P.E.
Phone: 206-291-4383

ASH DEVELOPMENT, LLC
EAST TOWN CROSSING
PUYALLUP, WA

TRAFFIC SIGNAL PLANS - PHASE 1

TS-01
SHEET:
OF

SECTION 26, TOWNSHIP 20 N, RANGE 4 E, W.M.

WIRING SCHEDULE (AFFECTED RUNS ONLY)																															
△ NO.	RACEWAY CONDUIT SIZE	E.V. DETECT. 3C(SH)		PRE-EMPT LIGHT 2C(SH)		VEH. HEAD 5C		PPB 2C(SH)		PED. HEAD/PPB 5C		ILLUM ST NAME SIGN 2C(SH)		VIDEO DETECT. ***		EQUIP. GRND. *		ILLUM #6		INTER 144 SMFO		PTZ CAMERA		BLANK OUT 3C		PULL WIRE		CONDUIT FILL		ALLOWABLE FILL	
		EX.	NEW	EX.	NEW	EX.	NEW	EX.	NEW	EX.	NEW	EX.	NEW	EX.	NEW	EX.	NEW	EX.	NEW	EX.	NEW	EX.	NEW	EX.	NEW	EX.	NEW	EX.	NEW		
1	2" SCH40 PVC																													0.28	0.86
	2" SCH40 PVC																													0.18	0.86
2	EX 2" SCH40 PVC**			1	1	2									1														0.60	1.32	
	EX 2" SCH40 PVC**	1	1			2								1	1	1													1.25	1.32	
	EX 2" SCH80 PVC**			1	1	2									1														1.02	1.15	
3	EX 2" SCH80 PVC**	1	1			2									1														0.99	1.15	
	EX 4" SCH80 PVC**			1												1													1.30	4.39	
	EX 2" SCH80 PVC SPARE														1														---	1.15	
4	EX 2" SCH80 PVC**					2									1									1					1.18	1.15	
	EX 3" SCH40 PVC**			1	1	4	2								1									1					1.93	2.91	
5	EX 2" SCH40 PVC**	1	1					2							2	1													1.08	1.32	
	EX 4" SCH40 PVC**			1					3						1	1													1.57	4.93	
	EX 2" SCH40 PVC SPARE																								1				---	1.32	
6	EX 2" SCH40 PVC**			1		2									1														0.65	1.32	
	EX 2" SCH40 PVC**	1													1	1						1							0.71	1.32	
	EX 3" SCH40 PVC**			2		6									1									1					1.51	2.91	
7	EX 3" SCH40 PVC**	2	1					2	4						3	1	1						1						2.13	2.91	
	EX 4" SCH40 PVC**			1		2									1														1.89	4.93	
8	EX 2" SCH40 PVC**											1	1		1		2												0.42	1.32	
9	EX 2" SCH80 PVC**											1	1		1		2												0.42	1.15	
	EX 2" SCH80 PVC SPARE																												---	1.15	
10	2" SCH80 PVC																												0.37	0.75	
11	EX 2" SCH40 PVC**												3	1			2												0.60	1.32	
12	2" SCH40 PVC																												0.42	0.86	
	2" SCH40 PVC																												0.27	0.86	

No spares? →

Type PS pole receiving Type PS pole? →

* EQUIPMENT GROUND SIZE SHALL BE EQUAL TO OR LARGER THAN THE LARGEST WIRE SIZE IN THE CONDUIT.
 ** OTHER CONDUIT AND CONDUCTORS MAY BE PRESENT.
 *** VIDEO DETECTION CABLE SHALL BE 14/3 CABLE AND SHIELDED CAT5.

GENERAL NOTES

- ALL WORK IN CITY RIGHT-OF-WAY REQUIRES A PERMIT FROM THE CITY OF PUYALLUP. PRIOR TO ANY WORK COMMENCING, THE GENERAL CONTRACTOR SHALL ARRANGE FOR A PRECONSTRUCTION MEETING AT THE DEVELOPMENT SERVICES CENTER TO BE ATTENDED BY ALL CONTRACTORS THAT WILL PERFORM WORK SHOWN ON THE APPROVED ENGINEERING PLANS, REPRESENTATIVES FROM ALL APPLICABLE UTILITY COMPANIES, THE PROJECT OWNER AND APPROPRIATE CITY STAFF. CONTACT ENGINEER SERVICES AT (253-841-5568) TO SCHEDULE THE MEETING. THE CONTRACTOR IS RESPONSIBLE TO HAVE THEIR OWN SET OF APPROVED PLANS AT THE MEETING.
- AFTER COMPLETION OF ALL ITEMS SHOWN ON THESE PLANS AND BEFORE ACCEPTANCE OF THE PROJECT THE CONTRACTOR SHALL OBTAIN A "PUNCH LIST" PREPARED BY THE CITY'S INSPECTOR DETAILING REMAINING ITEMS OF WORK TO BE COMPLETED. ALL ITEMS OF WORK SHOWN ON THESE PLANS SHALL BE COMPLETED TO THE SATISFACTION OF THE CITY PRIOR TO ACCEPTANCE OF THE WATER SYSTEM AND PROVISION OF SANITARY SEWER SERVICE.
- ALL MATERIALS AND WORKMANSHIP SHALL CONFORM TO THE STANDARD SPECIFICATIONS FOR ROAD, BRIDGE, AND MUNICIPAL CONSTRUCTION (HEREINAFTER REFERRED TO AS THE "STANDARD SPECIFICATIONS"), WASHINGTON STATE DEPARTMENT OF TRANSPORTATION AND AMERICAN PUBLIC WORKS ASSOCIATION, WASHINGTON STATE CHAPTER, LATEST EDITION, UNLESS SUPERSEDED OR AMENDED BY THE CITY OF PUYALLUP CITY STANDARDS FOR PUBLIC WORKS ENGINEERING AND CONSTRUCTION (HEREINAFTER REFERRED TO AS THE "CITY STANDARDS").
- A COPY OF THESE APPROVED PLANS AND APPLICABLE CITY DEVELOPER SPECIFICATIONS AND DETAILS SHALL BE ON SITE DURING CONSTRUCTION.
- ANY REVISIONS MADE TO THESE PLANS MUST BE REVIEWED AND APPROVED BY THE DEVELOPER'S ENGINEER AND THE CITY PRIOR TO ANY IMPLEMENTATION IN THE FIELD. THE CITY SHALL NOT BE RESPONSIBLE FOR ANY ERRORS AND/OR OMISSIONS ON THESE PLANS.
- THE CONTRACTOR SHALL HAVE ALL UTILITIES VERIFIED ON THE GROUND PRIOR TO ANY CONSTRUCTION. CALL (811) AT LEAST TWO WORKING DAYS IN ADVANCE. THE OWNER AND HIS/HER ENGINEER SHALL BE CONTACTED IMMEDIATELY IF A CONFLICT EXISTS.
- ANY STRUCTURE AND/OR OBSTRUCTION THAT REQUIRES REMOVAL OR RELOCATION RELATING TO THIS PROJECT SHALL BE DONE SO AT THE DEVELOPER'S EXPENSE.
- LOCATIONS OF EXISTING UTILITIES ARE APPROXIMATE. IT SHALL BE THE CONTRACTOR'S RESPONSIBILITY TO DETERMINE THE TRUE ELEVATIONS AND LOCATIONS OF HIDDEN UTILITIES. ALL VISIBLE ITEMS SHALL BE THE ENGINEER'S RESPONSIBILITY.
- THE CONTRACTOR SHALL INSTALL, REPLACE, OR RELOCATE ALL SIGNS, AS SHOWN ON THE PLANS OR AS AFFECTED BY CONSTRUCTION, PER CITY STANDARDS.
- POWER, STREET LIGHT, CABLE AND TELEPHONE LINES SHALL BE IN A TRENCH LOCATED WITHIN A 10-FOOT UTILITY EASEMENT ADJACENT TO PUBLIC RIGHT-OF-WAY. RIGHT-OF-WAY CROSSINGS SHALL HAVE A MINIMUM HORIZONTAL SEPARATION FROM OTHER UTILITIES (SEWER, WATER, AND STORM) OF 5 FEET.
- ALL CONSTRUCTION SURVEYING FOR EXTENSIONS OF PUBLIC FACILITIES SHALL BE DONE UNDER THE DIRECTION OF A WASHINGTON STATE LICENSED LAND SURVEYOR OR A WASHINGTON LICENSED PROFESSIONAL CIVIL ENGINEER.
- DURING CONSTRUCTION, ALL PUBLIC STREETS ADJACENT TO THIS PROJECT SHALL BE KEPT CLEAN OF ALL MATERIAL DEPOSITS RESULTING FROM ON-SITE CONSTRUCTION, AND EXISTING STRUCTURES SHALL BE PROTECTED AS DIRECTED BY THE CITY.
- CERTIFIED RECORD DRAWINGS ARE REQUIRED PRIOR TO PROJECT ACCEPTANCE.
- A NPDES STORMWATER GENERAL PERMIT MAY BE REQUIRED BY THE DEPARTMENT OF ECOLOGY FOR THIS PROJECT. FOR INFORMATION CONTACT THE DEPARTMENT OF ECOLOGY, SOUTHWEST REGION OFFICE AT (360-407-6300).
- ANY DISTURBANCE OR DAMAGE TO CRITICAL AREAS AND ASSOCIATED BUFFERS, OR SIGNIFICANT TREES DESIGNATED FOR PRESERVATION AND PROTECTION SHALL BE MITIGATED IN ACCORDANCE WITH A MITIGATION PLAN REVIEWED AND APPROVED BY THE CITY'S PLANNING DIVISION. PREPARATION AND IMPLEMENTATION OF THE MITIGATION PLAN SHALL BE AT THE DEVELOPER'S EXPENSE.
- ALL WORK SHALL BE IN ACCORDANCE WITH CITY OF PUYALLUP PUBLIC WORKS STANDARDS AND WSDOT STANDARDS AND SPECIFICATIONS.
- THE LOCATIONS OF FEATURES SHOWN ARE APPROXIMATE AND SHALL BE VERIFIED BY THE CONTRACTOR PRIOR TO CONSTRUCTION START.
- UTILITY LOCATIONS ARE APPROXIMATE AND SHALL BE VERIFIED IN THE FIELD BY THE CONTRACTOR PRIOR TO ANY ILLUMINATION WORK.
- ALL WORK SHALL BE CONSISTENT WITH UTILITY AGENCY REQUIREMENTS. THE CONTRACTOR SHALL COORDINATE WITH AFFECTED UTILITY AGENCIES THROUGHOUT THE PROJECT. THE CONTRACTOR SHALL BE RESPONSIBLE FOR ANY DAMAGE TO UTILITIES.
- CONDUIT LOCATIONS ARE SHOWN FOR ILLUSTRATIVE PURPOSES. ACTUAL LOCATIONS SHALL BE DETERMINED BY THE CONTRACTOR IN THE FIELD.
- CONTRACTOR SHALL COORDINATE WITH THE CITY SIGNAL/ILLUMINATION TECHNICIAN AT 253.405.4390 PRIOR TO CONSTRUCTION.
- THE LOCATION OF ALL CONDUITS, JUNCTION BOXES, POLES, AND CABINETS SHOWN ON THIS PLAN MAY BE ADJUSTED IN THE FIELD TO AVOID CONFLICTS AND MEET ADA REQUIREMENTS. ALL FINAL LOCATIONS SHALL BE APPROVED BY THE CITY TRAFFIC ENGINEER PRIOR TO CONSTRUCTION.
- JUNCTION BOX LOCATIONS SHOWN ARE FOR ILLUSTRATIVE PURPOSES ONLY. JUNCTION BOXES SHALL BE FIELD LOCATED BY THE CONTRACTOR WITH DIRECTION FROM THE CITY.
- CONTRACTOR SHALL ADJUST JUNCTION BOX LIDS TO BE FLUSH WITH TOP OF SIDEWALK.
- JUNCTION BOXES, CABLE VAULTS, AND PULL BOXES WHICH ARE PLACED WITHIN THE SIDEWALK SHALL HAVE SLIP RESISTANT LIDS WHICH MEET THE REQUIREMENTS OF AMERICANS WITH DISABILITIES ACT (ADA) AND PUBLIC RIGHT-OF-WAY ACCESSIBILITY GUIDELINES (PROWAG). APPROVED PRODUCTS ARE SLIPNOT GRIP PLATE GRADE 3 SURFACE AND IKG INDUSTRIES MEBAC#1.
- ILLUMINATION CONDUIT SHALL BE PLACED IN THE SAME TRENCH AS OTHER UTILITIES WHERE POSSIBLE. THE JUNCTION BOX AND CONDUIT LOCATIONS SHOWN ARE APPROXIMATE.
- THE CONTRACTOR SHALL SUBMIT A REQUEST TO THE CITY OF PUYALLUP FOR MATERIALS APPROVAL AT THE EARLIEST POSSIBLE DATE.
- LIGHT STANDARD FOUNDATIONS SHALL NOT BE EXCAVATED AND POURED BEFORE POLE LOCATIONS ARE APPROVED BY THE ENGINEER.
- THE CONTRACTOR SHALL CONFIRM THAT 10 FEET MINIMUM CIRCUMFERENTIAL CLEARANCE IS PROVIDED BETWEEN LUMINAIRE POLES AND OVERHEAD POWER LINES PRIOR TO FOUNDATION INSTALLATION. IF A CONFLICT IS DISCOVERED, THE CONTRACTOR SHALL NOTIFY THE ENGINEER PRIOR TO FOUNDATION INSTALLATION.

CIRCUIT	BREAKER	CONTACTOR
MAIN	1P-100 AMP	---
LT SIGN	1P-20 AMP	---
SIGNAL	1P-50 AMP	30 AMP
ILLUM 1 A	2P-20 AMP	30 AMP
ILLUM B (SPARE)	2P-30 AMP	30 AMP

ILLUMINATION & SIGNAL GENERAL NOTES

- ALL VEHICLE SIGNAL HEADS SHALL USE TYPE M MOUNTS (CONNECTED BETWEEN THE RED AND YELLOW SIGNAL FACES). ALL PEDESTRIAN SIGNAL HEADS SHALL USE TYPE E CLAMHELL MOUNTS.
- ALL PEDESTRIAN PUSH BUTTONS SHALL BE ACCESSIBLE PEDESTRIAN SIGNALS (APS) AND SHALL BE INSTALLED PER MUTCD STANDARDS. ALL CURB RAMPS SHALL MEET PROWAG STANDARDS.
- THE LOCATION OF ALL CONDUITS, JUNCTION BOXES, POLES AND CABINETS SHOWN ON THIS PLAN MAY BE SLIGHTLY ADJUSTED IN THE FIELD TO AVOID CONFLICTS. ALL FINAL LOCATIONS SHALL BE APPROVED BY THE ENGINEER PRIOR TO CONSTRUCTION.
- ALL NEW FOUNDATION LOCATIONS SHALL BE APPROVED BY THE ENGINEER PRIOR TO EXCAVATION. CONTRACTOR SHALL CHECK FOR MINIMUM OVERHEAD CLEARANCE OF 16'6" FOR ALL SIGNAL HEADS ABOVE THE STREET PRIOR TO POURING THE FOUNDATION.
- ALL TRAFFIC SIGNAL AND PEDESTRIAN HEADS, AND PUSH BUTTONS SHALL BE SECURELY AND COMPLETELY COVERED WHILE SIGNAL IS NOT IN OPERATION. SIGNAL HEADS WILL BE BAGGED WITH A SMALL HOLE IN LINE WITH EACH SIGNAL LENS.
- ALL CONDUCTORS FOR ALL ELECTRICAL EQUIPMENT SHALL BE LABELED IN EACH JUNCTION BOX.
- ALL CONDUITS SHALL BE RIGID HOT-DIPPED GALVANIZED STEEL OR SCHEDULE 80 PVC WHEN EXPOSED ABOVE THE GROUND. SEE SPECIAL PROVISIONS.
- ALL SIGNS SHALL BE VIP DIAMOND GRADE SHEETING FOR BOTH MAST ARM AND SHOULDER MOUNTS. STREET NAME SIGNS SHALL BE LED LIGHTED UNITS WITH THE CITY'S DAFFODIL LOGO. STREET NAME SIGNS WILL BE FURNISHED AND INSTALLED BY THE CONTRACTOR. ALL LIGHTED STREET NAME SIGN LAYOUTS SHALL BE APPROVED BY THE CITY SIGN TECHNICIAN PRIOR TO MANUFACTURING.
- ALL JUNCTION BOXES SHALL BE PLACED BEHIND SIDEWALK, UNLESS OTHERWISE NOTED.
- ALL WORK SHALL BE IN ACCORDANCE WITH CITY OF PUYALLUP STANDARDS AND SPECIFICATIONS.
- THE LOCATIONS OF FEATURES SHOWN ARE APPROXIMATE AND SHALL BE VERIFIED IN THE FIELD BY THE CONTRACTOR AS NECESSARY.
- THE CONTRACTOR SHALL SUBMIT A REQUEST TO THE INSPECTOR FOR MATERIALS APPROVAL AT THE EARLIEST POSSIBLE DATE.
- ALL WORK SHALL BE CONSISTENT WITH UTILITY AGENCY REQUIREMENTS. THE CONTRACTOR SHALL CONTACT ALL PERTINENT UTILITY AGENCIES 48 HOURS BEFORE COMMENCING WORK, AND SHALL COORDINATE WITH AFFECTED UTILITY AGENCIES THROUGHOUT THE PROJECT.
- THE CONTRACTOR SHALL BE RESPONSIBLE FOR ANY DAMAGE TO EXISTING UTILITIES. THE CONTRACTOR SHALL NOTIFY THE AFFECTED UTILITY COMPANY AND THE CITY OF PUYALLUP IMMEDIATELY UPON DAMAGE.
- EXISTING FEATURES TO REMAIN UNLESS OTHERWISE NOTED.
- ALL JUNCTION BOXES CARRYING SIGNAL EQUIPMENT AND/OR INTERCONNECT SHALL HAVE THE LETTERS "TS" INSCRIBED ON THE LID. ALL JUNCTION BOXES CARRYING ONLY INTERCONNECT EQUIPMENT SHALL HAVE THE LETTERS "INTC" INSCRIBED ON THE LID.
- ALL WORK SHALL MEET THE REQUIREMENTS OF THE PROJECT SPECIAL PROVISIONS AND THE CITY OF PUYALLUP STANDARD DRAWINGS.
- THE TOP ELEVATION OF ALL POLE FOUNDATIONS SHALL BE APPROVED BY THE INSPECTOR PRIOR TO PLACING CONCRETE.
- ANY NEW JUNCTION BOX WHICH WILL BE LOCATED WITHIN OR PARTIALLY WITHIN SIDEWALK SHALL HAVE LIDS AND FRAMES WITH A NON-SLIP COATING ON THE TOP SURFACE EQUAL TO MEBAC1 OR SLIPNOT#3.
- A COPY OF THE LOAD CALCULATIONS SHALL BE PROVIDED TO THE CITY'S SIGNAL TECHNICIAN PRIOR TO INSTALLATION.
- CONTRACTOR SHALL CONTACT THE CITY'S SIGNAL TECHNICIAN WHEN THE LIGHTS ARE READY TO BE ENERGIZED.
- THE APPLICANT SHALL PURCHASE INSYNC ADAPTIVE CAMERAS DIRECTLY FROM RHYTHM ENGINEER (CHRIS FEES AT 913-227-0603 EXT. 145 OR SAWYER BRESLOW 913-227-0603 EXT. 136) AND PROVIDE TO THE CONTRACTOR FOR INSTALLATION. CITY STAFF CAN ASSIST WITH PREPARING AN AGREEMENT BETWEEN THE APPLICANT AND RHYTHM ENGINEERING. THE CONTRACTOR SHALL INSTALL COMPLETE INSYNC ADAPTIVE SYSTEMS AT THE SHAW/SITE ACCESS INTERSECTIONS AND COORDINATE DIRECTLY WITH RHYTHM ENGINEERING FOR PROGRAMMING.
- THE REQUIRED SIGNAL MODIFICATIONS MUST BE FULLY CONFIGURED AND OPERATIONAL NO LESS THAN 2 WEEKS PRIOR TO RECEIVING OCCUPANCY FOR ANY BUILDING ON-SITE. ADAPTIVE SIGNAL CONTRACTOR (RHYTHM ENGINEERING) WILL BE REQUIRED TO CONFIGURE THE ADAPTIVE SYSTEM ON-SITE.

APPROVED
 BY: _____ CITY OF PUYALLUP ENGINEERING SERVICES
 DATE: _____
 NOTE: THIS APPROVAL IS VOID AFTER 1 YEAR FROM APPROVAL DATE.
 THE CITY WILL NOT BE RESPONSIBLE FOR ERRORS AND/OR OMISSIONS ON THESE PLANS. FIELD CONDITIONS MAY DICTATE CHANGES TO THESE PLANS AS DETERMINED BY THE ENGINEERING SERVICES MANAGER.

No.	Date	By	Revision Description

Designed By:	Issue Date:
LAB	09/29/2023
Drawn By:	Permit
LAB	
Checked By:	Project No.:
GRL	2022-295



TENW
 Transportation Engineering NorthWest
 Transportation Planning | Design | Traffic Impact & Operations
 11400 SE 6th Street, Suite 200, Bellevue, WA 98004 | Office (425) 889-6747
 Project Contact: Trevor Tokara, P.E.
 Phone: 206-914-3843




ASH DEVELOPMENT, LLC
 EAST TOWN CROSSING
 PUYALLUP, WA

TRAFFIC SIGNAL WIRE SCHEDULE - PHASE 1
 TS-02
 SHEET: _____ OF _____

FIELD WIRE TERMINATIONS

existing

CONTROLLER TERMINALS

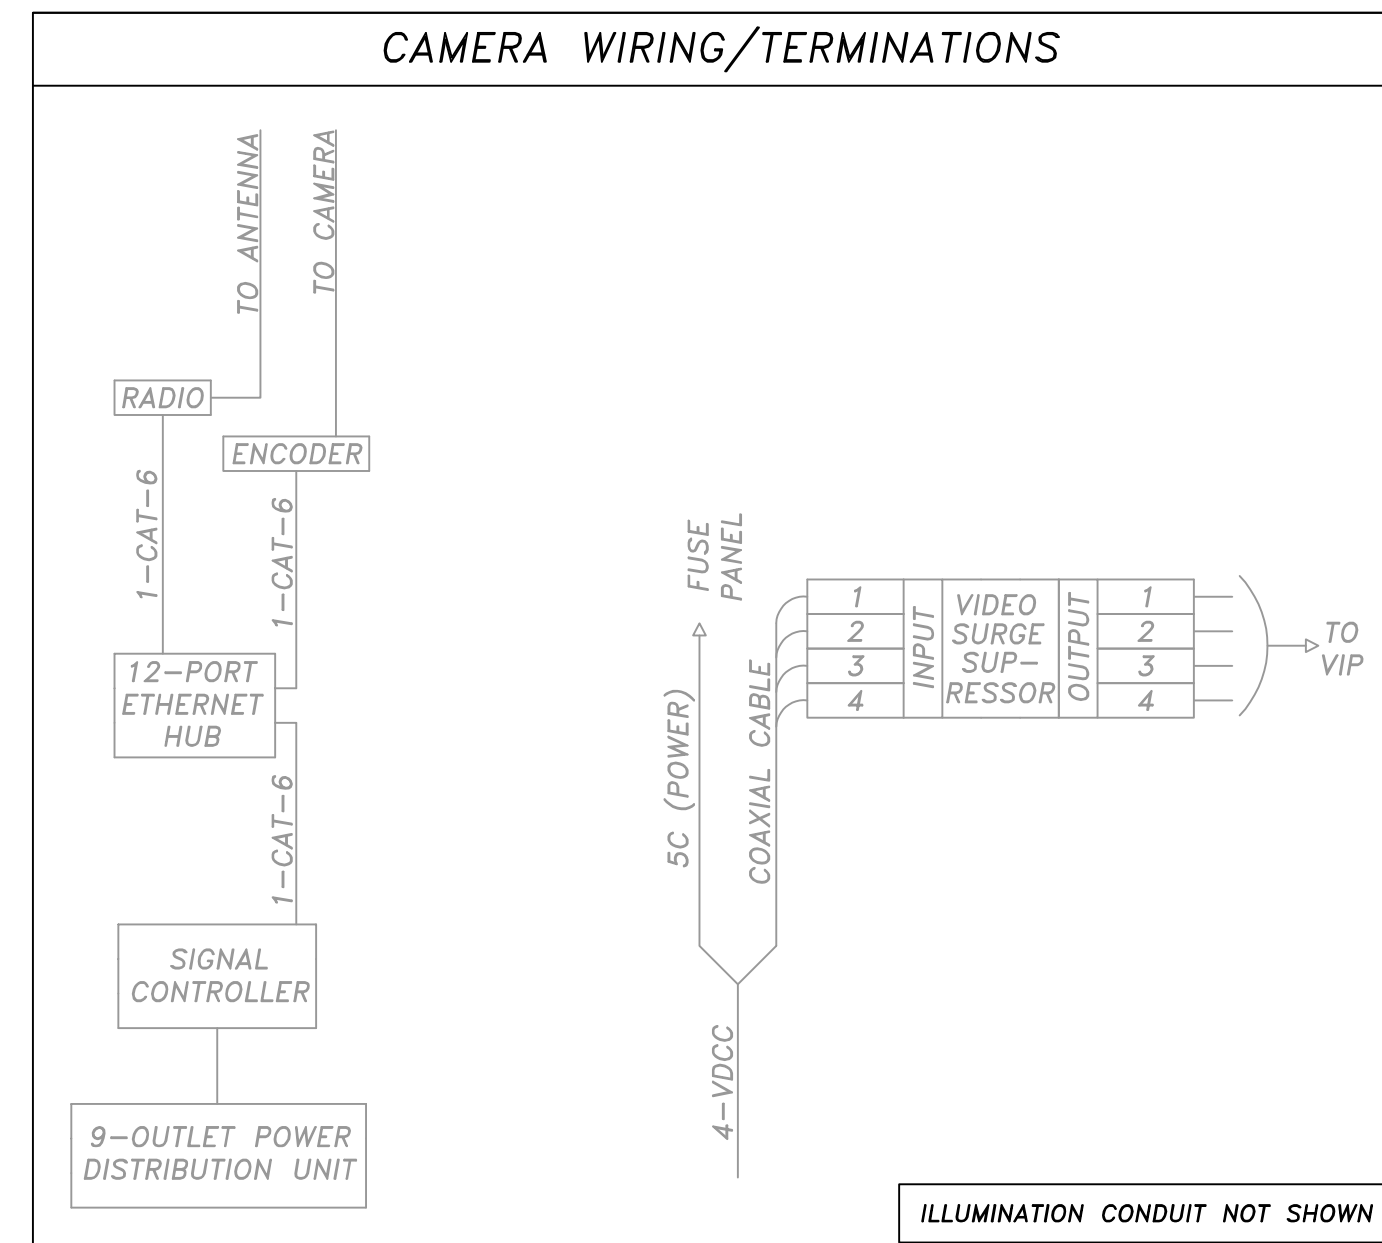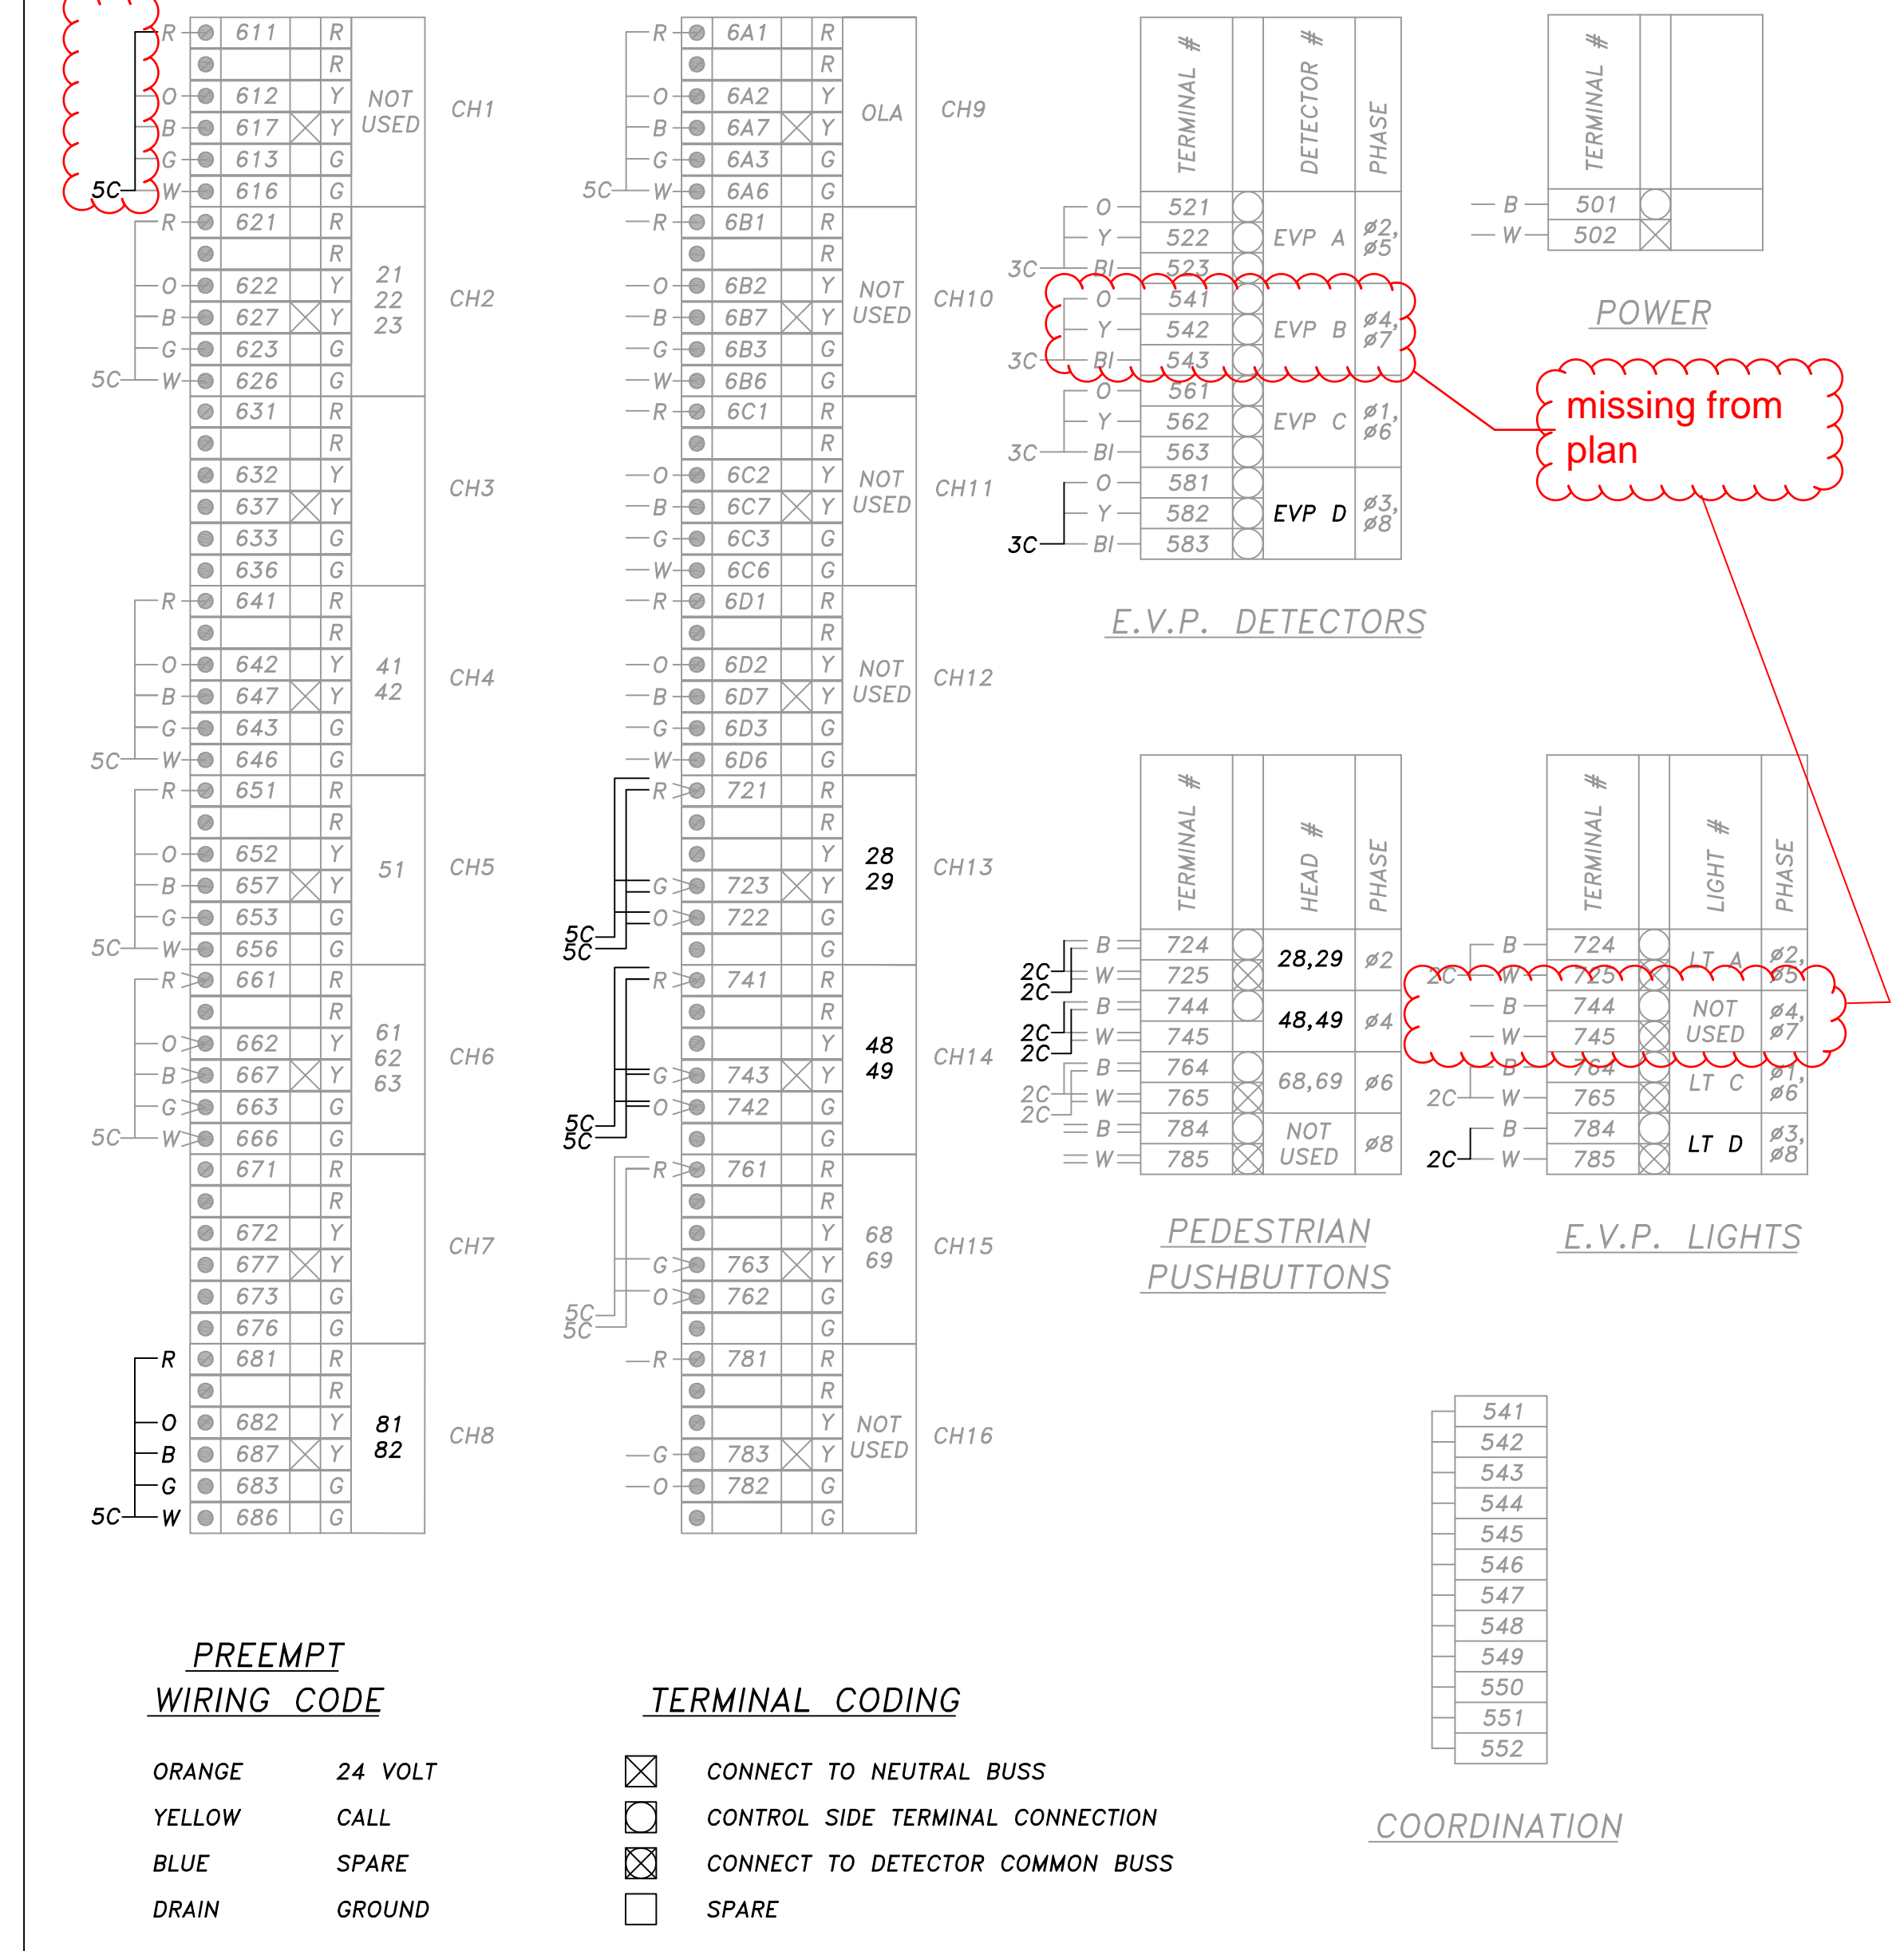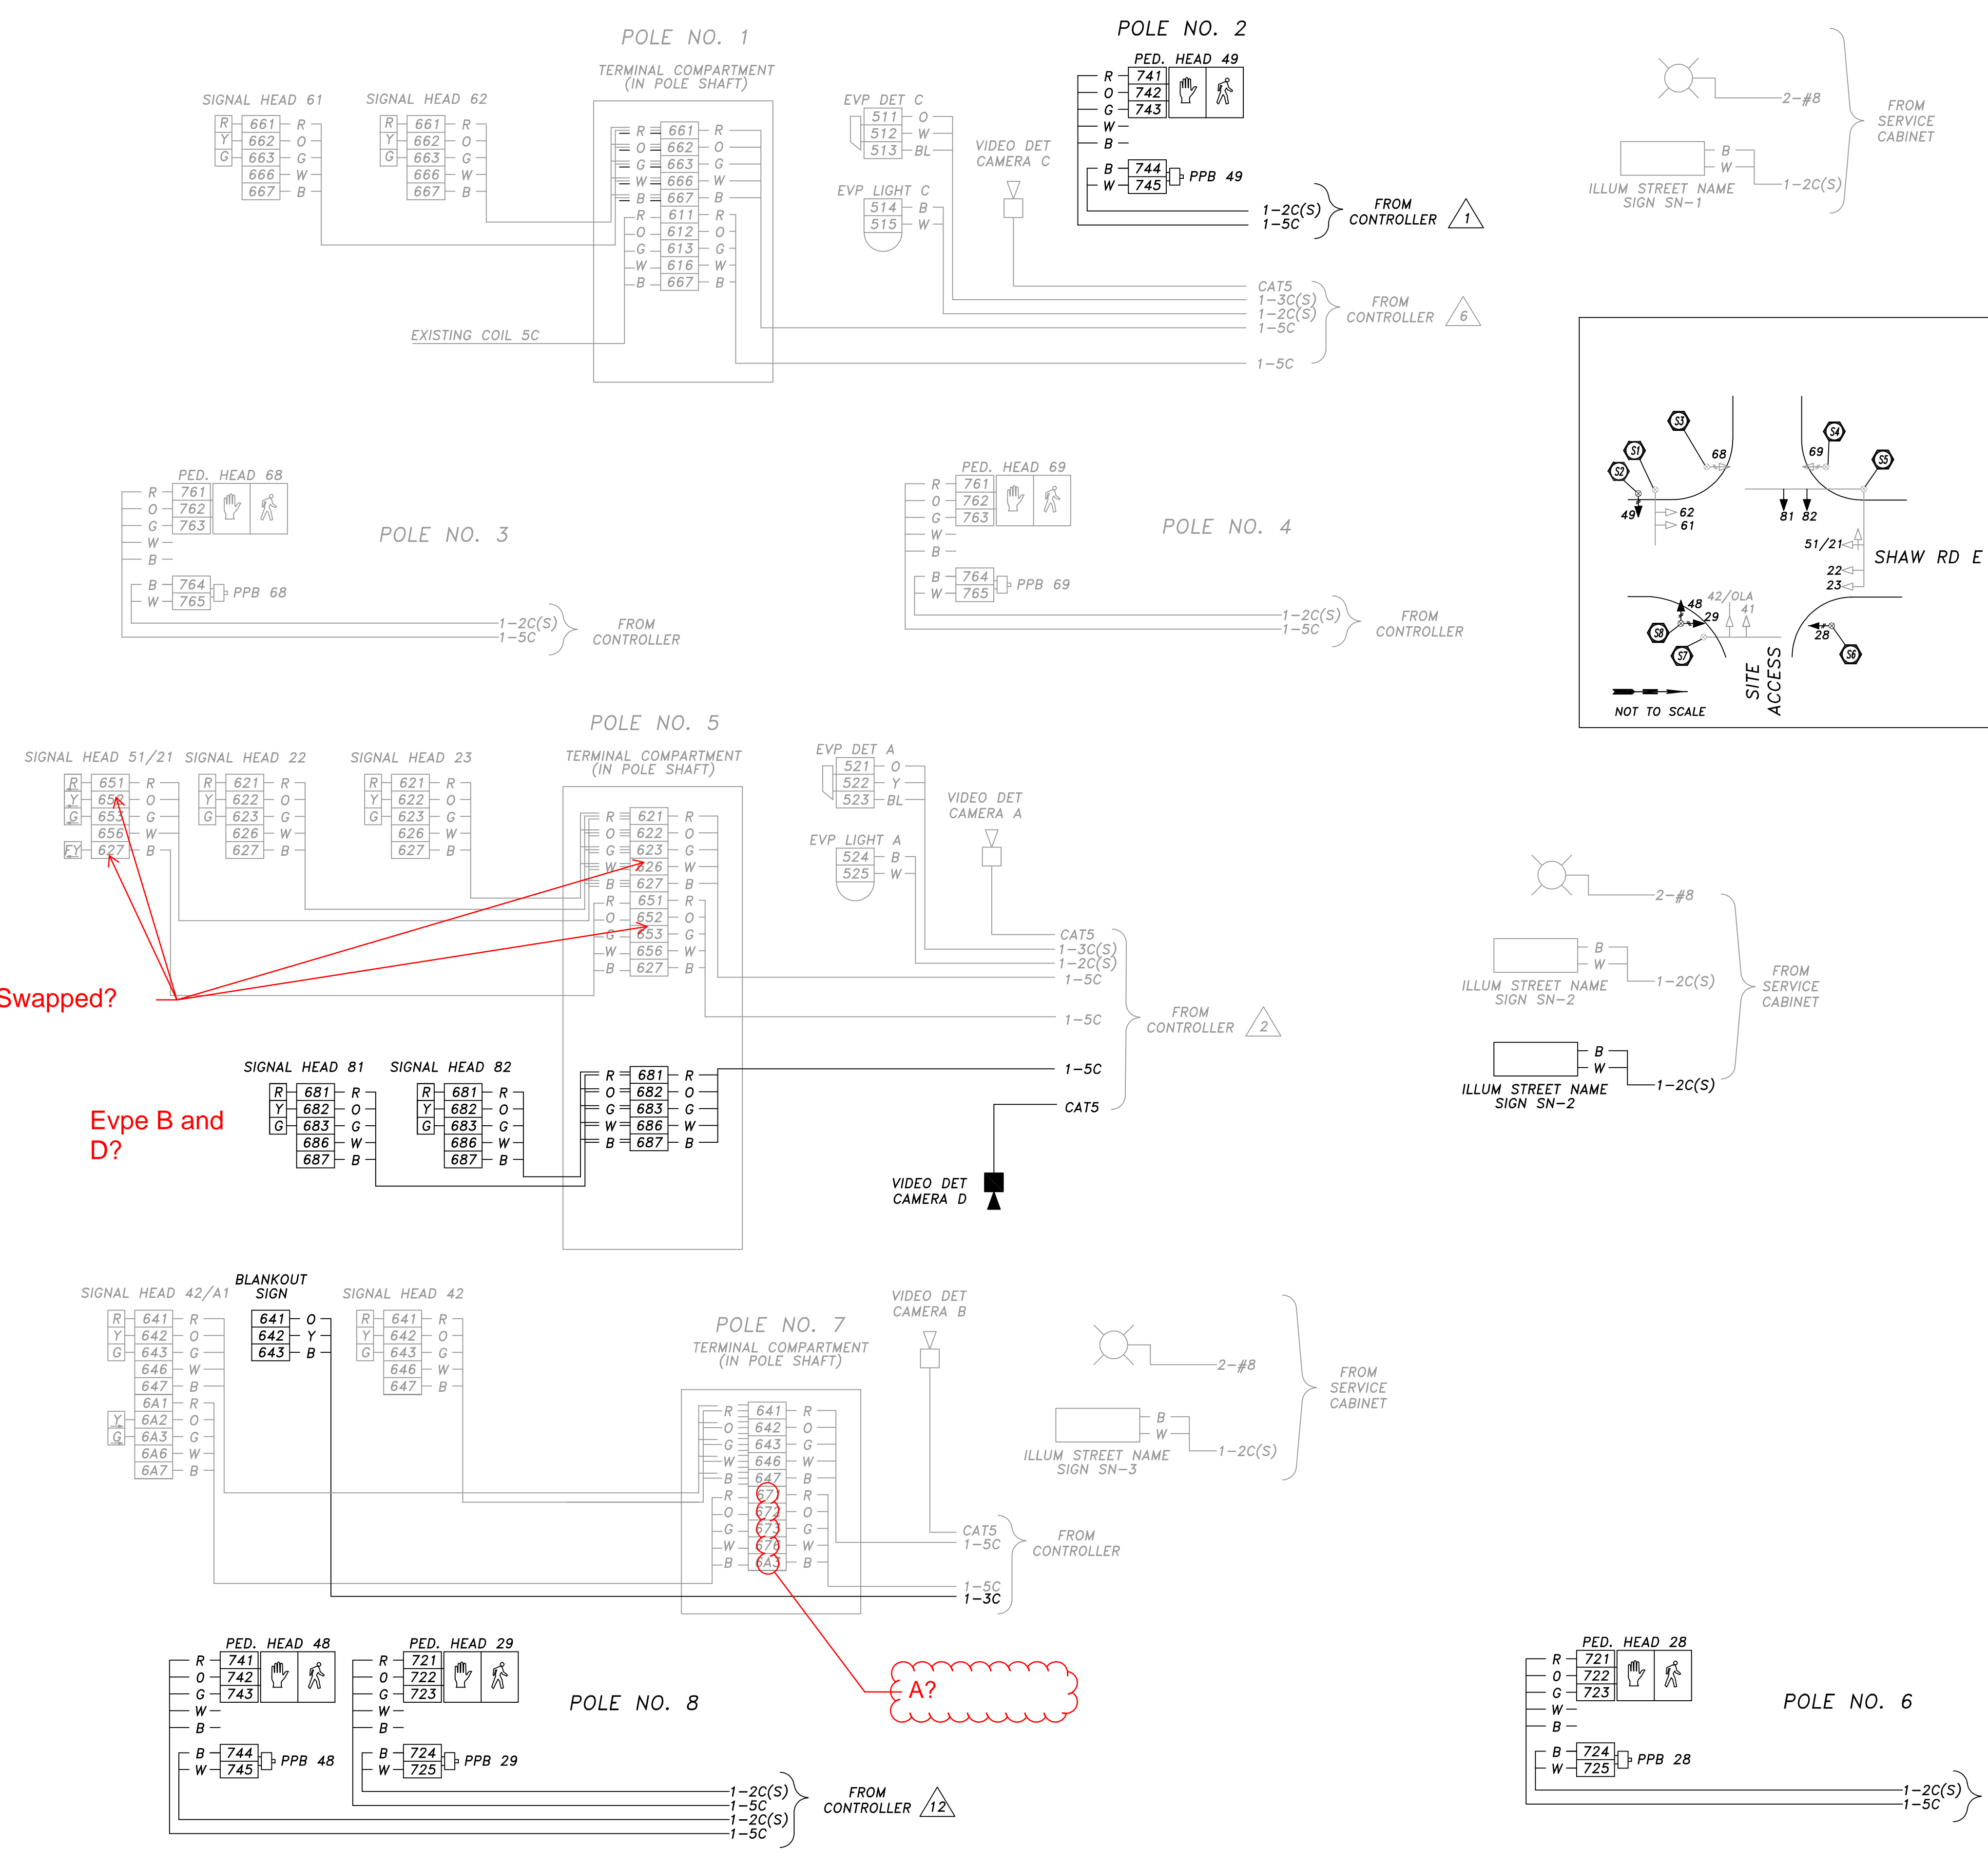

ABBREVIATIONS:
EVP: EMERGENCY VEHICLE PRE-EMPTION
VDCC: VIDEO DETECTION CAMERA CABLE

APPROVED
BY: _____
CITY OF PUYALLUP
ENGINEERING SERVICES
DATE: _____
NOTE: THIS APPROVAL IS VOID AFTER 1 YEAR FROM APPROVAL DATE.
THE CITY WILL NOT BE RESPONSIBLE FOR ERRORS AND/OR OMISSIONS ON THESE PLANS. FIELD CONDITIONS MAY DICTATE CHANGES TO THESE PLANS AS DETERMINED BY THE ENGINEERING SERVICES MANAGER.

Swapped?
Evep B and D?

missing from plan

A?

No.	Date	By	Revision Description

Designed By:	Issue Date:
LAB	09/29/2023
Drawn By:	PERMIT
LAB	
Checked By:	Project No.:
GRL	2022-295




TENW
Transportation Engineering NorthWest
11400 SE 8th Street, Suite 200, Bellevue, WA 98004 | Office (425) 899-6747
Project Contact: Trevor Takara, P.E.
Phone: 206-914-3843

ASH DEVELOPMENT, LLC
EAST TOWN CROSSING
PUYALLUP, WA


TRAFFIC SIGNAL
WIRING DIAGRAM - PHASE 1

TS-03
SHEET:
OF


SECTION 26, TOWNSHIP 20 N, RANGE 4 E, W.M.

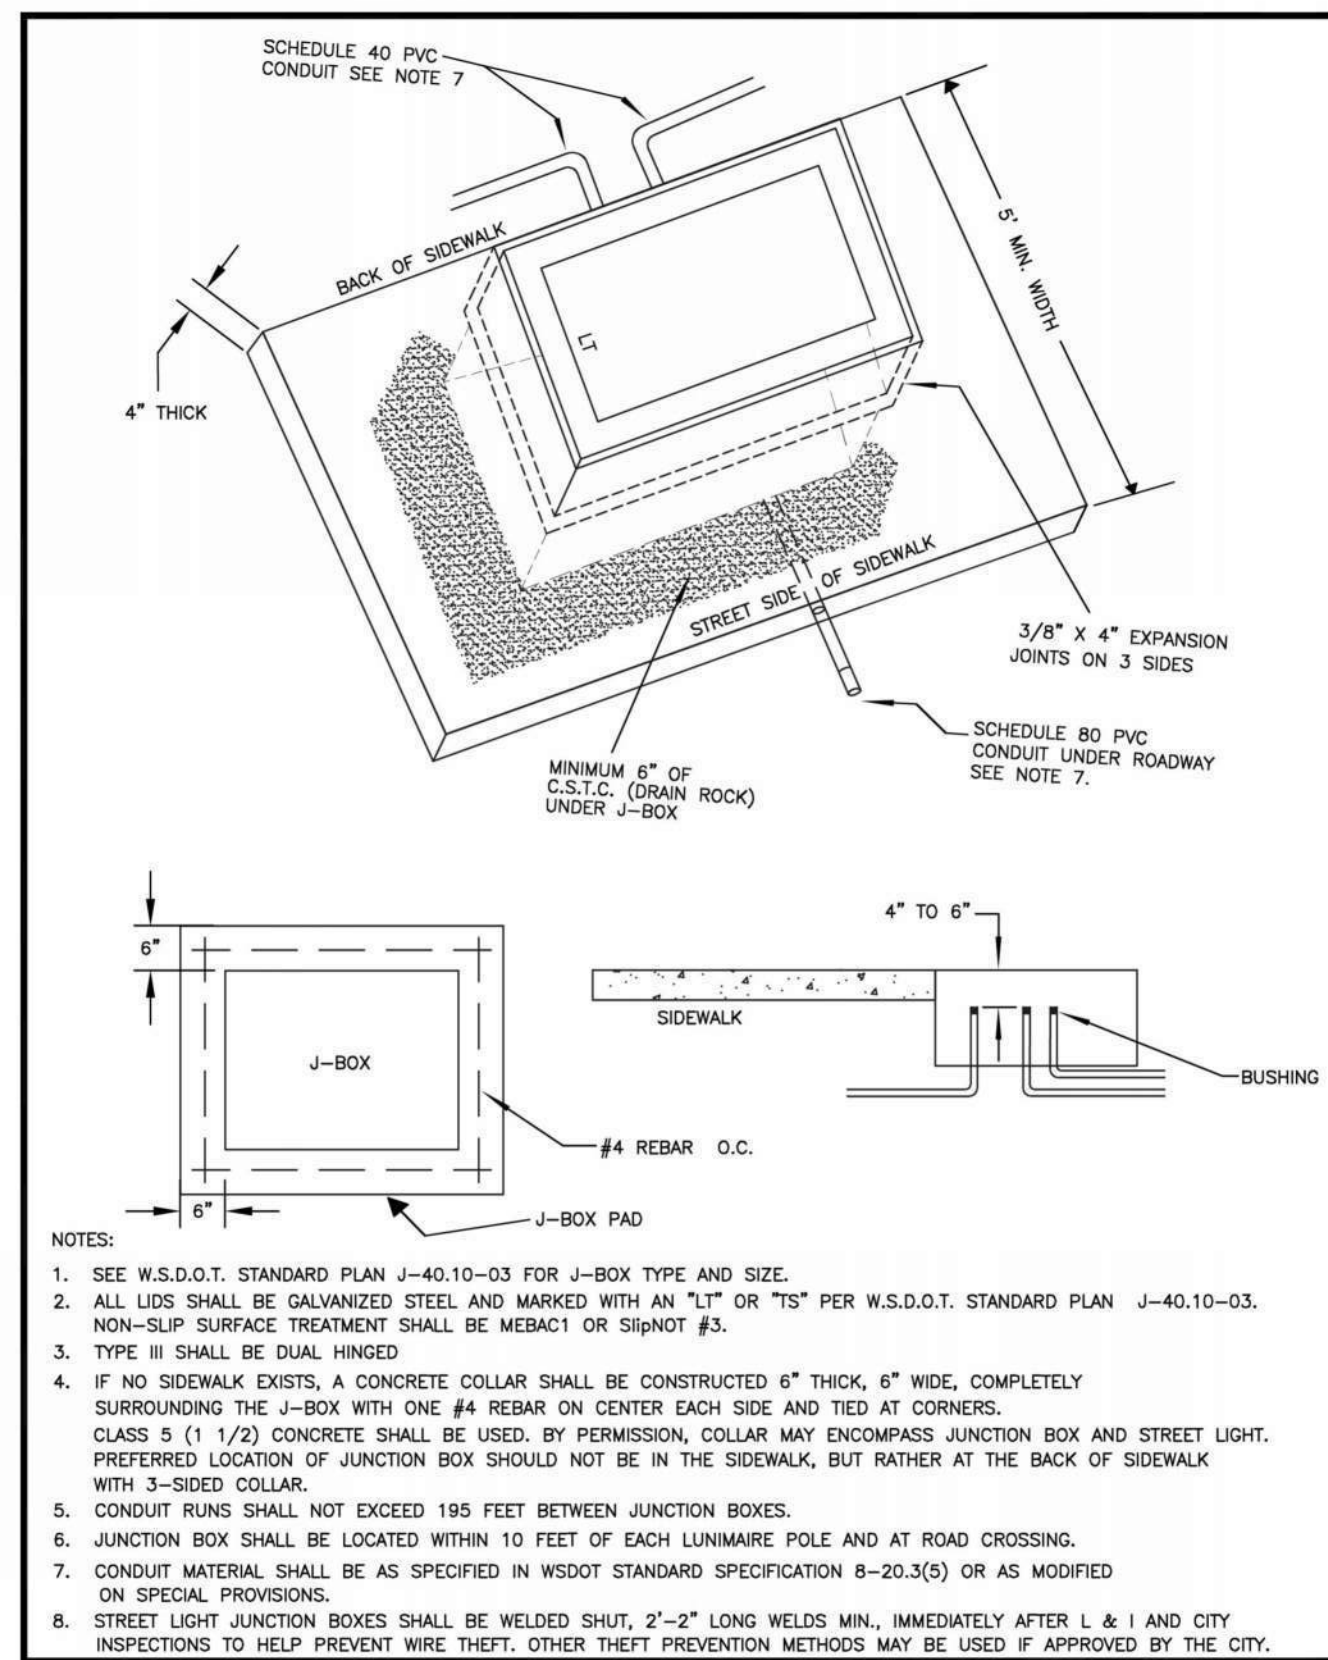


CITY OF PUYALLUP JUNCTION BOX. Includes approval stamps for Design, Check, Approve, and City Standard, dated 01.06.01.

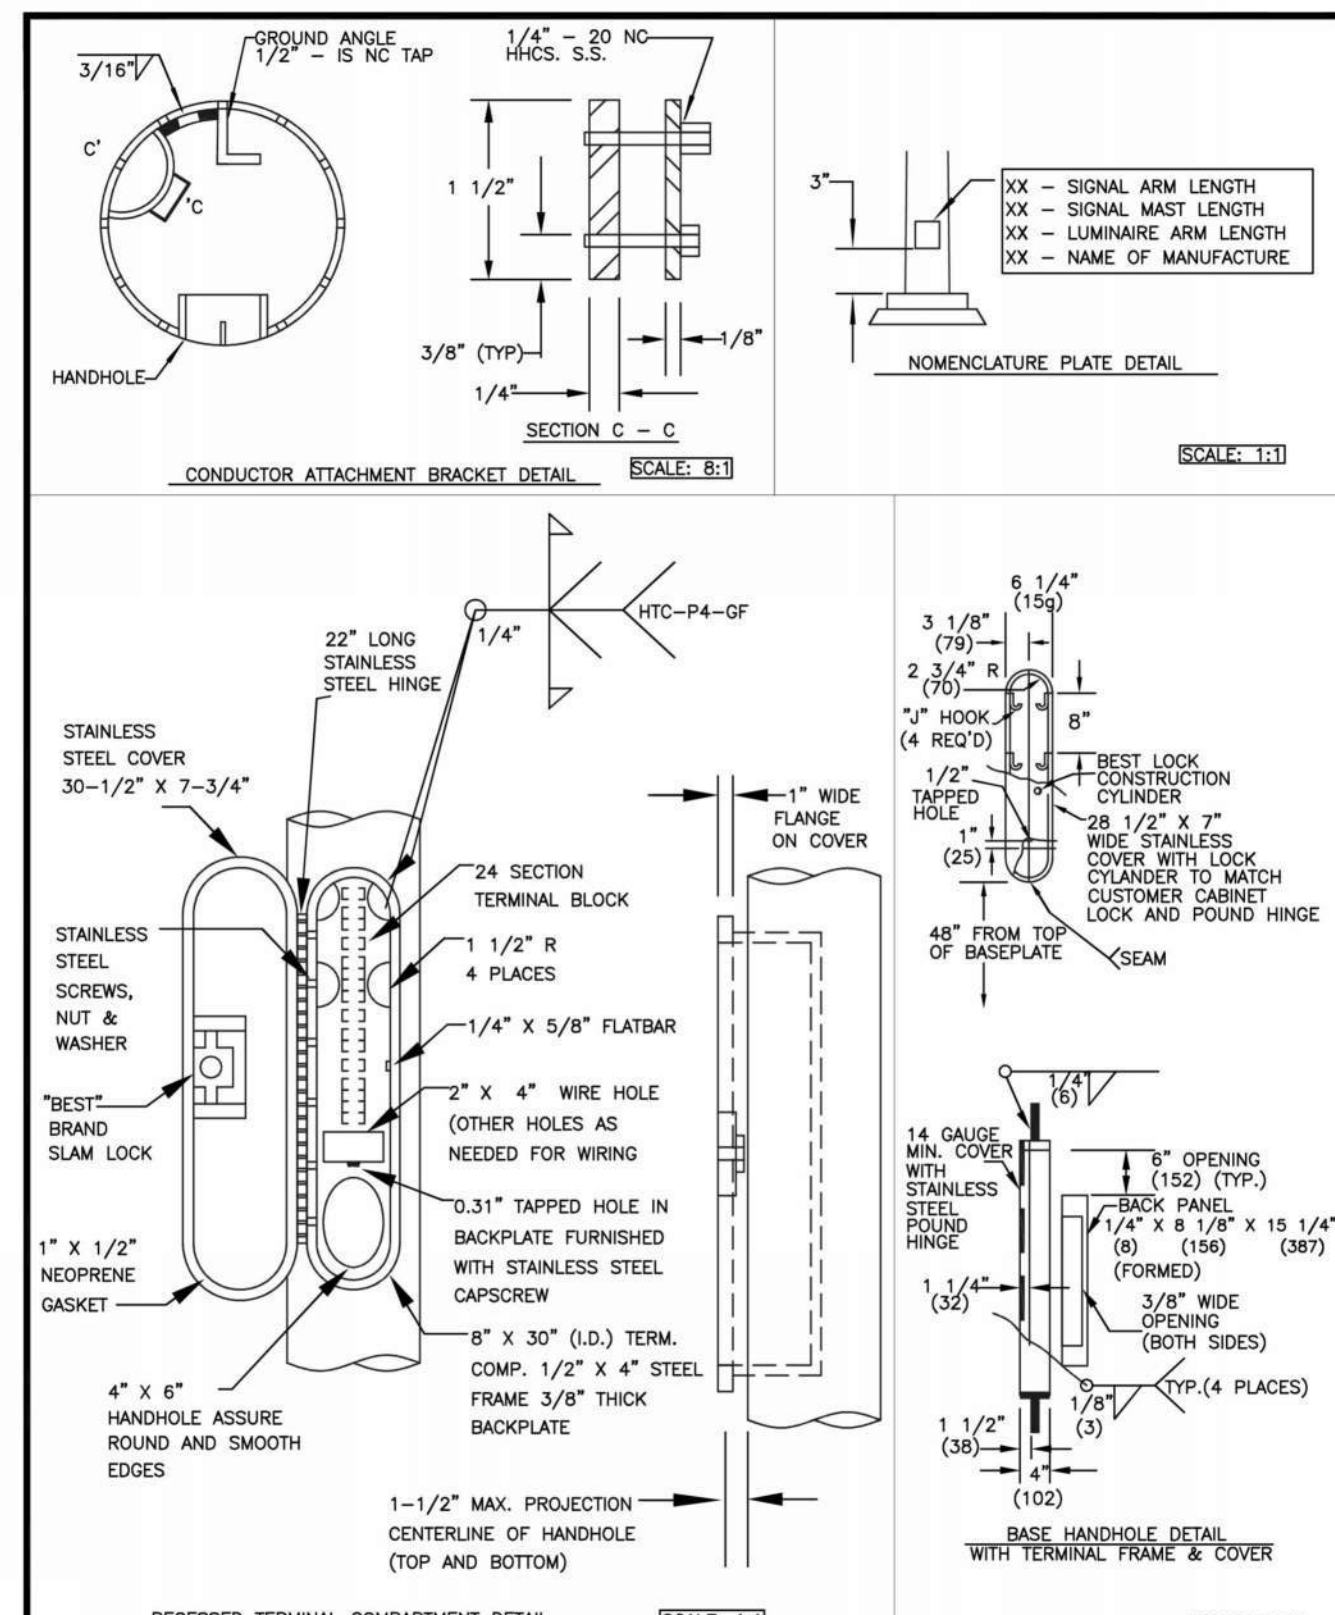


CITY OF PUYALLUP TERMINAL COMPARTMENT AND MISC. POLE DETAILS. Includes approval stamps, dated 01.06.02.

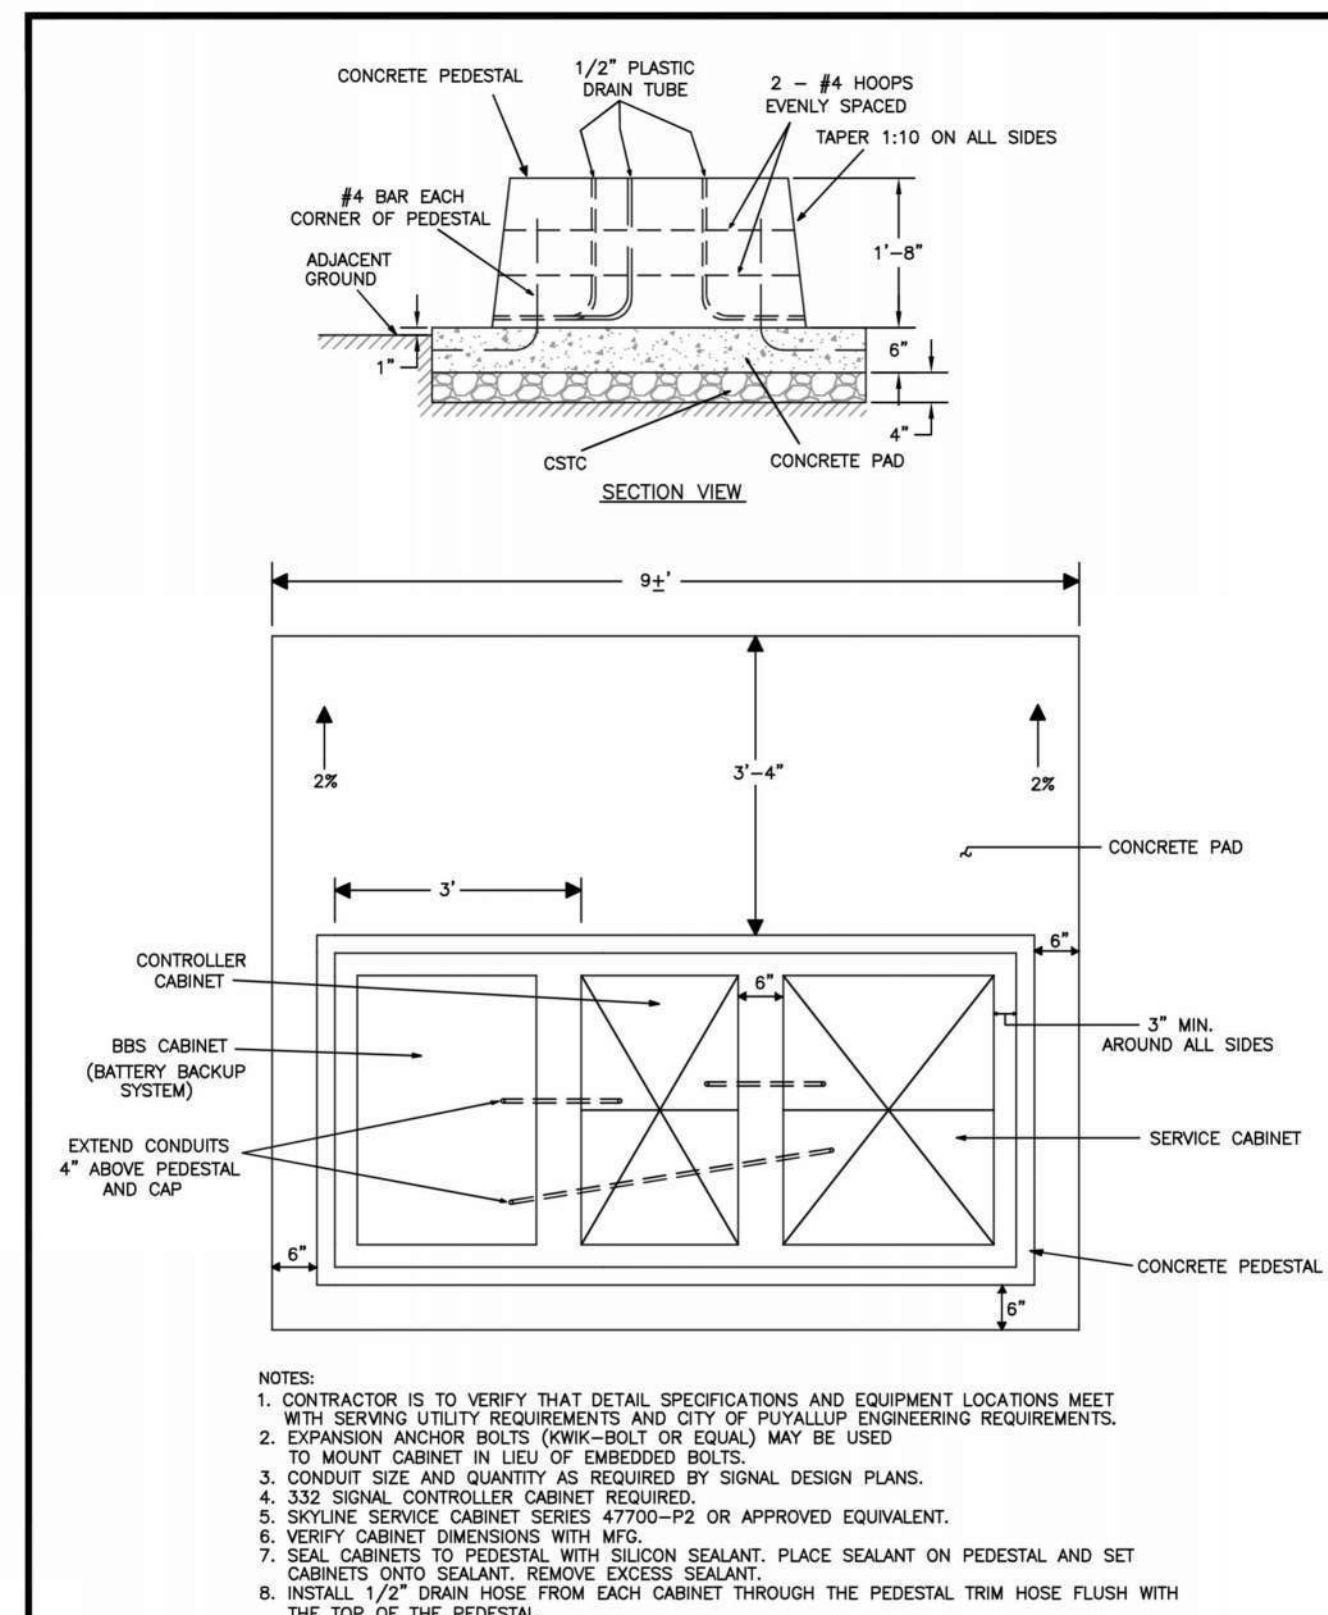


CITY OF PUYALLUP TRAFFIC SIGNAL, METER CABINET, AND BATTERY BACKUP SYSTEM CABINET FOUNDATION. Includes approval stamps, dated 01.06.06.

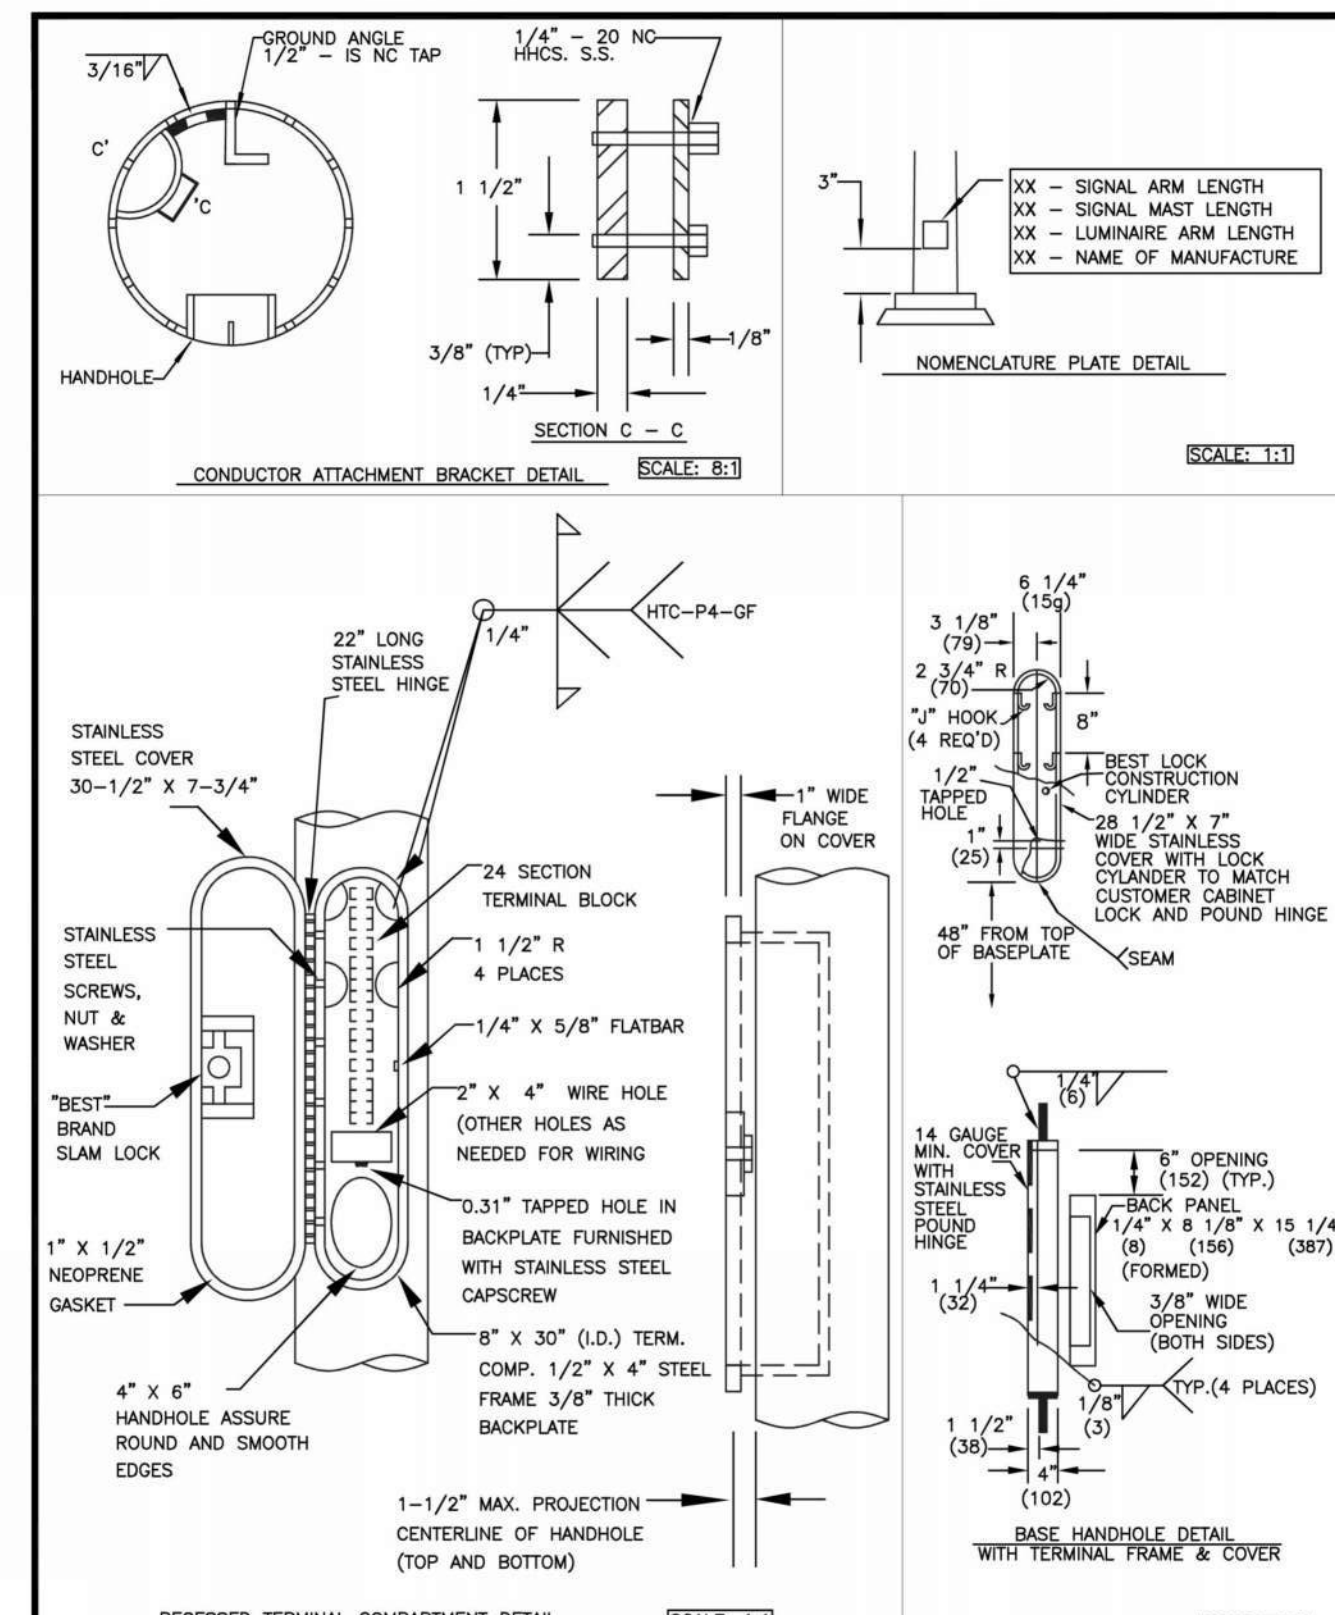


CITY OF PUYALLUP TERMINAL COMPARTMENT AND MISC. POLE DETAILS. Includes approval stamps, dated 01.06.02.

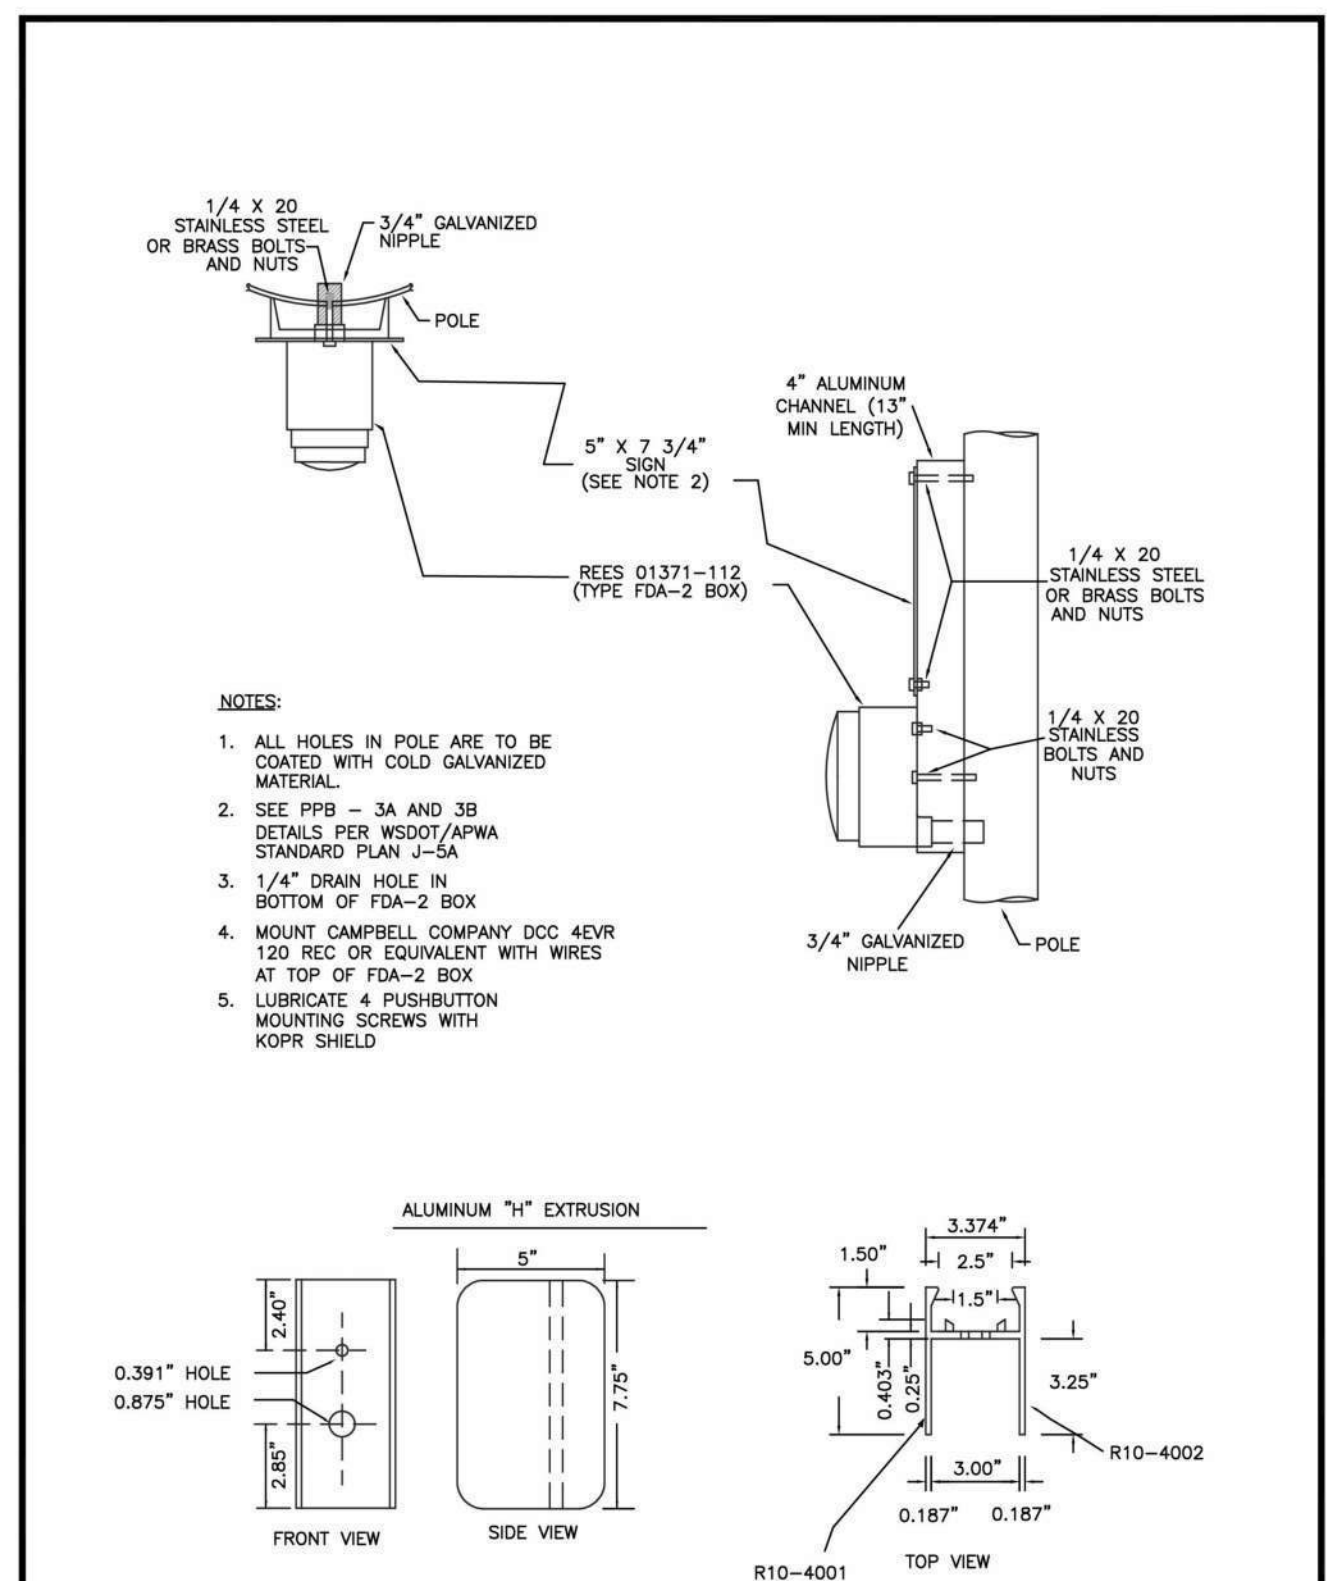


CITY OF PUYALLUP PEDESTRIAN PUSHBUTTON ASSEMBLY 1. Includes approval stamps, dated 01.06.03.

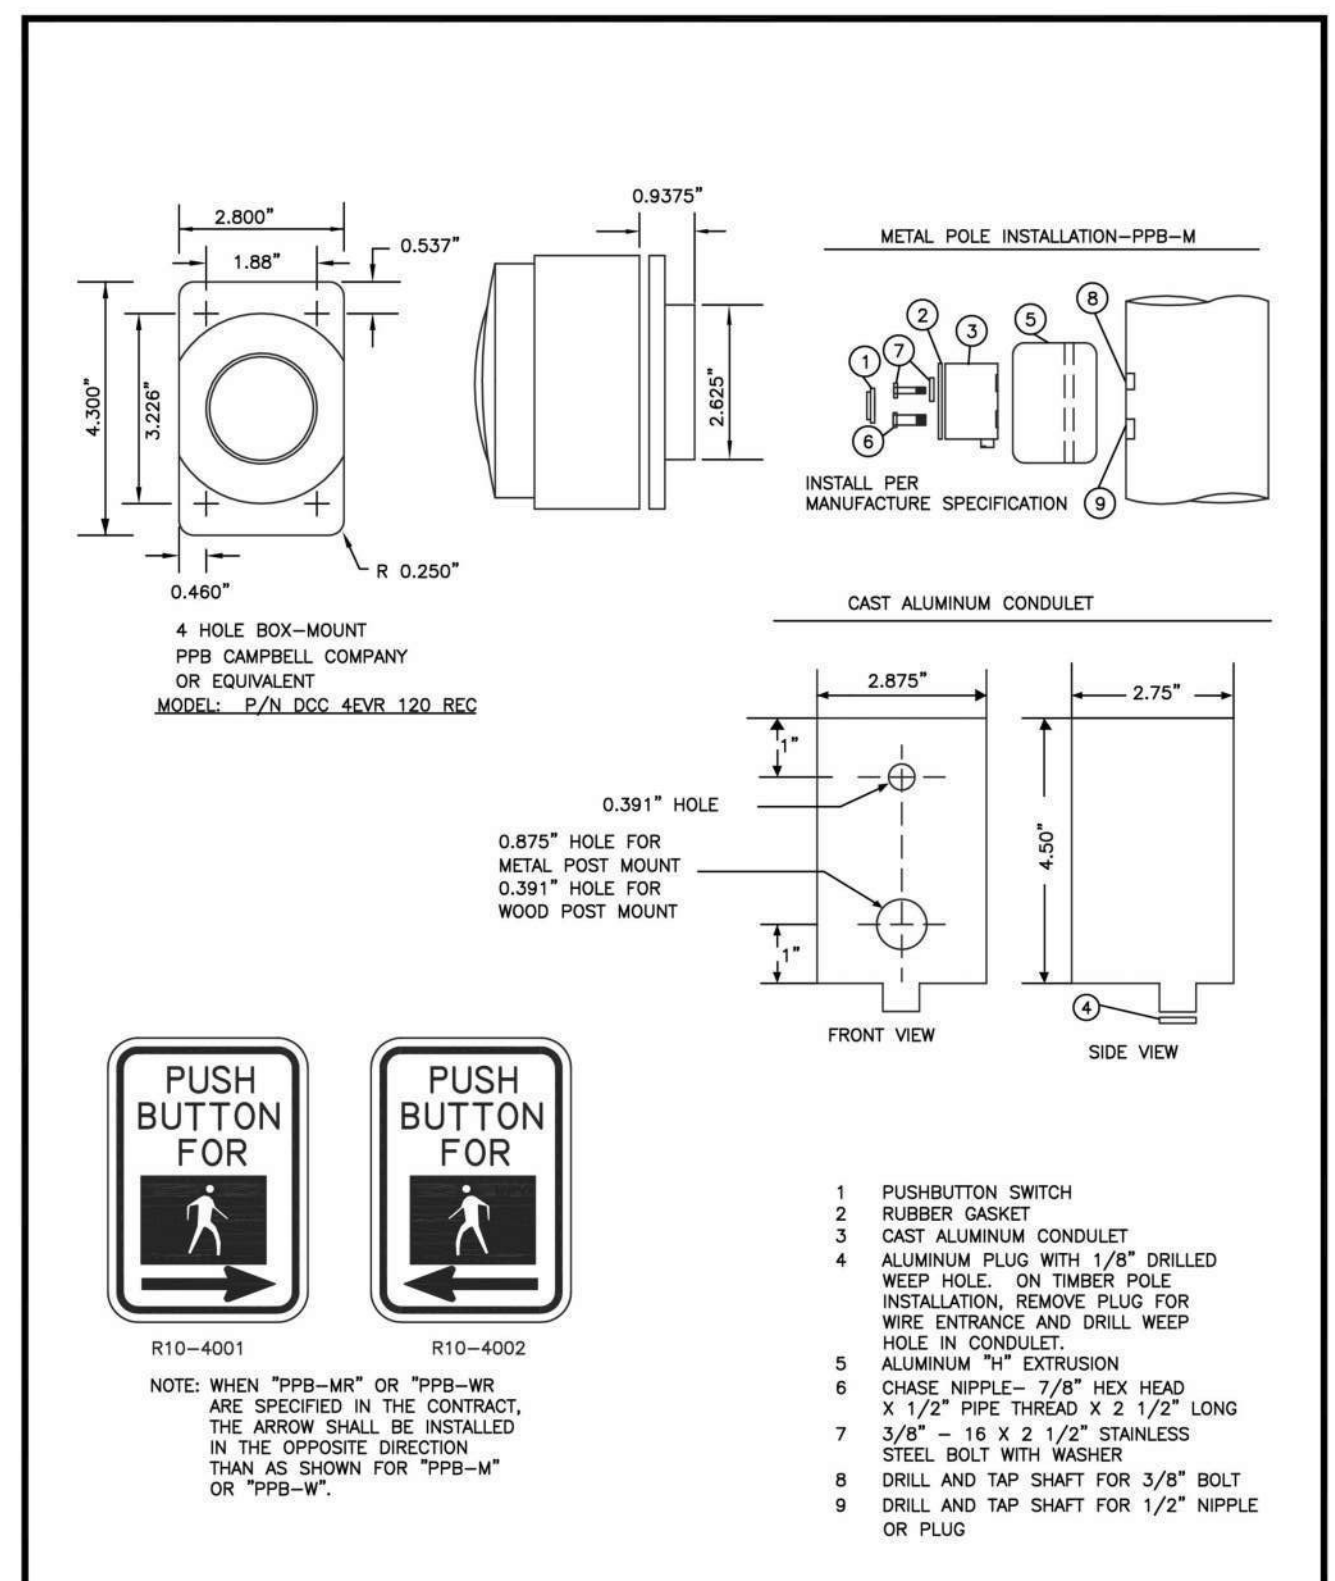

CITY OF PUYALLUP PEDESTRIAN PUSHBUTTON ASSEMBLY 2. Includes approval stamps, dated 01.06.04.

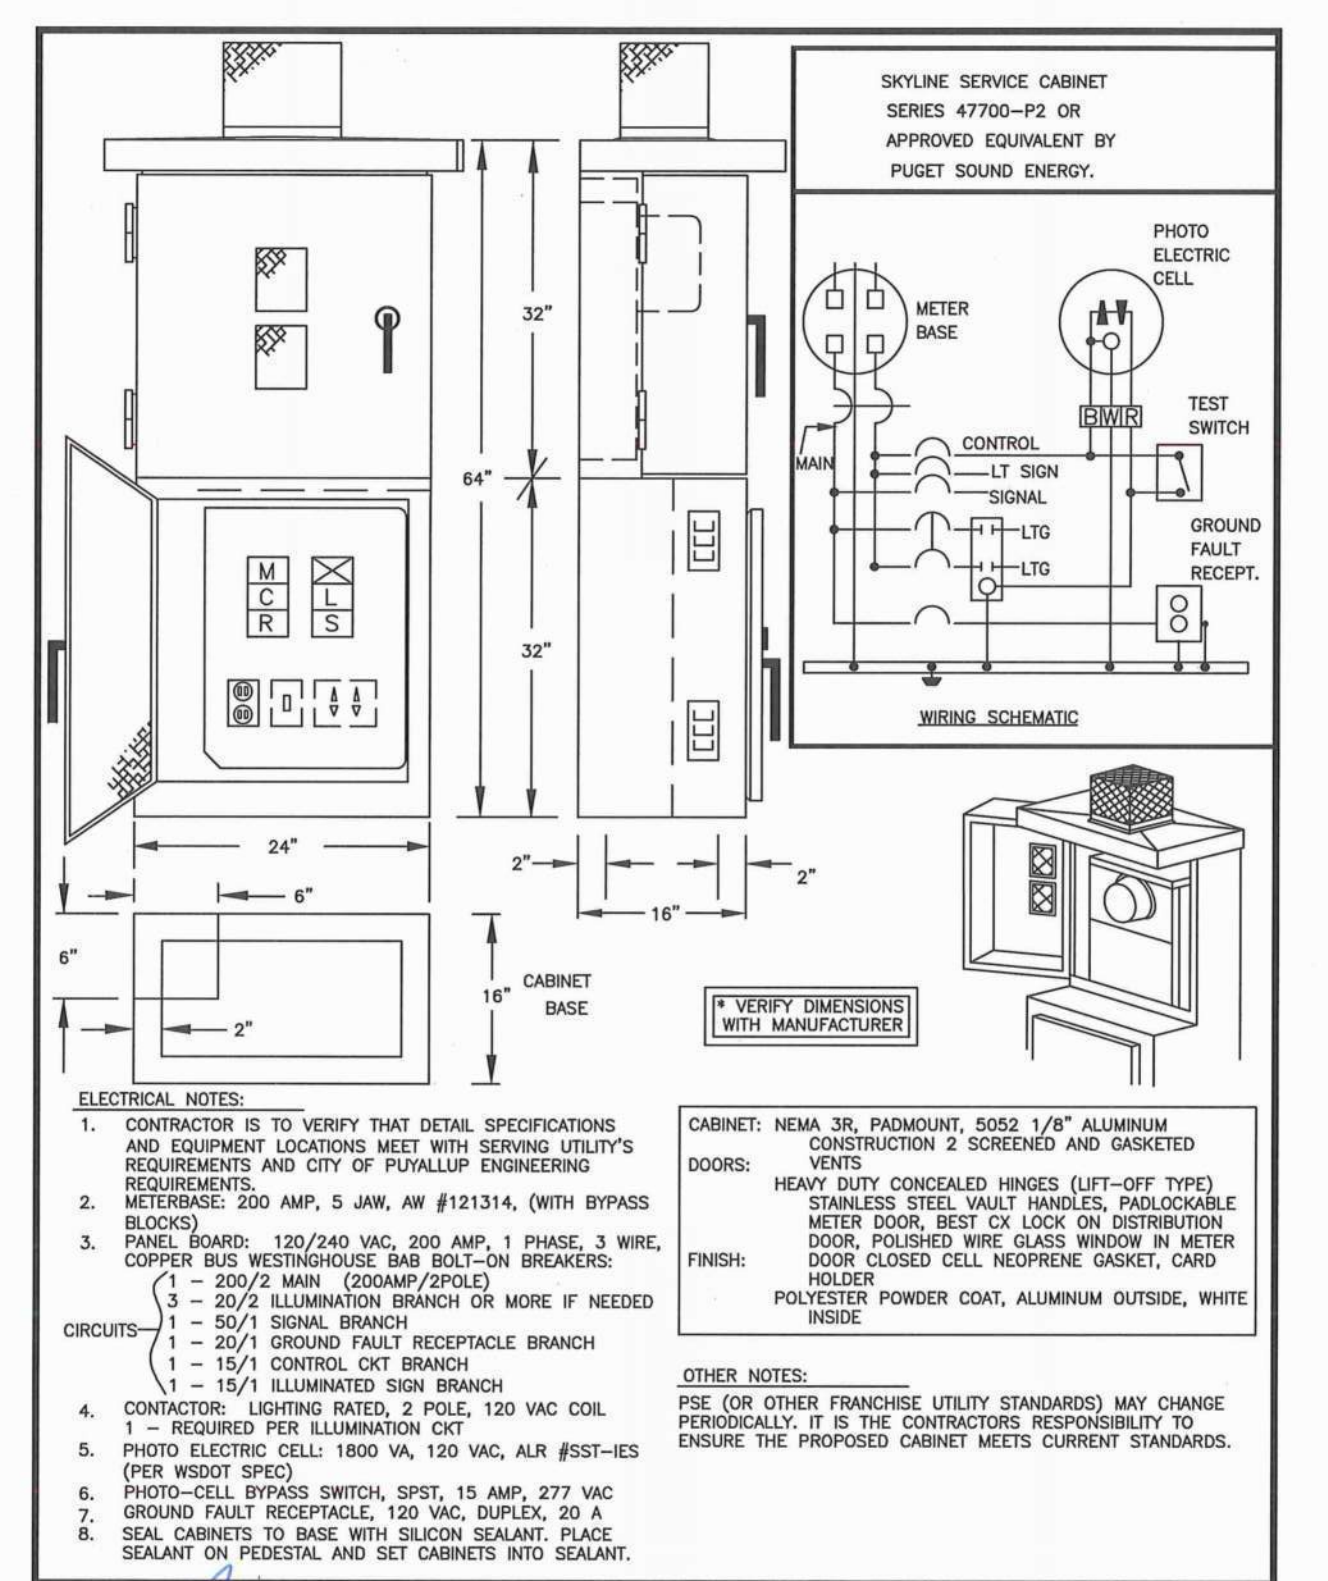

CITY OF PUYALLUP METER CABINET (STREET LIGHTING CONTROL & TRAFFIC CONTROL). Includes approval stamps, dated 01.06.05.

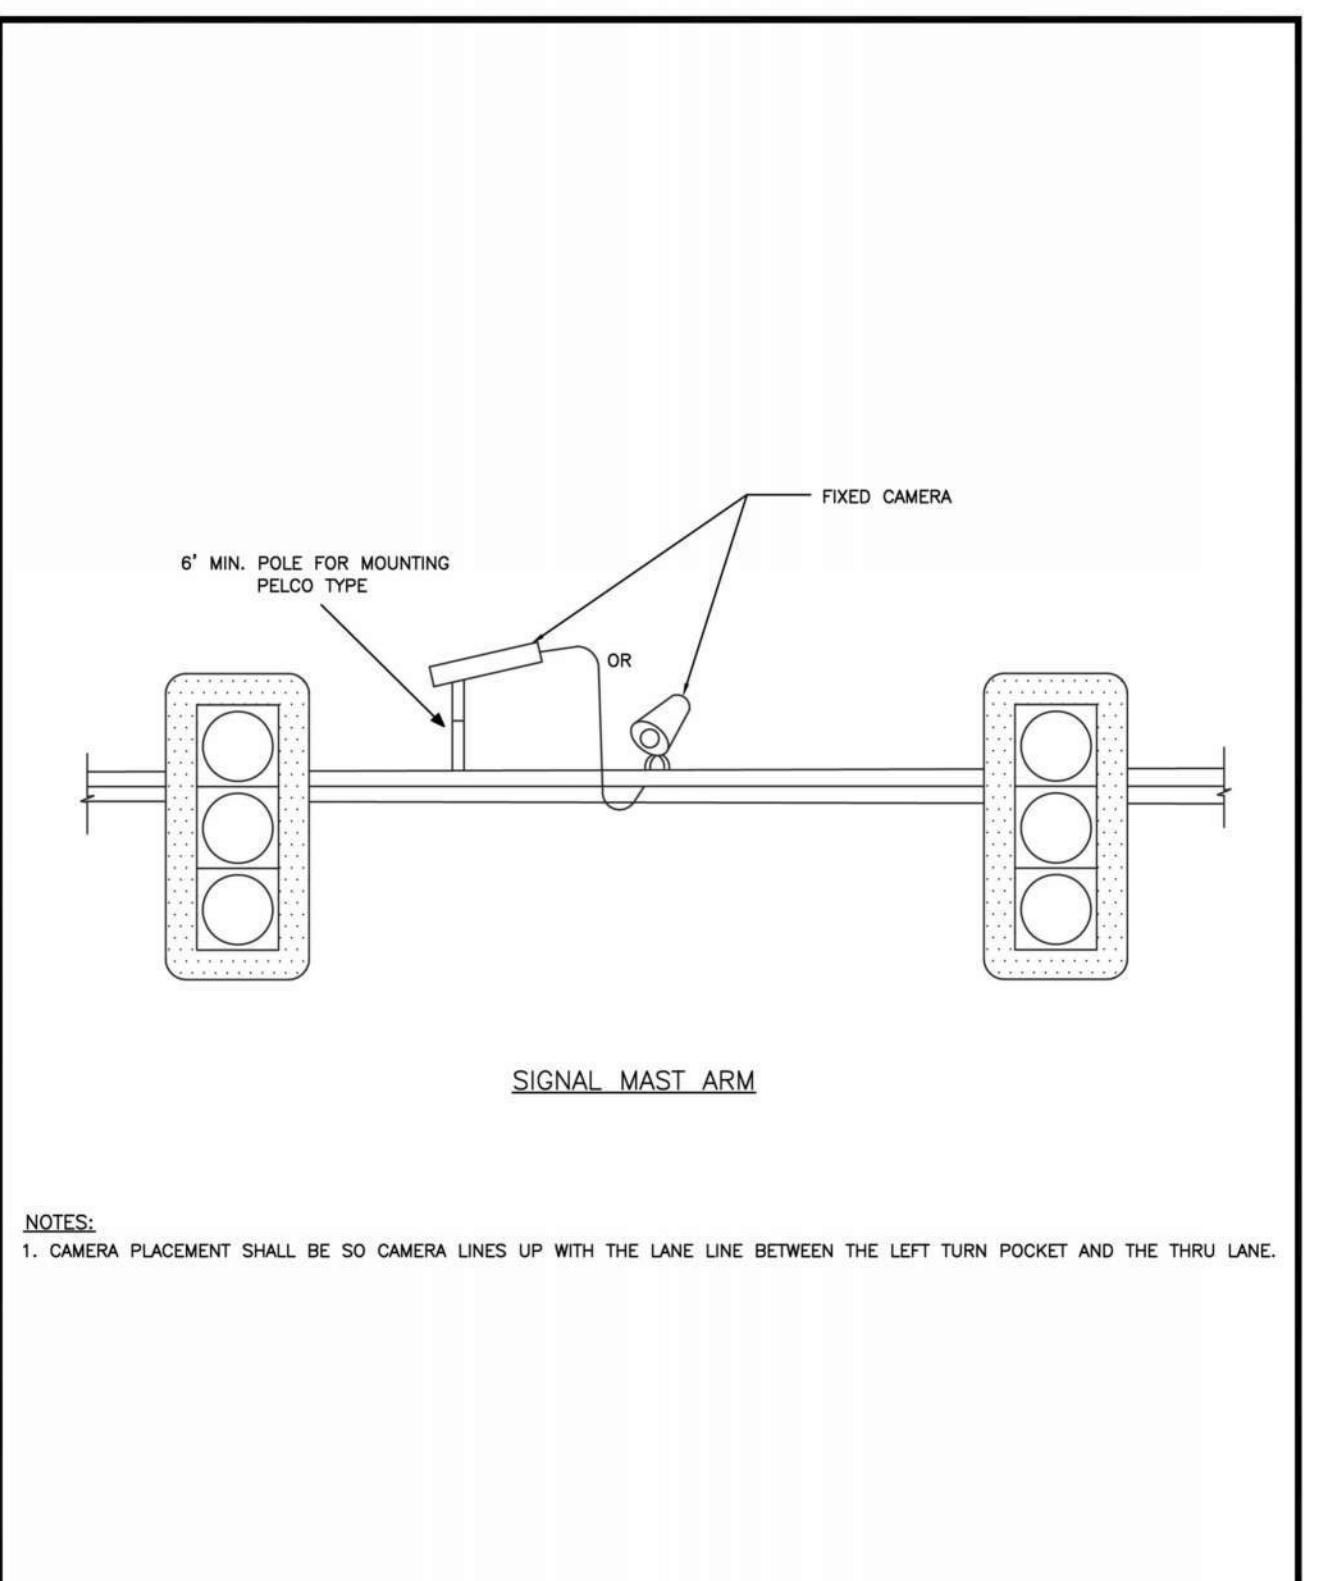


CITY OF PUYALLUP VIDEO CAMERA DETECTION. Includes approval stamps, dated 01.06.07.

APPROVED BY: CITY OF PUYALLUP ENGINEERING SERVICES. DATE: [blank]. NOTE: THIS APPROVAL IS VOID AFTER 1 YEAR FROM APPROVAL DATE.

Revision table with columns: No., Date, By, Revision Description.

Design and Issue information table with columns: Designed By, Issue Date, Drawn By, Project No., Checked By.

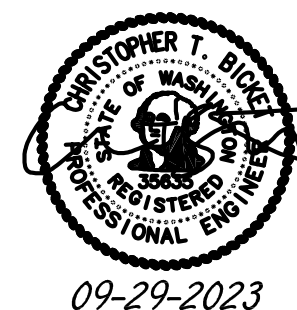

TENW Transportation Engineering NorthWest logo and contact information including address and phone number.

ASH DEVELOPMENT, LLC EAST TOWN CROSSING PUYALLUP, WA project title block.

TRAFFIC SIGNAL STANDARD DETAILS - PHASE 1 SHEET OF project title block.

GENERAL:

THE INTENT OF THE FOLLOWING SPECIFICATION IS TO PROVIDE A COMPLETE, READY TO INSTALL, 2-WAY PAGING CONTROL, SOLAR POWERED SCHOOL ZONE FLASHING BEACON SYSTEM.

DESCRIPTION:

THE PURPOSE OF THIS SPECIFICATION IS TO DESCRIBE THE MINIMUM ACCEPTABLE DESIGN FOR A 2-WAY PAGING SOLAR POWERED, DUAL BEACON SCHOOL ZONE FLASHING BEACON SYSTEM. THE SYSTEM WILL BE DESIGNED TO OPERATE FOR A PERIOD OF 4 HOURS PER DAY, 5 DAYS PER WEEK. THE SYSTEM SHALL BE DESIGNED TO OPERATE WITH A PROBABILITY OF NO LOSS OF LOAD DURING ALL MONTHS OF THE YEAR.

1. CABINET

THE CABINET SHALL BE MANUFACTURED OF 0.125" SHEET ALUMINUM. NOMINAL CABINET DIMENSIONS SHALL BE 28.25" H x 15.5" W x 14.75" D. THE CABINET SHALL BE A TWO (2) COMPARTMENT TYPE, THE BOTTOM COMPARTMENT SHALL HAVE A NEOPRENE GASKET SEAL SO AS TO PREVENT BATTERY GASES FROM SEEPING INTO THE TOP COMPARTMENT. THE CABINET SHALL HAVE WIRE SCREENED INSECT PROOF LOUVERS ON EACH SIDE OF BOTH COMPARTMENTS FOR VENTILATION. THE LOUVERS SHALL BE DESIGNED TO NOT ALLOW ANY RAIN TO ENTER THE CABINET. ON THE BOTTOM OF THE CABINET THERE SHALL BE TWO SCREENED INSECT PROOF DRAIN HOLES.

THE DOOR SHALL BE A SINGLE UNIT WITH A CONTINUOUS PIANO HINGE RIVETED TO THE DOOR AND THE CABINET. THE DOOR SHALL INCORPORATE A NEOPRENE GASKET WHICH, WHEN CLOSED, FORMS A SNUG WEATHER TIGHT SEAL. THE DOOR LOCK SHALL BE A STANDARD POLICE LOCK, REINFORCED WITH A STEEL PLATE.

EACH CABINET SHALL BE EQUIPPED WITH THE NECESSARY RIGID TOP AND BOTTOM MOUNT FOR A 4" ID POLE WITH 4.5" OD POLE CLAMPS. ALL NECESSARY HARDWARE FOR PROPER MOUNTING SHALL BE INCLUDED.

2. CONTROL PANEL


THE CONTROL PANEL CONTAINING THE ELECTRONICS (SOLAR CHARGE CONTROLLER AND FLASHER) AND 2-WAY PAGING TIME CLOCK SHALL BE MOUNTED IN THE TOP COMPARTMENT OF THE CABINET USING BOLTS WITH WING NUTS FOR QUICK AND EASY REMOVAL. THE SOLAR PANEL BEACON AND BATTERY SHALL BE CONNECTED THROUGH A MAIN WIRING HARNESS VIA A CIRCULAR PIN CONNECTOR (CPC).

THE SOLAR PANELS, LOAD, AND BATTERY SHALL BE FUSED FOR SHORT CIRCUIT PROTECTION AND EASE OF SYSTEM MAINTENANCE.

SOLAR CHARGE CONTROLLER

THE SOLAR CHARGE CONTROLLER SHALL CONTROL BATTERY CHARGING THROUGH PULSE WIDTH, MODULATED, TEMPERATURE COMPENSATING, CONSTANT CHARGING ALGORITHM. THE SOLAR CHARGE CONTROLLER WILL HAVE BOTH A LOW VOLTAGE DISCONNECT (LVD) OF 11.4 VDC AND A HIGH VOLTAGE DISCONNECT (HVD) OF 15.5 VDC. A LIQUID CRYSTAL DISPLAY (LCD) OF BATTERY VOLTAGE, SOLAR ARRAY CURRENT, AND LOAD CURRENT WILL BE AVAILABLE WITH THE SOLAR CHARGE CONTROLLER. IN ADDITION, COLORED LED'S WILL DISPLAY BATTERY STATE. A GREEN LED WILL INDICATE FULL CHARGE, AMBER LED WILL INDICATE HALF CHARGE, AND A FLASHING RED LED WILL INDICATE LOW CHARGE. A SOLID GLOWING RED LED WILL INDICATE THE LOAD HAS BEEN DISCONNECTED. A SEPARATE GREEN LED WILL INDICATE THE BATTERY IS BEING CHARGED.

THE SOLAR CHARGE CONTROLLER WILL HAVE A LOAD DISCONNECT PUSHBUTTON. WHEN THE LOAD IS DISCONNECTED THE BUTTON WILL GLOW RED.

 <p>CITY OF PUYALLUP DEVELOPMENT ENGINEERING and PUBLIC WORKS DEPARTMENTS</p>	<p>SOLAR POWERED SCHOOL ZONE FLASHING BEACON SYSTEM NOTES</p>				
	DESIGNED BY JIM PERIN-SYRVEDA	CHECKED BY LINDA LIAN	APPROVED BY COLLEEN HARKES	REVISED BY XXXX	CITY STANDARD
	FILE NAME P:\2023\COMMON\STANDARD\SYSTEM\2023\01\07.03	DATE APPROVED 09/01/2023	DATE REVISION XXXXXX	SCALE 1:1	01.07.03

THE SOLAR CHARGE CONTROLLER WILL BE CAPABLE OF OPERATING IN A TEMPERATURE RANGE OF -40 DEGREES C AND +85 DEGREES C.

FLASHER

THE FLASHER SHALL BE SOLID STATE, 2 CIRCUIT DEVICE WHICH CONTROLS THE FLASHING SEQUENCE OF THE BEACON. THE FLASHER WILL HAVE A SELECTABLE FLASH RATE OF 35-70 FLASHES PER MINUTE AND WILL FLASH A DUTY CYCLE OF 50% ON AND 50% OFF.

THE FLASHER WILL BE CAPABLE OF OPERATING IN A TEMPERATURE RANGE OF -40 DEGREES C AND +85 DEGREES C.

3. 2-WAY PAGING TIME CLOCK

THE 2-WAY PAGING TIME CLOCK WILL CONTAIN BOTH THE CAPABILITY OF RECEIVING PAGES FROM A CENTRAL LOCATION AND RESPONDING VIA EMAIL TO A DESIGNATED ADDRESS. THE 2-WAY PAGING TIME CLOCK WILL BE ABLE TO RECEIVE AND STORE AN ANNUAL PROGRAM OF UP TO 960 CHARACTERS INCLUDING STEPS AND EXCEPTIONS, AN ALTERNATE PROGRAM, AND AN IMMEDIATE PROGRAM. THE 2-WAY PAGING TIME CLOCK WILL SELECT THE APPROPRIATE PROGRAM AND/OR EXCEPTION FOR TODAY AND WILL RUN THAT PROGRAM. THE 2-WAY PAGING TIME CLOCK WILL ALSO HAVE THE CAPABILITY OF BEING PROGRAMMED VIA A KEY PAD ON THE TIME CLOCK.

THE 2-WAY PAGING TIME CLOCK WILL CONTAIN WATCH DOG CIRCUITS TO ENSURE THAT THE CLOCK RESETS ITSELF SHOULD IT FAULT FOR A PERIOD GREATER THAN SPECIFIED. THE CLOCK WILL CONTAIN 2 OUTPUT CIRCUITS, EACH CIRCUIT RATED AT 16 AMPS. THE CLOCK WILL BE CAPABLE OF BEING POWERED BY EITHER DC OR AC POWER. THE CLOCK WILL CONTAIN NON-VOLATILE MEMORY SO THAT A POWER FAILURE WILL NOT ERASE THE PROGRAM. THE CLOCK WILL HAVE CAPACITIVE BACKUP POWER RATED AT 168 HOURS IN THE EVENT OF POWER FAILURE. THE CLOCK WILL BE CAPABLE OF LEAP YEAR COMPENSATION AND WILL AUTOMATICALLY COMPENSATE FOR DAYLIGHT SAVINGS TIME.

SYSTEM SOFTWARE WILL BE PROVIDED FOR OPERATION OF THE SYSTEM. FUNCTIONS AND FEATURES OF THE SOFTWARE ARE DESCRIBED IN SECTION 3.1.

THE 2-WAY PAGING TIME CLOCK WILL BE CAPABLE OF OPERATING IN A TEMPERATURE RANGE OF -40 DEGREES C AND +85 DEGREES C


3.1 2-WAY PAGING SYSTEM SOFTWARE

THE 2-WAY PAGING SYSTEM SOFTWARE WILL RUN ON A STANDARD PC USING A WINDOWS 2000, XP, OR VISTA OPERATING SYSTEM.

THE SOFTWARE WILL HAVE THE CAPABILITY TO ASSIGN 99 GROUPS WITH 99 UNITS PER GROUP. THE SOFTWARE WILL ALLOW THE USER TO CREATE AN ANNUAL PROGRAM WITH EXCEPTIONS FOR EACH GROUP AND WILL ALLOW THE USER TO COPY PROGRAMS FROM ONE GROUP TO ANOTHER GROUP. THE SOFTWARE WILL ALLOW THE USER TO CREATE AN ALTERNATE PROGRAM WHICH OVERRIDES THE ANNUAL PROGRAM FOR A SPECIFIED PERIOD. THE SOFTWARE WILL ALLOW THE USER TO CREATE AN IMMEDIATE EXECUTABLE PROGRAM WHICH OPERATES ONLY ON THE DATE OF THE PROGRAM. THE SOFTWARE WILL ALSO ALLOW THE USER TO CONTROL THE CLOCK MANUALLY.

THE SOFTWARE WILL ALLOW THE USER TO PRINT A HARDCOPY LISTING OF ALL SCHOOL PROGRAMS. IT WILL ALLOW THE USER TO PRINT A LISTING OR ALL REMOTE SITES. IT WILL MAINTAIN A HISTORY OF THE LAST 500 PAGE MESSAGES SENT TO REMOTE UNITS.

THE SOFTWARE WILL ALLOW THE USER TO ADDRESS AND SEND A PAGE MESSAGE TO ALL UNITS WITH ONE COMMAND, ANY GROUP OF UNITS WITH ONE COMMAND, OR A SINGLE UNIT WITH ONE COMMAND.

 <p>CITY OF PUYALLUP DEVELOPMENT ENGINEERING and PUBLIC WORKS DEPARTMENTS</p>	<p>SOLAR POWERED SCHOOL ZONE FLASHING BEACON SYSTEM NOTES</p>				
	DESIGNED BY JIM PERIN-SYRVEDA	CHECKED BY LINDA LIAN	APPROVED BY COLLEEN HARKES	REVISED BY XXXX	CITY STANDARD
	FILE NAME P:\2023\COMMON\STANDARD\SYSTEM\2023\01\07.04	DATE APPROVED 09/01/2023	DATE REVISION XXXXXX	SCALE 1:1	01.07.04

THE SOFTWARE WILL ALLOW THE USER TO CHANGE THE EMAIL ADDRESS TO WHICH THE UNIT RESPONDS, TO SEND AN ANNUAL PROGRAM WITH EXCEPTIONS, TO SEND AN ALTERNATE PROGRAM, TO SEND AN IMMEDIATE PROGRAM, TO TURN ON OR TURN OFF THE RELAYS MANUALLY, TO SEND A TIME UPDATE, OR TO QUERY THE UNITS REGARDING STATUS (DATE, TIME, UNIT IDENTIFICATION, PROGRAM RUNNING, AND RELAY STATE).

4. SOLAR PANEL

THE SOLAR PANEL WILL BE HIGH EFFICIENCY, SINGLE CRYSTAL SILICON SOLAR CELLS THAT ARE LAMINATED TO GLASS WITH LAYERS OF ETHYLENE VINYL ACETATE (EVA). THE PANEL WILL BE SELF-CLEANING, IMPACT RESISTANT, HIGHLY TRANSMISSIVE, TEMPERED GLASS SUPERSTATE. THE PANEL MODULE FRAME WILL BE MADE OF EXTRUDED, POLYMER COATED ALUMINUM ALLOY OR SIMILAR APPROVED CONSTRUCTION. THE PANEL MODULE JUNCTION BOX WILL BE A UV RESISTANT, WEATHERPROOF WIRE TERMINATION SYSTEM WHICH HANDLES #14 AWG WIRING. THE MINIMUM ACCEPTABLE WATTAGE OF THE SOLAR PANEL WILL BE 85 WATTS.

5. BATTERIES

THE BATTERIES WILL BE A TYPE 27 ABSORBED GLASS MAT (AGM) LEAD ACID TYPE 12 VOLT DC BATTERY. THE BATTERIES WILL CONTAIN VALVE REGULATION WITH A SELF DISCHARGE RATE OF 1% PER MONTH OR LESS (AT 68 DEGREES F). THE BATTERIES WILL UTILIZE T8B1 TERMINALS. THE POSITIVE TERMINAL WILL BE COVERED WITH A RUBBER BOOT TO PROTECT THE BATTERIES FROM ACCIDENTAL SHORTING.

6. SIGNAL BEACON

THE SIGNAL BEACONS WILL CONSIST OF THE HEAD, AMBER LENS, VISOR, SIGNAL CLOSURE CAP, AND MOUNTING HARDWARE FOR A 4.5" OD ALUMINUM POLE. THE LENS WILL BE A 12VDC 12" AMBER LED BEACON USING ALL-LED TECHNOLOGY. THE HEAD WILL BE A ONE PIECE POLYCARBONATE SHELL WITH THE POLYCARBONATE DOOR USING STAINLESS STEEL HINGE PINS. THUMBSCREWS WILL HOLD THE DOOR AGAINST THE BODY. THE VISOR SHALL BE A ONE PIECE POLYCARBONATE TUNNEL UNIT WHICH SHALL BE DURALOCKED AT FOUR POINTS TO THE HEAD DOOR.


THE SIGNAL BEACON WILL BE ASSEMBLED AND WIRED AS A UNIT.

7. POLE AND BASE

THE POLE WILL BE A SCHEDULE 80 SPUN ALUMINUM 4" ID (4.5" OD) x 16' H. THE BASE WILL BE A BREAKAWAY BASE SIMILAR TO FELCO PART NUMBER PB-5340. A SET OF 4 ANCHOR BOLTS WILL BE PROVIDED. THE ANCHOR BOLTS WILL BE 3/4" x 10" AND WILL BE SIMILAR TO FELCO PART NUMBER PB-5306. A POLE COLLAR ASSEMBLY AND A POLE CAP WILL ALSO BE PROVIDED.

8. WARRANTY

A MINIMUM OF ONE YEAR WARRANTY FROM THE DATE OF SYSTEM INSTALLATION WILL BE REQUIRED FOR ALL SYSTEM COMPONENTS. THE BATTERY WILL BE PRO-RATED WARRANTED FOR 5 YEARS. THE SOLAR PANEL WILL BE WARRANTED FOR 20 YEARS. ALL SHIPPING COSTS FOR WARRANTY REPAIRS WILL BE PAID BY THE VENDOR.

 <p>CITY OF PUYALLUP DEVELOPMENT ENGINEERING and PUBLIC WORKS DEPARTMENTS</p>	<p>SOLAR POWERED SCHOOL ZONE FLASHING BEACON SYSTEM NOTES</p>				
	DESIGNED BY JIM PERIN-SYRVEDA	CHECKED BY LINDA LIAN	APPROVED BY COLLEEN HARKES	REVISED BY XXXX	CITY STANDARD
	FILE NAME P:\2023\COMMON\STANDARD\SYSTEM\2023\01\07.05	DATE APPROVED 09/01/2023	DATE REVISION XXXXXX	SCALE 1:1	01.07.05

APPROVED

BY: _____
CITY OF PUYALLUP
ENGINEERING SERVICES

DATE: _____

NOTE: THIS APPROVAL IS VOID AFTER 1 YEAR FROM APPROVAL DATE.

THE CITY WILL NOT BE RESPONSIBLE FOR ERRORS AND/OR OMISSIONS ON THESE PLANS. FIELD CONDITIONS MAY DICTATE CHANGES TO THESE PLANS AS DETERMINED BY THE ENGINEERING SERVICES MANAGER.

No.	Date	By	Revision Description

Designed By:	Issue Date:
LAB	09/29/2023
Drawn By:	PERMIT
LAB	
Checked By:	Project No.:
GRL	2022-295



TENW
Transportation Engineering NorthWest

Transportation Planning | Design | Traffic Impact & Operations
11400 SE 8th Street, Suite 200, Bellevue, WA 98004 | Office (425) 889-6747
Project Contact: Trevor Tokara, P.E.
Phone: 206-914-3843

ASH DEVELOPMENT, LLC
EAST TOWN CROSSING
PUYALLUP, WA

*FLASHING BEACON STANDARD
DETAILS - PHASE 1*

TS-06

SHEET:
OF