


WEST ELEVATION
SCALE: 1/32" = 1'-0"

PRSG20241236

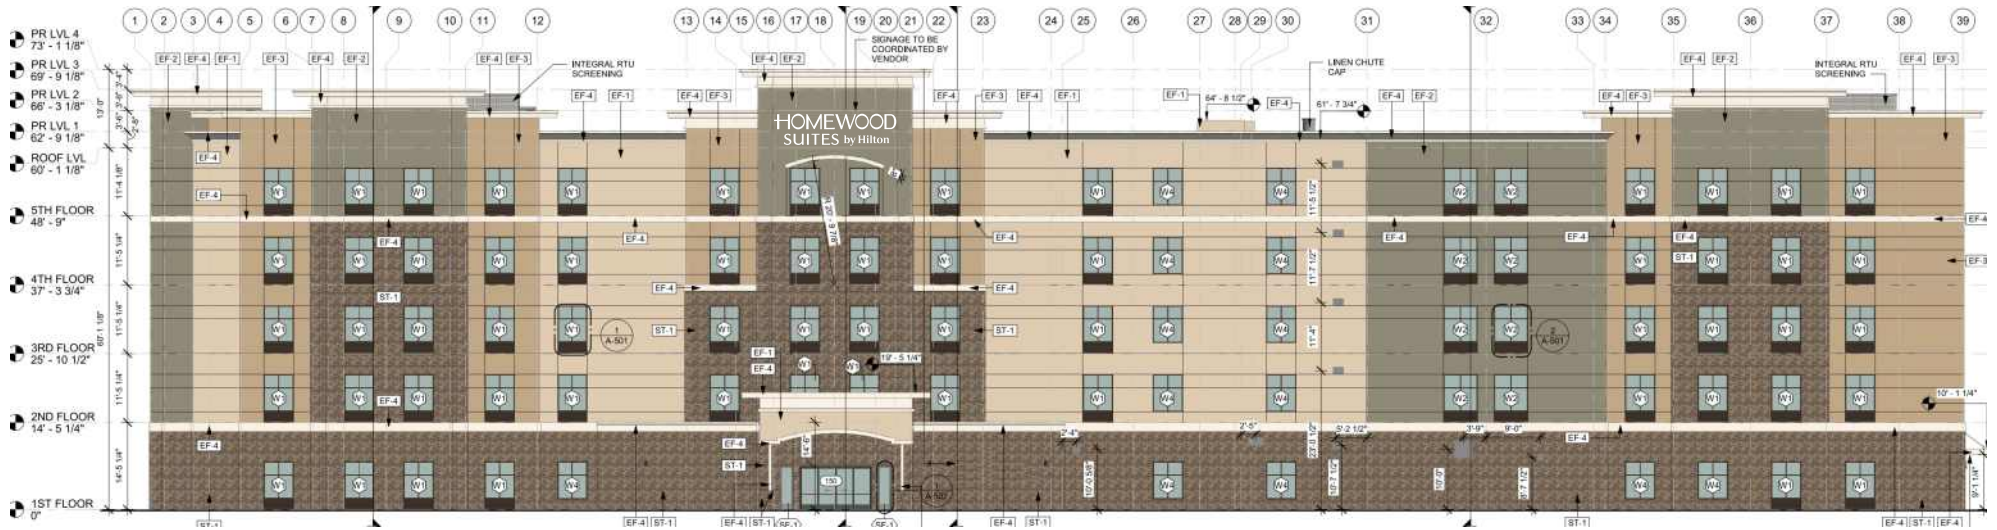

Provide the following information:

- How the signs will be affixed to the building
- Any information on the sign to include is there electrical that is penetrating the wall
- Is there a fire resistant backer
- What material is the sign made of so an approximate weight can be determined.

(Page 1, Sign Plan)



BOXED SIGN AREA:
108.35 SQ FT

CHANNEL LETTER DETAIL
SCALE: 3/16" = 1'-0"



Side Profile - NTS

City of Puyallup Development & Permitting Services ISSUED PERMIT	
Building	Planning
Engineering	Public Works
Fire	Traffic



APPROVAL BOX - PLEASE INITIAL

CUSTOMER APPROVAL	Date
-------------------	------

Customer: HOMEWOOD SUITES	Date: 06/26/24	Prepared By: CTM/AHD	Note: Color output may not be exact when viewing or printing this drawing. All colors used are PMS or the closest CMYK equivalent. If these colors are incorrect, please provide the correct PMS match and a revision to this drawing will be made.	Eng: -
Location: PUYALLUP, WA	File Name: 173100 - R3 - PUYALLUP, WA			

persona
SIGNS | LIGHTING | IMAGE

Persona Signs, LLC
700 21st Street Southwest
PO Box 210
Watertown, SD 57201-0210
1.800.843.9888 • www.personasigns.com

NORTH ELEVATION
SCALE: 1/32" = 1'-0"

PRSG20241236




BOXED SIGN AREA:
108.35 SQ FT

CHANNEL LETTER DETAIL
SCALE: 3/16" = 1'-0"



Side Profile - NTS

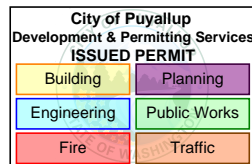

NIGHT VIEWS - NTS

HOMEWOOD
SUITES by Hilton

APPROVAL BOX - PLEASE INITIAL

CUSTOMER APPROVAL

Date

Customer:
HOMEWOOD SUITES

Date:
06/26/24

Prepared By:
JR/AHD

Note: Color output may not be exact when viewing or printing this drawing. All colors used are PMS or the closest CMYK equivalent. If these colors are incorrect, please provide the correct PMS match and a revision to this drawing will be made.

Location:
PUYALLUP, WA

File Name:
173100 - R3 - PUYALLUP, WA

Eng:
-

persona
SIGNS | LIGHTING | IMAGE

Persona Signs, LLC
700 21st Street Southwest
PO Box 210
Watertown, SD 57201-0210
1.800.843.9888 • www.personasigns.com

Provide information on how the sign is constructed to include:

- Is there a foundation
- How is the sign connected to the foundation?
- Is there frame work?
- Detail what materials are going to be used
- There is not information beyond height and width to review.

Page 3, Sign Plan)

PRSG20241236


City of Puyallup Development & Permitting Services			
ISSUED PERMIT			
Building	Planning	Engineering	Public Works
Fire	Traffic		

10"



Side Profile - NTS

BOXED SIGN AREA:
22.25 SQ FT

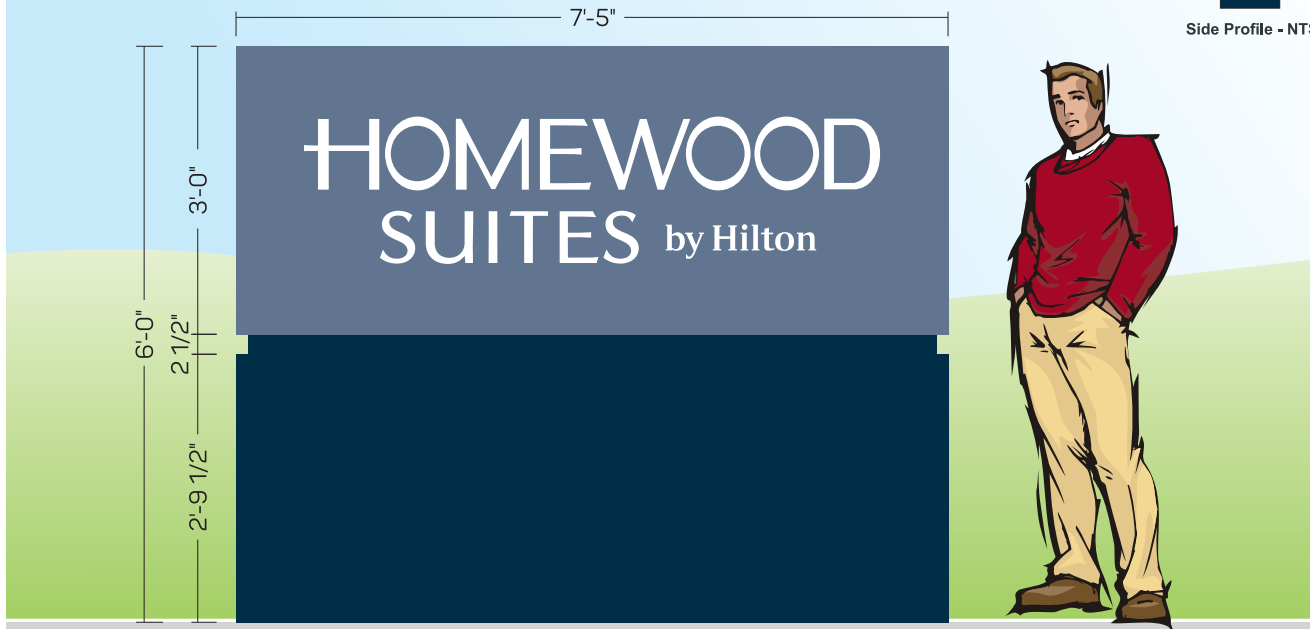


MONUMENT SIGN
SCALE: 1/2" = 1'-0"



NIGHT VIEW - NTS

APPROVAL BOX - PLEASE INITIAL		
CUSTOMER APPROVAL		Date

Customer: HOMEWOOD SUITES	Date: 06/26/24	Prepared By: CTM/AHD	<small>Note: Color output may not be exact when viewing or printing this drawing. All colors used are PMS or the closest CMYK equivalent. If these colors are incorrect, please provide the correct PMS match and a revision to this drawing will be made.</small>	 <p>Persona Signs, LLC 700 21st Street Southwest PO Box 210 Watertown, SD 57201-0210 1.800.843.9888 • www.personasigns.com</p>
Location: PUYALLUP, WA	File Name: 173100 - R3 - PUYALLUP, WA	Eng: -		