

Read Permit Conditions prior to calling for inspection. All sleeping units are required to report as Local only and not dispatch.



If hallways or corridors have drop tiles instead of hard lids, smoke detection is required above ceiling per Total Coverage NFPA 72 2019.

Emergency Radio points required to be monitored by FACP.

FIRE ALARM SYSTEM T.I.

HAMPTON INN & SUITES

1515 S. MERIDIAN, PUYALLUP, WA

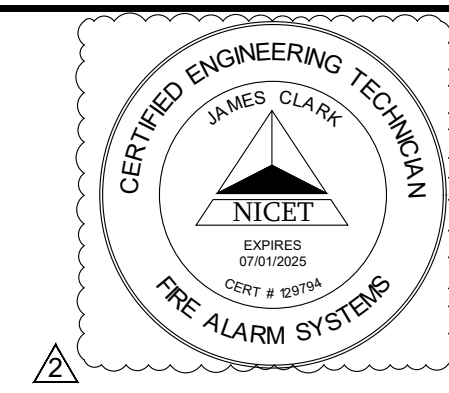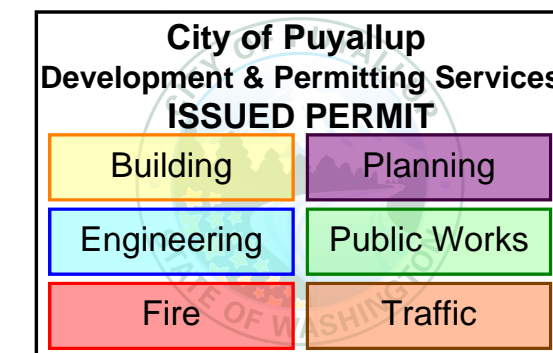

BRET A. FORSBERG
 SOUTH PRAIRIE, WA 98385
 UBI LICENSE # FORSEL776LK
 LICENSE EXPIRES: 03/11/2024

GENERAL NOTES

- ALL REQUIRED MATERIALS AND WORK SHALL COMPLY WITH ALL ADOPTED APPLICABLE CODES AND STANDARDS AS WELL AS WITH FEDERAL, STATE, LOCAL WIRING CODES AT THE TIME OF THE PERMIT SUBMITTAL, AND CUSTOMER CONTRACT SPECIFICATIONS.
- ALL SYSTEM-INSTALLED DEVICES SHALL NOT BE CONCEALED OR OBSTRUCTED IN ANY WAY AS TO IMPEDE THE PROPER FUNCTION OF THE DEVICE.
- INSTALLATION OF DEVICES SHALL BE IN ACCORDANCE WITH THE MANUFACTURER'S INSTRUCTIONS. POWER LIMITED AND NON-POWER LIMITED FIELD WIRING MUST BE INSTALLED WITHIN THE FACP ENCLOSURE IN ACCORDANCE WITH THE MANUFACTURER'S INSTRUCTIONS AND THE ELECTRICAL CODE.
- WRITTEN DIMENSIONS TAKE PRECEDENCE OVER SCALE ON THE DRAWINGS.
- INPUT POWER TO ALARM PANELS TO BE 120 VAC, ON A DEDICATED CIRCUIT THAT DOES NOT DE-ENERGIZE UPON SYSTEM ALARM OR EPO (EMERGENCY POWER OUT) ACTIVATION. THE ON-SITE ELECTRICAL CONTRACTOR PROVIDES WIRING AND TERMINATION OF THIS INPUT POWER. NO OTHER LOADS ARE PERMITTED ON THIS CIRCUIT.
- THE CIRCUIT DISCONNECTING MEANS SHALL HAVE A RED MARKING, SHALL BE ACCESSIBLE ONLY TO AUTHORIZED PERSONNEL, AND SHALL BE IDENTIFIED AS "FIRE ALARM CIRCUIT".
- ALL VAC (VOLT, ALTERNATING, CURRENT), WIRING IS TO BE KEPT SEPARATE FROM ALL 24 VDC (VOLT, DIRECT, CURRENT) WIRING.
- ALL VISUAL, AUDIBLE/VISUAL DEVICES ARE TO BE MOUNTED AT THE HEIGHT SPECIFIED IN THE PROJECT PLANS AND NOT CONCEALED OR OBSTRUCTED.
- ALL CABLING SHALL MEET THE REQUIREMENTS OF THE PANEL MANUFACTURER.
- ALL EQUIPMENT ELEVATIONS SHALL BE PER THE PROJECT PLANS AND DETAILS.
- ANY WIRING THAT IS REQUIRED FOR MONITORING OF THE ALARM PANEL SUCH AS LIFE SAFETY EQUIPMENT OR OFF-SITE MONITORING IS TO BE PROVIDED BY THE ON-SITE FIRE ALARM CONTRACTOR.
- CHECK FOR WIRE TO WIRE SHORTS AND SHORTS TO GROUND THROUGHOUT THE INSTALLATION. SHORTS AND GROUNDS ARE NOT ACCEPTABLE.
- ALL ALARM DEVICES AND PANEL WIRING SHALL BE LABELED ACCORDING TO THE PROJECT PLANS WITH AN APPROPRIATE MARKING SYSTEM. THE MARKING SHALL BE LEGIBLE AND NON REMOVABLE.
- ALL ALARM DEVICES TO BE LABELED AS SHOWN ON THE PROJECT DRAWINGS INCLUDING THE EOL IDENTIFICATION.
- FIRE ALARM BACKUP BATTERIES SHALL SUPPLY 24 HOURS OF STANDBY AND 5 MINUTES OF ALARM FOR NON-VOICE SYSTEMS.
- THE FIRE ALARM SYSTEM AUDIBLE SIGNAL SHALL BE THREE-PULSE TEMPORAL PATTERN. VOICE EVACUATION SHALL BE MORSE U PATTERN.
- UPON COMPLETION OF THE INSTALLATION OF THE FIRE ALARM SYSTEM, A SATISFACTORY TEST OF THE SYSTEM SHALL BE MADE IN THE PRESENCE OF THE AUTHORITY HAVING JURISDICTION.
- PRIOR TO REQUESTING FINAL APPROVAL OF THE INSTALLATION, THE INSTALLING CONTRACTOR SHALL FURNISH A WRITTEN STATEMENT TO THE AUTHORITY HAVING JURISDICTION TO THE EFFECT THAT THE SYSTEM HAS BEEN INSTALLED AND COMPLETELY TESTED.
- AS-BUILT DRAWINGS ACCURATELY REFLECTING THE SYSTEM INSTALLED IN ITS COMPLETED AND FINAL CONDITION ALONG WITH ANY APPROVALS OR TESTING RESULTS SHALL BE MAINTAINED ON SITE.


2021 Adopted codes

APPLICABLE CODES AND REGULATIONS

- 2018 INTERNATIONAL BUILDING CODE (IBC) W/ WAC 51-50
- 2018 INTERNATIONAL EXISTING BUILDING CODE W/ WAC 51-50-480000
- 2018 INTERNATIONAL MECHANICAL CODE W/ WAC 51-52
- 2018 INTERNATIONAL FIRE CODE W/ WAC 51-54A
- 2016 NATIONAL FIRE ALARM & SIGNALING CODE (NFPA-72)

2019

MOUNTING HEIGHTS

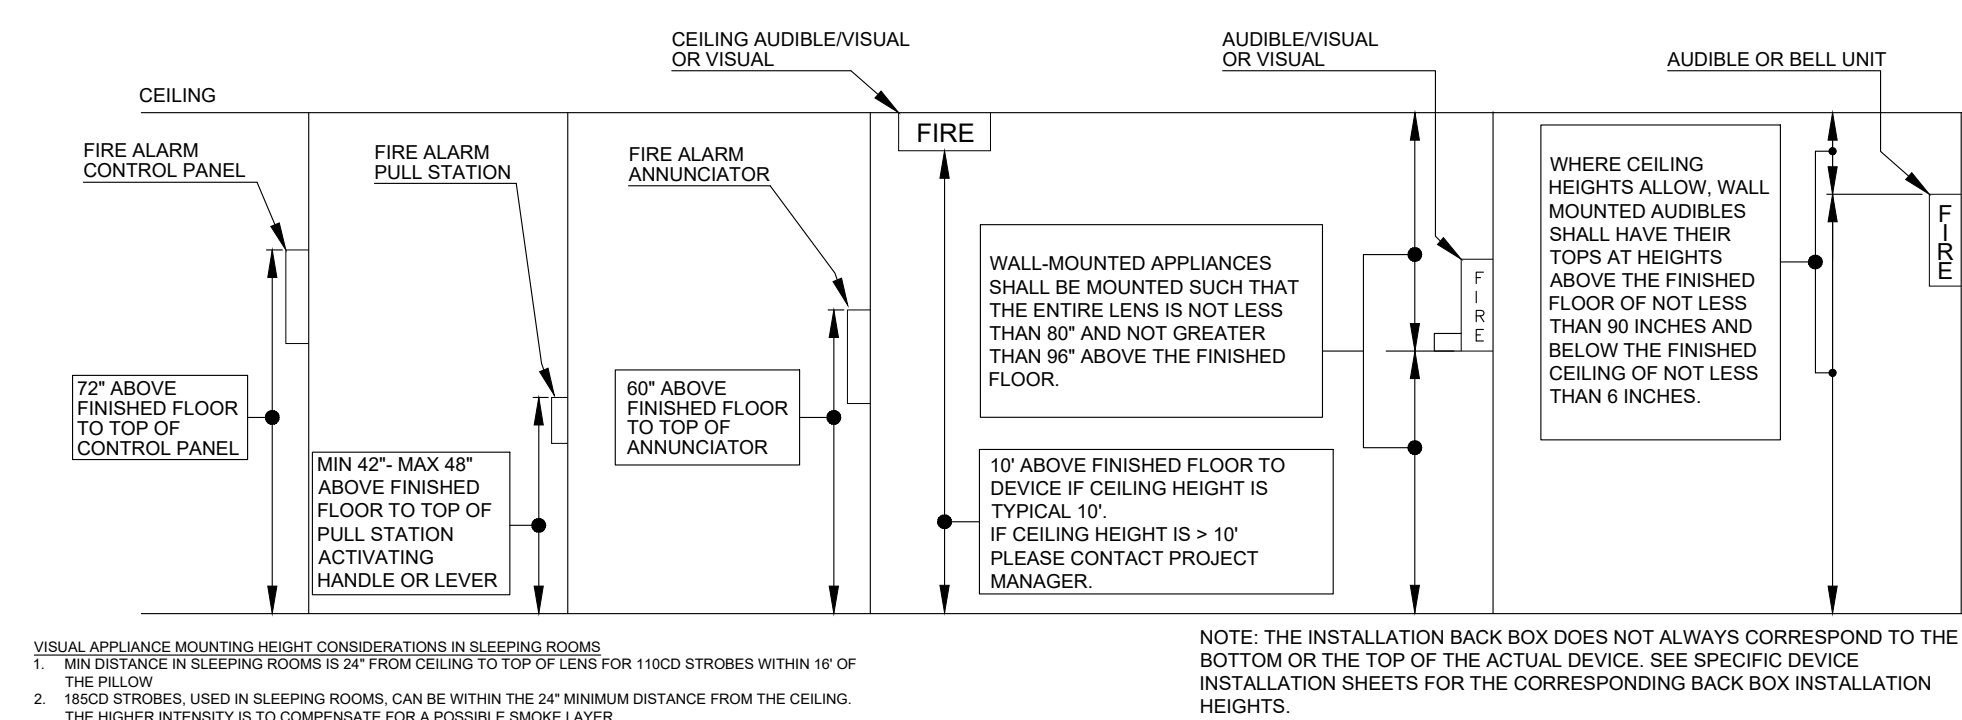

BILL OF MATERIAL

SYMBOL	NEW	EXISTING	MANUFACTURER	PART NO	DESCRIPTION
[FACP]		1	EDWARDS	3X-SFS1R0	FACP W/ CPU, 1 LOOP, 4 NACS, 10A POWER SUPPLY, RED
			EDWARDS	3-SFS1	ESTX3 ELECTRONICS CHASSIS
			EDWARDS	4X-LCD	ESTX3 USER INTERFACE CARD
			EDWARDS	PS10-4B	POWER SUPPLY
			EDWARDS	3X-NET	NETWORK OPTION CARD, RS485, CL A OR B, MAX 64 NODES
			EDWARDS	3-SDC1	SIGNATURE DEVICE CARD - UPGRADES A 3-SDDC2 TO A 3-SDDC2
			EDWARDS	SFS	SFS LED CONTROL/DISPLAY MODULE
			EDWARDS	SFS1-CPU	ESTX3 MAINBOARD
[NAC]	2		EDWARDS	BPS10A	REMOTE BOOSTER POWER SUPPLY, 10A, 120VAC, RED
			EDWARDS	SIGA-CC1	SIGNAL MODULE W/ 1 RISER IN, 1 OUTPUT OKT, CL 'B'
	3		EDWARDS	SIGA-CC1	SIGNAL MODULE W/ 1 RISER IN, 1 OUTPUT OKT, CL 'B'
[LFD]	30		EDWARDS	SIGA-PCD W/SIGA-AB4G-LF BASE	PHOTOELECTRIC SMOKE AND CARBON MONOXIDE LIFE SAFETY DETECTOR
	3		EDWARDS	SIGA-TCDR	TEMPORAL GENERATOR FOR SOUNDER BASES
[SD]	16		EDWARDS	SIGA-PD W/SIGA-SB4 BASE	PHOTOELECTRIC SMOKE DETECTOR
[RM]	3		EDWARDS	SIGA-RM1	RISER MONITOR MODULE, MONITORS ONE RISER
[LFD]	3		EDWARDS	GALFWF-HVM	LOW FREQUENCY (550HZ), WHITE, 15,30,75,110 CD, FIRE
[LFD]	27		EDWARDS	GALFWF-H	LOW FREQUENCY (550HZ) HORN, WHITE, FIRE
[X]	3		EDWARDS	G1F-VM	WALL STROBE, SWITCH SELECT 15, 30, 75, 110 CD, WHITE, W/ FIRE

WIRE LEGEND

TAG	CIRCUIT TYPE	WIRE TYPE	CLASS
A	SIGNAL LINE CIRCUIT (SLC)	2 #16 TWISTED / UNSHIELDED - FPL	CLASS B
N	NOTIFICATION APPLIANCE CIRCUIT (NAC)	2 #14 TWISTED / UNSHIELDED - FPL	CLASS B

SCOPE OF WORK

SCOPE:

INSTALLING COMPANY WILL PROVIDE:

ADDITION OF NEW DETECTION AND NOTIFICATION TO AN EXISTING SYSTEM IN THE GUEST ROOMS NEW WING OF THE EXISTING BUILDING.

ALL ADDRESSABLE DEVICES WILL BE CONNECTED TO FIRE ALARM CONTROL PANEL INTELLIGENT LOOP. ALL DEVICES ARE TO BE COMPATIBLE WITH THE HEAD-END EQUIPMENT AND OTHER DEVICES. ALL DEVICES WILL HAVE A TEXTUAL DISPLAY ON THE FIRE ALARM CONTROL PANEL DESCRIBING TYPE OF DEVICE AND LOCATION.

WIRING CLASS:
 SLC - CLASS B
 NAC - CLASS B


EXISTING SEQUENCE OF OPERATION

SYSTEM INPUTS	FACP ACTION				NOTIFICATION				EQUIPMENT CONTROLLED								
	ACTUATE ALARM SIGNAL INDICATOR (RED LED)	ACTUATE TROUBLE SIGNAL INDICATOR (AMBER LED)	ACTUATE SUPERVISORY SIGNAL INDICATOR (AMBER LED)	INDICATE INPUT SIGNAL ON LCD DISPLAY	TRANSMIT ALARM SIGNAL TO REMOTE ANNUNCIATOR	TRANSMIT TROUBLE SIGNAL TO REMOTE ANNUNCIATOR	TRANSMIT SUPERVISORY SIGNAL TO REMOTE ANNUNCIATOR	TRANSMIT ALARM SIGNAL TO MONITORING COMPANY	TRANSMIT TROUBLE SIGNAL TO MONITORING COMPANY	TRANSMIT SUPERVISORY SIGNAL TO MONITORING COMPANY	RECORD ALL SYSTEM EVENTS IN CPU MEMORY	DOOR HOLD OPENS RELEASE	ACTIVATE SOUNDER BASES IN ALL GUEST ROOMS	ELEVATOR RECALL TO DESIGNATED PRIMARY RECALL FLOOR	ELEVATOR RECALL TO DESIGNATED ALTERNATE RECALL FLOOR	ACTIVATE ELEVATOR SHUNT-TRIP	CLOSE DAMPERS THROUGHOUT BUILDING
MANUAL PULL STATION	•	•	•	•	•	•	•	•	•	•	•	•	•	•	•	•	•
AREA SMOKE DETECTOR	•	•	•	•	•	•	•	•	•	•	•	•	•	•	•	•	•
WATERFLOW SWITCH	•	•	•	•	•	•	•	•	•	•	•	•	•	•	•	•	•
VALVE TAMPER SWITCH	•	•	•	•	•	•	•	•	•	•	•	•	•	•	•	•	•
POST INDICATING VALVE	•	•	•	•	•	•	•	•	•	•	•	•	•	•	•	•	•
GUEST ROOM SMOKE DETECTOR	•	•	•	•	•	•	•	•	•	•	•	•	•	•	•	•	•
ADA/HEARING IMPAIRED SMOKE	•	•	•	•	•	•	•	•	•	•	•	•	•	•	•	•	•
ELEVATOR INTERFACE INPUTS:																	
LOBBY SMOKE DETECTOR @ 2ND & 3RD FLRS	•	•	•	•	•	•	•	•	•	•	•	•	•	•	•	•	•
LOBBY SMOKE DETECTOR @ 1ST FLR	•	•	•	•	•	•	•	•	•	•	•	•	•	•	•	•	•
MACHINE ROOM SMOKE DETECTOR	•	•	•	•	•	•	•	•	•	•	•	•	•	•	•	•	•
ELEVATOR SHAFT SMOKE DETECTOR	•	•	•	•	•	•	•	•	•	•	•	•	•	•	•	•	•
MACHINE ROOM HEAT DETECTOR	•	•	•	•	•	•	•	•	•	•	•	•	•	•	•	•	•
ELEVATOR SHAFT HEAT DETECTOR	•	•	•	•	•	•	•	•	•	•	•	•	•	•	•	•	•
INITIATING CIRCUIT CONDITIONS:																	
OPEN WIRE	•	•	•	•	•	•	•	•	•	•	•	•	•	•	•	•	•
GROUNDING WIRE	•	•	•	•	•	•	•	•	•	•	•	•	•	•	•	•	•
FA0.00	GENERAL INFORMATION
FA1.00	SECOND FLOOR FIRE ALARM ADDITION
FA1.01	THIRD FLOOR FIRE ALARM ADDITION
FA1.03	FOURTH FLOOR FIRE ALARM ADDITION
FA2.00	FIRE ALARM ADDITION RISER DIAGRAM
FA3.00	FIRE ALARM ADDITION CALCULATIONS
FA3.01	FIRE ALARM ADDITION CALCULATIONS

LOCATION MAP

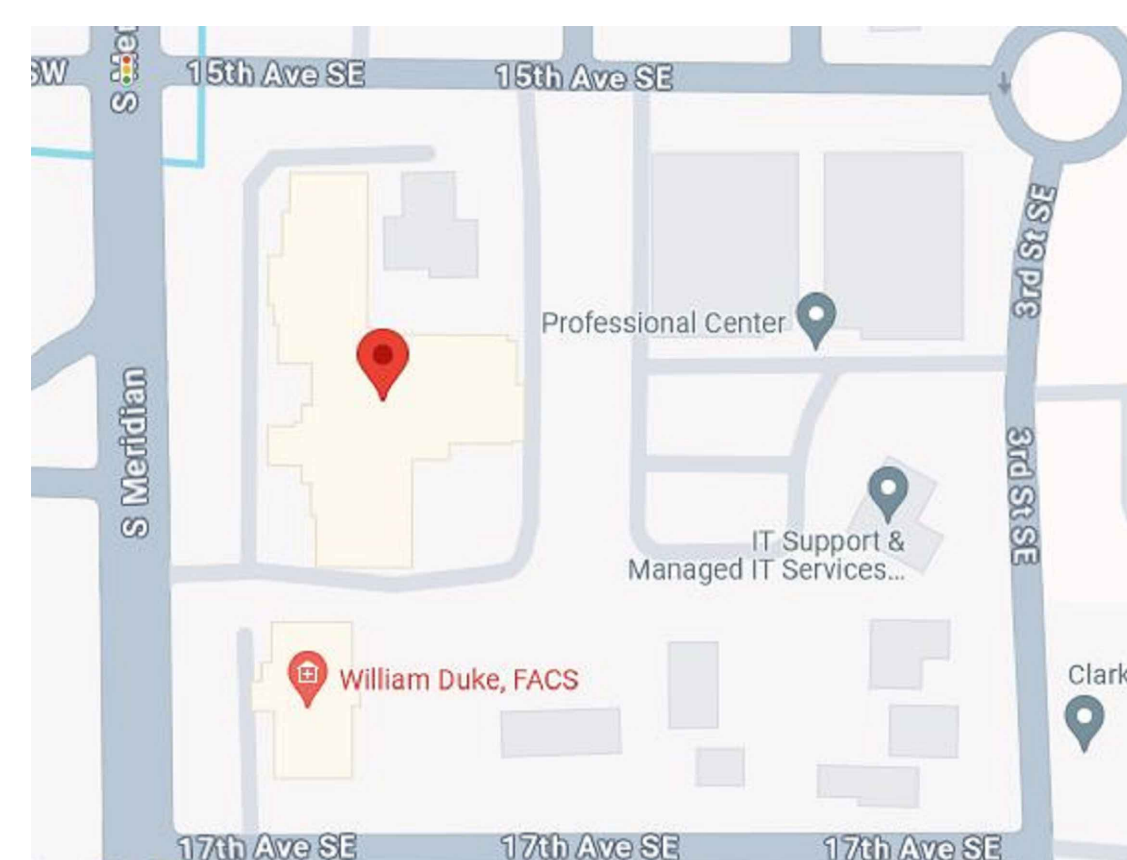

FIRE ALARM SYSTEM T.I.

GENERAL INFORMATION
 HAMPTON INN & SUITES
 1515 S. MERIDIAN
 PUYALLUP, WA


REVISION DESCRIPTION

REV. #	DATE	DESCRIPTION
1	2/1/2024	PLAN CHECK SET
2	9/4/2024	REVIEW CHANGES

DRAWN BY: JAMES CLARK DATE: 9/4/2024

SCALE: AS NOTED

SHEET #: FA0.00

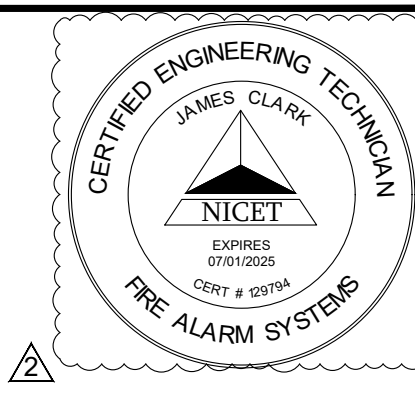


City of Puyallup
Development & Permitting Services
ISSUED PERMIT

Building	Planning
Engineering	Public Works
Fire	Traffic

BRET A. FORSBERG
SOUTH PRAIRIE, WA 98385
UBI LICENSE # FORSEL776LK
LICENSE EXPIRES: 03/11/2024

FIRE ALARM SYSTEM T.I.
SECOND FLOOR FIRE ALARM ADDITION
HAMPTON INN & SUITES
1515 S. MERIDIAN
PUYALLUP, WA

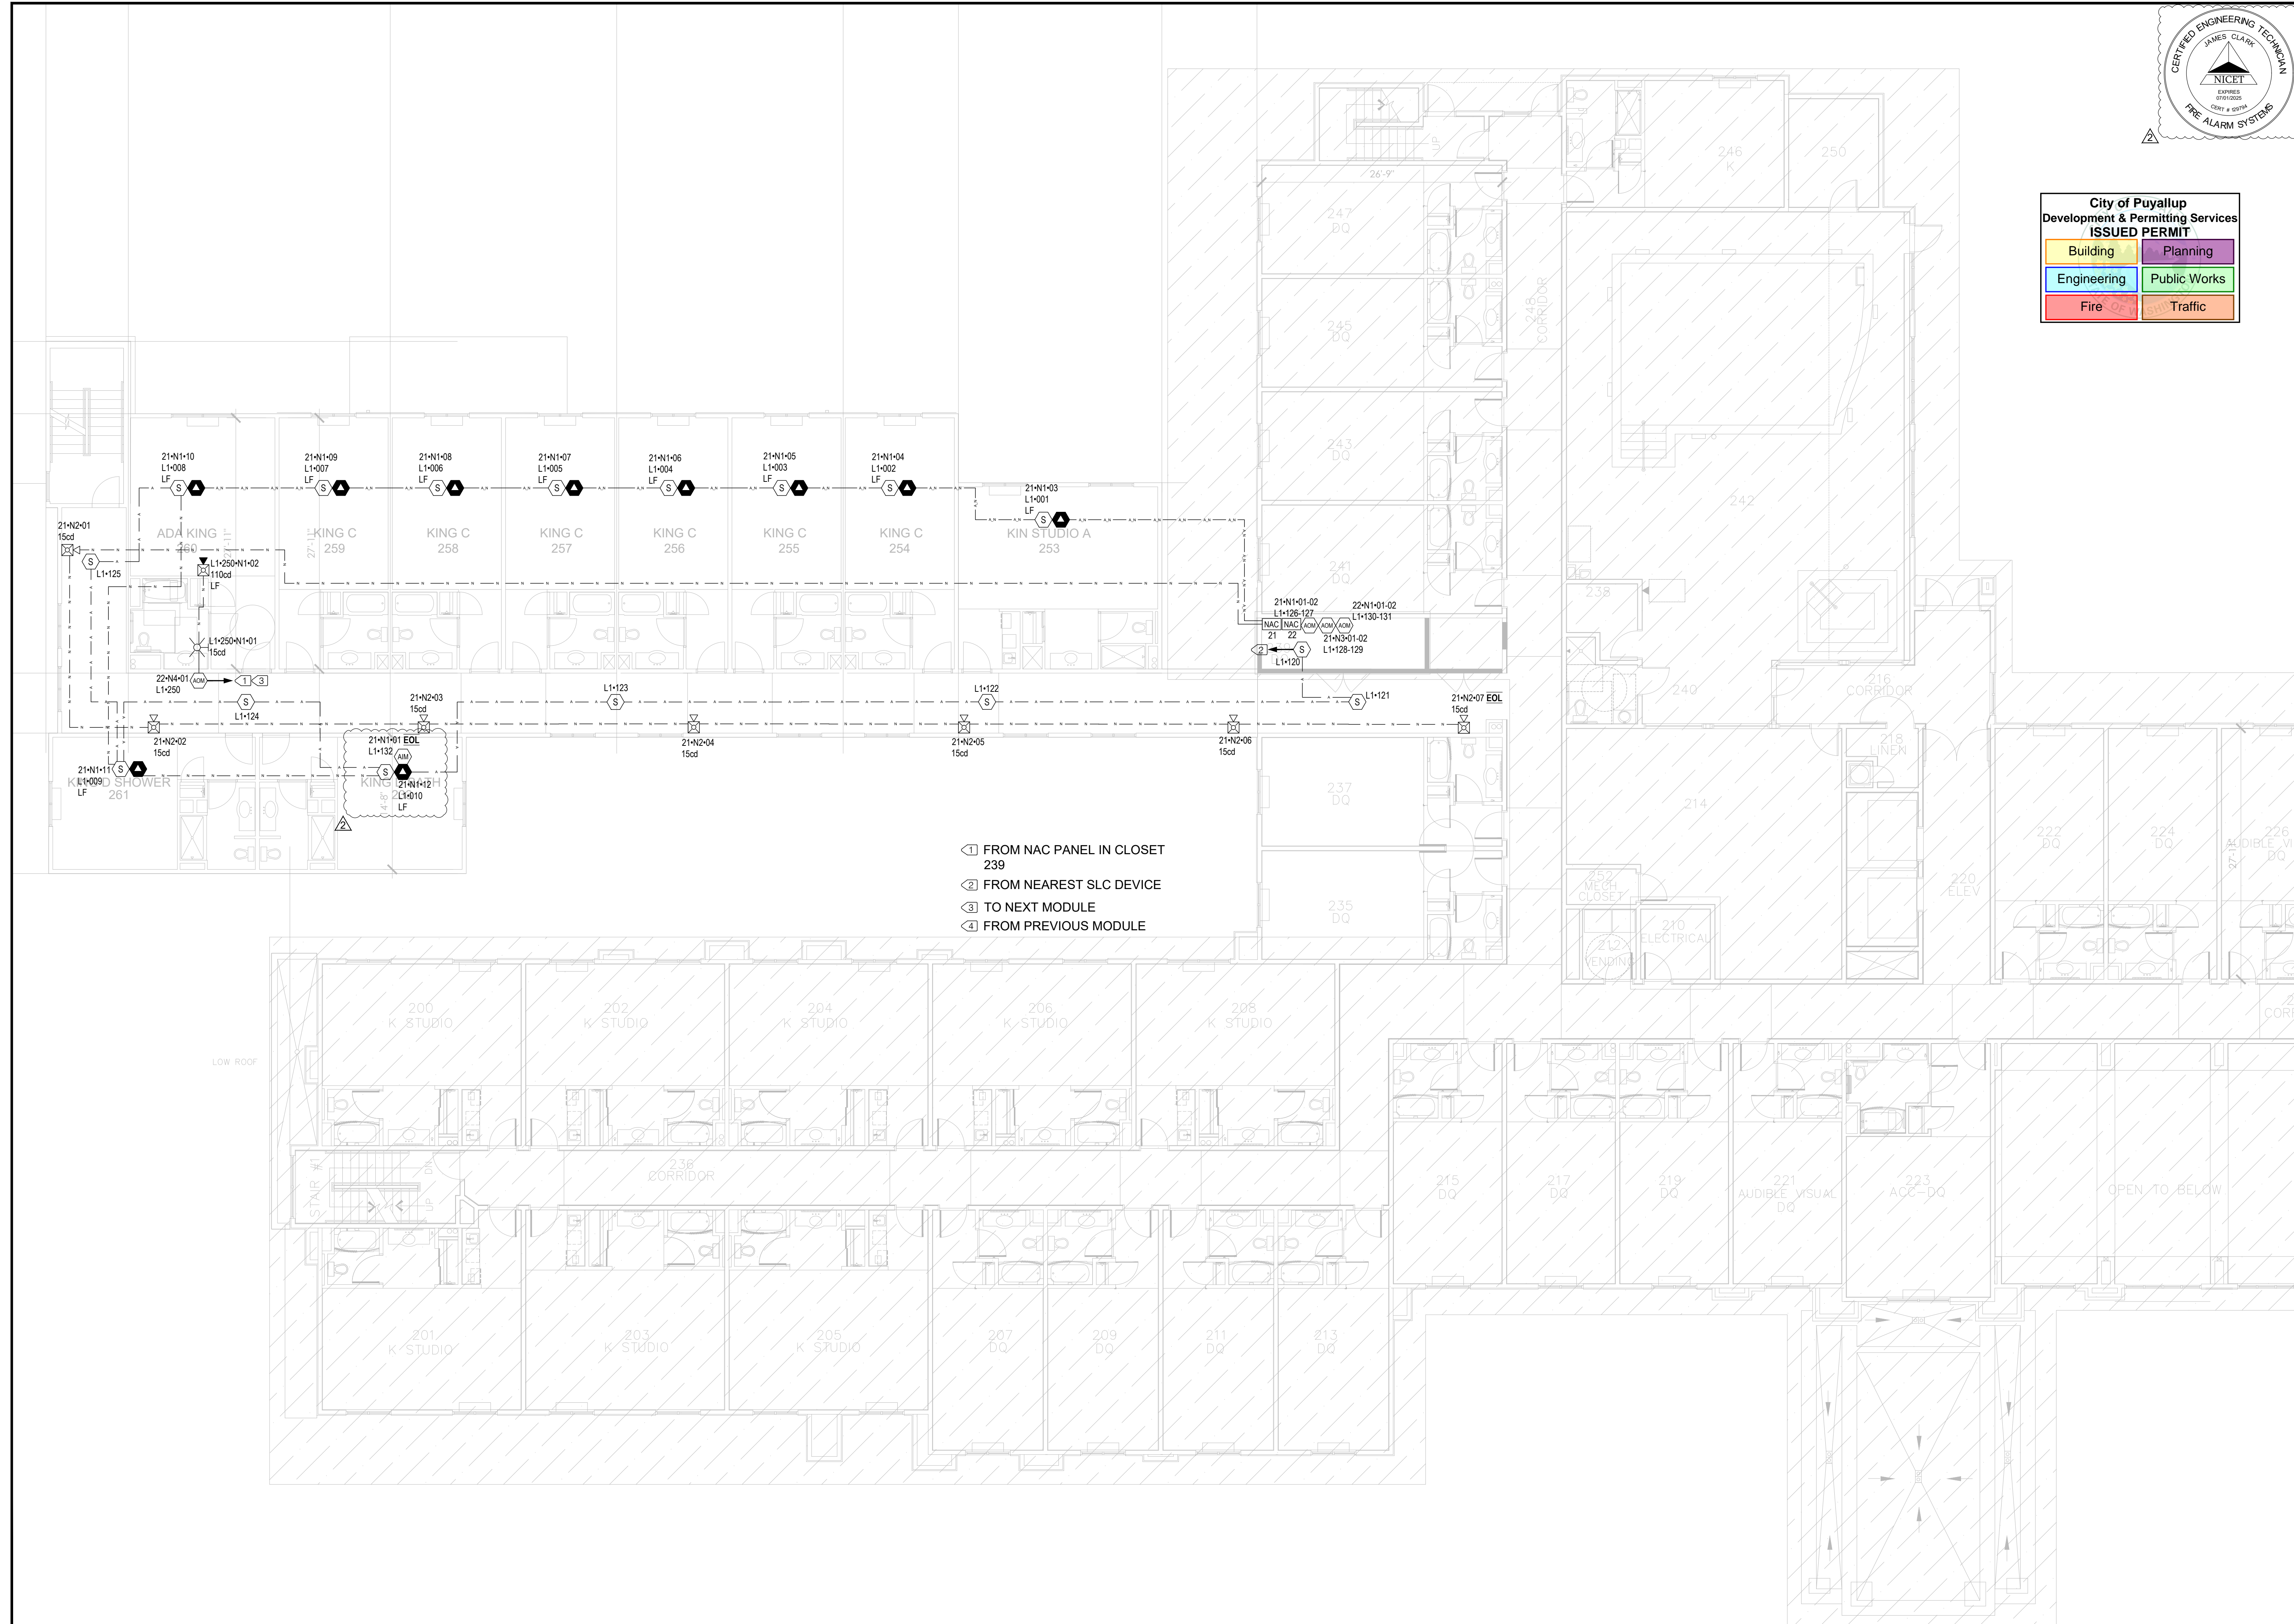


- ① FROM NAC PANEL IN CLOSET 239
- ② FROM NEAREST SLC DEVICE
- ③ TO NEXT MODULE
- ④ FROM PREVIOUS MODULE

REV. #	DATE	REVISION DESCRIPTION
1	2/11/2024	PLAN CHECK SET
2	9/4/2024	REVIEW CHANGES

DRAWN BY: JAMES CLARK DATE: 9/4/2024

SCALE: AS NOTED

SHEET #: FA1.00

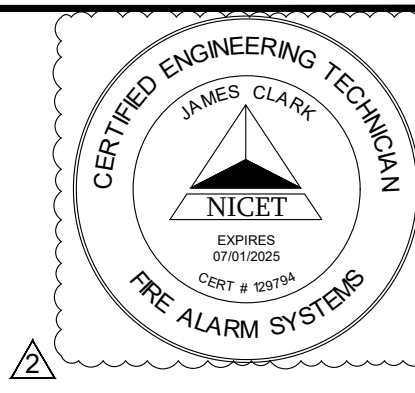


City of Puyallup
Development & Permitting Services
ISSUED PERMIT

Building	Planning
Engineering	Public Works
Fire	Traffic

BRET A. FORSBERG
SOUTH PRAIRIE, WA 98385
UBI LICENSE # FORSEL776LK
LICENSE EXPIRES: 03/11/2024

FIRE ALARM SYSTEM T.I.
THIRD FLOOR FIRE ALARM ADDITION
HAMPTON INN & SUITES
1515 S. MERIDIAN
PUYALLUP, WA

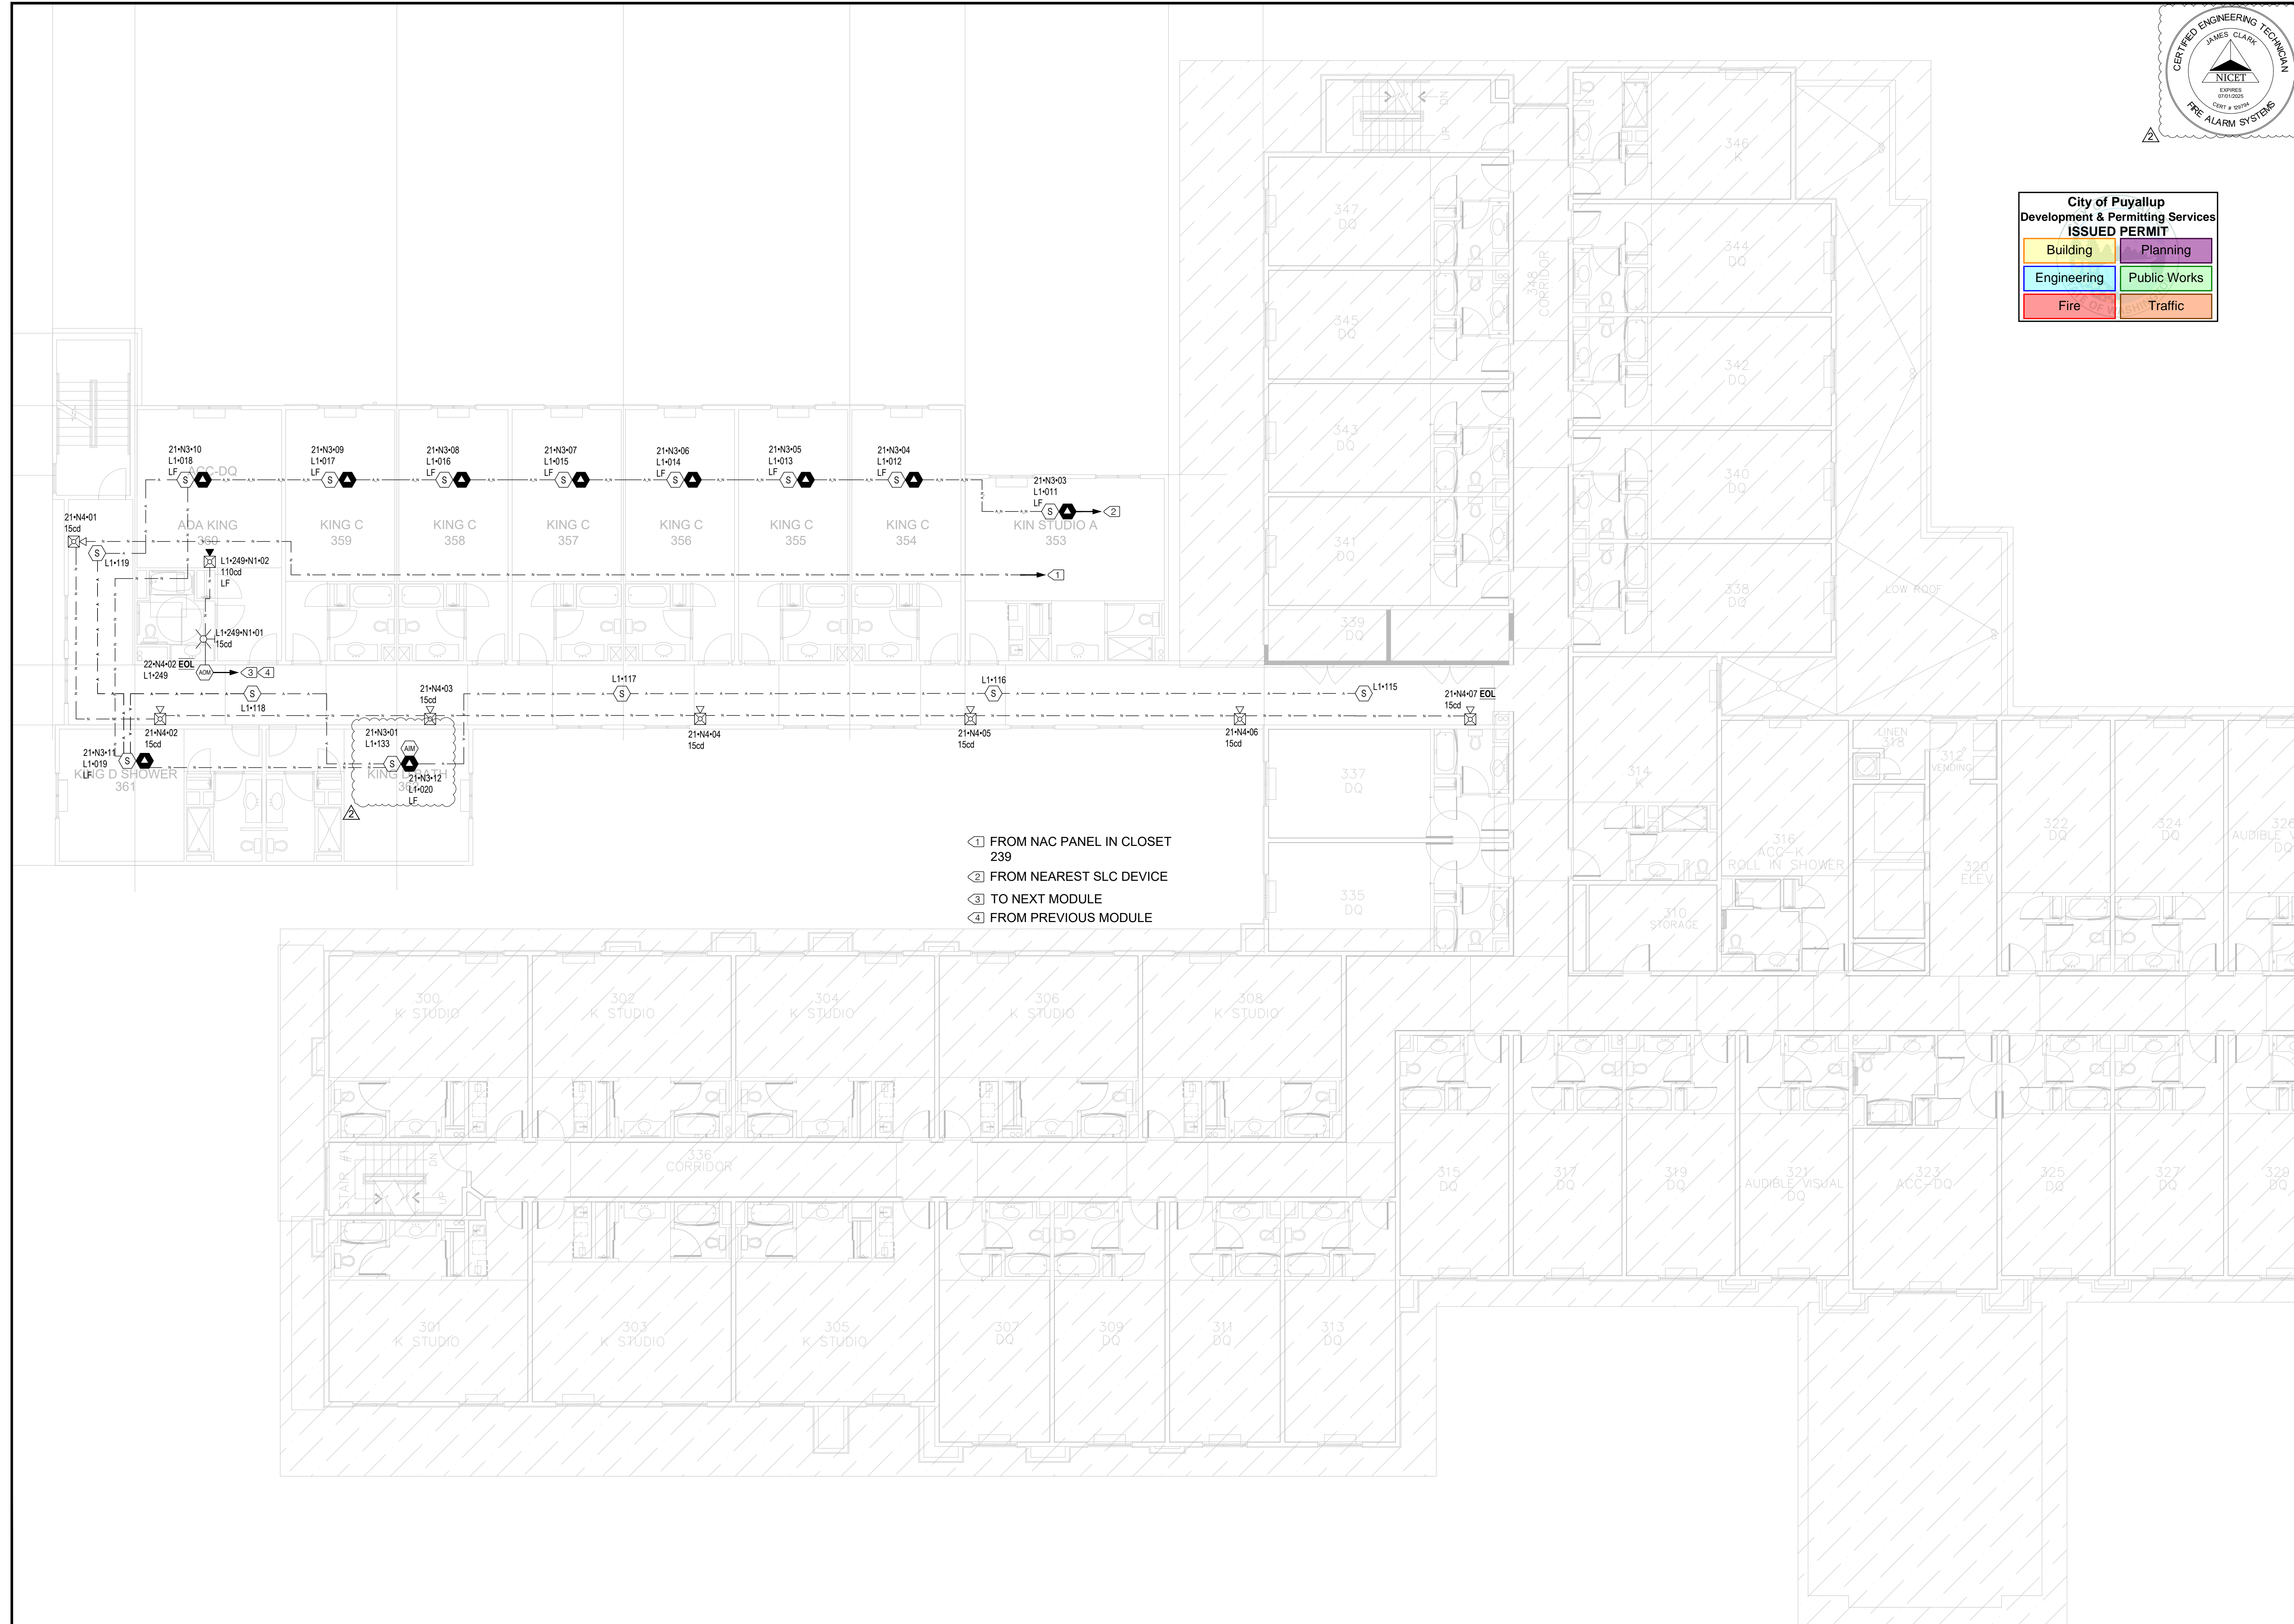


- ① FROM NAC PANEL IN CLOSET 239
- ② FROM NEAREST SLC DEVICE
- ③ TO NEXT MODULE
- ④ FROM PREVIOUS MODULE

REV. #	DATE	REVISION DESCRIPTION
1	2/1/2024	PLAN CHECK SET
2	9/4/2024	REVIEW CHANGES

DRAWN BY: JAMES CLARK DATE: 9/4/2024

SCALE: AS NOTED

SHEET #: FA1.01

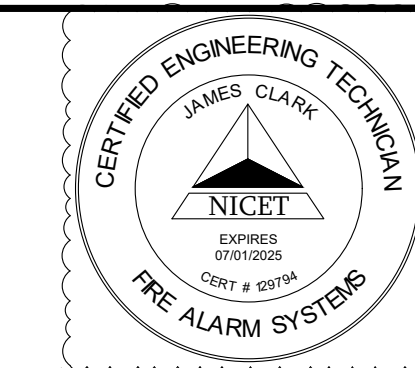

City of Puyallup
Development & Permitting Services
ISSUED PERMIT

Building	Planning
Engineering	Public Works
Fire	Traffic

ADD SMOKE DETECTOR



- ① FROM NAC PANEL IN CLOSET 239
- ② FROM NEAREST SLC DEVICE
- ③ TO NEXT MODULE
- ④ FROM PREVIOUS MODULE

BRET A. FORSBERG
SOUTH PRAIRIE, WA 98385
UBI LICENSE # FORSEL776LK
LICENSE EXPIRES: 03/11/2024



FIRE ALARM SYSTEM T.I.
FOURTH FLOOR FIRE ALARM ADDITION
HAMPTON INN & SUITES
1515 S. MERIDIAN
PUYALLUP, WA

REV. #	DATE	REVISION DESCRIPTION
1	2/11/2024	PLAN CHECK SET
2	9/4/2024	REVIEW CHANGES

DRAWN BY: JAMES CLARK DATE: 9/4/2024

SCALE: AS NOTED

SHEET #: **FA1.02**

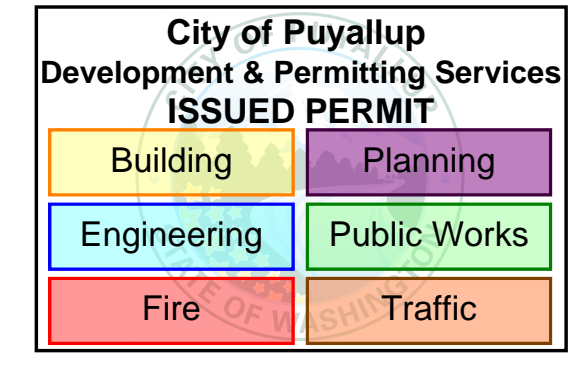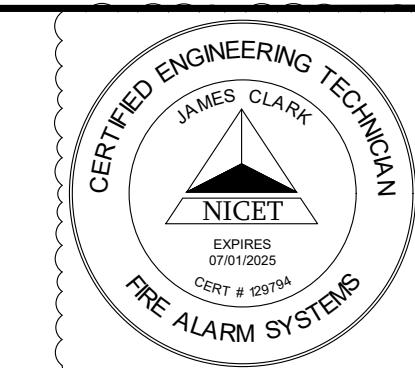

BRET A. FORSBERG
SOUTH PRAIRIE, WA 99385
UB LICENSE # FORSEL776LK
LICENSE EXPIRES: 03/11/2024

FIRE ALARM SYSTEM T.I.
FIRE ALARM ADDITION CALCULATIONS
HAMPTON INN & SUITES
1515 S. MERIDIAN
PUYALLUP, WA

REVISION DESCRIPTION
PLAN CHECK SET
REVIEW CHANGES

DATE: 2/1/2024
REV.#: 1
9/4/2024
DRAWN BY: JAMES CLARK
DATE: 9/4/2024

SCALE: AS NOTED

SHEET #: FA3.00

21 N1 POINT-TO-POINT REPORT. Circuit Settings: Starting Calculation Voltage 19.7, Max. Voltage Drop 1.97, Min. Operational Voltage 16, End Of Line Voltage 18.63, Max. Circuit Current (A) 3, Voltage Drop Percent 5.45 %, Wire Resistance (DMP) 3.07, Total Circuit Current (A) 1.5053, Total Circuit Length (F) 215, Spare Current (A) 1.4947, Total Circuit Resistance (D) 1.318758, Spare Current (A) Percent 49.98 %.

21 N2 POINT-TO-POINT REPORT. Circuit Settings: Starting Calculation Voltage 19.7, Max. Voltage Drop 0.81, Min. Operational Voltage 16, End Of Line Voltage 18.89, Max. Circuit Current (A) 3, Voltage Drop Percent 4.12 %, Wire Resistance (DMP) 3.07, Total Circuit Current (A) 0.567, Total Circuit Length (F) 320, Spare Current (A) 2.433, Total Circuit Resistance (D) 1.951932, Spare Current (A) Percent 81.10 %.

21 N3 POINT-TO-POINT REPORT. Circuit Settings: Starting Calculation Voltage 19.7, Max. Voltage Drop 1.41, Min. Operational Voltage 16, End Of Line Voltage 18.29, Max. Circuit Current (A) 3, Voltage Drop Percent 7.16 %, Wire Resistance (DMP) 3.07, Total Circuit Current (A) 1.5053, Total Circuit Length (F) 465, Spare Current (A) 1.4947, Total Circuit Resistance (D) 4.952296, Spare Current (A) Percent 49.98 %.

21 N4 POINT-TO-POINT REPORT. Circuit Settings: Starting Calculation Voltage 19.7, Max. Voltage Drop 1.32, Min. Operational Voltage 16, End Of Line Voltage 18.38, Max. Circuit Current (A) 3, Voltage Drop Percent 6.68 %, Wire Resistance (DMP) 3.07, Total Circuit Current (A) 0.567, Total Circuit Length (F) 465, Spare Current (A) 2.433, Total Circuit Resistance (D) 2.825283, Spare Current (A) Percent 81.10 %.

22 N1 POINT-TO-POINT REPORT. Circuit Settings: Starting Calculation Voltage 19.7, Max. Voltage Drop 1.64, Min. Operational Voltage 16, End Of Line Voltage 18.56, Max. Circuit Current (A) 3, Voltage Drop Percent 8.31 %, Wire Resistance (DMP) 3.07, Total Circuit Current (A) 1.5053, Total Circuit Length (F) 273, Spare Current (A) 1.4947, Total Circuit Resistance (D) 1.67678, Spare Current (A) Percent 49.98 %.



22 N2 POINT-TO-POINT REPORT. Circuit Settings: Starting Calculation Voltage 19.7, Max. Voltage Drop 2.75, Min. Operational Voltage 16, End Of Line Voltage 16.85, Max. Circuit Current (A) 3, Voltage Drop Percent 13.96 %, Wire Resistance (DMP) 3.07, Total Circuit Current (A) 0.567, Total Circuit Length (F) 476, Spare Current (A) 2.433, Total Circuit Resistance (D) 5.381118, Spare Current (A) Percent 81.10 %.

22 N3 POINT-TO-POINT REPORT. Circuit Settings: Starting Calculation Voltage 19.7, Max. Voltage Drop 1.47, Min. Operational Voltage 16, End Of Line Voltage 18.23, Max. Circuit Current (A) 3, Voltage Drop Percent 7.46 %, Wire Resistance (DMP) 3.07, Total Circuit Current (A) 0.337, Total Circuit Length (F) 712, Spare Current (A) 4.378272, Spare Current (A) Percent 88.7 %.

22 N4 POINT-TO-POINT REPORT. Circuit Settings: Starting Calculation Voltage 19.7, Max. Voltage Drop 1.38, Min. Operational Voltage 16, End Of Line Voltage 18.32, Max. Circuit Current (A) 3, Voltage Drop Percent 7.02 %, Wire Resistance (DMP) 3.07, Total Circuit Current (A) 0.674, Total Circuit Length (F) 541, Spare Current (A) 2.326, Total Circuit Resistance (D) 3.321777, Spare Current (A) Percent 77.53 %.

L1-248 N1 POINT-TO-POINT REPORT. Circuit Settings: Starting Calculation Voltage 18.23, Max. Voltage Drop 0.02, Min. Operational Voltage 16, End Of Line Voltage 18.2, Max. Circuit Current (A) 2, Voltage Drop Percent 0.13 %, Wire Resistance (DMP) 3.07, Total Circuit Current (A) 0.337, Total Circuit Length (F) 13, Spare Current (A) 1.663, Total Circuit Resistance (D) 0.081364, Spare Current (A) Percent 83.15 %.

L1-250 N1 POINT-TO-POINT REPORT. Circuit Settings: Starting Calculation Voltage 18.23, Max. Voltage Drop 0.02, Min. Operational Voltage 16, End Of Line Voltage 18.19, Max. Circuit Current (A) 2, Voltage Drop Percent 0.13 %, Wire Resistance (DMP) 3.07, Total Circuit Current (A) 0.337, Total Circuit Length (F) 13, Spare Current (A) 1.663, Total Circuit Resistance (D) 0.081425, Spare Current (A) Percent 83.15 %.

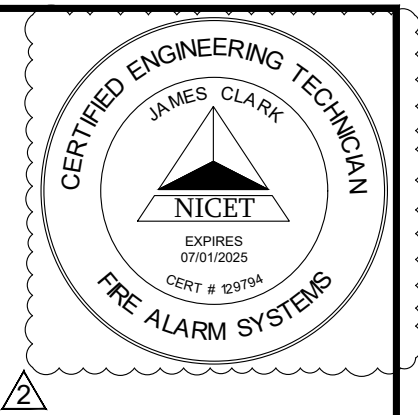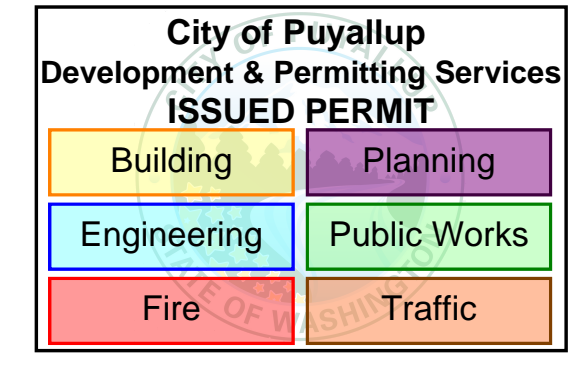

BRET A. FORSBERG
SOUTH PRAIRIE, WA 98385
UBI LICENSE # FORSEL776LK
LICENSE EXPIRES: 03/11/2024

FIRE ALARM SYSTEM T.I.
FIRE ALARM ADDITION CALCULATIONS
HAMPTON INN & SUITES
1515 S. MERIDIAN
PUYALLUP, WA

PANEL 21 (BP510A) BATTERY CALCULATION (SECONDARY POWER SOURCE REQUIREMENTS)								
PANEL COMPONENTS	QTY	PART NO.	DESCRIPTION	STANDBY CURRENT (AMPS)		SECONDARY ALARM CURRENT (AMPS)		
				CURRENT DRAW (A)	TOTAL (A)	CURRENT DRAW (A)	TOTAL (A)	
	1	BPS10A Mainboard	Mainboard for BPS10A assembly	0.07	0.07	0.27	0.27	
CIRCUIT	SYMBOL	QTY	PART NO.	DESCRIPTION	CURRENT DRAW (A)	TOTAL (A)	CURRENT DRAW (A)	TOTAL (A)
21-N1	LF	10	SIGA-PCD w/SIGA-AB4G-LF BASE	Photoelectric smoke and carbon monoxide life safety detector	0	0	0.15	1.5
		1	SIGA-RM1	Riser Monitor Module, monitors one riser	0	0	0	0
		1	SIGA-TCDR	Temporal Generator for Sounder Bases	0.00053	0.00053	0.0053	0.0053
21-N2	HDM	7	G1F-HDVM	Temporal Horn, 84.4 or 79.4 dBA, 15, 30, 75, 110 oct Strobe, white, "FIRE" 15sec	0	0	0.081	0.567
		10	SIGA-PCD w/SIGA-AB4G-LF BASE	Photoelectric smoke and carbon monoxide life safety detector	0	0	0.15	1.5
		2	SIGA-RM1	Riser Monitor Module, monitors one riser	0	0	0	0
21-N3	LF	1	SIGA-TCDR	Temporal Generator for Sounder Bases	0.00053	0.00053	0.0053	0.0053
		7	G1F-HDVM	Temporal Horn, 84.4 or 79.4 dBA, 15, 30, 75, 110 oct Strobe, white, "FIRE" 15sec	0	0	0.081	0.567
		10	SIGA-PCD w/SIGA-AB4G-LF BASE	Photoelectric smoke and carbon monoxide life safety detector	0	0	0.15	1.5
21-N4	HDM	1	SIGA-TCDR	Temporal Generator for Sounder Bases	0.00053	0.00053	0.0053	0.0053
		7	G1F-HDVM	Temporal Horn, 84.4 or 79.4 dBA, 15, 30, 75, 110 oct Strobe, white, "FIRE" 15sec	0	0	0.081	0.567
		10	SIGA-PCD w/SIGA-AB4G-LF BASE	Photoelectric smoke and carbon monoxide life safety detector	0	0	0.15	1.5
				TOTAL STANDBY (A)	0.07196	TOTAL ALARM (A)	4.40296	
				REQUIRED STANDBY TIME = 24 HOURS				
				REQUIRED ALARM TIME = 5 MINUTES				
SECONDARY STANDBY LOAD (A)				0.07196	24	1.68		
SECONDARY ALARM LOAD (A)				4.40296	0.08	0.37		
STANDBY AND ALARM SUBTOTAL (AMP HOURS)								
DERATING FACTOR				2.05				
SECONDARY LOAD REQUIREMENTS (AMP HOURS)				1.2				
				2.46				
PROVIDE (2) 12V 7AH BATTERIES								
*BATTERY BOX SIZE CAPACITY NOT SPECIFIED. REFER TO MANUFACTURER DOCUMENTATION.								

PANEL 22 (BP510A) BATTERY CALCULATION (SECONDARY POWER SOURCE REQUIREMENTS)								
PANEL COMPONENTS	QTY	PART NO.	DESCRIPTION	STANDBY CURRENT (AMPS)		SECONDARY ALARM CURRENT (AMPS)		
				CURRENT DRAW (A)	TOTAL (A)	CURRENT DRAW (A)	TOTAL (A)	
	1	BPS10A Mainboard	Mainboard for BPS10A assembly	0.07	0.07	0.27	0.27	
CIRCUIT	SYMBOL	QTY	PART NO.	DESCRIPTION	CURRENT DRAW (A)	TOTAL (A)	CURRENT DRAW (A)	TOTAL (A)
22-N1	LF	10	SIGA-PCD w/SIGA-AB4G-LF BASE	Photoelectric smoke and carbon monoxide life safety detector	0	0	0.15	1.5
		1	SIGA-TCDR	Temporal Generator for Sounder Bases	0.00053	0.00053	0.0053	0.0053
		7	G1F-HDVM	Temporal Horn, 84.4 or 79.4 dBA, 15, 30, 75, 110 oct Strobe, white, "FIRE" 15sec	0	0	0.081	0.567
22-N2	HDM	1	SIGA-CC1	Signal Module for 1 Riser in, 1 Output Ckt, C1 1"	0	0	0.337	0.337
		2	SIGA-CC1	Signal Module for 1 Riser in, 1 Output Ckt, C1 1"	0	0	0.337	0.674
		10	SIGA-PCD w/SIGA-AB4G-LF BASE	Photoelectric smoke and carbon monoxide life safety detector	0	0	0.15	1.5
				TOTAL STANDBY (A)	0.07053	TOTAL ALARM (A)	3.34853	
				REQUIRED STANDBY TIME = 24 HOURS				
				REQUIRED ALARM TIME = 5 MINUTES				
SECONDARY STANDBY LOAD (A)				0.07053	24	1.68		
SECONDARY ALARM LOAD (A)				3.34853	0.08	0.28		
STANDBY AND ALARM SUBTOTAL (AMP HOURS)								
DERATING FACTOR				1.56				
SECONDARY LOAD REQUIREMENTS (AMP HOURS)				1.2				
				2.35				
PROVIDE (2) 12V 7AH BATTERIES								
*BATTERY BOX SIZE CAPACITY NOT SPECIFIED. REFER TO MANUFACTURER DOCUMENTATION.								

BATTERY CALCULATION (SECONDARY POWER SOURCE REQUIREMENTS)								
PANEL COMPONENTS	QTY	PART NO.	DESCRIPTION	STANDBY CURRENT (AMPS)		SECONDARY ALARM CURRENT (AMPS)		
				CURRENT DRAW (A)	TOTAL (A)	CURRENT DRAW (A)	TOTAL (A)	
	1	3-SDC1	Signature Device Card; upgrades a 3-SDC2 to a 3-SDC2C	0.144	0.144	0.204	0.204	
	1	3X-NET	Network option card; RS485, C1 A or B, max 64 nodes	0.098	0.098	0.098	0.098	
	1	4X-LCD	ESTX User Interface Card	0.066	0.066	0.066	0.066	
	1	SFS	SFS LED control/display module	0.002	0.002	0.002	0.002	
	1	SFS-CPU	ESTX Mainboard	0.115	0.115	0.115	0.115	
CIRCUIT	SYMBOL	QTY	PART NO.	DESCRIPTION	CURRENT DRAW (A)	TOTAL (A)	CURRENT DRAW (A)	TOTAL (A)
L1	LF	30	SIGA-PCD w/SIGA-AB4G-LF BASE	Photoelectric smoke and carbon monoxide life safety detector	0	0	0	0
		16	SIGA-PD w/SIGA-SB4 BASE	Photoelectric smoke detector	0	0	0	0
		3	SIGA-RM1	Riser Monitor Module, monitors one riser	0.0002	0.0006	0.0002	0.0006
		3	SIGA-TCDR	Temporal Generator for Sounder Bases	0	0	0.0053	0.0159
		3	SIGA-CC1	Signal Module for 1 Riser in, 1 Output Ckt, C1 1"	0.00223	0.00669	0.0001	0.0003
				TOTAL STANDBY (A)	0.42629	TOTAL ALARM (A)	0.48749	
				REQUIRED STANDBY TIME = 24 HOURS				
				REQUIRED ALARM TIME = 5 MINUTES				
SECONDARY STANDBY LOAD (A)				0.42629	24	10.23		
SECONDARY ALARM LOAD (A)				0.48749	0.08	0.04		
STANDBY AND ALARM SUBTOTAL (AMP HOURS)								
DERATING FACTOR				10.27				
SECONDARY LOAD REQUIREMENTS (AMP HOURS)				1.2				
				12.33				
PROVIDE (2) 12V 15AH BATTERIES								
*BATTERY BOX SIZE CAPACITY NOT SPECIFIED. REFER TO MANUFACTURER DOCUMENTATION.								

REV. #	DATE	REVISION DESCRIPTION
1	2/11/2024	PLAN CHECK SET
2	9/4/2024	REVIEW CHANGES

DRAWN BY: JAMES CLARK	DATE: 9/4/2024
--------------------------	-------------------

SCALE: AS NOTED

SHEET #: FA3.01
