

Residential Sewer Service As-built

Service Address: 4102 S MERIDIAN, SPACE 10, RYALLUP

Subdivision: _____ Lot #: _____

Permit No.: PRSUR20241577 Contractor: PIONEER PLUMBING

Pipe Type: PVC Pipe Size: 4" & 6" No. of cleanouts: 1-4" & 2-6"

Approved by: Jason Little, Eng Insp Date: 15 OCT 2024

Inspector comments: _____

① Is SE CORNER OF BLDG

① 4" SCH35 PVC 40 WYE
4'E x 5' NOF A; ~5' DPTH

② 4" SCH35 PVC 22°
6'E x 6' NOF A; ~5' DPTH

③ 4" SCH35 PVC 22°
6'E x 4' NOF A; ~5' DPTH

④ 4" SCH35 PVC 45°
7'E x 13' NOF A; ~5' DPTH



⑤ 4" SCH35 PVC 45° → 4" x 6" SCH35 PVC RDCR
7'E x 13' NOF A; ~6' DPTH

⑥ 6" x 4" SCH35 PVC WYE (CAPPED)
7'E x 13' NOF A; ~7' DPTH

⑦ 6" SCH35 PVC 45° → 45°
7'E x 13' NOF A; ~9' DPTH

⑧ 6" SCH35 PVC Tee 90
9'E x 13' NOF A; ~9' DPTH

⑨ 6" SCH35 PVC WYE 90 (ROUNDED TO SIDE)
10'E x 13' NOF A; ~9' DPTH

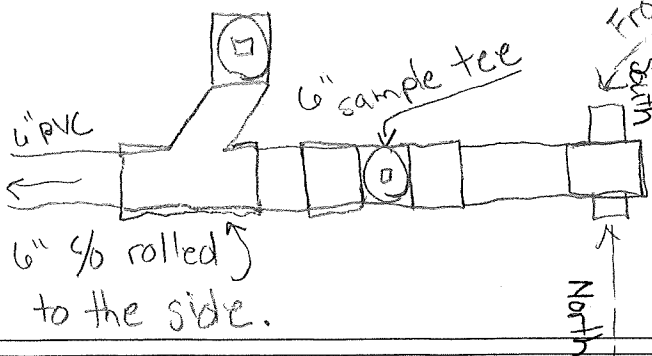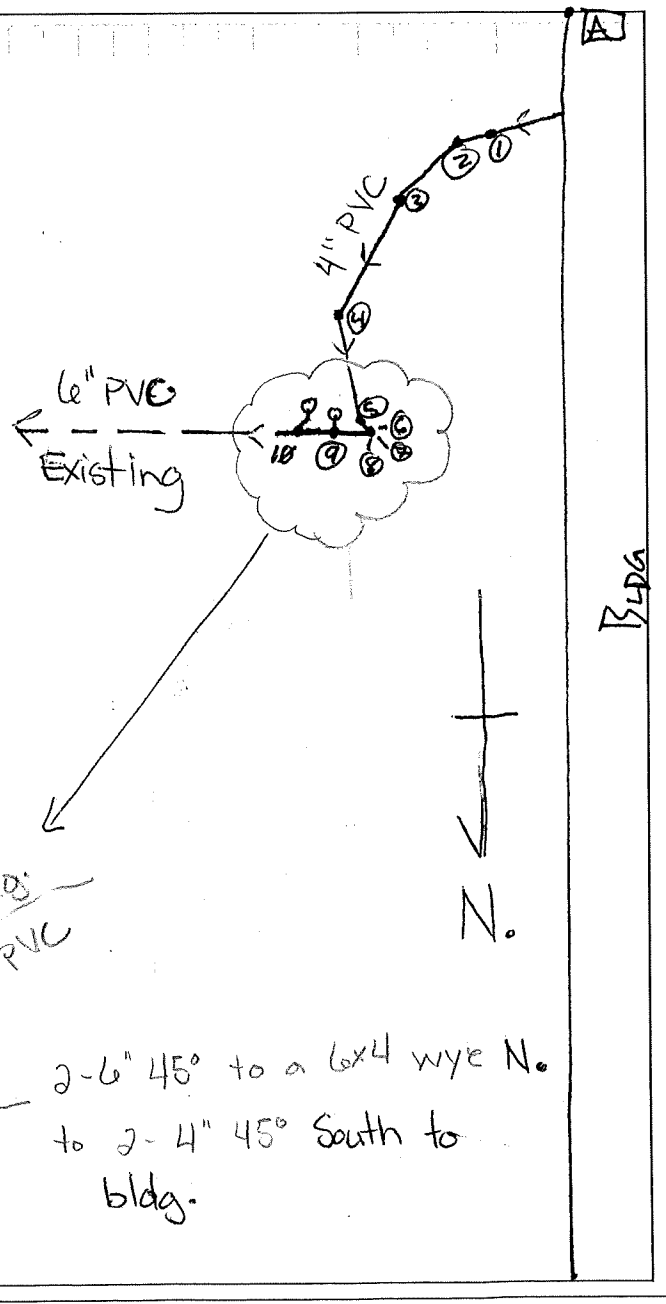

2-6" 45° to a 6x4 wye N.
to 2-4" 45° South to
bldg.