

Residential Sewer Service As-built

Service Address: 2902 Pioneer Way East

Building "B" North

Subdivision: East Town Crossing

Lot #: BLOG B N

Permit No.: PRMU20240139 Contractor: _____


Pipe Type: ABS/PVC Pipe Size: 6", 4" No. of cleanouts: 2

Approved by: Jason Little, Eng Insp Date: 1/14/25

Inspector comments: _____

- point A is the 6" main sewer
- point B is the first cleanout
- point C is the second clean out
- point D is the 6" x 4" eccentric reducer
- There is a 8" piece of 6" PVC between point C and D
- Point E is the 4" PVC x 4" ABS adapter coupling with a 4" piece of PVC pipe between points D and E.

• Between points E and F there is a 4" st. 45 into the PVC x ABS adapter. The pipe then rises up from 7'6" to 3'6" from dirt grade.

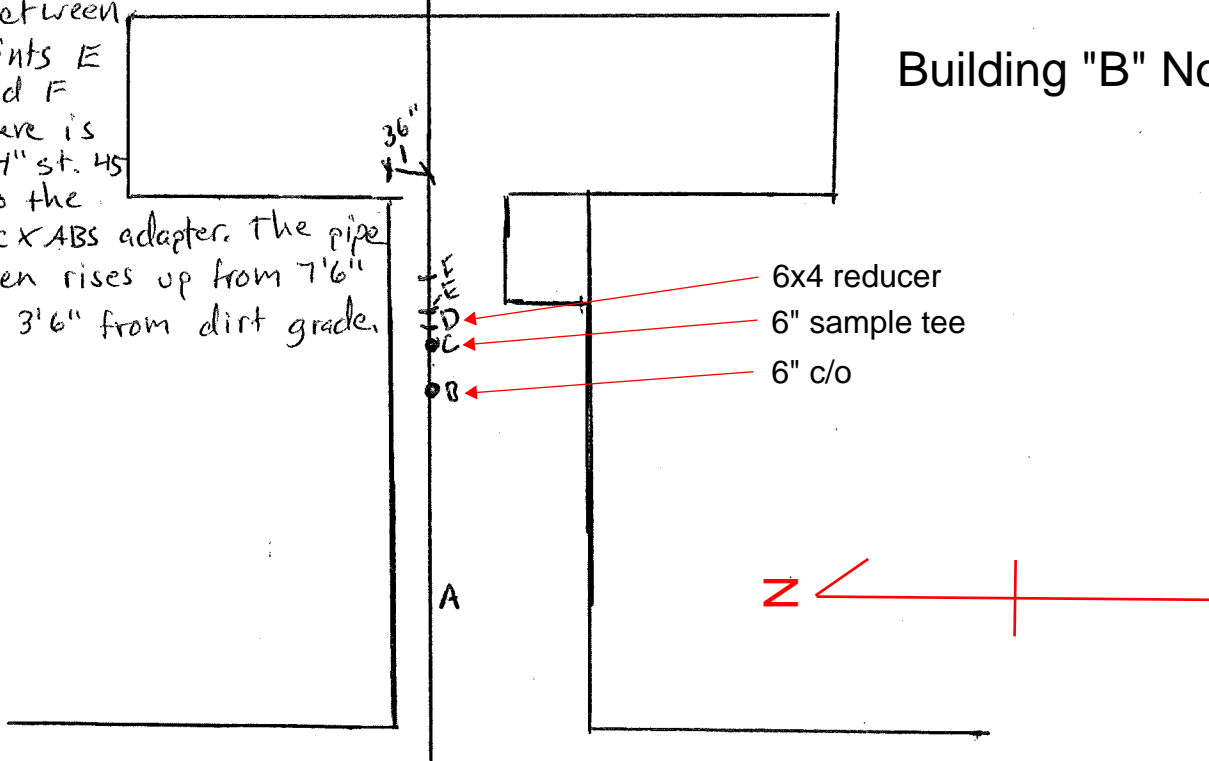

Building "B" North

North end of building