A FIRE ALARM REPLACEMENT SUBMITTAL



ROSS #0593

4102 S MERIDIAN, SUITE C PUYALLUP, WA 98373





	- FIRE ALARM DRAWING INDEX -
SHEET NO.	SHEET DESCRIPTION
FA-0	TITLE SHEET, GENERAL NOTES & COMMUNICATION MATRIX
FA-1	FIRE ALARM SYSTEM FLOOR PLAN & ADDRESS SCHEDULE
FA-2	FIRE ALARM SYSTEM FLOOR PLAN & RISER DIAGRAM
FA-3	SYSTEM CALCULATIONS

- SCOPE OF WORK -

THIS PROJECT IS FOR THE INSTALLATION OF A REPLACEMENT, ADDRESSABLE, MONITORED, U.L. LISTED, FIRE ALARM SYSTEM. EXISTING SMOKE & HEAT DETECTORS, PULL STATIONS, NOTIFICATION AND WIRE SHALL BE REPLACED. THE NEW SYSTEM SHALL HAVE A CELLULAR SOLE PATH COMMUNICATOR FOR OFF PREMISE NOTIFICATION. THE SYSTEM SHALL MEET NFPA 72 STANDARDS. FULL NOTIFICATION THROUGHOUT. A REMOTE ANNUNCIATOR SHALL BE LOCATED BY FRONT ENTRANCE. UPON COMMISSIONING OF NEW FIRE ALARM SYSTEM, ALL EXISTING DEVICES AND WIRE SHALL BE REMOVED.

- MONITORING NOTES -

EVERON SOLUTIONS 4221 W. JOHN CARPENTER FWY.

IRVING, TEXAS 75063

|ALARM SERVICE COMPANY: (3577745) |PARTY SITE NO: (3577745) LISTED SERVICE FROM: IRVING, TX

THE ALARM SERVICE COMPANY IS UL LISTED IN THE FOLLOWING CERTIFICATE SERVICE CATEGORIES:

FILE-VOL NO. CCN LISTING CATEGORY

BP10566-1 CZRM MONITORING STATIONS, NATIONAL INDUSTRIAL

UUFX CENTRAL-STATION PROTECTIVE SIGNALING S2684-20

SERVICES [SIGNAL AND FIRE ALARM EQUIPMENT CPVX [BURGLAR ALARMS SYSTEMS] CENTRAL STATION

UUJS LOCAL, AUXILIARY, REMOTE STATION AND PROPRIETARY PROTECTIVE SIGNALING SERVICES

CRZH NATIONAL INDUSTRIAL SECURITY SYSTEMS BP8312-38 CVSG MERCANTILE BURGLAR ALARM SYSTEMS

THIS CERTIFICATE EXPIRES ON 31-DEC-2025


				- FIRE EQUIPM	MENT LEGEND -
SYMBOL	QTY	EXISTING	MANUFACTURER	PART NO	DESCRIPTION
FACU	1		POTTER	AFC-1000	FIRE ALARM CONTROL PANEL
	1		SPACE AGE ELECTRONICS	E120V-GT	HYBRID SURGE PROTECTION DEVICE
	2		POWER SONIC	PS-12180	12V 18 AH BATTERY
	1		POTTER	UD-2000	PFC SERIES DIGITAL ALARM COMMUNICATOR TRANSMITTER
CELL	1		NAPCO	SLE-MAX2-FIRE	UNIVERSAL FIRE COMMUNICATOR, DUAL SIM, DUAL PATH, PANEL-POWERED TECHNOLO ABS PLASTIC HOUSING
DOC	1		SPACE AGE ELECTRONICS	SSU00690	FIRE ALARM DOCUMENT CABINET W/8GB USB DRIVE (ACE-11), RED WITH CUSTOM LOG
FAA	1		POTTER	RA-6500	160 CHARACTER LCD ANNUNCIATOR
	5		SYSTEM SENSOR	RTS151KEY	REMOTE TEST STATION W/ SWITCH, ALARM & POWER LEDS, KEY RESET
(s)	63		POTTER	PAD300-PD W/PAD300-6DB	PHOTOELECTRIC SMOKE DETECTOR WITH 6" STANDARD BASE
F	4		POTTER	PAD100-PSDA	ADDRESSABLE PULL STATION DUAL ACTION
AIM 2	2		POTTER	PAD100-DIM	DUAL INPUT MODULE
SS ₂	1		DITEK	DTK-2MHLP24BWB	2 PAIR / 4 WIRE SURGE MODULE W/BASE FOR PIV, NAC, IDC ETC.
(AIO)	5		POTTER	PAD100-OROI	ONE RELAY ONE INPUT MODULE
(s)	5	Х	GENERIC	EXISTING	DUCT DETECTOR
WF	1	Х	GENERIC	EXISTING	WATERFLOW SWITCH
VS	1	Х	GENERIC	EXISTING	VALVE TAMPER SUPERVISORY SWITCH
N N	1	Х	GENERIC	EXISTING	OS&Y
KX	1	Х	GENERIC	EXISTING	KNOX BOX
₩P	2		POTTER	HS-24WR-WP	OUTDOOR HORN STROBE, FIXED 75 CANDELA, STANDARD ENCLOSURE, RED
⊠c	13		POTTER	CHS-24W	HORN STROBE, CEILING, WHITE
\times^{c}	14		POTTER	CS-24W	STROBE, CEILING, WHITE

				- FIRE EQUIP	MENT LEGEND -
SYMBOL	QTY	EXISTING	MANUFACTURER	PART NO	DESCRIPTION
FACU	1		POTTER	AFC-1000	FIRE ALARM CONTROL PANEL
	1		SPACE AGE ELECTRONICS	E120V-GT	HYBRID SURGE PROTECTION DEVICE
	2		POWER SONIC	PS-12180	12V 18 AH BATTERY
	1		POTTER	UD-2000	PFC SERIES DIGITAL ALARM COMMUNICATOR TRANSMITTER
CELL	1		NAPCO	SLE-MAX2-FIRE	UNIVERSAL FIRE COMMUNICATOR, DUAL SIM, DUAL PATH, PANEL-POWERED TECHNOLOGY ABS PLASTIC HOUSING
DOC	1		SPACE AGE ELECTRONICS	SSU00690	FIRE ALARM DOCUMENT CABINET W/8GB USB DRIVE (ACE-11), RED WITH CUSTOM LOGO
FAA	1		POTTER	RA-6500	160 CHARACTER LCD ANNUNCIATOR
\bowtie	5		SYSTEM SENSOR	RTS151KEY	REMOTE TEST STATION W/ SWITCH, ALARM & POWER LEDS, KEY RESET
S	63		POTTER	PAD300-PD W/PAD300-6DB	PHOTOELECTRIC SMOKE DETECTOR WITH 6" STANDARD BASE
F	4		POTTER	PAD100-PSDA	ADDRESSABLE PULL STATION DUAL ACTION
AIM 2	2		POTTER	PAD100-DIM	DUAL INPUT MODULE
SS ₂	1		DITEK	DTK-2MHLP24BWB	2 PAIR / 4 WIRE SURGE MODULE W/BASE FOR PIV, NAC, IDC ETC.
(AIO)	5		POTTER	PAD100-OROI	ONE RELAY ONE INPUT MODULE
(s)	5	Х	GENERIC	EXISTING	DUCT DETECTOR
WF	1	Х	GENERIC	EXISTING	WATERFLOW SWITCH
VS	1	Х	GENERIC	EXISTING	VALVE TAMPER SUPERVISORY SWITCH
N N	1	Х	GENERIC	EXISTING	OS&Y
KX	1	Х	GENERIC	EXISTING	KNOX BOX
₩P	2		POTTER	HS-24WR-WP	OUTDOOR HORN STROBE, FIXED 75 CANDELA, STANDARD ENCLOSURE, RED
⊠c	13		POTTER	CHS-24W	HORN STROBE, CEILING, WHITE
	+	1			

- CABLE AND WIRE LEGEND -								
LABEL	PART NO	DESCRIPTION						
Α	16/2 FPLP SLC	2 COND. SOLID COPPER FPLP ADDRESSABLE UNSHIELDED						
V	14/2 FPLP/R	2 COND. SOLID COPPER FPLP/R ANALOG UNSHIELDED						
B, RTS, Z	18/4 FPLP/R	4 COND. SOLID COPPER FPLP/R ANALOG UNSHIELDED						

- SITE LOCATION -Sans Souci Mob

REJECTION REVISION-1/17/2025: CHANGE ALL HEAT DETECTORS TO SMOKE DETECTORS. ADD 4-SMOKE DETECTORS IN WOMEN'S R/R, MEN'S R/R, JAN. CLOSET, EQUIP. ROOM.

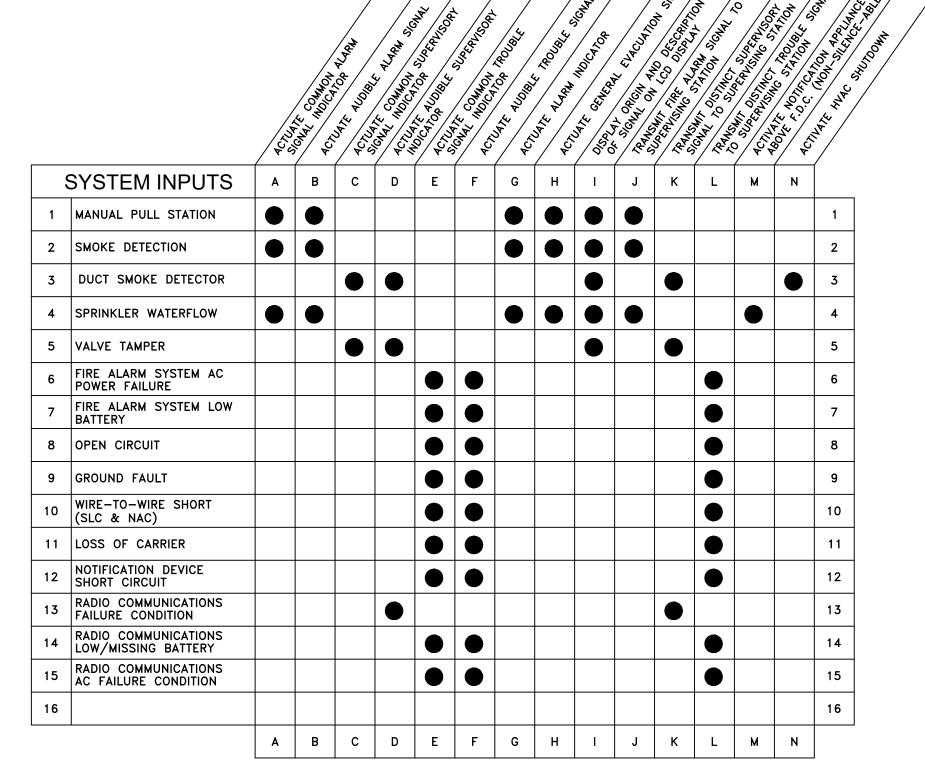

- PROJECT INFORMATION -

PROJECT INFORMATION: NAME OF PROJECT: ADDRESS:

4102 S MERIDIAN, SUITE C

PUYALLUP, WA 98373

PROPOSED USE: MERCANTILE, GROUP M **CENTRAL STATION EVERON SOLUTIONS**

4221 W JOHN CARPENTER FWY IRVING, TX 75067

FIRE ALARM DESIGNER MILISSA A. JOHNSON NI EVERON SOLUTIONS 4221 W JOHN CARPENTER FWY IRVING, TX 75067 NICET III # 147320 214-907-2437

CENTRAL STATION LISTING

CCN File No. Vol. No.

UUFX S2684 20

- COMMUNICATOR NOTE -

STARLINK FIRE SELF-SUPERVISION NFPA 72 REQUIRES THAT ANY FIRE COMMUNICATOR TROUBLE BE LOCALLY ANNUNCIATED BY THE FIRE PANEL WITHIN 200 SECONDS OF THE TROUBLE. THE TROUBLES INCLUDE LOSS OF SIGNAL. NOC SUPERVISION CHECKING FAILURE. ETC. THE STARLINK SLE-LTEV-FIRE FIRE COMMUNICATOR MODELS INCLUDE A "SELF-SUPERVISING FIRE COMMUNICATOR" FEATURE THAT ALLOWS THE COMMUNICATOR TO ANNUNCIATE A COMMUNICATION TROUBLE WITHOUT THE NEED FOR WIRING TO AN FACU ZONE INPUT OR ANY FACU REPROGRAMMING. THIS IS ACCOMPLISHED BY DROPPING THE EMULATED PHONE LINE VOLTAGE TO THE FACU SECONDARY PHONE LINE, CAUSING THE FACU TO ANNUNCIATE A COMMUNICATION TROUBLE. TO ENABLE SELF-SUPERVISION, SIMPLY REMOVE JUMPER JP2. NOTE THAT WHEN USING SELF-SUPERVISION, SOME FACUS MAY LINE TO RESTORE CORRECTLY. TO ALSO REPORT A COMMUNICATOR TROUBLE TO THE CENTRAL STATION, ENABLE THE FEATURE "TIP/RING WIRING FAULT REPORT" IN THE ADVANCED TAB IN THE STARLINK NOC.

SYSTEM OUTPUTS

- ALL WORK SHALL BE IN ACCORDANCE WITH NFPA STANDARDS
- SEE WIRING LEGEND FOR CABLE TYPES AND SIZES.

- THE FIELD. FOLLOW DRAWING NOTES FOR SPECIFIC AND
- ALL FIRE ALARM CONDUIT, FITTINGS, AND BACK BOXES SHALL BE PROVIDED BY THE ELECTRICAL CONTRACTOR. THE FIRE ALARM CONTRACTOR SHALL COORDINATE WITH THE ELECTRICAL CONTRACTOR TO DETERMINE THE EXTENT OF ALL FIRE ALARM
- ALL CABLE RUNS SHALL BE NEATLY BUNDLED, WRAPPED TIGHT AND PROPERLY SECURED. ANY CABLING NOT INSTALLED IN A NEAT
- CONTRACTOR RUNNING CABLING MUST MARK BOTH ENDS OF CABLING. PROVIDE A WIRE LEGEND FOR ALL LOCATIONS AND PROVIDE A CONTINUITY TEST LOG FOR EACH CABLE
- 10. EXPOSED CABLING SHALL BE RUN PARALLEL AND PERPENDICULAR TO BUILDING STRUCTURE. EXPOSED CABLING SHALL NOT BE RUN IN A "SPAN" FASHION BETWEEN BAR JOISTS OR BEAMS (I.E.:CABLING SHALL BE ROUTED ALONG PATH OF JOISTS AND BEAMS). ALL CABLING SHALL BE SECURED TO THE STRUCTURAL CEILING BETWEEN JOISTS OR BEAMS.
- STRUCTURAL MEMBERS.
- 13. ALL JUNCTION BOXES AND ADDRESSABLE MODULES SHALL BE INSTALLED TIGHT TO STRUCTURE OR AT THE BOTTOM OF STRUCTURE JOISTS. ALL JUNCTION BOXES AND CABLE SPLICES SHALL BE ACCESSIBLE FOR SERVICE. PROVIDE ANY REQUIRED
- 14. ALL WIRING CONDUCTORS FOR THE FIRE ALARM SYSTEM SEVEN FEET OR LESS ABOVE THE FINISHED FLOOR, CONCEALED IN CEILINGS OR PARTITIONS, SUBJECT TO PHYSICAL DAMAGE, NON POWER LIMITED, OR WHERE REQUIRED BY APPLICABLE CODES SHALL BE INSTALLED IN CONDUIT.
- 15. ALL FIRE ALARM CABLING RISERS SHALL BE INSTALLED IN METALLIC
- 16. ALL FIRE ALARM CABLING IN FINISHED AREAS SHALL BE
- CONCEALED.
- PENETRATIONS) WITH THE GENERAL CONTRACTOR AND ALL OTHER TRADES PRIOR TO INSTALLATION.
- SUPPORTED AND SEISMICALLY BRACED, AS REQUIRED BY ALL APPLICABLE CODES AND THE LOCAL JURISDICTION.
- 19. THE FIRE ALARM CONTRACTOR SHALL PROVIDE TRAINING OF

- GENERAL NOTES: -

- AND ALL LOCAL ADOPTED CODES.
- FIRE ALARM CABLING SHALL BE PLENUM RATED AND RED.
- FIRE ALARM CABLING SHALL NOT BE PAINTED.
- FIRE ALARM CABLING SHALL BE ACCEPTABLE TO THE FIRE
- ALARM EQUIPMENT MANUFACTURER FOR THE INTENDED PURPOSE CABLE ROUTING SHALL BE COORDINATED WITH OTHER TRADES IN
- ACCEPTABLE INSTALLATION METHODS.
- CONDUIT AND BACK-BOX REQUIREMENTS.
- MANNER SHALL BE PULLED OUT AND RE-RUN BY INSTALLER.

- 11. CABLING SHALL NOT BE STRAPPED TO THE UNDERSIDE OF THE
- 12. ALL CABLING SHALL BE SUPPORTED FROM BUILDING STRUCTURE AND NOT FROM GRID, TILES, OR SUPPORT WIRES. EXPOSED CABLING SHALL BE SUPPORTED BY BUILDING STRUCTURE AT NO MORE THAN FIVE (5) FOOT INTERVALS.
- ACCESS PANELS.
- CONDUIT.
- 17. COORDINATE DRILLING OF ANY HOLES (I.E. COLUMN
- 18. ALL CABLING, CONDUIT, AND BACK BOXES SHALL BE PROPERLY
- AVAILABLE STORE MANAGEMENT STAFF ON SYSTEM OPERATIONS.

City of Puyallup Development & Permitting Services ISSUED PERMIT								
Building	Planning							
Engineering	Public Works							
Fire OF W	Traffic							

RENTON WA 98057 844-538-3766 VEB: EVERONSOLUTIONS.CO

ever n

BRANCH #66955 600 OAKESDALE AVE SW,

SUITE 100

ROSS #0593 4102 S MERIDIAN, SUITE (

PUYALLUP, WA 98373

FIRE ALARM SYSTEN

nis fire alarm shop drawing was prepare for equipment application only. The nformation contained herein is intended to aid in the installation of this system. No design changes have been made to the engineer of record's contract document

Milissa A Johnson William Wohn NICET #147320 FIRE ALARM SYSTEMS LVL III EXPIRES 05/01/2027

CENTRAL STATION LISTING CCN File No. Vol. No. UUFX S2684 20 REVISIONS NO. DATE REVISION

FOR PERMIT -F.M. REJECTION: 1/17/2024 . 1 BY: ___

CODES ADOPTED BY LOCAL AHJ 21 WASHINGTON STATE BUILDING CODE 021 WASHINGTON STATE EX. BUILDING COD 2021 WASHINGTON STATE FIRE CODE 2023 WASHINGTON STATE ELECTRICAL CODE


2019 NFPA 72

PREPARED BY: M.A. JOHNSON D.J. TAYLO CHECKED BY: D. NEEDHAN

> 30032581 PROJECT NO: TITLE: COVER SHEET NOTES/LEGENDS

OPS MATRIX DEVICE SCHEDULE SHEET:

FA-0

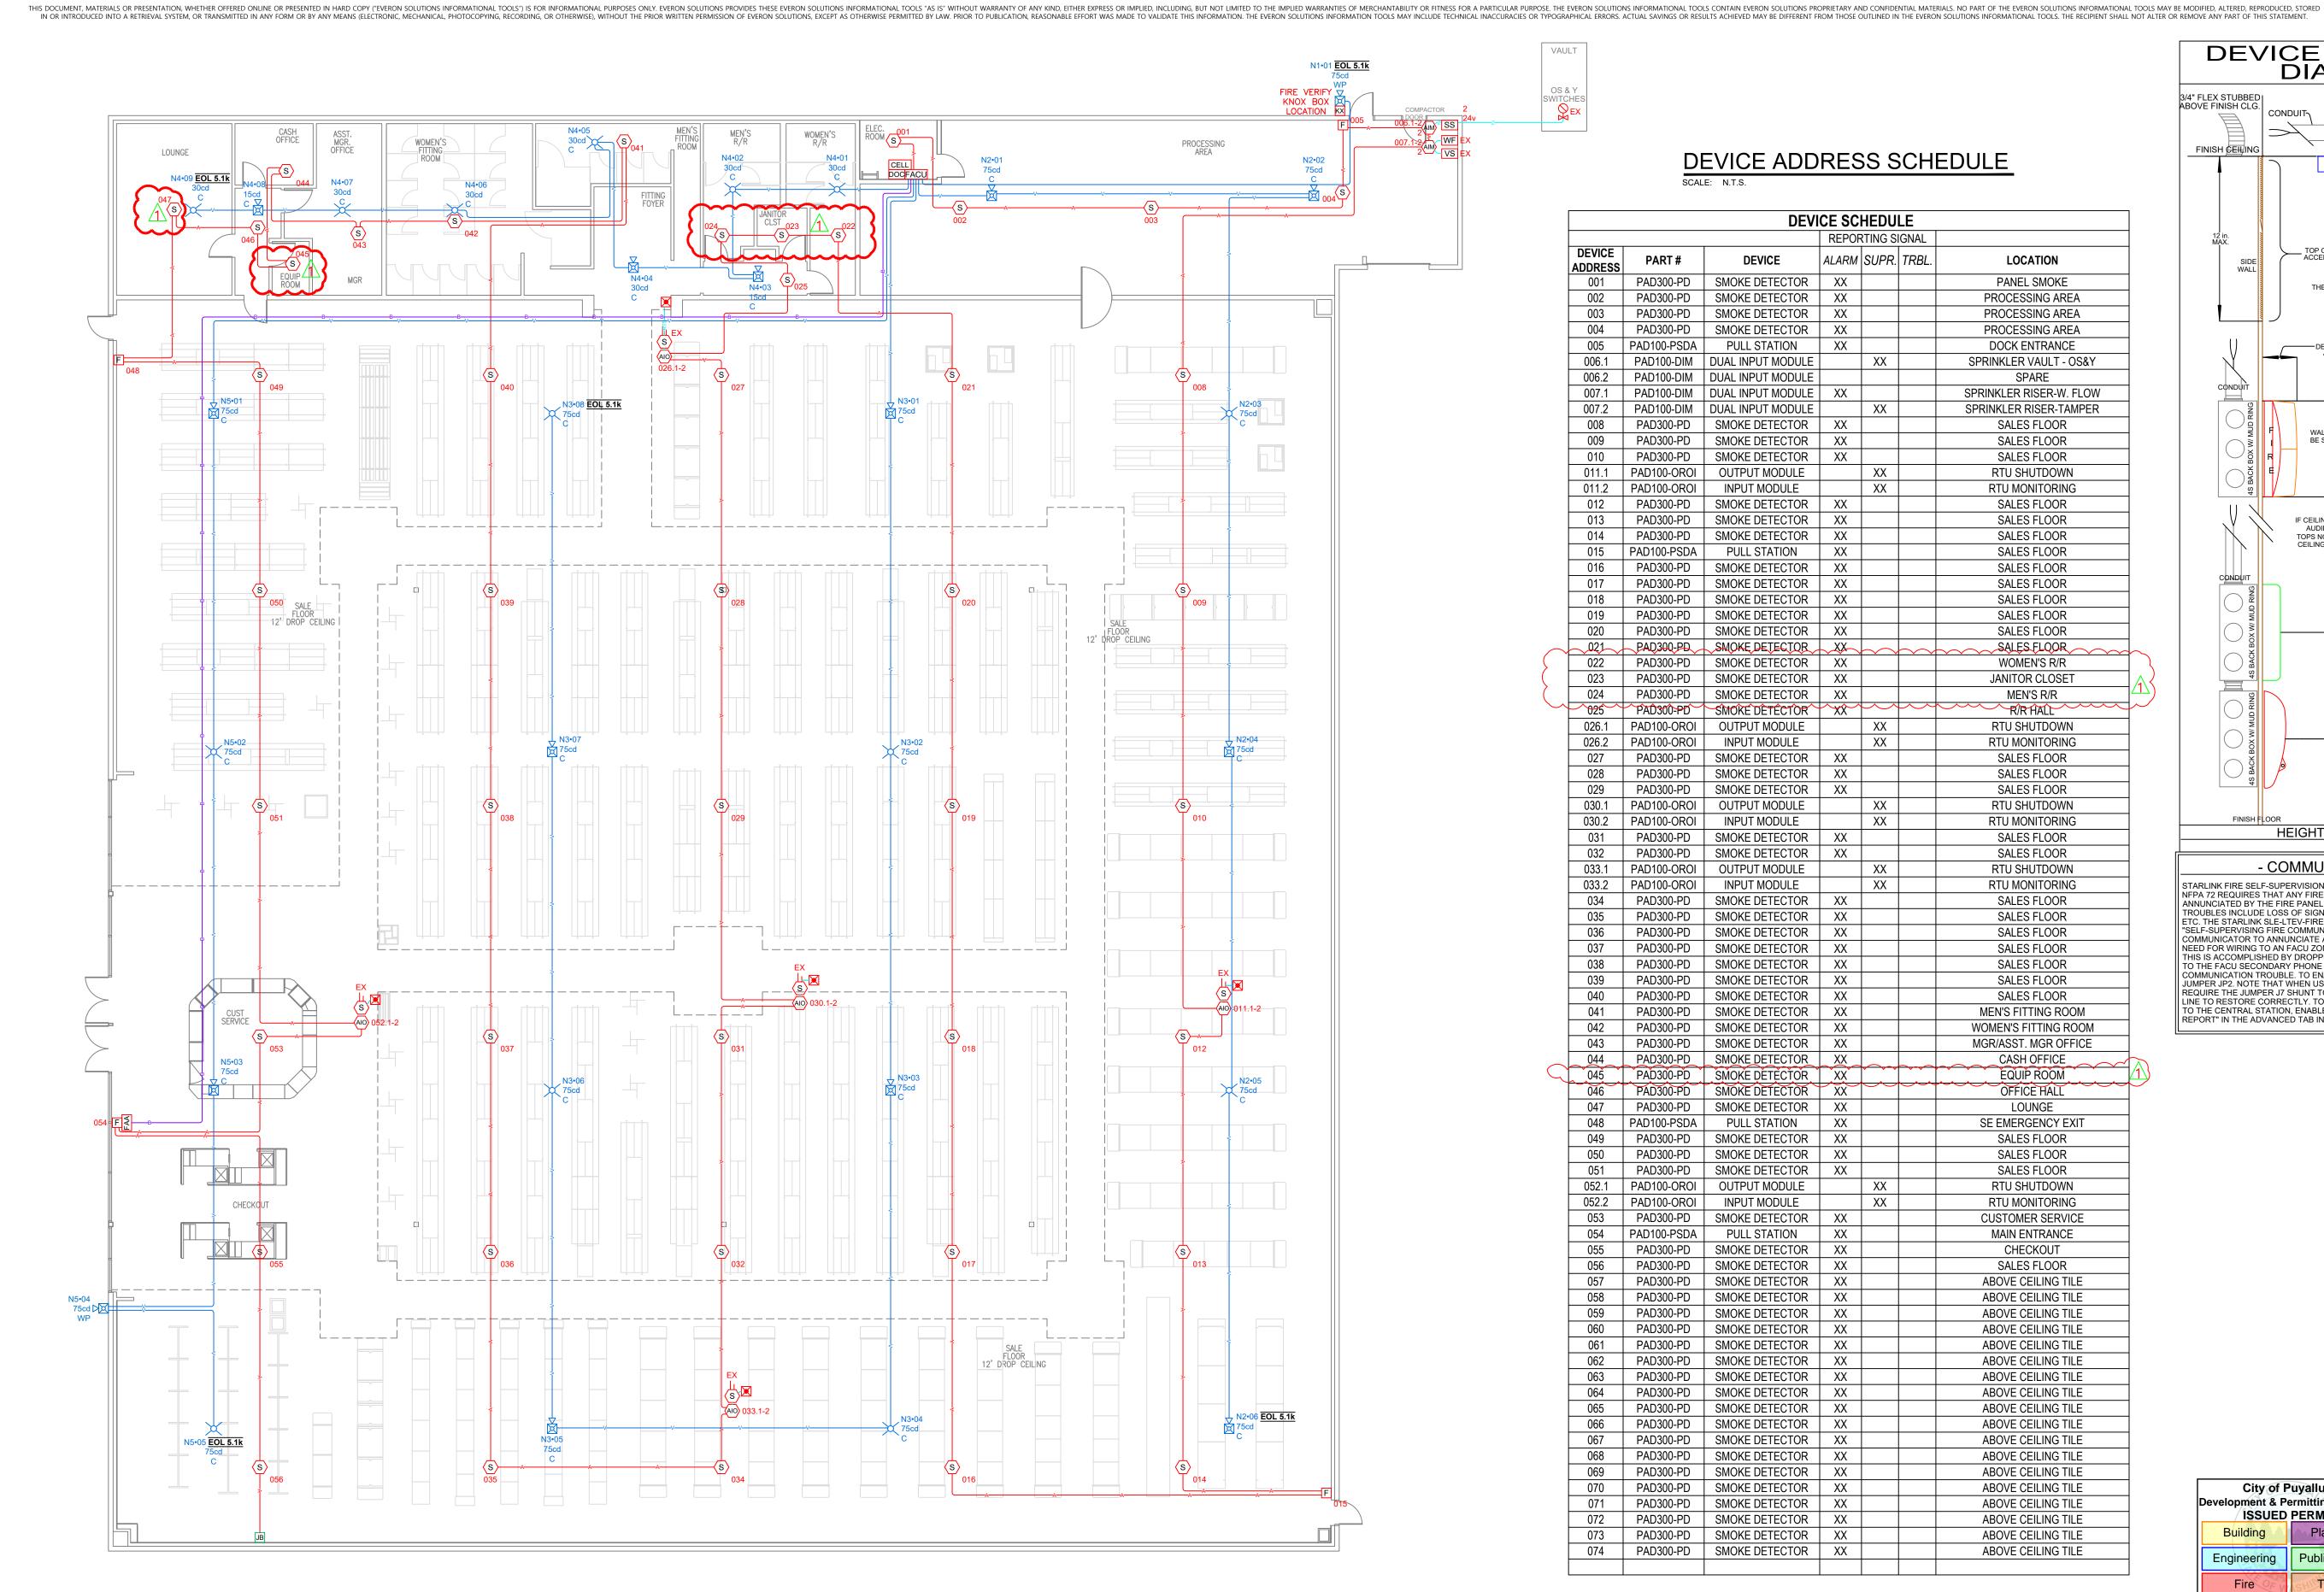

FLOOR PLAN

SCALE: 3/32" = 1'

DEVICE ADDRESS SCHEDULE SCALE: N.T.S.

		DEVI	ICE SC	HEDU RTING S		
DEVICE	DADT#	DEVICE	ALARM			LOCATION
ADDRESS	PART#	DEVICE		SUPK.	IRBL.	LOCATION
001 002	PAD300-PD	SMOKE DETECTOR	XX			PANEL SMOKE
002	PAD300-PD PAD300-PD	SMOKE DETECTOR SMOKE DETECTOR	XX			PROCESSING AREA PROCESSING AREA
003	PAD300-PD	SMOKE DETECTOR	XX			PROCESSING AREA
005	PAD100-PSDA	PULL STATION	XX			DOCK ENTRANCE
006.1	PAD100-DIM	DUAL INPUT MODULE		XX		SPRINKLER VAULT - OS&Y
006.2	PAD100-DIM	DUAL INPUT MODULE				SPARE
007.1	PAD100-DIM	DUAL INPUT MODULE	XX			SPRINKLER RISER-W. FLOW
007.2	PAD100-DIM	DUAL INPUT MODULE	201	XX		SPRINKLER RISER-TAMPER
008	PAD300-PD	SMOKE DETECTOR	XX			SALES FLOOR
009 010	PAD300-PD PAD300-PD	SMOKE DETECTOR SMOKE DETECTOR	XX			SALES FLOOR SALES FLOOR
010	PAD100-PD	OUTPUT MODULE		XX		RTU SHUTDOWN
011.2	PAD100-OROI	INPUT MODULE		XX		RTU MONITORING
012	PAD300-PD	SMOKE DETECTOR	XX			SALES FLOOR
013	PAD300-PD	SMOKE DETECTOR	XX			SALES FLOOR
014	PAD300-PD	SMOKE DETECTOR	XX			SALES FLOOR
015	PAD100-PSDA	PULL STATION	XX			SALES FLOOR
016	PAD300-PD	SMOKE DETECTOR	XX			SALES FLOOR
017	PAD300-PD	SMOKE DETECTOR	XX			SALES FLOOR
018 019	PAD300-PD PAD300-PD	SMOKE DETECTOR SMOKE DETECTOR	XX			SALES FLOOR SALES FLOOR
020	PAD300-PD	SMOKE DETECTOR	XX			SALES FLOOR SALES FLOOR
021	PAD300-PD	SMOKE DETECTOR	XX			SALES FLOOR
022	PAD300-PD	SMOKE DETECTOR	XX			WOMEN'S R/R
023	PAD300-PD	SMOKE DETECTOR	XX			JANITOR CLOSET
024	PAD300-PD	SMOKE DETECTOR	XX			MEN'S R/R
025	PAD300-PD	SMOKE DETECTOR	XX	<u> </u>		RÎR ĤALL
026.1	PAD100-OROI	OUTPUT MODULE		XX		RTU SHUTDOWN
026.2	PAD100-OROI	INPUT MODULE	V/V/	XX		RTU MONITORING
027 028	PAD300-PD PAD300-PD	SMOKE DETECTOR SMOKE DETECTOR	XX			SALES FLOOR SALES FLOOR
028	PAD300-PD	SMOKE DETECTOR	XX			SALES FLOOR SALES FLOOR
030.1	PAD100-OROI	OUTPUT MODULE		XX		RTU SHUTDOWN
030.2	PAD100-OROI	INPUT MODULE		XX		RTU MONITORING
031	PAD300-PD	SMOKE DETECTOR	XX			SALES FLOOR
032	PAD300-PD	SMOKE DETECTOR	XX			SALES FLOOR
033.1	PAD100-OROI	OUTPUT MODULE		XX		RTU SHUTDOWN
033.2	PAD100-OROI	INPUT MODULE		XX		RTU MONITORING
034	PAD300-PD	SMOKE DETECTOR	XX			SALES FLOOR
035 036	PAD300-PD PAD300-PD	SMOKE DETECTOR SMOKE DETECTOR	XX			SALES FLOOR SALES FLOOR
030	PAD300-PD	SMOKE DETECTOR	XX			SALES FLOOR SALES FLOOR
038	PAD300-PD	SMOKE DETECTOR	XX			SALES FLOOR
039	PAD300-PD	SMOKE DETECTOR	XX			SALES FLOOR
040	PAD300-PD	SMOKE DETECTOR	XX			SALES FLOOR
041	PAD300-PD	SMOKE DETECTOR	XX			MEN'S FITTING ROOM
042	PAD300-PD	SMOKE DETECTOR	XX			WOMEN'S FITTING ROOM
043	PAD300-PD	SMOKE DETECTOR	XX			MGR/ASST. MGR OFFICE
044	PAD300-PD	SMOKE DETECTOR	XX	~~		CASH OFFICE
045	PAD300-PD	SMOKE DETECTOR	XX	<u> </u>		ĚQŮIP ŘOĎM
046 047	PAD300-PD PAD300-PD	SMOKE DETECTOR SMOKE DETECTOR	XX			OFFICE HALL LOUNGE
047	PAD300-PD PAD100-PSDA	PULL STATION	XX			SE EMERGENCY EXIT
040	PAD300-PD	SMOKE DETECTOR	XX			SALES FLOOR
050	PAD300-PD	SMOKE DETECTOR	XX			SALES FLOOR
051	PAD300-PD	SMOKE DETECTOR	XX			SALES FLOOR
052.1	PAD100-OROI	OUTPUT MODULE		XX		RTU SHUTDOWN
052.2	PAD100-OROI	INPUT MODULE		XX		RTU MONITORING
053	PAD300-PD	SMOKE DETECTOR	XX			CUSTOMER SERVICE
054	PAD100-PSDA	PULL STATION	XX			MAIN ENTRANCE
055 056	PAD300-PD PAD300-PD	SMOKE DETECTOR SMOKE DETECTOR	XX			CHECKOUT SALES FLOOR
056	PAD300-PD PAD300-PD	SMOKE DETECTOR SMOKE DETECTOR	XX			ABOVE CEILING TILE
057	PAD300-PD	SMOKE DETECTOR	XX			ABOVE CEILING TILE ABOVE CEILING TILE
059	PAD300-PD	SMOKE DETECTOR	XX			ABOVE CEILING TILE
060	PAD300-PD	SMOKE DETECTOR	XX			ABOVE CEILING TILE
061	PAD300-PD	SMOKE DETECTOR	XX			ABOVE CEILING TILE
062	PAD300-PD	SMOKE DETECTOR	XX			ABOVE CEILING TILE
063	PAD300-PD	SMOKE DETECTOR	XX			ABOVE CEILING TILE
064	PAD300-PD	SMOKE DETECTOR	XX			ABOVE CEILING TILE
065	PAD300-PD	SMOKE DETECTOR	XX			ABOVE CEILING TILE
066	PAD300-PD	SMOKE DETECTOR	XX			ABOVE CEILING TILE
067 068	PAD300-PD	SMOKE DETECTOR	XX			ABOVE CEILING TILE
068	PAD300-PD PAD300-PD	SMOKE DETECTOR SMOKE DETECTOR	XX		 	ABOVE CEILING TILE ABOVE CEILING TILE
070	PAD300-PD PAD300-PD	SMOKE DETECTOR	XX			ABOVE CEILING TILE ABOVE CEILING TILE
070	PAD300-PD	SMOKE DETECTOR	XX			ABOVE CEILING TILE
072	PAD300-PD	SMOKE DETECTOR	XX			ABOVE CEILING TILE
073	PAD300-PD	SMOKE DETECTOR	XX			ABOVE CEILING TILE
07/	PΔD300-PD	SMOKE DETECTOR	XX			ABOVE CEILING TILE

074 PAD300-PD

SMOKE DETECTOR XX

DEV	/ICE MOUNTING DIAGRAM
3/4" FLEX STUBBED ABOVE FINISH CLG. FINISH CEILING	
12 in. MAX. SIDE WALL	TOP OF DETECTOR ACCEPTABLE HERE NOTE: MEASUREMENTS SHOWN ARE TO THE CLOSEST EDGE OF THE DETECTOR SPOT DETECTOR MOUNTING DETAIL -NFPA 72 2019 FIG A-17.6.3.1.3.1
CONDUIT	DEVICE TO PROTRUDE NO MORE THAN 4" IF IN CORRIDORS AND WALKWAYS.
4S BACK BOX W/ MUD RING	NOTIFICATION APPLIANCE WALL MOUNTED VISUAL DEVICES SHALL BE SUCH THAT THE ENTIRE LENS IS NOT LESS THAN 80" AND NOT GREATER THAN 96" A.F.FNFPA 72 2019 SECTION 18.5.5.1
CONDUIT	IF CEILING HEIGHTS ALLOW, WALL MOUNTED AUDIBLE APPLIANCES SHALL HAVE THEIR TOPS NOT LESS THAN 90" A.F. F. AND BELOW CEILING HEIGHTS AT HEIGHTS OF NOT LESS THAN 6". -NFPA 72 2019 ED. SECTION 18.5.5.2
4S BACK BOX W/ MUD	ANNUNCIATOR/KEYPAD TO BE MOUNTED BETWEEN 48"-54"
4S BACK BOX W/ MUD RING	MANUAL PULL STATION OPERATING HANDLE TO BE BETWEEN 42-48 INCHES -NFPA 72 2019 SECTION 17.14.5
FINISH F	LOOR THEIGHT REQUIREMENTS

STARLINK FIRE SELF-SUPERVISION NFPA 72 REQUIRES THAT ANY FIRE COMMUNICATOR TROUBLE BE LOCALLY
ANNUNCIATED BY THE FIRE PANEL WITHIN 200 SECONDS OF THE TROUBLE. THE
TROUBLES INCLUDE LOSS OF SIGNAL, NOC SUPERVISION CHECKING FAILURE,
ETC. THE STARLINK SLE-LTEV-FIRE FIRE COMMUNICATOR MODELS INCLUDE A
"SELF-SUPERVISING FIRE COMMUNICATOR" FEATURE THAT ALLOWS THE COMMUNICATOR TO ANNUNCIATE A COMMUNICATION TROUBLE WITHOUT THE NEED FOR WIRING TO AN FACU ZONE INPUT OR ANY FACU REPROGRAMMING.
THIS IS ACCOMPLISHED BY DROPPING THE EMULATED PHONE LINE VOLTAGE TO THE FACU SECONDARY PHONE LINE, CAUSING THE FACU TO ANNUNCIATE A COMMUNICATION TROUBLE. TO ENABLE SELF-SUPERVISION, SIMPLY REMOVE JUMPER JP2. NOTE THAT WHEN USING SELF-SUPERVISION, SOME FACUS MAY REQUIRE THE JUMPER J7 SHUNT TO BE REMOVED FOR THE PRIMARY PHONE LINE TO RESTORE CORRECTLY. TO ALSO REPORT A COMMUNICATOR TROUBLE TO THE CENTRAL STATION, ENABLE THE FEATURE "TIP/RING WIRING FAULT REPORT" IN THE ADVANCED TAB IN THE STARLINK NOC.

WEB: EVERONSOLUTIONS.COM ROSS #0593 4102 S MERIDIAN, SUITE C PUYALLUP, WA 98373 FIRE ALARM SYSTEM This fire alarm shop drawing was prepared for equipment application only. The information contained herein is intended to aid in the installation of this system. No design changes have been made to the engineer of record's contract documents. Milissa A Johnson William Wolfen Milcet #147320
FIRE ALARM SYSTEMS LVL III
EXPIRES 05/01/2027 12/9/2024 NOT TO SCALE - COMMUNICATOR NOTE -

		ATION LISTING No. Vol. No. 2684 20								
	REVISIONS									
NO.	DATE	REVISION								
Δ	12/9/2024 BY: MAJ	- FOR PERMIT								
⚠	1/17/2024 BY: MAJ	-F.M. REJECTION: CHANGE ALL HEATS TO SMOKES, ADD 4 SMOKES.								
2	BY:	-								
<u>\$</u>	BY:	-								
4	BY:	-								
Ŝ	- BY:	-								
COI	DES ADOPTEI	d by local ahj								

ever On "

BRANCH #66955 600 OAKESDALE AVE SW, SUITE 100

RENTON WA 98057

844-538-3766

2021 WASHINGTON STATE BUILDING CODE 2021 WASHINGTON STATE EX. BUILDING CODE 2021 WASHINGTON STATE FIRE CODE 2023 WASHINGTON STATE ELECTRICAL CODE

2019 NFPA 72

evelopment & Permitting Services ISSUED PERMIT Engineering Public Works

City of P REVIEW COMPLI 7:56:32 AM

ABOVE CEILING TILE


approval of omissions or oversight by this office or noncompliance with any applicable regulations of local government. The contractor is responsible for making sure that the building complies with all applicable building codes and regulations of the local government.

F	Traffic		PREPARED BY:	M.A. JOHNSON
uyallup	THE APPROVED CONSTRUCTION		CHECKED BY:	D.J. TAYLOR
·e ·	PLANS AND ALL ENGINEERING		PROJECT MANAGER:	D. NEEDHAM
WED R	MUST BE POSTED ON THE JOB AT ALL INSPECTIONS IN A VISIBLE AND		DATE:	12/9/2024
IANCE	READILY ACCESSIBLE LOCATION.		PROJECT NO:	300325818
ake 2025	Approval of submitted plans is not an] •	TITLE:	

FLOORPLAN _ _ _ _ _ _ **ADDRESS SCHEDULE**

FA-1

© 2024 Everon Solutions. All rights reserved. The product/service names listed in this document are marks and/or registered marks of their respective owners and used under license. Unauthorized use strictly prohibited.

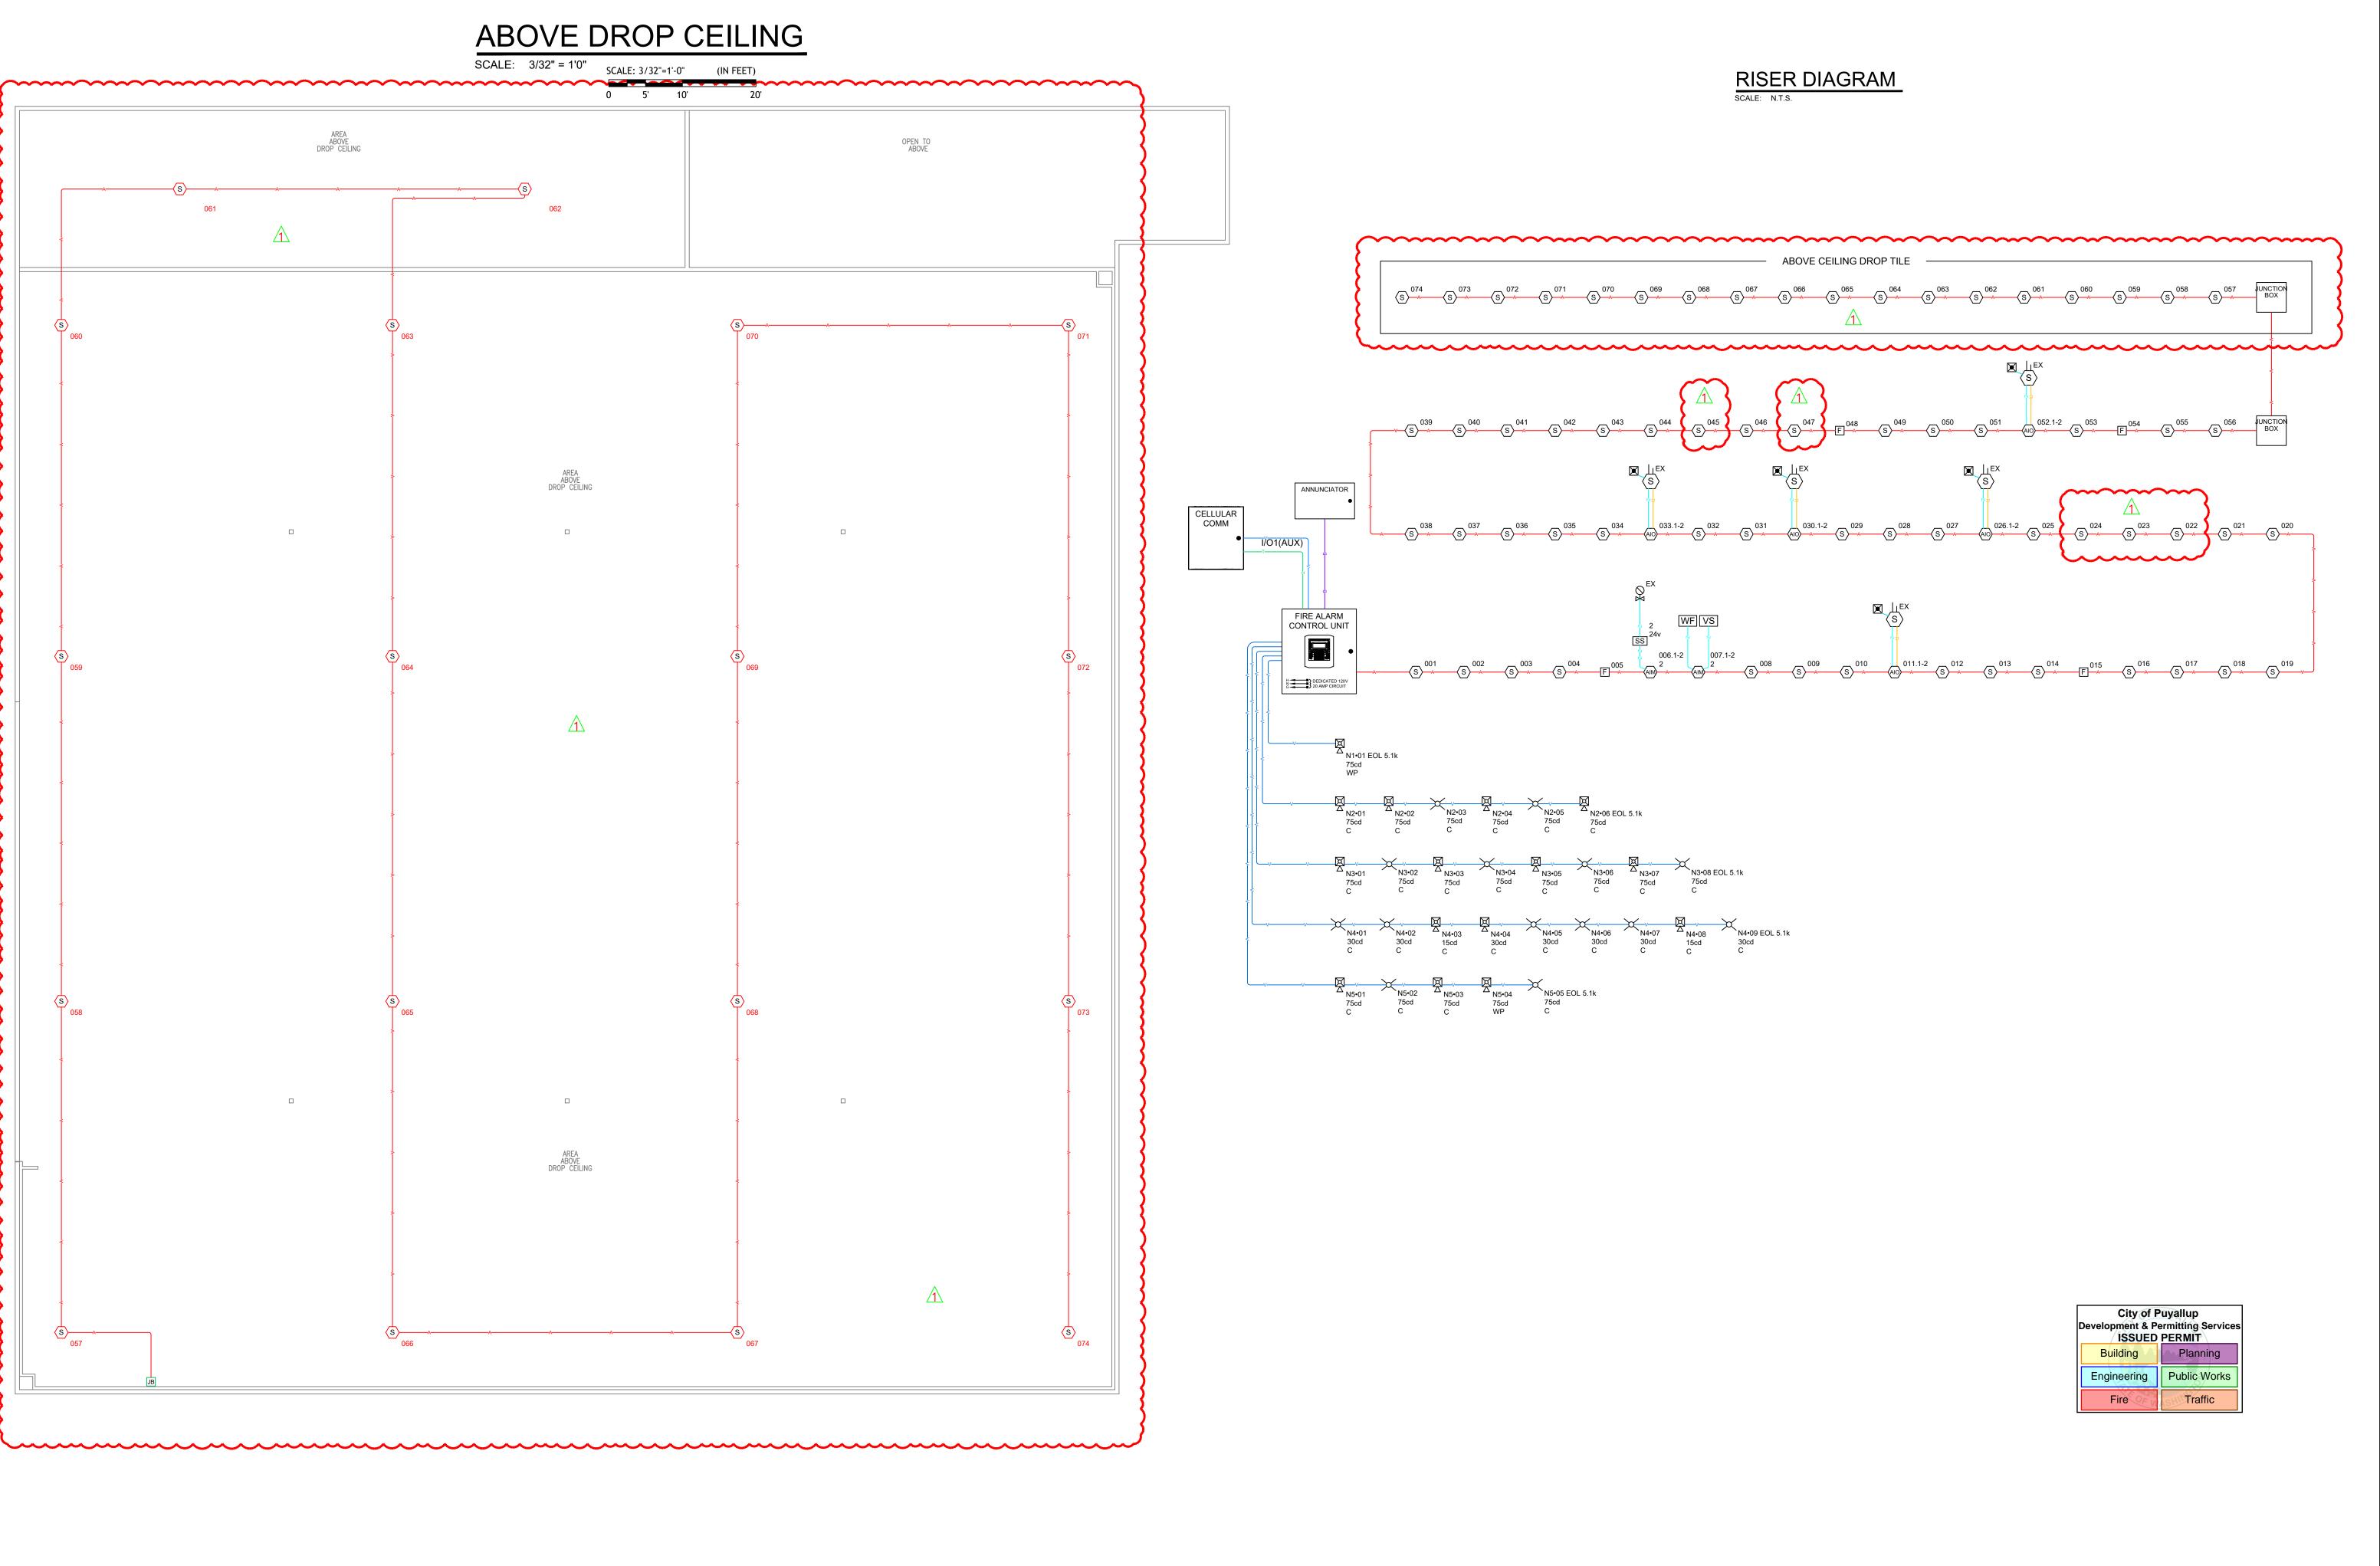

THIS DOCUMENT, MATERIALS OR PRESENTATION, WHETHER OFFERD ONLINE OR PRESENTED IN HARD COPY ("EVERON SOLUTIONS INFORMATIONAL TOOLS") IS FOR INFORMATIONAL TOOLS "AS IS" WITHOUT WARRANTY OF ANY KIND, EITHER EVERON SOLUTIONS INFORMATIONAL TOOLS "AS IS" WITHOUT WARRANTY OF ANY KIND, EITHER EVERON SOLUTIONS INFORMATIONAL TOOLS") IS FOR INFORMATIONAL TOOLS "AS IS" WITHOUT WARRANTY OF ANY KIND, EITHER EVERON SOLUTIONS INFORMATIONAL TOOLS "AS IS" WITHOUT WARRANTY OF ANY KIND, EITHER EVERON SOLUTIONS INFORMATIONAL TOOLS "AS IS" WITHOUT WARRANTY OF ANY KIND, EITHER EVERON SOLUTIONS INFORMATIONAL TOOLS "AS IS" WITHOUT THE EVERON SOLUTIONS INFORMATION INFORMAT

ever n

BRANCH #66955
600 OAKESDALE AVE SW,
SUITE 100
RENTON WA 98057

844-538-3766 WEB: EVERONSOLUTIONS.COM



ROSS #0593 4102 S MERIDIAN, SUITE C PUYALLUP, WA 98373

FIRE ALARM SYSTEM

This fire alarm shop drawing was prepared for equipment application only. The information contained herein is intended to aid in the installation of this system. No design changes have been made to the engineer of record's contract documents.

Milissa A Johnson With White White NICET #147320
FIRE ALARM SYSTEMS LVL III
EXPIRES 05/01/2027 12/9/2024

CENTRAL STATION LISTING
CCN File No. Vol. No.
UUFX S2684 20

REVISIONS

NO. DATE REVISION

A 12/9/2024 PY: MAJ - FOR PERMIT

CODES ADOPTED BY LOCAL AHJ

2021 WASHINGTON STATE BUILDING CODE

2021 WASHINGTON STATE EX. BUILDING CODE

2021 WASHINGTON STATE FIRE CODE

2023 WASHINGTON STATE ELECTRICAL CODE

2019 NFPA 72

PREPARED BY: M.A. JOHNSON

CHECKED BY: D.J. TAYLOR
PROJECT
MANAGER: D. NEEDHAM
DATE: 12/9/2024

PROJECT NO: 300325818

TITLE:
FLOOR PLAN

RISER DIAGRAM

EET:

FA-2

© 2024 Everon Solutions. All rights reserved. The product/service names listed in this document are marks and/or registered marks of their respective owners and used under license. Unauthorized use strictly prohibited.

VOLTAGE DROP CALCS

							CIRCUIT SETTING	S	TOTALS	
							Starting Calculation Voltage:	20.40	Max. Voltage Drop:	0.11
		N1 POINT-TO-PO	Min. Operational Voltage:	16	End Of Line Voltage:	20.29				
			Max. Circuit Current (A):	3	Voltage Drop Percent:	0.52 %				
			Wire Resistance (Ω/kFt):	3.07	Total Circuit Current (A):	0.226				
С	ircuit Wiring Prop	erties: 'V' 14/2 FPLP/R NAC 14 AWG,	Total Circuit Length (Ft):	76	Spare Current (A):	2.77				
	Distance m	neasured using drawn segment length	Total Circuit Resistance (Ω):	0.4669	Spare Current (A) Percent:	92.47 %				
Device Label	Part No.	Description	Device Current (A)	Remaining Current (A)	Dist. From Previous (Ft)	Resistance From Previous (Ω)	Voltage Drop From Previous	Voltage At Device	Total Voltage Drop	Voltage Drop Percent
N1•01 EOL 5.1k	HS-24WR-WP	Outdoor Horn Strobe, Fixed 75 Candela, Standard Enclosure, Red	0.226	0.226	76	0.4669	0.11	20.29	0.11	0.52 %
Calculation Meth	ods:									
Resistance From F	Previous (Ω) = Wi	re Resistance (Ω/Ft) x 2 x Dist. From	Previous (Ft)							
Voltage Drop Fron	n Previous = Resi	istance From Previous (Ω) x Remainin	g Current (A)							

							CIRCUIT SETTING	SS	TOTALS	
							Starting Calculation Voltage:	20.40	Max. Voltage Drop:	0.830
		N2 POINT-TO-PC	Min. Operational Voltage:	16	End Of Line Voltage:	19.57				
			Max. Circuit Current (A):	3	Voltage Drop Percent:	4.06 %				
			Wire Resistance (Ω/kFt):	3.07	Total Circuit Current (A):	1.09				
Cir	rcuit Wiring Prop	erties: 'V' 14/2 FPLP/R NAC 14 AWG	Total Circuit Length (Ft):	239	Spare Current (A):	1.91				
	Distance m	leasured using drawn segment length	s with 10.00 %	additional lengt	h calculated		Total Circuit Resistance (Ω):	1.47	Spare Current (A) Percent:	63.53 %
Device Label	Part No.	Description	Device	Remaining	Dist. From	Resistance From	Voltage Drop From Previous	Voltage At	Total Voltage Drop	Voltage Dro
Device Laber	rait No.	Description	Current (A)	Current (A)	Previous (Ft)	Previous (Ω)	Voltage Brop From Frevious	Device		Percent
N2•01	CHS-24W	Horn Strobe, Ceiling, White 75cd	0.19	1.09	12	0.0745	0.08	20.32	0.08	0.40 %
N2•02	CHS-24W	Horn Strobe, Ceiling, White 75cd	0.19	0.9040	45	0.2744	0.25	20.07	0.33	1.62 %
N2•03	CS-24W	Strobe, Ceiling, White 75cd	0.167	0.7140	42	0.2579	0.18	19.89	0.510	2.52 %
N2•04	CHS-24W	Horn Strobe, Ceiling, White 75cd	0.19	0.5470	46	0.2853	0.16	19.73	0.670	3.28 %
N2•05	CS-24W	Strobe, Ceiling, White 75cd	0.167	0.357	48	0.2919	0.1	19.63	0.770	3.79 %
N2•06 EOL 5.1k	CHS-24W	Horn Strobe, Ceiling, White 75cd	0.19	0.19	46	0.2853	0.05	19.57	0.830	4.06 %
Calculation Metho	ods:									

Resistance From Previous (Ω) = Wire Resistance (Ω /Ft) x 2 x Dist. From Previous (Ft) Voltage Drop From Previous = Resistance From Previous (Ω) x Remaining Current (A)

							CIRCUIT SETTING	SS	TOTALS	
							Starting Calculation Voltage:	20.40	Max. Voltage Drop:	1.74
		N3 POINT-TO-POI	Min. Operational Voltage:	16	End Of Line Voltage:	18.66				
			Max. Circuit Current (A):	3	Voltage Drop Percent:	8.51 %				
			Wire Resistance (Ω/kFt):	3.07	Total Circuit Current (A):	1.43				
Circ	cuit Wiring Prope	rties: 'V' 14/2 FPLP/R NAC 14 AWG	Total Circuit Length (Ft):	364	Spare Current (A):	1.57				
	Distance me	easured using drawn segment length	s with 10.00 %	additional lengt	h calculated		Total Circuit Resistance (Ω):	2.23	Spare Current (A) Percent:	52.40 %
Device Label	Part No.	Description	Device Current (A)	Remaining Current (A)	Dist. From Previous (Ft)	Resistance From Previous (Ω)	Voltage Drop From Previous	Voltage At Device	Total Voltage Drop	Voltage Drop Percent
N3•01	CHS-24W	Horn Strobe, Ceiling, White 75cd	0.19	1.43	35	0.2146	0.31	20.09	0.31	1.50 %
N3•02	CS-24W	Strobe, Ceiling, White 75cd	0.167	1.24	47	0.2904	0.36	19.73	0.670	3.26 %
N3•03	CHS-24W	Horn Strobe, Ceiling, White 75cd	0.19	1.07	46	0.2853	0.31	19.43	0.970	4.76 %
N3•04	CS-24W	Strobe, Ceiling, White 75cd	0.167	0.8810	47	0.2904	0.26	19.17	1.23	6.02 %
N3•05	CHS-24W	Horn Strobe, Ceiling, White 75cd	0.19	0.7140	47	0.2905	0.21	18.97	1.43	7.03 %
N3•06	CS-24W	Strobe, Ceiling, White 75cd	0.167	0.5240	46	0.2853	0.15	18.82	1.58	7.77 %
N3•07	CHS-24W	Horn Strobe, Ceiling, White 75cd	0.19	0.357	47	0.2904	0.1	18.71	1.69	8.27 %
N3•08 EOL 5.1k	CS-24W	Strobe, Ceiling, White 75cd	0.167	0.167	46	0.2853	0.05	18.66	1.74	8.51 %
									<u> </u>	

Resistance From Previous (Ω) = Wire Resistance (Ω /Ft) x 2 x Dist. From Previous (Ft)
Voltage Drop From Previous	= Resistance From Previous (Ω) x Remaining Current (A)

Voltage Drop From Previous = Resistance From Previous (Ω) x Remaining Current (A)


Voltage Drop From Previous = Resistance From Previous (Ω) x Remaining Current (A)

							CIRCUIT SETTING	GS	TOTALS	
							Starting Calculation Voltage:	20.40	Max. Voltage Drop:	0.49
		N4 POINT-TO-PC	Min. Operational Voltage:	16	End Of Line Voltage:	19.91				
			Max. Circuit Current (A):	3	Voltage Drop Percent:	2.39 %				
			Wire Resistance (Ω/kFt):	3.07	Total Circuit Current (A):	1.02				
Circuit Wiring Properties: 'V' 14/2 FPLP/R NAC 14 AWG, 2 Cond. Solid Copper FPLP/R Analog Unshielded							Total Circuit Length (Ft):	140	Spare Current (A):	1.98
Distance measured using drawn segment lengths with 10.00 % additional length calculated						Total Circuit Resistance (Ω):	0.8570	Spare Current (A) Percent:	66.13 %	
Device Label	Part No.	Description	Device Current (A)	Remaining Current (A)	Dist. From Previous (Ft)	Resistance From Previous (Ω)	Voltage Drop From Previous	Voltage At Device	Total Voltage Drop	Voltage Drop Percent
N4•01	CS-24W	Strobe, Ceiling, White 30cd	0.101	1.02	11	0.0681	0.07	20.33	0.07	0.34 %
N4•02	CS-24W	Strobe, Ceiling, White 30cd	0.101	0.9150	14	0.0866	0.08	20.25	0.15	0.73 %
N4•03	CHS-24W	Horn Strobe, Ceiling, White 15cd	0.143	0.8140	14	0.0841	0.07	20.18	0.22	1.06 %
N4•04	CHS-24W	Horn Strobe, Ceiling, White 30cd	0.124	0.6710	17	0.1047	0.07	20.11	0.29	1.41 %
N4•05	CS-24W	Strobe, Ceiling, White 30cd	0.101	0.5470	21	0.1303	0.07	20.04	0.36	1.76 %
N4•06	CS-24W	Strobe, Ceiling, White 30cd	0.101	0.446	26	0.1593	0.07	19.97	0.43	2.11 %
N4•07	CS-24W	Strobe, Ceiling, White 30cd	0.101	0.345	17	0.1065	0.04	19.93	0.47	2.29 %
N4•08	CHS-24W	Horn Strobe, Ceiling, White 15cd	0.143	0.244	11	0.0673	0.02	19.92	0.48	2.37 %
N4•09 EOL 5.1k	CS-24W	Strobe, Ceiling, White 30cd	0.101	0.101	8	0.0501	0.01	19.91	0.49	2.39 %
Calculation Metho	ds:									
Resistance From Pi	revious (Ω) = Wire	e Resistance (Ω/Ft) x 2 x Dist. From I	Previous (Ft)							

			CIRCUIT SETTING	es	TOTALS					
							Starting Calculation Voltage:	20.40	Max. Voltage Drop:	1.28
		N5 POINT-TO-PO	INT REP	ORT			Min. Operational Voltage:	16	End Of Line Voltage:	19.12
							Max. Circuit Current (A):	3	Voltage Drop Percent:	6.28 %
			Wire Resistance (Ω/kFt):	3.07	Total Circuit Current (A):	0.940				
С	ircuit Wiring Prope	erties: 'V' 14/2 FPLP/R NAC 14 AWG,	Total Circuit Length (Ft):	301	Spare Current (A):	2.06				
	Distance me	easured using drawn segment lengths	Total Circuit Resistance (Ω):	1.85	Spare Current (A) Percent:	68.67 %				
Device Label	Part No.	Description	Device Current (A)	Remaining Current (A)	Dist. From Previous (Ft)	Resistance From Previous (Ω)	Voltage Drop From Previous	Voltage At Device	Total Voltage Drop	Voltage Drop Percent
N5•01	CHS-24W	Horn Strobe, Ceiling, White 75cd	0.19	0.940	131	0.80470	0.760	19.64	0.760	3.71 %
N5•02	CS-24W	Strobe, Ceiling, White 75cd	0.167	0.750	47	0.2904	0.22	19.43	0.970	4.78 %
N5•03	CHS-24W	Horn Strobe, Ceiling, White 75cd	0.19	0.5830	46	0.2853	0.17	19.26	1.14	5.59 %
N5•04	HS-24WR-WP	Outdoor Horn Strobe, Fixed 75 Candela, Standard Enclosure, Red	0.226	0.393	45	0.2771	0.11	19.15	1.25	6.13 %
N5•05 EOL 5.1k	CS-24W	Strobe, Ceiling, White 75cd	0.167	0.167	31	0.1929	0.03	19.12	1.28	6.28 %
Calculation Metho		D : 1 (0/E) 0 D: 1 E	· /F:							
kesistance From F	revious (()) = Wire	e Resistance (Ω/Ft) x 2 x Dist. From P	revious (Ft)							

AFC-1000 BATTERY CALCS

				AFC-1000 (SECONDARY POWER SOURCE	REQUIREMENTS	5)			
			PANEL POWE	R SUPPLY MAX CURRENT = 10A			(IN ALARM) = 5.3184A (53.1		
		OT)(D.1 D.T. V.G		STANDBY CURREN		SECONDARY ALARM CURRENT (AMP		
PA	NEL	QTY	PART NO.	DESCRIPTION Fire Alarm Control Panel Main Board	CURRENT DRAW (A)	TOTAL (A)	CURRENT DRAW (A)	TOTAL	
COMP	ONENTS	1	AFC-1000 Main Board UD-2000	PFC Series Digital Alarm Communicator Transmitter	0.13 0.016	0.13 0.016	0.22 0.023	0.22 0.023	
CIRCUIT	SYMBOL	QTY	PART NO	DESCRIPTION	CURRENT DRAW (A)	TOTAL (A)	CURRENT DRAW (A)	TOTAL (A)	
I/O 1 (NAC)	CELL	1	SLE-MAX2-FIRE	Universal Fire Communicator, Dual SIM, Dual Path, Panel-Powered Technology, ABS Plastic Housing	0.085	0.085	0.325	0.325	
	AIM 2	2	PAD100-DIM	Dual Input Module	0.0002	0.0005	0.0002	0.0005	
L1	5 PAD100-OROI		PAD100-OROI	One Relay One Input Module	0.0002	0.0012	0.0002	0.0012	
	F	4	PAD100-PSDA	Addressable Pull Station Dual Action	0.0002	0.0008	0.0002	0.0008	
	(s)	63	PAD300-PD w/PAD300-6DB	Photoelectric Smoke Detector with 6" Standard Base	0.0003	0.0189	0.0003	0.0189	
N1	₩P	1	HS-24WR-WP	Outdoor Horn Strobe, Fixed 75 Candela, Standard Enclosure, Red 75cd	0	0	0.226	0.226	
N2	⊠c	4	CHS-24W	Horn Strobe, Ceiling, White 75cd	0	0	0.19	0.760	
INZ	\rtimes_{c}	2	CS-24W	Strobe, Ceiling, White 75cd	0	0	0.167	0.334	
N3	⊠c	4	CHS-24W	Horn Strobe, Ceiling, White 75cd	0	0	0.19	0.760	
NO	\rtimes_{c}	C 4 CS-24W		Strobe, Ceiling, White 75cd	0	0	0.167	0.6680	
	₽c	1	CHS-24W	Horn Strobe, Ceiling, White 30cd	0	0	0.124	0.124	
N4	v V C	2	CHS-24W	Horn Strobe, Ceiling, White 15cd	0	0	0.143	0.286	
	\rtimes_{c}	6	CS-24W	Strobe, Ceiling, White 30cd	0	0	0.101	0.6060	
	₩ c	2	CHS-24W	Horn Strobe, Ceiling, White 75cd	0	0	0.19	0.38	
N5	\rtimes_{c}	2	CS-24W	Strobe, Ceiling, White 75cd	0	0	0.167	0.334	
	₩ _{WP}	1	HS-24WR-WP	Outdoor Horn Strobe, Fixed 75 Candela, Standard Enclosure, Red 75cd	0	0	0.226	0.226	
P-LINK	FAA	1	RA-6500	160 Character LCD Annunciator	0.02	0.02	0.025	0.025	
					TOTAL STANDBY (A)	0.2724	TOTAL ALARM (A)	5.32	
							IDBY TIME = 24 HOURS		
	SECONDAR	ΑΤΡ. ΥΓ	NDRY I OAD (A)	0.2724	24	KEQUIKED ALA	RM TIME = 5 MINUTES 6.54		
SECONDARY STANDBY LOAD (A) 0.2724 SECONDARY ALARM LOAD (A) 5.32				0.08 0.44					
STANDE			JBTOTAL (AMP HOURS)	0.02	0.00		6.98		
			FACTOR				1.25		
SECOND	ARY LOAD	REQUI	REMENTS (AMP HOURS)				8.73		
				PROVIDE (2) 12V 18AH BATTERIES					

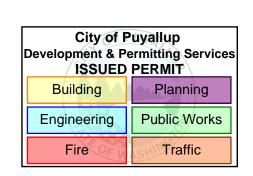

ever On ** BRANCH #66955

600 OAKESDALE AVE SW, SUITE 100 RENTON WA 98057

WEB: EVERONSOLUTIONS.COM

844-538-3766

ROSS #0593 4102 S MERIDIAN, SUITE C PUYALLUP, WA 98373

FIRE ALARM SYSTEM

This fire alarm shop drawing was prepared for equipment application only. The information contained herein is intended to aid in the installation of this system. No design changes have been made to the engineer of record's contract documents.

Milissa A Johnson William Oldern Milcet #147320 FIRE ALARM SYSTEMS LVL III EXPIRES 05/01/2027 12/9/2024

CENTRAL STATION LISTING
CCN File No. Vol. No.
UUFX S2684 20 REVISIONS

NO. DATE REVISION - FOR PERMIT 1/17/2024 PY: MAJ SMOKES, ADD 4 SMOKES. <u>BY: ___</u> BY: ___ BY: ___ BY: ___

CODES ADOPTED BY LOCAL AHJ 2021 WASHINGTON STATE BUILDING CODE 2021 WASHINGTON STATE EX. BUILDING CODE 2021 WASHINGTON STATE FIRE CODE 2023 WASHINGTON STATE ELECTRICAL CODE 2019 NFPA 72

PREPARED BY: M.A. JOHNSON

D.J. TAYLOF CHECKED BY: D. NEEDHAM 12/9/2024

BATTERY CALCS

300325818

PROJECT NO:

FA-3

THIS DOCUMENT, MATERIALS OR PRESENTATION, WHETHER OFFERED ONLINE OR PRESENTED IN HARD COPY ("EVERON SOLUTIONS INFORMATIONAL TOOLS") IS FOR INFORMATIONAL TOOLS") IS FOR INFORMATIONAL PURPOSES ONLY. EVERON SOLUTIONS PROVIDES THEE EVERON SOLUTIONS PROVIDES THE EVERON SOLUTIONS INFORMATIONAL TOOLS "AS IS" WITHOUT WARRANTY OF ANY KIND, EITHER EXPRESS OR IMPLIED, INCLUDING, BUT NOT LIMITED TO THE IMPLIED WARRANTIES OF MERCHANTABILITY OR FITNESS FOR A PARTICULAR PURPOSE. THE EVERON SOLUTIONS INFORMATIONAL TOOLS CONTAIN EVERON SOLUTIONS PROPRIETARY AND CONFIDENTIAL MATERIALS. NO PART OF THE EVERON SOLUTIONS, MECHANICAL, PHOTOCOPYING, RECORDING, OR OTHERWISE), WITHOUT THE PRIOR WRITTEN PERMISSION OF EVERON SOLUTIONS, PROPRIETARY AND CONFIDENTIAL MATERIALS. EXCEPT AS OTHERWISE PERMITTED BY LAW. PRIOR TO PUBLICATION, REASONABLE EFFORT WAS MADE TO VALIDATE THIS INFORMATION. THE EVERON SOLUTIONS INFORMATION TOOLS MAY INCLUDE TECHNICAL INACCURACIES OR TYPOGRAPHICAL ERRORS. ACTUAL SAVINGS OR RESULTS ACHIEVED MAY BE DIFFERENT FROM THOSE OUTLINED IN THE EVERON SOLUTIONS INFORMATIONAL TOOLS. THE RECIPIENT SHALL NOT ALTER OR REMOVE ANY PART OF THIS STATEMENT.