
PROJECT MAP:

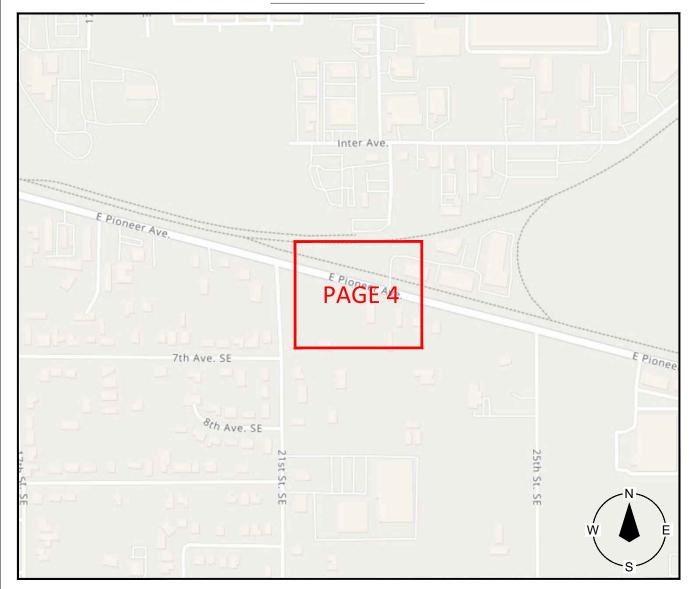

POLE INFORMATION: POLE COUNT = 2 TRANSMISSION = 1 POLES THAT NEED PERMIT = 2 DISTRIBUTION = 1 POLES THAT NEED MAKE READY = 2 DISTRIBUTION = 1

The City does not review, approve, authorize, or permit work in the BNSF Railway right-of-way. The applicant and permit holder are responsible to obtain the necessary permits from the jurisdictional agencies to complete this work. A BNSF Railway Company Pipeline or Wire Line permit may be required. The applicant or permit holder shall present a copy of the BNSF permit upon request of the City Inspector.

POWER MR

25-923

TK 6338160



SITE ADDRESS:

2202 E PIONEER PUYALLUP WA 98372



CONTACTS:

CANNON COMPANIES

Sam Sartain - (253) 363-7384 - ssartain@teamcannon.com

SCOPE OF WORK:

- POWER MAKE-READY (MAINTENANCE) AT 2 PSE POLES TO MEET NESC STANDARDS

SHEET INDEX

- 1 COVER
- 2 GENERAL NOTES
- 3 LEGEND
- 4 CONSTRUCTION PLAN

City of Puyallup evelopment & Permitting Services ISSUED PERMIT	
Building	Planning
Engineering	Public Works
Fire OF W	Traffic

STANDARD

- 1. THE LOCATIONS OF UTILITIES SHOWN ON THE PLANS ARE APPROXIMATE. ALL UTILITY LOCATIONS SHALL BE VERIFIED PRIOR TO CONSTRUCTION. THE CONTRACTOR, AT HIS OWN EXPENSE, SHALL MAKE EXCAVATIONS AND BORINGS AHEAD OF THE WORK, AS NECESSARY, TO DETERMINE THE EXACT LOCATIONS OF UTILITIES AND UNDERGROUND STRUCTURES. IT IS UNDERSTOOD THAT THERE WILL BE INTERFERING UTILITIES AND OTHER UNDERGROUND PIPES, DRAINS OR STRUCTURES ENCOUNTERED THAT ARE NOT SHOWN OR AREAS SHOWN INCORRECTLY ON THE PLANS OR THAT HAVE NOT BEEN PREVIOUSLY DISCOVERED IN THE FIELD. THE CONTRACTOR AGREES THIS IS A NORMAL AND USUAL OCCURRENCE IN THE CONSTRUCTION OF UNDERGROUND IMPROVEMENTS. FURTHERMORE, CONTRACTORS UNDERSTAND AND AGREE THAT WORK IN SOME CASES PROPOSED PATH MAYBE IN CLOSE PROXIMITY TO SAID UTILITIES AND UNDERGROUND PIPES, DRAINS AND STRUCTURES NOT SHOWN ON THE PLANS WHICH MAY REQUIRE A CHANGE IN OPERATIONS AND MAY CAUSE SLOUGHING OF THE TRENCH, ADDITIONAL TRAFFIC CONTROL, ADDITIONAL PAVEMENT AND BACKFILL COSTS AND TIME. THE CONTRACTOR AGREES THAT A REASONABLE NUMBER OF THESE OCCURRENCES IS USUAL AND ORDINARY, AND ARE REFLECTED IN THE BID AND PLAN OF OPERATION. THE CONTRACTORS AGREES TO PROVIDE FOR THESE CONFLICTS AND AGREES TO PROVIDE FOR A REASONABLE AMOUNT OF TIME FOR DESIGN CHANGES AND/OR UTILITY RELOCATIONS DUE TO SAID CONFLICTS.
- 2. CALL THE UTILITIES UNDERGROUND LOCATION CENTER AT 811
- 3. INSPECTIONS THE CONTRACTOR SHALL NOTIFY LOCAL JURISDICTIONS FOR REQUIRED INSPECTION SERVICES.
- 4. EXCESS WATER SHOULD WATER BE ENCOUNTERED DURING CONSTRUCTION, IT SHALL BE THE CONTRACTOR'S RESPONSIBILITY TO DEWATER, AS PER LOCAL JURISDICTIONS STANDARD SPECIFICATIONS, BEFORE CONSTRUCTION CONTINUES.
- 5. NO SILT LADEN WATER IS TO BE DISCHARGED FROM THE SITE WITHOUT PASSING THROUGH AN EROSION CONTROL SYSTEM.
- 6. THE CONTRACTOR SHALL SCHEDULE AND CONTROL HIS/HER WORK SO AS TO COMPLY WITH ALL APPLICABLE ORDINANCES TO PREVENT ANY HAZARDS TO PUBLIC SAFETY, HEALTH AND WELFARE.
- 7. ALL STREETS SHALL BE KEPT FREE OF DIRT AND DEBRIS ON A CONTINUOUS BASIS.
- 8. AN APPROVED COPY OF THESE PLANS WILL BE ON THE JOB SITE WHENEVER CONSTRUCTION IS IN PROGRESS.
- 9. THE CONTRACTOR SHALL BE SOLELY AND COMPLETELY RESPONSIBLE FOR THE CONDITIONS OF THE JOB SITE, INCLUDING SAFETY OF ALL PERSONS AND PROPERTY DURING THE PERFORMANCE OF THE WORK. THIS REQUIREMENT WILL APPLY CONTINUOUSLY AND NOT BE LIMITED TO NORMAL WORKING HOURS.
- 10. PEDESTRIAN AND VEHICULAR ACCESS TO ADJACENT PROPERTIES SHALL BE MAINTAINED AT ALL TIMES EXCEPT WHERE PRIOR WRITTEN APPROVAL FROM THE PROPERTY OWNER HAS BEEN OBTAINED.
- 11. BARRICADE OPEN DEPRESSIONS AND HOLES OCCURRING AS PART OF THIS WORK, AND POST WARNING LIGHTS ON ADJACENT PROPERTIES WITH PUBLIC ACCESS. OPERATE WARNING LIGHTS DURING HOURS FROM DUSK TO DAWN EACH DAY AND AS OTHERWISE REQUIRED.
- 12. PROTECT STRUCTURES, UTILITIES, PAVEMENTS, AND OTHER FACILITIES FROM DAMAGE CAUSED BY SETTLEMENT, LATERAL MOVEMENT, UNDERMINING WASHOUT AND OTHER HAZARDS CREATED BY OPERATIONS UNDER THIS SECTION.

TRAFFIC CONTROL

- 1. THE CONTRACTOR IS ADVISED THAT ALL LANE CLOSURES SHALL BE KEPT TO A MINIMUM. LOCAL JURISDICTIONS WILL APPROVE ONLY THOSE LANE AND ROADWAY CLOSURES DETERMINED TO BE NECESSARY FOR THE CONTRACTOR TO ACCOMPLISH A SPECIFIC TASK. NO LANE OR ROADWAY CLOSURES WILL BE PERMITTED WITHOUT PRIOR APPROVALS.
- 2. THE CONTRACTOR SHALL KEEP ALL TRAFFIC LANES AND SHOULDERS CLEAR OF EQUIPMENT AND MATERIALS DURING NON-WORKING HOURS. EQUIPMENT AND MATERIALS SHALL NOT BE STORED ON THE STREETS. THE CONTRACTOR'S EMPLOYEES AND AGENTS SHALL NOT PARK PRIVATE VEHICLES ALONG THE ROADWAY OR MEDIAN.

SITE PREPARATION

- 1. SOD AND LAWN TO BE REMOVED SHALL BE CUT TO A NEAT VERTICAL LINE 6" MINIMUM BEYOND THE TRENCH LINE. SOD SHALL BE EITHER REMOVED FROM THE SITE, OR CAREFULLY STOCKPILED FOR REUSE.
- 2. SAW CUT PAVEMENT TO A NEAT VERTICAL LINE 8" TO 12" MINIMUM BEYOND THE TRENCH LINE. REPLACE PAVEMENT WITH LIKE MATERIAL (I.E., ASPHALT WITH ASPHALT, CONCRETE WITH CONCRETE).
- 3. EXCEPT AS NOTED HEREIN, ALL MATERIAL REMOVED SHALL BE TAKEN FROM THE SITE AND DISPOSED OF BY THE CONTRACTOR.

TRENCH EXCAVATION AND BACKFILL

- 1. TRENCH BACKFILL WHERE MATERIAL EXCAVATED FROM TRENCHES IS UNSUITABLE FOR BACKFILL, THE CONTRACTOR SHALL BACKFILL WITH BANK RUN GRAVEL OR MAY ELECT TO USE CDF IN LIEU OF THE COMPACTION/PROCTOR PROCESS. STONEWAY MIX 351 IS ACCEPTABLE IN ALL LOCATIONS. QUICK SETTING MIX 1004 IS ACCEPTABLE IN NON-TRAFFIC AREAS. MIX 1121 IS TO BE USED IN TRAFFIC-BEARING LOCATIONS.
- 2. COMPACTION, WHEN NECESSARY, SHALL BE PERFORMED IN ACCORDANCE WITH LOCAL JURISDICTION REQUIREMENTS.

UTILITY DUCT

- 1. BURIED DUCT SHALL BE SCHEDULE 80 PVC OR EQUIVALENT, UNLESS NOTED OTHERWISE. MINIMUM CONDUIT COVER SHALL BE 36" WITH A MINIMUM SLOPE OF 1/2 % TO VAULT.
- THOROUGHLY CLEAN CONDUIT BEFORE USING OR LAYING. DURING CONSTRUCTION AND AFTER THE DUCT LINE IS COMPLETED, PLUG ENDS OF CONDUITS TO PREVENT WATER WASHING INTO CONDUIT OR MANHOLES, TAKE PARTICULAR CARE TO KEEP CONDUITS CLEAR OF CONCRETE, DIRT AND ANY OTHER SUBSTANCE DURING THE COURSE OF CONSTRUCTION.
- 3. AFTER DUCT PLACEMENT HAS BEEN COMPLETED, PROOF AND CLEAN DEBRIS FROM EACH DUCT, ITS ENTIRE LENGTH. INSTALL PULL ROPE AND PLACE WATERTIGHT COMPRESSION PLUGS AT BOTH ENDS. ANY CONDUITS CONTAINING FIBER CABLE WILL REQUIRE SIMPLEX COMPRESSION PLUGS SEALING THE CONDUITS AROUND THE CABLE.
- 4. OUTSIDE INNERDUCT SHALL BE 1-1/4" OPTIC-GUARD NON-METALLIC FLEXIBLE, IN COLOR SUCH AS RED OR ORANGE, WITH PULL ROPES AND PLUGS. EXPOSED INNERDUCT INSIDE OF BUILDINGS SHALL BE PLENUM-RATED.

CEMENT CONCRETE PAVEMENT

1. ALL CONCRETE PAVEMENT REMOVED OR DAMAGED BY THIS WORK SHALL BE REPLACED ACCORDING TO THE STANDARD SPECIFICATIONS OF EACH JURISDICTION.

ASPHALT CONCRETE PAVEMENT

1. ALL ASPHALT CONCRETE PAVEMENT REMOVED OR DAMAGED BY THIS WORK SHALL BE REPLACED WITH CLASS B ASPHALT CONCRETE ACCORDING TO THE REQUIREMENTS OF EACH JURISDICTION.

GRAVEL AREAS

1. ALL GRAVEL AREAS DAMAGED OR REMOVED BY THIS WORK SHALL BE REPLACED WITH CRUSHED SURFACING TOP COURSE IN ACCORDANCE WITH THE REQUIREMENTS OF EACH JURISDICTION.

SITE RESTORATIO

- 1. ALL DISTURBED OR DAMAGED AREAS SHALL BE RESTORED TO A CONDITION EQUAL TO, OR BETTER THAN, THAT WHICH EXISTED PRIOR TO PLACEMENT OF THE CONDUIT AND STRUCTURES.
- 2. VEGETATION REMOVED FOR THIS WORK SHALL BE REPLACED WITH IN-KIND PLANT MATERIAL AND SHALL BE PROPERLY PLANTED AND WATERED IN TO ENSURE ITS SURVIVAL.
- 3. SITE RESTORATION SHALL INCLUDE REPLACING EXISTING CABLING AND PULL ROPES IN EXISTING CONDUITS AS THEY EXISTED PRIOR TO CONSTRUCTION.

WATER QUALITY

- 1. CONSTRUCTION ACTIVITIES OCCURRING ADJACENT TO STORM DRAINAGE STRUCTURES SHALL COMPLY WITH THE STATE OF WASHINGTON'S WATER QUALITY STANDARDS
- 2. THE CONTRACTOR SHALL LIMIT THE USE OF PETROLEUM PRODUCTS ON THE SITE.

DIRECTIONAL BORING

- 1. WHEN BORING ROADWAYS, INSTALL (1) 4" SCHEDULE 40 PVC CONDUIT WITH PULL ROPES AND PLUGS.
- 2. PROTECT EXISTING UTILITIES -- COORDINATE WITH LOCAL JURISDICTIONS TO POTHOLE AS REQUIRED TO LOCATE EXISTING UTILITIES.

FIRE PROTECTION

- 1. ALL INSTALLED BACKBOARDS SHALL BE PAINTED WITH FIRE-RESISTANT PAINT.
- 2. ALL FIRE SEALED DUCT ENDS AND CORES SHALL BE 2 HOUR FIRE-RATED. ALL FIRE SEAL IN EXISTING LOCATIONS SHALL BE REPAIRED OR REPLACED UPON DUCT OR CABLE PLACEMENT.

AERIAL INSTALLATION

- 1. ALL AERIAL CONSTRUCTION IS TO BE PERFORMED TO INDUSTRY ACCEPTABLE STANDARDS.
- 2. ALL NEW AERIAL (AND EXISTING) CABLE HEIGHTS OF ATTACHMENT TO BE DOCUMENTED AT TIME OF CONSTRUCTION.
- 3. 6.35 MM STRAND TO BE USED WITH STANDARD 1/4" POLE LINE HARDWARE UNLESS OTHERWISE SPECIFIED. BOND STRAND TO POWER MAIN WHERE APPLICABLE.
- 4. ALL ANCHORS TO BE USED WILL BE 3/4" SCREW TYPE.
- 5. IT IS THE CONTRACTOR'S RESPONSIBILITY TO MAINTAIN AND FOLLOW ALL NESC CODES ALONG WITH APPLICABLE LOCAL AND REGIONAL GOVERNING AUTHORITIES. ANY DISCREPANCIES BETWEEN THESE AUTHORITIES AND OR THE CONSTRUCTION PERMITS IS TO BE VALIDATED WITH THE DESIGNER OR ENGINEER PRIOR TO CONSTRUCTION.



CANNON COMPANIES

PRFUP20241726



TK 6338160 2202 E PIONEER PUYALLUP WA 98372 POWER MR

PROJECT REVISIONS

PROJECT REVISIONS

REVI | 6/5/24 BREAKUP SHEETS

PROJECT REVISIONS

REVI | 6/5/24 BREAKUP SHEETS


TARGET | 11/6/24

PROSE |

GENERAL NOTES

NO SCALE

2 / 4

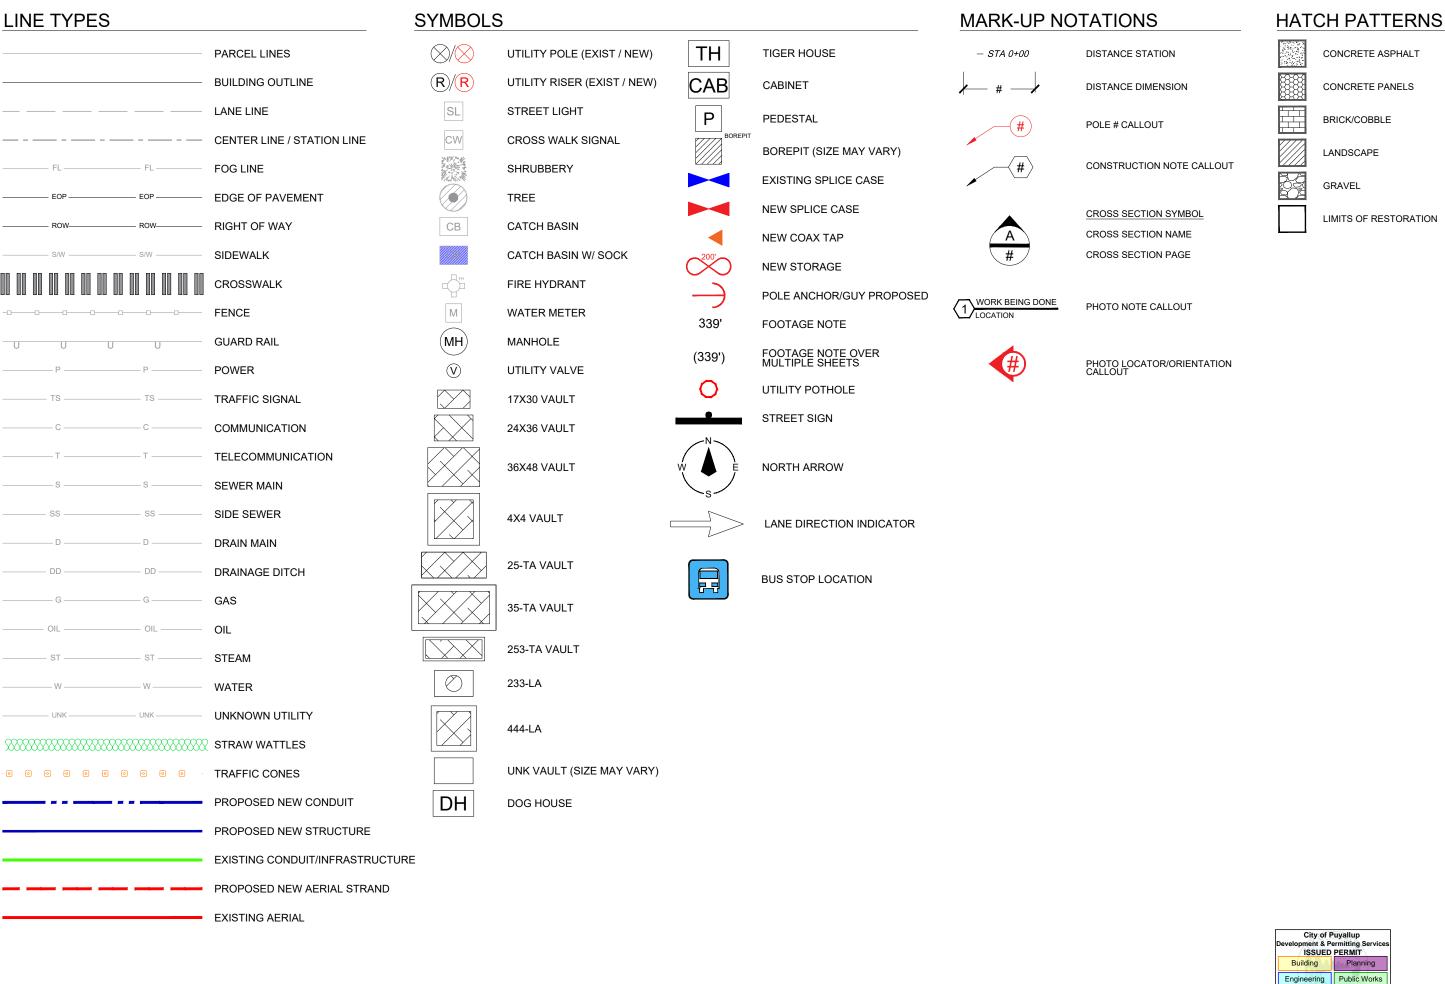

PRFUP20241726

Know what's below. CALL before you dig.

25-923 TK 6338160 2202 E PIONEER PUYALLUP WA 98372 M POWER

WK WK 25-923

> NAGER: S. SARTAIN ARMANDT B NO


11/6/24

SCALE

LEGEND

Fire

Traffic

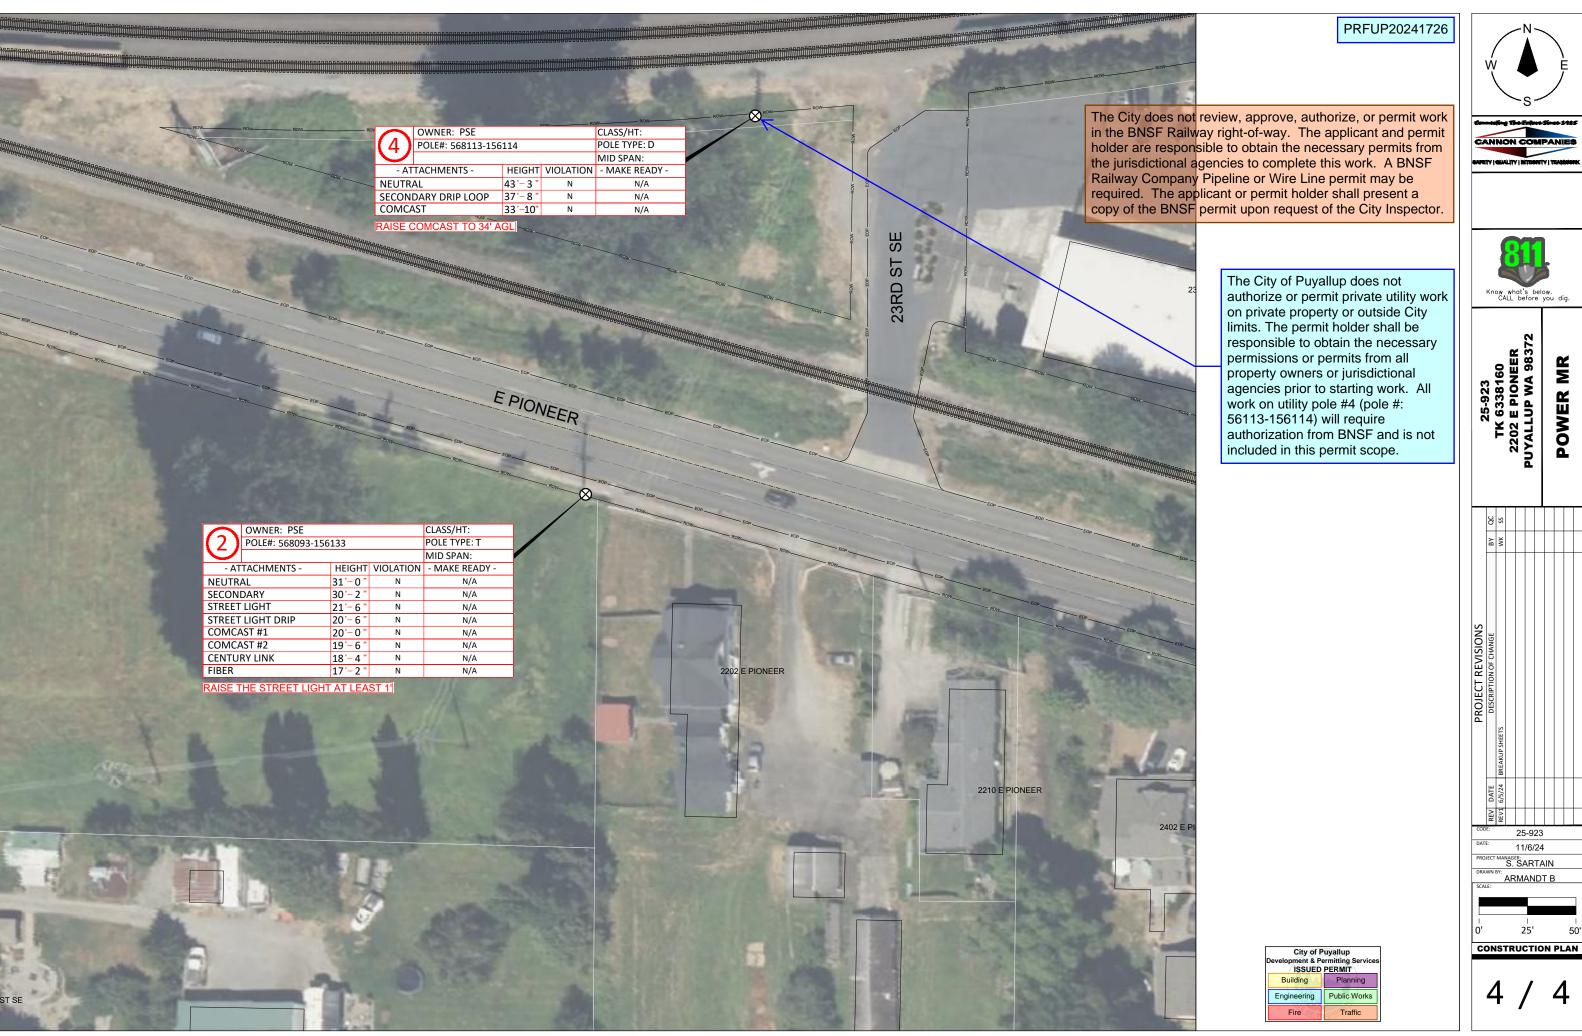







25-923 TK 6338160 2202 E PIONEER PUYALLUP WA 98372 POWER MR

