

SHOP DRAWING / SUBMITTAL REVIEW

- ☐ APPROVED
☐ REVISE & RESUBMIT
☒ APPROVED AS NOTED
☐ REJECTED

SUBMITTAL WAS REVIEWED FOR DESIGN CONFORMITY AND GENERAL CONFORMANCE TO CONTRACT DOCUMENTS ONLY. THE CONTRACTOR IS RESPONSIBLE FOR CONFIRMING AND CORRELATING DIMENSIONS AT JOBSITE FOR TOLERANCE, CLEARANCE, QUANTITIES, FABRICATION PROCESSES AND TECHNIQUES OF CONSTRUCTION, COORDINATION OF HIS WORK WITH OTHER TRADES AND FULL COMPLIANCE WITH CONTRACT DOCUMENTS

BY: CHON PIERUCCIONI DATE: 9/25/2024

PIERUCCIONI E&C, LLC

*****ATTENTION*****
TRIANGLE SHAPE ▲ = LEFT SIDE INDICATOR
RED MARK ON TRUSS IS LEFT SIDE
TRIANGLE SHAPE ▲ = INDICADOR DE LADO IZQUIERDO
MARCA ROJA EN ARMADURA ES LADO IZQUIERDO


PRMU20240139

City of Puyallup
 Building
 REVIEWED
 FOR
 COMPLIANCE

BSnowden
 02/06/2025
 9:02:28 AM



THIS IS A TRUSS PLACEMENT DIAGRAM ONLY. The trusses shown are for informational purposes only and are not to be incorporated into the building design at the specification of the building designer. See the individual design sheets for each truss design identified by the truss number. The building designer is responsible for temporary and permanent bracing of the roof and floor system and for the overall structure. The design of the truss support structure including headers, beams, girders, walls, and columns is the responsibility of the building designer.

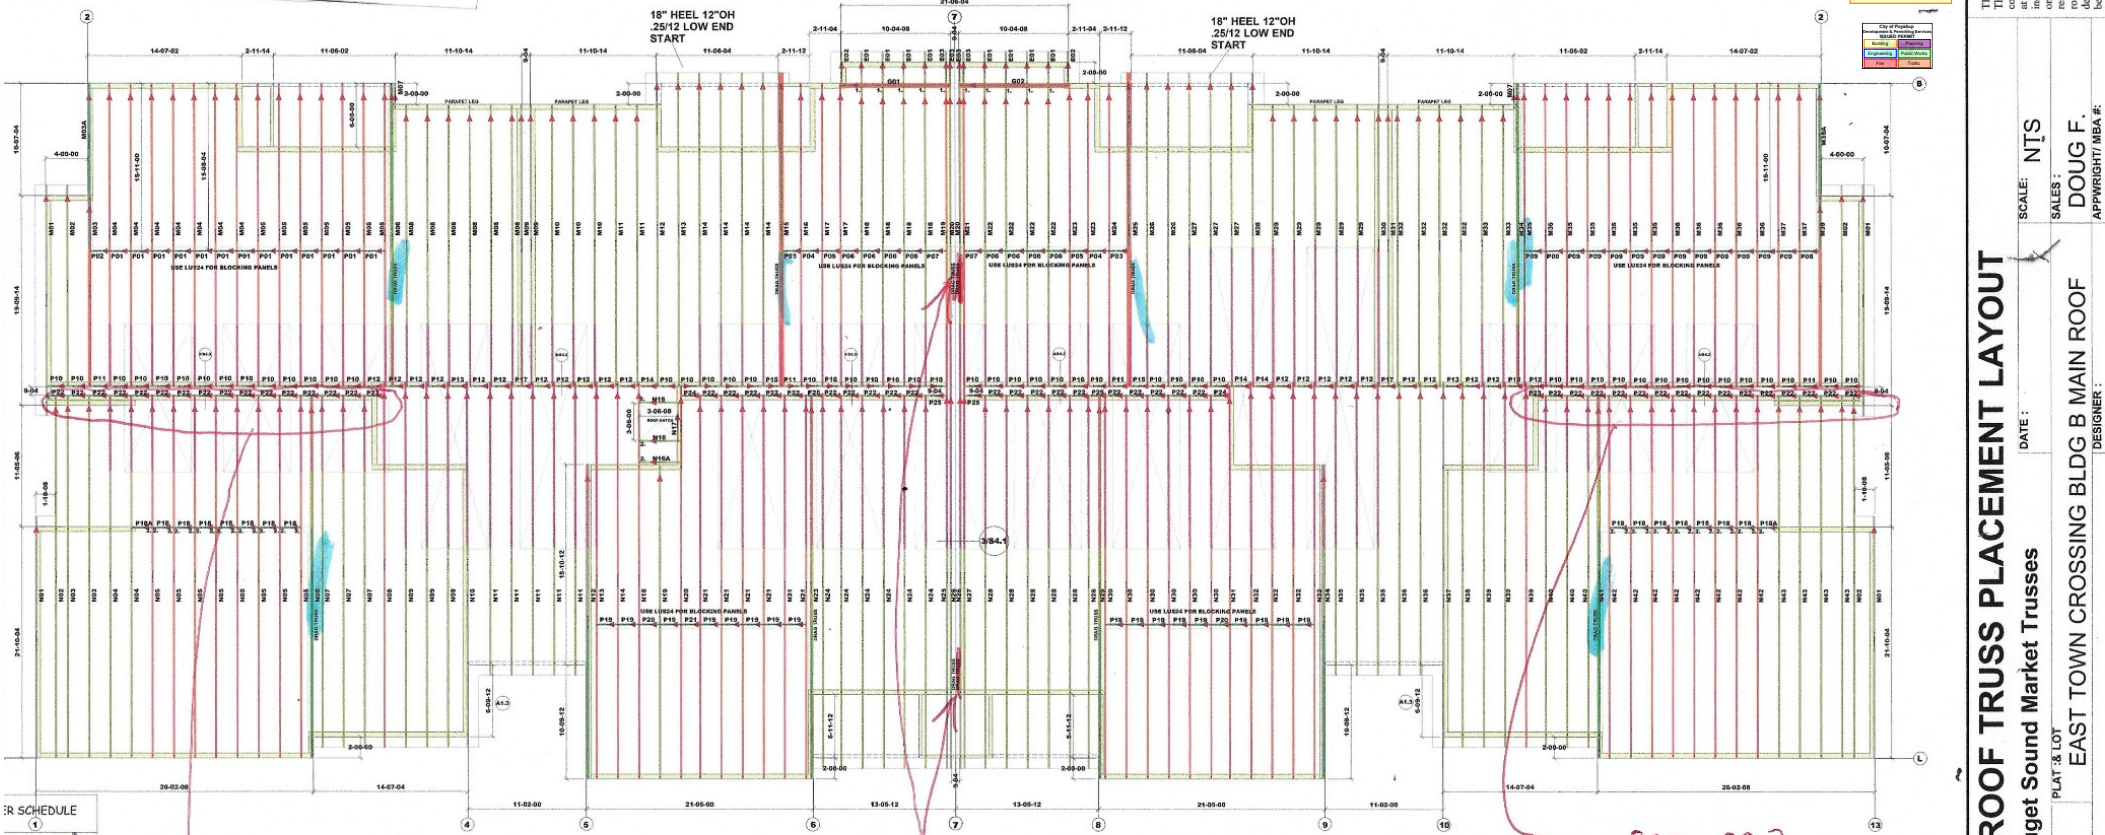

TR SCHEDULE	QTY
HUS26	12
MUS26	30

BLOCKING SCHEDULE

TYPE	QTY
2x6 SOLIDS	262
2x8 SOLIDS	59

OTHERS NOT	QTY
ED LUS24	128

P22 & P23
 DO NOT NEED TO
 BE DESIGNED FOR
 DRAG

DRAG TRUSS
 ONLY REQUIRED
 OVER LEFT WALL
 (SHEAR WALL)

P22 & P23
 DO NOT NEED TO
 BE DESIGNED
 FOR DRAG

DO NOT CUT, DRILL, NOTCH OR MODIFY TRUSS MEMBERS WITHOUT PRIOR APPROVAL FROM Builders FirstSource-Truss

ROOF TRUSS PLACEMENT LAYOUT

Puget Sound Market Trusses

Builders
FirstSource



BUILDER: MKM LEGACY

PLAN:

SCALE: NTS

DATE:

SALES: DOUG F.

DESIGNER:

APPROVER: MHA

EAST TOWN CROSSING BLDG B MAIN ROOF