

JD Entered in CV 2-11-25

Residential Sewer Service As-built

Service Address: 2402 Pioneer Way East Building "H" North

Subdivision: East Town Crossing Lot #: 14


Permit No.: PR MU20240405 Contractor: Rick the Plumber & Co.

Pipe Type: PVC/ABS Pipe Size: 6"/4" No. of cleanouts: 2

Approved by: Jason Little, Eng Insp Date: 1.14.25

Inspector comments: _____

- Point A is the 6" main line
- Point B is the first cleanout
- Point C is the second cleanout
- Point D is the 6" x 4" eccentric fitting. There is 8" of pipe between the eccentric fitting and the 4" PVC x 4" ABS adapter.
- Point E is the 4" PVC x 4" ABS adapter.
- There is a 4" ABS st. 45 going into point E. The pipe rises from 5' 7" to 3' at a 45° angle to point F.
- Point G is a 4" ABS combo to catch the unit.

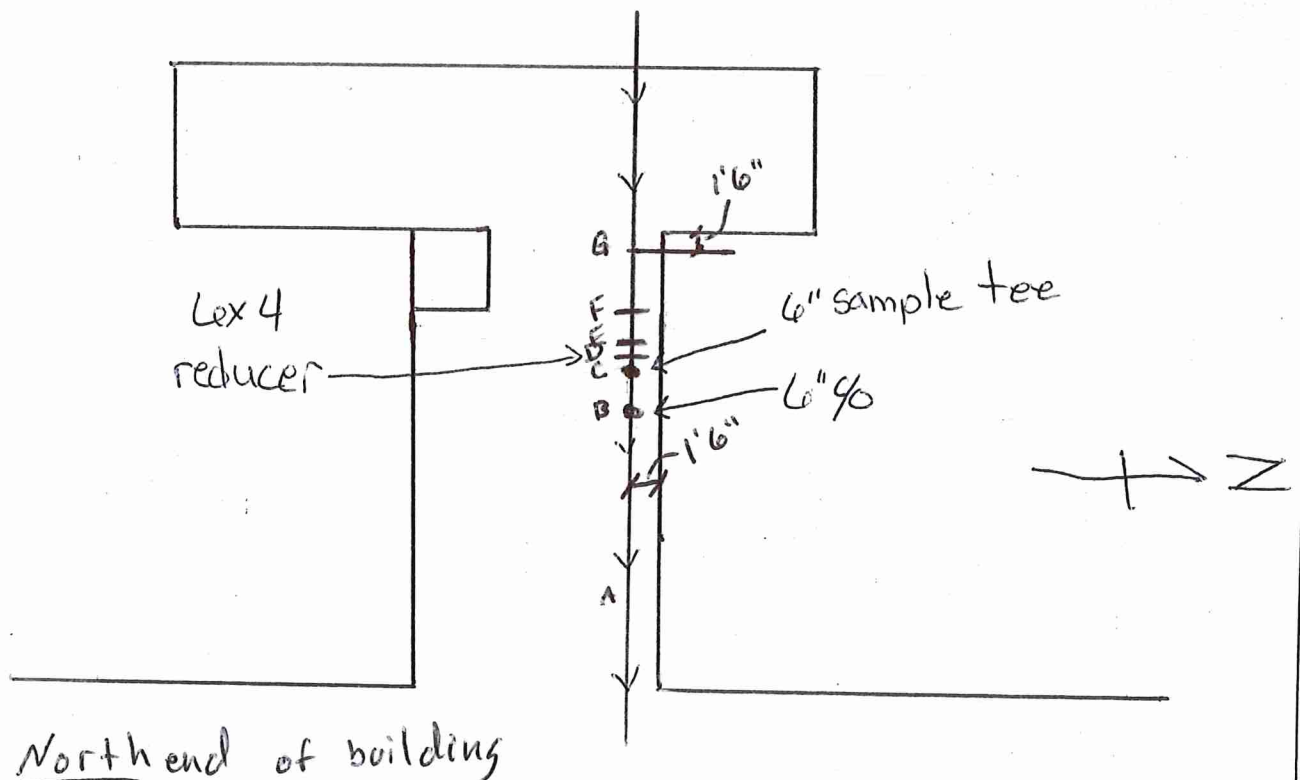

50 Entered in CV 2-11-25

Residential Sewer Service As-built

Service Address: 2902 Pioneer Way East Building "H" South

Subdivision: East Town Crossing Lot #: 14

Permit No.: PRMU20240405 Contractor: Rick the Plumber & Co.

Pipe Type: PVC/ABS Pipe Size: 6"/4" No. of cleanouts: 2

Approved by: Jason Little, Eng Insp Date: 1.14.25

Inspector comments: _____

- Point A is the 6" main line
- Point B is the first cleanout
- Point C is the second cleanout
- Point D is the 6"x4" eccentric fitting. There is 8" of pipe between the eccentric fitting and the 4" PVC x 4" ABS adapter
- Point E is the 4" PVC x 4" ABS adapter
- There is a 4" ABS st. 45 going into point E. The pipe rises from 5'7" to 3'3" at a 45° angle to another st. 45 that goes into a 4" ABS combo
- Point G is a 4" ABS combo to catch the unit.

