

Residential Sewer Service As-built *East side of building*

Service Address: 2902 Pioneer Way East

Building "C" East

Subdivision: East Town Crossing Lot #: Block C


Permit No.: PRMU20240400 Contractor: Rick the Plumber & Co.

Pipe Type: ABS/PVC Pipe Size: 6"/4" No. of cleanouts: 2

Approved by: Jason Little, Eng Insp Date: 2.18.25

Inspector comments: _____

- Point A is the 6" main sewer
- Point B is the first 6" cleanout
- Point C is the second 6" cleanout.
- Between point C and D is a 6" piece of PVC pipe 7" long.
- Point D is a 6"x4" eccentric fitting
- Between point D and E is a 4" PVC pipe 12" long
- Point E is a 4" ABS x 4" PVC coupling adapter
- Between point E and F is a 4" piece of ABS pipe 10" long.
- Point F is a 4" ABS 45°
- Between point F and G is a 4" piece of ABS pipe 16 3/4" long.
- Point G is a 4" ABS 45°

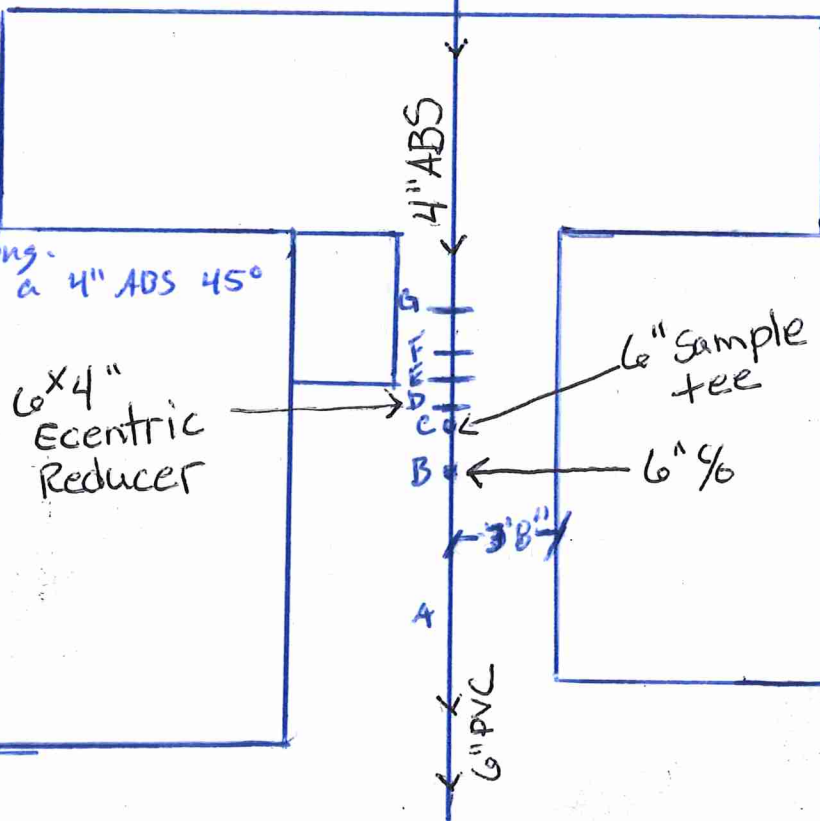

Residential Sewer Service As-built *West side of Building*

Service Address: 2902 Pioneer Way East

Building "C" West

Subdivision: East Town Crossing

Lot #: Bldg C

Permit No.: PR MU 20240400 Contractor: Rick the Plumber & Co.

Pipe Type: ABS/PVC Pipe Size: 6"/4" No. of cleanouts: 2

Approved by: Jason Little, Eng Insp Date: 2.18.25

Inspector comments: _____

- Point A is the 6" main sewer
- Point B is the first 6" cleanout
- Point C is the second 6" cleanout
- Between point C and D is a 6" piece of PVC pipe 7" long
- Point D is a 6" x 4" eccentric fitting
- Between point D and E is a 4" PVC pipe 12" long
- Point E is a 4" ABS x 4" PVC coupling adapter
- Between point E and F is a 4" piece of ABS pipe 12" long
- Point F is a 4" ABS 45°
- Between point F and G is a 4" piece of ABS pipe 19" long
- Point G is a 4" ABS 45°

6" x 4"
eccentric
Reducer

