

City of Puyallup
Building
REVIEWED
FOR
COMPLIANCE

SKinnear
03/03/2025
8:22:48 AM




Approval of submitted plans is not an approval of omissions or oversights by this office or non compliance with any applicable regulations of local government. The contractor is responsible for making sure that the building complies with all applicable codes and regulations of the local government.

The approved construction plans, documents, and all engineering must be posted on the job at all inspections in a visible and readily accessible location.


Full sized legible color plans are required to be provided by the permittee on site for inspection.

GENERAL NOTES:


1. VERIFY ALL EXISTING CONDITIONS AND ALL NEW PROPOSED WORK. (ELECTRICAL, CONDUIT, SPRINKLER LINES, ETC. CONTACT PM IF THERE ARE ANY CONFLICTS WITH PROPOSED DESIGN.)
2. ALL UNISTRUT, J-BOXES, THREADED ROD, ETC ABOVE TO BE PAINTED.
3. MOUNTING HEIGHT OF UNISTRUT AND LENGTH OF THREADED ROD TO BE COORDINATED IN FIELD AROUND EXISTING STRUCTURE CONDITIONS AND HVAC DUCTWORK. MAINTAIN HEIGHTS SHOWN FOR LIGHTING FIXTURES ON PLAN.

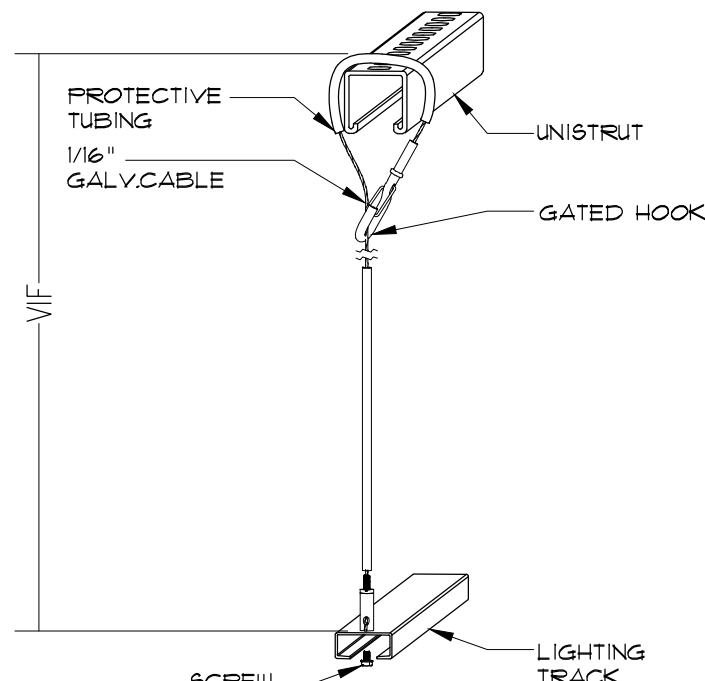


DETAIL AT TRACK LIGHT FIXTURE

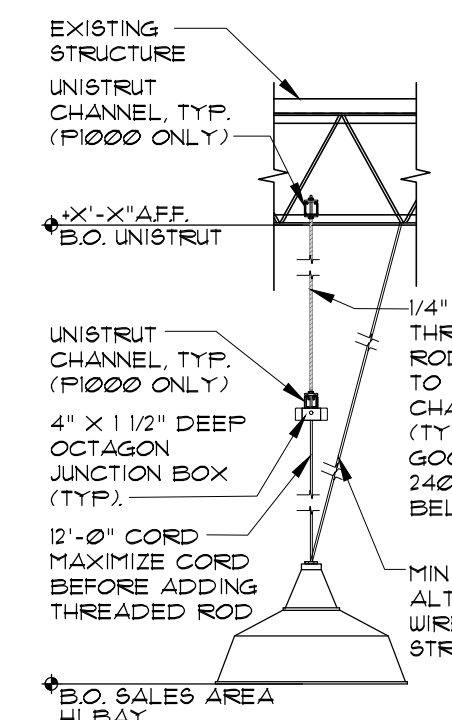

DETAIL AT SALES AREA HI-BAY FIXTURE

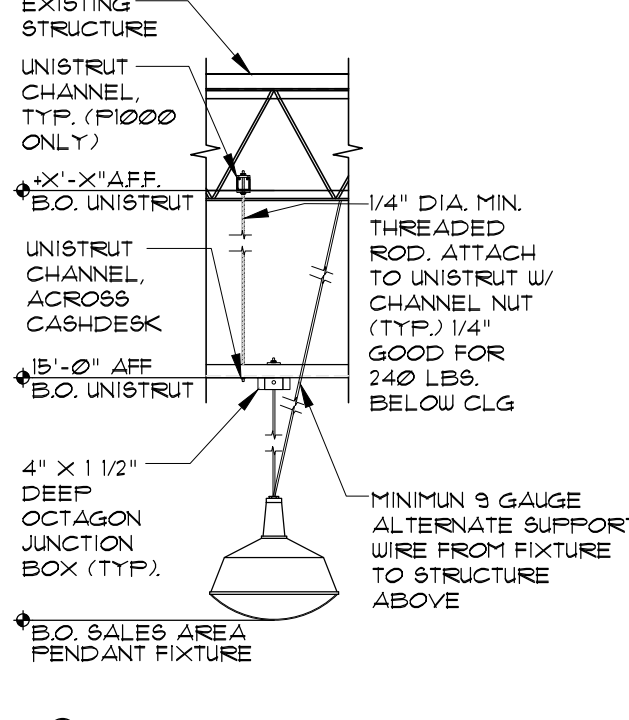

DETAIL AT CASH WRAP PENDANT LIGHT FIXTURE

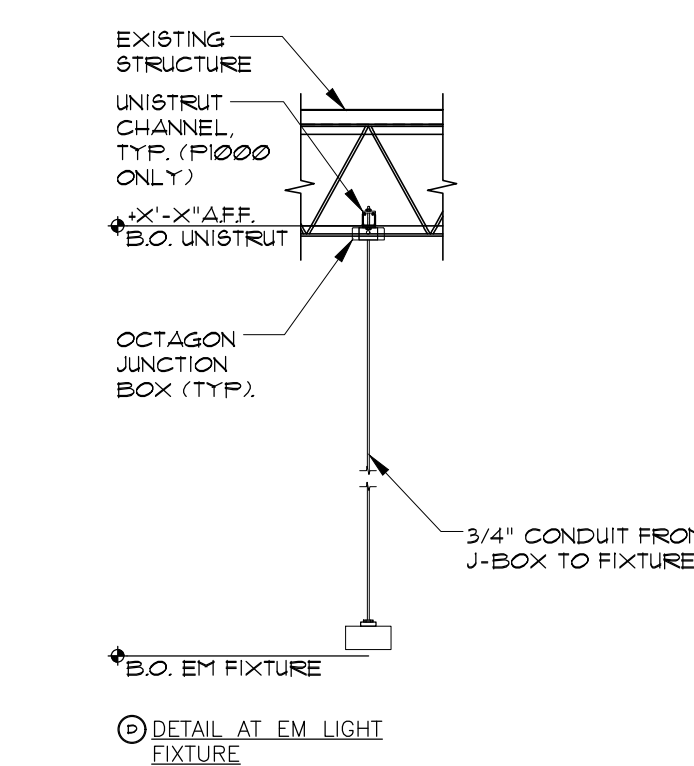


DETAIL AT EM LIGHT FIXTURE

1/8" = 1' - 0"

LIGHTING PLAN

1/8" = 1' - 0"

Separate Electrical Permit is required with the Washington State Department of Labor & Industries.
<https://lni.wa.gov/licensing-permits/electrical/electrical-permits-fees-and-inspections>
or call for Licensing Information:
1-800-647-0982

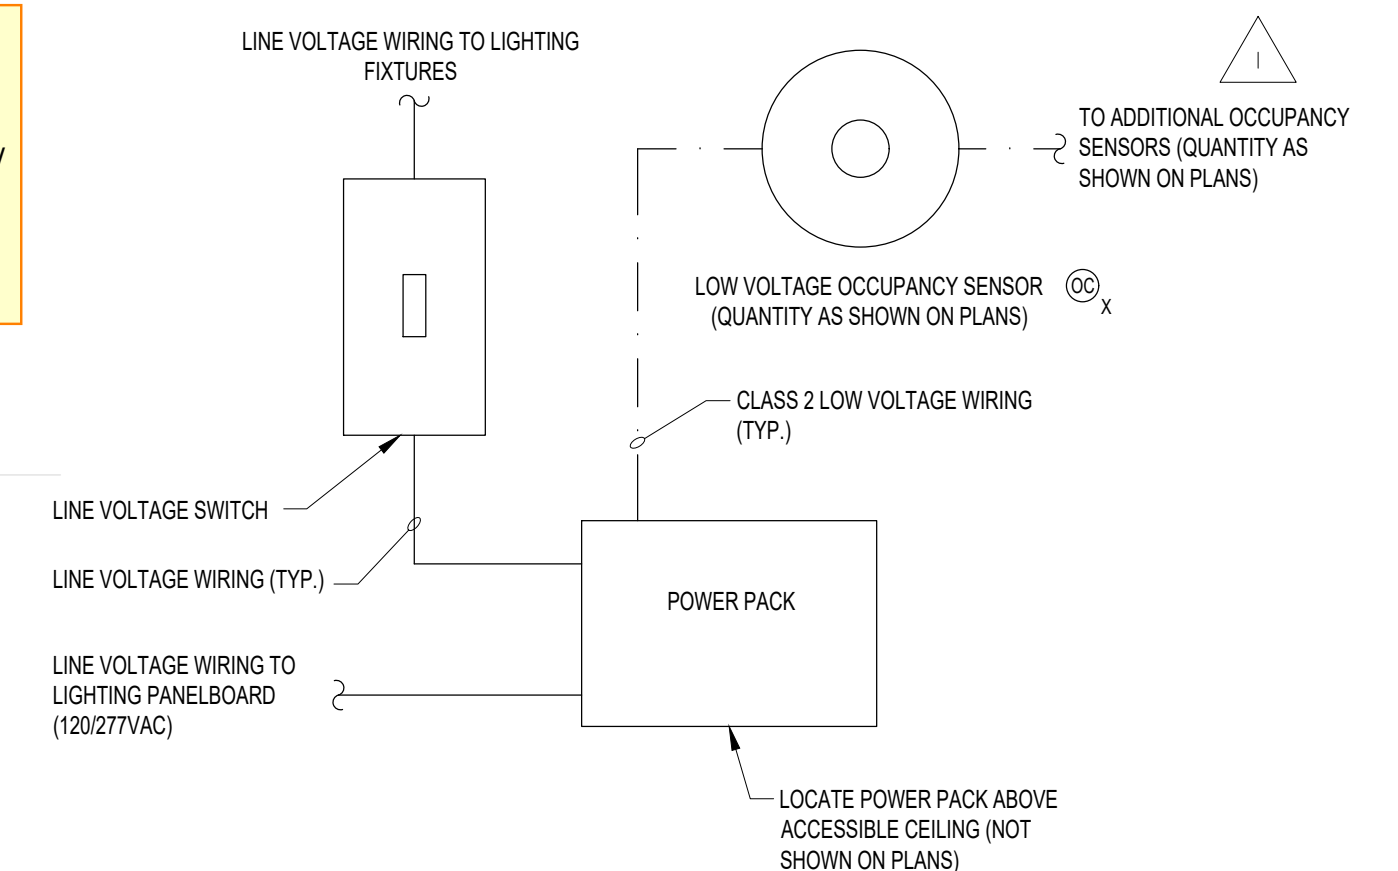

TYPICAL LOW VOLTAGE OCCUPANCY
SENSOR WIRING DIAGRAM (NON-LIGHTSTAT)
N.T.S.

- NOTES:
1. SENSOR SWITCH IS SHOWN AS THE BASIS OF DESIGN. REFER TO SPECIFICATIONS FOR ADDITIONAL INFORMATION AND OTHER ACCEPTABLE MANUFACTURERS. IF ANY OF THE OTHER ACCEPTABLE MANUFACTURERS ARE USED, NOTE THAT THEIR EXACT REQUIREMENTS, COMPONENTS AND WIRING WILL LIKELY DIFFER AND THE CONTRACTOR IS RESPONSIBLE TO PROVIDE A COMPLETE, OPERATIONAL SYSTEM EQUIVALENT TO THAT SHOWN.
 2. WIRING DIAGRAMS ARE DIAGRAMMATIC AND SHOWN FOR REFERENCE ONLY. REFER TO MANUFACTURERS WIRING DIAGRAMS FOR ALL REQUIRED COMPONENTS AND WIRING.
 3. INSTALL LOW VOLTAGE WIRING IN 3/4" CONDUIT (MIN.).
 4. REFER TO MANUFACTURERS LATEST LITERATURE FOR REQUIRED WIRING SIZES. INCREASE AS REQUIRED FOR VOLTAGE DROP.
 5. MOUNT POWER PACK IN DEEP JUNCTION BOX IF REQUIRED PER LOCAL A.H.U.
 6. LOW VOLTAGE WIRING IS NOT SHOWN ON PLANS AND NOT ALL LINE VOLTAGE WIRING IS SHOWN ON PLANS. PROVIDE ALL REQUIRED LINE AND LOW VOLTAGE WIRING FOR A COMPLETE, FUNCTIONAL SYSTEM.
 7. SOME AREAS HAVE OCCUPANCY SENSOR CONTROL ONLY (NO LINE VOLTAGE SWITCHES) AS SHOWN ON PLANS.

LIGHTING KEY NOTES

1. NOT USED.
2. CONNECT EXIT SIGNS AND EMINL IN SALES AREA TO UNSWITCHED CIRCUIT A-12. ALL FIXTURES ON THIS CIRCUIT ARE EMERGENCY LIGHTS OR EXIT SIGNS.
3. FURNISH AND INSTALL IN-LINE CURRENT LIMITER.
4. NOT USED.
5. NOT USED.
6. LIGHTING NOTE: NEC SECTION 700.12 (F) ALL UNIT EQUIPMENT (EMERGENCY LIGHTING) SHALL BE WIRED AHEAD OF SWITCH OR CONTROL OF NORMAL LIGHTING CIRCUIT SERVING THAT AREA. THE BRANCH CIRCUIT FEEDING THE UNIT EQUIPMENT SHALL BE THE SAME BRANCH CIRCUIT AS THAT SERVING THE NORMAL LIGHTING IN THE AREA AND CONNECTED AHEAD OF ANY LOCAL SWITCHES. THE BRANCH CIRCUIT THAT FEEDS UNIT EQUIPMENT SHALL BE CLEARLY IDENTIFIED AT THE DISTRIBUTION PANEL IN A SEPARATE AND UNINTERRUPTED AREA SUPPLIED BY A MINIMUM OF THREE NORMAL LIGHTING CIRCUITS. A SEPARATE BRANCH CIRCUIT FOR UNIT EQUIPMENT SHALL BE FROM THE SAME PANELBOARD AS THAT OF THE NORMAL LIGHTING CIRCUITS AND PROVIDED WITH A LOCK-ON FEATURE.
7. LOCAL SWITCHES FOR CAFE FIXTURES. VERIFY FINAL LOCATIONS AND MOUNTING HEIGHTS WITH OWNER PRIOR TO ROUGH-IN.

CONTRACTOR TO FURNISH AND INSTALL CURRENT LIMITERS TO LIMIT THE WATTAGE AVAILABLE FOR THE TRACK. CONTRACTOR TO UTILIZE CON-TECH LIGHTING LA-23A (TITLE 24 COMPLIANT-CALIF. ONLY) OR LA-23-RN (NON-TITLE 24 COMPLIANT). CURRENT LIMITING DEVICE OR EQUIVALENT.

CON-TECH CURRENT LIMITING DEVICES		
REG-05	16W	0.5A
REG-1	120W	1A
REG-2	210W	1.75A
REG-21	240W	2A
REG-3	300W	2.5A
REG-4	360W	3A
REG-5	480W	4A
REG-6	600W	5A
REG-7	720W	6A
REG-8	840W	7A
REG-9	900W	7.5A
REG-91	960W	8A
REG-10	1,200W	10A
REG-12	1,400W	12A
REG-14	1,680W	14A

LIGHTING GENERAL NOTES

- A. REFER TO SHEET E-201 FOR SYMBOL LEGEND, LIGHTING FIXTURE SCHEDULES AND NOTES.
- B. ALL LIGHTING FIXTURES IN SALES AND STOCK AREA S TO BE CONTROLLED BY THE LIGHTSTAT LIGHTING CONTROL SYSTEM. SEE DETAILS ON SHEET E-203.
- C. CONNECT SWITCHES AND BRANCH CIRCUITS TO OUTLETS, EQUIPMENT AND LIGHTING FIXTURES AS INDICATED ON PLANS AND PANELBOARD SCHEDULES WITH #12 MINIMUM CONDUCTORS IN CONCEALED RACEWAYS. CONDUCTOR SIZES AND QUANTITIES OTHER THAN #12 AWG SHALL BE AS NOTED. ALL FINAL CONNECTIONS TO TRANSFORMERS, MOTORIZED AND VIBRATING EQUIPMENT SHALL BE WITH FLEXIBLE METAL CONDUIT.
- D. CEILING MOUNTED OCCUPANCY SENSOR SHALL CONTROL LIGHTING IN ROOMS IDENTIFIED EXCEPT UNSWITCHED EMERGENCY LIGHTING. COORDINATE WITH ALL OTHER TRADES BEFORE FINAL PLACEMENT. SET TIME DELAY FOR ALL CEILING SENSORS AT 15 MINUTES.
- E. LIGHTING CIRCUITS UP TO 100'-0" IN LENGTH SHALL UTILIZE #12 CONDUCTORS MINIMUM. LIGHTING CIRCUITS FROM 101'-0" TO 150'-0" IN LENGTH SHALL UTILIZE #10 CONDUCTORS MINIMUM. LIGHTING CIRCUITS FROM 151'-0" TO 250'-0" IN LENGTH SHALL UTILIZE #8 CONDUCTORS MINIMUM. LIGHTING CIRCUITS ABOVE 251'-0" IN LENGTH SHALL UTILIZE #6 CONDUCTORS MINIMUM.
- F. ALL CONDUIT IN EXPOSED AREAS SHALL BE PAINTED. CONDUITS PAINT TO MATCH THE SAME COLOR OF DECK ABOVE. ALL CAMERA LOCATIONS TO BE PROVIDED WITH CONDUIT (PENDANTS).
- G. ALL SHADED FIXTURES INCLUDING EXIT SIGNS SHALL BE USED EMERGENCY LIGHTING PURPOSES (WITH BUILT-IN BATTERY).
- H. X INDICATES AN ELECTRICAL BREAK IN TRACK. (TYPICAL) AN ELECTRICAL BREAK IN THE TRACK INDICATES AN IN-FEED TRACK ACCESSORY, AN ELECTRICAL BREAK AT THE END OF THE TRACK INDICATES A LIVE END TRACK ACCESSORY.
- I. LOCATE EXIT SIGNS AS REQUIRED BY LOCAL CODE.

City of Puyallup
Development & Permitting Services
ISSUED PERMIT

Building	Planning
Engineering	Public Works
Fire	Traffic

BARNES&NOBLE


PROJECT DESIGNER:

WJCA
BUILDING VALUE SINCE 1994

ARCHITECT:

JOEL TORIELLI
422 BOGERT AVE
RIDGEWOOD, NJ 07450

Kenneth A. Fuller, P.E.

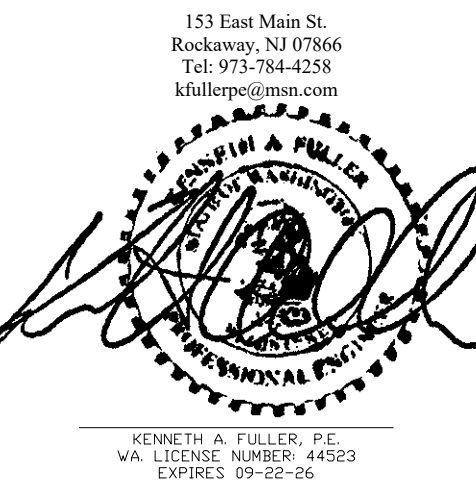

SOUTH HILL MALL
3500 S. MERIDIAN ST.
UNIT #800
PUYALLUP, WA 98373

Project Number 33247
Store Number 3507

Revision Log:

Date	Description	No.
12-19-24	ISSUED FOR PERMIT. BID, LANDLORD & CLIENT REVIEW	1
02-20-25	LANDLORD & BID COMMENTS	2
		3
		4
		5
These plans are an instrument of service and the property of the Architect. Infringements will be prosecuted.

General Contractor to verify all conditions and dimensions at the premises. Discrepancies shall be reported to the Architect prior to the commencement of any work.

Professional Seal:


LIC. # : 22005563
EXP. DATE : 10/02/25

Drawing Description:


LIGHTING PLAN

Drawing Number:

E-101

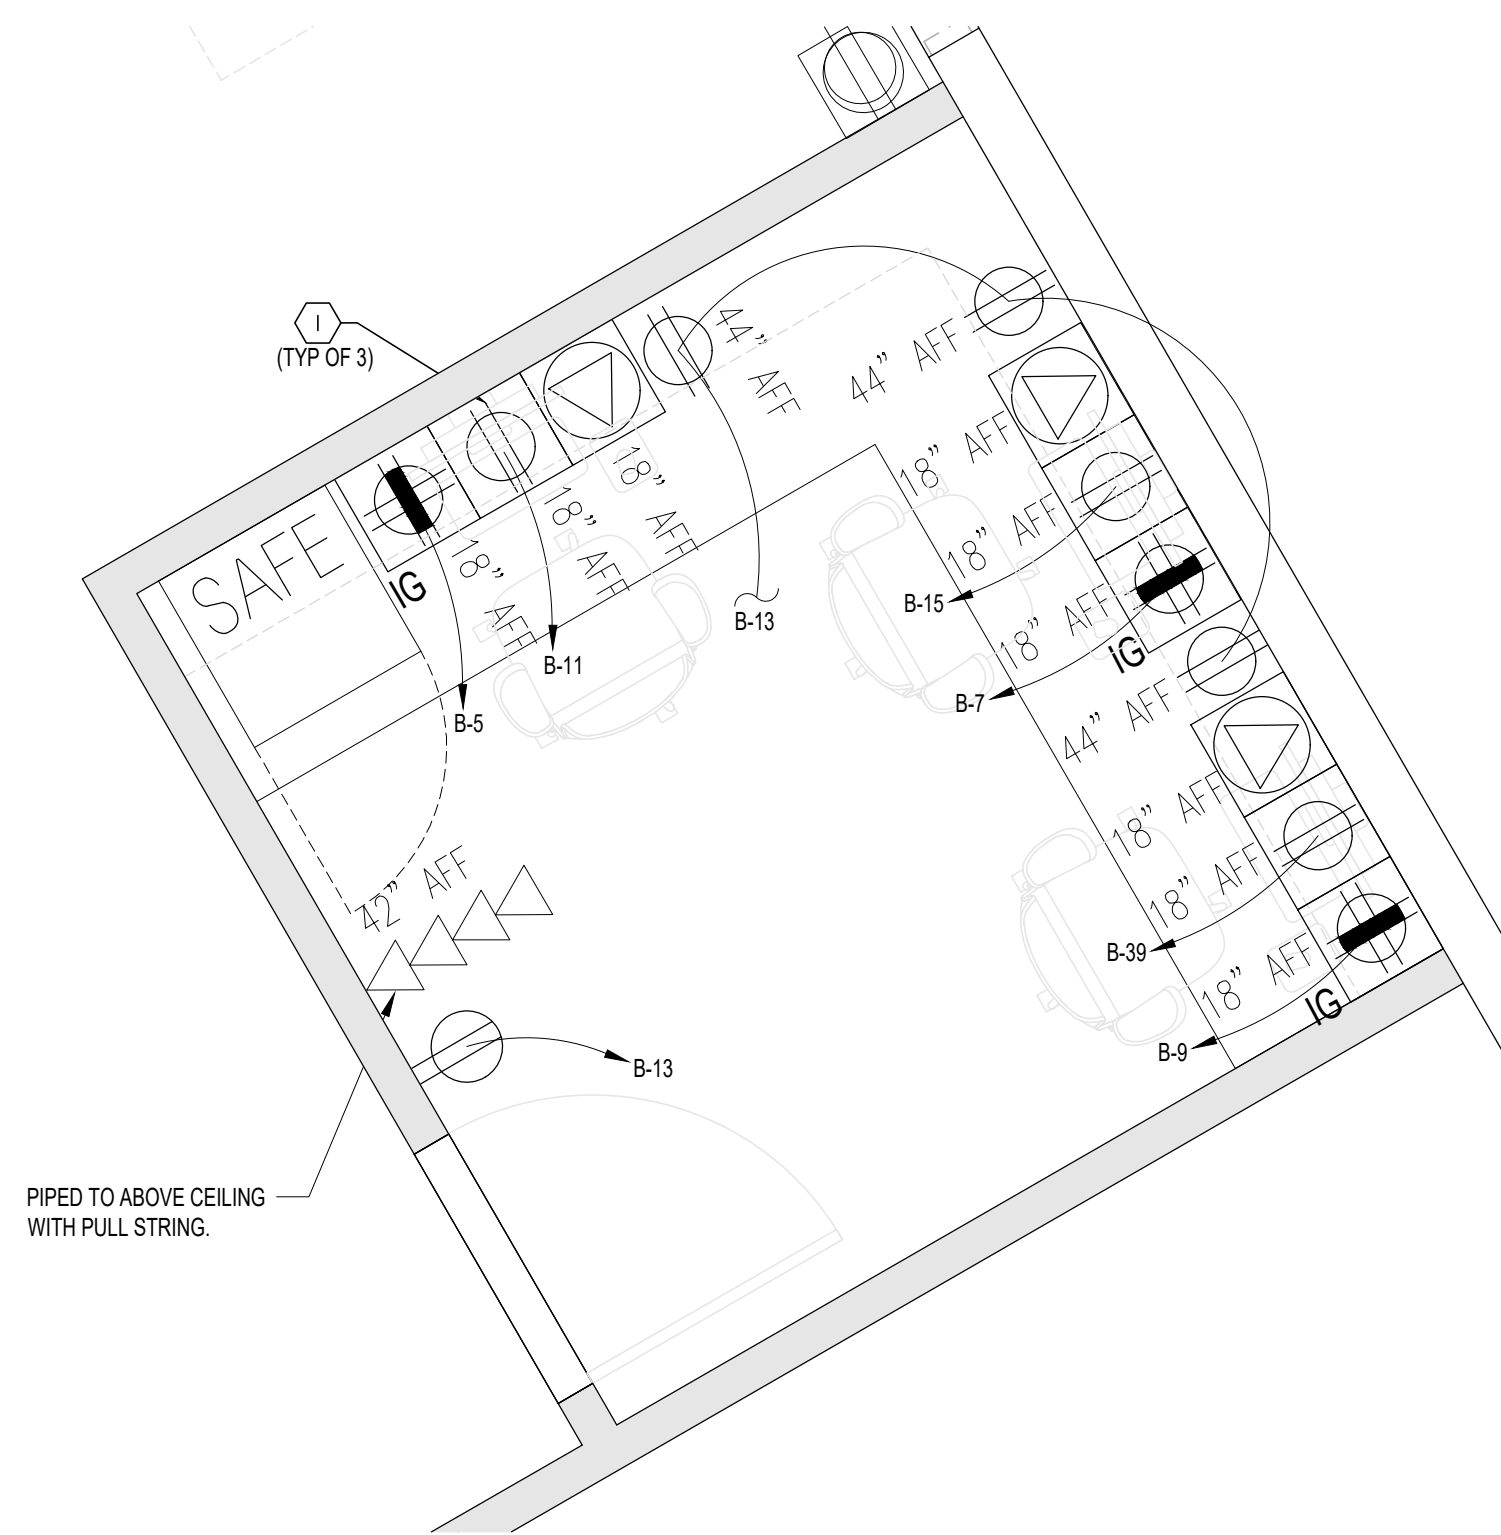


1 E-103 ENLARGED BREAK ROOM POWER PLAN 1/2" = 1' - 0"

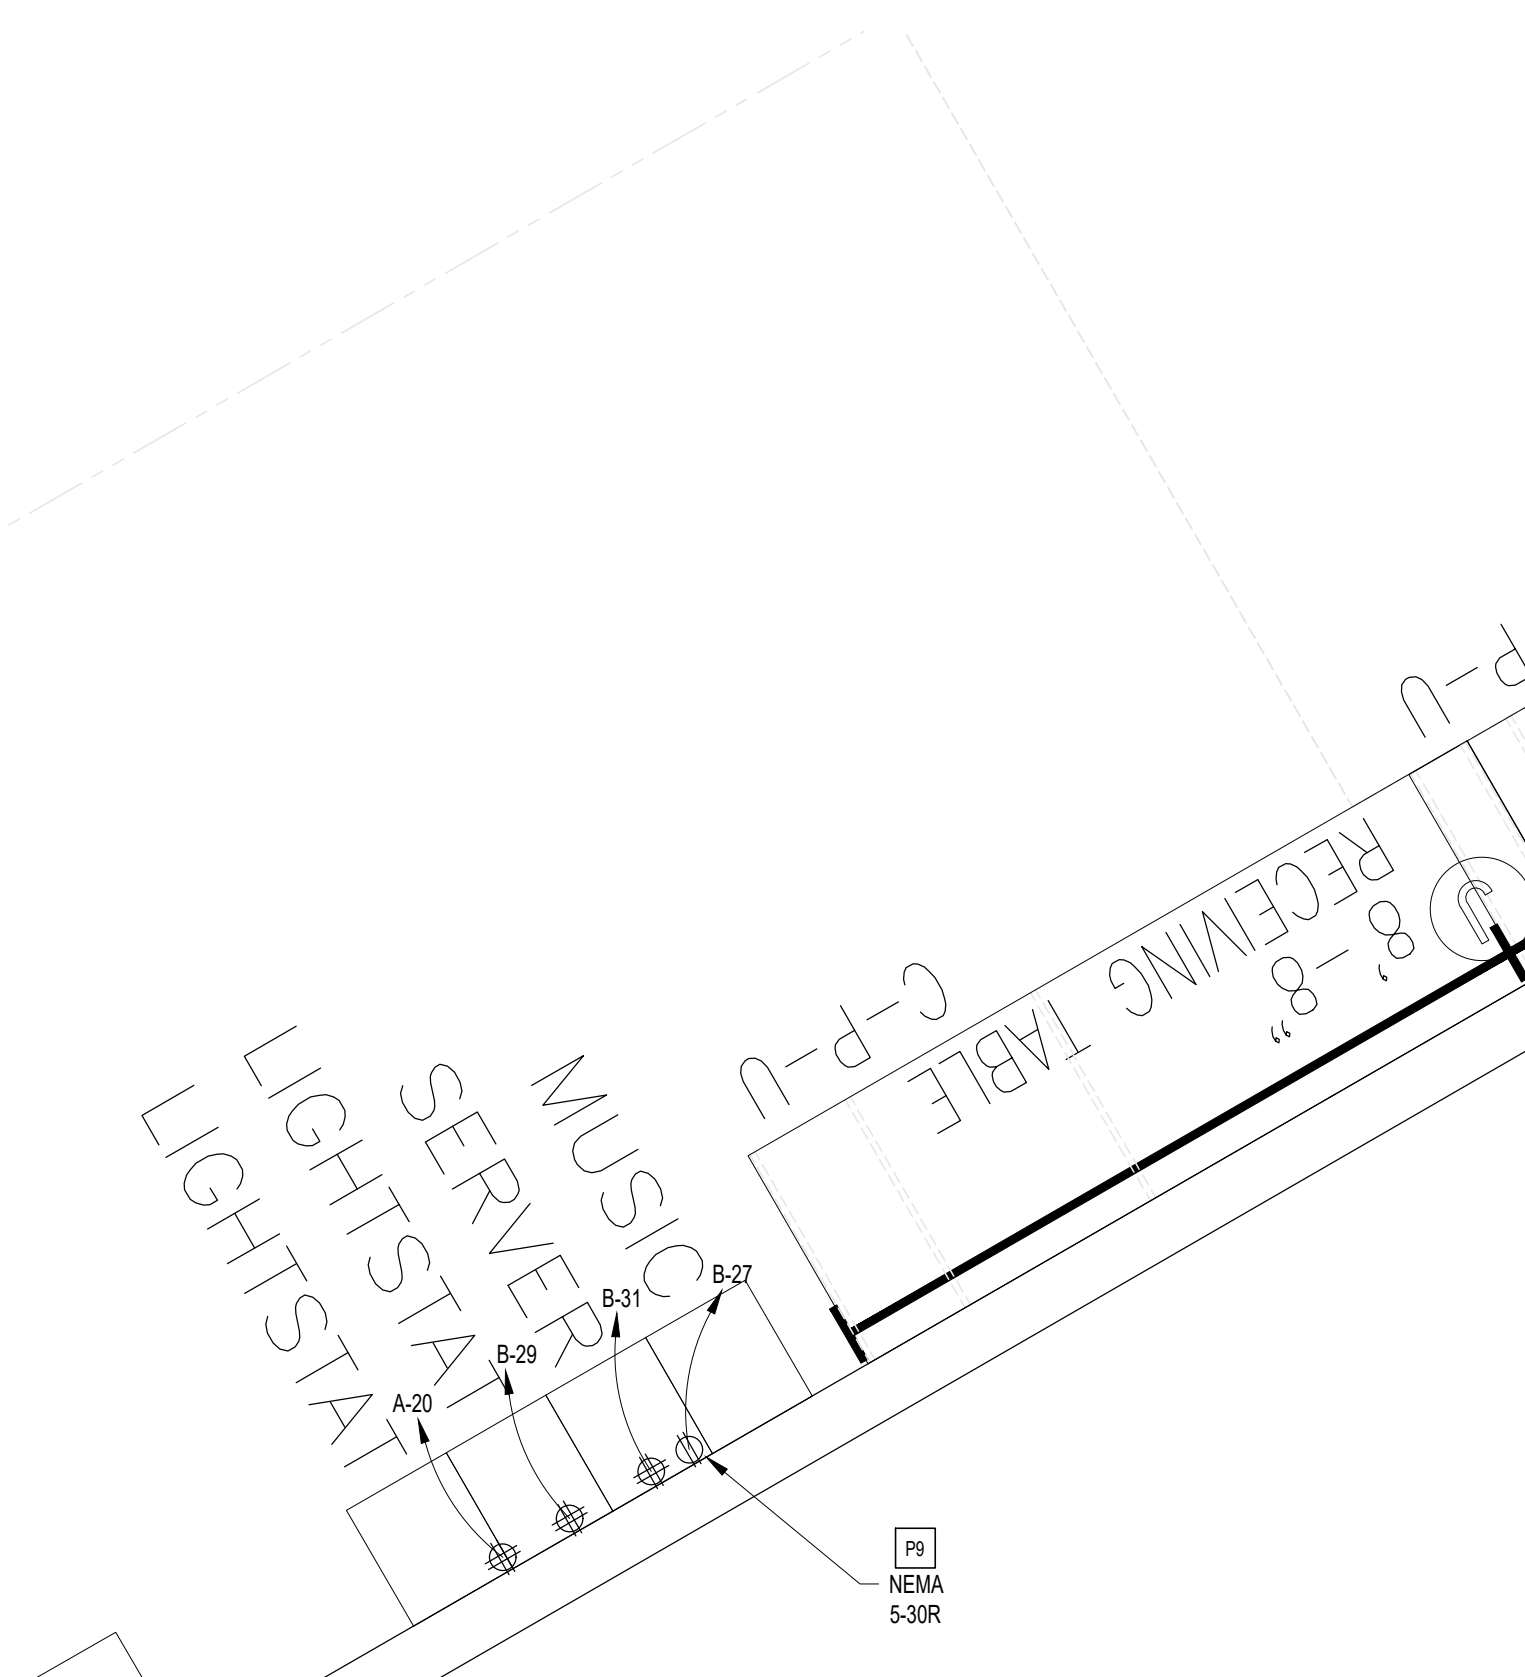

4
E-103

ENLARGED PART STOCK ROOM POWER PLAN

1/2" = 1' - 0"

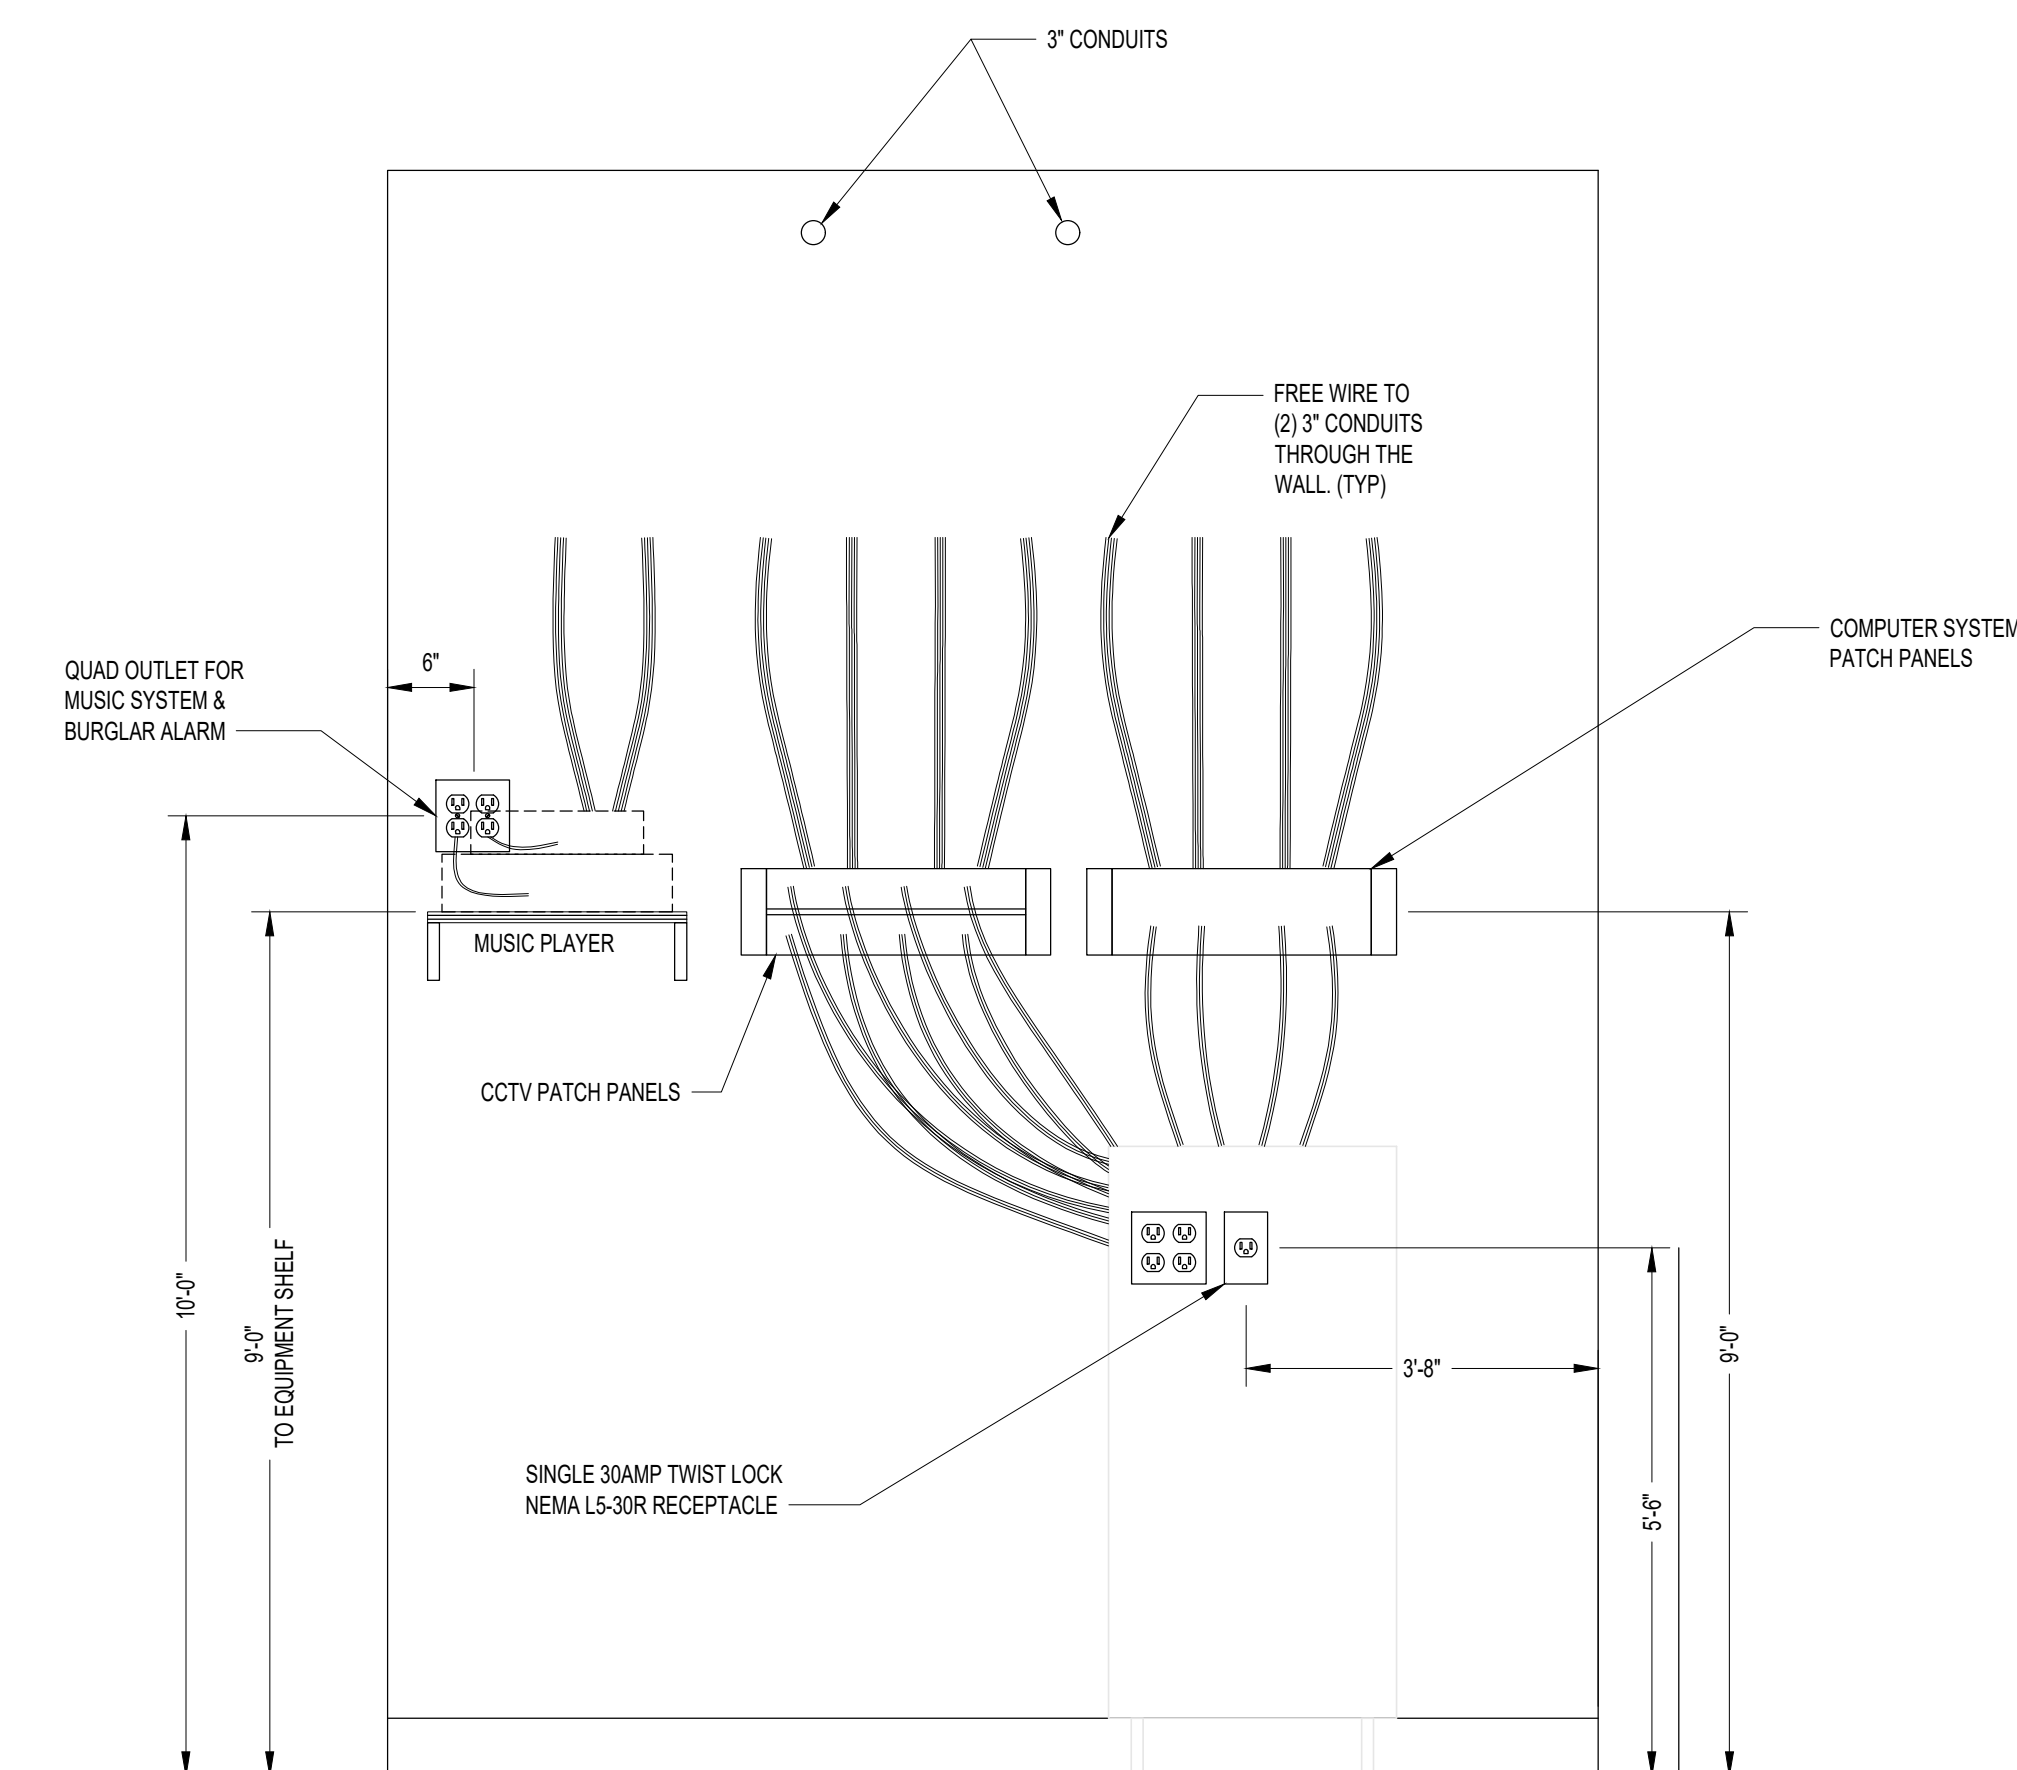

2
E-103

SERVER ROOM DETAIL

1/2" = 1' - 0"

Revision Log:		
Date	Description	No.
12-19-24	ISSUED FOR PERMIT, BID, LANDLORD & CLIENT REVIEW	1
02-20-25	LANDLORD & SE COMMENTS	2
		3
		4
These plans are an instrument service and the property of the Architect. Infringements will be prosecuted.

General Contractor to verify conditions and dimensions at the premises. Discrepancies shall be reported to the Architect prior to the commencement of any work.

Professional Seal:

LIC.# : 22005563
EXP. DATE : 10/02/25

Drawing Description:

ENLARGED
POWER PLANS


Drawing Number

E-103

GENERAL NOTE:
VERIFY FINAL LOCATIONS WITH KITCHEN DRAWINGS PRIOR TO ROUGH-IN.

GENERAL NOTE:
VERIFY ALL KITCHEN EQUIPMENT, SPECIFICATIONS, REQUIREMENTS, ETC. WITH KITCHEN VENDOR DRAWINGS & OWNER PRIOR TO BID.

ELECTRICAL KITCHEN SYMBOL LEGEND	
SYMBOL	DESCRIPTION
	WALL/FIXTURE MOUNTED DUPLEX OUTLET
	SPECIAL OUTLET. SEE CAFE EQUIPMENT POWER SCHEDULE FOR PLUG TYPE.
	WALL MOUNTED JUNCTION BOX

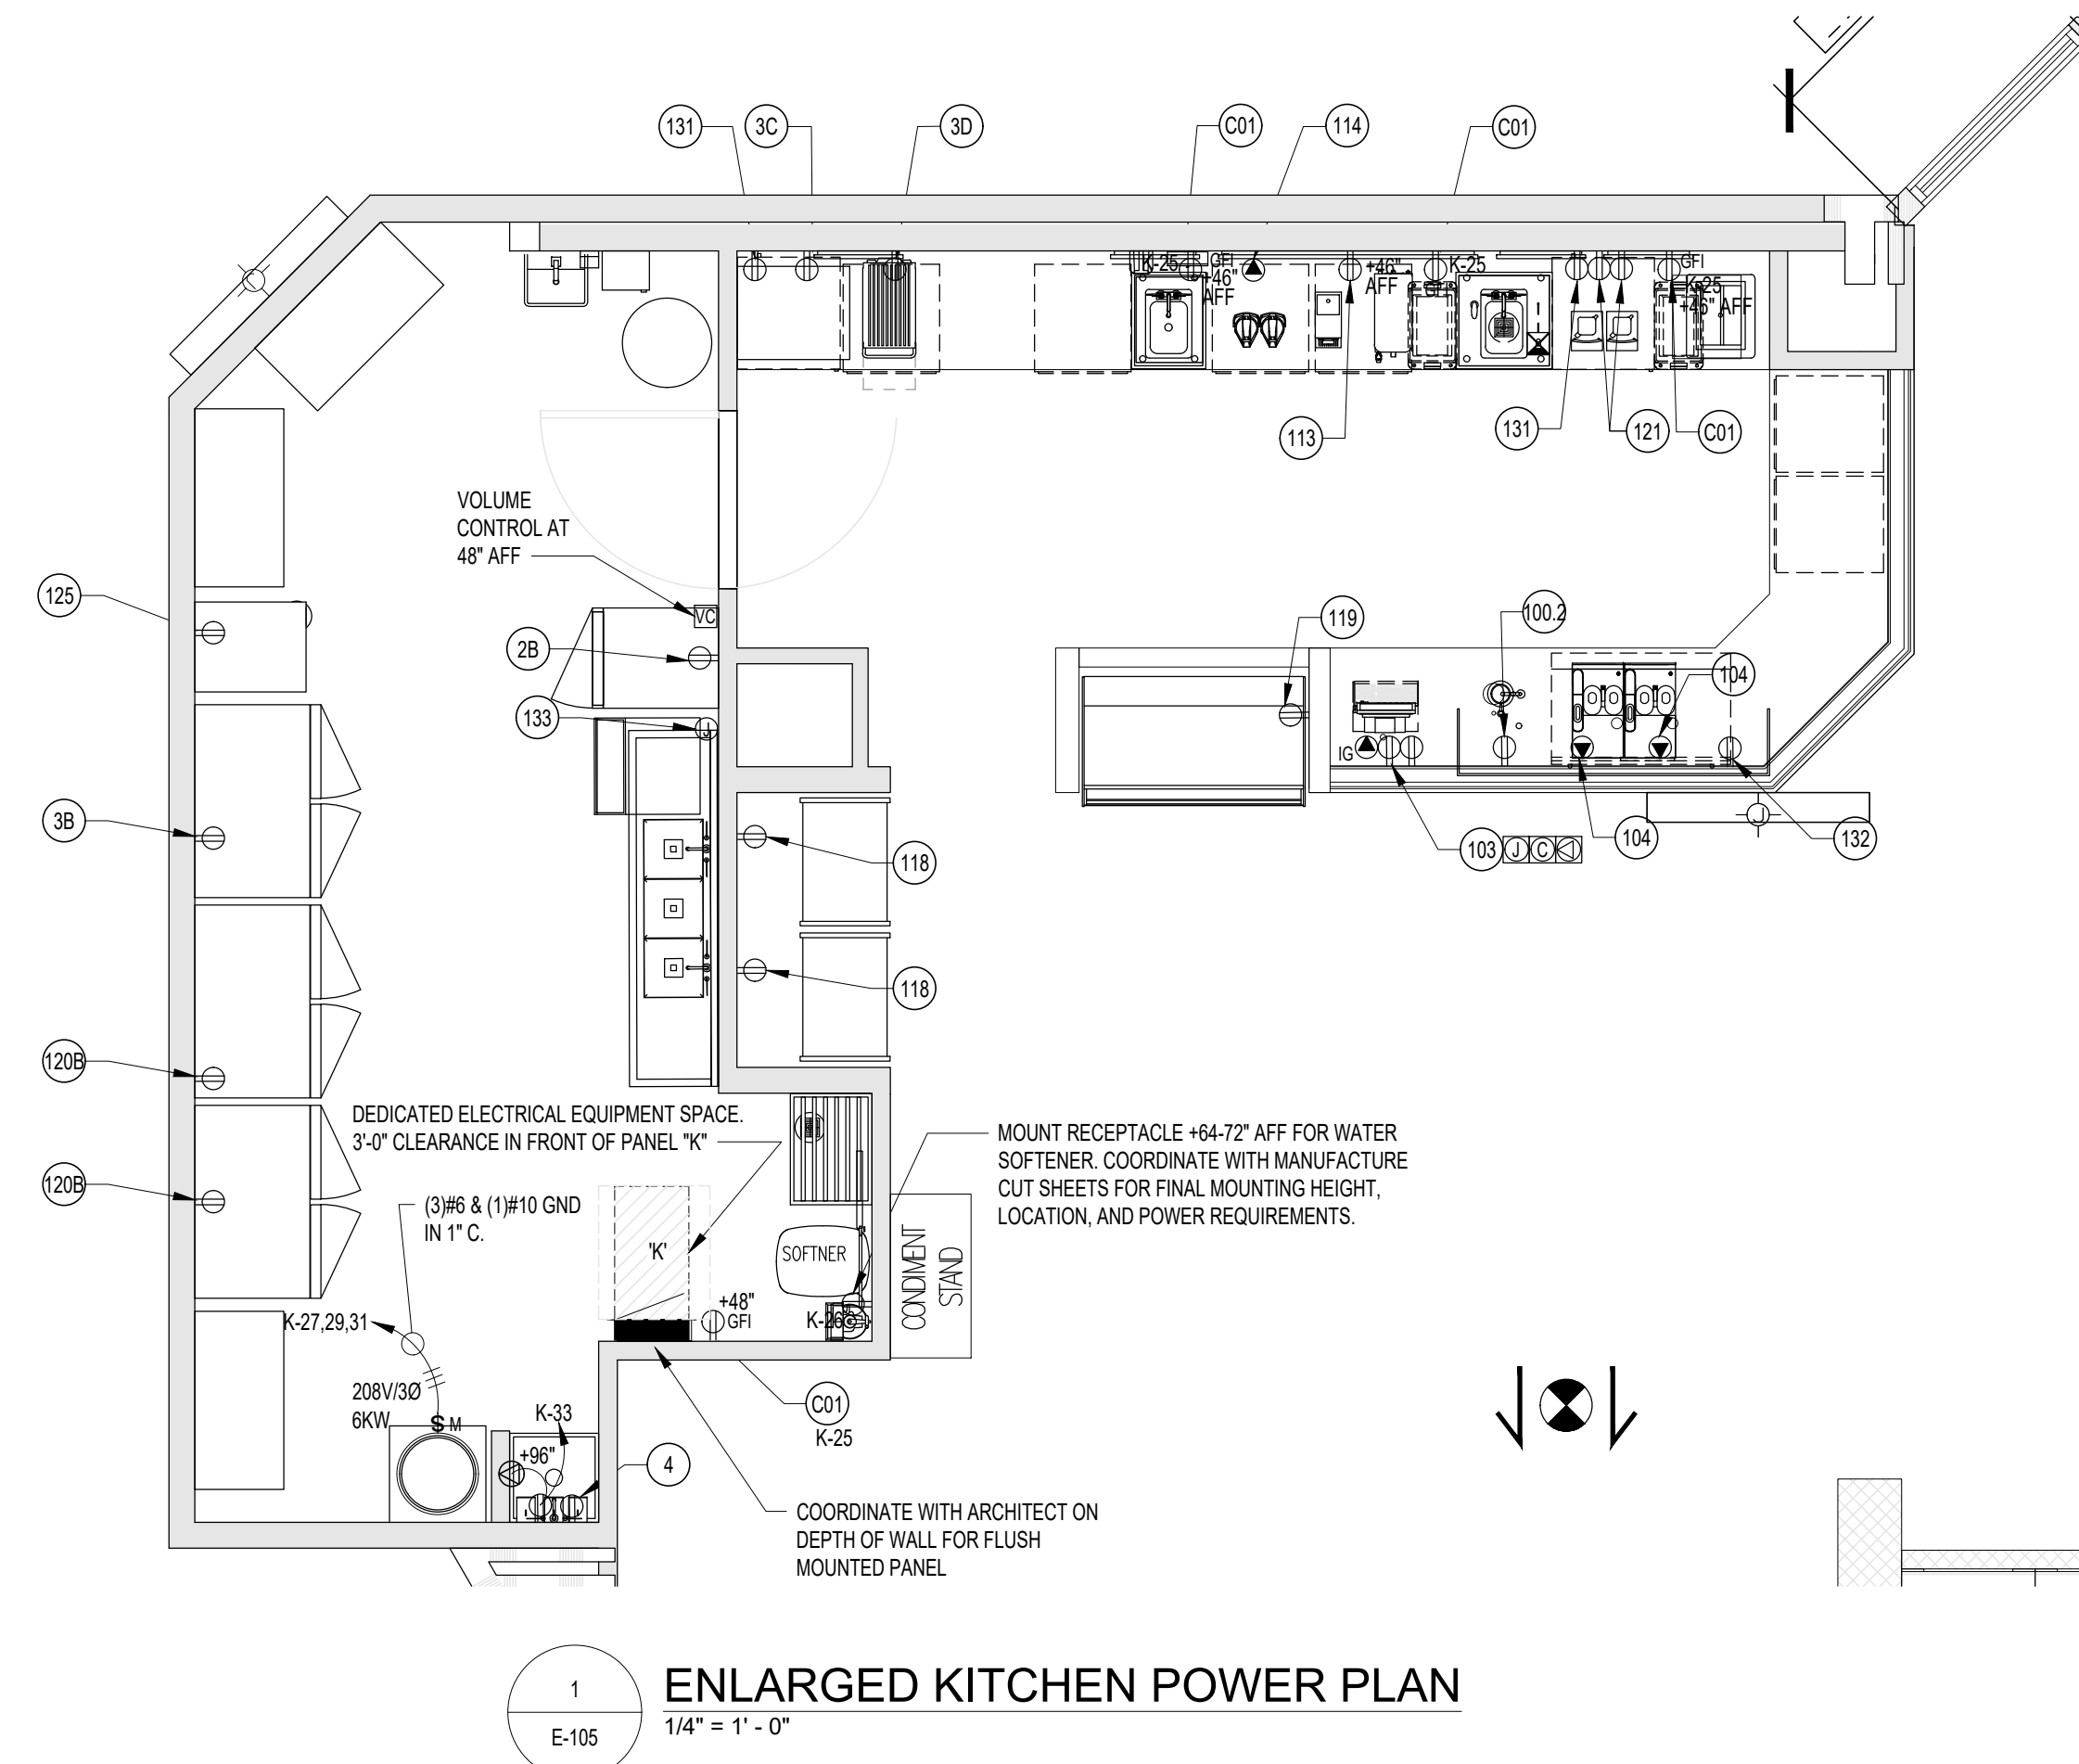

GENERAL NOTES:

- ALL DEVICES IN FOOD PREP AREA SHALL BE GFCI.
- FOR LOCATION OF ELECTRICAL DEVICES, REFER TO ARCHITECTURAL EQUIPMENT/CABINET PLANS (A-227 & A-227a). ALL DEVICES TO ALIGN WITH DESIGNATED EQUIPMENT AND CABINET LOCATIONS AS SHOWN. NO EXCEPTIONS SHALL BE TAKEN.
- GENERAL CONTRACTOR SHALL COORDINATE ELECTRICAL INSTALLATION WITH PLUMBING FOR INSTALLATION OF CARLON. SCHEDULE 40 CONDUIT CHASE FOR FILTER TUBING AS REQUIRED.
- SERVICE COUNTER MILL/WORK NOTE: EACH ELECTRICAL DEVICE WITHIN REAR COUNTER OF SERVICE AREA SHALL BE STUBBED-OUT WITH M.C. CONDUIT. GENERAL CONTRACTOR SHALL PROVIDE AND COORDINATE FINAL RECESSED INSTALLATION OF JUNCTION BOXES WITH MILL/WORK INSTALLATION.

FOOD SERVICE EQUIPMENT / UTILITIES SCHEDULE				
ITEM #	DESCRIPTION	MANUFACTURER	MODEL #	QTY
1	SINK BOWL, WELD-IN, DUMP SINK	N. WASSERSTROM & SONS	F4480234	1
1A	SINK BOWL, WELD-IN, HAND WASH	N. WASSERSTROM & SONS	F4480234	1
3C	BLODGETT OVEN	BLODGETT	CTB SGL	1
3D	RAPID COOK OVEN	MERRYCHIEF USA	E2S HIGH CLASSIC	1
100.1	PANTRY FAUCET	T&S BRASS	KL45-4000-WH	1
100.2	HOT WATER DISPENSER	IN SINK ERATOR	C1300	1
103	POS SYSTEM	-	-	1
104	ESPRESSO MACHINE	MELLITA	CT8	2
105	PASTRY CASE	RUBBERMAID COMMERCIAL PRODUCTS	-	1
108	GARBAGE CAN		FG354060BLA	3
111	TOUCH-FREE SOAP DISPENSER	GOJO INDUSTRIES, INC.	PURELL CS6	1
112	SURFACE-MOUNTED PAPER TOWEL DISPENSER	BOBRICK	B-2621	1
112.1	BLENDER RINSER	BLENDTEC	JRE-610	1
113	COFFEE GRINDER	GRINDMASTER-UNIC-CRATHCO	890BS	1
114	COFFEE BREWER	BUNN	53100.0100	1
115	MANIFOLD	-	-	1
116	GLASS FILLER	T&S BRASS	B-1210	-
117	AIRPOT	SERVICE IDEAS	ECALS22SS	2
118	SELF-SERVICE REFRIGERATED CASE	STRUCTURAL CONCEPTS	B3424	2
120	DROP-IN ICE BIN	KROWNE	D278	0
121	BLENDER	VITAMIX	36019-ABAB	2
123	DIPPER WELL	T&S BRASS	B-2282-01-F05	1
131	SINGLE UNDER COUNTER REFRIGERATOR	TRUE MGF.	TUC-27-HC	2
132	DOUBLE UNDER COUNTER REFRIGERATOR	TRUE MGF.	TWT-48-HC	1

WORKROOM EQUIPMENT / UTILITIES SCHEDULE				
ITEM #	DESCRIPTION	MANUFACTURER	MODEL #	QTY
1A	R.O. WATER FILTRATION SYSTEM MANIFOLD BOARD	-	-	1
1B	R.O. WATER FILTRATION SYSTEM - ACCUMULATOR TANK	-	-	1
1C	R.O. WATER FILTRATION SYSTEM - WATER SOFTENER	-	-	1
1D	R.O. WATER FILTRATION SYSTEM - BRINER	-	-	1
2B	FREEZER, REACH-IN, SINGLE DOOR	-	-	1
3B	FREEZER, REACH-IN, DOUBLE DOOR	TRUE MGF.	STG2F-2S-HC	1
4	WATER HEATER	-	-	1
5	MOP SINK	-	-	1
5.1	SERVICE FAUCET	-	-	1
6	WALL SHELF	-	-	1
8	SOAP DISPENSER	GOJO INDUSTRIES, INC.	TFX	1
9	HAND SINK - WALL MOUNTED	HAND SINK, PARTS & ACCESSORIES	DH-17-NO FAU	1
14	C-FOLD PAPER TOWEL DISPENSER	-	-	1
15	WASTE CONTAINER	-	-	1
16	THREE COMPARTMENT SINK	AMTEKCO INDUSTRIES LTD.	D724-03-74	1
16.1	PRE-RINSE FAUCET & ADD ON FAUCET	T&S BRASS	B-5110-12-CRB8P	1
16.4	LEVER WASTE	T&S BRASS	B-3950	3
120B	REFRIGERATOR, REACH-IN, DOUBLE DOOR	TRUE MGF.	STG2R-2S-HC	1
125	ICE MAKER, CUBE-STYLE	ITV ICE MAKER	SPIKA MS 500	1
127	WIRE SHELVING	1880 HOSPITALITY	FF2472C	3
133	DISHWASHER, UNDERCOUNTER	JACKSON WWS	DISHSTAR HT	1


CAFE EQUIPMENT POWER SCHEDULE													
EQUIPMENT NO. (E)	DESCRIPTION	QUANTITY	VOLTAGE AND PHASE	AMPS	HP	KVA	PANEL	CIRCUIT(S)	BREAKER SIZE	WIRE SIZE	CONDUIT	AFF	REFERENCE NOTES
120B	REFRIGERATOR, REACH-IN, DOUBLE DOOR	2	115V/1Ø	5.9	1/2	0.679	K	6 19	20A-1P	(2)#12 THWN & (1)#12 GND	3/4"	72"	1
2B	FREEZER, REACH-IN, SINGLE DOOR	1	115V/1Ø				K	32	20A-1P	(2)#12 THWN & (1)#12 GND	3/4"		1
3B	FREEZER, REACH-IN, DOUBLE DOOR	1	115V/1Ø	9.4	1-1/4	1.081	K	14	20A-1P	(2)#12 THWN & (1)#12 GND	3/4"	72"	1
3C	BLODGETT OVEN	1	208V/3Ø	24.0		5.6	K	36,38,40	20A-3P	(3)#12 THWN & (1)#12 GND	3/4"		1
3D	RAPID COOK OVEN	1	208V/1Ø	20.0		4.5	K	39,41	20A-1P	(2)#12 THWN & (1)#12 GND	3/4"		1
133	DISHWASHER, UNDERCOUNTER	1	208V/1Ø	37.2	-	7.74	K	21,23	40A-2P	(2)#8 THWN & (1)#10 GND	3/4"	18"	1,3
125	ICE MAKER, CUBE STYLE	1	115V/1Ø	16.0	-	1.289	K	1	20A-1P	(2)#12 THWN & (1)#12 GND	3/4"		1
100.2	HOT WATER DISPENSER	1	115V/1Ø	11.3	-	1.300	K	22	20A-1P	(2)#12 THWN & (1)#12 GND	3/4"	18"	1
103	POS SYSTEM	1	115V/1Ø	-	VERIFY	VERIFY	K K	37 35	20A-1P	(2)#12 THWN & (1)#12 GND & (1)#12 ISO GND	3/4"	18"	1,2
104	ESPRESSO MACHINE	2	208V-220V/1Ø	30.0	-	6.240	K K	5.7 9.11	30A-2P	(2)#10 THWN & (1)#10 GND	3/4"	30"	1
131	REFRIGERATOR, UNDERCOUNTER	2	115V/1Ø	2.0	1/6	0.24	K K	8 13	20A-1P	(2)#12 THWN & (1)#12 GND	3/4"	18"	1
121	BLENDER	2	120V/1Ø	15.0	3.0	1.800	K K	18 20	20A-1P	(2)#12 THWN & (1)#12 GND	3/4"	48"	1
113	COFFEE GRINDER	1	120V/1Ø	8.0	1/2	0.820	K	15	20A-1P	(2)#12 THWN & (1)#12 GND	3/4"	48"	1
114	COFFEE BREWER	1	208V/1Ø	14.0	-	2.912	K	10,12	20A-2P	(2)#12 THWN & (1)#12 GND	3/4"	48"	1
118	SELF-SERVICE REFRIGERATED CASE	2	120V/1Ø	15.6	-	1.108	K K	2 4	20A-1P	(2)#12 THWN & (1)#12 GND	3/4"	18"	1
119	DISPLAY CASE, REFRIGERATED, SELF-SERVE	1	208V/1Ø	10.0	1/2	2.08	K	32,34	20A-2P	(2)#12 THWN & (1)#12 GND	3/4"	18"	1
132	SINGLE UNDER COUNTER REFRIGERATOR	2	TBD	-	-	-	K	30	20A-1P	(2)#12 THWN & (1)#12 GND	3/4"	48"	1
CD1	CONVENIENCE RECEPTACLE	-	120V/1Ø	1.5	-	0.180	SEE PLANS	SEE PLANS	20A-1P	(2)#12 THWN & (1)#12 GND	3/4"	48"	1

REFERENCE NOTES:

- OWNER/VENDOR PROVIDED ITEM. VERIFY ALL UTILITY REQUIREMENTS AND LOCATIONS PRIOR TO ROUGH-IN.
- POS SYSTEM. PROVIDE ISOLATED, DEDICATED, GROUNDED CIRCUIT. PROVIDE 3/4" CONDUIT WITH PULL WIRE. GENERAL CONTRACTOR TO COORDINATE WITH SYSTEM INSTALLER.
- THE ELECTRICAL CONTRACTOR SHALL BE REQUIRED TO FURNISH AND INSTALL A CODE-COMPLIANT DISCONNECTING MEANS FOR EACH PIECE OF EQUIPMENT IDENTIFIED IN THE ELECTRICAL CONNECTION SCHEDULE AS REQUIRING A DIRECT CONNECTION OR PROVIDE A LOCK-OFF TYPE BREAKER AS SHOWN IN THE PANEL SCHEDULE ON SHEET E202. ALL DISCONNECTS SHALL BE NEMA 4X. DISCONNECTS SHALL BE FUSED WHERE REQUIRED BY N.E.C. (TYPICAL).

KITCHEN ELECTRICAL NOTES

- ALL COVERPLATES AND DISCONNECT SWITCHES IN KITCHEN AREA SHALL BE STAINLESS STEEL.
- ALL ELECTRICAL WORK FOR FOOD SERVICE EQUIPMENT SHALL BE COMPLETELY INTERWIRE BY ELECTRICAL CONTRACTOR. FINAL CONNECTIONS TO EQUIPMENT JUNCTION BOX OR PULL BOX AND ALL ELECTRICAL WORK FROM PANEL BOARDS, TO BE BY THE ELECTRICAL CONTRACTOR.
- THE ELECTRICAL CONTRACTOR SHALL PROVIDE ALL ROUGH-IN AND FINAL CONNECTION TO THE FOOD SERVICE EQUIPMENT. ALL WORK TO BE IN COMPLIANCE WITH ALL NATIONAL, STATE AND LOCAL CODES APPLICABLE.
- VERIFY OUTLET RATING AND CONFIGURATION WITH EQUIPMENT SUPPLIER PRIOR TO ROUGH-IN.
- ELECTRICAL CONTRACTOR TO FURNISH AND INSTALL ALL PLUGS AND CORDS REQUIRED. ALL CORDS SHALL BE NEMA RATED AND UL APPROVED FOR MANUFACTURER AND EQUIPMENT.
- ELECTRICAL CONTRACTOR TO FURNISH AND INSTALL ALL JUNCTION BOXES. PVC OR METAL CONDUIT, CONVENIENCE OUTLETS WITH COVERS, SWITCHES CONNECTORS, CONTROLS, AND OTHER ACCESSORIES THAT ARE NOT AN INTEGRAL PART OF THE FOOD SERVICE EQUIPMENT AS REQUIRED TO MAKE FINAL CONNECTIONS TO THE FOOD SERVICE EQUIPMENT FOR A COMPLETE AND FUNCTIONAL OPERATION MEETING ALL APPLICABLE NATIONAL, STATE, AND LOCAL CODES AND ORDINANCES.
- ELECTRICAL CONTRACTOR TO FURNISH AND INSTALL ALL DISCONNECTS OR CIRCUIT BREAKERS AS REQUIRED BY CODES FOR EACH CONNECTION. COORDINATE LOCATION WITH THE KITCHEN EQUIPMENT CONTRACTOR.
- ELECTRICAL CONTRACTOR TO FURNISH AND INSTALL WALL SWITCH FOR FACTORY INSTALLED LIGHTING FIXTURES IN EXHAUST VENTILATOR HOODS PER APPLICABLE STATE AND LOCAL CODES APPLICABLE. ELECTRICAL CONTRACTOR SHALL PROVIDE WIRE AND CONNECTION TO EACH LIGHT FIXTURE. THE ELECTRICAL CONTRACTOR SHALL FULLY COORDINATE ALL WIRING BETWEEN POWER SOURCE, WALL SWITCH, AND JUNCTION BOX ON HOOD. THE ELECTRICAL CONTRACTOR SHALL BE RESPONSIBLE FOR PROVIDING ANY INNER WIRING OF LIGHT FIXTURES BETWEEN VENTILATOR HOOD SECTIONS AS REQUIRED. ALL WIRING WITHIN HOOD AND POWER SOURCE TO BE IN STRICT ACCORDANCE WITH MANUFACTURER'S RECOMMENDATIONS, NFPA #96 AND ALL OTHER APPLICABLE CODES.
- IN ACCORDANCE WITH NFPA #96 AND MANUFACTURER'S RECOMMENDATIONS, THE ELECTRICAL CONTRACTOR SHALL FURNISH AND INSTALL A PUSH BUTTON STATION WITH PILOT LIGHT FOR VENTILATOR FAN MOTOR(S). THE ELECTRICAL CONTRACTOR IS TO BE RESPONSIBLE FOR, AND TO PROVIDE ALL REQUIRED WIRING FROM POWER SUPPLY THROUGH FAN SWITCH TO FAN MOTOR(S) AND PROVIDE MAGNETIC STARTERS AND FULLY INTERWIRE SYSTEM WITH ALL POWER INTERRUPTION DEVICES BUILT INTO HOOD AND FIRE PROTECTION SYSTEM AS REQUIRED BY NFPA #96, NATIONAL, STATE AND/OR LOCAL CODES APPLICABLE. ELECTRICAL CONTRACTOR TO PROVIDE LOCK-OUT DEVICES ON CONTROL BOXES FOR EXHAUST HOOD FANS, SYSTEM AND FIRE PROTECTION SYSTEM.
- ELECTRICAL CONTRACTOR TO PROVIDE, INSTALL AND FULLY WIRE SHUNT-TRIP BREAKERS FOR SHUT DOWN OF FUEL AND POWER TO COOKING EQUIPMENT AS REQUIRED BY NFPA #96 AND ALL OTHER NATIONAL, STATE, OR LOCAL CODES APPLICABLE. THE HOLDING COILS FOR SHUNT-TRIP BREAKERS SHALL BE WIRED TO A 120 VOLT SINGLE PHASE CONTROL CIRCUIT BY THE ELECTRICAL CONTRACTOR AND EXTENDED THROUGH A CONTACTOR AND MAINTAINED BY A PRESSURE SWITCH LOCATED AT THE MOUNTING BRACKET OF THE CHEMICAL CYLINDER FOR HOOD PROTECTION. THE ELECTRICAL CONTRACTOR SHALL ALSO PROVIDE, INSTALL, AND FULLY INTERWIRE WITH POWER SHUTDOWN RELAY SWITCH, AND ADDITIONAL RELAY OR SWITCHES REQUIRED TO INTERFACE FIRE PROTECTION SYSTEM WITH FAN VENTILATOR MOTORS AND BUILDING ALARM SYSTEMS AS REQUIRED BY NFPA #96, NATIONAL, STATE, AND LOCAL CODES APPLICABLE. COORDINATE WITH FIRE SUPPRESSION CONTRACTOR FOR LOCATION OF FIRE SUPPRESSION SYSTEM, AND GAS SHUT-OFF VALVE AS PART OF THE COMPLETE SYSTEM AS APPLICABLE.
- AT THE REMOTE FIRE CABLE PULL, ELECTRICAL TRADES TO PROVIDE EMPTY JUNCTION BOX AT 54" AFF AND CONDUIT CONCEALED IN WALL TO 6" ABOVE FINISHED CEILING. COORDINATE EXACT REQUIREMENTS WITH FOOD SERVICE EQUIPMENT TRADE AND FIRE SUPPRESSION CONTRACTOR.
- ELECTRICAL CONTRACTOR SHALL INTERWIRE DISPOSER CONTROL SWITCH AND TO TIME DELAY RELAY, MAGNETIC STARTER, DISPOSER MOTOR, AND SOLENOID VALVE WITH WATER TIGHT CONDUIT AS REQUIRED PER LOCAL CODES.
- ELECTRICAL CONTRACTOR SHALL INTERWIRE THROUGH TIME CLOCK FOR LOW TEMPERATURE COMPRESSOR AND WALK-IN COMPARTMENT BLOWER COIL FAN MOTORS AND DEFROST ELEMENT POWER SOURCE AS PART OF MAIN POWER SOURCE. PROVIDE ALL WIRING AND CONDUIT WITH DISCONNECT. (VERIFY REQUIREMENTS WITH EQUIPMENT SUPPLIER)
- ELECTRICAL CONTRACTOR SHALL PROVIDE FINAL CONNECTION TO A JUNCTION BOX MOUNTED ON TOP OF A PREFABRICATED REFRIGERATOR AND/OR FREEZER WALL AT APPROXIMATELY 8'-6" AFF. INTERWIRE THE LIGHT ADJACENT TO THE DOOR WITH THE FACTORY MOUNTED LIGHT SWITCH. ALL CONDUIT SHALL BE RUN EXPOSED ON TOP OF WALK-IN, NO EXPOSED CONDUIT WILL BE ALLOWED ON INSIDE OF WALK-IN. ELECTRICAL SERVICE REQUIRED FOR WALK-IN SHALL BE AS SHOWN FOR LIGHTS, DOOR AND DOOR FRAME HEATER, THRESHOLD PLATE HEATERS (WHERE SPECIFIED), HEATED PRESSURE RELIEF PORT (ON FREEZERS) AND ALARM SYSTEMS (WHERE SPECIFIED). (VERIFY REQUIREMENTS WITH EQUIPMENT SUPPLIER)
- ELECTRICAL CONTRACTOR TO PROVIDE THE REQUIRED POWER SUPPLY AND FINAL CONNECTIONS TO THE TERMINAL BLOCK AT THE CONDENSING UNIT AND TO FULLY INTERWIRE TO ANY ADDITIONAL COMPONENTS. INCLUDE THE PROPER SIZE DISCONNECTS OR CIRCUIT BREAKERS. ALL WIRING FOR LOW AND MEDIUM TEMPERATURE CONDENSING UNIT TO BE ROUTED THROUGH DEFROST TIME CLOCK AND THEN WIRED TO EVAPORATOR COIL FOR PROPER POWER SUPPLY WITH THE REQUIRED QUANTITY OF WIRES. THE EVAPORATOR COIL DEFROST HEATER AND FAN MOTOR VOLTAGES AND LOADS ARE AS NOTED ON PLAN. VERIFY LOCATION OF COMPRESSORS AND COORDINATE WITH REFRIGERATOR CONTRACTOR FOR FINAL CONNECTIONS. (VERIFY REQUIREMENTS WITH EQUIPMENT SUPPLIER)
- ALL 50AMP OR LESS - SINGLE PHASE AND 100AMP OR LESS - THREE PHASE, RECEPTACLES IN KITCHEN AREAS SHALL BE GFCI PROTECTION PER N.E.C. 210-8(B).

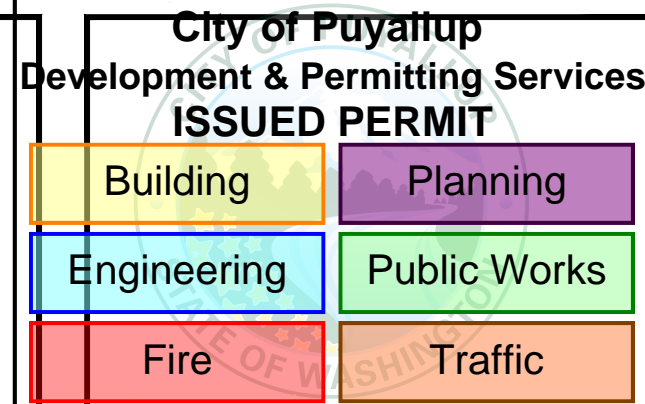

BARNES & NOBLE


PROJECT DESIGNER:

WJCA
BUILDING VALUE SINCE 1994

ARCHITECT:

JOEL TORIELLI
422 BOGERT AVE
RIDGEWOOD, NJ 07450

Kenneth A. Fuller, P.E.

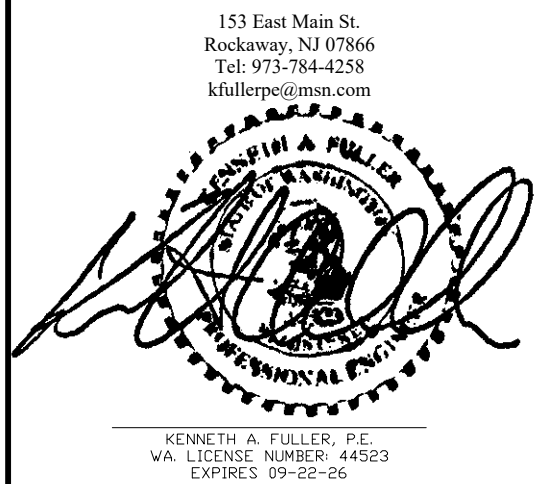

SOUTH HILL MALL
3500 S. MERIDIAN ST.
UNIT #800
PUYALLUP, WA 98373

Project Number 33247
Store Number 3507

Revision Log:

Date	Description	No.
12-19-24	ISSUED FOR PERMIT, BID, LANDLORD & CLIENT REVIEW	1
02-20-25	LANDLORD & BID COMMENTS	2
		3
		4
		5
These plans are an instrument of service and the property of the Architect. Infringements will be prosecuted.

General Contractor to verify all conditions and dimensions at the premises. Discrepancies shall be reported to the Architect prior to the commencement of any work.

Professional Seal:

LIC.# : 22005563
EXP. DATE : 10/02/25

Drawing Description:

ENLARGED
KITCHEN
POWER PLANS

Drawing Number:

E-105















LIGHT FIXTURE SCHEDULE (LIGHT CONCEPT)

SYMBOL	TAG	LOAD (VAE)	DESCRIPTION	AREA
	HB	15	HIGH BAY HALOGEN LIGHTINGS NUVO SF78-283, L16A19N1530K FINISH : WHITE	SUSPENDED IN SALES FLOOR AT 10'-8" A.F.F.
	HB-B	15	HIGH BAY HALOGEN LIGHTINGS NUVO SF78-283, L16A19N1530K FINISH : BLACK	SUSPENDED ABOVE CAFE SEATING AREA AT 8'-0" A.F.F.
	HB-R	15	HIGH BAY HALOGEN LIGHTINGS NUVO SF78-283, L16A19N1530K FINISH : RED	SUSPENDED IN SALES FLOOR AT 10'-8" A.F.F.
	LW-01	22	NEW TRACK HEADS MANUFACTURER: ATTAIN LED TRACK HEAD HP MODEL: AT-25-35-95-24-WH-J	TRACK MOUNTED IN SALES AREA
	LWT-01 TRACK	-	NEW PENDANT MOUNTED MANUFACTURER: CONTECH SINGLE CIRCUIT LINE VOLTAGE TRACK VARIOUS LENGTHS-WHITE UNISTRUT AND HANGING HARDWARE	SUSPENDED IN SALES FLOOR AT 12'-0" A.F.F.
	A1	68	BOH LIGHTING MANUFACTURER: LITHONIA LIGHTING MODEL: TZLIN LED L96 10000LM FST MVOLT 30K 80CRI PLR E7W WH	SUSPENDED AT 12'-0" A.F.F. IN STOCK ROOM
	A2	-	OFFICE AND BREAK ROOM LIGHTING MANUFACTURER: DT BY TCP MODEL:DTF2UZD3835K	LAY-IN CEILING
	A3	46	ATTAIN 2 FT. X 4 FT. INTEGRATED LED 4000 LUMENS 4000K 120V COMMERCIAL GRADE RECESSED TROFFER W/ PRISMATIC LENSES	LAY-IN CEILING
	A14	34	MANUFACTURER: LITHONIA LIGHTING MODEL: ZLIN LED STRIPLIGHT L48 5000LM FST MVOLT 30K 80CRI PLR E7W WH	SURFACE MOUNTED TO CEILING OR SUSPENDED AT 12FT A.F.F.
	X1	3.8	THERMOPLASTIC LED EXIT SIGN MANUFACTURER: BEST LIGHTING MODEL: EZXTEU-2RW-EM	SUSPENDED OR WALL MOUNTED AT 8'-0" A.F.F. MIN. B.O. SIGN
	X2	5	LED EXIT SIGN AND EMERGENCY LIGHT, THERMOPLASTIC COMBO MANUFACTURER: BEST LIGHTING MODEL: LEDCXTEU-2-R-W-RC	SUSPENDED OR WALL MOUNTED AT 8'-0" A.F.F. MIN. B.O. FIXTURE
	EM1	5	EMERGENCY LIGHT MANUFACTURER: ASTRALITE MODEL: EU-5-LED	SUSPENDED OR WALL MOUNTED AT 8'-0" A.F.F. MIN. B.O. FIXTURE
	D4	12	4" DIAMETER LED DOWNLIGHT MANUFACTURER: ATTAIN LED MODEL: AT-DL4-12-35-WH	RECESSED IN CAFE CEILING
	D6	32	6" DIAMETER LED DOWNLIGHT MANUFACTURER: MAXI LUME MODEL: H6-LED-2000L-DIM10-120-MD-35K-90/ L807 SHZ WH	RECESSED IN RESTROOM CEILING
	PD1	60	22" DIAMETER LED PENDANT MANUFACTURER: WAYFAIR MODEL: METAIRIE 1 LIGHT SINGLE DOME PENDANT	SUSPENDED ABOVE COUNTER AT 7'-8" AFF
	L-8 L-6 L-4 L-2	80 60 40 20	LED TUBE PENDANT ADJUSTABLE MANUFACTURER: CORONET LED MODEL: 8ft: CRD3-8-30-HIGH-UNV-DB-BLK -AC-SD 6ft: CRD3-6-30-HIGH-UNV-DB-BLK -AC-SD 4ft: CRD3-4-30-HIGH-UNV-DB-BLK -AC-SD 2ft: CRD3-2-30-HIGH-UNV-DB-BLK -AC-SD	SUSPENDED ABOVE COUNTER AT 9'-0" AFF
	E(EM)	-	EXISTING EMERGENCY LIGHT	EXITING IN SALES FLOOR. VERIFY EXACT LOCATION AND COVERAGE ON SITE
	SP	-	SPEAKER	OFFICE
	-	-	2X2 DIFFUSER PAINTED TO MATCH ADJACENT CEILING	-

LIGHTING FIXTURE SCHEDULE NOTES:

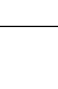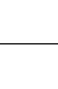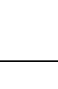- PROVIDE WITH INTEGRAL EMERGENCY BATTERY PACK. EMERGENCY BATTERY PACKS SHALL PROVIDE A MINIMUM OF NINETY (90) MINUTES OF CODE REQUIRED EMERGENCY LIGHTING. EACH BATTERY PACK PROVIDED SHALL PRODUCE THE MAXIMUM LUMEN OUTPUT AVAILABLE WITH THE MAXIMUM NUMBER OF LAMPS. BODINE OR APPROVED EQUAL. CIRCUIT BATTERY PACK AHEAD OF ALL LIGHTING CONTROLS.
- REFER TO ARCHITECTURAL REFLECTED CEILING PLAN AND/OR ROOM FINISH SCHEDULE TO DETERMINE PROPER TYPE OF LIGHT FIXTURE REQUIRED FOR THE CEILING CONSTRUCTION PRIOR TO ORDERING THE FIXTURES & PROVIDE FIXTURES THAT ARE COMPATIBLE WITH THE CEILING SYSTEM.
- NOT USED
- NOT USED
- NOT USED
- NOT USED
- VERIFY ALL INFORMATION MARKED AS "B.O." WITH BARNES & NOBLE PROJECT MANAGER AND THE ARCHITECT PRIOR TO PURCHASE.
- VERIFY ALL MOUNTING HEIGHTS AND METHODS WITH ARCHITECT PRIOR TO INSTALLATION / ROUGH-IN.

LOW VOLTAGE SCHEDULE

SYMBOL	TAG	DESCRIPTION	MOUNTING HEIGHT
	OCCUPANCY SENSOR (LIGHTSTAT)	DECK MOUNTED J-BOX WITH 3/4" CONDUIT DROP	10'-6" AFF
	SPEAKER	-	LAY -IN CEILING
	SPEAKER	PROVIDE J-BOX MOUNTED TO DECK	MATCH HEIGHT BOTTOM OF LIGHT GRID
	CCTV	PROVIDE SURFACE MOUNTED J-BOX WITH 3/4" CONDUIT AND SWIVEL MOUNTED J-BOX	MATCH HEIGHT BOTTOM OF LIGHT GRID
	CCTV	PROVIDE 3/4" CONDUIT THROUGH CEILING TO ABOVE VESTIBULE	CEILING MOUNTED
	CCTV	PROVIDE 3/4" CONDUIT SLEEVE THRU WALL 12"-15" ABOVE CENTRE OF DOOR FRAME	WALL MOUNTED
	MOTION DETECTOR	DECK MOUNTED J-BOX WITH 3/4" CONDUIT DROP	10'-6" AFF
	KEYPAD	PROVIDE 3/4" CONDUIT FLUSH AND CENTERED 48" AFF TO ABOVE VESTIBULE WITH PULL STRING. SEE ELECTRICAL DRAWINGS FOR OUTLET	48" AFF
	CELL BOOST ANTENNA	DUPLEX OUTLET MOUNTED IN THE CEILING. SEE ELECTRICAL DRAWINGS FOR OUTLET.	MATCH HEIGHT BOTTOM OF LIGHT GRID
	ACCESS POINT	PROVIDE SURFACE MOUNTED J-BOX WITH 3/4" CONDUIT AND SWIVEL MOUNTED J-BOX	MATCH HEIGHT BOTTOM OF LIGHT GRID
	ANTENNA	PROVIDE SURFACE MOUNTED J-BOX WITH 3/4" CONDUIT AND SWIVEL MOUNTED J-BOX, FOR BN INTERNAL PHONE SYSTEM, 2-TOTAL, 1-FRONT, 1-BACK SALES ONLY	MATCH HEIGHT BOTTOM OF LIGHT GRID
	SECURITY PADDLE	PROVIDE 3/4" CONDUIT FLUSH AND CENTERED ON WOOD FRAME FROM 48" AFF TO ABOVE CEILING IN CORRIDOR. SEE ELECTRICAL DRAWINGS FOR OUTLET	WALL MOUNTED 48" AFF
	SECURITY PADDLE	PROVIDE 1" CONDUIT FROM SLAB TO ABOVE VESTIBULE CEILING. BOTH OUTLETS ON SAME CIRCUIT. SEE ELECTRICAL DRAWINGS FOR OUTLET	FLOOR MOUNTED 24" FROM VESTIBULE TO CENTRELINE
	-	-	WALL MOUNTED

LOW VOLTAGE GENERAL NOTES

- GENERAL CONTRACTOR SHALL COORDINATE FINAL LOCATIONS FOR LOW VOLTAGE DEVICES WITH INDIVIDUAL LV VENDORS.
- CAMERAS SHOULD NOT BE PLACED WHERE NOT OBSTRUCTED BY AWNING, STOREFRONT ETC.

NOTE: AS PER LANDLORD SPECIFICATIONS ALL MECHANICAL, PLUMBING, AND ELECTRICAL EQUIPMENTS BE PROPERLY SUPPORTED FROM STEEL STRUCTURE, NOT ROOF DECK.

GENERAL NOTES

- REFER TO ARCHITECTURAL REFLECTED CEILING PLANS FOR EXACT LOCATION OF LIGHT FIXTURES. CONTRACTORS TO COORDINATE LOCATIONS OF LIGHTING, SPEAKERS, AIR DIFFUSERS, GRILLES, SPRINKLER HEADS & THE LIKE WITH REFLECTED CEILING LAYOUTS AS REQUIRED & DIRECTED BY THE ARCHITECT.
- ALL DEVICES, EQUIPMENT, FIXTURES & THE LIKE MUST BE GROUNDED BY USE OF A PROPERLY SIZED GROUNDING CONDUCTOR. MECHANICAL ELECTRICAL BONDS OF THE METALLIC RACEWAY SYSTEM SHALL ALSO BE MAINTAINED.
- REFER TO MECHANICAL, PLUMBING, AND FIRE PROTECTION PLANS FOR EXACT LOCATION OF MECHANICAL, AND PLUMBING EQUIPMENT. COORDINATE LOCATION OF DISCONNECT SWITCH ASSOCIATED WITH EACH PIECE OF EQUIPMENT WITH RESPECTIVE CONTRACTOR AND INSTALL IN ACCORDANCE WITH THE NEC.
- REFER TO DIVISION 15 (21, 22 & 23) SPECIFICATIONS, HVAC, PLUMBING AND FIRE PROTECTION PLANS FOR ADDITIONAL ELECTRICAL WORK REQUIREMENTS & COORDINATION.
- ALL RECEPTACLES SHOWN BACK-TO-BACK IN WALLS SHALL BE SEPARATED HORIZONTALLY BY 8" MINIMUM.
- WHERE OPEN WIRING METHODS FOR LOW VOLTAGE SYSTEMS ARE PERMITTED BY THE CONTRACT DOCUMENTS AND LOCAL AUTHORITY, THE CONDUCTOR INSULATION MUST BE PLENUM RATED.
- BRANCH CIRCUIT CONDUCTOR SIZES (& CONDUITS) SHALL BE INCREASED FROM THOSE INDICATED ON THE PLANS TO PREVENT EXCESSIVE VOLTAGE DROP. BRANCH CIRCUITS SHALL BE INSTALLED WITH WIRES OF SUFFICIENT SIZE SO THAT VOLTAGE DROP BETWEEN THE PANEL & THE LOADS DO NOT EXCEED A LIMIT OF 3%.
- REGARDLESS OF THE TEMPERATURE RATING OF THE CONDUCTOR INSULATION, ALL CONDUCTOR AMPACITY RATINGS FOR THIS PROJECT SHALL BE DETERMINED FROM THE 75°C CONDUCTOR TEMPERATURE RATINGS INDICATED IN THE NEC TABLES. WHERE EQUIPMENT OR DEVICES ARE PROVIDED WITH TERMINALS RATED FOR 60°C, THE AMPACITY RATING OF THE 75°C CONDUCTOR SHALL BE LIMITED TO ITS ASSOCIATED 60°C RATING AS INDICATED IN THE NEC TABLES. THE ELECTRICAL CONTRACTOR SHALL BE RESPONSIBLE TO INCREASE THE CONDUCTORS AND CONDUIT SIZE AS REQUIRED.
- ALL 120V AND 277V BRANCH CIRCUITS SHALL BE PROVIDED WITH SEPARATE NEUTRAL CONDUCTORS. SHARED NEUTRALS WILL NOT BE PERMITTED FOR MULTI-CIRCUIT INSTALLATIONS. WHERE MULTIPLE CIRCUITS ARE RUN IN A COMMON RACEWAY, THE AMPACITY OF THE CONDUCTORS SHALL BE PROPERLY DERATED & CONDUIT SHALL BE SIZED PER CODE. UNDER NO CIRCUMSTANCES SHALL MORE THAN SIX (6) CURRENT CARRYING CONDUCTORS BE RUN IN A SINGLE CONDUIT. REFERENCE NEC ARTICLE AND TABLE 310.15(B)(2)(a).
- ALL CONDUITS SHALL CONTAIN A GROUND CONDUCTOR SIZED PER NEC TABLE #250.122. IN ADDITION, WHERE AN ISOLATED, INSULATED GROUND IS REQUIRED, A SEPARATE GROUND CONDUCTOR WITH GREEN INSULATION SHALL BE RUN FROM THE PANEL, GROUND BUS TO THE ISOLATED GROUND CONNECTION OF THE DEVICE. IN NO CASE SHALL THE SYSTEM GROUND (CONDUCTOR & ASSOCIATED OUTLET BOXES, CONDUIT & BUILDING STEEL) BE ALLOWED TO CONTACT THE ISOLATED GROUND (CONDUCTOR & DEVICE). WHERE CIRCUIT CONDUCTORS ARE INCREASED IN SIZE FOR VOLTAGE DROP, THE GROUND CONDUCTOR SIZE SHALL BE INCREASED PROPORTIONATELY (ACCORDING TO CIRCULAR MIL AREA) FROM THE SIZE REQUIRED BY NEC TABLE #250.122.
- ALL ELECTRICAL INSTALLATION REQUIREMENTS FOR ALL HVAC, PLUMBING, FIRE PROTECTION, SPECIAL SYSTEMS AND OWNER EQUIPMENT BEING FURNISHED BY OTHERS SHALL BE REVIEWED AND COORDINATED WITH OTHER TRADES PRIOR TO ROUGH-IN. OBTAIN EQUIPMENT SHOP DRAWINGS FROM INSTALLER/SUPPLIER/CONTRACTOR/OWNER FURNISHING EQUIPMENT, AS REQUIRED, FOR REVIEW AND COORDINATION. CONTACT ARCHITECT/ENGINEER WITH ANY DISCREPANCIES FOUND BETWEEN CONSTRUCTION DRAWINGS AND EQUIPMENT BEING FURNISHED PRIOR TO ROUGH-IN.
- THE ELECTRICAL CONTRACTOR SHALL FURNISH ALL ACCESS PANELS, AS REQUIRED FOR SERVICING AND TESTING, FOR EQUIPMENT AND/OR DEVICES FURNISHED UNDER HIS CONTRACT. THE GENERAL CONTRACTOR SHALL INSTALL ACCESS PANELS. THE ELECTRICAL CONTRACTOR SHALL COORDINATE THE SIZE AND LOCATION OF EACH ACCESS PANEL WITH THE ARCHITECT AND GENERAL CONTRACTOR PRIOR TO ROUGH-IN.
- ELECTRICAL CONTRACTOR SHALL INCLUDE IN HIS BID ALL CUTTING, TRENCHING AND PATCHING ASSOCIATED WITH THE ELECTRICAL INSTALLATION.
- ALL PENETRATIONS THROUGH FIRE RATED WALLS ASSOCIATED WITH THE ELECTRICAL INSTALLATION SHALL BE SLEEVED AND FIRE STOPPED USING A UL APPROVED METHOD. UL APPROVED METHOD SHALL MEET OR EXCEED FIRE RATING OF STRUCTURE BEING PENETRATED. REFERENCE ARCHITECTURAL PLANS FOR FIRE RATED STRUCTURES.
- NO CONDUIT, BOXES, WIRING, OR CABLES SHALL BE INSTALLED WITHIN 1 1/2" OF THE LOWEST POINT OF THE UNDERSIDE OF THE ROOF DECKING. NOR SHALL THEY BE INSTALLED CONCEALED WITHIN METAL-CORRUGATED ROOF DECKING. FOR EXISTING INSTALLATIONS, THE ELECTRICAL CONTRACTOR SHALL BE RESPONSIBLE TO REPLACE AND/OR REWORK EXISTING CONDUIT, BOXES, WIRING, AND CABLES THAT IS NOT IN COMPLIANCE WITH THIS REQUIREMENT.
- ALL ELECTRICAL EQUIPMENT AND DEVICES FOR THIS PROJECT MUST BE UL LISTED. DEVICES, EQUIPMENT, SYSTEMS SHALL BE INSTALLED PER N.E.C. REQUIREMENTS AND MANUFACTURER'S INSTRUCTIONS.
- ALL CONDUIT AND CABLEING SHALL BE PROPERLY SUPPORTED AS REQUIRED BY THE NATIONAL ELECTRICAL CODE. FOR EXISTING INSTALLATIONS, THE ELECTRICAL CONTRACTOR SHALL BE RESPONSIBLE TO REPLACE AND/OR REWORK EXISTING CONDUIT AND/OR CABLEING THAT IS NOT IN COMPLIANCE WITH THIS REQUIREMENT.
- CONTRACTOR SHALL FIELD VERIFY SLAB ON GRADE FLOOR CONSTRUCTION TYPE PRIOR TO CUTTING. UNDER NO CIRCUMSTANCES SHALL THE CONTRACTOR CUT A STRUCTURAL FLOOR SLAB THICKER THAN FOUR (4) INCHES WITHOUT PRIOR WRITTEN APPROVAL FROM ENGINEER OF RECORD. NOTIFY ENGINEER OF RECORD OF ANY SLAB THICKNESS GREATER THAN FOUR (4) INCHES PRIOR TO PROCEEDING WITH ANY SAW CUTTING.

ELECTRICAL ABBREVIATIONS

A	AMPS
AC	AIR CONDITIONING UNIT
APC	ABOVE FINISH COUNTER
AFF	ABOVE FINISH FLOOR
AFG	ABOVE FINISH GRADE
AHU	AIR HANDLING UNIT
AIC	ASYMMETRICAL INTERRUPTING CURRENT
ARCH	ARCHITECTURAL
ATS	AUTOMATIC TRANSFER SWITCH
AWG	AMERICAN WIRE GAGE
BGR	BUILDING
BLDG	BUILDING
C	CONDUIT
CATV	CABLE TELEVISION
CCTV	CLOSED CIRCUIT TELEVISION
CH	CHILLER
CONTR	CONTRACTOR
COOL	COOLING TOWER
CU	COPPER
CUH	CABLE UNIT HEATER
DE	DUAL ELEMENT
DN	DOWN
DS	DISCONNECT SWITCH
DWG	DRAWING
(E) or EXIST.	EXISTING
EBB	ELECTRIC BASEBOARD
E.C.	ELECTRICAL CONTRACTOR
EF	EXHAUST FAN
EH	ELECTRIC HEATER
ELEC	ELECTRICAL
EM	EMERGENCY
ENT	ELECTRICAL METALLIC TUBING
EQ	EQUAL
ETR	EXISTING TO REMAIN
EHU	ELECTRIC UNIT HEATER
EWC	ELECTRIC WATER COOLER
EW	ELECTRIC WATER HEATER
F	FUSE
FA	FIRE ALARM
FACP	FIRE ALARM CONTROL PANEL
FCU	FAN COIL UNIT
FLUOR	FLUORESCENT
FPB	FAN POWER BOX (VAV)
FPC	FIRE PROTECTION CONTRACTOR
FS	FLOW SWITCH
FT	FOOT/FEET
GC	GENERAL CONTRACTOR
GFI	GROUND FAULT INTERRUPTING PROTECTION
GRD	GROUND
HID	HIGH INTENSITY DISCHARGE
HOA	HAND OFF AUTOMATIC
HORSEPOWER	HORSEPOWER
HPS	HIGH PRESSURE SODIUM
HVAC	HEATING, VENTILATION, AIR CONDITIONING
IG	ISOLATED GROUND
INCAND.	INCANDESCENT
J	JUNCTION BOX
KCMIL	ONE THOUSAND CIRCULAR MILS
K.E.C.	KITCHEN EQUIPMENT CONTRACTOR
KV	KILOVOLT AMPERE
KW	KILOWATT
LTG	LIGHTING
MAV	MASTER ANTENNA TV
MAU	MAKE-UP AIR UNIT
MAX	MAXIMUM
MCB	MAIN CIRCUIT BREAKER
MCC	MOTOR CIRCUIT BREAKER
M.C.	MECHANICAL CONTRACTOR
MECH	MECHANICAL
MFR	MANUFACTURER
MH	METAL HALIDE
MIN	MINIMUM
MLO	MAIN LUGS ONLY
MOD	MOTOR OPERATED DAMPER
MSB	MAIN SWITCHBOARD
MTD	MOUNTED
NEC	NATIONAL ELECTRIC CODE
NF	NON FUSED
NFPA	NATIONAL FIRE PROTECTION ASSOCIATION
NIC	NOT IN CONTRACT
NTS	NIGHTLIGHT
NTS	NOT TO SCALE
Ø or PH	PHASE
P	POLE
PH	PULL BOX
P.C.	PLUMBING CONTRACTOR
PNL	PANEL
PRE	POWER ROOF EXHAUSTER
PVC	POLYVINYL CHLORIDE
RTU	ROOF TOP UNIT
SPKR	SPEAKER
SPT	SINGLE POLE SINGLE THROW
STIE	MULTIPLE OUTLETS WIRED ON SAME BRANCH CIRCUIT
TS	TAMPER SWITCH
TTB	TELEPHONE TERMINAL BOARD
TV	TELEVISION
TV	TYPICAL
U	UNIT
UNO	UNDERWRITERS LABORATORY
UNV	UNLESS NOTED OTHERWISE
UV	UNIT VENTILATOR
W	WATTS
VP	VOLTS
WR	WEATHER-PROOF
XTMR	WEATHER-RESISTANT TYPE DEVICE (NEMA RATED)
	TRANSFORMER

ELECTRICAL SYMBOL LEGEND

SYMBOL	DESCRIPTION
	CONDUIT WITH WIRING RUN CONCEALED IN OR ABOVE CEILING OR WALL, OR RUN EXPOSED IN UNFINISHED AREAS. CROSS HATCHING INDICATES NUMBER OF CONDUCTORS (#12 AVG - MINIMUM). PROVIDE A CODE-SIZED GROUND WIRE IN ALL CONDUITS IN ADDITION TO THE CONDUCTORS SHOWN. SHADED DOT INDICATES CODE-SIZED ISOLATED GROUND WIRE IN CONDUIT.
	CONDUIT WITH WIRING RUN CONCEALED BELOW FLOOR. CROSS HATCHING INDICATES NUMBER OF CONDUCTORS (#12 AVG - MINIMUM). PROVIDE A CODE-SIZED GROUND WIRE IN ALL CONDUITS IN ADDITION TO THE CONDUCTORS SHOWN. SHADED DOT INDICATES CODE-SIZED ISOLATED GROUND WIRE IN CONDUIT.
	PANELBOARD MOUNTED 6'-6" TO TOP. SEE PANEL SCHEDULES & ELECTRICAL ONE-LINE DIAGRAM.
	DISCONNECT SWITCH - TYPE & RATING AS SHOWN ON PLANS
	20A - 120V/277V SINGLE POLE TOGGLE SWITCH MOUNTED 48" AFF TO TOP OF BOX, UNLESS NOTED OTHERWISE. IF APPLICABLE, LOWER CASE SUBSCRIPT "x" - KEYS SWITCH TO FIXTURES BEING CONTROLLED (TYPICAL OF ALL SWITCH SYMBOLS).
	LINE VOLTAGE PASSIVE INFRARED WALL SWITCH OCCUPANCY SENSOR MOUNTED 48" AFF TO TOP OF BOX, UNLESS NOTED OTHERWISE (OC = DUAL RELAY, MANUFACTURER SHALL BE WATTSOPPER, HUBBELL, SENSOR SWITCH, COOPER CONTROLS, OR LUTRON.)
	LOW VOLTAGE CEILING MOUNTED OCCUPANCY SENSOR. LOCATE AS DIRECTED PER MANUFACTURER AND PROVIDE STANDARD VS. EXTENDED COVERAGE RANGE AS DIRECTED BY MANUFACTURER. REFER TO TYPICAL LOW VOLTAGE OCCUPANCY SENSOR WIRING DIAGRAM ON SHEET E-101. (1 = DUAL TECHNOLOGY 360° COVERAGE PATTERN, 2 = PAR TECHNOLOGY CORNER MOUNTED WITH WIDE VIEW COVERAGE PATTERN, 3 = PAR NARROW HALLWAY COVERAGE PATTERN). MANUFACTURER SHALL BE WATTSOPPER, HUBBELL, SENSOR SWITCH, COOPER CONTROLS, OR LUTRON.)
	20A - 120V GROUNDING TYPE SIMPLEX RECEPTACLE MOUNTED 18" AFF TO TOP OF BOX, UNLESS NOTED OTHERWISE
	20A - 120V GROUNDING TYPE DUPLEX RECEPTACLE MOUNTED 18" AFF, UNLESS NOTED OTHERWISE
	20A - 120V GROUNDING TYPE QUADRAPLEX RECEPTACLE MOUNTED 18" AFF, UNLESS NOTED OTHERWISE
	20A - 120V ISOLATED GROUND TYPE DUPLEX RECEPTACLE MOUNTED 18" AFF, UNLESS NOTED OTHERWISE
	20A - 120V GROUND FAULT INTERRUPTING TYPE DUPLEX RECEPTACLE, WEATHER RESISTANT LISTED WITH DIE-CAST ALUMINUM *WHILE IN-USE COVER* AND MOUNTED 18" AFF TO TOP OF BOX, UNLESS NOTED OTHERWISE
	20A - 120V GROUND FAULT INTERRUPTING TYPE DUPLEX RECEPTACLE MOUNTED 18" AFF TO TOP OF BOX, UNLESS NOTED OTHERWISE
	20A - 120V GROUNDING TYPE DUPLEX RECEPTACLE WITH (2) USB PORTS MOUNTED 18" AFF TO TOP OF BOX, UNLESS NOTED OTHERWISE
	20A - 120V GROUNDING TYPE DUPLEX RECEPTACLE WITH (4) USB PORTS MOUNTED 18" AFF, UNLESS NOTED OTHERWISE
	FURNISH AND INSTALL A COMPLETE FLOOR BOX SYSTEM WHICH INCLUDES, BUT IS NOT LIMITED TO THE FOLLOWING: SINGLE GANG, CAST IRON, FULLY ADJUSTABLE FLOOR BOX RECESSED IN CONCRETE FLOOR SLAB WITH (1) 20A DUPLEX RECEPTACLE, FLUSH ALUMINUM FINISHED CARPET FLANGE AND COVER. FOR TILE FLOOR INSTALLATION, PROVIDE APPROPRIATE FLANGE SO THAT TOP COVER OF FLOOR BOX IS FLUSH WITH TILE. COORDINATE EXACT LOCATION WITH ARCHITECT PRIOR TO INSTALLATION. FLOOR BOX IS CAPABLE OF ACCEPTING (4) 1" CONDUITS. FURNISH AND INSTALL SYSTEM PER MANUFACTURER'S INSTRUCTIONS. WIREMOLD #860CS-1, #818TCL, #828R-TCL.
	FURNISH AND INSTALL A COMPLETE FLOOR BOX SYSTEM WHICH INCLUDES, BUT IS NOT LIMITED TO THE FOLLOWING: 2-GANG, CAST IRON, FULLY ADJUSTABLE MULTI-SERVICE FLOOR BOX RECESSED IN CONCRETE FLOOR SLAB WITH (1) 20A DUPLEX RECEPTACLE, (1) 6-PORT TELEDATA MOUNTING BEZEL, FLUSH ALUMINUM FINISHED CARPET FLANGE AND COVERS, AND VOLTAGE DIVIDER. THE FURNISHED FLOOR BOX SHALL BE SIZED TO ACCEPT THE QUANTITY AND SIZE OF CONDUITS REQUIRED FOR THE TELEDATA CABLEING. FOR TILE FLOOR INSTALLATION, PROVIDE APPROPRIATE FLANGE SO THAT TOP COVER OF FLOOR BOX IS FLUSH WITH TILE. COORDINATE EXACT LOCATION WITH ARCHITECT PRIOR TO INSTALLATION. COORDINATE BRACKET AND TELEDATA DEVICE REQUIREMENTS WITH TECHNOLOGY INSTALLER PRIOR TO ORDERING MATERIALS. FLOOR BOX IS CAPABLE OF ACCEPTING (6) 1" CONDUITS. FURNISH AND INSTALL SYSTEM PER MANUFACTURER'S INSTRUCTIONS. WIREMOLD #860CS-1, #828TCL, #828R-TCL, #828COMTCL.
	STANDARD GANG BOX. REFER TO TERMINAL LIST BELOW FOR INDIVIDUAL DEVICES:
	TELEPHONE
	DATA
	DUPLEX
	DEDICATED DUPLEX WITH ISOLATED GROUND
	SPARE CONDUIT (RAN UP TO CEILING)
	J-BOX WITH GENERAL POWER
	J-BOX POWER FROM LIGHTING CONTACTOR
	QUAD
	DOOR BELL ASSEMBLY. MOUNTING, TYPE, RATINGS AS INDICATED ON PLANS. MAKE CONNECTIONS PER MANUFACTURER'S INSTRUCTIONS.
	CHIME ASSEMBLY. MOUNTING, TYPE, RATINGS AS INDICATED ON PLANS. MAKE CONNECTIONS PER MANUFACTURER'S INSTRUCTIONS.
	PUSHBUTTON ASSEMBLY MOUNTED AT 48" AFF TO TOP OF BOX. TYPE AND RATINGS PER LOAD BEING SERVED. MAKE CONNECTIONS TO EQUIPMENT PER MANUFACTURER'S INSTRUCTIONS.
	JUNCTION BOX - SIZE AS REQUIRED BY NEC
	TELEPHONE OUTLET MOUNTED 18" AFF UNLESS NOTED OTHERWISE. PROVIDE 1" C WITH PULLWIRE TO ACCESSIBLE CEILING SPACE. PROVIDE CONDUIT BUSHING.
	DATA OUTLET MOUNTED 18" AFF, UNLESS NOTED OTHERWISE. PROVIDE 1" C WITH PULLWIRE TO ACCESSIBLE CEILING SPACE. PROVIDE CONDUIT BUSHING.
	COMBINATION TELEPHONE/DATA OUTLET MOUNTED 18" AFF, UNLESS NOTED OTHERWISE. 1" C WITH PULLWIRE TO ACCESSIBLE CEILING SPACE. PROVIDE CONDUIT BUSHING.
	PLUG MOLD NTD. ABOVE COUNTERTOP.

NOTE: NOT ALL SYMBOLS MAY APPLY TO PROJECT.

City of Puyallup
Development & Permitting Services
ISSUED PERMIT

BuildingPlanningEngineeringPublic Works

FireTraffic

BARNES&NOBLE


PROJECT DESIGNER:

WJCA
BUILDING VALUE SINCE 1994

ARCHITECT:

JOEL TORIELLI
422 BOGERT AVE
RIDGEWOOD, NJ 07450

Kenneth A. Fuller, P.E.

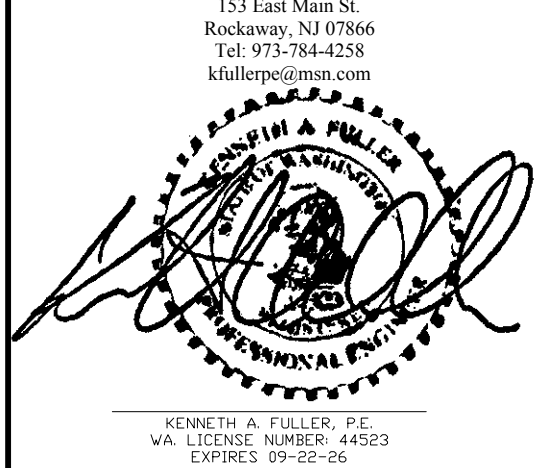

SOUTH HILL MALL
3500 S. MERIDIAN ST.
UNIT #800
PUYALLUP, WA 98373

Project Number 33247
Store Number 3507

Revision Log:

Date	Description	No.
12-19-24	ISSUED FOR PERMIT. BID, LANDLORD & CLIENT REVIEW	1
02-20-25	LANDLORD & BID COMMENTS	2
		3
		4
		5
These plans are an instrument of service and the property of the Architect. Infringements will be prosecuted.

PROJECT DESIGNER:


WJCA
BUILDING VALUE SINCE 1994

ARCHITECT:

JOEL TORIELLI
422 BOGERT AVE
RIDGEWOOD, NJ 07450

Kenneth A. Fuller, P.E.

151 East Main St.
Rockaway, NJ 07866
Tel: 973-964-8258
kfuller@main.com

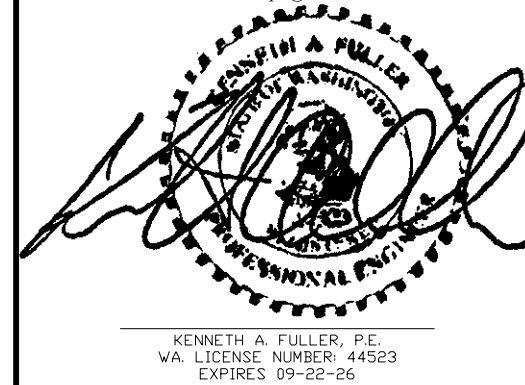

SOUTH HILL MALL
3500 S. MERIDIAN ST.
UNIT #800
PUYALLUP, WA 98373

Project Number 33247
Store Number 3507

Revision Log		
Date	Description	No.
12-19-24	ISSUED FOR PERMIT. BID. LANDLORD & CLIENT REVIEW	1
02-20-25	LANDLORD & BID COMMENTS	2
		3
		4
		5
These plans are an instrument of service and the property of the Architect. Infringements will be prosecuted.

General Contractor to verify all conditions and dimensions at the premises. Discrepancies shall be reported to the Architect prior to the commencement of any work.

Professional Seal:


LIC.# : 22005563
EXP. DATE : 10/02/25

Drawing Description:

ELECTRICAL
ONE-LINE DIAGRAM
& LOAD SUMMARY


Drawing Number:

E-202

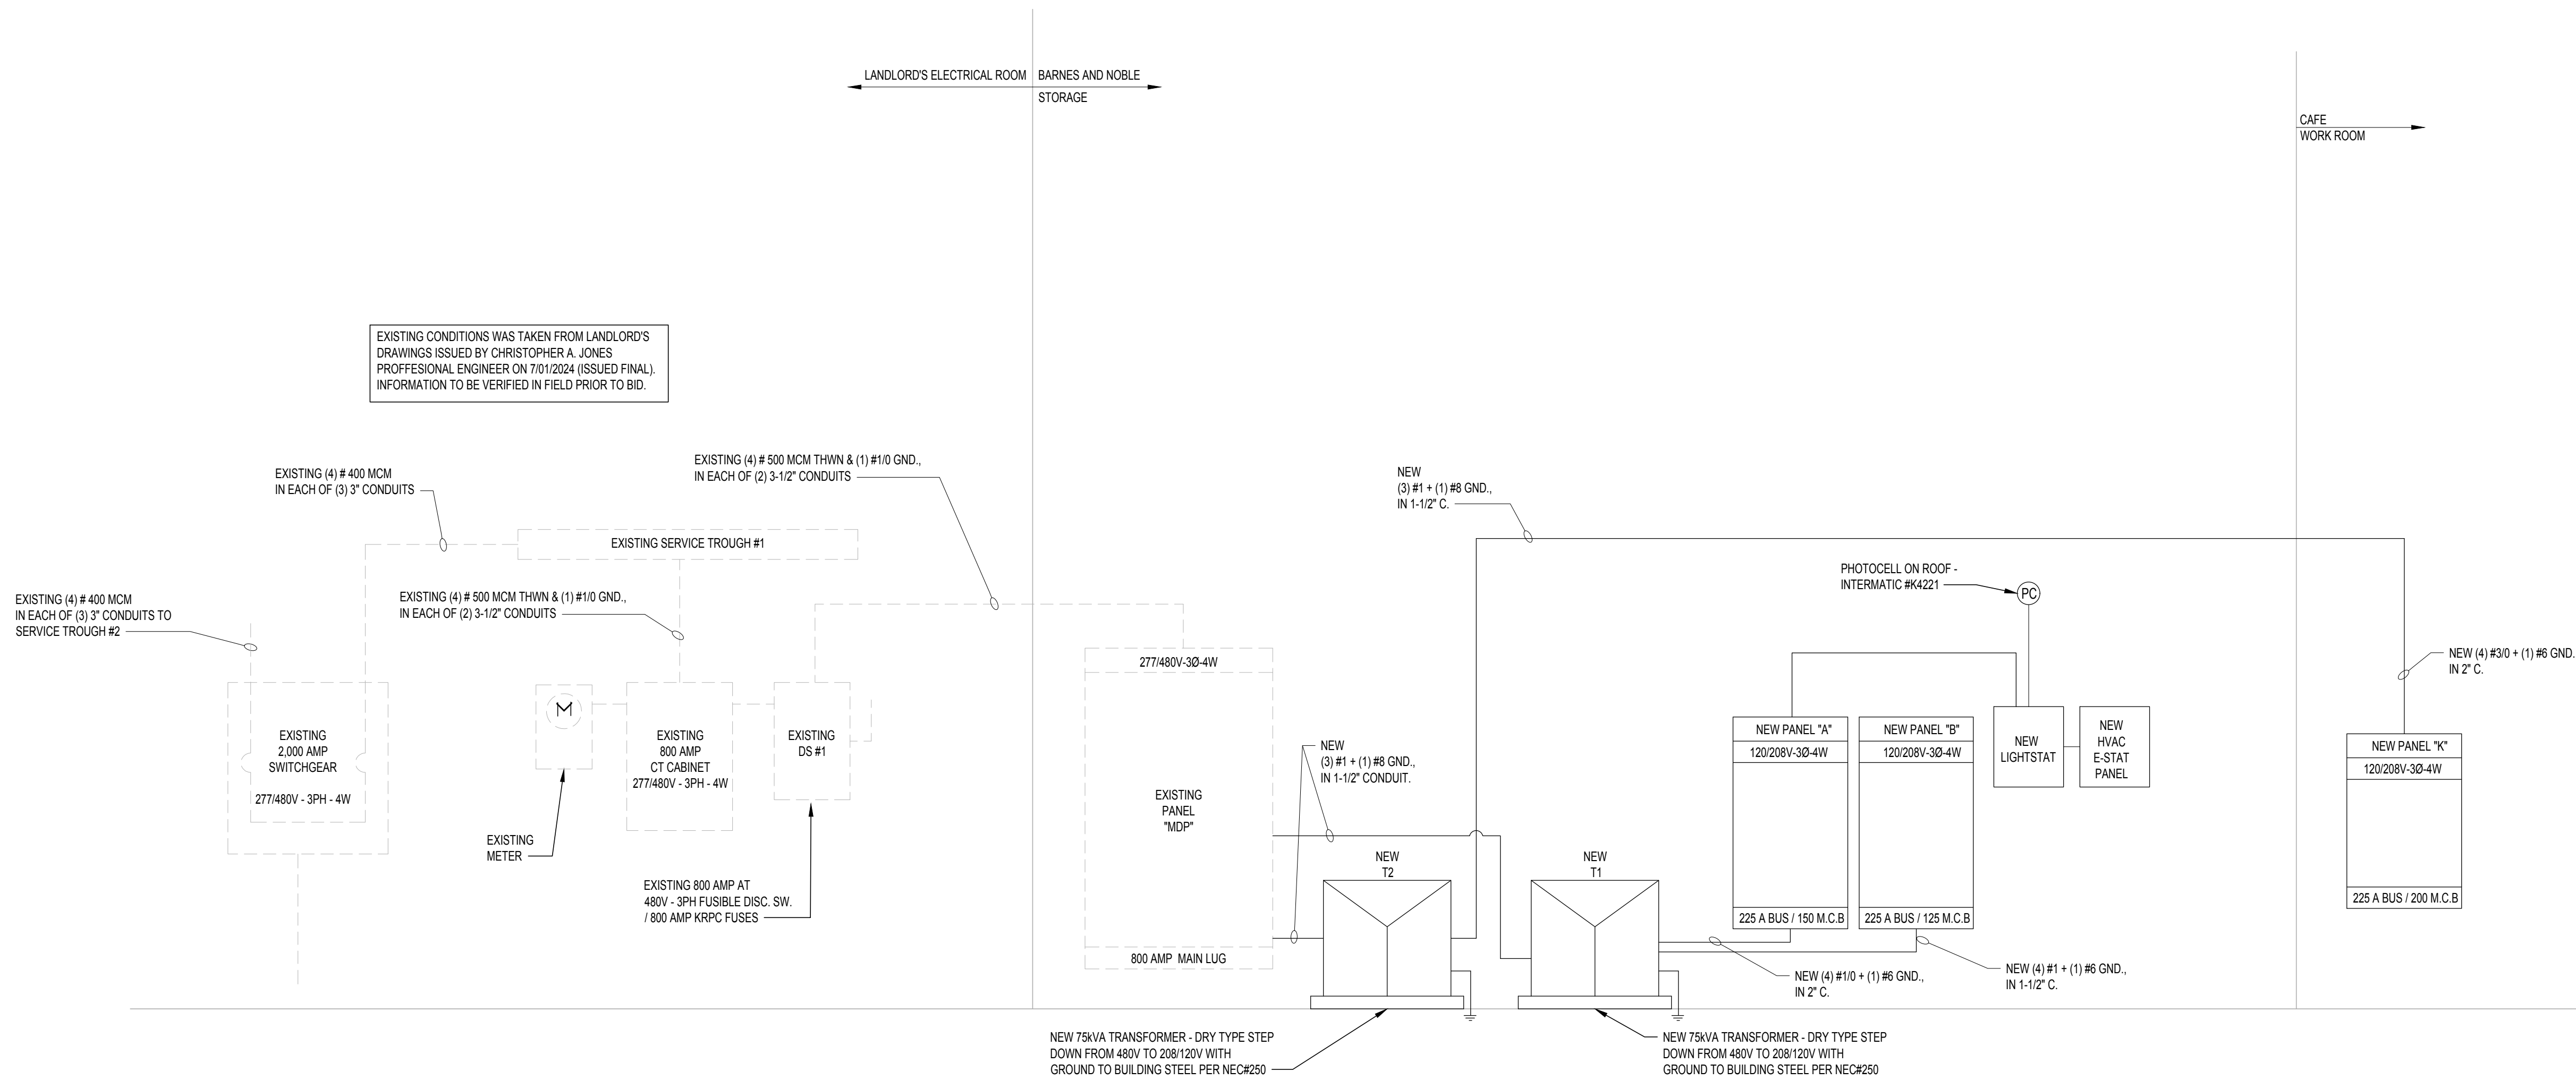

ELECTRICAL ONE-LINE DIAGRAM
N.T.S.


--- INDICATES EXISTING EQUIPMENT/CONDUIT/WIRE, UNLESS NOTED OTHERWISE
— INDICATES EQUIPMENT/CONDUIT/WIRE INSTALLED UNDER THIS CONTRACT

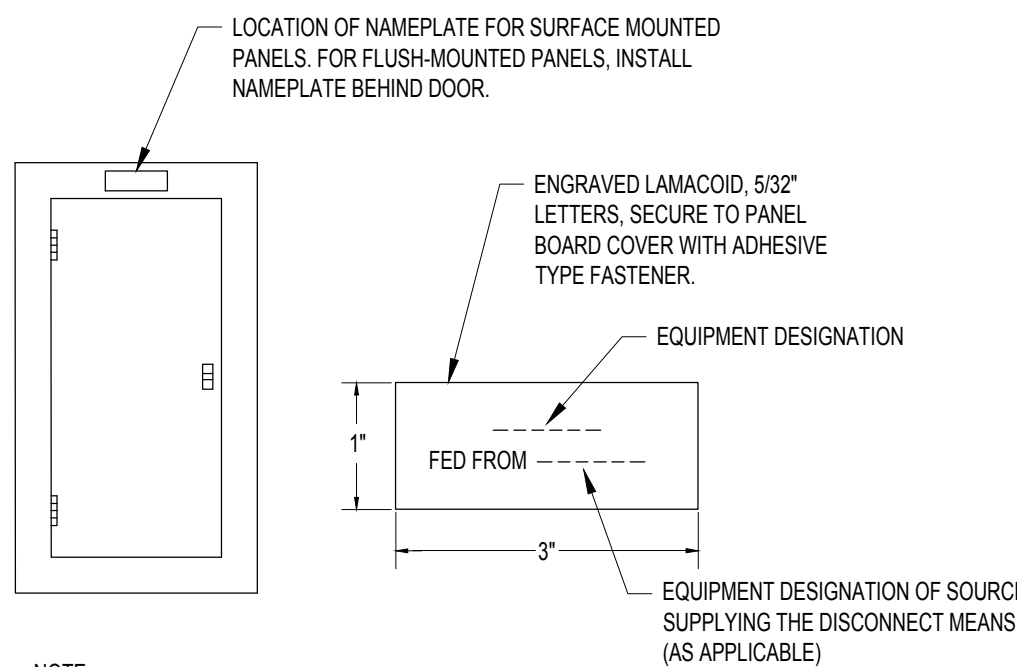

NOTE:
NAMEPLATES ARE REQUIRED ON ALL SWITCHBOARDS, DISTRIBUTION PANELS, PANELBOARDS, ENCLOSURES AND ELECTRICAL CABINETS, ACCESS DOORS/PANELS FOR CONCEALED ELECTRICAL EQUIPMENT, EMERGENCY SYSTEMS/BOXES, MOTOR CONTROL CENTERS, ENCLOSED SWITCHES/CIRCUIT BREAKERS/CONTROLLERS, POWER TRANSFER DEVICES, PUSH-BUTTONS, CONTACTORS, LIGHTING CONTROL SYSTEMS, INVERTERS, GENERATORS, UPS, MONITORING EQUIPMENT, STARTERS, DISCONNECT SWITCHES, METER SOCKETS, RELAYS, TRANSFORMERS, AND JUNCTION BOXES GREATER THAN 4 1/16" SQUARE. ALSO PROVIDE NAMEPLATES ON BRANCH SWITCHES/BREAKERS OF SWITCHBOARDS AND DISTRIBUTION PANELS.

STANDARD COLORS:
1. NORMAL POWER - WHITE BACKGROUND, BLACK LETTERS
2. EMERGENCY POWER - RED BACKGROUND, WHITE LETTERING
3. IN ADDITION TO THE FUNCTION NAMEPLATE, PROVIDE NAMEPLATES IDENTIFYING ALL "MAIN SERVICE NAMEPLATE DISCONNECTS" - RED BACKGROUND - WHITE LETTERING

NAMEPLATE DETAIL
N.T.S.

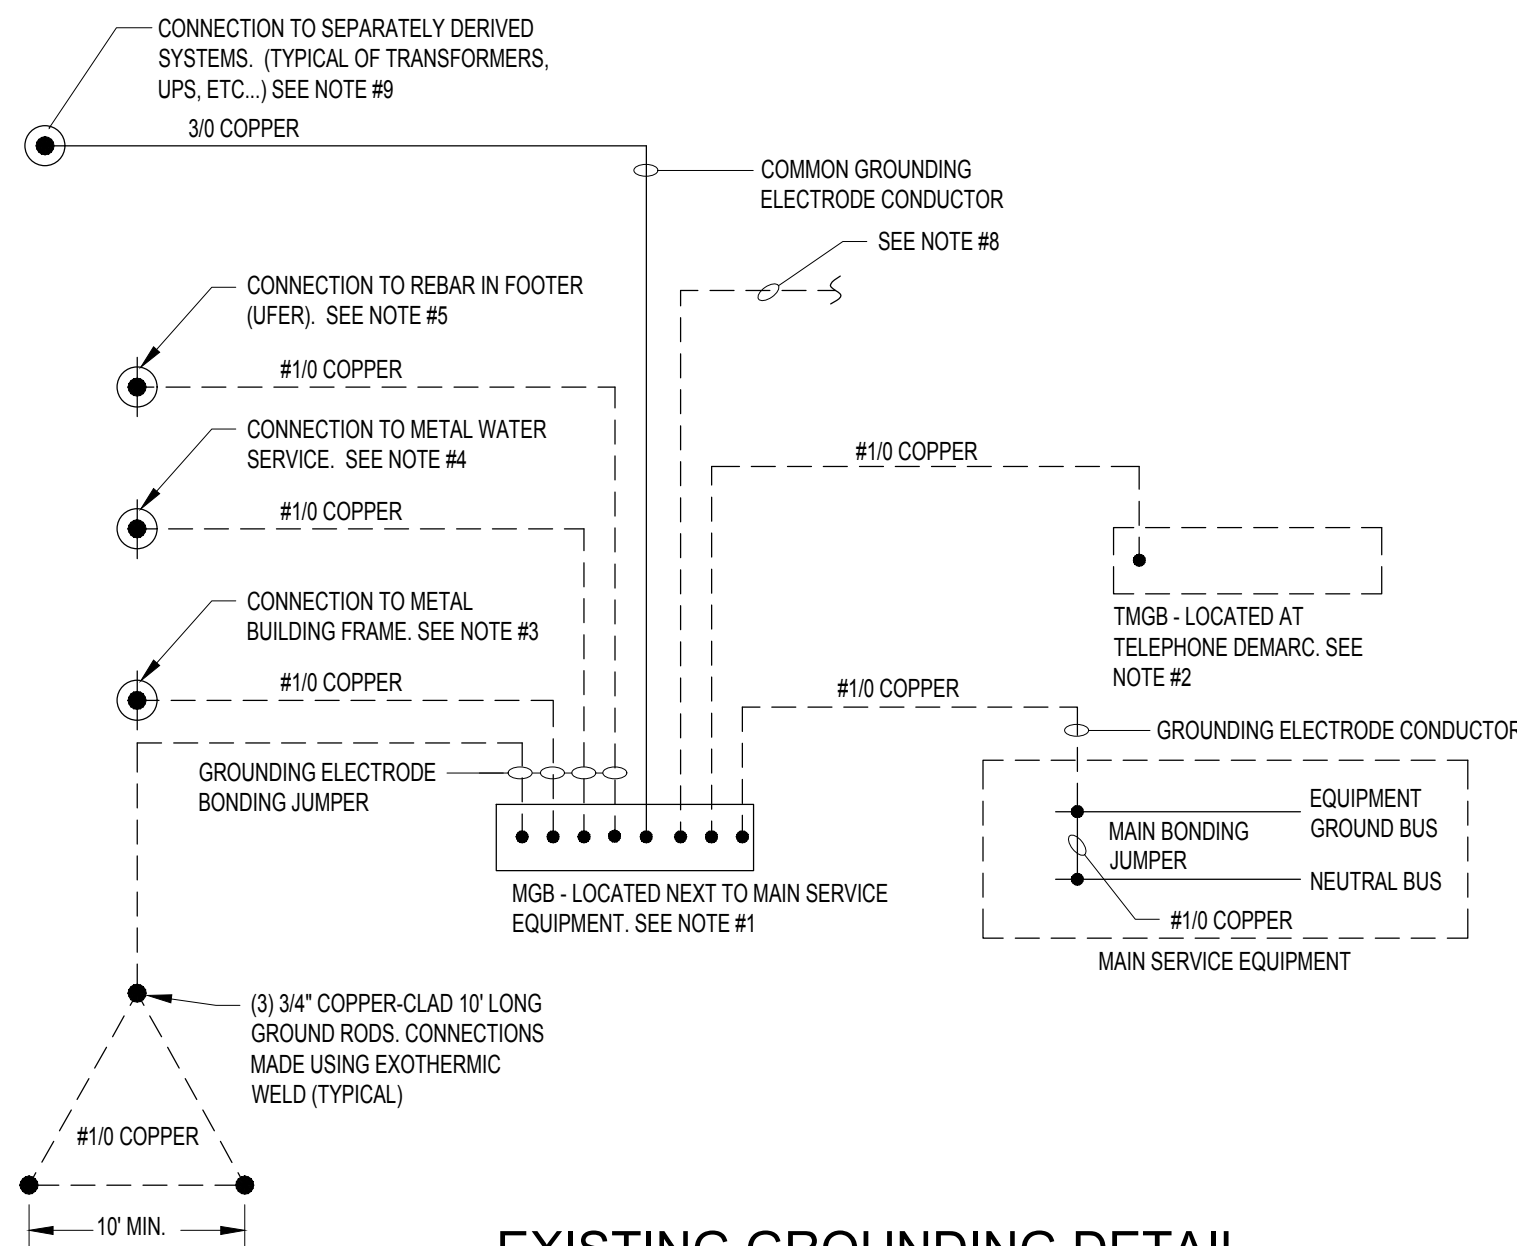

EXISTING GROUNDING DETAIL
N.T.S.

REFERENCED DETAIL NOTES:

- MGB (MAIN GROUND BAR) SHALL BE ERICO #EGBA14412 - (INCLUDES MOUNTING BRACKET AND INSULATORS, HOLE PATTERN AS REQUIRED FOR INSTALLATION, INCLUDING SPARE HOLES FOR FUTURE USE.) OR EQUAL BY HARGER. USE COMPRESSION CONNECTORS (LISTED FOR GROUNDING) TO CONNECT COPPER WIRE TO MGB.
- TMGB (TELECOMMUNICATION MAIN GROUND BAR) SHALL BE ERICO #TMGBA12L15PT (INCLUDES MOUNTING BRACKET AND INSULATORS) OR EQUAL BY HARGER. USE COMPRESSION CONNECTORS (LISTED FOR GROUNDING) TO CONNECT COPPER WIRE TO TMGB.
- METAL BUILDING FRAME MUST BE USED AS A GROUNDING ELECTRODE WHERE IT IS EFFECTIVELY GROUNDING PER NEC SECTION 250.52. PROVIDE #30 BONDING JUMPERS AS REQUIRED TO PROVIDE CONTINUOUS CONDUCTIVITY WHERE BUILDING FRAME IS SEPARATED INTO ELECTRICALLY ISOLATED SECTIONS AS MAY OCCUR FROM EXPANSION JOINTS, BUILDING ADDITIONS, BUILDING ELEVATION CHANGES, AND THE LIKE.
- WHERE A WATER METER, FILTERING EQUIPMENT, OR NON-METAL PIPING IS IN THIS METAL WATER PIPING SYSTEM, IT MUST BE BONDED AROUND TO MAINTAIN CONTINUITY EVEN IF THE WATER METER OR FILTER IS REMOVED PER NEC SECTION 250.52.
- THE REBAR MUST NOT BE LESS THAN 20 FEET IN LENGTH AND 1/2" IN DIAMETER OR 20 FEET OR MORE OF BARE COPPER CONDUCTOR NOT SMALLER THAN NO. 4 IN THE BOTTOM OF THE FOOTER PER NEC SECTION 250.52.
- IF INSTALLED IN OR ATTACHED TO A BUILDING OR STRUCTURE, METAL PIPING SYSTEM(S), INCLUDING GAS PIPING, THAT IS LIKELY TO BECOME ENERGIZED SHALL BE BONDED PER NEC 250.104 (B). THE BONDING CONDUCTOR(S) OR JUMPER(S) SHALL BE SIZED IN ACCORDANCE WITH TABLE 250.102(C)(1) OR 250.122, AND EQUIPMENT GROUNDING CONDUCTORS SHALL BE SIZED IN ACCORDANCE WITH TABLE 250.100(C)(1) OR 250.122 USING THE RATING OF THE CIRCUIT THAT IS LIKELY TO ENERGIZE THE PIPING SYSTEM(S). THE POINTS OF ATTACHMENT OF THE BONDING JUMPER(S) SHALL BE ACCESSIBLE.
- THE METAL FRAME OF THE BUILDING SHALL BE USED AS A COMMON GROUNDING ELECTRODE CONDUCTOR. IF BUILDING DOES NOT HAVE A METAL FRAME, A #30 COMMON GROUNDING ELECTRODE CONDUCTOR SHALL BE RUN FROM THE MAIN GROUND BAR FOR ALL SEPARATELY DERIVED SYSTEMS. MULTIPLE SEPARATELY DERIVED SYSTEMS MAY BE CONNECTED TO THE GROUNDING ELECTRODE SYSTEM BY INDIVIDUAL CONDUCTORS OR A COMMON CONDUCTOR WITH TAPS. THE GROUNDING ELECTRODE TAP CONDUCTOR FOR EACH SYSTEM SHALL BE CONNECTED TO THE COMMON GROUNDING ELECTRODE CONDUCTOR WITH THE CONNECTION IN AN ACCESSIBLE LOCATION.
- GROUNDING CONDUCTORS TO ADDITIONAL EQUIPMENT AS REQUIRED BY NEC 250 AND SPECIFICATIONS.

GENERAL GROUNDING DETAIL NOTES:

- ALL GROUNDING WORK AND MATERIALS SHALL BE FURNISHED AND INSTALLED IN ACCORDANCE WITH REQUIREMENTS IN NEC 250.
- ALL GROUNDING CONDUCTORS SHALL BE COPPER. PROVIDE INSULATED CONDUCTORS FOR INTERIOR INSTALLATIONS AND BARE COPPER FOR EXTERIOR INSTALLATIONS.
- ALL UNDERGROUND CONNECTIONS TO ELECTRODES AND CONDUCTORS SHALL BE MADE BY EXOTHERMIC WELDING.
- CONDUCTOR CONNECTIONS TO MAIN GROUND BAR SHALL BE MADE WITH COMPRESSION CONNECTORS LISTED FOR GROUNDING.
- GROUNDING ELECTRODE AND BONDING JUMPERS SHALL BE INSTALLED SO THAT THEY ARE NOT ANY LONGER THAN NECESSARY AND ANY UNNECESSARY BENDS AND LOOPS ARE AVOIDED.
- REFERENCE ONE-LINE DIAGRAM FOR CONDUCTOR SIZE OF THE SUPPLY SIDE BONDING JUMPER AND GROUNDING ELECTRODE TAP CONDUCTOR SERVING SEPARATELY DERIVED SYSTEM(S).
- REFERENCE ONE-LINE DIAGRAM FOR CONDUCTOR SIZE OF THE EQUIPMENT GROUNDING CONDUCTOR SERVING ELECTRICAL DISTRIBUTION EQUIPMENT.
- INSTALL SLEEVES, SLEEVE SEALS, FIRE STOPPING, RACEWAYS TO PROTECT AGAINST PHYSICAL DAMAGE AND ENVIRONMENTAL CONDITIONS WHERE REQUIRED. FURNISH AND INSTALL BONDING BUSHINGS WHERE FERROUS METALLIC RACEWAYS ARE UTILIZED.


PROJECT DESIGNER:



ARCHITECT:

JOEL TORIELLI
422 BOGERT AVE
RIDGECREEK, NJ 07450

Kenneth A. Fuller, P.E.

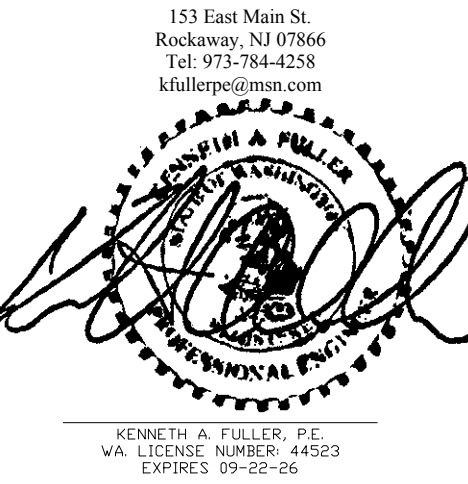

SOUTH HILL MALL
3500 S. MERIDIAN ST.
UNIT #800
PUYALLUP, WA 98373

Project Number 33247
Store Number 3507

Revision Log		
Date	Description	No.
12-19-24	ISSUED FOR PERMIT, BID, LANDLORD & CLIENT REVIEW	1
02-20-25	LANDLORD & BID COMMENTS	2
		3
		4
		5
These plans are an instrument of service and the property of the Architect. Infringements will be prosecuted.

General Contractor to verify all conditions and dimensions at the premises. Discrepancies shall be reported to the Architect prior to the commencement of any work.

Professional Seal:

LIC.# : 22005563
EXP. DATE : 10/02/25

Drawing Description:
ELECTRICAL
PANEL SCHEDULES

Drawing Number:
E-202.1

ELECTRICAL PANEL SCHEDULE													
PANELBOARD			MDP	VOLTAGE	277 / 480 V		PHASE	3		WIRE	4		
PANEL TYPE			EXIST.	MAINS	MILO		BUS RATING	800		AIC RATING	30,000		
NEMA TYPE ENCLOSURE			EXIST.	MOUNTING	SURFACE		OPTIONS	NOTE					
CKT. NO.		DESCRIPTION	POLE	WIRE SIZE	BKR SIZE	TOTAL WATTS	PHASE	TOTAL WATTS	BKR SIZE	WIRE SIZE	POLE	DESCRIPTION	CKT. NO.
1						6366	A	6,920					2
3	E	RTU-4	3	10	25	6366	B	6,920	25	10	3	RTU-5	E 4
5						6366	C	6,920					6
7						9965	A	23,805					8
9	E	RTU-6	3	8	40	9965	B	23,805	90	2	3	RTU-1	E 10
11						9965	C	23,805					12
13						23905	A	23905					14
16	E	RTU-2	3	2	90	23905	B	23905	90	2	3	RTU-3	E 16
17						23905	C	23905					18
19	N	LO WATER HEATER	1	12	20	4000	A	24,866					20
21		SPARE	1		20		B	23,970	100	1	3	76kVA TRANSFORMER (PANEL 'A' & 'B')	N 22
23		SPARE	1		20		C	25,854					24
26							A	18,974					26
27		200 AMP SPACE					B	22,420	100	1	3	76kVA TRANSFORMER (PANEL 'K')	N 28
29							C	23,661					30
ALL PHASES TO BE BALANCED TO WITHIN 7%													
A=		142,606	WATTS				E	EXISTING TO REMAIN					
B=		141,056	WATTS				N	NEW LOAD / CIRCUIT BREAKER					
C=		144,181	WATTS				LO	CIRCUITS WITH HANDLE LOCK-OFF DEVICE					
TOTAL CONNECTED LOAD			427743	WATTS		514	AMPS						
TOTAL DEMAND LOAD			403746	WATTS		486	AMPS						

ELECTRICAL PANEL SCHEDULE													
PANELBOARD		A	VOLTAGE	120 / 208 V		PHASE		3	WIRE	4			
PANEL TYPE		NQ	MAINS	150	BUS RATING				225	AIC RATING	25,000		
NEMA TYPE ENCLOSURE		NEMA 1	MOUNTING	SURFACE	OPTIONS				NOTE				
CKT. NO.		DESCRIPTION	POLE	WIRE SIZE	BKR SIZE	TOTAL WATTS	PHASE	TOTAL WATTS	BKR SIZE	WIRE SIZE	POLE	DESCRIPTION	CKT. NO.
1	LCP	SIW TRACK/VEST. LIGHTS	1	12	20	818	A	210	20	12	1	SALES HIGH BAY LTS	LCP 2
3	LCP	SALES PENDANT LIGHTS	1	12	20	360	B	285	20	12	1	SALES HIGH BAY LTS	LCP 4
6	LCP	SALES TRACK LIGHTING	1	12	20	1200	C	1440	20	12	1	PERIMETER SHELF REC	LCP 6
7	LCP	SALES TRACK LIGHTING	1	12	20	960	A	800	20	12	1	CAFÉ/WORKRM LIGHTS	8
9	LCP	SALES TRACK LIGHTING	1	12	20	1200	B	125	20	12	1	CORRIDOR LIGHTS	LCP 10
11	LCP	SALES TRACK LIGHTING	1	12	20	1200	C	1000	20	12	1	EM LIGHTS/EXIT SIGNS	LO 12
13	LO	RE-CIRCULATION PUMP	1	12	20	300	A	1,560	20	12	1	JAN CL. / RESTRM LTS / EF-1,2,3	14
16	LCP	SALES TRACK LIGHTING	1	12	20	1200	B	1,100	20	12	1	STOCK / STORAGE LTG	16
17	LCP	SALES TRACK LIGHTING	1	12	20	1200	C	700	20	12	1	OFFICE / BREAK RM LTS	18
19	LCP	SALES TRACK LIGHTING	1	12	20	1200	A	500	20	12	1	LCP	20
21	LCP	SALES TRACK LIGHTING	1	12	20	900	B	500	20	12	1	CAFÉ SIGN	LCP 22
23	LCP	CAFÉ SEATING TRACK	1	12	20	1680	C	720	20	12	1	FLOOR MILLWORK REC	LCP 24
25		CAFÉ SEATING J-BOX	1	12	20	1080	A	1440	20	12	1	PERIMETER SHELF REC	LCP 26
27	LCP	SALES TRACK LIGHTING	1	12	20	1440	B	1080	20	12	1	PERIMETER SHELF REC	LCP 28
29	LCP	SALES RECESSED LIGHTS	1	12	20	576	C	1080	20	12	1	PERIMETER SHELF REC	LCP 30
31	LCP	SIGN	1	12	20	1200	A	1440	20	12	1	PERIMETER SHELF REC	LCP 32
33	LCP	SALES TRACK LIGHTING	1	12	20	1440	B	1440	20	12	1	FLOOR MILLWORK REC	LCP 34
35	LCP	STOREFRONT CAFÉ SIGN	1	12	20	1000	C	1440	20	12	1	FLOOR MILLWORK REC	LCP 36
37	LCP	SIW OUTLETS	1	12	20	1440	A	1440	20	12	1	FLOOR MILLWORK REC	LCP 38
39	LCP	SIGN	1	12	20	1200	B	1800	20	12	1	PERIMETER SHELF REC	LCP 40
41		FIXTURE UTILITY OUTLETS	1	12	20	720	C	1080	20	12	1	FIXTURE UTILITY OUTLETS	42
ALL PHASES TO BE BALANCED TO WITHIN 7%													
A=		14,388	WATTS				LO	CIRCUITS WITH HANDLE LOCK-OFF DEVICE					
B=		14,070	WATTS				IG	CIRCUITS WITH ISOLATED GROUND					
C=		15,036	WATTS				LCP	CIRCUITS ON LIGHTING CONTROL PANEL					
TOTAL CONNECTED LOAD			43484	WATTS		121	AMPS						
TOTAL DEMAND LOAD			46618	WATTS		130	AMPS						

ELECTRICAL LOAD SUMMARY					
DESCRIPTION	NEC CONNECTED KW	VOLT	PHASE	NEC DEMAND FACTOR	NEC DEMAND KW
LIGHTING- 120V	6.7	120	1	1.25	8.4
INTERIOR SIGN	1.5	120	1	1.25	1.9
TRACK LIGHTS	14.4	120	1	TRACK LENGTH=	14.4
RECEPTACLES	40.3	120	1	>10KW=10+[0.5*(KW-10)]	25.2
STOREFRONT SIGN	4.8	120	1	1.25	6.0
S/W OUTLETS	1.4	120	1	1.25	1.8
HAND DRYER	2.9	120	1	1.00	2.9
AHU-1 / CU-1	5.6	208	1	1.00	5.6
WATER HEATER "EWH-1"	12.3	208	3	1.25	15.4
CAFÉ EQUIPMENT (208V,3PH)	5.6	208	3	1.00	5.6
EXISTING RTU-1,2,3,4,5 AND RTU-6	284.0	480	3	1.00	284.0
WATER HEATER "EWH-2"	4.0	277	1	1.25	5.0
CAFÉ EQUIPMENT (208V,1PH)	29.7	208	1	1.00	29.7
CAFÉ EQUIPMENT	14.4	120	1	1.00	14.4
ADD'L TO MEET NEC 220.12 *****	40.22	120	1	1.00	40.2
TOTALS	468.0				460.5
NOTES:					
* USE GREATER VALUE OF THE TWO CATEGORIES.					
** 125% OF THE LARGEST MOTOR OR COMPRESSOR IN SYSTEM APPLIED ONLY ON ONE UNIT.					
*** N.E.C. ARTICLE 220-12 REQUIREMENT (200 VA PER FOOT OF SHOW WINDOW)					
**** MINUS ACTUAL SHOW WINDOW LIGHTING KVA.					
***** N.E.C. 2014 ARTICLE 220.43(B) EXCEPTION (CURRENT LIMITERS)					
N.E.C. DEMAND KVA x 1.000 MINIMUM FEEDER AMPERAGE					
SYSTEM VOLTAGE x 1.732					
460.5	x 1000 =	460,504	553.9 AMPS	USE (EXIST) 800 AMP SERVICE	
480	x 1.732 =	831			

ELECTRICAL PANEL SCHEDULE															
PANELBOARD			K	VOLTAGE		120 / 208 V		PHASE		3		4			
PANEL TYPE			NQ	MAINS		200	BUS RATING			225	AIC RATING		25,000		
NEMA TYPE ENCLOSURE			NEMA 1	MOUNTING		SURFACE		OPTIONS		NOTE					
CKT. NO.	ITEM #	DESCRIPTION	POLE	WIRE SIZE	BKR SIZE	TOTAL WATTS	PHASE	TOTAL WATTS	BKR SIZE	WIRE SIZE	POLE	DESCRIPTION	ITEM #	CKT. NO.	
1	125	ICE MAKER, CUBE STYLE	1	12	20	1289	A	1198	20	12	1	SELF-SERVICE REF. CASE	118	GFCI 2	
3		SPARE	1				B	1198	20	12	1	SELF-SERVICE REF. CASE	118	GFCI 4	
5	GFCI 104	ESPRESSO MACHINE	2	10	30	3120	C	679	20	12	1	REACH-IN FRIDGE	120B	6	
7						3120	A	240	20	12	1	REFRIGERATOR U/C	131	GFCI 8	
9	GFCI 104	ESPRESSO MACHINE	2	10	30	3120	B	1456	20	12	2	COFFEE BREWER	114	10	
11						3120	C	1456						12	
13	GFCI 131	REFRIGERATOR U/C	1	12	20	240	A	1081	20	12	1	REACH-IN FREEZER	38	GFCI 14	
15	GFCI 113	COFFEE GRINDER	1	12	20	920	B		20		1	SPARE		16	
17		SPARE	1		20		C	1800	20	12	1	BLENDER	112	GFCI 18	
19	120B	REACH-IN FRIDGE	1	12	20	679	A	1800	20	12	1	BLENDER	112	GFCI 20	
21	133	DISHWASHER, U/C	2	8	40	3869	B	1300	20	12	1	HOT WATER DISPENSER	100.2	GFCI 22	
23						3869	C		20		1	SPARE		24	
26		KITCHEN CONVEN. REC.	1	12	20	720	A	1000	20	12	1	WATER SOFTENER		26	
27						4100	B	1000	20	12	1	REACH-IN FREEZER	28	28	
29	LO 4	WATER HEATER	3	6	45	4100	C	1000	20	12	1	U/C REFRIGERATOR	132	30	
31						4100	A	1040						32	
33	LO	RE-CIRCULATING PUMP	1	12	20	300	B	1040	20	12	2	DISPLAY CASE, REFRIG.	119	34	
36	IG 103	CAFÉ POS CASHWRAP	1	12	20	400	C	1867						36	
37	LO	CAFÉ POS CASHWRAP	1	12	20	600	A	1867	20	12	3	BLODGETT OVEN	3C	38	
41						2250	B	1867						40	
49	3D	RAPID COOK OVEN	2	10	30	2250	C		20		1	SPARE		42	
ALL PHASES TO BE BALANCED TO WITHIN 7%															
A=	16,974	WATTS					LO	CIRCUITS WITH HANDLE LOCK-OFF DEVICE							
B=	22,420	WATTS					IG	CIRCUITS WITH ISOLATED GROUND							
C=	23,661	WATTS					GFCI	GROUND FAULT CIRCUIT INTERRUPTER							
TOTAL CONNECTED LOAD				60556	WATTS		181	AMPS							
TOTAL DEMAND LOAD				68130	WATTS		190	AMPS							

PROJECT DESIGNER:

WJCA
BUILDING VALUE SINCE 1994

ARCHITECT:

JOEL TORIELLI
422 BOGERT AVE
RIDGEWOOD, NJ 07450

Kenneth A. Fuller, P.E.

151 East Main St.
Rockaway, NJ 07866
Tel: 973-964-0255
kfuller@kafusa.com

Kenneth A. Fuller, P.E.
VA LICENSE NUMBER: 44503
EXPIRES: 09-22-26

SOUTH HILL MALL
3500 S. MERIDIAN ST.
UNIT #800
PUYALLUP, WA 98373

Project Number 33247
Store Number 3507

Revision Log:

Date	Description	No.
12-19-24	ISSUED FOR PERMIT, BID, LANDLORD & CLIENT REVIEW	1
02-20-25	LANDLORD & BID COMMENTS	2
		3
		4
		5
These plans are an instrument of service and the property of the Architect. Infringements will be prosecuted.

General Contractor to verify all conditions and dimensions at the premises. Discrepancies shall be reported to the Architect prior to the commencement of any work.




Professional Seal:

LIC.# : 22005563
EXP. DATE : 10/02/25

Drawing Description:
ELECTRICAL
DETAILS

Drawing Number:

E-203

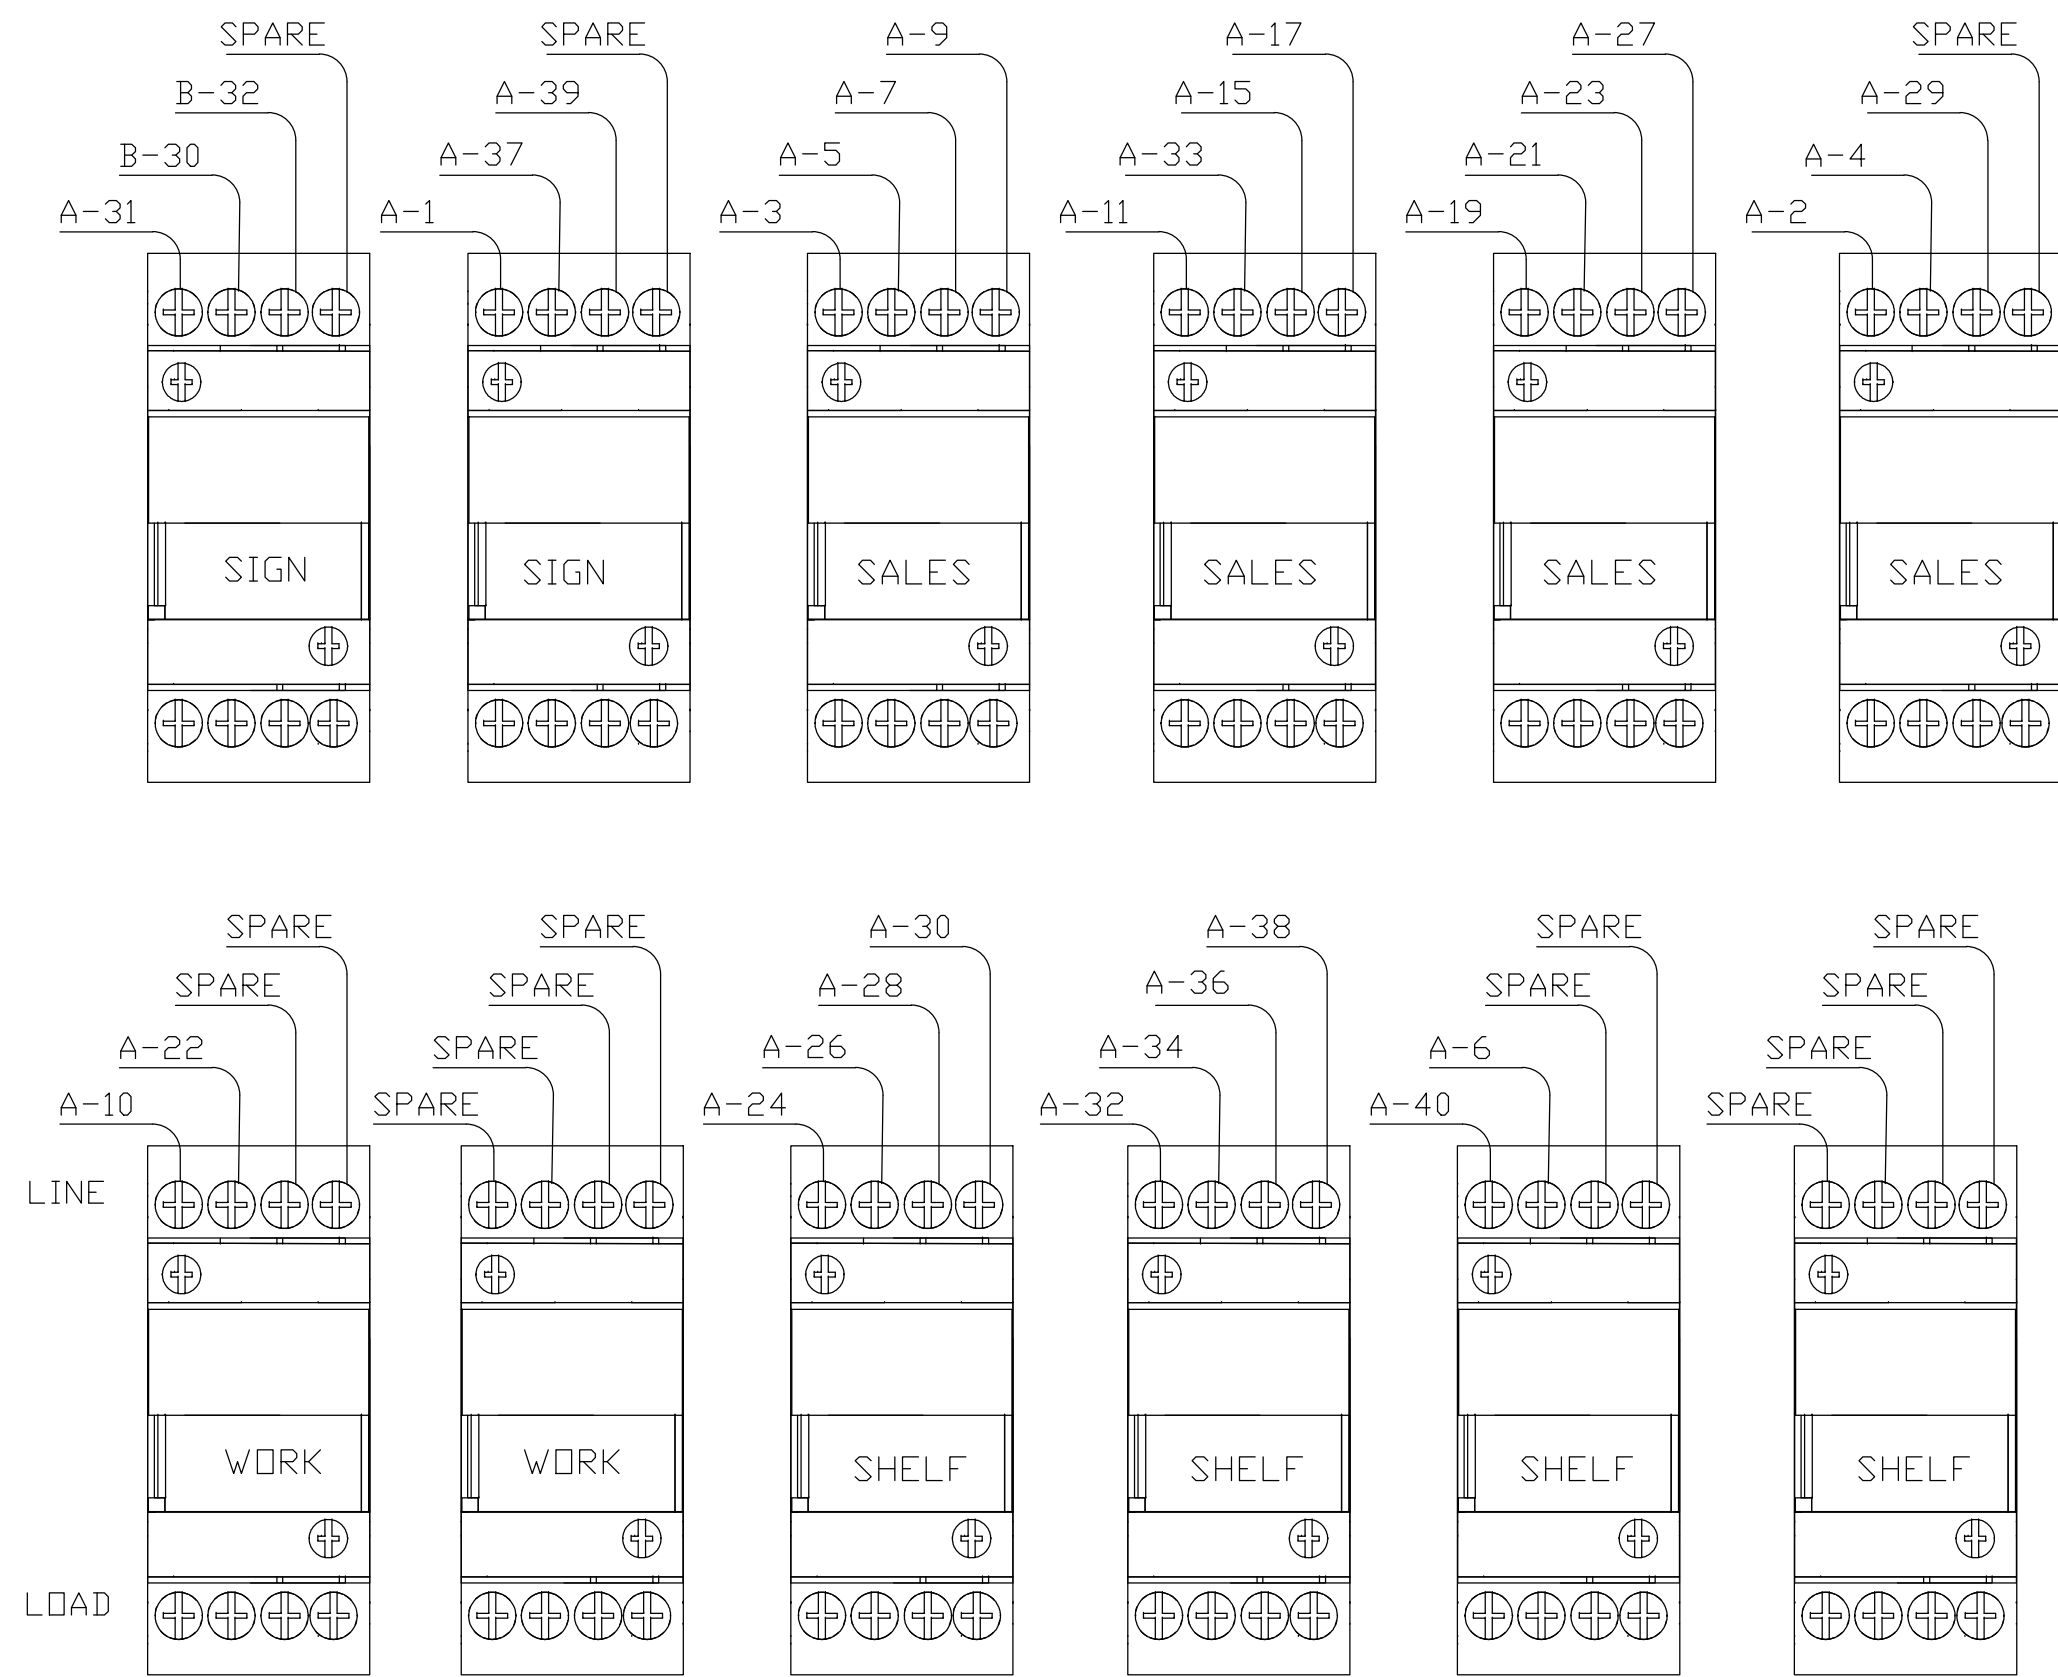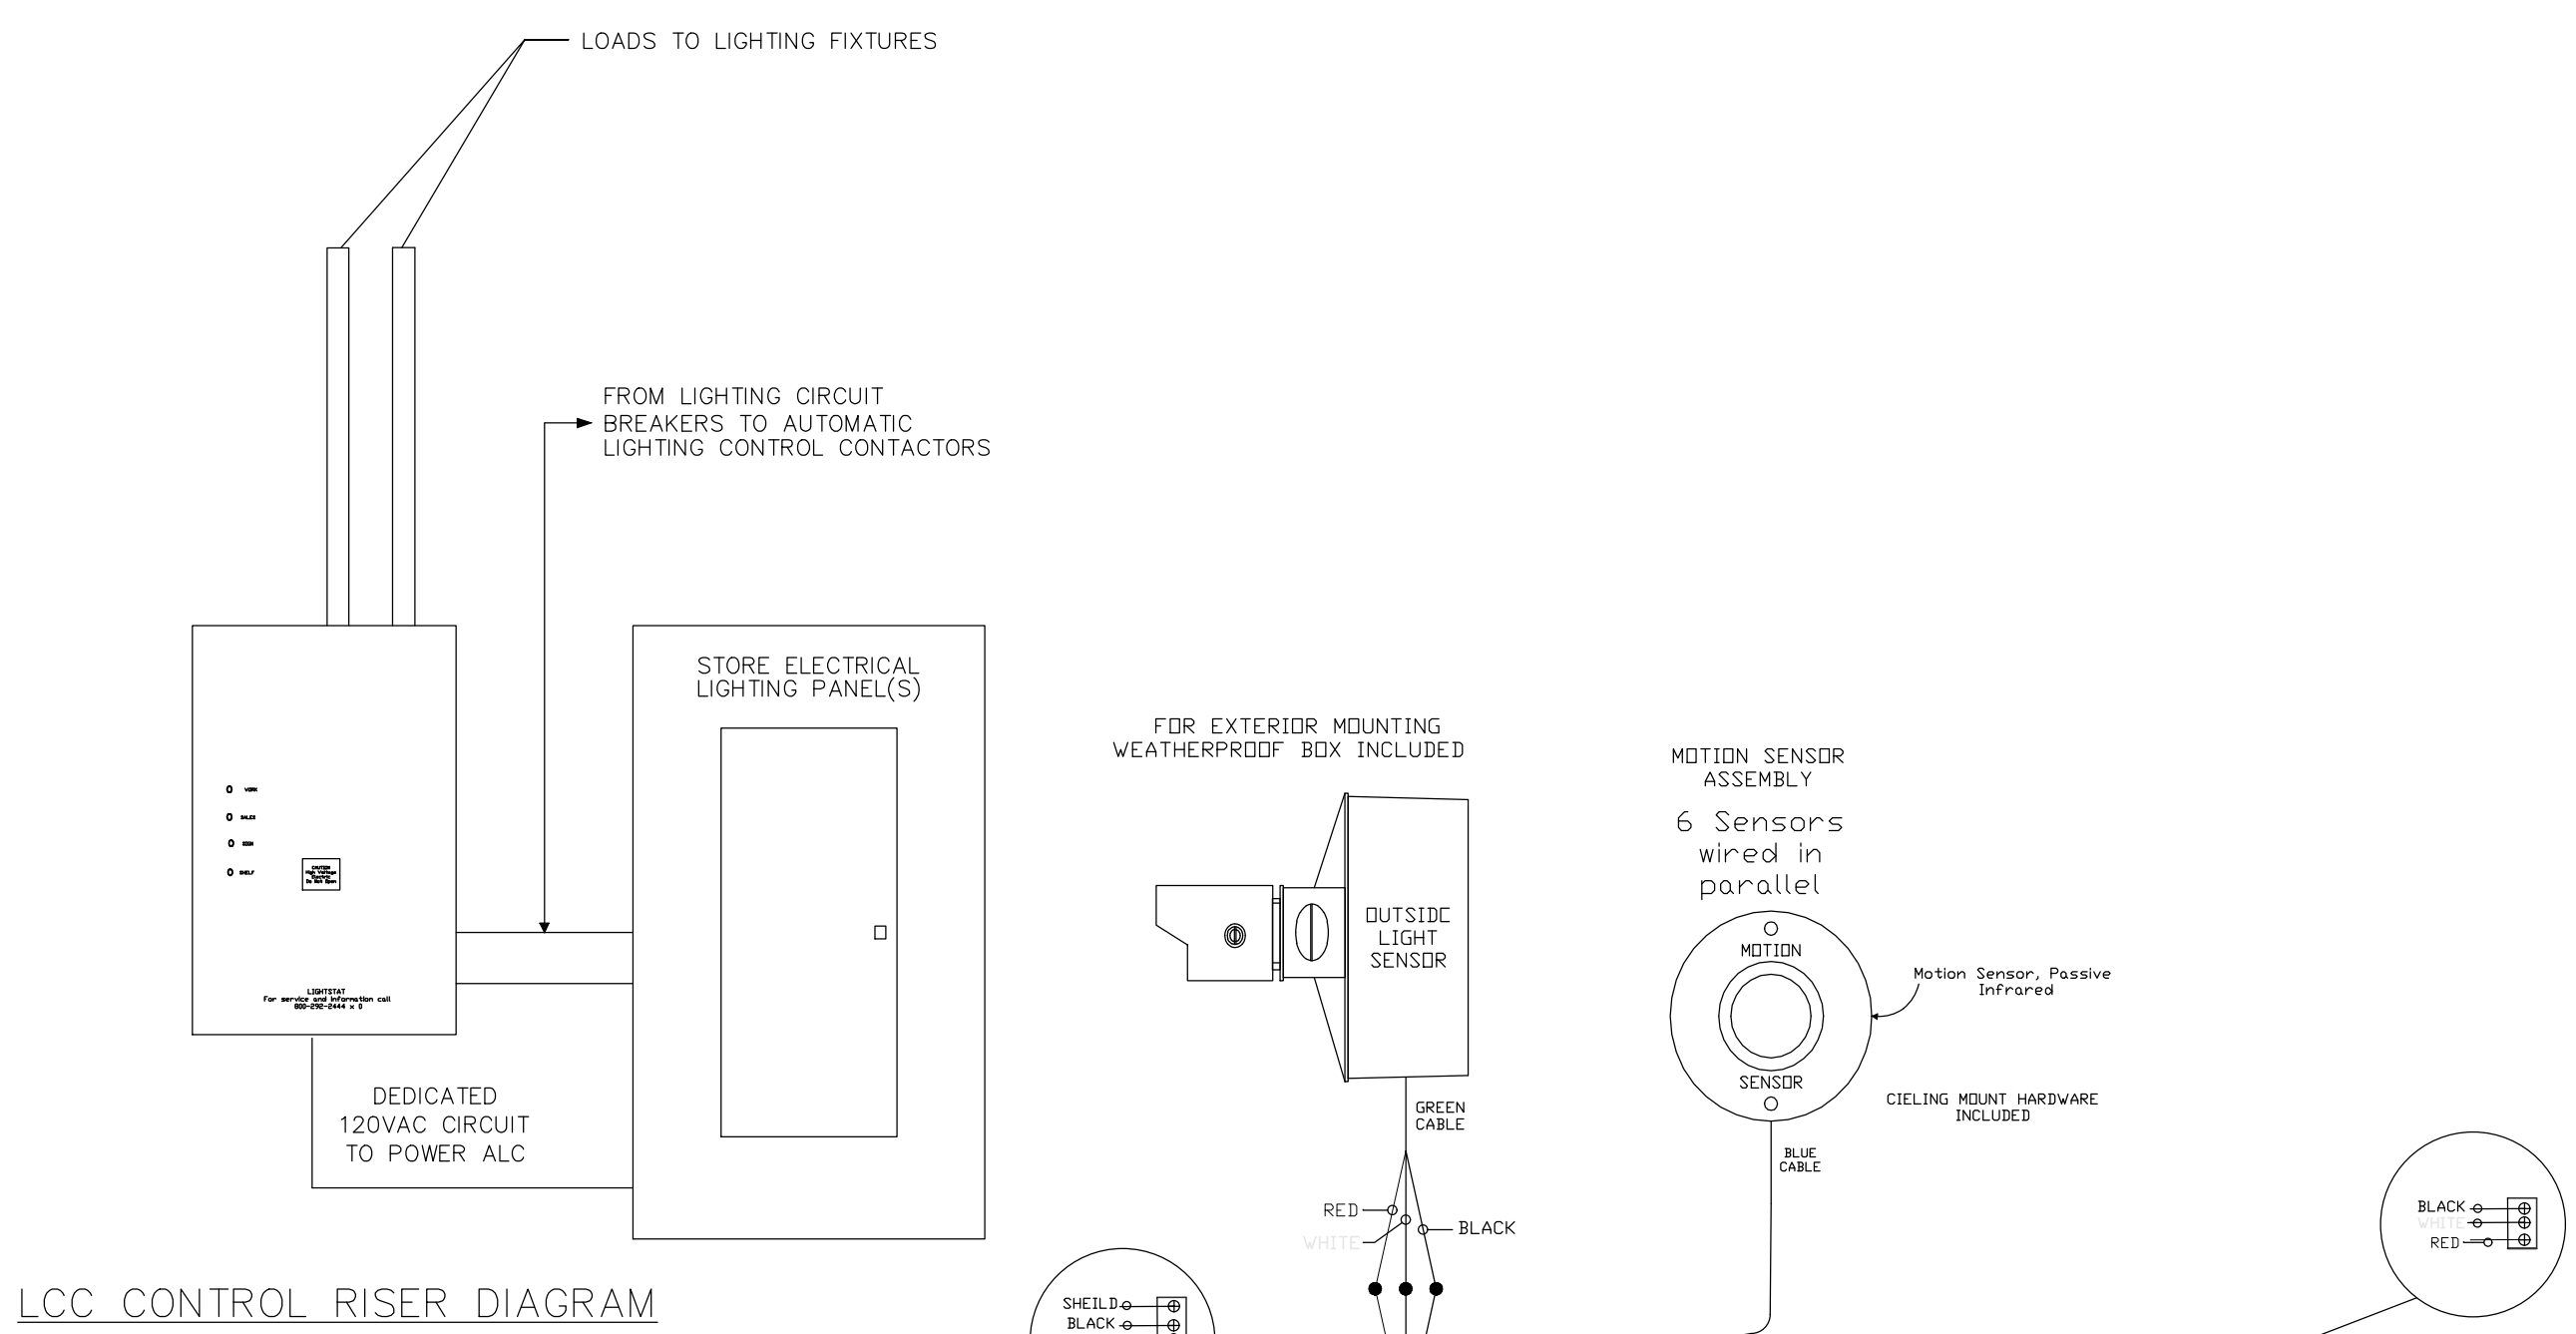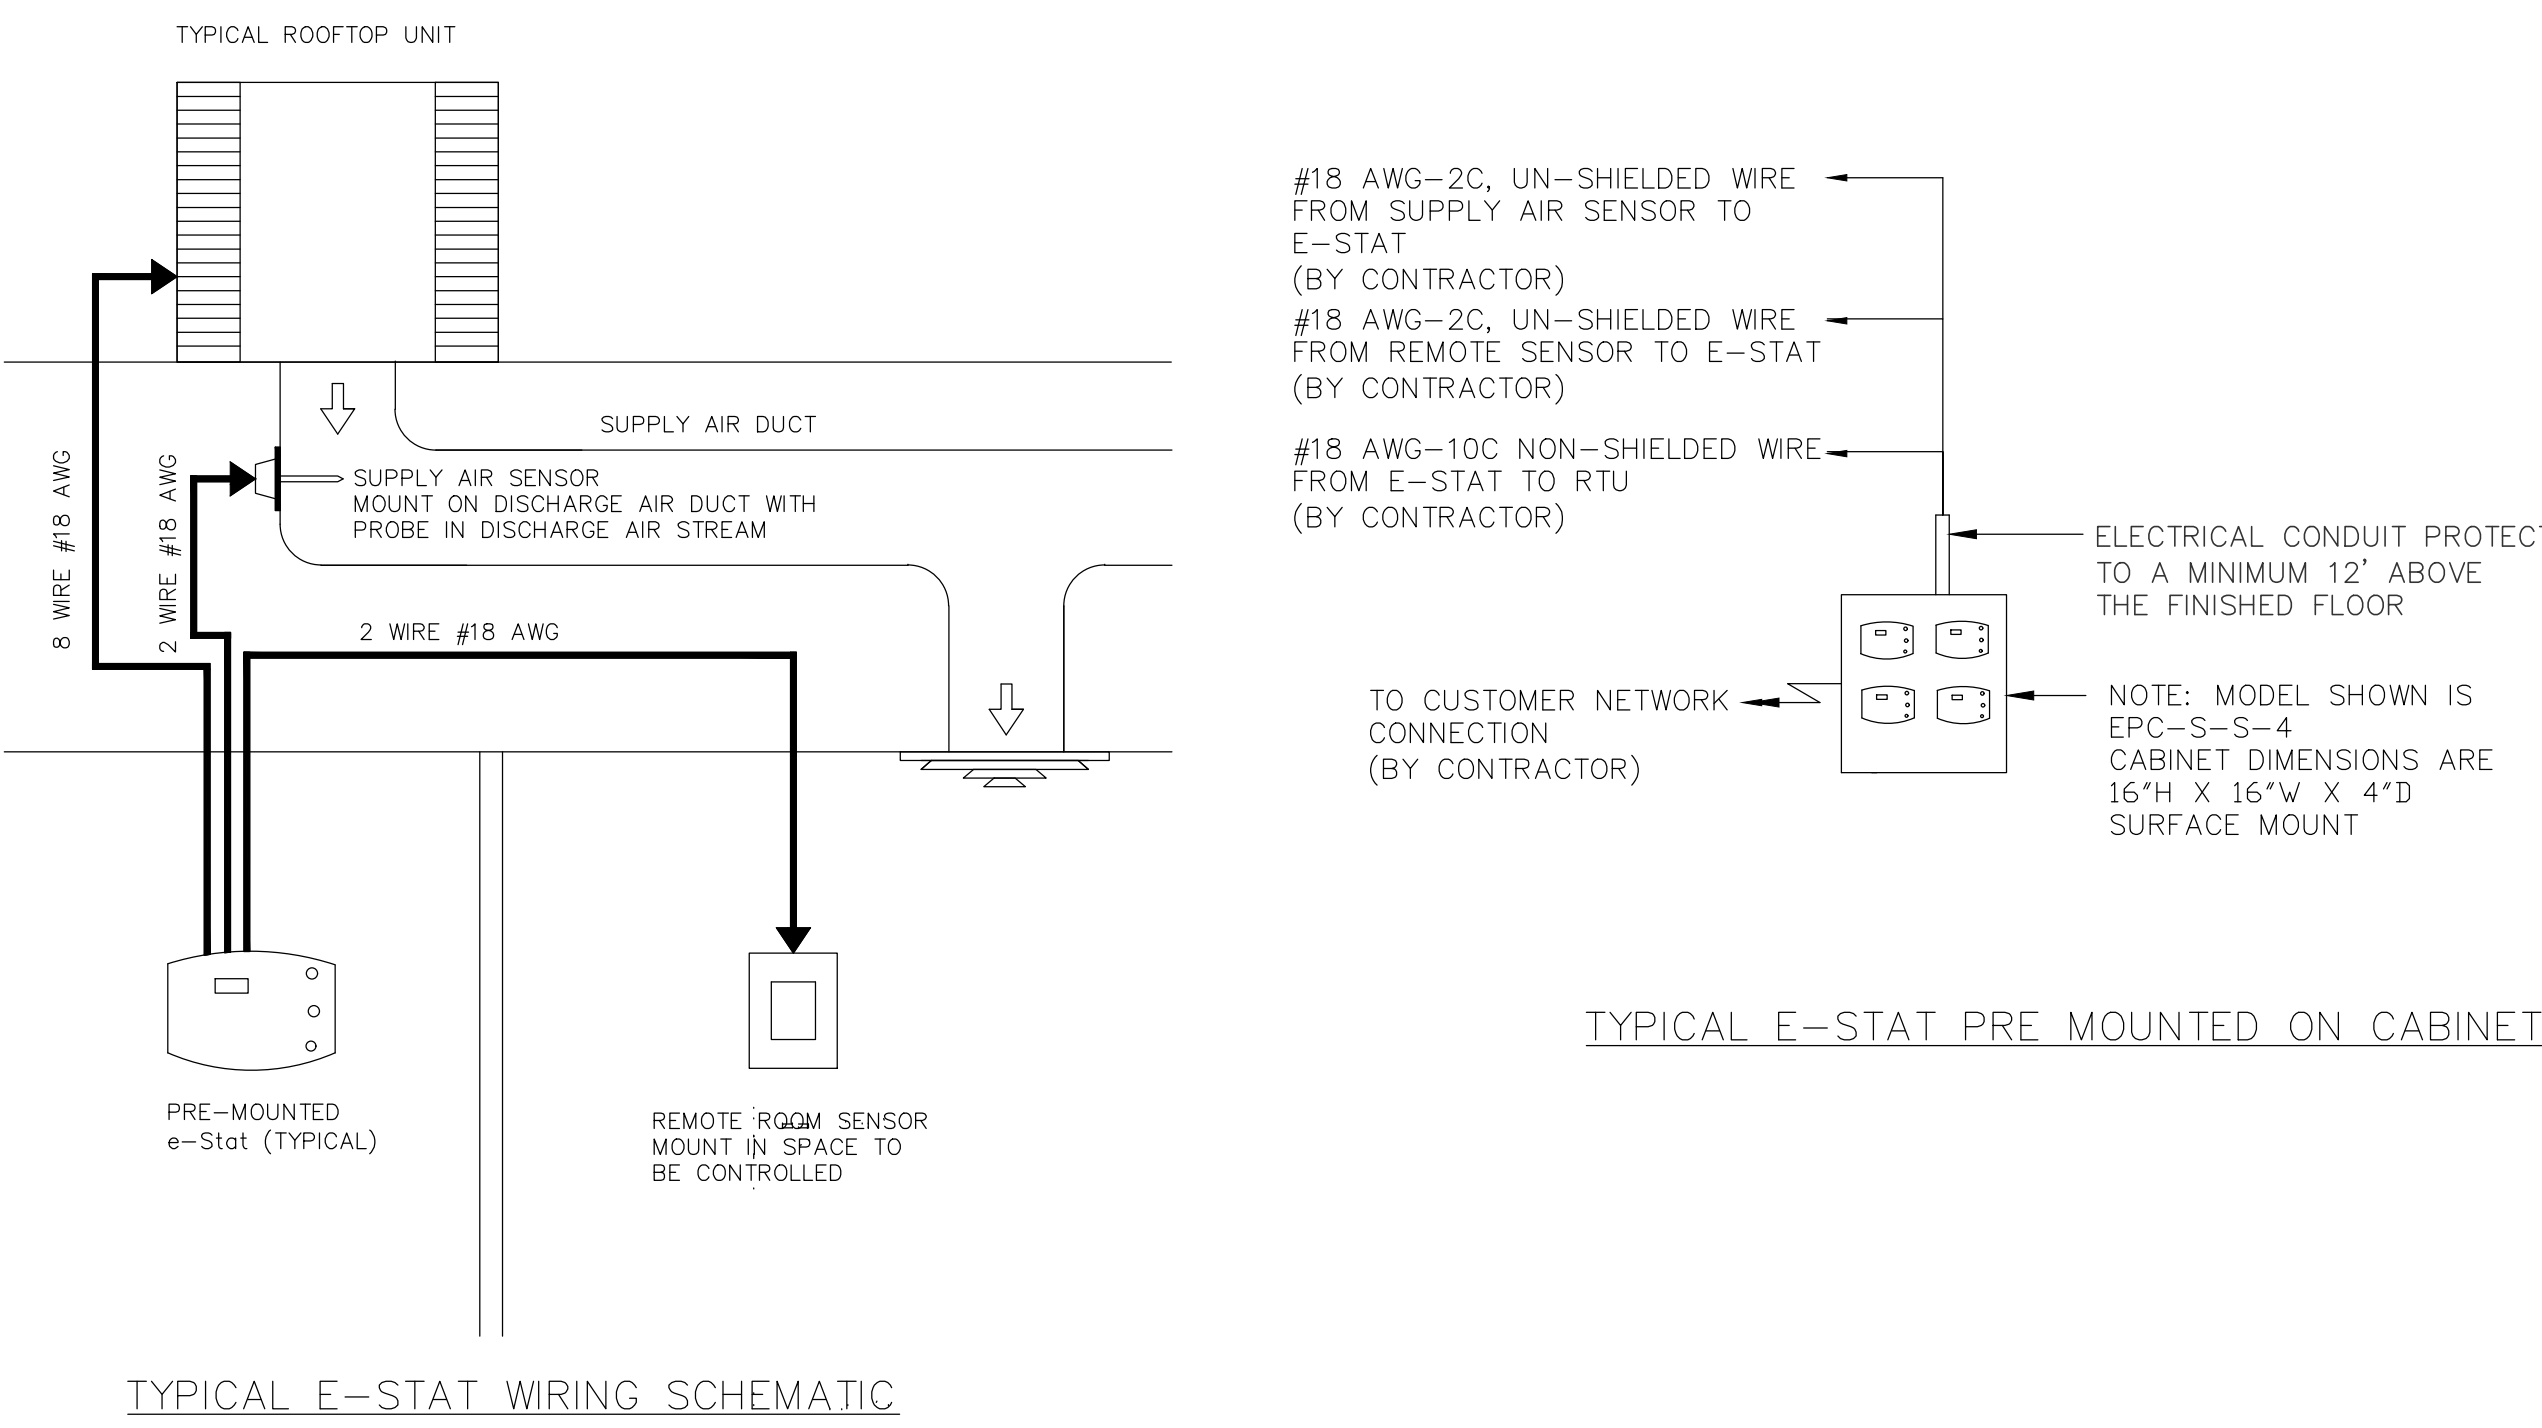

DRAWINGS FOR INFORMATION ONLY - BN VENDOR TO VERIFY ALL INFORMATION PRIOR TO WORK

ELECTRICAL SPECIFICATIONS (cont.)

Section 284621 - Alarm System

A. Fire Alarm System (addressable analog type):

1. This contractor shall submit fire alarm system drawings and specification to the local fire department for their approval before installation of any fire alarm components or wiring.
2. All devices, components, equipment, and materials used in the fire alarm system shall be listed for the purpose for which they are used, and shall be installed in compliance with applicable codes and standards.
3. Provide a complete, supervised, power-limited, fire alarm system. All equipment herein specified is that of Simplex Time Recorder Co. Equipment specified by listed acceptable alternate manufacturers shall meet or exceed the quality of the Simplex equipment specified.
4. The fire alarm system shall be an electrically supervised system, which shall monitor the integrity of all components and conductors and shall be capable of transmitting trouble signals.
5. The installation organization shall be a company specializing in the installation of fire alarm systems. This organization shall have a minimum of five years experience with installation of such systems.
6. The Contractor shall provide and maintain on the site an up-to-date record set of approved shop drawings.
7. Record drawings shall include location of end-of-line device locations.
8. Upon completion of the work, and final acceptance by the local authority, the contractor shall submit record drawings to the owner.
9. A remote monitoring facility output circuit, selectable for interface to remote station reverse polarity, local alarm master box, digital alarm communicator, or radio transmitter monitoring systems, shall be provided. The equipment supplier must contact the local authorities prior to bidding and supply all required equipment in the base bid.
10. The control panel shall be Simplex #408-9301 or Simplex #408-9310 Internal D.A.C.T. The power supply shall be adequate to serve control panel modules, relays and alarm indicating appliances. Include a secondary emergency power supply with capacity for operating system for a minimum time as specified by the local authorities having jurisdiction and/or Owner/Building Standards. The strictest provision shall govern.
11. LCD annunciator panel shall be Simplex #4606-9111 with Simplex #4603-9111 brushed aluminum annunciator panel.
12. Addressable pull stations shall be semi-fush, action push/pull type. simplex #4099-9003.
13. Smoke detectors shall be analog photoelectric type. Simplex #4098-9710.
14. Analog heat detectors shall be 135 degrees F fixed temperature with rate-of-rise type. Simplex #4098-9735 with addressable base. Simplex #4098-9788.
15. Duct-mounted smoke detectors shall have a base with auxiliary relay (Simplex Type 4098-9756) analog photoelectric detector (Simplex Type 4098-9714), and sampling tubes (length as required).
16. Remote control remote control module (AM) shall be Simplex #4098-9756.
17. Semi-fush audio/visual unit shall be Simplex Type 4093-9301 Series with A.D.A. complying 1575 Candela strobe and horn. All strobe lights shall be synchronized.
18. Semi-fush unit shall be Simplex Type 4904-9307 with A.D.A. complying 1575 Candela strobe. All strobe lights shall be synchronized.
19. Waterflow and tamper switches shall be furnished and installed by the sprinkler contractor. The electrical contractor shall determine reach device to the fire alarm system using an individual waterflow module (AM) or tamper module (AM).
20. Magnetic door holders shall be electrically operated and magnetically hold smoke doors in an open position. Provide a flush, surface or floor mounted as required:
 - a. Flush mounting - Simplex Type: 2088-6582
 - b. Surface mounting - Simplex Type: 2088-6582
 - c. Floor mounting - Simplex Type: 2088-6575
21. Provide and install wiring per manufacturers' specifications. All wiring shall be in conduit (3/4" minimum).
22. The completed fire alarm system shall be fully tested in accordance with NFPA-72H, and local fire department requirements, by the installer, in the presence of the owner's representative and the local fire department.
23. Upon successful completion of a successful test, the installer shall certify, in writing, to the owner and general contractor.
24. Include on-site services of a certified technician to provide technical installation support for panel and program editing (if needed) for the duration of the project.
25. The contractor shall provide a complete fire alarm system check-out in accordance with the field quality control section of these specifications.
26. Acceptable manufacturers/suppliers shall be Simplex, Notifier (as supplied by a certified Necso affiliate) or Siemens.

City of Puyallup
Development & Permitting Services
ISSUED PERMIT

Building	Planning
Engineering	Public Works
Fire	Traffic

BARNES & NOBLE

PROJECT DESIGNER:


WJCA
BUILDING VALUE SINCE 1994

ARCHITECT

JOEL TORIELLI
422 BOGERT AVE
RIDGEWOOD, NJ 07450

Kenneth A. Fuller, P.E.

153 East Main St.
Rockaway, NJ 0786
Tel: 973-784-4258
kfullerpe@msn.com

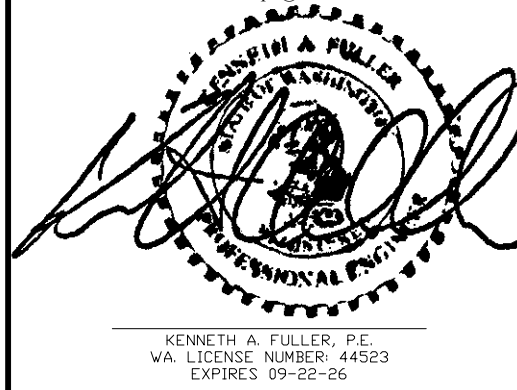

SOUTH HILL MALL
3500 S. MERIDIAN ST.
UNIT #800
PUYALLUP, WA 98373

Project Number 33247
Store Number 3507

Revision Log

Date	Description	No.
12-19-24	ISSUED FOR PERMIT, BID, LANDLORD & CLIENT REVIEW	1
02-20-25	LANDLORD & BD COMMENTS	2
		3
		4
		5
These plans are an instrument of service and the property of the Architect. Infringements will be prosecuted.

General Contractor to verify conditions and dimensions at the premises. Discrepancies shall be reported to the Architect prior to the commencement of any work.

Professional Seal

LIC.# : 22005563
EXP. DATE : 10/02/25

Drawing Description

ELECTRICAL SPECIFICATIONS

Drawing Number

E-302

GENERAL NOTES

- DESIGN CRITERIA
1. ASHRAE Design Requirements
- A. Heating/Cooling Loads
- 1) Heating
- a) Outside air temperatures: 20 degrees F DB (ASHRAE 90.6%).
- 2) Cooling
- a) Outside air temperatures: 86 degrees F DB / 65 degrees F WB (ASHRAE 99%).
- B. Building Design
- 1) ASHRAE and Energy Code guidelines.
- 2) Indoor relative humidity at 50 percent RH for cooling loads only.
- a) Humidity is not being controlled or maintained in the heating or cooling equipment modes.
3. Design Ventilation
- A. Use ASHRAE 62 Standard or 2021 Washington State Mechanical Code.
- B. See Ventilation Schedule on drawings.
- C. See floor plans for rooms that need to be in a positive or negative relation to other rooms shown by the difference in supply and return or exhaust air quantities.
- GENERAL
1. The term General Contractor (G.C.) as used in these documents refers to the Contractor / Construction Manager in responsible charge of the project in terms of coordination, scheduling, subcontractor coordination, etc. This term refers to, but is not limited to, General Contractor, Construction Manager, Design Build Contractor, Prime Contractor, etc. The term is referencing the entity that coordinates the work of other trades.
2. These drawings are diagrammatic and indicate the general extent of the work. The contractor shall be responsible for the coordination and proper installation of all mechanical systems. The contractor shall provide all necessary offsets and fitting which may be required due to space constraints or other conditions.
3. Existing building HVAC, Plumbing and Fire Protection systems shown on these drawings which are to be removed or modified where taken from the original drawings dated 2010 and may not show current installations or conditions. Each contractor shall field verify all existing systems.
4. The mechanical systems or its modifications are designed to be a complete operating system and stable after the building or its modifications are fully completed. It is solely the contractor's responsibility to determine construction, installation, and programming procedures and sequences to have a complete and working system and to ensure the safety of the construction personnel, public, building and its component parts, and adjacent buildings and properties. This includes the addition of whatever temporary or permanent bracing, etc., that may be necessary to brace new or existing construction, walls, and framing to remain so that the structure is braced for construction loads, etc., and that no horizontal settlement or any damage occurs to the adjacent new or permanent supports and bracing that are installed. Design of these supports shall be provided by the contractor. Provide all materials, labor, equipment, and accessories required to furnish and install the systems identified in specifications and drawings.
5. It is the contractor's responsibility to enforce all applicable safety codes and regulations during all phases of construction.
6. Construction loads shall not exceed structural design live loads. The contractor shall be responsible for all design of support construction equipment used in constructing this project. Verify and coordinate with structural drawings.
7. The contractor shall perform all construction for the project in a manner and sequence that are based on accepted industry standards that recognize the interaction of the components that comprise the systems, without causing distress, unanticipated movements or irregular load paths as a result of the construction means and methods employed.
8. The contractor shall provide all miscellaneous supporting steel, etc. for the proper installation of all mechanical systems.
9. Before fabrication and/or installing any work, contractor shall see that it does not interfere with clearance required for finish on beams, columns, plenums, walls, or other structural or architectural members, as shown on architectural drawings. If any work is so installed and a later design that architectural design cannot be followed, contractor shall, at his own expense, make any changes in his work as architect may direct to permit completion of architectural work in accordance with plans and specifications.
10. All piping shall be protected as required by the applicable Mechanical, Plumbing, Fire Protection and Building Codes: "General Regulations" and other Code Chapters.
11. Pipes passing through or under walls shall be protected from breakage. Pipes passing through studs, joists, rafters or similar members less than 1 1/2" from the nearest edge of the members shall be protected by steel shield plates.
12. Piping shall be installed to prevent strains and stresses that exceed the structural strength of the pipe. Where necessary, provisions shall be made to protect piping from the damage resulting from pipe expansion and contraction and structural/settlement. Expansion joint fittings shall be used where necessary to provide for expansion and contraction of the pipes. Sleeved openings shall be sized appropriately to accommodate pipe movement and structural/settlement. Expansion joint fittings shall be of the typical material suitable for use with the type of piping in which fittings are installed. A minimum install rubber mechanical joint couplings or CSA-certified expansion joints on all vertical piping at every other floor of the building and rightly support the stack pipe on alternating floors to direct any movement into the appropriate expansion compensator. Design of these expansion fittings shall be provided by the contractor. Any analysis which requires additional support or expansion detailing shall be shared with the mechanical design professional and any stresses or point loads created by the engineered system shall be shared with the structural designer for review.
13. Install additional offsets on piping or ductwork where required to obtain maximum headroom or to avoid conflict with other work without additional cost to owner.
14. Report any interference between work under this division and that of any other contractors to architect as soon as they are discovered. Architect will determine which equipment shall be relocated, regardless of which was first installed, and his decision shall be final.
15. The contractor shall coordinate floor, wall, and roof penetrations, lower sizes, etc. with general trades.
16. Principal openings on these drawings through the framing are shown on the structural drawings. The mechanical contractor shall examine the structural and mechanical drawings for the required openings and shall verify size and location of all openings with the general contractor. General contractor shall provide all openings required through the framing by the mechanical, electrical, plumbing, or other trades, whether or not shown on the structural drawings. Any deviation from the openings shown on the structural drawings shall be brought to the engineer's attention for review.
17. All mechanical and electrical work: Ductwork, plumbing, piping, wiring, lighting, etc., and all architectural items that need to be removed during the modification or reinforcing of existing structure shall be replaced in kind by the respective contractor. The contractors shall keep all existing systems in operation during the construction phase of the project.
18. All contractors are required to examine the drawings and specifications carefully, visit the site and fully inform themselves as to all existing conditions and limitations, prior to agreeing to perform the work. Failure to visit the site and familiarize themselves with the existing conditions and limitations will in no way relieve the contractor from furnishing any materials or performing any work in accordance with drawings and specification without additional cost to the owner to have a complete and working system.
19. Details labeled "Typical Details" or "Typical" on drawings apply to situations occurring on the whole project that are the same or similar to those specifically detailed. Such details apply whether or not details are referenced at each location on drawings. Notify engineer for clarifications regarding applicability of "Typical Details".
20. Work and coordinate these drawings with architectural, civil, structural, mechanical, plumbing, fire protection, electrical, and technology drawings.
21. Do not scale drawings.
22. Any discrepancies between mechanical and architectural drawings shall be brought to the attention of the architect and mechanical engineer.
23. Should any of the general notes conflict with any details or instructions on plans, or in the specifications, the strictest provision shall govern.
24. Shop drawings and submittals
- A. Shop drawings and submittals shall be checked and coordinated with other materials and contracts by the general, mechanical and electrical contractors and shop drawings and submittals shall bear the prime contractor's review stamp with the checker's initials before being submitted to the architect for approval.
- B. When the contractor has been authorized to use the architect and engineer's drawings as construction coordination drawings, the contractor must remove all title blocks, professional seals and any other references to the architect and engineer from those drawings. The contractors name and title shall be placed on the drawings.
- C. Where voltage, amp draw, dimensions and elevations of existing construction could affect the new construction, it is the contractor's responsibility to make field verifications and measurements in time for their incorporation into the shop drawings.
24. Refer to architectural and electrical reflected ceiling plans for exact location of light fixtures. Contractors to coordinate locations of lighting, speakers, air diffusers, grilles, sprinkler heads and tie line, with reflecting ceiling lay-outs as required and directed by the architect.
25. Ductwork or piping shall not be located over the top of any electrical panels or equipment.
26. Contractor shall include in his bid all cutting, trenching, and patching associated with the installation of this projects work.
27. Cutting, Patching and Drilling
- A. All cutting and patching of the building construction required for this work shall be by this contractor unless shown on architectural drawings and confirmed as to size and location prior to new construction. Cutting shall be in a neat and workmanlike manner.
- B. Neatly saw cut all rectangular openings, set sleeve through opening, and finish patch or provide trim flange around opening.
- C. Neatly saw cut floors and patch floor to match existing, including floor covering.
- D. Contractor shall field verify slab-on-grade or supported floor construction type prior to cutting. Under no circumstances shall this contractor cut a floor thicker than 4 inches, a structural floor slab, whether on grade or supported, without prior written approval from the architect. If floor slab indicated to be cut on mechanical plans is found to be structural in nature, do not cut. Contact architect immediately for further directions.
- E. Core drill and sleeve all round openings.
- F. Do not cut any structural components without architect's written approval, including, but not limited to roof joists, columns, floor joists, beams, girders, structural floor slabs, etc.
- G. Patch, and finish to match adjacent areas that have been cut, damaged or modified as a result of the installation of the mechanical systems. Fire-stop all penetrations of fire rated construction in a code approved manner.
- H. All contractors shall confirm with owner, prior to bid, times available for noise producing work such as cutting and core drilling of floors, walls, etc. as well as times for work which requires access into adjoining tenant spaces. Include any premium time in bid.
- I. Exact location of roof top air conditioning units shall be approved by the structural engineer. Mechanical contractor shall furnish and install all supplemental support steel for equipment and roof penetrations after approval of structural engineer.
- J. The mechanical contractor shall coordinate work with the general contractor prior to construction. The mechanical contractor shall provide information regarding openings in walls, floors, etc., concrete equipment pads and foundations to the general contractor. If the mechanical contractor fails to comply with this request, or if incorrect information is given, the necessary cutting and patching will be performed by the general contractor, the mechanical contractor's expense.
- K. All openings required for this branch of work shall be accomplished in time to be incorporated in, and be compatible with the construction program; otherwise this contractor shall be responsible and pay for all changes made necessary for his failure to do so. Pipe holes in floors and walls shall be core drilled if not sleeved during construction.
28. Refer to mechanical, plumbing, fire protection, and electrical plans for location of mechanical, plumbing, and electrical equipment. Coordinate location of disconnect switch associated with each piece of mechanical and plumbing equipment with electrical

contractor.

29. Installation requirements for all HVAC, plumbing, and fire protection systems shall be reviewed and coordinated with all other trades involved prior to rough-in. Give equipment shop drawings from installer/supplier/contractor equipment, as required, for review and coordination to all other trades involved. Contact architect/engineer with any discrepancies found between construction drawings and equipment being furnished prior to rough-in.
30. The contractor shall furnish all access panels or doors in hard ceilings and walls with a size as required for servicing and testing, for equipment, valves and/or devices furnished under this contract. The general contractor shall install access panels. The contractor shall coordinate the size and location of each access panel with the architect and general contractor prior to rough-in.
31. Firestopping
- A. All penetrations through fire rated walls associated with the installation shall be sleeved and fire-stopped using a UL approved method. UL approved method shall meet or exceed fire rating of structure being penetrated. Reference architectural plans for fire rated structures. If shown, reference architectural, mechanical and electrical drawings for penetration details.
- B. All openings through fire rated walls, floors, and/or roofs for ductwork, piping, conduit, etc., shall be fire sealed with a calcium silicate, silicone "RTV" foam, "3M" fire rated sealants, Hill Firestop Systems, or approved equal to maintain the intended fire rating and associated UL ratings as recommended by the architect and/or sealant manufacturer.
- C. All fire stopping sealants shall be hydroscopic so as not to slump or sag and shall be trowelable. Fire stopping sealants shall be intumescent and shall be free of asbestos, halogens, and volatile solvents.
- D. Fire stopping materials shall be classified in the Underwriters Laboratories (UL) fire resistance directory or listed in the Wamock Hersey International Directory.
32. All equipment and devices for this project must be UL listed. Devices, equipment, systems shall be installed per National Electrical Code requirements and manufacturer's instructions.
33. All conduit and cabling shall be properly supported as required by the National Electrical Code. For existing installations, the contractor shall be responsible to replace and/or rework existing conduit and/or cabling that is not in compliance with this requirement.
34. All materials and work in the selling volume air plenum shall be approved for plenum rated application in accordance to the current building code. Where open wiring methods for low voltage systems is permitted by the contract documents and local authority, the conductor insulation must be plenum rated.
35. All hot water heating supply and return branch run-out piping shall be 3/4 inches unless otherwise noted on drawing.
36. Shop Areas and Material Storage
- A. No plumbing or mechanical trade is permitted to use as shop working area, any concrete slab that is to receive metallic waterproofing, asphalt tile, plastic tile, etc., except by express permission of the architect.
- B. The contractor shall make provisions for the delivery and safe storage of his materials and equipment in coordination with the work of others. Materials and equipment shall be delivered at such stages of the work as will expedite the work as a whole and shall be marked and stored in such a way as to be easily checked and inspected. The arrival and placing of large equipment items shall be scheduled early enough to permit entry and setting when there is no restriction or problem due to size and weight.
37. Temporary Heat
- A. The HVAC contractor under this division shall set up temporary heat and other services as may be required and/or requested by the general contractor. See "General Conditions" and "Special Conditions." This contractor shall pay expenses resulting from temporary heat and services used solely by him.

- DEMOLITION
1. The architectural drawings are to be used only as a guideline for demolition. The contractor must visit the site prior to bidding to verify all work required for a complete job and include the cost of such work in his bid.
2. The mechanical drawings are intended to show only the general existing building construction within the area of demolition. The drawings do not show all systems, quantities, sizes, obstructions, etc., and are not intended to be used by the contractor to define the complete scope of demolition. The contractor must field verify the actual building and systems conditions to define all elements within the scope of demolition.
3. Examine areas and conditions under which demolition work must be performed. This contractor shall coordinate his work with other trades performing demolition work and/or demolition work performed by the owner. In every instance of demolition and/or remodeling, the contractor shall figure a complete job as none other shall be accepted.
4. The extent of work shown or not shown shall include removal and legally dispose off site, all the items and systems being removed.
5. Where temperature controls are indicated for demolition, retain the services of a temperature control contractor to perform such demolition.
6. This contractor shall retain on the premises in neatly stacked piles where instructed for selection by the owner, all material, wire, fixtures and/or equipment which are specified to be removed or replaced. All such items, not selected for salvage by the owner, shall become the property of this contractor and shall be removed from the premises and legally disposed.
7. Conform to all applicable codes for demolition of items and systems, safety of adjacent systems, dust control, legal run-off control, disposal and all items necessary to complete the work completely.
8. Demolition shall be done in a manner so as not to damage adjacent work and not affect the operation of systems to remain in use. Any item to remain that is damaged by the contractor shall be replaced and/or repaired at the contractor's expense.
9. Demolition and cutting shall be done in a manner which does not deform or apply loads to the existing framing and equipment of the building to remain.
10. All walls, ceilings, floors, etc., being disturbed by the work shall be returned to finished conditions to match existing by the contractor and contractor shall do his own cutting and patching as necessary under his contract.
11. The contractor shall maintain existing services to and in the existing areas as required.
12. The existing systems to remain are to be supported as required until the modified elements are installed and supported.
13. If necessary, the contractor shall provide temporary services in the existing areas.
14. Existing slabs shall be saw-cut in a manner that does not cause the steel framing or the rebar supporting the slab to be cut. Contractor shall field verify slab thickness and rebar spacing.
15. Existing slabs shall be core drilled at reentrant corners of new floor openings to prevent over cutting.
16. The demolished systems shall be reduced to pieces of a weight, and transported across the remaining structure in a manner, such that the remaining structure is not overstressed.
17. The electrical contractor shall disconnect and remove electric service to all mechanical equipment being removed as a result of the renovation.
18. Equipment and devices shall be removed complete including hangers, supports, conduits, control, wire, pipes, ductwork, etc. Wiring shall be disconnected at circuit breakers, removed and breakers marked "spare."
19. All open ended piping and ductwork that is to remain shall be capped and properly secured.
20. Any existing pipes, ductwork, conduit, low voltage control, wiring and/or electrical and mechanical devices being disturbed by the work shall be reworked by this contractor as required to return to its former existing operating condition.
21. Any pipes or ductwork, or control wiring, or tubing feeding through devices or equipment being relocated, reworked, or abandoned and serving other devices, and/or equipment shall be maintained in working condition.
22. Mechanical contractor shall remove and reclaim any refrigerant in existing systems prior to demolition of any equipment according to federal requirements.
23. All asbestos removal will be handled by the owner and is not a part of this work.
24. Use of explosives shall not be permitted.
25. Existing architectural, mechanical and electrical equipment and systems shall be protected from damage resulting from demolition.
26. Contractor shall submit a proposed deconstruction sequence to the owner and architect for review prior to commencement of work.

- EXCAVATING/BACKFILLING
1. The contractor shall familiarize himself with the survey and the geotechnical investigation report before starting construction. All underground work shall be in accordance with the recommendations of the geotechnical report except where noted otherwise on drawings or specifications.
2. All building pad preparation and patching shall follow the recommendations of the geotechnical report and the structural drawings and architectural drawings (uno).
3. All objectionable materials encountered are to be removed from excavated areas of the site per the geotechnical report.
4. If unstable subgrade sections cannot be stabilized by excavation and re-compaction, then crushed stone or similar coarse aggregate materials shall be rolled into the subgrade until a firm subgrade reaction is achieved.
5. The geotechnical engineer shall determine on site or off site imported material that can be used for engineered fill. All fill material shall be approved by the geotechnical engineer.
6. The proposed engineered fill materials are to be placed in lifts not exceeding eight (8) inches in loose measured thickness. Each lift is to be compacted as follows:
- A. Slab on grade: Minimum of 95 percent maximum density by ASTM D698.
7. All fill materials shall be free of organic contaminations and other deleterious matter.
8. For back fill against basement walls, retaining walls, footings, etc., place in 8 inch thick layers, with each lift compacted at near optimum moisture content, until a minimum in place density of 95 percent of the maximum density as determined by ASTM D698 is achieved.
9. All soil surrounding and under footing shall be protected from frost action and freezing during the course of construction.
10. Notify structural engineer of any unusual soil conditions that are in variance with the geotechnical report.
- CONCRETE PADS
1. This contractor shall provide to the general contractor, dimensions for the concrete foundations or bases under all equipment that rests on floors in mechanical equipment rooms or outside on grade. He shall follow drawings and/or manufacturer's literature with regard to design and construction of same. In the absence of more specific information, either on drawings or manufacturer's literature, the bases shall be level, shall have a minimum height above finished floor of 4 inches and extend 3 inches beyond the slabs, feet or bed plate of the item of equipment.
2. Concrete pedestals and/or saddles for support of piping and/or tanks shall be designed to withstand stresses to which they may be subjected and to distribute properly the load and impact over building areas.
3. Concrete shall be of a mix producing compressive strength after 28 days of 3,000 psi minimum reinforcing and bolts shall be provided as required and work shall be done in accordance with applicable articles covering concrete work.
4. Space approximately 1 inch thick between bottom of equipment and top of concrete foundation or base which remains after shimming, shall be filled completely with grouting. Grout shall be made up with sand and cement designed for the purpose which does not shrink or setting up. Exposed surface of grouting shall be finished to make a neat appearance.

A	AMPS	DF	DRINKING FOUNTAIN	GC	GENERAL CONTRACTOR	ASSOCIATION		SYM	SYMMETRICAL
ACU	AIR CONDITIONING UNIT	DIA (Ø)	DIAMETER	GE	GENERAL EXHAUST	NIC	NOT IN CONTRACT	TA	TRANSFER AIR
AD	AREA DRAIN	DN	DOWN	GND	GROUND	NTS	NOT TO SCALE	TC	TEMPERATURE CONTROL
ADOL	ADDITIONAL	DS	DOWN SPOUT	GRE	GRAVITY ROOF EXHAUSTER	OA	OUTSIDE AIR INTAKE	TCC	TEMPERATURE CONTROL CONTRACTOR
AF	AIRFOIL BLADE FAN	DSW	DISCONNECT SWITCH	GUH	GAS UNIT HEATER	OD	OUTSIDE AIR INTAKE	TD	TRENCH DRAIN
AFC	ABOVE FINISH COUNTER	DT	DRAIN TILE	GW	GAS WATER HEATER	OC	ON CENTER	TP	TRANSFER GRILLE
AFF	ABOVE FINISH FLOOR	DWI	DOUBLE WIDTH DOUBLE INLET FAN	HW	HUMIDIFIER	OD	OVERFLOW DRAIN	TPV	TRAP PRIMER VALVE
AFG	ABOVE FINISH GRADE	DWG	DRAWING	HB	HOSE BIBB	P	PUMP	TS	TAMPER SWITCH
AHU	AIR HANDLING UNIT	DWH	DOMESTIC WATER HEATER	HC	HEATING COIL	PC	PLUMBING CONTRACTOR	TPV OR T	TYPICAL
AP	ACCESS PANEL	EA	EXHAUST AIR	HE	HOOD EXHAUST	PH (Ø)	PHASE	UH	UNIT HEATER
ARCH	ARCHITECTURAL	EBB	ELECTRIC BASEBOARD	HOA	HAND-OFF-AUTOMATIC	PNL	PANEL	UL	UNDERWRITER'S LABORATORY
B	BOLTER	EC	ELECTRICAL CONTRACTOR	HORIZ	HORIZONTAL	PRE	POWER ROOF EXHAUSTER	UNO	UNLESS NOTED OTHERWISE
BOLD	BUILDING	EF	EXHAUST FAN	HP	HORSEPOWER	PRV	PRESSURE REDUCING VALVE	UR	URNAL
BOT	BOTTOM	EG	EXHAUST GRILLE	HVAC	HEATING, VENTILATION, AIR CONDITIONING	PSI	POUNDS/SQUARE FOOT	UV	UNIT VENTILATOR
BT	BATHTUB	EH	ELECTRIC HEATER	HS	HEAT EXCHANGER	PVC	POLYVINYL CHLORIDE	V	VOLTS
C	CONDENSER	EJ	EXPANSION JOINT	IE	INVERT ELEVATION	RA	RETURN AIR	VD	VOLUME DAMPER
CB	CATCH BASIN	EL	ELEVATION	JB	JUNCTION BOX	RAD	RADIUS	VERT	VERTICAL
CC	COOLING COIL	ELEC	ELECTRICAL	KEC	KITCHEN EQUIPMENT	RD	ROOF DRAIN	VT	VERTIFIED TILE
CD	CEILING DIFFUSER	ELEV	ELEVATOR	KITCHEN	KITCHEN EQUIPMENT	RE	RETURN EXHAUST	VTR	VENT THRU ROOF
CFH	CUBIC FEET PER HOUR	EM	EMERGENCY	KHE	KITCHEN HOOD EXHAUST	REF	RETURN EXHAUST FAN	W	WATTS
CFM	CUBIC FEET PER MINUTE	EQ	EQUIPMENT	KVA	KILOVOLT AMPERE	REQD	REQUIRED	WI	WITH
CH	CHILLER	ETR	EXISTING TO REMAIN	KW	KILOWATT	RF	RETURN FAN	WC	WATER CLOSET
CJ	CAST IRON	EJH	ELECTRIC UNIT HEATER	L	LOUVER	RG	RETURN GRILLE	WCO	WALL CLEANOUT
CL	CONTROL	EJC	ELECTRIC WATER COOLER	LAV / L	LAVATORY	RHC	RETURN COIL	WH	WALL-HYDRANT
CL (C)	CENTERLINE	EW	ELECTRIC WATER HEATER	LT	LAUNDRY TUB	RSP	REDUCED PRESSURE BACKFLOW PREVENTER	YH	YARD HYDRANT
CLG	CEILING	EXP	EXPANSION	LTG	LIGHTING	RPZ	REDUCED PRESSURE ZONE	YH	YARD HYDRANT
CO	CLEANOUT	F	FURNACE	MAU	MAKE-UP AIR UNIT	ASSEMBLY		YFMR	TRANSFORMER
COL	COLUMN	FA	FIRE ALARM	MB	MOP BASIN	RTU	ROOF TOP UNIT		
CONST	CONSTRUCTION	FBD	FACE & BYPASS DAMPER	MBH	1,000 BTUH	SA	SUPPLY AIR		
CONT	CONTINUOUS	FC	FORWARD CURVE BLADE FAN	MC	MECHANICAL CONTRACTOR	SECT	SECTION		
CONTR	CONTRACTOR	FOO	FLOOR CLEAN-OUT	MECH	MECHANICAL	SG	SUPPLY GRILLE		
CONV	CONVECTOR	FCU	FAN COIL UNIT	MFR	MANUFACTURER	SH	SHOWER		
CS	CULIC SINK	FD	FLOOR DRAIN / FIRE DAMPER	MH	MANHOLE	SK	SINK		
CT	COOLING TOWER	FPE	FINISH FLOOR ELEVATION	MM	MINIMUM	SOV	SHUT-OFF VALVE BOX		
CTX	CONNECT TO EXISTING	FPB	FAN POWER BOX	MTD	MOUNTED	SQ	SQUARE		
CU	CONDENSING UNIT	FPC	FIRE PROTECTION CONTRACTOR	MWB	MIXING BOX	SS	SERVICE SINK		
CUH	CABINET UNIT HEATER	FS	FLOW SWITCH	N	NEW	STL	STEEL		
D	DAMPER	FT	FIN TUBE RADIATION / FEET	NEC	NATIONAL ELECTRIC CODE	STRUCT	STRUCTURAL		
DCBP	DOUBLE CHECK BACKFLOW PREVENTER	G	GRILLE (EXHAUST, RETURN, OR TRANSFER)	NF	NON FUSED	SW	SAFE WASTE		
DCDA	DOUBLE CHECK DETECTOR ASSEMBLY	GA	GAUGE	NFPA	NATIONAL FIRE PROTECTION	SWI	SINGLE WIDTH SINGLE INLET FAN		
DE	DESHWASHER EXHAUST	GALV	GALVANIZED						
DET	DETAIL								

ABBREVIATIONS



GC	GENERAL CONTRACTOR	ASSOCIATION		SYM	SYMMETRICAL
GE	GENERAL EXHAUST	NIC	NOT IN CONTRACT	TA	TRANSFER AIR
GND	GROUND	NTS	NOT TO SCALE	TC	TEMPERATURE CONTROL
GRE	GRAVITY ROOF EXHAUSTER	OA	OUTSIDE AIR INTAKE	TCC	TEMPERATURE CONTROL CONTRACTOR
GUH	GAS UNIT HEATER	OD	OUTSIDE AIR INTAKE	TD	TRENCH DRAIN
GW	GAS WATER HEATER	OC	ON CENTER	TP	TRANSFER GRILLE
HW	HUMIDIFIER	OD	OVERFLOW DRAIN	TPV	TRAP PRIMER VALVE
HB	HOSE BIBB	P	PUMP	TS	TAMPER SWITCH
HC	HEATING COIL	PC	PLUMBING CONTRACTOR	TPV OR T	TYPICAL
HE	HOOD EXHAUST	PH (Ø)	PHASE	UH	UNIT HEATER
HOA	HAND-OFF-AUTOMATIC	PNL	PANEL	UL	UNDERWRITER'S LABORATORY
HORIZ	HORIZONTAL	PRE	POWER ROOF EXHAUSTER	UNO	UNLESS NOTED OTHERWISE
HP	HORSEPOWER	PRV	PRESSURE REDUCING VALVE	UR	URNAL
HVAC	HEATING, VENTILATION, AIR CONDITIONING	PSI	POUNDS/SQUARE FOOT	UV	UNIT VENTILATOR
HX	HEAT EXCHANGER	PVC	POLYVINYL CHLORIDE	V	VOLTS
IE	INVERT ELEVATION	RA	RETURN AIR	VD	VOLUME DAMPER
JB	JUNCTION BOX	RAD	RADIUS	VERT	VERTICAL
KEC	KITCHEN EQUIPMENT	RD	ROOF DRAIN	VT	VERTIFIED TILE
KITCHEN	KITCHEN EQUIPMENT	RE	RETURN EXHAUST	VTR	VENT THRU ROOF
KHE	KITCHEN HOOD EXHAUST	REF	RETURN EXHAUST FAN	W	WATTS
KVA	KILOVOLT AMPERE	REQD	REQUIRED	WI	WITH
KW	KILOWATT	RF	RETURN FAN	WC	WATER CLOSET
L	LOUVER	RG	RETURN GRILLE	WCO	WALL CLEANOUT
LAV / L	LAVATORY	RHC	RETURN COIL	WH	WALL-HYDRANT
LT	LAUNDRY TUB	RSP	REDUCED PRESSURE BACKFLOW PREVENTER	YH	YARD HYDRANT
LTG	LIGHTING	RPZ	REDUCED PRESSURE ZONE	YH	YARD HYDRANT
MAU	MAKE-UP AIR UNIT	ASSEMBLY		YFMR	TRANSFORMER
MAX	MAXIMUM	RTU	ROOF TOP UNIT		
MB	MOP BASIN	SA	SUPPLY AIR		
MBH	1,000 BTUH	SECT	SECTION		
MC	MECHANICAL CONTRACTOR	SG	SUPPLY GRILLE		
MECH	MECHANICAL	SH	SHOWER		
MFR	MANUFACTURER	SK	SINK		
MH	MANHOLE	SOV	SHUT-OFF VALVE BOX		
MM	MINIMUM	SQ	SQUARE		
MTD	MOUNTED	SS	SERVICE SINK		
MWB	MIXING BOX	N	NEW		
N	NEW	STL	STEEL		
NEC	NATIONAL ELECTRIC CODE	STRUCT	STRUCTURAL		
NF	NON FUSED	SW	SAFE WASTE		
NFPA	NATIONAL FIRE PROTECTION	SWI	SINGLE WIDTH SINGLE INLET FAN		

MECHANICAL LEGEND


CD	CONDENSATE DRAIN PIPING		
CW	DOMESTIC COLD WATER PIPING		
HW	DOMESTIC HOT WATER PIPING		
RHW	DOMESTIC RECIRCULATING HOT WATER PIPING		
HW (120°)	DOMESTIC HOT WATER PIPING - 120° F		
RHW (120°)	DOMESTIC RECIRCULATING HOT WATER PIPING - 120° F		
HW (140°)	DOMESTIC HOT WATER PIPING - 140° F		
RHW (140°)	DOMESTIC RECIRCULATING HOT WATER PIPING - 140° F		
G	GAS PIPING		
GW	GREASE WASTE		
GV	GREASE WASTE VENT		
RL	REFRIGERANT LIQUID		
RS	REFRIGERANT SUCTION		
FCW	FILTERED COLD WATER PIPING		
SROCW	SOFT REVERSE OSMOSIS WATER PIPING		
RO	REVERSE OSMOSIS WATER PIPING		
SAN	SANITARY SEWER PIPING		
SCW	SOFT COLD WATER PIPING		
SHW	SOFT HOT WATER PIPING		
SHW (120°)	SOFT HOT WATER PIPING		
SHW (140°)	SOFT HOT WATER PIPING		
V	VENT PIPING		
	PIPING ABOVE GRADE/FLOOR		
	PIPING BELOW GRADE/FLOOR		
	EXISTING PIPING TO BE REMOVED		
	EXISTING PIPING TO REMAIN		
	2-WAY MODULATING VALVE		
	3-WAY MODULATING VALVE		
	AUTOMATIC CONTROL VALVE		
	BALANCE VALVE		
	CHECK VALVE		
	MODULATING VALVE		
	PRESSURE REGULATING / REDUCING VALVE		
	RELIEF VALVE		
	SHUTOFF VALVE		
	PRESSURE GAUGE W/COCK		
	STRAINER		
	THERMOMETER		
	PIPE UNION		
	UTILITY METER		
	DIRECTION OF DOWNWARD PITCH		
	DIRECTION OF FLOW		
	DUCT TEMPERATURE SENSOR		
	NEW DUCTWORK		
	EXISTING DUCTWORK TO REMAIN		
	MOTORIZED FIRE/SMOKE DAMPER		
	FIRE DAMPER		
	SMOKE DAMPER		
	MOTOR OPERATED DAMPER		
	BACKDRAFT DAMPER		

ROOMS OR AREAS SHOWN SHADED ON THIS PLAN, WITH THE FOLLOWING SHADING TYPE ARE DEDICATED FOR A SPECIFIC USE. EXAMPLES INCLUDE ELECTRICAL ROOMS, TECHNOLOGY/DATA CLOSETS, EXIT STAIRWELLS, AND ELEVATOR EQUIPMENT ROOMS. UNDER NO CIRCUMSTANCES SHALL PIPING, DUCTWORK, OR EQUIPMENT BE INSTALLED IN OR ROUTED THROUGH THESE ROOMS OR AREAS EXCEPT FOR BRANCH PIPING OR DUCTWORK SPECIFICALLY SERVING THE ROOM OR AREA. DEDICATED SPACE SHALL EXTEND VERTICALLY FROM FLOOR TO STRUCTURAL CEILING.

DUCT-TYPE SMOKE DETECTOR WITH REMOTE TEST STATION AND AUXILIARY RELAY. FURNISHED AND WIRED BY ELECTRICAL CONTRACTOR. INST

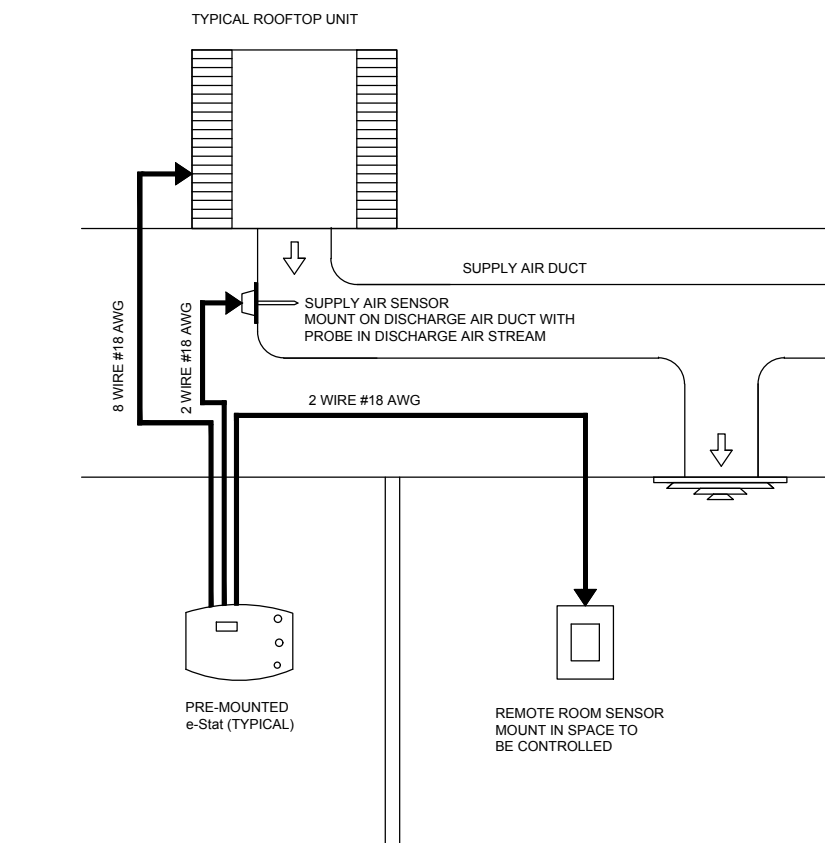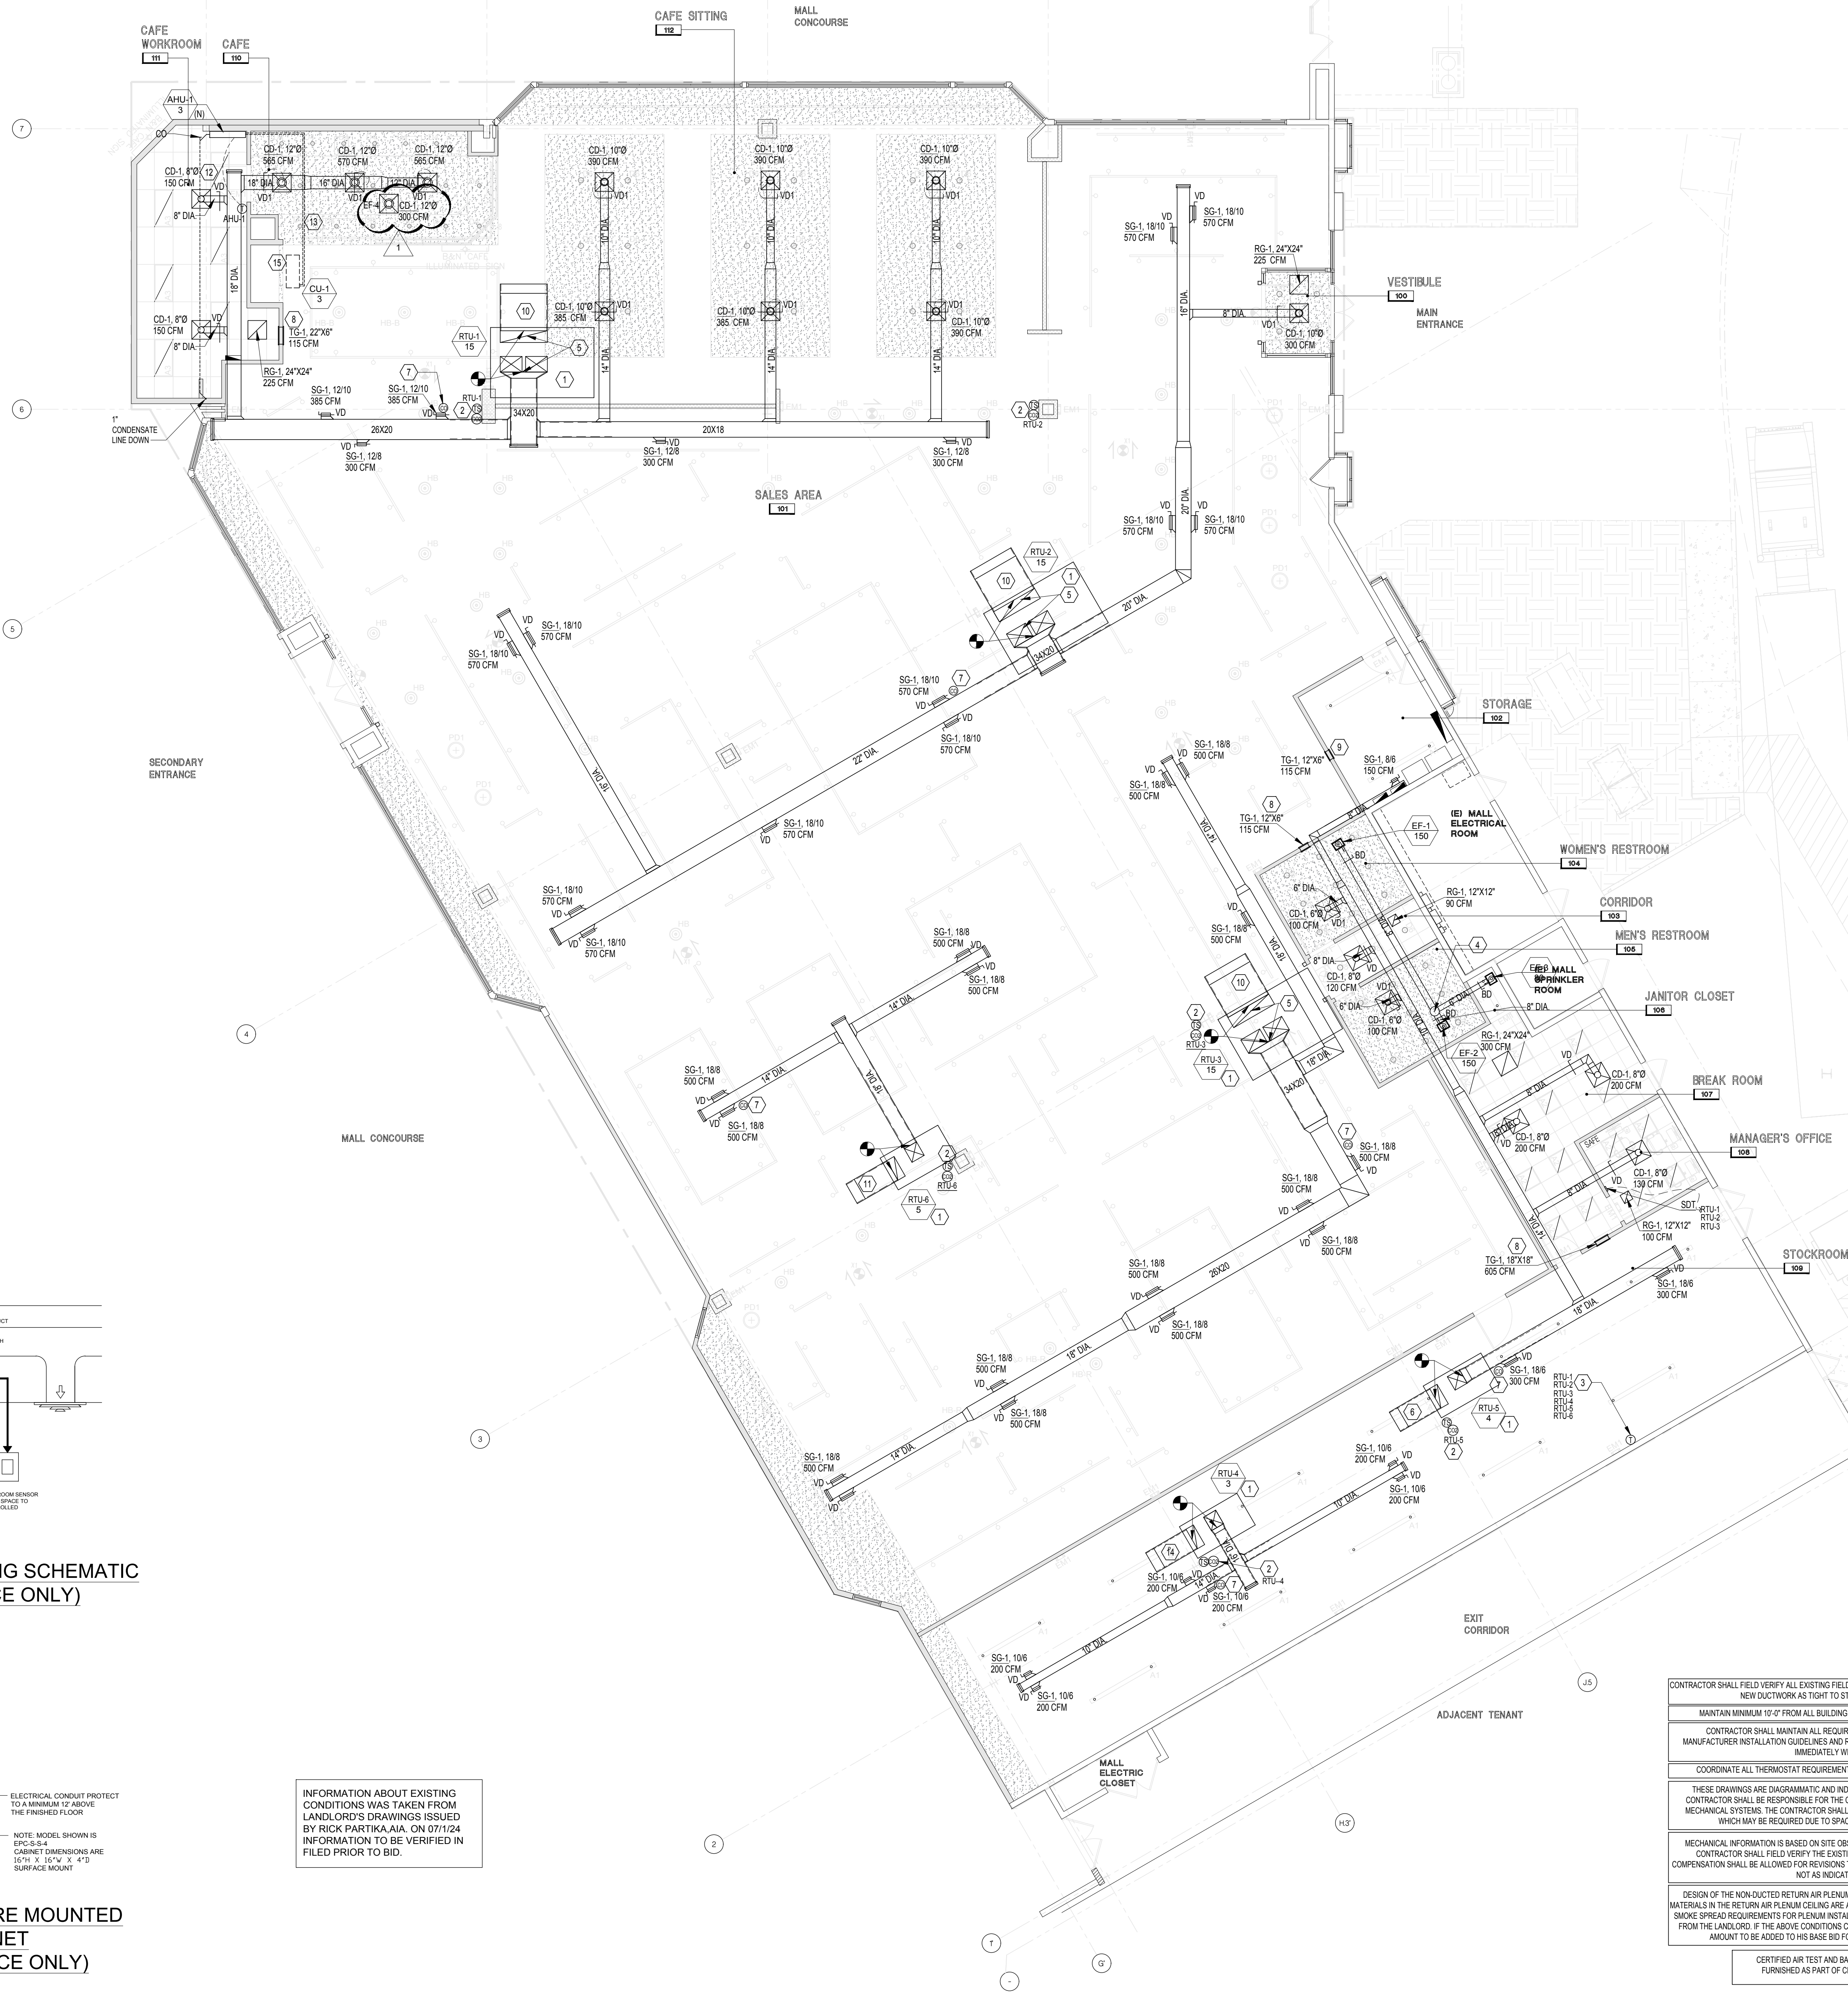

TYPICAL E-STAT WIRING SCHEMATIC
(FOR REFERENCE ONLY)

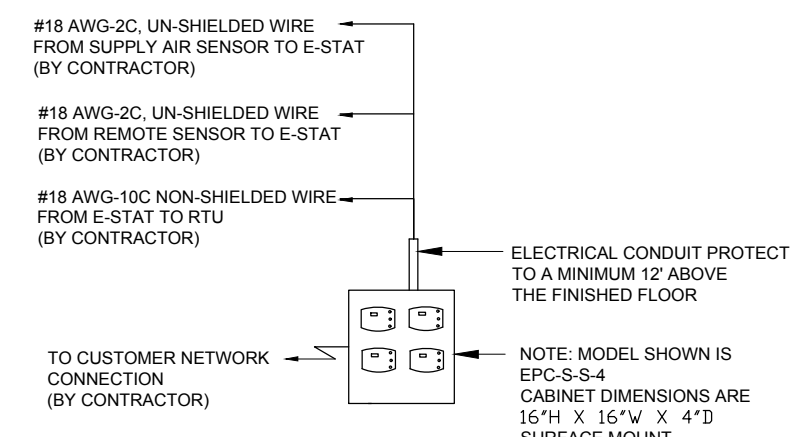

TYPICAL E-STAT PRE MOUNTED
ON CABINET
(FOR REFERENCE ONLY)

INFORMATION ABOUT EXISTING
CONDITIONS WAS TAKEN FROM
LANDLORD'S DRAWINGS ISSUED
BY RICK PARTIKIA AIA, ON 07/1/24
INFORMATION TO BE VERIFIED IN
FILED PRIOR TO BID.

CONTRACTOR SHALL FIELD VERIFY ALL EXISTING FIELD CONDITIONS PRIOR TO BEGINNING WORK. HOLD ALL
NEW DUCTWORK AS TIGHT TO STRUCTURE ABOVE AS POSSIBLE.

MAINTAIN MINIMUM 10'-0" FROM ALL BUILDING INTAKES AND EXHAUST.

CONTRACTOR SHALL MAINTAIN ALL REQUIRED SERVICE CLEARANCES ON EQUIPMENT PER
MANUFACTURER INSTALLATION GUIDELINES AND RECOMMENDATIONS. CONTACT ENGINEER OF RECORD
IMMEDIATELY WITH ANY CONFLICTS.

COORDINATE ALL THERMOSTAT REQUIREMENTS WITH LIGHTSTAT.

THESE DRAWINGS ARE DIAGRAMMATIC AND INDICATE THE GENERAL EXTENT OF THE WORK. THE
CONTRACTOR SHALL BE RESPONSIBLE FOR THE COORDINATION AND PROPER INSTALLATION OF ALL
MECHANICAL SYSTEMS. THE CONTRACTOR SHALL PROVIDE ALL NECESSARY OFFSETS AND FITTINGS
WHICH MAY BE REQUIRED DUE TO SPACE CONSTRAINTS OR OTHER CONDITIONS.

MECHANICAL INFORMATION IS BASED ON SITE OBSERVATION AND EXISTING DRAWINGS. THE GENERAL
CONTRACTOR SHALL FIELD VERIFY THE EXISTING CONDITIONS FOR ACCURACY. NO ADDITIONAL
COMPENSATION SHALL BE ALLOWED FOR REVISIONS TO THE DESIGN TO CORRECT FOR EXISTING CONDITIONS
NOT AS INDICATED ON THE PLANS.

DESIGN OF THE NON-DUCTED RETURN AIR PLENUM CEILING IS BASED ON THE REQUIREMENT THAT ALL
MATERIALS IN THE RETURN AIR PLENUM CEILING ARE ALL LABELED AS PLENUM RATED AND MEET THE FLAME &
SMOKE SPREAD REQUIREMENTS FOR PLENUM INSTALLATION AND THE APPROVAL OF A RETURN AIR PLENUM
FROM THE LANDLORD. IF THE ABOVE CONDITIONS CANNOT BE MET, THIS CONTRACTOR SHALL STATE THE
AMOUNT TO BE ADDED TO HIS BASE BID FOR A TOTALLY DUCTED RETURN AIR SYSTEM.

CERTIFIED AIR TEST AND BALANCE REPORT TO BE
FURNISHED AS PART OF CLOSE OUT PACKAGE.

WORK RESPONSIBILITY

TENANTS MECHANICAL CONTRACTOR SHALL ACCOMPLISH THE FOLLOWING:

1. REFURBISH THE EXISTING ROOFTOP UNITS TO LIKE NEW CONDITION. REPLACE FILTERS, BELTS, MOTORS
AND ALL OTHER SERVICEABLE PARTS AS REQUIRED. POWER WASH COILS THOROUGHLY TO REMOVE ALL
FOREIGN MATTER. UNITS MUST PERFORM TO NAMEPLATE SPECIFICATIONS. REPLACE IF REQUIRED.
2. CONTRACTOR TO CONFIRM THAT THE EXISTING SYSTEM MEETS OR EXCEEDS THE REQUIREMENTS AS
SHOWN ON THE HVAC CALCULATIONS. CONTRACTOR TO CONFIRM THAT ALL ITEMS INDICATED ARE PRESENT
AND IN GOOD WORKING ORDER. ITEMS MISSING OR NOT FUNCTIONING MUST BE REPLACED AT THIS
CONTRACTOR'S EXPENSE.

TENANTS MECHANICAL CONTRACTOR SHALL FURNISH AND INSTALL THE FOLLOWING:

1. THIS CONTRACTOR SHALL FURNISH AND INSTALL THREE (3) EXHAUST FANS, ONE (1) SPLIT SYSTEM UNIT (3
TON), DUCTWORK, DIFFUSERS, REGISTERS, HANGERS, PROGRAMMABLE THERMOSTATS, SMOKE DETECTOR
TEST STATION AND ALL ITEMS REQUIRED TO PRODUCE A COMPLETE AND OPERABLE HVAC SYSTEM.
2. DUCTWORK: THE MECHANICAL CONTRACTOR IS TO FURNISH AND INSTALL, IN COMPLIANCE WITH THE
MOST RECENT SMACNA STANDARDS FOR LOW AND MEDIUM PRESSURE, NEW DUCTWORK, INSULATION, FLEX
DUCT, GRILLES, REGISTERS, DIFFUSERS, VOLUME DAMPERS, FIRE DAMPERS, SMOKE DETECTORS,
SECONDARY CONDENSATE DRAIN, ETC. NECESSARY TO RENDER THE SYSTEM OPERATIONAL AS DESCRIBED
IN THESE PLANS AND SPECIFICATIONS AND AS REQUIRED BY THE LANDLORD, LOCAL AND STATE CODES.
3. ALL DUCTWORK SHALL BE HUNG AS HIGH AS POSSIBLE TO MAINTAIN ARCHITECTURAL CEILING HEIGHT
REQUIREMENTS.
4. ALL OUTSIDE AIR AND UNEXPOSED DUCTWORK WITHIN BUILDING, EXCEPT WHERE ACOUSTICALLY LINED,
SHALL HAVE 3 INCH IN CLIMATE ZONES 1-4 AND 4" IN CLIMATE ZONES 5-8, FIBERGLASS DUCT WRAP
INSULATION WITH FOM FACING EQUIVALENT TO JOHNS MANVILLE "MIGROULITE EQ TYPE 72" (INSTALLED "R
VALUE" = 8.3 FOR 3" AND 12 FOR 4").
5. FIRE DAMPERS MUST BE INSTALLED AT ALL LOCATIONS WHERE DUCTWORK PENETRATES A FIRE RATED
WALL. PROVIDE ACCESS DOORS AS REQUIRED. FIRE DAMPERS TO BE OF THE TYPE APPROVED BY THE
AGENCIES HAVING JURISDICTION.
6. WHEN NEW DUCTWORK CONFLICTS WITH EXISTING DUCTWORK, PIPING, ETC., NEW DUCTWORK SHALL BE
SET UP OR DOWN AS REQUIRED.
7. PROVIDE VOLUME DAMPERS ON ALL NEW SUPPLY AIR DUCT SPLITS AND TAPS.
8. POWER WIRING:
A. THE ELECTRICAL CONTRACTOR IS TO FURNISH AND INSTALL ALL EQUIPMENT AND MATERIAL REQUIRED TO
PROVIDE POWER TO THE ROOFTOP UNITS FROM THE TENANTS POWER SUPPLY.
B. THE ELECTRICAL CONTRACTOR IS TO FURNISH AND INSTALL A DISCONNECT SWITCH ON THE ROOFTOP
UNITS AND SPLIT SYSTEM UNIT.
C. THE ELECTRICAL CONTRACTOR IS TO PROVIDE POWER WIRING TO THE EXHAUST FANS.
9. CONTROL WIRING AND CONTROLS: THE MECHANICAL CONTRACTOR IS TO FURNISH AND INSTALL ALL
NECESSARY WIRING (IN CONDUIT IF REQUIRED) AND CONTROLS REQUIRED TO PROVIDE A COMPLETE AND
OPERATING SYSTEM.
10. WHEN THE SMOKE DETECTOR, IN SUPPLY & RETURN DUCTWORK, ACTIVATES IT SHALL SHUT DOWN THE
ROOFTOP UNIT.
11. REFER TO ARCHITECTURAL DRAWINGS FOR EXACT LOCATION OF ALL CEILING DIFFUSERS AND
REGISTERS.
12. THE MECHANICAL CONTRACTOR IS TO FURNISH AND INSTALL A CONDENSATE DRAIN SYSTEM PER THE
MANUFACTURER'S RECOMMENDATIONS AND THE LANDLORD'S REQUIREMENTS. INTERIOR CONDENSATE
DRAIN LINE SHALL BE INSULATED WITH 1/2" THICK ARMAFLEX, R-14" PER FOOT.
13. TENANT'S MECHANICAL CONTRACTOR IS RESPONSIBLE FOR COMPLYING WITH ALL THE LANDLORD'S
SPECIFICATIONS FOR THIS INSTALLATION.
14. THIS CONTRACTOR IS TO HIRE LANDLORD'S SPECIFIED CONTRACTOR FOR ALL ROOF PENETRATIONS.
15. THE MECHANICAL CONTRACTOR, AS PART OF THEIR WORK, IS TO STENCIL THE TENANT NAME AND SPACE
NUMBER ON ALL ROOFTOP EQUIPMENT WITH 1" HIGH BLOCK LETTERS. 1" HIGH BLOCK LETTERS ON ALL
SMALL EQUIPMENT WHERE 4" WILL NOT FIT IN A COLOR APPROVED BY THE BUILDING MANAGER /
CONSTRUCTION INDIVIDUAL.
16. IF STRUCTURAL DRAWINGS FOR HVAC EQUIPMENT SUPPORTS ARE NOT ALREADY INCORPORATED INTO
THIS SET OF PLANS AND SPECIFICATIONS, THE MECHANICAL CONTRACTOR, AT THEIR OWN COST AND
EXPENSE, AND AS PART OF THE BID TO THE G.C., IS TO HIRE A STRUCTURAL ENGINEER TO DESIGN THE
SUPPORTS FOR THE NEW HVAC UNITS AND A STRUCTURAL SUBCONTRACTOR TO FURNISH AND INSTALL
SUCH HANGERS, SUPPORTS, COLUMNS, BEAMS, BRACKETS, ETC. TO HANG FROM THE STRUCTURAL AND / OR
SUPPORT AT THE ROOF TOP FOR ALL NEW HVAC EQUIPMENT. G.C. TO SUBMIT AS REQUIRED ALL
STRUCTURAL SHOP DRAWINGS TO THE LANDLORD'S ARCHITECT, AS REQUIRED, FOR APPROVAL, PRIOR TO
STARTING WORK.

GENERAL NOTES:

- A. THESE DRAWINGS ARE DIAGRAMMATIC AND INDICATE THE
GENERAL EXTENT OF THE WORK. THE CONTRACTOR SHALL BE
RESPONSIBLE FOR THE COORDINATION AND PROPER
INSTALLATION OF ALL MECHANICAL SYSTEMS. THE
CONTRACTOR SHALL PROVIDE ALL NECESSARY OFFSETS AND
FITTINGS WHICH MAY BE REQUIRED DUE TO SPACE
CONSTRAINTS OR OTHER CONDITIONS.
- B. THE CONTRACTOR SHALL PROVIDE ALL MISCELLANEOUS
SUPPORTING STEEL, ETC. FOR THE PROPER INSTALLATION OF
ALL MECHANICAL SYSTEMS.
- C. THE CONTRACTOR SHALL COORDINATE FLOOR, WALL AND
ROOF PENETRATIONS, LOUVER SIZES, ETC. WITH GENERAL
TRADES.
- D. THE CONTRACTOR SHALL VERIFY ALL CLEARANCES PRIOR TO
FABRICATION OF ANY WORK.
- E. THE CONTRACTOR SHALL COORDINATE THE LOCATION OF
CEILING GRILLES, REGISTERS AND DIFFUSERS WITH THE
ARCHITECTURAL REFLECTED CEILING PLANS.
- F. DUCTWORK AND PIPING SHALL NOT BE LOCATED OVER THE
TOP OF ANY ELECTRICAL PANELS OR EQUIPMENT.
- G. THE CONTRACTOR SHALL COORDINATE AND PROVIDE ACCESS
DOORS IN HARD CEILINGS FOR ALL EQUIPMENT WHICH
REQUIRES ACCESS, SUCH AS FIRE AND SMOKE DAMPERS,
SMOKE DETECTORS, BALANCING DAMPERS, VAV BOXES, ETC.
- H. CONTRACTOR SHALL FIELD VERIFY SLAB ON GRADE FLOOR
CONSTRUCTION TYPE PRIOR TO CUTTING. UNDER NO
CIRCUMSTANCES SHALL THE CONTRACTOR CUT A
STRUCTURAL FLOOR SLAB THICKER THAN FOUR (4) INCHES
WITHOUT PRIOR WRITTEN APPROVAL FROM ENGINEER OF
RECORD. NOTIFY ENGINEER OF RECORD OF ANY SLAB
THICKNESS GREATER THAN FOUR (4) INCHES PRIOR TO
PROCEEDING WITH ANY SAW CUTTING.

CODED NOTES:

1. EXISTING ROOFTOP UNITS.
2. PROVIDE NEW REMOTE TEMPERATURE SENSOR AT 96" A.F.F. SENSOR FURNISHED BY LIGHTSTAT.
COORDINATE FINAL LOCATION WITH OWNER.
3. PROVIDE NEW THERMOSTAT ON LIGHTSTAT PANEL. THERMOSTAT FURNISHED BY LIGHTSTAT. COORDINATE
FINAL LOCATION WITH OWNER.
4. 12" DIA. EXHAUST DUCT UP THROUGH ROOF. PROVIDE WITH ROOF CURB AND CAP. VERIFY ROUTING AND
ROOF PENETRATION LOCATION IN FIELD PRIOR TO BID. COORDINATE ROOF WORK WITH LANDLORD'S
ROOFING CONTRACTOR.
5. PROVIDE SMOKE DETECTOR LOCATED IN SUPPLY AND RETURN AIR DUCT TO SHUT DOWN UNIT UNDER ALARM.
DETECTORS SHALL BE FURNISHED AND WIRED BY ELECTRICAL CONTRACTOR, INSTALLED BY MECHANICAL.
ALL WIRING SHALL BE IN CONDUIT PER N.E.C.
6. 1,190 CFM FULL SIZE RETURN WITH WIRE MESH SCREEN.
7. CARBON MONOXIDE DETECTOR TO BE MOUNTED NEAR BY FIRST SUPPLY DIFFUSER. VERIFY EXACT MOUNTED
LOCATION IN FIELD PRIOR TO BID.
8. RETURN AIR GRILLE TO BE MOUNTED AS HIGH AS POSSIBLE ABOVE CEILING.
9. RETURN AIR GRILLE TO BE MOUNTED AS HIGH AS POSSIBLE.
10. 4,475 CFM FULL SIZE RETURN WITH WIRE MESH SCREEN.
11. 1,490 CFM FULL SIZE RETURN WITH WIRE MESH SCREEN.
12. 1" COPPER CONDENSATE DRAIN FROM AIR HANDLING UNIT TO MOP SINK. MATERIALS TO CONFORM TO NFPA80A. PIPE
TO PITCH 1/4" PER FOOT.
13. REFRIGERANT PIPING FROM CONDENSING UNIT TO AIR HANDLING UNIT. SIZE AND INSULATE PIPE PER
MANUFACTURER'S RECOMMENDATIONS. NOTIFY ARCHITECT IMMEDIATELY IF LENGTH OF RUN EXCEEDS
MANUFACTURER'S RECOMMENDATIONS.
14. 885 CFM FULL SIZE RETURN WITH WIRE MESH SCREEN.
15. CONDENSING UNIT TO BE LOCATED ON ROOF. VERIFY WITH OWNER REPRESENTATIVE EXACT LOCATION IN
FIELD.

City of Puyallup
Development & Permitting Services
ISSUED PERMIT

Building	Planning
Engineering	Public Works
Fire	Traffic

BARNES & NOBLE

PROJECT DESIGNER:

WJCA
BUILDING VALUE SINCE 1994

ARCHITECT:

JOEL TORIELLI
422 BOGERT AVE
RIDGEWOOD, NJ 07450

Kenneth A. Fuller, P.E.

151 East Main St.
Rockaway, NJ 07866
Tel: 973-584-2328
kfuller@penn.com

KENNETH A. FULLER, P.E.
VA. LICENSE NUMBER: 44593
EXPIRES: 09-22-26

SOUTH HILL MALL
3500 S. MERIDIAN ST.
UNIT #800
PUYALLUP, WA 98373

Project Number 33247
Store Number 3507

Revision Log:

Date	Description	No.
12-19-24	ISSUED FOR PERMIT. BID.	1
02-20-25	LANDLORD & CLIENT REVIEW	2
02-20-25	LANDLORD & BID COMMENTS	3
		4
		5
		6
		7
		8
		9
		10
		11
		12
		13
		14
		15

These plans are an instrument of
service and the property of the
Architect. Infringements will be
prosecuted.

General Contractor to verify all
conditions and dimensions at the
premises. Discrepancies shall be
reported to the Architect prior to the
commencement of any work.

Professional Seal:

LIC.# : 22005563
EXP. DATE : 10/02/25

Drawing Description:
HVAC PLAN

Drawing Number:

M-102

Section 200500 - General Requirements

- A. General
- Specifications are applicable to all contractors and/or subcontractors for all mechanical systems in Divisions 01, 20, 21, 22, and 23.
 - This contractor is also referred to the architectural, structural, electrical and all other drawings and specifications pertinent to this project and fully coordinate with all other trades, owner and architect requirements. All of the above mentioned drawings and specifications are considered a part of the contract documents.
 - Conform to all Instructions to Bidders, general and special conditions of contract as specified by architect and/or contract documents.
 - Refer to "Alternate Proposals" for possible changes affecting the extent of this section of work.
 - Before submitting a bid, each contractor is requested to visit the job site to familiarize themselves with construction condition, check facilities and conditions and make all necessary observations and measurements. Note conditions under which work is to be performed and take all items into consideration in bid. No consideration will be given for his failure to do so.
 - Systems are to be complete and workable in all respects, placed in operation and properly adjusted.
 - Each contractor shall provide for his own clean-up, removal and legal disposal of all rubbish daily.
 - Each contractor shall protect his work, his existing and adjacent property against weather.
 - Each contractor shall protect his work, materials, apparatus and fixtures from damage. Any work damaged by failure to provide protection required, shall be removed and replaced with new material at the contractor's expense.
 - Each contractor must confirm all utility company requirements and connection points in field, prior to starting work. Each contractor shall include cost of utility companies work in their bid.
 - Each contractor must confirm size, location and materials at point of tie in connections in the field prior to rough-in of new work.
 - Arrange for and obtain owner's and insurance representative's permission for any service shutdowns.
 - Each contractor shall be solely responsible for construction means, methods, sequences of construction and the safety of workmen.
 - No piping, ductwork, wiring, etc., shall be installed or routed above or below electrical panels and equipment, through elevator equipment rooms or elevator shafts or stairways unless these items serve these areas only.
 - All contractors shall coordinate with the electrical contractor and obtain a written approval identifying the electrical characteristics of all mechanical equipment prior to ordering of equipment. No additional payment will be made for lack of contractor coordination of electrical characteristics.
 - Each contractor shall include modifying existing conditions to complete the project. During construction the contractors may uncover an existing condition that will have to be modified. Any such work which comes under the jurisdiction of this contractor shall be done by this contractor without extra cost to the owner and project.
 - Work related to the existing building shall be coordinated to minimize interference or interruption of normal building use by the owner. Refer to architectural plans for phasing requirements.
 - Ceiling grid systems shall not be supported from ductwork, heating or plumbing lines or any other utility lines, and vice versa. Each utility and the ceiling grid system shall be a separate installation and shall be independently supported from the building structure - concrete, steel or masonry. Where interferences occur, in order to support ductwork, piping, ceiling grid systems, etc., trapeze type hangers or supports shall be employed which shall be located so as not to interfere with access to such mechanical equipment as valves, regulators, mixing boxes, fire dampers, etc.
- B. Work Coordination and Scope
- Each contractor under this division shall familiarize himself with the work to be done under other divisions of this specification and their related drawings and shall so coordinate and schedule his work as not to cause delays or interference with the work of others. Such coordination and scheduling shall accomplish the installation of mechanical and plumbing equipment with piping with a minimum of cutting through masonry and other adjustments.
 - Work included under this division shall consist of furnishing all materials, supplies, equipment, tools, transportation and facilities and performing all labor and services necessary for the complete installation of the mechanical systems of plumbing, fire protection, heating, ventilating, air conditioning, and specialty systems.
 - The contractor under this division shall report discrepancies in the work of others which affect his work. Any changes made necessary by failure or neglect to report such discrepancies shall be made by and at the expense of the contractor of this division. Obtain written instructions for changes necessary to accommodate work of others.
 - The contractor under this division shall be responsible for proper size and location of anchors, chases, recesses, opening, etc., required for the proper installation of his work.
 - The division of responsibility under separate mechanical, fire protection and plumbing contracts for tie-in points shall be as follows:
 - The plumbing contractor shall provide domestic water and gas to within five feet (5'-0") of equipment connection furnished by the mechanical or electrical contractor, final connection by mechanical or electrical contractor. On the water lines, the plumbing contractor shall provide the shut-off valve, check valve, backflow preventor and pressure regulator. On the gas lines, the plumbing contractor shall provide the shut-off valve and pressure regulator.
 - The plumbing contractor shall run the gas, water, sanitary and storm to 5'-0" outside the building or to points as noted on the drawings.
 - Fire protection, plumbing and mechanical contractor shall provide sleeves to the general contractor for placement in floors, walls and to coordinate such location. The plumbing contractor shall be responsible for flashing at vent roof terminals.
 - The fire protection, plumbing and mechanical contractor shall check with the architectural drawings concerning the test borings to determine areas of rock which should be included in his excavation work. Failure to adjust for rock conditions shall not warrant cause for additional compensation.
 - The plumbing contractor shall rough-in and connect all other fixtures and equipment where shown on the drawings but not previously mentioned. Provide with shut-off valves and p-traps with clean-out plug.
 - The plumbing contractor shall provide gas, cold water and drain for the emergency generator and install valves, etc. Generator furnished by the electrical contractor.
 - Unless responsibility to provide or furnish is otherwise stated on the electrical or mechanical drawings and electrical and mechanical specifications the contractor, under these divisions shall provide motors, special controls, disconnects, transformers, starters and relays as required for the proper operations of all equipment furnished under this division. All electrical equipment shall conform to requirements set forth under the electrical division and be suitable for operation on 60 cycle current available at the site.
 - All motors 1/3 HP and smaller shall be single phase motors, 1/2 HP and larger, shall be three phase motors except where otherwise specified. Thermal overload protection for all motors shall be provided. Combination fused disconnect and magnetic line starters with auto-off-test switch shall be provided for all three-phase motors. Thermal relays shall be sized for 115 percent of full load motor current. For motors with VFD, motors shall be inverter duty motors that meets current "MG 1 Part 31" specifications. Motors to have a minimum of 20:1 turn down ratio. Motors over 20 hp shall have shaft ground rings. The installation of all motors, starters and other electrical under this division shall be done so as to conform with the National Electric Code. Each motor shall be of squirrel cage type, open-drip proof, normal starting torque, having ball bearings unless otherwise specified. For manufacturers that use PMAC motors, this contractor shall supply VFD's to operate motors.
 - Each contractor shall provide OSHA approved handrail (Guard) system for all roof mounted equipment within 10'-0" of roof edge where the roof edge does not have a 42" high parapet or higher.
- C. Codes, Permits, Standards and Regulations
- Contractors shall install work in full accordance with rules and regulations of all applicable codes (local, city, county, state, national codes, NFPA, OSHA, etc.), government regulations, utility company requirements, and applicable standards having jurisdiction over premises. This shall include safety requirements of the state department. Do not construe this as relieving contractor from compliance with any requirements of specifications which are in excess of code requirements and not in conflict therewith.
 - Contractors shall secure and pay for all fees, permits, and certificates of inspection incidental to the work required by foregoing authorities. Arrange for all required inspections and approvals.
 - Contractor shall be responsible for payments to all public utilities for work performed by them in connection with provision of service connections required under this division of specifications.
 - Deliver all permits and certificates to architect in duplicate.
- D. Design Drawings
- The design drawings, as submitted, are diagrammatic and are not intended to show exact location of equipment, piping and ductwork unless dimensions are given. Piping and ductwork are to be installed along the general plans shown on the drawings while conforming to actual building conditions. Each contractor shall confirm all dimensions by field measurement.
 - Before entering into a contract, the successful bidder may be required to submit satisfactory evidence to show that the manufacturer of all parts of the equipment offered have been regularly engaged in the manufacture of such equipment for three (3) years and have not less than three (3) installations of a similar type which have been in successful operation under conditions similar to those specified for not less than two (2) years.
 - All equipment, piping and material specified herein after as shown on the drawings shall be furnished and installed by the contractor, unless specifically indicated to the contractor. Installation shall comply with all required "Building Codes" and "Reference Standards."
 - If this contractor proposes to use equipment requiring special conditions other than those as specified and/or shown on the design drawings, or to rearrange the equipment, he shall assume full responsibility and submit drawings for the rearrangement of the space and shall obtain the full approval of the architect prior to start of any work.
 - The exact locations for fixtures, equipment and piping which is not covered by drawings shall be obtained from the architect or his representative in the field and the work shall be laid out accordingly.
 - Drawings and specifications are intended to supplement one another. Any materials or labor called for in one but not the other shall be furnished as if both were mentioned in the specifications and shown on the drawings.
- E. Base Bid Equipment, Materials and Substitutions
- All equipment and materials shall be new, free of defects and UL labeled.
 - Base bid manufacturers are included in the specification or listed in schedules on the drawings. All other manufacturers are considered substitution.
 - The name or make of any article, device, material, form of construction, fixture, etc., stated in this specification, whether or not the words "or approved equal" are used, shall be known as a "standard".
 - All cost shall be based on "standards" specified.
 - The equipment schedules on the drawings indicate manufacturer and their equipment model numbers that this design has been based on. Each contractor is required to bid upon the basis of design and furnish the makes specified.
 - Where more than one make or name is mentioned as being acceptable, it shall be understood that only the name or make referring to the manufacturers model numbers or sizes shall be considered the "Specified Standards". It shall be further understood that other makes and names, even though mentioned, have not been checked for detail and that their size and arrangement are the contractor's responsibility the same as a proposed substitute item. The use of other manufacturer's equipment that is listed as acceptable alternates that entails general trades, structural, mechanical, electrical, etc.,

- revisions is this contractor's responsibility to provide revisions. Any additional cost of such changes shall be paid by the contractor submitting the acceptable alternates which necessitates changes in installing such substituted alternate equipment, even though such costs may be part of another division of work.
- Bids concerning the use of substitute products must be accompanied by complete specifications and performance characteristics covering these products. Contractor shall provide all available test data and experience records which may be helpful to the architect in evaluating the quality and/or suitability of alternate products.
 - Contractor is also invited to bid on any other similar products the contractor desires to propose as substitutions, stating any difference in cost (add or deduct from base bid cost) for each proposed substitution on the substitution sheet. If the architect decides to accept any of the proposed substitutions, proper notations thereof shall be made in the written contract. Where several makes are mentioned in the specifications and the contractor fails to state that he prefers a particular make in his bid, the owner shall have the right to choose any of the makes mentioned without change in price. No consideration will be given to proposals for alternative products unless submitted with the original bids.
 - Substitutions are subject to the approval of the owner. If a substitution is submitted, it is the contractor's responsibility to evaluate it and certify that the substitution is equivalent in all respects to the base specifications.
 - If substitutions are approved, notify all other contractors, subcontractors, etc., affected by the substitution and fully coordinate with them. Any costs resulting from substitution, whether by this contractor or others, shall be the responsibility of and paid for by the substituting contractor. Approved shop drawings do not absolve this contractor from this responsibility.
 - All equipment shall be installed in full accordance with the manufacturer's data and installation instructions and service clearances. It is this contractor's responsibility to check and confirm these requirements prior to starting of any work.
- F. Warranty
- Fully warrant all materials, equipment and workmanship and the successful operation of all equipment and apparatus installed by this contractor for one (1) year from date of final acceptance.
 - Extend all manufacturers' warranties to owner, including five (5) year compressor and ten (10) year heat exchanger extended warranty on HVAC equipment to include material and labor.
 - Repair or replace without material and labor charge to the owner all items found defective during the warranty periods. In the case of replacement or repair due to failure within the warranty period, the warranty on that portion of the work shall be extended for a minimum period of one (1) year from the date of such replacement or repair.
- G. Shop Drawing Submittals
- Submit shop drawings for mechanical, plumbing, fire protection, and control systems; including but not limited to sheetmetal, plumbing fixtures and equipment with adequate details and scales to clearly show construction. Indicate the operating characteristics for each required item. Clearly identify each item on the submittal as to mark, location and use, using the same identification as provided on the construction documents.
 - Sheetmetal and fire protection shop drawings shall be fully dimensioned and coordinated based on field verified building dimensions and clearances and architectural ceiling layouts. Indicate structural systems, lighting, ductwork and piping at all critical locations.
 - Contractor shall review and indicate his approval of each shop drawing prior to submittal for review. Shop drawings will not be reviewed by the engineer unless the contractor's approval is noted. Do not start work or fabrication until shop drawings have been reviewed by the engineer and returned to the contractor.
 - Submittals will be reviewed only for general compliance with the contract documents and not for dimensions or quantities. The architect and engineer will make every effort to detect and correct errors, omissions, and inaccuracies in such drawings, but the failure to detect errors, omissions, and inaccuracies shall not relieve the contractor of responsibility for the proper and complete installation in accordance with the intent of the contract documents. The submittal review shall not relieve the contractor of responsibility for purchase of any item in full compliance with the contract documents or its complete and proper installation.
 - Where submittals vary from the contract requirements, the contractor shall clearly indicate on submittal or accompanying documents the nature and reason for the variations.
 - Each manufacturer or his representative must check the application of his equipment and certify at time of shop drawing submittal that the equipment specified has been properly applied and can be installed, serviced and maintained where indicated on the drawings. Advise engineer in writing with submittal drawings of any potential problems. The manufacturer shall be responsible for any changes that might be necessary because of physical characteristics of equipment that have not been called to the engineer's attention at the time of submittal.
 - Submit a minimum of one (1) print and an electronic "pdf" of shop drawings to the architect. The architect and engineer shall review and return a pdf. The contractor shall distribute copies as required to properly conduct the work, including requirements of the operating manual.
- H. Record Drawings
- Each contractor or subcontractor shall keep one (1) complete set of the contract drawings and equipment submittals on the job site on which he shall regularly record any deviations or changes from such contract drawings made during construction. All recording shall be done in color ink.
 - These drawings shall record the installed location of all concealed equipment, piping, electric service, sewers, wastes, vents, ducts, conduits, etc., by measure dimensions to each such item from column centerlines or readily identifiable and accessible walls or corners of the building. Plans also shall show invert elevation of sewers and vent elevation of all other below-grade lines.
 - Record drawings shall be kept clean and undamaged and shall not be used for any purpose other than recording deviations from working drawings and exact locations of concealed work.
 - After the project is completed, these drawings shall be scanned to electronic "pdf" format and pdf and hard drawings shall be delivered to the architect in good condition, as a permanent record of the installation as actually constructed.
- I. Supervision
- The contractor shall have in charge of work at all times during construction a competent foreman or superintendent whose experience and background shall qualify him for the work to be performed under this division. Once assigned, the foreman or superintendent shall be retained until completion of the project and any consideration as to his removal on grounds of incompetence shall either be initiated by or referred to the architect for decision.

SECTION 200510 - BASIC MATERIALS AND METHODS

- A. GENERAL
- PROVIDE ALL MATERIALS, LABOR, EQUIPMENT, AND ACCESSORIES REQUIRED TO FURNISH AND INSTALL THE MECHANICAL ITEMS IDENTIFIED IN THIS SECTION.
 - THIS SECTION INCLUDES BASIC MECHANICAL, MATERIALS AND METHODS TO COMPLEMENT OTHER DIVISION SECTIONS IN THIS SPECIFICATION AND REQUIREMENTS INDICATED ON THE MECHANICAL DRAWINGS.
- B. INTERFERENCES
- BEFORE INSTALLING ANY WORK, CONTRACTOR SHALL SEE THAT IT DOES NOT INTERFERE WITH CLEARANCE REQUIRED FOR FINISH ON BEAMS, COLUMNS, PILASTERS, WALLS, OR OTHER STRUCTURAL OR ARCHITECTURAL MEMBERS, AS SHOWN ON ARCHITECTURAL DRAWINGS. IF ANY WORK IS SO INSTALLED AND IT LATER DEVELOPS THAT ARCHITECTURAL DESIGN CANNOT BE FOLLOWED, CONTRACTOR SHALL, AT HIS OWN EXPENSE, MAKE SUCH CHANGES IN HIS WORK AS ARCHITECT MAY DIRECT TO PERMIT COMPLETION OF ARCHITECTURAL WORK IN ACCORDANCE WITH PLANS AND SPECIFICATIONS.
 - INSTALL ADDITIONAL OFFSETS ON PIPING OR DUCTWORK WHERE REQUIRED TO OBTAIN MAXIMUM HEADROOM OR TO AVOID CONFLICT WITH OTHER WORK WITHOUT ADDITIONAL COST TO OWNER.
 - REPORT ANY INTERFERENCES BETWEEN WORK UNDER THIS DIVISION AND THAT OF ANY OTHER CONTRACTORS TO ARCHITECT AS SOON AS THEY ARE DISCOVERED. ARCHITECT WILL DETERMINE WHICH EQUIPMENT SHALL BE RELOCATED, REGARDLESS OF WHICH WAS FIRST INSTALLED, AND HIS DECISION SHALL BE FINAL.
- C. PROTECTION OF WORK AND PROPERTY
- THE CONTRACTOR SHALL BE RESPONSIBLE FOR SAFEGUARDING WORK, PROPERTY, AND FACILITIES AGAINST DAMAGE, BOTH HIS OWN AS WELL AS OTHERS WITH WHICH HE MAY COME INTO CONTACT IN THE PERFORMANCE OF HIS WORK.
 - STORED MATERIALS SHALL BE PROTECTED AGAINST DAMAGE FROM WEATHER, PIPE, AND DUCT OPENINGS SHALL BE CLOSED WITH CAPS OR PLUGS DURING INSTALLATION. ALL FIXTURES AND EQUIPMENT SHALL BE COVERED AND PROTECTED AGAINST DAMAGE. ANY MATERIALS OR EQUIPMENT DAMAGED AT ANY STAGE IN THE CONSTRUCTION SHALL BE REPLACED OR REPAIRED. FINAL COMPLETION, ALL WORK SHALL BE IN A CLEAN AND UNBlemISHED CONDITION.
 - DURING CONSTRUCTION, ALL RETURN AIR DUCTWORK AND TRANSFER AIR OPENINGS SERVING NEW AND EXISTING AIR HANDLING EQUIPMENT AND/OR ADJACENT TENANT SPACES SHALL BE PROTECTED. OPENINGS WHICH NEED TO REMAIN ACTIVE SHALL BE COVERED AND PROTECTED WITH MEDIA FILTRATION MEDIA. OPENINGS WHICH CAN REMAIN INACTIVE DURING CONSTRUCTION SHALL BE COVERED WITH PLASTIC SHEATHING AND SEALED AIR TIGHT. FILTER MEDIA SHALL BE REPLACED REGULARLY AS REQUIRED DURING CONSTRUCTION IN ORDER TO ENSURE ADEQUATE AIRFLOW THROUGH ALL REQUIRED ACTIVE OPENINGS. IN ADDITION, AT THE END OF EACH PHASE OF CONSTRUCTION AND AT THE END OF THE CONSTRUCTION PROJECT, ALL FILTRATION MEDIA WITHIN EACH PIECE OF EQUIPMENT SERVING THE SPACE SHALL BE REPLACED.
- D. EXCAVATION AND BACKFILL
- PERFORM ALL EXCAVATION AND BACKFILL REQUIRED FOR INSTALLATION OF BELOW-GRADE PIPING AND DUCTWORK.
 - EXCAVATE AS REQUIRED TO INSTALL PIPING AT REQUIRED DEPTH AND PITCH. PIPE TO BE LAID ON SAND BEDDING TO GIVE UNIFORM BEARING ALONG LENGTH OF PIPE (SAND INSIDE BUILDING AND INTERLOCKING AGGREGATE OUTSIDE BUILDING).
 - BACKFILL WITH BEDDING MATERIAL TO A MINIMUM OF 12" ABOVE TOP OF PIPE AND COMPACT. BALANCE OF BACKFILL IN OUTDOOR GRASS AREAS SHALL BE CLEAN EARTH UP TO 6" ABOVE SURROUNDING GRADES. BACKFILL BELOW FINISHED FLOORS SHALL BE SAND. BACKFILL OUTDOORS UNDER PAVING SHALL BE INTERLOCKING AGGREGATE AND SHALL BE COMPACTED IN MAXIMUM 10" LAYERS.
 - ALL OTHER EXCAVATIONS SHALL BE BACKFILLED WITH CLEAN EARTH, EXCLUDING RUBBISH AND BouldERS. BACKFILL SHALL BE THOROUGHLY TAMPED AND PUDDLED.
 - PATCH FLOOR AND PAVING TO MATCH EXISTING ADJACENT SURFACES.
 - BACKFILLING SHALL NOT BE DONE UNTIL, PIPE LINES ARE PROPERLY TESTED IN THE PRESENCE OF THE ARCHITECT AND/OR INSPECTION OF THE GOVERNMENT AGENCY HAVING JURISDICTION.
 - CONTROL TRENCH SOIL COMPACTION DURING CONSTRUCTION FOR COMPLIANCE WITH

THE MAXIMUM DENSITY SPECIFIED FOR THE FOLLOWING AREAS:


- BUILDING SLABS, WALKWAYS, ROADWAYS, OR PUBLIC THOROUGHFARES; COMPACT TOP 1/2" OF SUBGRADE AND EACH LAYER OF BACKFILL FOR FILL MATERIAL AT 95 PERCENT DENSITY FOR COHESIONLESS SOILS, AND 90 PERCENT DENSITY FOR COHESIVE SOIL MATERIAL. TESTS TO BE PERFORMED BY AN INDEPENDENT TESTING SERVICE, WITH THE COMPLIANCE REPORT SUBMITTED TO THE ARCHITECT.
 - PIPE SHALL NOT BE LAID IN WATER. FURNISH ALL PUMPING EQUIPMENT, POWER, TEMPORARY CONNECTIONS, ETC., AND DO ALL PUMPING NECESSARY TO REMOVE GROUND OR CASUAL WATER.
 - WHERE TRENCHES CROSS ROADS, WALKS, OR PUBLIC THOROUGHFARES, PROVIDE SUITABLE BRIDGES ADEQUATELY PROTECTED BY SIGNS OR RED FLAGS DURING DAY AND LIGHTS AS NIGHT.
 - REPAVE ALL STREETS OR SIDEWALKS DISTURBED AT THIS CONTRACTOR'S EXPENSE TO RECOMMENDATIONS, PROCEDURES AND SATISFACTION OF ARCHITECT AND AUTHORITIES HAVING JURISDICTION.
- E. SUPPORTS AND HANGERS
- HANGERS AND SUPPORTS ARE TO BE PROVIDED TO PROPERLY SUPPORT, SECURE AND ALIGN PIPING AND TO MEET FIELD CONDITIONS AND AS MANUFACTURED BY GRINNELL, MICHIGAN HANGER OR CADDY.
 - ALL HANGERS, BRACKETS, CLAMPS, ETC., SHALL BE OF STANDARD WEIGHT STEEL. PERFORATED STRAP HANGERS SHALL NOT BE USED IN ANY WORK. WHEN TWO OR MORE PIPES ARE RUN PARALLEL, THEY MAY BE SUPPORTED ON UNISTRUT-TYPE TRAPEZE HANGERS. OTHER HANGERS FOR PIPE 3" IN SIZE AND SMALLER SHALL BE CLEVIS, FOR PIPE TRANSPORTING MEDIUM ABOVE 150 DEGREES F AND 4" IN SIZE AND ABOVE, USE PIPE ROLL. EACH HANGER IS TO BE SIZED TO INCLUDE PIPE INSULATION SADDLE FOR PROTECTION.
 - WHERE BUILDING SERVICE LINES ENTER OR LEAVE BUILDING SUCH AS WATER, SEWER, GAS, ETC., AND ARE INSTALLED ON FIELD EARTH, PROVIDE CONTINUOUS SUPPORT ON A REINFORCED CONCRETE BEAM FURNISHED AND INSTALLED UNDER THIS DIVISION. SUPPORT BEAM ON BUILDING AND WITH VERTICAL SUPPORT DOWN TO FOUNDATION FOOTING AND ON UNDISTURBED EARTH AT OTHER END. GAS MAIN SHALL ENTER BUILDING ABOVE GRADE.
 - ALL VERTICAL PIPING PASSING THROUGH FLOORS SHALL BE SUPPORTED AT THE FLOOR BY A RISER CLAMP.
 - ISOLATE ALL COPPER LINES FORM FERROUS HANGERS OR SUPPORTS BY USING FOIL FILLER OR VINYL TAPE.
 - SPACING TO COMPLY WITH ASHRAE STANDARDS AND CODE REQUIREMENTS.
- F. PIPE SLEEVES, FLOOR AND CEILING PLATES
- ALL PIPES PASSING THROUGH FLOORS OR MASONRY WALLS SHALL BE PROVIDED WITH MACHINE-CUT SCHEDULE 40 PIPE STEEL SLEEVES. THE SLEEVES SHALL BE SO SIZED TO ALLOW AT LEAST 1/4" CLEARANCE BETWEEN THE INSIDE SLEEVE WALL AND THE PIPE OR INSULATION SURFACE. SHEET METAL SLEEVES SHALL NOT BE USED IN THIS WORK. PIPE SLEEVES ARE TO EXTEND 2" ABOVE FINISHED FLOOR AND SEALED. PIPE SLEEVES ARE TO BE FULL WALL THICKNESS AND SEALED.
 - UNUSED SLEEVES SHALL BE PLUGGED AND FINISHED TO MATCH ADJOINING SURFACE.
- G. ESCUTCHEONS
- FIT ALL PIPE PASSING THROUGH WALLS, FLOORS OR CEILINGS IN FINISHED ROOMS WITH STEEL OR BRASS ESCUTCHEONS. WHERE SURFACE IS TO RECEIVE A PAINT FINISH, MAKE ESCUTCHEONS PRIME PAINTED; OTHERWISE, MAKE ESCUTCHEONS NICKEL OR CHROME PLATED. WHERE PIPING IS INSULATED, FIT ESCUTCHEONS OUTSIDE INSULATION.
- H. PIPE IDENTIFICATION AND TAGS
- IDENTIFY EACH PIPE, VALVE AND CONTROLS IN EQUIPMENT ROOMS, ABOVE ACCESSIBLE CEILINGS AND IN ACCESSIBLE SHAFTS.
 - COLOR CODE IDENTIFICATION BANDS OR MARKER LOCATIONS TO IDENTIFY CONTENTS OF PIPE WITH INITIALS AND DIRECTION OF FLOW BACKGROUND NEAR EACH VALVE AND FITTING, ON BOTH SIDES OF PIPE PASSING THROUGH WALLS AND ON LONG RUNS AT NOT OVER 20'-0" INTERVALS.
 - AT PLACE WHERE PIPE IS TO HAVE MARKING, COVERED PIPE SHALL BE PROPERLY PRIMED WITH CLEAR LACQUER. AFTER MARKING IS APPLIED, COAT WITH LACQUER, APPLY MARKING ADJACENT TO VALVES AND EQUIPMENT AT MAJOR CHANGES IN DIRECTIONS, WHERE PIPES PASS THROUGH WALLS OR FLOORS.
 - EACH PIECE OF EQUIPMENT SHALL BE IDENTIFIED BY A NUMBER, TOGETHER WITH A BRIEF DESCRIPTION OF ITS PURPOSE, E.G. "AIR HANDLING UNIT - EAST LOBBY." IDENTIFICATION SHALL BE EMBOSSED OR ENGRAVED PLASTIC OR STAMPED BRASS STRIPS FIRMLY ATTACHED TO THE EQUIPMENT OR ADJACENT WALL AT THE OBVIOUS LOCATION. THE LETTERING FOR SUCH STRIPS SHALL BE NOT LESS THAN 1/2" HIGH.
 - ALL VALVES SHALL BE PROVIDED WITH BRASS NUMBERED TAGS ATTACHED TO HANDLE WITH A BRASS CHAIN OR RING. WIRING OF TAGS WILL NOT BE ACCEPTABLE. AT THE COMPLETION OF THE WORK, A REPRODUCIBLE VALVE SCHEDULE SHALL BE PROVIDED. THREE (3) COPIES OF THIS SHALL BE MOUNTED IN METAL, GLASS COVERED FRAMES WHERE REQUESTED BY THE ARCHITECT. THE SCHEDULE SHALL GIVE A DESCRIPTION OF THE LINE OR EQUIPMENT CONTROLLED; THE NORMAL POSITION; EMERGENCY AND/OR SHUTDOWN POSITION AND LOCATION GIVEN EITHER BY DESCRIPTION OR DIAGRAM.
 - ALL CONTROLS, STARTERS, SWITCHES, ETC. SHALL BE IDENTIFIED BY EMBOSSED STENCIL OR ENGRAVED PLATE AS TO PURPOSE AND/OR EQUIPMENT CONTROLLED. CONTROL WIRING SHALL BE IDENTIFIED WITH PROGRAM NUMBER AND DEVICE IT SERVES.
- I. ACCESS PANELS
- EACH CONTRACTOR SHALL BE RESPONSIBLE FOR PROVIDING ALL REQUIRED ACCESS PANELS NECESSARY FOR HIS WORK. THIS INCLUDES ANY ACCESS PANELS REQUIRED FOR HVAC, PLUMBING AND FIRE PROTECTION. EACH CONTRACTOR SHALL ALSO PROVIDE ACCESS PANELS FOR ANY EXISTING CONDITIONS AS REQUIRED.
 - REFER TO ARCHITECTURAL DRAWINGS AND SPECIFICATIONS FOR TYPE OF ACCESS PANEL AND COORDINATE LOCATIONS PRIOR TO ANY WORK.
 - CONTRACTOR SHALL MARK LAY-IN CEILING TILES, IN A METHOD APPROVED BY THE ARCHITECT, WHERE ACCESS IS REQUIRED TO SUCH MECHANICAL, PLUMBING, AND FIRE PROTECTION EQUIPMENT, VALVES, REGULATORS, MIXING BOXES, FIRE DAMPER, ETC.
- J. NOISE AND VIBRATION ISOLATION
- FURNISH AND INSTALL VIBRATION ISOLATING MOUNTINGS TO ISOLATE FROM THE STRUCTURE, BY MEANS OF RESILIENT VIBRATION AND NOISE ISOLATORS, ALL MECHANICAL EQUIPMENT OVER 1 HP HAVING ROTATING OR RECIPROCATING PARTS. ISOLATORS SHALL BE SUPPLIED BY A SINGLE SOURCE, AND SHALL BE GUARANTEED BY THE MANUFACTURER TO PROVIDE ISOLATION EFFICIENCIES IN ACCORDANCE WITH THIS SPECIFICATION. SELECTION SHALL BE BASED ON EQUIPMENT PURPOSED, POWER DISSIPATED, FREQUENCY, WEIGHT DISTRIBUTION AND NATURE OF THE BUILDING STRUCTURE. MOUNTINGS SHALL BE DESIGNED TO PERMIT ATTACHMENT TO THE EQUIPMENT BASE OR PAD AND TO THE STRUCTURE AND SHALL BE SELECTED FOR UNIFORM DEFLECTION ALLOWING FOR UNEQUAL WEIGHT DISTRIBUTION.
 - SELECTION SHALL BE MADE BY THE MANUFACTURER OF THE MOUNTINGS TO PROVIDE A TRANSMISSIBILITY NOT EXCEEDING 10 PERCENT. THIS CONTRACTOR SHALL PROVIDE INERTIA PADS FOR EQUIPMENT WHERE CALLED FOR ON DRAWINGS OR RECOMMENDED BY THE MANUFACTURER OF THE MOUNTINGS. THESE SHALL CONSIST OF REINFORCED CONCRETE PADS OF SUITABLE SHAPE, OF WEIGHT 1-1/2 TIMES THE WEIGHT OF THE EQUIPMENT AND PROVIDED WITH WELD PLATES OR CHANNELS AT THE CORNERS TO WHICH THE MOUNTINGS MAY BE SECURED.
 - VIBRATION OR NOISE CREATED IN ANY PART OF THE BUILDING BY THE OPERATION OF ANY EQUIPMENT FURNISHED AND/OR INSTALLED UNDER THIS CONTRACT WILL BE PROHIBITED, AND THIS CONTRACTOR SHALL TAKE ALL PRECAUTIONS BY ISOLATING THE VARIOUS ITEMS OF EQUIPMENT, PIPE AND SHEET METAL WORK FORM THE BUILDING STRUCTURE. THE MAJOR ITEMS OF EQUIPMENT SHALL BE ISOLATED AS CALLED FOR ON THE PLANS AND SPECIFIED HEREIN. THE MINOR ITEMS SHALL BE HELD THE RESPONSIBILITY OF THIS CONTRACTOR.
 - MECHANICAL EQUIPMENT NOT INTERNALLY ISOLATED BY THE MANUFACTURER SHALL BE ISOLATED AS FOLLOWS:
 - CONNECTIONS FROM PUMP OUTLET AND DISCHARGE NOZZLES TO PIPING SHALL BE MADE WITH FLEXIBLE CONNECTORS.
 - ISOLATE EACH BASE MOUNTED PUMP FROM THE PIPING SYSTEMS BY USE OF APPROPRIATE SIZE CORRUGATED BELLOWS, TYPE 347 STAINLESS STEEL COUPLINGS WITH CONTROL RODS AS MANUFACTURED BY KERLEX MFG. OR FLEXIMONTS FOR 300 PSIG DESIGN PRESSURE AT 800 DEGREES F. DESIGN TEMPERATURE.
 - CENTRIFUGAL FANS, AIR CONDITIONING AND/OR HEATING AND VENTILATING UNITS UP TO 3" STATIC PRESSURE ON GRADE SHALL BE MOUNTED ON PRECOMPRESSED MOLDED FIBERGLASS, RUBBER-IN-SHEAR, OR STEEL SPRING ISOLATORS. IF TAN DRIVE MOTOR IS NOT SUPPORTED DIRECTLY ON THE FAN, BOTH UNITS SHALL BE MOUNTED ON AN INTEGRAL STRUCTURAL STEEL BASE SUPPLIED BY THE ISOLATOR MANUFACTURER, OR SUFFICIENT RIGIDITY TO MAINTAIN ALIGNMENT BETWEEN THE FAN AND THE DRIVE MOTOR. THE BASE SHALL IN TURN BE MOUNTED ON PRECOMPRESSED MOLDED FIBERGLASS, RUBBER-IN-SHEAR, OR STEEL SPRING ISOLATORS.

THE FANS' ISOLATORS SHALL PROVIDE ISOLATION EFFICIENCIES AS FOLLOWS:

FAN SPEED OVER 700 RPM	95 PERCENT
FAN SPEED BETWEEN 450 AND 700 RPM	90 PERCENT
BELOW-GRADE PIPING AND DUCTWORK, FAN	
WHEEL OVER 48" DIAMETER	80 PERCENT
FAN SPEED BELOW 450 RPM, FAN	
WHEEL UNDER 48" DIAMETER	NOISE ISOLATION ONLY

- CENTRIFUGAL FANS, AIR CONDITIONING AND/OR HEATING AND VENTILATING UNITS UP TO 3" STATIC PRESSURE ABOVE GRADE SHALL BE MOUNTED ON STEEL SPRING VIBRATION ISOLATORS IN COMBINATION WITH PRECOMPRESSED MOLDED FIBERGLASS NOISE ISOLATION PADS. IF THE DRIVE MOTOR IS NOT SUPPORTED DIRECTLY ON THE FAN, BOTH UNITS SHALL BE MOUNTED ON AN INTEGRAL CONCRETE INERTIA BASE, SUPPLIED BY THE ISOLATOR MANUFACTURER, OF SUFFICIENT RIGIDITY TO MAINTAIN ALIGNMENT BETWEEN THE FAN AND ISOLATORS IN COMBINATION WITH PRECOMPRESSED MOLDED FIBERGLASS NOISE ISOLATION PADS. SEE "C" ABOVE FOR ISOLATION EFFICIENCIES.
- CENTRIFUGAL FANS, AIR CONDITIONING AND/OR HEATING AND VENTILATING UNITS UP TO 3" STATIC PRESSURE CEILING SUSPENDED SHALL BE MOUNTED ON A SUITABLE

City of Puyallup
Development & Permitting Services
ISSUED PERMIT

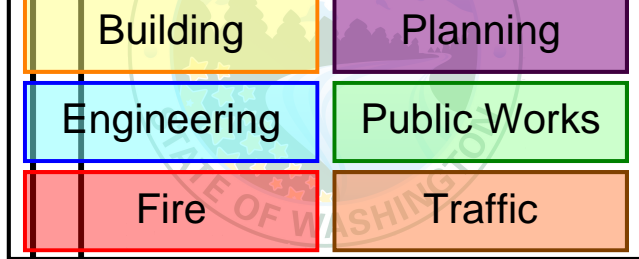

BARNES & NOBLE

PROJECT DESIGNER:



ARCHITECT:

JOEL TORIELLI
422 BOGERT AVE
RIDGEWOOD, NJ 07450

Kenneth A. Fuller, P.E.

151 East Main St.
Rockaway, NJ 07866
Tel: 973-982-1100
kfuller@penn.com



SOUTH HILL MALL
3500 S. MERIDIAN ST.
UNIT #800
PUYALLUP, WA 98373

Project Number 33247
Store Number 3507

Revision Log		
Date	Description	No.
12-19-24	ISSUED FOR PERMIT. BID, LANDLORD & CLIENT COMMENTS	1
02-20-25	LANDLORD & BID COMMENTS	2
		3
		4
		5
These plans are an instrument of service and the property of the Architect. Infringements will be prosecuted.

General Contractor to verify all conditions and dimensions at the premises. Discrepancies shall be reported to the Architect prior to the commencement of any work.

Professional Seal:

LIC.# : 22005563
EXP. DATE : 10/02/25

Drawing Description:

MECHANICAL
SPECIFICATIONS

Drawing Number:

M-301

- d. DEFECTIVE WORK OR MATERIALS SHALL BE REPLACED AND INSPECTION AND TESTS REPEATED WITHIN 10 DAYS.
13. CERTIFICATES OF APPROVAL OF SATISFACTORY COMPLETION AND FINAL INSPECTION SHALL BE OBTAINED BY THE PLUMBING CONTRACTOR. ONE COPY OF EACH APPROVAL SHALL BE GIVEN TO THE ARCHITECT.
14. DAMAGES WHICH RESULT FROM BREAKAGE OR FAULTY INSTALLATION SHALL BE THE RESPONSIBILITY OF THE PLUMBING CONTRACTOR.
15. AFTER THE SYSTEM HAS BEEN IN SERVICE FOR A TWO-WEEK PERIOD AND AGAIN BEFORE THE SYSTEM IS TURNED OVER TO THE OWNER, ALL DIRT POCKETS, TRAPS, AND STRAINERS SHALL BE CLEANED, REMOVED, AND REINSTALLED.

D. WATER USING EQUIPMENT: ALL WATER USING EQUIPMENT, SUCH AS BUT NOT LIMITED TO, COOLING COILS, SHALL BE BALANCED TO OBTAIN THE REQUIRED WATER PRESSURE DROP AND FLOW. THIS CONTRACTOR SHALL LIST THE FLOW RATE AND REQUIRED PRESSURE DROP AND THE OBSERVED PRESSURE DROP FOR EACH PIECE OF EQUIPMENT.

E. AIR HANDLING EQUIPMENT: FOR EACH PIECE OF AIR HANDLING EQUIPMENT, THIS CONTRACTOR SHALL LIST THE DATA OF THE FAN, MOTOR AND DRIVE AND SHALL OBTAIN BY MEASUREMENT AND THE FAN SPEED, THE FAN SPEED, THE FAN SPEED, MOTOR VOLTAGE, OPERATING AMPS, FOR CFM AND STATIC PRESSURE AS DETERMINED FROM THE MANUFACTURER'S FAN CURVES. THIS CONTRACTOR SHALL ALSO DETERMINE THE FAN CFM BY MEANS OF A VELOCITY TRAVERSE WHICH SHALL BE TAKEN A MINIMUM OF THREE FAN DIAMETERS FROM FAN OUTLET, BEFORE RUNNING ANY TESTS. THE CONTRACTOR SHALL HAVE INSTALLED ALL THE COMPONENTS OF THE SYSTEM AND SHALL ENSURE THE CLEANLINESS OF THE FILTERS.

F. DIFFUSERS, REGISTERS, GRILLES: AFTER COMPLETION OF THE AIR DISTRIBUTION SYSTEMS AND FINAL ADJUSTMENTS, THE CONTRACTOR SHALL ADJUST ALL DAMPERS AND AIR SUPPLY, RETURN AND EXHAUST OUTLETS SO THAT EACH OUTLET HANDLES ITS PROPER QUANTITY OF AIR. SUPPLY REGISTERS AND DIFFUSERS SHALL BE ADJUSTED TO PROVIDE FOR THE PROPER THROW AND A UNIFORM DISTRIBUTION PATTERN.

1. FOR SUPPLY, RETURN AND EXHAUST AIR OUTLETS, THE VELOCITY SHALL BE MEASURED WITH A HEATED WIRE RESISTANCE TYPE ANEMOMETER HELD 1" FROM THE FACE OF THE OUTLETS; THE AIR VELOCITY SHALL BE THE AVERAGE OF VELOCITY READINGS TAKEN AT POINTS NO MORE THAN 6" APART. THE AREA SHALL BE THE NET CORE AREA OF THE OUTLET.
2. TEST READINGS SHALL BE TAKEN FOR EACH REGISTER, GRILLE AND DIFFUSER. FOR EACH OF THESE UNITS, OBTAIN AND FURNISH INFORMATION ON MANUFACTURER, TESTING EQUIPMENT USED, PROCEDURE FOLLOWED, LOCATION, SIZE, AVERAGE, VELOCITY, GROSS AND NET CORE AREAS, OBSERVED CFM AND VELOCITY, SEPARATE TABULATIONS SHALL BE FURNISHED FOR EACH MANUFACTURER, EACH SYSTEM AND EACH TYPE OF REGISTER, GRILLE AND DIFFUSER.

G. MIXING DAMPERS: MIXING DAMPERS SHALL BE ADJUSTED ON THE BASIS OF THE TEMPERATURE OF THE MIXED OUTSIDE AND RETURN AIRSTREAMS.

1. THE MINIMUM FRESH AIR DAMPER POSITION SHALL BE DETERMINED BY OBTAIN A MIXED AIR TEMPERATURE DETERMINED FROM THE FOLLOWING EQUATION:
$$\text{MIXED AIR TEMPERATURE} = (\text{OUTSIDE AIR TEMP.} \times (\text{MIN. PERCENT OUTSIDE AIR}) + (\text{RETURN AIR TEMP.} \times (1 - \text{MIN. PERCENT OUTSIDE AIR}))$$
2. PERCENTAGE OF AIR QUANTITY SHALL BE EXPRESSED AS A FRACTION OF THE TOTAL AIR SUPPLY.

H. HOLES IN DUCTS AND CASINGS USED FOR STATIC PRESSURE AND VELOCITY READINGS SHALL BE PROVIDED WITH REMOVABLE CLOSURES.

I. DURING THE TESTING PERIOD, THIS CONTRACTOR SHALL MAINTAIN ON THE JOB A COMPETENT INDIVIDUAL THOROUGHLY FAMILIAR WITH ALL PHASES OF AIR CONDITIONING, INCLUDING REFRIGERATION, TEMPERATURE CONTROL AND DISTRIBUTION, FOR AS LONG A PERIOD AS MAY BE REQUIRED TO THOROUGHLY ADJUST ALL OF THE SYSTEMS AND TO DEMONSTRATE TO THE ARCHITECT THAT THEY ARE FUNCTIONING PROPERLY.

J. THE TESTING AND BALANCING ENGINEER SHALL, AS PART OF HIS WORK, PERFORM A "SPOT" RE-CHECK BALANCING CONDITIONS BETWEEN 30 TO 90 DAYS AFTER BOTH SUMMER AND WINTER BALANCING OPERATIONS AT WHICH TIME A REPRESENTATIVE OF THE TEMPERATURE CONTROL MANUFACTURER CAPABLE OF PERFORMING ADJUSTMENTS TO HIS SYSTEM SHALL ACCOMPANY THE BALANCING ENGINEER. THIS OPERATION SHALL INCLUDE A CHECK OF SPACE TEMPERATURE, CALIBRATION OF CONTROLS, PUMP AND FAN PERFORMANCE AND THE NECESSARY ADJUSTMENTS THERETO.

SECTION 200700 - INSULATION

A. GENERAL

1. FURNISH ALL MATERIAL, LABOR AND EQUIPMENT AS REQUIRED TO INSTALL COMPLETE PLUMBING AND HVAC INSULATION AS INDICATED ON MECHANICAL DRAWINGS AND IN THESE SPECIFICATIONS.
2. INSTALL IN FULL ACCORDANCE WITH MANUFACTURER'S RECOMMENDATIONS.

B. SCOPE: THIS CONTRACTOR SHALL FURNISH AND INSTALL ALL INSULATION NECESSARY TO THE PROJECT AND IN ACCORDANCE WITH THE FOLLOWING REQUIREMENTS. ALL INSULATION AND ACCESSORIES USED IN AN AIR PLENUM SPACE, AND ALL DUCT COVERING AND LINING, REGARDLESS OF PHYSICAL LOCATION, SHALL HAVE A COMPOSITE (INSULATION, JACKET, AND ADHESIVE) FIRE AND AS TESTED UNDER PROCEEDURE ASTM E-84, NFPA 255 AND UL 723, NOT EXCEEDING A FLAME SPREAD 25 AND SMOKE DEVELOPED 50. ALL OTHER AREAS SHALL HAVE INSULATING MATERIALS AND ACCESSORIES ON PIPES AND VESSELS RATED AT A FLAME SPREAD 25 AND SMOKE DEVELOPED 150 AS TESTED BY THE SAME PROCEDURE. ALL CALCIUM SILICATE SHALL BE ASBESTOS FREE.

C. WORKMANSHIP:

1. ALL INSULATION SHALL BE INSTALLED OVER CLEAN, DRY SURFACES. INSULATION MUST BE DRY AND IN GOOD CONDITION. WET OR DAMAGED INSULATION WILL NOT BE ACCEPTABLE. NO INSULATION SHALL BE APPLIED PRIOR TO PRESSURE TEST COMPLETION OF THE RESPECTIVE PIPING AND/OR DUCT SYSTEM.
 2. PIPE INSULATION SHALL BE INSTALLED WITH JOINTS BUTTED FIRMLY TOGETHER. ALL VALVES AND FITTINGS SHALL BE INSULATED USING MITERED SECTIONS OF INSULATION EQUAL IN DENSITY AND THICKNESS TO THE ADJOINING INSULATION, OR WITH AN INSULATION CEMENT EQUAL IN THICKNESS TO THE ADJOINING INSULATION OR PREMOULDED INSULATED FITTINGS. THE INSULATION APPLIED TO THE VALVES AND FITTINGS SHALL BE COVERED WITH THE SAME TYPE OF COVERING AS USED ON THE PIPE INSULATION. NO STAPLES.
 3. ALL INSULATION ENDS SHALL BE TAPERED AND SEALED REGARDLESS OF SERVICES.
 4. ALL INSULATED, EXPOSED PIPING 8'-0" AND BELOW TO THE FINISHED FLOOR SHALL INCLUDE A 0.020" THICK VINYL JACKET. THIS JACKET IS IN ADDITION TO THE NORMAL FINISH FOR THE RESPECTIVE SERVICE.
 5. DRAIN DUCT INSULATION SHALL BE IMPALED OVER WELDED PINS AND SECURED WITH WHITE INSULATION CAPS. ALL SEAMS SHALL BE FIRMLY BUTTED AND SEALED WITH WHITE PRESSURE SENSITIVE VAPOR BARRIER TAPE. NO STAPLES.
 6. WRAP AROUND DUCT INSULATION SHALL BE APPLIED WITH ALL JOINTS BUTTED FIRMLY TOGETHER. INSULATION SHALL BE CEMENTED TO THE SURFACE WITH FIREPROOF ADHESIVE APPLIED IN 6" WIDE STRIPS ON 12" CENTERS. ALL JOINTS IN THE INSULATION COVERING SHALL BE SEALED WITH ADHESIVE. WHERE DUCTS ARE OVER 24" WIDE, THE DUCTWRAP SHALL BE ADDITIONALLY SECURED TO BOTTOM OF RECTANGULAR OR OVAL DUCTS WITH MECHANICAL FASTENERS ON 18" CENTERS TO PREVENT SAGGING. VAPOR BARRIER SHALL BE LEGIBLY PRINTED BY THE MANUFACTURER TO SHOW NOMINAL THICKNESS AND TYPE OF INSULATION. ALUMINUM CORNER ANGLES SHALL BE USED TO PREVENT OVER COMPRESSING INSULATION DURING INSTALLATION.
 7. DUCTLINER INSULATION SHALL BE APPLIED WITH JOINTS PRECOATED WITH ADHESIVE AND BUTTED FIRMLY TOGETHER. LINING SHALL BE CEMENTED TO DUCTWORK WITH A MINIMUM OF 75 PERCENT COVERAGE OF FIRE RESISTANT ADHESIVE. MECHANICAL FASTENERS ON 18" CENTERS AND ADHESIVE SHALL BE USED WHEN DUCT WIDTH EXCEEDS 12" OR WHEN DUCT HEIGHT EXCEEDS 24".
 8. ALL DUCTWORK IN THE MECHANICAL ROOMS IS TO BE CONSIDERED AS "EXPOSED DUCTWORK," I.E. SUPPLY, RETURN, RELIEF, AND OUTDOOR AIR.
 9. ALL ROUND DIFFUSER DUCT DROPS CONNECTED TO LINED DUCTWORK SHALL BE INSULATED THE SAME AS "DUCTWORK" SCHEDULED NON-LINED.
 10. ALL FLEXIBLE ELASTOMERIC INSULATION SHALL HAVE ALL FITTINGS, BUTT ENDS, AND SEAMS SEALED WITH VAPOR BARRIER ADHESIVE.
 11. PROVIDE REMOVABLE INSULATION SECTIONS TO COVER PARTS OF EQUIPMENT WHICH MUST BE OPENED PERIODICALLY FOR MAINTENANCE INCLUDING METAL PANELS, GASKETS, FASTENERS, FLANGES, CHILLED WATER PUMPS, FRAMES AND ACCESSORIES.
 12. REPAIR ALL DAMAGED SECTIONS OF THE EXISTING PIPING AND MECHANICAL INSULATION DAMAGED DURING THIS CONSTRUCTION PERIOD. USE INSULATION OF SAME THICKNESS AS EXISTING INSULATION. INSTALL NEW JACKET LAPPING AND SEAL OVER EXISTING.
 13. REPLACE DAMAGED INSULATION WHICH CANNOT BE REPAIRED SATISFACTORILY, INCLUDING UNITS WITH VAPOR BARRIER DAMAGE AND MOISTURE SATURATED UNITS.
- D. PLUMBING INSULATION (AS MANUFACTURED BY OWENS CORNING, KNAUF OR SCHULLER)
1. INSULATE ALL ABOVE-GRADE HOT WATER, HOT WATER RETURN AND COLD WATER PIPING WITH 1" THICK MOLDED FIBERGLASS HAVING AN ALL SERVICE JACKET.
 2. INSULATE ALL ABOVE-GRADE, HORIZONTAL AIR CONDITIONING CONDENSATE FLOOR DRAINS AND WASTE LINES, OVERFLOW ROOF DRAINS AND PIPING, ROOF DRAINS AND PIPING AND ROOF DRAIN SUMPS WITH 1" THICK MOLDED FIBERGLASS HAVING AN ALL SERVICE JACKET.
 3. INCLUDE INSULATION OF FITTINGS AND VALVES. KEEP VAPOR BARRIERS INTACT. APPLY PER MANUFACTURER'S RECOMMENDATIONS.
 4. INSULATE ALL EXPOSED WASTE AND WATER SUPPLY PIPING UNDER LAVATORY WITH SAFETY COVERS PER ADA REQUIREMENTS (AS MANUFACTURED BY PLUMBEREX SPECIALTY PRODUCTS, MCQUIRE OR TRUEBERG).
- E. HVAC INSULATION (AS MANUFACTURED BY OWENS CORNING, KNAUF)
1. ALL INSULATION TO BE APPLIED IN FULL ACCORDANCE WITH THE MANUFACTURER'S RECOMMENDATIONS AND COMPLY WITH 2550 FLAME AND SMOKE HAZARD RATINGS PER ASTM E-84, NFPA 255 AND UL 723.

2. INSULATE ALL SUPPLY, RETURN, OUTSIDE AND EXHAUST AIR DUCTS WITH 3/4" THICK LINED INSULATION OR LESS THAN 1-1/2" THICK, C-0.9 FOLDED REINFORCED KRAFT JACKET FIBERGLASS DUCT WRAP FULLY SECURED TO DUCT. LAP AND TAPE SEAMS AND SECURE TIGHTLY TO THE DUCTS WITH WIRE OR STICK PINS. EXPOSED DUCTWORK IN CONDITIONED SPACES WITHOUT CEILING SHALL NOT BE INSULATED UNLESS OTHERWISE NOTED TO BE INSULATED. DUCTWORK IN CEILING PLENUM SPACE SHALL BE INSULATED.
3. INSULATE ALL SUPPLY, RETURN, OUTSIDE AND EXHAUST AIR DUCTS LINED OR NOT LINED LOCATED IN THE ATTIC SPACE WITH 1" THICK MOLDED FIBERGLASS DUCT WRAP FULLY SECURED TO DUCT. LAP AND TAPE SEAMS AND SECURE TIGHTLY TO THE DUCTS WITH WIRE OR STICK PINS.
4. INSULATE ALL SUPPLY, RETURN, OUTSIDE AND EXHAUST AIR DUCTS LINED OR NOT LINED EXPOSED TO WEATHER OUTSIDE WITH 3" THICK MINERAL-FIBER BOARD, 3 PCT NOMINAL DENSITY, R-13. PROVIDE A VENTURE CLAD INSULATION JACKETING, COLOR AS SELECTED BY ARCHITECT, FIELD-APPLIED JACKET.
5. INSULATE ALL AIR CONDITIONING CONDENSATE DRAIN PIPING WITH 1" THICK MOLDED FIBERGLASS INSULATION, C-0.92.
6. INSULATE EXHAUST DUCTS FOR KITCHEN HOODS WITH TWO (2) LAYERS OF FIRE RATED 1" THICK INSULATING WOOL RATED FOR 1000 DEGREES F OR FIREMASTER DUCTWRAP AS MANUFACTURED BY 3M FOR A MINIMUM OF 2 HR RATING. PROVIDE REMOVABLE SECTIONS AT DUCT CLEANOUT PANELS.
7. INSULATE ALL SINGLE WALL BOILER BREECHING INSIDE THE BUILDING WITH A 3" TIOK CALCIUM SILICATE WITH FIELD APPLIED 8-1/2 OZ. GLASS CLOTH LAGGING WRAP.
8. INSULATE ALL SINGLE WALL HOT WATER FLUES INSIDE THE BUILDING WITH A 2" THICK CALCIUM SILICATE WITH FIELD APPLIED 8-1/2 OZ. GLASS CLOTH LAGGING WRAP.
9. INSULATE ALL HOT WATER TANKS, CONVERTERS, COLD WATER STORAGE TANKS, CHILLED WATER PUMPS AND CHILLED WATER AIR SEPARATORS WITH A 2" THICK FIBERGLASS SERVICE BOARD 6 PCF NOMINAL DENSITY, R-10, WITH FIELD APPLIED 8-1/2 OZ. GLASS CLOTH LAGGING WRAP. DEVICES MAY BE INSULATED WITH 2" THICK FLEXIBLE ELASTOMERIC INSULATION, C-0.24. ALL COLD WATER DEVICES SHALL HAVE A VAPOR SEAL.
10. INSULATE ALL REFRIGERATION SUCTION AND HOT GAS LINES WITH 1" ELASTOMERIC FOAM INSULATION, C-0.24 WITH JOINTS AND SEAMS SEALED VAPOR TIGHT. INSULATION SHALL BE PAINTED WITH TWO COATS OF PROTECTIVE COATING PER MANUFACTURER FOR PROTECTION TO WEATHER (AS MANUFACTURED BY AEROFLEX, ARMOCCELL, OR K-FLEX).

SECTION 211000 - FIRE PROTECTION SYSTEMS

A. GENERAL

1. FURNISH ALL LABOR, MATERIALS AND EQUIPMENT AS REQUIRED TO INSTALL A COMPLETE FIRE PROTECTION SYSTEM FOR PROJECT.
2. FIELD-VERIFY SIZES AND LOCATION OF EXISTING SPRINKLER PIPING BEFORE FABRICATION OF NEW.
3. THIS CONTRACTOR SHALL BE RESPONSIBLE FOR THE REMOVAL AND REINSTALLATION OF EXISTING CEILING AND HEADS, AS REQUIRED, FOR THE INSTALLATION OF WORK SHOWN IN AREAS WHERE EXISTING CEILINGS ARE TO REMAIN. SEE ARCHITECTURAL DRAWINGS FOR AREAS WHERE EXISTING CEILINGS ARE TO REMAIN.
4. THIS REMOVAL AND REINSTALLATION OF EXISTING LAY IN CEILING TILES SHALL BE THE RESPONSIBILITY OF THE FIRE PROTECTION CONTRACTOR, UNDER THE SUPERVISION OF THE GENERAL CONTRACTOR) AS REQUIRED TO PERFORM HIS WORK, ANY DAMAGE TO EXISTING CEILING TILES OR SUPPORTS SHALL BE THE RESPONSIBILITY OF THE GENERAL CONTRACTOR. CEILING TILES MAY BE LEFT ON THE CEILING AREAS UNDER CONSTRUCTION ONLY IF STORED IN AREAS AS DIRECTED BY THE OWNER SO AS NOT TO HINDER THE DAILY OPERATIONS OF THE BUILDING'S OCCUPANTS.
5. THIS CONTRACTOR SHALL MODIFY AND RELOCATE SPRINKLER PIPING AND PROVIDE NEW SPRINKLER PIPING AND HEADS, AS REQUIRED, TO ACCOMMODATE NEW MECHANICAL WORK IN FULL COMPLIANCE WITH NFPA 13. THIS CONTRACTOR SHALL ALSO PERFORM HYDRAULIC CALCULATIONS FOR SPRINKLER PIPING IN THE REMODELED AREAS IN ACCORDANCE WITH NFPA 13.

B. DESIGN BASIS

1. DESIGN BASIS FOR SYSTEM SHALL BE PER NFPA 13 (LATEST EDITION) BUILDING CODE REQUIREMENTS, LOCAL WATER DEPARTMENT, LOCAL FIRE DEPARTMENT, STATE FIRE MARSHAL, LOCAL CODE, AND OWNER AND OWNER'S FIRE INSURANCE UNDERWRITER REQUIREMENTS.
2. SYSTEM SHALL BE HYDRAULICALLY CALCULATED AS REQUIRED BY CODE.
3. PIPE SIZES INDICATED ON DRAWINGS ARE APPROXIMATE AND SHALL BE VERIFIED PER THE CONTRACTOR'S HYDRAULIC CALCULATIONS.

C. DRAWINGS AND CALCULATIONS

1. CONTRACTOR SHALL PREPARE SUBMITTAL DRAWINGS AND HYDRAULIC CALCULATIONS WITH A 10% FACTOR OF SAFETY FOR BUILDING IN ACCORDANCE WITH OWNER'S INSURANCE COMPANY BUILDING DEPARTMENT, AND LOCAL FIRE AUTHORITY REQUIREMENTS. TENANT'S REQUIREMENTS FOR DESIGN DENSITY, WHICHEVER IS MOST STRINGENT.
2. CONTRACTOR SHALL PERFORM A FLOW TEST DATA ON WATER MAIN AND SUBMIT DATA WITH CALCULATIONS.
3. IT IS THE FIRE PROTECTION CONTRACTOR'S RESPONSIBILITY TO VERIFY EACH TENANT'S DESIGN DENSITY WITH AGREED UPON LEASE DOCUMENTATION AND THAT TENANT'S PROTOTYPE OR INSURANCE UNDERWRITERS REQUIREMENTS.
4. PROVIDE WET STANDPIPE SYSTEM FOR PROJECT IN ACCORDANCE WITH NFPA 14 REQUIREMENTS.
5. CONTRACTOR AND DESIGNER SHALL BE STATE CERTIFIED.
6. COORDINATE LAYOUT AND INSTALLATION OF SPRINKLERS WITH DUCTWORK AND EQUIPMENT ABOVE CEILINGS AND OTHER CONSTRUCTION THAT PENETRATES CEILINGS, INCLUDING BUT NOT LIMITED TO LIGHT FIXTURES, SPEAKERS, HVAC EQUIPMENT, DOORS AND PARTITION ASSEMBLIES. NO SPRINKLER PIPING SHALL BE ROUTED BENEATH EQUIPMENT ABOVE ANY CEILINGS THAT MUST BE DROPPED DIRECTLY DOWN FOR SERVICE, REPAIR, OR REPLACEMENT.
7. EXAMINE AREAS AND CONDITIONS UNDER WHICH FIRE PROTECTION MATERIALS AND PRODUCTS ARE TO BE INSTALLED. DO NOT PROCEED WITH WORK UNTIL UNSATISFACTORY CONDITIONS HAVE BEEN CORRECTED IN MANNER ACCEPTABLE TO INSTALLER. SCHEDULE ROUGH-IN INSTALLATIONS WITH INSTALLATIONS OF OTHER BUILDING COMPONENTS.
8. SHOP DRAWINGS REVIEW DOES NOT RELIEVE FIRE PROTECTION CONTRACTOR FROM RESPONSIBILITY TO MEET EACH TENANT'S REQUIREMENTS FOR SPRINKLER COVERAGE.
9. FIRE PROTECTION CONTRACTOR IS RESPONSIBLE FOR VERIFYING ANY HIGH PILE STORAGE REQUIREMENTS OF FUTURE TENANTS AND PROVIDING AN INCOMING SPRINKLER SERVICE SIZE AND RISERS TO MEET THE REQUIREMENTS FOR ADEQUATE SPRINKLER COVERAGE.

D. PIPING

1. ALL PIPING SHALL BE INSTALLED IN ACCORDANCE WITH NFPA 13, 14 (LATEST EDITION) AND LOCAL CODE REQUIREMENTS.
2. FIRE PROTECTION PIPING SHALL BE AS FOLLOWS:
 - a. BELOW-GRADE OUTSIDE BUILDING: DUCTILE IRON, CEMENT LINED, GLASS OF PIPE AS DIRECTED BY LOCAL WATER PURVEYOR WITH MECHANICAL OR PUSH-ON TYPE JOINTS.
 - b. INSIDE BUILDING - PIPE AND TUBING SHALL BE STEEL OR COPPER IN ACCORDANCE WITH NFPA REQUIREMENTS.
 - c. PIPING SHALL MATCH EXISTING BUILDING STANDARDS.
 - d. CONTRACTOR SHALL ARRANGE WITH OWNER AND INSURANCE UNDERWRITER PRIOR TO SHUT DOWN OF EXISTING SYSTEMS.
 - e. FLUSH ALL PIPING UPON COMPLETION OF PROJECT AND TEST PER NFPA REQUIREMENTS.
 - f. NO PIPING SHALL BE INSTALLED AT LOCATIONS SUBJECT TO FREEZING.
3. EXCAVATION AND BACKFILL - SEE SECTION 200510, BASIC MATERIALS AND METHODS.

E. SPRINKLER HEADS

1. SPRINKLER HEADS SHALL BE UL LISTED, MATCH EXISTING BUILDING STANDARDS AND BE MANUFACTURED BY CENTRAL, STAR OR VIKING.
2. SPRINKLER HEADS SHALL BE AS FOLLOWS:
 - a. AREAS WITH EXPOSED STRUCTURE
 - b. AREAS WITH CEILINGS
3. RECESSED PENDENT - CHROME PLATED WITH OFF-WHITE CEILING COVER PLATE.
4. CONCEALED - BRASS FINISH WITH OFF-WHITE CEILING COVER PLATE.
5. SIDEWALL - CHROME PLATED WITH OFF-WHITE, TWO (2) PIECE, SEMI-RECESSED ESCUTCHEON.
6. INSTALL CONCEALED HEADS WITH WHITE FLUSH MOUNTED COVER PLATE IN (SALES AREAS).
7. INSTALL HIGHER TEMPERATURE SPRINKLER HEADS WHERE REQUIRED BY CODE OR APPLICATION.
8. SPRINKLER HEADS SHALL BE LOCATED IN THE CENTER OF CEILING TILES OR THE CENTER OF AN AREA OF A 24" X 24" TILE SECTION. SEE ARCHITECTURAL REFLECTED CEILING PLANS.
9. SUBMIT SAMPLES OF SPRINKLER HEADS TO ARCHITECT PRIOR TO FABRICATION OF ANY PIPING.
11. INSTALL INSPECTOR'S TEST CONNECTION WITH VALVE AND TERMINATE DRAIN THROUGH EXTERIOR WALL WITH TEXT FITTING AND SPLASH BLOCK.

F. VALVES

1. INSTALL ALL VALVES AS REQUIRED BY NFPA 13, UL OR FM LISTED AND AS MANUFACTURED BY GRINVELL, HAMMOND OR MILWAUKEE.

2. ALL SHUT-OFF VALVES SHALL BE FITTED WITH TAMPER SWITCHES BY FIRE PROTECTION CONTRACTOR OR BY THE PLUMBING CONTRACTOR. TAMPER SWITCHES SHALL BE AS MANUFACTURED BY NOTIFIER, POTTER OR VIKING.
3. INSTALL FLOW SWITCH IN RISER AS MANUFACTURED BY NOTIFIER, POTTER OR VIKING AND WIRE BY ELECTRICAL CONTRACTOR.
4. INSTALL UL LISTED ALARM CHECK VALVE WITH ALL REQUIRED TRIM, INCLUDING WATER MOTOR, ALARM BELL, AND DRAINS AS MANUFACTURED BY CENTRAL, STAR OR VIKING.
5. INSTALL WALL MOUNTED INDICATOR VALVE AS MANUFACTURED BY POTTER ROEMER, CROKER OR ELKHART AND APPROVED BY LOCAL AUTHORITIES.
6. INSTALL DOUBLE CHECK DETECTOR ASSEMBLY BACKFLOW PREVENTER, AS REQUIRED BY LOCAL WATER PURVEYOR AND AS MANUFACTURED BY WATTS, ZURN OR CONBRACO.

G. FIRE DEPARTMENT CONNECTION

1. WALL TYPE SIAMENSE CONNECTIONS SHOULD BE POLISHED CAST BRASS WALL TYPE WITH WALL ESCUTCHEON AND TWO-WAY CONNECTIONS. CONNECTION SIZES SHALL BE 4" OUTLET AND TWO - 2-1/2" FEMALE INLETS, HAVING NH (STORZ) STANDARD THREADS FOR THE CONNECTION SIZE INDICATED AS SPECIFIED IN NFPA. PROVIDE THE QUANTITY, SIZE AND TYPE OF CONNECTIONS AS REQUIRED BY THE LOCAL FIRE DEPARTMENT. EACH INLET SHALL HAVE A CLAPPER VALVE AND PLUG AND CHAIN. EACH INLET SHALL HAVE AN ESCUTCHEON OF CAST BRASS, FINISH TO MATCH CONNECTIONS, WITH WORDS "AUTO SPRK", "FIRE DEPT. CONNECTION" IN RAISED LETTERS.
2. MANUFACTURER: SUBJECT TO COMPLIANCE WITH REQUIREMENTS, PROVIDE WALL TYPE SIAMENSE CONNECTION OF ONE OF THE FOLLOWING:
 - a. POTTER-ROEMER
 - b. GUARDIAN FIRE EQUIPMENT, INC.
 - c. CROKER
 - d. ELKHART

H. EXTRA MATERIALS

1. VALVE WRENCHES: FURNISH TO OWNER, 2 VALVE WRENCHES FOR EACH TYPE OF SPRINKLER HEAD INSTALLED.
2. SPRINKLER HEADS AND CABINETS: FURNISH 2 EXTRA SPRINKLER HEADS OF EACH STYLE INCLUDED IN THE PROJECT. FURNISH EACH STYLE WITH ITS OWN SPRINKLER HEAD CABINET AND SPECIAL WRENCHES.
3. OBTAIN RECEIPT FROM OWNER THAT EXTRA STOCK HAS BEEN RECEIVED AND GIVE ARCHITECT A COPY OF THIS RECEIPT.

SECTION 224000 - PLUMBING FIXTURES AND EQUIPMENT

A. GENERAL

1. FURNISH ALL FIXTURES AND EQUIPMENT INDICATED AND SCHEDULED ON DRAWINGS, COMPLETE WITH ALL ACCESSORIES, CONTROLS, ETC., AS REQUIRED.
2. PROVIDE FACTORY-FABRICATED FIXTURES OF TYPE, STYLE AND MATERIAL INDICATED. FOR EACH TYPE FIXTURE, PROVIDE FIXTURE MANUFACTURER'S STANDARD TRIM, CARRIER, SEATS AND VALVES AS SHOWN BY THEIR PUBLISHED PRODUCT INFORMATION AND INDICATED IN THE PLUMBING FIXTURES SCHEDULE; EITHER AS DESIGNED AND CONSTRUCTED OR AS RECOMMENDED BY MANUFACTURER AND AS REQUIRED FOR COMPLETE INSTALLATION. WHERE MORE THAN ONE TYPE IS INDICATED, SELECTION IS INSTALLER'S OPTION, BUT ALL FIXTURES OF SAME TYPE MUST BE FURNISHED BY SINGLE MANUFACTURER. WHERE TYPE IS NOT OTHERWISE INDICATED, PROVIDE FIXTURES COMPLYING WITH GOVERNING REGULATIONS.
3. WHERE FITTINGS, TRIM AND ACCESSORIES ARE EXPOSED OR SEMI-EXPOSED, PROVIDE BRIGHT CHROME-PLATED OR POLISHED STAINLESS STEEL UNITS. PROVIDE COPPER OR BRASS WHERE NOT EXPOSED.
4. WATER OUTLETS: AT LOCATIONS WHERE WATER IS SUPPLIED (BY MANUAL, AUTOMATIC OR REMOTE CONTROL), PROVIDE COMMERCIAL QUALITY FAUCETS, VALVES OR DISPENSING DEVICES OF TYPE AND SIZE INDICATED AND AS REQUIRED TO OPERATE AS INDICATED. INCLUDE MANUAL SHUT-OFF VALVES AND CONNECTING STEM PIPES TO PERMIT OUTLET SERVICING WITHOUT SHUT-DOWN OF WATER SUPPLY PIPING SYSTEM.
5. VACUUM BREAKERS: PROVIDE WITH FLUSH VALVES WHERE REQUIRED BY GOVERNING REGULATIONS, INCLUDING LOCATIONS WHERE WATER OUTLETS ARE EQUIPPED FOR HOSE ATTACHMENT.
6. WATER HAMMER ARRESTORS: PROVIDE WATER HAMMER ARRESTORS WHERE SHOWN ON THE DRAWINGS AND AS REQUIRED TO PREVENT WATER HAMMER AND EXCESSIVE VIBRATION IN THE DOMESTIC WATER SYSTEM. ARRESTORS TO BE OF SIZE INDICATED OR THOSE RECOMMENDED BY THE MANUFACTURER.
7. P-TRAPS: INCLUDE REMOVABLE P-TRAPS (WITH CLEAN OUT PLUG) WHERE DRAINS ARE INDICATED FOR DIRECT CONNECTION TO DRAINAGE SYSTEM.
8. CARRIERS: PROVIDE CAST IRON SUPPORTS FOR FIXTURES OF EITHER GRAPHICITE GRAY IRON, DUCTILE IRON OR MALLEABLE IRON AS INDICATED.
9. FIXTURE BOLT CAPS: PROVIDE MANUFACTURER'S STANDARD EXPOSED FIXTURE BOLT CAPS FINISHED TO MATCH FIXTURE FINISH.
10. ESCUTCHEONS: WHERE FIXTURE SUPPLIES AND DRAINS PENETRATE WALLS IN EXPOSED LOCATIONS, PROVIDE CHROME-PLATED SHEET STEEL ESCUTCHEONS WITH FRICTION SLIPS.
11. AERATORS: PROVIDE AERATORS OF TYPES APPROVED BY HEALTH DEPARTMENT HAVING JURISDICTION.
12. COMPLY WITH ADDITIONAL FIXTURE REQUIREMENTS CONTAINED IN FIXTURE SCHEDULE ON DRAWINGS.

B. BACKFLOW PREVENTER (IF REQUIRED)

1. PROVIDE REDUCED PRESSURE BACKFLOW PREVENTER CONSISTING OF ASSEMBLY INCLUDING ADJUSTABLE VALVES ON INLET AND OUTLET, AND DISCHARGE FUNNEL. BACKFLOW PREVENTER SHALL INCLUDE A MINIMUM OF FOUR (4) TEST COCKS AND PRESSURE-DIFFERENTIAL RELIEF VALVE LOCATED BETWEEN TWO (2) POSITIVE SEATING CHECK VALVES. BACKFLOW PREVENTER AND SHUTOFF VALVES SHALL BE THE SAME SIZE AS THE UPTREAM PIPE.
2. BACKFLOW PREVENTERS SIZES 2" AND SMALLER SHALL HAVE NPT CONNECTIONS, BE OF BRONZE BODY CONSTRUCTION WITH BRONZE BALL TYPE SHUT-OFF VALVES AS SPECIFIED IN SECTION 15100 AND TEST COCK AND BRONZE BODY RELIEF VALVES WITH STAINLESS STEEL TRIM.
3. BACKFLOW PREVENTERS SIZES 2-1/2" AND LARGER SHALL HAVE FLANGED CONNECTIONS, BE OF EPOXY COATED CAST OR DUCTILE IRON BODY CONSTRUCTION WITH BRONZE TRIM, RESILIENT SEAT OSBY SHUT-OFF GATE VALVES, EPOXY COATED RELIEF VALVE WITH STAINLESS STEEL TRIM AND BRONZE BODY-BALL VALVE TEST COCKS.
4. COMPLETE BACKFLOW PREVENTER ASSEMBLY SHALL BE RATED TO 150 PSI WORKING PRESSURE AND WATER TEMPERATURE RANGE FROM 32° F TO 140° F.
5. PROVIDE EACH BACKFLOW PREVENTER WITH A DRAIN FUNNEL FURNISHED BY THE MANUFACTURER, EXTEND DRAIN FROM FUNNEL TO NEAREST FLOOR DRAIN.
6. BACKFLOW DEVICES MUST MEET ASSE STANDARDS 1013, 1015 AND 1020 AND SHALL BE TESTED AT THE TIME OF INSTALLATION BY A PERSON CERTIFIED BY THE OHIO DEPARTMENT OF HEALTH. THE PLUMBING CONTRACTOR SHALL PAY FOR ALL COSTS OF TESTING WITH THIS TEST.
7. MANUFACTURER: SUBJECT TO COMPLIANCE WITH REQUIREMENTS, PROVIDE BACKFLOW PREVENTERS OF ONE OF THE FOLLOWING:
 - a. CLA-VAL COMPANY
 - b. CONBRACO INDUSTRIES, INC.
 - c. FEBCO SALES, INC., SUB. OF CHARLES M. BAILEY CO., INC.
 - d. HERSEY PRODUCTS, INC.
 - e. WATTS REGULATOR COMPANY

SECTION 230900 - INSTRUMENTATION AND CONTROLS

GENERAL

1. FURNISH AND INSTALL COMPLETE TEMPERATURE CONTROL FOR ALL HVAC SYSTEMS.
2. PROVIDE NEW CONTROL DEVICES INCLUDING THERMOSTATS, HUMIDISTATS, DAMPER OPERATORS, MOTORS, TEMPERATURE SENSORS, STAGING RELAYS, AND OTHER RELATED DEVICES FOR A COMPLETE OPERATIONAL SYSTEM PER THE OPERATING SEQUENCE AND INDUSTRY STANDARDS.
3. MOUNT ALL CONTROLS FURNISHED AS ACCESSORIES TO EQUIPMENT AND PROVIDE ALL CONTROL WIRING AS INDICATED ON MECHANICAL DRAWINGS. ALL WIRING SHALL BE IN CONDUIT PER N.E.C. AND LOCAL CODE REQUIREMENTS.
4. MECHANICAL CONTRACTOR SHALL INSTALL ALL DUCT-MOUNTED SMOKE DETECTORS. ELECTRICAL CONTRACTOR SHALL FURNISH AND WIRE PHOTO-ELECTRIC DUCT SMOKE DETECTORS AT EACH UNIT TO SHUT DOWN FAN UPON ACTIVATION. DETECTOR SHALL BE LOCATED IN THE SUPPLY RETURN AIR DUCT DOWNSTREAM/UPSTREAM OF THE UNIT CONNECTION. DETECTOR WILL HAVE MANUAL RESET AND WILL ACTIVATE A LOCAL ALARM PANEL.

SECTION 233000 - AIR DISTRIBUTION SYSTEMS

A. GENERAL

1. FURNISH ALL MATERIALS, LABOR, EQUIPMENT AND ACCESSORIES REQUIRED TO INSTALL COMPLETE AIR DISTRIBUTION SYSTEMS.
2. CONTRACTORS BIDDING THIS PROJECT SHALL VISIT THIS SITE AND FAMILIARIZE THEMSELVES WITH ALL CONDITION AFFECTING THEIR WORK. SUBMISSION OF A BID ON THIS PROJECT SHALL BE CONSTRUED AS HAVING SUCH KNOWLEDGE.
3. VERIFY EXACT CONDITIONS IN FIELD AND COORDINATE WITH THESE DRAWINGS AND OTHER TRADES BEFORE BEGINNING NEW WORK.

4. DETERMINE EXACT LOCATIONS FOR ALL NEW AND RELOCATED DUCTWORK AND EQUIPMENT IN FIELD.
5. COORDINATE WORK OF THIS CONTRACT WITH OTHER TRADES.
6. ANY DISCREPANCIES BETWEEN WHAT IS SHOWN ON DRAWINGS OR SPECIFIED AND THE ACTUAL CONDITIONS IN THE FIELD SHALL IMMEDIATELY BE BROUGHT TO THE ATTENTION OF THE ARCHITECT BEFORE PROCEEDING.
7. EQUIPMENT OR SURFACES DAMAGED DURING INSTALLATION SHALL BE REPAIRED, REPLACED, AND/OR RESTORED TO ORIGINAL CONDITION AFTER COMPLETION OF WORK AND BEFORE ACCEPTANCE BY OWNER.
8. THIS CONTRACTOR IS ALSO REFERRED TO THE APPROPRIATE MECHANICAL AND ELECTRICAL SPECIFICATION SECTIONS THE ITEMS OF EQUIPMENT TO BE BID AS A PART OF THIS PROJECT.

B. DUCTWORK

1. FABRICATE AND ERECT ALL DUCTWORK TO ASHRAE AND SMACNA STANDARDS FROM GALVANIZED STEEL. COMPLY WITH NFPA 90A REQUIREMENTS.
2. DUCTWORK SHALL BE SMACNA LOW PRESSURE CONSTRUCTION 2" STATIC PRESSURE RATING WITH SEAL CLASS 5 SEAMS AND JOINTS, UNLESS OTHERWISE NOTED.
3. INCLUDE ALL ACUSTIC, AIRFOIL SHAPED PERFORATED ALUMINUM TURNING VANES, MANUAL DAMPERS, FLEXIBLE CONNECTORS, GRILLES AND DIFFUSERS, ACOUSTIC LINING, AND OTHER SHEET METAL ACCESSORIES FOR THE PROJECT.
4. CHANGES IN DIRECTION, IN LOW VELOCITY SUPPLY AIR RECTANGULAR DUCTWORK, SHALL BE MADE WITH FULL RADIUS ELBOWS WITH RADIUS EQUAL TO 1, 1/2 TIMES THE HORIZONTAL WIDTH OF THE DUCT, OR WITH SQUARE ELBOWS WITH TURNING VANES. TURNING VANES SHALL BE CONSTRUCTED OF THE SAME MATERIAL AS THE SURROUNDING DUCTWORK AND TWO (2) GAUGE NUMBERS HEAVIER.
5. FURNISH AND INSTALL ALL MANUAL BALANCING DAMPERS, SPLITTER DAMPERS, EXTRACTORS, AND DEFLECTORS REQUIRED TO PROPERLY DISTRIBUTE THE AIR. ALL DAMPERS, EXTRACTORS AND DEFLECTORS SHALL BE CONSTRUCTED OF THE SAME MATERIAL AS THE SURROUNDING DUCTWORK, UNLESS NOTED OTHERWISE ON THE DRAWINGS. ALL MANUAL BALANCING DAMPERS SHALL BE THE OPPOSED BLADE TYPE.
6. FURNISH AND INSTALL ALL AUTOMATIC CONTROL DAMPERS UNLESS NOTED OTHERWISE ON THE DRAWINGS. ALL CONTROL DAMPERS SHALL BE OPPOSED BLADE TYPE AND SHALL HAVE A MINIMUM OF TWO (2) INCHES OF AIR GAP BETWEEN DAMPER AND TANK SHALL, THROUGH THE DDC CONTROLLER, CLOSE A TWO (2) INCH STATIC PRESSURE AND WHEN SIZED FOR 2000 FPM VELOCITY.
7. ALL MANUAL BALANCING DAMPERS, SPLITTER DAMPERS, EXTRACTORS AND DEFLECTORS SHALL BE CONTROLLED BY YOUNG NO. 1 OR VENTLOCK NO. 088 REGULATORS. IF DUCTWORK IS ACCESSIBLE, MOUNT THE REGULATOR ON THE DUCTWORK. IF DUCTWORK WILL BE INACCESSIBLE AFTER THE INSTALLATION OF THE CEILING OR WALLS, MOUNT THE REGULATOR IN A STEEL FLUSH MOUNTED BOX SPECIFICALLY DESIGNED FOR THIS PURPOSE. PROVIDE ALL LINKAGE, TOW BEARINGS AND/OR GEAR DRIVES REQUIRED FOR THE REMOTE INSTALLATION OF THE REGULATOR.
8. ALL BRANCH CONNECTION FITTINGS IN RECTANGULAR DUCTWORK SHALL BE 45 DEGREE TRANSITION TYPE, CONICAL FITTINGS OR SPIN-IN FITTINGS WITH INTEGRAL AIR SCOOPS. BUT FITTINGS ARE NOT ACCEPTABLE.
9. EXHAUST DUCT OUTLETS SHALL BE INSTALLED A MINIMUM OF 10'-0" FROM ALL OUTSIDE AIR INTAKES.
10. ALL EXPOSED ROUND DUCTWORK SHALL BE SPIRAL SEAM DUCTWORK AND PAINTED A COLOR AS SELECTED BY THE ARCHITECT.

C. DRAIN PANS

1. INSTALL 2" DEEP SECONDARY DRAIN PAN BELOW ALL FURNACES, HOT WATER GENERATORS, AND DOMESTIC WATER HEATERS. PIPE 3/4" DRAIN TO FLOOR DRAIN INDEPENDENTLY OFF ALL THE OTHER DRAINS.

D. DUCT LINER

1. ACOUSTIC LINE ALL RECTANGULAR DUCTS INDICATED ON DRAWINGS WITH 1" THICK NON-FLAMING, COATED MEDIUM DENSITY LINER. APPLY TO MANUFACTURER'S RECOMMENDATIONS.
2. DUCT DIMENSIONS INDICATED ON DRAWINGS ARE CLEAR INSIDE DIMENSIONS (FREE SPACE) WITH GOVERNING REGULATIONS.
3. DUCT LINER SHALL COMPLY WITH NFPA 90A AND 90B (LATEST EDITION) REQUIREMENTS.

E. DUCT ACCESSORIES

1. FLEXIBLE DUCTWORK (AS MANUFACTURED BY CLEVAFLEX, FLEXMASTER OR WIREMOLD).
 - a. FLEXIBLE DUCTS SHALL BE INDEPENDENTLY SUPPORTED FROM THE STRUCTURE AND CONNECTED WITH PLASTIC DRAW BANDS AND TIGHTENED. FLEXIBLE DUCTS SHALL BE LIMITED TO 48" MAXIMUM STRAIGHT LENGTH. FLEXIBLE DUCTS SHALL BE CONSTRUCTED WITH VINYL CLAD VAPOR BARRIER JACKET AND RATED AT 10" W.C. FOR SIZES THOUGH 12", UL LISTED, AND MEET 2550 FLAME AND SMOKE TEST. FLEXIBLE DUCTS ARE NOT PERMITTED IN ROOMS WITHOUT CEILING.
2. DAMPERS (AS MANUFACTURED BY RUSKIN, NAILOR OR SAFE-AIR).
 - a. FABRICATE IN ACCORDANCE WITH SMACNA STANDARDS. PROVIDE END BEARINGS AND LOCKING, INDICATING QUADRANT REGULATORS. BLADES TO BE SINGLE THICKNESS WITH CONTINUOUS HINGE OR ROD.
3. CONTROL DAMPERS (AS MANUFACTURED BY RUSKIN, NAILOR OR SAFE-AIR).
 - a. FABRICATE BLADE OF DOUBLE THICKNESS SHEET METAL, OPPOSED BLADE TYPE WITH SELF-ALIGNING ROD AND END BEARINGS SUITABLE FOR USE WITH AN ACTUATOR.
4. BACKDRAP DAMPERS (AS MANUFACTURED BY RUSKIN, NAILOR OR SAFE-AIR).
 - a. MULTIPLE BLADE, PARALLEL TYPE DAMPER CONSTRUCTED OF GALVANIZED STEEL WITH FELT OR FLEXIBLE VINYL SEALED EDGES, BALL BEARINGS, PIVOT PIN AND ADJUSTMENT DEVICE FOR VARYING PRESSURES.
5. FIRE DAMPERS (AS MANUFACTURED BY RUSKIN, NAILOR OR SAFE-AIR).
 - a. FABRICATE IN ACCORDANCE WITH NFPA 90A AND UL565. DAMPERS SHALL BE SUITABLE FOR USE IN THE VERTICAL OR HORIZONTAL POSITION AS INDICATED ON THE DRAWINGS, BE TYPE "B" WITH BLADES OUT OF AIRSTREAM, AND BE RATED FOR 1-1/2 HOURS MINIMUM (UNLESS NOTED OTHERWISE ON DRAWINGS). PROVIDE A MINIMUM OF TWO (2) INCHES OF INSULATION WITH SHEET METAL COVER.
 - b. PROVIDE DUCT MOUNTED ACCESS DOORS AT ALL FIRE DAMPER LOCATIONS.
6. ACCESS DOORS (AS MANUFACTURED BY RUSKIN, NAILOR OR SAFE-AIR).
 - a. FABRICATE IN ACCORDANCE WITH SMACNA STANDARDS. DOORS TO BE FABRICATED OF GALVANIZED STEEL WITH SEALING GASKET AND QUICK LOCKING DEVICE.
 - b. FOR INSULATED DUCTWORK, DOORS SHALL HAVE MINIMUM 1" INSULATION WITH SHEET METAL COVER.
7. HIGH EFFICIENT BOILERS AND DOMESTIC WATER HEATERS SHALL HAVE STAINLESS STEEL OR PVC COMBUSTION AIR INTAKES AND FLUE GAS OUTLETS AS RECOMMENDED BY THE EQUIPMENT MANUFACTURER.
8. DOMESTIC WATER HEATER FLUES SHALL CONFORM TO THE SPECIFICATION FOR LOW PRESSURE DUCTWORK.
9. ALL GRILLES, REGISTERS, DIFFUSERS AND LOUVERS SHALL BE OF THE SIZES, TYPE, ETC., AS SHOWN ON THE PLAN AND SCHEDULES.
10. GRILLES, REGISTERS, LOUVERS AND DIFFUSERS AS MANUFACTURED BY KRUEGER, ANEMOSTAT OR TITUS COMPANY WILL BE CONSIDERED PROVIDED DIMENSIONS, CAPACITIES, CONSTRUCTION AND SOUND CHARACTERISTICS ARE COMPATIBLE AND SO SHOWN BY SHOP DRAWINGS AND PERFORMANCE SPECIFICATIONS. ALL GRID REGISTERS AND DIFFUSERS SHALL BE FINISHED A COLOR AS SELECTED BY THE ARCHITECT.
11. FURNISH AND INSTALL, AS SHOWN ON THE DRAWINGS AND SCHEDULE, THE CENTRIFUGAL ROOF EXHAUST FANS. THE FAN WHEELS, HOUSING AND CURB CAPS SHALL BE CONSTRUCTED OF ALUMINUM. THE FANS SHALL BE COMPLETE WITH BIRD SCREENS, DISCONNECT SWITCHES, BACKDRAP DAMPERS AND PREFABRICATED CURBS. THE PREFABRICATED CURBS SHALL BE CONSTRUCTED OF 18 GAUGE GALVANIZED STEEL WITH BUILT IN CANT AND WOOD NAILER STRIP AT TOP OF CURB.
12. FURNISH AND INSTALL THE INTAKE AND RELIEF VENTS AS SHOWN ON THE DRAWINGS AND SCHEDULE. THESE VENTS SHALL BE CONSTRUCTED OF ALUMINUM. EACH RELIEF VENT SHALL BE COMPLETE WITH BIRD SCREEN, BACKDRAP DAMPER AND PREFABRICATED CURB.
13. CENTRIFUGAL ROOF EXHAUST FANS, INTAKE, AND RELIEF VENTS AS MANUFACTURED BY LOREN COOK OR GREENHECK WILL BE CONSIDERED PROVIDED SIZE, PERFORMANCE RATINGS AND DIMENSIONS ARE COMPATIBLE AND SO SHOWN BY SHOP DRAWINGS AND PERFORMANCE SPECIFICATIONS.
14. ROOF MOUNTED EQUIPMENT SHALL BE SUPPORTED USING PATE CURBS.

SECTION 235000 - HEAT GENERATION EQUIPMENT

A. GENERAL

1. FURNISH ALL MATERIAL, LABOR, EQUIPMENT, AND ACCESSORIES AS REQUIRED TO INSTALL EQUIPMENT AS INDICATED ON MECHANICAL DRAWINGS.
2. INSTALL IN FULL ACCORDANCE WITH LOCAL CODE REQUIREMENTS, OTHER SPECIFICATION SECTION REQUIREMENTS, AND MANUFACTURER RECOMMENDATIONS.



2. SEE EQUIPMENT SCHEDULES ON MECHANICAL DRAWINGS.

SECTION 236000 - REFRIGERATION EQUIPMENT


A. GENERAL

FOOD SERVICE EQUIPMENT / UTILITIES SCHEDULE				
ITEM #	DESCRIPTION	MANUFACTURER	MODEL #	QTY
1	SINK BOWL, WELD-IN, DUMP SINK	N. WASSERSTROM & SONS	F4480234	1
1A	SINK BOWL, WELD-IN, HAND WASH	N. WASSERSTROM & SONS	F4480234	1
3C	BLODGETT OVEN	BLODGETT	CTB SGL	1
3D	RAPID COOK OVEN	MERRYCHEF USA	E2S HIGH CLASSIC	1
100.1	PANTRY FAUCET	T&S BRASS	KL45-4000-WH	1
100.2	HOT WATER DISPENSER	IN SINK ERATOR	C1300	1
103	POS SYSTEM	-	-	1
104	ESPRESSO MACHINE	MELLITA	CT8	2
108	GARBAGE CAN	RUBBERMAID COMMERCIAL PRODUCTS	FG354060BLA	3
111	TOUCH-FREE SOAP DISPENSER	GOJO INDUSTRIES, INC.	PURELL CS6	1
112	SURFACE-MOUNTED PAPER TOWEL DISPENSER	BOBRICK	B-2621	1
112.1	BLENDER RINSE	BLENDTEC	JRE-610	1
113	COFFEE GRINDER	GRINDMASTER-UNIC-CRATHCO	890BS	1
114	COFFEE BREWER	BUNN	53100.0100	1
115	MANIFOLD	-	-	1
116	GLASS FILLER	T&S BRASS	B-1210	1
117	AIRPOT	SERVICE IDEAS	ECALS22SS	2
118	SELF-SERVICE REFRIGERATED CASE	STRUCTURAL CONCEPTS	B3424	2
119	PASTRY CASE, CURVED GLASS	FEDERAL INDUSTRIES	CGR5948DZ	0
120	DROP-IN ICE BIN	KROWNE	D278	0
121	BLENDER	VITAMIX	36019-ABAB	2
123	DIPPER WELL	T&S BRASS	B-2282-01-F05	1
131	SINGLE UNDER COUNTER REFRIGERATOR	TRUE MGF.	TUC-27-HC	2
132	DOUBLE UNDER COUNTER REFRIGERATOR	TRUE MGF.	TWT-48-HC	1

WORKROOM EQUIPMENT / UTILITIES SCHEDULE				
ITEM #	DESCRIPTION	MANUFACTURER	MODEL #	QTY
1A	R.O. WATER FILTRATION SYSTEM MANIFOLD BOARD	-	-	1
1B	R.O. WATER FILTRATION SYSTEM - ACCUMULATOR TANK	-	-	1
1C	R.O. WATER FILTRATION SYSTEM - WATER SOFTENER	-	-	1
1D	R.O. WATER FILTRATION SYSTEM - BRINER	-	-	1
2B	FREEZER, REACH-IN, SINGLE DOOR	-	-	1
3B	FREEZER, REACH-IN, DOUBLE DOOR	TRUE MGF.	STG2F-2S-HC	1
4	WATER HEATER	-	-	1
5	MOP SINK	-	-	1
5.1	SERVICE FAUCET	-	-	1
6	WALL SHELF	-	-	1
8	SOAP DISPENSER	GOJO INDUSTRIES, INC.	TFX	1
9	HAND SINK - WALL MOUNTED	HAND SINK, PARTS & ACCESSORIES	DH-17-NO FAU	1
14	C-FOLD PAPER TOWEL DISPENSER	-	-	1
15	WASTE CONTAINER	-	-	1
16	THREE COMPARTMENT SINK	AMTEKCO INDUSTRIES LTD.	D724-03-74	1
16.1	PRE-RINSE FAUCET & ADD ON FAUCET	T&S BRASS	B-5110-12-CRB8P	1
16.4	LEVER WASTE	T&S BRASS	B-3950	3
120B	REFRIGERATOR, REACH-IN, DOUBLE DOOR	TRUE MGF.	STG2R-2S-HC	1
125	ICE MAKER, CUBE-STYLE	ITV ICE MAKER	SPIKA MS 500	1
127	WIRE SHELVING	1880 HOSPITALITY	FF2472C	3
133	DISHWASHER, UNDERCOUNTER	JACKSON WWS	DISHSTAR HT	1
134	DISCONNECT SWITCH	-	-	1
135	RECIRCULATION PUMP	-	-	1

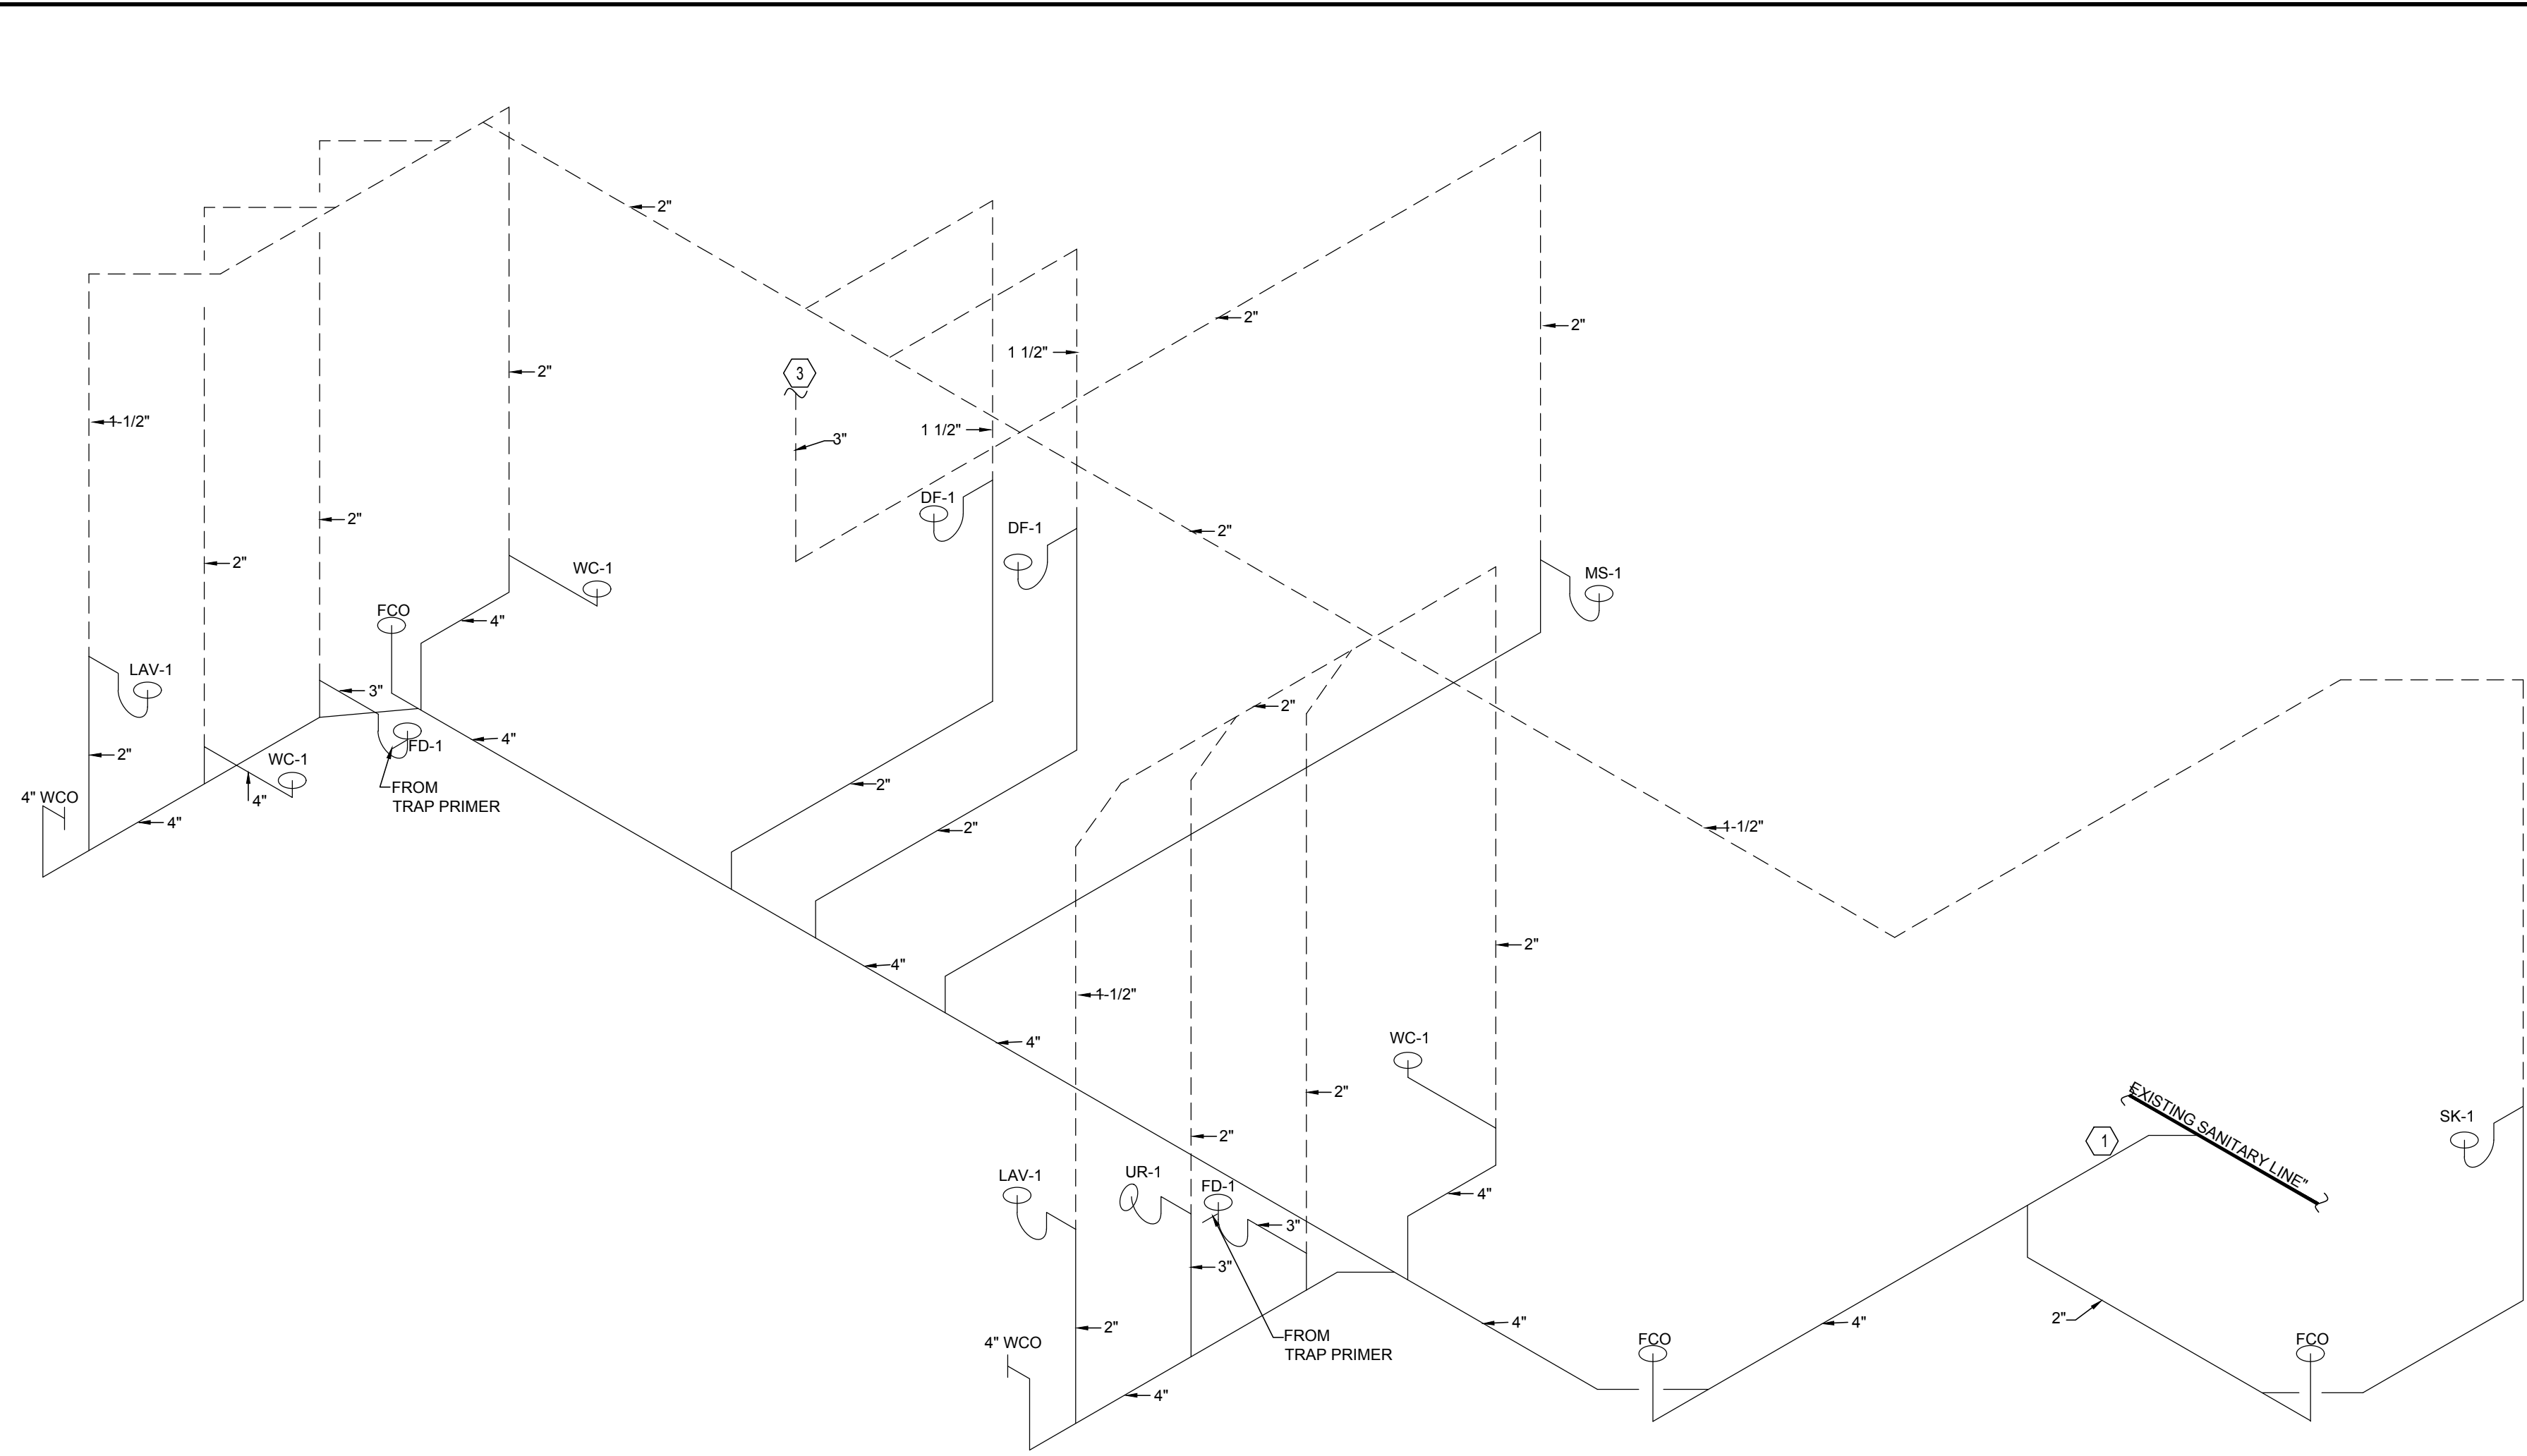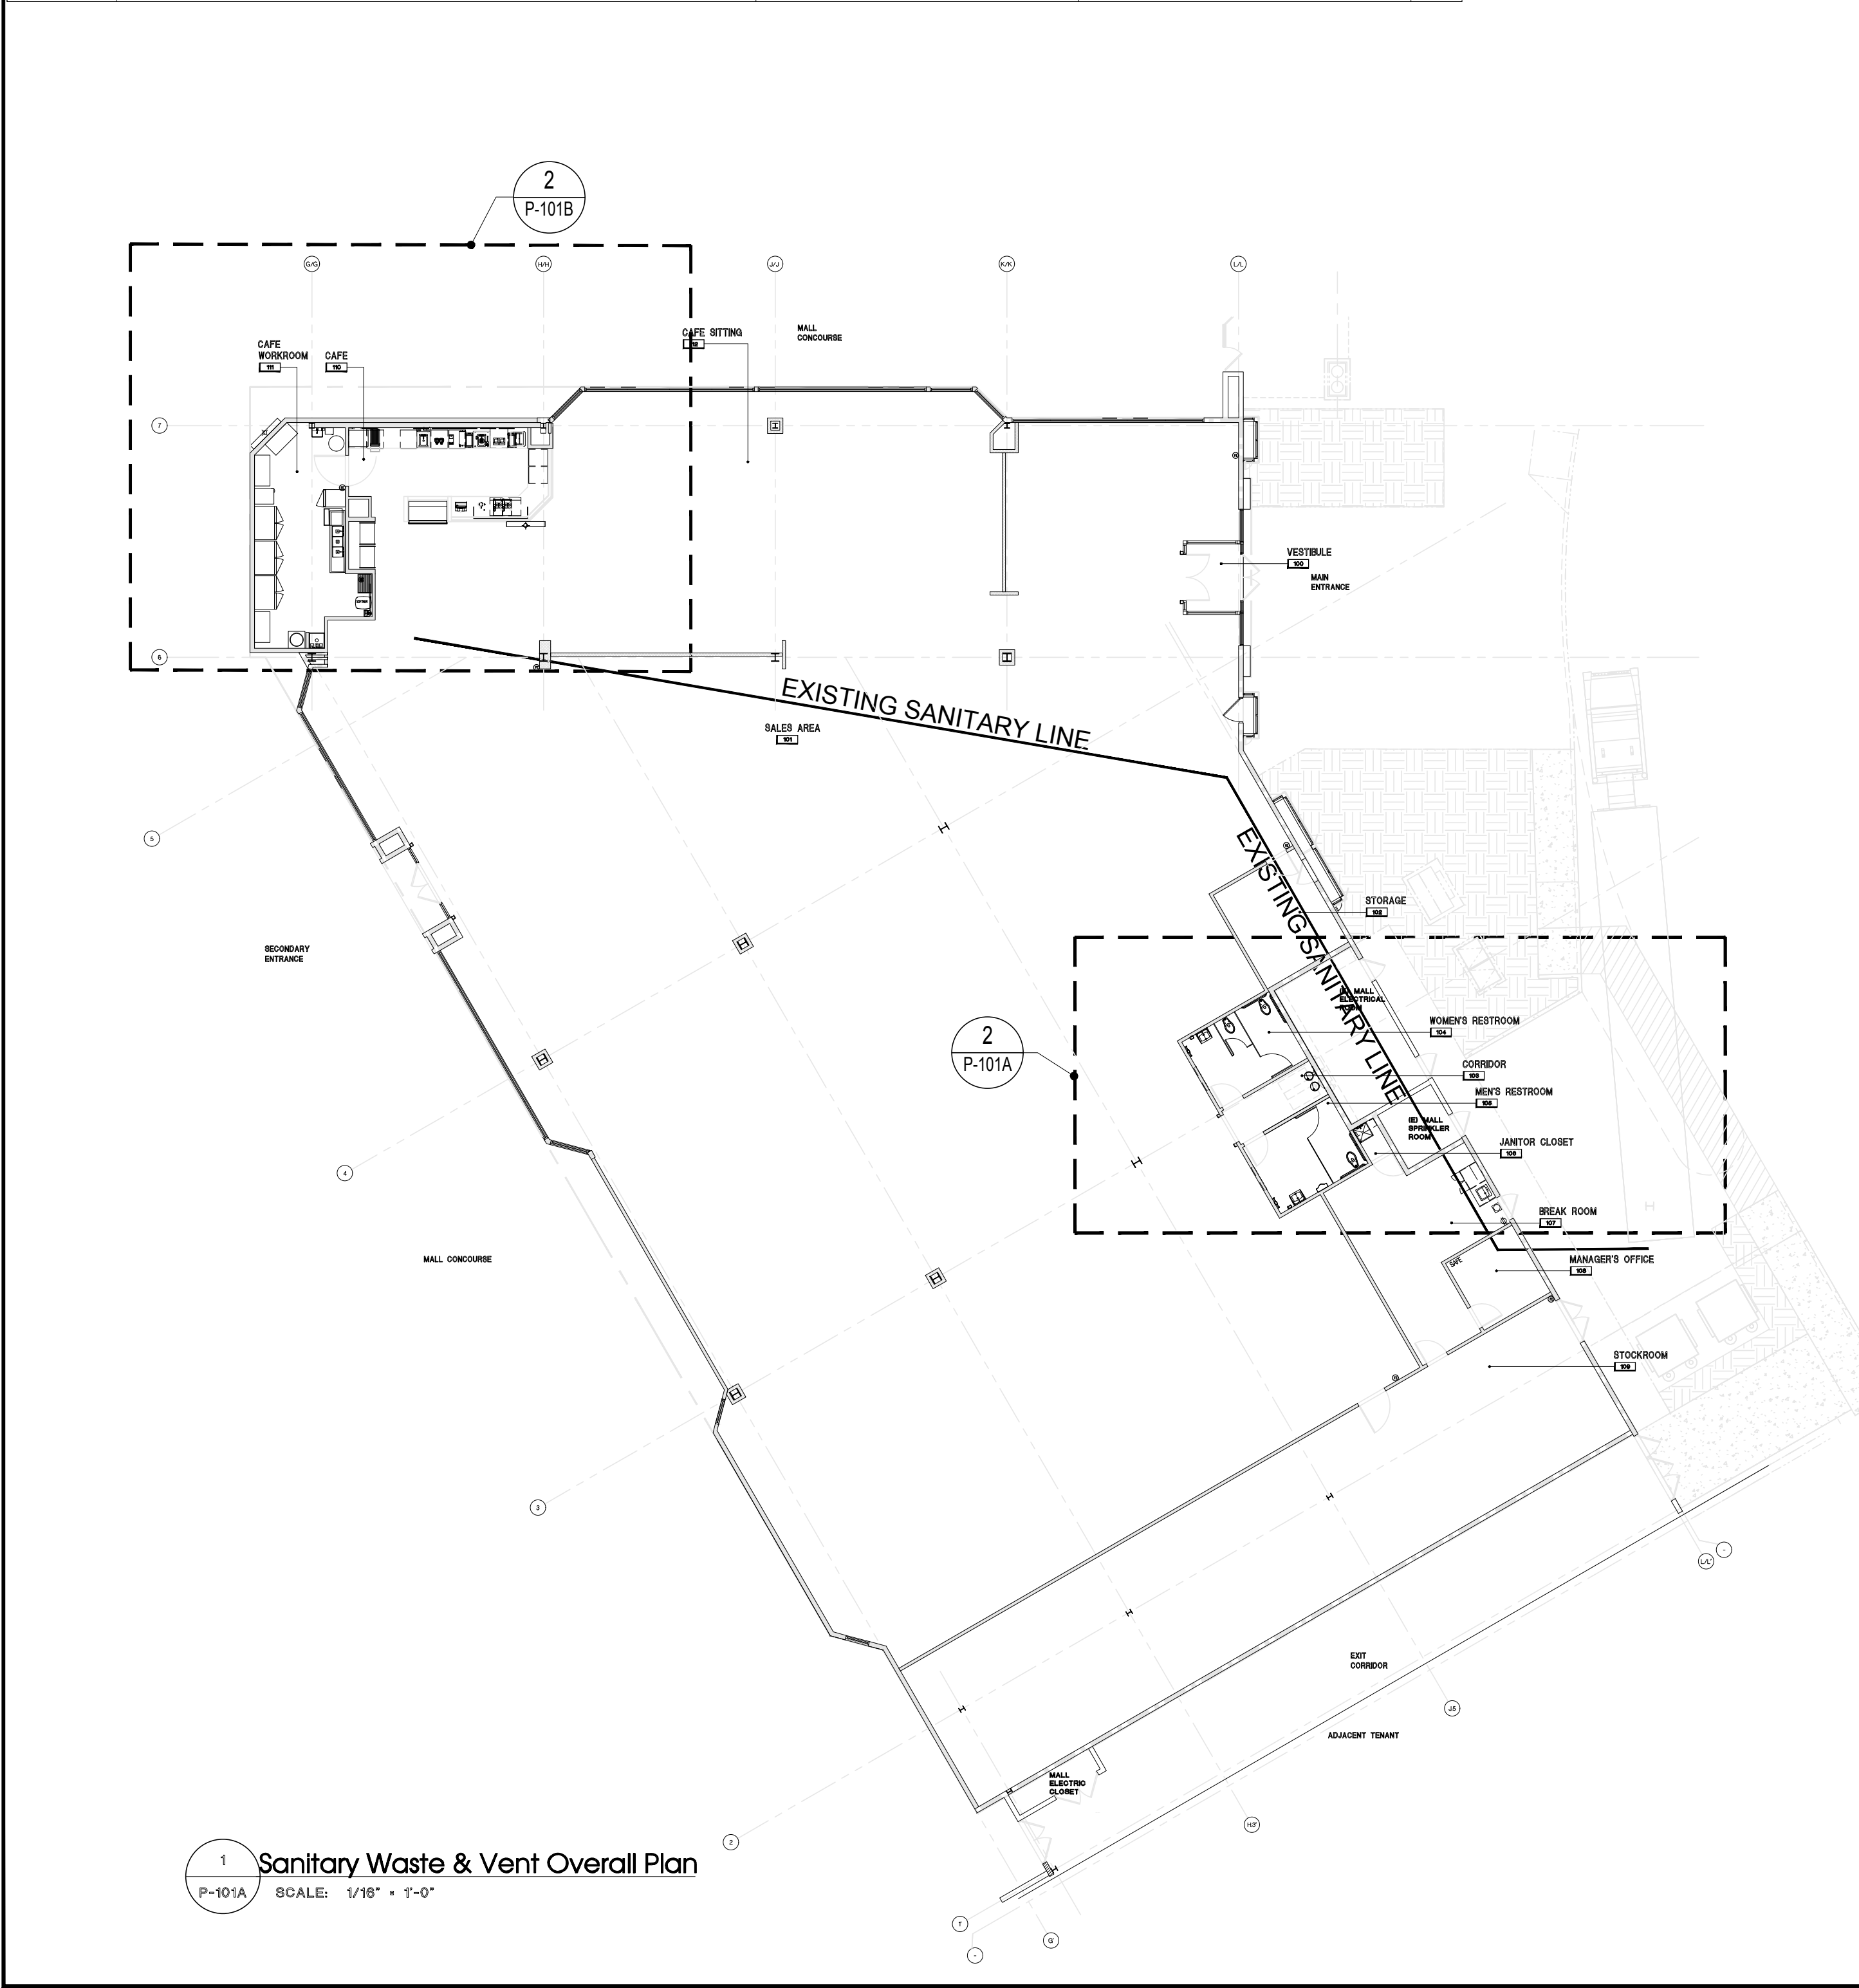

Isometric Riser Diagram
SCALE: N.T.S.

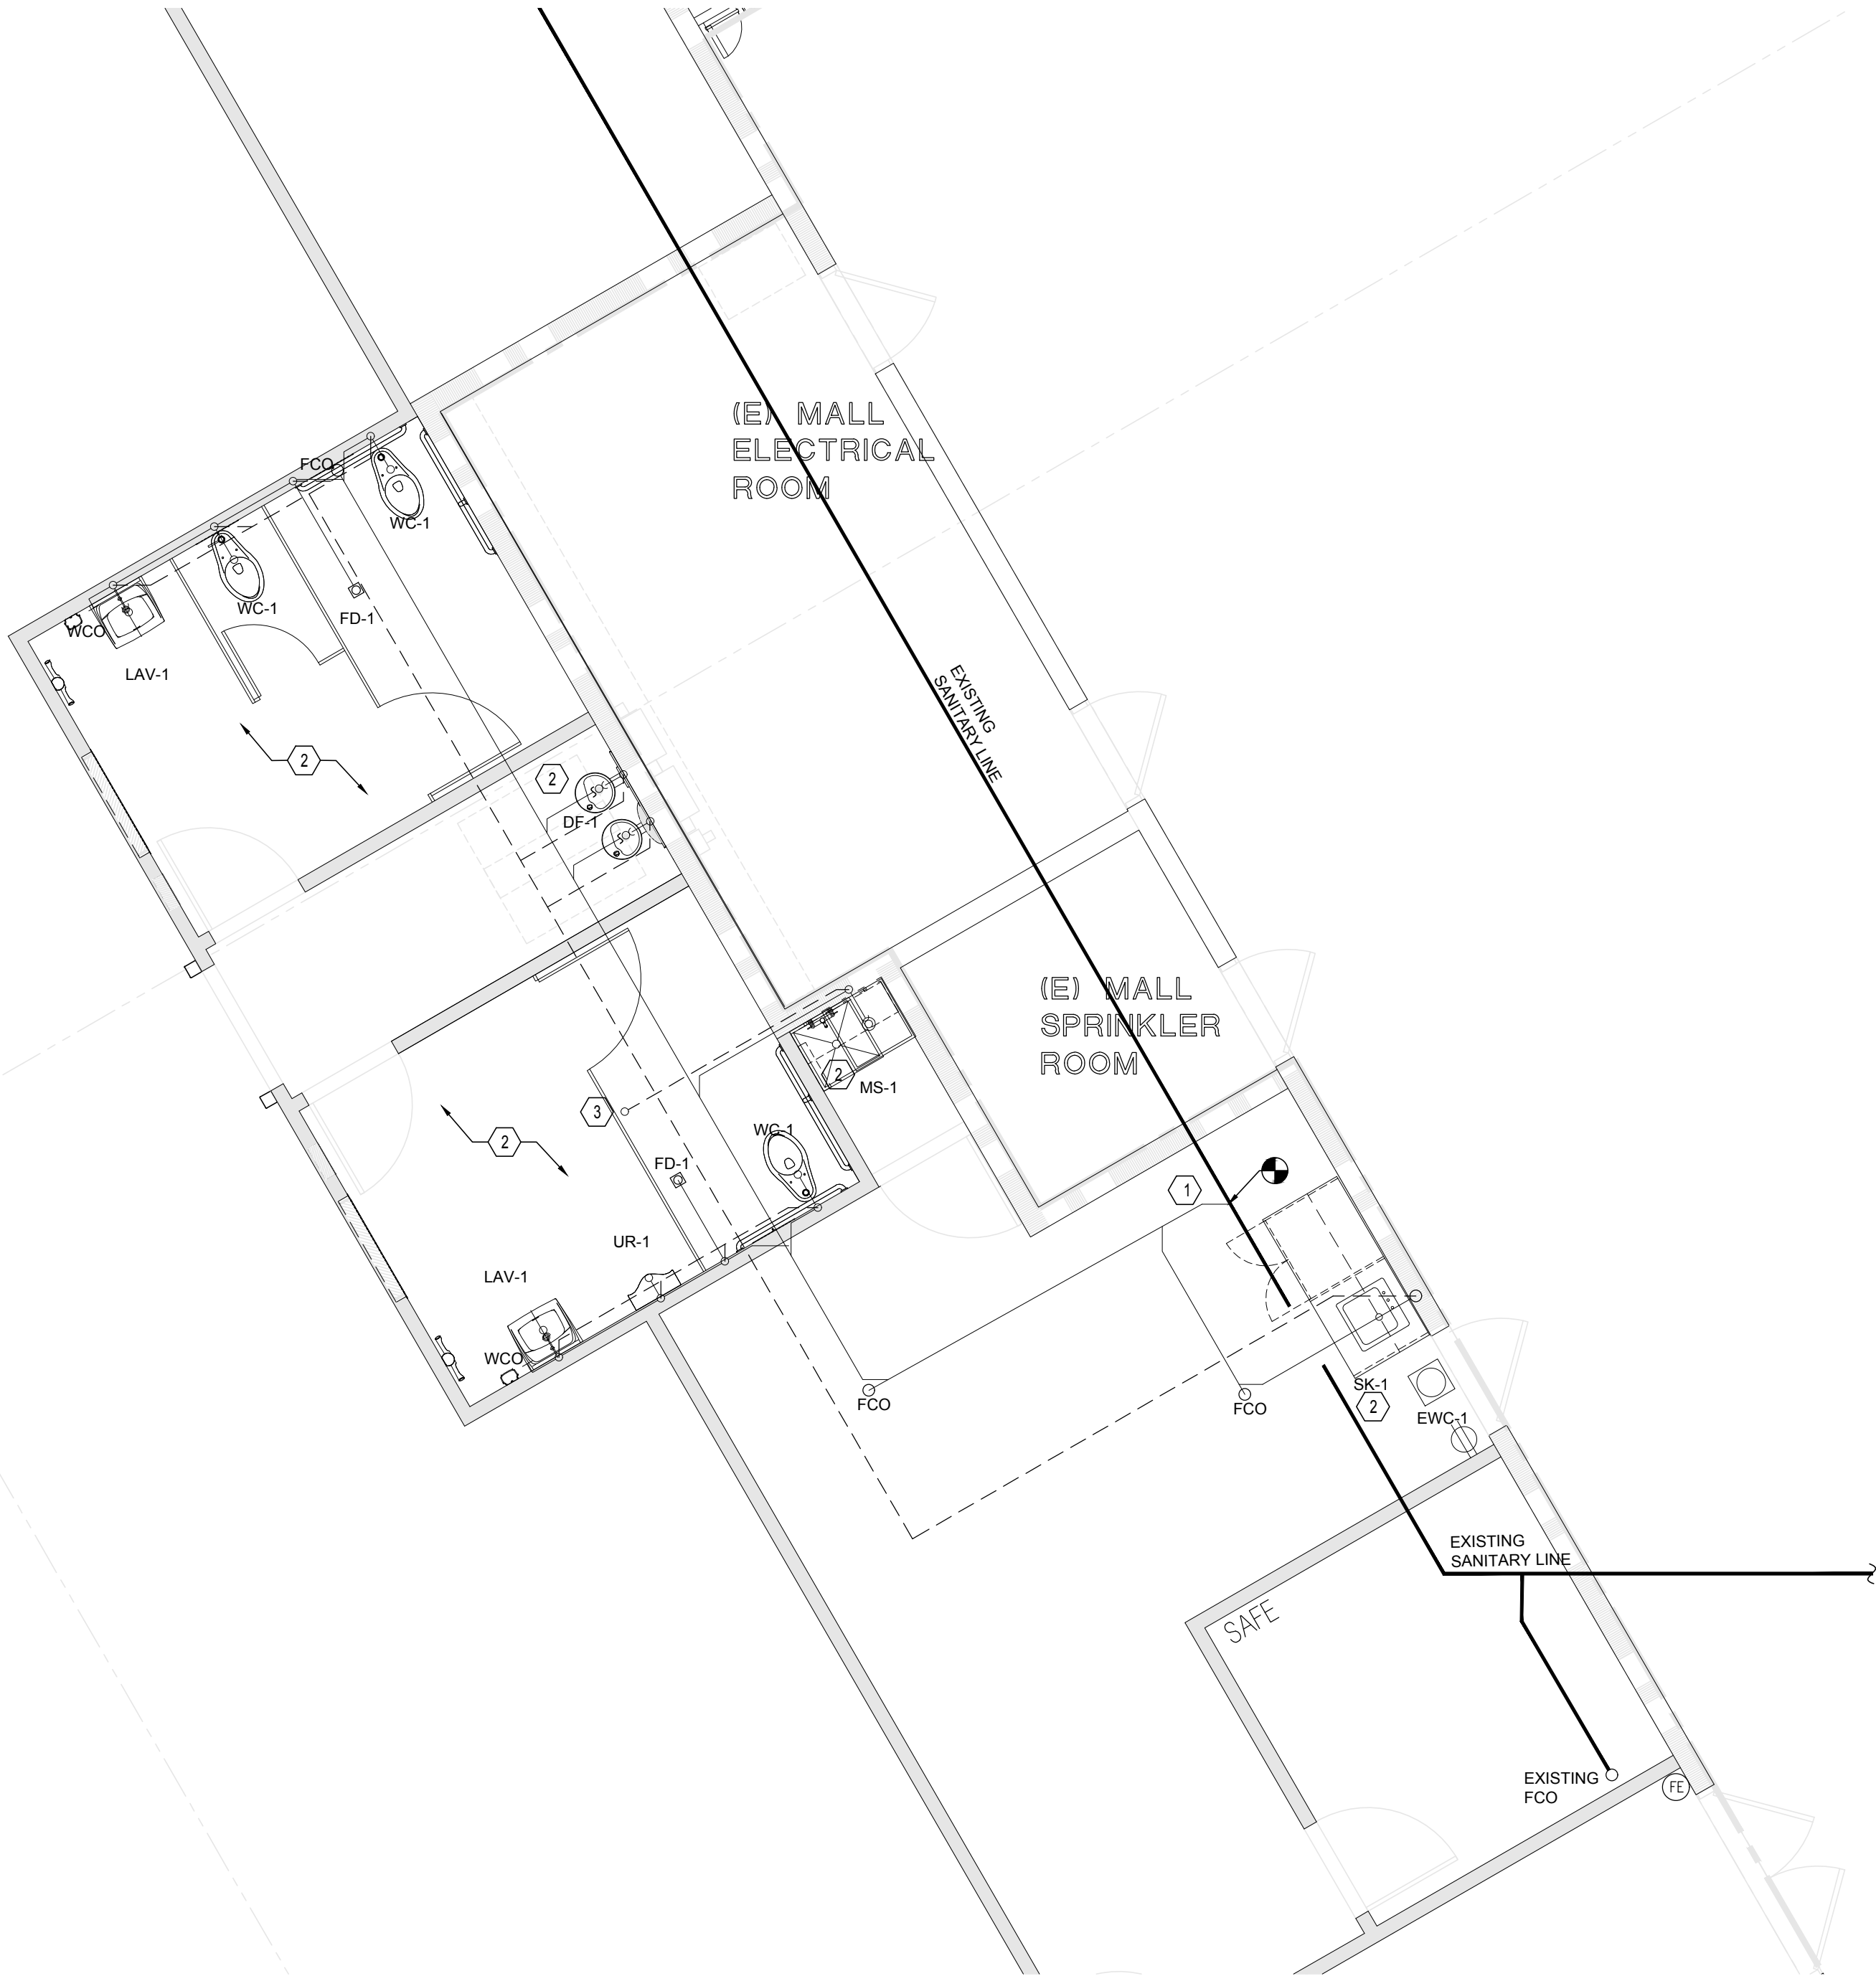

Plumbing Plan
SCALE: 1/4\"/>

[2021 Uniform Plumbing Code, section 901.2]
Vents Required.
Each plumbing fixture trap, except as otherwise provided in this code, shall be protected against siphonage and backpressure, and air circulation shall be ensured throughout all parts of the drainage systems by means of vent pipes installed in accordance with the requirements of this chapter and as otherwise required by this code.

[2021 Uniform Plumbing Code, section 402.1]
Cleaning.
Plumbing fixtures shall be installed in a manner to afford easy access for repairs and cleaning. Pipes from fixtures shall be run to the nearest wall.

[2021 Uniform Plumbing Code, section 402.2]
Joints.
Where a fixture comes in contact with the wall or floor, the joint between the fixture and the wall or floor shall be made watertight.

Provide cross connection in accordance with the
2021 Uniform Plumbing Code w/ Washington State
amendments for all applicable water connections

GENERAL NOTES: (PLUMBING)

- THESE DRAWINGS ARE DIAGRAMMATIC AND INDICATE THE GENERAL EXTENT OF WORK. THE CONTRACTOR SHALL BE RESPONSIBLE FOR THE COORDINATION AND PROPER INSTALLATION OF ALL PLUMBING SYSTEMS. REFERENCE FOOD SERVICE DRAWINGS WHEN INSTALLING FOR EXACT LOCATIONS AND HEIGHTS.
- THE CONTRACTOR SHALL PROVIDE ALL MISCELLANEOUS SUPPORTING STEEL ETC. FOR THE PROPER INSTALLATION OF ALL PLUMBING SYSTEMS.
- THE CONTRACTOR SHALL COORDINATE FLOOR, WALL AND ROOF PENETRATIONS WITH THE GENERAL CONTRACTOR.
- PIPING SHALL NOT BE LOCATED IN ELECTRICAL ROOMS OR OVER THE TOP OF ANY ELECTRICAL PANELS OR EQUIPMENT.
- CONTRACTOR SHALL FIELD VERIFY SLAB ON GRADE FLOOR CONSTRUCTION TYPE PRIOR TO CUTTING. UNDER NO CIRCUMSTANCES SHALL THE CONTRACTOR CUT A STRUCTURAL FLOOR SLAB THICKER THAN FOUR (4) INCHES WITHOUT PRIOR WRITTEN APPROVAL FROM ENGINEER OF RECORD. NOTIFY ENGINEER OF RECORD OF ANY SLAB THICKNESS GREATER THAN FOUR (4) INCHES PRIOR TO PROCEEDING WITH ANY SAW CUTTING.

CODED NOTES:

- EXTEND AND CONNECT NEW 4\"/>
- CONTRACTOR PROVIDE PLUMBING FIXTURES AS SPECIFIED ON SHEET #P-201. RECONNECT TO EXISTING SANITARY LINE AND EXISTING VENT LINE AS REQUIRED.
- NEW 3\"/>
- 1-1/2\"/>
- 2\"/>
- 3\"/>

THESE DRAWINGS ARE DIAGRAMMATIC AND INDICATE THE GENERAL EXTENT OF THE WORK. THE CONTRACTOR SHALL BE RESPONSIBLE FOR THE COORDINATION AND PROPER INSTALLATION OF ALL PLUMBING SYSTEMS. THE CONTRACTOR SHALL PROVIDE ALL NECESSARY OFFSETS AND FITTINGS WHICH MAY BE REQUIRED DUE TO SPACE CONSTRAINTS OR OTHER CONDITIONS.

CONTRACTOR SHALL FIELD VERIFY ALL EXISTING FIELD CONDITIONS PRIOR TO BEGINNING WORK.

City of Puyallup
Development & Permitting Services
ISSUED PERMIT

Building	Planning
Engineering	Public Works
Fire	Traffic

BARNES&NOBLE


PROJECT DESIGNER:

WJCA
BUILDING VALUE SINCE 1994

ARCHITECT:

JOEL TORIELLI
422 BOGERT AVE
RIDGEWOOD, NJ 07450

Kenneth A. Fuller, P.E.

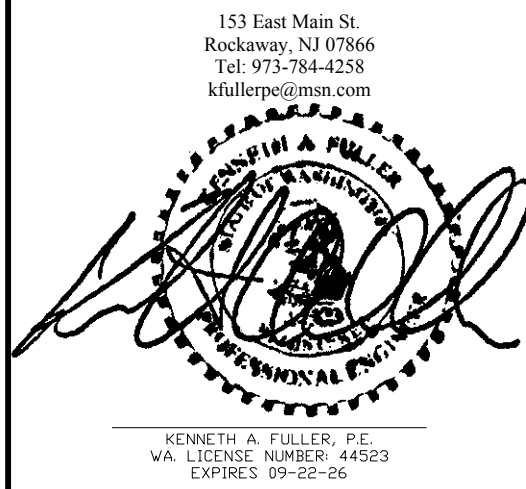

SOUTH HILL MALL
3500 S. MERIDIAN ST.
UNIT #800
PUYALLUP, WA 98373

Project Number 33247
Store Number 3507

Revision Log:

Date	Description	No.
12-19-24	ISSUED FOR PERMIT, BID, LANDLORD & CLIENT REVIEW	1
02-20-25	LANDLORD & BID COMMENTS	2
		3
		4
		5
These plans are an instrument of service and the property of the Architect. Infringements will be prosecuted.

General Contractor to verify all conditions and dimensions at the premises. Discrepancies shall be reported to the Architect prior to the commencement of any work.

Professional Seal:

LIC.# : 22005563
EXP. DATE : 10/02/25

Drawing Description:


SANITARY WASTE & VENT PLAN

Drawing Number:


P-101A

FOOD SERVICE EQUIPMENT / UTILITIES SCHEDULE				
ITEM #	DESCRIPTION	MANUFACTURER	MODEL #	QTY
1	SINK BOWL, WELD-IN, DUMP SINK	N. WASSERSTROM & SONS	F4480234	1
1A	SINK BOWL, WELD-IN, HAND WASH	N. WASSERSTROM & SONS	F4480234	1
3C	BLODGETT OVEN	BLODGETT	CTB SGL	1
3D	RAPID COOK OVEN	MERRYCHIEF USA	E2S HIGH CLASSIC	1
100.1	PANTRY FAUCET	T&S BRASS	KL45-4000-WH	1
100.2	HOT WATER DISPENSER	IN SINK ERATOR	C1300	1
103	POS SYSTEM	-	-	1
104	ESPRESSO MACHINE	MELLITA	CT8	2
108	GARBAGE CAN	RUBBERMAID COMMERCIAL PRODUCTS	FG354060BLA	3
111	TOUCH-FREE SOAP DISPENSER	GOJO INDUSTRIES, INC.	PURELL CS6	1
112	SURFACE-MOUNTED PAPER TOWEL DISPENSER	BOBRICK	B-2521	1
112.1	BLENDER RINSE	BLENDTEC	JRE-610	1
113	COFFEE GRINDER	GRINDMASTER-UNIC-CRATHCO	890BS	1
114	COFFEE BREWER	BUNN	53100.0100	1
115	MANIFOLD	-	-	1
116	GLASS FILLER	T&S BRASS	B-1210	1
117	AIRPOT	SERVICE IDEAS	ECALS22SS	2
118	SELF-SERVICE REFRIGERATED CASE	STRUCTURAL CONCEPTS	B3424	2
119	PASTRY CASE, CURVED GLASS	FEDERAL INDUSTRIES	CGR5948DZ	0
120	DROP-IN ICE BIN	KROWNE	D278	0
121	BLENDER	VITAMIX	36019-ABAB	2
123	DIPPER WELL	T&S BRASS	B-2282-01-F05	1
131	SINGLE UNDER COUNTER REFRIGERATOR	TRUE MGF.	TUC-27-HC	2
132	DOUBLE UNDER COUNTER REFRIGERATOR	TRUE MGF.	TWT-48-HC	1


WORKROOM EQUIPMENT / UTILITIES SCHEDULE				
ITEM #	DESCRIPTION	MANUFACTURER	MODEL #	QTY
1A	R.O. WATER FILTRATION SYSTEM MANIFOLD BOARD	-	-	1
1B	R.O. WATER FILTRATION SYSTEM - ACCUMULATOR TANK	-	-	1
1C	R.O. WATER FILTRATION SYSTEM - WATER SOFTENER	-	-	1
1D	R.O. WATER FILTRATION SYSTEM - BRINER	-	-	1
2B	FREEZER, REACH-IN, SINGLE DOOR	-	-	1
3B	FREEZER, REACH-IN, DOUBLE DOOR	TRUE MGF.	STG2F-2S-HC	1
4	WATER HEATER	-	-	1
5	MOP SINK	-	-	1
5.1	SERVICE FAUCET	-	-	1
6	WALL SHELF	-	-	1
8	SOAP DISPENSER	GOJO INDUSTRIES, INC.	TFX	1
9	HAND SINK - WALL MOUNTED	HAND SINK, PARTS & ACCESSORIES	DH-17-NO FAU	1
14	C-FOLD PAPER TOWEL DISPENSER	-	-	1
15	WASTE CONTAINER	-	-	1
16	THREE COMPARTMENT SINK	AMTEKCO INDUSTRIES LTD.	D724-03-74	1
16.1	PRE-RINSE FAUCET & ADD ON FAUCET	T&S BRASS	B-5110-12-CRB8P	1
16.4	LEVER WASTE	T&S BRASS	B-3950	3
120B	REFRIGERATOR, REACH-IN, DOUBLE DOOR	TRUE MGF.	STG2R-2S-HC	1
125	ICE MAKER, CUBE-STYLE	ITV ICE MAKER	SPIKA MS 500	1
127	WIRE SHELVING	1880 HOSPITALITY	FF2472C	3
133	DISHWASHER, UNDERCOUNTER	JACKSON WWS	DISHSTAR HT	1
134	DISCONNECT SWITCH	-	-	1
135	RECIRCULATION PUMP	-	-	1

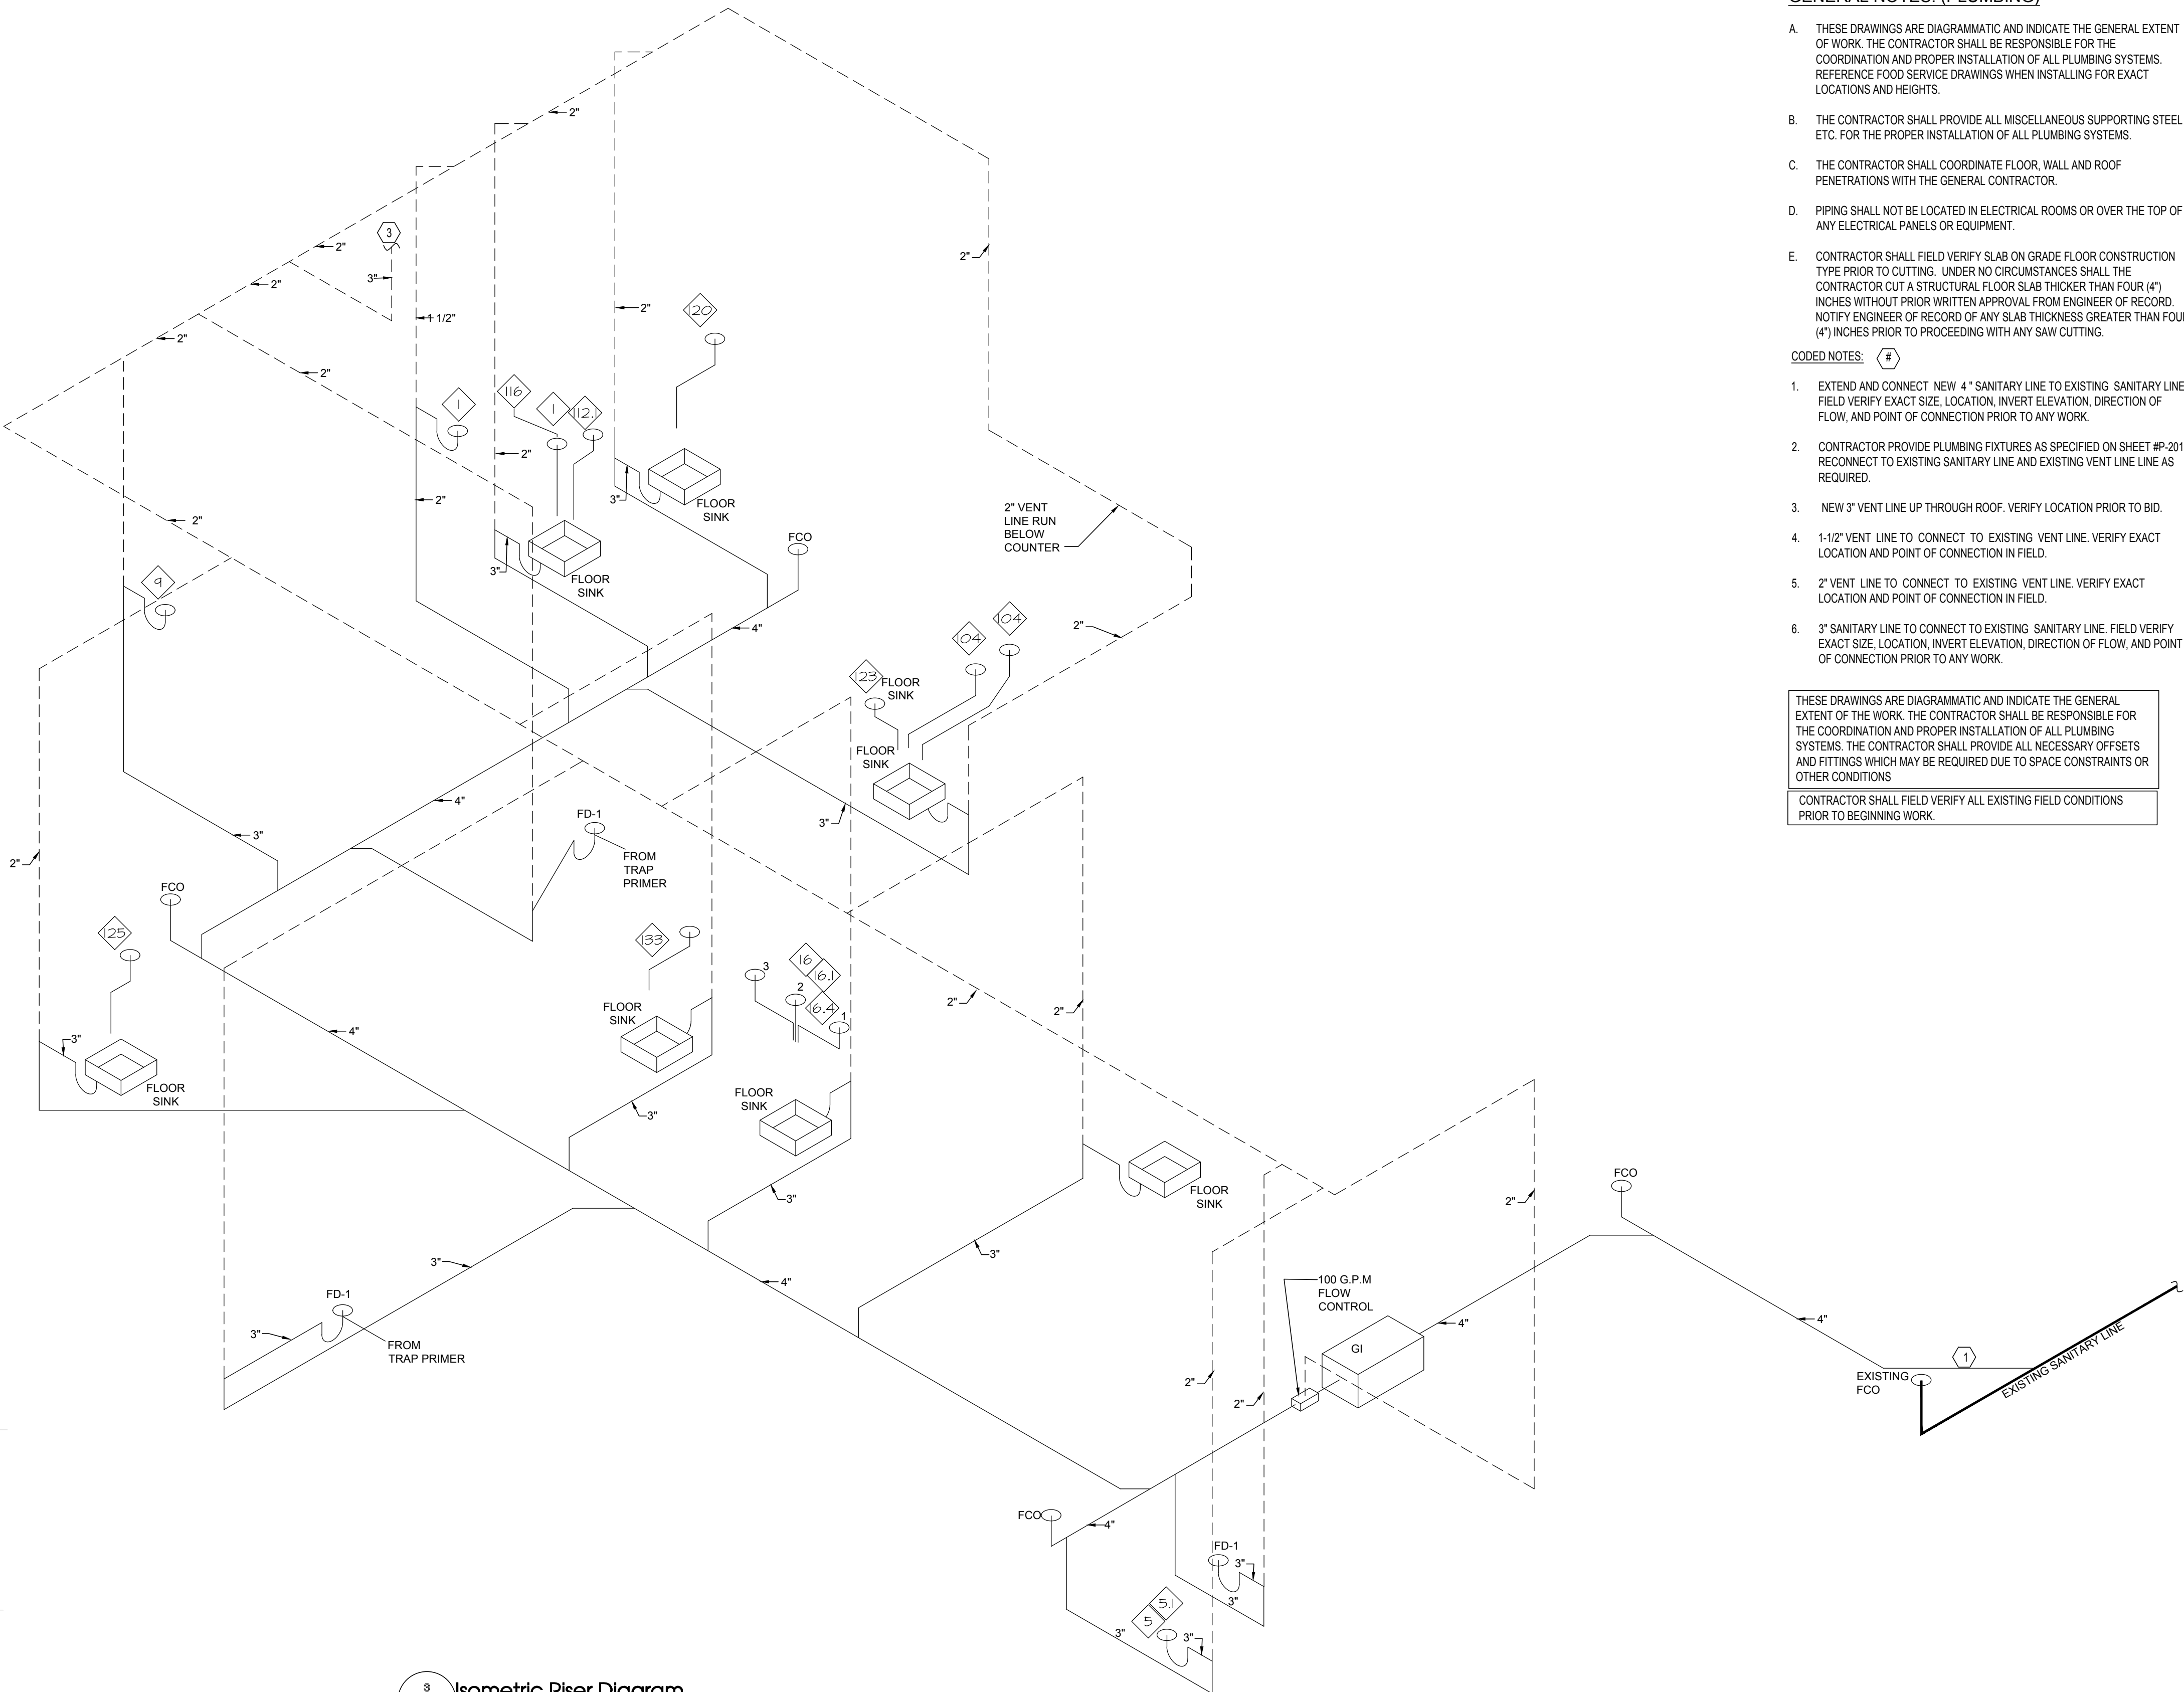

3 Isometric Riser Diagram
P-101B SCALE: N.T.S.

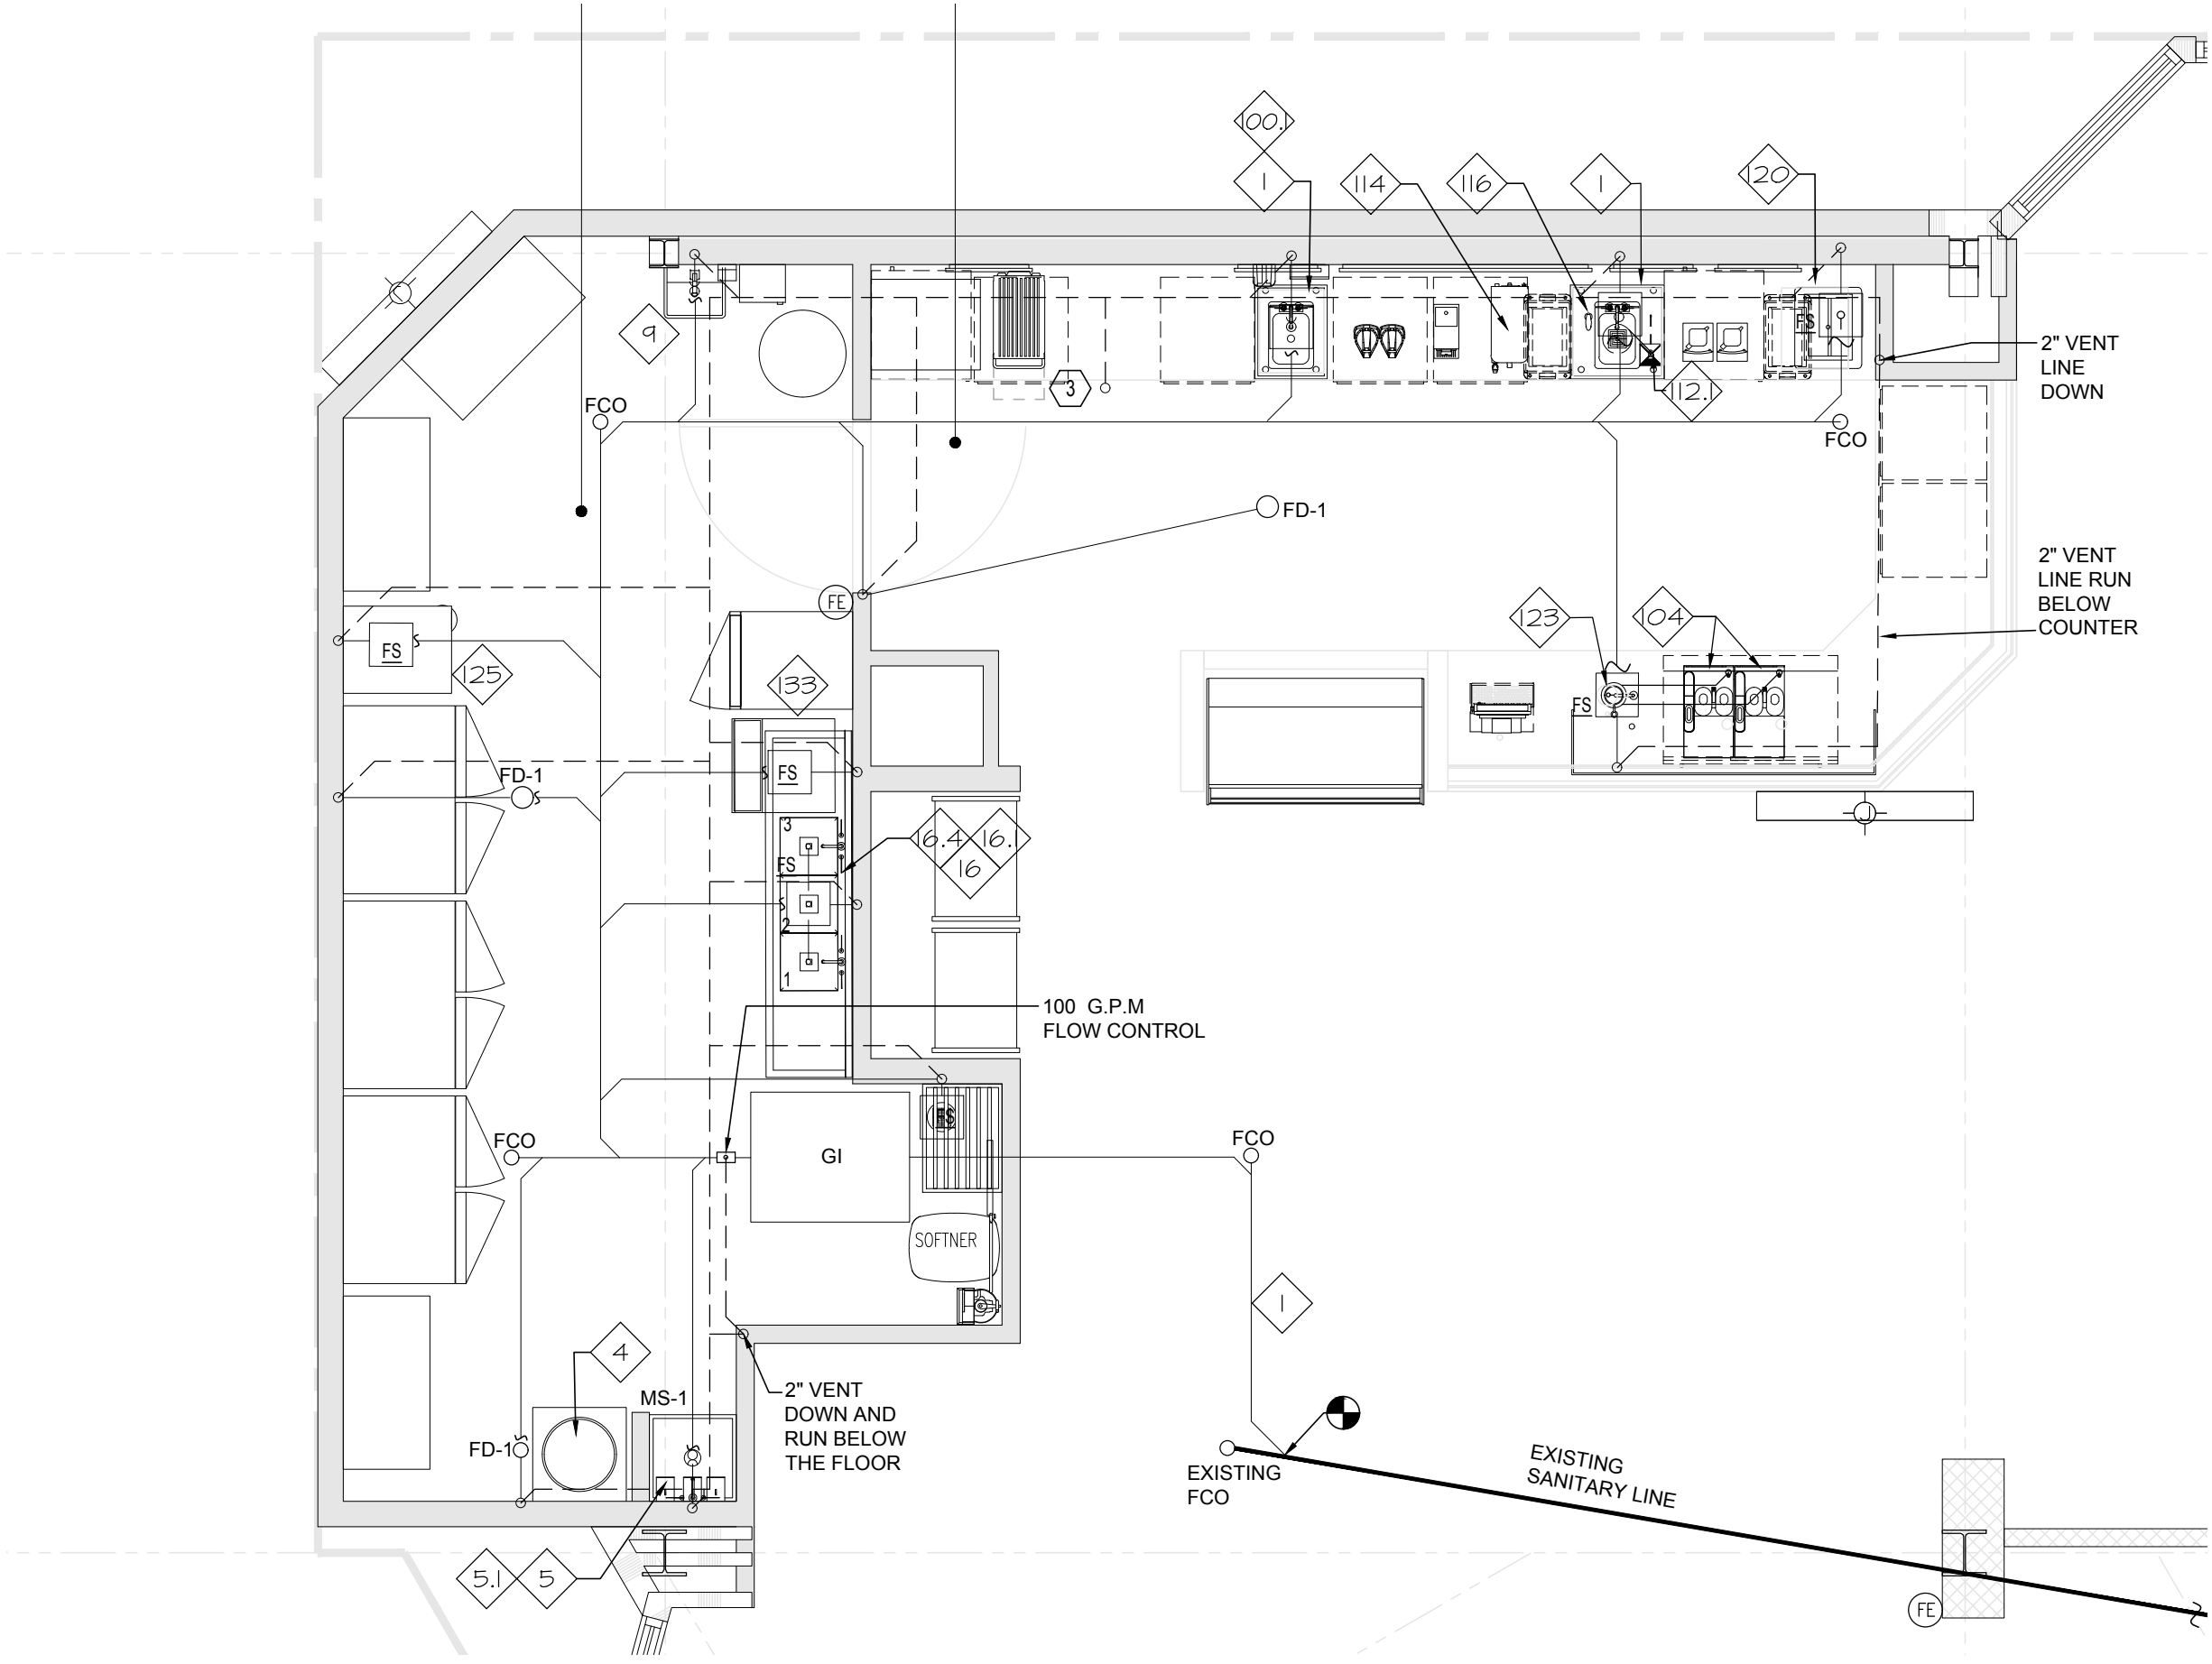

2 Plumbing Plan
P-101B SCALE: 1/4" = 1'-0"

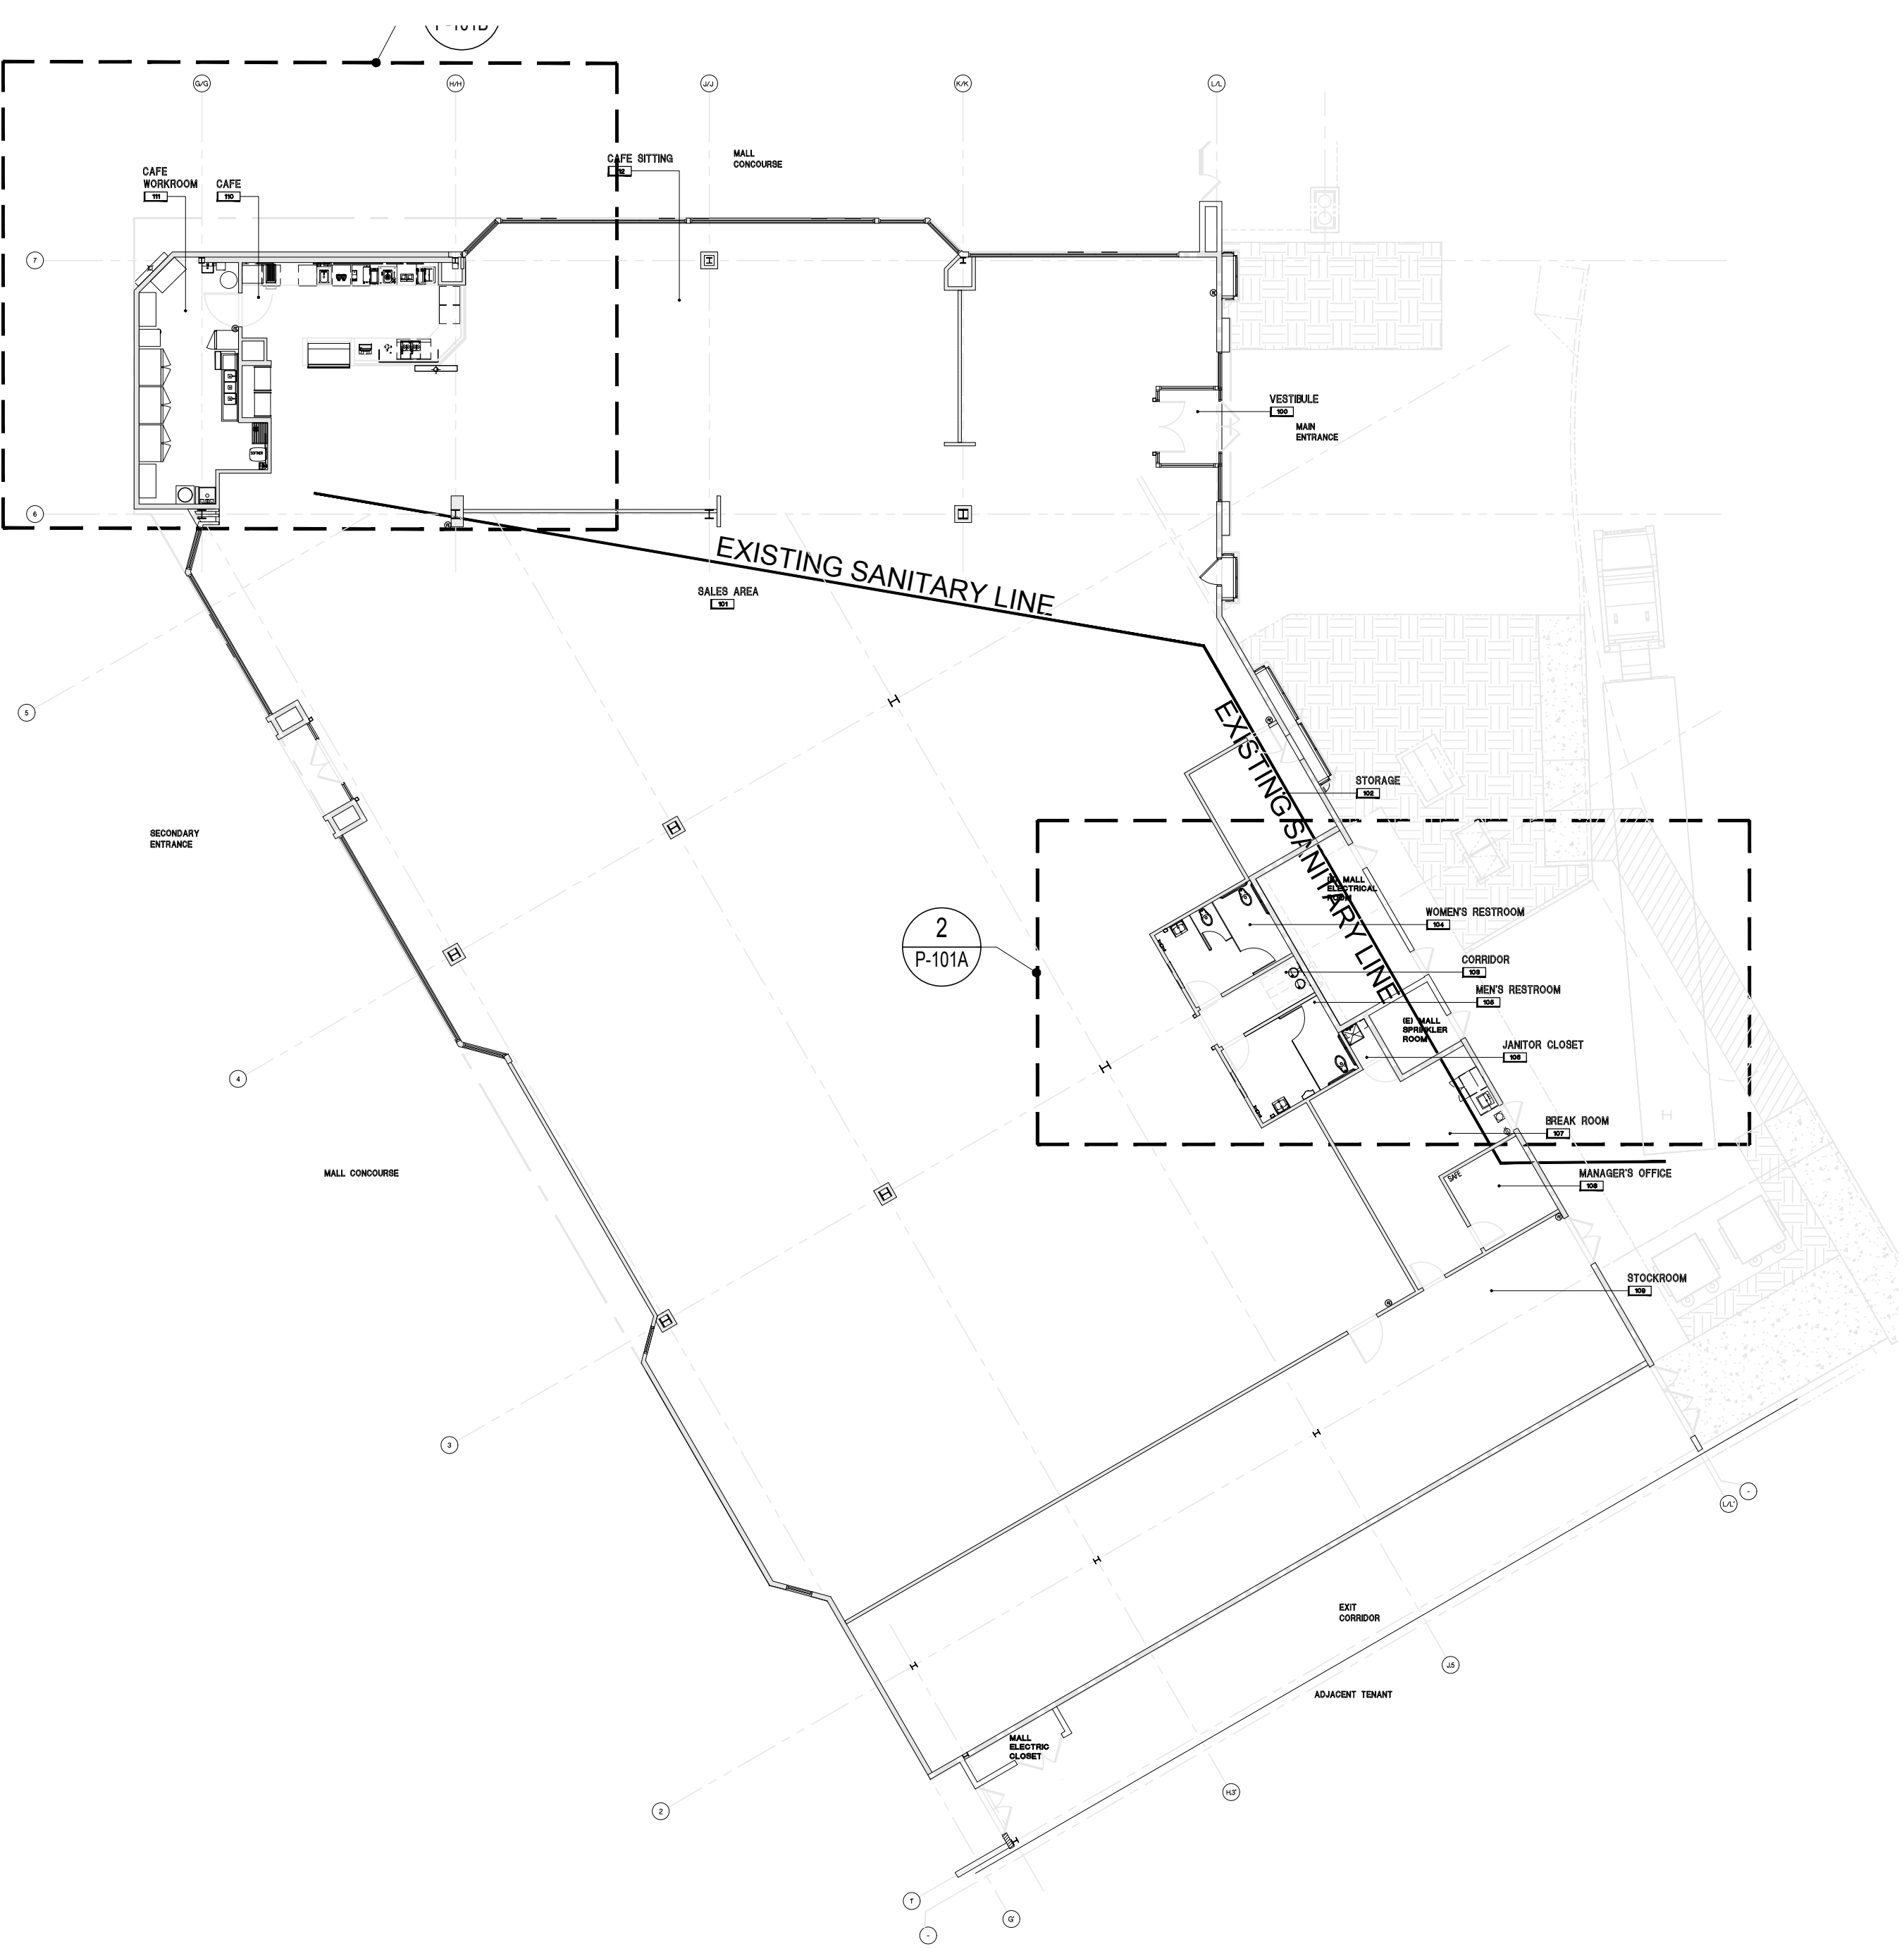

1 Sanitary Waste & Vent Overall Plan
P-101B SCALE: 1/16" = 1'-0"

GENERAL NOTES: (PLUMBING)


- THESE DRAWINGS ARE DIAGRAMMATIC AND INDICATE THE GENERAL EXTENT OF WORK. THE CONTRACTOR SHALL BE RESPONSIBLE FOR THE COORDINATION AND PROPER INSTALLATION OF ALL PLUMBING SYSTEMS. REFERENCE FOOD SERVICE DRAWINGS WHEN INSTALLING FOR EXACT LOCATIONS AND HEIGHTS.
- THE CONTRACTOR SHALL PROVIDE ALL MISCELLANEOUS SUPPORTING STEEL ETC. FOR THE PROPER INSTALLATION OF ALL PLUMBING SYSTEMS.
- THE CONTRACTOR SHALL COORDINATE FLOOR, WALL AND ROOF PENETRATIONS WITH THE GENERAL CONTRACTOR.
- PIPING SHALL NOT BE LOCATED IN ELECTRICAL ROOMS OR OVER THE TOP OF ANY ELECTRICAL PANELS OR EQUIPMENT.
- CONTRACTOR SHALL FIELD VERIFY SLAB ON GRADE FLOOR CONSTRUCTION TYPE PRIOR TO CUTTING. UNDER NO CIRCUMSTANCES SHALL THE CONTRACTOR CUT A STRUCTURAL FLOOR SLAB THICKER THAN FOUR (4) INCHES WITHOUT PRIOR WRITTEN APPROVAL FROM ENGINEER OF RECORD. NOTIFY ENGINEER OF RECORD OF ANY SLAB THICKNESS GREATER THAN FOUR (4) INCHES PRIOR TO PROCEEDING WITH ANY SAW CUTTING.

CODED NOTES: (1)

- EXTEND AND CONNECT NEW 4" SANITARY LINE TO EXISTING SANITARY LINE. FIELD VERIFY EXACT SIZE, LOCATION, INVERT ELEVATION, DIRECTION OF FLOW, AND POINT OF CONNECTION PRIOR TO ANY WORK.
- CONTRACTOR PROVIDE PLUMBING FIXTURES AS SPECIFIED ON SHEET #P-201. RECONNECT TO EXISTING SANITARY LINE AND EXISTING VENT LINE LINE AS REQUIRED.
- NEW 3" VENT LINE UP THROUGH ROOF. VERIFY LOCATION PRIOR TO BID.
- 1-1/2" VENT LINE TO CONNECT TO EXISTING VENT LINE. VERIFY EXACT LOCATION AND POINT OF CONNECTION IN FIELD.
- 2" VENT LINE TO CONNECT TO EXISTING VENT LINE. VERIFY EXACT LOCATION AND POINT OF CONNECTION IN FIELD.
- 3" SANITARY LINE TO CONNECT TO EXISTING SANITARY LINE. FIELD VERIFY EXACT SIZE, LOCATION, INVERT ELEVATION, DIRECTION OF FLOW, AND POINT OF CONNECTION PRIOR TO ANY WORK.

THESE DRAWINGS ARE DIAGRAMMATIC AND INDICATE THE GENERAL EXTENT OF THE WORK. THE CONTRACTOR SHALL BE RESPONSIBLE FOR THE COORDINATION AND PROPER INSTALLATION OF ALL PLUMBING SYSTEMS. THE CONTRACTOR SHALL PROVIDE ALL NECESSARY OFFSETS AND FITTINGS WHICH MAY BE REQUIRED DUE TO SPACE CONSTRAINTS OR OTHER CONDITIONS.

CONTRACTOR SHALL FIELD VERIFY ALL EXISTING FIELD CONDITIONS PRIOR TO BEGINNING WORK.

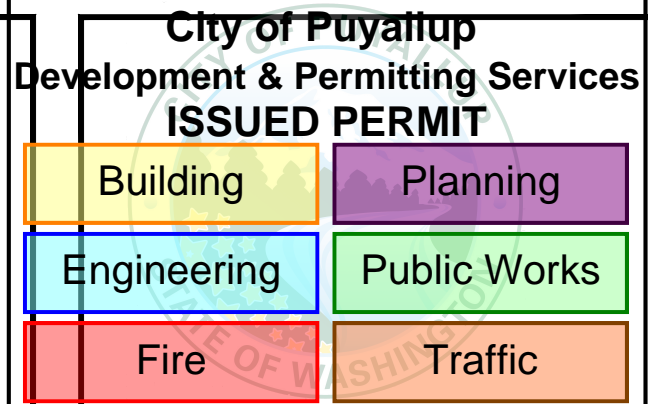

BARNES&NOBLE


PROJECT DESIGNER:

WJCA
BUILDING VALUE SINCE 1994

ARCHITECT:

JOEL TORIELLI
422 BOGERT AVE
RIDGEWOOD, NJ 07450

Kenneth A. Fuller, P.E.

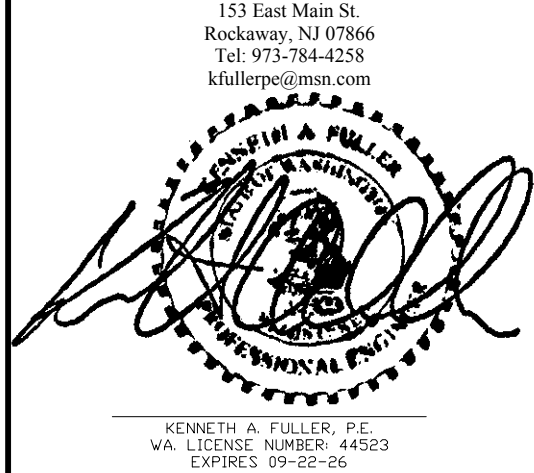

SOUTH HILL MALL
3500 S. MERIDIAN ST.
UNIT #800
PUYALLUP, WA 98373

Project Number 33247
Store Number 3507

Revision Log:

Date	Description	No.
12-19-24	ISSUED FOR PERMIT. BID, LANDLORD & CLIENT REVIEW	1
02-20-25	LANDLORD & BID COMMENTS	2
		3
		4
		5
These plans are an instrument of service and the property of the Architect. Infringements will be prosecuted.

General Contractor to verify all conditions and dimensions at the premises. Discrepancies shall be reported to the Architect prior to the commencement of any work.

Professional Seal:

LIC.# : 22005563
EXP. DATE : 10/02/25

Drawing Description:


SANITARY WASTE & VENT PLAN

Drawing Number:

P-101B

FOOD SERVICE EQUIPMENT / UTILITIES SCHEDULE				
ITEM #	DESCRIPTION	MANUFACTURER	MODEL #	QTY
1	SINK BOWL, WELD-IN, DUMP SINK	N. WASSERSTROM & SONS	F4480234	1
1A	SINK BOWL, WELD-IN, HAND WASH	N. WASSERSTROM & SONS	F4480234	1
3C	BLODGETT OVEN	BLODGETT	CTB SGL	1
3D	RAPID COOK OVEN	MERRYCHIEF USA	E2S HIGH CLASSIC	1
100.1	PANTRY FAUCET	T&S BRASS	KL45-4000-WH	1
100.2	HOT WATER DISPENSER	IN SINK ERATOR	C1300	1
103	POS SYSTEM	-	-	1
104	ESPRESSO MACHINE	MELLITA	CT8	2
108	GARBAGE CAN	RUBBERMAID COMMERCIAL PRODUCTS	FG354060BLA	3
111	TOUCH-FREE SOAP DISPENSER	GOJO INDUSTRIES, INC.	PURELL CS6	1
112	SURFACE-MOUNTED PAPER TOWEL DISPENSER	BOBRICK	B-2521	1
112.1	BLENDER RINSER	BLENDTEC	JRE-610	1
113	COFFEE GRINDER	GRINDMASTER-UNIC-CRATHCO	890BS	1
114	COFFEE BREWER	BUNN	53100.0100	1
115	MANIFOLD	-	-	1
116	GLASS FILLER	T&S BRASS	B-1210	1
117	AIRPOT	SERVICE IDEAS	ECALS22SS	2
118	SELF-SERVICE REFRIGERATED CASE	STRUCTURAL CONCEPTS	B3424	2
119	PASTRY CASE, CURVED GLASS	FEDERAL INDUSTRIES	CGR5948DZ	0
120	DROP-IN ICE BIN	KROWNE	D278	0
121	BLENDER	VITAMIX	36019-ABAB	2
123	DIPPER WELL	T&S BRASS	B-2282-01-F05	1
131	SINGLE UNDER COUNTER REFRIGERATOR	TRUE MGF.	TUC-27-HC	2
132	DOUBLE UNDER COUNTER REFRIGERATOR	TRUE MGF.	TWT-48-HC	1

WORKROOM EQUIPMENT / UTILITIES SCHEDULE				
ITEM #	DESCRIPTION	MANUFACTURER	MODEL #	QTY
1A	R.O. WATER FILTRATION SYSTEM MANIFOLD BOARD	-	-	1
1B	R.O. WATER FILTRATION SYSTEM - ACCUMULATOR TANK	-	-	1
1C	R.O. WATER FILTRATION SYSTEM - WATER SOFTENER	-	-	1
1D	R.O. WATER FILTRATION SYSTEM - BRINER	-	-	1
2B	FREEZER, REACH-IN, SINGLE DOOR	-	-	1
3B	FREEZER, REACH-IN, DOUBLE DOOR	TRUE MGF.	STG2F-2S-HC	1
4	WATER HEATER	-	-	1
5	MOP SINK	-	-	1
5.1	SERVICE FAUCET	-	-	1
6	WALL SHELF	-	-	1
8	SOAP DISPENSER	GOJO INDUSTRIES, INC.	TFX	1
9	HAND SINK - WALL MOUNTED	HAND SINK, PARTS & ACCESSORIES	DH-17-NO FAU	1
14	C-FOLD PAPER TOWEL DISPENSER	-	-	1
15	WASTE CONTAINER	-	-	1
16	THREE COMPARTMENT SINK	AMTEKCO INDUSTRIES LTD.	D724-03-74	1
16.1	PRE-RINSE FAUCET & ADD ON FAUCET	T&S BRASS	B-5110-12-CRB8P	1
16.4	LEVER WASTE	T&S BRASS	B-3950	3
120B	REFRIGERATOR, REACH-IN, DOUBLE DOOR	TRUE MGF.	STG2R-2S-HC	1
125	ICE MAKER, CUBE-STYLE	ITV ICE MAKER	SPIKA MS 500	1
127	WIRE SHELVING	1880 HOSPITALITY	FF2472C	3
133	DISHWASHER, UNDERCOUNTER	JACKSON WWS	DISHSTAR HT	1
134	DISCONNECT SWITCH	-	-	1
135	RECIRCULATION PUMP	-	-	1

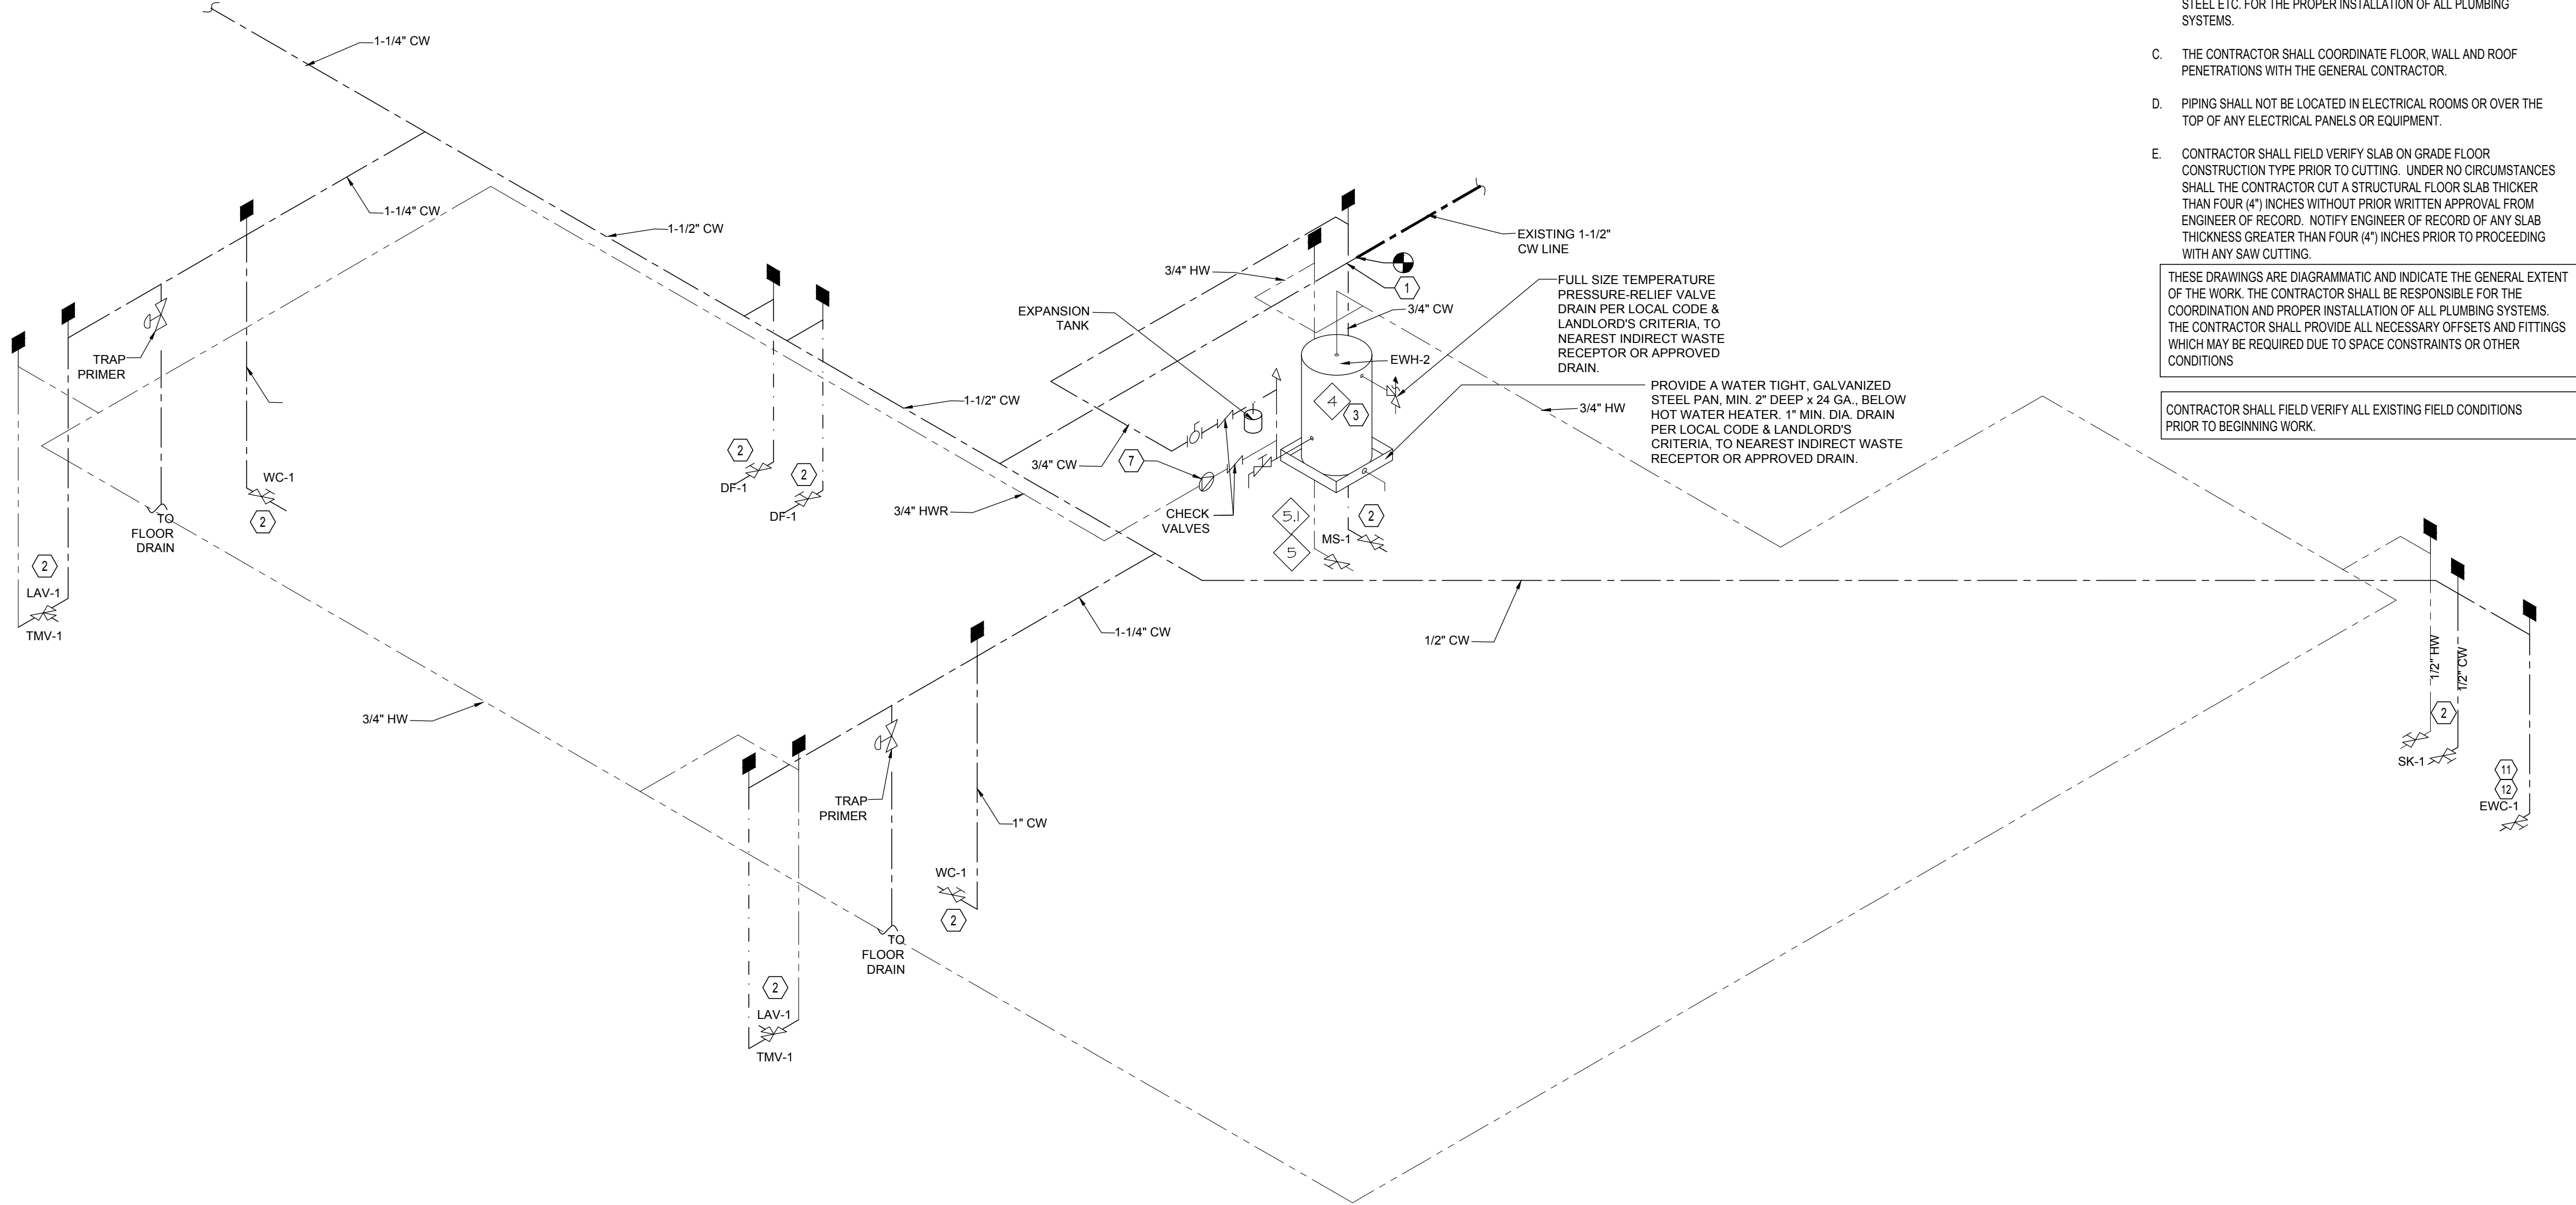

GENERAL NOTES: (PLUMBING)

A. THESE DRAWINGS ARE DIAGRAMMATIC AND INDICATE THE GENERAL EXTENT OF WORK. THE CONTRACTOR SHALL BE RESPONSIBLE FOR THE COORDINATION AND PROPER INSTALLATION OF ALL PLUMBING SYSTEMS. REFERENCE FOOD SERVICE DRAWINGS WHEN INSTALLING FOR EXACT LOCATIONS AND HEIGHTS.

B. THE CONTRACTOR SHALL PROVIDE ALL MISCELLANEOUS SUPPORTING STEEL ETC. FOR THE PROPER INSTALLATION OF ALL PLUMBING SYSTEMS.

C. THE CONTRACTOR SHALL COORDINATE FLOOR, WALL AND ROOF PENETRATIONS WITH THE GENERAL CONTRACTOR.

D. PIPING SHALL NOT BE LOCATED IN ELECTRICAL ROOMS OR OVER THE TOP OF ANY ELECTRICAL PANELS OR EQUIPMENT.

E. CONTRACTOR SHALL FIELD VERIFY SLAB ON GRADE FLOOR CONSTRUCTION TYPE PRIOR TO CUTTING. UNDER NO CIRCUMSTANCES SHALL THE CONTRACTOR CUT A STRUCTURAL FLOOR SLAB THICKER THAN FOUR (4") INCHES WITHOUT PRIOR WRITTEN APPROVAL FROM ENGINEER OF RECORD. NOTIFY ENGINEER OF RECORD OF ANY SLAB THICKNESS GREATER THAN FOUR (4") INCHES PRIOR TO PROCEEDING WITH ANY SAW CUTTING.

THESE DRAWINGS ARE DIAGRAMMATIC AND INDICATE THE GENERAL EXTENT OF THE WORK. THE CONTRACTOR SHALL BE RESPONSIBLE FOR THE COORDINATION AND PROPER INSTALLATION OF ALL PLUMBING SYSTEMS. THE CONTRACTOR SHALL PROVIDE ALL NECESSARY OFFSETS AND FITTINGS WHICH MAY BE REQUIRED DUE TO SPACE CONSTRAINTS OR OTHER CONDITIONS.

CONTRACTOR SHALL FIELD VERIFY ALL EXISTING FIELD CONDITIONS PRIOR TO BEGINNING WORK.

City of Puyallup
Development & Permitting Services
ISSUED PERMIT

Building

Planning

Engineering

Public Works

Fire

Traffic

BARNES&NOBLE


PROJECT DESIGNER:

WJCA
BUILDING VALUE SINCE 1994

ARCHITECT:
JOEL TORIELLI
422 BOGERT AVE
RIDGEWOOD, NJ 07450


Kenneth A. Fuller, P.E.
151 East Main St.
Rockaway, NJ 07866
Tel: 973-964-4258
kfuller@sjma.com

KENNETH A. FULLER, P.E.
VA. LICENSE NUMBER: 44593
EXPIRES: 09-22-26

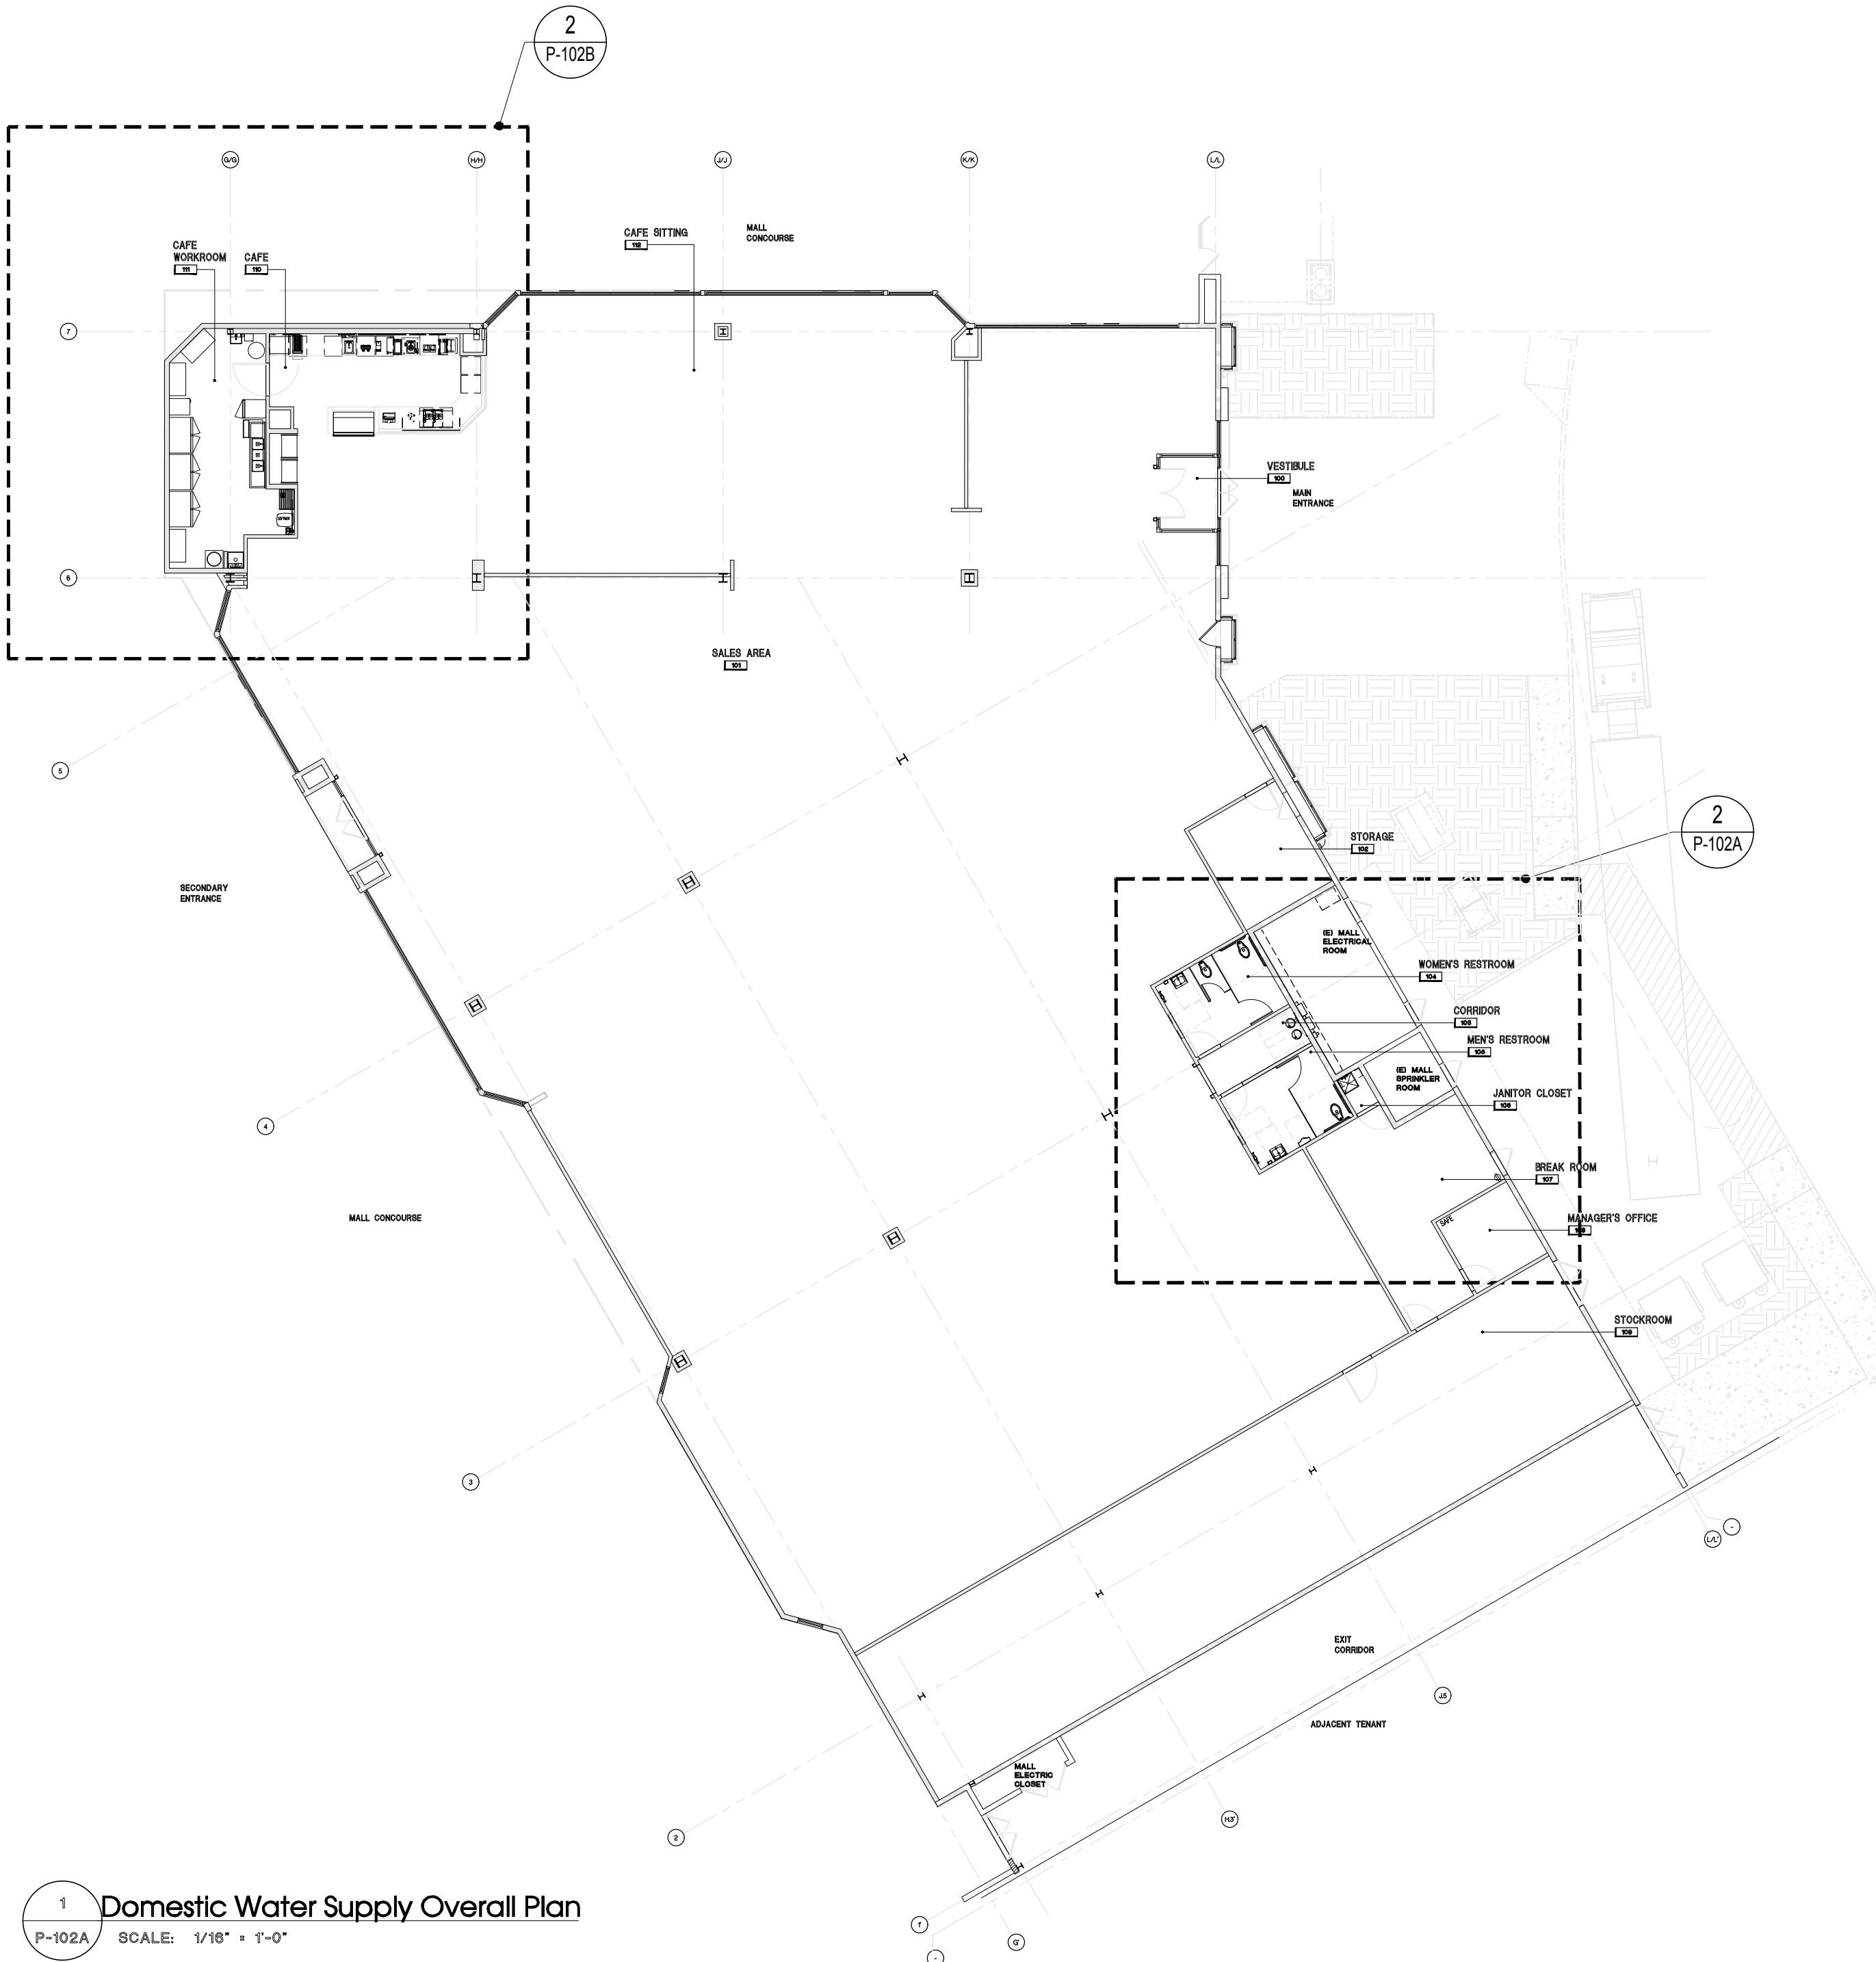

9 ISOMETRIC RISER DIAGRAM
P-102A SCALE: N.T.S.

- CODED NOTES: (#)
- 1-1/2" COLD WATER LINE TO CONNECT TO EXISTING COLD WATER LINE. VERIFY LOCATION AND POINT OF CONNECTION IN FIELD PRIOR TO BID.
 - NEW PLUMBING FIXTURE AS SPECIFIED ON SHEET #P-201.
 - NEW 20 GALLON ELECTRIC WATER HEATER TANK (EWH-2). REFER TO SHEET #P-201 FOR SPECIFICATIONS.
 - ROUTE 1/2" SROOW BELOW COUNTER AND CONNECT TO EQUIPMENT AS REQUIRED.
 - DROP 1/2" CW DOWN BELOW SLAB AT THIS LOCATION.
 - 3/4" FCW TO ICE MAKER FILTER BOARD. REFER TO GENERAL KITCHEN PLUMBING SCHEMATIC FOR MORE DETAIL.
 - NEW RE-CIRCULATION PUMP. REFER TO SHEET #P-201 FOR SPECIFICATIONS.
 - SOFTENED COLD WATER TO REVERSE OSMOSIS FILTER BOARD. REFER TO GENERAL KITCHEN PLUMBING SCHEMATIC FOR MORE DETAIL.
 - DROP 3/4" SROOW DOWN BELOW SLAB AT THIS LOCATION. PROVIDE WATER SEALED PIPE SLEEVE AS REQUIRED. TRANSITION TO TYPE 'K' COOPER PIPE BELOW ROUTE PIPING BELOW SLAB TO BAR AREA AS SHOWN. NO FITTINGS FOR CHANGE OF DIRECTION SHALL BE INSTALLED IN PIPING BELOW SLAB.
 - SROOW CONNECTION TO ITEM # 114 @ 48" A.F.F.
 - 1/2" COLD WATER LINE TO THE BOTTLEFREE WATER COOLER MANUFACTURED BY QUENCH. *QUENCH Q3* MODEL #Q3FS.
 - SINGLE WATER BOX FOR WATER COOLER'S WATER SUPPLY PIPE. SINGLE WATER BOX TO BE MANUFACTURED BY WATER-TITE IPS CORPORATION, ITEM # 87987 MODEL # A89700 OR EQUIVALENT.
 - SROOW CONNECTION TO ITEM # 116.
 - ROUTE 1/2" CW BELOW COUNTER AND CONNECT TO EQUIPMENT AS REQUIRED.
 - 1-1/4" CW LINE.
 - WATER SOFTENER
 - NEW 30 GALLON ELECTRIC WATER HEATER TANK (EWH-1). REFER TO SHEET #P-201 FOR SPECIFICATIONS.

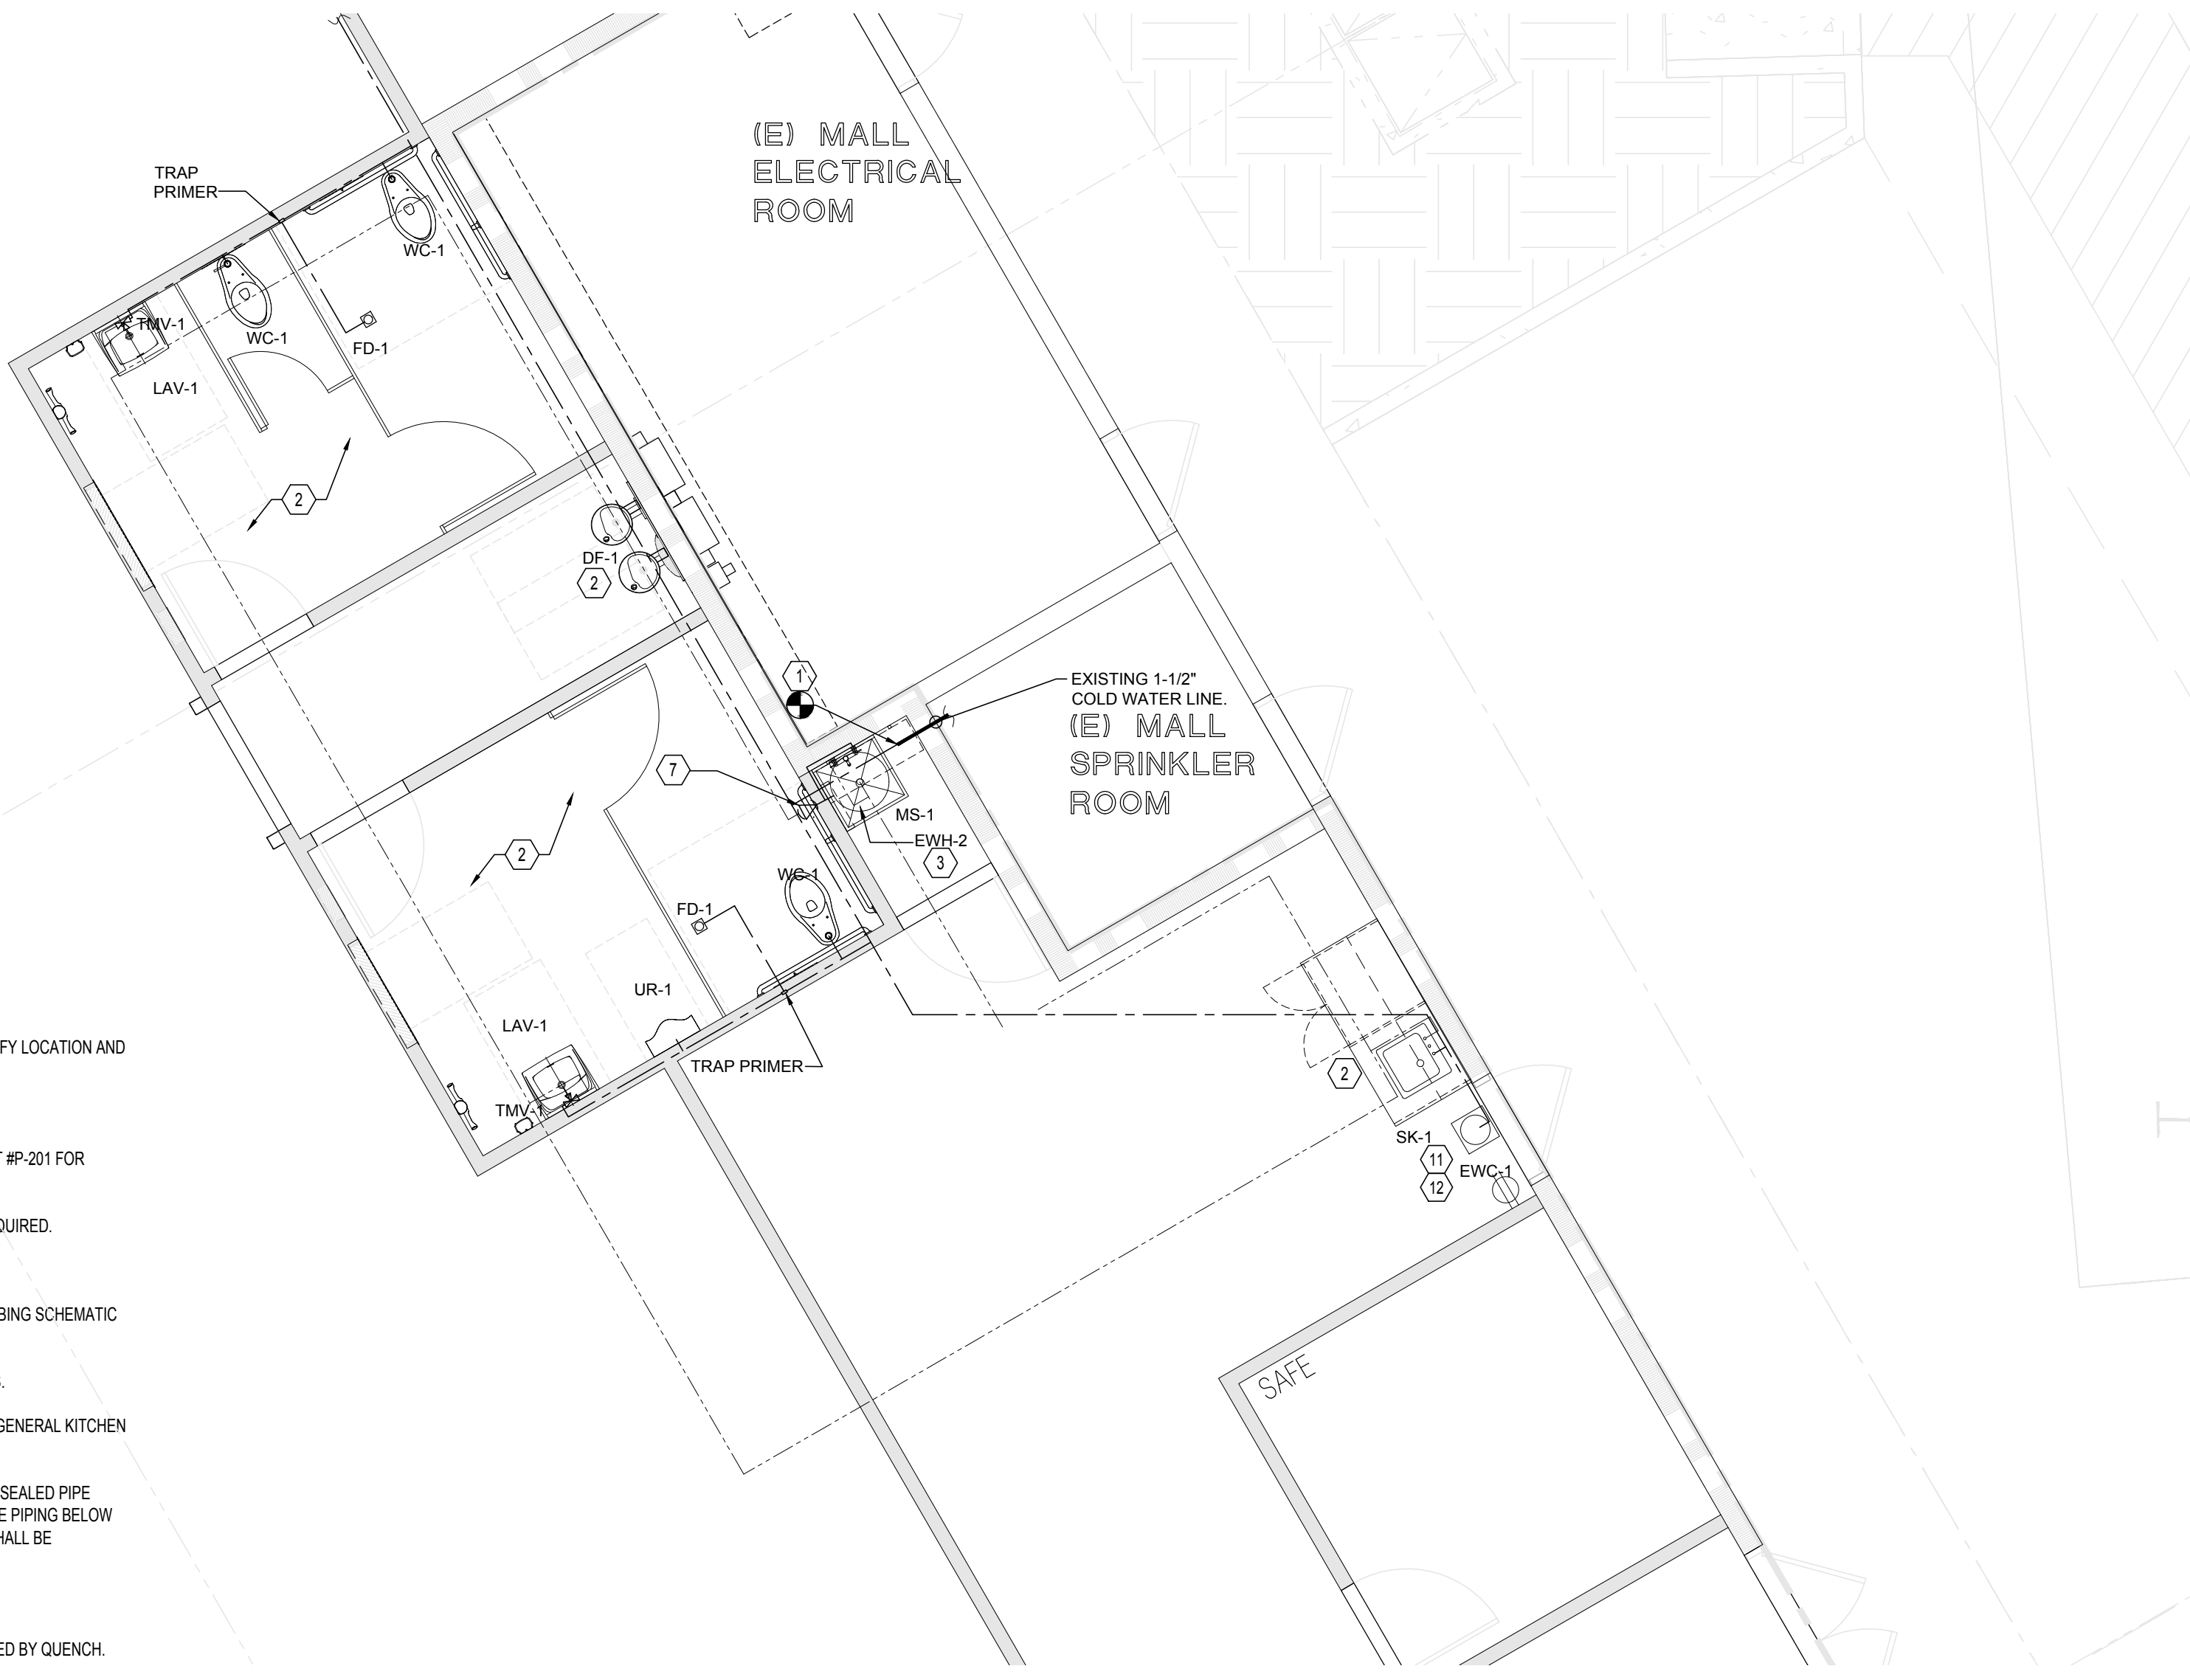

2 Enlarged Domestic Water Supply Plan
P-102A SCALE: 1/4" = 1'-0"

SOUTH HILL MALL
3500 S. MERIDIAN ST.
UNIT #800
PUYALLUP, WA 98373

Project Number 33247
Store Number 3507

Revision Log

Date	Description	No.
12-19-24	ISSUED FOR PERMIT. BID LANDLORD & CLIENT REVIEW	1
02-20-25	LANDLORD & BID COMMENTS	2
		3
		4
		5
These plans are an instrument of service and the property of the Architect. Infringements will be prosecuted.

General Contractor to verify all conditions and dimensions at the premises. Discrepancies shall be reported to the Architect prior to the commencement of any work.

Professional Seal:



LIC.# : 22005563
EXP. DATE : 10/02/25

Drawing Description:
DOMESTIC WATER PLAN


Drawing Number:
P-102A

FOOD SERVICE EQUIPMENT / UTILITIES SCHEDULE				
ITEM #	DESCRIPTION	MANUFACTURER	MODEL #	QTY
1	SINK BOWL, WELD-IN, DUMP SINK	N. WASSERSTROM & SONS	F4480234	1
1A	SINK BOWL, WELD-IN, HAND WASH	N. WASSERSTROM & SONS	F4480234	1
3C	BLODGETT OVEN	BLODGETT	CTB SGL	1
3D	RAPID COOK OVEN	MERRYCHEF USA	E2S HIGH CLASSIC	1
100.1	PANTRY FAUCET	T&S BRASS	KL45-4000-WH	1
100.2	HOT WATER DISPENSER	IN SINK ERATOR	C1300	1
103	POS SYSTEM	-	-	1
104	ESPRESSO MACHINE	MELLITA	CT8	2
108	GARBAGE CAN	RUBBERMAID COMMERCIAL PRODUCTS	FG354060BLA	3
111	TOUCH-FREE SOAP DISPENSER	GOJO INDUSTRIES, INC.	PURELL CS6	1
112	SURFACE-MOUNTED PAPER TOWEL DISPENSER	BOBRICK	B-2621	1
112.1	BLENDER RINSE	BLENDTEC	JRE-610	1
113	COFFEE GRINDER	GRINDMASTER-UNIC-CRATHCO	890BS	1
114	COFFEE BREWER	BUNN	53100.0100	1
115	MANIFOLD	-	-	1
116	GLASS FILLER	T&S BRASS	B-1210	1
117	AIRPOT	SERVICE IDEAS	ECALS22SS	2
118	SELF-SERVICE REFRIGERATED CASE	STRUCTURAL CONCEPTS	B3424	2
119	PASTRY CASE, CURVED GLASS	FEDERAL INDUSTRIES	CGR5948DZ	0
120	DROP-IN ICE BIN	KROWNE	D278	0
121	BLENDER	VITAMIX	36019-ABAB	2
123	DIPPER WELL	T&S BRASS	B-2282-01-F05	1
131	SINGLE UNDER COUNTER REFRIGERATOR	TRUE MGF.	TUC-27-HC	2
132	DOUBLE UNDER COUNTER REFRIGERATOR	TRUE MGF.	TWT-48-HC	1

WORKROOM EQUIPMENT / UTILITIES SCHEDULE				
ITEM #	DESCRIPTION	MANUFACTURER	MODEL #	QTY
1A	R.O. WATER FILTRATION SYSTEM MANIFOLD BOARD	-	-	1
1B	R.O. WATER FILTRATION SYSTEM - ACCUMULATOR TANK	-	-	1
1C	R.O. WATER FILTRATION SYSTEM - WATER SOFTENER	-	-	1
1D	R.O. WATER FILTRATION SYSTEM - BRINER	-	-	1
2B	FREEZER, REACH-IN, SINGLE DOOR	-	-	1
3B	FREEZER, REACH-IN, DOUBLE DOOR	TRUE MGF.	STG2F-2S-HC	1
4	WATER HEATER	-	-	1
5	MOP SINK	-	-	1
5.1	SERVICE FAUCET	-	-	1
6	WALL SHELF	-	-	1
8	SOAP DISPENSER	GOJO INDUSTRIES, INC.	TFX	1
9	HAND SINK - WALL MOUNTED	HAND SINK, PARTS & ACCESSORIES	DH-17-NO FAU	1
14	C-FOLD PAPER TOWEL DISPENSER	-	-	1
15	WASTE CONTAINER	-	-	1
16	THREE COMPARTMENT SINK	AMTEKCO INDUSTRIES LTD.	D724-03-74	1
16.1	PRE-RINSE FAUCET & ADD ON FAUCET	T&S BRASS	B-5110-12-CRB8P	1
16.4	LEVER WASTE	T&S BRASS	B-3950	3
120B	REFRIGERATOR, REACH-IN, DOUBLE DOOR	TRUE MGF.	STG2R-2S-HC	1
125	ICE MAKER, CUBE-STYLE	ITV ICE MAKER	SPIKA MS 500	1
127	WIRE SHELVING	1880 HOSPITALITY	FF2472C	3
133	DISHWASHER, UNDERCOUNTER	JACKSON WWS	DISHSTAR HT	1
134	DISCONNECT SWITCH	-	-	1
135	RECIRCULATION PUMP	-	-	1

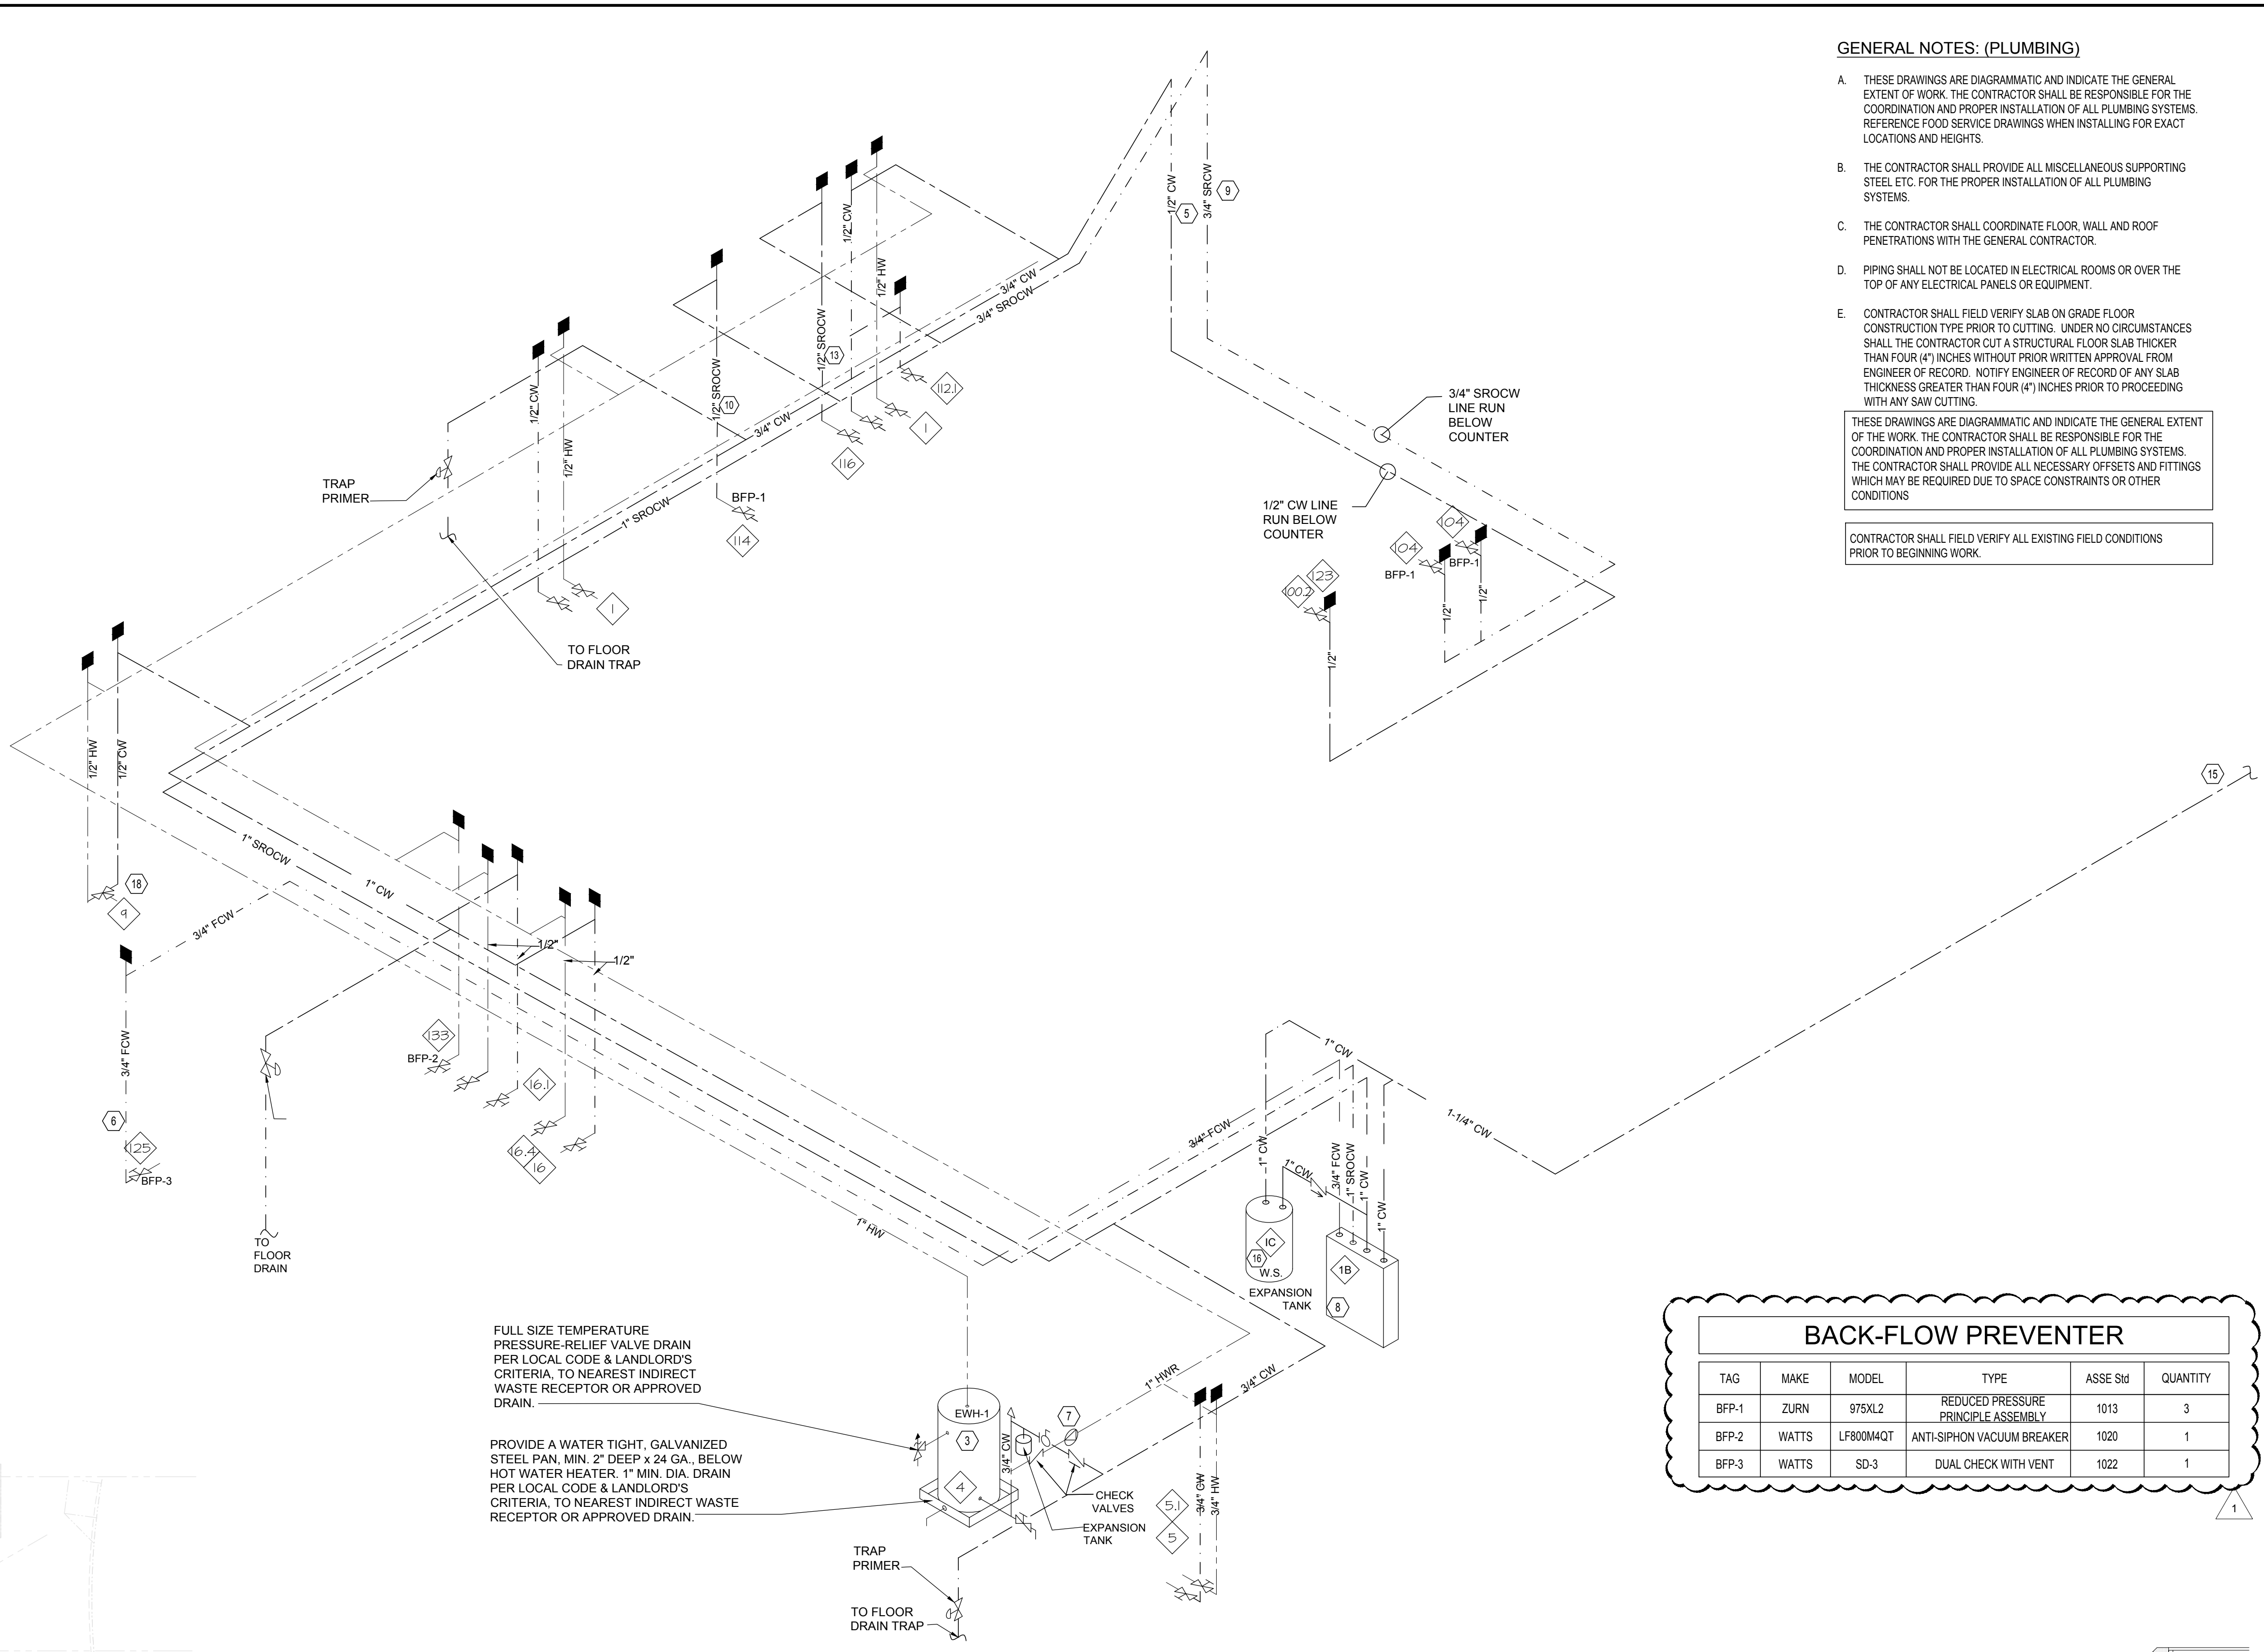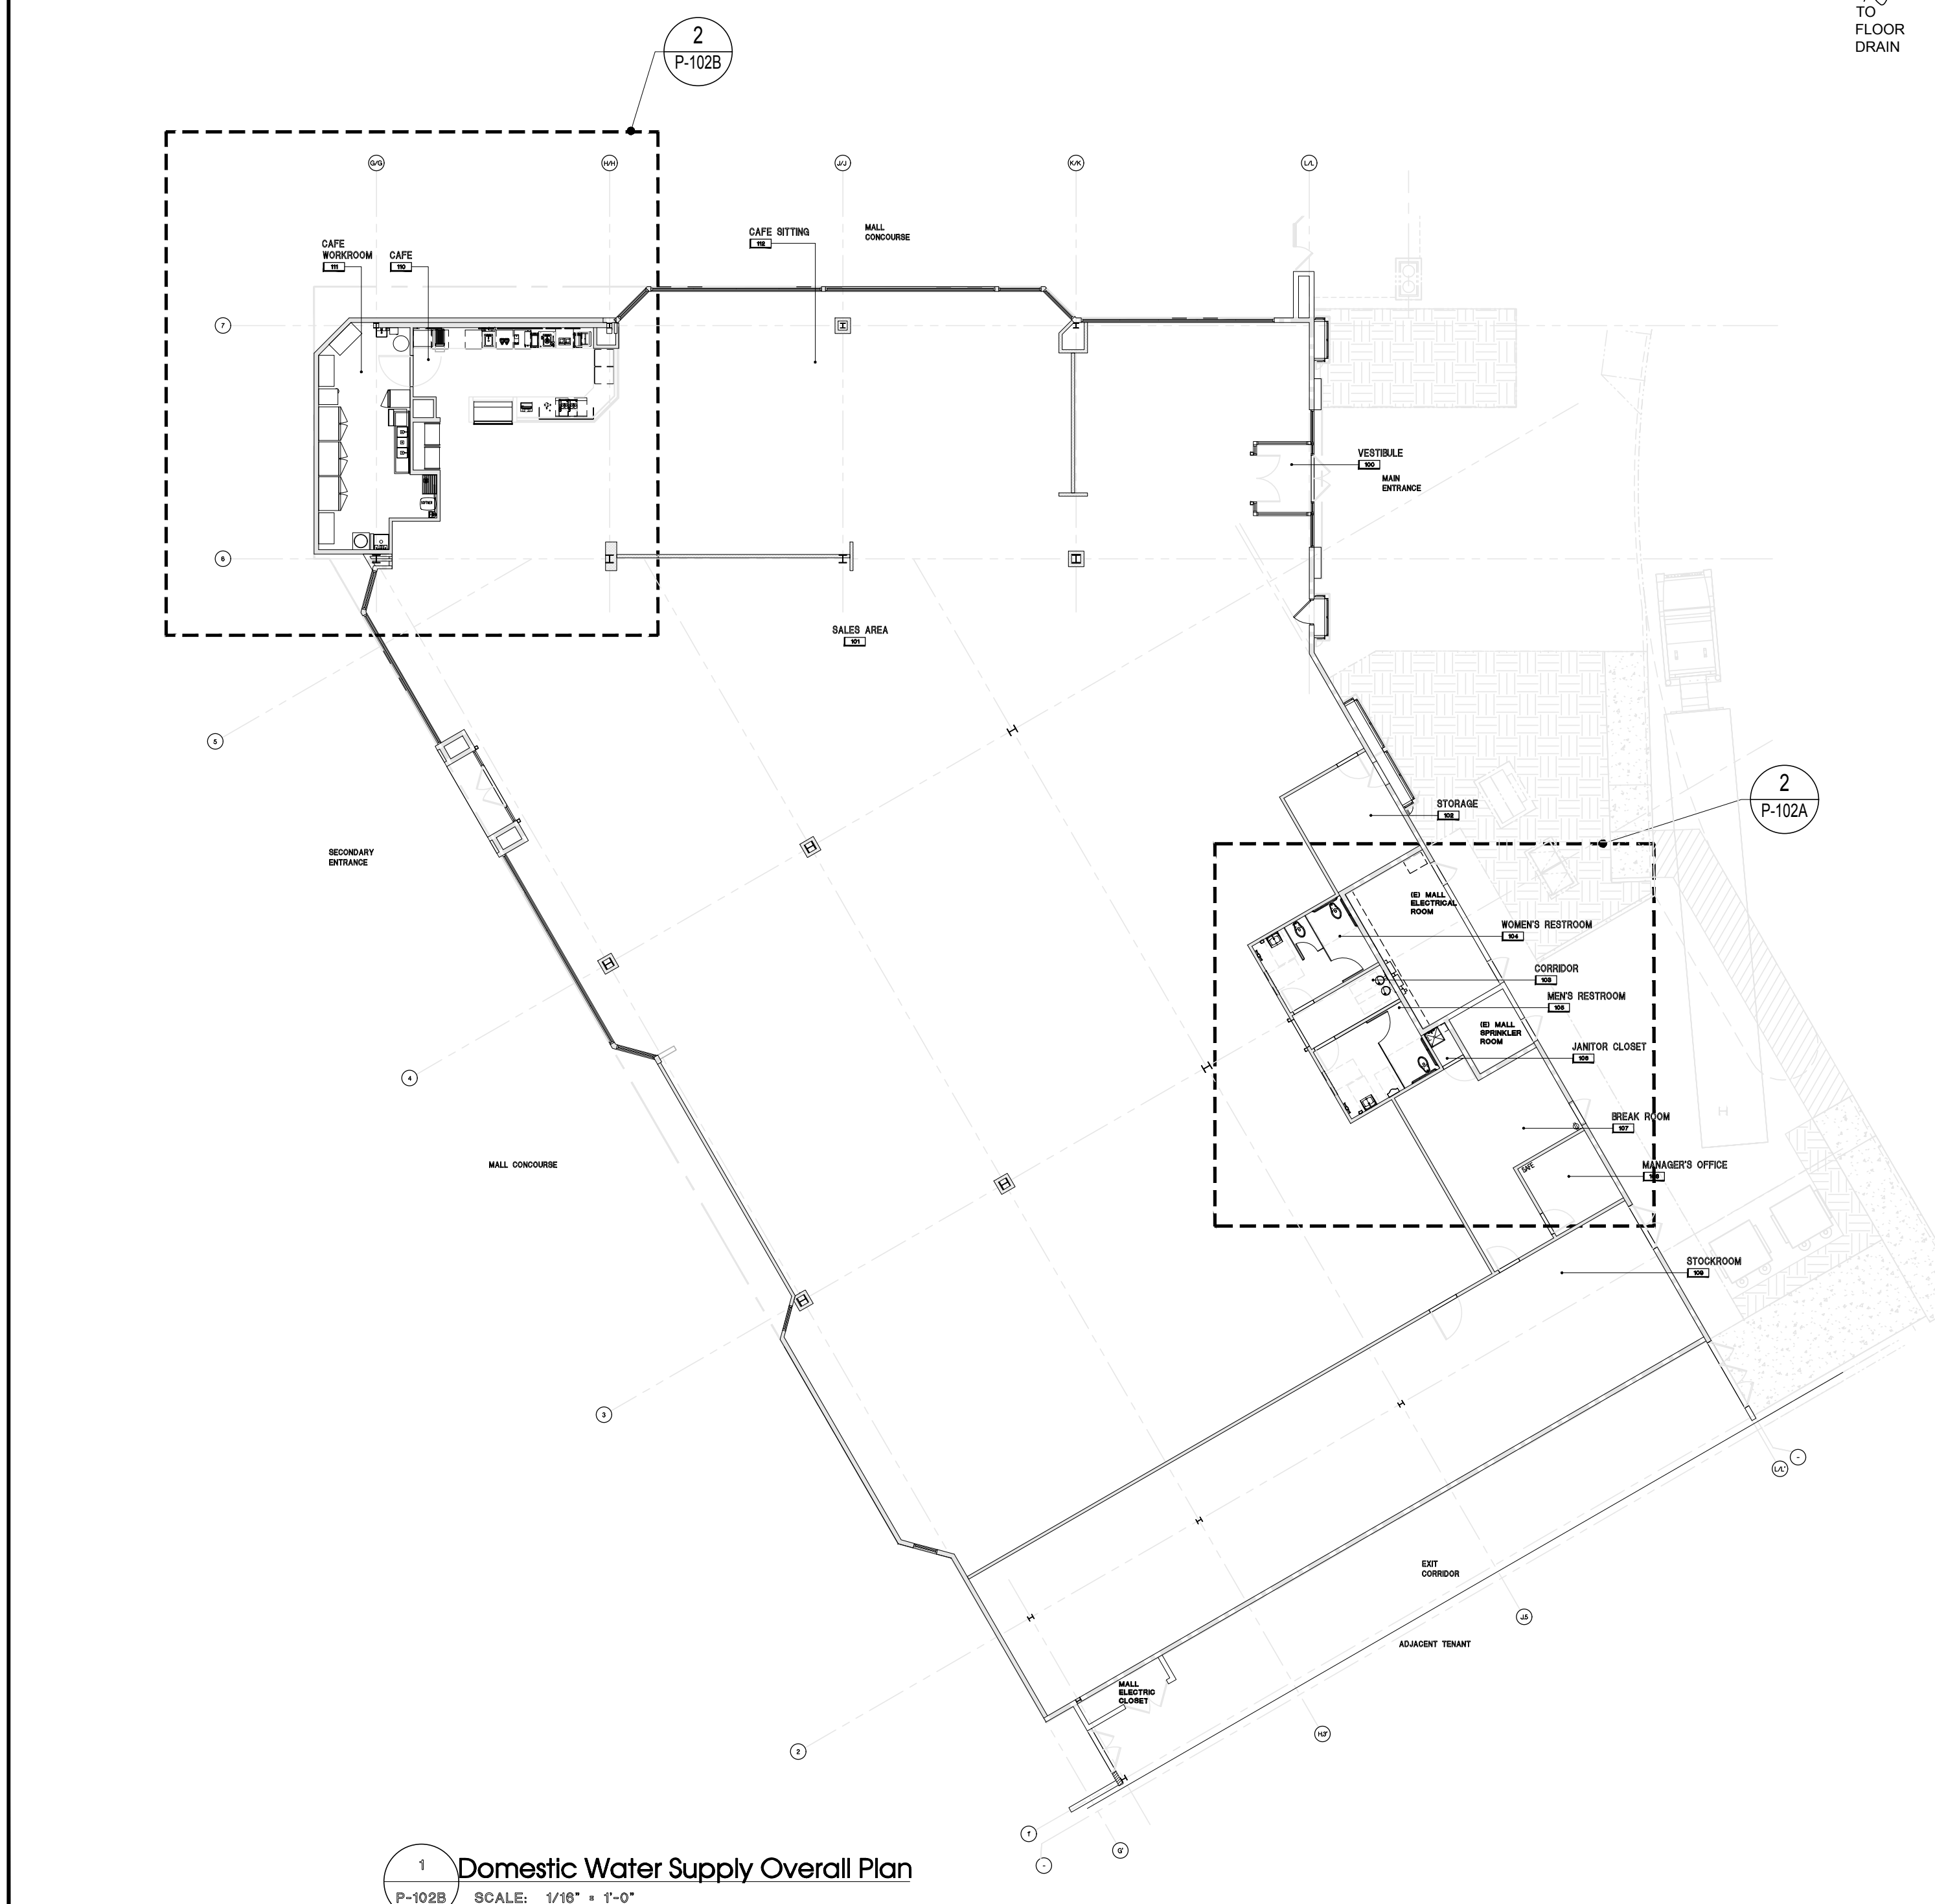

- CODED NOTES:**
- 1-1/2" COLD WATER LINE TO CONNECT TO EXISTING COLD WATER LINE. VERIFY LOCATION AND POINT OF CONNECTION IN FILED PRIOR TO BID.
 - NEW PLUMBING FIXTURE AS SPECIFIED ON SHEET #P-201.
 - NEW 20 GALLON ELECTRIC WATER HEATER TANK (EWH-2); REFER TO SHEET #P-201 FOR SPECIFICATIONS.
 - ROUTE 1/2" SROCW BELOW COUNTER AND CONNECT TO EQUIPMENT AS REQUIRED.
 - DROP 1/2" CW DOWN BELOW SLAB AT THIS LOCATION.
 - 3/4" FOW TO ICE MAKER FILTER BOARD. REFER TO GENERAL KITCHEN PLUMBING SCHEMATIC FOR MORE DETAIL.
 - NEW RE-CIRCULATION PUMP. REFER TO SHEET #P-201 FOR SPECIFICATIONS.
 - SOFTENED COLD WATER TO REVERSE OSMOSIS FILTER BOARD. REFER TO GENERAL KITCHEN PLUMBING SCHEMATIC FOR MORE DETAIL.
 - DROP 3/4" SROCW DOWN BELOW SLAB AT THIS LOCATION. PROVIDE WATER SEALED PIPE SLEEVE AS REQUIRED. TRANSITION TO TYPE 'K' COOPER PIPE BELOW ROUTE PIPING BELOW SLAB TO BAR AREA AS SHOWN. NO FITTINGS FOR CHANGE OF DIRECTION SHALL BE INSTALLED IN PIPING BELOW SLAB.
 - SROCW CONNECTION TO ITEM # 114 @ 48" A.F.F.
 - 1/2" COLD WATER LINE TO THE BOTTLEFREE WATER COOLER MANUFACTURED BY QUENCH. 'QUENCH Q3' MODEL #Q3FS.
 - SINGLE WATER BOX FOR WATER COOLERS WATER SUPPLY PIPE. SINGLE WATER BOX TO BE MANUFACTURED BY WATER-TITE IPS CORPORATION, ITEM # 87367 MODEL # A89700 OR EQUIVALENT.
 - SROCW CONNECTION TO ITEM # 116.
 - ROUTE 1/2" CW BELOW COUNTER AND CONNECT TO EQUIPMENT AS REQUIRED.
 - 1-1/4" CW LINE.
 - WATER SOFTENER.
 - NEW 30 GALLON ELECTRIC WATER HEATER TANK (EWH-1); REFER TO SHEET #P-201 FOR SPECIFICATIONS.
 - THERMOSTATIC MIXING VALVE, WATTS SERIES LFMMV, ASPE 1017, 1089 & 1070 APPROVED.

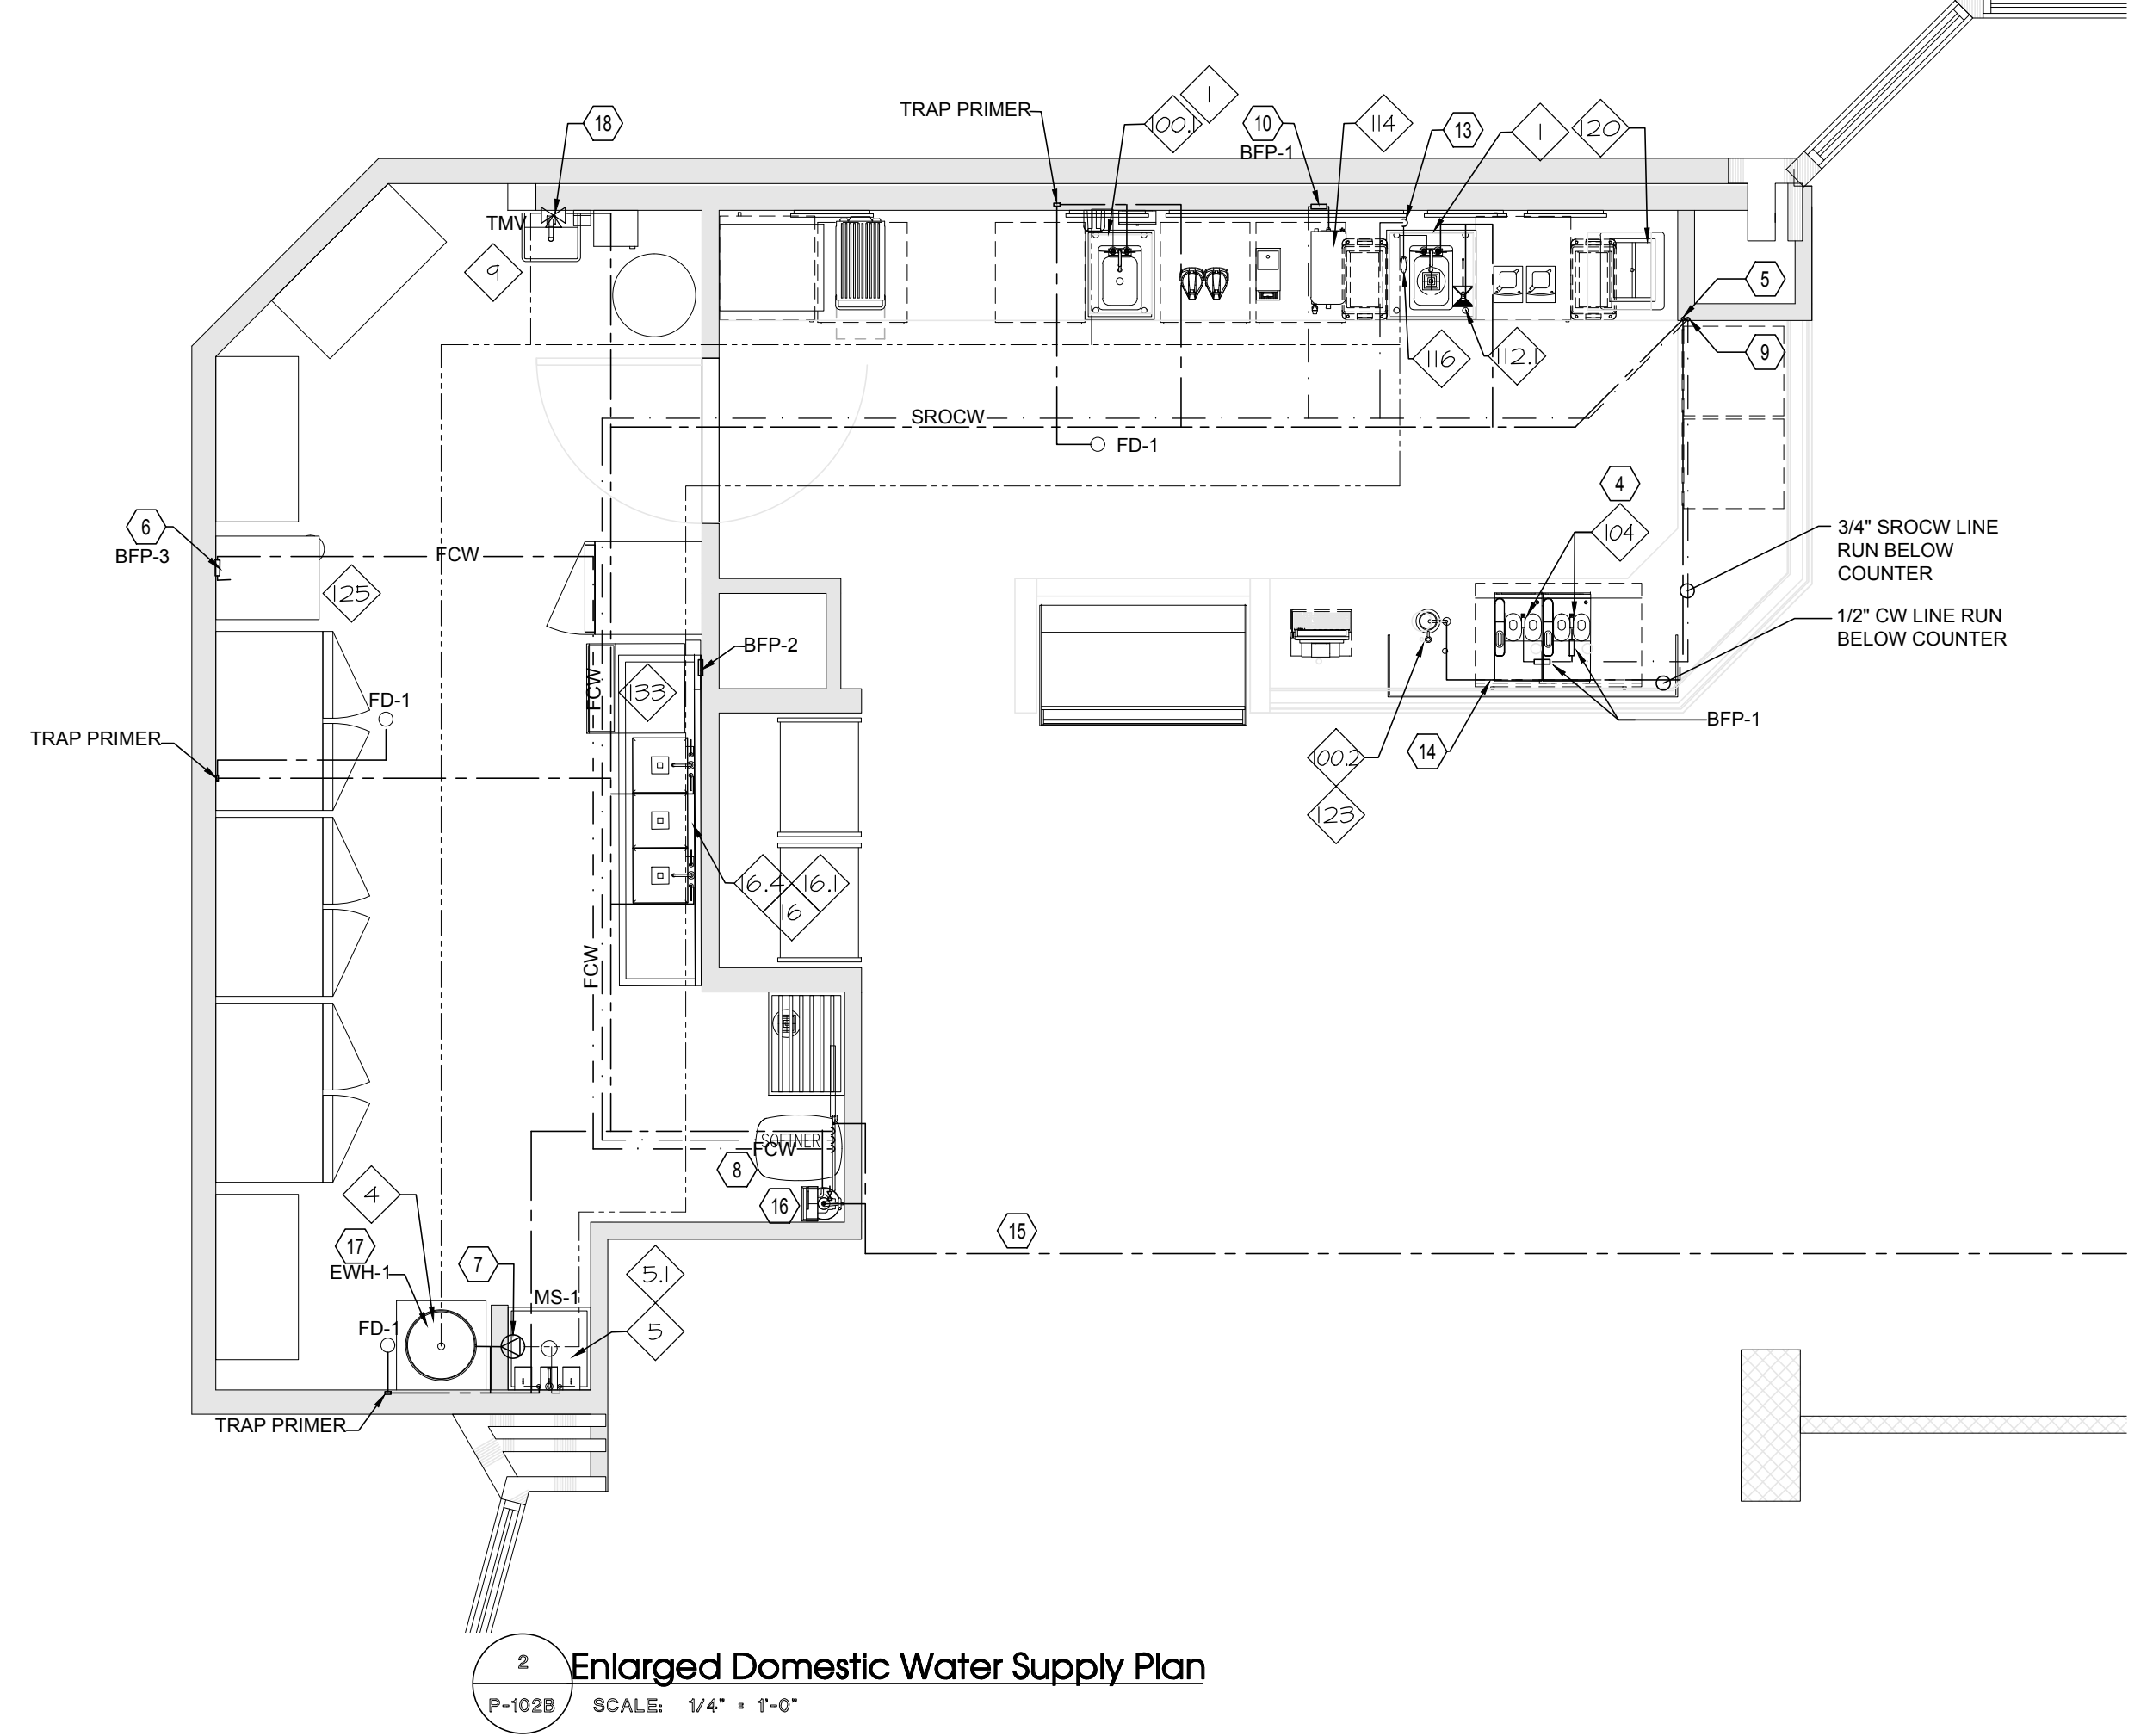

GENERAL NOTES: (PLUMBING)

A. THESE DRAWINGS ARE DIAGRAMMATIC AND INDICATE THE GENERAL EXTENT OF WORK. THE CONTRACTOR SHALL BE RESPONSIBLE FOR THE COORDINATION AND PROPER INSTALLATION OF ALL PLUMBING SYSTEMS. REFERENCE FOOD SERVICE DRAWINGS WHEN INSTALLING FOR EXACT LOCATIONS AND HEIGHTS.

B. THE CONTRACTOR SHALL PROVIDE ALL MISCELLANEOUS SUPPORTING STEEL ETC. FOR THE PROPER INSTALLATION OF ALL PLUMBING SYSTEMS.

C. THE CONTRACTOR SHALL COORDINATE FLOOR, WALL AND ROOF PENETRATIONS WITH THE GENERAL CONTRACTOR.

D. PIPING SHALL NOT BE LOCATED IN ELECTRICAL ROOMS OR OVER THE TOP OF ANY ELECTRICAL PANELS OR EQUIPMENT.

E. CONTRACTOR SHALL FIELD VERIFY SLAB ON GRADE FLOOR CONSTRUCTION TYPE PRIOR TO CUTTING. UNDER NO CIRCUMSTANCES SHALL THE CONTRACTOR CUT A STRUCTURAL FLOOR SLAB THICKER THAN FOUR (4) INCHES WITHOUT PRIOR WRITTEN APPROVAL FROM ENGINEER OF RECORD. NOTIFY ENGINEER OF RECORD OF ANY SLAB THICKNESS GREATER THAN FOUR (4) INCHES PRIOR TO PROCEEDING WITH ANY SAW CUTTING.

THESE DRAWINGS ARE DIAGRAMMATIC AND INDICATE THE GENERAL EXTENT OF THE WORK. THE CONTRACTOR SHALL BE RESPONSIBLE FOR THE COORDINATION AND PROPER INSTALLATION OF ALL PLUMBING SYSTEMS. THE CONTRACTOR SHALL PROVIDE ALL NECESSARY OFFSETS AND FITTINGS WHICH MAY BE REQUIRED DUE TO SPACE CONSTRAINTS OR OTHER CONDITIONS.

CONTRACTOR SHALL FIELD VERIFY ALL EXISTING FIELD CONDITIONS PRIOR TO BEGINNING WORK.

City of Puyallup
Development & Permitting Services
ISSUED PERMIT

Building	Planning
Engineering	Public Works
Fire	Traffic

BARNES & NOBLE

PROJECT DESIGNER:

WJCA
BUILDING VALUE SINCE 1994

ARCHITECT:
JOEL TORIELLI
422 BOGERT AVE
RIDGEWOOD, NJ 07450

Kenneth A. Fuller, P.E.
151 East Main St.
Rockaway, NJ 07866
Tel: 973-984-4338
kfuller@penn.com

Kenneth A. Fuller, P.E.
VA LICENSE NUMBER: 44593
EXPIRES: 09-22-26

SOUTH HILL MALL
3500 S. MERIDIAN ST.
UNIT #800
PUYALLUP, WA 98373

Project Number 33247
Store Number 3507

Revision Log:

Date	Description	No.
12-19-24	ISSUED FOR PERMIT, BID, LANDLORD & CLIENT REVIEW	1
02-20-25	LANDLORD & BID COMMENTS	2
		3
		4
		5
These plans are an instrument of service and the property of the Architect. Infringements will be prosecuted.

General Contractor to verify all conditions and dimensions at the premises. Discrepancies shall be reported to the Architect prior to the commencement of any work.

Professional Seal:

LIC.# : 22005563
EXP. DATE : 10/02/25

Drawing Description:
DOMESTIC WATER PLAN

Drawing Number:
P-102B

