

# Bradley Heights Apartments

## A 236-Unit Apartment Development Puyallup, Washington

### Bradley Heights SS LLC

#### PROJECT TEAM

Owner/Developer	Bradley Heights SS LLC 614 Boylston Ave E Seattle, WA 98102 (206) 557-7236
Architect	Milbrandt Architects, Inc., P.S. 25 Central Way, Suite 210 Kirkland, WA 98033 (425) 454-7130
Structural Engineer	Solutions 4 Structure, Inc. 11605 135th St Ct E Puyallup, WA 98374 (253) 268-2923
Civil Engineer	Azure Green Consultants 409 East Pioneer Puyallup, WA 98372 (253) 770-3144
Landscape Architect	Nature By Design 1320 Alameda Avenue, Suite B Fircrest, WA 98466 (253) 460-6067
MEP Engineer	Robison Engineering Inc. 19401 40th Avenue W, Suite 302 Lynnwood, WA 98036 (206) 364-3343

#### PROJECT INFORMATION

Site Address:	202 27th Ave SE, Puyallup, WA 98374
Project Description:	Construction of 236 wood framed apartment units in eight stacked flat buildings along with a leasing amenity building.
Site Area:	7.785 acres (+/- 339,107 SQ. FT.)
Tax Parcel Number:	149036006
Occupancy Type:	All Apartment Buildings are R2 occupancy.
Type of Construction	All Apartment Buildings are Type V-B construction with NFPA 13R automatic sprinklers .
Applicable Codes:	2018 International Building Code 2018 Uniform Plumbing Code 2018 Washington State Energy Code 2018 International Mechanical code 2018 International Fire Code 2022 National Electrical Code ICC/ANSI A117.1-2009 Standard Washington State Amendments as modified and adopted by the local jurisdiction.

#### RATED ASSEMBLIES

Rated assemblies shall be provided in accordance with IBC section 420

Assembly	Fire Rating	Detail
Common walls separating dwelling units:	1-hour	4/D1
Exterior walls:	non-rated	1/D1
Interior bearing walls:	non-rated	2/D1
Interior non-bearing walls:	non-rated	2/D1
Corridor-to-unit walls:	1-hour	3/D1
Floor/ceiling:	1-hour	13/D1
Roof/ceiling:	1-hour	17/D1
Penetrations (firestopping)	Per situation	17/D8 D9
Stair fire barrier wall:	1-hour @ 3-story 2-hour @ 4-story	3/D1 7/D1

Fire Alarm systems and smoke alarms shall be provided in accordance with IBC section 420.5 Refer to unit plan sheets for smoke detector locations and requirements.

#### GENERAL NOTES

- Comply with 2018 IBC and all applicable codes and ordinances of the local jurisdiction and the State of Washington.
- Do not scale drawings.
- Verify all rough-in dimensions for equipment provided in this contract or by others.  
All rough-ins shall be approved and fireblocking shall be installed prior to framing inspection.
- Verify size and location of and provide all openings through floors and walls, furring, anchors, inserts, rough bucks and backing for surface mounted items.
- Provide furring as required to conceal mechanical and electrical work in all finished areas.
- All swinging doors not located by dimensions on plans, interior elevations, or details shall be 3" from face of stud to edge of rough openings or centered between room partitions as shown.
- Plans are drawn assuming the following rough openings:  
Swinging doors: Nominal size +2".  
Bi-Fold doors: Nominal size +1-1/2".  
Bi-Pass doors: Nominal size +0".  
Windows: Nominal size +0".  
Sliding glass doors: Nominal size +0".
- Fill where required with earth free from organic material. Compact fill in 12" layers maximum.
- "Finish Floor" refers to the top of concrete slab or top of wood floor sheathing .
- Exterior walls shall be 2x6 studs at 16" o.c. and interior walls shall be 2x4 studs at 16" o.c., unless noted otherwise.
- Unless otherwise noted, plan dimensions are to face of studs and face of concrete walls.
- Refer to interior elevations for cabinet and counter lengths, dimensions, countertop materials and detail reference. Verify all existing dimensions before installation.
- Provide caulking between sole plates and subfloor and between rim joists at both top plate and subfloor.
- Hydrants shall be in service prior to start of framing.
- Through penetrations and membrane penetrations of rated wall or floor/ceiling assembly will require firestopping per 2018 IBC Section 714. See detail sheets for diagram of specifics.
- Shall be no asbestos used on this project.
- All Tub-Shower valves installed shall conform to UPC 408.3 & ASSE 1016 or ASME A112.18.1
- Milbrandt Architects is not responsible for construction means, methods, techniques or procedures, or for the safety precautions and programs in connection with the work, and is not responsible for the failure of any contractor or subcontractor to carry out the work in accordance with the various contract documents and or governing jurisdiction, regardless of what is shown on these drawings.

#### FEDERALLY DECLARED SAFE HARBOR

Declared Safe Harbor: HUD Fair Housing Accessibility Guidelines published on March 6, 1991 and the Supplemental Notice to Fair Housing Accessibility Guidelines: Questions and Answers about the Guidelines, published on June 28, 1994.

#### ACCESSIBILITY

Design is based on the 2018 IBC Chapter 11 which has been amended by the State of Washington, & 2009 ICC A117.1 Accessible & Useable Buildings & Facilities.

None of the buildings are an elevator type building.  
There are a total of 84 one-story dwelling units at ground level. All ground floor units are 1 or 2-bed unit designs. Provided total 84 accessible units: 12 Type A and 72 Type B units.

Type A units meet the requirements for Type B units.

- The 12 Type A units are proportioned as follows (see Site Plan):
  - (7) 1-Bed units (1 BR) in each of Buildings A, C, D, E, F & G - for a total of 7.
  - (5) 2-Bed units (2 BR) in Buildings A, D, E, F & G - for a total of 5.

#### Parking:

Section 1106.2 IBC requires 2% of each proposed parking stall type to be accessible.  
Of the 354 total open stalls, 12 are accessible, including 5 van stalls. Each accessible open stall is indicated by the wheelchair symbol on the site plan and further designated by the detail symbols 10/A3.

#### VENTILATION NOTES

- Design Criteria: 2018 International Mechanical Code with Washington State Amendments.
- System Type: Balanced whole house fan system with energy recovery ventilator
- Use: Group R occupancy.
- Specifics: See mechanical plans by others.

#### ENERGY NOTES

Reference: 2018 WSEC  
Chapter 4 using climate zone category 5 & marine 4 for all calculations.

All residential units shall comply with the Requirements By Component Table 402.1.1. Including but not limited to the following:

Code Requirements	Associated Notes/Details Showing Compliance
Window U-Factor	.24 or better See Insul. Notes on sheets U1, U2, U3, U4, U5
Ceiling R-Value	R-49 13 / D1
Wood Frame Wall R-Value	R-21 int. 1, 3, 4, 7 & 8 / D1
Floor R-Value	R-30 N/A
Slab R-Value & Depth	R-10, 2ft 1, 3, 5 & 6 / D2
"int." (intermediate framing) denotes standard framing 16" o.c. with headers insulated with a min. of R-10 (see 6/D6).	

All units need to have a certificate posted within 3 feet of the electrical distribution panel listing the following information: R-values, U-values, duct air leakage test results, building envelope air leakage test results, types and efficiencies of heating, cooling and service water heating equipment per R401.3

All insulation shall comply with table R402.4.1.1 WSEC  
Hot water piping shall be insulated to a minimum of R-3 per R403.5.2  
Water heaters in unheated spaces, or on concrete floors shall be placed on minimum of R-10 incompressible insulated surface per R403.5.5  
Mechanical ventilation shall be provided per R403.6  
A minimum of 90% of all permanently installed lamps in lighting fixtures shall be high-efficacy lamps per R404.1

See Insulation Notes on the Unit Plans and Insulation and Energy Notes on sheet D7

Energy Credits used (see 2018 WSEC table 406.3 for all requirements):

Fuel Normalization Credit System Type 0	0.0 CREDITS
Option 1.1 Efficient Building Envelope	0.5 CREDITS
Option 2.1 Air Leakage Control	1.0 CREDITS
Option 3.4 Ductless Mini-Split Heat Pump System	2.0 CREDITS
Option 7.1 Appliance Package	1.5 CREDITS
<b>TOTAL PROVIDED</b>	<b>5.0 CREDITS</b>

#### FIRE SYSTEMS

Buildings shall have an NFPA 13R sprinkler system installed throughout per 2018 IBC Section 903.3.1.2 which shall include a notification appliance which is activated upon sprinkler flow. Any alarms, bells or lights required due to the design of the sprinkler system or integral with the sprinkler system shall be considered part of the sprinkler system. The sprinkler system design, therefore, needs to include any and all integrated alarms.

Plans and specifications for sprinklers shall be submitted to the city of Puyallup as a separate permit for review and approval before installation.

#### DESIGN LOADS

See structural notes, Sheet S1.0


#### DEFERRED SUBMITTALS

Shop drawings and calculations are required for:


- Firestopping details. Firestopping methods and materials shall be determined by the Contractor except where details or notes are indicated in these drawings. Firestopping locations are indicated in part by detail sheet D9. Contractor shall submit UL assembly details and product cuts of all relevant situations to the Architect for conformance to the building design. Upon the Architect's approval, they shall be submitted to the Building Official for approval. Firestopping shall not be installed without City approval.

#### SEPARATE PERMITS

The following required permits will be submitted separately:  
1. Automatic Fire Sprinkler System (See fire systems note, this sheet).  
2. Fire Alarm System.

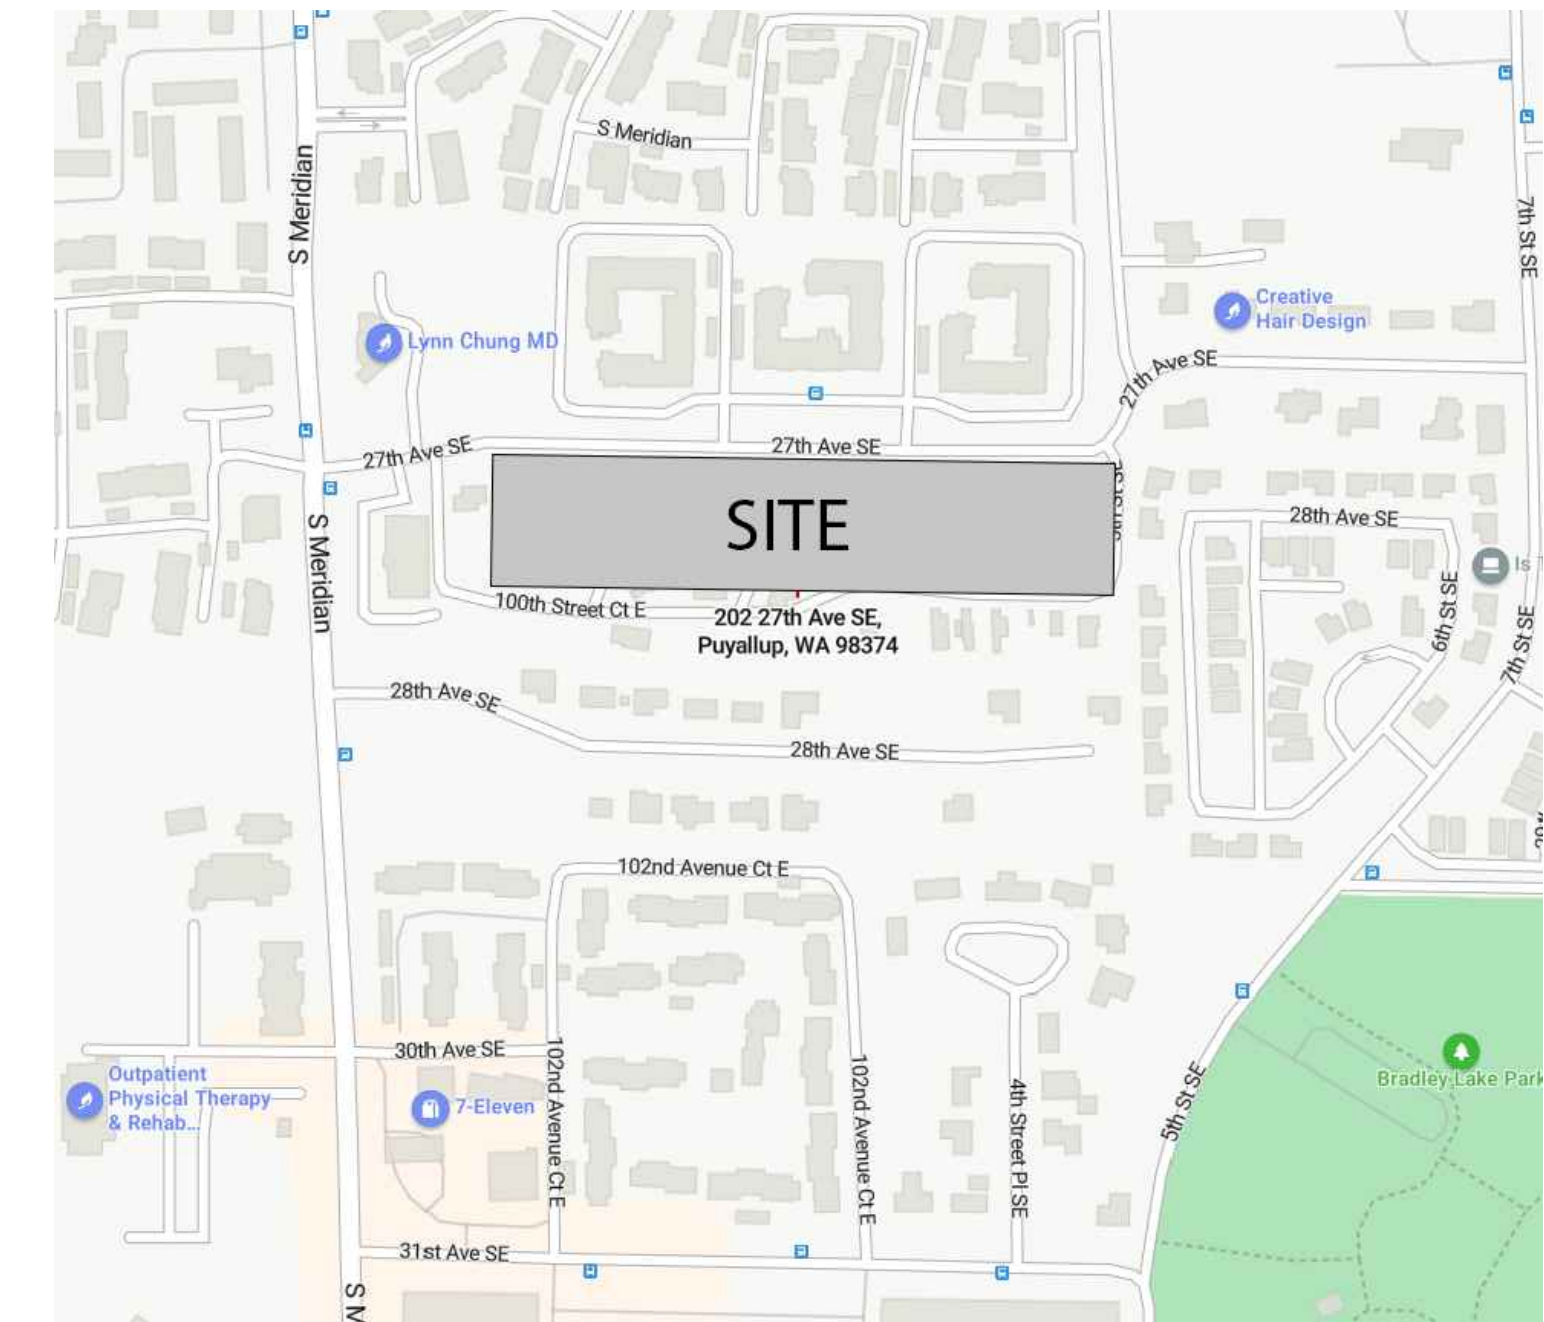

#### VICINITY MAP

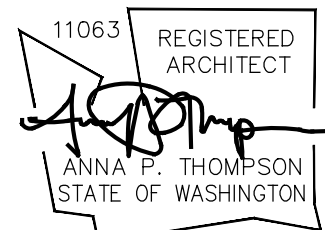

#### Bradley Heights Apartments

Puyallup, Wa

#### Timberlane Partners

#### Revisions

No.	Date	Description
1	8-30-24	Owner Changes/ Permit Corrections

Initial Publish Date:

Date Plotted: 2-18-25

Job No.: 23-06  
Drawn By: TMK/HDM/APT

Sheet No.:

# Bradley Heights Apartments

## Building H Puyallup, Washington Bradley Heights SS LLC

### Bradley Heights Building Areas

Bldg Letter	Floor Level	Unit			1-Bed End-Alt (SF)	Deck Area (SF)	1-Bed Int-1 (SF)	Unit Area (SF)	Deck Area (SF)	1-Bed Int-2 (SF)	Unit Area (SF)	Deck Area (SF)	1-Bed Int-3 (SF)	Unit Area (SF)	Deck Area (SF)	1-Bed Int-4 (SF)	Unit Area (SF)	Deck Area (SF)	Other Unheated			Total Heated Area (SF)	Total Unheated Area (b)	Total Floor Area (SF)	Total Building Area (SF)	Total Allowable Bldg. Area (d)	Units Per Building		
		1-Bed End	Unit Area (SF)	Deck Area (SF)															Misc. (a)	Stair 1 Area (SF)	Stair 2 Area (SF)								
A	Bsmt	1	712	67																	118								
	1st	2	1424	134																									
	2nd	2	1424	134																									
	3rd	1	712	67	1	625	78	1	684	61	1	684	71	1	634	74	1	634	86										
B	Bsmt																					69							
	1st																												
	2nd																												
	3rd																												
C	1st																												
	2nd																												
	3rd																												
D	Bsmt																												
	1st																												
	2nd																												
	3rd																												
E	Bsmt																												
	1st																												
	2nd																												
	3rd																												
F	Bsmt																												
	1st																												
	2nd																												
	3rd																												
G	1st																												
	2nd																												
	3rd																												
H	1st																												
	2nd																												
	3rd																												

All buildings are Type V-B construction; all occupancies are R-2; all have NFPA 13R sprinkler systems throughout.  
a. Misc. Areas include SF of sprinkler riser rooms and basement storage rooms.  
b. Unheated Areas include SF of Decks, Patios, storage & sprinkler rooms.  
c. Base Area allowed is 7000SF per floor for Type V-B construction (Table 506.2). See area increase diagrams on sheet A4 for total area allowed.

### Unit Area Summary



Unit	Unit SF	Patio/Deck SF
1 Bed End	1BR/1BA	712
1 Bed End Alt	1BR/1BA	625
1 Bed Int	1BR/1BA	684
1 Bed Int 2	1BR/1BA	684
2 Bed	2BR/2BA	1019
2 Bed Alt	2BR/2BA	1019
2 Bed Alt (3rd Floor)	2BR/2BA	980
2 Bed-2	2BR/2BA	1115
1-Bed-Int-Alt-1	1BR/1BA	634
1-Bed-Int-Alt-2	1BR/1BA	634
1-Bed-Int-Alt-3	1BR/1BA	795
1-Bed-Int-Alt-4	1BR/1BA	795

**SINGLE EXITS**  
Per IBC 1006.3.2 section 5, Individual single-story or multistory dwelling units shall be permitted to have a single exit or access to a single exit provided that the dwelling unit has a maximum occupant load of 20, is equipped throughout with an automatic sprinkler system in accordance with section 903.3.1.1 or 903.3.1.2, is provided with emergency escape and rescue openings in accordance with section 1030, and the common path of egress travel does not exceed 125'.

### LIST OF DRAWINGS

A	Cover Sheet
A1	Building Areas and Statistics
A2	Site Plan
A3	Site Standards
A4	Area Increase Diagram
B12	Building H - Building Floor Plans
U1	1-Bed-Int Unit - Basement & 1st Level Floor Plans
U2	1-Bed-Int Unit - 2nd & 3rd Level Floor Plans
U4	2-Bed Unit - Basement & 1st Level Floor Plans
U5	2-Bed Unit - 2nd & 3rd Level Floor Plans
U6	Interior Elevations - 1-Bed-Int-1, 1-Bed-Int-2, -1-Bed-Int-Alt-1, & 1-Bed-Int-Alt-2
U9	Interior Elevations - 2-Bed & 2-Bed-Alt
U11	Accessibility Standards
U12	Stair 1 - Floor Plans
U14	Door Schedule
F14	Building H - Partial Architectural Foundation Plan
F15	Building H - Partial Architectural Foundation Plan
R8	Building H - Roof Plan
E17	Building H - Exterior Elevations
E18	Building H - Building Sections
E19	Building Glazing Diagram - Building H
S1.0	Structural Notes - Building H
S1.1	Structural Notes & Tables - Building H
S1.2	Shear Wall Notes - Building H
S1.3	Shear Wall Notes - Building H
S2.19	Foundation & 2nd Floor Framing Plans - Building H
S2.20	3rd Floor & Roof Framing Plans - Building H
S3.0	Details - Building H
S3.1	Details - Building H
S4.0	Details - Building H
S4.1	Details - Building H
S5.0	Details - Building H
S5.1	Details - Building H
D1	Details
D2	Details

D3	Details
D4	Details
D5	Details
D6	Details
D7	Details
D8	Details
D9	Details
BE1	Building Envelope Details
BE2	Building Envelope Details
BE3	Building Envelope Details
BE4	Building Envelope Details
BE5	Building Envelope Details
M0.0	Legend, General Notes & Drawing Index
M0.1	Project Notes
M0.2	Tables & Calculations
M0.3	Mechanical Schedules & WSEC Forms
M2.0	Building H - HVAC Plans
M2.0	Building H - HVAC Plans
M3.0	HVAC Enlarged Plan
M3.1	HVAC Enlarged Plan
E0.00	Electrical Cover Sheet
E0.01	Electrical Cover Sheet
E0.10	Power Site Plan
E0.11	Power Site Plan
E0.12	Lighting Site Plan
E0.13	Lighting Site Plan
E1.01	1st Floor Lighting Plan
E1.02	2nd & 3rd Floor Lighting Plan
E1.50	Lighting Notes
E3.00	1st & 2nd Floor Power Plans
E3.01	3rd Floor & Roof Power Plans
E5.00	Unit Plan Notes
E5.01	Unit Electrical Plans
E5.02	Unit Electrical Plans
E6.00	One-Line Diagram & Notes
E6.01	Panel Schedule
POH.00	Plumbing - Legend, General Notes & Drawing Index
POH.01	Plumbing Notes & Tables
POH.02	Plumbing Calculations
POH.03	Plumbing Schedules
P2H.00	Underslab Waste & Vent Plan
P2H.01	1st Floor Waste & Vent Plan
P2H.02	2nd Floor Waste & Vent Plan

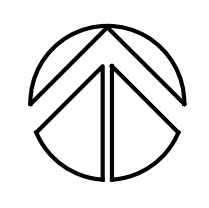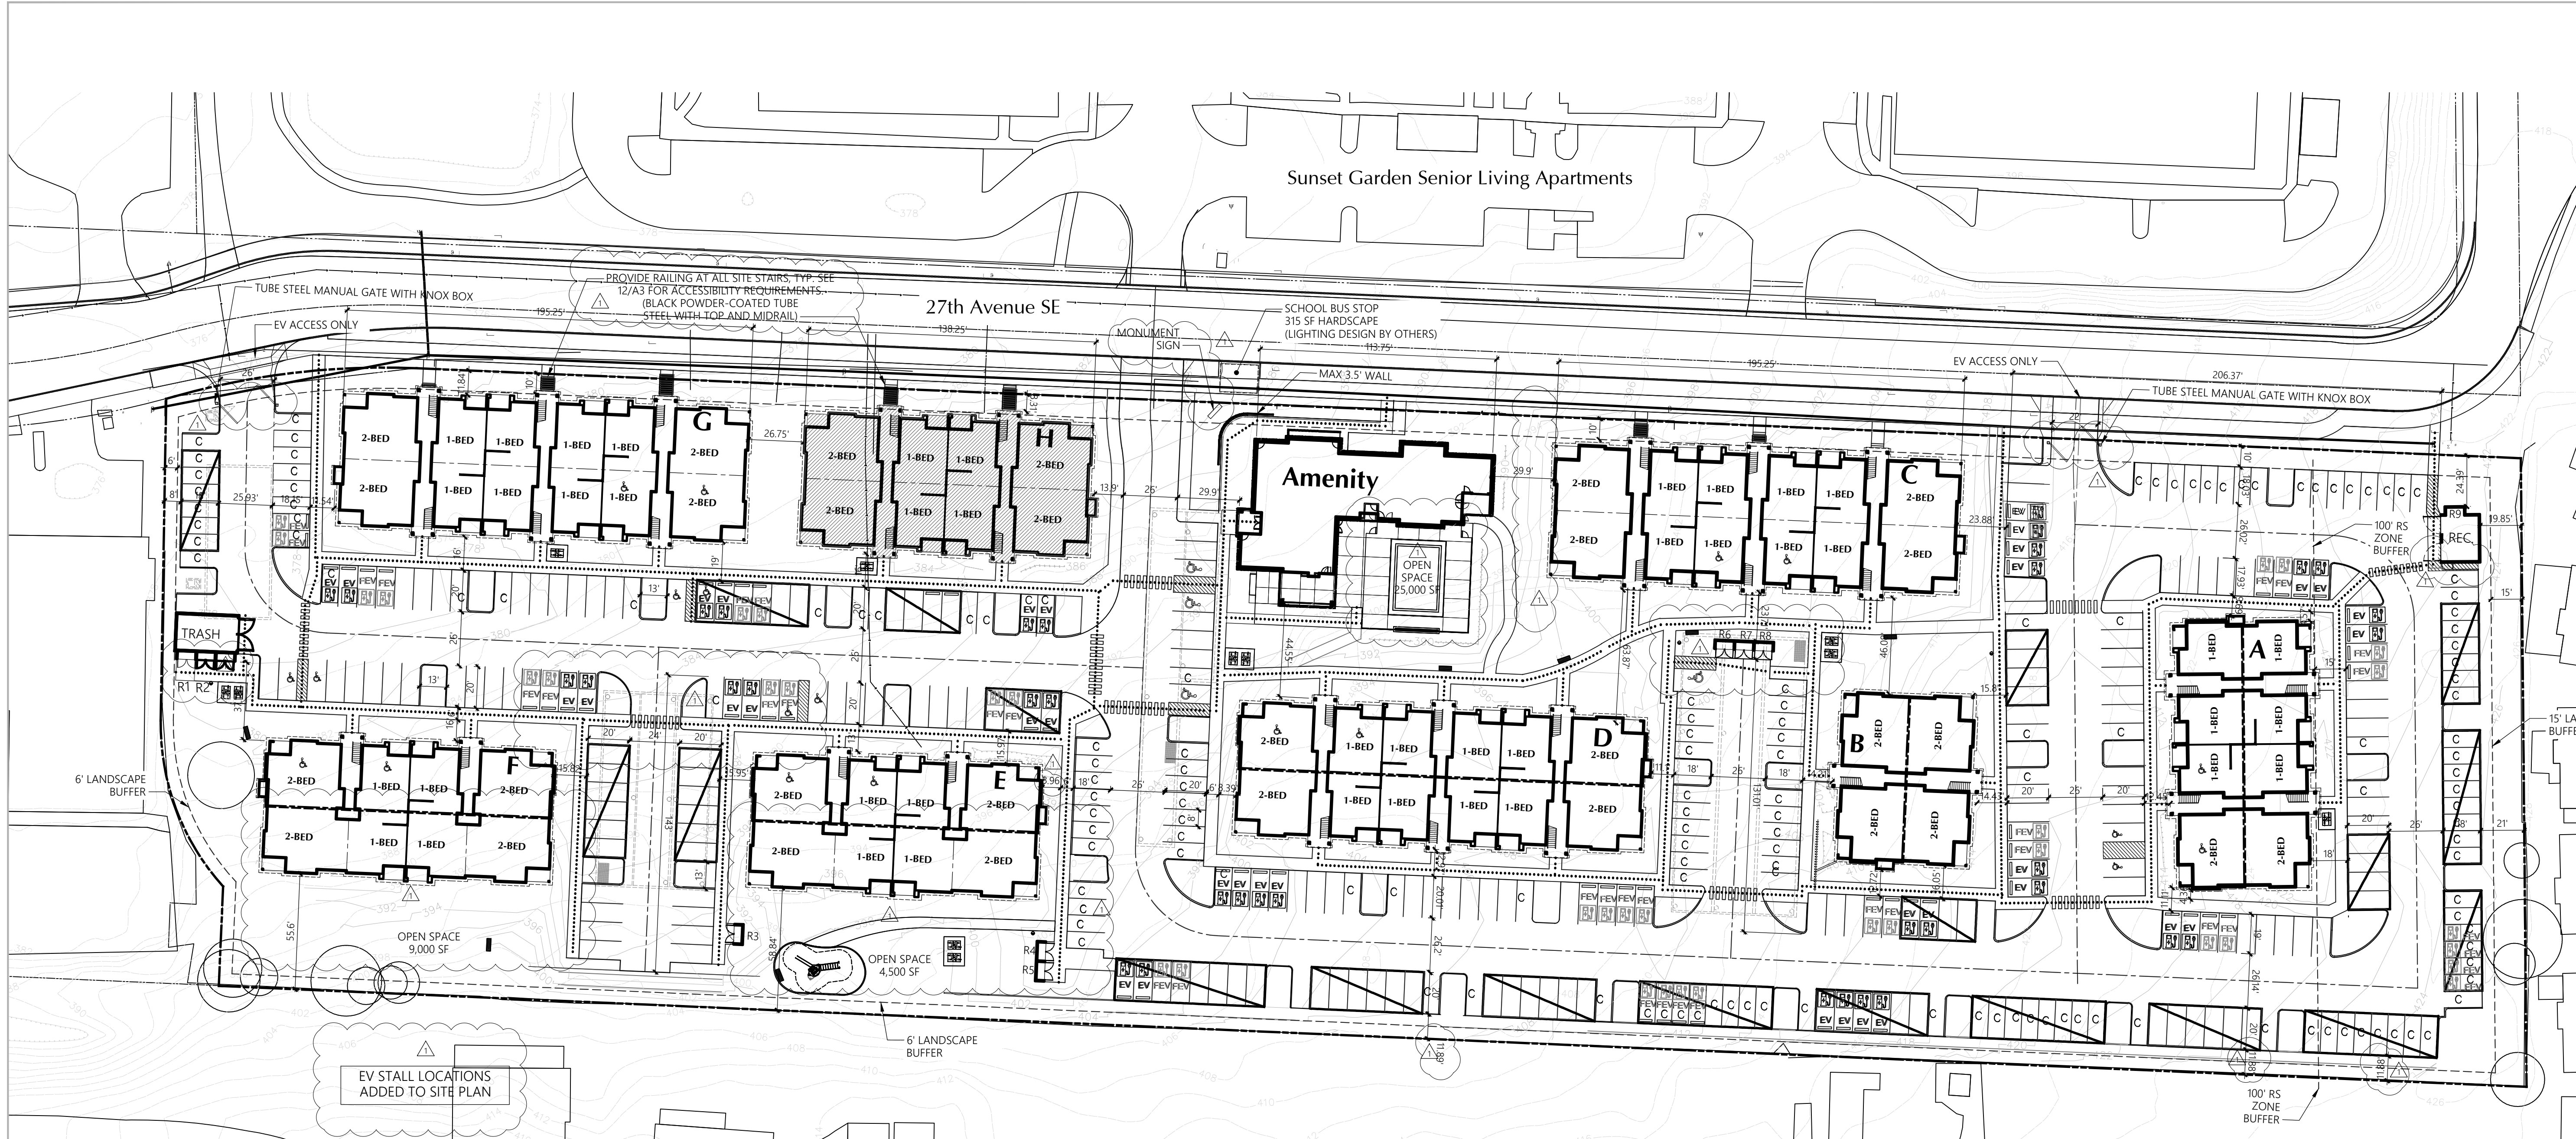

**SITE PLAN** 236 UNITS  
1" = 40'

**SITE INFORMATION**

SITE ADDRESS: 202 27th Ave SE, Puyallup, WA  
 PARCEL #: 419036006  
 SITE AREA: 339,107 SF (7.785 Acres)  
 ZONE: RM-CORE  
 SETBACKS: NORTH/FRONT: 10 FT setback to buildings  
 WEST/SIDE: 0 FT Building setback - 6 FT landscape buffer  
 SOUTH/REAR: 0 FT Building setback - 6 FT landscape buffer  
 EAST/SIDE: 25 FT Building setback - 15 ft landscape buffer  
 BUILDING HEIGHT: 50' Max  
 DENSITY: Min 16 units per acre (125 units) no Max density  
 LOT COVERAGE: Max 90%  
 LANDSCAPE AREA: Min 10% of net lot area (33,910 SF)  
 OPEN SPACE: 10% of net lot area (33,910 SF) 38,500 SF provided  
 PRIVATE OPEN SPACE: 60 SF per ground floor unit 10' x 6' per upper story unit  
 PARKING: 1.5 PARKING SPACES PER UNIT Required Parking: 354 Stalls Provided Parking: 354 Stalls  
 EASEMENTS: no existing easements on site

PARKING SUMMARY	
Parking Stalls Required	354
Standard Stalls	124
Compact Stalls	41.5% 98
Parallel Stalls	0
Carport Stalls	118
Attached Garage Stalls	0
Detached Garage Stalls	0
Accessible Standard Stalls	6
Accessible Van Stalls	5
Accessible Parallel Stalls	0
Accessible Carport Stalls	1
Accessible Garage Stalls	0
Tandem Stalls	0
Tandem Garage Stalls	0
Subtotal	352 1.49 Stalls / D.U.
Aprons	0
<b>Total Parking Stalls Provided</b>	<b>352 1.49 Stalls / D.U.</b>


**UNIT COUNT**  
 1 BED 137 (58%)  
 2 BED 99 (42%)  
**TOTAL 236**

**EV STALL COUNT**  
 Total Electric Vehicle Charging stations: **36 Stalls**  
 Total Future Electric Vehicle Stall Infrastructure: **36 Stalls**

Provide at least 1 accessible parking space for each Type A unit per Washington State Building, Section 1106.2 and insure that the accessible parking spaces are on the shortest accessible route of travel per Washington State Building Code Section 1106.6. See accessible parking for buildings C and D as an example, there may be others.  
 (Construction Set, Sheet A2, Site Plan)

Provide a definition of "future electric vehicle charging stall infrastructure" as listed on the Site Key.  
 (Construction Set, Sheet A2, Site Key)

- SITE NOTES**
- TYPICAL SIDEWALK WIDTH IS 6'
  - A MINIMUM CLEAR WIDTH OF 44" IS REQUIRED FOR ALL EXTERIOR ACCESSIBLE ROUTES PER WASHINGTON STATE AMENDMENT SECTION 1101.2.1
  - SEE SHEET A3 FOR SITE ACCESSIBILITY STANDARDS
  - SEE CIVIL SITE PLAN PERMIT DRAWINGS FOR SPECIFIC UTILITY, ROAD AND GRADING INFORMATION
  - POOL TO BE UNDER SEPARATE PERMIT

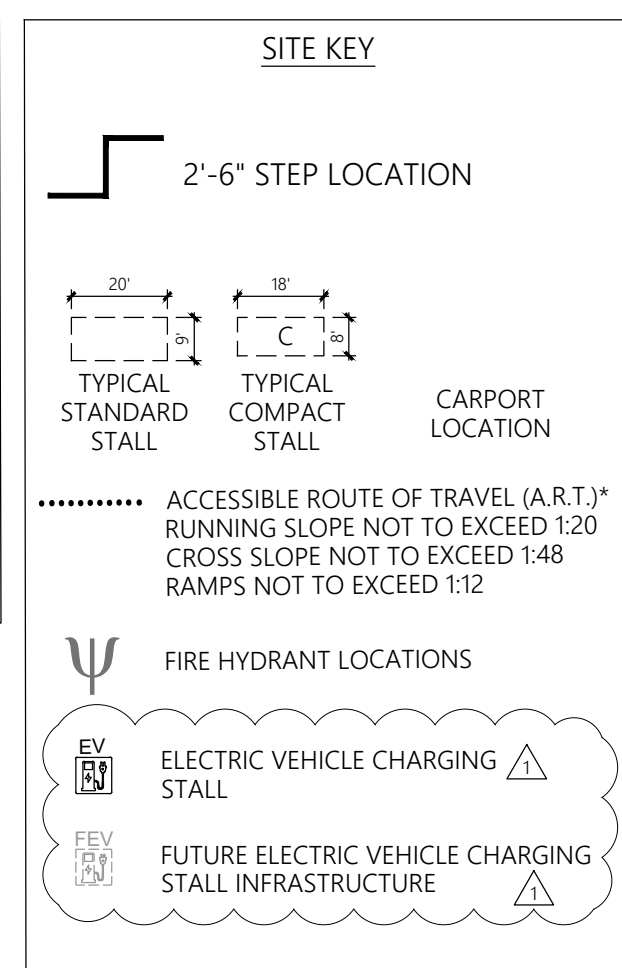


CODE REFERENCES ARE TO ICC A117.1-2009 UNLESS NOTED OTHERWISE

NOTE: ALL DIMENSIONS ARE FROM FINISHED SURFACE


**CHANGES IN LEVEL**  
CHANGES IN LEVEL OF 1/4" MAX. SHALL BE PERMITTED TO BE VERTICAL AND WITHOUT EDGE TREATMENT.  
CHANGES IN LEVEL BETWEEN 1/4" AND 1/2" MAX. SHALL BE BEVELED WITH A SLOPE NOT STEEPER THAN 1:2

**TURNING SPACE & CLEAR FLOOR SPACE**  
TURNING SPACES SHALL BE EITHER A 60" CIRCLE OR A T-SHAPED SPACE WITHIN A 60" SQUARE.  
CLEAR FLOOR SPACE IS DEFINED AS A SPACE 30"x48"  
A SLOPE OF NOT MORE THAN 1:48 SHALL BE PERMITTED WITHIN TURNING AND CLEAR FLOOR SPACES. NO CHANGES IN LEVEL ARE PERMITTED.

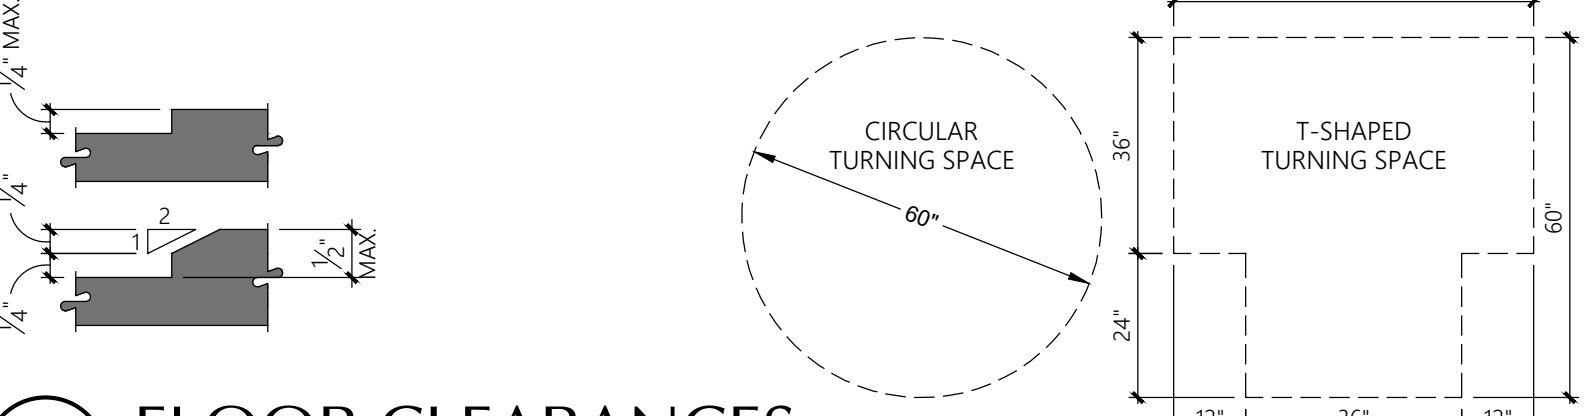


**1 FLOOR CLEARANCES**  
3/8"=1'-0"

**KNEE AND TOE CLEARANCE**  
TOE OR KNEE CLEARANCE SHALL BE 30" WIDE MIN. THE DIP OF THE OVERFLOW ON A SINK SHALL NOT BE CONSIDERED IN DETERMINING KNEE AND TOE CLEARANCE.  
\* WATER SUPPLY & DRAINPIPES UNDER LAVATORIES AND SINKS SHALL BE INSULATED OR OTHERWISE CONFIGURED TO PROTECT AGAINST CONTACT. THERE SHALL BE NO SHARP OR ABRASIVE SURFACES UNDER LAVATORIES AND SINKS.

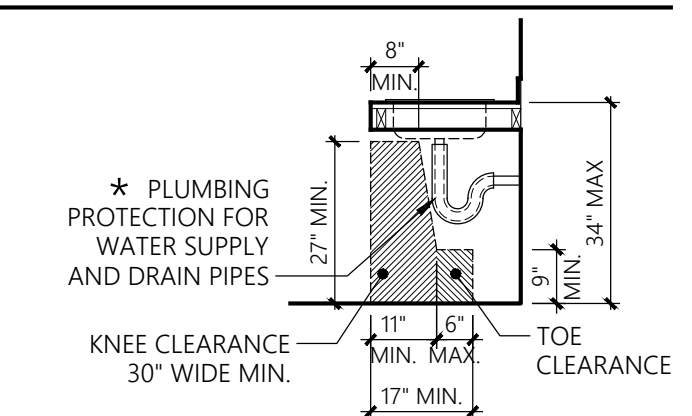

**2 KNEE AND TOE SPACE**  
3/8"=1'-0"

**PROTRUDING OBJECTS**  
OBJECTS WITH LEADING EDGES MORE THAN 27" AND NOT MORE THAN 80" ABOVE THE FINISH FLOOR MAY PROTRUDE 4" MAX INTO THE CIRCULATION PATH, EXCEPT HANDRAILS, WHICH ARE PERMITTED TO PROTRUDE 4 1/2".  
WHERE VERTICAL CLEARANCE IS LESS THAN 80", GUARDRAILS OR OTHER BARRIERS SHALL BE PROVIDED WITH THE LEADING EDGE OF THE GUARDRAIL NO MORE THAN 27" MAX. ABOVE THE FLOOR.

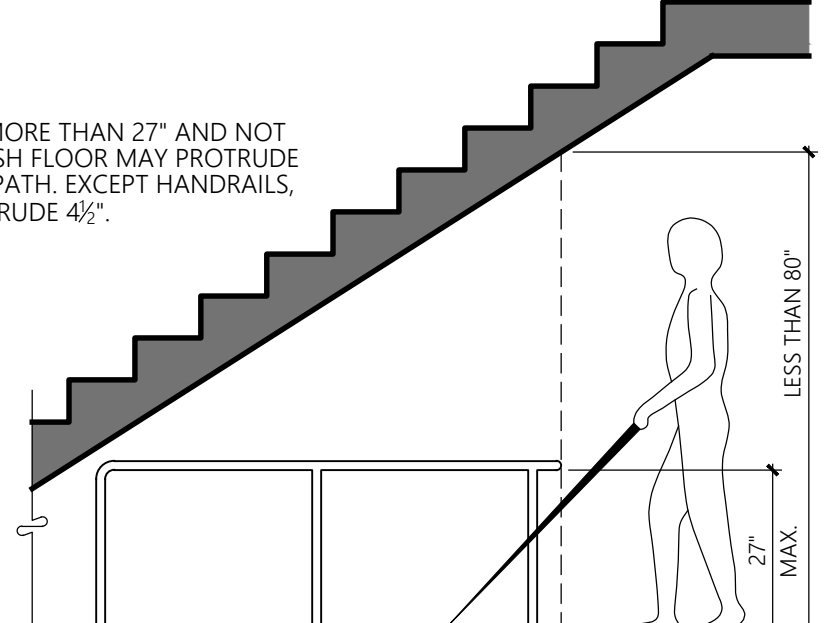

**3 PROTRUDING OBJECTS**  
3/8"=1'-0"

CLEAR FLOOR SPACE SHALL EXTEND BENEATH THE ELEMENT FOR A DISTANCE NOT LESS THAN THE REQUIRED REACH DEPTH OVER THE OBSTRUCTION.  
UNOBSTRUCTED FRONT REACH: 15" MIN. to 48" MAX.  
OBSTRUCTED FRONT HIGH REACH: 48" MAX. to 80" MAX.

UNOBSTRUCTED SIDE REACH: 15" MIN. to 48" MAX.  
OBSTRUCTED SIDE HIGH REACH: 34" MAX. to 48" MAX.

**OPERABLE PARTS**  
A 30"x48" CLEAR FLOOR SPACE SHALL BE PROVIDED AT ALL OPERABLE PARTS. ALL OPERABLE PARTS SHALL BE WITHIN ONE OR MORE OF THE REACH RANGES.  
OPERABLE PARTS SHALL BE OPERABLE WITH ONE HAND AND SHALL NOT REQUIRE TIGHT GRASPING, PINCHING, OR TWISTING OF THE WRIST. THE FORCE REQUIRED TO ACTIVATE OPERABLE PARTS SHALL BE 5.0 LBS. MAX.


**4 REACH RANGES**  
3/8"=1'-0"

BUILDING BLOCKS  
CHAPTER 3

**ACCESSIBLE ROUTE** (PER IBC SECTION 1104.2)  
AT LEAST ONE ACCESSIBLE ROUTE WITHIN THE SITE SHALL BE PROVIDED FROM PUBLIC TRANSPORTATION STOPS, ACCESSIBLE PARKING, ACCESSIBLE PASSENGER LOADING ZONES, AND PUBLIC STREETS OR SIDEWALKS TO THE ACCESSIBLE BUILDING ENTRANCES SERVED.  
WHEN A BUILDING OR PORTION OF A BUILDING IS REQUIRED TO BE ACCESSIBLE, AT LEAST ONE ACCESSIBLE ROUTE SHALL BE PROVIDED TO EACH PORTION OF THE BUILDING, TO ACCESSIBLE BUILDING ENTRANCES CONNECTING ACCESSIBLE WALKWAYS AND TO THE PUBLIC WAY.  
ACCESSIBLE ROUTES SHALL COINCIDE WITH OR BE LOCATED IN THE SAME AREAS AS A GENERAL CIRCULATION PATH.

ACCESSIBLE ROUTES SHALL CONSIST OF ONE OR MORE OF THE FOLLOWING COMPONENTS: WALKING SURFACES WITH A SLOPE NOT STEEPER THAN 1:20, DOORS & DOORWAYS, RAMPS, CURB RAMPS EXCLUDING THE FLARED SIDES, ELEVATORS, AND PLATFORM LIFTS.

**5 ACCESSIBLE ROUTE**

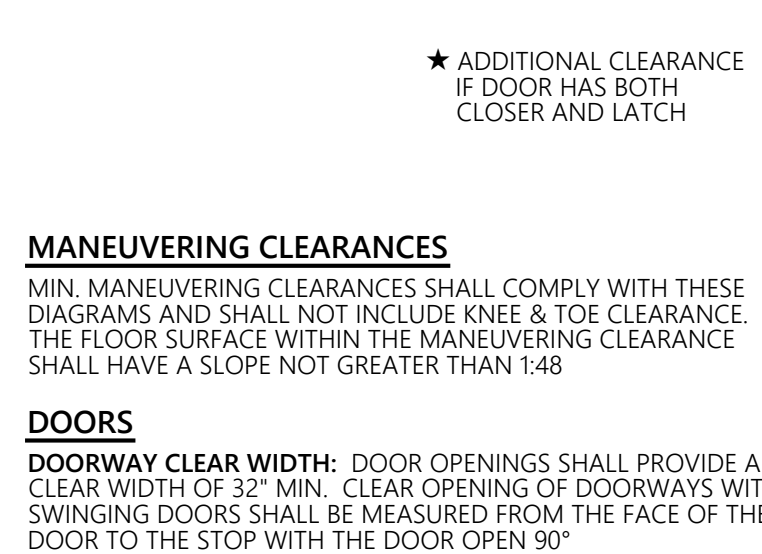

**MANEUVERING CLEARANCES**  
MIN. MANEUVERING CLEARANCES SHALL COMPLY WITH THESE DIAGRAMS AND SHALL NOT INCLUDE KNEE & TOE CLEARANCE. THE FLOOR SURFACE WITHIN THE MANEUVERING CLEARANCE SHALL HAVE A SLOPE NOT GREATER THAN 1:48

**6 DOORS**  
1/4"=1'-0"

**DOORS**  
**DOORWAY CLEAR WIDTH:** DOOR OPENINGS SHALL PROVIDE A CLEAR WIDTH OF 32" MIN. CLEAR OPENING OF DOORWAYS WITH SWINGING DOORS SHALL BE MEASURED FROM THE FACE OF THE DOOR TO THE STOP WITH THE DOOR OPEN 90°.  
**THRESHOLDS:** IF PROVIDED, THRESHOLDS SHALL BE 1/2" MAX. IN HEIGHT & SHALL COMPLY WITH SECTIONS 302 & 303. (See detail 1 ACC sheets)  
**DOOR HARDWARE:** HANDLES, PULLS, LATCHES, LOCKS AND OTHER OPERABLE PARTS ON ACCESSIBLE DOORS SHALL HAVE A SHAPE THAT IS EASY TO GRASP WITH ONE HAND AND DOES NOT REQUIRE TIGHT GRASPING, PINCHING, OR TWISTING OF THE WRIST TO OPERATE. OPERABLE PARTS OF SUCH HARDWARE SHALL BE 34" MIN. AND 48" MAX. ABOVE THE FLOOR.

**RAMPS**  
**GENERAL:** RAMP RUNS SHALL HAVE A RUNNING SLOPE GREATER THAN 1:20 AND NOT STEEPER THAN 1:12. THE MAX. CROSS SLOPE OF A RAMP SHALL BE 1:48. THE MAX. RISE FOR ANY RAMP RUN SHALL BE 30". LANDINGS SUBJECT TO WET CONDITIONS SHALL BE DESIGNED TO PREVENT THE ACCUMULATION OF WATER.  
**CHANGES IN LEVEL:** CHANGES IN LEVEL SHALL COMPLY WITH SECTION 303 (See detail 1 ACC sheets)  
**CLEAR WIDTH:** THE CLEAR WIDTH SHALL BE 36" MIN. FOR EXTERIOR ROUTES OF TRAVEL THE CLEAR WIDTH SHALL BE 44" MIN. THE HANDRAILS SHALL NOT PROJECT INTO THE REQUIRED CLEAR WIDTH OF THE RAMP RUN.  
**LANDINGS:** RAMP RUNS SHALL HAVE LANDINGS AT THE BOTTOM & TOP OF EACH RAMP RUN WITH A MAX. SLOPE OF 1:48. CLEAR WIDTH OF LANDINGS SHALL BE AS WIDE AS THE WIDEST RAMP RUN LEADING TO THE LANDING AND A MIN. CLEAR LENGTH OF 60". RAMP RUNS THAT CHANGE DIRECTION AT THE LANDING SHALL BE SIZED TO PROVIDE A TURNING SPACE (See detail 1 ACC sheets)  
**HANDRAILS:** RAMP RUNS WITH A RISE GREATER THAN 6" SHALL HAVE HANDRAILS  
**EDGE PROTECTION:** THE FLOOR SURFACE OF THE RAMP RUN OR LANDING SHALL EXTEND 12" BEYOND THE INSIDE FACE OF A RAILING OR THERE SHALL BE A 4" MIN. HEIGHT CURB OR A BARRIER AT THE EDGE OF THE RAMP OR LANDING CONSTRUCTED SO THAT IT PREVENTS THE PASSAGE OF A 4" DIAMETER SPHERE

**7 RAMPS**  
1/4"=1'-0"


**CURB RAMPS**  
THE MIN. WIDTH OF CURB RAMPS SHALL BE 36". ALL ADJOINING GUTTERS AND ROAD SURFACES IMMEDIATELY ADJACENT TO THE CURB RAMP SHALL NOT BE STEEPER THAN 1:20. THE CURB RAMP SHALL HAVE A MAX. SLOPE OF 1:12 WITH A MAX. CROSS SLOPE OF 1:48. LANDINGS SUBJECT TO WET CONDITIONS SHALL BE DESIGNED TO PREVENT THE ACCUMULATION OF WATER.  
A 36" MIN. LENGTH LANDING AT LEAST AS WIDE AS THE CURB RAMP SHALL BE PROVIDED AT THE TOP OF CURB RAMPS.  
CURB RAMPS SHALL BE LOCATED OR PROTECTED TO PREVENT THEIR OBSTRUCTION BY PARKED VEHICLES.  
CURB RAMP 1:12 MAX. SLOPE  
FLARED SIDES 1:10 MAX. SLOPE  
CURB RAMP FLARES PAINTED IF ADJACENT CURB IS PAINTED

**8 CURB RAMPS AND DETECTABLE WARNINGS**  
1/4"=1'-0"


DETECTABLE WARNING (IF PROVIDED): 6" TO 8" height, 24" length, 36" width.

**WALKING SURFACES**  
**SLOPE:** THE RUNNING SLOPE OF WALKING SURFACES SHALL NOT BE STEEPER THAN 1:20. THE CROSS SLOPE OF A WALKING SURFACE SHALL NOT BE STEEPER THAN 1:48.  
**CHANGES IN LEVEL:** CHANGES IN LEVEL SHALL COMPLY WITH SECTION 303 (See detail 1 ACC sheets)  
**CLEAR WIDTH:** THE WIDTH OF AN ACCESSIBLE ROUTE SHALL BE 36" MIN. THE CLEAR WIDTH SHALL BE PERMITTED TO BE REDUCED TO 32" MIN. FOR A LENGTH OF 24" MAX. PROVIDED THE REDUCED WIDTH SEGMENTS ARE SEPARATED BY SEGMENTS THAT ARE 48" MIN. IN LENGTH AND 36" MIN. IN WIDTH. FOR EXTERIOR ROUTES OF TRAVEL, THE CLEAR WIDTH SHALL BE 44" MIN.


**PASSING SPACE:** AN ACCESSIBLE ROUTE WITH A CLEAR WIDTH LESS THAN 60" SHALL PROVIDE PASSING SPACES AT MAXIMUM INTERVALS OF 200 FEET. PASSING SPACES SHALL BE EITHER A 60"x60" MIN. SPACE, OR AN INTERSECTION OF WALKING SURFACES WITH A T-SHAPED TURNING SPACE (See detail 1 ACC sheets). PROVIDED THE BASE AND ARMS OF THE T-SHAPED SPACE EXTEND 48" MIN. BEYOND THE INTERSECTION.

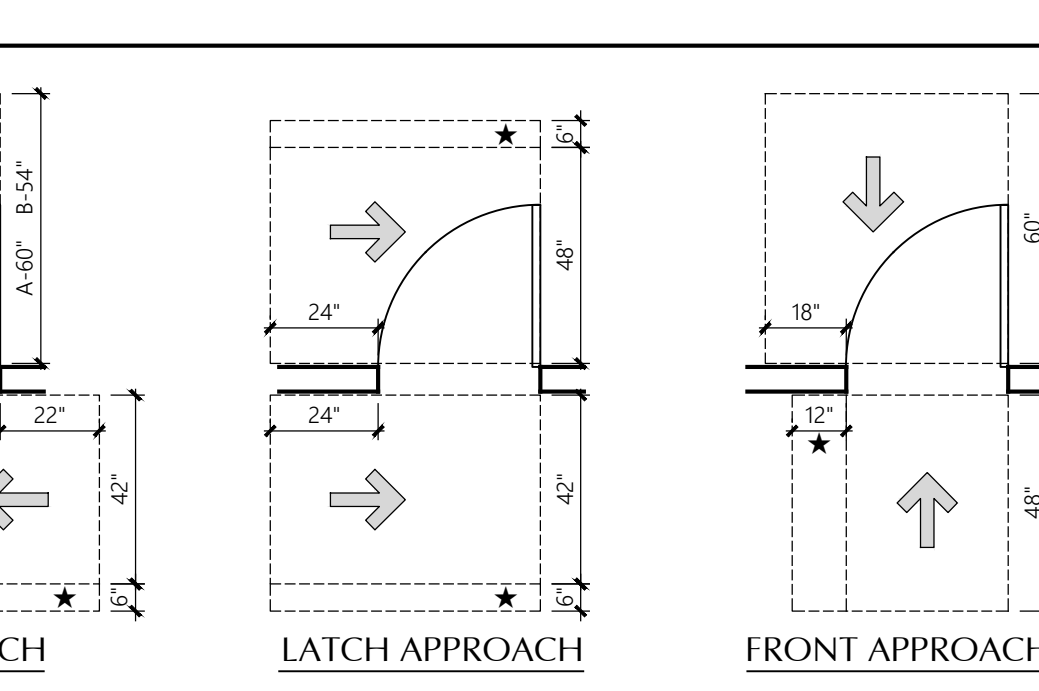

**CLOSING SPEED:** DOORS WITH CLOSERS SHALL BE ADJUSTED SO THAT FROM A 90° OPEN POSITION, THE TIME REQUIRED TO MOVE THE DOOR TO A POSITION OF 12° FROM THE LATCH IS 5 SECONDS MIN.  
**DOORS WITH A SPRING HINGE SHALL BE ADJUSTED SO THAT FROM A 70° OPEN POSITION, THE TIME REQUIRED TO MOVE THE DOOR TO A CLOSED POSITION IS 1.5 SECONDS MIN.**  
**DOOR OPENING FORCE:** HINGED, SLIDING OR FOLDING DOORS OTHER THAN FIRE DOORS SHALL HAVE AN OPENING FORCE AS FOLLOWS:  
INTERIOR DOORS: 5 LBS. MAX.  
EXTERIOR DOORS: 10 LBS. MAX.

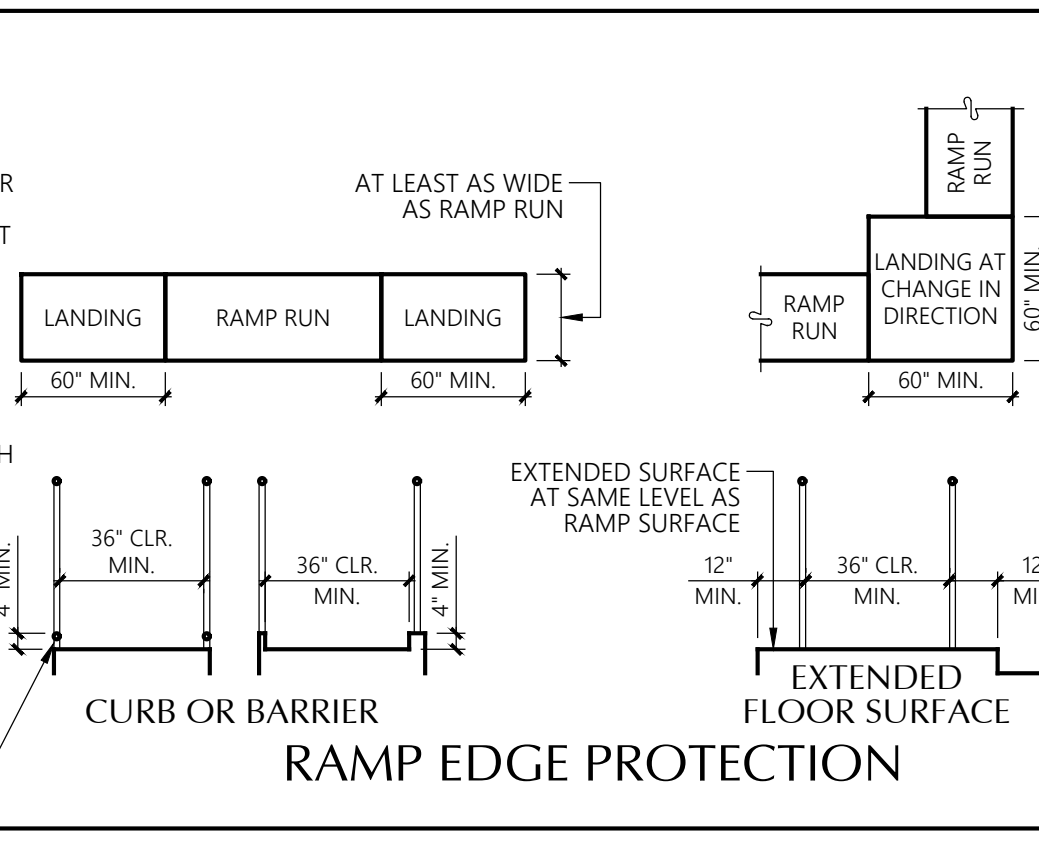


**DETECTABLE WARNINGS**  
DETECTABLE WARNINGS SHALL CONTRAST VISUALLY WITH ADJACENT SURFACES, EITHER LIGHT-ON-DARK OR DARK-ON-LIGHT.  
DETECTABLE WARNING SURFACES IN INTERIOR LOCATIONS SHALL DIFFER FROM ADJOINING WALKING SURFACES IN RESILIENCY OR SOUND-ON-CANE CONTACT. TRUNCATED DOMES SHALL BE ALIGNED IN A SQUARE PATTERN.

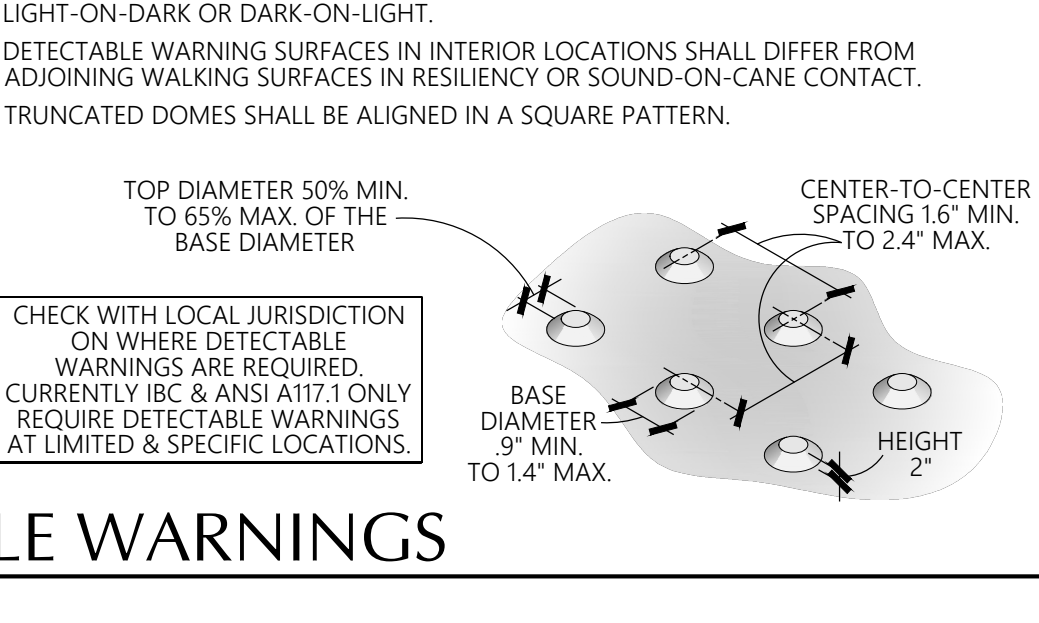

CHECK WITH LOCAL JURISDICTION ON WHERE DETECTABLE WARNINGS ARE REQUIRED. CURRENTLY IBC & ANSI A117.1 ONLY REQUIRE DETECTABLE WARNINGS AT LIMITED & SPECIFIC LOCATIONS.


**ACCESSIBLE PARKING SPACES**

**LOCATION:** PER IBC SECTION 1106.6, ACCESSIBLE PARKING SPACES SHALL BE LOCATED ON THE SHORTEST ACCESSIBLE ROUTE OF TRAVEL FROM ADJACENT PARKING TO AN ACCESSIBLE BUILDING ENTRANCE. WHERE PRACTICAL, THE ACCESSIBLE ROUTE SHALL NOT CROSS LANES OF TRAFFIC. WHERE CROSSING TRAFFIC LANES IS NECESSARY, THE ROUTE SHALL BE DESIGNATED AND MARKED AS A CROSSWALK.  
**PARKING STALL SIZE:** CAR AND VAN PARKING SPACES SHALL BE 96" MIN. WIDTH. ACCESS AISLES SERVING CAR PARKING SPACES SHALL BE 60" MIN. IN WIDTH. ACCESS AISLES SERVING VAN PARKING SPACES SHALL BE 96" MIN. IN WIDTH.  
**ACCESS AISLE:** CAR AND VAN PARKING SPACES SHALL HAVE AN ADJACENT ACCESS AISLE ON EITHER SIDE OF THE PARKING SPACE. THE ACCESS AISLES SHALL BE 60" MIN. IN WIDTH FOR CAR STALLS AND 96" MIN. IN WIDTH FOR VAN STALLS AND EXTEND THE FULL LENGTH OF AND AT THE SAME LEVEL AS THE PARKING SPACE THEY SERVE. ACCESS AISLES SHALL BE MARKED SO AS TO DISCOURAGE PARKING IN THEM.  
**FLOOR SURFACES:** PARKING STALLS & ADJACENT ACCESS AISLES SHALL HAVE A SURFACE SLOPE NOT GREATER THAN 1:48. WHERE MOUNTING IS NECESSARY WITHIN A PATH OF CIRCULATION, SIGNS SHALL MEET THE REQUIREMENTS OF IBC SECTION 1003.3 FOR PROTRUDING OBJECTS AND POST-MOUNTED OBJECTS.  
**IDENTIFICATION:** ACCESSIBLE PARKING SPACES SHALL BE INDICATED BY A VERTICAL SIGN. SIGNS SHALL INCLUDE THE INTERNATIONAL SYMBOL OF ACCESSIBILITY THAT IS WHITE WITH A BLUE BACKGROUND. SIGNS IDENTIFYING VAN PARKING SPACES SHALL CONTAIN THE DESIGNATION "VAN ACCESSIBLE". A VERTICAL "NO PARKING" SIGN SHALL BE ERRECTED AT THE HEAD OF EACH ACCESS AISLE LOCATED ADJACENT TO AN ACCESSIBLE PARKING SPACE. THESE SIGNS MAY INCLUDE ADDITIONAL LANGUAGE SUCH AS, BUT NOT LIMITED TO, AN INDICATION OF THE AMOUNT OF THE MONETARY PENALTY FOR PARKING IN THE SPACE WITHOUT A VALID PERMIT OR THE ACCESS AISLE. THESE SIGNS SHALL BE 60" MIN. ABOVE THE FLOOR OF THE PARKING SPACE MEASURED TO THE BOTTOM OF THE SIGN.  
**SIGN MOUNTING:** SIGNS ARE TO BE MOUNTED COMPLETELY OUTSIDE OF CIRCULATION PATHS WHEREVER POSSIBLE. WHERE MOUNTING IS NECESSARY WITHIN A PATH OF CIRCULATION, SIGNS SHALL MEET THE REQUIREMENTS OF IBC SECTION 1003.3 FOR PROTRUDING OBJECTS AND POST-MOUNTED OBJECTS.  
\* SIGNS MOUNTED ON POSTS WITHIN A CIRCULATION PATH SHALL BE INSTALLED WITH A VERTICAL CLEARANCE OF 80" MIN. FROM THE LOWEST POINT OF THE SIGN(S) TO THE WALKING SURFACE. IF A POST MOUNTED SIGN IS SUCH THAT IT PROTRUDES 4" MAX. FROM THE MOUNTING POST, THEN THE MOUNTING HEIGHT SHALL BE MOUNTED AT 60" MIN. ABOVE THE PARKING SURFACE SO AS TO NOT BE OBSTRUCTED BY ANY PARKED VEHICLES.

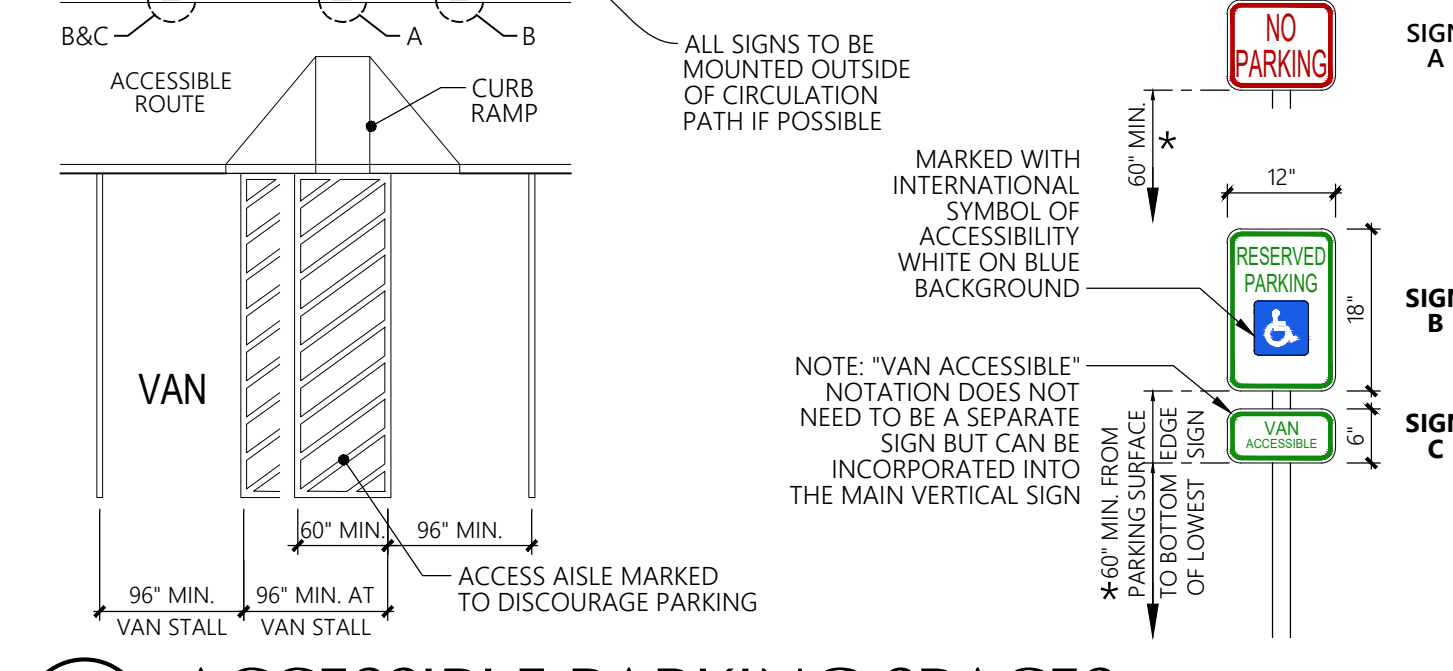


**10 ACCESSIBLE PARKING SPACES**  
NTS

**ACCESSIBLE STAIR REQUIREMENTS**  
ALL STEPS ON A FLIGHT OF STAIRS SHALL HAVE UNIFORM RISER HEIGHTS AND UNIFORM TREAD DEPTHS. RISERS SHALL BE 4" HIGH MIN. AND 7" HIGH MAX. TREADS SHALL BE 11" DEEP MIN.  
OPEN RISERS ARE NOT PERMITTED & TREADS SHALL HAVE A SLOPE NOT MORE THAN 1:48.  
STAIR NOSINGS SHALL CONFORM TO THE DIAGRAMS SHOWN HERE AND THE LEADING 2" OF THE TREAD SHALL HAVE VISUAL CONTRAST OF DARK-ON-LIGHT OR LIGHT-ON-DARK FROM THE REMAINDER OF THE TREAD.  
STAIR TREADS & LANDINGS SUBJECT TO WET CONDITIONS SHALL BE DESIGNED TO PREVENT ACCUMULATION OF WATER.  
FLOOR IDENTIFICATION SIGNS SHALL BE LOCATED AT EACH FLOOR LANDING ADJACENT TO THE STAIRWELL DOOR LEADING INTO THE CORRIDOR. SIGNS SHALL BE IN RAISED CHARACTERS & BRAILLE. "EXIT" SIGNS SHALL BE LOCATED AT STAIRS LEADING TO THE EXTERIOR OF THE BUILDING. (See detail 21 ACC sheets)

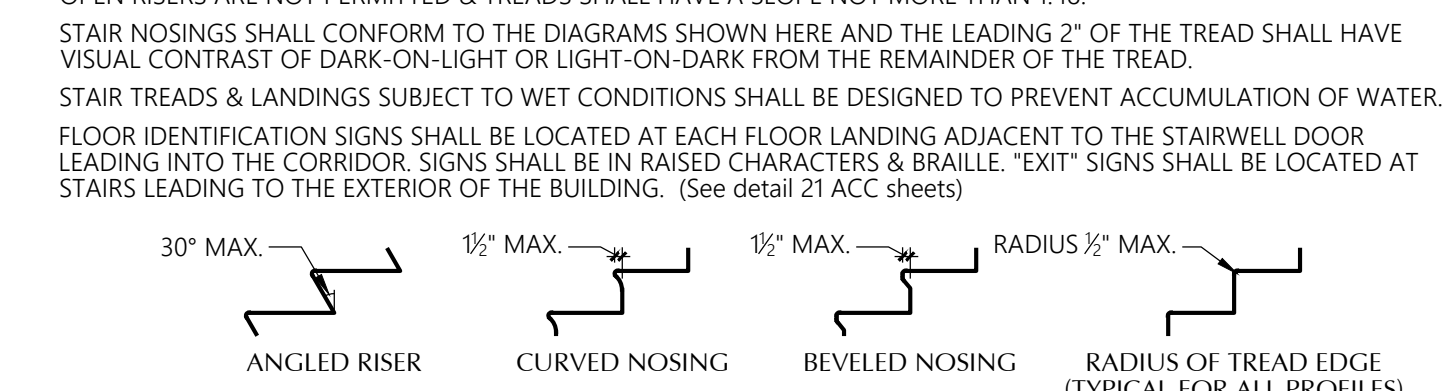

**11 ACCESSIBLE STAIRS**  
3/8"=1'-0"

**HANDRAILS**  
HANDRAILS SHALL BE PROVIDED ON BOTH SIDES OF STAIRS & RAMPS. THEY SHALL BE CONTINUOUS FOR THE FULL LENGTH OF EACH STAIR FLIGHT OR RAMP RUN. INSIDE HANDRAILS ON SWITCHBACK STAIRS SHALL BE CONTINUOUS BETWEEN FLIGHTS OR RUNS.  
HANDRAIL GRIPPING SURFACES & ANY SURFACES ADJACENT TO THEM SHALL BE FREE OF SHARP OR ABRASIVE ELEMENTS & SHALL HAVE ROUNDED EDGES. THEY SHALL BE CONTINUOUS ALONG THEIR LENGTH AND SHALL NOT BE OBSTRUCTED ALONG THEIR TOPS OR SIDES. THE BOTTOM SHALL NOT BE OBSTRUCTED FOR MORE THAN 20% OF ITS LENGTH

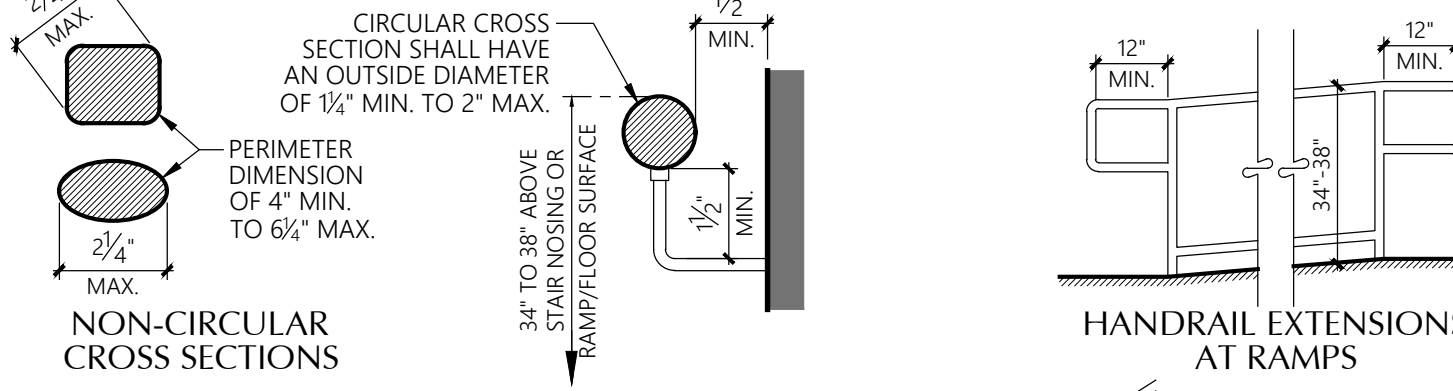


**HANDRAIL EXTENSIONS**  
EXTENSIONS SHALL EXTEND BEYOND AND IN THE SAME DIRECTION OF A STAIR FLIGHT OR RAMP RUN EXCEPT FOR THE INSIDE CONTINUOUS HANDRAIL AT SWITCHBACK STAIRS OR RAMPS. HANDRAILS SHALL RETURN TO A WALL, GUARD OR THE LANDING SURFACE, OR BE CONTINUOUS TO THE HANDRAIL OF AN ADJACENT STAIR FLIGHT OR RAMP RUN.  
AT THE BOTTOM OF A STAIR FLIGHT THE HANDRAIL SHALL EXTEND AT THE SLOPE OF THE STAIR FLIGHT FOR A HORIZONTAL DISTANCE EQUAL TO ONE TREAD DEPTH BEYOND THE BOTTOM TREAD NOSING.

**12 HANDRAILS**  
1 1/2" = 1'-0" AND 3/8"=1'-0"

GENERAL SITE & BLDG. ELEMENTS  
CHAPTER 5

25 Central Way, Suite 210  
Kirkland, Washington 98033  
P: 425.454.7130 F: 425.658.1208  
Web: www.milbrandtarch.com

© Copyright 2023  
Milbrandt Architects, INC., P.S.  
All rights reserved

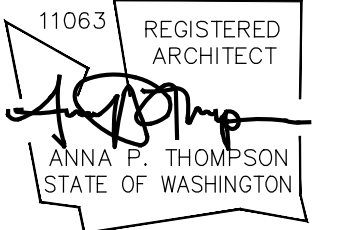

Bradley Heights Apartments  
Puyallup, Wa


Timberlane Partners

Revisions  
No. Date Description

Initial Publish Date:  
Date Plotted: 12-20-24  
Job No.: 23-06  
Drawn By: APT/DJV/JLL  
Sheet No.:

FILED: 2023.05.15 10:45 AM - STANDARDS & TRASH ENCLOSURE DWG

**LEGEND**

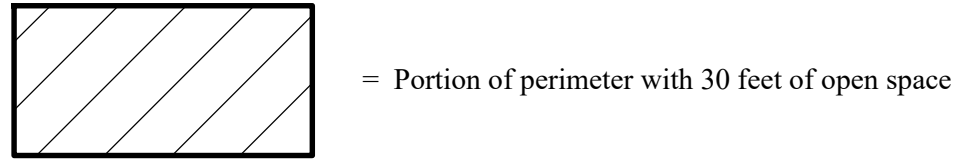

**FRONTAGE INCREASE TO BUILDING AREA**

Per IBC Section 506.3 buildings that adjoin or have access to a public way or qualifying green space for more than 25% of their total perimeter are eligible for an area factor increase based on frontage.  
To qualify for an area factor increase based on frontage, the public way or open space adjacent to the building perimeter shall have a minimum distance (W) of 20 feet, and only the first 30 feet shall be considered in the calculation. The measurement shall be to the nearest lot line, the entire width of a street, alley or public way, or the exterior face of an adjacent building on the same property.  
For purposes of simplifying this calculation only those portions of perimeter fronting right of way or green space with a dimension of 30 feet or more are considered. Those portions of perimeter that front areas that may qualify (are more than 20 feet, but are less than 30 feet) are not included in the frontage calculation.

Frontage Area increase calculation:  
 $I_f = [F/P - 0.25]W/30$   
 $I_f$  = area of increase due to frontage  
 F = Building perimeter that fronts on a public way or open space  
 P = Full building perimeter  
 W = Width of public way or open space (max of 30')


For Building H  
 F = 374.45'  
 P = 416.26'  
 W = 30'  
 $I_f = [374.45/416.26 - 0.25]30/30 = 0.65$  factor of increase due to frontage

**ALLOWABLE BUILDING AREA**

Per IBC Table 506.2: Buildings of R-2 occupancy with VB construction type are allowed to have an area of 7,000 square feet per floor. With the area factor increase from above this allowable area per floor is increased as follows:  
 7,000 s.f. x (7,000 s.f. X 0.65) = **11,546 square feet per floor allowed**

**Proposed floor area for Building H**


Floor 1:	8,266 s.f.
Floor 2:	8,028 s.f.
Floor 3:	8,284 s.f.

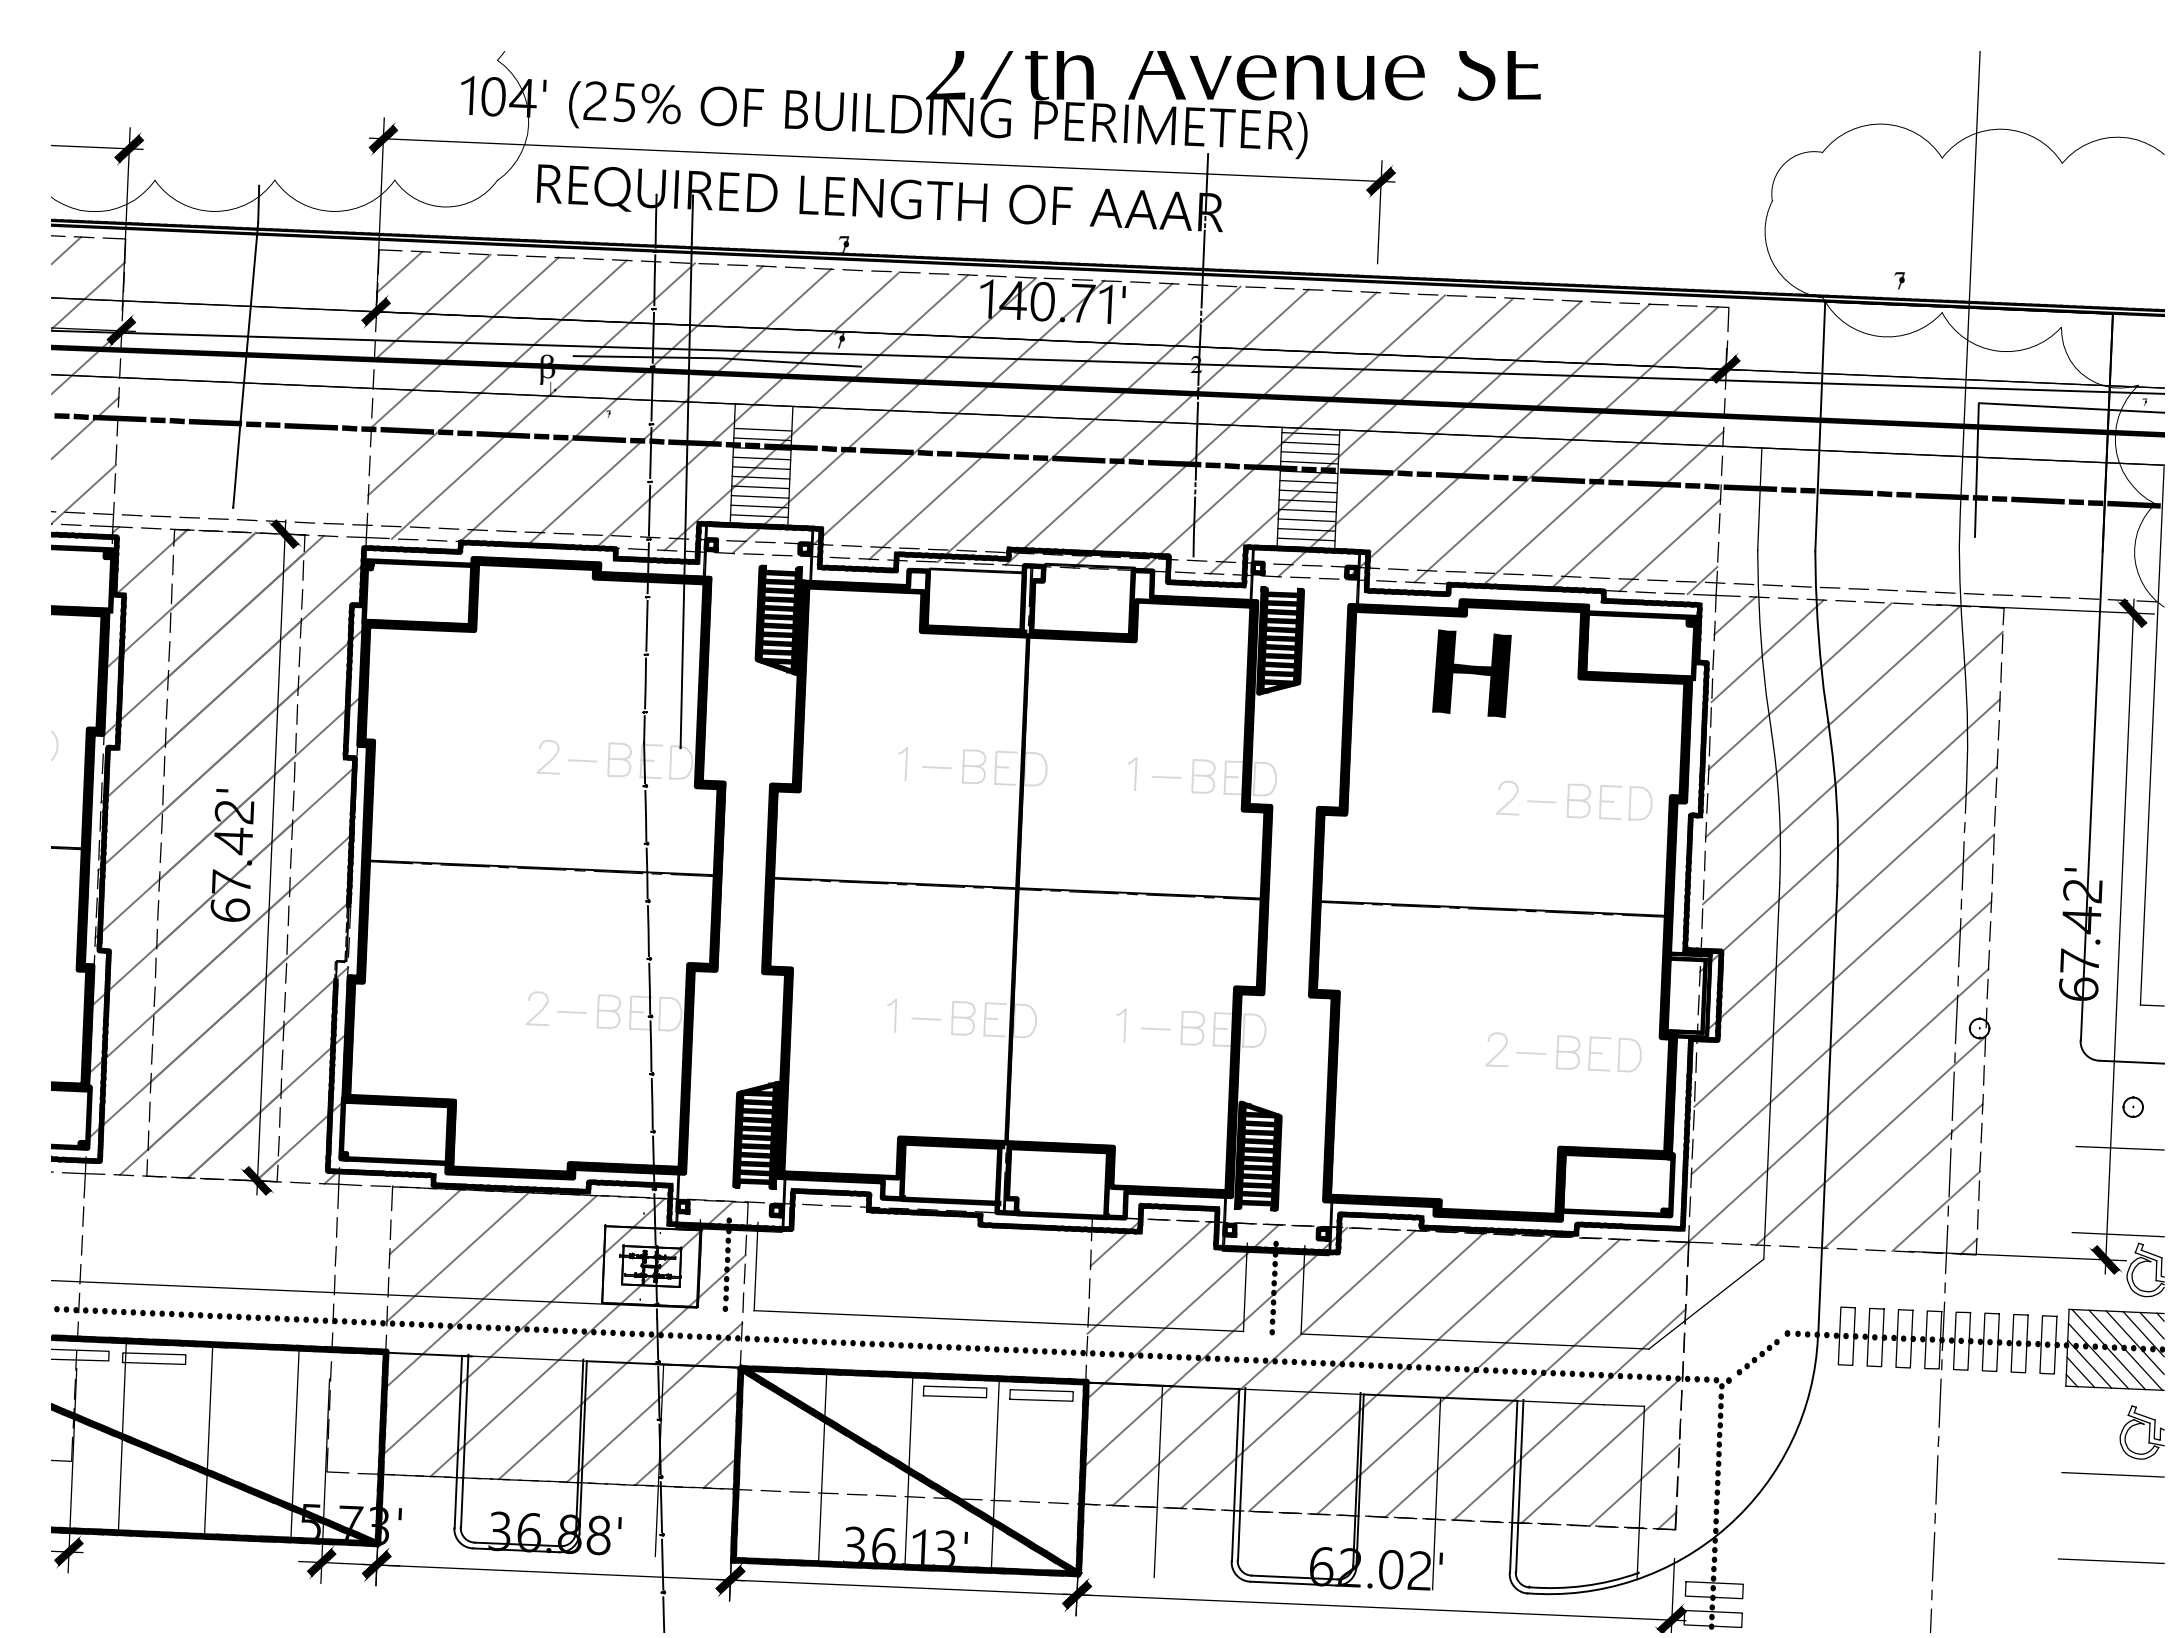


**BUILDING H** AREA INCREASE DIAGRAM  
1" = 20'

**Revisions**

No.	Date	Description
1	8-30-24	Owner Changes/ Permit Corrections

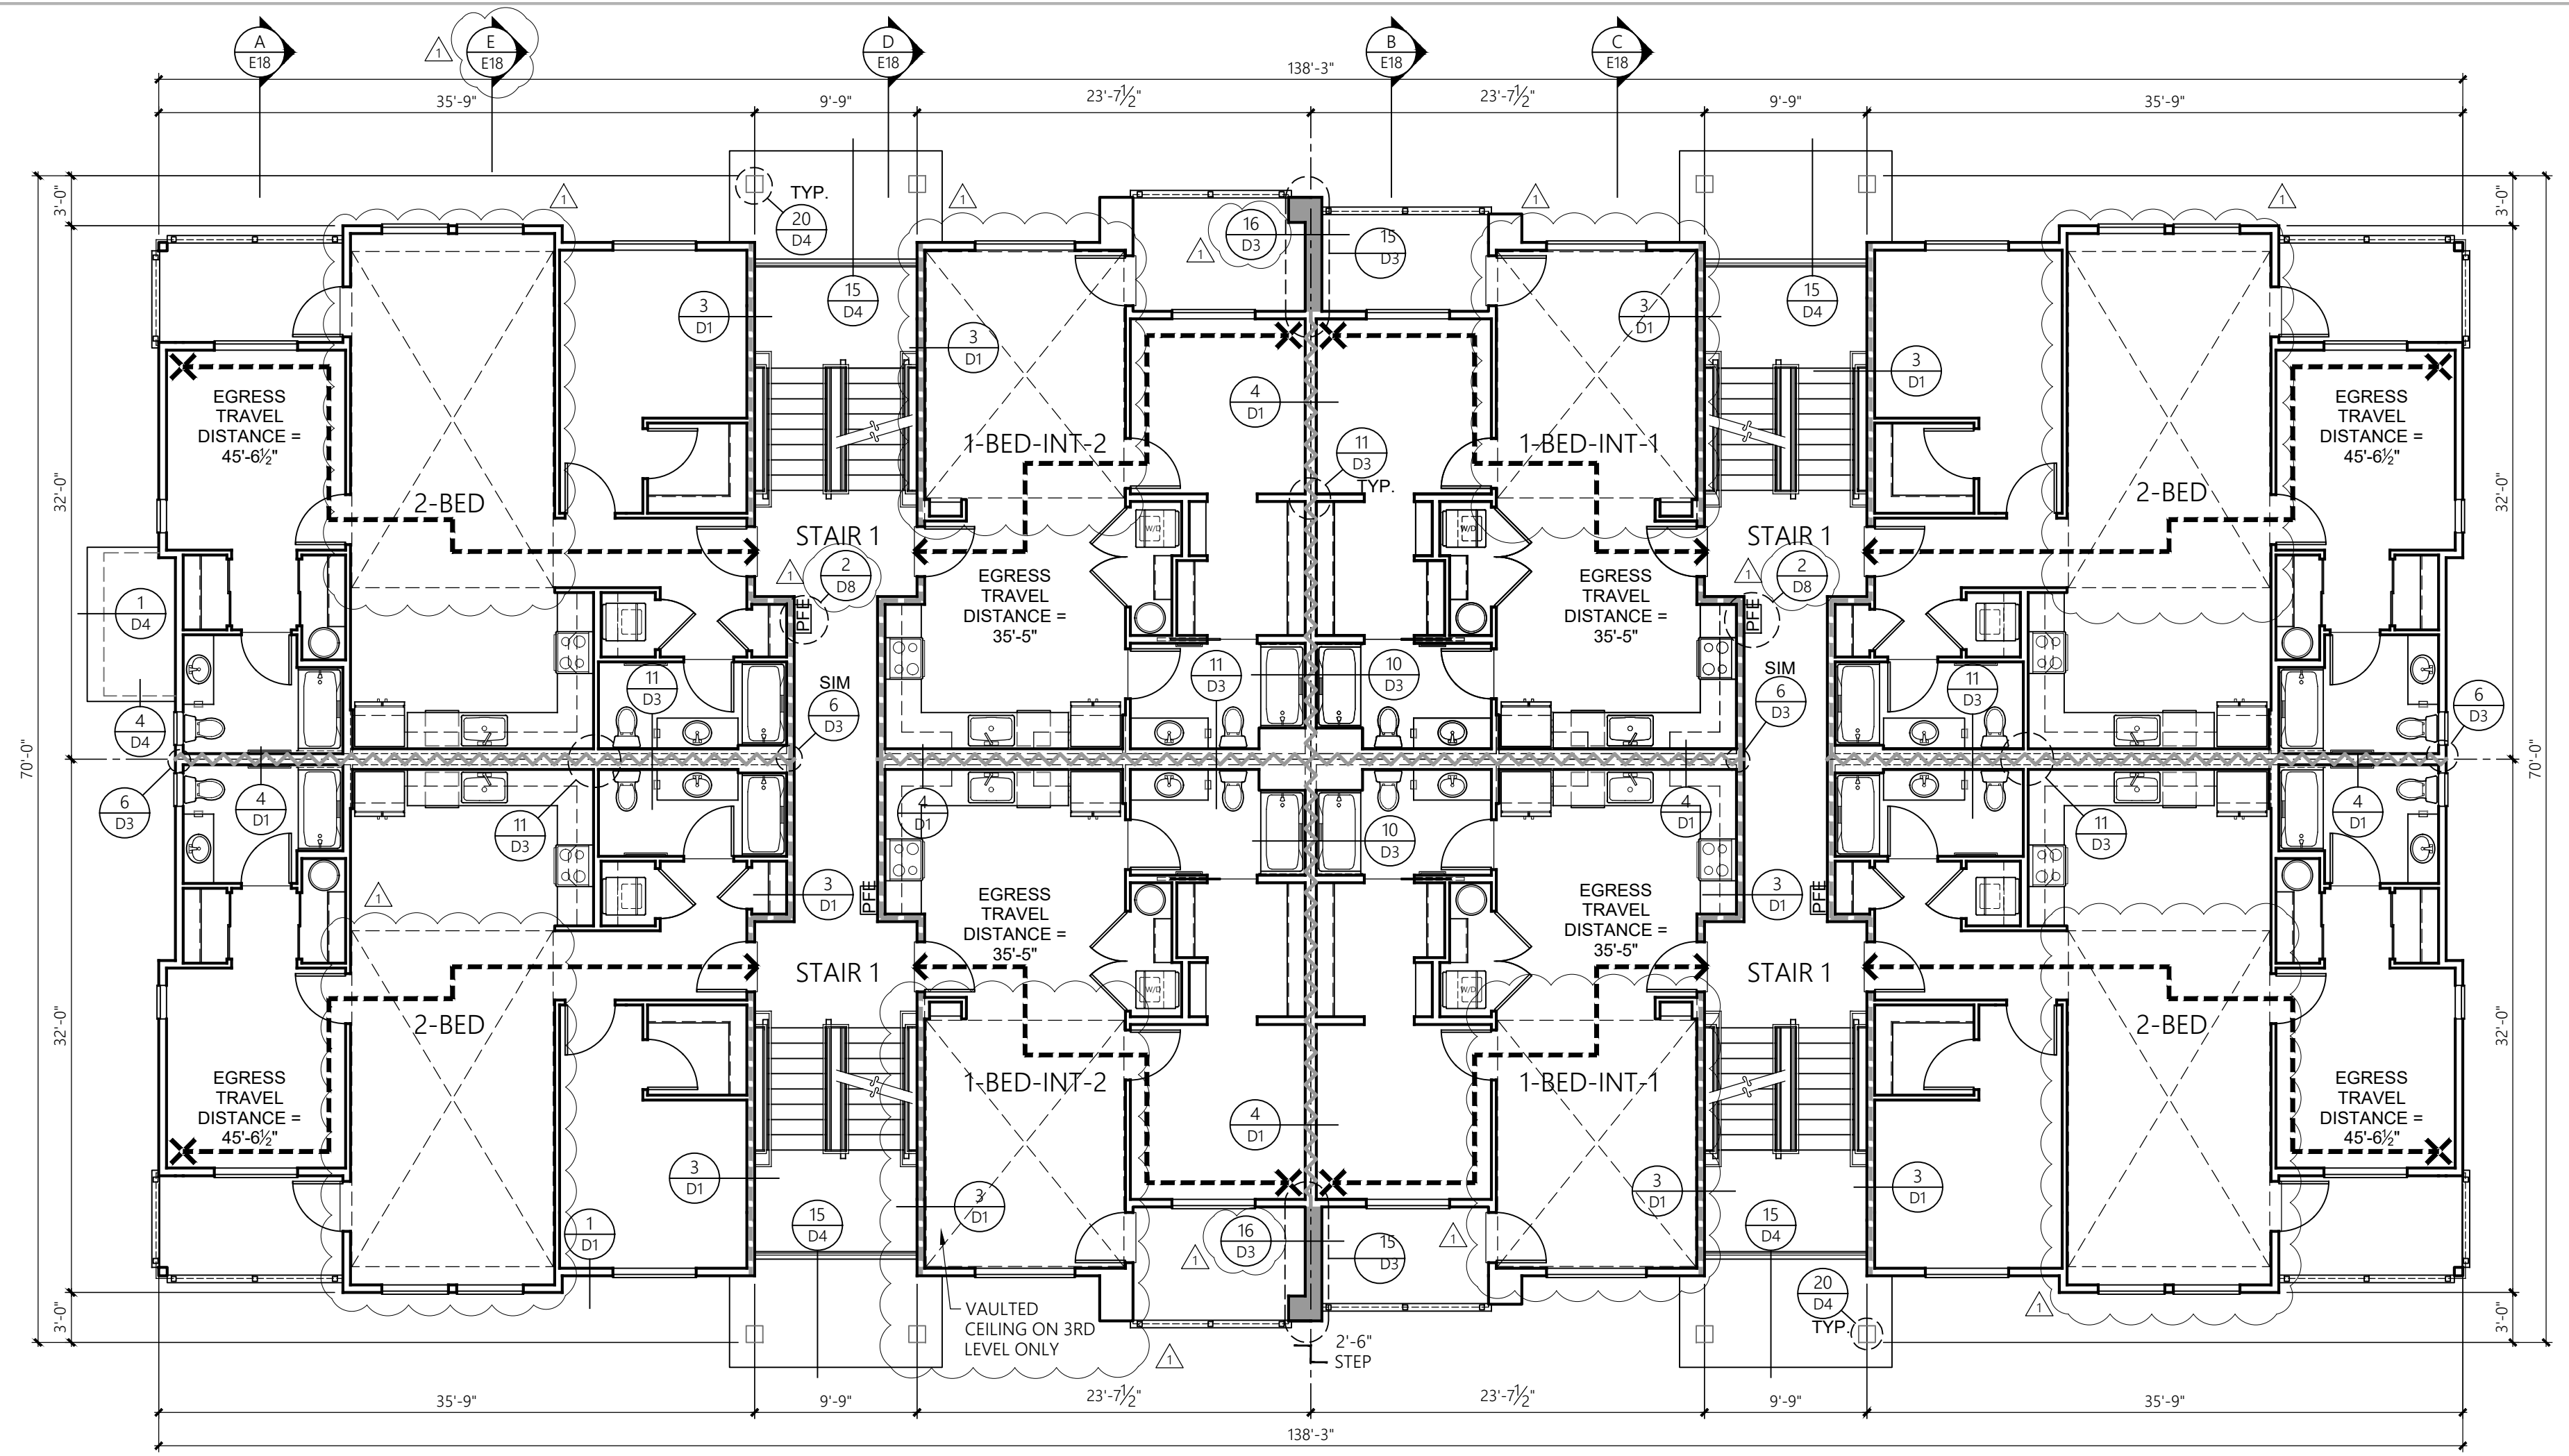

**BUILDING H** 2nd & 3rd LEVEL PLAN  
1/8" = 1'-0"  
3-STORY, 24-UNIT BUILDING

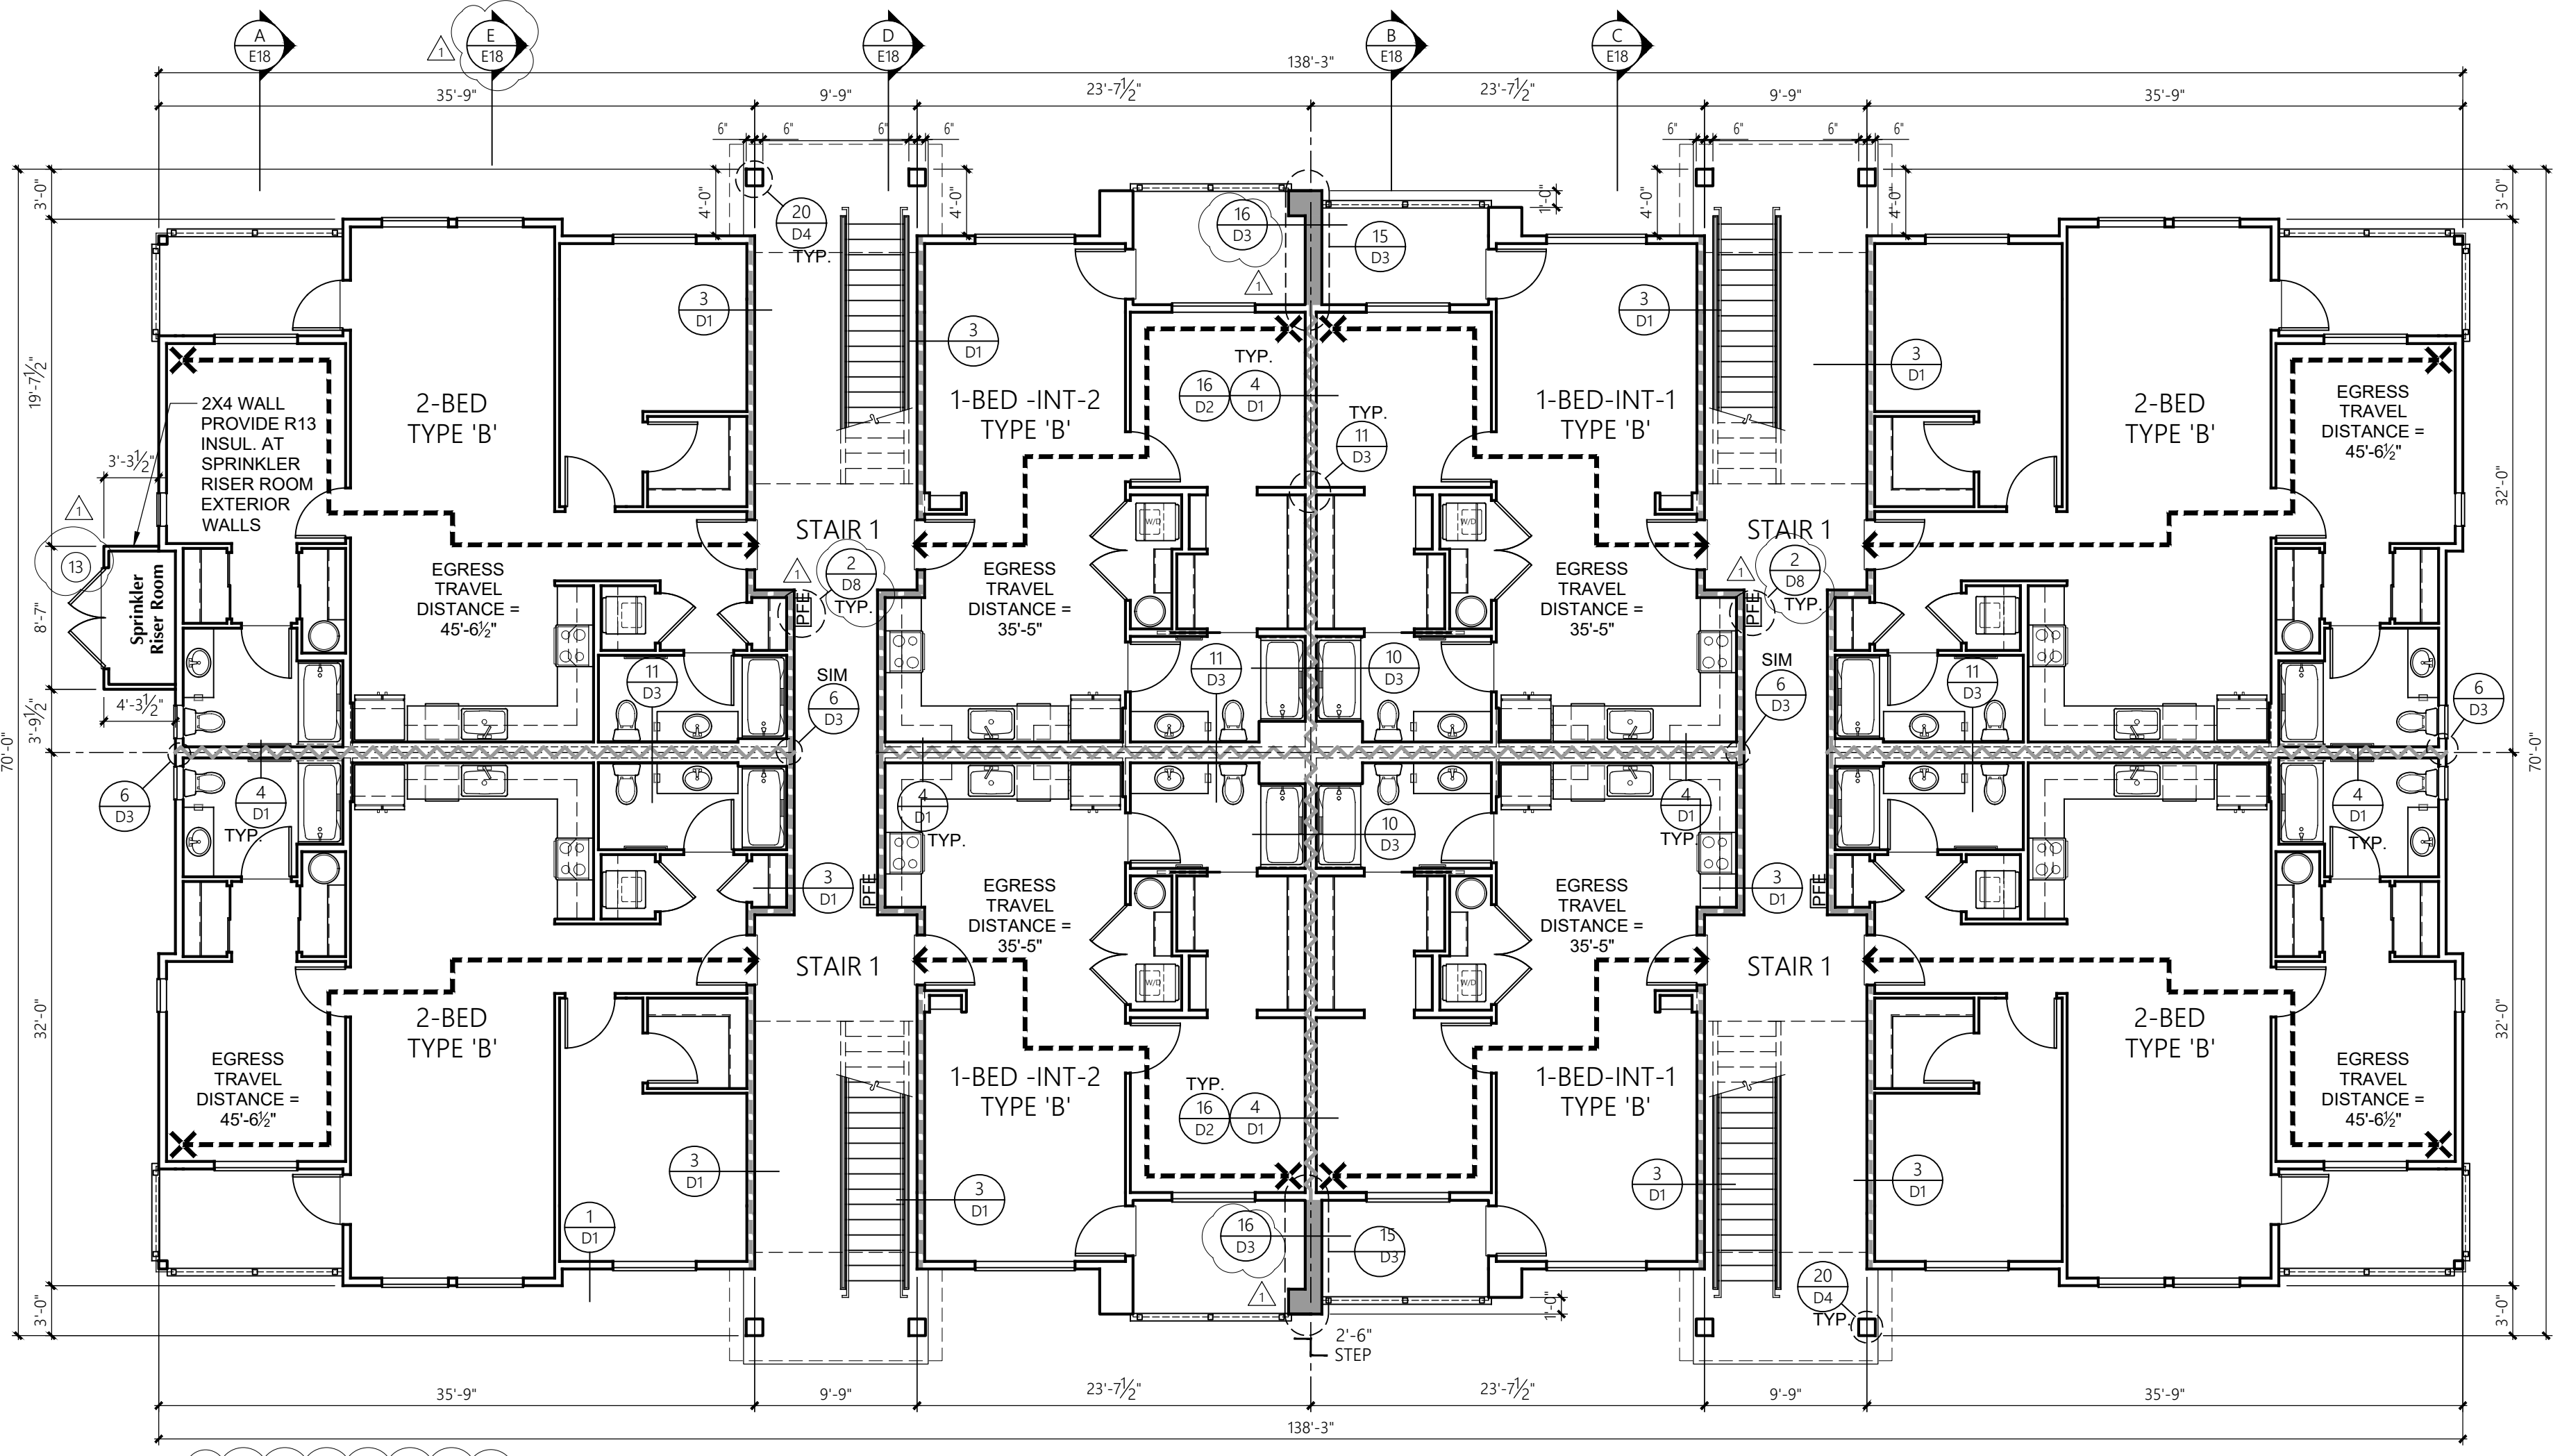


**BUILDING H** 1st LEVEL PLAN  
1/8" = 1'-0"  
3-STORY, 24-UNIT BUILDING

**LEGEND**

- EXTENT OF 1-HR FIRE PARTITION
- 1-HR FIRE PARTITION SEPARATES THE INTERIOR SPACES BETWEEN UNITS IN THE SAME BUILDINGS. IT'S EXTENT ENDS WHERE ONE SIDE WOULD BE AN EXTERIOR FACE. SEE 4/D1
- EXTENT OF 1-HR FIRE BARRIER AROUND EXIT STAIRS/CORRIDOR. SEE 3/D1
- EXTENT OF 1-HR EXTERIOR WALL. SEE LOCATION SPECIFIC DETAIL
- FE\* - SEMI RECESSED FIRE EXTINGUISHER CABINET/SEE DETAIL 2/D7
- DOOR TAG, SEE SHEET U14

F:\2306\BUILDING\FLOORING

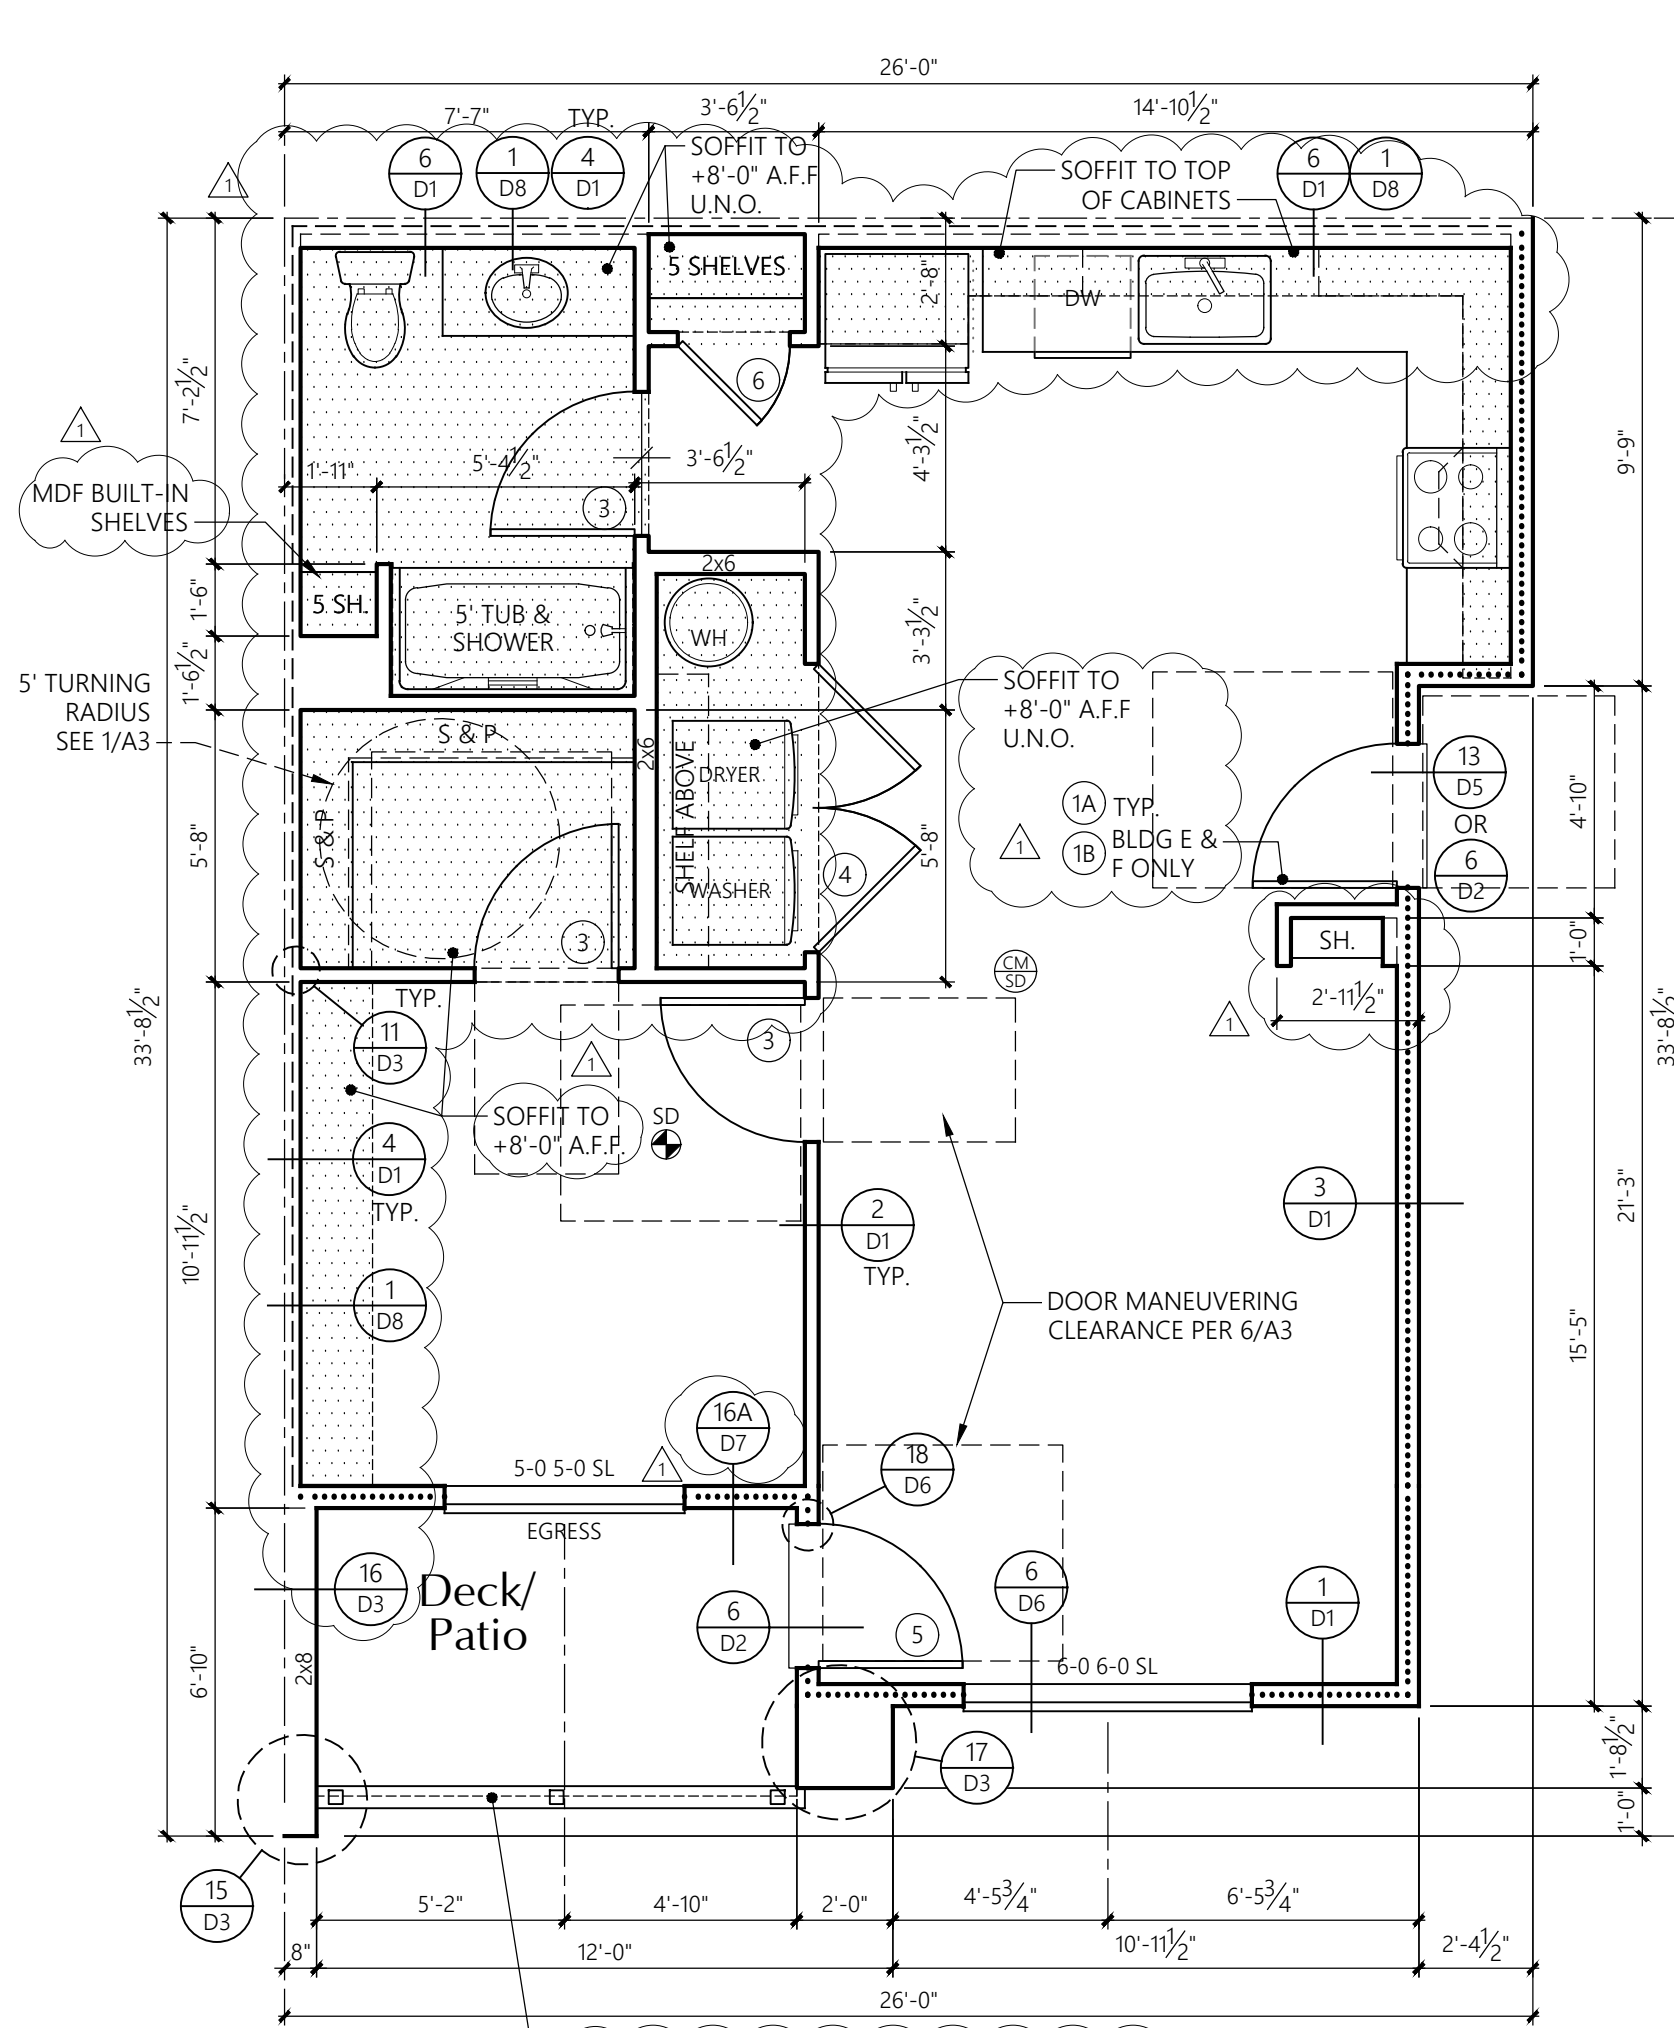


**1-BED-INT-1 UNIT** TYPE 'A' ACCESSIBLE  
BASEMENT & 1st LEVEL FLOOR PLAN  
1/4" = 1'-0"

AREA SUMMARY		
Total SF	Heated SF	Patio/Deck SF
684	684	61


Door Key references Sheet U13 update plan or sheet numbers as needed, as there is no Sheet U13.

(Construction Set, Sheet U1-U5.1, Door Key)

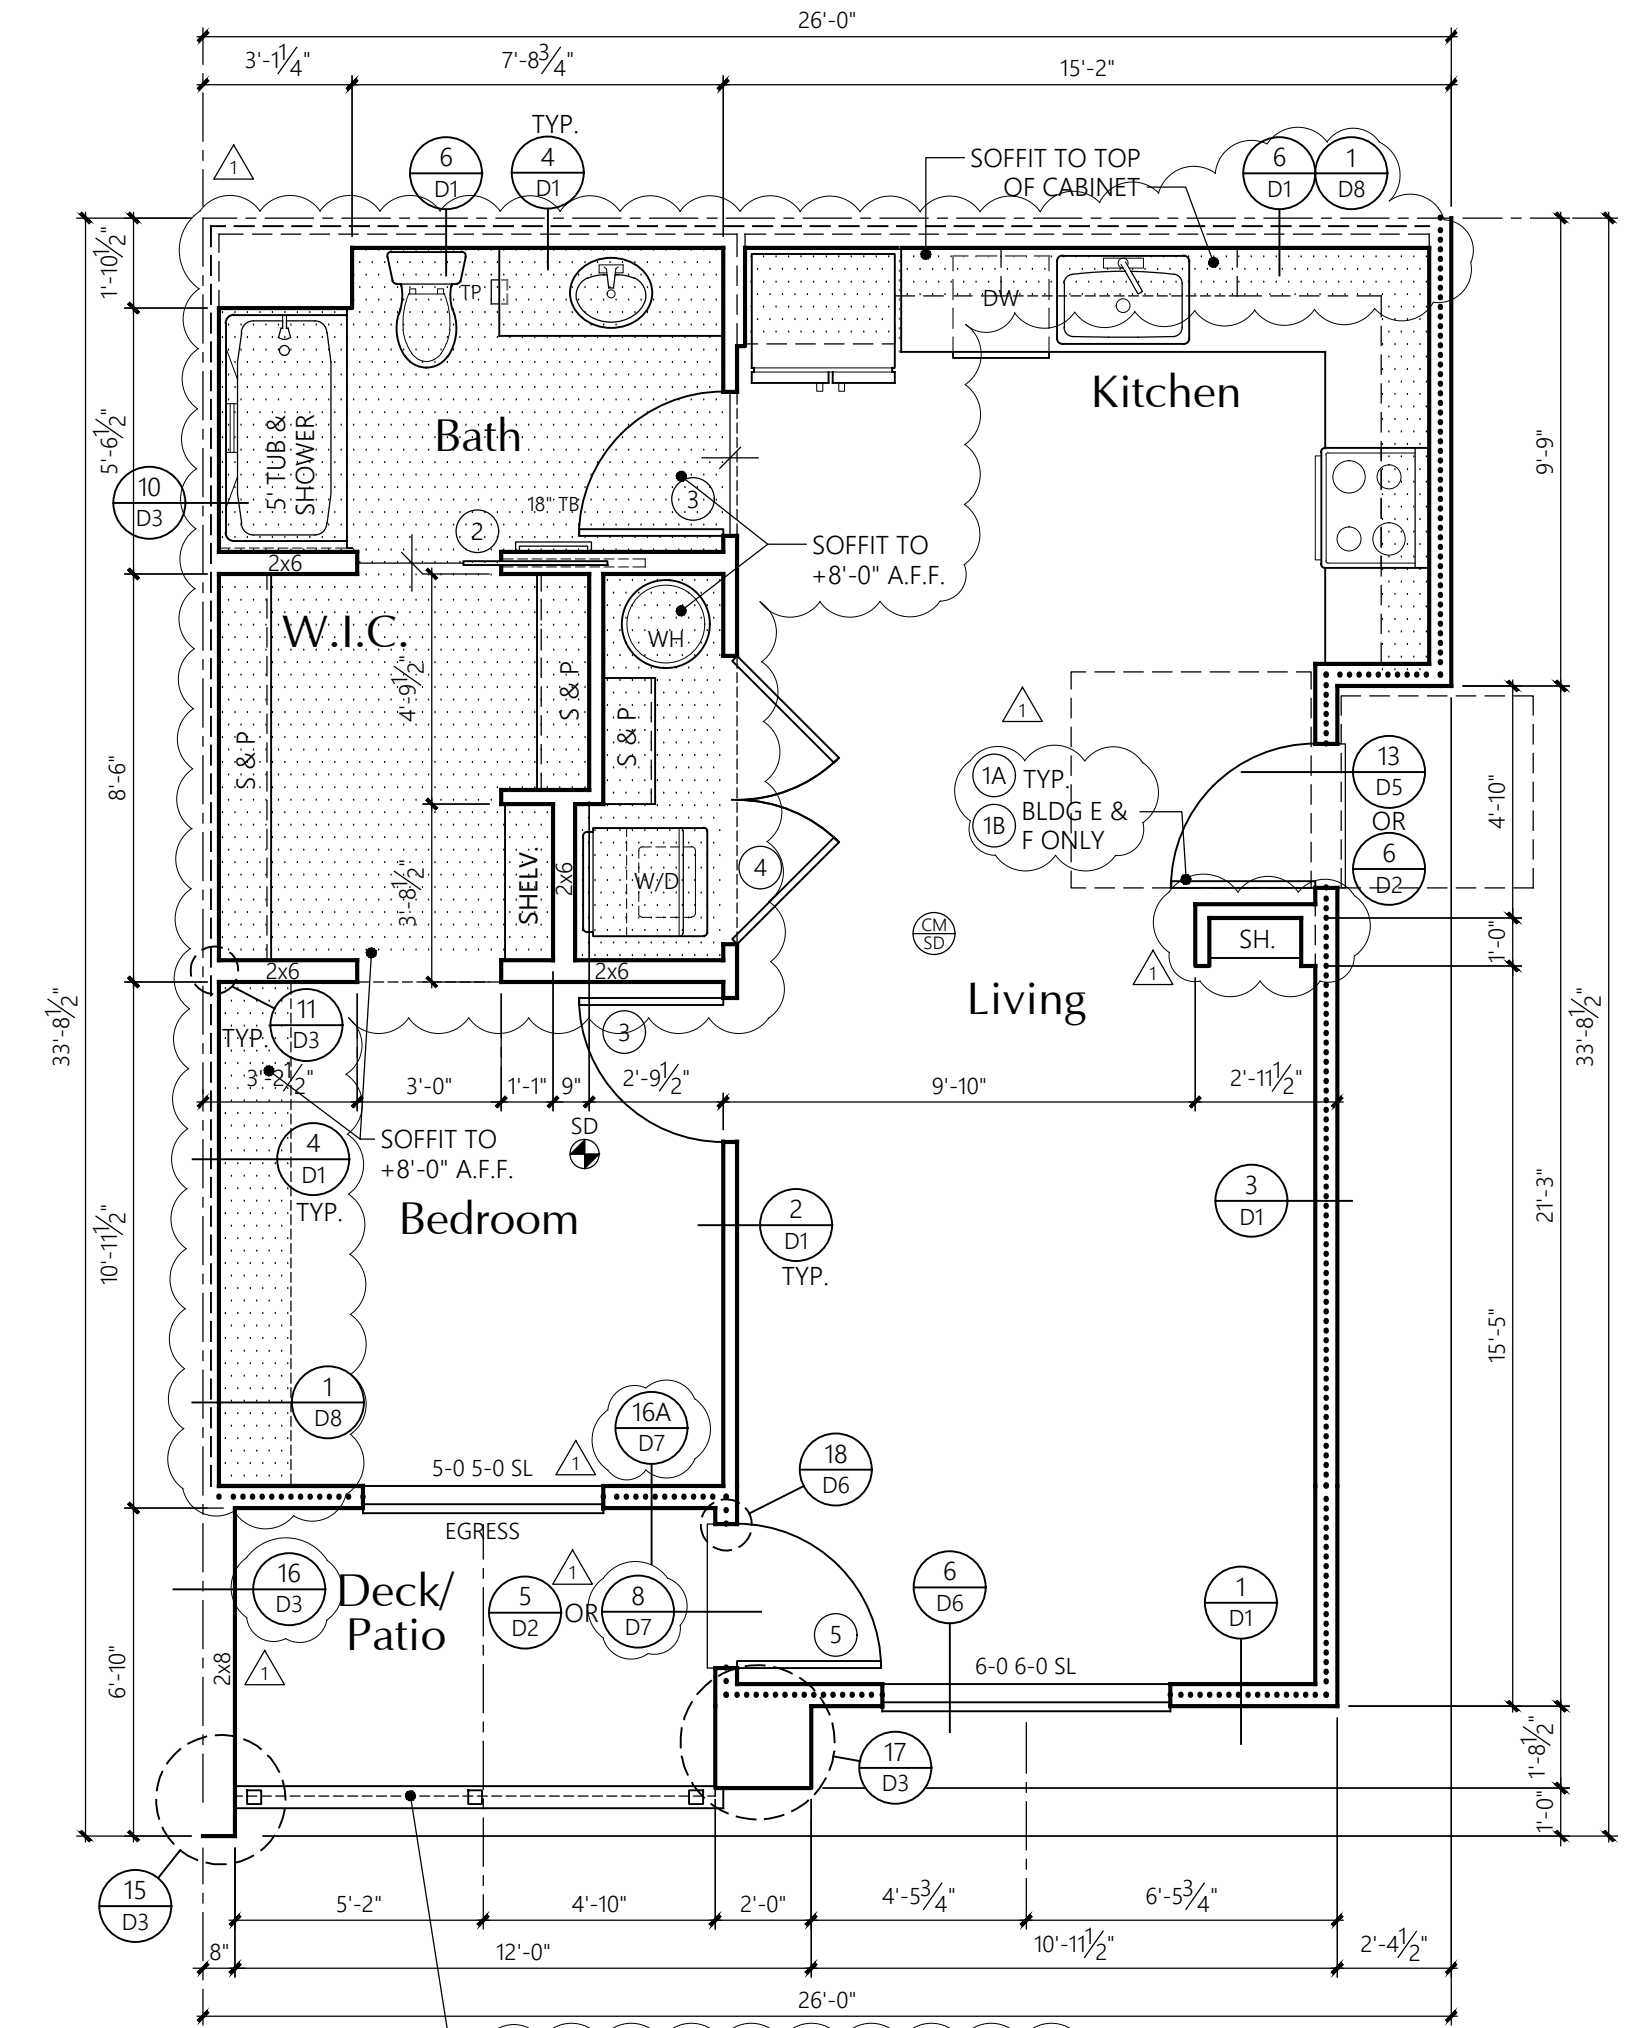

**1-BED-INT-1 UNIT** TYPE 'B' ACCESSIBLE  
BASEMENT & 1st LEVEL FLOOR PLAN  
1/4" = 1'-0"

AREA SUMMARY		
Total SF	Heated SF	Patio/Deck SF
684	684	61

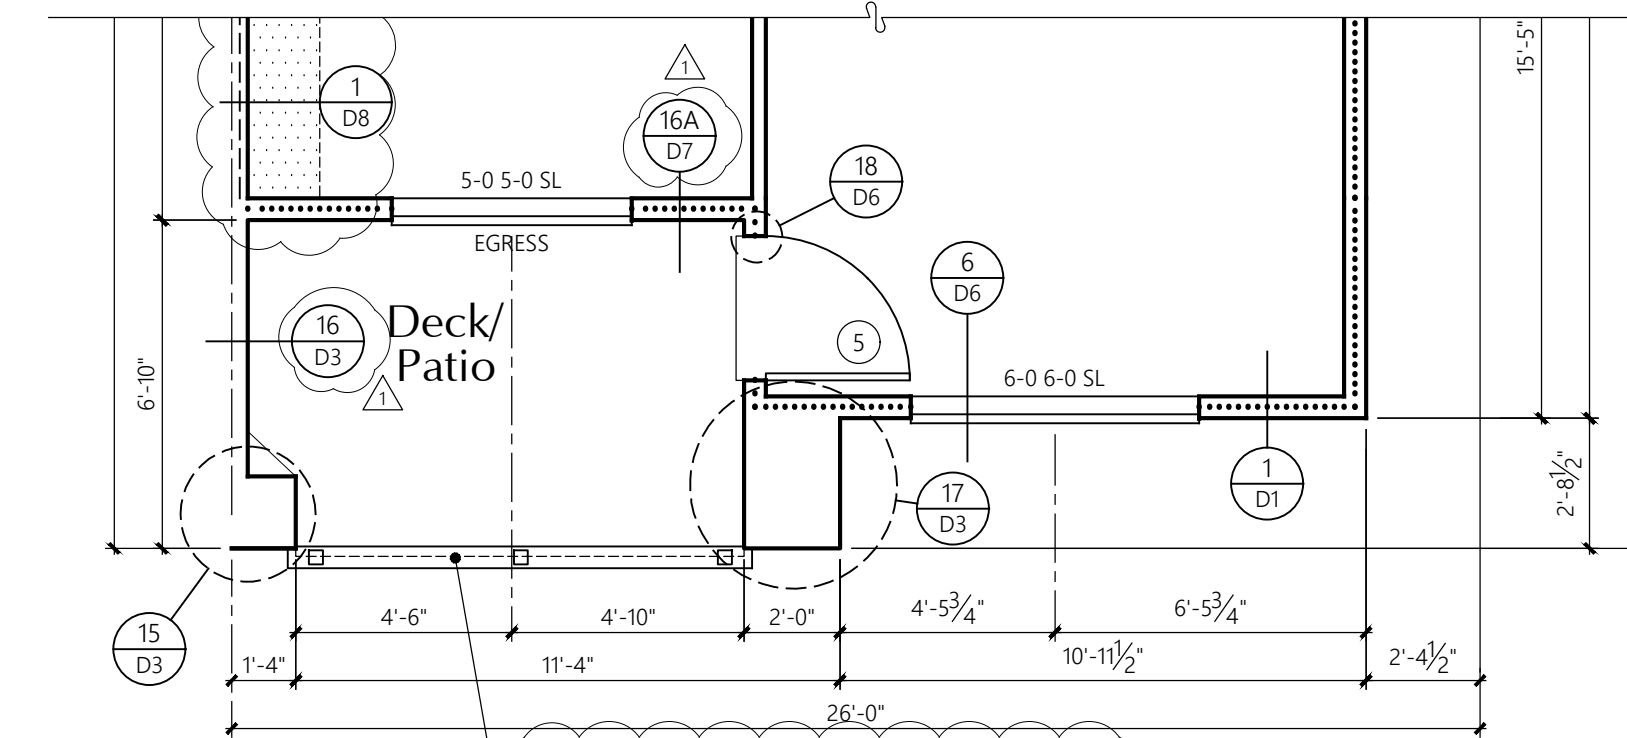

**1-BED-INT-2 UNIT** TYPE 'A' & 'B' ACCESSIBLE  
BASEMENT & 1st LEVEL FLOOR PLAN  
1/4" = 1'-0"

AREA SUMMARY		
Total SF	Heated SF	Patio/Deck SF
71	684	71

\* SEE 1-BED-INT-1 UNIT TYPE 'A' OR 1-BED-INT-1 UNIT TYPE 'B' FOR REMAINDER OF UNIT

Unit Plan Notes state that no plumbing shall be located in the 1" air gap. See plumbing plans plumbing multiple penetrations are being made within the 1" air gap. Coordinate drawings for consistency and ease of construction.

(Construction Set, Sheet U1-U5.1, Unit Plan Notes)

Unit Plan Notes identify that R-13 insulation will be provided on 1 side U.N.O., but detail 4/D1 states to insulate both sides U.N.O. Please clarify if the wall will be insulated on both sides or one side only.

(Construction Set, Sheet U1-U5.1, Unit Plan Notes)

**UNIT PLAN NOTES**

- FRAMING:** 2x6'S AT EXTERIOR WALLS  
2x4'S AT INTERIOR WALLS  
UNLESS NOTED OTHERWISE.
- ..... R-21 BATT INSULATION U.N.O.
- R-13 BATT INSULATION  
3/8" ACOUSTICAL INSULATION ONE SIDE OF PARTYWALL, U.N.O.
- [Pattern] LOCATION OF SOFFIT FOR VENT RUNS, SOFFIT HEIGHT +8'-0" A.F.F. U.N.O. ON PLANS; SEE DETAIL 14/D8
- SD SMOKE DETECTOR
- [Symbol] CARBON MONOXIDE/SMOKE DETECTOR
- CONCEALED SPACES SHALL BE FIRESTOPPED IN BOTH DIRECTIONS AT 10'-0" ON CENTER AND AT FLOORS. TYPICAL.
- ALL ESCAPE OR RESCUE WINDOWS FROM SLEEPING ROOMS SHALL HAVE A MINIMUM NET CLEAR OPENING OF 5.7 SQUARE FEET. THE MINIMUM CLEAR OPENING HEIGHT DIMENSION SHALL BE 24". MINIMUM CLEAR OPENING WIDTH DIMENSION SHALL BE 20". EMERGENCY ESCAPE AND RESCUE OPENINGS SHALL HAVE THE BOTTOM OF CLEAR OPENING NOT GREATER THAN 44 INCHES MEASURED FROM THE FLOOR.
- WHERE THE OPENING OF THE SILL PORTION OF AN OPERABLE WINDOW IS LOCATED MORE THAN 72 INCHES ABOVE THE FINISHED GRADE OR OTHER SURFACE BELOW, THE LOWEST PART OF THE CLEAR OPENING OF THE WINDOW SHALL BE AT A HEIGHT NOT LESS THAN 36 INCHES ABOVE THE FINISHED FLOOR SURFACE OF THE ROOM IN WHICH THE WINDOW IS LOCATED. OPERABLE SECTIONS OF WINDOWS SHALL NOT PERMIT OPENINGS THAT ALLOW PASSAGE OF A 4 INCH DIAMETER SPHERE WHERE SUCH OPENINGS ARE LOCATED WITHIN 36 INCHES OF THE FINISHED FLOOR.
- ALL GLAZING SHALL CONFORM TO THE 2018 IBC, CHAPTER 24, SEC. 2406, SAFETY GLAZING. GLAZING IN ALL DOORS SHALL BE SAFETY TYPE AND ALL GLAZING WITHIN A 24" ARC OF EITHER VERTICAL EDGE SHALL BE SAFETY TYPE.
- PROVIDE 3/8" TYPE 'X' (MIN.) GYPSUM SHEATHING ON WALLS BEHIND TUB/SHOWERS TO SATISFY FIRE REQUIREMENTS AT PARTYWALL CONDITION. PROVIDE 3/8" PLYWOOD UNDER TUB IN PLACE OF THE GYPCRETE, SEE DETAIL 14/D1

- PROVIDE WATER RESISTANT GYPSUM WALLBOARD BEHIND TUB AND SHOWER ENCLOSURE MATERIALS TO A HEIGHT OF 70" MINIMUM ABOVE THE DRAIN INLET.
- NO PLUMBING SHALL BE LOCATED IN THE 1" AIR SPACE OF FIRE PARTITIONS OR FIRE WALLS.
- ALL BEDROOM AND BATHROOM DOORS SHALL BE UNDERCUT BEHIND TUB AND SHOWER ENCLOSURE MATERIALS TO A HEIGHT OF 70" MINIMUM ABOVE THE DRAIN INLET.
- THE FRONT DOOR SHALL BE OPENABLE FROM THE INSIDE WITHOUT THE USE OF A KEY OR ANY SPECIAL KNOWLEDGE OR EFFORT. IT MAY BE PROVIDED WITH A NIGHT LATCH, DEAD BOLT OR SECURITY CHAIN, PROVIDED SUCH DEVICES ARE OPENABLE FROM THE INSIDE WITHOUT THE USE OF A KEY OR TOOL, AND MOUNTED NOT TO EXCEED 48" ABOVE THE FINISHED FLOOR.

**GYPSUM WALLBOARD SCHEDULE**  
EXCEPT WHERE NOTED OTHERWISE, 3/8" TYPE 'X' GYPSUM WALLBOARD SHALL BE USED THROUGHOUT;  
ON INTERIOR NON-RATED WALLS, EXTERIOR WALLS, CORRIDOR WALLS, AND 1-HOUR AND 2-HOUR FIRE-RATED WALLS.

STANDARD PLATE  
HEIGHT: 9'-1"

SEE ELEVATION SHEETS FOR FLOOR TO FLOOR HEIGHTS

WINDOW HDR IS 8'-0"  
UNLESS NOTED OTHERWISE

SEE SHEET U6 FOR INTERIOR ELEVATIONS AND ACCESSIBILITY REQUIREMENTS.

**DOOR KEY:**

(X) DOOR TAG. SEE SHEET U13 FOR SCHEDULE

**WINDOW KEY:**

TYPE:  
FIX = FIXED/PICTURE  
SL = SLIDER  
SH = SINGLE HUNG  
SGD = SLIDING GLASS DOOR

**ACCESSIBILITY NOTES:**

- ALL GROUND FLOOR UNITS IN THIS PROJECT MUST MEET THE ACCESSIBILITY REQUIREMENTS OF TYPE 'B' ACCESSIBLE UNITS AS REQUIRED BY CHAPTER 11 OF THE 2018 IBC.
- INCLUDED IN THE ABOVE GROUND FLOOR UNITS 5% OF ALL UNITS NEED TO MEET THE ACCESSIBILITY REQUIREMENTS OF 'TYPE A' ACCESSIBLE UNITS AS REQUIRED BY CHAPTER 11 OF THE 2018 IBC. SEE BUILDING PLANS FOR LOCATION OF 'TYPE A' UNITS
- SEE SHEET U9 FOR SPECIFIC ADAPTABILITY STANDARD FOR BOTH 'TYPE A' AND 'TYPE B' ACCESSIBLE UNITS. SEE INTERIOR ELEVATION SHEETS FOR ADDITIONAL ACCESSIBILITY REQUIREMENTS.
- LIGHTING CONTROLS, ELECTRICAL SWITCHES, ENVIRONMENTAL CONTROLS, OPERATING HARDWARE FOR DOORS AND WINDOWS, AND PLUMBING FIXTURE CONTROLS SHALL BE OPERABLE WITH ONE HAND AND SHALL NOT REQUIRE TIGHT GRASPING, PINCHING OR TWISTING OF THE WRIST TO OPERATE. EXCEPT FOR OPERABLE DOOR HARDWARE, SUCH ITEMS SHALL BE 15" MINIMUM AND 44" MAXIMUM ABOVE THE FLOOR (48" FOR WINDOWS).
- OPERABLE ENTRY DOOR HARDWARE SHALL BE 34" MINIMUM AND 48" MAXIMUM ABOVE THE FLOOR.
- OPENING FORCES FOR ENTRY DOOR SHALL BE: 15 POUNDS TO RELEASE THE LATCH 30 POUNDS TO SET DOOR IN MOTION 15 POUNDS TO OPEN DOOR TO FULL 90° FORCE MEASURED AT LATCH SIDE OF DOOR.
- THE DOOR CLOSER ON THE ENTRY DOOR SHALL BE ADJUSTED TO CLOSE FROM AN OPEN POSITION OF 90° TO AN OPEN POSITION OF 12° IN NOT LESS THAN 5 SECONDS.
- OPENING FORCE OF ALL SWINGING INTERIOR DOORS AND THE SLIDING GLASS DOOR SHALL NOT EXCEED 5 POUNDS APPLIED TO THE LATCH SIDE OF THE DOOR.
- THE FORCE REQUIRED TO ACTIVATE ALL OTHER OPERABLE ITEMS LISTED ABOVE SHALL BE 5 POUNDS.
- \*BIFOLD DOOR HARDWARE AT LAUNDRY TO BE 'FULL ACCESS HARDWARE'.
- THE 30"x48" CLEAR FLOOR SPACE IS REQUIRED AT EACH FIXTURE OR LOCATION SHOWN ON THE FLOOR PLAN.

**INSULATION**

- FOUNDATION PERIMETER - R-10 RIGID INSULATION TO A DEPTH OF 24" OR TO TOP OF FOOTING AT HEATED PERIMETER
- EXTERIOR WALLS - FIBERGLASS BATTS OR BLANKETS 2x6 WALLS - R21
- FLOORS OVER UNHEATED SPACES - R30
- ATTICS AND ROOF ASSEMBLIES - R-49
- FULL HEIGHT OF UNCOMPRESSED INSULATION EXTENDS OVER THE WALL TOP PLATE AT THE EAVES
- EXTERIOR DOORS: MAIN ENTRY U=0.20  
ALL OTHERS U=0.40
- WINDOWS: MILGARD VINYL U-VALUE  
TYPE (VINYL) MODEL 0.24 or BETTER  
SLIDING 6110 ARGON/LoE 0.24 or BETTER  
FIXED 6310 ARGON/LoE 0.24 or BETTER  
SINGLE HUNG 6210 ARGON/LoE 0.24 or BETTER  
DBL SLIDER 8125 ARGON/LoE 0.24 or BETTER  
SGD 6610 ARGON/LoE 0.24 or BETTER
- NOTE: ALL CONCEALED OR EXPOSED INSULATION SHALL HAVE A FLAME SPREAD INDEX OF NOT MORE THAN 25 AND A SMOKE-DEVELOPED INDEX OF NOT MORE THAN 450

30X48

**UNIT PLAN NOTES**

- FRAMING:**
- 2x6'S AT EXTERIOR WALLS  
2x4'S AT INTERIOR WALLS  
UNLESS NOTED OTHERWISE.
  - R-21 BATT INSULATION U.N.O.
  - R-13 BATT INSULATION  
3 1/2" ACOUSTICAL INSULATION ONE  
SIDE OF PARTYWALL, U.N.O.
  - LOCATION OF SOFFIT FOR VENT  
RUNS. SOFFIT HEIGHT +8'-0" A.F.F.  
U.N.O. ON PLANS; SEE DETAIL V/D8
  - SMOKE DETECTOR
  - CARBON MONOXIDE/SMOKE DETECTOR

PROVIDE WATER RESISTANT GYPSUM WALLBOARD  
BEHIND TUB AND SHOWER ENCLOSURE MATERIALS TO A  
HEIGHT OF 70" MINIMUM ABOVE THE DRAIN INLET.

NO PLUMBING SHALL BE LOCATED IN THE 1" AIR SPACE OF FIRE  
PARTITIONS OR FIRE WALLS.

ALL BEDROOM AND BATHROOM DOORS SHALL BE UNDERCUT  
A MINIMUM OF 1/2" ABOVE THE ADJACENT FLOOR COVERING.

THE FRONT DOOR SHALL BE OPENABLE FROM THE INSIDE  
WITHOUT THE USE OF A KEY OR ANY SPECIAL KNOWLEDGE OR  
EFFORT. IT MAY BE PROVIDED WITH A NIGHT LATCH, DEAD  
BOLT OR SECURITY CHAIN, PROVIDED SUCH DEVICES ARE  
OPENABLE FROM THE INSIDE WITHOUT THE USE OF A KEY OR  
TOOL, AND MOUNTED NOT TO EXCEED 48" ABOVE THE  
FINISHED FLOOR.

**GYPSUM WALLBOARD SCHEDULE**  
EXCEPT WHERE NOTED OTHERWISE, 3/4" TYPE 'X' GYPSUM  
WALLBOARD SHALL BE USED THROUGHOUT;  
ON INTERIOR NON-RATED WALLS, EXTERIOR WALLS,  
CORRIDOR WALLS, AND 1-HOUR AND 2-HOUR FIRE-RATED  
WALLS.

**DOOR KEY:**  
(X) DOOR TAG. SEE SHEET U13 FOR SCHEDULE

**WINDOW KEY:**  
TYPE:  
FIX = FIXED/PICTURE  
SL = SLIDER  
SH = SINGLE HUNG  
SGD = SLIDING GLASS DOOR

**ACCESSIBILITY NOTES:**

ALL GROUND FLOOR UNITS IN THIS PROJECT MUST  
MEET THE ACCESSIBILITY REQUIREMENTS OF  
TYPE 'B' ACCESSIBLE UNITS AS REQUIRED  
BY CHAPTER 11 OF THE 2018 IBC.

INCLUDED IN THE ABOVE GROUND FLOOR UNITS  
5% OF ALL UNITS NEED TO MEET THE ACCESSIBILITY  
REQUIREMENTS OF 'TYPE A' ACCESSIBLE UNITS  
AS REQUIRED BY CHAPTER 11 OF THE 2018 IBC.  
SEE BUILDING PLANS FOR LOCATION OF 'TYPE A' UNITS

SEE SHEET U9 FOR SPECIFIC ADAPTABILITY STANDARD  
FOR BOTH 'TYPE A' AND 'TYPE B' ACCESSIBLE UNITS.  
SEE INTERIOR ELEVATION SHEETS FOR ADDITIONAL  
ACCESSIBILITY REQUIREMENTS.

LIGHTING CONTROLS, ELECTRICAL SWITCHES,  
ENVIRONMENTAL CONTROLS, OPERATING HARDWARE  
FOR DOORS AND WINDOWS, AND PLUMBING  
FIXTURE CONTROLS SHALL BE OPERABLE WITH  
ONE HAND AND SHALL NOT REQUIRE TIGHT  
GRASPING, PINCHING OR TWISTING OF THE WRIST  
TO OPERATE. EXCEPT FOR OPERABLE DOOR  
HARDWARE, SUCH ITEMS SHALL BE 15" MINIMUM  
AND 44" MAXIMUM ABOVE THE FLOOR (48" FOR  
WINDOWS).

OPERABLE ENTRY DOOR HARDWARE SHALL BE  
34" MINIMUM AND 48" MAXIMUM ABOVE THE FLOOR.

OPENING FORCES FOR ENTRY DOOR SHALL BE:  
15 POUNDS TO RELEASE THE LATCH  
30 POUNDS TO SET DOOR IN MOTION  
15 POUNDS TO OPEN DOOR TO FULL 90°  
FORCE MEASURED AT LATCH SIDE OF DOOR.

THE DOOR CLOSER ON THE ENTRY DOOR  
SHALL BE ADJUSTED TO CLOSE FROM AN OPEN  
POSITION OF 90° TO AN OPEN POSITION OF 12°  
IN NOT LESS THAN 5 SECONDS.

OPENING FORCE OF ALL SWINGING INTERIOR  
DOORS AND THE SLIDING GLASS DOOR SHALL  
NOT EXCEED 5 POUNDS APPLIED TO THE  
LATCH SIDE OF THE DOOR.

THE FORCE REQUIRED TO ACTIVATE ALL OTHER  
OPERABLE ITEMS LISTED ABOVE SHALL BE  
5 POUNDS.

\*BIFOLD DOOR HARDWARE AT LAUNDRY TO BE  
'FULL ACCESS HARDWARE'.

THE 30"x48" CLEAR FLOOR  
SPACE IS REQUIRED AT EACH  
FIXTURE OR LOCATION SHOWN  
ON THE FLOOR PLAN.

**INSULATION**

FOUNDATION PERIMETER - R-10 RIGID INSULATION  
TO A DEPTH OF 24" OR TO TOP OF FOOTING AT  
HEATED PERIMETER

EXTERIOR WALLS: FIBERGLASS BATTS OR BLANKETS  
2x6 WALLS - R21

FLOORS OVER UNHEATED SPACES - R30  
ATTICS AND ROOF ASSEMBLIES - R-49  
FULL HEIGHT OF UNCOMPRESSED INSULATION  
EXTENDS OVER THE WALL TOP PLATE AT  
THE EAVES

EXTERIOR DOORS: MAIN ENTRY U=0.20  
ALL OTHERS U=0.40


WINDOWS: MILGARD VINYL	MODEL	U-VALUE
TYPE (VINYL)		
SLIDING	6110 ARGON/LoE	0.24 or BETTER
FIXED	6310 ARGON/LoE	0.24 or BETTER
SINGLE HUNG	6210 ARGON/LoE	0.24 or BETTER
DBL. SLIDER	8125 ARGON/LoE	0.24 or BETTER
SGD	6610 ARGON/LoE	0.24 or BETTER

NOTE: ALL CONCEALED OR EXPOSED INSULATION  
SHALL HAVE A FLAME SPREAD INDEX OF NOT  
MORE THAN 25 AND A SMOKE-DEVELOPED  
INDEX OF NOT MORE THAN 450

STANDARD PLATE  
HEIGHT: 9'-1"  
SEE ELEVATION SHEETS FOR  
FLOOR TO FLOOR HEIGHTS

WINDOW HDR IS 8'-0"  
UNLESS NOTED OTHERWISE

SEE SHEET U6 FOR INTERIOR ELEVATIONS  
AND ACCESSIBILITY REQUIREMENTS.

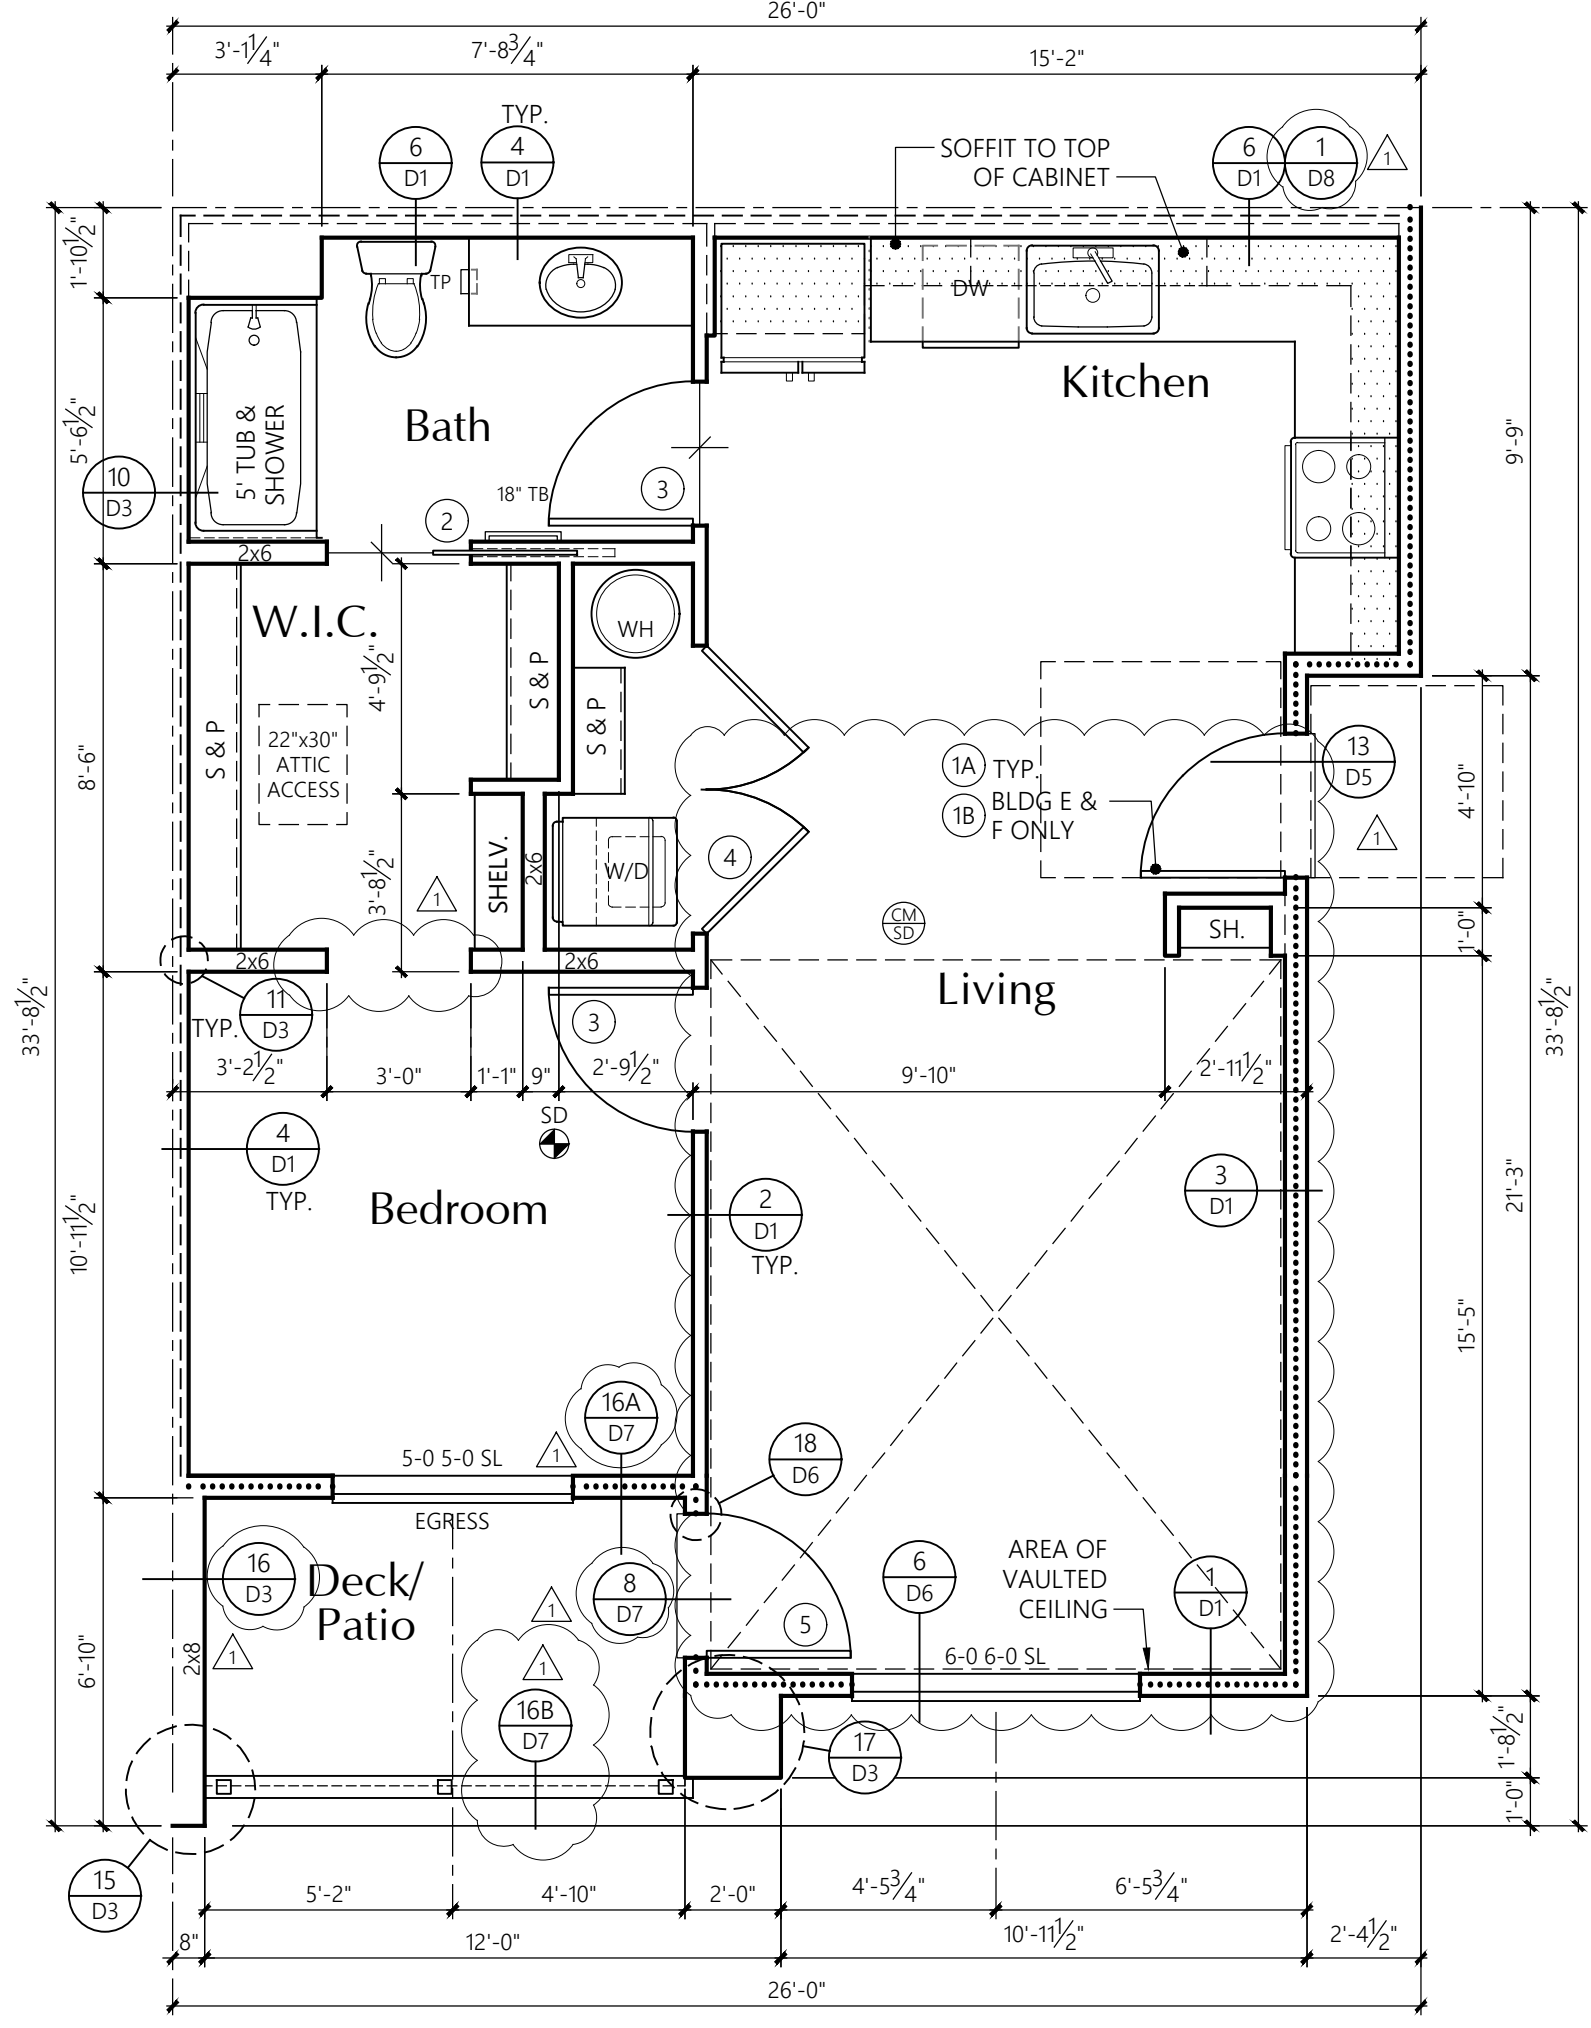


**1-BED-INT-1 UNIT** NON-ACCESSIBLE  
3rd LEVEL FLOOR PLAN

1/4" = 1'-0"  
TOP FLOOR VENTS TO VENT THROUGH ROOF

AREA SUMMARY		
	Heated SF	Patio/Deck SF
Total SF	684	61

\* Side of exterior walls to which area was measured

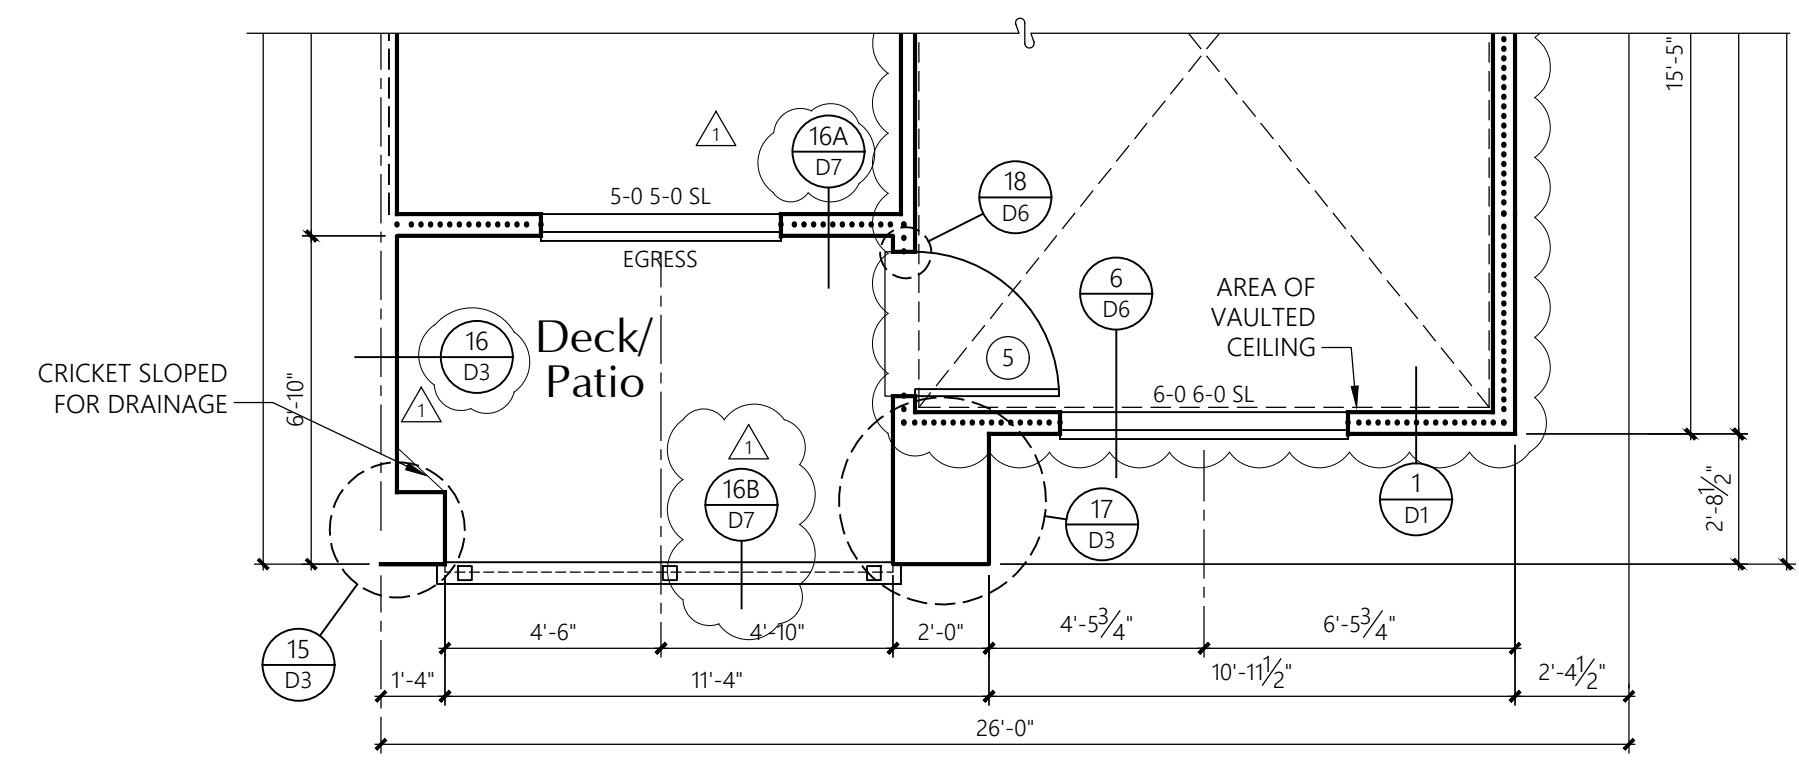


**1-BED-INT-2 UNIT** NON-ACCESSIBLE  
3rd LEVEL FLOOR PLAN

1/4" = 1'-0"  
TOP FLOOR VENTS TO VENT THROUGH ROOF

AREA SUMMARY		
	Heated SF	Patio/Deck SF
Total SF	684	71

\* Side of exterior walls to which area was measured

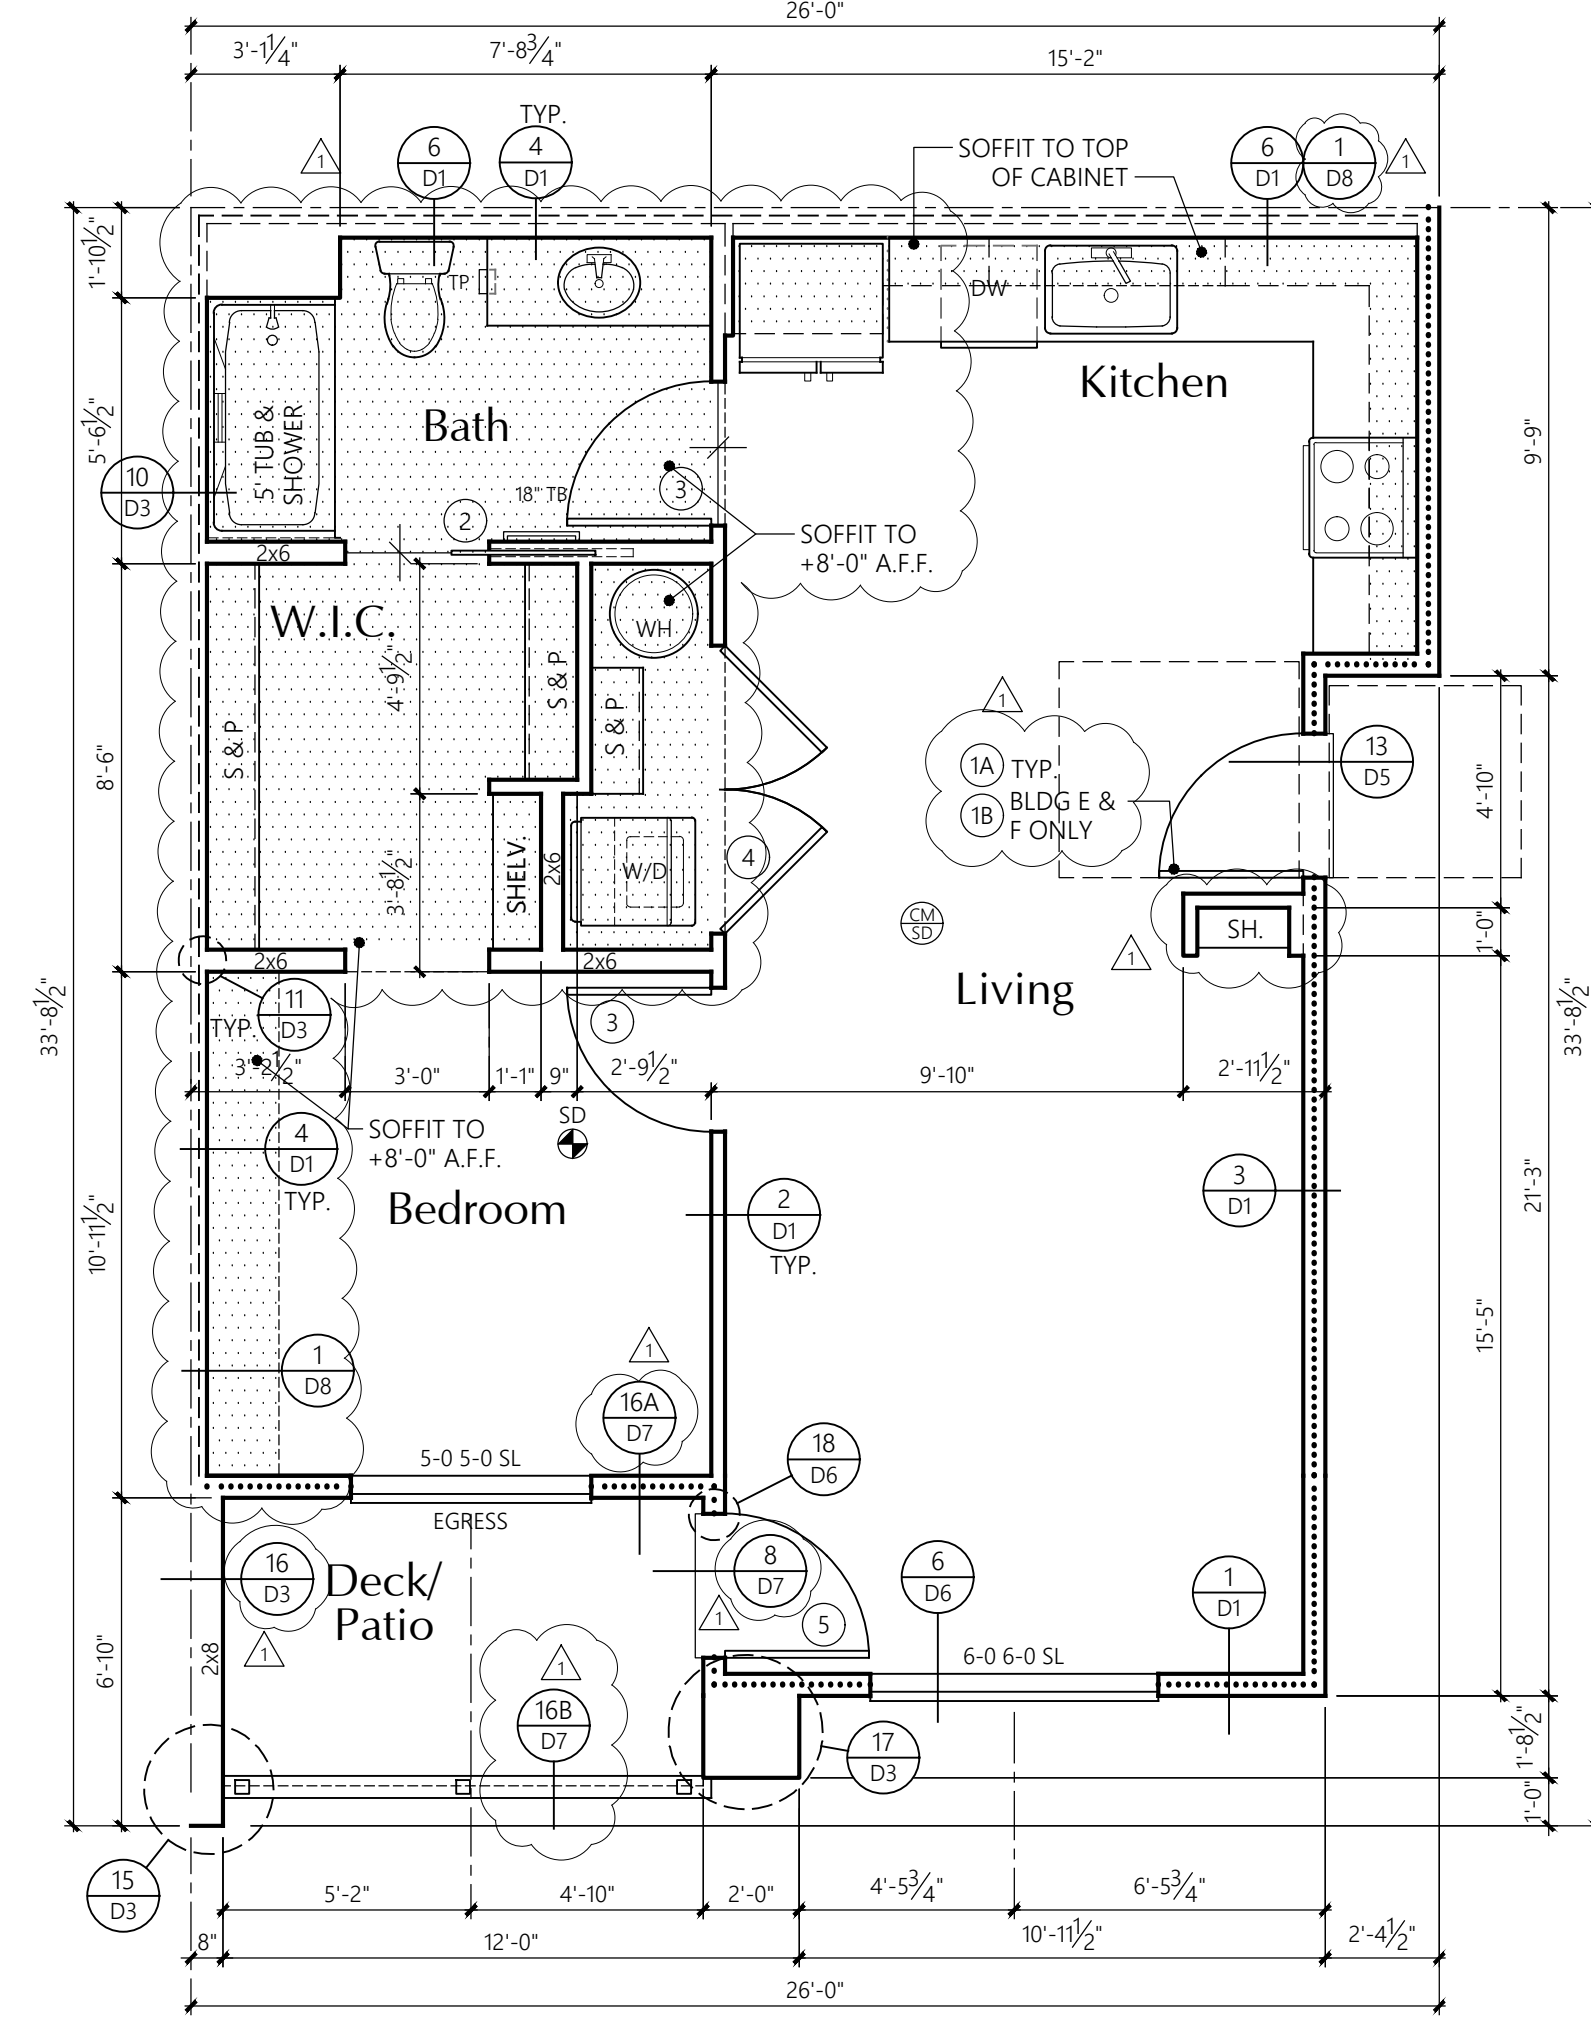


**1-BED-INT-1 UNIT** NON-ACCESSIBLE  
2nd LEVEL FLOOR PLAN

1/4" = 1'-0"

AREA SUMMARY		
	Heated SF	Patio/Deck SF
Total SF	684	61

\* Side of exterior walls to which area was measured

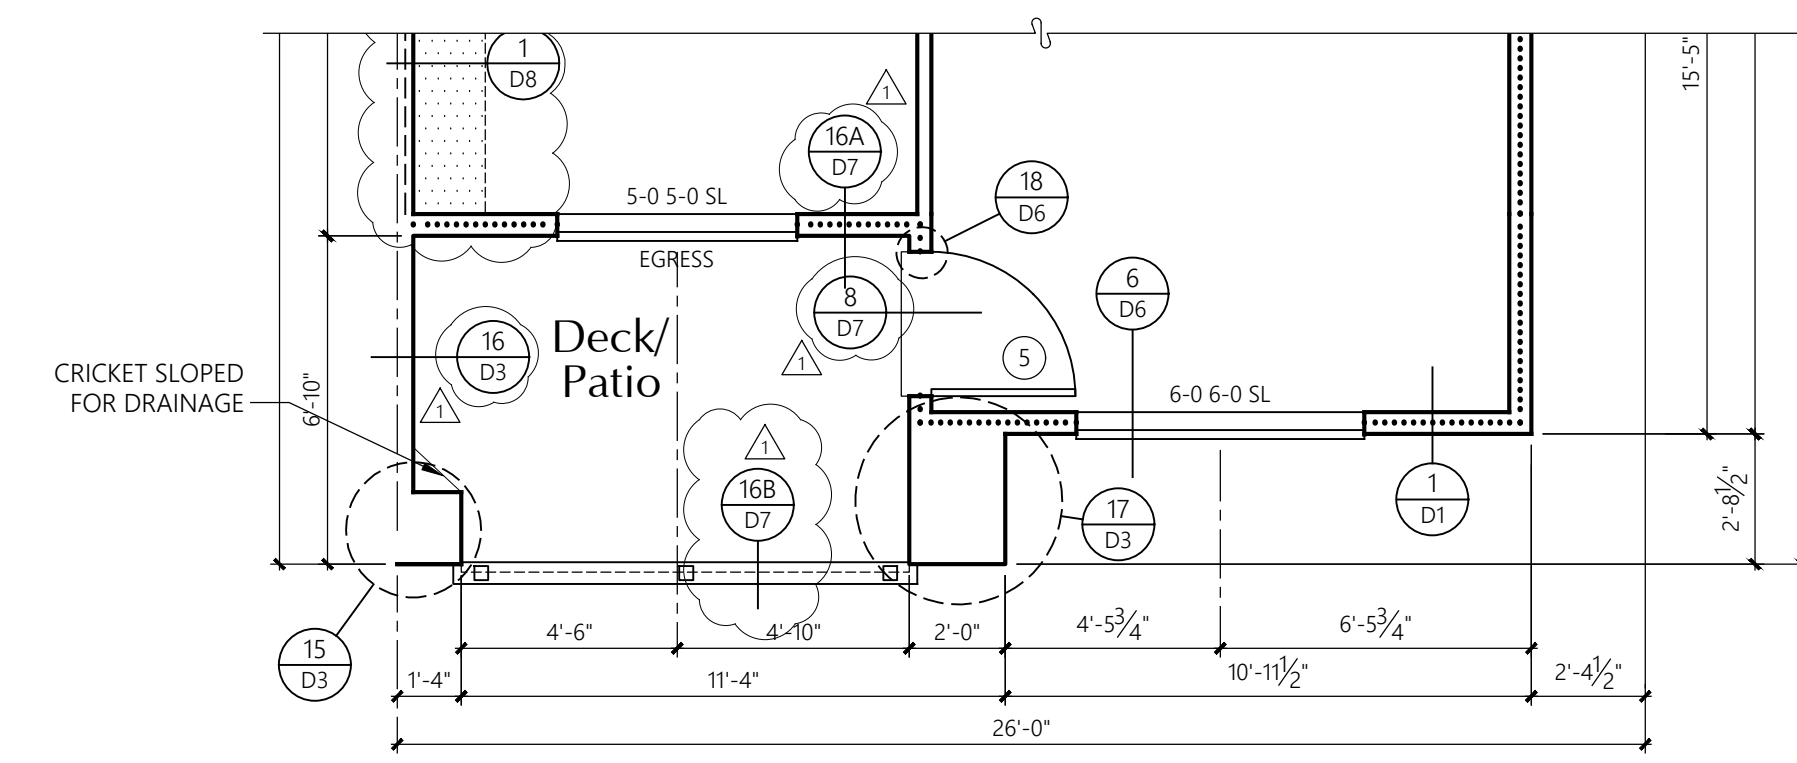

**1-BED-INT-2 UNIT** NON-ACCESSIBLE  
2nd LEVEL FLOOR PLAN


1/4" = 1'-0"

AREA SUMMARY		
	Heated SF	Patio/Deck SF
Total SF	684	71

\* Side of exterior walls to which area was measured

25 Central Way, Suite 210  
Kirkland, Washington 98033  
P: 425.454.7130 F: 425.658.1208  
Web: www.milbrandtarch.com

© Copyright 2023  
Milbrandt Architects, Inc., P.S.  
All rights reserved

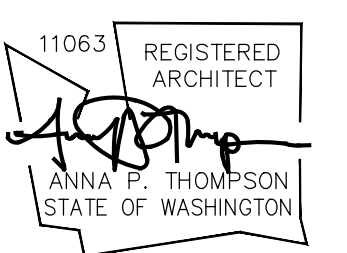

**Bradley Heights Apartments**

Puyallup, Wa

**Timberlane Partners**

**Revisions**

No.	Date	Description
1	8-30-24	Owner Changes/ Permit Corrections

Initial Publish Date:  
Date Plotted: 2-11-25

Job No.: 23-06  
Drawn By: APT/HDM/TMK

Sheet No.:




Review and clarify instances where header height will change as the header height is called out as 8' U.N.O. in Unit Plan Notes. Example 2 Bed Unit on Sheet U4 has a furred down ceiling. Review other units for additional instances and adjust if necessary.

(Construction Set, Sheet U1-U5, Unit Plan Notes)


Review and clarify how washer and dryer in all Type A units shall meet Washington Accessibility Code 2009, Section 611. Example 2 Bed Unit shows a washer and dryer that appear to be stackable which could put the loading openings outside the perimeters set by 611.4. Review and updated as needed.

(Construction Set, Sheet U1-U6, Unit Plan Plans)

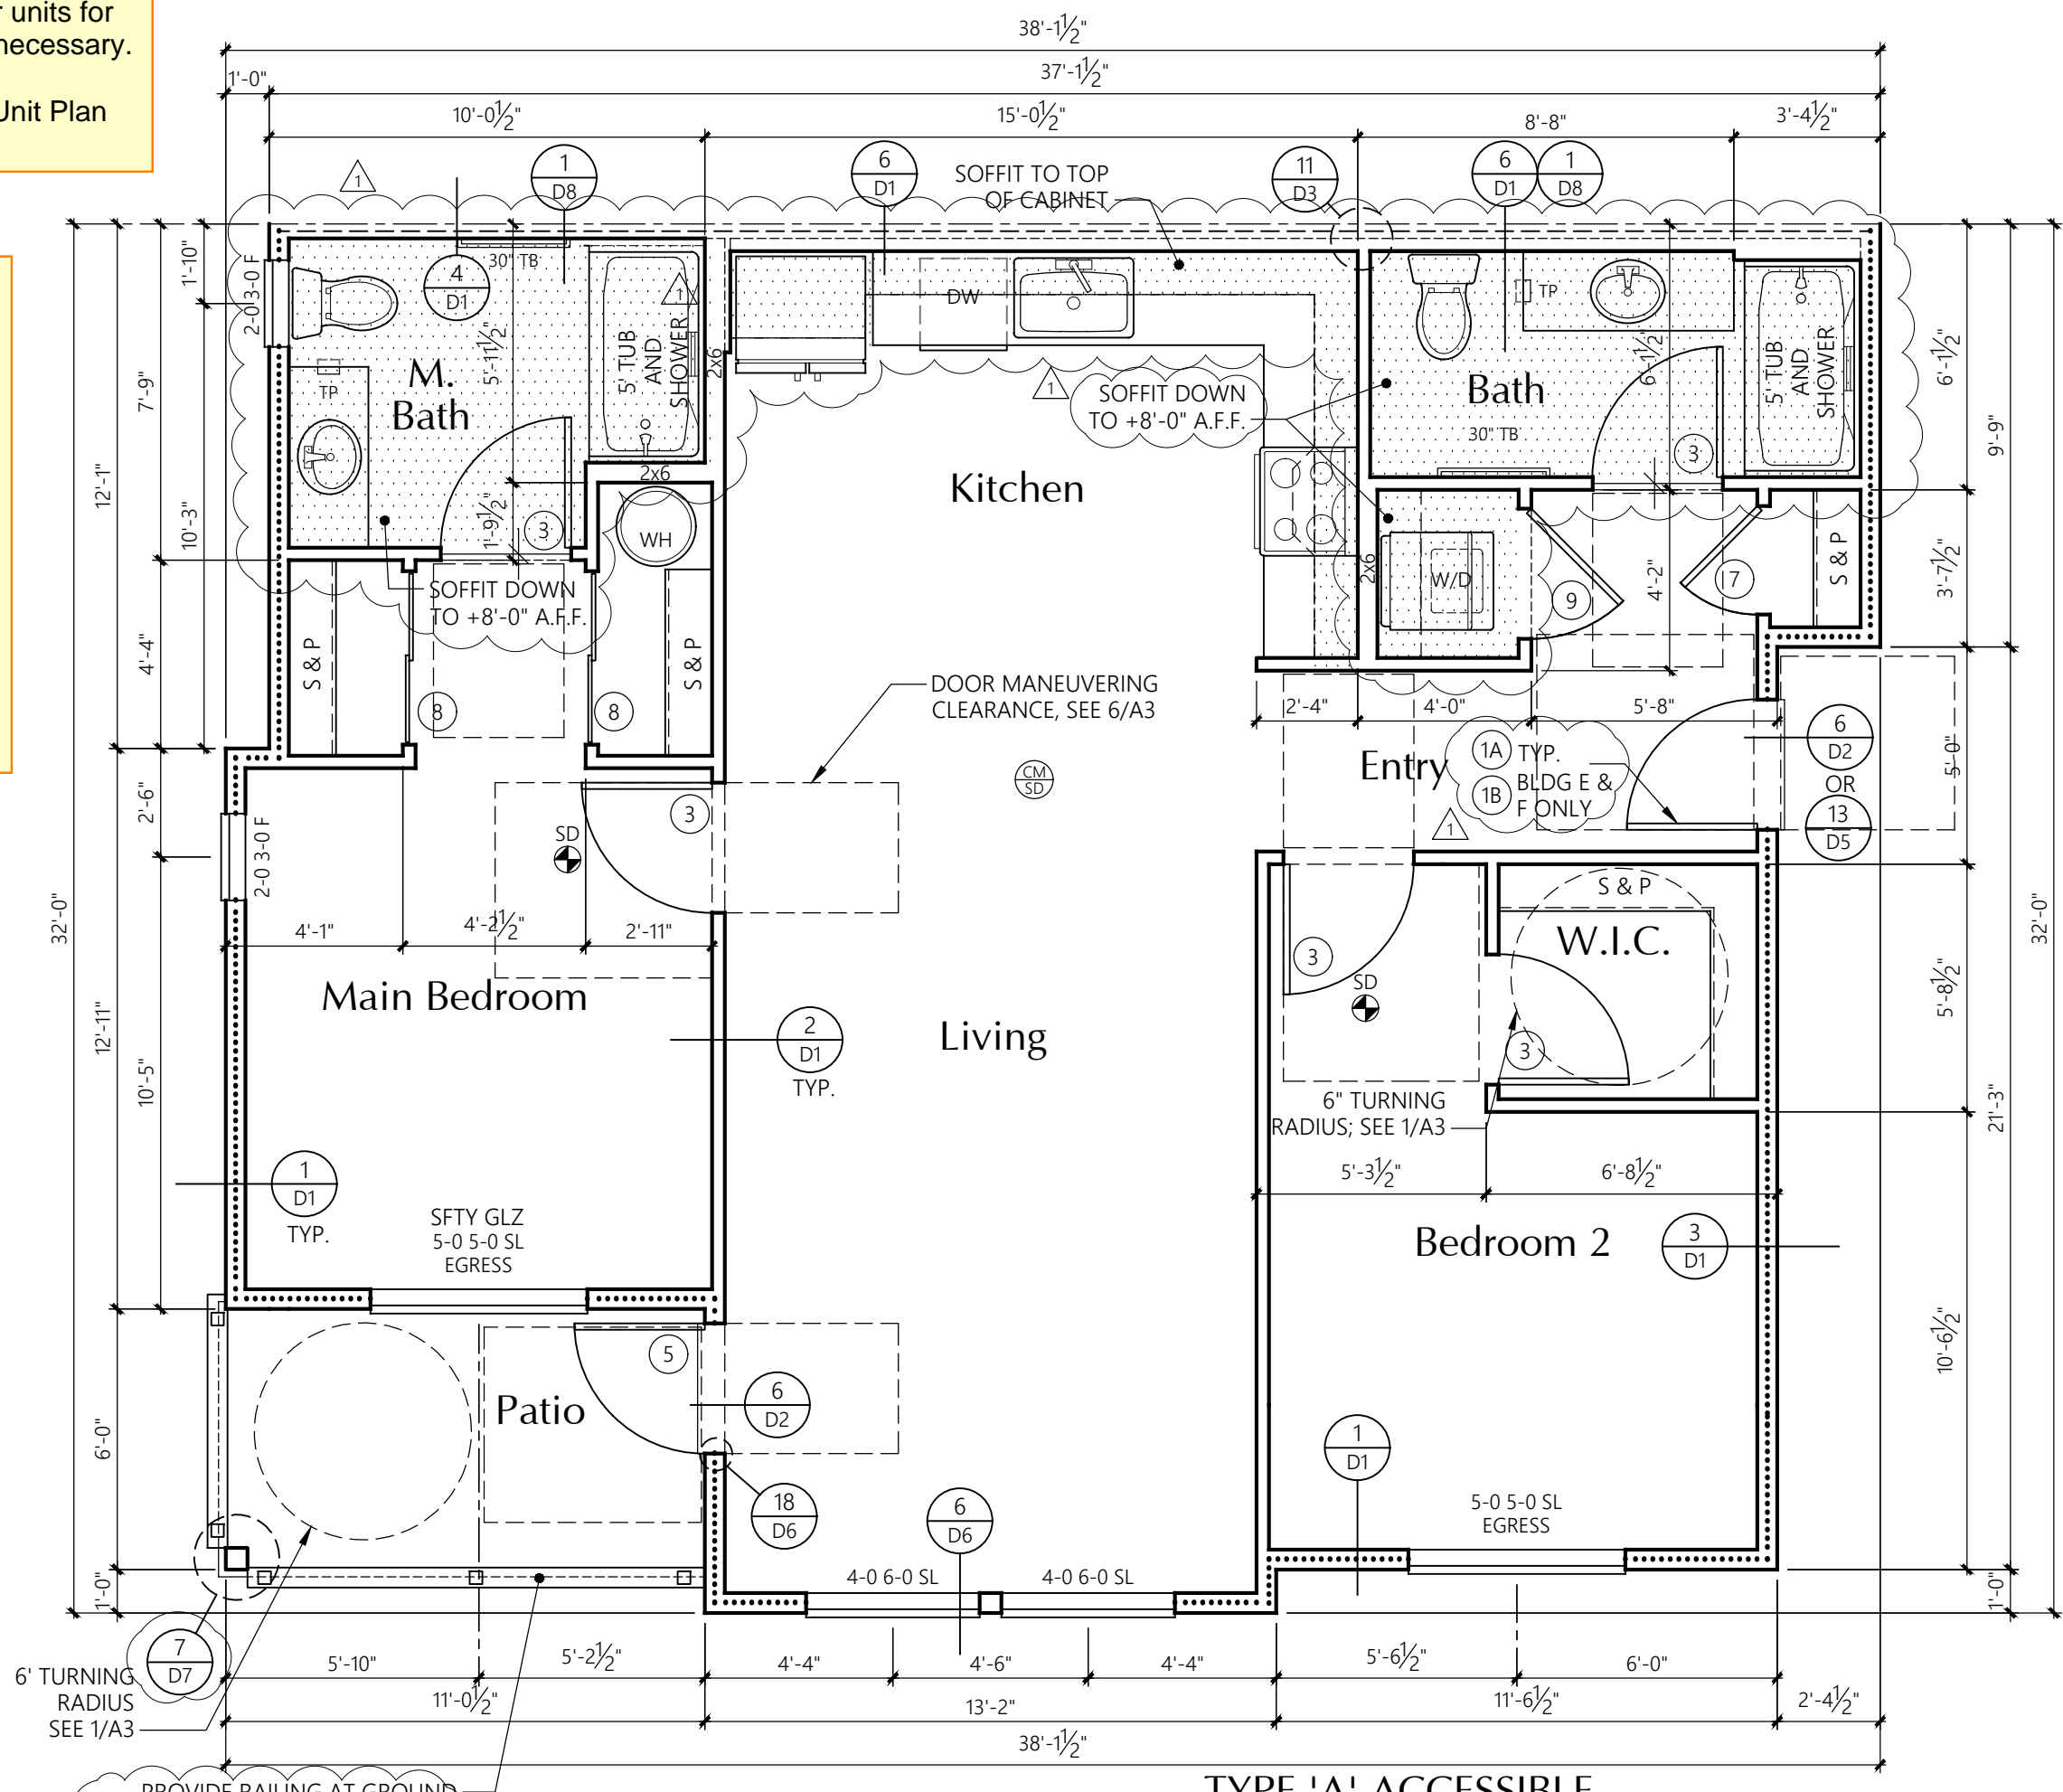

**TYPE 'A' ACCESSIBLE 2 BED UNIT**  
1st LEVEL FLOOR PLAN  
1/4" = 1'-0"

AREA SUMMARY	
Heated SF	Patio/Deck SF
Total SF	1019
	66

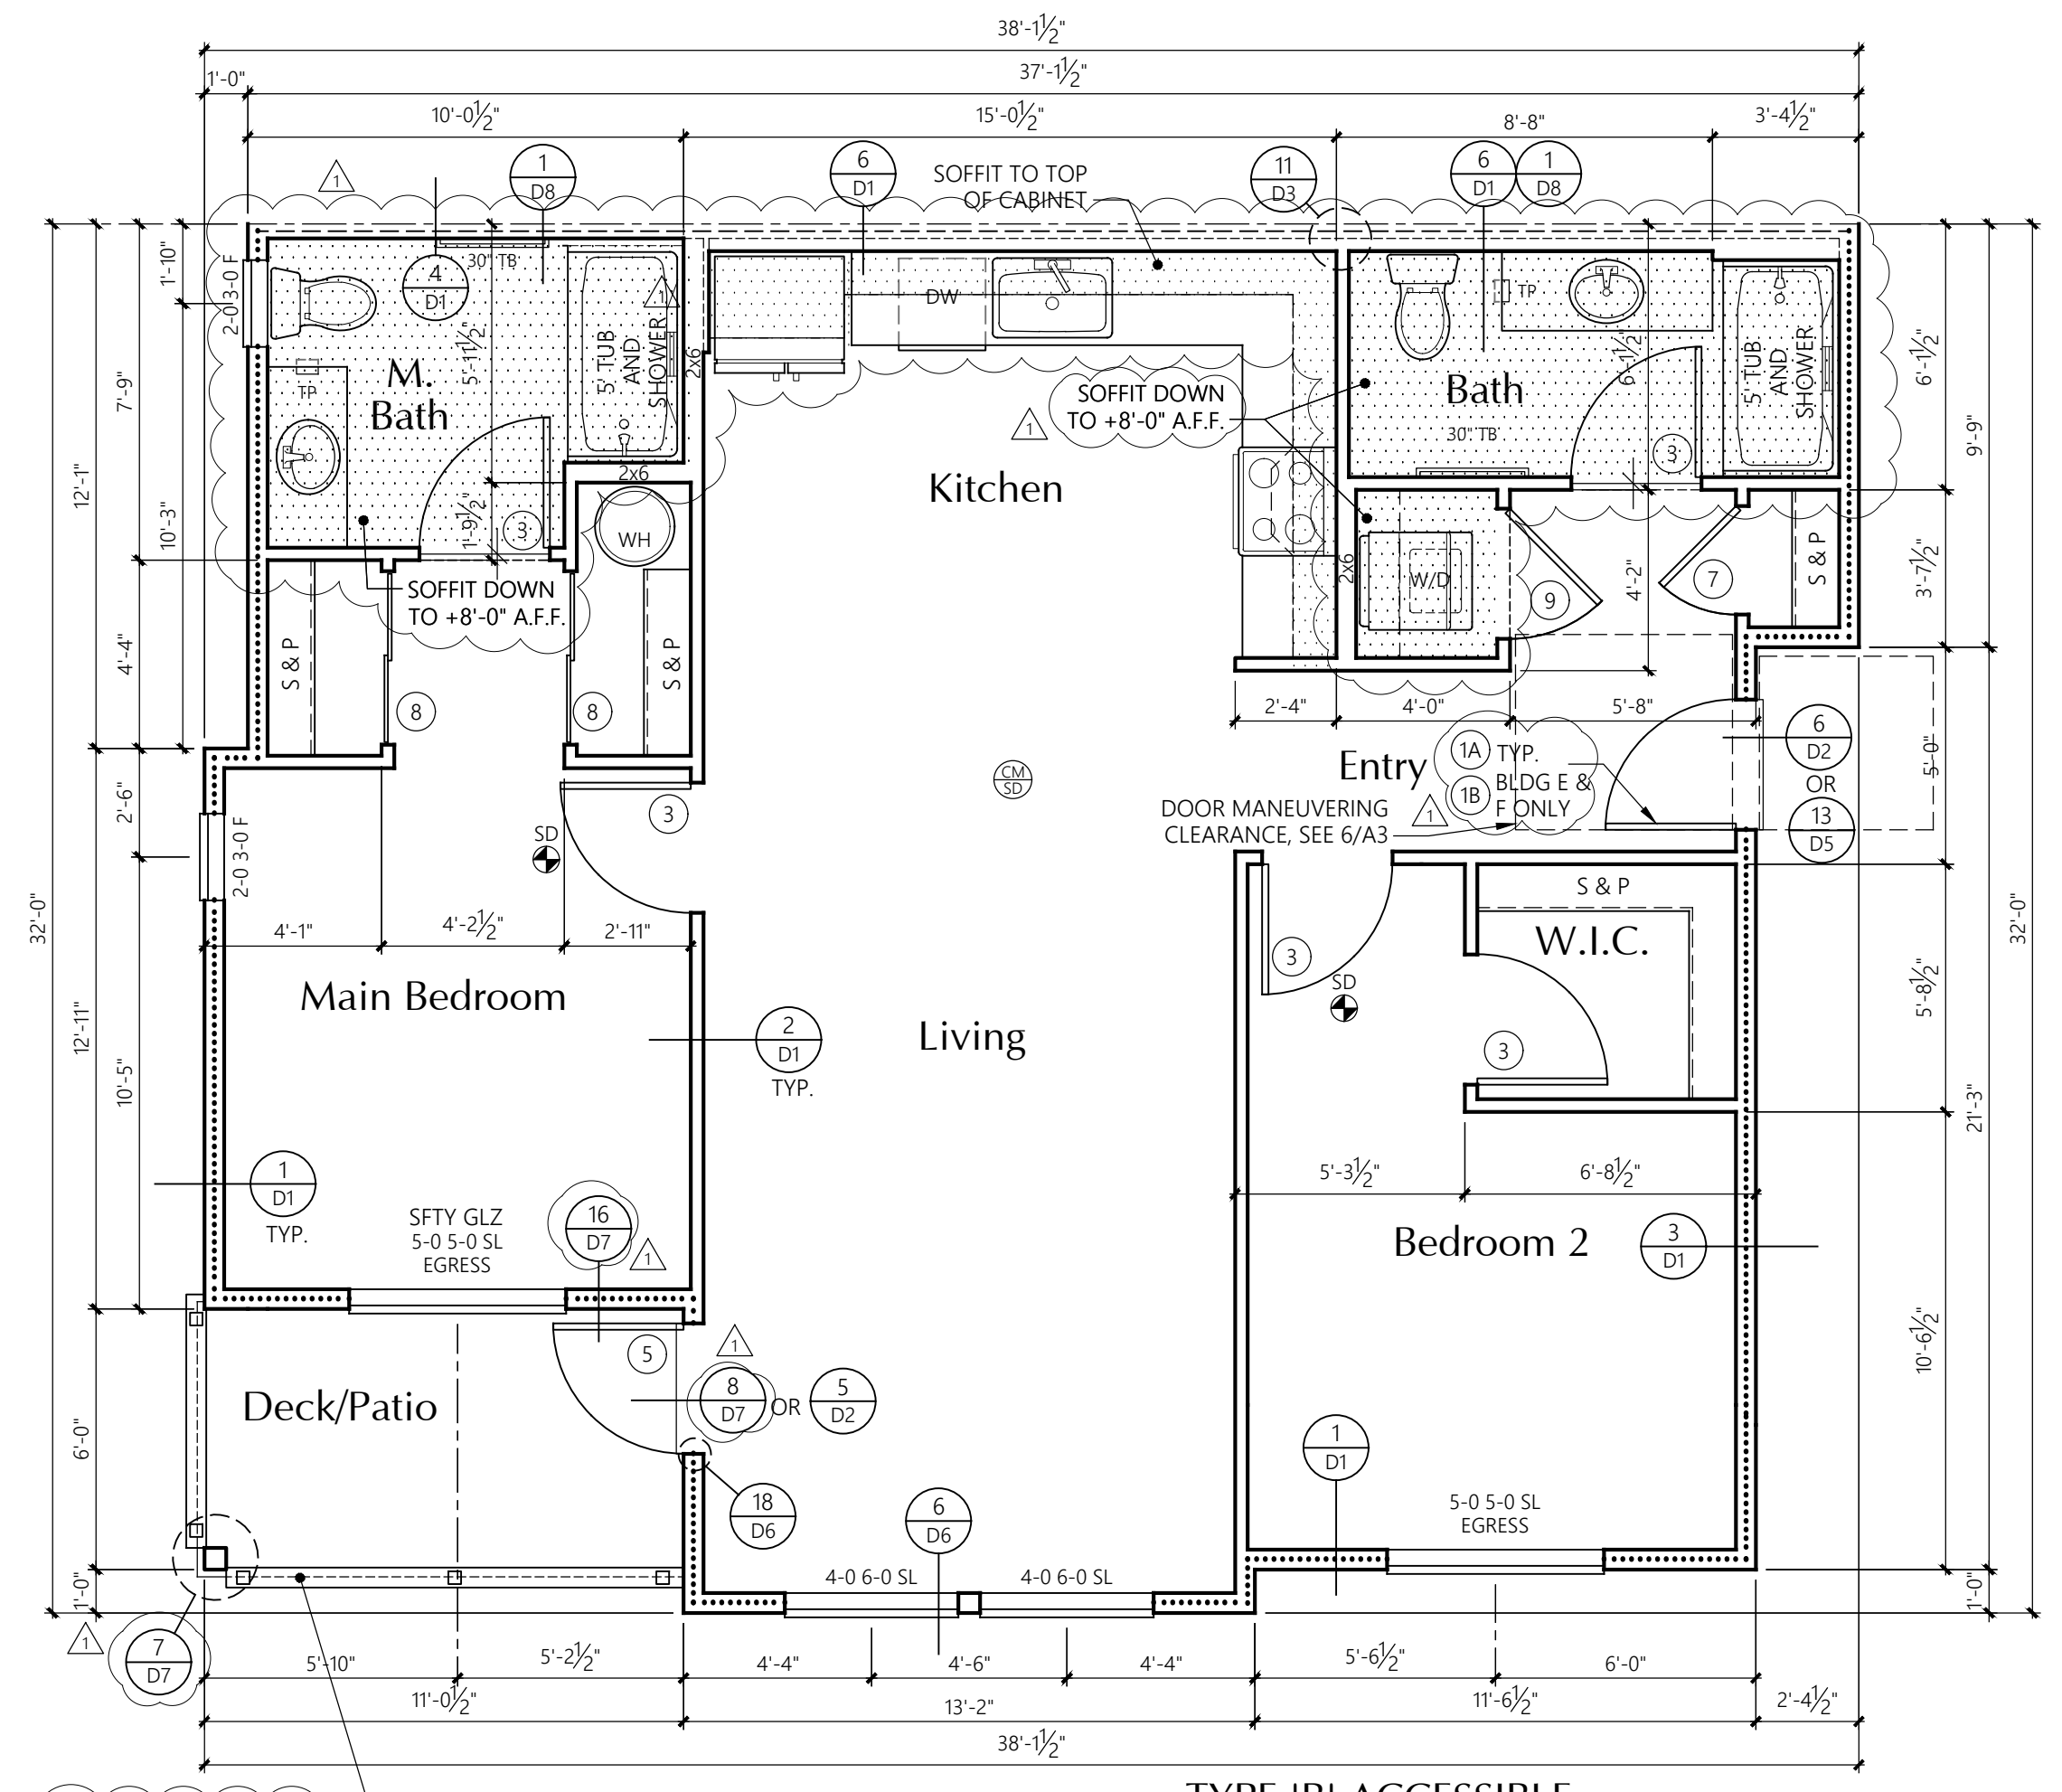

**TYPE 'B' ACCESSIBLE 2-BED UNIT**  
1st LEVEL FLOOR PLAN  
1/4" = 1'-0"

AREA SUMMARY	
Heated SF	Patio/Deck SF
Total SF	1019
	66

**UNIT PLAN NOTES**

**FRAMING:**  
 2x6'S AT EXTERIOR WALLS  
 2x4'S AT INTERIOR WALLS UNLESS NOTED OTHERWISE.  
 R-21 BATT INSULATION U.N.O.  
 R-13 BATT INSULATION  
 3/8" ACOUSTICAL INSULATION ONE SIDE OF PARTYWALL, U.N.O.  
 LOCATION OF SOFFIT FOR VENT RUNS, SOFFIT HEIGHT +8'-0" A.F.F. U.N.O. ON PLANS; SEE DETAIL 1/D8.  
 SMOKE DETECTOR  
 CARBON MONOXIDE/SMOKE DETECTOR

CONCEALED SPACES SHALL BE FIRESTOPPED IN BOTH DIRECTIONS AT 10'-0" ON CENTER AND AT FLOORS. TYPICAL.

ALL ESCAPE OR RESCUE WINDOWS FROM SLEEPING ROOMS SHALL HAVE A MINIMUM NET CLEAR OPENING OF 5.7 SQUARE FEET. THE MINIMUM CLEAR OPENING HEIGHT DIMENSION SHALL BE 24". MINIMUM CLEAR OPENING WIDTH DIMENSION SHALL BE 20". EMERGENCY ESCAPE AND RESCUE OPENINGS SHALL HAVE THE BOTTOM OF CLEAR OPENING NOT GREATER THAN 44 INCHES MEASURED FROM THE FLOOR.

WHERE THE OPENING OF THE SILL PORTION OF AN OPERABLE WINDOW IS LOCATED MORE THAN 72 INCHES ABOVE THE FINISHED GRADE OR OTHER SURFACE BELOW, THE LOWEST PART OF THE CLEAR OPENING OF THE WINDOW SHALL BE AT A HEIGHT NOT LESS THAN 36 INCHES ABOVE THE FINISHED FLOOR SURFACE OF THE ROOM IN WHICH THE WINDOW IS LOCATED. OPERABLE SECTIONS OF WINDOWS SHALL NOT PERMIT OPENINGS THAT ALLOW PASSAGE OF A 4 INCH DIAMETER SPHERE WHERE SUCH OPENINGS ARE LOCATED WITHIN 36 INCHES OF THE FINISHED FLOOR.

ALL GLAZING SHALL CONFORM TO THE 2018 IBC, CHAPTER 24, SEC. 2406, SAFETY GLAZING. GLAZING IN ALL DOORS SHALL BE SAFETY TYPE AND ALL GLAZING WITHIN A 24" ARC OF EITHER VERTICAL EDGE SHALL BE SAFETY TYPE.

PROVIDE WATER RESISTANT GYPSUM WALLBOARD BEHIND TUB AND SHOWER ENCLOSURE MATERIALS TO A HEIGHT OF 70" MINIMUM ABOVE THE DRAIN INLET.

NO PLUMBING SHALL BE LOCATED IN THE 1" AIR SPACE OF FIRE PARTITIONS OR FIRE WALLS.

ALL BEDROOM AND BATHROOM DOORS SHALL BE UNDERCUT A MINIMUM OF 1/2" ABOVE THE ADJACENT FLOOR COVERING.

THE FRONT DOOR SHALL BE OPENABLE FROM THE INSIDE WITHOUT THE USE OF A KEY OR ANY SPECIAL KNOWLEDGE OR EFFORT. IT MAY BE PROVIDED WITH A NIGHT LATCH, DEAD BOLT OR SECURITY CHAIN, PROVIDED SUCH DEVICES ARE OPENABLE FROM THE INSIDE WITHOUT THE USE OF A KEY OR TOOL, AND MOUNTED NOT TO EXCEED 48" ABOVE THE FINISHED FLOOR.

GYPSUM WALLBOARD SCHEDULE EXCEPT WHERE NOTED OTHERWISE; 3/4" TYPE 'X' GYPSUM WALLBOARD SHALL BE USED THROUGHOUT; ON INTERIOR NON-RATED WALLS, EXTERIOR WALLS, CORRIDOR WALLS, AND 1-HOUR AND 2-HOUR FIRE-RATED WALLS.

STANDARD PLATE HEIGHT: 9'-1"

SEE ELEVATION SHEETS FOR FLOOR TO FLOOR HEIGHTS

WINDOW HDR IS 8'-0" UNLESS NOTED OTHERWISE

SEE SHEET U9 FOR INTERIOR ELEVATIONS AND ACCESSIBILITY REQUIREMENTS.

**DOOR KEY:**  
 (X) DOOR TAG: SEE SHEET U13 FOR SCHEDULE

**WINDOW KEY:**  
 TYPE:  
 FIX = FIXED/PICTURE  
 SL = SLIDER  
 SH = SINGLE HUNG  
 SGD = SLIDING GLASS DOOR

**INSULATION**

FOUNDATION PERIMETER - R-10 RIGID INSULATION TO A DEPTH OF 24" OR TO TOP OF FOOTING AT HEATED PERIMETER

EXTERIOR WALLS: FIBERGLASS BATTS OR BLANKETS 2x6 WALLS - R21

FLOORS OVER UNHEATED SPACES - R30

ATTICS AND ROOF ASSEMBLIES - R-49

FULL HEIGHT OF UNCOMPRESSED INSULATION EXTENDS OVER THE WALL TOP PLATE AT THE EAVES

EXTERIOR DOORS: MAIN ENTRY U=0.20  
 ALL OTHERS U=0.40

WINDOWS: MILGARD VINYL  
 TYPE (VINYL) MODEL U-VALUE  
 SLIDING 6110 ARGON/LoE 0.24 or BETTER  
 FIXED 6310 ARGON/LoE 0.24 or BETTER  
 SINGLE HUNG 6210 ARGON/LoE 0.24 or BETTER  
 DBL. SLIDER 8125 ARGON/LoE 0.24 or BETTER  
 SGD 6610 ARGON/LoE 0.24 or BETTER

NOTE: ALL CONCEALED OR EXPOSED INSULATION SHALL HAVE A FLAME SPREAD INDEX OF NOT MORE THAN 25 AND A SMOKE-DEVELOPED INDEX OF NOT MORE THAN 450

**ACCESSIBILITY NOTES:**

ALL GROUND FLOOR UNITS IN THIS PROJECT MUST MEET THE ACCESSIBILITY REQUIREMENTS OF 'TYPE B' ACCESSIBLE UNITS AS REQUIRED BY CHAPTER 11 OF THE 2018 IBC.

INCLUDED IN THE ABOVE GROUND FLOOR UNITS 5% OF ALL UNITS NEED TO MEET THE ACCESSIBILITY REQUIREMENTS OF 'TYPE A' ACCESSIBLE UNITS AS REQUIRED BY CHAPTER 11 OF THE 2018 IBC. SEE BUILDING PLANS FOR LOCATION OF 'TYPE A' UNITS

SEE SHEET U9 FOR SPECIFIC ADAPTABILITY STANDARD FOR BOTH 'TYPE A' AND 'TYPE B' ACCESSIBLE UNITS. SEE INTERIOR ELEVATION SHEETS FOR ADDITIONAL ACCESSIBILITY REQUIREMENTS.

LIGHTING CONTROLS, ELECTRICAL SWITCHES, ENVIRONMENTAL CONTROLS, OPERATING HARDWARE FOR DOORS AND WINDOWS, AND PLUMBING FIXTURE CONTROLS SHALL BE OPERABLE WITH ONE HAND AND SHALL NOT REQUIRE TIGHT GRASPING, PINCHING OR TWISTING OF THE WRIST TO OPERATE. EXCEPT FOR OPERABLE DOOR HARDWARE, SUCH ITEMS SHALL BE 15" MINIMUM AND 44" MAXIMUM ABOVE THE FLOOR (48" FOR WINDOWS).

OPERABLE ENTRY DOOR HARDWARE SHALL BE 34" MINIMUM AND 48" MAXIMUM ABOVE THE FLOOR.

OPENING FORCES FOR ENTRY DOOR SHALL BE: 15 POUNDS TO RELEASE THE LATCH  
 30 POUNDS TO SET DOOR IN MOTION  
 15 POUNDS TO OPEN DOOR TO FULL 90° FORCE MEASURED AT LATCH SIDE OF DOOR.

THE DOOR CLOSER ON THE ENTRY DOOR SHALL BE ADJUSTED TO CLOSE FROM AN OPEN POSITION OF 90° TO AN OPEN POSITION OF 12° IN NOT LESS THAN 5 SECONDS.

OPENING FORCE OF ALL SWINGING INTERIOR DOORS AND THE SLIDING GLASS DOOR SHALL NOT EXCEED 5 POUNDS APPLIED TO THE LATCH SIDE OF THE DOOR.

THE FORCE REQUIRED TO ACTIVATE ALL OTHER OPERABLE ITEMS LISTED ABOVE SHALL BE 5 POUNDS.

\*BIFOLD DOOR HARDWARE AT LAUNDRY TO BE 'FULL ACCESS HARDWARE'

THE 30"x48" CLEAR FLOOR SPACE IS REQUIRED AT EACH FIXTURE OR LOCATION SHOWN ON THE FLOOR PLAN.

PROVIDE 3/4" TYPE 'X' (MIN) GYPSUM SHEATHING ON WALLS BEHIND TUB/SHOWERS TO SATISFY FIRE REQUIREMENTS AT PARTYWALL CONDITION. PROVIDE 3/4" PLYWOOD UNDER TUB IN PLACE OF THE GYPCRETE, SEE DETAIL 14/D1

25 Central Way, Suite 210  
 Kirkland, Washington 98033  
 P: 425.454.7130 F: 425.658.1208  
 Web: www.milbrandtarch.com

© Copyright 2023  
 Milbrandt Architects, INC., P.S.  
 All rights reserved



**Bradley Heights Apartments**


Puyallup, Wa

**Timberlane Partners**

**Revisions**

No.	Date	Description
1	8-30-24	Owner Changes/ Permit Corrections


Initial Publish Date:  
 Date Plotted: 12-20-24  
 Job No.: 23-06  
 Drawn By: APT/HDM/TMK  
 Sheet No.:

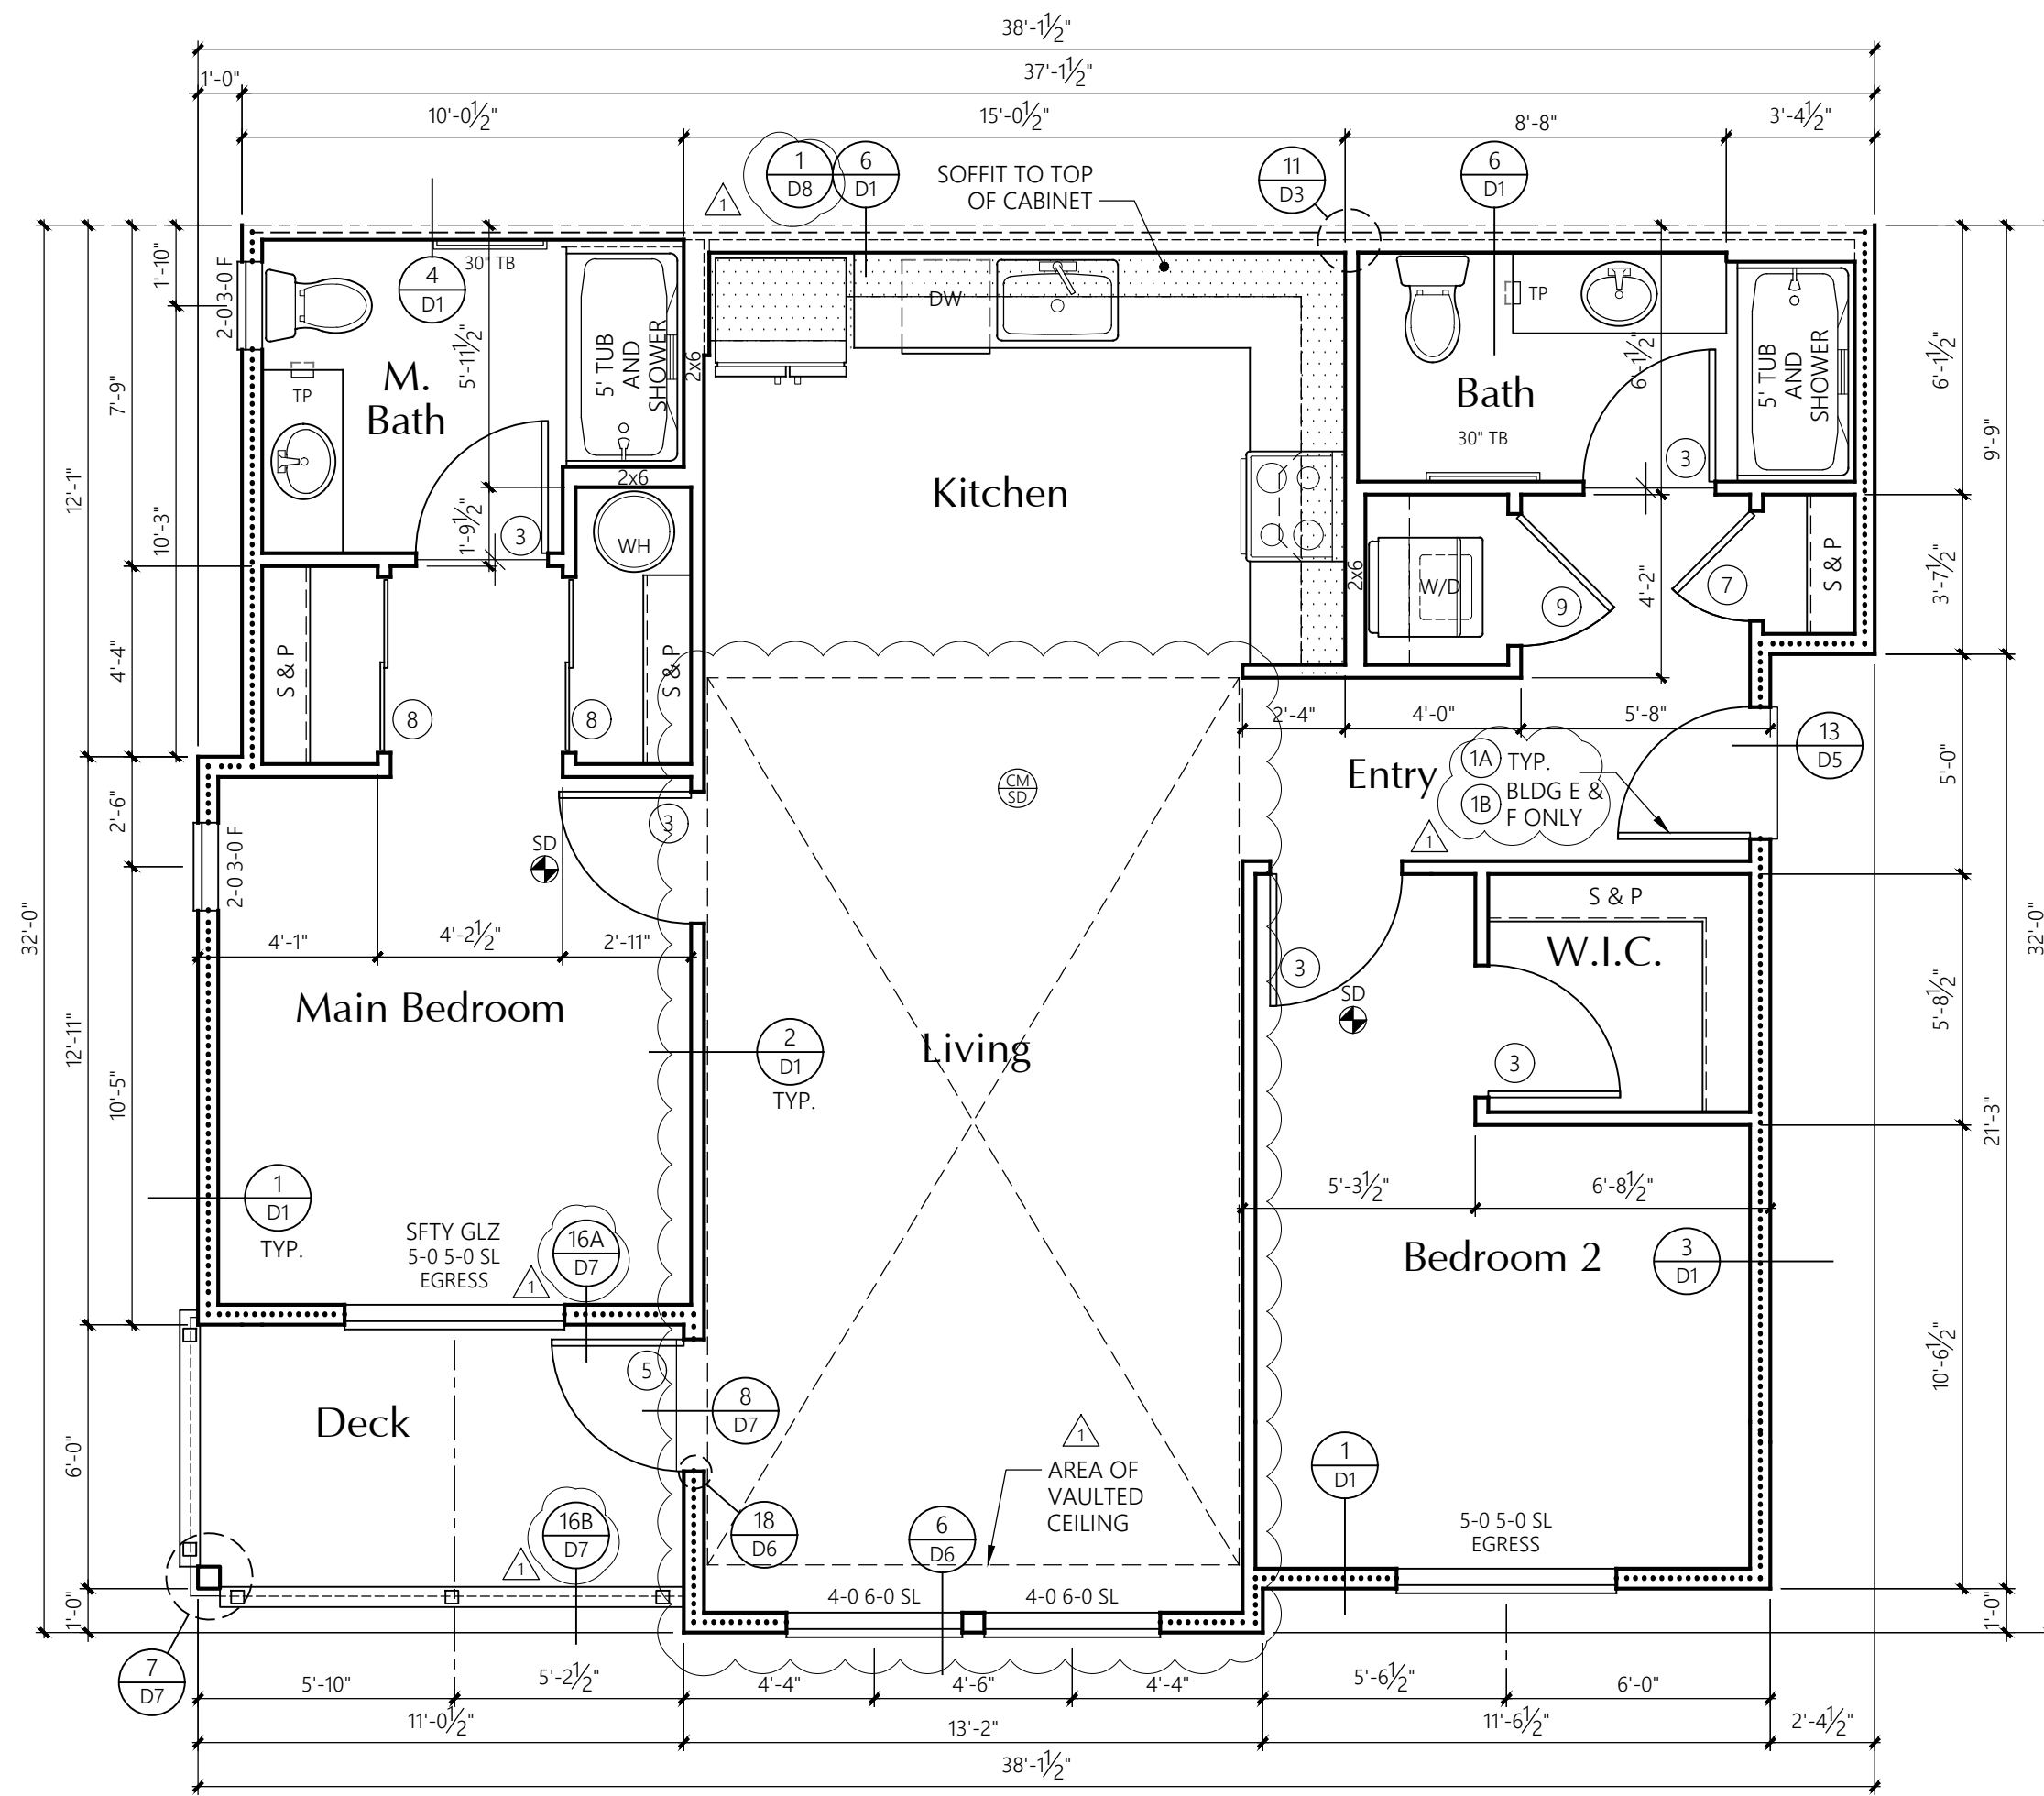

**2-BED UNIT**  
1/4" = 1'-0"

NON-ACCESSIBLE  
3rd LEVEL FLOOR PLAN

AREA SUMMARY		
Total SF	Heated SF	Patio/Deck SF
	1019	66

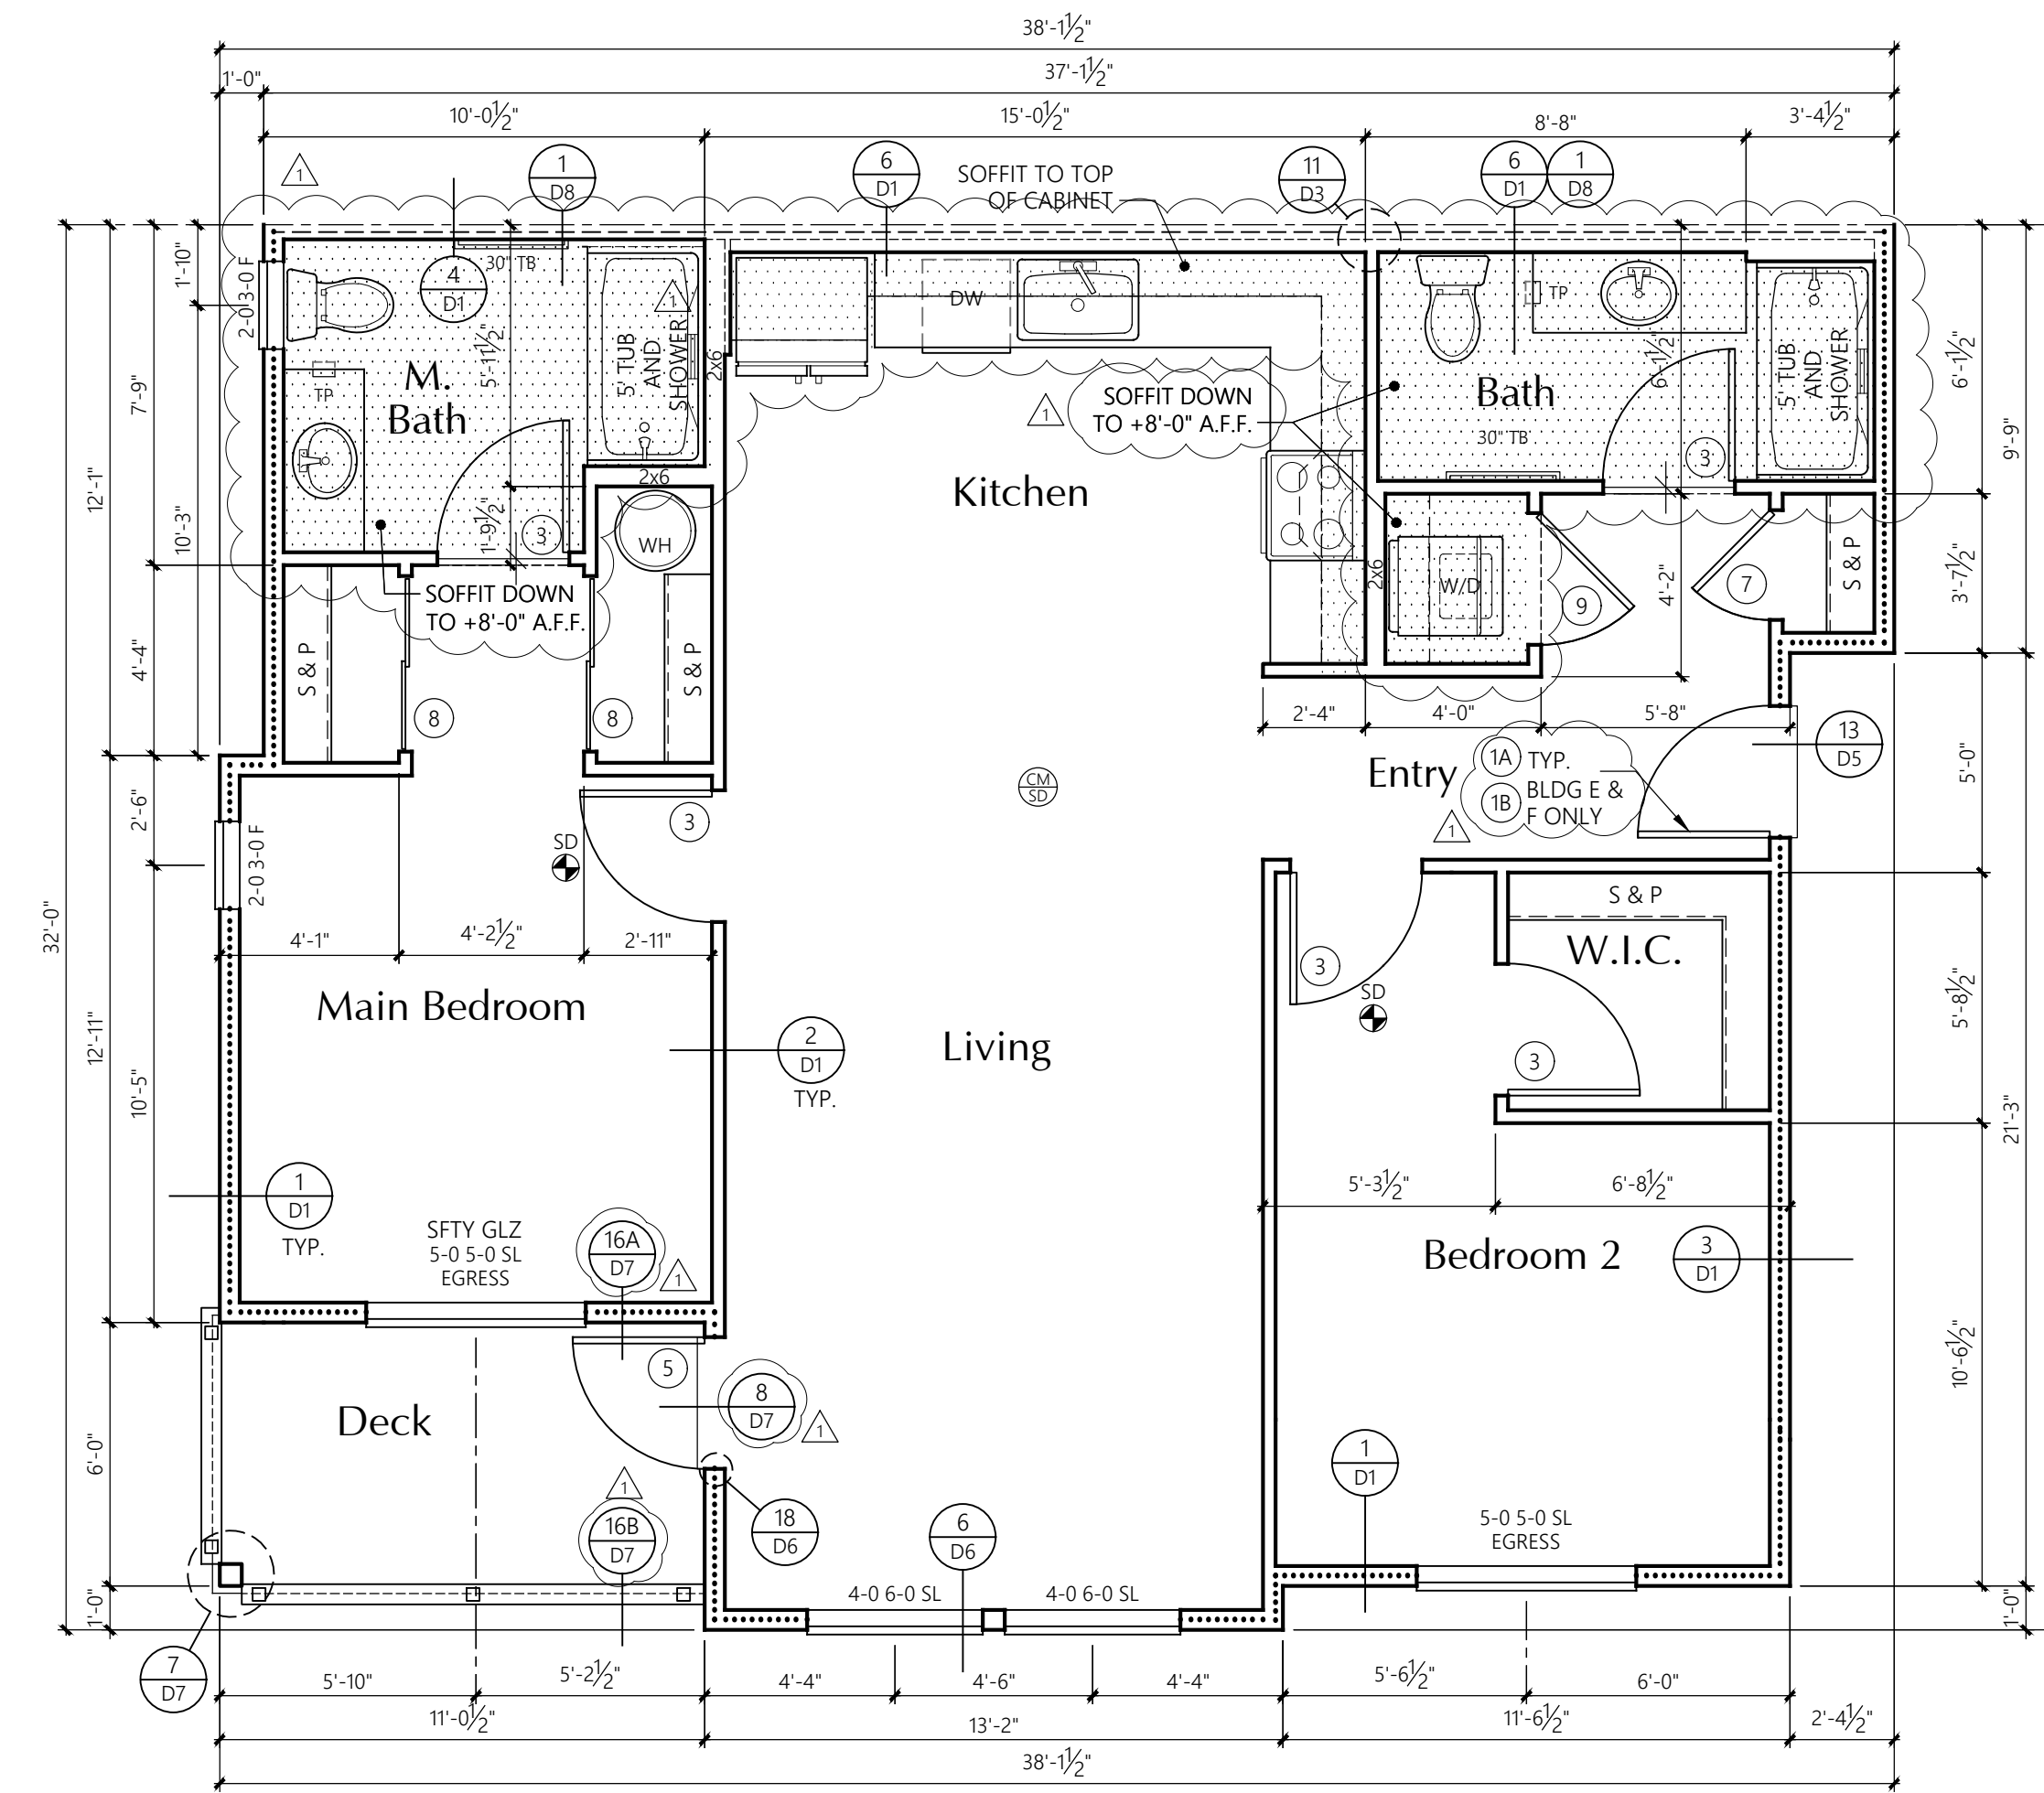

**2-BED UNIT**  
1/4" = 1'-0"

NON-ACCESSIBLE  
2nd LEVEL FLOOR PLAN

AREA SUMMARY		
Total SF	Heated SF	Patio/Deck SF
	1019	66

**UNIT PLAN NOTES**

- FRAMING:** 2x6'S AT EXTERIOR WALLS  
2x4'S AT INTERIOR WALLS  
UNLESS NOTED OTHERWISE.
- ..... R-21 BATT INSULATION U.N.O.
- R-13 BATT INSULATION  
3/4" ACOUSTICAL INSULATION ONE  
SIDE OF PARTYWALL U.N.O.
- LOCATION OF SOFFIT FOR VENT  
RUNS. SOFFIT HEIGHT +8'-0" A.F.F.  
U.N.O. ON PLANS; SEE DETAIL 1/D8
- SD SMOKE DETECTOR
- CM CARBON MONOXIDE/SMOKE DETECTOR

- PROVIDE WATER RESISTANT GYPSUM WALLBOARD  
BEHIND TUB AND SHOWER ENCLOSURE MATERIALS TO A  
HEIGHT OF 70" MINIMUM ABOVE THE DRAIN INLET.
- NO PLUMBING SHALL BE LOCATED IN THE 1" AIR SPACE OF FIRE  
PARTITIONS OR FIRE WALLS.
- ALL BEDROOM AND BATHROOM DOORS SHALL BE UNDERCUT  
A MINIMUM OF 1/2" ABOVE THE ADJACENT FLOOR COVERING.
- THE FRONT DOOR SHALL BE OPENABLE FROM THE INSIDE  
WITHOUT THE USE OF A KEY OR ANY SPECIAL KNOWLEDGE OR  
EFFORT. IT MAY BE PROVIDED WITH A NIGHT LATCH, DEAD  
BOLT OR SECURITY CHAIN, PROVIDED SUCH DEVICES ARE  
OPENABLE FROM THE INSIDE WITHOUT THE USE OF A KEY OR  
TOOL, AND MOUNTED NOT TO EXCEED 48" ABOVE THE  
FINISHED FLOOR.

- GYPSUM WALLBOARD SCHEDULE  
EXCEPT WHERE NOTED OTHERWISE, 3/8" TYPE 'X' GYPSUM  
WALLBOARD SHALL BE USED THROUGHOUT;  
ON INTERIOR NON-RATED WALLS, EXTERIOR WALLS,  
CORRIDOR WALLS, AND 1-HOUR AND 2-HOUR FIRE-RATED  
WALLS.
- STANDARD PLATE  
HEIGHT: 9'-1"
- SEE ELEVATION SHEETS FOR  
FLOOR TO FLOOR HEIGHTS
- WINDOW HDR IS 8'-0"  
UNLESS NOTED OTHERWISE
- SEE SHEET U9 FOR INTERIOR ELEVATIONS  
AND ACCESSIBILITY REQUIREMENTS.

CONCEALED SPACES SHALL BE FIRESTOPPED IN BOTH  
DIRECTIONS AT 10'-0" ON CENTER AND AT FLOORS. TYPICAL.

ALL ESCAPE OR RESCUE WINDOWS FROM SLEEPING ROOMS  
SHALL HAVE A MINIMUM NET CLEAR OPENING OF 7.7 SQUARE  
FEET. THE MINIMUM CLEAR OPENING HEIGHT DIMENSION  
SHALL BE 24". MINIMUM CLEAR OPENING WIDTH DIMENSION  
SHALL BE 20". EMERGENCY ESCAPE AND RESCUE OPENINGS  
SHALL HAVE THE BOTTOM OF CLEAR OPENING NOT GREATER  
THAN 44 INCHES MEASURED FROM THE FLOOR.

WHERE THE OPENING OF THE SILL PORTION OF AN OPERABLE  
WINDOW IS LOCATED MORE THAN 72 INCHES ABOVE THE  
FINISHED GRADE OR OTHER SURFACE BELOW, THE LOWEST  
PART OF THE CLEAR OPENING OF THE WINDOW SHALL BE AT  
A HEIGHT NOT LESS THAN 36 INCHES ABOVE THE FINISHED  
FLOOR SURFACE OF THE ROOM IN WHICH THE WINDOW IS  
LOCATED. OPERABLE SECTIONS OF WINDOWS SHALL NOT  
PERMIT OPENINGS THAT ALLOW PASSAGE OF A 4 INCH  
DIAMETER SPHERE WHERE SUCH OPENINGS ARE LOCATED  
WITHIN 36 INCHES OF THE FINISHED FLOOR.

ALL GLAZING SHALL CONFORM TO THE 2018 IBC,  
CHAPTER 24, SEC. 2406, SAFETY GLAZING. GLAZING IN ALL  
DOORS SHALL BE SAFETY TYPE AND ALL GLAZING WITHIN A  
24" ARC OF EITHER VERTICAL EDGE SHALL BE SAFETY TYPE.

PROVIDE 3/8" TYPE 'X' (MIN.) GYPSUM SHEATHING ON WALLS  
BEHIND TUB/SHOWERS TO SATISFY FIRE REQUIREMENTS AT  
PARTYWALL CONDITION. PROVIDE 3/4" PLYWOOD UNDER TUB  
IN PLACE OF THE GYPCRETE, SEE DETAIL 14/D1

**DOOR KEY:**

- (X) DOOR TAG. SEE SHEET U13 FOR SCHEDULE

**WINDOW KEY:**

- TYPE:  
FIX = FIXED/PICTURE  
SL = SLIDER  
SH = SINGLE HUNG  
SGD = SLIDING GLASS DOOR


**INSULATION**

- FOUNDATION PERIMETER - R-10 RIGID INSULATION  
TO A DEPTH OF 24" OR TO TOP OF FOOTING AT  
HEATED PERIMETER
- EXTERIOR WALLS: FIBERGLASS BATTS OR BLANKETS  
2x6 WALLS - R21
- FLOORS OVER UNHEATED SPACES - R30
- ATTICS AND ROOF ASSEMBLIES - R-49  
FULL HEIGHT OF UNCOMPRESSED INSULATION  
EXTENDS OVER THE WALL TOP PLATE AT  
THE EAVES
- EXTERIOR DOORS: MAIN ENTRY U=0.20  
ALL OTHERS U=0.40
- WINDOWS: MILGARD VINYL  
TYPE (VINYL) MODEL U-VALUE  
SLIDING 6110 ARGON/LoE 0.24 or BETTER  
FIXED 6310 ARGON/LoE 0.24 or BETTER  
SINGLE HUNG 6210 ARGON/LoE 0.24 or BETTER  
DBL SLIDER 8125 ARGON/LoE 0.24 or BETTER  
SGD 6610 ARGON/LoE 0.24 or BETTER

NOTE: ALL CONCEALED OR EXPOSED INSULATION  
SHALL HAVE A FLAME SPREAD INDEX OF NOT  
MORE THAN 25 AND A SMOKE-DEVELOPED  
INDEX OF NOT MORE THAN 450


**Revisions**

No.	Date	Description
1	8-30-24	Owner Changes/ Permit Corrections

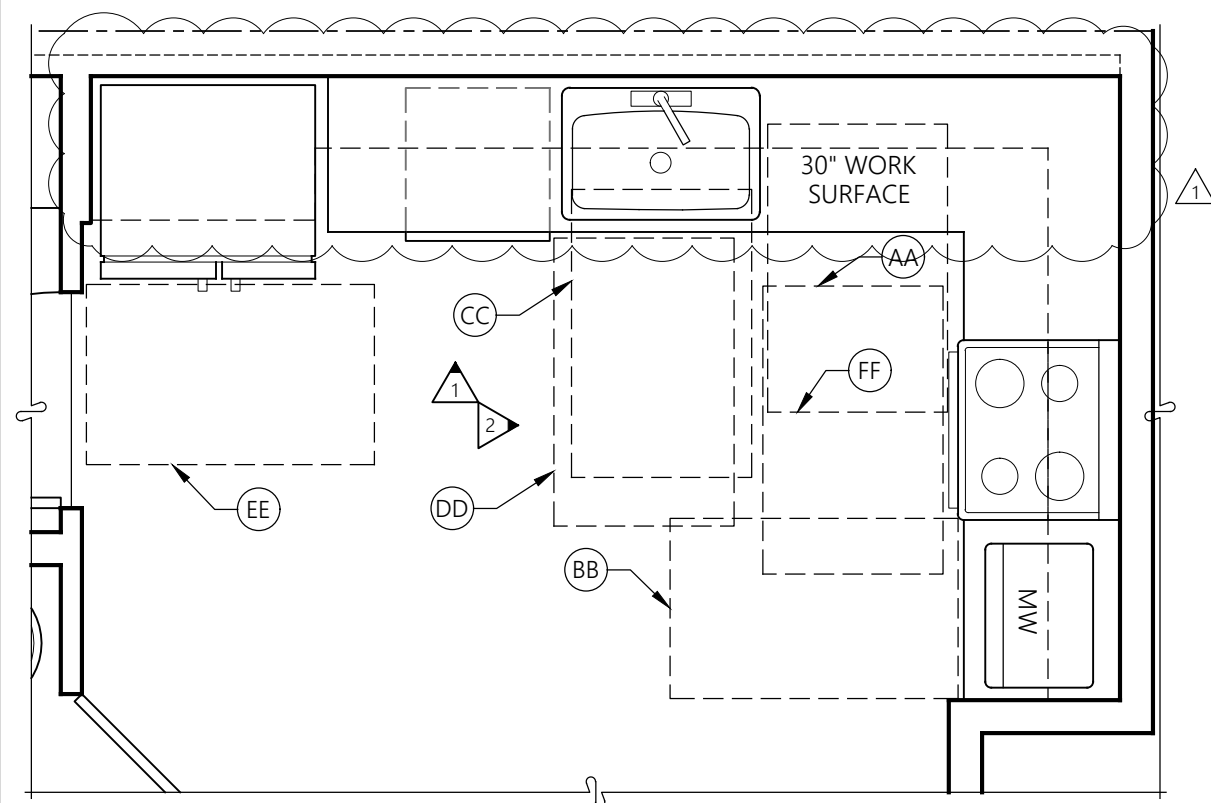


**1-BED-INT-1 & 1-BED-INT-2** TYPE 'A' KITCHEN PLAN (1) KITCHEN

3/8" = 1'-0"

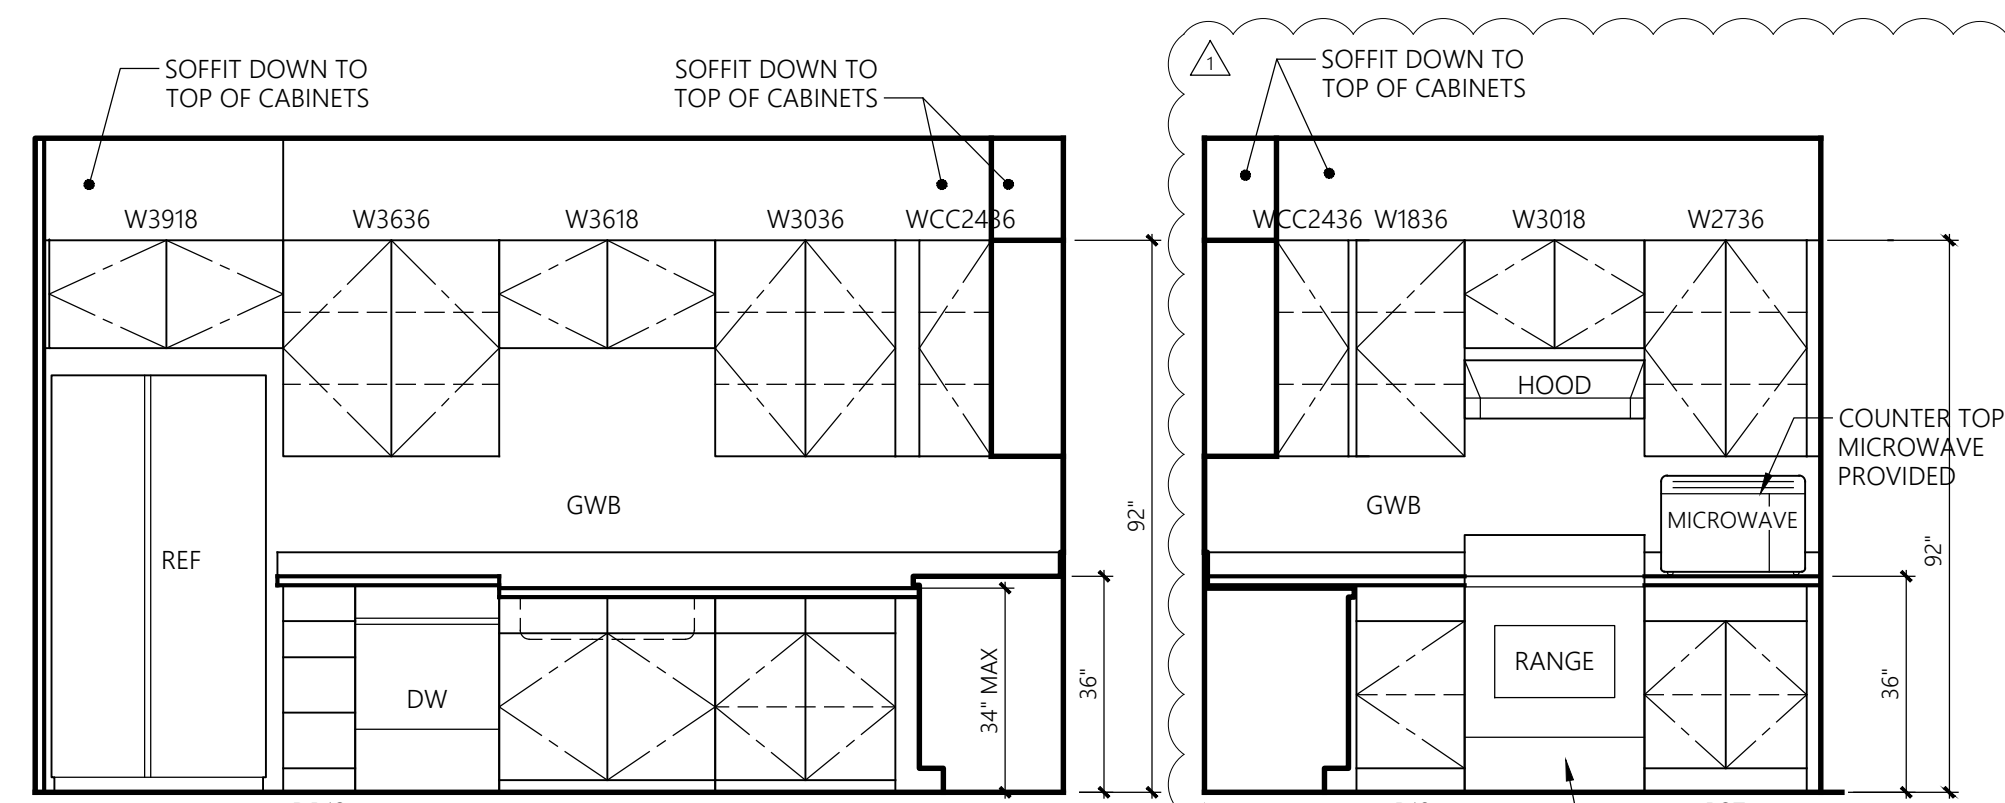


(2) KITCHEN

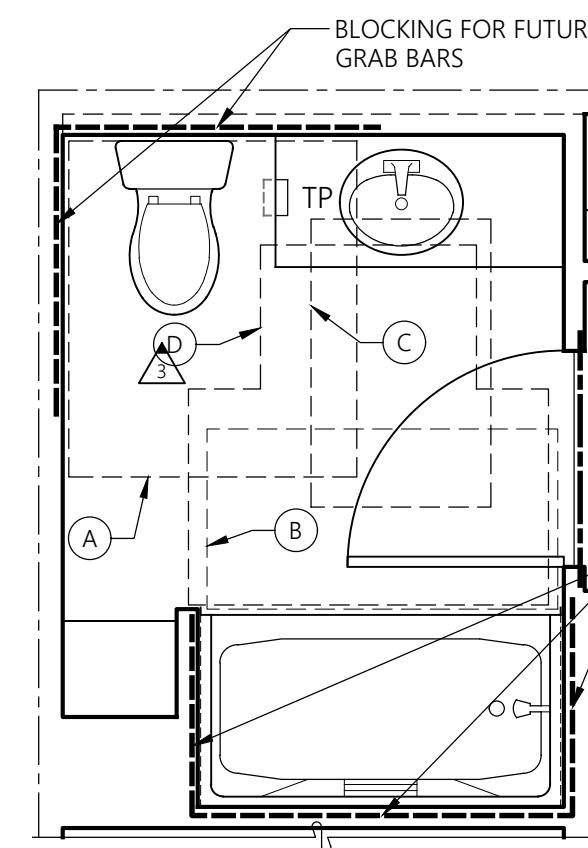


**1-BED-INT-1 & 1-BED-INT-2** TYPE 'A' BATH PLAN (3) BATH

3/8" = 1'-0"

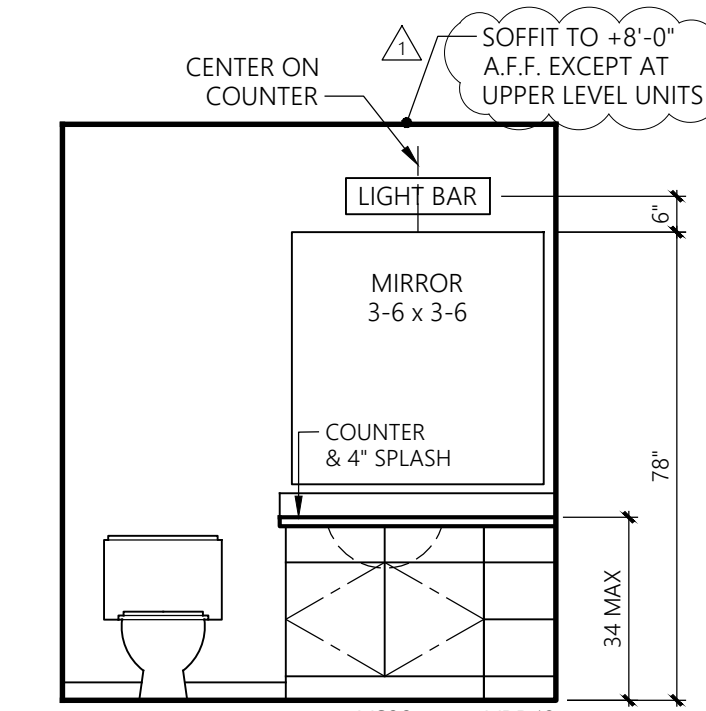


(3) BATH

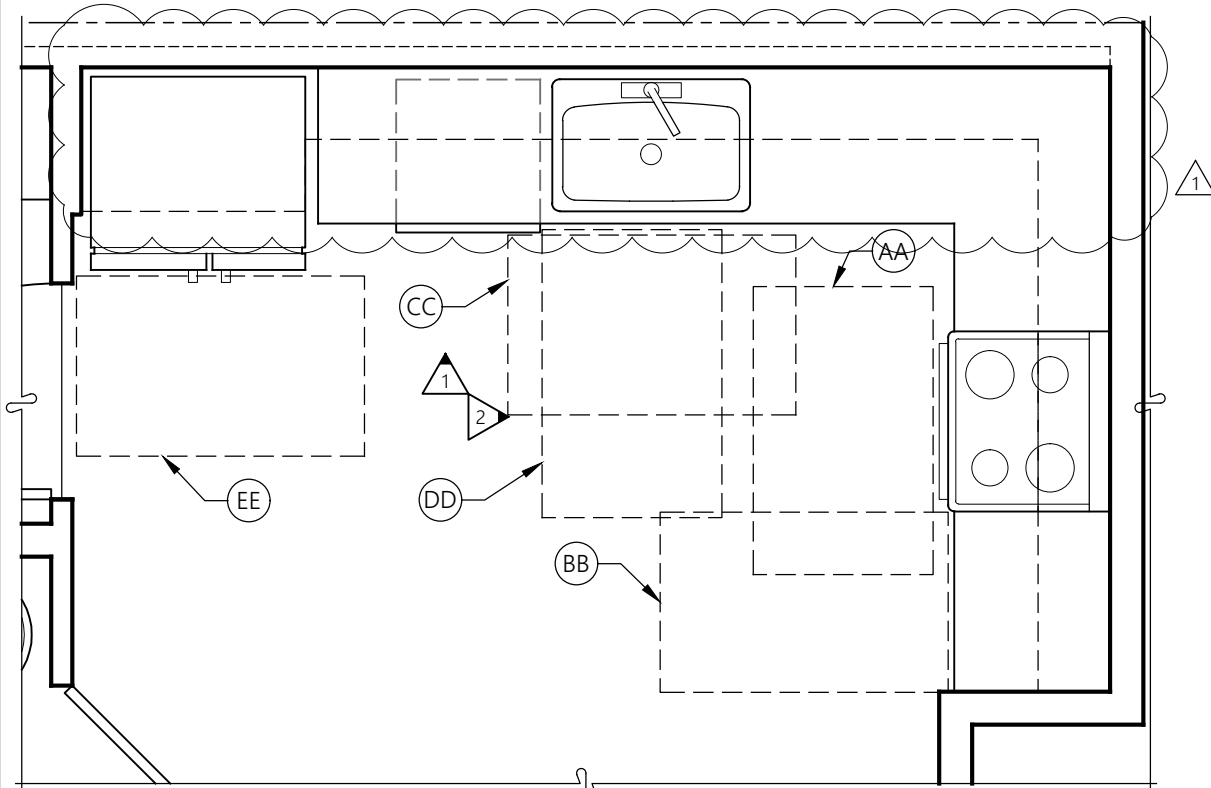


**1-BED-INT-1 & 1-BED-INT-2** TYPE 'B' KITCHEN PLAN (1) KITCHEN

3/8" = 1'-0"


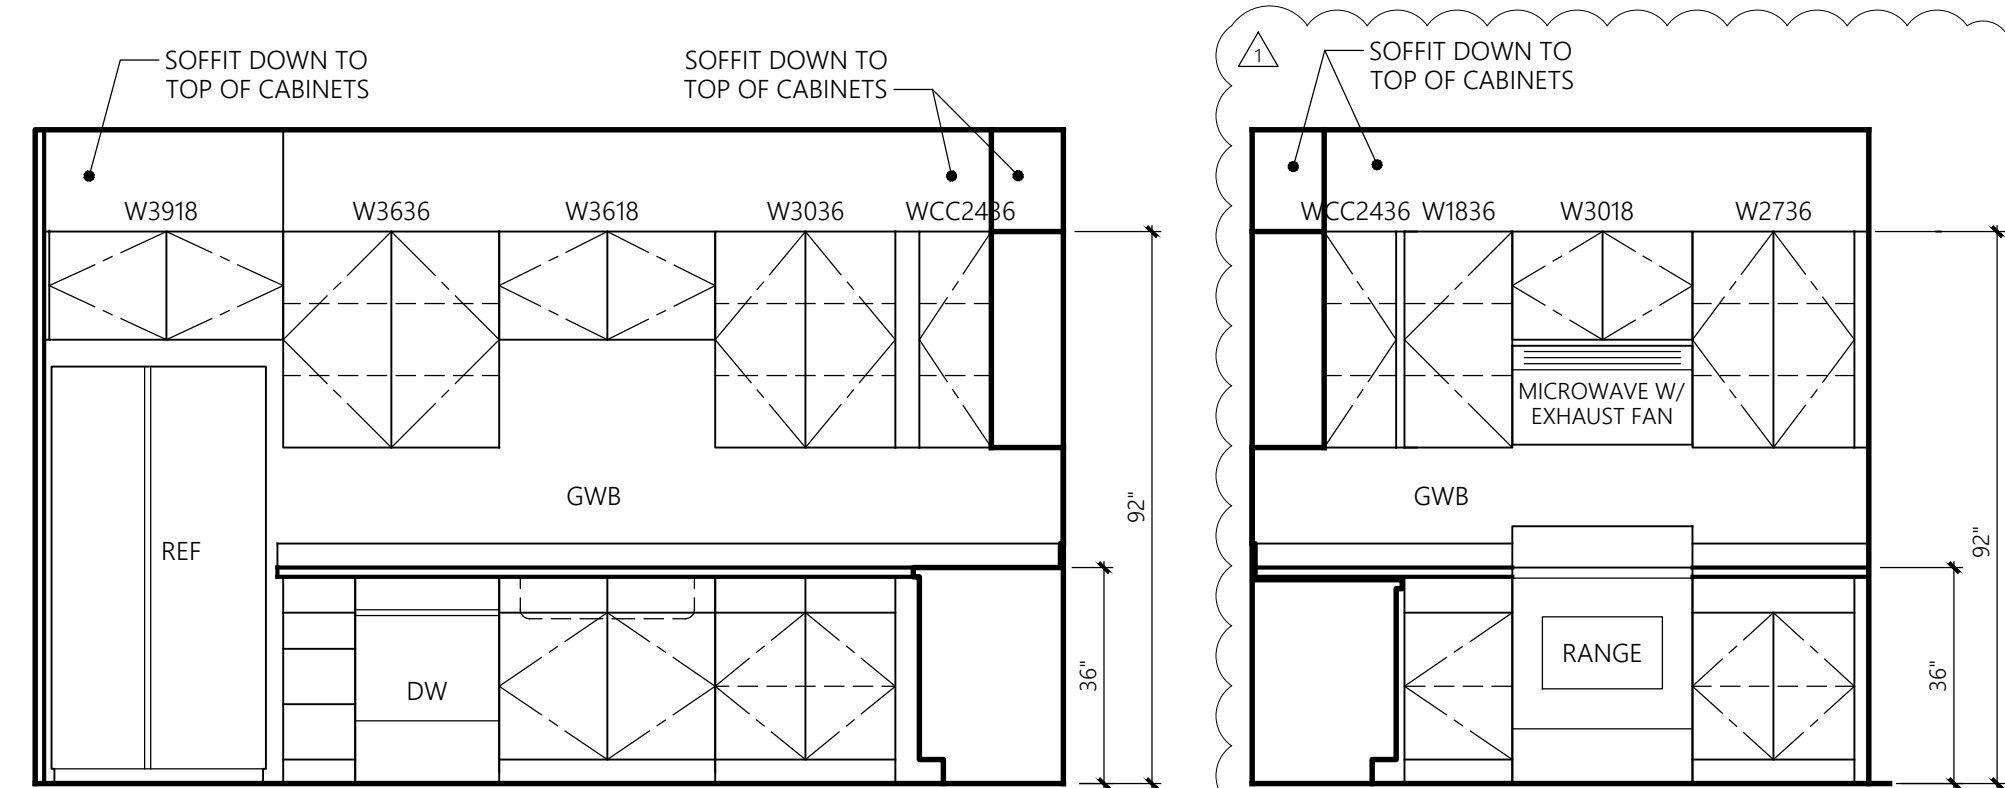


(2) KITCHEN

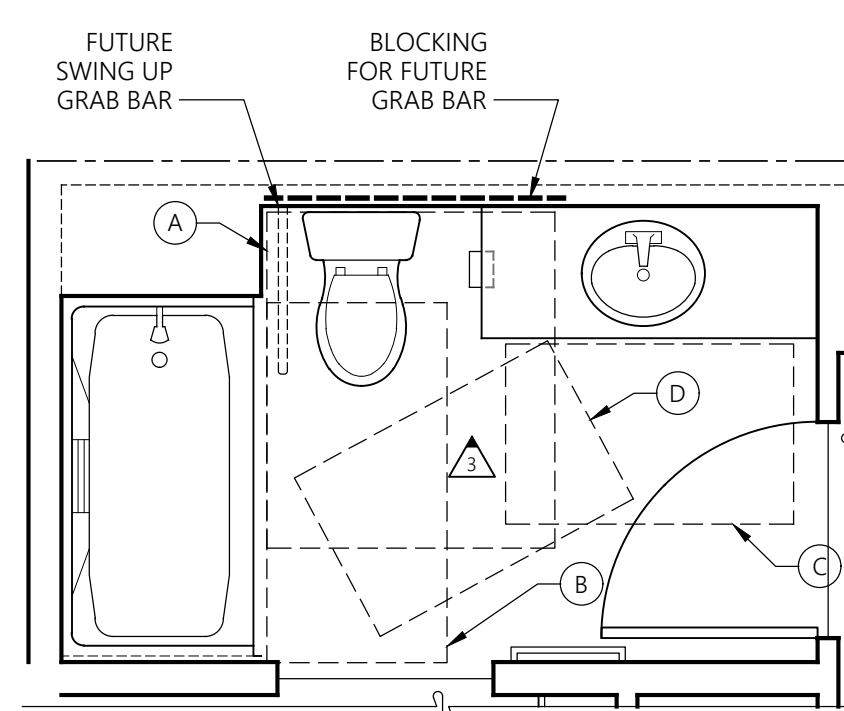


**1-BED-INT-1 & 1-BED-INT-2** TYPE 'B' BATHROOM PLAN (3) BATH

3/8" = 1'-0"

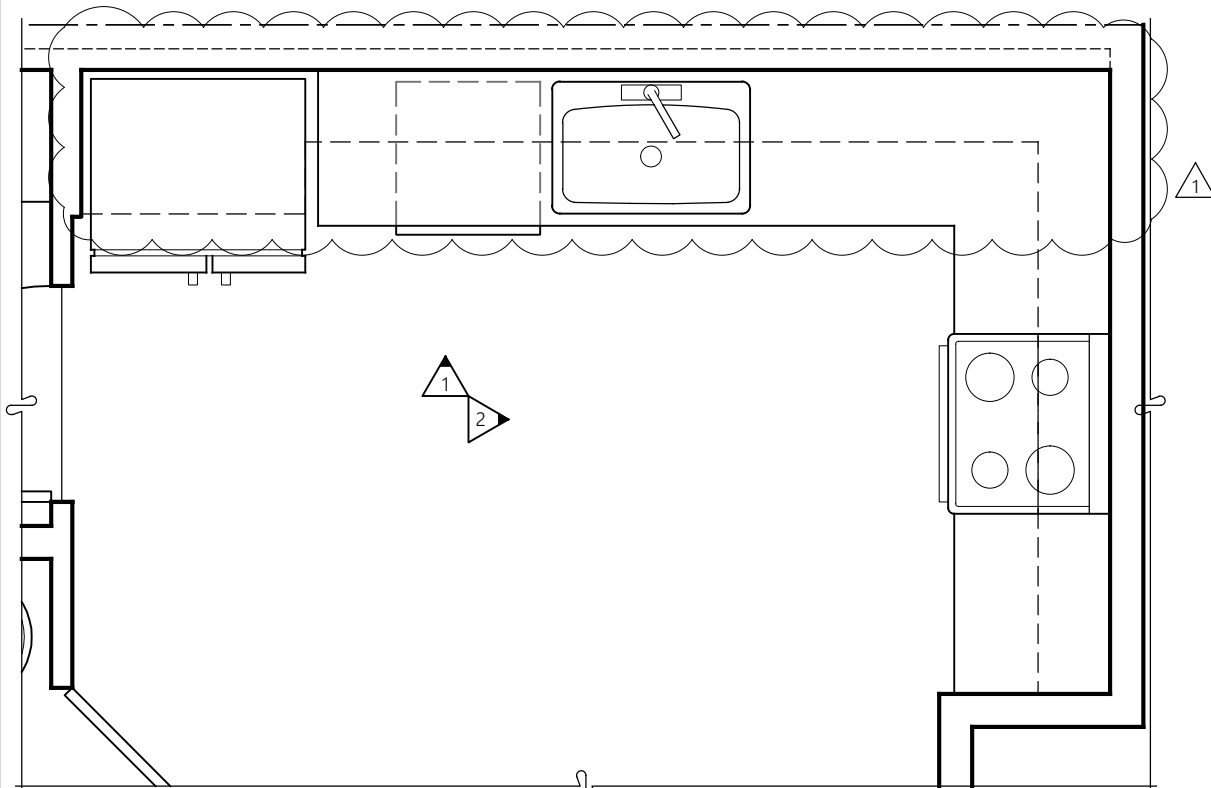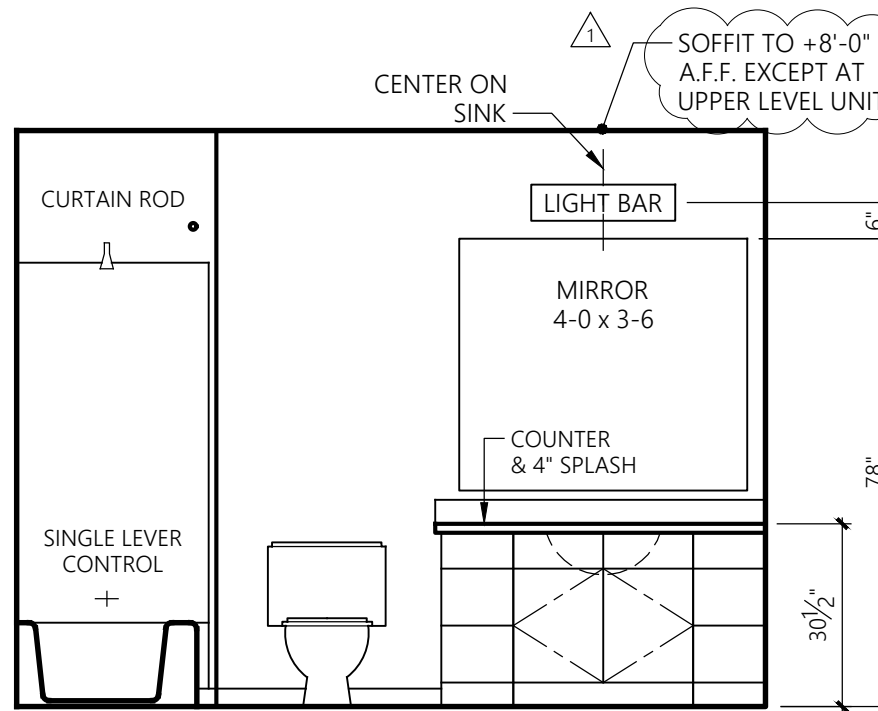


**1-BED-INT-1, 2, ALT-1 & ALT-2** NON-ACCESSIBLE KITCHEN PLAN (1) KITCHEN

3/8" = 1'-0"


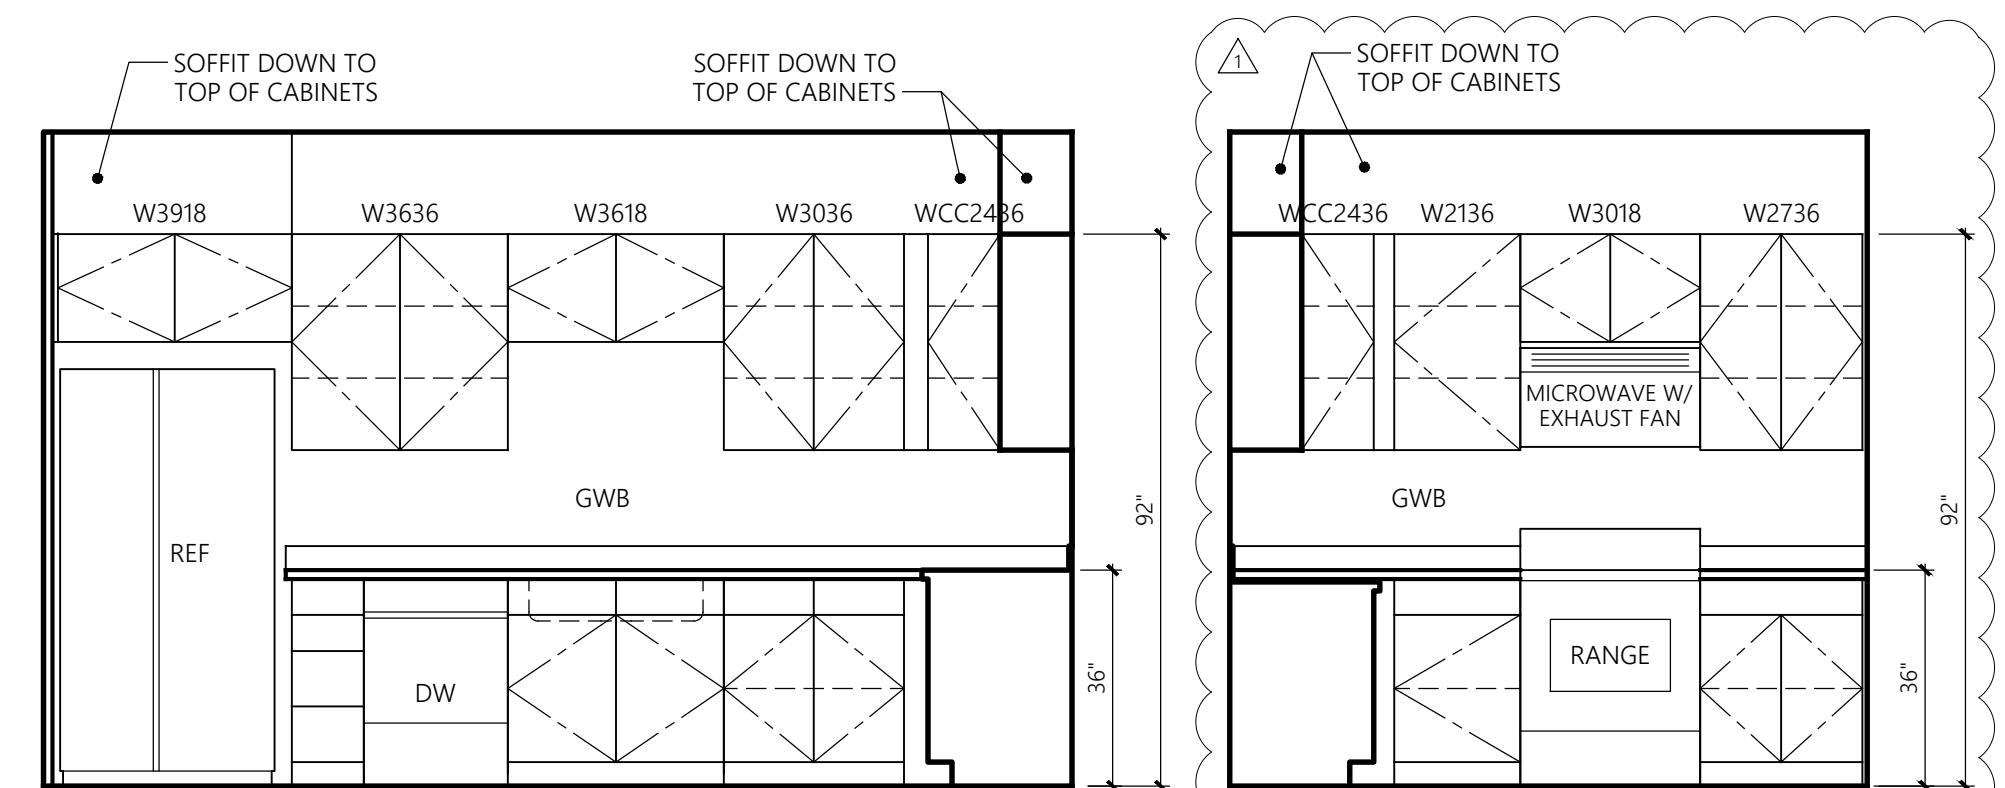


(2) KITCHEN

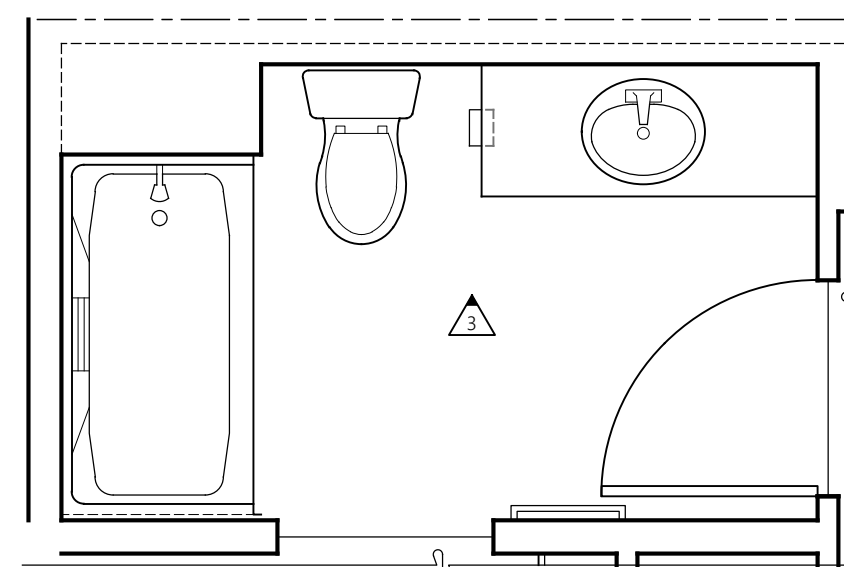

**1-BED-INT-1, 2, ALT-1, & ALT-2** NON-ACC. BATH PLAN (3) BATH

3/8" = 1'-0"

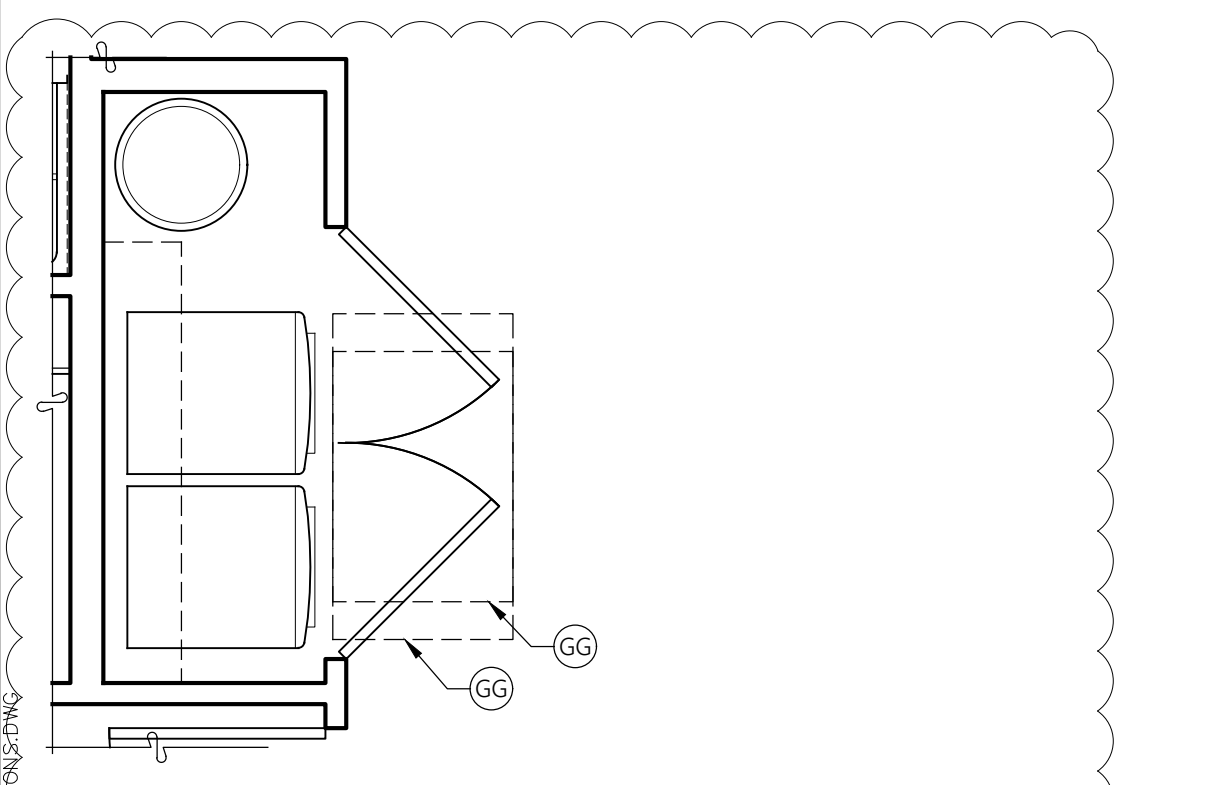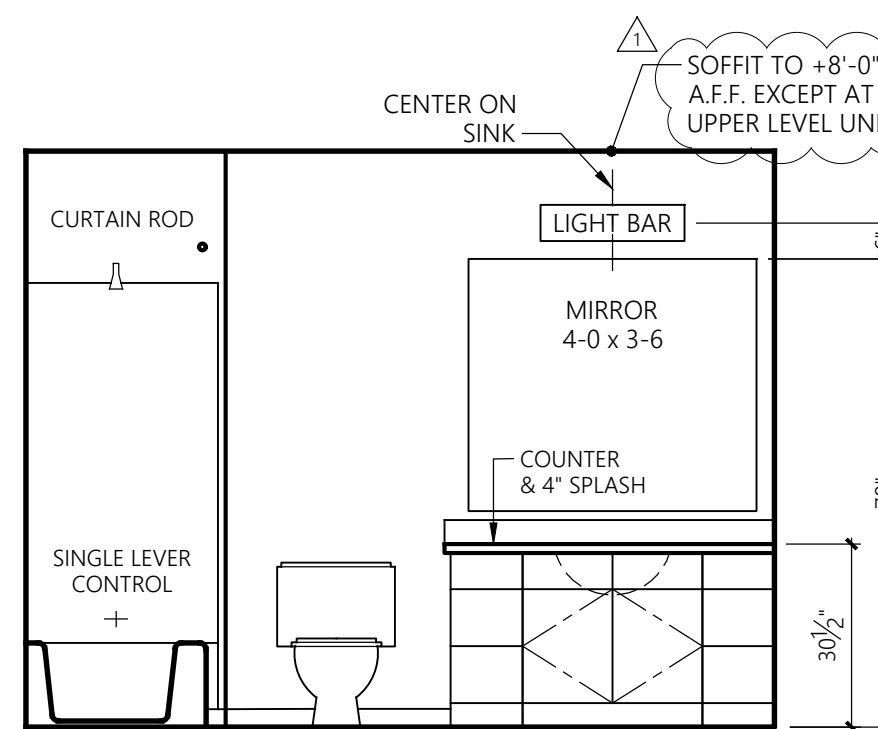

**1-BED-INT-1 & 1-BED-INT-2** TYPE 'A' LAUNDRY PLAN

3/8" = 1'-0"

\*SEE SHEET U11 FOR ACCESSIBILITY STANDARDS

**CLEAR FLOOR SPACE LEGEND**  
TYPE A UNIT


- (A) 60x66 CLEAR FLOOR SPACE AT TOILET.
- (B) 30x60 CLEAR FLOOR SPACE AT TUB.
- (C) 30"x48" CLEAR FLOOR SPACE CENTERED ON SINK
- (D) 60" DIAMETER TURNING CIRCLE OR T-SHAPE TURNING SPACE
- (AA) 30x48 CLEAR FLOOR SPACE AT STOVE.
- (BB) 30x48 CLEAR FLOOR SPACE AT OVEN.
- (CC) 30x48 CLEAR FLOOR SPACE AT SINK.
- (DD) 30x48 CLEAR FLOOR SPACE AT DISHWASHER.
- (EE) 30x48 CLEAR FLOOR SPACE AT REFRIGERATOR.
- (FF) 30x48 CLEAR FLOOR SPACE AT WORK SURFACE.
- (GG) 30x48 CLEAR FLOOR SPACE AT WASHER/DRYER

**CLEAR FLOOR SPACE LEGEND**  
TYPE B UNIT

- (A) 48x56 CLEAR FLOOR SPACE AT TOILET.
- (B) 30x48 CLEAR FLOOR SPACE AT TUB.
- (C) 30"x48" CLEAR FLOOR SPACE CENTERED ON SINK
- (D) 30"x48" CLEAR FLOOR SPACE BEYOND ARC OF DOOR.
- (AA) 30x48 CLEAR FLOOR SPACE AT STOVE.
- (BB) 30x48 CLEAR FLOOR SPACE AT OVEN.
- (CC) 30x48 CLEAR FLOOR SPACE AT SINK.
- (DD) 30x48 CLEAR FLOOR SPACE AT DISHWASHER.
- (EE) 30x48 CLEAR FLOOR SPACE AT REFRIGERATOR.
- (GG) 30x48 CLEAR FLOOR SPACE AT WASHER/DRYER

**Revisions**


No.	Date	Description
1	8-30-24	Owner Changes/ Permit Corrections

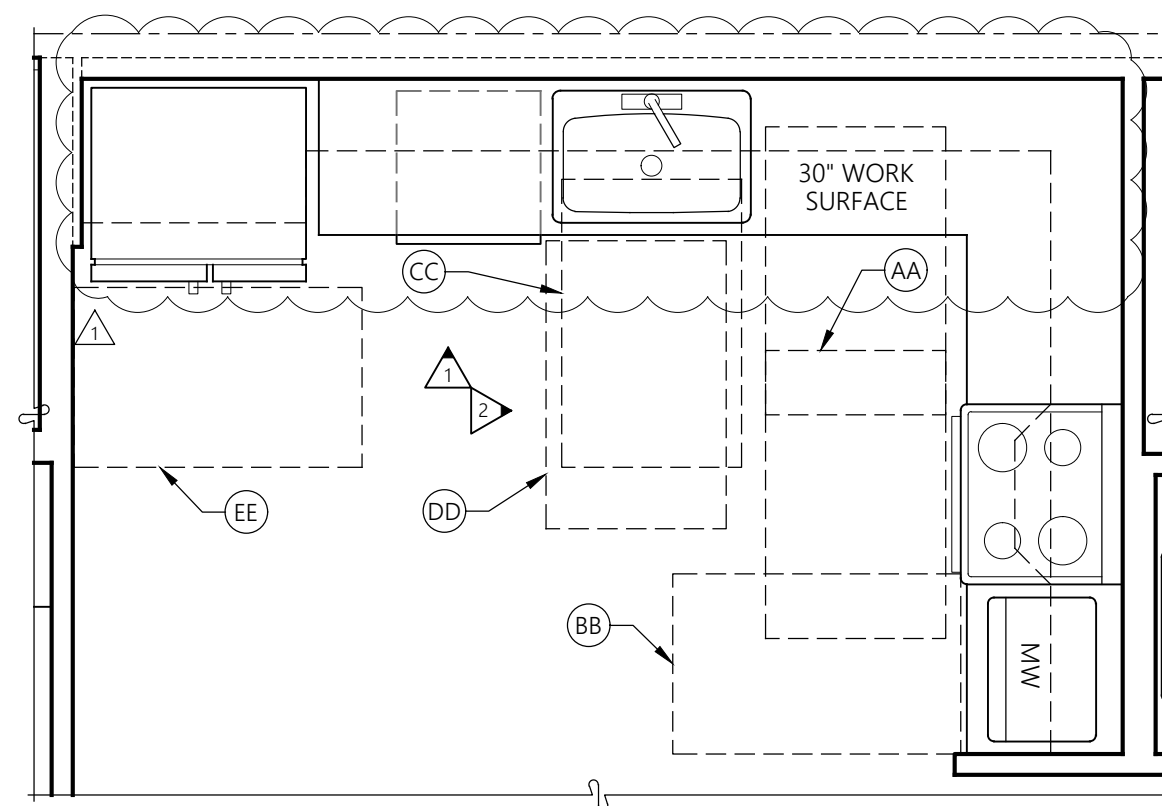


**2-BED & 2-BED-ALT**

3/8" = 1'-0"

TYPE 'A' KITCHEN PLAN (1) KITCHEN

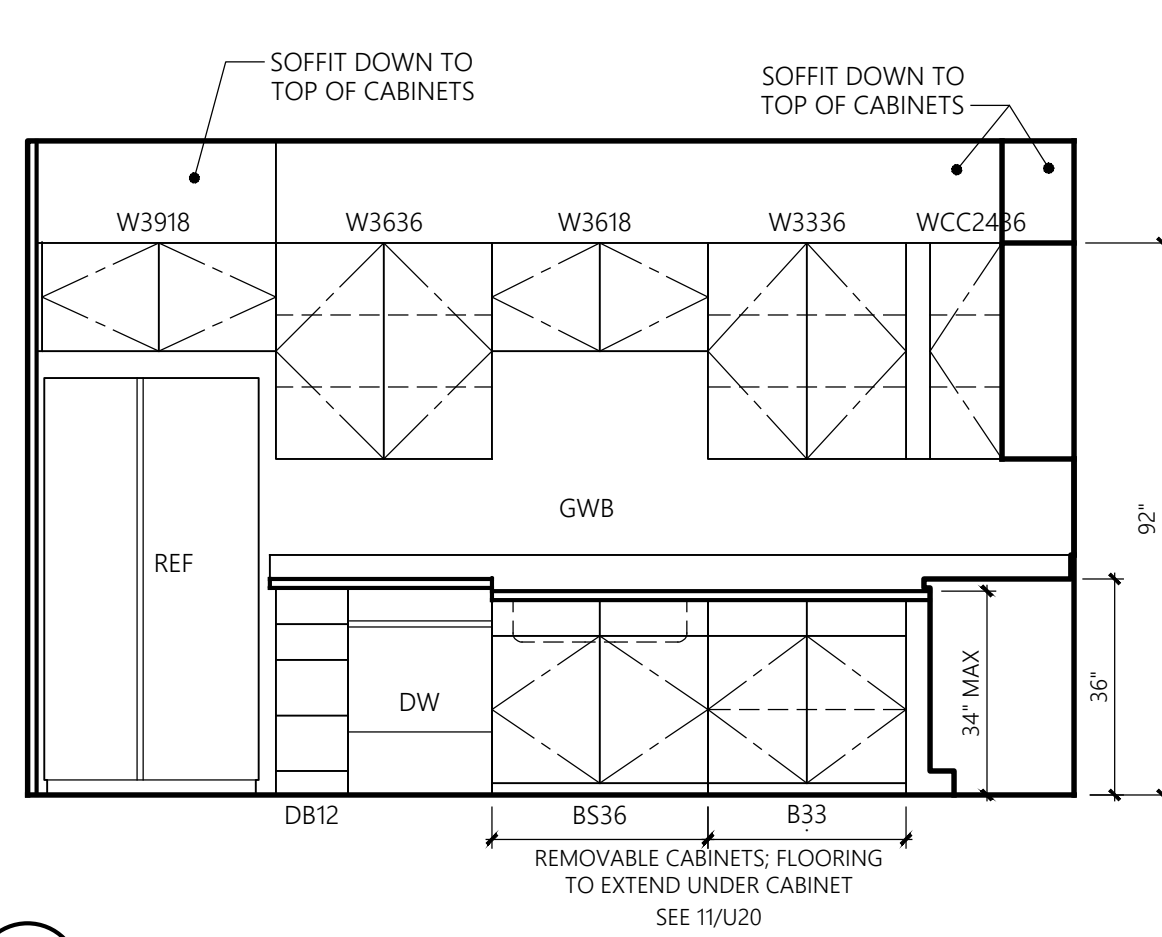




(2) KITCHEN

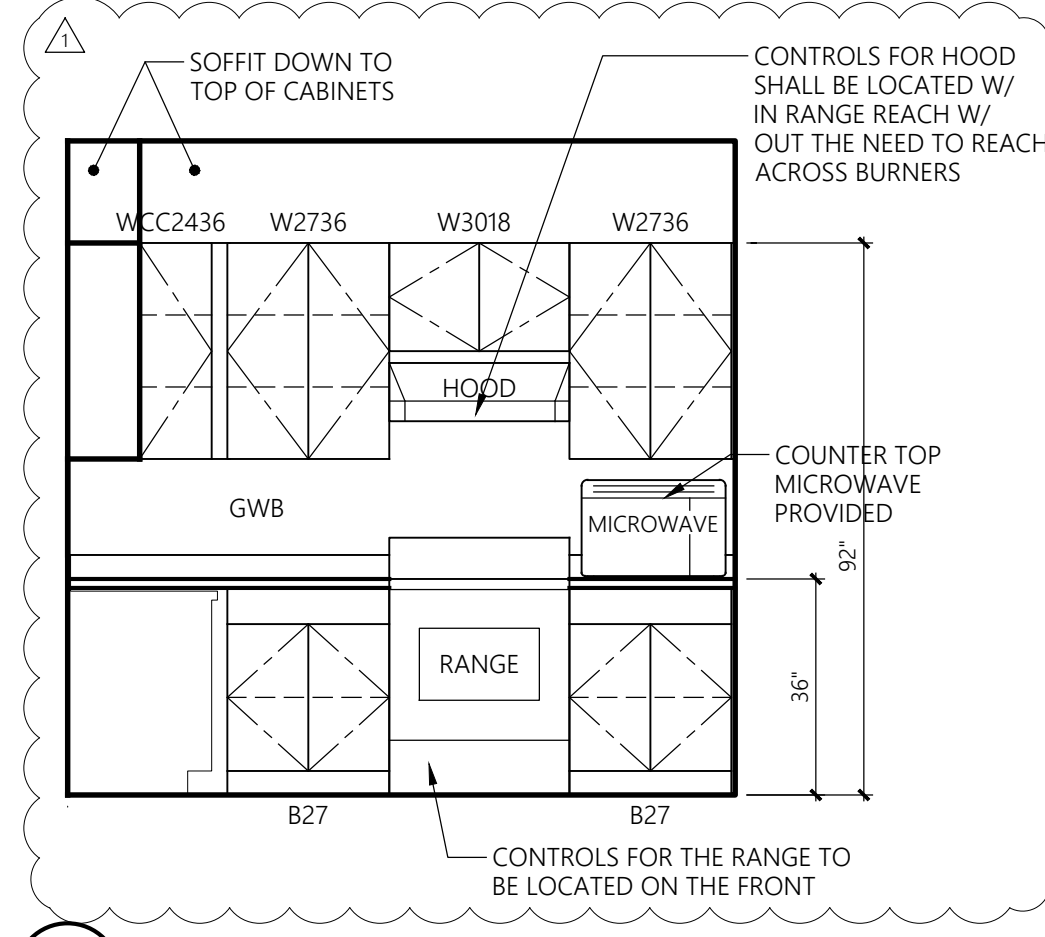

**2-BED & 2-BED-ALT**

3/8" = 1'-0"


TYPE 'A' M. BATH PLAN (3) MAIN BATH

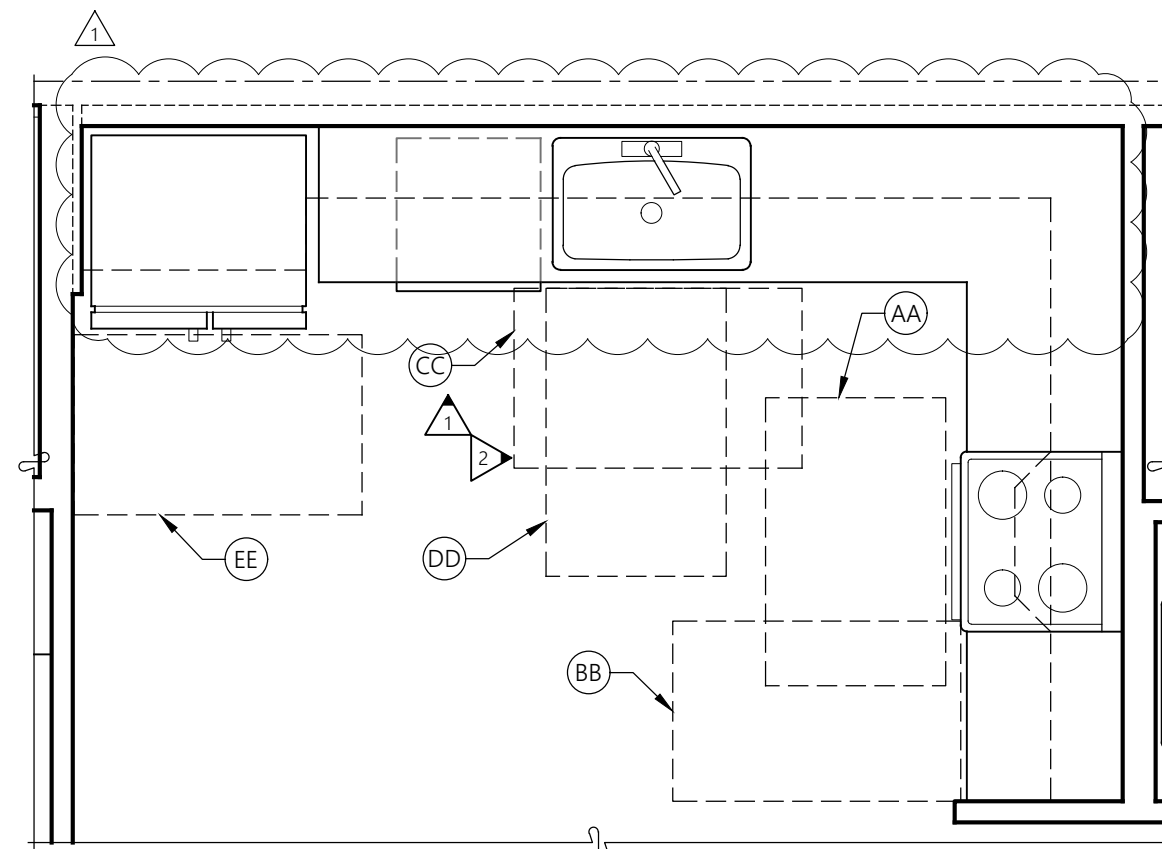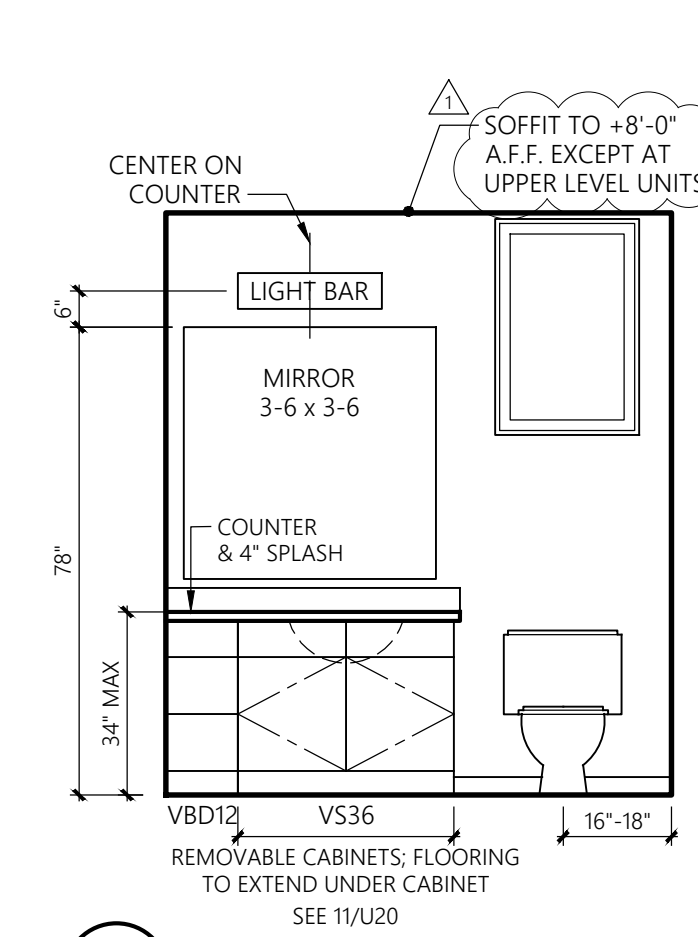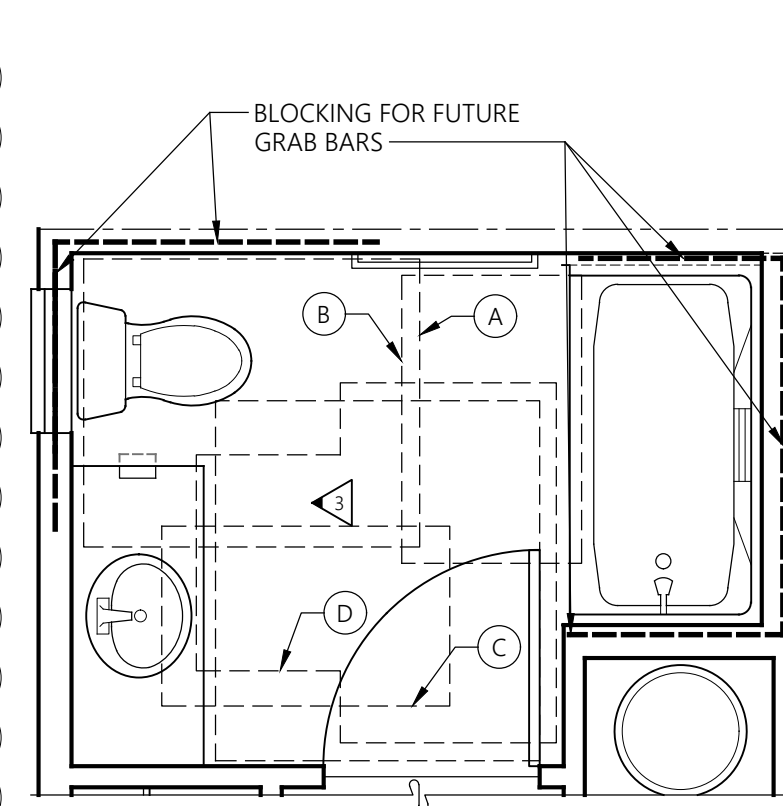


**2-BED & 2-BED-ALT**

3/8" = 1'-0"

TYPE 'B' KITCHEN PLAN (1) KITCHEN

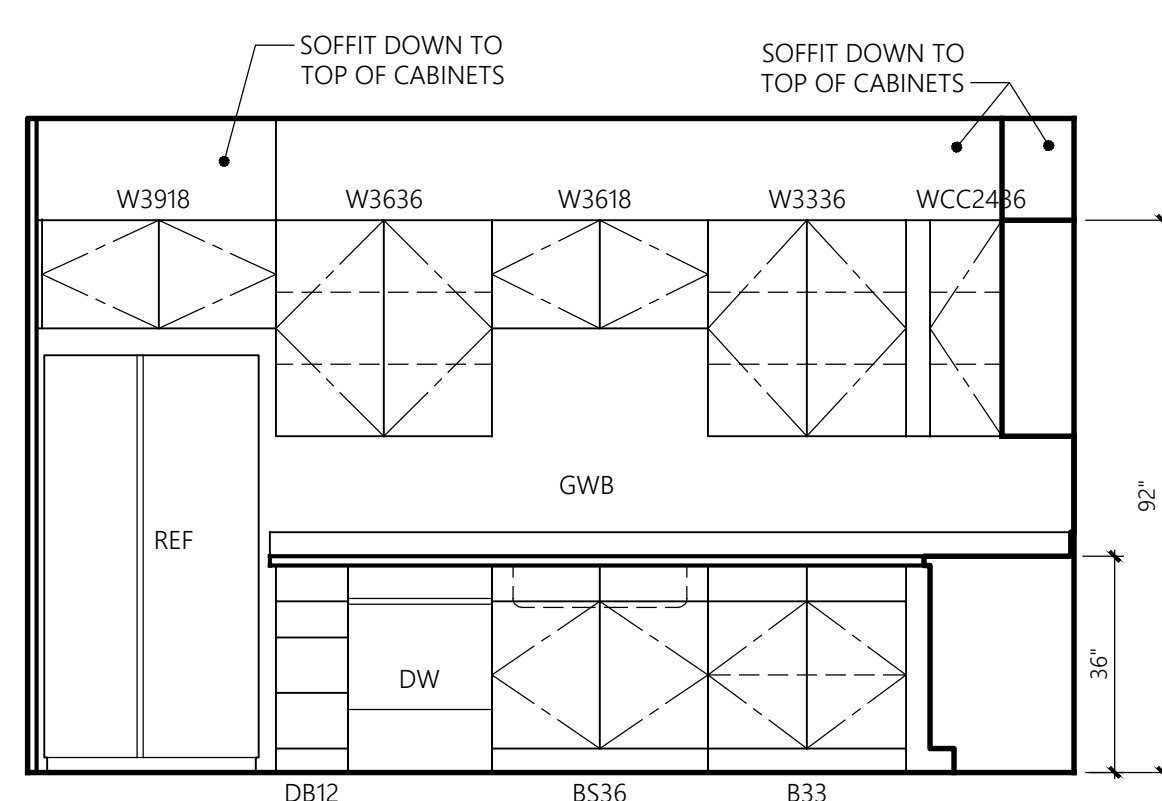




(2) KITCHEN

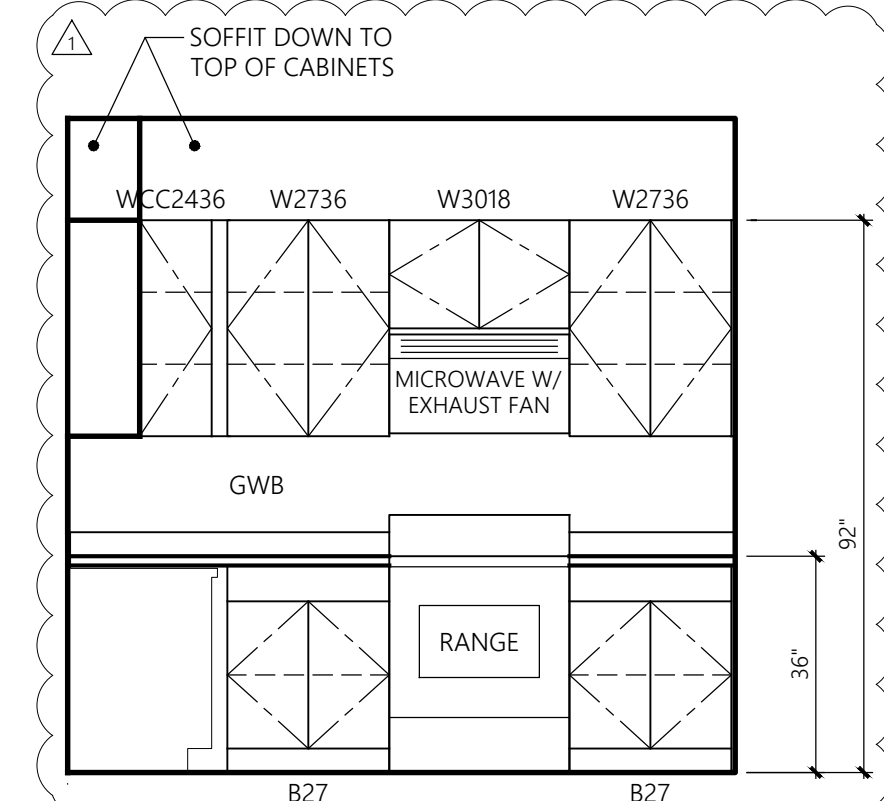

**2-BED & 2-BED-ALT**

3/8" = 1'-0"


TYPE 'B' M. BATH PLAN (3) MAIN BATH

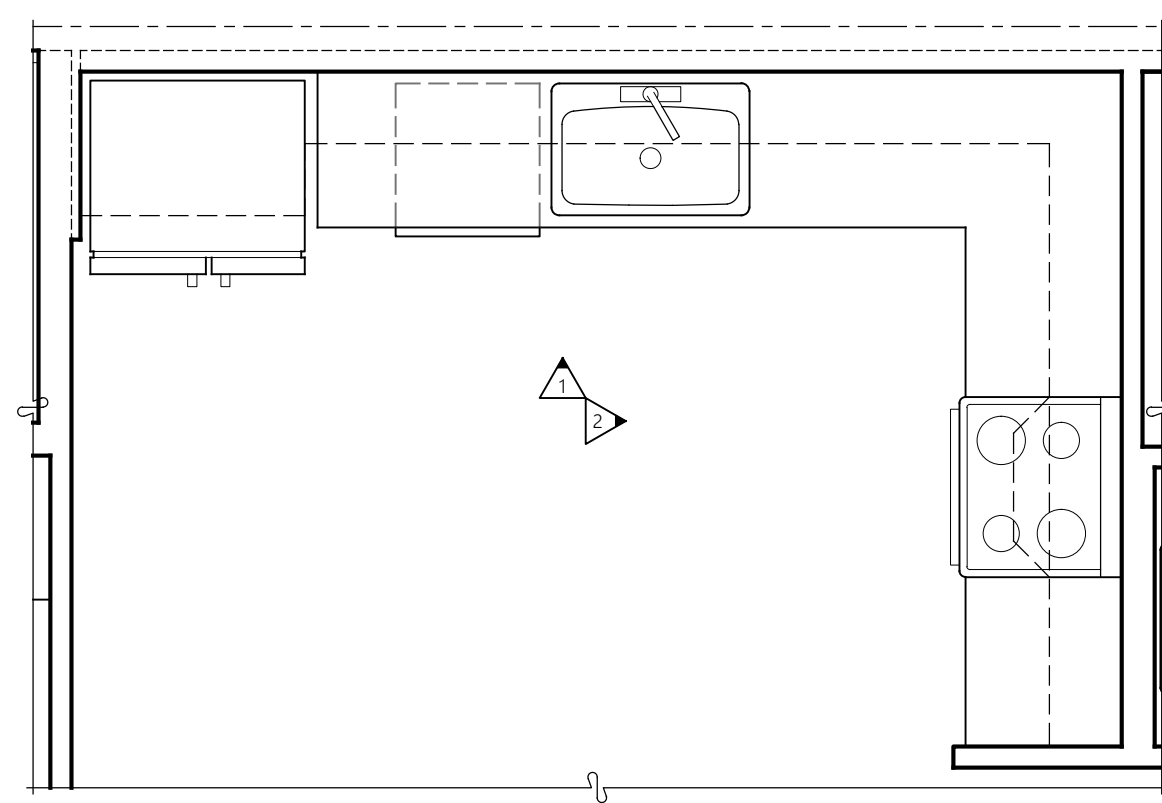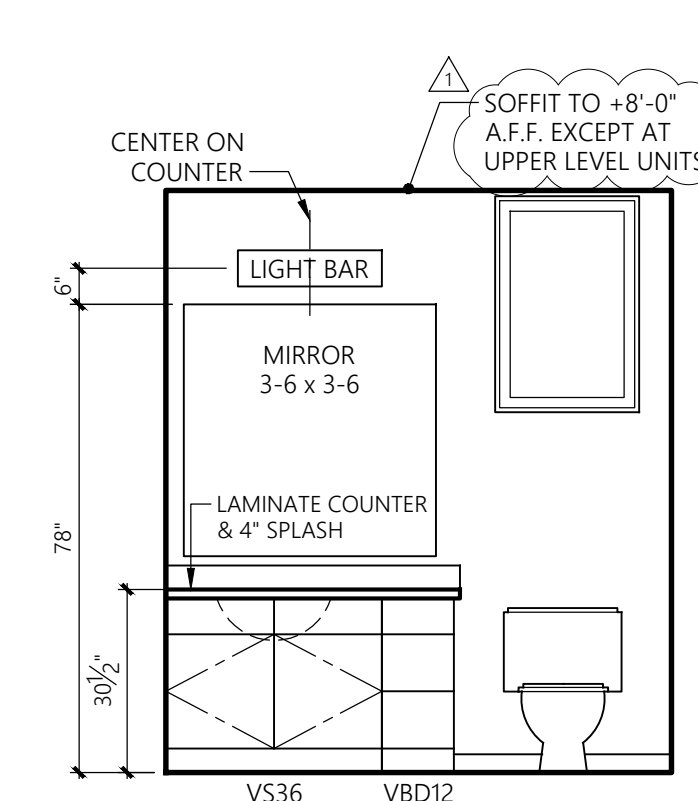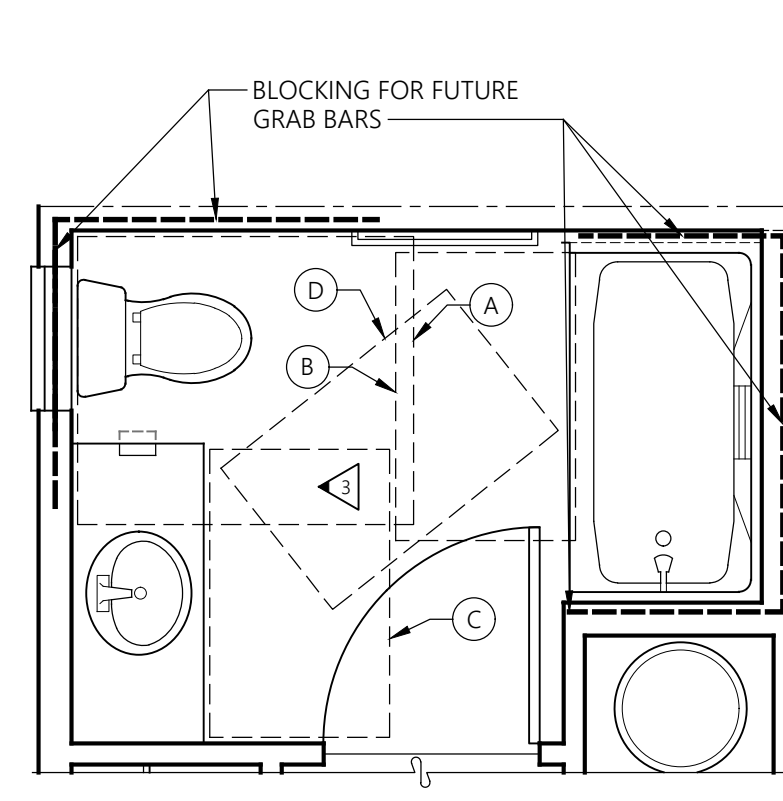


**2-BED & 2-BED-ALT**

3/8" = 1'-0"

NON-ACCESSIBLE KITCHEN PLAN (1) KITCHEN

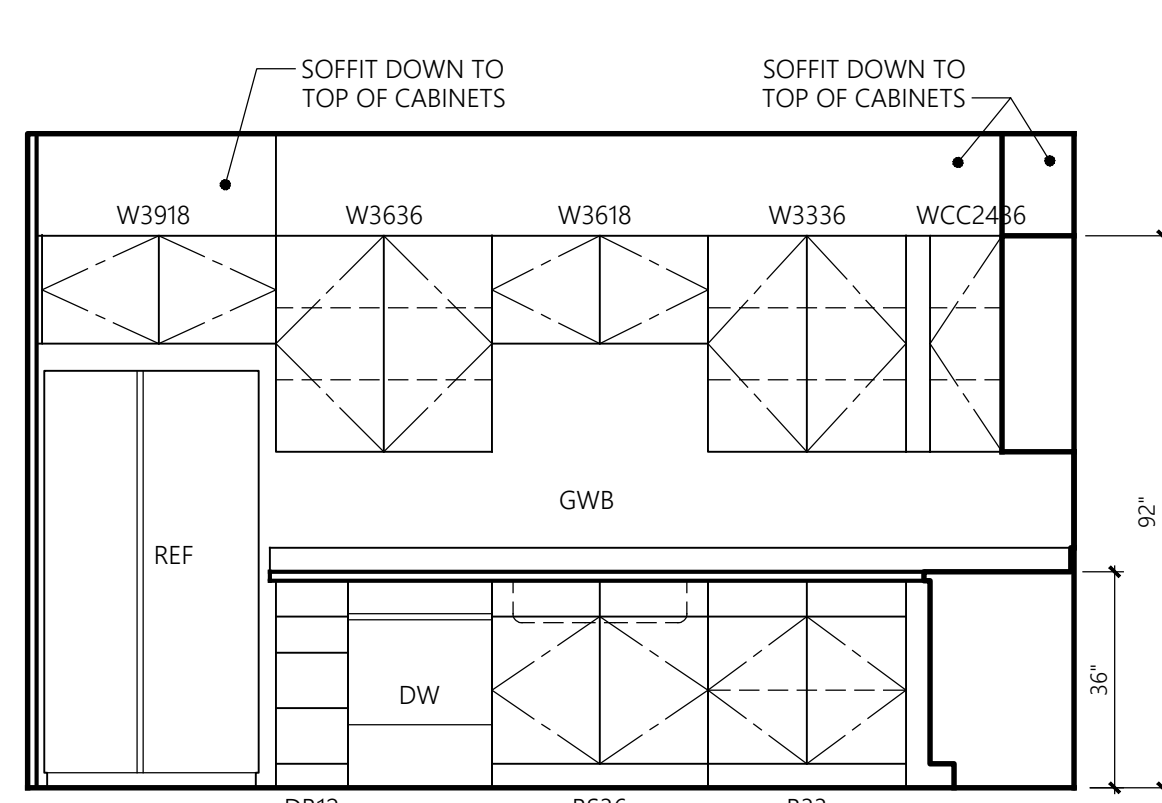




(2) KITCHEN

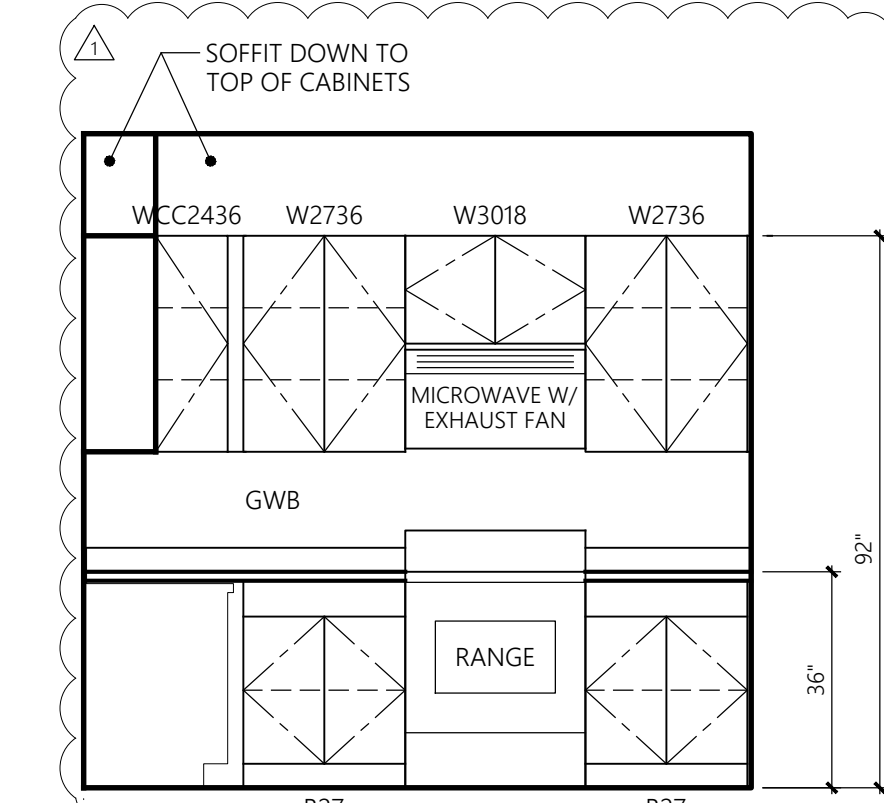

**2-BED & 2-BED-ALT**

3/8" = 1'-0"


NON-ACCESSIBLE M. BATH PLAN (3) MAIN BATH

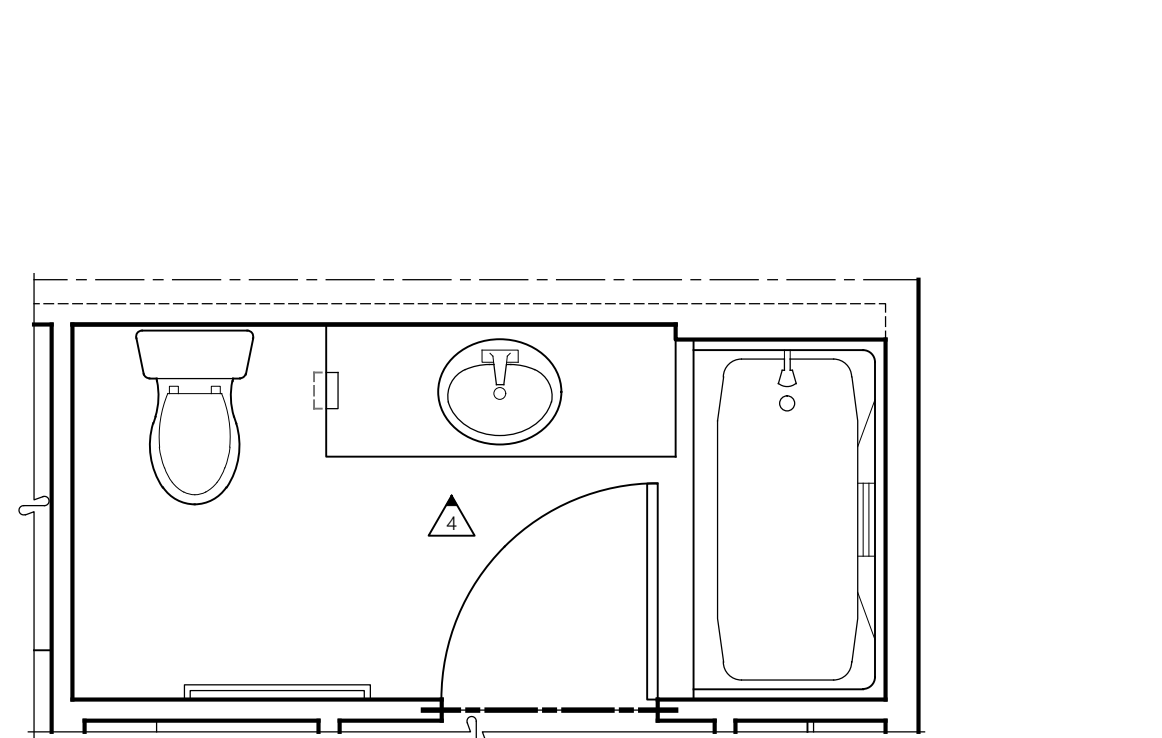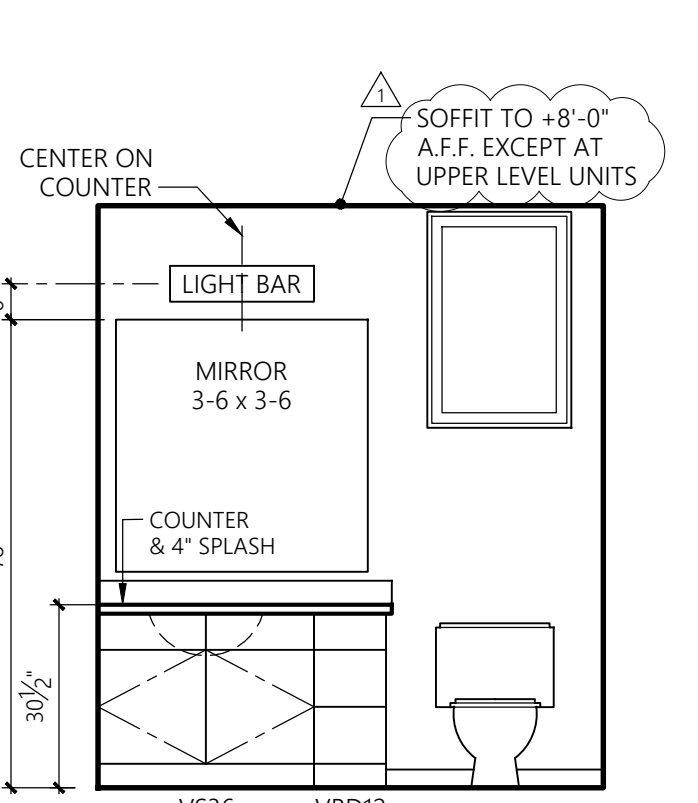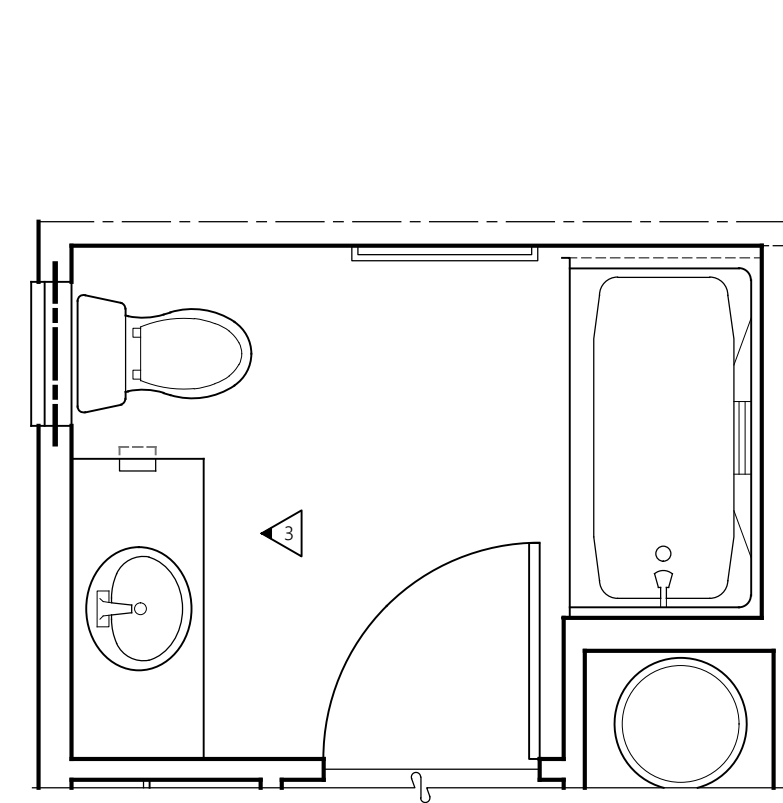

**2-BED & 2-BED-ALT**

3/8" = 1'-0"

TYPE 'A' & 'B' & NON-ACCESSIBLE SECONDARY BATHROOM PLAN (4) SECONDARY

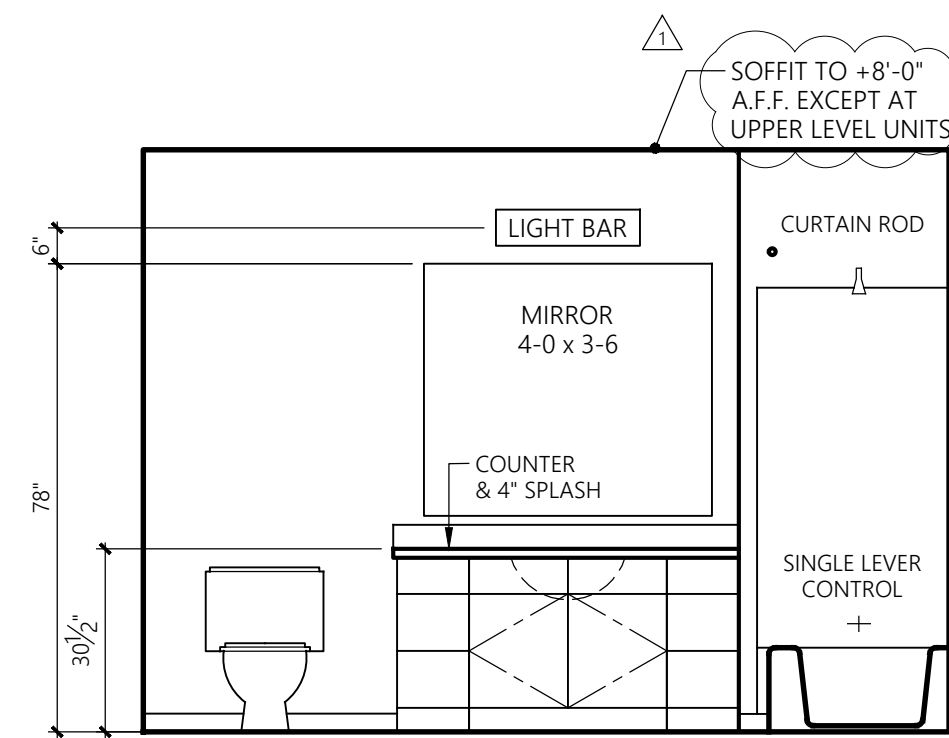

\*SEE SHEET U11 FOR ACCESSIBILITY STANDARDS

**CLEAR FLOOR SPACE LEGEND**  
TYPE A UNIT

- (A) 60x66 CLEAR FLOOR SPACE AT TOILET.
- (B) 30x60 CLEAR FLOOR SPACE AT TUB.
- (C) 30"x48" CLEAR FLOOR SPACE CENTERED ON SINK
- (D) 60" DIAMETER TURNING CIRCLE OR T-SHAPE TURNING SPACE
- (AA) 30x48 CLEAR FLOOR SPACE AT STOVE.
- (BB) 30x48 CLEAR FLOOR SPACE AT OVEN.
- (CC) 30x48 CLEAR FLOOR SPACE AT SINK.
- (DD) 30x48 CLEAR FLOOR SPACE AT DISHWASHER.
- (EE) 30x48 CLEAR FLOOR SPACE AT REFRIGERATOR.
- (FF) 30x48 CLEAR FLOOR SPACE AT WORK SURFACE.
- (GG) 30x48 CLEAR FLOOR SPACE AT WASHER/DRYER

**CLEAR FLOOR SPACE LEGEND**  
TYPE B UNIT

- (A) 48x56 CLEAR FLOOR SPACE AT TOILET.
- (B) 30x48 CLEAR FLOOR SPACE AT TUB.
- (C) 30"x48" CLEAR FLOOR SPACE CENTERED ON SINK
- (D) 30"x48" CLEAR FLOOR SPACE BEYOND ARC OF DOOR.
- (AA) 30x48 CLEAR FLOOR SPACE AT STOVE.
- (BB) 30x48 CLEAR FLOOR SPACE AT OVEN.
- (CC) 30x48 CLEAR FLOOR SPACE AT SINK.
- (DD) 30x48 CLEAR FLOOR SPACE AT DISHWASHER.
- (EE) 30x48 CLEAR FLOOR SPACE AT REFRIGERATOR.
- (GG) 30x48 CLEAR FLOOR SPACE AT WASHER/DRYER

**Revisions**

No.	Date	Description
1	8-30-24	Owner Changes/ Permit Corrections

### NUMBER OF TYPE A UNITS

IN GROUP R-2 OCCUPANCIES CONTAINING MORE THAN 10 DWELLING UNITS OR SLEEPING UNITS AT LEAST 5% BUT NOT LESS THAN ONE OF THE UNITS SHALL BE A TYPE A UNIT. ALL UNITS ON THE SITE SHALL BE CONSIDERED TO DETERMINE THE TOTAL NUMBER OF UNITS AND THE REQUIRED NUMBER OF TYPE A UNITS. EXISTING STRUCTURES ON A SITE SHALL NOT CONTRIBUTE TO THE TOTAL NUMBER OF UNITS ON A SITE. TYPE A UNITS SHALL BE DISPERSED AMONG THE VARIOUS CLASSES OF UNITS. THE NUMBER OF TYPE A UNITS IS PERMITTED TO BE REDUCED IN ACCORDANCE WITH CONDITIONS DEFINED IN SECTION 1107.7 OF THE IBC.

### ACCESSIBLE ROUTE

AT LEAST ONE ACCESSIBLE ROUTE SHALL CONNECT ALL SPACES AND ELEMENTS THAT ARE PART OF THE UNIT. ACCESSIBLE ROUTES SHALL CONCLUDE WITH OR BE LOCATED IN THE SAME AREA AS THE GENERAL CIRCULATION PATH. (See detail 5 ACC sheets)

### TURNING SPACE & CLEAR FLOOR SPACE

ALL ROOMS SERVED BY AN ACCESSIBLE ROUTE SHALL PROVIDE A TURNING SPACE EXCEPT FOR BATHROOMS THAT ARE NOT REQUIRED TO MEET ACCESSIBILITY STANDARDS, OR CLOSETS OR PANTRIES THAT ARE 48" MAX IN DEPTH. (See detail 1 ACC sheets)

NOTE: BALCONIES AND CORRIDORS ARE NOT ROOMS AND AS SUCH DO NOT NEED TO HAVE A TURNING SPACE

### DOORS AND DOORWAYS

THE PRIMARY ENTRANCE DOOR AND ALL DOORS INTENDED FOR USER PASSAGE, SHALL COMPLY WITH SECTION 404. (See detail 6 ACC sheets)

BALCONY DOORS: THRESHOLDS AT EXTERIOR SLIDING DOORS SHALL BE PERMITTED TO BE 3/4" MAX. IN HEIGHT PROVIDED THEY ARE BEVELLED WITH A MAX. SLOPE OF 1:2

WHERE EXTERIOR SPACE DIMENSIONS OF BALCONIES ARE LESS THAN THE REQUIRED MANEUVERING CLEARANCE, DOOR MANEUVERING CLEARANCES ARE NOT REQUIRED ON THE EXTERIOR SIDE OF THE DOOR.

BATHROOM DOORS: BATHROOMS NOT REQUIRED TO BE ACCESSIBLE ONLY NEED TO PROVIDE DOOR MANEUVERING CLEARANCE ON THE OUTSIDE OF THE DOOR.

BATHROOM DOORS MAY SWING INTO THE BATHROOM AND INTO THE REQUIRED CLEAR FLOOR SPACE AT ANY FIXTURE WHEN A CLEAR FLOOR SPACE OF AT LEAST 30"x48" IS PROVIDED WITHIN THE ROOM BEYOND THE ARC OF THE DOOR SWING.

### OPERABLE PARTS


LIGHTING CONTROLS, ELECTRICAL PANELBOARDS, ELECTRICAL SWITCHES & RECEPTACLE OUTLETS, ENVIRONMENTAL CONTROLS, APPLIANCE CONTROLS, OPERATING HARDWARE FOR OPERABLE WINDOWS, PLUMBING FIXTURES CONTROLS, AND USER CONTROLS FOR SECURITY OR INTERCOM SYSTEMS SHALL COMPLY WITH SECTION 309. (See detail 4 ACC sheets)

1. Receptacle outlets serving a dedicated use.
2. Where two or more receptacle outlets are provided in a kitchen above a counter top that is unintercepted by a sink or appliance, one receptacle outlet shall not be required to comply with Section 309.
3. Floor receptacle outlets.
4. HVAC diffusers.
5. Controls mounted on ceiling fans.
6. Where redundant controls other than light switches are provided for a single element, one control shall not be required to be accessible.
7. Reset buttons & shut-offs serving appliances, piping & plumbing fixtures.
8. Electrical panelboards shall not be required to comply with Section 309.4.


### WINDOWS

ONLY WINDOWS REQUIRED TO BE OPERABLE FOR NATURAL VENTILATION OR TO PROVIDE AN EMERGENCY ESCAPE AND RESCUE OPENING NEED TO HAVE OPERABLE PARTS COMPLYING WITH SECTION 309. (See detail 4 ACC sheets)


## 23 GENERAL TYPE A UNIT NOTES

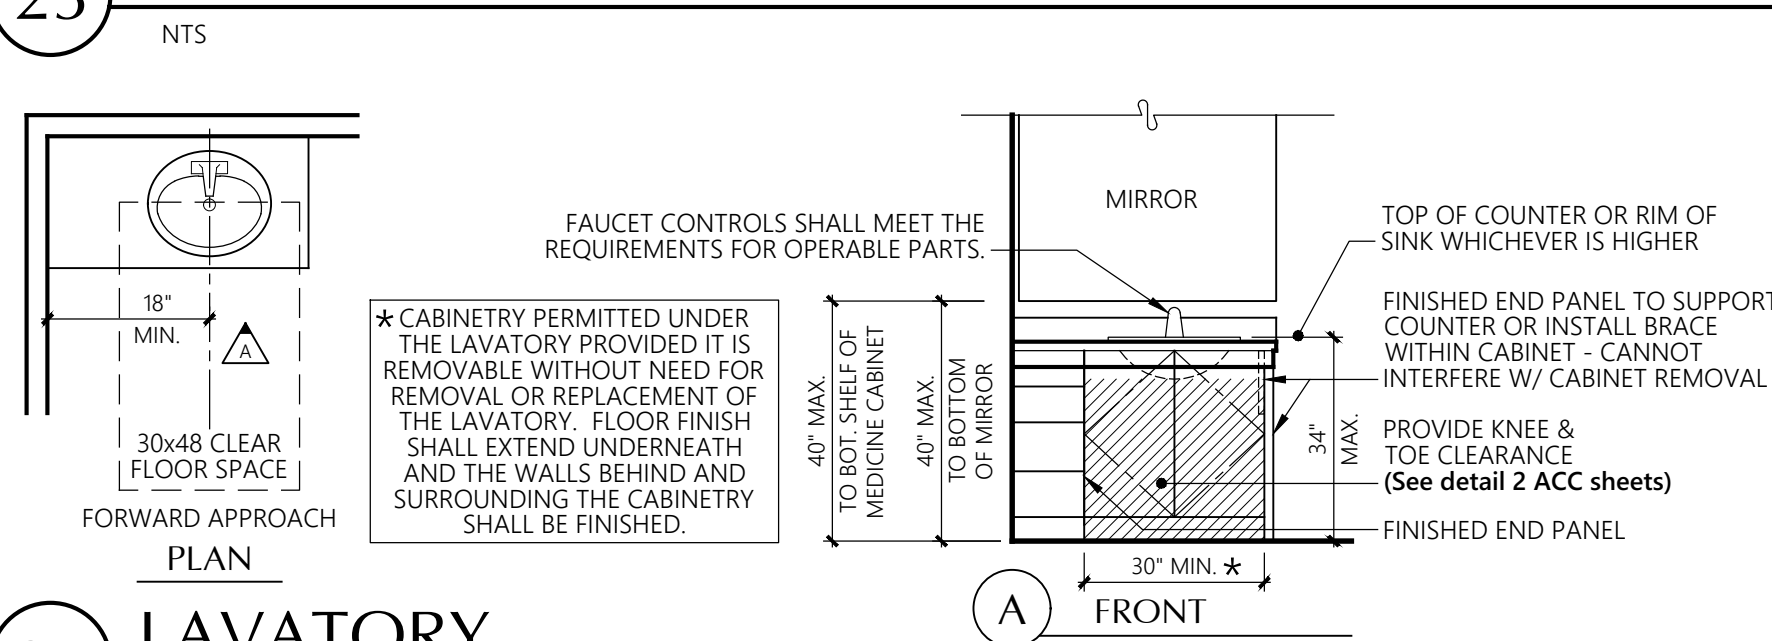

## 24 LAVATORY

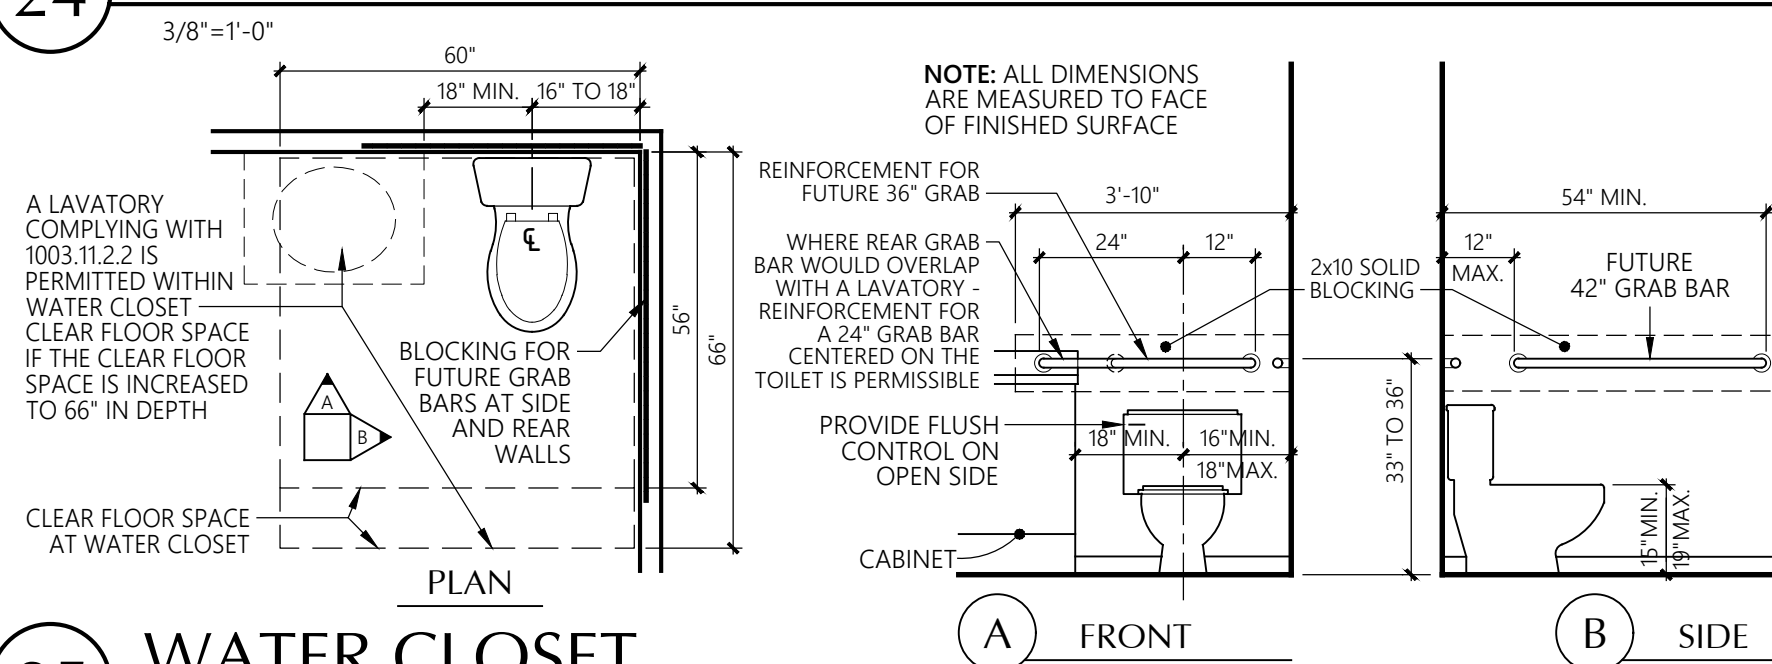

## 25 WATER CLOSET

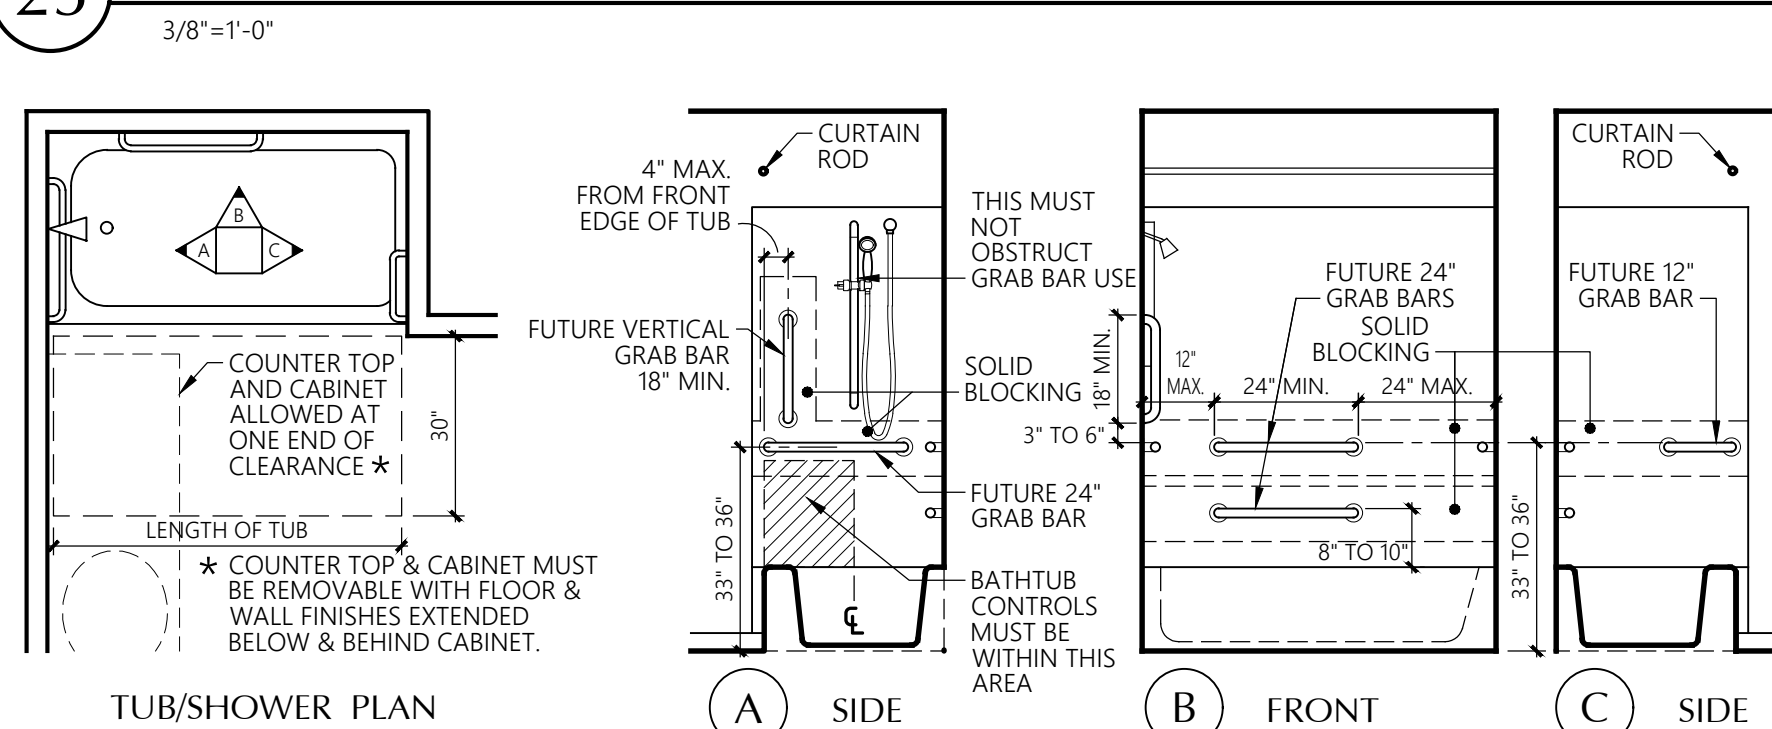

## 26 BATHTUB & TUB / SHOWER COMBO



### LAUNDRY EQUIPMENT

WASHING MACHINES AND CLOTHES DRYERS SHALL COMPLY WITH SECTION 611.

### TOILET AND BATHING FACILITIES

AT LEAST ONE TOILET AND BATHING FACILITY SHALL CONTAIN ONE LAVATORY, ONE WATER CLOSET AND EITHER A BATHTUB OR SHOWER WITHIN THE UNIT THAT MEETS THE REQUIREMENTS DETAILED FOR TYPE A FIXTURES (See details 23 thru 28 ACC sheets). THE ACCESSIBLE TOILET AND BATHING FIXTURES SHALL BE IN A SINGLE TOILET/BATHING AREA SUCH THAT TRAVEL BETWEEN FIXTURES DOES NOT REQUIRE TRAVEL THROUGH OTHER PARTS OF THE UNIT.

ALL TOILET & BATHING FACILITIES WITHIN A TYPE A UNIT SHALL PROVIDE REINFORCEMENT FOR THE FUTURE INSTALLATION OF GRAB BARS AT WATER CLOSETS, BATHTUBS AND SHOWER SEATS. REINFORCEMENT IS NOT REQUIRED IN ANY OTHER PURPOSES ONLY A LAVATORY AND A WATER CLOSET, PROVIDED THE ROOM DOES NOT CONTAIN THE ONLY LAVATORY OR WATER CLOSET ON THE ACCESSIBLE LEVEL OF THE DWELLING UNIT.

### ALARMS

ACCESSIBLE AUDIBLE AND VISIBLE ALARMS AND NOTIFICATION APPLIANCES SHALL BE INSTALLED IN ACCORDANCE WITH NFPA 72 LISTED IN SECTION 105.2.2. BE POWERED BY A COMMERCIAL LIGHT AND POWER SOURCE, BE PERMANENTLY CONNECTED TO THE WIRING OF THE PREMISES ELECTRIC SYSTEM, AND BE PERMANENTLY INSTALLED.

### VISIBLE NOTIFICATION APPLIANCES

IN GROUP R-2 OCCUPANCIES REQUIRED TO HAVE A FIRE ALARM SYSTEM, EACH STORY THAT CONTAINS DWELLING UNITS & SLEEPING UNITS SHALL BE PROVIDED WITH THE CAPABILITY TO SUPPORT VISIBLE ALARM NOTIFICATION APPLIANCES. SUCH CAPABILITY SHALL ACCOMMODATE WIRED OR WIRELESS EQUIPMENT. THE FUTURE CAPABILITY SHALL INCLUDE ONE OF THE FOLLOWING:

1. The interconnection of the building fire alarm system with the unit smoke alarms.
2. Replacement of audible appliances with combination audible/visible appliances.
3. The future extension of the existing wiring from the unit smoke alarm location to required locations for visible appliances.


VISIBLE NOTIFICATION APPLIANCES, WHERE PROVIDED AS PART OF THE UNIT SMOKE DETECTION SYSTEM OR BUILDING FIRE ALARM SYSTEM, SHALL BE ACTIVATED UPON SMOKE DETECTION OR WITH ACTIVATION OF THE BUILDING FIRE ALARM. THE SAME VISIBLE NOTIFICATION APPLIANCE CAN BE USED FOR BOTH SMOKE DETECTION AND FIRE ALARM ACTIVATION, BUT SHALL NOT BE USED FOR ANY OTHER PURPOSES WITHIN THE UNIT.

### UNIT PRIMARY ENTRANCE




THE ACCESSIBLE PRIMARY ENTRANCE SHALL BE ON AN ACCESSIBLE ROUTE FROM PUBLIC AND COMMON AREAS.

COMMUNICATION FEATURES SHALL BE PROVIDED AT THE UNIT PRIMARY ENTRANCE. A HARD-WIRED ELECTRIC DOORBELL SHALL BE PROVIDED. A BUTTON OR SWITCH SHALL BE PROVIDED ON THE PUBLIC SIDE OF THE UNIT PRIMARY ENTRANCE. WHERE A SYSTEM PERMITTING VOICE COMMUNICATION BETWEEN A VISITOR AND THE OCCUPANT OF THE UNIT IS PROVIDED AT A LOCATION OTHER THAN THE UNIT ENTRY DOOR, THE SYSTEM SHALL INCLUDE THE CAPABILITY OF SUPPORTING VOICE AND TTY COMMUNICATION WITHIN THE UNIT INTERFERENCE.



A MEANS FOR VISUALLY IDENTIFYING A VISITOR WITHOUT OPENING THE UNIT ENTRY DOOR SHALL BE PROVIDED. PEEPHOLES, WHERE USED SHALL PROVIDE A MINIMUM 180-DEGREE RANGE OF VIEW. PEEPHOLES SHALL BE PLACED AT A STANDARD HEIGHT FOR BOTH STANDING PERSONS AND WHEELCHAIR USERS. (See detail 32 ACC sheets)

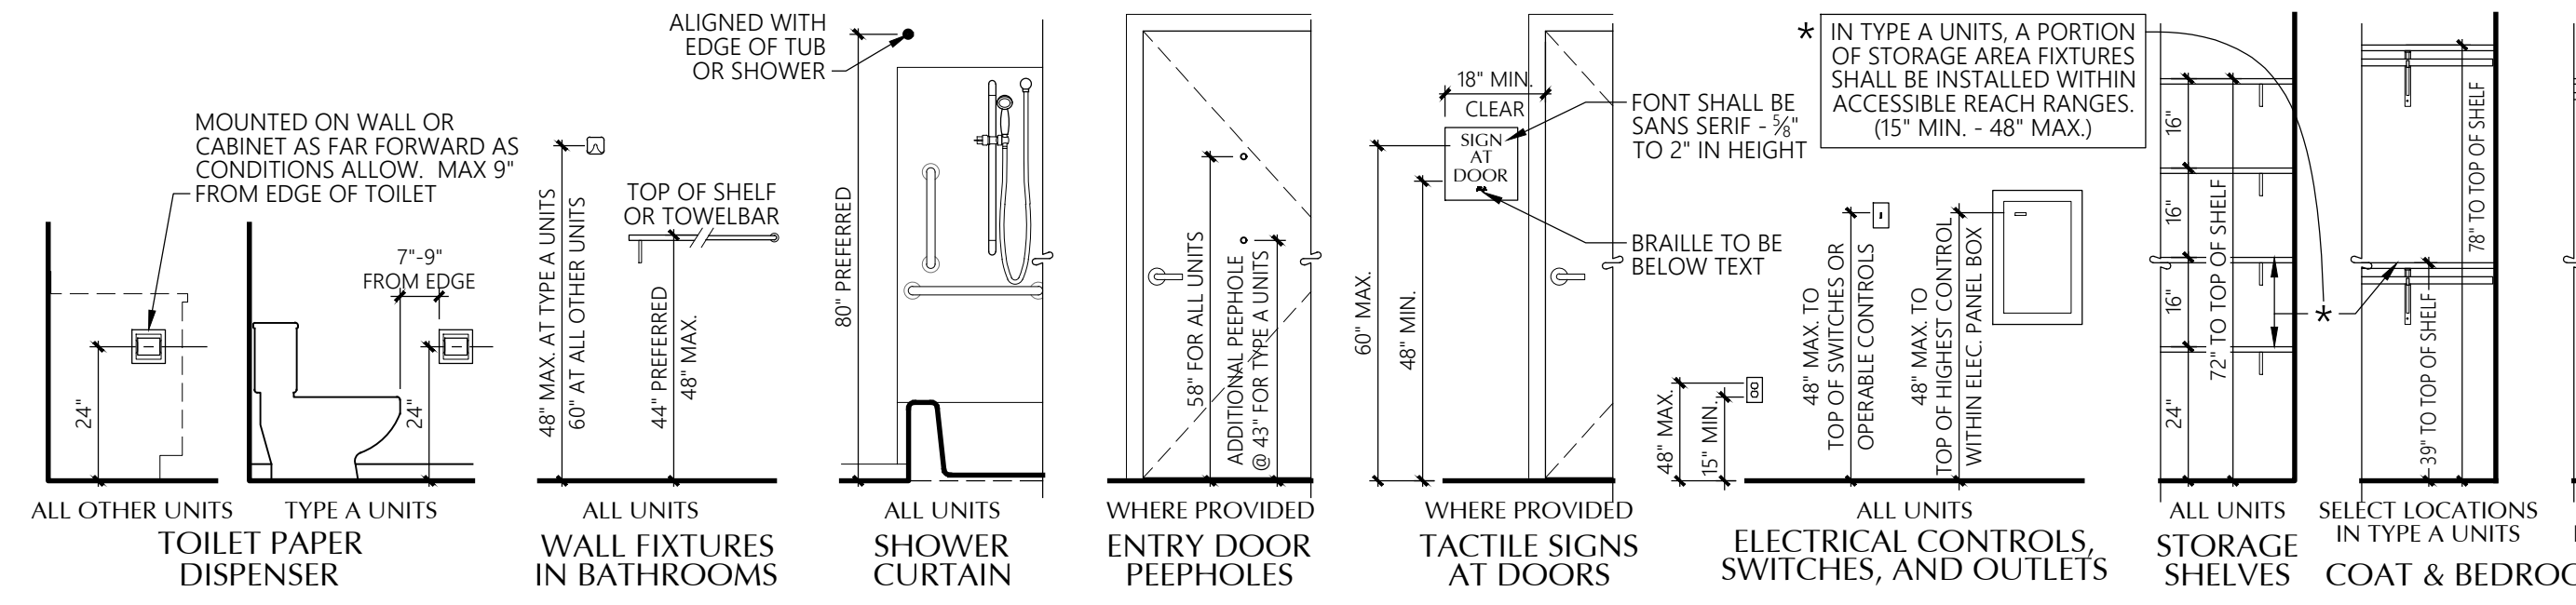

## 32 TYPICAL ACCESSORY & FIXTURE MOUNTING HEIGHTS

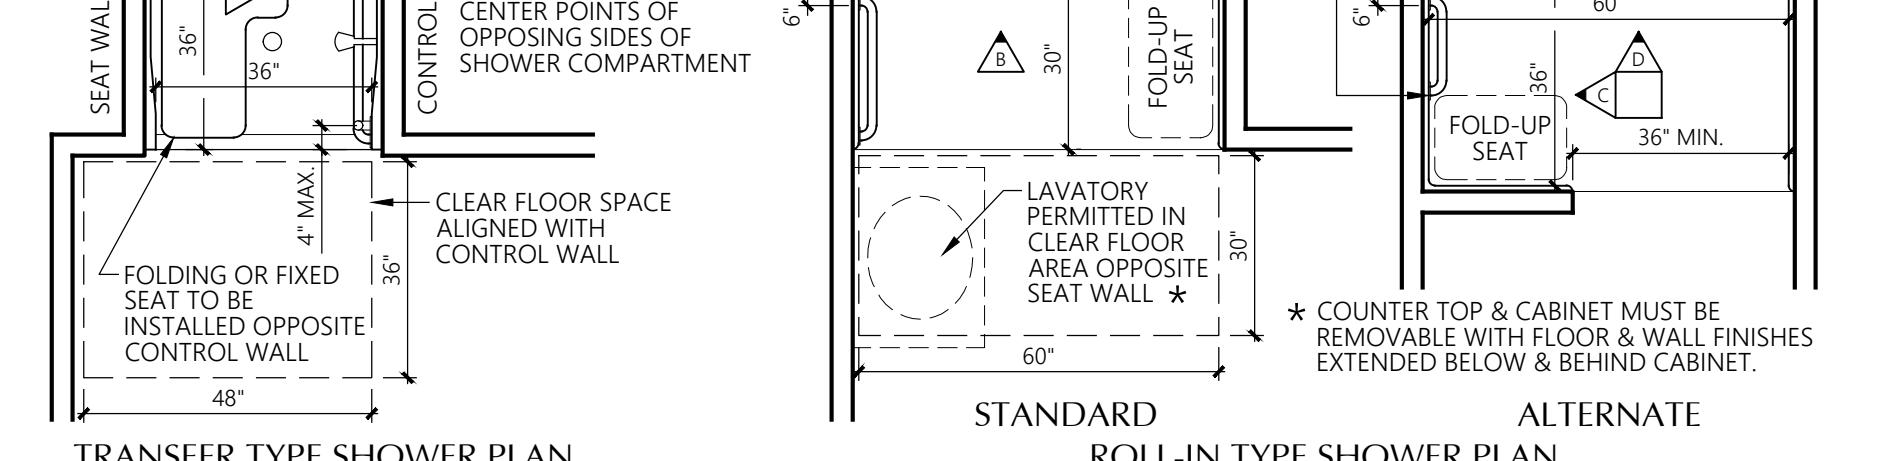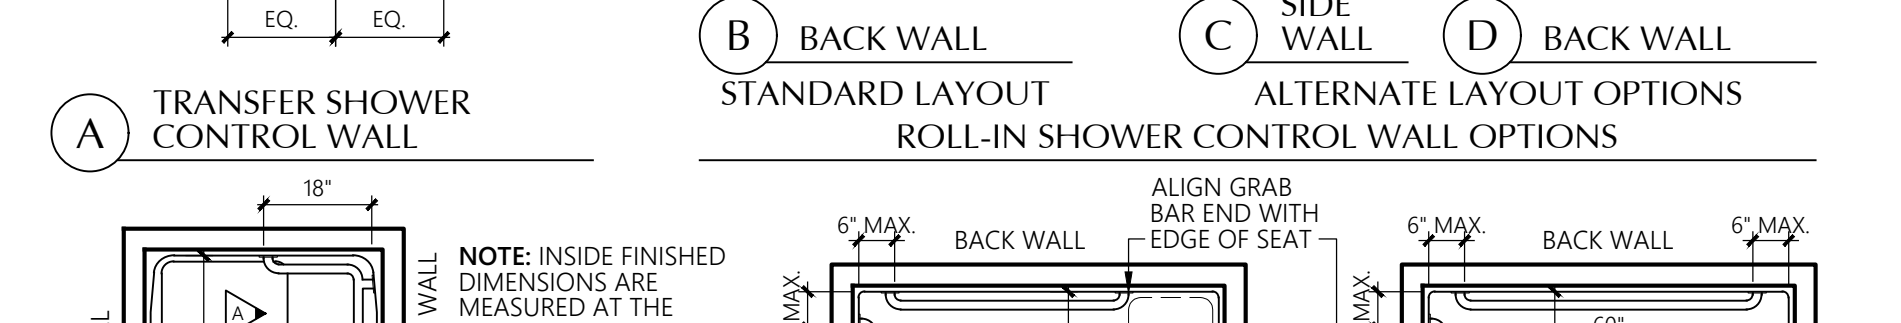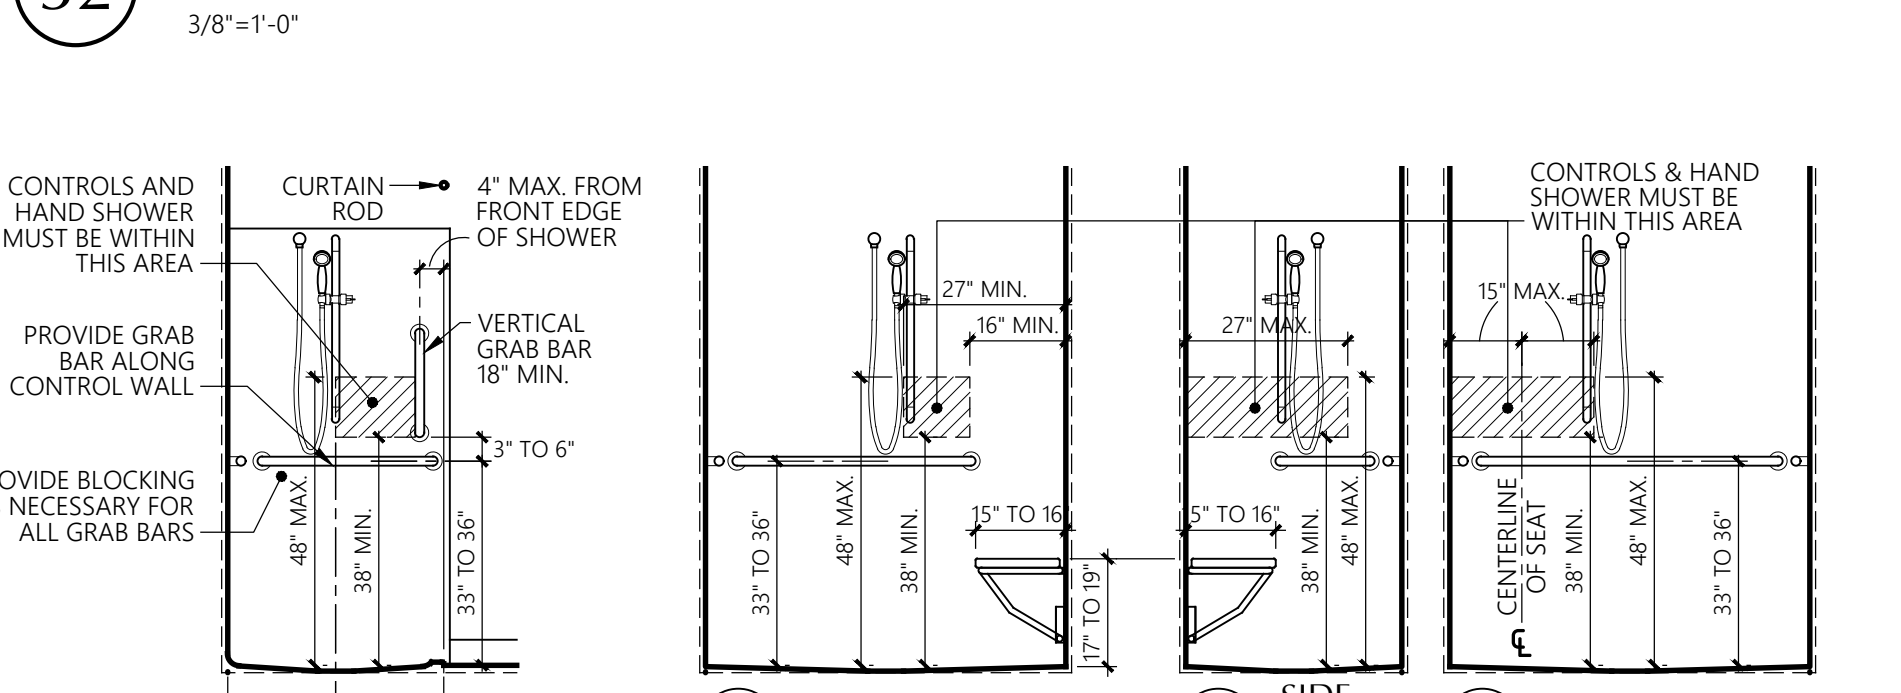

## 27 SHOWER COMPARTMENTS

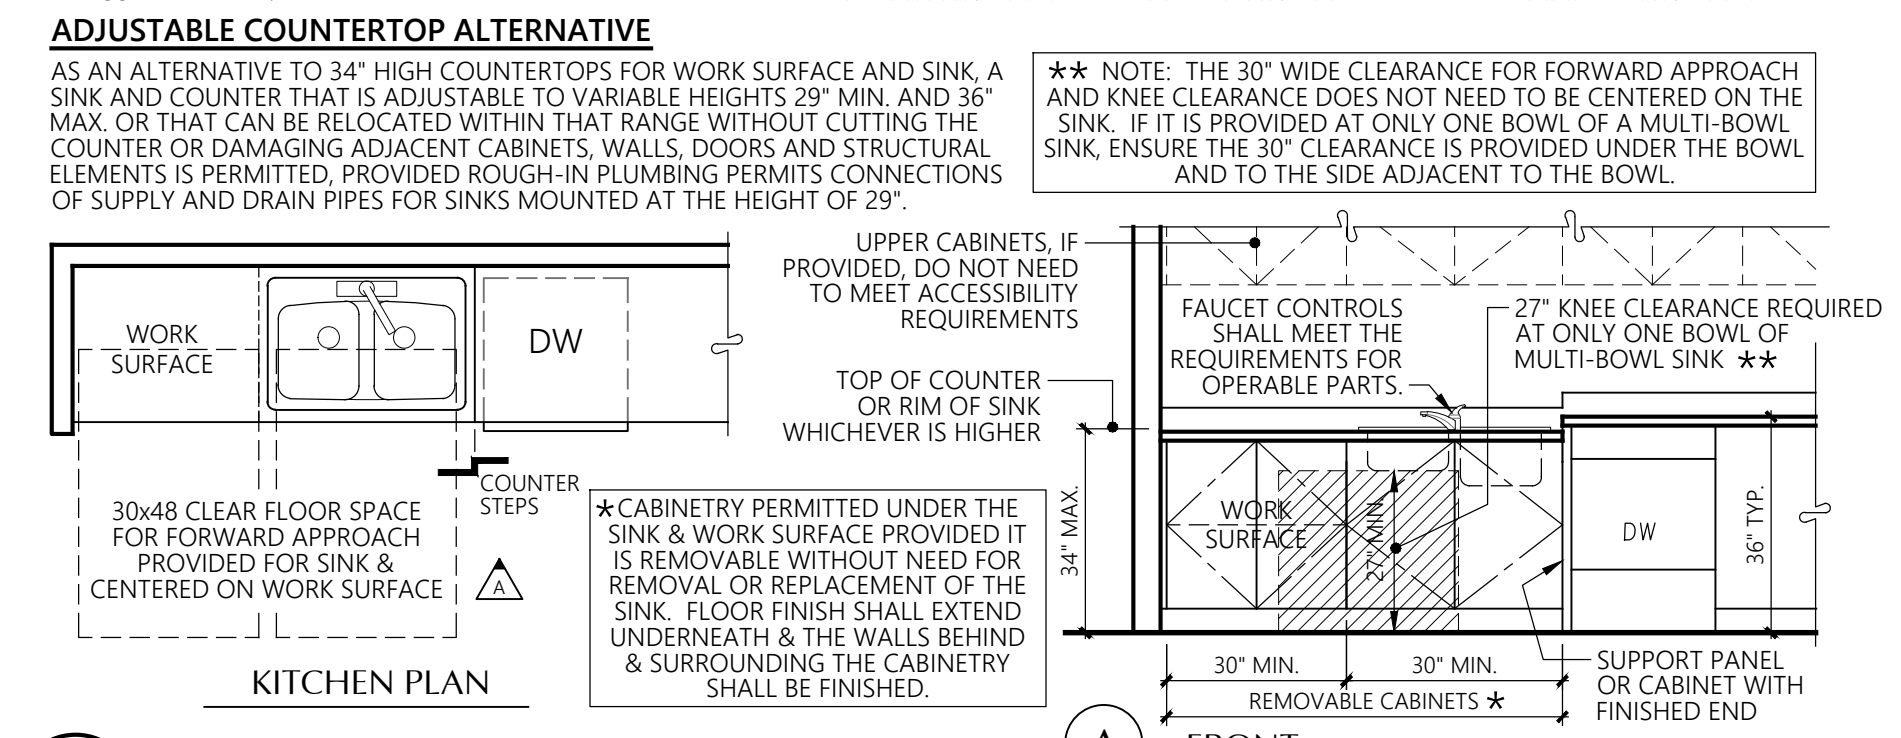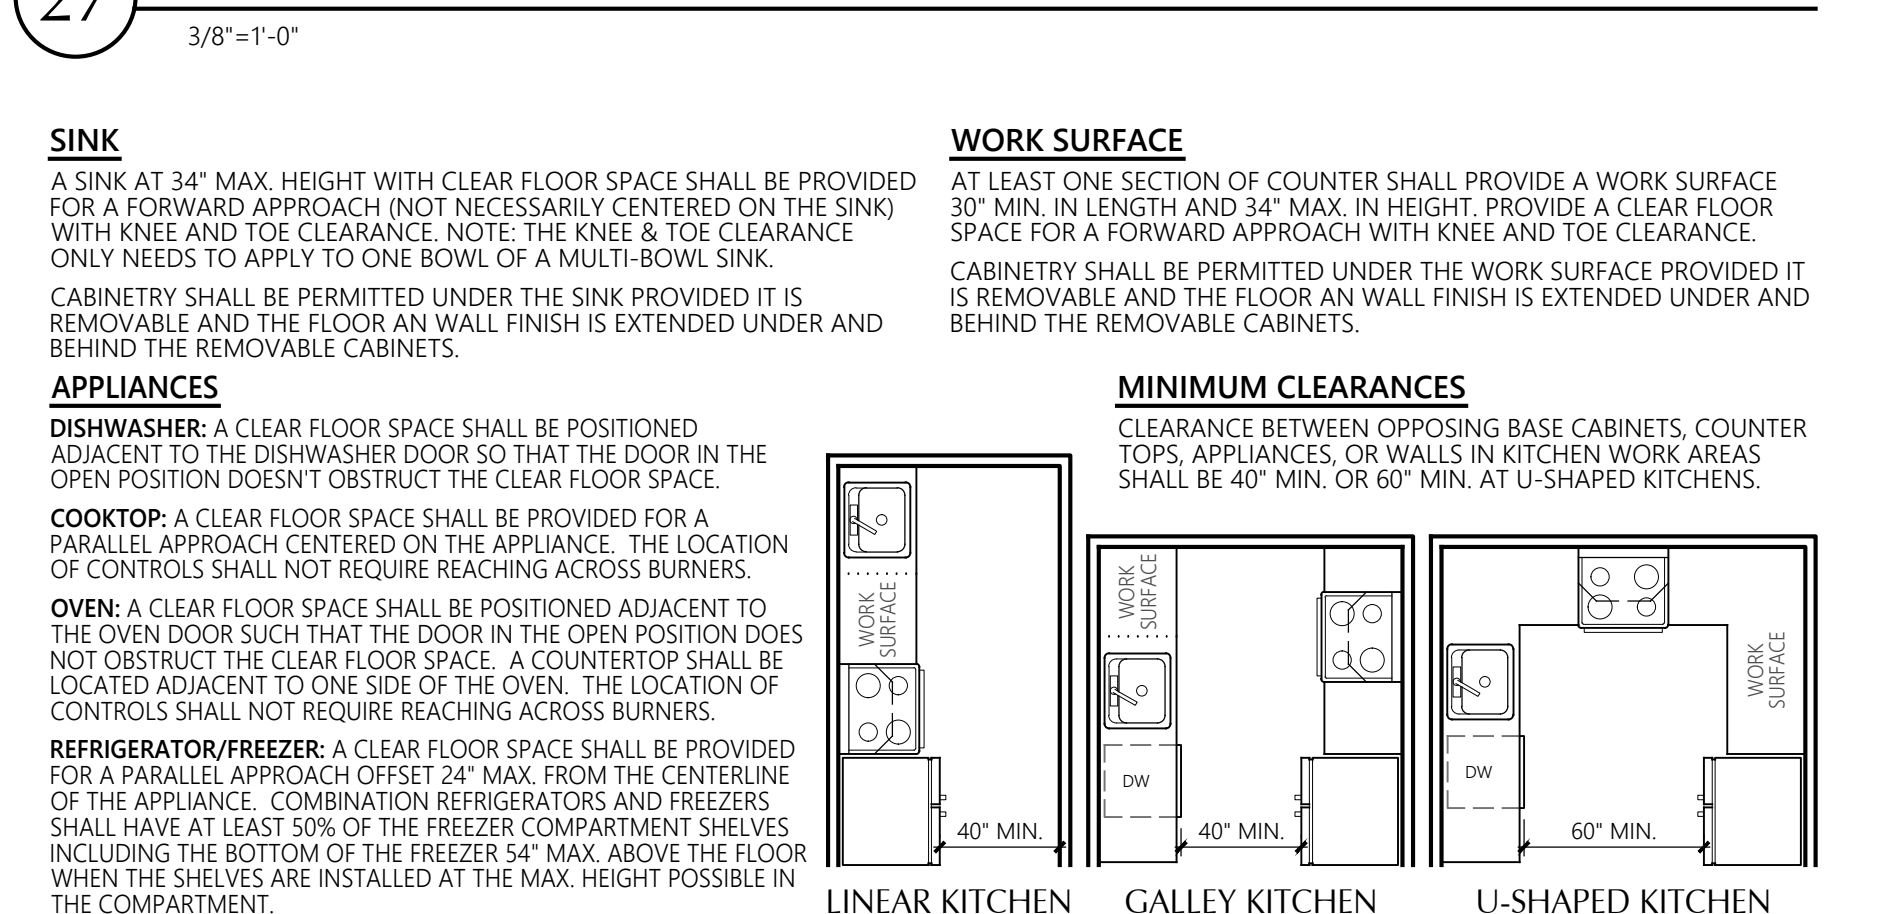

## 28 KITCHENS & KITCHENETTES



### NUMBER OF TYPE B UNITS

IN GROUP R-2 OCCUPANCIES WHERE THERE ARE 4 OR MORE DWELLING UNITS OR SLEEPING UNITS INTENDED TO BE OCCUPIED AS A RESIDENCE IN A SINGLE STRUCTURE, EVERY DWELLING UNIT AND SLEEPING UNIT SHALL BE A TYPE B UNIT. THE NUMBER OF TYPE B UNITS IS PERMITTED TO BE REDUCED IN ACCORDANCE WITH CONDITIONS DEFINED IN SECTION 1107.7 OF THE IBC. THIS REDUCTION OF TYPE B UNITS IS TYPICALLY FOR UNITS THAT ARE ON UPPER STORIES OF A MULTISTORY BUILDING WITHOUT ELEVATOR SERVICE OR MULTI-STORY DWELLING UNITS (SEE IBC FOR SPECIFIC CONDITIONS ALLOWING REDUCTION OF TYPE B UNITS).

### UNIT PRIMARY ENTRANCE

SAME REQUIREMENTS AS FOR TYPE A UNITS EXCEPT THAT ONLY A SINGLE PEEP-HOLE NEED BE PROVIDED AT A STANDARD HEIGHT FOR STANDING PERSONS.

### ACCESSIBLE ROUTE

SAME REQUIREMENTS AS FOR TYPE A UNITS EXCEPT YOU ARE PERMITTED TO HAVE ONE OF THE FOLLOWING: A RAISED / SUNKEN FLOOR AREA IN A LIVING, DINING OR SLEEPING ROOM OR IN THE MEZZANINE THAT IS NOT ENCLOSED AND DOES NOT HAVE PLUMBING FIXTURES.

### CHANGES IN LEVEL



SAME REQUIREMENTS AS FOR TYPE A UNITS EXCEPT WHERE EXTERIOR DECK, PATIO OR BALCONY SURFACE MATERIALS ARE IMPERVIOUS, THE IMPERVIOUS SURFACE SHALL BE 4" MAX. BELOW THE INTERIOR FLOOR LEVEL.

### DOORS


SAME REQUIREMENTS AS FOR TYPE A UNITS EXCEPT DOORS INTENDED FOR USER PASSAGE SHALL HAVE A CLEAR OPENING WIDTH OF 31 3/4" MIN. MEASURED BETWEEN THE FACE OF THE DOOR & THE STOP WITH THE DOOR OPENED 90°.

BATHROOM DOORS: BATHROOM DOORS MAY SWING INTO THE REQUIRED CLEAR FLOOR SPACE AT ANY FIXTURE WHEN A CLEAR FLOOR SPACE OF AT LEAST 30"x48" IS PROVIDED WITHIN THE ROOM BEYOND THE ARC OF THE DOOR SWING.

## 29 GENERAL TYPE B UNIT NOTES

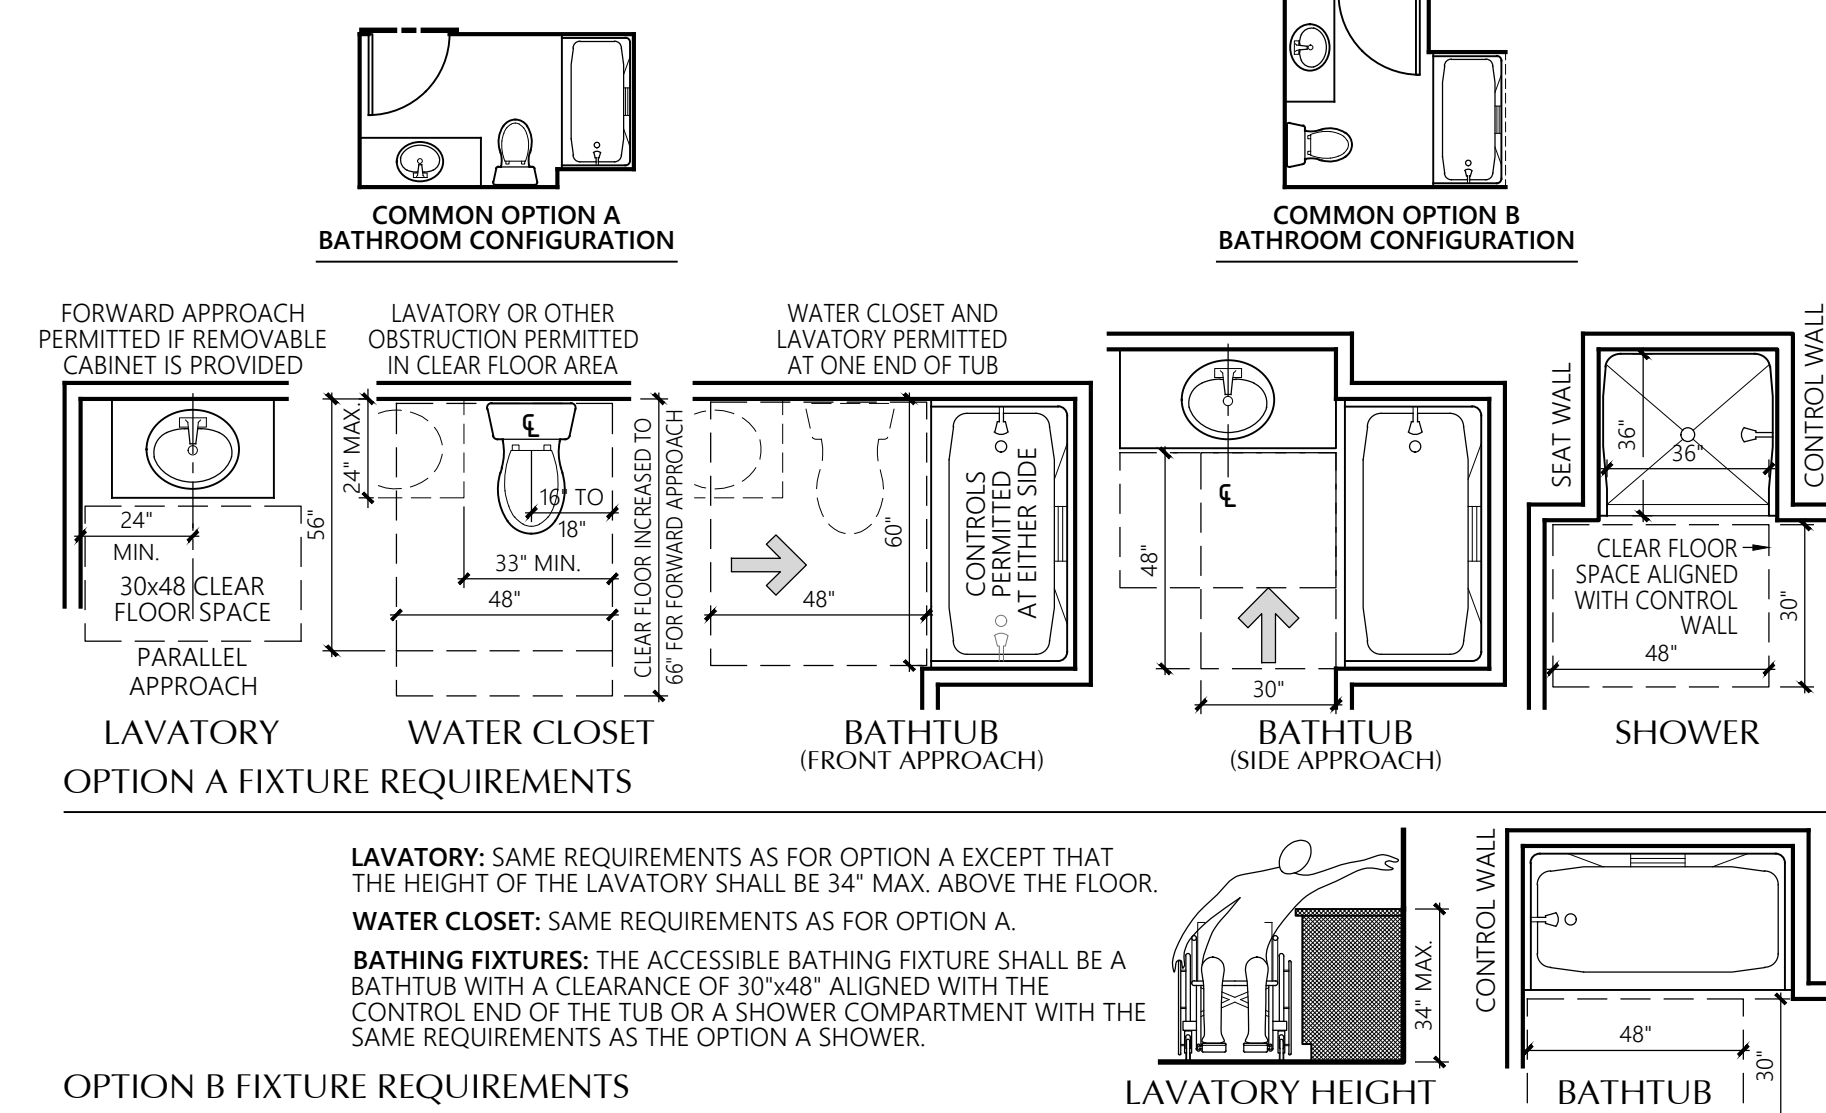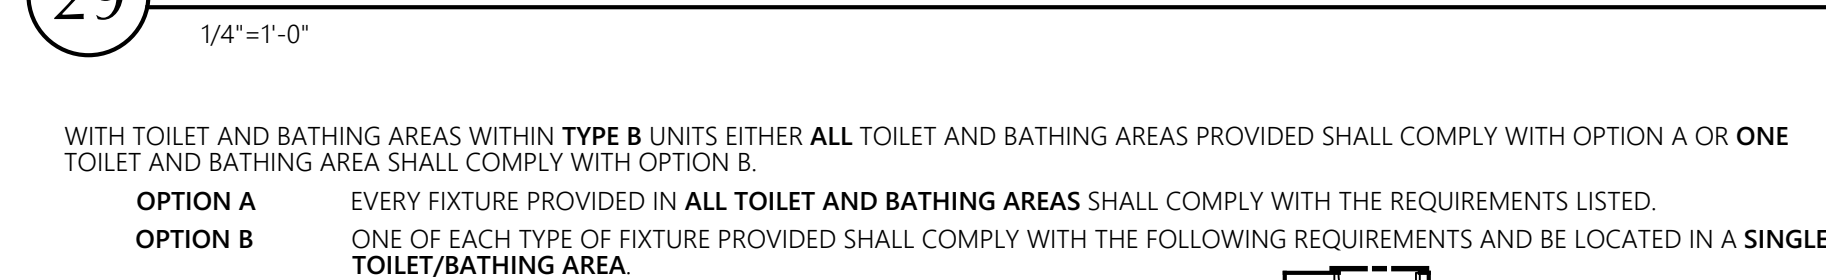

## 30 TYPE B - TOILET & BATHING FIXTURES

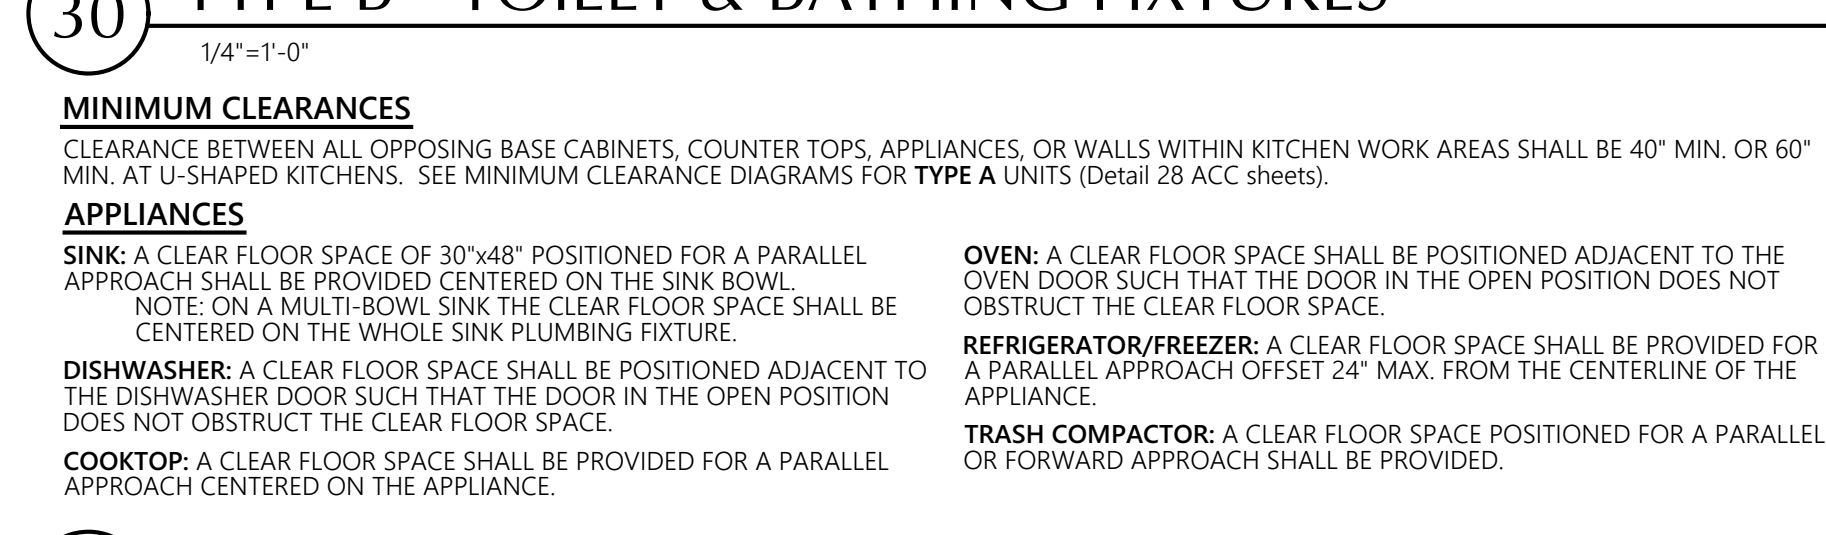

## 31 KITCHENS AND KITCHENETTES



# TYPE A DWELLING UNITS

CHAPTER 10 SECTION 1003

# TYPE B DWELLING UNITS

CHAPTER 10 SECTION 1004



**Stair 1**  
Floor Plans


**Bradley Heights Apartments**  
Puyallup, Wa

**Timberlane Partners**


**Revisions**

No.	Date	Description
1	8-30-24	Owner Changes/ Permit Corrections


Initial Publish Date:  
Date Plotted: 12-20-24  
Job No.: 23-06  
Drawn By: APT/HDM/TMK  
Sheet No.:

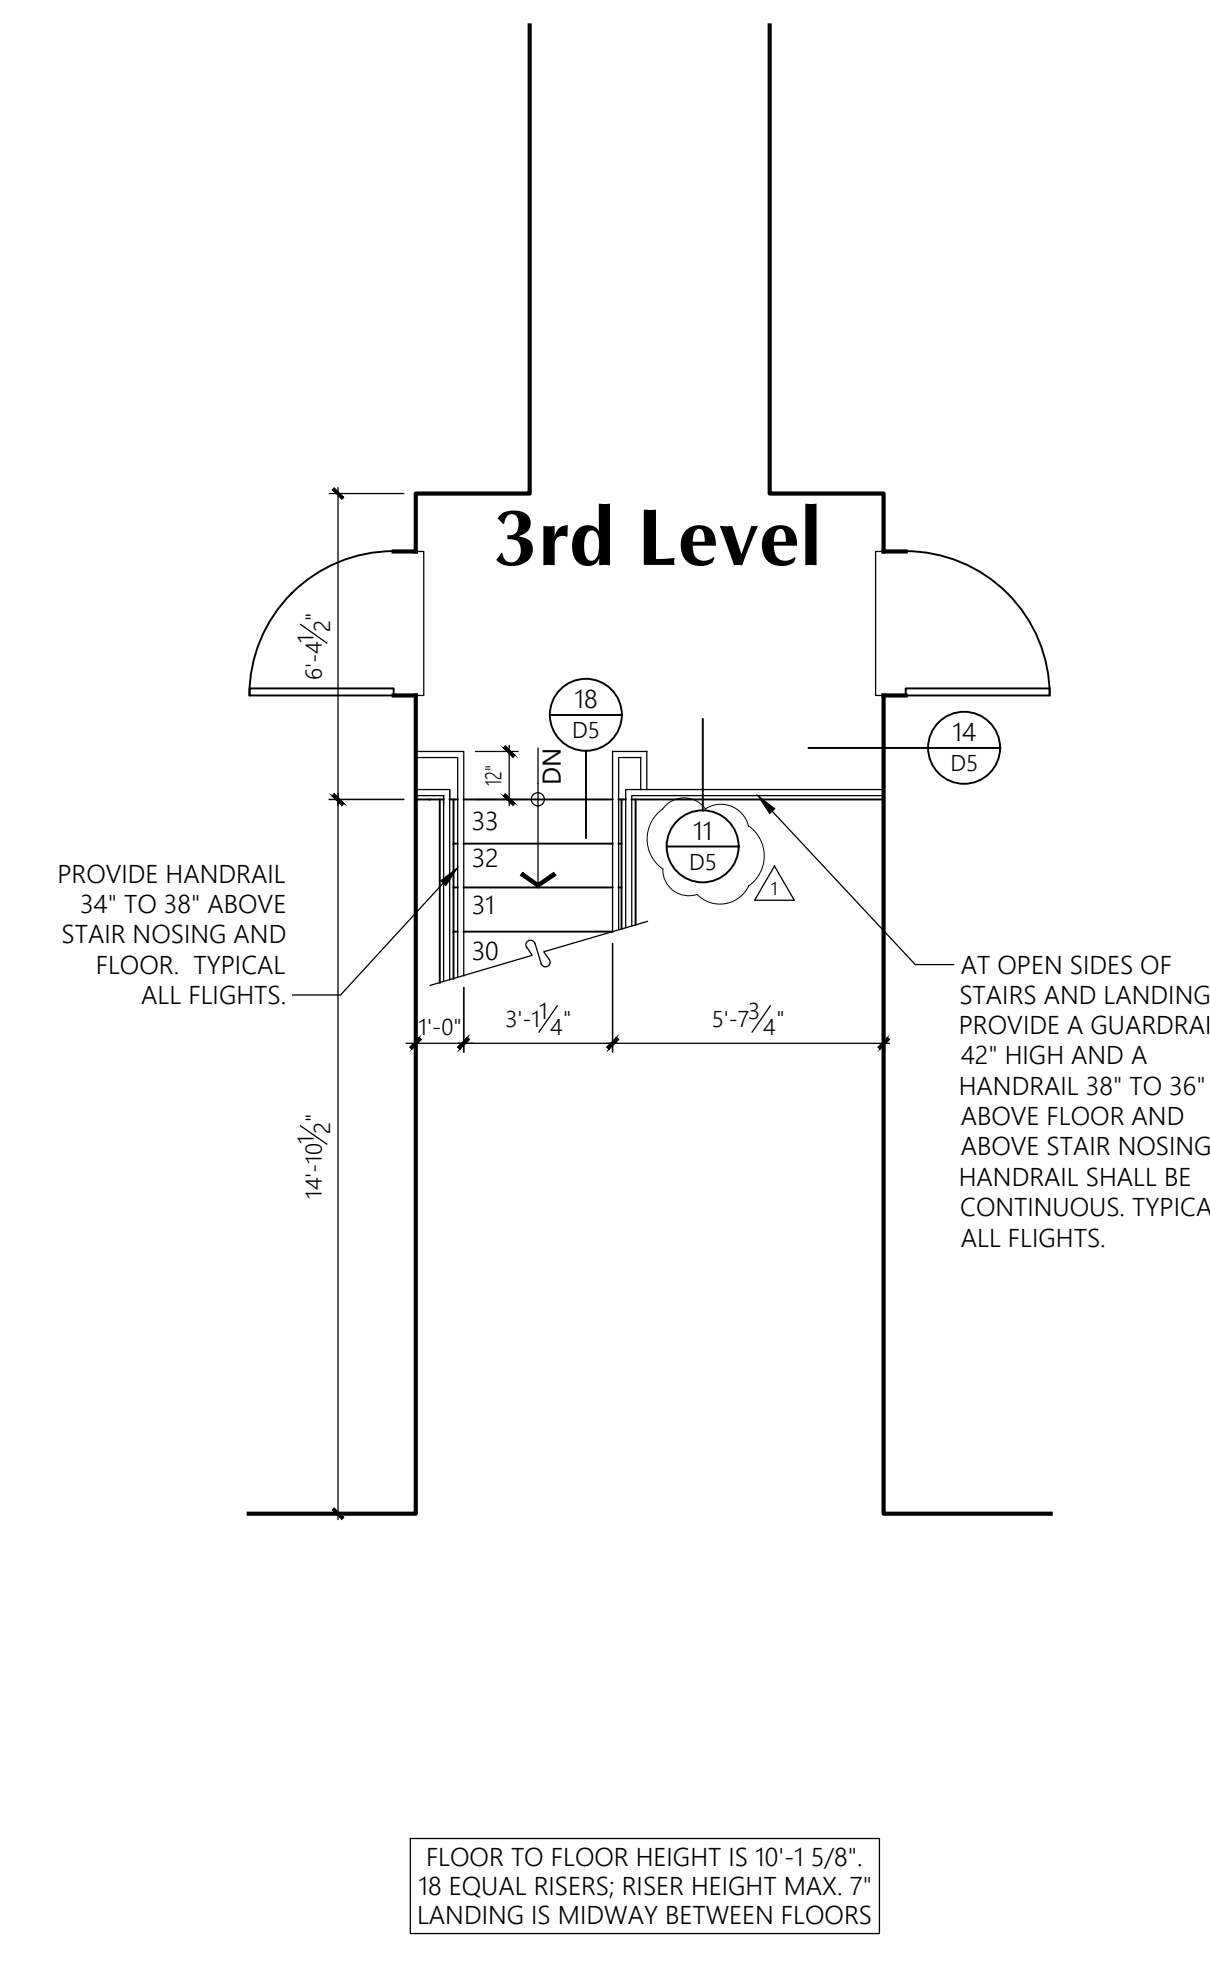


**STAIR 1** 3RD LEVEL FLOOR PLAN  
1/4" = 1'-0"

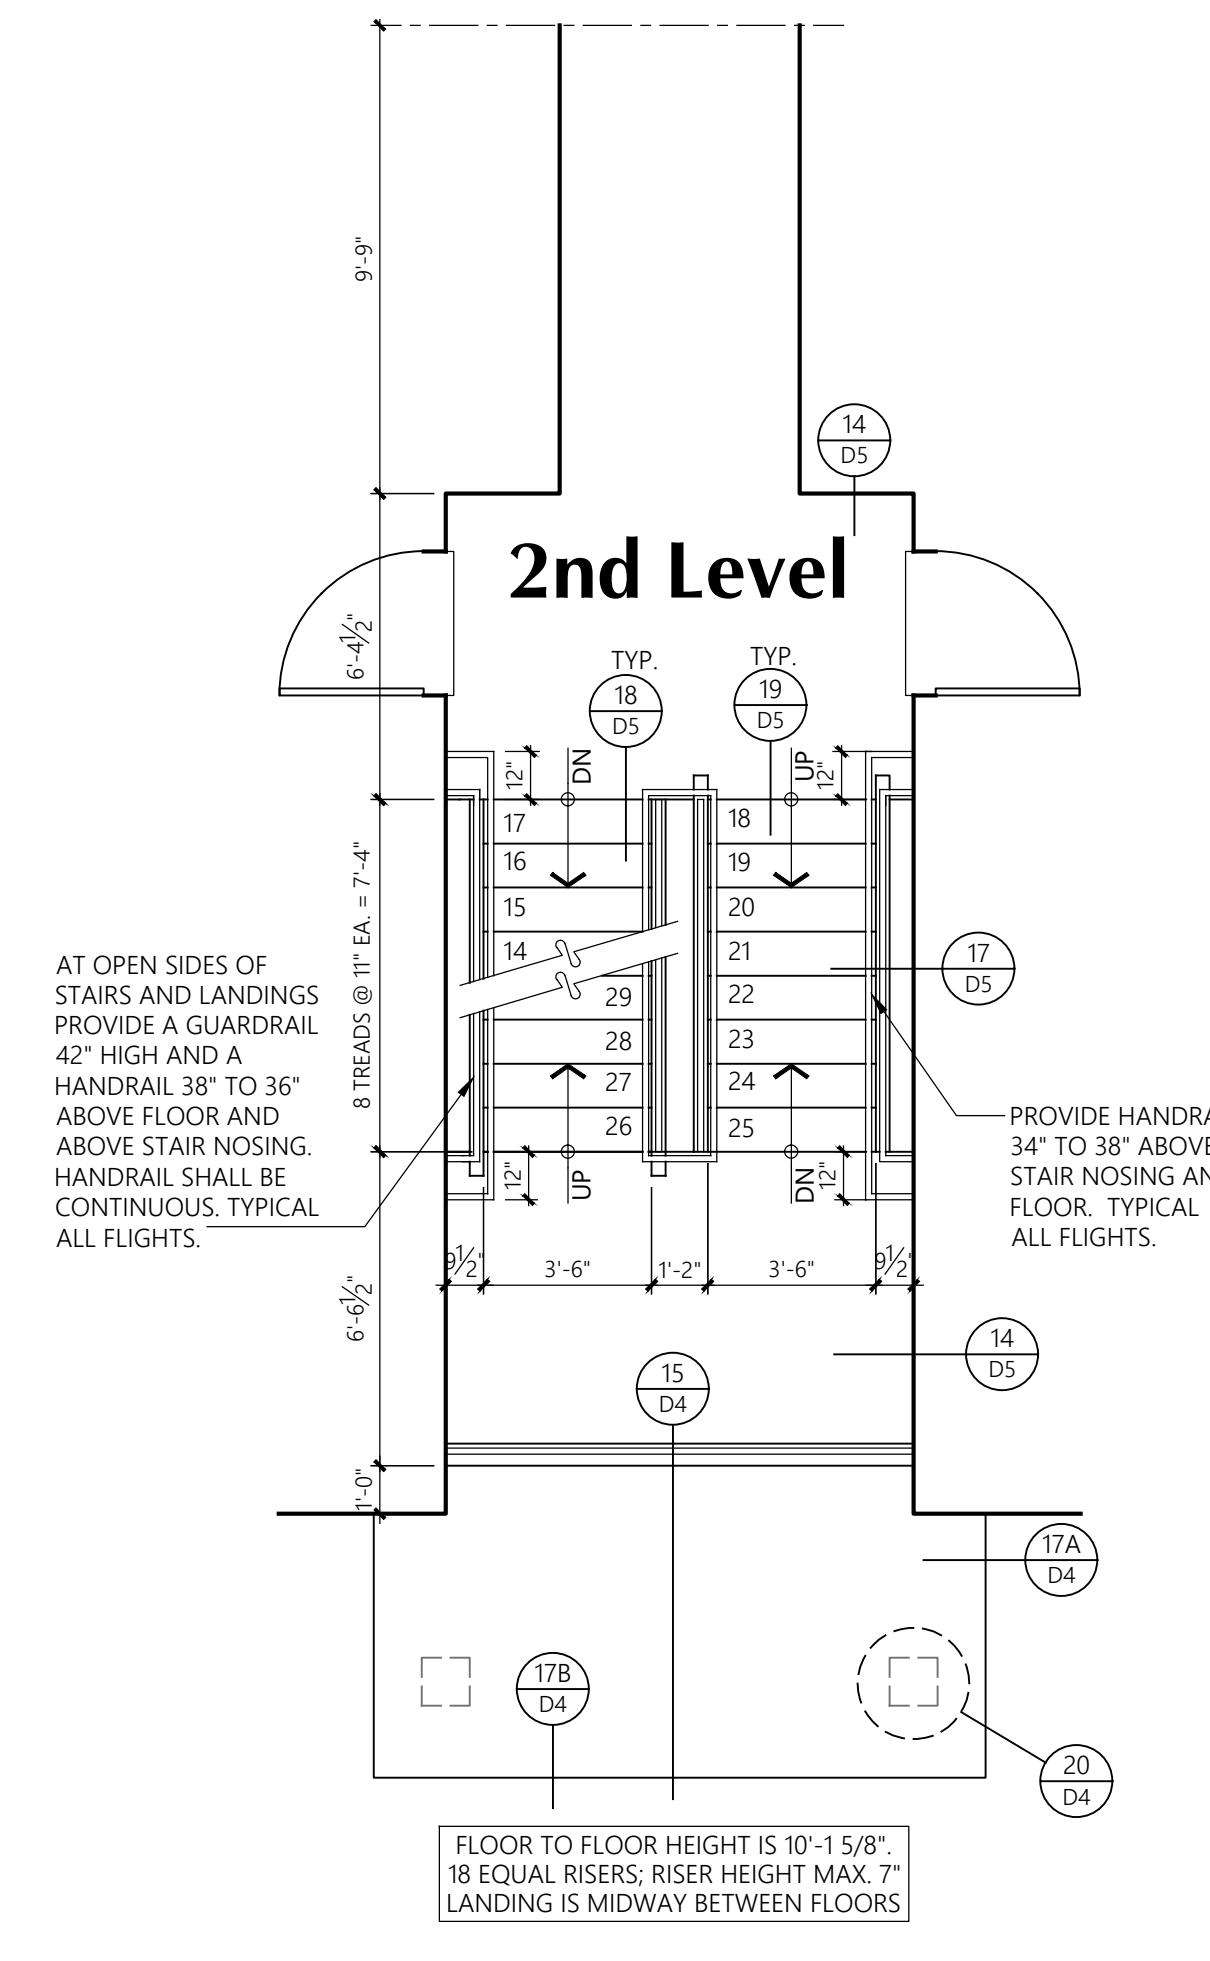

**STAIR 1** 2ND LEVEL FLOOR PLAN  
1/4" = 1'-0"

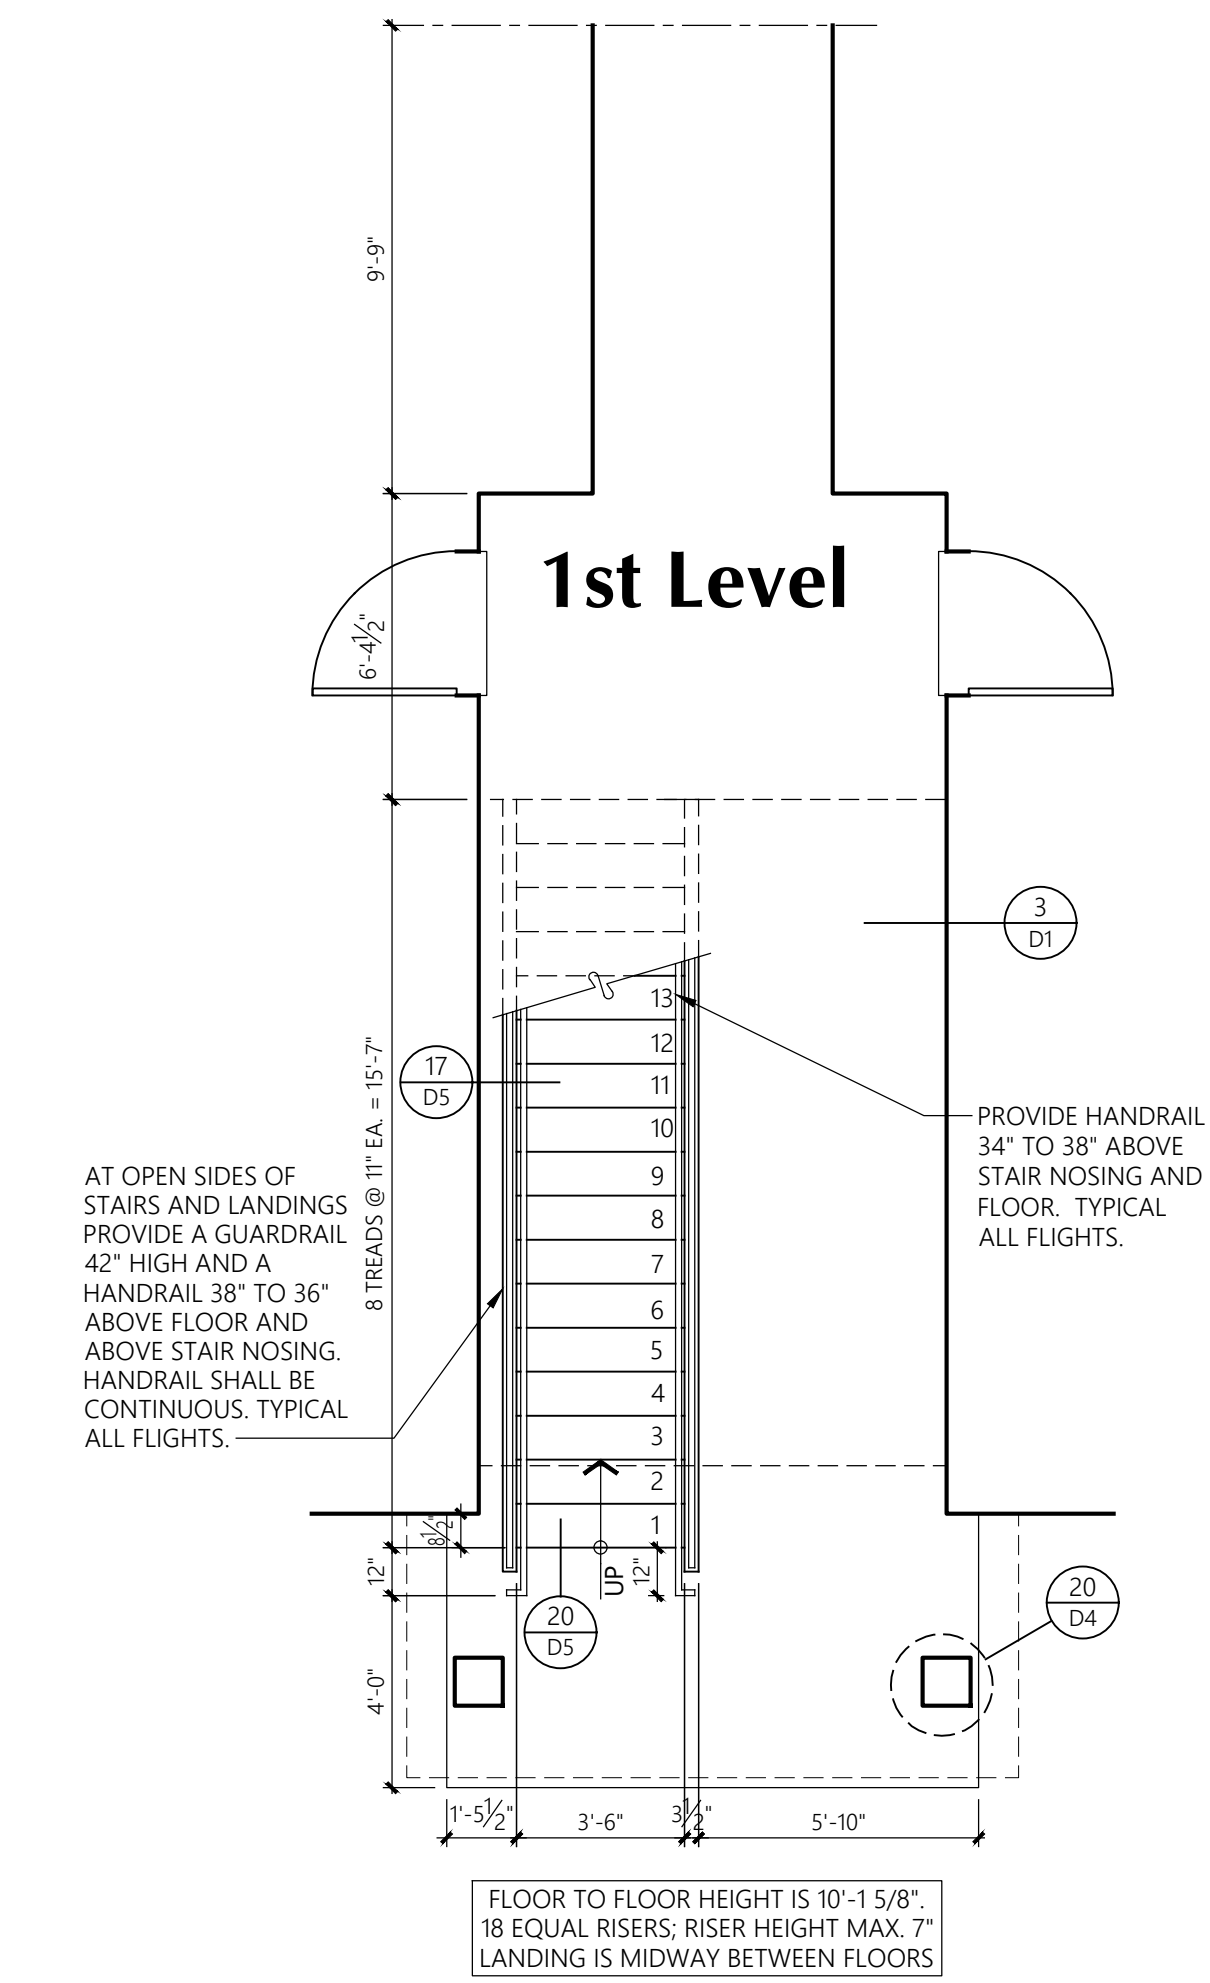


**STAIR 1** 1ST LEVEL FLOOR PLAN  
1/4" = 1'-0"

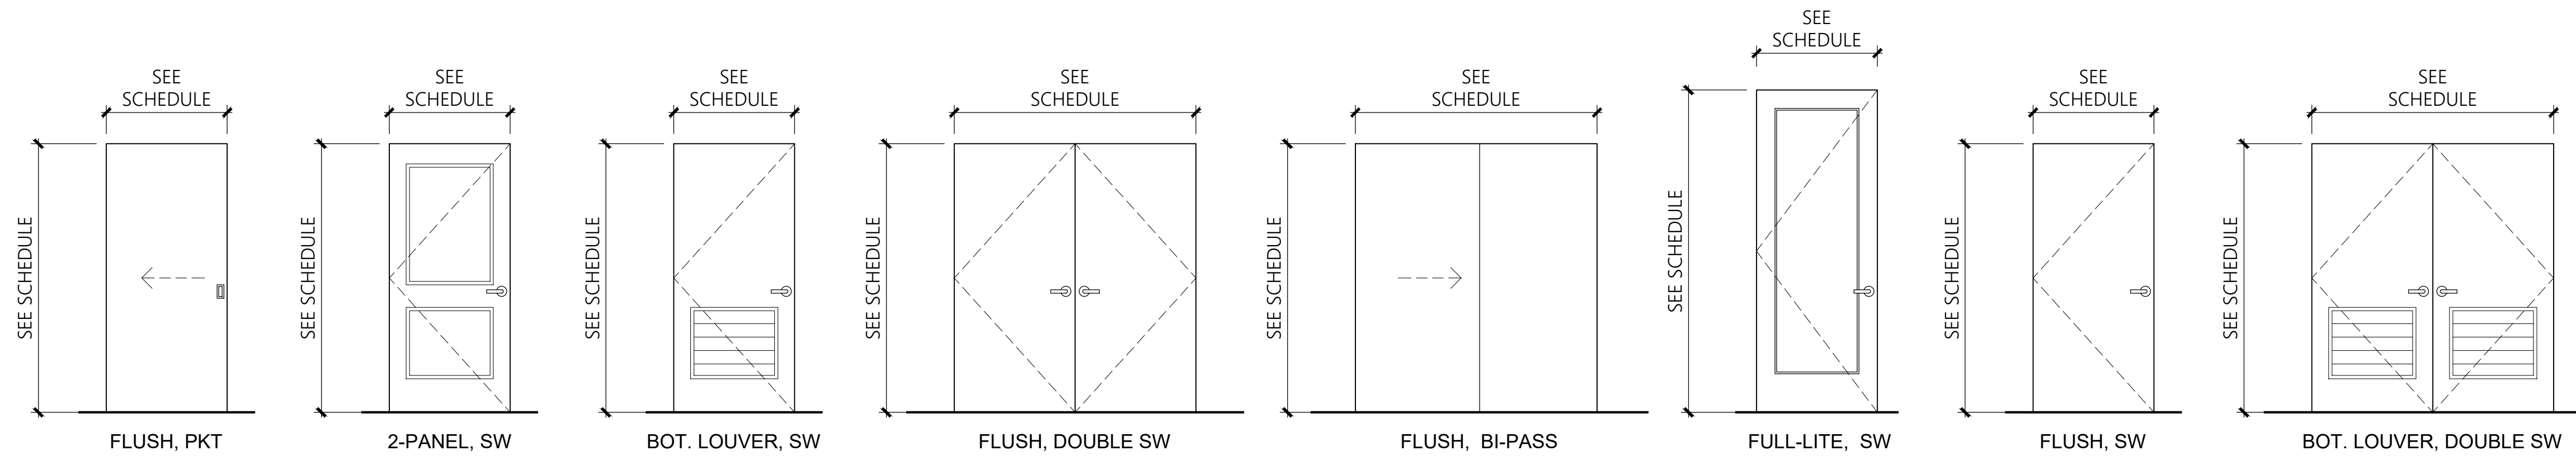

**Door Schedule - Units**

Door No.	Type	Size	Thickness	Construct	Finish	Fire Rating	Frame or Head/Jamb		Remarks	Min. U Factor	Max. SHGC
							Construct.	Finish			
1A	2-Panel, SW	3'-0" x 8'-0"	1-3/4"	INSUL MTL	PP	20 min.	Wood	PP	Keylock, Dead Bolt w/Thumb, Self Closure/Smoke Seal, Flush Threshold, Weatherstrip, Ext. Grade Door, Peep Sight, Self Closing	0.24	-
1B	2-Panel, SW	3'-0" x 8'-0"	1-3/4"	INSUL MTL	PP	90 min.	MTL	PP	Keylock, Dead Bolt w/Thumb, Self Closure/Smoke Seal, Flush Threshold, Weatherstrip, Ext. Grade Door, Peep Sight, Self Closing	0.24	-
2	2-Panel, PKT	3'-0" x 6'-8"	1-3/8"	HCW	PP		Wood	PP	Privacy Lock @ Bath	-	-
3	2-Panel, SW	3'-0" x 6'-8"	1-3/8"	HCW	PP		Wood	PP	Privacy Lock @ Bath	-	-
4	Bot. Louver Dbl, SW	6'-0" x 6'-8"	1-3/8"	HCW	PP		Wood	PP		-	-
5	Full-Lite, SW	3'-0" x 8'-0"	1-3/4"	INSUL MTL	PP		Wood	PP	Keylock, Safety Glass, Flush Threshold, Weatherstrip, Ext. Grade Door	0.24	0.61
6	2-Panel, SW	2'-4" x 6'-8"	1-3/8"	HCW	PP		Wood	PP		-	-
7	2-Panel, SW	2'-6" x 6'-8"	1-3/8"	HCW	PP		Wood	PP		-	-
8	BP	4'-0" x 6'-8"	1-3/8"	HCW	PP		GWB	PP		-	-
9	Bot. Louver, SW	3'-0" x 6'-8"	1-3/8"	HCW	PP		Wood	PP		-	-
10	BP	5'-0" x 6'-8"	1-3/8"	HCW	PP		GWB	PP		-	-
11	2-Panel, SW	2'-0" x 6'-8"	1-3/8"	HCW	PP		Wood	PP		-	-
12	Flush, SW	3'-0" x 8'-0"	1-3/8"	MTL	PP	90 min.	Wood	PP	Lockable from outside, Ext. Grade Door	-	-
13	Flush, Dbl SW	6'-0" x 6'-8"	1-3/8"	INSUL MTL	PP		Wood	PP	Lockable from outside, Ext. Grade Door	0.24	-
14	Flush, SW	3'-0" x 8'-0"	1-3/8"	MTL	PP	20 min.	Wood	PP	Lockable from outside, Ext. Grade Door	-	-

**DOOR KEY:**  
 TYPE:  
 SCW = SOLID CORE WOOD  
 MTL = METAL  
 SW = SWING  
 DBL SW = DOUBLE SWING  
 SOHD = SECTIONAL OVERHEAD DOOR  
 PP = PRIME & PAINT  
 FF = FACTORY FINISH

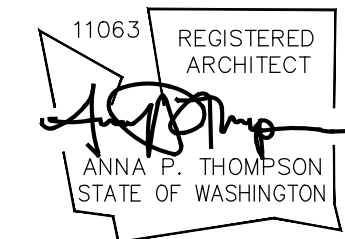

**Door Schedule**

**Bradley Heights Apartments**  
 Puyallup, Wa

**Timberlane Partners**

**Revisions**


No.	Date	Description
1	8-30-24	Owner Changes/ Permit Corrections

Initial Publish Date:  
 Date Plotted: 2-11-25  
 Job No.: 23-06  
 Drawn By: APT/HDM/TMK  
 Sheet No.:



**Revisions**

No.	Date	Description
1	8-30-24	Permit Corrections/ Owner Changes

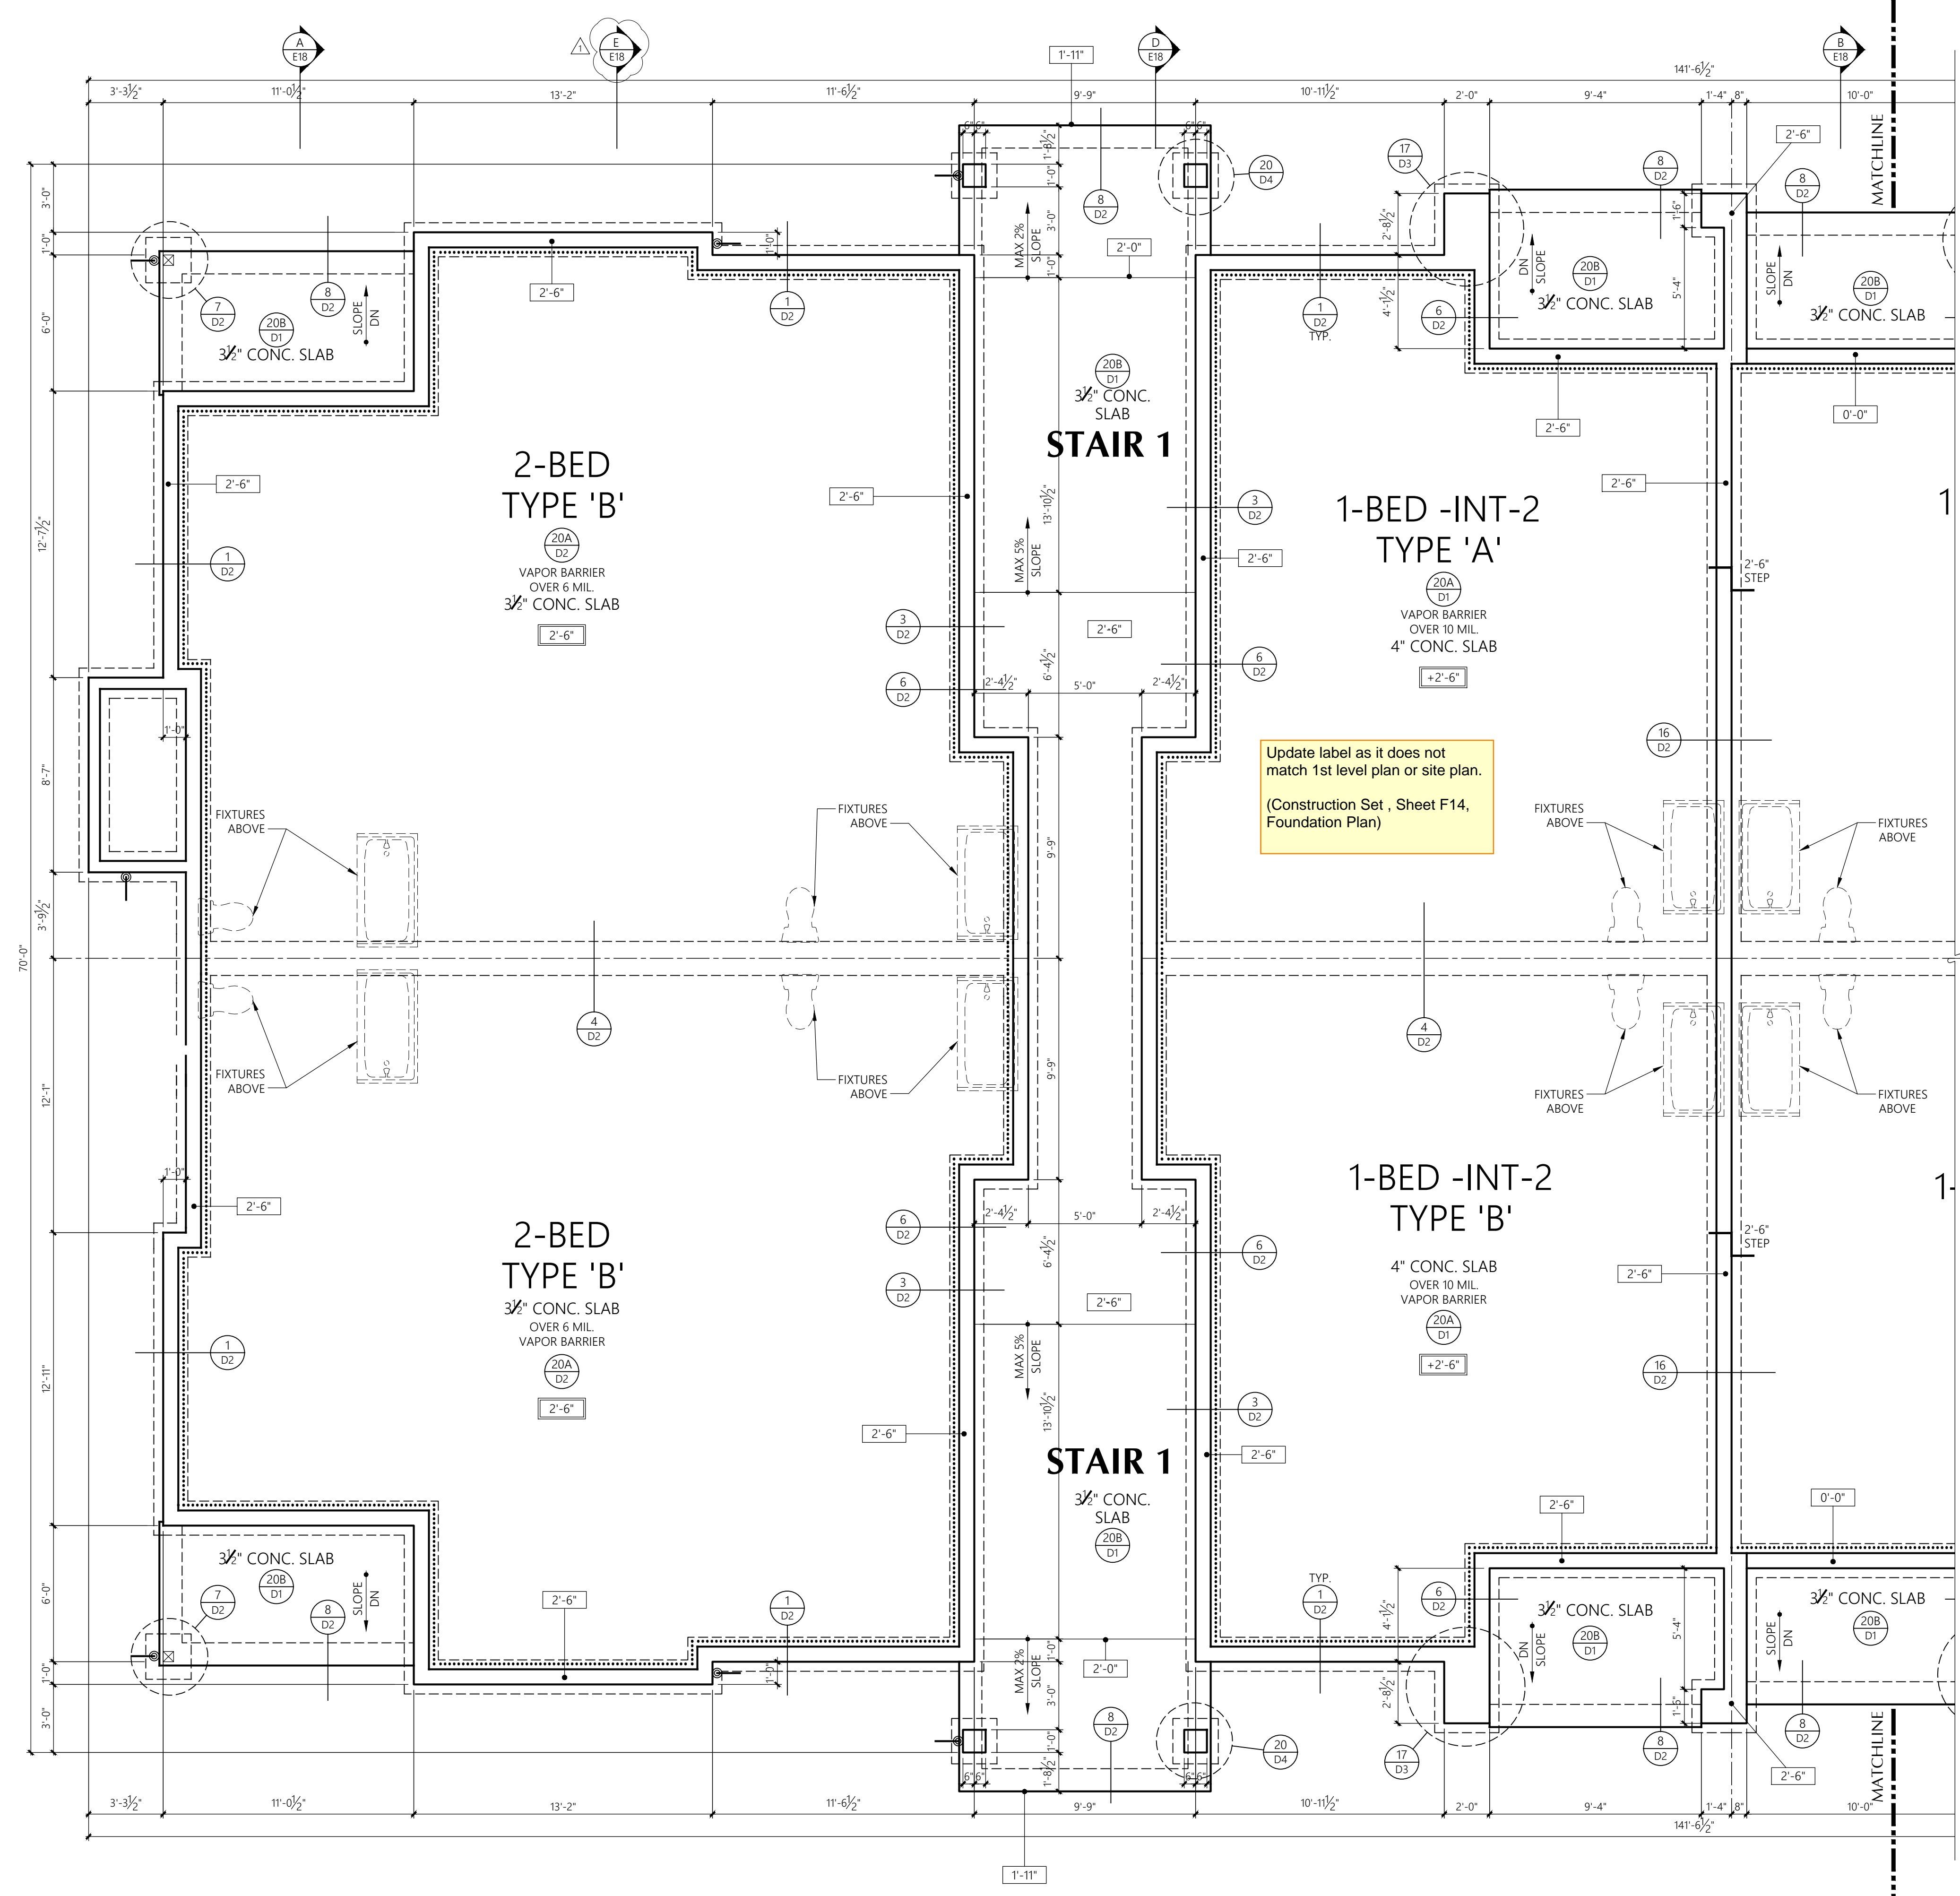

Update label as it does not match 1st level plan or site plan.  
(Construction Set, Sheet F14, Foundation Plan)

**FOUNDATION NOTES**

- LOCATION OF DOWNSPOUT: PROVIDE TIGHT LINE AND RISER BOOT
- X" ELEVATION AT TOP OF CONCRETE (TOP OF FOOTING MAY VARY BECAUSE OF EXCAVATION)
- +X'-X" FINISH SLAB ELEVATION
- ..... R-10 RIGID PERIMETER INSULATION

**BUILDING H** PARTIAL ARCHITECTURAL FOUNDATION PLAN  
1/4" = 1'-0"  
3 SPLIT LEVEL, 24-UNIT BUILDING

SEE S2.6 FOR STRUCTURAL FOUNDATION PLAN





**Building H**  
Partial Architectural Foundation Plan


**Bradley Heights Apartments**  
Puyallup, Wa

**Timberlane Partners**

Revisions		
No.	Date	Description

Initial Publish Date:	
Date Plotted:	12-20-24
Job No.:	23-06
Drawn By:	APT/HDM/TMK
Sheet No.:	

**F15**

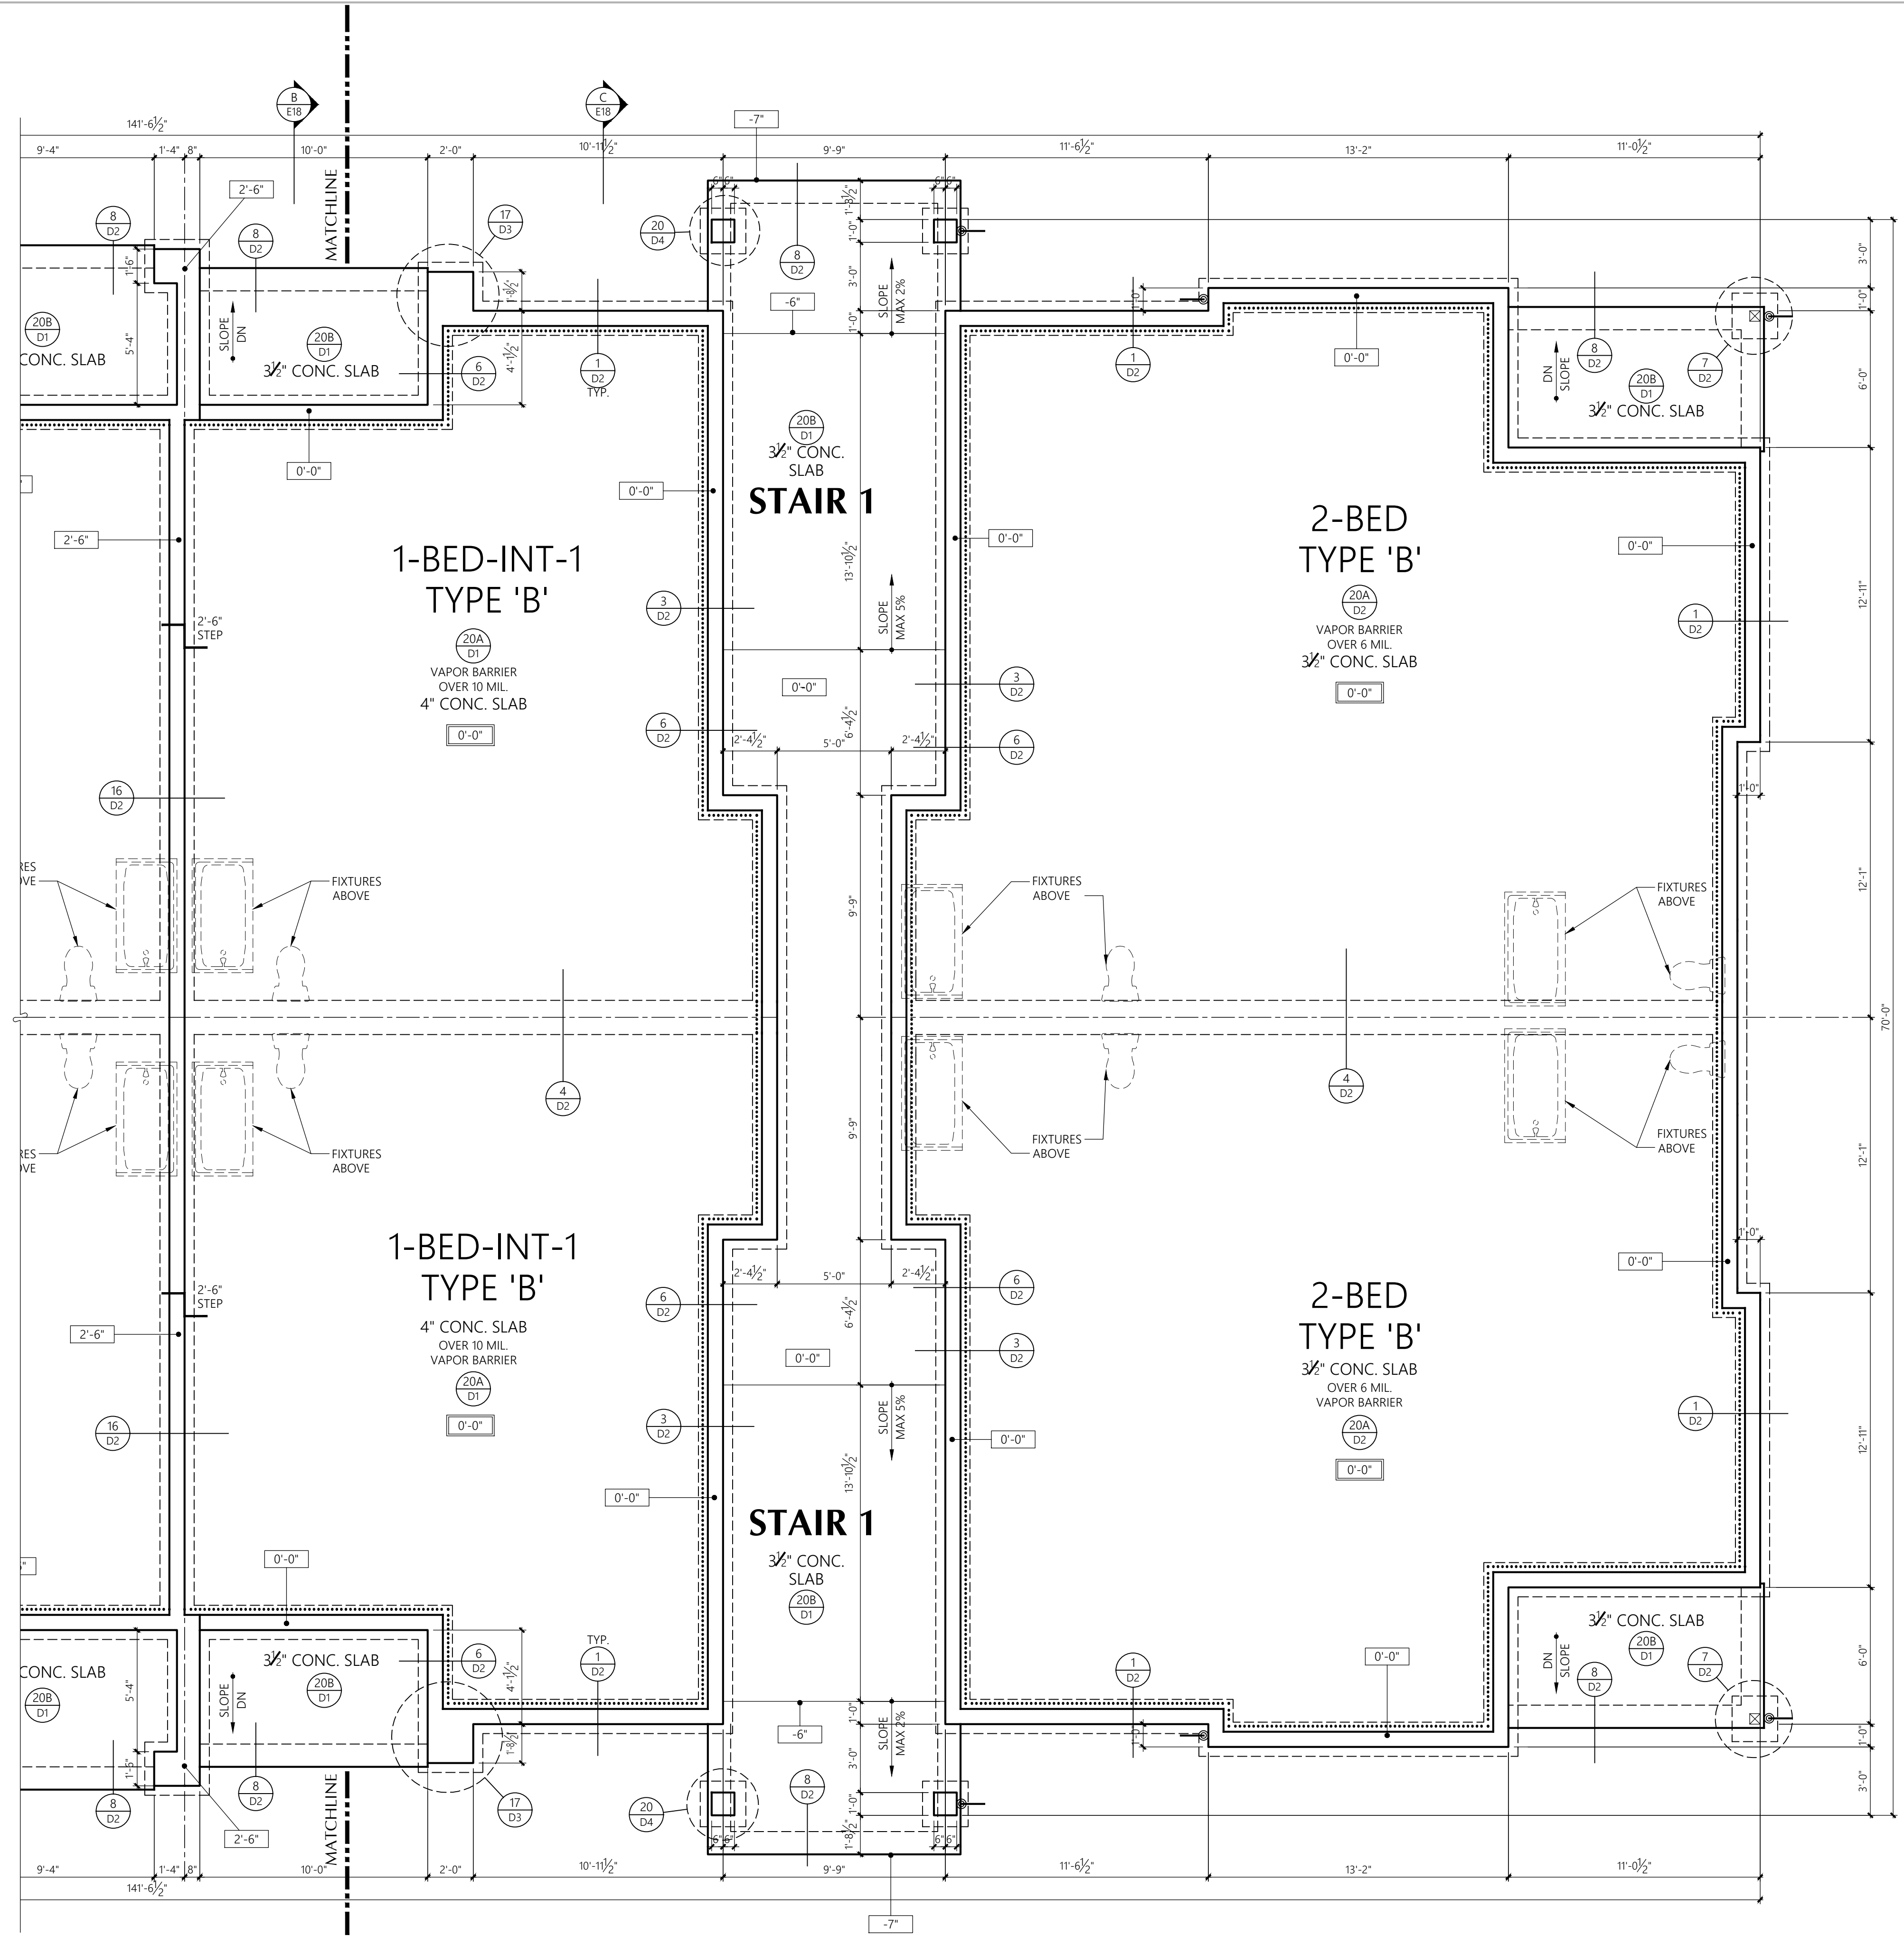

**FOUNDATION NOTES**

- LOCATION OF DOWNSPOUT: PROVIDE TIGHT LINE AND RISER BOOT
- ELEVATION AT TOP OF CONCRETE (TOP OF FOOTING MAY VARY BECAUSE OF EXCAVATION)
- FINISH SLAB ELEVATION
- R-10 RIGID PERIMETER INSULATION

SEE S2.6 FOR STRUCTURAL FOUNDATION PLAN

**BUILDING H**  
1/4" = 1'-0"

PARTIAL ARCHITECTURAL FOUNDATION PLAN  
3 SPLIT LEVEL, 24-UNIT BUILDING



**Building H**  
Roof Plan

**Bradley Heights Apartments**  
Puyallup, Wa


**Timberlane Partners**

**Revisions**

No.	Date	Description
1	8-30-24	Owner Changes/ Permit Corrections

Initial Publish Date:  
Date Plotted: 12-20-24  
Job No.: 23-06  
Drawn By: APT/HDM/TMK  
Sheet No.:

**R8**

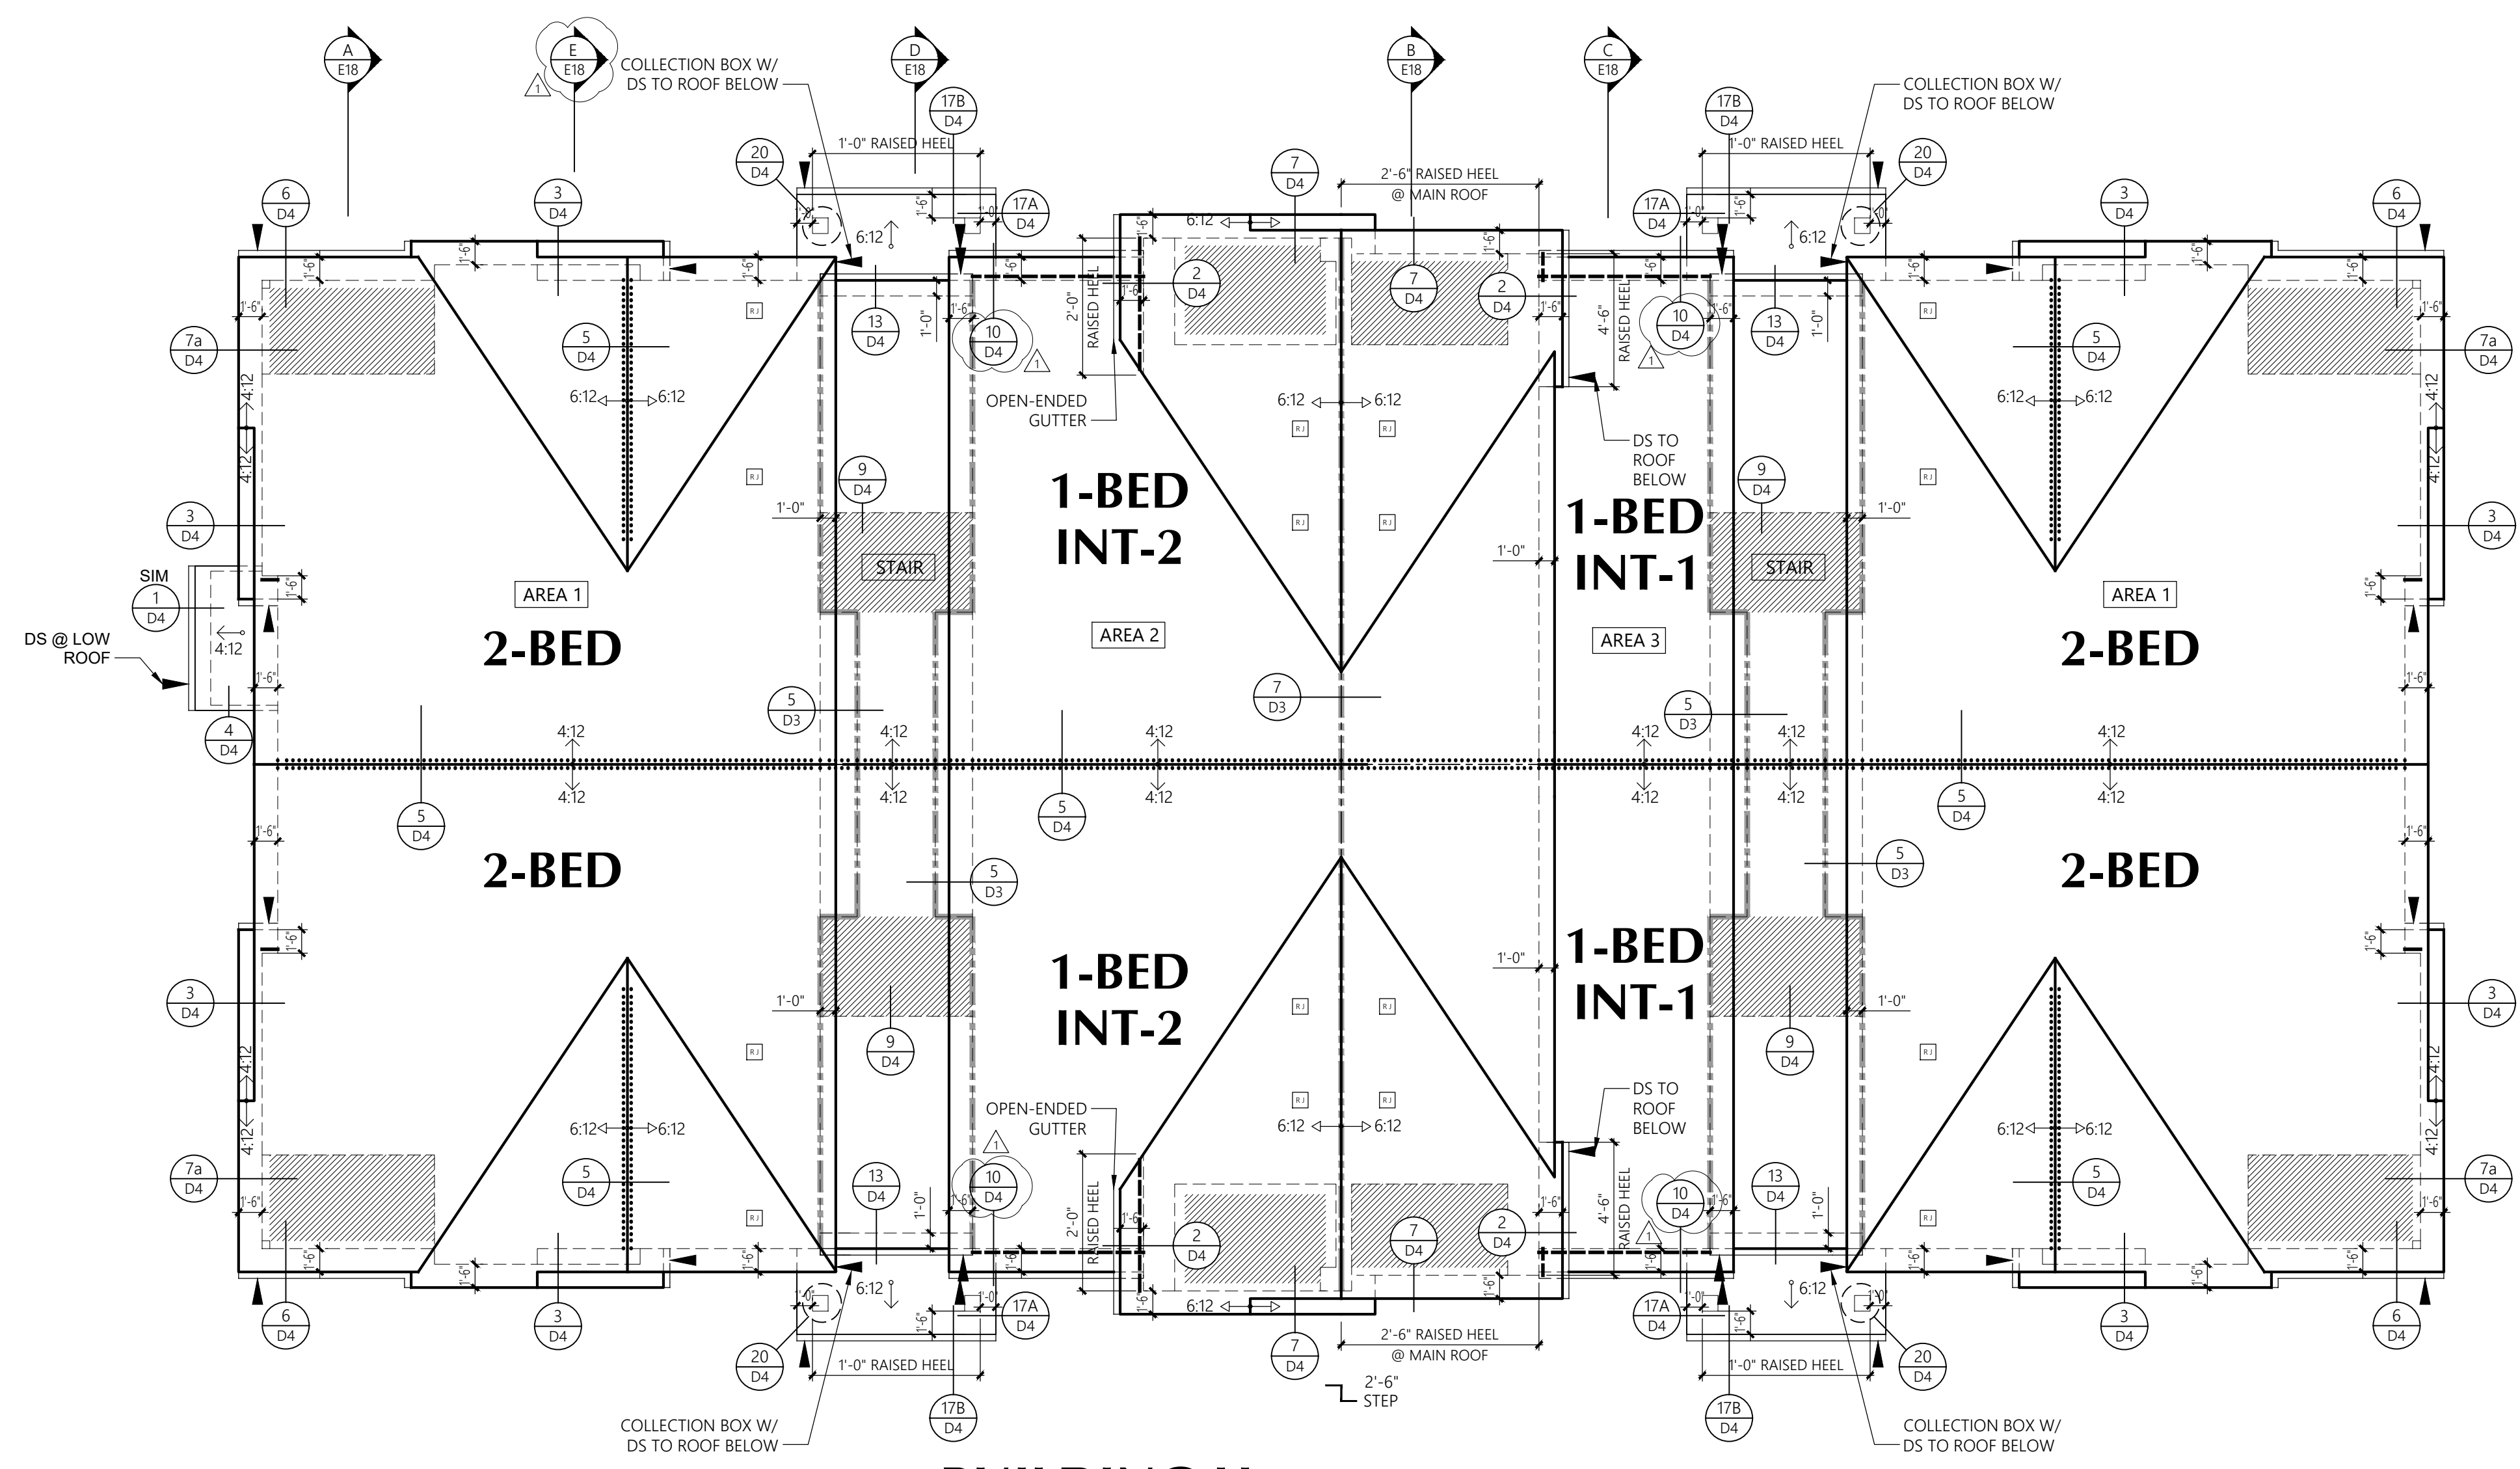

**BUILDING H** ROOF PLAN  
1/8" = 1'-0"


**ROOF VENTING CALCULATIONS**

Area Description	Attic Area (SF)	Venting Ratio	Required Venting (SI)	Low Eave Vent (LF)		High Jacks (Qty)		Vented Soffit (SF)	Ridge Vent (LF)		Venting Provided (SI)				% of req'd	
				2.4	50.0	50.0	5.9		12.0	Lower	%	Upper	%	Total	%	
AREA 1	2,265	1/ 300	1,087	0	4	0	116	68	884	52%	816	48%	1,700	156%		
AREA 2	1,580	1/ 300	758	36	0	4	102	25	688	58%	500	42%	1,188	157%		
AREA 3	1,556	1/ 300	747	20	0	4	108	24	685	58%	488	42%	1,173	157%		
STAIR	492	1/ 150	472	0	0	0	124	5	732	92%	60	8%	792	168%		


Detail and show draftstops in attic as needed per Washington State Building Code, 708.4.2. Update the attic ventilation as needed based upon changes for draftstops.  
(Construction Set, Sheet R8, Unit Plans)

**ROOF LEGEND**


- ROOF JACK 50 SQ.IN. NET FREE AREA
- 4:12 SLOPE INDICATOR U.N.O.
- 6:12 SLOPE INDICATOR U.N.O.
- BUILDING OUTLINE
- EAVE VENTING 2.4 SQ.IN./L.F. NET FREE AREA
- RIDGE VENTING 12 SQ.IN./L.F. NET FREE AREA
- UNIT SEPARATION AND DRAFT STOPPING LOCATIONS AT ATTIC
- GUTTER (DOUBLE LINE)
- DOWNSPOUT LOCATION
- VENTED FIBER CEMENT SOFFIT 5.9 SQ.IN./L.F. NET FREE AREA

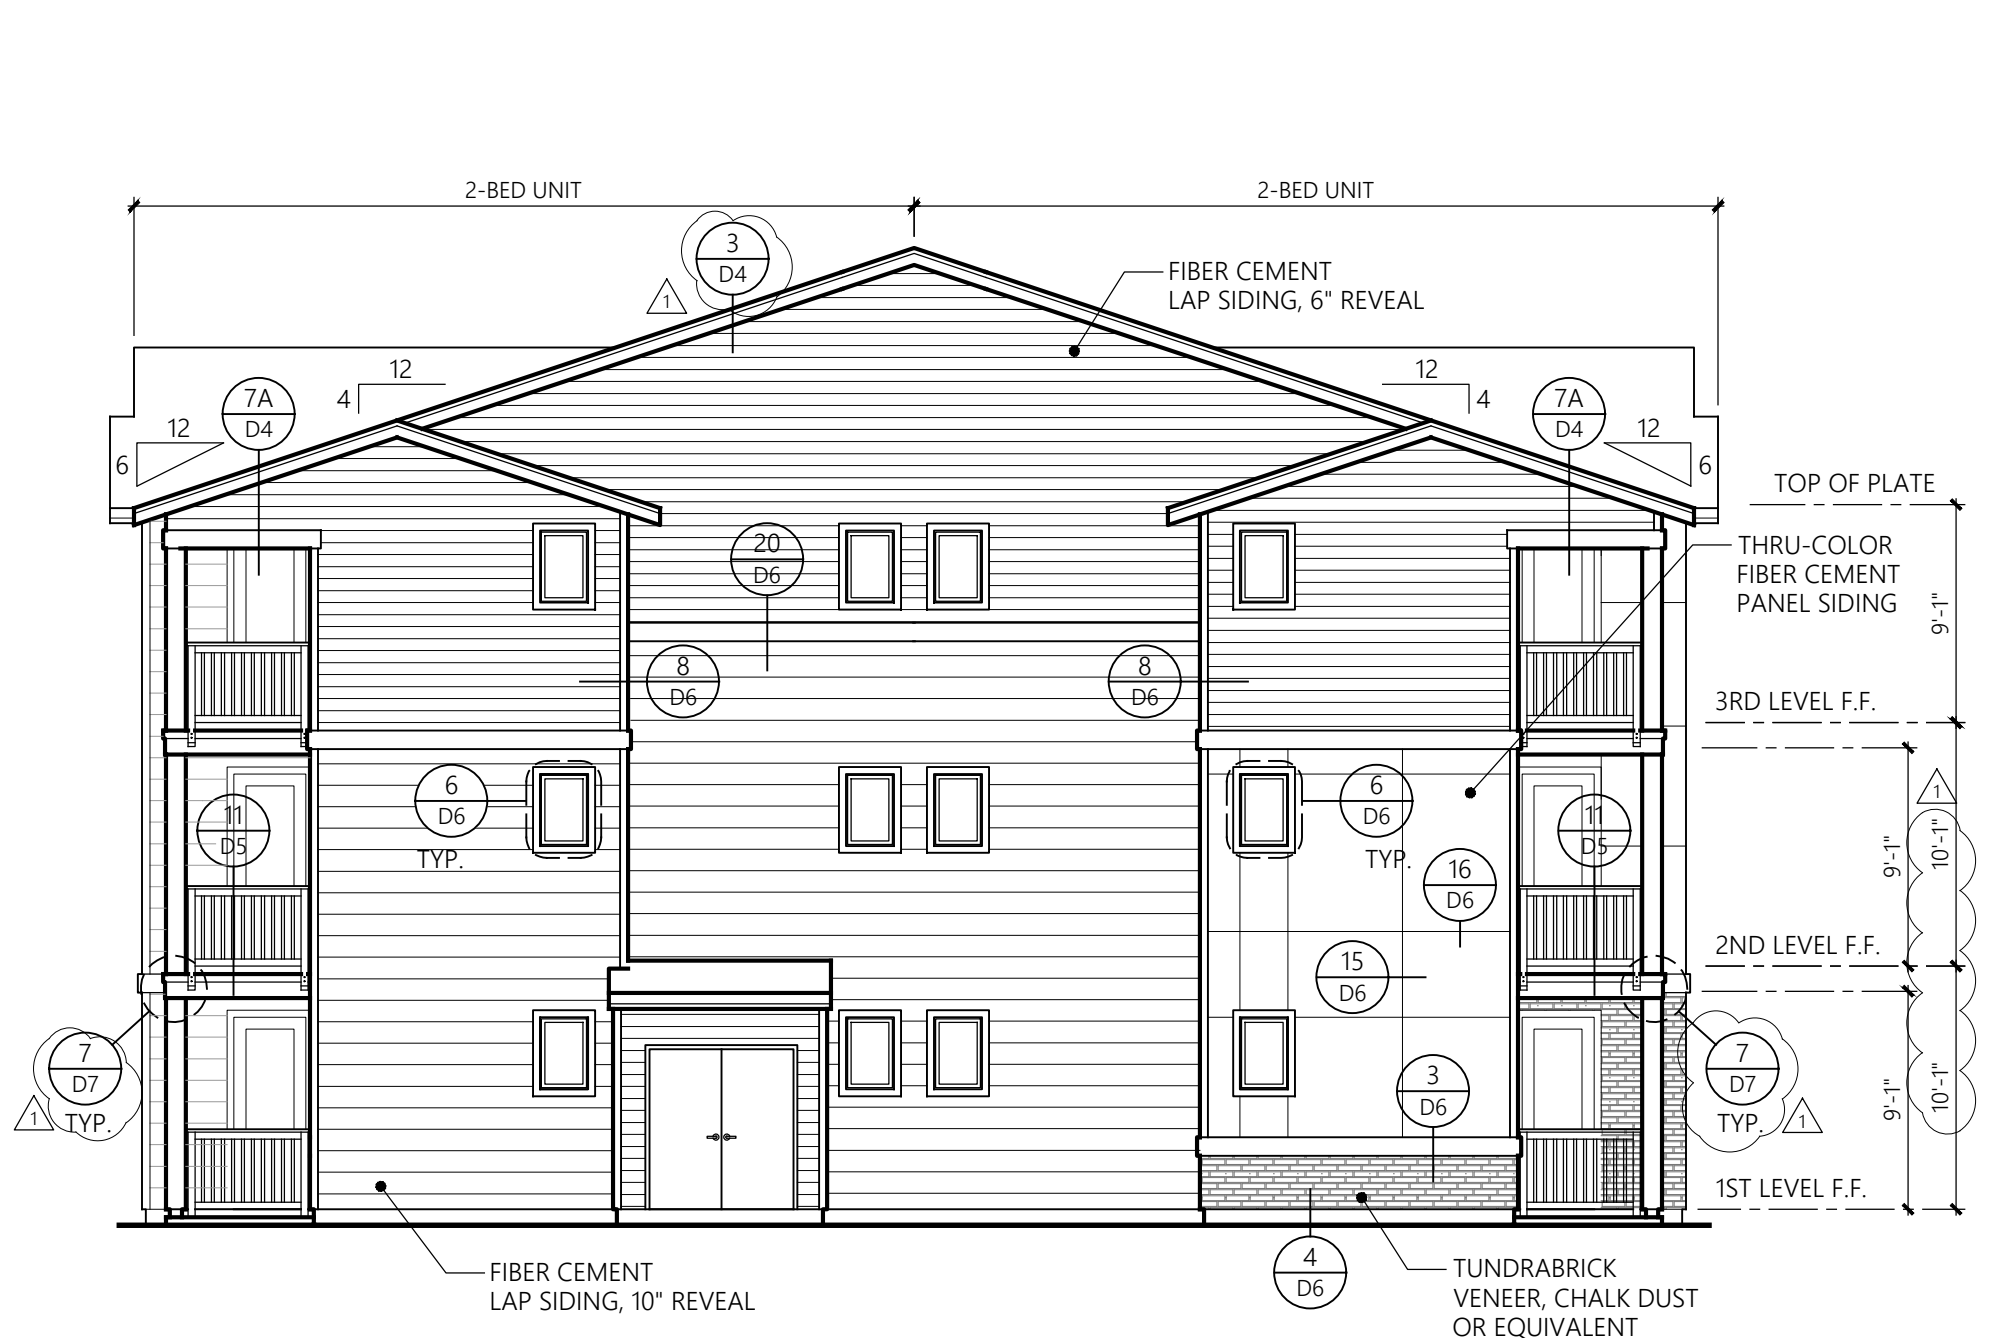


**BUILDING H** SIDE ELEVATION  
1/8" = 1'-0"  
ELEVATION SCHEME 1

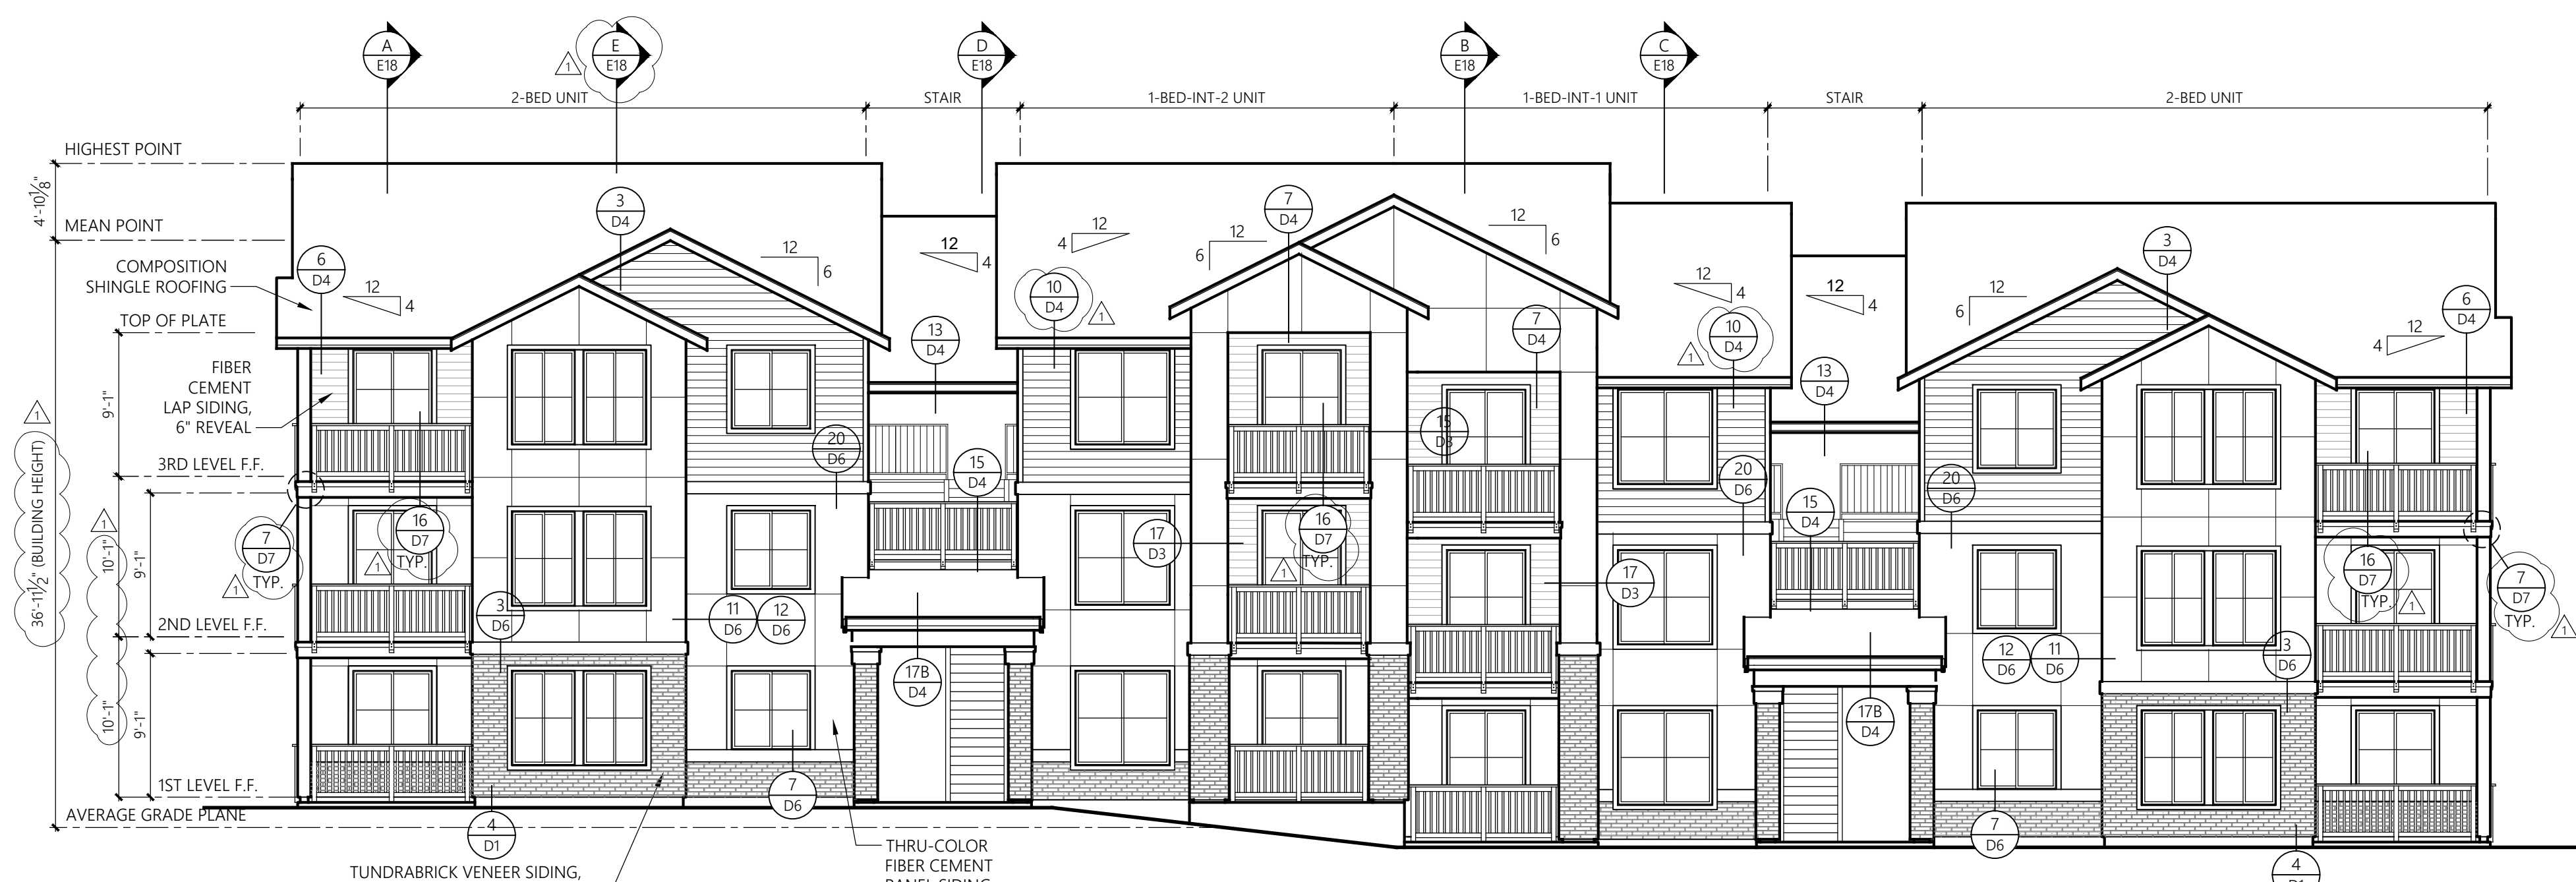

**BUILDING H** FRONT ELEVATION  
1/8" = 1'-0"  
ELEVATION SCHEME 1

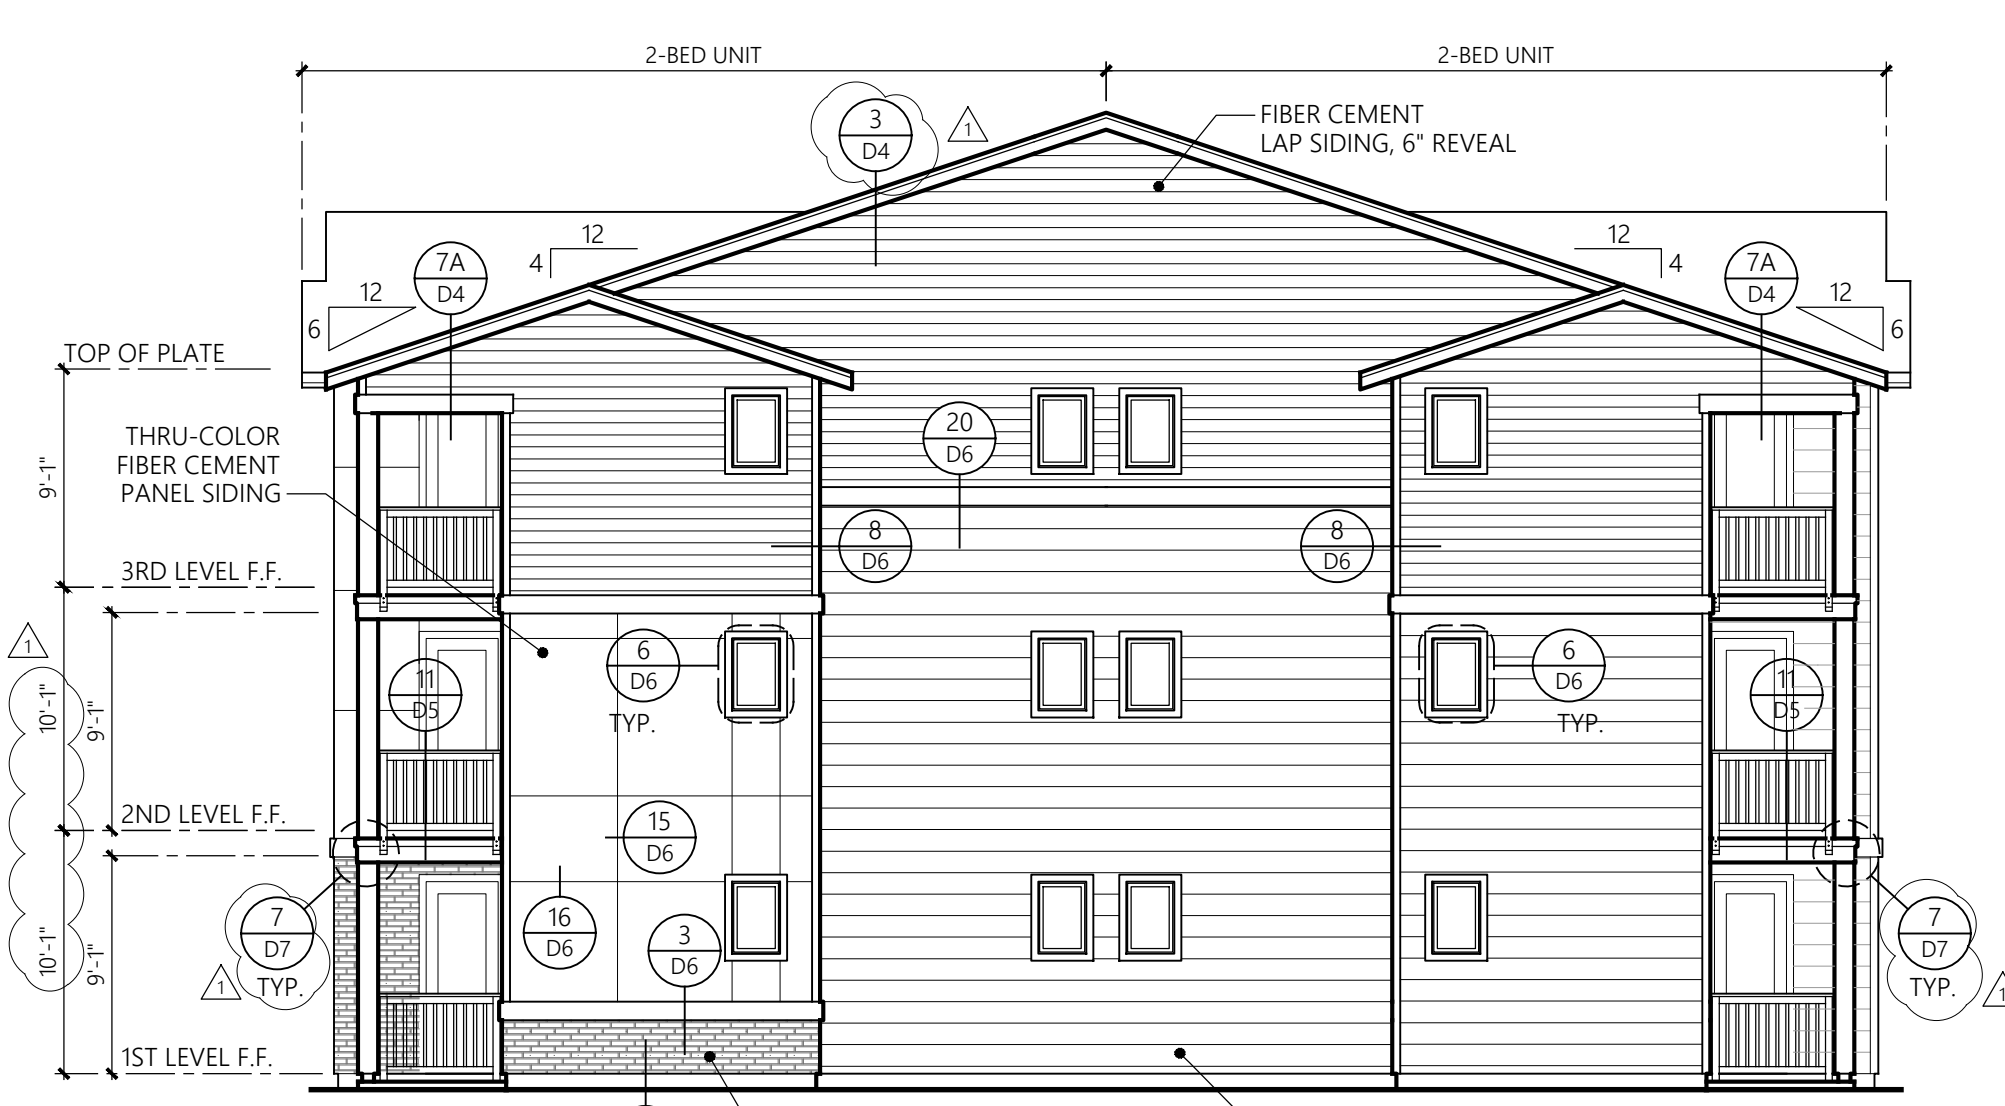

**BUILDING H** SIDE ELEVATION  
1/8" = 1'-0"  
ELEVATION SCHEME 1

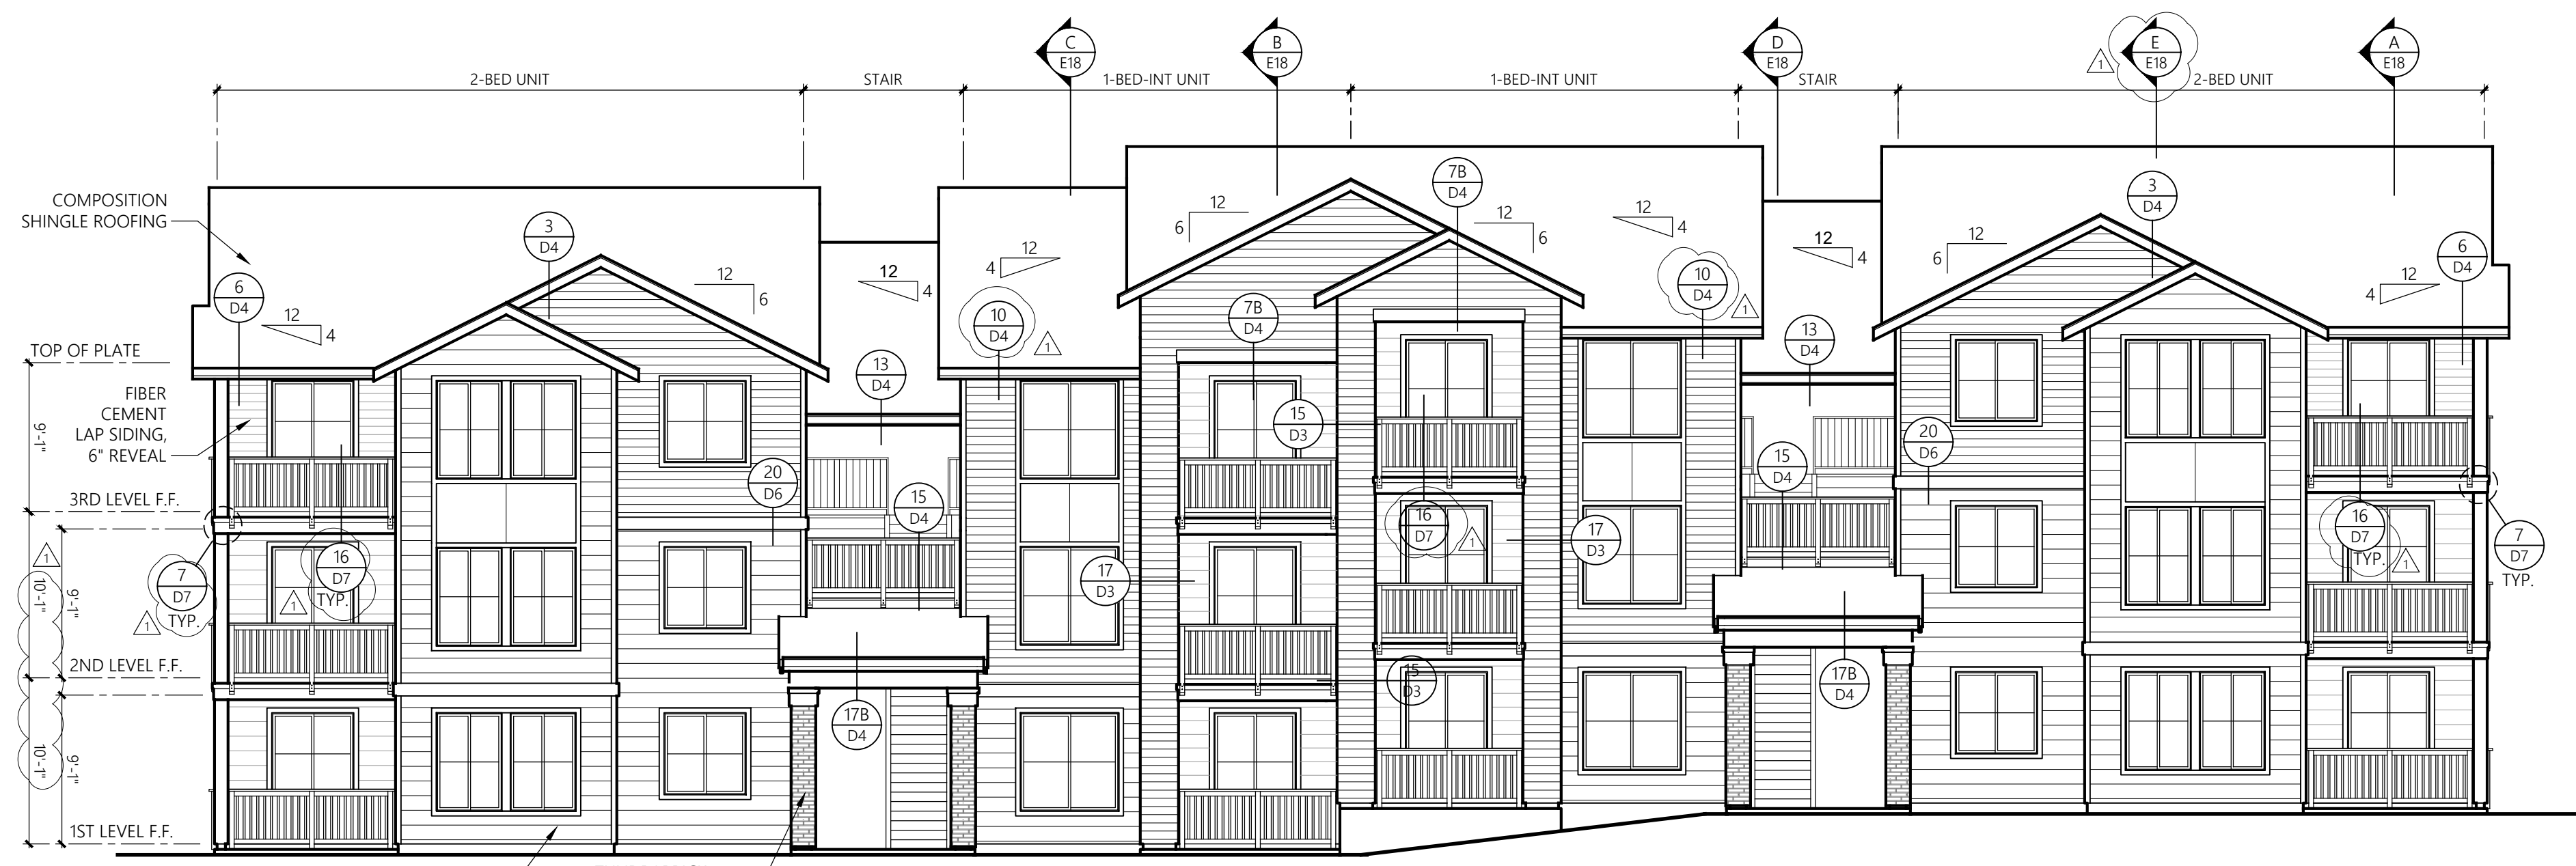

**BUILDING H** REAR ELEVATION  
1/8" = 1'-0"  
ELEVATION SCHEME 1

**Building H**  
Exterior Elevations

**Bradley Heights Apartments**  
Puyallup, Wa






**Timberlane Partners**

**Revisions**

No.	Date	Description
1	8-30-24	Owner Changes/ Permit Corrections

Initial Publish Date:  
Date Plotted: 12-20-24  
Job No.: 23-06  
Drawn By: APT/HDM/TMK  
Sheet No.:

**CONTRACTOR NOTE**  
Studs shall be continuous  
from support at sole plate to  
a support at the top plate, per  
Washington State Building  
Code 23080.5.1

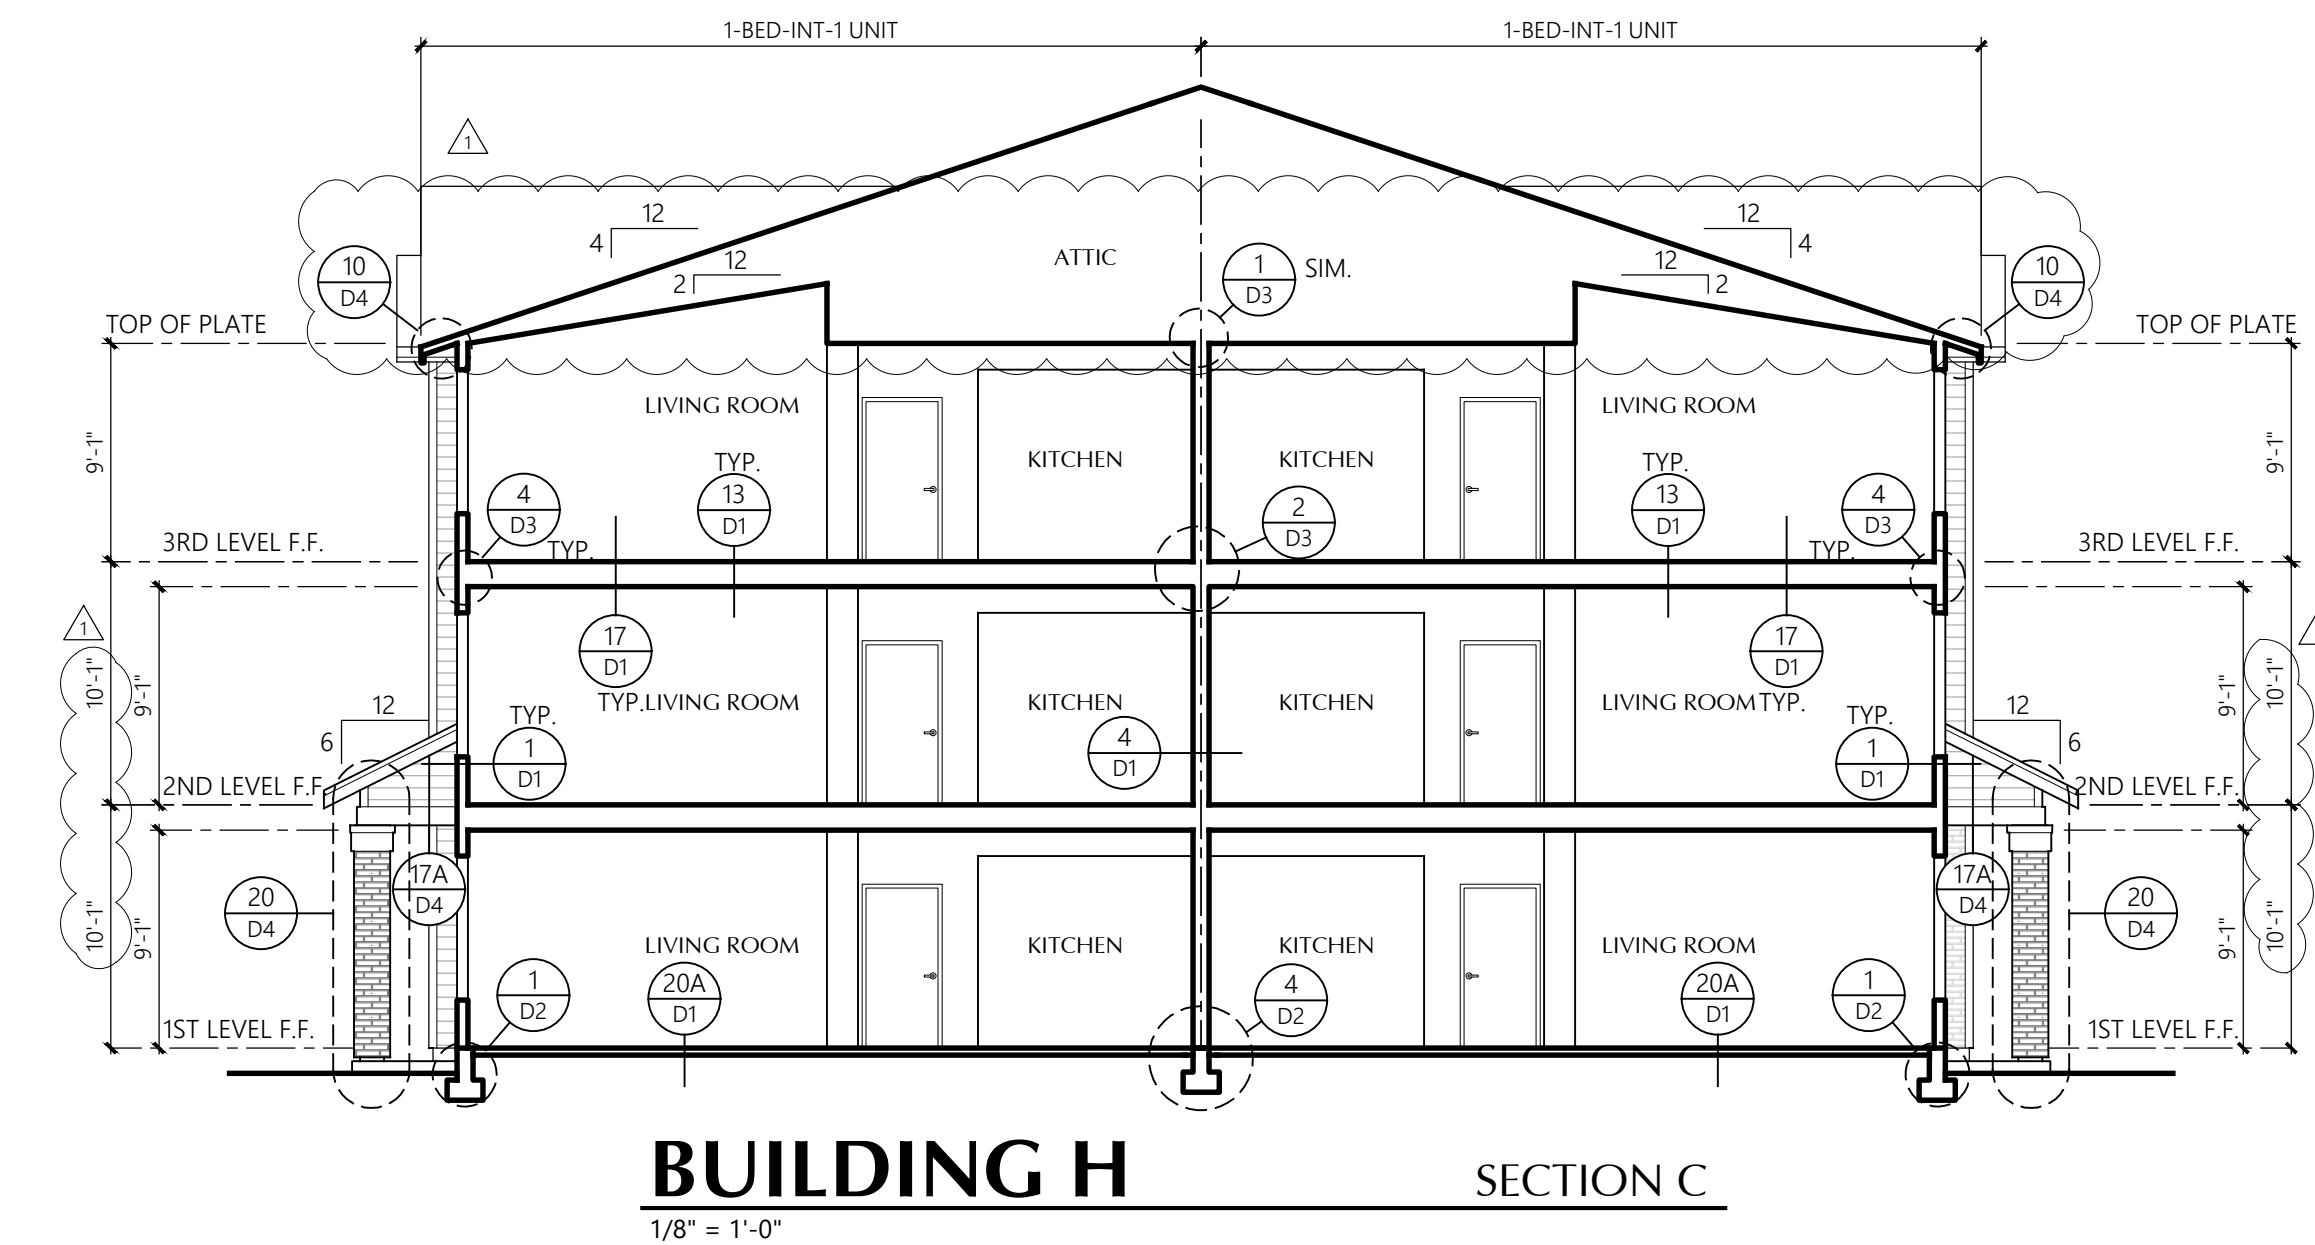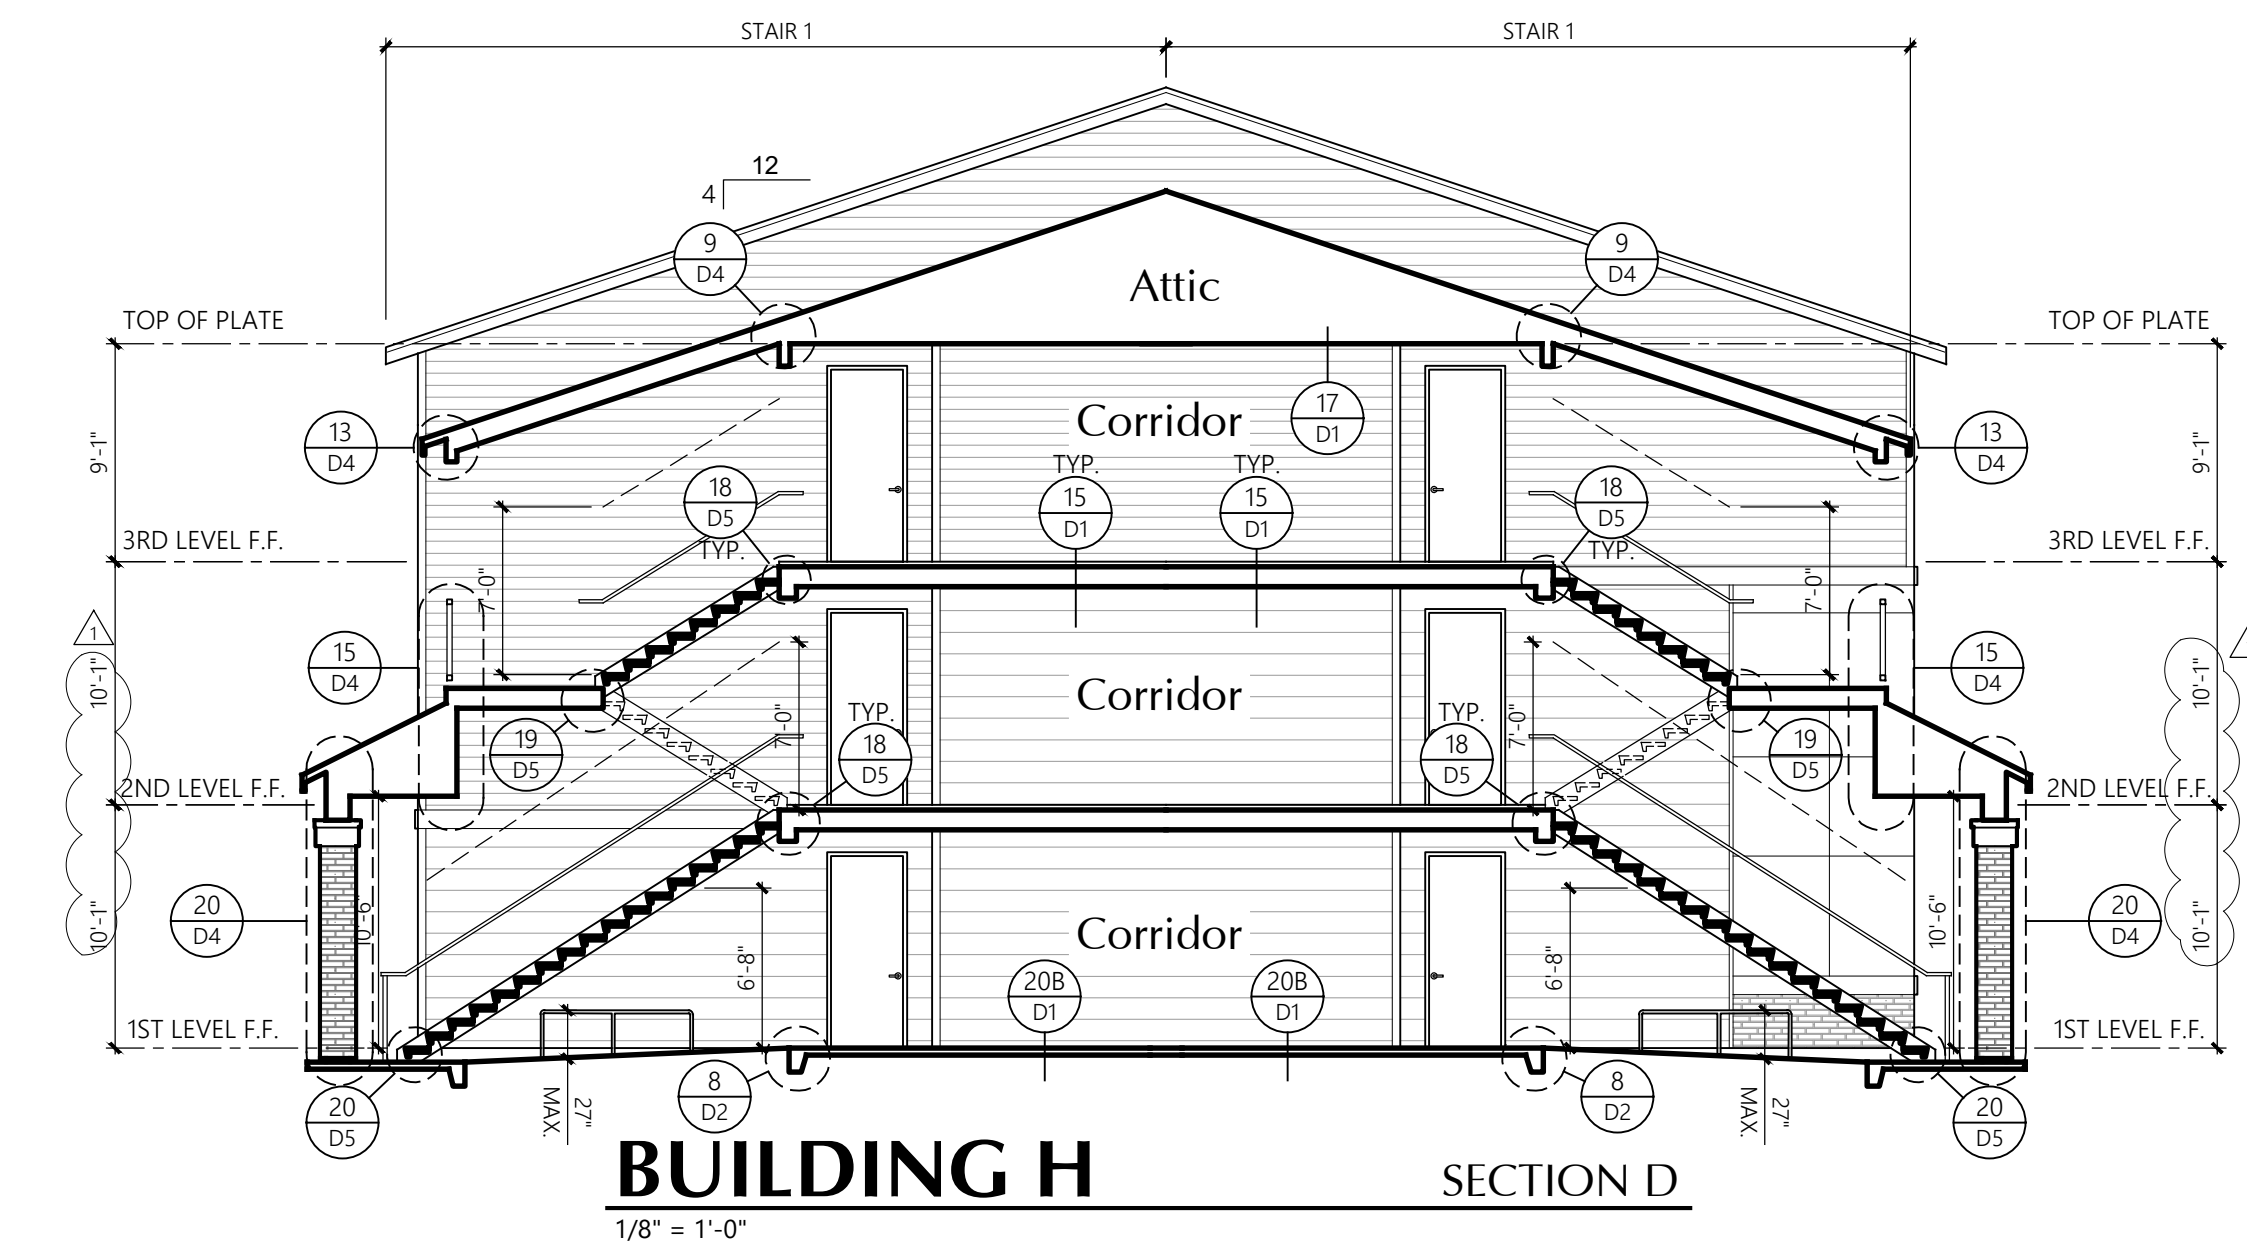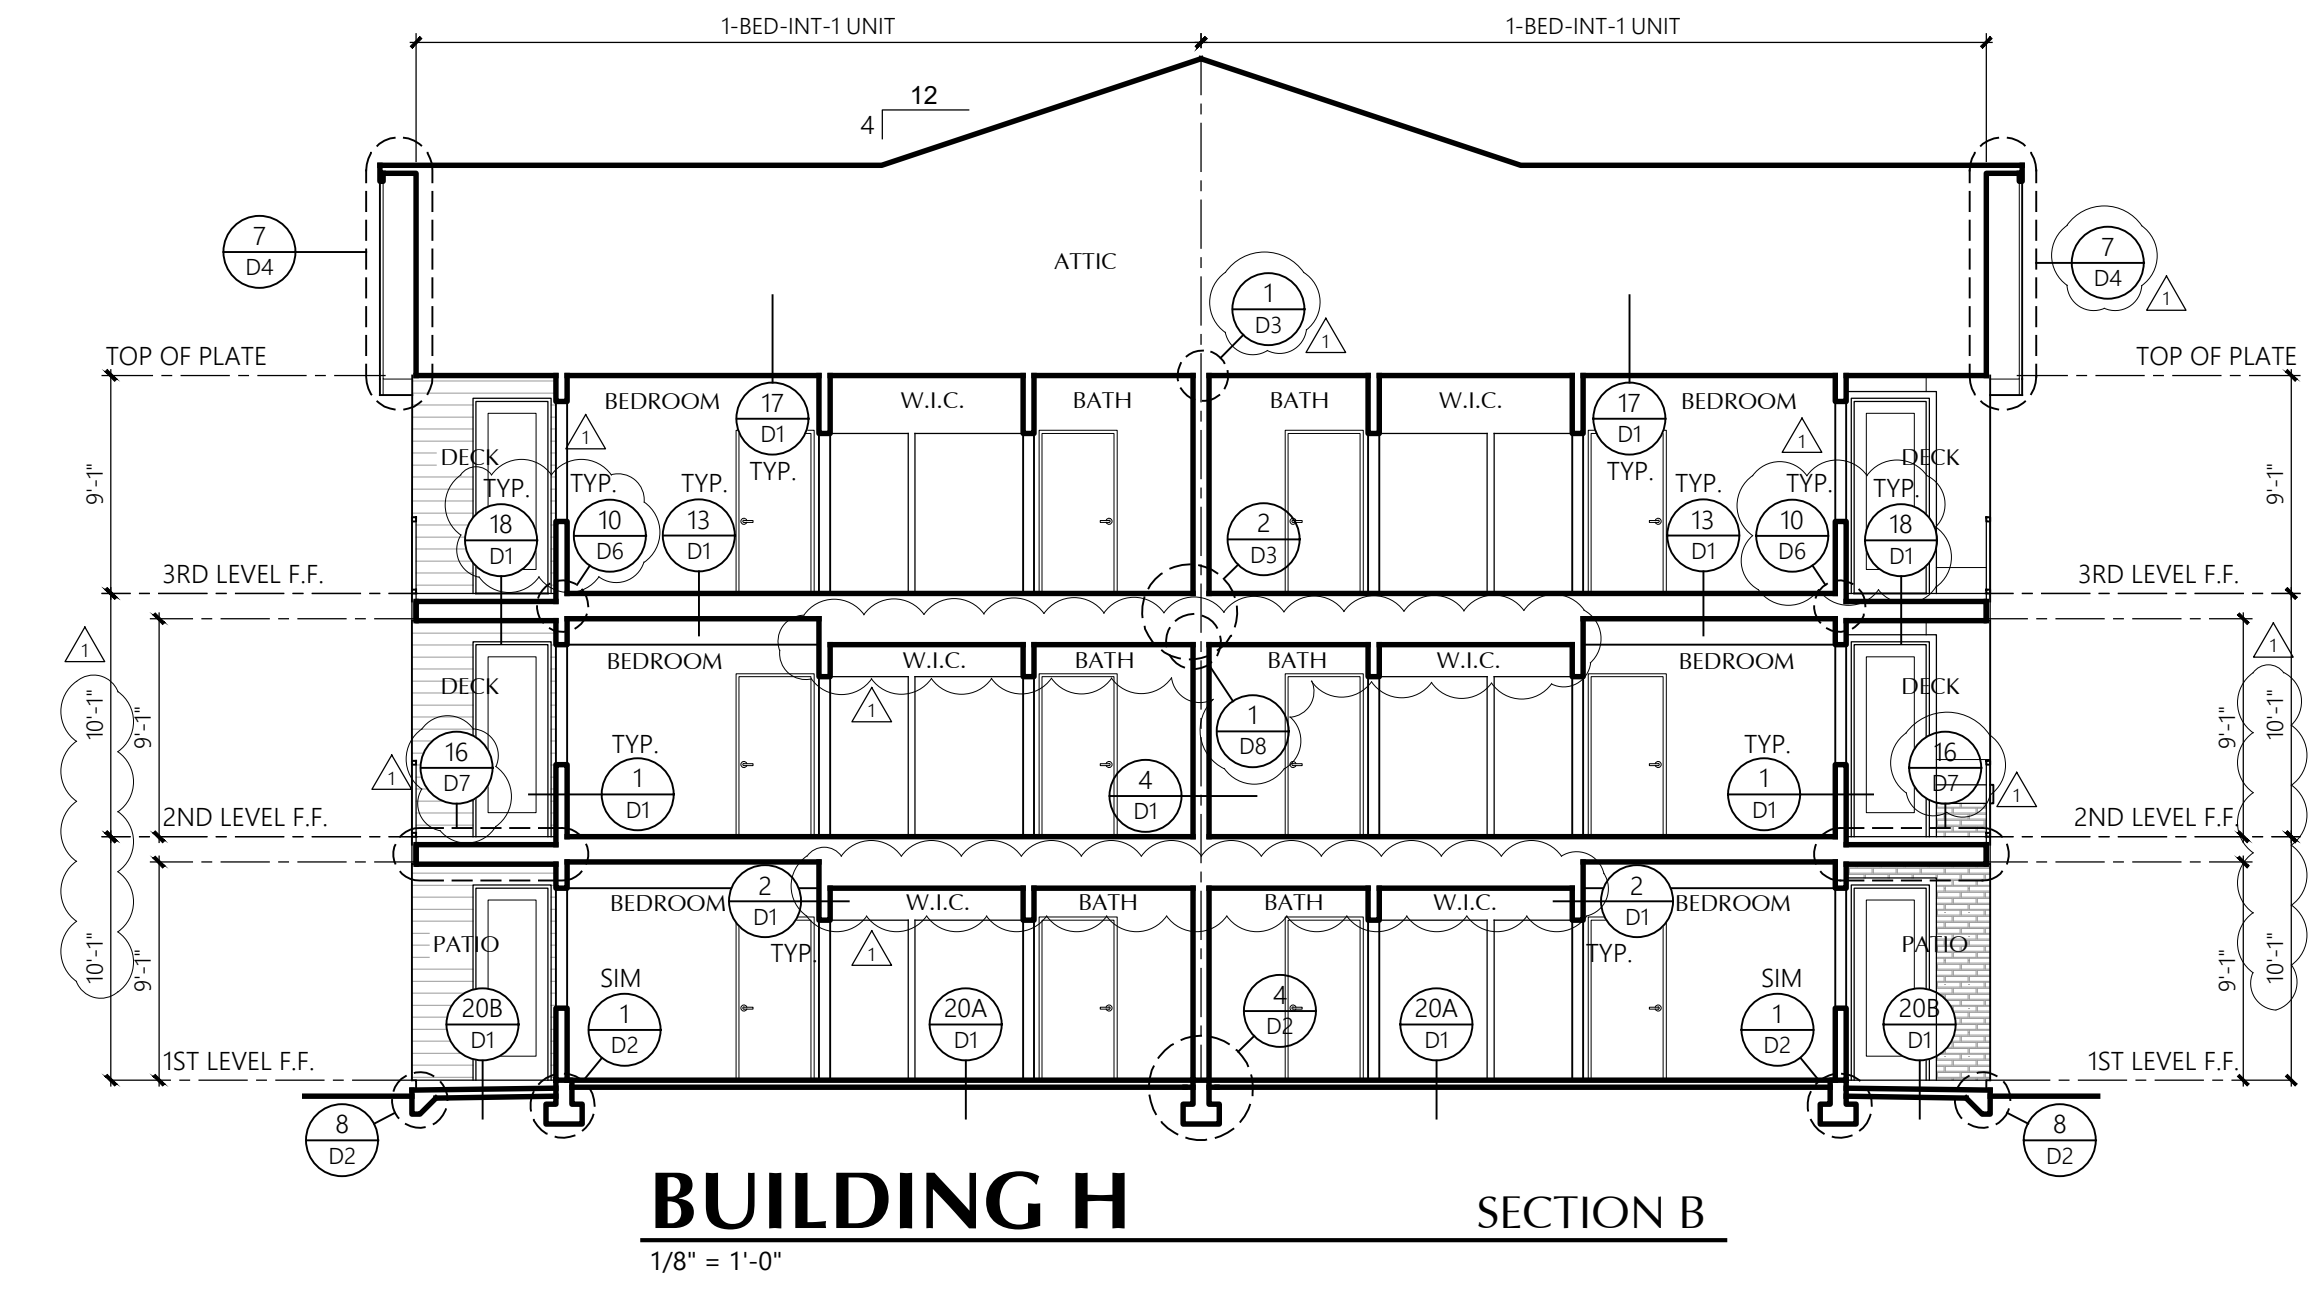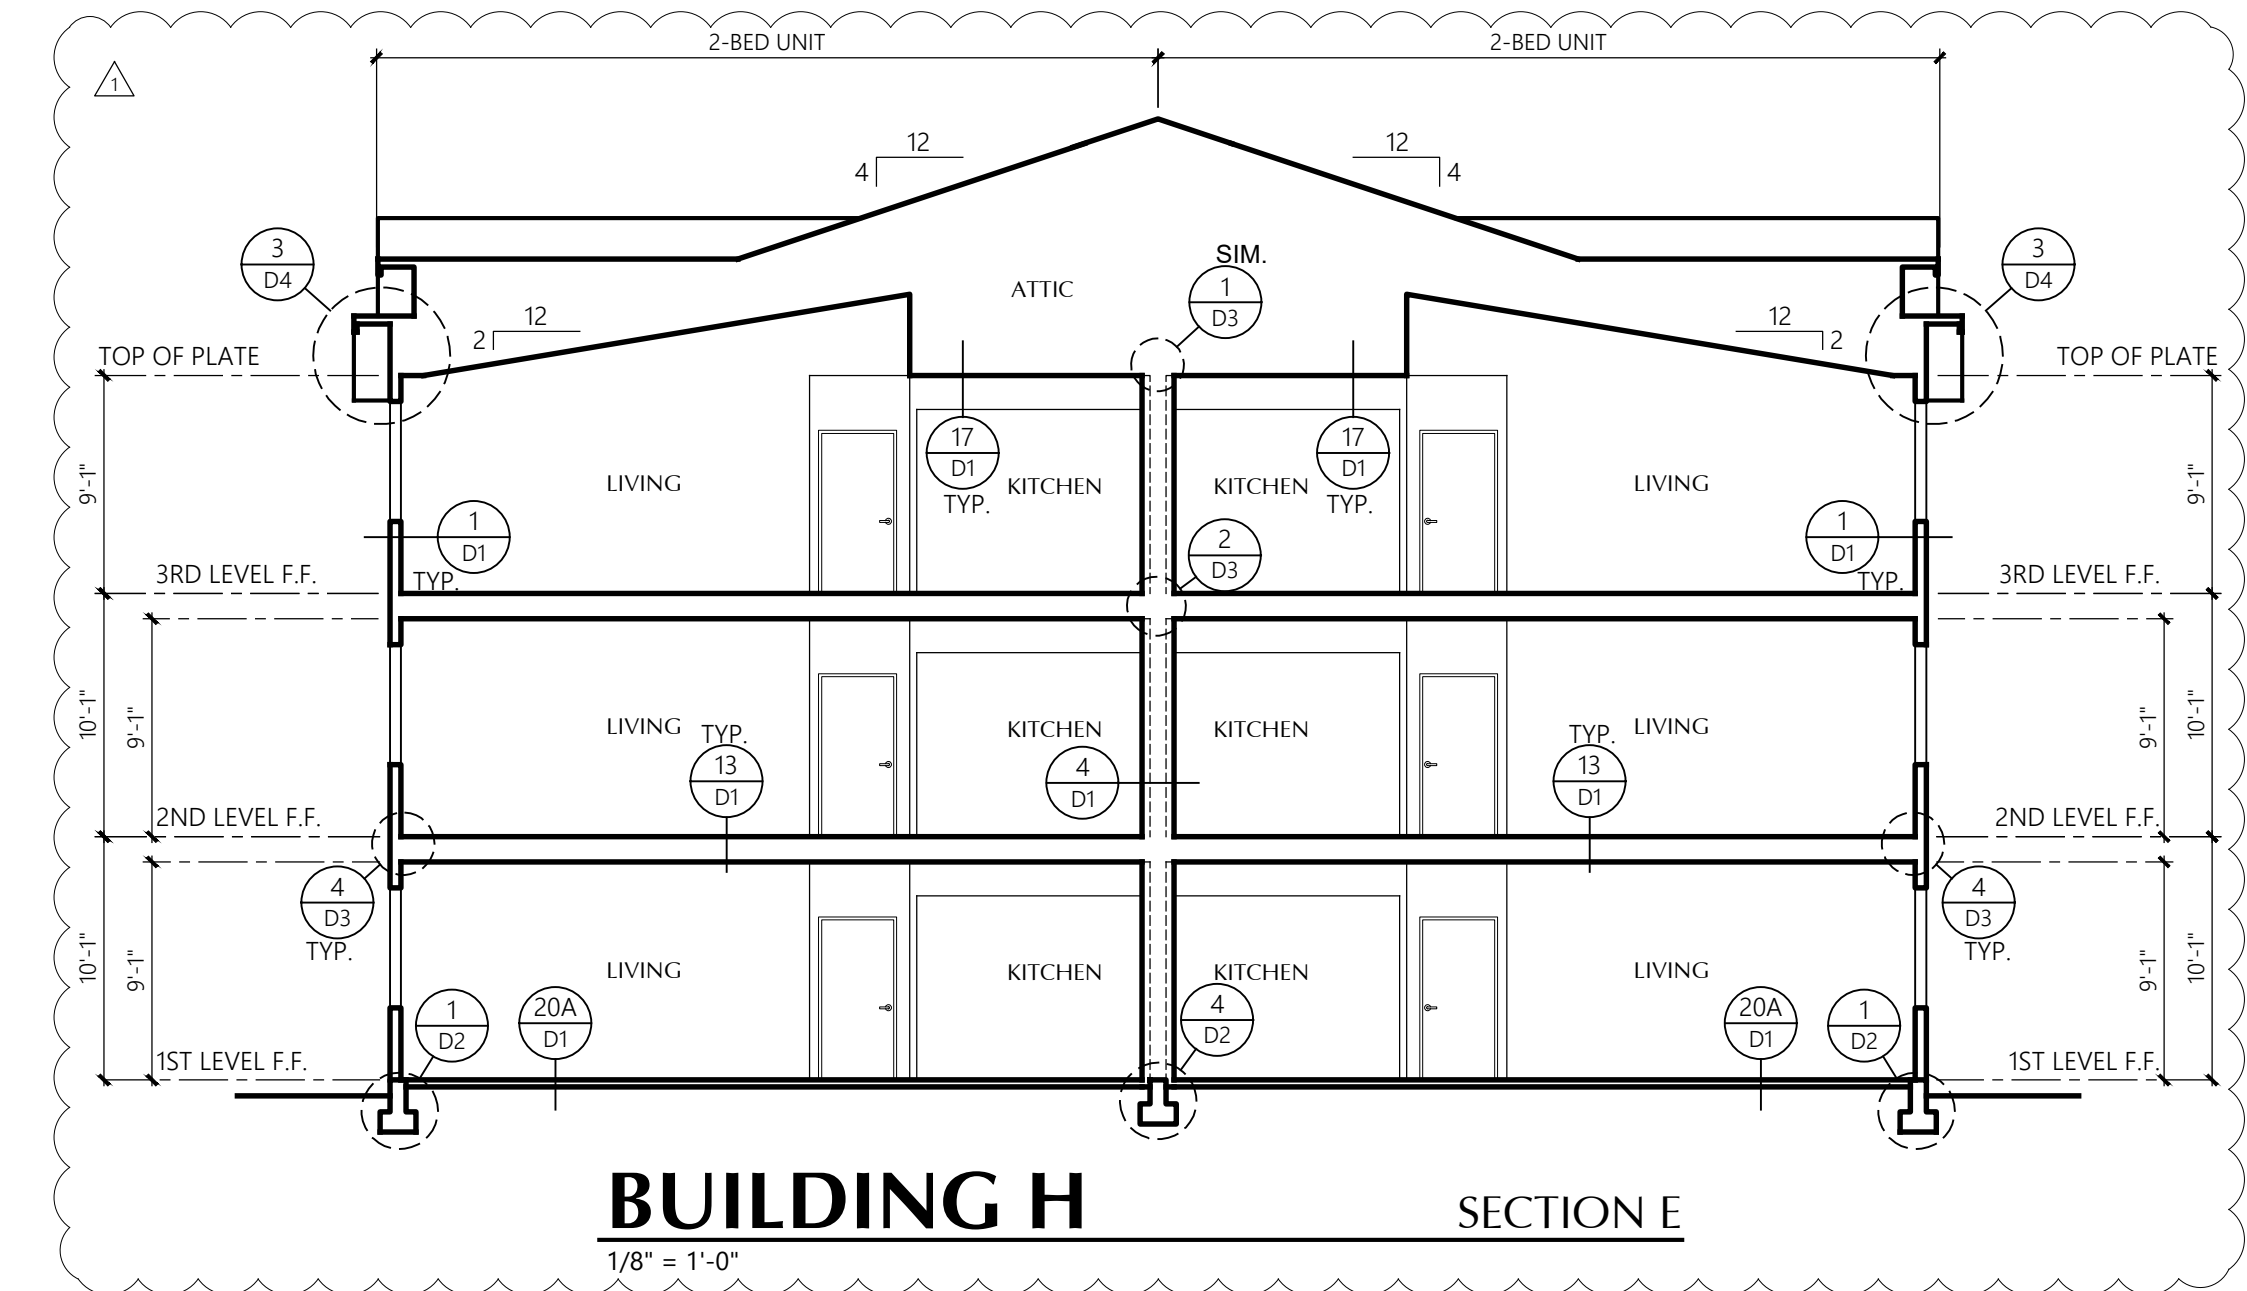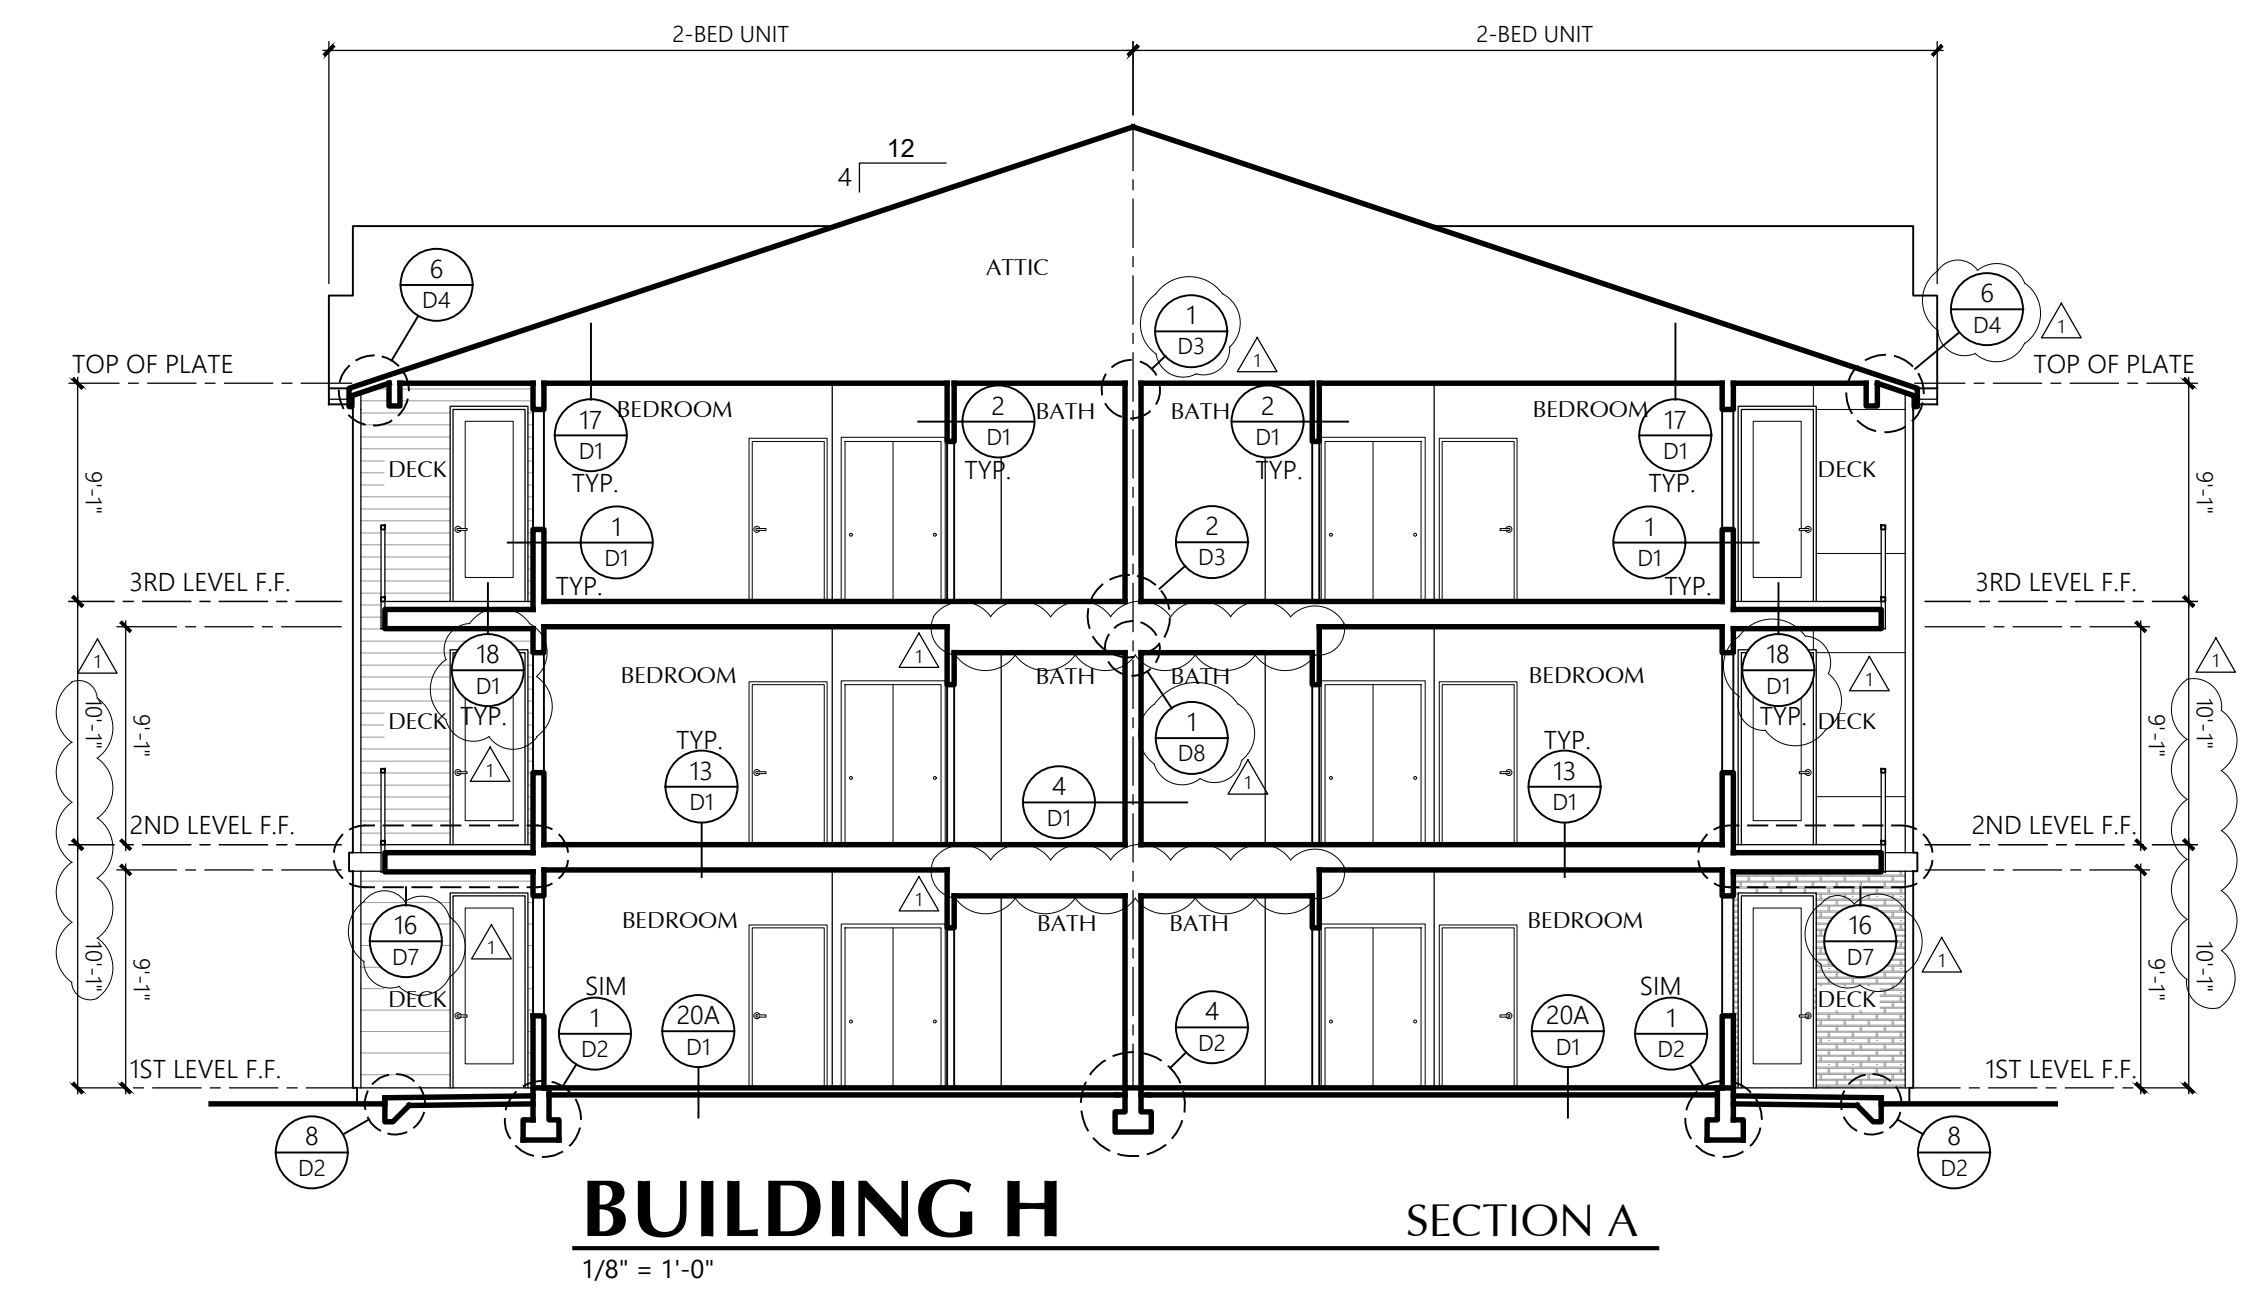

**Building H**  
Building Sections


**Bradley Heights Apartments**  
Puyallup, Wa

**Timberlane Partners**

**Revisions**

No.	Date	Description
1	8-30-24	Owner Changes/ Permit Corrections

Initial Publish Date:  
Date Plotted: 12-20-24  
Job No.: 23-06 APT/HDM/TMK  
Drawn By:  
Sheet No.:

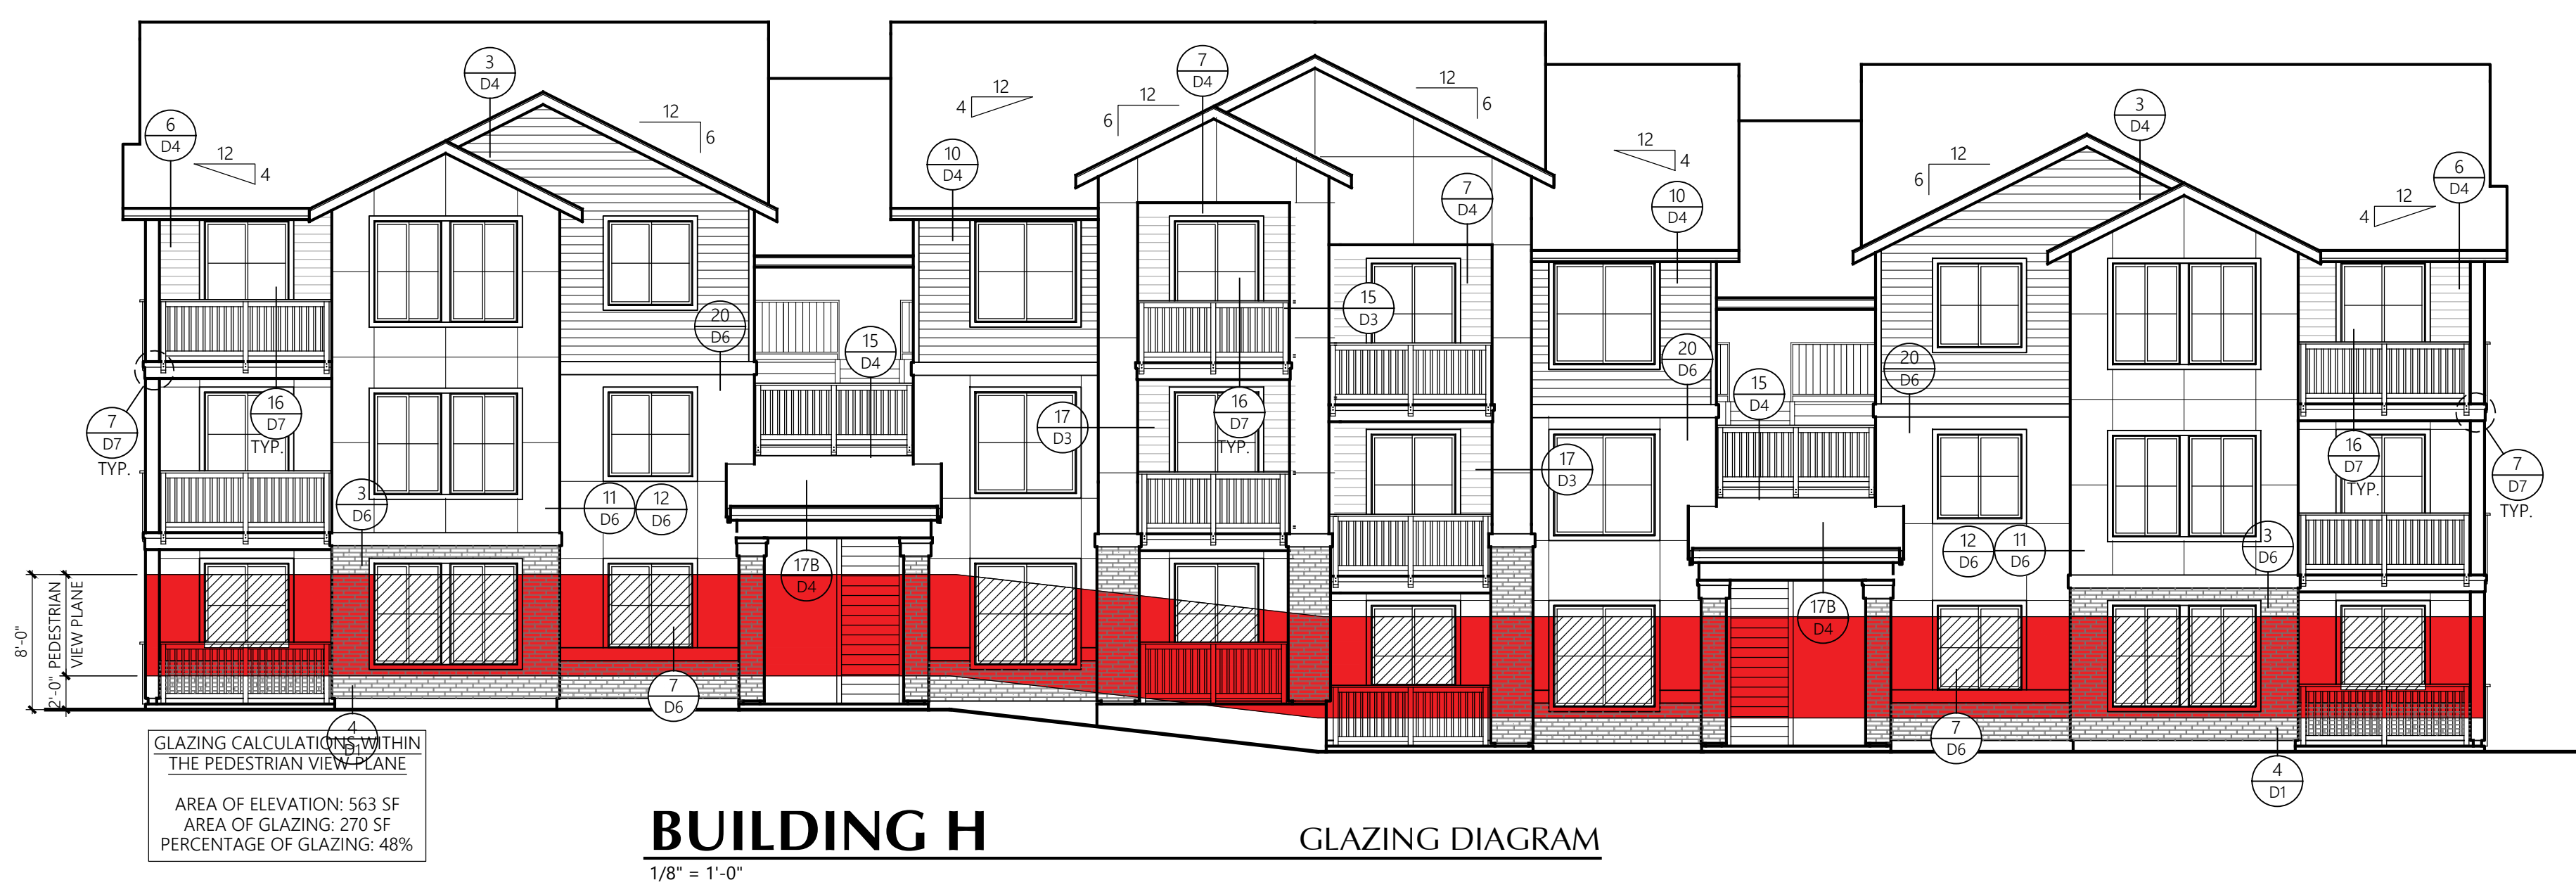

**Building Glazing Diagram**  
Building H

**Bradley Heights Apartments**  
Puyallup, Wa

**Timberlane Partners**

**Revisions**

No.	Date	Description
-----	------	-------------

Initial Publish Date:	
Date Plotted:	12-20-24
Job No.:	23-06
Drawn By:	APT/DJV/JLL
Sheet No.:	



# STRUCTURAL NOTES-TABLES

WIND PRESSURE TABLE FOR COMPONENTS & CLADDING (ASD)						
ROOF SURFACES <sup>1</sup>						
EFFECTIVE WIND AREA	POSITIVE PRESSURE (PSF)			NEGATIVE PRESSURE (PSF)		
	ZONE <sup>2</sup>					
	1	2	3	1	2	3
10 SF	7.80	7.80	7.80	-12.39	-21.56	-31.89
20 SF	7.04	7.04	7.04	-12.01	-19.65	-29.59
50 SF	6.27	6.27	6.27	-11.62	-17.74	-27.30
100 SF	5.51	5.51	5.51	-11.24	-15.83	-25.01
500 SF	5.51	5.51	5.51	-11.24	-15.83	-25.01

WALL SURFACES						
EFFECTIVE WIND AREA	POSITIVE PRESSURE (PSF)			NEGATIVE PRESSURE (PSF)		
	ZONE <sup>2</sup>					
	4	5	4	5	4	5
10 SF	12.18	12.18	-13.21	-16.31		
20 SF	11.56	11.56	-12.59	-15.07		
50 SF	10.94	10.94	-11.98	-13.83		
100 SF	10.32	10.32	-11.36	-12.57		
500 SF	9.08	9.08	-10.12	-10.12		

1. NET WIND PRESSURES AT ROOF SURFACES = VALUE FROM TABLE ABOVE +2/3 DEAD LOAD (DEAD LOAD REDUCES NEGATIVE PRESSURE + ADDS TO POSITIVE PRESSURES)

2. ZONES ARE DEFINED BY FIGURE 30.6-1 ASCE/SEI 07-10 FOR ROOF AND WALL ELEMENTS

2018 International Building Code – Statement of Special Inspection						
MATERIAL/ TYPE INSPECTION	IBC CODE REFERENCE	REFERENCE STANDARD	FREQUENCY APPLICABLE TO THIS PROJECT			SCOPE OF SERVICE
			CONT.	PERIODIC	REQUIRED	
Site Preparation	Table 1705.6 Item 5	–	–	X	N/A	Inspection to determine that the site has been prepared in accordance with the approved soils or geotechnical report.
Prepared Fill – During Fill Preparation	Table 1705.6 Item 4	–	X	–	YES	Inspection to determine that the materials being used and maximum lift thicknesses comply with the approved report as specified in Section 1804.2.
Evaluation of in-place Density	Table 1705.6 Item 3	–	–	X	YES	Tests to determine, at the approved frequency, that the in-place dry density of the compacted fill complies with the approved report.
Footings and Foundations	1805.1 – 1805.9 Table 1705.6 Item 1	–	–	X	YES	Confirm soils suitable for the design allowable soil bearing pressure are present at bearing grade. Confirm the footing dimensions are as specified on the project plans.
Foundation Depth	Table 1705.6 Table 1705.6 Item 2	–	–	X	YES	Confirm excavation are extended to proper depth and have reached proper materials.


2018 International Building Code – Statement of Special Inspection						
CONCRETE CONSTRUCTION						
MATERIAL/ TYPE INSPECTION	IBC CODE REFERENCE	REFERENCE STANDARD	FREQUENCY APPLICABLE TO THIS PROJECT			SCOPE OF SERVICE
			CONT.	PERIODIC	REQUIRED	
Materials	1705.3.1, Table 1705.3 Item 1	Applicable ASTM material spec.; AISC 360, Section A3.3	–	X	YES	Manufacturer's Certificates of Compliance or Tests per Chapter 3 of ACI 318, per ASTM A 706, and per 1705.3.1
Installation of Reinforcing Steel	1910.4 Table 1705.3 Item 1	ACI 318.3.5; 7.1 – 7.7	–	X	YES	Inspection to confirm compliance with details shown on approved Construction Documents, Shop Drawings, ACI 318 and Code Section 1910.4
Welding of Reinforcing Steel	Table 1705.3 Item 2	AWS D1.4, ACI 318.3.5.2	–	–	N/A	Observation of reinforcing steel welding in accordance with Table 1705.2.2, Item 2, ( see attached steel construction table).
Bolt Installation	1908.5, 1901.1 Table 1705.3 Item 3	ACI 318: 8.1.3, 21.2.8	X	–	YES	Observation of anchor bolts to be installed in concrete prior to and during placement of concrete where allowable loads have been increased.
Formwork	Table 1705.3 Item 12	ACI 318.6.1.1	–	X	YES	Inspection for compliance with ACI 318, Section 6.1, 6.2, for shape, location and dimensions of concrete member being formed.
Concrete Strength	1910.10, Table 1705.3 Item 6	ASTM C 172, ASTM C 31, ACI 318.5.6, 5.8	–	X	NO	Evaluation of Concrete strength in accordance with ACI 318, Section 5.6 and in accordance with the requirements of IBC 1905.6.
Concrete Mixes	1904.2, 1910.2, 1910.3 Table 1705.3 Item 5	ACI 318: 4, 5.2–5.4	–	X	YES	Inspection for use of proper mix proportions and techniques, ACI 318, Chapter 4, Sections 5.2 – 5.4.
Concrete Sampling	1910.10 Table 1705.3 Item 6	ASTM C 172, ASTM C 31, ACI 318.5.6, 5.8	X	–	NO	
Concrete Placement	1910.6, 1910.7, 1910.8, Table 1705.3 Item 7	ACI 318.5.9, 5.10	X	–	YES	Inspection for proper application techniques; ACI 318, Sections 5.9 and 5.10
Curing Temperatures and Techniques	1910.9 Table 1705.3 Item 8	ACI 318: 5.11–5.13	–	X	NO	Inspection for maintenance of curing temperatures and techniques; ACI 318, Sections 5.11, 5.12 and 5.13.
Prestressed Concrete: Application Prestressing Forces	Table 1705.3 Item 9a	ACI 318: 18.20, ACI 18.18.4	X	–	NO	Field inspections of precast concrete members in accordance with ACI 318, Section 18.20.
Prestressed Concrete: Grouting of unbonded prestressing tendons in seismic-force-resisting system	Table 1705.3 Item 9b	ACI 318: 18.20, ACI 18.18.4	X	–	NO	Field inspections of precast concrete members in accordance with ACI 318, Chapter 18.18.4.
Manufacture of Precast Concrete	1704.2.1	–	–	X	NO	Certificate from Independent Agency and current agreement for periodic (minimum 6 month intervals) in-plant quality assurance inspections.
Erection of Precast Concrete	Table 1705.3 Item 10	ACI 318: 16	–	X	NO	Field inspections of precast concrete members in accordance with ACI 318, Chapter 16.
Post Tensioning	Table 1705.3 Item 11	ACI 318: 6.2	–	X	NO	Verification of in-situ concrete strength, prior to stressing of tendons in post-tensioned concrete and prior to removal of shores and forms for beams and structural slabs in accordance with ACI 318, Section, 6.2.
Post Installed Anchors	1909.1, Table 1705.3 Item 11	ACI 318: 3.8.6, 8.1.3, 21.1.8	–	X	YES	Verification of anchors post installed in hardened concrete members.

2018 International Building Code – Statement of Special Inspection						
WOOD CONSTRUCTION						
MATERIAL/ TYPE INSPECTION	IBC CODE REFERENCE	REFERENCE STANDARD	FREQUENCY APPLICABLE TO THIS PROJECT			SCOPE OF SERVICE
			CONT.	PERIODIC	REQUIRED	
Fabrication – Inspection of Fabricator's Quality Control Procedures	1704.2.5	–	–	X	YES	Certificate from Independent Agency and current agreement for periodic (minimum 6 month intervals) in-plant quality assurance inspections.

2018 International Building Code – Statement of Special Inspection						
SPECIAL INSPECTIONS FOR SEISMIC RESISTANCE						
MATERIAL/ TYPE INSPECTION	IBC CODE REFERENCE	REFERENCE STANDARD	FREQUENCY APPLICABLE TO THIS PROJECT			SCOPE OF SERVICE
			CONT.	PERIODIC	REQUIRED	
Structural Steel	1705.11.1	AISC 341	X	–	N/A	Observation of structural welding in accordance with AISC Seismic. Not required for 5/16" single pass fillet welds or welding of metal deck.
Structural Wood: Inspection of field gluing operations of elements of the seismic force resisting system.	1705.11.2	–	X	–	N/A	Inspection of field gluing operations of elements of the seismic force resisting system.
Structural Wood: Inspection of nailing, bolting, anchoring and other fastening components within the seismic force resisting system, including drag struts, braces and hold-downs.	1705.11.2	–	–	X	YES	Inspection of nailing, bolting, anchoring and other fastening components within the seismic force resisting system, including drag struts, braces and hold-downs. Not required for nailing o.c., spacing greater than 4" o.c.
Cold-formed Steel Framing	1705.11.3	–	–	X	NO	Inspection of welding operations of elements of the seismic force resisting system.
Cold-formed Steel Framing	1705.11.3	–	–	X	NO	Inspection of screw attachments, bolting, anchoring and other fastening components within the seismic force resisting system, including struts, braces and hold-downs.

2018 International Building Code – Statement of Special Inspection						
STRUCTURAL OBSERVATIONS						
MATERIAL/ TYPE INSPECTION	IBC CODE REFERENCE	REFERENCE STANDARD	FREQUENCY APPLICABLE TO THIS PROJECT			SCOPE OF SERVICE
			CONT.	PERIODIC	REQUIRED	
Structural Observations	1704.5	–	–	X	If required by jurisdiction	Structural observations to be performed to observe general conformance to the construction documents.

Special Inspection required per Chapter 17 of the 2018 IBC - SUBMIT REPORTS TO INSPECTORS WITH THE CITY OF PUYALLUP

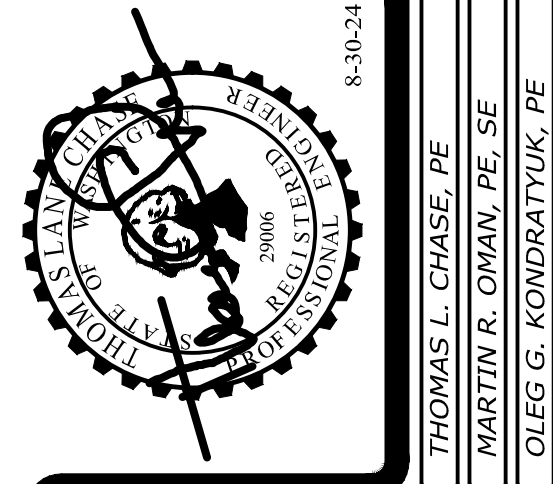

Revisions to this sheet:

**Bradley Heights Apartments**  
202 27th Ave SE  
Puyallup, Washington


**Solutions 4 Structures**  
A Structural Engineering Corporation

Puyallup, Washington 98374  
Ph. 253-314-9822  
www.solutions4structures.com


PROJECT NO. : 23-007  
 DESIGNED BY : TLC, OGG, MRO  
 DRAWN BY : RSO  
 ISSUE DATE : 2-20-24  
 LATEST REV. OF DWG. SET : 8-30-24

SUBMITTAL SET ONLY NOT FOR CONSTRUCTION  
 THESE DRAWINGS ARE SUBJECT TO REVISIONS  
 PENDING LOCAL JURISDICTIONAL REVIEW.


# S1.1

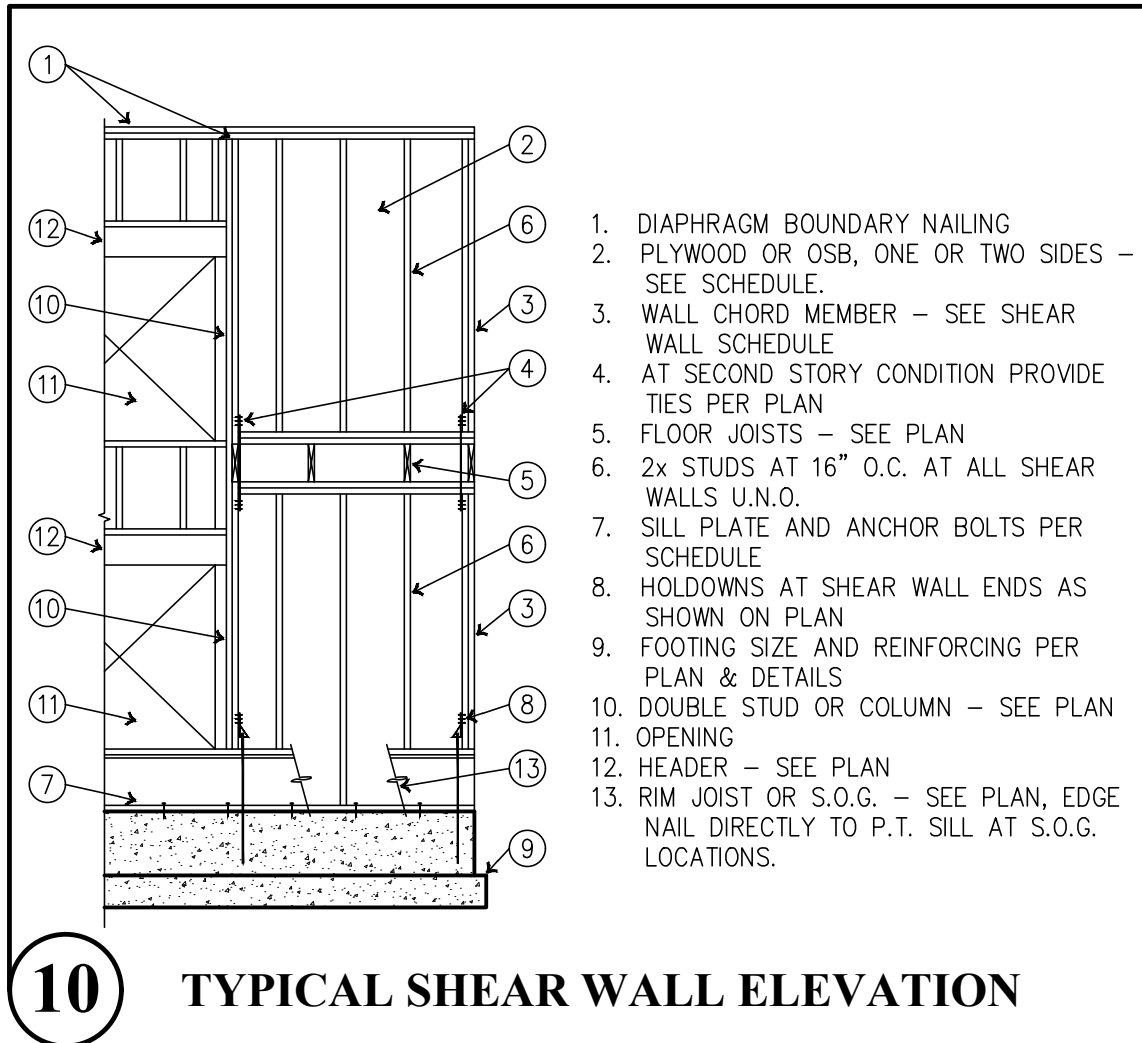


**10** TYPICAL SHEAR WALL ELEVATION

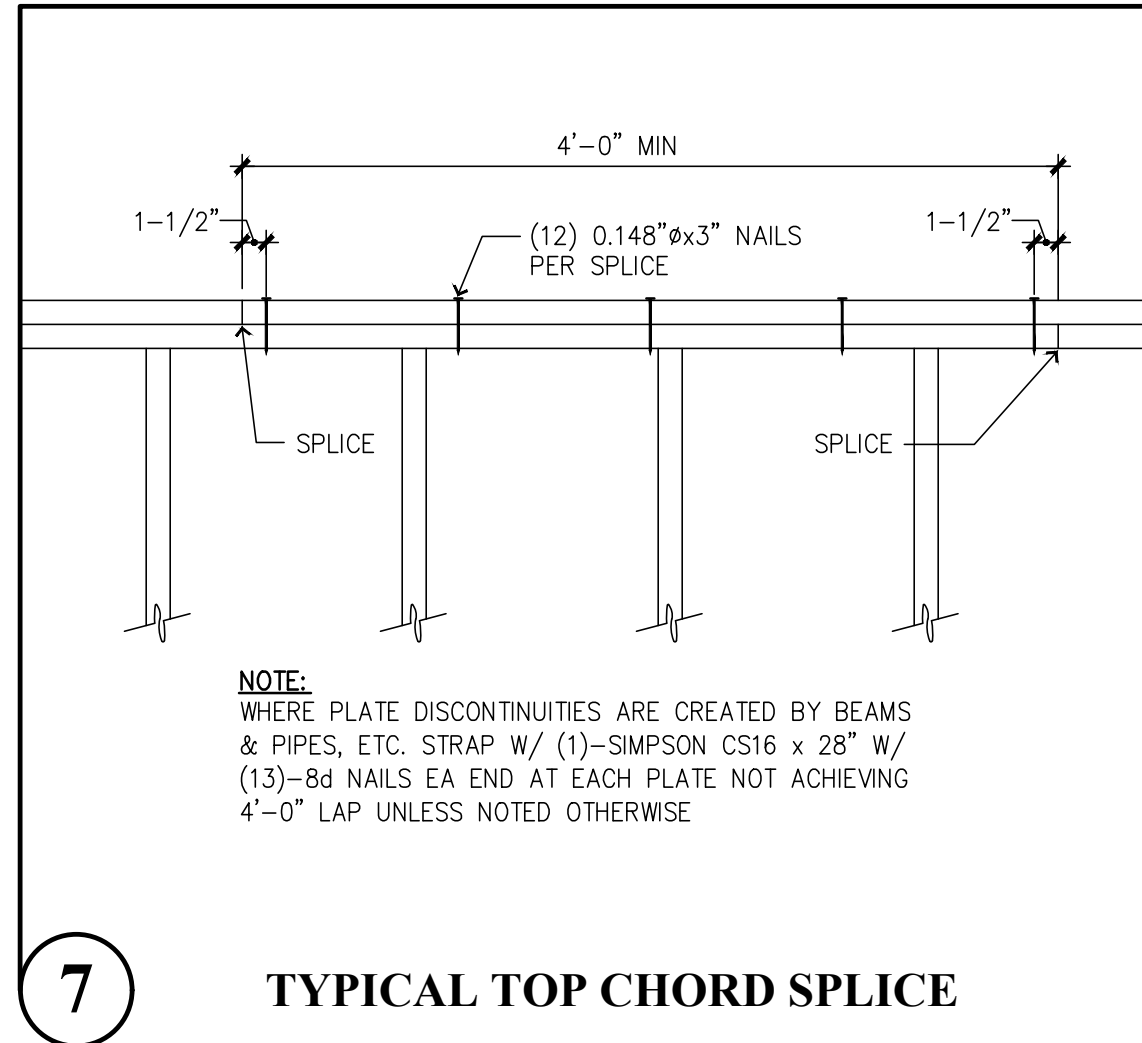


**7** TYPICAL TOP CHORD SPLICE

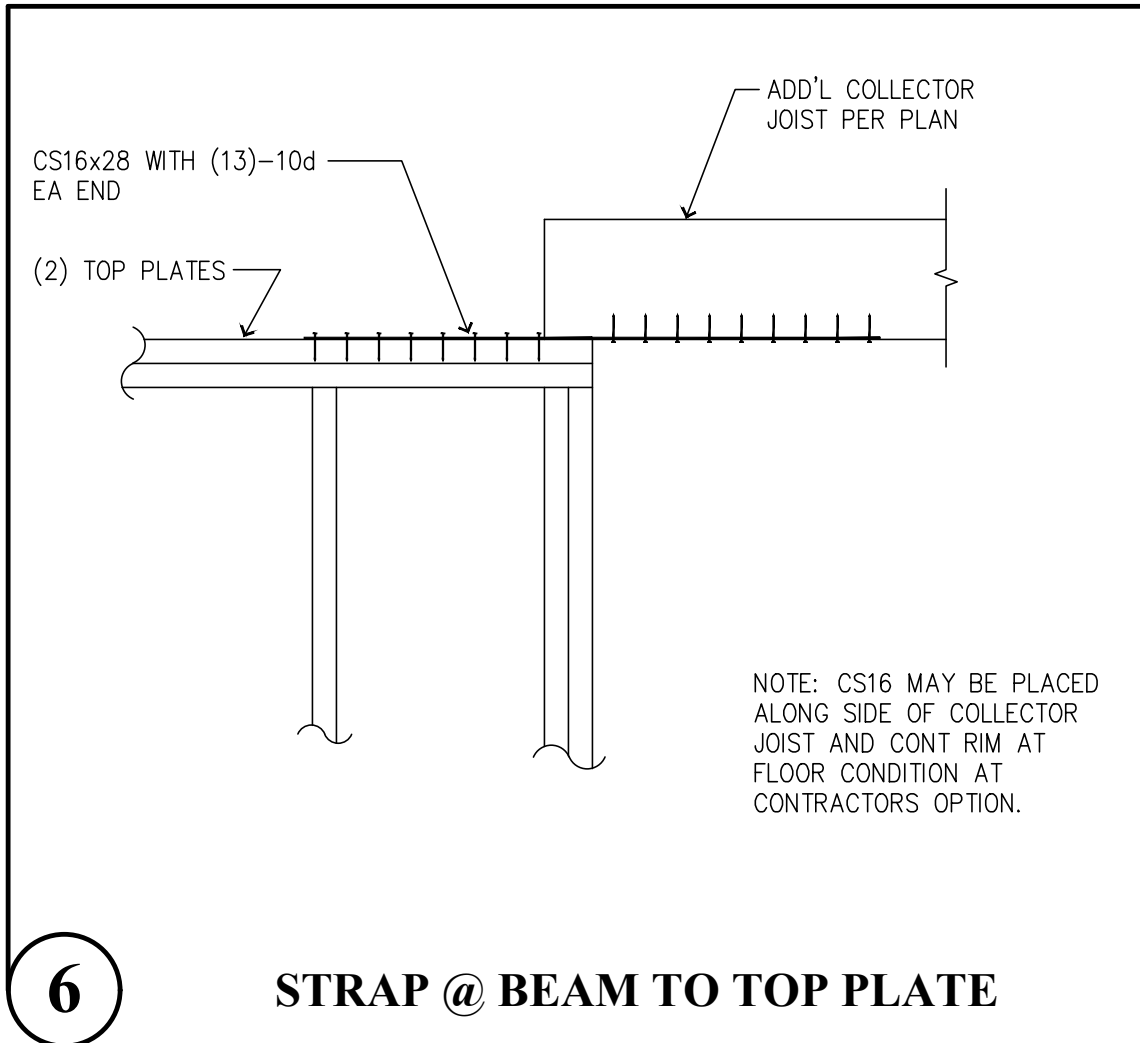


**6** STRAP @ BEAM TO TOP PLATE

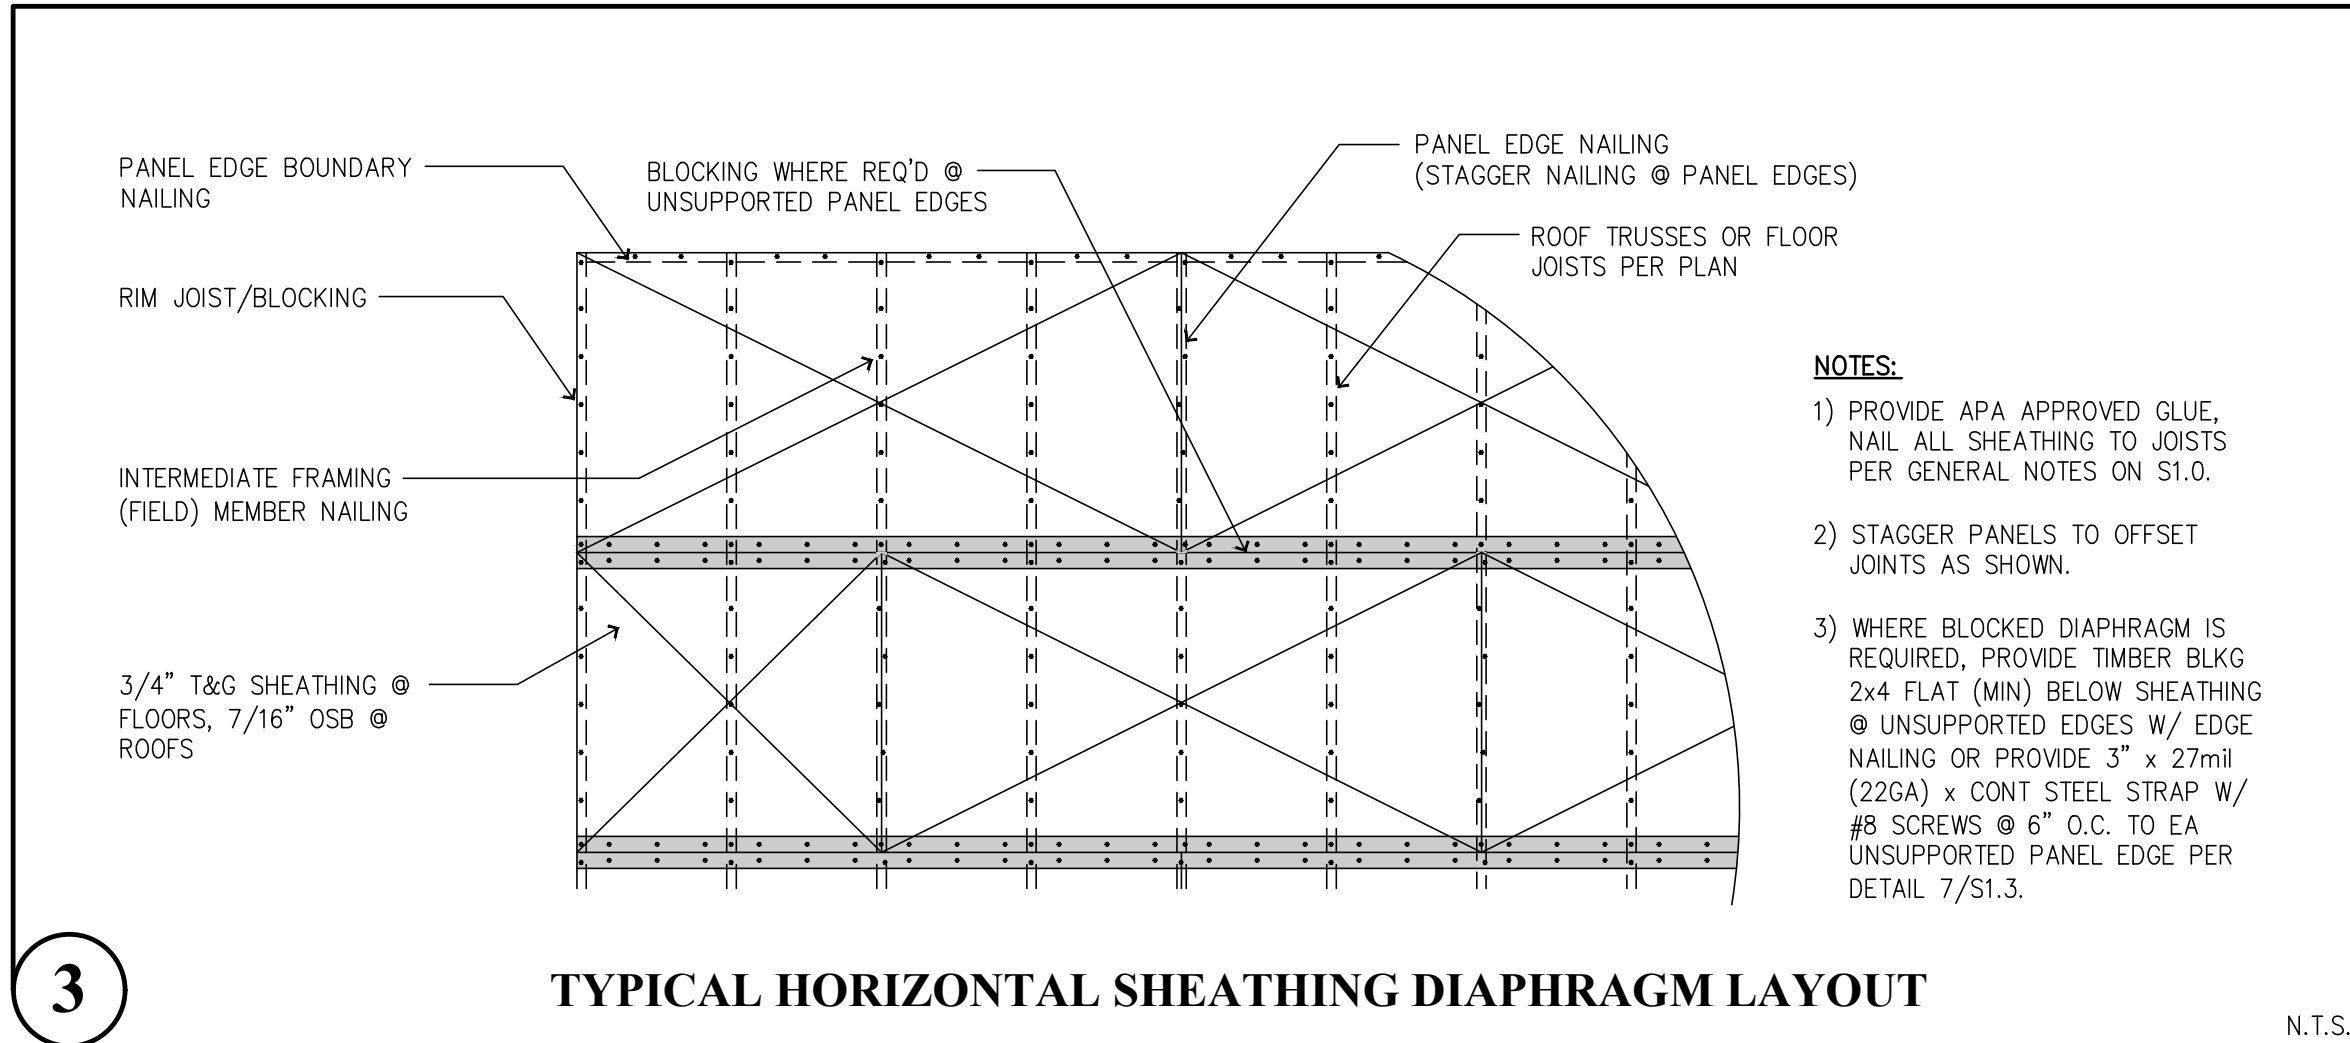


**3** TYPICAL HORIZONTAL SHEATHING DIAPHRAGM LAYOUT

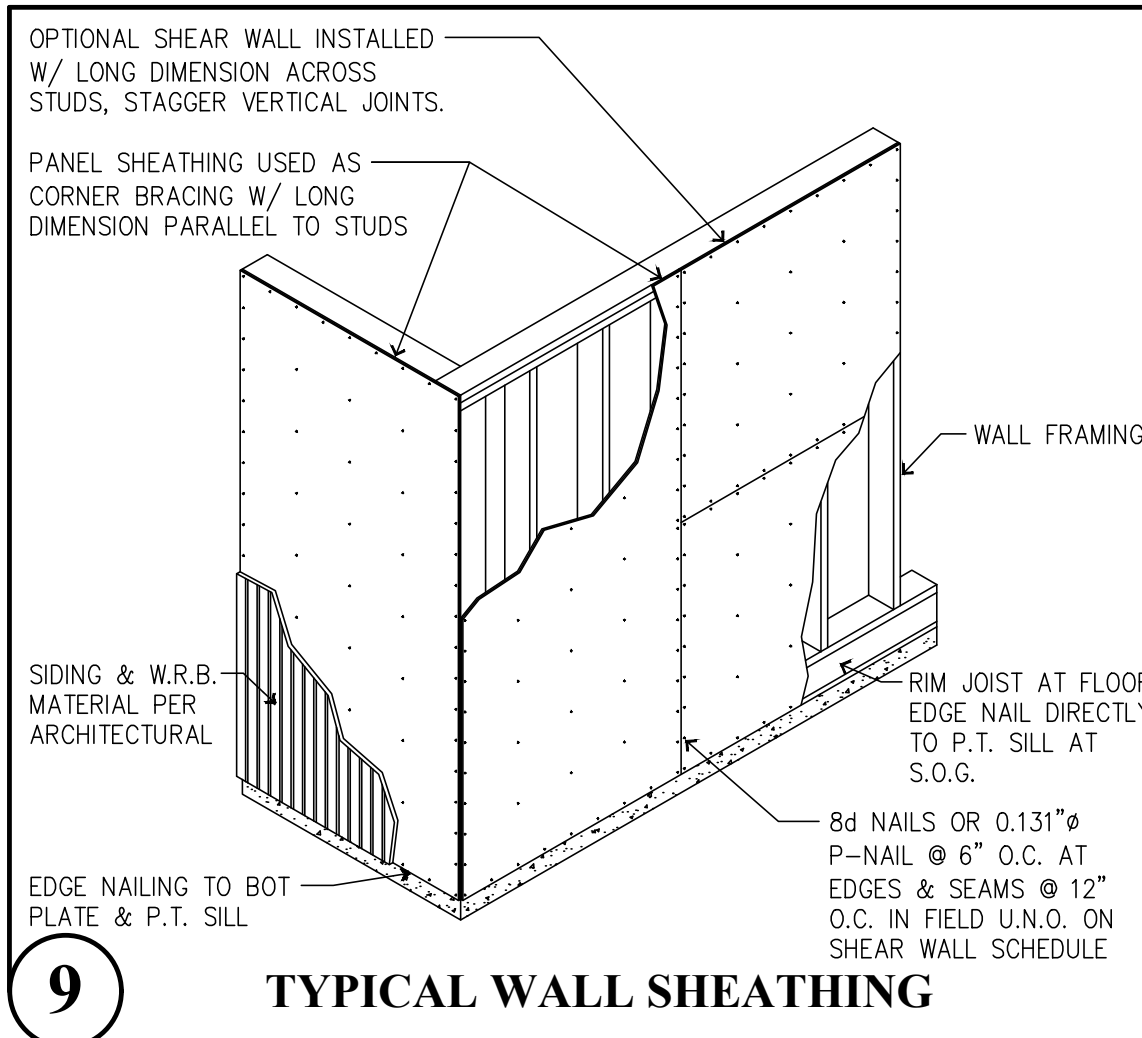


**9** TYPICAL WALL SHEATHING

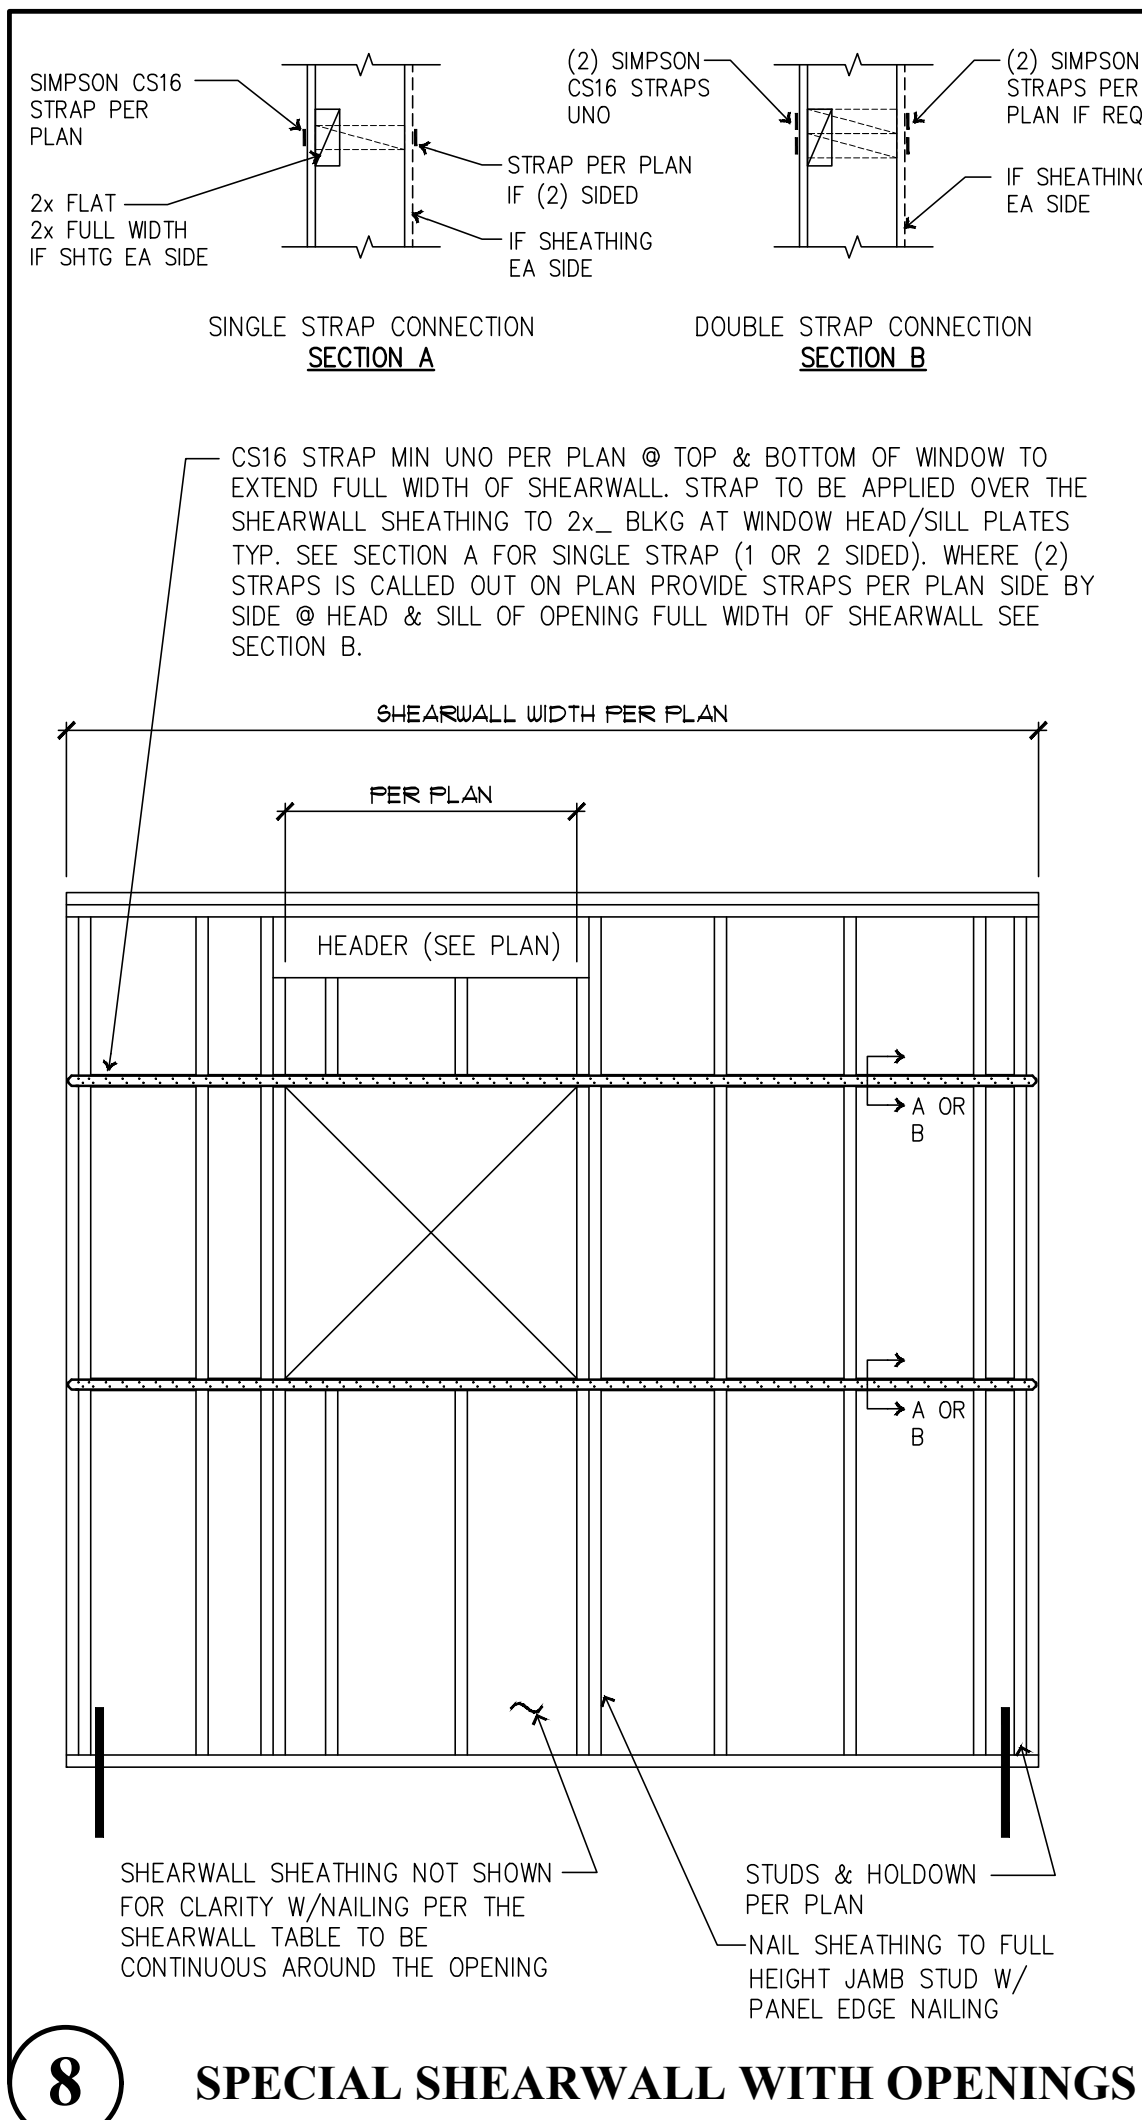

**8** SPECIAL SHEAR WALL WITH OPENINGS

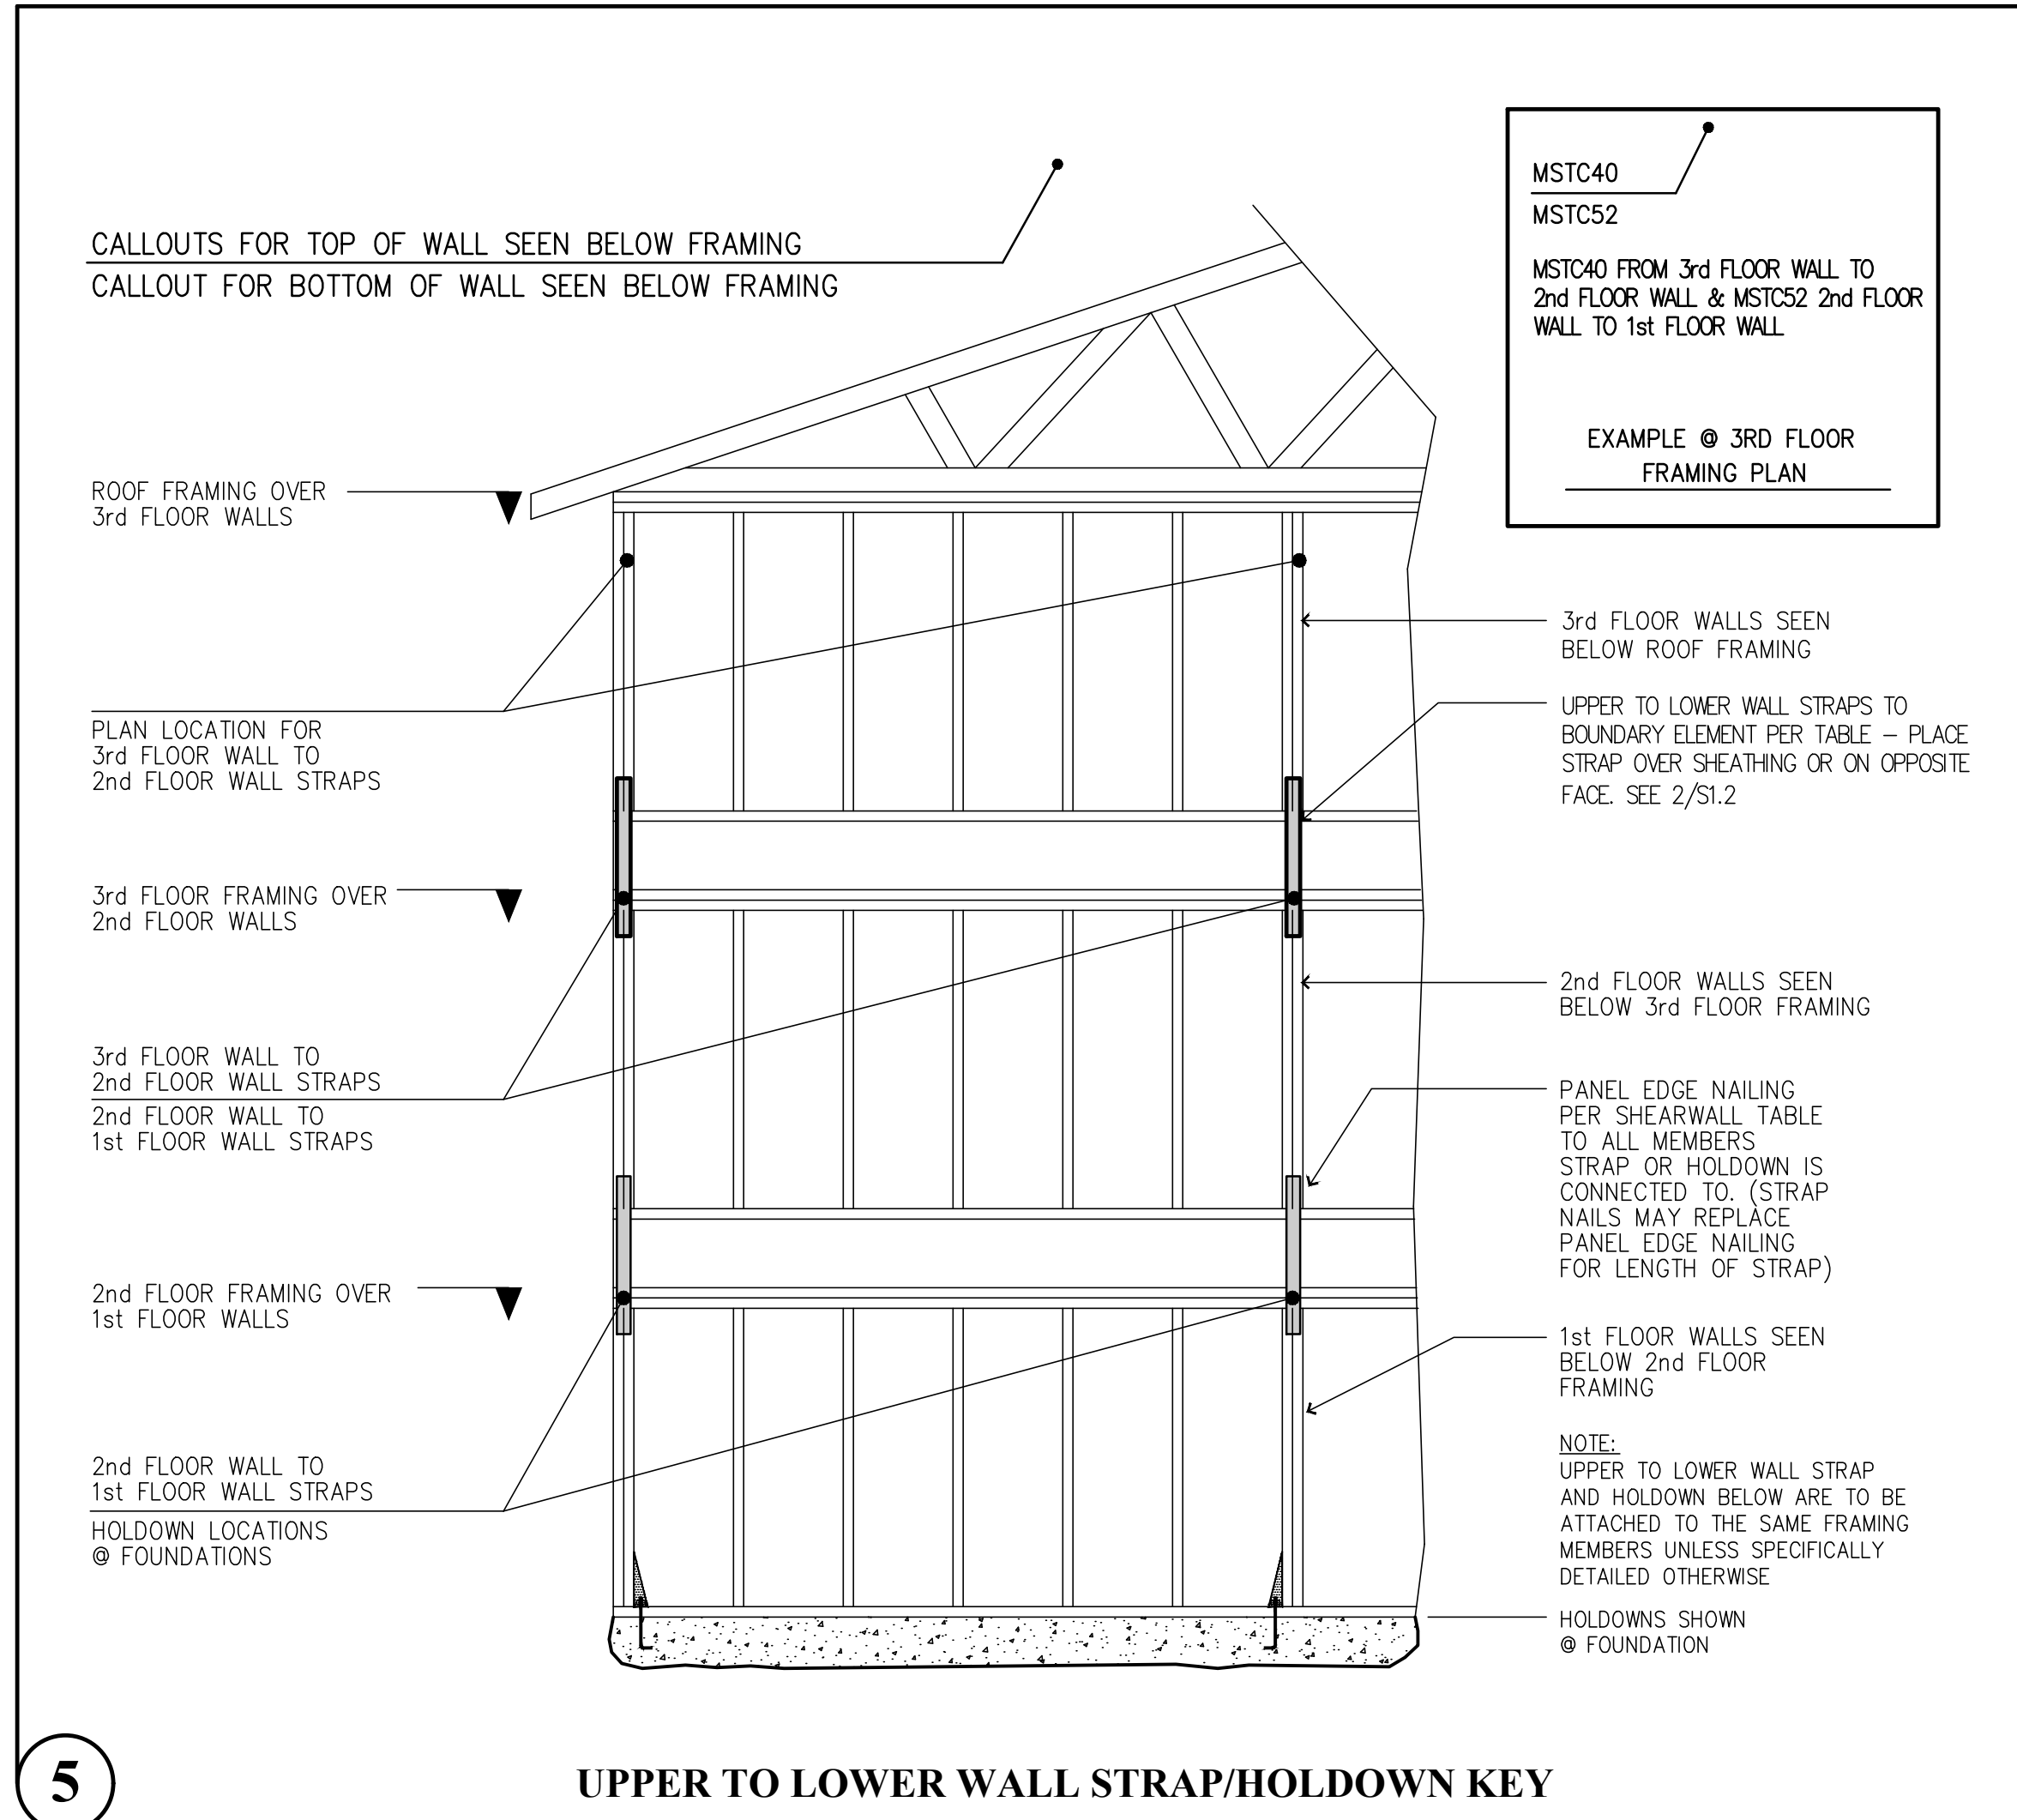

**5** UPPER TO LOWER WALL STRAP/HOLDOWN KEY

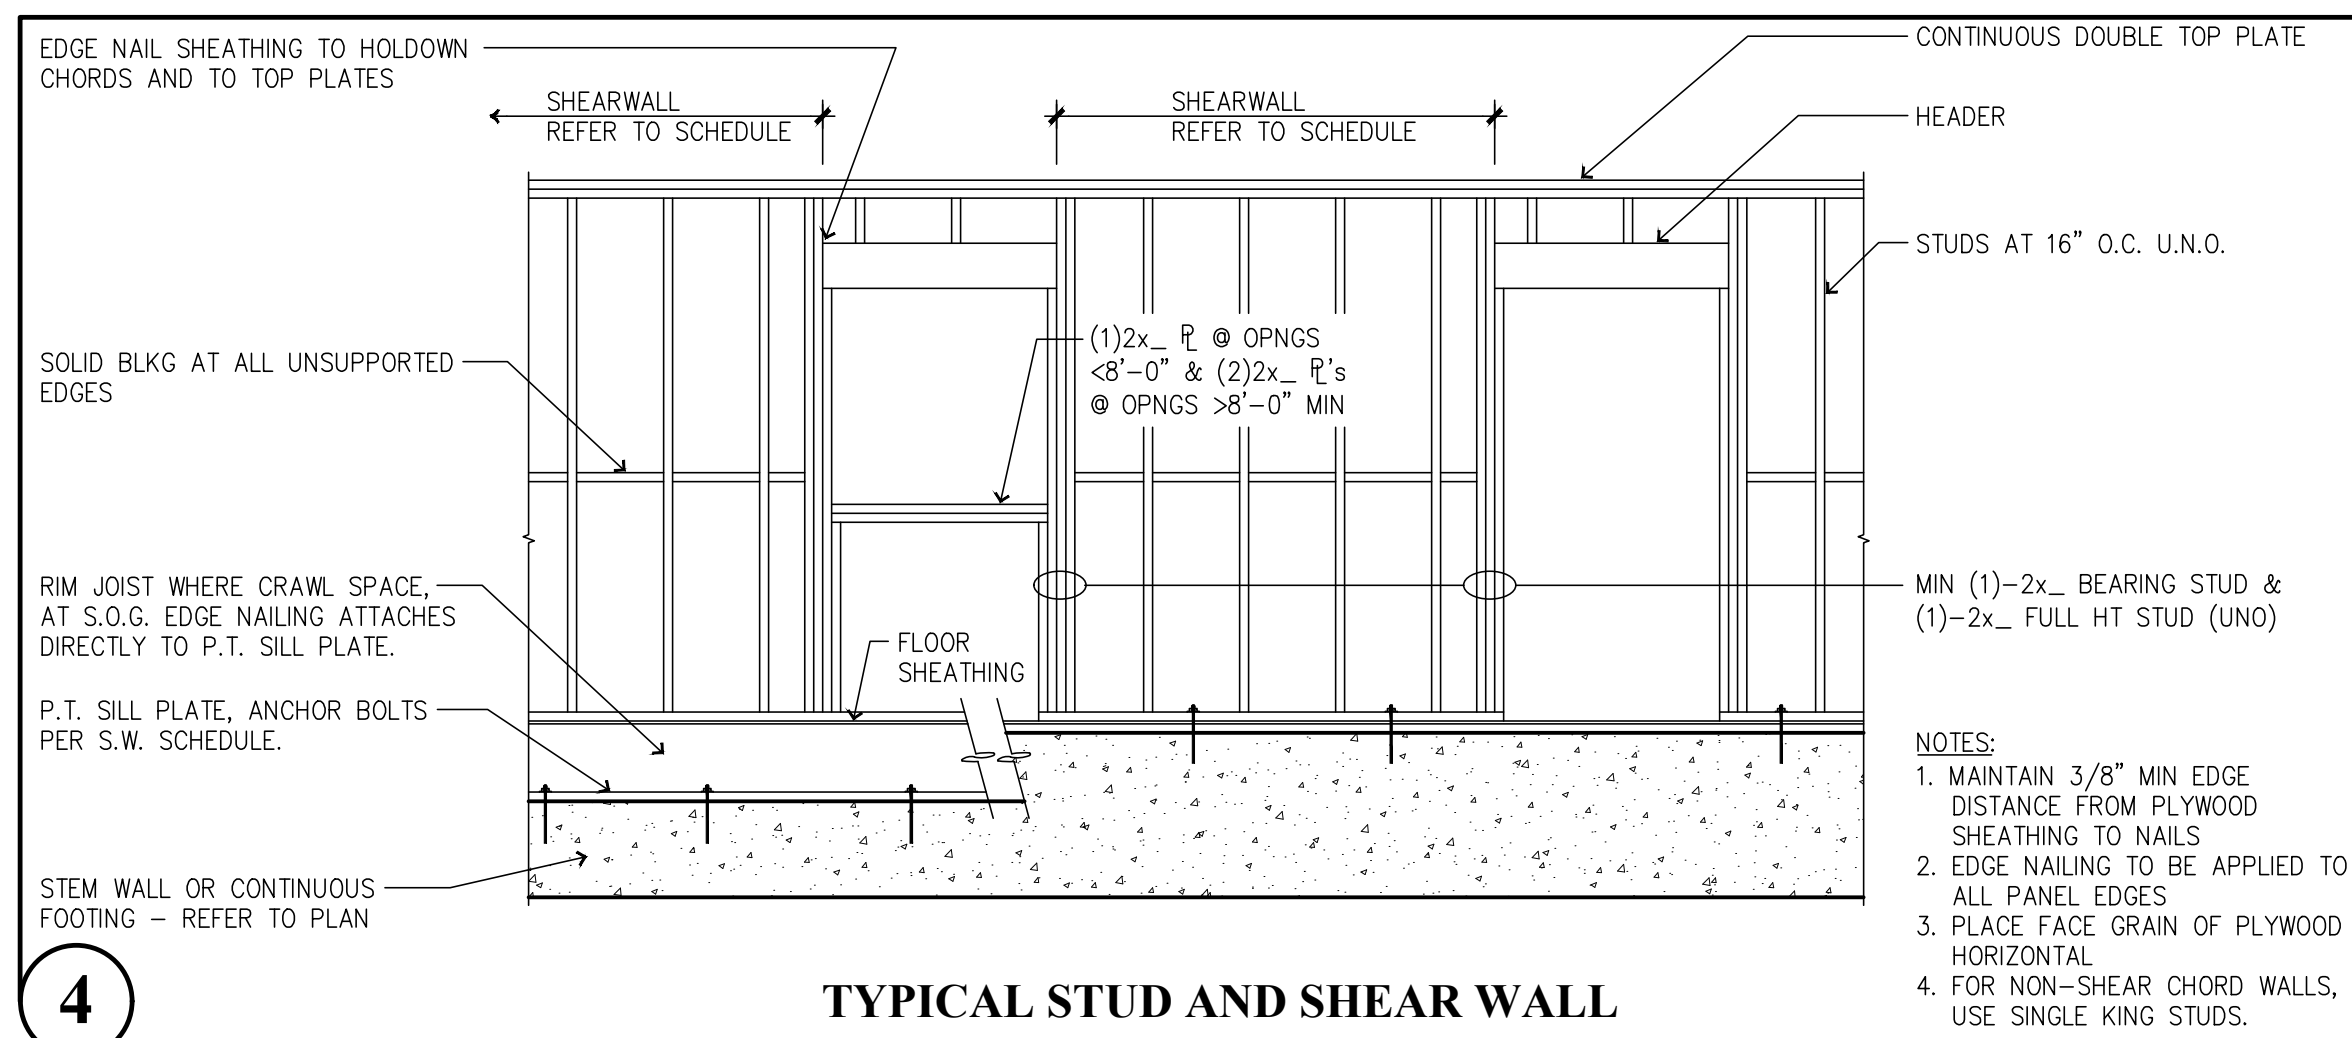

**4** TYPICAL STUD AND SHEAR WALL

**HOLDOWN TABLE**


MARK	BOUNDARY ELEMENT		TOTAL FASTENERS	ANCHOR DIAMETER	ANCHOR EMBEDMENT	MIN EDGE DISTANCE WITHOUT ADD'L REINF
	2x4 WALL	2x6 WALL				
MST37	4x4 #2 HF	4x6 #2 HF	(20) 16d	N/A	N/A	N/A
MST48	4x4 #2 HF	4x6 #2 HF	(32) 16d	N/A	N/A	N/A
(2)MST48	4x6 #2 HF	6x6 #2 DF	(46) 16d	N/A	N/A	N/A
MST60	4x6 #2 HF	4x6 #2 HF	(64) 16d	N/A	N/A	N/A
(2)MST60	4x6 #2 HF	6x6 #2 DF	PER MFR	N/A	N/A	N/A
HDU2	4x4 #2 HF	4x6 #2 HF	PER MFR	5/8"	8"	4"
HDU4	4x4 #2 HF	4x6 #2 HF	PER MFR	5/8"	8"	4"
HDU5	4x6 #2 HF	4x6 #2 HF	PER MFR	5/8"	8"	8"
HDU8	4x6 #2 DF	6x6 #2 DF	PER MFR	7/8"	12"	8"
HDU11	4x6 #2 DF	6x6 #2 DF	PER MFR	1"	12"	12"
HDU14	4x8 #2 DF	6x6 #2 DF	PER MFR	1"	12"	16"

- NOTES:**
- STRAP HOLDOWNS MAY BE APPLIED DIRECTLY TO BOUNDARY MEMBER ON OPPOSITE SIDE OF SHEATHING OR APPLIED DIRECTLY OVER PWD/OSB SHEATHING. DO NOT LOCATE STRAPS UNDER WOOD SHEATHING OF ANY TYPE OR OVER GYPSUM SHEATHING. (DO NOT INSTALL MSTC TYPE STRAPS OVER SHEATHING, SEE 4/S1.3)
  - NAIL SHEATHING PER SHEARWALL TABLE TO EACH BOUNDARY ELEMENT PER TABLE ABOVE.
  - ALIGN FLOOR TO FLOOR STRAPS WITH HOLDOWNS AT FOUNDATION, TYP. (SEE DETAIL 5/S1.2)
  - HOLDOWNS/STRAPS MUST BE ATTACHED TO FULL HEIGHT MEMBERS UNLESS NOTED OTHERWISE. BOUNDARY ELEMENTS ARE IN ADDITION TO TRIMMER/BEARING STUDS CALLED OUT ON PLAN. (SEE DETAILS 1.2 & 3/S1.3)
  - ANCHOR BOLTS SHALL BE CAST IN PLACE AND ALL ANCHORS EXCEPT HDU2 AND HDU4 REQUIRE ADDITIONAL REBAR IF EMBEDDED IN STEMWALLS OR IF MIN EDGE DISTANCE IS LESS THAN AS NOTED USE A STANDARD WASHER WITH A STANDARD NUT ON EACH SIDE AT BOTTOM OF ANCHOR. ADDITIONAL REINFORCEMENT SHALL BE PER DETAILS 1.2, & 3/S1.3.
  - THREADED RODS/ANCHORS ARE ASTM A307 OR ASTM F1554 U.N.O.
  - STRAPS/HOLDOWNS SHALL BE INSTALLED WITH THE FASTENERS SPECIFIED BY THE MANUFACTURER TO ACHIEVE THE MAXIMUM TABULATED LOAD & AS INDICATED IN THE TABLE ABOVE.
  - INSTALL HALF OF SPECIFIED FASTENERS EACH END OF STRAPS PER SIMPSON STRONGTIE.
  - SEE DETAIL 4/S1.3 FOR MSTC - HOLDOWN STRAPS FROM SHEARWALL TO BEAM & DETAIL 6/S1.3 FOR MSTC - HOLDOWN STRAPS @ END OF BEAM TO POST/COLUMN. (\*) SYMBOL AT END OF MSTC STRAP CALLOUT (i.e. (2)MSTC48B3\*) INDICATES STRAP IS INVERTED AND ATTACHES END OF BEAM TO POST BELOW PER 6/S1.3

**SHEARWALL COMPONENT TABLE**

MARK	MARK <sup>14</sup>	COMPONENTS	1/2" A.B. PL TO CONCRETE SPACING (IN)	5/8" A.B. PL TO CONCRETE SPACING (IN)	10d COMMON PL TO PL SPACING (IN)	SIMPSON A35 CLIP ANGLE SPACING (IN)	SIMPSON LTP4 CLIP ANGLE SPACING (IN)
W1	W1P	7/16" PWD OR OSB, BLOCKED, W/ 8d NAILS @ 6" O.C. @ PANEL EDGES AND @ 12" O.C. @ FIELD.	47" O.C.	68" O.C.	8.1" O.C.	30" O.C.	29" O.C.
W2	W2P	7/16" PWD OR OSB, BLOCKED, W/ 8d NAILS @ 4" O.C. @ PANEL EDGES AND @ 12" O.C. @ FIELD.	32" O.C.	47" O.C.	5.5" O.C.	20" O.C.	20" O.C.
W3	W3P	7/16" PWD OR OSB, BLOCKED, W/ 8d NAILS @ 3" O.C. @ PANEL EDGES AND @ 12" O.C. @ FIELD. SEE NOTE 2	25" O.C.	36" O.C.	4.3" O.C.	16" O.C.	15" O.C.
W4	W4P	7/16" PWD OR OSB, BLOCKED, W/ 8d NAILS @ 2" O.C. @ PANEL EDGES AND @ 12" O.C. @ FIELD. SEE NOTE 2	19" O.C.	28" O.C.	6.6" O.C. EA ROW	12" O.C.	12" O.C.
W5	W5P	7/16" PWD OR OSB, BLOCKED, W/ 10d NAILS @ 2" O.C. @ PANEL EDGES AND @ 12" O.C. @ FIELD. SEE NOTE 2.	16" O.C.	23" O.C.	5.6" O.C. EA ROW	10" O.C.	10" O.C.
W6	W6P	15/32" PWD OR OSB, (2) LAYERS (ONE EACH SIDE), BLOCKED, W/ 10d NAILS @ 3" O.C. @ PANEL EDGES AND @ 12" O.C. @ FIELD. SEE NOTE 2, 3 & 15	12" O.C.	18" O.C.	4.3" O.C. EA ROW	8" O.C.	8" O.C.
W7	W7P	15/32" PWD OR OSB, (2) LAYERS (ONE EACH SIDE), BLOCKED, W/ 10d NAILS @ 2" O.C. @ PANEL EDGES AND @ 12" O.C. @ FIELD. SEE NOTE 2, 3, & 15	9" O.C.	14" O.C.	3" O.C. EA ROW STAGGERED	5" O.C.	5" O.C.

- NOTES:**
- ALL NAILING PER ANS/AF & PA SDPWS - 2018 TABLE 4.3A
  - USE 3x STUDS AT ALL ADJUTING PANEL EDGES. NAILS SHALL BE STAGGERED WHERE NAILS ARE SPACED AT 2" O.C.
  - EXTEND SHEATHING UP TO DOUBLE TOP PLATES AND INSTALL NAILS THROUGH SHEATHING INTO UPPER TOP PLATE PER TYPICAL DETAILS. NO PLATE TO PLATE NAILING REQUIRED IN DOUBLE TOP PLATES WITH THIS CONFIGURATION.
  - WALL SHEATHING CALLED OUT SHALL EXTEND FOR ENTIRE WALL LENGTH AT THAT ELEVATION AND SHALL BE CONTINUOUS AROUND OPENINGS TYPICALLY.
  - 8d NAILS ARE TO BE .131" AND 2-1/2" IN LENGTH. 10d NAILS ARE TO BE .148" AND A MINIMUM OF 3" IN LENGTH. 16d NAILS ARE TO BE .162" AND 3-1/4" IN LENGTH. NAILS SHALL BE INSTALLED SO AS TO NOT SPLIT THE TIMBER FRAMING.
  - SIMPSON A35 OR LTP4 CLIP ANGLES SHALL BE INSTALLED WITH THE APPROPRIATE FASTENERS PER THE MANUFACTURER'S SPECIFICATIONS.
  - USE 3"x3"x0.229" PLATE WASHERS AT ALL ANCHOR BOLTS PER SECTION 4.3.6.4.3
  - SPACING SHOWN ABOVE FOR ANCHOR BOLTS, NAILING AND CLIPS IS MAXIMUM AMOUNT ALLOWED.
  - FRAMING AT SHEARWALLS SHALL BE SPACED NO FARTHER THAN 16" O.C.
  - MINIMUM NAIL SPACING IN A SINGLE ROW SHALL BE 4 INCHES ON CENTER. USE (2) ROWS IF SPACING LESS THAN THIS. USE 2ND RIM BOARD, RIM JOIST OR BLOCKING WHERE THREE ROWS OF NAILING CALLED OUT.
  - EXTEND SHEATHING UP TO DOUBLE TOP PLATES AND INSTALL NAILS THROUGH SHEATHING INTO UPPER TOP PLATE PER TYPICAL DETAILS. NO PLATE TO PLATE NAILING REQUIRED IN DOUBLE TOP PLATES WITH THIS CONFIGURATION.
  - OPTIONAL TO USE (2) 2x's IN PLACE OF SINGLE 3x IN SHEARWALLS W3, W4 AND W5 W/ STITCH NAILING.
  - (2) ROWS OF 0.148" x 3" STITCH NAILING (2) 2x STUDS TOGETHER @ 10" O.C. FOR W3 SHW, 8" O.C. FOR W4 SHW & 6" O.C. FOR W5 SHW PER SECTION 4.3.7 NOTE 4.
  - THE "W\_P" INDICATES SHEAR WALL TYPE WITH OPENINGS. PROVIDE SHEATHING AROUND ALL OPENINGS AND ABOVE AND BELOW ALL OPENINGS. PROVIDE HORIZONTAL STRAPS & NAILING AT OPENINGS PER 8/S1.2

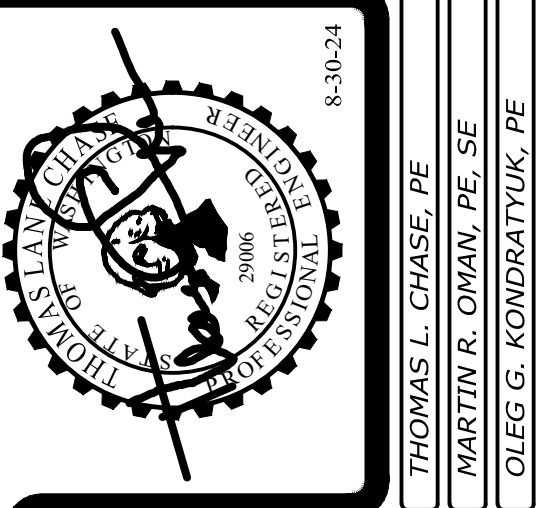

Revisions to this sheet:

**Bradley Heights Apartments**  
202 27th Ave SE  
Puyallup, Washington

**Solutions 4 Structures**  
A Structural Engineering Corporation

PROJECT NO. : 23-007  
DESIGNED BY : TLC, OGG, MRO  
DRAWN BY : RSO  
ISSUE DATE : 2-20-24  
LATEST REV. OF DWG. SET : 8-30-24


Puyallup, Washington 98374  
Ph. 253-314-9822  
www.solutions4structures.com

SUBMITTAL SET ONLY NOT FOR CONSTRUCTION  
THESE DRAWINGS ARE SUBJECT TO REVISIONS PENDING LOCAL JURISDICTIONAL REVIEW.


**S1.2**




CAD FILE: F:\Projects\2023\Projects\23.007 Bradley Heights\Drawings\51\_3.dwg  
 PLOT DATE/TIME: 8/28/2024 7:16am THANK YOU FOR USING SOLUTIONS 4 STRUCTURES

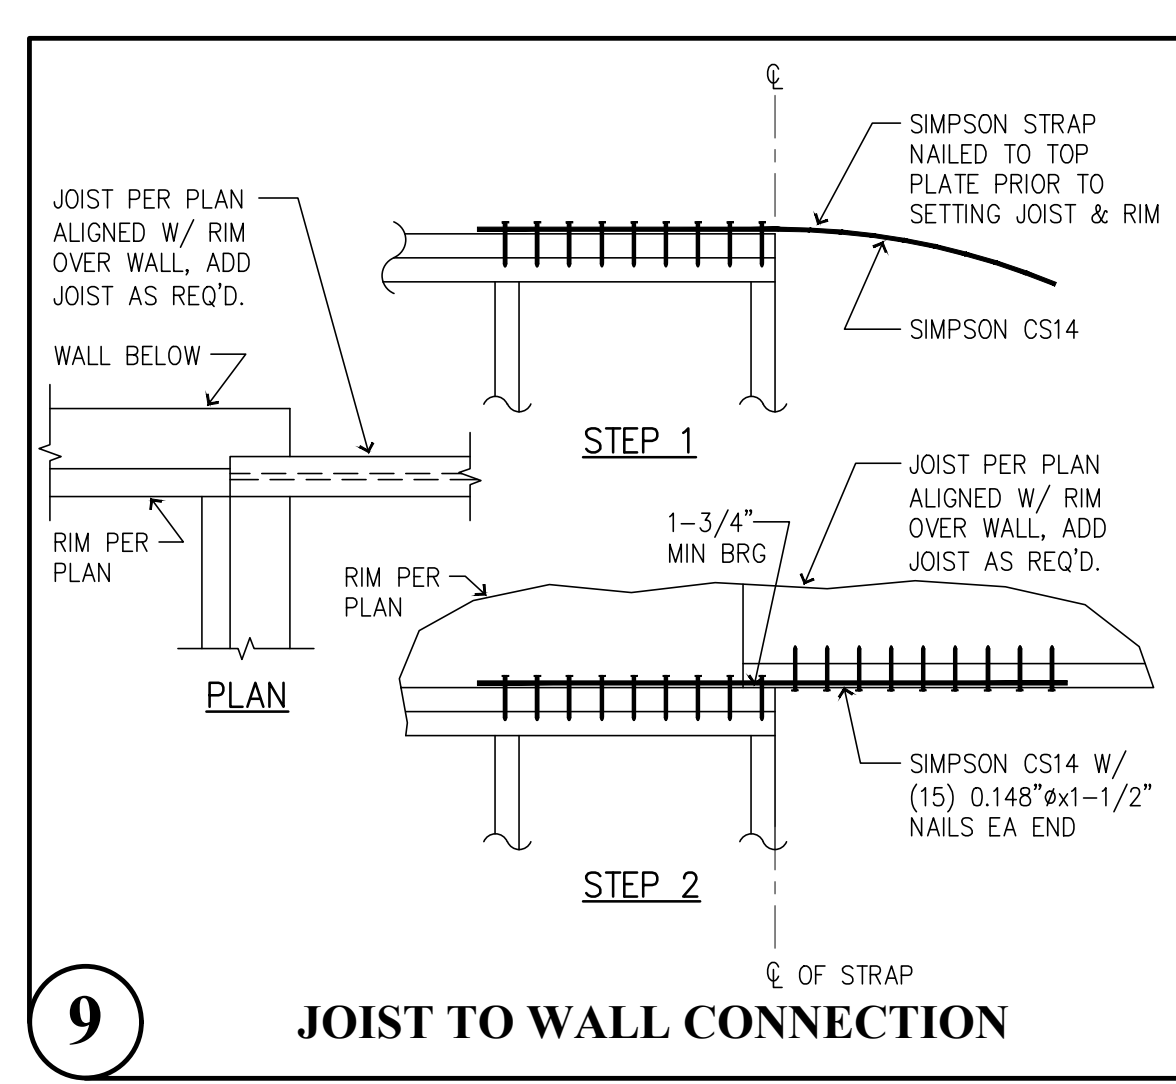


**9** JOIST TO WALL CONNECTION

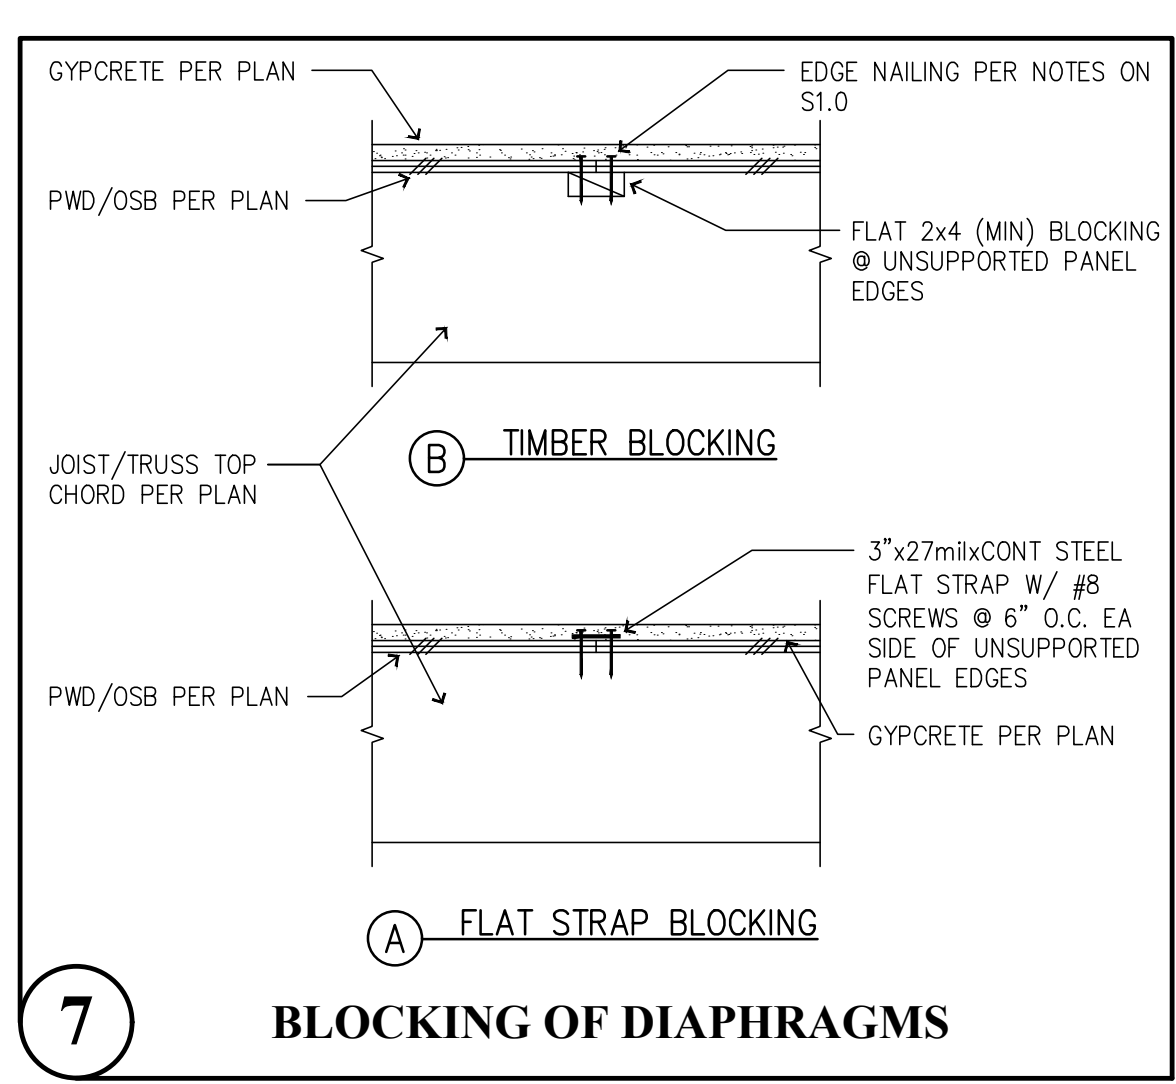


**7** BLOCKING OF DIAPHRAGMS

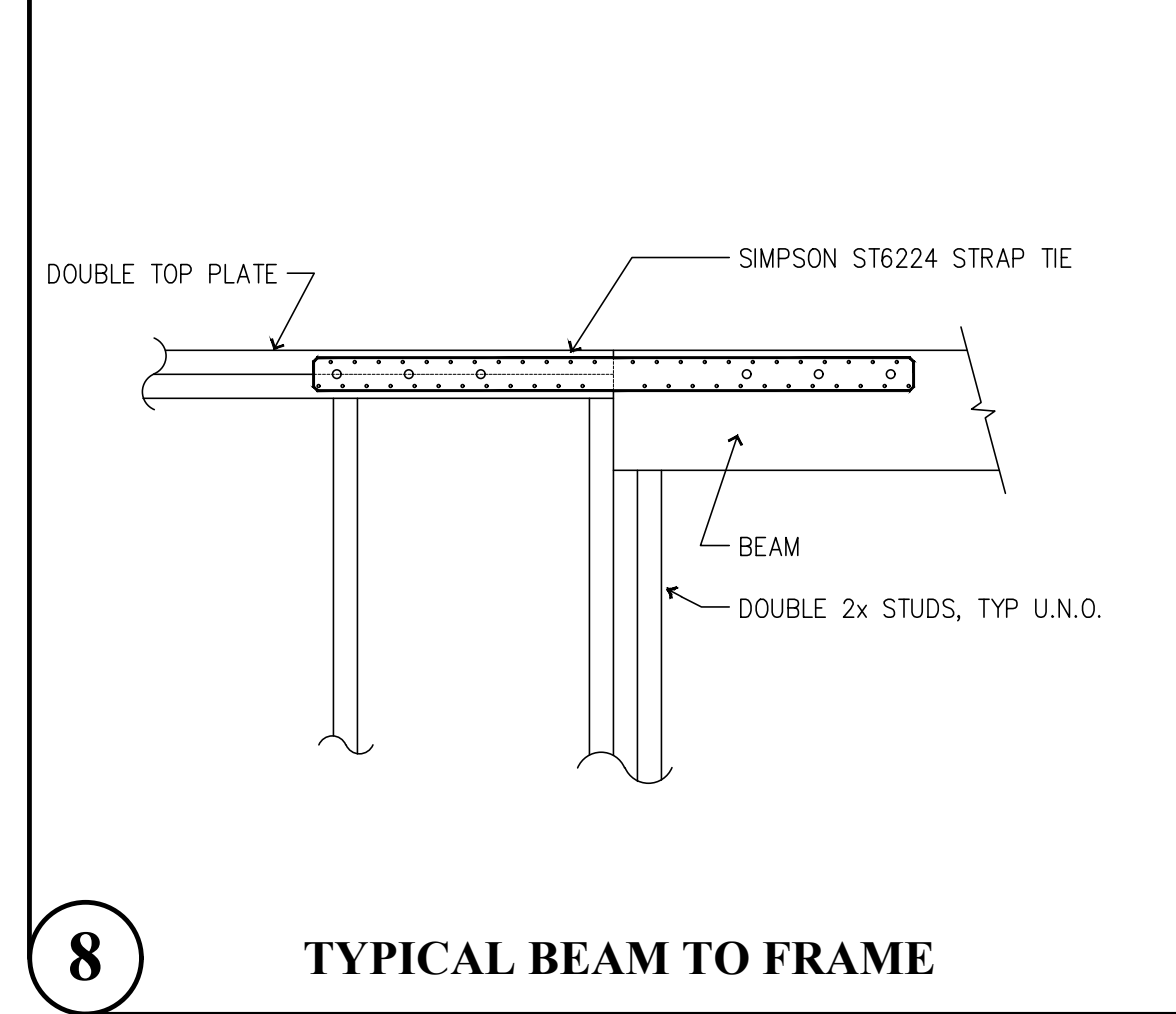


**8** TYPICAL BEAM TO FRAME

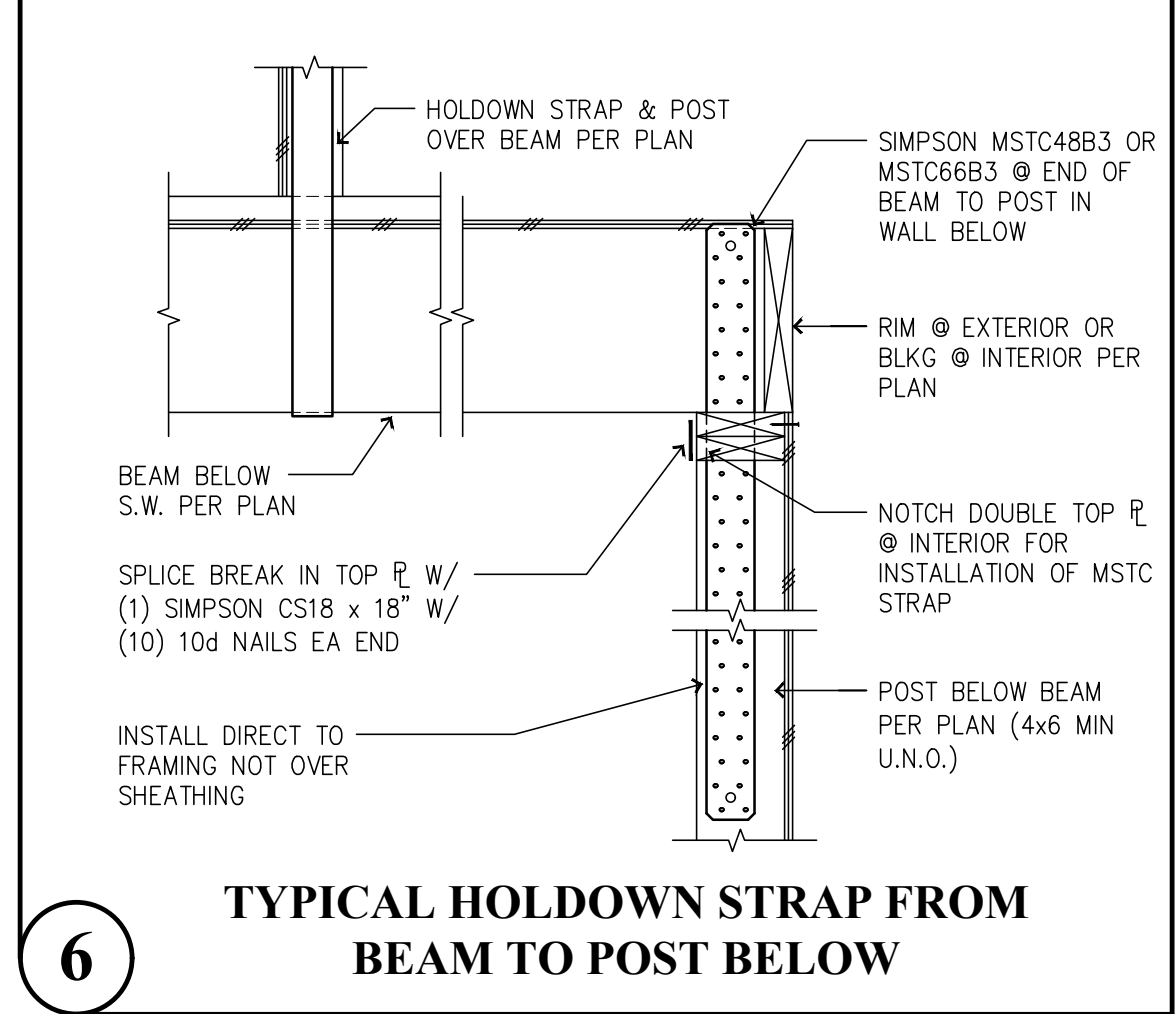


**6** TYPICAL HOLDOWN STRAP FROM BEAM TO POST BELOW

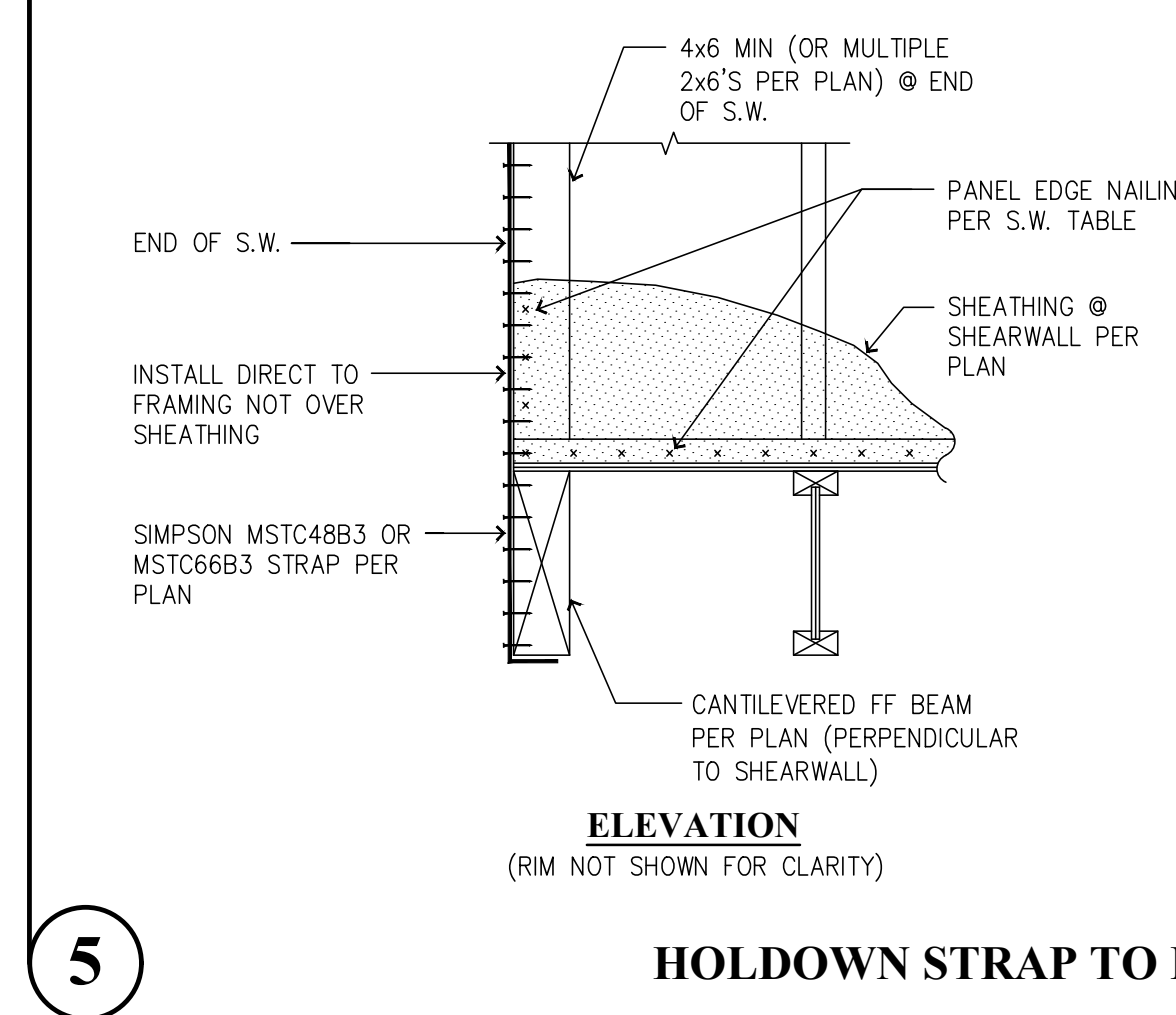


**5** HOLDOWN STRAP TO PERPENDICULAR BEAM

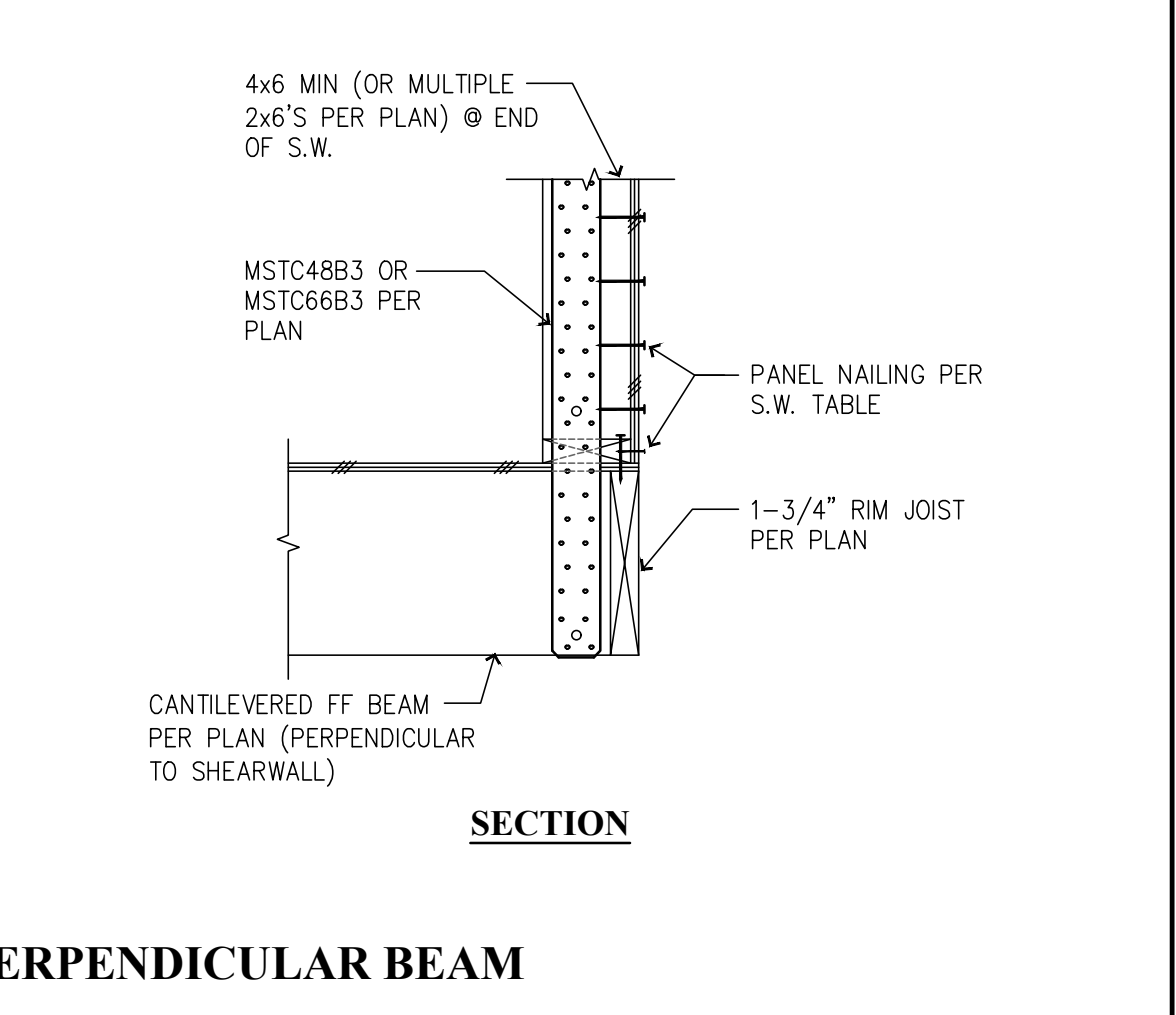


**4** TYPICAL HOLDOWN STRAP TO BEAM BELOW

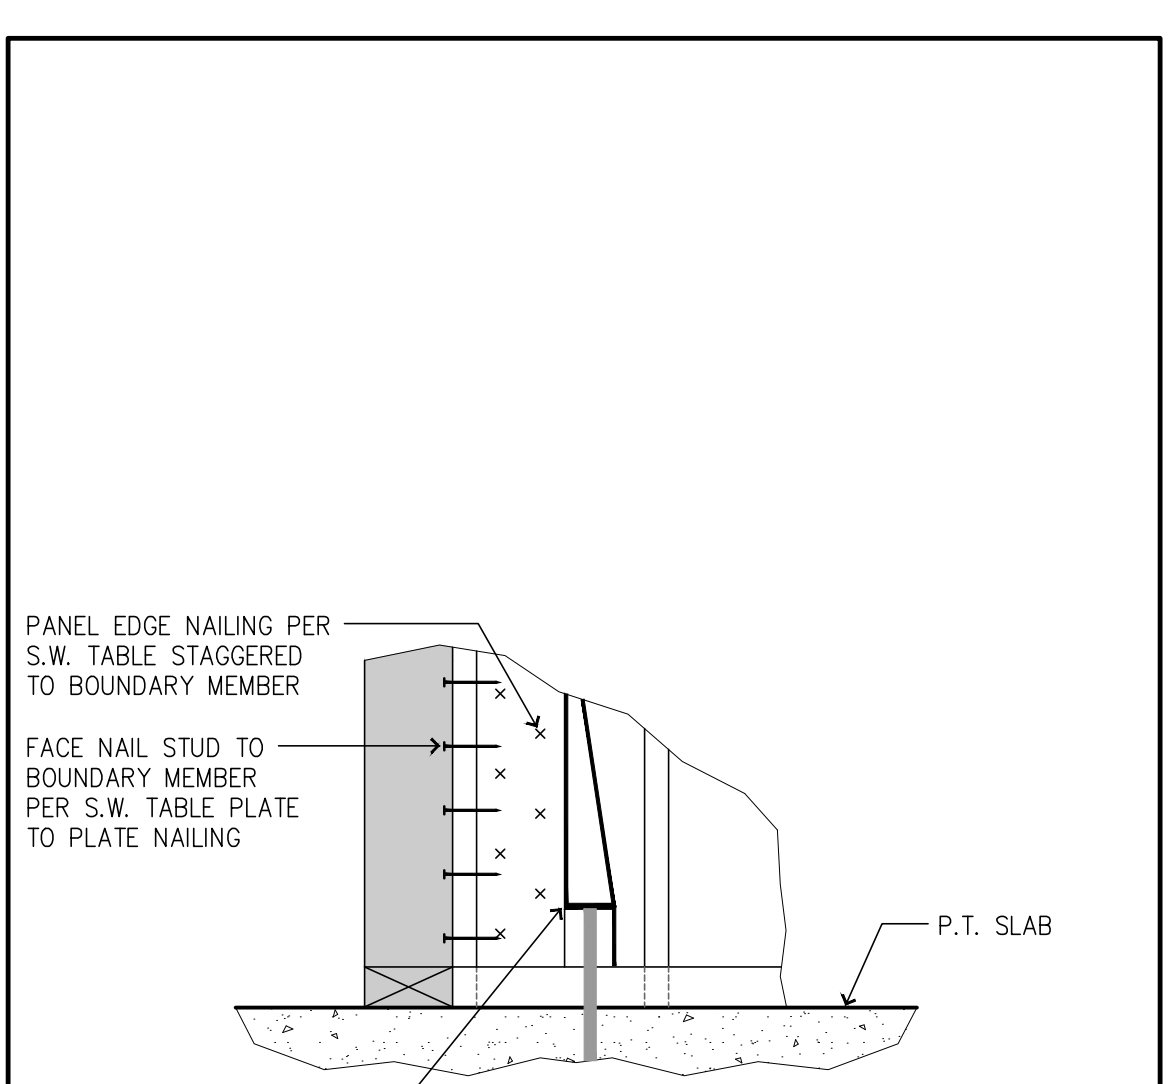


**3** FLOOR TO FOUNDATION HOLDOWN

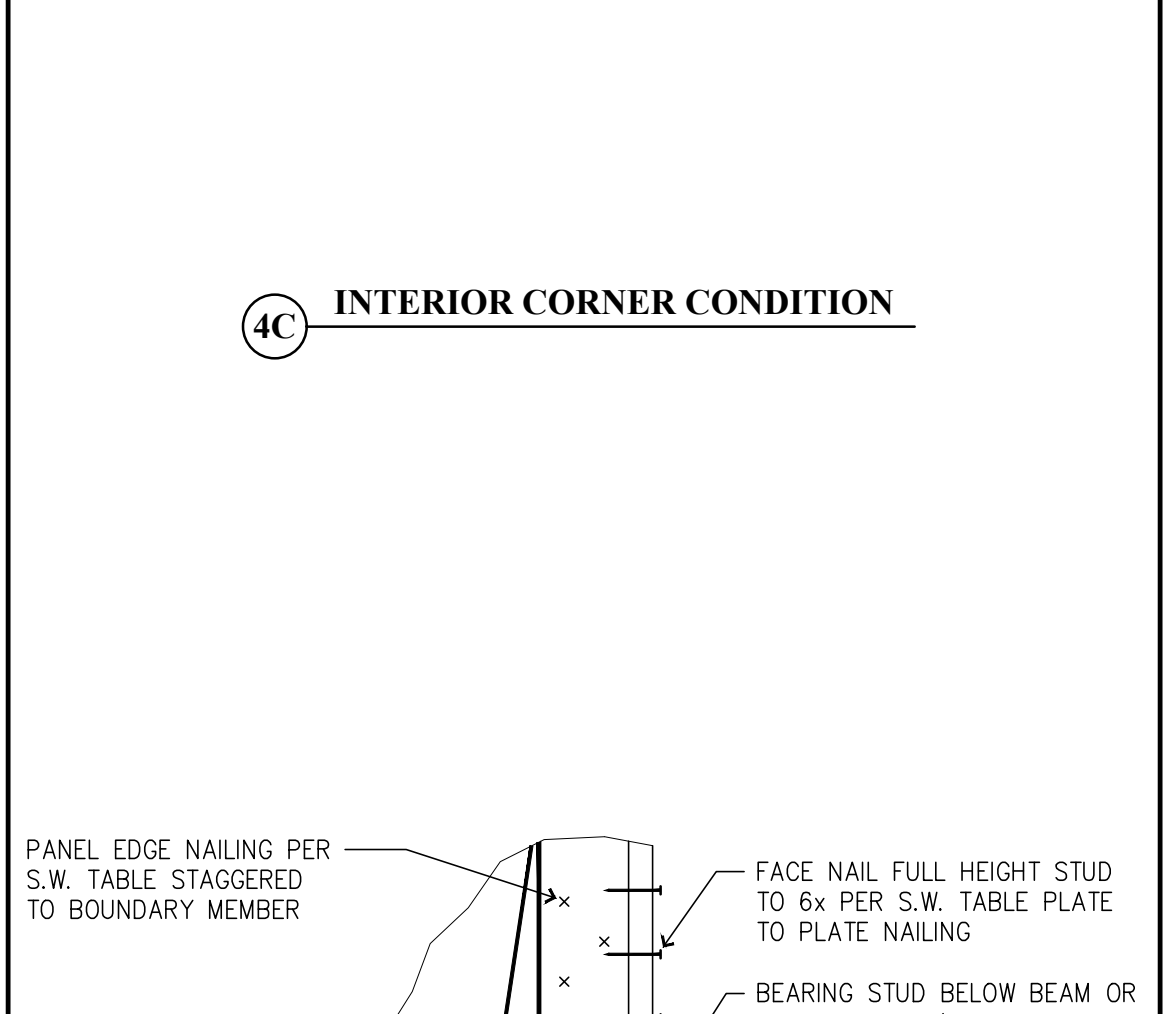


**4C** INTERIOR CORNER CONDITION

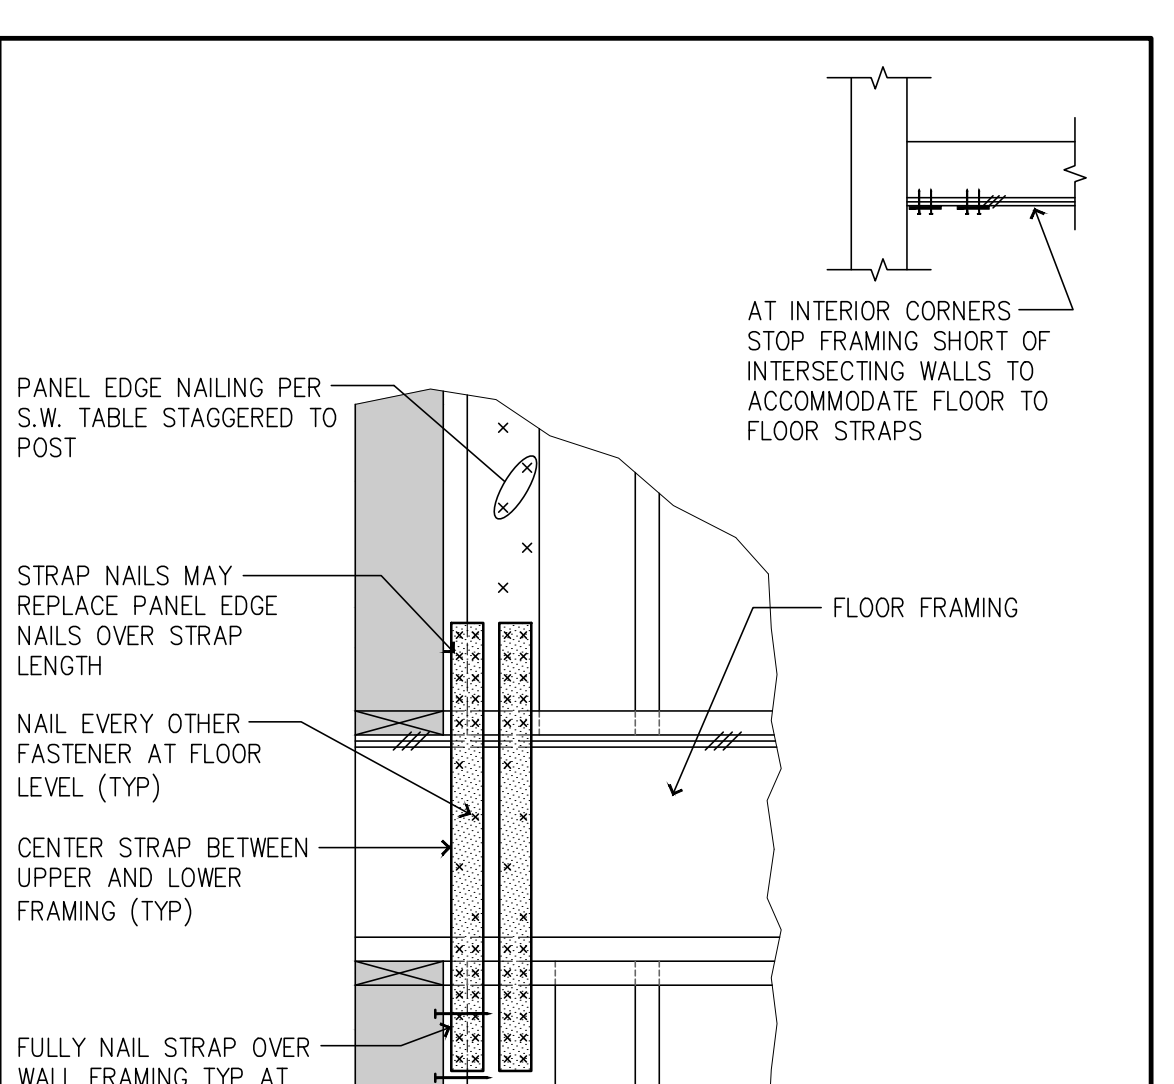


**2C** INTERIOR CORNER CONDITION

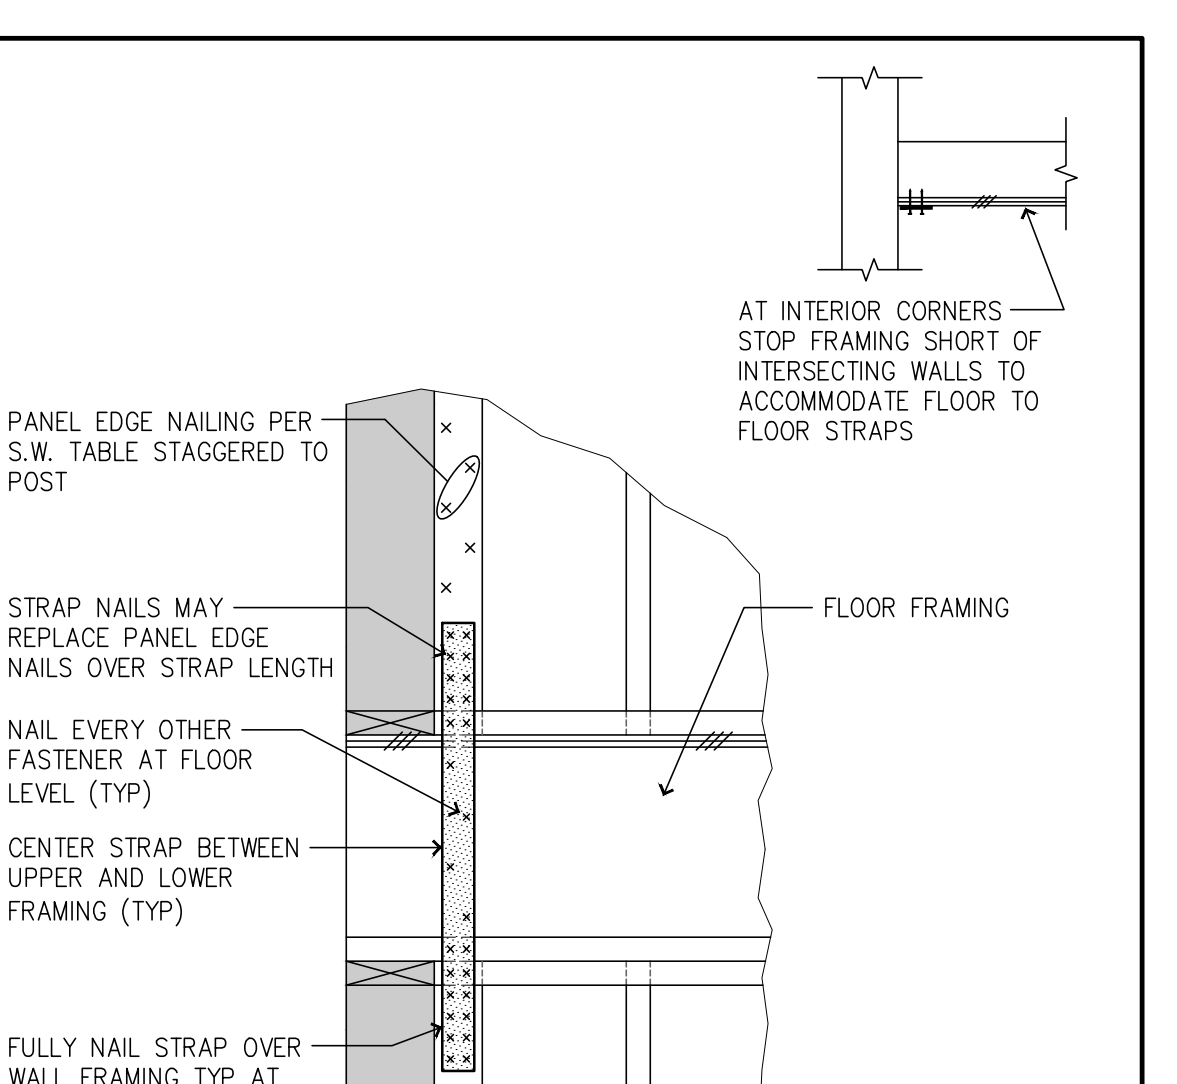


**1C** INTERIOR CORNER CONDITION

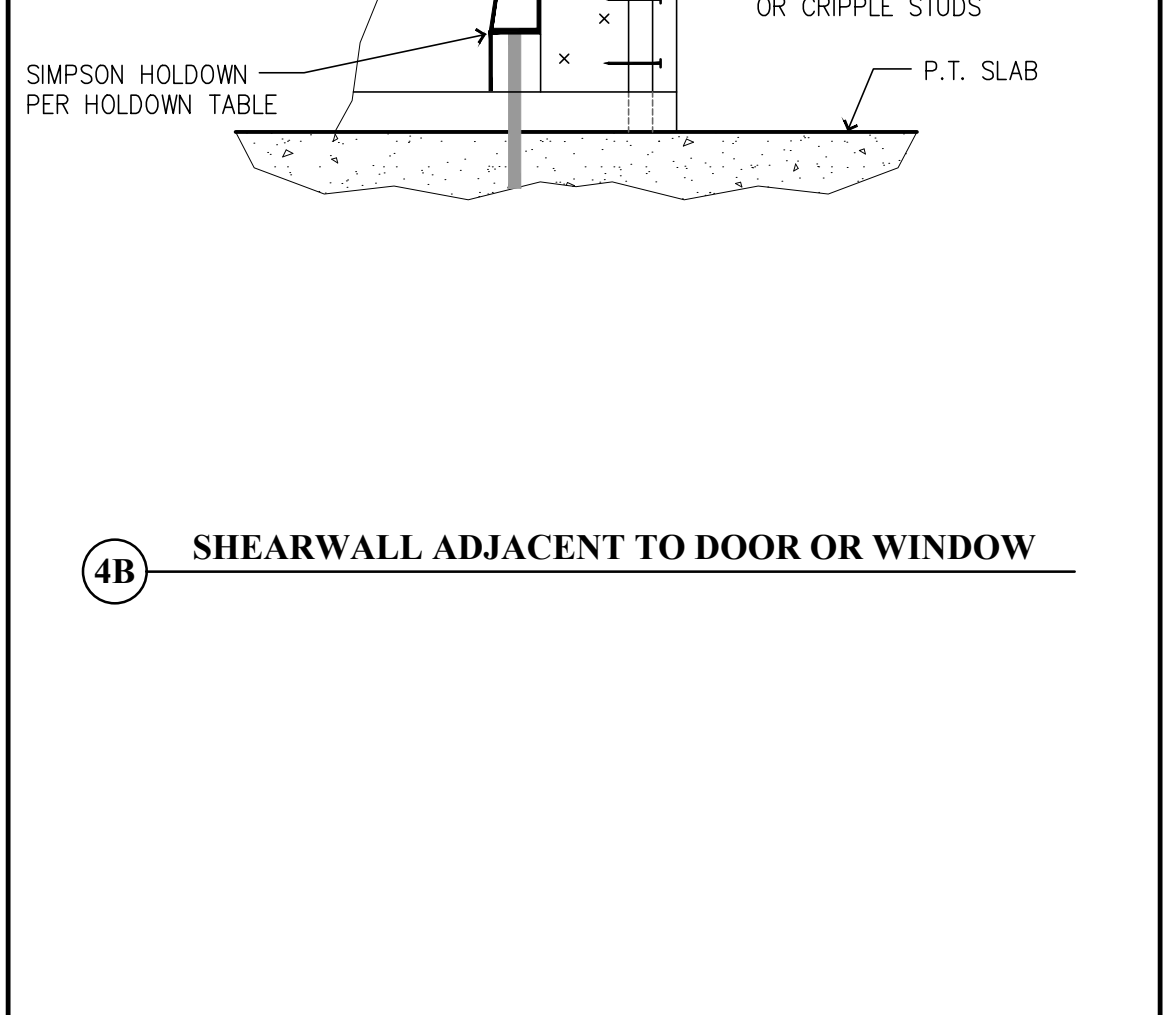


**4B** SHEARWALL ADJACENT TO DOOR OR WINDOW

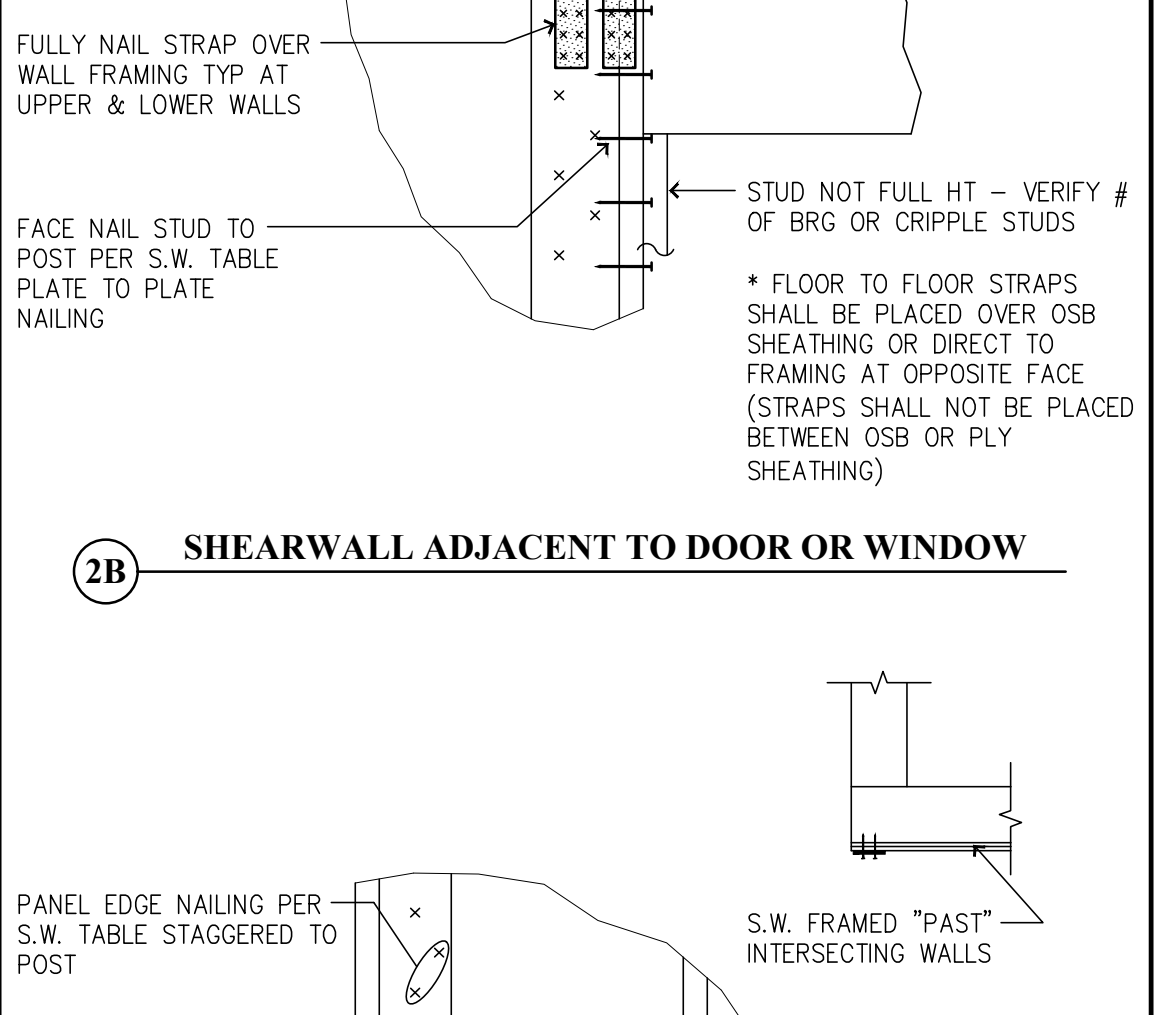


**2B** SHEARWALL ADJACENT TO DOOR OR WINDOW

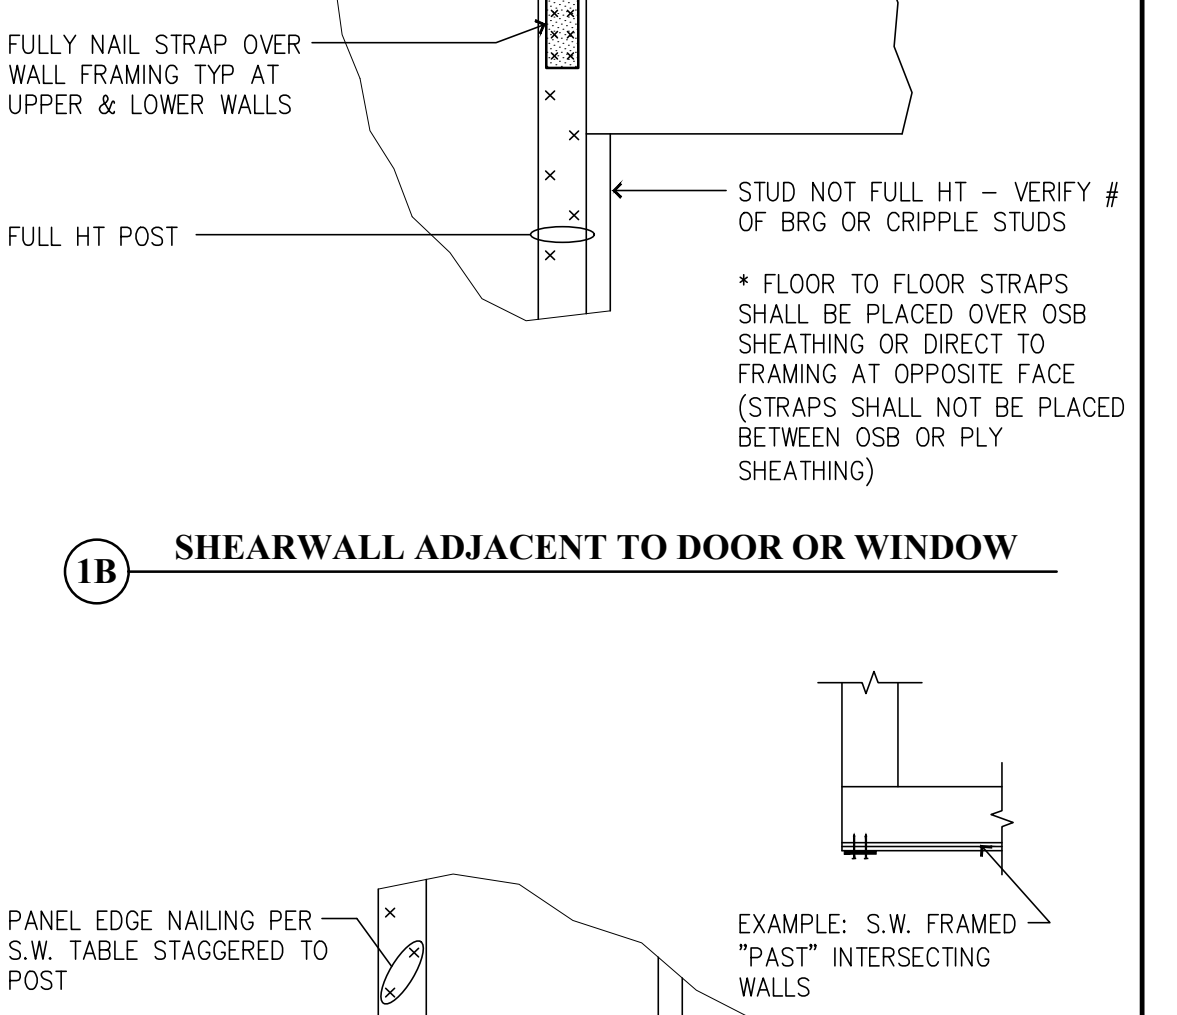


**1B** SHEARWALL ADJACENT TO DOOR OR WINDOW

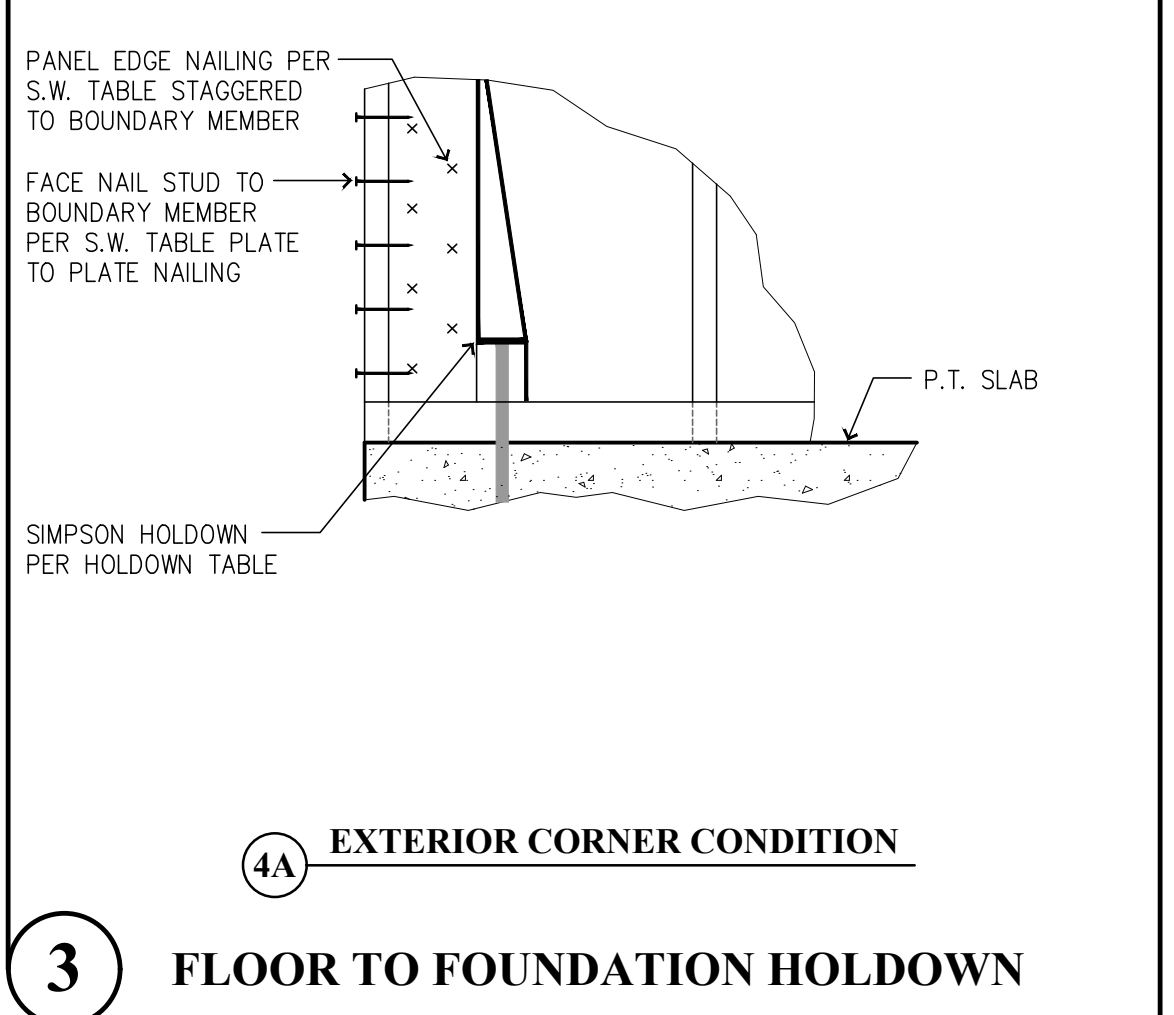


**4A** EXTERIOR CORNER CONDITION

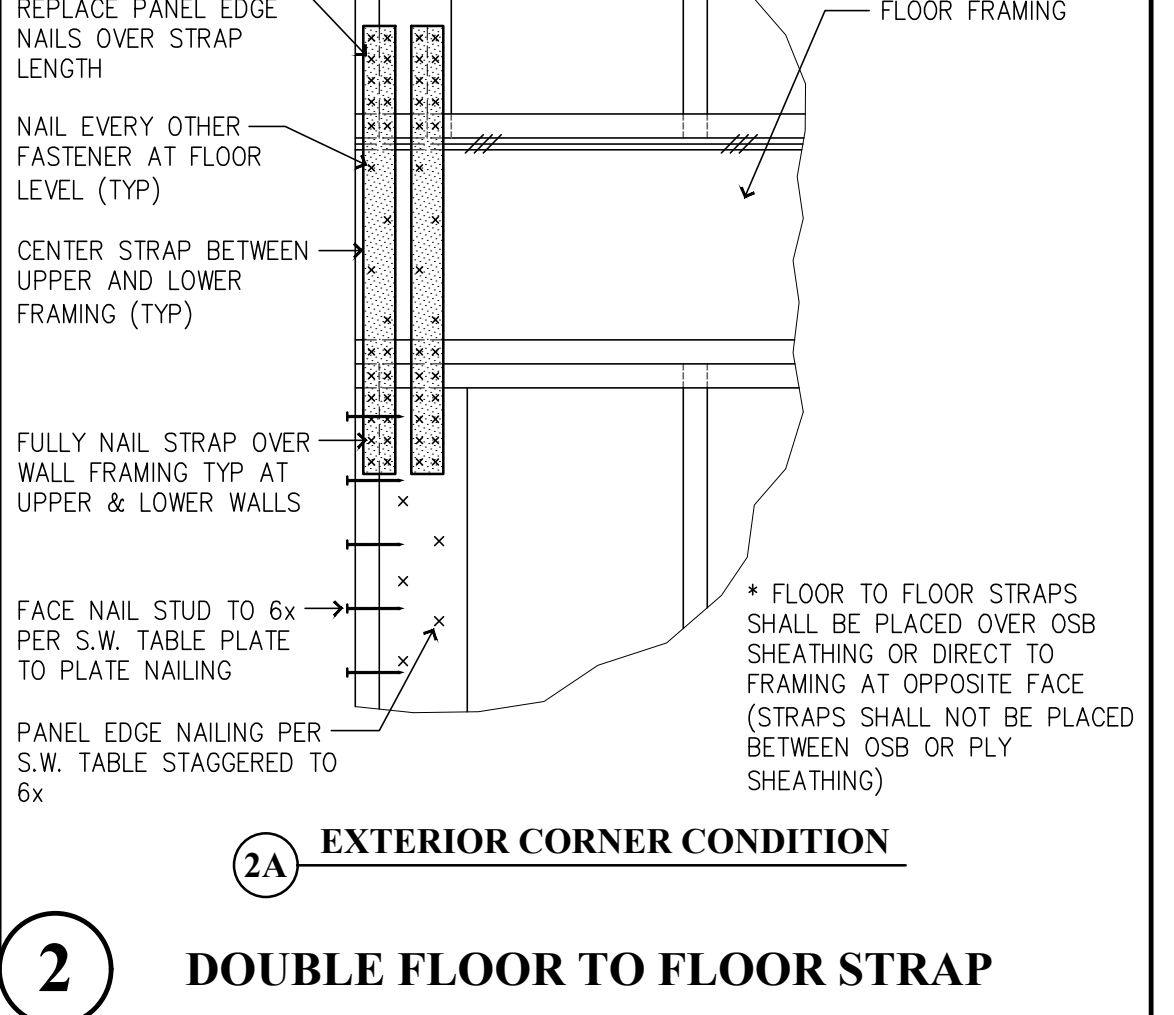

**2A** EXTERIOR CORNER CONDITION

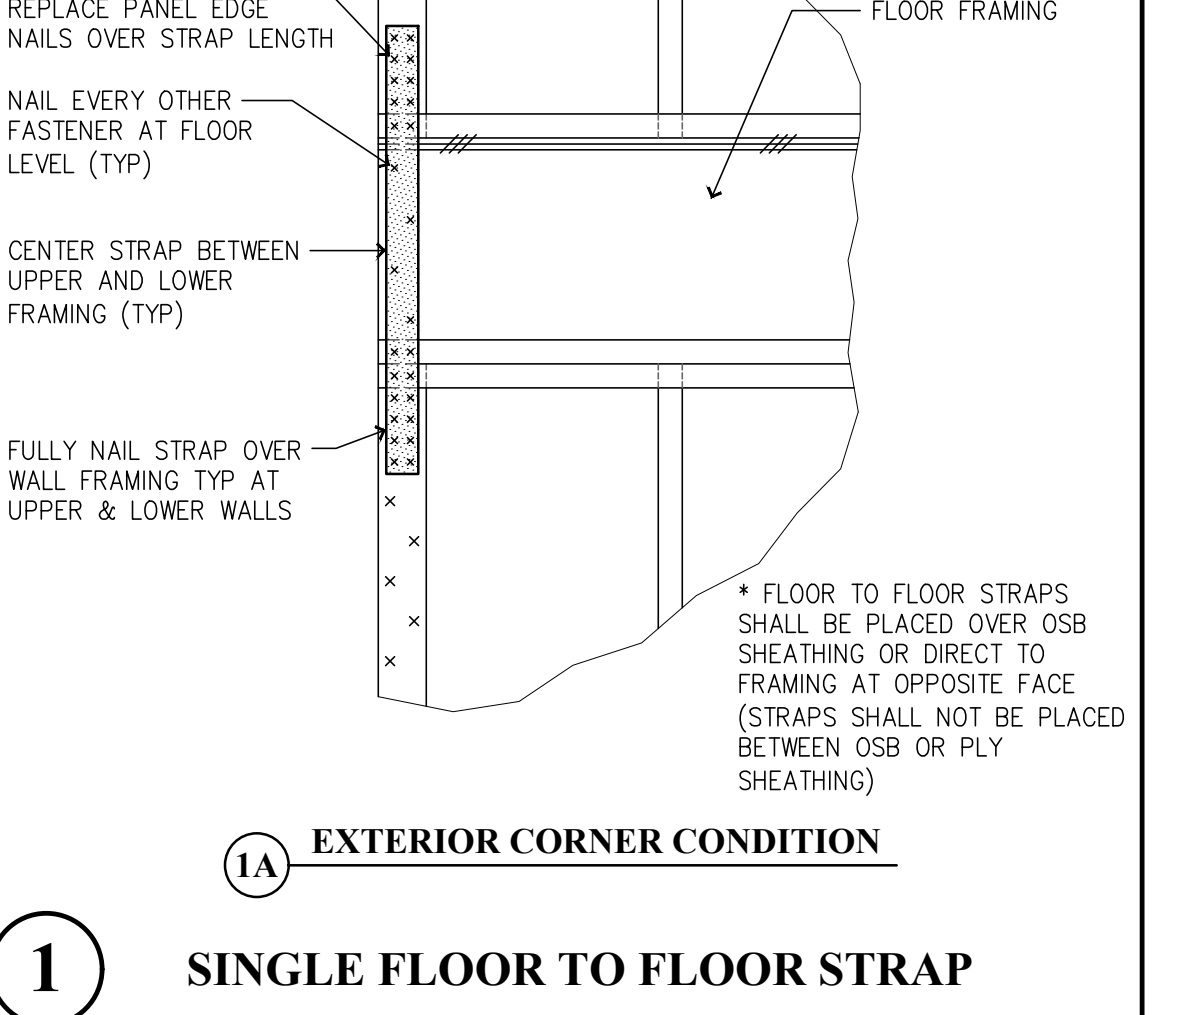

**1A** EXTERIOR CORNER CONDITION

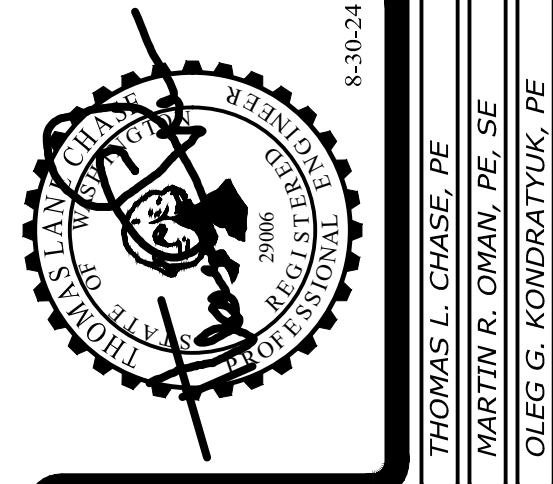

Revisions to this sheet:

**Bradley Heights Apartments**  
 202 27th Ave SE  
 Puyallup, Washington

**Solutions 4 Structures**  
 A Structural Engineering Corporation

Puyallup, Washington 98374  
 Ph 253-314-9822  
 www.solutions4structures.com

PROJECT NO. : 23.007  
 DESIGNED BY : TLC, OGG, MRO  
 DRAWN BY : RSO  
 ISSUE DATE : 2-20-24  
 LATEST REV. OF DWG. SET : 8-30-24


SUBMITTAL SET ONLY NOT FOR CONSTRUCTION  
 THESE DRAWINGS ARE SUBJECT TO REVISIONS  
 PENDING LOCAL JURISDICTIONAL REVIEW.

**S1.3**

**Floor & Roof Framing Notes**

- ROOF AND FLOOR JOIST LOCATIONS ARE SCHEMATICALLY SHOWN ON THE PLANS. IT IS NOT THE INTENT OF THE STRUCTURAL PLANS TO GRAPHICALLY LOCATE ALL FRAMING MEMBERS. THE ARCHITECT SHALL VERIFY THE COMPATIBILITY OF JOIST LAYOUT AND FRAMING W/ MECHANICAL, ELECTRICAL & PLUMBING AND ARCHITECTURAL PLANS. THE CONTRACTOR IS RESPONSIBLE FOR SPACING FRAMING MEMBERS AS NOTED ON THE PLANS AND GENERATING MEMBER LAYOUT FOR SHOP DRAWINGS AND QUANTITY TAKEOFFS.
- FOR ALL UNITS TYPES SEE WALL STUD SCHEDULE FOR BEARING WALL STUD REQUIREMENTS. ALL OTHER NON-BEARING 2x4 & 2x6 WALLS ARE AT 16" O.C.
- THE TRUSS AND JOIST MANUFACTURER SHALL VERIFY BEARING COMPATIBILITY (CRUSHING) WITH THE PLATE MATERIAL. TYPICALLY, COMPOSITE BEAMS SHALL BE FULLY BEARING ON 2x... WALLS. I.E. BREAK RIM OR BLOCKING TO ALLOW FULL BEARING OVER PLATES.
- PLACE LONG DIRECTION OF ALL OSB SHEETS PERPENDICULAR TO TRUSS/RAFTER OR JOIST DIRECTION. SEE DETAIL 3/S1.2. FLOOR SHEATHING IS TO BE CONTINUOUS FROM UNIT TO UNIT. TYPICAL NAILING AT FLOOR AND ROOF DIAPHRAGMS IS PROVIDED IN THE GENERAL STRUCTURAL NOTES ON SHEETS S1.0.
- W- DENOTES THE SHEARWALL TYPE. SEE THE SHEARWALL TABLE ON SHEET S1.2. INDICATES SHEARWALL LOCATION. THE CALLOUTS ON THE SHEARWALL TABLE APPLY ONLY ALONG THE LENGTH OF WALL SHOWN SHADED. PROVIDE SOLID BLOCKING IN FLOOR SPACE BELOW PERPENDICULAR SHEARWALLS.
- INDICATES SHEAR WALL TYPE WITH OPENINGS. PROVIDE SHEATHING AROUND ALL OPENINGS AND ABOVE AND BELOW ALL OPENINGS. PROVIDE HORIZONTAL STRAPS & NAILING AT OPENINGS PER 8/S1.2
- THE DOUBLE TOP PLATE IS TO BE CONTINUOUS ALONG ALL EXTERIOR WALLS AND AT ALL WALL LINES CONTAINING SHEARWALLS. TYPICAL WALL TOP PLATE SPICES SHALL BE PER DETAIL 7/S1.2 TYP.
- WHERE COMPOSITE JOISTS AND BEAMS ARE USED AS DRAG STRUTS THE MANUFACTURER SHALL PROVIDE THE FRAMING MEMBERS WITH THE CAPACITY CALLED OUT ON THE PLANS.
- TYPICAL FLOOR JOISTS SHALL BE 2x12 HF#2 MIN @ 16" O.C. TYP. U.N.O. THE MANUFACTURER SHALL BE RESPONSIBLE FOR ALL JOIST AND BEAM HANGERS, WEB STIFFENERS, SOLID BLOCKING, AND ADDITIONAL RIM OR JOIST MATERIAL TO ACCOMMODATE FLUSH-FRAMED CONDITIONS (F.F.), CANTILEVERED CONDITIONS, CONCENTRATED BEARING LOADS AND NAILING FROM SHEARWALLS ABOVE AND BELOW.
- F.F. = FLUSH-FRAMED BEAM. VERIFY FLUSH OR DROPPED BEAM CONDITION PER ARCHITECT.
- ALL BEAMS PER SCHEDULE U.N.O. ALL NON BEARING BEAMS SHALL BE A MIN OF (2)x8 U.N.O. ALL OTHER BEAMS ARE AS MARKED ON PLANS.
- AT ALL BEAM BEARING/JAMB LOCATIONS, AT MINIMUM PROVIDE BEARING (TRIMMER) STUDS AND FULL HEIGHT (KIND) STUDS PER THE JAMB STUD SCHEDULE FOR EACH BUILDING. IF NO CALLOUT, PROVIDE (1) 2x... BEARING AND (1) 2x... FULL HEIGHT STUD MINIMUM.
- EXPOSED FRAMING SHALL BE PRESSURE TREATED (P.T.) VERTICAL & HORIZONTAL FRAMING @ WATERPROOFED WALKWAYS AND PRIVATE DECKS. ALL EXPOSED BEAM HANGERS SHALL BE POST HOT-DIPPED GALVANIZED AND HAVE CONCEALED FLANGES. VERIFY W/ ARCHITECT. SEE NOTE ON SHEET S1.0
- FOR TYPICAL HOLDOWN ASSEMBLIES SEE THE HOLDOWN TABLE ON 2/S1.2 AND DETAILS ON SHEET S3.0.
- SEE ARCHITECTURAL PLANS FOR STAIR FRAMING DETAILS & STAIR FRAMING DETAILS AND NOTES, CONTROL JOINTS IN CONCRETE FLOORING AND ROOF VENTILATION REQUIREMENTS AND DETAILS.
- SEE CIVIL AND ARCHITECTURAL PLANS FOR TOP OF WALL HEIGHTS AND ELEVATIONS. SEE ARCHITECTURAL PLANS FOR DIMENSIONS. WHERE DIMENSIONS ARE SHOWN ON THE STRUCTURAL PLANS, CONTRACTOR SHALL VERIFY COMPATIBILITY W/ ARCHITECTURAL PLANS. WHERE DISCREPANCY EXISTS, CONTRACTOR SHALL NOTIFY BOTH THE ENGINEER AND ARCHITECT FOR CLARIFICATION.
- WINDOW SUPPLIER TO VERIFY THAT WINDOW AND WINDOW FRAMES TRANSFER WINDOW LOADS EVENLY TO STRUCTURAL FRAMING ON ALL 4 SIDES OF WINDOW. WINDOW SUPPLIER TO VERIFY MINIMUM .005" STORY DRIFT TOLERANCE IN PLANE OF ALL WINDOWS AND ALLOW FOR 1/240 DEFLECTION (PERPENDICULAR) AT WINDOW MULLIONS.
- SEE GENERAL STRUCTURAL NOTES ON S1.0 TO S1.3 FOR ADDITIONAL INFORMATION.
- LEGEND:

- INDICATES BEAM / GIRDER TRUSS PER PLAN SEE FRAMING PLANS
- INDICATES HANGER PER MANUFACTURER
- GT INDICATES GIRDER TRUSS PER PLAN
- INDICATES JOIST / TRUSS BEARING @ WALL / BEAM
- INDICATES JOIST / TRUSS INTERMEDIATE BEARING @ WALL / BEAM
- INDICATES TYPICAL TOILET, BATHTUB & SHOWER LAYOUT. CONTRACTOR TO COORDINATE JOIST LAYOUT WITH FIXTURE LOCATIONS TO AVOID PLUMBING & FRAMING CONFLICTS.
- INDICATES ROOF OVERFRAMING - SEE DETAILS 5/S3.0
- PROVIDE WALL FIREBLOCKING @ DROPPED SOFFITS SHOWN ON ARCH.
- PROVIDE WALL BLOCKING FOR ALL WALL MOUNTED EQUIPMENT (SUCH AS TOWEL BARS, GRAB BARS, TOILET PAPER HOLDERS, DOOR STOPS, ETC.).
- LFA INDICATES - LOAD FROM ABOVE
- FF INDICATES FLUSH FRAMED BEAM
- INDICATES STRAP HOLDOWN, SEE SHEET 2/S1.2 FOR HOLDOWN TABLE & UPPER TO LOWER WALL STRAP/HOLDOWN KEY.
- REFER TO ARCHITECTURAL DRAWINGS FOR ALL FLOOR ELEVATIONS.
- SIMPSON STRONG-TIE PRODUCTS ARE CALLED OUT ON THE DRAWINGS. HOWEVER, EITHER SIMPSON OR KC METALS PRODUCTS MAY BE USED PROVIDED IT HAS SAME OR GREATER CAPACITY.

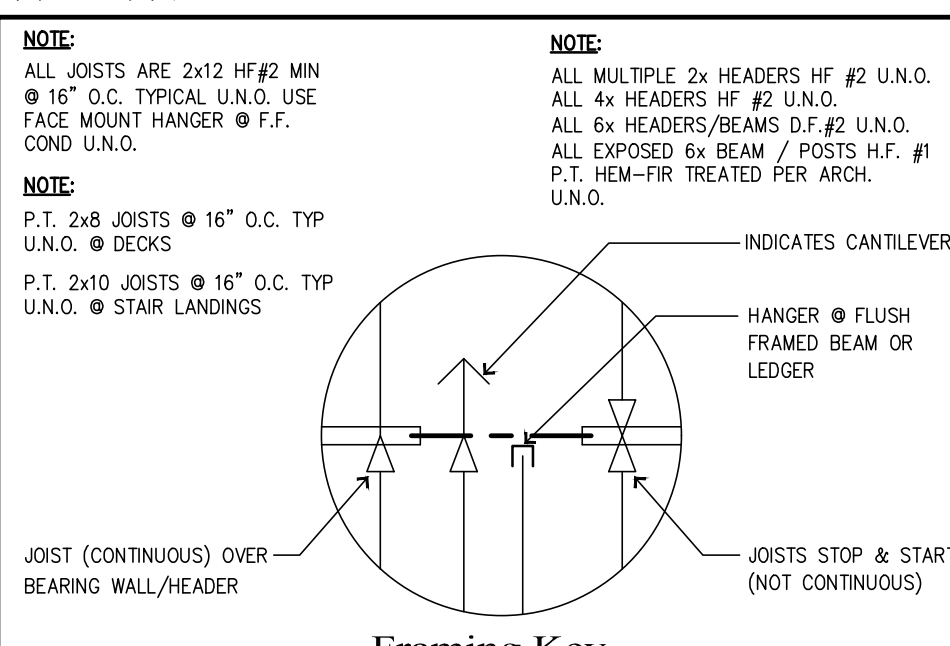

**SEE SHEET S1.2 FOR SHEARWALL AND HOLDOWN TABLES**

**Beam Schedule**

MARK	BEAM SIZE
B1	4x8
B2	4x10
B3	6x10 DF #2
B4	3-1/8 x 10-1/2 GLB
B5	P.T. 4x8
B6	P.T. 4x10
B7	P.T. 6x10 HF#1
B8	P.T. 3-1/8 x 10-1/2 GLB
B9	P.T. 5-1/8 x 10-1/2 GLB
B10	5-1/8x10-1/2 GLB OR 5-1/4x11-7/8 PSL
B11	4x12 OR 3-1/2x11-7/8 LSL

**Jamb Stud Schedule**

TYPE	C1	C2	C3	C4	C5	C6	-	-
BEARING/FULL HT STUDS	1/2	1/3	2/1	2/2	2/3	2/4	-	-

NOTE: STUD SIZE SHOULD MATCH WALL SIZE PER PLAN.

**Wall Stud Schedule**


FRAMING LEVEL	2x6 EXTERIOR SINGLE WALL	2x6 BRG INT PARTLY WALLS	2x4 BRG INT SINGLE WALL	2x4 BRG EXTERIOR PARTLY WALLS
ROOF	2x6 @ 16" O.C.	2x6 @ 16" O.C.	2x4 HF#2 @ 16" O.C.	2x4 HF#2 @ 16" O.C.
3RD	2x6 @ 16" O.C.	2x6 @ 16" O.C.	2x4 HF#2 @ 16" O.C.	2x4 HF#2 @ 16" O.C.
2ND	2x6 @ 16" O.C.	2x6 @ 16" O.C.	2x4 HF#2 @ 16" O.C.	2x4 HF#2 @ 16" O.C.
BASEMENT	2x6 @ 16" O.C.	2x6 @ 16" O.C.	2x4 HF#2 @ 12" O.C.	2x4 HF#2 @ 16" O.C.

NOTES:


- ALL STUD MATERIAL SHALL BE HEM FIR STUD GRADE OR BETTER UNLESS NOTED OTHERWISE AND PLATE MATERIAL SHALL BE HEM FIR STANDARD OR BETTER UNLESS NOTED OTHERWISE.
- STUDS CALLED OUT IN THIS SCHEDULE ARE FOR WALL SUPPORTING THE FRAMING LEVEL INDICATED. THIS IS WALLS BELOW THE FRAMING LEVEL SHOWN.
- THIS SCHEDULE COVERS BUILDING UNITS 3 STORES IN HEIGHT. FIRST, DETERMINE THE NUMBER OF STORES FOR THE UNIT SECOND, DETERMINE THE FRAMING LEVEL, THIRD, READ SCHEDULE HORIZONTALLY FOR THE WALL LOCATION.

**Foundation Notes**


- TYPICAL DIMENSIONS ARE TO FACE OF WALL OR TO CENTERLINE OF COLUMN OR FOOTING. VERIFY ALL DIMENSIONS & ELEVATIONS WITH THE ARCHITECT.
- PROVIDE FOOTING SUBSTRATE PREPARATION PER THE SOILS REPORT.
- F- INDICATES ISOLATED FOOTING TYPICAL ISOLATED FTG SHALL BE CONSTRUCTED PER FOOTING SCHEDULE 5/S3.0.
- EXTEND ALL CONTINUOUS FOOTINGS AT END WALLS 1'-0" MIN. BEYOND END OF ALL BEARING WALLS & SHEARWALLS. (TYPICAL) UNO
- ALL EXTERIOR WALLS SHALL HAVE AN 8" STEEL W/ AND A 18" WIDE X 8" DEEP FOOTING W/ STEEL REINFORCING 3" CLR. OF SOIL UNLESS NOTED OTHERWISE.
- ADD STRIP DRAINS AT FACE OF BUILDINGS WHEN WALKS SLOPE TOWARD BUILDING, CONNECT TO TIGHTLINE.
- PROVIDE #4-24" X 24" CORNER BARS TO MATCH ALL HORIZONTAL REINFORCEMENT IN STEMWALLS AND FOOTINGS. (TYPICAL)
- FLOOR SLABS - 4" CONC. SLAB ON GRADE 6x6 - W1.2x1.2 W/ WF @ CENTER-LINE OR FIBER MESH PER MANUFACTURER OVER SUBSTRATE PER SOILS ENGINEER, USE W/ WHERE INDICATED. PROVIDE CONTROL JOINTS PER DETAIL 15/S3.0 AT THE DIRECTION OF THE ARCHITECT.
- ENTRY SLABS - 4" CONC. SLAB (BROOM FINISH)
- PATIO SLABS - 4" CONC. W/ THICKENED EDGES. SLOPE AWAY FROM BUILDING AT 1/4"/FT. SEE 3/S3.0
- ALL THICKENED SLABS FOR BEARING WALLS AND PARTY WALLS SHALL BE 18" WIDE X 12" DEEP W/ (2) #4 BARS CONTINUOUS UNLESS NOTED OTHERWISE. DEEPEN LOCALLY AT HOLDOWNS TO OBTAIN EMBEDMENT DEPTH +3" MIN.
- ALL THICKENED EDGE SLABS SHALL BE 8" WIDE X 8" DEEP W/ (1) #4 BAR CONTINUOUS (3" FROM BOTTOM) UNLESS NOTED OTHERWISE. SEE 3/S3.0.
- W- DENOTES THE SHEARWALL TYPE. SEE THE SHEARWALL TABLE ON SHEET S1.2. INDICATES SHEARWALL LOCATION. THE CALLOUTS ON THE SHEARWALL TABLE APPLY ONLY ALONG THE LENGTH OF WALL SHOWN SHADED. PROVIDE SOLID BLOCKING IN FLOOR SPACE BELOW PERPENDICULAR SHEARWALLS.
- INDICATES SHEAR WALL TYPE WITH OPENINGS. PROVIDE SHEATHING AROUND ALL OPENINGS AND ABOVE AND BELOW ALL OPENINGS. PROVIDE HORIZONTAL STRAPS & NAILING AT OPENINGS PER 8/S1.2
- INDICATES HOLDOWN, SEE 2/S1.2 FOR HOLDOWN TABLE & UPPER TO LOWER WALL STRAPS HOLDOWN/KEY.
- VERIFY ALL TOP OF SLAB ELEVATIONS AND BUILDING STEPS WITH ARCH/CIVIL PLANS TYPICAL.
- TYPICAL PERIMETER FOOTING SHALL BE LOCATED A MIN. 18" BELOW GRADE OR AS REQUIRED BY LOCAL JURISDICTION.
- SEE DETAILS FOR TYPICAL STEMWALL/FOOTING & THICKENED SLAB CONSTRUCTION.
- T.O.W. = TOP OF STEMWALL  
T.O.F. = TOP OF FOOTING  
T.O.S. = TOP OF SLAB
- SEE THE GENERAL STRUCTURAL NOTES ON SHEET S1.0 FOR ADDITIONAL INFORMATION.
- VERIFY WITH CIVIL GRADING PLAN FOR GARAGE SLAB ELEVATION @ GARAGE DOORWAY.
- DEEPEN FOOTINGS AS NECESSARY TO MAINTAIN MINIMUM COVER. COORDINATE WITH CIVIL GRADING PLAN FOR GRADE CONDITIONS.
- INDICATES DEPRESSED TOP OF STEMWALL AT DOORWAY. POUR SLAB OVER SEE 4/S3.0.
- ALL INTERSECTING FOOTINGS / STEM WALLS SHALL HAVE CORNER BARS TO MATCH HORIZ REINFORCEMENT SEE 10/S3.0.

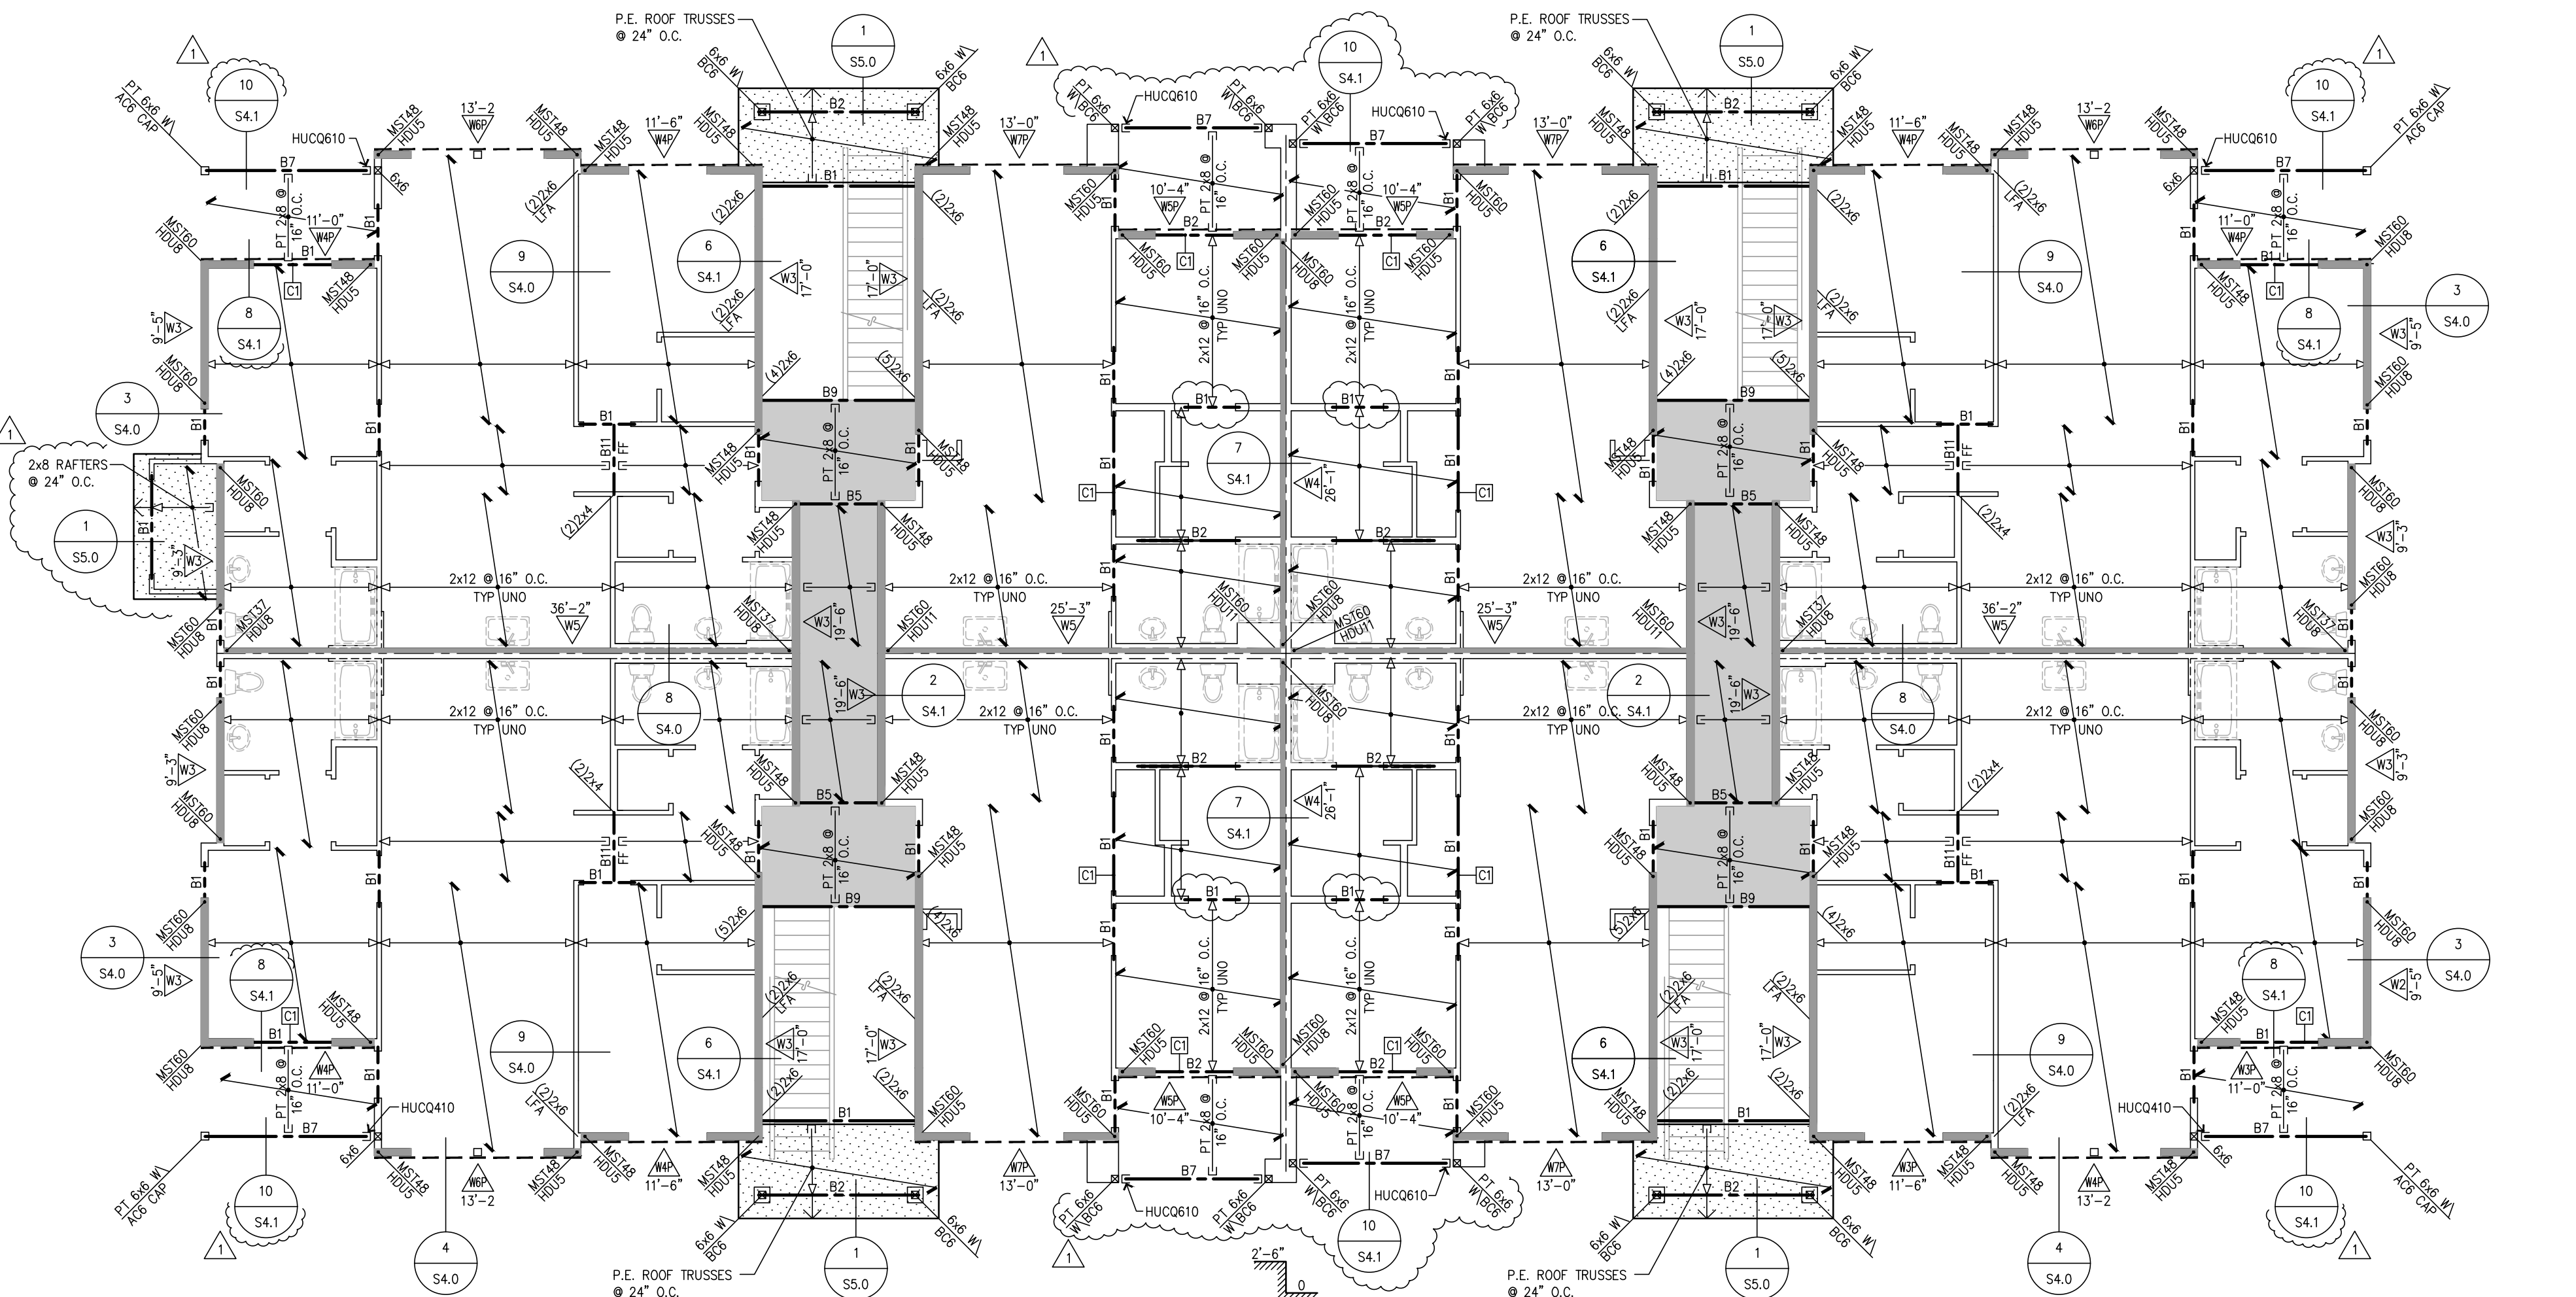

**2nd Floor Framing Plan - Bldg H**  
SCALE 1/8"=1'-0"

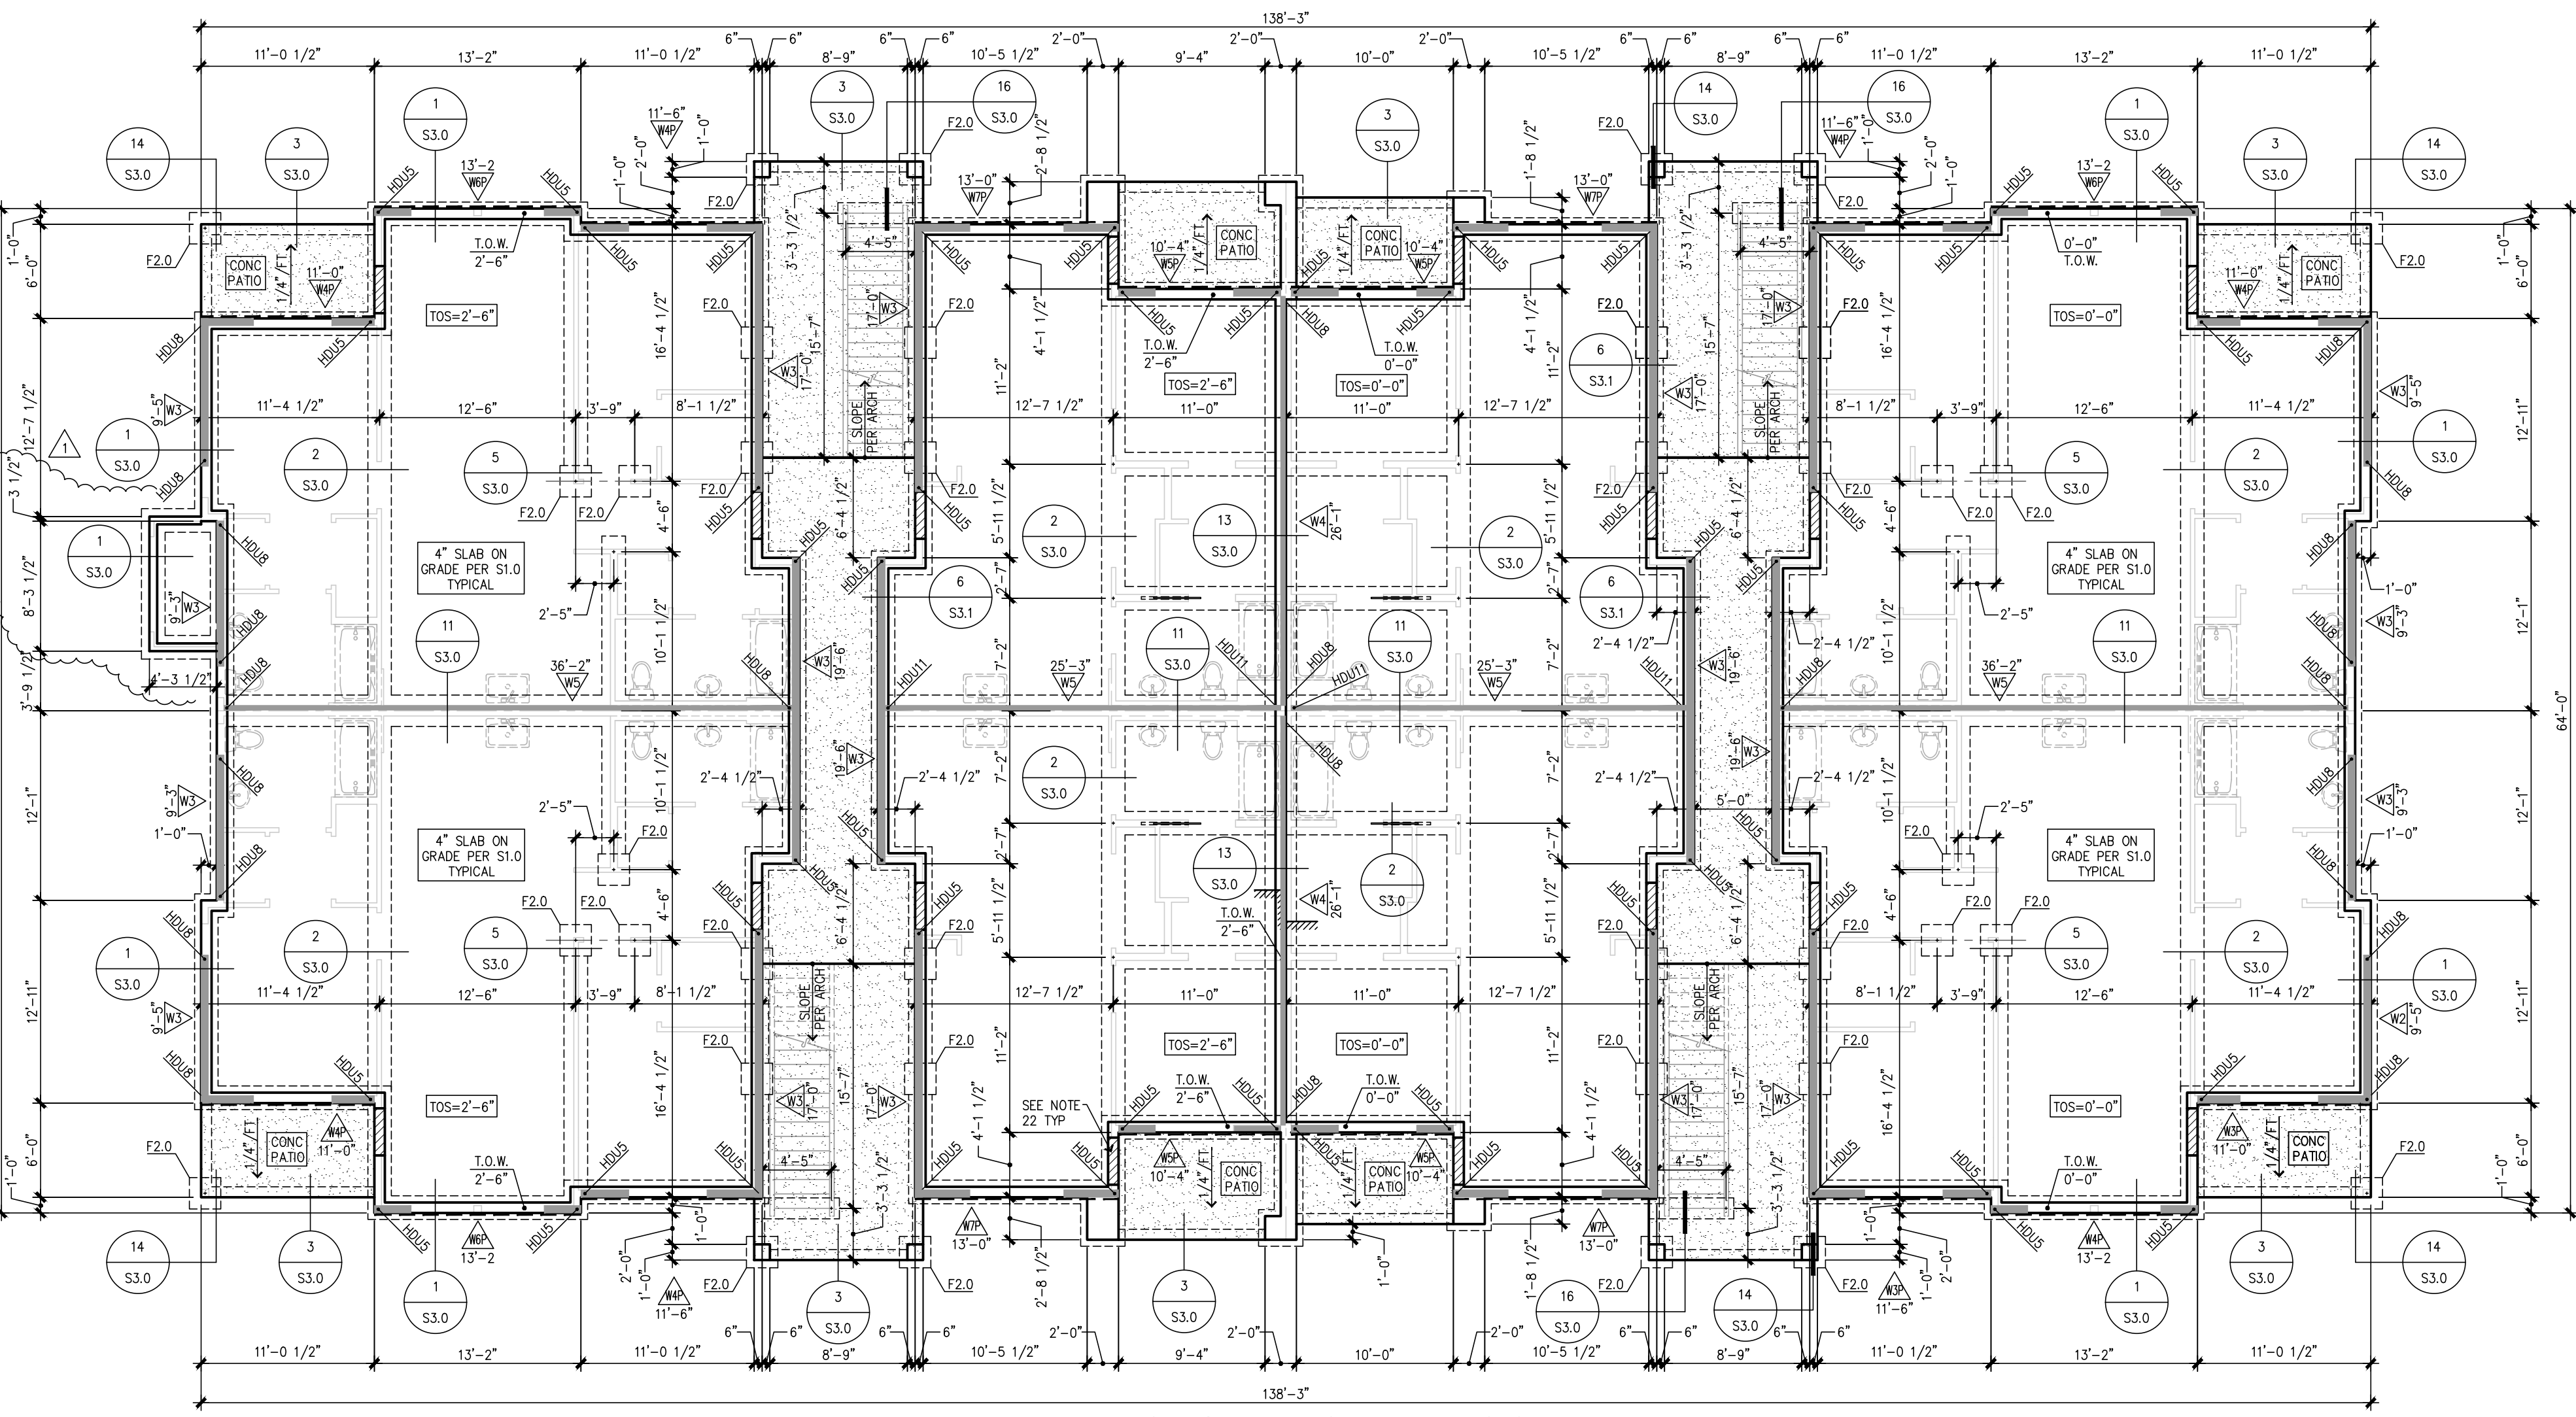

**Foundation Plan - Bldg H**  
SCALE 1/8"=1'-0"

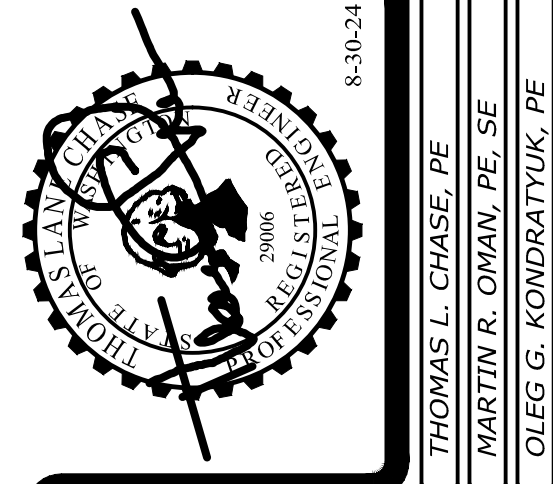

THOMAS L. CHASE, PE  
MARTIN R. OMAN, PE, SE  
OLEG G. KONDRATYUK, PE

Revisions to this sheet:  
8-30-24 PERMIT CORRECTIONS & OWNER CHANGES

**Bradley Heights Apartments**  
202 27th Ave SE  
Puyallup, Washington

Puyallup, Washington 98374  
Ph 253-314-9822  
www.solutions4structures.com

**Solutions 4 Structures**  
A Structural Engineering Corporation

PROJECT NO. : 23-007  
DESIGNED BY : TLC, OGG, MRO  
DRAWN BY : RSO  
ISSUE DATE : 2-20-24  
LATEST REV. OF DWG. SET : 8-30-24

SUBMITTAL SET ONLY NOT FOR CONSTRUCTION  
THESE DRAWINGS ARE SUBJECT TO REVISIONS PENDING LOCAL JURISDICTIONAL REVIEW.


**S2.19**

CAD FILE: F:\Projects\2023 Projects\Drawings\S2.19.dwg PLOT DATE/TIME: 10/2/2024 - 7:54am THANK YOU FOR USING SOLUTIONS 4 STRUCTURES

**Floor & Roof Framing Notes**

- ROOF AND FLOOR JOIST LOCATIONS ARE SCHEMATICALLY SHOWN ON THE PLANS. IT IS NOT THE INTENT OF THE STRUCTURAL PLANS TO GRAPHICALLY LOCATE ALL FRAMING MEMBERS. THE ARCHITECT SHALL VERIFY THE COMPATIBILITY OF JOIST LAYOUT AND FRAMING W/ MECHANICAL, ELECTRICAL & PLUMBING AND ARCHITECTURAL PLANS. THE CONTRACTOR IS RESPONSIBLE FOR SPACING FRAMING MEMBERS AS NOTED ON THE PLANS AND GENERATING MEMBER LAYOUT FOR SHOP DRAWINGS AND QUANTITY TAKEOFFS.
- FOR ALL UNITS TYPES SEE WALL STUD SCHEDULE FOR BEARING WALL STUD REQUIREMENTS. ALL OTHER NON-BEARING 2x4 & 2x6 WALLS ARE AT 16" O.C.
- THE TRUSS AND JOIST MANUFACTURER SHALL VERIFY BEARING COMPATIBILITY (CRUSHING) WITH THE PLATE MATERIAL. TYPICALLY, COMPOSITE BEAMS SHALL BE FULLY BEARING ON 2x WALLS. I.E. BREAK RIM OR BLOCKING TO ALLOW FULL BEARING OVER PLATES.
- PLACE LONG DIRECTION OF ALL OSB SHEETS PERPENDICULAR TO TRUSS/RAFTER OR JOIST DIRECTION. SEE DETAIL 3/S1.2. FLOOR SHEATHING IS TO BE CONTINUOUS FROM UNIT TO UNIT. TYPICAL NAILING AT FLOOR AND ROOF DIAPHRAGMS IS PROVIDED IN THE GENERAL STRUCTURAL NOTES ON SHEETS S1.0.
- △ DENOTES THE SHEARWALL TYPE. SEE THE SHEARWALL TABLE ON SHEET S1.2.
  - △ INDICATES SHEARWALL LOCATION. THE CALLOUTS ON THE SHEARWALL TABLE APPLY ONLY ALONG THE LENGTH OF WALL SHOWN SHADDED. PROVIDE SOLID BLOCKING IN FLOOR SPACE BELOW PERPENDICULAR SHEARWALLS.
  - △ INDICATES SHEAR WALL TYPE WITH OPENINGS. PROVIDE SHEATHING AROUND ALL OPENINGS AND ABOVE AND BELOW ALL OPENINGS. PROVIDE HORIZONTAL STRAPS & NAILING AT OPENINGS PER 8/S1.2
- THE DOUBLE TOP PLATE IS TO BE CONTINUOUS ALONG ALL EXTERIOR WALLS AND AT ALL WALL LINES CONTAINING SHEARWALLS. TYPICAL WALL TOP PLATE SPICES SHALL BE PER DETAIL 7/S1.2 TYP.
- WHERE COMPOSITE JOISTS AND BEAMS ARE USED AS DRAG STRUTS THE MANUFACTURER SHALL PROVIDE THE FRAMING MEMBERS WITH THE CAPACITY CALLED OUT ON THE PLANS.
- TYPICAL FLOOR JOISTS SHALL BE 2x12 HF#2 MIN @ 16" O.C. TYP. U.N.O. THE MANUFACTURER SHALL BE RESPONSIBLE FOR ALL JOIST AND BEAM HANGERS, WEB STIFFENERS, SOLID BLOCKING, AND ADDITIONAL RIM OR JOIST MATERIAL TO ACCOMMODATE FLUSH-FRAMED CONDITIONS (F.F.), CANTILEVERED CONDITIONS, CONCENTRATED BEARING LOADS AND NAILING FROM SHEARWALLS ABOVE AND BELOW.
- F.F. = FLUSH-FRAMED BEAM. VERIFY FLUSH OR DROPPED BEAM CONDITION PER ARCHITECT.
- ALL BEAMS PER SCHEDULE U.N.O. ALL NON BEARING BEAMS SHALL BE A MIN OF (2)x8 U.N.O. ALL OTHER BEAMS ARE AS MARKED ON PLANS.
- AT ALL BEAM BEARING/JAMB LOCATIONS, AT MINIMUM PROVIDE BEARING (TRIMMER) STUDS AND FULL HEIGHT (KNO) STUDS PER THE JAMB STUD SCHEDULE FOR EACH BUILDING. IF NO CALLOUT, PROVIDE (1) 2x BEARING AND (1) 2x FULL HEIGHT STUD MINIMUM.
- EXPOSED FRAMING SHALL BE PRESSURE TREATED (P.T.) VERTICAL & HORIZONTAL FRAMING @ WATERPROOFED WALKWAYS AND PRIVATE DECKS. ALL EXPOSED BEAM HANGERS SHALL BE POST HOT-DIPPED GALVANIZED AND HAVE CONCEALED FLANGES. VERIFY W/ ARCHITECT. SEE NOTE ON SHEET S1.0
- FOR TYPICAL HOLDOWN ASSEMBLIES SEE THE HOLDOWN TABLE ON 2/S1.2 AND DETAILS ON SHEET S3.0.
- SEE ARCHITECTURAL PLANS FOR STAIR FRAMING DETAILS & STAIR FRAMING DETAILS AND NOTES, CONTROL JOINTS IN CONCRETE FLOORING AND ROOF VENTILATION REQUIREMENTS AND DETAILS.
- SEE CIVIL AND ARCHITECTURAL PLANS FOR TOP OF WALL HEIGHTS AND ELEVATIONS. SEE ARCHITECTURAL PLANS FOR DIMENSIONS. WHERE DIMENSIONS ARE SHOWN ON THE STRUCTURAL PLANS, CONTRACTOR SHALL VERIFY COMPATIBILITY W/ ARCHITECTURAL PLANS. WHERE DISCREPANCY EXISTS, CONTRACTOR SHALL NOTIFY BOTH THE ENGINEER AND ARCHITECT FOR CLARIFICATION.
- WINDOW SUPPLIER TO VERIFY THAT WINDOW AND WINDOW FRAMES TRANSFER WIND LOADS EVENLY TO STRUCTURAL FRAMING ON ALL 4 SIDES OF WINDOW. WINDOW SUPPLIER TO VERIFY MINIMUM .005H" STORY DRIFT TOLERANCE IN PLANE OF ALL WINDOWS AND ALLOW FOR L/240 DEFLECTION (PERPENDICULAR) AT WINDOW MULLIONS.
- SEE GENERAL STRUCTURAL NOTES ON S1.0 TO S1.3 FOR ADDITIONAL INFORMATION.

18. LEGEND:
- INDICATES BEAM / GIRDER TRUSS PER PLAN SEE FRAMING PLANS
  - INDICATES HANGER PER MANUFACTURER
  - GT INDICATES GIRDER TRUSS PER PLAN
  - INDICATES JOIST / TRUSS BEARING @ WALL / BEAM
  - INDICATES JOIST / TRUSS INTERMEDIATE BEARING @ WALL / BEAM
  - INDICATES TYPICAL TOILET, BATHTUB & SHOWER LAYOUT. CONTRACTOR TO COORDINATE JOIST LAYOUT WITH FIXTURE LOCATIONS TO AVOID PLUMBING & FRAMING CONFLICTS.
  - INDICATES ROOF OVERFRAMING - SEE DETAILS 5/S5.0
  - PROVIDE WALL FIREBLOCKING @ DROPPED SOFFITS SHOWN ON ARCH.
  - PROVIDE WALL BLOCKING FOR ALL WALL MOUNTED EQUIPMENT (SUCH AS TOWEL BARS, GRAB BARS, TOILET PAPER HOLDERS, DOOR STOPS, ETC.).
  - LFA INDICATES - LOAD FROM ABOVE
  - FF INDICATES FLUSH FRAMED BEAM
  - INDICATES STRAP HOLDOWN, SEE SHEET 2/S1.2 FOR HOLDOWN TABLE & UPPER TO LOWER WALL STRAP/HOLDOWN KEY.
  - REFER TO ARCHITECTURAL DRAWINGS FOR ALL FLOOR ELEVATIONS.
  - SIMPSON STRONG TIE PRODUCTS ARE CALLED OUT ON THE DRAWINGS. HOWEVER, EITHER SIMPSON OR KC METALS PRODUCTS MAY BE USED PROVIDED IT HAS SAME OR GREATER CAPACITY.

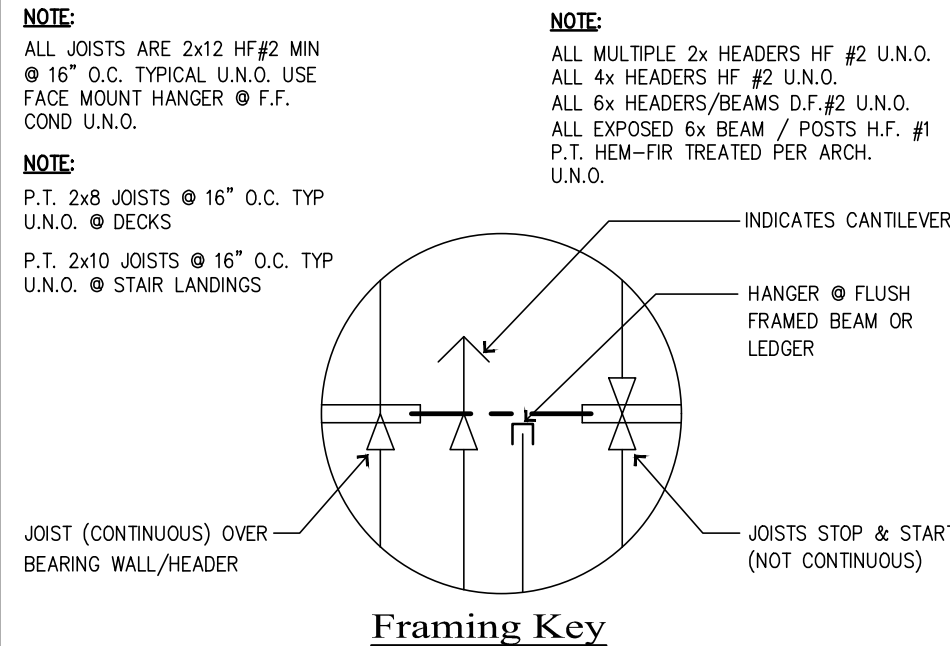

**SEE SHEET S1.2 FOR SHEARWALL AND HOLDOWN TABLES**

**Beam Schedule**

MARK	BEAM SIZE
B1	4x8
B2	4x10
B3	6x10 DF #2
B4	3-1/8 x 10-1/2 GLB
B5	P.T. 4x8
B6	P.T. 4x10
B7	P.T. 6x10 HF#1
B8	P.T. 3-1/8 x 10-1/2 GLB
B9	P.T. 5-1/8 x 10-1/2 GLB
B10	5-1/8x10-1/2 GLB OR 5-1/4x11-7/8 PSL
B11	4x12 OR 3-1/2x11-7/8 LSL

**Jamb Stud Schedule**

TYPE	C1	C2	C3	C4	C5	C6	-	-
BEARING/FULL HT STUDS	1/2	1/3	2/1	2/2	2/3	2/4	-	-




NOTE: STUD SIZE SHOULD MATCH WALL SIZE PER PLAN.

**Wall Stud Schedule**

FRAMING LEVEL	2x6 BRG EXTERIOR	2x6 BRG INT SINGLE WALL	2x6 BRG INT PARTY WALLS	2x4 BRG @ SINGLE WALL	2x4 BRG @ PARTY WALLS
ROOF	2x6 @ 16" O.C.	2x6 @ 16" O.C.	2x6 @ 16" O.C.	2x4 HF#2 @ 16" O.C.	2x4 HF#2 @ 16" O.C.
3RD	2x6 @ 16" O.C.	2x6 @ 16" O.C.	2x6 @ 16" O.C.	2x4 HF#2 @ 16" O.C.	2x4 HF#2 @ 16" O.C.
2ND	2x6 @ 16" O.C.	2x6 @ 16" O.C.	2x6 @ 16" O.C.	2x4 HF#2 @ 16" O.C.	2x4 HF#2 @ 16" O.C.
BASEMENT	2x6 @ 16" O.C.	2x6 @ 12" O.C.	2x6 @ 16" O.C.	2x4 HF#2 @ 12" O.C.	2x4 HF#2 @ 16" O.C.

**NOTES:**

- ALL STUD MATERIAL SHALL BE HEM FIR STUD GRADE OR BETTER UNLESS NOTED OTHERWISE AND PLATE MATERIAL SHALL BE HEM FIR STANDARD OR BETTER UNLESS NOTED OTHERWISE.
- STUDS CALLED OUT IN THIS SCHEDULE ARE FOR WALL SUPPORTING THE FRAMING LEVEL INDICATED. THAT IS WALLS BELOW THE FRAMING LEVEL SHOWN.
- THIS SCHEDULE COVERS BUILDING UNITS 3 STORES IN HEIGHT. FIRST, DETERMINE THE NUMBER OF STORES FOR THE UNIT SECOND, DETERMINE THE FRAMING LEVEL, THIRD, READ SCHEDULE HORIZONTALLY FOR THE WALL LOCATION.

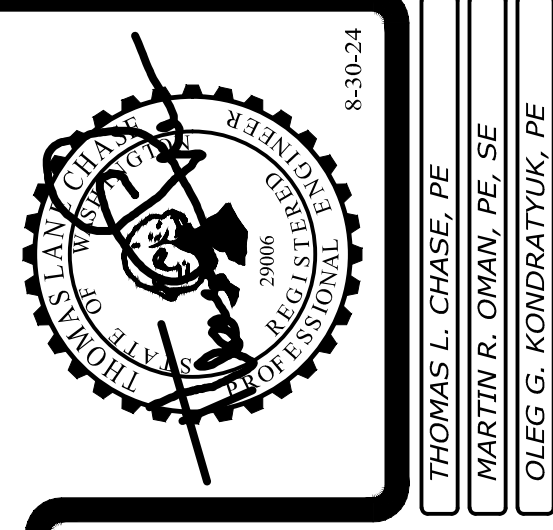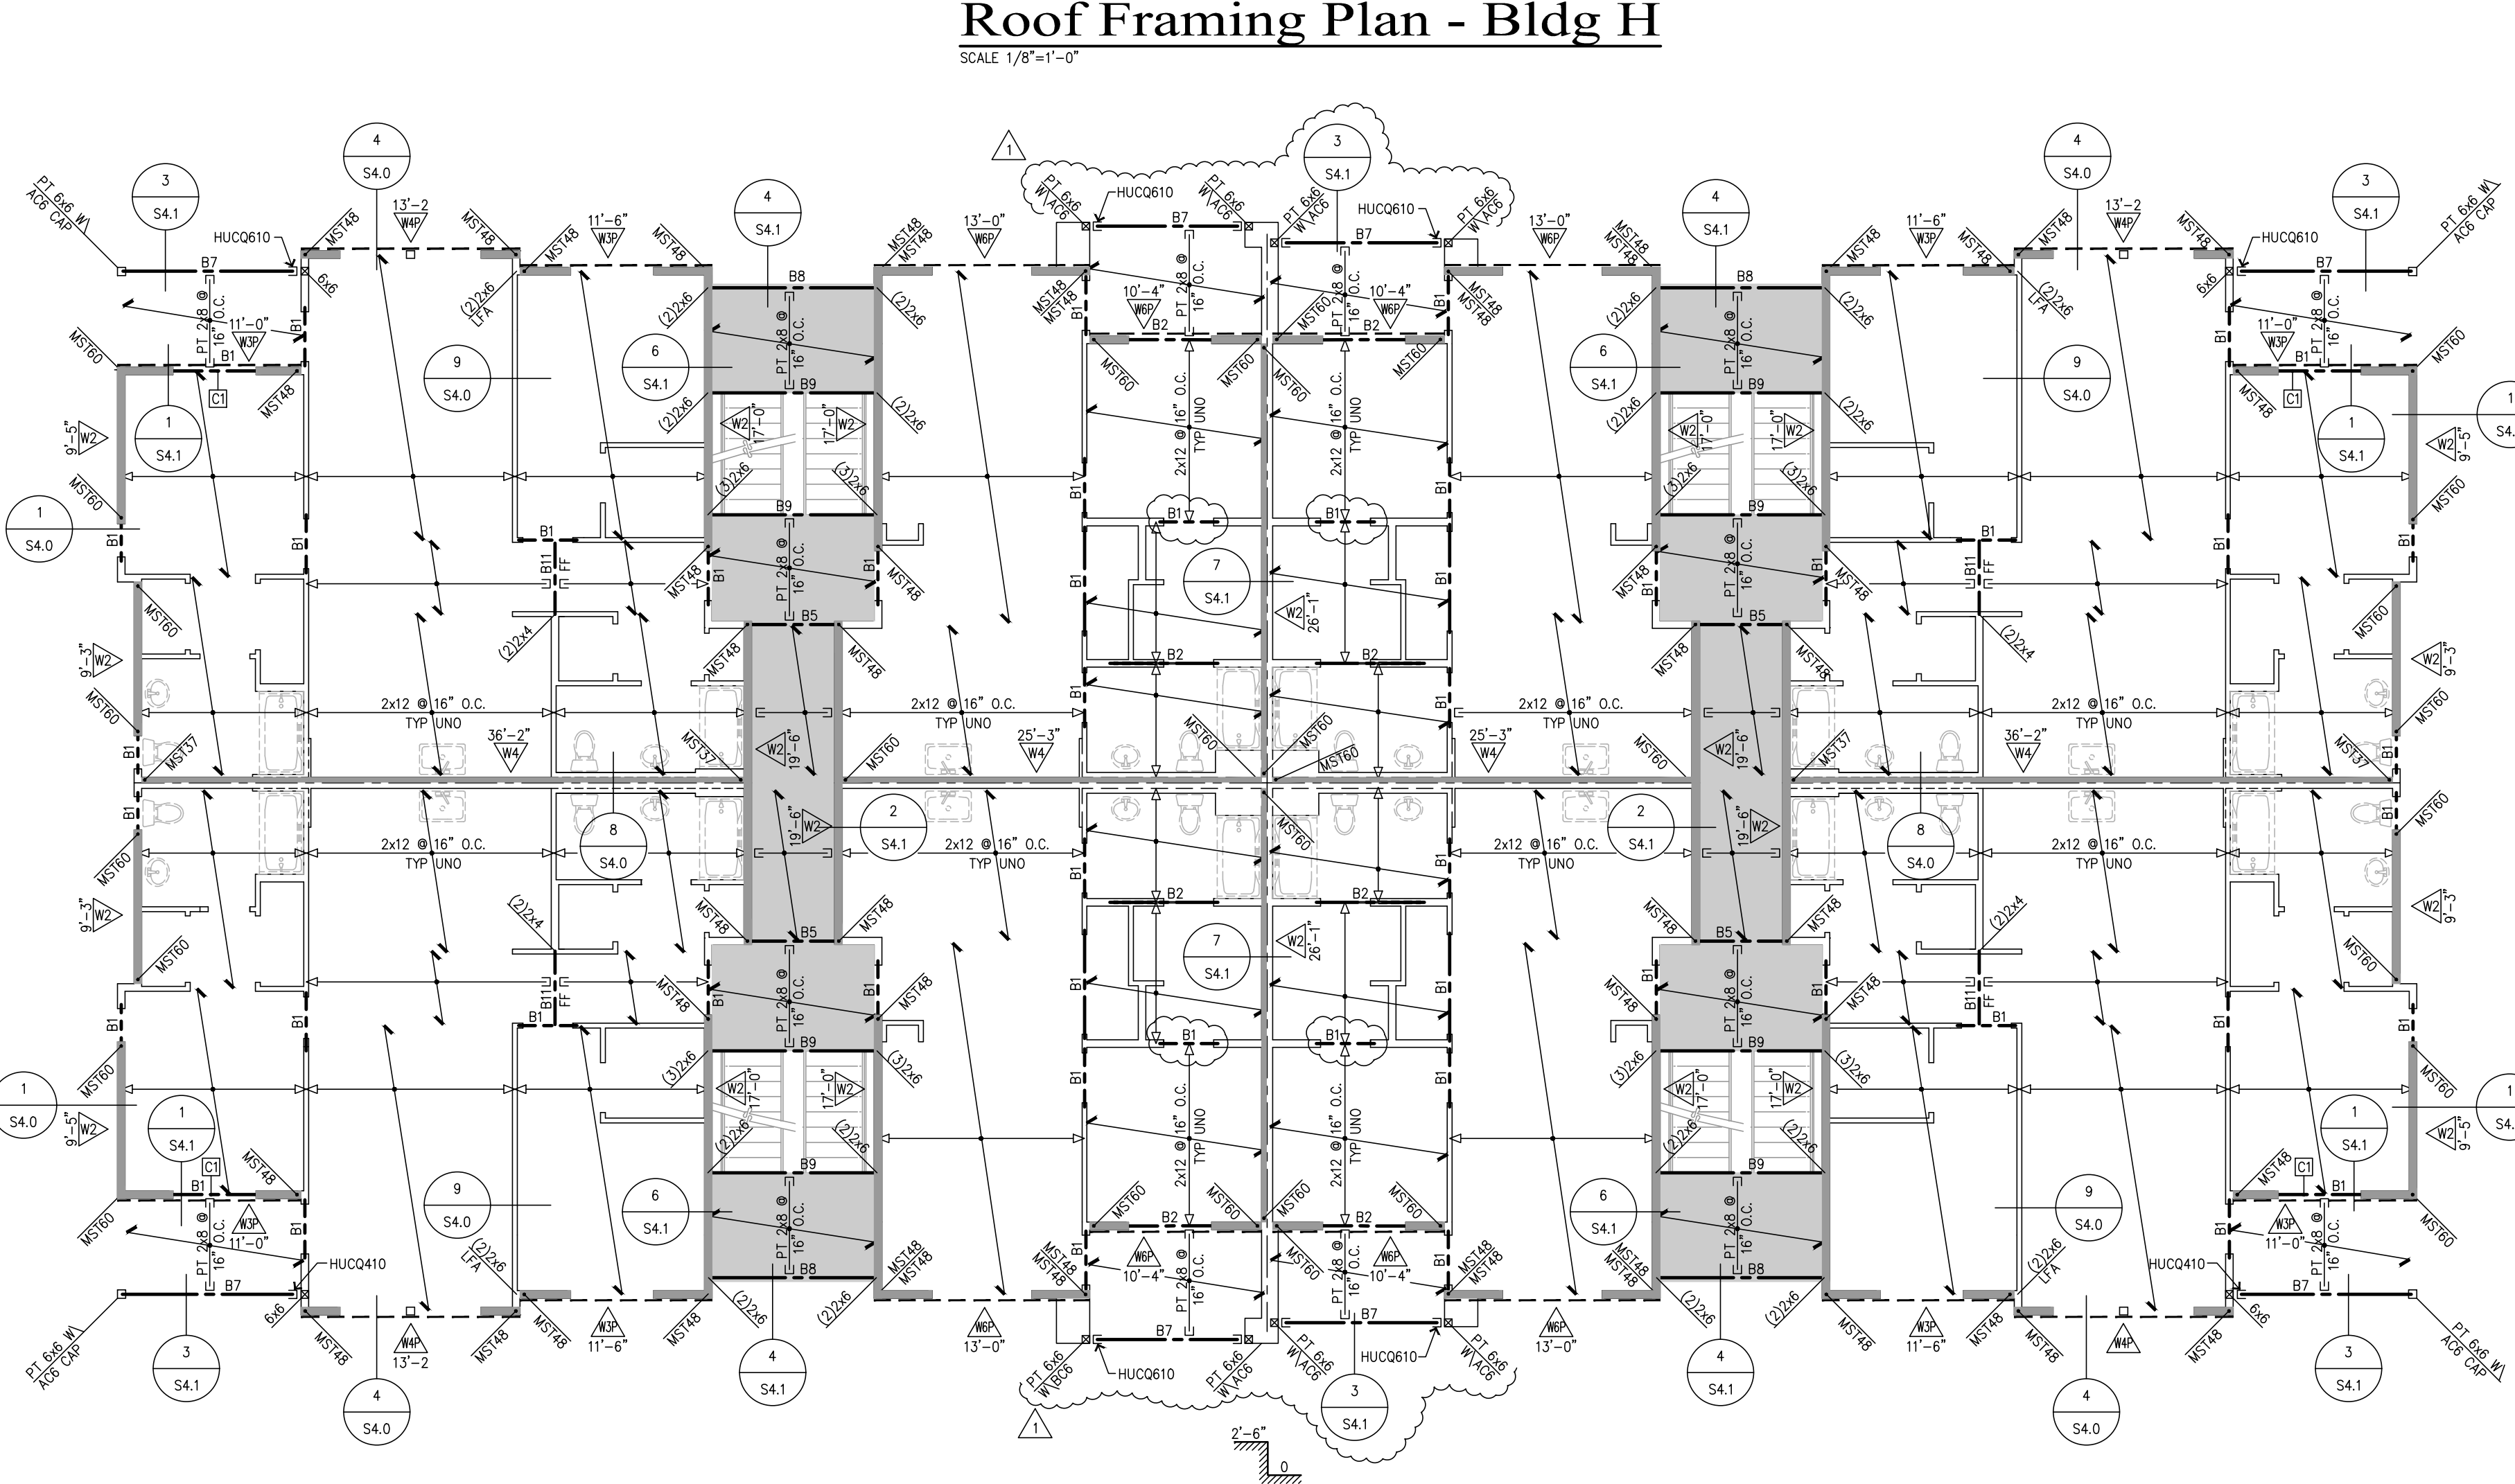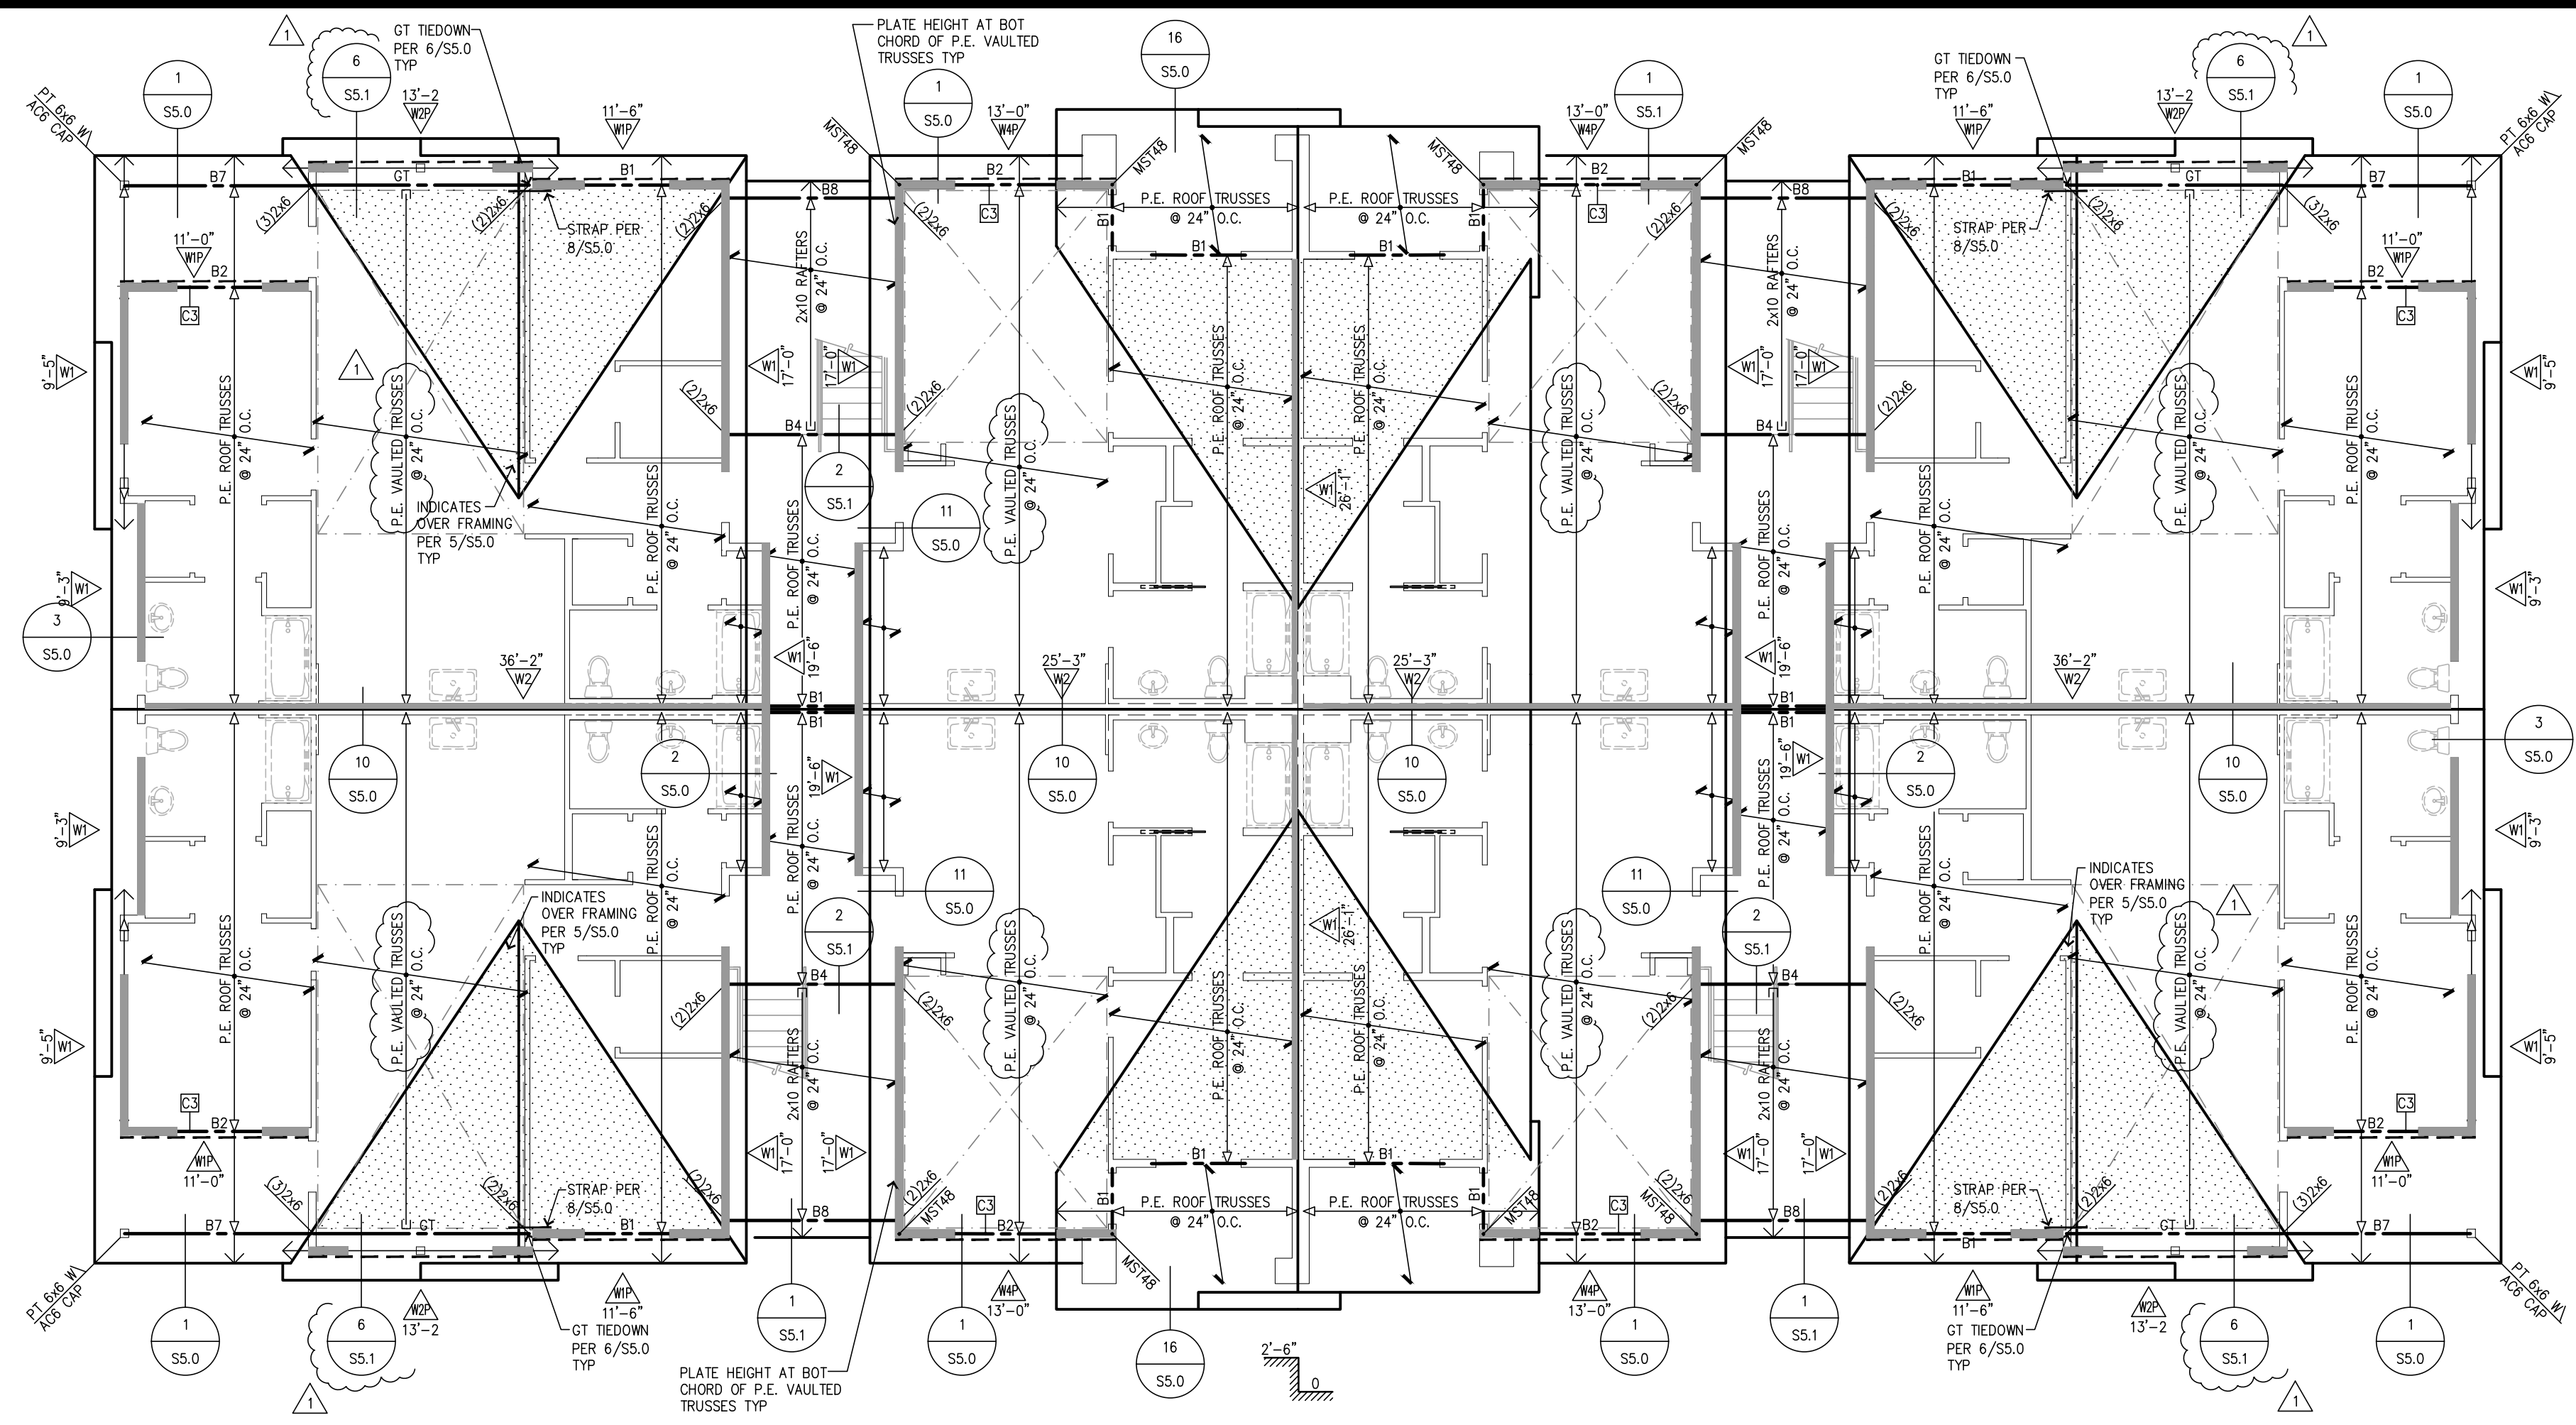

Revisions to this sheet:  
8-30-24 PERMIT CORRECTIONS & OWNER CHANGES

**Bradley Heights Apartments**  
202 27th Ave SE  
Puyallup, Washington


**Solutions 4 Structures**  
A Structural Engineering Corporation

PROJECT NO. : 23-007  
DESIGNED BY : TLC, OGG, MRO  
DRAWN BY : RSO  
ISSUE DATE : 2-20-24  
LATEST REV. OF DWG. SET : 8-30-24


SUBMITTAL SET ONLY NOT FOR CONSTRUCTION  
THESE DRAWINGS ARE SUBJECT TO REVISIONS PENDING LOCAL JURISDICTIONAL REVIEW.

**S2.20**


CAD FILE: F:\Projects\2023 Projects\33.007 Bradley Heights\Drawings\S3.0.dwg  
 PLOT DATE/TIME: 8/28/2024 7:15am THANK YOU FOR USING SOLUTIONS 4 STRUCTURES

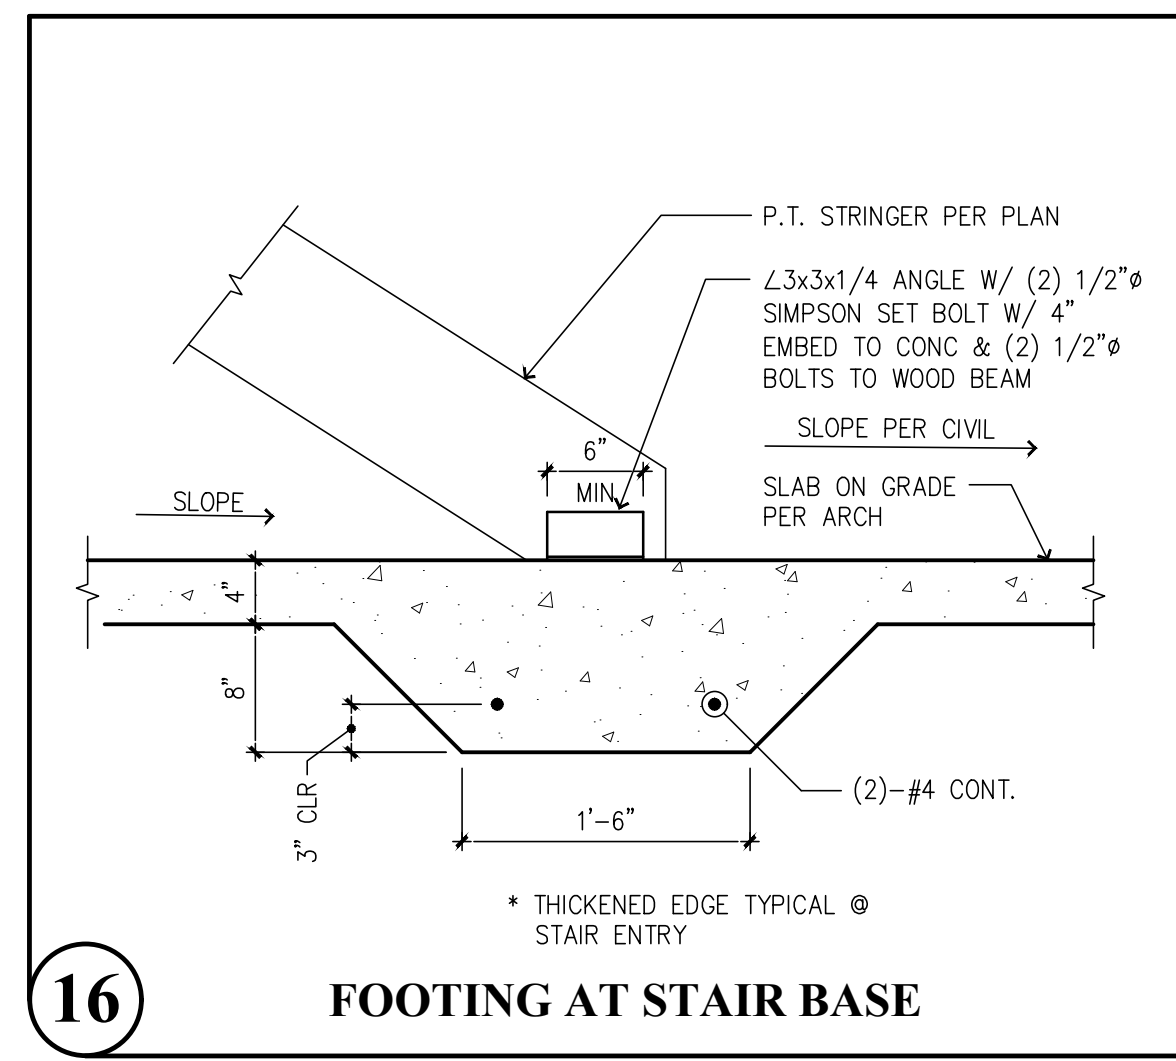


**16** FOOTING AT STAIR BASE

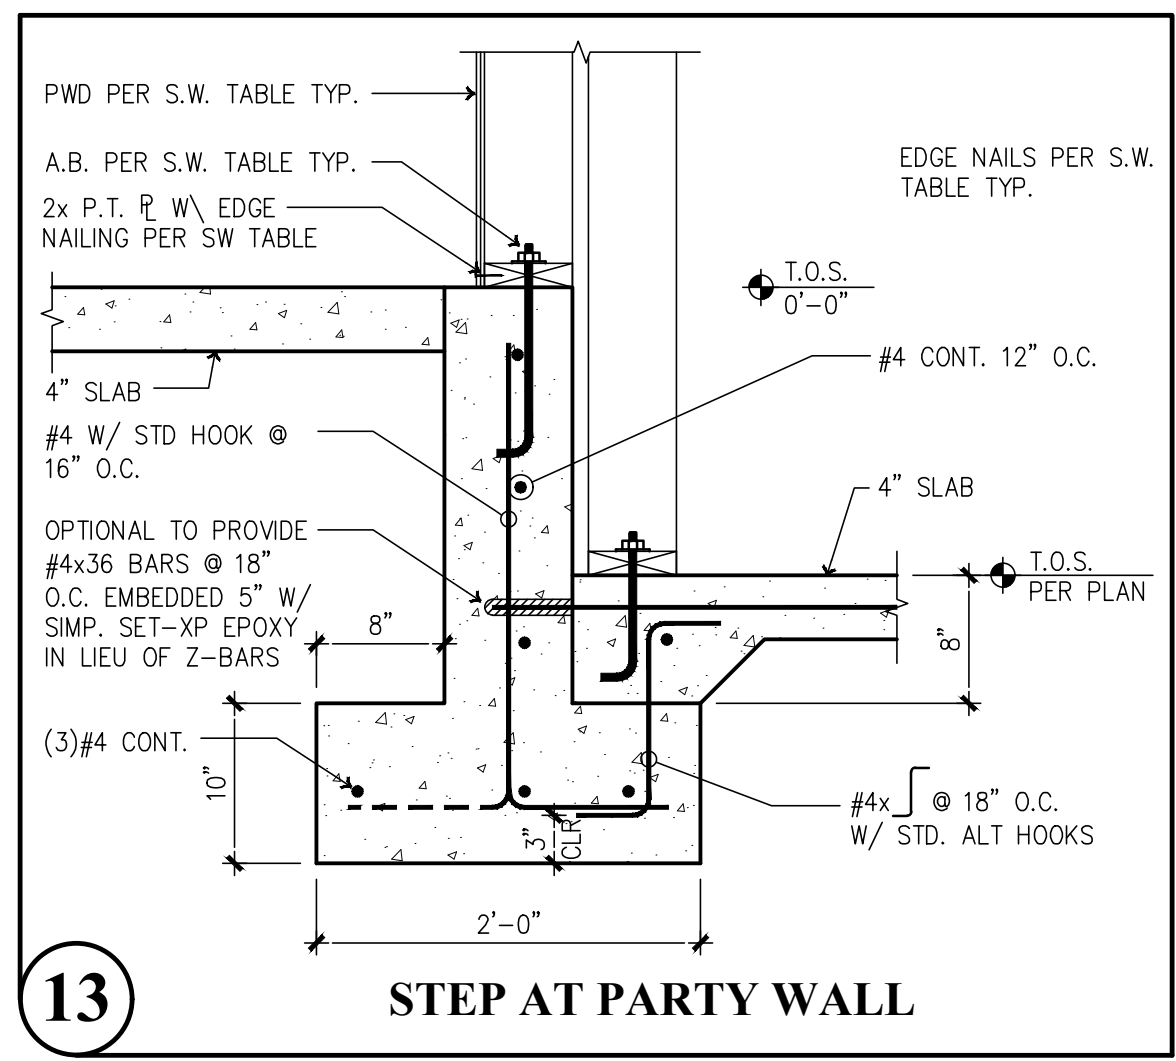


**13** STEP AT PARTY WALL

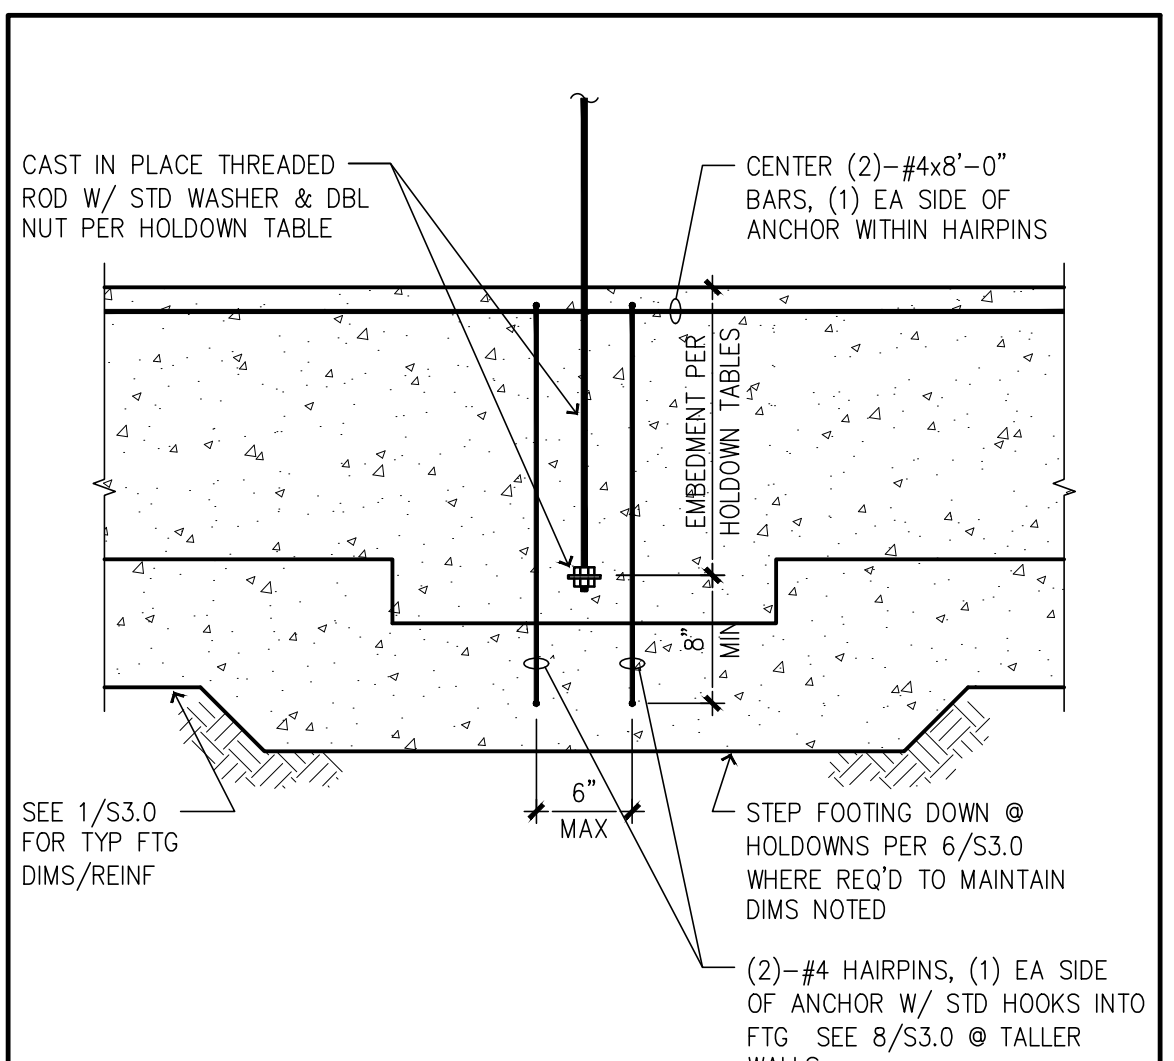


**7** HOLDOWNS @ THICKENED SLAB FOOTINGS

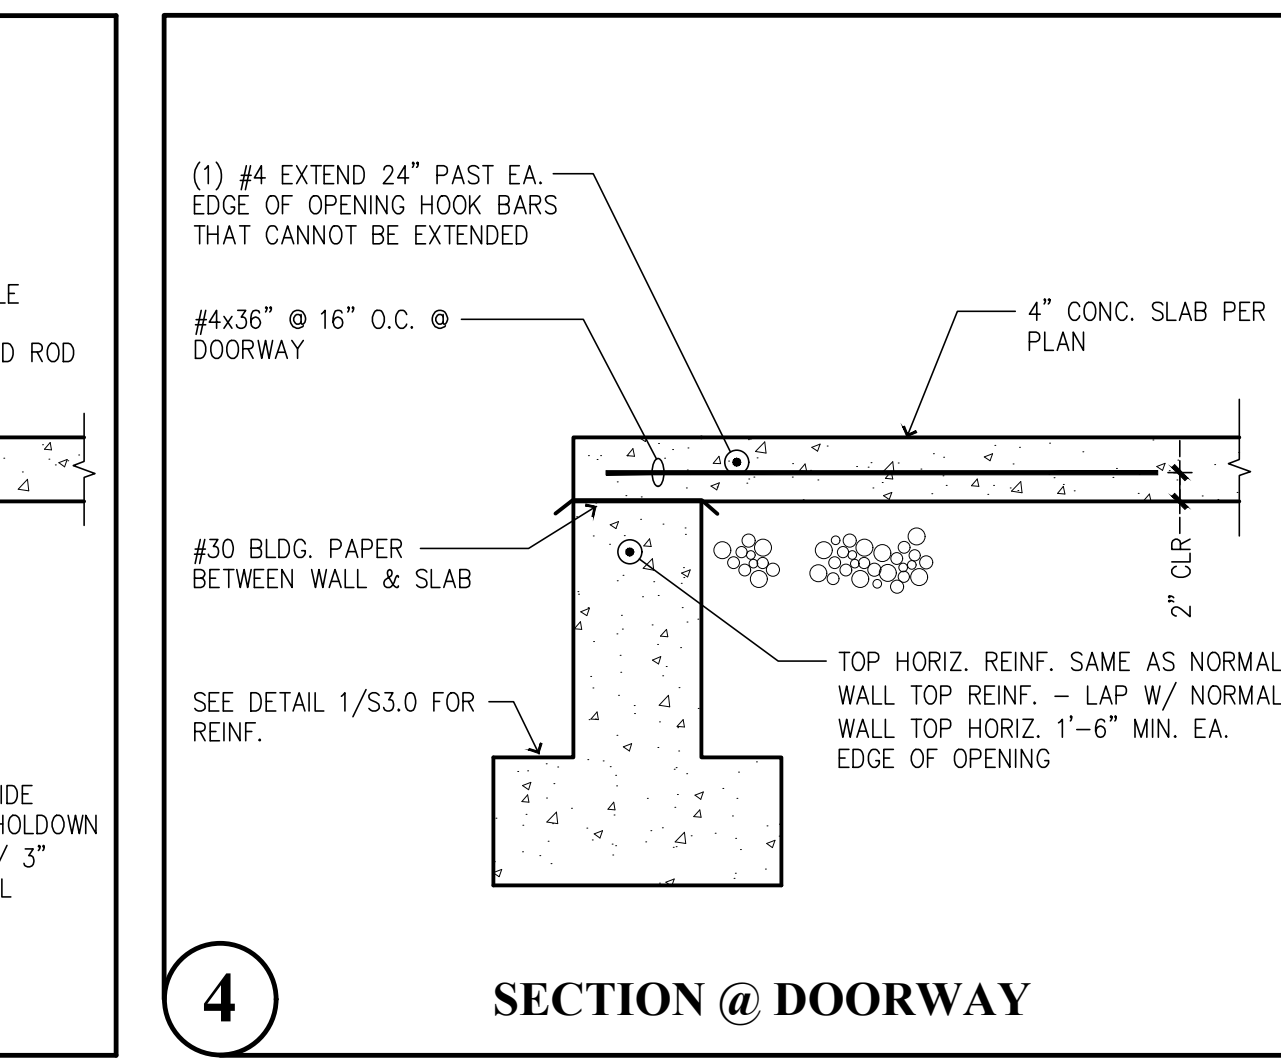


**4** SECTION @ DOORWAY

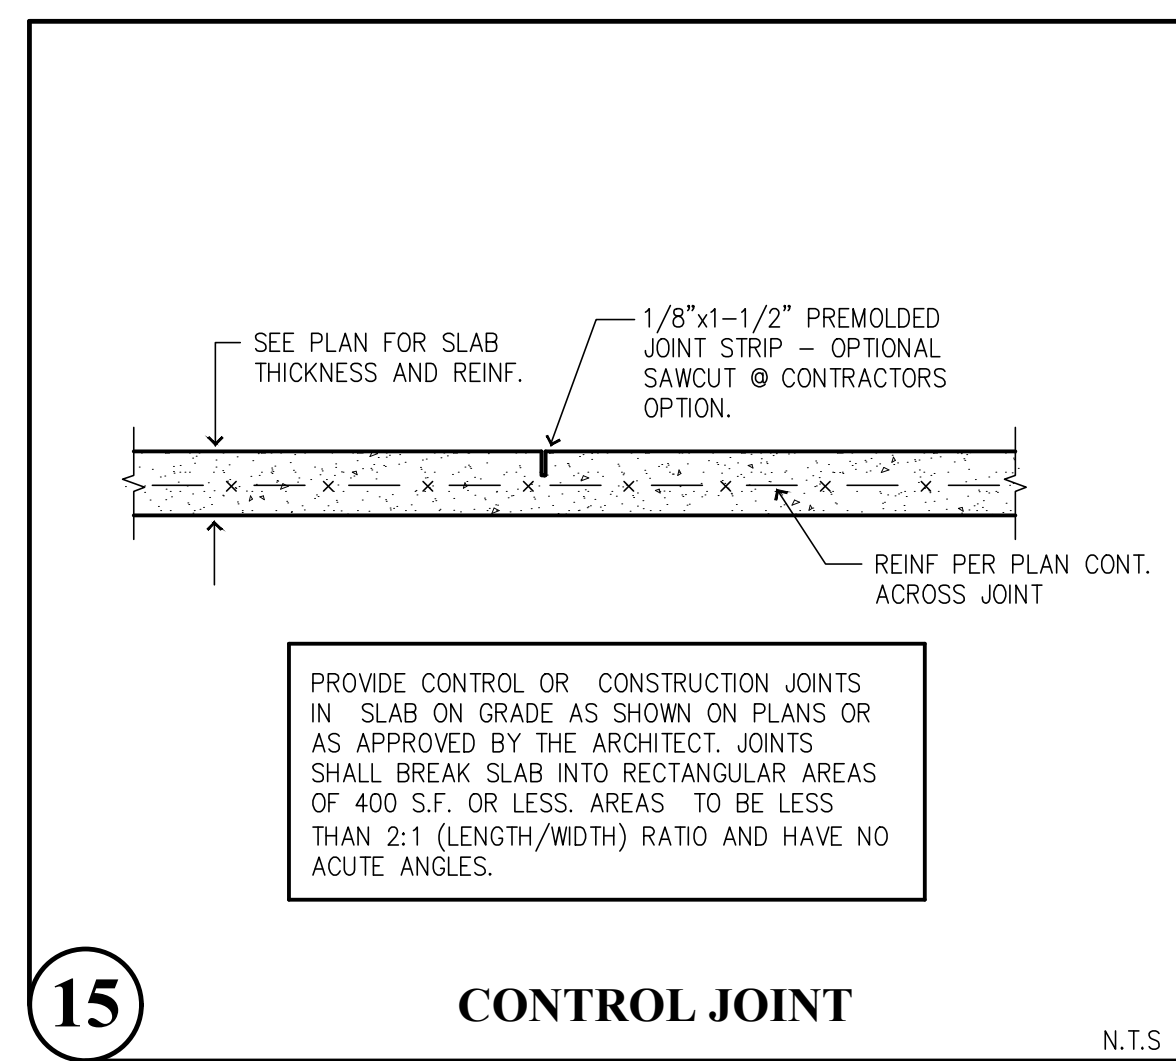


**15** CONTROL JOINT

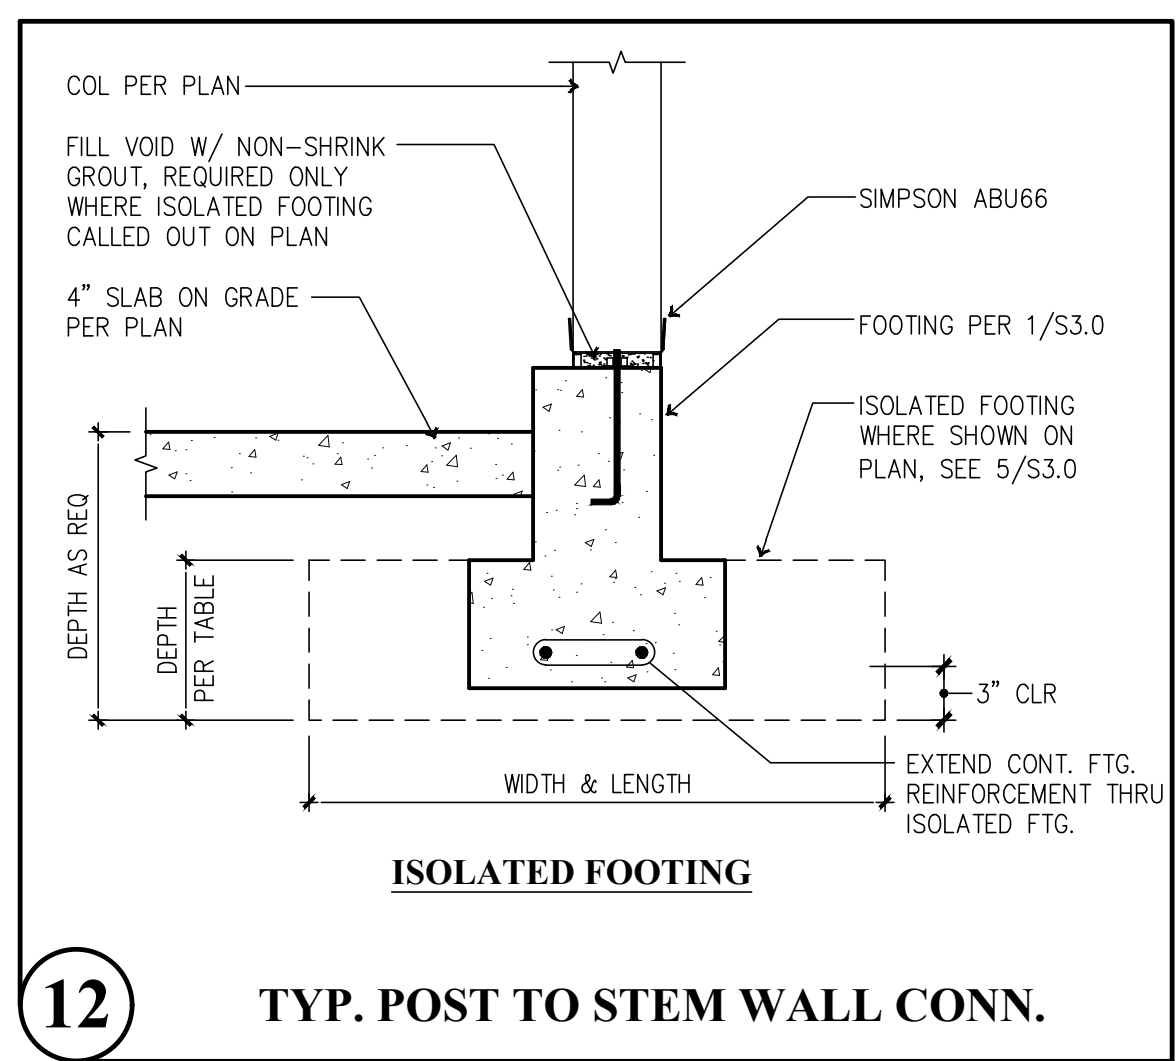


**12** TYP. POST TO STEM WALL CONN.

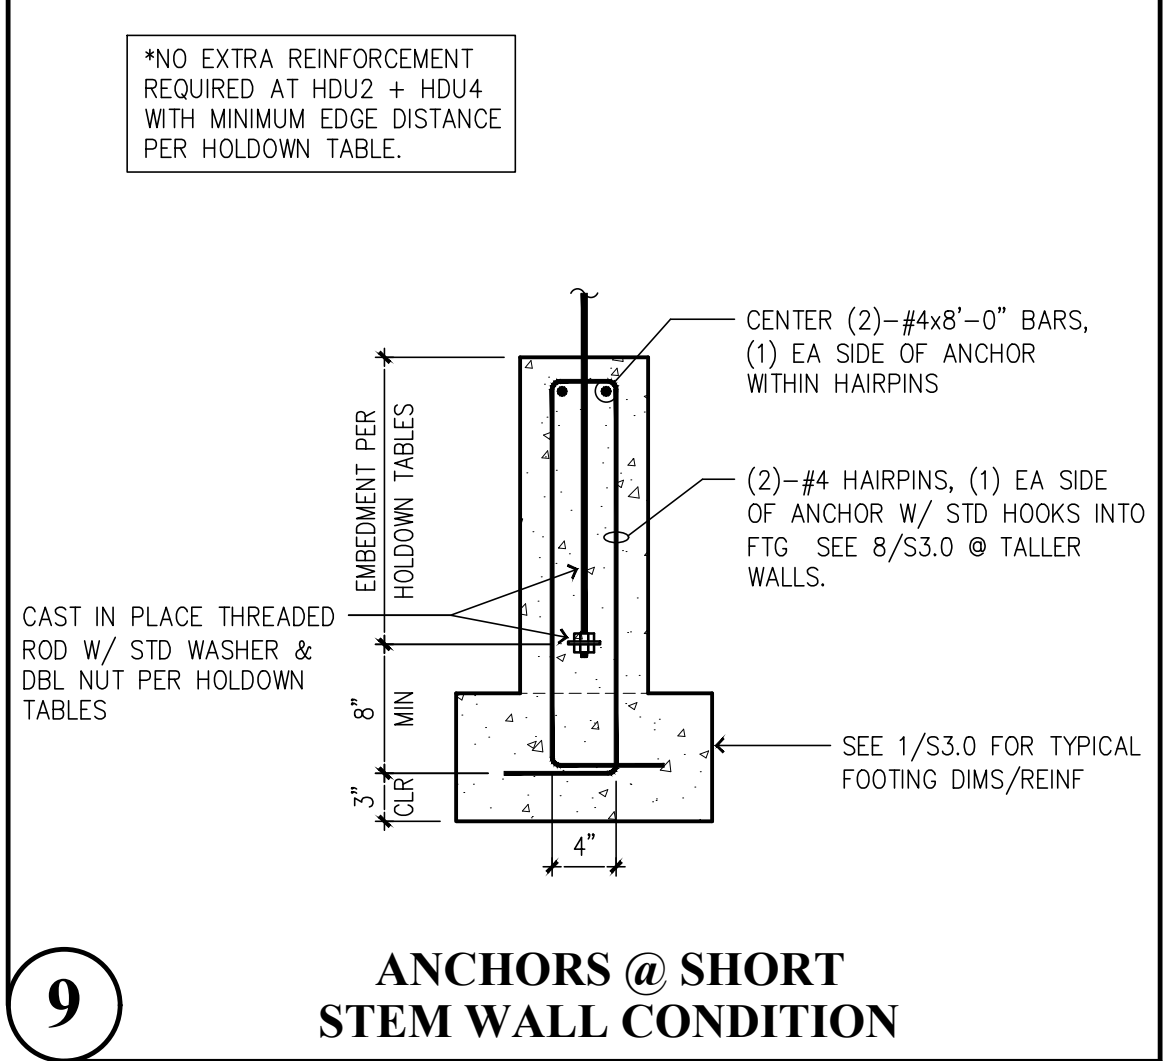


**9** ANCHORS @ SHORT STEM WALL CONDITION

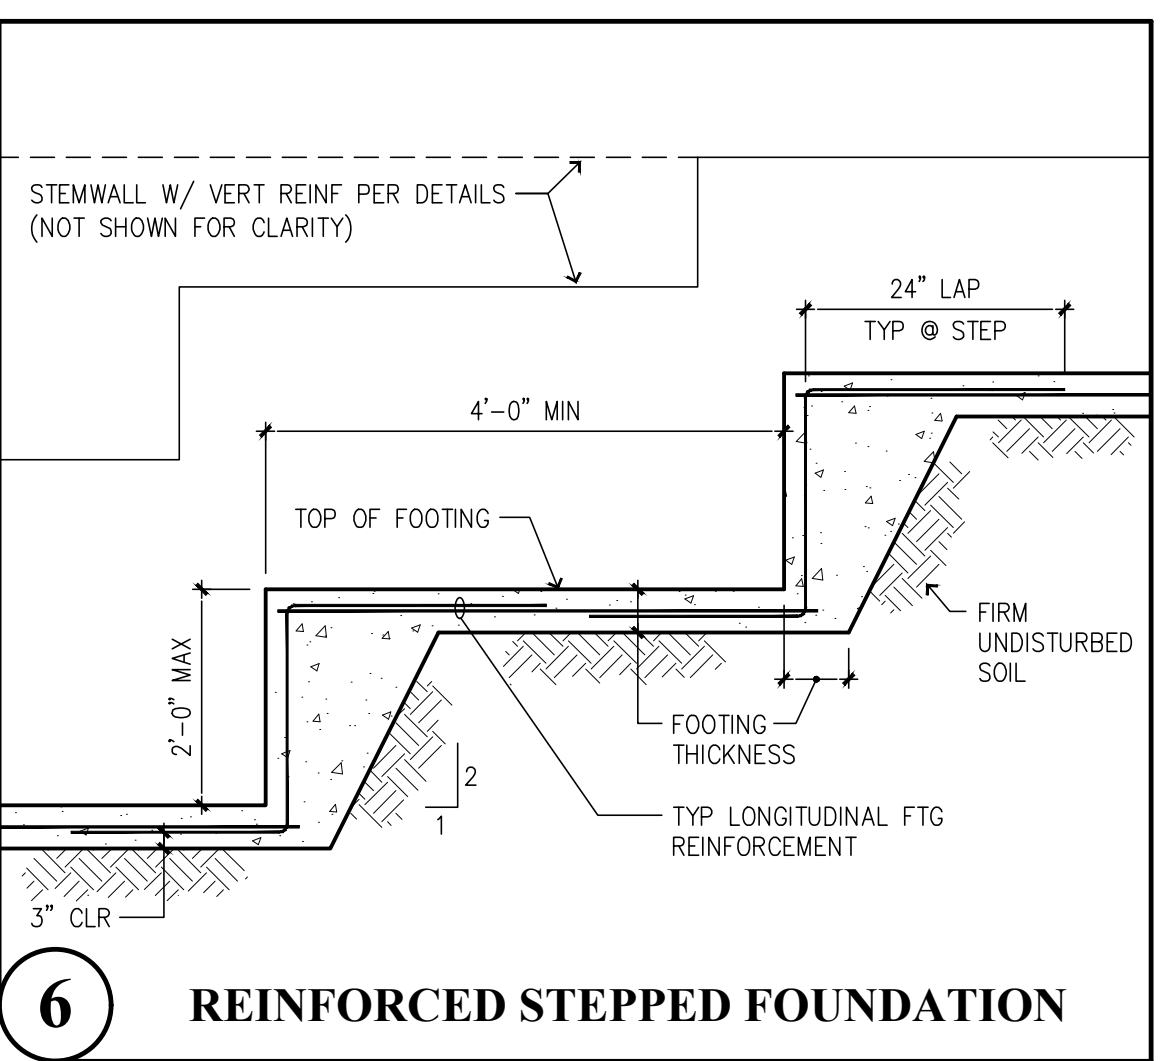


**6** REINFORCED STEPPED FOUNDATION

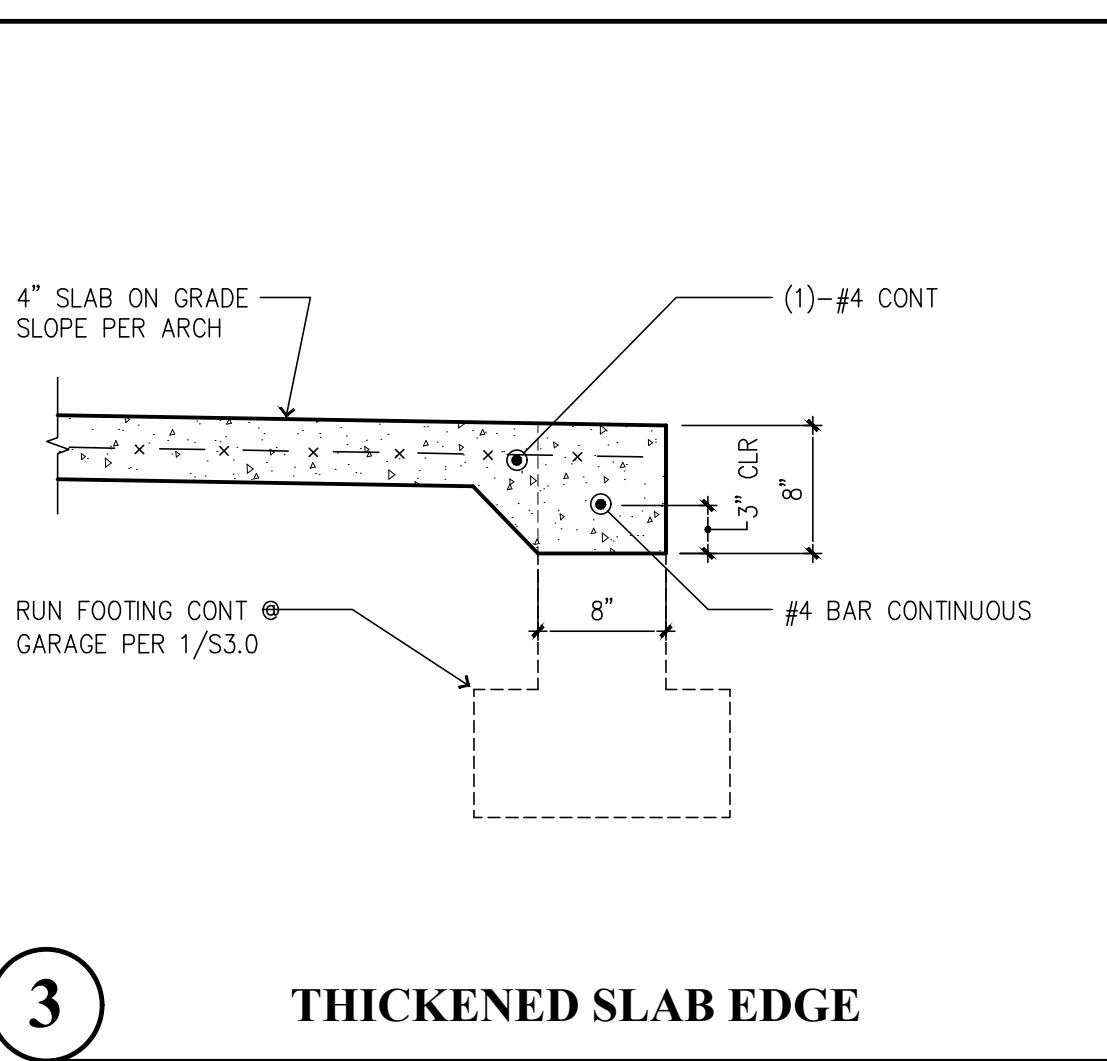


**3** THICKENED SLAB EDGE

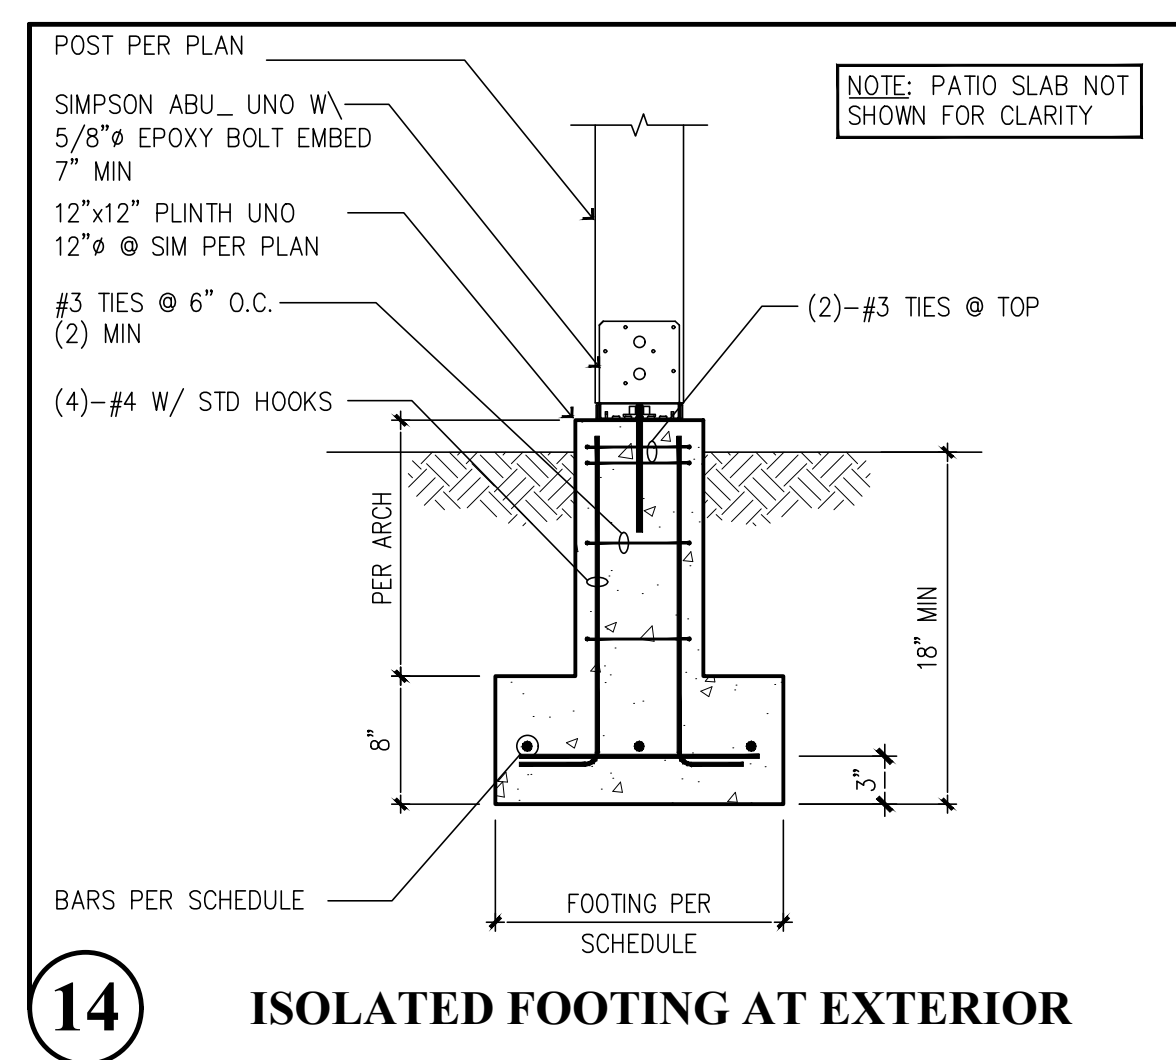


**14** ISOLATED FOOTING AT EXTERIOR

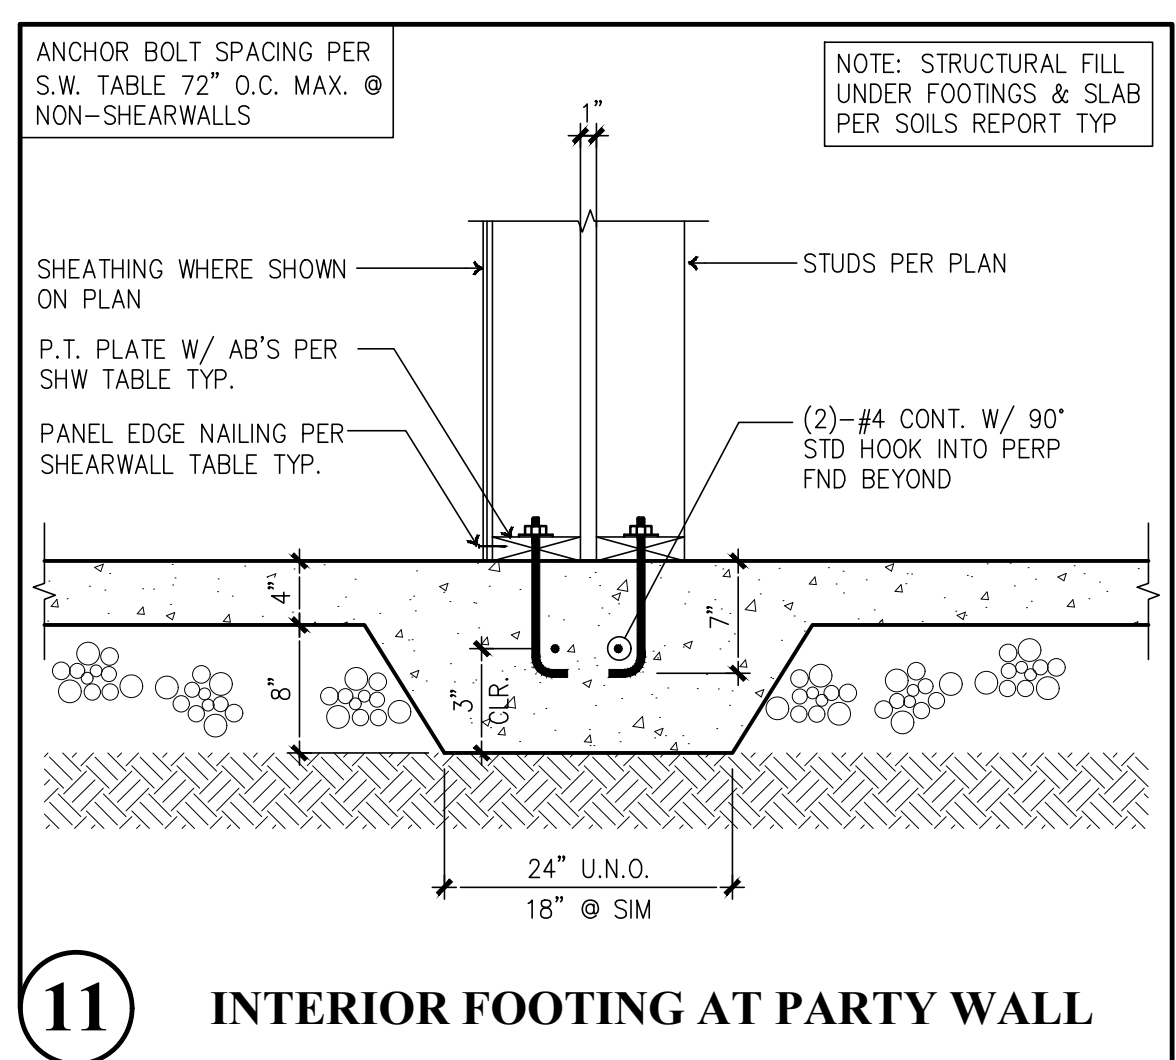


**11** INTERIOR FOOTING AT PARTY WALL

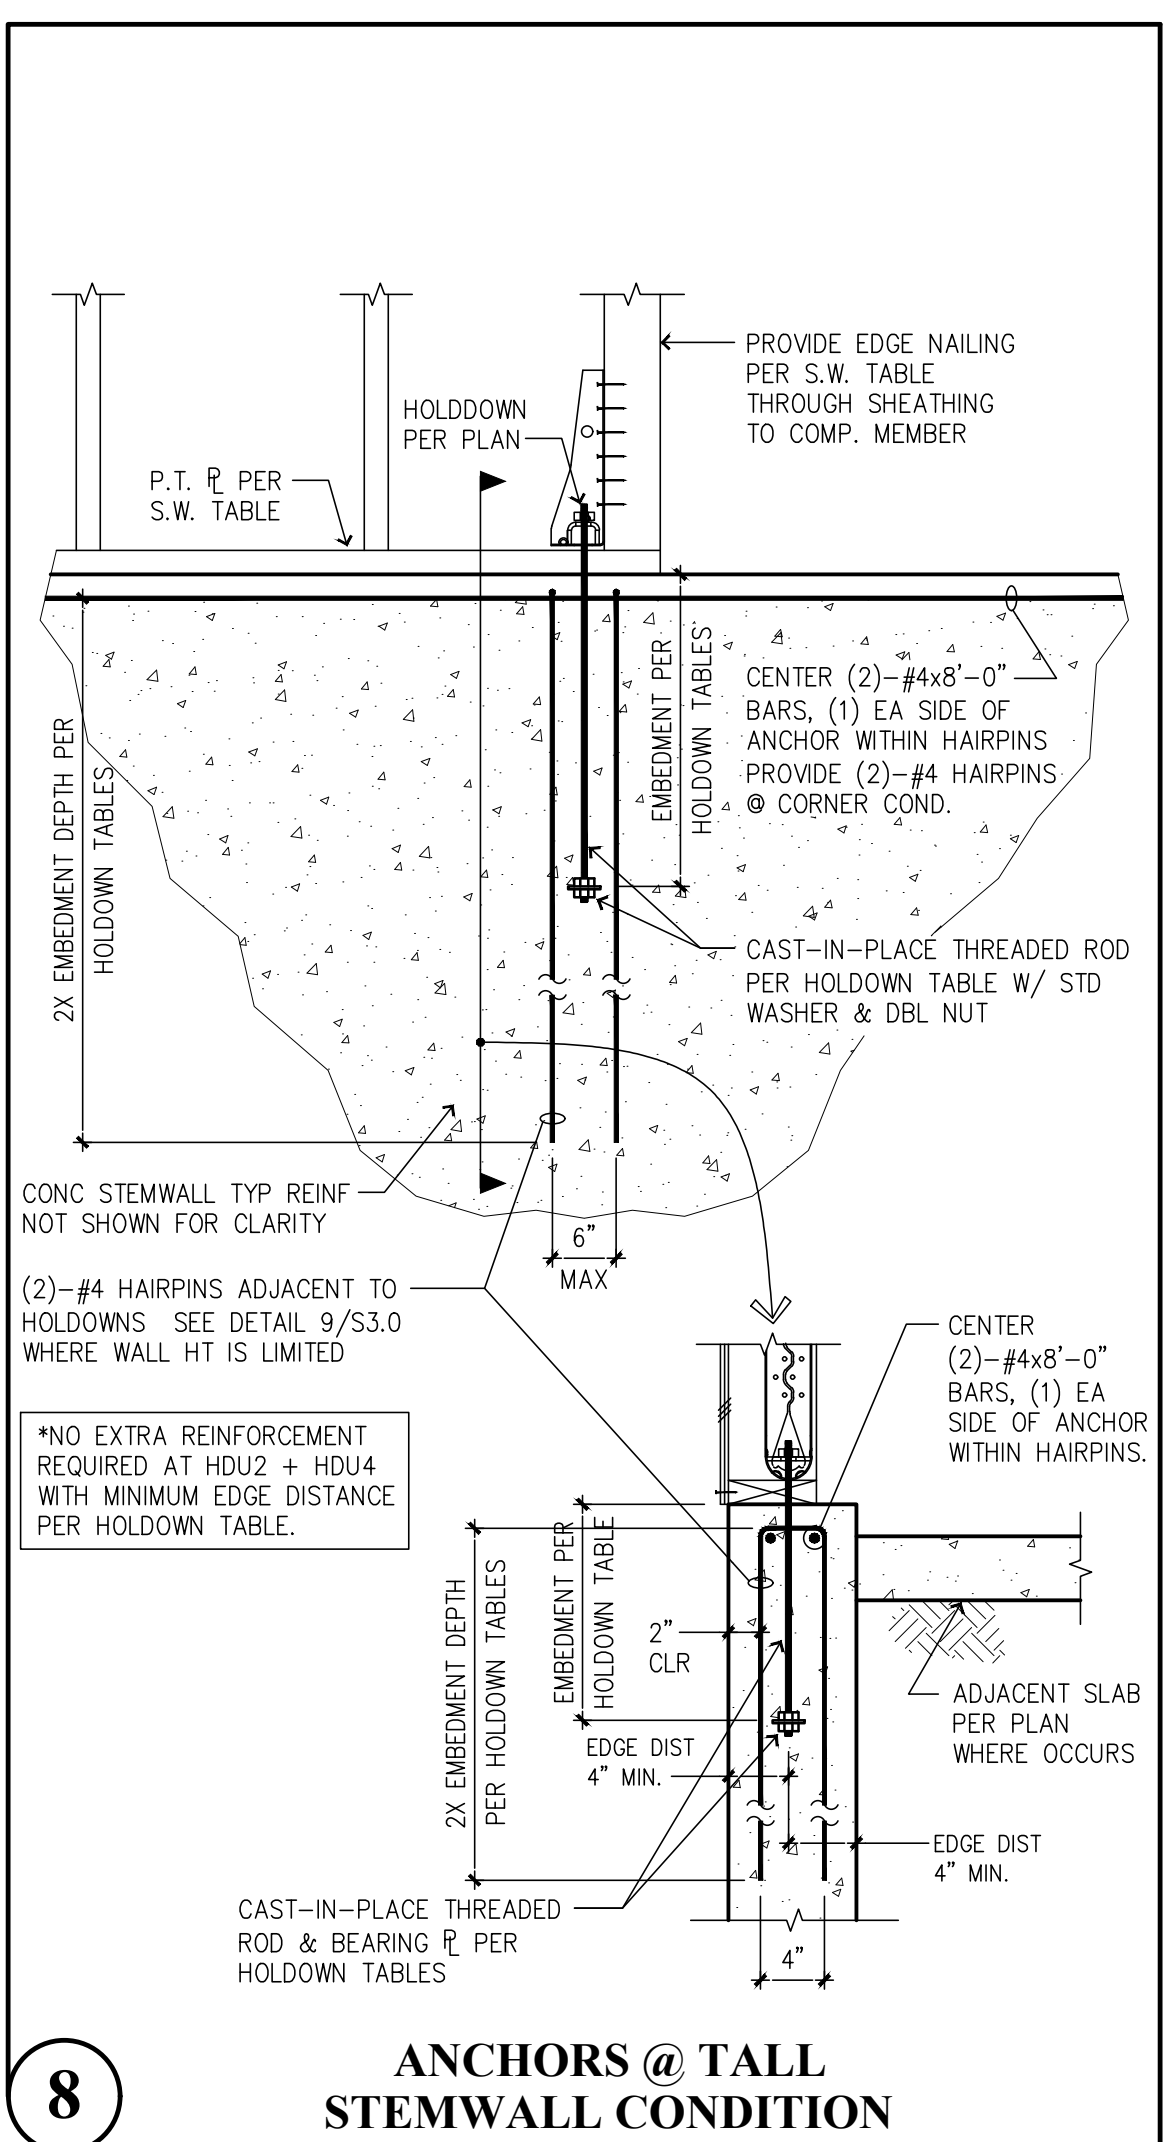


**8** ANCHORS @ TALL STEM WALL CONDITION

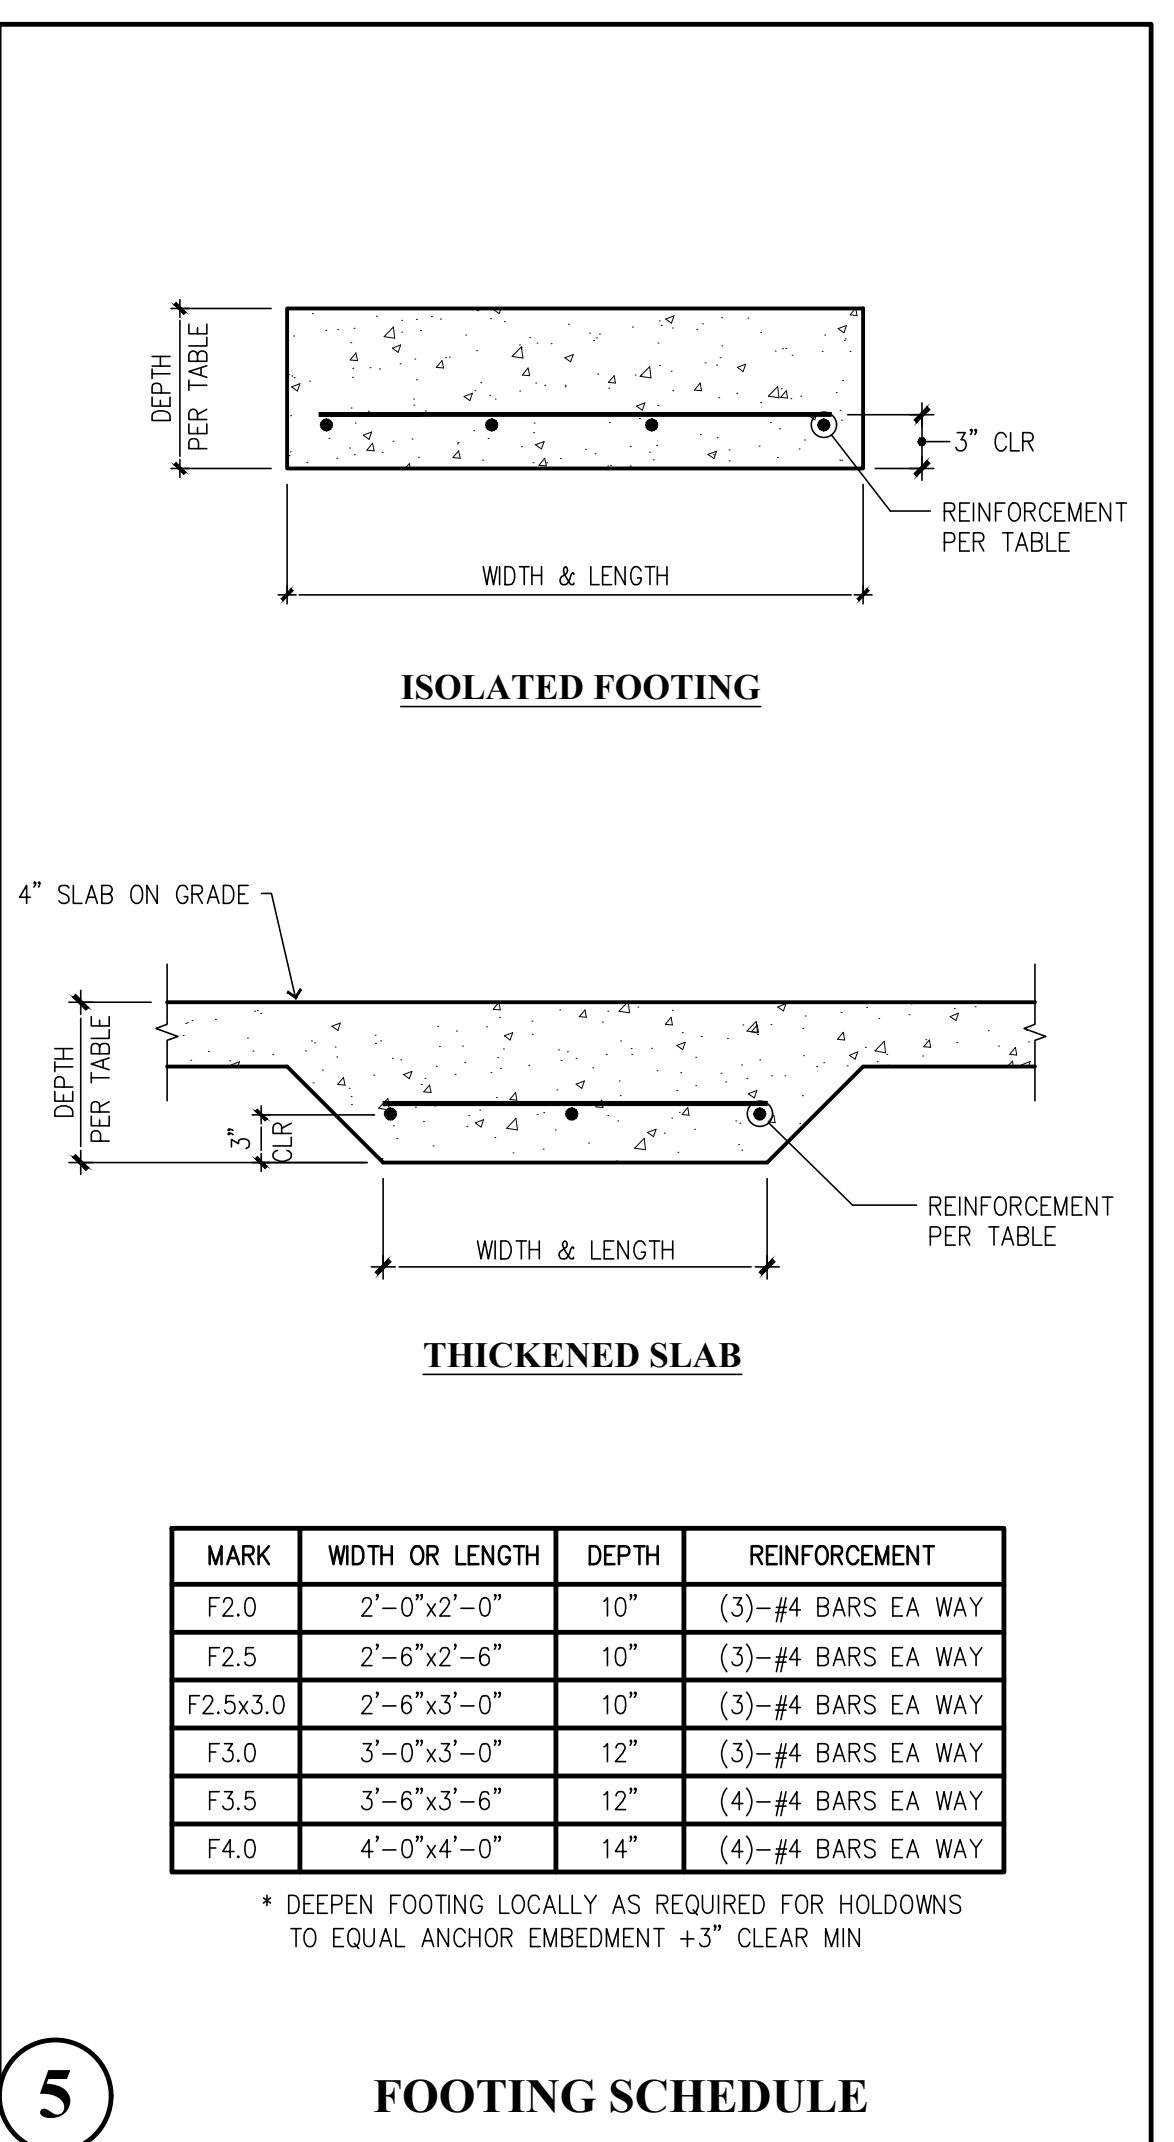

**5** FOOTING SCHEDULE

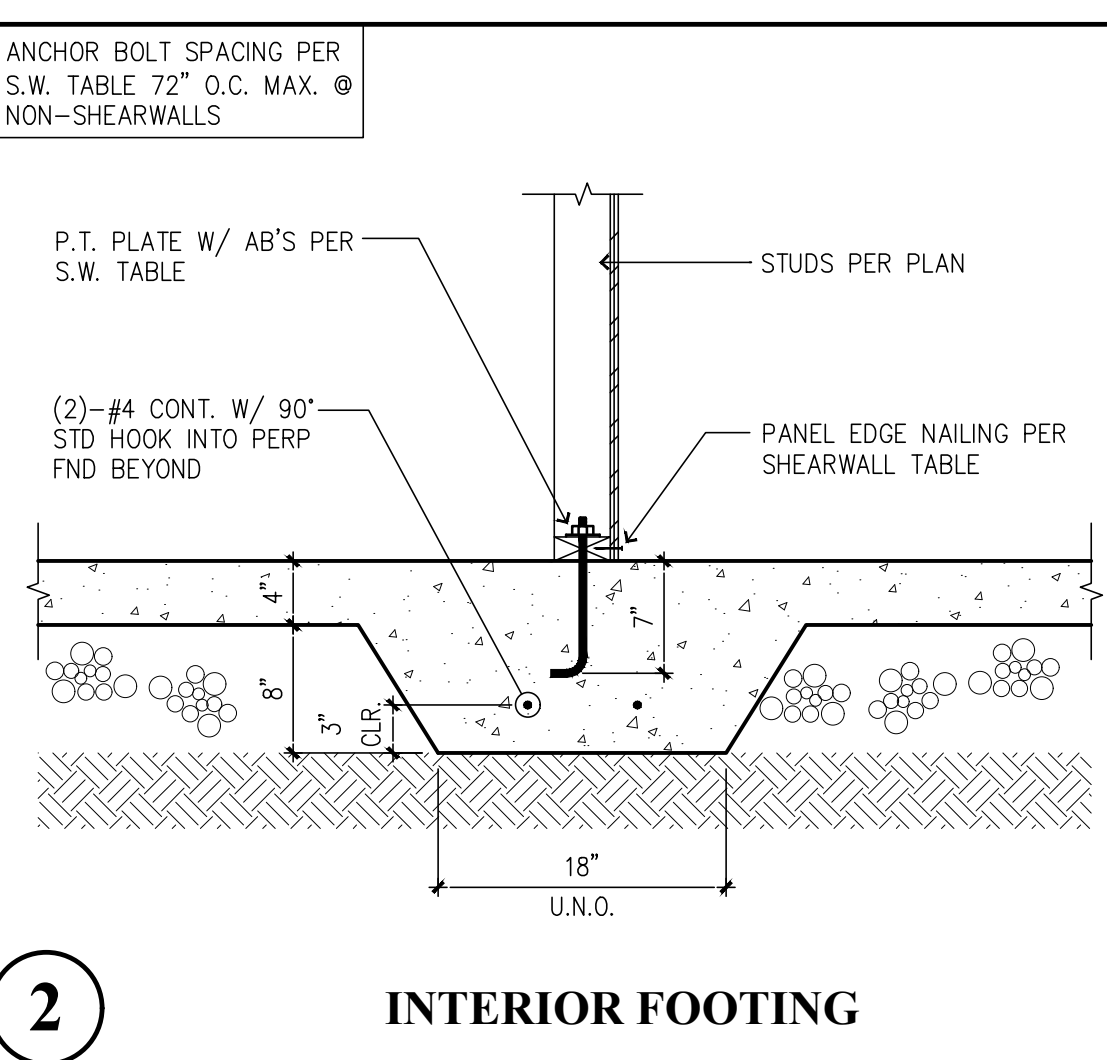


**2** INTERIOR FOOTING

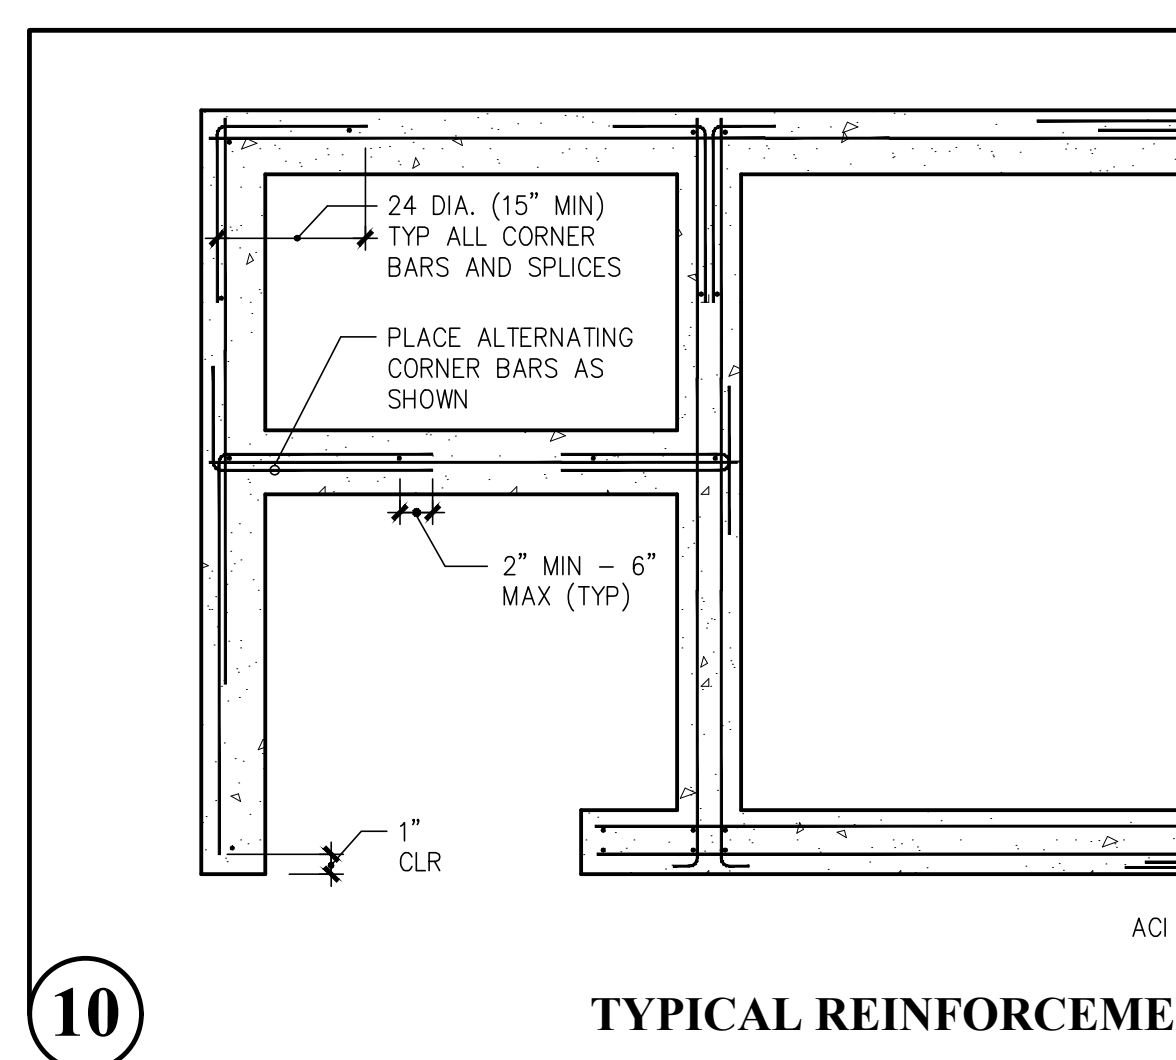


**10** TYPICAL REINFORCEMENT PLACEMENT DIAGRAM

- NOTES:**
- VERTICAL REINF SHOWN IS ADDED IF NORMAL WALL REINF IS NOT IN PROPER LOCATIONS.
  - CORNER BARS ARE SAME SIZE AND SPACING AS HORIZ REINF
  - 90° HOOKS MAY BE SUBSTITUTED FOR CORNER BARS (SEE NOTE 5).
  - REINF AT ALL WALL CORNERS, ENDS AND INTERSECTIONS SHALL BE FABRICATED AND PLACED IN ACCORDANCE WITH APPROPRIATE DETAIL SHOWN.
  - USE ACI MIN 90° HOOK FOR EMBEDMENT LESS THAN 24 DIAMETERS PAST FACE OF WALL.
  - CONCRETE WALLS SHOWN; MASONRY WALLS SIMILAR.
  - WALL DETAILS SHOWN; FTG DETAILS SIMILAR.
  - VARIOUS WALL SECTIONS AND INTERSECTIONS SHOWN; USE APPROPRIATE DETAILS.
  - ALL BENDS SHALL BE PER ACI

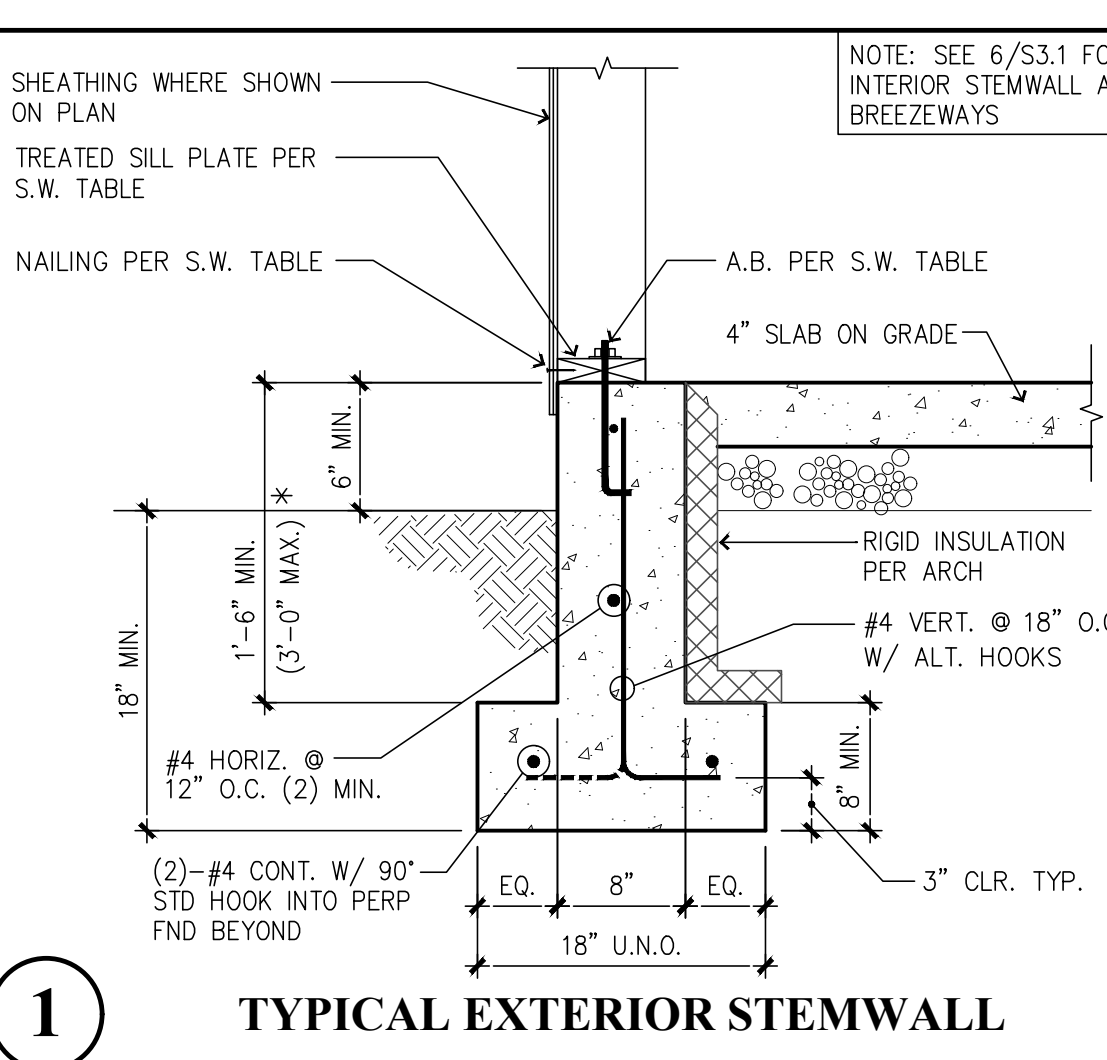

**1** TYPICAL EXTERIOR STEMWALL

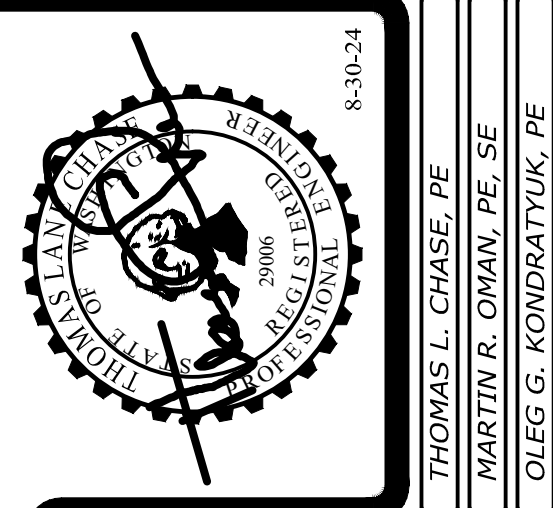

Revisions to this sheet:

**Bradley Heights Apartments**  
 202 27th Ave SE  
 Puyallup, Washington


**Solutions 4 Structures**  
 A Structural Engineering Corporation

Puyallup, Washington 98374  
 Ph 253-314-9822  
 www.solutions4structures.com


PROJECT NO. : 23.007  
 DESIGNED BY : TLC, OGG, MRO  
 DRAWN BY : RSO  
 ISSUE DATE : 2-20-24  
 LATEST REV. OF DWG. SET : 8-30-24

SUBMITTAL SET ONLY NOT FOR CONSTRUCTION  
 THESE DRAWINGS ARE SUBJECT TO REVISIONS PENDING LOCAL JURISDICTIONAL REVIEW.


S3.0

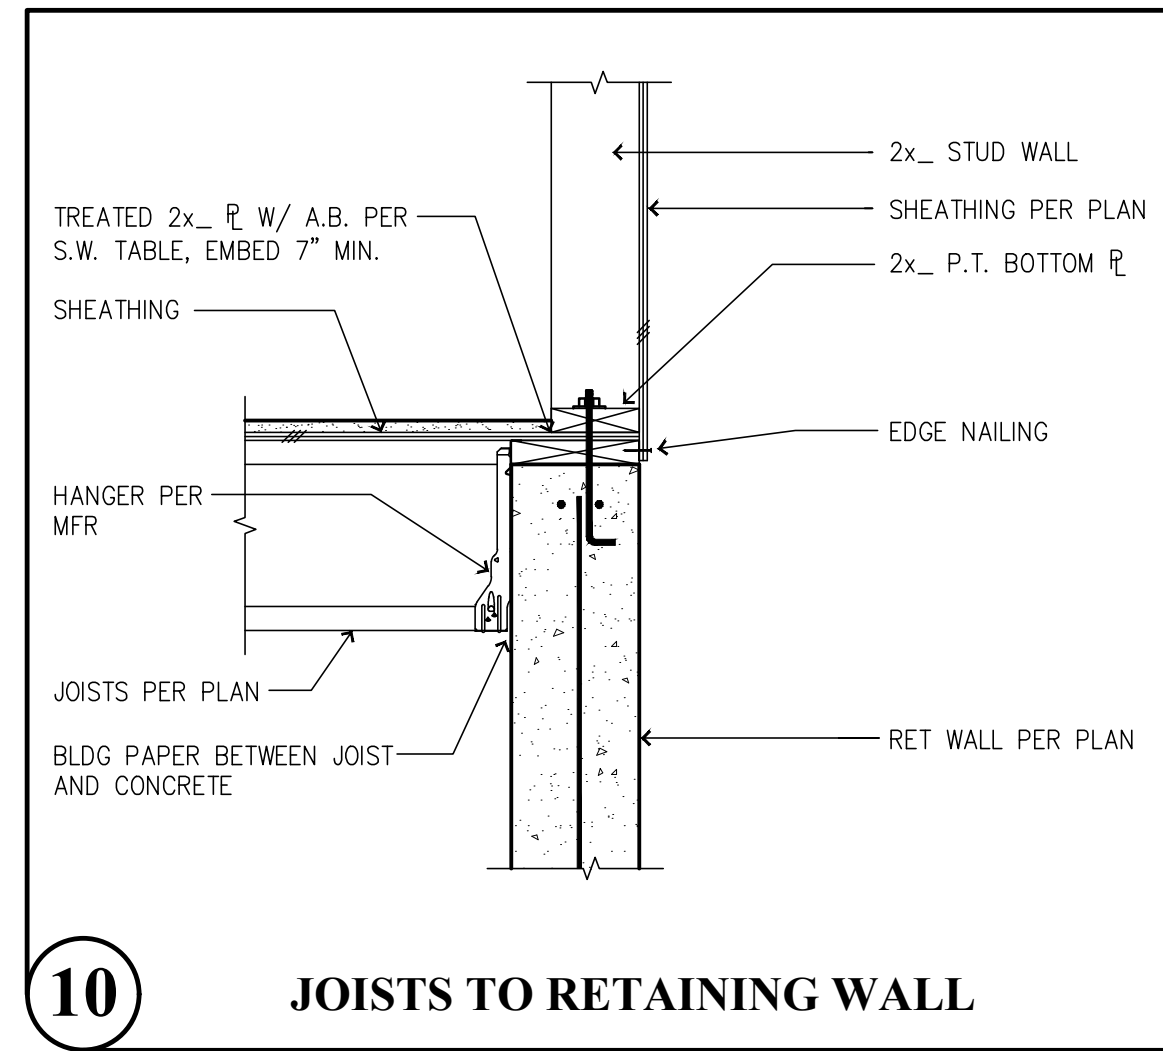


10 JOISTS TO RETAINING WALL

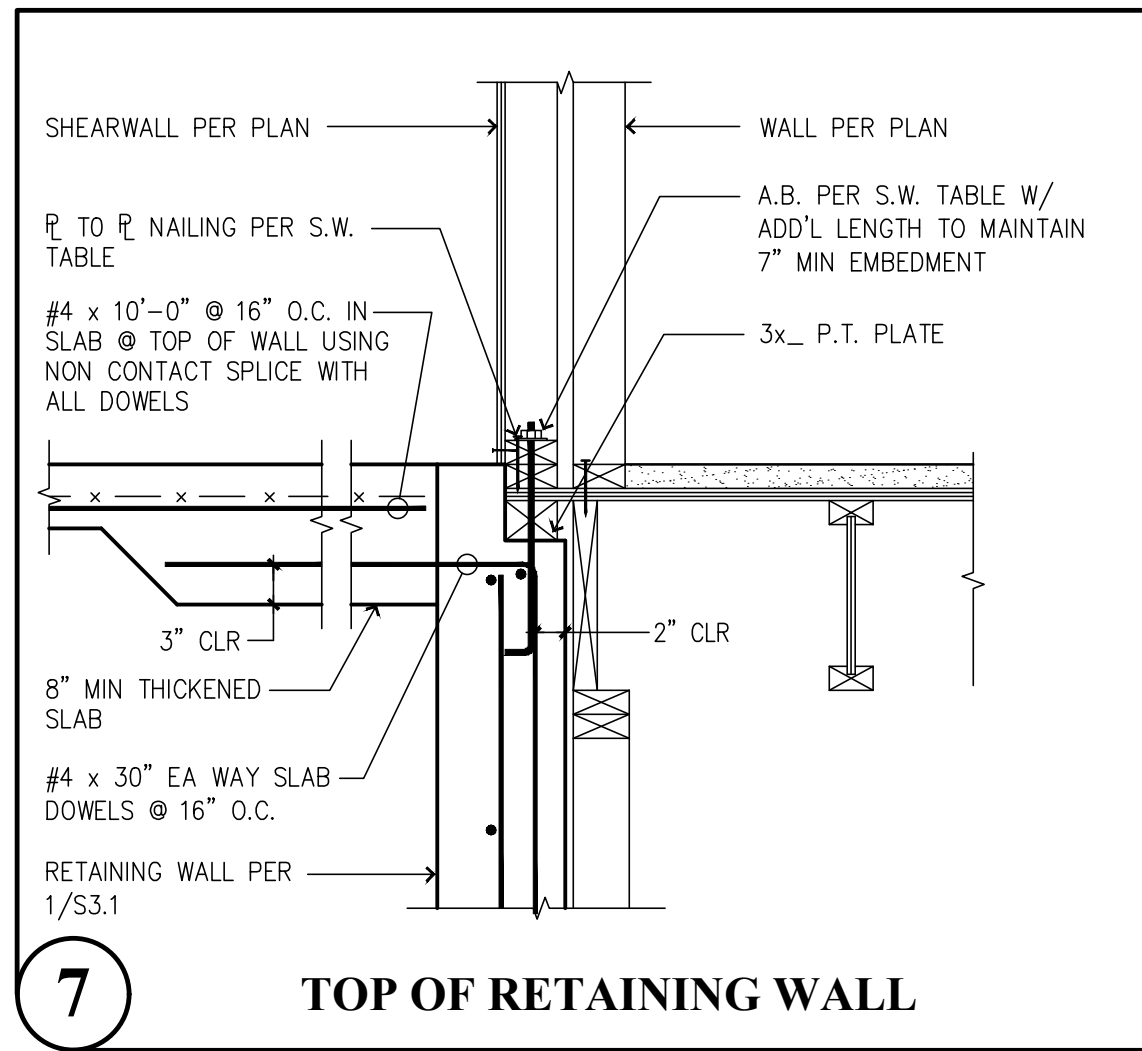


7 TOP OF RETAINING WALL

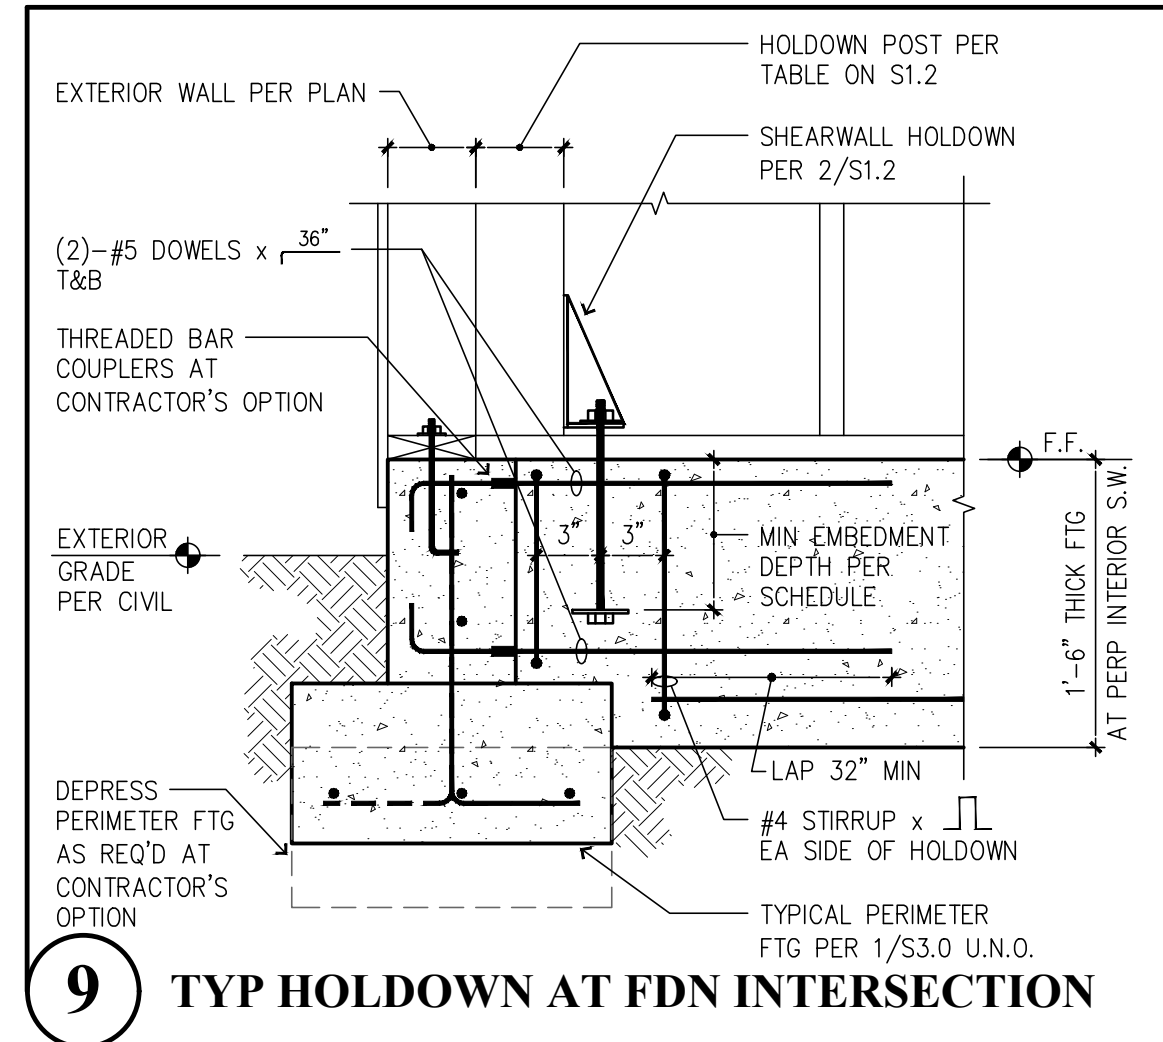


9 TYP HOLDOWN AT FDN INTERSECTION

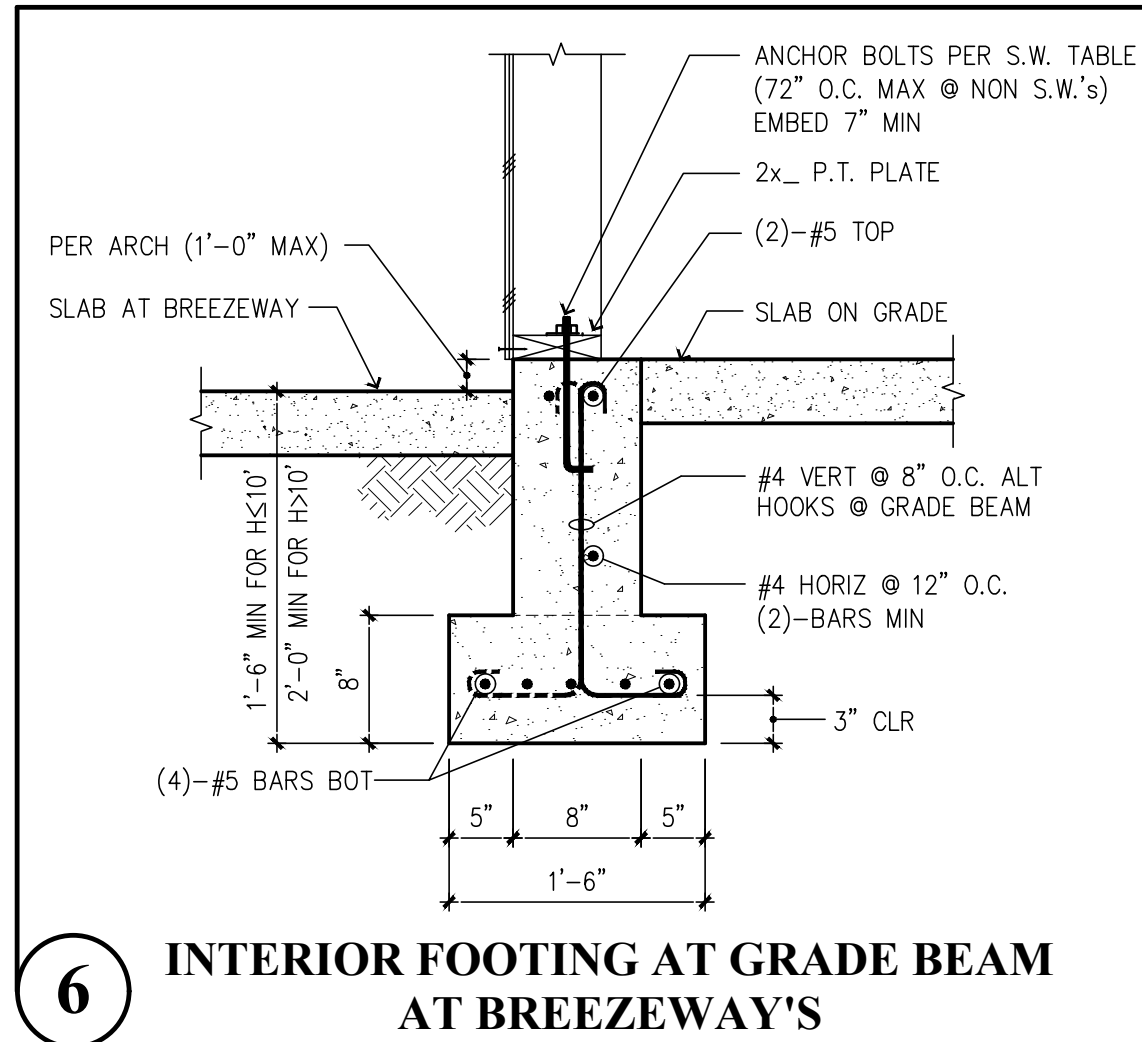


6 INTERIOR FOOTING AT GRADE BEAM AT BREEZEWAY'S

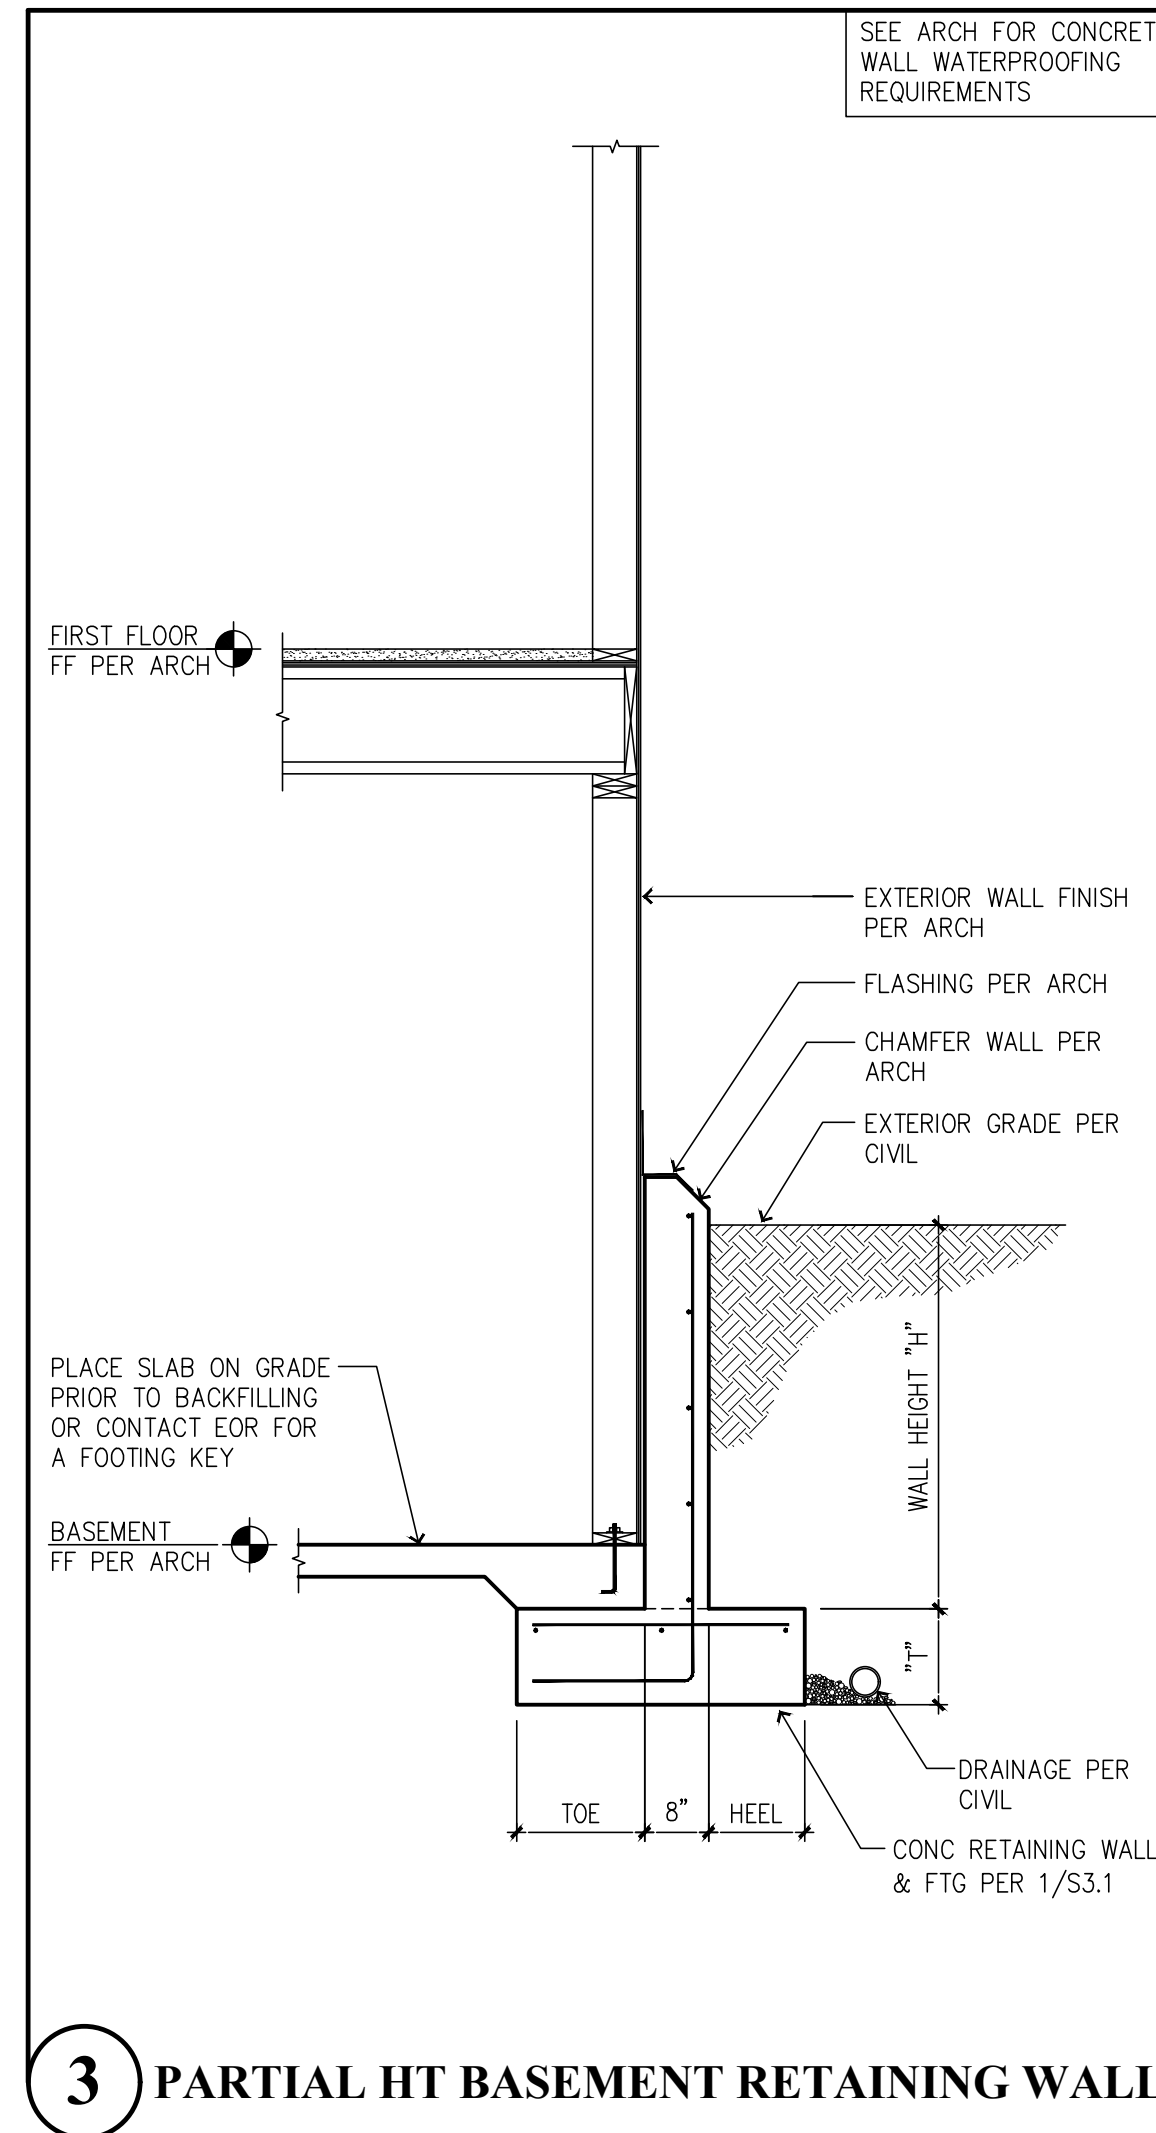


3 PARTIAL HT BASEMENT RETAINING WALL

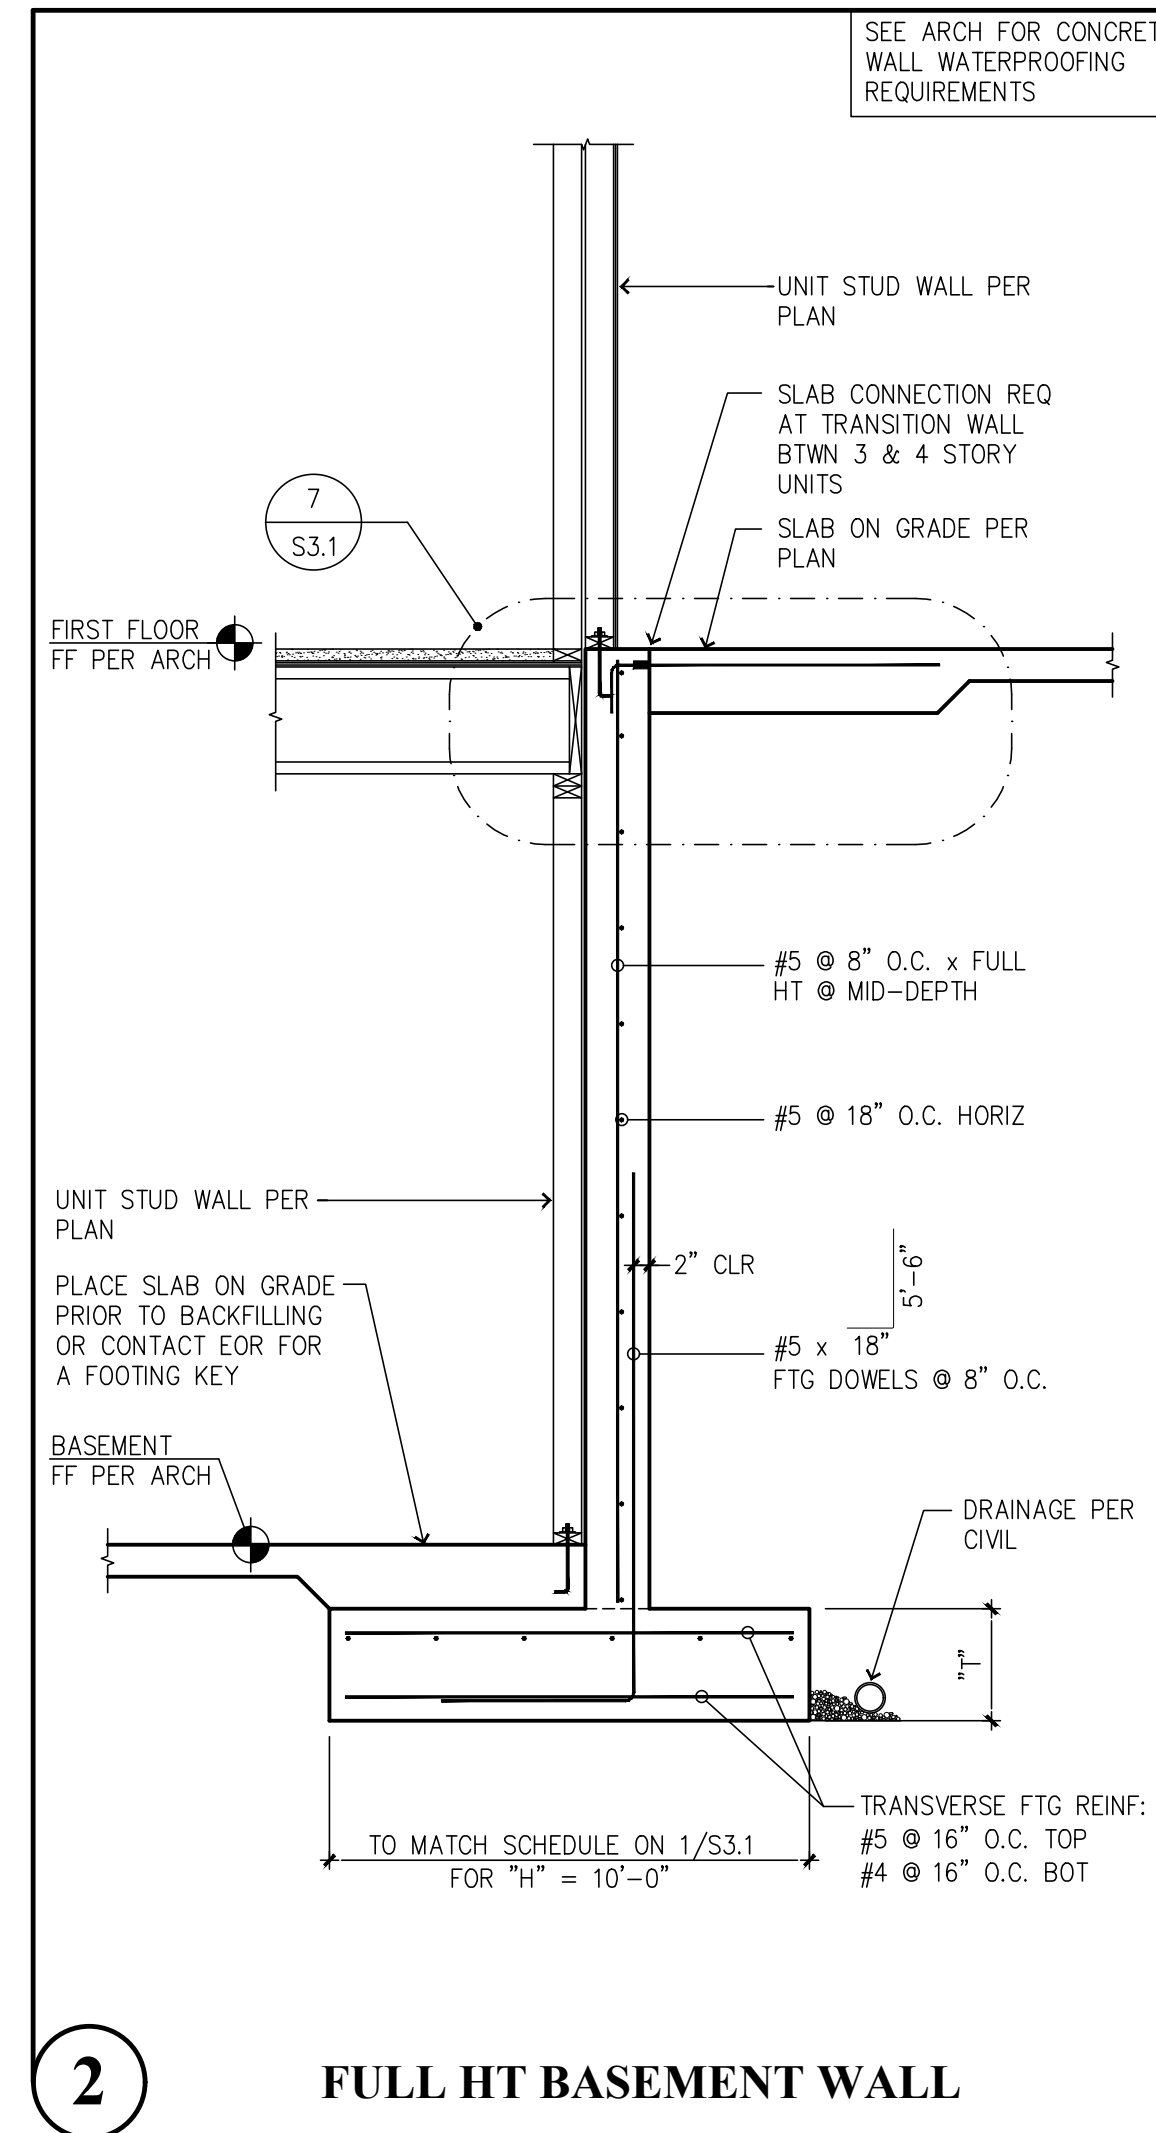

2 FULL HT BASEMENT WALL

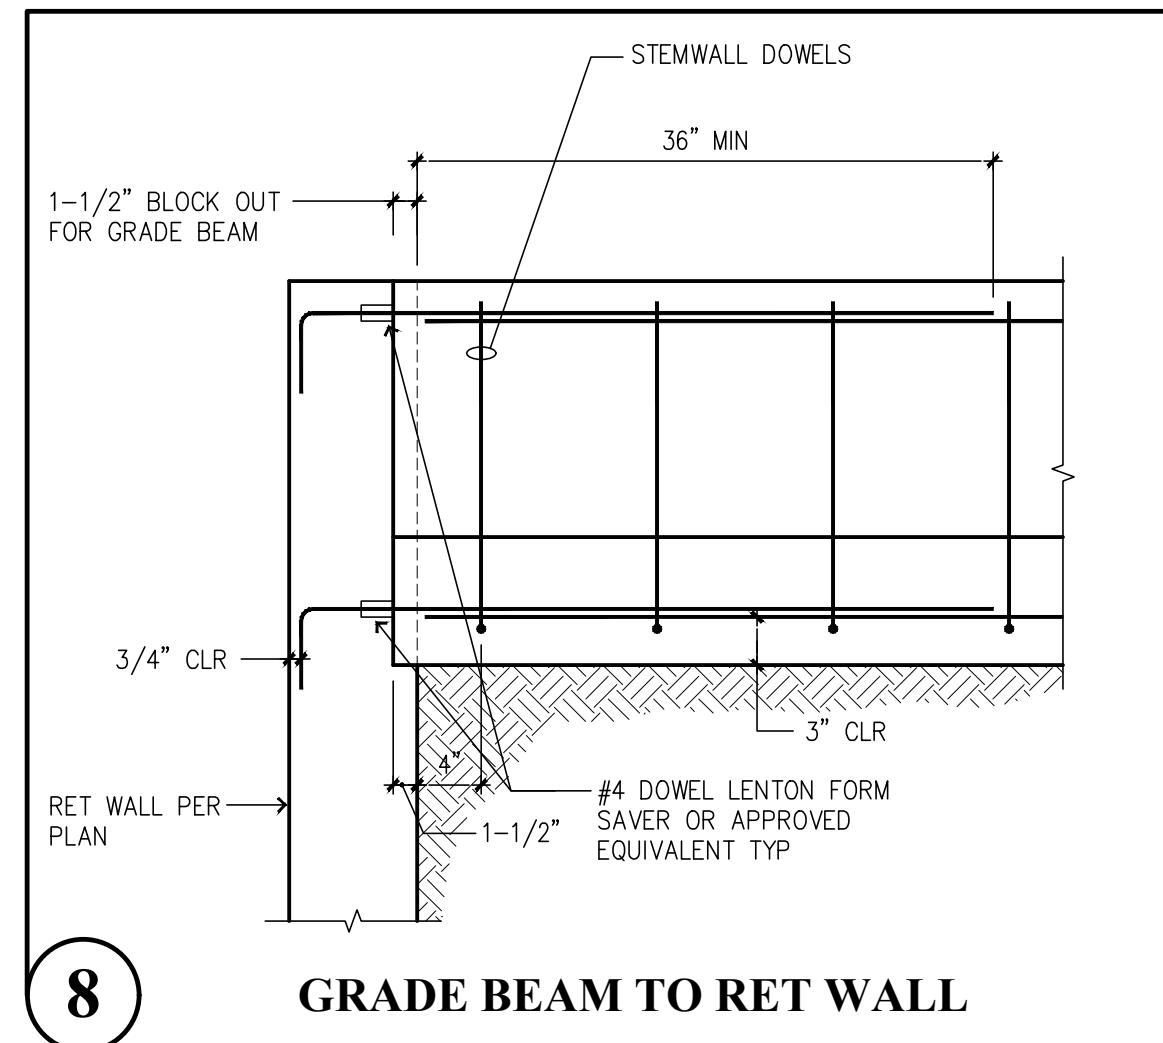

8 GRADE BEAM TO RET WALL

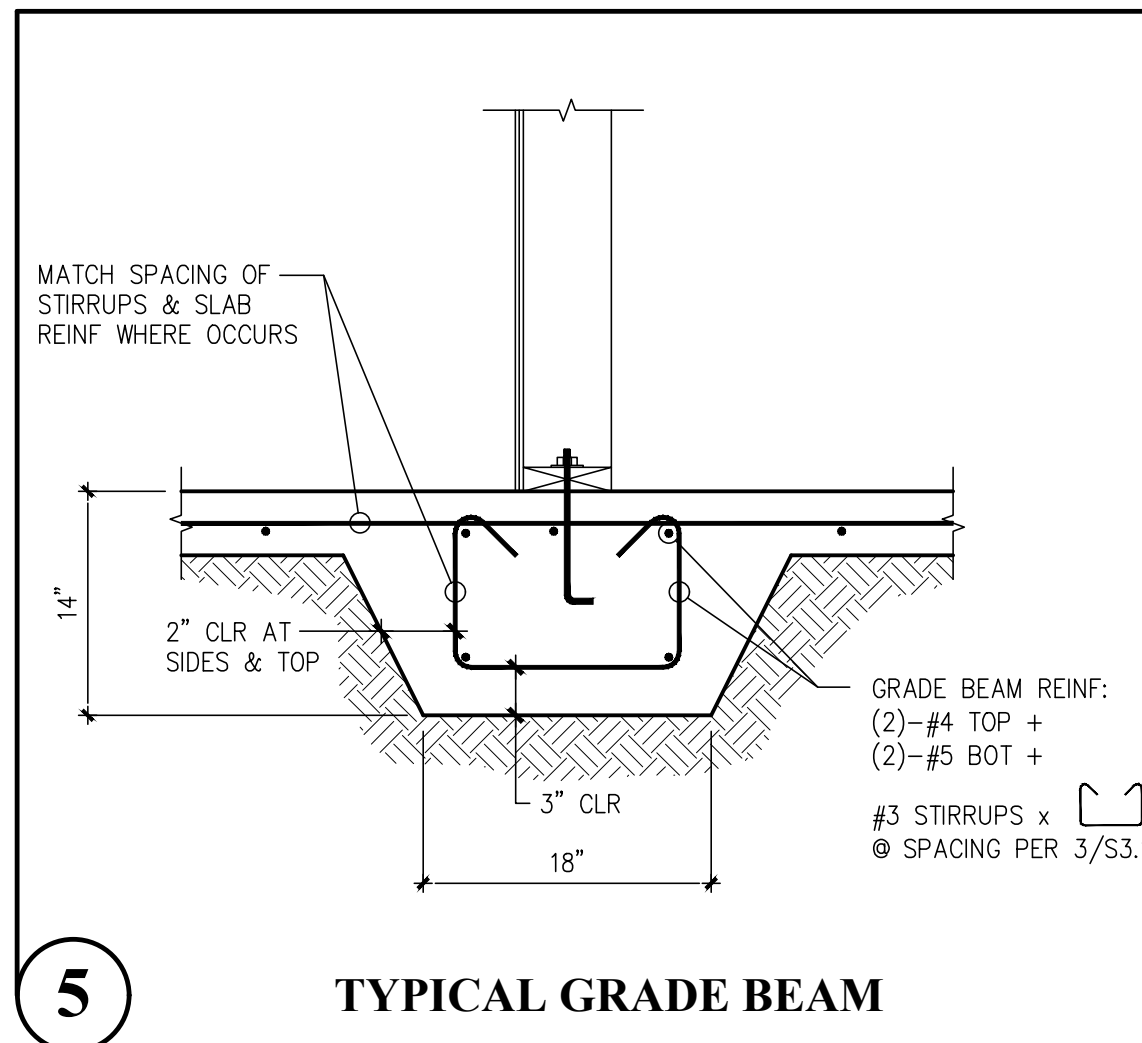


5 TYPICAL GRADE BEAM

DESIGN PARAMETERS

1. SOIL BEARING = 2,000 PSF
2. ACTIVE & AT REST FLUID PRESSURES PER DIAGRAM
3. PASSIVE FLUID PRESSURE = 450 PCF
4. 20 PSF (MAX) LIVE LOAD SURCHARGE, HORIZ.
5. 12" H PSF (MAX) SEISMIC SURCHARGE, HORIZ.
6. SOIL FRICTION COEF. = 0.53
7. SOIL UNIT WEIGHT = 120 PCF (MIN)


NOTES

1. PROVIDE CORNER STEEL @ FTG CORNERS & INTERSECTIONS. USE 36"x36" ELBOW STEEL TO LAP HORIZ REINF, MATCH SIZE.
2. CONTRACTOR SHALL VERIFY ALL DIMENSIONS AND HEIGHTS PRIOR TO CONSTRUCTION. NOTIFY ENGR/OWNER OF ANY DISCREPANCIES.
3. REINFORCEMENT GRADES SHALL TYPICALLY BE : GRADE 60
4. CONCRETE STRENGTH SHALL BE A MINIMUM OF 2500 PSI PRIOR TO BACKFILL.

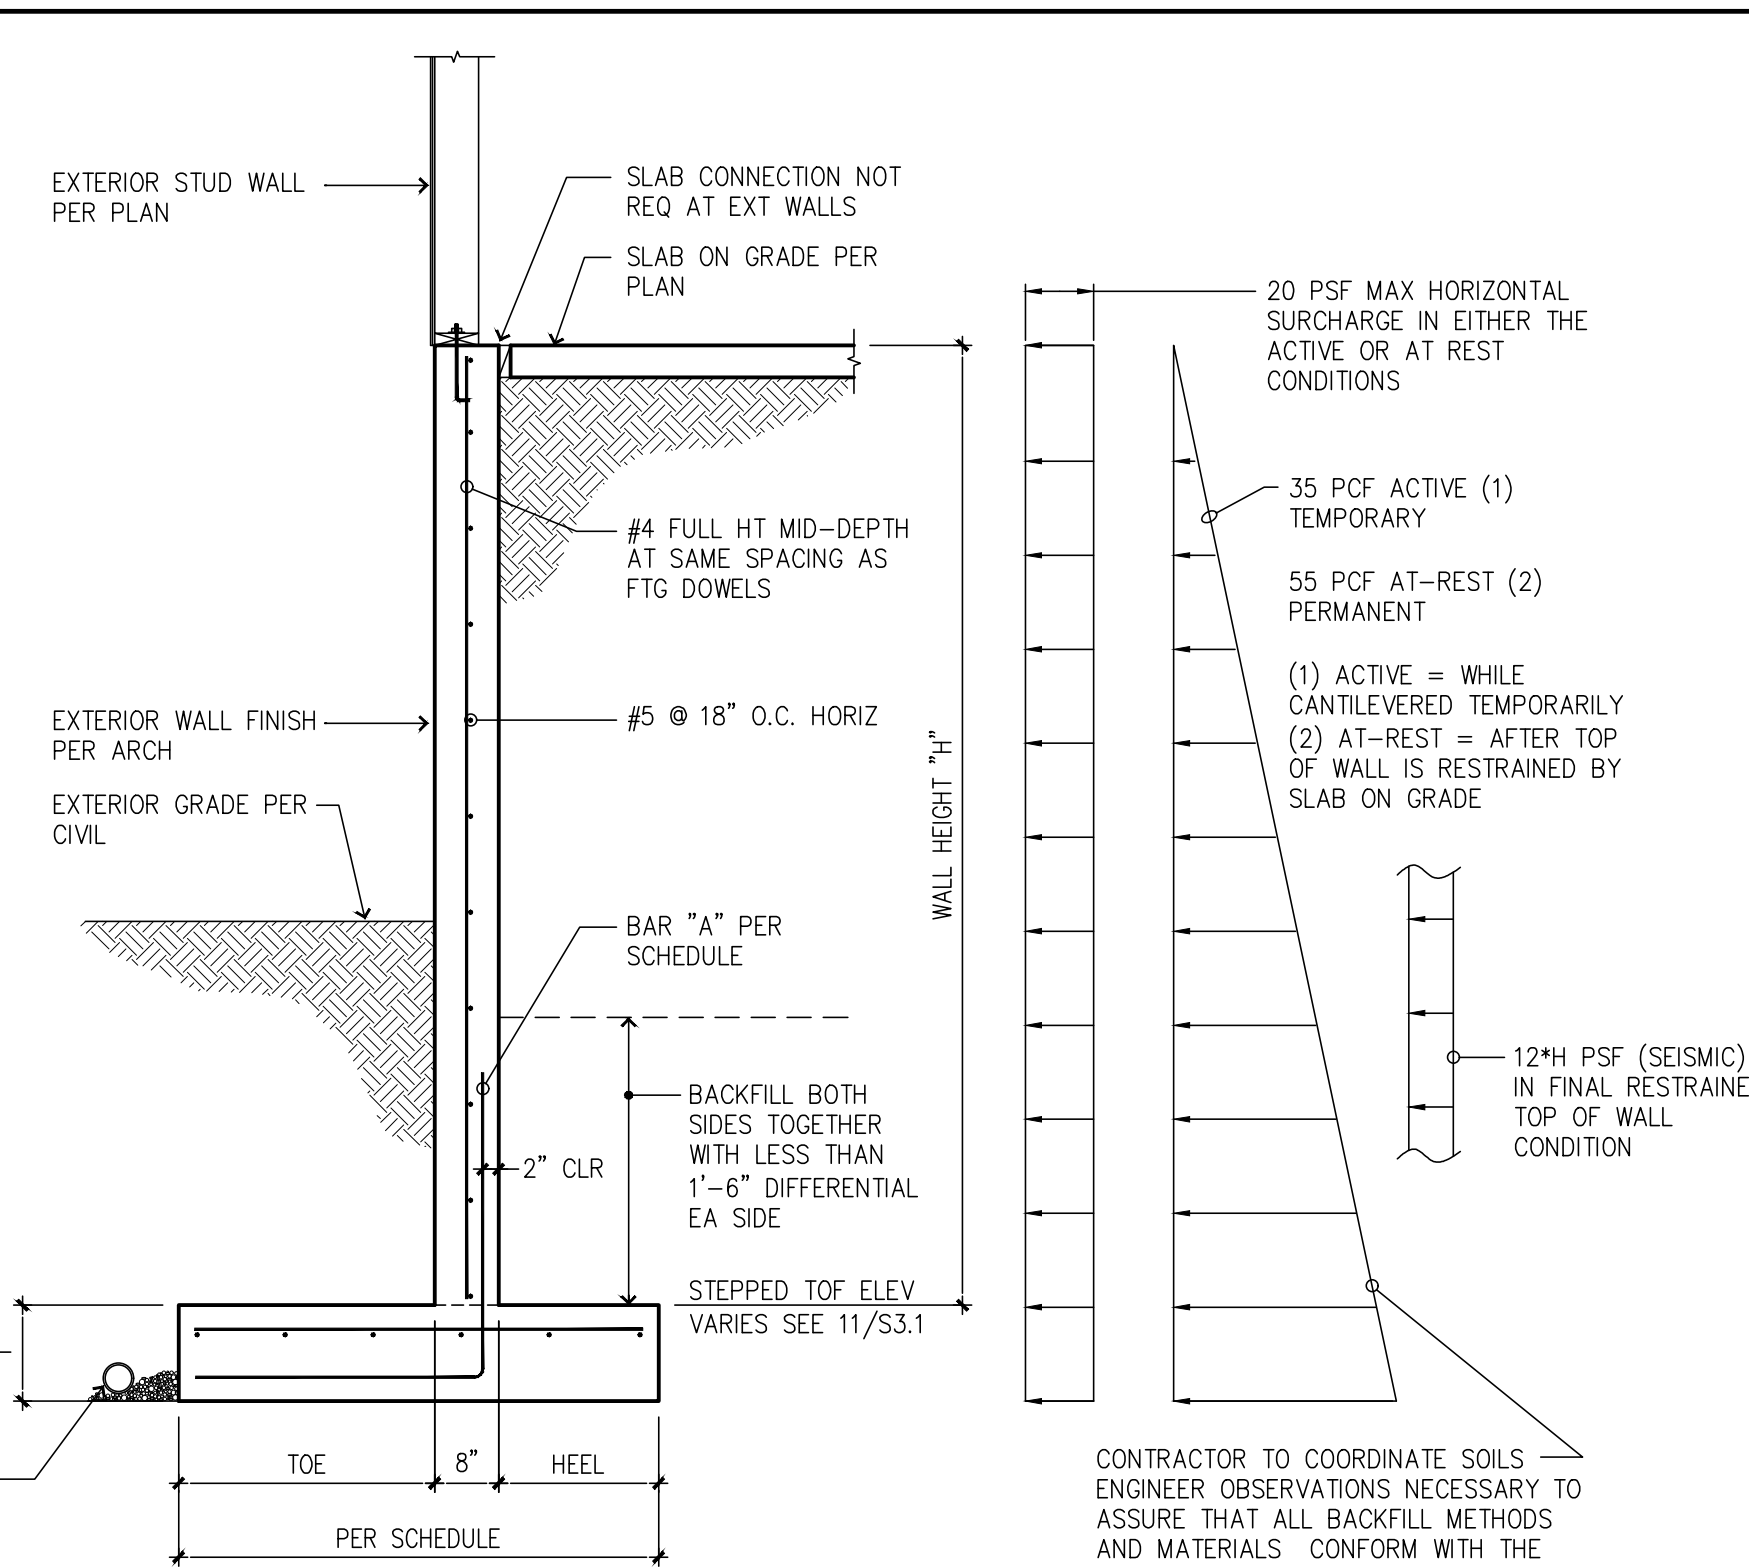


WALL HEIGHT MAX	FOOTING DIMENSIONS				"T" THKNS	BAR "A"		BAR "B"	
	TOE	STEM	HEEL	TOTAL		SIZE & SPACING	VERT LEG	HORIZ LEG	SIZE & SPACING
10'-0"	2'-8"	8"	1'-8"	5'-0"	14"	#5 @ 10" O.C.	5'-6"	2'-10"	#4 @ 10" O.C.
8'-0"	2'-0"	8"	1'-4"	4'-0"	12"	#5 @ 12" O.C.	4'-6"	2'-2"	#4 @ 12" O.C.
6'-0"	1'-4"	8"	1'-0"	3'-0"	12"	#4 @ 12" O.C.	FULL HT	1'-6"	#4 @ 12" O.C.
4'-0"	0'-8"	8"	0'-8"	2'-0"	10"	#4 @ 16" O.C.	FULL HT	0'-10"	#4 @ 16" O.C.

1 STEPPED BASEMENT WALL SCHEDULE

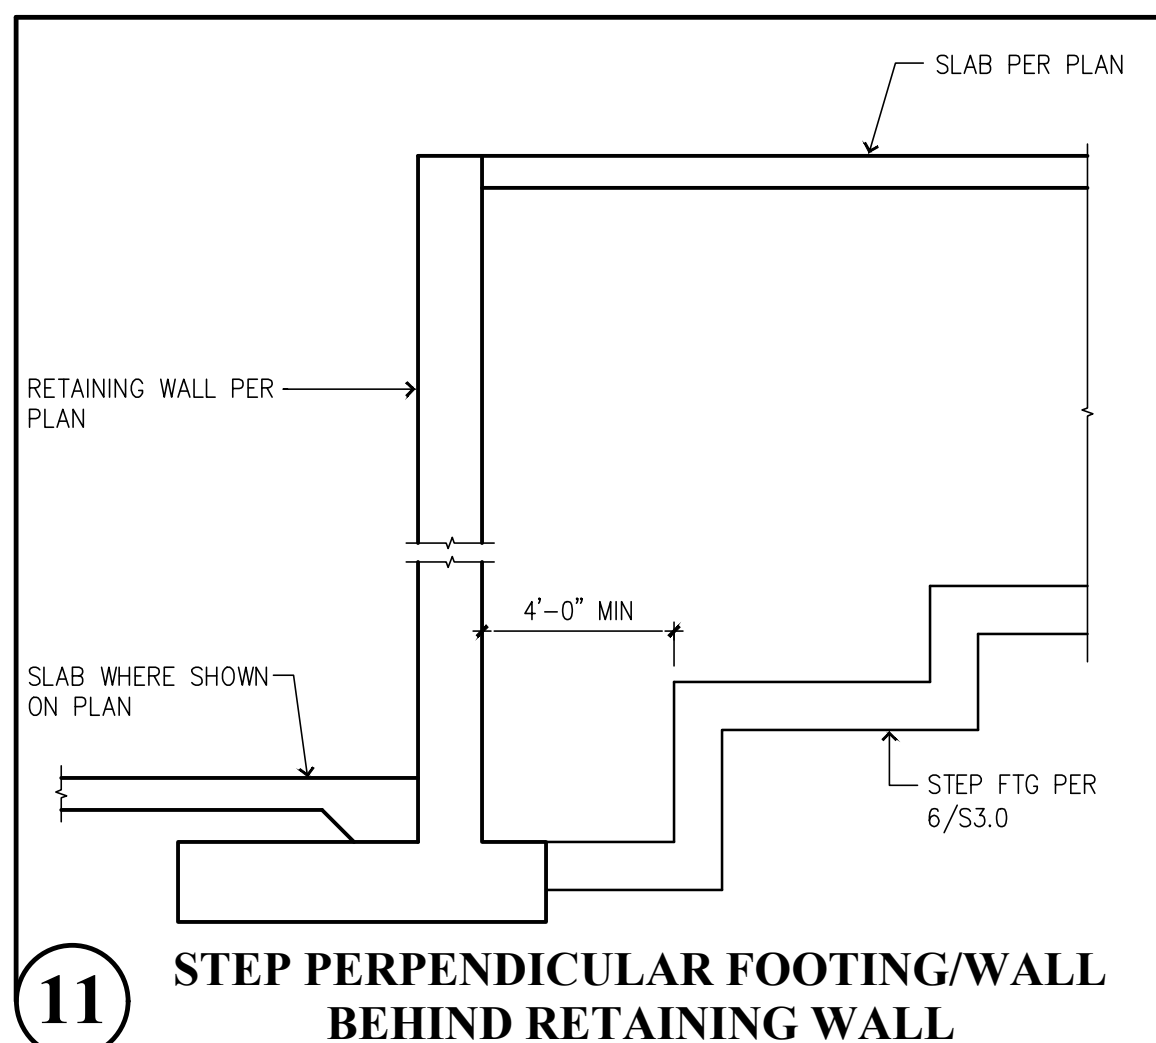

11 STEP PERPENDICULAR FOOTING/WALL BEHIND RETAINING WALL

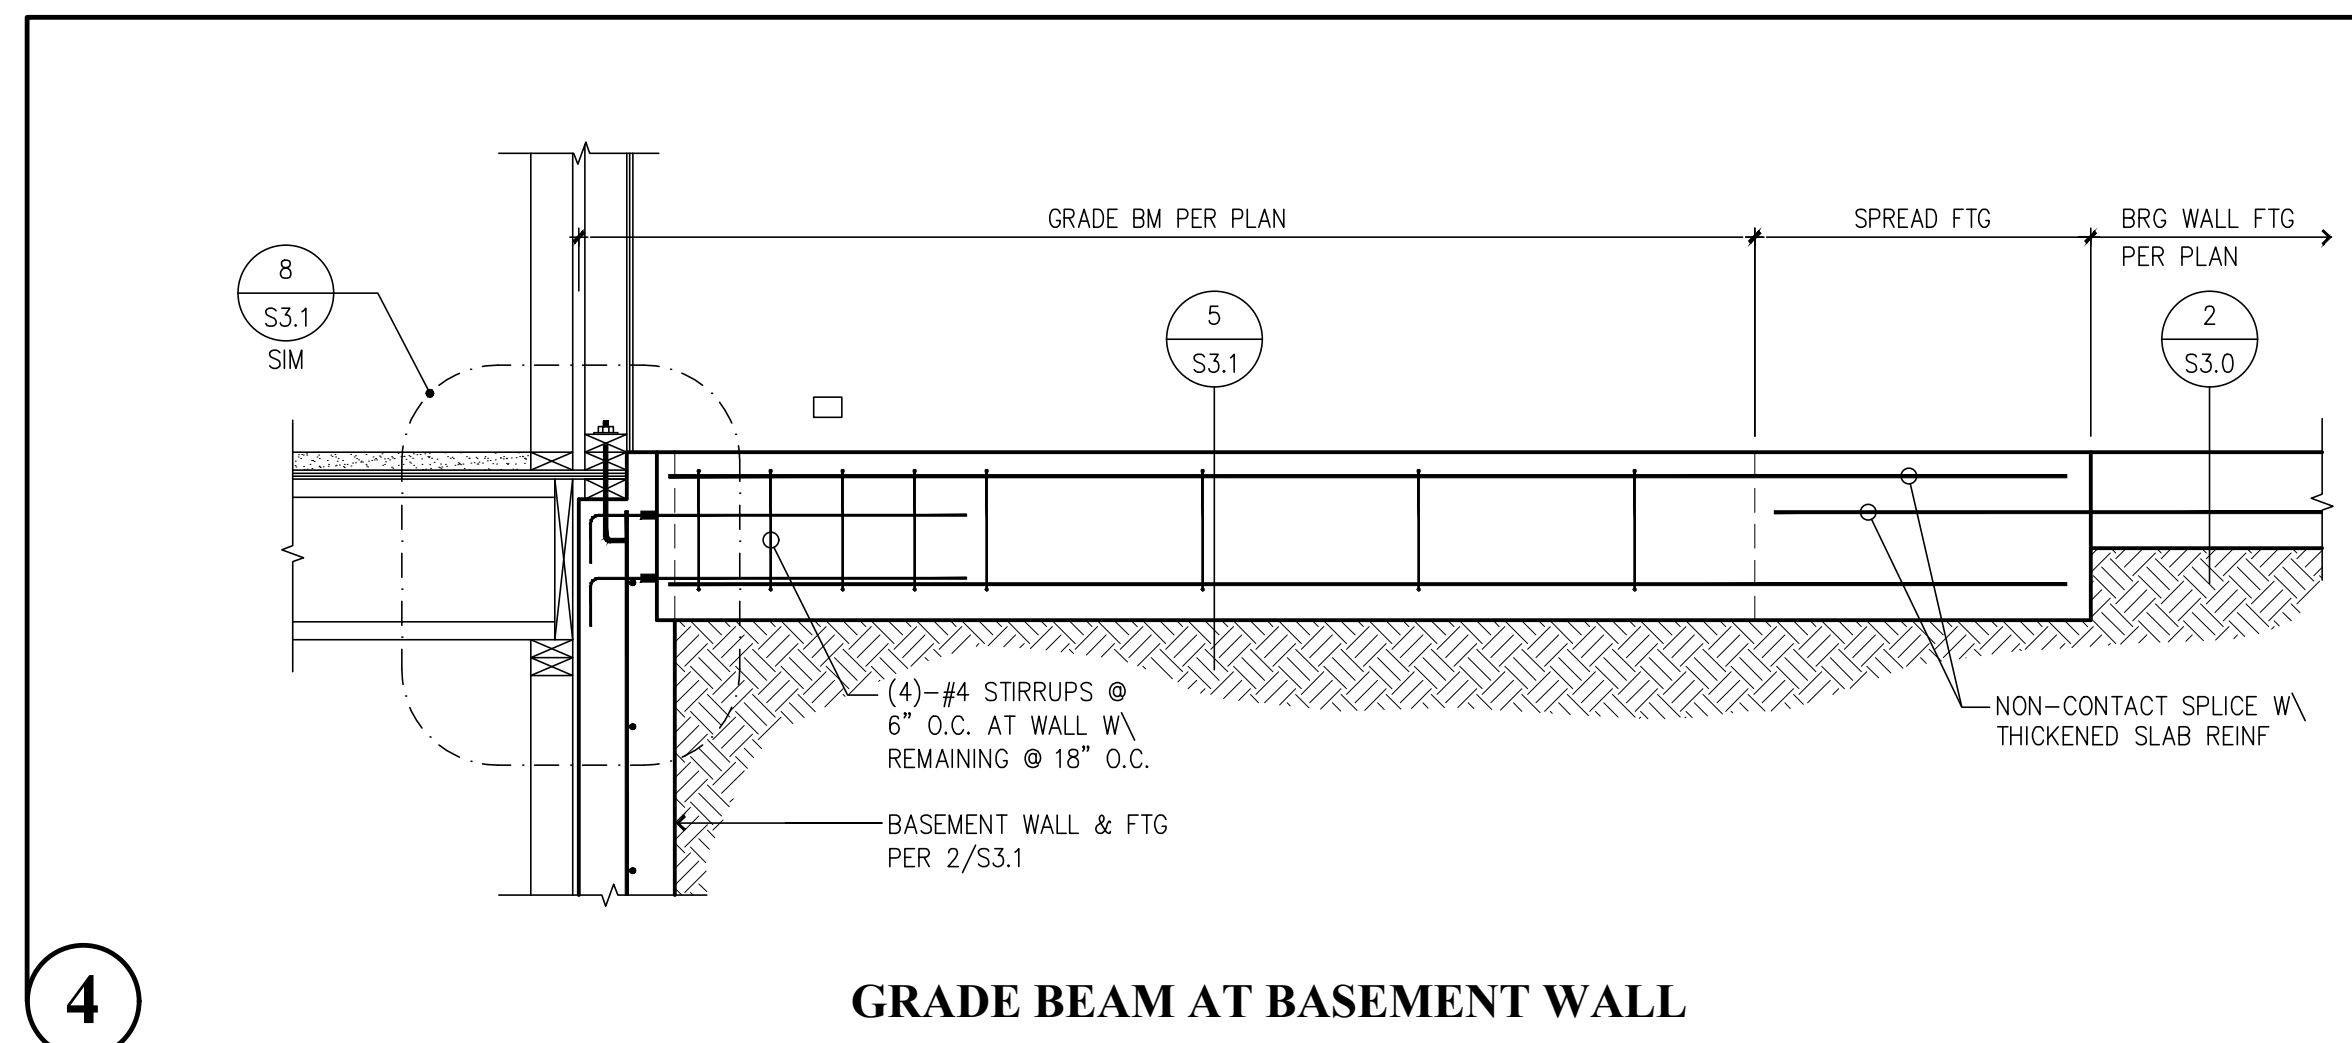

4 GRADE BEAM AT BASEMENT WALL

Revisions to this sheet:

**Bradley Heights Apartments**  
202 27th Ave SE  
Puyallup, Washington

**Solutions 4 Structures**  
A Structural Engineering Corporation

PROJECT NO. : 23.007  
DESIGNED BY : TLC, OGG, MRO  
DRAWN BY : RSO  
ISSUE DATE : 2-20-24  
LATEST REV. OF DWG. SET : 8-30-24

THOMAS L. CHASE, PE  
MARTIN R. OMAN, PE, SE  
OLEG G. KONDRATYUK, PE


Puyallup, Washington 98374  
Ph 253-314-9822  
www.solutions4structures.com

SUBMITTAL SET ONLY NOT FOR CONSTRUCTION  
THESE DRAWINGS ARE SUBJECT TO REVISIONS  
PENDING LOCAL JURISDICTIONAL REVIEW.

**S3.1**

PLOT DATE/TIME: 8/28/2024 - 7:16am THANK YOU FOR USING SOLUTIONS 4 STRUCTURES

CAD FILE: F:\Projects\2023 Projects\23.007 Bradley Heights\Drawings\S4.0.dwg

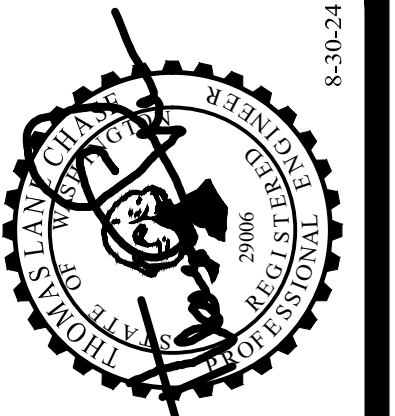

THOMAS L. CHASE, PE  
MARTIN R. OMAN, PE, SE  
OLEG G. KONDRATYUK, PE

Revisions to this sheet:  
8-30-24 PERMIT CORRECTIONS & OWNER CHANGES


Bradley Heights Apartments  
202 27th Ave SE  
Puyallup, Washington

Solutions 4 Structures  
A Structural Engineering Corporation  
Puyallup, Washington 98374  
Ph 253-314-9822  
www.solutions4structures.com


PROJECT NO. : 23.007  
DESIGNED BY : TLC, OGG, MRO  
DRAWN BY : RSO  
ISSUE DATE : 2-20-24  
LATEST REV. OF DWG. SET : 8-30-24

SUBMITTAL SET ONLY NOT FOR CONSTRUCTION  
THESE DRAWINGS ARE SUBJECT TO REVISIONS PENDING LOCAL JURISDICTIONAL REVIEW.


S4.0

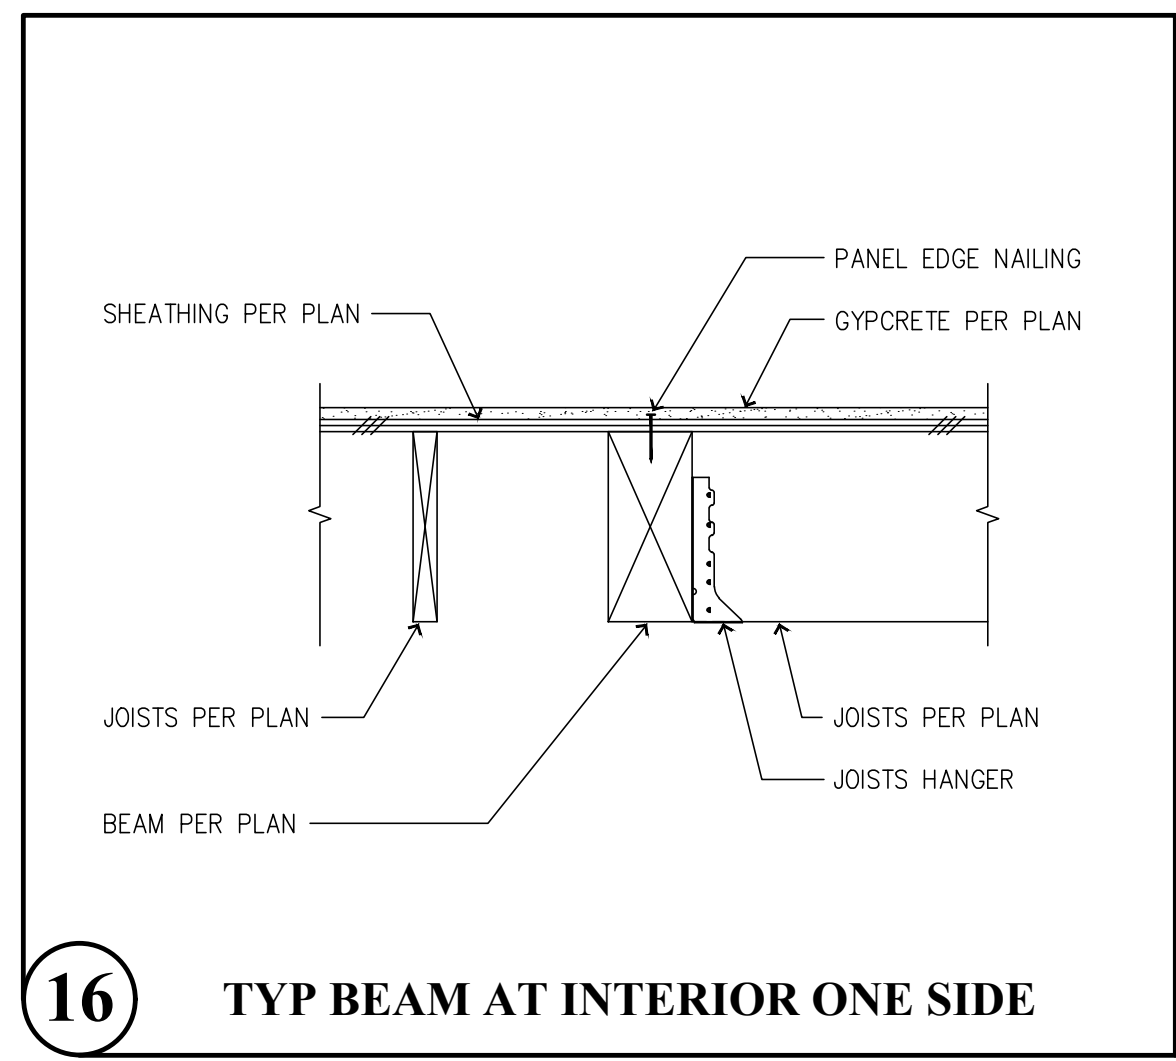


16 TYP BEAM AT INTERIOR ONE SIDE

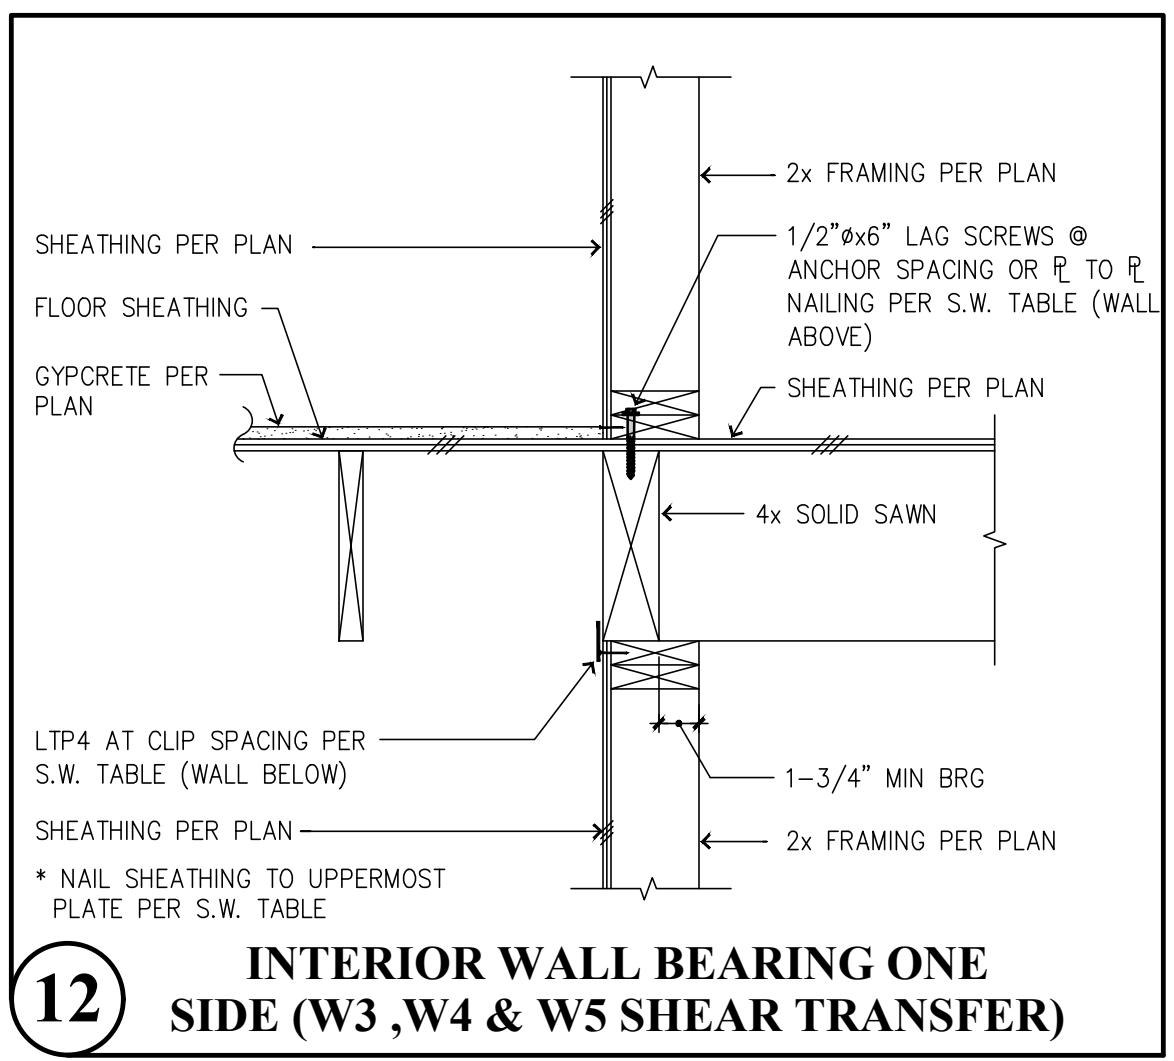


12 INTERIOR WALL BEARING ONE SIDE (W3, W4 & W5 SHEAR TRANSFER)

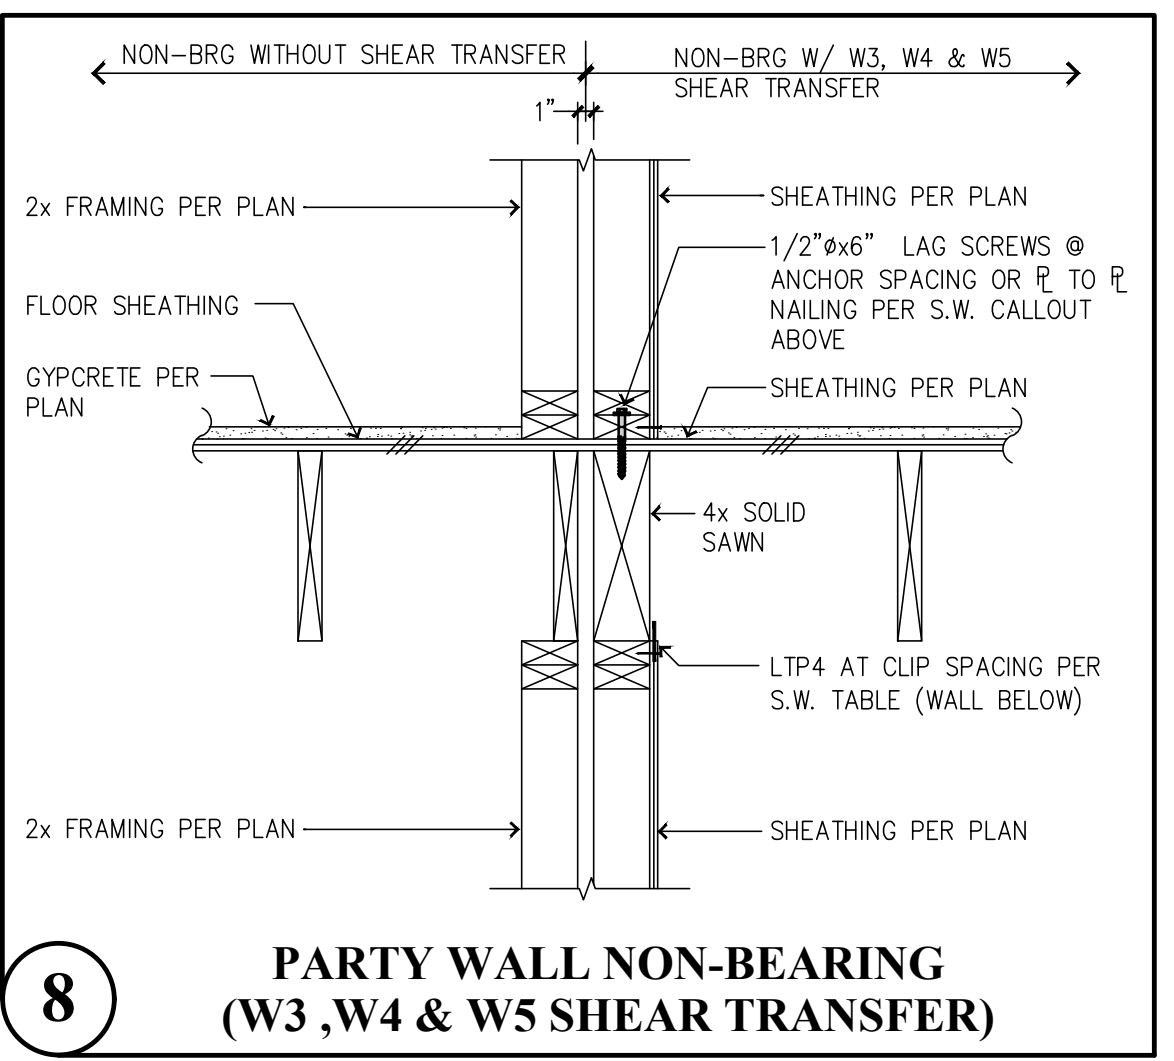


8 PARTY WALL NON-BEARING (W3, W4 & W5 SHEAR TRANSFER)

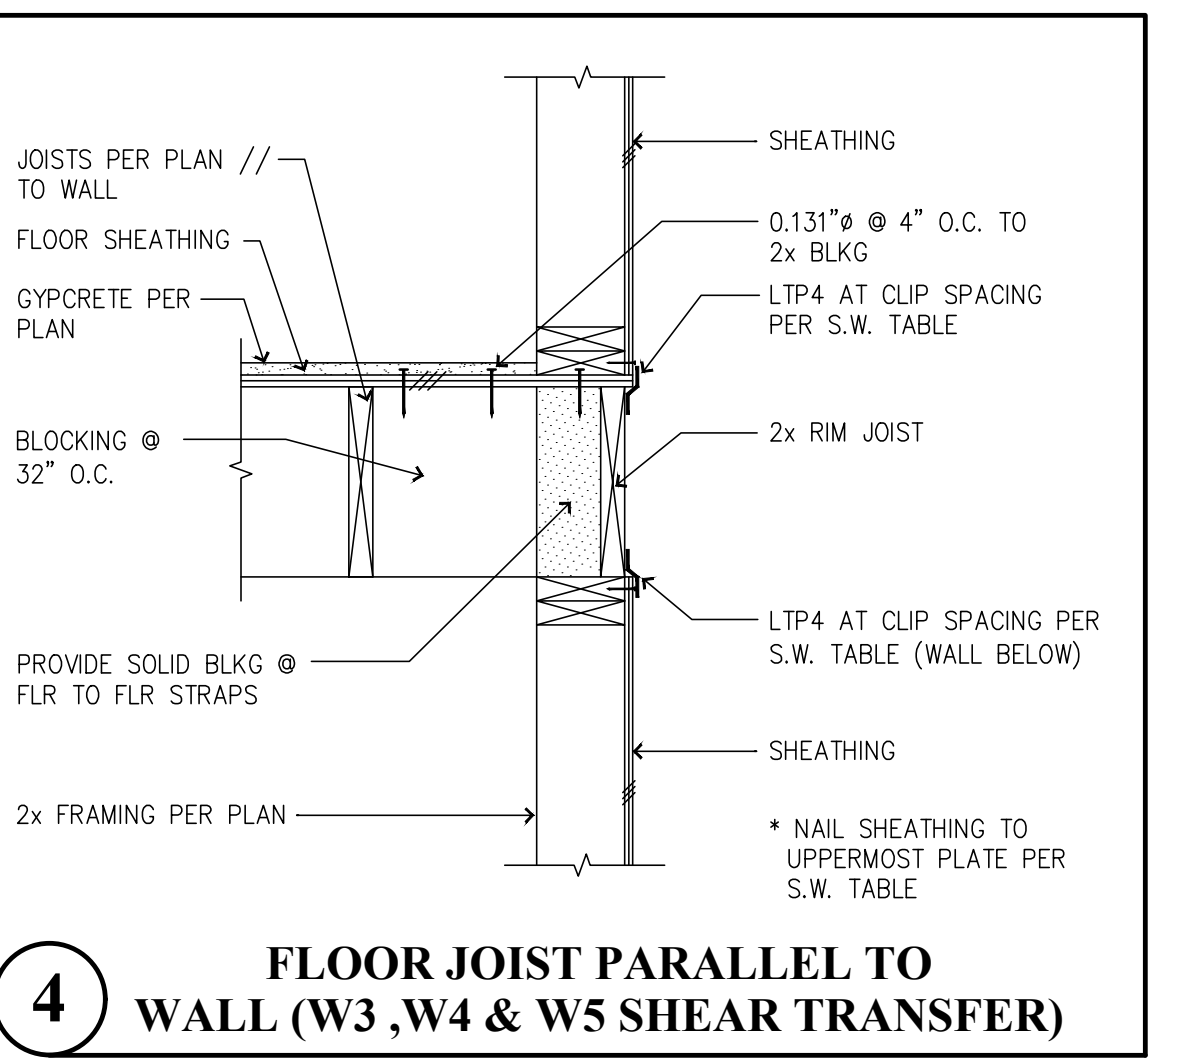


4 FLOOR JOIST PARALLEL TO WALL (W3, W4 & W5 SHEAR TRANSFER)

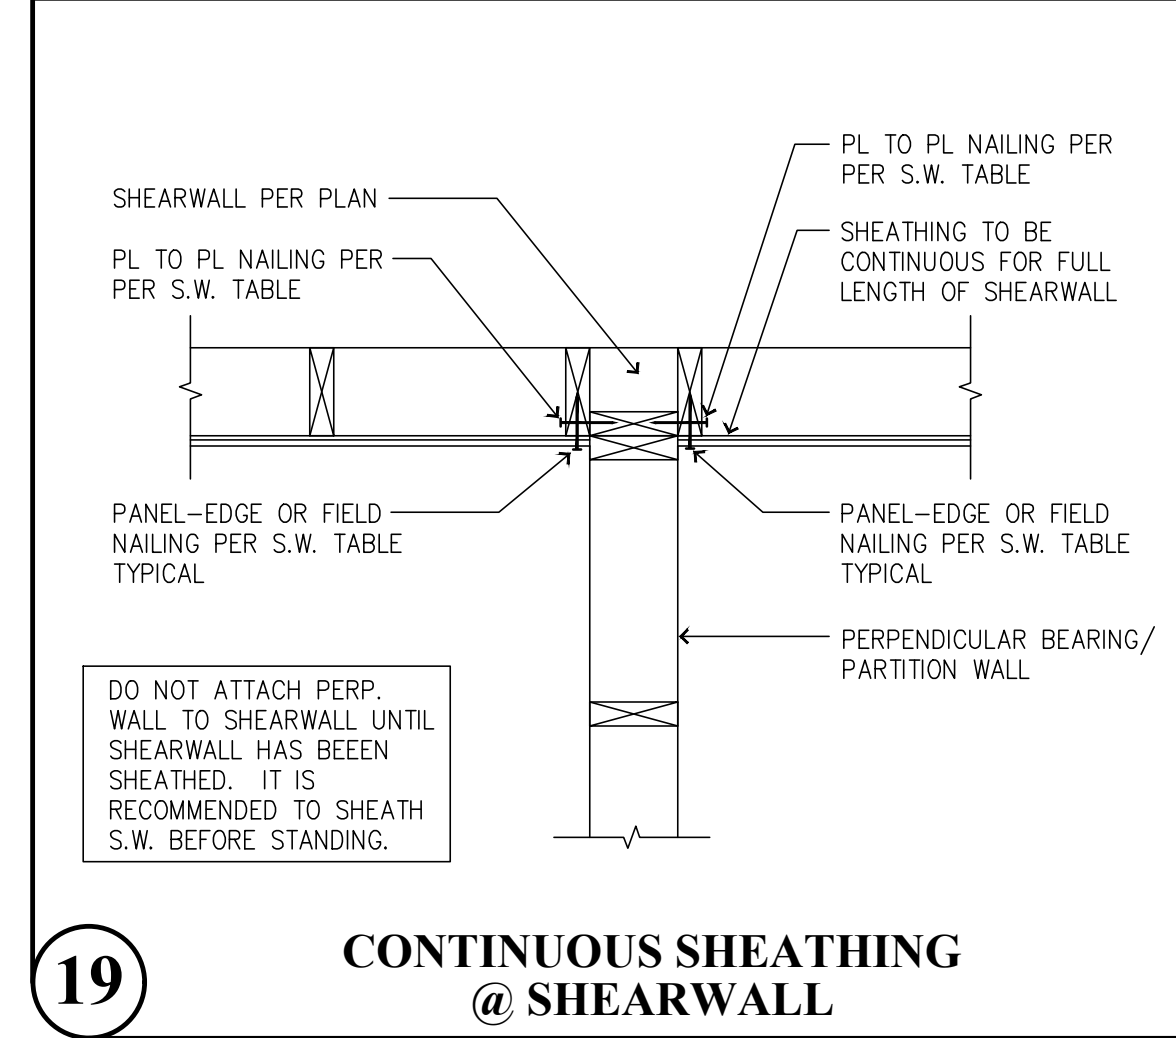


19 CONTINUOUS SHEATHING @ SHEARWALL

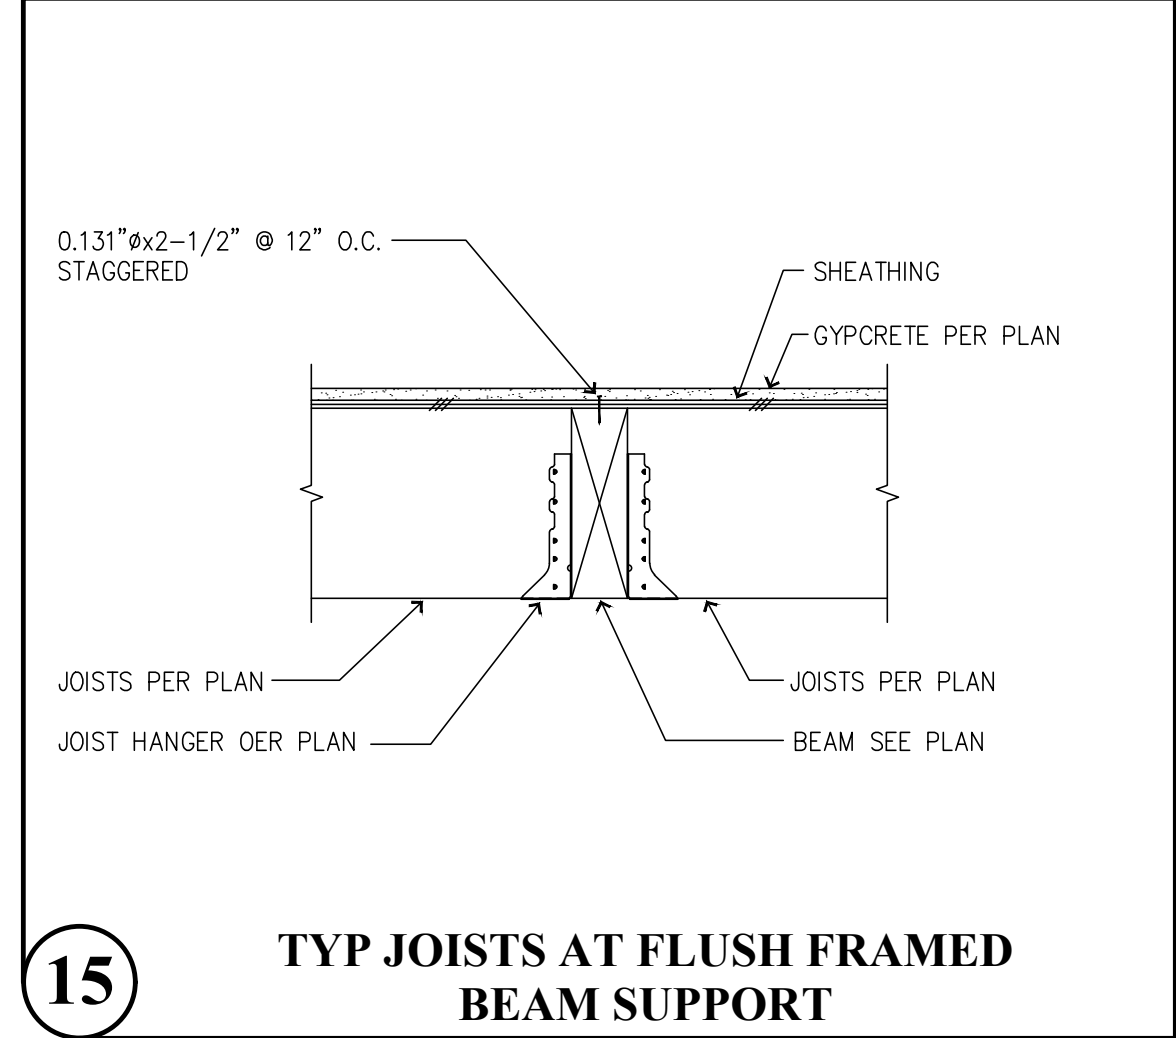


15 TYP JOISTS AT FLUSH FRAMED BEAM SUPPORT

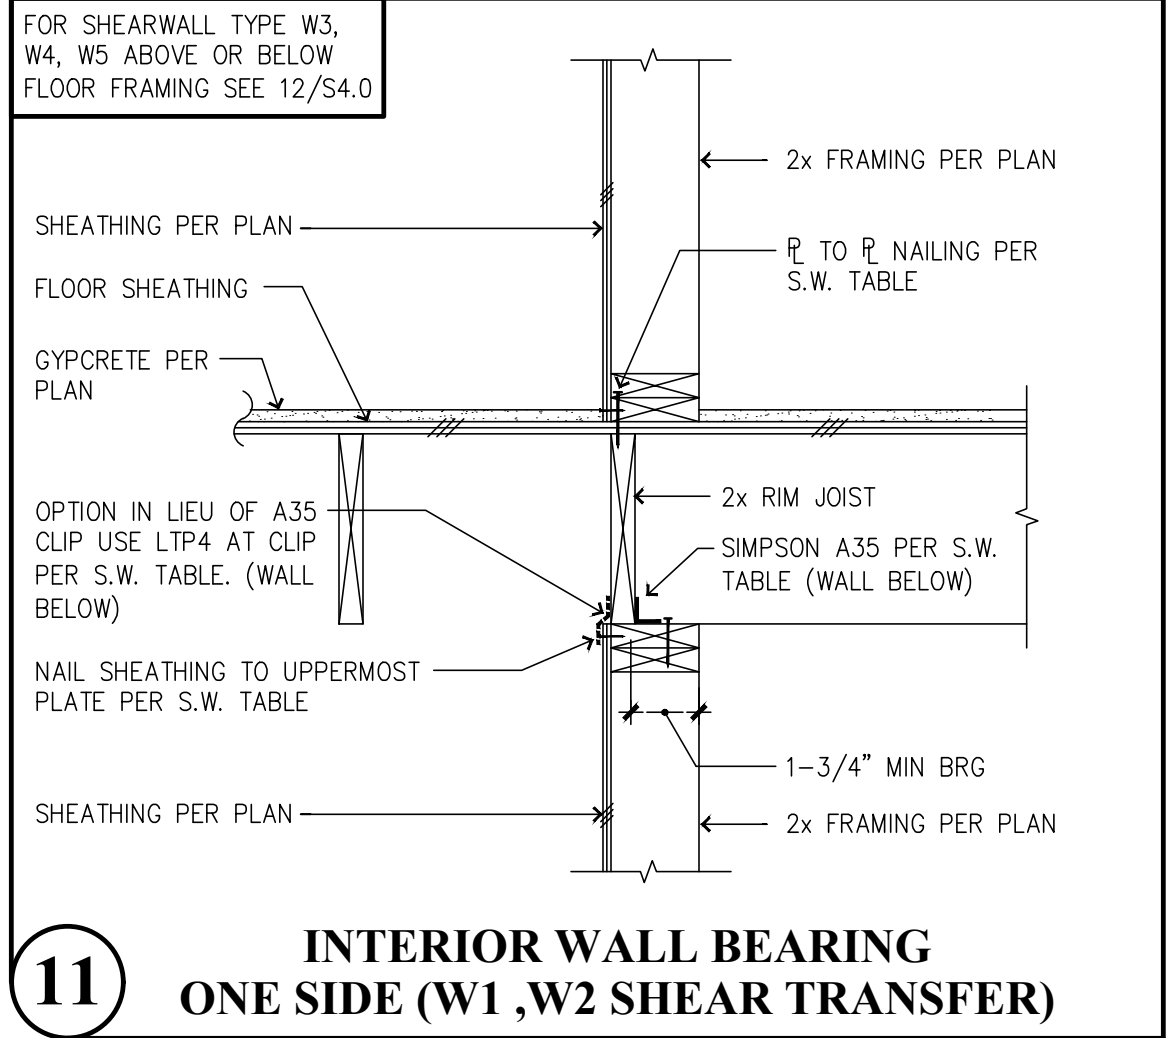


11 INTERIOR WALL BEARING ONE SIDE (W1, W2 SHEAR TRANSFER)

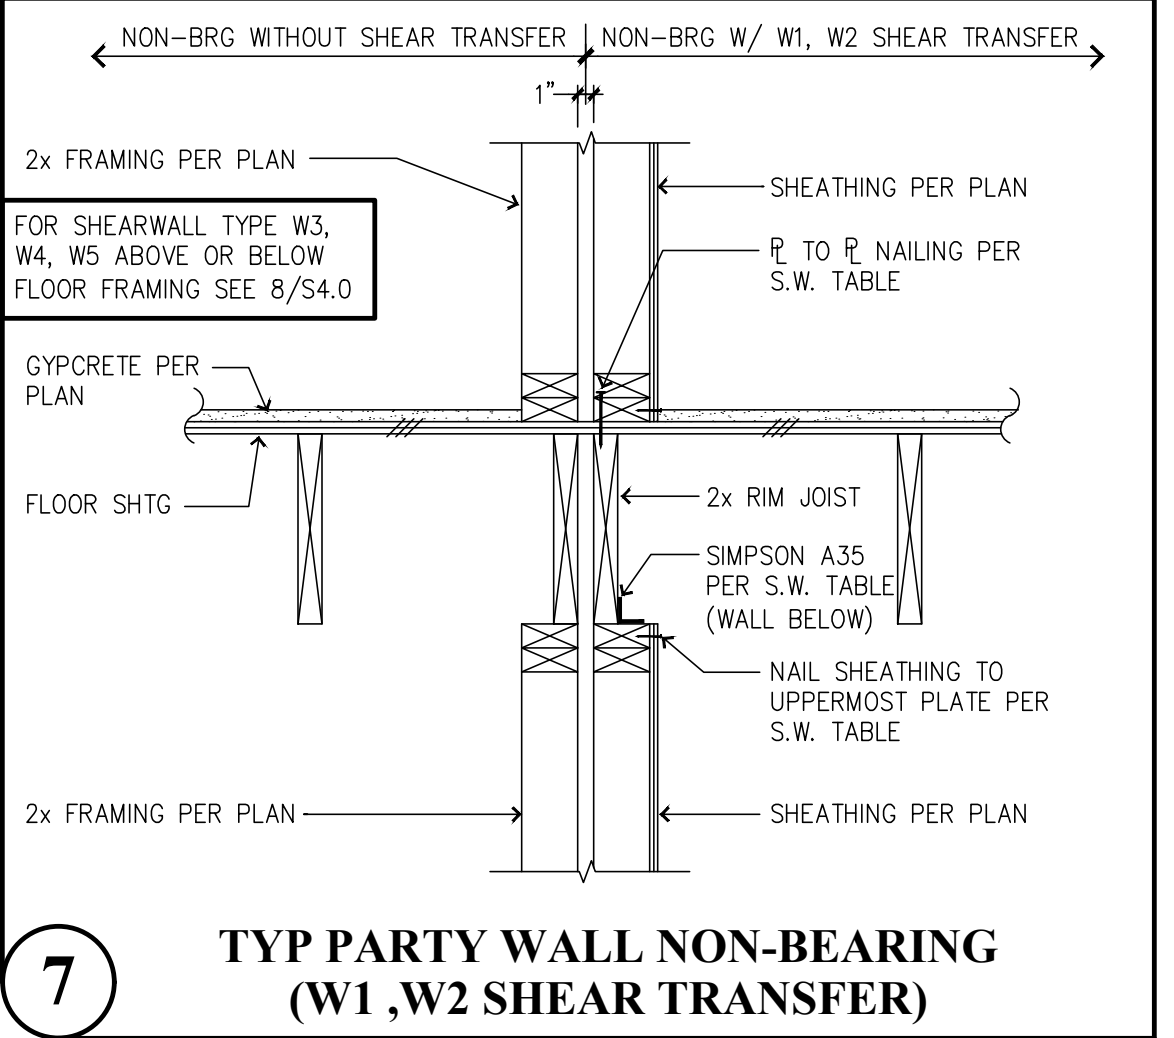


7 TYP PARTY WALL NON-BEARING (W1, W2 SHEAR TRANSFER)

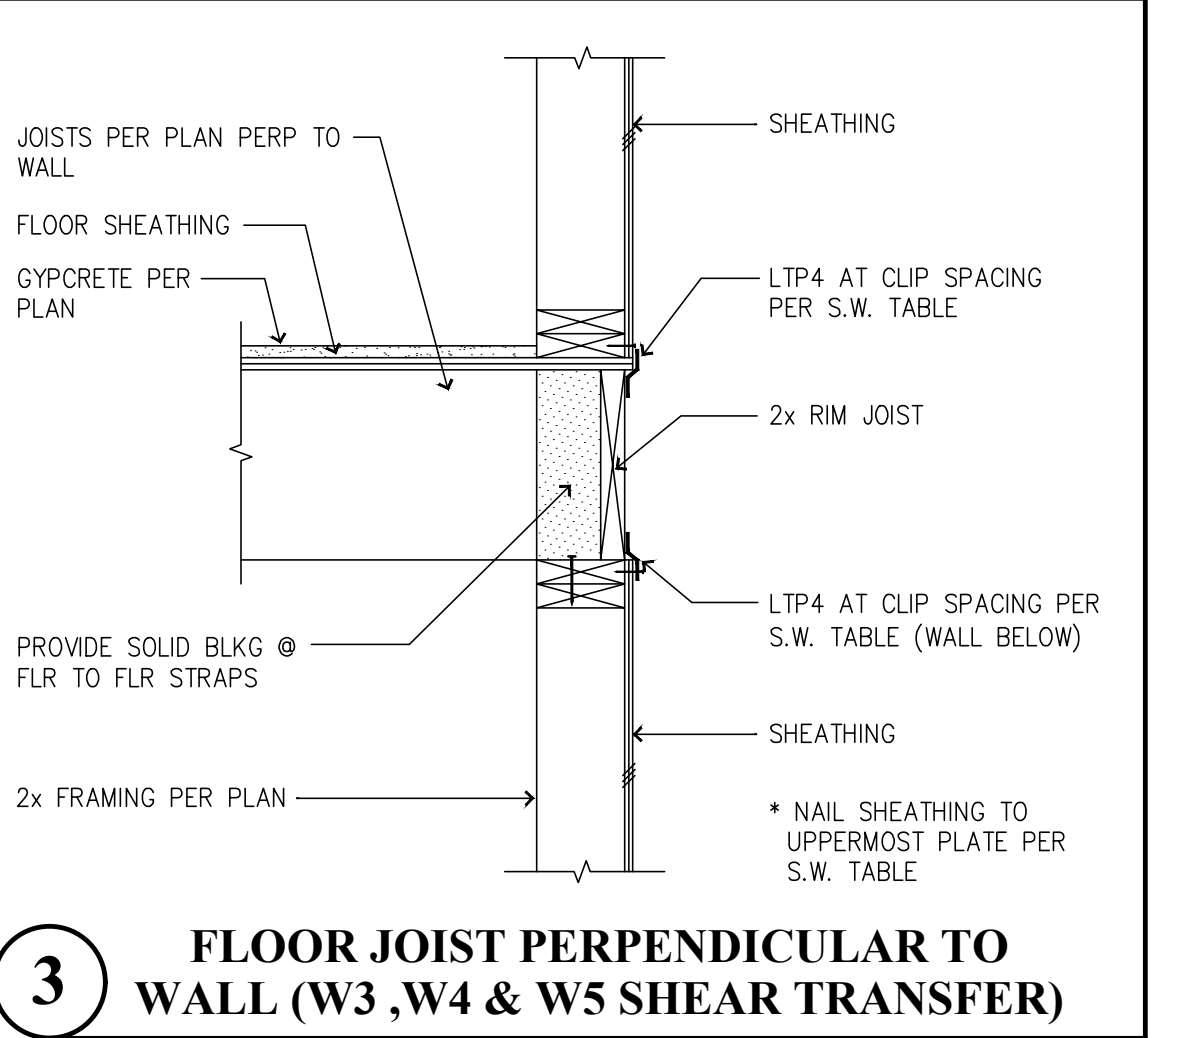


3 FLOOR JOIST PERPENDICULAR TO WALL (W3, W4 & W5 SHEAR TRANSFER)

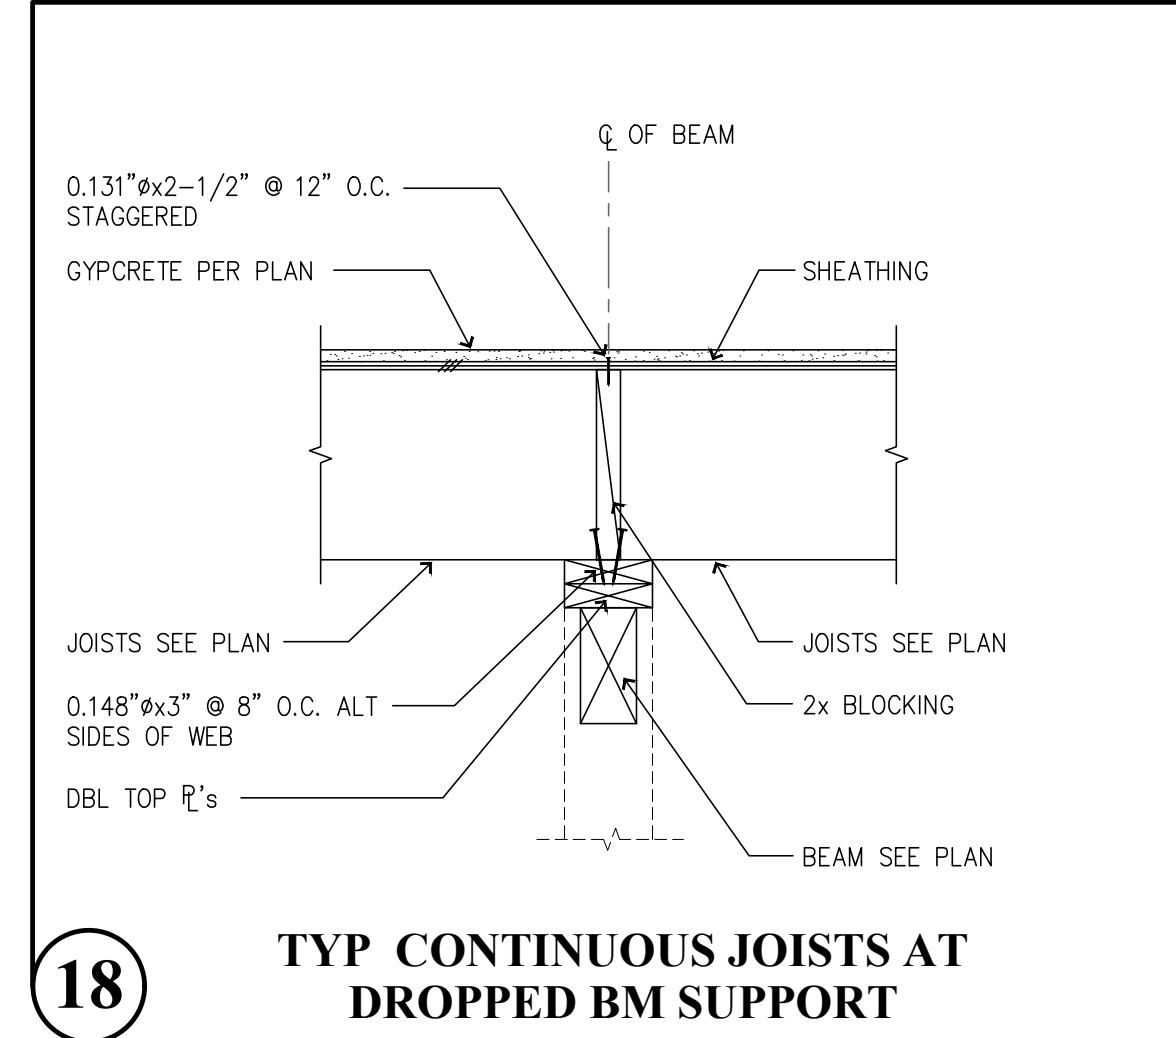


18 TYP CONTINUOUS JOISTS AT DROPPED BM SUPPORT

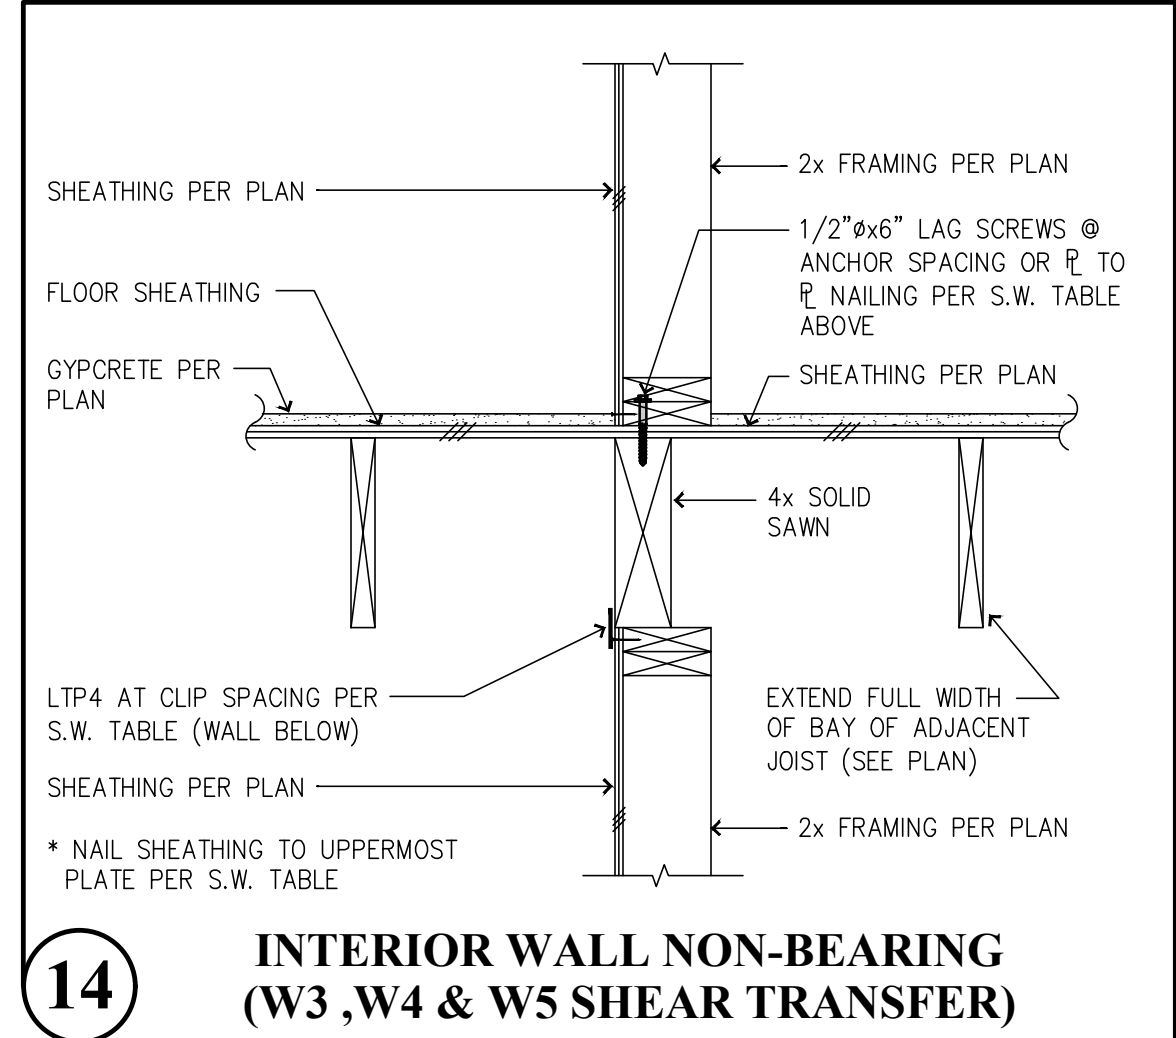


14 INTERIOR WALL NON-BEARING (W3, W4 & W5 SHEAR TRANSFER)

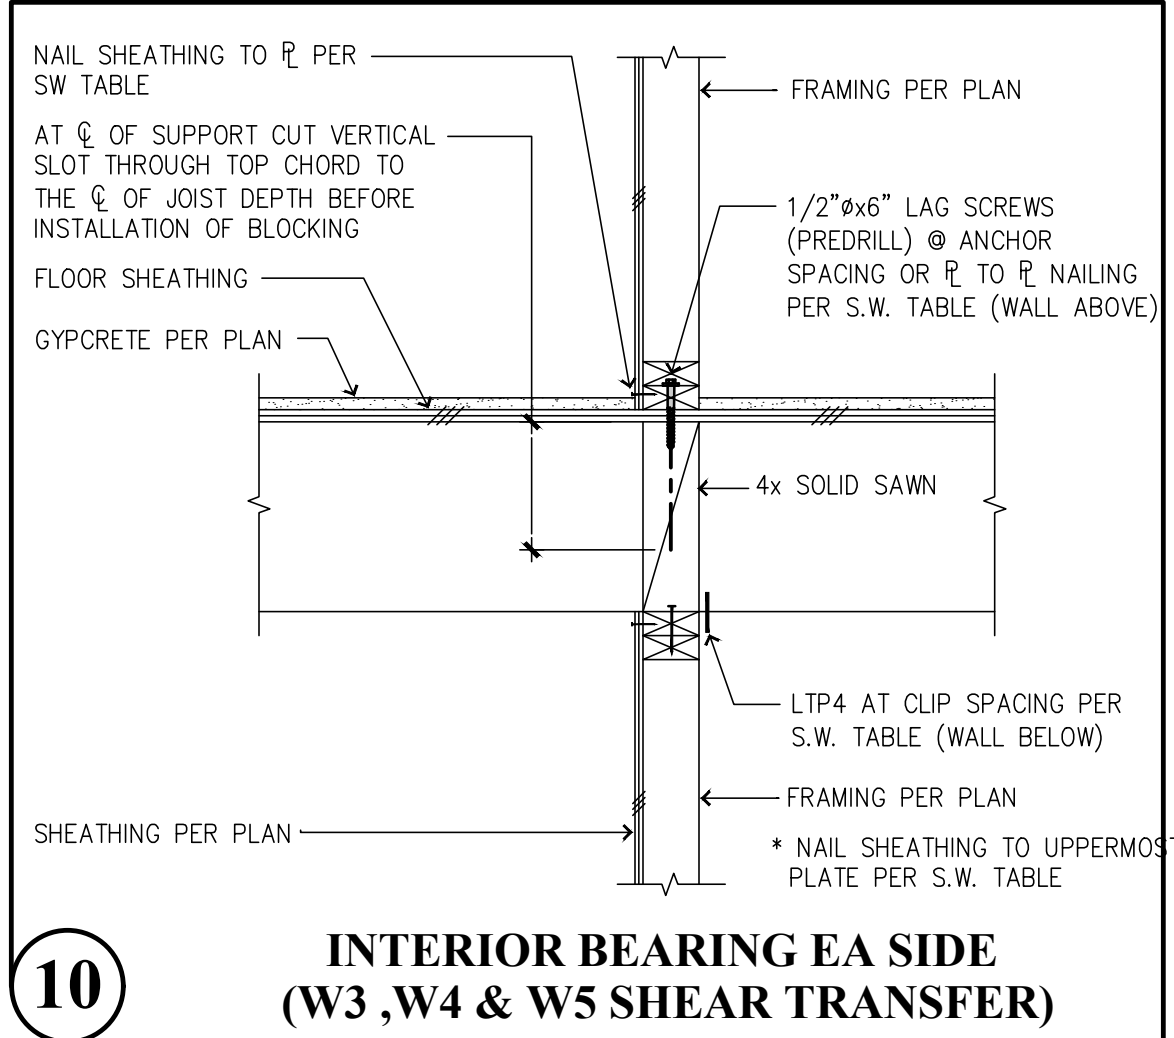


10 INTERIOR BEARING EA SIDE (W3, W4 & W5 SHEAR TRANSFER)

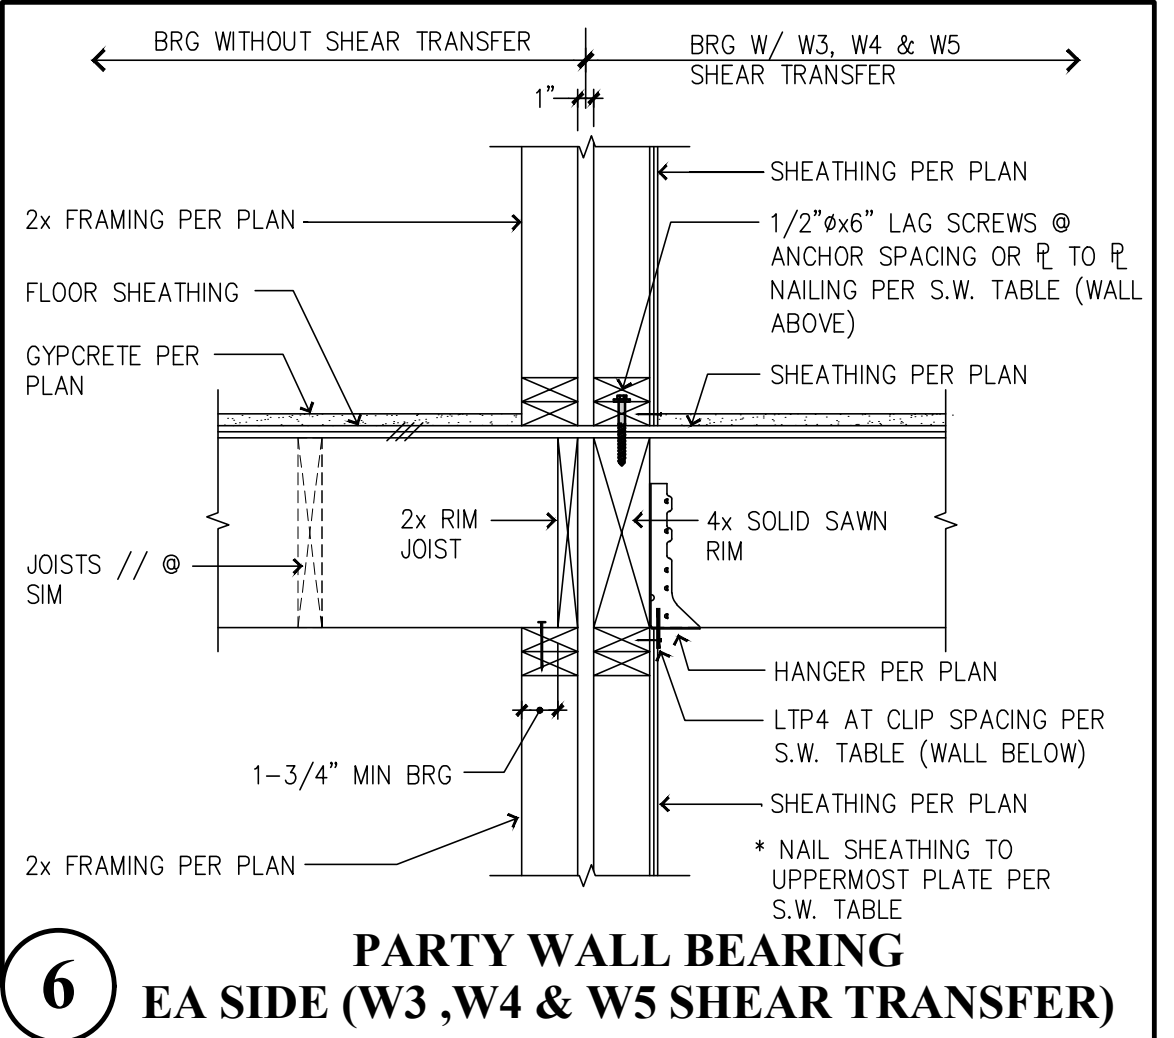


6 PARTY WALL BEARING EA SIDE (W3, W4 & W5 SHEAR TRANSFER)

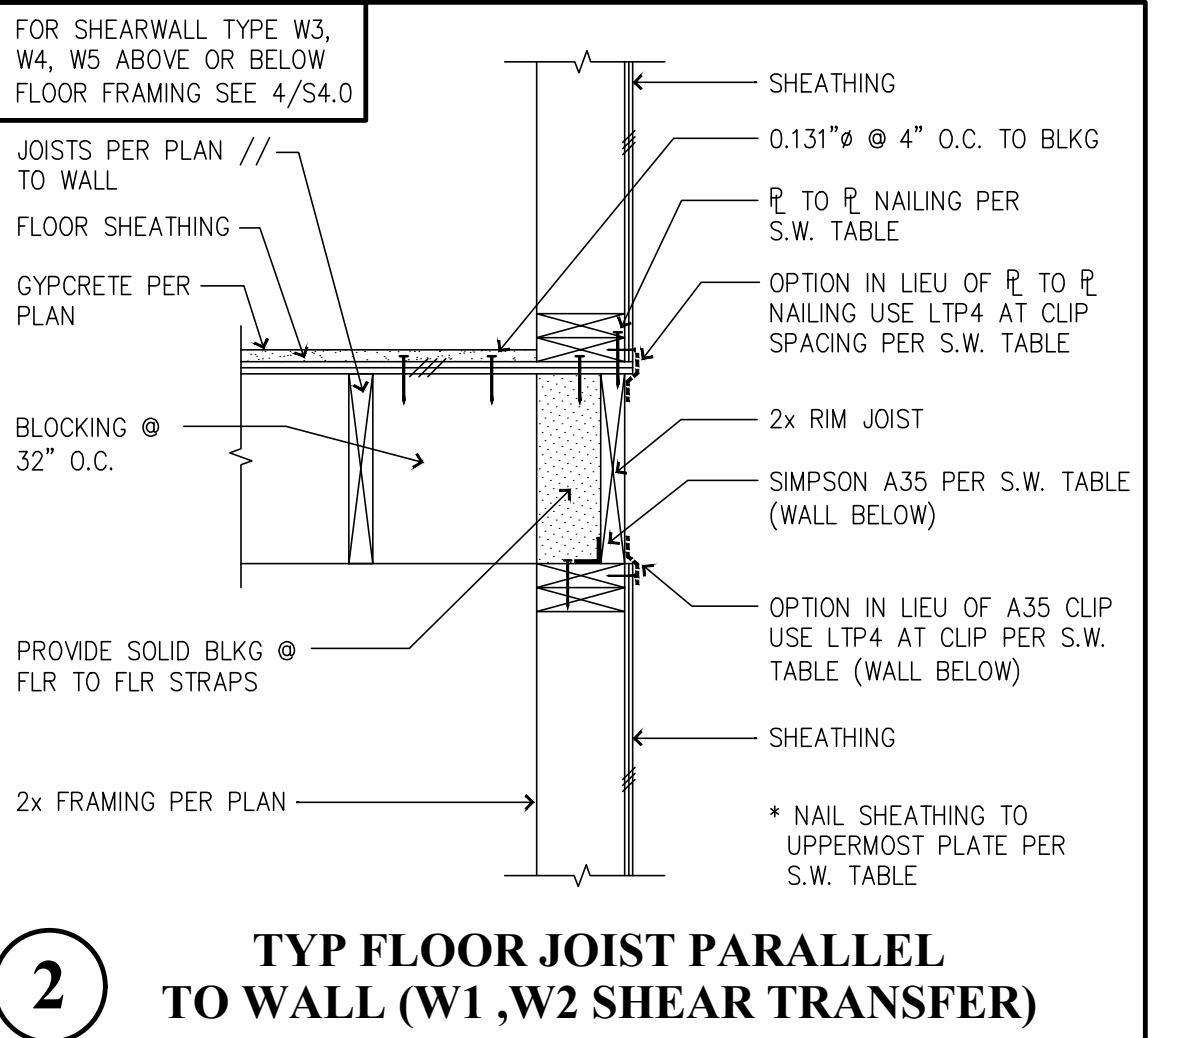


2 TYP FLOOR JOIST PARALLEL TO WALL (W1, W2 SHEAR TRANSFER)

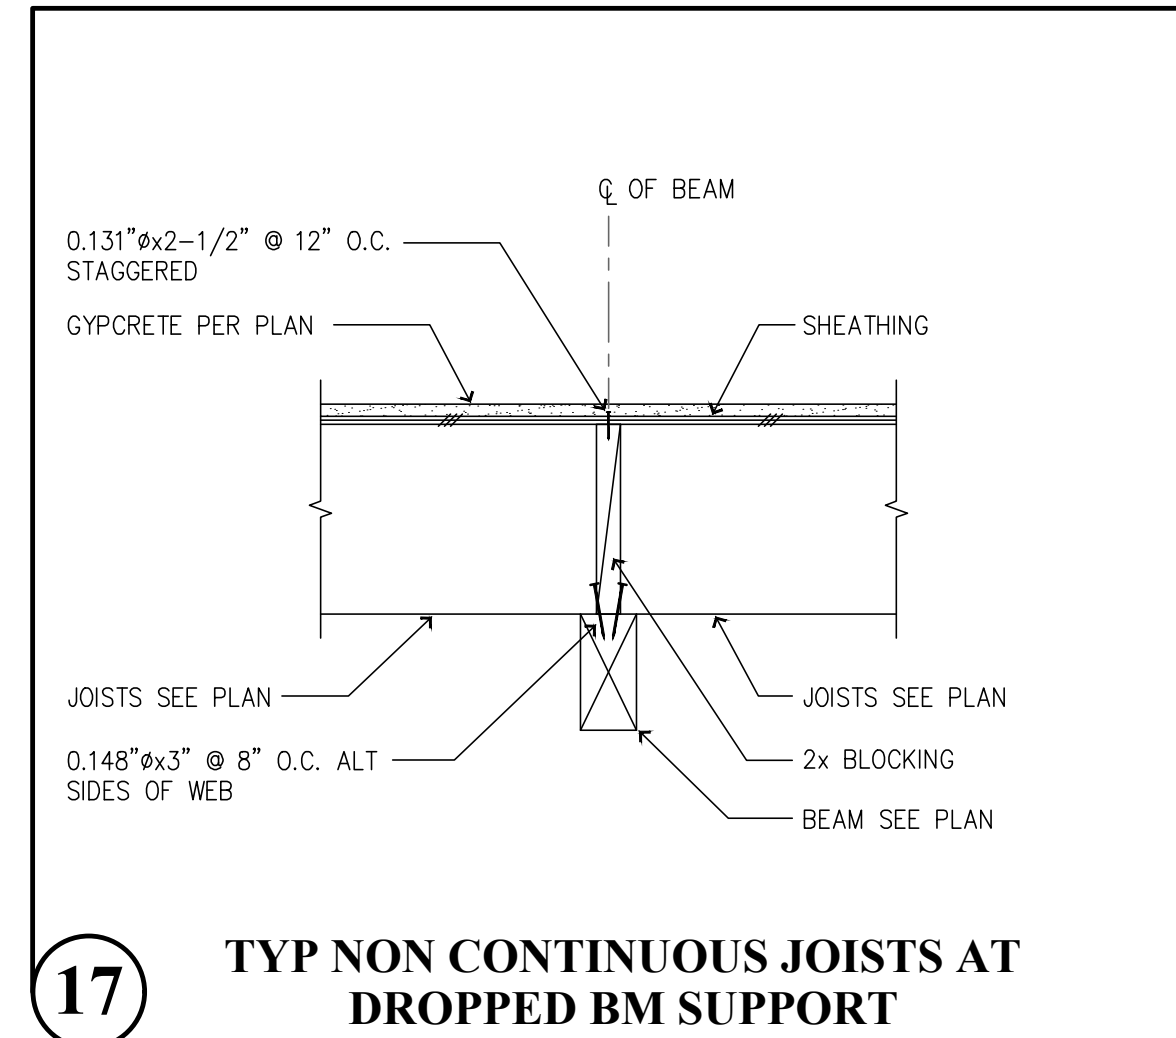


17 TYP NON CONTINUOUS JOISTS AT DROPPED BM SUPPORT

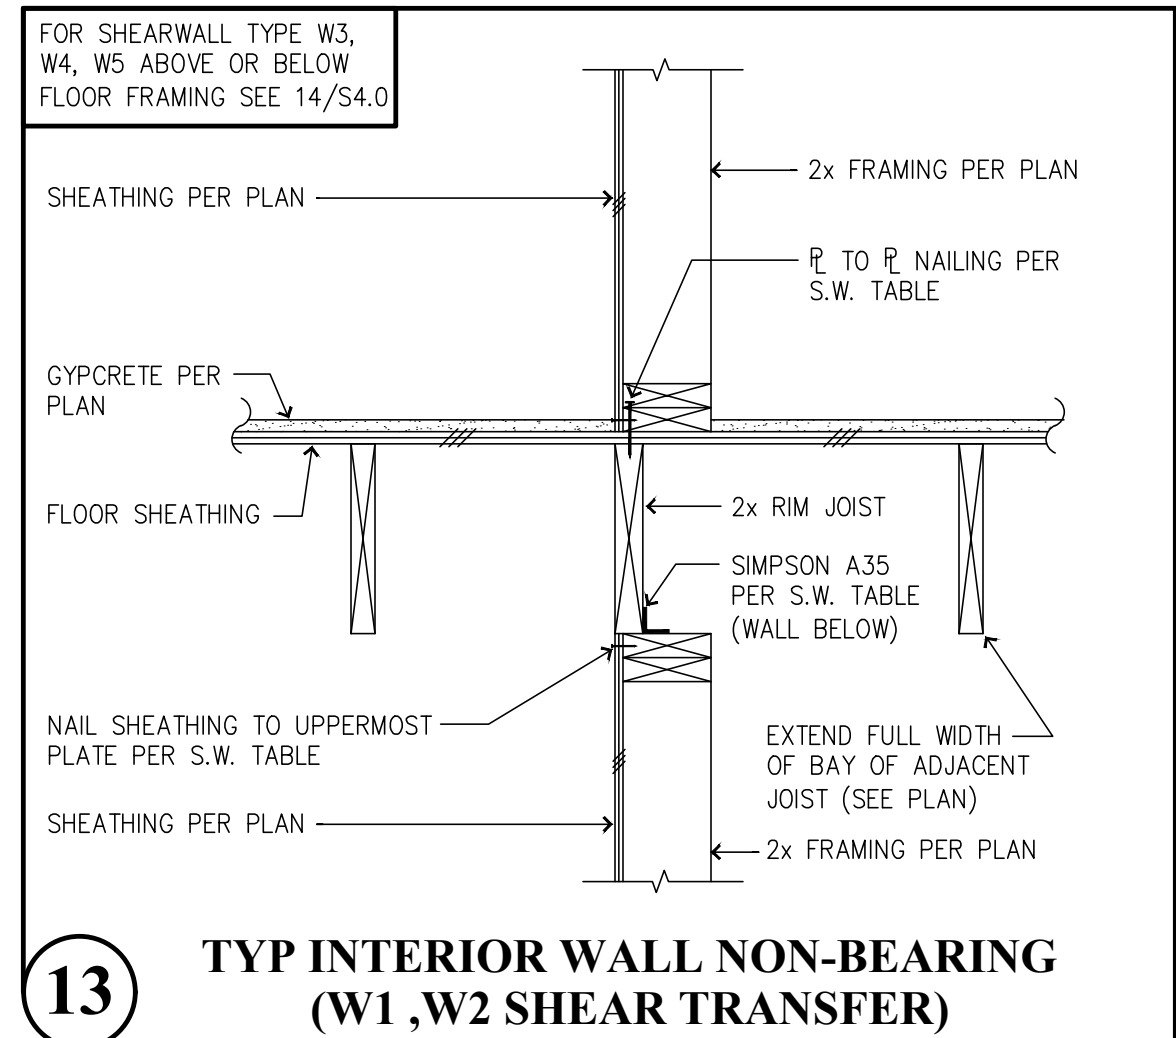


13 TYP INTERIOR WALL NON-BEARING (W1, W2 SHEAR TRANSFER)

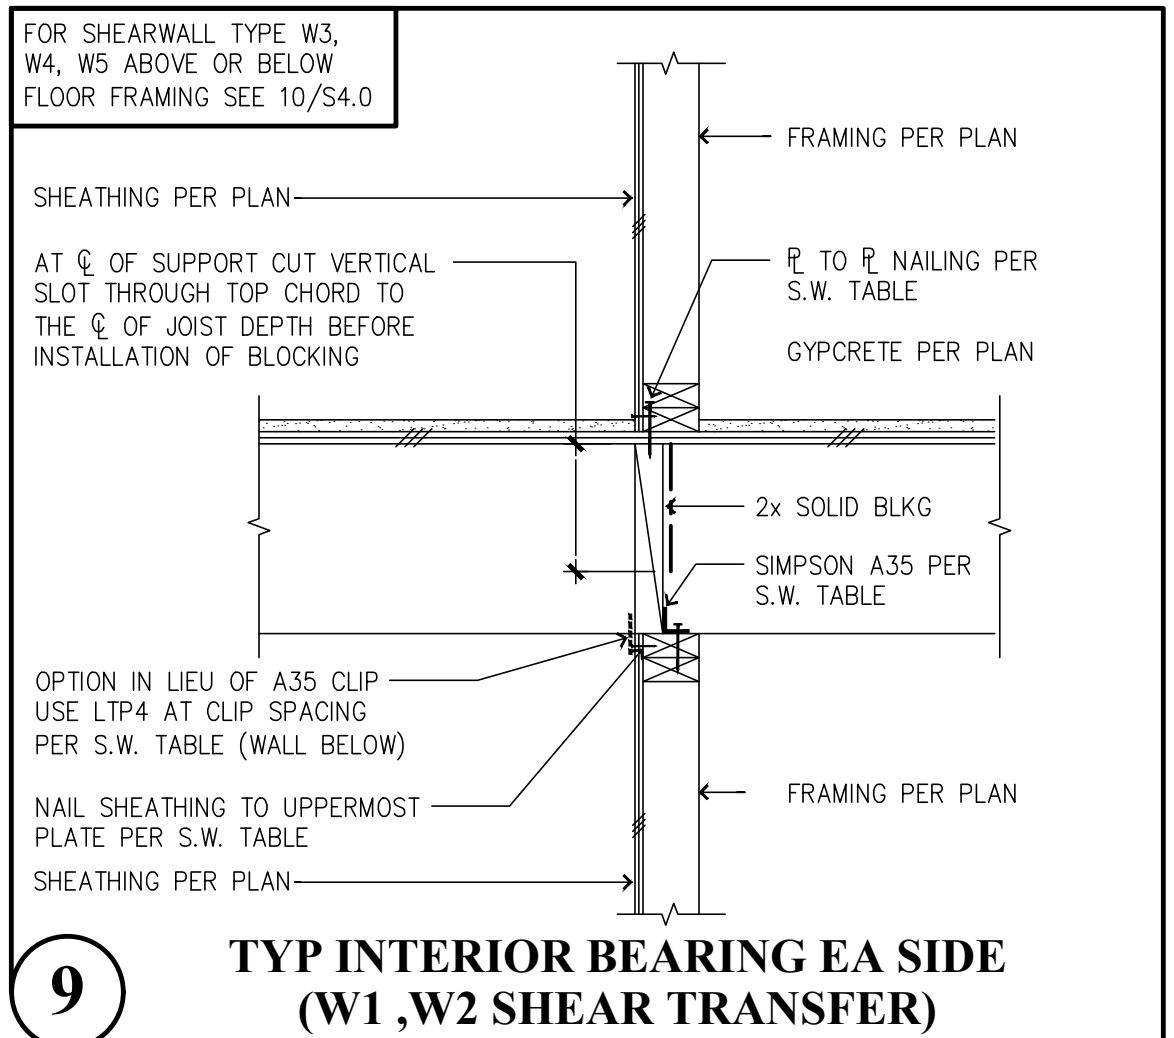

9 TYP INTERIOR BEARING EA SIDE (W1, W2 SHEAR TRANSFER)













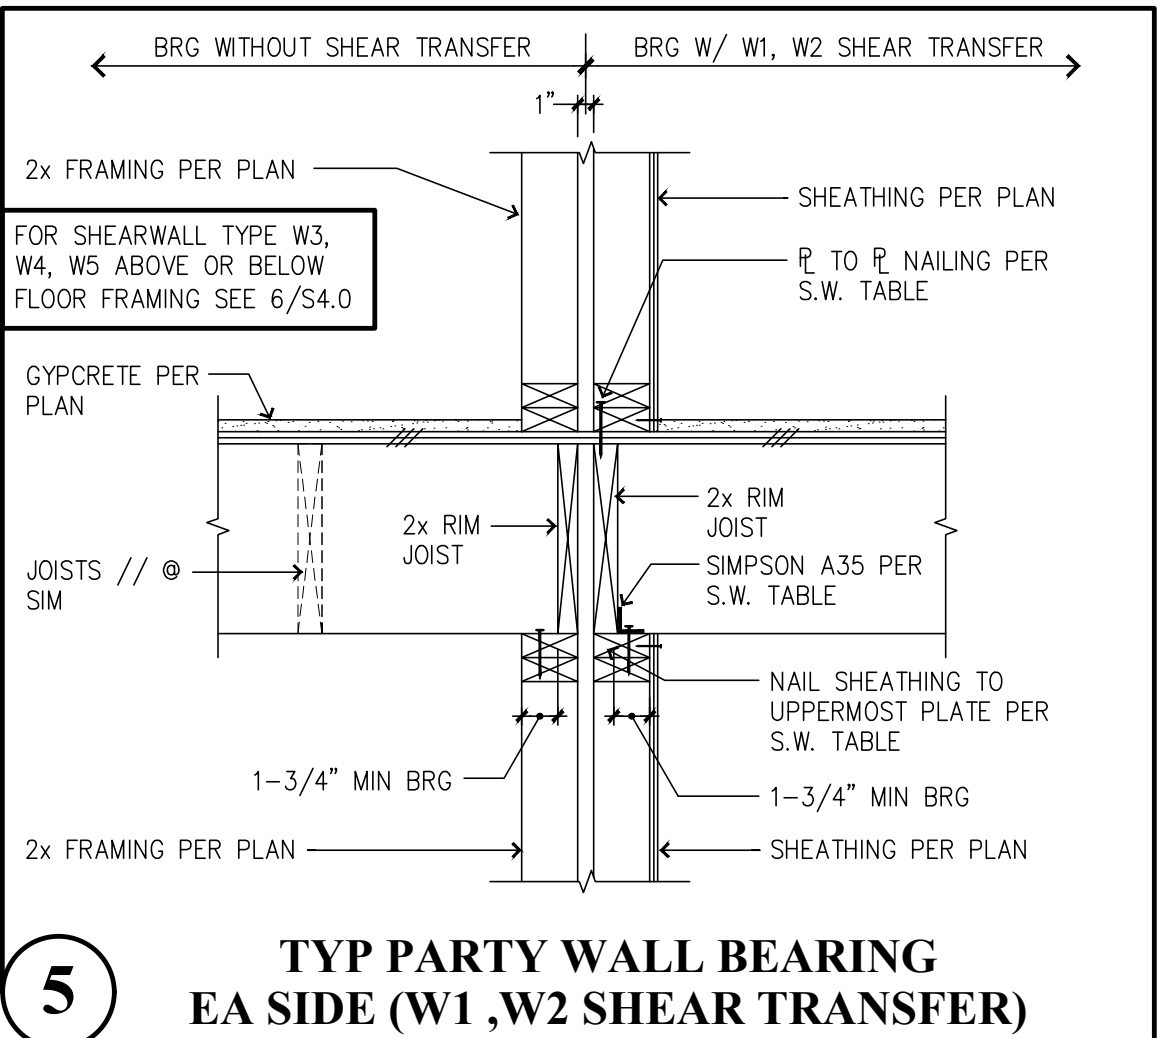


5 TYP PARTY WALL BEARING EA SIDE (W1, W2 SHEAR TRANSFER)

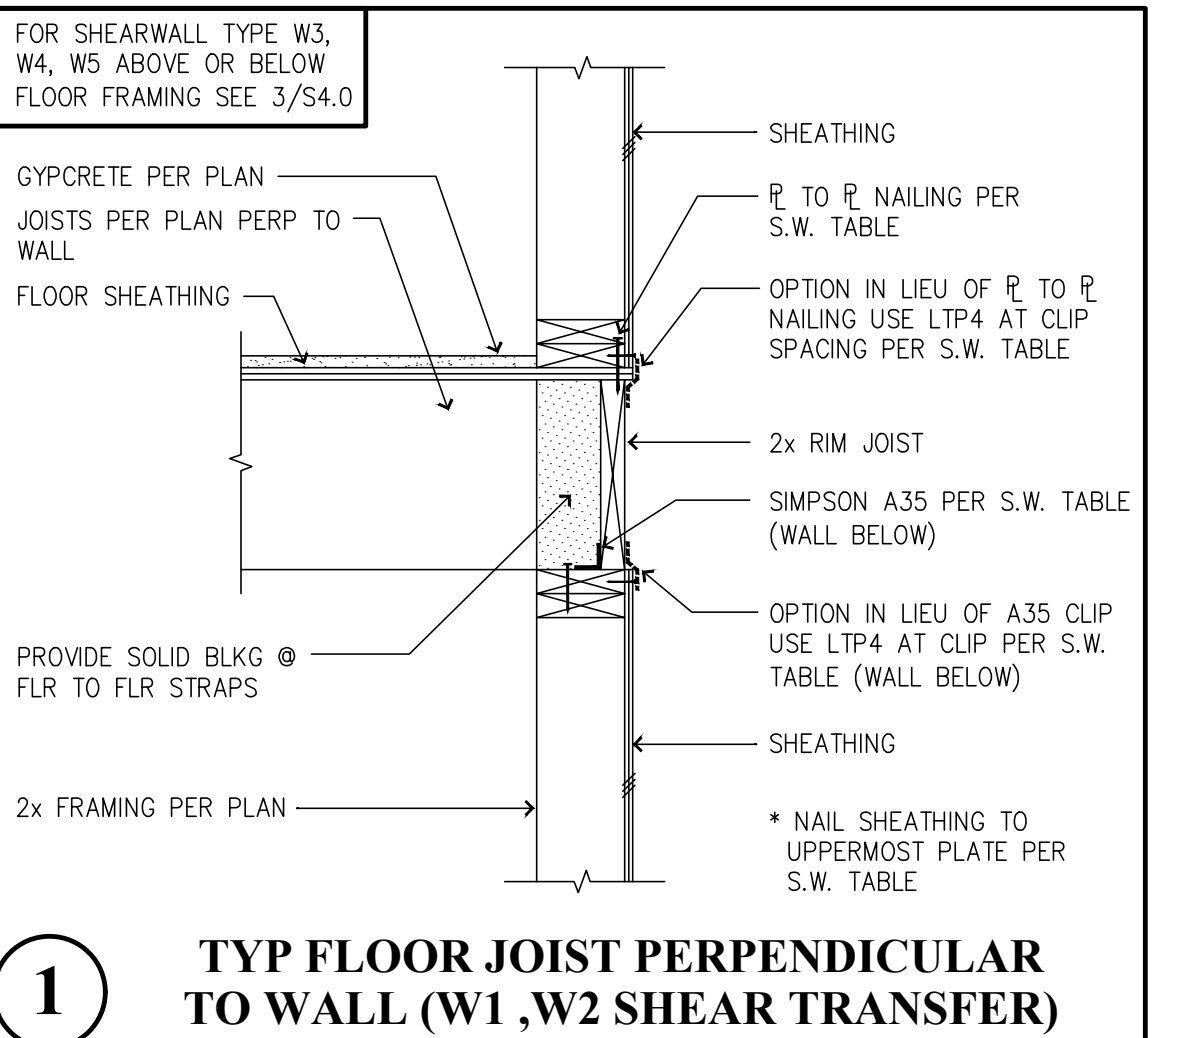

1 TYP FLOOR JOIST PERPENDICULAR TO WALL (W1, W2 SHEAR TRANSFER)

CAD FILE: F:\Projects\2023\Projects\23.007 Bradley Heights\Drawings\S4.1.dwg  
 PLOT DATE/TIME: 8/28/2024 1:12pm THANK YOU FOR USING SOLUTIONS 4 STRUCTURES

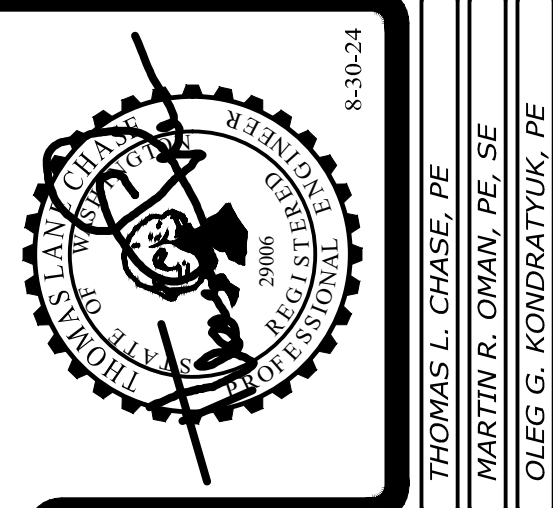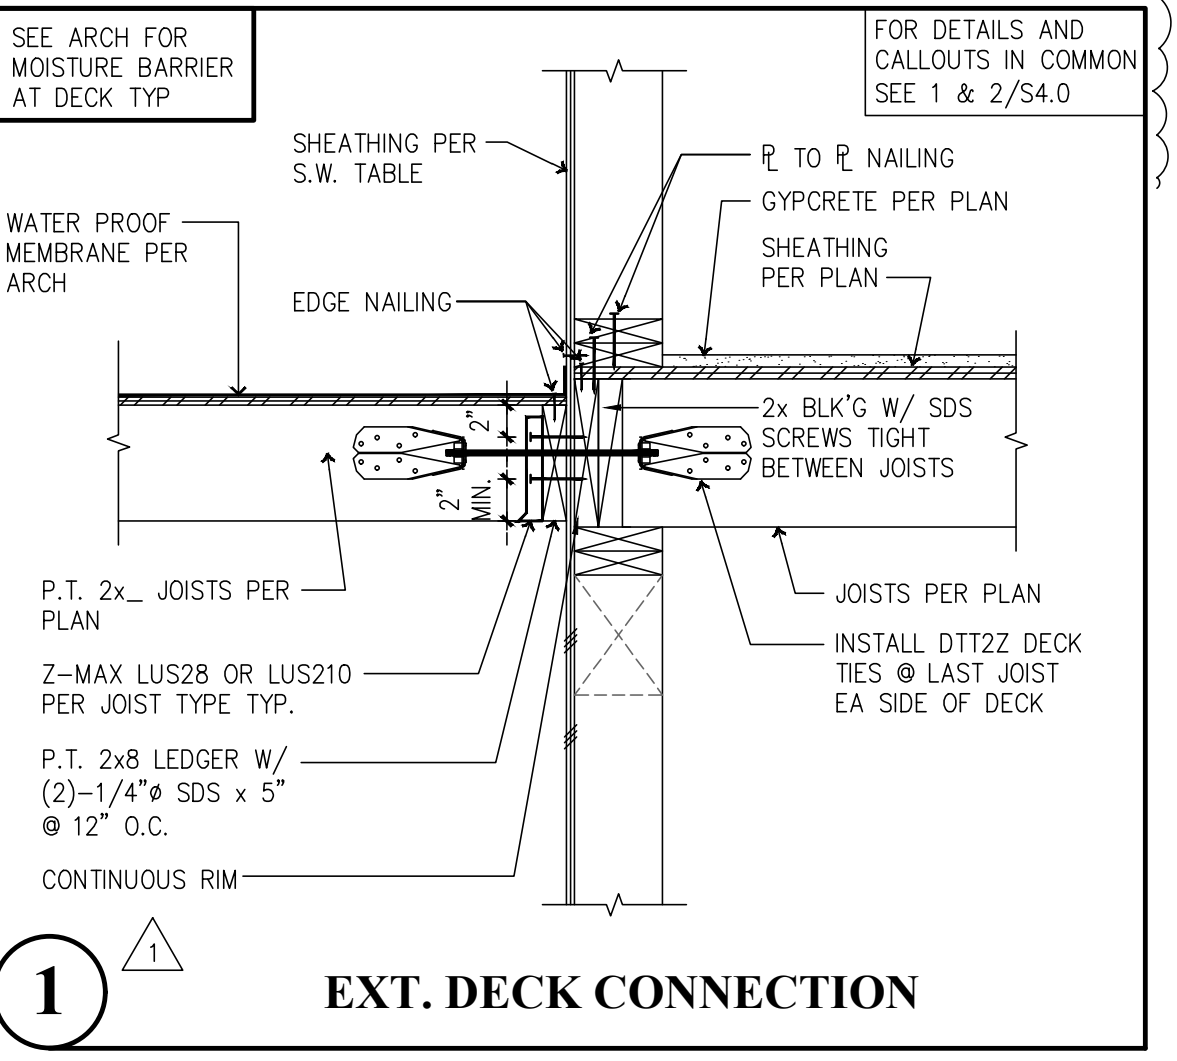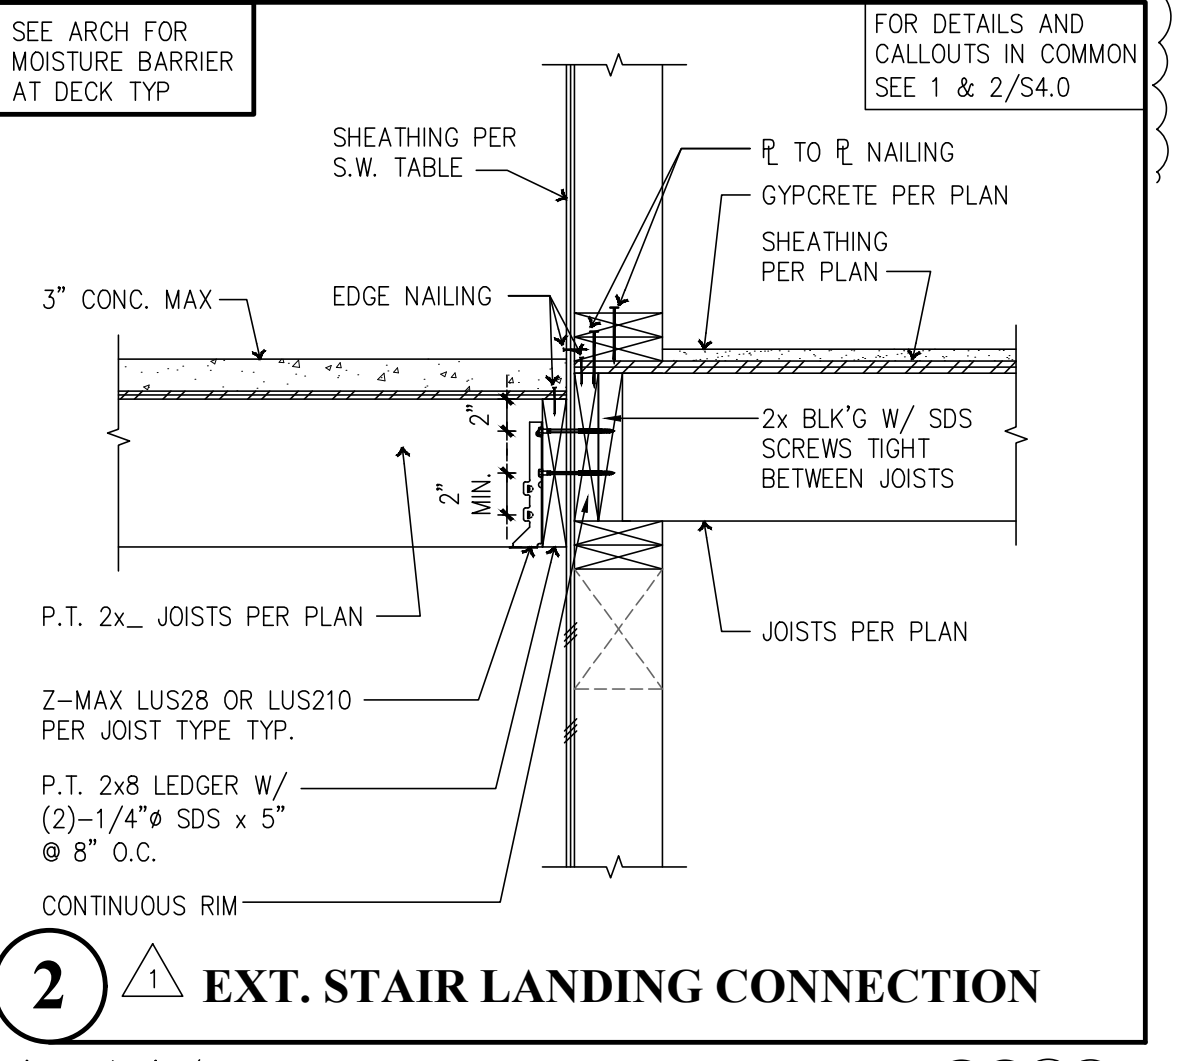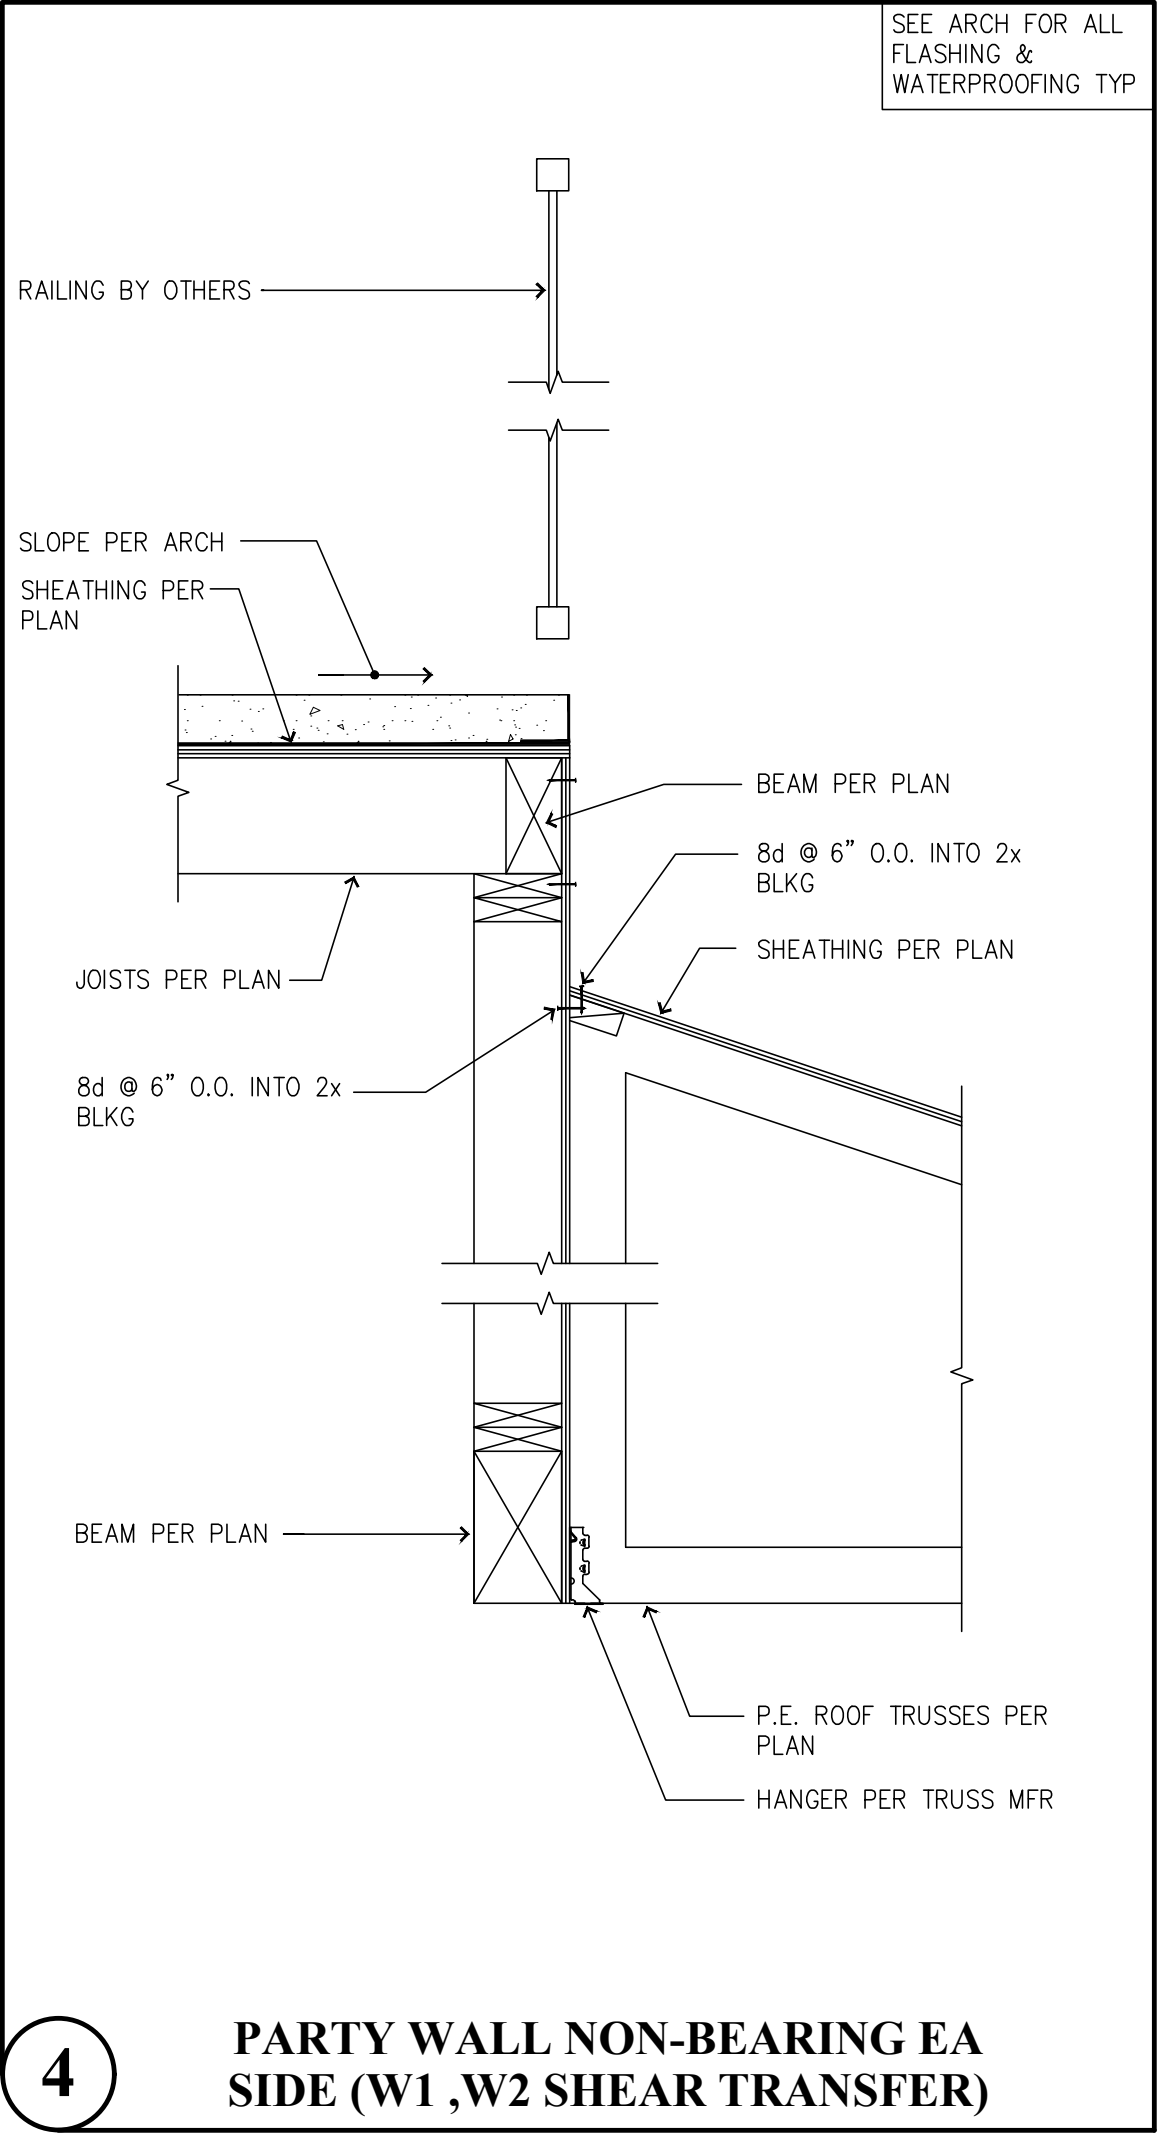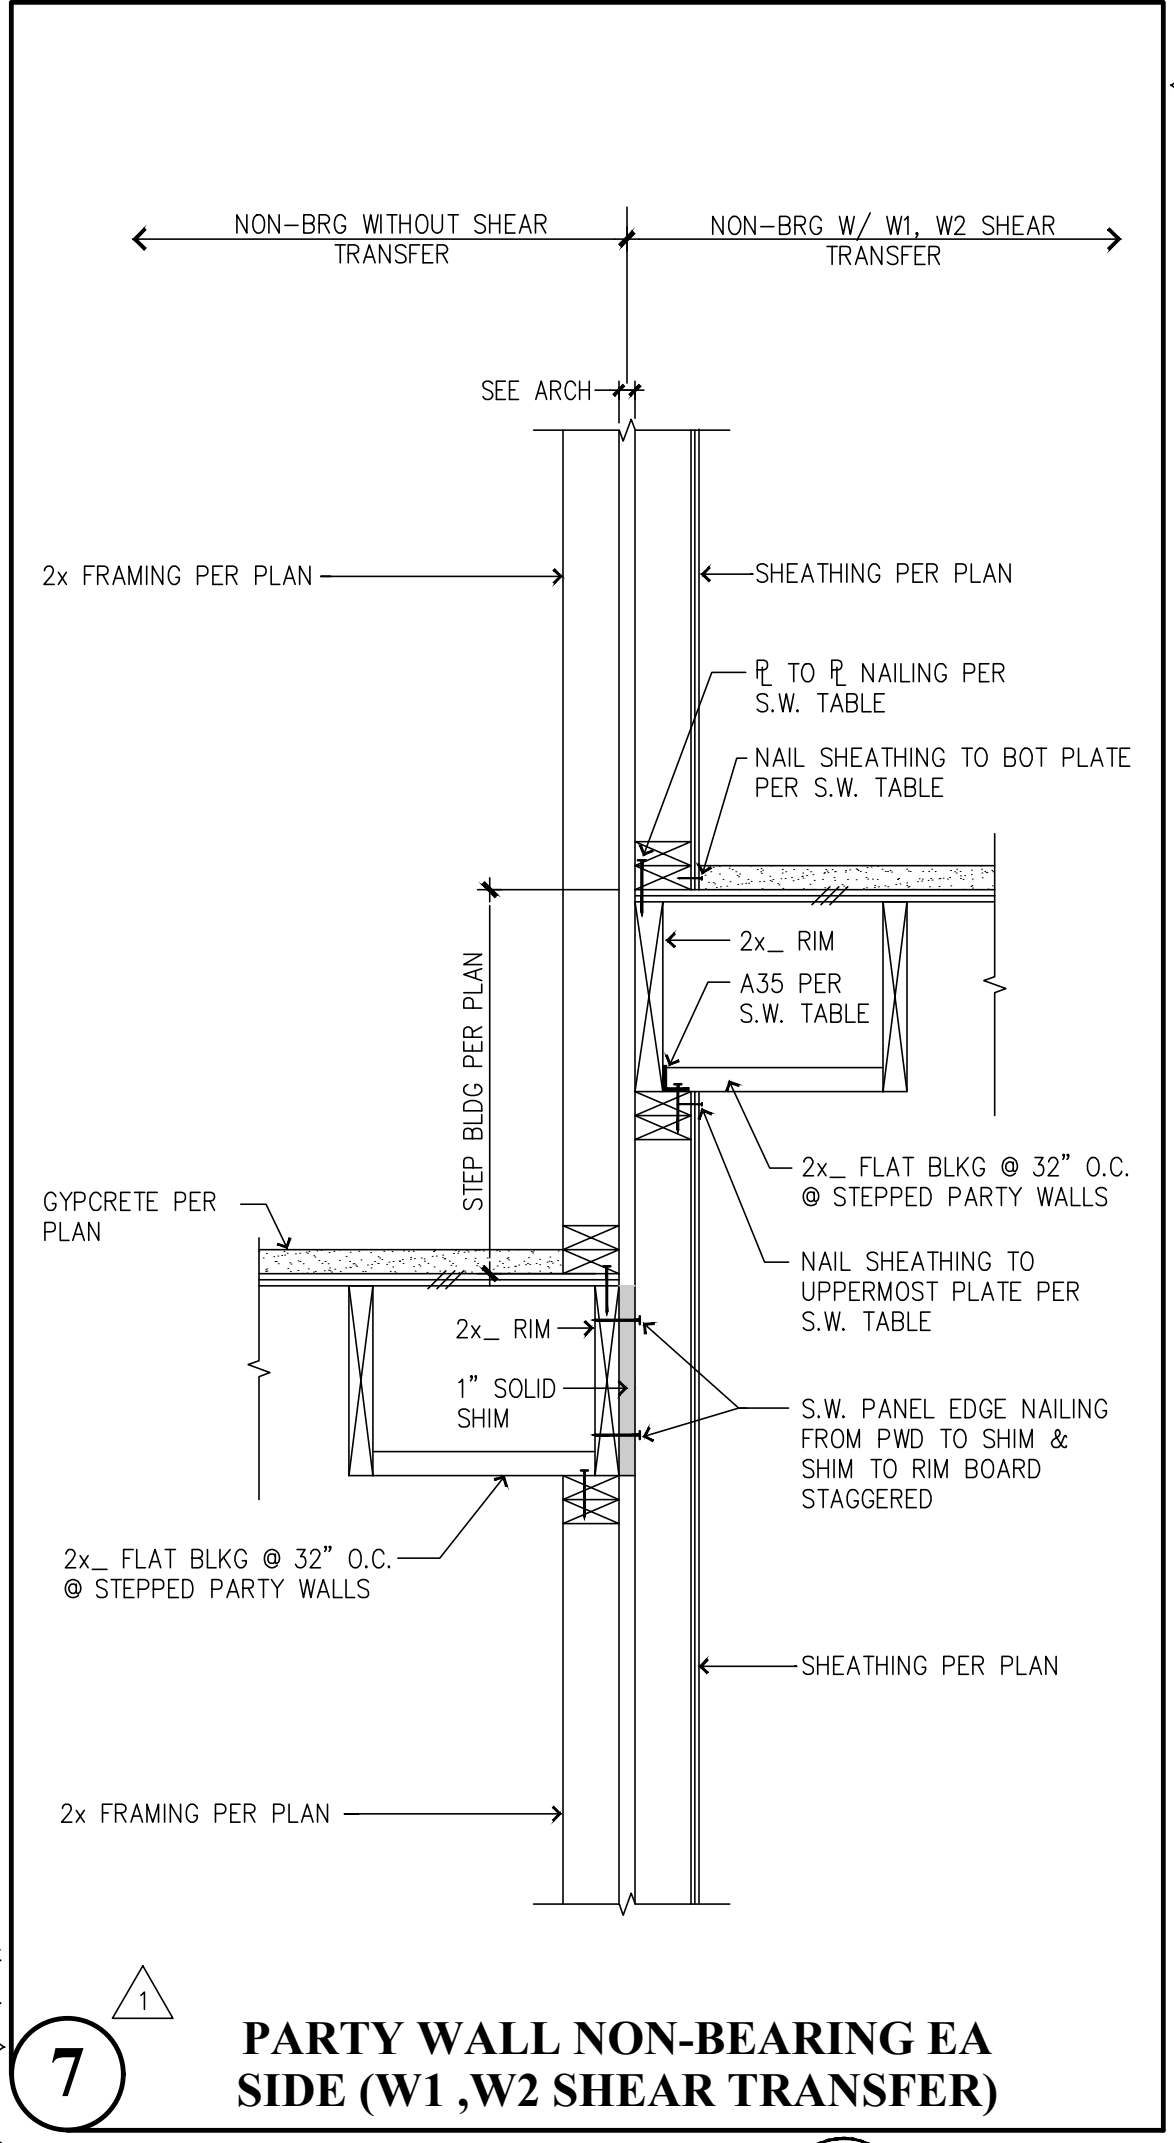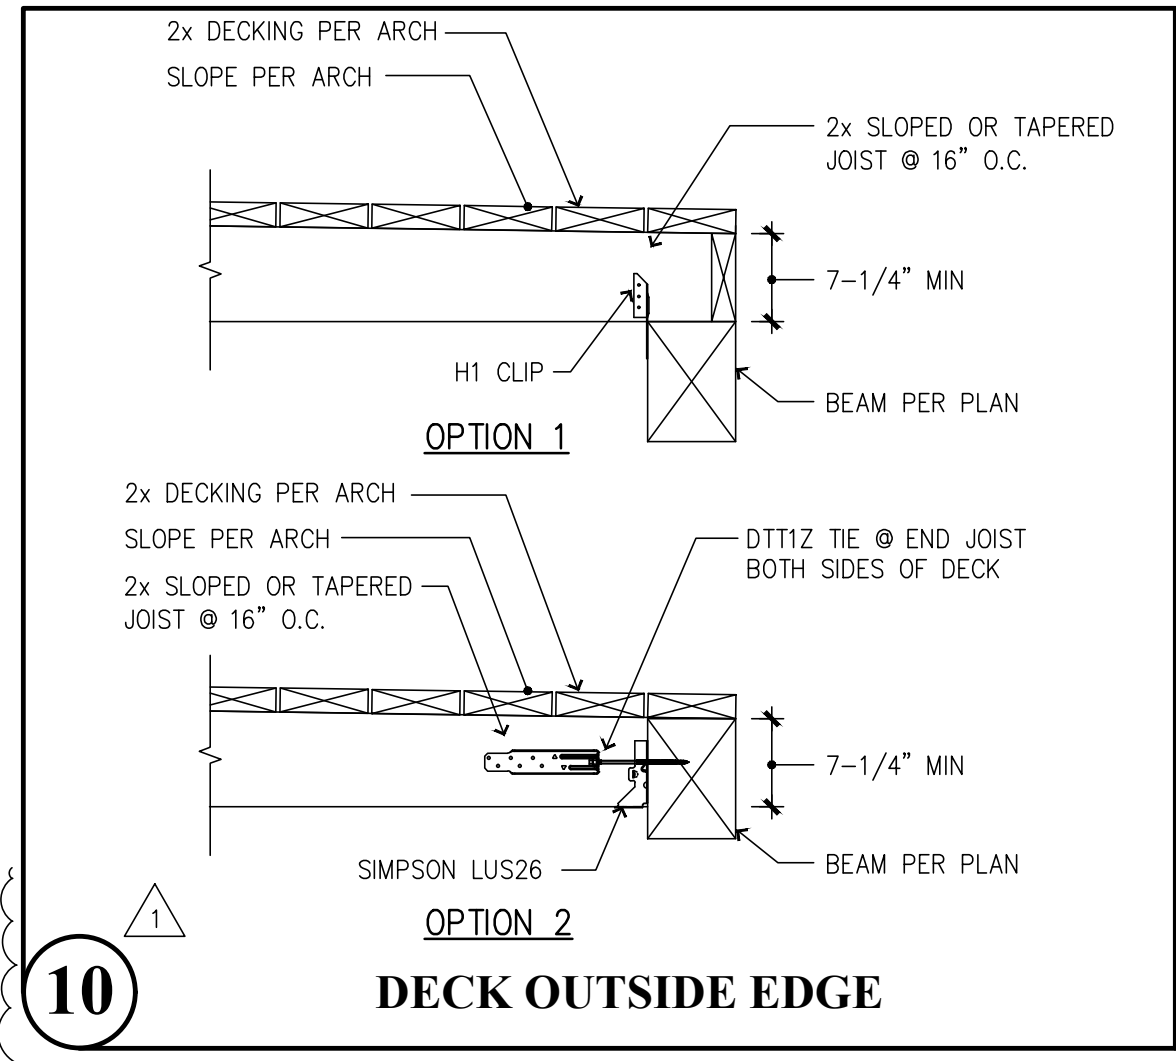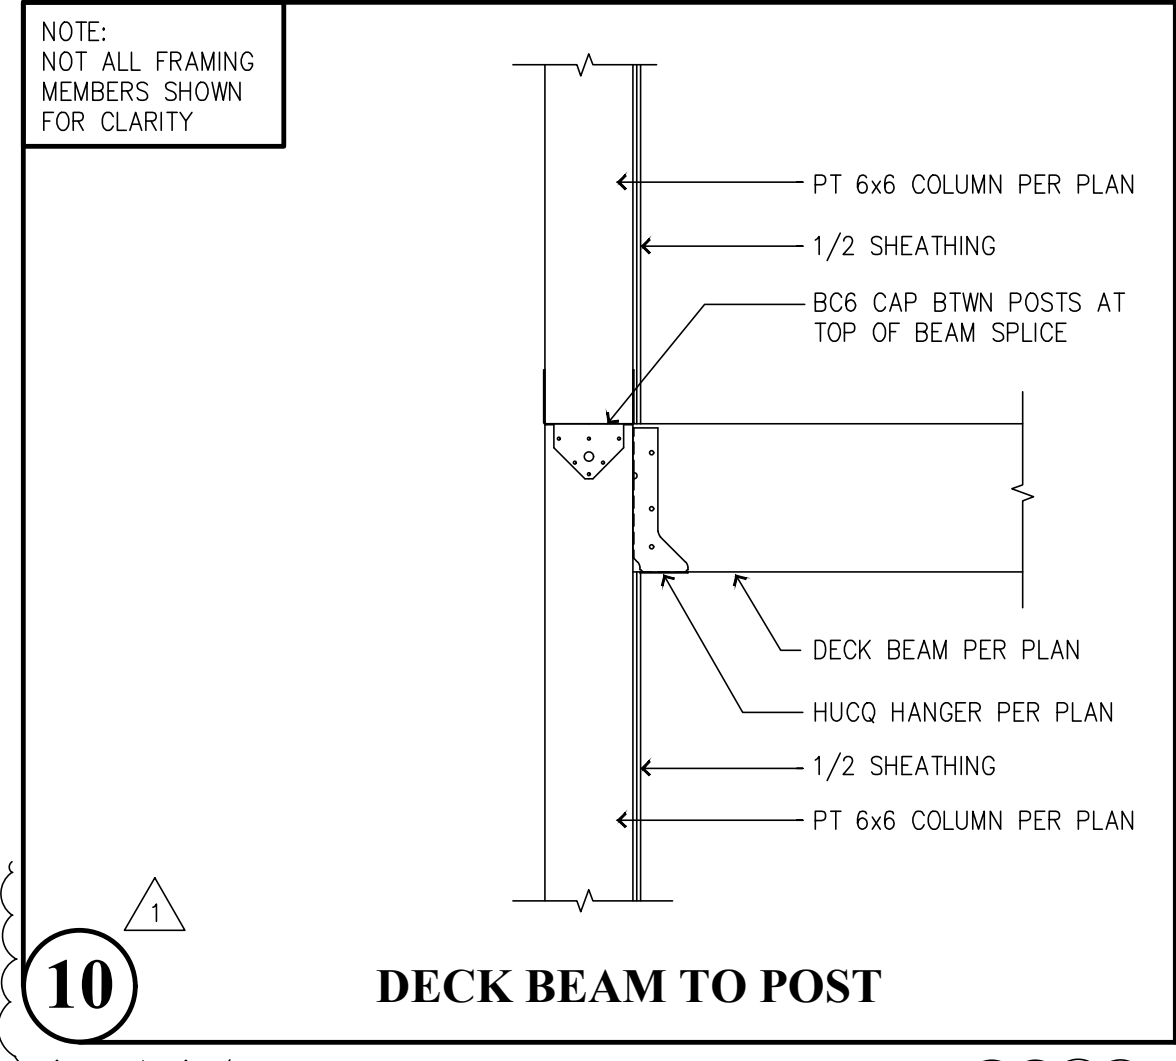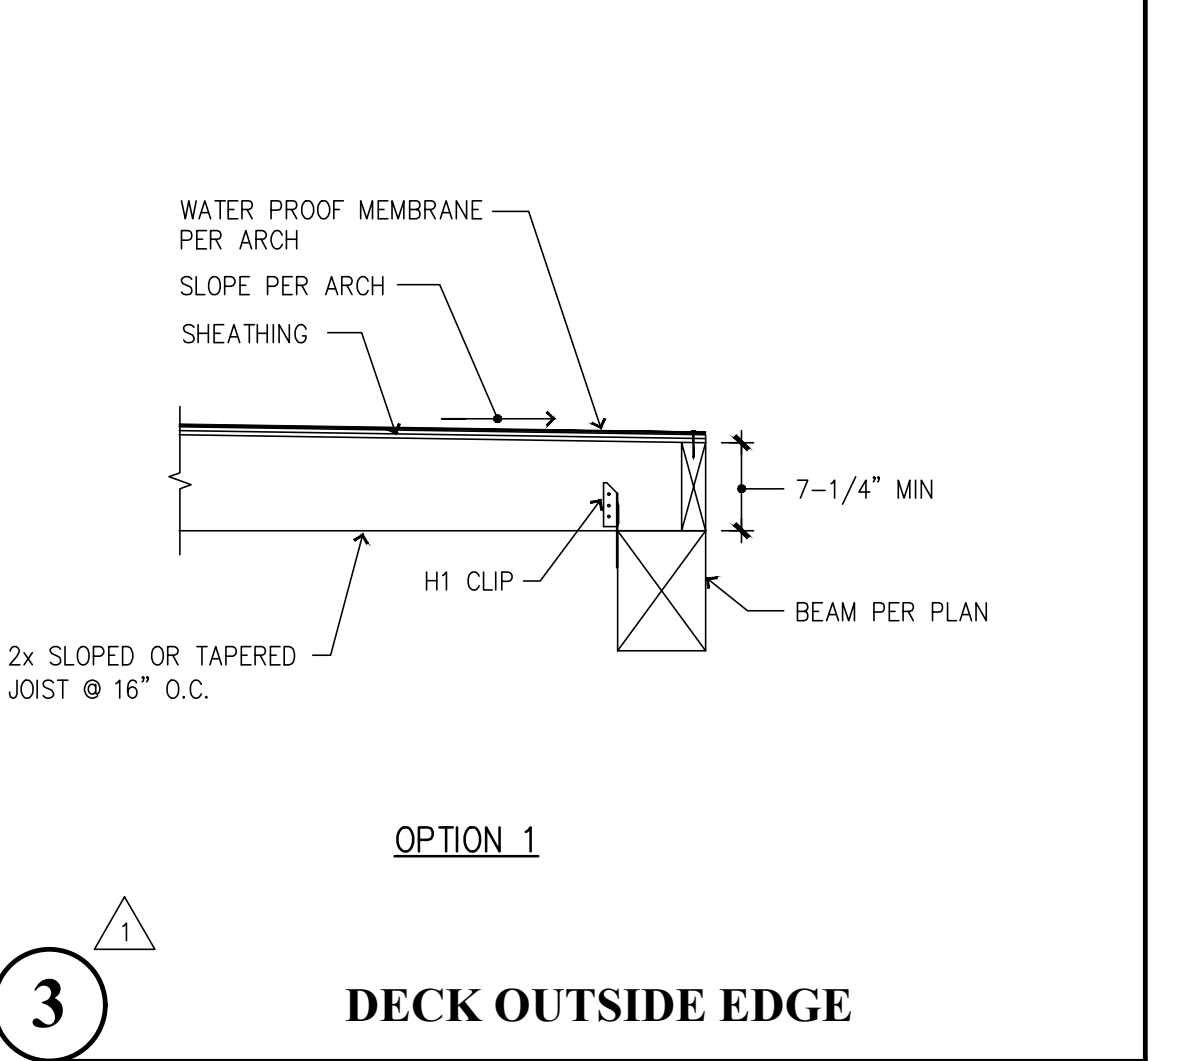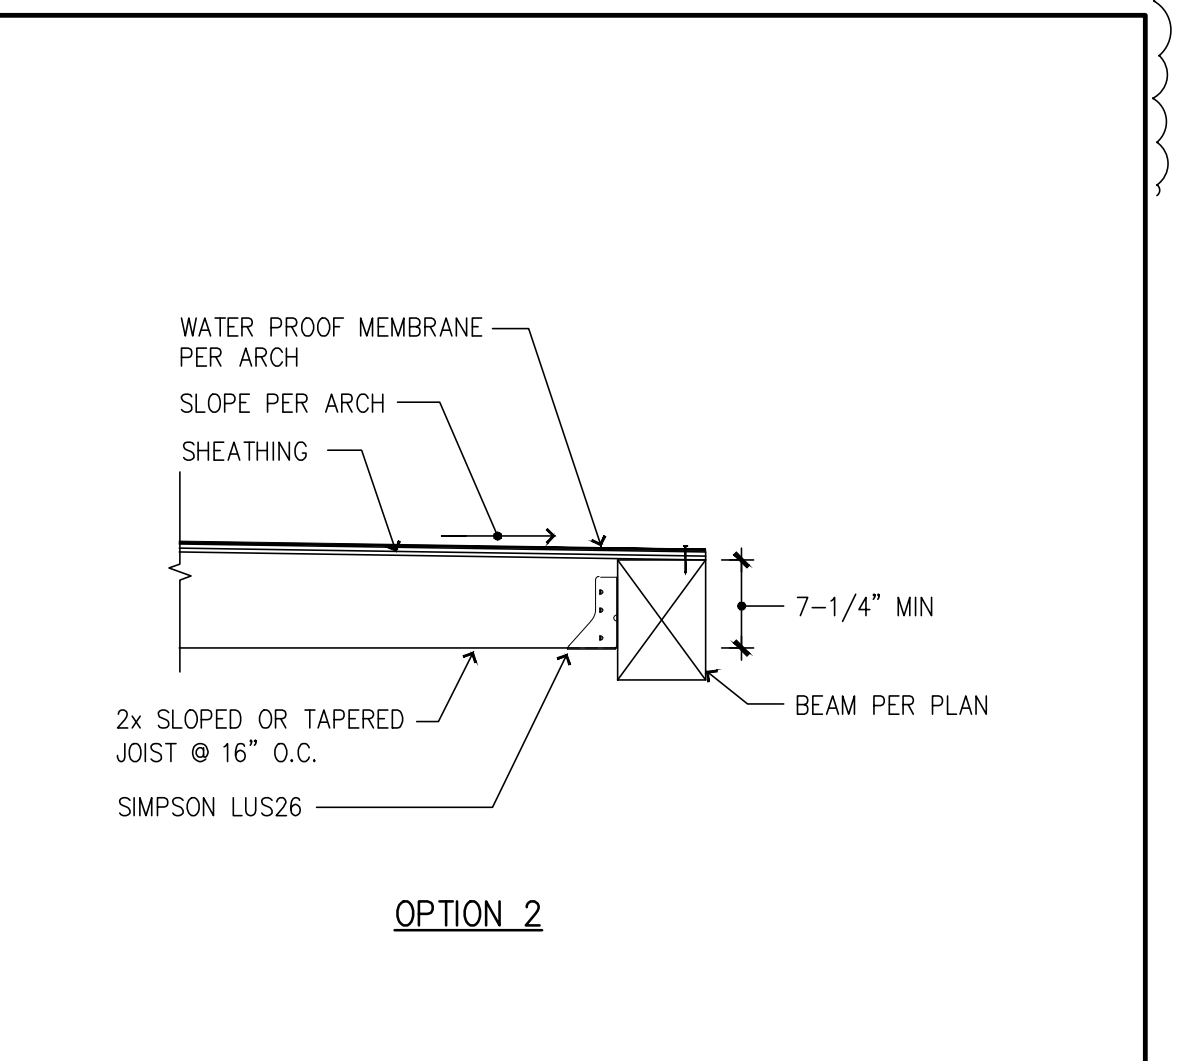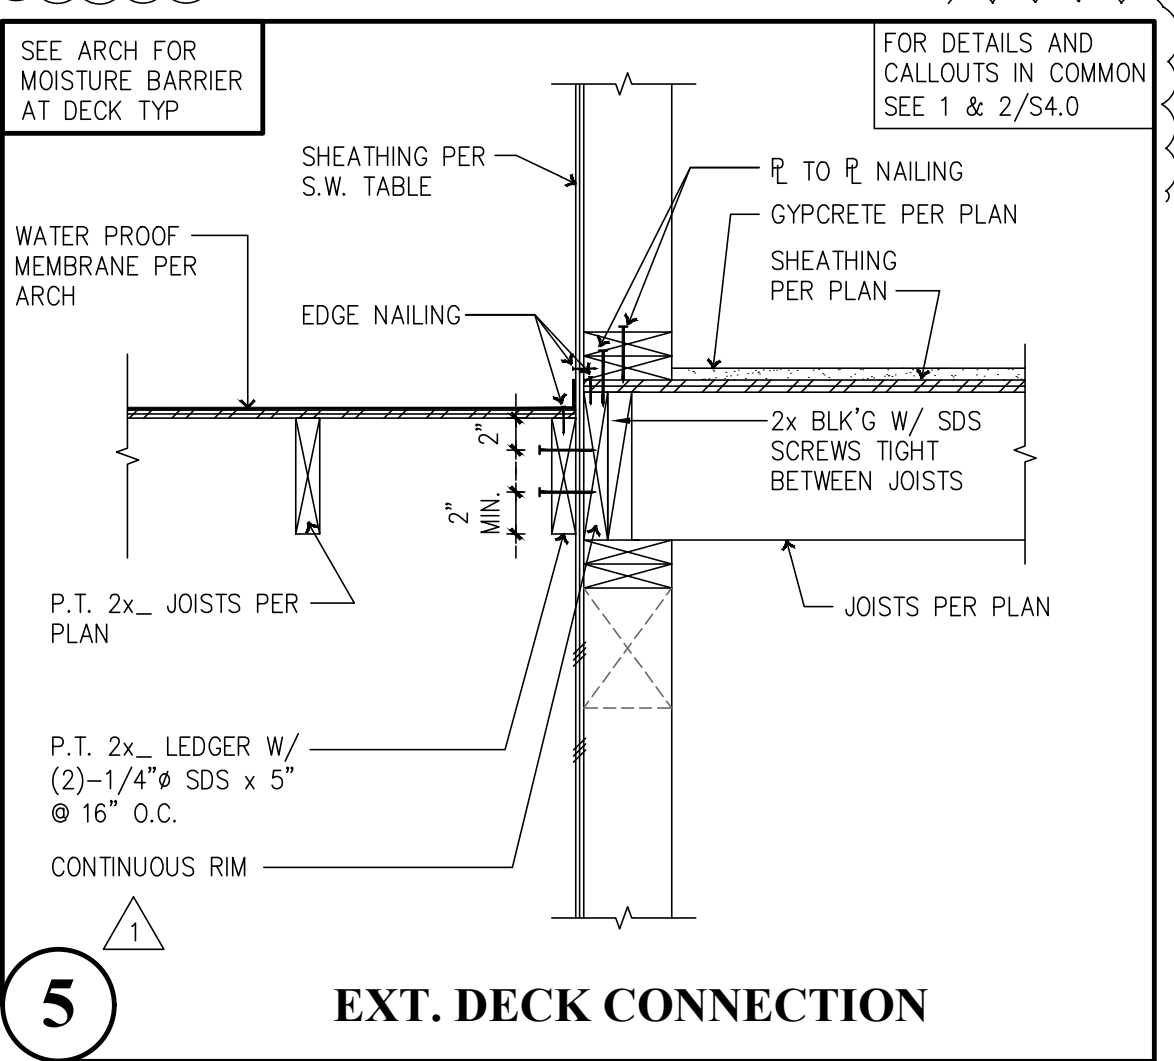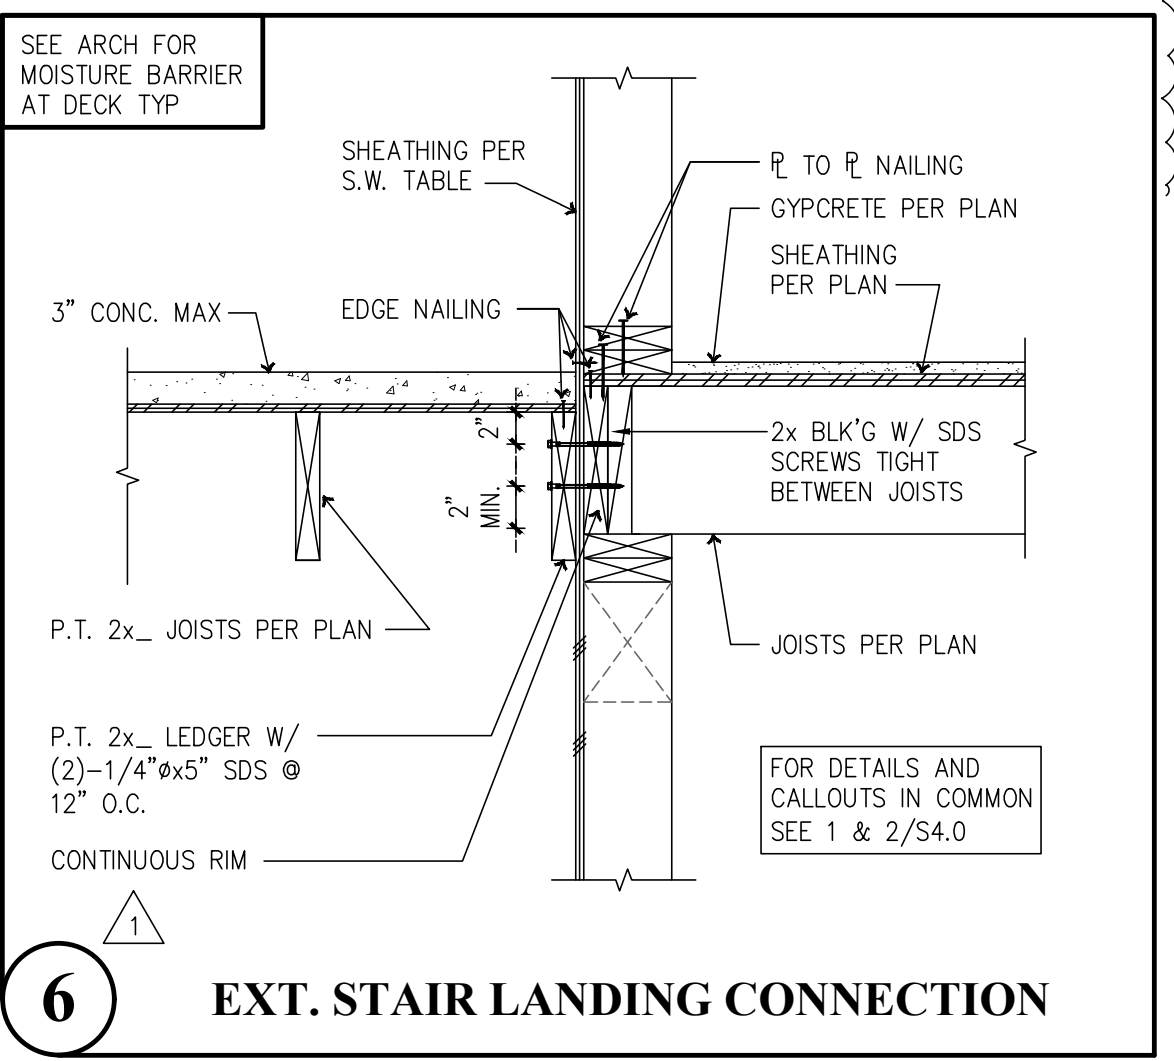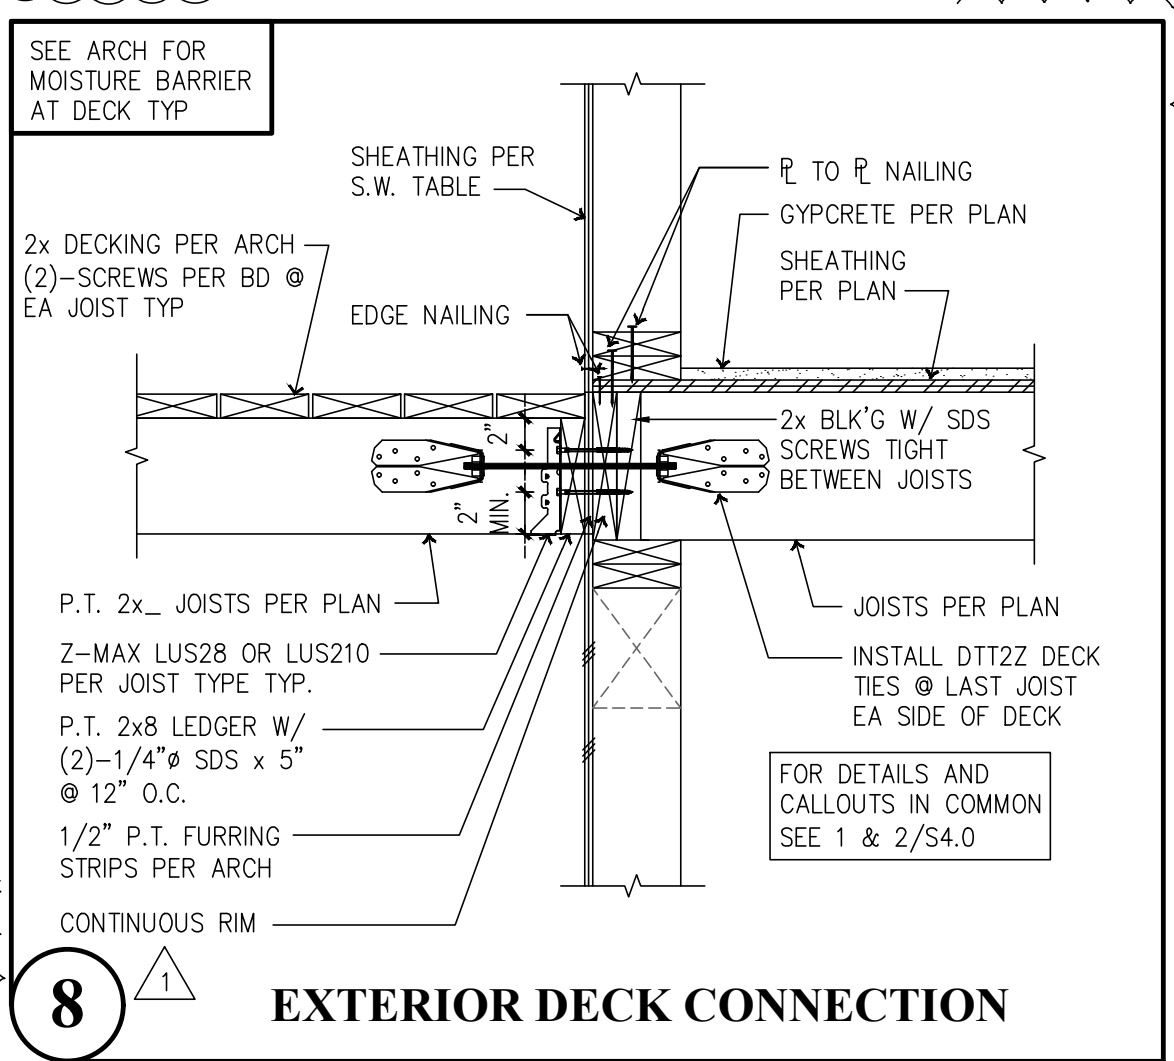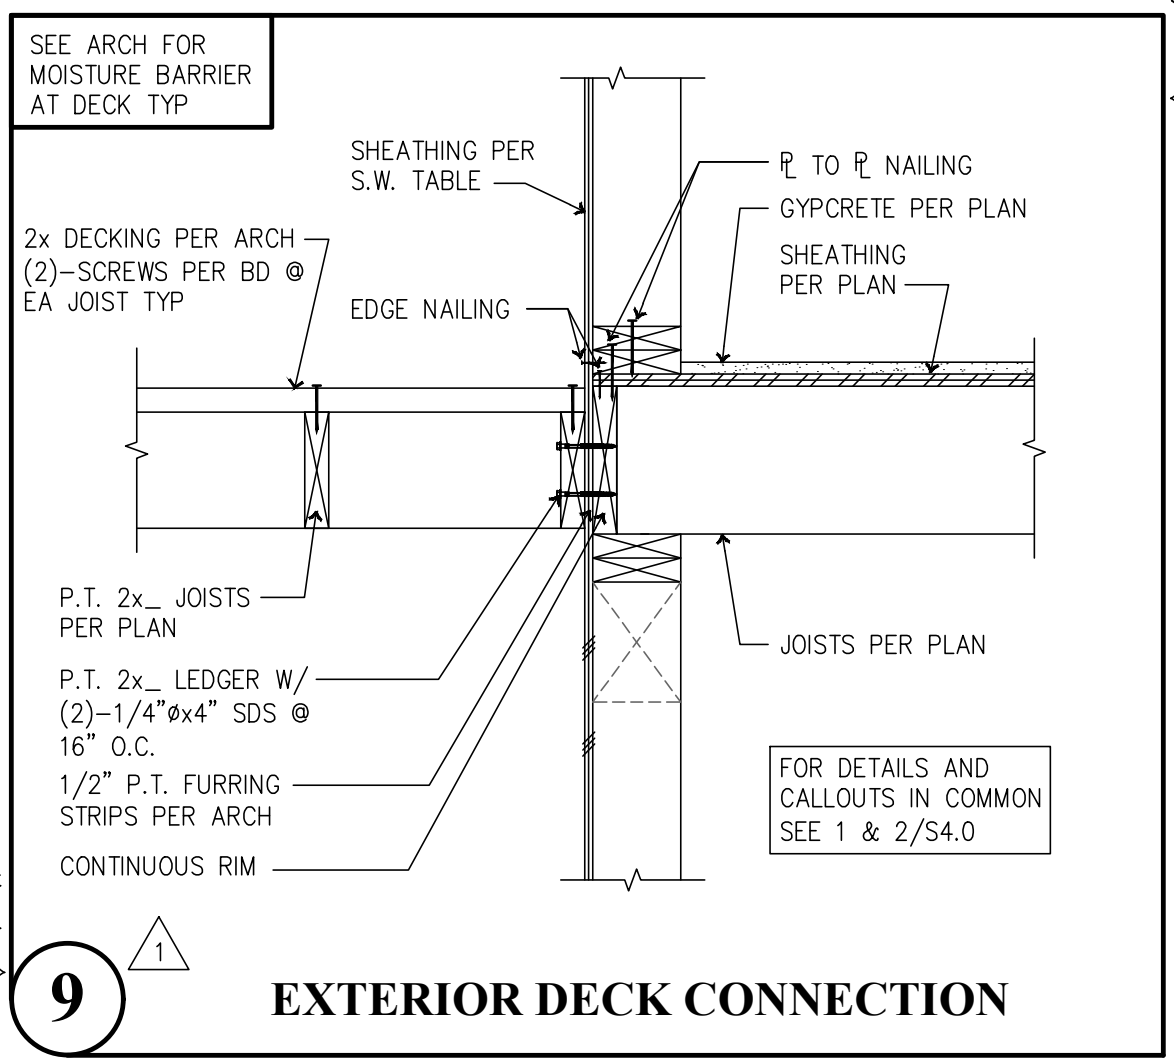

Revisions to this sheet:  
 8-30-24 PERMIT CORRECTIONS & OWNER CHANGES

**Bradley Heights Apartments**  
 202 27th Ave SE  
 Puyallup, Washington

**Solutions 4 Structures**  
 A Structural Engineering Corporation






















Puyallup, Washington 98374  
 Ph. 253-314-9822  
 www.solutions4structures.com

PROJECT NO. : 23.007  
 DESIGNED BY : TLC, OGG, MRO  
 DRAWN BY : RSO  
 ISSUE DATE : 2-20-24  
 LATEST REV. OF DWG. SET : 8-30-24

SUBMITTAL SET ONLY NOT FOR CONSTRUCTION  
 THESE DRAWINGS ARE SUBJECT TO REVISIONS  
 PENDING LOCAL JURISDICTIONAL REVIEW.

PLOT DATE/TIME: 8/28/2024 - 7:19am THANK YOU FOR USING SOLUTIONS 4 STRUCTURES

CAD FILE: F:\Projects\2023 Projects\Drawings\SS.Dwg

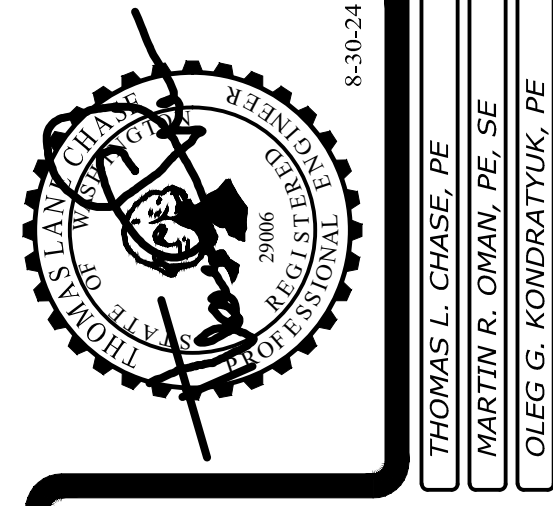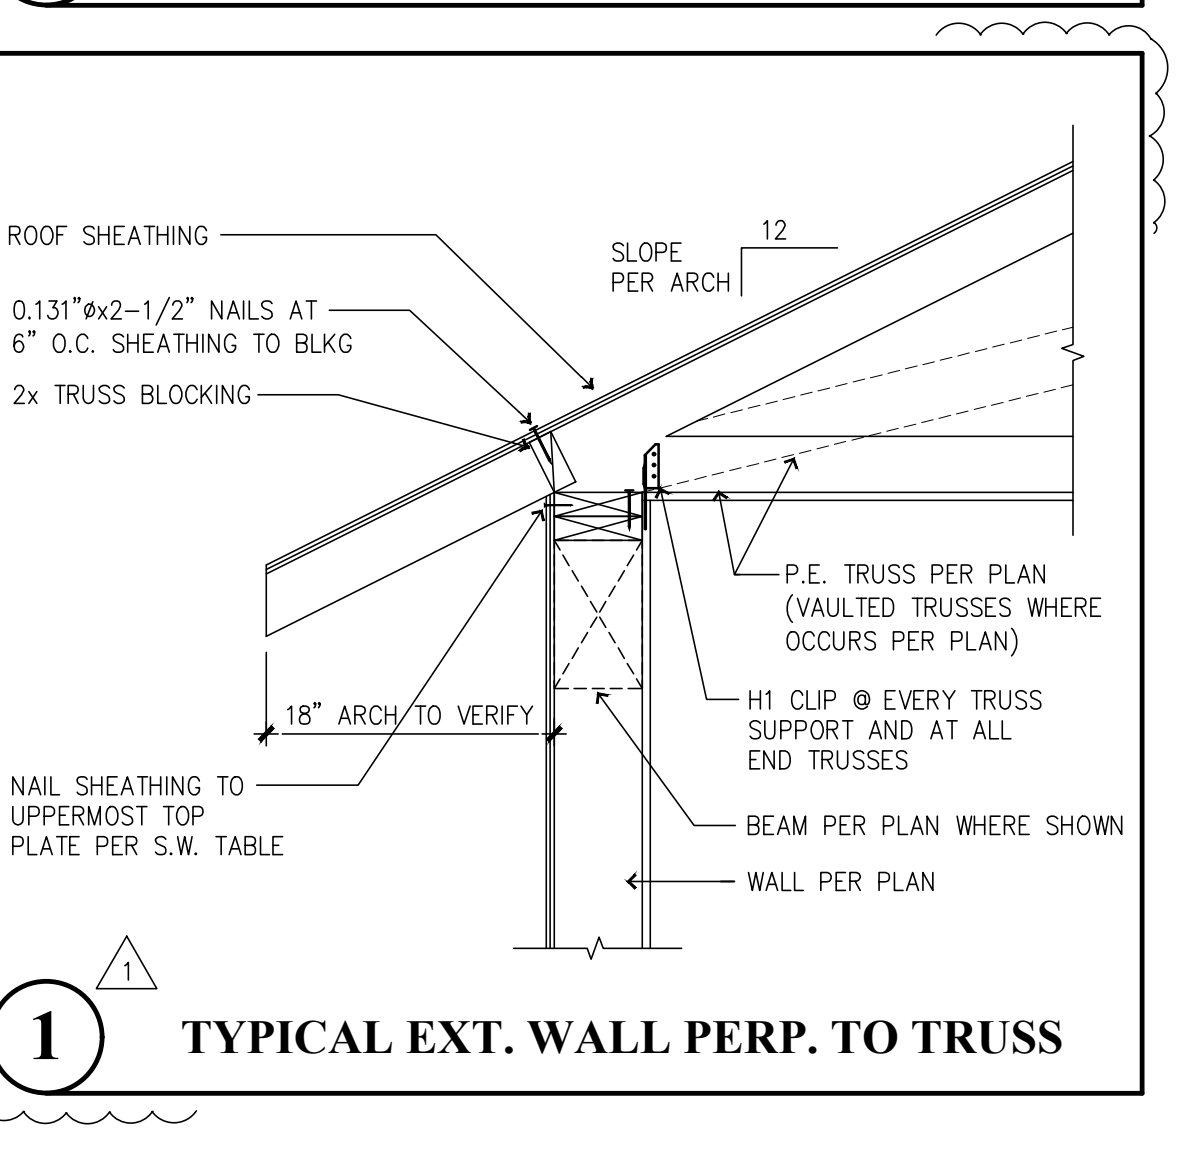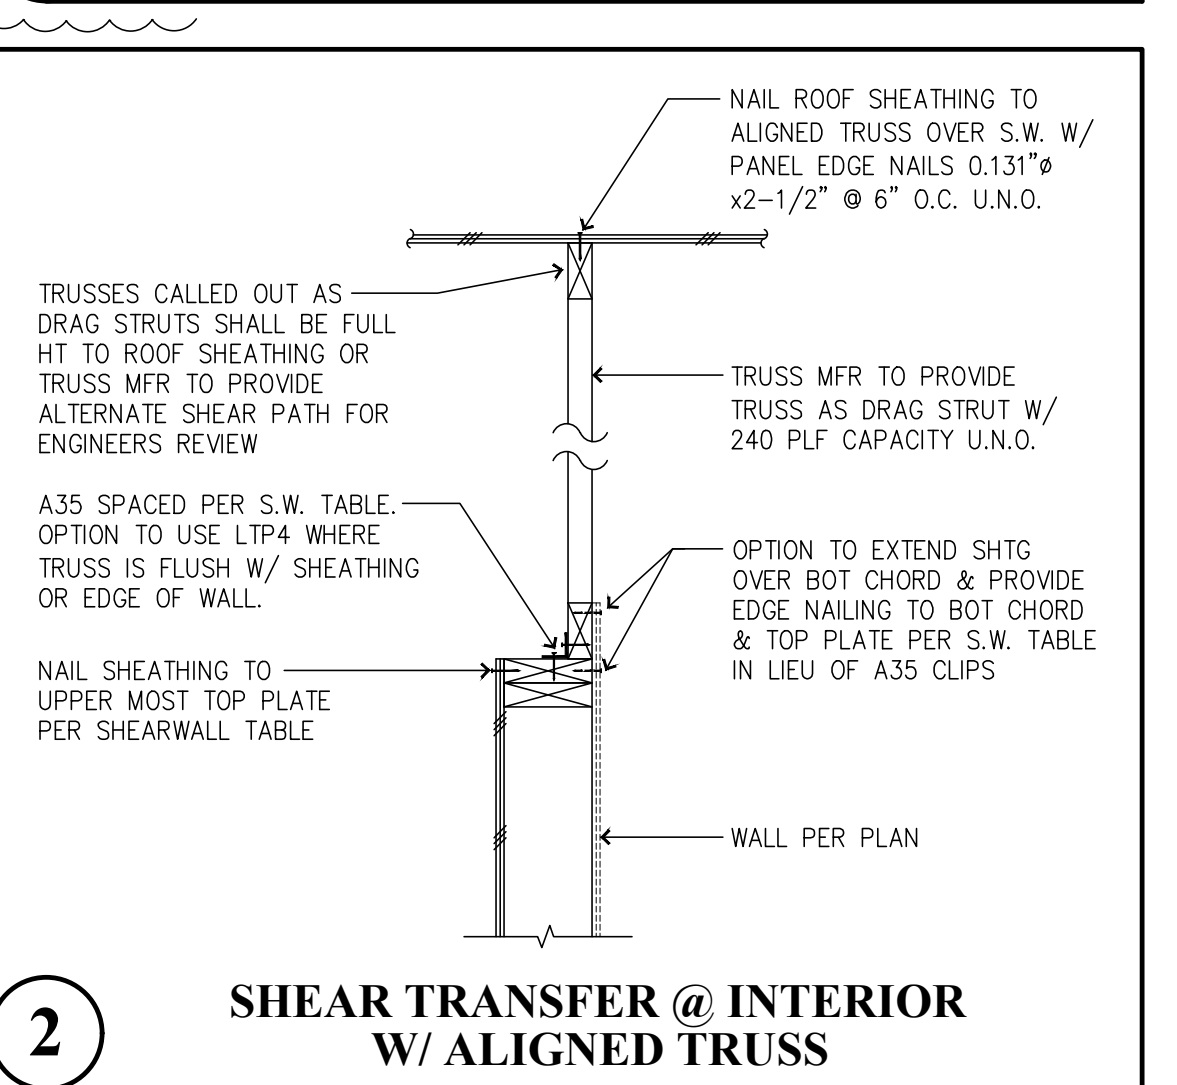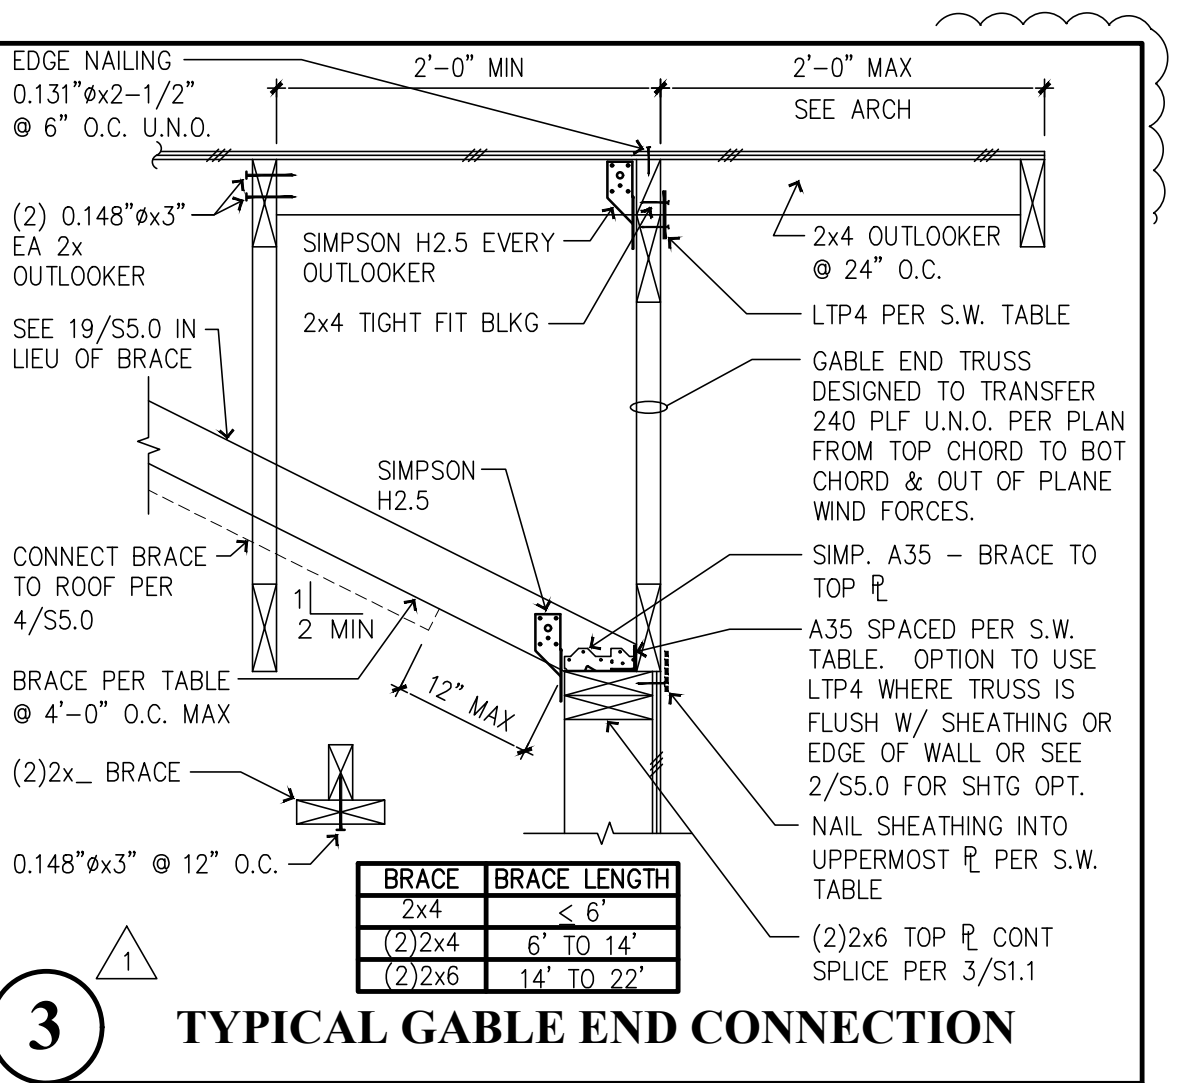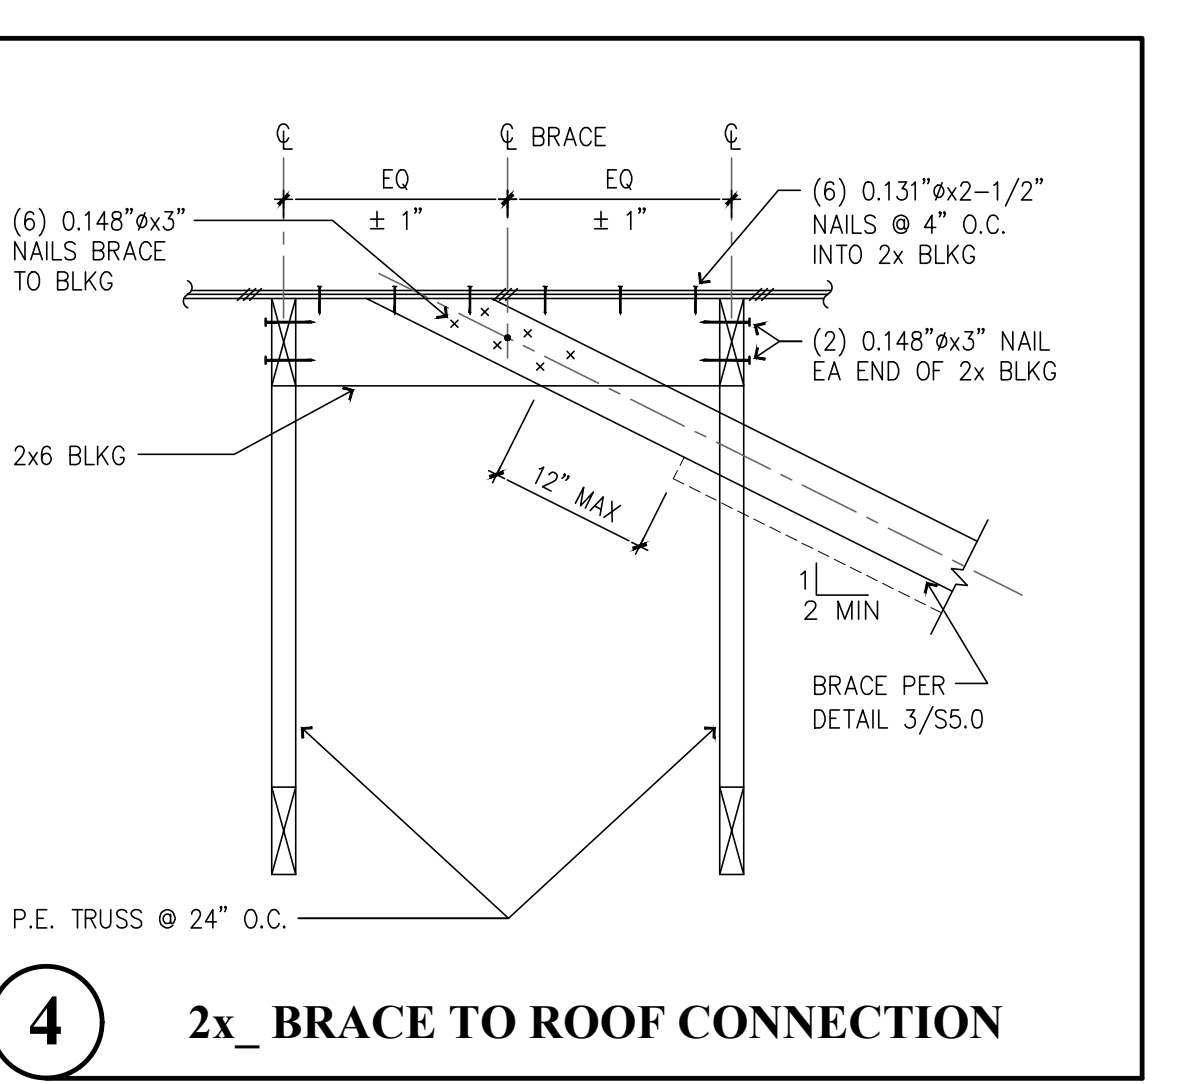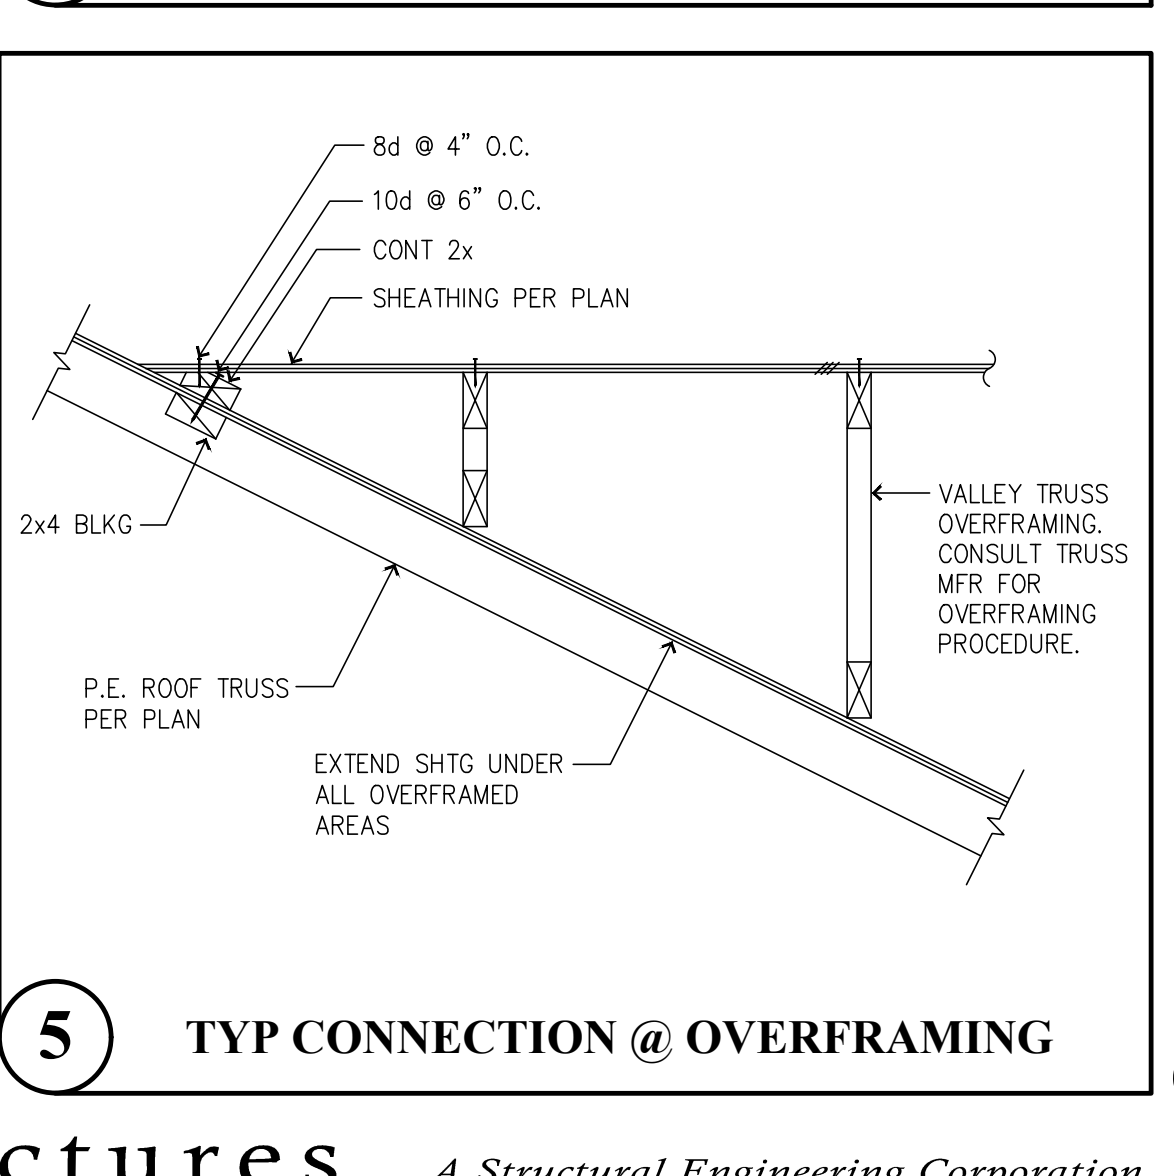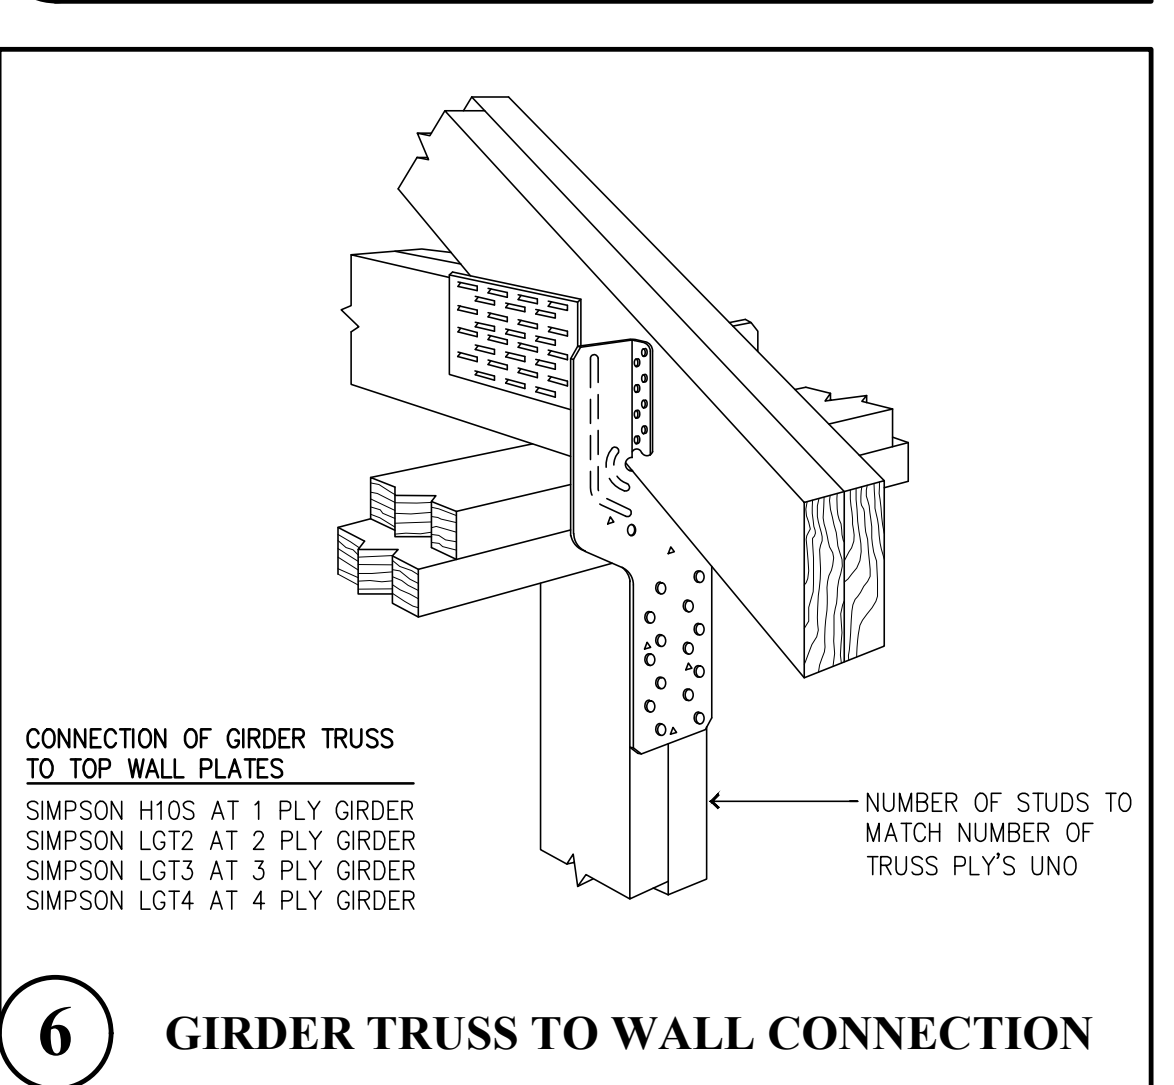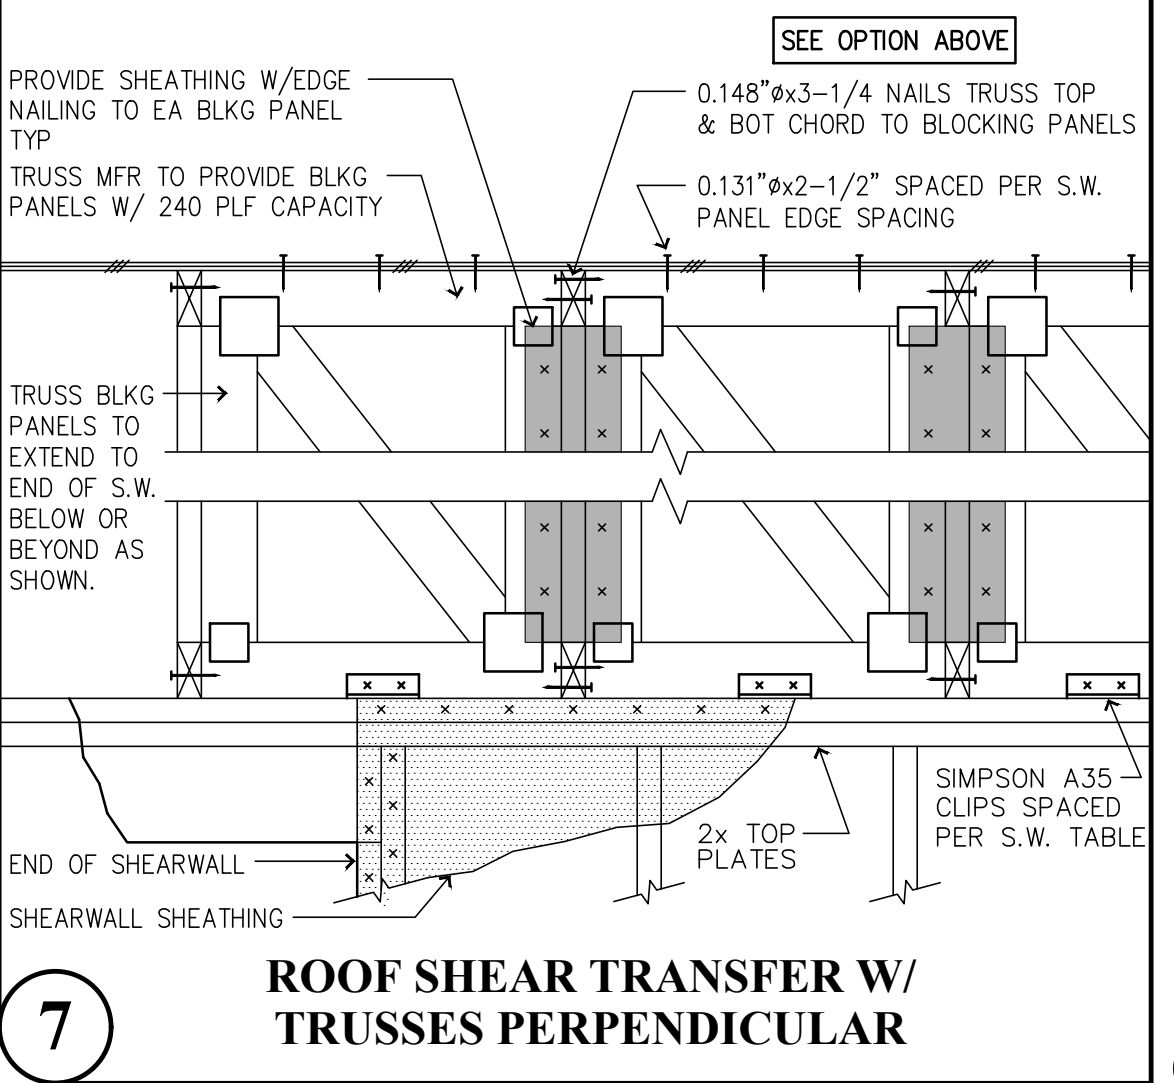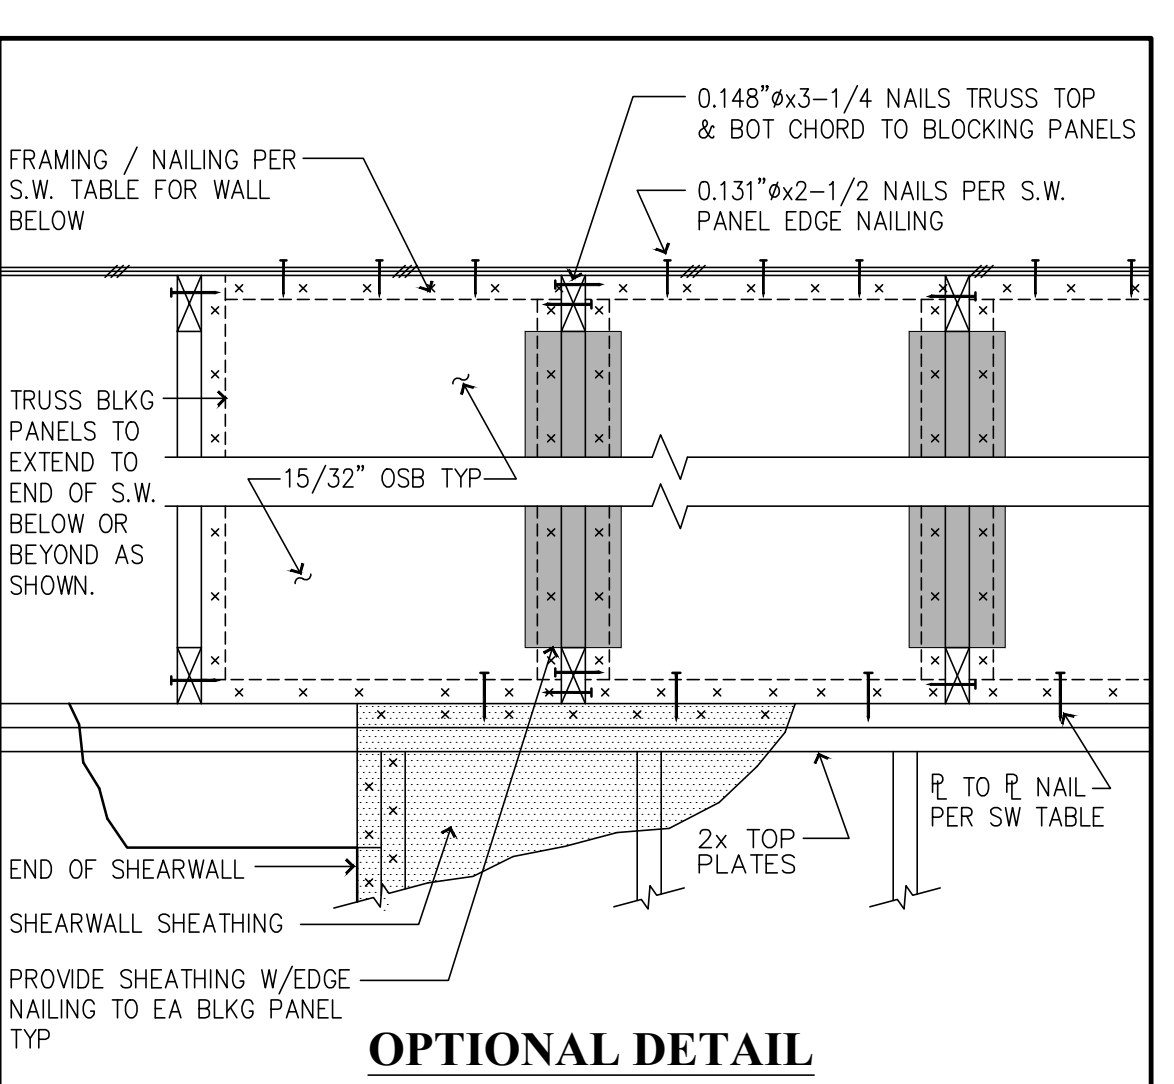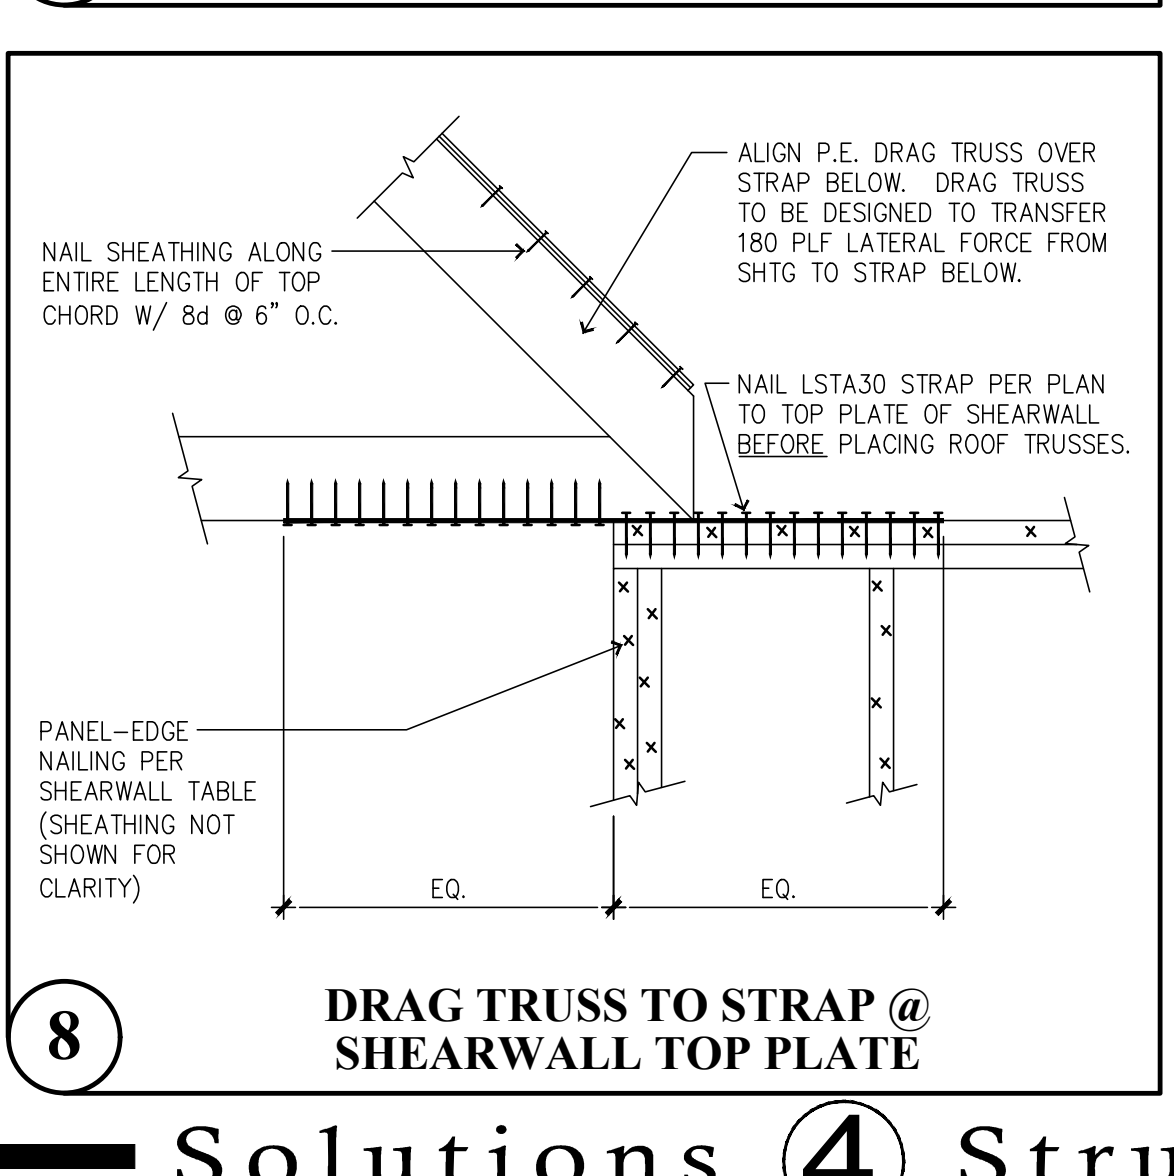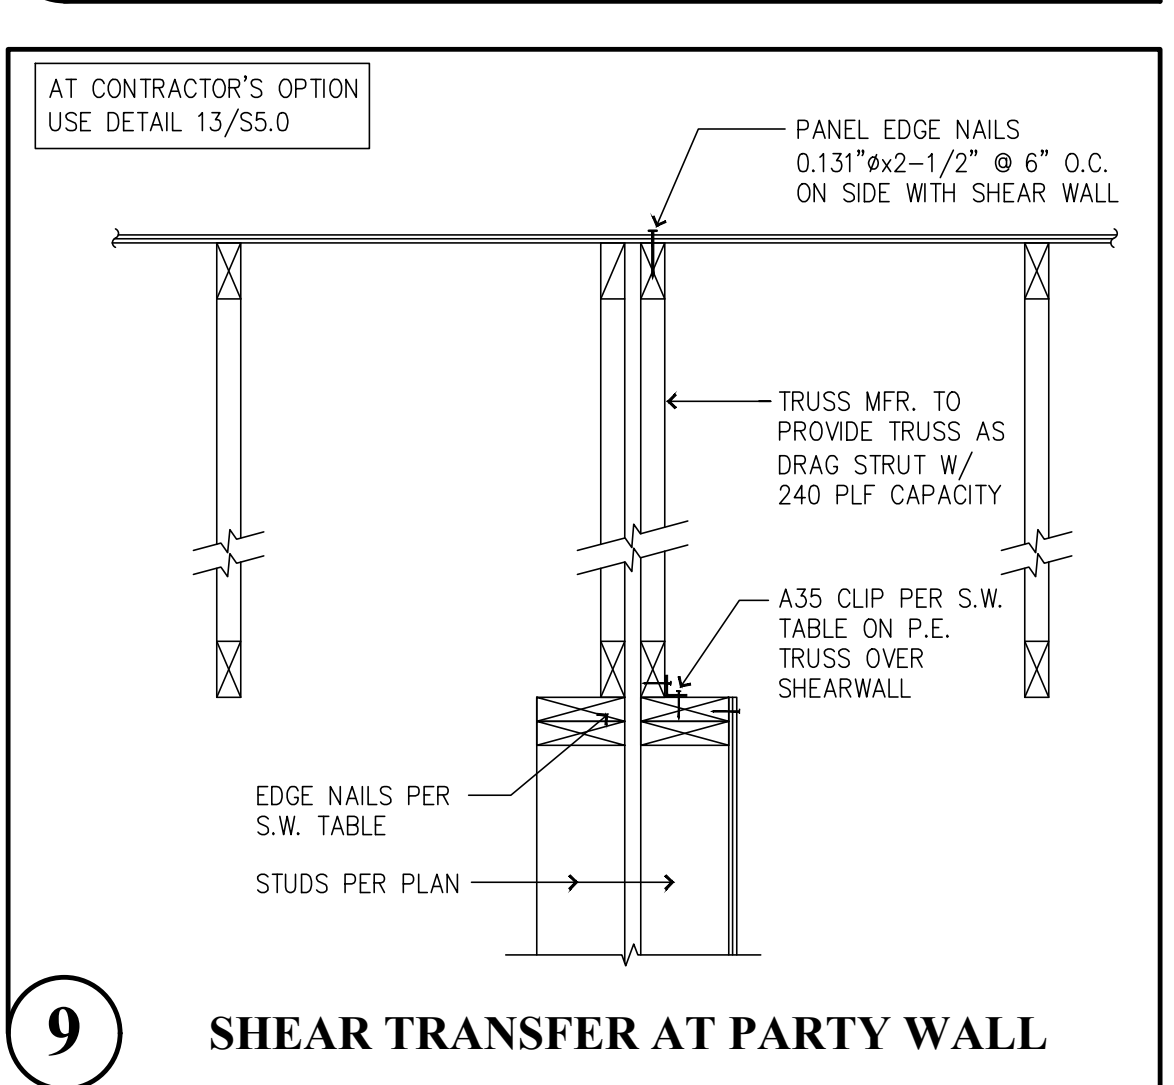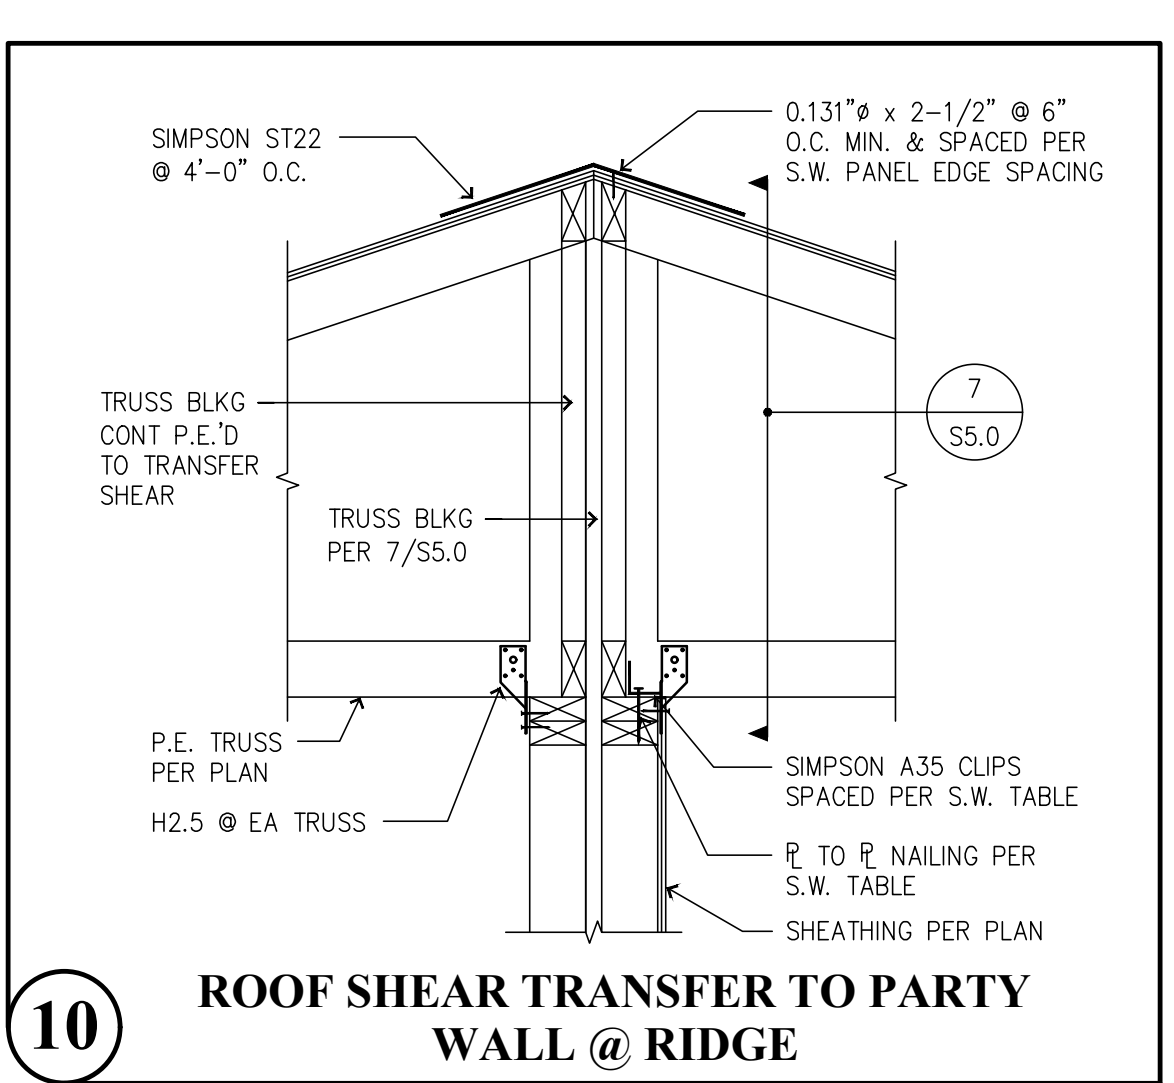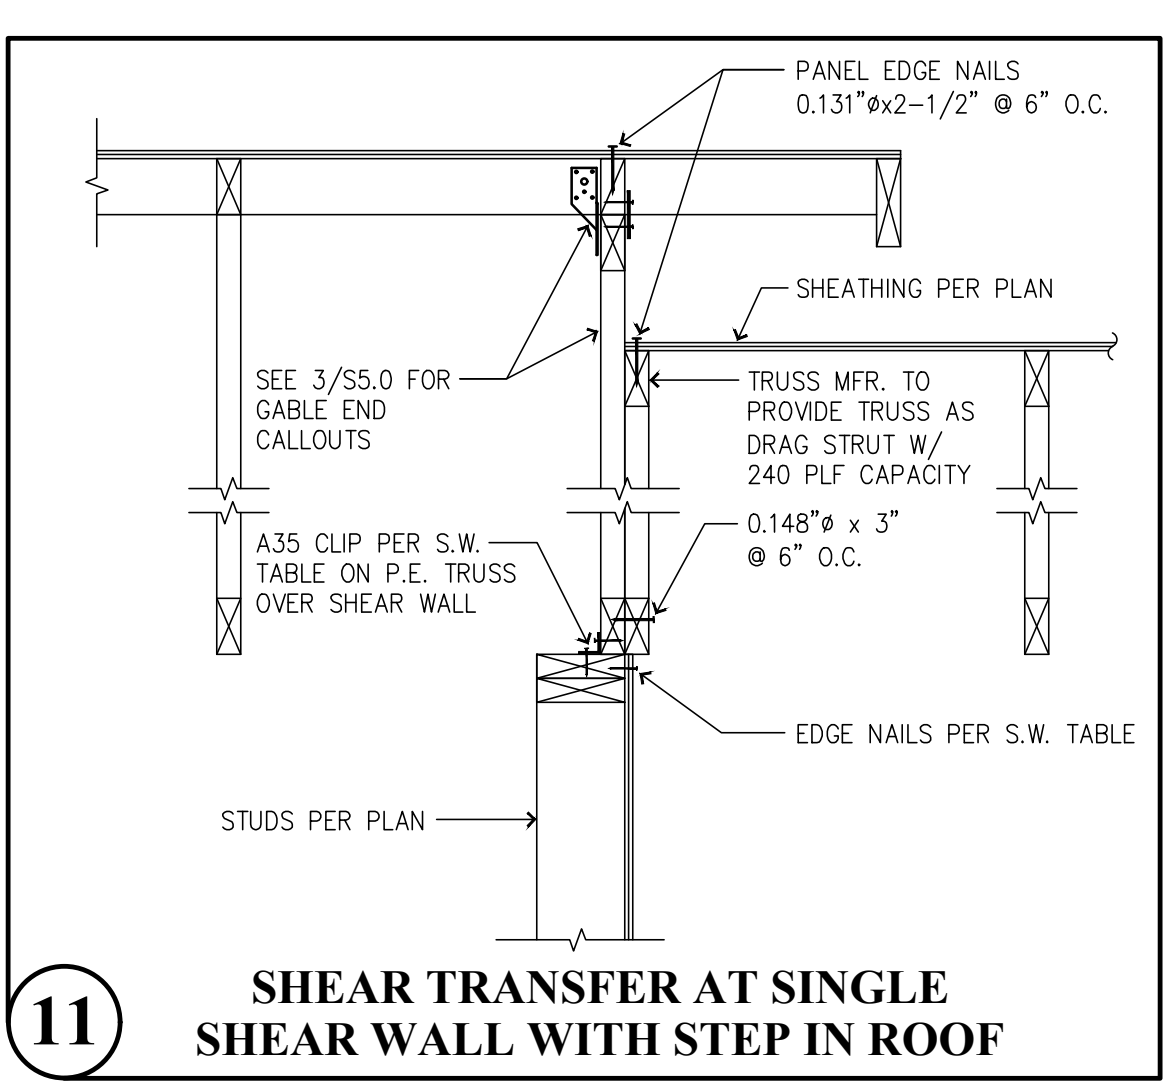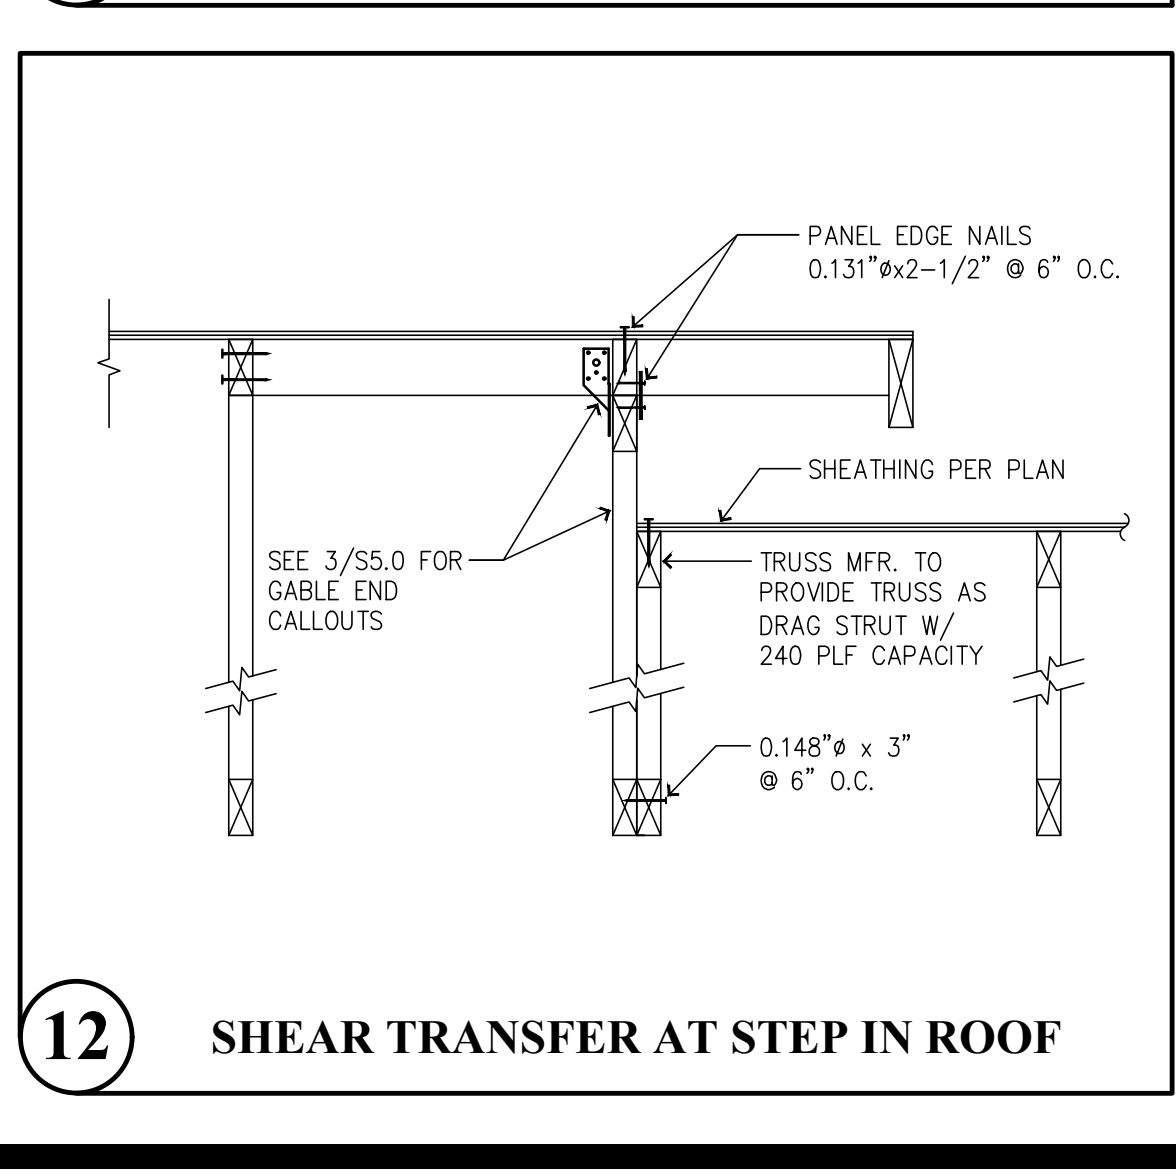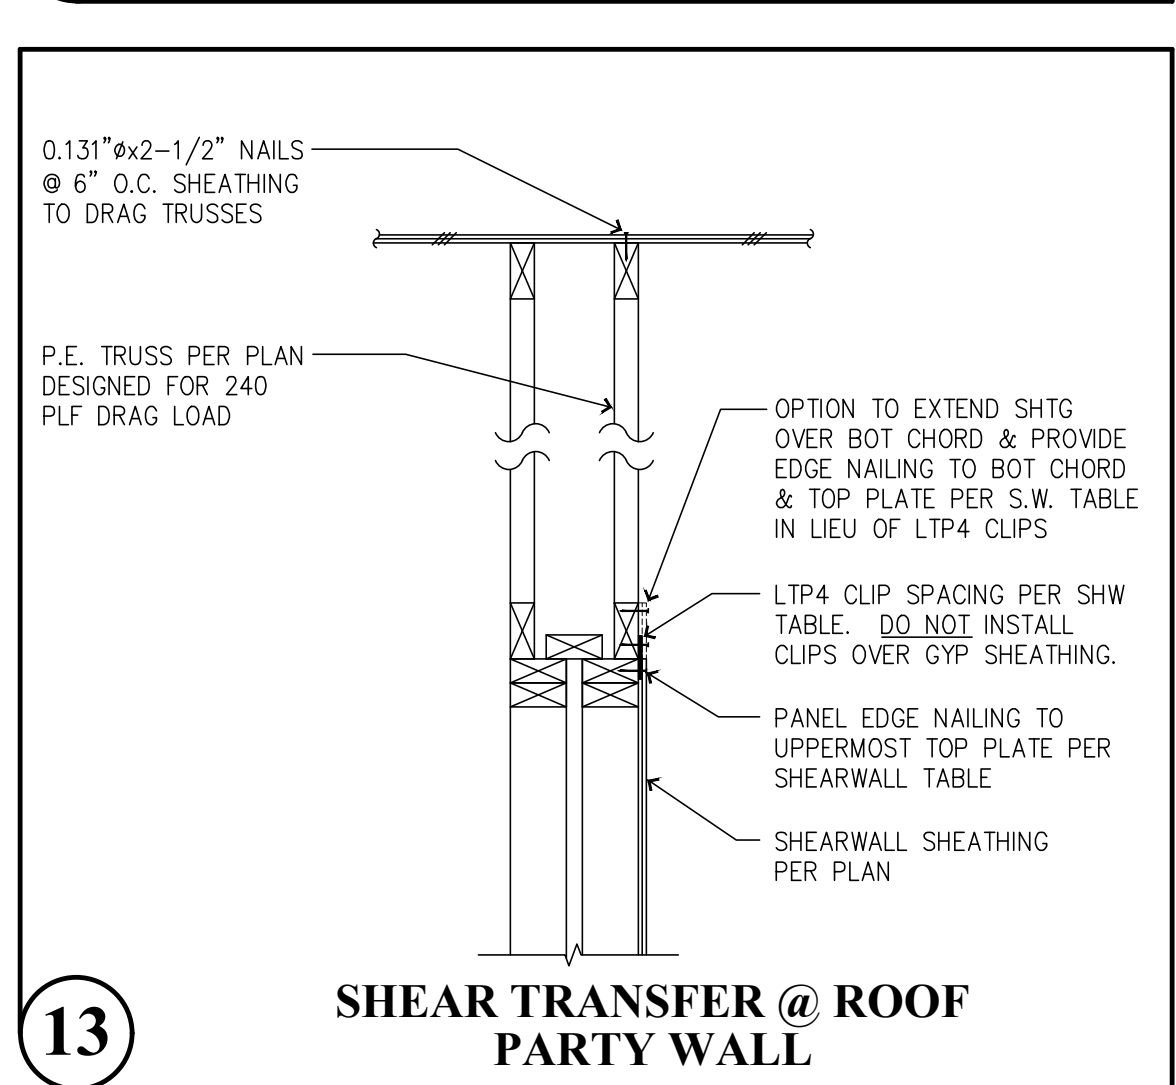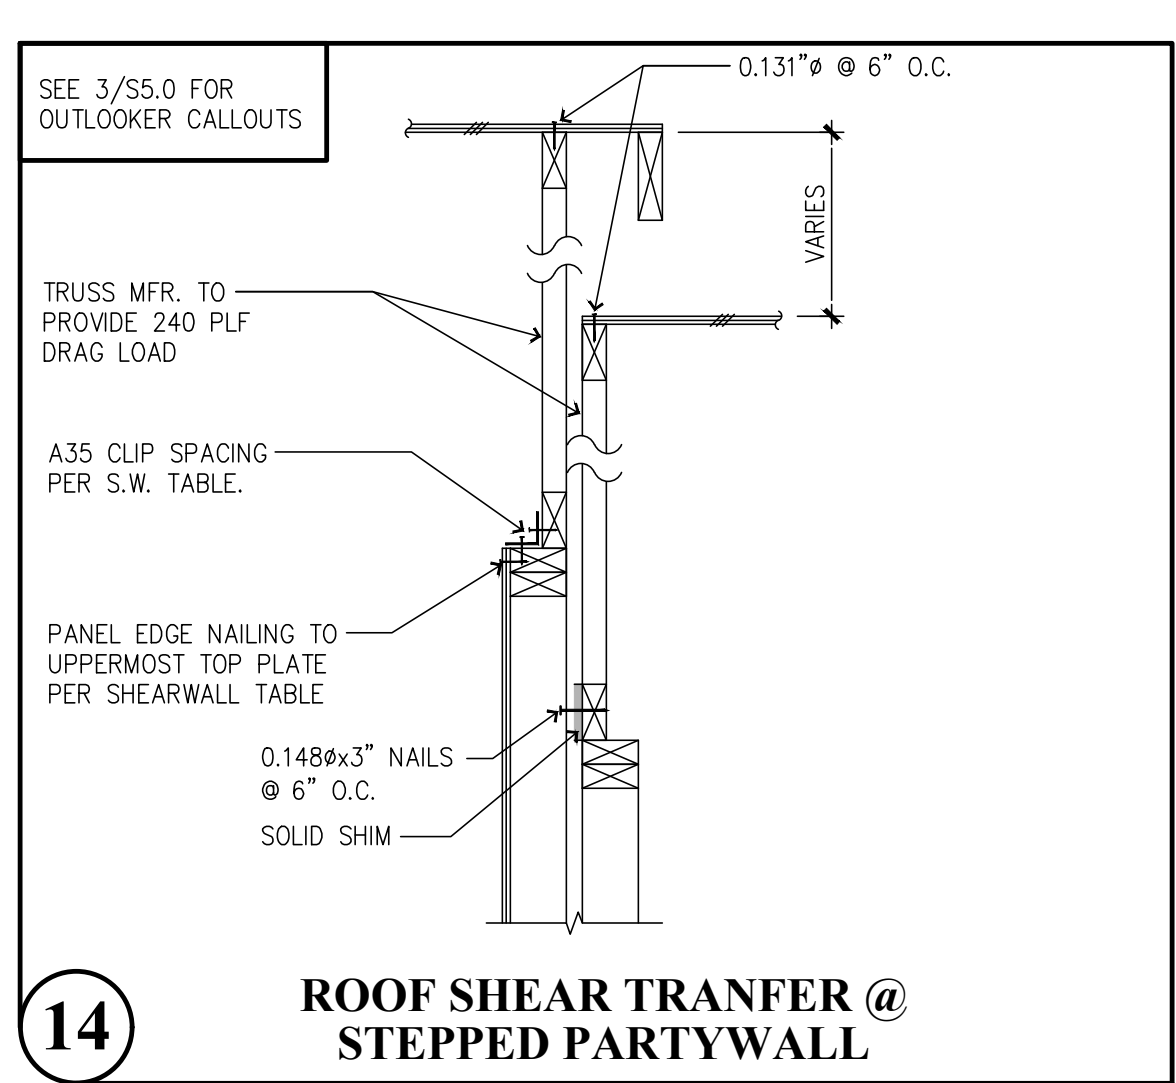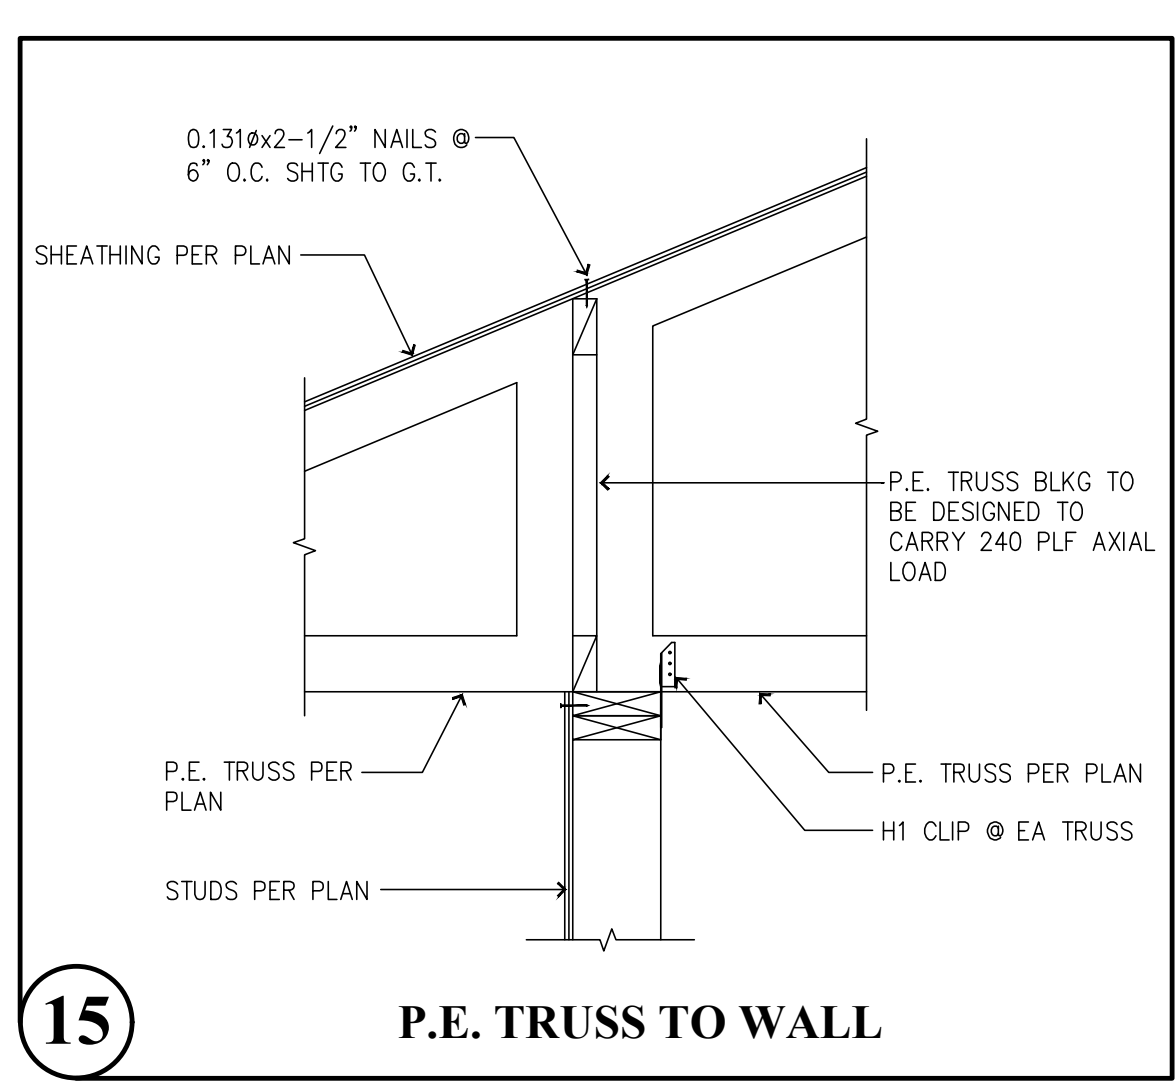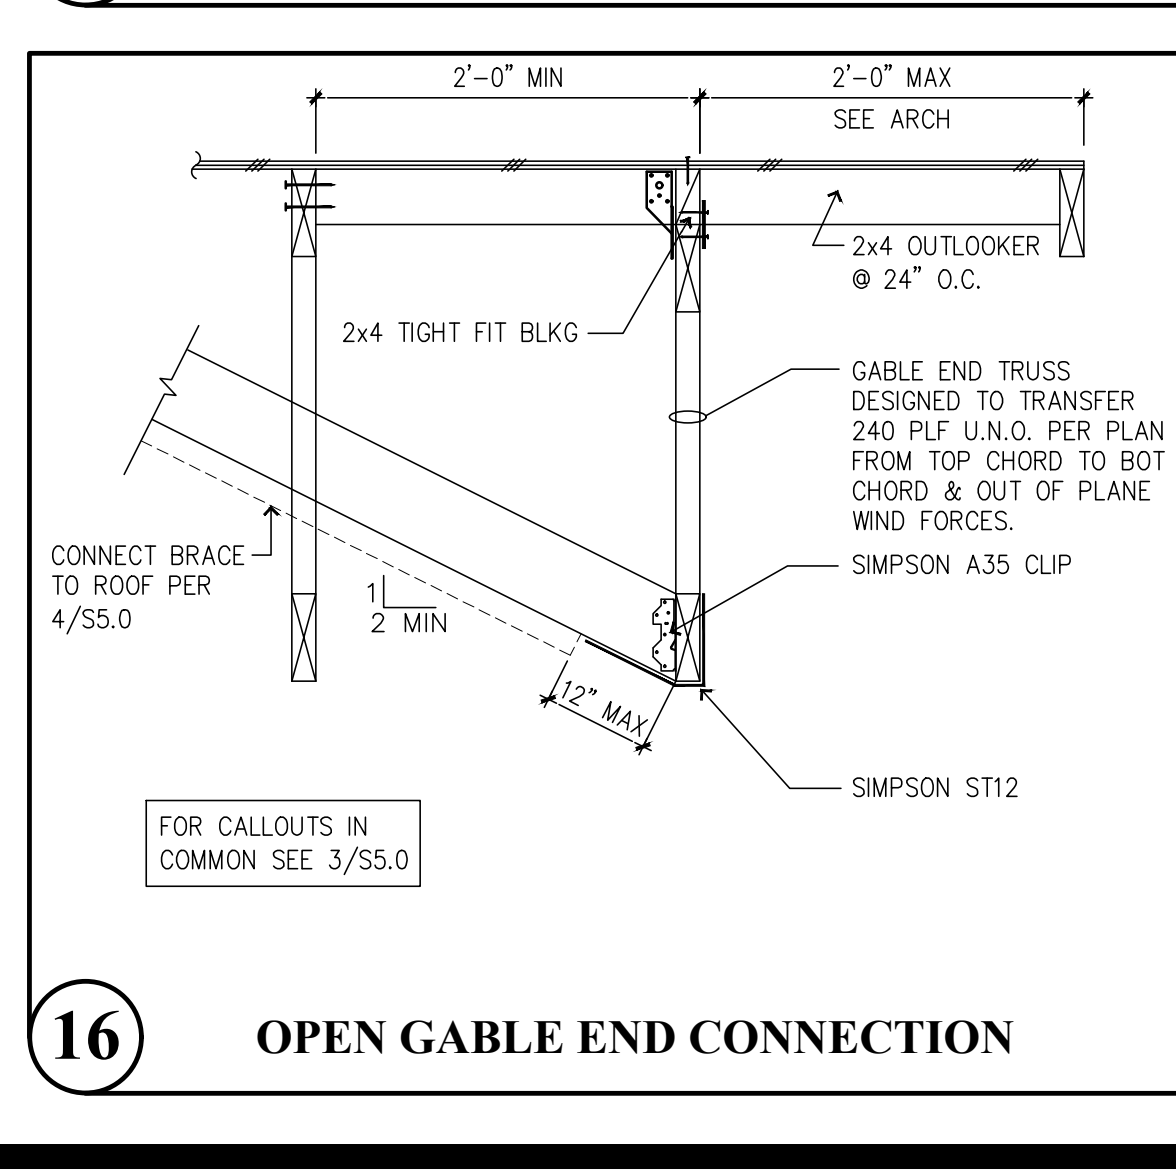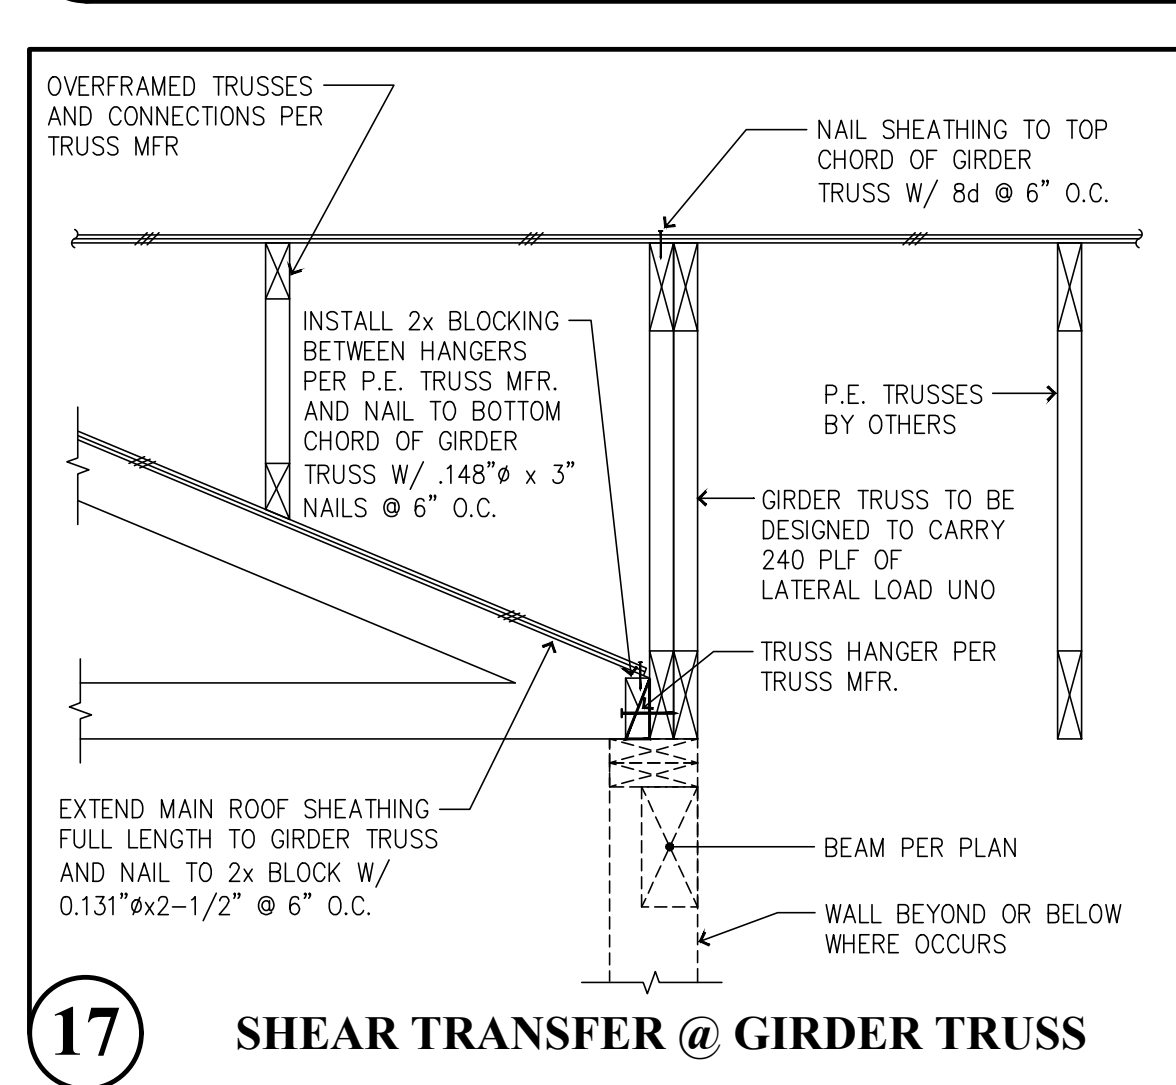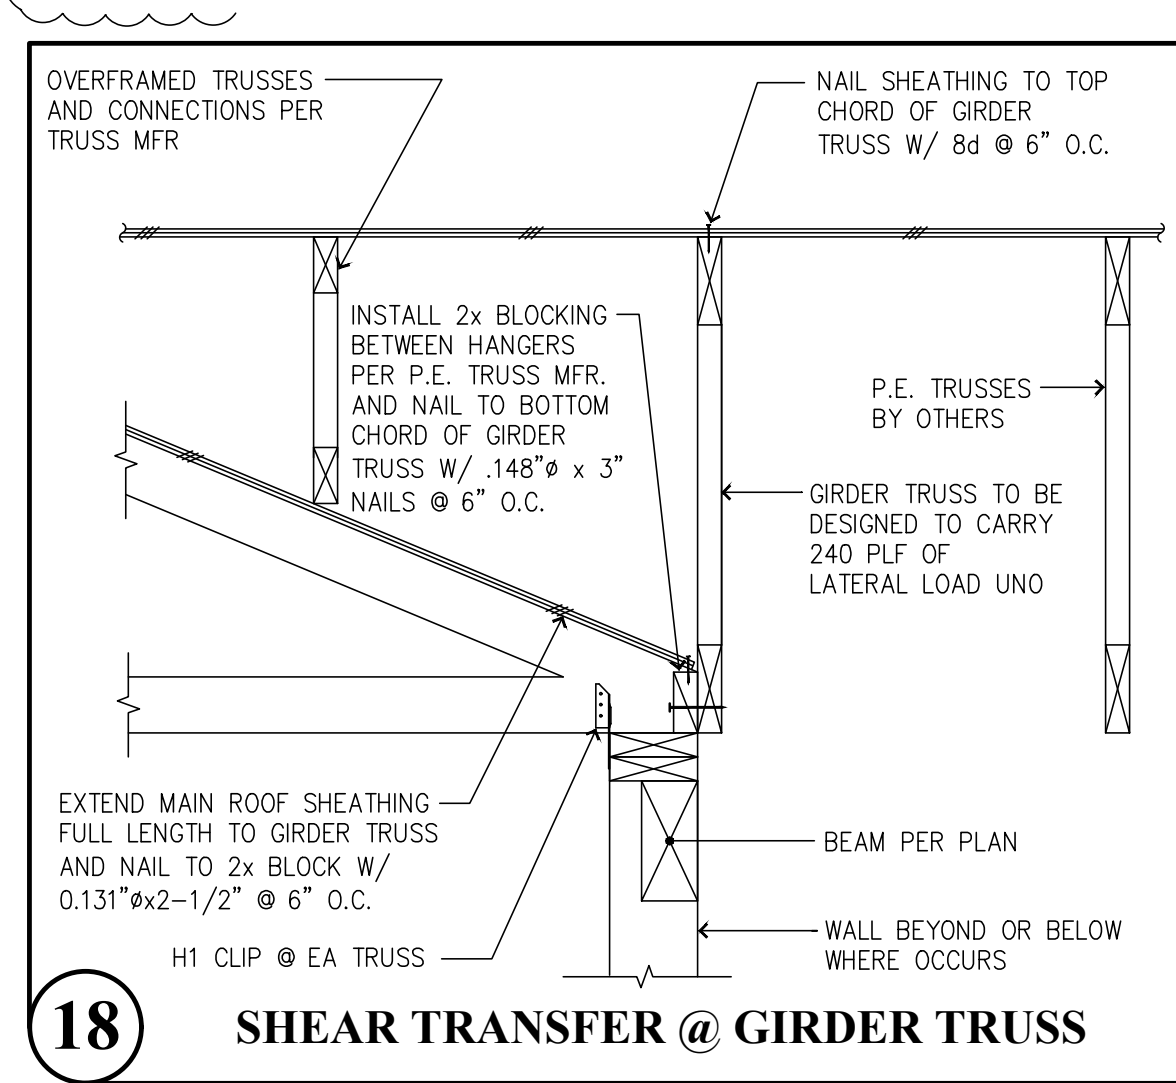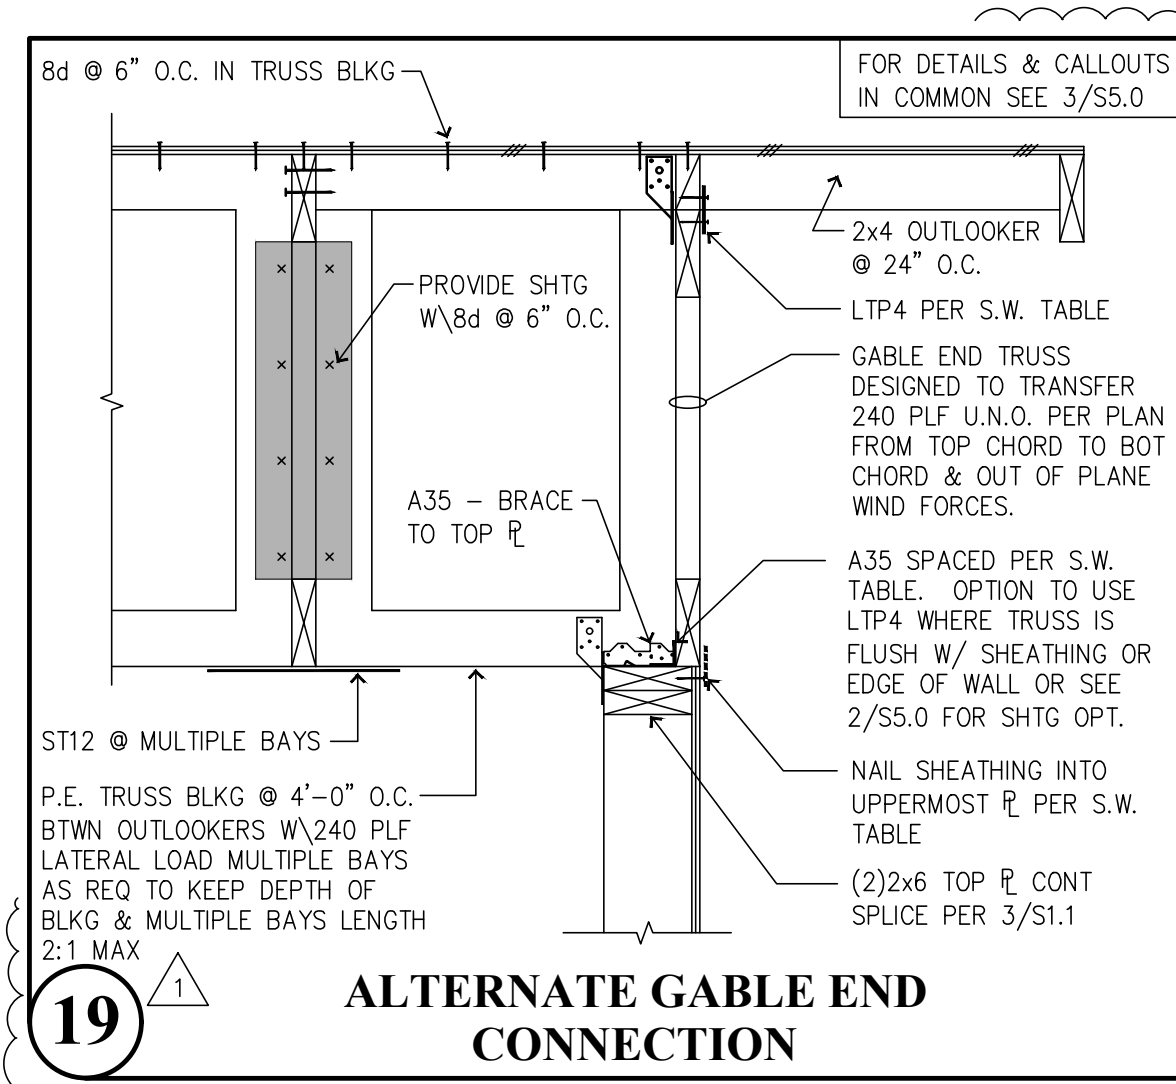

Revisions to this sheet:  
8-30-24 PERMIT CORRECTIONS & OWNER CHANGES

**Bradley Heights Apartments**  
202 27th Ave SE  
Puyallup, Washington


**Solutions 4 Structures**  
A Structural Engineering Corporation

Puyallup, Washington 98374  
Ph 253-314-9822  
www.solutions4structures.com


PROJECT NO. : 23-007  
DESIGNED BY : TLC, OGG, MRO  
DRAWN BY : RSO  
ISSUE DATE : 2-20-24  
LATEST REV. OF DWG. SET : 8-30-24

SUBMITTAL SET ONLY NOT FOR CONSTRUCTION  
THESE DRAWINGS ARE SUBJECT TO REVISIONS PENDING LOCAL JURISDICTIONAL REVIEW.




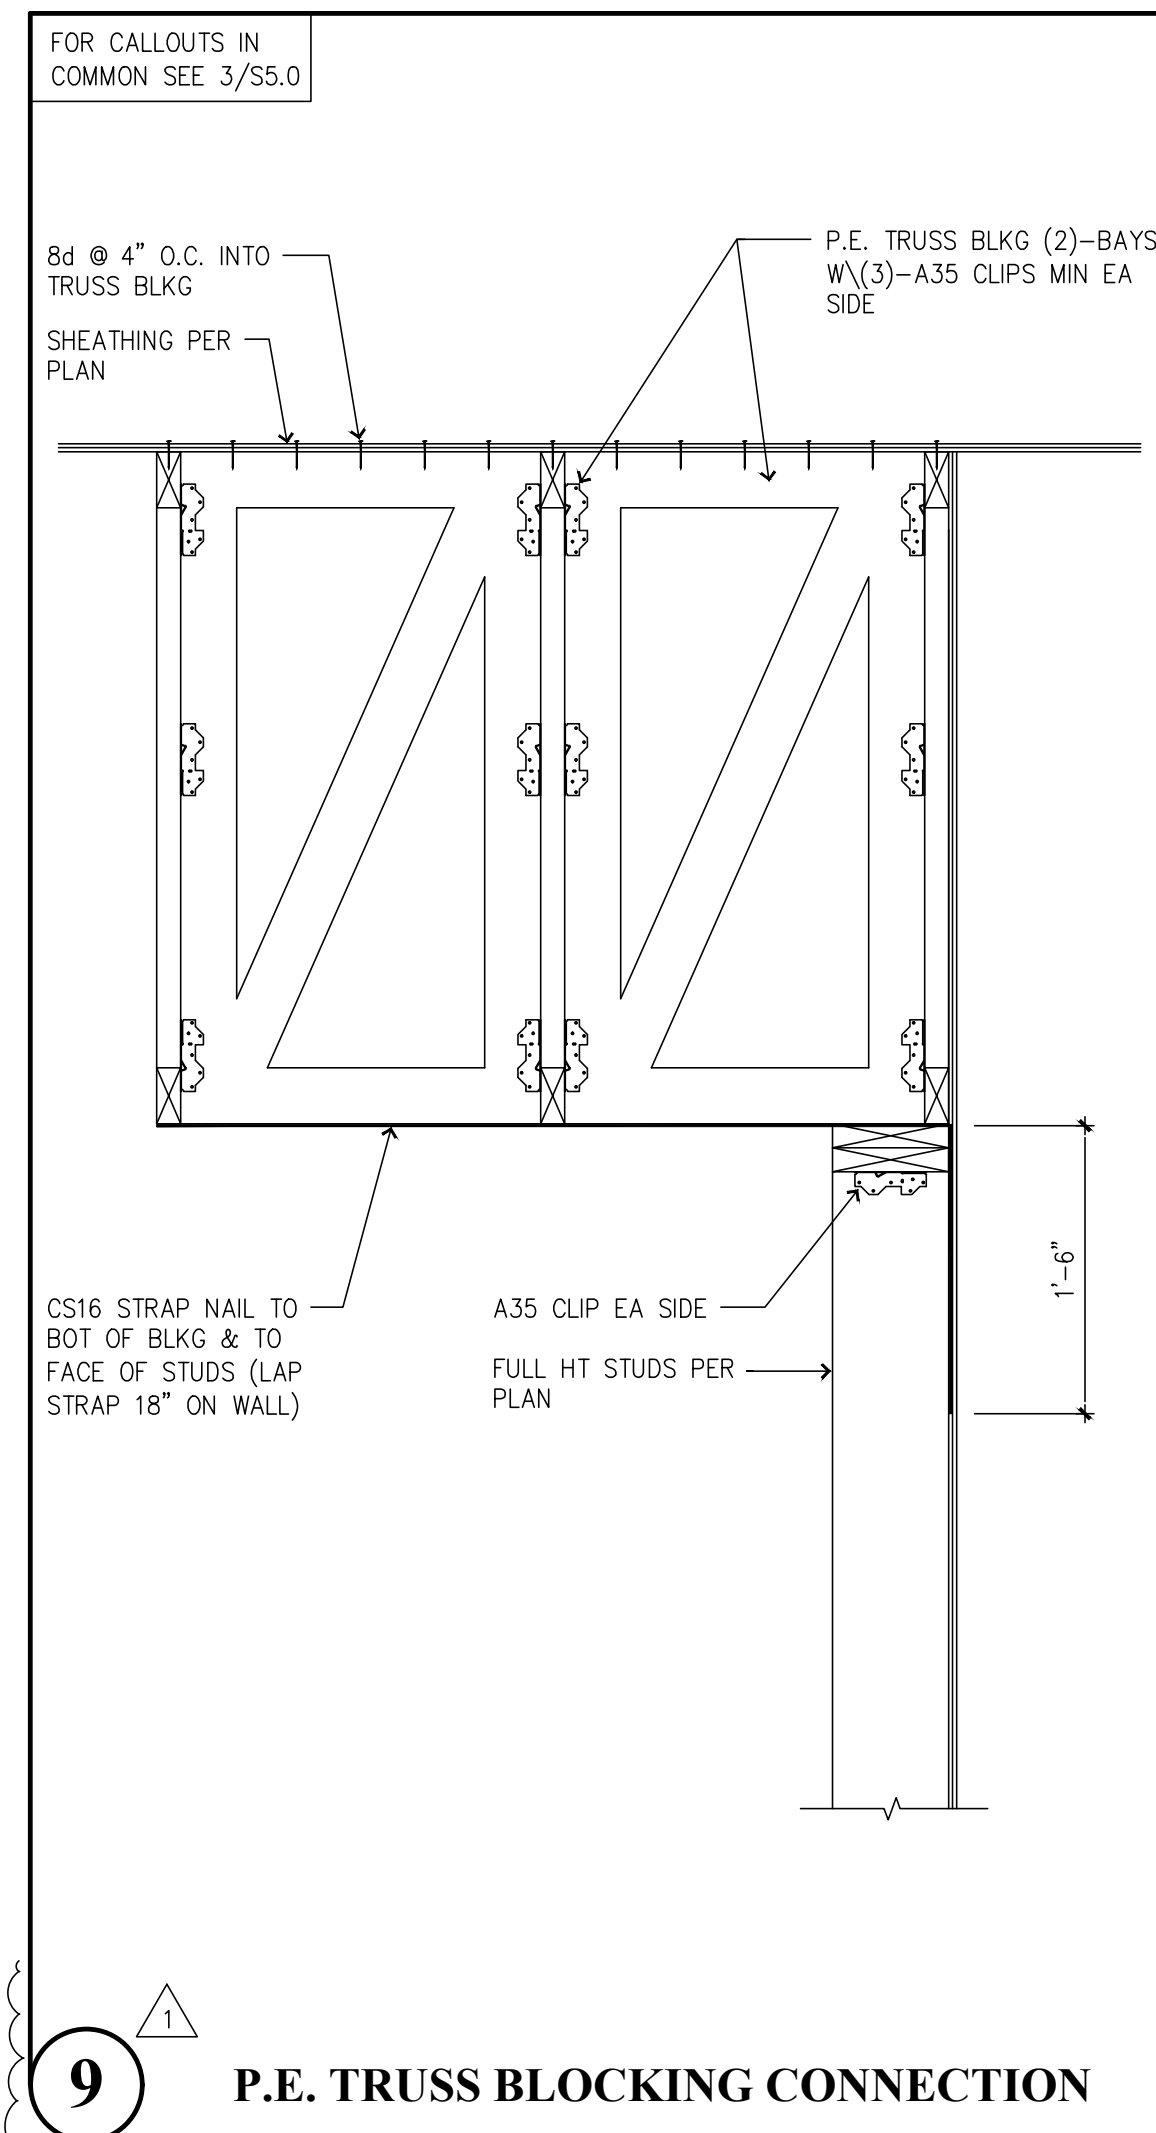


**9** P.E. TRUSS BLOCKING CONNECTION

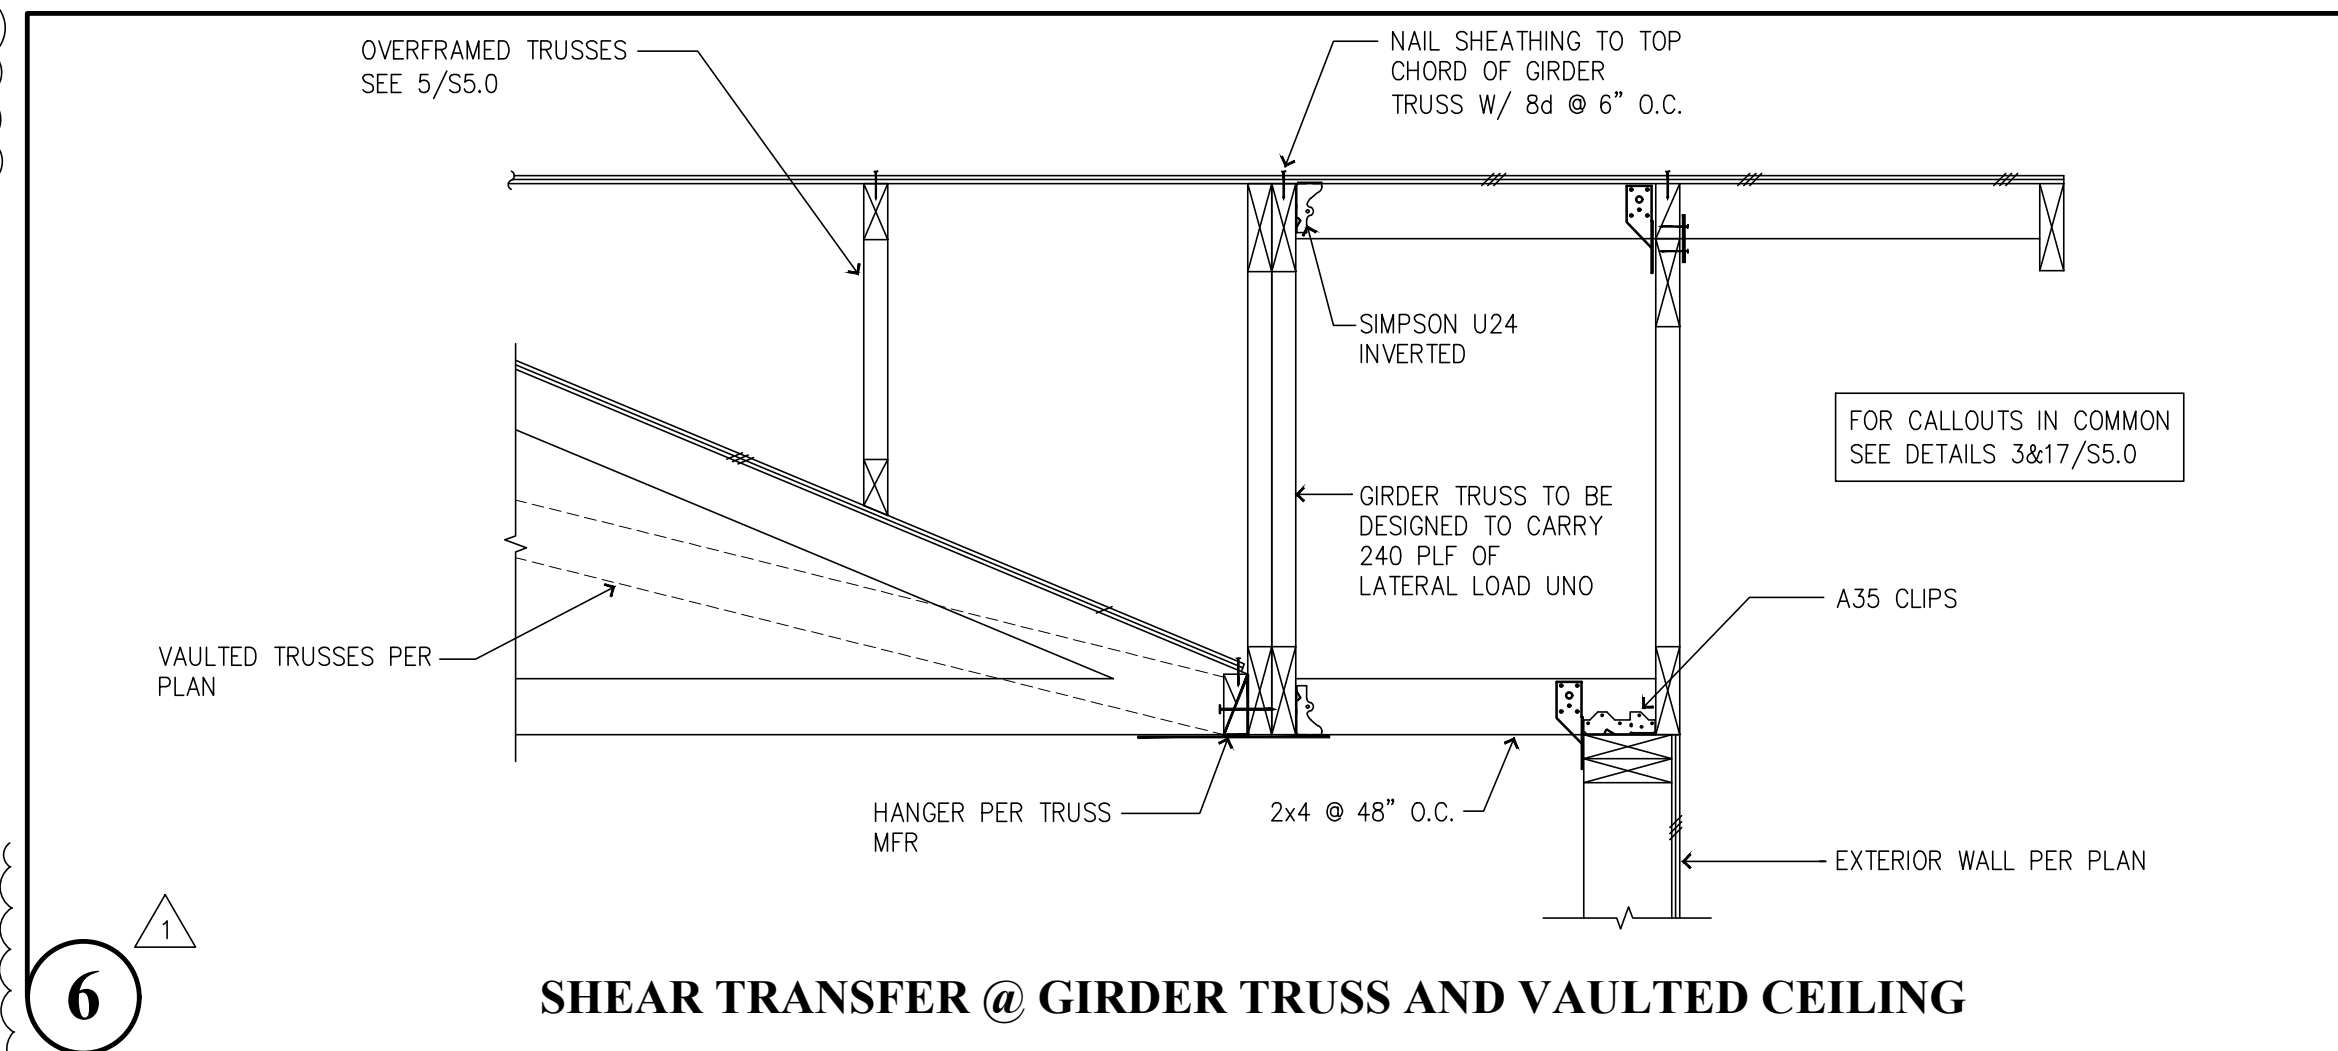


**6** SHEAR TRANSFER @ GIRDER TRUSS AND VAULTED CEILING

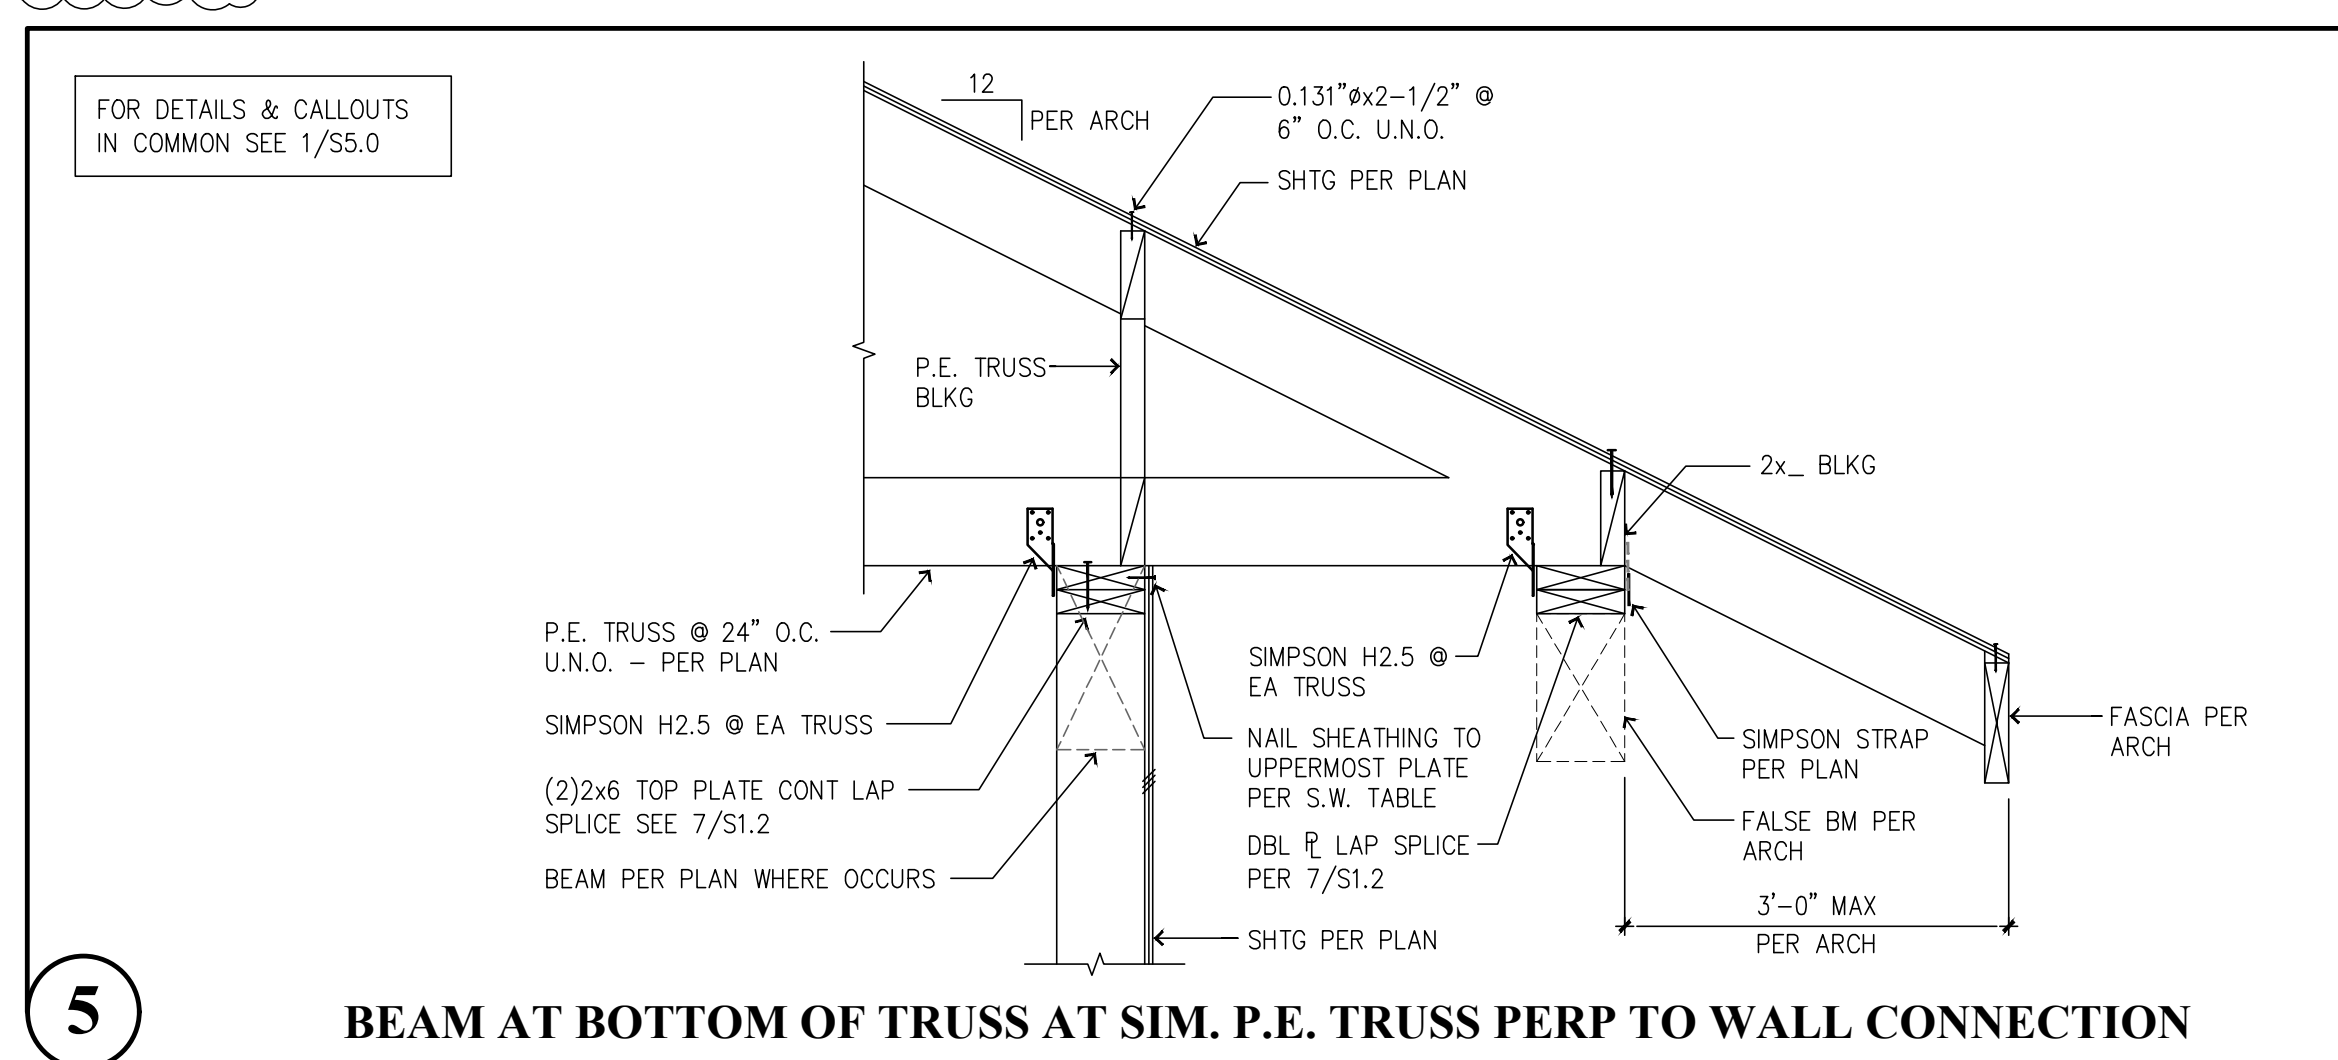


**5** BEAM AT BOTTOM OF TRUSS AT SIM. P.E. TRUSS PERP TO WALL CONNECTION

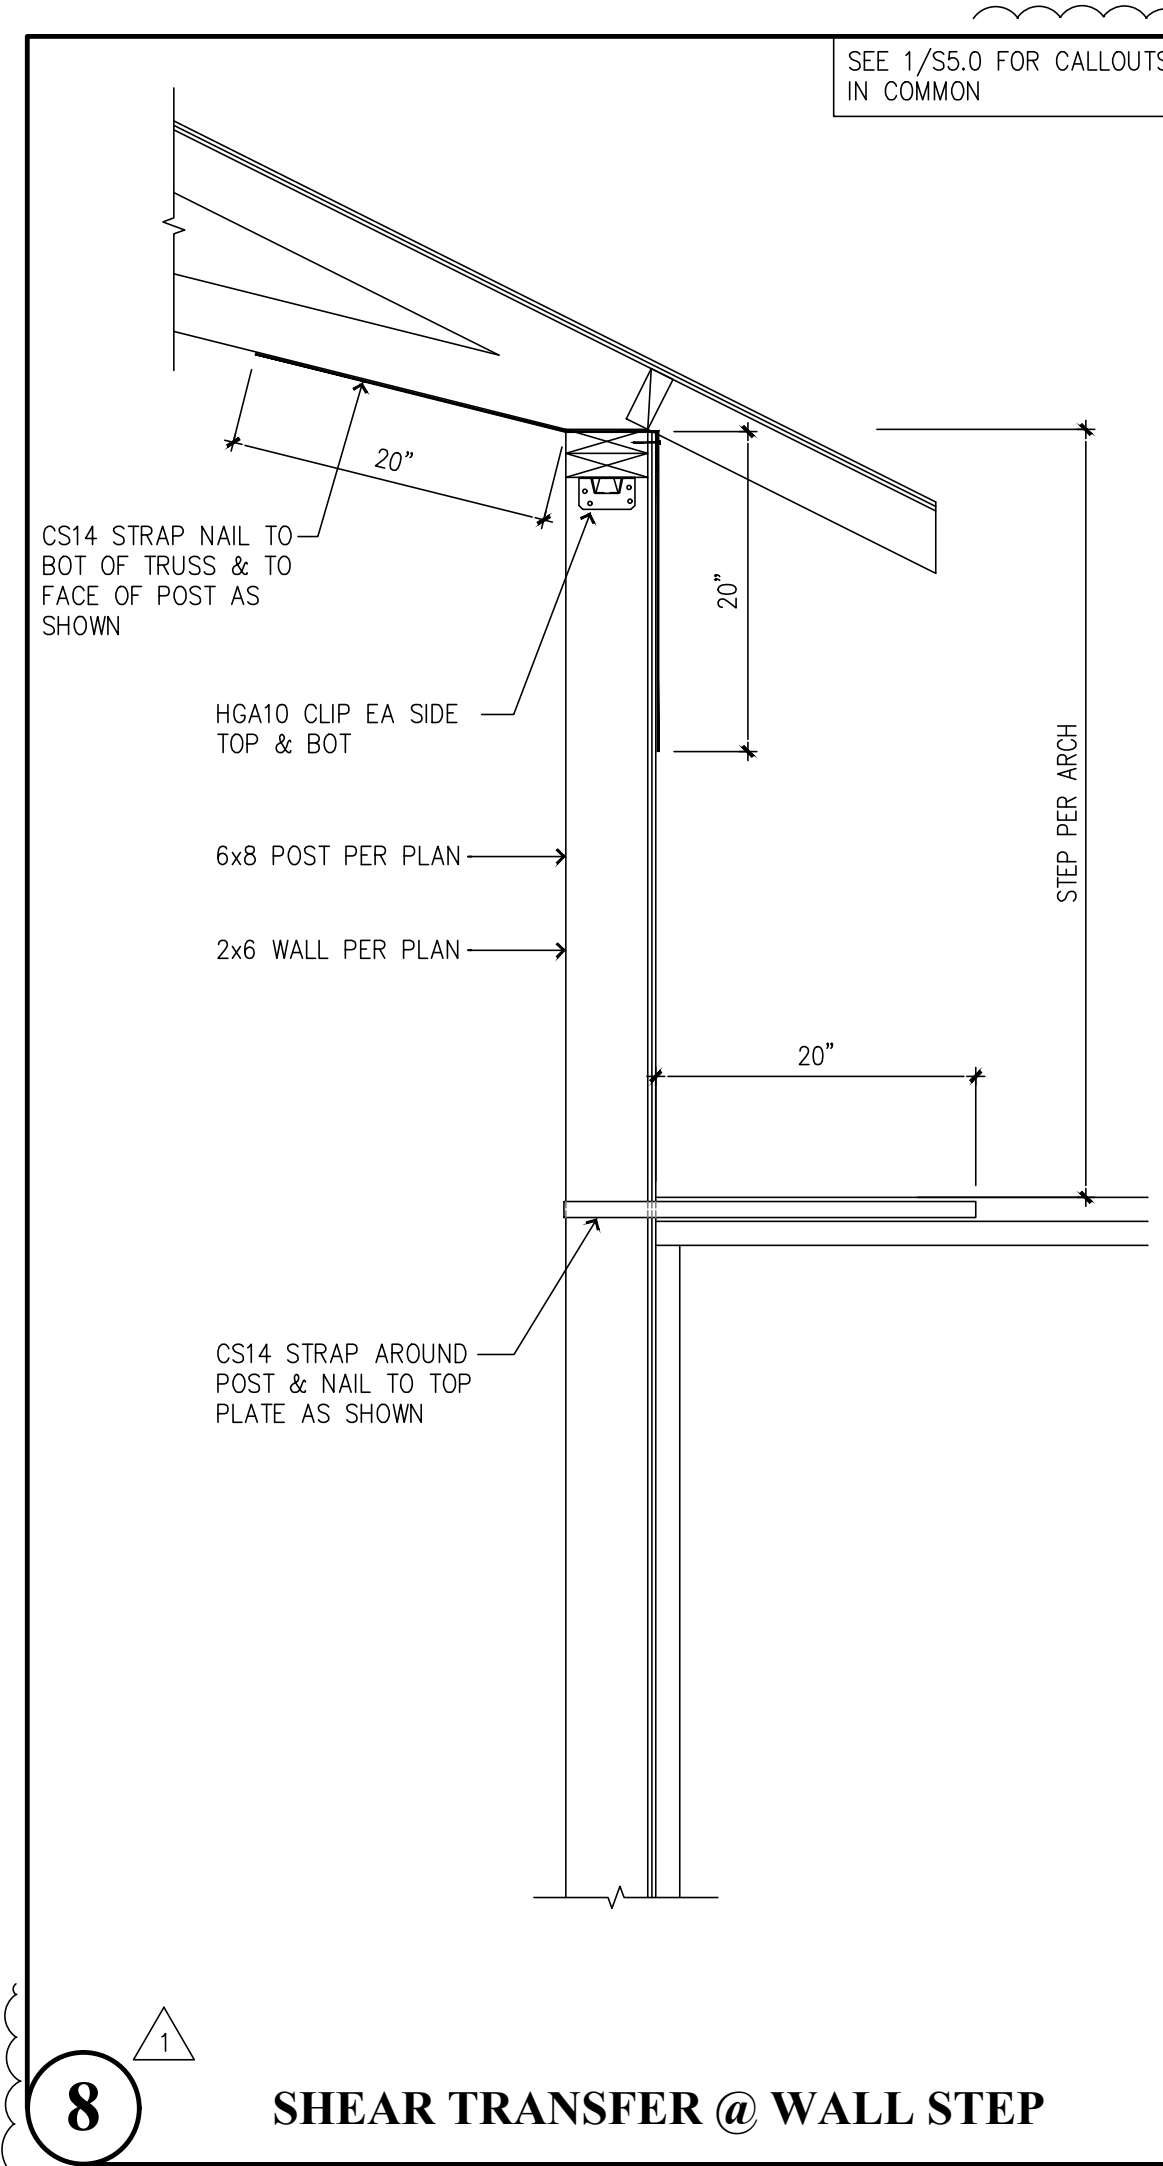


**8** SHEAR TRANSFER @ WALL STEP

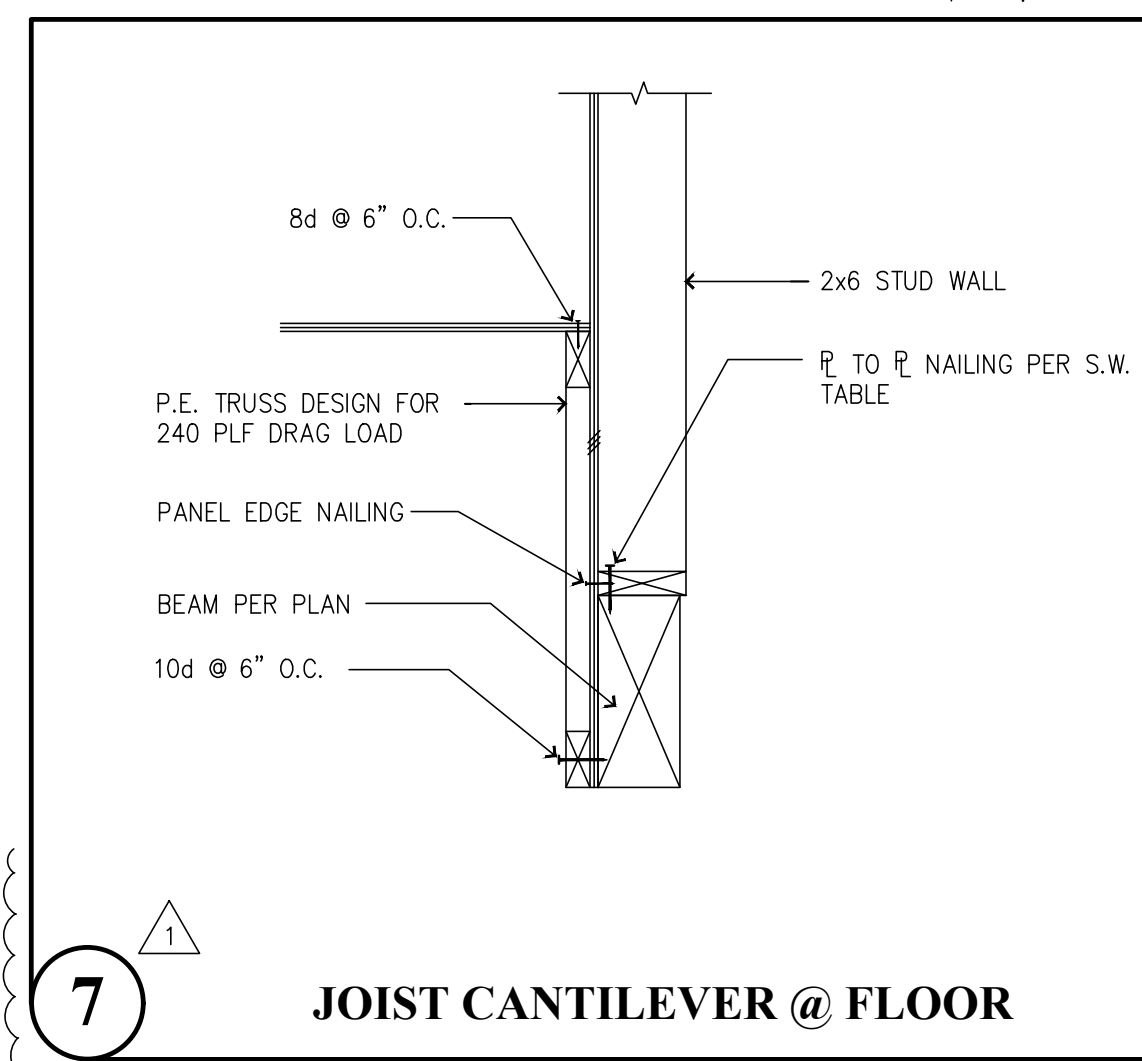


**7** JOIST CANTILEVER @ FLOOR

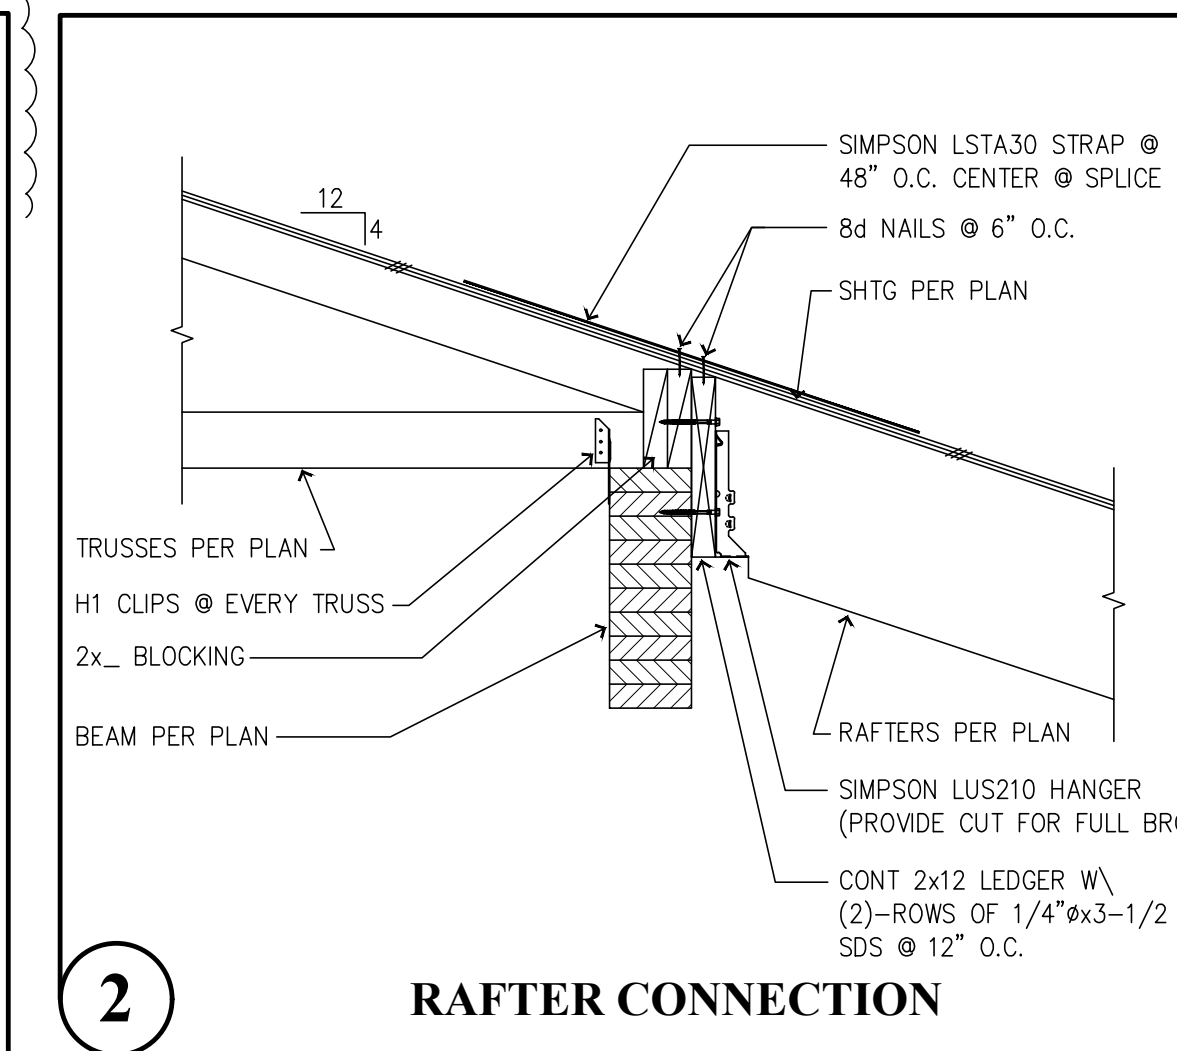


**2** RAFTER CONNECTION

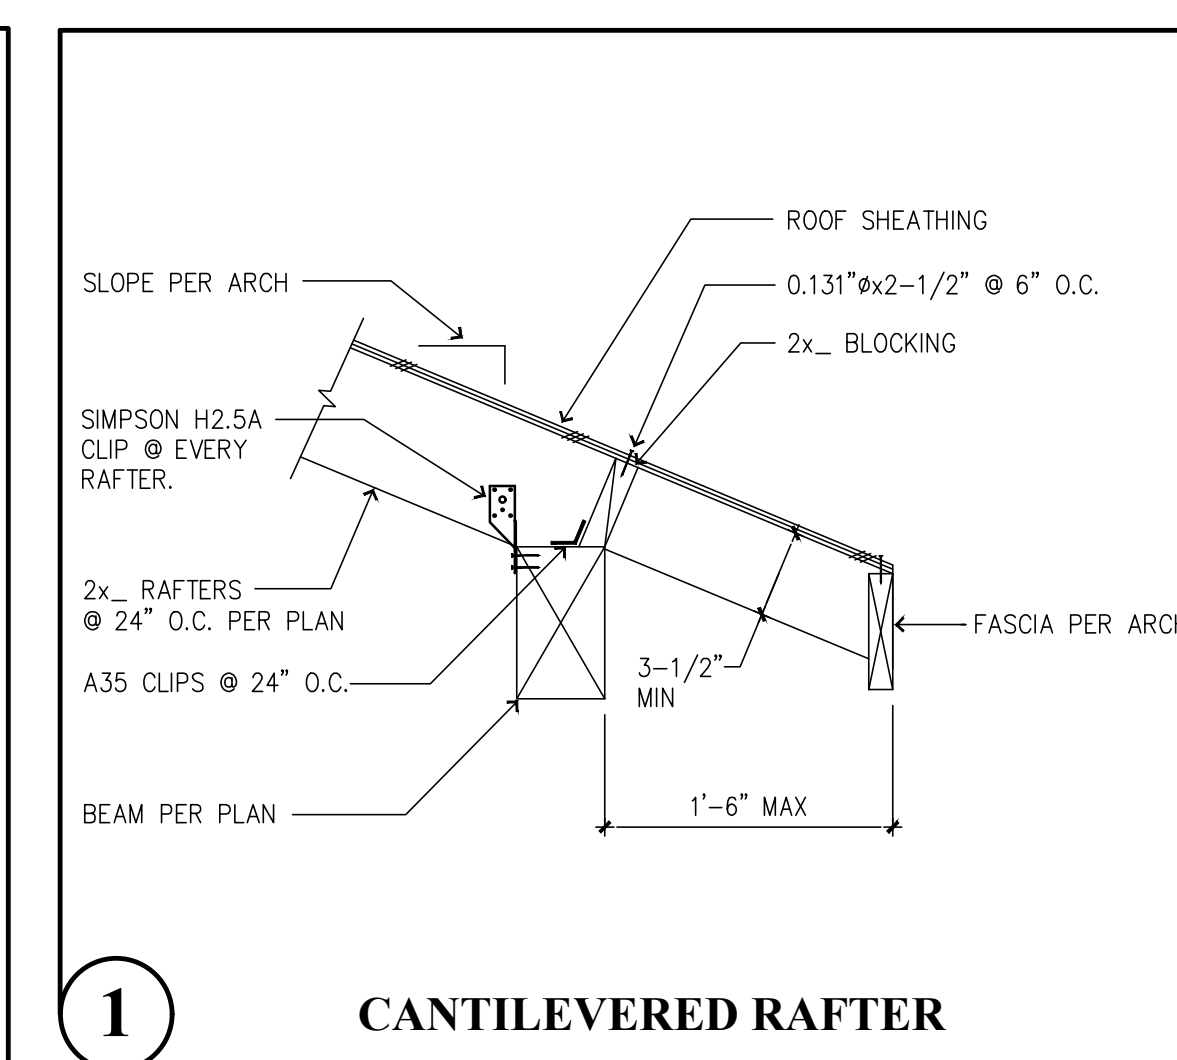


**1** CANTILEVERED RAFTER

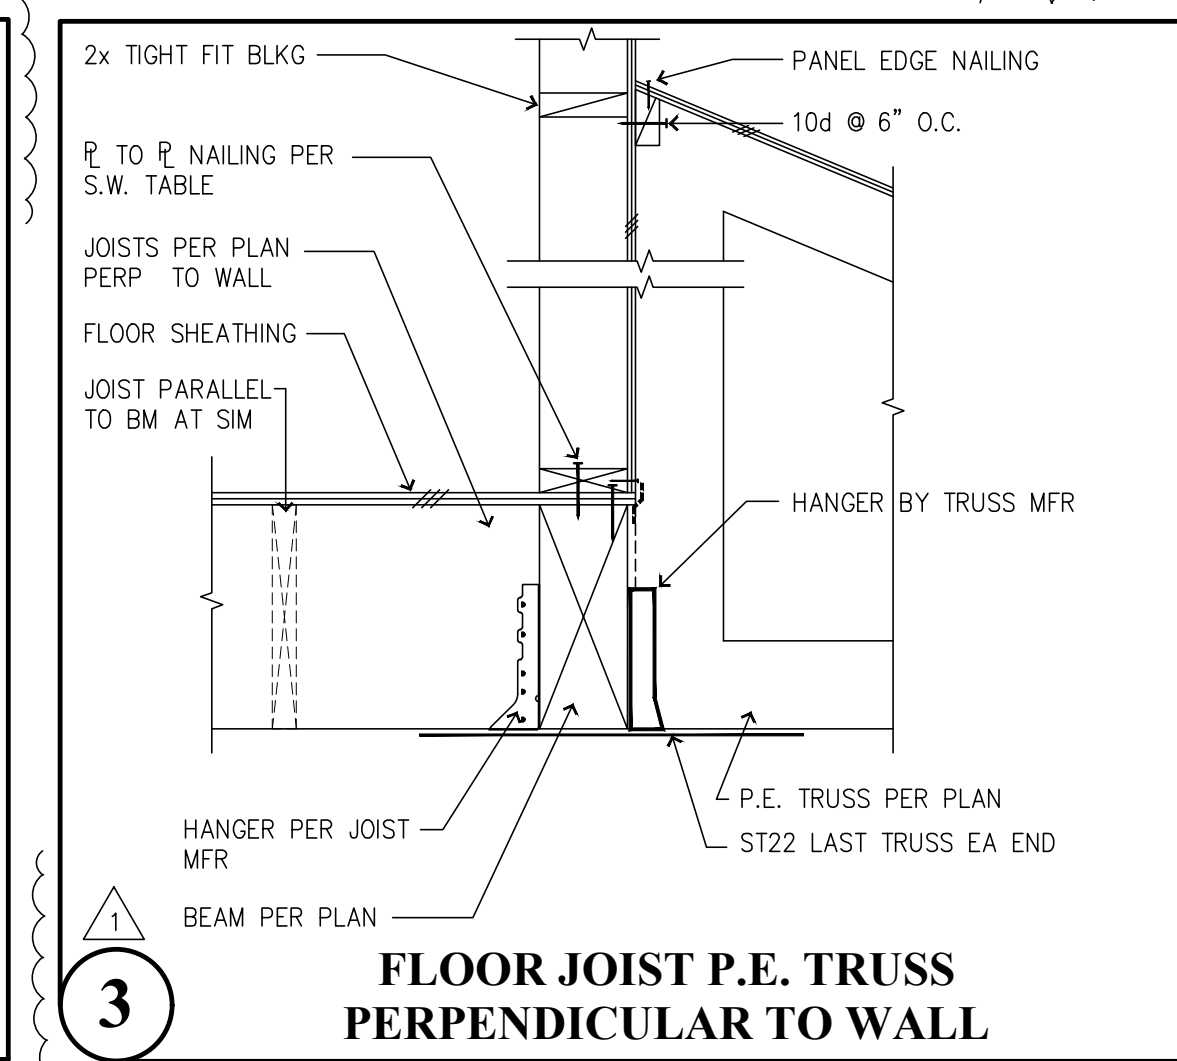

**3** FLOOR JOIST P.E. TRUSS PERPENDICULAR TO WALL

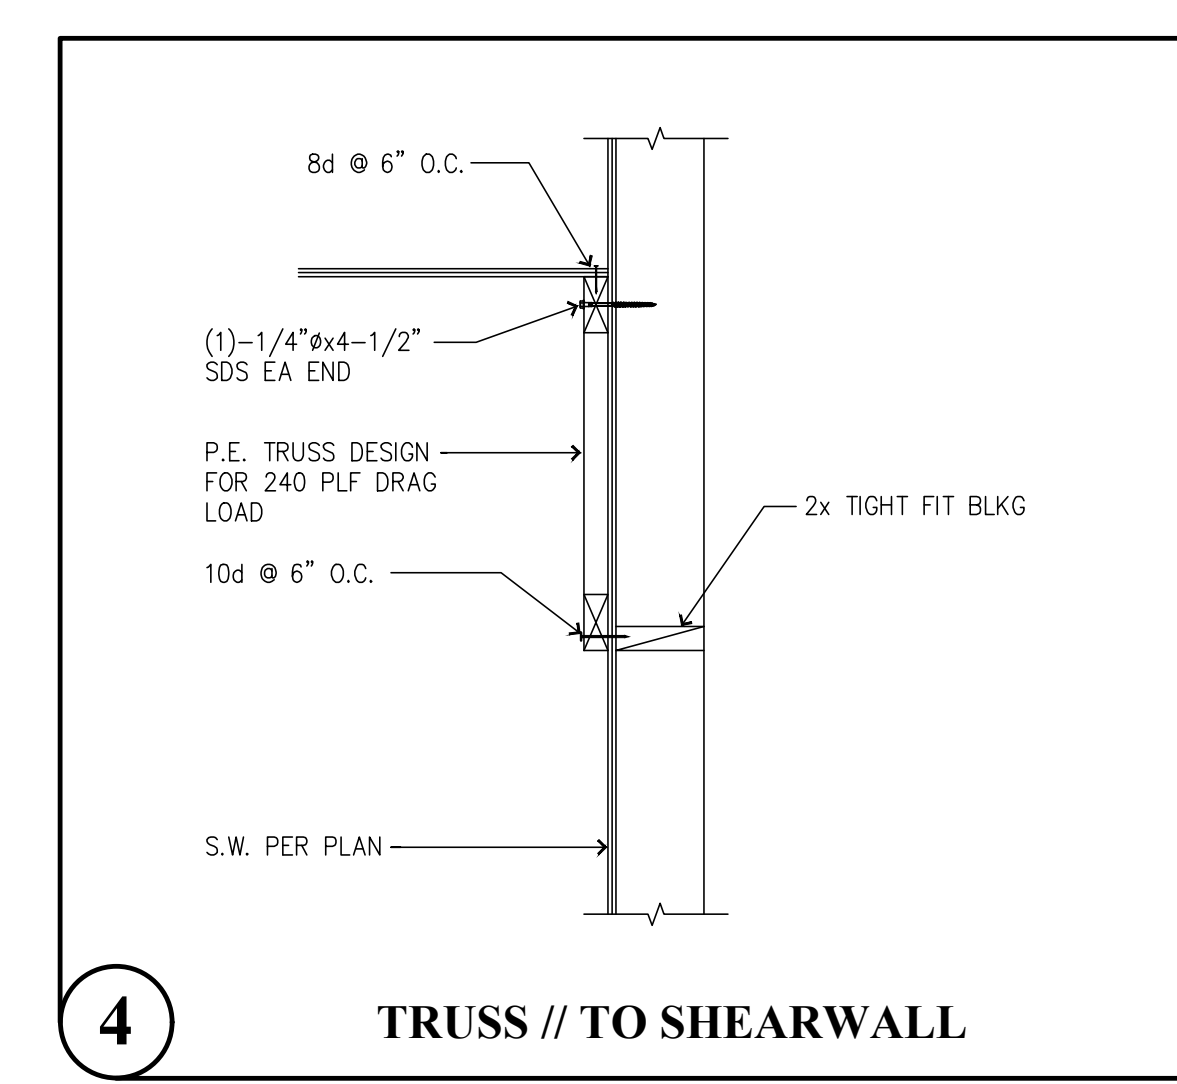

**4** TRUSS // TO SHEARWALL

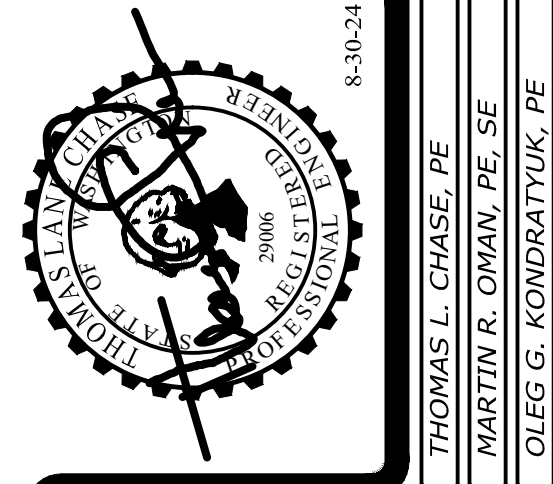

Revisions to this sheet:  
 8-30-24 PERMIT CORRECTIONS & OWNER CHANGES


**Bradley Heights Apartments**  
 202 27th Ave SE  
 Puyallup, Washington

**Solutions 4 Structures**  
 A Structural Engineering Corporation

Puyallup, Washington 98374  
 Ph 253-314-9822  
 www.solutions4structures.com


PROJECT NO. : 23.007  
 DESIGNED BY : TLC, OGG, MRO  
 DRAWN BY : RSO  
 ISSUE DATE : 2-20-24  
 LATEST REV. OF DWG. SET : 8-30-24

SUBMITTAL SET ONLY NOT FOR CONSTRUCTION  
 THESE DRAWINGS ARE SUBJECT TO REVISIONS  
 PENDING LOCAL JURISDICTIONAL REVIEW.

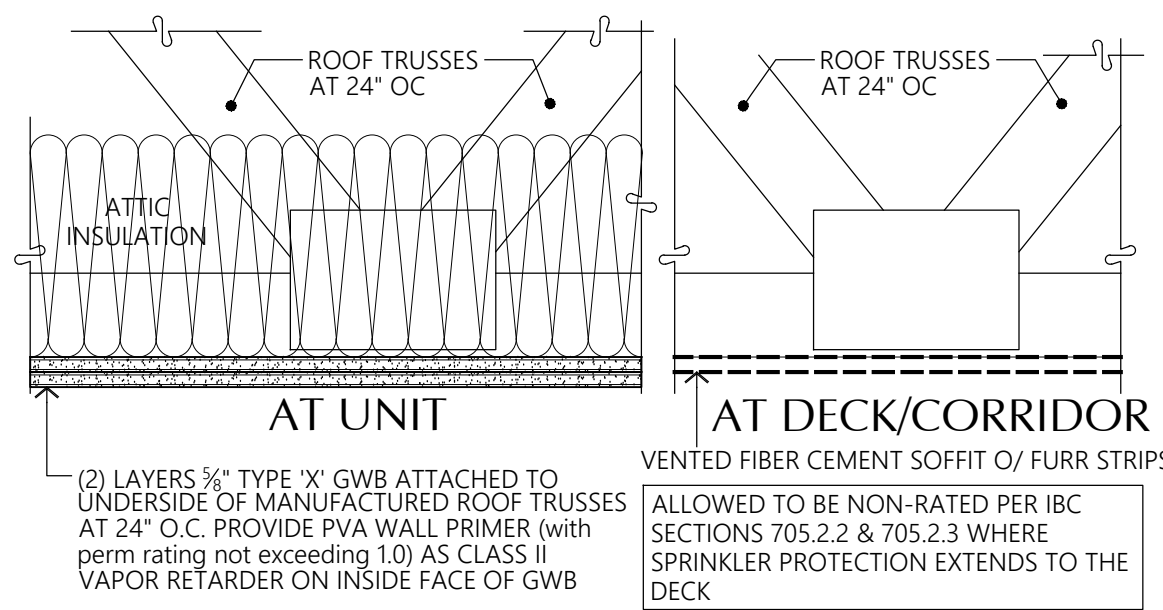


**17 TYPICAL 1-HR ROOF/CEILING SECTION**  
 1-1/2" = 1'-0"

**1-HR GA File No. RC 2602**  
 Base layer 5/8" type X gypsum wallboard applied at right angles to wood roof trusses 24" o.c. with 1 1/2" Type W or S drywall screws 24" o.c. Face layer 5/8" type X gypsum wallboard or gypsum veneer base applied at right angles to trusses with 1 1/2" Type W or S drywall screws 12" o.c. at joints and intermediate trusses and 1 1/2" Type G drywall screws 12" o.c. placed 2" back on either side of end joints. Joints offset 24" from base layer joints. Wood trusses supporting 5/8" wood structural panels applied at right angles to trusses with 8d nails. Appropriate roof covering. Ceiling provides one hour fire resistance protection for trusses.

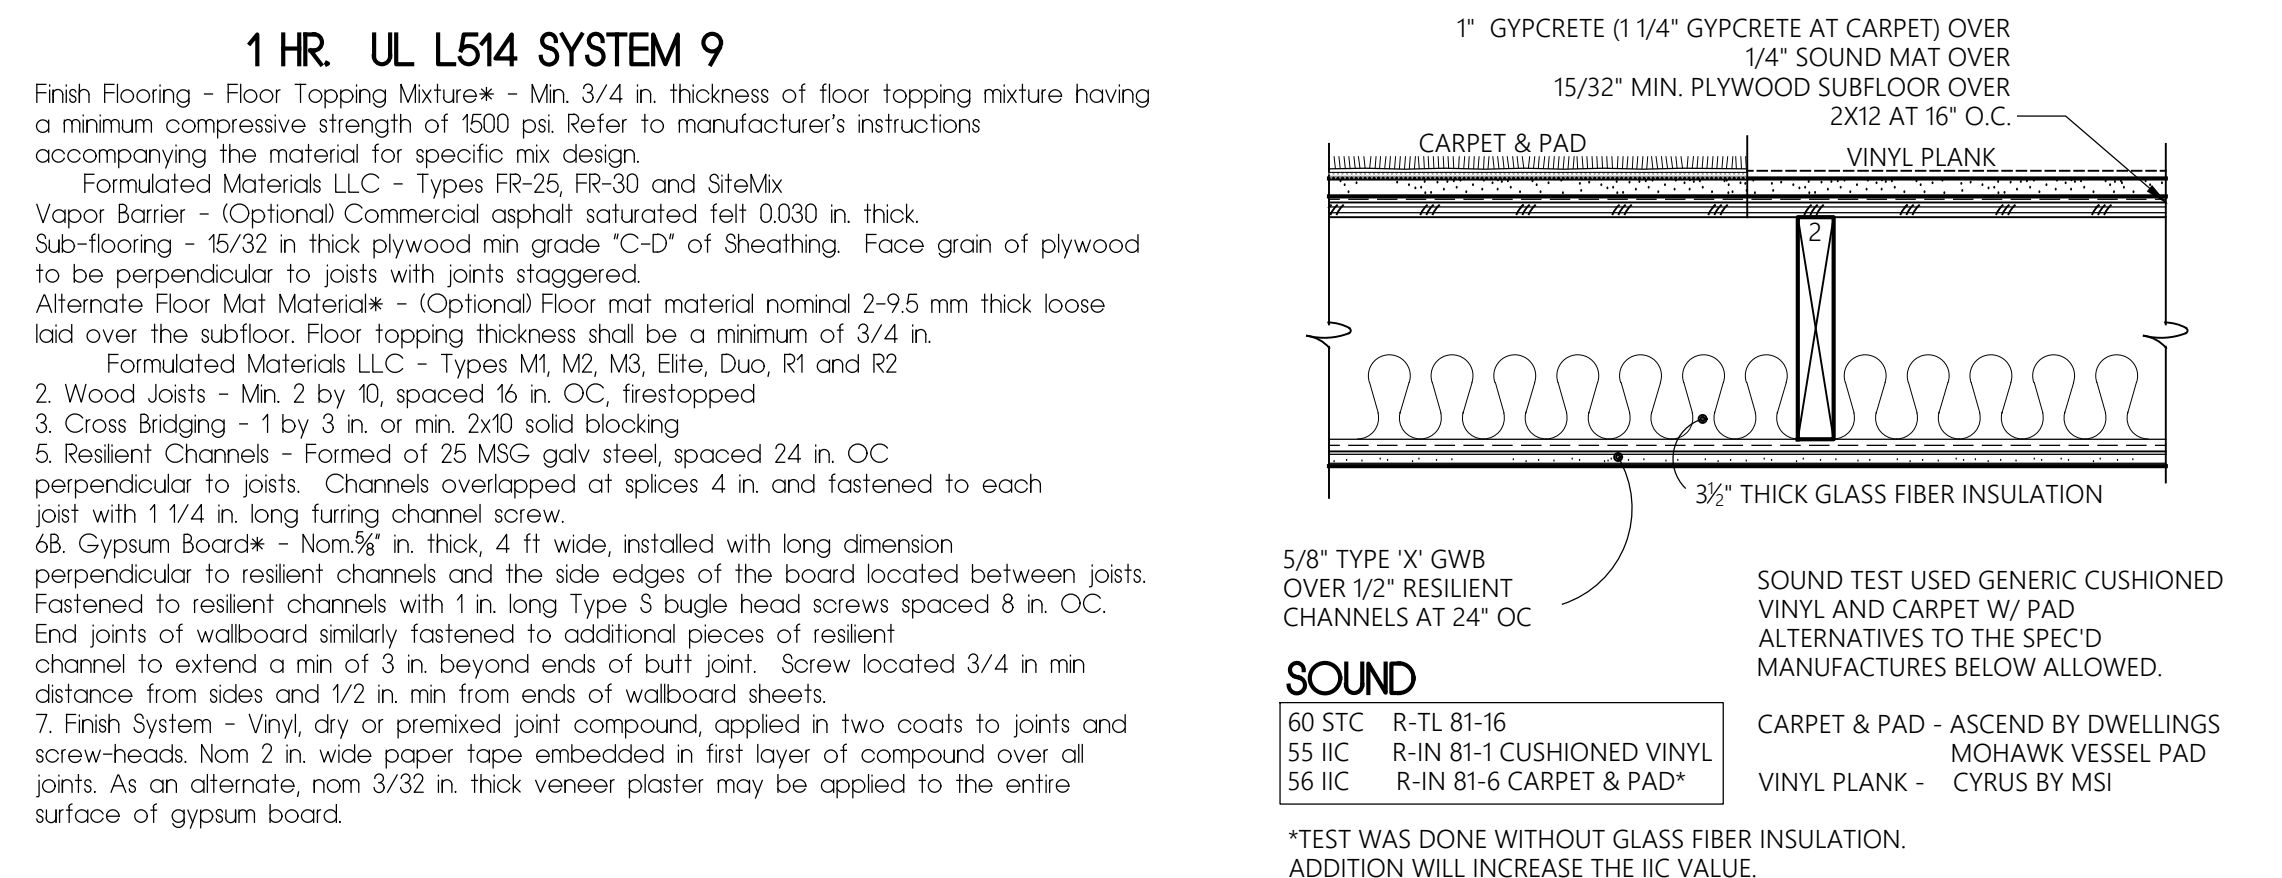


**13 TYPICAL FLOOR SECTION**  
 1 1/2" = 1'-0"

**1 HR. UL L514 SYSTEM 9**  
 Finish Flooring - Floor Topping Mixture - Min. 3/4 in. thickness of floor topping mixture having a minimum compressive strength of 1500 psi. Refer to manufacturer's instructions accompanying the material for specific mix design.  
 Formulated Materials LLC - Types FR-25, FR-30 and SiteMx  
 Vapor Barrier - (Optional) Commercial asphalt saturated felt 0.030 in. thick.  
 Sub-flooring - 15/32 in thick plywood min grade "C-D" of Sheathing. Face grain of plywood to be perpendicular to joists with joints staggered.  
 Alternate Floor Mat Material - (Optional) Floor mat material nominal 2-9.5 mm thick loose laid over the subfloor. Floor topping thickness shall be a minimum of 3/4 in.  
 Formulated Materials LLC - Types MT, M2, M3, Elite, Duo, R1 and R2  
 2. Wood Joists - Min. 2 by 10, spaced 16 in. O.C., freestopped  
 3. Cross Bridging - 1 by 3 in. or min. 2x10 solid blocking  
 5. Resilient Channels - Formed of 25 MSG galv steel, spaced 24 in. O.C. perpendicular to joists. Channels overlapped at splices 4 in. and fastened to each joist with 1 1/4 in. long furring channel screw.  
 6B. Gypsum Board - Nom 5/8" in. thick, 4 ft wide, installed with long dimension perpendicular to resilient channels and the side edges of the board located between joists. Fastened to resilient channels with 1 in. long Type S bugle head screws spaced 8 in. O.C. End joints of wallboard similarly fastened to additional pieces of resilient channel to extend a min of 3 in. beyond ends of butt joint. Screw located 3/4 in. min. distance from sides and 1/2 in. min. from ends of wallboard sheets.  
 7. Finish System - Vinyl, dry or premeled joint compound, applied in two coats to joints and screw-heads. Nom 2 in. wide paper tape embedded in first layer of compound over all joints. As an alternate, nom 3/32 in. thick veneer plaster may be applied to the entire surface of gypsum board.  
 3 1/2" THICK GLASS FIBER INSULATION  
 5/8" TYPE 'X' GWB OVER 1/2" RESILIENT CHANNELS AT 24" O.C.  
 SOUND  
 60 STC R-TL 81-16  
 55 IIC R-IN 81-1 CUSHIONED VINYL  
 56 IIC R-IN 81-6 CARPET & PAD  
 CARPET & PAD - ASCEND BY DWELLINGS MOHAWK VESSEL PAD  
 VINYL PLANK - CYRUS BY MSI  
 \*TEST WAS DONE WITHOUT GLASS FIBER INSULATION. ADDITION WILL INCREASE THE IIC VALUE.

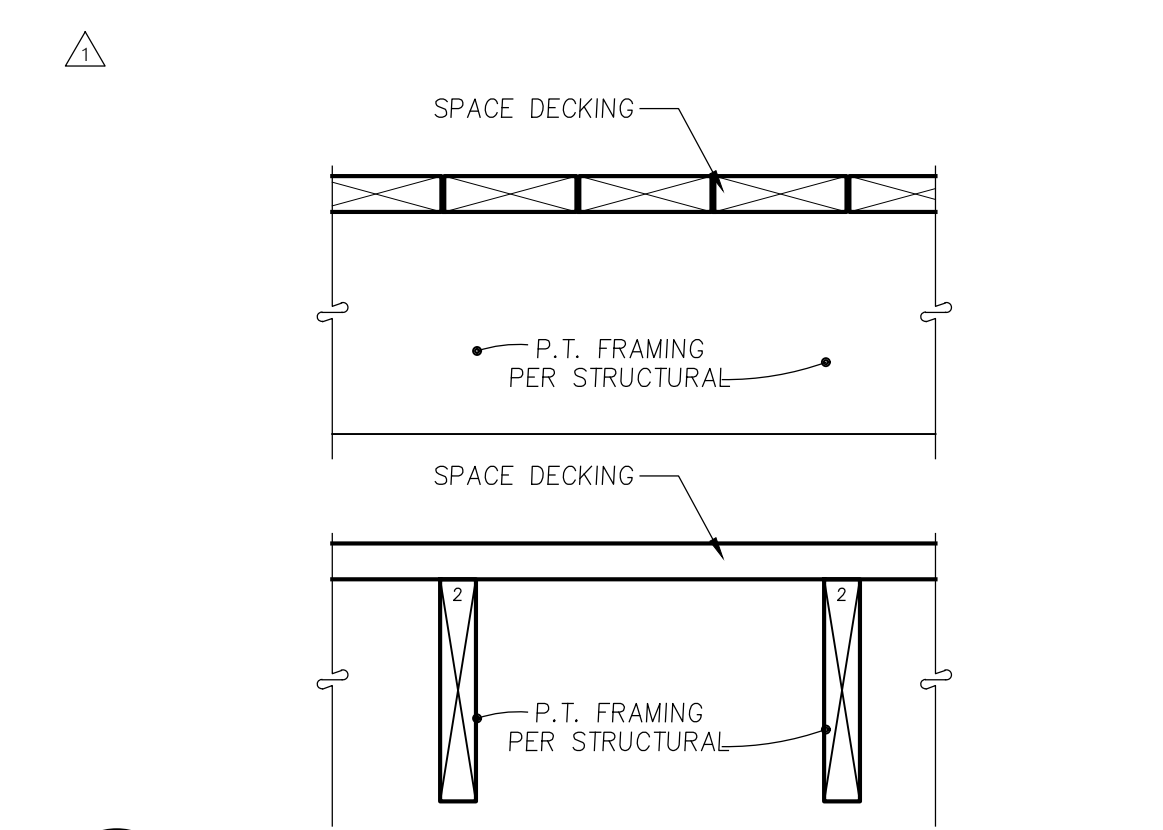


**18 SPACED DECKING FLOOR SECTION**  
 1 1/2" = 1'-0"

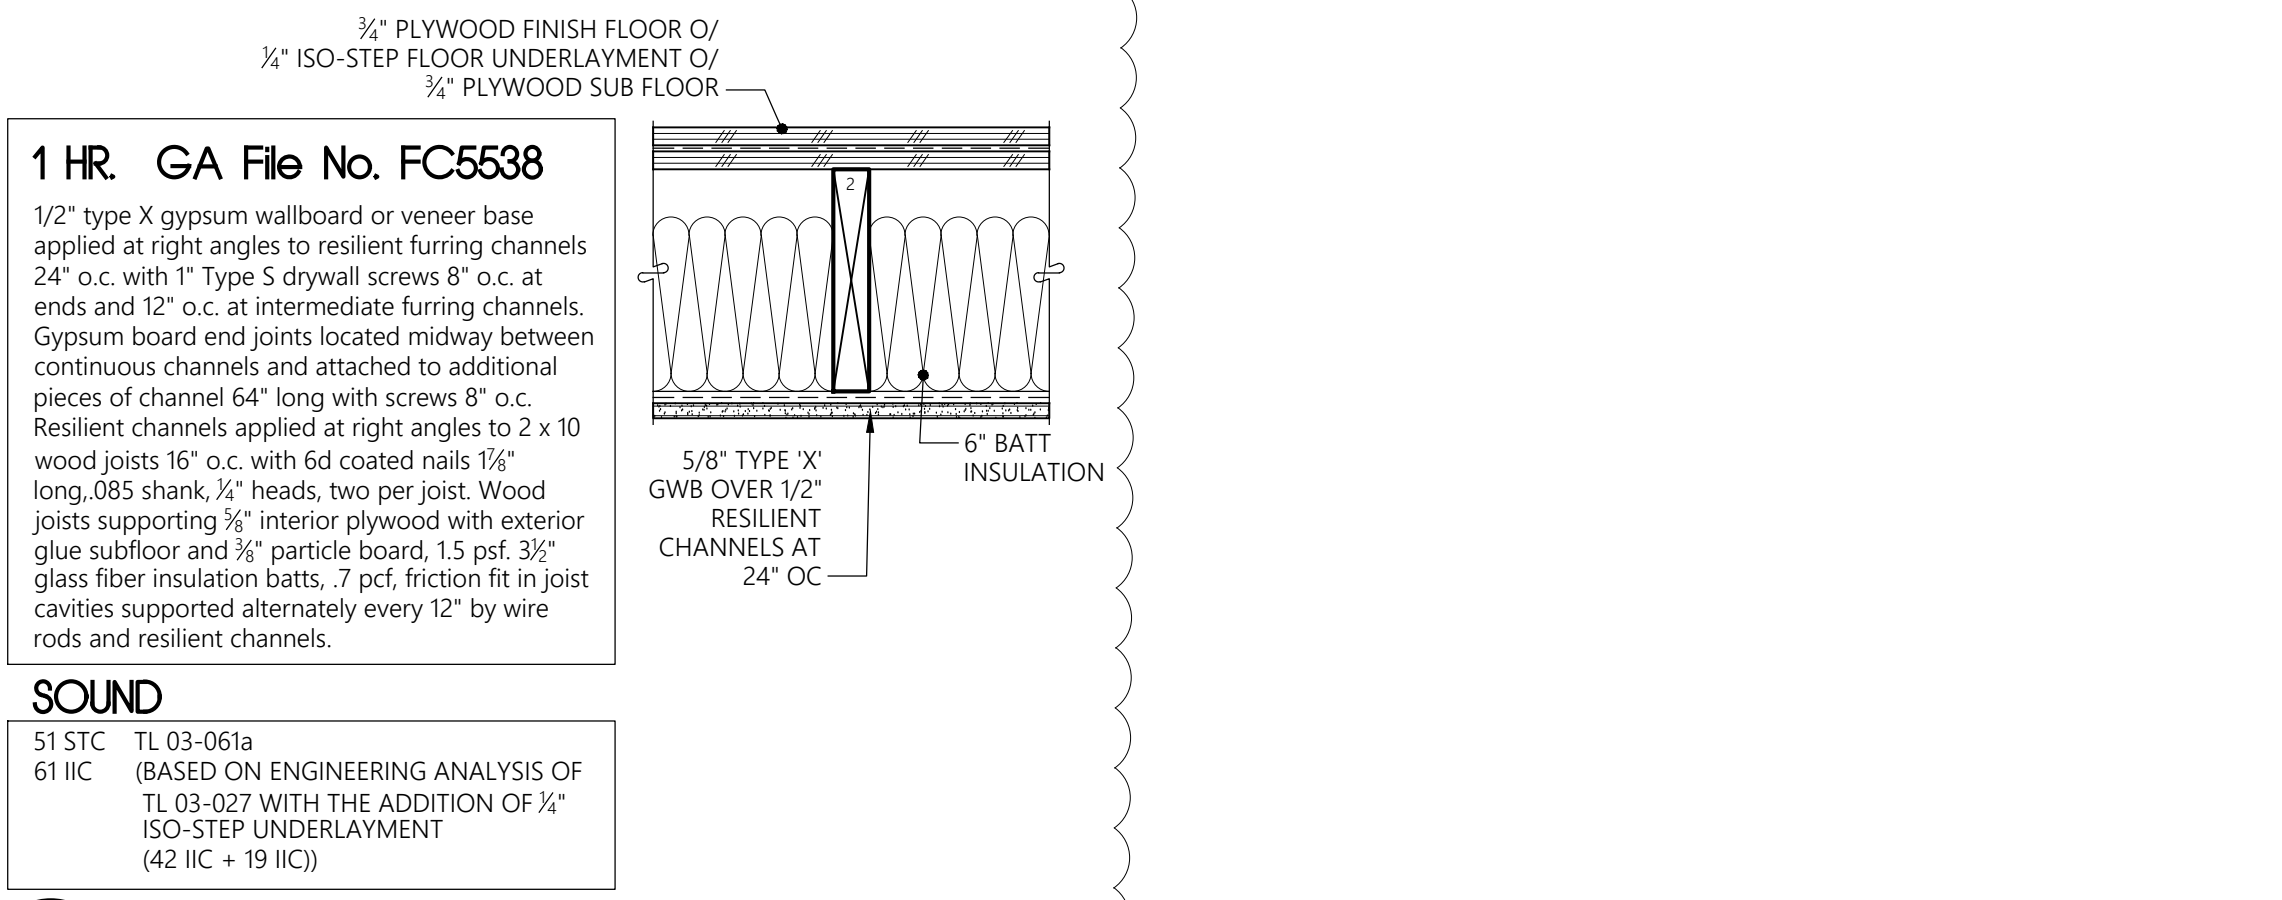

**14 FLOOR BENEATH TUB SECTION**  
 1 1/2" = 1'-0"

**1 HR. GA File No. FC5538**  
 1/2" type X gypsum wallboard or veneer base applied at right angles to resilient furring channels 24" o.c. with 1" Type S drywall screws 8" o.c. at ends and 12" o.c. at intermediate furring channels. Gypsum board end joints located midway between continuous channels and attached to additional pieces of channel 64" long with screws 8" o.c. Resilient channels applied at right angles to 2 x 10 wood joists 16" o.c. with 6d coated nails 1 1/2" long, .085 shank, 1/2" heads, two per joist. Wood joists supporting 5/8" interior plywood with exterior glue subfloor and 3/8" particle board, 1.5 psf. 3 1/2" glass fiber insulation batts, 7 pcf, friction fit in joist cavities supported alternately every 12" by wire rods and resilient channels.  
 5/8" TYPE 'X' GWB OVER 1/2" RESILIENT CHANNELS AT 24" O.C.  
 6" BATT INSULATION  
 SOUND  
 51 STC TL 03-061a  
 61 IIC (BASED ON ENGINEERING ANALYSIS OF TL 03-027 WITH THE ADDITION OF 1/4" ISO-STEP UNDERLAYMENT (42 IIC + 19 IIC))

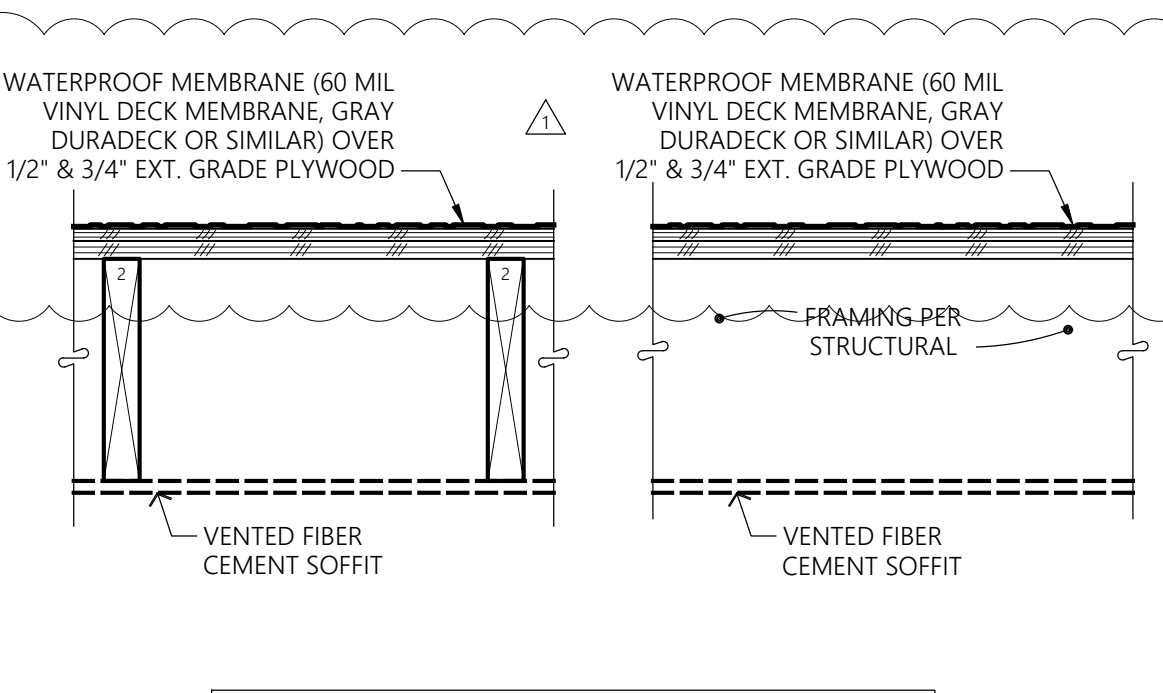


**19 WATERPROOF DECK FLOOR SECTION**  
 1 1/2" = 1'-0"

ASSEMBLY ALLOWED TO BE NON-RATED PER OSSC SECTIONS 705.2.2 AND 705.2.3 WITH FIRE SPRINKLERS PROTECTING DECK




**15 FLOOR AT CORRIDOR/LANDING SECTION**  
 1-1/2" = 1'-0"


CORRIDOR CEILING MUST MEET CLASS C FLAME SPREAD  
 FIBER CEMENT VENTED SOFFIT BOARD

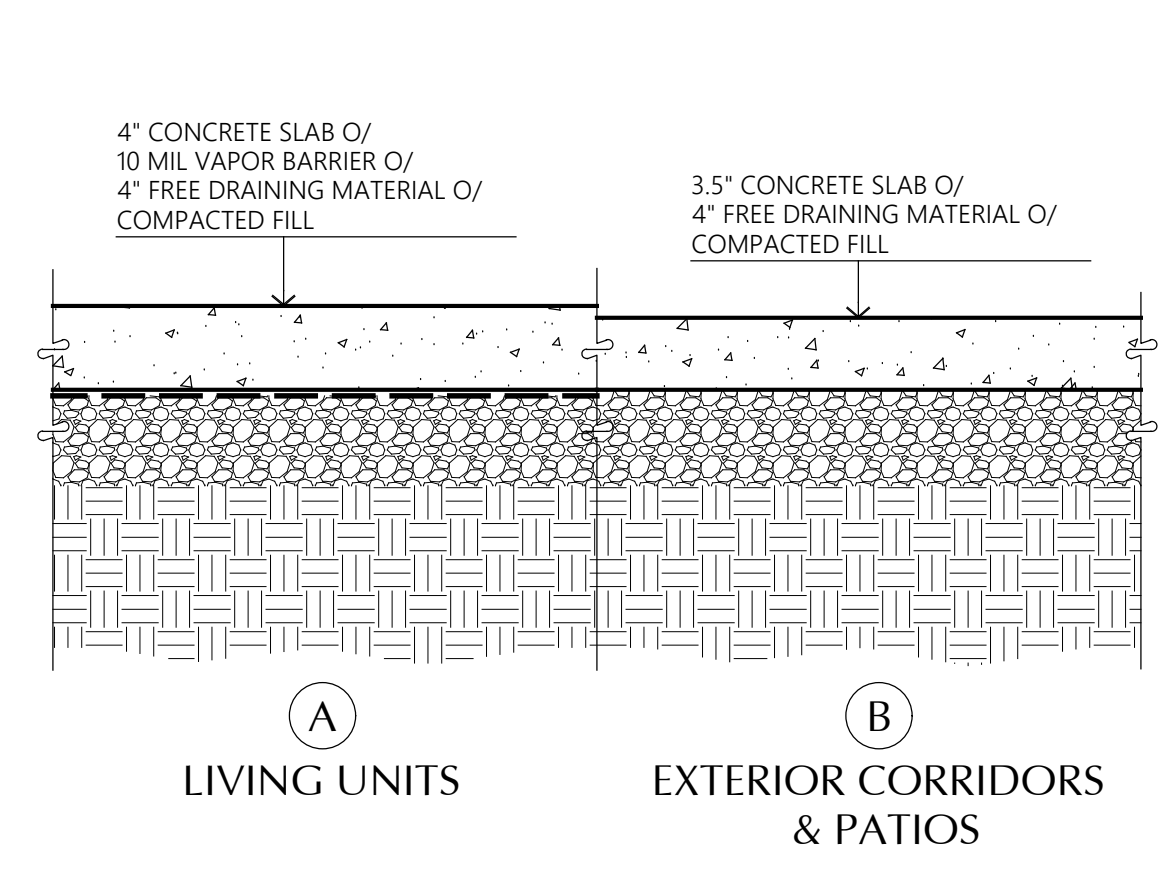


**20 TYP. SLAB-ON-GRADE SECTION**  
 1-1/2" = 1'-0"

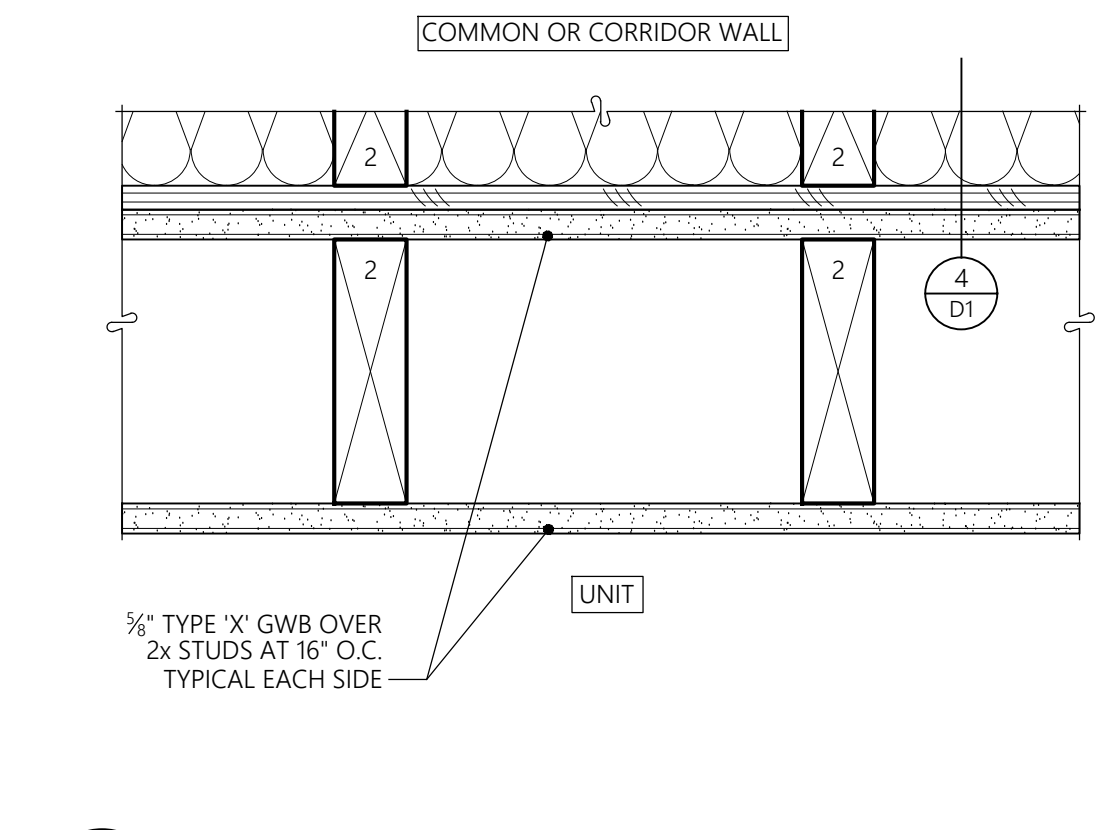

**6 FURRED PLUMBING WALL SECTION**  
 3" = 1'-0"

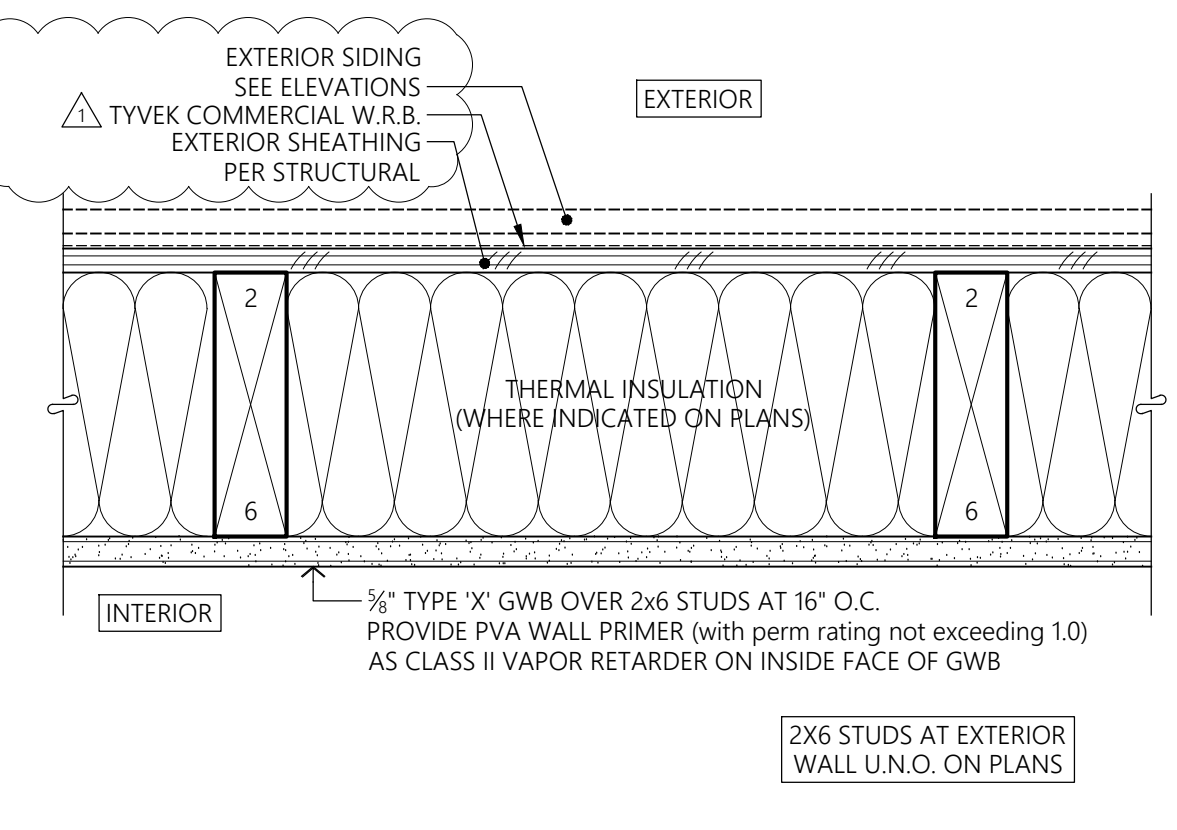

**1 TYPICAL EXTERIOR WALL SECTION**  
 3" = 1'-0"

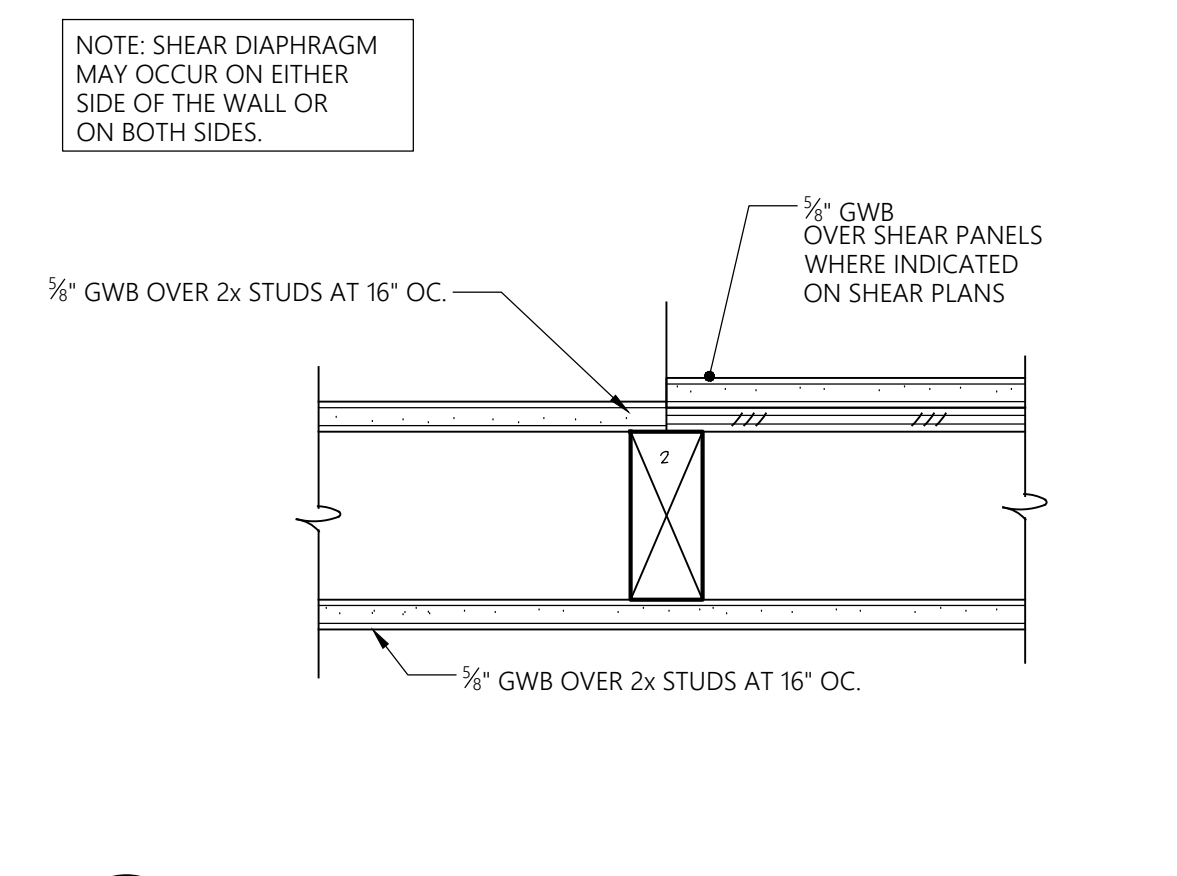


**2 TYP. INTERIOR WALL SECTION**  
 3" = 1'-0"




**8 BASEMENT RETAINING WALL SECTION**  
 1-1/2" = 1'-0"

NO SPRAY-ON OR SHEET-TYPE VAPOR BARRIER AT INTERIOR SIDE. PAINT W/ LATEX PAINT ONLY.  
 CONCRETE WALL SHALL BE DRY TO THE TOUCH AND CAVITY SHALL BE CLEAN OF DEBRIS BEFORE INSTALLING INSULATION AND GWB.

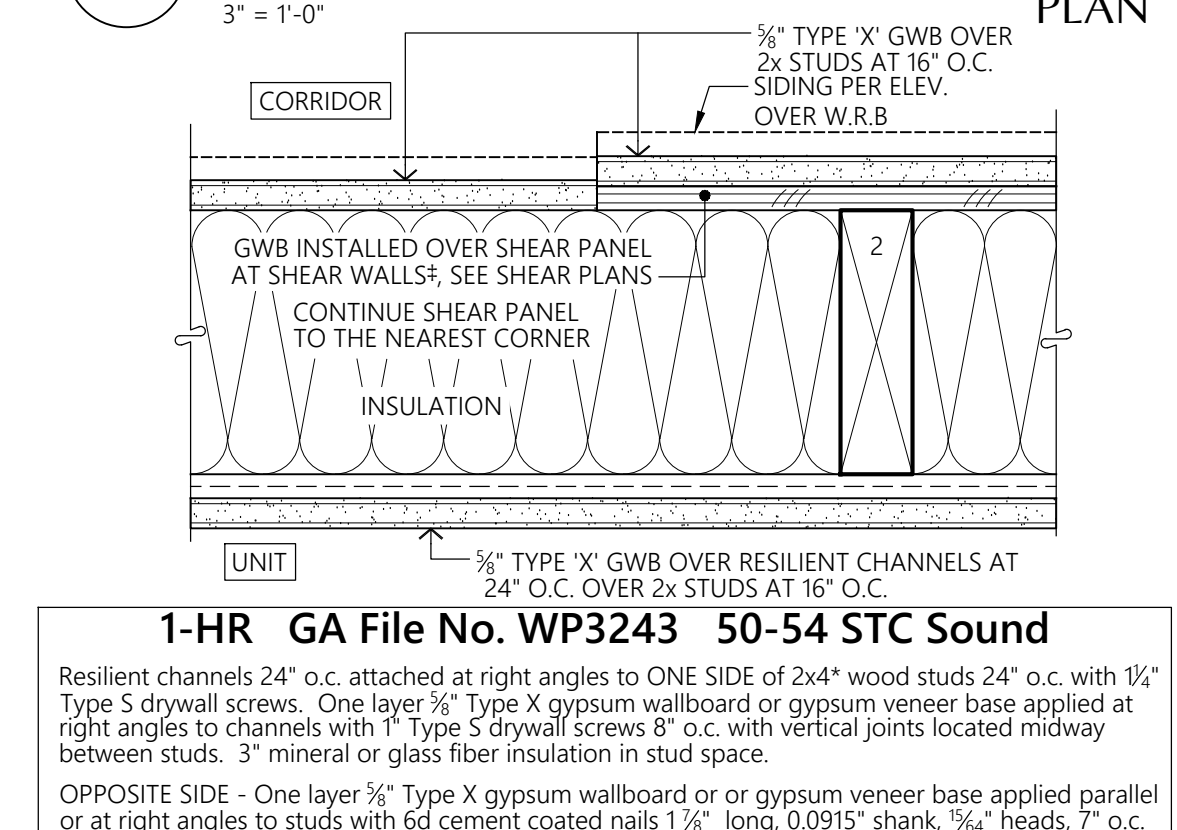

**3 TYP. 1-HR CORRIDOR WALL SECTION**  
 3" = 1'-0"


**1-HR GA File No. WP3243 50-54 STC Sound**  
 Resilient channels 24" o.c. attached at right angles to ONE SIDE of 2x4" wood studs 24" o.c. with 1 1/2" Type S drywall screws. One layer 5/8" Type X gypsum wallboard or gypsum veneer base applied at right angles to channels with 1" Type S drywall screws 8" o.c. with vertical joints located midway between studs. 3" mineral or glass fiber insulation in stud space.  
 OPPOSITE SIDE - One layer 5/8" Type X gypsum wallboard or gypsum veneer base applied parallel or at right angles to studs with 6d cement coated nails 1 1/2" long, 0.0915" shank, 3/16" heads, 7" o.c. Vertical joints staggered 24" on opposite sides. (LOAD-BEARING)  
 \* Per general note 16 greater stud sizes are permitted than those specified.  
 † At shear walls, increase fastener length by the thickness of the shear panel

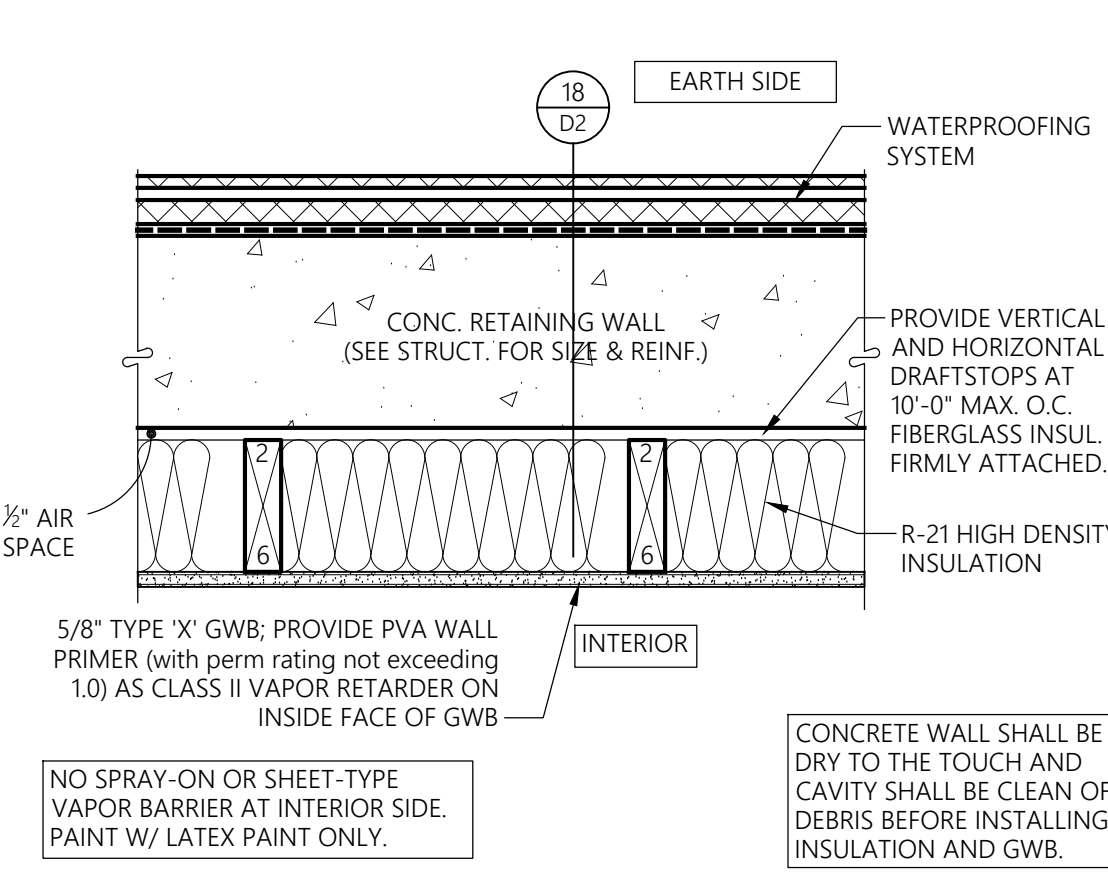


**4 TYP. 1-HR COMMON WALL SEPARATING DWELLING UNITS SECTION**  
 3" = 1'-0"

**1-HR Using Calculated Fire Resistance Method**  
 Using IBC Section 722, Tables 722.6.2(1) and 722.6.2(2), 5/8" Type 'X' GWB (40 min.) and studs at 16" o.c. (20 min.) provide 60 minutes of protection  
 DETAIL SIMILAR WHERE UNIT SEPARATION WALL CONTINUES DOWN TO GARAGES


No.	Date	Description
1	8-30-24	Owner Changes/ Permit Corrections

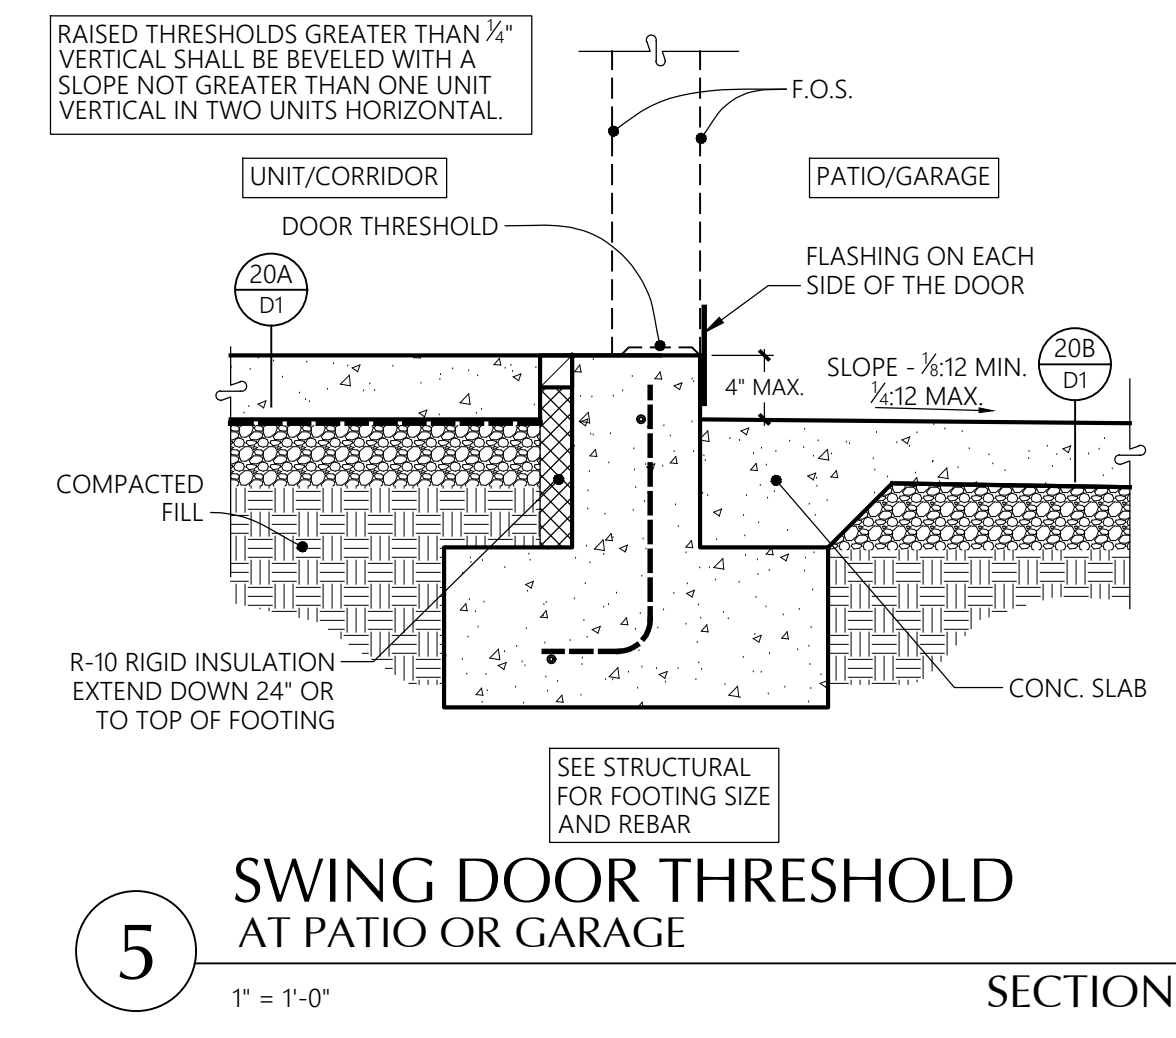


**5** SWING DOOR THRESHOLD AT PATIO OR GARAGE  
1" = 1'-0" SECTION

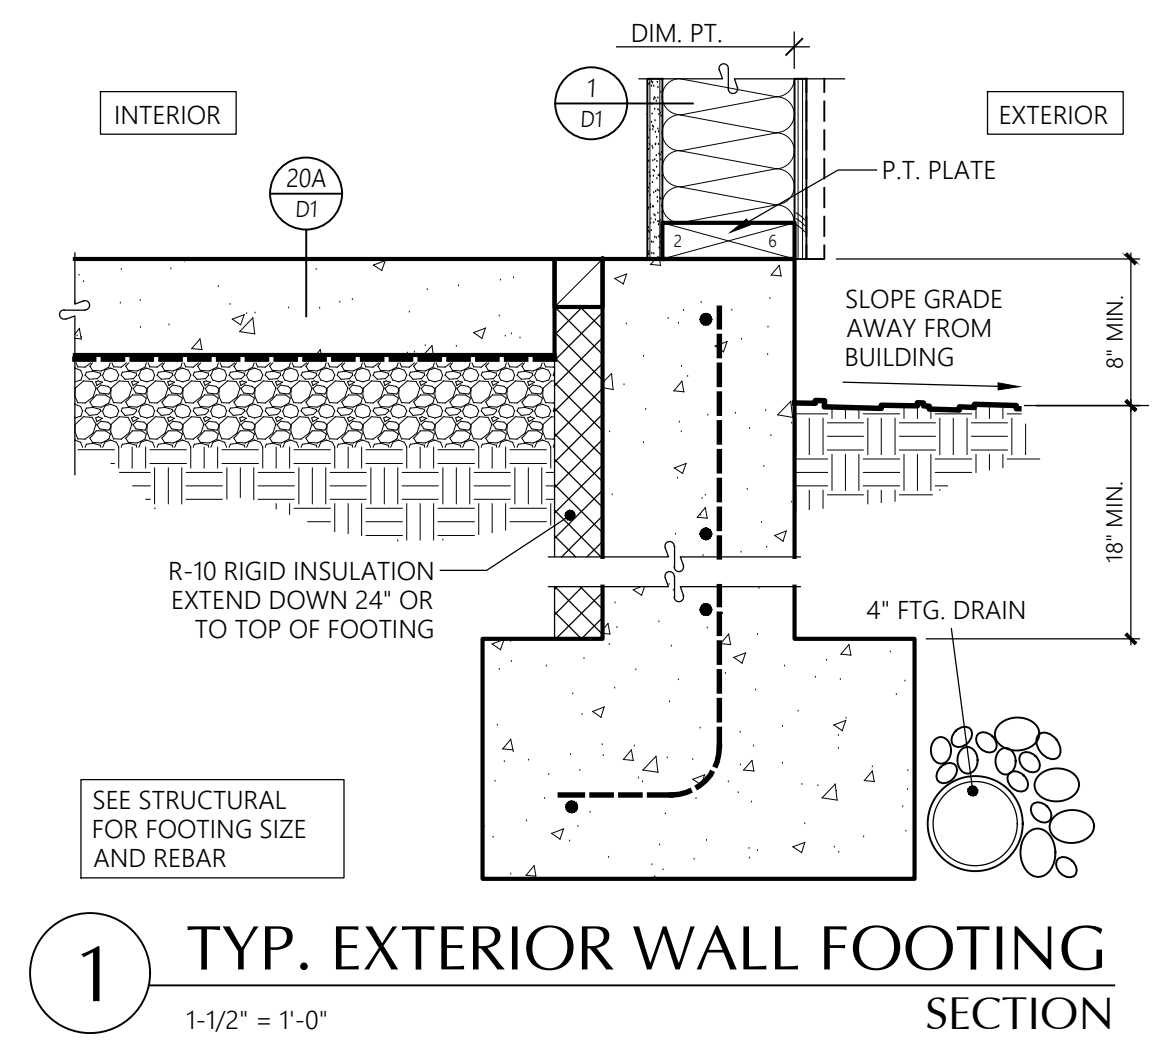


**1** TYP. EXTERIOR WALL FOOTING  
1-1/2" = 1'-0" SECTION

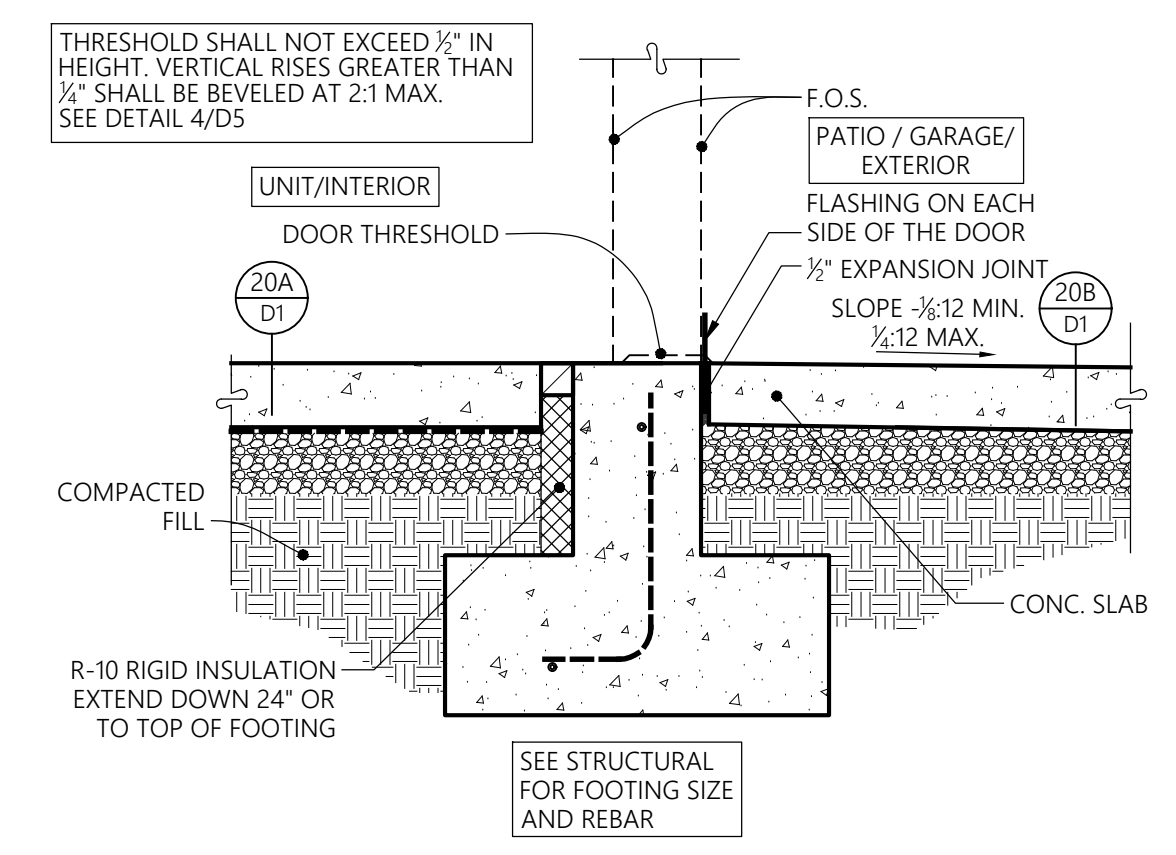


**6** SWING DOOR THRESHOLD AT ACCESSIBLE ENTRANCE  
1" = 1'-0" SECTION

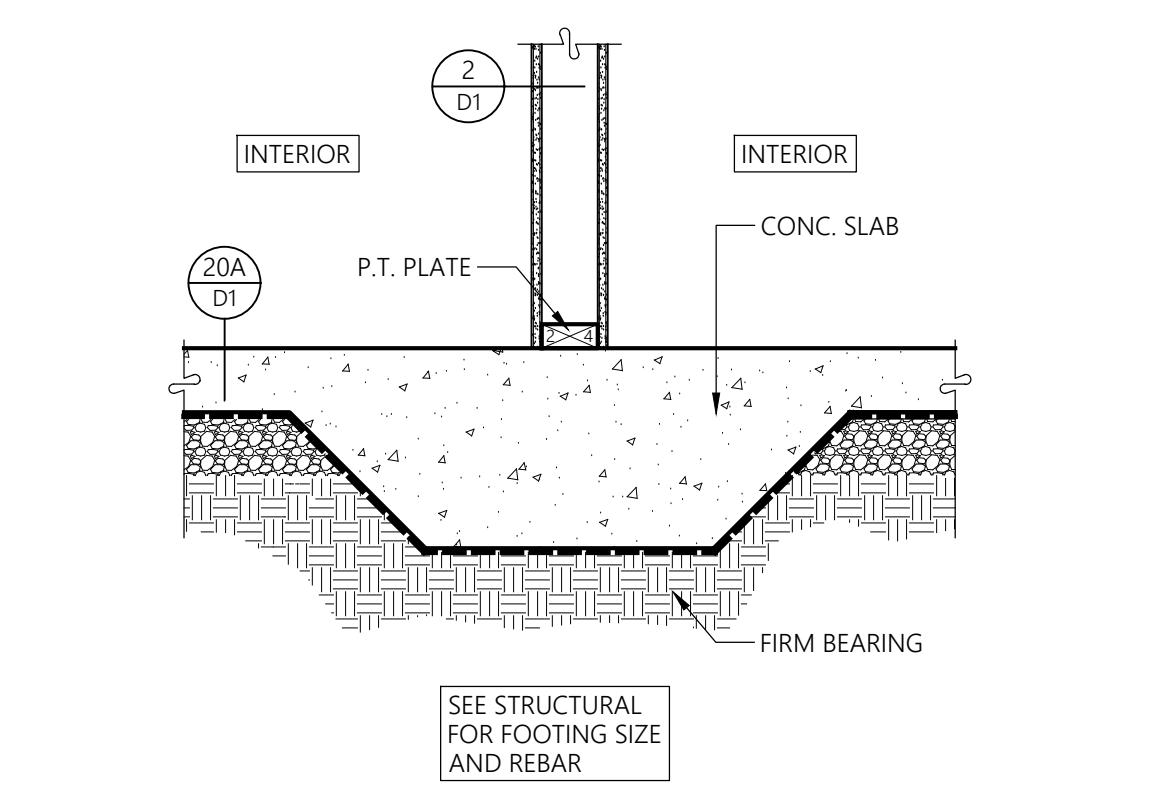


**2** INTERIOR WALL FOOTING  
1" = 1'-0" SECTION

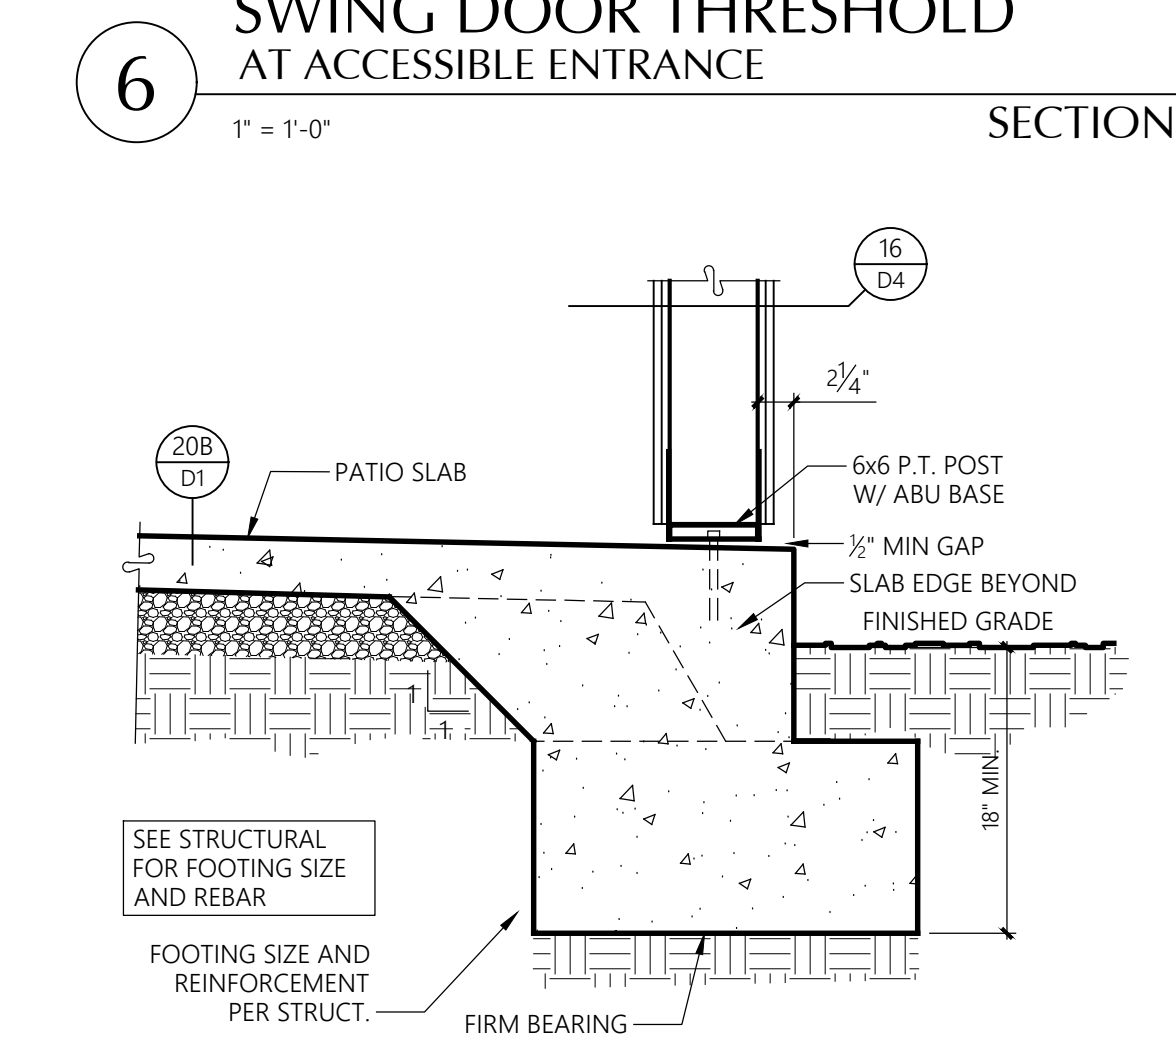


**7** POST FOOTING AT PATIO  
1" = 1'-0" SECTION

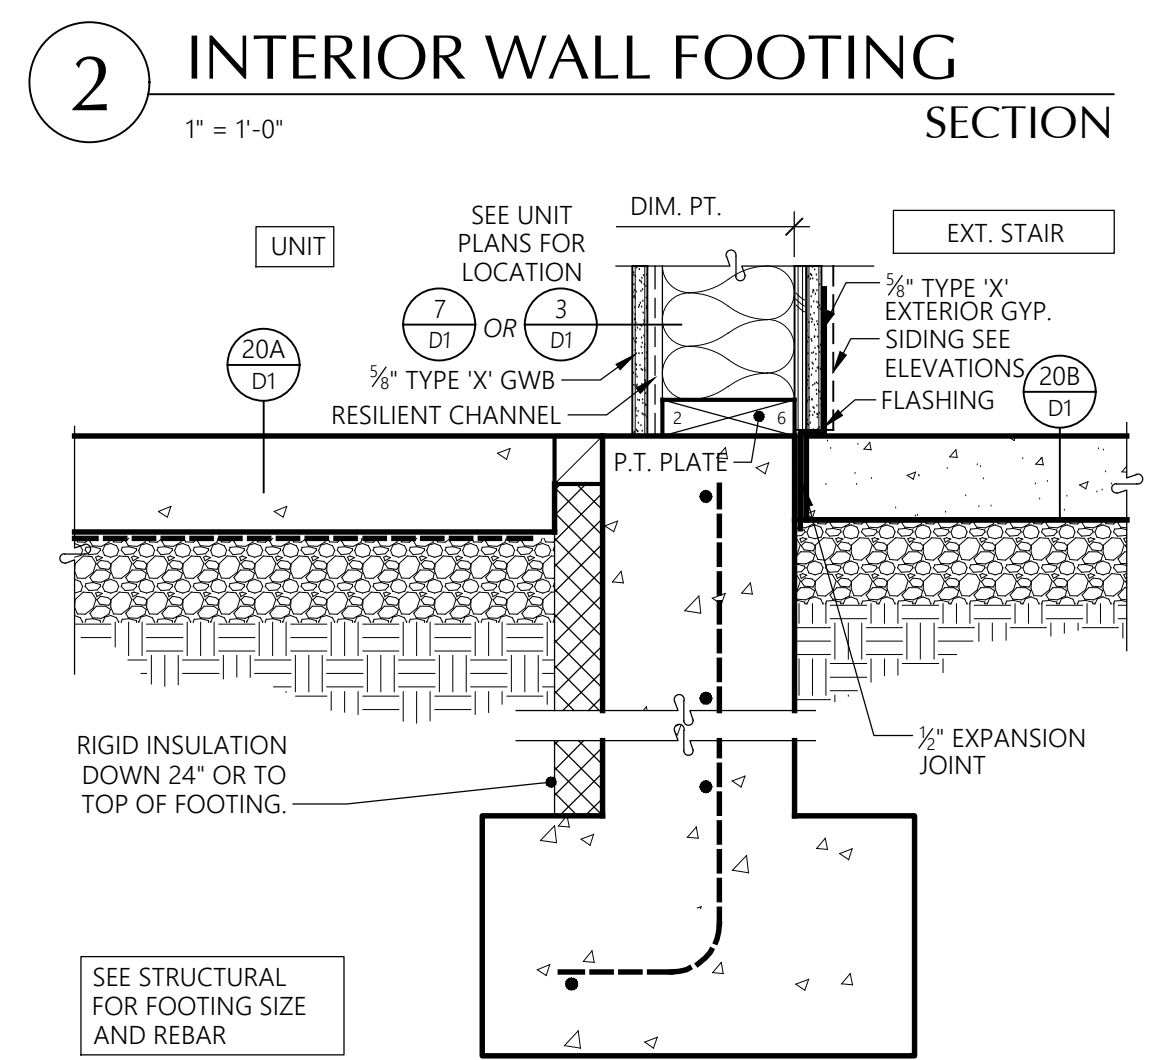


**3** TYP. STAIR WALL FOOTING  
1 1/2" = 1'-0" SECTION

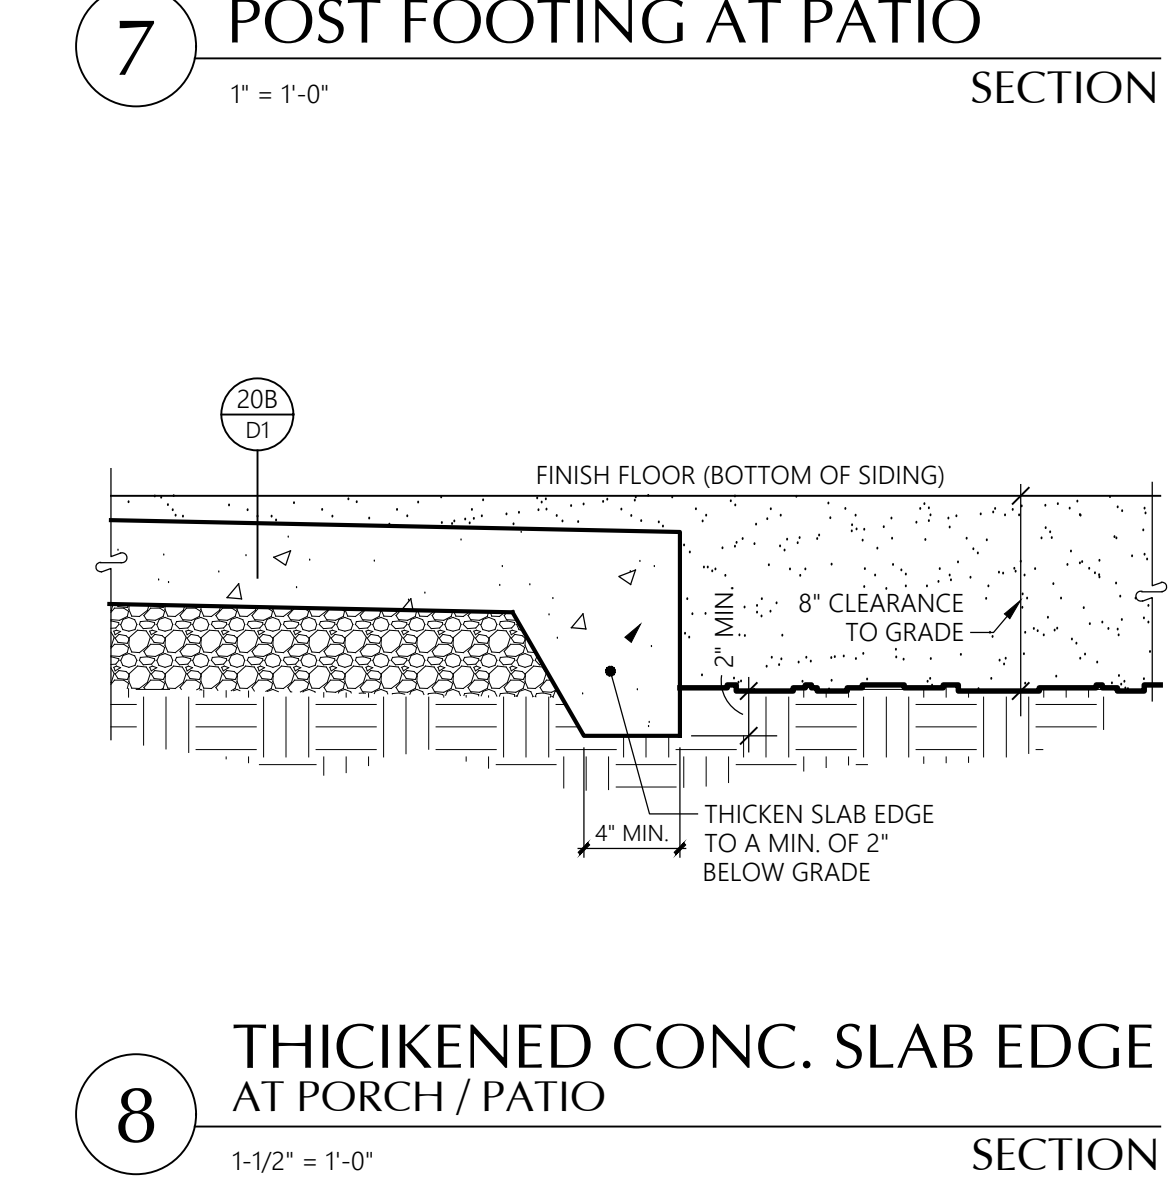

**8** THICKENED CONC. SLAB EDGE AT PORCH / PATIO  
1-1/2" = 1'-0" SECTION


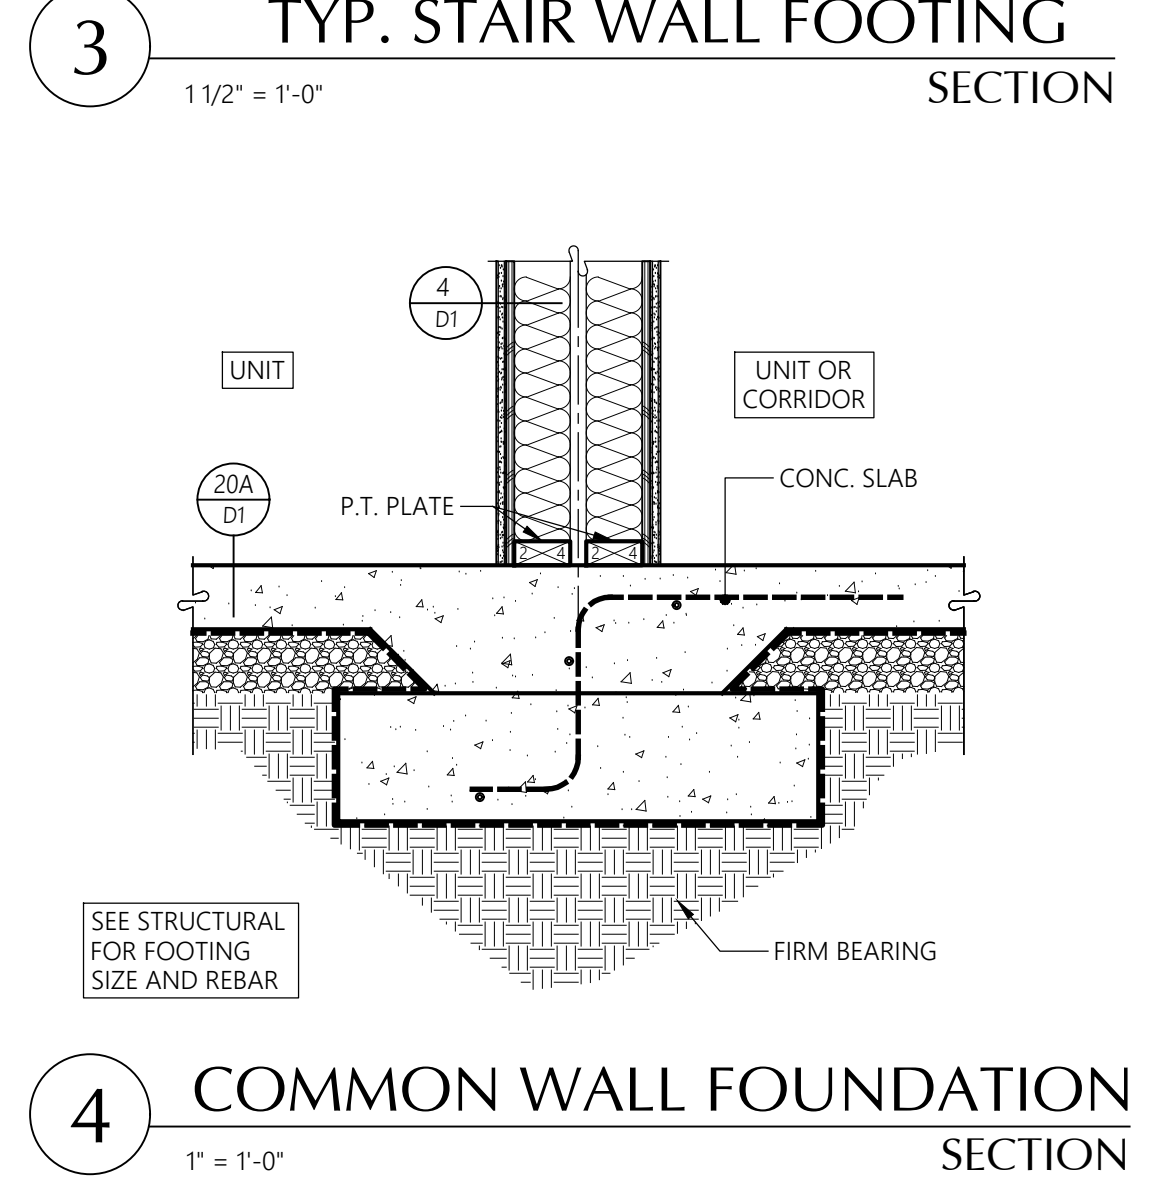


**4** COMMON WALL FOUNDATION  
1" = 1'-0" SECTION


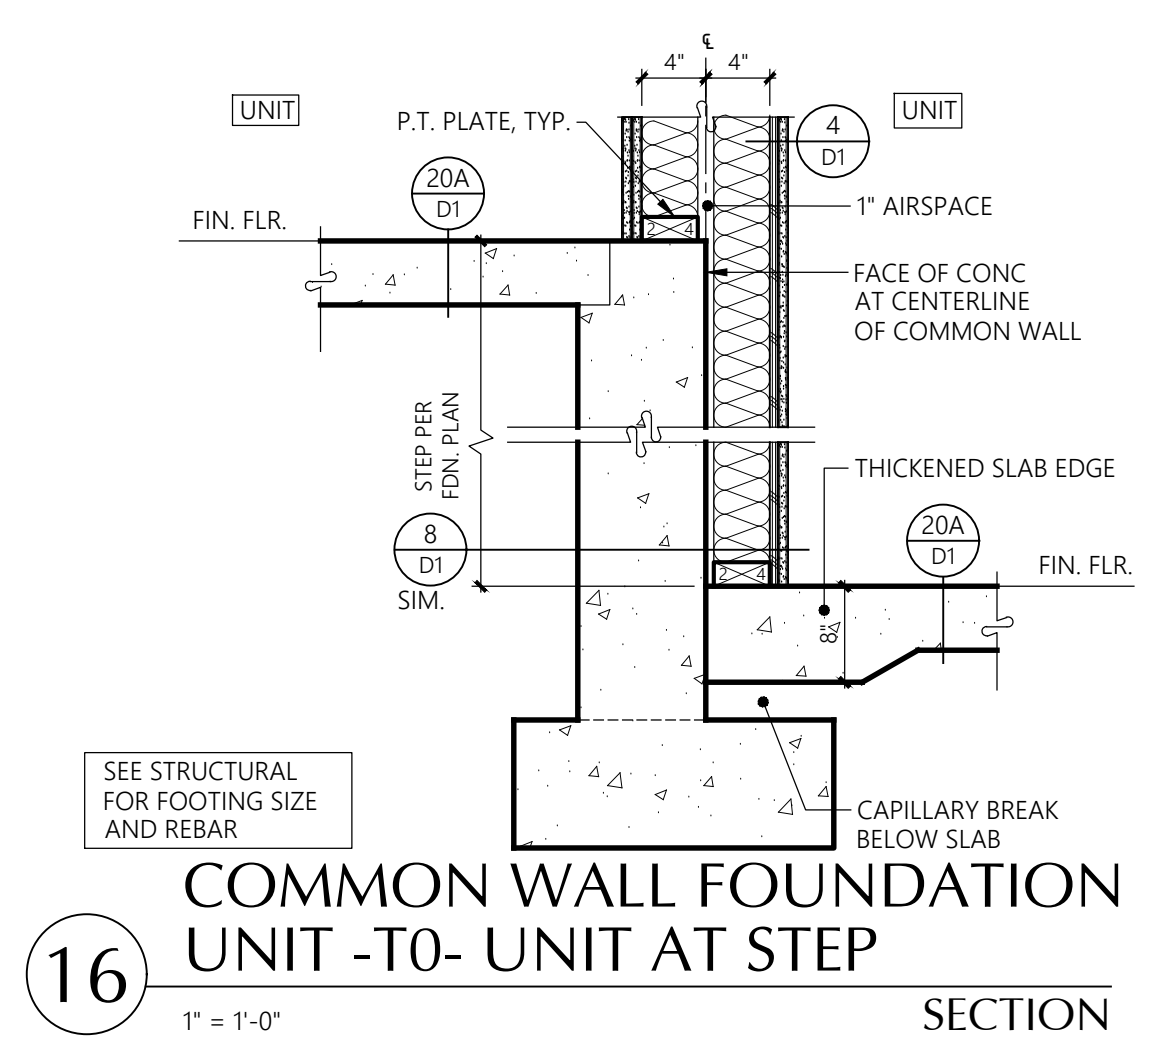


**16** COMMON WALL FOUNDATION UNIT -TO- UNIT AT STEP  
1" = 1'-0" SECTION

PT 12/20/24 DETAILS (01-10X) DWG

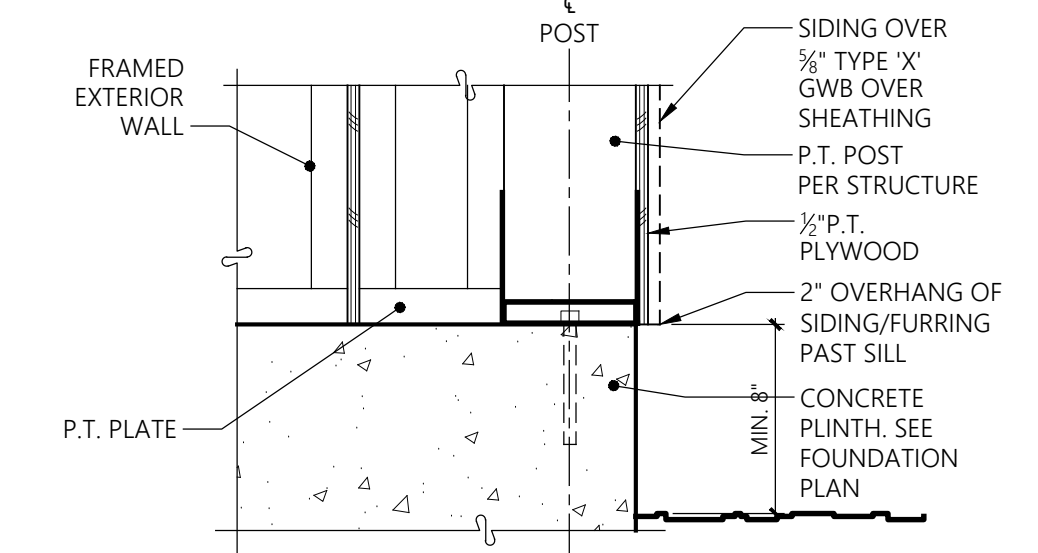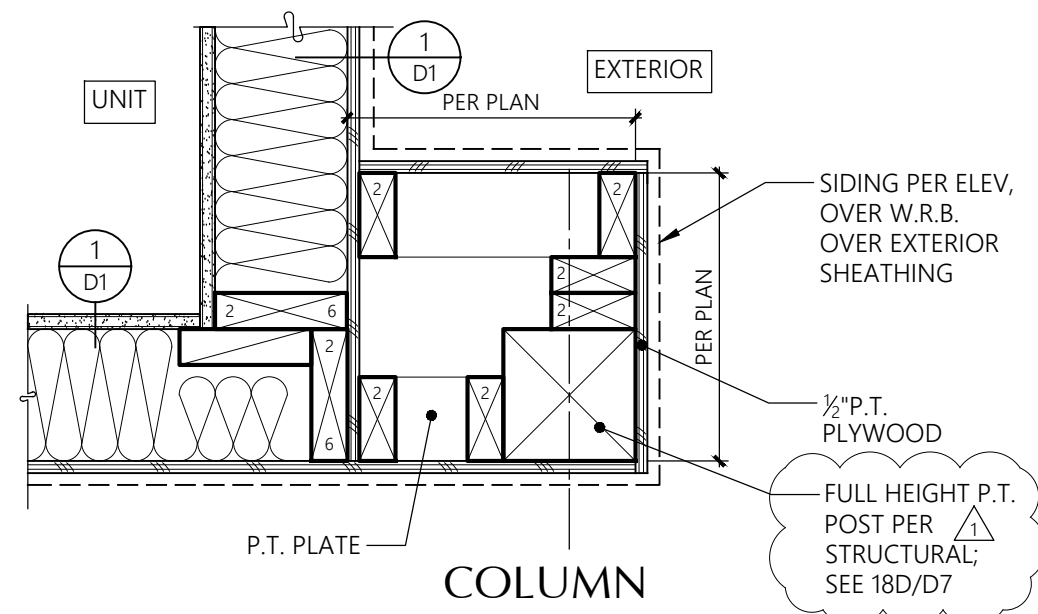


**17** FURRED COLUMN  
1-1/2" = 1'-0"

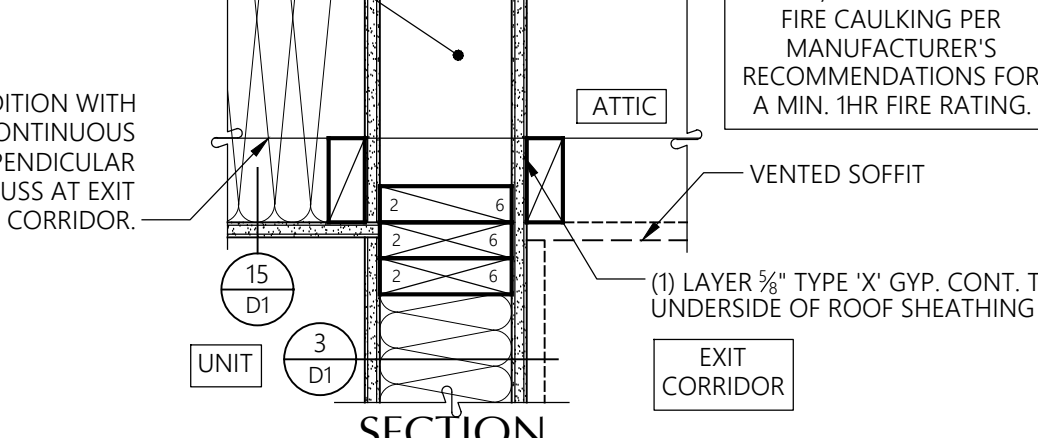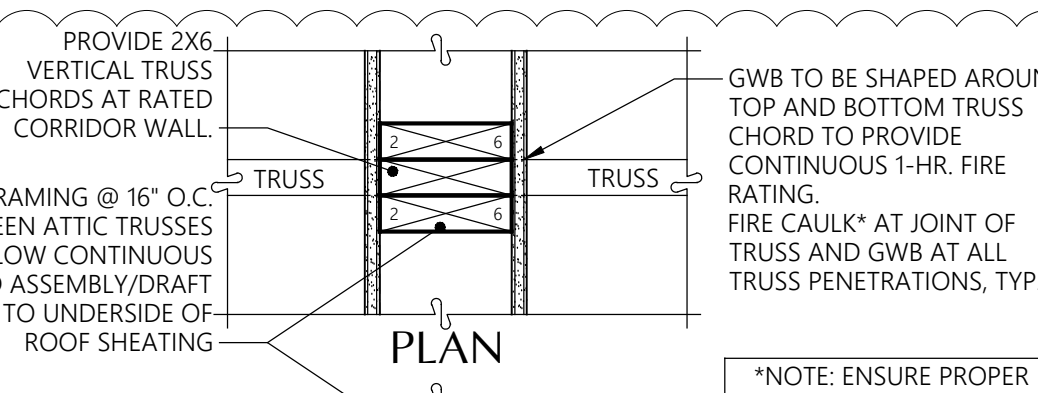


**18** ATTIC SEPARATION @ CONT. PERP. TRUSS @ RATED CORRIDOR WALL  
1-1/2" = 1'-0"


DETAIL REMOVED

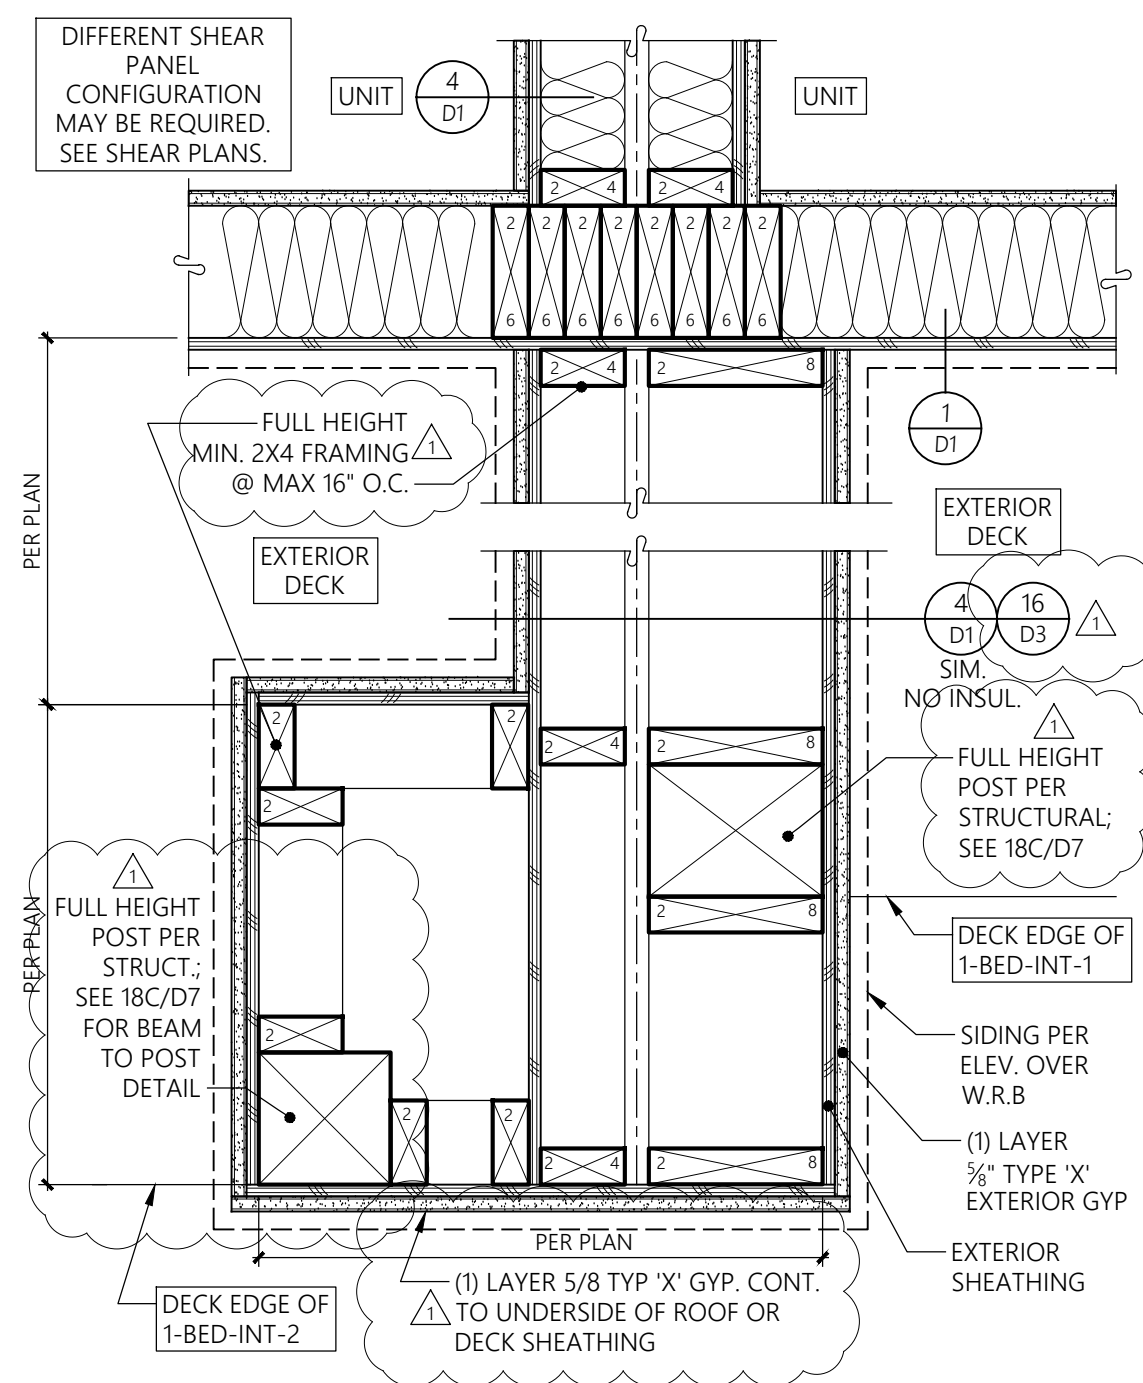


**15** UNIT SEP. WALL AT DECK  
1-1/2" = 1'-0"

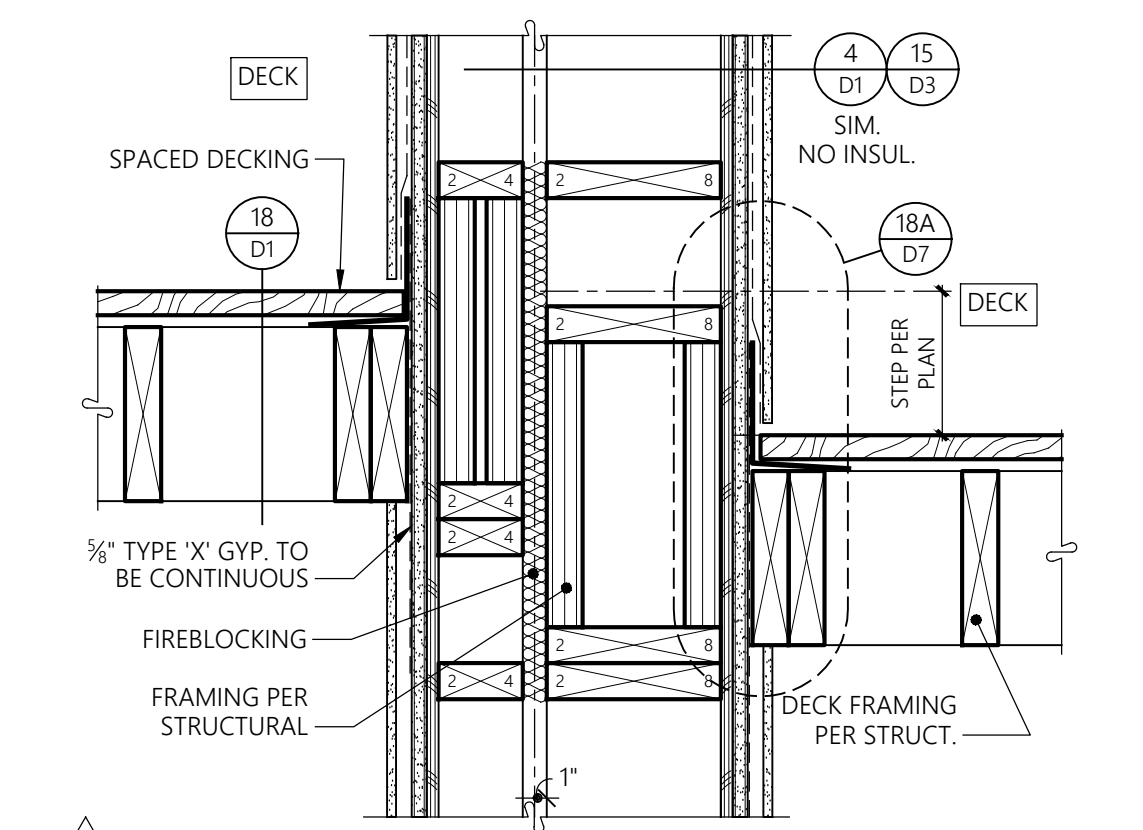


**16** STEPPED COMMON WALL @ SPACED DECKING  
1-1/2" = 1'-0"

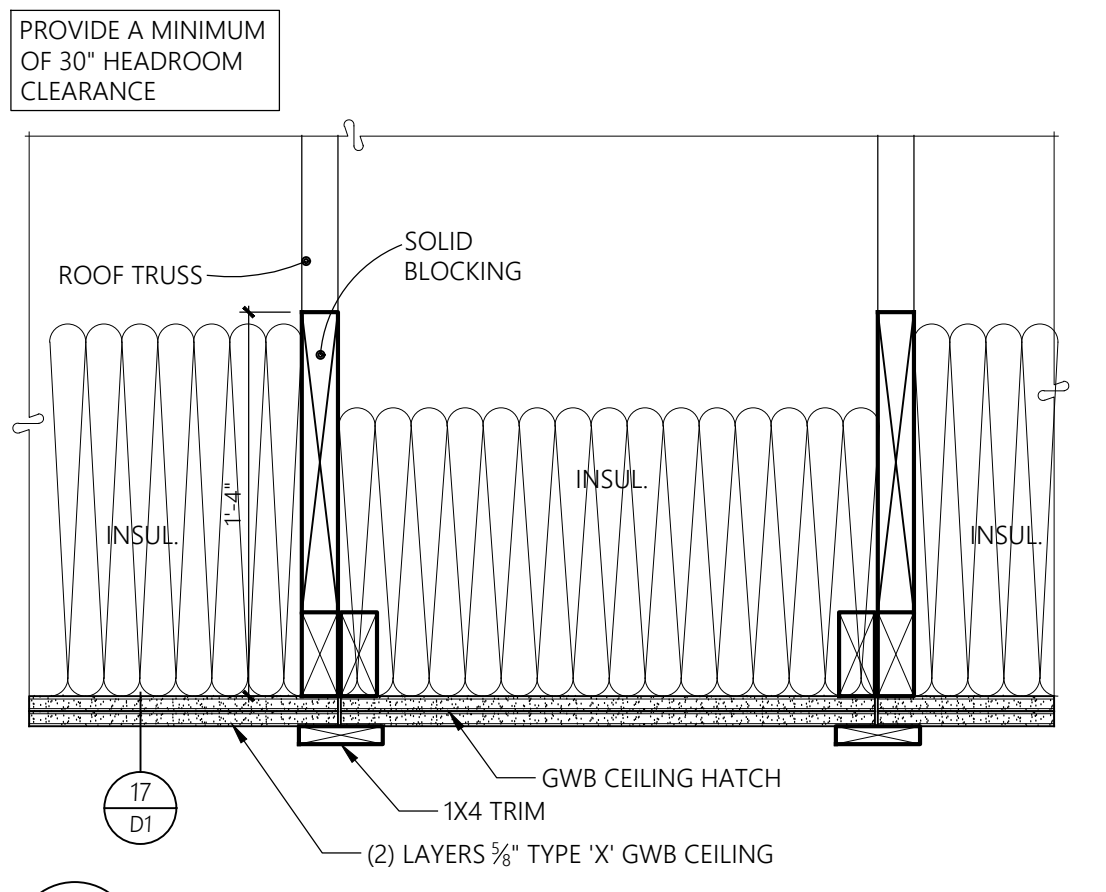


**9** ATTIC ACCESS  
1-1/2" = 1'-0"

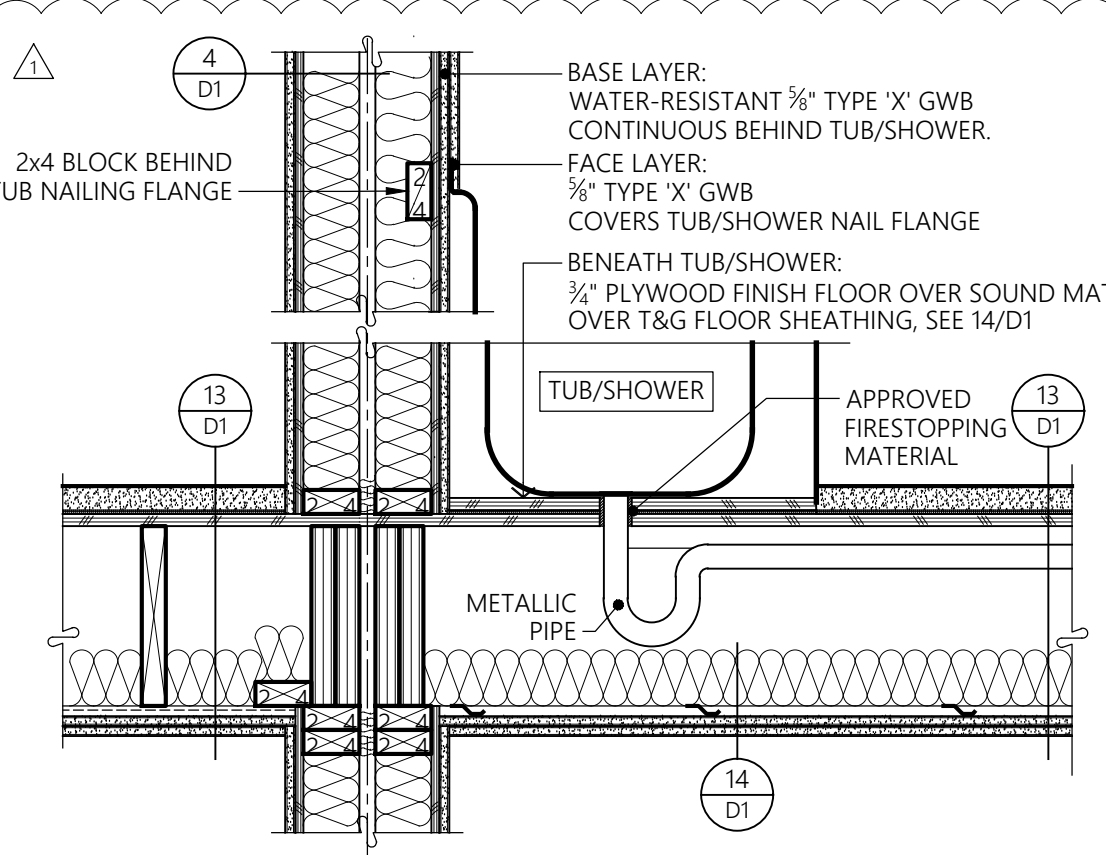


**10** TUB/SHOWER AT 1-HR SEP. WALL  
1" = 1'-0"

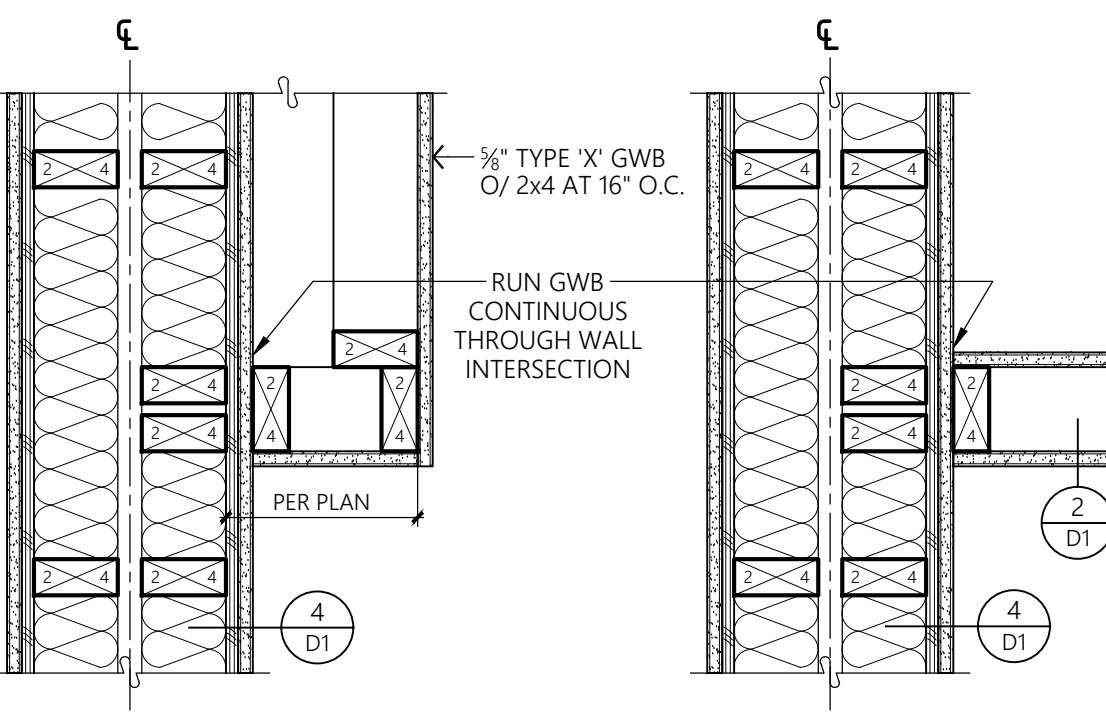


**11** INTERIOR WALL AT UNIT SEP. WALL  
1-1/2" = 1'-0"

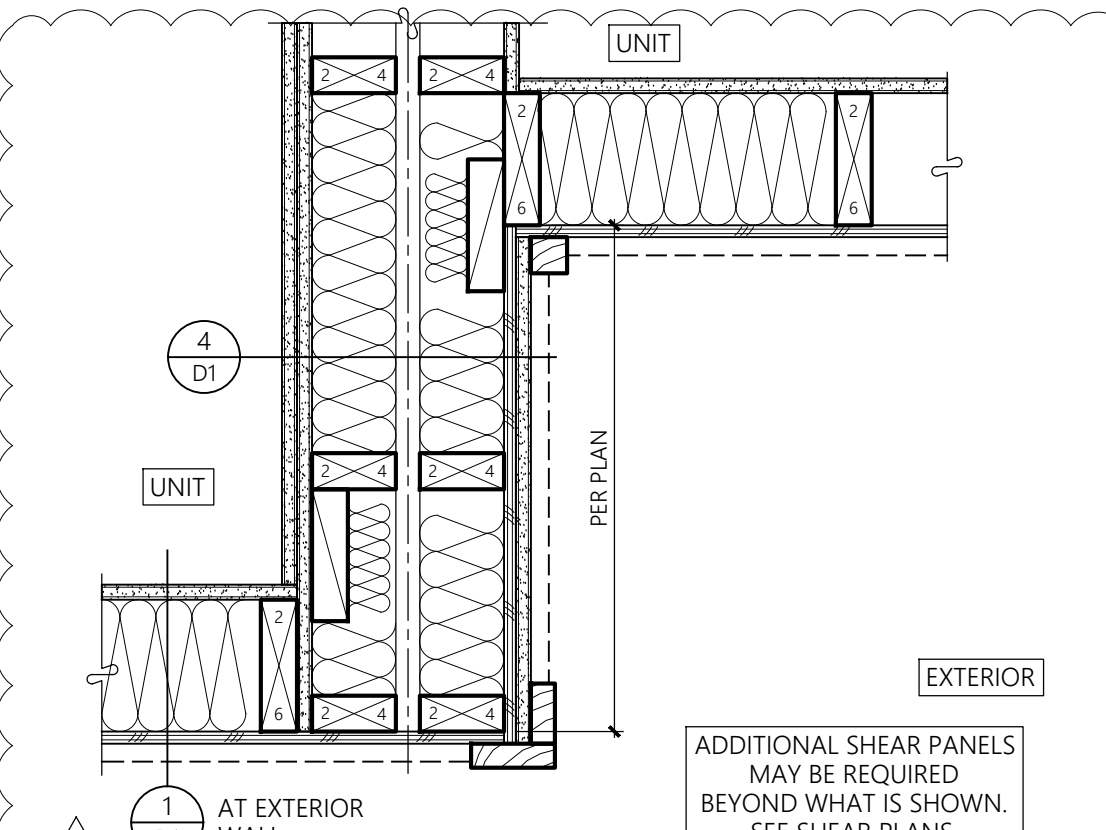


**12** UNIT SEP. WALL AT BLDG. JOG  
1-1/2" = 1'-0"

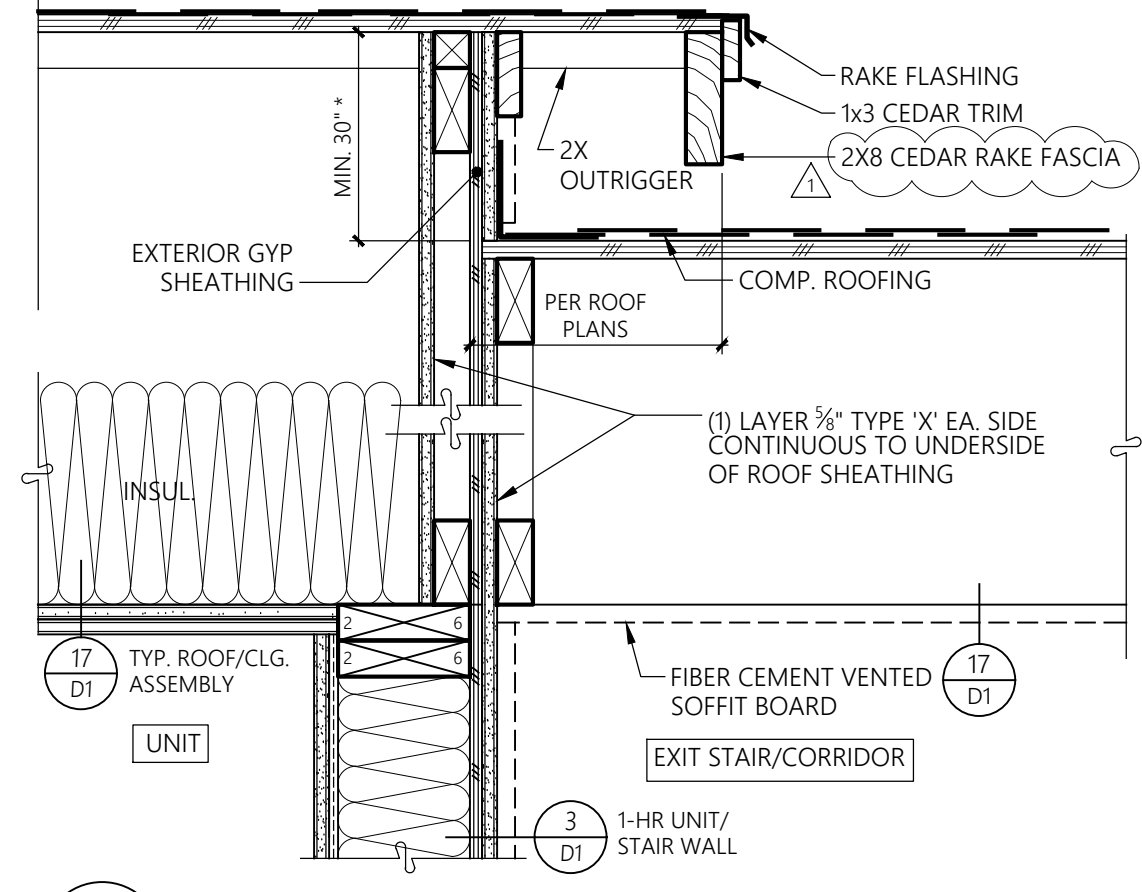


**5** 1-HR STAIR WALL AT ROOF  
1-1/2" = 1'-0"

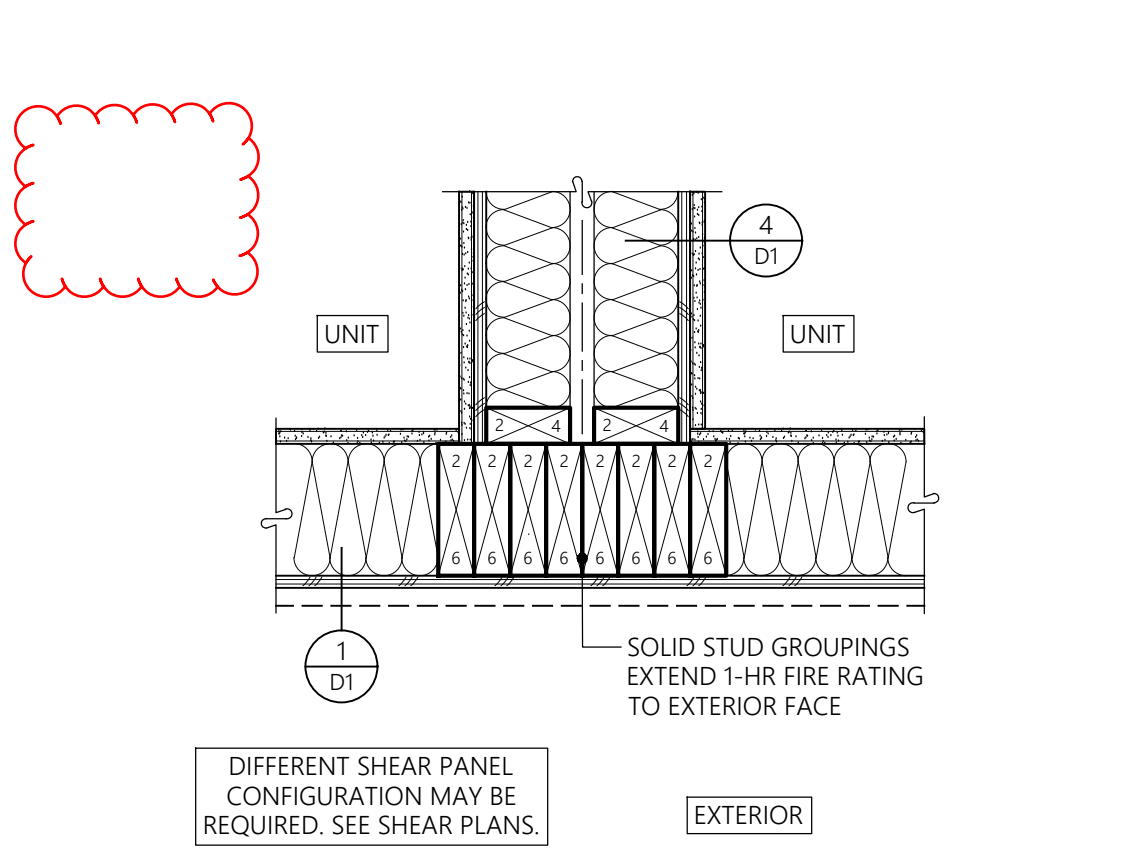


**6** UNIT SEP. WALL AT EXT. WALL  
1-1/2" = 1'-0"

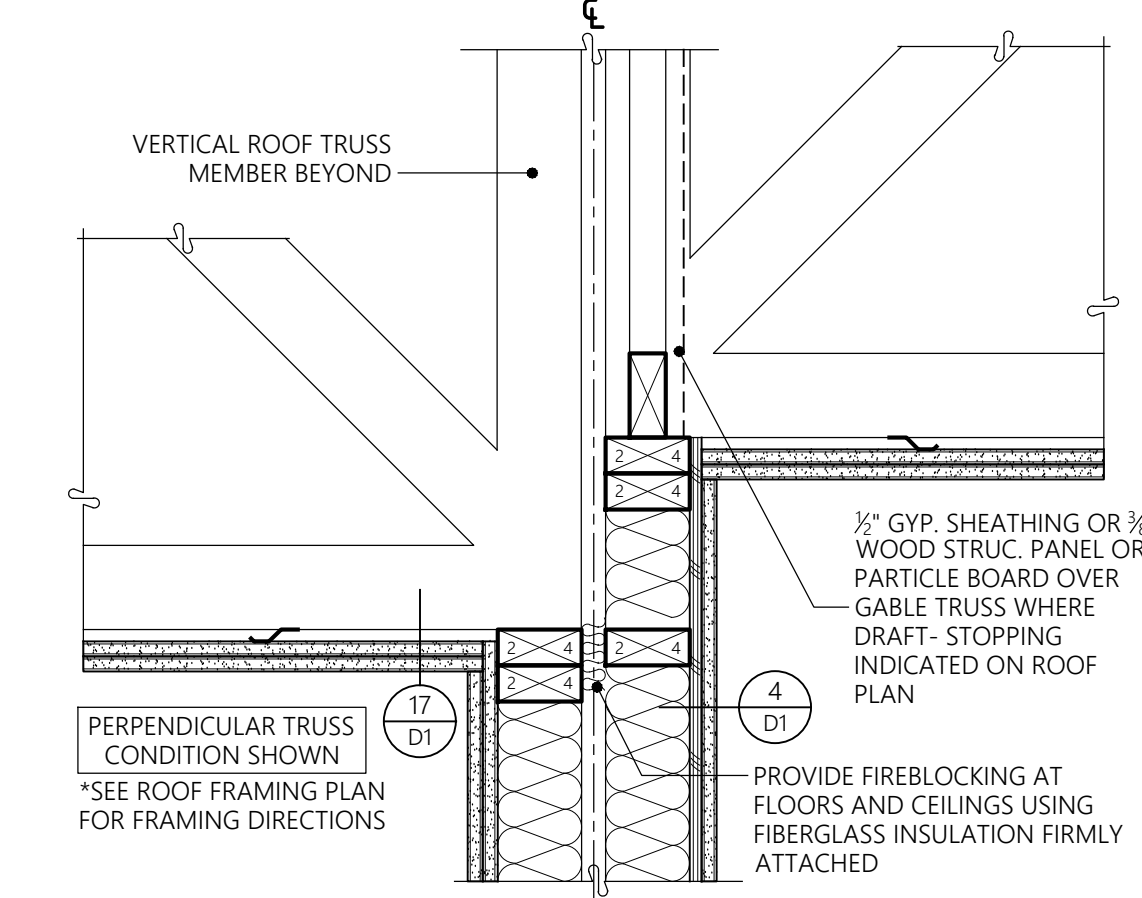


**7** UNIT SEP. WALL AT STEPPED ROOF  
1-1/2" = 1'-0"

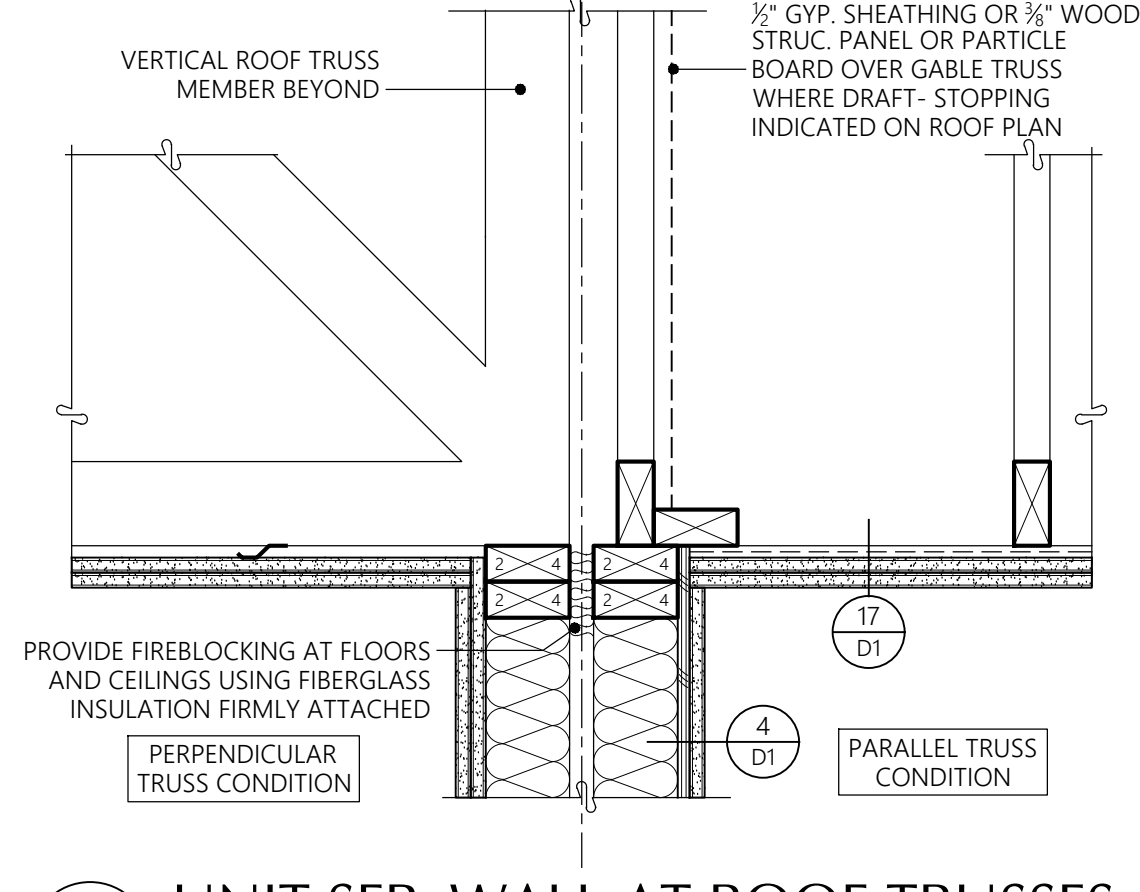


**1** UNIT SEP. WALL AT ROOF TRUSSES  
1-1/2" = 1'-0"

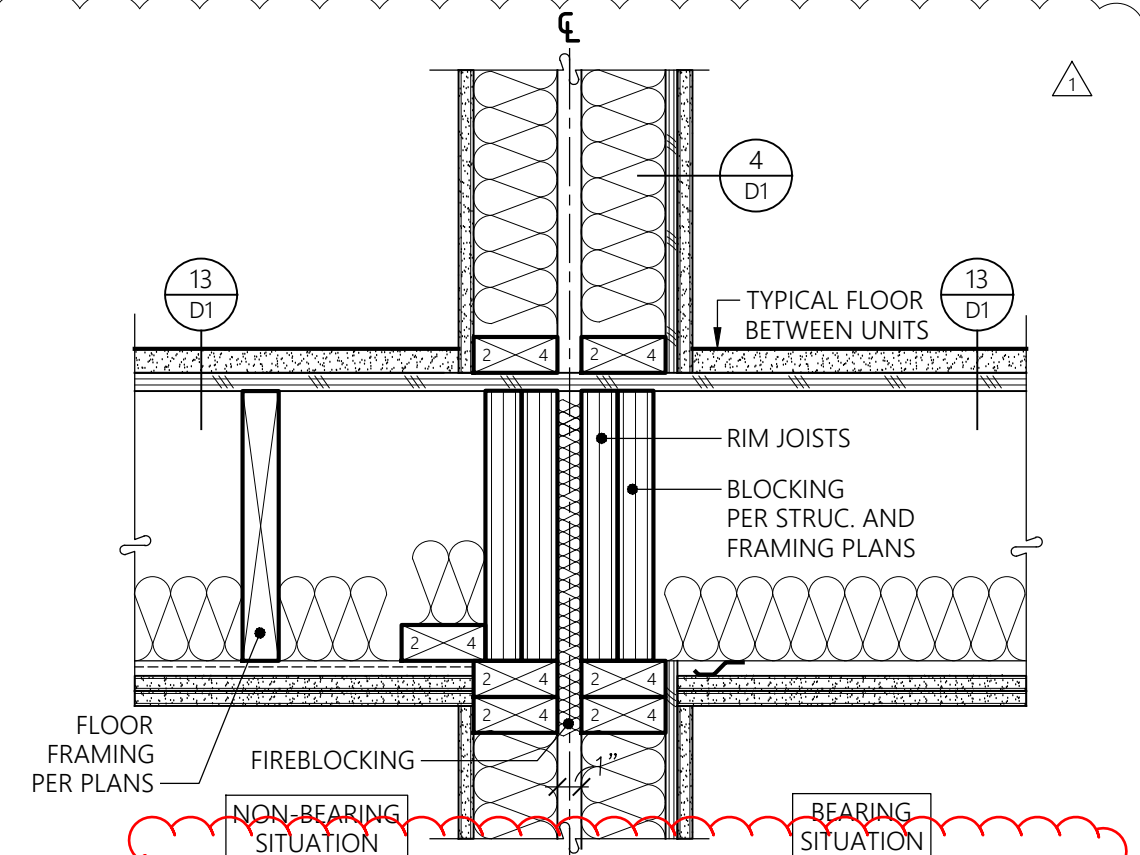

**2** UNIT SEPAR. AT FLOOR  
1-1/2" = 1'-0"

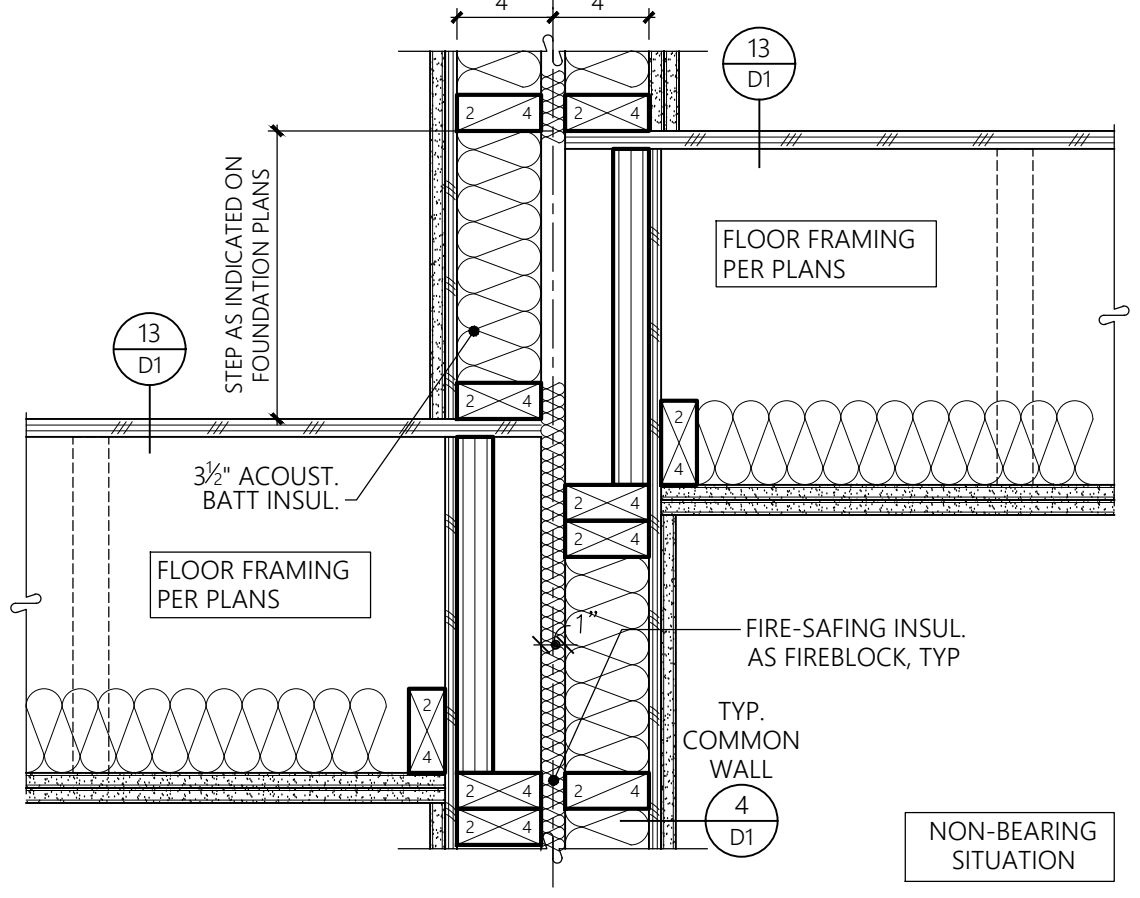























**3** COMMON WALL AT STEPPED FLOOR  
1-1/2" = 1'-0"

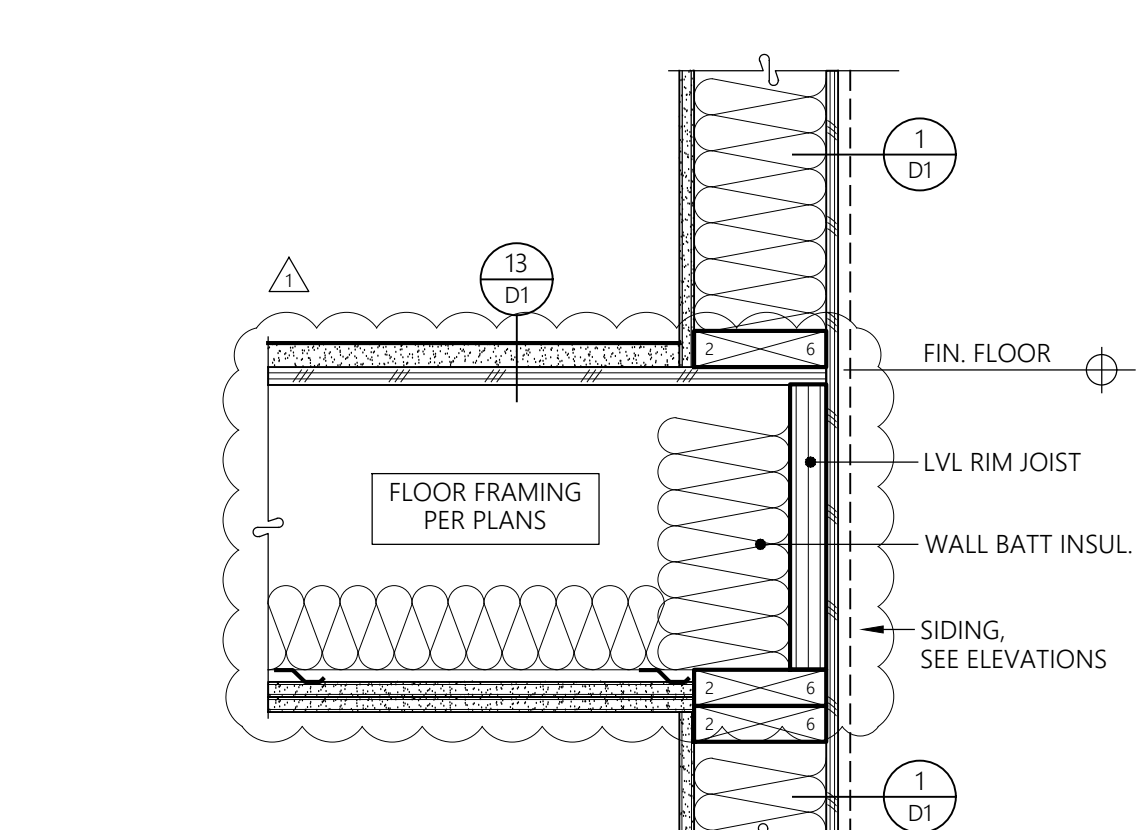


**4** EXTERIOR WALL AT FLOOR  
1-1/2" = 1'-0"

No.	Date	Description
1	8-30-24	Owner Changes/ Permit Corrections


No.	Date	Description
1	8-30-24	Owner Changes/ Permit Corrections

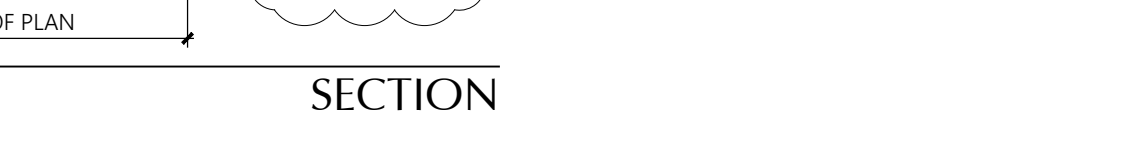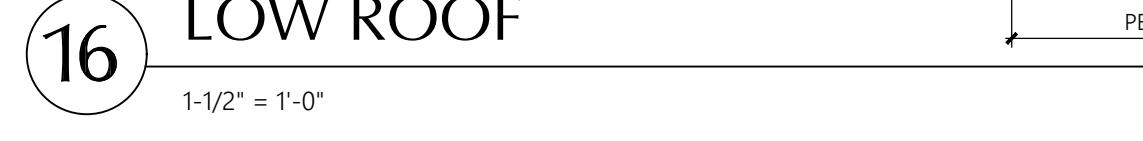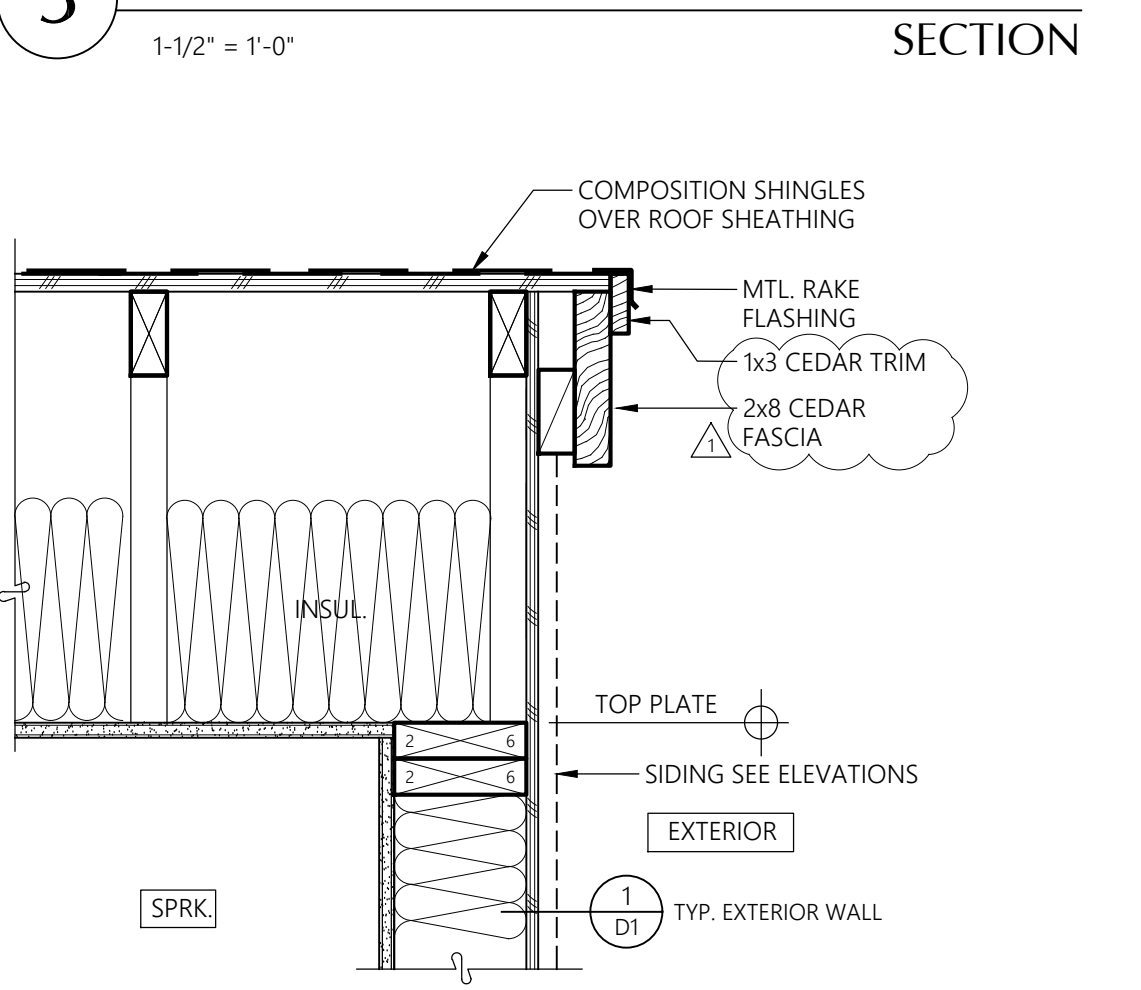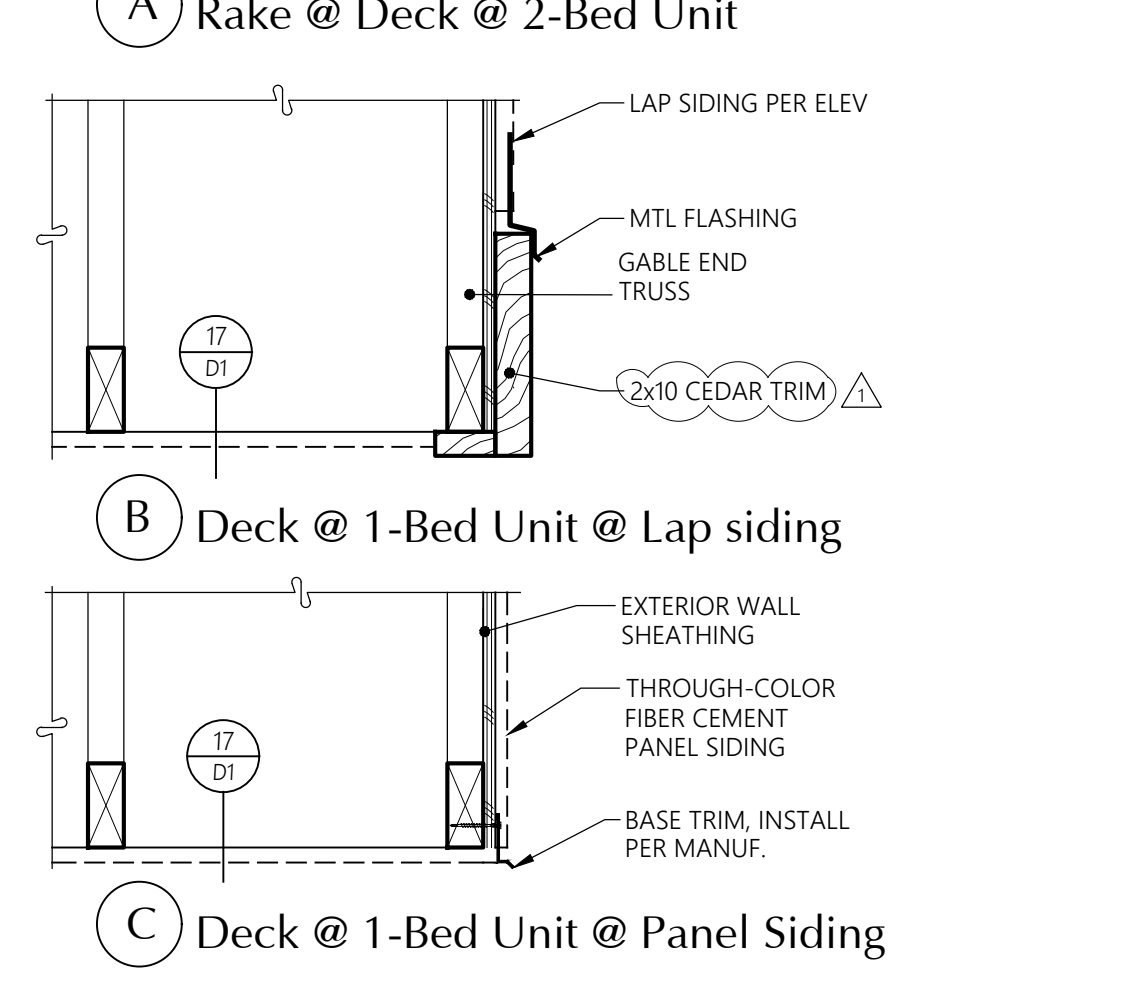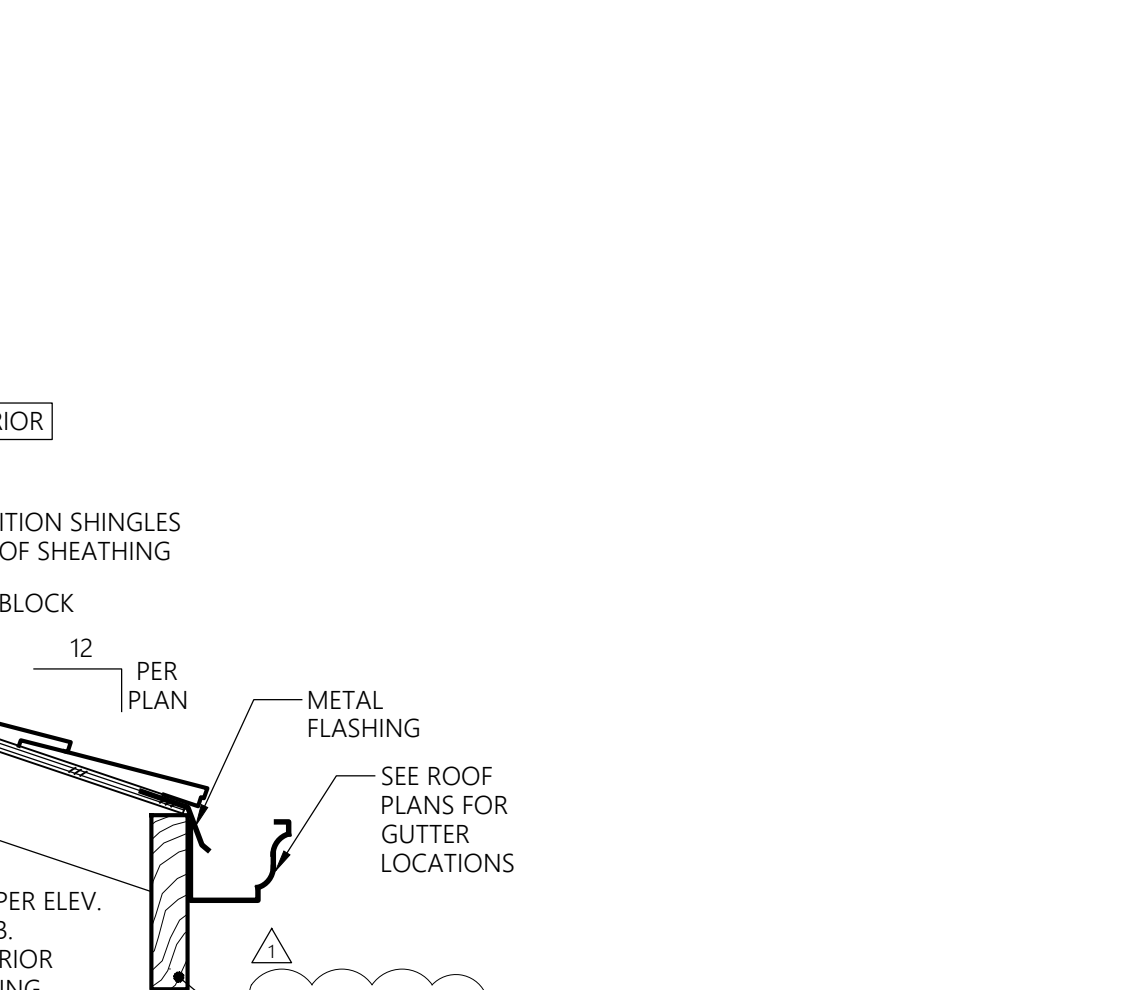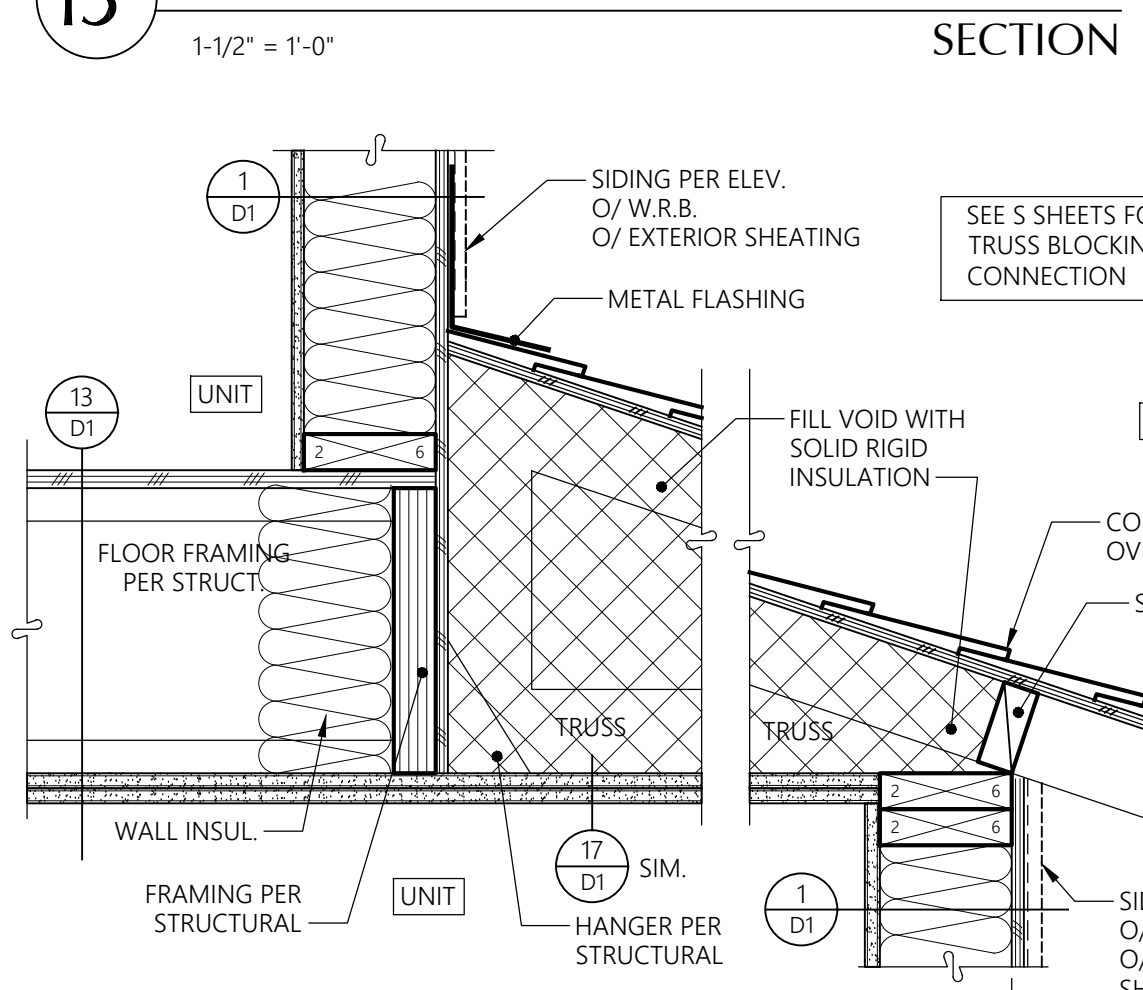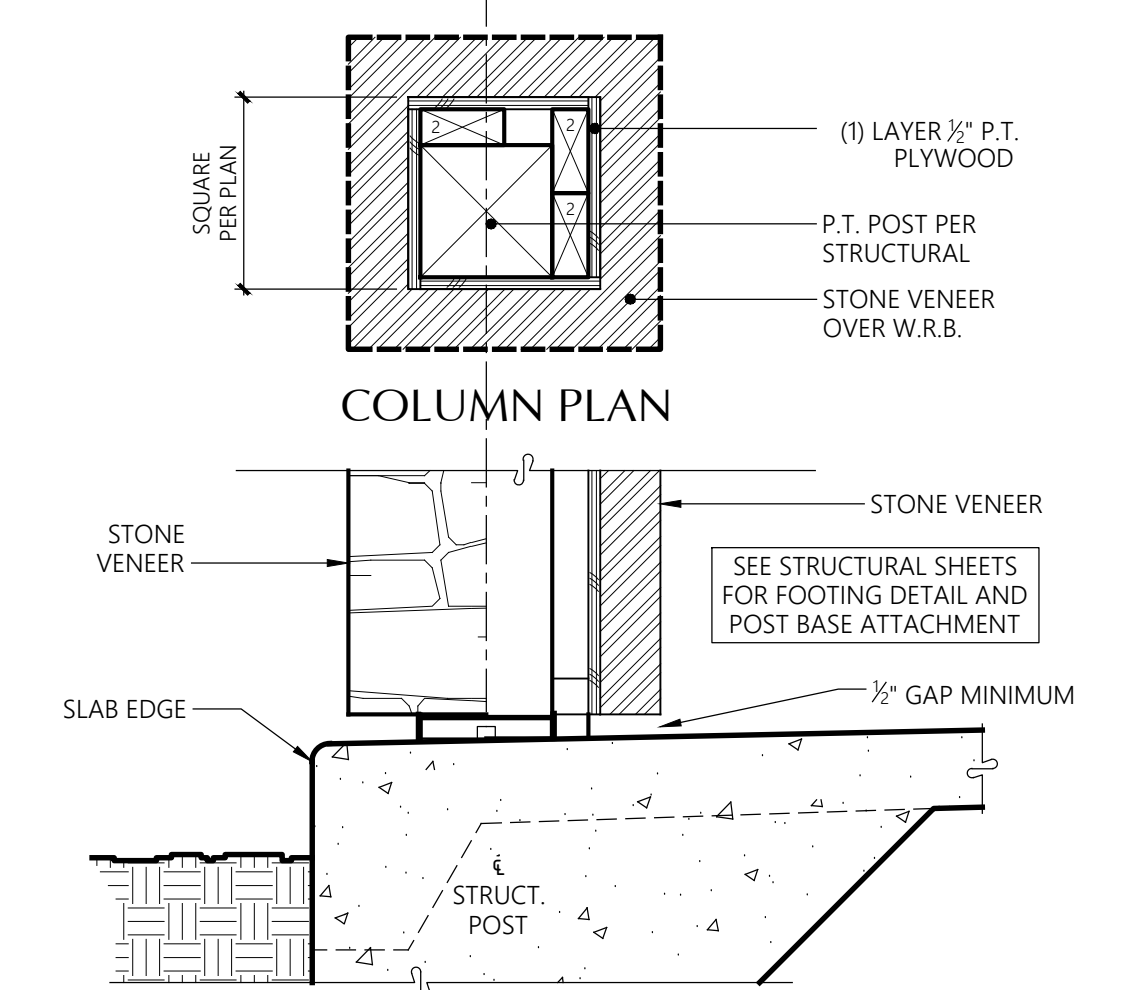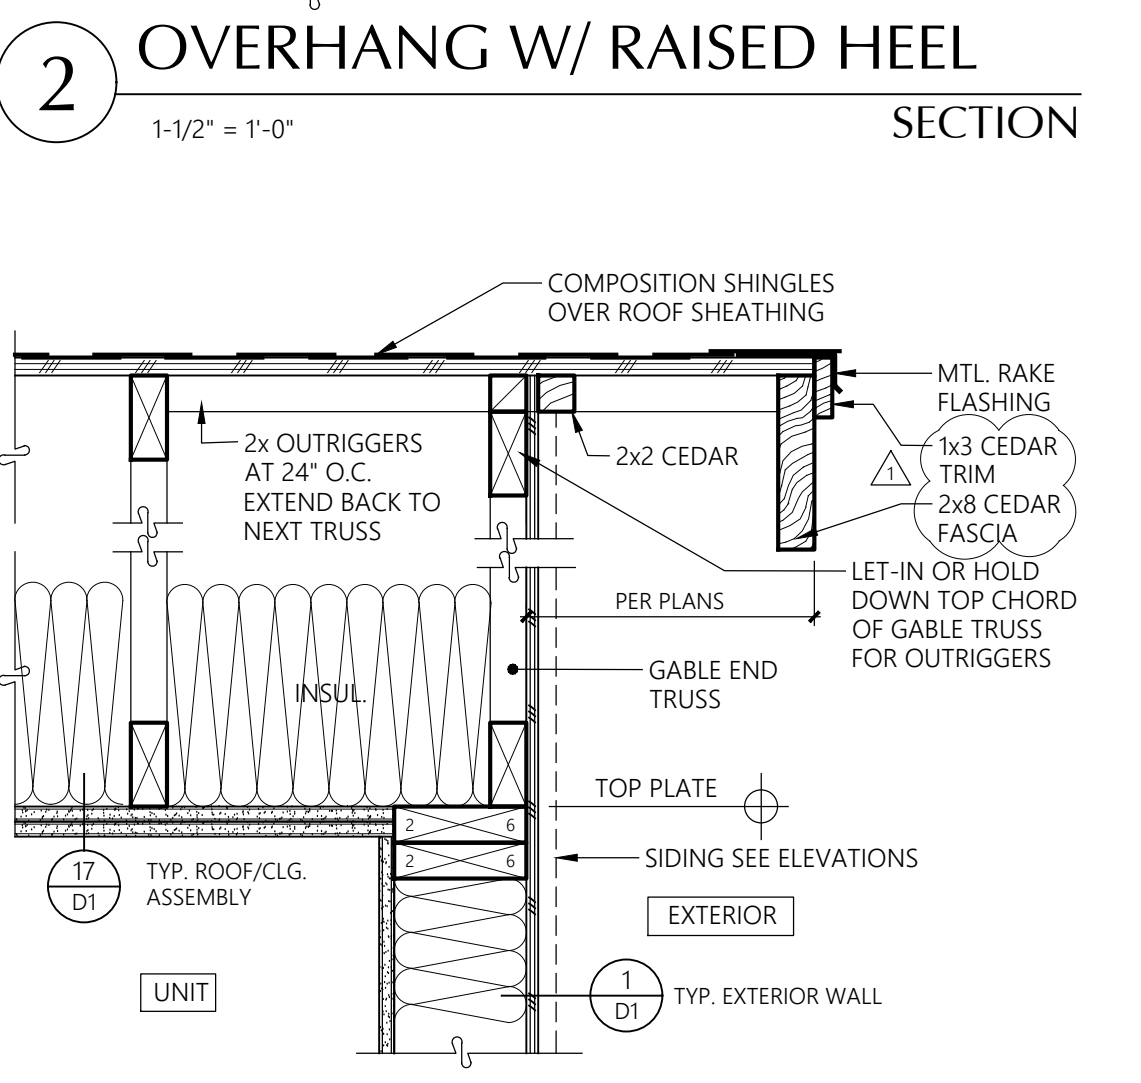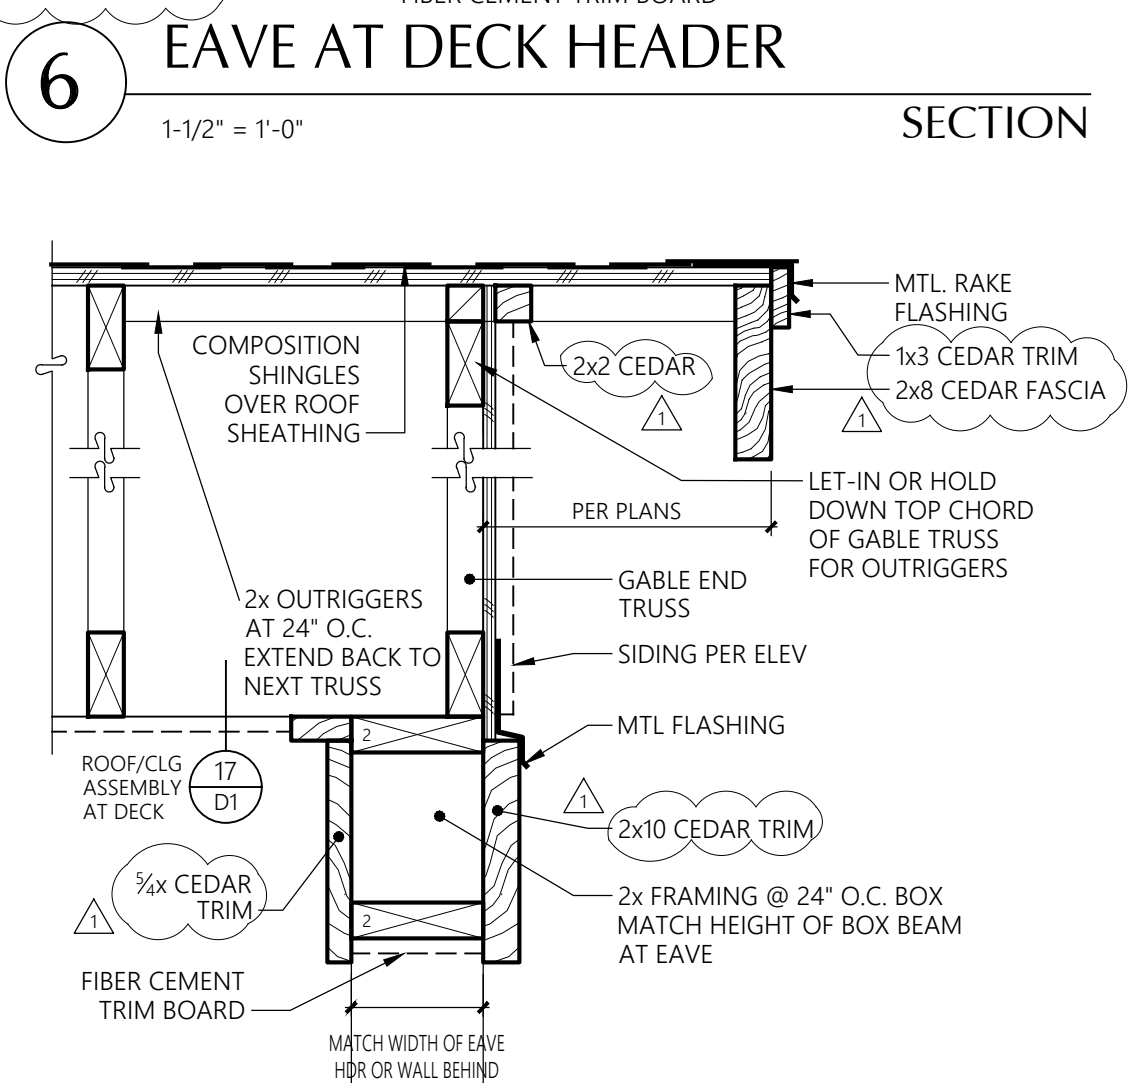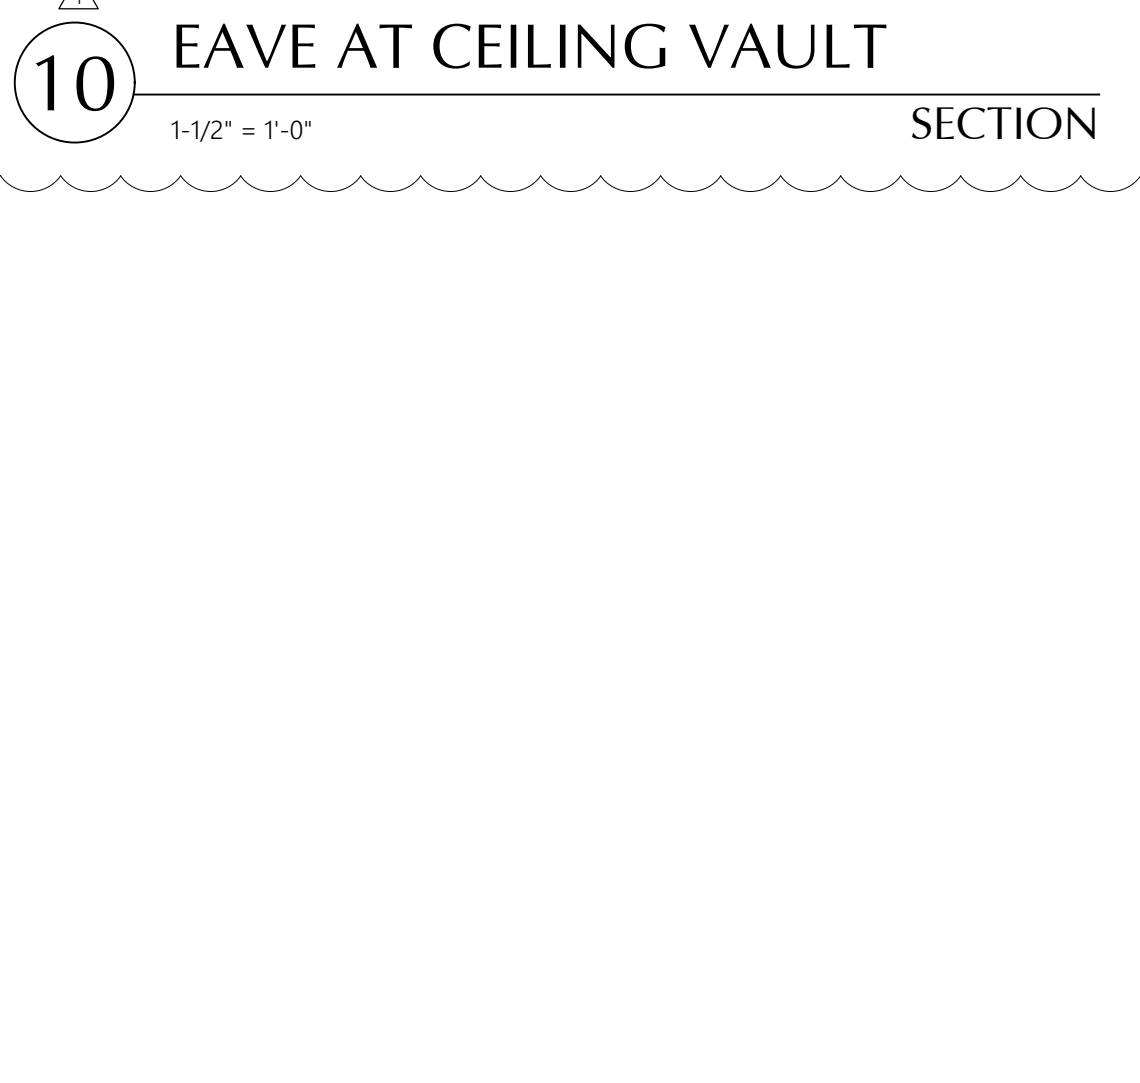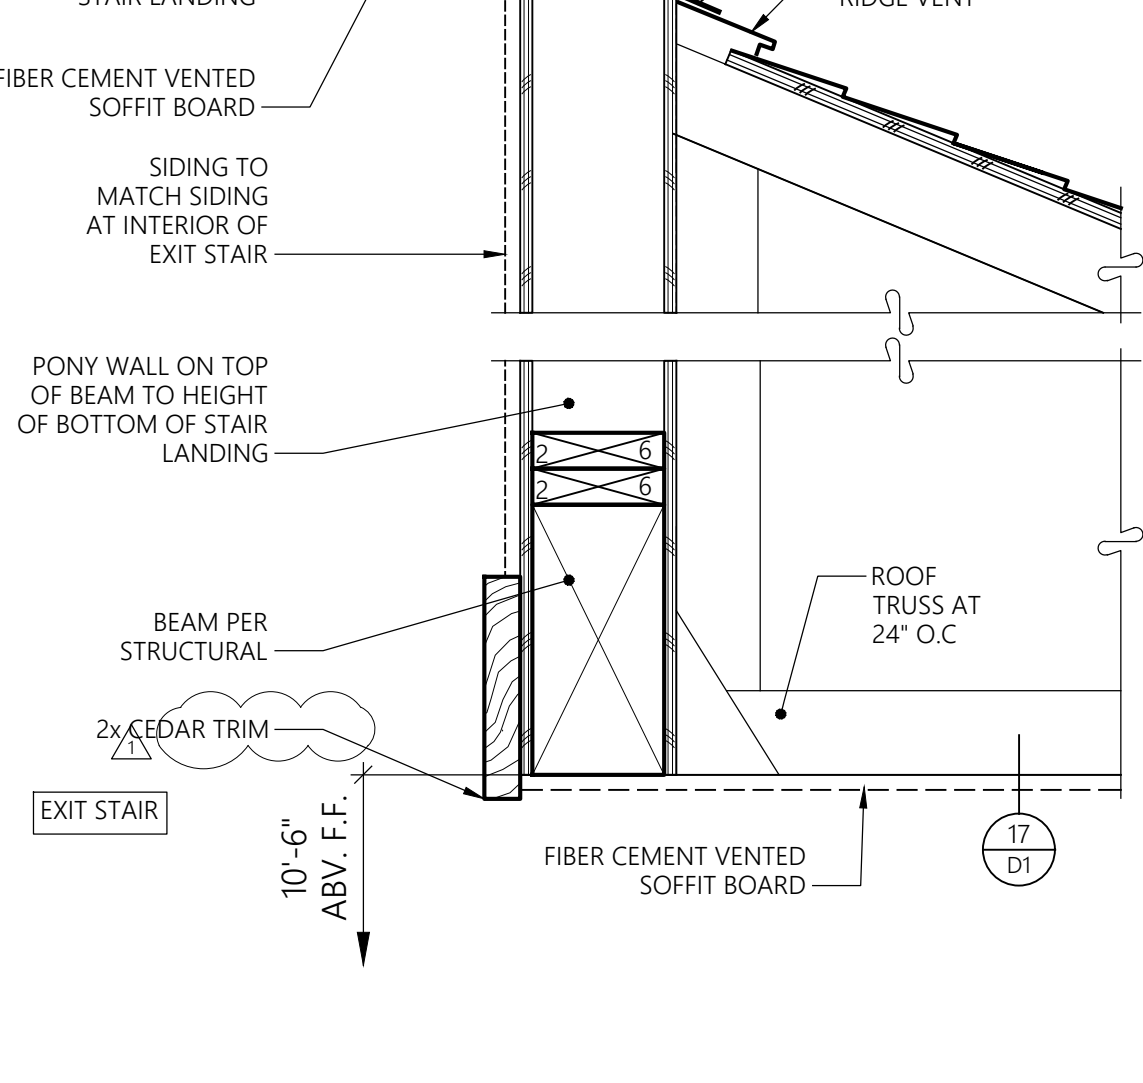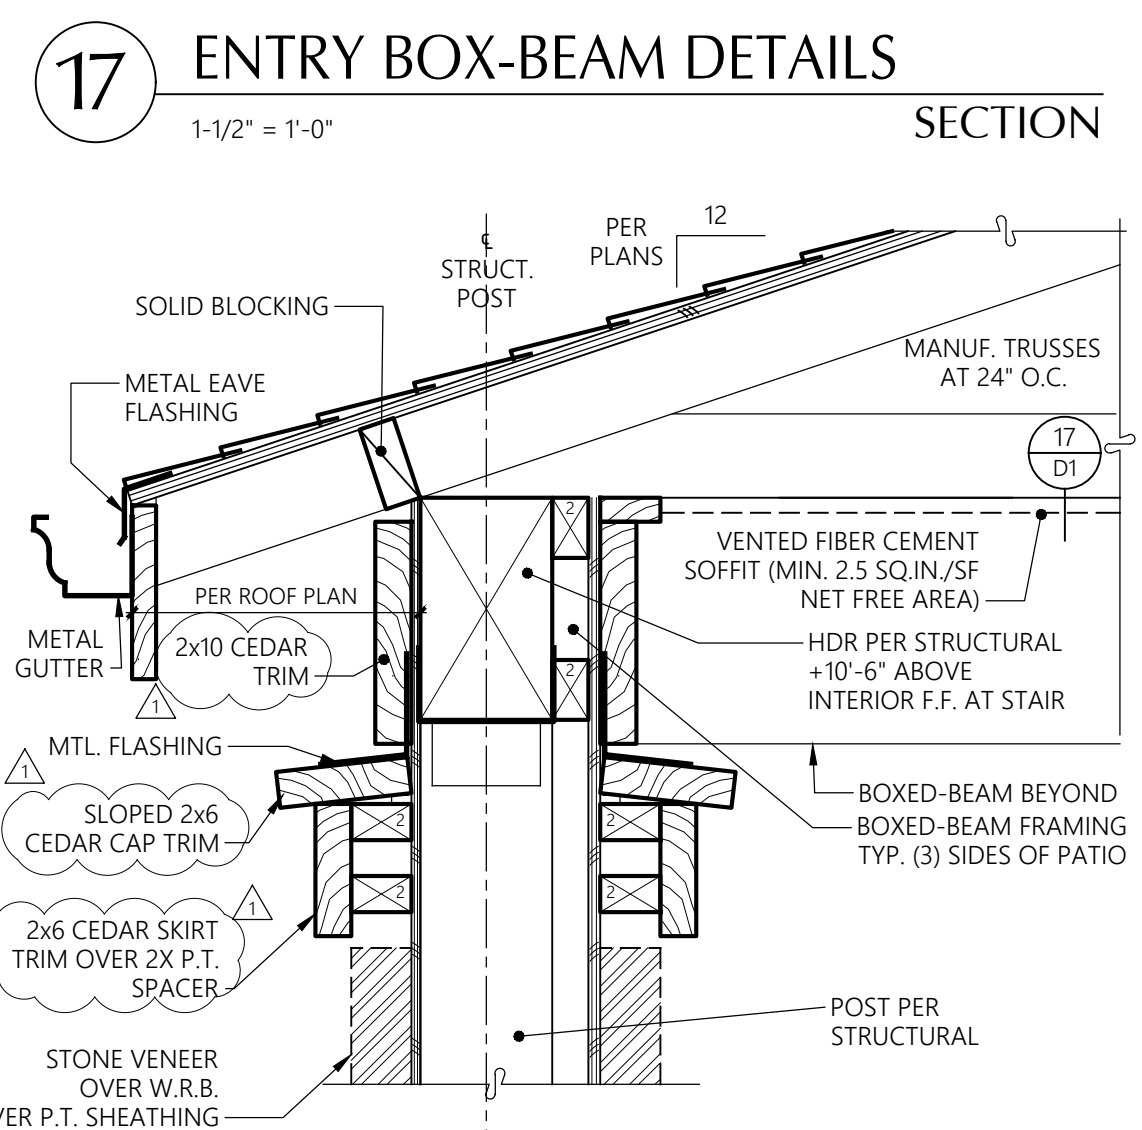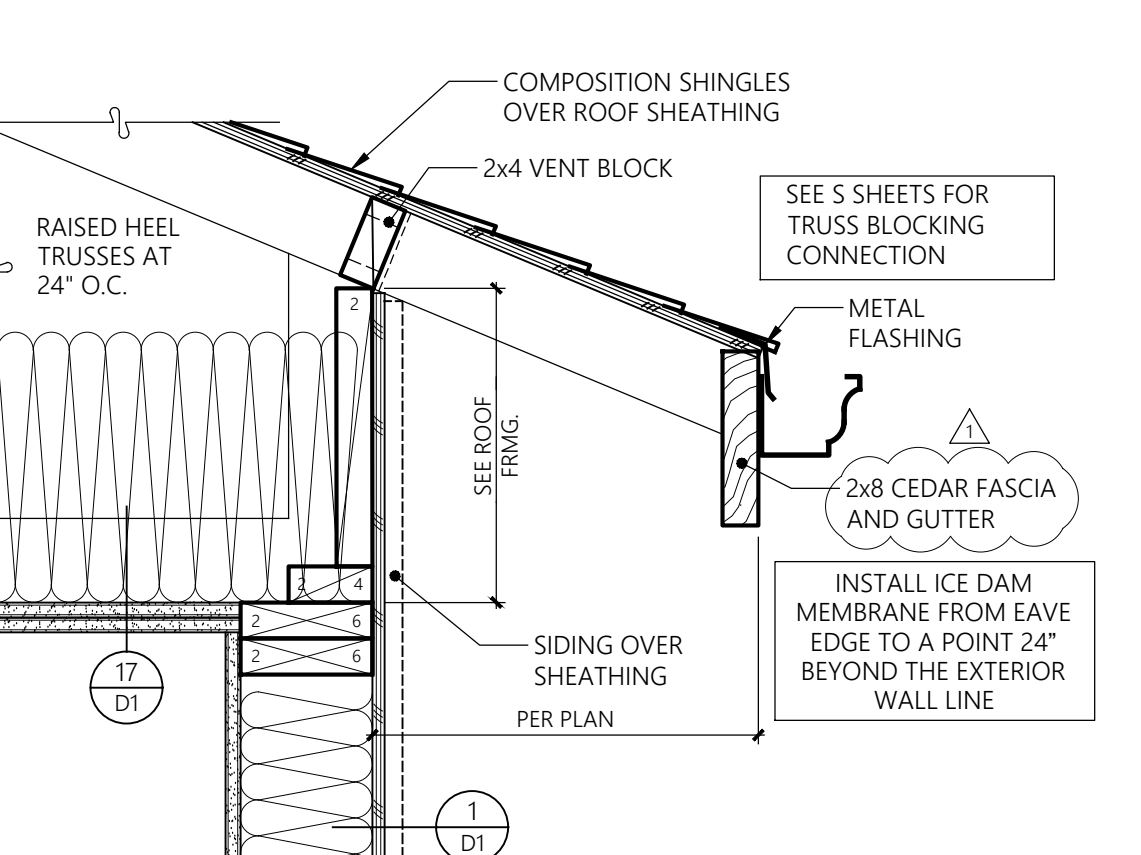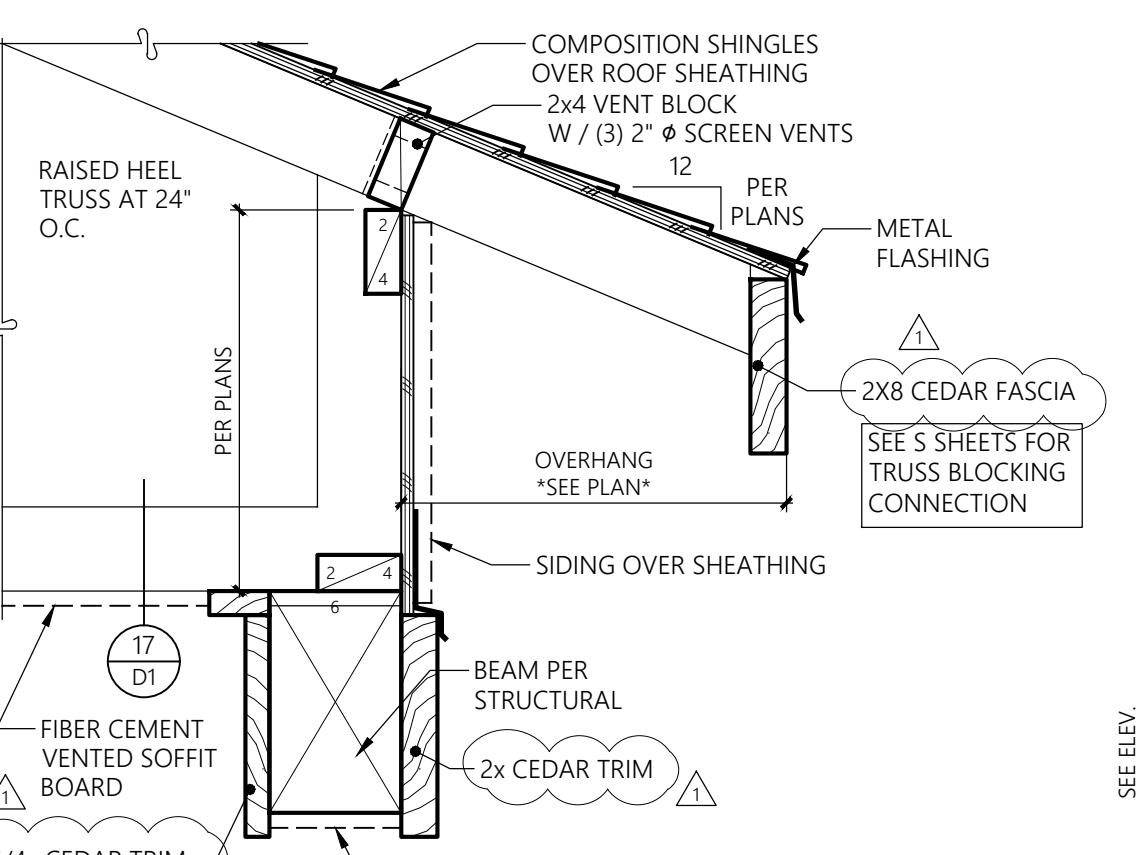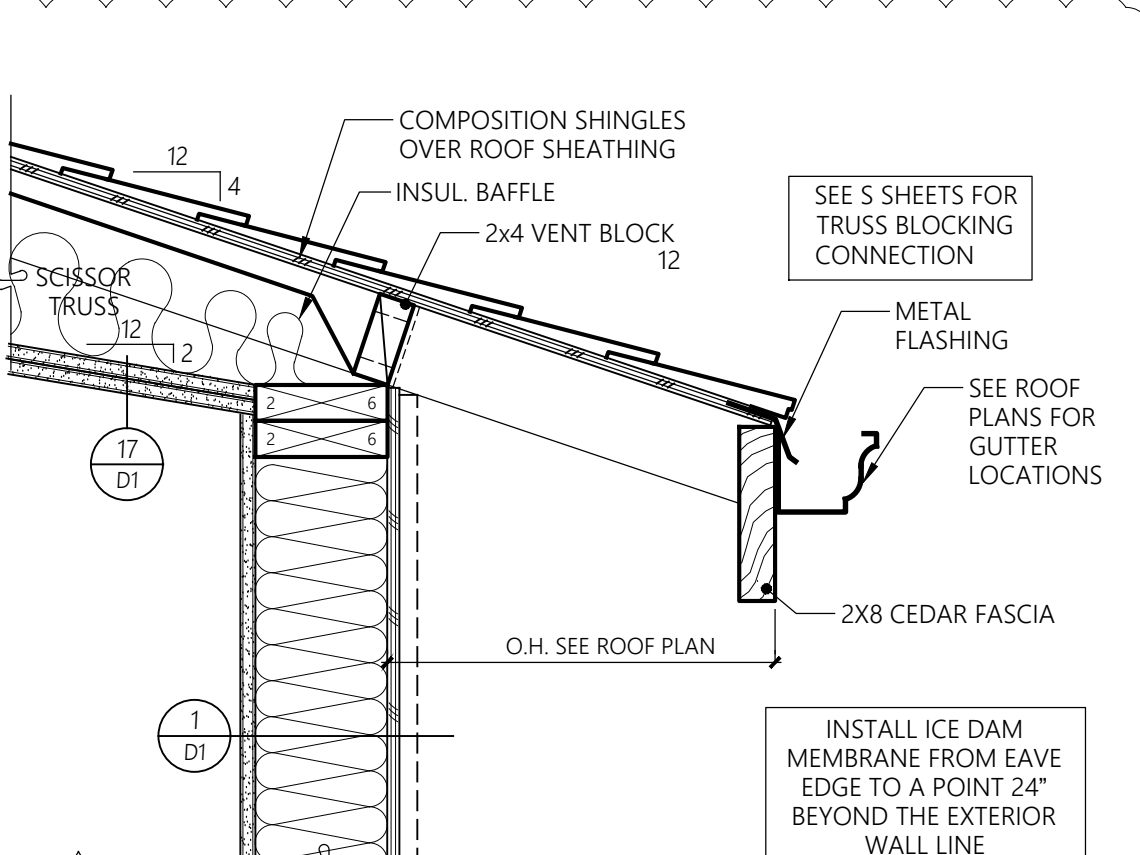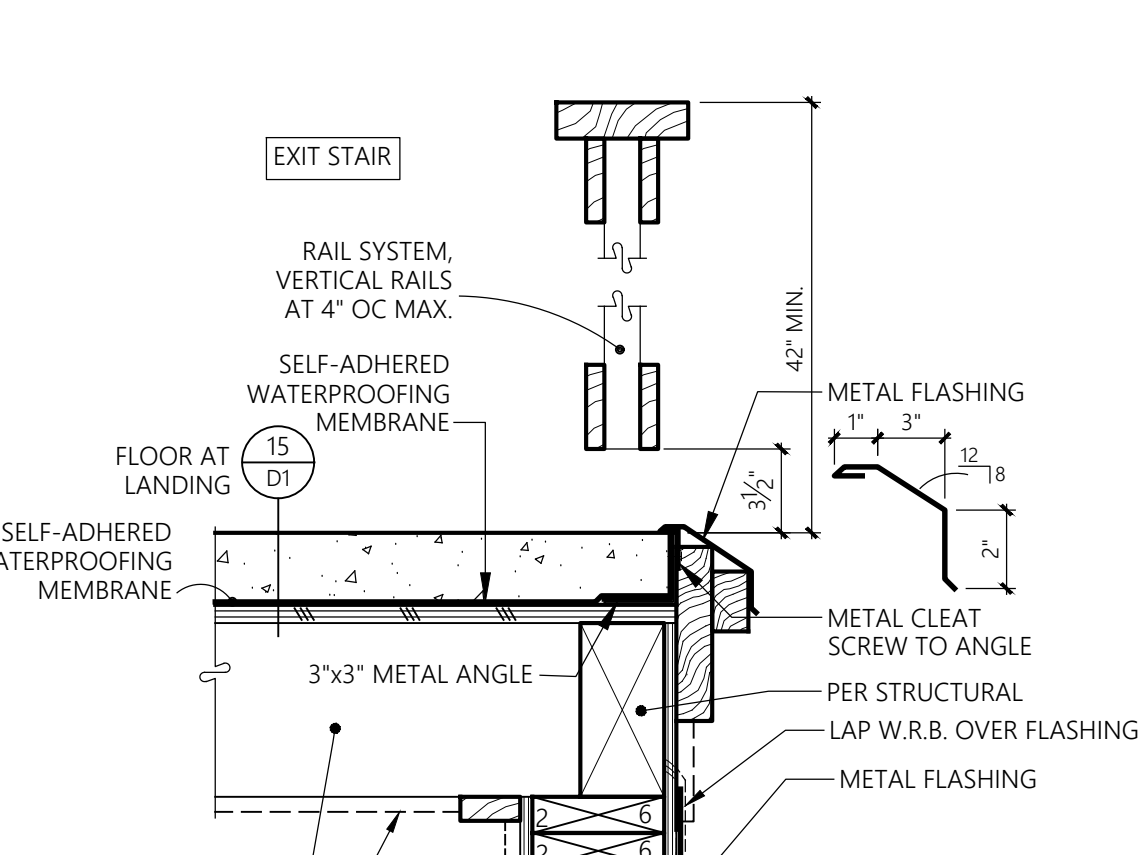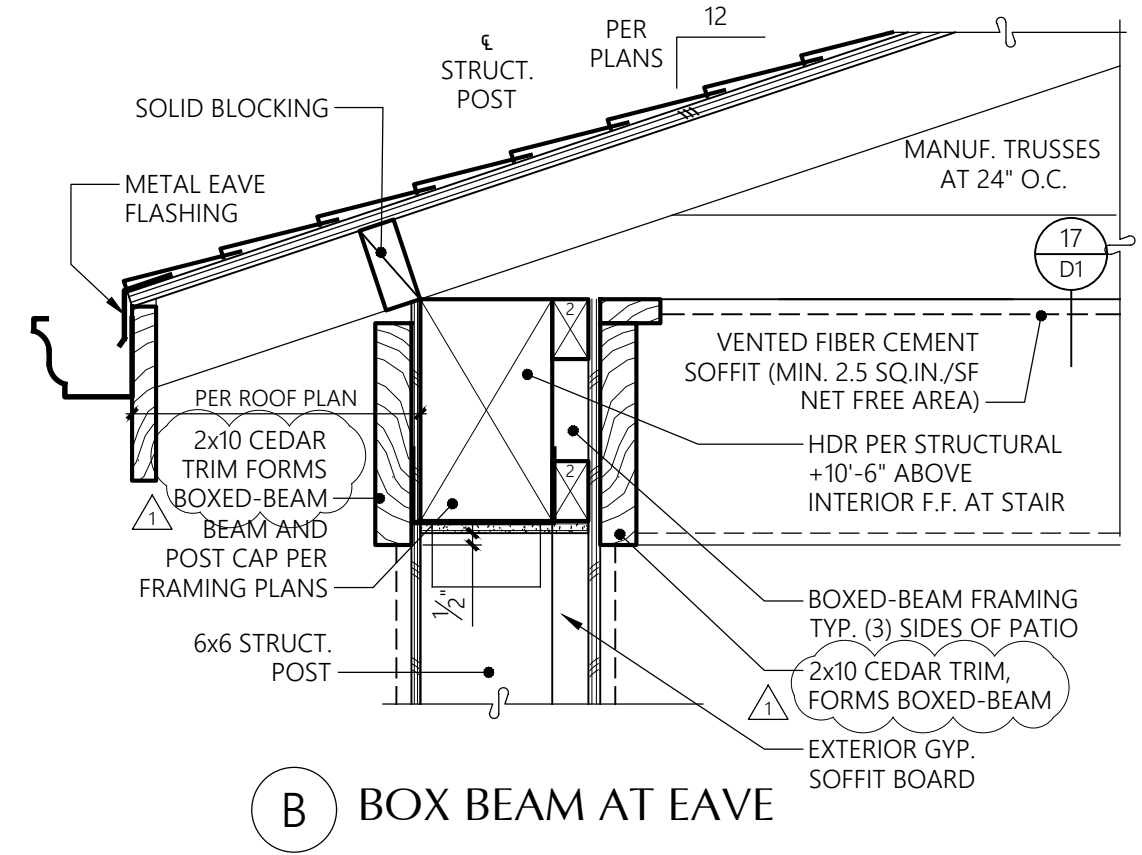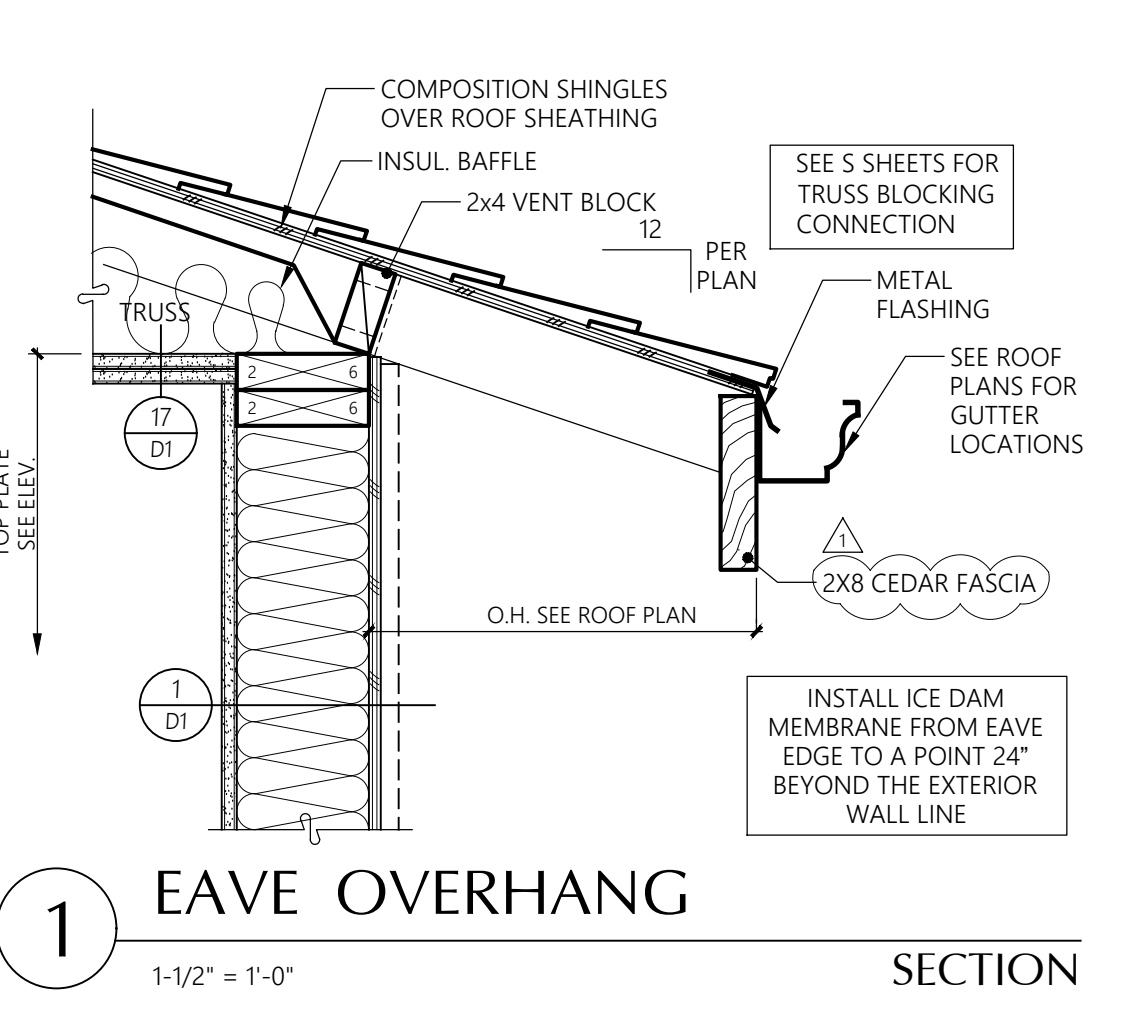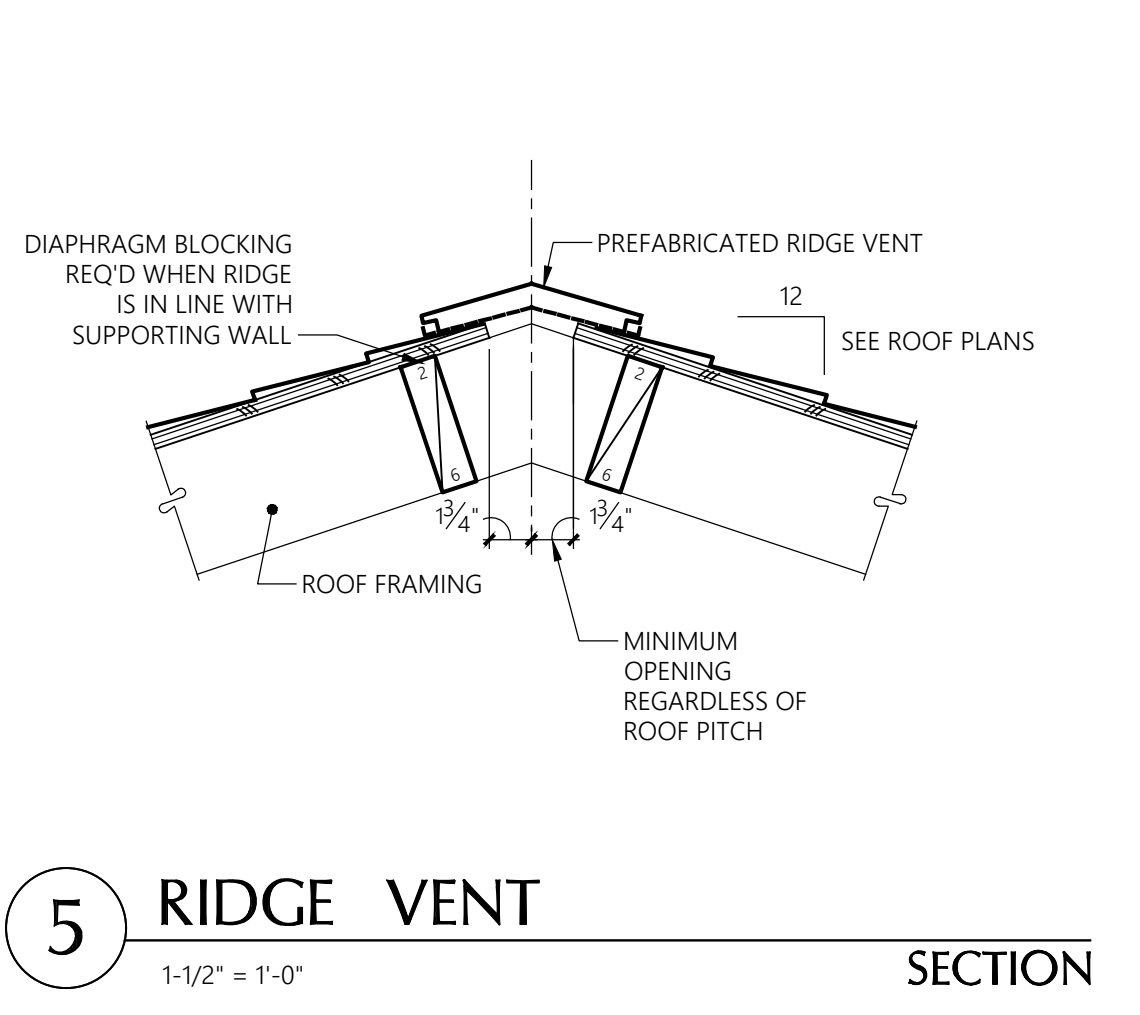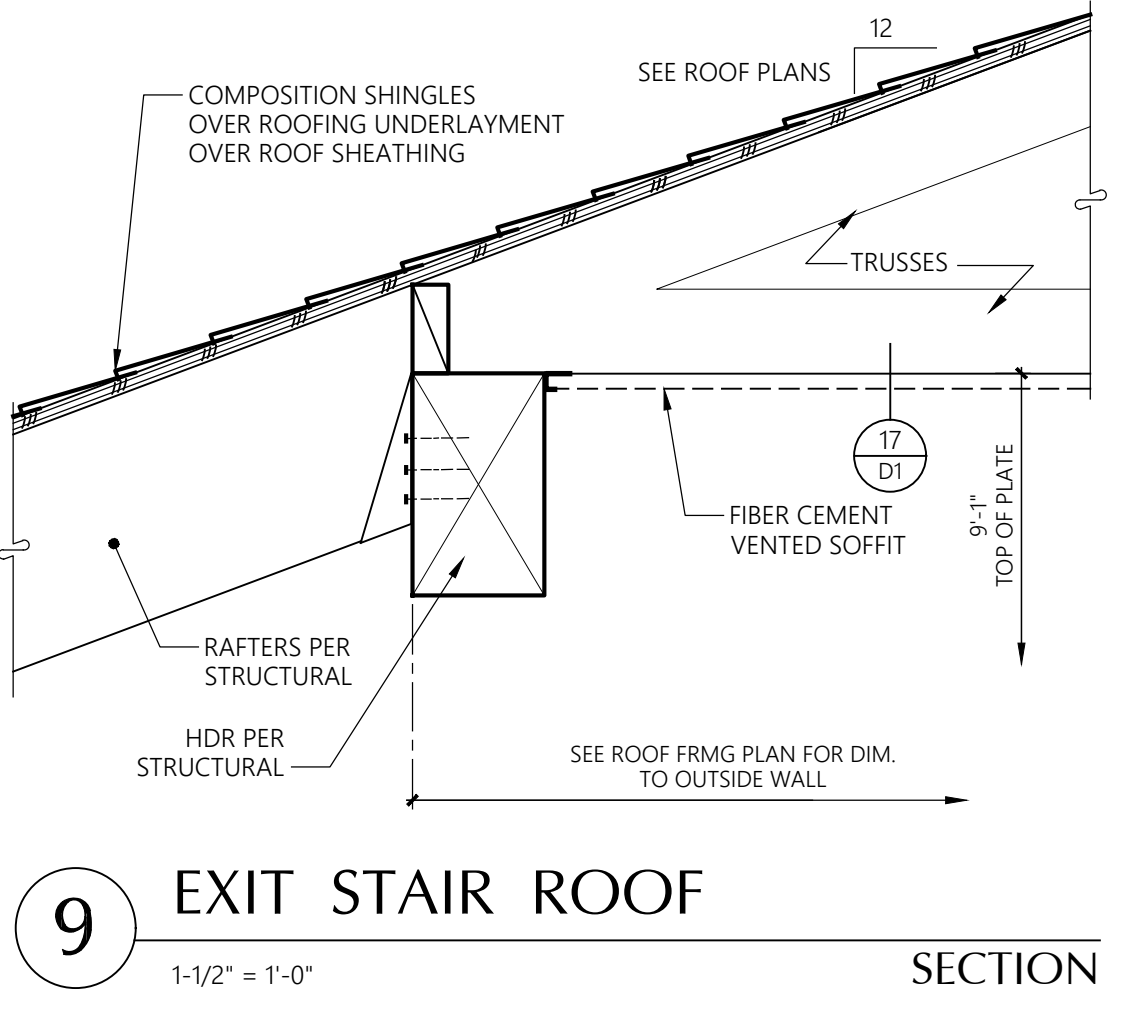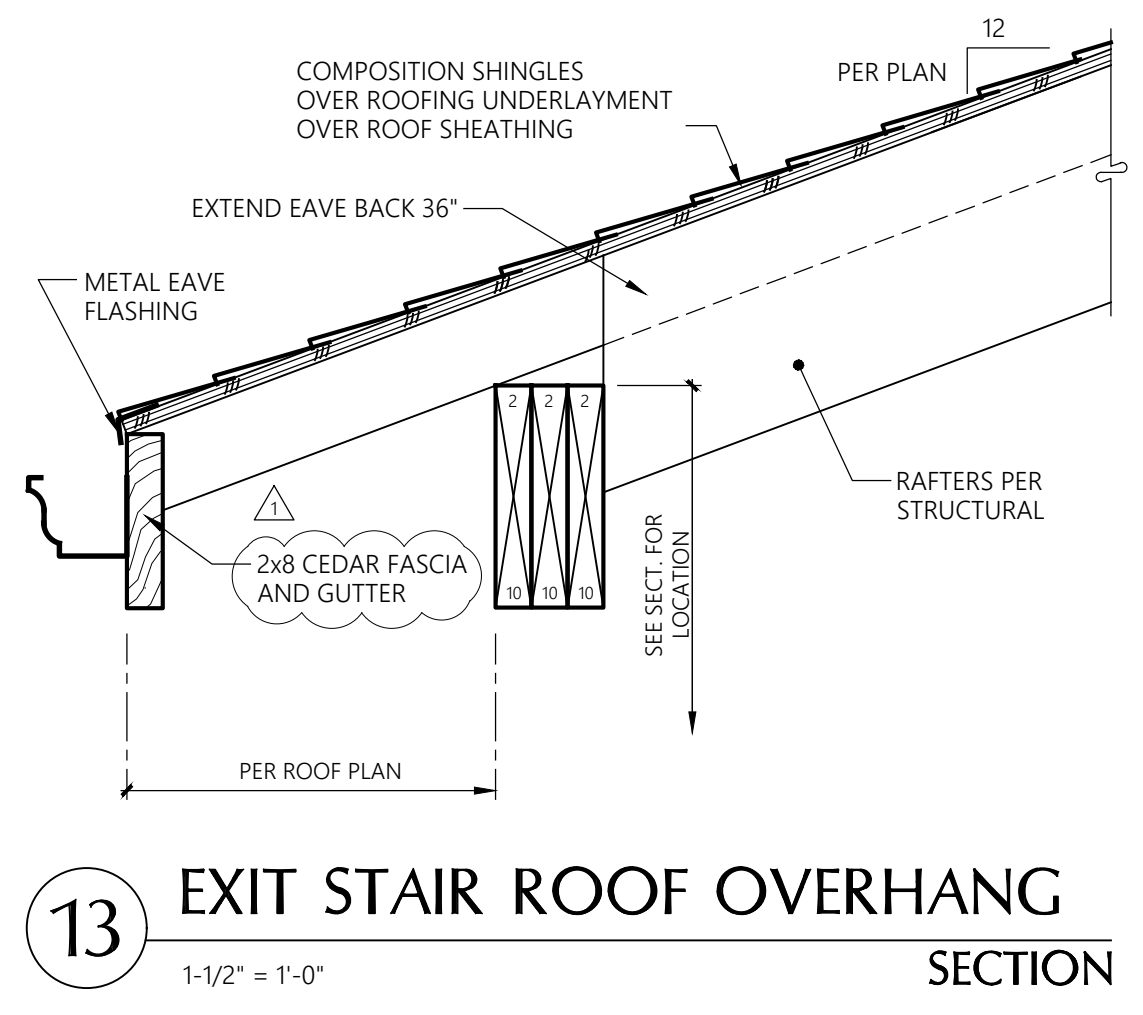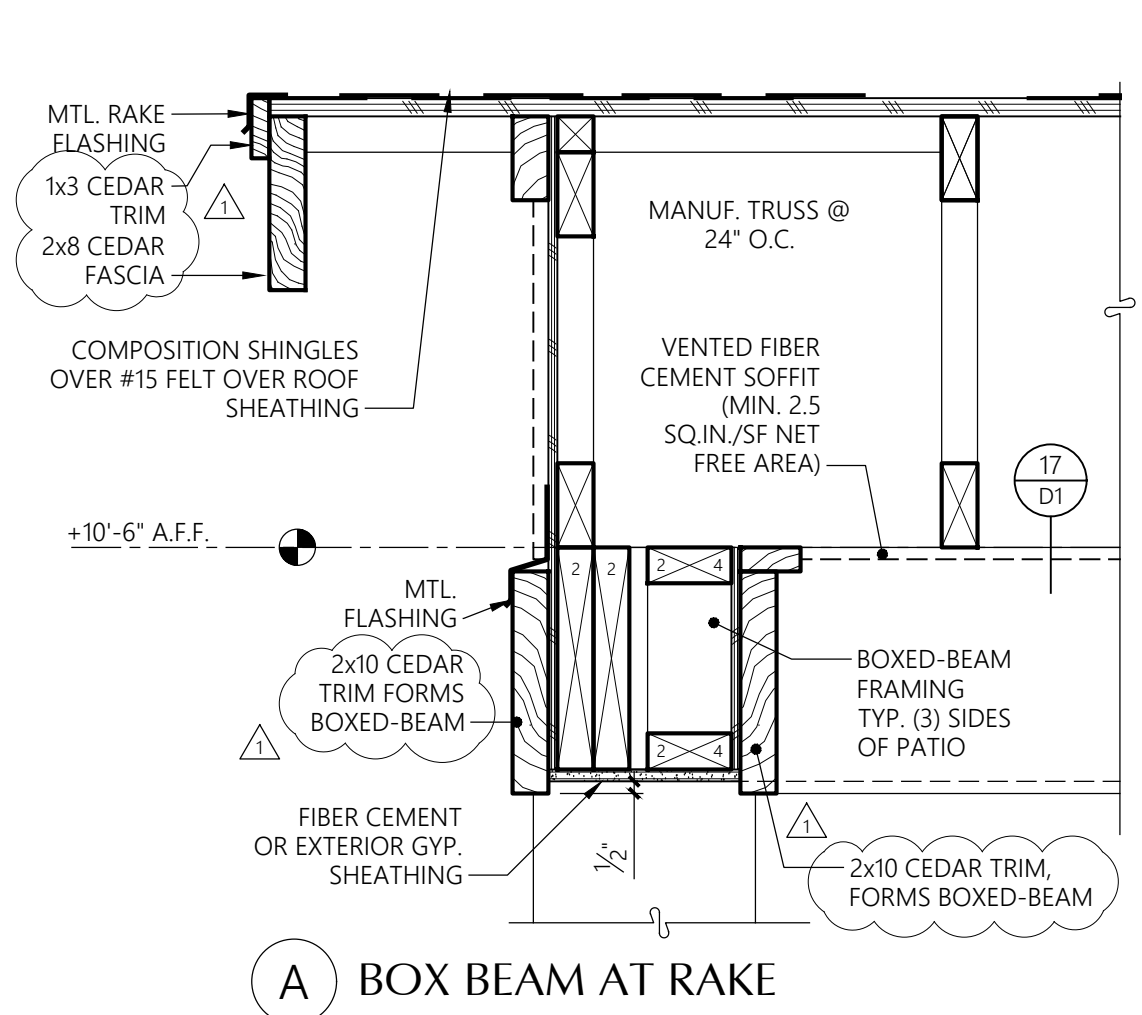


FR: 2306-VEDETAILS (01-10X) DWG

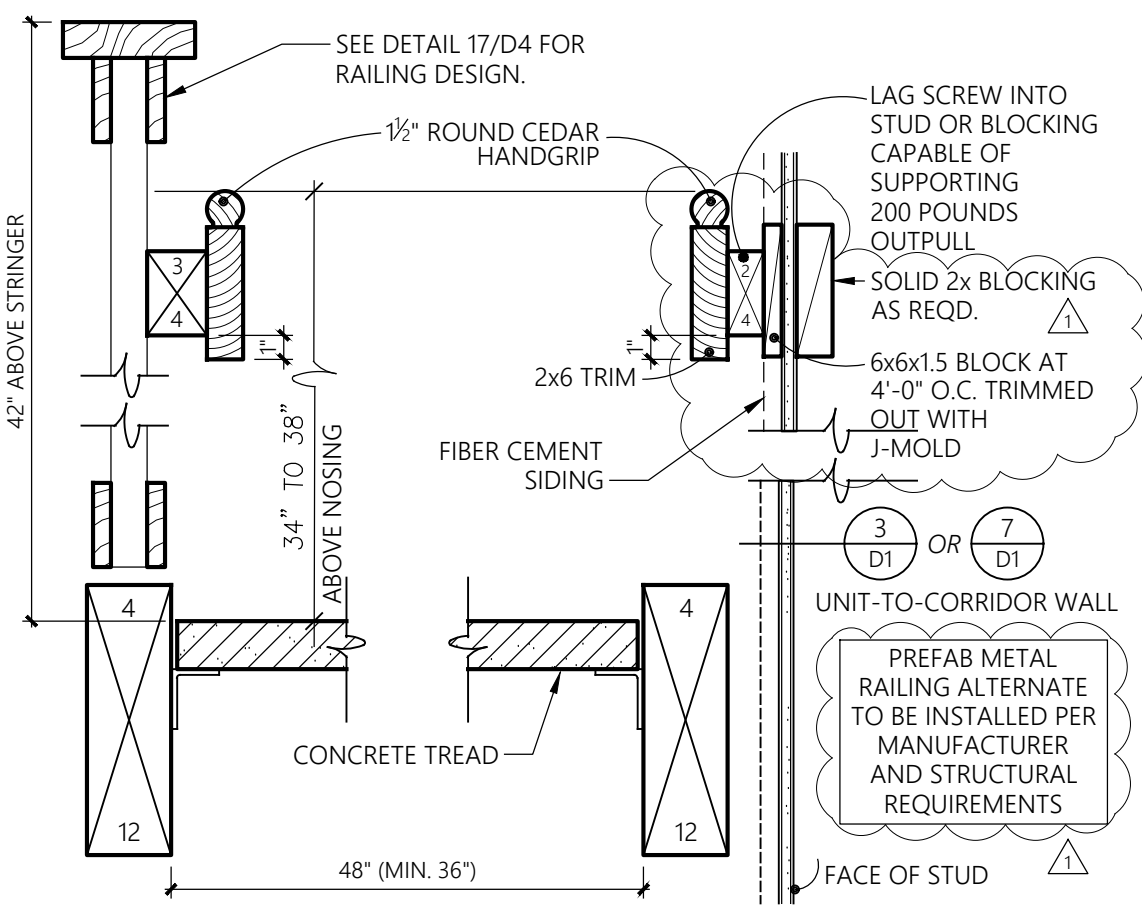


**17** STRINGER/RAILING AT WALL  
1 1/2" = 1'-0"  
SECTION

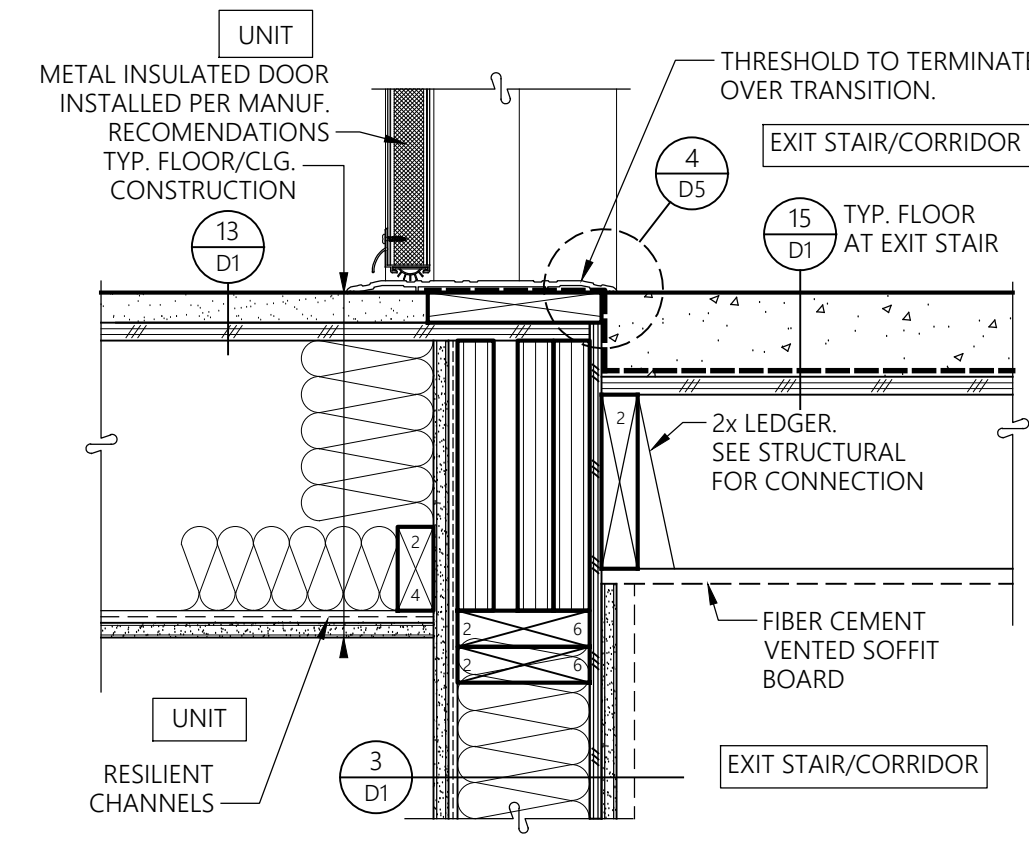


**13** ENTRY DOOR THRESHOLD  
1-1/2" = 1'-0"  
SECTION

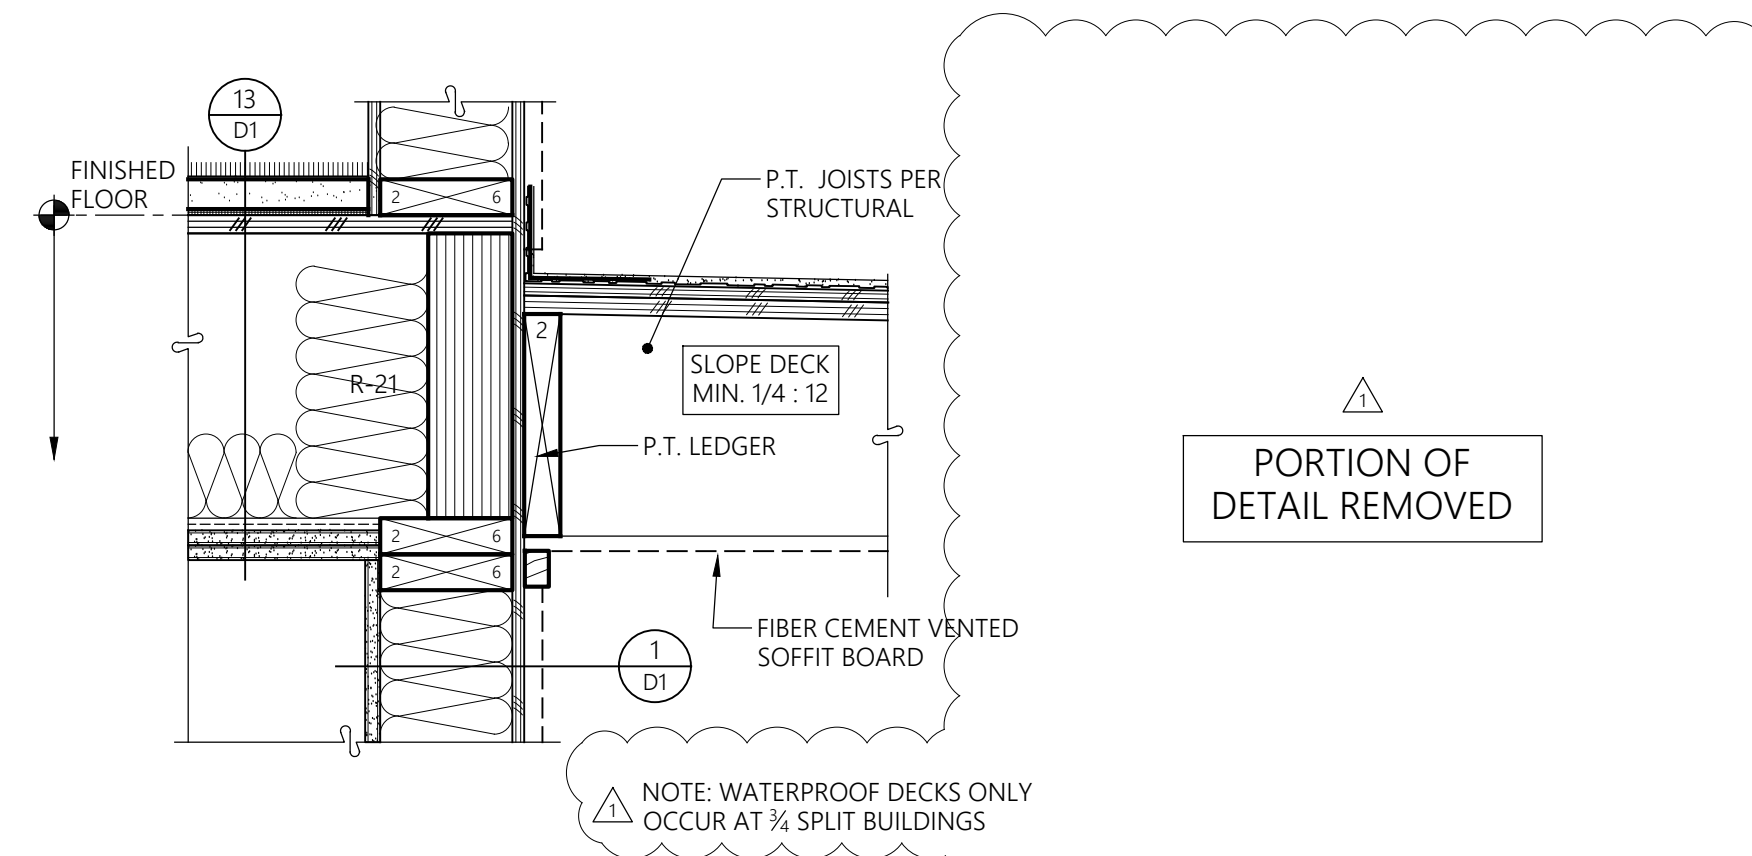


**9** WATERPROOF DECK @ WALL  
1-1/2" = 1'-0"  
SECTION

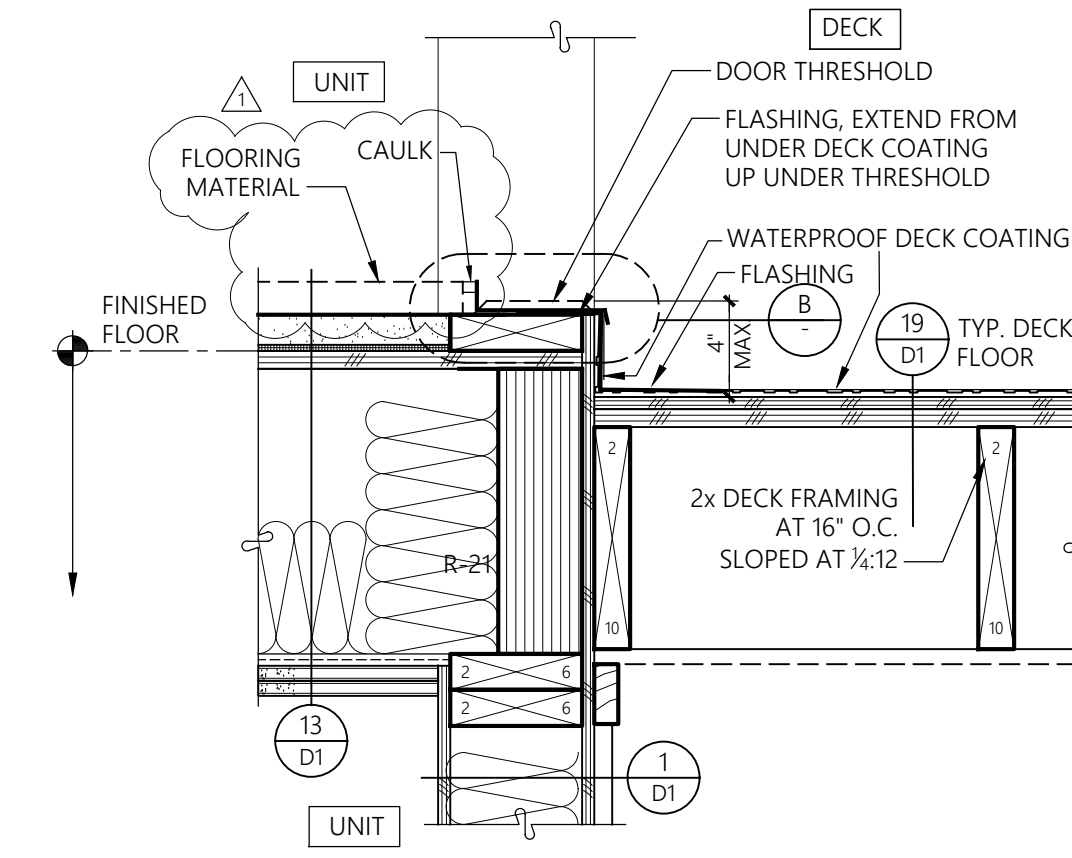


**A** PATIO SWING DOOR STANDARD THRESHOLD

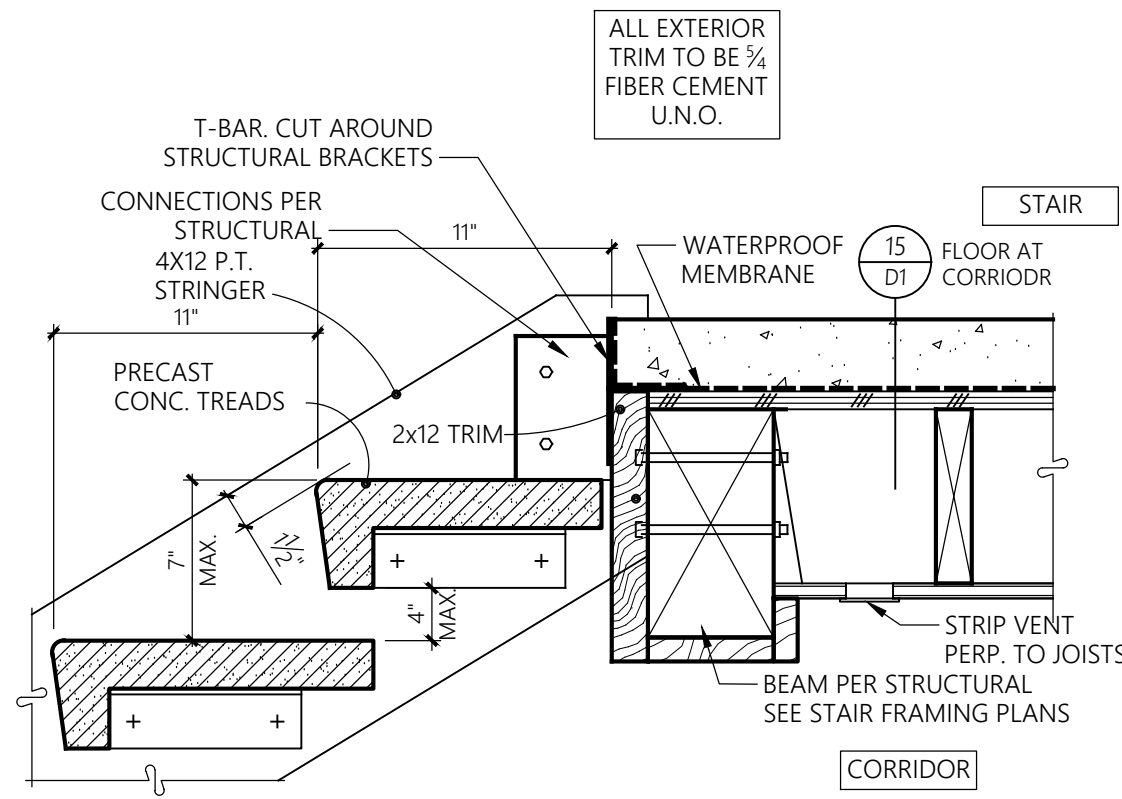


**18** UPPER FLOOR STAIR DETAIL  
1 1/2" = 1'-0"  
SECTION

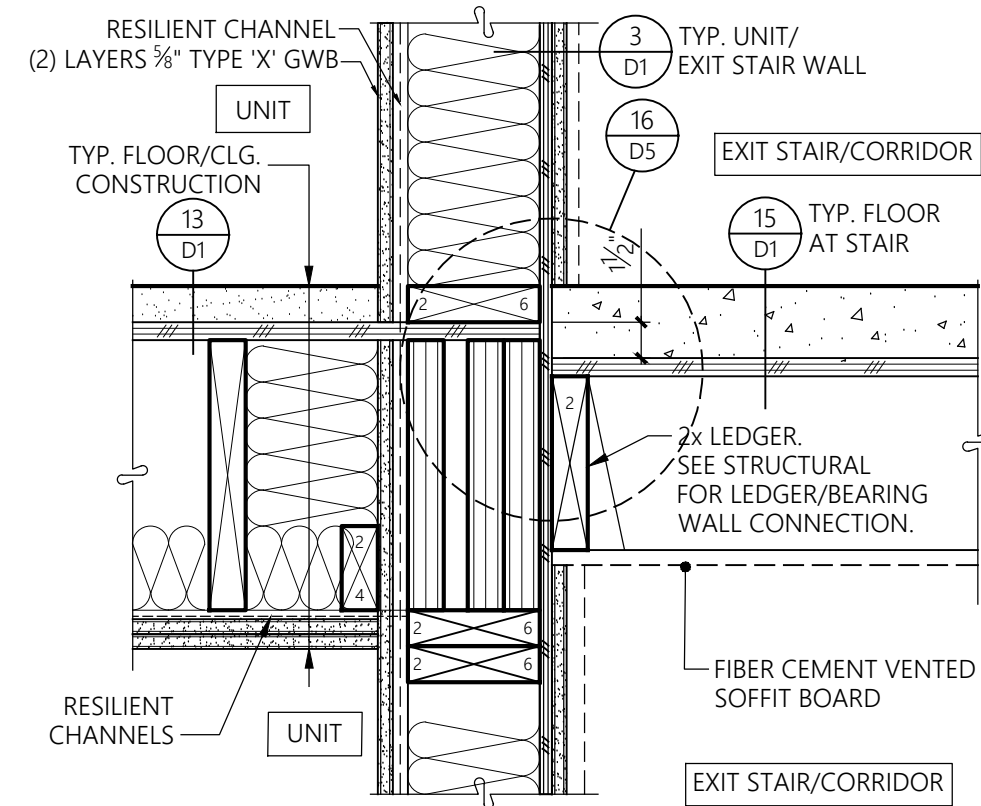


**14** STAIR WALL AT FLOOR  
1-1/2" = 1'-0"  
SECTION

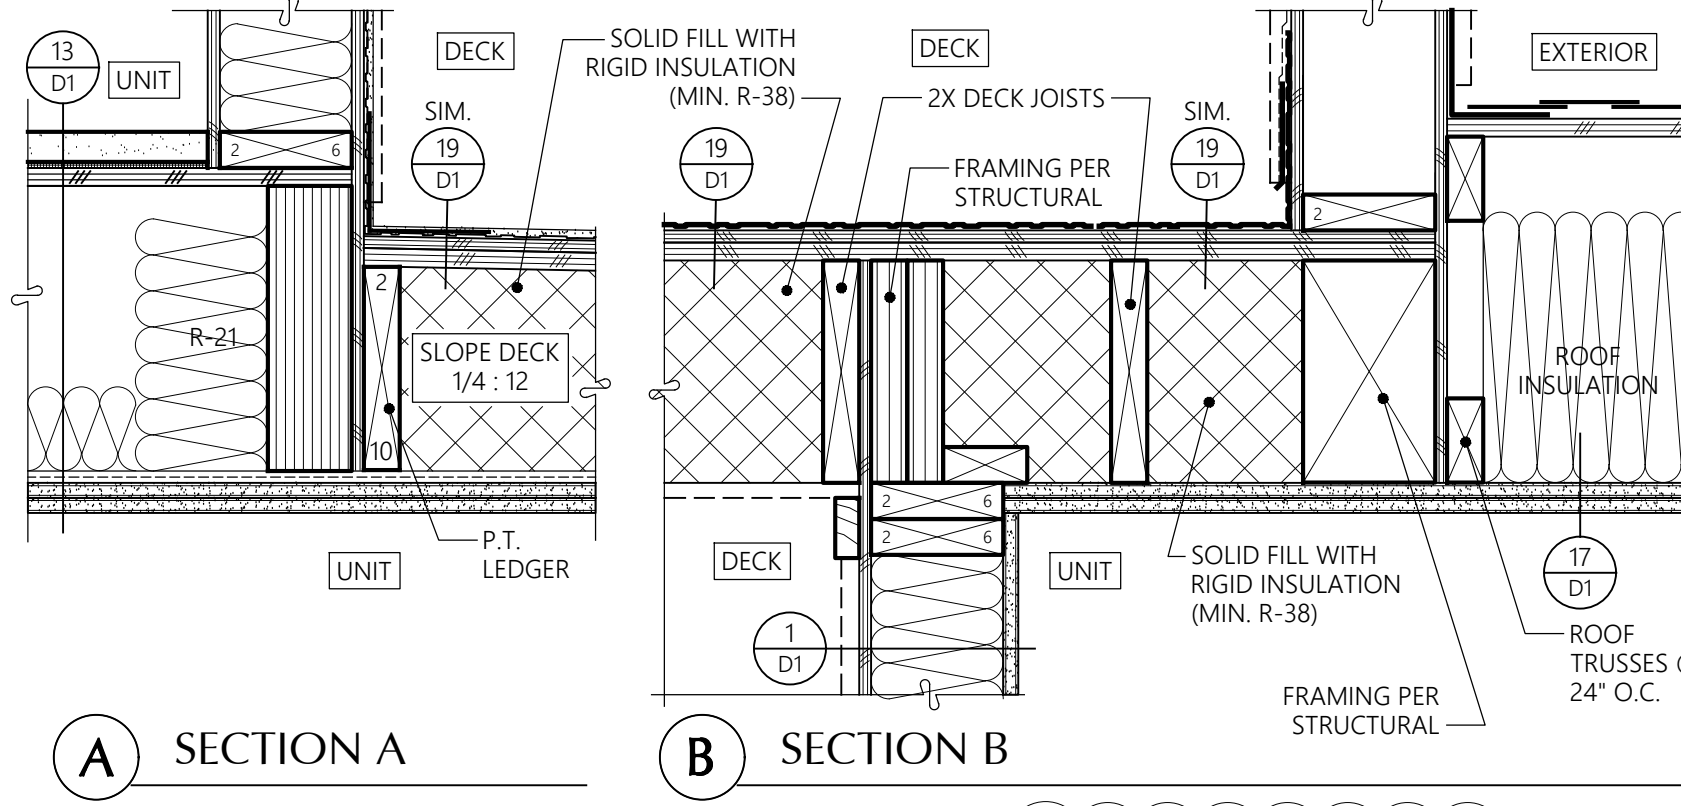


**10** DECK OVER UNIT BELOW  
1-1/2" = 1'-0"  
SECTION

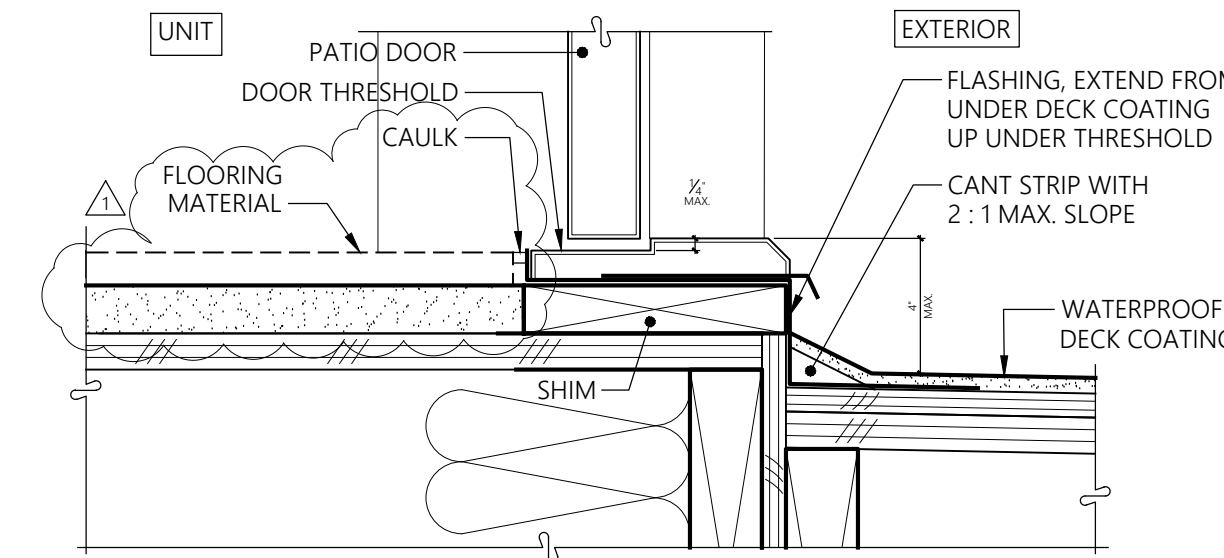


**B** PATIO SWING DOOR STANDARD THRESHOLD

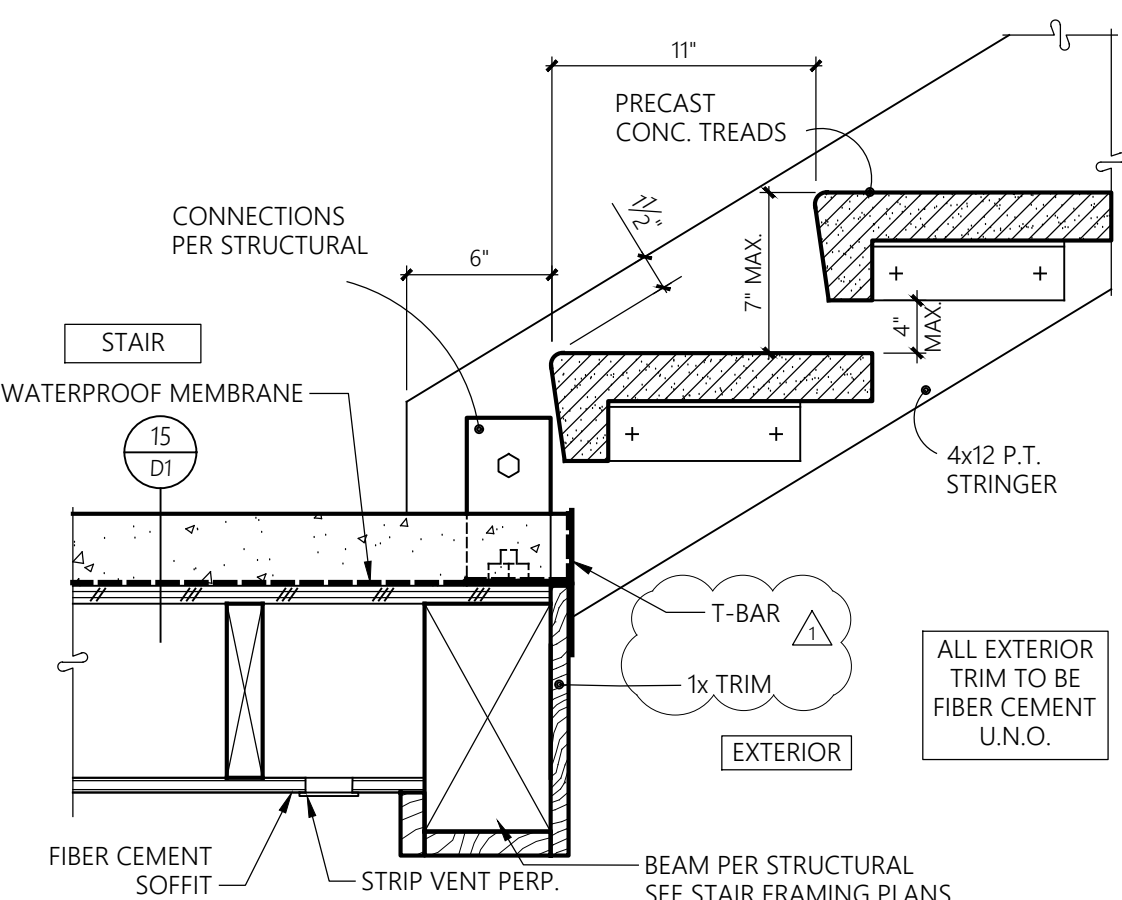


**19** UPPER FLOOR STAIR DETAIL  
1 1/2" = 1'-0"  
SECTION

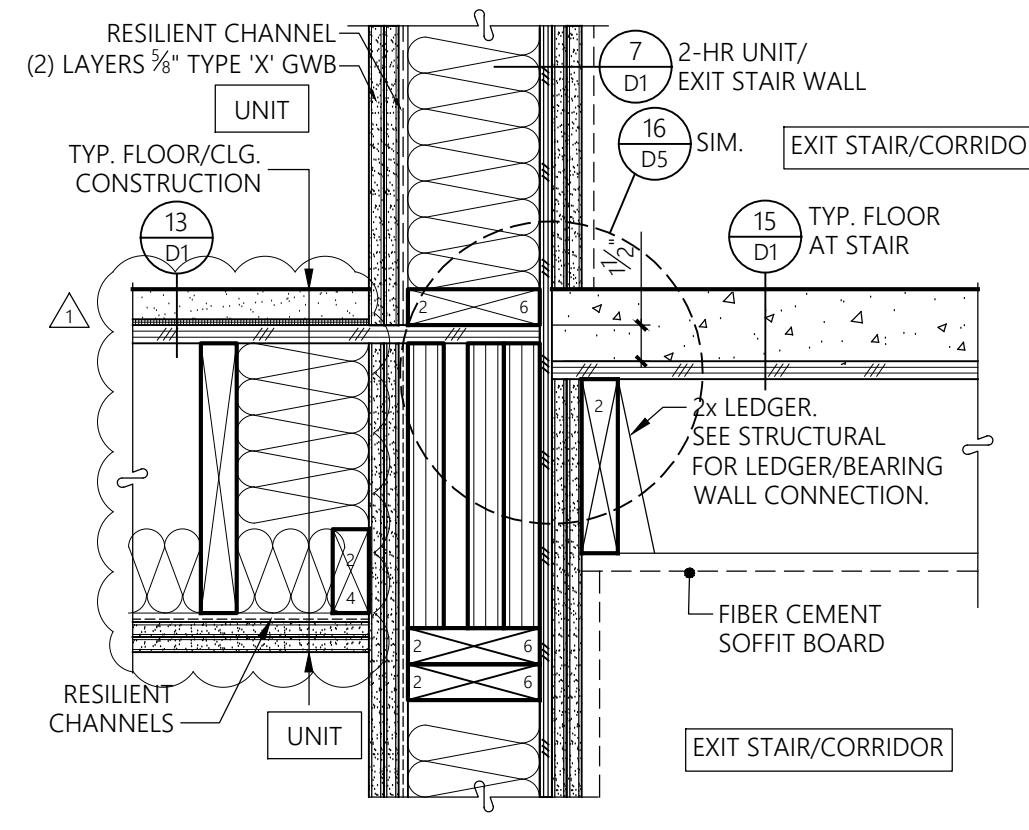


**15** 2-HR STAIR WALL AT FLOOR  
1-1/2" = 1'-0"  
SECTION

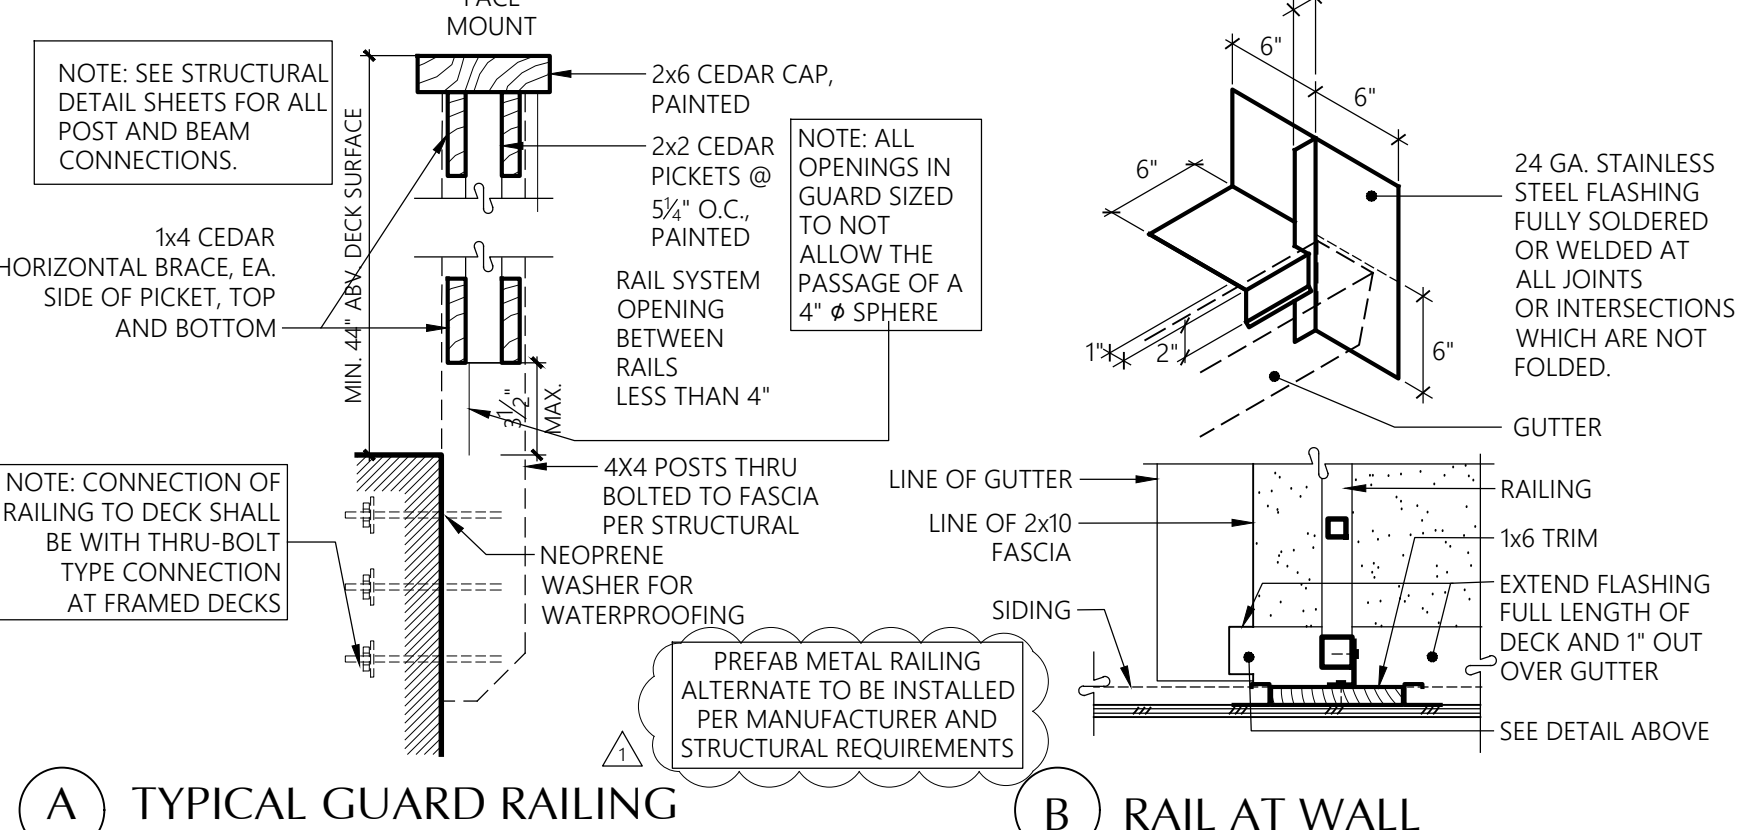


**11** GUARD RAIL DETAILS  
1-1/2" = 1'-0"  
SECTION

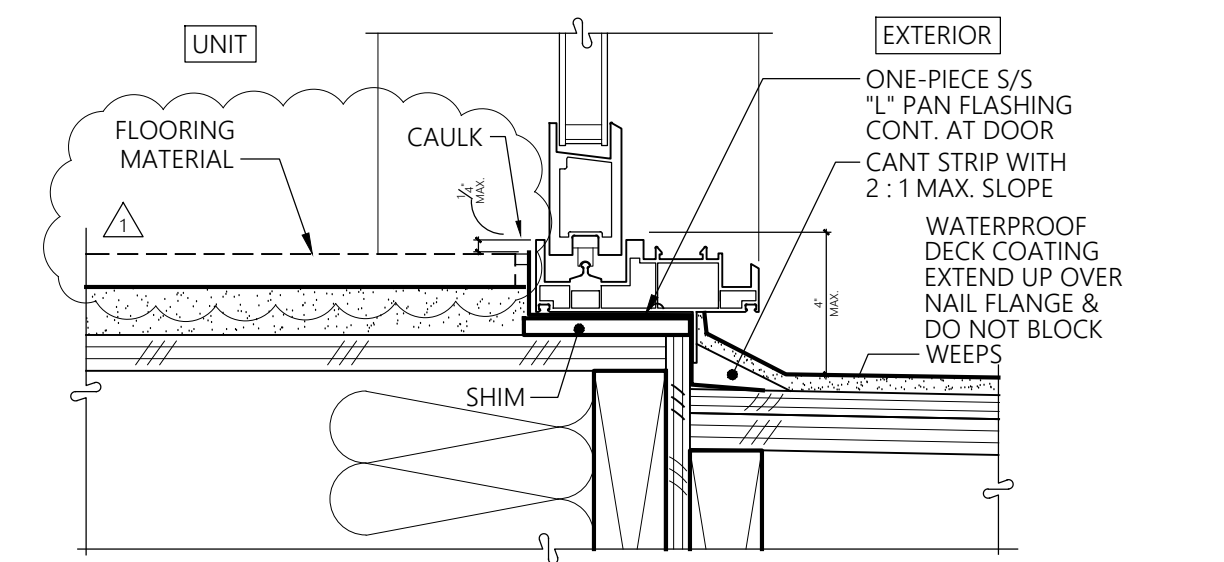


**C** SLIDING GLASS DOOR STANDARD CONDITION

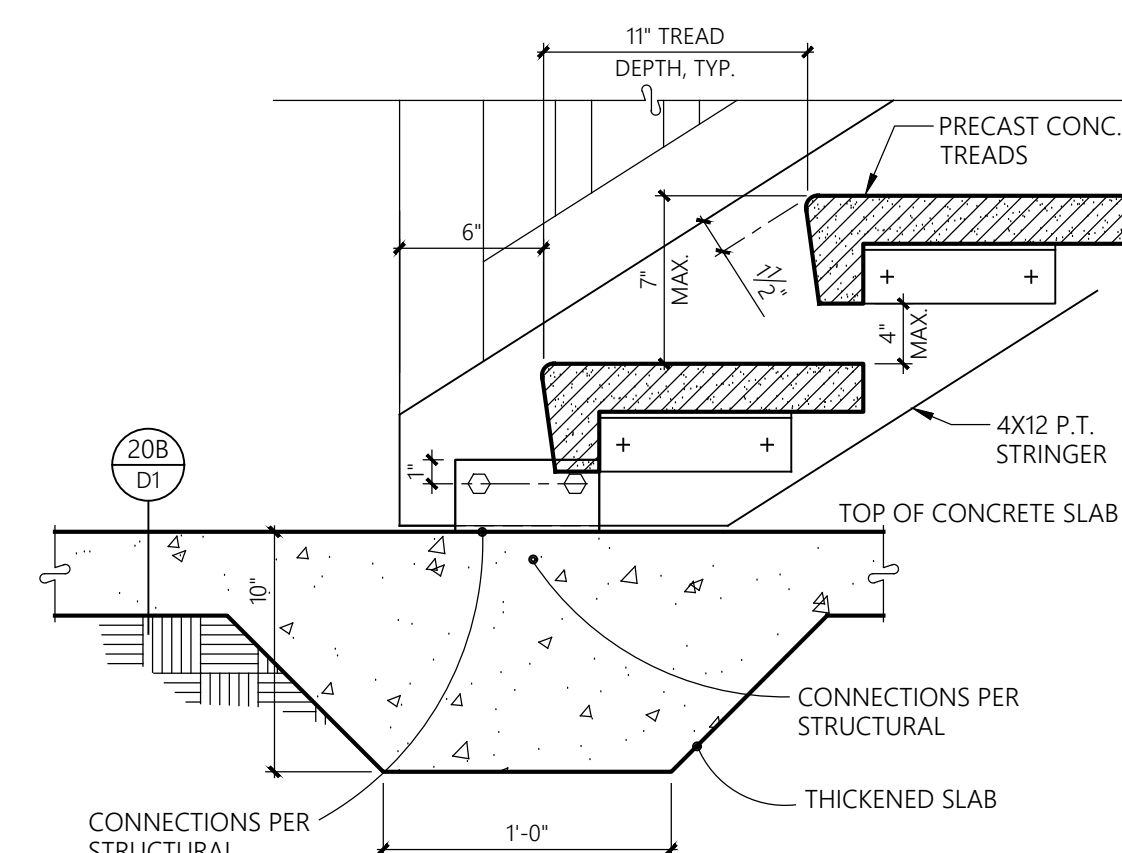

**20** STAIR AT BASE  
1-1/2" = 1'-0"  
SECTION

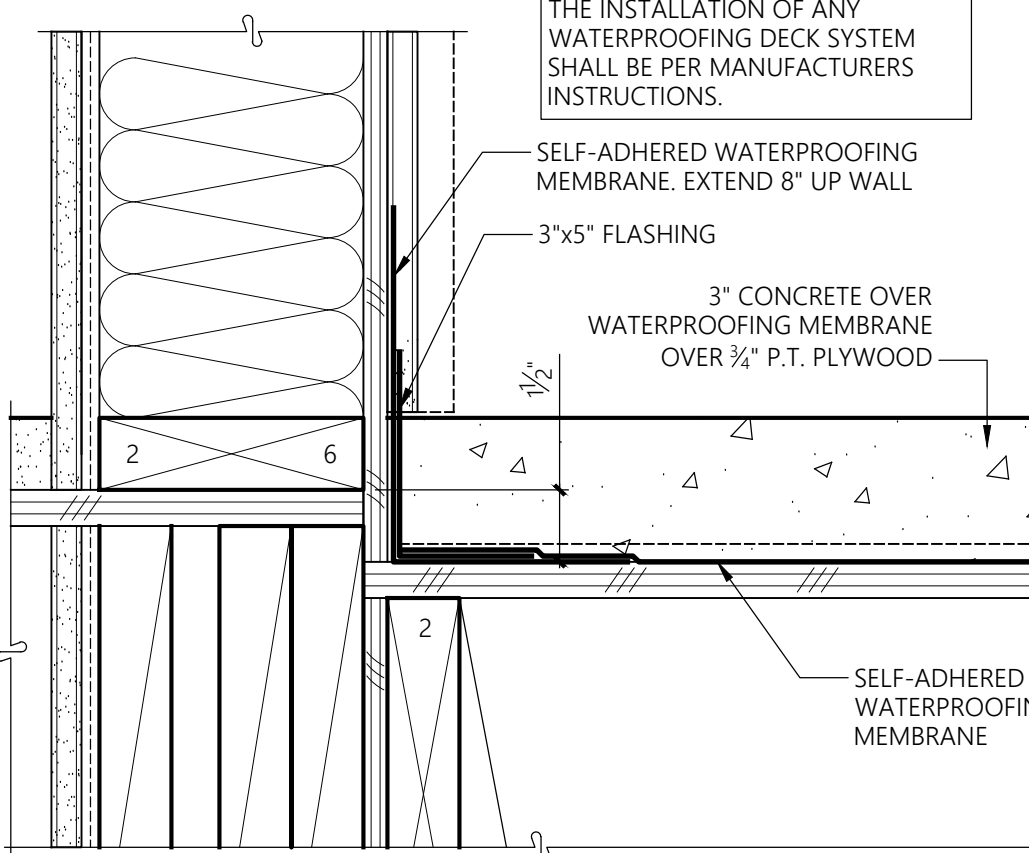


**16** STAIR FLOOR  
3" = 1'-0"  
SECTION

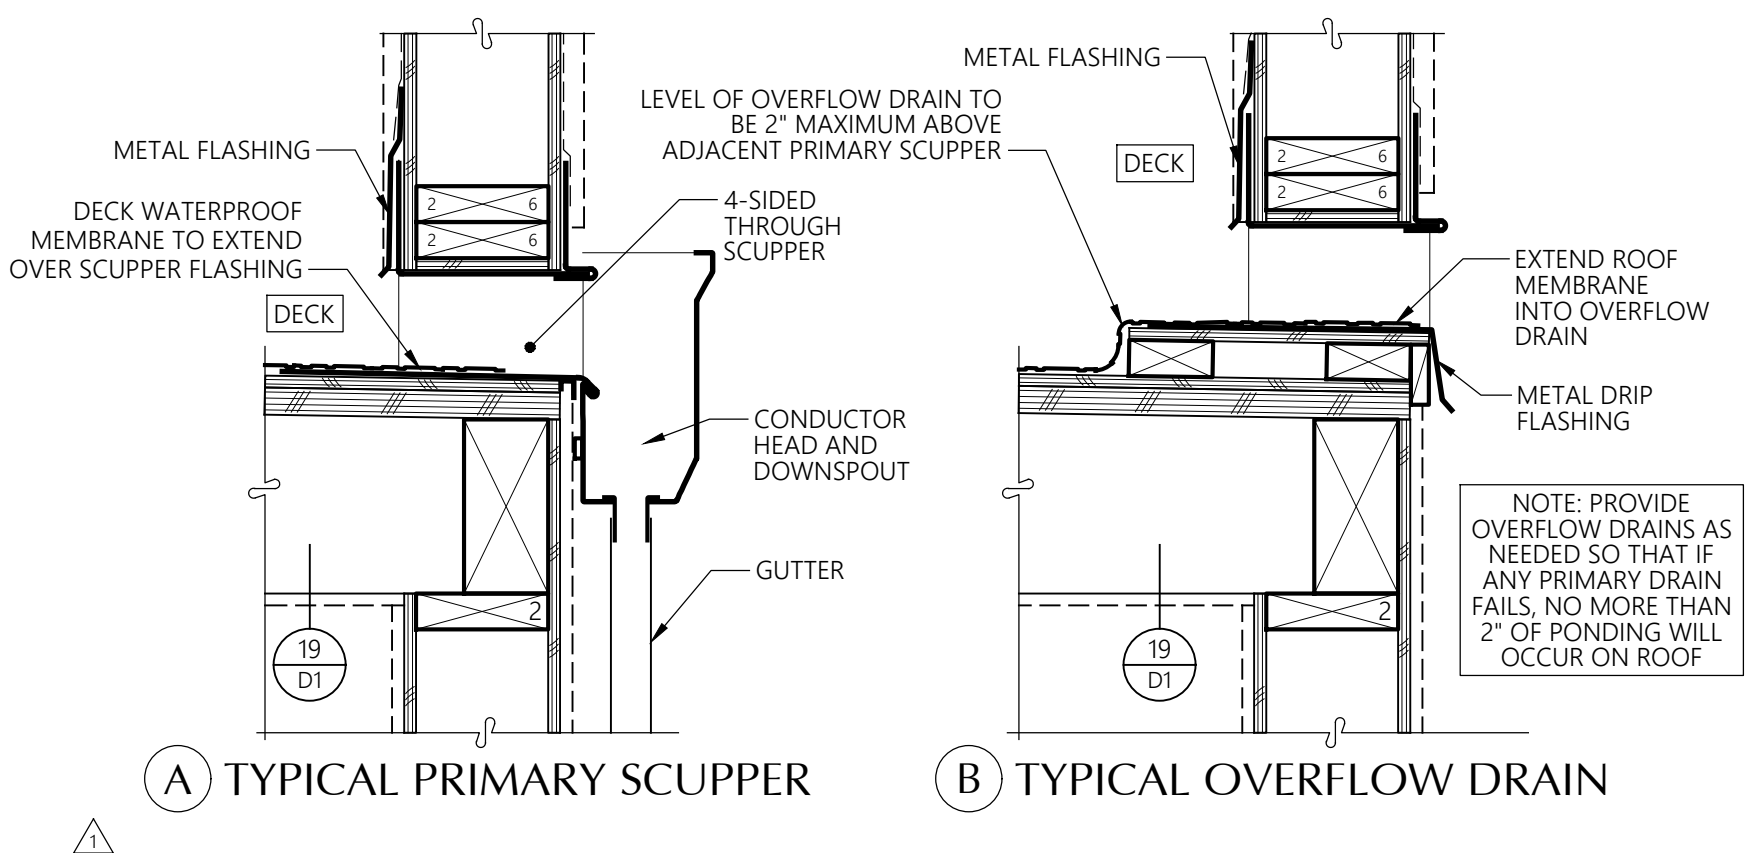


**12** SCUPPER AT WATERPROOF DECK  
1-1/2" = 1'-0"  
SECTION


**2** WATERPROOF DECK THRESHOLD DETAILS  
SECTION

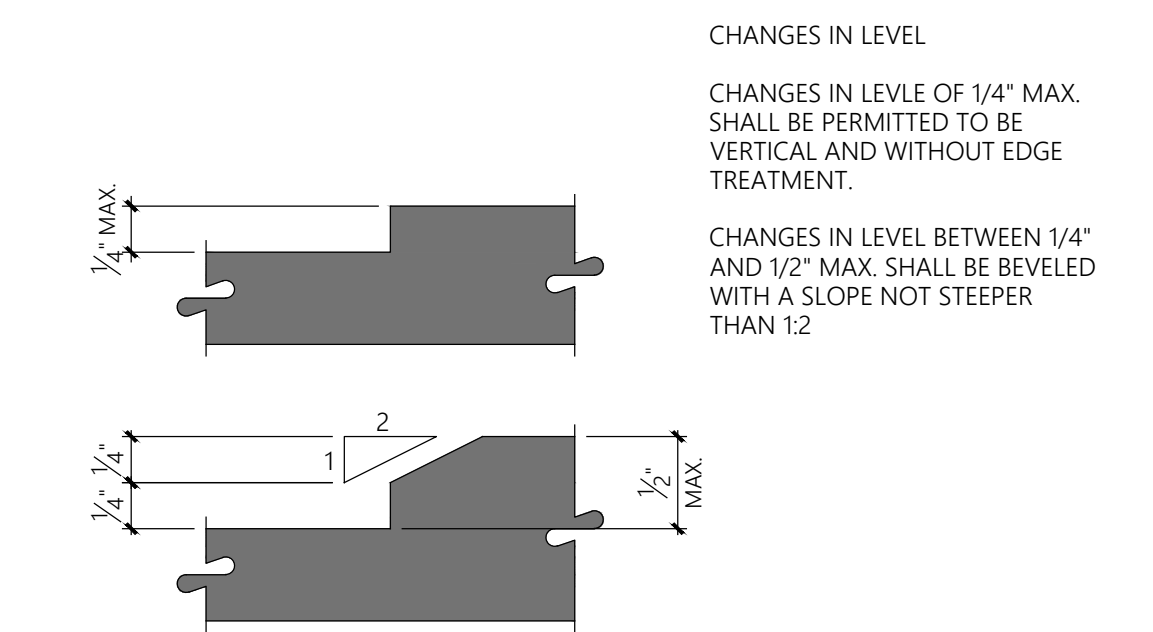


**4** DOOR CHANGES IN LEVEL  
1" = 1'-0"  
SECTION

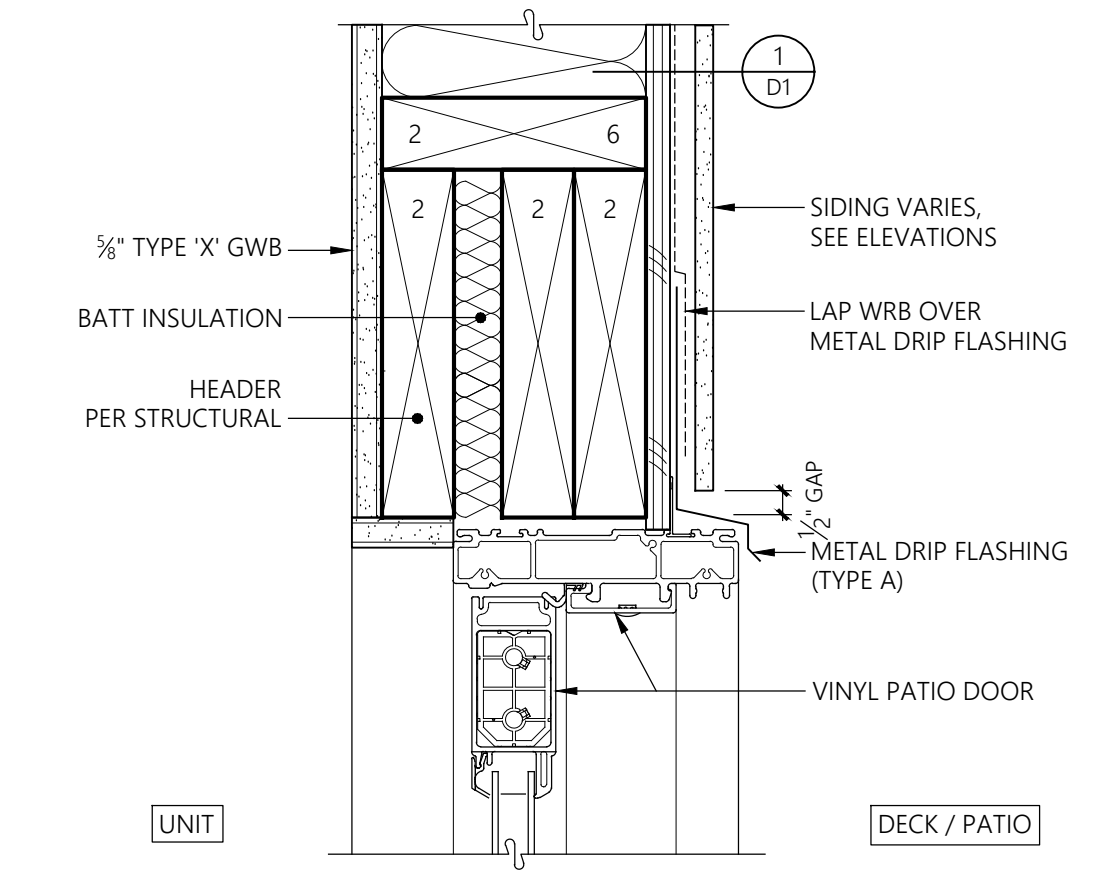


**17** PATIO SWING DOOR - HEAD  
UNIT DECK OR PATIO  
SECTION  
3" = 1'-0"

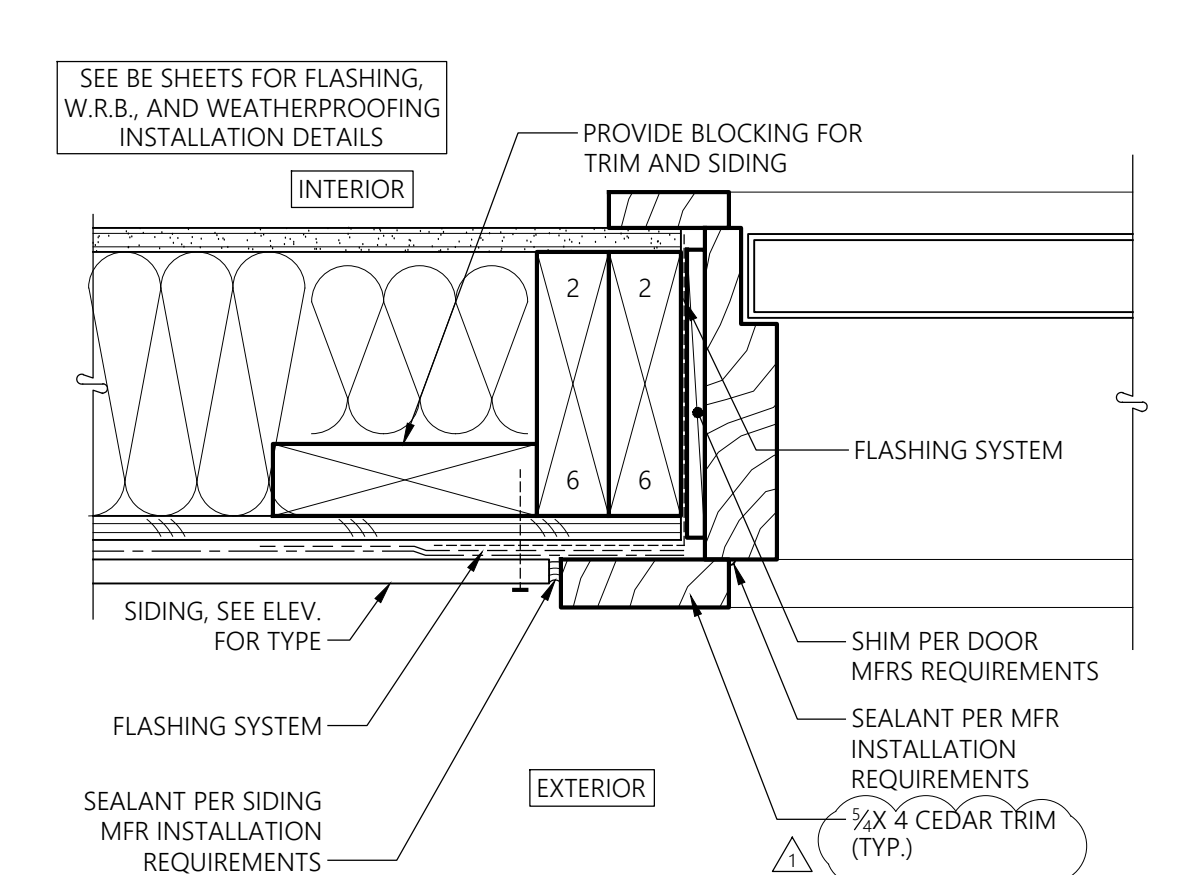


**13** EXTERIOR DOOR JAMB  
SECTION  
3" = 1'-0"

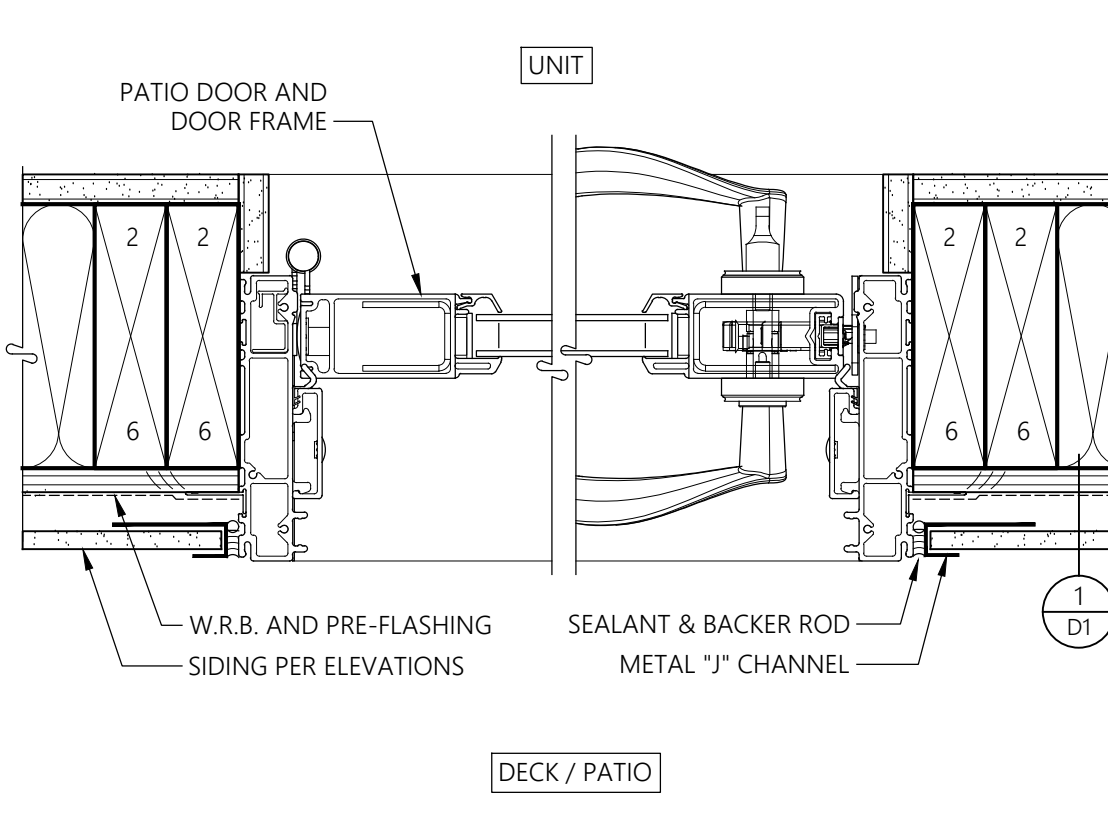


**18** PATIO SWING DOOR - JAMB  
UNIT DECK OR PATIO  
PLAN  
3" = 1'-0"

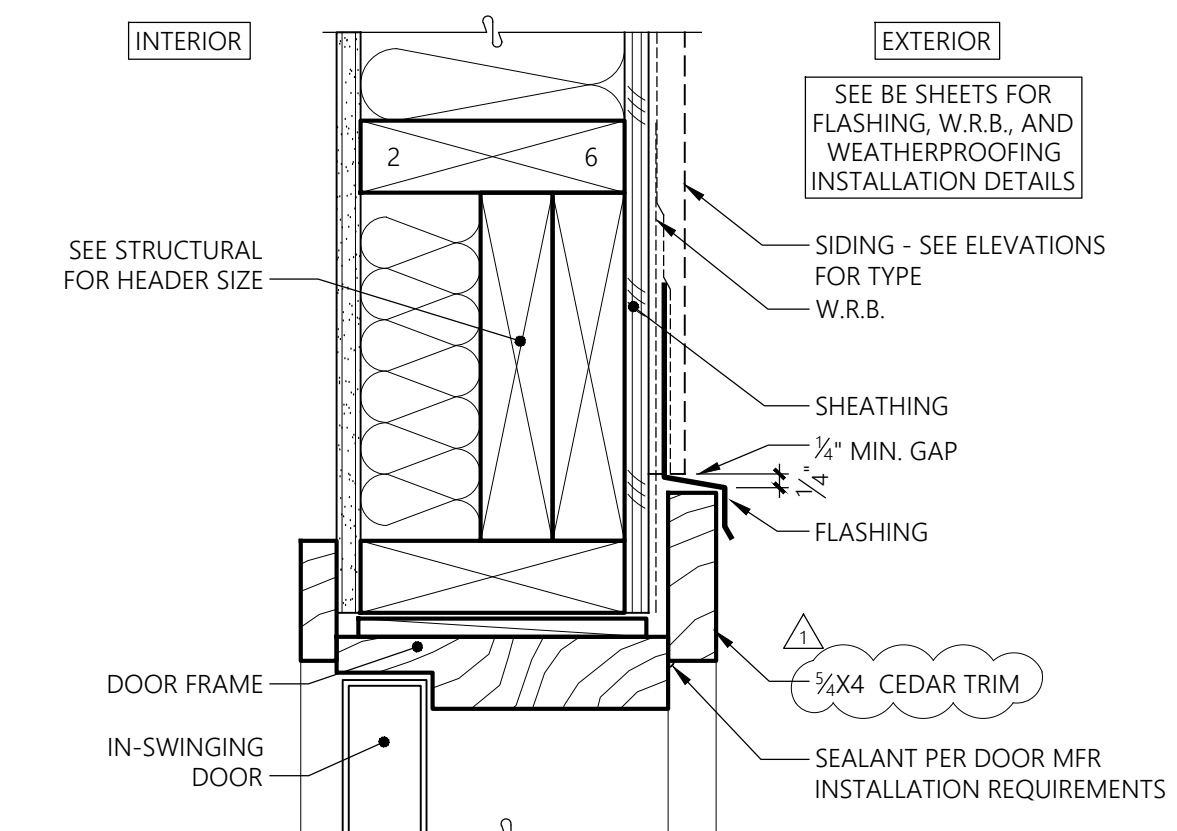


**14** EXTERIOR DOOR HEAD  
SECTION  
3" = 1'-0"

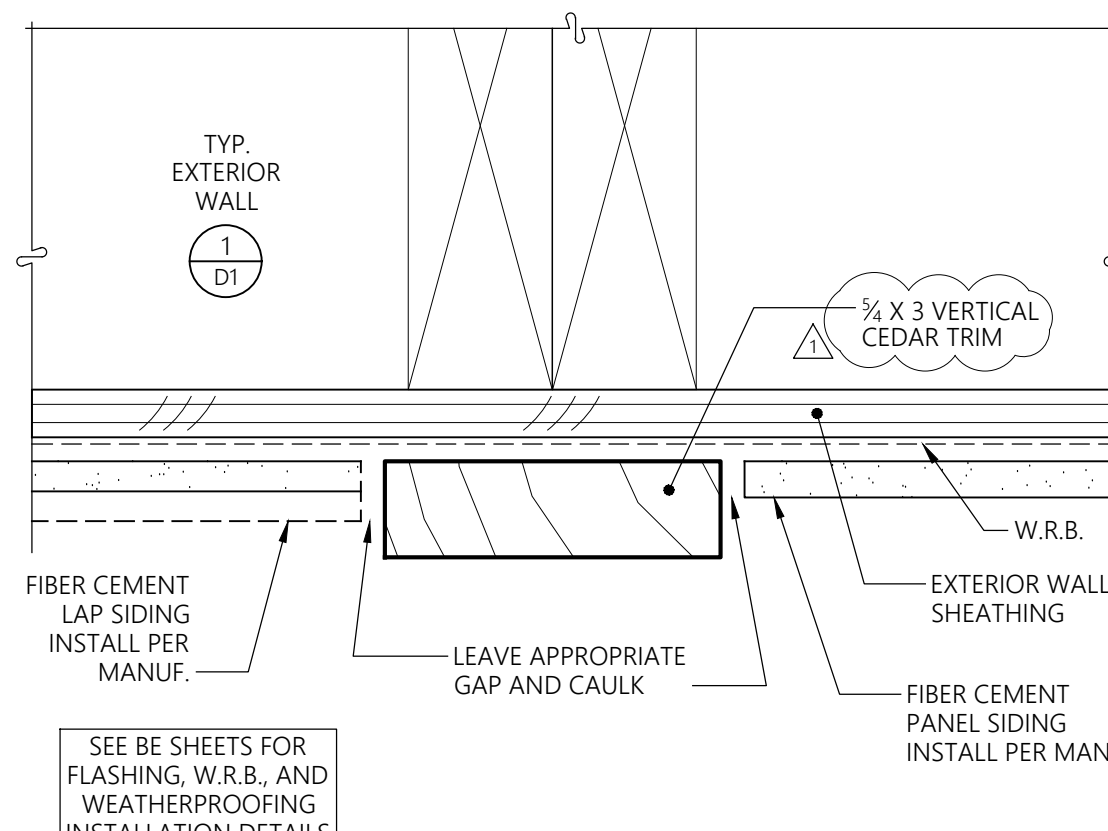


**19** VERTICAL SIDING TRANSITION  
PLAN  
6" = 1'-0"

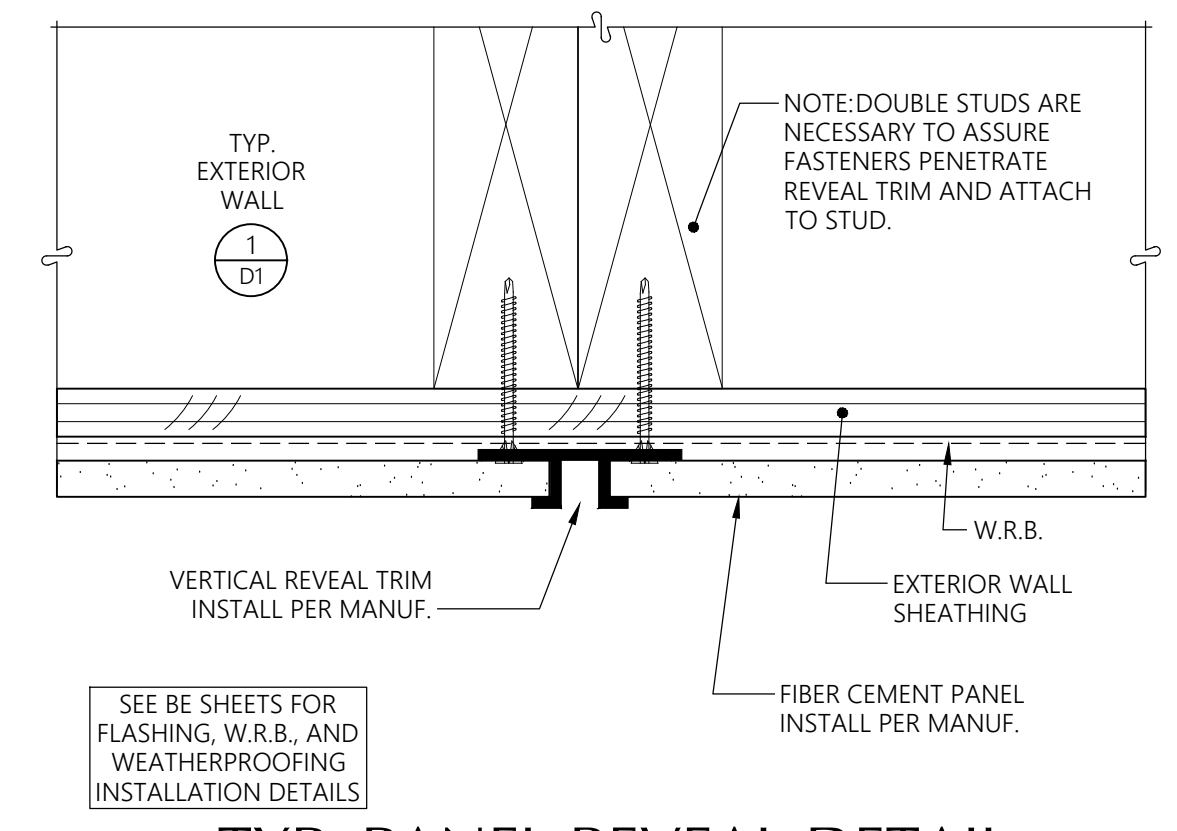


**15** TYP. PANEL REVEAL DETAIL:  
VERTICAL REVEAL TRIM  
PLAN  
6" = 1'-0"

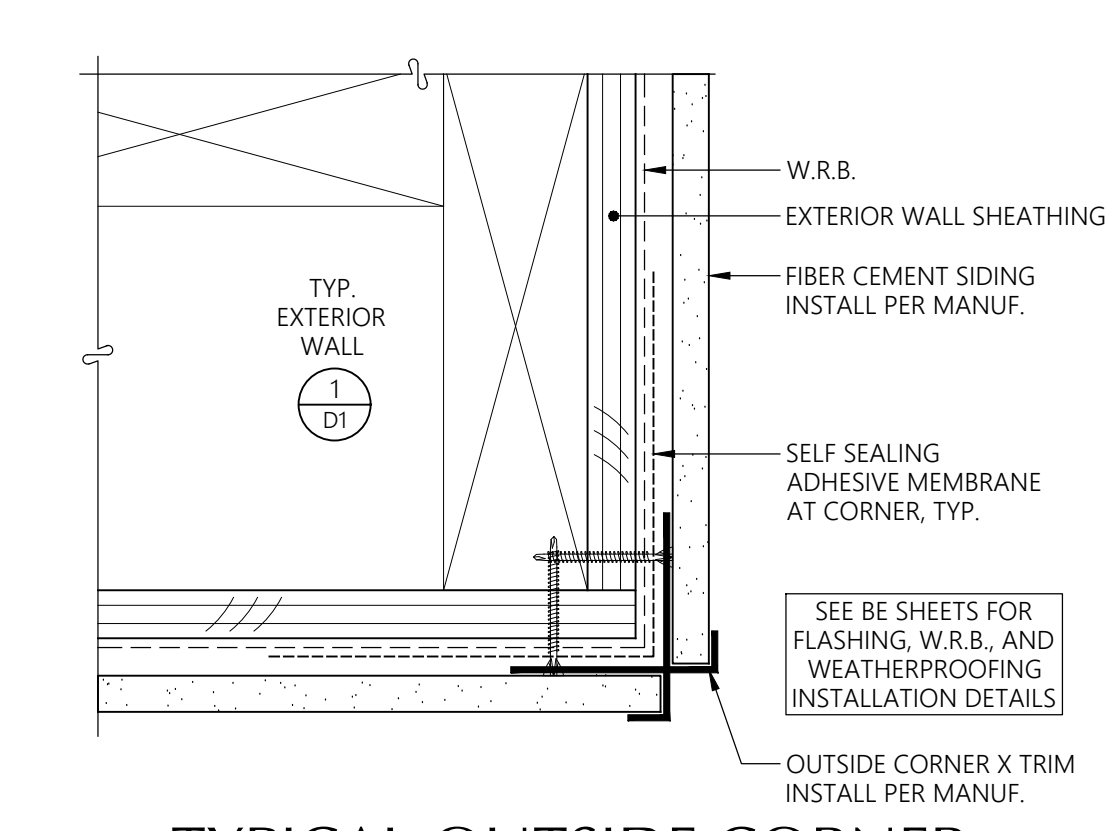


**11** TYPICAL OUTSIDE CORNER  
@ PANEL SIDING  
PLAN  
6" = 1'-0"

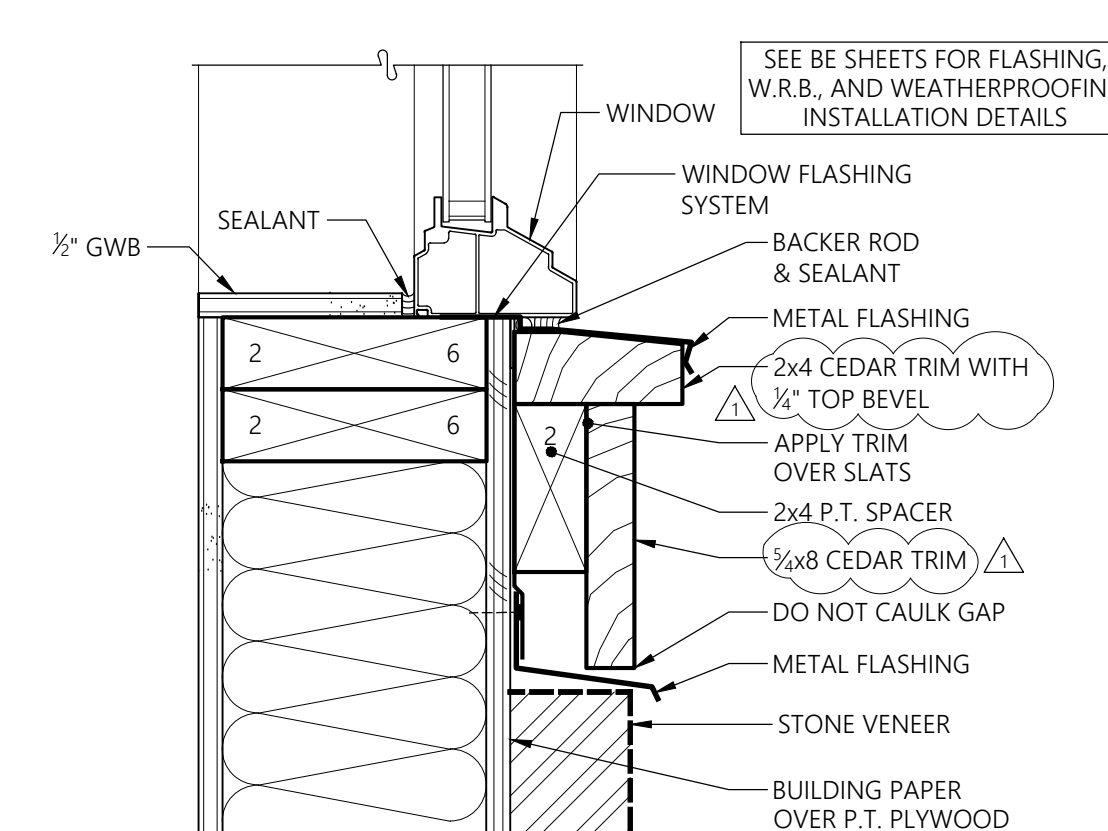


**7** SILL @ STONE VENEER  
SECTION  
3" = 1'-0"

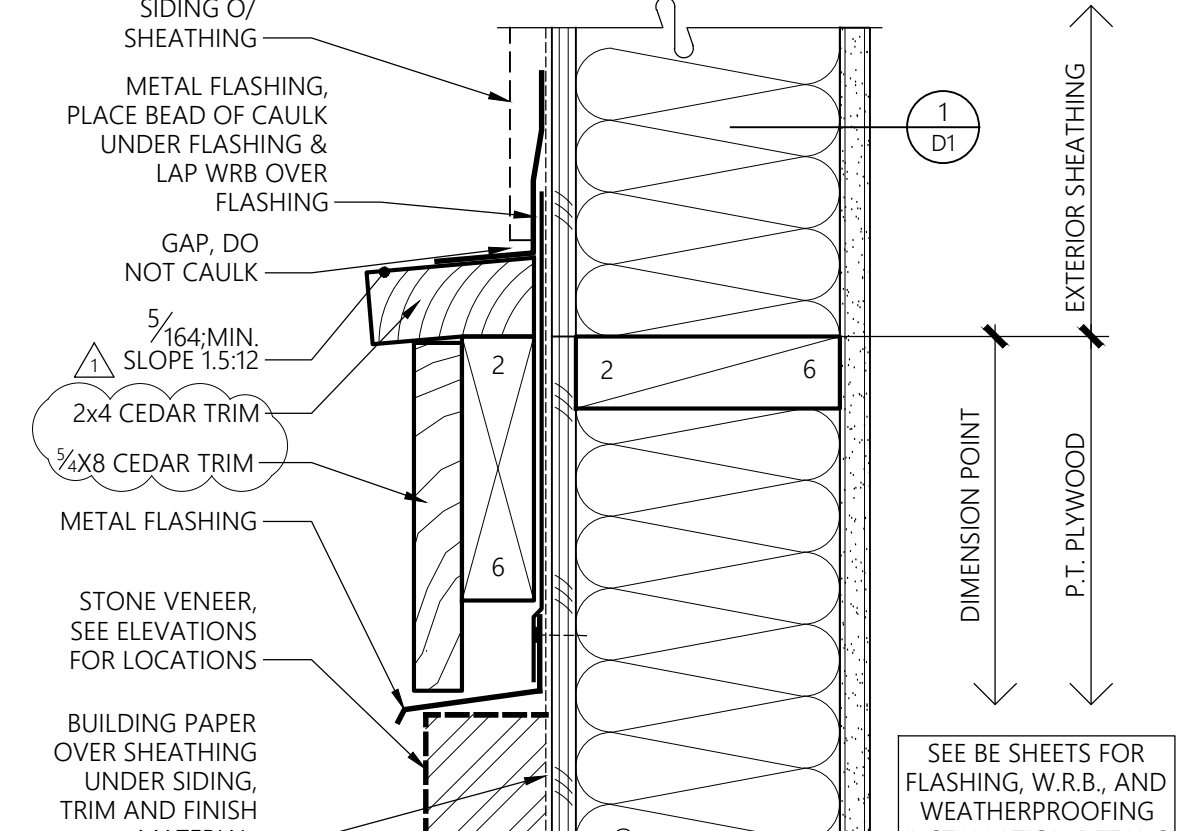


**3** EXT. VENEER @ TRIM CAP  
SECTION  
3" = 1'-0"

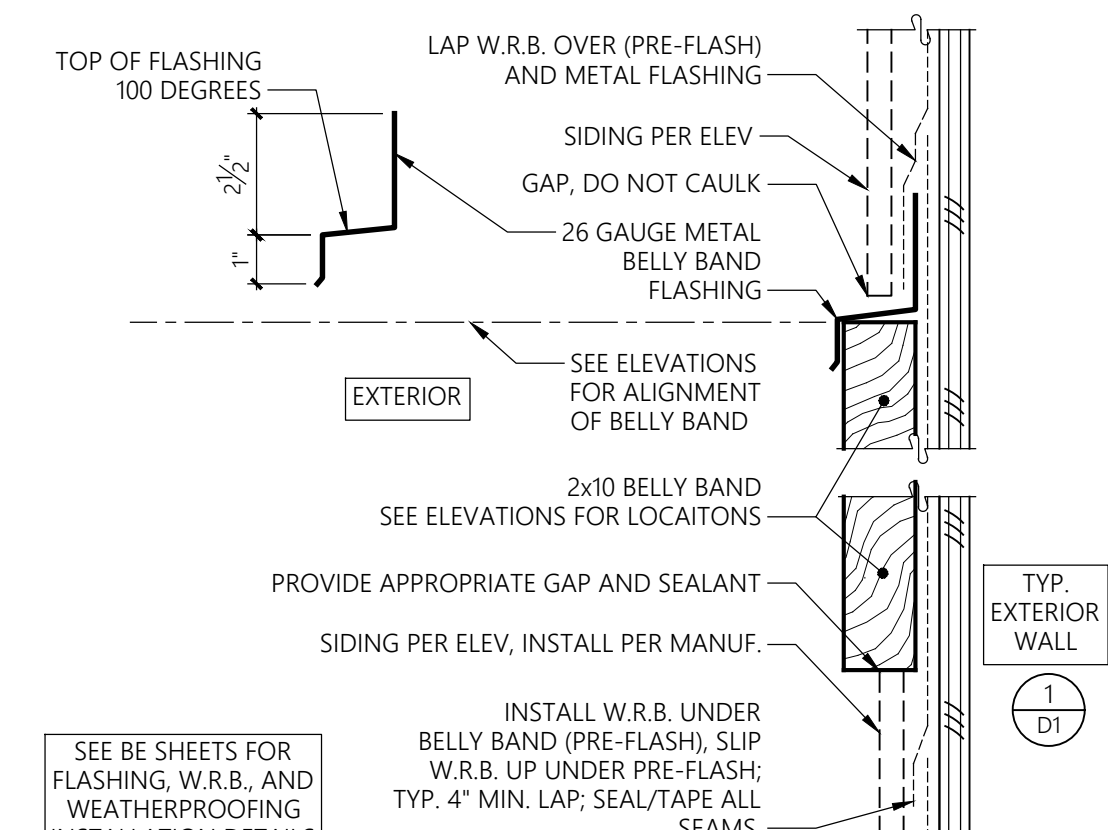


**20** TYPICAL BELLY BAND  
SECTION  
3" = 1'-0"

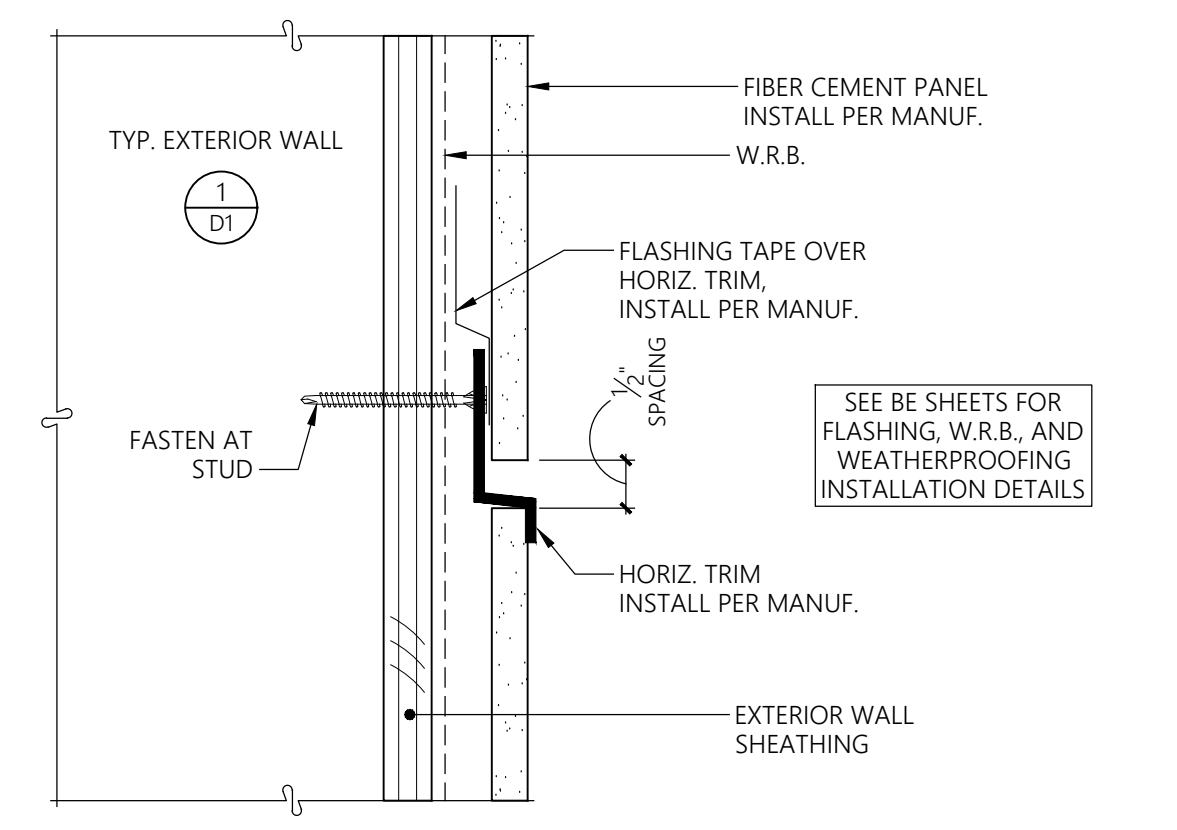


**16** TYP. PANEL REVEAL DETAIL:  
HORIZONTAL REVEAL TRIM  
SECTION  
6" = 1'-0"

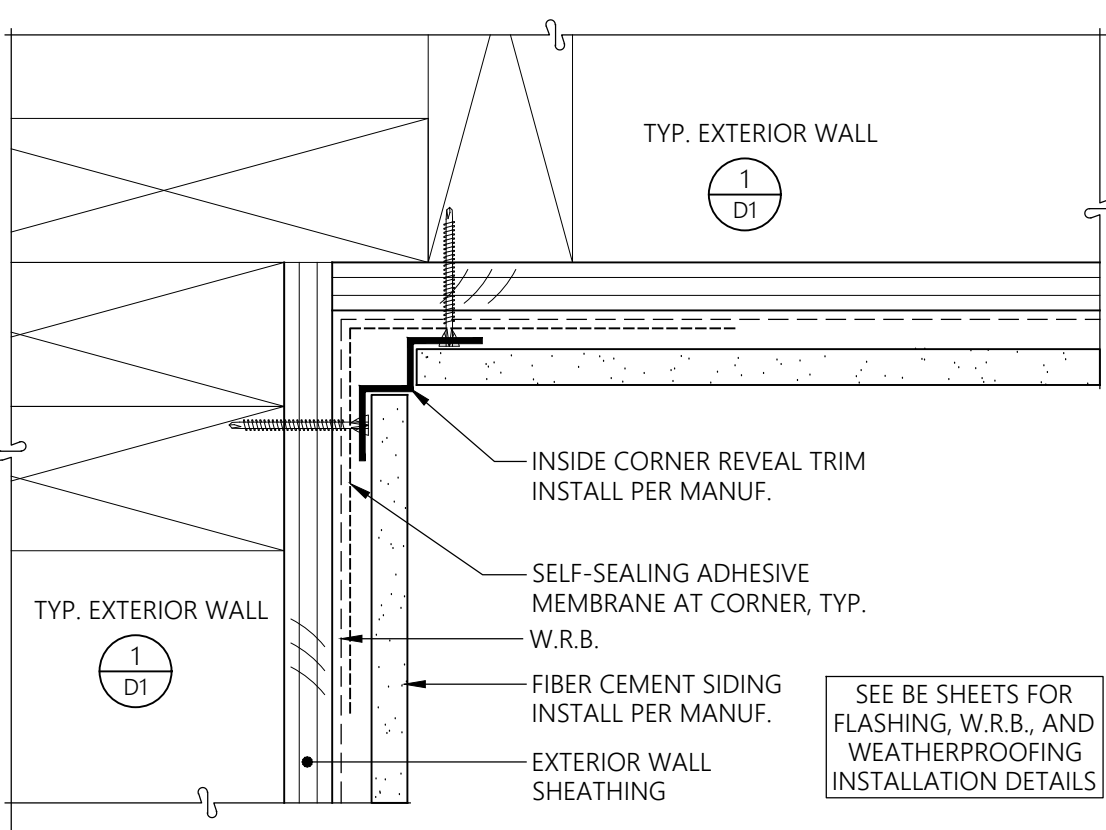


**12** TYPICAL INSIDE CORNER  
@ PANEL SIDING  
PLAN  
6" = 1'-0"

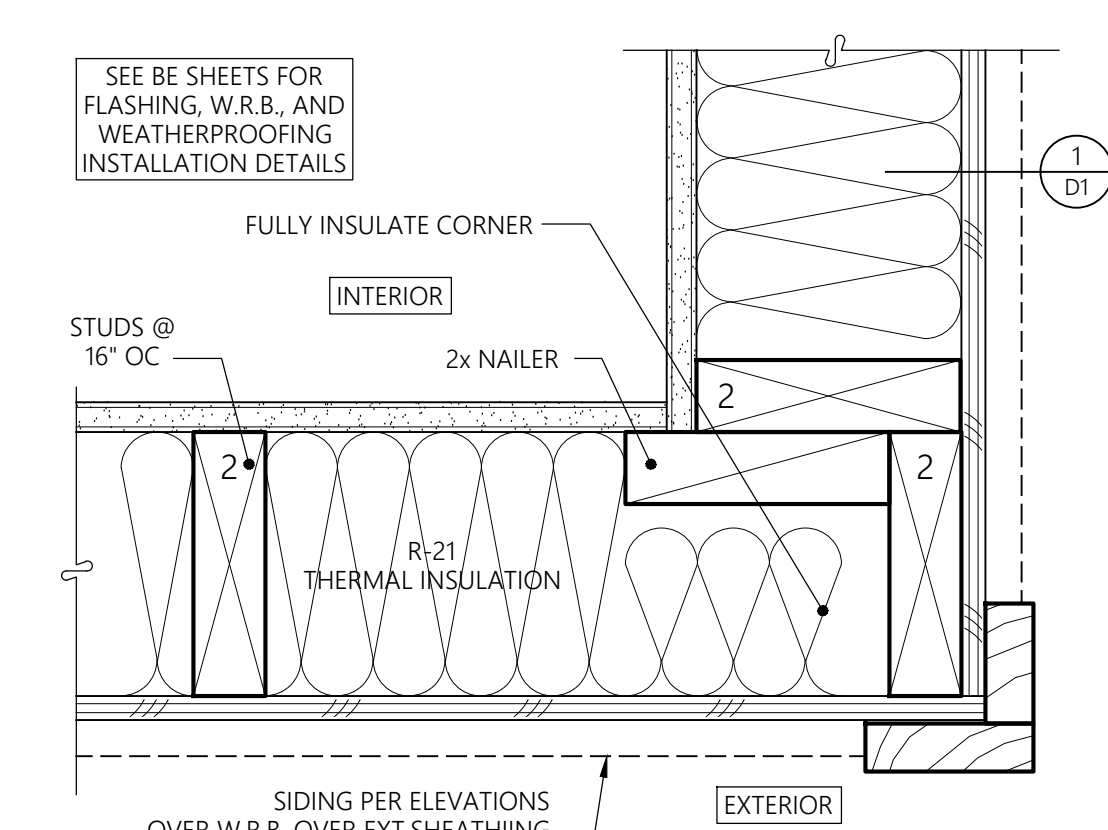


**8** TYPICAL EXTERIOR CORNER  
PLAN  
3" = 1'-0"

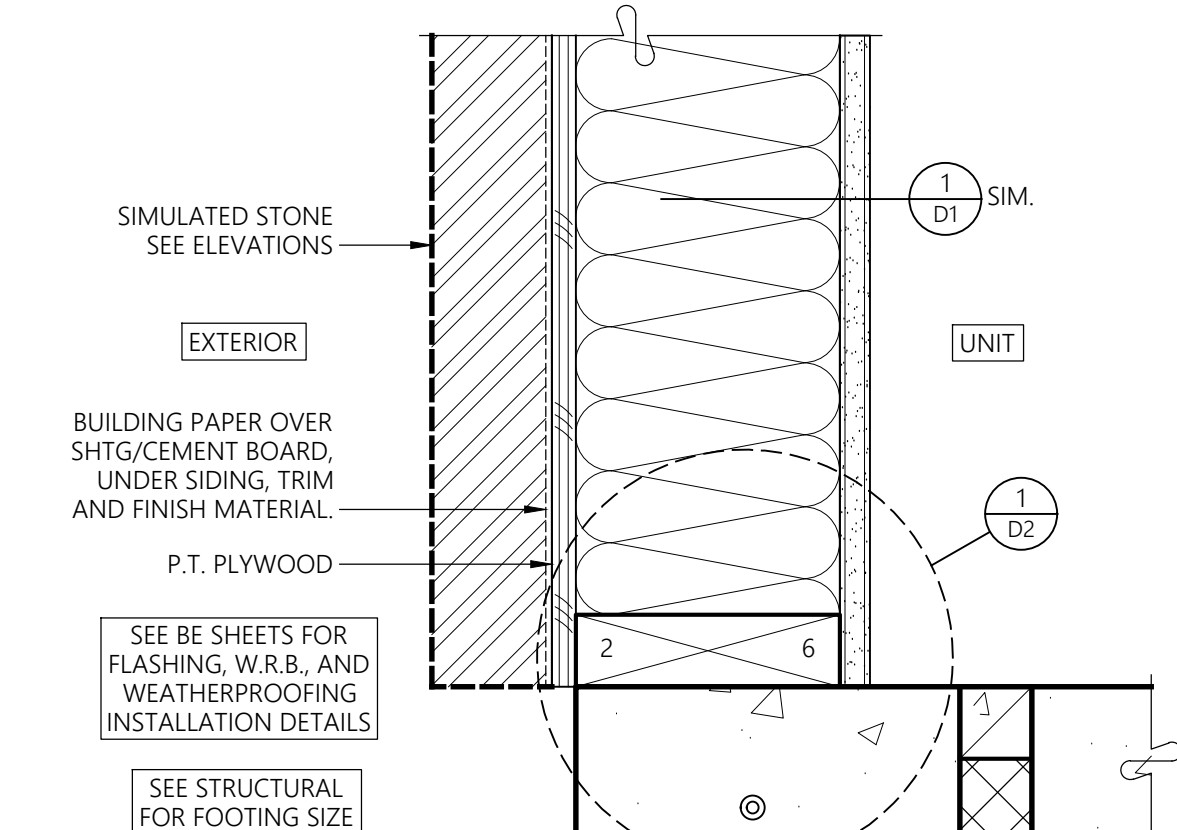


**4** EXT. VENEER BASE  
SECTION  
3" = 1'-0"

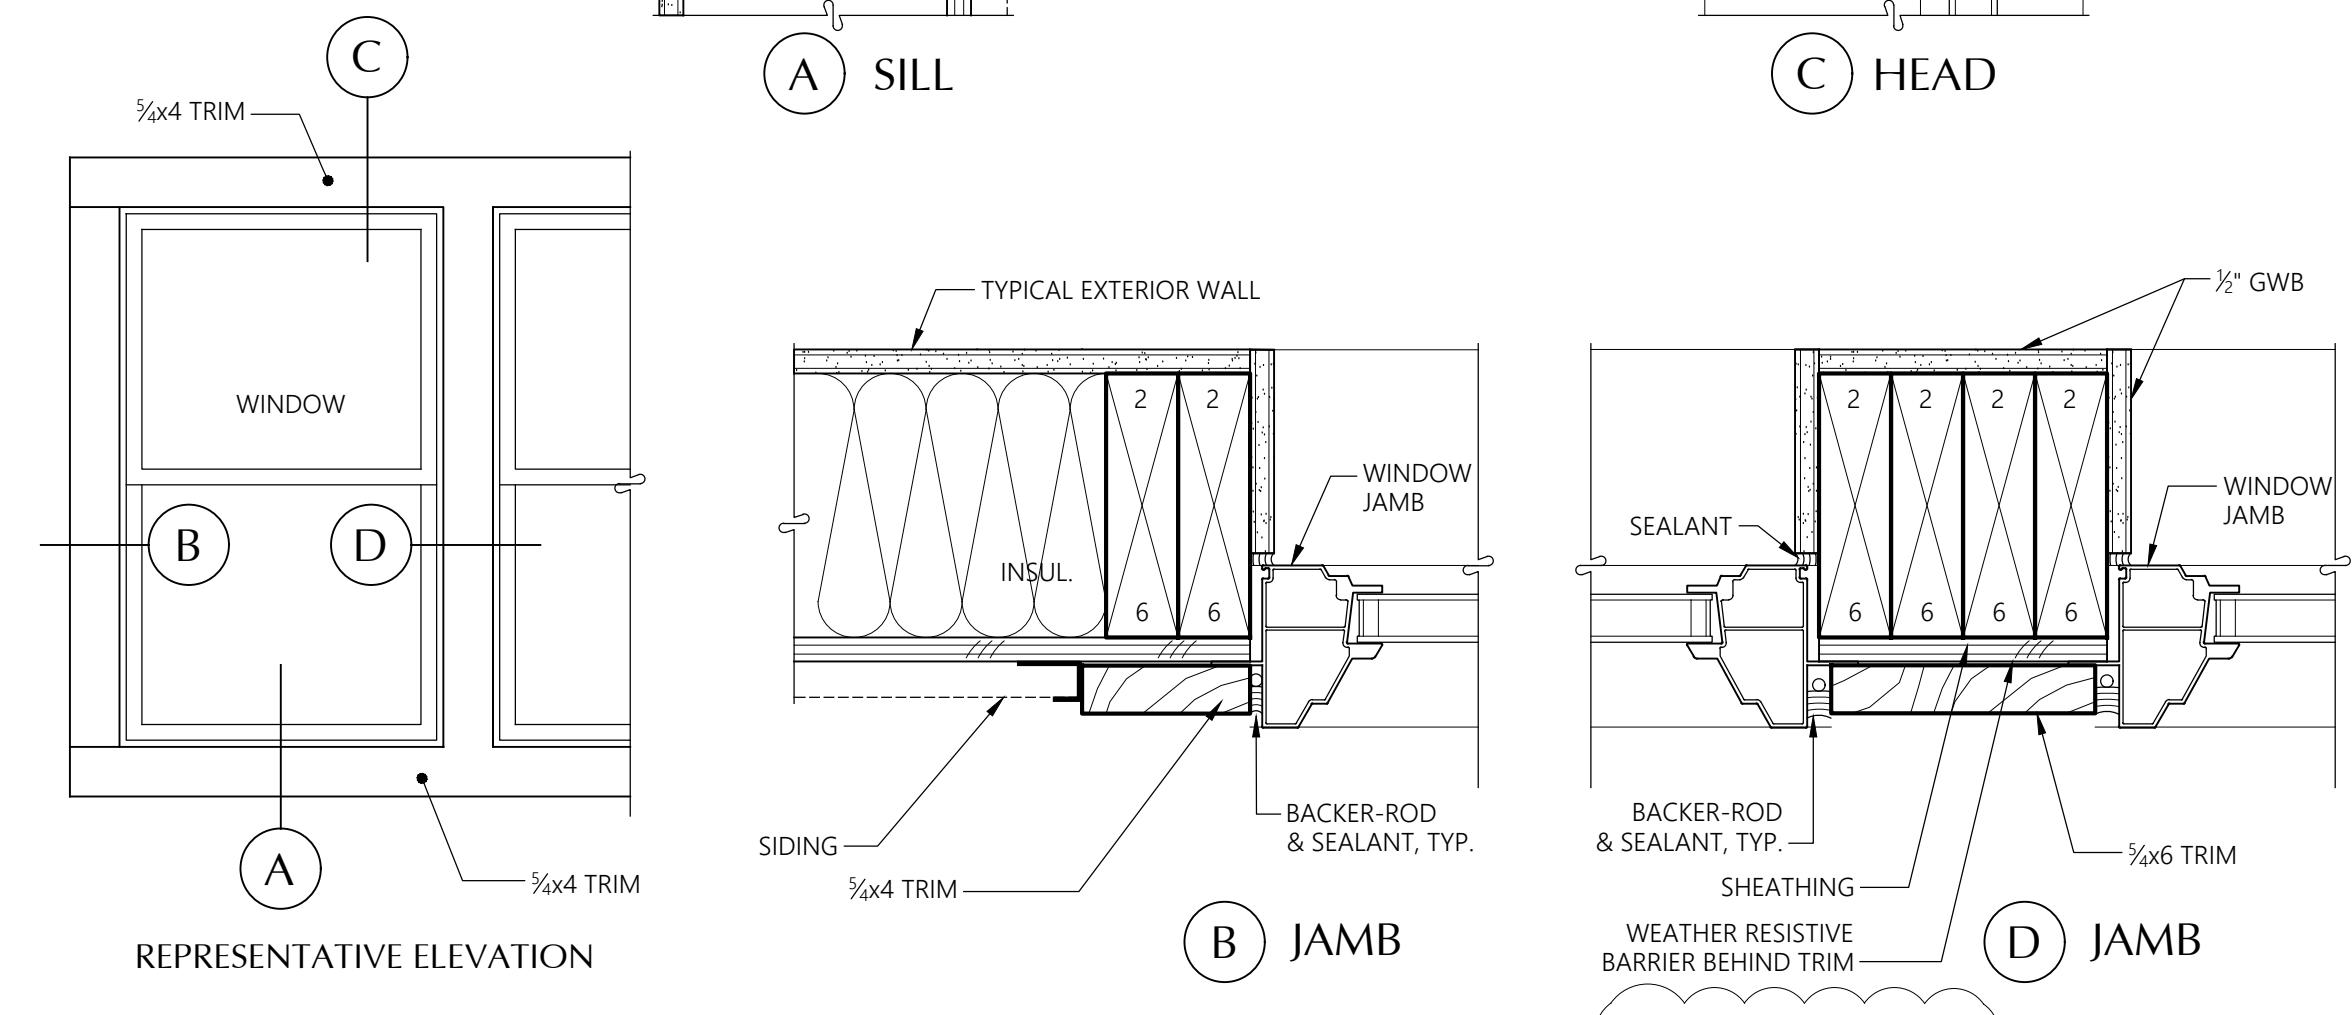


**6** TYPICAL WINDOW DETAILS  
SECTION  
3" = 1'-0"

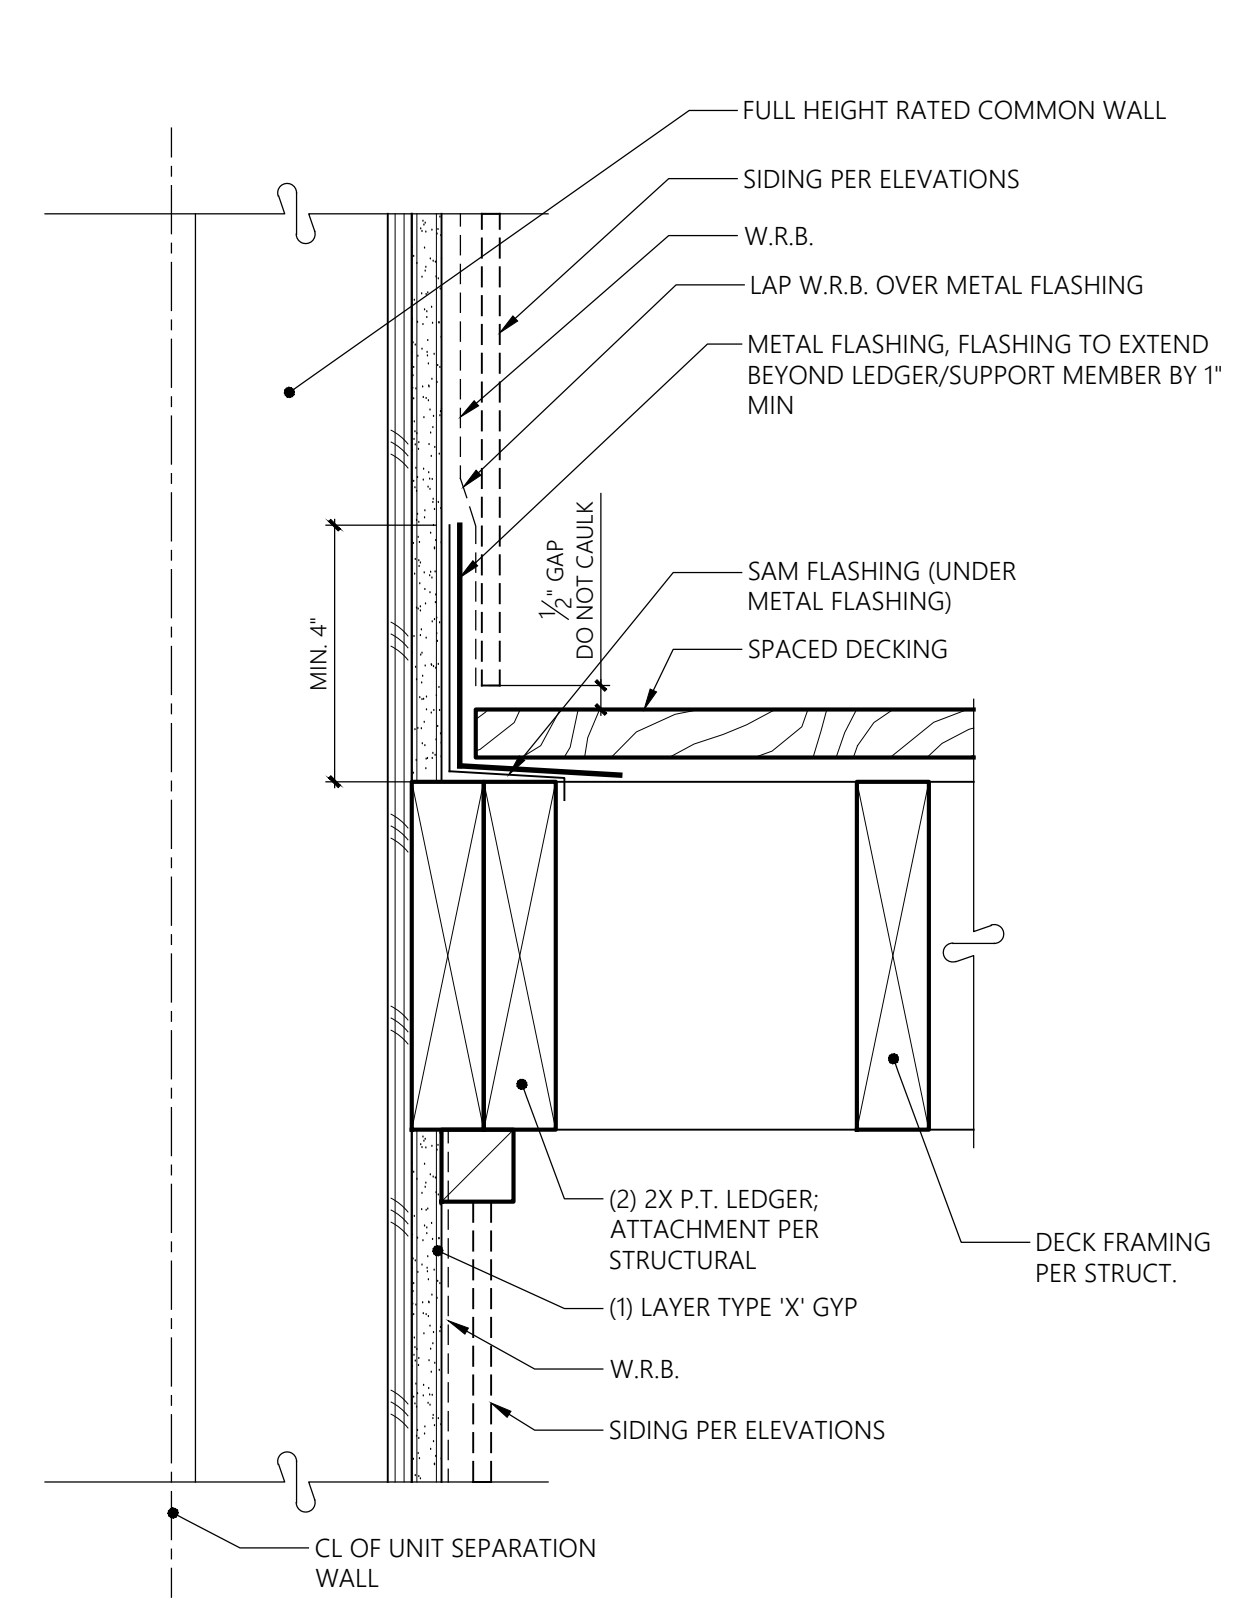


**A** DECK AT RATED WALL

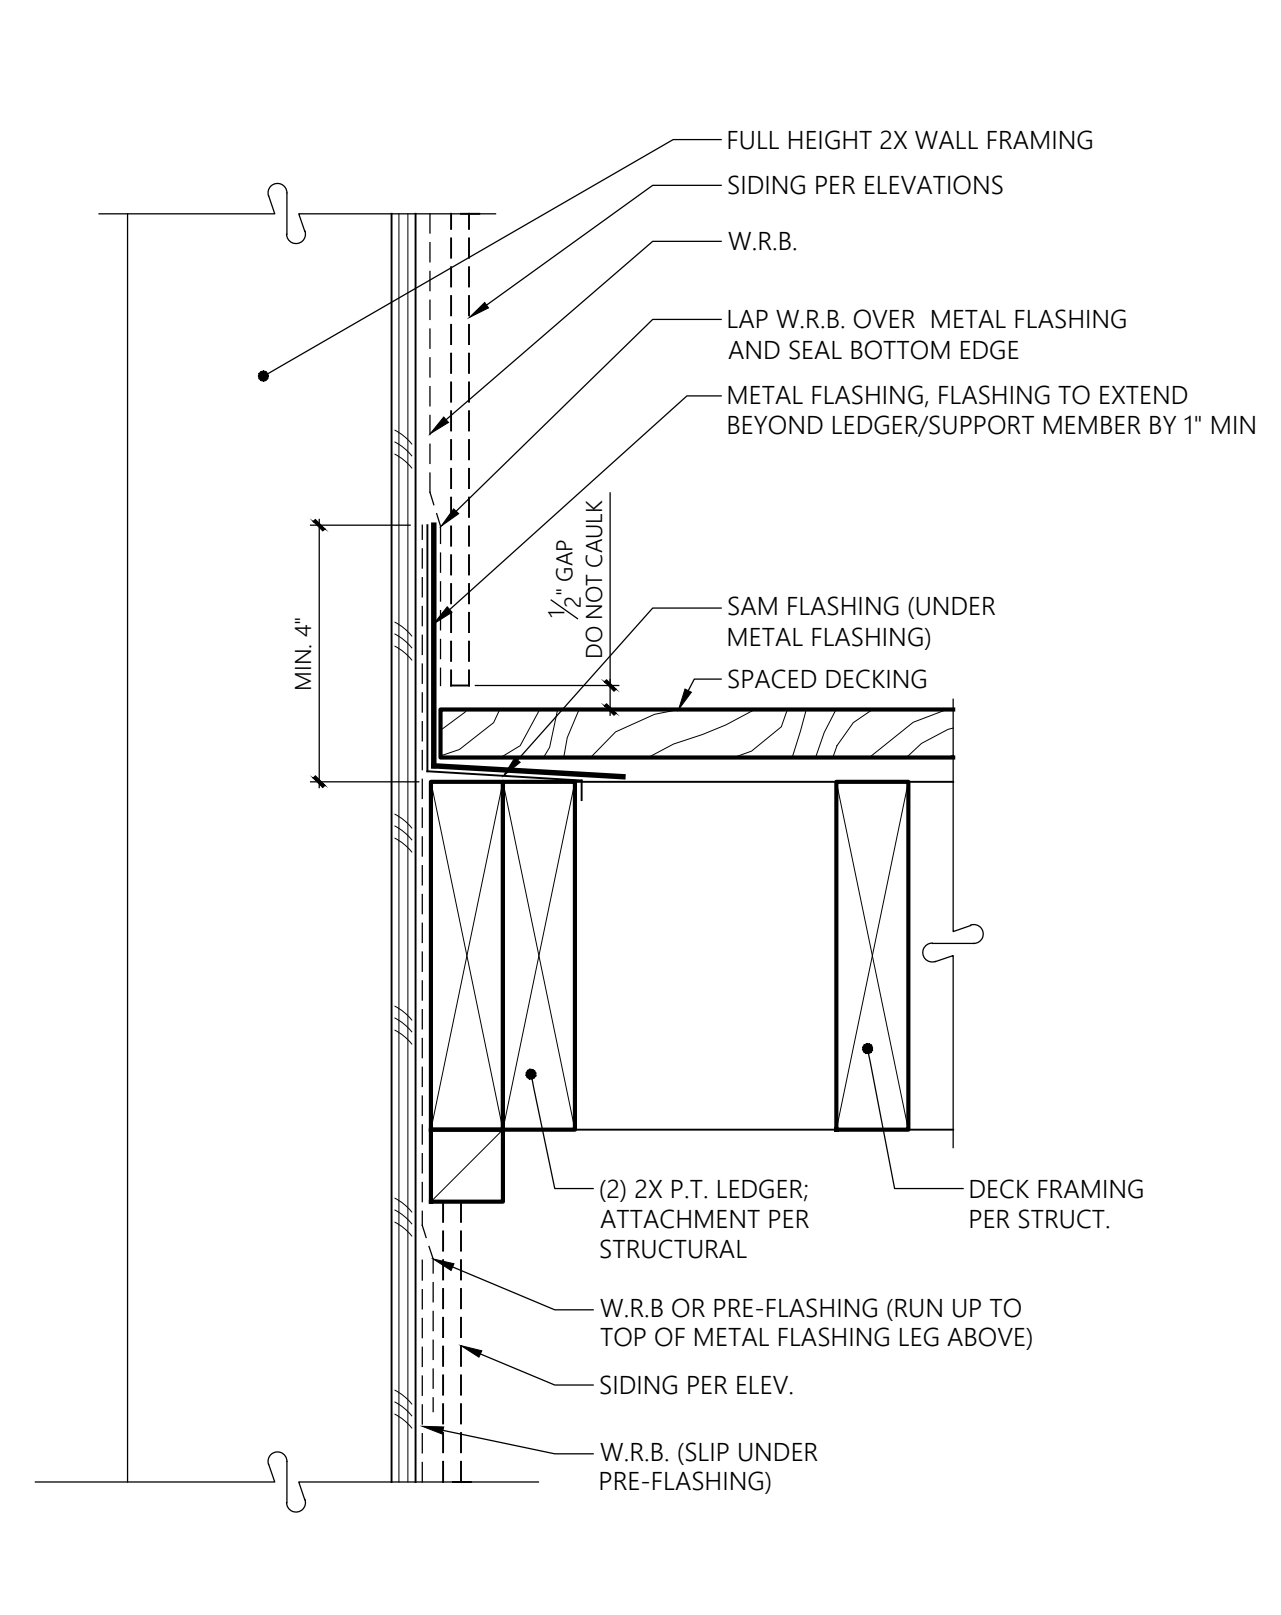

**B** DECK AT UN-RATED WALL

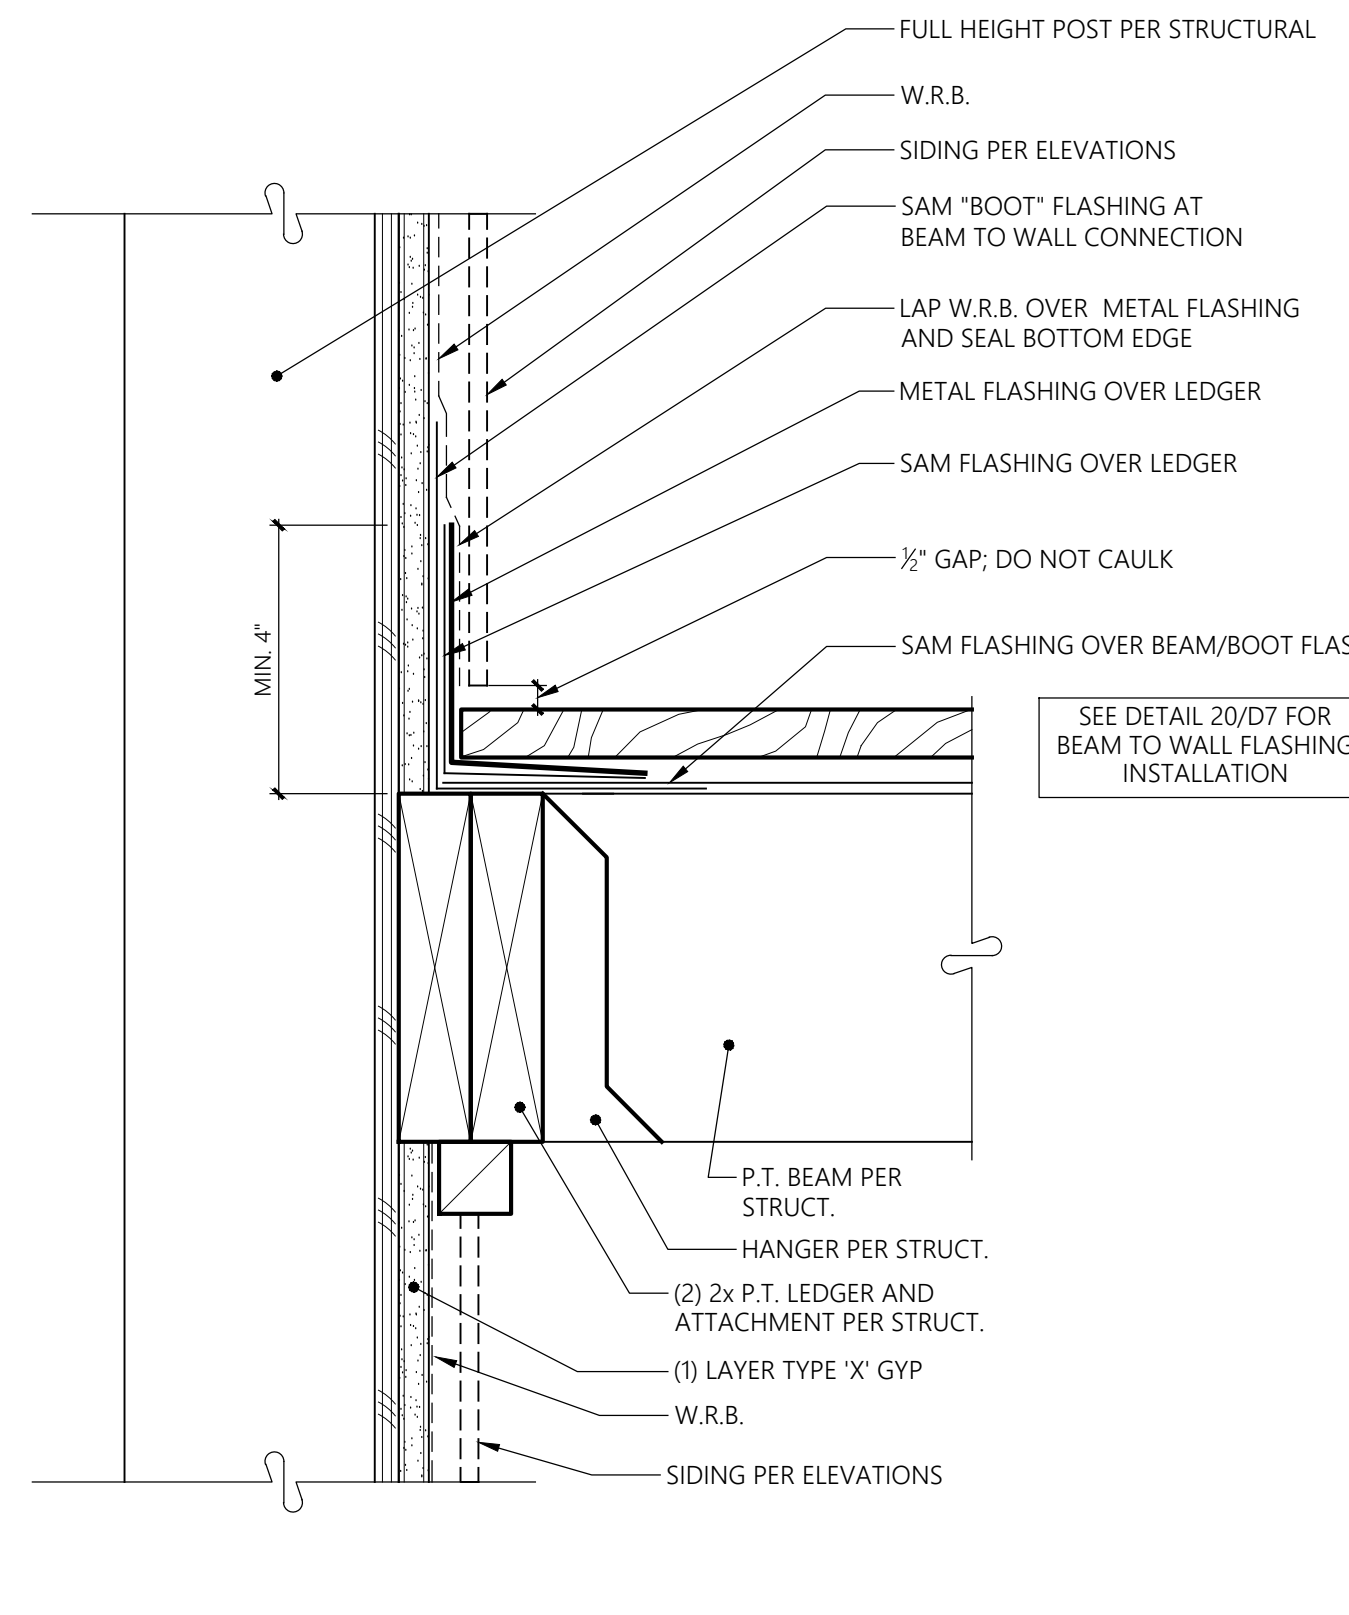


**C** BEAM AT RATED COLUMN

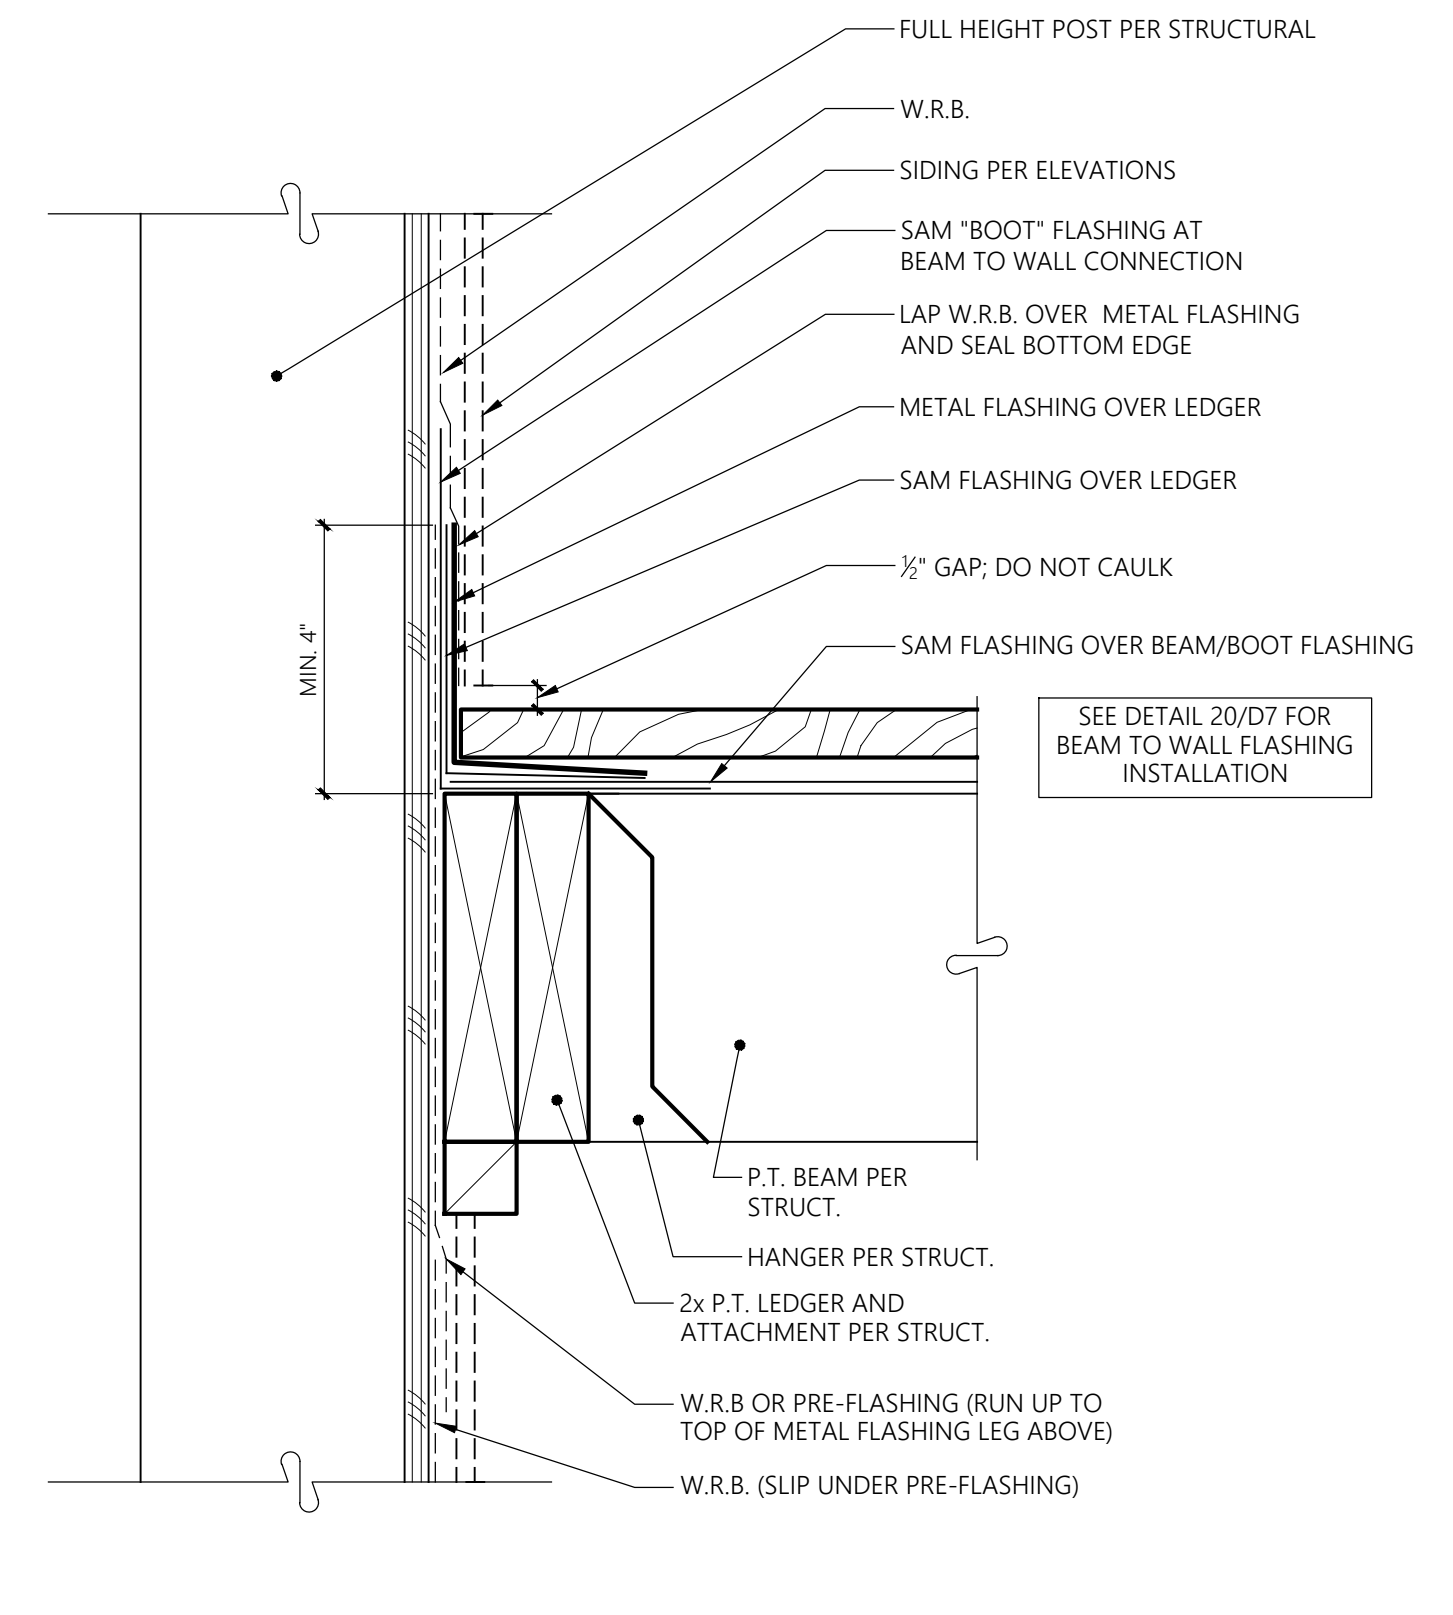


**D** BEAM AT UN-RATED COLUMN

**18** SPACED DECKING TO WALL  
3" = 1'-0"


SECTION

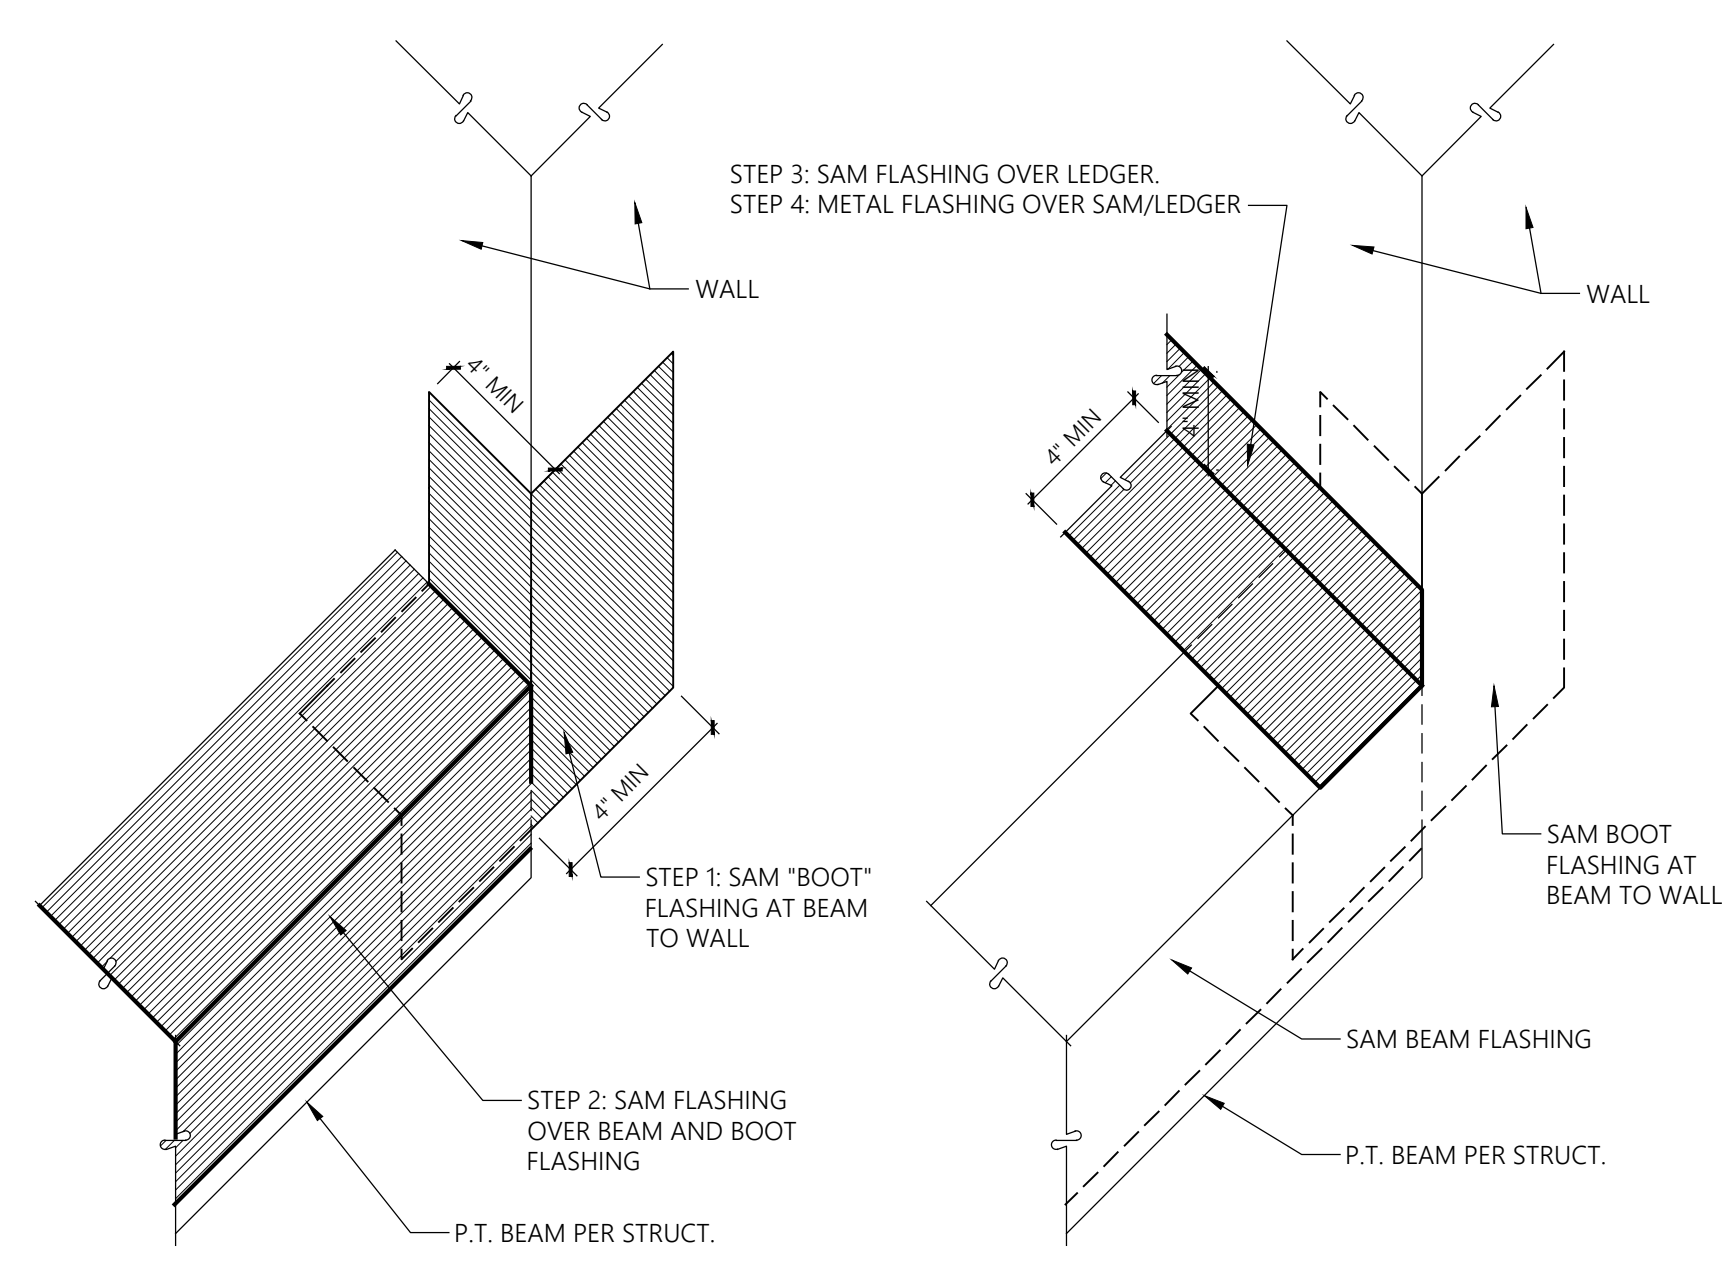

**20** BEAM TO WALL FLASHING  
NTS

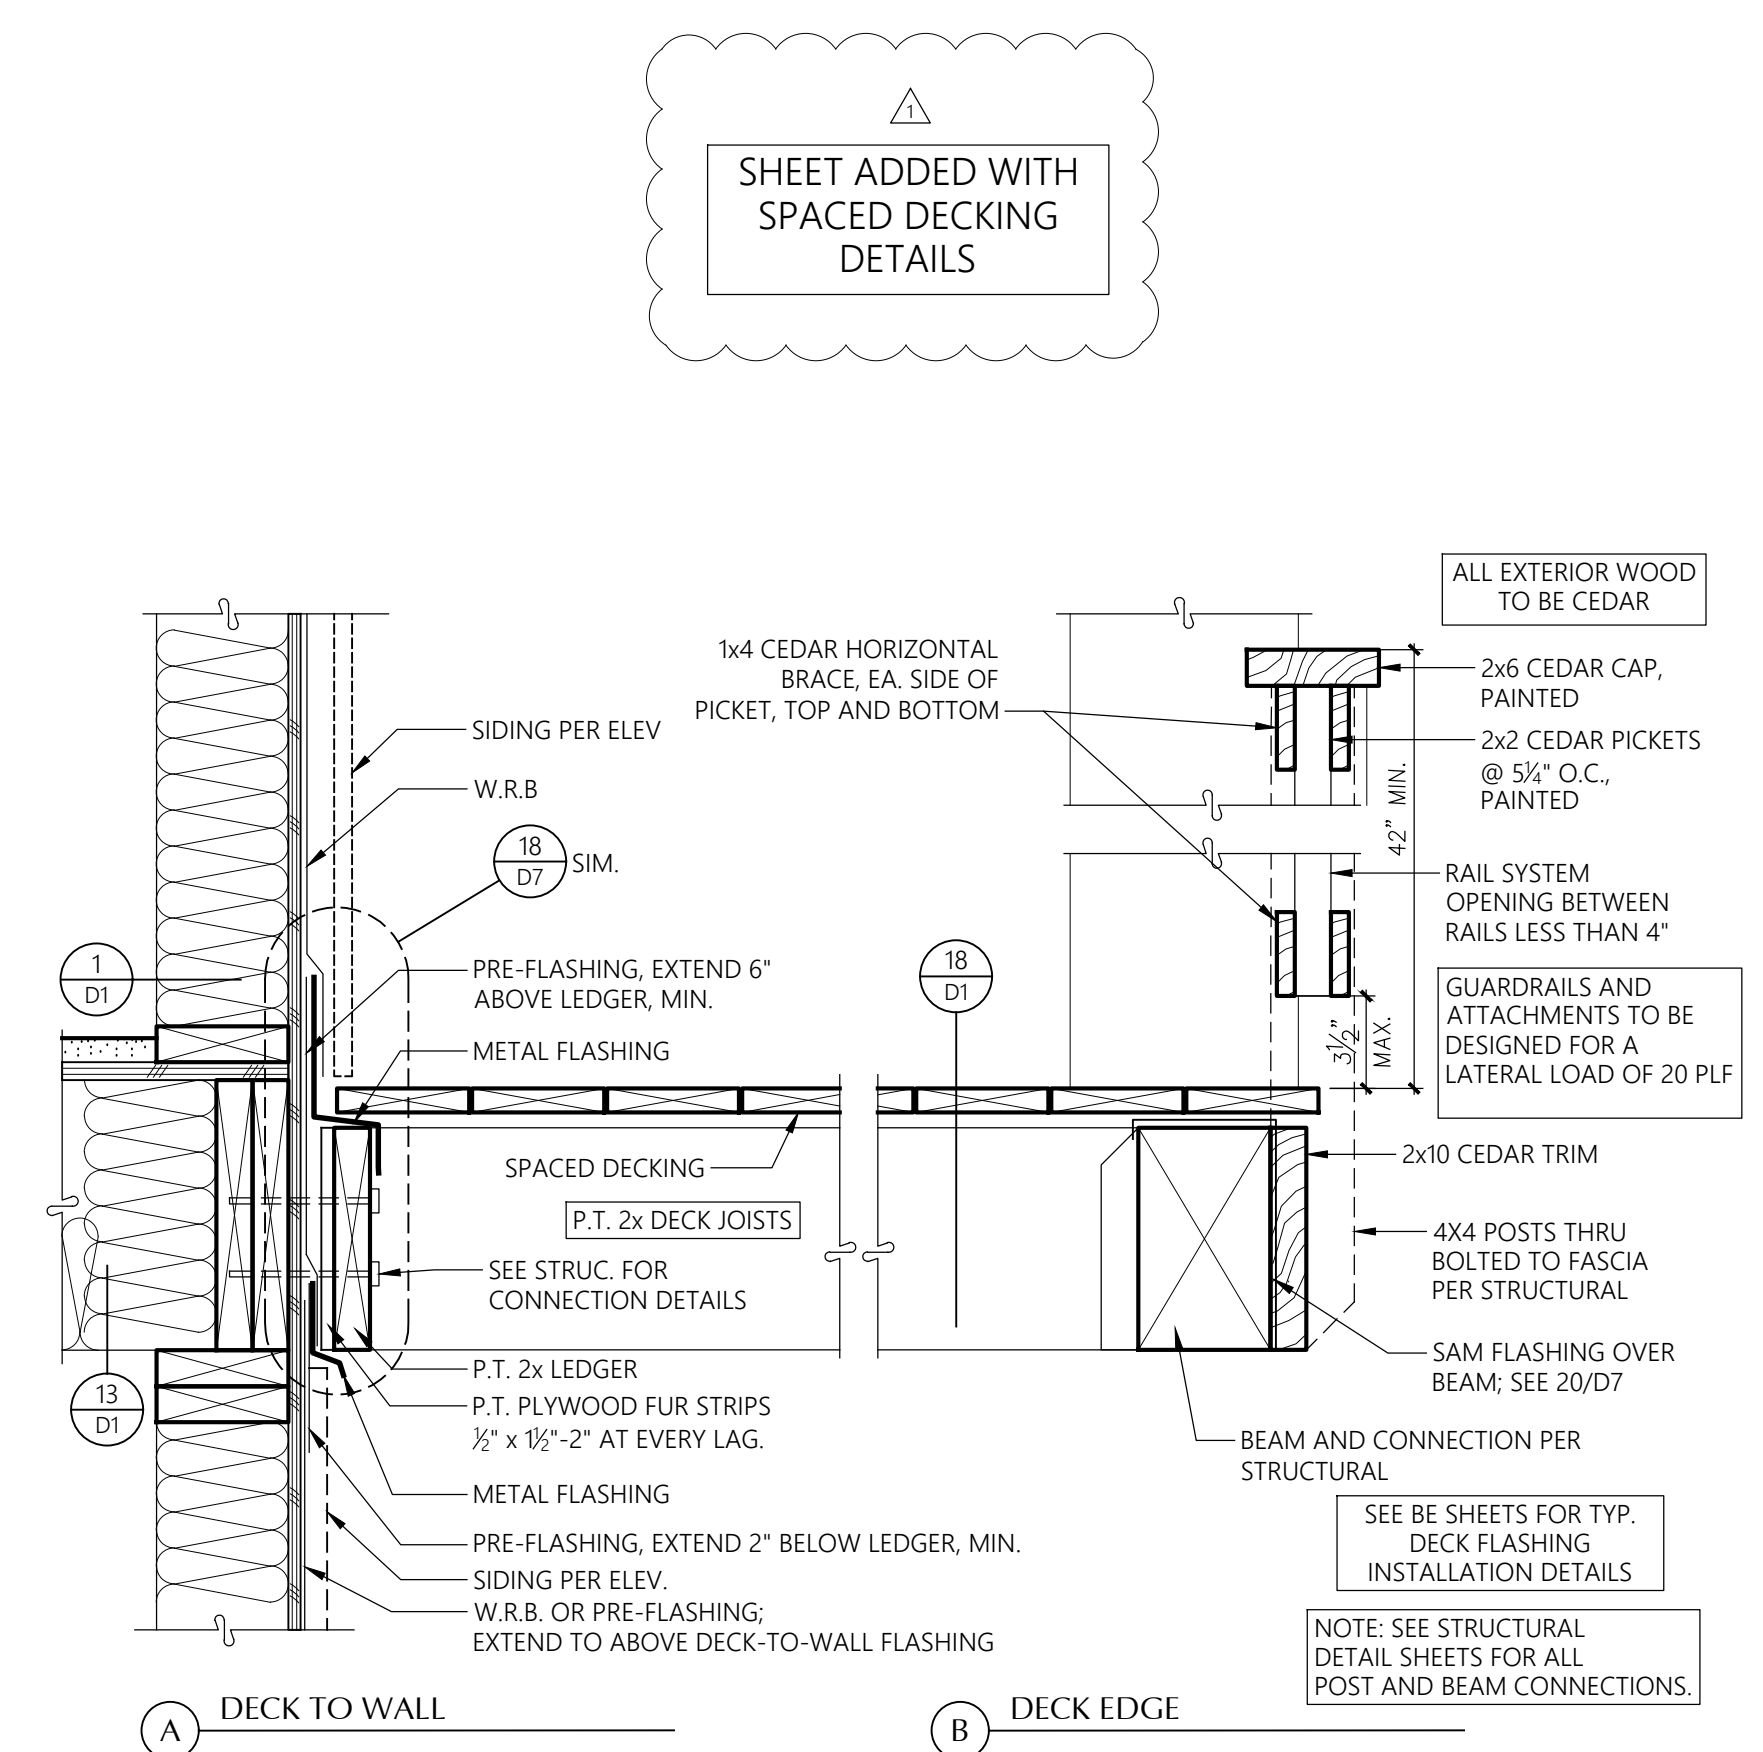


**16** TYP. SPACED DECKING DETAILS  
1-1/2" = 1'-0"

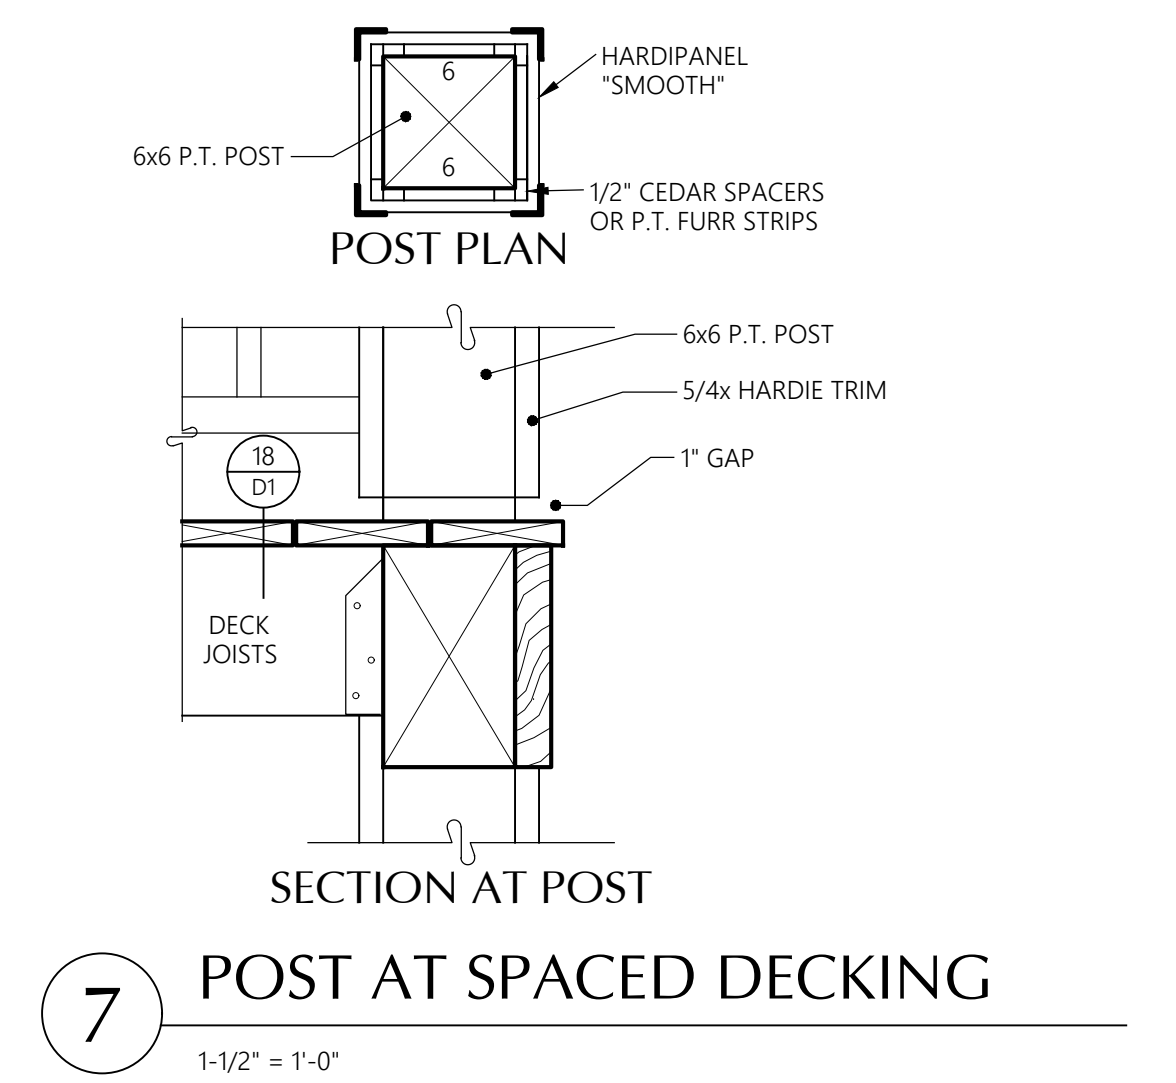

**7** POST AT SPACED DECKING  
1-1/2" = 1'-0"

**8** SPACED DECKING @ DOOR THRESHOLD  
3" = 1'-0"

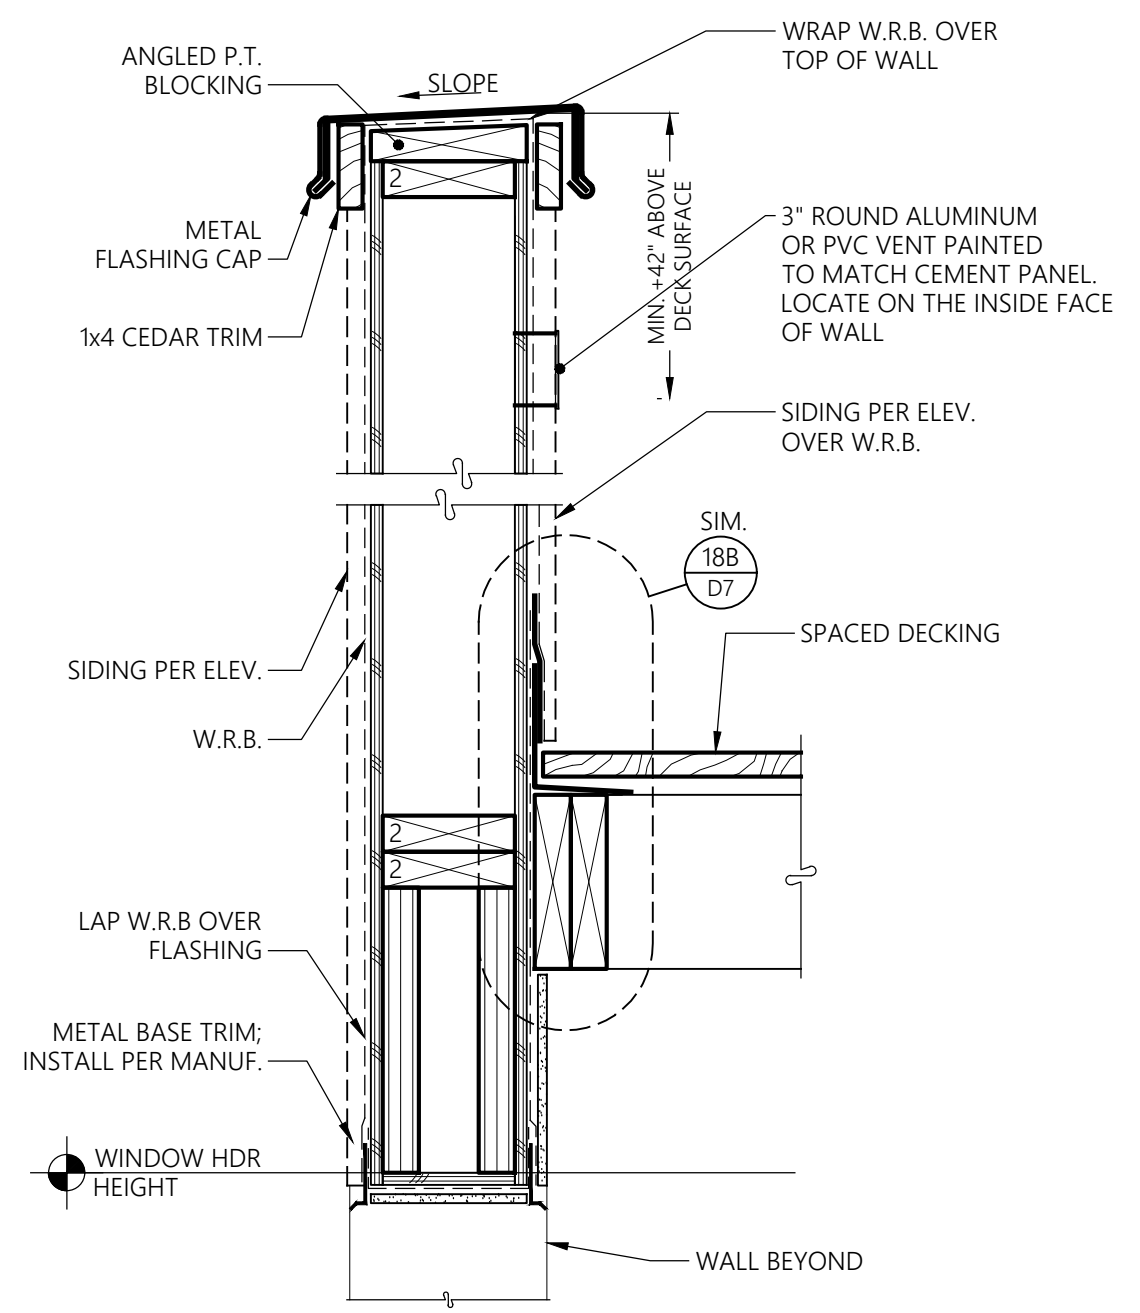

**4** WALL @ SPACED DECKING  
1-1/2" = 1'-0"

Details

**Bradley Heights Apartments**  
Puyallup, Wa

**Timberlane Partners**

Revisions


No.	Date	Description
1	8-30-24	Owner Changes/ Permit Corrections

Initial Publish Date:  
Date Plotted: 12-20-24

Job No.: 23-06  
Drawn By: APT/HDM  
Sheet No.:


**D7**



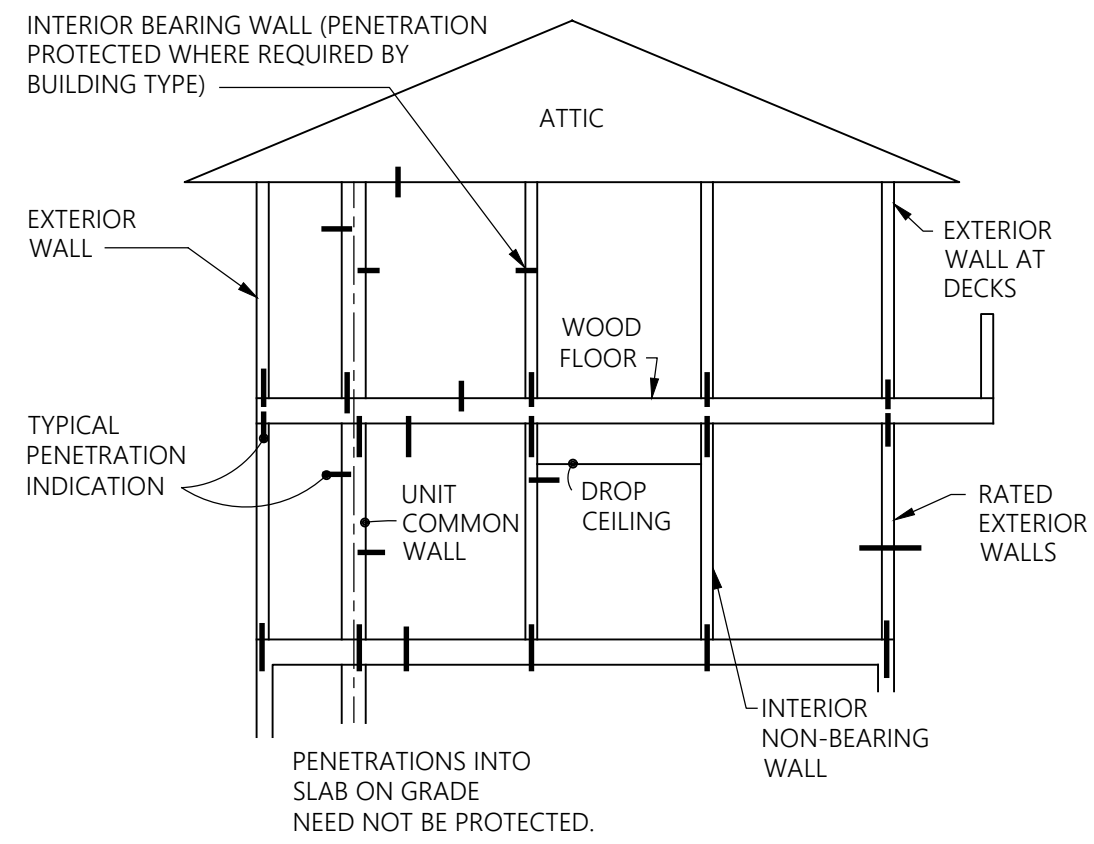


THE PURPOSE OF THIS DETAIL IS TO INDICATE TYPES OF LOCATIONS OF WALL, CEILING AND FLOOR PENETRATIONS THAT NEED TO BE FIRESTOPPED IN ACCORDANCE WITH 706, 708, 711, 713, 714 AND 717 OF THE 2018 INTERNATIONAL BUILDING CODE. THE THICK LINES IN THE DETAIL INDICATE A PENETRATION BY A PIPE, CONDUIT, VENT, ETC., WHETHER PLASTIC (COMBUSTIBLE) OR NON-COMBUSTIBLE. IN GENERAL THESE PENETRATIONS (OR THE ANNULAR SPACE AROUND THEM) WOULD COMPROMISE THE INTEGRITY OF THE FIRE-RATED ASSEMBLY UNLESS IT WERE CLOSED OFF AND PROTECTED DURING A FIRE. COMMON WALLS BETWEEN UNITS ARE FIRE-RATED WALLS. UNRATED WALLS WITHIN UNITS (EVEN THOUGH THEY MAY HAVE RATED WALLBOARD) NEED NOT BE PROTECTED. HOWEVER, PENETRATION OF THE TOP AND BOTTOM PLATES OF UNRATED WALLS INTO THE RATED FLOOR ASSEMBLY NEEDS TO BE FIRESTOPPED. THE CONTRACTOR SHALL DETERMINE FIRESTOPPING FOR EACH SITUATION, AND TESTED ASSEMBLIES SHALL BE SUBMITTED TO THE ARCHITECT AND THE CITY IN ACCORDANCE WITH THE "DEFERRED SUBMITTALS" SECTION ON THE COVER SHEET.

**17** PENETRATION LOCATIONS FOR FIRESTOPPING  
NO SCALE SECTION

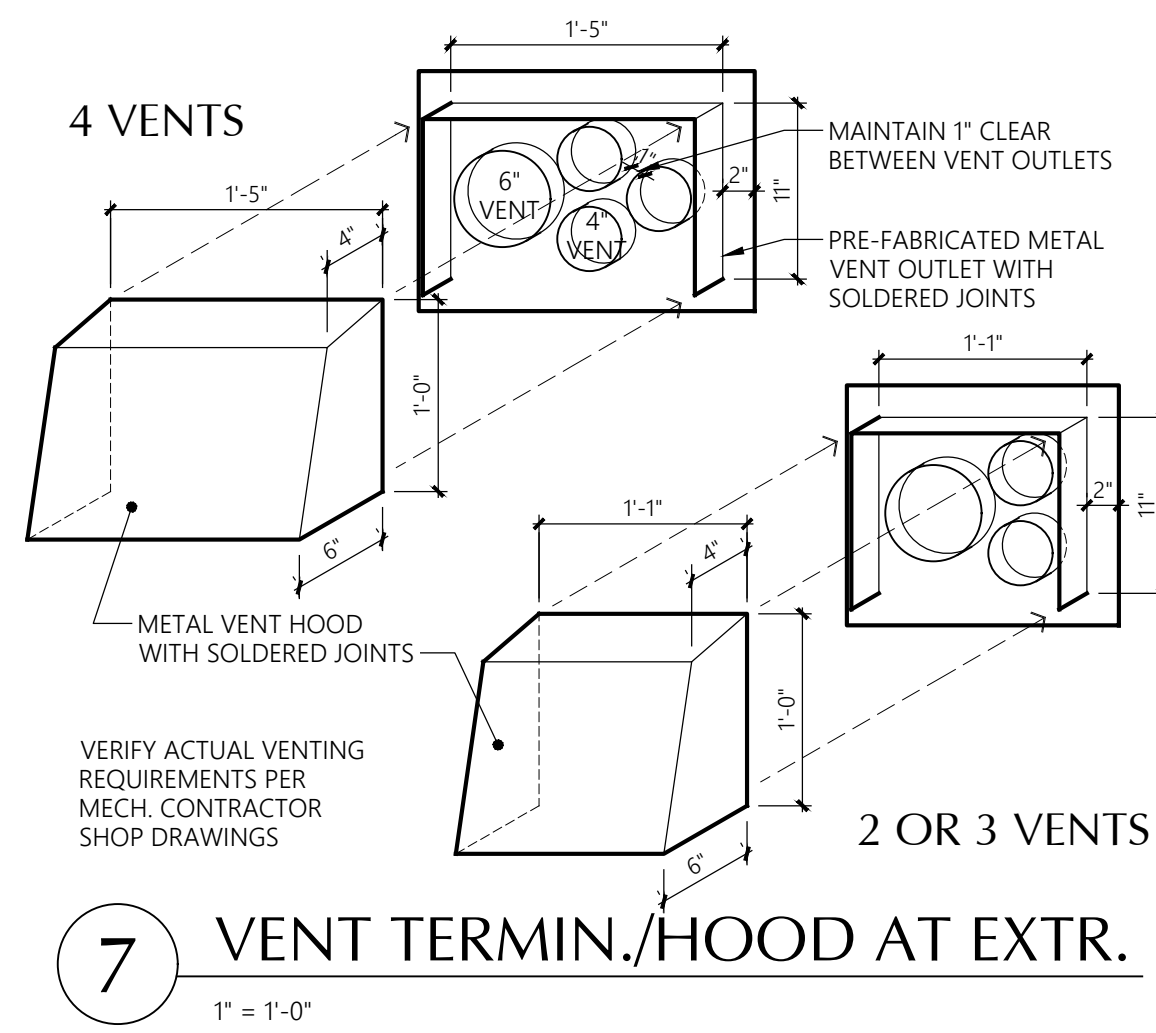


**7** VENT TERMIN./HOOD AT EXTR.  
1" = 1'-0"

Detail 1 for the Furred Ceiling at 1-hr wall appears to have sheathing being used to create a positive connection between the metal framing that is attached to the ceiling and metal framing at the bottom of the soffit. Identify the minimum sheathing material needed, also identify minimum faster for field and edge of sheathing. Identify minimum metal framing requirements to include type, minimum fasteners for positive connection.  
(Construction Set, Sheet D8, Detail 1)

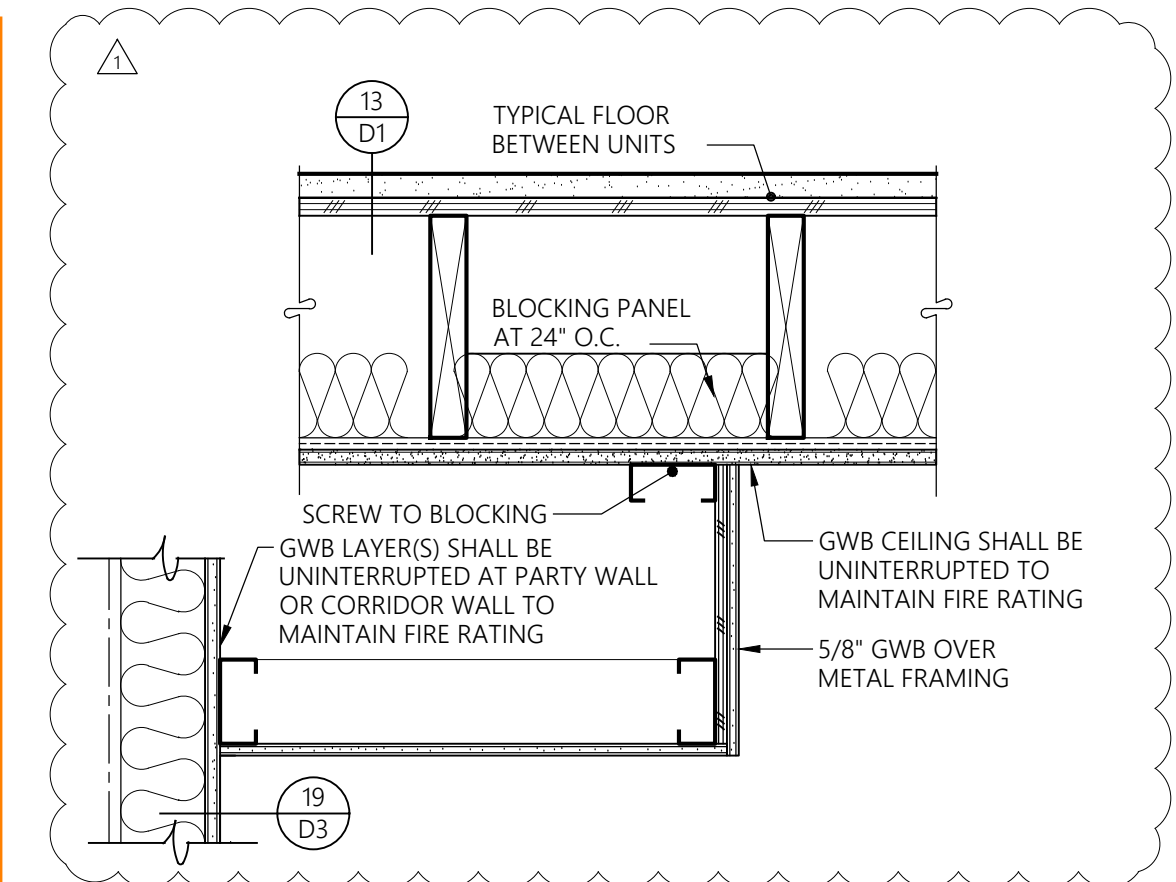


**1** FURRED CEILING AT 1-HR WALL  
1 1/2" = 1'-0" SECTION

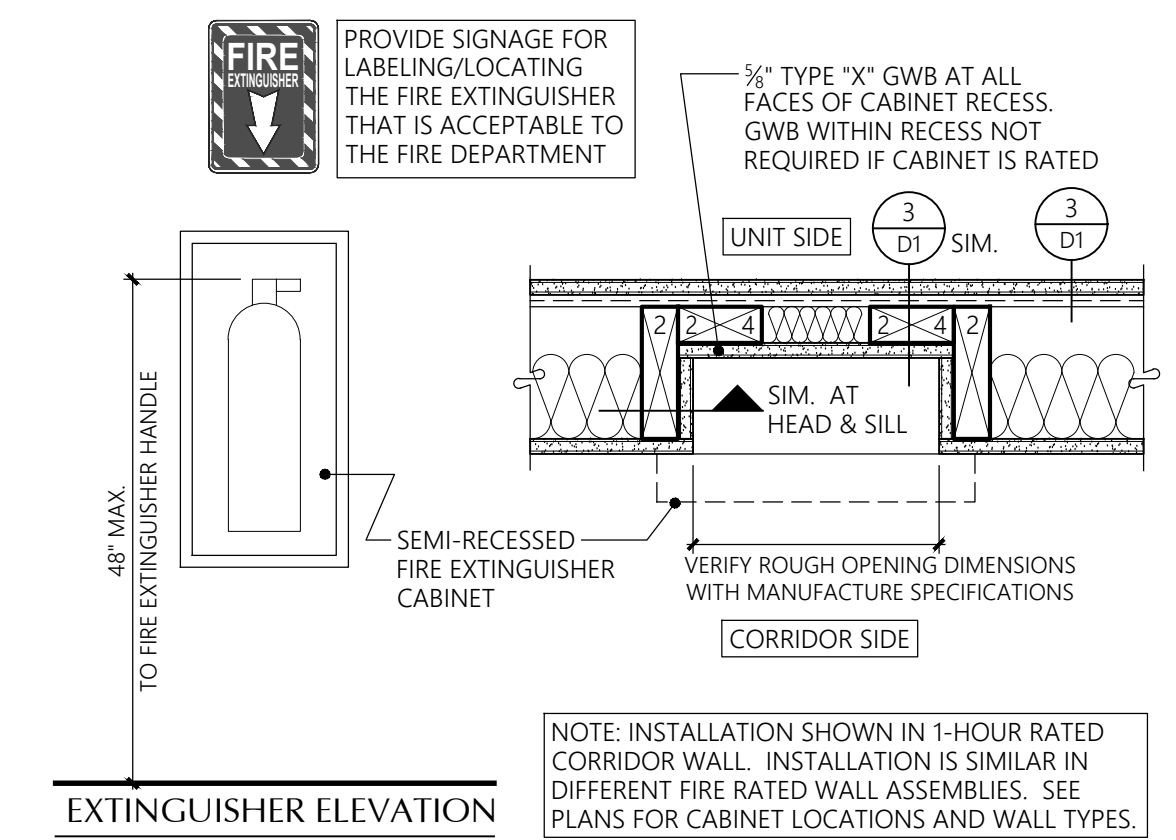

**2** SEMI-RECESSED FIRE EXT. CAB.  
1-1/2" = 1'-0" PLAN

DETAIL 18/D8 REMOVED

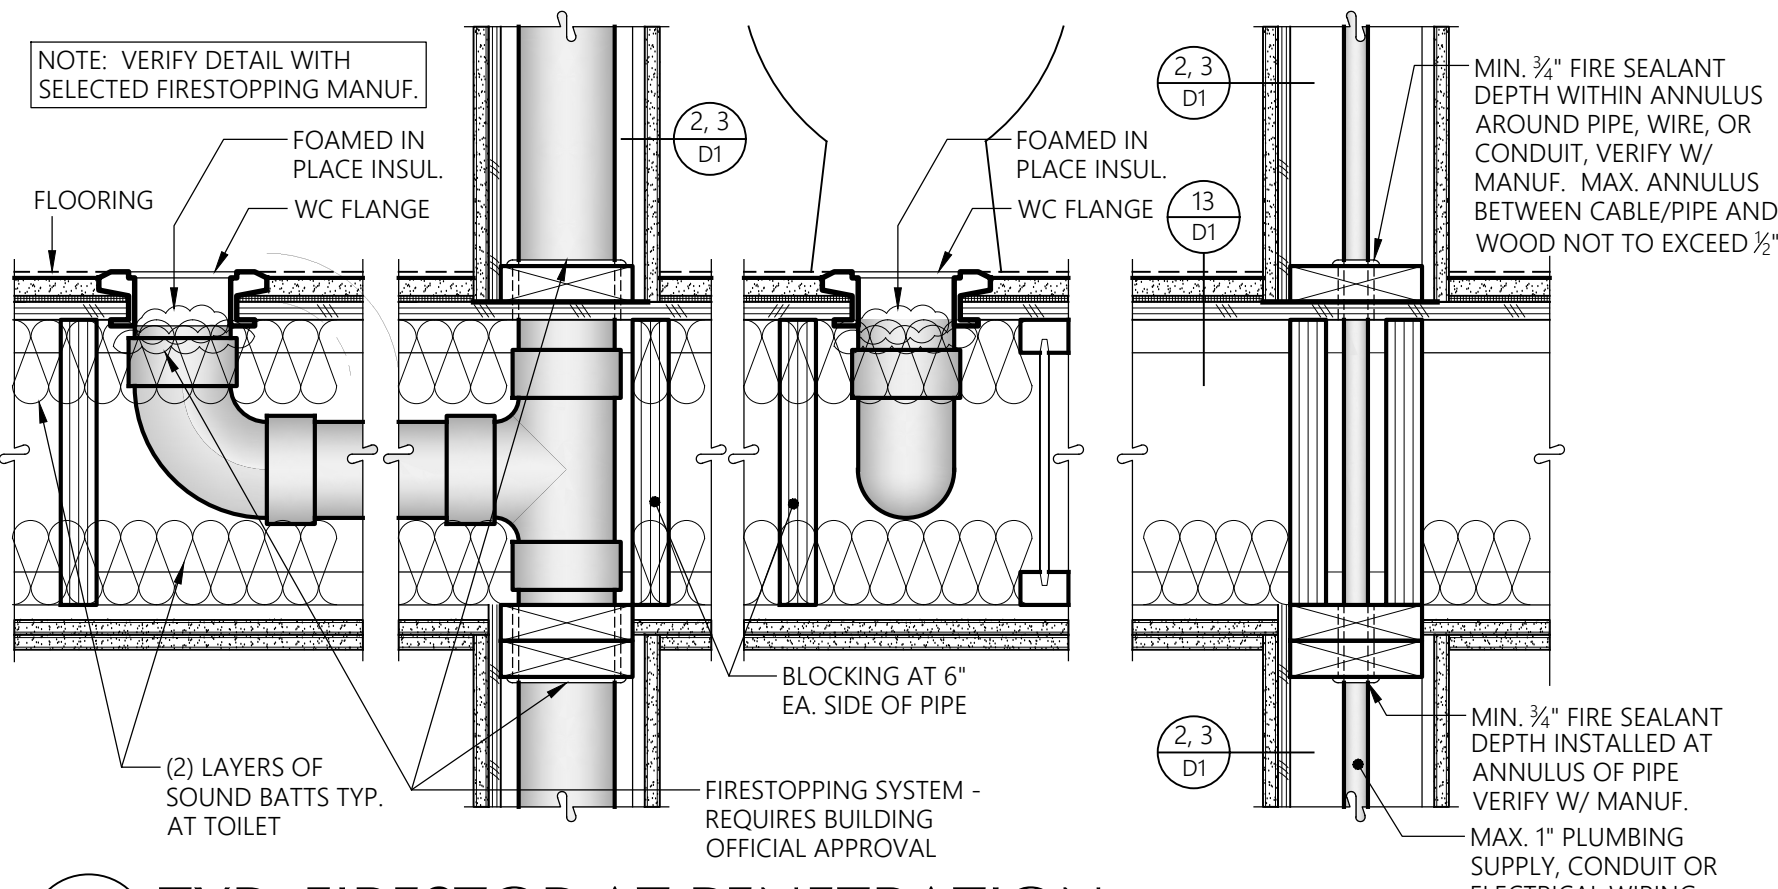

**19** TYP. FIRESTOP AT PENETRATION  
1-1/2" = 1'-0" SECTION

INSULATION AND ENERGY NOTES

**Insulation - General**

All insulation materials shall be installed according to the manufacturer's instructions to achieve proper densities, and maintain uniform R-values. Substantial contact of the insulation with the surface being insulated is required.

Where required, insulation shall be installed with clearances according to manufacturer's specifications. Insulation shall be installed so that required ventilation is unobstructed. For blown or poured loose fill insulation clearances shall be maintained through installation of a permanent retainer.

**Slab on Grade**

R-10 slab on grade insulation shall be installed inside the foundation wall.

**Insulated Floors**

Floor insulation shall be installed in a permanent manner in substantial contact with the surface being insulated. Insulation supports shall be installed so spacing is no more than twenty-four inches on center.

Floors separating conditioned space from unconditioned space shall have a vapor barrier installed. Vapor barrier shall be installed on the warm side of the insulation. The vapor barrier shall have a one perm dry cup rating or less (i.e. four mil polyethylene or kraft faced material). The floor sheathing may be used as the vapor barrier if rated (and so stamped) at one perm (max). Otherwise place vapor barrier on top of joists before placing sheathing.

**Exterior Walls**

All wall insulation shall fill the entire cavity. Exterior wall cavities isolated during framing shall be fully insulated to the levels of the surrounding walls. All faced insulation shall be face stapled to avoid compression.

Walls separating conditioned space from unconditioned space shall have a vapor barrier installed. Faced batt insulation shall be face stapled. Vapor barrier shall be installed on the warm side of the insulation.

**Air Leakage**

These air leakage notes apply to those locations separating outdoor ambient conditions from interior spaces that are heated or mechanically cooled.

Exterior joints around windows and door frames, between wall cavities and window or door frames, openings between walls and foundation, between walls and roof and wall panels, openings at penetrations of utility services through walls, floors and roof, and all other openings in the building envelope shall be sealed, caulked, gasketed, or weatherstripped to limit air leakage in a manner approved by the building official.

**Doors**

All exterior doors or doors serving as access to an enclosed unheated area shall be weatherstripped to limit leakage around their perimeter when in a closed position. The thermal transfer characteristics of insulated doors shall be determined per NFRC 100-91.

**Windows**

Glazing U-values shall be determined in accordance with NFRC 100-91. Windows and SGD shall be double glazed vinyl type with the U-values indicated on the unit plans.

Windows shall be furnished with outdoor air inlets as indicated on the Unit Electrical plans. Inlets shall have a controllable and secure opening and be capable of a total opening area of not less than four (4) square inches and tested by a nationally recognized standard or approved agency and located to avoid drafts. Inlets shall be screened or otherwise protected from entry by insects, leaves, or other material.

**Roof/Ceilings**


Roof/Ceiling insulation: Open-Blown or poured loose fill insulation may be used in attic spaces where the slope of the ceiling is more than 4 in 12 and there is at least 44 inches of clear distance from the top of the bottom chord of the truss or ceiling joist to the underside of the sheathing. When eave vents are installed, baffling of the vent openings shall be provided so as to deflect the incoming air above the surface of the insulation. Baffles shall be rigid material, resistant to wind driven moisture. When feasible, the baffles shall be installed from the top of the outside of the exterior wall, extending inward, to a point six inches vertically above the height of noncompressed insulation, and twelve inches vertically above loose fill insulation. Baffles shall be in place at the time of framing inspection.

Where the ventilation space above the insulation is less than an average of twelve inches roof ceiling assemblies shall be provided with a vapor barrier having a 0.5 perm cup rating or less. Faced batt insulation where used as a vapor barrier shall be face stapled.

Vapor barriers shall not be required in roof/ceiling assemblies where the ventilation space above the insulation averages twelve inches or greater.


Vapor barriers shall be installed on the warm side of the insulation.

Revisions		
No.	Date	Description
1	8-30-24	Owner Changes/ Permit Corrections

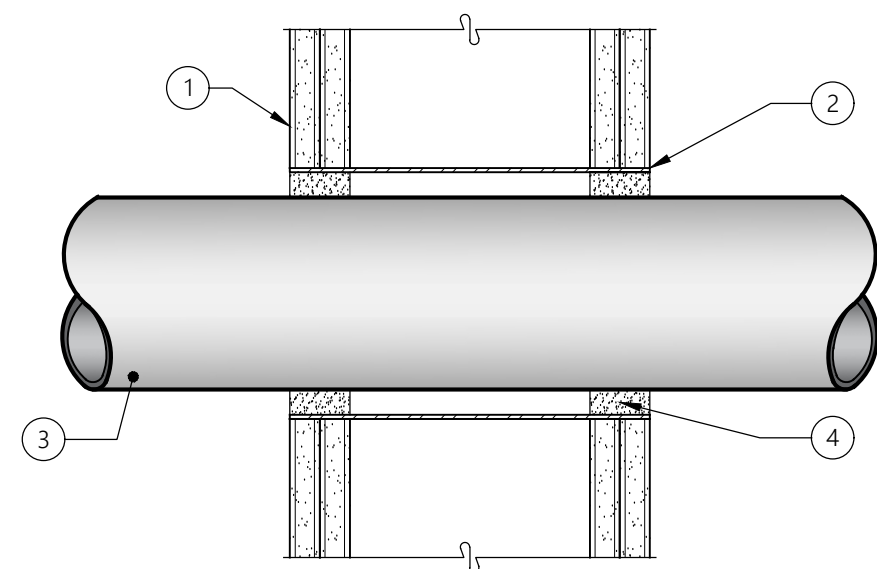


- 1 TYP. FIRE RATED WALL ASSEMBLY, SEE SHEET D1 FOR DETAILS
- 2 METALLIC SLEEVE - OPTIONAL - SEE MANUFACTURER INFORMATION FOR ACCEPTABLE METALLIC SLEEVES
- 3 ONE NONMETALLIC PIPE WITHIN FIRESTOP SYSTEM. PIPE MAY BE INSTALLED AT AN ANGLE NOT GREATER THAN 45 DEGREES FROM PERPENDICULAR. PIPE TO BE RIGIDLY SUPPORTED ON BOTH SIDERS OF THE WALL ASSEMBLY. THE SPACE BETWEEN THE PIPE AND PERIPHERY OF THE OPENING SHALL BE MIN. 1/4" TO MAX. 3/8". SEE MANUFACTURER INFORMATION FOR ACCEPTABLE PIPE TYPES AND SIZES.
- 4 FOR 1 HR F RATING, MIN. 3/8" THICKNESS OF FILL MATERIAL APPLIED WITHIN THE ANNULUS, FLUSH WITH BOTH SURFACES OF THE WALL. FOR 2 HOUR F RATING, MIN 1-1/4" THICKNESS OF FILL MATERIAL APPLIED WITHIN ANNULUS, FLUSH WITH BOTH SURFACES OF WALL. HILTI FS-ONE OR FS-ONE MAX INTUMESCENT SEALANT

**17 WL2128**  
3" = 1'-0" SECTION

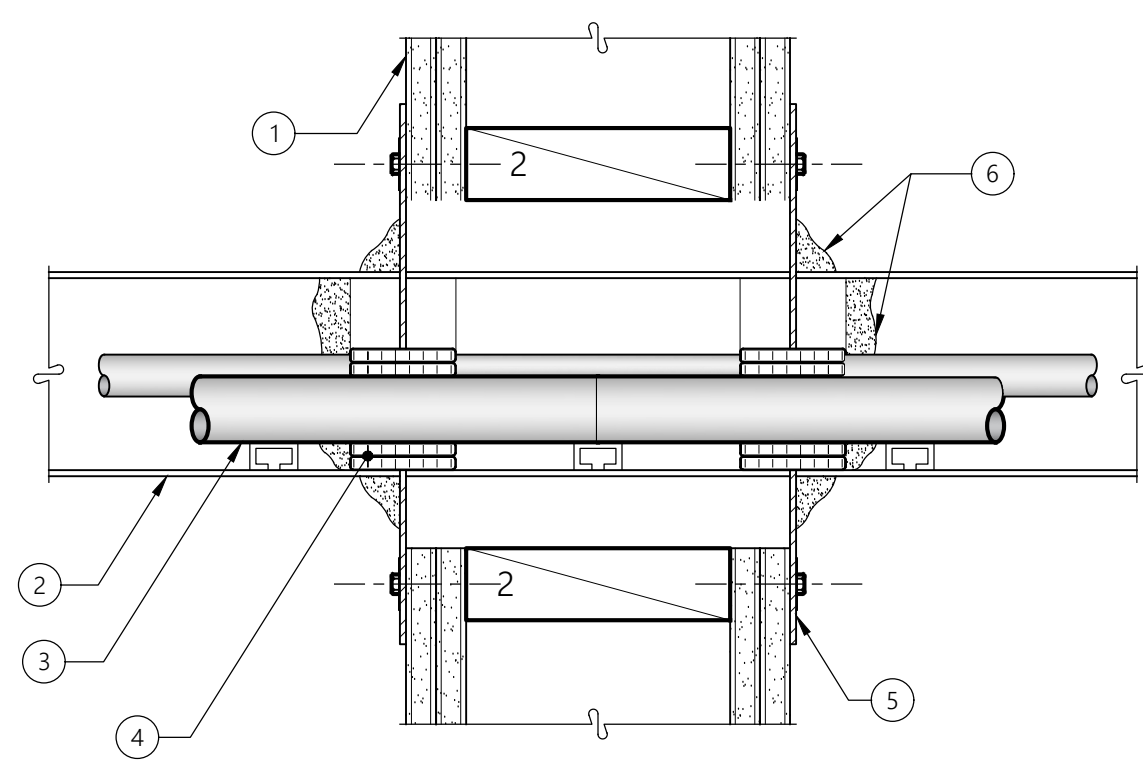


- 1 TYP. FIRE RATED WALL ASSEMBLY, SEE SHEET D1 FOR DETAILS
  - 2 MAX 24" WIDE BY MAX 4" DEEP OPEN LADDER STEEL OR ALUMINUM CABLE TRAY. CABLE TRAY TO CONSIST OF CHANNEL-SHAPED SIDE-RAILS WITH BOXED CHANNEL RUNGS SPACED 9" O.C. CABLE TRAY CENTERED IN FRAMED OPENING AND RIGIDLY SUPPORTED ON BOTH SIDERS OF WALL ASSEMBLY.
  - 3 AGGREGATE CROSS-SECTIONAL AREA OF CABLES IN CABLE TRAY NOT TO EXCEED 32% OF THE CROSS-SECTIONAL AREA OF THE CABLE TRAY BASED ON A MAX 3" CABLE LOADING DEPTH WITHIN THE CABLE TRAY. ACCEPTABLE TYPES AND SIZES OF CABLE AS NOTED BY MANUF.
  - 4 RIGID ALUMINUM FOIL-FACED SHEET WITH GALV. STEEL SHEET BACKER SHEETS CUT TO TIGHTLY FOLLOW THE CONTOURS OF THE CABLES AROUND THE ENTIRE PERIMETER OF THE CABLE TRAY AND CABLE FILL. SHEETS CUT TO LAP A MIN. OF 2" ON THE WALL ON ALL SIDERS OF THE OPENING ON BOTH SIDERS OF THE WALL.
  - 5 MIN. 2" WIDE STRIP OF MIN 0.020" THICK (26 GAUGE) GALV. STEEL CENTERED OVER ENTIRE LENGTH OF EACH BUTTED SEAM OR SLIT MADE IN THE INTUMESCENT SHEET. INSTALL PER MANUF.
  - 6 ONE LAYER OF 1/2" x 1/2" ADHESIVE BACKED GRAPHITE INTUMESCENT SEAL POSITIONED UNDER INTUMESCENT SHEET AROUND ENTIRE PERIMETER OF THROUGH OPENING OR MIN. 1/2" DIAM. CONTINUOUS BEAD OF CAULK OR PUTTY APPLIED TO EDGE OF INTUMESCENT SHEET AT ITS INTERFACE WITH SURFACE OF FLOOR OR WALL AROUND ENTIRE PERIMETER OF THROUGH OPENING. CAULK APPLIED TO FILL ALL INTERSTICES BETWEEN CABLES AND BETWEEN CABLES AND WRAP STRIP (ITEM 4). CAULK DEPTH TO BE MIN. 2" WITHIN CONFINES OF WRAP STRIP ON BOTH SIDERS OF FLOOR OR WALL ASSEMBLY. GENEROUS APPLICATION OF CAULK TO BE APPLIED AROUND THE BASE OF THE CABLE TRAY SIDE-RAILS AND CONTOUR APPLIED WRAP STRIPS AT THEIR EGRESS FROM THE INTUMESCENT SHEET ON BOTH SIDERS OF THE WALL ASSEMBLY. CAULK ALSO APPLIED TO COVER ALL EXPOSED EDGES OF WRAP STRIPS TO A MIN. THICKNESS OF 1/2"
- SEE MANUF. INFORMATION FOR USE OF PUTTY AS CAULKING ALTERNATIVE.

**10 WL4004**  
3" = 1'-0" SECTION

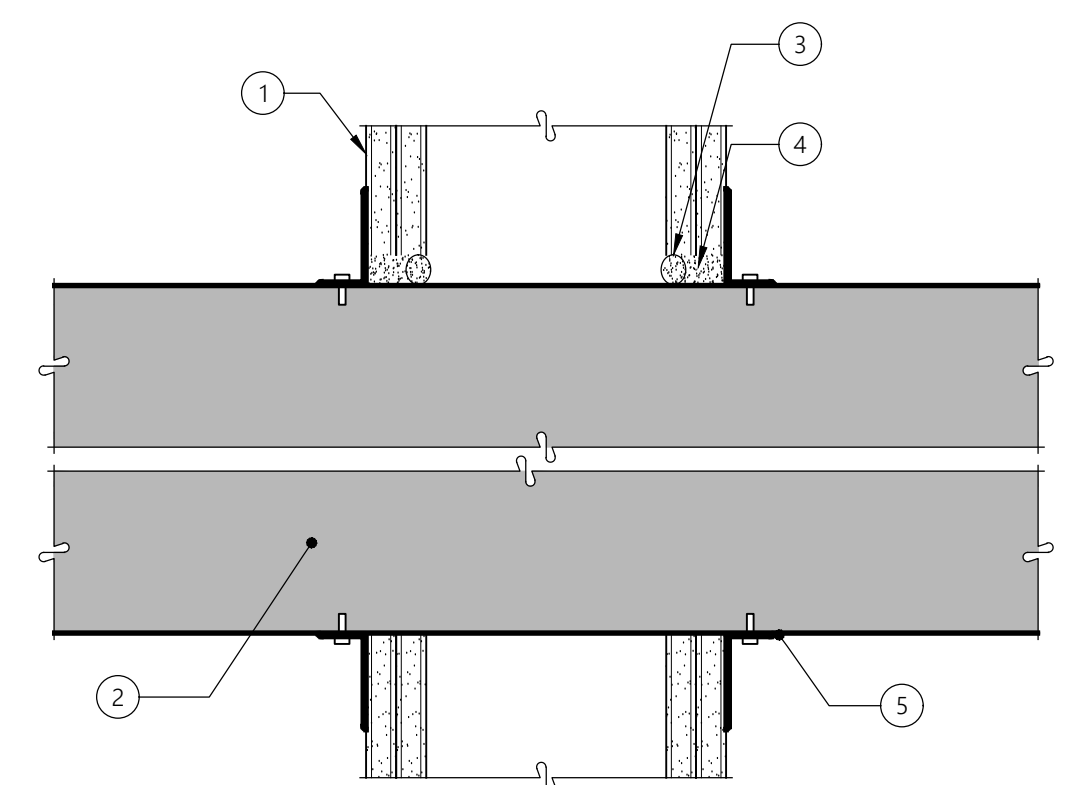


- 1 TYP. FIRE RATED WALL ASSEMBLY, SEE SHEET D1 FOR DETAILS
- 2 NOM. 36" x 30" (OR SMALLER) NO. 24 GAUGE (OR HEAVIER) GALV. STEEL DUCT TO BE INSTALLED EITHER CONCENTRICALLY OR ECCENTRICALLY WITHIN THE FIRESTOP SYSTEM. AN ANNULAR SPACE OF MIN 0" TO MAX 2" IS REQUIRED WITHIN THE FIRESTOP SYSTEM.
- 3 PACKING MATERIAL (OPTIONAL) - POLYETHYLENE BACKER ROD, MINERAL WOOL BATT INSULATION OR FIBERGLASS BATT INSULATION FRICTION-FIT INTO ANNULAR SPACE FOR 2 HR RATED WALL ASSEMBLIES ONLY. PACKING MATERIAL TO BE RECESSED FROM BOTH SURFACES OF WALL TO ACCOMMODATE THE REQUIRED THICKNESS OF FILL MATERIAL (ITEM 3B).
- 4 MIN. 3/8" THICKNESS OF FILL MATERIAL APPLIED WITHIN ANNULUS, FLUSH WITH BOTH SURFACES OF WALL ASSEMBLY. AT THE POINT CONTACT LOCATION BETWEEN DUCT AND WALLBOARD, A MIN 1/2" DIAM. BEAD OF SEALANT SHALL BE APPLIED AT THE WALLBOARD/DUCT INTERFACE ON BOTH SURFACES OF WALL ASSEMBLY.
- 5 MIN. 16 GAUGE GALV. STEEL ANGLES SIZED TO LAP DUCT A MIN OF 2" AND LAP WALL SURFACES OF A MIN OF 1". ANGLES ATTACHED TO DUCT ON BOTH SIDERS OF WALL WITH MIN 1/2" LONG, NO. 10 (OR LARGER) SHEET METAL SCREWS SPACED A MAX OF 1" FROM EACH END OF DUCT AND SPACED A MAX OF 6" OC.

**6 WL7008**  
3" = 1'-0" SECTION

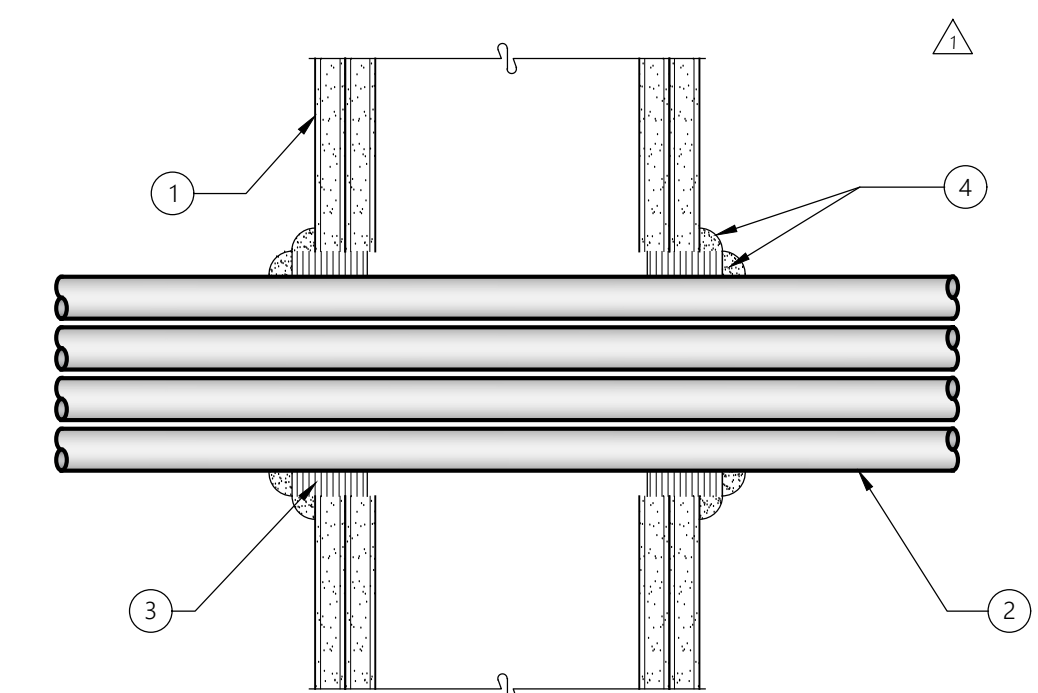


- 1 TYP. FIRE RATED WALL ASSEMBLY, SEE SHEET D1 FOR DETAILS
- 2 CABLES - MAX 4 IN. DIAM TIGHT BUNDLE OF CABLES CENTERED IN CIRCULAR CUTOUPS IN GWB AND RIGIDLY SUPPORTED ON BOTH SIDERS OF THE WALL ASSEMBLY. SEE MANUFACTURER INFORMATION FOR ACCEPTABLE TYPES AND SIZES CABLES.
- 3 WRAP STRIP - NOM 1/2" THICK INTUMESCENT MATERIAL FACED ON ONE SIDE WITH ALUMINUM FOIL, SUPPLIED IN NOM 2 IN. WIDE STRIP TIGHTLY WRAPPED AROUND CABLE BUNDLE (FOIL SIDE OUT) WITH SEAM BUTTED. WRAP STRIP SECURELY BOUND WITH STEEL WIRE TIE AND SLID INTO ANGULAR SPACE APPROX. 1-1/4" SUCH THAT APPROX 1/2" OF THE WRAP WIDTH PROTRUDES FROM WALL SURFACE ON EACH SIDE OF ASSEMBLY
- 4 MIN. 1/2" THICKNESS DIAM OF MOLDABLE PUTTY APPLIED TO THE WRAP STRIP/WALL INTERFACE AND TO THE EXPOSED EDGE OF WRAP STRIP APPROX 1/2" FROM WALL SURFACE ON EITHER SIDE OF ASSEMBLY. PUTTY TO BE FORCED INTO INTERSTICES OF CABLE BUNDLE TO MAX EXTENT POSSIBLE WITHIN CONFINES OF THE WRAP STRIP EACH SIDE OF ASSEMBLY

**7 WL3030**  
3" = 1'-0" SECTION

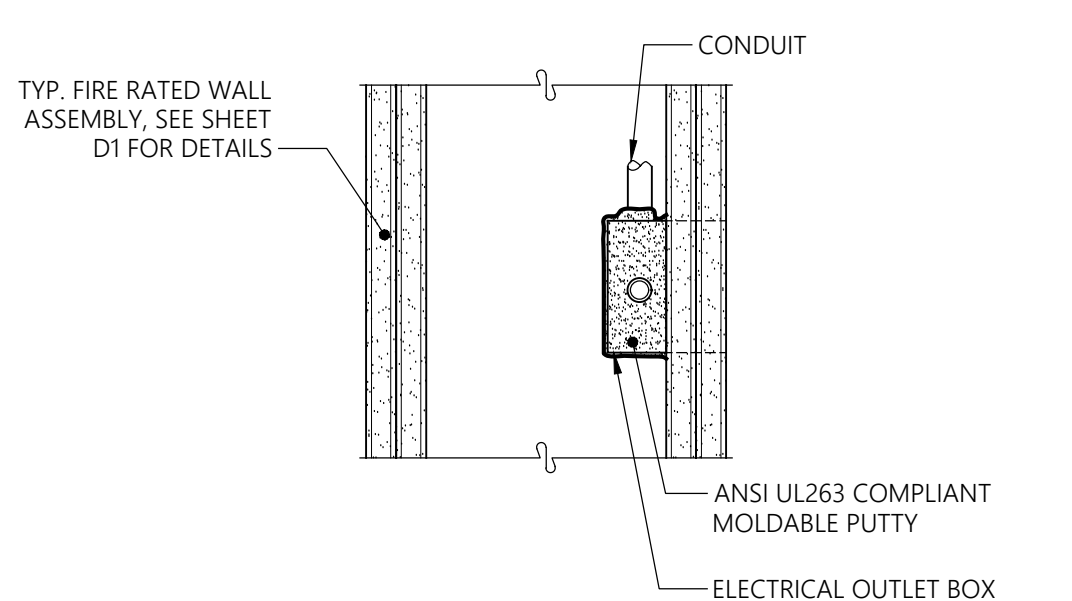


- 1 TYP. FIRE RATED WALL ASSEMBLY, SEE SHEET D1 FOR DETAILS
- 2 CONDUIT
- 3 ANSIL UL263 COMPLIANT MOLDABLE PUTTY
- 4 ELECTRICAL OUTLET BOX

**8 ANSI / UL 263**  
3" = 1'-0" SECTION

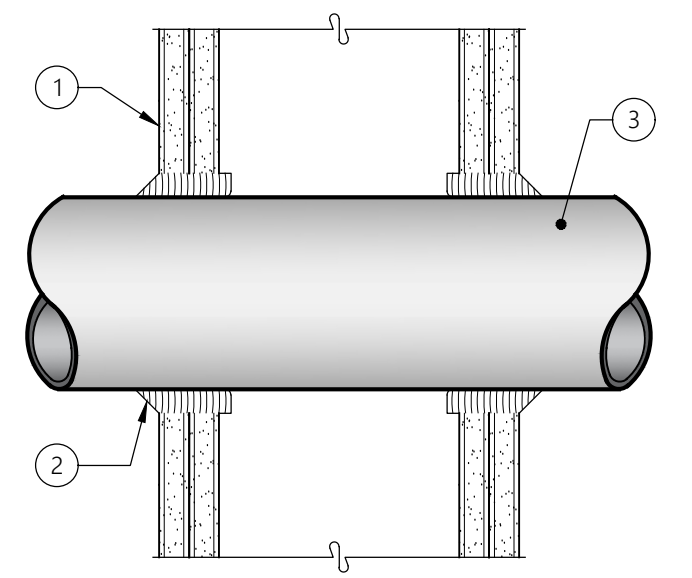


- 1 TYP. FIRE RATED WALL ASSEMBLY, SEE SHEET D1 FOR DETAILS
- 2 MIN. 1/2" x 1/2" THICKNESS OF CAULK FOR 1, 2, 3 HOUR, RESPECTIVELY, APPLIED WITHIN ANNULUS, FLUSH WITH BOTH SURFACES OF WALL. MIN 1/2" DIA. BEAD OF CAULK APPLIED TO GYPSUM BOARD/PENETRANT INTERFACE AT POINT CONTACT LOCATION ON BOTH SIDERS OF WALL.
- 3 METALLIC PIPE, CONDUIT OR TUBING INSTALLED EITHER CONCENTRICALLY OR ECCENTRICALLY WITHIN THE FIRESTOP SYSTEM. ANNULAR SPACE BETWEEN PIPE, CONDUIT OR TUBING AND PERIPHERY OF OPENING SHALL BE MIN OF 0 IN. (POINT CONTACT) TO MAX 2 IN.

**1 WL1001**  
3" = 1'-0" SECTION

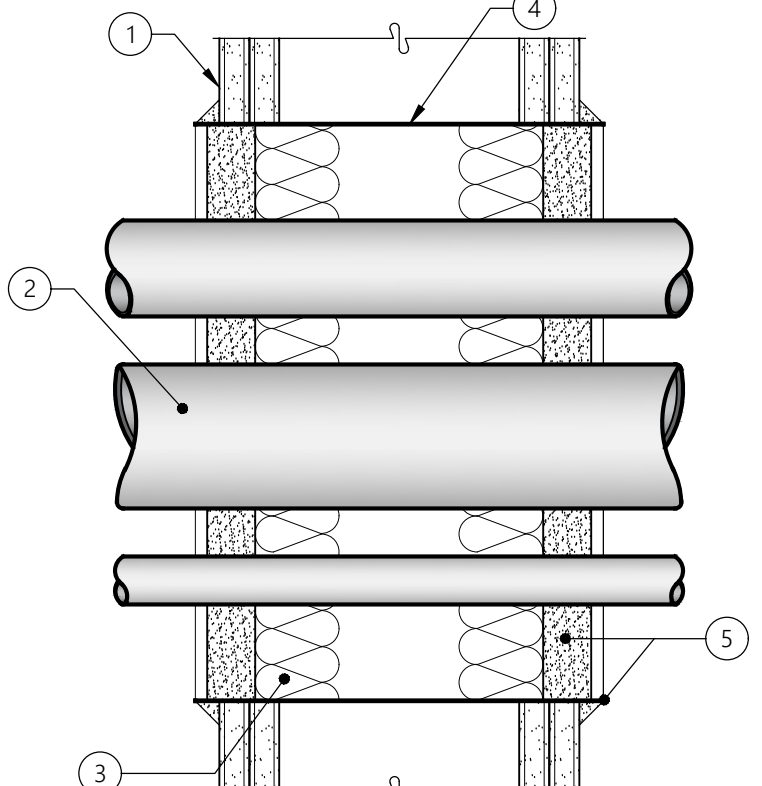

- 1 TYP. FIRE RATED WALL ASSEMBLY, SEE SHEET D1 FOR DETAILS
- 2 NOM 3 IN. DIAM (OR SMALLER) SCHEDULE 10 (OR HEAVIER) STEEL PIPE, STEEL CONDUIT OR STEEL ELECTRICAL METALLIC TUBING. MULTIPLE PIPES AND/OR CONDUIT PERMITTED IN SLEEVED OPENING PROVIDED A MIN SEPARATION OF 1/2" IS MAINTAINED BETWEEN PIPES OR CONDUITS.
- 3 MIN. 1" THICKNESS OF RIGID GLASS FIBER INSULATION OR MINERAL WOOL BATT INSULATION FIRMLY PACKED INTO STEEL SLEEVE ON BOTH SIDERS OF WALL ASSEMBLY AS A PERMANENT FORM. PACKING MATERIAL TO BE RECESSED MIN. 3/8" FROM SURFACE OF WALL ON BOTH SIDERS OF WALL ASSEMBLY.
- 4 NO. 28 GAUGE GALV. SHEET STEEL FORMED INTO MAX 12 IN. DIA. OR MAX 12 IN. BY 9 IN. SLEEVE WITH NOM 2 IN. OVERLAP AT SEAM. LENGTH OF SLEEVE TO BE APPROX. 1 IN. GREATER THAN OVERALL THICKNESS OF WALL ASSEMBLY, SUCH THAT, WHEN INSTALLED, THE ENDS OF THE SLEEVE WILL PROJECT APPROX. 1/2 IN. BEYOND THE SURFACE OF THE WALL ON BOTH SIDERS OF THE WALL ASSEMBLY.
- 5 CAULK OR SEALANT APPLIED TO FILL THE STEEL SLEEVE TO A MIN. DEPTH OF 1" ON BOTH SIDERS OF WALL ASSEMBLY. A NOM. 1/2" DIA. CONTINUOUS BEAD OF CAULK SHALL BE APPLIED AROUND THE CIRCUMFERENCE OF THE STEEL SLEEVE AT ITS EGRESS FROM THE GYPSUM WALLBOARD LAYERS ON BOTH SIDERS OF THE WALL ASSEMBLY.

**2 WL1016**  
3" = 1'-0" SECTION

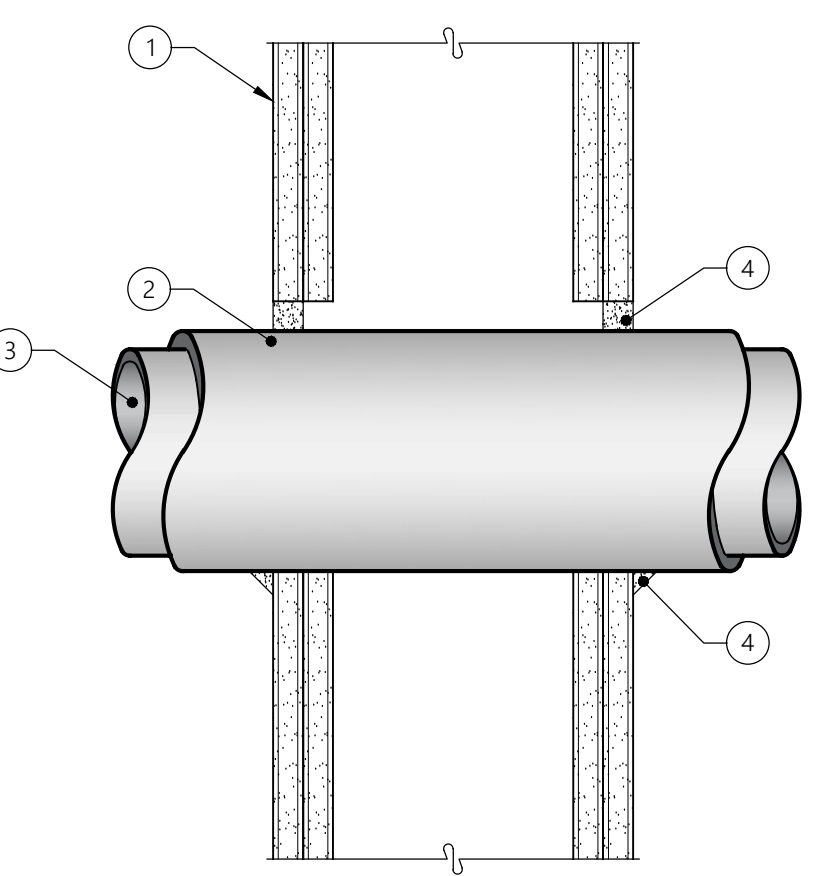

- 1 TYP. FIRE RATED WALL ASSEMBLY, SEE SHEET D1 FOR DETAILS
- 2 NOM. 1/2" TO 2" THICK HOLLOW CYLINDRICAL HEAVY DENSITY (MIN 3.5 PCF) GLASS FIBER UNITS FOR 1 HR RATED ASSEMBLIES, NOM. 1/2" TO 1 1/2" THICK CYLINDRICAL HEAVY DENSITY GLASS FIBER UNITS FOR 2 HR RATED ASSEMBLIES, JACKETED ON THE OUTSIDE WITH AN ALL SERVICE JACKET. THE ANNULAR SPACE BETWEEN THE INSULATED PIPE AND THE EDGE OF THE THROUGH OPENING SHALL BE MIN 0" TO MAX. 1/2"
- 3 ONE METALLIC PIPE OR TUBE TO BE INSTALLED EITHER CONCENTRICALLY OR ECCENTRICALLY WITHIN THE FIRESTOP SYSTEM. PIPE TO BE RIGIDLY SUPPORTED ON BOTH SIDERS OF WALL ASSEMBLY.
- 4 MIN. 3/8" THICKNESS OF CAULK APPLIED WITHIN ANNULAR SPACE FLUSH WITH EACH SURFACE OF WALL. A MIN. 1/2" DIAM. BEAD OF CAULK SHALL BE APPLIED TO THE PIPE INSULATION/WALLBOARD INTERFACE AT THE POINT CONTACT LOCATION ON BOTH SIDERS OF WALL.

**4 WL5039**  
3" = 1'-0" SECTION


Update details call outs to reflect correct details and detail sheets in matrix.  
(Construction Set, Sheet D9, Detail 12, Matrix of UL Tested)

NOTE: THESE FIRESTOPPING DETAILS ARE REPRESENTATIVE OF TYPICAL SITUATIONS ONLY. FOR OTHER CONDITIONS REFER TO 3M MATRIX OF UL TESTED SYSTEMS BELOW. IF CONDITION IS NOT COVERED IN THIS MATRIX, CONTACT MANUFACTURER FOR TESTED ASSEMBLY RECOMMENDATION. ALL FIRESTOP DETAILS TO BE EXECUTED BY LICENSED AND/OR CERTIFIED INSTALLER. FIRESTOPPING PENETRATIONS AND VOIDS IN RATED CONSTRUCTION: MATRIX OF UL TESTED SYSTEMS:

PENETRATING ITEM	FIRE ASSEMBLY	RATING	SYSTEM	PROD	ASSOCIATED DETAIL
METAL PIPE/CONDUIT	GYP. WALLS	1,2&3 HR	WL1001	CP25WB+	1/D8
MULTIPLE METAL	GYP. WALLS	1&2 HR	WL1016	CP25WB+	2/D8
INSULATED PIPE	GYP. WALLS	1&2 HR	WL5039	CP25WB+	4/D8
HVAC DUCTS	GYP. WALLS	1&2 HR	WL7008	CP25WB+	6/D8
BUND CABLES	GYP. WALLS	1&2 HR	WL3031	MOLDABLE PUTTY	7/D8
ELEC. OUTLET BOXES	GYP. WALLS	1&2 HR	ANSI UL263	MOLDABLE PUTTY	8/D8
CABLE TRAYS	GYP. WALLS	1&2 HR	WL4004	CP25WB+ CS195+	10/D8


**12 MATRIX OF UL TESTED SYSTEMS FOR FIRESTOPPING**  
NTS


NOTE: ALL DETAILS ON THIS SHEET ARE RECOMMENDED FIRE RATED PENETRATION DETAILS BASED ON PRODUCTS LISTED IN 12/D9. OTHER PRODUCTS MEETING THE SAME LEVEL OF ASSEMBLY SHALL BE DEEMED ACCEPTABLE.

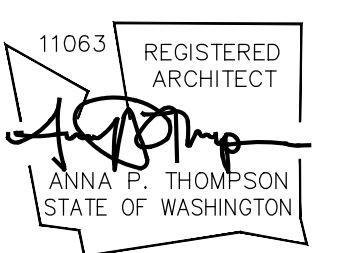


**Revisions**

No.	Date	Description
1	8-30-24	Owner Changes/ Permit Corrections

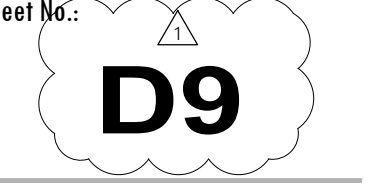


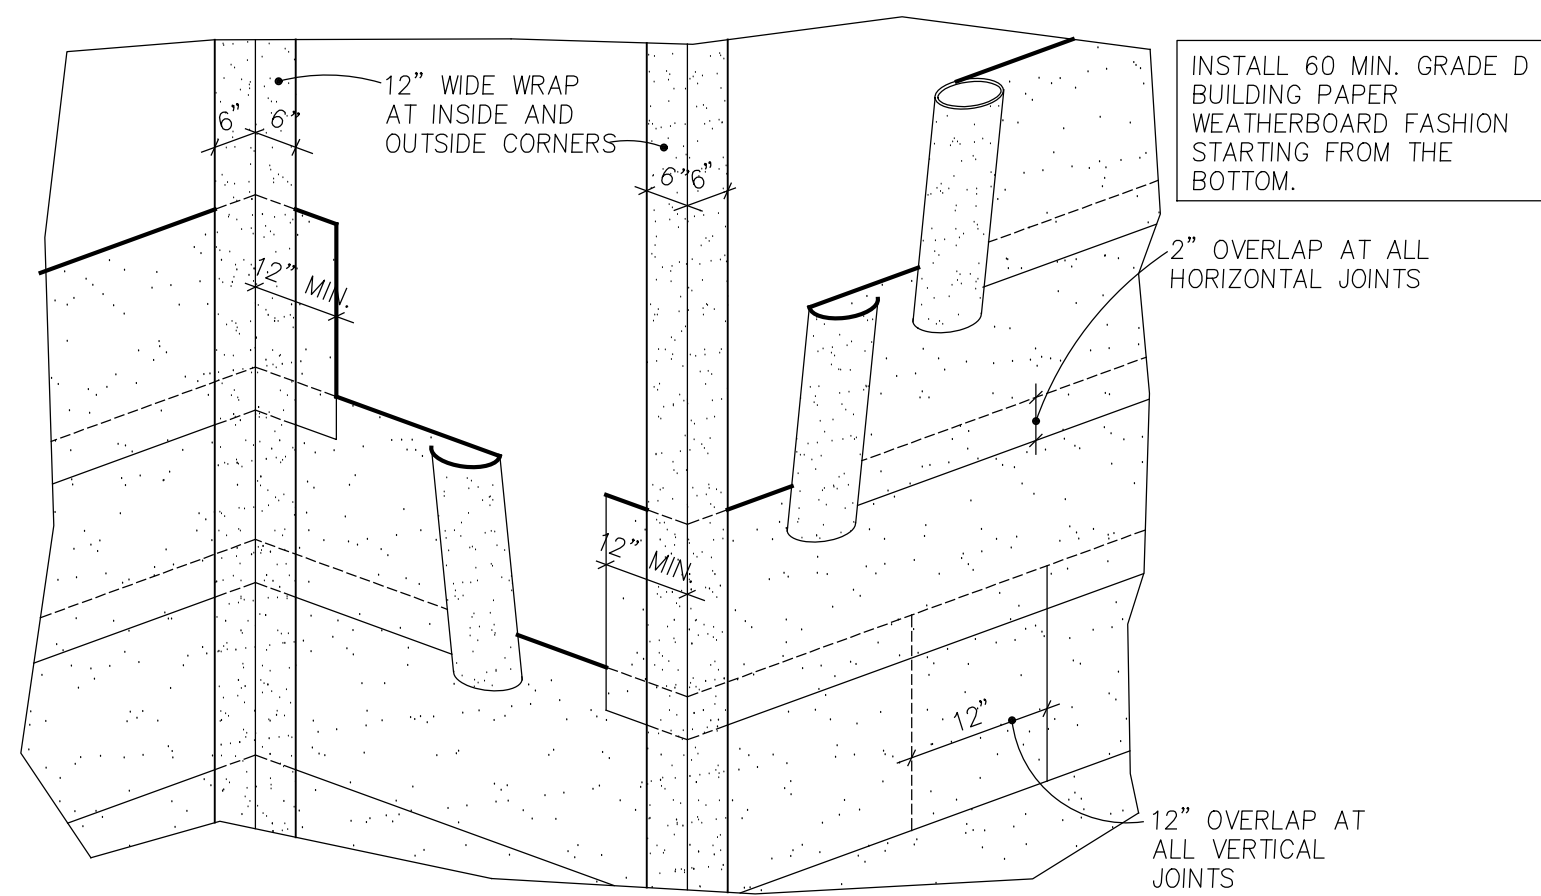

**17 BUILDING PAPER INSTALLATION**  
NO SCALE



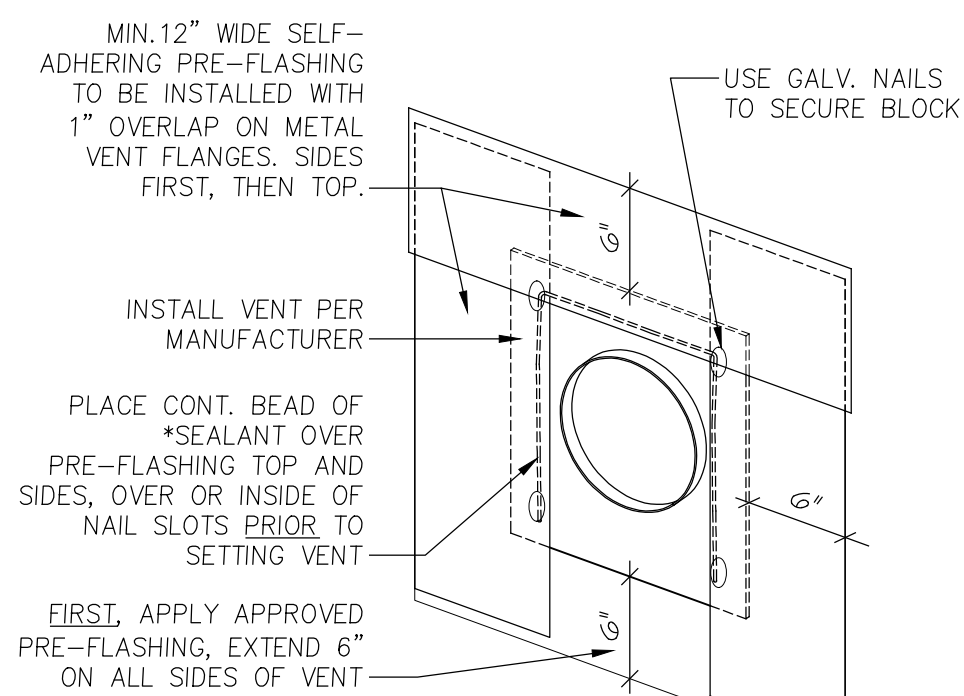


STEP 1

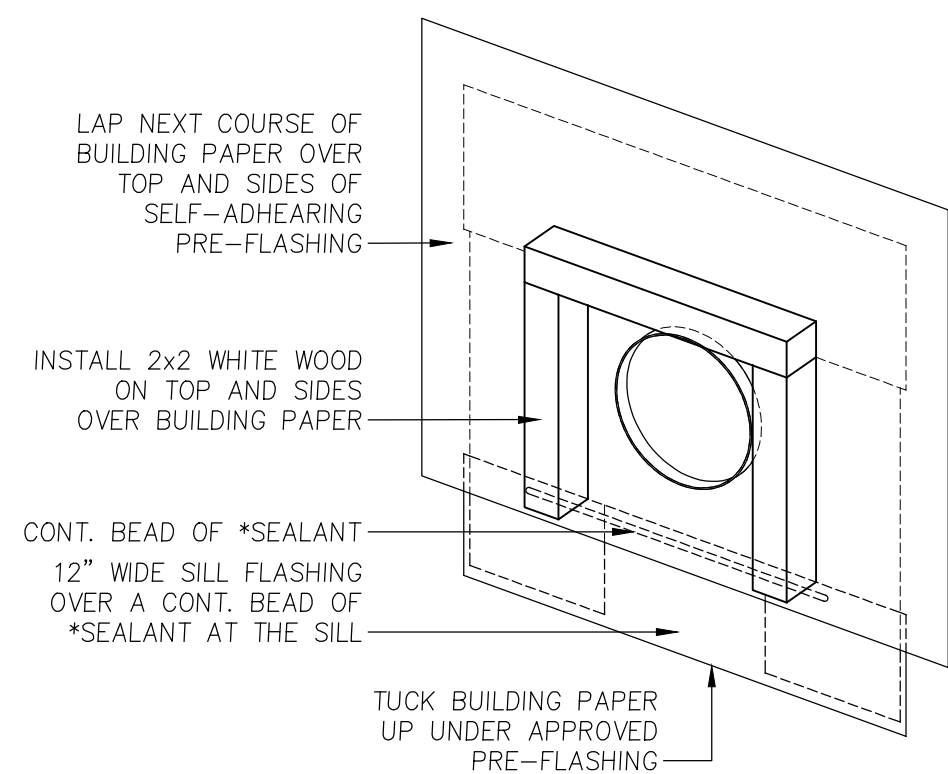


STEP 2


**18 AIR VENT (8" OR LARGER)**  
NO SCALE

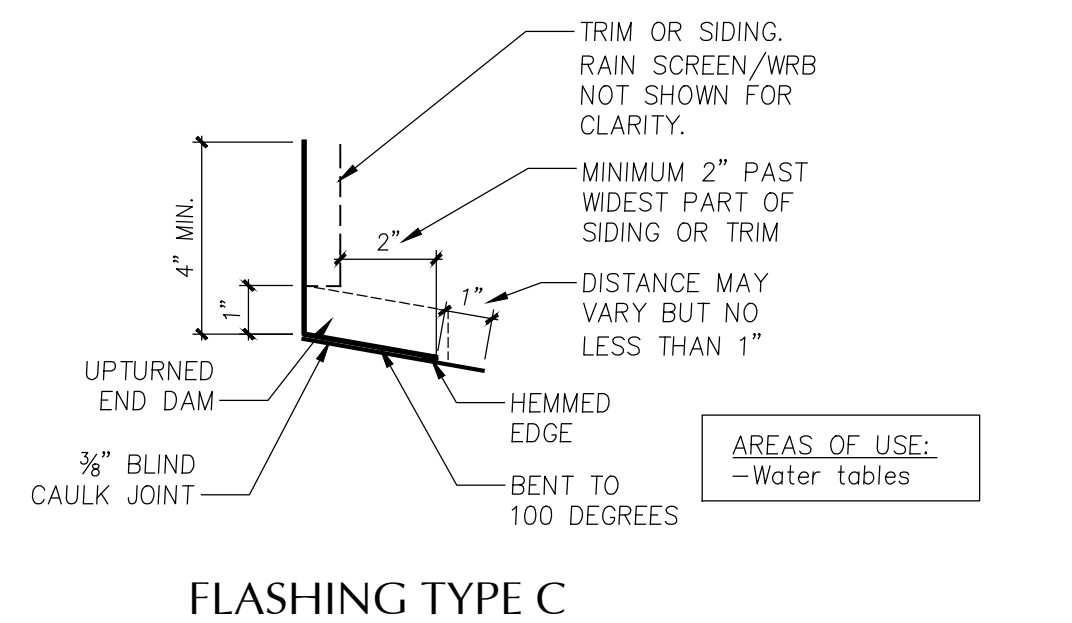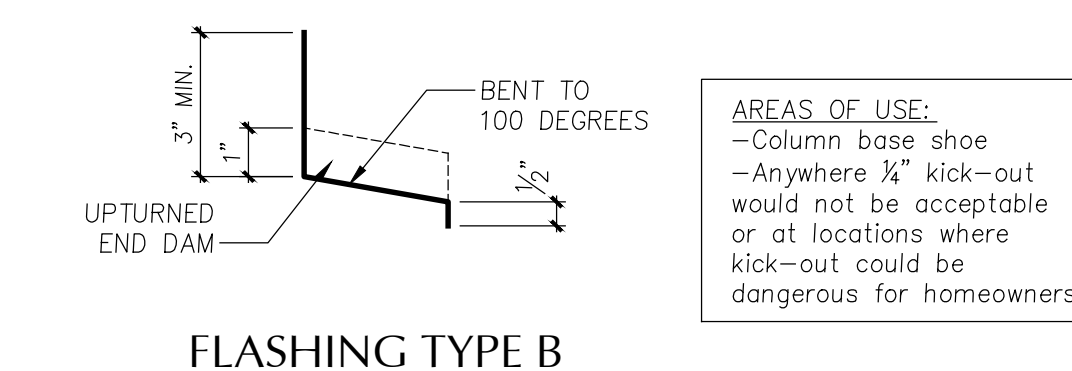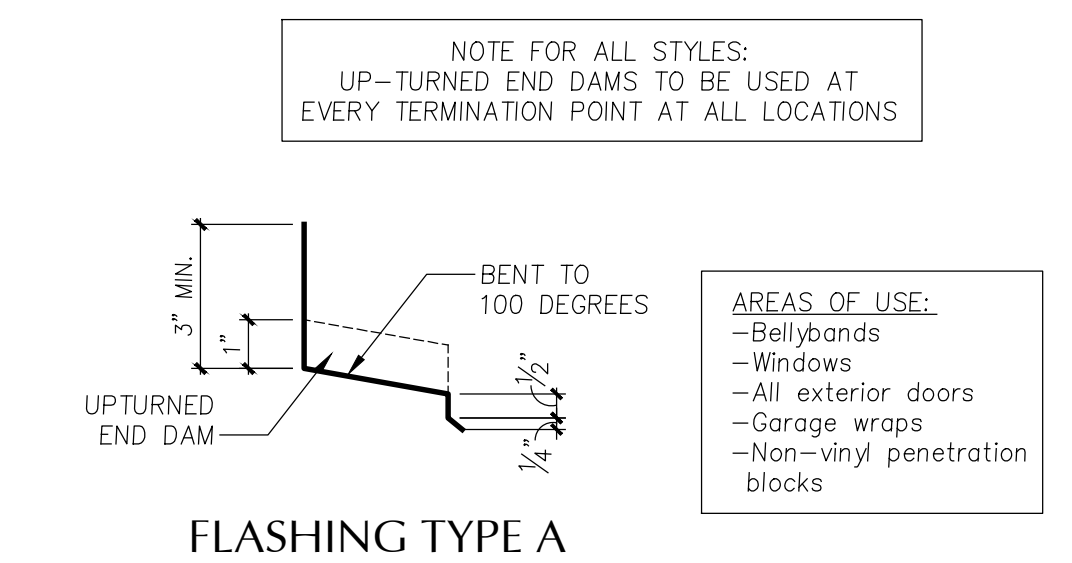

**20 HEAD FLASHING TYPES**  
3" = 1'-0" SECTION

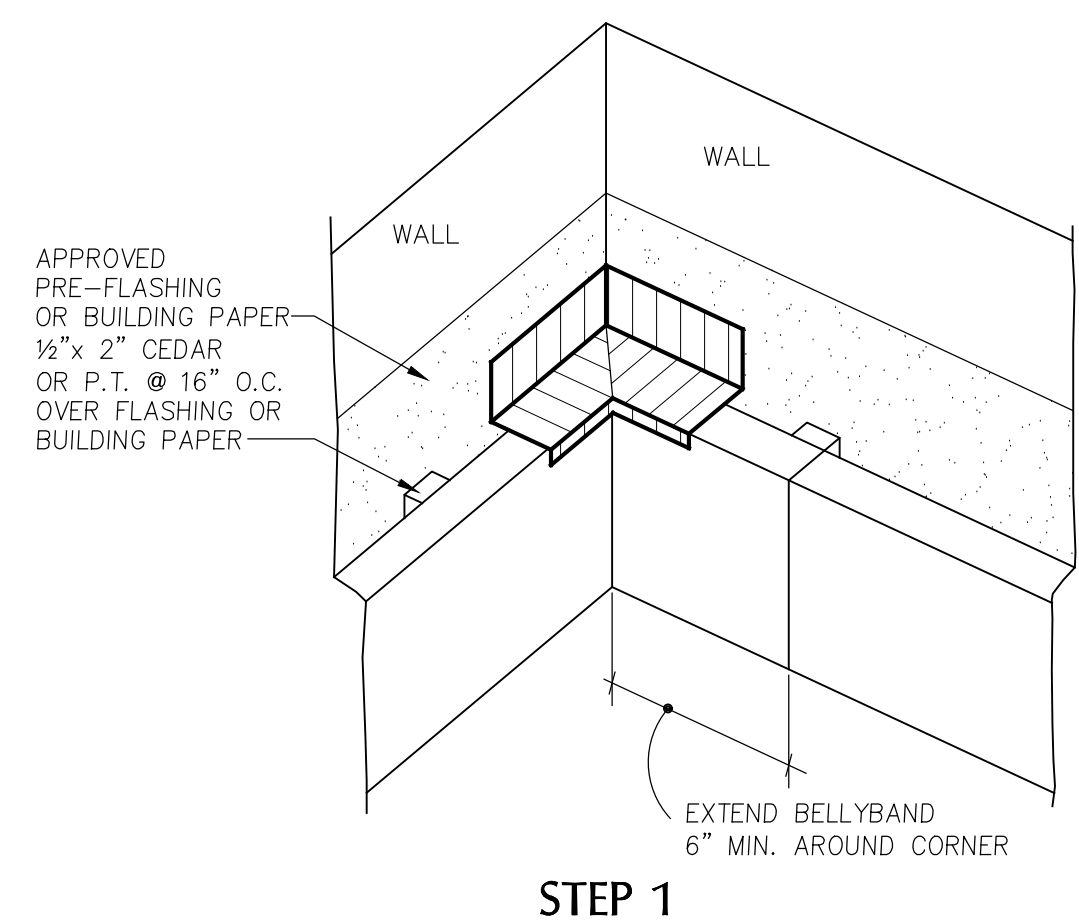


STEP 1

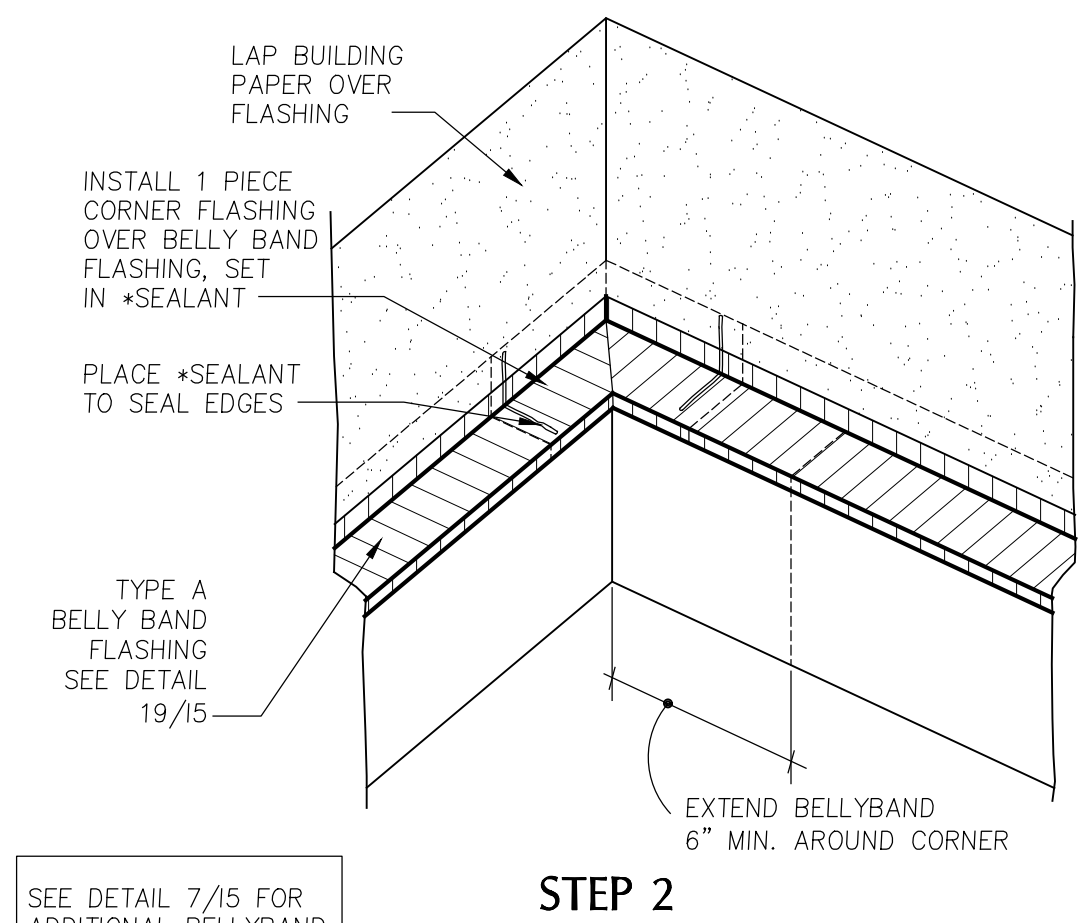


STEP 2

**16 BELLYBAND FLASHING**  
NO SCALE

**10 DIRECT VENT F.P.**  
NO SCALE

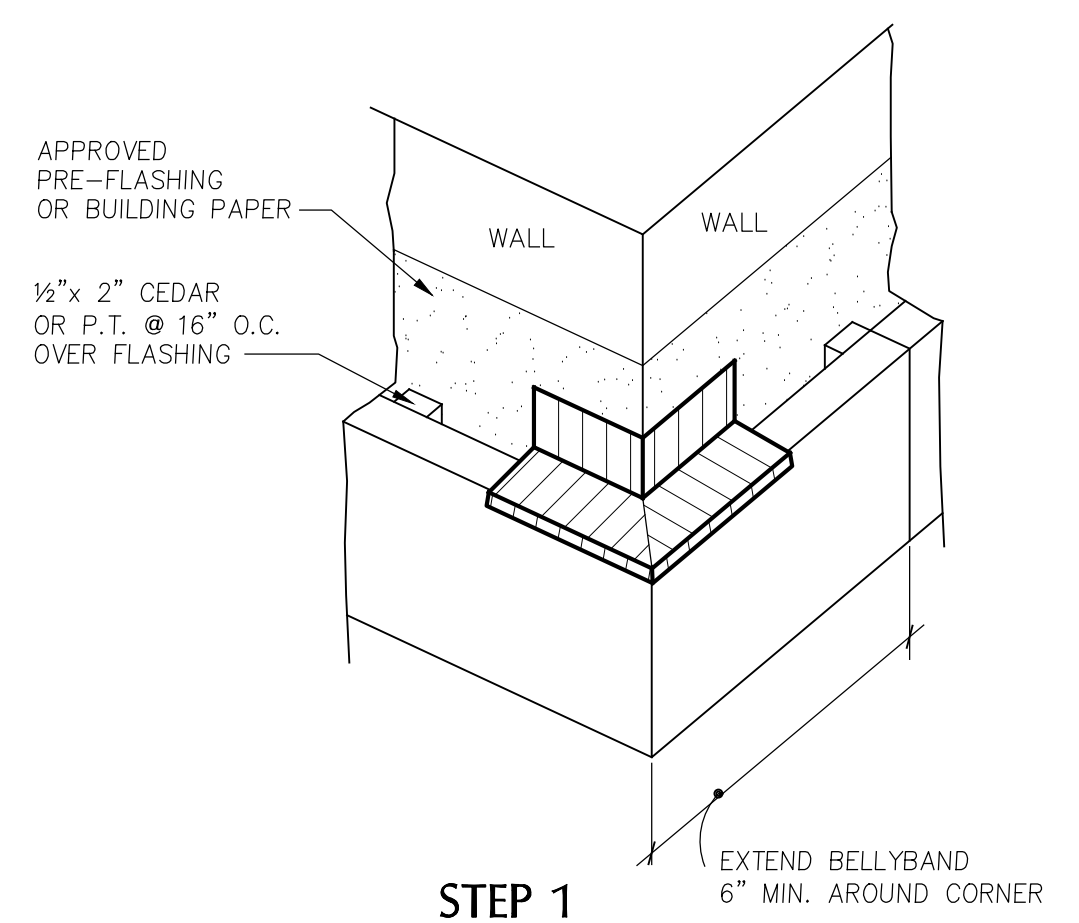


STEP 1

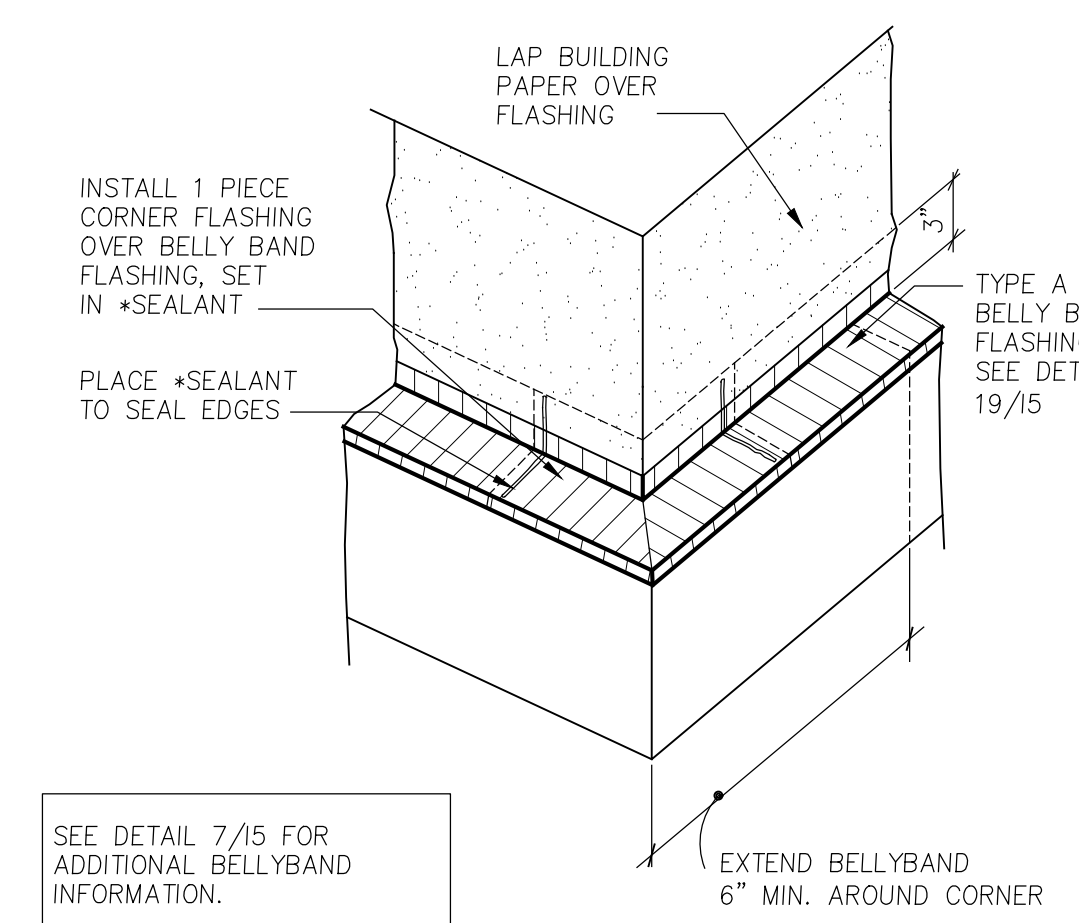

STEP 2


**12 BELLYBAND FLASHING**  
NO SCALE

**6 PENETRATION DETAIL**  
NO SCALE

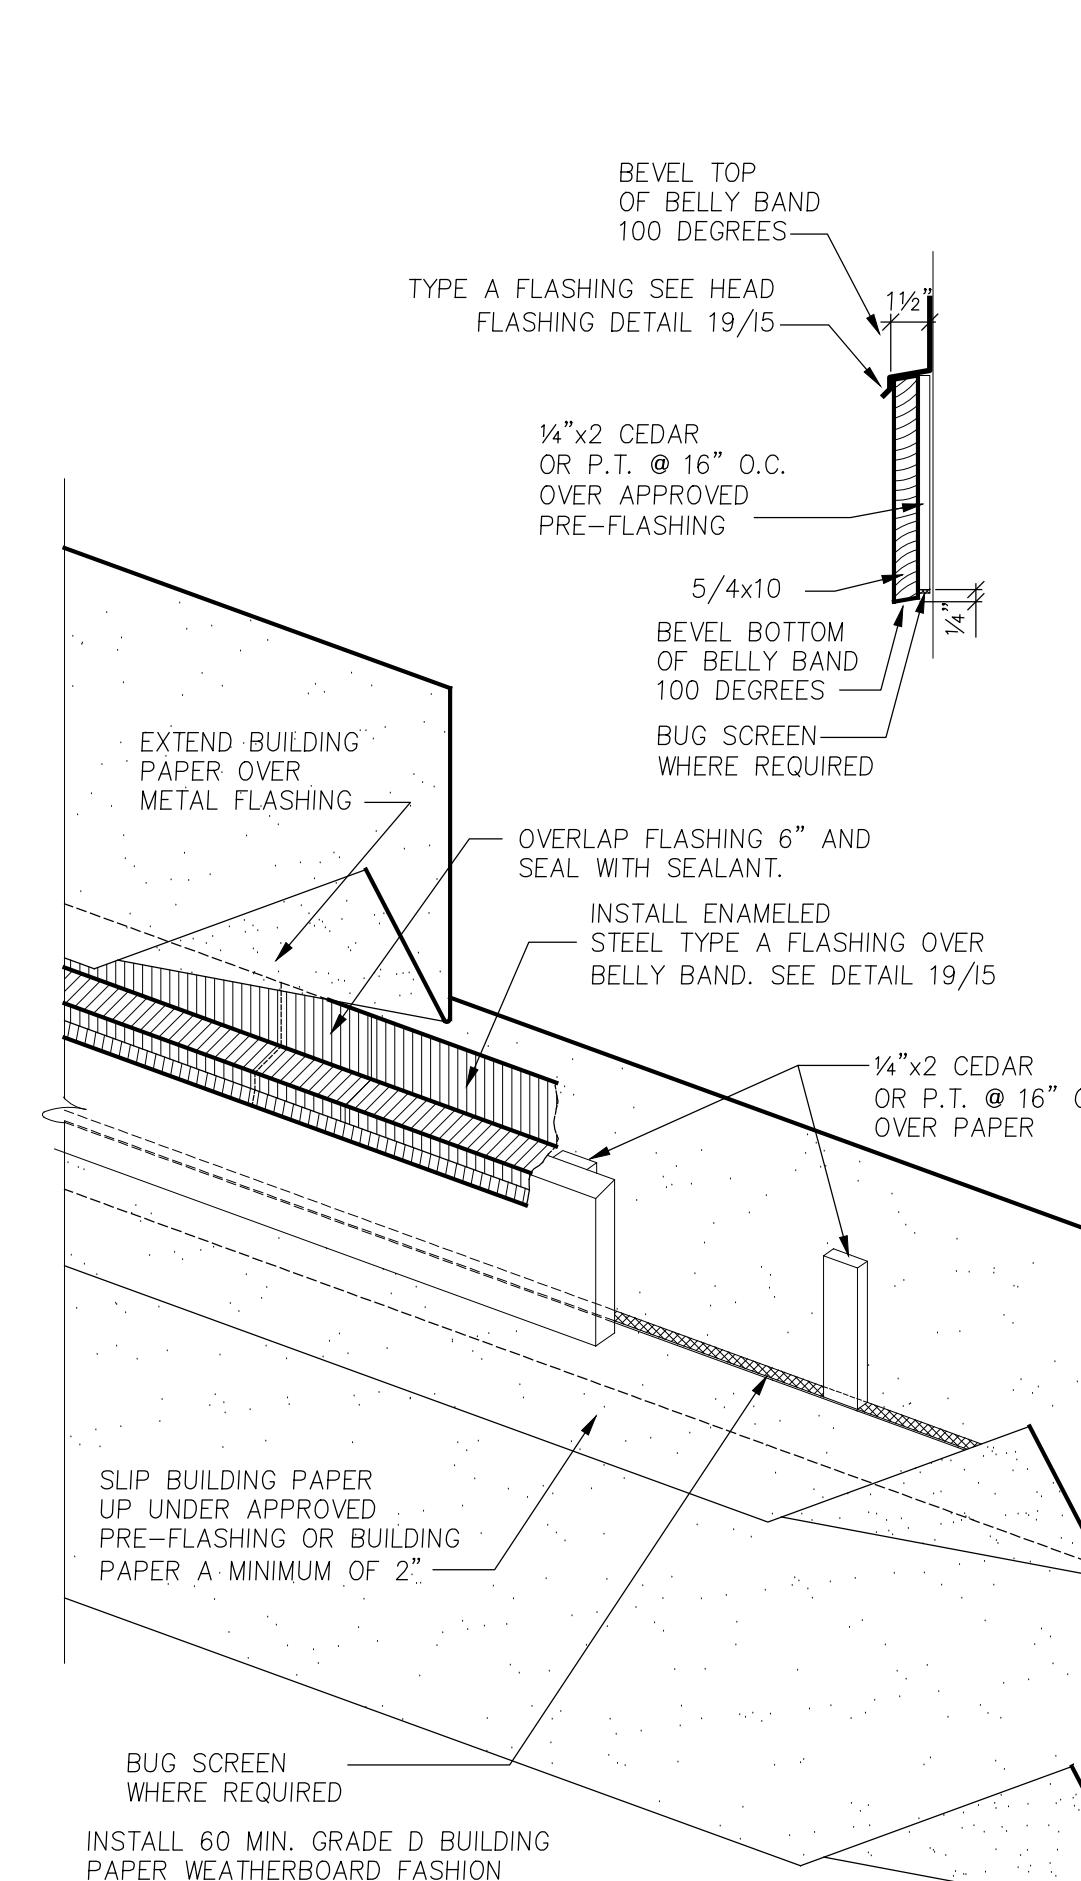


**8 BELLY BAND**  
NO SCALE

Multiple detail call outs need to be corrected on this sheet, as the call outs do not exist.  
(Construction Set, Sheets BE1 and BE3 and BE4)

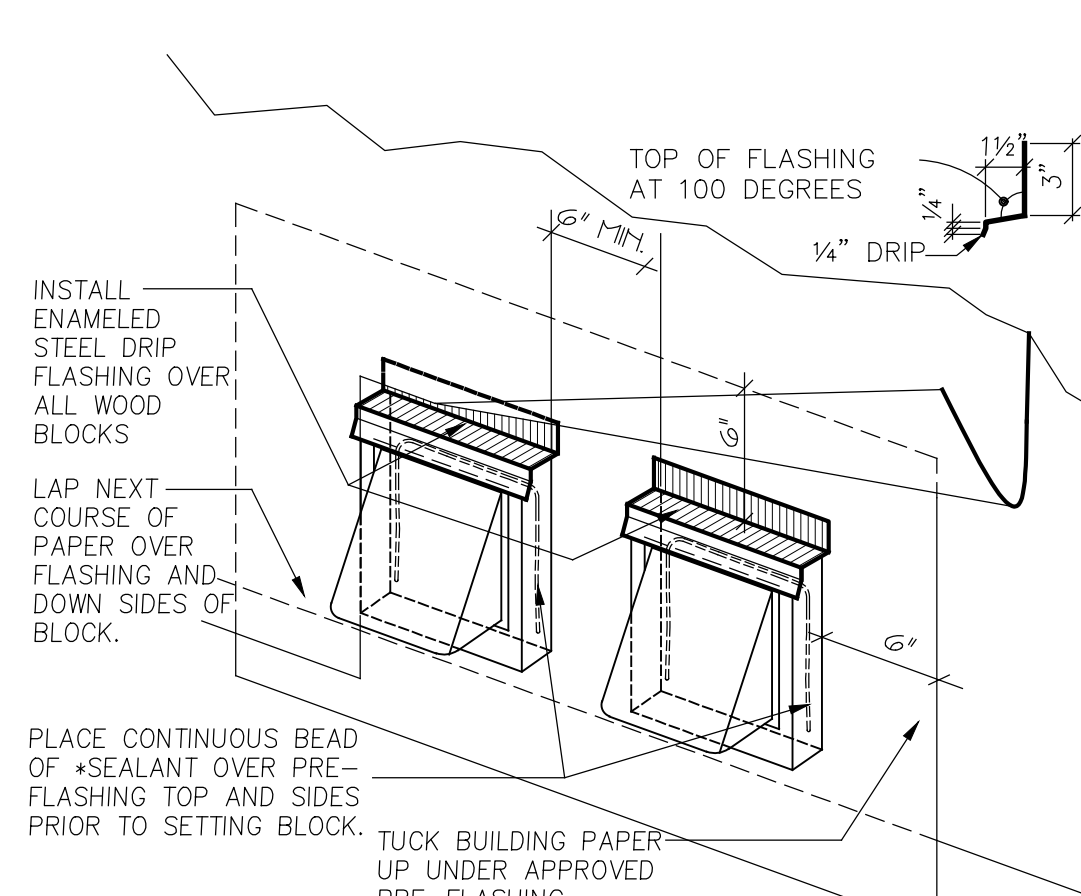


**5 VENT PENETRATION**  
NO SCALE

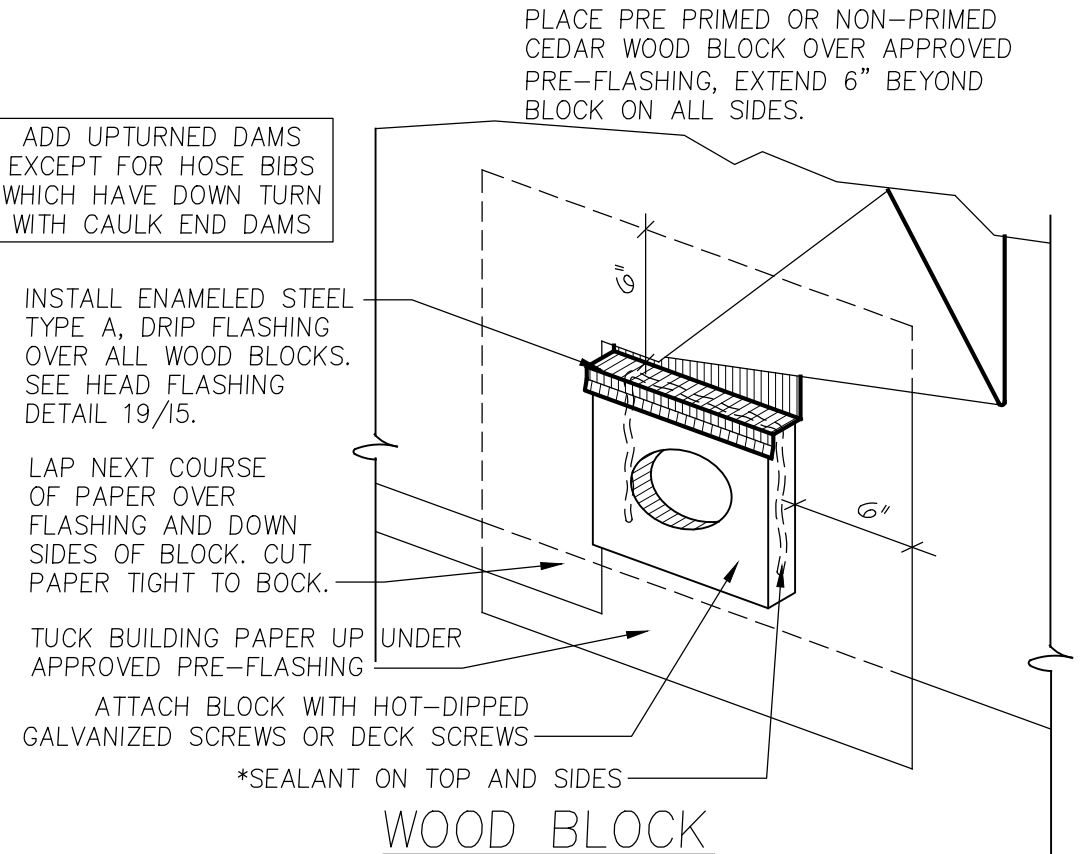


WOOD BLOCK

**2 CORNER AT FDN. STEP**  
NO SCALE

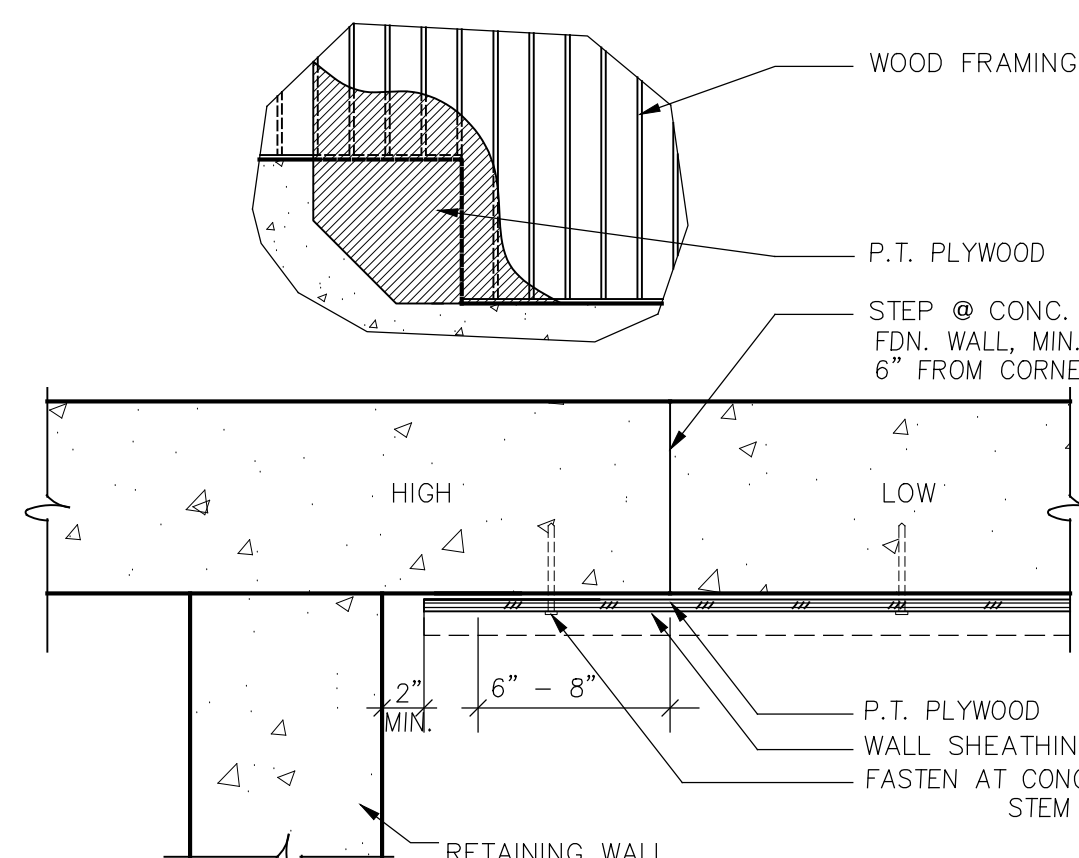


**3 SIDING AT FDN. STEP**  
NO SCALE

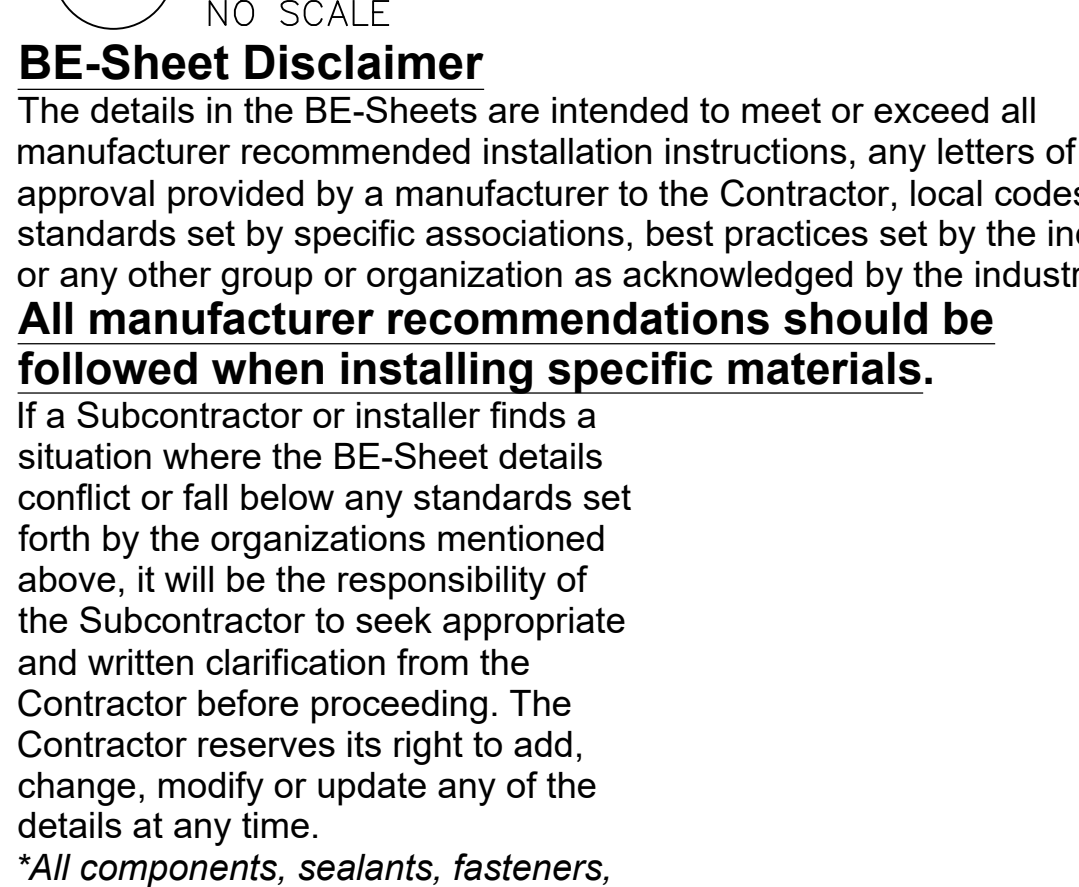


**3 SIDING AT FDN. STEP**  
NO SCALE


**BE-Sheet Disclaimer**  
The details in the BE-Sheets are intended to meet or exceed all manufacturer recommended installation instructions, any letters of approval provided by a manufacturer to the Contractor, local codes, standards set by specific associations, best practices set by the industry or any other group or organization as acknowledged by the industry. **All manufacturer recommendations should be followed when installing specific materials.**  
If a Subcontractor or installer finds a situation where the BE-Sheet details conflict or fall below any standards set forth by the organizations mentioned above, it will be the responsibility of the Subcontractor to seek appropriate and written clarification from the Contractor before proceeding. The Contractor reserves its right to add, change, modify or update any of the details at any time.  
*\*All components, sealants, fasteners, or materials shall be approved for specific use or application described by the designs, and shall be compatible with all material with which each component comes in contact with.*

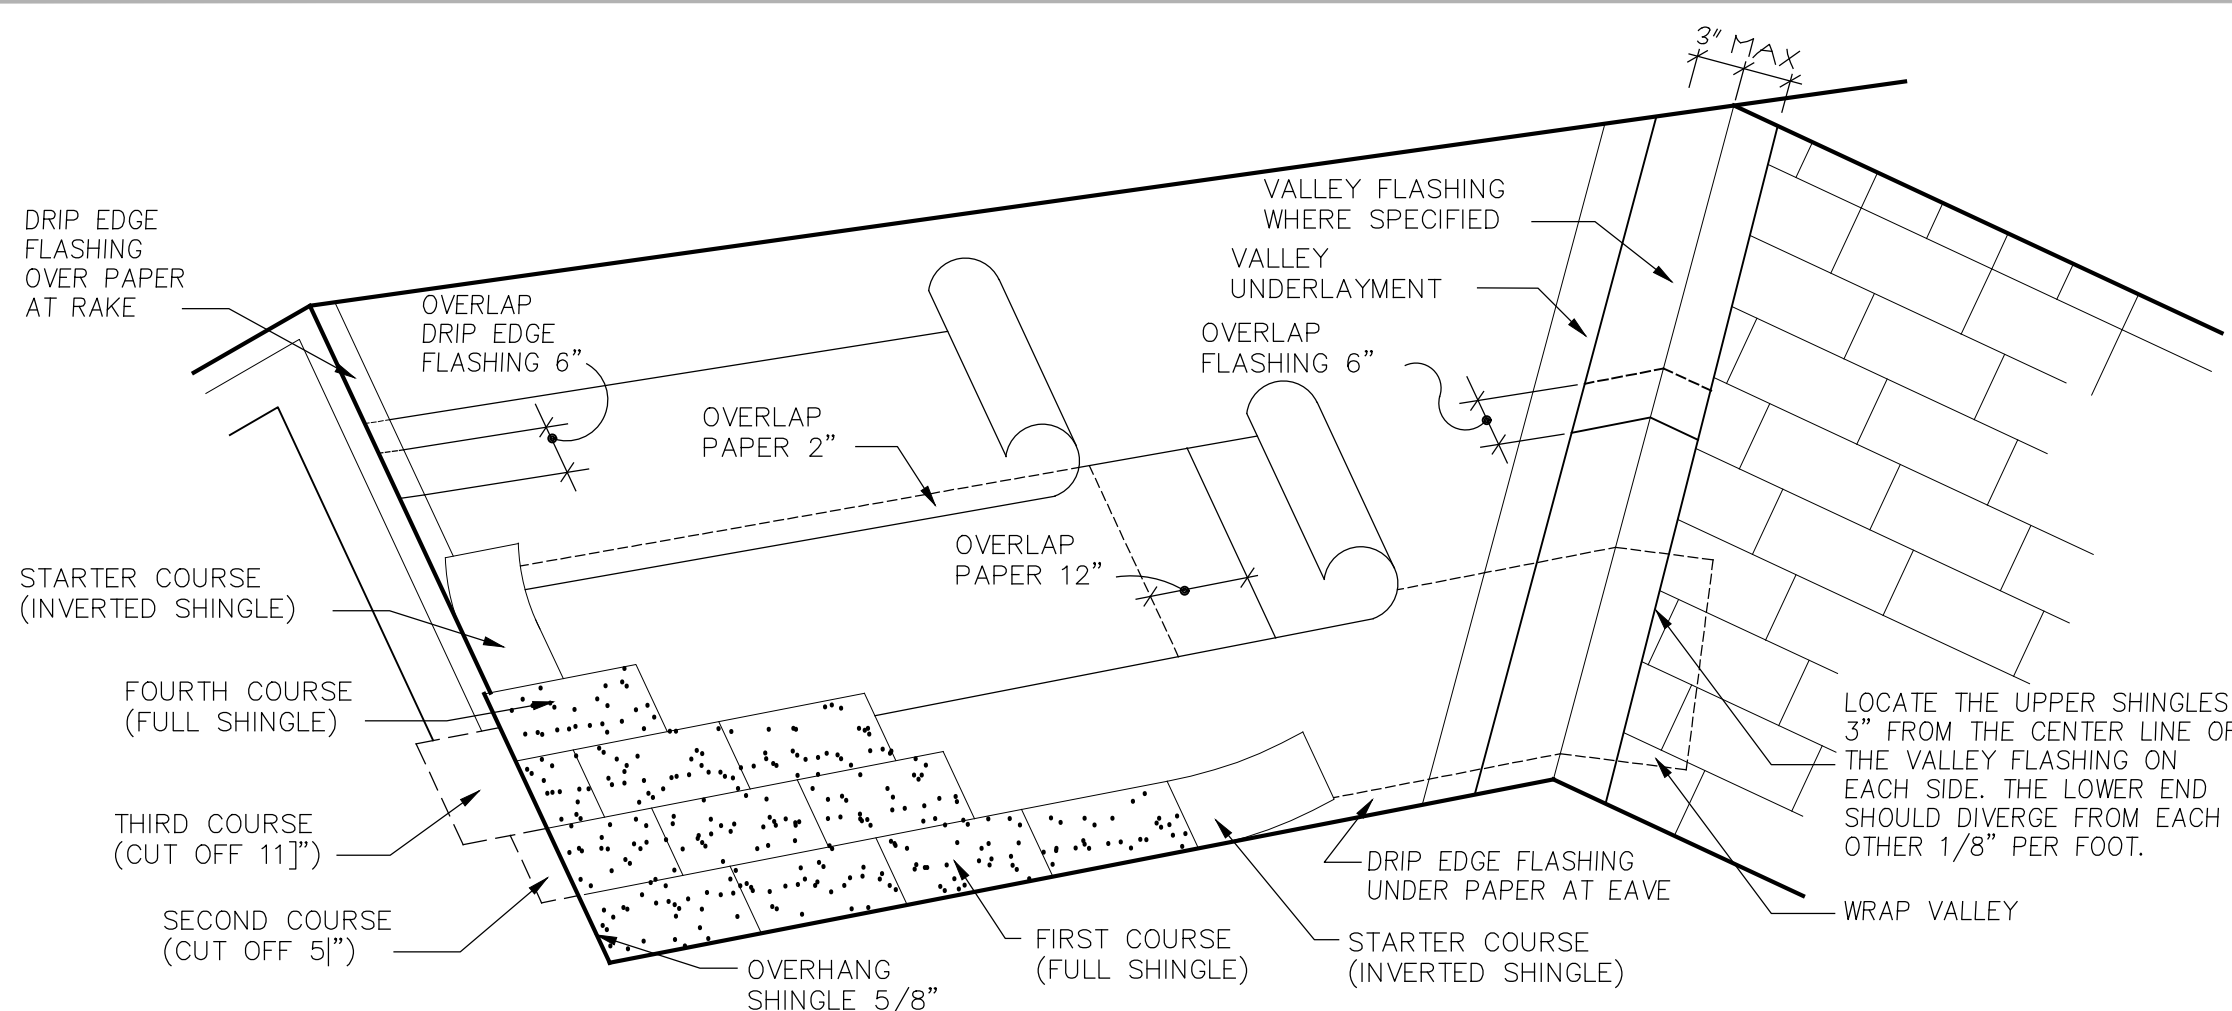


**17** ROOF AND VALLEY INSTALLATION  
NO SCALE

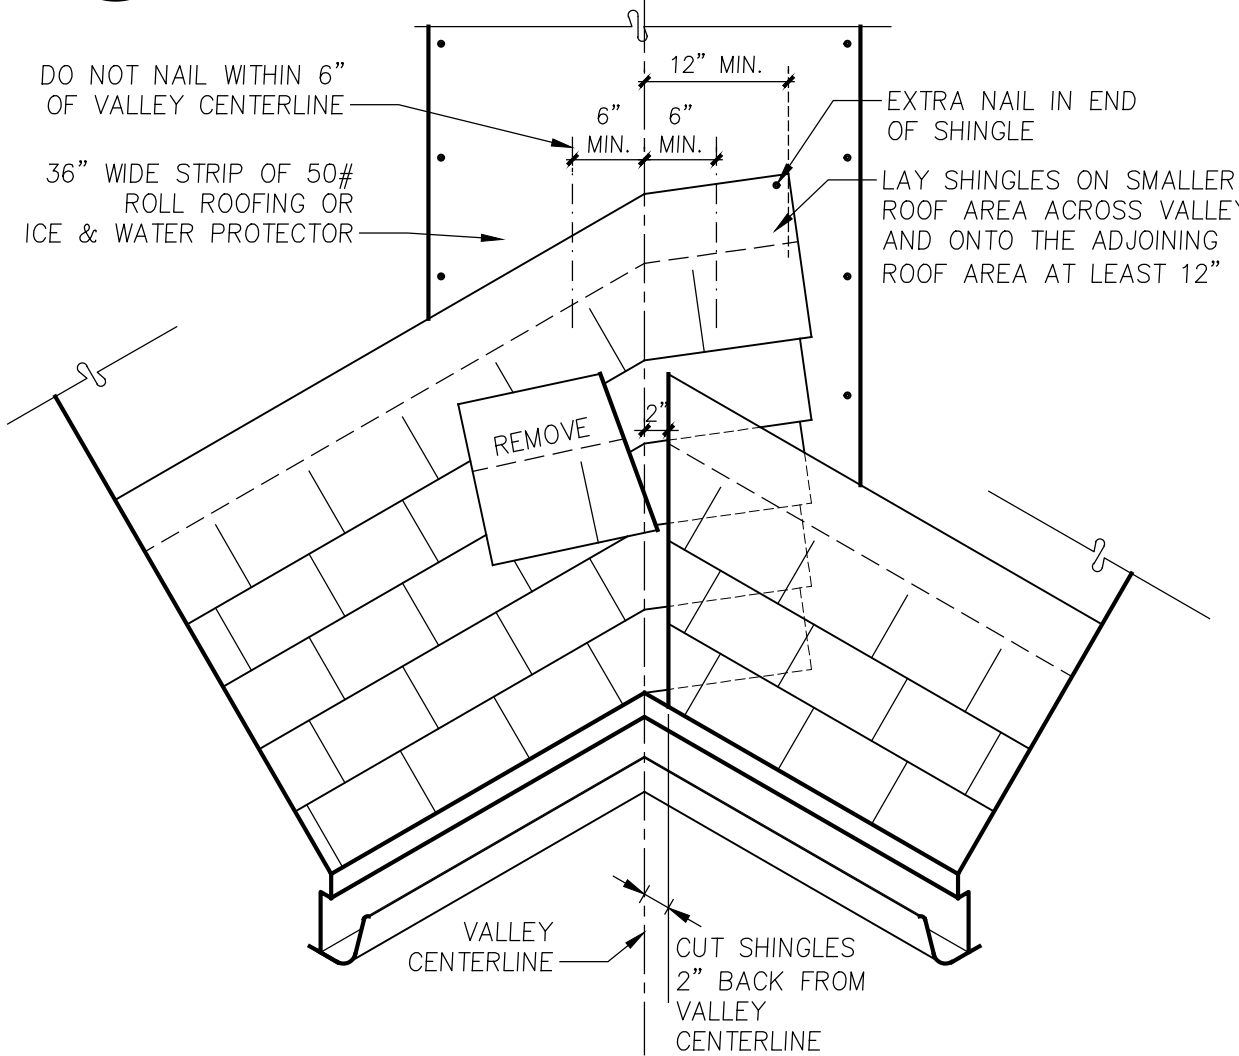


**18** NON METAL VALLEY INSTALLATION  
NO SCALE

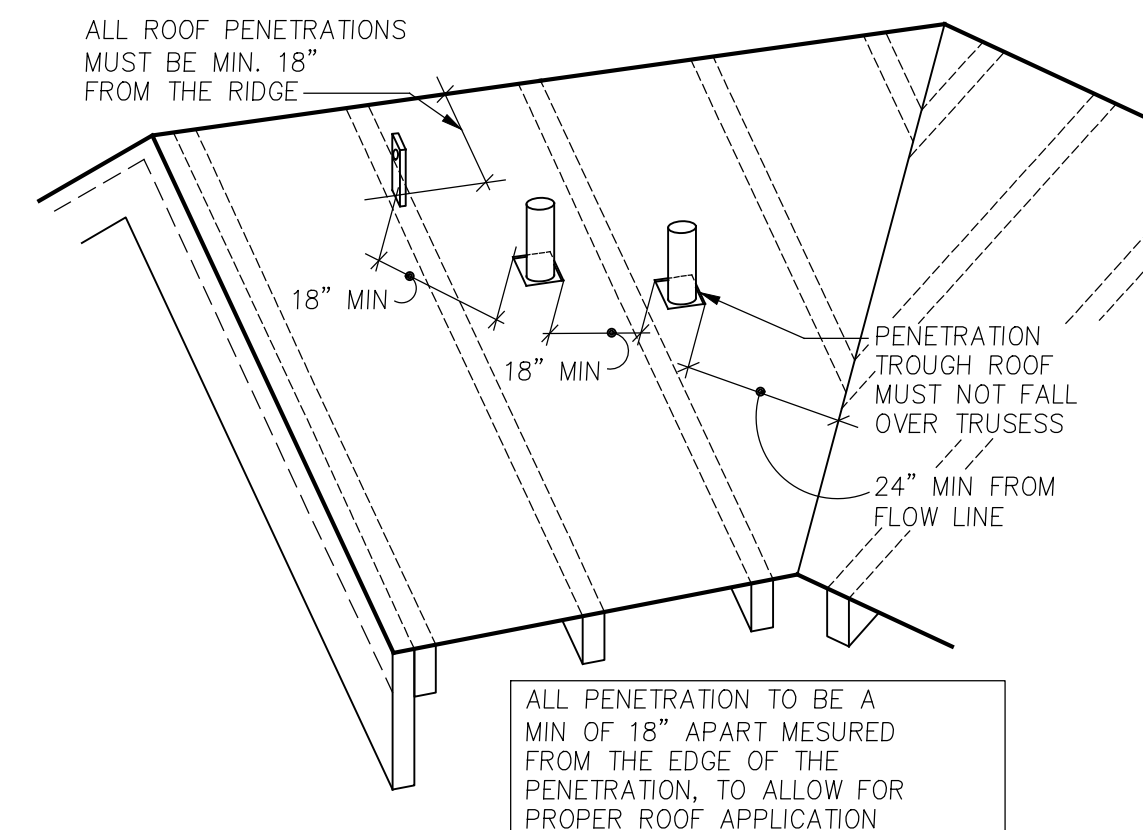


**14** ROOF PENETRATION  
NO SCALE

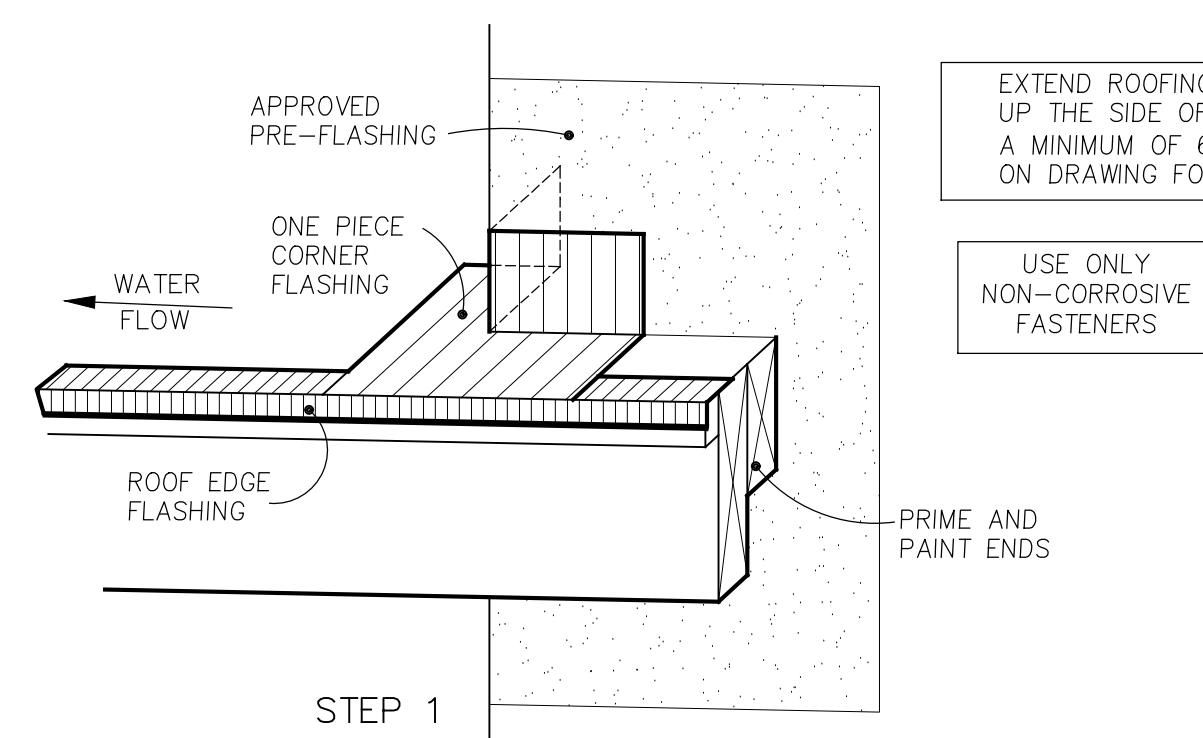


**19** ROOF / CORNER OVERLAP  
1-1/2" = 1'-0"

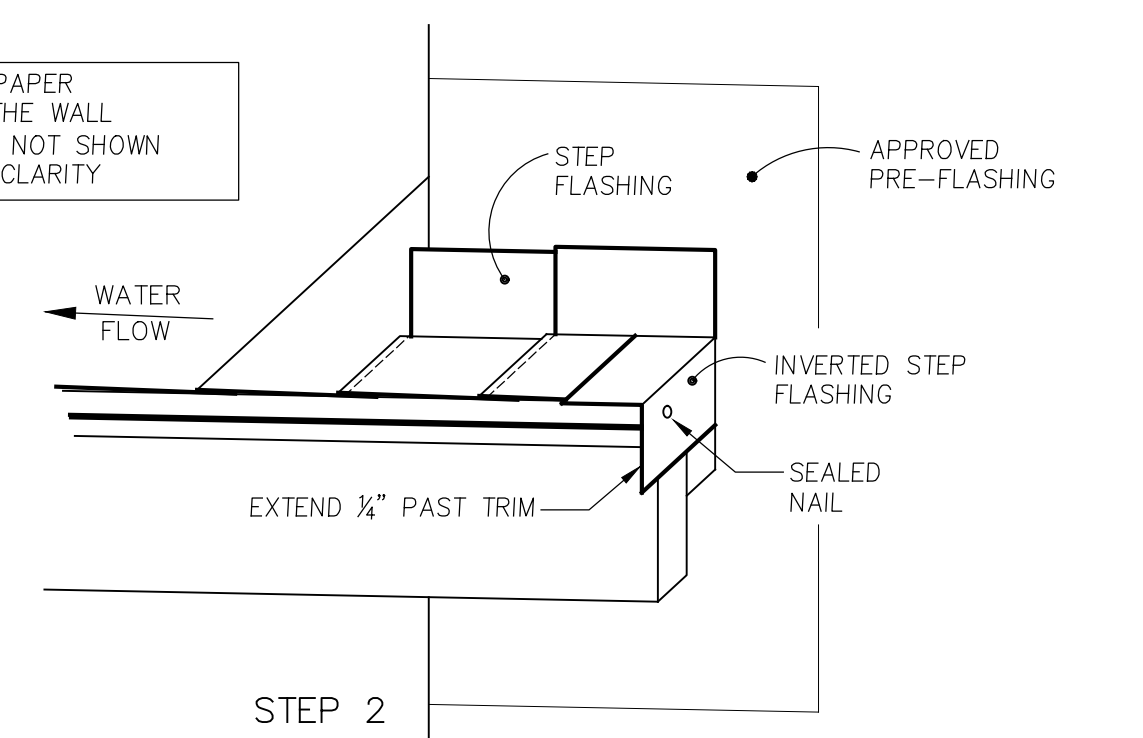


**16** ROOF SEPARATION  
NO SCALE

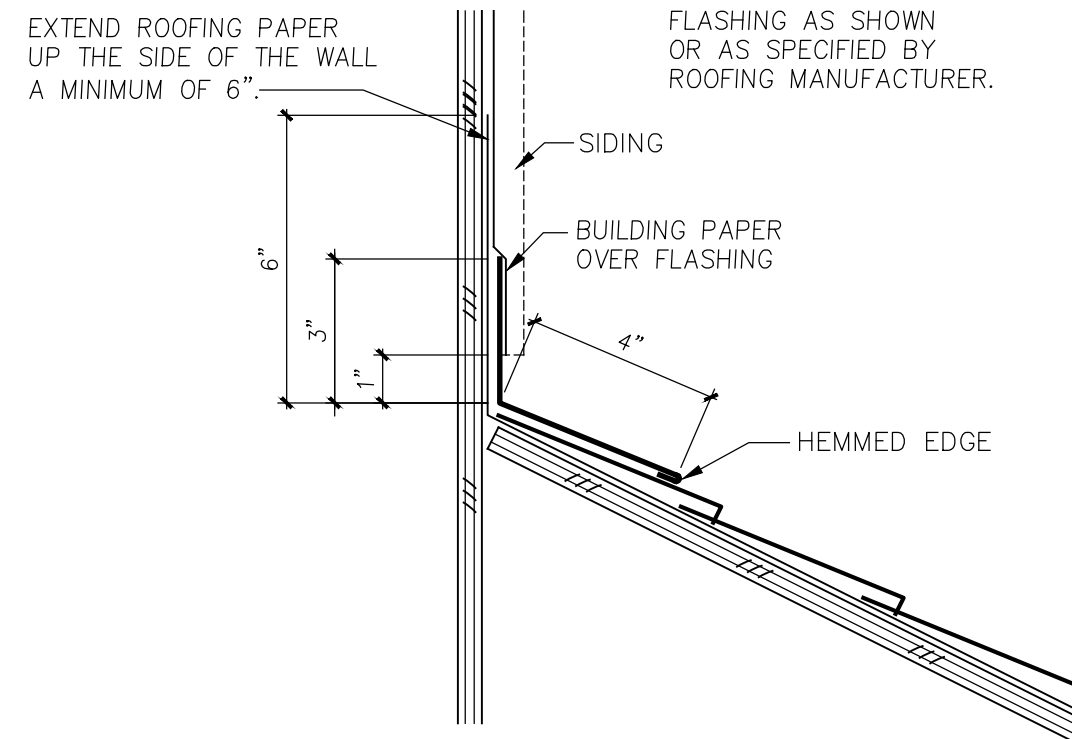


**9** ROOF TO WALL  
3" = 1'-0"

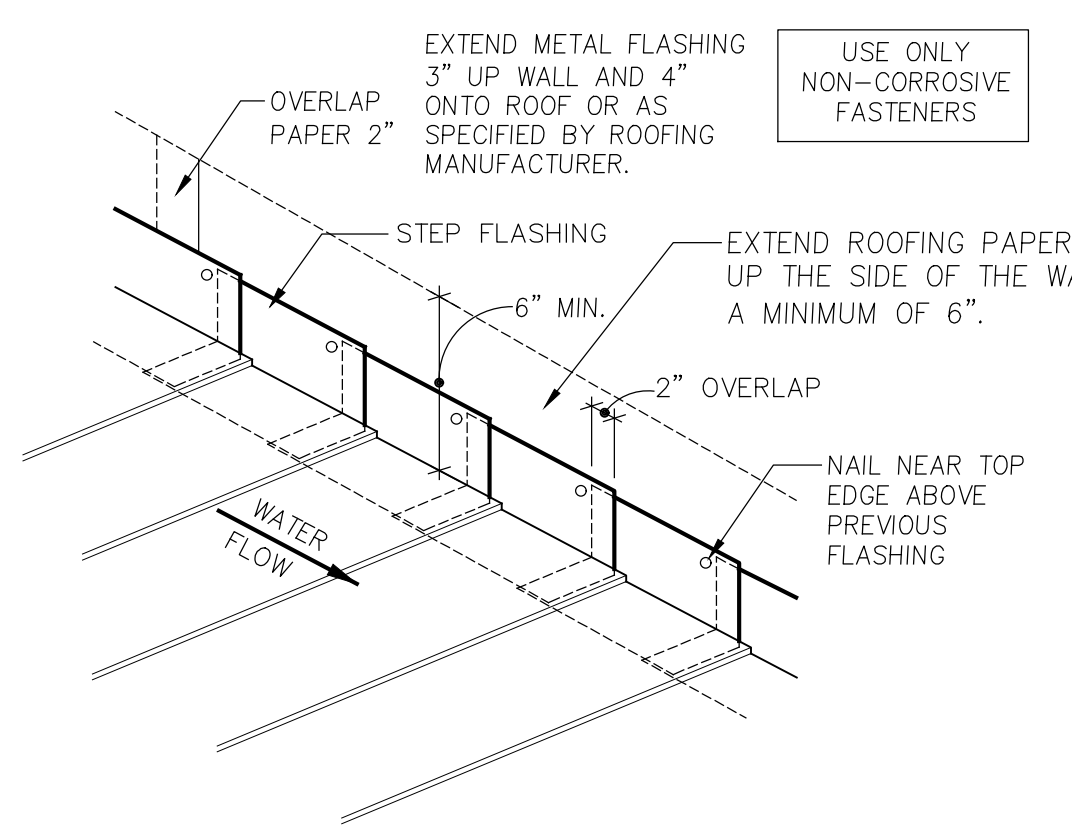


**10** STEP FLASHING  
NO SCALE

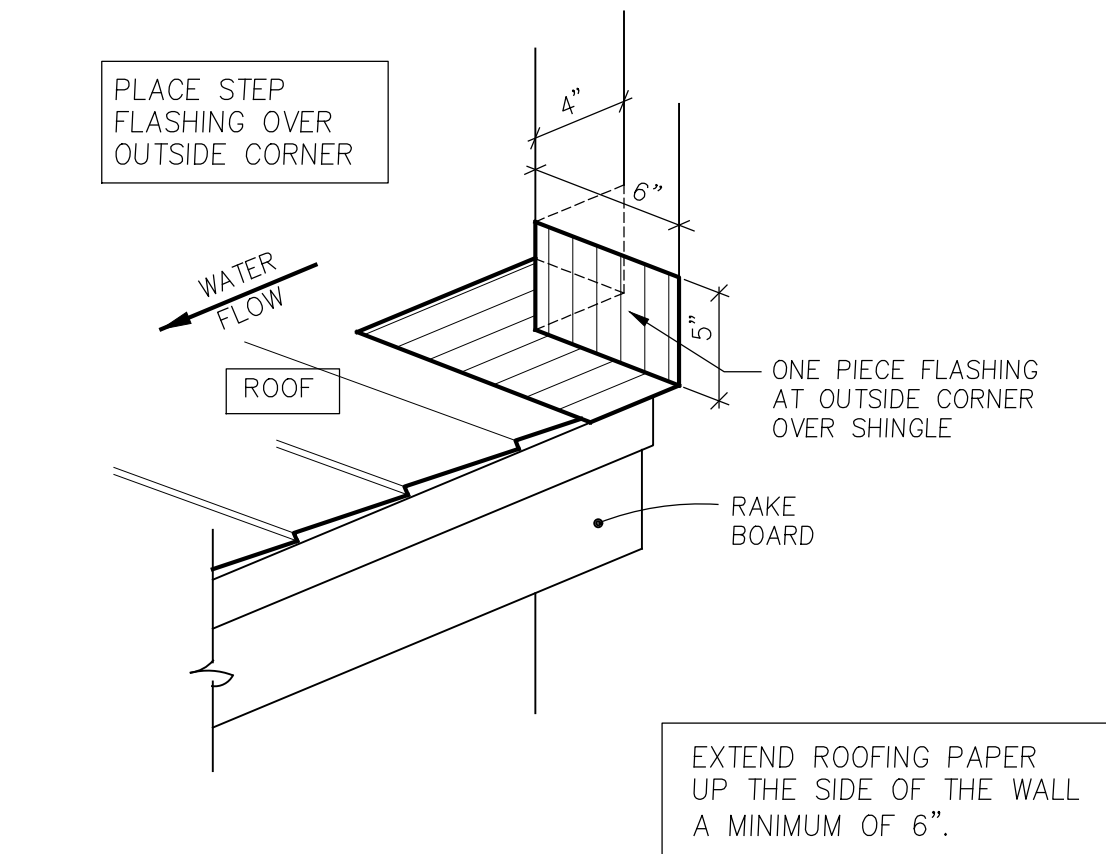


**5** ROOF / OUTSIDE CORNER  
1-1/2" = 1'-0"

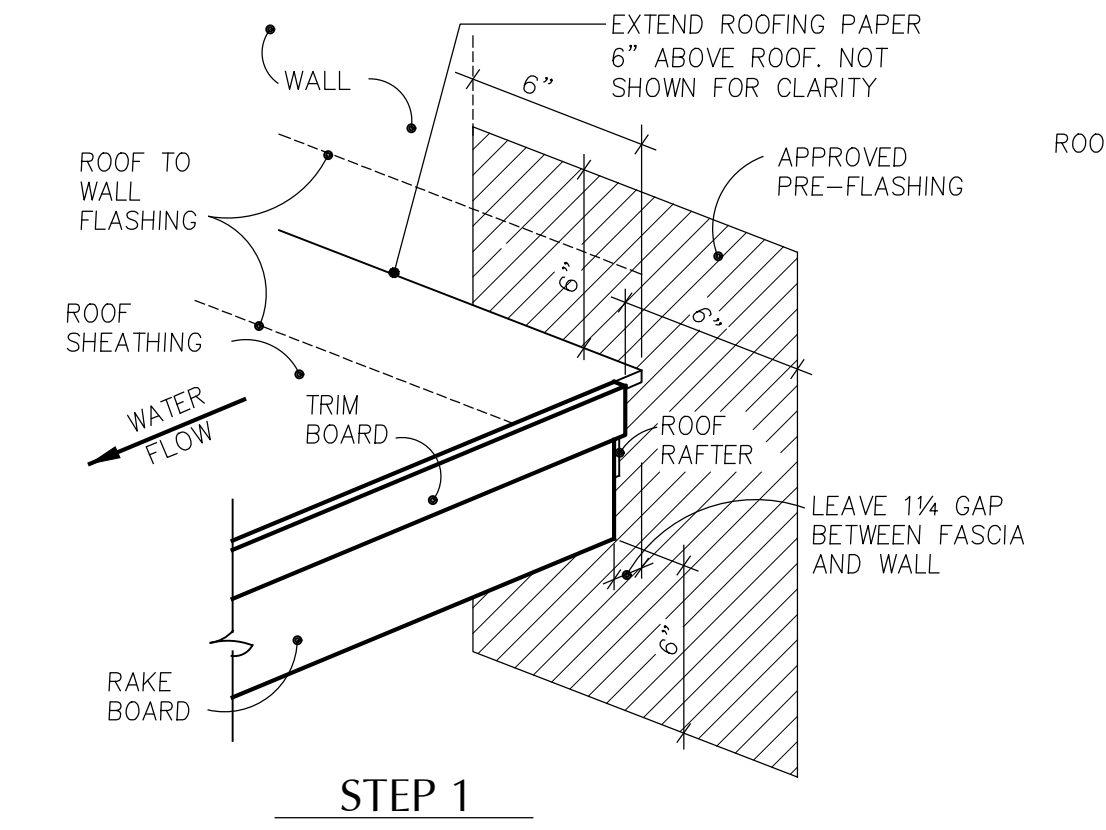


**6** SHED ROOF TO WALL  
NO SCALE

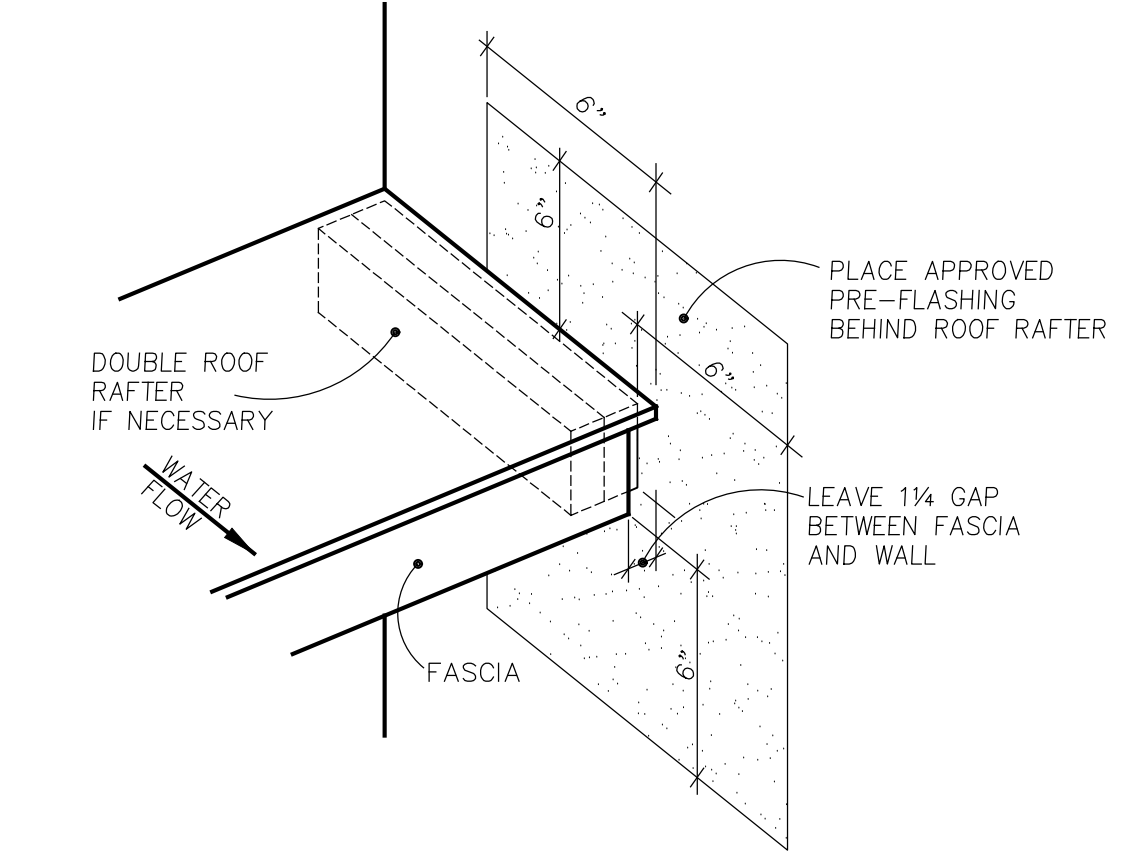


**1** ROOF TO WALL  
NO SCALE

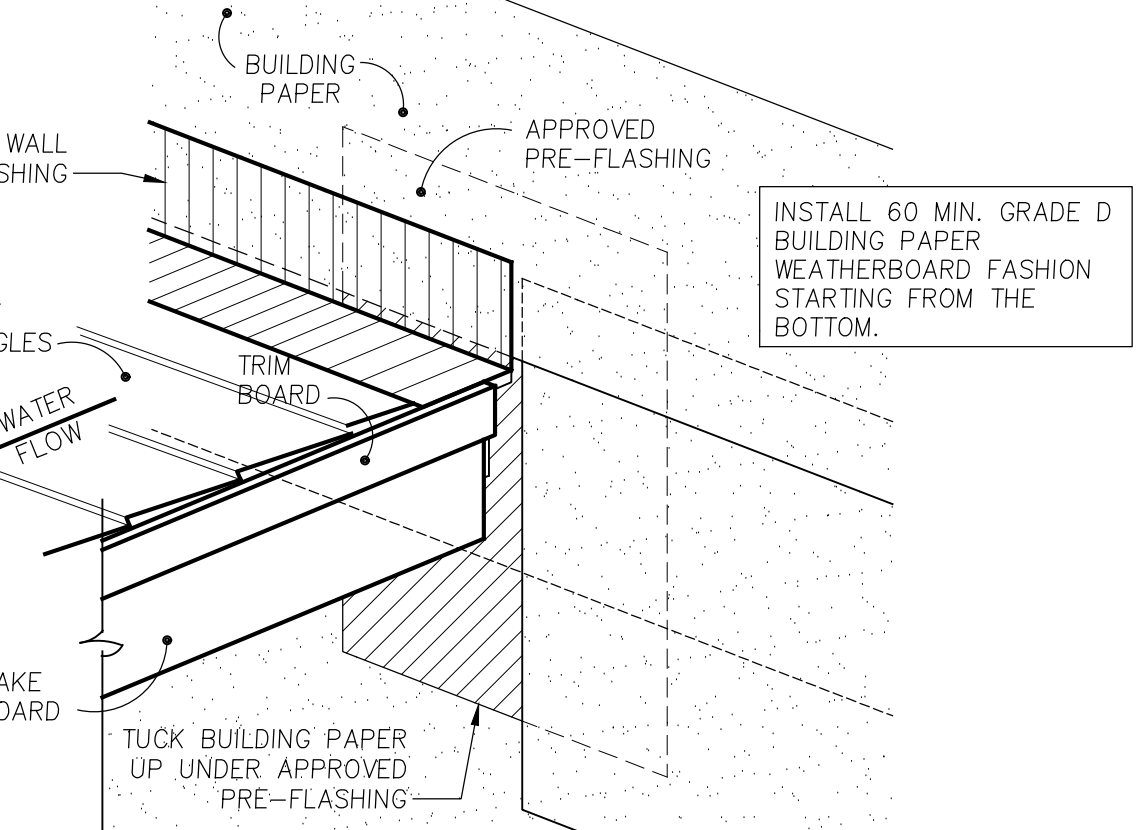


**3** OUTSIDE CORNER AT VALLEY  
NO SCALE

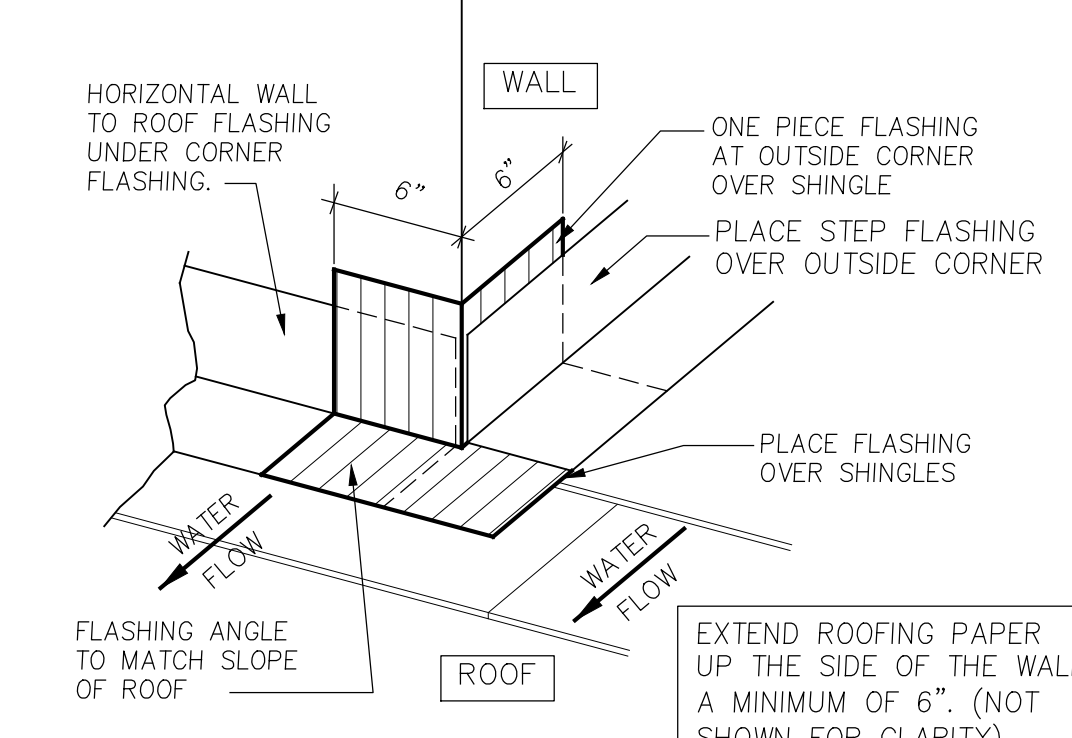


**11** OUTSIDE CORNER  
NO SCALE

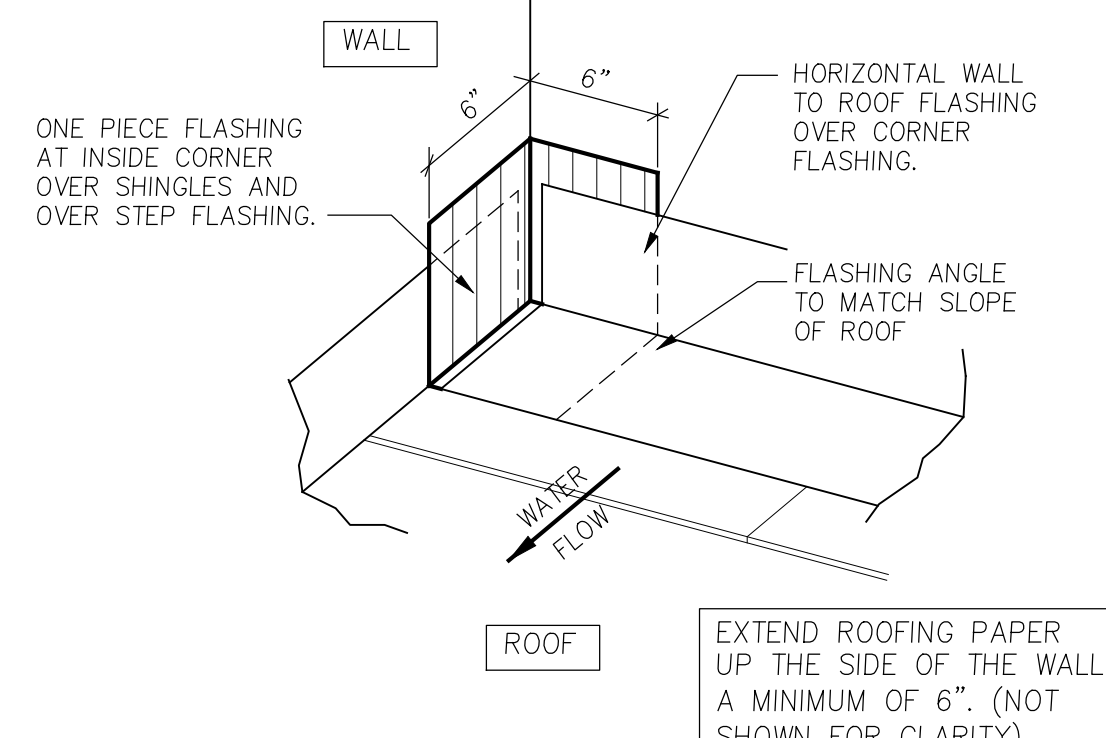


**7** INSIDE CORNER AT ROOF  
NO SCALE

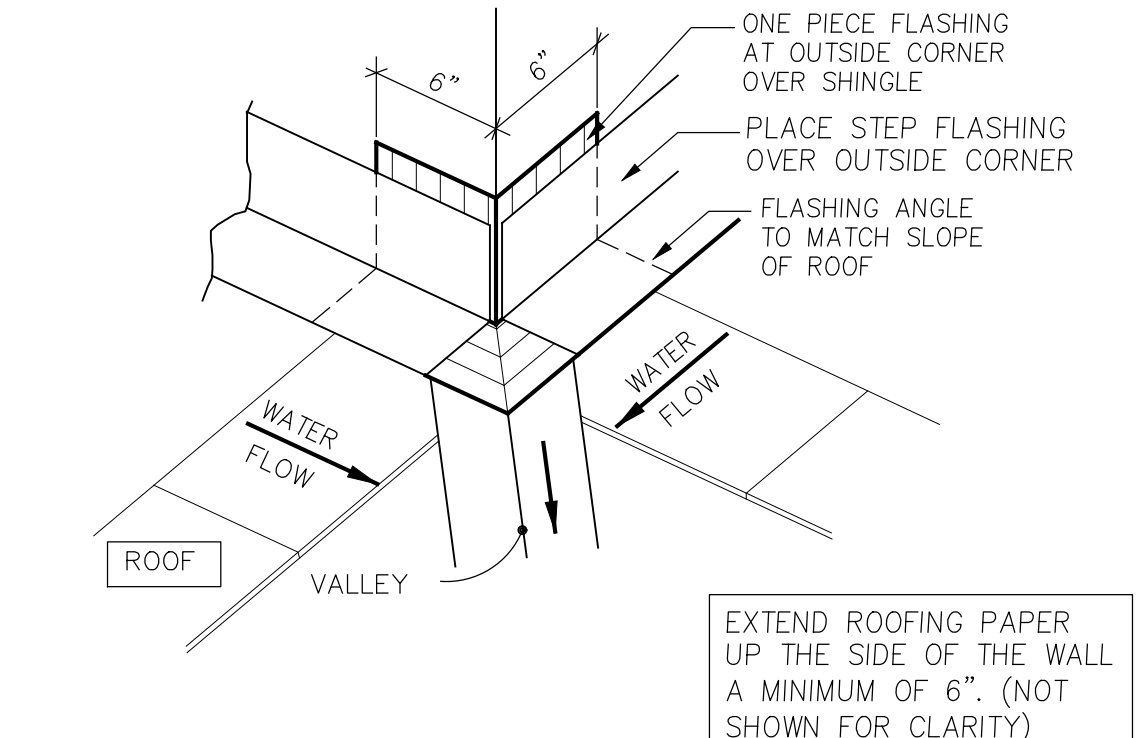


**12** CRICKET DETAIL  
3/4" = 1'-0"

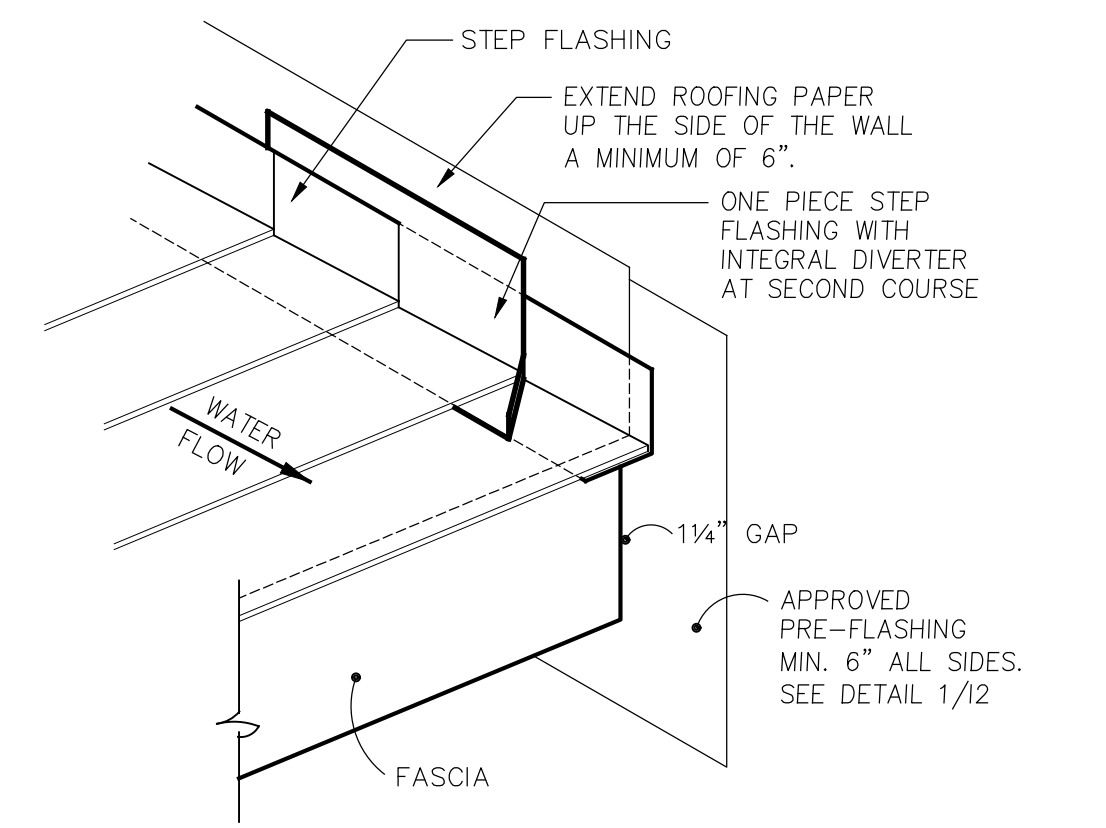

**8** ROOF DIVERTER  
NO SCALE

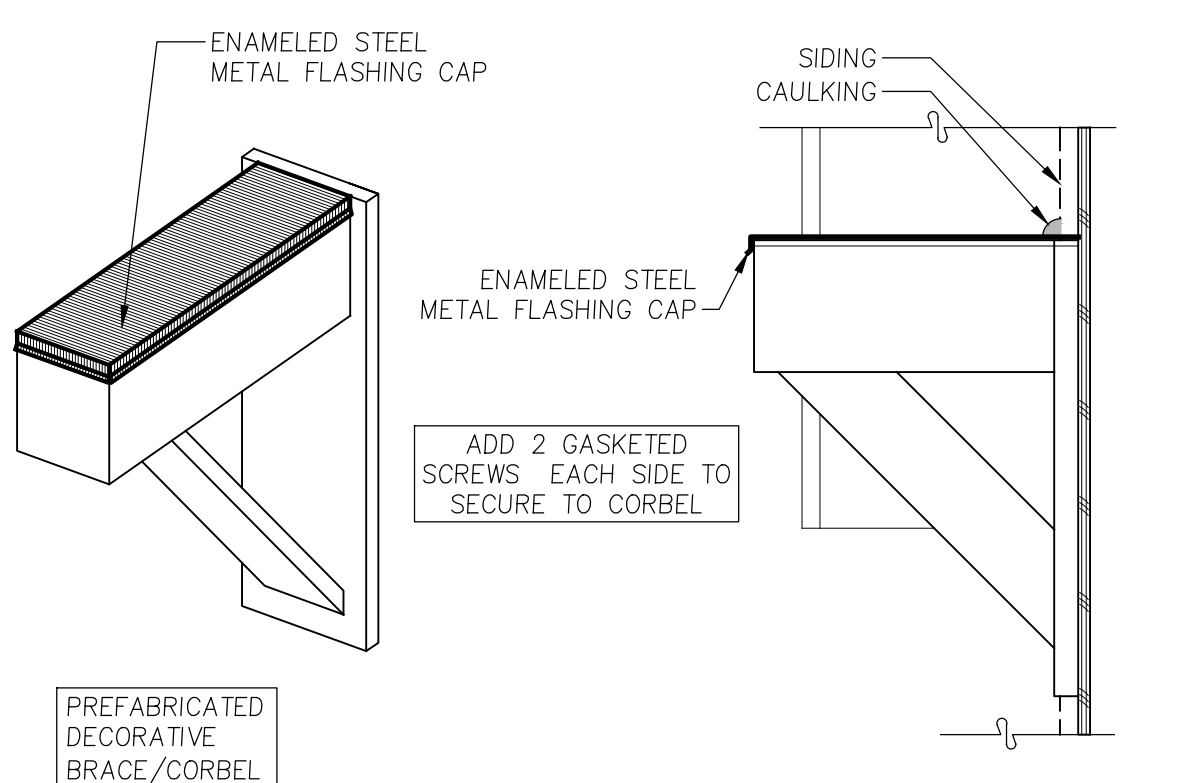


**20** DECORATIVE CORBEL/BRACE  
NO SCALE

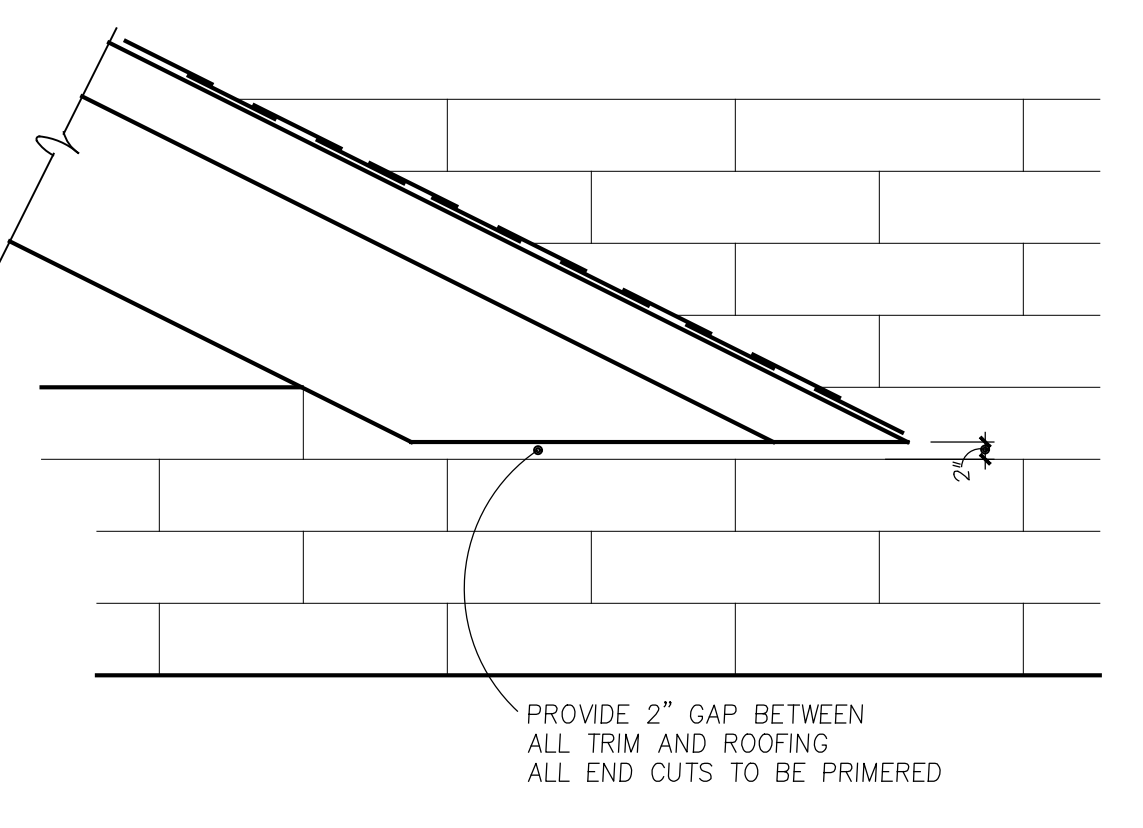

**16** ROOF SEPARATION  
NO SCALE

**BE-Sheet Disclaimer**  
The details in the BE-Sheets are intended to meet or exceed all manufacturer recommended installation instructions, any letters of approval provided by a manufacturer to the Contractor, local codes, standards set by specific associations, best practices set by the industry or any other group or organization as acknowledged by the industry. **All manufacturer recommendations should be followed when installing specific materials.**  
If a Subcontractor or installer finds a situation where the BE-Sheet details conflict or fall below any standards set forth by the organizations mentioned above, it will be the responsibility of the Subcontractor to seek appropriate and written clarification from the Contractor before proceeding. The Contractor reserves its right to add, change, modify or update any of the details at any time.  
*\*All components, sealants, fasteners, or materials shall be approved for specific use or application described by the designs, and shall be compatible with all material with which each component comes in contact with.*


P:\2306\BE-SHEETS\BE2-REV.DWG

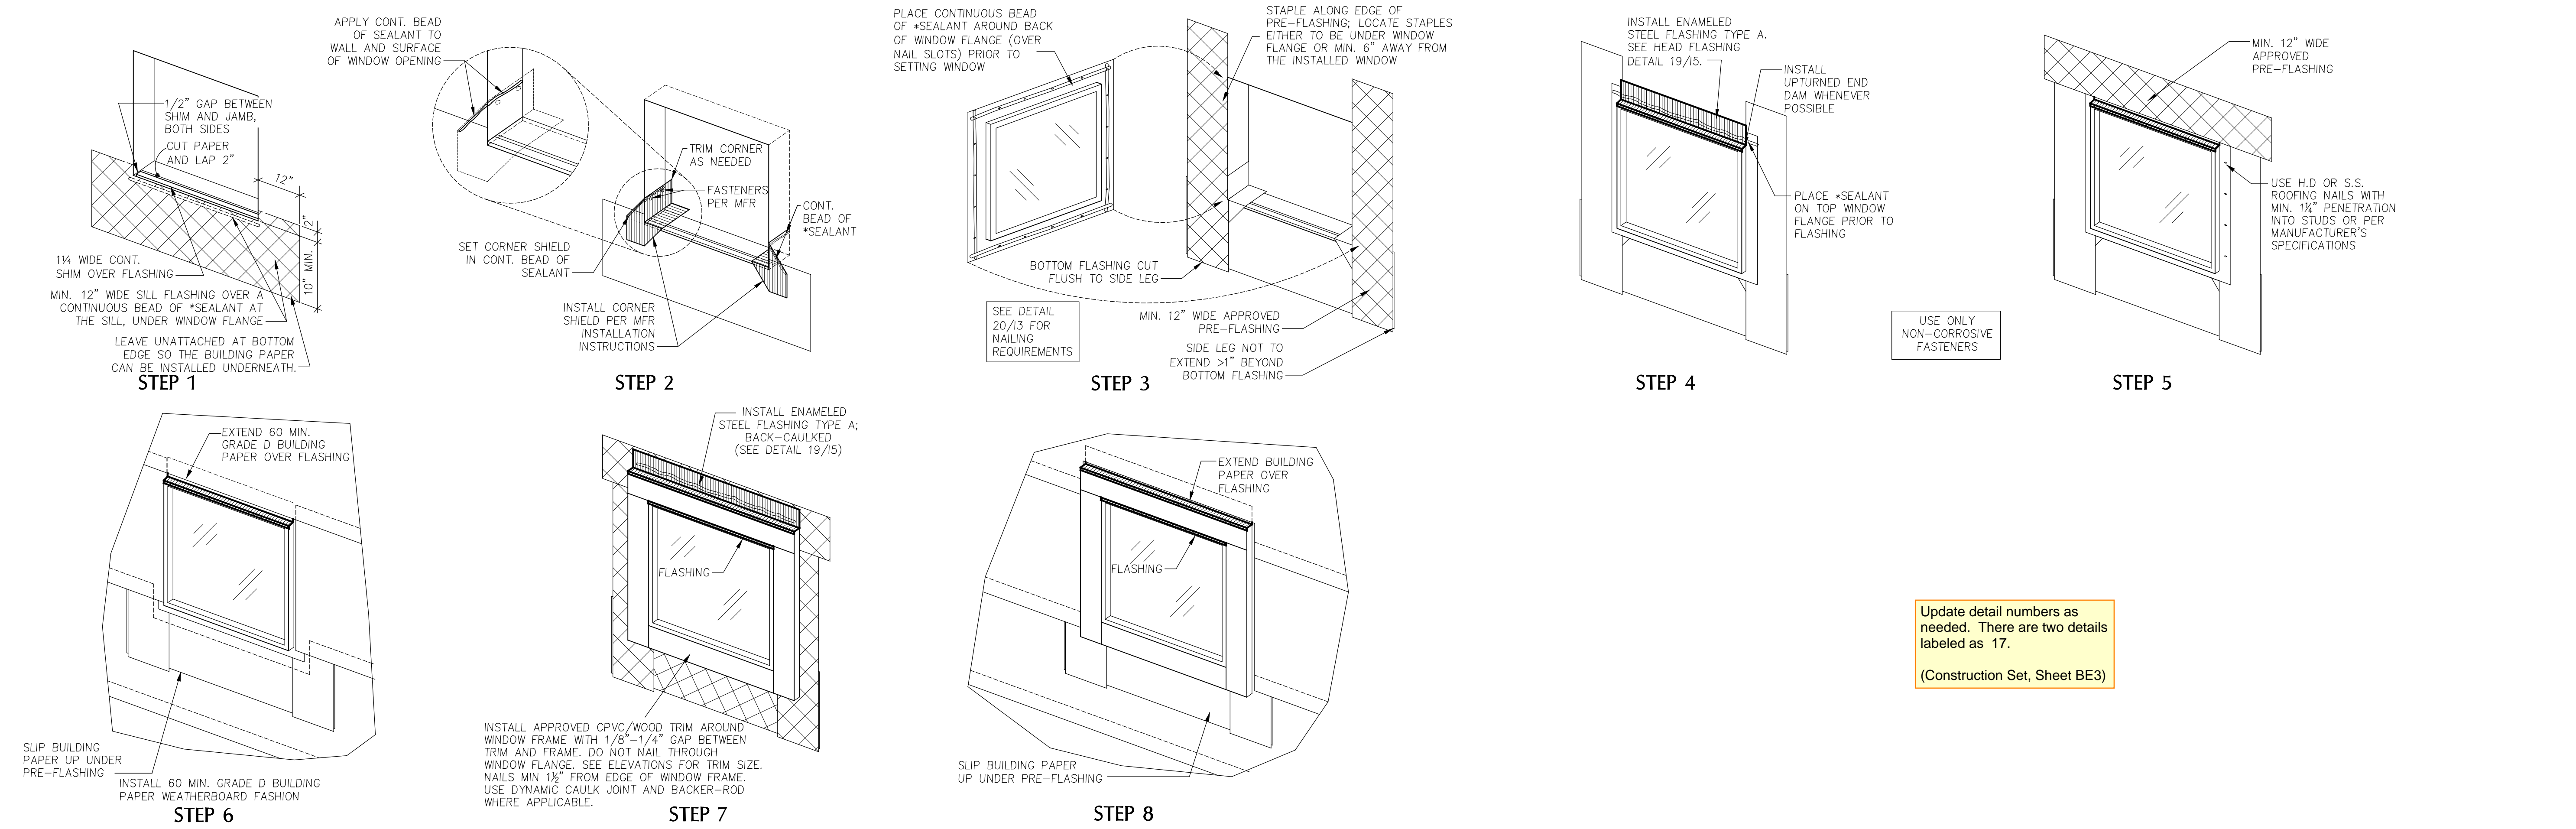


USE ONLY NON-CORROSIVE FASTENERS

Update detail numbers as needed. There are two details labeled as 17.  
(Construction Set, Sheet BE3)

17 WINDOW INSTALLATION WITH WOOD TRIM  
NO SCALE

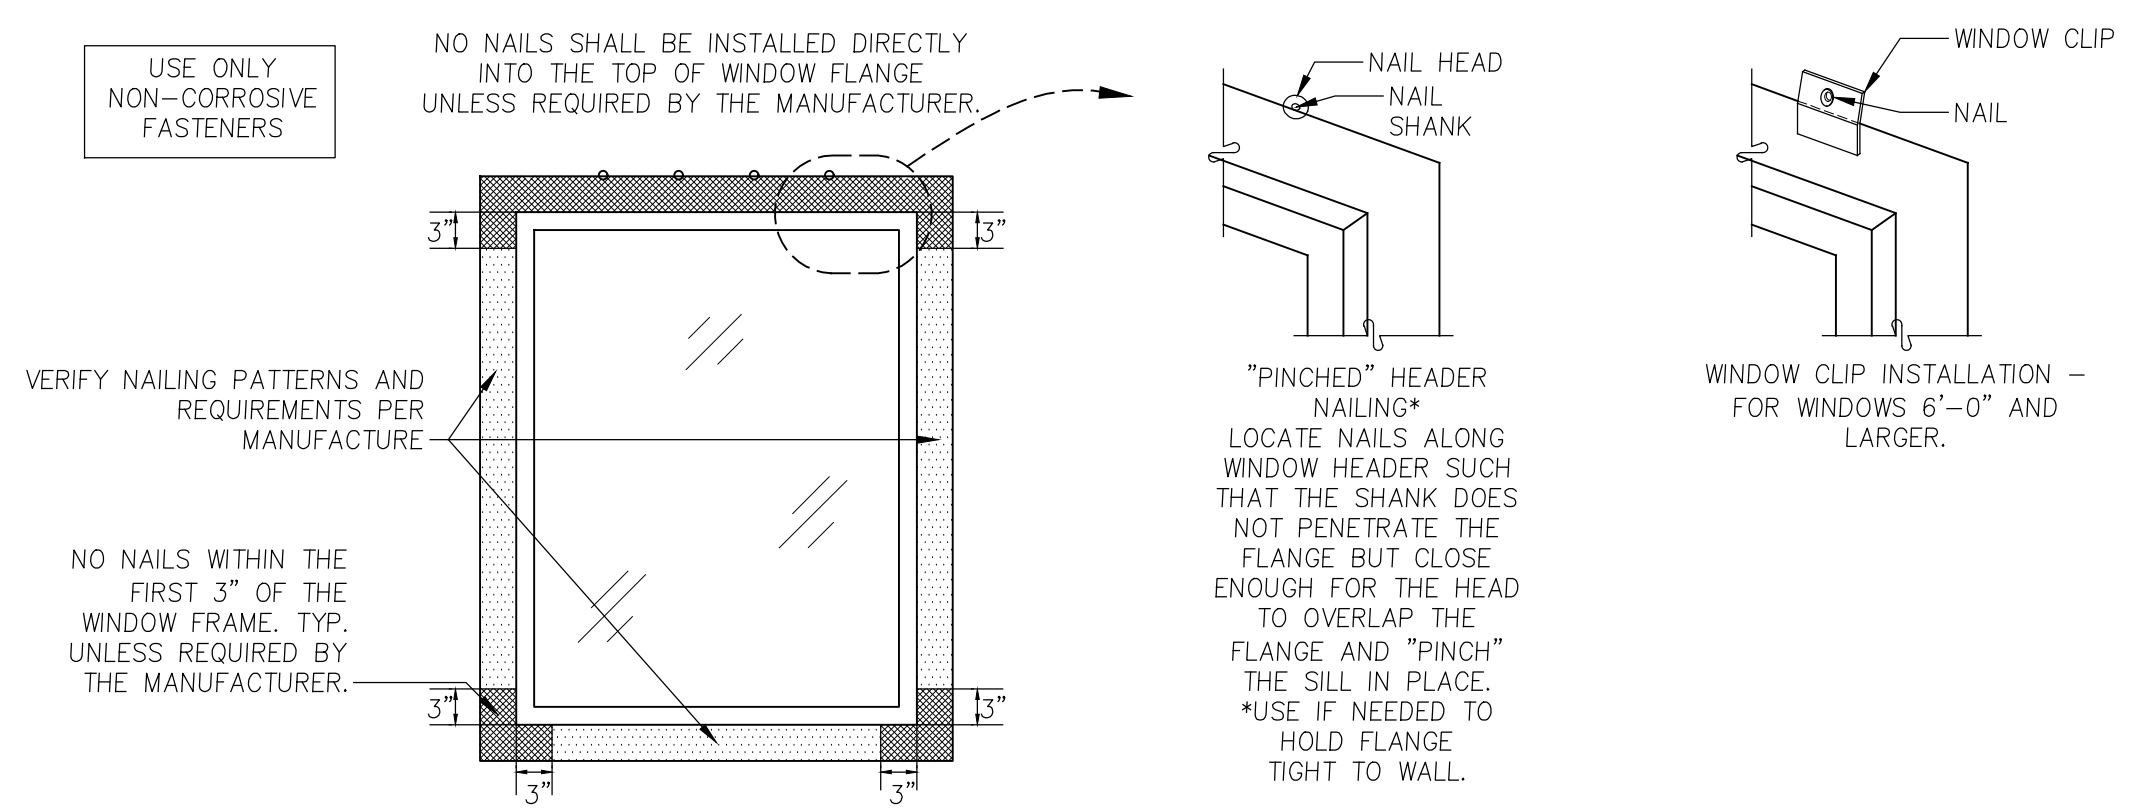


20 TYPICAL WINDOW FLANGE NAILING  
NO SCALE

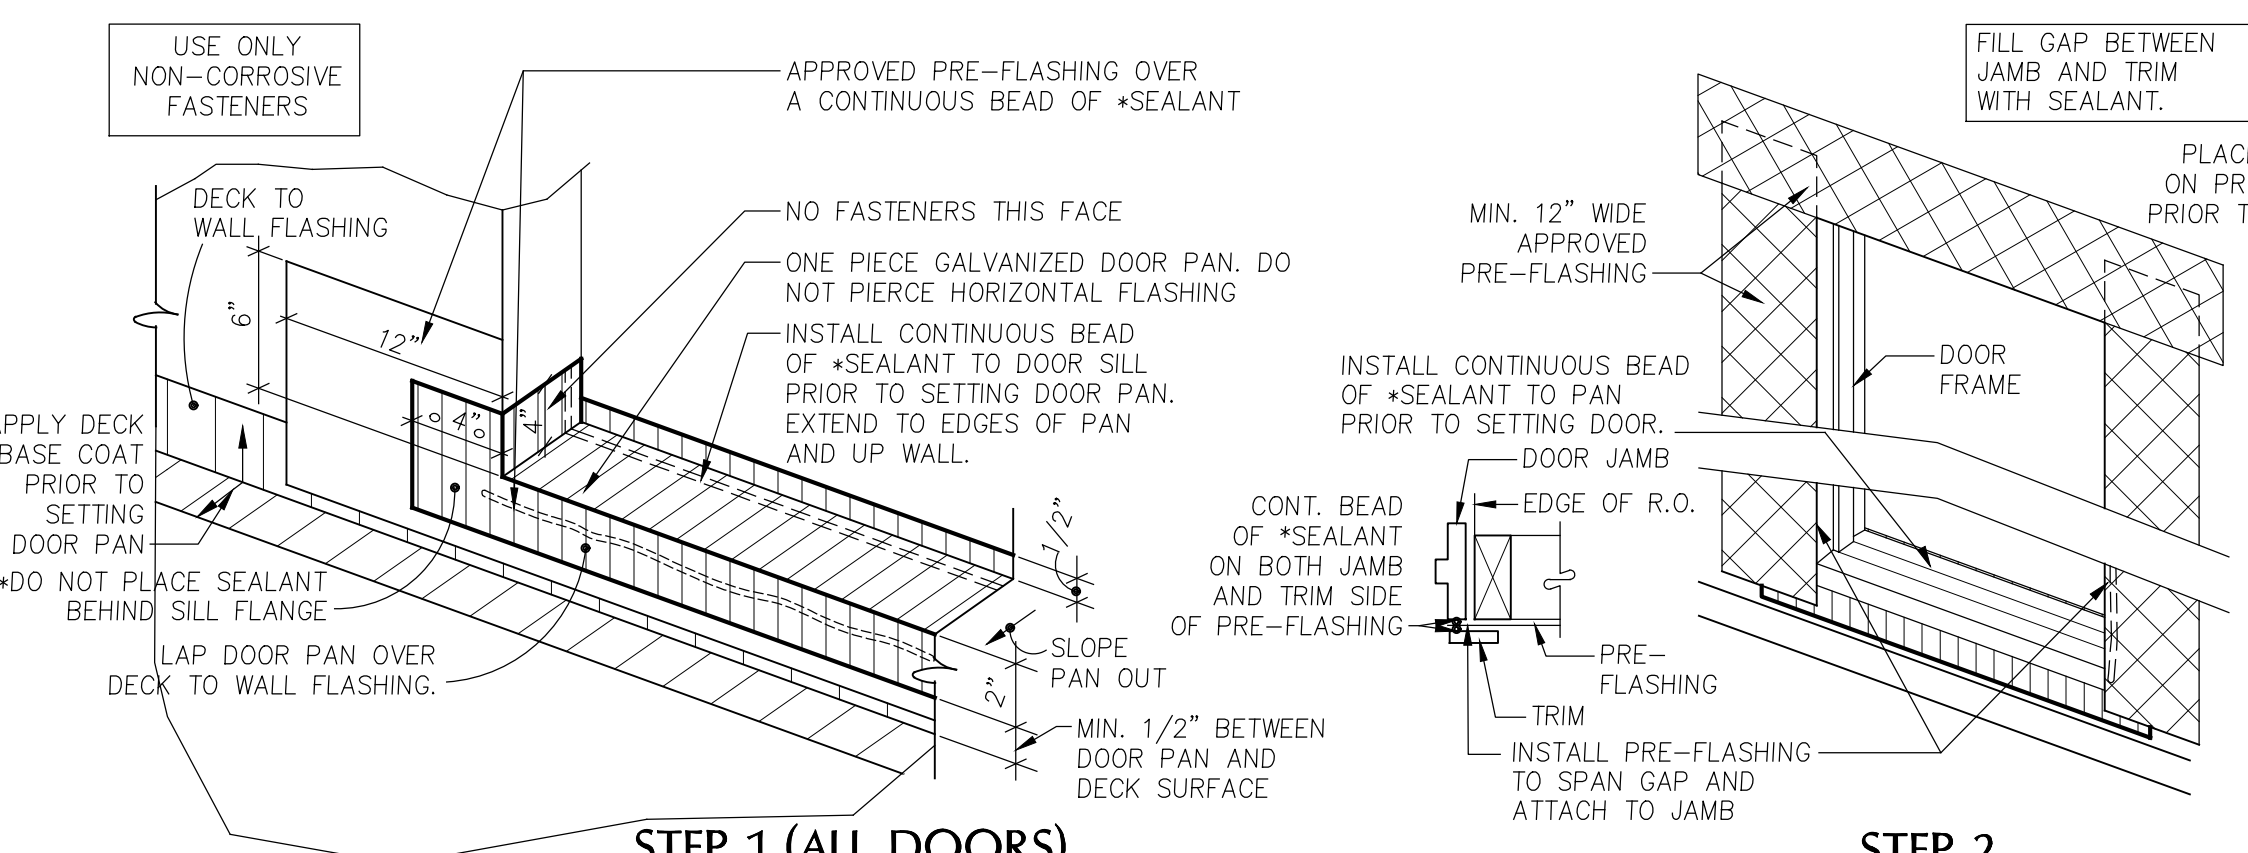

17 DOOR INSTALLATION PROCEDURE  
NO SCALE

12 MULTI-WINDOW  
NO SCALE

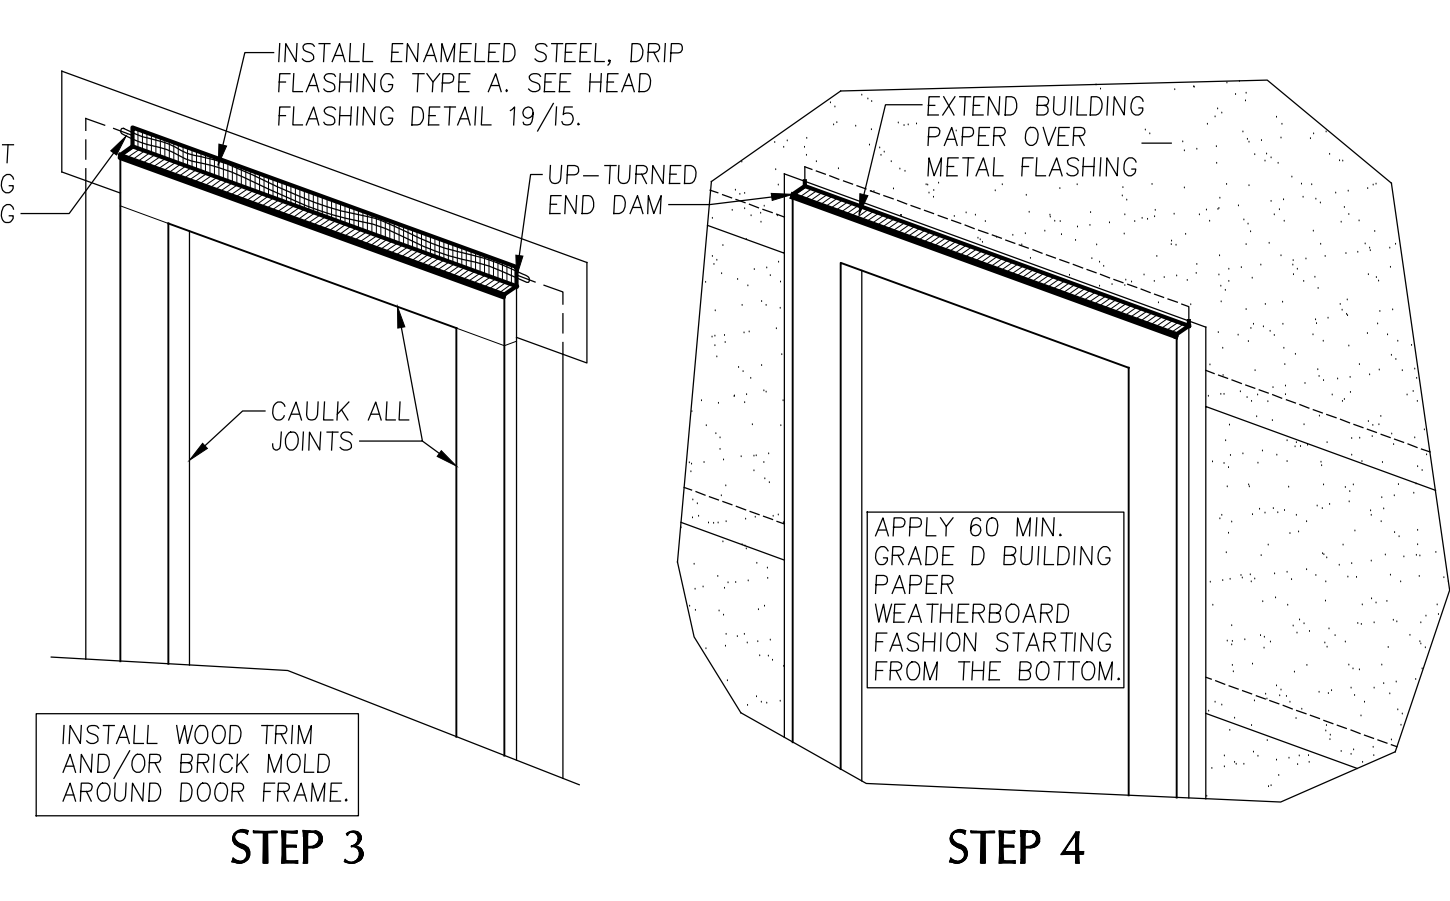


11 GARAGE DOOR JAMB  
NO SCALE


**BE-Sheet Disclaimer**  
The details in the BE-Sheets are intended to meet or exceed all manufacturer recommended installation instructions, any letters of approval provided by a manufacturer to the Contractor, local codes, standards set by specific associations, best practices set by the industry or any other group or organization as acknowledged by the industry. **All manufacturer recommendations should be followed when installing specific materials.**  
If a Subcontractor or installer finds a situation where the BE-Sheet details conflict or fall below any standards set forth by the organizations mentioned above, it will be the responsibility of the Subcontractor to seek appropriate and written clarification from the Contractor before proceeding. The Contractor reserves its right to add, change, modify or update any of the details at any time.  
*\*All components, sealants, fasteners, or materials shall be approved for specific use or application described by the designs, and shall be compatible with all material with which each component comes in contact with.*

F:\2306\BE-SHEETS\BE3-REV.DWG


CLEAN AND PREPARE SURFACES  
PRIOR TO COATING, REFER TO  
MANUFACTURER'S INSTALLATION  
INSTRUCTIONS FOR BEST PRACTICES.

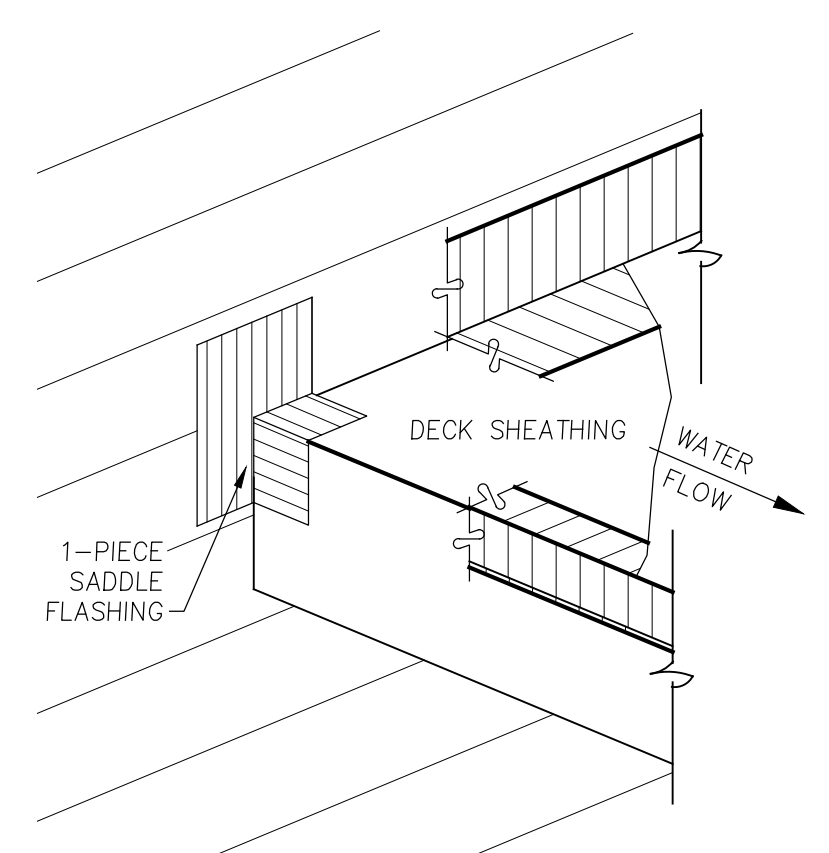


14 1-PIECE DECK SADDLE FLASHING  
NO SCALE

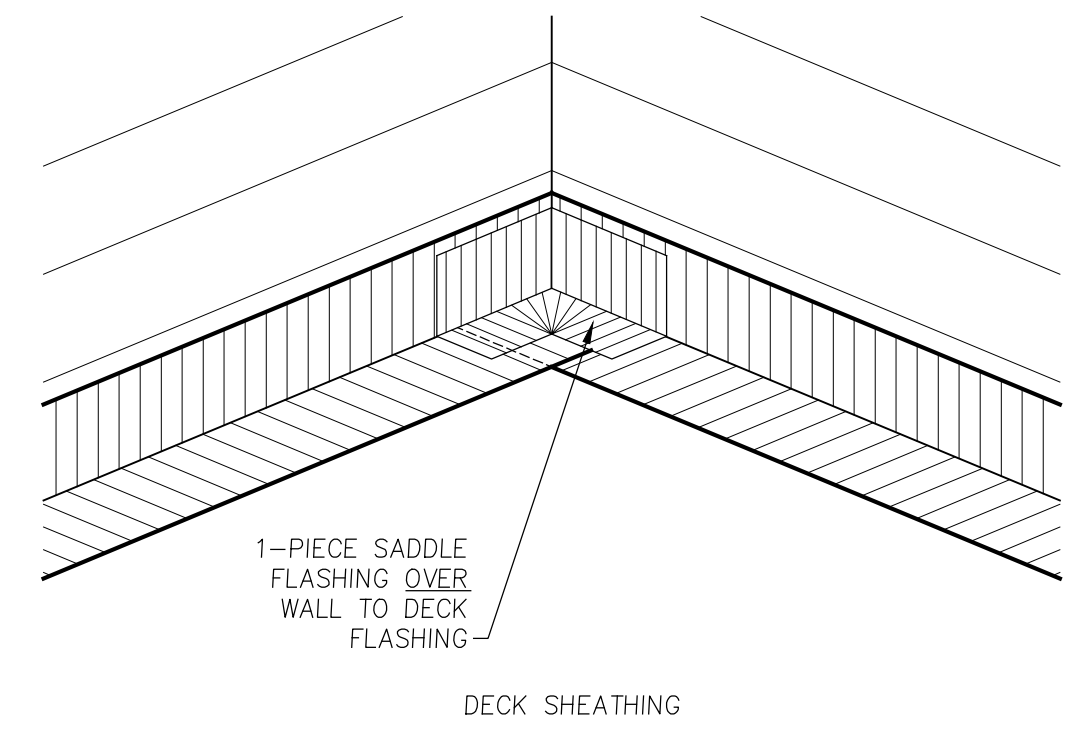


15 DECK FLASHING - INSIDE CORNER  
NO SCALE

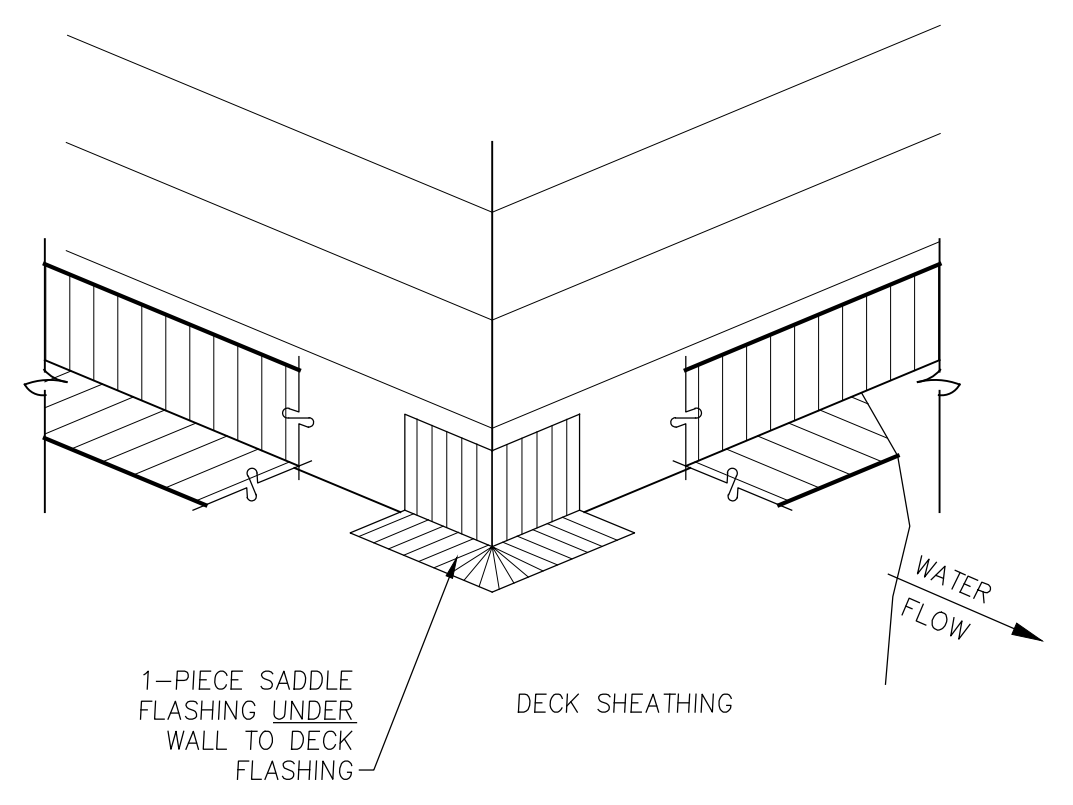


16 DECK FLASHING - OUTSIDE CORNER  
NO SCALE

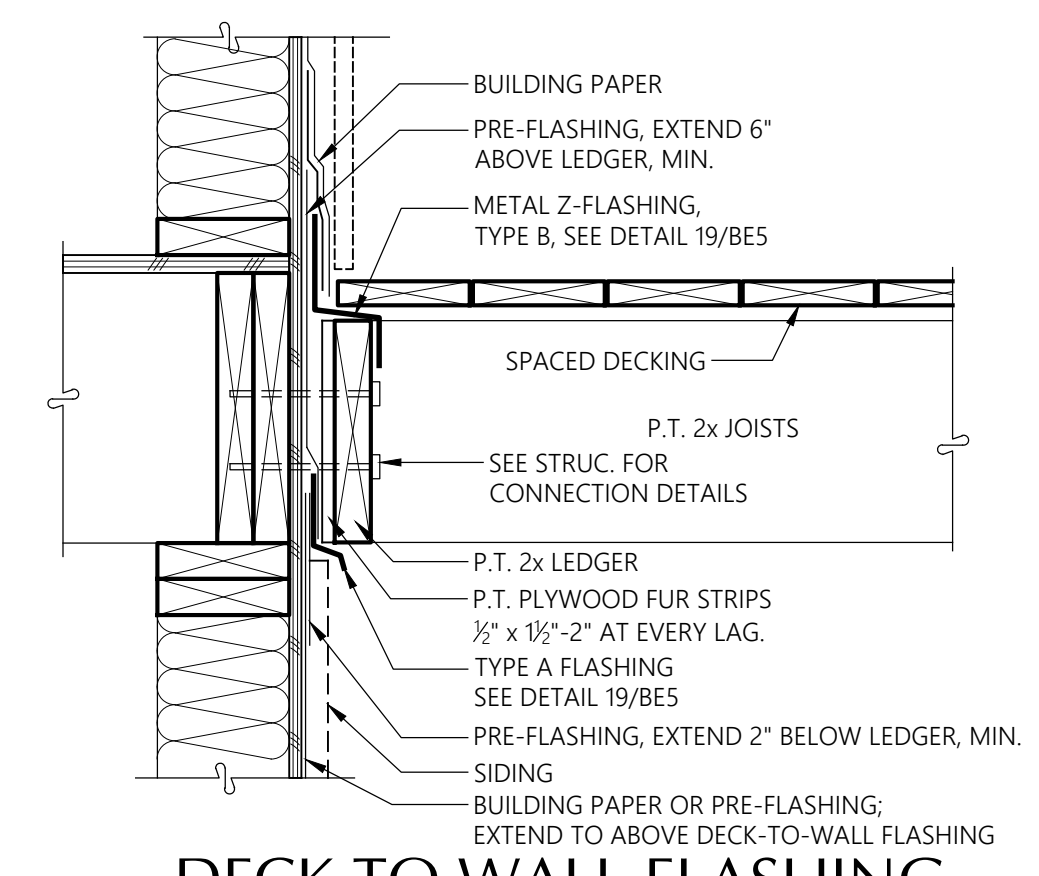

2 DECK TO WALL FLASHING  
SPACED DECKING  
SECTION  
1-1/2" = 1'-0"

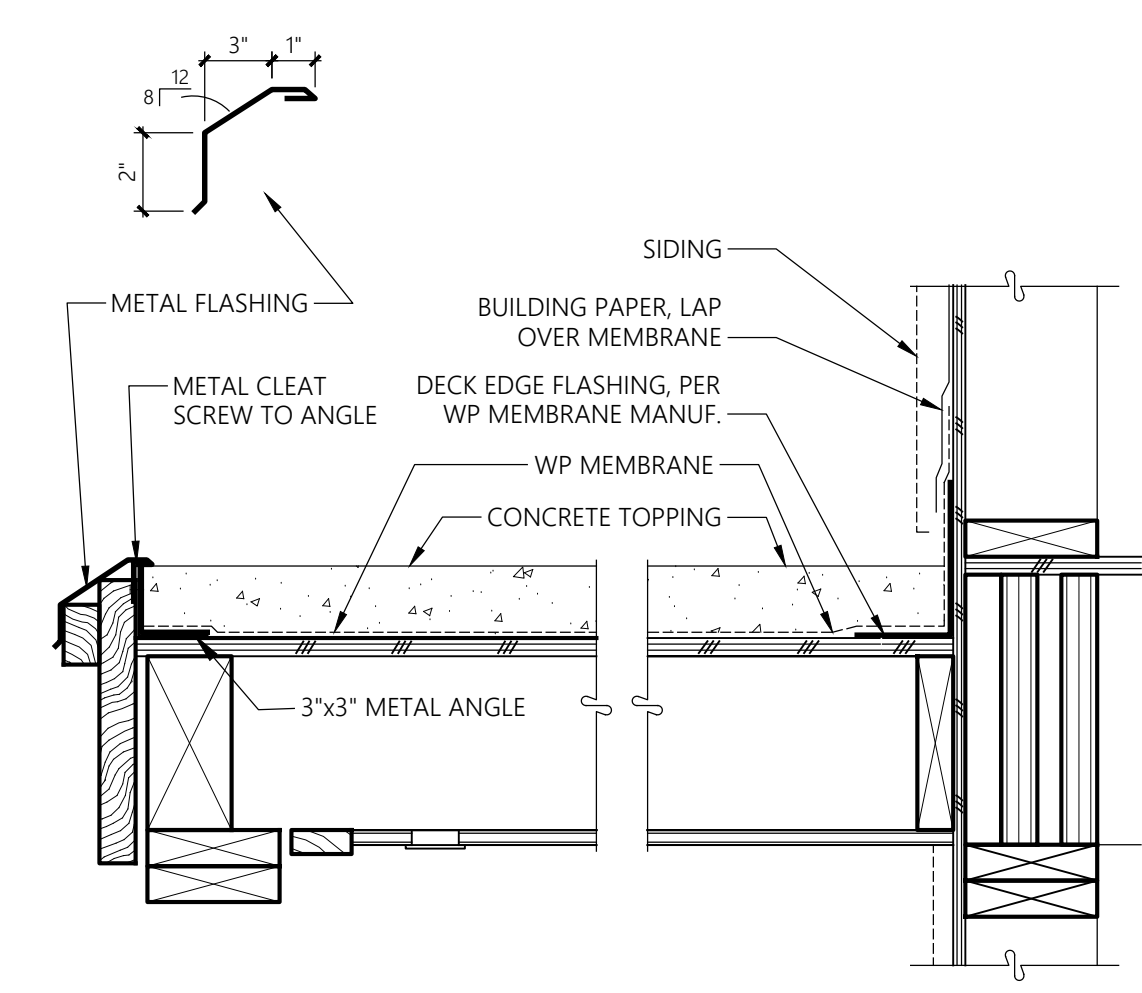


20 DECK DETAILS  
NO SCALE

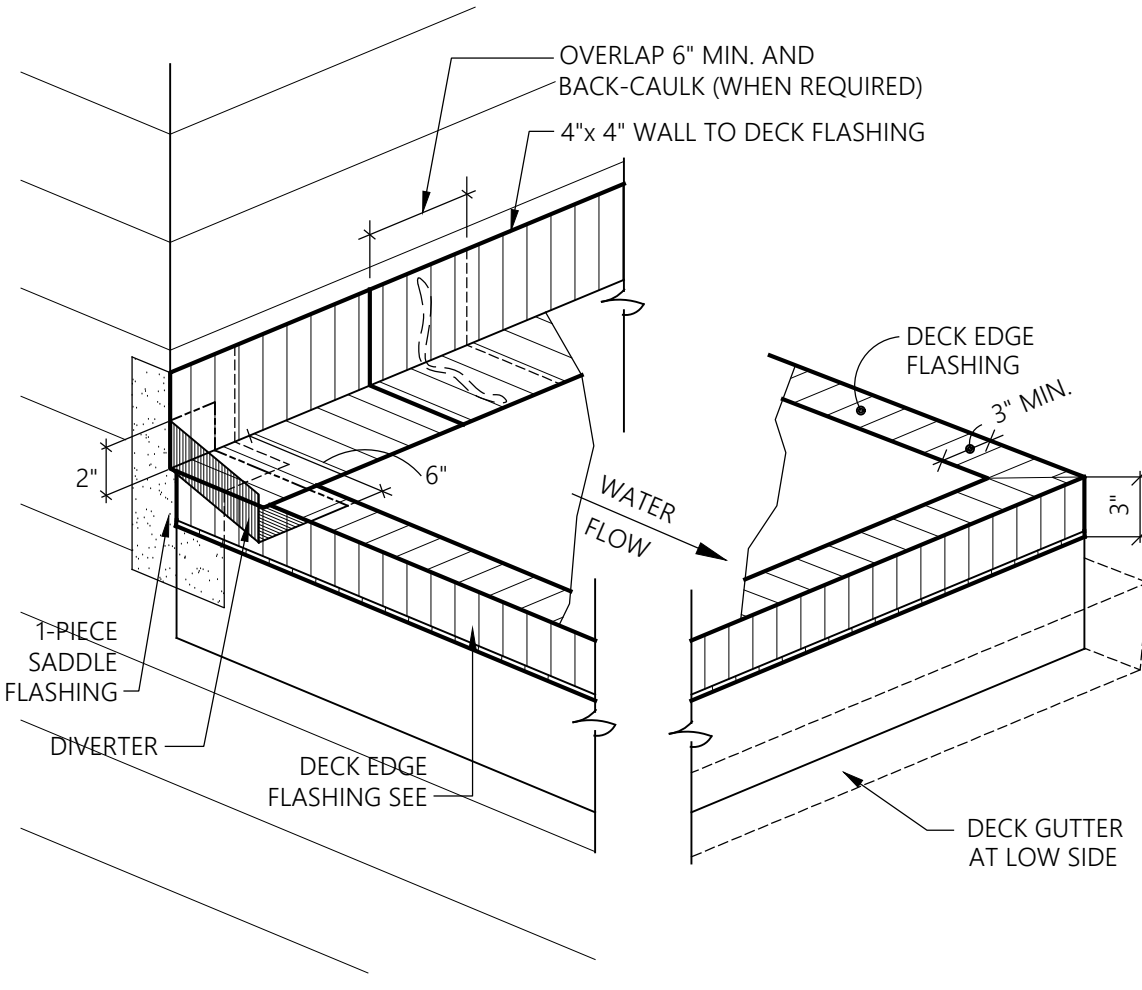


**BE-Sheet Disclaimer**  
The details in the BE-Sheets are intended to meet or exceed all manufacturer recommended installation instructions, any letters of approval provided by a manufacturer to the Contractor, local codes, standards set by specific associations, best practices set by the industry or any other group or organization as acknowledged by the industry. **All manufacturer recommendations should be followed when installing specific materials.**  
If a Subcontractor or installer finds a situation where the BE-Sheet details conflict or fall below any standards set forth by the organizations mentioned above, it will be the responsibility of the Subcontractor to seek appropriate and written clarification from the Contractor before proceeding. The Contractor reserves its right to add, change, modify or update any of the details at any time.  
*\*All components, sealants, fasteners, or materials shall be approved for specific use or application described by the designs, and shall be compatible with all material with which each component comes in contact with.*


PT\_2306\_VBE-SHEETS(BE1-BE5).DWG

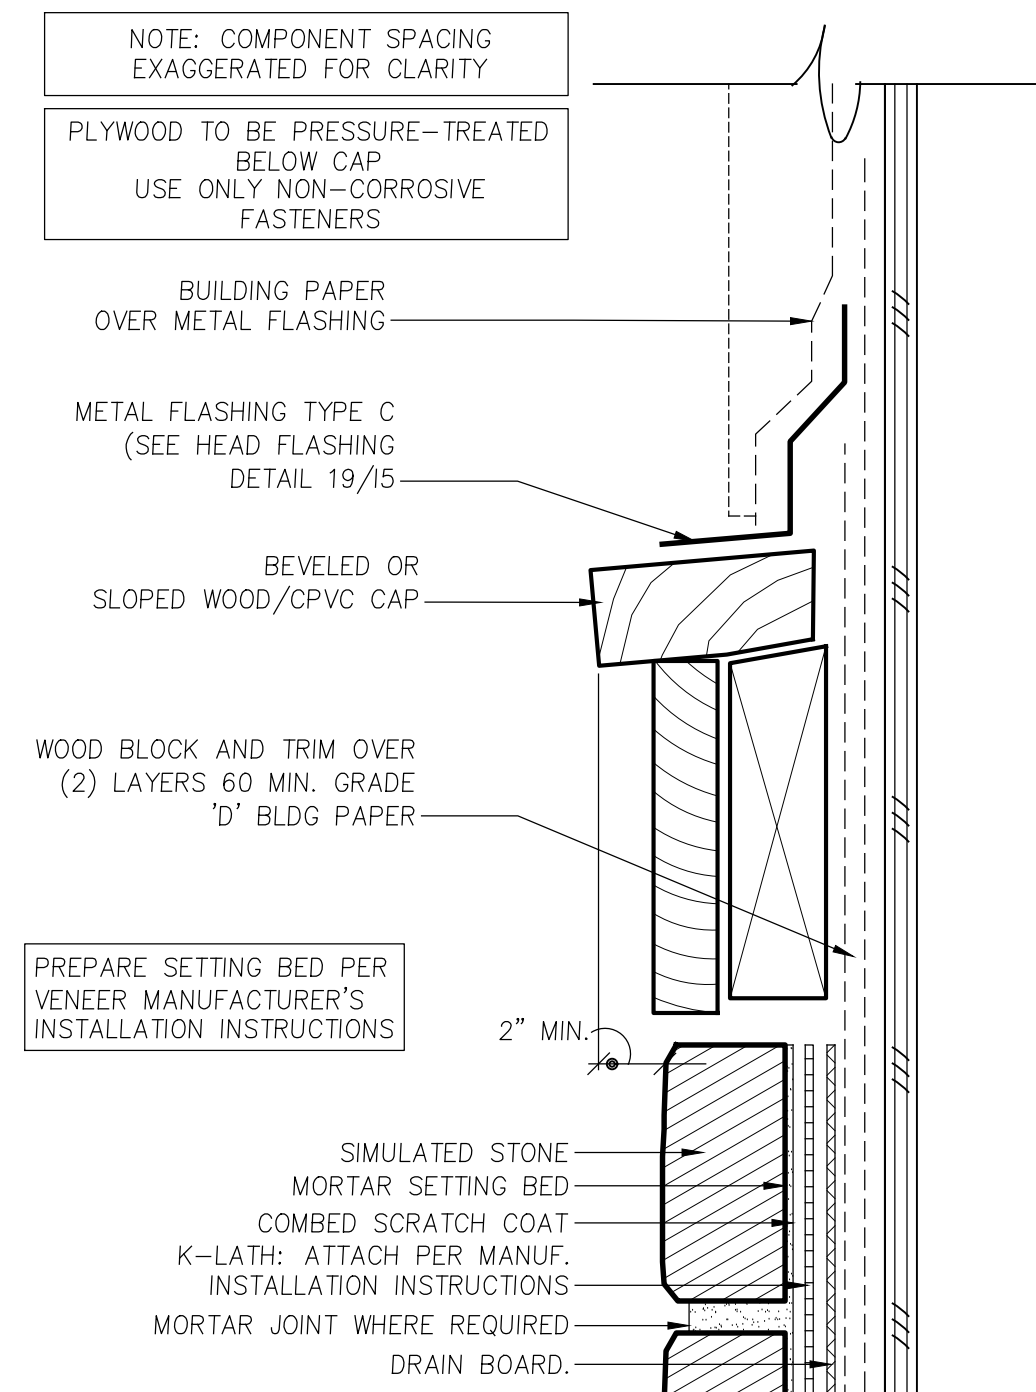


**18** TYPICAL WATERTABLE TRIM  
4" = 1'-0" SECTION

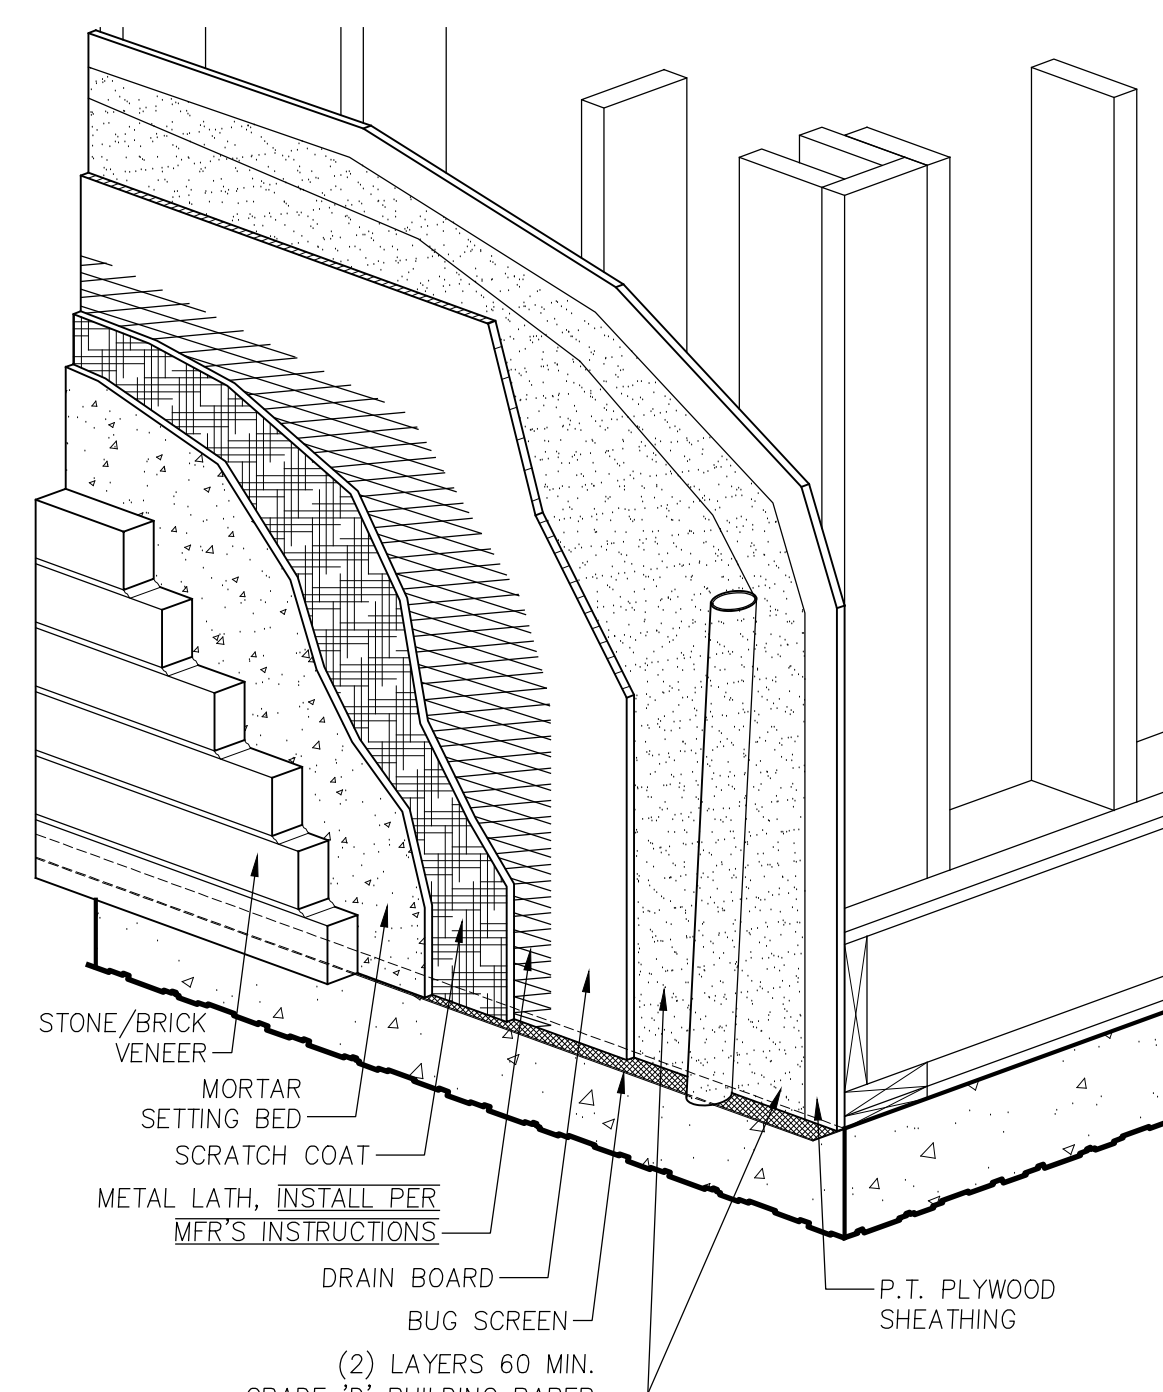


**14** STONE VENEER INSTALLATION  
NO SCALE

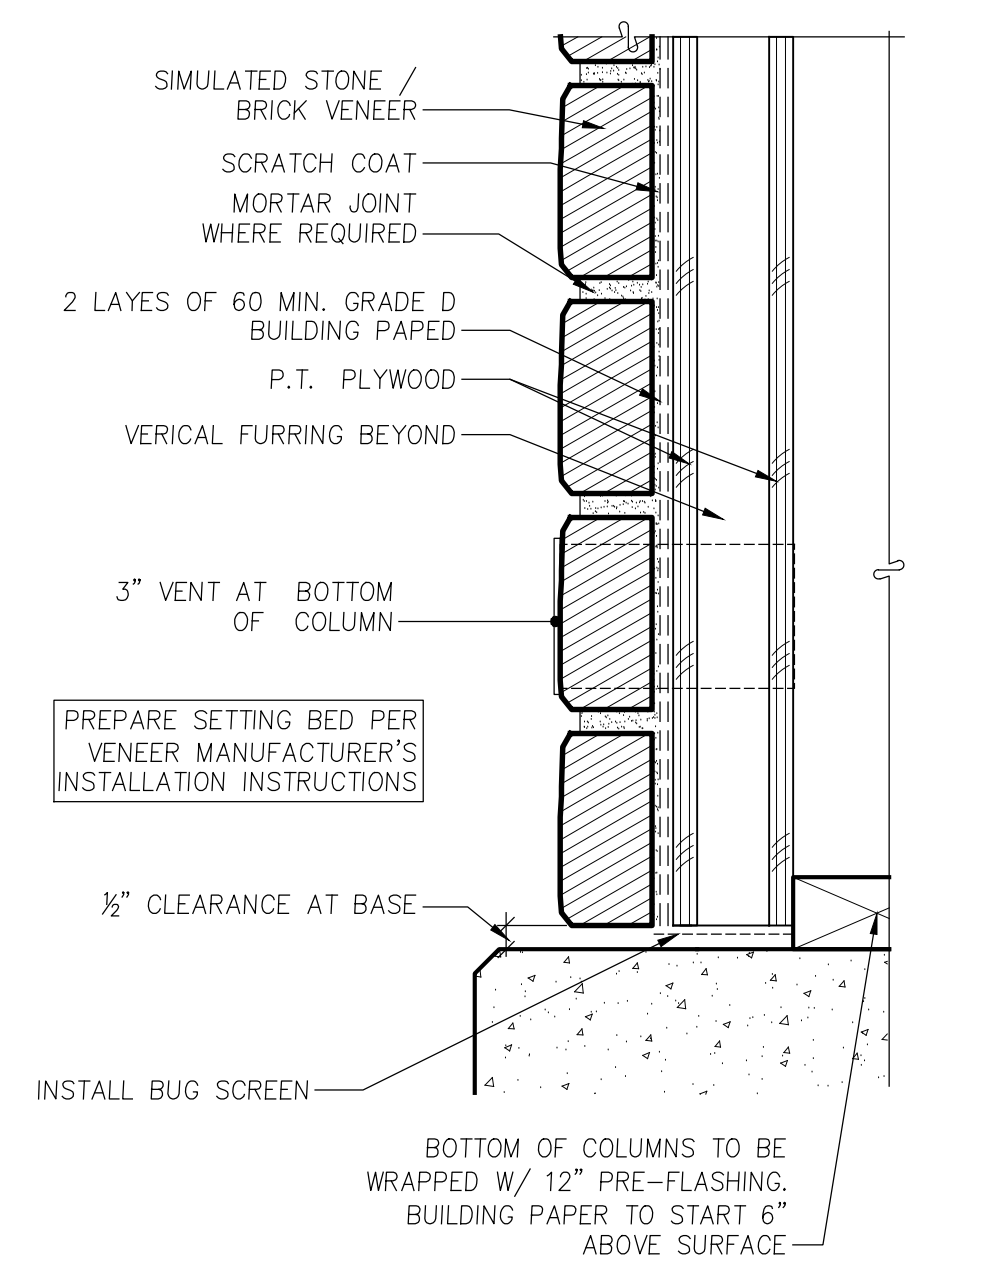


**10** BRICK VENEER AT COLUMN BASE  
3" = 1'-0" SECTION

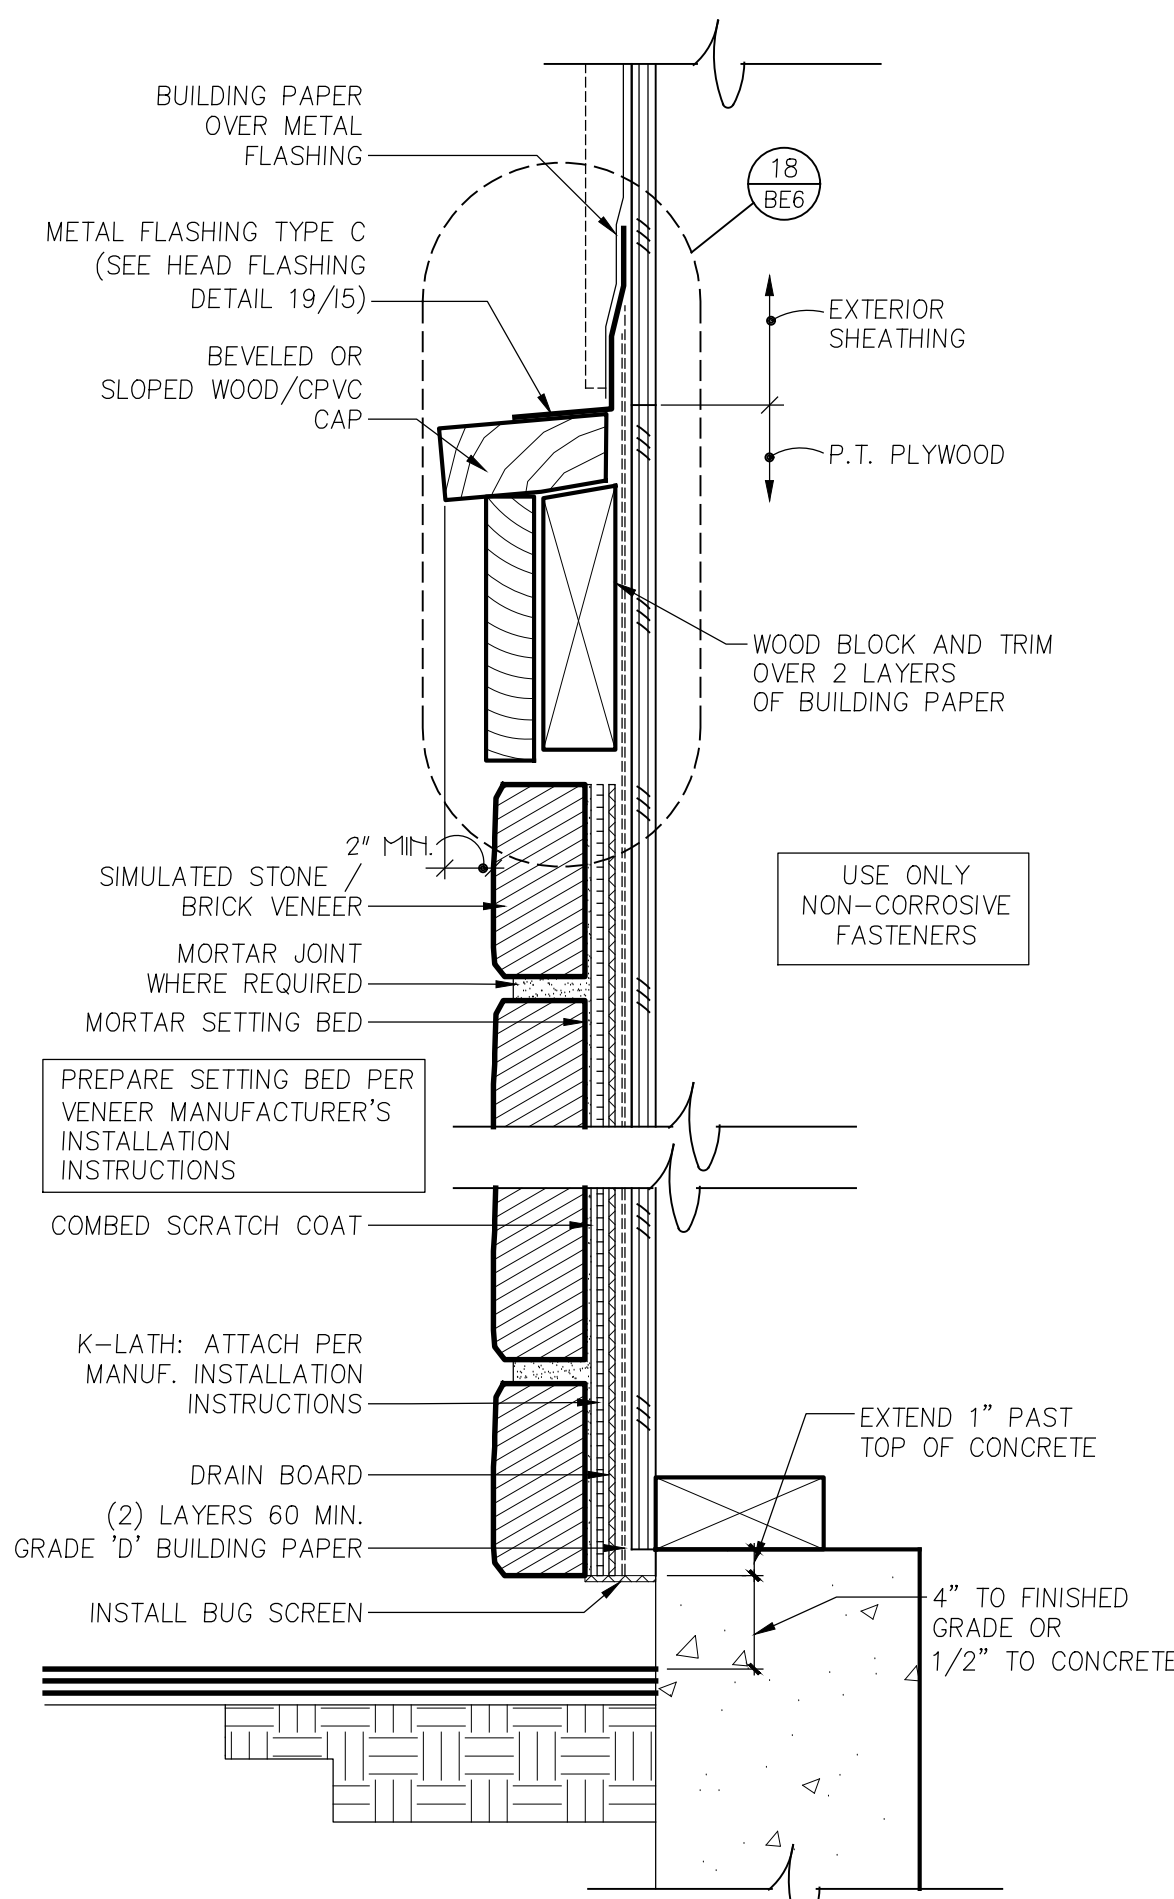


**20** STONE WATERTABLE ON FRAMING  
3" = 1'-0" SECTION

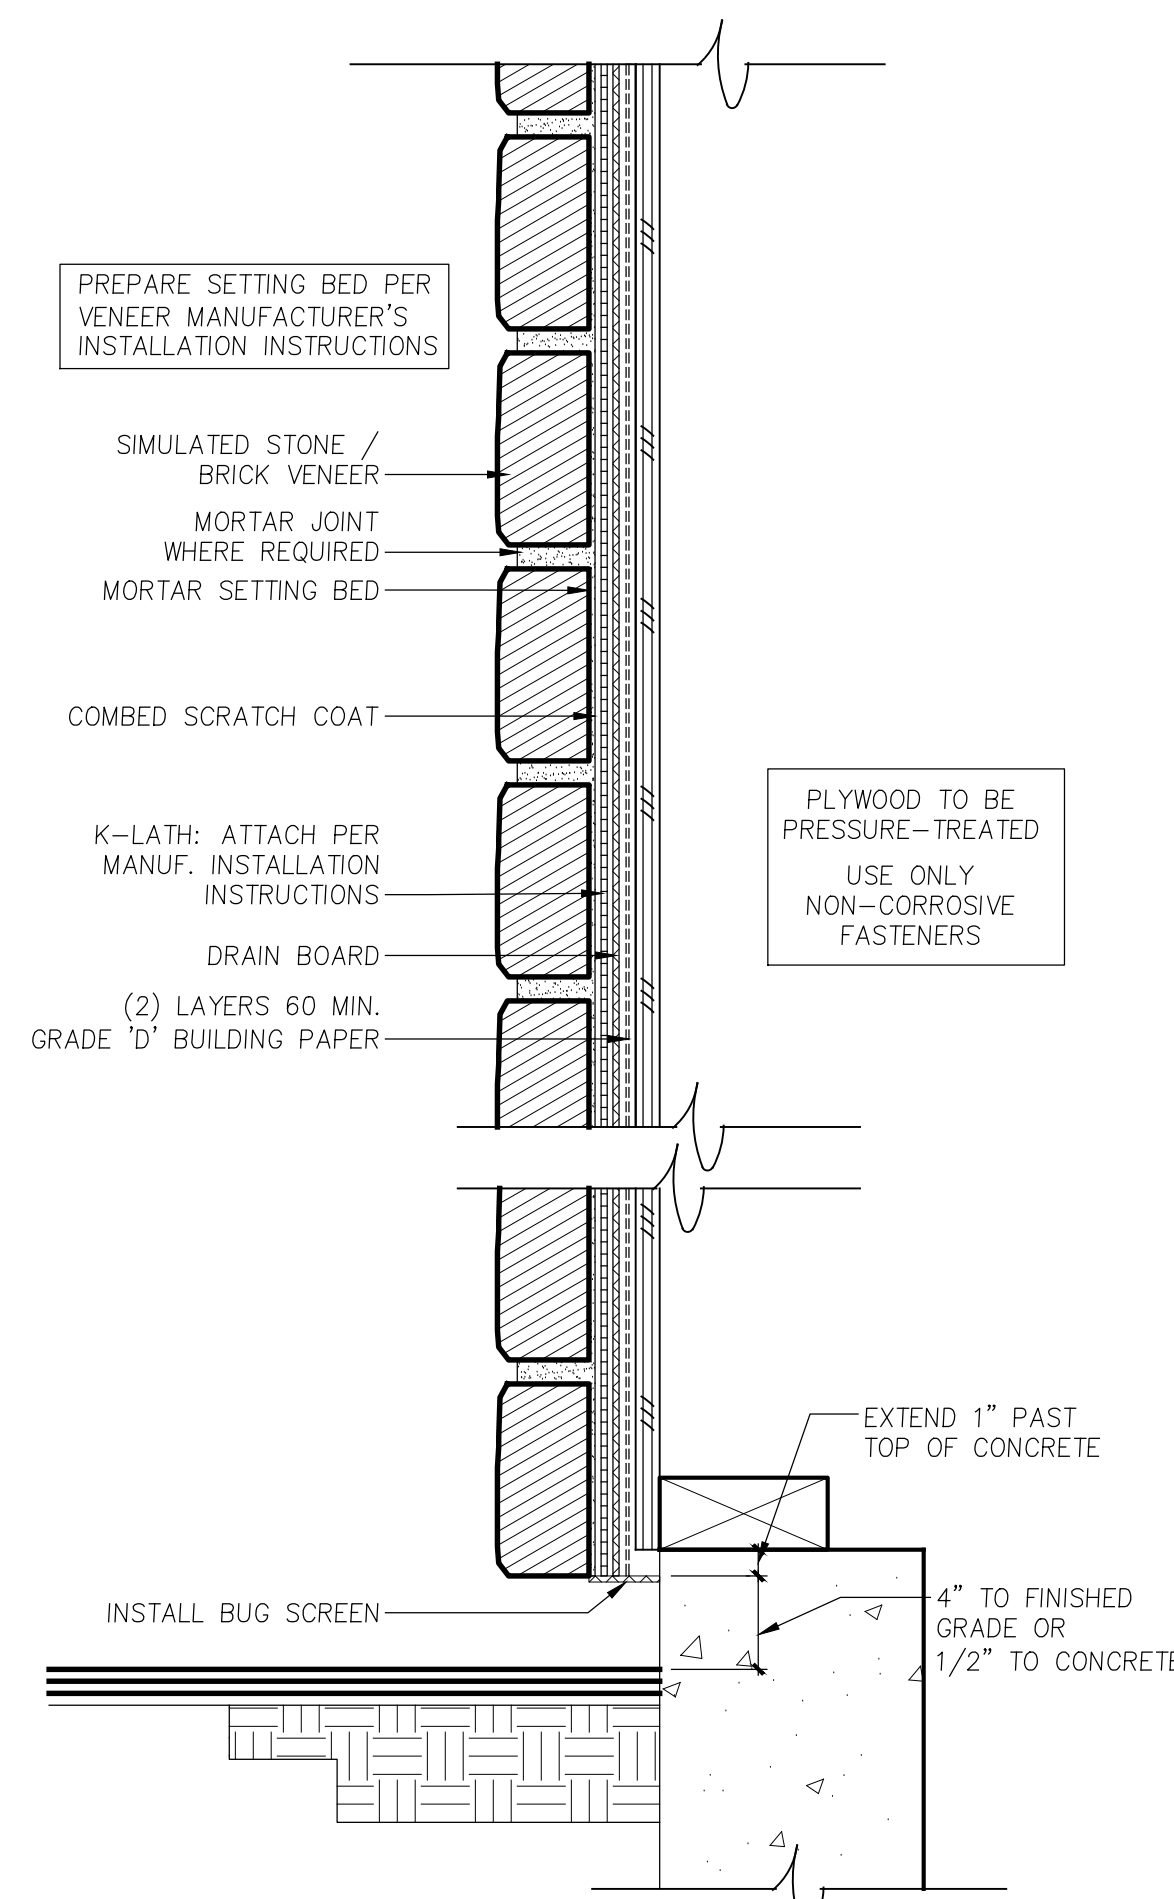

**16** STONE ON FRAMING (FULL-HEIGHT)  
3" = 1'-0" SECTION

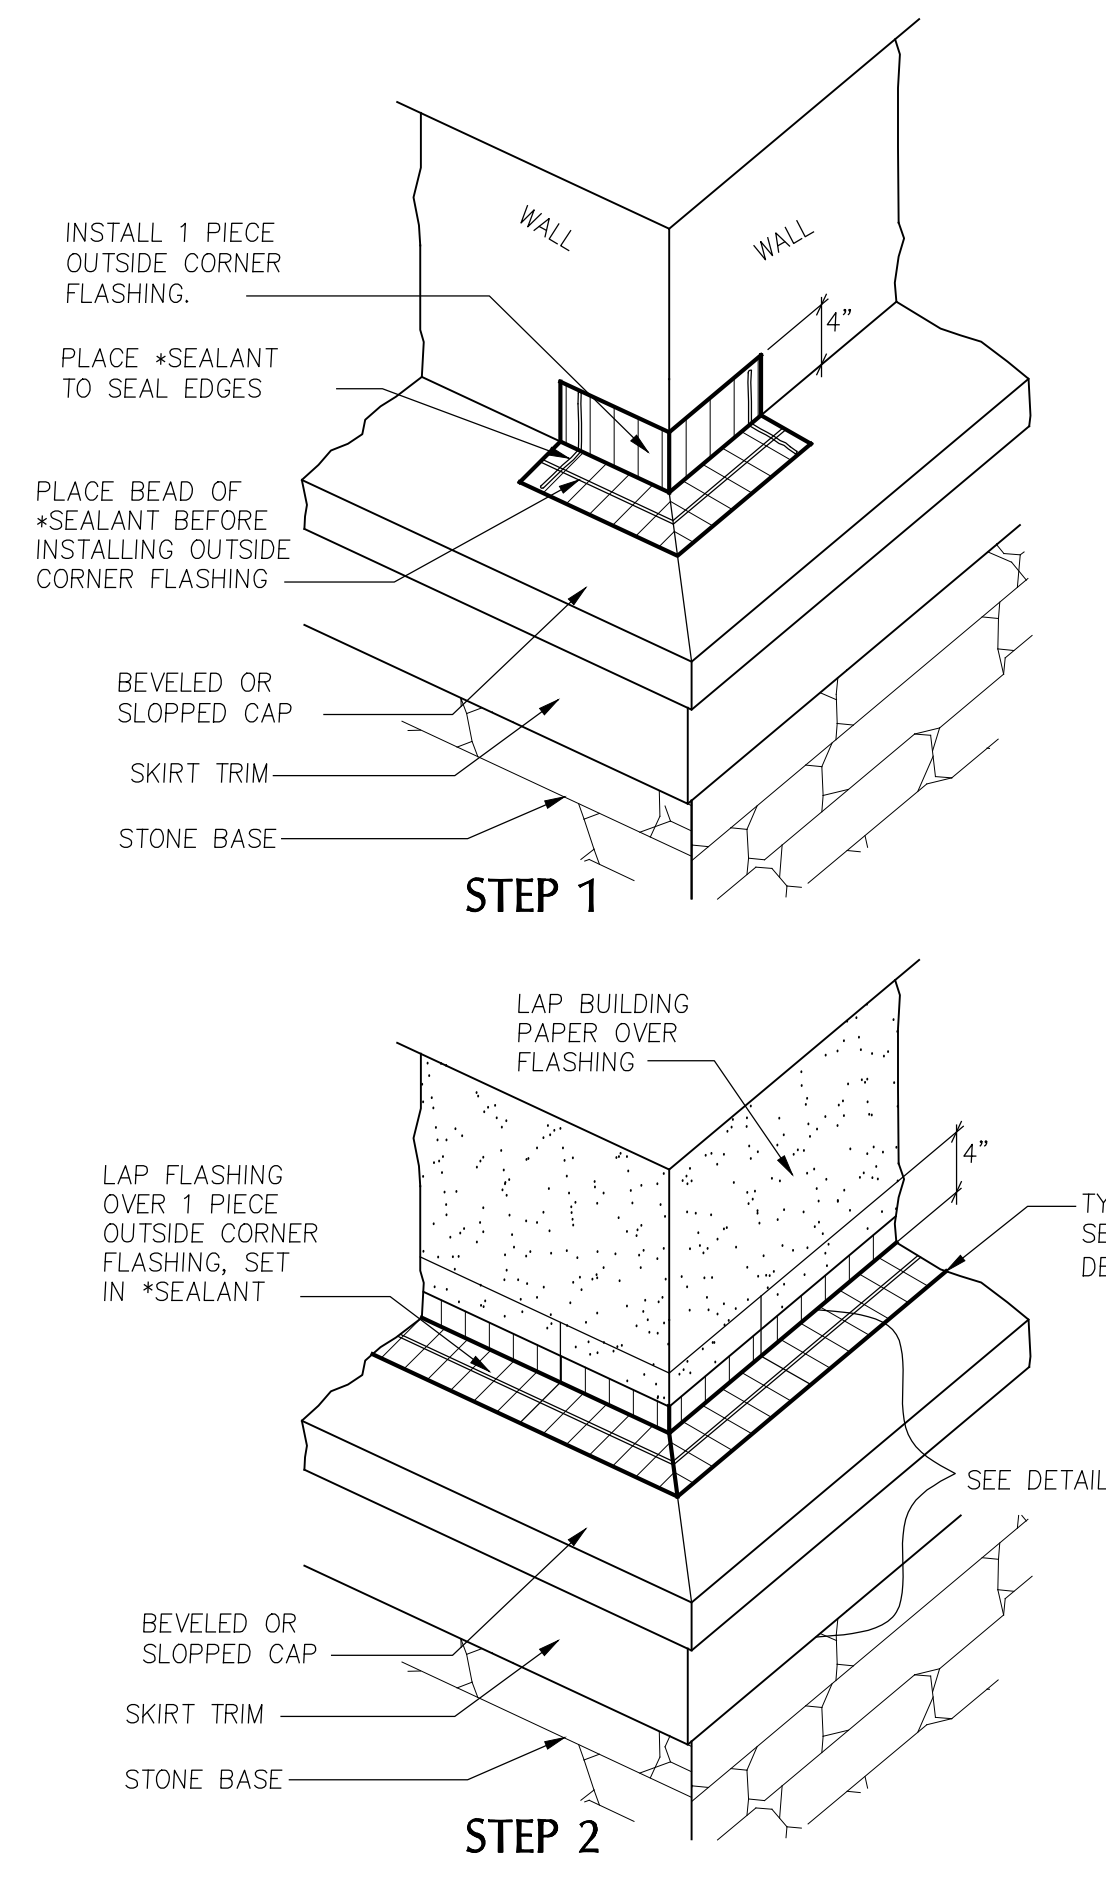

**12** STONE TRIM FLASHING (WATERTABLE TRIM)  
NO SCALE

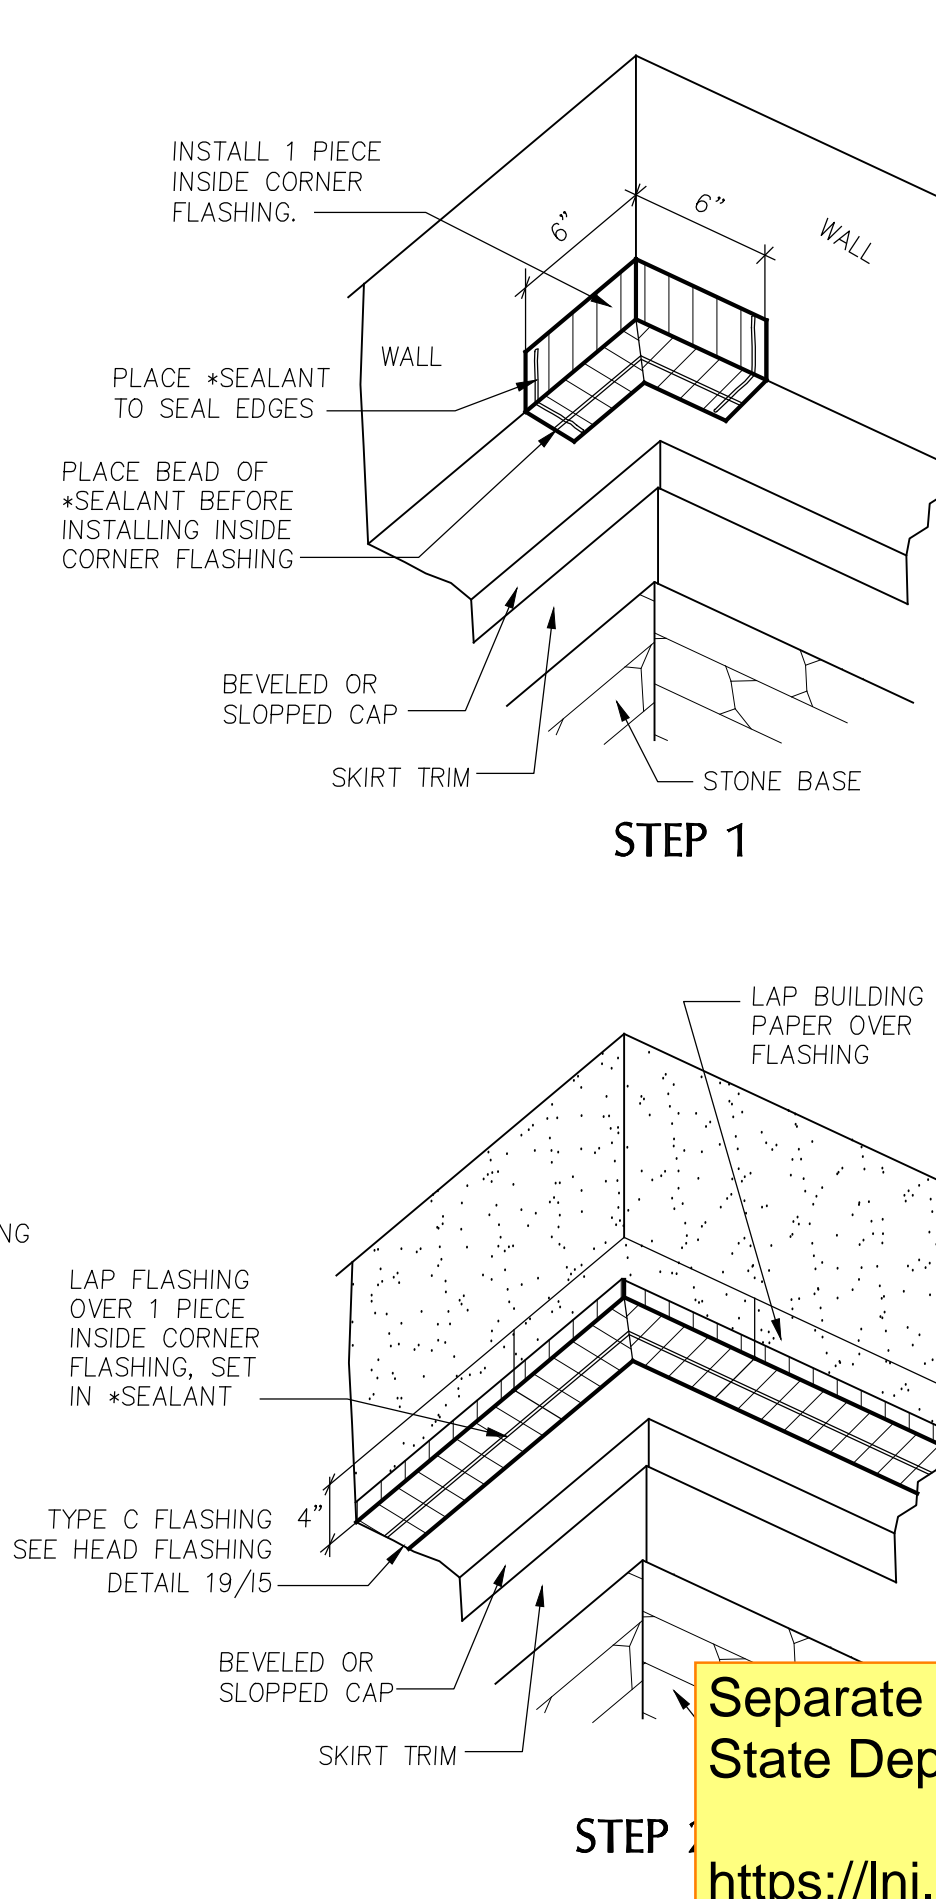

**12** STONE TRIM FLASHING (WATERTABLE TRIM)  
NO SCALE

**BE-Sheet Disclaimer**

The details in the BE-Sheets are intended to meet or exceed all manufacturer recommended installation instructions, any letters of approval provided by a manufacturer to the Contractor, local codes, standards set by specific associations, best practices set by the industry or any other group or organization as acknowledged by the industry. **All manufacturer recommendations should be followed when installing specific materials.** If a Subcontractor or installer finds a situation where the BE-Sheet details conflict or fall below any standards set forth by the organizations mentioned above, it will be the responsibility of the Subcontractor to seek appropriate and written clarification from the

Separate electrical permit is required with Washington State Department of Labor & Industries.

<https://lni.wa.gov/licensing-permits/electrical/electrical-permits-fees-and-inspections> or Licensing information: Call 1-800-647-0982

GENERAL NOTES

GENERAL NOTES - MECHANICAL

- REFERENCE TO RELATED WORK: "REF" INDICATIONS DENOTE WORK COVERED ELSEWHERE (ARCHITECTURAL, STRUCTURAL, CIVIL, ELECTRICAL, LANDSCAPE, OR KITCHEN), OR ITEM BASED ON A SPECIFIC MANUFACTURER'S DIMENSIONS (VERIFY).

PIPING NOTES

- DISASSEMBLY PROVISIONS: PROVIDE UNIONS OR FLANGES AT PIPING CONNECTIONS TO EQUIPMENT, COILS, TRAPS, CONTROL VALVES, AND OTHER COMPONENTS TO ALLOW DISASSEMBLY FOR MAINTENANCE.

INSULATION/LINING NOTES

- ENERGY CODE: AS A MINIMUM, COMPLY WITH THICKNESSES AND TYPES LISTED IN ENERGY CODE ENFORCED BY AHJ.

PLAN NOTES

- DUCTWORK SHALL BE METALLIC DUCTWORK
- TEST AND BALANCE WORK SHALL BE PERFORMED BY AN INDEPENDENT TEST AND BALANCE AGENCY, PROVIDE (3) COPIES OF TEST AND BALANCE REPORT TO OWNER.

SHEET METAL NOTES

- REFERENCE: SMACNA HVAC DUCT CONSTRUCTION STANDARDS, METAL AND FLEXIBLE, CURRENT EDITION.
- CLEARANCE: COORDINATE DUCTWORK WITH MISCELLANEOUS OBSTRUCTIONS IN CEILING SPACE.

COORDINATION REQUIREMENTS

- PIPING: COORDINATE WITH STRUCTURAL FOR EXACT LOCATION OF ALL STRUCTURAL FRAMING AND FOOTINGS AND FINALIZE THE EXACT ROUTING OF ALL PIPES WITH STRUCTURAL AND AT THE SITE PRIOR AND DURING THE CONSTRUCTION.

HVAC NOTES

- ATTACHMENTS: AIR DISTRIBUTION OUTLETS AND LOUVERS

SHALL HAVE ALL REQUIRED ACCESSORIES AND ATTACHMENTS FOR A COMPLETE CONNECTION TO THE SPECIFIC TYPE OF STRUCTURE THAT THEY ARE BEING ATTACHED TO. THIS INCLUDES, BUT IS NOT LIMITED TO, EXTERIOR BRICKS, GWB WALLS, GWB CEILING, ETC.

- DUCTWORK: DUCTWORK SHALL BE SMOOTH SHEET METAL (CLASS-1). DUCTWORK THROUGH FIRE RATED STRUCTURE AND FLOOR SHALL BE MIN. 26 GA. STEEL. MAXIMUM LENGTH OF FLEXIBLE DUCTS SHALL BE 5'-0", UNLESS OTHERWISE NOTED ON DRAWINGS. DUCTWORK SIZES SHOWN ARE INSIDE CLEAR DIMENSIONS.
- SEISMIC: PROVIDE SEISMIC RESTRAINTS FOR MECHANICAL EQUIPMENT, PIPING, AND DUCTWORK PER SMACNA AND LOCAL REGULATIONS.

APPLICABLE CODE

BUILDING CODE:

- 2018 WASHINGTON STATE ENERGY CODE-RESIDENTIAL BY WASHINGTON ADMINISTRATIVE CODE CHAP 51-50 (WSEC)
- 2018 INTERNATIONAL RESIDENTIAL CODE WITH ADMINISTRATIVE CODE CHAP 51-51 (WSRC)
- 2018 INTERNATIONAL MECHANICAL CODE WITH ADMINISTRATIVE CODE CHAP 51-52 (WSMC)

DRAWINGS ARE DIAGRAMMATIC, SHOWING THE GENERAL LOCATION, TYPE, LAYOUT, AND EQUIPMENT REQUIRED. THE DRAWINGS SHALL NOT BE SCALED FOR EXACT MEASUREMENT. REFER TO ARCHITECTURAL DRAWINGS FOR DIMENSIONS. REFER TO MANUFACTURER'S STANDARD INSTALLATION DRAWINGS FOR EQUIPMENT CONNECTIONS AND INSTALLATION REQUIREMENTS. PROVIDE DUCTWORK, CONNECTIONS, ACCESSORIES, OFFSETS, AND MATERIALS NECESSARY FOR A COMPLETE SYSTEM.

PRE-CON MEETING NOTES

CONTRACTORS SHALL ATTEND A PRE-CONSTRUCTION MEETING WITH THE ENGINEER FOR THE PURPOSE OF REVIEWING THE WORK PRIOR TO ORDERING ANY EQUIPMENT OR PERFORMING ANY WORK. THE MEETING SHALL BE LOCATED AT THE PROJECT SITE ON A DATE AND TIME TO BE MUTUALLY AGREED. THE MEETING WILL BE A WORKING SESSION. THE MEETING WILL BE FACILITATED BY THE ENGINEER AND THE AGENDA WILL INCLUDE A DETAILED REVIEW OF THE PLANS AND SPECIFICATIONS, CROSS CHECK WITH OTHER TRADES FOR COORDINATION ISSUES, REVIEW OF PROPOSED PRODUCTS, REVIEW OF PLANNED MEANS AND METHODS, AND ON-SITE INVESTIGATION OF FIELD CONDITIONS RELATIVE TO EXISTING CONDITIONS THAT COULD AFFECT THE WORK. PERSONS ATTENDING THE MEETING SHALL BE KNOWLEDGEABLE OF THE PROJECT AND SHALL BE THE SPECIFIC PERSONS INTENDED TO CONTINUE WITH THE PROJECT THROUGH TO COMPLETION. IF REQUIRED, REVISED PLANS WILL BE ISSUED THROUGH OFFICIAL CHANNELS. CHANGES IN THE BID PRICE WILL BE DISCUSSED, BUT NO CHANGE ORDERS WILL BE ISSUED UNLESS PROCESSED THROUGH OFFICIAL CHANNELS. IT SHALL BE UNDERSTOOD THAT THE ENGINEER HAS NO AUTHORITY TO ISSUE CHANGE ORDERS.

THE FOLLOWING TRADES SHALL BE REPRESENTED FOR THE MINIMUM TIME INDICATED:

Table with 2 columns: Trade Name, Duration. Includes MECHANICAL SHEET METAL (4 HOURS), PLUMBING/PIPING (4 HOURS), ELECTRICAL (4 HOURS), SPRINKLER (2 HOURS), GENERAL CONTRACTOR (ALL SESSIONS).

ANNOTATIONS

- ACU AIR CONDITIONING UNIT
- AFF ABOVE FINISHED FLOOR
- AHJ AUTHORITY HAVING JURISDICTION
- AHU AIR HANDLING UNIT
- BDD BACKDRAFT DAMPER
- BHP BRAKE HORSEPOWER
- BTUH BRITISH THERMAL UNIT PER HOUR COMMON
- CAP CAPACITY
- CC COOLING COIL
- CD CEILING DIFFUSER
- CFM CUBIC FEET PER MINUTE
- CLG CEILING, COOLING
- CO CLEANOUT
- COMB COMBUSTION
- CONT CONTINUE, CONTROL
- CONTR CONTRACTOR
- COP COEFFICIENT OF PERFORMANCE
- CWS CHILLED WATER SUPPLY
- CWR CHILLED WATER RETURN
- D DIAMETER
- DBG DRY BULB, DECIBEL
- DEGREE DEGREE
- DIM DIMENSION
- DISCH DISCHARGE
- DN DOWN
- EA EXHAUST AIR
- EAT ENTERING AIR TEMPERATURE
- EER ENERGY EFFICIENCY RATIO
- EF EXHAUST FAN
- EFF EFFICIENCY
- EG EXHAUST GRILLE, ENGINE GENERATOR
- ELEC ELECTRIC
- EQUIV EQUIVALENT
- ESP EXTERNAL STATIC PRESSURE
- EXH EXHAUST
- EXT EXTERIOR, EXTERNAL FAHRENHEIT
- F FAN DAMPER
- FCU FAN COIL UNIT
- FLR FLOOR
- FPM FEET PER MINUTE
- FPS FEET PER SECOND
- FSD FIRE/SMOKE DAMPER
- G GAS
- GRD GRILLES, REGISTERS, AND DIFFUSERS
- GWB GYPSUM WALLBOARD
- HORIZ HORIZONTAL
- HP HORSEPOWER, HEAT PUMP
- HRT HEAT RECOVERY UNIT
- HVAC HEATING, VENTILATING, AND AIR CONDITIONING
- HVU HEATING AND VENTILATION UNIT
- HWR HIGH WALL RETURN, HOT WATER RETURN
- HWS HIGH WALL SUPPLY, HOT WATER SUPPLY
- HX HEAT EXCHANGER
- ID INDIRECT DRAIN, INSIDE DIAMETER
- IN INCH
- KW KILOWATT
- L LONG, LENGTH
- LB POUND
- LWR LOW WALL RETURN
- LWS LOW WALL SUPPLY
- MBH THOUSAND BTU PER HOUR
- MECH MECHANICAL
- MCA MINIMUM CIRCUIT AMPACITY
- MOCP MAXIMUM OVER CURRENT PROTECTION
- MTD MOUNTED
- OSA OUTDOOR AIR
- OBD OPPOSED BLADE DAMPER
- OD OUTSIDE DIMENSION OR DIAMETER
- OPNG OPENING
- P PUMP
- PD PRESSURE DROP
- POC POINT OF CONNECTION
- PRV PRESSURE REDUCING VALVE
- PSIG POUNDS PER SQUARE INCH GAUGE
- RA RETURN AIR
- REF REFERENCE
- RF RELIEF FAN
- RG RETURN GRILLE
- RPM REVOLUTIONS PER MINUTE
- SA SUPPLY AIR
- SCH SCHEDULE
- SF SUPPLY FAN, SQUARE FOOT
- SENS SENSIBLE
- SG SUPPLY GRILLE
- SMACNA SHEET METAL AND AIR CONDITIONING CONTRACTORS NATIONAL ASSOCIATION
- SO SCREENED OPENING
- SP STATIC PRESSURE
- SS STAINLESS STEEL, SANITARY SEWER
- SQ SQUARE
- TG TRANSFER GRILLE
- TP TYPICAL
- UH UNIT HEATER
- UON UNLESS OTHERWISE NOTED
- V VENT
- VENT VENTILATION, VENTILATOR
- VTR VENT THRU ROOF
- W WASTE, WATT, WIDE
- WB WET BULB (TEMPERATURE)

SYMBOLS


DUCTWORK: DUCT (1ST FIGURE = SIDE SHOWN, 2ND FIGURE = SIDE NOT SHOWN), DUCT SECTION, POSITIVE PRESSURE, DUCT SECTION, NEGATIVE PRESSURE, ROUND DUCT SECTION, DUCT PENETRATION THRU FLOOR OR ROOF, VOLUME DAMPER, FIRE/SMOKE DAMPER, 90° ELBOW, SQUARE CORNER ELBOW, 90° TAKE-OFF OR TEE, 90° CONICAL TAKE-OFF, 45° LATERAL TAKE-OFF, TRANSITION OR REDUCER, WYE FITTING, 90° RECTANGULAR TAKE-OFF, 90° DIVERGING RECTANGULAR TEE, PARALLEL FLOW BRANCH CONNECTION, FLEXIBLE DUCT, ROUND DUCT INDICATOR.

EQUIPMENT: TYPICAL EQUIPMENT DESIGNATION (EXHAUST FAN SHOWN), DUCT SMOKE DETECTOR, ROOM THERMOSTAT OR TEMPERATURE TRANSMITTER, ROOM HUMIDISTAT OR HUMIDITY TRANSMITTER, CARBON MONOXIDE SENSOR SMOKE DETECTOR, DIFFUSER/GRILLE TYPE, LINEAR DIFFUSER, WALL MOUNTED, WALL SUPPLY GRILLE, WALL RETURN/EXHAUST GRILLE, TRANSFER GRILLE, DUCT CONNECTED, TRANSFER GRILLE, CEILING MOUNTED WITH FULL-SIZED LINED DUCT CONNECTION.

DRAWING INDEX

Sheet List Table with columns: Sheet Number, Sheet Title, PERMIT SET, 02/15/2024. Lists sheets M0.0 through M3.1 including LEGEND, GENERAL NOTES, DRAWING INDEX, PROJECT NOTES, TABLES & CALCULATIONS, MECHANICAL SCHEDULES & WSEC FORMS, HVAC PLAN - FLOOR PLANS, and HVAC ENLARGED PLANS.

Revisions table with columns: NO., DATE, DESCRIPTION, REVISIONS.

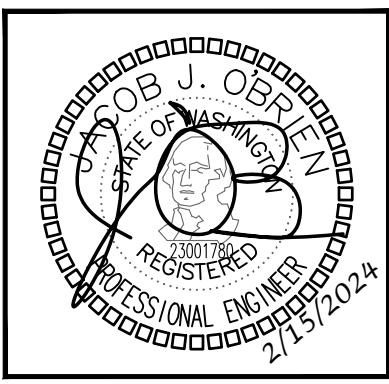

Designation table with columns: DRAWN, DESIGNED, CHECKED, APPROVED, JOB. Includes names: OP, ABE, ABE, JOB.

PROJECT: BRADLEY HEIGHT APARTMENTS - BUILDING H  
202 27TH AVE SE  
PUYALLUP, WA 98374  
19401 40TH AVE W, SUITE 302  
LYNNWOOD, WA 98036  
PHONE: 206-844-3878  
ROBISON ENGINEERING, INC.

DATE: 02/15/2024

SHEET TITLE: LEGEND, GENERAL NOTES, & DRAWING INDEX

SHEET NO. M0.0



# ENERGY CODE NOTES

## WASHINGTON STATE ENERGY CODE

- HVAC THERMOSTATS SHALL BE SET TO MAINTAIN A MINIMUM DEADBAND OF 5F IN AREAS SERVED AS REQUIRED PER WSEC C403.2.4.2.
- PER WSEC, ALL DUCTS SHALL BE INSULATED AS FOLLOWS:

### DUCT INSULATION SCHEDULE

CODE	DUCT SYSTEM	DUCT LOCATION AND USE (1)(2)(3)	MATERIAL	R-VALUE (MIN. INSTALLED)
WSEC TABLE C403.10.1.1	OUTSIDE AIR (4)	>= 2800 CFM INSIDE CONDITION SPACE AND UPSTREAM OF AUTOMATIC SHUTOFF DAMPER	MINERAL-WOOL BLANKET	16.0
		>= 2800 CFM INSIDE CONDITION SPACE AND DOWNSTREAM OF AUTOMATIC SHUTOFF DAMPER TO HVAC UNIT OR ROOM	MINERAL-WOOL BLANKET	8.0
		< 2800 CFM INSIDE CONDITION SPACE	MINERAL-WOOL BLANKET	7.0
WSEC TABLE C403.10.1.2	SUPPLY AIR & RETURN AIR (4)	OUTSIDE THE BUILDING (OUTDOOR AND EXPOSED TO WEATHER) WHICH INCLUDE ATTICS ABOVE INSULATION CEILINGS, PARKING GARAGE AND CRAWL SPACE	MINERAL-WOOL BLANKET	8.0
		UNCONDITIONED SPACE (ENCLOSED BUT NOT IN THE BUILDING CONDITIONED ENVELOPE)	MINERAL-WOOL BLANKET	6.0
		UNCONDITIONED SPACE WHERE THE DUCT CONVEYS AIR THAT IS WITHIN 15' OF THE AIR TEMPERATURE OF THE SURROUNDING UNCONDITIONED SPACE (5)	MINERAL-WOOL BLANKET	3.3
		WHERE LOCATED IN THE BUILDING ENVELOPE ASSEMBLY	MINERAL-WOOL BLANKET	16.0
	SUPPLY AIR (4)	WITHIN CONDITIONED SPACE WHERE SUPPLY DUCT CONVEYS AIR <55°F OR >105°F	MINERAL-WOOL BLANKET	3.3
		WITHIN CONDITIONED SPACE THAT THE DUCT DIRECTLY SERVES WHERE SUPPLY DUCT CONVEYS AIR <55°F OR >105°F	MINERAL-WOOL BLANKET	0.0
		WITHIN CONDITIONED SPACE WHERE SUPPLY DUCT CONVEYS AIR >55°F OR <105°F	MINERAL-WOOL BLANKET	0.0
	RETURN OR EXHAUST AIR	WITHIN CONDITION SPACE, DOWNSTREAM OF AN ENERGY RECOVERY MEDIA, UPSTREAM OF AUTOMATIC SHUTOFF DAMPER	MINERAL-WOOL BLANKET	8.0
	RELIEF OR EXHAUST AIR	CONDITION SPACE AND DOWNSTREAM OF AN AUTOMATIC SHUTOFF DAMPER	MINERAL-WOOL BLANKET	16
	NOTES (1) DUCT INSULATION SHALL COMPLY WITH WSEC (2) INSULATION SHALL HAVE A MAXIMUM FLAME SPREAD INDEX OF 25 AND MAXIMUM SMOKE DEVELOPED INDEX OF 50 PER WSEC 604.3 (3) EXTERNAL DUCT INSULATION IS IDENTIFIABLE PER WSEC 604.7 (4) VAPOR RETARDER IS INSTALLED ON SUPPLY AND OUTSIDE AIR DUCT PER WSEC 604.11 (5) CONDENSATION CONTROL FOR DUCTWORK			

- MOTORIZED DAMPERS: PER WSEC C403.7.8.1 PROVIDE MOTORIZED DAMPERS ON ALL OUTSIDE AIR INTAKES, EXHAUST OUTLETS AND RELIEF OUTLETS SERVING CONDITIONED SPACES WHICH CLOSE AUTOMATICALLY WHEN THE SYSTEM IS OFF. RETURN AIR DAMPERS SHALL BE EQUIPPED WITH MOTORIZED DAMPERS. SEE WSEC C402.4.5.2 FOR EXCEPTIONS AND ADDITIONAL REQUIREMENTS.

## RESIDENTIAL ENERGY CODE

- WHOLE-HOUSE FAN EFFICACY PER TABLE R403.6.1.
- EQUIPMENT AND APPLIANCE SIZING PER R403.7, HEATING AND COOLING EQUIPMENT AND APPLIANCES SHALL BE SIZED IN ACCORDANCE WITH ACCA MANUAL S OR OTHER APPROVED SIZING METHODOLOGIES BASED ON BUILDING LOADS CALCULATED IN ACCORDANCE WITH ACCA MANUAL J OR OTHER APPROVED HEATING AND COOLING CALCULATION METHODOLOGIES
- ELECTRIC RESISTANCE ZONE PER R403.7.1, ELECTRIC ZONAL HEATING AS PRIMARY HEAT SOURCE SHALL INSTALL DUCTLESS MINI-SPLIT HEAT PUMP IN THE LARGEST ZONE IN THE DWELLING UNLESS TOTAL INSTALLED HEATING CAPACITY OF 2 KW PER DWELLING OR LESS. PROVIDED ONE THERMOSTAT FOR EACH HEATING AND COOLING SYSTEM PER R403.1
- PER R403.3.6, SUPPLY AND RETURN DUCTS IN CEILING INSULATION SHALL HAVE MIN R-8 INSULATION ALL AROUND. THE SUM OF THE CEILING INSULATION OF THE TOP AND BELOW OF THE DUCT SHALL BE MIN R-19, EXCLUDING THE R-VALUE OF THE DUCT INSULATION
- MECHANICAL SYSTEM PIPING CARRYING FLUIDS ABOVE 105F OR BELOW 55F SHALL BE INSULATED WITH MIN R-6 PER R403.4. INSULATION SHALL BE PROTECTED FROM DAMAGE AND SHALL PROVIDE SHIELDING FROM SOLAR RADIATION. ADHESIVE TAPE SHALL NOT BE PERMITTED.

# WHOLE HOUSE VENTILATION NOTES

EACH DWELLING UNIT OR SLEEPING UNIT SHALL BE EQUIPPED WITH A WHOLE-HOUSE MECHANICAL VENTILATION SYSTEM THAT COMPLIES WITH SECTIONS 403.4.1 THROUGH 403.4.6. EACH DWELLING UNIT OR SLEEPING UNIT SHALL BE EQUIPPED WITH LOCAL EXHAUST COMPLYING WITH SECTION 403.4.7. ALL OCCUPIED SPACES, INCLUDING PUBLIC CORRIDORS, OTHER THAN GROUP R DWELLING UNITS AND/OR SLEEPING UNITS, THAT SUPPORT THESE GROUP R OCCUPANCIES, SHALL MEET THE VENTILATION REQUIREMENTS OF SECTION 402 OR THE MECHANICAL VENTILATION REQUIREMENTS OF SECTIONS 403.1 THROUGH 403.3.

THE WHOLE HOUSE VENTILATION SYSTEM SHALL CONSIST OF ONE OR MORE SUPPLY FANS, ONE OR MORE EXHAUST FANS, OR AN ERV/HRV WITH INTEGRAL FANS; AND THE ASSOCIATED DUCTS AND CONTROLS. LOCAL EXHAUST FANS SHALL BE PERMITTED TO SERVE AS PART OF THE WHOLE-HOUSE VENTILATION SYSTEM WHEN PROVIDED WITH THE PROPER CONTROLS IN ACCORDANCE WITH SECTION 403.4.5. THE SYSTEMS SHALL BE DESIGNED AND INSTALLED TO SUPPLY AND EXHAUST THE MINIMUM OUTDOOR AIRFLOW RATES PER SECTION 403.4.2 AS CORRECTED BY THE BALANCED AND/OR DISTRIBUTED WHOLE-HOUSE VENTILATION SYSTEM COEFFICIENTS IN ACCORDANCE WITH SECTION 403.4.3 WHERE APPLICABLE.

THE DWELLING UNIT WHOLE-HOUSE MECHANICAL VENTILATION MINIMUM OUTDOOR AIRFLOW RATE SHALL BE DETERMINED IN ACCORDANCE WITH EQUATION 4-10 OR TABLE 403.4.2.

RESIDENTIAL DWELLING AND SLEEPING UNITS IN GROUP R-2 OCCUPANCIES SYSTEM SHALL INCLUDE SUPPLY AND EXHAUST FANS AND BE A BALANCED WHOLE-HOUSE VENTILATION SYSTEM IN ACCORDANCE WITH SECTION 403.4.6.3. THE SYSTEM SHALL INCLUDE A HEAT OR ENERGY RECOVERY VENTILATOR WITH A SENSIBLE HEAT RECOVERY EFFECTIVENESS AS PRESCRIBED IN SECTION C403.3.6 OF THE WASHINGTON STATE ENERGY CODE. THE WHOLE-HOUSE VENTILATION SYSTEM SHALL OPERATE CONTINUOUSLY AT THE MINIMUM VENTILATION RATE DETERMINED IN ACCORDANCE WITH SECTION 403.4. THE WHOLE-HOUSE SUPPLY FAN SHALL PROVIDE DUCTED OUTDOOR VENTILATION AIR TO EACH HABITABLE SPACE WITHIN THE RESIDENTIAL UNIT.

CONTROLS FOR THE WHOLE-HOUSE VENTILATION SYSTEM SHALL COMPLY WITH THE FOLLOWING:

- THE WHOLE-HOUSE VENTILATION SYSTEM SHALL BE CONTROLLED WITH MANUAL SWITCHES, TIMERS OR OTHER MEANS THAT PROVIDE FOR AUTOMATIC OPERATION OF THE VENTILATION SYSTEM THAT HAVE READY ACCESS FOR THE OCCUPANT.
- THE WHOLE-HOUSE MECHANICAL VENTILATION SYSTEM SHALL BE PROVIDED WITH CONTROLS THAT ENABLE MANUAL OVERRIDE OFF OF THE SYSTEM BY THE OCCUPANT DURING PERIODS OF POOR OUTDOOR AIR QUALITY. CONTROLS SHALL INCLUDE PERMANENT TEXT OR A SYMBOL INDICATING THEIR FUNCTION. RECOMMENDED CONTROL PERMANENT LABELING TO INCLUDE TEXT SIMILAR TO THE FOLLOWING; "LEAVE ON UNLESS OUTDOOR AIR QUALITY IS VERY POOR." MANUAL CONTROLS SHALL HAVE READY ACCESS FOR THE OCCUPANT.
- WHOLE-HOUSE VENTILATION SYSTEMS SHALL BE CONFIGURED TO OPERATE CONTINUOUSLY EXCEPT WHERE INTERMITTENT OFF CONTROLS ARE PROVIDED IN ACCORDANCE WITH SECTION 403.4.6.5 AND ALLOWED BY SECTION 403.4.4.2.

WHOLE HOUSE VENTILATION SUPPLY AND EXHAUST FANS SPECIFIED IN THIS SECTION SHALL HAVE A MINIMUM EFFICACY AS PRESCRIBED IN THE WASHINGTON STATE ENERGY CODE. THE FANS SHALL BE RATED FOR SOUND AT A MAXIMUM OF 1.0 SOME AT DESIGN AIRFLOW AND STATIC PRESSURE CONDITIONS. DESIGN AND INSTALLATION OF THE SYSTEM OR EQUIPMENT SHALL BE CARRIED OUT IN ACCORDANCE WITH MANUFACTURERS' INSTALLATION INSTRUCTIONS

A BALANCED WHOLE HOUSE VENTILATION SYSTEM SHALL INCLUDE BOTH SUPPLY AND EXHAUST FANS. THE SUPPLY AND EXHAUST FANS SHALL HAVE AIRFLOW THAT IS WITHIN 10 PERCENT OF EACH OTHER. THE TESTED AND BALANCED TOTAL MECHANICAL EXHAUST AIRFLOW RATE IS WITHIN 10 PERCENT OR 5 CFM, WHICHEVER IS GREATER, OF THE TOTAL MECHANICAL SUPPLY AIRFLOW RATE. THE FLOW RATE TEST RESULTS SHALL BE SUBMITTED AND POSTED IN ACCORDANCE WITH SECTION 403.4.6.6. THE EXHAUST FAN SHALL MEET THE REQUIREMENTS OF SECTION 403.4.6.2. THE SUPPLY FAN SHALL MEET THE REQUIREMENTS OF SECTION 403.4.6.3. FOR R-2 DWELLING AND SLEEPING UNITS, THE SYSTEM IS REQUIRED TO HAVE BALANCED WHOLE-HOUSE VENTILATION BUT IS NOT REQUIRED TO HAVE DISTRIBUTED WHOLE-HOUSE VENTILATION WHERE THE NOT DISTRIBUTED SYSTEM COEFFICIENT FROM TABLE 403.4.3 IS UTILIZED TO CORRECT THE WHOLE-HOUSE MECHANICAL VENTILATION RATE. THE SYSTEM SHALL BE DESIGNED AND BALANCED TO MEET THE PRESSURE EQUALIZATION REQUIREMENTS OF SECTION 501.4. INTERMITTENT DRYER EXHAUST, INTERMITTENT RANGE HOOD EXHAUST, AND INTERMITTENT TOILET ROOM EXHAUST AIRFLOW RATES ABOVE THE RESIDENTIAL DWELLING OR SLEEPING UNIT MINIMUM VENTILATION RATE ARE EXEMPT FROM THE BALANCED AIRFLOW CALCULATION.

### FACTORY-BUILT INTAKE/EXHAUST COMBINATION TERMINATIONS

PER 2018 IMC 401.4.3, ITEM 3, EXCEPTION, SEPARATION IS NOT REQUIRED BETWEEN INTAKE AIR OPENINGS AND LIVING SPACE RELIEF AIR EXHAUST AIR OPENINGS OF AN INDIVIDUAL DWELLING UNIT OR SLEEPING UNIT, NOT TO INCLUDE COMMON AREAS OUTSIDE OF THE DWELLING OR SLEEPING UNIT, WHERE A FACTORY-BUILT INTAKE/EXHAUST COMBINATION TERMINATION FITTING, LISTED AND INSTALLED IN ACCORDANCE WITH THE MANUFACTURER'S INSTRUCTIONS, IS USED TO SEPARATE THE AIR STREAMS. A MINIMUM OF 5 FEET HORIZONTAL SEPARATION BETWEEN OTHER ENVIRONMENTAL AIR EXHAUST OUTLETS AND OTHER DWELLING OR SLEEPING UNIT FACTORY-BUILT INTAKE/EXHAUST COMBINATION TERMINATION FITTINGS SHALL BE MAINTAINED.


# CALCULATIONS

## RESIDENTIAL VENTILATION CALCULATIONS

UNIT TYPE	UNIT SQUARE FOOTAGE	NUMBER OF BEDROOMS	2018 IMC CRITERIA (1)			VENTILATION QUALITY ADJUSTMENT COEFFICIENT (3)	MINIMUM WHOLE HOUSE VENTILATION RATE, CFM	TOTAL CFM PROVIDED BY WHOLE HOUSE FAN SYSTEM
			FLOOR AREA, SQFT	NUMBER OF BEDROOMS	REQUIRED CFM (2)			
1 BEDROOM	660	1	500 - 1,000	1	30	1.5	45	55
2 BEDROOM	1000	2	500 - 1,000	2	35	1.5	53	55

- NOTE:
- VENTILATION CRITERIA IS PER THE 2018 WA RESIDENTIAL CODE SECTION M1505.4.3
  - MINIMUM OSA FOR CONTINUOUSLY OPERATING FAN(S).
  - ADJUSTMENT COEFFICIENT IS PER 2018 WRC, TABLE M1505.4.3(2) FOR A NOT BALANCED, AND NOT DISTRIBUTED WHOLE HOUSE VENTILATION SYSTEM.

NO.	DATE	DESCRIPTION	REVISIONS

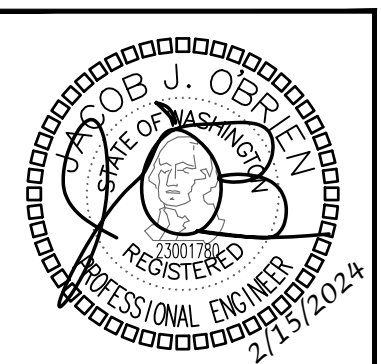

DRAWN: OP	DESIGNED: ABE	CHECKED: ABE	APPROVED: JOB
-----------	---------------	--------------	---------------

PROJECT: BRADLEY HEIGHT APARTMENTS - BUILDING H  
 202 27TH AVE SE  
 PUYALLUP, WA 98374


19401 40TH AVE W, SUITE 302  
 LYNNWOOD, WA 98036  
 PHONE: (206) 364-3343

**ROBISON ENGINEERING, INC.**

DATE: 02/15/2024

SHEET TITLE:  
**PROJECT NOTES & CALCULATIONS**

SHEET NO.  
**M0.1**

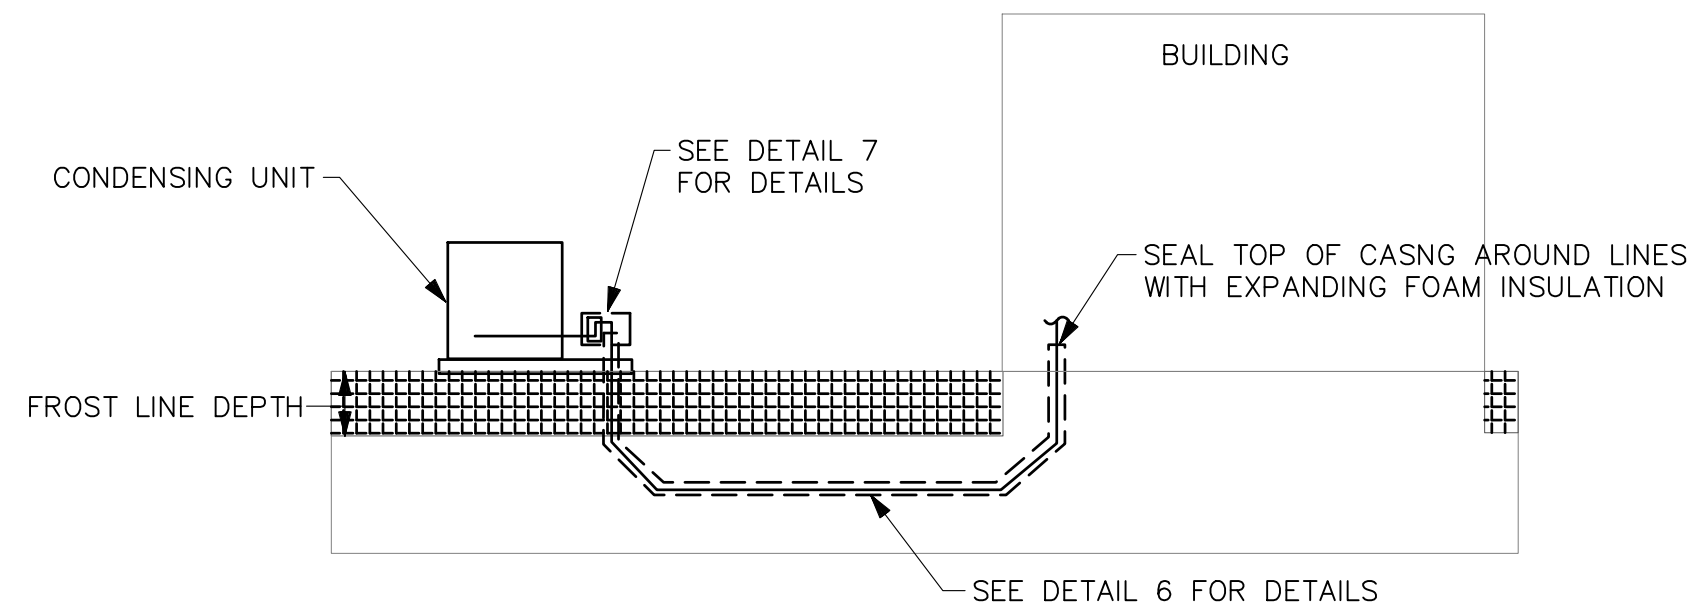


- NOTES:**
- REFRIGERANT LINES MUST BE INSTALLED BELOW THE FROST LINES (24" MINIMUM). INCREASE MINIMUM DEPTH FOOT OR VEHICLE TRAFFIC OVER THE REFRIGERANT LINE PATH TO 36" MINIMUM.
  - USE 45° ELBOWS TO SIMPLIFY COVERING THE REFRIGERANT LINES WITH CASING FOR REFRIGERANT PIPING WITH OUTSIDE DIAMETERS OF UP TO 3/4". SOFT TUBING CAN BE USED AND LARGE SWEEPING CURVES CAN BE BENT BY HAND.
  - PRESSURE-TEST REFRIGERANT PIPING BEFORE INSULATION AND COVERING WITH CASING
  - IF MORE THAN ONE SYSTEM IS INSTALLED, USE A SEPARATE CASING FOR EACH SET OF REFRIGERANT PIPING.
  - CAUTION: CASING MUST BE WATERTIGHT. IF ANY MOISTURE ENTERS THE CASING, SYSTEM PERFORMANCE WILL BE REDUCED, AND EQUIPMENT FAILURE MAY OCCUR. IF THIS OCCURS, THE WARRANTY OF THE EQUIPMENT IS NO LONGER VALID.

**UNDERGROUND INSTALLATION OF REFRIGERANT PIPING  
DETAIL**

SCALE: NONE


3

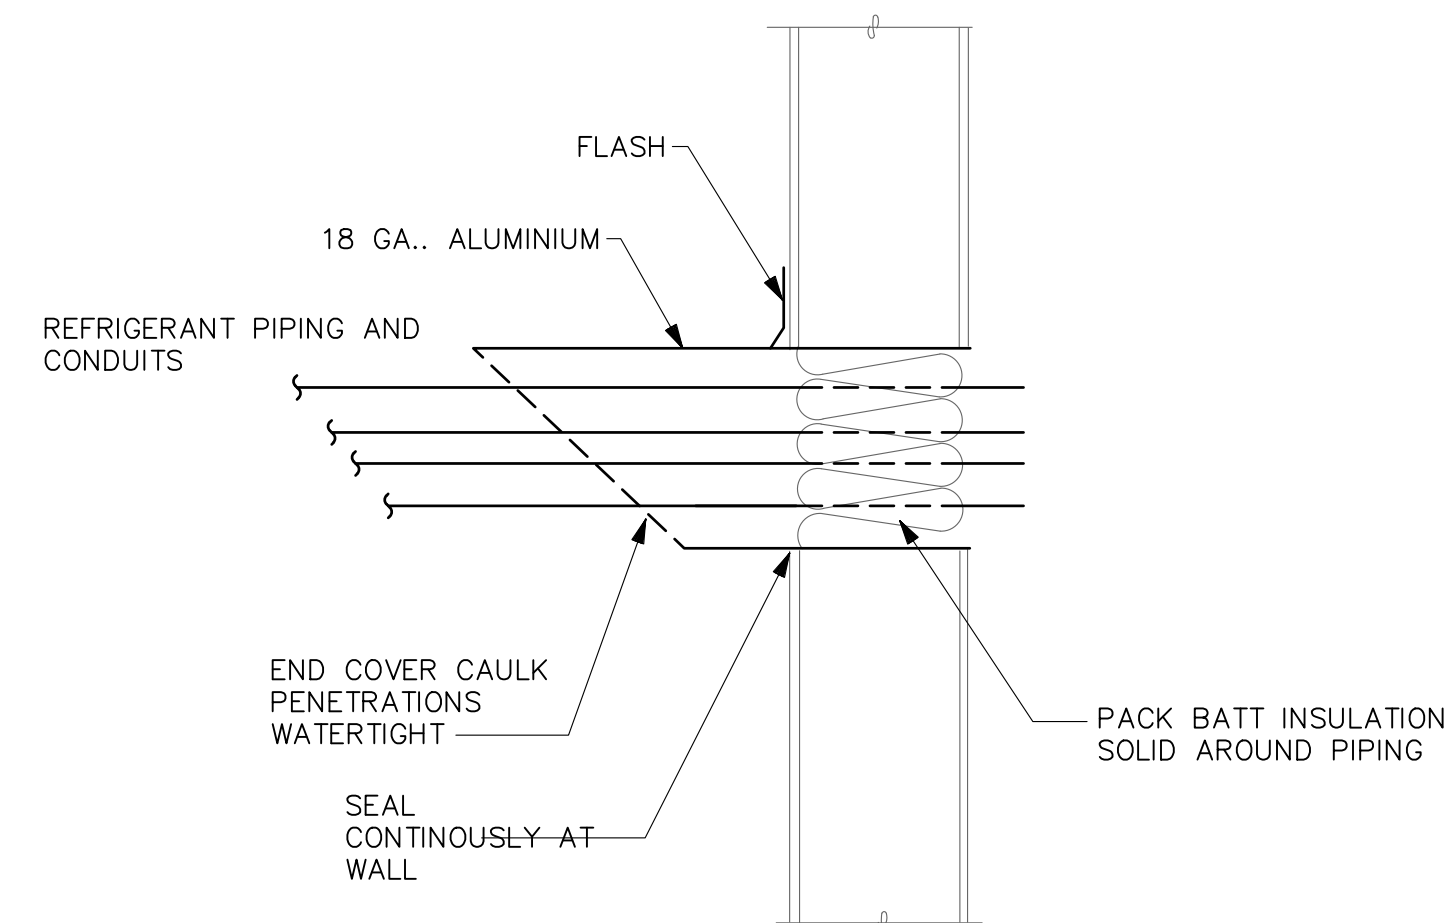

**WALL PIPE PENETRATION  
DETAIL**

SCALE: NONE

2

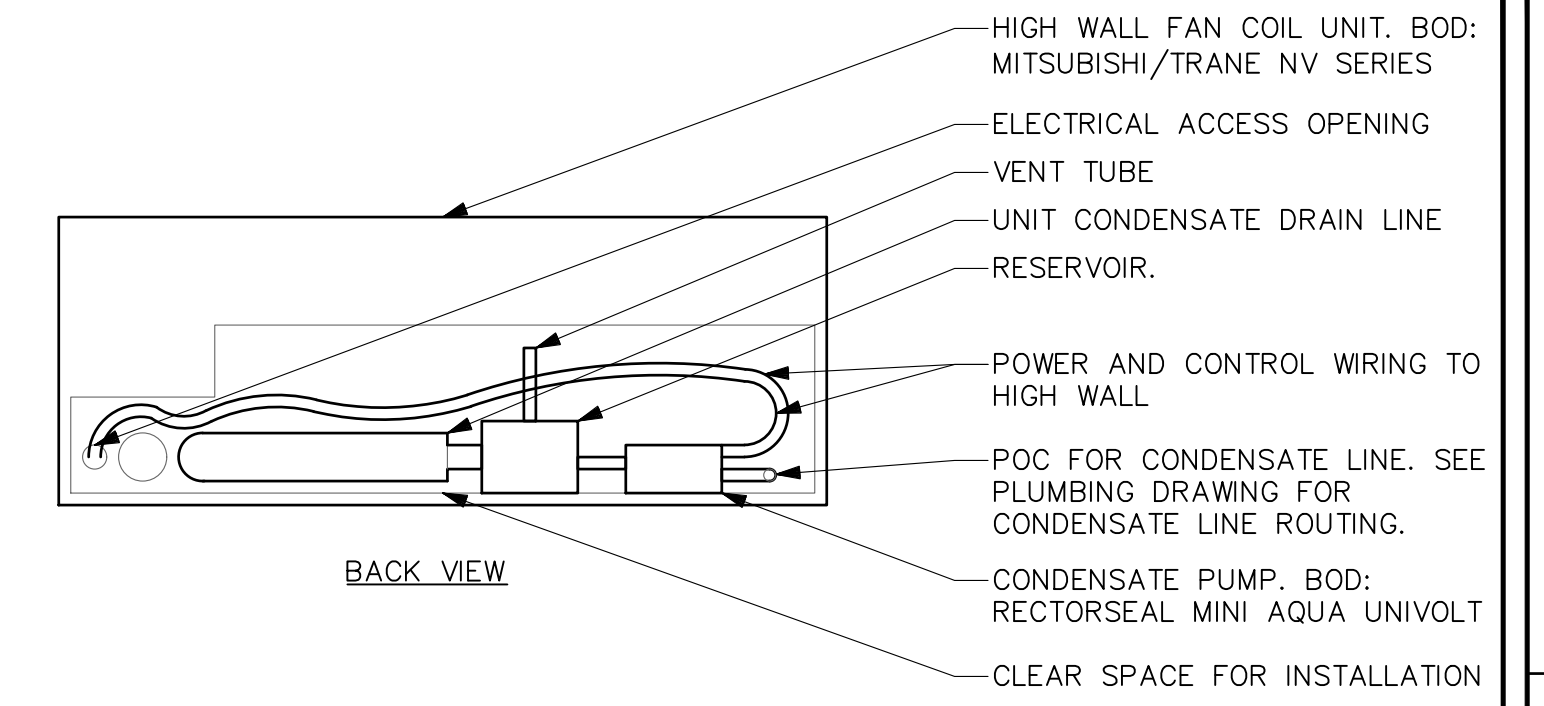


- NOTE:**
- BOD: RECTORSEAL MINI AQUA UNIVOLT. FOLLOW OTHER CONDENSATE PUMP MANUFACTURE'S INSTRUCTION FOR INSTALLATION REQUIREMENT.

**EXTERNAL CONDENSATE PUMP IN HIGH WALL  
DETAIL**

SCALE: NONE


3

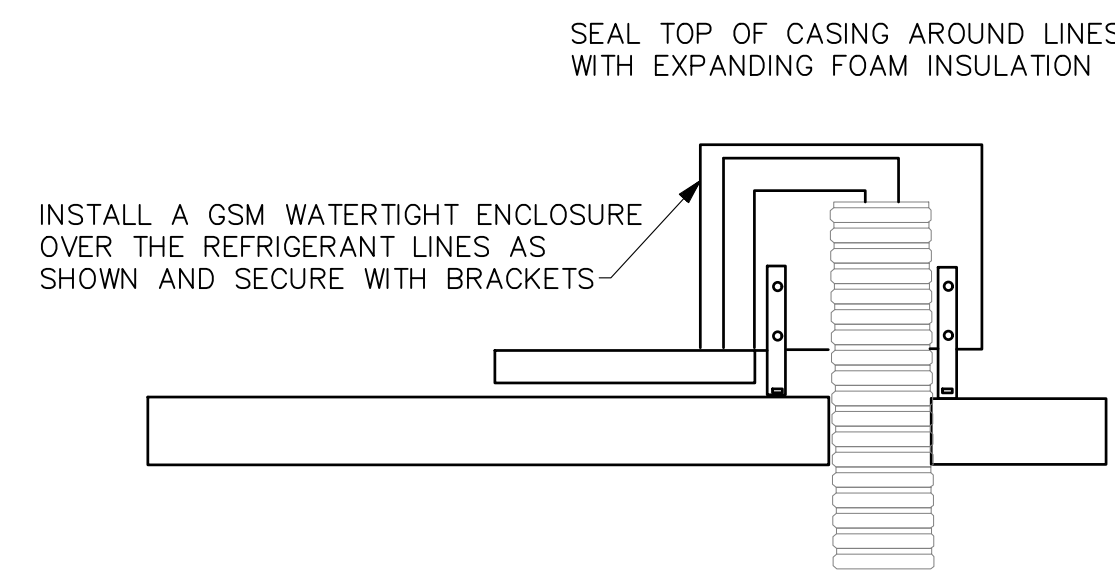

**WATERTIGHT PIPING ENCLOSURE  
DETAIL**

SCALE: NONE

7

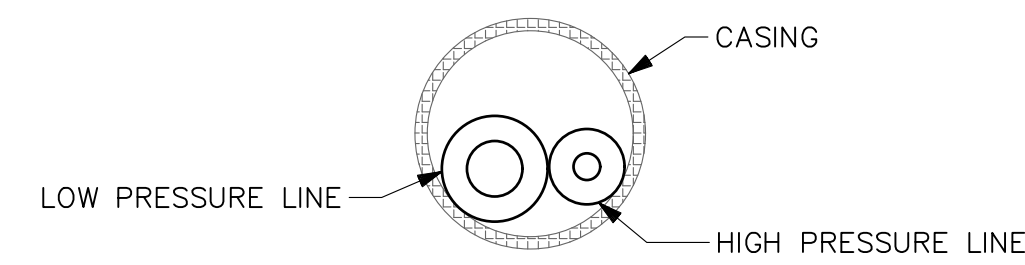


- NOTES:**
- REFRIGERANT LINES MUST BE INSULATED SEPARATELY
  - SEE PROTECTION FOR INSULATION THICKNESS
  - IF POSSIBLE, INSTALL CASING AS ONE CONTINUOUS PIECE OF FLEXIBLE WATERTIGHT DRAIN PIPE
  - IF RIGID PVC CASING IS USED, SEAL THE JOINTS TO MAKE THEM WATERTIGHT.

**TYPICAL CROSS SECTION OF PIPING  
DETAIL**

SCALE: NONE


6

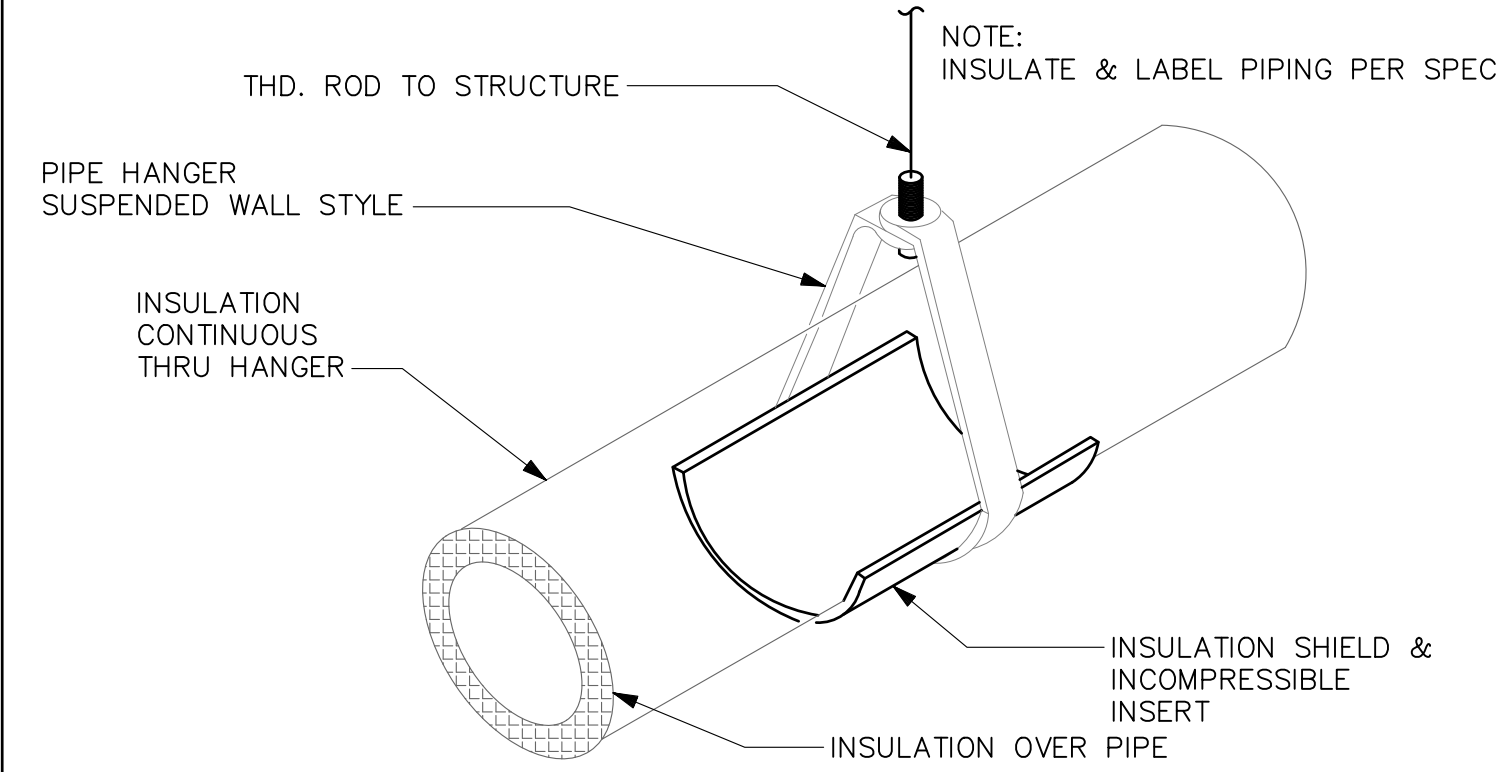

**REFRIGERANT PIPE HANGER  
DETAIL**

SCALE: NONE


5

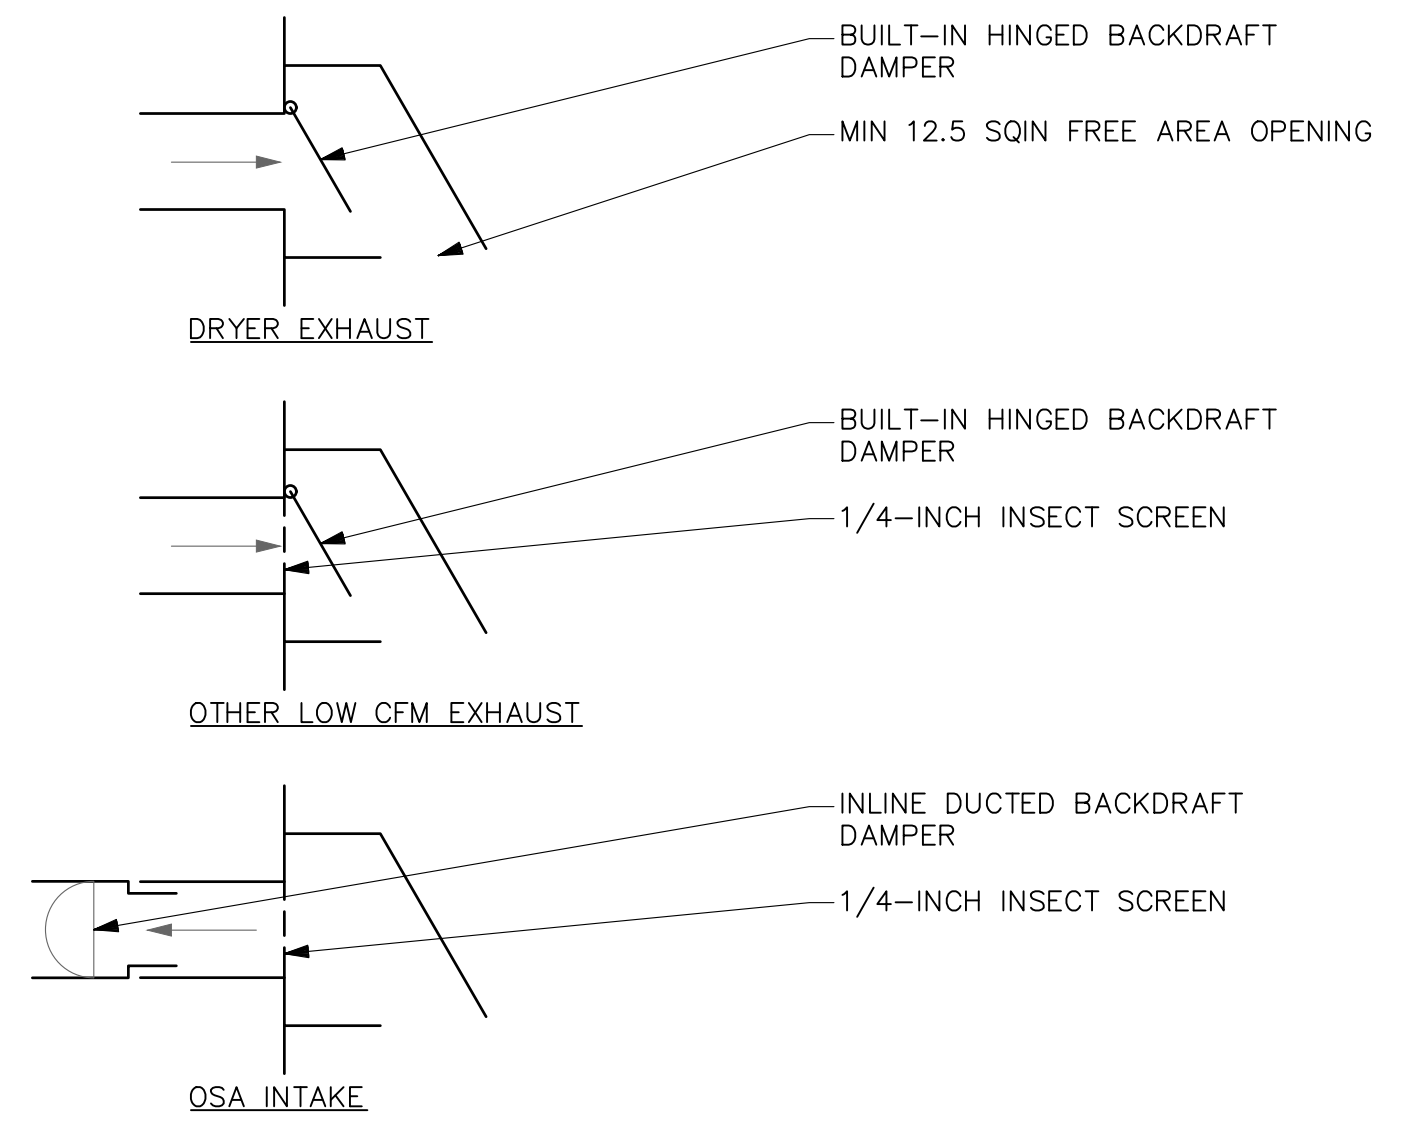

**WALL CAP TERMINATION  
DETAIL**

SCALE: NONE

4

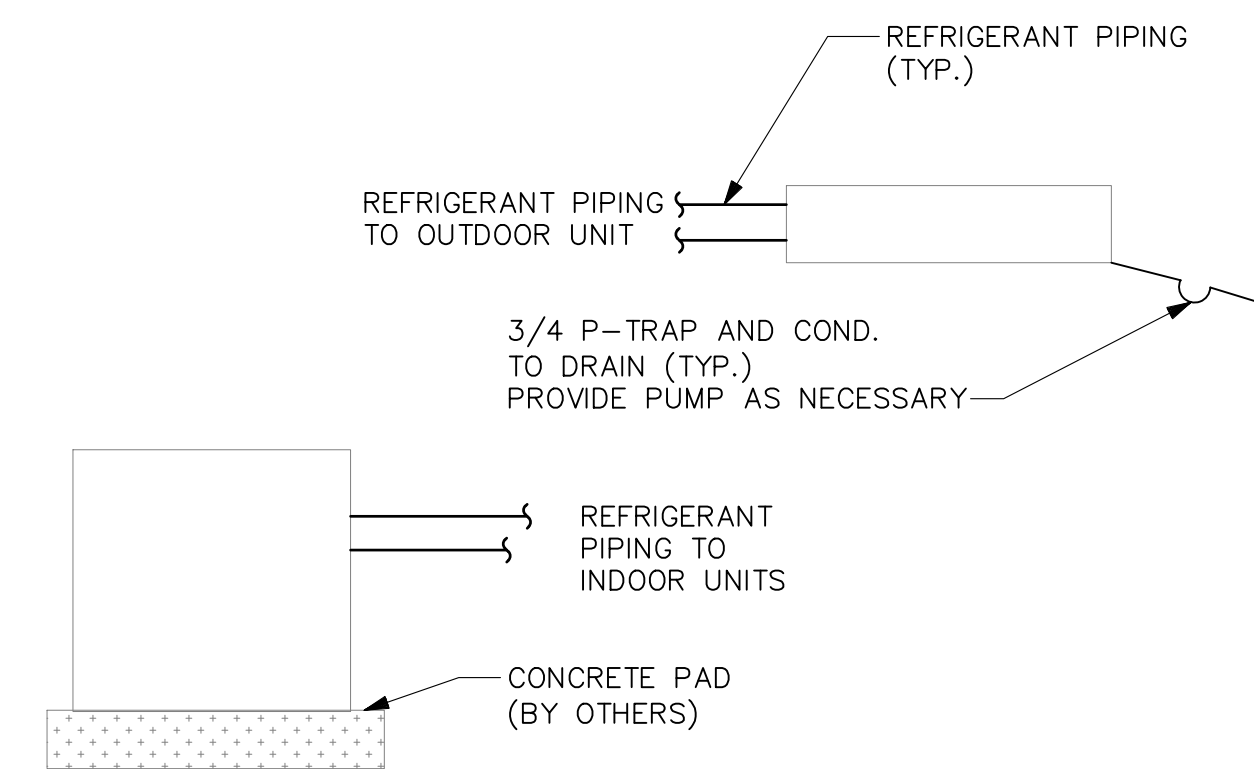


- NOTES:**
- INSULATE BOTH LIQUID AND VAPOR LINES THRU OUT SYSTEM
  - SECURE OUTDOOR UNIT TO CONCRETE PAD
  - SIZE REFRIGERANT LINES BASED ON MITSUBISHI SYSTEM CALCULATIONS
  - CONTRACTOR TO FIELD VERIFY ROUTING FOR REFRIGERANT PIPING AND CONDENSATE DRAINS

**SPLIT SYSTEM INSTALLATION  
DETAIL**

SCALE: NONE


10

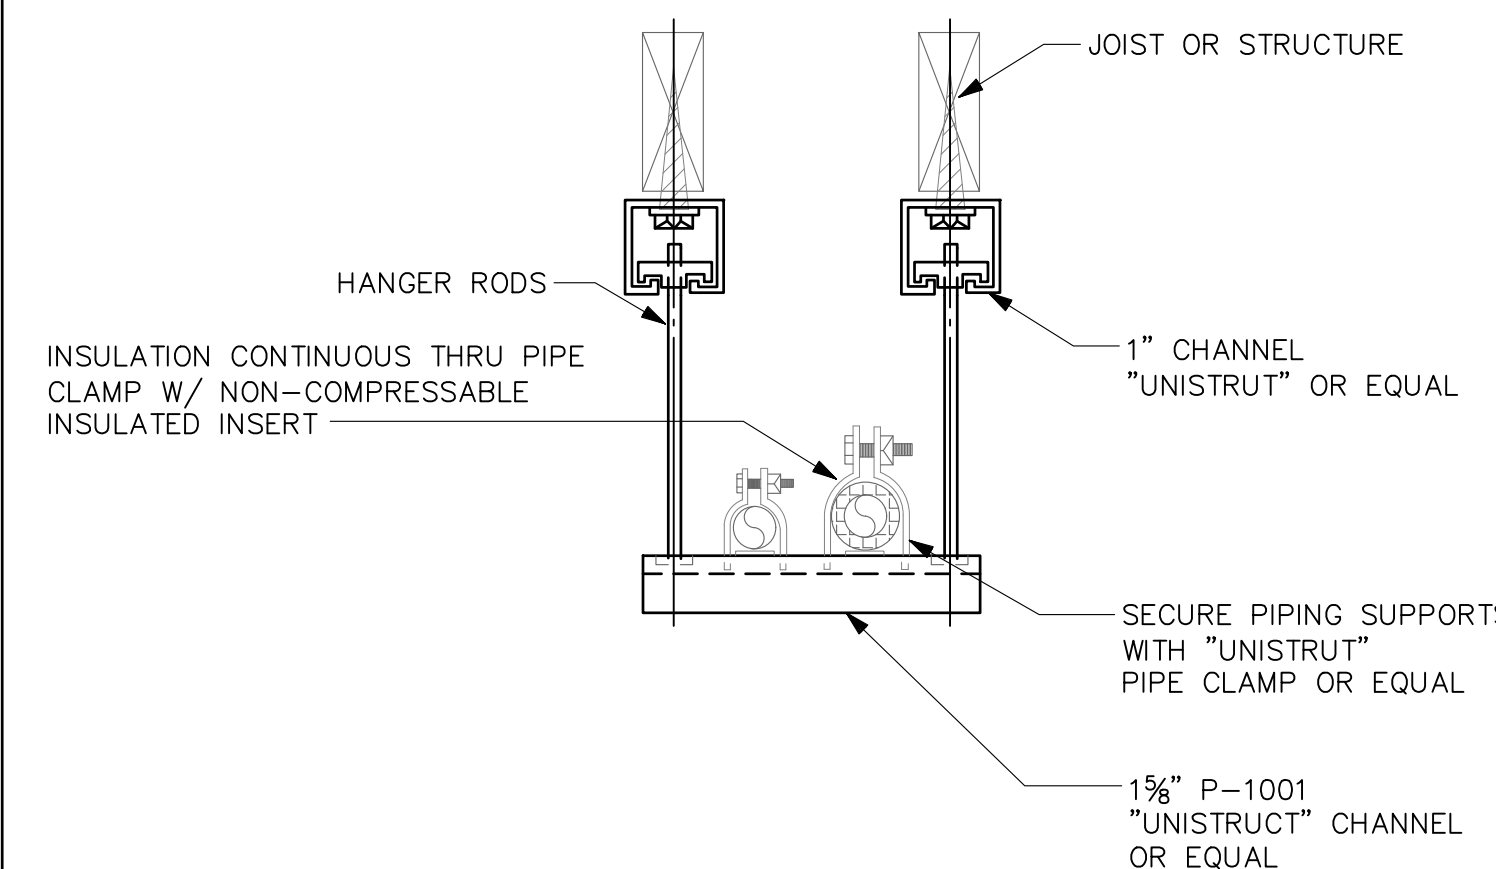

**SUSPENDED REFRIGERANT PIPE SUPPORT  
DETAIL**

SCALE: NONE

9

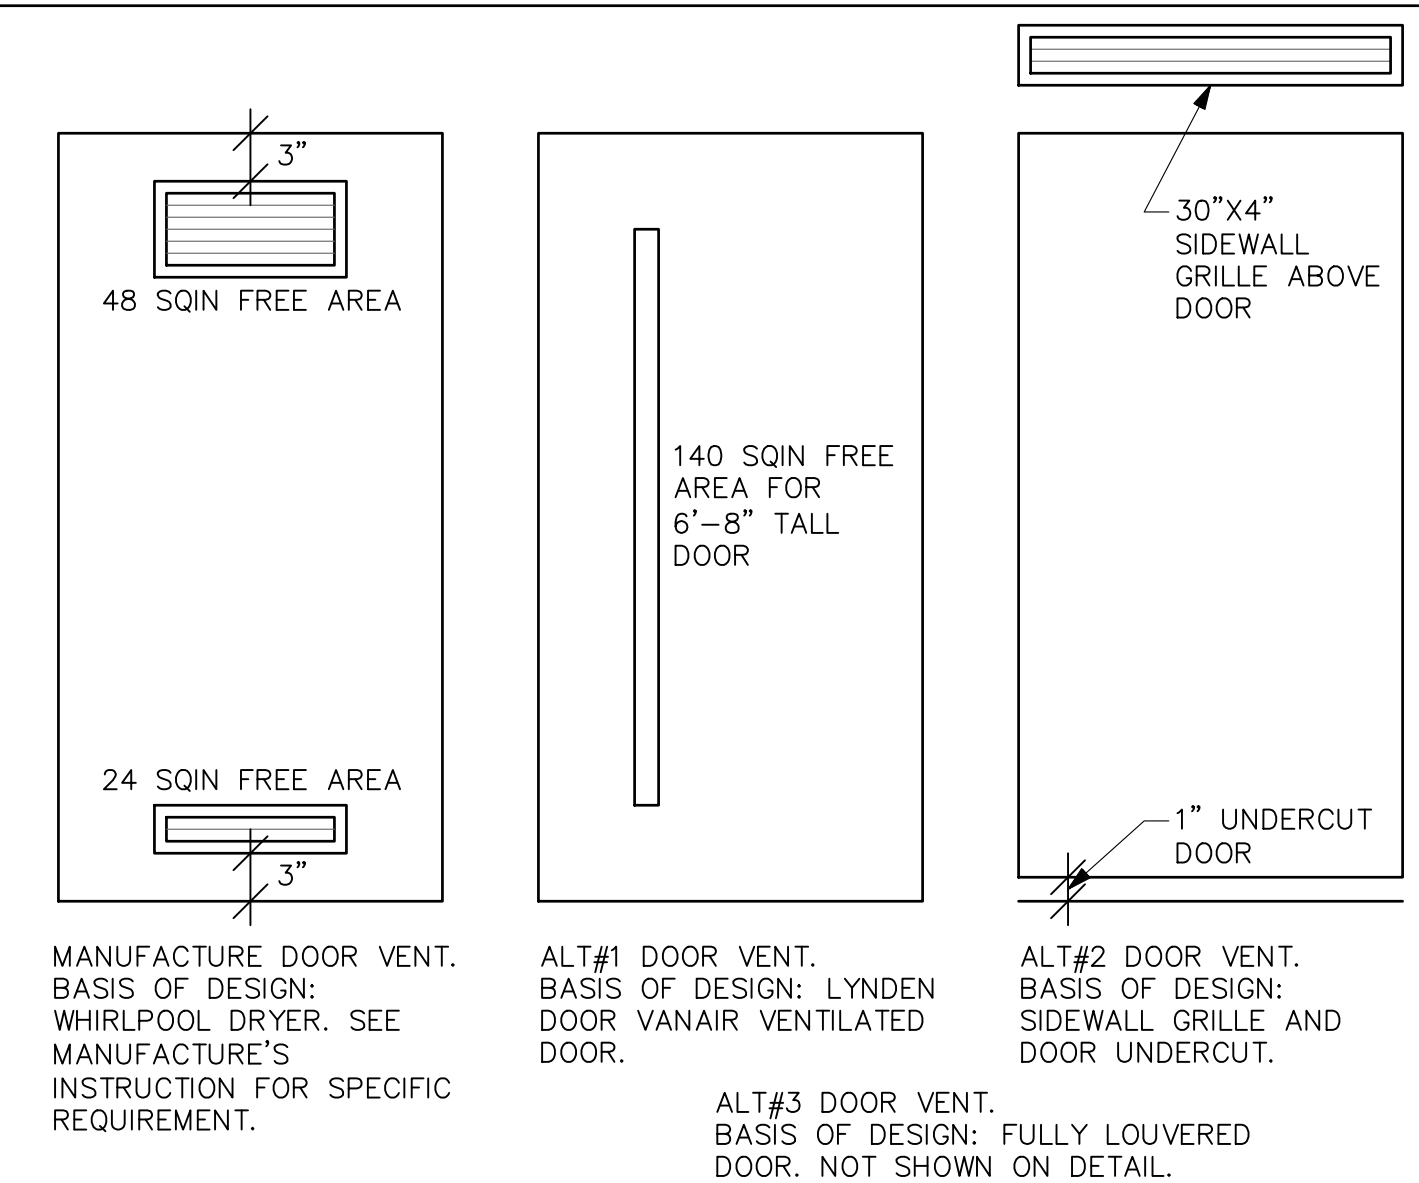

**LAUNDRY ROOM AND CLOSET DOOR  
DETAIL**


SCALE: NONE

8

**NOT USED  
DETAIL**

SCALE: NONE

11

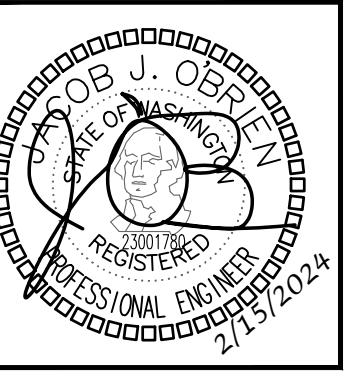

DRAWN:	OP
DESIGNED:	ABE
CHECKED:	ABE
APPROVED:	JOB

PROJECT: **BRADLEY HEIGHT APARTMENTS - BUILDING H**  
 19401 40TH AVE W. SUITE 302  
 LYNNWOOD, WA 98036  
 PUYALLUP, WA 98374  
**ROBISON ENGINEERING, INC**  
 PHONE: (206) 364-3343

DATE: 02/15/2024

SHEET TITLE: DETAILS

SHEET NO. **M0.2**

# WSEC FORMS

6/16/23, 11:49 AM waenergycodes.com/print\_project\_summary\_form.php?k=aWQ9MTkxMmZmZnZzPTE3JmN0aT00Ng=&print=1

**MECHANICAL COMPLIANCE SUMMARY**

2018 WSEC Compliance Forms for Commercial Buildings including Group R2, R3 & R4 over 3 stories and all R1 Administered by: ©2023 NEEA, All rights reserved

Project Title: Bradley Heights Apartments Building H - 2018 WSEC  
 Project Address: 202 27th Ave SE, Puyallup, WA 98374  
 Applicant Name: Ark Equitech  
 Applicant Phone: 206-364-3343  
 Applicant Email: aespindel@robisonengineering.com  
 Date: Jun 16, 2023

General Occupancy: All Group R - R2, R3 & R4 over 3 stories and all R1  
 General Building Use Type: Multifamily/Residential  
 Building Cond. Floor Area: 21,500  
 Project Cond. Floor Area: 21,500  
 Floors Above Grade: 3  
 Compliance Method: Compliance Method 1 - General

General Project Types: New Building, New Building or Addition Mechanical Scope, Single Zone Systems & Equipment, Alteration Mechanical Scope

Mechanical Project Description: Full mechanical design for new 3 story residential building.

Mechanical Compliance Scope and Method	Project Type	Mechanical Scope	Economizer Exceptions Applied?	DOAS Ventilation Provided?	Higher Equipment Efficiency Option Applied?	Equipment Efficiency Compliance Verification
	New Building	Single Zone Systems & Equipment	No	Yes	NA	COMPLIES

Additional Efficiency Credits Included (AEC):  
 Does building include occupancy classifications requiring DOAS? No  
 Does project include DOAS equipment? No  
 Based on project scope do TSPR requirements apply? No  
 Do all systems comply with Appendix D standard reference design or qualify for an exception to TSPR? No

Scope & Space Conditioning: NEW BUILDING - SINGLE ZONE SYSTEMS & EQUIPMENT  
 Compliance Verification: COMPLIES

Single Zone Air Systems Category - Unit heaters & duct heaters

System/Equip ID	Quantity of Items	Ventilation Standard	Ventilation CFM (Total if Multiple Items)	Ventilation Air Source	Paired with DOAS
EW1-1	48	IMC Ventilation		Other System	
EW1-2	12	IMC Ventilation		Other System	

System/Equip ID	Heating System/Equip Type	Specific Type	Heating Capacity	HC Units	Proposed Heating Efficiency	HE Units	Efficiency Compliance Verification
EW1-1	Unit heater	Electric resistance	1	Btu/h			COMPLIES
EW1-2	Unit heater	Electric resistance	2	Btu/h			COMPLIES

System/Equip ID	Area(s) Served	Location In Project Documents - Plan/Detail #
EW1-1	APARTMENT UNITS	M0.3
EW1-2	APARTMENT UNITS	M0.3

System/Equip ID for a single or multiple items? Multiple items w/ identical heating & cooling capacity

System/Equip ID for a single or multiple items? Multiple items w/ identical heating & cooling capacity

https://waenergycodes.com/print\_project\_summary\_form.php?k=aWQ9MTkxMmZmZnZzPTE3JmN0aT00Ng=&print=1 1/1

# MECHANICAL SCHEDULES

ELECTRIC HEATERS					
EQUIP NO.	SERVICE	MOUNTING/ DISCHARGE	HEATING	ELECTRICAL	BASIS OF DESIGN (3)
			KW	VOLTAGE	
EW1-1	APARTMENT UNIT	WALL	1.0	208V/1P	(1)(2)
EW1-2	APARTMENT UNIT	WALL	1.5	208V/1P	(1)(2)

- NOTES: (1) BROAN, KING, CADET OR EQUIVALENT.  
 (2) PROVIDE REMOTE THERMOSTAT. COORDINATE FINAL LOCATION WITH ELECTRICAL DRAWINGS.  
 (3) ALL ELECTRIC HEATERS TO BE FURNISHED AND INSTALLED BY ELECTRICAL CONTRACTOR.

FAN SCHEDULE									
EQUIP NO.	SERVICE	TYPE	AIRFLOW, CFM	ESP. IN WG	ELECTRICAL		OPERATION	WEIGHT, LBS	BASIS OF DESIGN (1)(2)(3)
					VOLTAGE	HP			
BEF-1	RESTROOM	CEILING MOUNTED	55/80	0.5	115V/1P	FHP	CONTINUOUS	10	GREENHECK SP-AP0511W (4)
BEF-2	RESTROOM	CEILING MOUNTED	50	0.5	115V/1P	FHP	(2)	10	GREENHECK SP-AP0511W

- NOTES: (1) PROVIDE BACKDRAFT DAMPERS ON EXHAUST FANS.  
 (2) 1.0 SONES MAXIMUM.  
 (3) VIBRATION ISOLATION: FANS < 125 LBS RUBBER ISOLATORS, FANS > 125 LBS SPRING ISOLATORS  
 (4) FAN SHALL BE 2-SPEED: 35 CFM CONTINUOUS LOW SETTING AND 80 CFM HIGH SPEED ACTIVATED BY INTEGRAL OCCUPANCY SENSOR ON GRILLE.


SPLIT SYSTEM HEAT PUMP SCHEDULE - INDOOR UNIT									
EQUIP NO.	SERVICE	MOUNTING/ DISCHARGE	FAN		ELECTRICAL			BASIS OF DESIGN (1)(2)(4)	CONNECTED OUTDOOR UNIT
			AIRFLOW, CFM	ESP. IN WG	VOLTAGE	MCA	MOCP		
FCU-1-X	RES. UNIT	HIGH WALL	473	N/A	(3)	(3)	(3)	DAIKIN FTXB12BXVJU	HP-1-X
FCU-2-X	RES. UNIT	HIGH WALL	716	N/A	(3)	(3)	(3)	DAIKIN FTXB18BXVJU	HP-2-X

- NOTES: (1) INSTALL IN ACCORDANCE WITH MANUFACTURER'S INSTALLATION REQUIREMENTS.  
 (2) PROVIDE MANUFACTURER'S OPTIONAL CONDENSATE PUMP WITH RESERVOIR AND SENSOR.  
 (3) INDOOR UNIT POWERED FROM OUTDOOR UNIT.  
 (4) "X" DENOTES THE UNIT BEING SERVED.

SPLIT SYSTEM HEAT PUMP SCHEDULE - OUTDOOR UNIT												
EQUIP NO.	SERVICE	CAPACITY, TONS	TOTAL COOLING CAPACITY, BTUH	SEER2	TOTAL HEATING CAPACITY, BTUH	HSPF2	ELECTRICAL			WEIGHT, LBS	BASIS OF DESIGN (1)(2)(3)(4)(5)(6)	CONNECTED FAN COIL UNIT
							VOLTAGE	MCA	MOCP			
HP-1-X	RES. UNIT	1.0	11,000	18.0	11,300	9.0	208V/1P	12.40	15	62	DAIKIN RXB12BXVJU	FCU-1
HP-2-X	RES. UNIT	1.5	18,000	18.0	17,900	8.5	208V/1P	16.55	20	97	DAIKIN RXB18BXVJU	FCU-1

- NOTES: (1) INSTALL IN ACCORDANCE WITH MANUFACTURER'S INSTALLATION REQUIREMENTS.  
 (2) ARI LISTED WITH ALL STANDARD FEATURES, INSTALLATION ACCESSORIES AND COMPRESSOR SHORT CYCLING PROTECTION. FILTER DRIVER, REFRIGERANT LINE FILTER, LIQUID SOLENOID VALVE, AND SAFETY PRESSURE SWITCHES. INSTALL REFRIGERANT TUBING AND LENGTH IN STRICT ACCORDANCE WITH MANUFACTURER'S RECOMMENDATIONS.  
 (3) PROVIDE ALL REQUIRED ACCESSORIES FOR LOW-AMBIENT.  
 (4) ROUTING OF REFRIGERANT LINES FROM INDOOR TO OUTDOOR UNITS NOT SHOWN ON PLANS. CONTRACTOR TO FIELD COORDINATE ROUTING.  
 (5) REFRIGERANT SHALL BE R-410A.  
 (6) "X" DENOTES THE UNIT BEING SERVED.

NO.	DATE	DESCRIPTION	REVISIONS

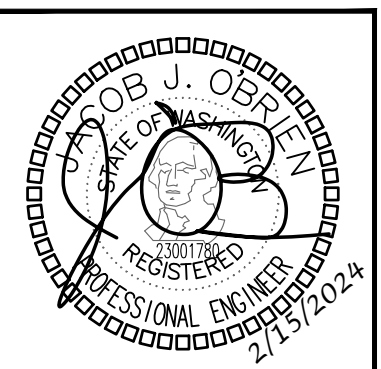

DRAWN: OP	DESIGNED: ABE	CHECKED: ABE	APPROVED: JOB
-----------	---------------	--------------	---------------

PROJECT: BRADLEY HEIGHT APARTMENTS - BUILDING H  
 202 27TH AVE SE  
 PUYALLUP, WA 98374

19401 40TH AVE W, SUITE 302  
 LYNNWOOD, WA 98036  
 PHONE: (206) 364-3343


**ROBISON ENGINEERING, INC.**

DATE: 02/15/2024


SHEET TITLE: MECHANICAL SCHEDULES & WSEC FORMS

SHEET NO. M0.3

There are two duct runs that appear to terminate in the sprinkler riser room. The ducts are within a furred down ceiling to 8 foot and riser room plate is 9 foot with shed roof on top. update ducting design as needed.  
(Construction Set, Sheet M2, 1st Level Plan)

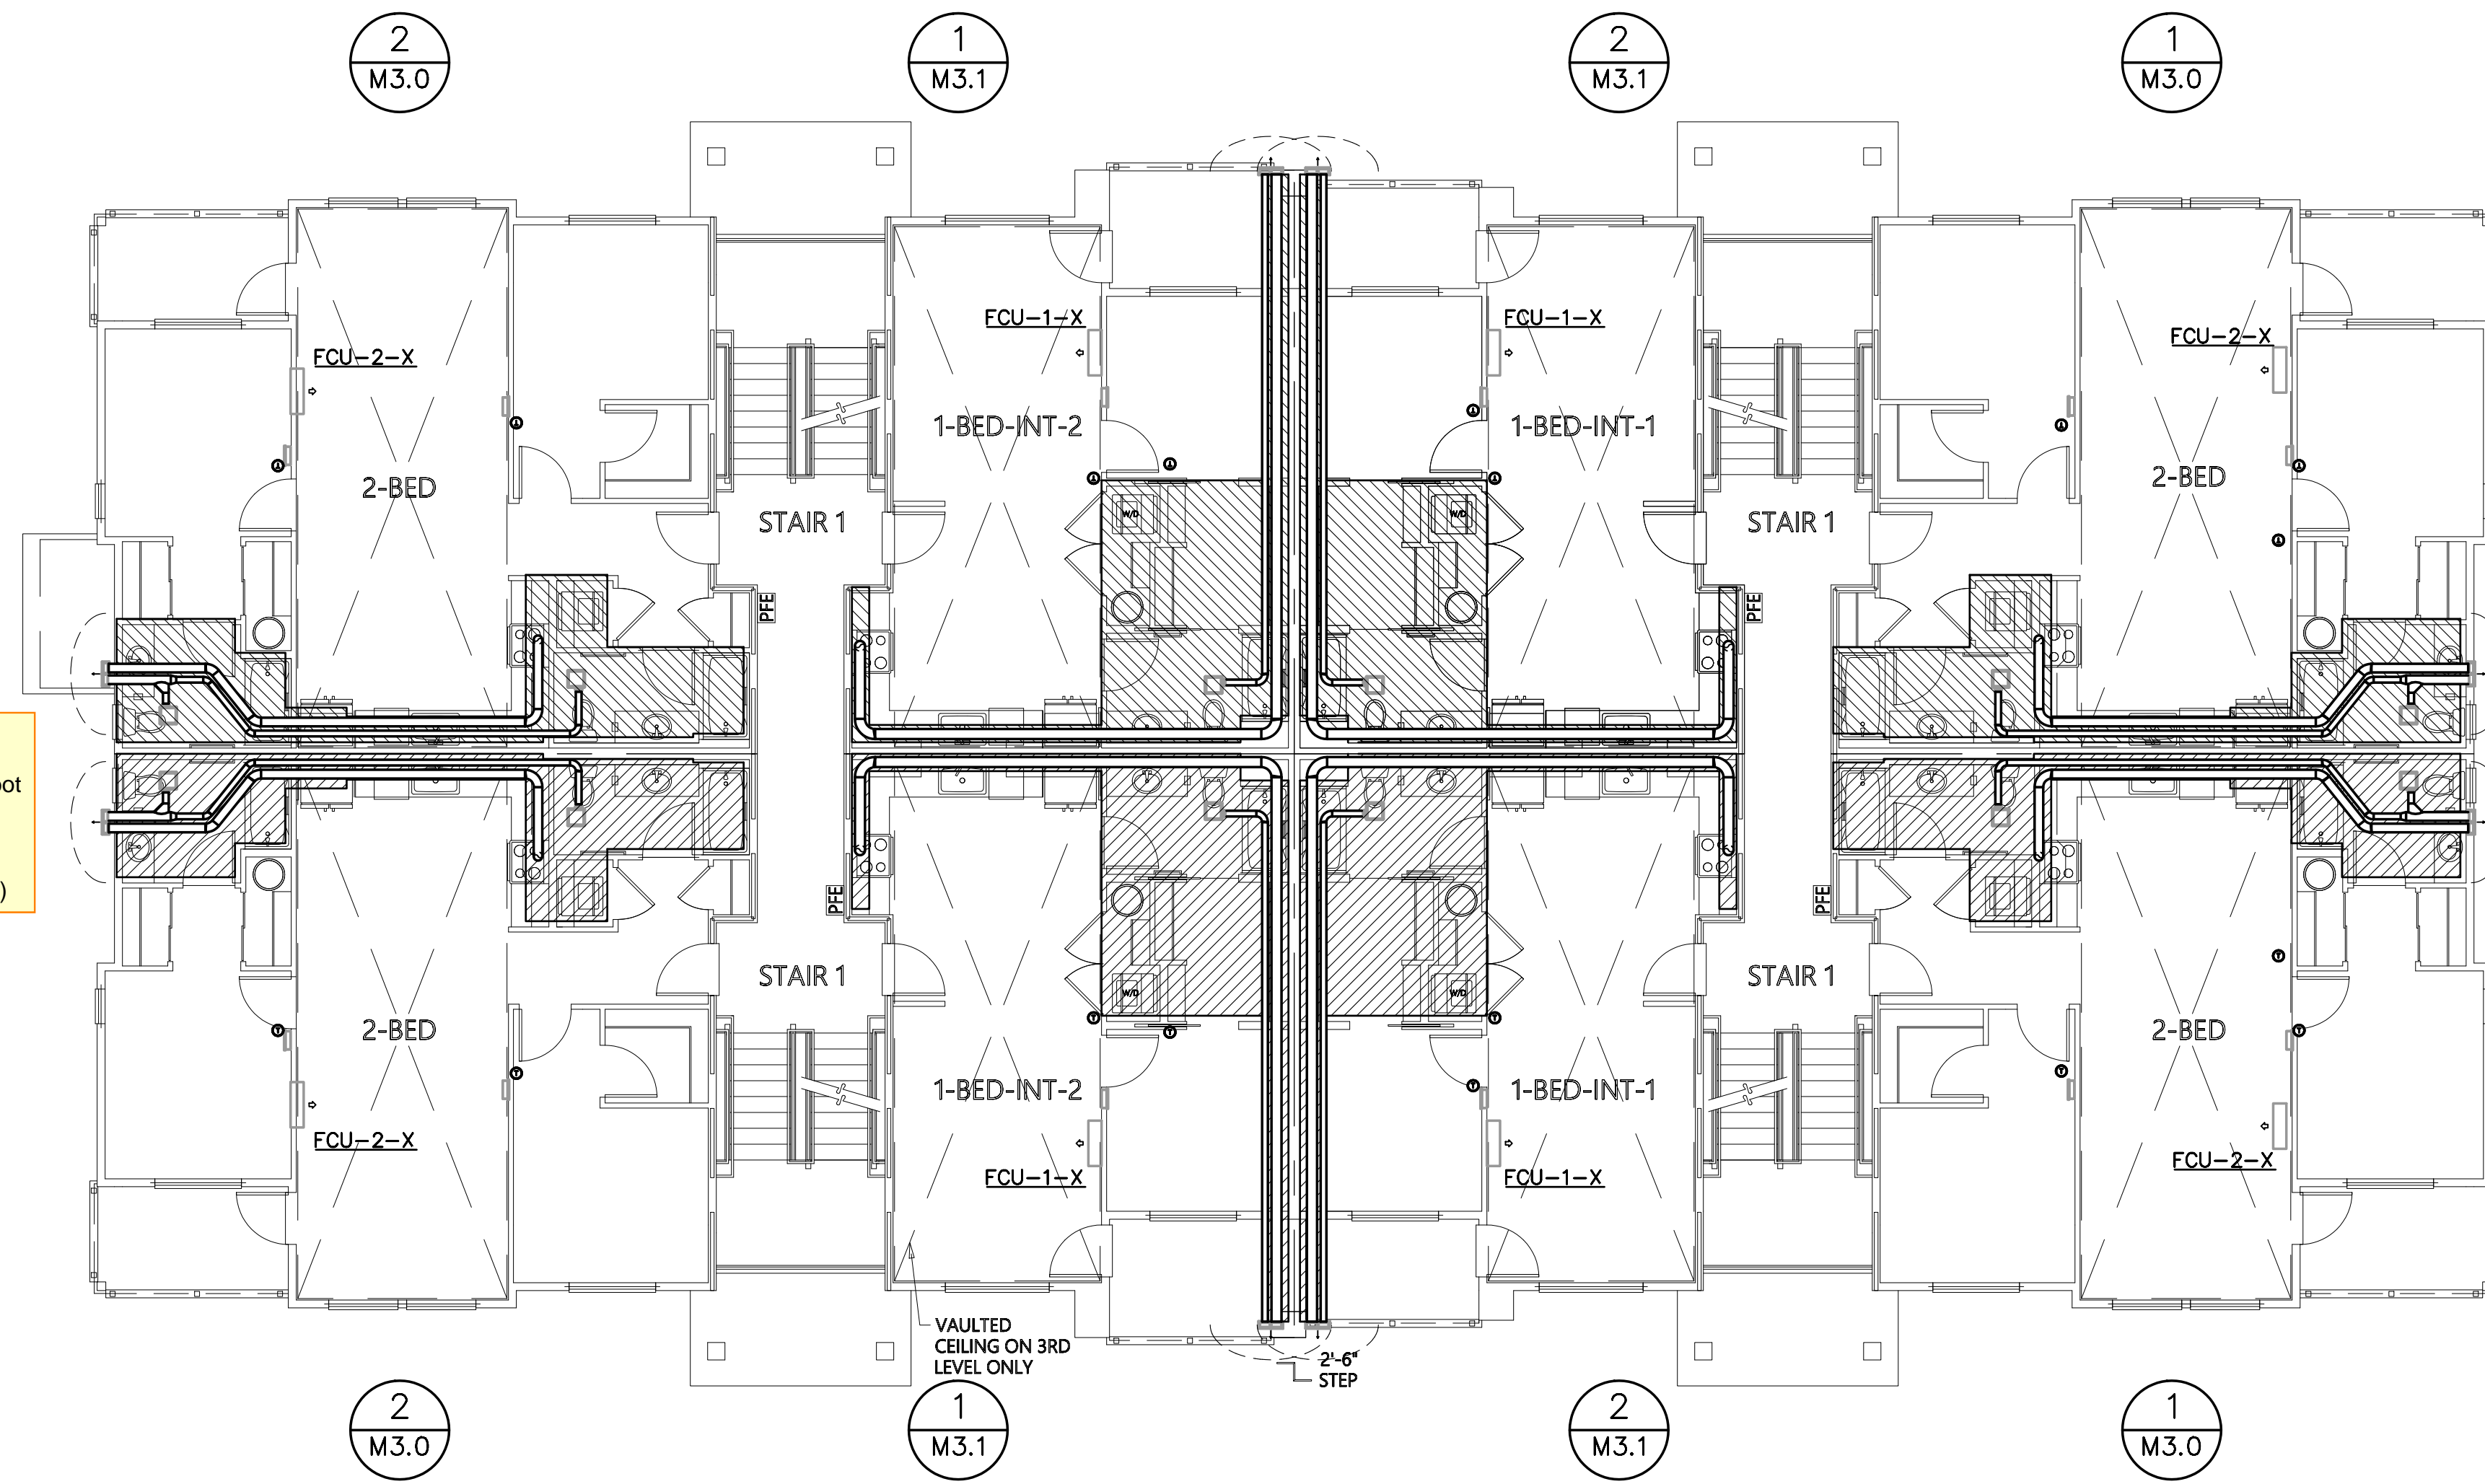



BUILDING H 2nd & 3rd LEVEL PLAN  
1/8" = 1'-0"  
3-STORY, 24-UNIT BUILDING

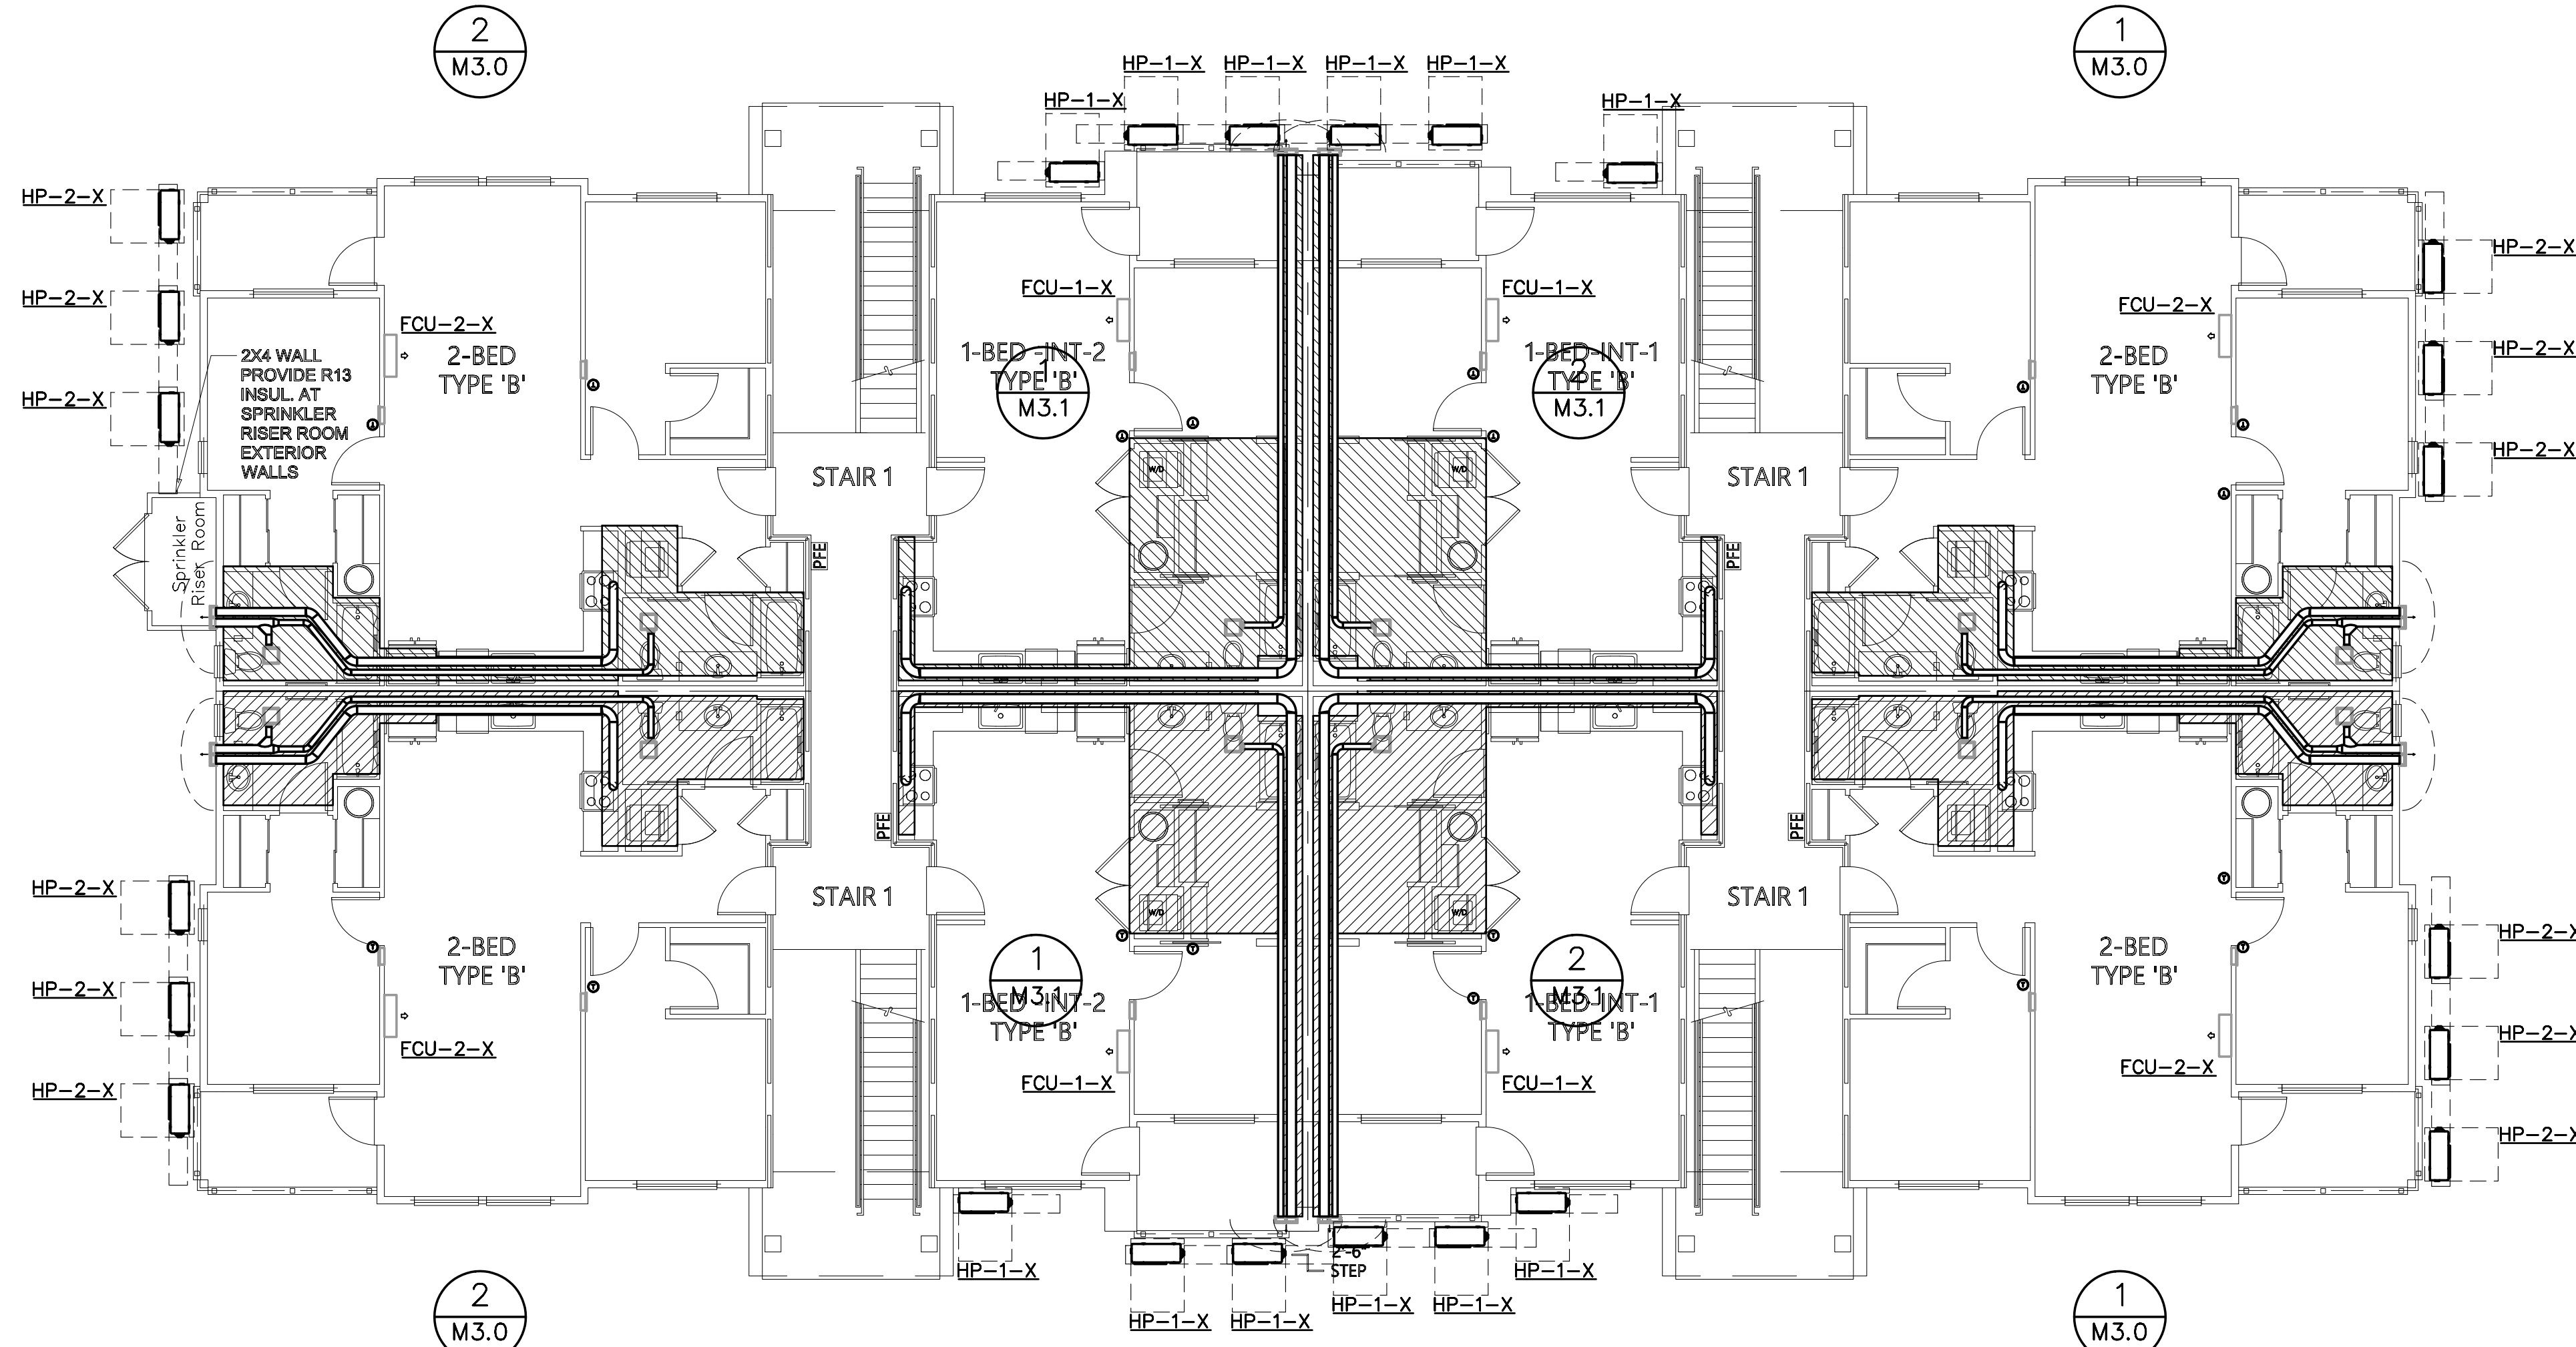

BUILDING H 1st LEVEL PLAN  
1/8" = 1'-0"  
3-STORY, 24-UNIT BUILDING

Duct runs for range hoods on interior units appear to be about 63 feet. Provide specifications on range hood that will accommodate a long run.  
(Construction Set, Sheet M2 and M3.1)

NO.	DATE	DESCRIPTION	REVISIONS

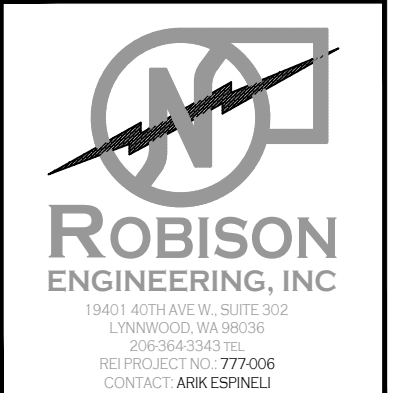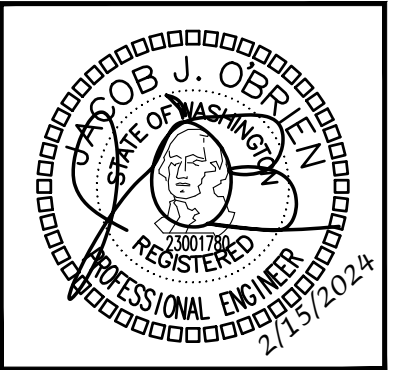

DRAWN:	OP
DESIGNED:	ABE
CHECKED:	ABE
APPROVED:	JOB

PROJECT: BRADLEY HEIGHT APARTMENTS - BUILDING H  
202 27TH AVE SE  
PUYALLUP, WA 98374


19401 40TH AVE W SUITE 302  
LYNNWOOD, WA 98036  
PHONE: (206) 364-3343

**ROBISON**  
ENGINEERING, INC.

DATE: 02/15/2024

SHEET TITLE:  
HVAC PLAN -  
FLOOR PLANS

SHEET NO.  
**M2.0**

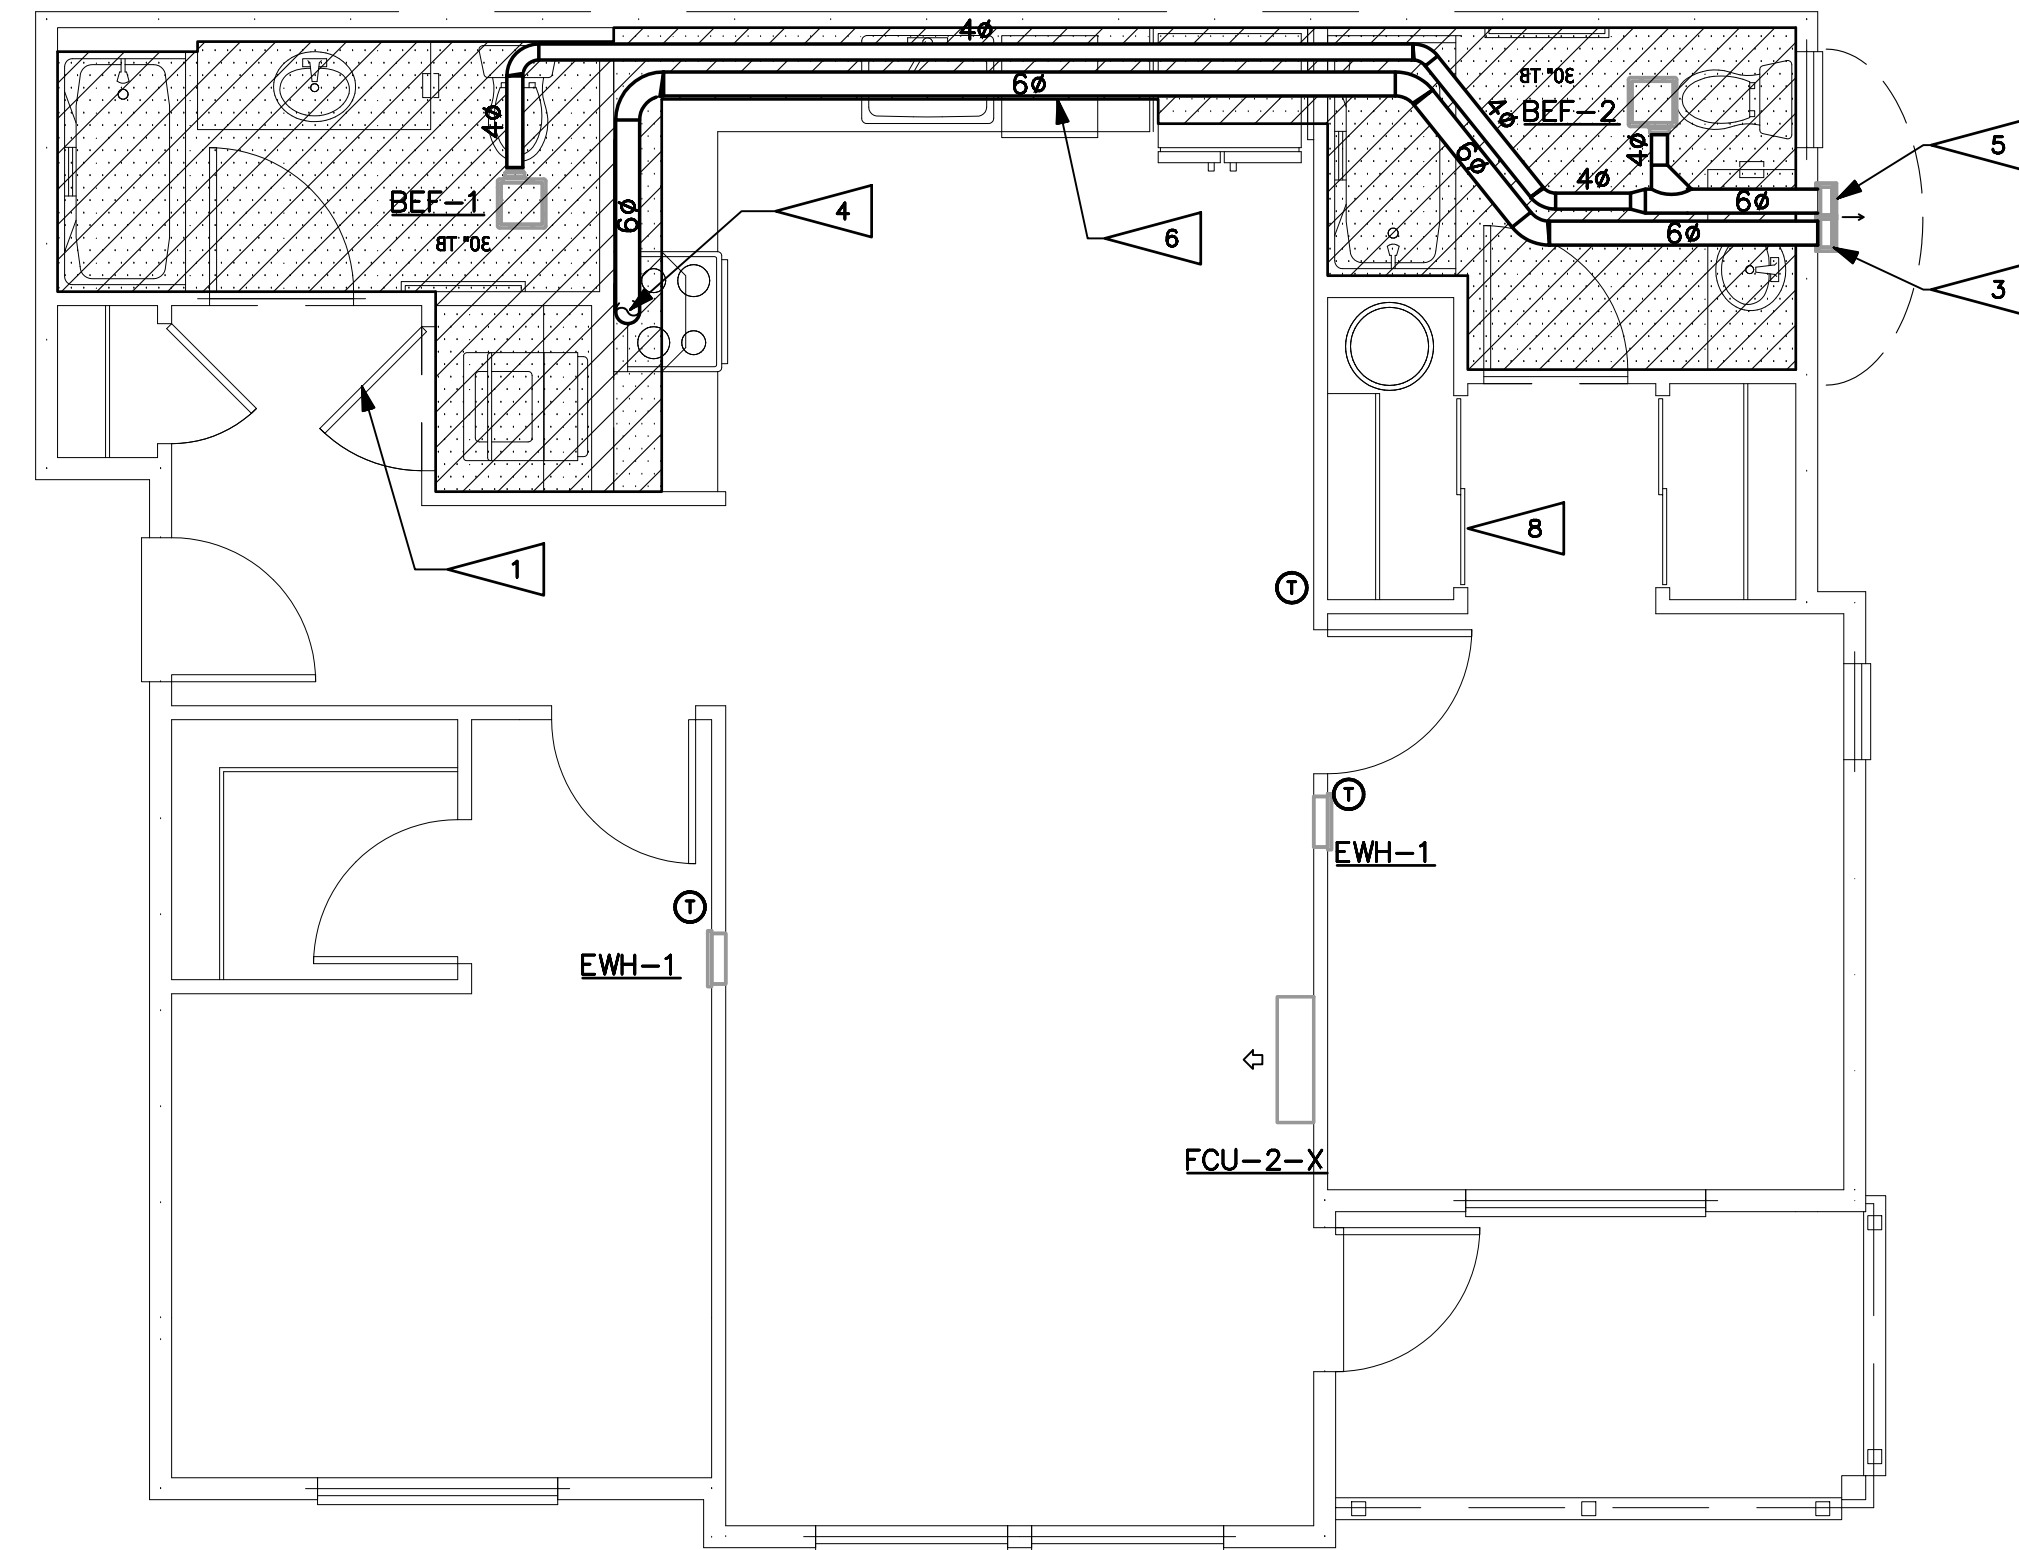


HVAC ENLARGED PLANS

2-BED-ALT-MIRROR

SCALE: 1/4" = 1'-0"

1  
M3.0

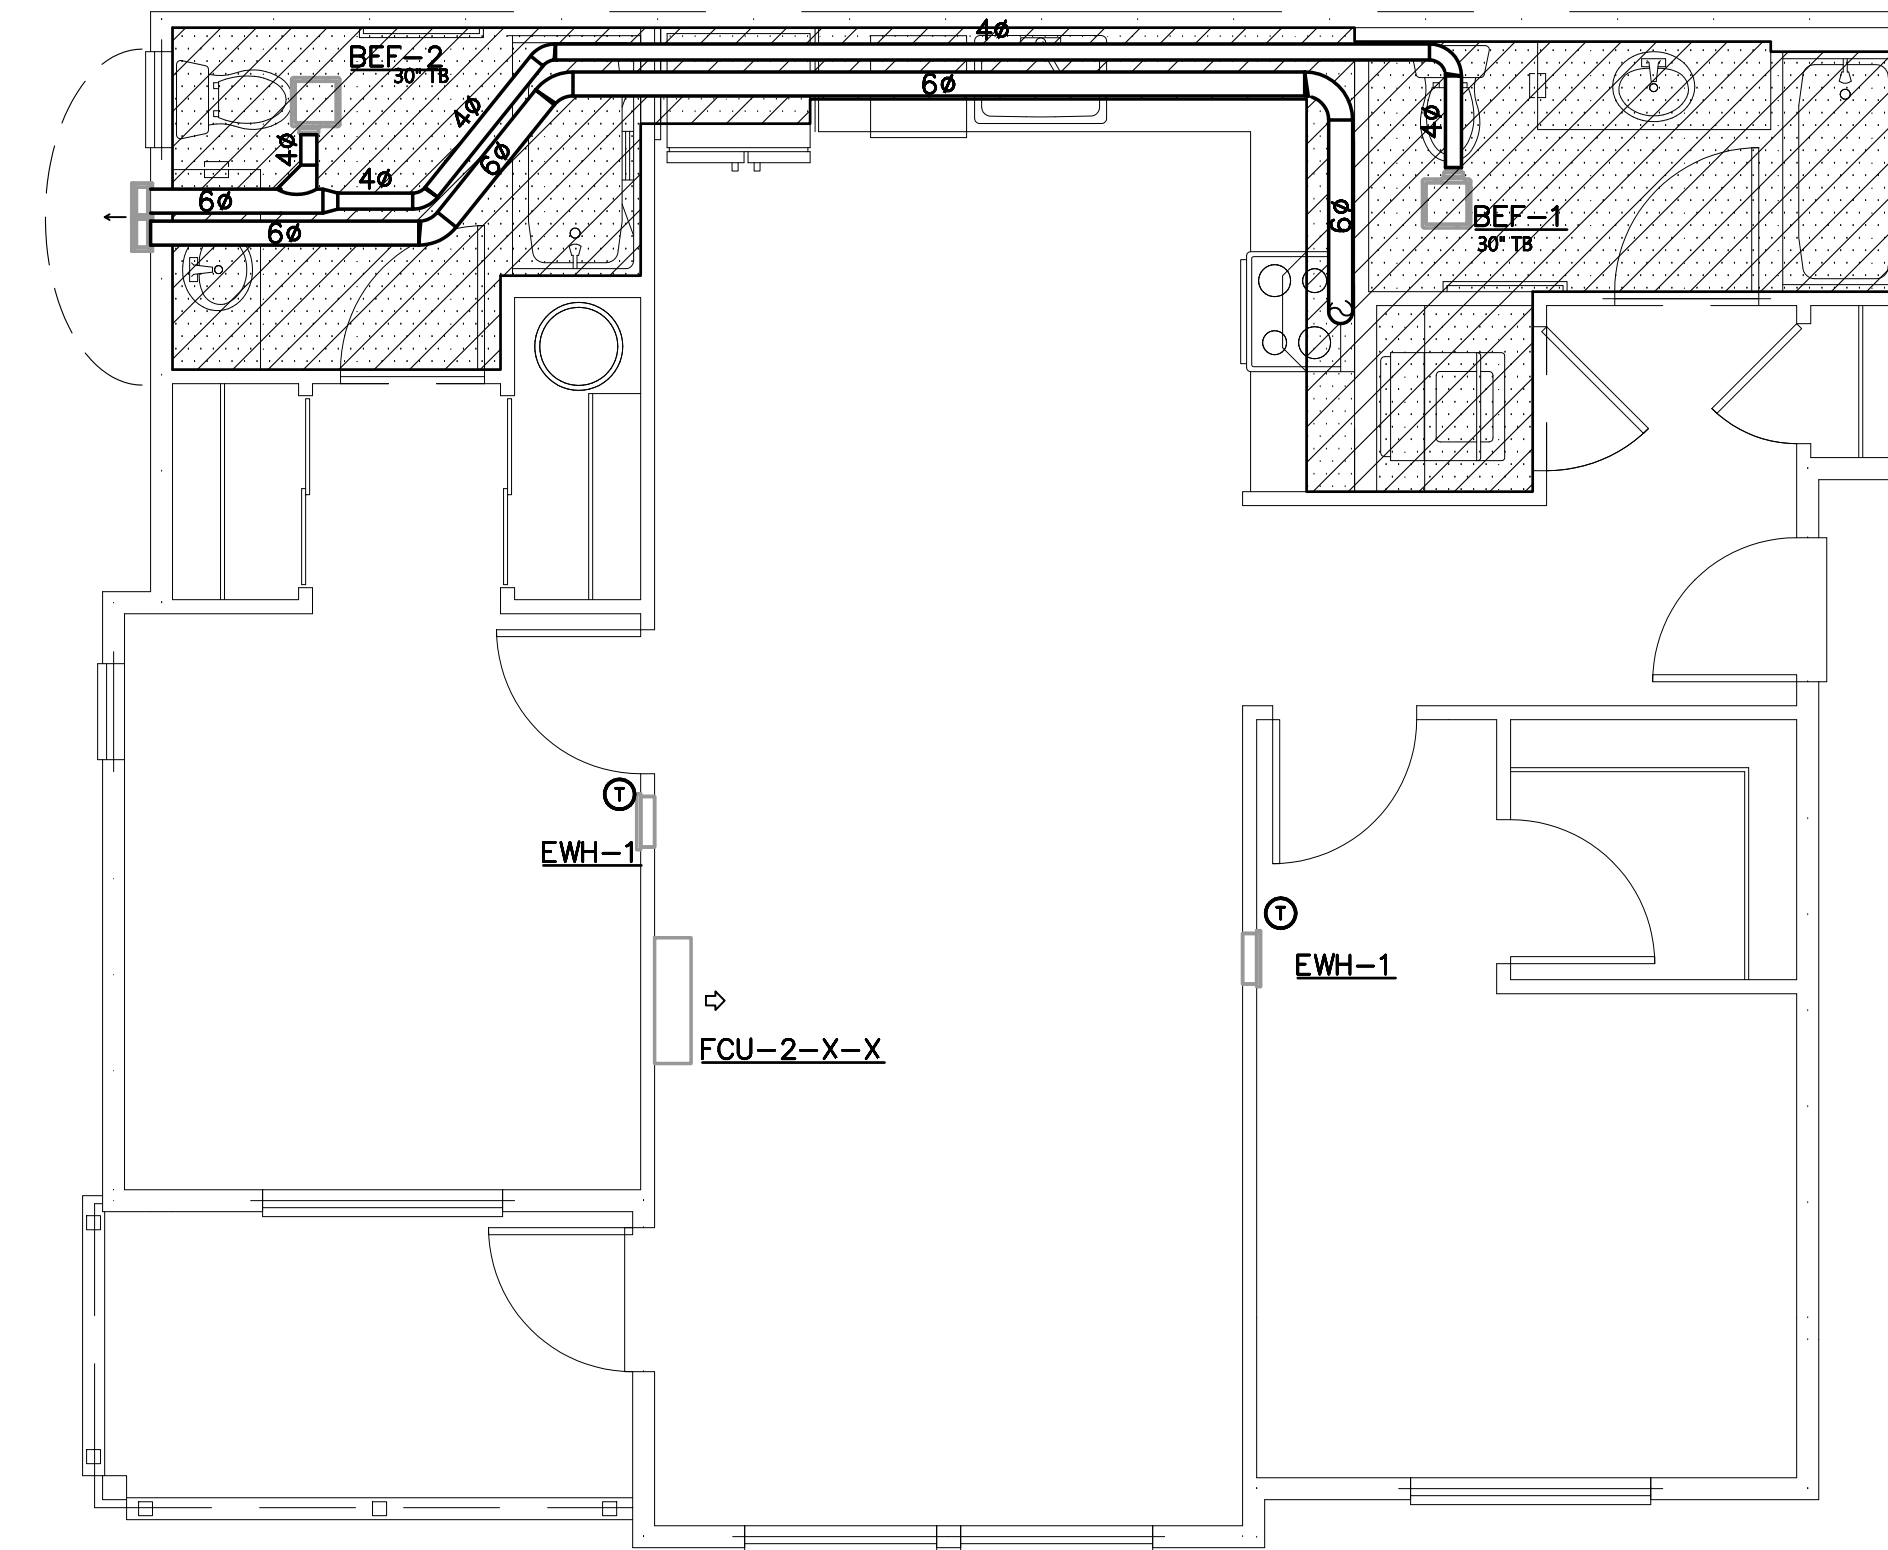

HVAC ENLARGED PLANS

2-BED-ALT

SCALE: 1/4" = 1'-0"

2  
M3.0

GENERAL NOTES:



- ENVIRONMENTAL EXHAUST TERMINATIONS: MAINTAIN 3 FOOT SEPARATION FROM PROPERTY LINES AND OPERABLE OPENINGS INTO BUILDING, 10 FEET FROM MECHANICAL AIR INTAKES.
- MOUNT REMOTE THERMOSTATS 48" AFF. PER WSEC C403.4.9, AT LEAST ONE THERMOSTAT SHALL BE PROGRAMMABLE ON A 5-2 SCHEDULE.
- UNDERCUT ALL BATHROOM DOORS BY MINIMUM 1/2" TO ALLOW TRANSFER OF MAKEUP AIR FOR BATHROOM EXHAUST.
- ELECTRIC WALL HEATERS SHALL BE RECESSED IN WALL UNLESS FIRE RATED OR EXTERIOR WALL. FOR HEATERS MOUNTED ON SUCH WALL, PROVIDE SURFACE-MOUNT WALL CAN.
- PROVIDE ACCESSIBLE MANUAL VOLUME DAMPERS AT BRANCHES OR OPPOSED-BLADE DAMPERS AT GRILLES FOR AIR BALANCING PER VOLUME DAMPERS NOTE ON SHEET M0.00.

FLAG NOTES:

- CLOSETS CONTAINING DRYERS SHALL BE PROVIDED WITH LOUVERED DOOR OR 100 SQ. IN FREE-AREA OPENING ABOVE DOOR. OPENING PROVIDES PATH FOR EXHAUST AIR DURING WASHER OPERATION PER WSMC TABLE 403.3.1.1 NOTE (I) AND MAKEUP AIR DURING DRYER OPERATION PER 504.6.
- 4" POC TO DRYER. PROVIDE METAL DRYER BOX WHERE DUCT IS ROUTED IN 2x6 FRAMED WALL. REFER TO MANUFACTURER'S INSTALLATION INSTRUCTIONS AND WSMC 504.8.4.1 FOR THE MAXIMUM ALLOWED LENGTH OF THE DRYER VENT. PROVIDE PERMANENT PLACARD OF TYPE PLAC34 SHOWING NET EQUIVALENT LENGTH. DUCT SHALL REMAIN SEPARATE FROM OTHER EXHAUST SYSTEMS UP TO TERMINATION.
- 4" DRYER EXHAUST TERMINATION WALL CAP. PROVIDE BACKDRAFT DAMPER AT TERMINATION. DO NOT INSTALL SCREENS ON DRYER EXHAUST TERMINATIONS. CLEARANCES PER GENERAL NOTE 1.

- POC TO DOMESTIC KITCHEN RANGE HOOD. SEE PLANS FOR SIZE. DUCT SHALL REMAIN SEPARATE FROM OTHER EXHAUST SYSTEMS UP TO TERMINATION.
- DOMESTIC KITCHEN RANGE HOOD EXHAUST TERMINATION WALL CAP WITH SCREEN. PROVIDE BACKDRAFT DAMPER AT TERMINATION. CLEARANCES PER GENERAL NOTE 1.
- LOWERED SOFFIT FOR MECHANICAL EQUIPMENT.
- 8" POC FOR HEAT PUMP WATER HEATER EXHAUST.
- CLOSETS CONTAINING WATER HEATERS SHALL BE PROVIDED WITH MINIMUM 3/4" UNDERCUT.

NO.	DATE	DESCRIPTION	REVISIONS

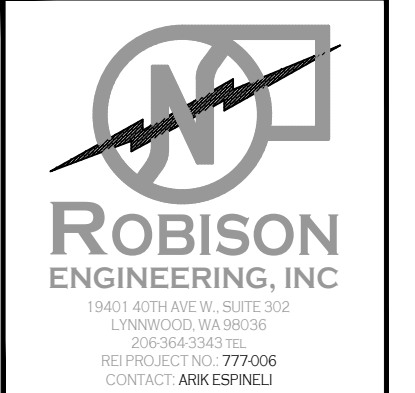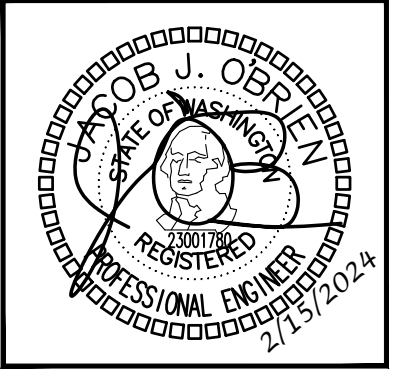

DRAWN:	OP
DESIGNED:	ABE
CHECKED:	ABE
APPROVED:	JOB

PROJECT: BRADLEY HEIGHT APARTMENTS - BUILDING H  
202 27TH AVE SE  
PUYALLUP, WA 98374


19401 40TH AVE. W. SUITE 302  
LYNNWOOD, WA 98036  
PHONE: (206) 864-3343

**ROBISON**  
ENGINEERING, INC

DATE: 02/15/2024

SHEET TITLE:  
HVAC  
ENLARGED  
PLANS

SHEET NO.  
M3.0

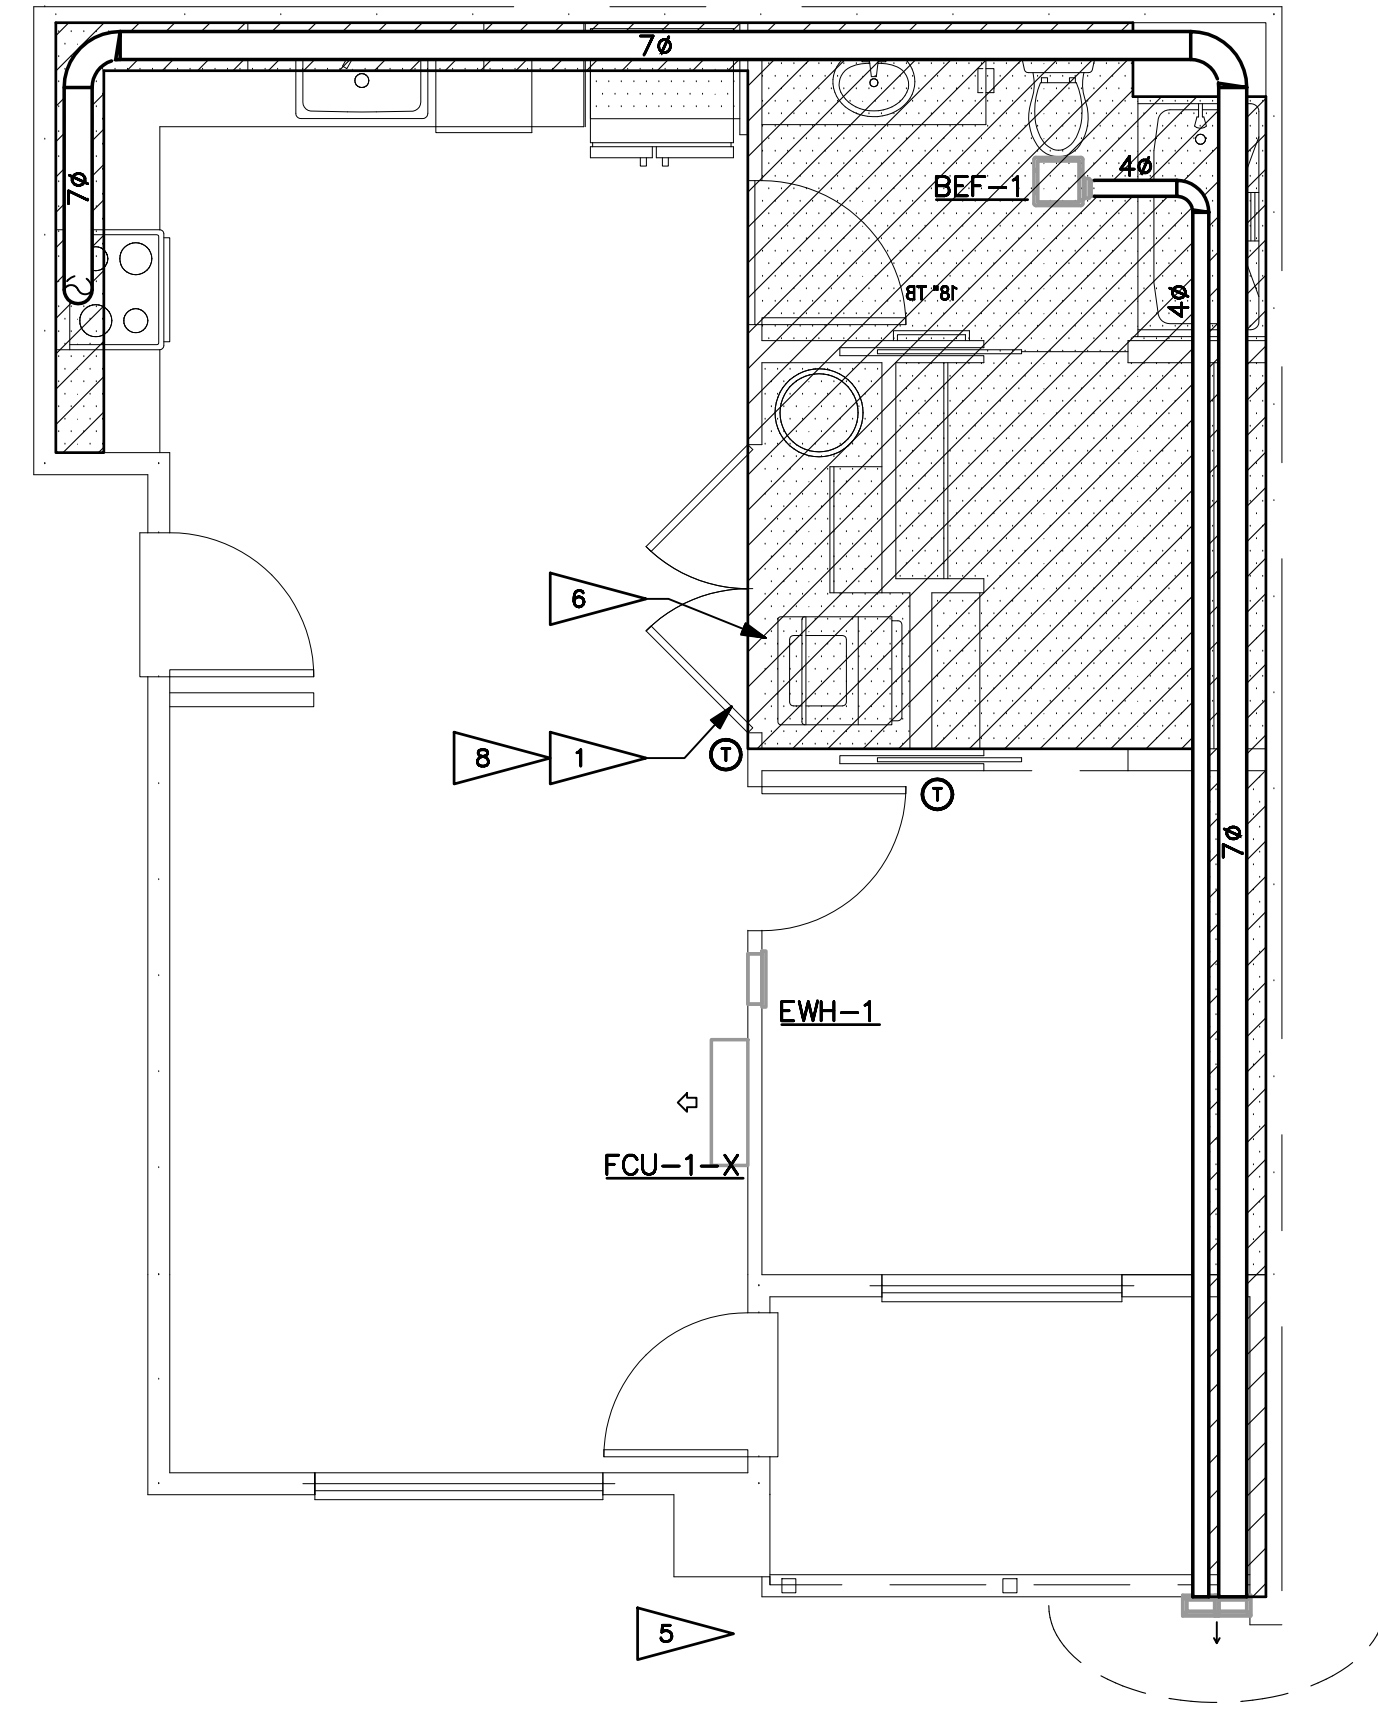


HVAC ENLARGED PLANS

1-BED-INT-1

SCALE: 1/4" = 1'-0"

1  
M3.1

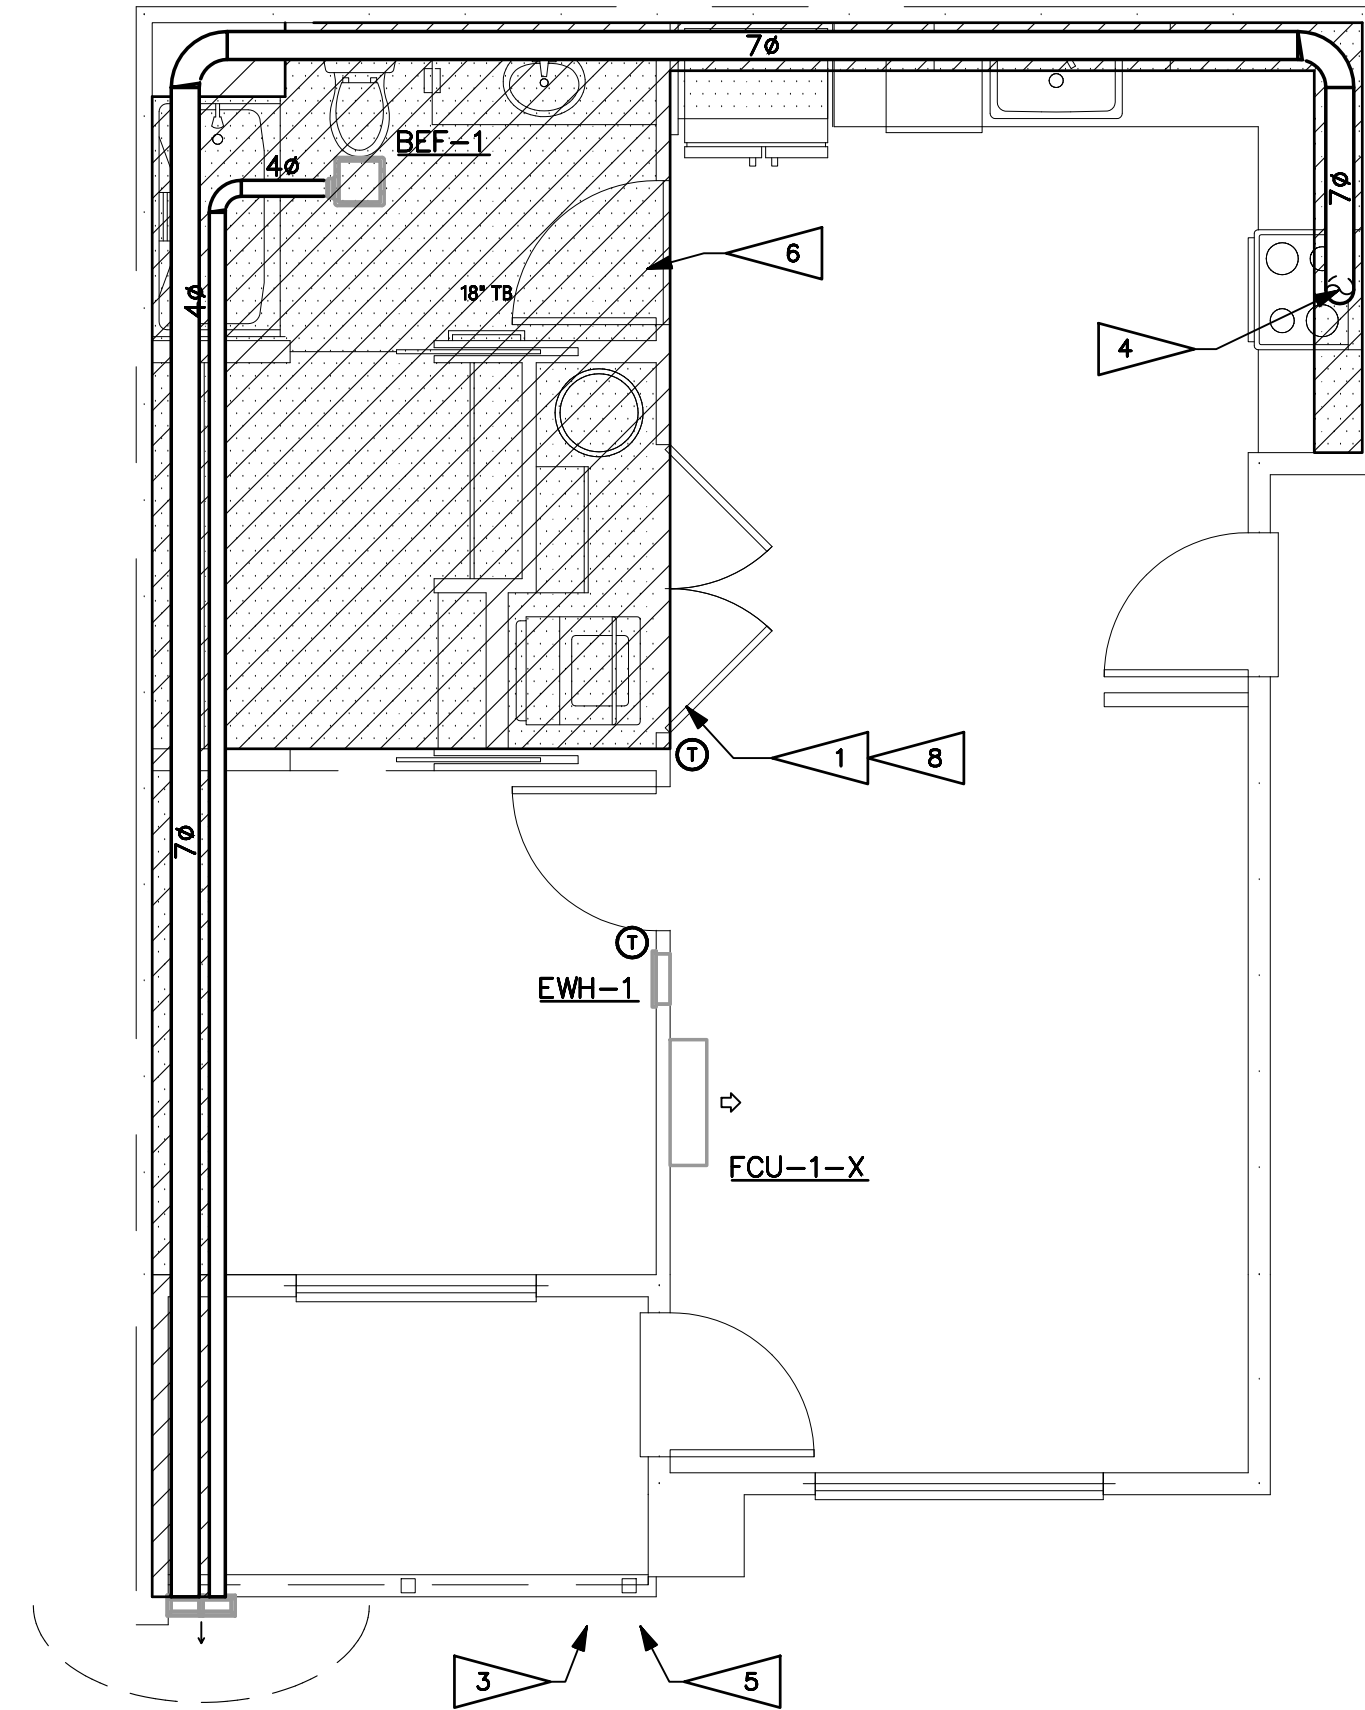


HVAC ENLARGED PLANS

1-BED-INT-2

SCALE: 1/4" = 1'-0"

2  
M3.1

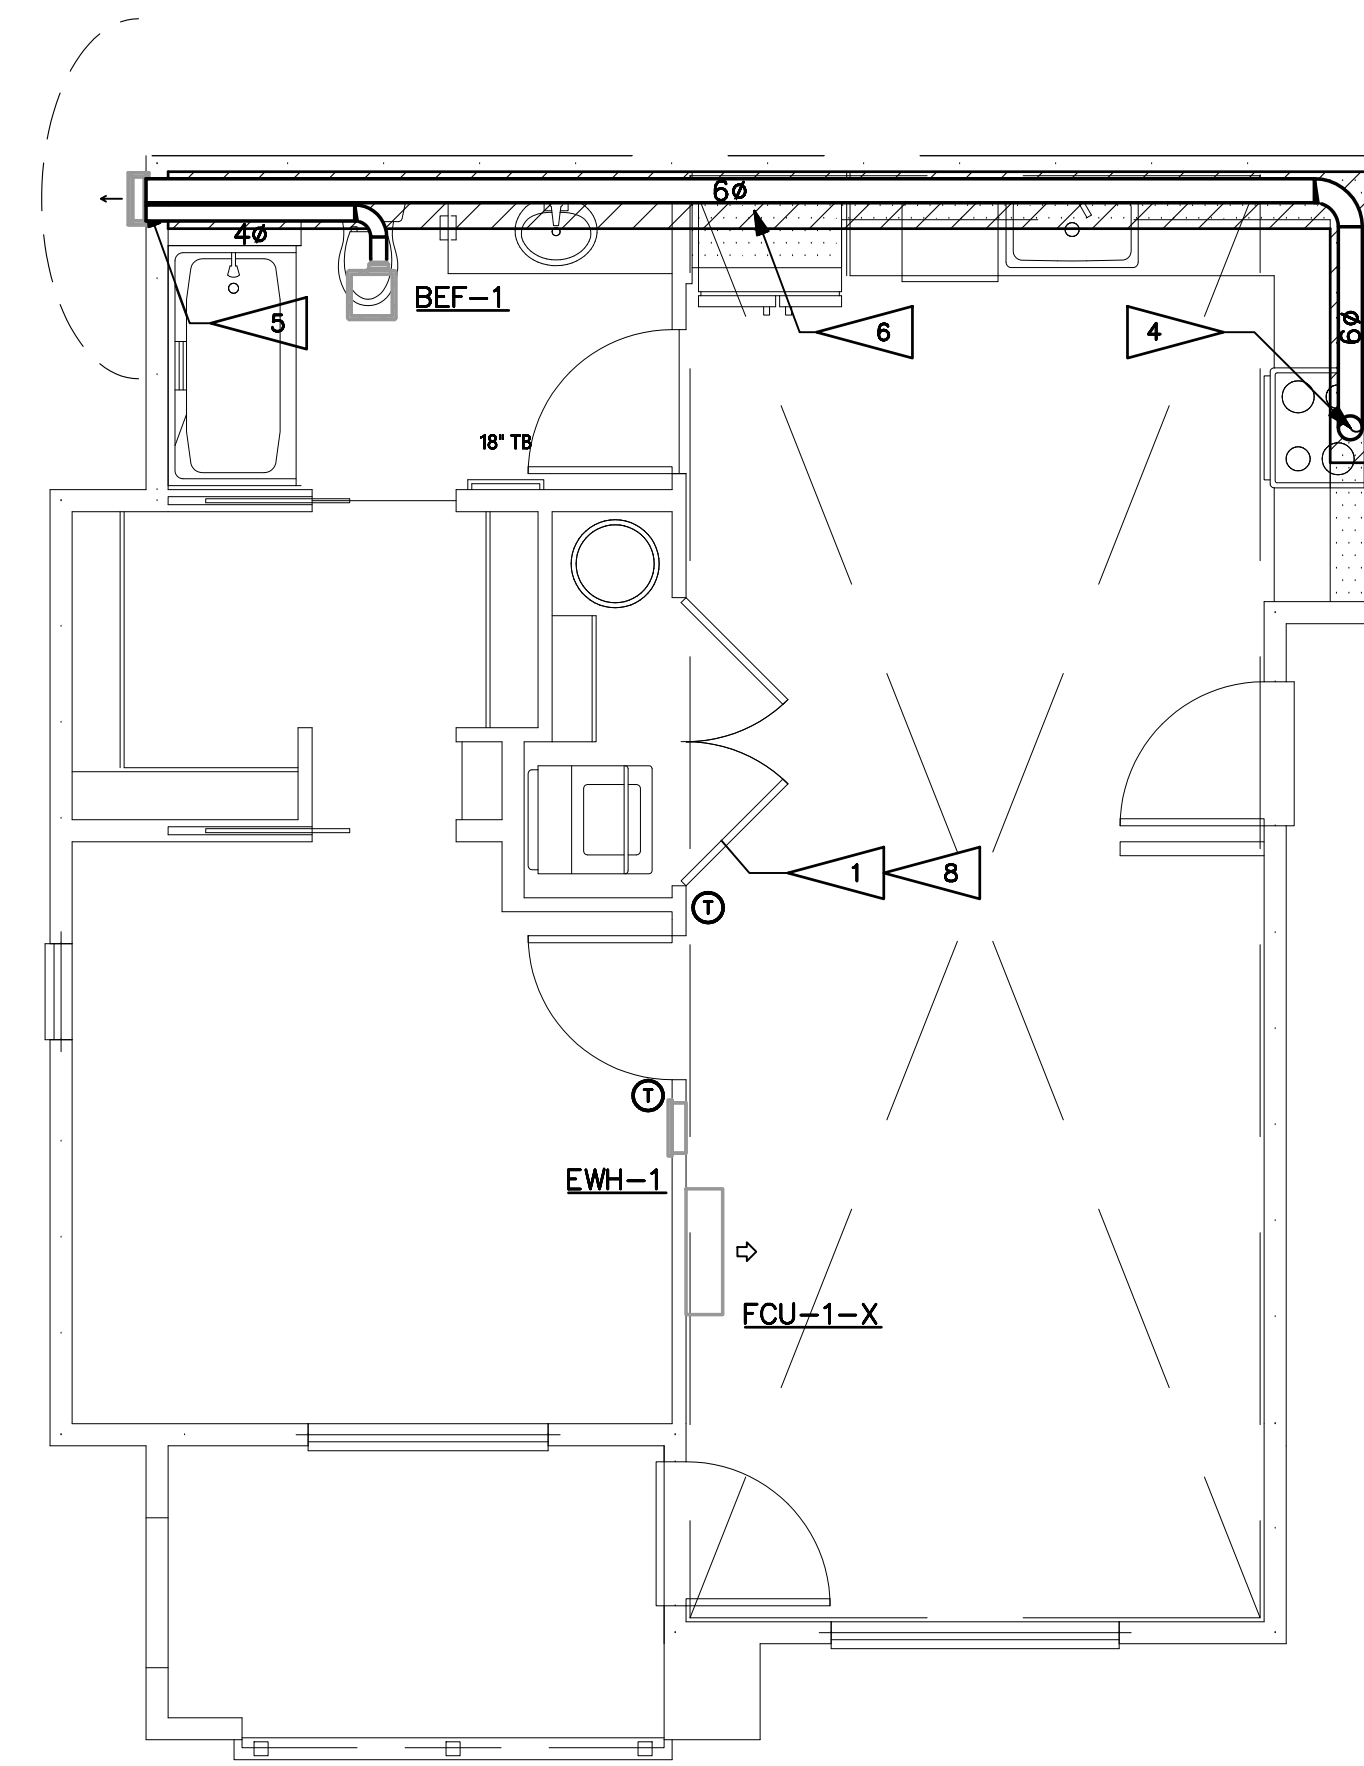

HVAC ENLARGED PLANS

1-BED-END

SCALE: 1/4" = 1'-0"

3  
M3.1

GENERAL NOTES:


- ENVIRONMENTAL EXHAUST TERMINATIONS: MAINTAIN 3 FOOT SEPARATION FROM PROPERTY LINES AND OPERABLE OPENINGS INTO BUILDING, 10 FEET FROM MECHANICAL AIR INTAKES.
- MOUNT REMOTE THERMOSTATS 48" AFF. PER WSEC C403.4.9, AT LEAST ONE THERMOSTAT SHALL BE PROGRAMMABLE ON A 5-2 SCHEDULE.
- UNDERCUT ALL BATHROOM DOORS BY MINIMUM 1/2" TO ALLOW TRANSFER OF MAKEUP AIR FOR BATHROOM EXHAUST.
- ELECTRIC WALL HEATERS SHALL BE RECESSED IN WALL UNLESS FIRE RATED OR EXTERIOR WALL. FOR HEATERS MOUNTED ON SUCH WALL, PROVIDE SURFACE-MOUNT WALL CAN.
- PROVIDE ACCESSIBLE MANUAL VOLUME DAMPERS AT BRANCHES OR OPPOSED-BLADE DAMPERS AT GRILLES FOR AIR BALANCING PER VOLUME DAMPERS NOTE ON SHEET M0.00.

FLAG NOTES: #

- CLOSETS CONTAINING DRYERS SHALL BE PROVIDED WITH LOUVERED DOOR OR 100 SQ. IN FREE-AREA OPENING ABOVE DOOR. OPENING PROVIDES PATH FOR EXHAUST AIR DURING WASHER OPERATION PER WSMC TABLE 403.3.1.1 NOTE (I) AND MAKEUP AIR DURING DRYER OPERATION PER 504.6.
- 4ø POC TO DRYER. PROVIDE METAL DRYER BOX WHERE DUCT IS ROUTED IN 2x6 FRAMED WALL. REFER TO MANUFACTURER'S INSTALLATION INSTRUCTIONS AND WSMC 504.8.4.1 FOR THE MAXIMUM ALLOWED LENGTH OF THE DRYER VENT. PROVIDE PERMANENT PLACARD OF TYPE PLAC34 SHOWING NET EQUIVALENT LENGTH. DUCT SHALL REMAIN SEPARATE FROM OTHER EXHAUST SYSTEMS UP TO TERMINATION.
- 4" DRYER EXHAUST TERMINATION WALL CAP. PROVIDE BACKDRAFT DAMPER AT TERMINATION. DO NOT INSTALL SCREENS ON DRYER EXHAUST TERMINATIONS. CLEARANCES PER GENERAL NOTE 1.

- POC TO DOMESTIC KITCHEN RANGE HOOD. SEE PLANS FOR SIZE. DUCT SHALL REMAIN SEPARATE FROM OTHER EXHAUST SYSTEMS UP TO TERMINATION.
- DOMESTIC KITCHEN RANGE HOOD EXHAUST TERMINATION WALL CAP WITH SCREEN. PROVIDE BACKDRAFT DAMPER AT TERMINATION. CLEARANCES PER GENERAL NOTE 1.
- LOWERED SOFFIT FOR MECHANICAL EQUIPMENT.
- 8ø POC FOR HEAT PUMP WATER HEATER EXHAUST.
- CLOSETS CONTAINING WATER HEATERS SHALL BE PROVIDED WITH MINIMUM 3/4" UNDERCUT.

NO.	DATE	DESCRIPTION	REVISIONS

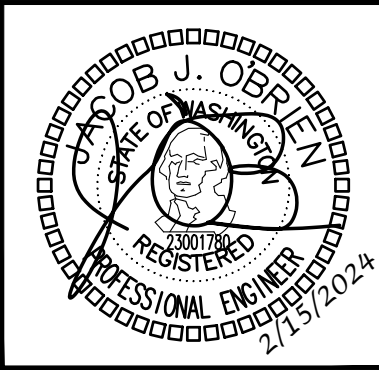

DRAWN:	OP
DESIGNED:	ABE
CHECKED:	ABE
APPROVED:	JOB

PROJECT: BRADLEY HEIGHT APARTMENTS - BUILDING H  
202 27TH AVE SE  
PUYALLUP, WA 98374

19401 40TH AVE W, SUITE 302  
LYNNWOOD, WA 98036  
PHONE: (206) 364-3343

**ROBISON**  
ENGINEERING, INC.

DATE: 02/15/2024

SHEET TITLE:  
HVAC  
ENLARGED  
PLANS

SHEET NO.  
M3.1



## APPLICABLE CODES

THE FOLLOWING PROJECT DESIGN IS BASED ON THE FOLLOWING CODES:

- 2020 NATIONAL ELECTRICAL CODE (NEC)
- 2018 WASHINGTON STATE ENERGY CODE (WSEC)
- 2018 INTERNATIONAL BUILDING CODE (IBC) & WASHINGTON STATE AMENDMENTS
- 2018 INTERNATIONAL FIRE CODE (IFC) & WASHINGTON STATE AMENDMENTS
- 2018 INTERNATIONAL MECHANICAL CODE (IMC) & WASHINGTON STATE AMENDMENTS
- 2018 UNIFORM PLUMBING CODE (UPC) & WASHINGTON STATE AMENDMENTS

## VIBRATION AND ACOUSTICAL ISOLATION

THE FOLLOWING MEASURES SHALL BE TAKEN TO MINIMIZE VIBRATION AND NOISE TRANSMISSION FROM MECHANICAL AND ELECTRICAL EQUIPMENT TO THE INTERIOR SPACES:

TRANSFORMERS:

- A) PROVIDE FLEXIBLE CONDUIT OR MC CABLE AT EQUIPMENT CONNECTION.
- B) MOUNT TRANSFORMERS ON NEOPRENE GROMMET ISOLATORS.

SUBDUCT EXHAUST FANS:

- A) PROVIDE FLEXIBLE CONDUIT OR MC CABLE AT EQUIPMENT CONNECTION.

ENCLOSED GARAGE EXHAUST FANS:

- A) PROVIDE FLEXIBLE CONDUIT OR MC CABLE AT EQUIPMENT CONNECTION.

ROOFTOP AIR HANDLERS:

- A) PROVIDE FLEXIBLE CONDUIT OR MC CABLE AT EQUIPMENT CONNECTION.

FAN COIL UNITS:

- A) PROVIDE FLEXIBLE CONDUIT OR MC CABLE AT EQUIPMENT CONNECTION.

ROOF MOUNTED CONDENSERS:

- A) PROVIDE FLEXIBLE CONDUIT OR MC CABLE AT EQUIPMENT CONNECTION.

FLEXIBLE CONDUIT OR MC CABLE CONNECTIONS FOR VIBRATION ISOLATION SHALL BE A MINIMUM OF TWO FEET LONG.


## TEMPERATURE LIMITATION OF CONDUCTORS

ADDITIONAL ADJUSTMENTS FOR CONDUITS EXPOSED TO SUNLIGHT ON OR ABOVE ROOFTOPS SHALL BE FACTORED PER NEC TABLE 310.15(B)(2)(C)

## CONDUIT & CONDUCTOR FIRE RATING

1. CONDUIT FOR ELECTRICAL CONDUCTORS BY THE FACP OR FIRE ALARM SYSTEM SHALL BE IN 2 HOUR RATED ENCLOSURES OR ENCASED IN 2-INCH OF CONCRETE AND RATED CABLE ASSEMBLIES, OR BE CONDUCTORS IN 2 HOUR-RATED RACEWAYS PER NFPA 72.
2. THE EQUIPMENT AND CONTROL WIRING SHALL BE ENCLOSED BY FIRE BARRIERS CONSTRUCTED IN ACCORDANCE WITH IBC SECTION 707 OR HORIZONTAL ASSEMBLIES CONSTRUCTED IN ACCORDANCE WITH IBC SECTION 711, OR USING A 2 HR RATED CABLE SYSTEM OR ENCLOSED WITHIN 2" OF CONCRETE.
3. FIRE ALARM WIRING SHALL COMPLY WITH IBC 907.6.1. WIRING SHALL COMPLY WITH THE REQUIREMENTS OF NFPA 70.
4. RACEWAYS FOR THE DEDICATED BRANCH CIRCUIT(S) REQUIRED FOR PRIMARY POWER TO THE FIRE ALARM CONTROL PANEL (FACP) SHALL BE IN 2 HOUR RATED ENCLOSURES OR ENCASED IN 2-INCH OF CONCRETE AND RATED CABLE ASSEMBLIES, OR BE CONDUCTORS IN 2 HOUR-RATED RACEWAYS PER IBC 907 AND NFPA 72 SECTION 10.6.11.3.1.3

NO.	DATE	DESCRIPTION	REVISIONS

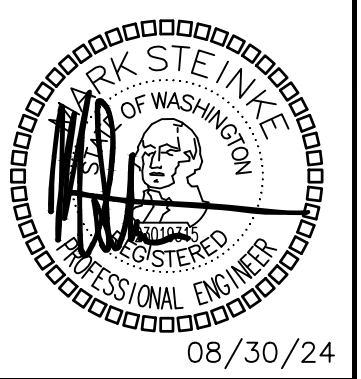

DRAWN: KL	DESIGNED: MHS	CHECKED: PSR	APPROVED: JAY
-----------	---------------	--------------	---------------

PROJECT: BRADLEY HEIGHTS APARTMENTS BUILDING H  
27TH AVE SE AND 5TH ST SE PUYALLUP, WA

19401 40TH AVE W, SUITE 302  
LYNNWOOD, WA 98036  
PHONE: (206) 364-3343


ROBISON ENGINEERING, INC

DATE: 08/30/24

SHEET TITLE:  
LEGEND, GENERAL NOTES, DRAWING INDEX

SHEET NO.  
**E0.01**



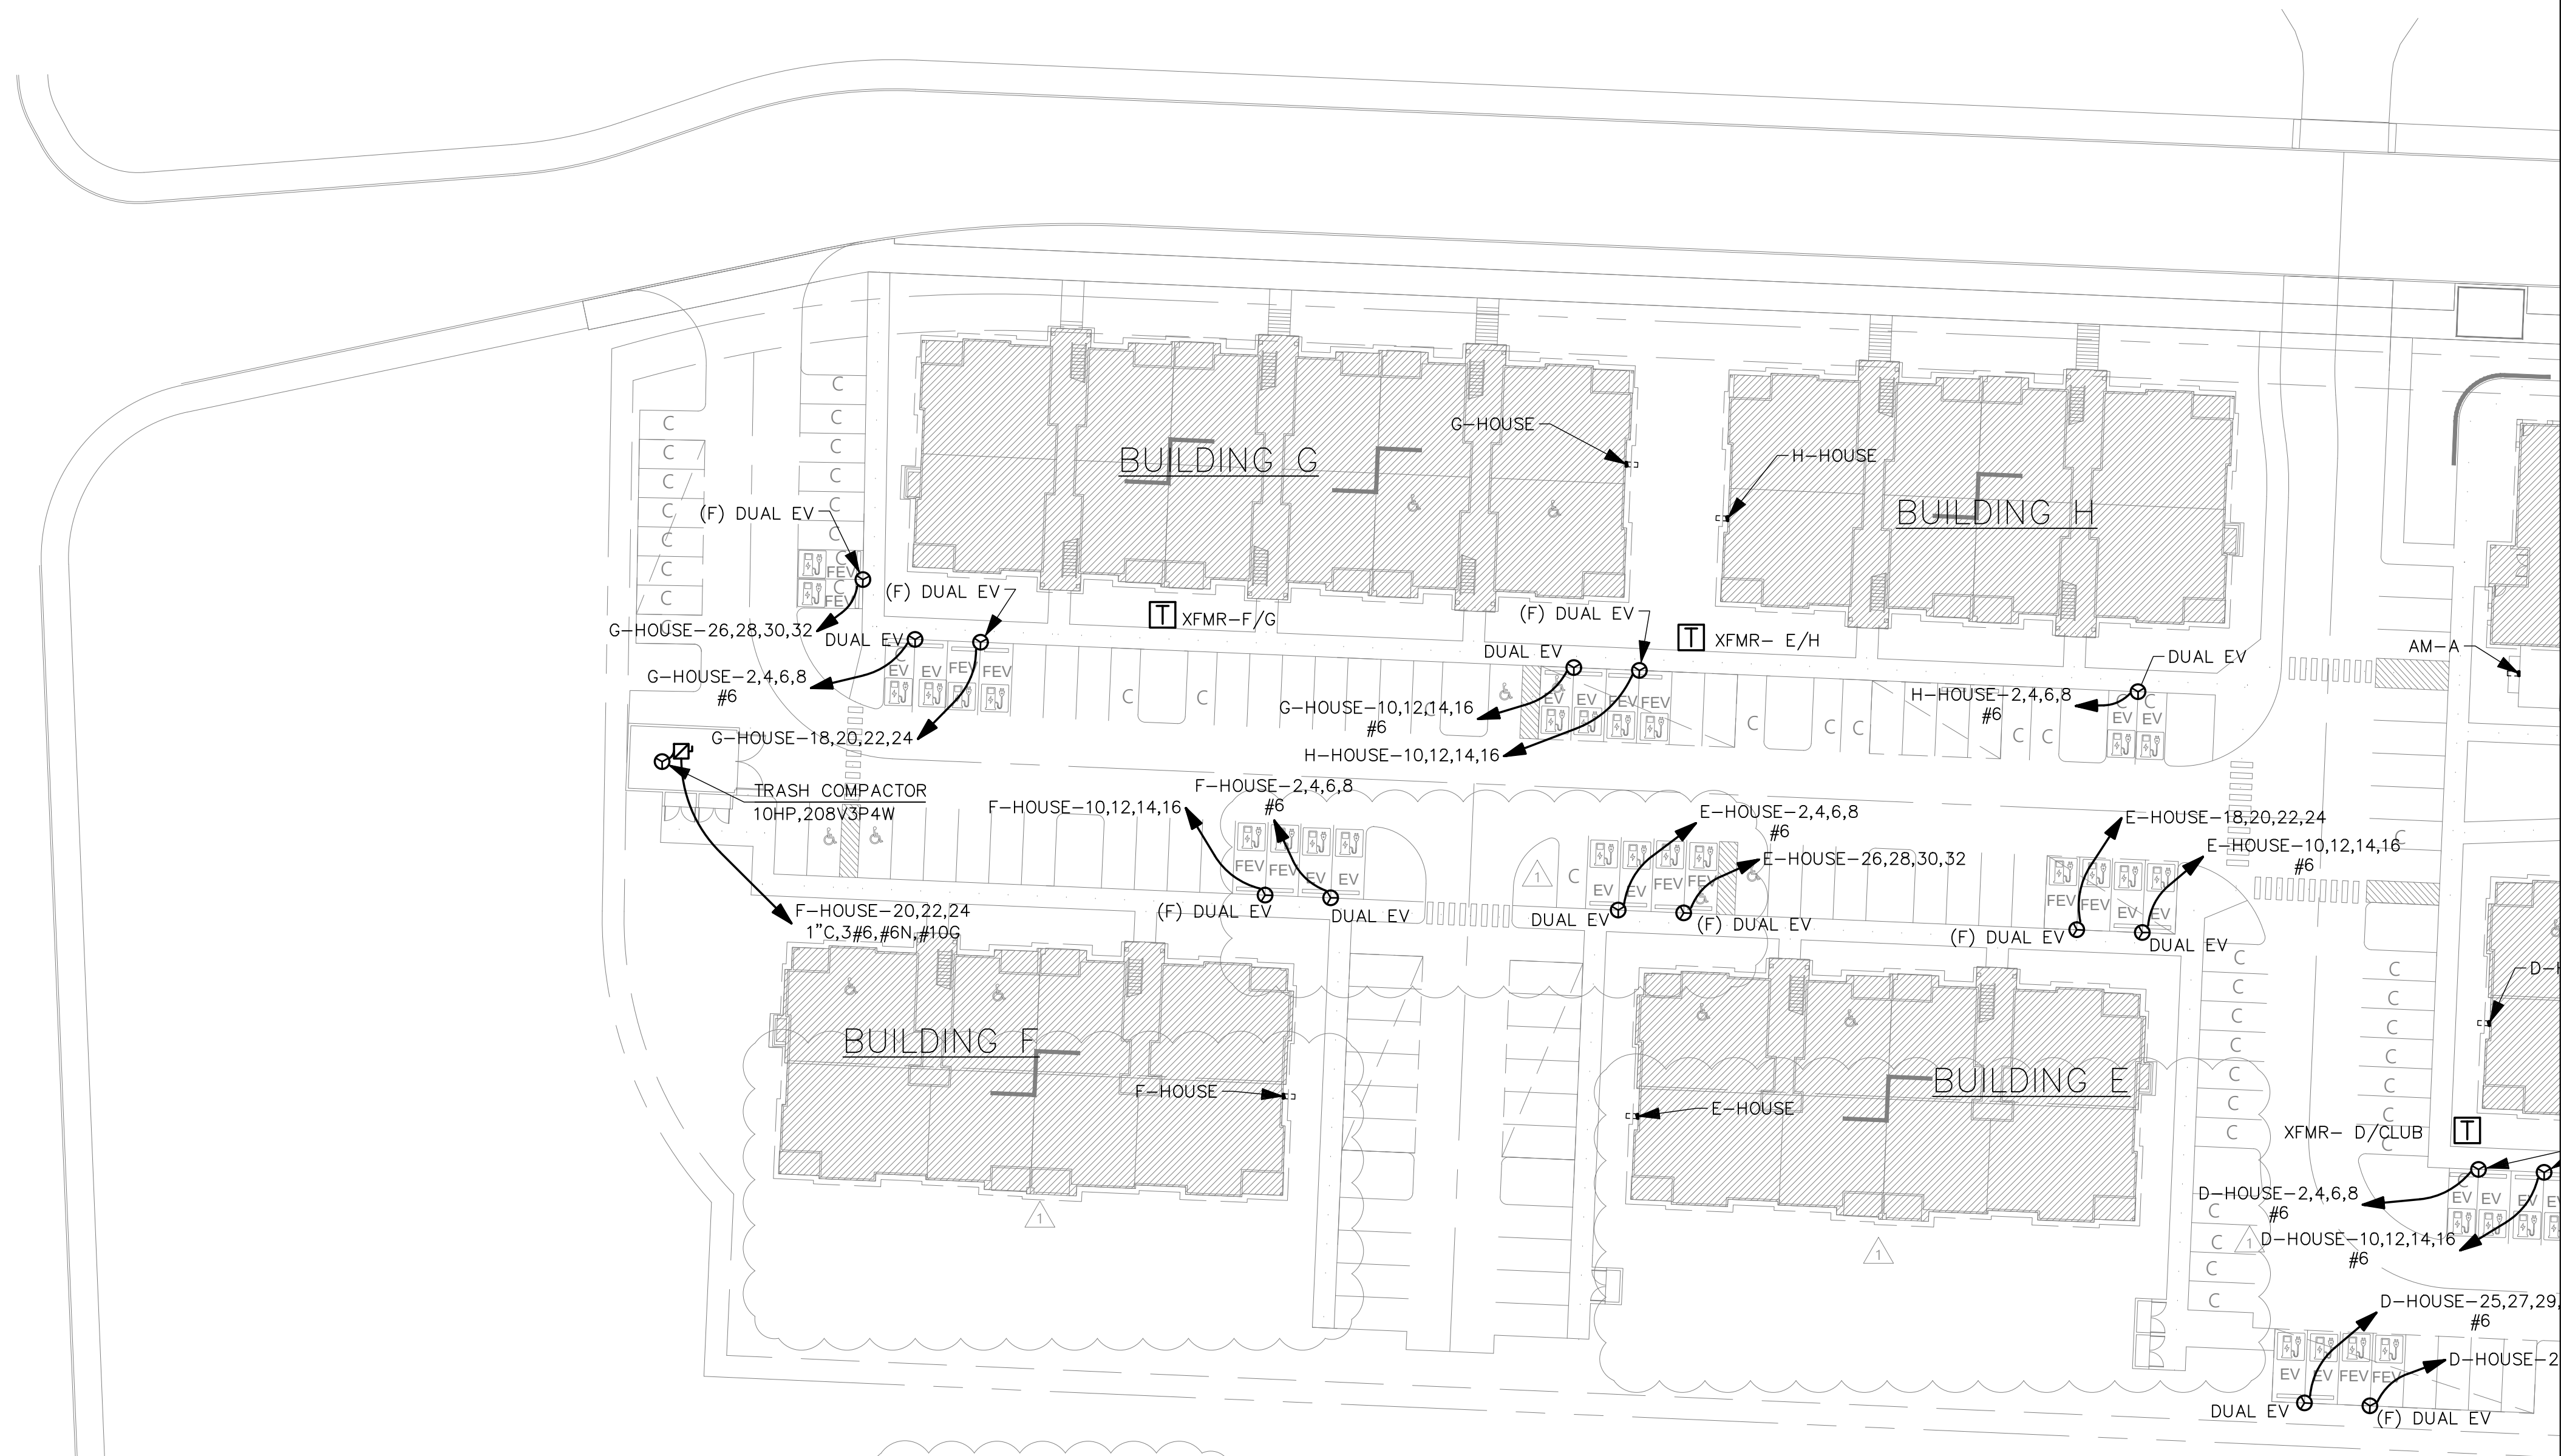


**SITE POWER PLAN – WEST**  
SCALE: 1/32" = 1'-0"

- SHEET NOTES:**
- EV CHARGER LOCATIONS:
    - PROVIDE PRE-FABRICATED EV CHARGING STATION. BOD: PULSAR 40A DUAL EV CHARGERS. PROVIDE (2) 50A CIRCUITS TO EACH DUAL CHARGER.
    - FOUNDATION TO INCLUDE ACCESSIBLE UNDERGROUND PULLBOX, CONDUIT ENTRY PORTS AND COVERPLATE DESIGNED FOR DIRECT-MOUNTING EV CHARGER PEDESTAL.
    - PROVIDE FOUNDATION PRODUCTS BY BREEZE-EV, EV-BLOCKS OR EQUIVALENT.
    - IF FOUNDATION IS INSTALLED LESS THAN 2'-0" FROM THE EDGE OF THE CURB, THEN PROVIDE A BOLLARD AT EACH CORNER OF THE FOUNDATION THAT COMPLIES WITH 2018 IBC 1607.9
  - (F) DUAL EV CHARGING STATIONS: PROVIDE 1-1/4" CONDUIT WITH PULL WIRE FROM EV PANEL(S) IN ELECTRICAL ROOM AS INDICATED.
  - DUAL EV CHARGING STATIONS: PROVIDE AND INSTALL 1-1/4" CONDUIT, CONDUCTORS, AND REQUIRED BREAKERS FOR DUAL EV CHARGING STATIONS.

**SITE PLAN**  
1" = 40'

NO.	DATE	DESCRIPTION	REVISIONS

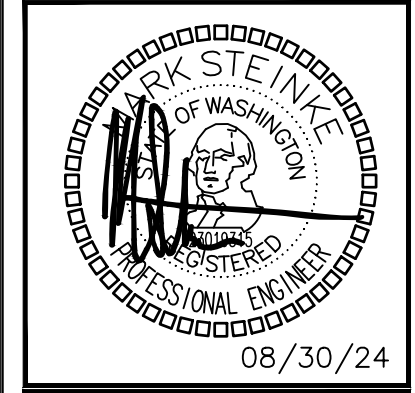

DRAWN: KL	DESIGNED: MHS	CHECKED: PSR	APPROVED: JAY
-----------	---------------	--------------	---------------

PROJECT: BRADLEY HEIGHTS APARTMENTS BUILDING H  
27TH AVE SE AND 5TH ST SE PUYALLUP, WA


19401 40TH AVE W, SUITE 302  
LYNNWOOD, WA 98036  
PHONE: (206) 364-3343

**ROBISON ENGINEERING, INC.**

DATE: 08/30/24

SHEET TITLE:  
**SITE POWER - WEST SITE PLAN**

SHEET NO.  
**E0.10**

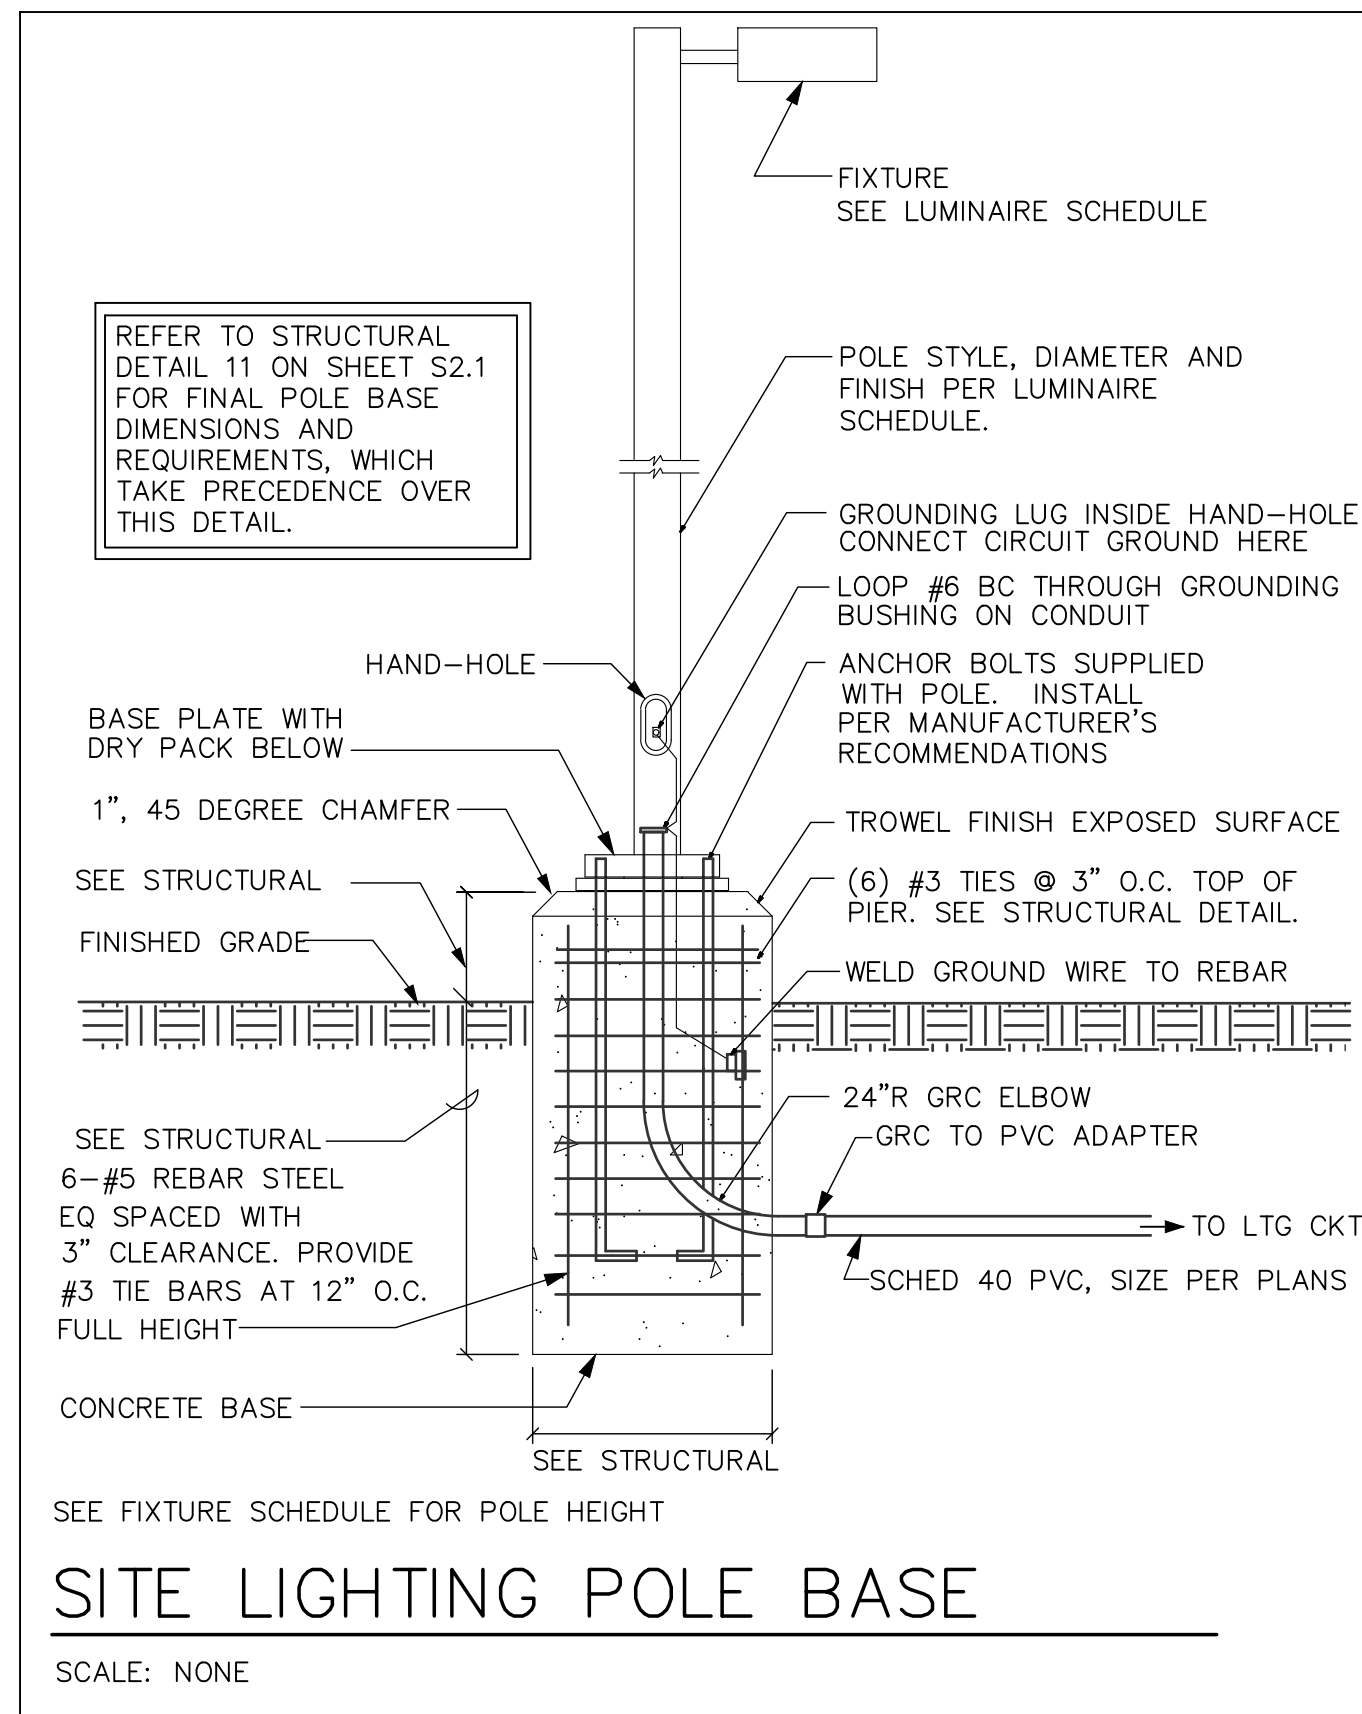


**SITE LIGHTING POLE BASE**

*Drive Aisle Photometric Schedule*

AVERAGE FOOT-CANDLES	0.74
MAXIMUM FOOT-CANDLES	10.5
MINIMUM FOOT-CANDLES	0.0
MAXIMUM TO MINIMUM FC RATIO	912.07
AVERAGE TO MINIMUM FC RATIO	64.31

*Walkway Photometric Schedule*


AVERAGE FOOT-CANDLES	0.82
MAXIMUM FOOT-CANDLES	3.1
MINIMUM FOOT-CANDLES	0.1
MAXIMUM TO MINIMUM FC RATIO	41.68
AVERAGE TO MINIMUM FC RATIO	11.02

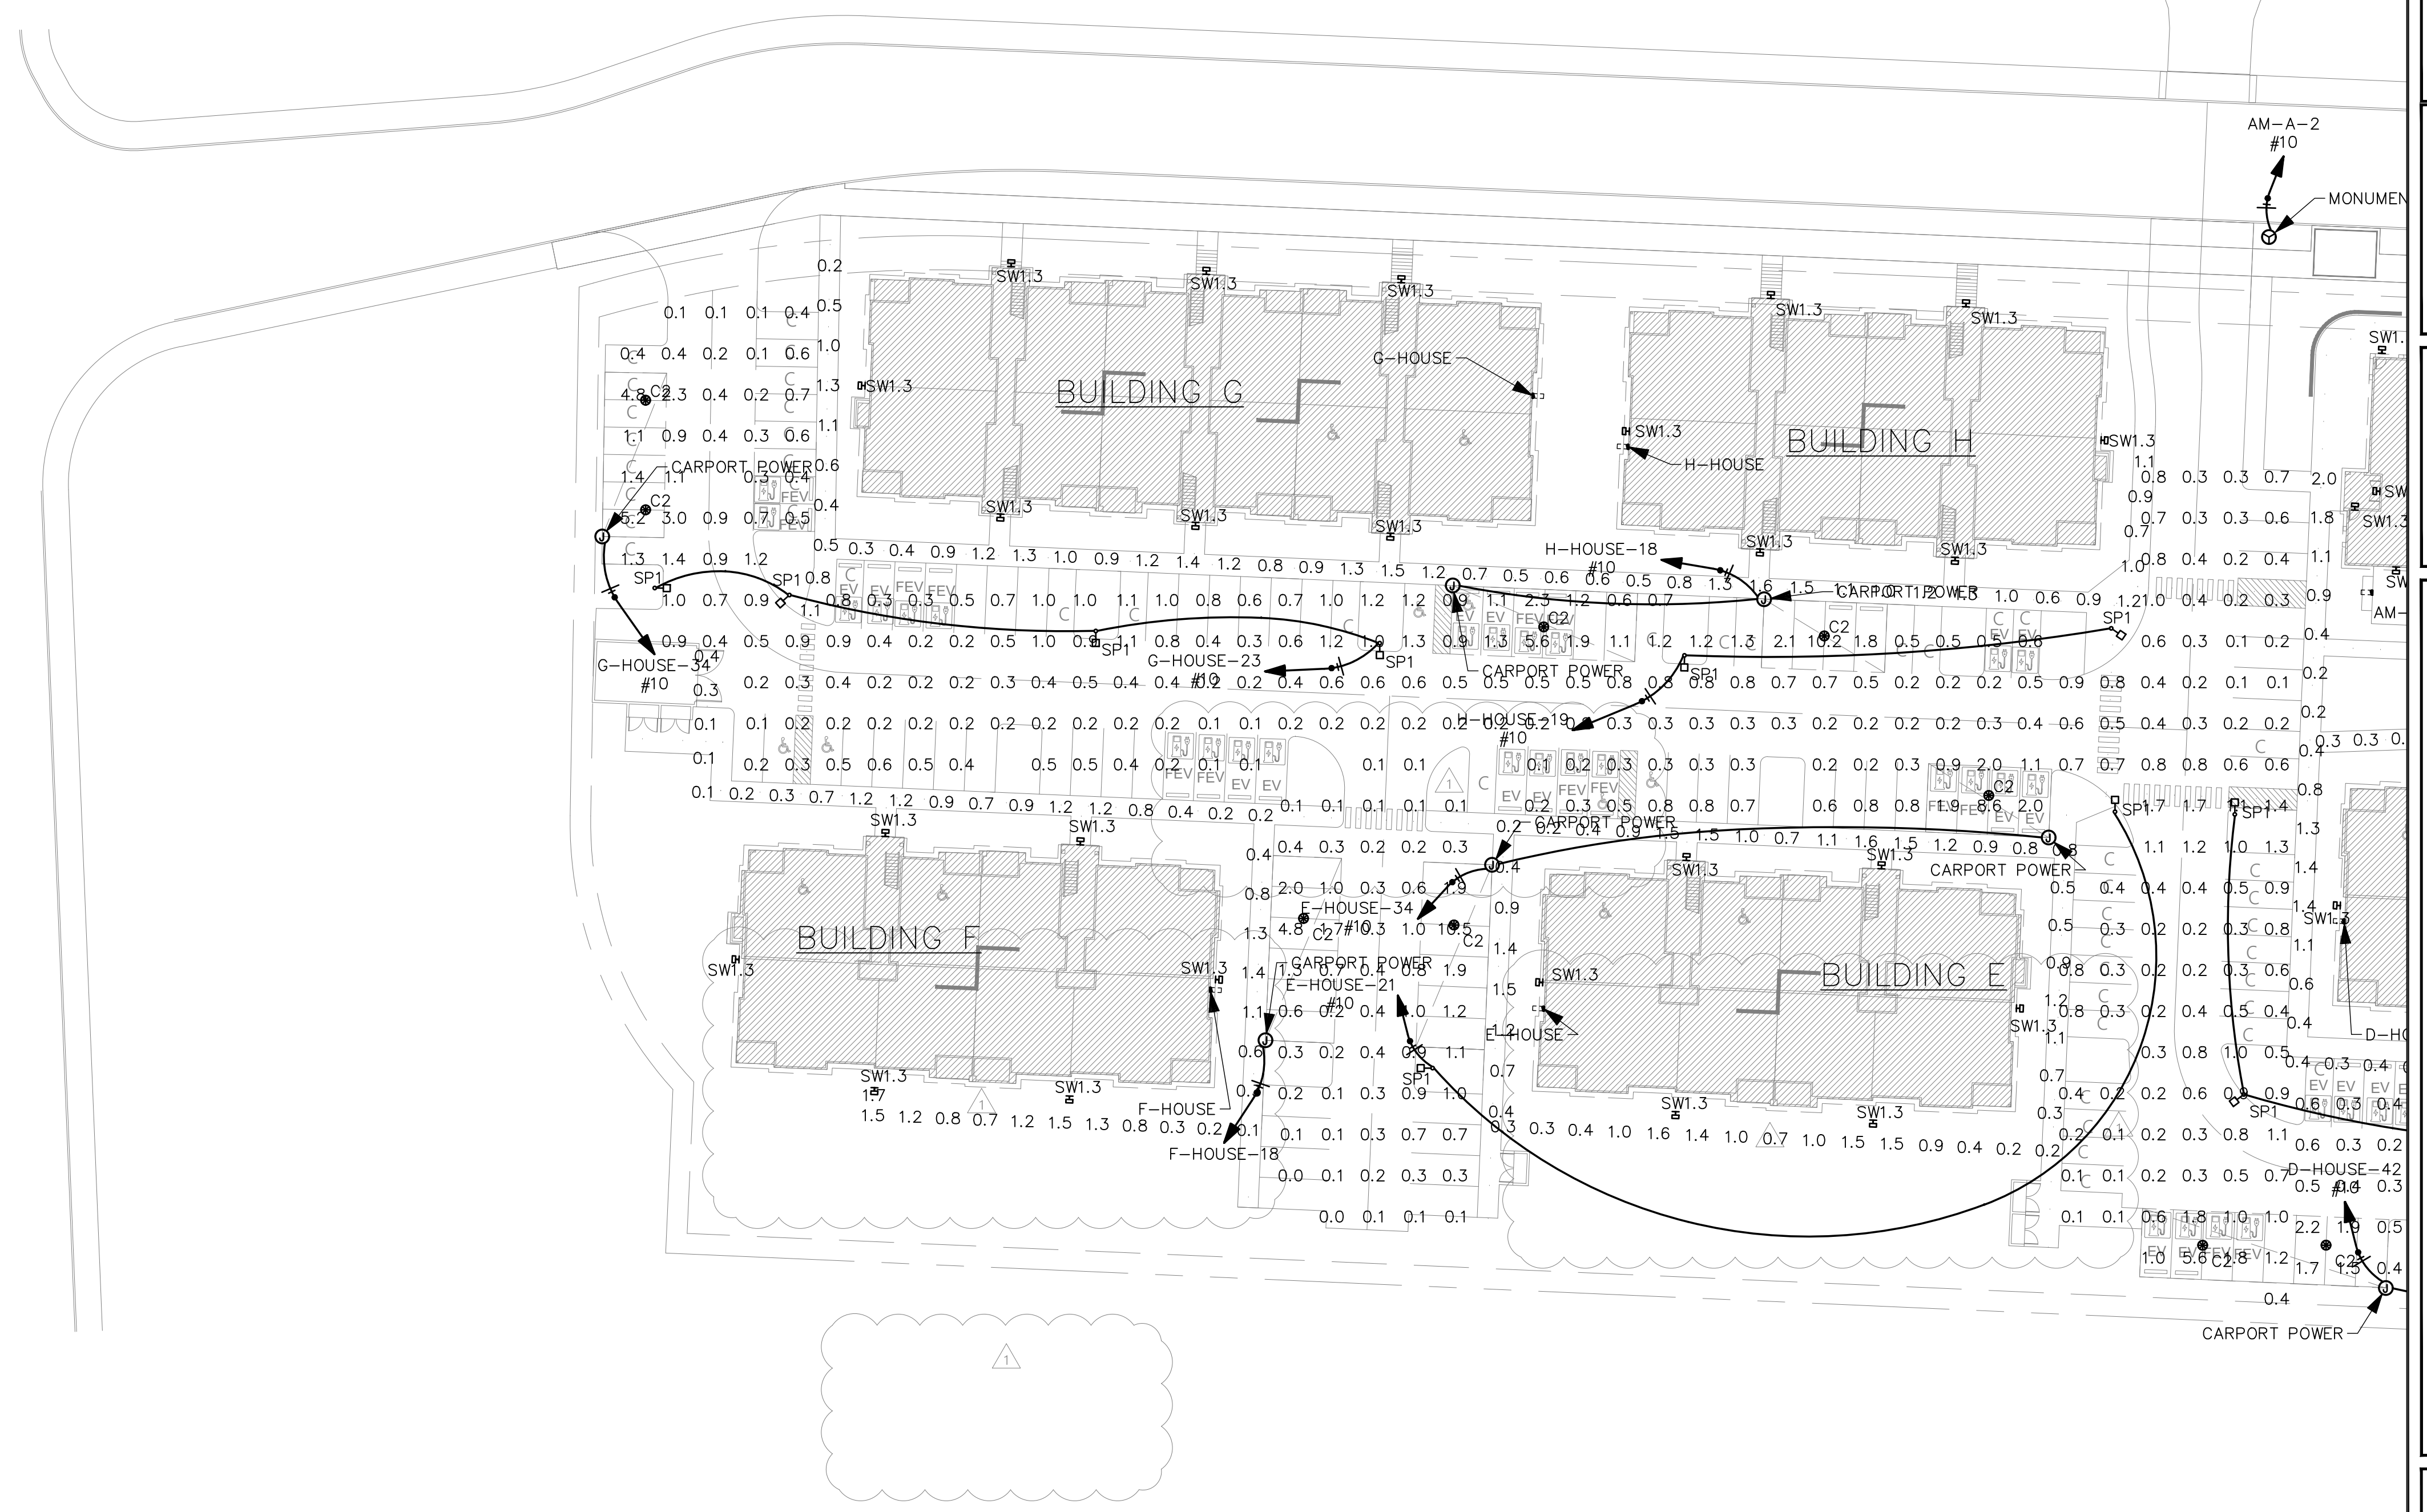

**SITE LIGHTING PLAN - WEST**

SCALE: 1/32" = 1'-0"

NO.	DATE	DESCRIPTION	REVISIONS

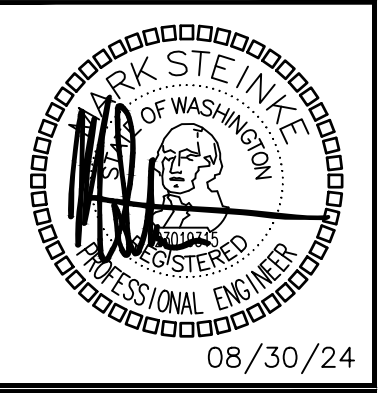

DRAWN: KL	DESIGNED: MHS	CHECKED: PSR	APPROVED: JAY
-----------	---------------	--------------	---------------

PROJECT: BRADLEY HEIGHTS APARTMENTS BUILDING H  
27TH AVE SE AND 5TH ST SE PUYALLUP, WA


19401 40TH AVE W, SUITE 302  
LYNNWOOD, WA 98036  
PHONE: (206) 364-3343

**ROBISON ENGINEERING, INC.**

DATE: 08/30/24



SHEET TITLE:  
**SITE LIGHTING - WEST SITE PLAN**

SHEET NO.  
**E0.11**

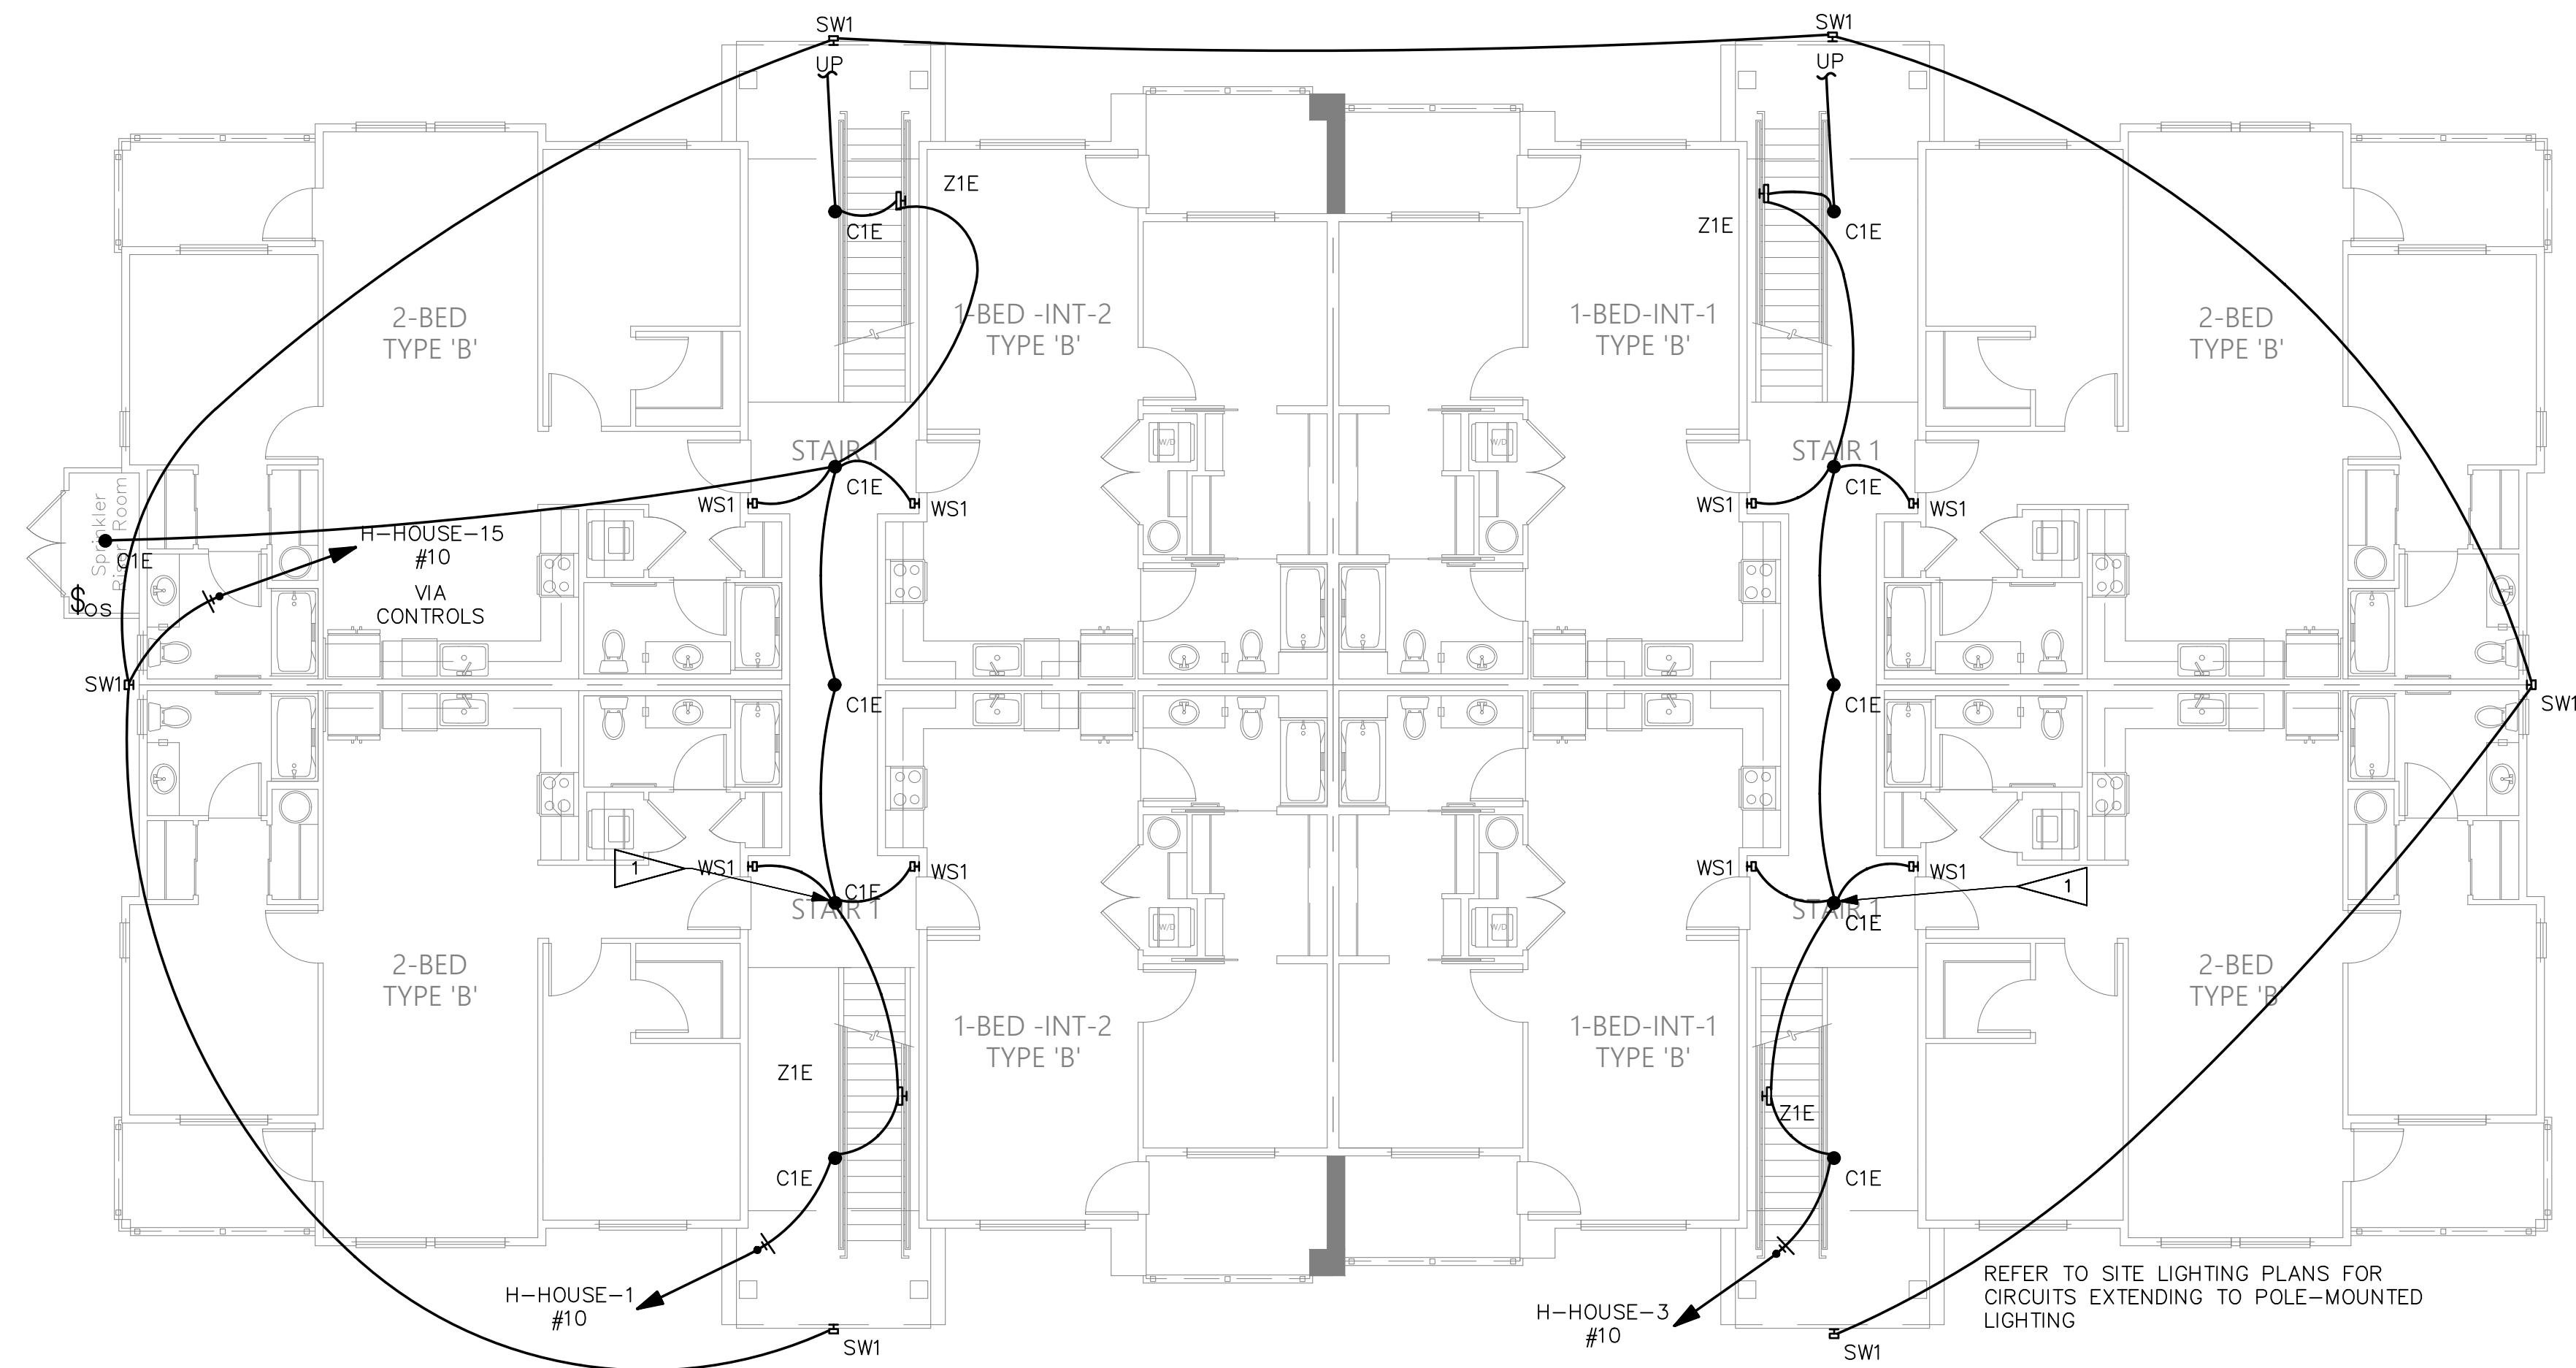


LIGHTING PLAN – BASEMENT

SCALE: 1/8" = 1'-0"

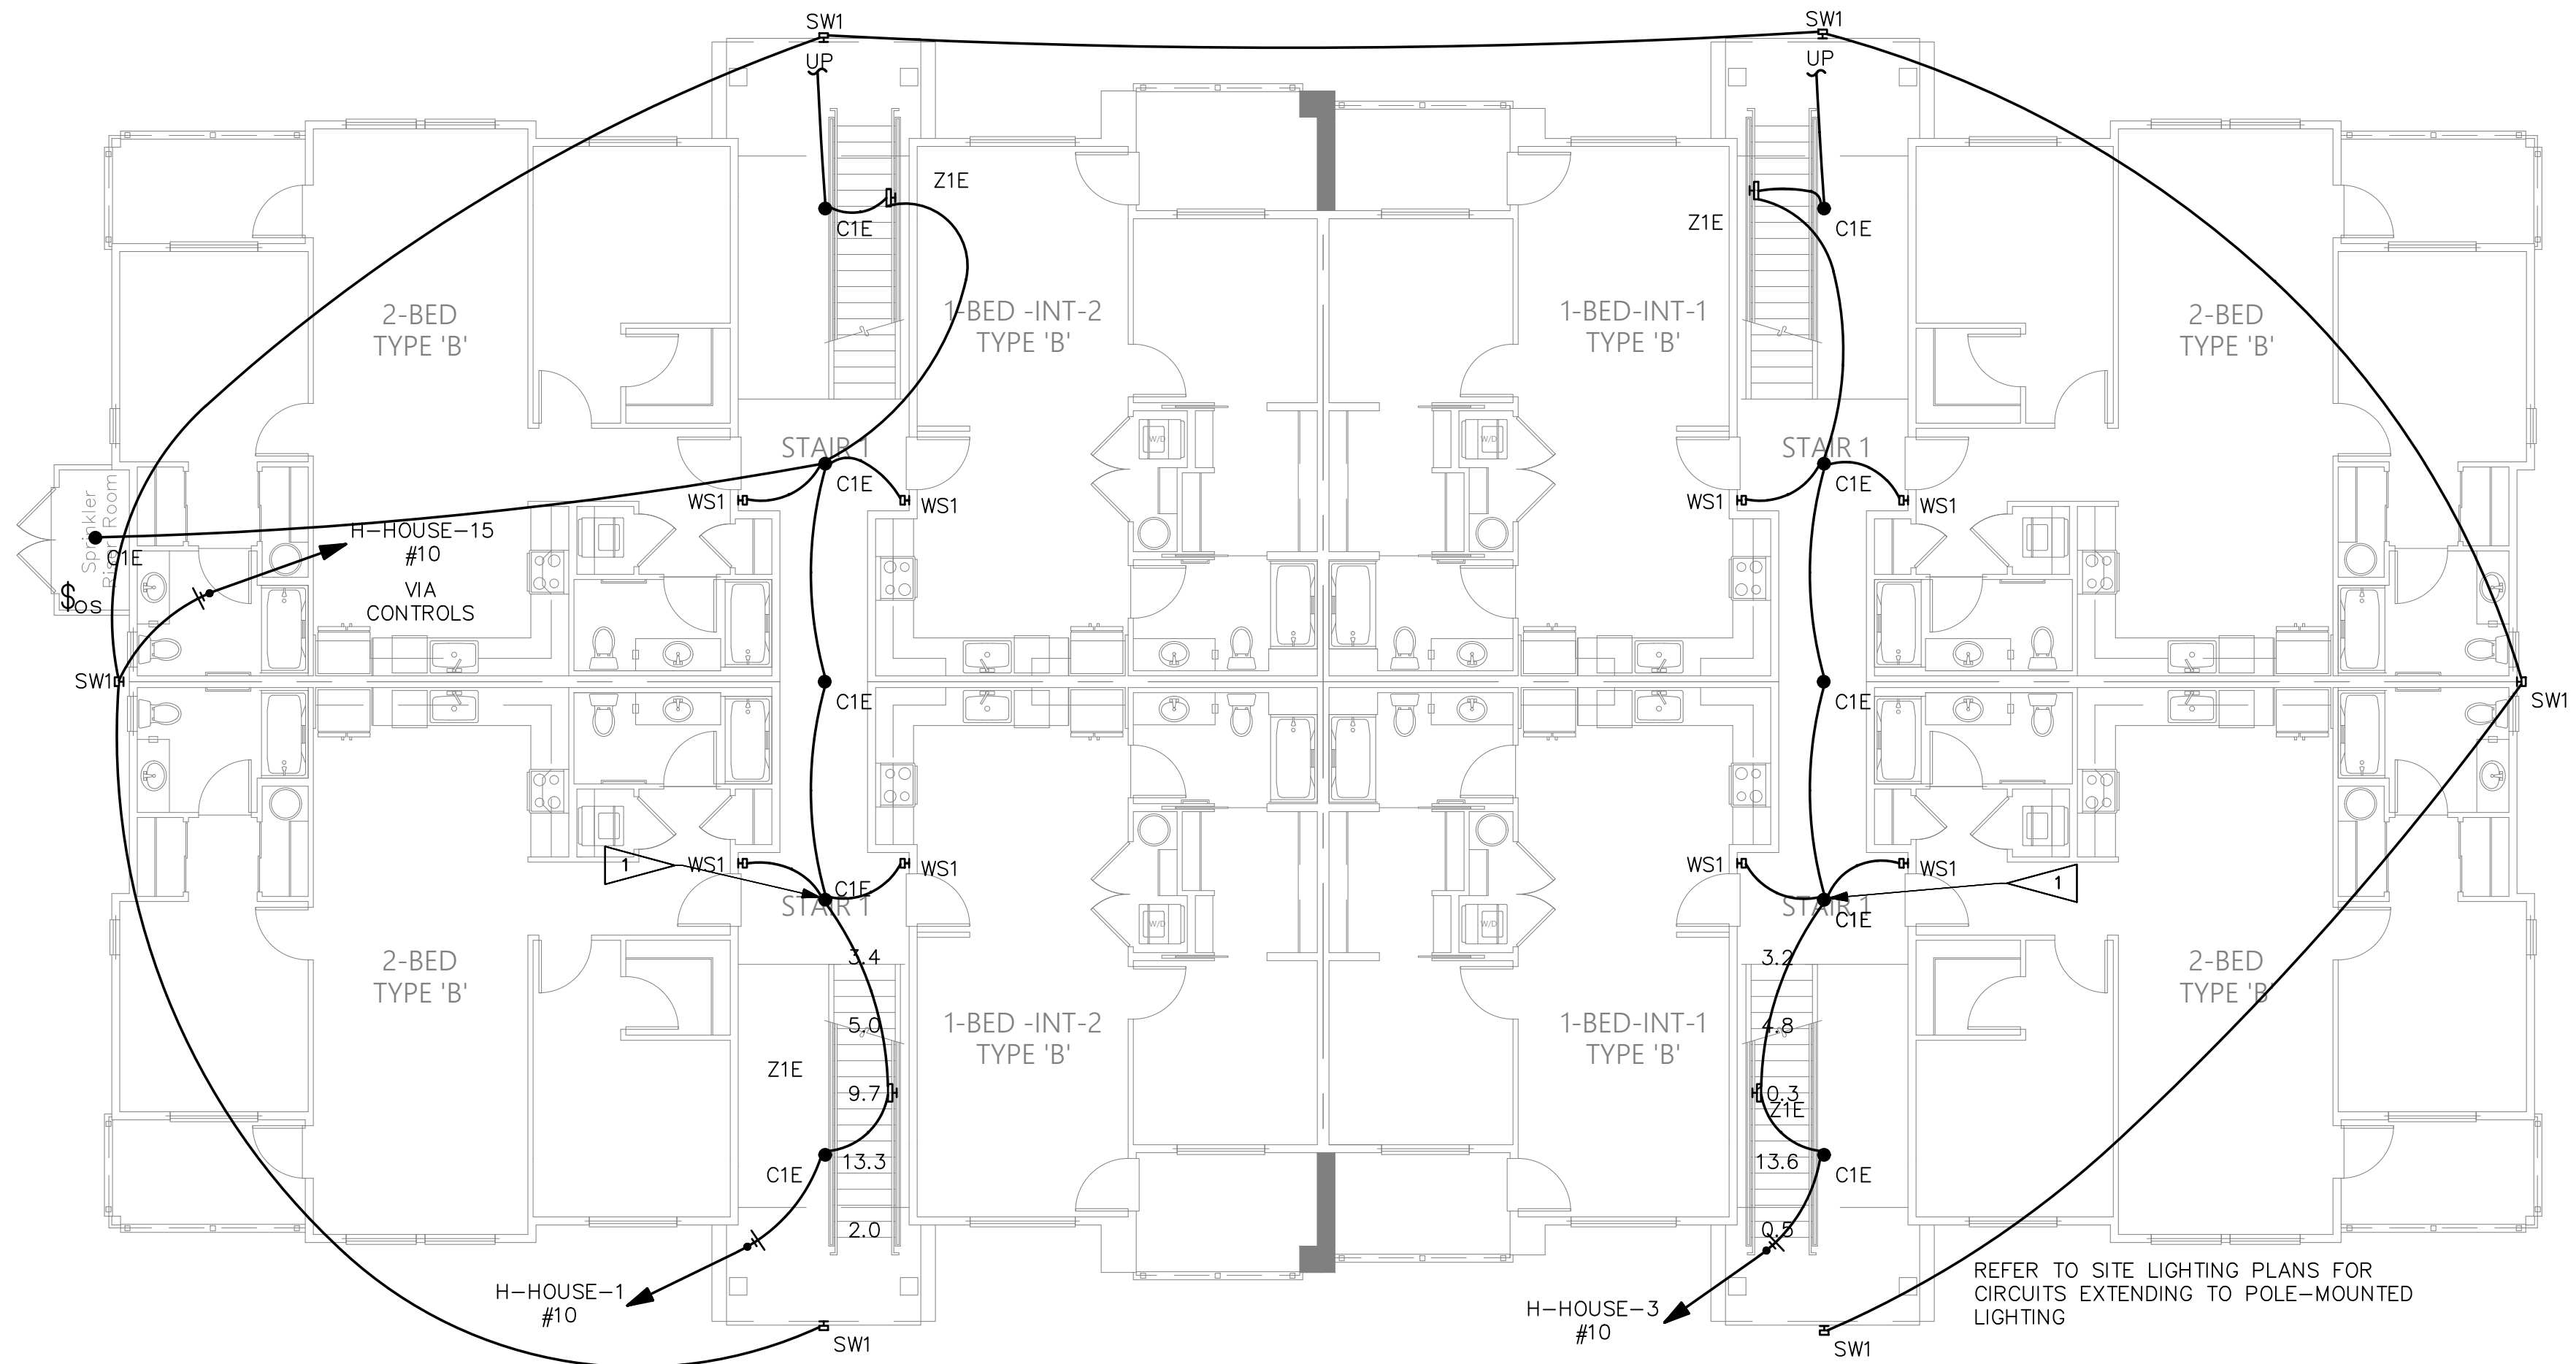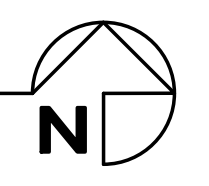

PHOTOMETRIC PLAN – BASEMENT

SCALE: 1/8" = 1'-0"

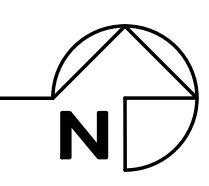


GENERAL NOTES

- EMERGENCY EGRESS LIGHTING: EMERGENCY LUMINAIRES WITH 90 MINUTE BATTERY BACKUP.
- REFER TO SERIES E500 DRAWINGS FOR TYPICAL UNIT PLANS SHOWING ELECTRICAL AND LIGHTING LAYOUT.
- SEE SHEET E1.50 FOR LUMINAIRE SCHEDULE AND LIGHTING NOTES.

FLAG NOTES

- CIRCUIT STAIRS VERTICALLY. LUMINAIRE(S) IN STAIRWELL
- EXIT SIGNS: PROVIDE UNSWITCHED HOT.

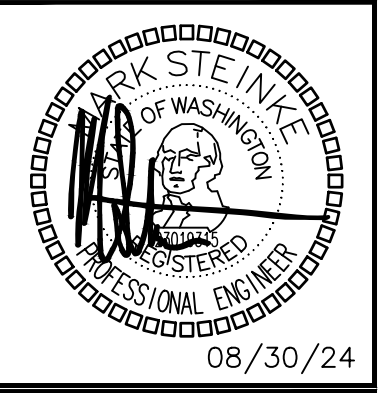

DRAWN:	KL
DESIGNED:	MHS
CHECKED:	PSR
APPROVED:	JAY

PROJECT: BRADLEY HEIGHTS APARTMENTS BUILDING H  
27TH AVE SE AND 5TH ST SE PUYALLUP, WA

19401 40TH AVE W, SUITE 302  
LYNNWOOD, WA 98036  
PHONE: (206) 364-3343

**ROBISON ENGINEERING, INC**


DATE: 08/30/24

SHEET TITLE:  
**LIGHTING & PHOTOMETRIC PLAN - BASEMENT**

SHEET NO.  
**E1.00**



*Egress Basement Stairs Photometric Schedule*

AVERAGE FOOT-CANDLES	6.67
MAXIMUM FOOT-CANDLES	13.3
MINIMUM FOOT-CANDLES	2.0
MINIMUM TO MAXIMUM FC RATIO	0.15
MAXIMUM TO MINIMUM FC RATIO	6.74
AVERAGE TO MINIMUM FC RATIO	3.38

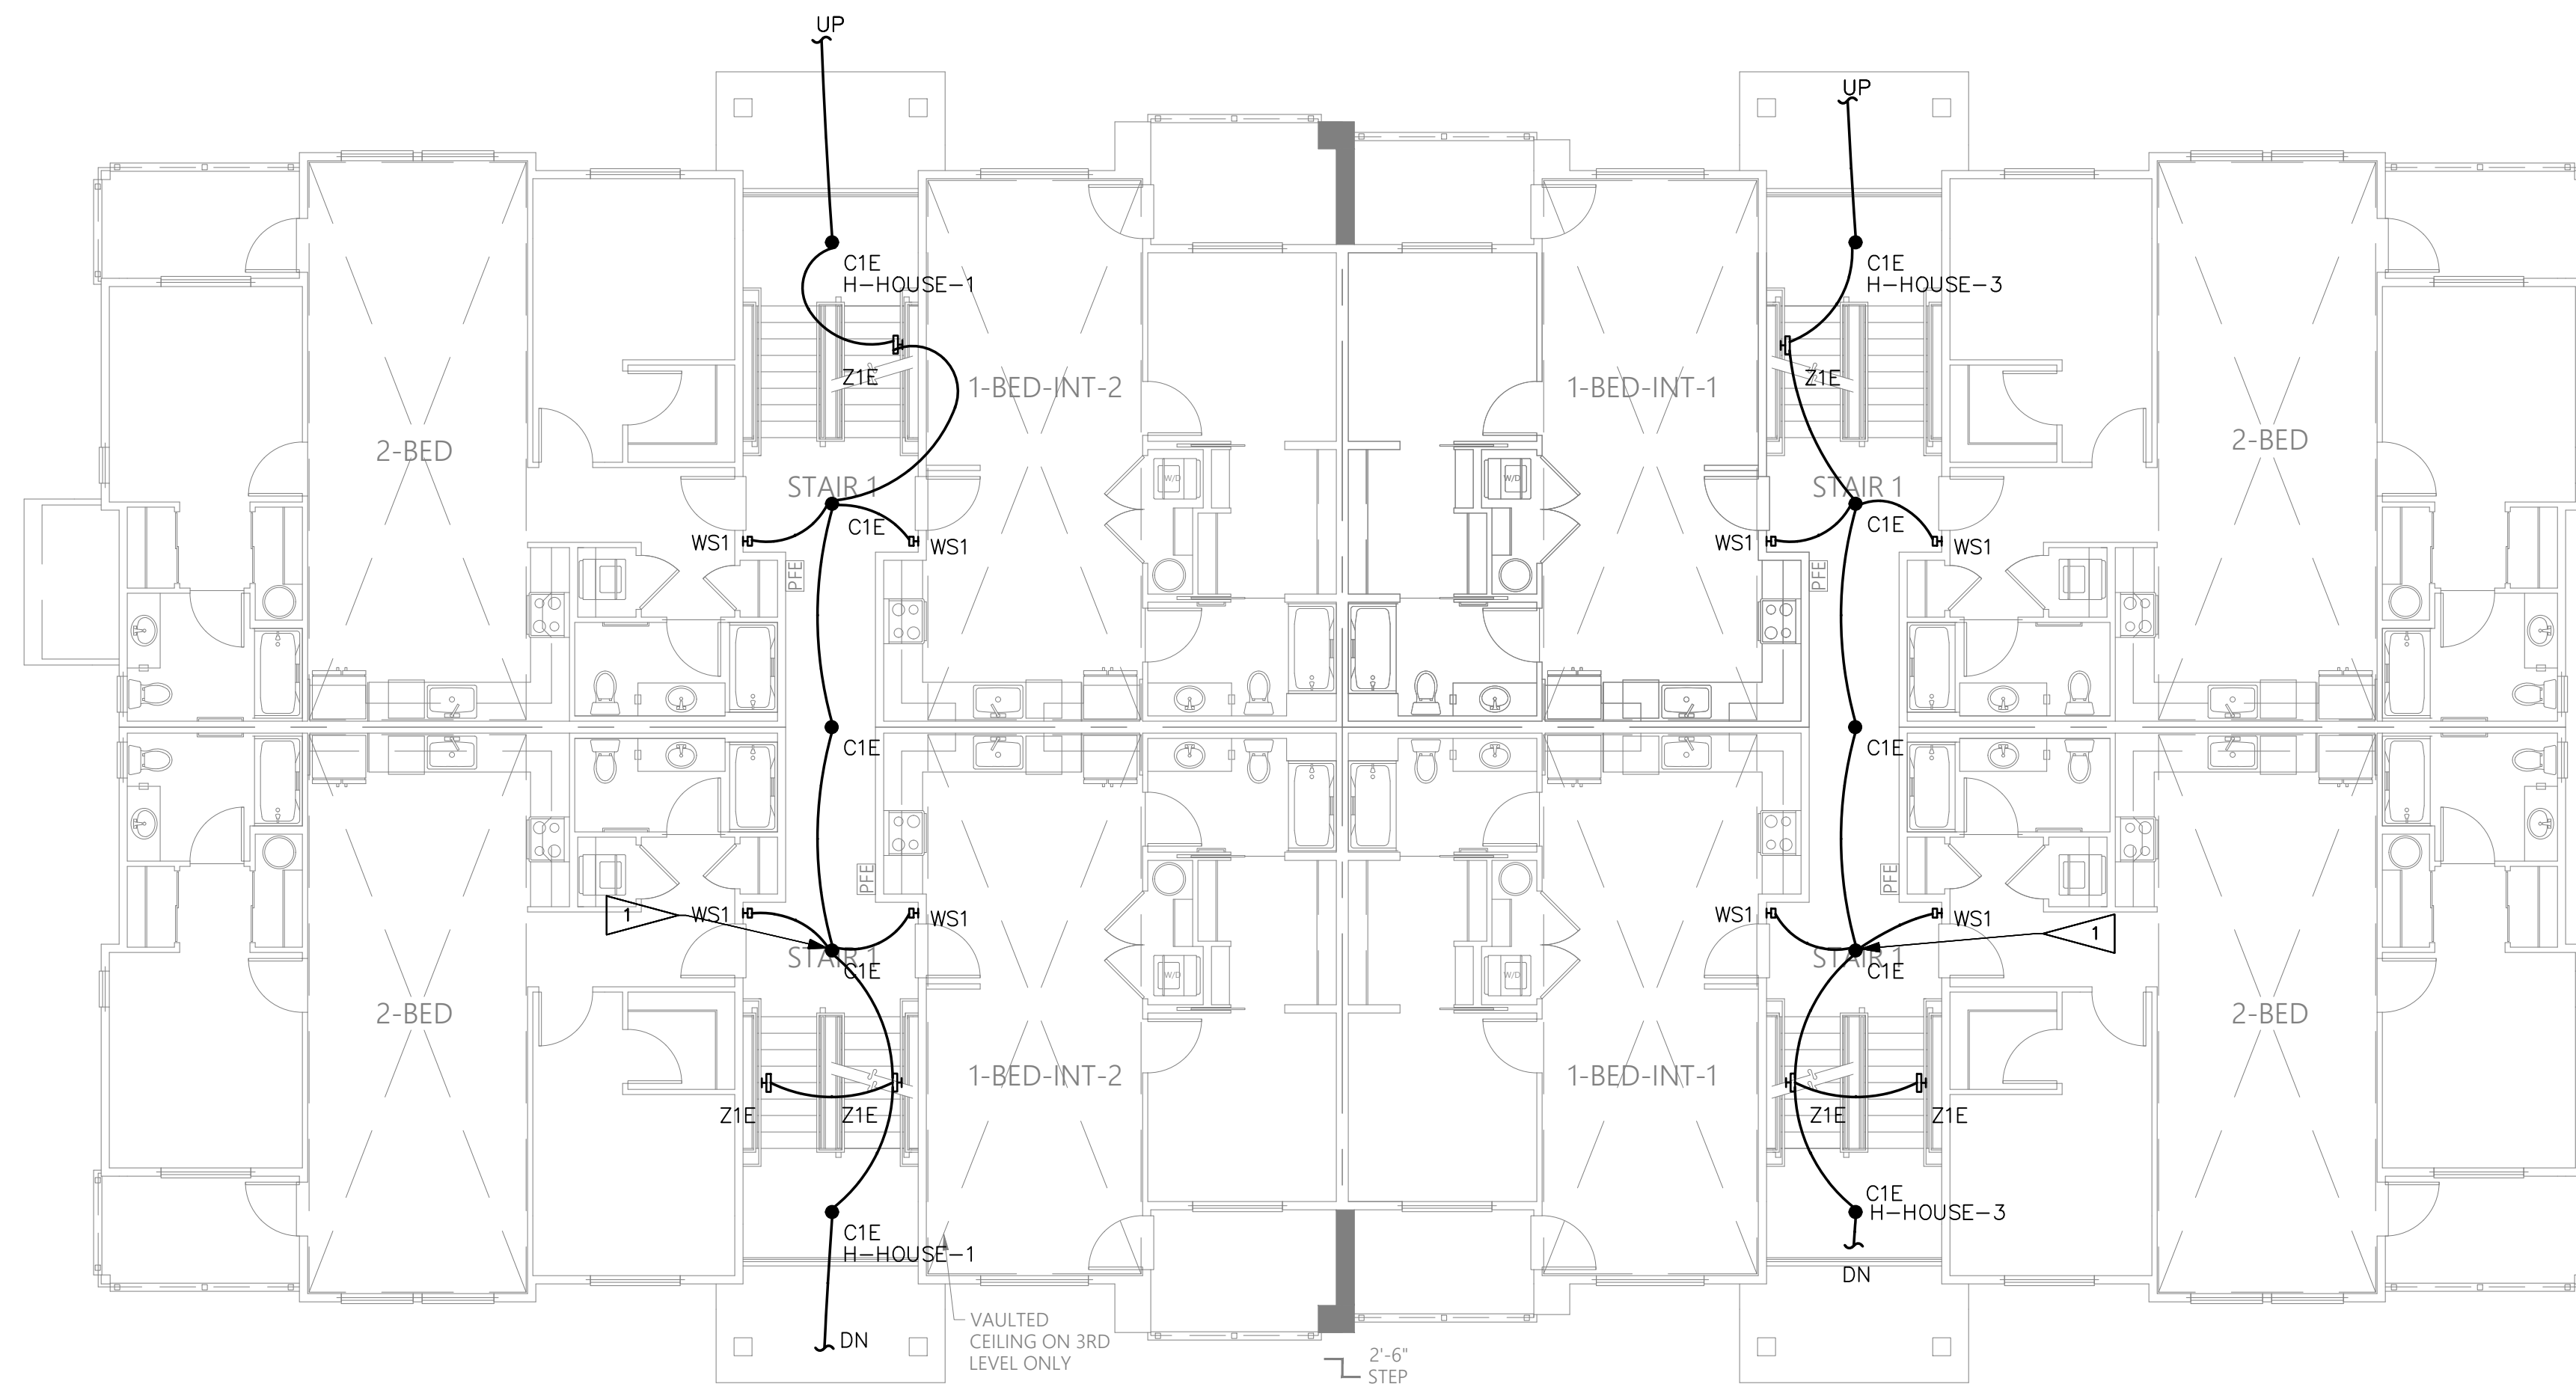

LIGHTING PLAN – 1ST FLOOR

SCALE: 1/8" = 1'-0"

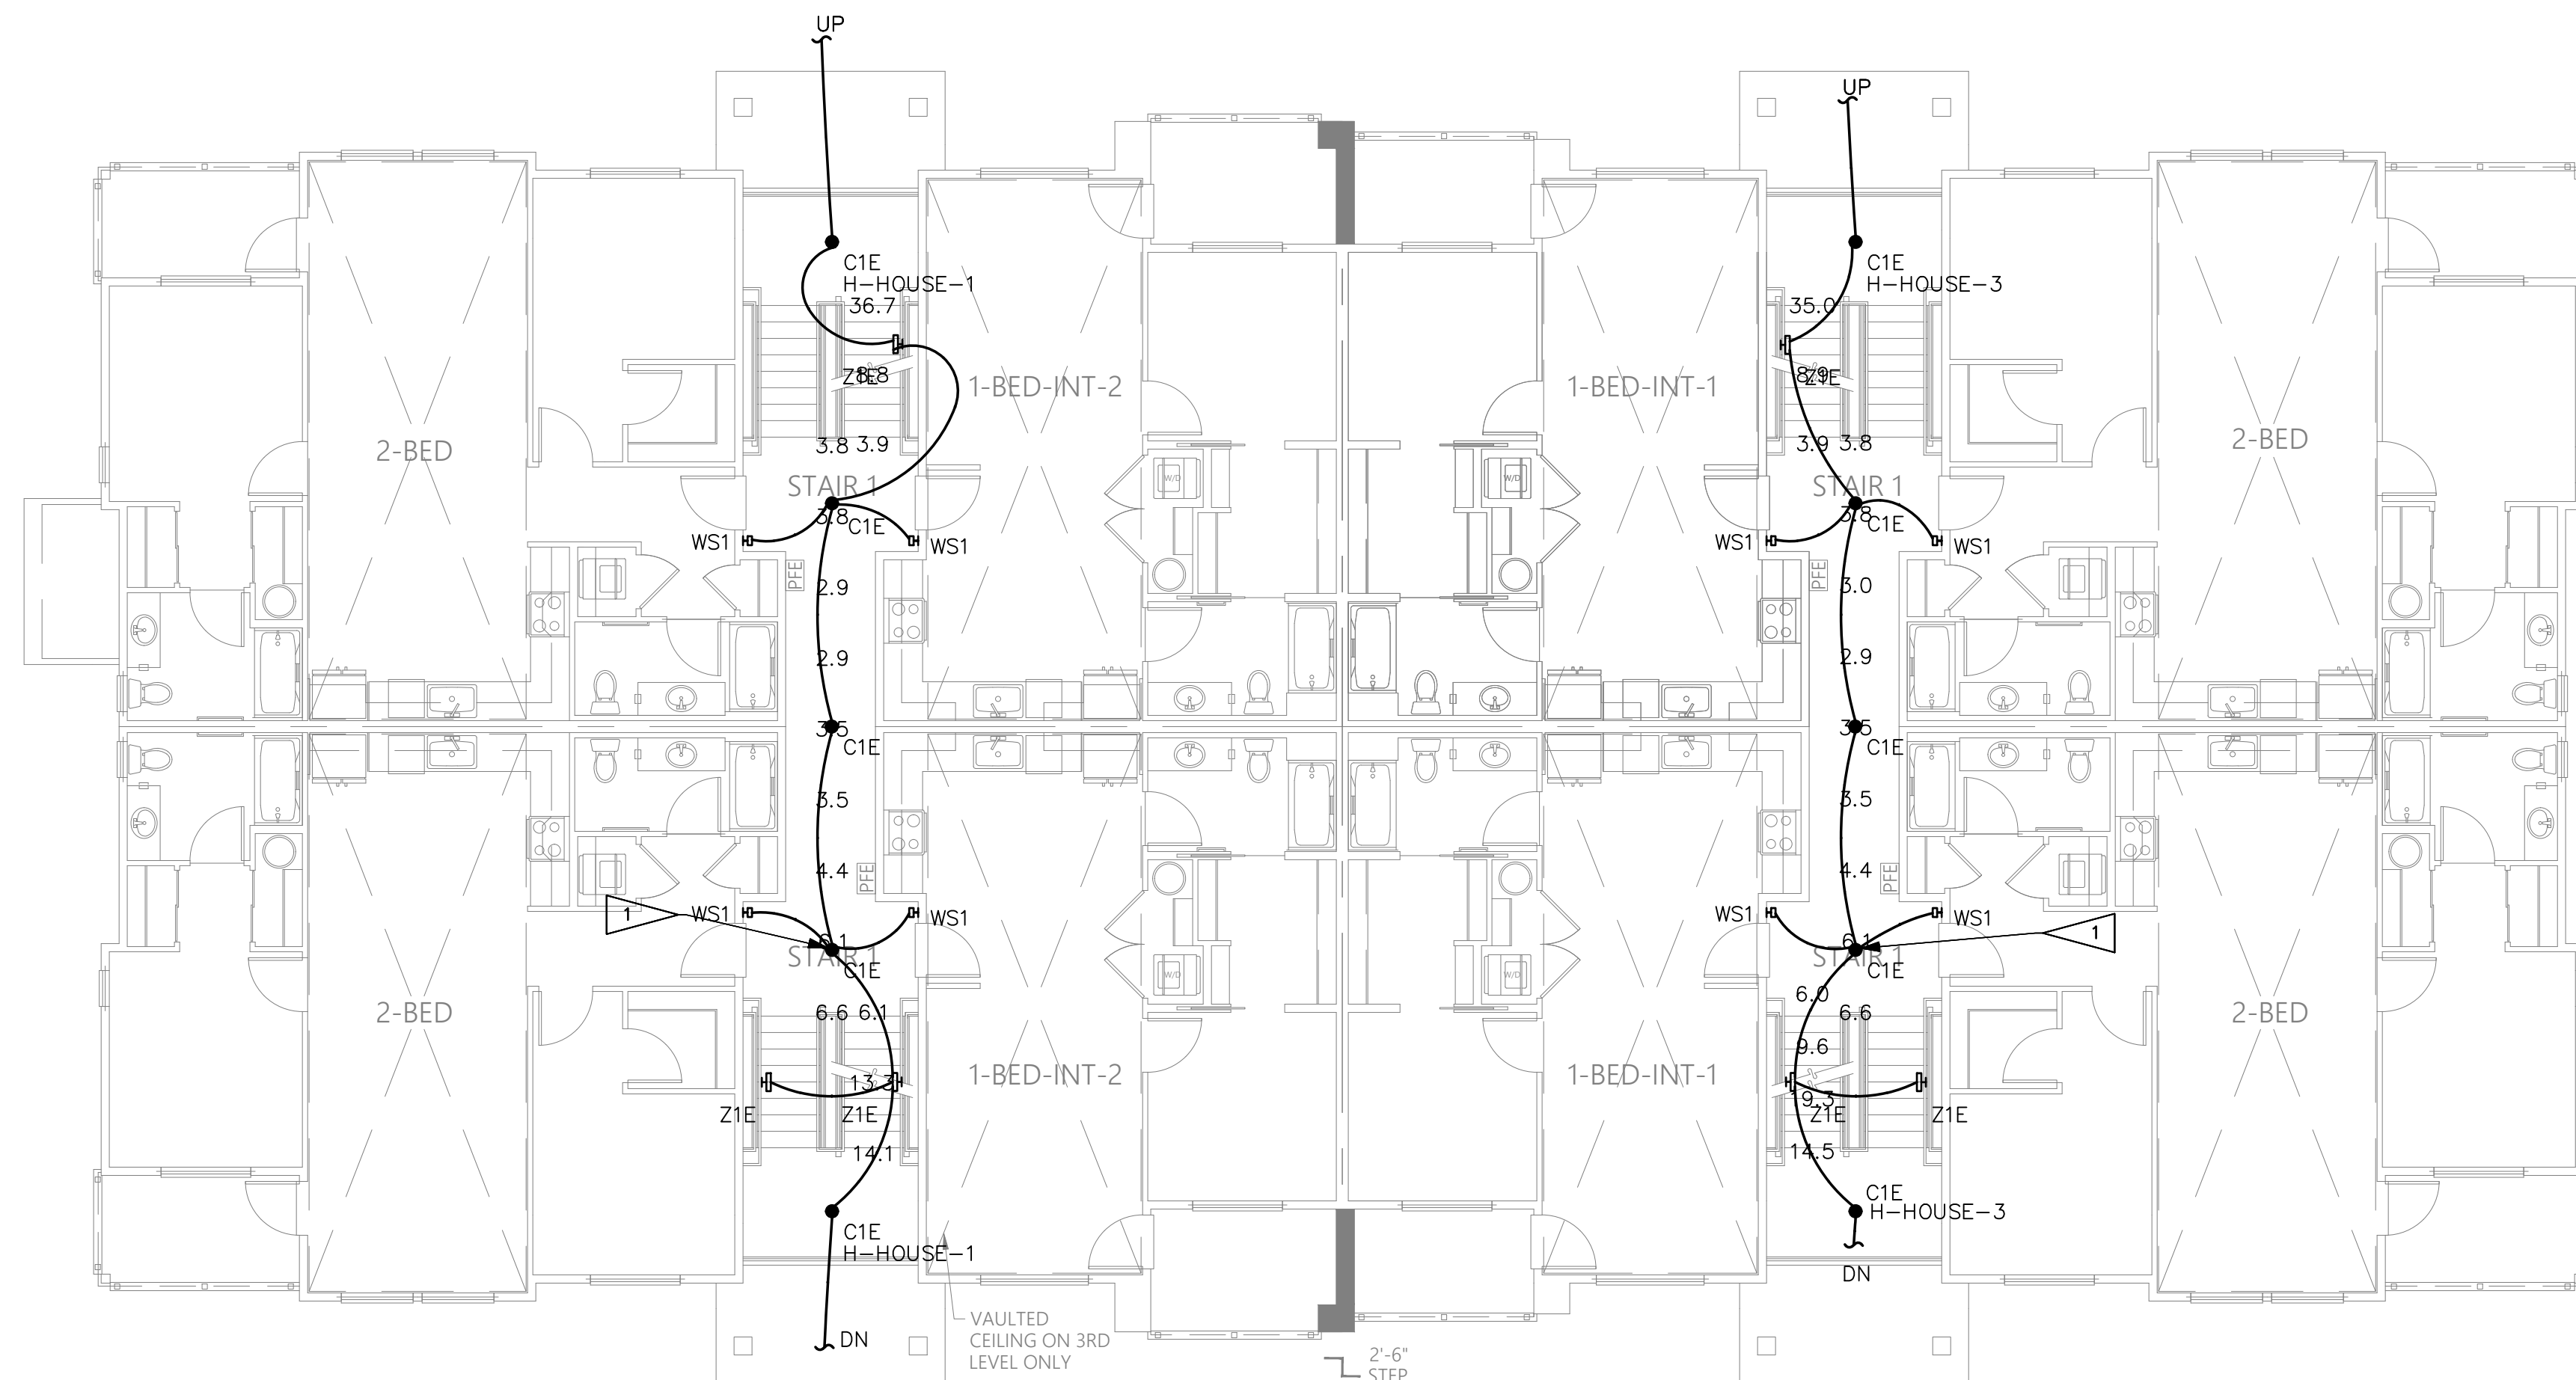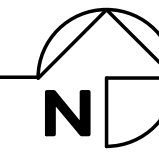

PHOTOMETRIC PLAN – 1ST FLOOR

SCALE: 1/8" = 1'-0"



GENERAL NOTES

- EMERGENCY EGRESS LIGHTING: EMERGENCY LUMINAIRES WITH 90 MINUTE BATTERY BACKUP.
- REFER TO SERIES E500 DRAWINGS FOR TYPICAL UNIT PLANS SHOWING ELECTRICAL AND LIGHTING LAYOUT.
- SEE SHEET E1.50 FOR LUMINAIRE SCHEDULE AND LIGHTING NOTES.

FLAG NOTES

- CIRCUIT STAIRS VERTICALLY. LUMINAIRE(S) IN STAIRWELL
- EXIT SIGNS: PROVIDE UNSWITCHED HOT.

Egress Stairs  
Photometric Schedule


AVERAGE FOOT-CANDLES	11.16
MAXIMUM FOOT-CANDLES	14.1
MINIMUM FOOT-CANDLES	6.1
MINIMUM TO MAXIMUM FC RATIO	0.44
MAXIMUM TO MINIMUM FC RATIO	2.30
AVERAGE TO MINIMUM FC RATIO	1.82

Egress Corridor  
Photometric Schedule

AVERAGE FOOT-CANDLES	4.18
MAXIMUM FOOT-CANDLES	6.6
MINIMUM FOOT-CANDLES	2.9
MINIMUM TO MAXIMUM FC RATIO	0.44
MAXIMUM TO MINIMUM FC RATIO	2.26
AVERAGE TO MINIMUM FC RATIO	1.43

Egress Long Stairs  
Photometric Schedule

AVERAGE FOOT-CANDLES	16.50
MAXIMUM FOOT-CANDLES	36.7
MINIMUM FOOT-CANDLES	3.9
MINIMUM TO MAXIMUM FC RATIO	0.11
MAXIMUM TO MINIMUM FC RATIO	9.32
AVERAGE TO MINIMUM FC RATIO	4.19

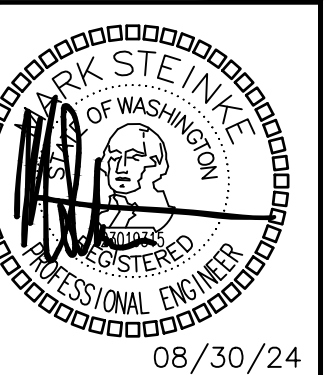


DRAWN: KL  
DESIGNED: MHS  
CHECKED: PSR  
APPROVED: JAY

PROJECT: BRADLEY HEIGHTS APARTMENTS BUILDING H  
27TH AVE SE AND 5TH ST SE PUYALLUP, WA  
19401 40TH AVE W, SUITE 302  
LYNNWOOD, WA 98036  
PHONE: (206) 364-3343  
**ROBISON ENGINEERING, INC.**

DATE: 08/30/24

SHEET TITLE:  
LIGHTING &  
PHOTOMETRIC  
PLAN - 1ST  
FLOOR

SHEET NO.  
**E1.01**

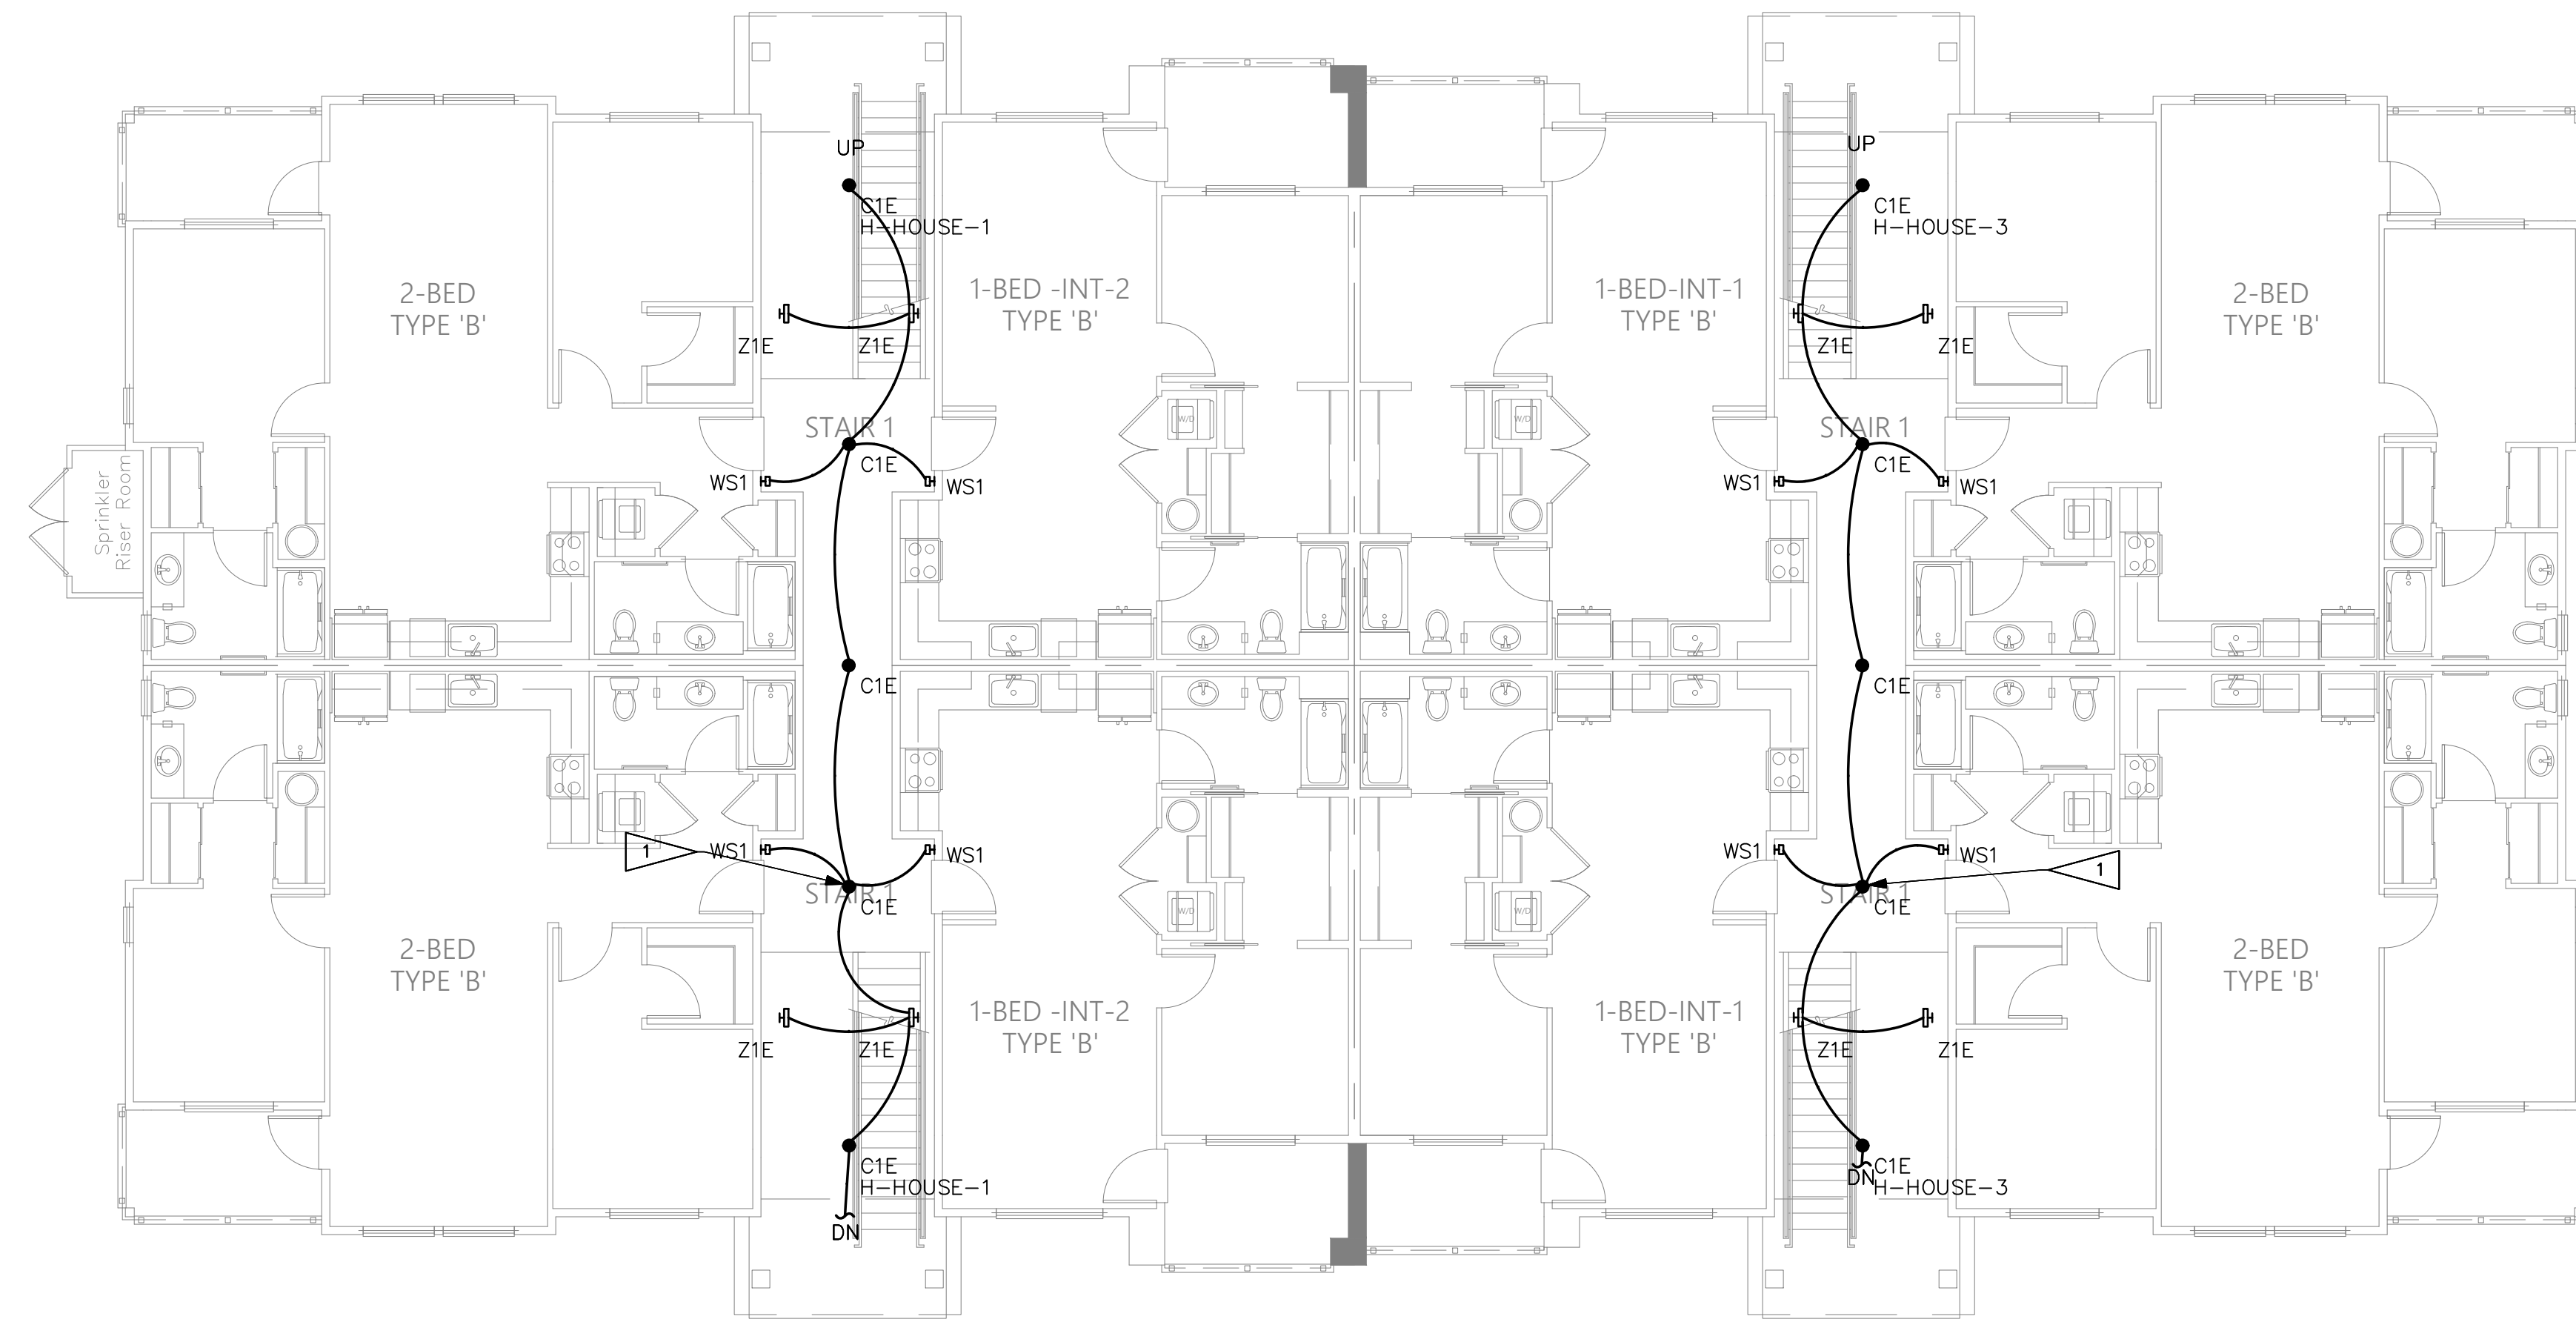

LIGHTING PLAN – 2ND FLOOR

SCALE: 1/8" = 1'-0"



GENERAL NOTES

1. EMERGENCY EGRESS LIGHTING: EMERGENCY LUMINAIRES WITH 90 MINUTE BATTERY BACKUP.
2. REFER TO SERIES E500 DRAWINGS FOR TYPICAL UNIT PLANS SHOWING ELECTRICAL AND LIGHTING LAYOUT.
3. SEE SHEET E1.50 FOR LUMINAIRE SCHEDULE AND LIGHTING NOTES.

FLAG NOTES

1. CIRCUIT STAIRS VERTICALLY. LUMINAIRE(S) IN STAIRWELL
2. EXIT SIGNS: PROVIDE UNSWITCHED HOT.



DRAWN:	KL
DESIGNED:	MHS
CHECKED:	PSR
APPROVED:	JAY

PROJECT: BRADLEY HEIGHTS APARTMENTS BUILDING H  
27TH AVE SE AND 5TH ST SE PUYALLUP, WA

19401 40TH AVE W, SUITE 302  
LYNNWOOD, WA 98036  
PHONE: (206) 364-3343

**ROBISON ENGINEERING, INC**

DATE: 08/30/24

SHEET TITLE:  
LIGHTING  
PLAN - 2ND &  
3RD FLOOR

SHEET NO.  
E1.02

### EXTERIOR LUMINAIRE SCHEDULE

CALLOUT	SYMBOL	MOUNTING	DESCRIPTION	MODEL	VOLTAGE	TYPE	CRI / CCT	LAMPING	WATTAGE
SP1		16' POLE	POLE LIGHT - PARKING & DRIVE AISLE - COMFORT OPTICS - B2 U0 G2	GARDCO: P20 C A02 830 T1S AR1 120 BL30-MW PCB	MULTIPLE	INTEGRAL CONTROLS	80 / 3000K	(1) 36W LED	36
SW1		SURFACE - 12' AFF	WALL SCONCE - AREA LIGHT - B1 U0 G1	GARDCO: GWM A06 830 T3M 120 MW30 PCB	120	INTEGRAL CONTROLS	80 / 3000K	(1) 16W LED	16

- NOTES:
- CONTRACTOR TO FURNISH AND INSTALL ALL FIXTURES.
  - LUMINAIRE SCHEDULE IS BOD ONLY. CONTRACTOR TO SUBMIT FIXTURE MODEL OR EQUIVALENT. CONTRACTOR TO COORDINATE FIXTURE FINISHES WITH ARCHITECT/OWNER.
  - FIXTURE CATALOG NUMBERS DO NOT NECESSARILY DENOTE SPECIFIC MOUNTING ACCESSORIES. CONTRACTOR TO PROVIDE ALL NECESSARY ACCESSORIES TO SUCCESSFULLY COMPLETE THE INSTALLATION.
  - 'BUG' RATING ON EXTERIOR FIXTURES INDICATES 'BACKLIGHT', 'UPLIGHT', AND 'GLARE' AS STANDARDS IN CLASSIFYING OUTDOOR LIGHT FIXTURES.

### GENERAL LUMINAIRE SCHEDULE

CALLOUT	SYMBOL	MOUNTING	DESCRIPTION	MODEL	VOLTAGE	TYPE	CRI / CCT	LAMPING	WATTAGE
B1		SURFACE	4' NARROW WRAP - BOH	DAY-BRITE CF: FSW440L835 UNV DIM	120	0-10V DIMMING	80 / 3000K	(1) 31.4W LED	31.4
C1E		SURFACE	4" SURFACE DOWNLIGHT	DMF: DRDH N JO 70S EM / DRD5S 4 R 07 9 30 EM	120	0-10V DIMMING	90 / 3000K	(1) 9W LED	9
D1		RECESSED	RECESSED DOWNLIGHT - SLOPED CEILING	DMF: DRD4M 10 9 30 FL X 0 / DRDH N JS 1004	120	0-10V DIMMING	90 / 3000K	(1) 12W LED	12
P1		PENDANT	STEM MOUNT DOWNLIGHT - SLOPED CEILING - 4' STEM	DMF: DCR T4 S X A 30 FL 0 00 30 XX 0 00 [FINISH]	120	0-10V DIMMING	90 / 3000K	(1) 40W LED	40
WS1		SURFACE	WALL SCONCE - EM BATTERY BACKUP	TBD	120	TBD DIMMING	TBD / TBD	(1) 5W LED	5
X1		SURFACE	EXIT SIGN - EMERGENCY BATTERY BACKUP - HATCH INDICATES LIT FACE	LSI: EMS WB SERIES (OR EQUAL)	MULTIPLE	EM	EM / EM	(1) 5W EM	5
X2		SURFACE	COMBO EXIT SIGN	LSI: CEC (OR EQUAL)	MULTIPLE	EM	EM / EM	(1) 5W EM	5
X3		SURFACE	EMERGENCY LIGHT - EMERGENCY BATTERY BACKUP DAMP LOCATION RATED - MAX 35' SPACING	LITHONIA: ELM2LF (OR EQUAL)	120	EM	EM / EM	(1) 5W EM	5
X4		WALL	EXTERIOR EMERGENCY LIGHT - EMERGENCY ON ONLY - MAX SPACING 35'	NORA LIGHTING: NE-902LED	120	EM	35' MAX SPACING	(1) 5W LED	5
Z1E		WALL	WALL PACK	LITHONIA: WPX1 LED P1 30K MVOLT	120	EM	70 / 3000K	(1) 11W LED	11

- NOTES:
- CONTRACTOR TO FURNISH AND INSTALL ALL FIXTURES.
  - LUMINAIRE SCHEDULE IS BOD ONLY. CONTRACTOR TO SUBMIT FIXTURE MODEL OR EQUIVALENT. CONTRACTOR TO COORDINATE FIXTURE FINISHES WITH ARCHITECT/OWNER.
  - FIXTURE CATALOG NUMBERS DO NOT NECESSARILY DENOTE SPECIFIC MOUNTING ACCESSORIES. CONTRACTOR TO PROVIDE ALL NECESSARY ACCESSORIES TO SUCCESSFULLY COMPLETE THE INSTALLATION.

### LIGHTING CONTROLS LEGEND

SYMBOL	CONTROL TYPE	CONTROL FUNCTION
	TOGGLE SWITCH	MANUAL ON/OFF LIGHTING CONTROL. SUBSCRIPT INDICATES WHICH FIXTURES ARE TO BE CONTROLLED BY WHICH SWITCH (WSEC C405.2.3). SUBSCRIPT 'k' INDICATES TAMPER RESISTANT KEYED SWITCH FOR USE BY AUTHORIZED PERSONNEL ONLY.
	DIMMER SWITCH	MANUAL MULTI-LEVEL LIGHTING CONTROL. SWITCH SHALL ALSO HAVE MANUAL ON/OFF FUNCTIONALITY. SUBSCRIPT INDICATES WHICH FIXTURES ARE TO BE CONTROLLED BY WHICH DIMMER. (C405.2.3)
	TOGGLE/DIMMER SWITCH WITH OCCUPANCY SENSOR	SWITCHES LABELED 'os' OR 'vs' SHALL TURN OFF ALL CONNECTED LUMINAIRES WITHIN 20 MINUTES OF SPACE BEING VACANT. (C405.2.1.1)
	CONTROL STATION; SEE LIGHTING CONTROL ZONE TABLE ON PLANS.	MANUAL LOCAL LIGHTING CONTROL (C405.2.1.1). CONTROL STATION SHALL HAVE CAPACITY TO CONTROL MULTIPLE ZONES AND MULTIPLE SCENES AS NEEDED. SUBSCRIPT CORRESPONDS TO 'LIGHTING CONTROLS' TABLE ON PLANS.
	SURFACE MOUNTED OCCUPANCY SENSOR	AUTOMATIC LIGHTING CONTROL SHALL TURN OFF ALL CONNECTED LUMINAIRES WITHIN 20 MINUTES OF SPACE BEING VACANT. (C404.2.1.1)
	MULTIZONE PHOTOSENSOR	AUTOMATIC LIGHTING CONTROL SHALL AUTOMATICALLY ADJUST THE LIGHT OUTPUT OF ALL CONNECTED LUMINAIRES BASED ON THE DAYLIGHT LEVEL IN THE PRIMARY AND SECONDARY ZONES (C405.2.4). SUBSCRIPT INDICATES WHICH FIXTURES ARE TO BE CONTROLLED BY ZONE; 'x' INDICATES MULTIPLE ZONE CONTROL.

### GENERAL LIGHTING NOTES

- LIGHTING CONTROLS SHALL BE INSTALLED WHICH MEET ALL REQUIREMENTS OF LOCAL ENERGY CODES.
- EMERGENCY LIGHT FIXTURES: IN ADDITION TO SWITCH-LEG, PROVIDE UNSWITCHED HOT TO SERVE INTERNAL BATTERY AND CHARGER.
- LOCATIONS OF OCCUPANCY SENSORS, PHOTO SENSORS, DIMMERS, AND SWITCHES ARE DIAGRAMMATIC. CONTRACTOR TO COORDINATE QUANTITIES AND OPTIMAL LOCATIONS WITH LIGHTING CONTROL MANUFACTURER AND ARCH/OWNER.
- AUTOMATIC LIGHTING SHUT-OFF CONTROLS SHALL BE PROVIDED BY LOCAL OCCUPANCY SENSORS UNLESS OTHERWISE NOTED. PUBLIC SPACES ARE ACTIVE 24/7 AND THEREFORE EXEMPT FROM AUTOMATIC LIGHTING SHUT-OFF REQUIREMENTS FOR SECURITY. (WSEC C405.2)
- DAYLIGHT ZONES ARE SHOWN ON PLANS AS DEFINED BY WASHINGTON STATE ENERGY CODE (WSEC) C405.2.4.2. SIDELIGHT DAYLIGHT ZONES ARE REFERRED TO AS 'PRIMARY' AND 'SECONDARY' ON PLANS AND DENOTED BY DASHED LINES.
- FOR CUSTOM FF&E FIXTURES, IT IS THE MANUFACTURER'S RESPONSIBILITY TO FURNISH PRODUCTS WHICH ARE COMPLIANT WITH ALL REQUIREMENTS OF LOCAL ENERGY CODES, AS WELL AS MATCH THE ELECTRICAL SPECIFICATIONS PROVIDED IN THE LUMINAIRE SCHEDULES. PROVIDE SUBMITTAL SHOP DRAWINGS WITHIN 30 DAYS OF RECEIVING FIXTURE ORDER. SUBMITTALS SHALL CLEARLY INDICATE LAMPING AND MAXIMUM WATTAGE RATING OF LAMP SOCKETS. NON-COMPLIANT FIXTURES REJECTED BY ELECTRICAL INSPECTOR SHALL BE RETURNED TO THE MANUFACTURER FOR REWORKING AND/OR RE-LABELING.
- ALL FIXTURES SHALL BE INSTALLED ACCORDING TO THE MANUFACTURER'S INSTRUCTIONS.
- CONTRACTOR SHALL BE RESPONSIBLE TO ORDER ALL NECESSARY HARDWARE, ELECTRICAL CABLE, TIMERS, TRANSFORMERS, ETC., AS REQUIRED FOR COMPLETION OF INSTALLATION OF A FULLY FUNCTIONING SYSTEM.
- CONTRACTOR SHALL BE RESPONSIBLE FOR EQUIPPING ALL FIXTURES WITH THE EXACT LAMPS SPECIFIED IN THE FIXTURE SCHEDULE.
- WHERE FIXTURES REQUIRE REMOTE TRANSFORMERS OR BALLASTS, THE CONTRACTOR SHALL DETERMINE LOCATIONS AS REQUIRED FOR EVEN LOAD DISTRIBUTION, SERVICE ACCESS, AND VENTILATION.
- THE CONTRACTOR SHALL COORDINATE WITH THE ELECTRICAL ENGINEER FOR EXACT LOCATIONS OF TIMERS AND/OR PHOTO CELLS, IF ANY.
- WHERE APPLICABLE, THE CONTRACTOR SHALL AIM AND ADJUST LIGHTING FIXTURES AS DIRECTED BY THE LIGHTING DESIGNER UPON COMPLETION OF THE INSTALLATION.

#### SPECIAL NOTE TO THE CONTRACTOR:

- FIXTURE SUBMITTALS THAT DO NOT INCLUDE LAMP SPECIFICATIONS WILL BE CONSIDERED INCOMPLETE AND WILL NOT BE REVIEWED.


### LIGHTING CONTROL SYSTEM REQUIREMENTS

- CONTRACTOR TO PROVIDE A FULLY OPERATIONAL LIGHTING CONTROL SYSTEM.
- CONTRACTOR SHALL VERIFY THE COMPATIBILITY OF DIMMING AND CONTROL MODULES WITH FIXTURE TYPES PRIOR TO INSTALLATION.
- ELECTRICAL CONTRACTOR SHALL COORDINATE WITH A LIGHTING CONTROLS VENDOR TO OBTAIN LIGHTING CONTROL SYSTEM PACKAGE COMPLETE WITH DEVICES, WIRING DIAGRAMS, ANNOTATED PLANS INDICATING WHICH DEVICE TO BE USED IN EACH LOCATION, CONNECTION REQUIREMENTS, SET UP INSTRUCTIONS, COMMISSIONING AND CHECK-OUT FOLLOWING COMPLETION. PROVIDE ALL LOW VOLTAGE WIRING AS REQUIRED FOR CONTROL DEVICE INTERCONNECTIONS.
- INSTALLER QUALIFICATIONS: TECHNICIAN INSTALLING AND WIRING THE LIGHTING CONTROL SYSTEM SHALL HAVE INSTALLED THIS SAME SYSTEM AT LEAST ONCE PREVIOUSLY. TECHNICIAN SHALL HAVE RECEIVED TRAINING BY FACTORY REPRESENTATIVE ON THE SYSTEM BEING INSTALLED.
- PROVIDE LIGHTING CONTROL SYSTEM TO PERFORM THE FUNCTIONS DESCRIBED BELOW:
  - LIGHTING CONTROL SCHEDULE: PROVIDE SEPARATE SWITCHING AND DIMMING CONTROL FOR LIGHTING ZONES AS INDICATED.
  - AUTOMATIC LIGHTING CONTROLS:
    - UNLESS OTHERWISE NOTED ON PLANS, OCCUPANCY SENSORS SHALL AUTOMATICALLY TURN OFF ALL CONNECTED LIGHTING WITHIN 20 MINUTES OF SPACE BEING UNOCCUPIED. OCCUPANCY SENSORS SHALL EITHER BE MANUAL ON OR SHALL BE CONTROLLED TO AUTOMATICALLY TURN THE LIGHTING ON TO NOT MORE THAN 50 PERCENT POWER EXCEPT WHERE MANUAL ON WOULD ENDANGER THE SAFETY OR SECURITY OF THE ROOM OR BUILDING OCCUPANTS. (C405.2.1.1)
    - MULTI-ZONE PHOTO-SENSORS SHALL PROVIDE SEPARATE CONTROL FOR LUMINAIRES IN EACH TYPE OF DAYLIGHT ZONE. (C405.2.4.1)
    - EXTERIOR LIGHTING CONTROLS SHALL AUTOMATICALLY TURN OFF ALL EXTERIOR LIGHTING AS A FUNCTION OF AVAILABLE DAYLIGHT. BUILDING FACADE AND LANDSCAPE LIGHTING SHALL HAVE CONTROLS THAT AUTOMATICALLY SHUT OFF THE LIGHTING FOR A MINIMUM OF 6 HOURS PER NIGHT OR NOT LATER THAN ONE HOUR AFTER BUSINESS CLOSING TO NOT EARLIER THAN ONE HOUR BEFORE BUSINESS OPENING, WHICHEVER IS LESS. OTHER LIGHTING SHALL HAVE CONTROLS CONFIGURED TO AUTOMATICALLY REDUCE THE CONNECTED LIGHTING POWER BY AT LEAST 30 PERCENT FROM NO LATER THAN 12 MIDNIGHT TO 6 AM OR FROM ON HOUR AFTER BUSINESS CLOSING TO ONE HOUR BEFORE BUSINESS OPENING OR DURING ANY PERIOD WHEN NO ACTIVITY HAS BEEN DETECTED FOR A TIME OF NO LONGER THAN 15 MINUTES. (C405.2.6)
  - MEANS OF EGRESS ILLUMINATION: AT ANY TIME THE BUILDING IS OCCUPIED, THE MEANS OF EGRESS SHALL BE ILLUMINATED AT AN INTENSITY OF NOT LESS THAN 1 FOOTCANDLE AT FLOOR LEVEL. (IBC 1008.2.1)
  - DURING EMERGENCY CONDITIONS EMERGENCY LIGHTING CIRCUITS SHALL BYPASS ALL LIGHTING CONTROLS IN ORDER TO ENERGIZE ALL CONNECTED LUMINAIRES AT FULL CAPACITY. PROVIDE UL924 RELAYS AS REQUIRED TO BYPASS AREA CONTROLS.
    - EMERGENCY PATHWAY EGRESS LIGHTING: ILLUMINATION PROVIDED ALONG THE EGRESS PATH AT FLOOR LEVEL SHALL AVERAGE AT LEAST 1 FOOT CANDLE. (IBC 1008.3.5)
    - EMERGENCY LIGHTING SHALL BE SUPPLIED BY: ELECTRICAL CONTRACTOR

### EXIT SIGN NOTES

DURING CONSTRUCTION UPON COMPLETION OF A TYPICAL FLOOR FRAMING AND BEFORE WALL COVER, ELECTRICAL CONTRACTOR SHALL WALK THE EGRESS PATHS WITH THE LOCAL INSPECTOR (AHJ) TO CONFIRM THAT ALL THE EXIT SIGNS ARE LOCATED PER THE AHJ'S SATISFACTION AND IDENTIFY ANY ADDITIONAL EXIT SIGNS THAT THE AHJ WISHES TO BE INSTALLED (IBC 1013.1). CONTRACTOR SHALL PROVIDE UP TO 10% ADDITIONAL EXIT SIGNS AT NO ADDITIONAL COST.

NO.	DATE	DESCRIPTION	REVISIONS

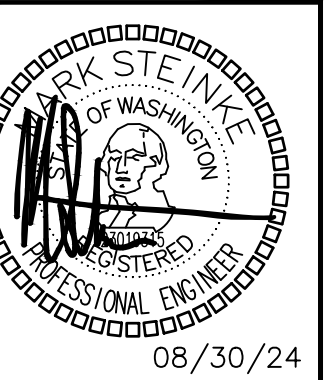

DRAWN: KL	DESIGNED: MHS	CHECKED: PSR	APPROVED: JAY
-----------	---------------	--------------	---------------

PROJECT: BRADLEY HEIGHTS APARTMENTS BUILDING H  
27TH AVE SE AND 5TH ST SE PUYALLUP, WA


19401 40TH AVE W, SUITE 302  
LYNNWOOD, WA 98036  
PHONE: (206) 364-3343

**ROBISON ENGINEERING, INC.**

DATE: 08/30/24



SHEET TITLE:  
**LIGHTING NOTES & LUMINAIRE SCHEDULE**

SHEET NO.  
**E1.50**

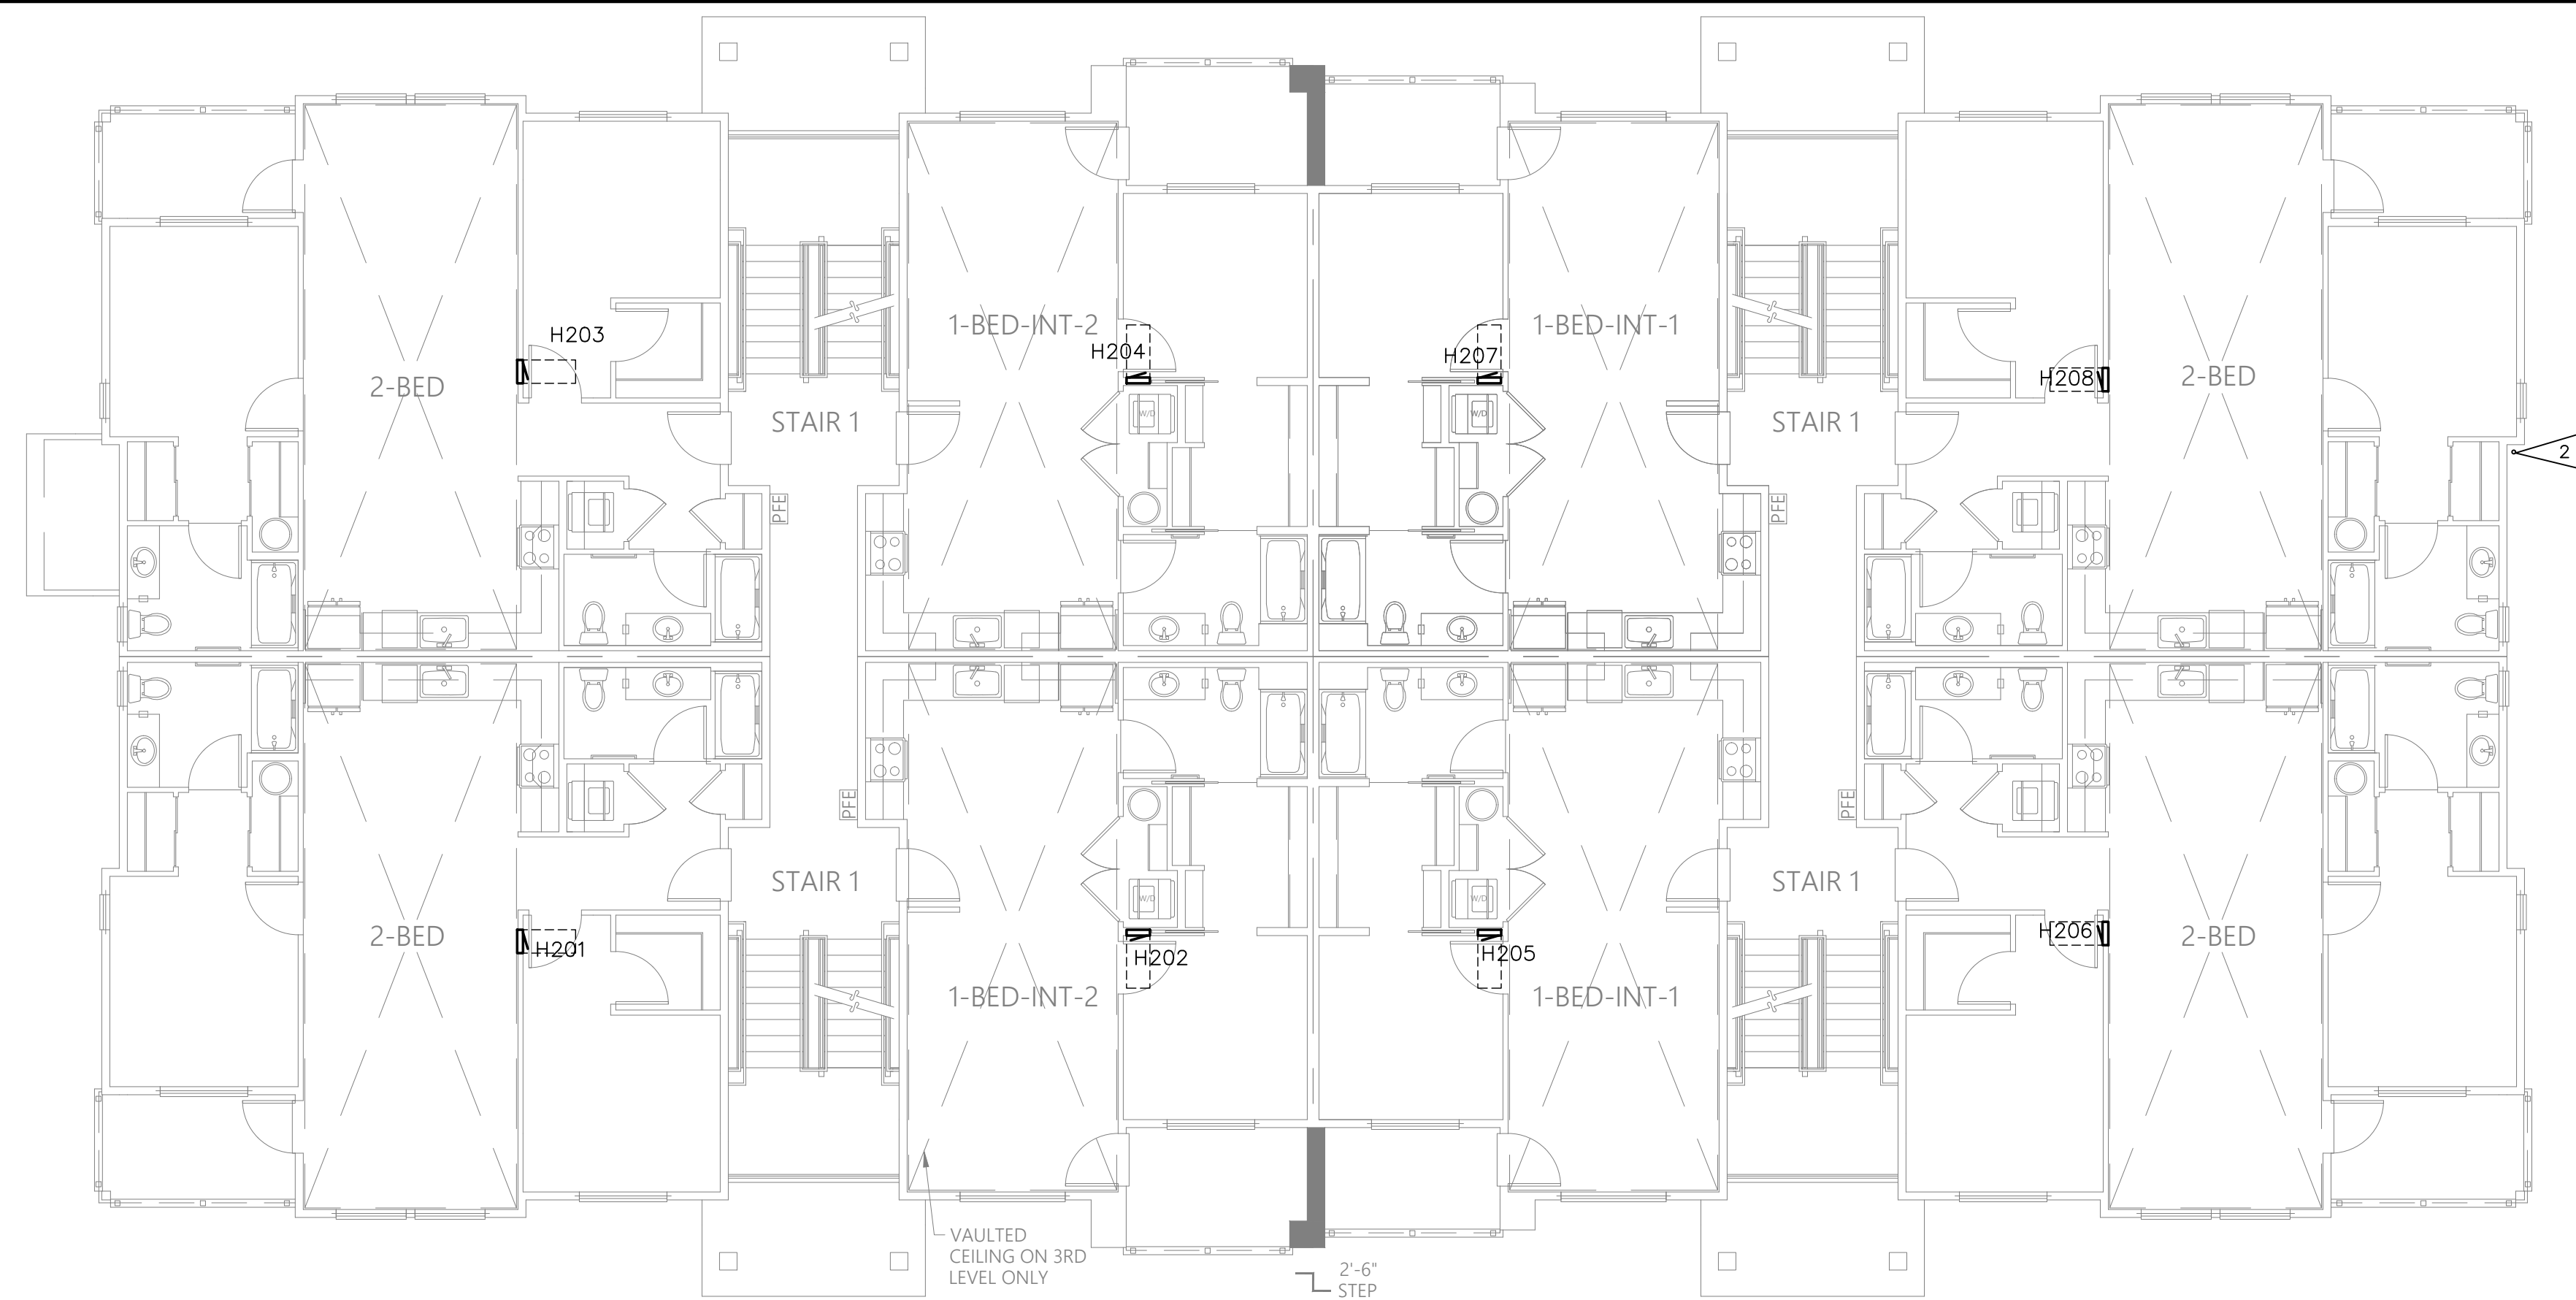

**POWER PLAN – 1ST FLOOR**

SCALE: 1/8" = 1'-0"

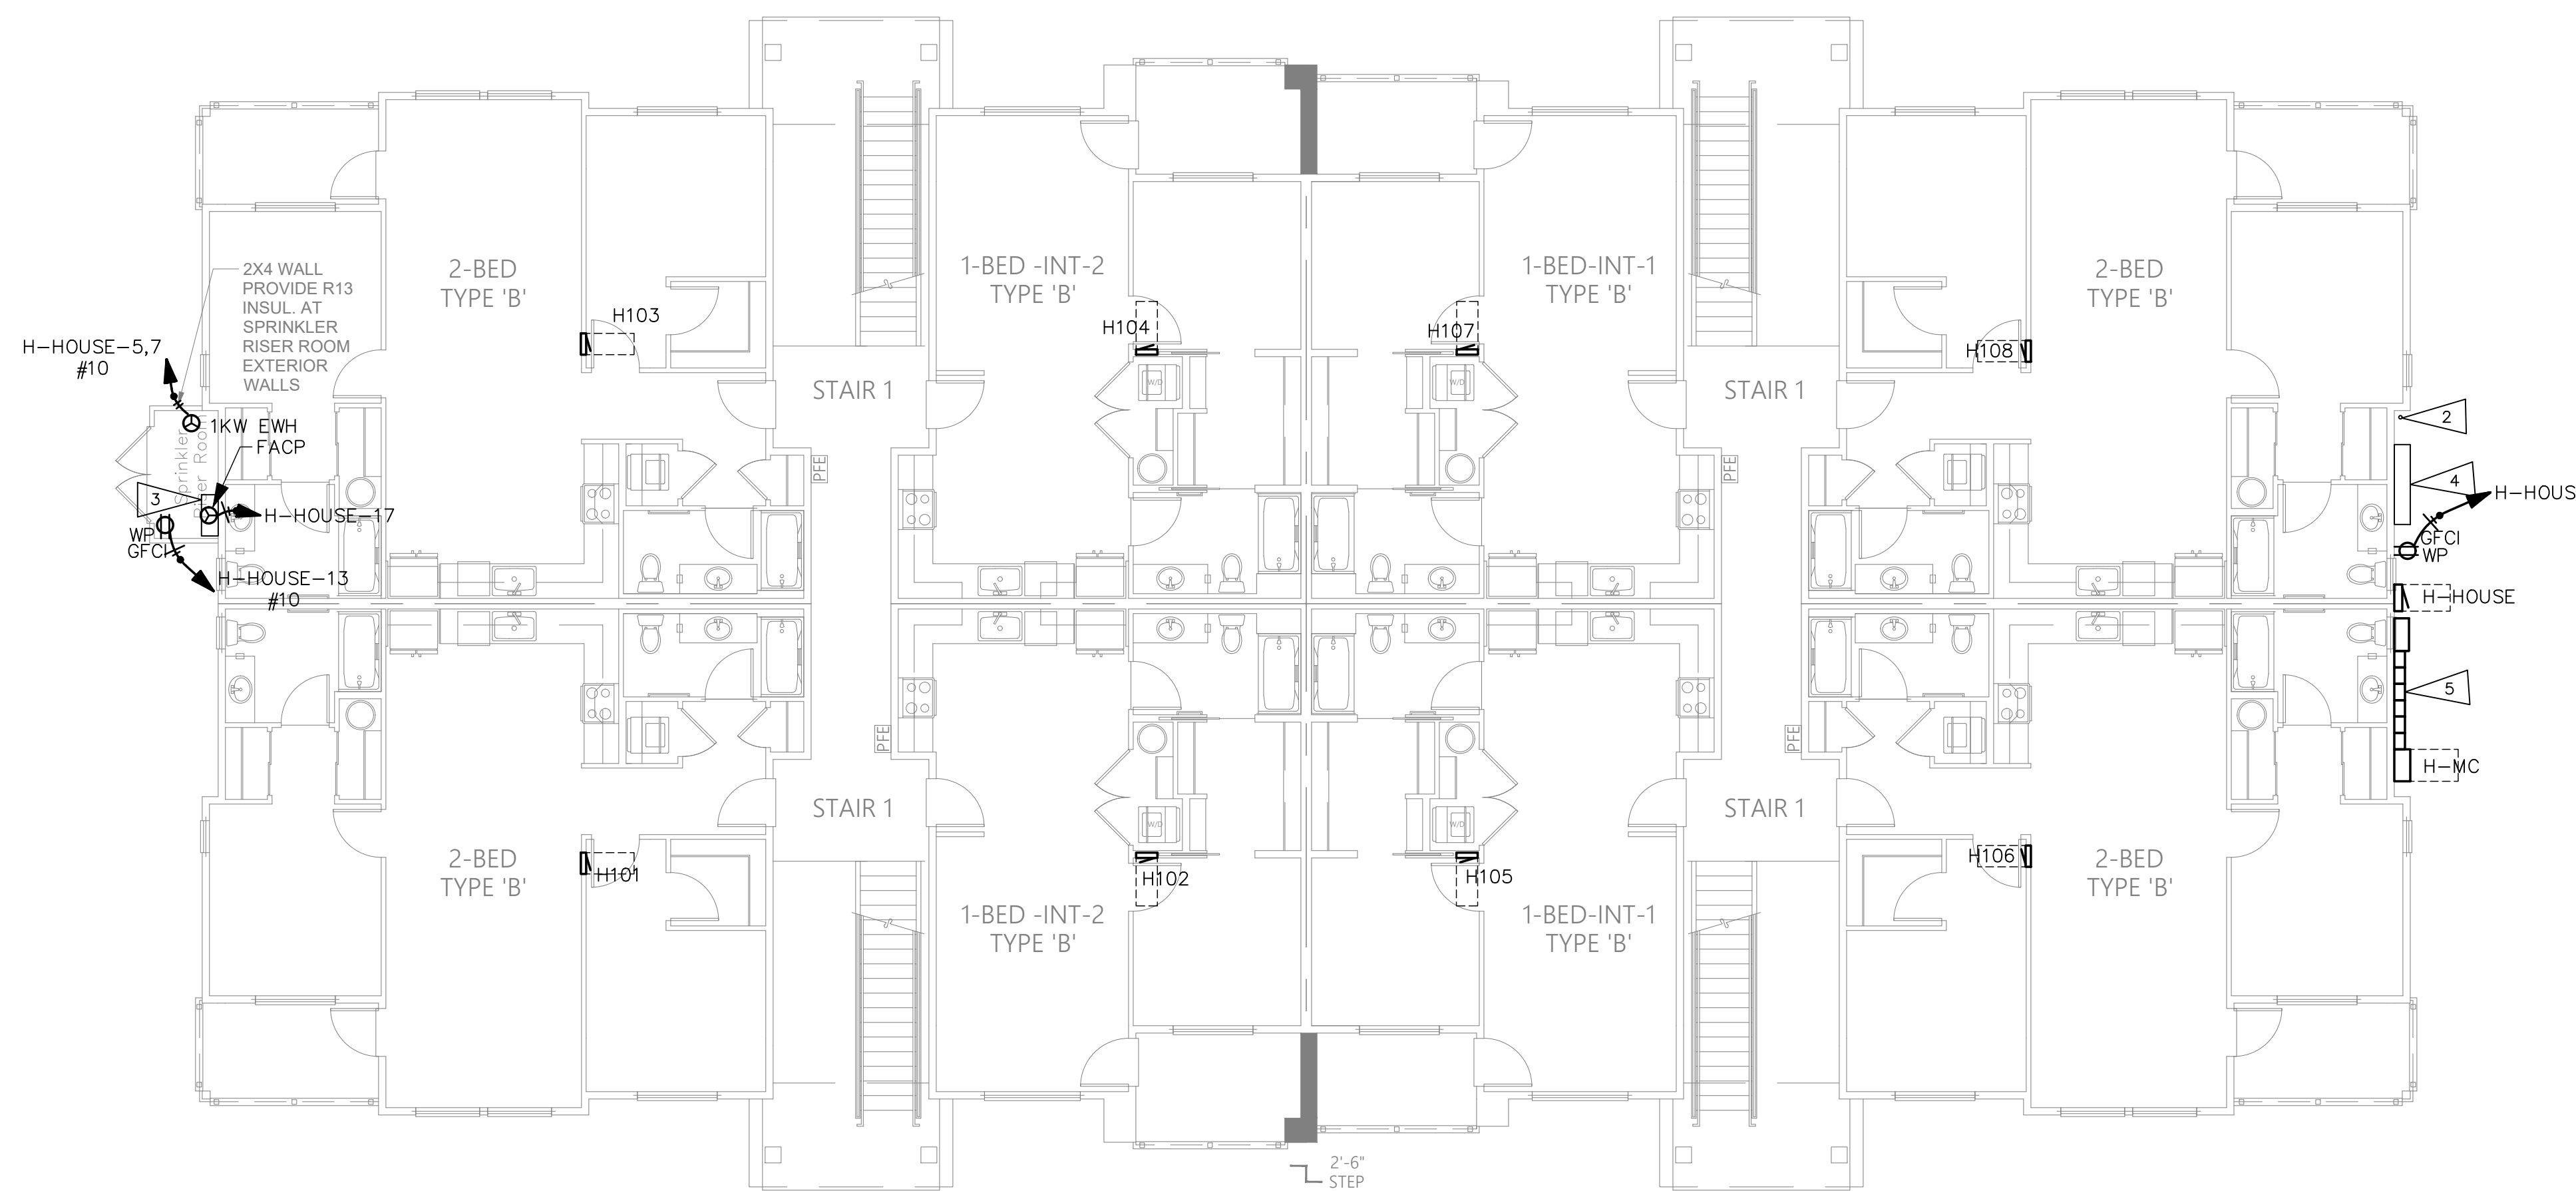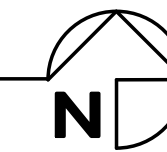

**POWER PLAN – BASEMENT**

SCALE: 1/8" = 1'-0"




**SHEET NOTES:**

1. WIRING METHOD FOR APARTMENT FEEDERS MUST BE SUITABLE FOR THE TYPE OF CONSTRUCTION. SEE NEC 334.10

**FLAG NOTES:** (NOT EVERY FLAG IS USED ON EVERY SHEET)

1. FUTURE EV CHARGING STATIONS: PROVIDE 1-1/4" CONDUIT WITH PULL WIRE FROM EV PANEL(S) IN MAIN ELECTRICAL ROOM. TERMINATE CONDUIT IN A J-BOX ON WALL FOR FUTURE USE.
2. PROVIDE 2 1/2" C WITH PULL STRING WEATHER CAP TO ROOF FOR FUTURE SOLAR PATHWAY. COORDINATE RISER LOCATION WITH ARCHITECT.
3. LOCATION OF FIRE ALARM PANEL TO BE COORDINATED BY FIRE ALARM CONTRACTOR WITH FIRE AUTHORITIES.
4. SPACE FOR FUTURE SOLAR EQUIPMENT.
5. PROVIDE LEVEL ACCESS SURFACE IN FRONT OF ELECTRICAL EQUIPMENT.

NO.	DATE	DESCRIPTION	REVISIONS

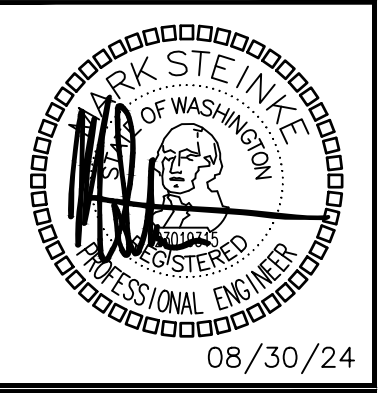


DRAWN: KL	DESIGNED: MHS	CHECKED: PSR	APPROVED: JAY
-----------	---------------	--------------	---------------

PROJECT: BRADLEY HEIGHTS APARTMENTS BUILDING H  
 27TH AVE SE AND 5TH ST SE PUYALLUP, WA  
**ROBISON ENGINEERING, INC**  
 19401 40TH AVE W, SUITE 302  
 LYNNWOOD, WA 98036  
 PHONE: (206) 364-3343

DATE: 08/30/24



SHEET TITLE:  
**POWER PLAN  
 - BASEMENT &  
 1ST FLOOR**

SHEET NO.  
**E3.00**

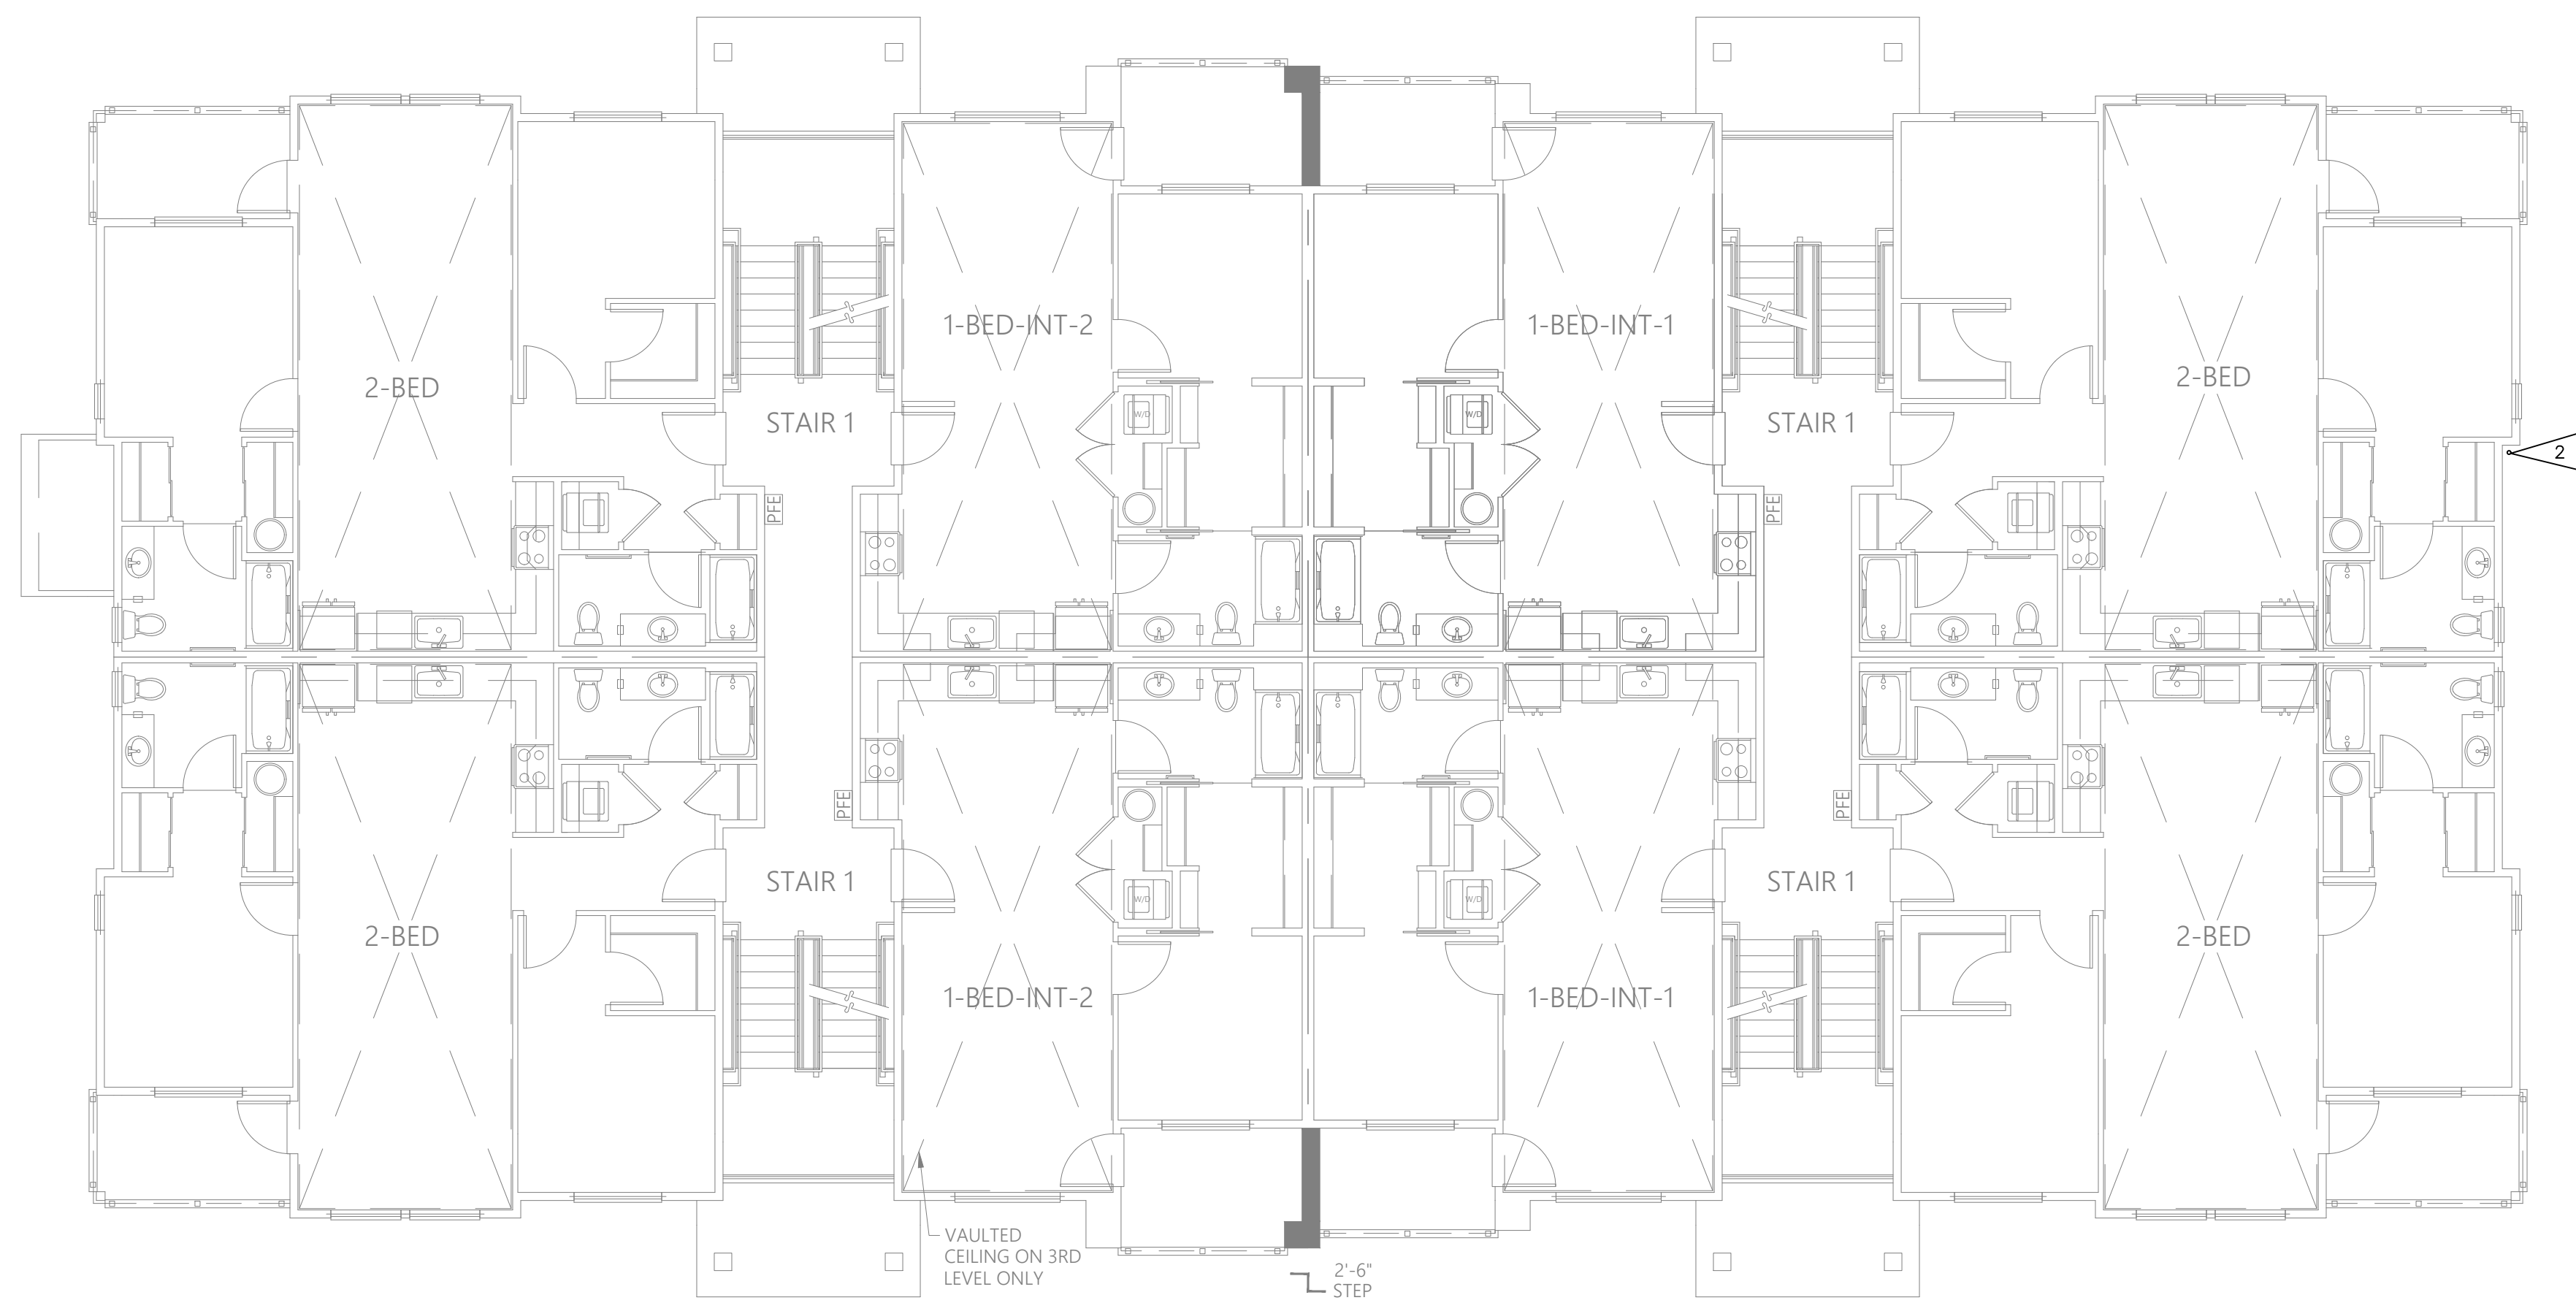


**POWER PLAN – ROOF**

SCALE: 1/8" = 1'-0"

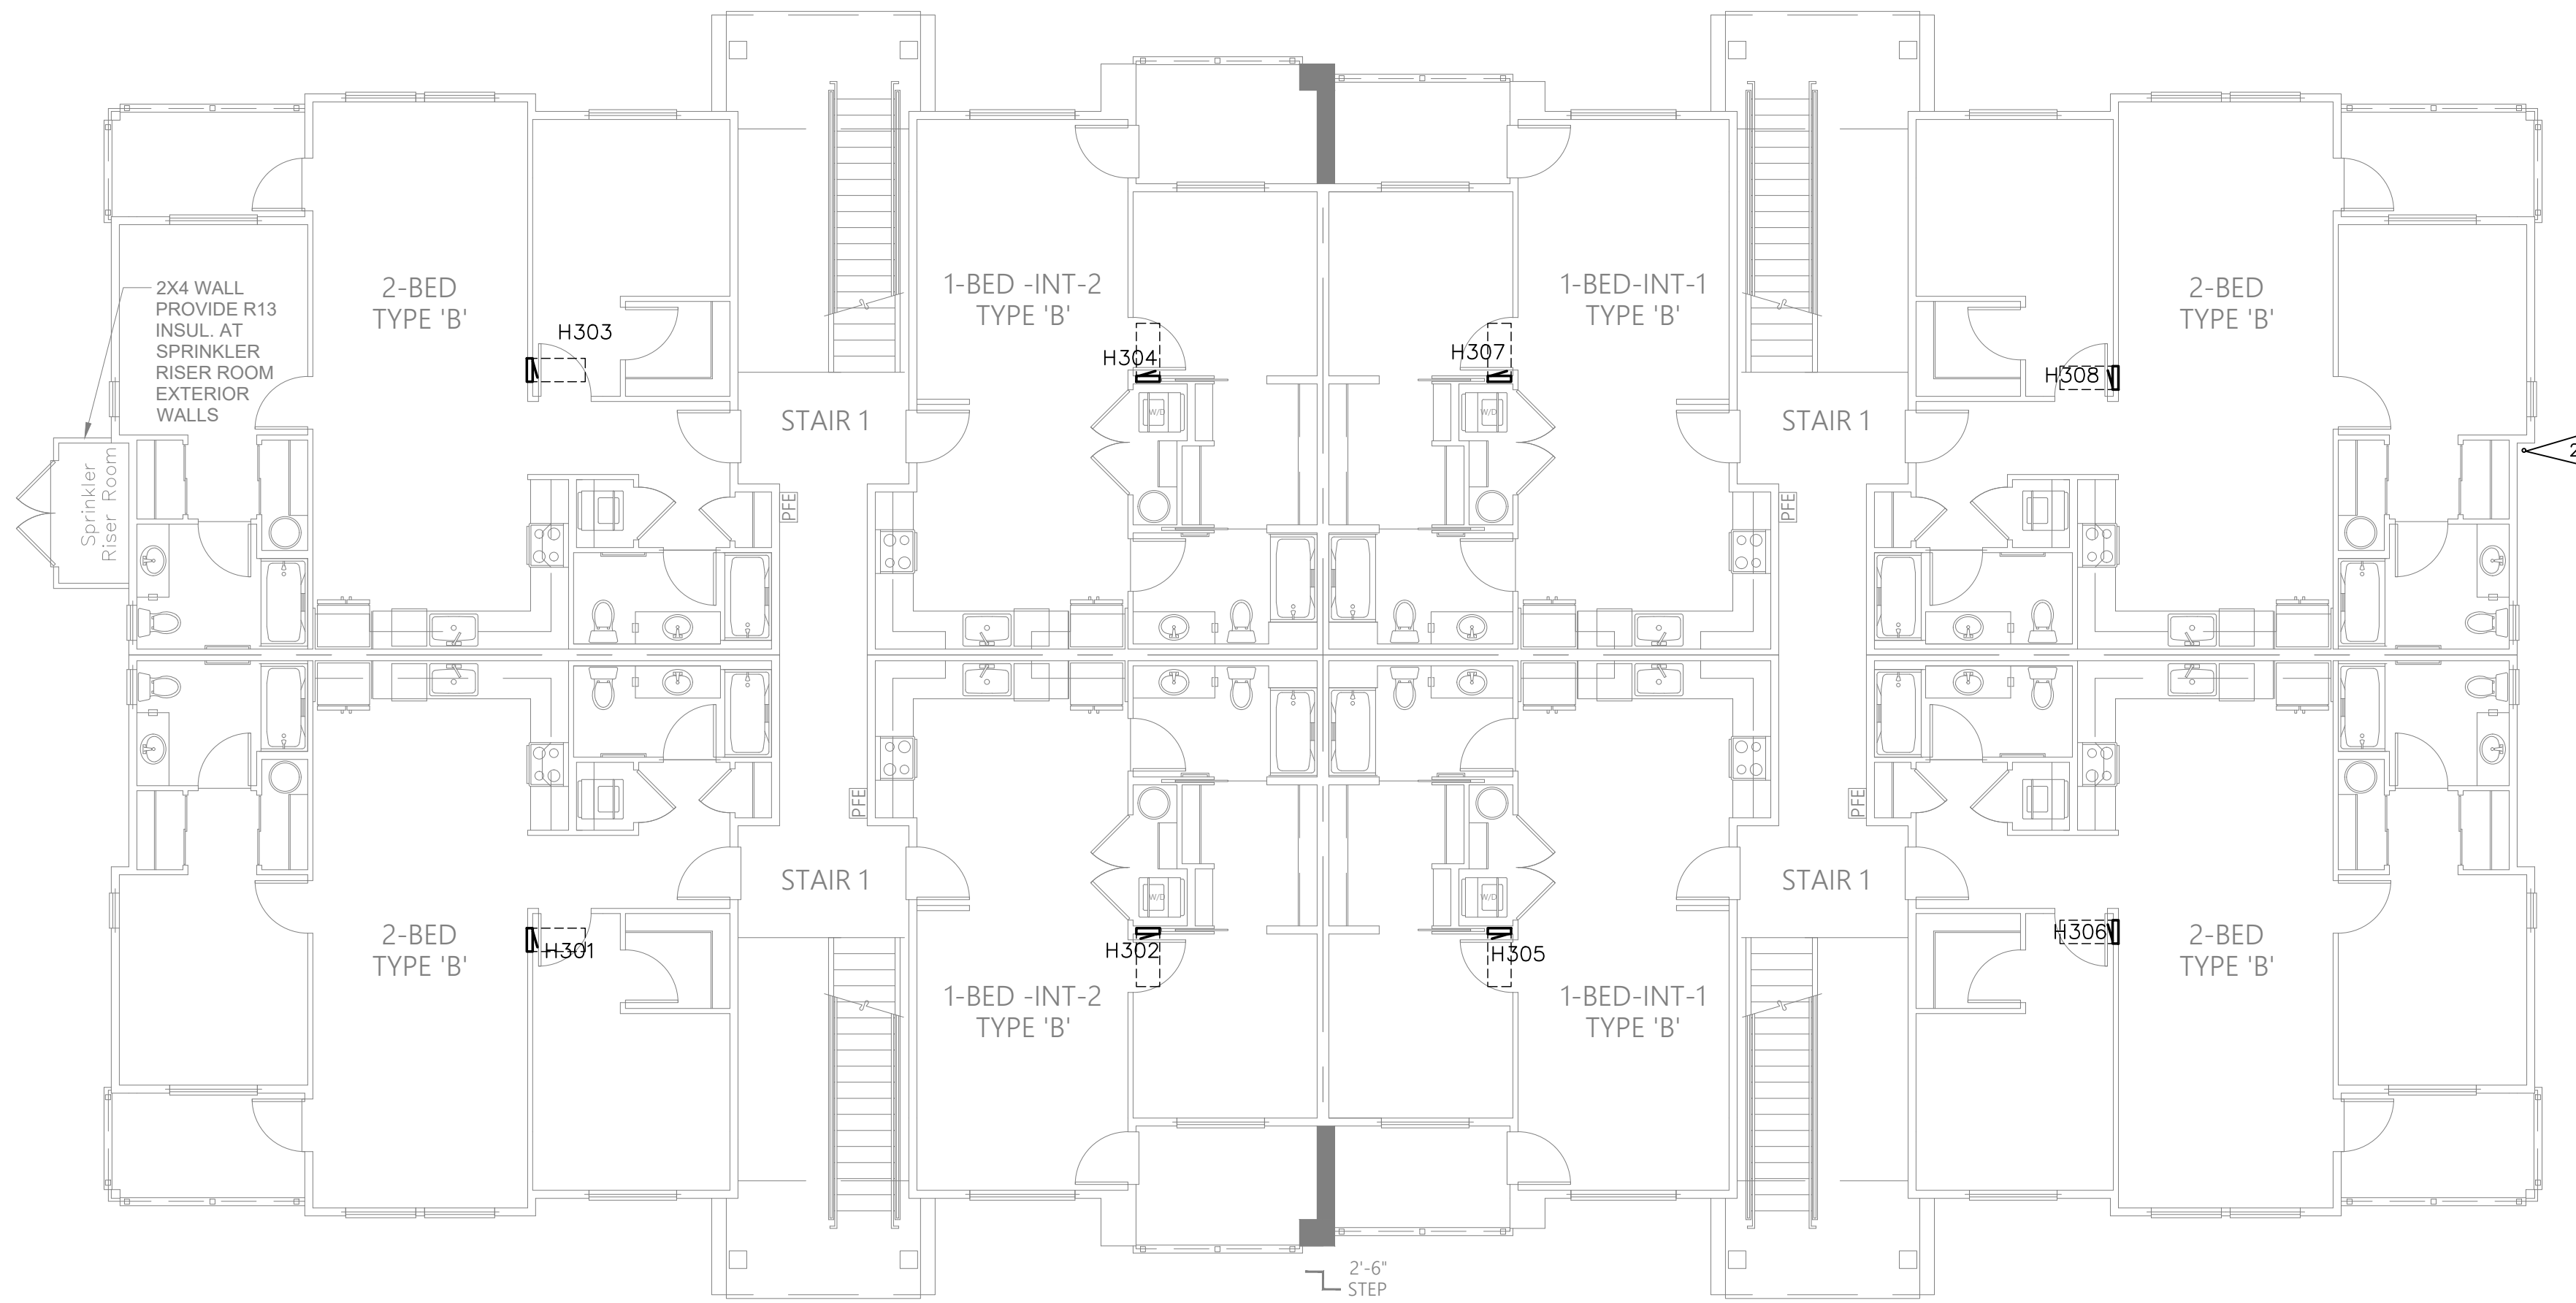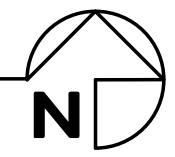

**POWER PLAN – 2ND FLOOR**

SCALE: 1/8" = 1'-0"

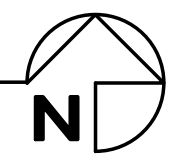


**SHEET NOTES:**

1. WIRING METHOD FOR APARTMENT FEEDERS MUST BE SUITABLE FOR THE TYPE OF CONSTRUCTION. SEE NEC 334.10

**FLAG NOTES:** (NOT EVERY FLAG IS USED ON EVERY SHEET)

1. FUTURE EV CHARGING STATIONS: PROVIDE 1-1/4" CONDUIT WITH PULL WIRE FROM EV PANEL(S) IN MAIN ELECTRICAL ROOM. TERMINATE CONDUIT IN A J-BOX ON WALL FOR FUTURE USE.
2. PROVIDE 2 1/2" C WITH PULL STRING WEATHER CAP TO ROOF FOR FUTURE SOLAR PATHWAY. COORDINATE RISER LOCATION WITH ARCHITECT.
3. LOCATION OF FIRE ALARM PANEL TO BE COORDINATED BY FIRE ALARM CONTRACTOR WITH FIRE AUTHORITIES.
4. SPACE FOR FUTURE SOLAR EQUIPMENT.
5. PROVIDE LEVEL ACCESS SURFACE IN FRONT OF ELECTRICAL EQUIPMENT.

NO.	DATE	DESCRIPTION	REVISIONS

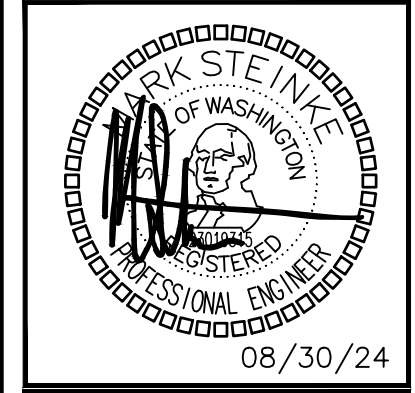

DRAWN: KL	DESIGNED: MHS	CHECKED: PSR	APPROVED: JAY
-----------	---------------	--------------	---------------

PROJECT: BRADLEY HEIGHTS APARTMENTS BUILDING H  
 27TH AVE SE AND 5TH ST SE PUYALLUP, WA

19401 40TH AVE W, SUITE 302  
 LYNNWOOD, WA 98036  
 PHONE: (206) 364-3343

**ROBISON ENGINEERING, INC**

DATE: 08/30/24

SHEET TITLE:  
**POWER PLAN - 2ND & ROOF**

SHEET NO.  
**E3.01**



**UNIT LUMINAIRE SCHEDULE**


CALLOUT	SYMBOL	MOUNTING	DESCRIPTION	MODEL	VOLTAGE	TYPE	LAMPING	WATTAGE	NOTES
U1	○	CEILING	4" DOWNLIGHT	DMF: DRD5S-4-R-10-9-30-0	120	0-10V DIMMING	(1) 12W LED 3000K	12	
U2	○	CEILING	4" DOWNLIGHT WET RATED	DMF: DRD5S-4-S-10-9-30-0	120	0-10V DIMMING	(1) 12W LED 3000K	12	
U3	⏏	WALL	24" VANITY LIGHT	MAXIM - 52102	120	ELV DIMMING	(1) 16W LED 3000K	16	
U4	⏏	WALL	SLIM BALCONY LIGHT	MAXIM - 26106BK	120	NON DIMMING	(1) 10W LED 3000K	10	
U5	○	SURFACE	6" FLUSH MOUNT DOWNLIGHT	MAXIM - 57413WTWT	120	0-10V DIMMING	(1) 11W LED 3000K	11	

**ACCESSIBILITY NOTES:**

- ALL SWITCHES AND CONTROLS - 15" MIN; 48" MAX TO CONTROL.
- GENERAL OUTLETS MIN 18" AFF.
- ALL SWITCHES/CONTROLS ABOVE COUNTERTOPS 48" MAX.
- ELECTRICAL SUB-PANELS IN UNITS MUST COMPLY WITH ABOVE REACH RANGES.
- SWITCHES FOR EXHAUST HOODS AND GARBAGE DISPOSALS MUST COMPLY WITH ABOVE REACH RANGES. INSTALL SWITCHES ON FACE OF CABINETS IF REQUIRED TO COMPLY.

**APARTMENT NOTES:**

- ALL ELECTRICAL WORK SHALL COMPLY WITH ALL LOCAL AND NATIONAL CODES.
- DEVICE BOXES ON OPPOSITE SIDES OF DEMISING WALLS SHALL BE IN SEPARATE STUD BAYS. PROVIDE BACKING EQUIVALENT TO LOWRY'S OUTLET BOX PADS. CONDUIT FROM ONE UNIT SHALL NOT PASS THROUGH STUDS OF A SHARED WALL(DOUBLE STUDS) FROM AN ADJACENT UNIT(BRIDGING).
- PROVIDE ARC-FAULT PROTECTION, TAMPER PROOF AND GFCI RECEPTACLES AS REQUIRED BY CODE AND LOCAL AHJ. ARC-FAULT PROTECTION MUST BE PROVIDED FOR CIRCUITS IN THE AREAS LISTED IN NEC 210.12(A).
- PROVIDE SUFFICIENT DUPLEX RECEPTACLES TO MEET NEC 210.52.
- THERMOSTATS SHALL NOT INTERFERE WITH DOOR SWINGS.
- ELECTRICAL CONTRACTOR SHALL MAKE ALL FINAL CONNECTIONS FOR KITCHEN APPLIANCES. COORDINATE ALL J-BOX LOCATIONS WITH APPLIANCE INSTALLATION INSTRUCTIONS PRIOR TO ROUGH-IN.
- ELECTRICAL CONTRACTOR SHALL FURNISH AND INSTALL CORD AND PLUG ASSEMBLY FOR EACH DISPOSER.
- PROVIDE A DEDICATED 20 AMP CIRCUIT TO EACH UNIT BATHROOM RECEPTACLE. BATHROOM LIGHTS, FAN TO BE ON SAME CIRCUIT PER 210.11(C)(3) EXCEPTION.
- HOME RUNS AND LOOPS CONNECTING LIGHT FIXTURES, WIRING DEVICES, AND HVAC EQUIPMENT ON PLANS INDICATE CIRCUITING SCHEME. SEE TYPICAL PANEL SCHEDULES FOR ACTUAL CIRCUIT NUMBERS FOR TYPICAL APARTMENT.
- LIGHTS WITHIN 3' HORIZONTAL OF SHOWER OR TUB TO BE WET LOCATION RATED AND HAVE FULLY ENCLOSED TRIMS. PROVIDE GFCI PROTECTION IF THE LUMINAIRE INSTALLATION MANUAL STATES IT IS REQUIRED.
- PROVIDE SMOKE DETECTORS AND CO ALARMS AS REQUIRED. DETECTORS AND ALARMS TO BE HARDWIRED AND PROVIDED WITH BATTERY BACKUP.
- ELECTRICAL CONTRACTOR SHALL INSTALL RECEPTACLES AND TV, DATA/PHONE OUTLETS UNDER COMMON COVER PLATE WHERE POSSIBLE. PROVIDE AND INSTALL DIVIDERS AS REQUIRED FOR CABLE/POWER SEPARATION.
- SEE ARCHITECTURAL DRAWINGS FOR DIMENSIONS AND LAYOUTS OF ALL DEVICES.
- ALL WALL PENETRATIONS SHALL BE CAULKED WITH APPROVED MATERIAL TO MAINTAIN THE FIRE RATING OF ALL WALLS AND FLOORS.
- ALL CONDUIT SHALL BE INSTALLED IN NEAT SYMMETRICAL LINES HORIZONTAL OR PERPENDICULAR TO BUILDING COLUMNS AND ROOF LINES. CONDUITS SHALL BE GROUPED ON COMMON SUPPORTS WHEREVER POSSIBLE.
- REFERENCE MECHANICAL DRAWINGS FOR EXACT LOCATION OF ALL MECHANICAL EQUIPMENT.
- ELECTRICAL CONTRACTOR SHALL VERIFY ALL FUSE RATING WIRE SIZES AND DISCONNECT SIZES WITH EQUIPMENT SERVED ON THE JOB PRIOR TO INSTALLATION.
- SEE ARCHITECTURAL DRAWINGS AND ELEVATIONS FOR ADDITIONAL DETAILS AND CASEWORK DIMENSIONS.
- DEVICE LOCATIONS IN 1ST DWELLING/RESIDENT UNIT SHALL BE REVIEWED AND APPROVED BY OWNER PRIOR TO ROUGH-IN OF REMAINING UNITS
- CONFIRM FINAL LOCATION OF HEATERS AND THERMOSTATS IN FIELD PRIOR TO ROUGH-IN

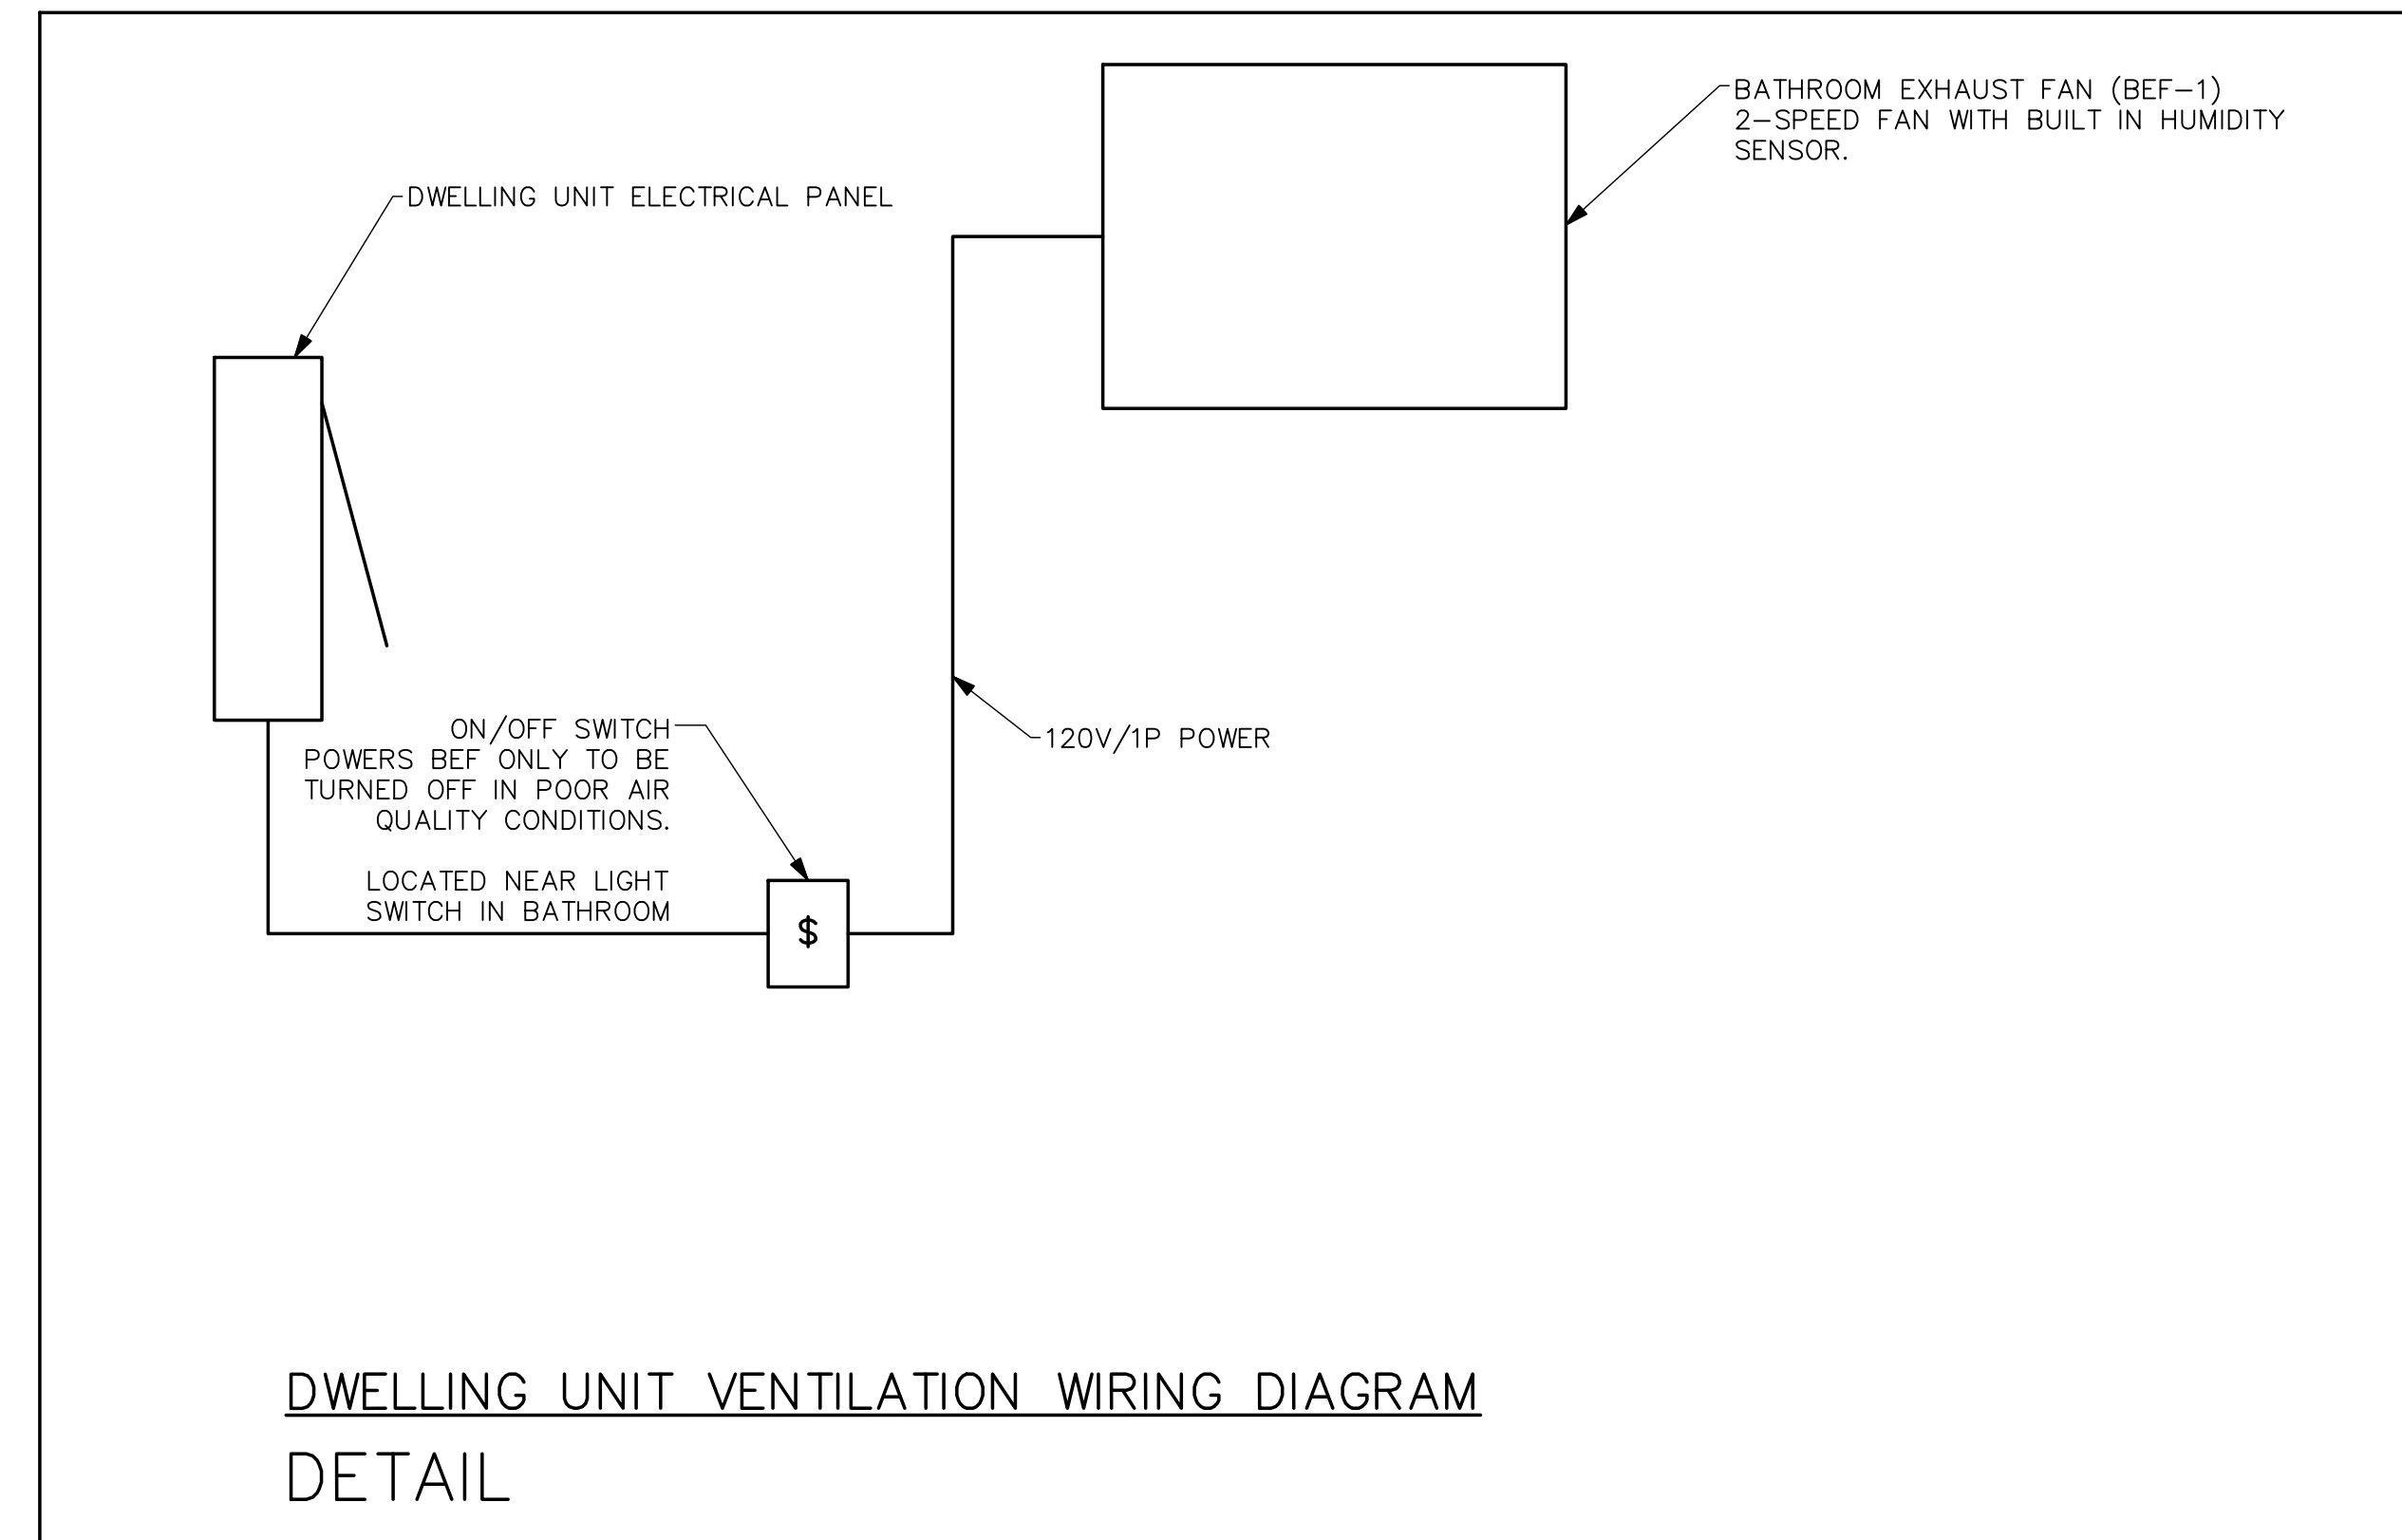


**DWELLING UNIT VENTILATION WIRING DIAGRAM DETAIL**

ELECTRIC HEATERS					
EQUIP NO.	SERVICE	MOUNTING/DISCHARGE	HEATING	ELECTRICAL	BASIS OF DESIGN
			KW	VOLTAGE	
EWH-1	BEDROOM	WALL	1	208V/1P	(1)
EWH-2	LIVING ROOM	WALL	1.5	208V/1P	(1)

- NOTES:
- (1) BROAN, CADET OR EQUIVALENT.
  - (2) PROVIDE REMOTE THERMOSTAT.

NO.	DATE	DESCRIPTION	REVISIONS

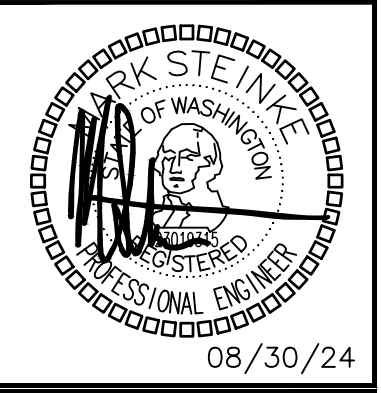

DRAWN: KL	DESIGNED: MHS	CHECKED: PSR	APPROVED: JAY
-----------	---------------	--------------	---------------

PROJECT: BRADLEY HEIGHTS APARTMENTS BUILDING H  
27TH AVE SE AND 5TH ST SE PUYALLUP, WA



19401 40TH AVE W, SUITE 302  
LYNNWOOD, WA 98036  
PHONE: (206) 364-3343

**ROBISON ENGINEERING, INC**

DATE: 08/30/24

SHEET TITLE:  
**UNIT PLANS NOTES**

SHEET NO.  
**E5.00**

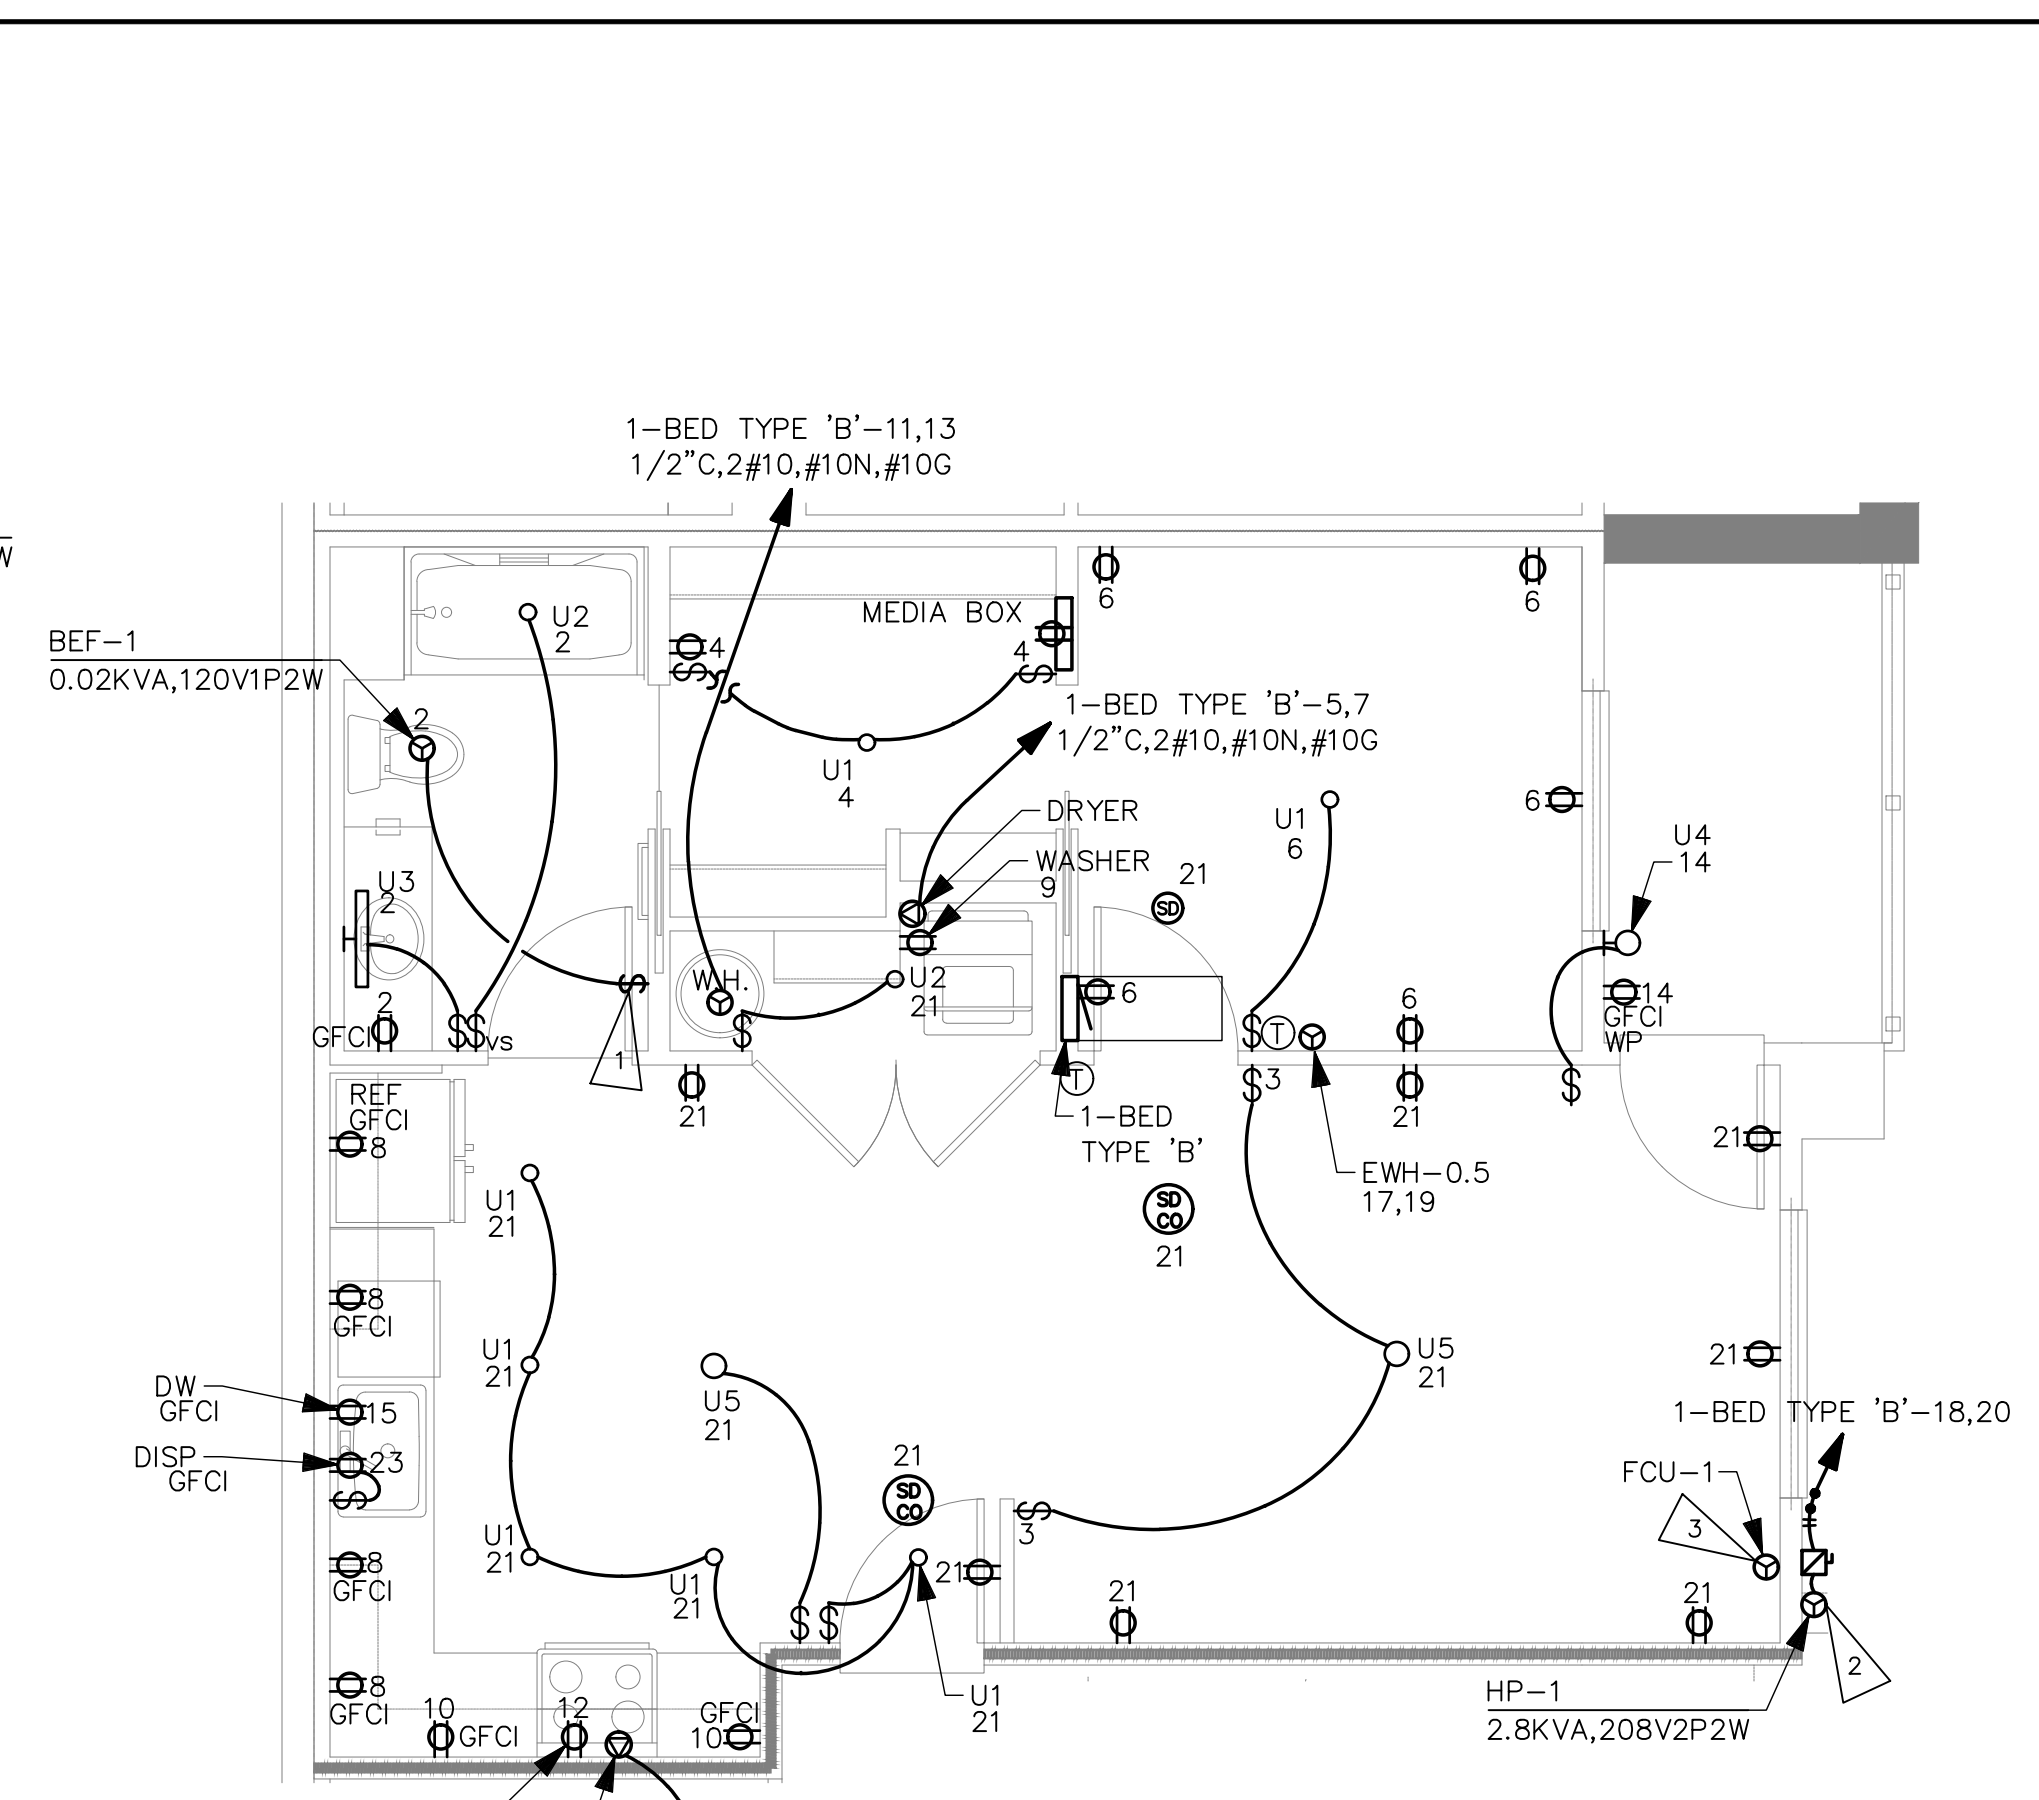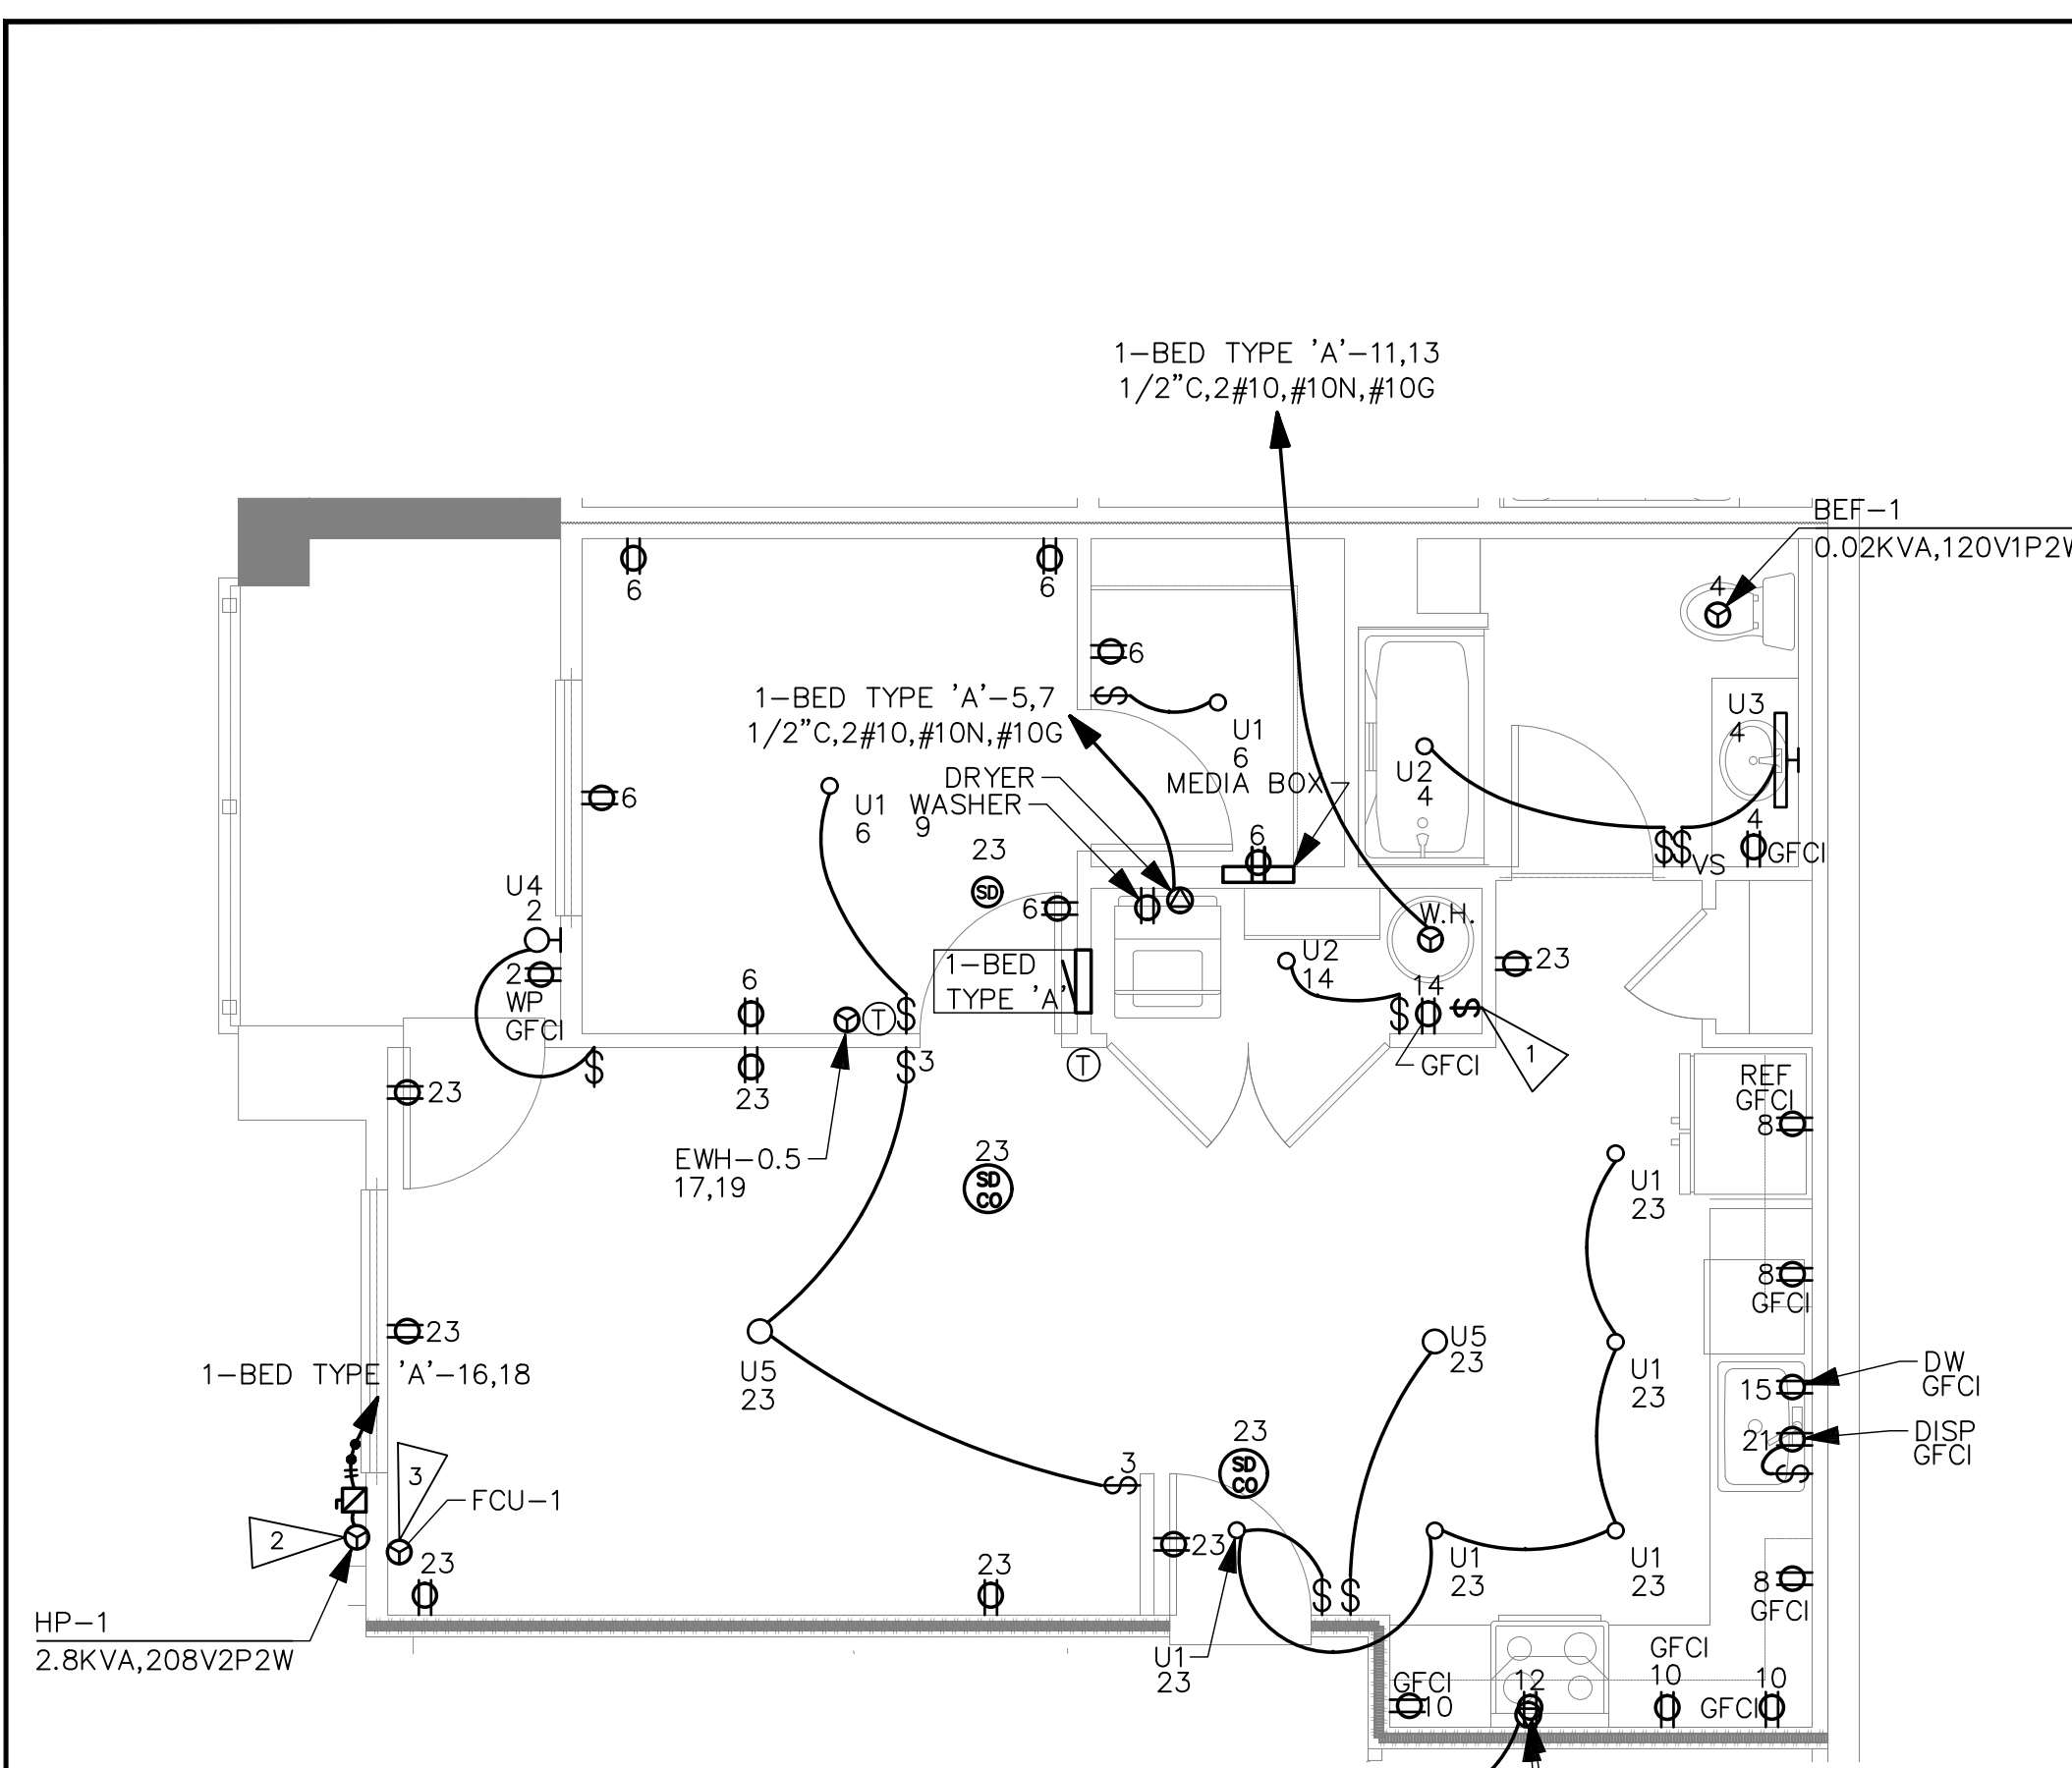

UNIT TYPICALS

1-BED-INT-2 TYPE 'A'

SCALE: 1/4" = 1'-0"

UNIT TYPICALS

1-BED-INT-1 TYPE 'B'

SCALE: 1/4" = 1'-0"

1-BED TYPE 'A'				AIC 22,000			
ROOM MOUNTING	FLUSH	VOLTS 208/120V 2P 3W	MAIN BKR MLO				
FED FROM	NEUTRAL	BUS AMPS 125	LUGS STANDARD				
NOTE							
CKT #	CKT BKR	LOAD KVA	CIRCUIT DESCRIPTION	CKT #	CKT BKR	LOAD KVA	CIRCUIT DESCRIPTION
1	50/2	8	RANGE	a 2	20/1	0.19	LIGHTING, RECEPTACLE
3				b 4	20/1	0.23	BEF-1, LIGHTING, RECEPTACLE
5	30/2	4.99	DRYER	a 6	20/1	1.28	LIGHTING, MEDIA BOX, RECEPTACLE
7				b 8	20/1	1.5	SMALL APPLIANCE
9	20/1	1.5	WASHER	a 10	20/1	1.5	SMALL APPLIANCE
11	30/2	4.4	WATER HEATER	b 12	20/1	1.58	MICRO/HOOD
13				a 14	20/1	0.192	LIGHTING, RECEPTACLE
15	20/1	1.2	DISHWASHER	b 16	20/2	2.8	HP-1
17	20/2	0.5	WALL HEATER	a 18		0	SPACE
19				b 20	-/1	0	SPACE
21	20/1	0.7	DISPOSAL	a 22	-/1	0	SPACE
23	20/1	1.49	LIGHTING, RECEPTACLE, SDCO	b 24	-/1	0	SPACE

OPTIONAL DWELLING UNIT CALCULATION (NEC 220.82)					
	CONN KVA	871 SF (3 VA/SF)	GENERAL LOAD UP TO 10 KVA	CONN KVA	CALC KVA
LIGHTING AND RECEPTACLES	2.61		10	10	(100%)
SMALL-APPLIANCE	3		OVER 10 KVA	13.6	5.43 (40%)
LAUNDRY	1.5		MAX HEATING OR COOLING	3.19	(220.82(C)(4))
APPLIANCES	8.47		TOTAL LOAD	18.6	
ELECTRIC COOKING	8		BALANCED LOAD	89.5 A	
TOTAL GENERAL LOAD	23.6		PHASE A	98.3%	
			PHASE B	102%	

1-BED TYPE 'B'				AIC 22,000			
ROOM MOUNTING	FLUSH	VOLTS 208/120V 2P 3W	MAIN BKR MLO				
FED FROM	NEUTRAL	BUS AMPS 125	LUGS STANDARD				
NOTE							
CKT #	CKT BKR	LOAD KVA	CIRCUIT DESCRIPTION	CKT #	CKT BKR	LOAD KVA	CIRCUIT DESCRIPTION
1	50/2	8	RANGE	a 2	20/1	0.23	BEF-1, LIGHTING, RECEPTACLE
3				b 4	20/1	0.372	LIGHTING, MEDIA BOX, RECEPTACLE
5	30/2	4.99	DRYER	a 6	20/1	0.912	LIGHTING, RECEPTACLE
7				b 8	20/1	1.5	SMALL APPLIANCE
9	20/1	1.5	WASHER	a 10	20/1	1.5	SMALL APPLIANCE
11	30/2	4.4	WATER HEATER	b 12	20/1	1.58	MICRO/HOOD
13				a 14	20/1	0.19	LIGHTING, RECEPTACLE
15	20/1	1.2	DISHWASHER	b 16	20/1	0.38	RECEPTACLE, SDCO
17	20/2	0.5	WALL HEATER	a 18	20/2	2.8	HP-1
19				b 20		0	SPACE
21	20/1	1.5	LIGHTING, RECEPTACLE, SDCO	a 22	-/1	0	SPACE
23	20/1	0.7	DISPOSAL	b 24	-/1	0	SPACE

OPTIONAL DWELLING UNIT CALCULATION (NEC 220.82)					
	CONN KVA	871 SF (3 VA/SF)	GENERAL LOAD UP TO 10 KVA	CONN KVA	CALC KVA
LIGHTING AND RECEPTACLES	2.61		10	10	(100%)
SMALL-APPLIANCE	3		OVER 10 KVA	13.6	5.43 (40%)
LAUNDRY	1.5		MAX HEATING OR COOLING	3.19	(220.82(C)(4))
APPLIANCES	8.47		TOTAL LOAD	18.6	
ELECTRIC COOKING	8		BALANCED LOAD	89.5 A	
TOTAL GENERAL LOAD	23.6		PHASE A	100%	
			PHASE B	99.7%	

GENERAL NOTES:

- COORDINATE FINAL LOCATION OF THERMOSTATS, SWITCHES, RECEPTACLES, DATA, PHONE, LIGHT FIXTURES AND J-BOXES WITH ARCHITECTURAL ELEVATIONS AND INTERIOR DESIGN PLANS PRIOR TO ROUGH-IN.
- ADA UNITS SHALL HAVE HOOD CONTROLS INSTALLED IN THE FACE OF THE LOWER CABINET WORK.
- PROVIDE TAMPER RESISTANT RECEPTACLES PER NEC 406.12.
- ALL UNITS: PROVIDE SWITCH CONTROLLING GARBAGE DISPOSAL TO BE LOCATED ABOVE BACKSPASH NEXT TO SINK OR ON COUNTER. SEE ARCHITECTURE.
- BATHROOM GFCI RECEPTACLES TO HAVE INTEGRAL NIGHTLIGHT.
- RECESSED CEILING LIGHT IN BATHROOM SHALL BE LED RATED FOR WET LOCATIONS W/ SHATTER PROOF LENS.
- ALL RECEPTACLES SHALL MEET REQUIREMENTS OF NEC ARTICLE 210.
- PROVIDE TELEPHONE & CABLE T.V. MEDIA TERMINATION ENCLOSURE (MEDIA BOX): PROVIDE LEVITON COMPACT MEDIA ENCLOSURE OR EQUIVALENT IN WALL WITH TOP NO HIGHTER THAN 60" AFF WITH 120V RECEPTACLE ADJACENT.
- PROVIDE COMBINATION HARDWIRED 120VAC PHOTOELECTRIC SMOKE DETECTOR AND CARBON MONOXIDE DETECTOR WITH BATTERY-BACKUP
  - DETECTOR SHALL BE MINIMUM 6' HORIZONTAL DISTANCE FROM PERMANENT COOKING APPLIANCE PER CFC 90.2.11.8.
  - DETECTOR SHALL BE MINIMUM 3' HORIZONTAL DISTANCE FROM THE DOOR OF A BATHROOM THAT CONTAINS A BATHTUB OR SHOWER PER CFC 90.2.11.8.
  - PROVIDE INTERCONNECTION WIRING SUCH THAT ACTUATION OF ONE ALARM WILL ACTIVATE ALL ALARMS IN THE DWELLING UNIT.
  - COORDINATE WITH AHJ ON INTERCONNECTING EACH DWELLING UNIT INTO THE FIRE ALARM SYSTEM FOR THE BUILDING.
  - COORDINATE WITH AHJ AS TO THE NUMBER AND LOCATION OF DEVICES PRIOR TO ROUGH-IN. DEVICES SHOWN ARE DIAGRAMMATIC.
- DISHWASHER OUTLET SHALL BE ACCESSIBLE. RECEPTACLE SHALL BE LOCATED IN SPACE ADJACENT TO THE DISHWASHER.
- PROVIDE 7-DAY PROGRAMMABLE THERMOSTAT FOR THE LIVING ROOM.


FLAG NOTES

- INTERLOCK ERV/BEF TO ON/OFF SWITCH. PROVIDE PERMANENT LABEL SAYING, "WHOLE HOUSE VENTILATION. LEAVE ON UNLESS OUTDOOR AIR QUALITY IS VERY POOR." ADHERE PERMANENT LABEL TO WALL ABOVE WALL SWITCH.
- COORDINATE OUTDOOR LOCATION OF INDIVIDUAL HP UNITS WITH MECHANICAL PLANS.
- POWERED FROM OUTDOOR UNIT.

AFCI/GFCI REQUIREMENTS FOR DWELLING UNITS:

- ALL 15 AND 20A, 120V SINGLE PHASE CIRCUITS NOT INCLUDING THE BATHROOM SHALL BE AFCI PROTECTED (210.12).
- ALL DWELLING UNIT CIRCUITS IN BATHROOMS, GARAGES, OUTDOORS, KITCHENS, LAUNDRY AREAS, AND AREAS WITHIN 6' OF A SINK SHALL BE GFCI PROTECTED (210.8).
  - BATHROOM CIRCUIT TO BE GFCI PROTECTED VIA A GFCI RECEPTACLE, WHILE OTHER CIRCUITS SHALL BE PROTECTED AT THE BREAKER.
- UTILIZE "DUAL FUNCTION" BREAKER WHEN BOTH AFCI AND GFCI PROTECTION IS REQUIRED.

NO.	DATE	DESCRIPTION	REVISIONS

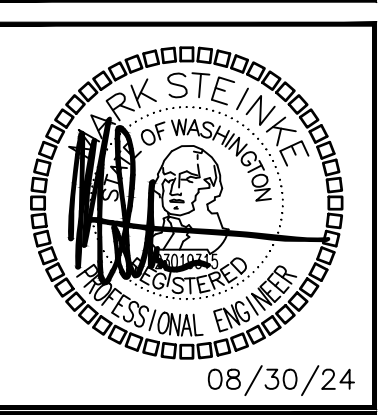

DRAWN: KL	DESIGNED: MHS	CHECKED: PSR	APPROVED: JAY
-----------	---------------	--------------	---------------

PROJECT: BRADLEY HEIGHTS APARTMENTS BUILDING H  
27TH AVE SE AND 5TH ST SE PUYALLUP, WA


19401 40TH AVE SE SUITE 302  
LYNNWOOD, WA 98036  
PHONE: (206) 364-3343

**ROBISON ENGINEERING, INC**

DATE: 08/30/24

SHEET TITLE:  
**UNIT PLANS & SCHEDULES**

SHEET NO.  
**E5.01**

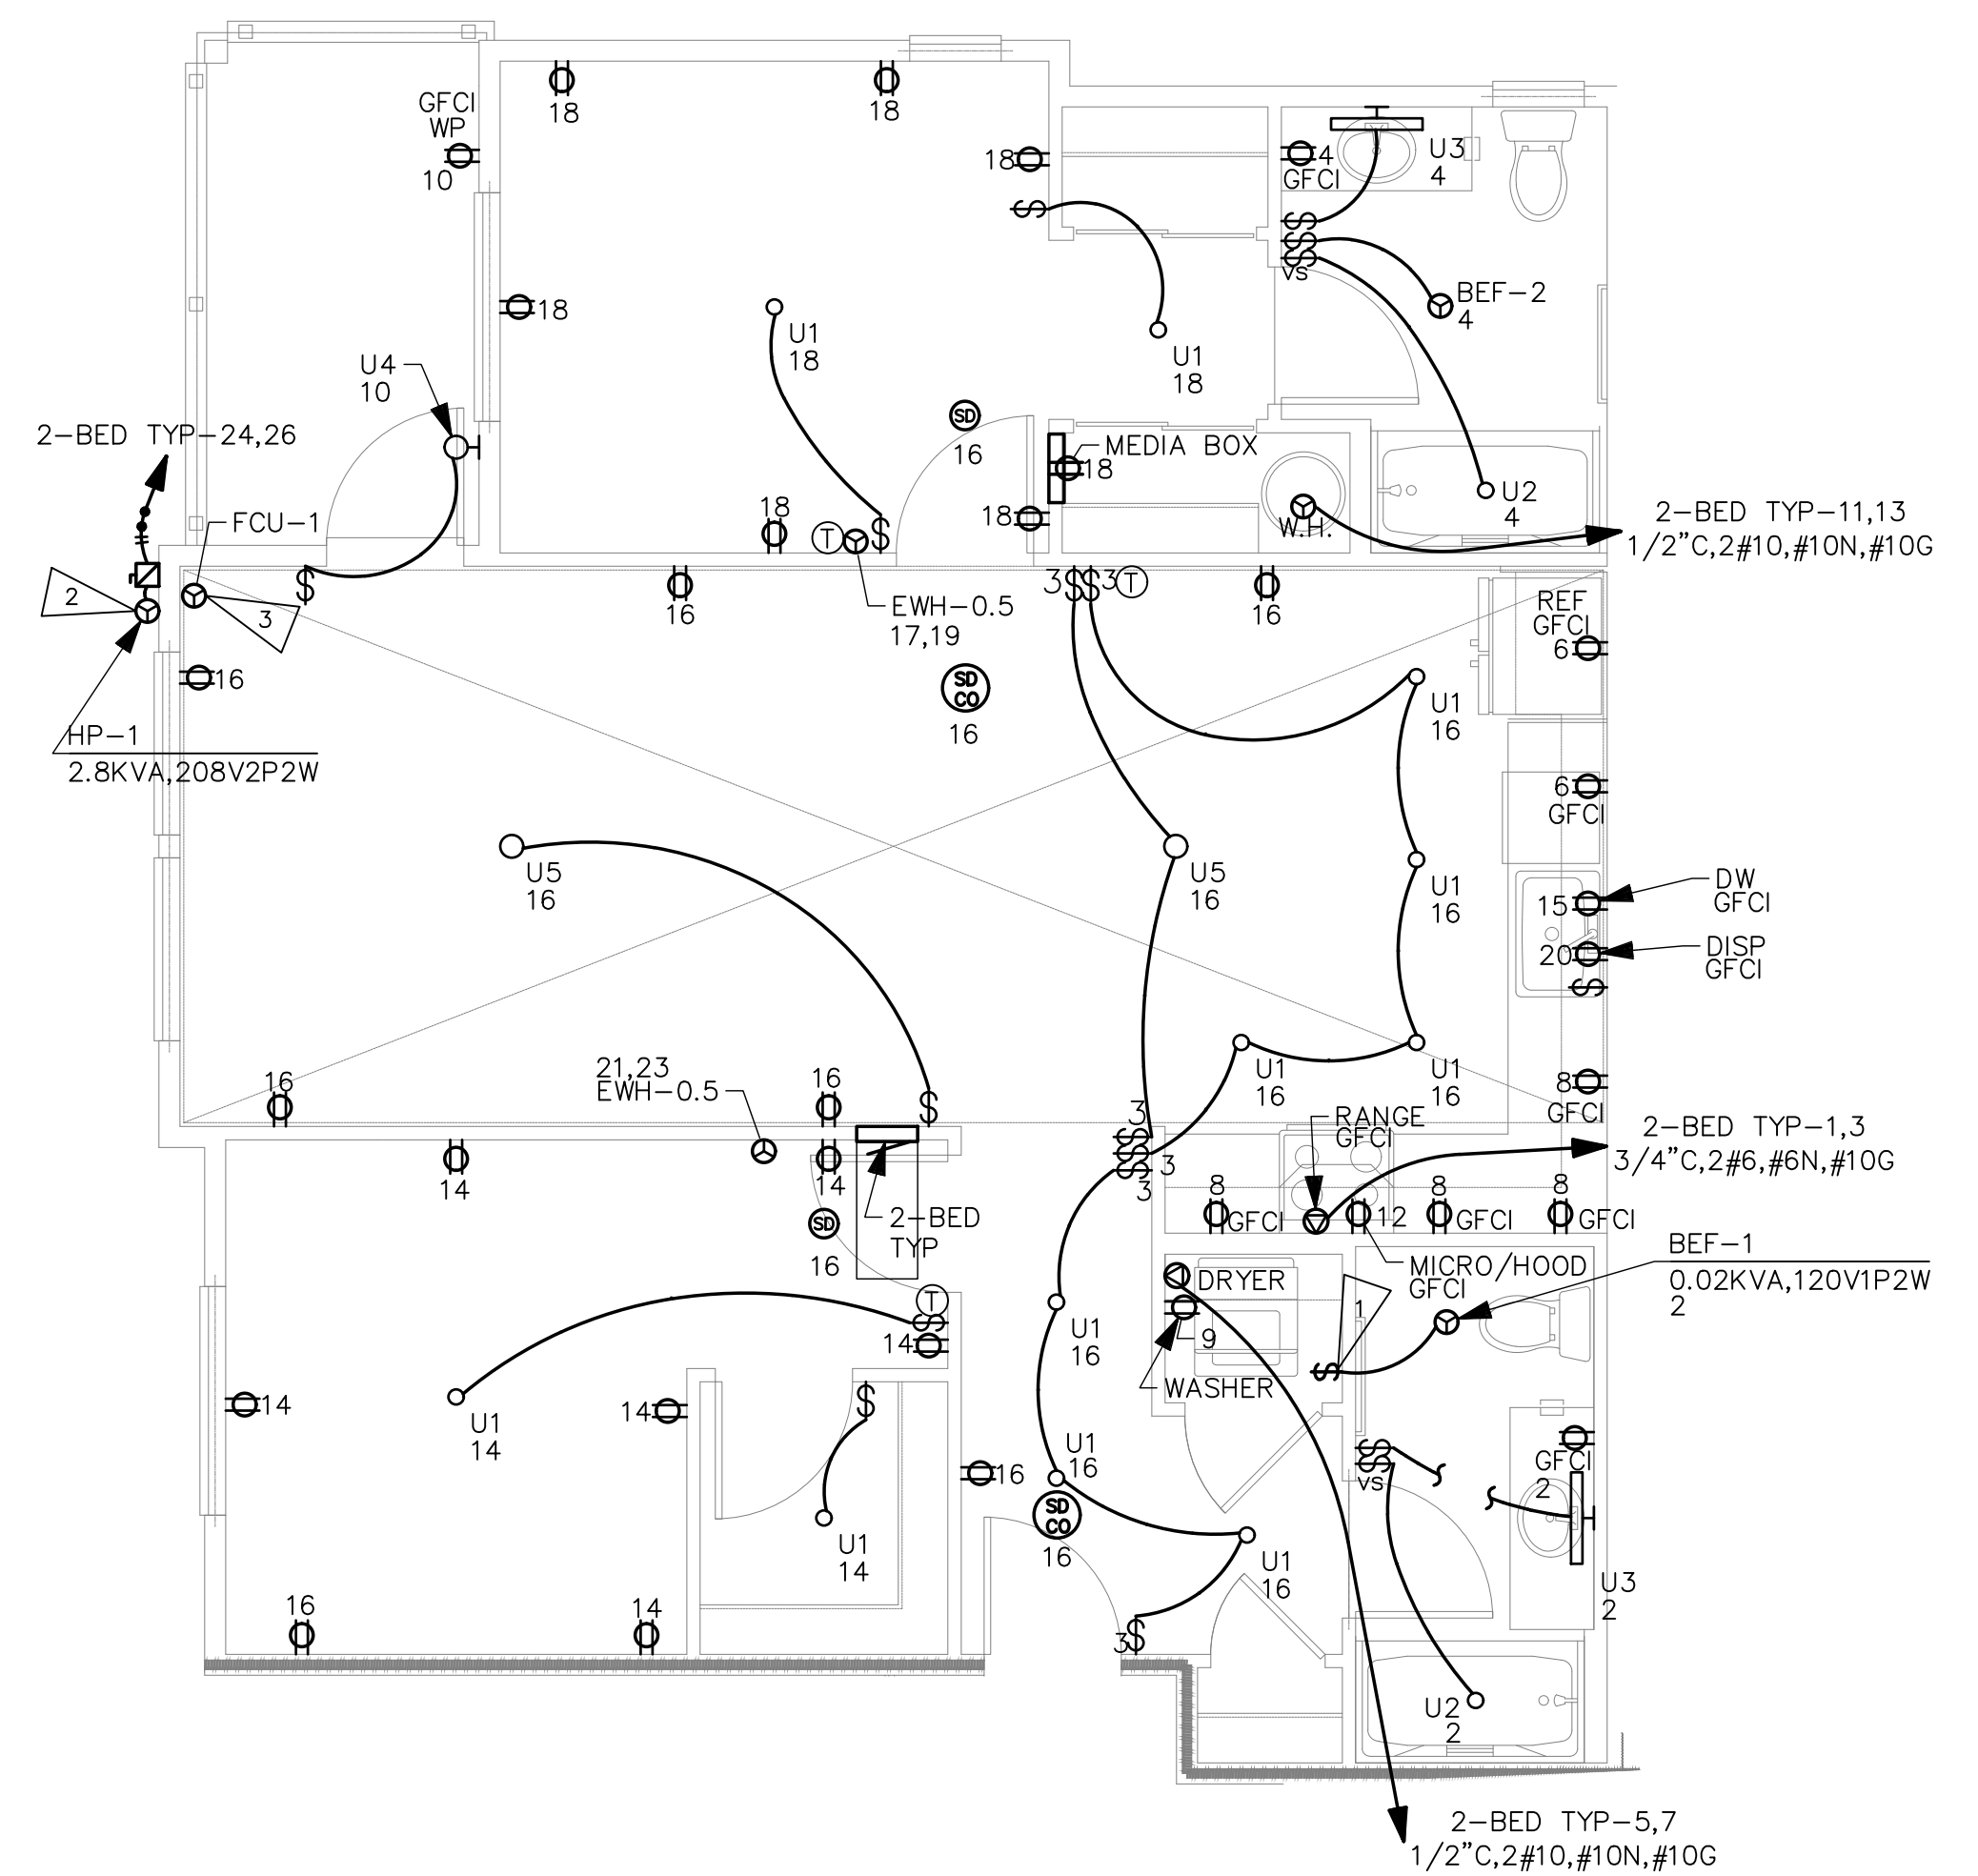

**UNIT TYPICALS**  
**2-BED TYP**  
 SCALE: 1/4" = 1'-0"

<b>2-BED TYP</b>							
ROOM MOUNTING	<b>FLUSH</b>	VOLTS	<b>208/120V 2P 3W</b>				
FED FROM		BUS AMPS	<b>125</b>				
NOTE		NEUTRAL	<b>100%</b>				
		AIC	<b>22,000</b>				
		MAIN BKR	<b>MLO</b>				
		LUGS	<b>STANDARD</b>				
CKT #	CKT BKR	LOAD KVA	CIRCUIT DESCRIPTION	CKT #	CKT BKR	LOAD KVA	CIRCUIT DESCRIPTION
1	50/2	8	RANGE	a 2	20/1	0.23	BEF-1, LIGHTING, RECEPTACLE
3				b 4	20/1	0.308	BATH EX FAN, LIGHTING, RECEPTACLE
5	30/2	4.99	DRYER	a 6	20/1	1.5	SMALL APPLIANCE
7				b 8	20/1	1.5	SMALL APPLIANCE
9	20/1	1.5	WASHER	a 10	20/1	0.19	LIGHTING, RECEPTACLE
11	30/2	4.4	WATER HEATER	b 12	20/1	1.58	MICRO/HOOD
13				a 14	20/1	1.1	LIGHTING, RECEPTACLE
15	20/1	1.2	DISHWASHER	b 16	20/1	1.19	LIGHTING, RECEPTACLE
17	20/2	0.5	WALL HEATER	a 18	20/1	1.28	LIGHTING, MEDIA BOX, RECEPTACLE
19				b 20	20/1	0.7	DISPOSAL
21	20/2	0.5	WALL HEATER	a 22	20/1	0.2	SDCO
23				b 24	20/2	2.8	HP-1
25	-/1	0	SPACE	a 26			

OPTIONAL DWELLING UNIT CALCULATION (NEC 220.82)				
	CONN KVA		CONN KVA	CALC KVA
LIGHTING AND RECEPTACLES	3.52	1,173 SF (3 VA/SF)	GENERAL LOAD UP TO 10 KVA	10 (100%)
SMALL-APPLIANCE	3		OVER 10 KVA	6.49 (40%)
LAUNDRY APPLIANCES	1.5		MAX HEATING OR COOLING	3.51 (220.82(C)(4))
TOTAL GENERAL LOAD	16.5		TOTAL LOAD	16.1
			BALANCED LOAD	77.4 A
			PHASE A	98.8%
			PHASE B	101%

**GENERAL NOTES:**

- COORDINATE FINAL LOCATION OF THERMOSTATS, SWITCHES, RECEPTACLES, DATA, PHONE, LIGHT FIXTURES AND J-BOXES WITH ARCHITECTURAL ELEVATIONS AND INTERIOR DESIGN PLANS PRIOR TO ROUGH-IN.
- ADA UNITS SHALL HAVE HOOD CONTROLS INSTALLED IN THE FACE OF THE LOWER CABINET WORK.
- PROVIDE TAMPER RESISTANT RECEPTACLES PER NEC 406.12.
- ALL UNITS: PROVIDE SWITCH CONTROLLING GARBAGE DISPOSAL TO BE LOCATED ABOVE BACKSPLASH NEXT TO SINK OR ON COUNTER. SEE ARCHITECTURE.
- BATHROOM GFCI RECEPTACLES TO HAVE INTEGRAL NIGHTLIGHT.
- RECESSED CEILING LIGHT IN BATHROOM SHALL BE LED RATED FOR WET LOCATIONS W/ SHATTER PROOF LENS.
- ALL RECEPTACLES SHALL MEET REQUIREMENTS OF NEC ARTICLE 210.
- PROVIDE TELEPHONE & CABLE T.V. MEDIA TERMINATION ENCLOSURE (MEDIA BOX); PROVIDE LEVITON COMPACT MEDIA ENCLOSURE OR EQUIVALENT IN WALL WITH TOP NO HIGHTER THAN 60" AFF WITH 120V RECEPTACLE ADJACENT.
- PROVIDE COMBINATION HARDWIRED 120VAC PHOTOELECTRIC SMOKE DETECTOR AND CARBON MONOXIDE DETECTOR WITH BATTERY-BACKUP
  - DETECTOR SHALL BE MINIMUM 6' HORIZONTAL DISTANCE FROM PERMANENT COOKING APPLIANCE PER CFC 90.2.11.8.
  - DETECTOR SHALL BE MINIMUM 3' HORIZONTAL DISTANCE FROM THE DOOR OF A BATHROOM THAT CONTAINS A BATHTUB OR SHOWER PER CFC 90.2.11.8.
  - PROVIDE INTERCONNECTION WIRING SUCH THAT ACTUATION OF ONE ALARM WILL ACTIVATE ALL ALARMS IN THE DWELLING UNIT.
  - COORDINATE WITH AHJ ON INTERCONNECTING EACH DWELLING UNIT INTO THE FIRE ALARM SYSTEM FOR THE BUILDING.
  - COORDINATE WITH AHJ AS TO THE NUMBER AND LOCATION OF DEVICES PRIOR TO ROUGH-IN. DEVICES SHOWN ARE DIAGRAMMATIC.
- DISHWASHER OUTLET SHALL BE ACCESSIBLE. RECEPTACLE SHALL BE LOCATED IN SPACE ADJACENT TO THE DISHWASHER.
- PROVIDE 7-DAY PROGRAMMABLE THERMOSTAT FOR THE LIVING ROOM.


**FLAG NOTES**

- INTERLOCK ERV/BEF TO ON/OFF SWITCH. PROVIDE PERMANENT LABEL SAYING, "WHOLE HOUSE VENTILATION. LEAVE ON UNLESS OUTDOOR AIR QUALITY IS VERY POOR." ADHERE PERMANENT LABEL TO WALL ABOVE WALL SWITCH.
- COORDINATE OUTDOOR LOCATION OF INDIVIDUAL HP UNITS WITH MECHANICAL PLANS.
- POWERED FROM OUTDOOR UNIT.

**AFCI/GFCI REQUIREMENTS FOR DWELLING UNITS:**

- ALL 15 AND 20A, 120V SINGLE PHASE CIRCUITS NOT INCLUDING THE BATHROOM SHALL BE AFCI PROTECTED (210.12).
- ALL DWELLING UNIT CIRCUITS IN BATHROOMS, GARAGES, OUTDOORS, KITCHENS, LAUNDRY AREAS, AND AREAS WITHIN 6' OF A SINK SHALL BE GFCI PROTECTED (210.8).
  - BATHROOM CIRCUIT TO BE GFCI PROTECTED VIA A GFCI RECEPTACLE, WHILE OTHER CIRCUITS SHALL BE PROTECTED AT THE BREAKER.
- UTILIZE "DUAL FUNCTION" BREAKER WHEN BOTH AFCI AND GFCI PROTECTION IS REQUIRED.

NO.	DATE	DESCRIPTION	REVISIONS

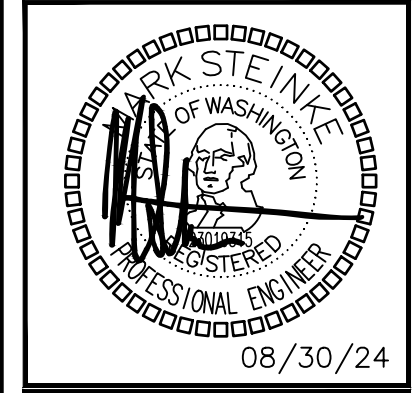

DRAWN:	KL
DESIGNED:	MHS
CHECKED:	PSR
APPROVED:	JAY

PROJECT: BRADLEY HEIGHTS APARTMENTS BUILDING H  
 27TH AVE SE AND 5TH ST SE PUYALLUP, WA  
 19401 40TH AVE SE SUITE 302  
 LYNNWOOD, WA 98036  
 PHONE: 206-364-3343  
**ROBISON ENGINEERING, INC.**

DATE: 08/30/24

SHEET TITLE:  
**UNIT PLANS & SCHEDULES**

SHEET NO.  
**E5.02**

# REQUIRED ELECTRIC VEHICLE CHARGING INFRASTRUCTURE WAC 427:

- WHERE PARKING IS PROVIDED, TEN PERCENT OF PARKING SPACES SHALL BE PROVIDED WITH ELECTRIC VEHICLE CHARGING INFRASTRUCTURE.
- ELECTRICAL ROOM(S) SERVING PARKING AREAS SHALL BE DESIGNED TO ACCOMMODATE THE ELECTRICAL EQUIPMENT AND DISTRIBUTION REQUIRED TO SERVE A MINIMUM OF 20 PERCENT OF THE TOTAL PARKING SPACES WITH 208V/240 V 40-AMP ELECTRIC VEHICLE CHARGING INFRASTRUCTURE.
- MINIMUM ONE ACCESSIBLE PARKING SPACE SHALL BE SERVED BY ELECTRIC VEHICLE CHARGING INFRASTRUCTURE.

TOTAL NUMBER OF PARKING SPACES = 354  
 AVERAGE NUMBER OF PARKING SPACES PER BUILDING =  $354/8 = 44.25$   
 $44.25 \times 0.2 = 8.85$   
 5 OUTDOOR EV CHARGERS WITH INFRASTRUCTURE  
 4 CONDUITS TO FUTURE EV CHARGING LOCATIONS

CAPACITY FOR 9 CHARGERS  $\times$  208V/1PH  $\times$  40A = 74.9 KVA = (208)A 3 PHASE POWER @ 120/208V  
 UTILIZING LOAD MANAGEMENT INFRASTRUCTURE, EV LOAD CAN BE REDUCED BY 50%.  $208A/2 = 37.5$ KVA (104)A @ 208V 3 PHASE

PER WAC 427, ELECTRICAL INFRASTRUCTURE FOR EACH BUILDING SHALL BE DESIGNED TO ACCOMMODATE 104 AMPS OF EV ELECTRICAL LOAD.

## GROUNDING NOTES AND REQUIREMENTS:

THE ELECTRICAL CONTRACTOR SHALL COORDINATE WITH THE GENERAL CONTRACTOR, POWER COMPANY, PHONE COMPANY, INTERNET COMPANY, CABLE TV COMPANY, AND THE SATELLITE TV COMPANY TO ENSURE REQUIRED GROUNDING IS INSTALLED FOR EACH SYSTEM.

THIS SHALL BE DONE PRIOR TO AND DURING INSTALLATION OF FOUNDATION RE-BAR AND CONTINUE DURING THE CONSTRUCTION PHASES, TO ENSURE EACH SYSTEM HAS IT'S REQUIRED GROUNDING INSTALLED FOR PROPER OPERATION OF THE SYSTEM.

- THE ELECTRICAL CONTRACTOR SHALL COORDINATE AND PROVIDE WHAT IS REQUIRED TO DO THE FOLLOWING:
- FOOTING GROUND RE-BAR COMES UP IN THE ELECTRICAL ROOM AND THE RE-BAR IS SNUGLY SECURED TO THE FOOTING RE-BAR.
- THE MSB GROUNDING TIES TO THE FOOTING RE-BAR, COUNTERPOISE, BUILDING STEEL, AND WATER PIPING.
- THE GROUND WIRE FOR THE COUNTERPOISE SHALL BE STRANDED, INSULATED WIRE IN CONDUIT UNTIL IT REACHES THE FIRST BAR OF THE COUNTERPOISE. BETWEEN THE COUNTERPOISE BARS IT SHALL BE A STRANDED BARE COPPER WIRE.

## GENERAL FEEDER SCHEDULE

ID	FEEDER AMPS	CONDUIT AND FEEDER	FEEDING THESE DEVICES
1	100	1-1/2" C, 3#1/0 AL, #1/0 AL N, #6 AL G	POOL
2	125	2" C, 3#2/0 AL, #2/0 AL N, #4 AL G	AM-B
3	200	2" C, 3#3/0, #3/0N, #6G	A-HOUSE, B-HOUSE, C-HOUSE, D-HOUSE, E-HOUSE, F-HOUSE, G-HOUSE, H-HOUSE
4	400	(2)2-1/2" C, 3#250kcmil AL, #250kcmil AL N, #1/0 AL G	AM-CT
5	400	(2)2-1/2" C, 3#250kcmil AL, #250kcmil AL N, #1 AL G	AM-DISC
6	400	3-1/2" C, 3#500kcmil, #500kcmil N, #2G	AM-A
7	800	(3)3" C, 3#400kcmil AL, #400kcmil AL N, #4/0 AL G	B-MC
8	1000	(4)3" C, 3#350kcmil AL, #350kcmil AL N, #4/0 AL G	H-MC
9	1200	(4)3-1/2" C, 3#500kcmil AL, #500kcmil AL N, #250kcmil AL G	A-MC, C-MC, E-MC, F-MC, G-MC
10	1600	(5)4" C, 3#600kcmil AL, #600kcmil AL N, #500kcmil AL G	D-MC
11	125	1-1/2" C, 2#2/0 AL, #2/0 AL N, #4 AL G	A-001, A-002, A-003, A-004, A-101, A-102, A-103, A-104, A-105, A-106, A-107, A-108, A-201, A-202, A-203, A-204, A-205, A-206, A-207, A-208, A-301, A-302, A-303, A-304, A-305, A-306, A-307, A-308, B-001, B-002, B-101, B-102, B-103, B-104, B-201, B-202, B-203, B-204, B-301, B-302, B-303, B-304, C-101, C-102, C-103, C-104, C-105, C-106, C-107, C-108, C-109, C-110, C-111, C-112, C-201, C-202, C-203, C-204, C-205, C-206, C-207, C-208, C-209, C-210, C-211, C-212, C-301, C-302, C-303, C-304, C-305, C-306, C-307, C-308, C-309, C-310, C-311, C-312, D001, D002, D003, D004, D005, D006, D101, D102, D103, D104, D105, D106, D107, D108, D109, D110, D111, D112, D201, D202, D203, D204, D205, D206, D207, D208, D209, D210, D211, D212, D301, D302, D303, D304, D305, D306, D307, D308, D309, D310, D311, D312, E001, E002, E003, E004, E101, E102, E103, E104, E105, E106, E107, E108, E201, E202, E203, E204, E205, E206, E207, E208, E301, E302, E303, E304, E305, E306, E307, E308, F001, F002, F003, F004, F101, F102, F103, F104, F105, F106, F107, F108, F201, F202, F203, F204, F205, F206, F207, F208, F301, F302, F303, F304, F305, F306, F307, F308, G101, G102, G103, G104, G105, G106, G107, G108, G109, G110, G111, G112, G201, G202, G203, G204, G205, G206, G207, G208, G209, G210, G211, G212, G301, G302, G303, G304, G305, G306, G307, G308, G309, G310, G311, G312, H101, H102, H103, H104, H105, H106, H107, H108, H201, H202, H203, H204, H205, H206, H207, H208, H301, H302, H303, H304, H305, H306, H307, H308

SIZING METHOD: COPPER, 60°C #12 THROUGH #1, 75°C 1/0 AND ABOVE

### FEEDER SCHEDULE NOTES:

- CONDUIT FILL:  
 \* FOR CONDUIT SIZES 1-1/2" AND BELOW, FILL IS BASED ON EMT.  
 \* FOR CONDUIT SIZES 2" AND ABOVE, FILL IS BASED ON SCHEDULE 40 PVC.

IN LOCATIONS APPROVED FOR THE PURPOSE, CONTRACTOR MAY USE MC CABLE.  
 IN LOCATIONS APPROVED FOR THE PURPOSE CONTRACTOR MAY USE OTHER CONDUIT TYPES, INCLUDING RMC, FMC AND LFMC. CONTRACTOR REQUIRED TO ENSURE CONDUIT FILL DOES NOT EXCEED 40%.

CONTRACTOR RESPONSIBLE TO ENSURE TERMINATION/LUG CAPACITY FOR ALL SCHEDULED FEEDERS.

XHHW/THHN/THWN SHALL BE USED FOR INSULATION OF THE CONDUCTOR.

## COORDINATION AND ARC FLASH STUDIES:

IMMEDIATELY UPON SELECTION OF ACTUAL EQUIPMENT BEING PROVIDED FOR THE PROJECT, THE ELECTRICAL CONTRACTOR SHALL PERFORM AN ARC FLASH ANALYSIS AND COORDINATION STUDY ON THE STANDBY DISTRIBUTION BASED ON ACTUAL EQUIPMENT TO BE PROVIDED. CONDUCTOR TYPES/SIZES/LENGTHS, ETC. COORDINATION SHALL BE CONFIRMED BASED ON FAULT NUMBERS SHOWN ON THIS DRAWING.

STUDIES SUBMITTED SHALL BE STAMPED BY A PROFESSIONAL ELECTRICAL ENGINEER HOLDING A CURRENT LICENSE FROM THE STATE OF WA.

PRELIMINARY ARC FLASH AND COORDINATION STUDIES ARE TO BE SUBMITTED WITH THE SUBMITTALS FOR THE PROTECTIVE DEVICES, PANELBOARDS, SWITCHBOARDS, AND OTHER ELECTRICAL EQPT.

THE ELECTRICAL CONTRACTOR SHALL SUBMIT THE STAMPED AND SIGNED ARC FLASH AND COORDINATION STUDY TO THE AHJ AS REQUIRED.



THE ELECTRICAL CONTRACTOR SHALL PROVIDE AND INSTALL PERMANENT LABELS INDICATING ARC FLASH HAZARD RISK CATEGORIES ON ALL DISTRIBUTION POINTS (SWITCHBOARDS, PANELBOARDS, VFDs, DISCONNECT SWITCHES, ETC). LABELS SHALL COMPLY WITH NFPA 70E.

## SHEET NOTES:


- CONTRACTOR TO OBTAIN UTILITY APPROVAL OF ALL SERVICE AND METERING EQUIPMENT PRIOR TO ORDERING.
- DISTRIBUTION SYSTEM AS DESIGNED IS FULLY RATED. CONTRACTOR WILL BE RESPONSIBLE FOR ENGINEERING IF SER RATED SYSTEMS ARE SUBMITTED, THE SUBMITTED SYSTEM SH MEET NEC 240.86(B) REQUIREMENTS FOR TESTED COMBINATIC AND SHALL NOT BE USED IF MOTOR CONTRIBUTION EXCEEDS LIMITS PER 240.86(C). NEC 110.22 MARKING REQUIREMENTS MUST BE MET.
- PROVIDE PERMANENT WARNING LABELS FOR ARC FLASH AND PPE REQUIREMENTS FOR THE SERVICE EQUIPMENT AND PANEL

## FLAG NOTES:

- GROUNDING ELECTRODE CONDUCTOR AND SYSTEM GROUNDING SIZED PER N.E.C. 250
- PROVIDE ARC ENERGY REDUCTION: ENERGY REDUCING MAINTENANCE SWITCH PER NEC 240.87(B)(3)
- PROVIDE A LISTED SURGE PROTECTIVE DEVICE FOR DWELLING UNITS AS REQUIRED BY NEC 230.67. CONTRACTOR TO CONFIR LOCATION IS ACCEPTABLE TO AUTHORITY HAVING JURISDICTION OBTAIN PRICING FOR OPTION TO HAVE SPDs LOCATED IN UNI PANELS VS UPSTREAM.
- METER ELEVATIONS AND METERS PER STACK SHALL BE INSTALLED PER UTILITY ELECTRICAL PROVIDER REQUIREMENTS METER SOCKET IN ELECTRICAL ROOM. VERIFY EXACT LOCATION AND REQUIREMENTS WITH ELECTRIC UTILITY (TYPICAL)
- PROVIDE (1) 2 1/2" CONDUITS FOR SOLAR READY PATHWAY AND RESERVE SPACE IN THE MAIN ELECTRIC ROOM FOR FUTU SOLAR EQUIPMENT. RESERVE SPACE FOR INSTALLATION OF FUTURE SOLAR CIRCUIT BREAKER AND PERMANENTLY MARK LOCATION AS "FOR FUTURE SOLAR ELECTRIC".

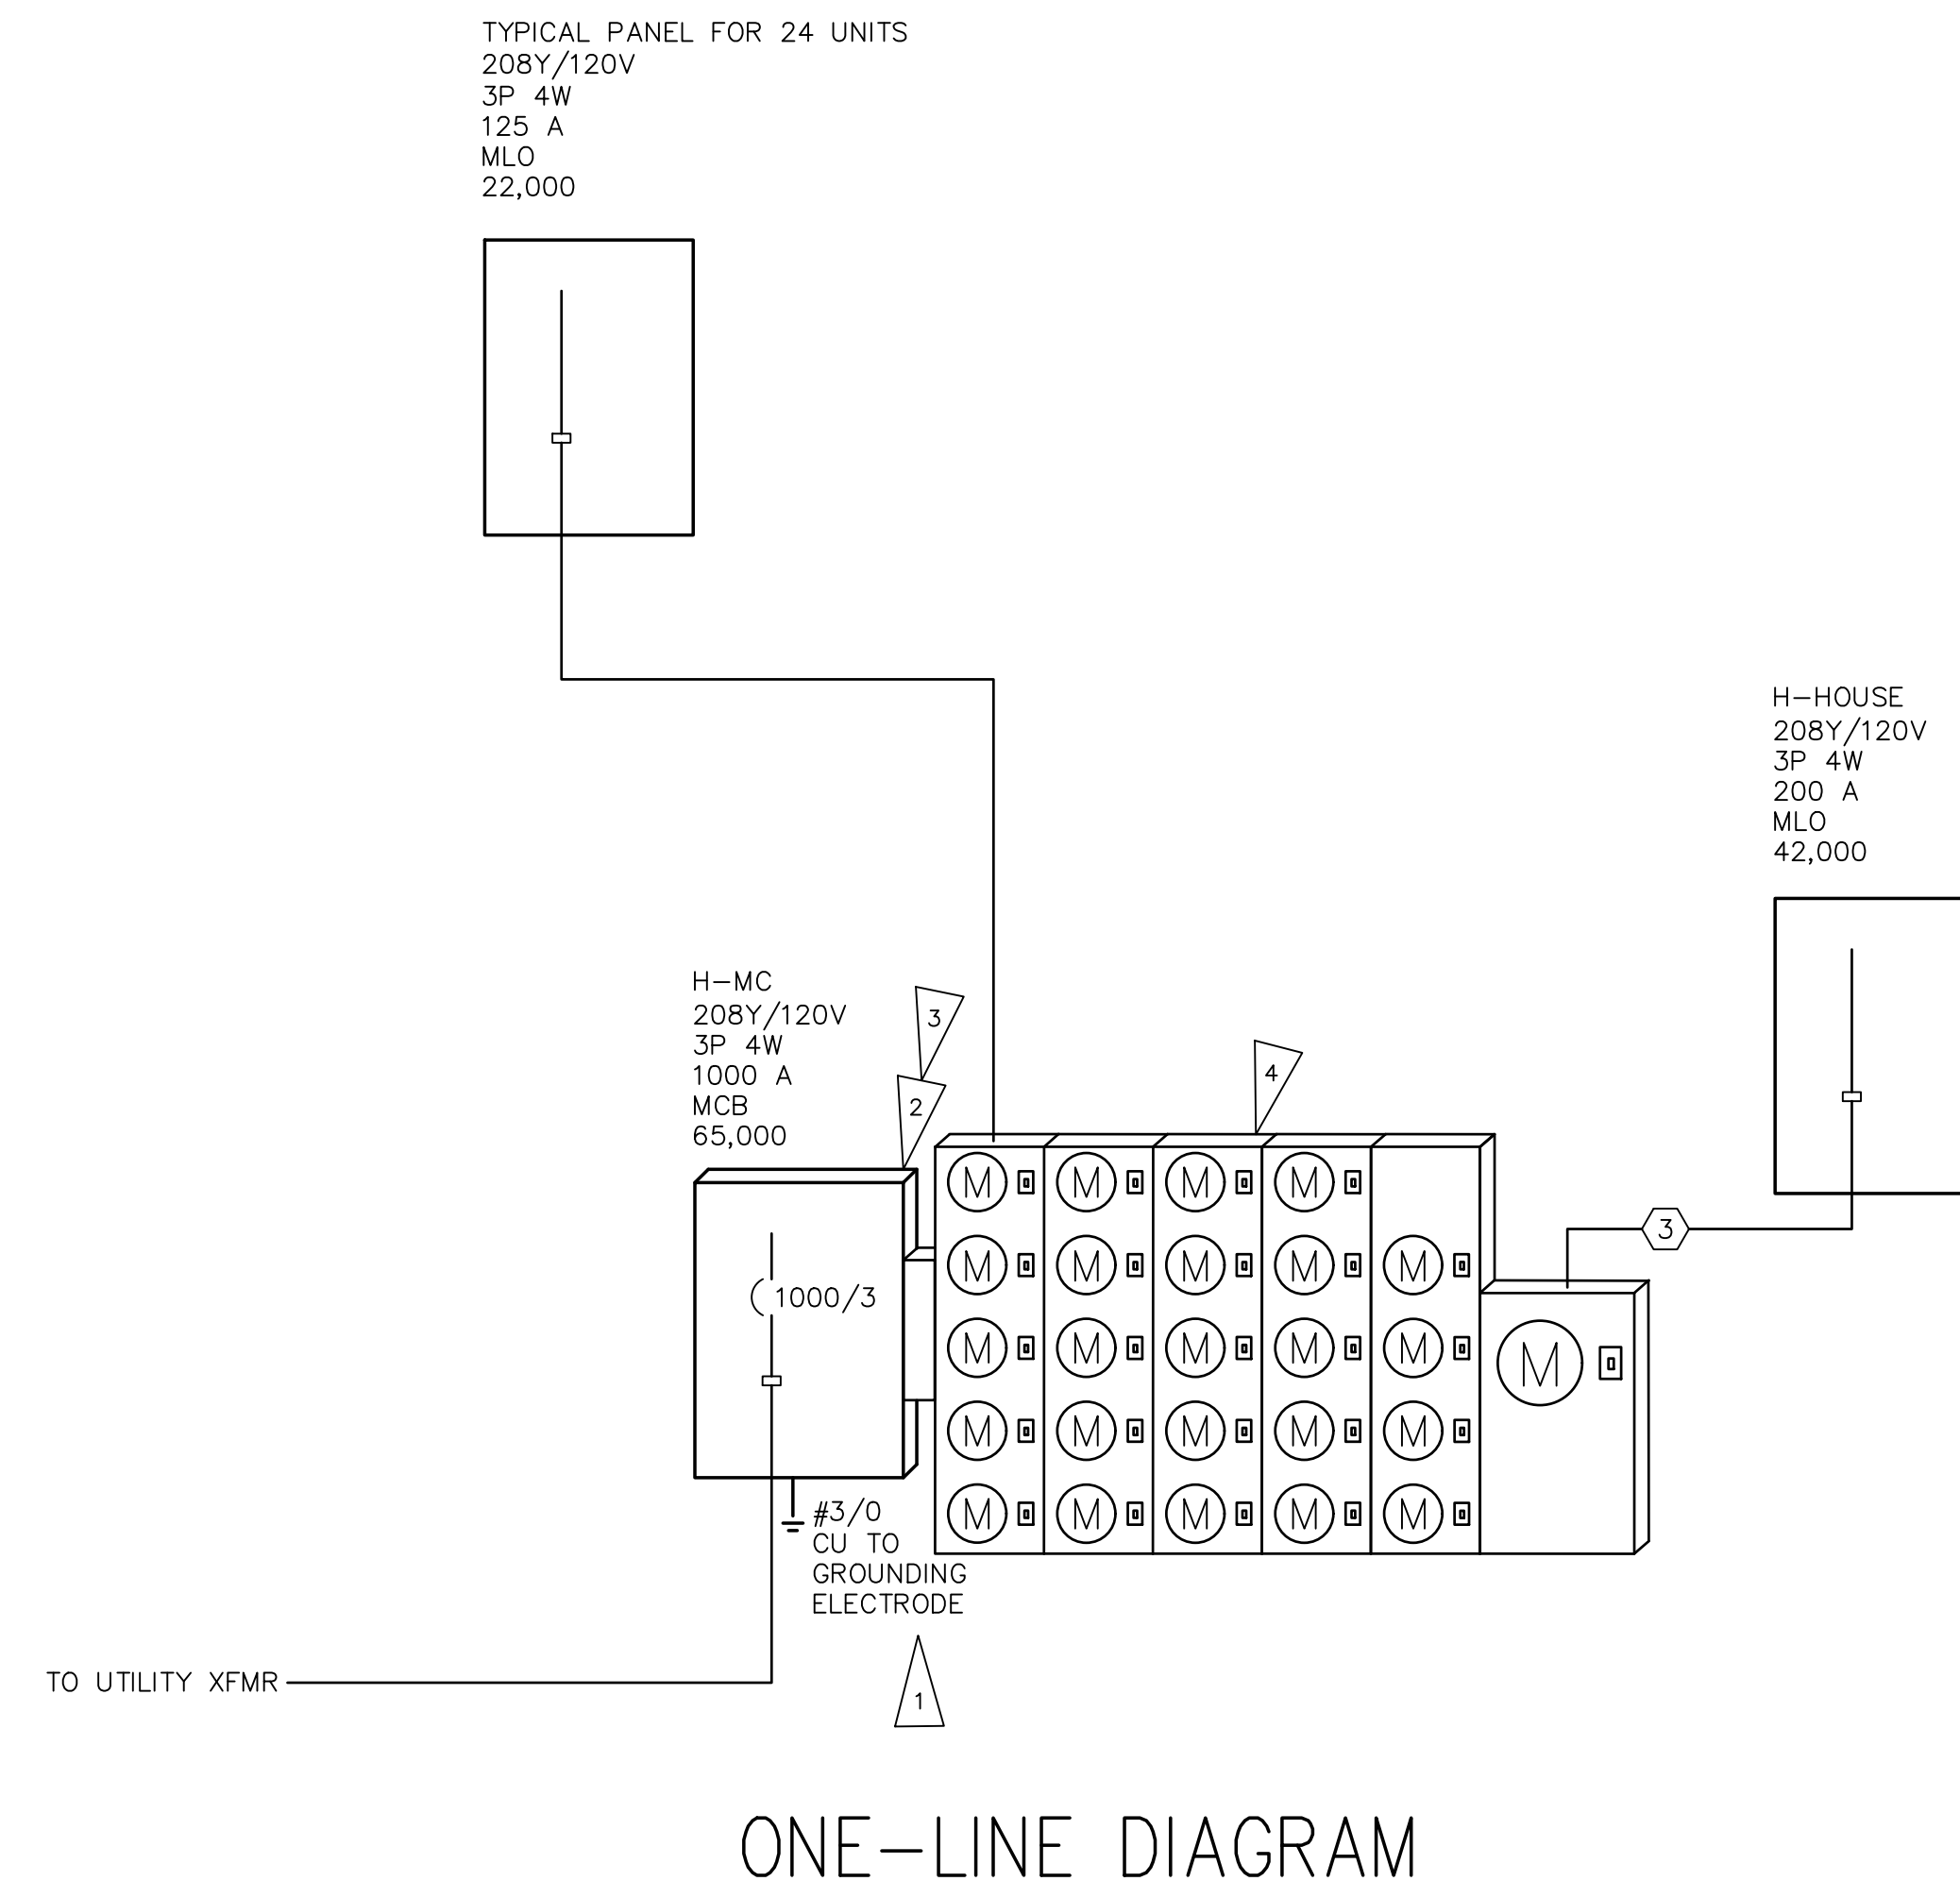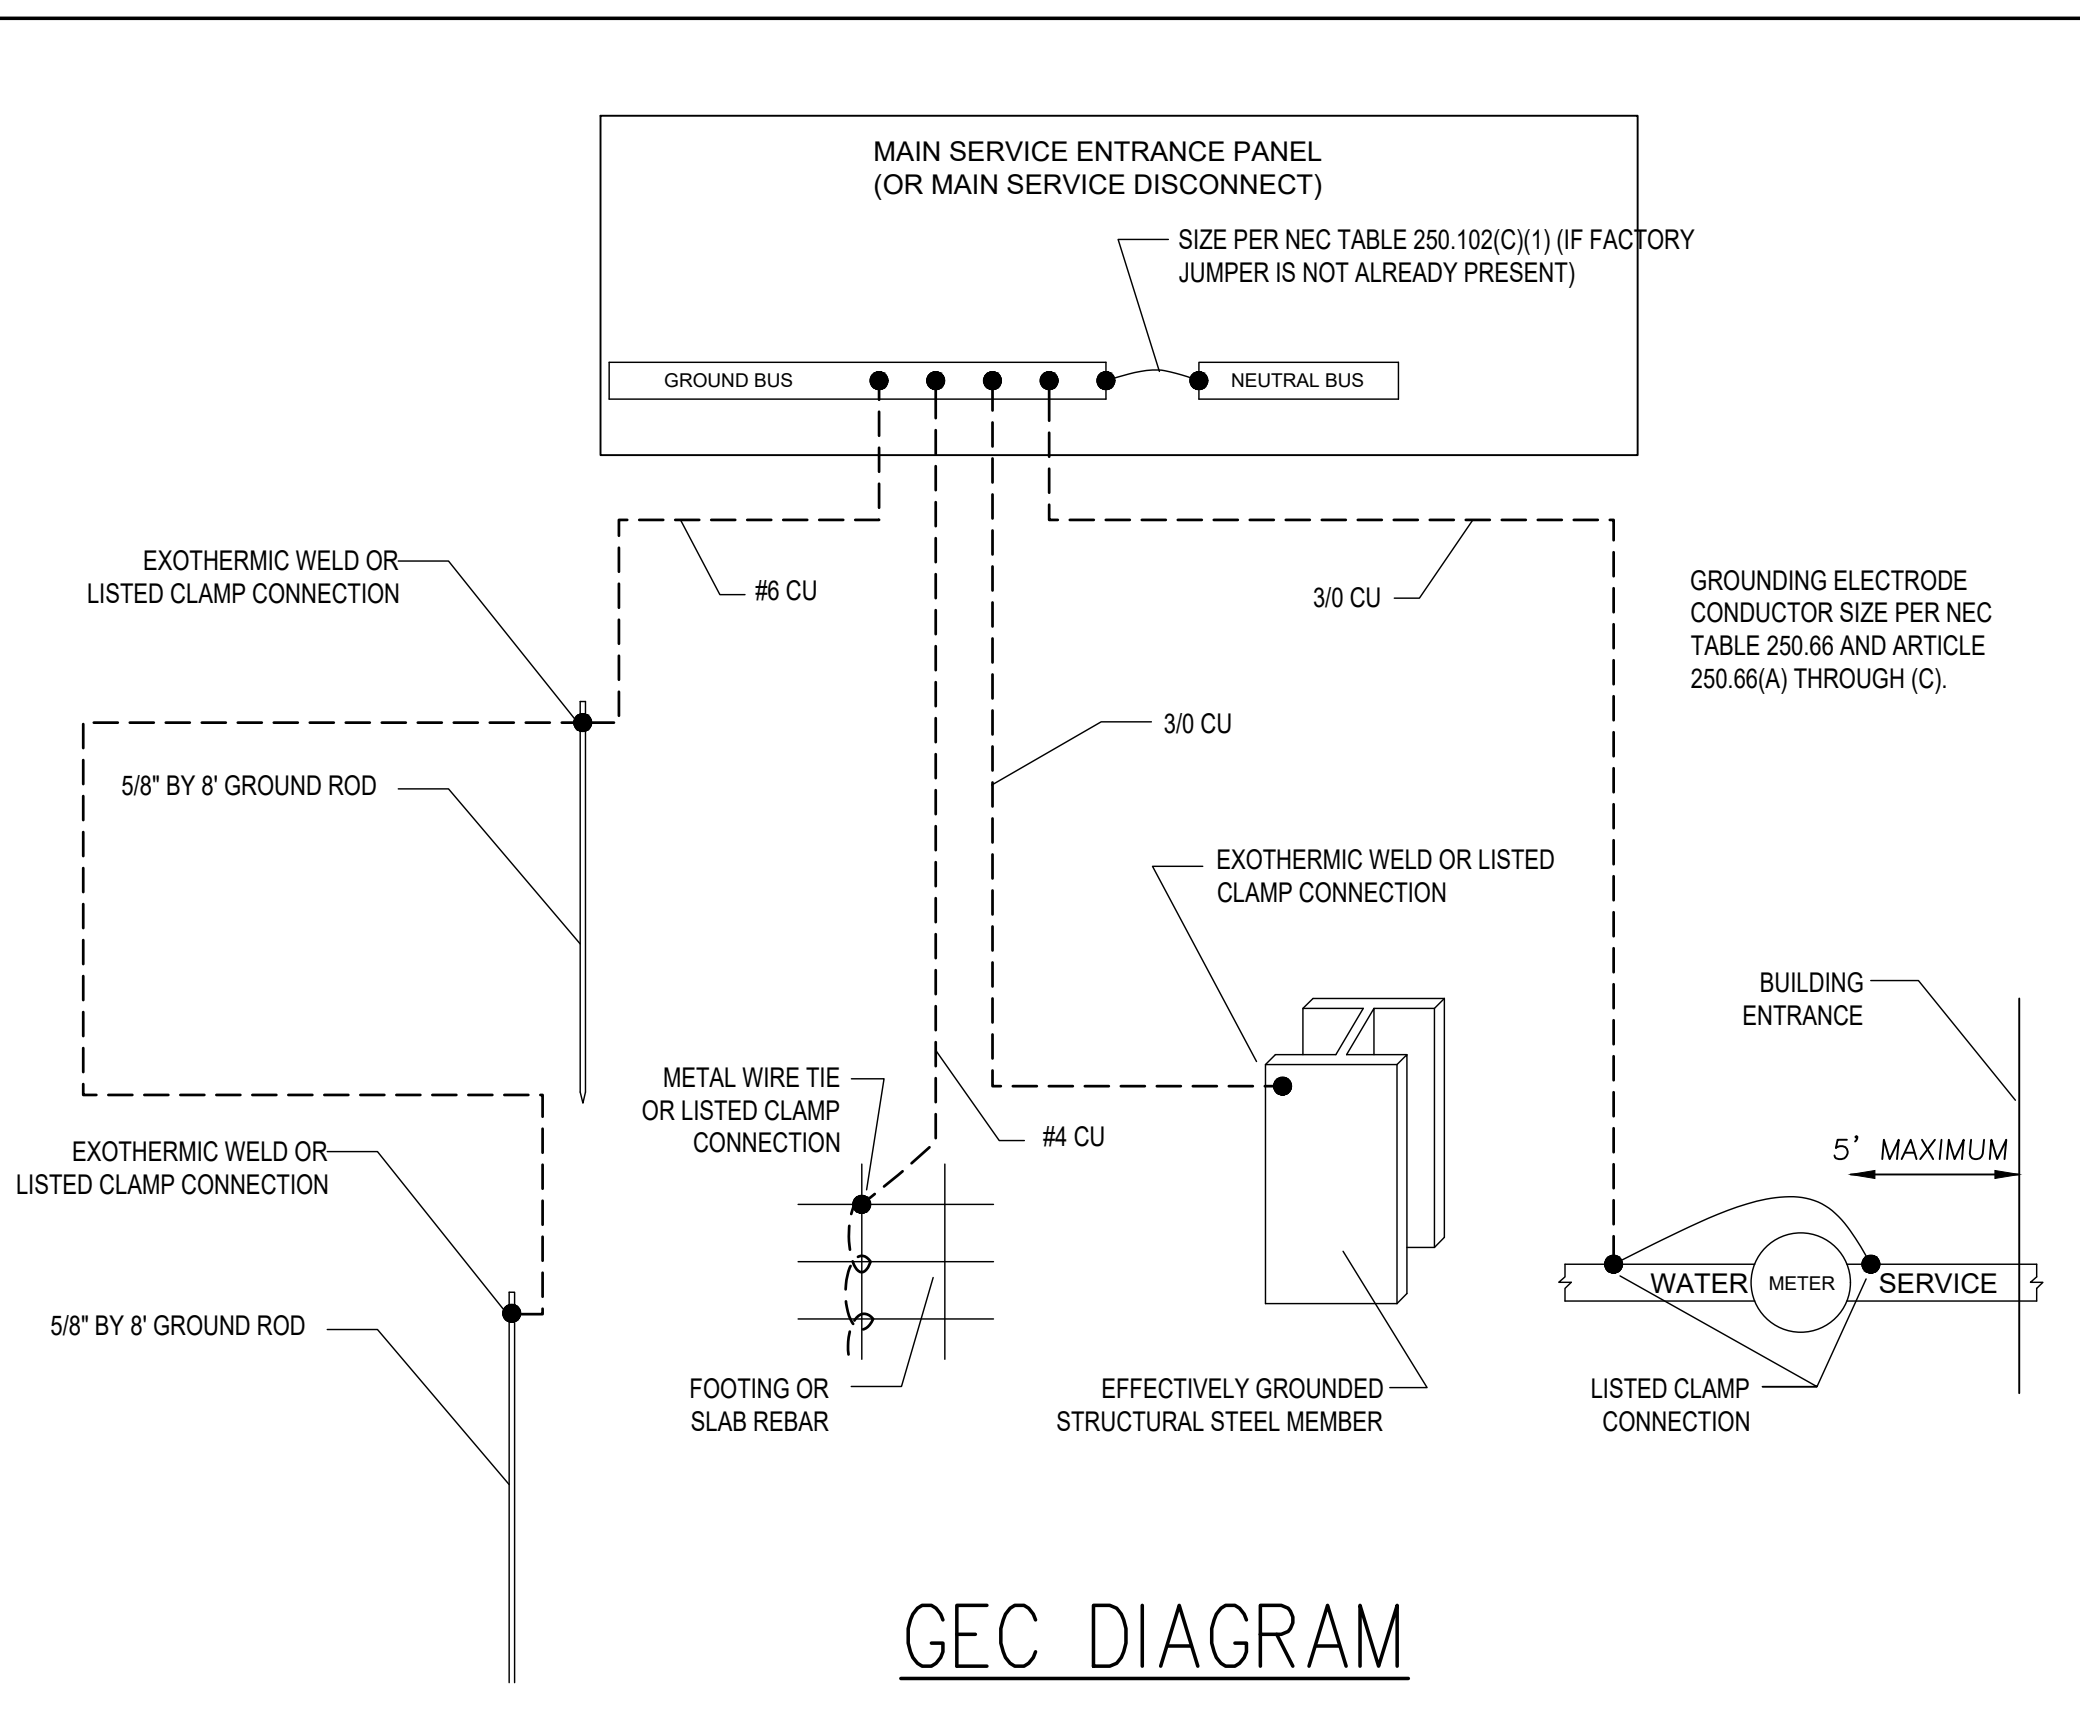

NO.	DATE	DESCRIPTION	REVISIONS

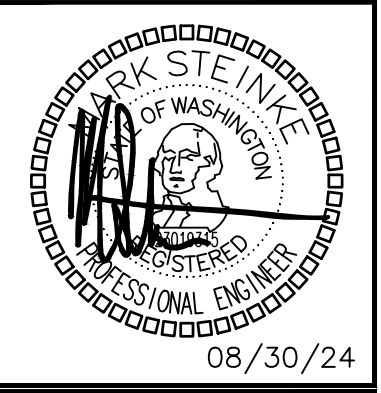

DRAWN: KL	DESIGNED: MHS	CHECKED: PSR	APPROVED: JAY
-----------	---------------	--------------	---------------

PROJECT: BRADLEY HEIGHTS APARTMENTS BUILDING H  
 27TH AVE SE AND 5TH ST SE PUYALLUP, WA  
 19401 40TH AVE W, SUITE 302  
 LYNNWOOD, WA 98036  
 PHONE: (206) 364-3343  
**ROBISON ENGINEERING, INC.**

DATE: 08/30/24

SHEET TITLE:  
**ONE-LINE DIAGRAM & NOTES**

SHEET NO.  
**E6.00**







# PLUMBING CALCULATIONS

**Water Demand Calculator® (WDC v2.2)**

**PROJECT NAME :** Bradley Heights - Building H
**Total Number of Apartments in the Building** → 24  
Click for Drop-down Menu →
Multi-Family Building
**Total Apartments in this Calculation** → 24
Wednesday, September 4, 2024  
10:48 PM

FIXTURE GROUPS	FIXTURE	ENTER TOTAL NUMBER OF FIXTURES	PROBABILITY OF USE (%)	ENTER FIXTURE FLOW RATE (GPM)	MAXIMUM RECOMMENDED FIXTURE FLOW RATE (GPM)
Bathroom Fixtures	1 Bathtub (no Shower)	0	0.54	5.5	5.5
	2 Bidet	0	0.60	2.0	2.0
	3 Combination Bath/Shower	36	2.08	5.5	5.5
	4 Faucet, Lavatory	36	1.37	1.5	1.5
	5 Shower, per head (no Bathtub)	0	1.42	2.0	2.0
	6 Water Closet, 1.28 GPF Gravity Tank	36	0.60	3.0	3.0
Kitchen Fixtures	7 Dishwasher	24	0.36	1.3	1.3
	8 Faucet, Kitchen Sink	24	1.37	2.2	2.2
Laundry Room Fixtures	9 Clothes Washer	24	2.01	3.5	3.5
	10 Faucet, Laundry	0	1.37	2.0	2.0
Bar/Prep Fixtures	11 Faucet, Bar Sink	0	1.37	1.5	1.5
	12 Fixture 1	0	0.00	0.0	6.0
Other Fixtures	13 Fixture 2	0	0.00	0.0	6.0
	14 Fixture 3	0	0.00	0.0	6.0

**COMPUTED RESULTS FOR PEAK PERIOD CONDITIONS**

**Total No. of Fixtures in Calculation**  
N = 180

**99<sup>th</sup> Percentile Demand Flow**  
Q = 22.5 GPM

**Hunter Number**  
H(n,p) = 2.36

**Stagnation Probability**  
Pr[Zero Demand] = 9%

**Method of Computation**  
Modified Wirstort's Method

NOTES:  
1. ADD 4 GPM FLOW RATE FOR HOSE BIBBS - TOTAL FLOW IS 26.5 GPM.

CALCULATIONS BASED ON 2021 UPC														
1 Bedroom Units (1 Bath)														
FIXTURE	FIXTURE UNITS				1	2	3	R	# OF FIXTURES PER UNIT	TOTAL QTY OF FIXTURES	TOTAL FIXTURE UNITS			
	TOTAL	CW	HW	WV							SERVICE	CW ONLY	HW ONLY	WV ONLY
WATER CLOSET	2.5	2.5	0	3	4	4	4	0	12	30	30	0	36	
LAVATORY	1	0.75	0.75	1	4	4	4	0	12	12	9	9	12	
BATHTUB	4	3	3	2	4	4	4	0	12	48	36	36	24	
CLOTHES WASHER	4	3	3	3	4	4	4	0	12	48	36	36	36	
KITCHEN SINK W/ DISHWASHER	3	2.25	2.25	2	4	4	4	0	12	36	27	27	24	
<b>TOTAL:</b>										174	138	108	132	
2 Bedroom Unit (2 Bath)														
FIXTURE	FIXTURE UNITS				1	2	3	R	# OF FIXTURES PER UNIT	TOTAL QTY OF FIXTURES	TOTAL FIXTURE UNITS			
	TOTAL	CW	HW	WV							SERVICE	CW ONLY	HW ONLY	WV ONLY
WATER CLOSET	2.5	2.5	0	3	4	4	4	0	24	60	60	0	72	
LAVATORY	1	0.75	0.75	1	4	4	4	0	24	24	18	18	24	
BATHTUB	4	3	3	2	4	4	4	0	24	96	72	72	48	
CLOTHES WASHER	4	3	3	3	4	4	4	0	12	48	36	36	36	
KITCHEN SINK W/ DISHWASHER	3	2.25	2.25	2	4	4	4	0	12	36	27	27	24	
<b>TOTAL:</b>										264	213	153	204	
Public Fixtures														
FIXTURE	FIXTURE UNITS				1	2	3	R	# OF FIXTURES PER UNIT	TOTAL QTY OF FIXTURES	TOTAL FIXTURE UNITS			
	TOTAL	CW	HW	WV							SERVICE	CW ONLY	HW ONLY	WV ONLY
HOSE BIB	2.5/1	2.5/1	0	0	2	0	0	0	2	3.5	3.5	0	0	
4" FLOOR DRAIN	0	0	0	8	1	0	0	0	1	0	0	0	8	
<b>TOTAL:</b>										3.5	3.5	0	8	
TOTAL FIXTURE UNITS:														
	TOTAL	CW	HW	WV										
	441.5	354.5	261	344										
PEAK FLOW: FOR SUPPLY USE APPENDIX M CALCULATIONS														
	SUPPLY	WASTE												
	1 1/2"	6"												
REQUIRED SERVICE SIZE IN BUILDING:														
	1 1/2"	6"												
REQUIRED METER SIZE:														
	1"													

BRADLEY HEIGHTS APARTMENTS - WATER SUPPLY PRESSURE CALCULATIONS ARE BASED ON 2018 UPC APPENDIX A	
FROM STREET TO RPB	
STREET PRESSURE, PSI	75
MINIMUM STREET PRESSURE, PSI	75
ASSUME +/- 5 PSI FLUCTUATION	
EQUIPMENT LOSSES, PSI	
WATER METER LOSS	4
BACKFLOW PREVENTER	10
SITE SERVICE LINE (ESTIMATE)	
PIPING SYSTEM LENGTH, FEET	50
FITTING ALLOWANCE, FEET	12.5
FROM STREET TO RPB	
ZONE FRICTION LOSS FACTOR, PSI/100'	3.0
TOTAL ZONE FRICTION LOSS, PSI	1.88
MINIMUM PRESSURE AT RPB, PSI	59.13
FROM RPB TO FURTHEST APARTMENT UNIT	
MINIMUM PRESSURE AT END PREVIOUS ZONE, PSI	59.1
EQUIPMENT LOSSES, PSI	
THERMOSTATIC MIXING VALVE LOSS	4
STATIC HEAD, PSI	
TOTAL ELEVATION GAIN, FT	30
13.0	
PIPING FRICTION LOSSES	
PIPING SYSTEM LENGTH, FEET	150
FITTING ALLOWANCE, FEET	22.5
ZONE FRICTION LOSS FACTOR, PSI/100'	3.0
TOTAL ZONE FRICTION LOSS, PSI	5.175
MINIMUM PRESSURE AT FURTHEST APARTMENT UNIT, PSI	37.0
FROM FURTHEST APARTMENT UNIT TO FURTHEST FIXTURE	
MINIMUM PRESSURE AT FURTHEST APARTMENT UNIT, PSI	37.0
PIPING FRICTION LOSSES	
RISER TO MANIFOLD, FEET	4
FITTING ALLOWANCE, FEET	6
FROM MANIFOLD TO FURTHEST FIXTURE	
ZONE FRICTION LOSS FACTOR, PSI/100'	14.0
TOTAL ZONE FRICTION LOSS, PSI	6.3
MINIMUM PRESSURE AT FURTHEST FIXTURE, PSI	30.7

NO.	DATE	DESCRIPTION	REVISIONS



JM	JM	RJ	JR
DRAWN	DESIGNED	CHECKED	APPROVED

PROJECT: **BRADLEY HEIGHT APARTMENTS - BUILDING H**  
202 27TH AVE SE  
PUYALLUP, WA 98374

19401 40TH AVE W, SUITE 302  
LYNNWOOD, WA 98036  
PHONE: (206) 364-3343

ROBISON  
ENGINEERING, INC

DATE: 09/05/2024

SHEET TITLE:  
**PLUMBING CALCULATIONS**

SHEET NO.  
**POH.02**



# PLUMBING SCHEDULES

## PIPE MATERIALS

PIPE TYPE	MATERIAL	JOINT	NOTES
WATER DISTRIBUTION PIPING	COPPER, TYPE L.	SOLDERED	2
APARTMENT WATER PIPING	PEX-A	EXPANSION OR PUSH-FIT FITTINGS	2
WASTE AND VENT PIPING	SCHEDULE 40 SOLID CORE PVC	SOLVENT CEMENT	1,3
CONDENSATE DRAIN PIPING	COPPER, TYPE M.	SOLDERED OR PROPPRESS FITTINGS	

**NOTES:**

1. ALL SANITARY SYSTEM MATERIALS SHALL BE LISTED BY AN APPROVED LISTING AGENCY.
2. PROVIDE THERMAL EXPANSION LOOPS FOR ALL WATER PIPING IN ACCORDANCE WITH MANUFACTURER INSTRUCTIONS.
3. PROVIDE CAST IRON PIPING FOR WASTE DISCHARGE EXCEEDING 110 DEGREES FAHRENHEIT.

### PIPE SIZING SCHEDULE - COPPER TYPE L AT 3.0 PSI/100 FEET

PIPE SIZE	COLD WATER, FLUSH TANK			HOT WATER		
	FIXTURE UNITS	FLOW, GPM	VELOCITY, FPS	FIXTURE UNITS	FLOW, GPM	VELOCITY, FPS
1/2"	0.8	1.8	2.4	1.0	2.0	2.8
3/4"	5.5	4.7	3.1	6.5	5.5	3.6
1"	12.8	9.8	3.8	15.2	11.2	4.4
1-1/4"	25.5	17.3	4.4	29.3	19.6	5.0
1-1/2"	46.6	27.7	5.0	46.8	27.7	5.0
2"	166.0	58.2	6.0	116.9	48.2	5.0
2-1/2"	395.0	104.0	7.0	246.9	74.4	5.0
3"	735.1	167.3	7.9	405.8	106.2	5.0
4"	1782.4	303.2	8.0	872.0	189.5	5.0
6"	6381.3	669.1	8.0	2847.0	418.2	5.0

### PIPE SIZING SCHEDULE - PEX AT 14.0 PSI/100 FEET

PIPE SIZE	COLD WATER, FLUSH TANK			HOT WATER		
	FIXTURE UNITS	FLOW, GPM	VELOCITY, FPS	FIXTURE UNITS	FLOW, GPM	VELOCITY, FPS
1/2"	1.9	2.9	5.3	3.4	3.4	6.2
3/4"	9.0	7.5	6.8	11.2	8.6	7.8
1"	21.2	14.7	8.1	20.9	14.6	8.0
1-1/4"	40.8	25.3	9.3	33.5	21.8	8.0
1-1/2"	76.3	37.9	10.0	53.3	30.3	8.0
2"	199.8	65.0	10.0	134.8	52.0	8.0
2-1/2"	369.5	98.9	10.0	270.6	79.1	8.0
3"	588.9	141.0	10.0	439.0	112.8	8.0

## REDUCED PRESSURE BACKFLOW ASSEMBLY

EQUIP NO.	QTY	SERVICE	INLET/OUTLET SIZE	BASIS OF DESIGN	NOTES
RPBP-1	1	DOMESTIC WATER	1/2"	ZURN WILKINS 375XL	1,2

**NOTES:**

1. INSTALL IN ACCORDANCE WITH MANUFACTURER INSTRUCTIONS.
2. ALL DOMESTIC WATER EQUIPMENT SHALL BE NSF-61 LISTED.

## ELECTRIC WATER HEATER

EQUIP NO.	SERVICE	GPH RECOVERY AT 100°F TR	STORAGE (GAL)	INLET/OUTLET CONNECTION	OPERATING WEIGHT (LBS)	ELECTRICAL			BASIS OF DESIGN	NOTES
						VOLTAGE	AMPS	HEATER KW		
WH-1	APARTMENTS	16	50	3/4"	550	208V/3P	18.75	4.5	BRADFORD WHITE RE250T6-1NCWW	1,2,3,4,5

**NOTES:**

1. PROVIDE CONDENSATE NEUTRALIZER. VENT PER MANUFACTURER'S INSTRUCTIONS.
2. FOR WATER HEATER PIPING SEE DETAIL 1/P4.00.
3. UNITS SHALL BE CERTIFIED IN THE AIR QUALITY MANAGEMENT DISTRICT HAVING JURISDICTION.
4. FACTORY AUTHORIZED START-UP AND OWNERS TRAINING REQUIRED. OWNER, ENGINEER, AND CONTRACTOR TO RECEIVE A COPY OF START UP REPORT.
5. ALL DOMESTIC WATER EQUIPMENT SHALL BE NSF-61 LISTED.

Update detail reference for the electric water heater. in note 2.  
(Construction Set, Sheet P0G.03, Electric Water Heater)

## EXPANSION TANK

EQUIP NO.	SERVICE	CAPACITY GAL.	PRE-CHARGE PRESSURE, PSI	TANK SIZE		OPERATING WEIGHT, LBS	BASIS OF DESIGN	NOTES
				DIAMETER	HEIGHT			
ET-1	DOMESTIC HOT WATER	4.5	50	11	15	9	THERM-X-TROL ST-12	1

**NOTES:**

1. INSTALL PER MANUFACTURER'S RECOMMENDATIONS



DRAWN: JM	DESIGNED: JM	CHECKED: RJ	APPROVED: JR
-----------	--------------	-------------	--------------


PROJECT: BRADLEY HEIGHT APARTMENTS - BUILDING H  
 202 27TH AVE SE  
 PUYALLUP, WA 98374  
 19401 40TH AVE W, SUITE 302  
 LYNWOOD, WA 98036  
 PHONE: (206) 364-3343  
**ROBISON ENGINEERING, INC.**

DATE: 09/05/2024

SHEET TITLE:  
**PLUMBING SCHEDULES**

SHEET NO.  
**P0H.03**

NO.	DATE	DESCRIPTION

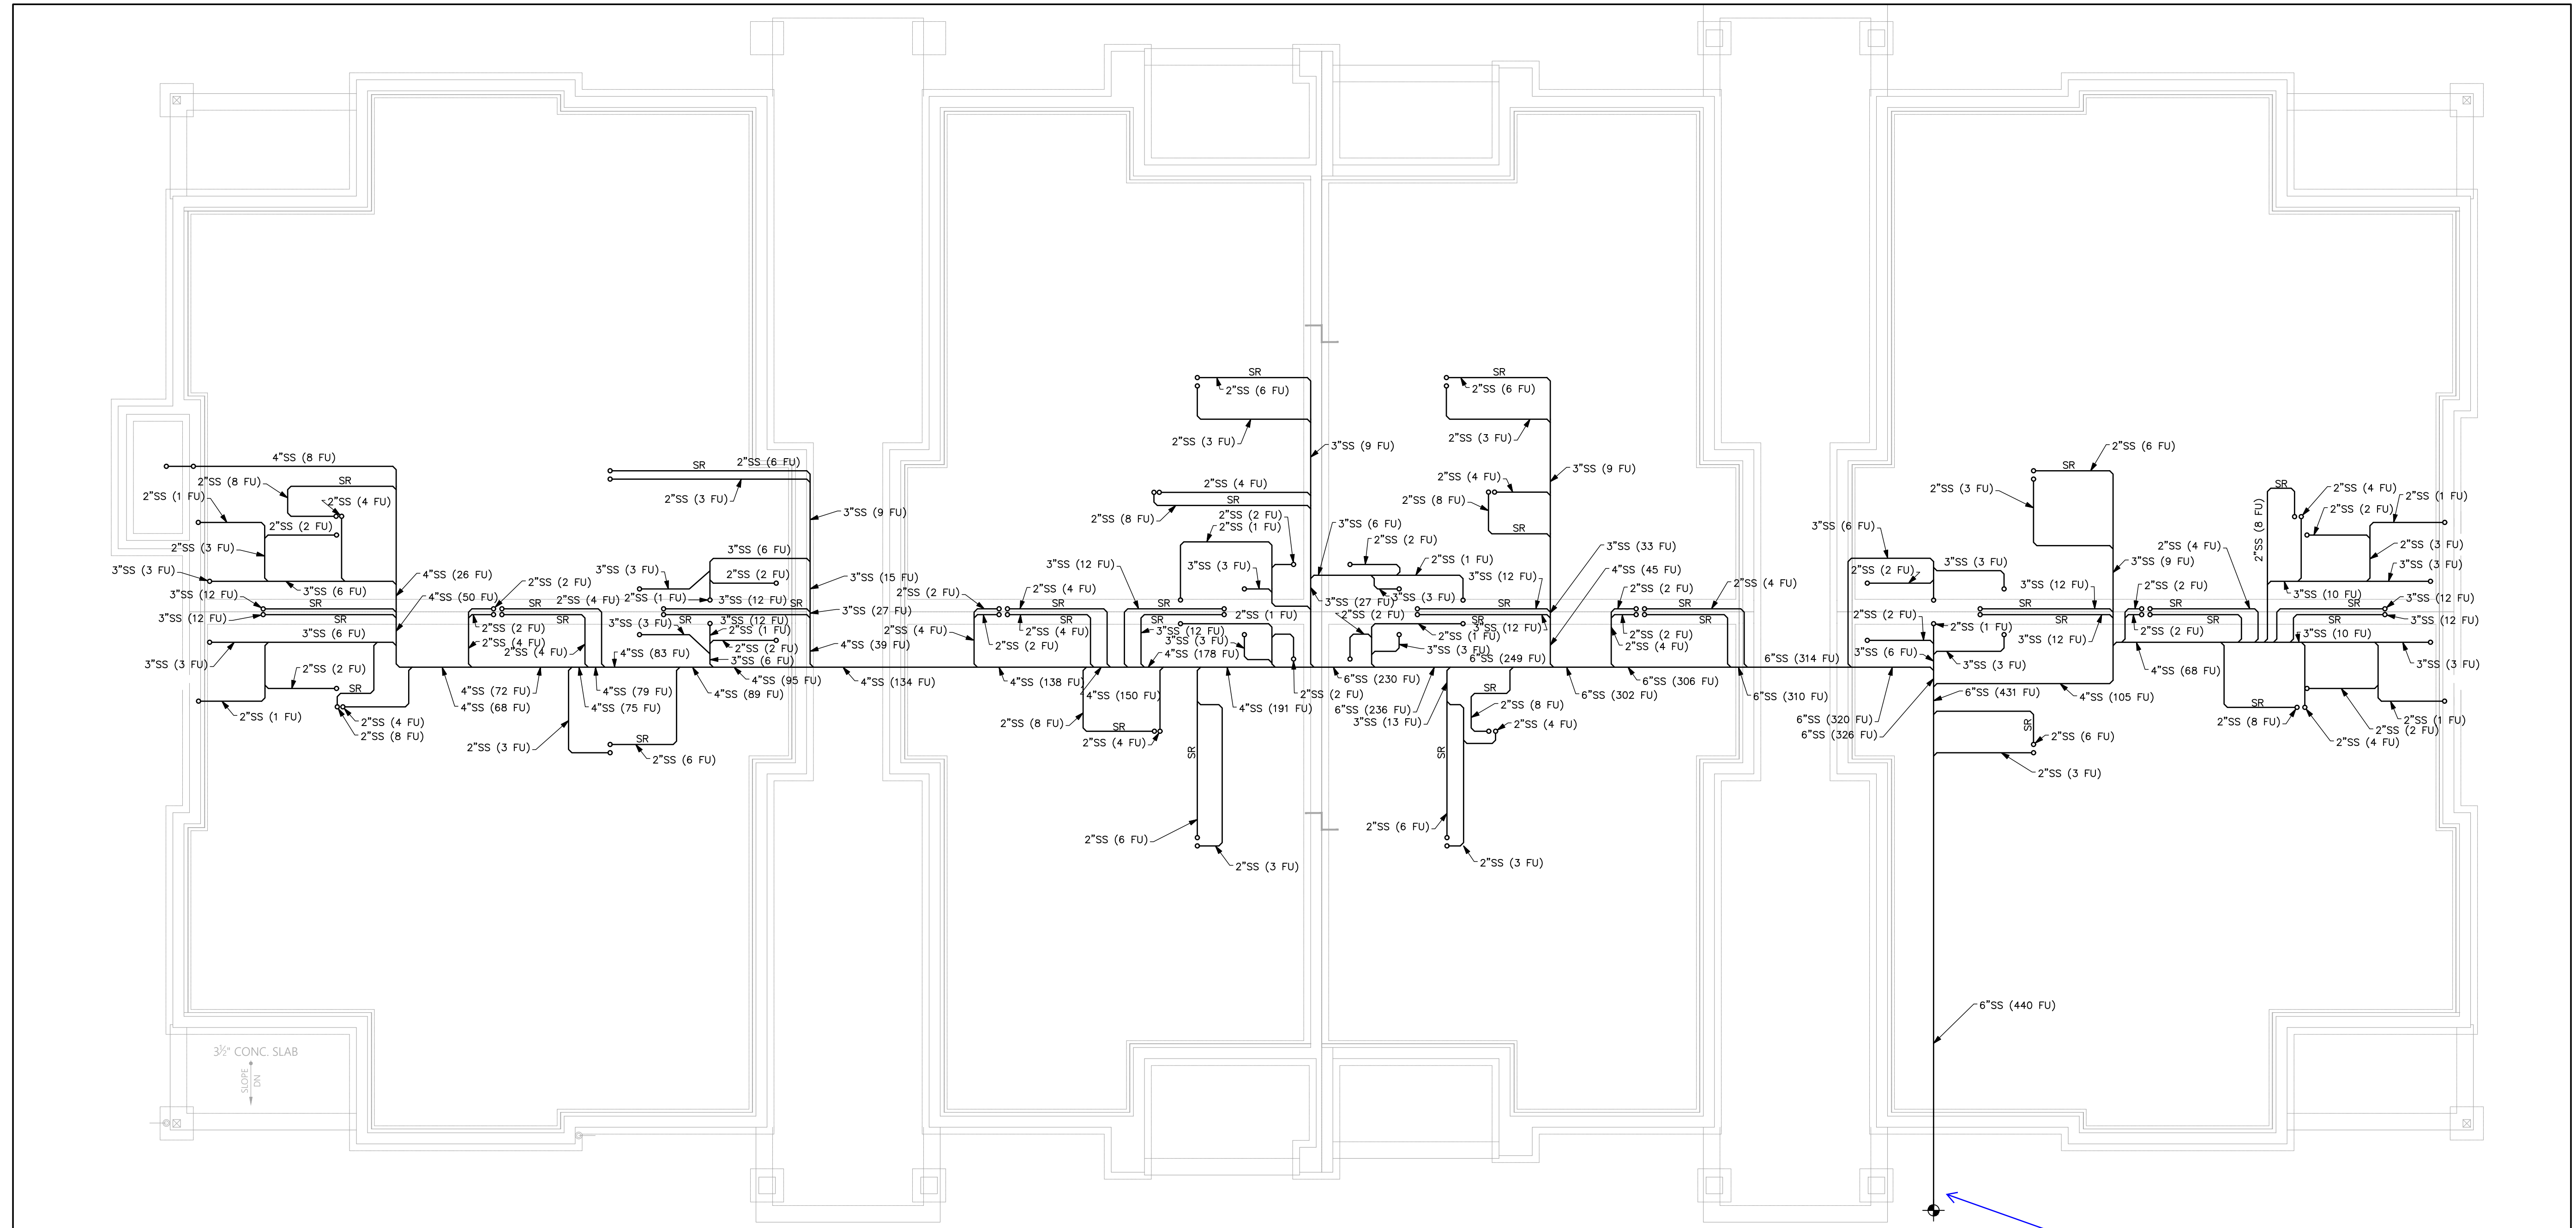

**GENERAL NOTES**

1. PROVIDE TRAP PRIMERS FOR ALL FLOOR DRAINS PER 2018 UPC 1007.1. SEE DETAIL 5/P7.01.
2. WASTE & VENT SIZING: WASTE & VENT PIPING IS SIZED PER 2018 UPC TABLE 703.2. DRAINAGE PIPING SHALL BE SLOPED AT 1/4" PER FOOT OR 2%. WHERE IT IS IMPRACTICAL TO OBTAIN A SLOPE OF 2% DUE TO THE DEPTH OF THE STREET SEWER OR TO STRUCTURAL FEATURES OF THE BUILDING, DRAINAGE PIPING 4" AND LARGER MAY BE SLOPED AT 1/8" PER FOOT OR 1% WITH APPROVAL FROM THE AHJ.

PIPE SIZE	VERTICAL	HORIZONTAL	VENT
1 1/2"	2 DFU	1 DFU	8 DFU
2"	16 DFU	8 DFU	24 DFU
3"	48 DFU	35 DFU	84 DFU
4"	256 DFU	172 DFU	256 DFU
6"	1,380 DFU	576 DFU	1,380 DFU
8"	3,600 DFU	2,112 DFU	3,600 DFU

**FLAG NOTES** #

NOT USED

**BACKWATER VALVE ANALYSIS -- SS POC:**


IF UPSTREAM MANHOLE RIM ELEVATION IS HIGHER THAN FINISH FLOOR ELEVATION CONTACT ENGINEER FOR FURTHER EVALUATION.

Verify sanitary sewer POC location with PRCCP20240845 civil plans for continuity to civil utility design and revise plumbing plans accordingly. Include reference to permit PRCCP20240845 in callout. [CONSTRUCTION PLAN SET, sheet P2H.00]

Compass rose is incorrect. Revise accordingly. [CONSTRUCTION PLAN SET, all plumbing plan sheets]

**UNDERSLAB WASTE & VENT PLAN**

SCALE: 3/16" = 1'-0"

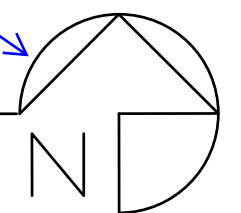

NO.	DATE	DESCRIPTION	REVISIONS



DRAWN:	JM
DESIGNED:	JM
CHECKED:	RJ
APPROVED:	JR

PROJECT: **BRADLEY HEIGHT APARTMENTS - BUILDING H**  
 202 27TH AVE SE  
 PUYALLUP, WA 98374


19401 40TH AVE W, SUITE 302  
 LYNNWOOD, WA 98036  
 PHONE: 206/364-3343

**ROBISON ENGINEERING, INC.**

DATE: 09/05/2024

SHEET TITLE:  
**UNDERSLAB WASTE & VENT PLAN**

SHEET NO.  
**P2H.00**

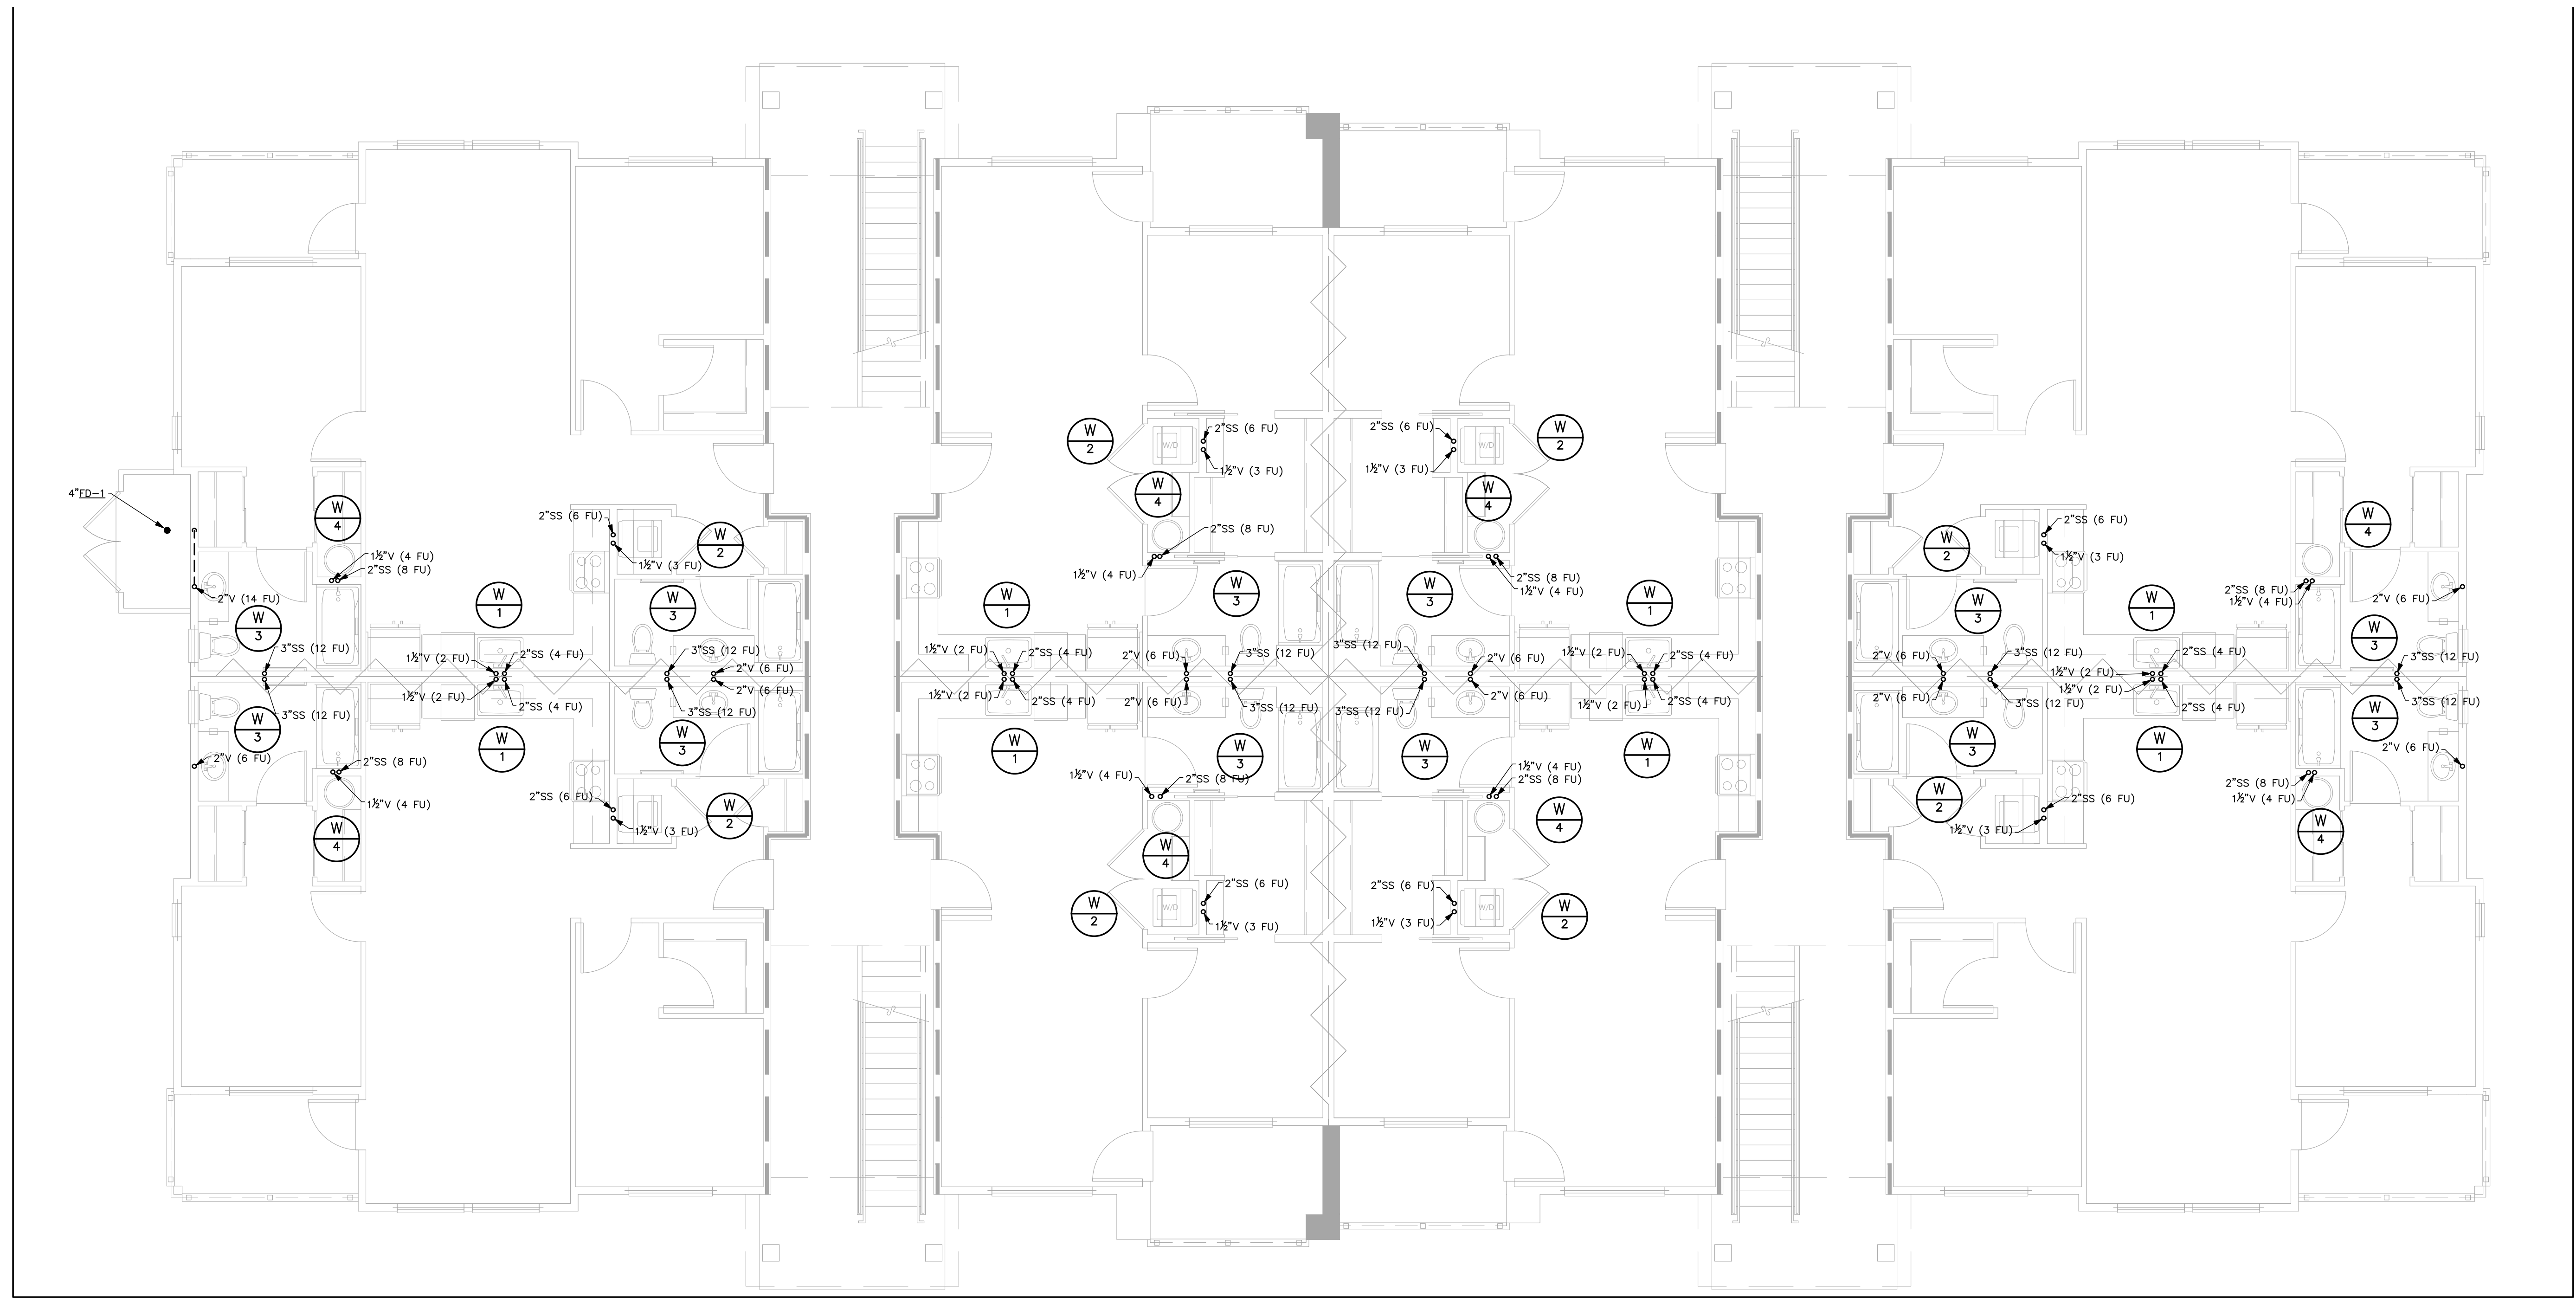

**GENERAL NOTES**


1. PROVIDE TRAP PRIMERS FOR ALL FLOOR DRAINS PER 2018 UPC 1007.1. SEE DETAIL 5/P7.01.
2. WASTE & VENT SIZING: WASTE & VENT PIPING IS SIZED PER 2018 UPC TABLE 703.2. DRAINAGE PIPING SHALL BE SLOPED AT 1/4" PER FOOT OR 2%. WHERE IT IS IMPRACTICAL TO OBTAIN A SLOPE OF 2% DUE TO THE DEPTH OF THE STREET SEWER OR TO STRUCTURAL FEATURES OF THE BUILDING, DRAINAGE PIPING 4" AND LARGER MAY BE SLOPED AT 1/8" PER FOOT OR 1% WITH APPROVAL FROM THE AHJ.

PIPE SIZE	VERTICAL	HORIZONTAL	VENT
1 1/2"	2 DFU	1 DFU	8 DFU
2"	16 DFU	8 DFU	24 DFU
3"	48 DFU	35 DFU	84 DFU
4"	256 DFU	172 DFU	256 DFU
6"	1,380 DFU	576 DFU	1,380 DFU
8"	3,600 DFU	2,112 DFU	3,600 DFU

**FLAG NOTES** #

NOT USED

**LEVEL 1 WASTE & VENT PLAN**  
SCALE: 3/16" = 1'-0"

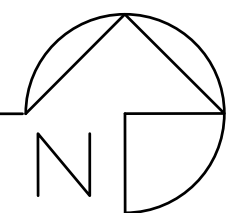

NO.	DATE	DESCRIPTION	REVISIONS



DRAWN:	JM	DESIGNED:	JM	CHECKED:	RJ	APPROVED:	JR
--------	----	-----------	----	----------	----	-----------	----

PROJECT: **BRADLEY HEIGHT APARTMENTS - BUILDING H**  
202 27TH AVE SE  
PUYALLUP, WA 98374

19401 40TH AVE W, SUITE 302  
LYNNWOOD, WA 98036  
PHONE: (206) 364-3343


**ROBISON ENGINEERING, INC.**

DATE: 09/05/2024

SHEET TITLE:  
**LEVEL 1 WASTE & VENT PLAN**

SHEET NO.  
**P2H.01**

NO.	DATE	DESCRIPTION	REVISIONS

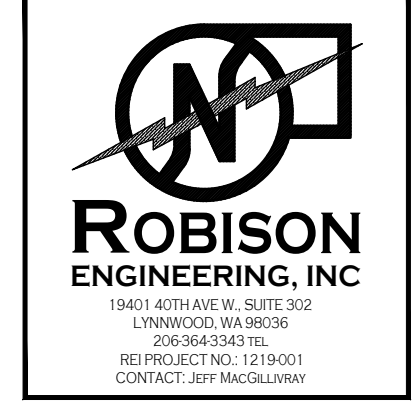

DRAWN:	JM	DESIGNED:	JM	CHECKED:	RJ	APPROVED:	JR
--------	----	-----------	----	----------	----	-----------	----

PROJECT: BRADLEY HEIGHT APARTMENTS - BUILDING H  
 202 27TH AVE SE  
 PUYALLUP, WA 98374


19401 40TH AVE W, SUITE 302  
 LYNNWOOD, WA 98036  
 PHONE: (206) 364-3343

**ROBISON ENGINEERING, INC.**

DATE: 09/05/2024

SHEET TITLE:  
**LEVEL 2 WASTE & VENT PLAN**

SHEET NO.  
**P2H.02**

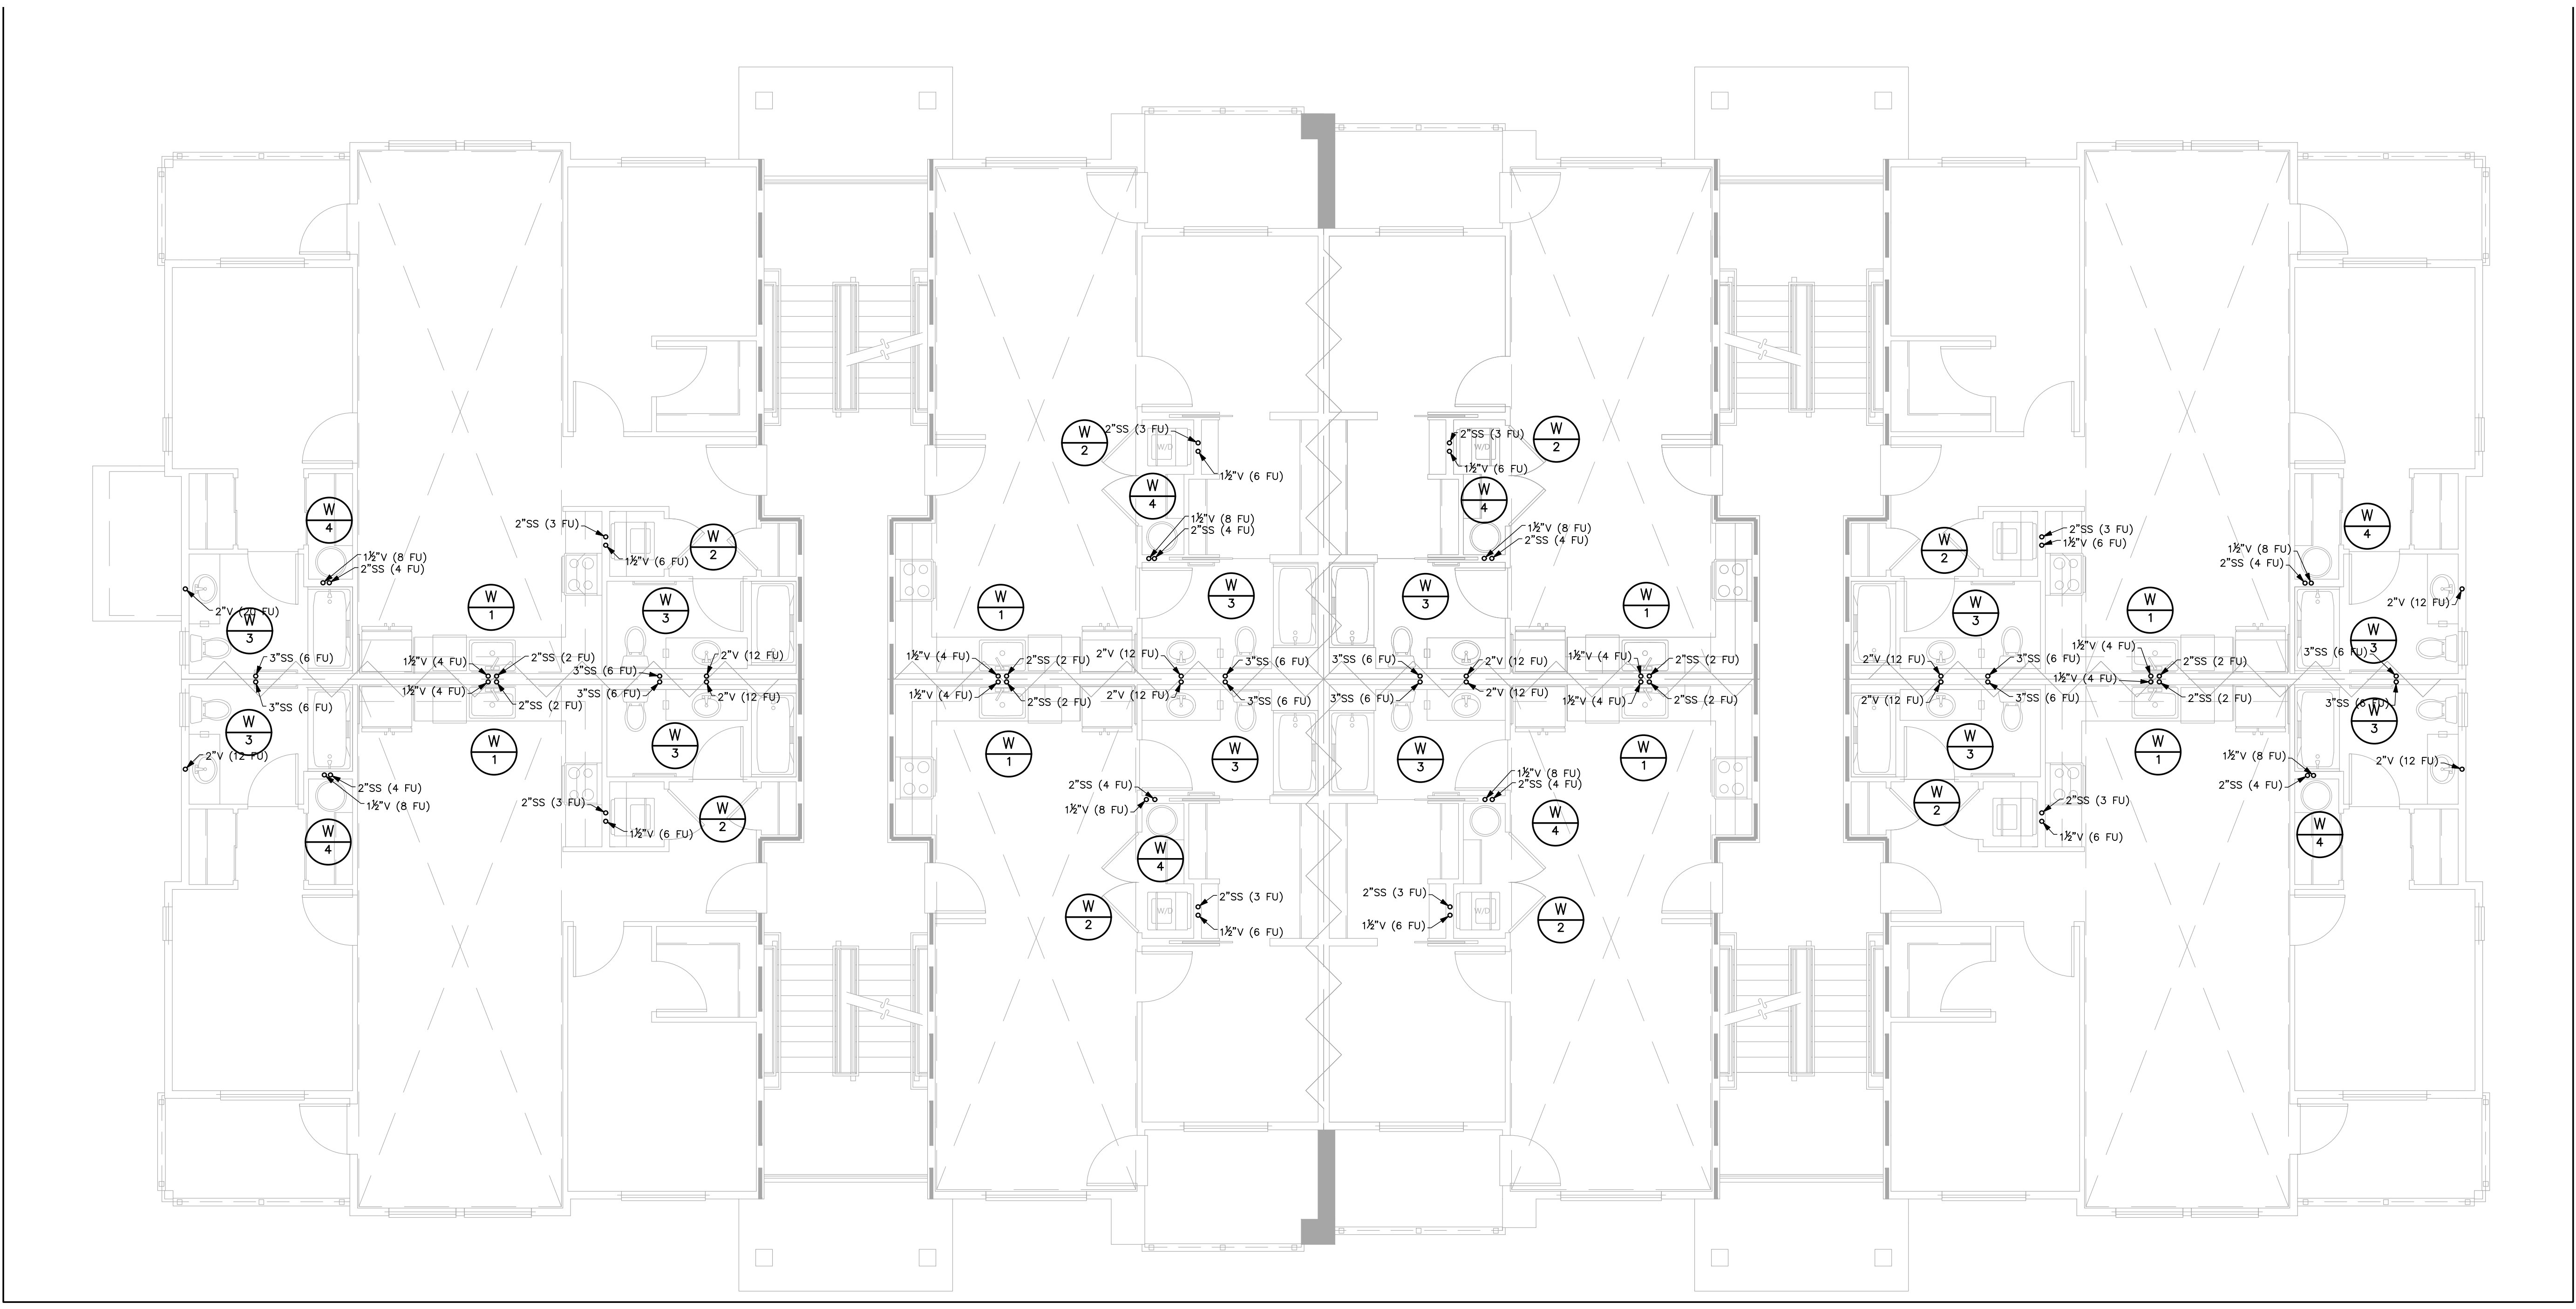

**GENERAL NOTES**


1. PROVIDE TRAP PRIMERS FOR ALL FLOOR DRAINS PER 2018 UPC 1007.1. SEE DETAIL 5/P7.01.
2. WASTE & VENT SIZING: WASTE & VENT PIPING IS SIZED PER 2018 UPC TABLE 703.2. DRAINAGE PIPING SHALL BE SLOPED AT 1/4" PER FOOT OR 2%. WHERE IT IS IMPRACTICAL TO OBTAIN A SLOPE OF 2% DUE TO THE DEPTH OF THE STREET SEWER OR TO STRUCTURAL FEATURES OF THE BUILDING, DRAINAGE PIPING 4" AND LARGER MAY BE SLOPED AT 1/8" PER FOOT OR 1% WITH APPROVAL FROM THE AHJ.


PIPE SIZE	VERTICAL	HORIZONTAL	VENT
1 1/2"	2 DFU	1 DFU	8 DFU
2"	16 DFU	8 DFU	24 DFU
3"	48 DFU	35 DFU	84 DFU
4"	256 DFU	172 DFU	256 DFU
6"	1,380 DFU	576 DFU	1,380 DFU
8"	3,600 DFU	2,112 DFU	3,600 DFU

**FLAG NOTES** #

NOT USED

**LEVEL 2 WASTE & VENT PLAN**  
 SCALE: 3/16" = 1'-0"

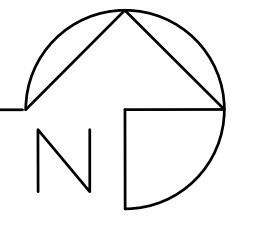

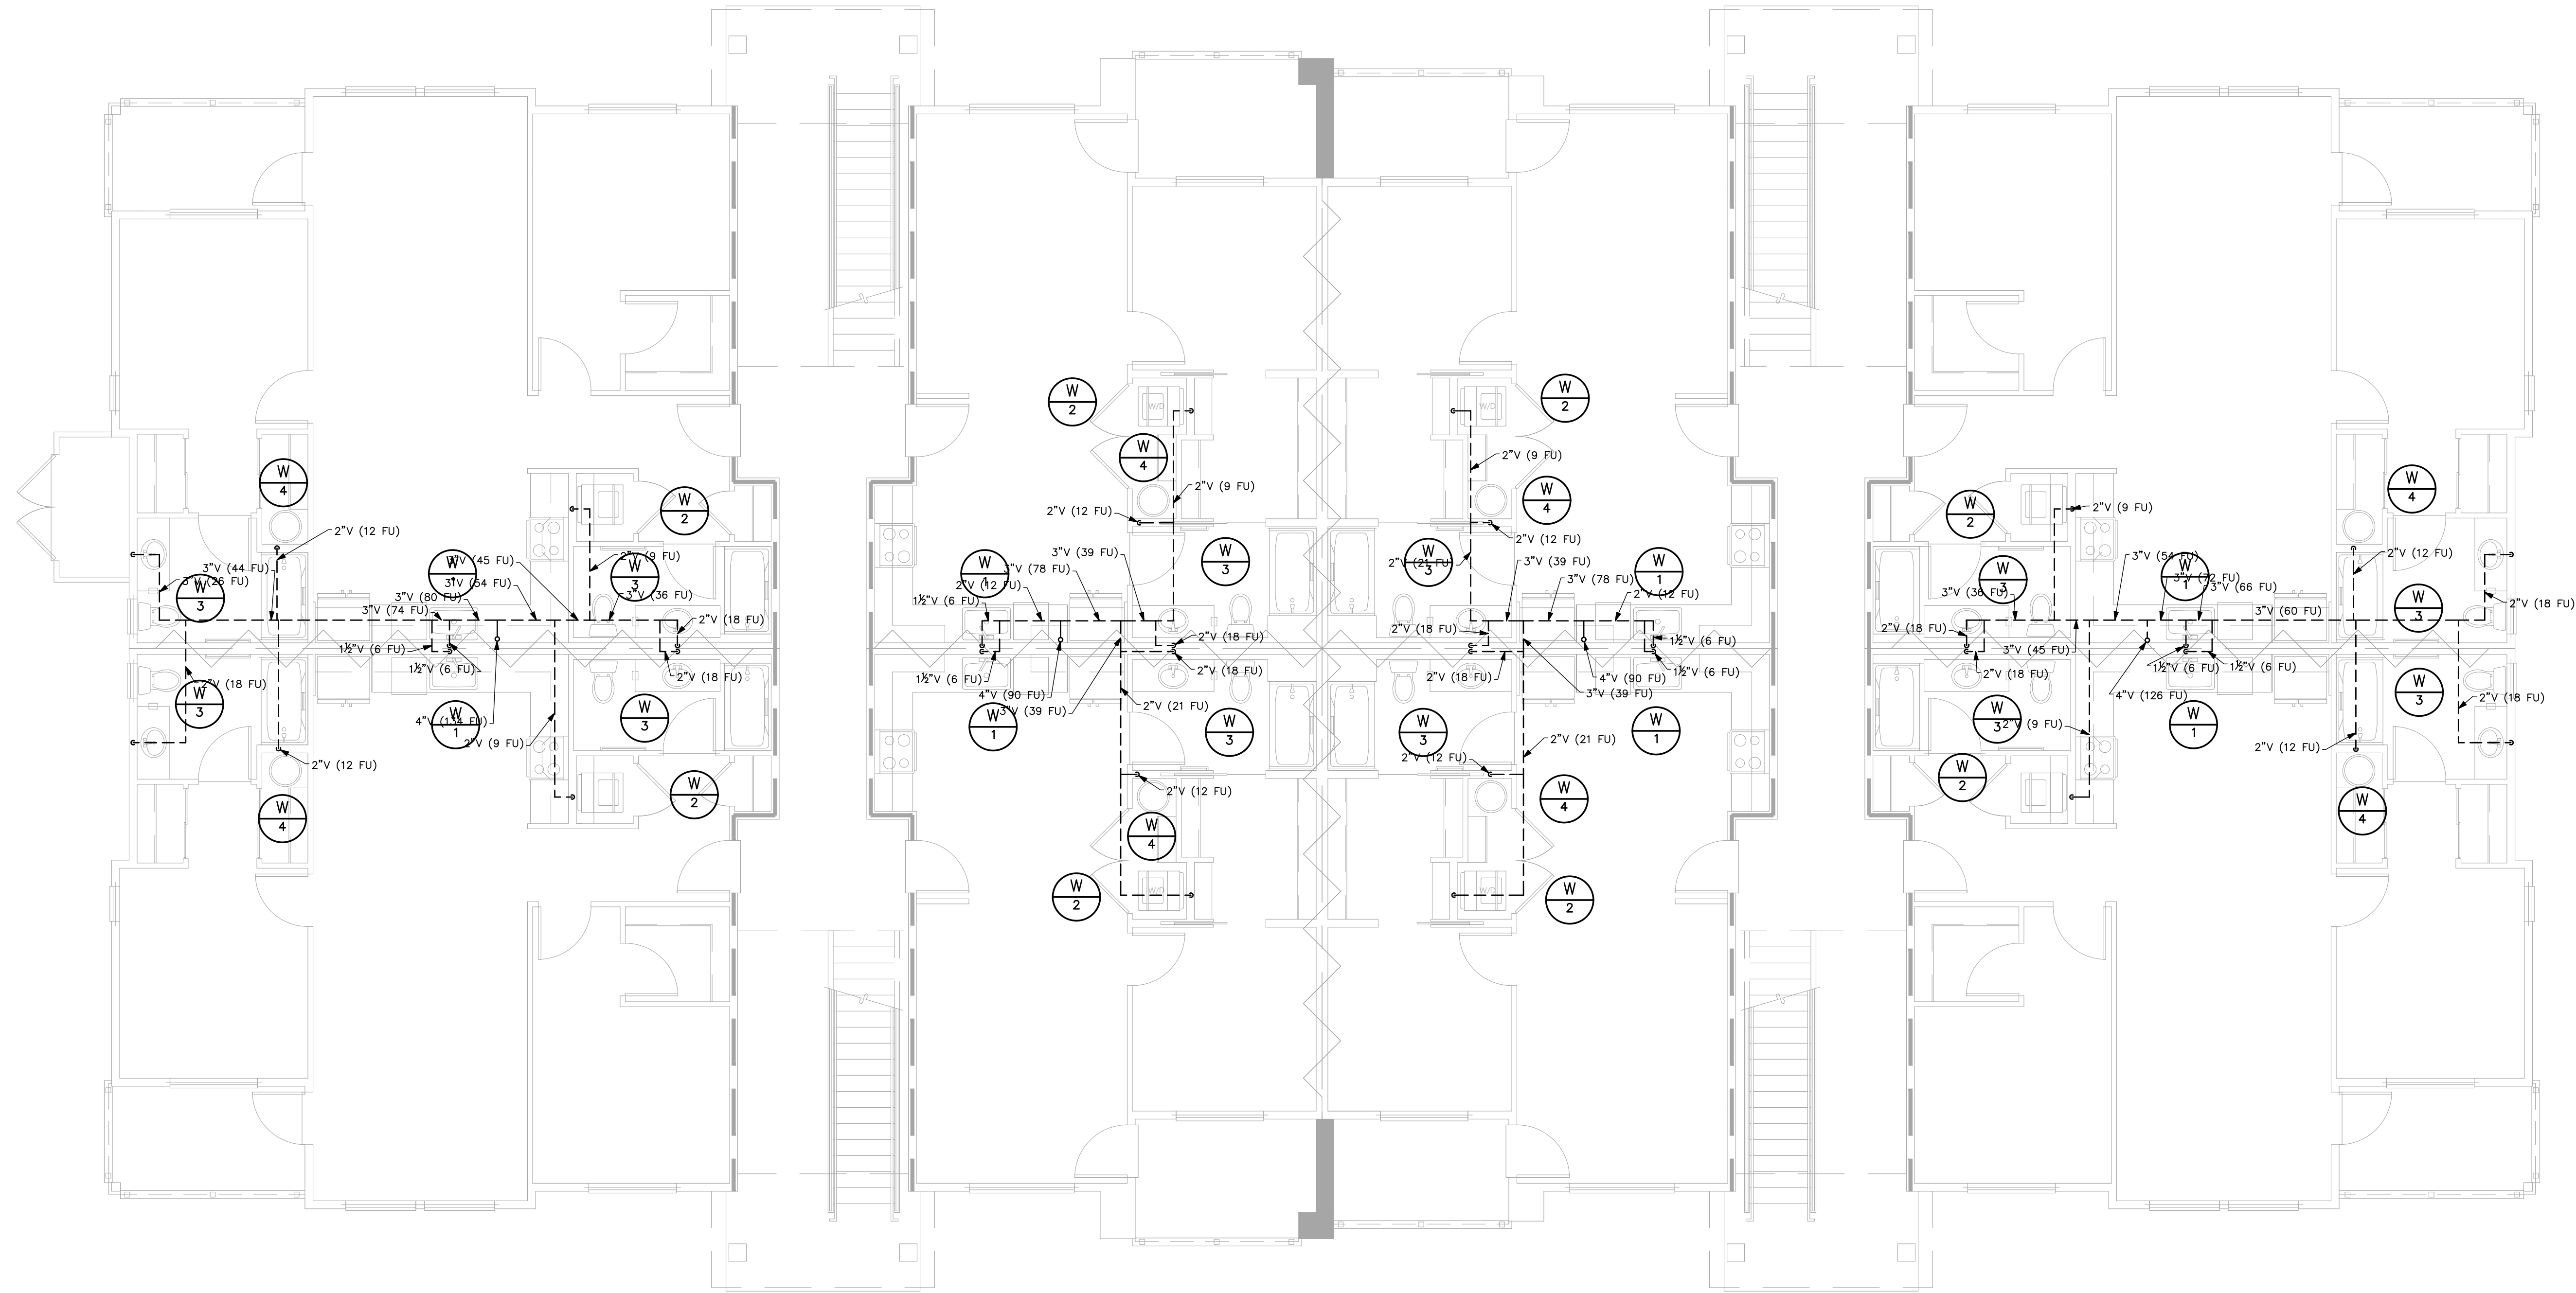

**GENERAL NOTES**


1. PROVIDE TRAP PRIMERS FOR ALL FLOOR DRAINS PER 2018 UPC 1007.1. SEE DETAIL 5/P7.01.
2. WASTE & VENT SIZING: WASTE & VENT PIPING IS SIZED PER 2018 UPC TABLE 703.2. DRAINAGE PIPING SHALL BE SLOPED AT 1/4" PER FOOT OR 2%. WHERE IT IS IMPRACTICAL TO OBTAIN A SLOPE OF 2% DUE TO THE DEPTH OF THE STREET SEWER OR TO STRUCTURAL FEATURES OF THE BUILDING, DRAINAGE PIPING 4" AND LARGER MAY BE SLOPED AT 1/8" PER FOOT OR 1% WITH APPROVAL FROM THE AHJ.

PIPE SIZE	VERTICAL	HORIZONTAL	VENT
1 1/2"	2 DFU	1 DFU	8 DFU
2"	16 DFU	8 DFU	24 DFU
3"	48 DFU	35 DFU	84 DFU
4"	256 DFU	172 DFU	256 DFU
6"	1,380 DFU	576 DFU	1,380 DFU
8"	3,600 DFU	2,112 DFU	3,600 DFU

**FLAG NOTES** #

NOT USED

**LEVEL 3 WASTE & VENT PLAN**  
SCALE: 3/16" = 1'-0"

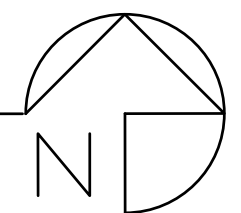

NO.	DATE	DESCRIPTION	REVISIONS



DRAWN:	JM	DESIGNED:	JM	CHECKED:	RJ	APPROVED:	JR
--------	----	-----------	----	----------	----	-----------	----

PROJECT: **BRADLEY HEIGHT APARTMENTS - BUILDING H**  
202 27TH AVE SE  
PUYALLUP, WA 98374


19401 40TH AVE W, SUITE 302  
LYNNWOOD, WA 98036  
PHONE: 206/364-3343

**ROBISON ENGINEERING, INC.**

DATE: 09/05/2024

SHEET TITLE:  
**LEVEL 3 WASTE & VENT PLAN**

SHEET NO.  
**P2H.03**

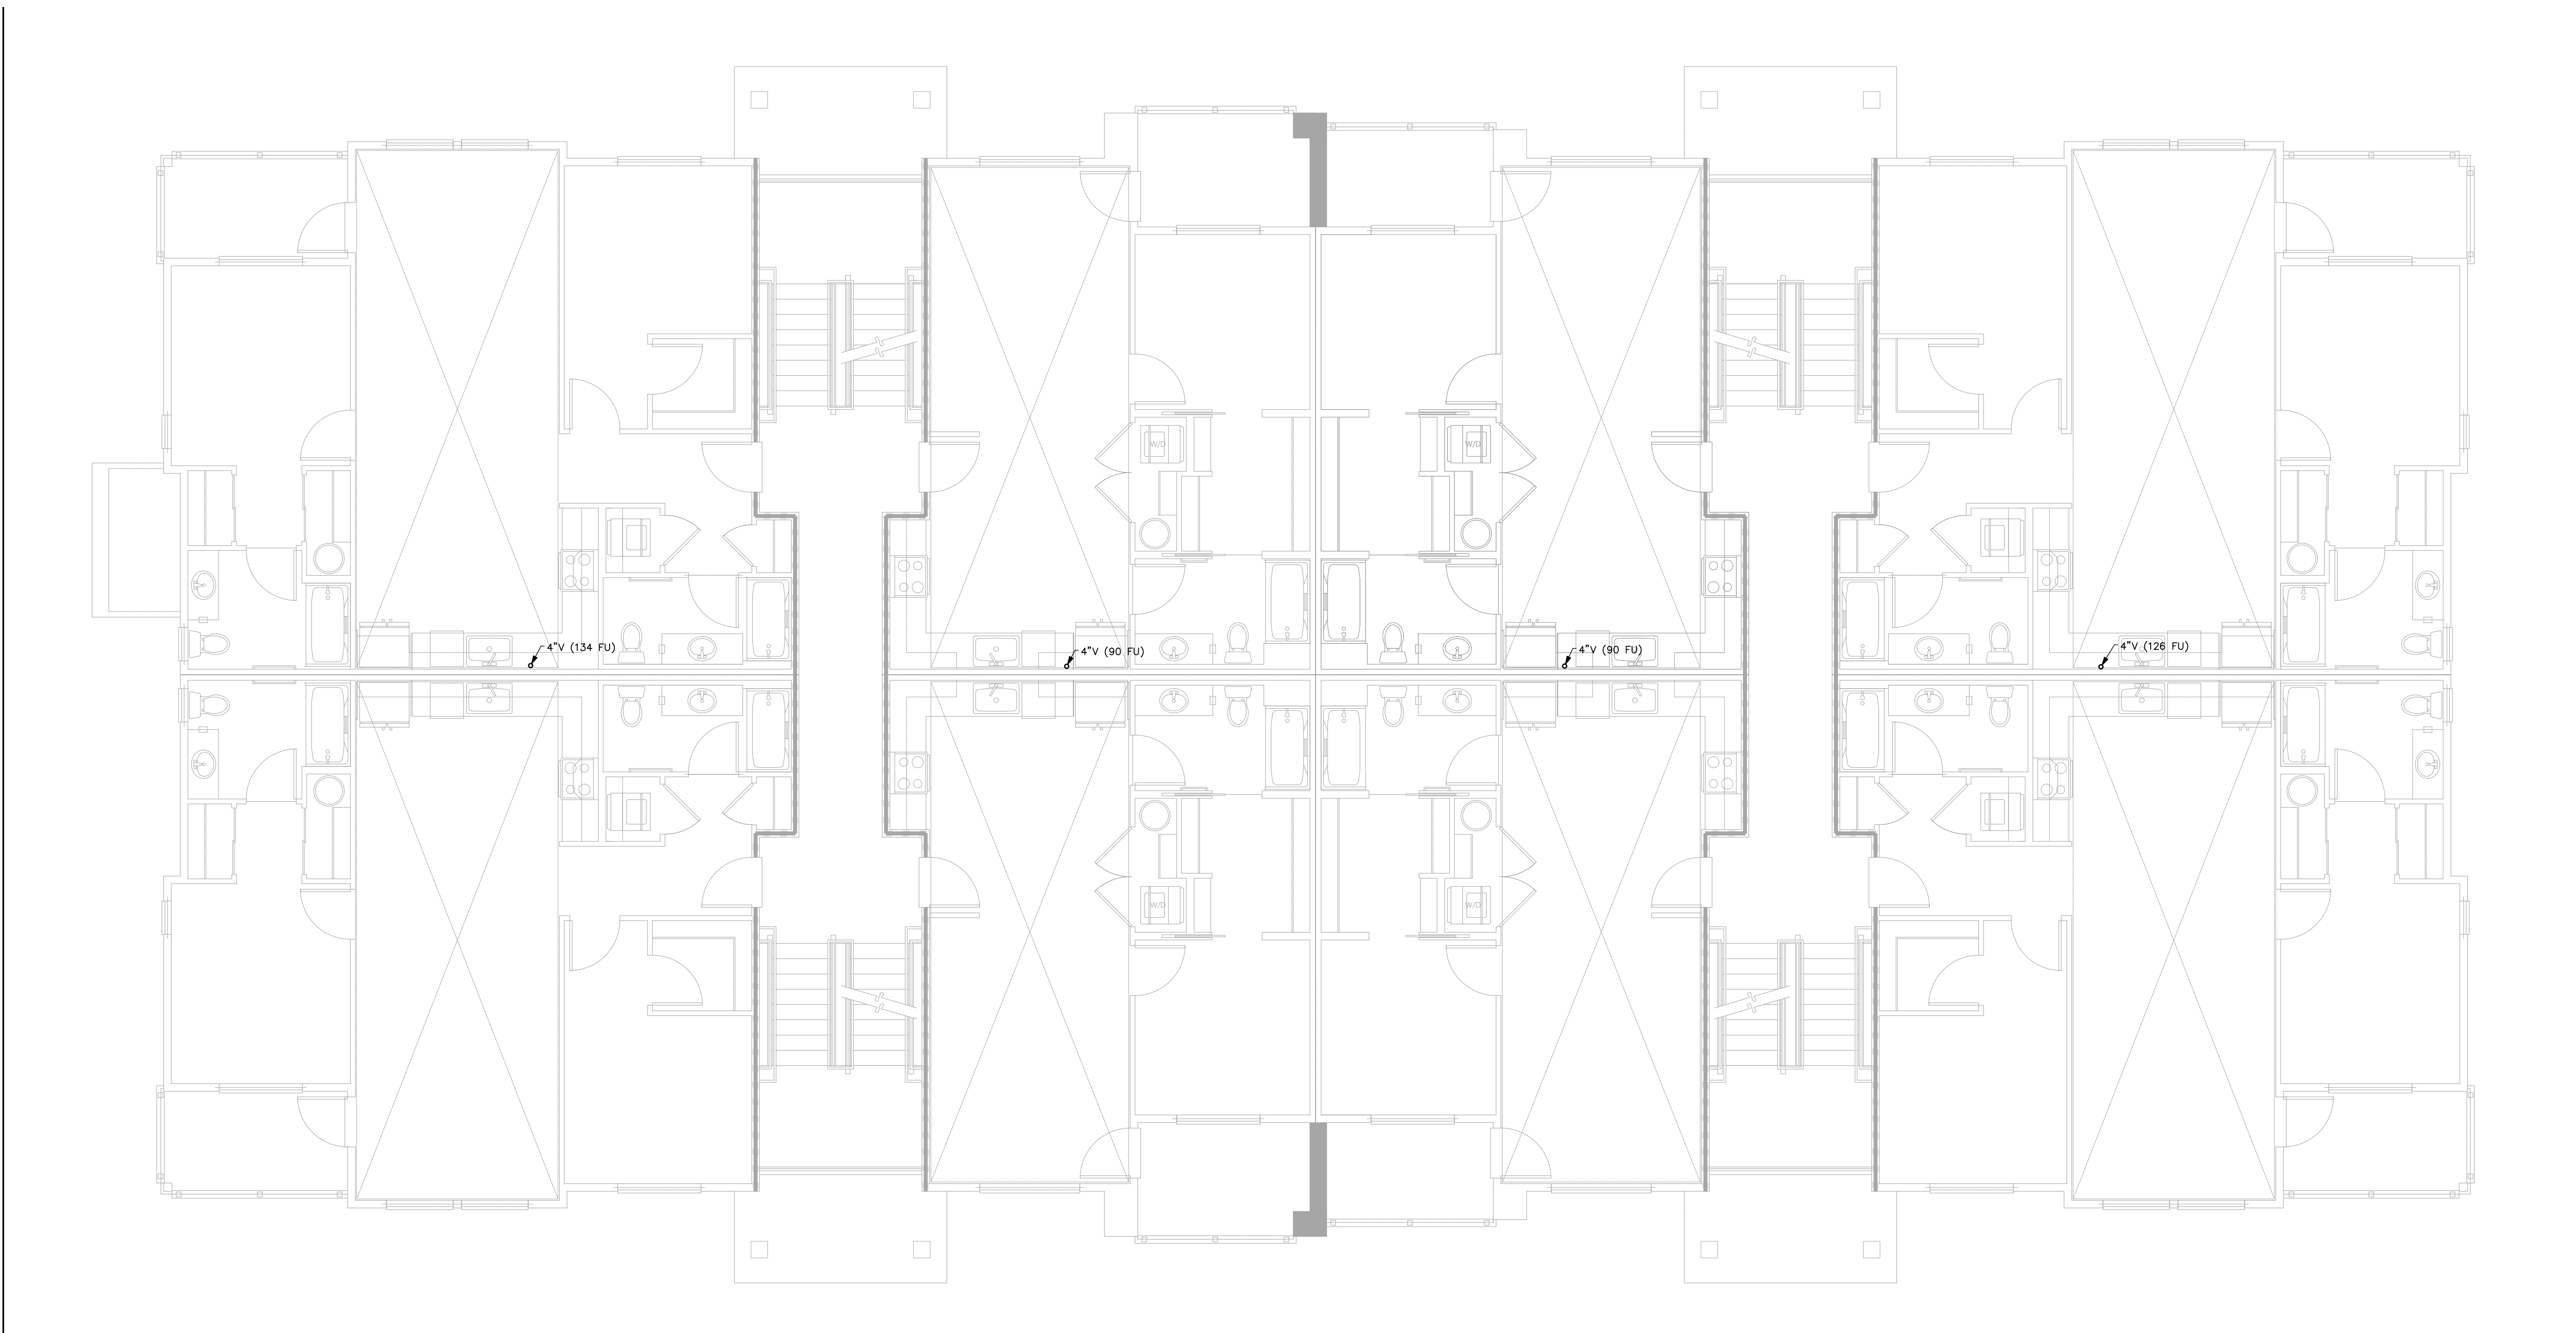

**GENERAL NOTES**

1. PROVIDE TRAP PRIMERS FOR ALL FLOOR DRAINS PER 2018 UPC 1007.1. SEE DETAIL 5/P7.01.
2. WASTE & VENT SIZING: WASTE & VENT PIPING IS SIZED PER 2018 UPC TABLE 703.2. DRAINAGE PIPING SHALL BE SLOPED AT 1/4" PER FOOT OR 2%. WHERE IT IS IMPRACTICAL TO OBTAIN A SLOPE OF 2% DUE TO THE DEPTH OF THE STREET SEWER OR TO STRUCTURAL FEATURES OF THE BUILDING, DRAINAGE PIPING 4" AND LARGER MAY BE SLOPED AT 1/8" PER FOOT OR 1% WITH APPROVAL FROM THE AHJ.


PIPE SIZE	VERTICAL	HORIZONTAL	VENT
1 1/2"	2 DFU	1 DFU	8 DFU
2"	16 DFU	8 DFU	24 DFU
3"	48 DFU	35 DFU	84 DFU
4"	256 DFU	172 DFU	256 DFU
6"	1,380 DFU	576 DFU	1,380 DFU
8"	3,600 DFU	2,112 DFU	3,600 DFU

**FLAG NOTES** #

NOT USED

**ROOF WASTE & VENT PLAN**

SCALE: 3/16" = 1'-0"

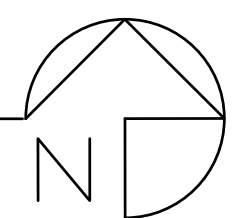

NO.	DATE	DESCRIPTION	REVISIONS



DRAWN:	JM
DESIGNED:	JM
CHECKED:	RJ
APPROVED:	JR

PROJECT: **BRADLEY HEIGHT APARTMENTS - BUILDING H**  
 202 27TH AVE SE  
 PUYALLUP, WA 98374


19401 40TH AVE W, SUITE 302  
 LYNNWOOD, WA 98036  
 PHONE: 206/364-3343

**ROBISON ENGINEERING, INC.**

DATE: 09/05/2024

SHEET TITLE:  
**ROOF WASTE & VENT PLAN**

SHEET NO.  
**P2H.04**

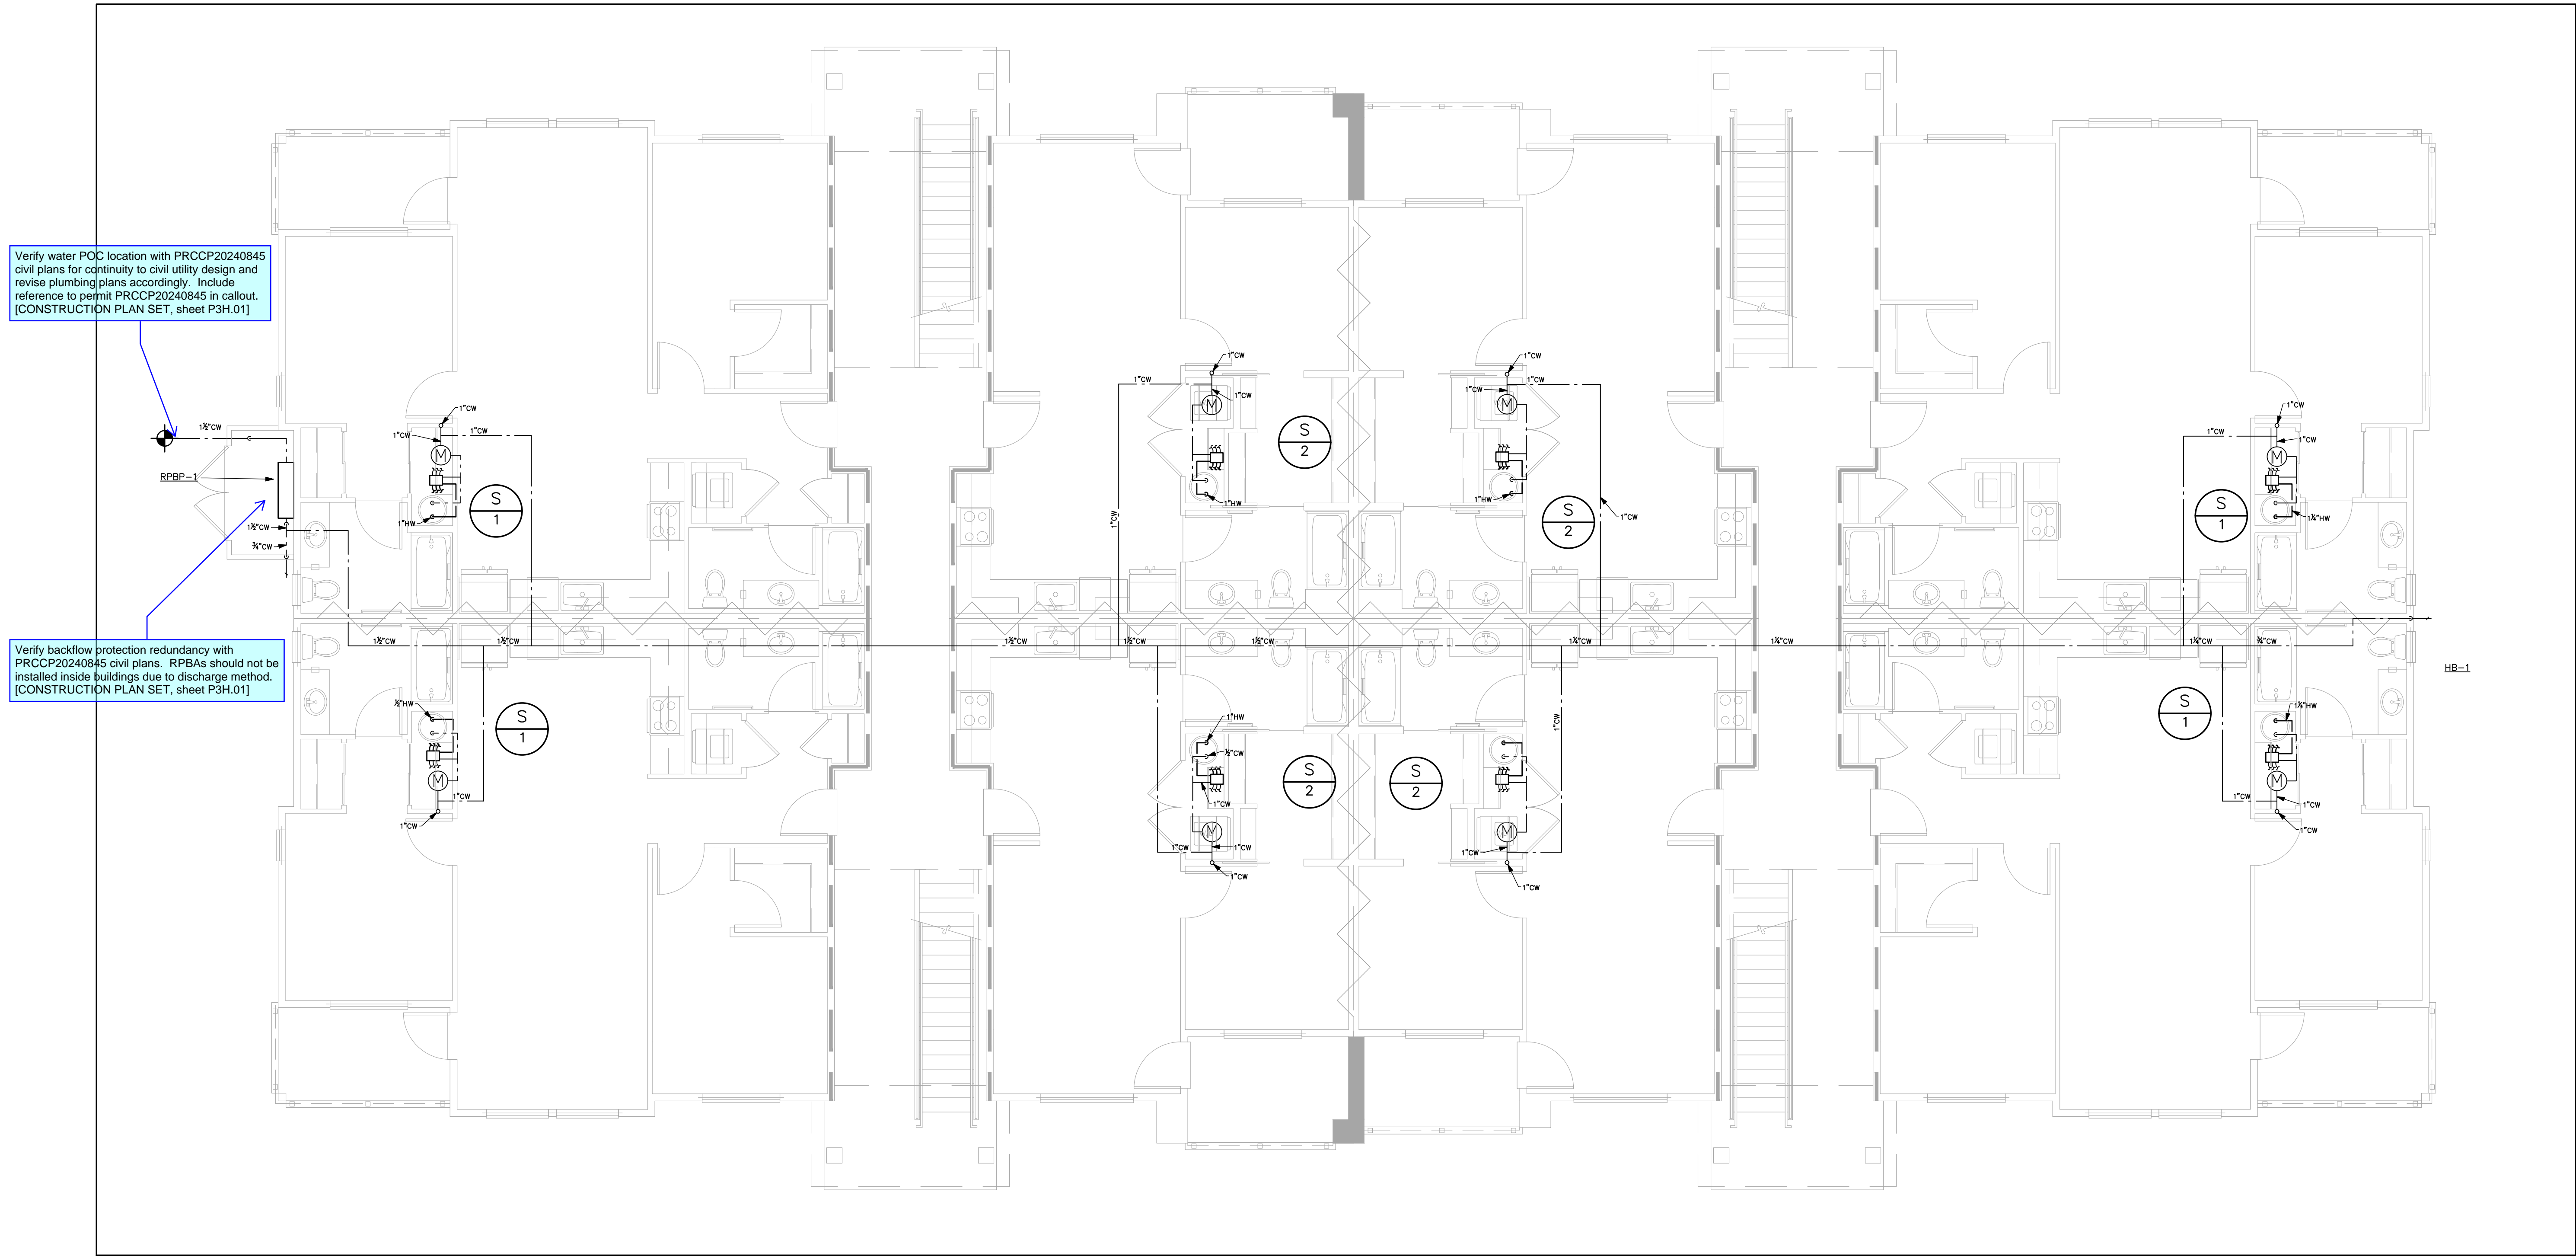

Verify water POC location with PRCCP20240845 civil plans for continuity to civil utility design and revise plumbing plans accordingly. Include reference to permit PRCCP20240845 in callout. [CONSTRUCTION PLAN SET, sheet P3H.01]

Verify backflow protection redundancy with PRCCP20240845 civil plans. RPBA's should not be installed inside buildings due to discharge method. [CONSTRUCTION PLAN SET, sheet P3H.01]


**GENERAL NOTES**

1. PROVIDE EXPANSION LOOPS FOR ALL WATER PIPING PER THE MANUFACTURER'S INSTRUCTIONS. SEE DETAIL 3/P7.01.
2. INSTALL HEAT TRACE ON SUPPLY PIPE IN NON CONDITIONED SPACES.

**FLAG NOTES** #

NOT USED

**LEVEL 1 PLUMBING SUPPLY PLAN**  
SCALE: 3/16" = 1'-0"

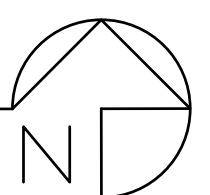

NO.	DATE	DESCRIPTION	REVISIONS



DRAWN:	JM	DESIGNED:	JM	CHECKED:	RJ	APPROVED:	JR
--------	----	-----------	----	----------	----	-----------	----

PROJECT: **BRADLEY HEIGHT APARTMENTS - BUILDING H**  
202 27TH AVE SE  
PUYALLUP, WA 98374


19401 40TH AVE W SUITE 302  
LYNNWOOD, WA 98036  
PHONE: 206.864.3343

**ROBISON ENGINEERING, INC.**

DATE: 09/05/2024

SHEET TITLE:  
**LEVEL 1  
PLUMBING  
SUPPLY PLAN**

SHEET NO.

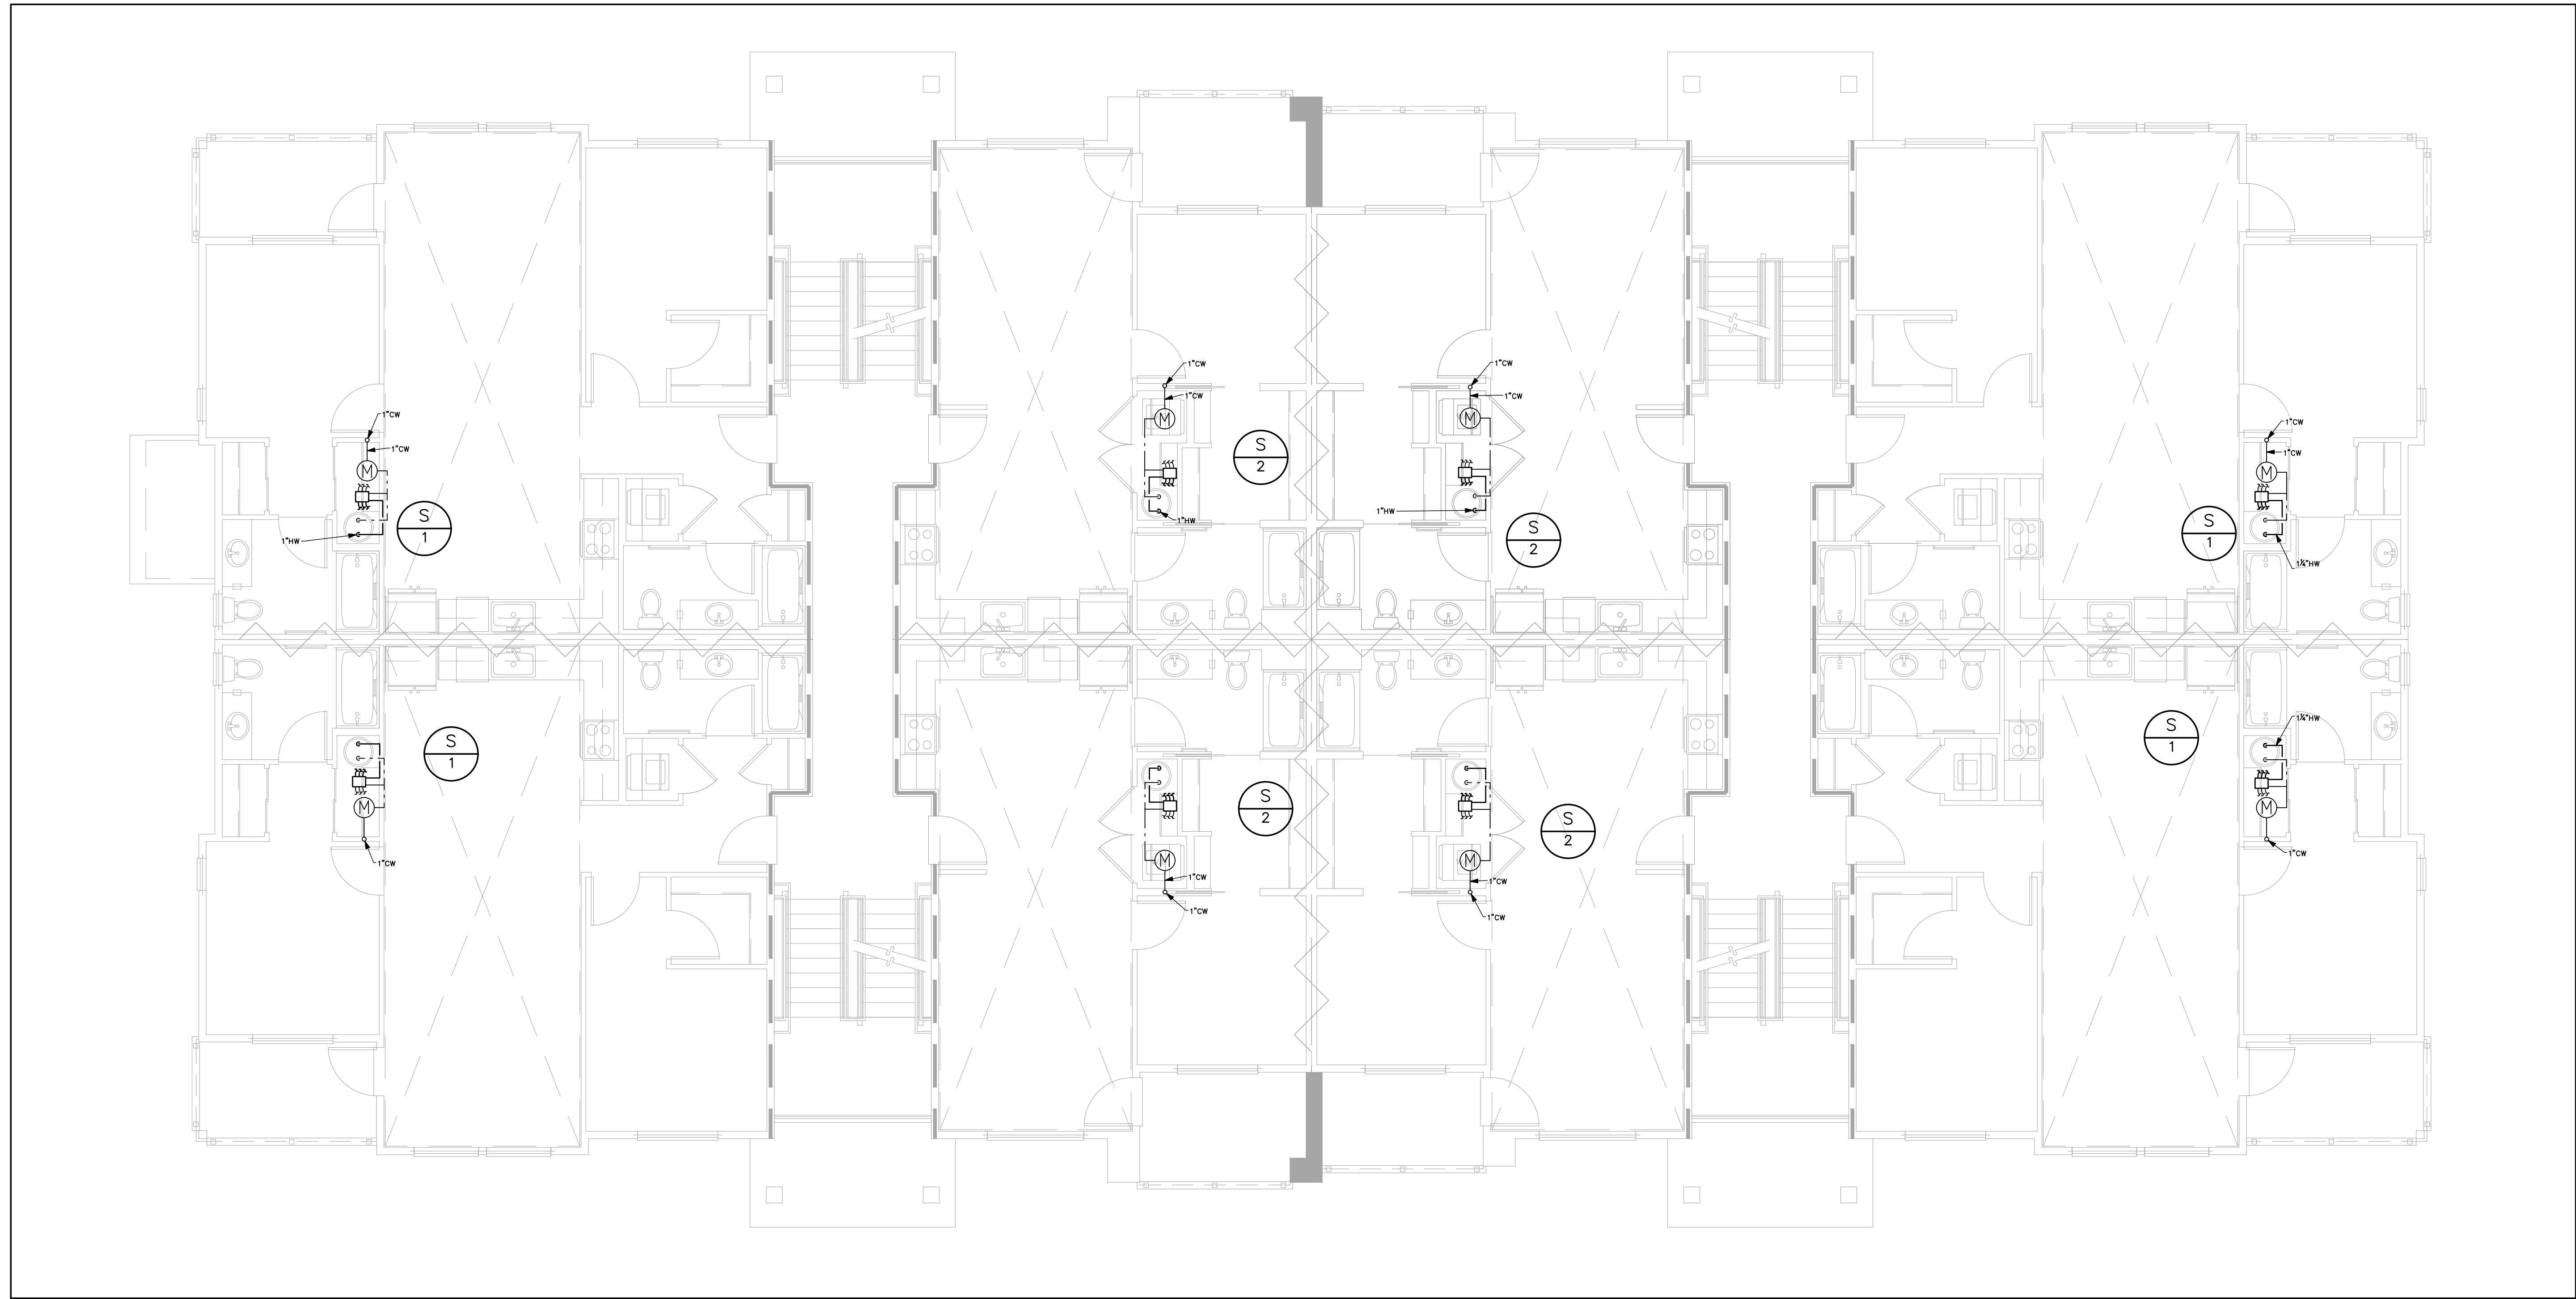


**GENERAL NOTES**

1. PROVIDE EXPANSION LOOPS FOR ALL WATER PIPING PER THE MANUFACTURER'S INSTRUCTIONS. SEE DETAIL 3/P7.01.
2. INSTALL HEAT TRACE ON SUPPLY PIPE IN NON CONDITIONED SPACES.

**FLAG NOTES**

NOT USED

**LEVEL 2 PLUMBING SUPPLY PLAN**  
SCALE: 3/16" = 1'-0"

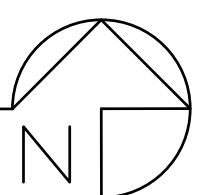

NO.	DATE	DESCRIPTION	REVISIONS



DRAWN:	JM
DESIGNED:	JM
CHECKED:	RJ
APPROVED:	JR

PROJECT: **BRADLEY HEIGHT APARTMENTS - BUILDING H**  
202 27TH AVE SE  
PUYALLUP, WA 98374

19401 40TH AVE W. SUITE 302  
LYNNWOOD, WA 98036  
PHONE: 206.864.3343

**ROBISON ENGINEERING, INC.**





DATE: 09/05/2024

SHEET TITLE:  
**LEVEL 2  
PLUMBING  
SUPPLY PLAN**


SHEET NO. \_\_\_\_\_





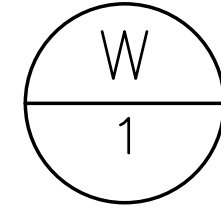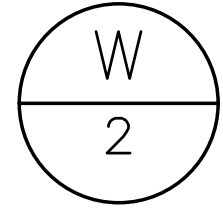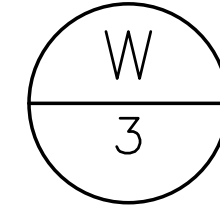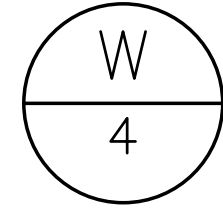

GENERAL NOTES

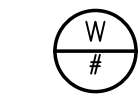

= WASTE & VENT RISER IDENTIFICATION (I.E. RISER "#"). REFER TO P4 SERIES FOR RISER DIAGRAMS.

1. PROVIDE TRAP PRIMERS FOR ALL FLOOR DRAINS AND HUB DRAINS PER 2015 SPC 1007.1. SEE DETAIL 6/P7.01.
2. WASTE & VENT SIZING: WASTE & VENT PIPING IS SIZED PER 2015 SPC TABLE 703.2. DRAINAGE PIPING SHALL BE SLOPED AT 1/4" PER FOOT OR 2% WHERE IT IS IMPRACTICAL TO OBTAIN A SLOPE OF 2% DUE TO THE DEPTH OF THE STREET SEWER OR TO STRUCTURAL FEATURES OF THE BUILDING, DRAINAGE PIPING MAY BE SLOPED AT 1/8" PER FOOT OR 1% WITH APPROVAL FROM THE AHJ.

PIPE SIZE	VERTICAL	HORIZONTAL	VENT
1 1/2"	2 DFU	1 DFU	8 DFU
2"	16 DFU	8 DFU	24 DFU
3"	48 DFU	35 DFU	84 DFU
4"	256 DFU	172 DFU	256 DFU
6"	1,360 DFU	576 DFU	1,360 DFU
8"	3,600 DFU	2,112 DFU	3,600 DFU

NO.	DATE	DESCRIPTION	REVISIONS




SHEET NOTES (X)

- 1.

ABBREVIATION LEGEND:

LV = LAVATORY	(1 DFU)
BT = BATHTUB	(2 DFU)
SH = SHOWER	(2 DFU)
KS = KITCHEN SINK WITH DISHWASHER	(2 DFU)
WB = WASHER BOX	(3 DFU)
WC = WATER CLOSET	(3 DFU)
FD = FLOOR DRAIN	(2 DFU)
FS = FLOOR SINK	(4 DFU)
HD = HUB DRAIN	(8 DFU)

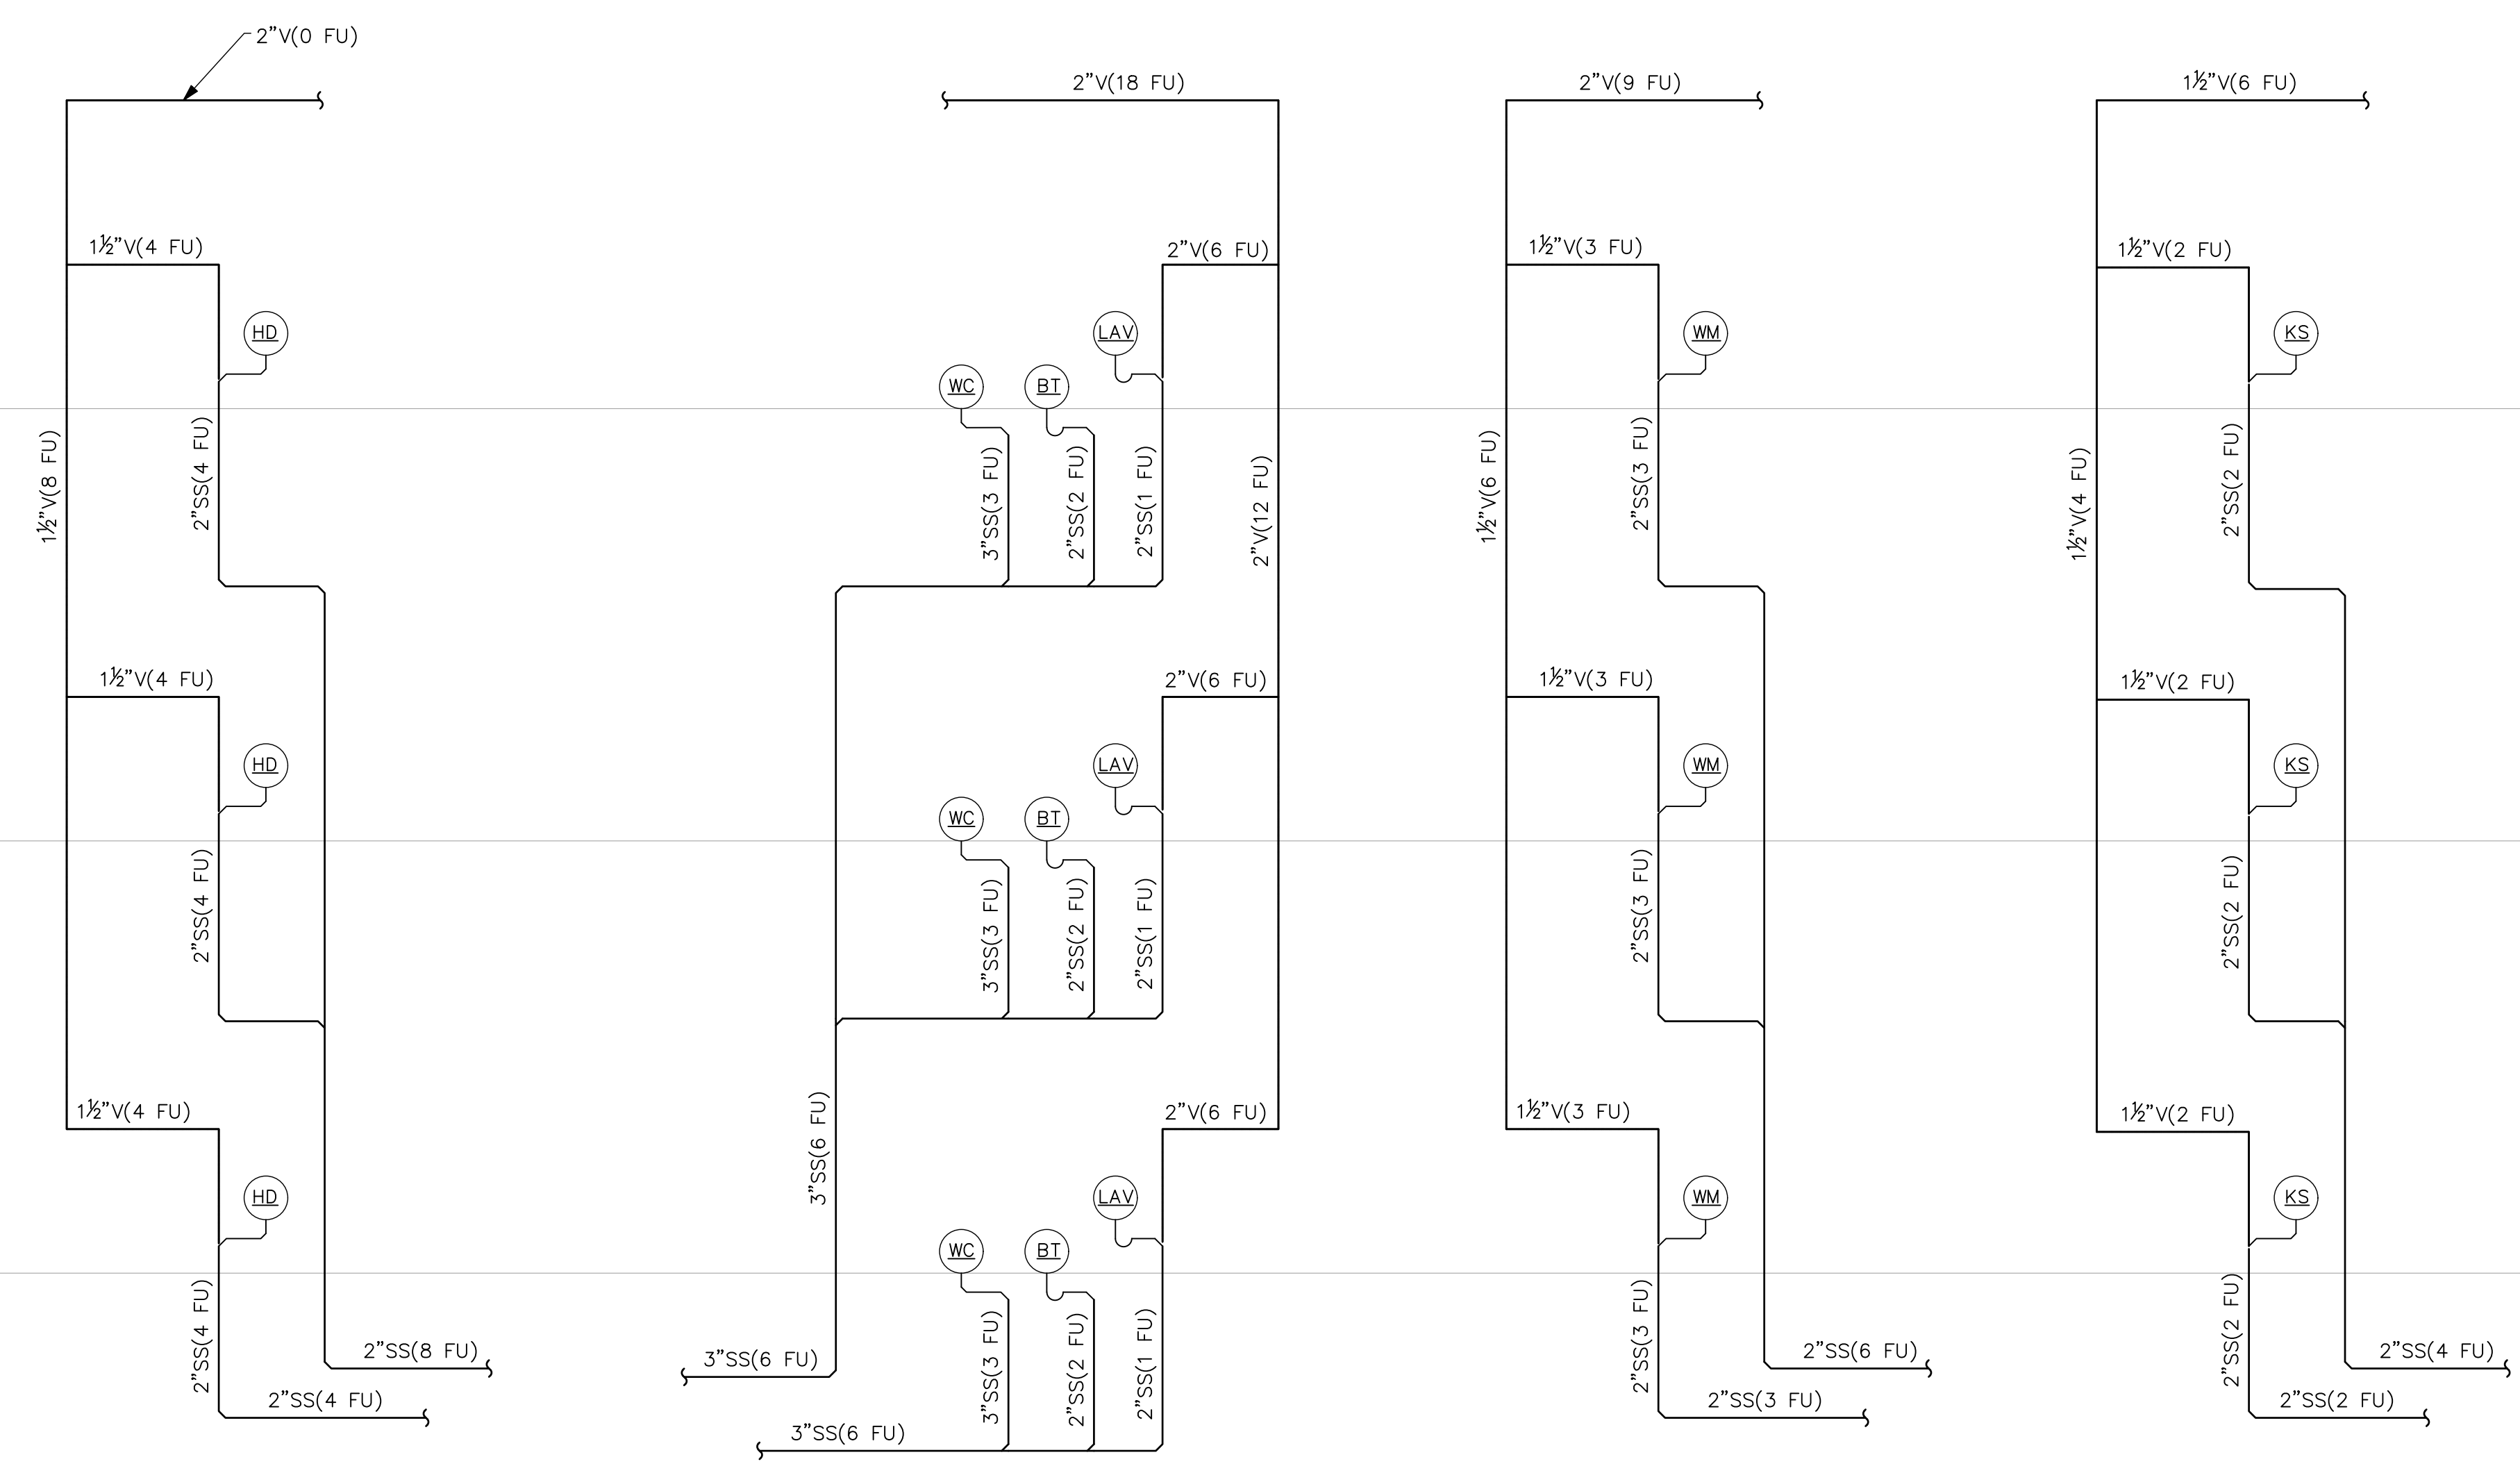

ROOF

LEVEL 3

LEVEL 2

LEVEL 1

BASEMENT

DRAWN:	JM
DESIGNED:	JM
CHECKED:	RJ
APPROVED:	JR

PROJECT: BRADLEY HEIGHT APARTMENTS - BUILDING H  
 202 27TH AVE SE  
 PUYALLUP, WA 98374

19401 40TH AVE W, SUITE 302  
 LYNNWOOD, WA 98036  
 PHONE: 206/364-3343

**ROBISON**  
 ENGINEERING, INC

DATE: 09/05/2024

SHEET TITLE: WASTE & VENT RISER DIAGRAMS

SHEET NO. P4H.00

S  
2

S  
1



ROOF

LEVEL 3

LEVEL 2

LEVEL 1

UNDERSLAB

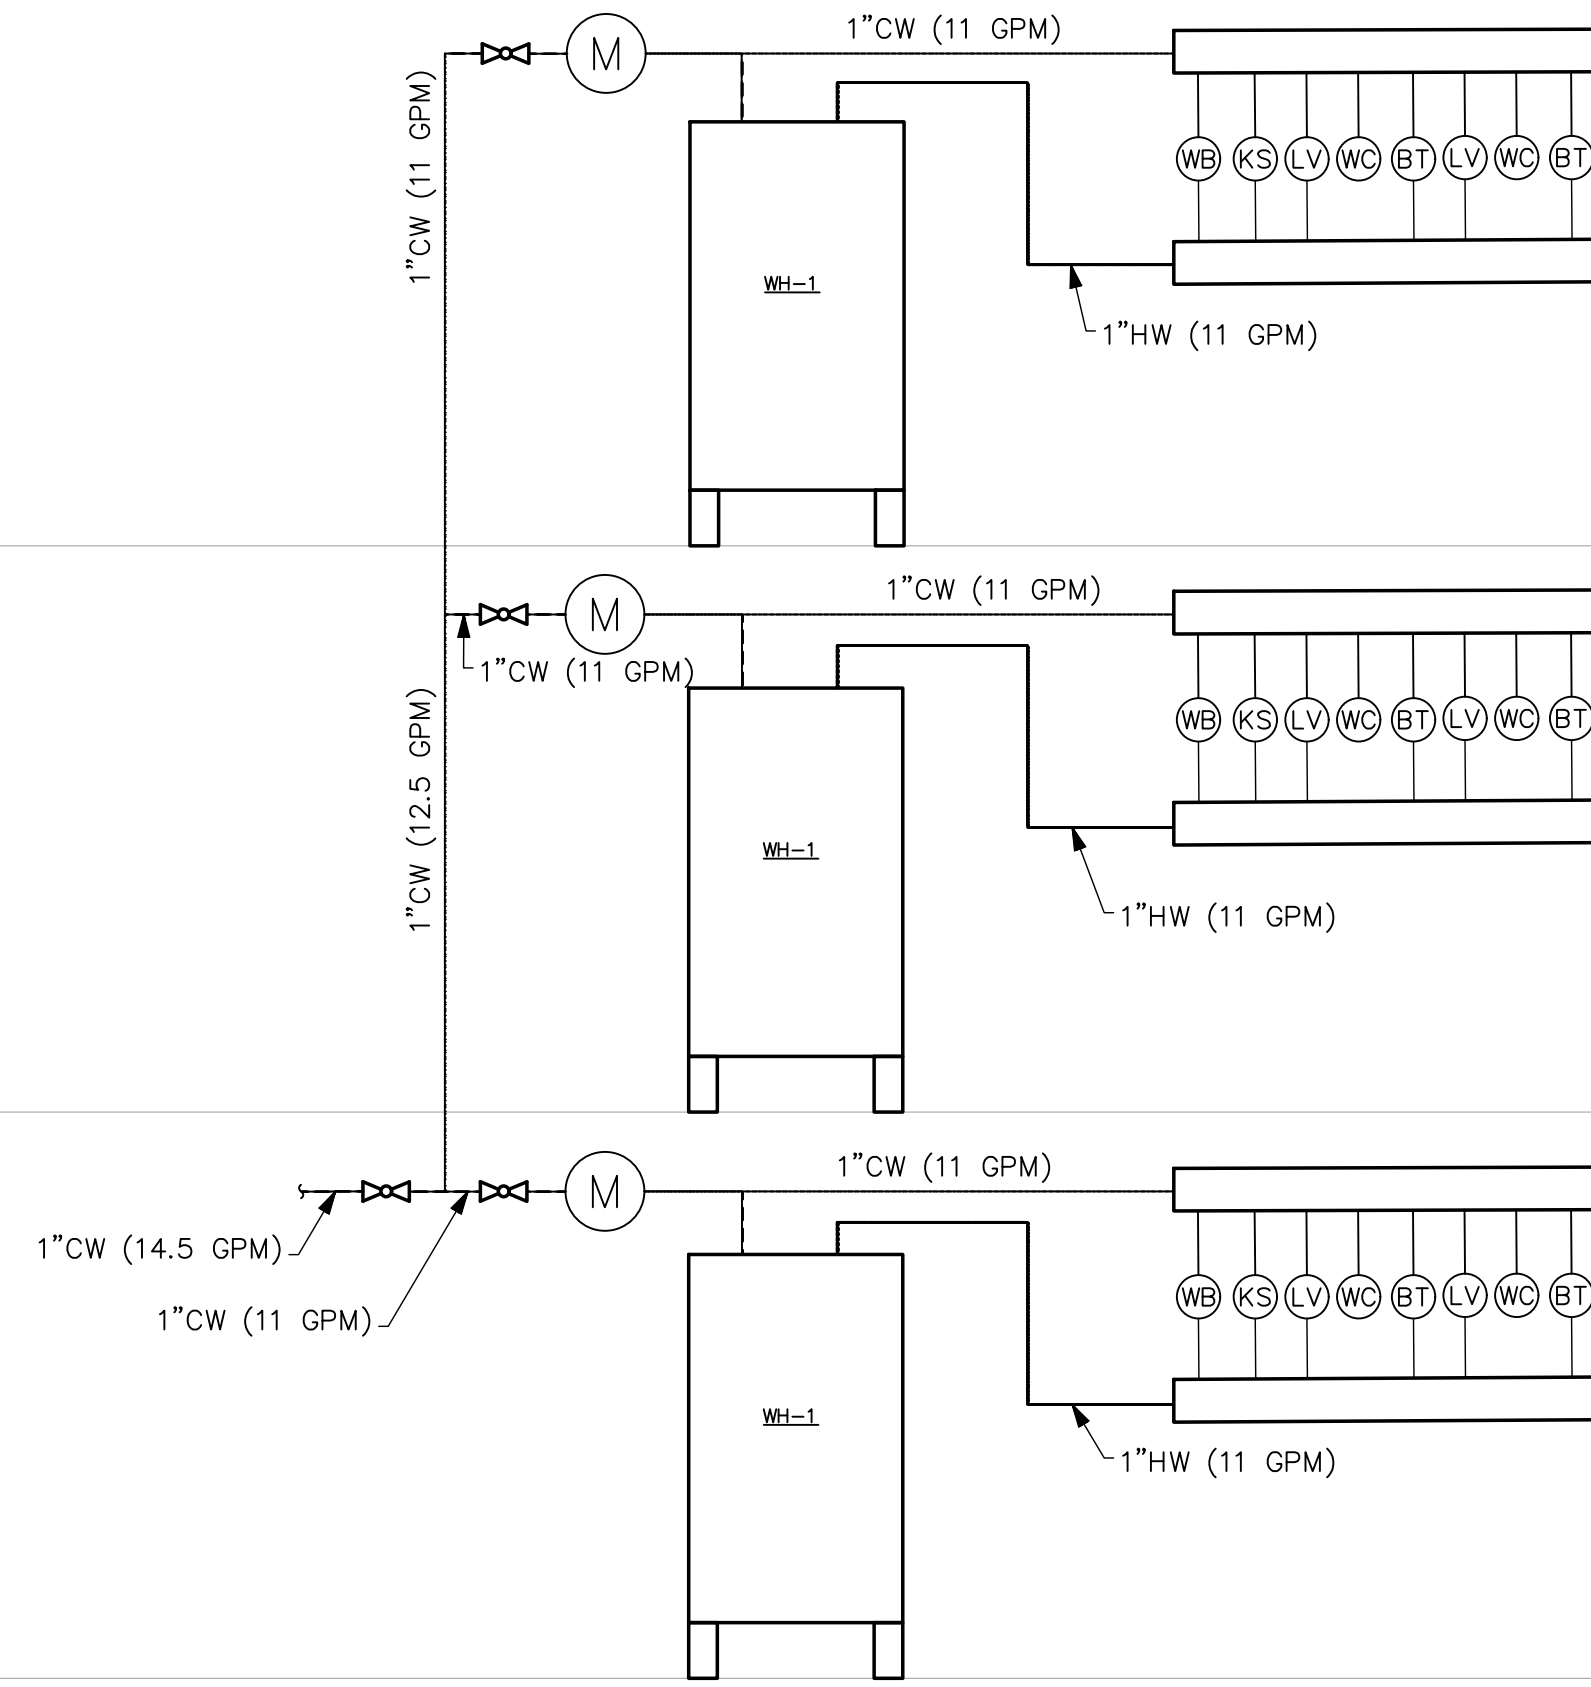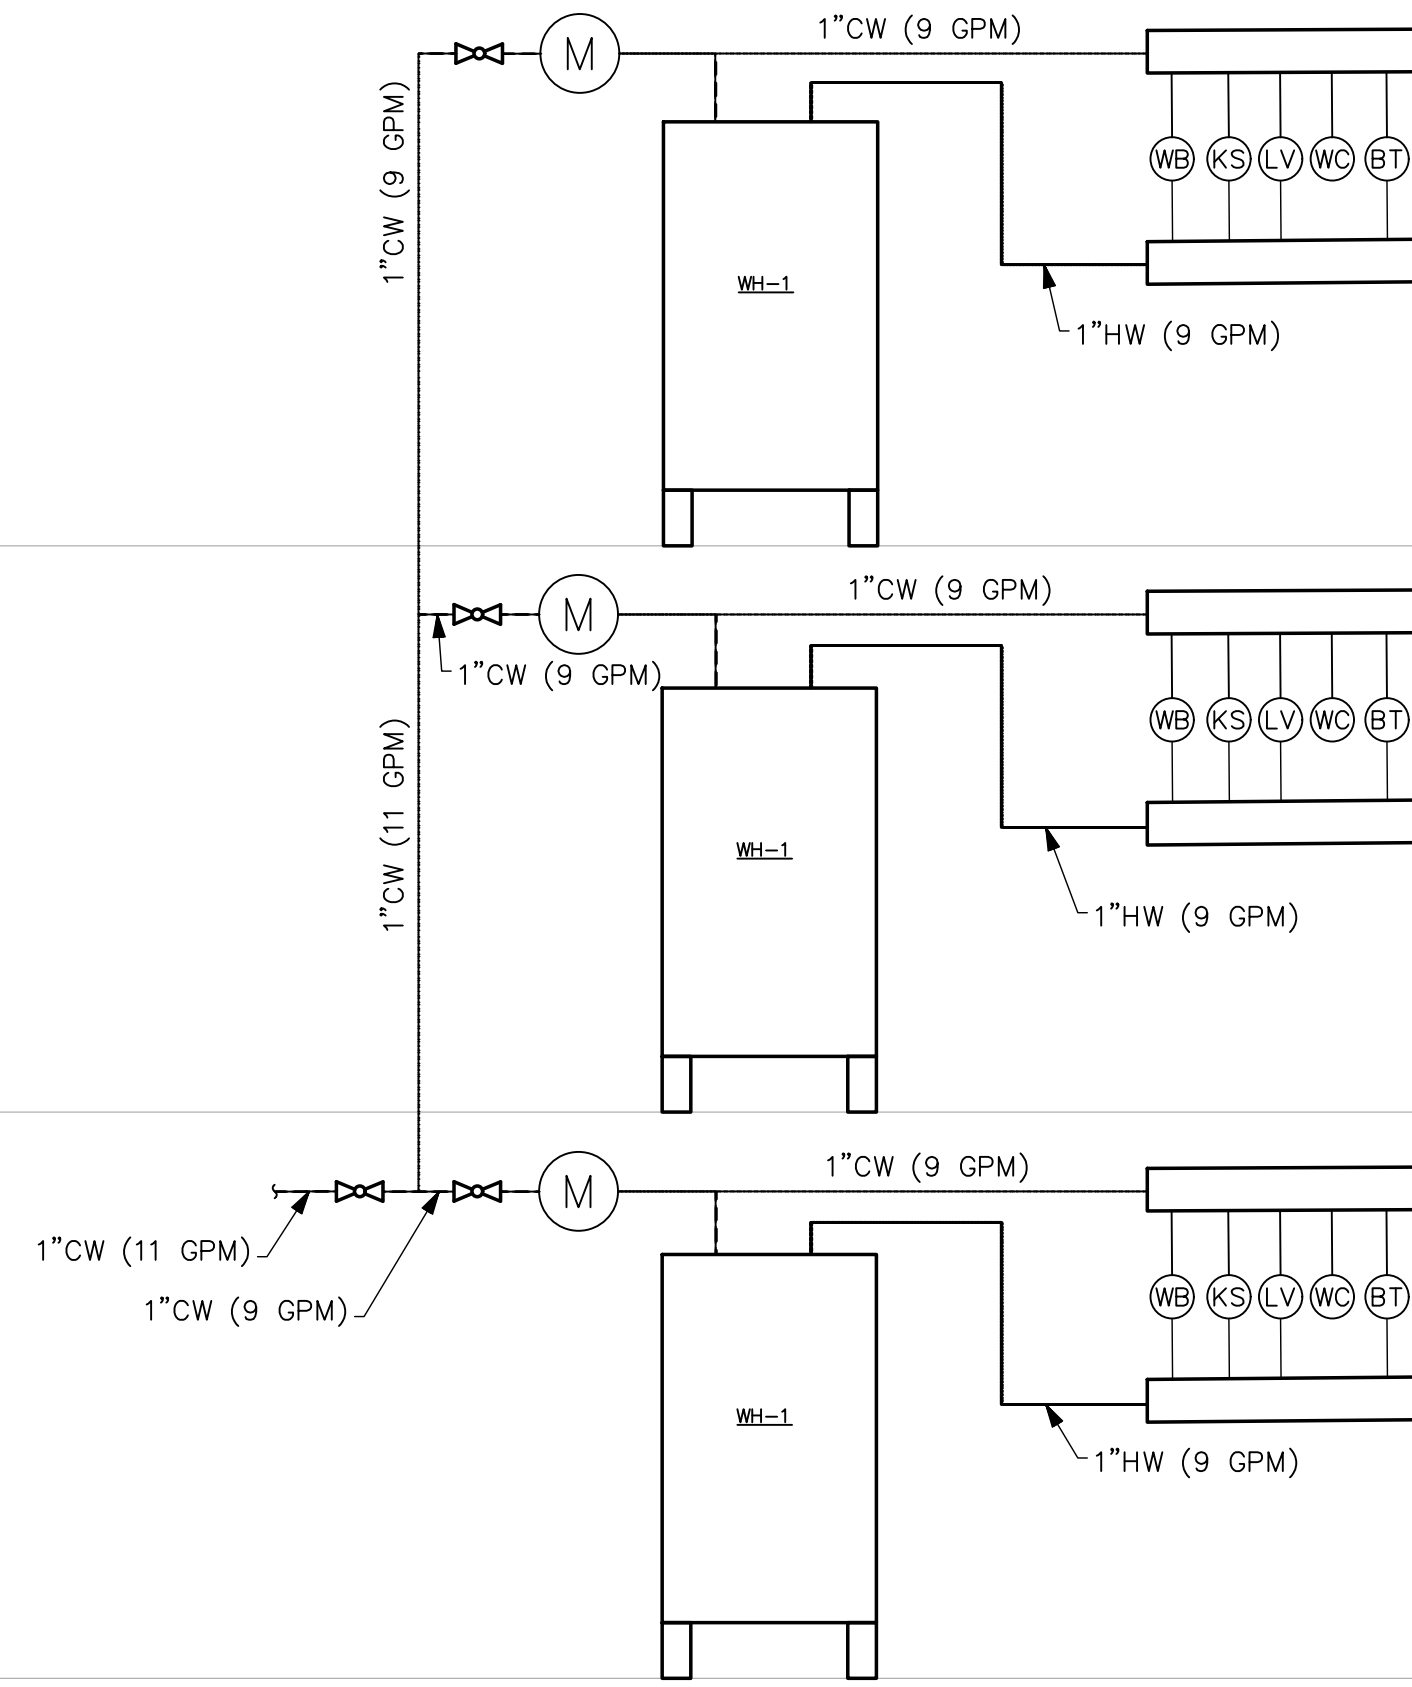

**GENERAL NOTES**

- ⊙  
# = SUPPLY RISER IDENTIFICATION (I.E. RISER "#"). REFER TO P5 SERIES FOR RISER DIAGRAMS.
1. PROVIDE TRAP PRIMERS FOR ALL FLOOR DRAINS AND HUB DRAINS PER 2021 UPC 1007.1. SEE DETAIL 5/P7.01
  2. WATER PIPES ARE SIZED PER THE WATER SUPPLY PRESSURE CALCULATION ON POB.02.


**ABBREVIATION LEGEND:**

LV = LAVATORY	(0.75 WSFU)
BT = BATHTUB	(4 WSFU)
SH = SHOWER	(2 WSFU)
KS = KITCHEN SINK WITH DISHWASHER	(3 WSFU)
WB = WASHER BOX	(4 WSFU)
WC = WATER CLOSET	(2.5 WSFU)

PIPE SIZE	COLD WATER, FLUSH TANK			HOT WATER		
	FIXTURE UNITS	FLOW, GPM	VELOCITY, FPS	FIXTURE UNITS	FLOW, GPM	VELOCITY, FPS
1/2"	1.9	2.9	5.3	3.4	3.4	6.2
3/4"	9.0	7.5	6.8	11.2	8.6	7.8
1"	21.2	14.7	8.1	20.9	14.6	8.0
1-1/4"	40.8	25.3	9.3	33.5	21.8	8.0
1-1/2"	76.3	37.9	10.0	53.3	30.3	8.0
2"	139.8	65.0	10.0	134.8	52.0	8.0
2-1/2"	369.5	98.9	10.0	270.6	79.1	8.0
3"	588.9	141.0	10.0	439.0	112.8	8.0

PIPE SIZE	COLD WATER, FLUSH TANK			HOT WATER		
	FIXTURE UNITS	FLOW, GPM	VELOCITY, FPS	FIXTURE UNITS	FLOW, GPM	VELOCITY, FPS
1/2"	0.8	1.8	2.4	1.0	2.0	2.8
3/4"	5.5	4.7	3.1	6.5	5.5	3.6
1"	12.8	9.8	3.8	15.2	11.2	4.4
1-1/4"	25.5	17.3	4.4	23.3	19.6	5.0
1-1/2"	46.6	27.7	5.0	46.8	27.7	5.0
2"	166.0	58.2	6.0	116.9	48.2	5.0
2-1/2"	395.0	104.0	7.0	246.9	74.4	5.0
3"	735.1	167.3	7.9	405.8	106.2	5.0
4"	1782.4	303.2	8.0	872.0	189.5	5.0
6"	6381.3	669.1	8.0	2847.0	418.2	5.0

NO.	DATE	DESCRIPTION	REVISIONS

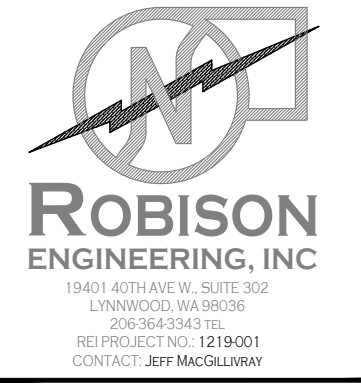

DRAWN:	JM	DESIGNED:	JM	CHECKED:	RJ	APPROVED:	JR
--------	----	-----------	----	----------	----	-----------	----

PROJECT: BRADLEY HEIGHT APARTMENTS - BUILDING H  
202 27TH AVE SE  
PUYALLUP, WA 98374


19401 40TH AVE W, SUITE 302  
LYNNWOOD, WA 98036  
PHONE: 2063643343

**ROBISON ENGINEERING, INC.**


DATE: 09/05/2024

SHEET TITLE: SUPPLY RISER DIAGRAMS


SHEET NO. P5.00H

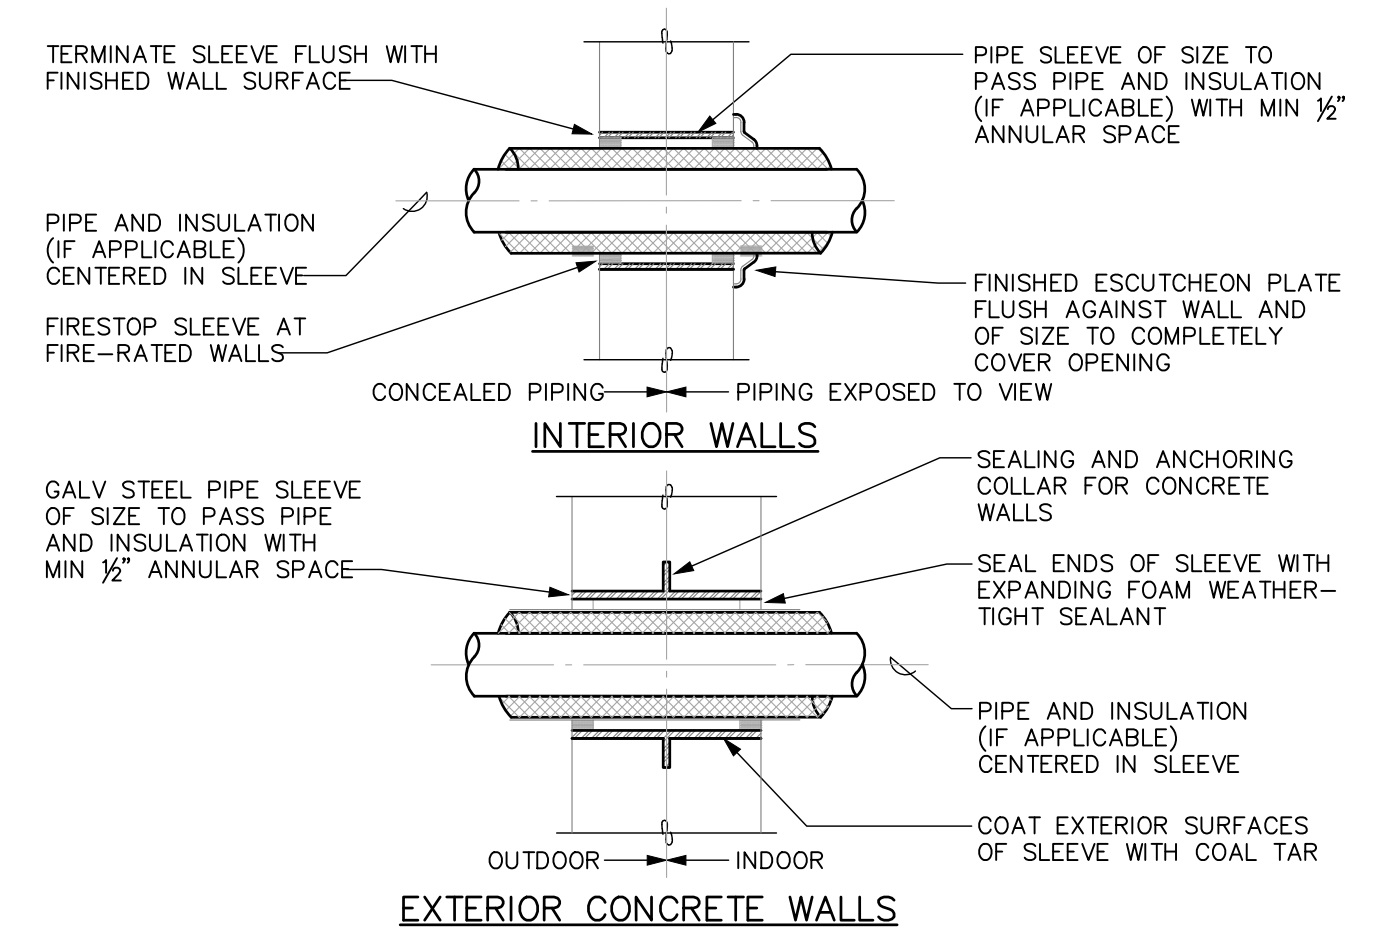


**PIPE SLEEVES THROUGH WALLS**  
SCALE: NONE

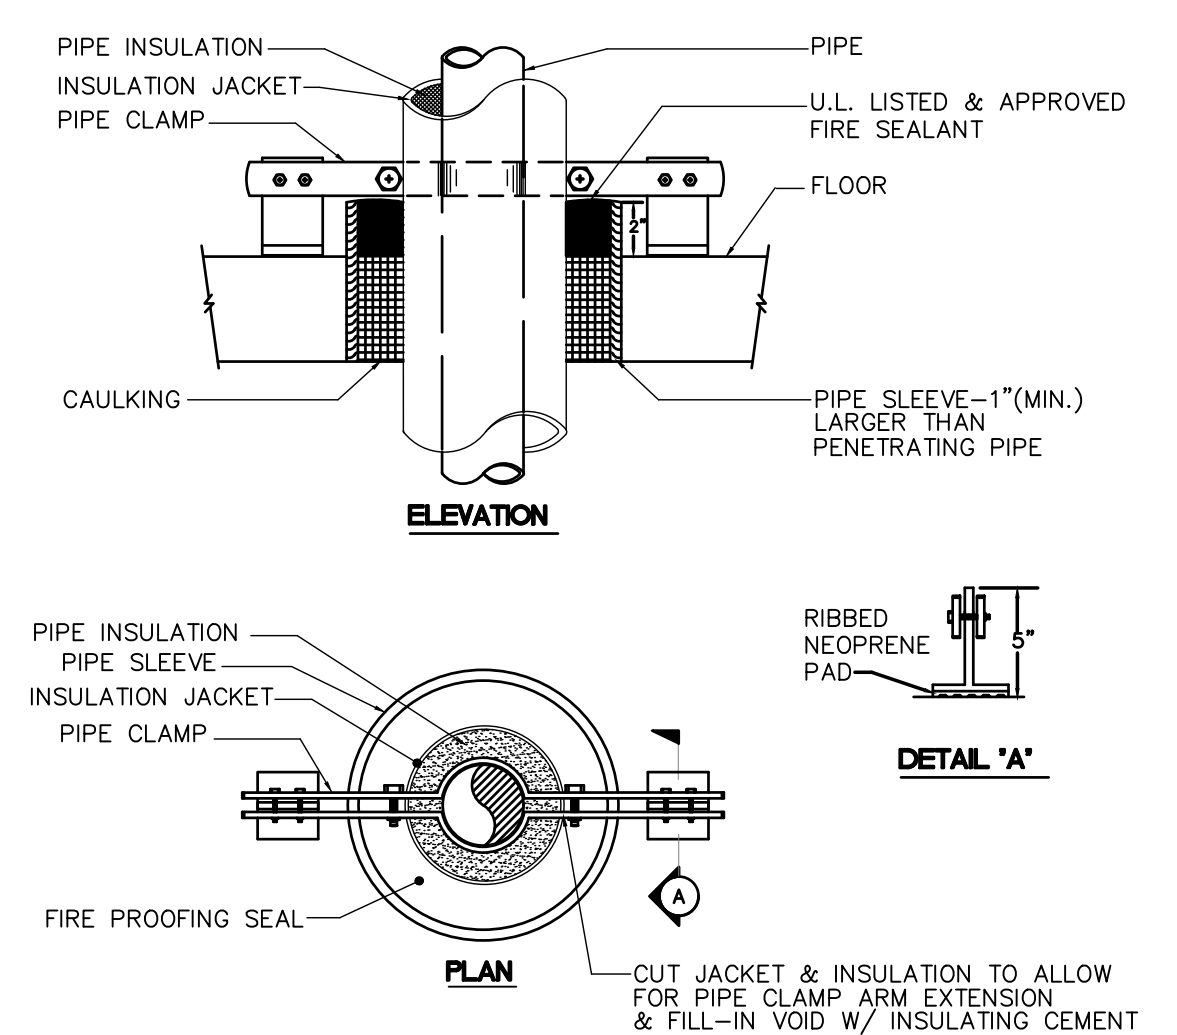


**RISER PIPE SUPPORT**  
SCALE: NONE

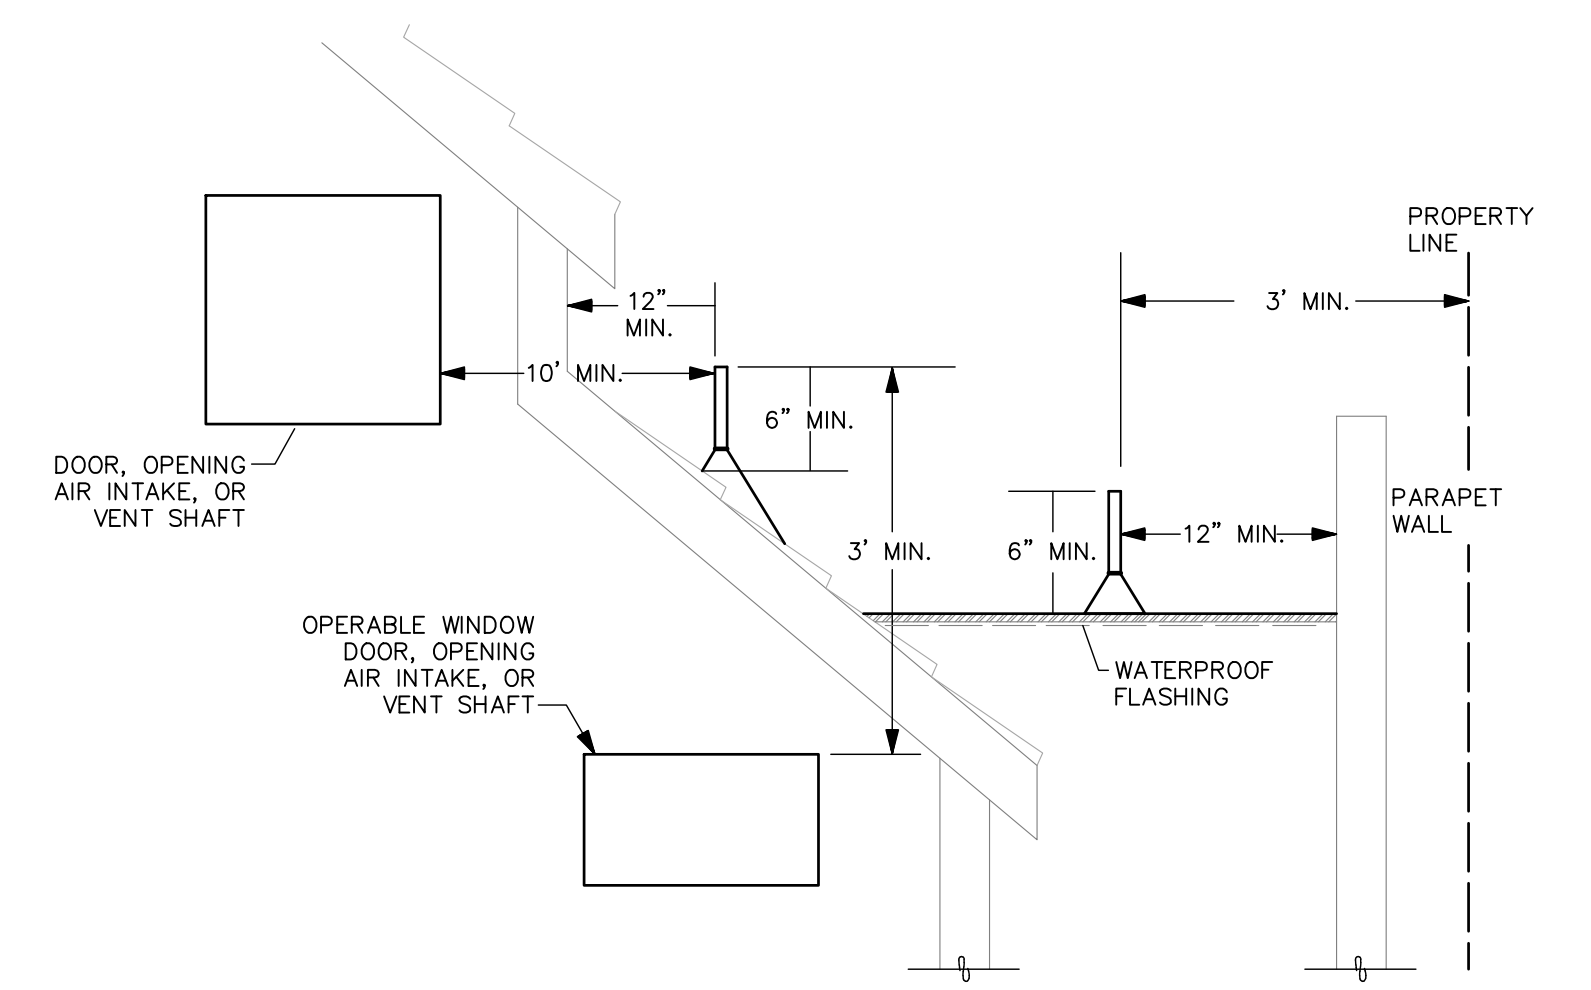


**VENT TERMINATION CLEARANCE**  
SCALE: NONE

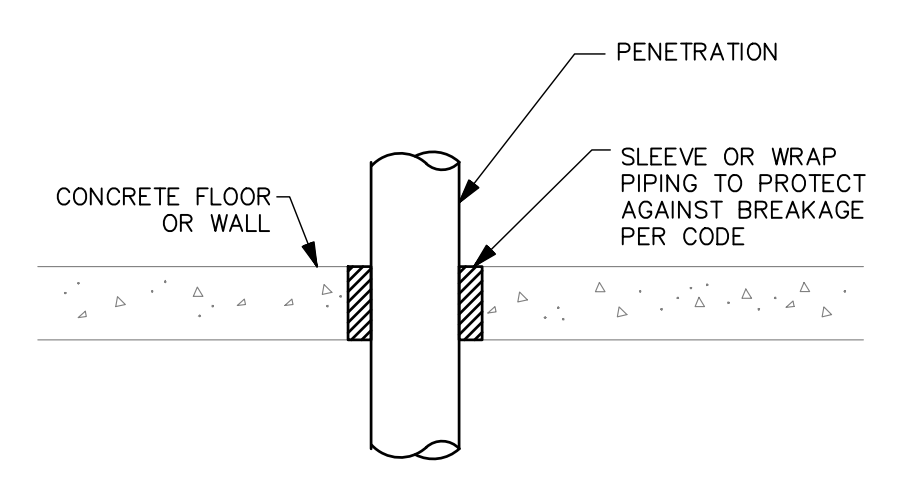

**PIPE SLAB PENETRATION**  
SCALE: NONE

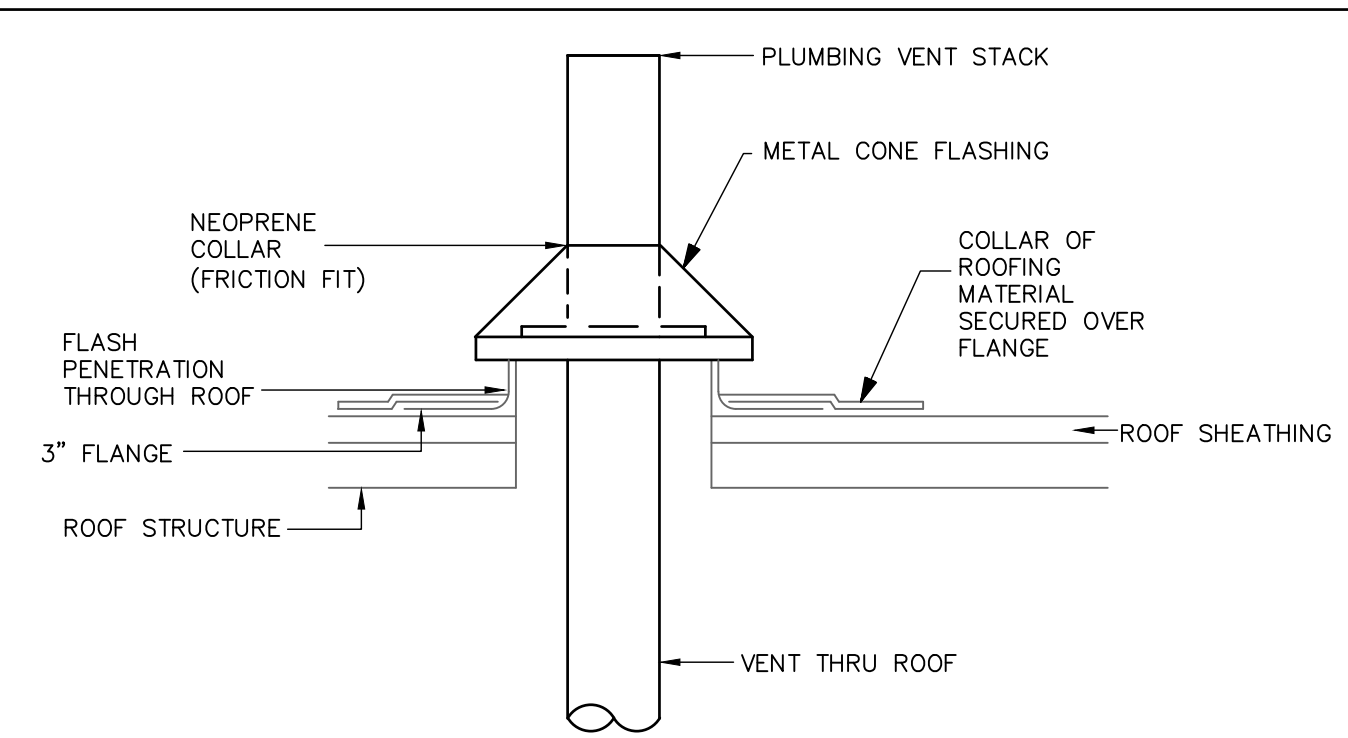

**VENT THROUGH ROOF**  
SCALE: NONE

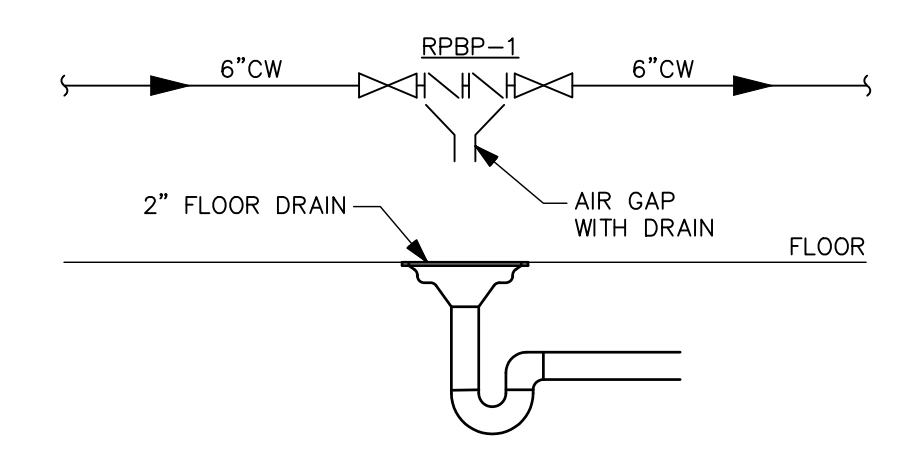


**REDUCED PRESSURE BACKFLOW PREVENTER**  
SCALE: NONE

**EQUIPMENT SCHEDULE**


- WATER METERS (NEXT CENTURY MULTI-JET WATER METER MODEL M201CH, 3/4").
- TRANSCIVER: WIRELESS METERING DATA TRANSCIVER DUAL INPUT WITH DISPLAY, WITH BATTERIES. TEHAMA WIRELESS MODEL TW-165A-PP.
- WIRELESS REPEATERS: TEHAMA COMPATIBLE REPEATERS; QUANTITY TWO. TEHAMA WIRELESS TW-191X.
- UDATA CONCENTRATING ACCESS POINT (DCAP): TEHAMA WIRELESS TW-203X-1-150.
  - DCAP TO BE INSTALLED ON MAIN COMM/DATA BOARD AND POWER SUPPLY PLUGGED INTO RECEPTACLE.
  - PROVIDE ETHERNET OR WIFI ACCESS FOR INTERNET ACCESS TO DCAP.

**NOTES:**

- PROVIDE COLD WATER METER AND REMOTE TRANSCIVER FOR EACH APARTMENT.
- SECURE METER TO FLOOR/CEILING ASSEMBLY.
- REFER TO P5 SERIES FOR PIPE SIZES.
- TRANSITION TO PEX PIPING WITHIN EACH UNIT.

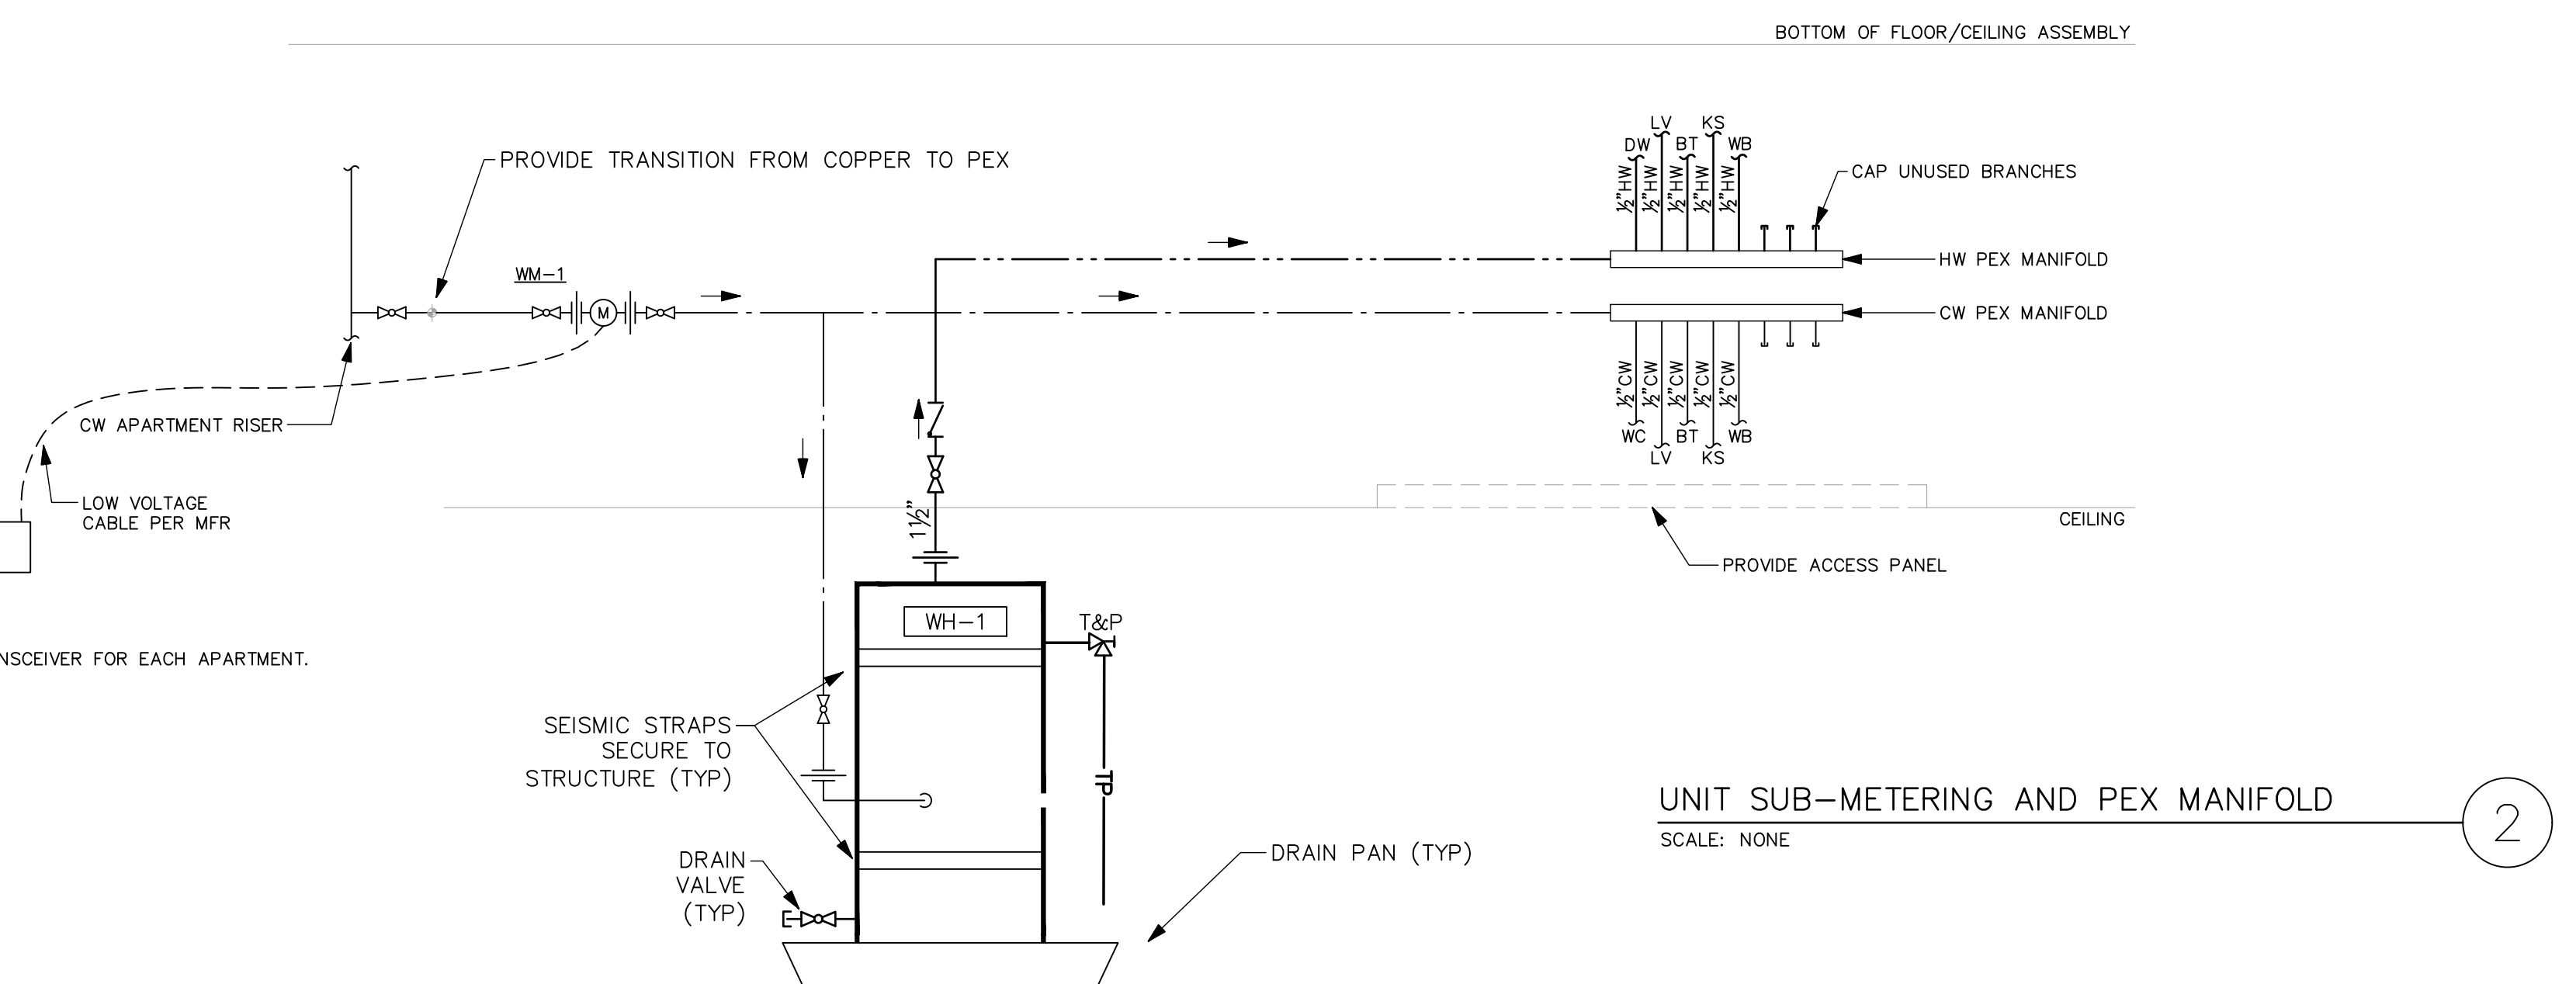

**UNIT SUB-METERING AND PEX MANIFOLD**  
SCALE: NONE

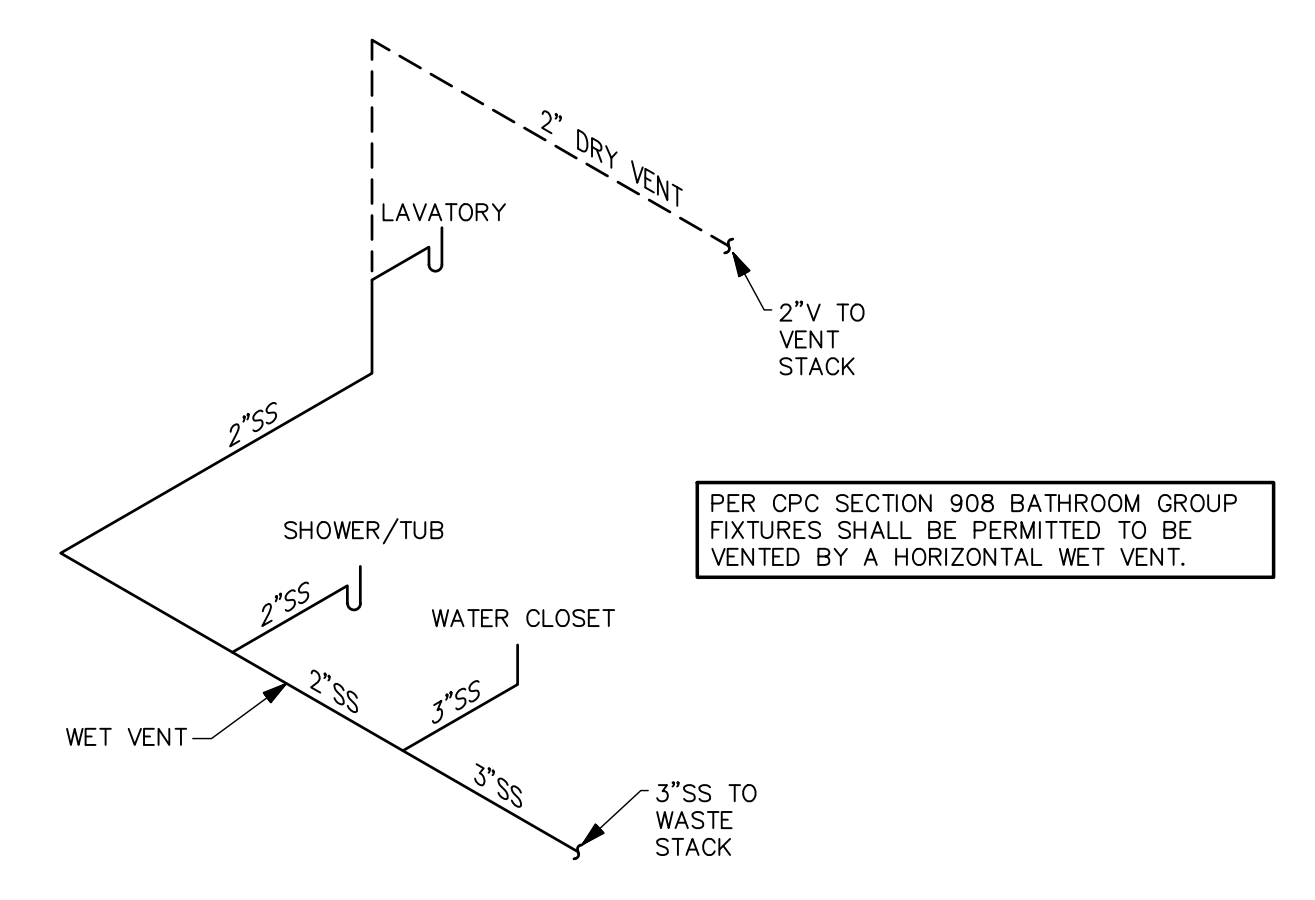

**HORIZONTAL WET VENTING**  
SCALE: NONE

NO.	DATE	DESCRIPTION	REVISIONS

**ROBISON ENGINEERING, INC.**  
 19401 40TH AVE W, SUITE 302  
 LYNNWOOD, WA 98036  
 206.843.8476  
 REPRODUCTION OF THIS DRAWING WITHOUT THE WRITTEN PERMISSION OF ROBISON ENGINEERING, INC. IS STRICTLY PROHIBITED.  
 CONTACT: JAY MAGUIRANE


DRAWN:	JM
DESIGNED:	JM
CHECKED:	RJ
APPROVED:	JR

**BRADLEY HEIGHT APARTMENTS - BUILDING H**  
 PROJECT: 202 27TH AVE SE  
 PUYALLUP, WA 98374  
 19401 40TH AVE W, SUITE 302  
 LYNNWOOD, WA 98036  
 PHONE: 206.843.8476  
**ROBISON ENGINEERING, INC.**

DATE: 09/05/2024


SHEET TITLE:  
**DETAILS**

SHEET NO.  
**P7H.00**

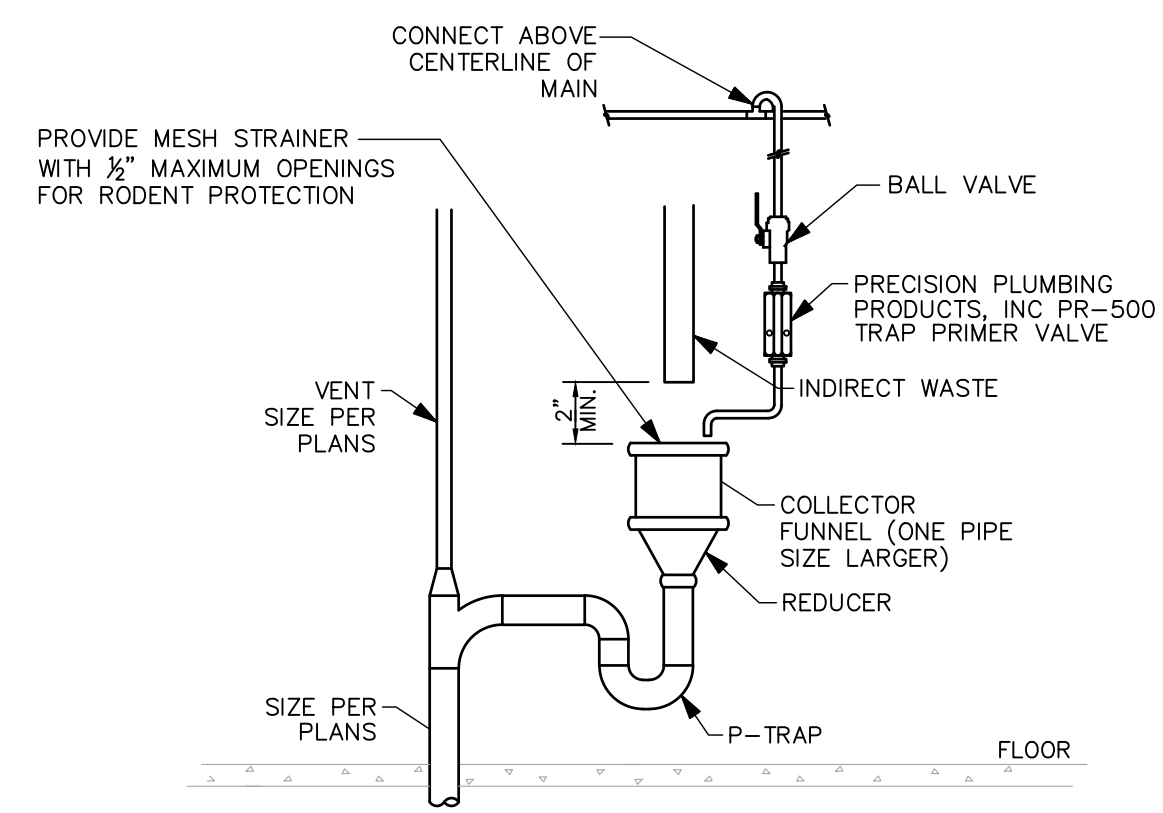


HUB DRAIN  
SCALE: NONE

6

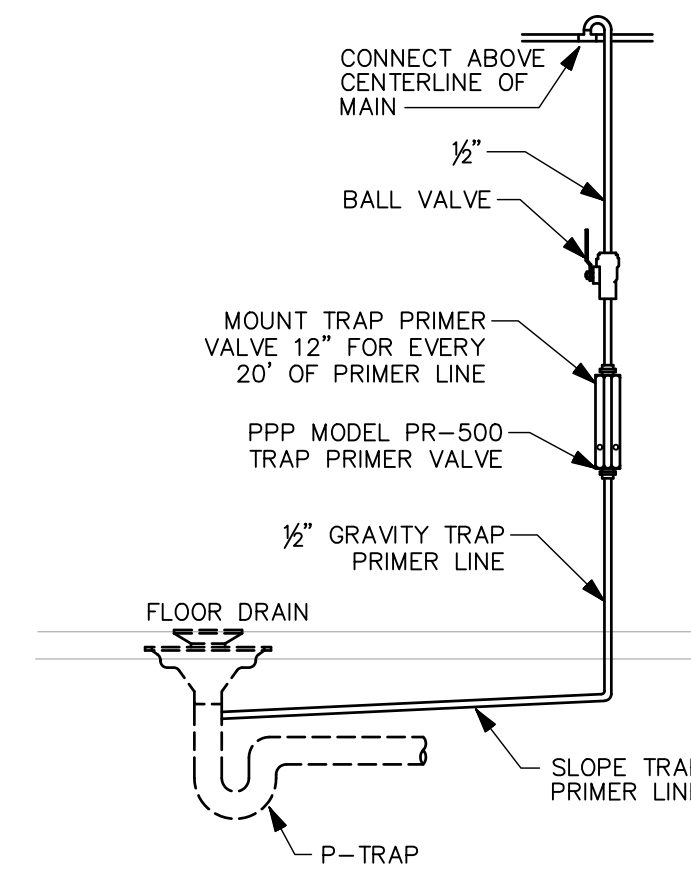


TRAP PRIMER  
SCALE: NONE

5

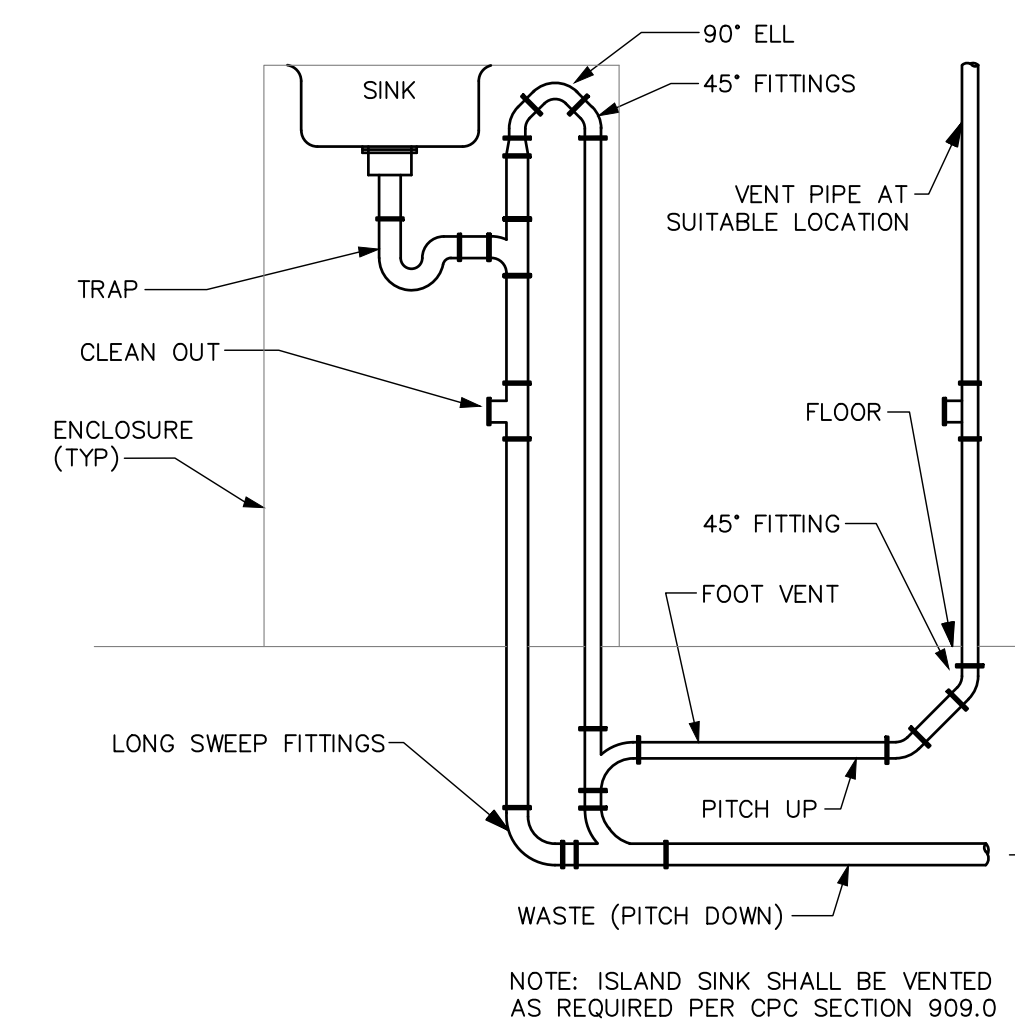


ISLAND SINK INSTALLATION  
SCALE: NONE

4

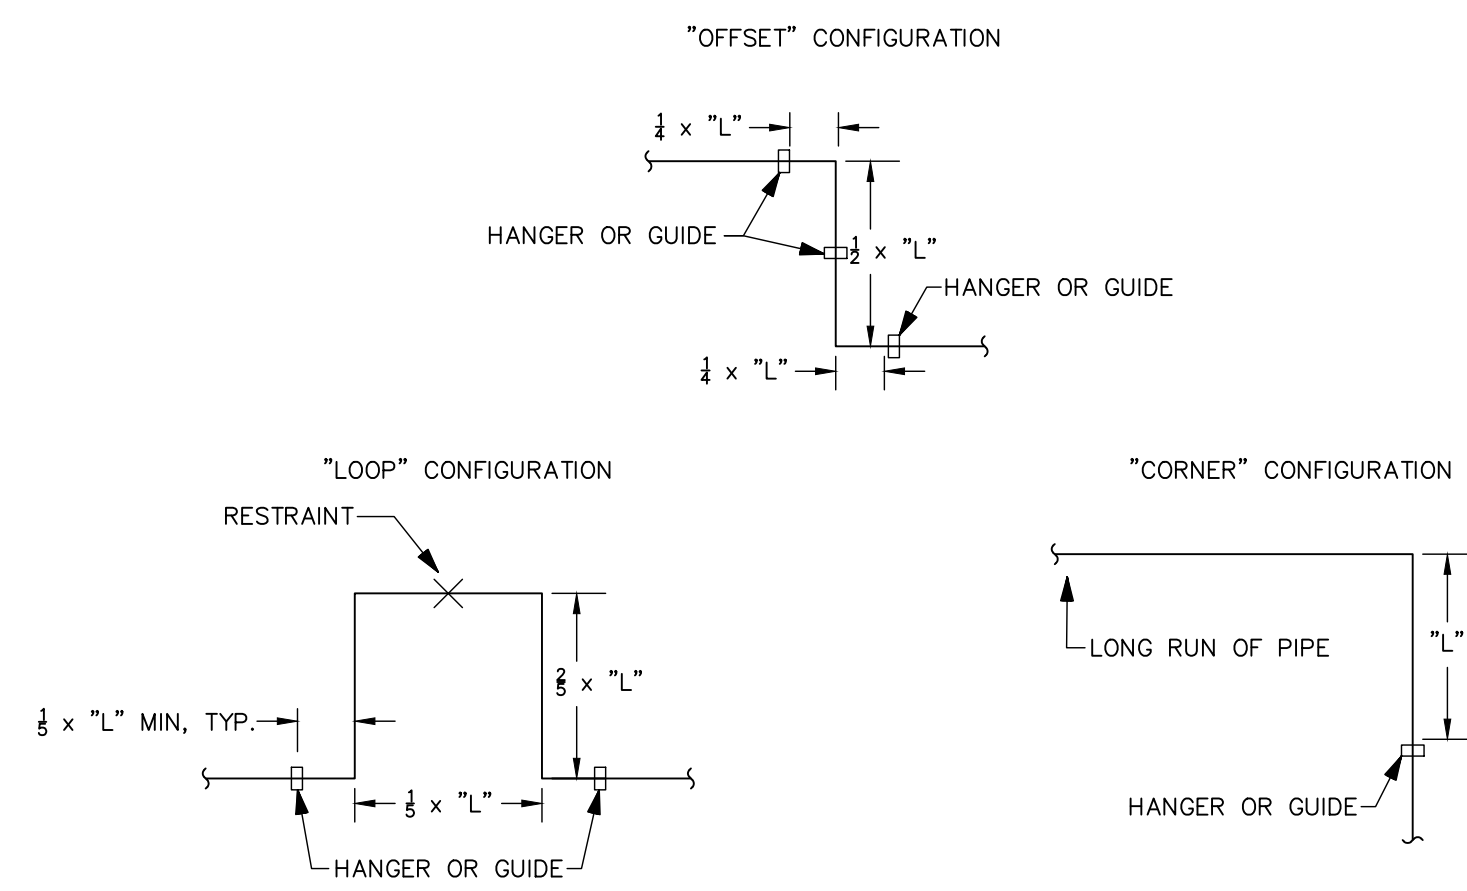


EXPANSION LOOP CONFIGURATIONS  
SCALE: NONE

3

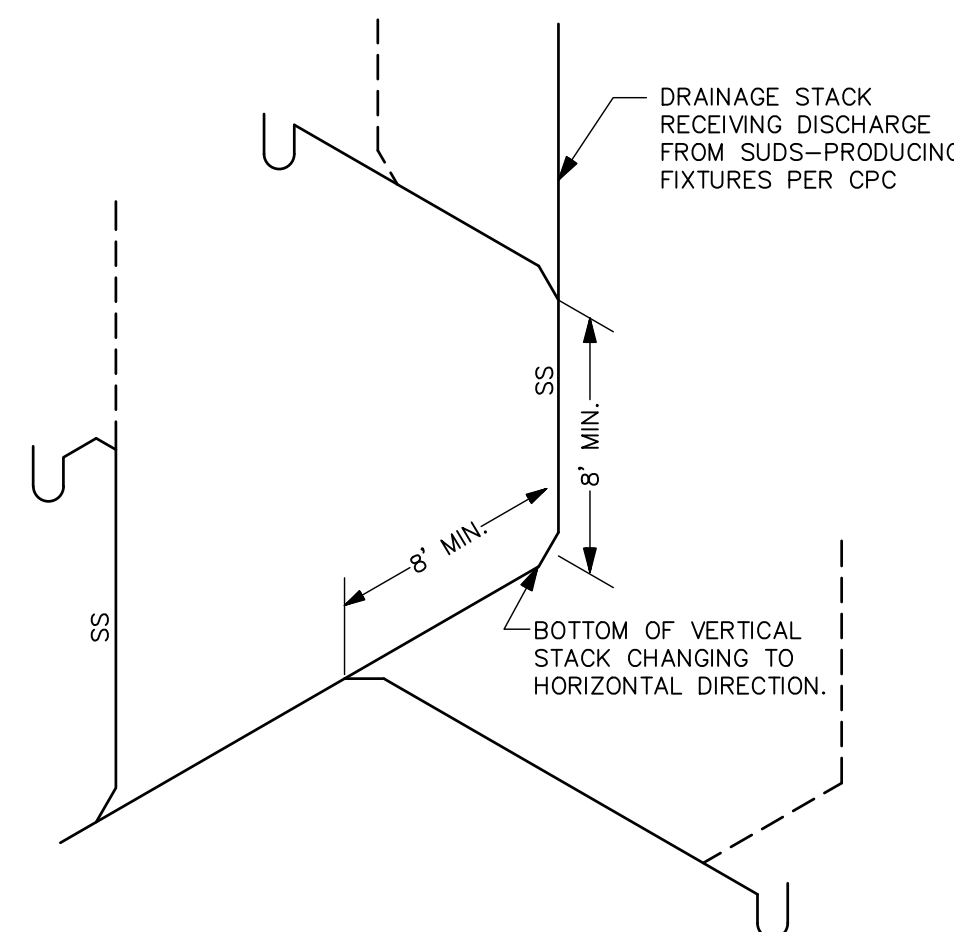

SUDS RELIEF  
SCALE: NONE


2

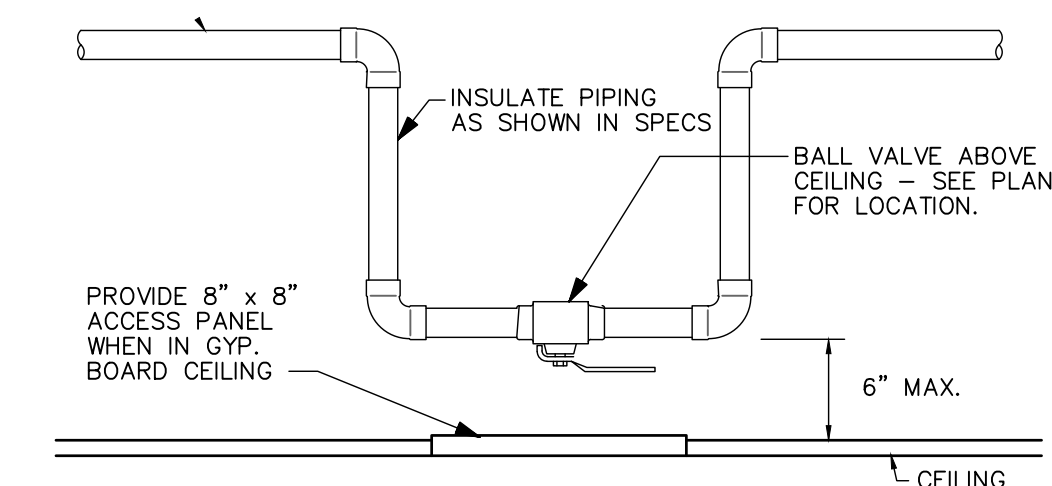

TYPICAL VALVE PLACEMENT  
SCALE: NONE

1

NO.	DATE	DESCRIPTION	REVISIONS

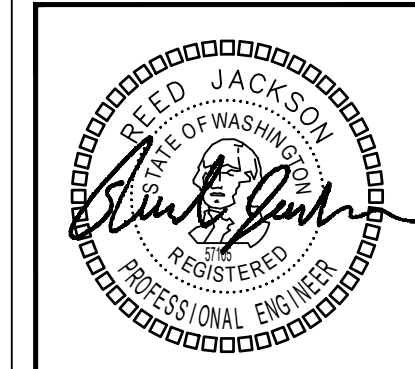

DRAWN:	JM	DESIGNED:	JM	CHECKED:	RJ	APPROVED:	JR
--------	----	-----------	----	----------	----	-----------	----

PROJECT: BRADLEY HEIGHT APARTMENTS - BUILDING H  
202 27TH AVE SE  
PUYALLUP, WA 98374

19401 40TH AVE W, SUITE 302  
LYNNWOOD, WA 98036  
PHONE: 2063643343

**ROBISON**  
ENGINEERING, INC.

DATE: 09/05/2024

SHEET TITLE:  
**DETAILS**

SHEET NO.  
**P7H.01**