

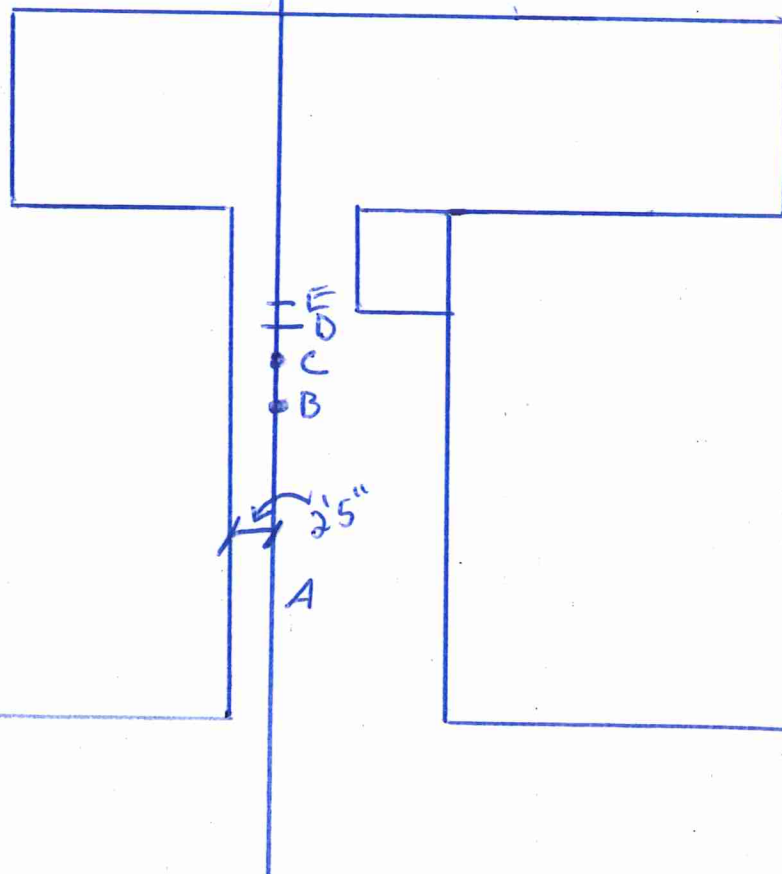
Residential Sewer Service As-built

East side of building

Service Address: 2902 Pioneer Way E Puyallup, WA 98375Subdivision: East Town Crossing Lot #: D EastPermit No.: PRMU20240401 Contractor: Rick the Plumber & Co.Pipe Type: PVC / ABS Pipe Size: 6"/4" No. of cleanouts: 2Approved by: Jason Little, Eng Insp Date: 4.23.25

Inspector comments: _____

- Point A is the 6" PVC main 4'2" below dirt grade.
- Point B is the first cleanout.
- Point C is the second cleanout.
- Between point C and D is a 6" PVC pipe 7" long.
- Point D is the 6"x4" eccentric fitting.
- Between point D and E is a 4" PVC pipe 6" long.
- Point E is the 4" PVC x 4" ABS adapter.

N
↓

PRMU20240401 Building "D" west

Residential Sewer Service As-built *west side of Building*

Service Address: 2402 Pioneer Way E Puyallup, WA 98375

Subdivision: East Town Crossing Lot #: D west

Permit No.: PRMU20240401 Contractor: Rick the Plumber & Co.

Pipe Type: PVC/ABS Pipe Size: 6"/4" No. of cleanouts: 2

Approved by: Jason Little, Eng Insp Date: 4.23.25

Inspector comments: _____

- POINT A IS THE 6" PVL MAIN 4' 4" BELOW DIRT GRADE
- POINT B IS THE FIRST CLEAN OUT
- POINT C IS THE SECOND CLEAN OUT
- POINT D IS THE 6" X 4" ECCENTRIC FITTING
- BETWEEN POINT D AND E IS A 4" PVL PIPE 6" LONG
- POINT E IS THE 4" PVL X 4" ABS ADAPTER

