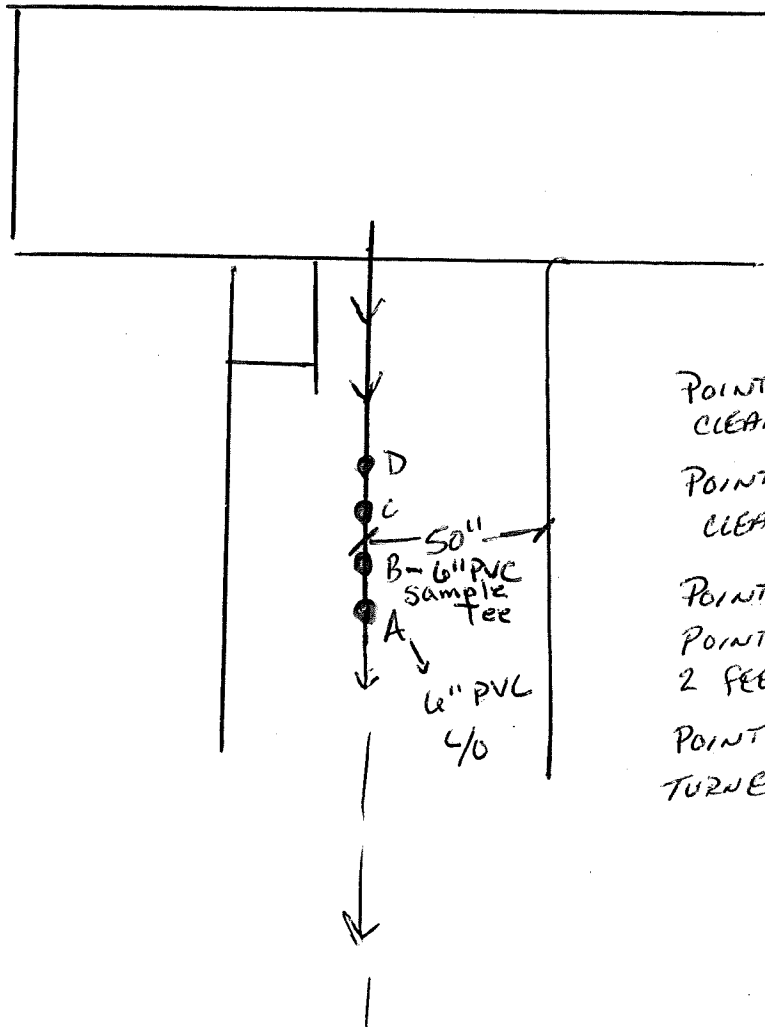


Residential Sewer Service As-built

Service Address: 2902 PIONEER WAY RYALLUP, WA 98375Subdivision: EAST TOWN CROSSING Lot #: EPermit No. PRMU20240402 Contractor: Rick The Plumber, Inc.Pipe Type: ABS Pipe Size: 4 No. of cleanouts: 2Approved by: Jason Little, Eng Insp Date: 4.28.25

Inspector comments: _____

WEST SIDE

N
↓POINT A - 1ST SEWER
CLEAN OUTPOINT B 2ND SEWER
CLEAN OUTPOINT C 1ST 45°
POINT UP TRAVELING
2 FEETPOINT D 2ND 45°
TURNED HORIZONTAL

Residential Sewer Service As-built

Service Address: 2902 PIONEER WAY RYALUP, WA 98375Subdivision: EAST TOWN CROSSING Lot #: EPermit No.: PRMU20240402 Contractor: Rick The Plumber Inc.Pipe Type: ABS ~~PRMU20240402~~ Pipe Size: 4" No. of cleanouts: 2Approved by: Jason Little, Eng Insp Date: 4-28-25

Inspector comments: _____

EAST SIDE

