

Bradley Heights Apartments

A 236-Unit Apartment Development

Puyallup, Washington

Bradley Heights SS LLC

City of Puyallup
Development Services
Building, Planning
Engineering, Public Works
Fire, Traffic

PROJECT TEAM

Owner/Developer	Bradley Heights SS LLC 614 Boylston Ave E Seattle, WA 98102 (206) 557-7236
Architect:	Milbrandt Architects, Inc., P.S. 25 Central Way, Suite 210 Kirkland, WA 98033 (425) 454-7130
Structural Engineer	Solutions 4 Structure, Inc. 11605 135th St Ct E Puyallup, WA 98374 (253) 268-2923
Civil Engineer	Azure Green Consultants 409 East Pioneer Puyallup, WA 98372 (253) 770-3144
Landscape Architect	Nature By Design 1320 Alameda Avenue, Suite B Firecrest, WA 98466 (253) 460-6067
MEP Engineer	Robison Engineering Inc. 19401 40th Avenue W, Suite 302 Lynnwood, WA 98036 (206) 364-3343

PROJECT INFORMATION

Site Address: 206 27th Ave SE, Puyallup, WA 98374

Project Description: Construction of 236 wood framed apartment units in eight stacked flat buildings along with a leasing amenity building.

Site Area: 7.785 acres (+/- 339,107 SQ. FT.)

Tax Parcel Number: 1 419036006

Occupancy Type: All Apartment Buildings are R2 occupancy.

Type of Construction: All Apartment Buildings are Type V-B construction with NFPA 13R automatic sprinklers.

Applicable Codes: 2018 International Building Code
2018 Uniform Plumbing Code
2018 Washington State Energy Code
2018 International Mechanical code
2018 International Fire Code
2022 National Electrical Code
ICC/ANSI A117.1-2009 Standard
Washington State Amendments as modified and adopted by the local jurisdiction.

RATED ASSEMBLIES

Rated assemblies shall be provided in accordance with IBC section 420

Assembly	Fire Rating	Detail
Common walls separating dwelling units:	1-hour	4/D1
Exterior walls:	non-rated	1/D1
Interior bearing walls:	non-rated	2/D1
Interior non-bearing walls:	non-rated	2/D1
Corridor-to-unit walls:	1-hour	3/D1
Floor/ceiling:	1-hour	13/D1
Roof/ceiling:	1-hour	17/D1
Penetrations (firestopping)	Per situation	17/D8 D9
Stair fire barrier wall:	1-hour @ 3-story 2-hour @ 4-story	3/D1 7/D1

Fire Alarm systems and smoke alarms shall be provided in accordance with IBC section 420.5
Refer to unit plan sheets for smoke detector locations and requirements.

GENERAL NOTES

1. Comply with 2018 IBC and all applicable codes and ordinances of the local jurisdiction and the State of Washington.
2. Do not scale drawings.
3. Verify all rough-in dimensions for equipment provided in this contract or by others.
4. All rough-ins shall be approved and fireblocking shall be installed prior to framing inspection.
5. Verify size and location of and provide all openings through floors and walls, furring, anchors, inserts, rough bucks and backing for surface mounted items.
6. Provide furring as required to conceal mechanical and electrical work in all finished areas.
7. All swinging doors not located by dimensions on plans, interior elevations, or details shall be 3" from face of stud to edge of rough openings or centered between room partitions as shown.
8. Plans are drawn assuming the following rough openings:
Swinging doors: Nominal size +2".
Bi-Fold doors: Nominal size +1-1/2".
Bi-Pass doors: Nominal size +0".
Windows: Nominal size +0".
Sliding glass doors: Nominal size +0".
9. Fill where required with earth free from organic material. Compact fill in 12" layers maximum.
10. "Finish Floor" refers to the top of concrete slab or top of wood floor sheathing.
11. Exterior walls shall be 2x6 studs at 16" o.c. and interior walls shall be 2x4 studs at 16", unless noted otherwise.
12. Unless otherwise noted, plan dimensions are to face of studs and face of concrete walls.
13. Refer to interior elevations for cabinet and counter lengths, dimensions, countertop materials and detail reference. Verify all existing dimensions before installation.
14. Provide caulkng between sole plates and subfloor and between rim joists at both top plate and subfloor.
15. Hydrants shall be in service prior to start of framing.
16. Through penetrations and membrane penetrations of rated wall or floor/ceiling assembly will require firestopping per 2018 IBC Section 714. See detail sheets for diagram of specifics.
17. Shall be no asbestos used on this project.
18. All Tub-Shower valves installed shall conform to UPC 408.3 & ASSE 1016 or ASME A112.18.1
19. Milbrandt Architects is not responsible for construction means, methods, techniques or procedures, or for the safety precautions and programs in connection with the work, and is not responsible for the failure of any contractor or subcontractor to carry out the work in accordance with the various contract documents and or governing jurisdiction, regardless of what is shown on these drawings.

FEDERALLY DECLARED SAFE HARBOR

Declared Safe Harbor: HUD Fair Housing Accessibility Guidelines published on March 6, 1991 and the Supplemental Notice to Fair Housing Accessibility Guidelines: Questions and Answers about the Guidelines, published on June 28, 1994.

ACCESSIBILITY

Design is based on the 2018 IBC Chapter 11 which has been amended by the State of Washington, & 2009 ICC A117.1 Accessible & Usable Buildings & Facilities.

None of the buildings are an elevator type building.

There are a total of 84 one-story dwelling units at ground level. All ground floor units are 1 or 2-bed unit designs. Provided total 84 accessible units: 12 Type A and 72 Type B units.

Type A units meet the requirements for Type B units.

The 12 Type A units are proportioned as follows (see Site Plan):

- (7) 1-Bed units (1 BR) in each of Buildings A, C, D, E, F & G - for a total of 7.
- (5) 2-Bed units (2 BR) in Buildings A, D, E, F & G - for a total of 5.

PARKING:

Section 1106.2 IBC requires 2% of each proposed parking stall type to be accessible. Of the 354 total open stalls, 12 are accessible, including 5 van stalls. Each accessible open stall is indicated by the wheelchair symbol on the site plan and further designated by the detail symbols 10/A3.

VENTILATION NOTES

1. Design Criteria: 2018 International Mechanical Code with Washington State Amendments.
2. System Type: Balanced whole house fan system with energy recovery ventilator.
3. Use: Group R occupancy.
4. Specifics: See mechanical plans by others.

ENERGY NOTES

Reference: 2018 WSEC
Chapter 4 using climate zone category 5 & marine 4 for all calculations.

All residential units shall comply with the Requirements By Component Table 402.1.1. Including but not limited to the following:

Code Requirements	Associated Notes/Details
Window U-Factor .24 or better	See Insul. Notes on sheets U1, U2, U3, U4, US
Ceiling R-Value R-49	13 / D1
Wood Frame Wall R-Value R-21 int.	1, 3, 4, 7 & 8 / D1
Floor R-Value R-30	N/A
Slab R-Value & Depth R-10, 2ft	1, 3, 5 & 6 / D2

"int." (intermediate framing) denotes standard framing 16" o.c. with headers insulated with a min. of R-10 (see 6/D6).

All units need to have a certificate posted within 3 feet of the electrical distribution panel listing the following information: R-values, U-values, duct air leakage test results, building envelope air leakage test results, types and efficiencies of heating, cooling and service water heating equipment per R401.3

All insulation shall comply with table R402.4.1.1 WSEC

Hot water piping shall be insulated to a minimum of R-3 per R403.5.2

Water heaters in unheated spaces, or on concrete floors shall be placed on minimum of R-10 incompressible insulated surface per R403.5.5

Mechanical ventilation shall be provided per R403.6

A minimum of 90% of all permanently installed lamps in lighting fixtures shall be high-efficacy lamps per R404.1

See Insulation Notes on the Unit Plans, and Insulation and Energy Notes on sheet D7.

Energy Credits used (see 2018 WSEC table 406.3 for all requirements):

Fuel Neutralization Credit System Type 4	0.0 CREDITS
Option 2.1 Air Leakage Control	1.0 CREDITS
Option 3.4 Ductless Mini-Split Heat Pump System	2.0 CREDITS
Option 7.1 Appliance Package	1.5 CREDITS
TOTAL PROVIDED	4.5 CREDITS

See Insulation Notes on the Unit Plans, and Insulation and Energy Notes on sheet D7.

Energy Credits used (see 2018 WSEC table 406.3 for all requirements):

Fuel Neutralization Credit System Type 4

Option 2.1 Air Leakage Control

Option 3.4 Ductless Mini-Split Heat Pump System

Option 7.1 Appliance Package

TOTAL PROVIDED

FIRE SYSTEMS

Buildings shall have an NFPA 13R sprinkler system installed throughout per 2018 IBC Section 903.3.1.2 which shall include a notification appliance which is activated upon sprinkler flow. Any alarms, bells or lights required due to the design of the sprinkler system or integral with the sprinkler system shall be considered part of the sprinkler system. The sprinkler system design, therefore, needs to include any and all integrated alarms.

Plans and specifications for sprinklers shall be submitted to the city of Puyallup as a separate permit for review and approval before installation.

DESIGN LOADS

See structural notes. Sheet S1.0

DEFERRED SUBMITTALS

Shop drawings and calculations are required for:

1. Firestopping details. Firestopping methods and materials shall be determined by the Contractor except where details or notes are indicated in these drawings. Firestopping locations are indicated in part by detail sheet D9. Contractor shall submit UL assembly details and product cuts of all relevant situations to the Architect for conformance to the building design. Upon the Architect's approval, they shall be submitted to the Building Official for approval. Firestopping shall not be installed without City approval.

SEPARATE PERMITS

The following required permits will be submitted separately:

1. Automatic Fire Sprinkler System (See fire systems note, this sheet).

2. Fire Alarm System.

3. Use: Group R occupancy.

4. Specifics: See mechanical plans by others.

Approval of submitted plans is not an approval of omissions or oversights by this office or non compliance with any applicable regulations of local government. The contractor is responsible for making sure that the building complies with all applicable codes and regulations of the local government.

The approved construction plans, documents, and all engineering must be posted on the job at all inspections in a visible and readily accessible location.

Full sized legible color plans are required to be provided by the permittee on site for inspection.

City of Puyallup Building REVIEWED FOR COMPLIANCE
SKinner
05/15/2025
4:00:48 PM

Initial Publish Date: 5-6-25
Date Plotted: 5-6-25
Job No.: 23-06
Drawn By: TMK/HDM/APT
Sheet No.: A
F:\2008\COVER (A).dwg



VICINITY MAP



Bradley Heights Apartments

Puyallup, Wa

Timberlane Partners


Revisions

No. Date Description
8-30-24 Owner Changes/ Permit Corrections

PRMU20240280
Initial Publish Date: 5-6-25
Date Plotted: 5-6-25
Job No.: 23-06
Drawn By: TMK/HDM/APT
Sheet No.: A

NOTE: ALL DIMENSIONS ARE FROM FINISHED SURFACE

CHANGES IN LEVEL
 CHANGES IN LEVEL OF $\frac{1}{4}$ " MAX. SHALL BE PERMITTED TO BE VERTICAL AND WITHOUT EDGE TREATMENT.
 CHANGES IN LEVEL BETWEEN $\frac{1}{4}$ " AND $\frac{1}{2}$ " MAX. SHALL BE BEVELED WITH A SLOPE NOT STEEPER THAN 1:2.

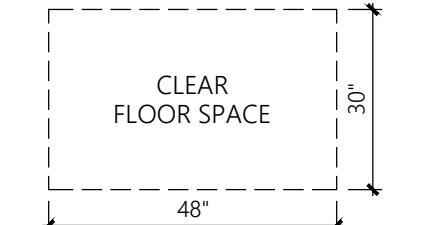TURNING SPACE & CLEAR FLOOR SPACE
 TURNING SPACES SHALL EITHER A 60" CIRCLE OR A T-SHAPED SPACE WITHIN A 60" SQUARE.
 CLEAR FLOOR SPACE IS DEFINED AS A SPACE 30" x 48".
 A SLOPE OF NOT MORE THAN 1:48 SHALL BE PERMITTED WITHIN TURNING AND CLEAR FLOOR SPACES. NO CHANGES IN LEVEL ARE PERMITTED.


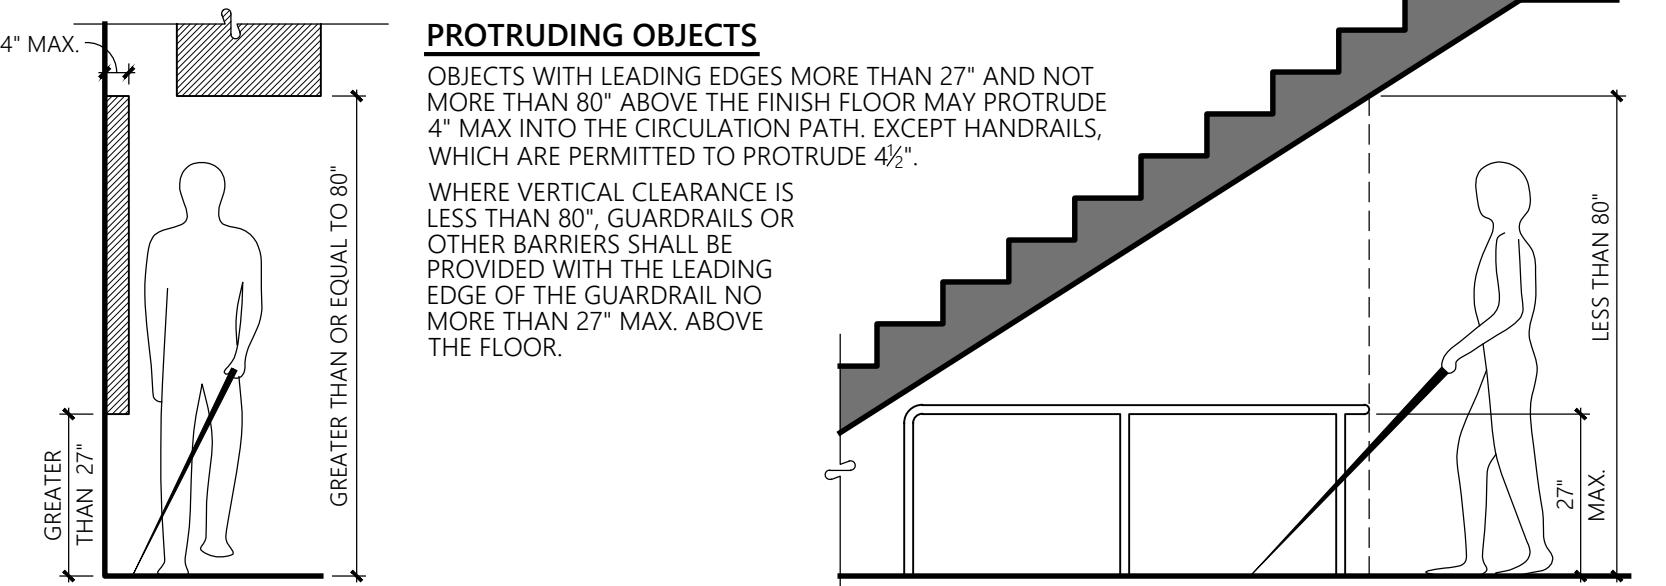
1 FLOOR CLEARANCES

KNEE AND TOE CLEARANCE
 TOE OR KNEE CLEARANCE SHALL BE 30" WIDE MIN. THE DIP OF THE OVERFLOW ON A SINK SHALL NOT BE CONSIDERED IN DETERMINING KNEE AND TOE CLEARANCE.

* WATER SUPPLY & DRAINPIES UNDER LATRINES AND SINKS SHALL BE INSULATED OR OTHERWISE CONFIGURED TO PROTECT AGAINST CONTACT. THERE SHALL BE NO SHARP OR ABRASIVE SURFACES UNDER LATRINES AND SINKS.


2 KNEE AND TOE SPACE

3/8"=1'-0"



3 PROTRUDING OBJECTS

3/8"=1'-0"

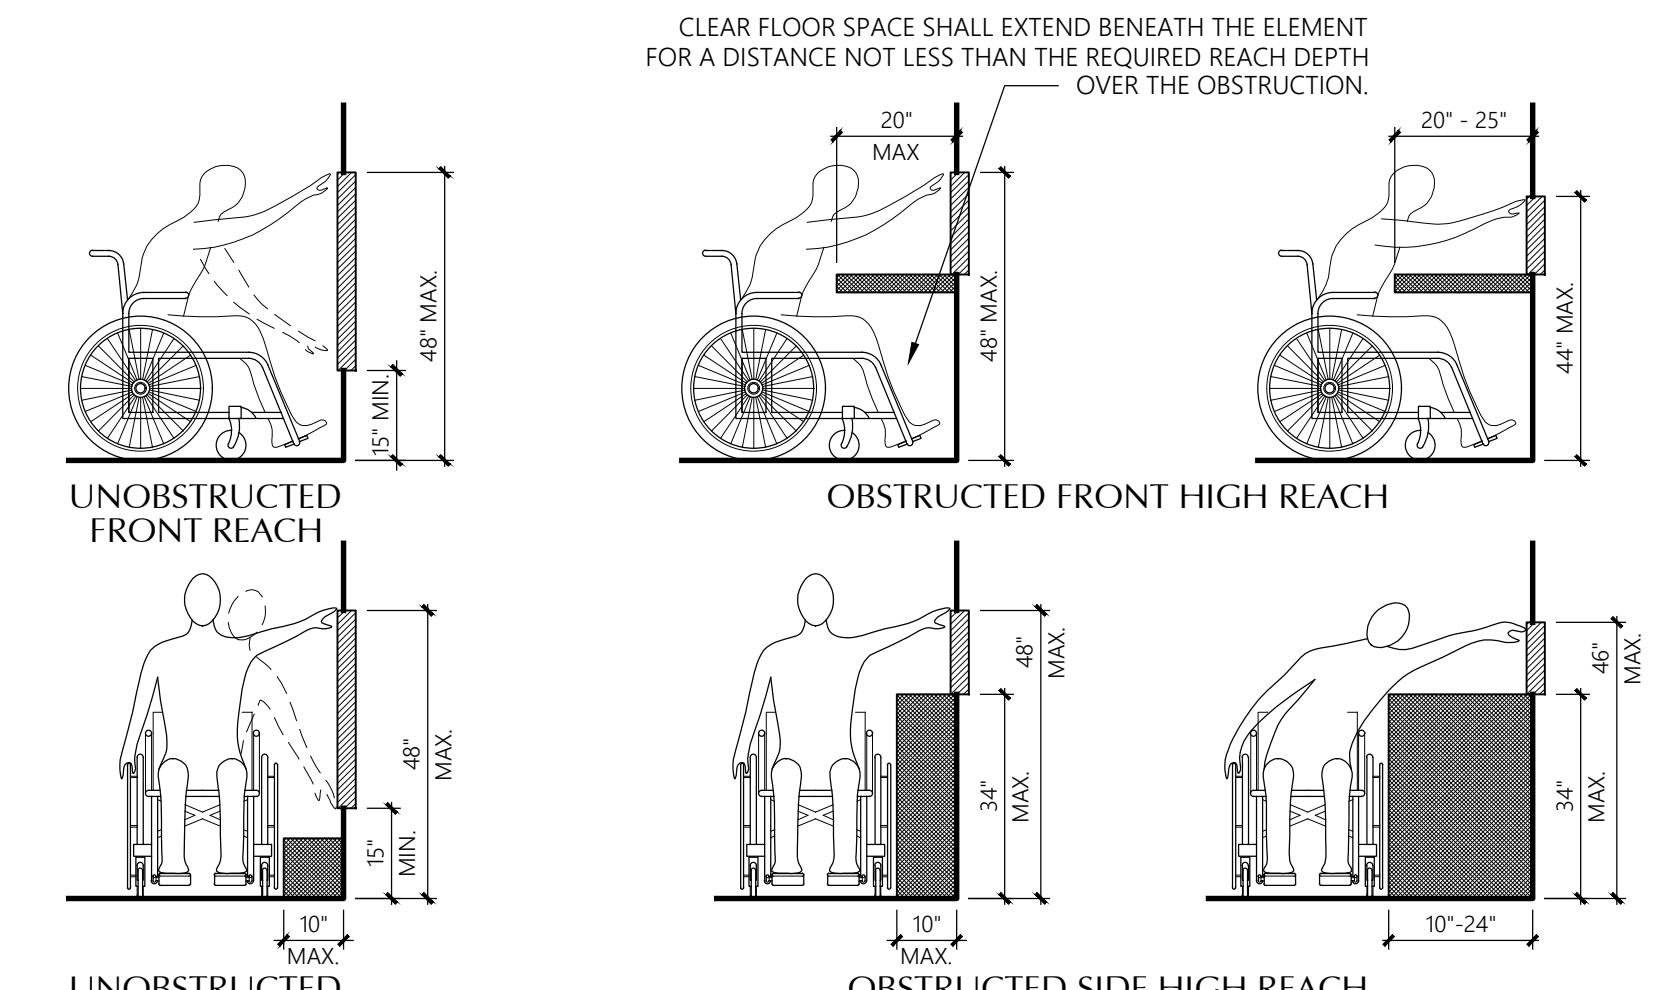

OPERABLE PARTS
 A 30" x 48" CLEAR FLOOR SPACE SHALL BE PROVIDED AT ALL OPERABLE PARTS. ALL OPERABLE PARTS SHALL BE WITHIN ONE OR MORE OF THE REACH RANGES.

OPERABLE PARTS SHALL BE OPERABLE WITH ONE HAND AND SHALL NOT REQUIRE TIGHT GRASPING, PINCHING, OR TWISTING OF THE WRIST. THE FORCE REQUIRED TO ACTIVATE OPERABLE PARTS SHALL BE 5.0 lbs MAX.

4 REACH RANGES

3/8"=1'-0"

BUILDING BLOCKS CHAPTER 3

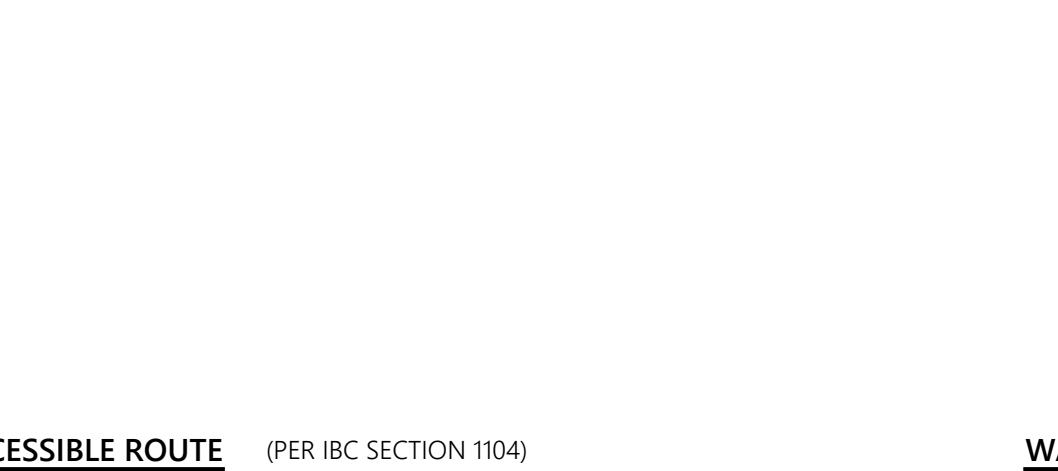

5 ACCESSIBLE ROUTE

ACCESSIBLE ROUTE (PER IBC SECTION 1104)
 AT LEAST ONE ACCESSIBLE ROUTE WITHIN THE SITE SHALL BE PROVIDED FROM PUBLIC TRANSPORTATION STOPS, ACCESSIBLE PARKING, ACCESSIBLE PASSENGER LOADING ZONES, AND PUBLIC STREETS OR SIDEWALKS TO THE ACCESSIBLE BUILDING ENTRANCES SERVED. WHEN A BUILDING OR PORTION OF A BUILDING IS REQUIRED TO BE ACCESSIBLE, AT LEAST ONE ACCESSIBLE ROUTE SHALL BE PROVIDED TO EACH PORTION OF THE BUILDING, TO ACCESSIBLE BUILDING ENTRANCES CONNECTING ACCESSIBLE WALKWAYS AND TO THE PUBLIC WAY.

ACCESSIBLE ROUTES SHALL COINCIDE WITH OR BE LOCATED IN THE SAME AREAS AS A GENERAL CIRCULATION PATH.

ACCESSIBLE ROUTES SHALL CONSIST OF ONE OR MORE OF THE FOLLOWING

COMPONENTS: WALKING SURFACES WITH A SLOPE NOT STEEPER THAN 1:20, DOORS & DOORWAYS, RAMPS, CURB RAMPS EXCLUDING THE FLARED SIDES, ELEVATORS, AND

PLATFORM LIFTS.

PASSING SPACE: AN ACCESSIBLE ROUTE WITH A CLEAR WIDTH LESS THAN 60" SHALL PROVIDE PASSING SPACES AT MAXIMUM INTERVALS OF 200 FEET. PASSING SPACES SHALL BE EITHER A 60" x 60" MIN. SPACE, OR AN INTERSECTION OF WALKING SURFACES WITH A T-SHAPED TURNING SPACE. (See detail 1 ACC sheets). PROVIDED THE BASE AND ARMS OF THE T-SHAPED SPACE EXTEND 48" MIN. BEYOND THE INTERSECTION.

WALKING SURFACES: SLOPE: THE RUNNING SLOPE OF WALKING SURFACES SHALL NOT BE STEEPER THAN 1:20. THE CROSS SLOPE OF A WALKING SURFACE SHALL NOT BE STEEPER THAN 1:48.

CHANGES IN LEVEL: CHANGES IN LEVEL SHALL COMPLY WITH SECTION 303 (See detail 1 ACC sheets).

CLEAR WIDTH: THE WIDTH OF AN ACCESSIBLE ROUTE SHALL BE 36" MIN. THE CLEAR WIDTH SHALL BE PERMITTED TO BE REDUCED TO 32" MIN. FOR A LENGTH OF 24" MAX. PROVIDED THE REDUCED WIDTH SEGMENTS ARE SEPARATED BY SEGMENTS THAT ARE 48" MIN. IN LENGTH AND 36" MIN. IN WIDTH. FOR EXTERIOR ROUTES OF TRAVEL, THE CLEAR WIDTH SHALL BE 44" MIN.

ACCESSIBLE ROUTES: ACCESSIBLE ROUTES SHALL COINCIDE WITH OR BE LOCATED IN THE SAME AREAS AS A GENERAL CIRCULATION PATH.

ACCESSIBLE ROUTES SHALL CONSIST OF ONE OR MORE OF THE FOLLOWING

COMPONENTS: WALKING SURFACES WITH A SLOPE NOT STEEPER THAN 1:20, DOORS & DOORWAYS, RAMPS, CURB RAMPS EXCLUDING THE FLARED SIDES, ELEVATORS, AND

PLATFORM LIFTS.

PASSING SPACE: AN ACCESSIBLE ROUTE WITH A CLEAR WIDTH LESS THAN 60" SHALL PROVIDE PASSING SPACES AT MAXIMUM INTERVALS OF 200 FEET. PASSING SPACES SHALL BE EITHER A 60" x 60" MIN. SPACE, OR AN INTERSECTION OF WALKING SURFACES WITH A T-SHAPED TURNING SPACE. (See detail 1 ACC sheets). PROVIDED THE BASE AND ARMS OF THE T-SHAPED SPACE EXTEND 48" MIN. BEYOND THE INTERSECTION.

WALKING SURFACES: SLOPE: THE RUNNING SLOPE OF WALKING SURFACES SHALL NOT BE STEEPER THAN 1:20. THE CROSS SLOPE OF A WALKING SURFACE SHALL NOT BE STEEPER THAN 1:48.

CHANGES IN LEVEL: CHANGES IN LEVEL SHALL COMPLY WITH SECTION 303 (See detail 1 ACC sheets).

CLEAR WIDTH: THE WIDTH OF AN ACCESSIBLE ROUTE SHALL BE 36" MIN. THE CLEAR WIDTH SHALL BE PERMITTED TO BE REDUCED TO 32" MIN. FOR A LENGTH OF 24" MAX. PROVIDED THE REDUCED WIDTH SEGMENTS ARE SEPARATED BY SEGMENTS THAT ARE 48" MIN. IN LENGTH AND 36" MIN. IN WIDTH. FOR EXTERIOR ROUTES OF TRAVEL, THE CLEAR WIDTH SHALL BE 44" MIN.

ACCESSIBLE ROUTES: ACCESSIBLE ROUTES SHALL COINCIDE WITH OR BE LOCATED IN THE SAME AREAS AS A GENERAL CIRCULATION PATH.

ACCESSIBLE ROUTES SHALL CONSIST OF ONE OR MORE OF THE FOLLOWING

COMPONENTS: WALKING SURFACES WITH A SLOPE NOT STEEPER THAN 1:20, DOORS & DOORWAYS, RAMPS, CURB RAMPS EXCLUDING THE FLARED SIDES, ELEVATORS, AND

PLATFORM LIFTS.

PASSING SPACE: AN ACCESSIBLE ROUTE WITH A CLEAR WIDTH LESS THAN 60" SHALL PROVIDE PASSING SPACES AT MAXIMUM INTERVALS OF 200 FEET. PASSING SPACES SHALL BE EITHER A 60" x 60" MIN. SPACE, OR AN INTERSECTION OF WALKING SURFACES WITH A T-SHAPED TURNING SPACE. (See detail 1 ACC sheets).

WALKING SURFACES: SLOPE: THE RUNNING SLOPE OF WALKING SURFACES SHALL NOT BE STEEPER THAN 1:20. THE CROSS SLOPE OF A WALKING SURFACE SHALL NOT BE STEEPER THAN 1:48.

CHANGES IN LEVEL: CHANGES IN LEVEL SHALL COMPLY WITH SECTION 303 (See detail 1 ACC sheets).

CLEAR WIDTH: THE WIDTH OF AN ACCESSIBLE ROUTE SHALL BE 36" MIN. THE CLEAR WIDTH SHALL BE PERMITTED TO BE REDUCED TO 32" MIN. FOR A LENGTH OF 24" MAX. PROVIDED THE REDUCED WIDTH SEGMENTS ARE SEPARATED BY SEGMENTS THAT ARE 48" MIN. IN LENGTH AND 36" MIN. IN WIDTH. FOR EXTERIOR ROUTES OF TRAVEL, THE CLEAR WIDTH SHALL BE 44" MIN.


ACCESSIBLE ROUTES: ACCESSIBLE ROUTES SHALL COINCIDE WITH OR BE LOCATED IN THE SAME AREAS AS A GENERAL CIRCULATION PATH.

ACCESSIBLE ROUTES SHALL CONSIST OF ONE OR MORE OF THE FOLLOWING

COMPONENTS: WALKING SURFACES WITH A SLOPE NOT STEEPER THAN 1:20, DOORS & DOORWAYS, RAMPS, CURB RAMPS EXCLUDING THE FLARED SIDES, ELEVATORS, AND

PLATFORM LIFTS.

PASS

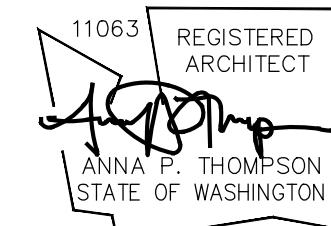

Area Increase Diagram

Building G

Bradley
Heights
Apartments


Puyallup,
Wa

Timberlane
Partners


Revisions

No. Date Description

PRMU20240280

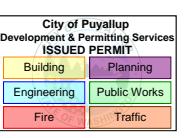

LEGEND

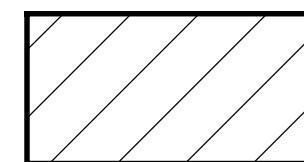

= Portion of perimeter with 30 feet of open space

FRONTAGE INCREASE TO BUILDING AREA

Per IBC Section 506.3 buildings that adjoin or have access to a public way or qualifying green space for more than 25% of their total perimeter are eligible for an area factor increase based on frontage.

To qualify for an area factor increase based on frontage, the public way or open space adjacent to the building perimeter shall have a minimum distance (W) of 20 feet, and only the first 30 feet shall be considered in the calculation. The measurement shall be to the nearest lot line, the entire width of a street, alley or public way, or the exterior face of an adjacent building on the same property.

For purposes of simplifying this calculation only those portions of perimeter fronting right of way or green space with a dimension of 30 feet or more are considered. Those portions of perimeter that front areas that may qualify (are more than 20 feet, but are less than 30 feet) are not included in the frontage calculation.

Frontage Area increase calculation:

$$I_f = [F/P-0.25]W/30$$

I_f = area of increase due to frontage
F = Building perimeter that fronts on a public way or open space
P = Full building perimeter
W = Width of public way or open space (max of 30')

For Building G
F = 508.31'
P = 530.28'
W = 30'
 $I_f = [508.31/530.28-0.25]30/30' = 0.70$ factor of increase due to frontage


ALLOWABLE BUILDING AREA

Per IBC Table 506.2: Buildings of R-2 occupancy with VB construction type are allowed to have an area of 7,000 square feet per floor. With the area factor increase from above this allowable area per floor is increased as follows:

$$7,000 \text{ s.f.} + (7,000 \text{ s.f.} \times 0.70) = 11,959 \text{ square feet per floor allowed}$$

Proposed floor area for Building G

Floor 1: 11,920 s.f.
Floor 2: 11,390 s.f.
Floor 3: 11,774 s.f.

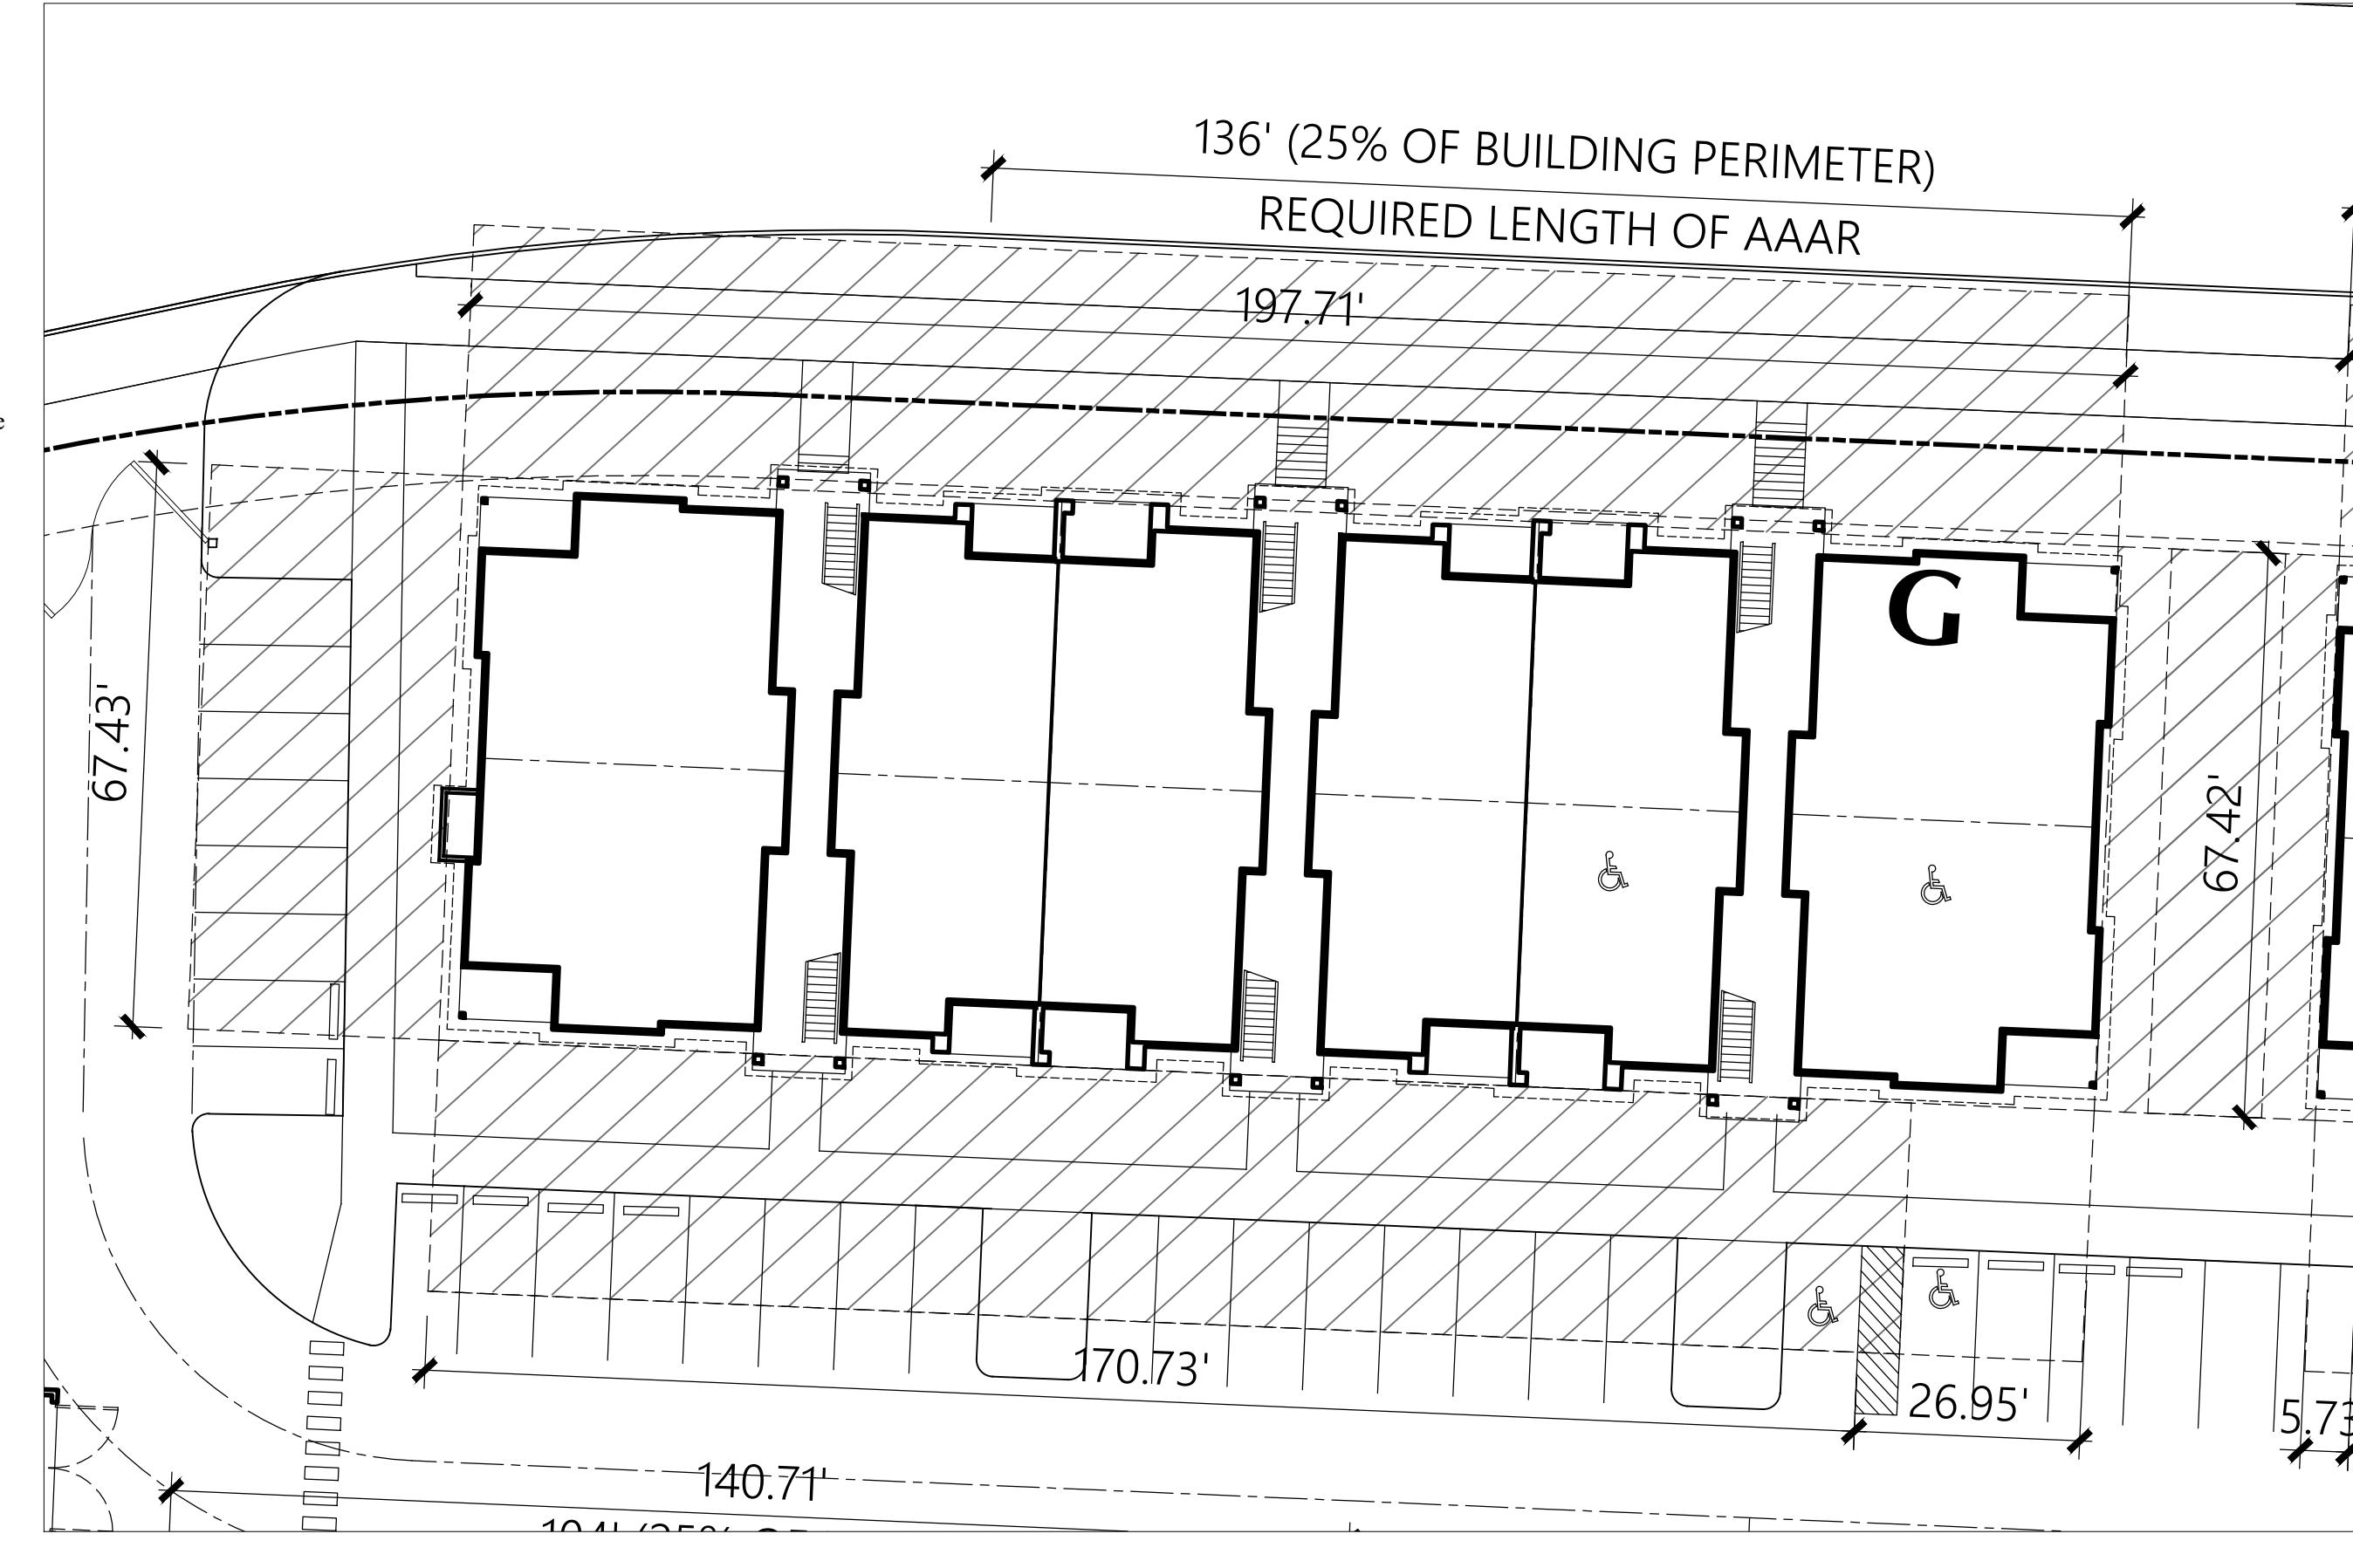

BUILDING G AREA INCREASE DIAGRAM

1" = 20'


Building G

Building Floor Plans

BUILDING G

2nd & 3rd LEVEL PLAN


3-STORY, 36-UNIT BUILDING

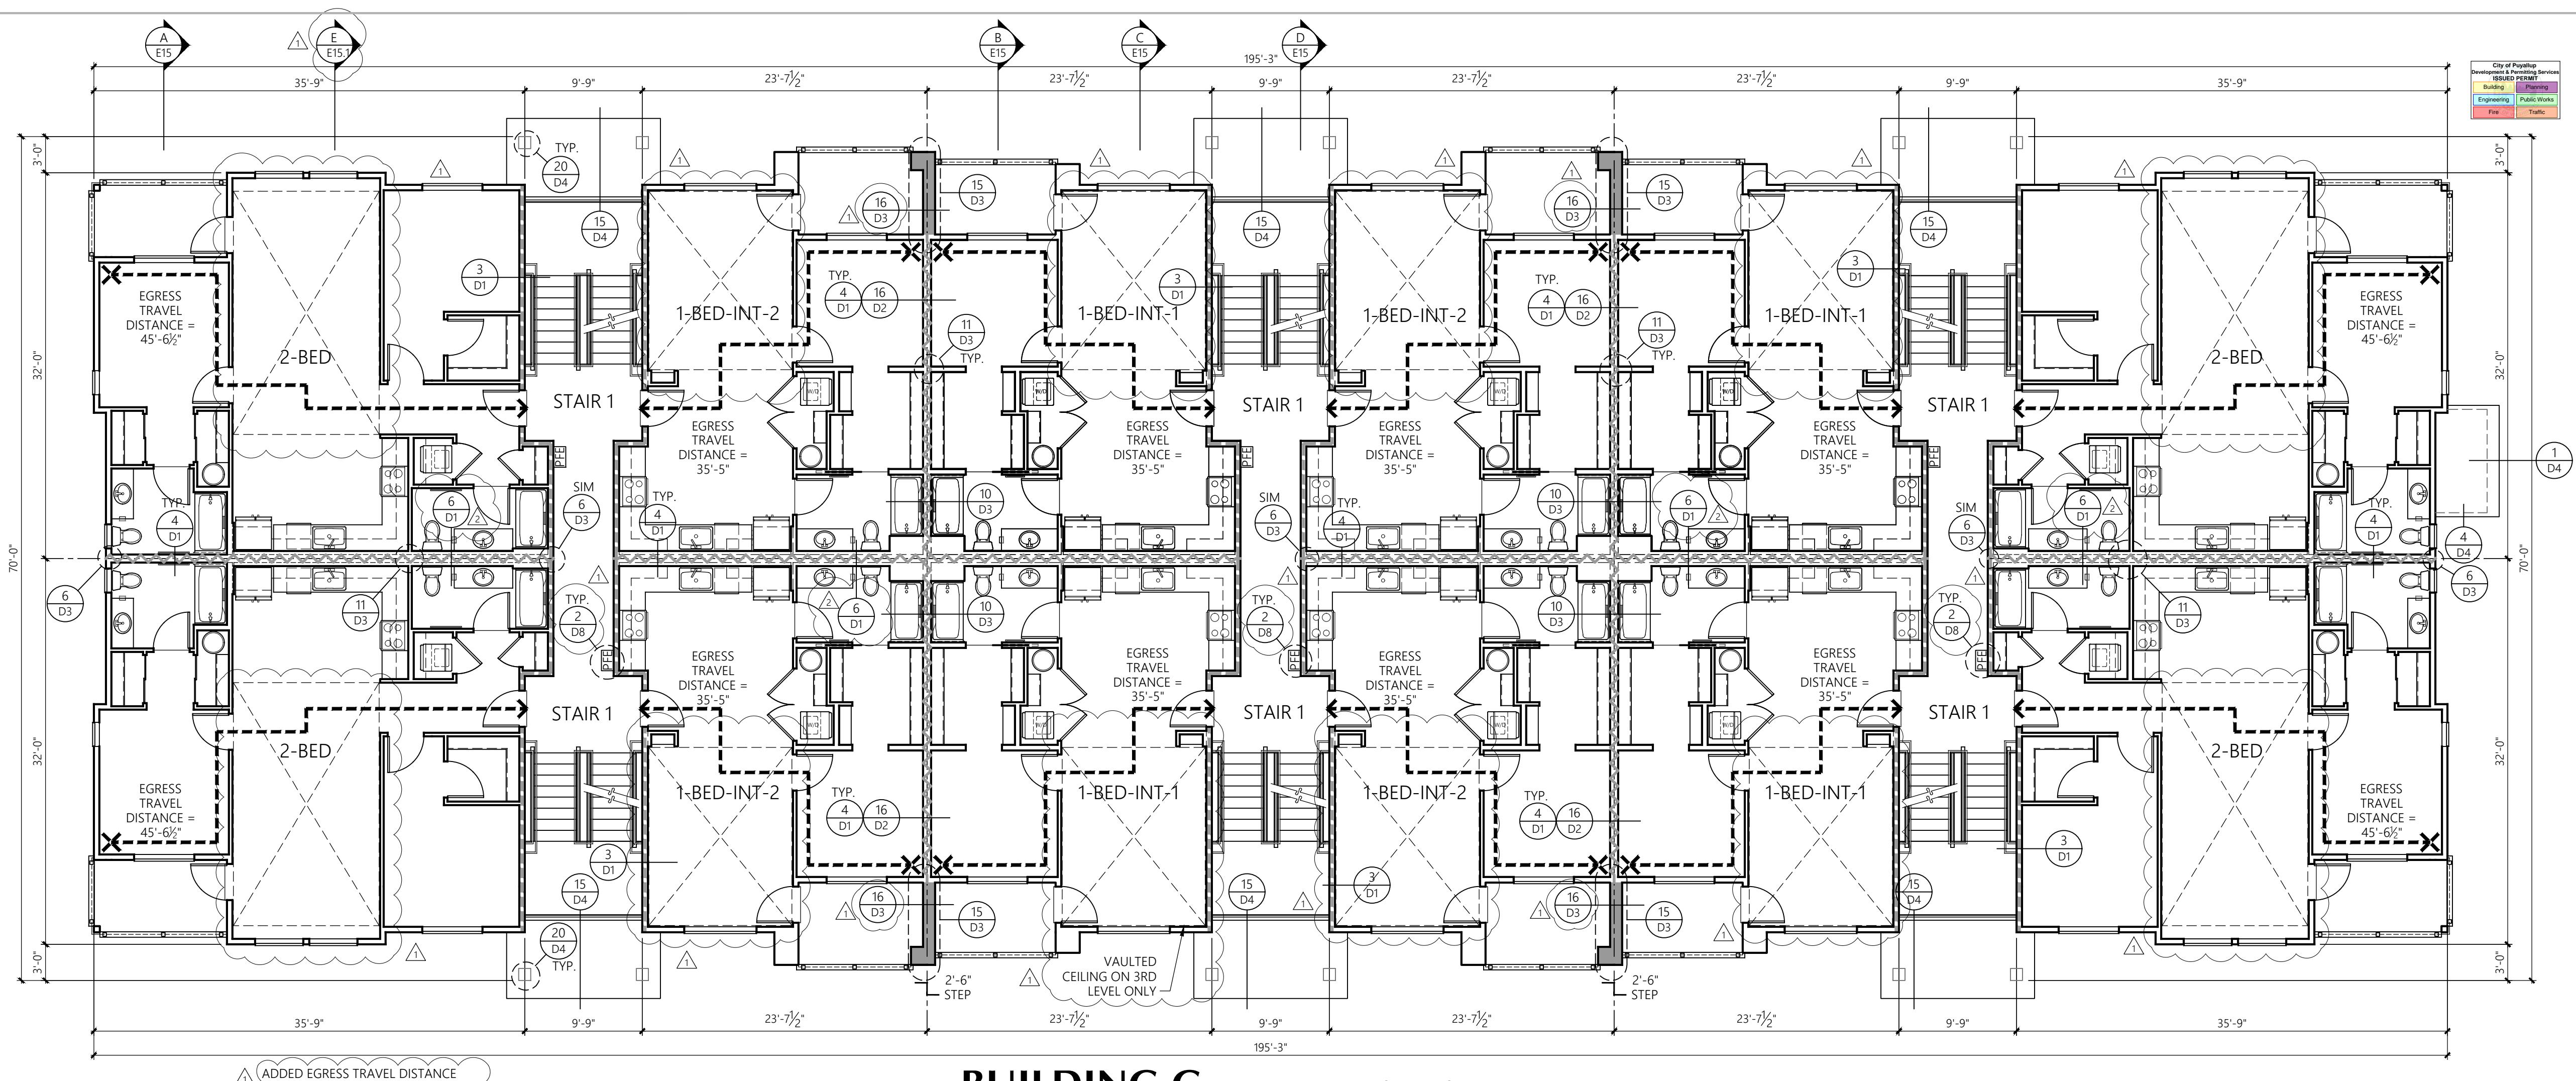

BUILDING G

2nd & 3rd LEVEL PLAN

3-STORY, 36-UNIT BUILDING

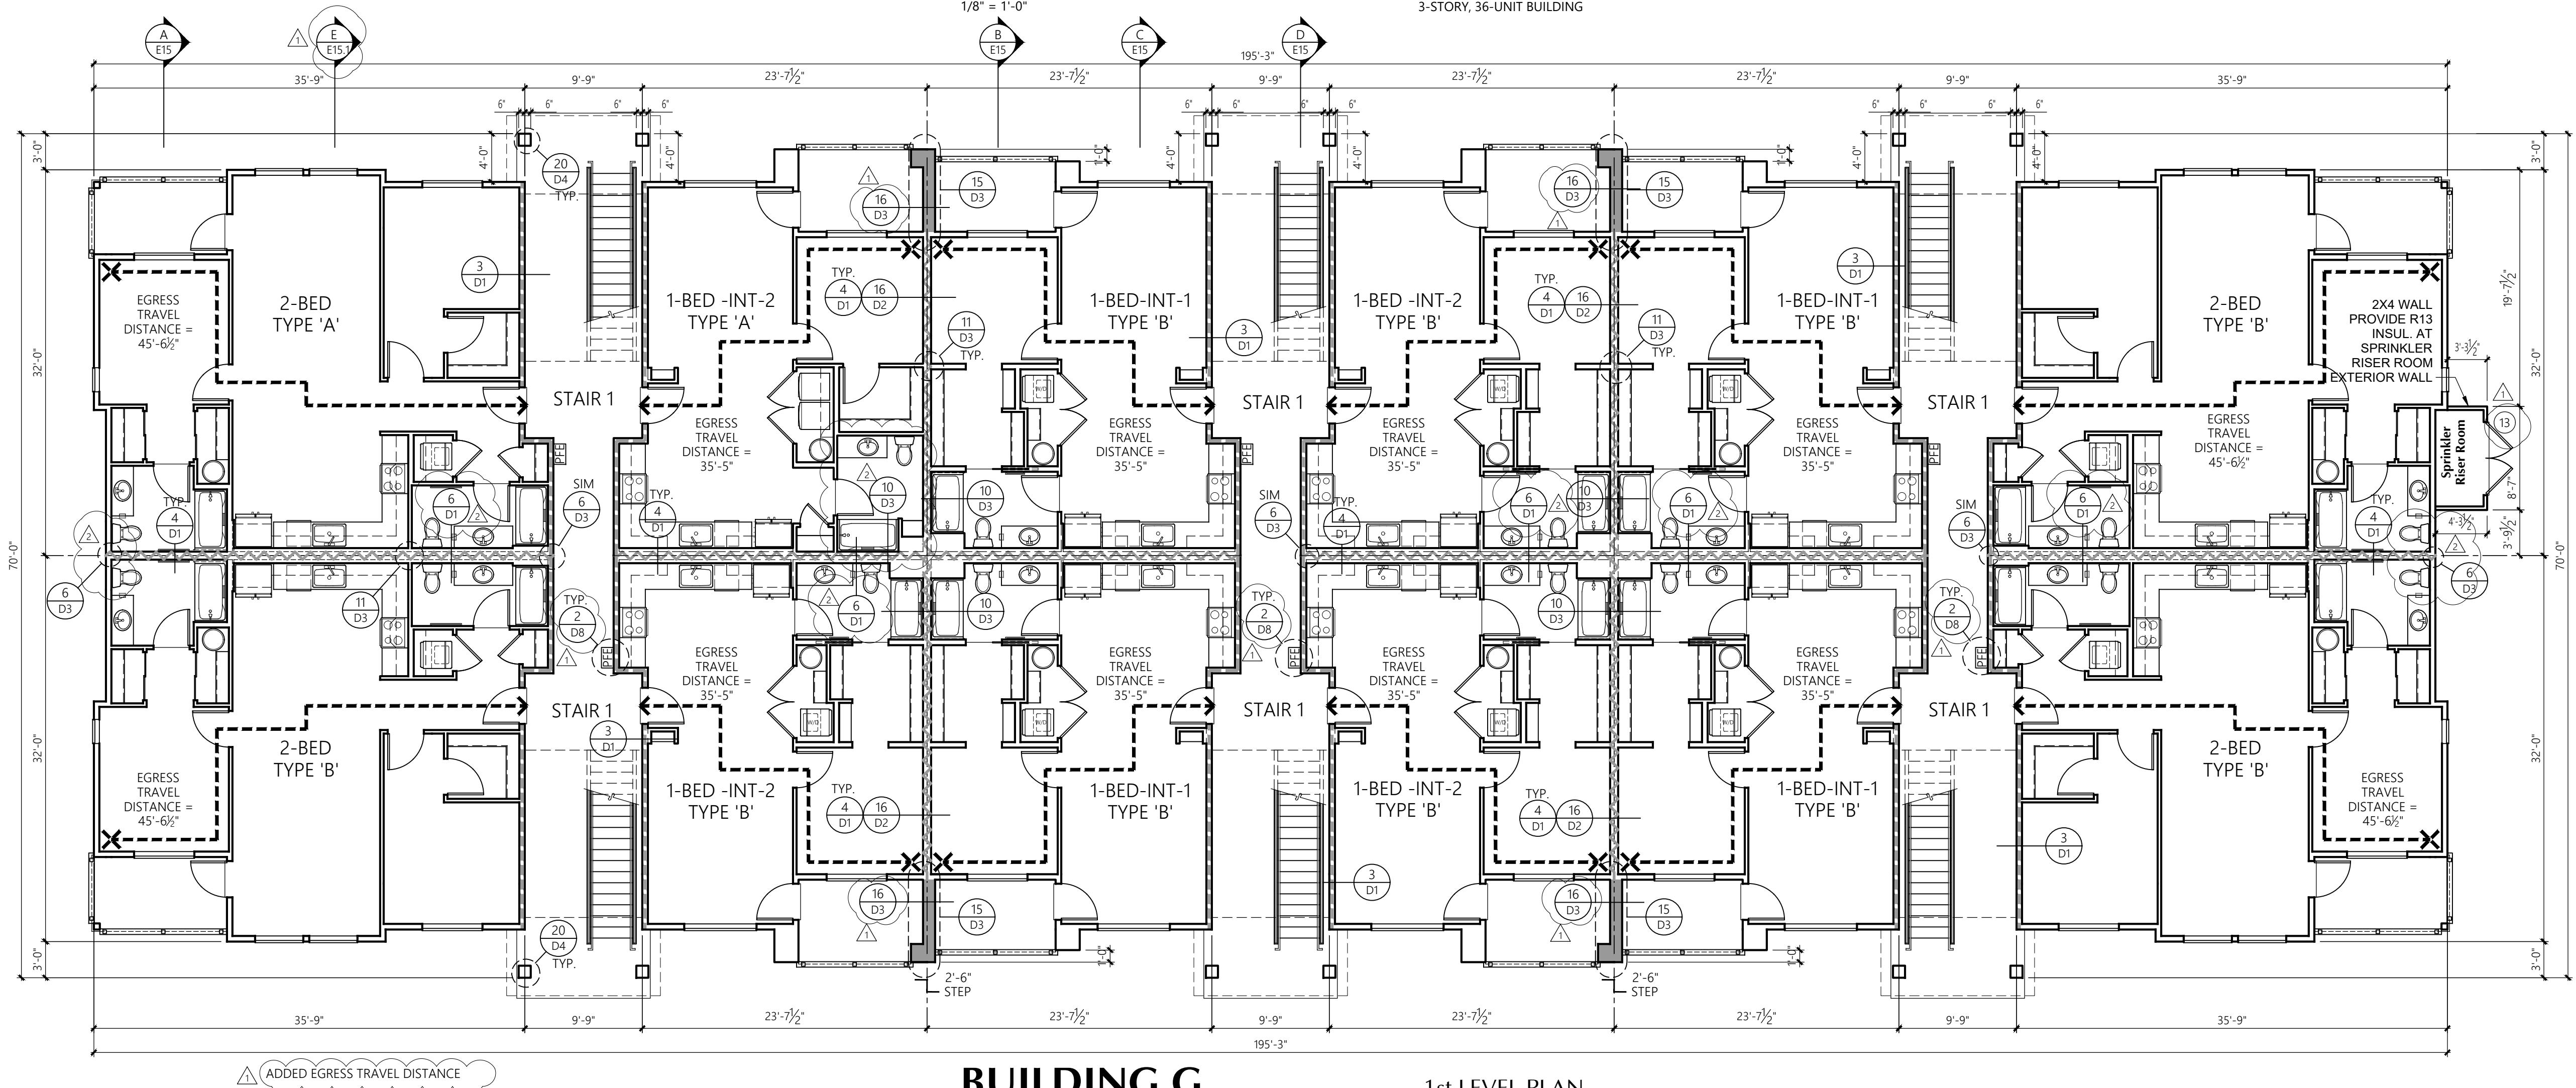


BUILDING G

1st LEVEL PLAN

3-STORY, 36-UNIT BUILDING

1/8" = 1'-0"

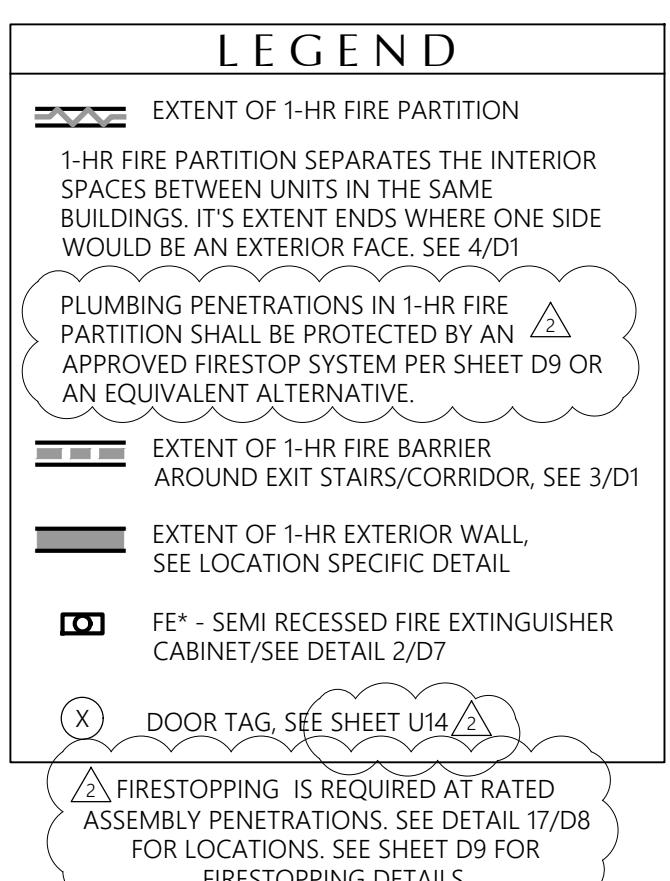

Bradley Heights Apartments

Puyallup, Wa

Timberlane Partners

Revisions

No. Date Description
1 8-30-24 Owner Changes/ Permit Corrections
2 4-24-25 Permit Corrections

PRMU20240280

Initial Publish Date:

Date Plotted:


5-6-25

Job No. Drawn By:

23-06 APT/HDM/TMK


Sheet No.:

B11

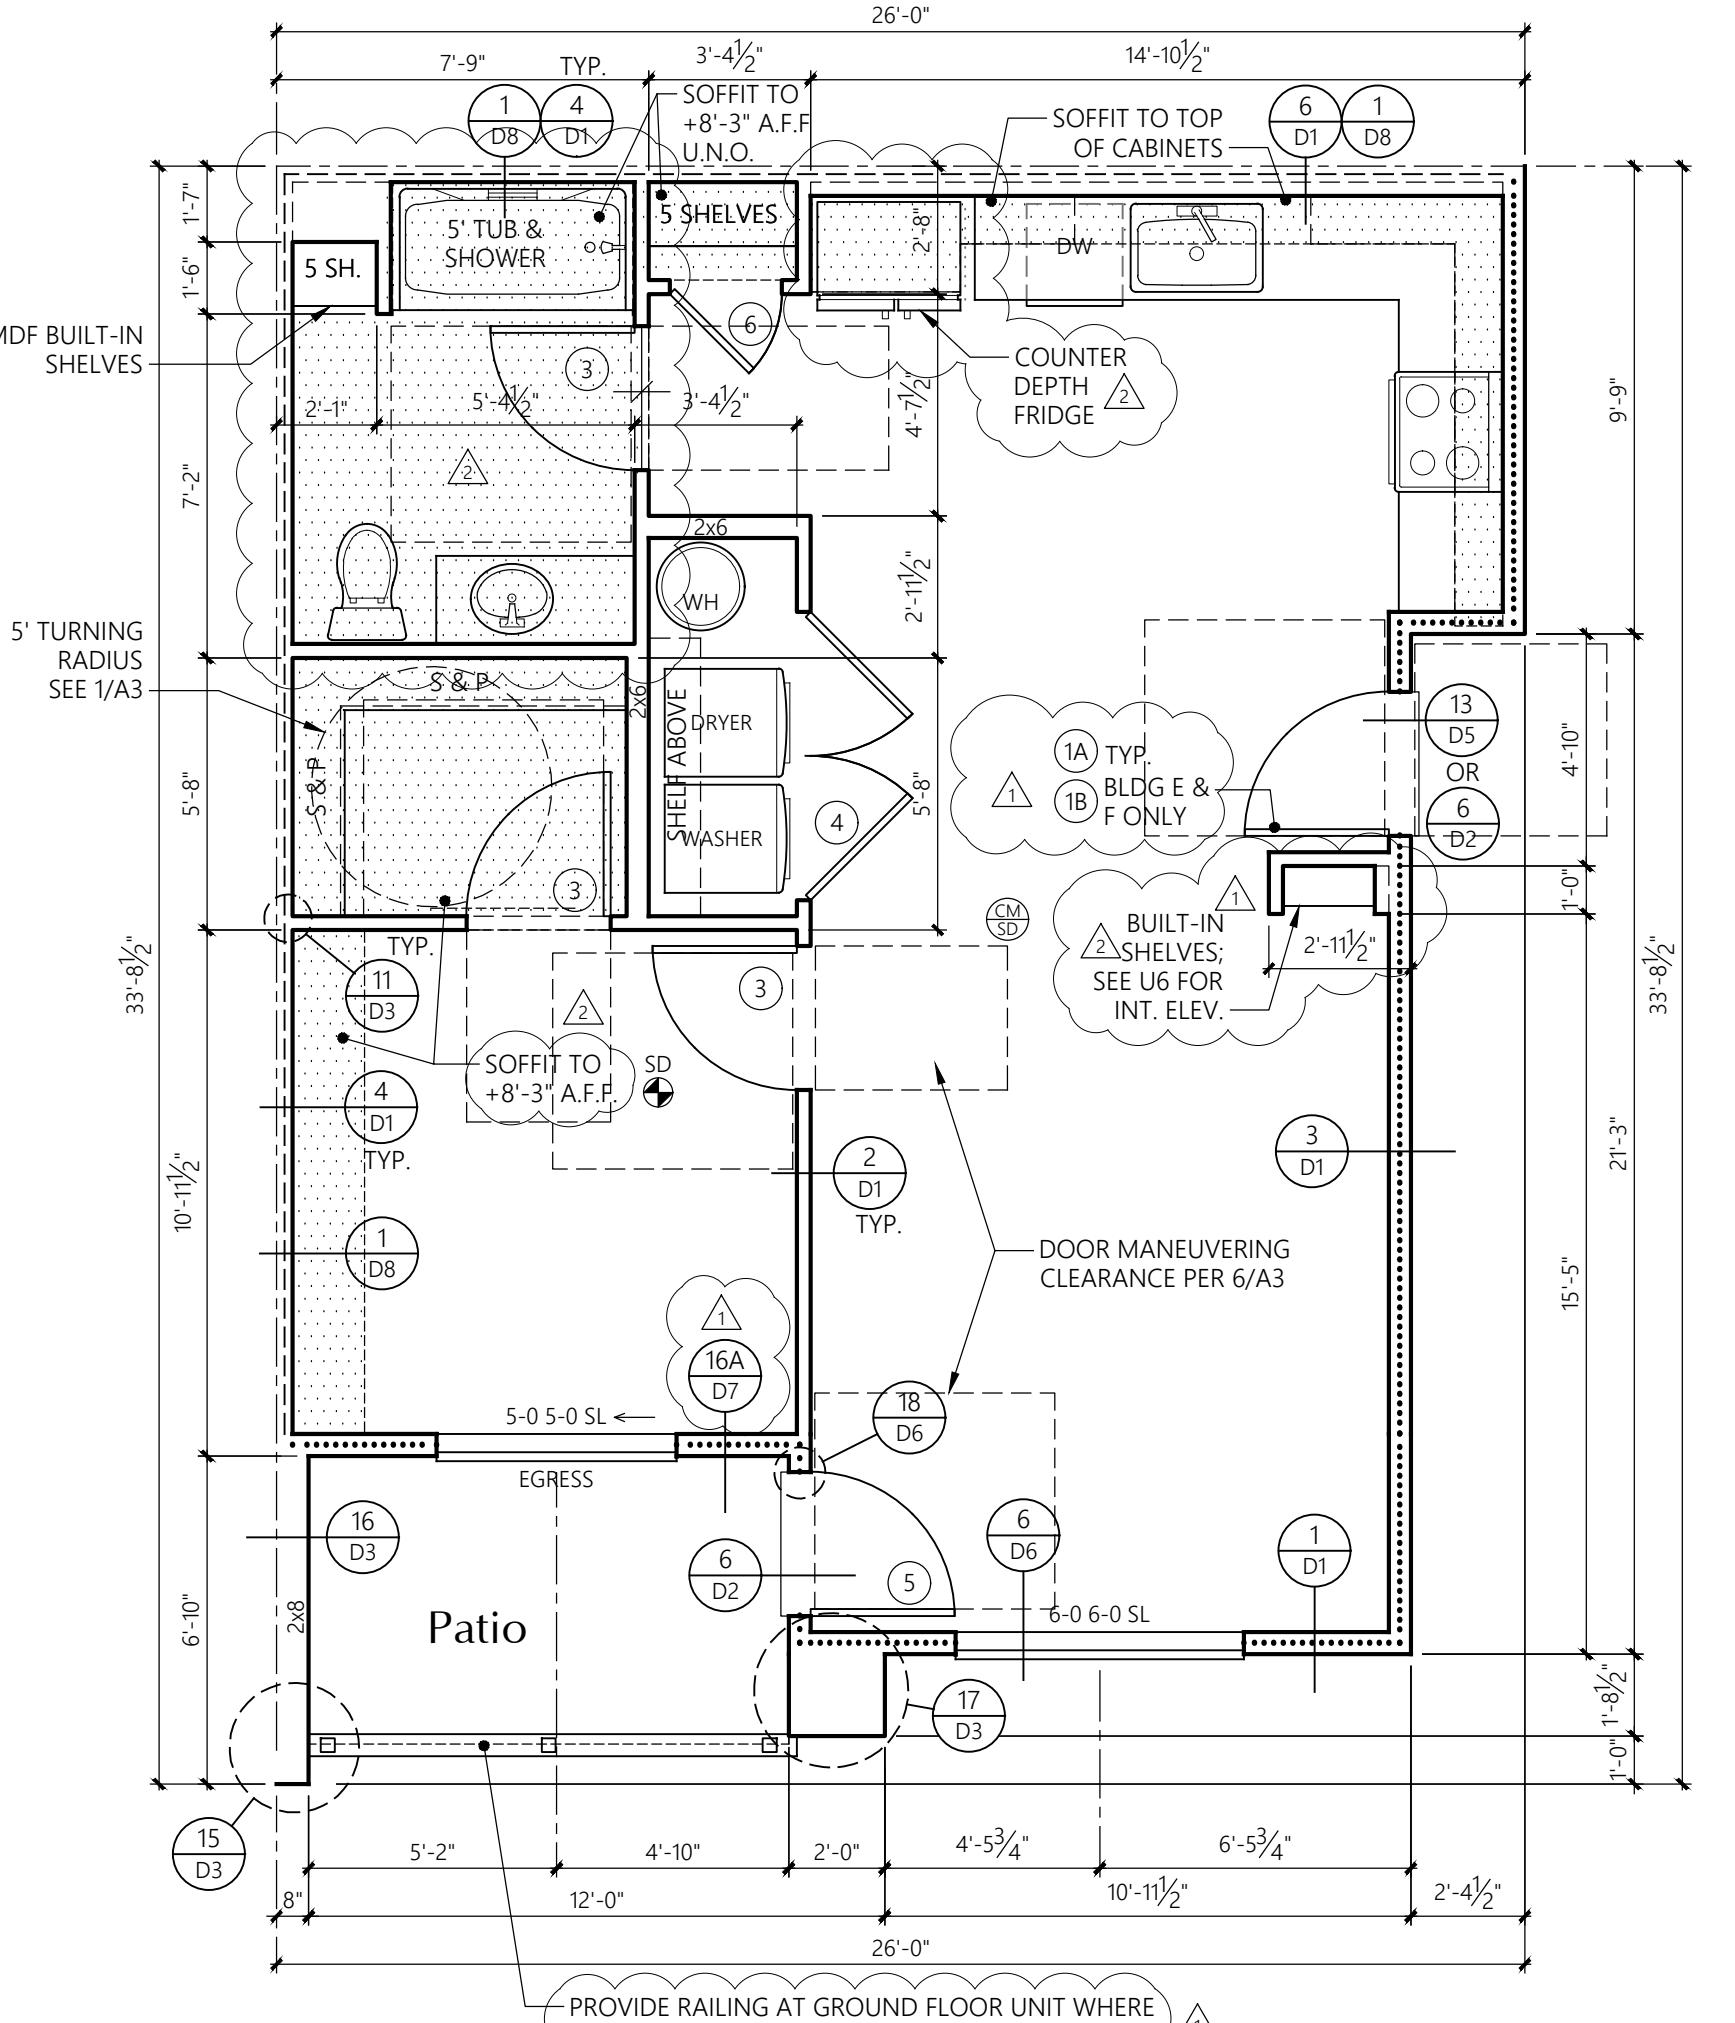

1-BED-INT-1 UNIT
1/4" = 1'-0"

AREA SUMMARY		
	Heated SF	Patio/Deck SF
Total SF	684	61

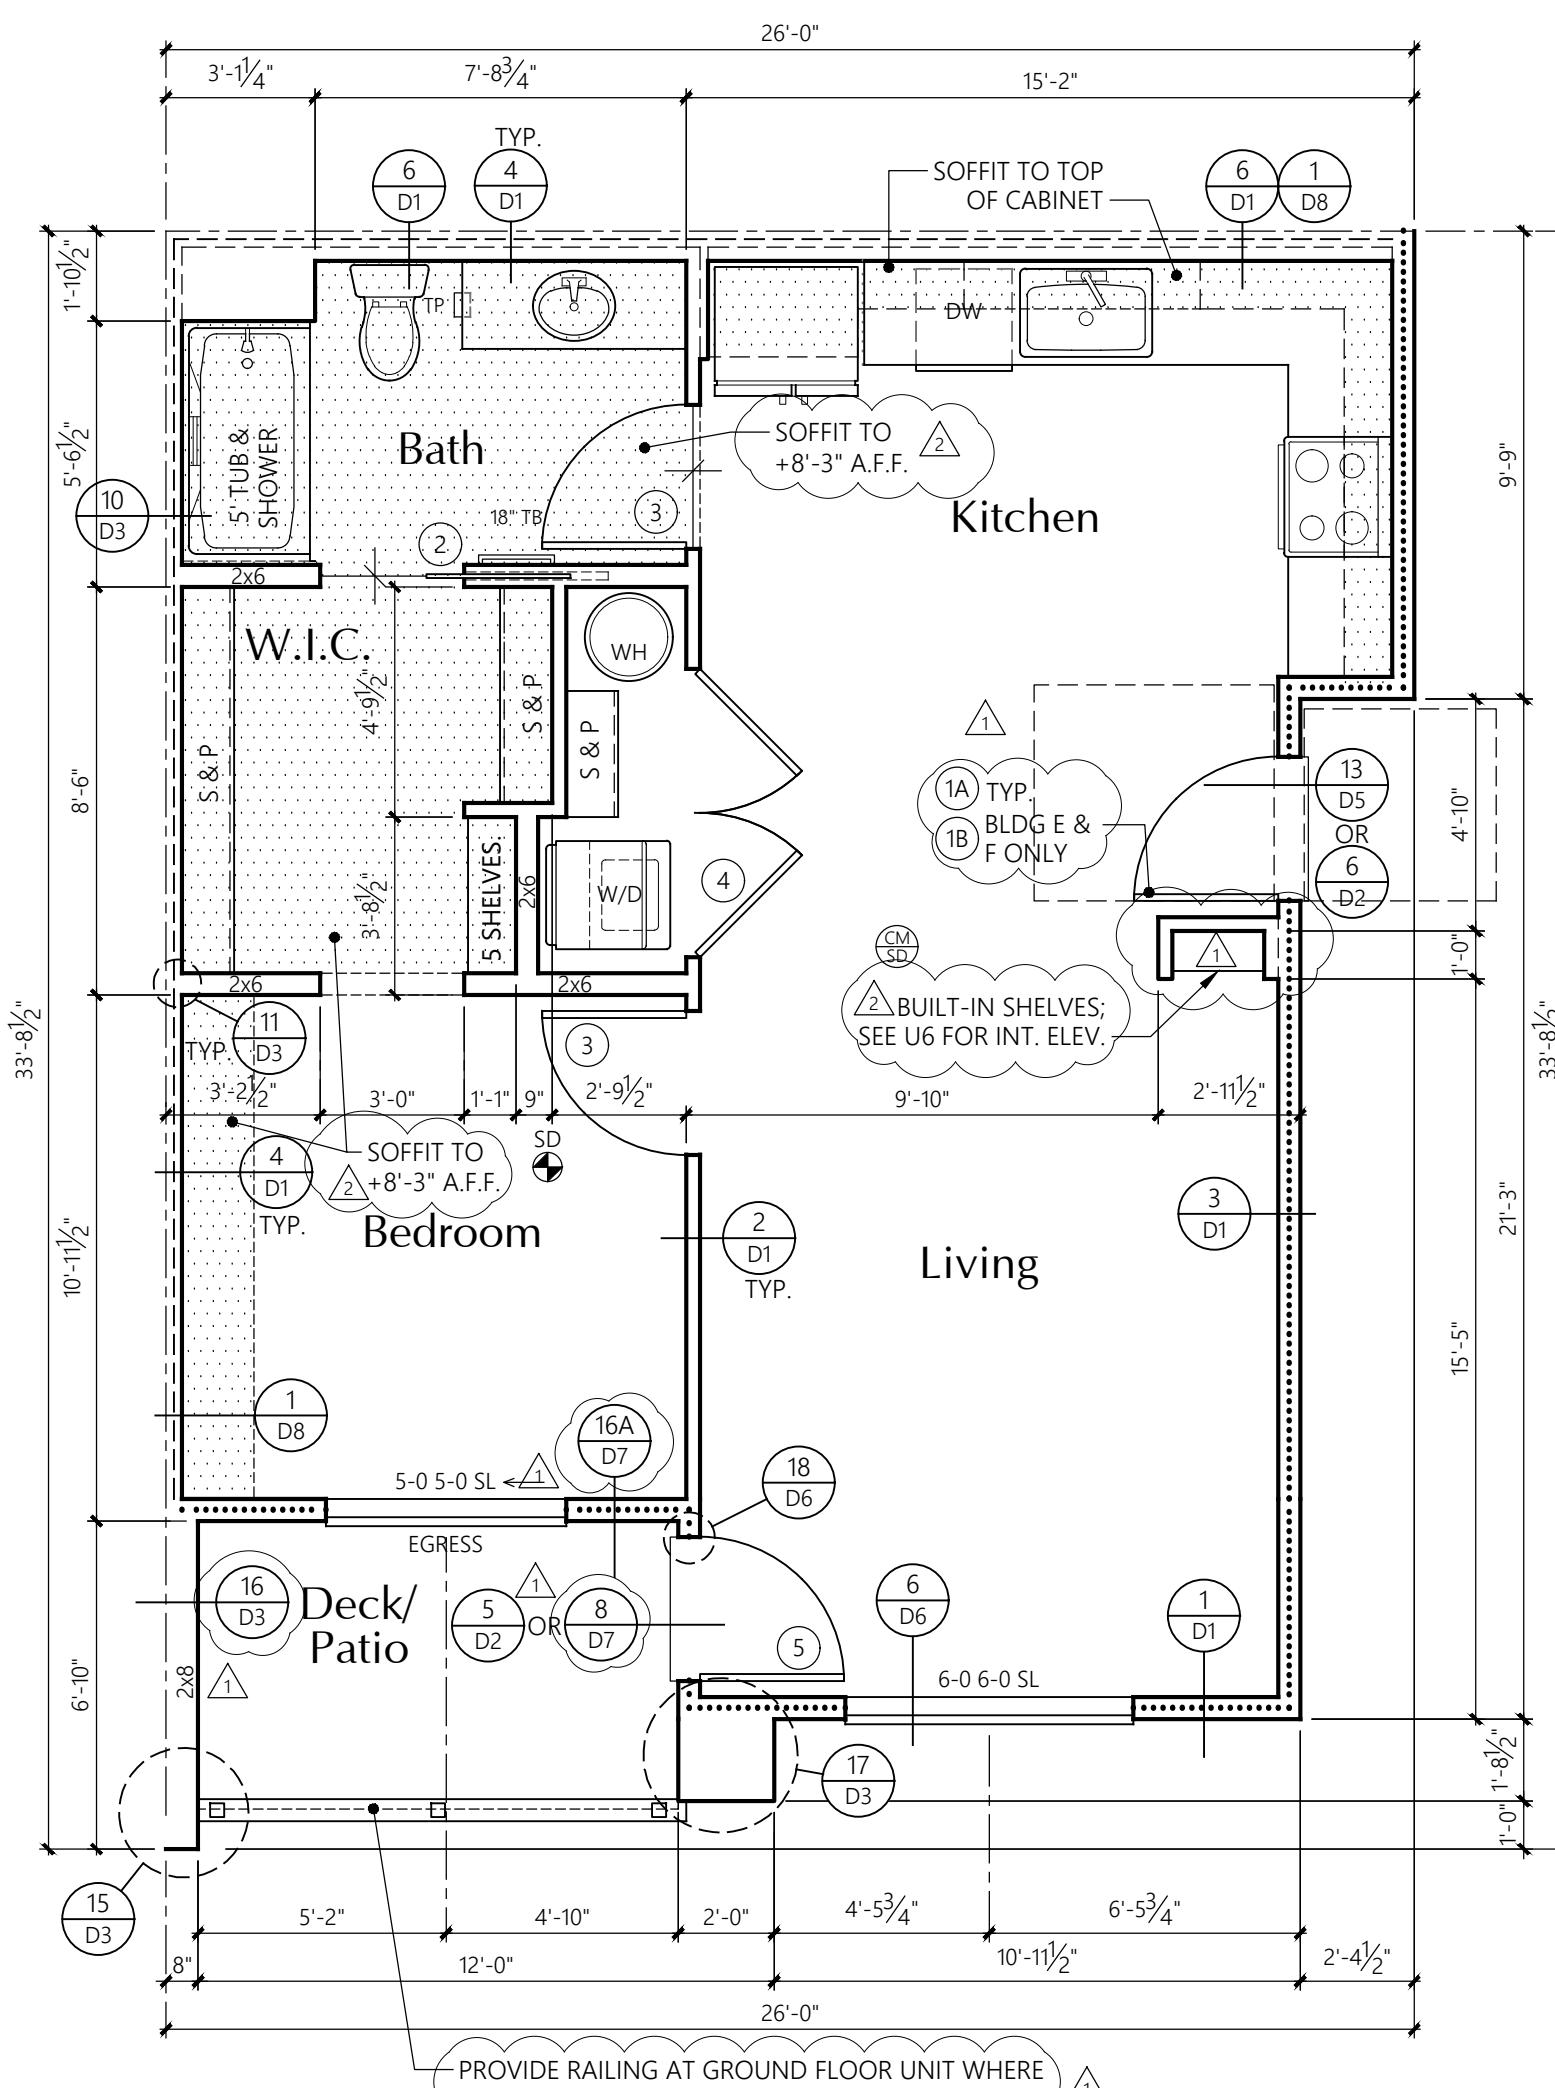

1-BED-INT-1 UNIT
1/4" = 1'-0"

AREA SUMMARY		
	Heated SF	Patio/Deck SF
Total SF	684	61

UNIT PLAN NOTES

FRAMING: 2x6's AT EXTERIOR WALLS
2x4's AT INTERIOR WALLS
UNLESS NOTED OTHERWISE.

R-21 BATT INSULATION
3/4" ACOUSTICAL INSULATION BOTH
SIDES OF PARTITION U.N.O.

LOCATION OF SOFFIT FOR VENT
RUNS, SOFFIT HEIGHT: 8'-0" A.F.F.
U.N.O. ON PLANS: SEE DETAIL 1/D8

SD SMOKE DETECTOR

CM/CO CARBON MONOXIDE/SMOKE DETECTOR

CONCEALED SPACES SHALL BE FIRESTOPPED IN BOTH
DIRECTIONS AT 10'-0" ON CENTER AND AT FLOORS. TYPICAL.

ALL ESCAPE OR RESCUE WINDOWS FROM SLEEPING ROOMS
SHALL HAVE A MINIMUM NET CLEAR OPENING OF 5.7 SQUARE
FEET. THE MINIMUM CLEAR OPENING HEIGHT DIMENSION
SHALL BE 24". MINIMUM CLEAR OPENING WIDTH DIMENSION
SHALL BE 20". EMERGENCY ESCAPE AND RESCUE OPENINGS
SHALL HAVE THE BOTTOM OF CLEAR OPENING NOT GREATER
THAN 44 INCHES MEASURED FROM THE FLOOR.

WHERE THE OPENING OF THE SLIDING PORTION OF AN OPERABLE
WINDOW IS LOCATED MORE THAN 12'-0" ABOVE THE
FINISHED GRADE OR OTHER SURFACE BELOW THE LOWEST
PART OF THE CLEAR OPENING OF THE WINDOW SHALL BE AT
A HEIGHT NOT LESS THAN 36 INCHES ABOVE THE FINISHED
FLOOR SURFACE OF THE ROOM IN WHICH THE WINDOW IS
LOCATED. OPERABLE SECTIONS OF WINDOWS SHALL NOT
PERMIT OPENINGS THAT ALLOW PASSAGE OF A 4 INCH
DIAMETER SPHERE WHERE SUCH OPENINGS ARE LOCATED
WITHIN 36 INCHES OF THE FINISHED FLOOR.

ALL GLAZING SHALL CONFORM TO THE 2018 IBC,
CHAPTER 24, SEC. 2406. SAFETY GLAZING. GLAZING IN ALL
DOORS SHALL BE SAFETY TYPE AND ALL GLAZING WITHIN A
24" ARC OF EITHER VERTICAL EDGE SHALL BE SAFETY TYPE.

PROVIDE 3/8" TYPE 'X' (MIN.) GYPSUM SHEATHING ON WALLS
BEHIND TUB/SHOWERS TO SATISFY FIRE REQUIREMENTS AT
PARTYWALL CONDITION. PROVIDE 3/8" PLYWOOD UNDER TUB
IN PLACE OF THE GYPCRETE, SEE DETAIL 14/D1

DOOR KEY:

(X) DOOR TAG, SEE SHEET U14 FOR SCHEDULE

WINDOW KEY:

TYPE:
FIX = FIXED/PICTURE
SL = SLIDER
SH = SINGLE HUNG
SGD = SLIDING GLASS DOOR

GYPSUM WALLBOARD SCHEDULE

EXCEPT WHERE NOTED OTHERWISE, 3/8" TYPE 'X' GYPSUM
WALLBOARD SHALL BE USED THROUGHOUT.
ON INTERIOR NON-RATED WALLS, EXTERIOR WALLS,
CORRIDOR WALLS, AND 1-HOUR AND 2-HOUR FIRE-RATED
WALLS.

STANDARD PLATE
HEIGHT: 9'-1"
SEE ELEVATION SHEETS FOR
FLOOR TO FLOOR HEIGHTS

WINDOW HDR IS 8'-0"
UNLESS NOTED OTHERWISE

SEE SHEET U6 FOR INTERIOR ELEVATIONS

INSULATION

FOUNDATION PERIMETER - R-10 RIGID INSULATION
TO A DEPTH OF 24" OR TO TOP OF FOOTING AT
HEATED PERIMETER

EXTERIOR WALLS: FIBERGLASS BATT'S OR BLANKETS
2x6 WALLS - R21

FLOORS OVER UNHEATED SPACES - R30
ATTICS AND ROOF ASSEMBLIES - R-49
FULL HEIGHT OF UNCOMPRESSED INSULATION
EXTENDS OVER THE WALL TOP PLATE AT THE EAVES

EXTERIOR DOORS: MAIN ENTRY U=0.20

ALL OTHERS U=0.40

WINDOWS: MILGARD VINYL
TYPE (VINYL) MODEL U-VALUE

SLIDING 6110 ARGON/LoE 0.24 or BETTER

FIXED 6310 ARGON/LoE 0.24 or BETTER

SINGLE HUNG 6210 ARGON/LoE 0.24 or BETTER

DBL SLIDER 8125 ARGON/LoE 0.24 or BETTER

SGD 6610 ARGON/LoE 0.24 or BETTER

NOTE: ALL CONCEALED OR EXPOSED INSULATION
SHALL HAVE A FLAME SPREAD INDEX OF NOT
MORE THAN 25 AND A SMOKE-DEVELOPED
INDEX OF NOT MORE THAN 450

*BIFOLD DOOR HARDWARE AT LAUNDRY TO BE
'FULL ACCESS HARDWARE'.

THE 30'x48" CLEAR FLOOR
SPACE IS REQUIRED AT EACH
Fixture OR Location Shown
ON THE FLOOR PLAN.

ACCESSIBILITY NOTES:

ALL GROUND FLOOR UNITS IN THIS PROJECT MUST
MEET THE ACCESSIBILITY REQUIREMENTS OF
TYPE 'B' ACCESSIBLE UNITS AS REQUIRED
BY CHAPTER 11 OF THE 2018 BC.

INCLUDED IN THE ABOVE GROUND FLOOR UNITS
5% OF ALL UNITS NEED TO MEET THE ACCESSIBILITY
REQUIREMENTS OF 'TYPE 'A' ACCESSIBLE UNITS
AS REQUIRED BY CHAPTER 11 OF THE 2018 BC.
SEE BUILDING PLANS FOR LOCATION OF 'TYPE 'A' UNITS

SEE SHEET U11 & U11.1 FOR SPECIFIC ADAPTABLE STANDARD
FOR BOTH 'TYPE 'A' AND 'TYPE 'B' ACCESSIBLE UNITS.
SEE INTERIOR ELEVATION SHEETS FOR ADDITIONAL
ACCESSIBILITY REQUIREMENTS.

LIGHTING CONTROLS, ELECTRICAL SWITCHES,
ENVIRONMENTAL CONTROLS, OPERATING HARDWARE
FOR DOORS AND WINDOWS, AND PLUMBING
FIXTURE CONTROLS SHALL BE OPERABLE WITH
ONE HAND AND SHALL NOT REQUIRE TIGHT
GRASPING, PINCHING OR TWISTING OF THE WRIST
TO OPERATE. EXCEPT FOR OPERABLE DOOR
HARDWARE, SUCH ITEMS SHALL BE 15" MINIMUM
AND 44" MAXIMUM ABOVE THE FLOOR (48" FOR
WINDOWS).

OPERABLE ENTRY DOOR HARDWARE SHALL BE
34" MINIMUM AND 48" MAXIMUM ABOVE THE FLOOR.

OPENING FORCES FOR ENTRY DOOR SHALL BE:
15 POUNDS TO RELEASE THE LATCH
30 POUNDS TO SET DOOR IN MOTION
15 POUNDS TO OPEN DOOR TO FULL 90°
FORCE MEASURED AT LATCH SIDE OF DOOR.


THE DOOR CLOSER ON THE ENTRY DOOR
SHALL BE ADJUSTED TO CLOSE FROM AN OPEN
POSITION OF 90° TO AN OPEN POSITION OF 12°
IN NOT LESS THAN 5 SECONDS.

OPENING FORCE OF ALL SWINGING INTERIOR
DOORS AND THE SLIDING GLASS DOOR SHALL
NOT EXCEED 5 POUNDS APPLIED TO THE
LATCH SIDE OF THE DOOR.

THE FORCE REQUIRED TO ACTIVATE ALL OTHER
OPERABLE ITEMS LISTED ABOVE SHALL BE
5 POUNDS.


*BIFOLD DOOR HARDWARE AT LAUNDRY TO BE
'FULL ACCESS HARDWARE'.

THE 30'x48" CLEAR FLOOR
SPACE IS REQUIRED AT EACH
Fixture OR Location Shown
ON THE FLOOR PLAN.

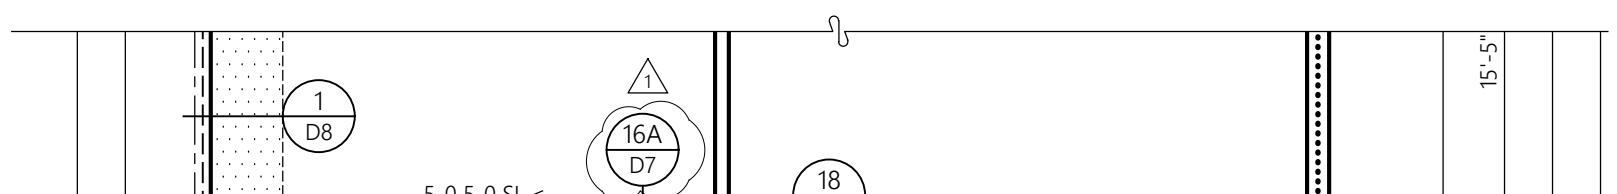

1-BED-INT-2 UNIT
1/4" = 1'-0"

AREA SUMMARY		
	Heated SF	Patio/Deck SF
Total SF	684	71

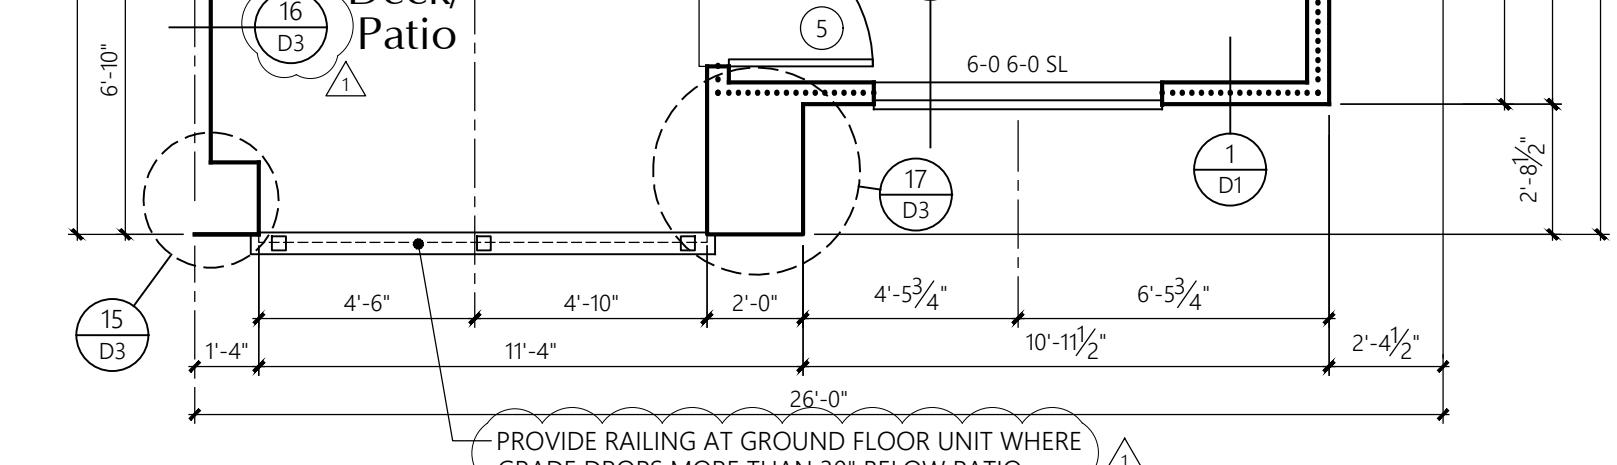

1-BED-INT-2 UNIT
1/4" = 1'-0"

AREA SUMMARY		
	Heated SF	Patio/Deck SF
Total SF	684	71

Bradley Heights Apartments

Puyallup, Wa

Timberlane Partners

Revisions

No. Date Description

8-30-24 Owner Changes/Permit Corrections

PRMU20240280

Initial Publish Date:

Date Plotted:


5-1-25

Job No.:

23-06 APT/HDM/TMK

Sheet No.:

U1

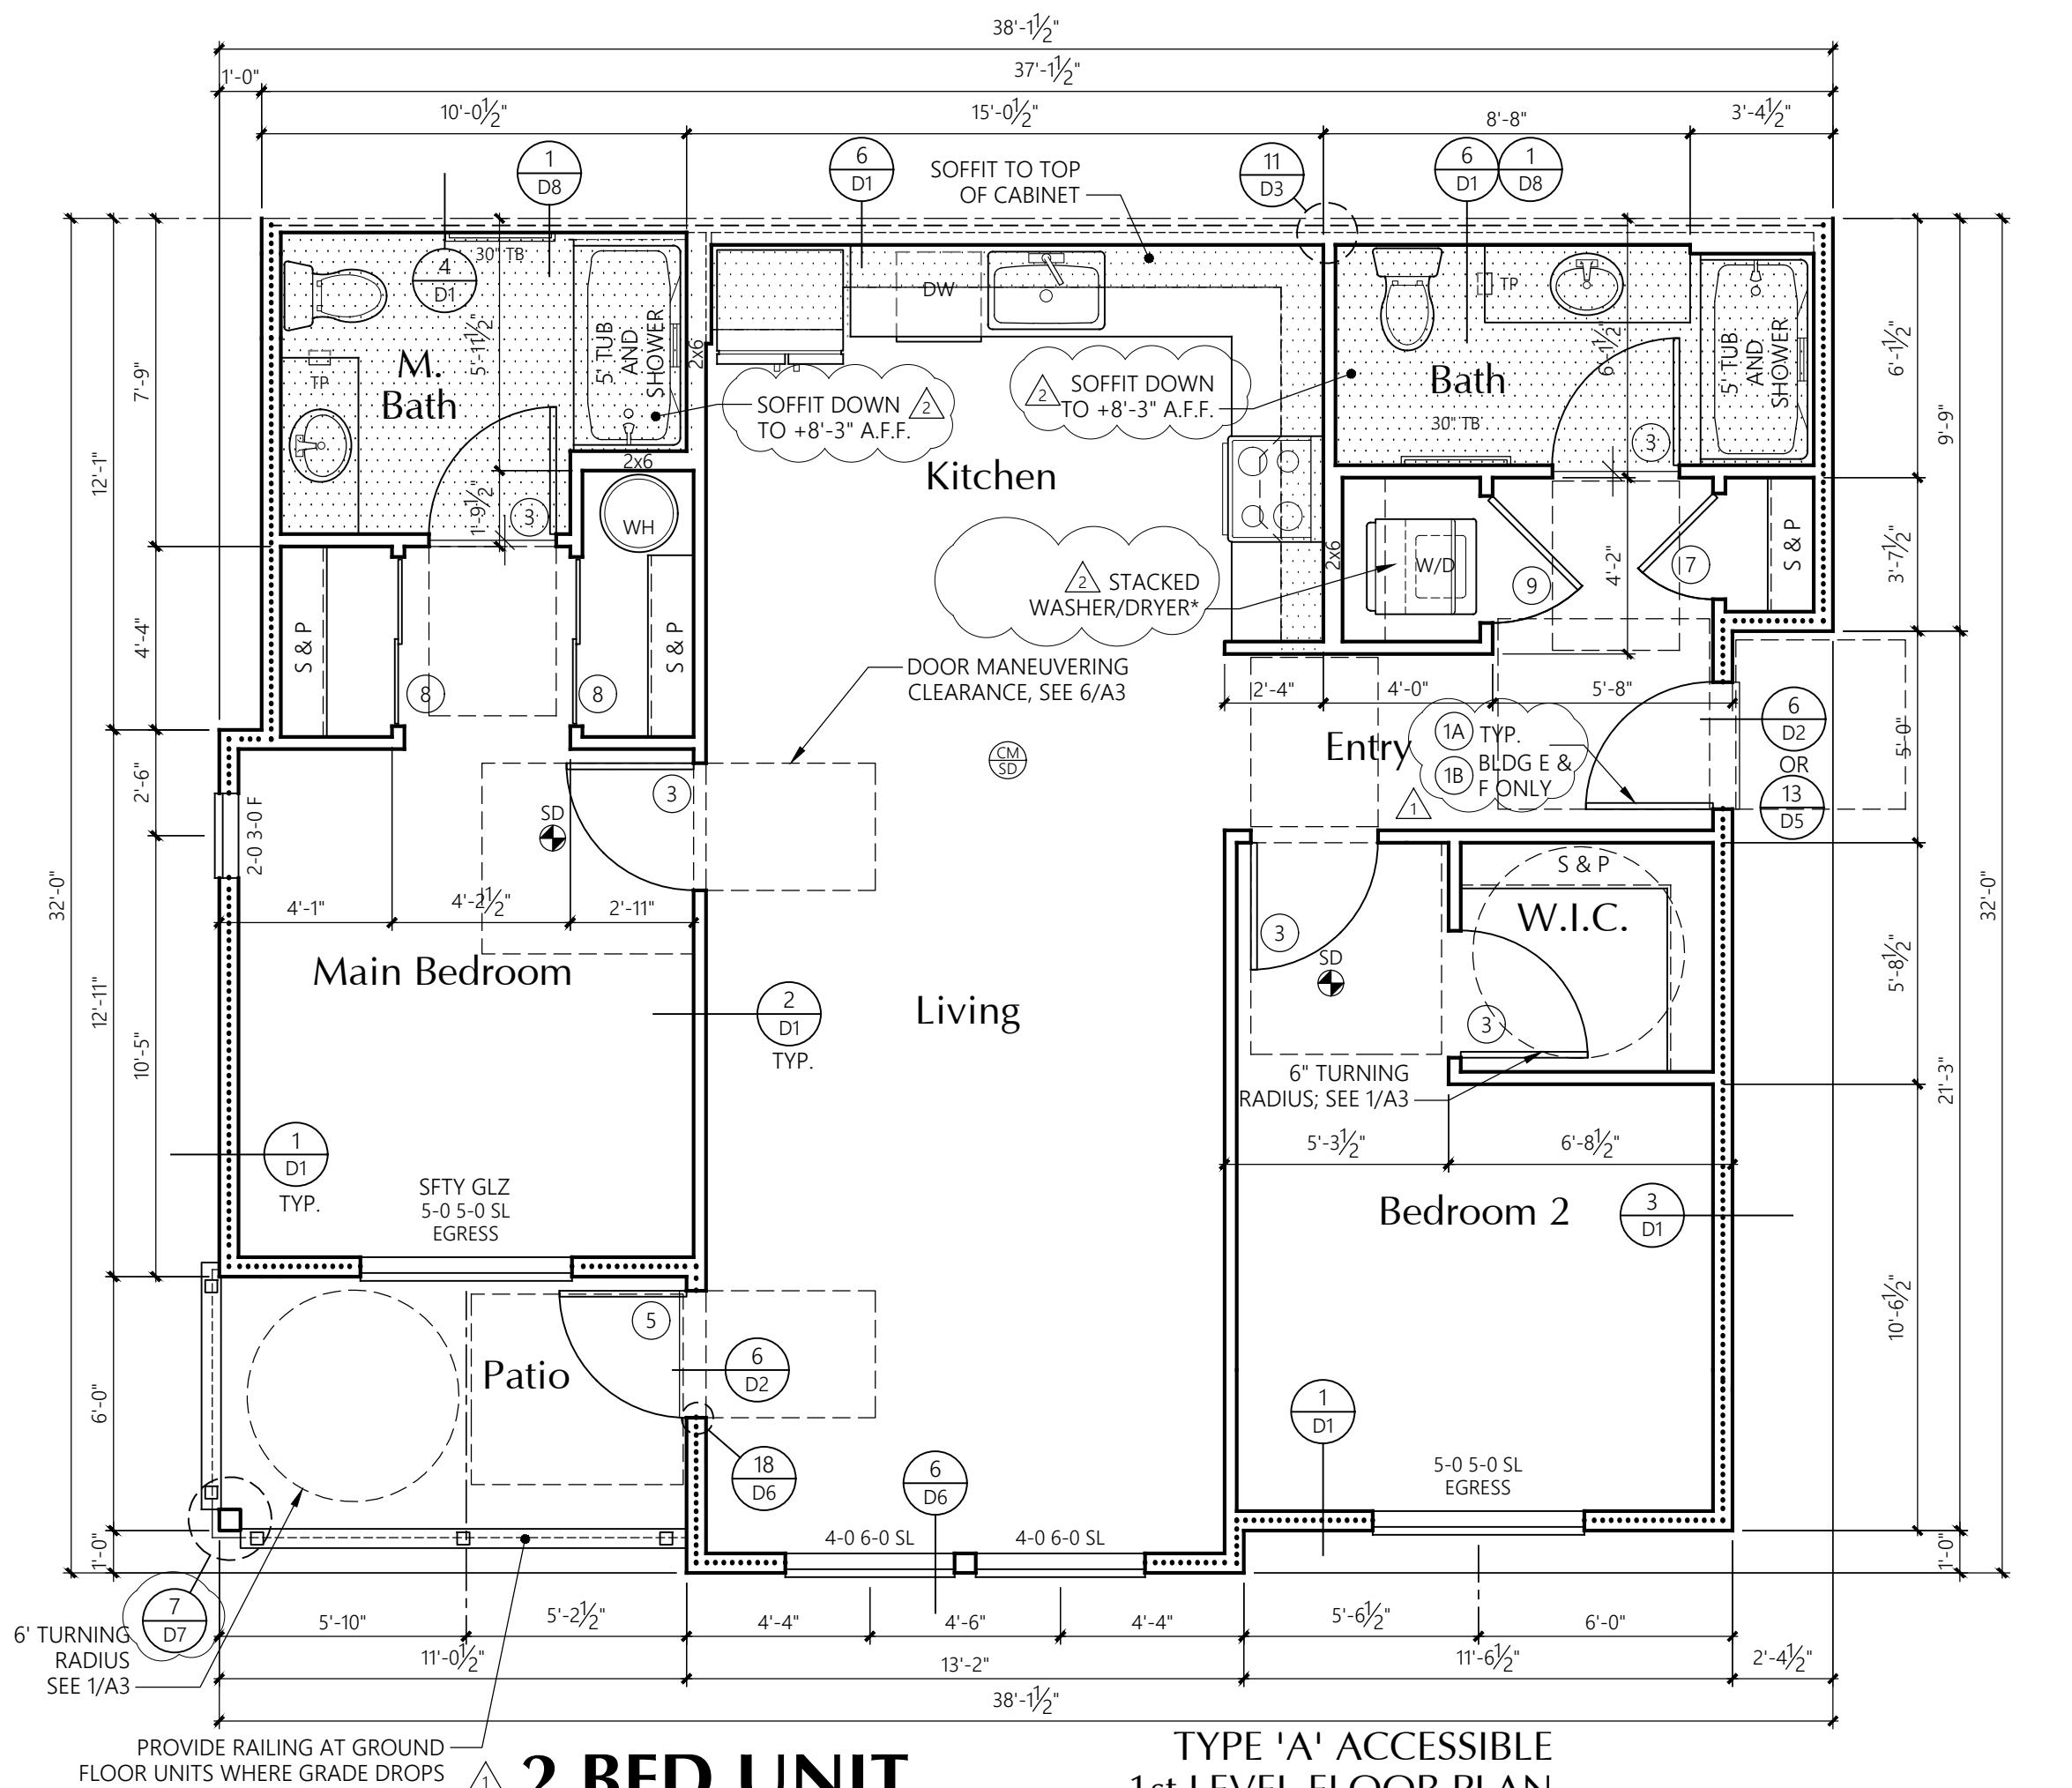

2 BED UNIT

TYPE 'A' ACCESSIBLE
1st LEVEL FLOOR PLAN

*STACKED WASHER/DRYER IN TYPE 'A' UNIT TO BE
REPLACED WITH ACCESSIBLE COMBO UNIT AS
REQUIRED BY TENANT. ACCESSIBLE COMBO UNIT TO BE
PURCHASED IN ADVANCE AND STORED ON SITE. SEE
DETAIL 20/U11.1 FOR ADDITIONAL REQUIREMENTS.

AREA SUMMARY	
Heated SF	Patio/Deck SF

Total SF 1019 66

UNIT PLAN NOTES

FRAMING:
2x6's AT EXTERIOR WALLS
2x4's AT INTERIOR WALLS
UNLESS NOTED OTHERWISE.

R-21 BATT INSULATION U.N.O.

R-13 BATT INSULATION
3 1/2" ACOUSTICAL INSULATION BOTH
SIDES OF EXTERIOR WALL U.N.O.

LOCATION OF SOFFIT FOR VENT
RUNS. SOFFIT HEIGHT +8'-0" A.F.F.
U.N.O. ON PLANS; SEE DETAIL 1/D8

SD SMOKE DETECTOR

CM CARBON MONOXIDE/SMOKE DETECTOR

CONCEALED SPACES SHALL BE FIRESTOPPED IN BOTH
DIRECTIONS AT 10'-0" ON CENTER AND AT FLOORS. TYPICAL.

ALL ESCAPE OR RESCUE WINDOWS FROM SLEEPING ROOMS
SHALL HAVE A MINIMUM NET CLEAR OPENING OF 5.7 SQUARE
FEET. THE MINIMUM CLEAR OPENING HEIGHT DIMENSION
SHALL BE 24". MINIMUM CLEAR OPENING WIDTH DIMENSION
SHALL BE 20". EMERGENCY ESCAPE AND RESCUE OPENINGS
SHALL HAVE THE BOTTOM OF CLEAR OPENING NOT GREATER
THAN 44 INCHES MEASURED FROM THE FLOOR.

WHERE THE OPENING OF THE SILL PORTION OF AN OPERABLE
WINDOW IS LOCATED MORE THAN 72 INCHES ABOVE THE
FINISHED GRADE OR OTHER SURFACE BELOW, THE LOWEST
PART OF THE CLEAR OPENING OF THE WINDOW SHALL BE AT
A HEIGHT NOT LESS THAN 36 INCHES ABOVE THE FINISHED
FLOOR SURFACE. THE PORTION OF THE WINDOW WHICH IS
LOCATED OPERABLE SECTIONS OF WINDOWS SHALL NOT
PERMIT OPENINGS THAT ALLOW PASSAGE OF A 4 INCH
DIAMETER SPHERE WHERE SUCH OPENINGS ARE LOCATED
WITHIN 36 INCHES OF THE FINISHED FLOOR.

ALL GLAZING SHALL CONFORM TO THE 2018 IBC.
CHAPTER 24, SEC. 2406, SAFETY GLAZING. GLAZING IN ALL
DOORS SHALL BE SAFETY TYPE AND ALL GLAZING WITHIN A
24" ARC OF EITHER VERTICAL EDGE SHALL BE SAFETY TYPE.

PROVIDE 3/8" TYPE 'X' (MIN) GYPSUM SHEATHING ON WALLS
BEHIND TUB/SHOWERS TO SATISFY FIRE REQUIREMENTS AT
PARTYWALL CONDITION. PROVIDE 3/8" PLYWOOD UNDER TUB
IN PLACE OF THE GYPCRETE, SEE DETAIL 14/D1

DOOR KEY:

WINDOW KEY:

TYPE:
FIX = FIXED/PICTURE
SL = SLIDER
SH = SINGLE HUNG
SGD = SLIDING GLASS DOOR

GYPSUM WALLBOARD SCHEDULE

EXCEPT WHERE NOTED OTHERWISE, 5/8" TYPE 'X' GYPSUM
WALLBOARD SHALL BE USED THROUGHOUT.
ON INTERIOR NON-RATED WALLS, EXTERIOR WALLS,
CORRIDOR WALLS, AND 1-HOUR AND 2-HOUR FIRE-RATED
WALLS.

**STANDARD PLATE
HEIGHT: 9'-1"**

SEE ELEVATION SHEETS FOR
FLOOR TO FLOOR HEIGHTS

**WINDOW HDR IS 8'-0"
UNLESS NOTED OTHERWISE**

SEE SHEET U9 FOR INTERIOR ELEVATIONS

NOTE: ALL CONCEALED OR EXPOSED
INSULATION SHALL HAVE A FLAME SPREAD INDEX OF NOT
MORE THAN 25 AND A SMOKE-DEVELOPED
INDEX OF NOT MORE THAN 450

THE FORCE REQUIRED TO ACTIVATE ALL OTHER
OPERABLE ITEMS LISTED ABOVE SHALL BE
5 POUNDS.

*BI-FOLD DOOR HARDWARE AT LAUNDRY TO BE
FULL ACCESS HARDWARE.

THE 30x48" CLEAR FLOOR
SPACE IS REQUIRED AT EACH
FIXTURE OR LOCATION SHOWN
ON THE FLOOR PLAN.

ACCESSIBILITY NOTES:

ALL GROUND FLOOR UNITS IN THIS PROJECT MUST
MEET THE ACCESSIBILITY REQUIREMENTS OF
TYPE B ACCESSIBLE UNITS AS REQUIRED
BY CHAPTER 11 OF THE 2018 IBC.

INCLUDED IN THE ABOVE GROUND FLOOR UNITS
5% OF ALL UNITS NEED TO MEET THE ACCESSIBILITY
REQUIREMENTS OF TYPE A ACCESSIBLE UNITS
AS REQUIRED BY CHAPTER 11 OF THE 2018 IBC.
SEE BUILDING PLANS FOR LOCATION OF TYPE A UNITS.

SEE SHEET U11/U11.1 FOR SPECIFIC ADAPTABILITY STANDARD
FOR BOTH TYPE A AND TYPE B ACCESSIBLE UNITS.
SEE INTERIOR ELEVATION SHEETS FOR ADDITIONAL
ACCESSIBILITY REQUIREMENTS.

LIGHTING CONTROLS, ELECTRICAL SWITCHES,
ENVIRONMENTAL CONTROLS, OPERATING HARDWARE
FOR DOORS AND WINDOWS, AND PLUMBING
FIXTURE CONTROLS SHALL BE OPERABLE WITH
ONE HAND AND SHALL NOT REQUIRE TIGHT
GRASPING, CHINING OR TWISTING OF THE WRIST
TO OPERATE, EXCEPT FOR OPERABLE DOOR
HARDWARE. SUCH ITEMS SHALL BE 15" MINIMUM
AND 44" MAXIMUM ABOVE THE FLOOR (48" FOR
WINDOWS).

OPERABLE ENTRY DOOR HARDWARE SHALL BE
34" MINIMUM AND 48" MAXIMUM ABOVE THE FLOOR.

OPENING FORCES FOR ENTRY DOOR SHALL BE:
15 POUNDS TO RELEASE THE LATCH
30 POUNDS TO SET DOOR IN MOTION
15 POUNDS TO OPEN DOOR IN FULL 90°
FORCE MEASURED AT LATCH SIDE OF DOOR.


THE DOOR CLOSER ON THE ENTRY DOOR
SHALL BE ADJUSTED TO CLOSE FROM AN OPEN
POSITION OF 90° TO AN OPEN POSITION OF 12°
IN NOT LESS THAN 5 SECONDS.

OPENING FORCE OF ALL SWINGING INTERIOR
DOORS AND THE SLIDING GLASS DOOR SHALL
NOT EXCEED 5 POUNDS APPLIED TO THE
LATCH SIDE OF THE DOOR.

THE FORCE REQUIRED TO ACTIVATE ALL OTHER
OPERABLE ITEMS LISTED ABOVE SHALL BE
5 POUNDS.

*BI-FOLD DOOR HARDWARE AT LAUNDRY TO BE
FULL ACCESS HARDWARE.

THE 30x48" CLEAR FLOOR
SPACE IS REQUIRED AT EACH
FIXTURE OR LOCATION SHOWN
ON THE FLOOR PLAN.

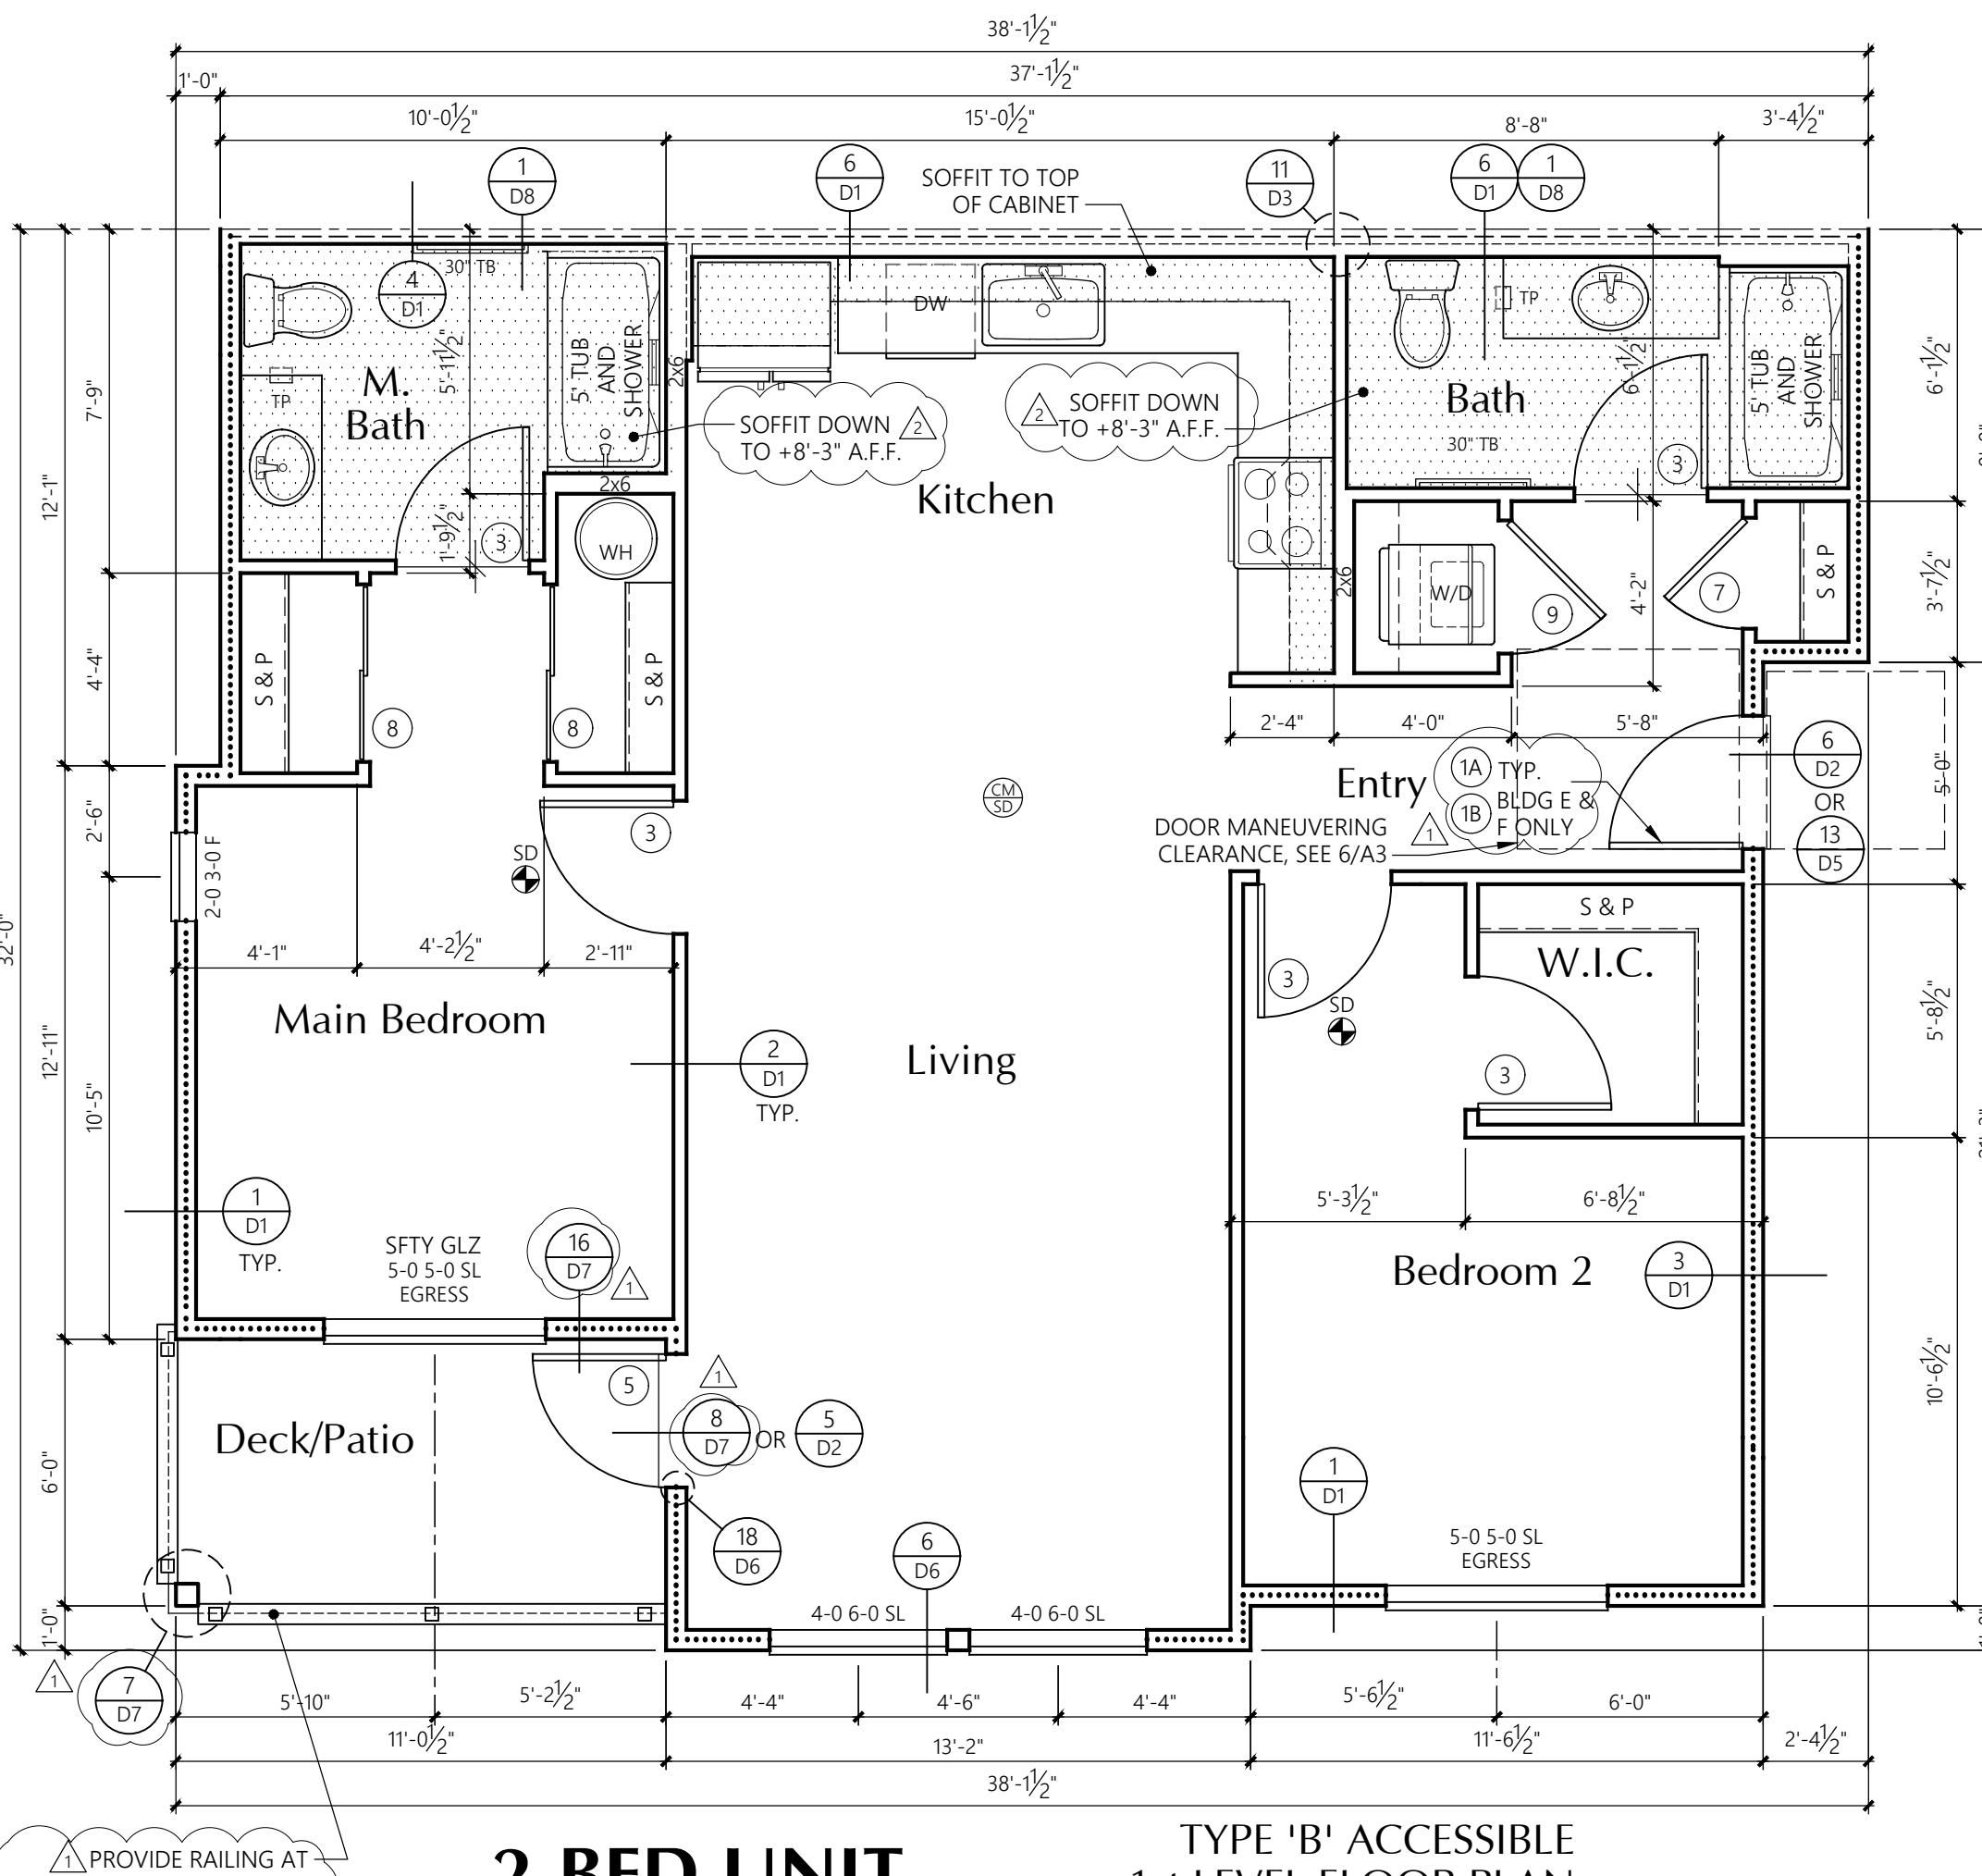


2-BED UNIT

TYPE 'B' ACCESSIBLE
1st LEVEL FLOOR PLAN

1/4" = 1'-0"

AREA SUMMARY	
Heated SF	Patio/Deck SF

Total SF 1019 66

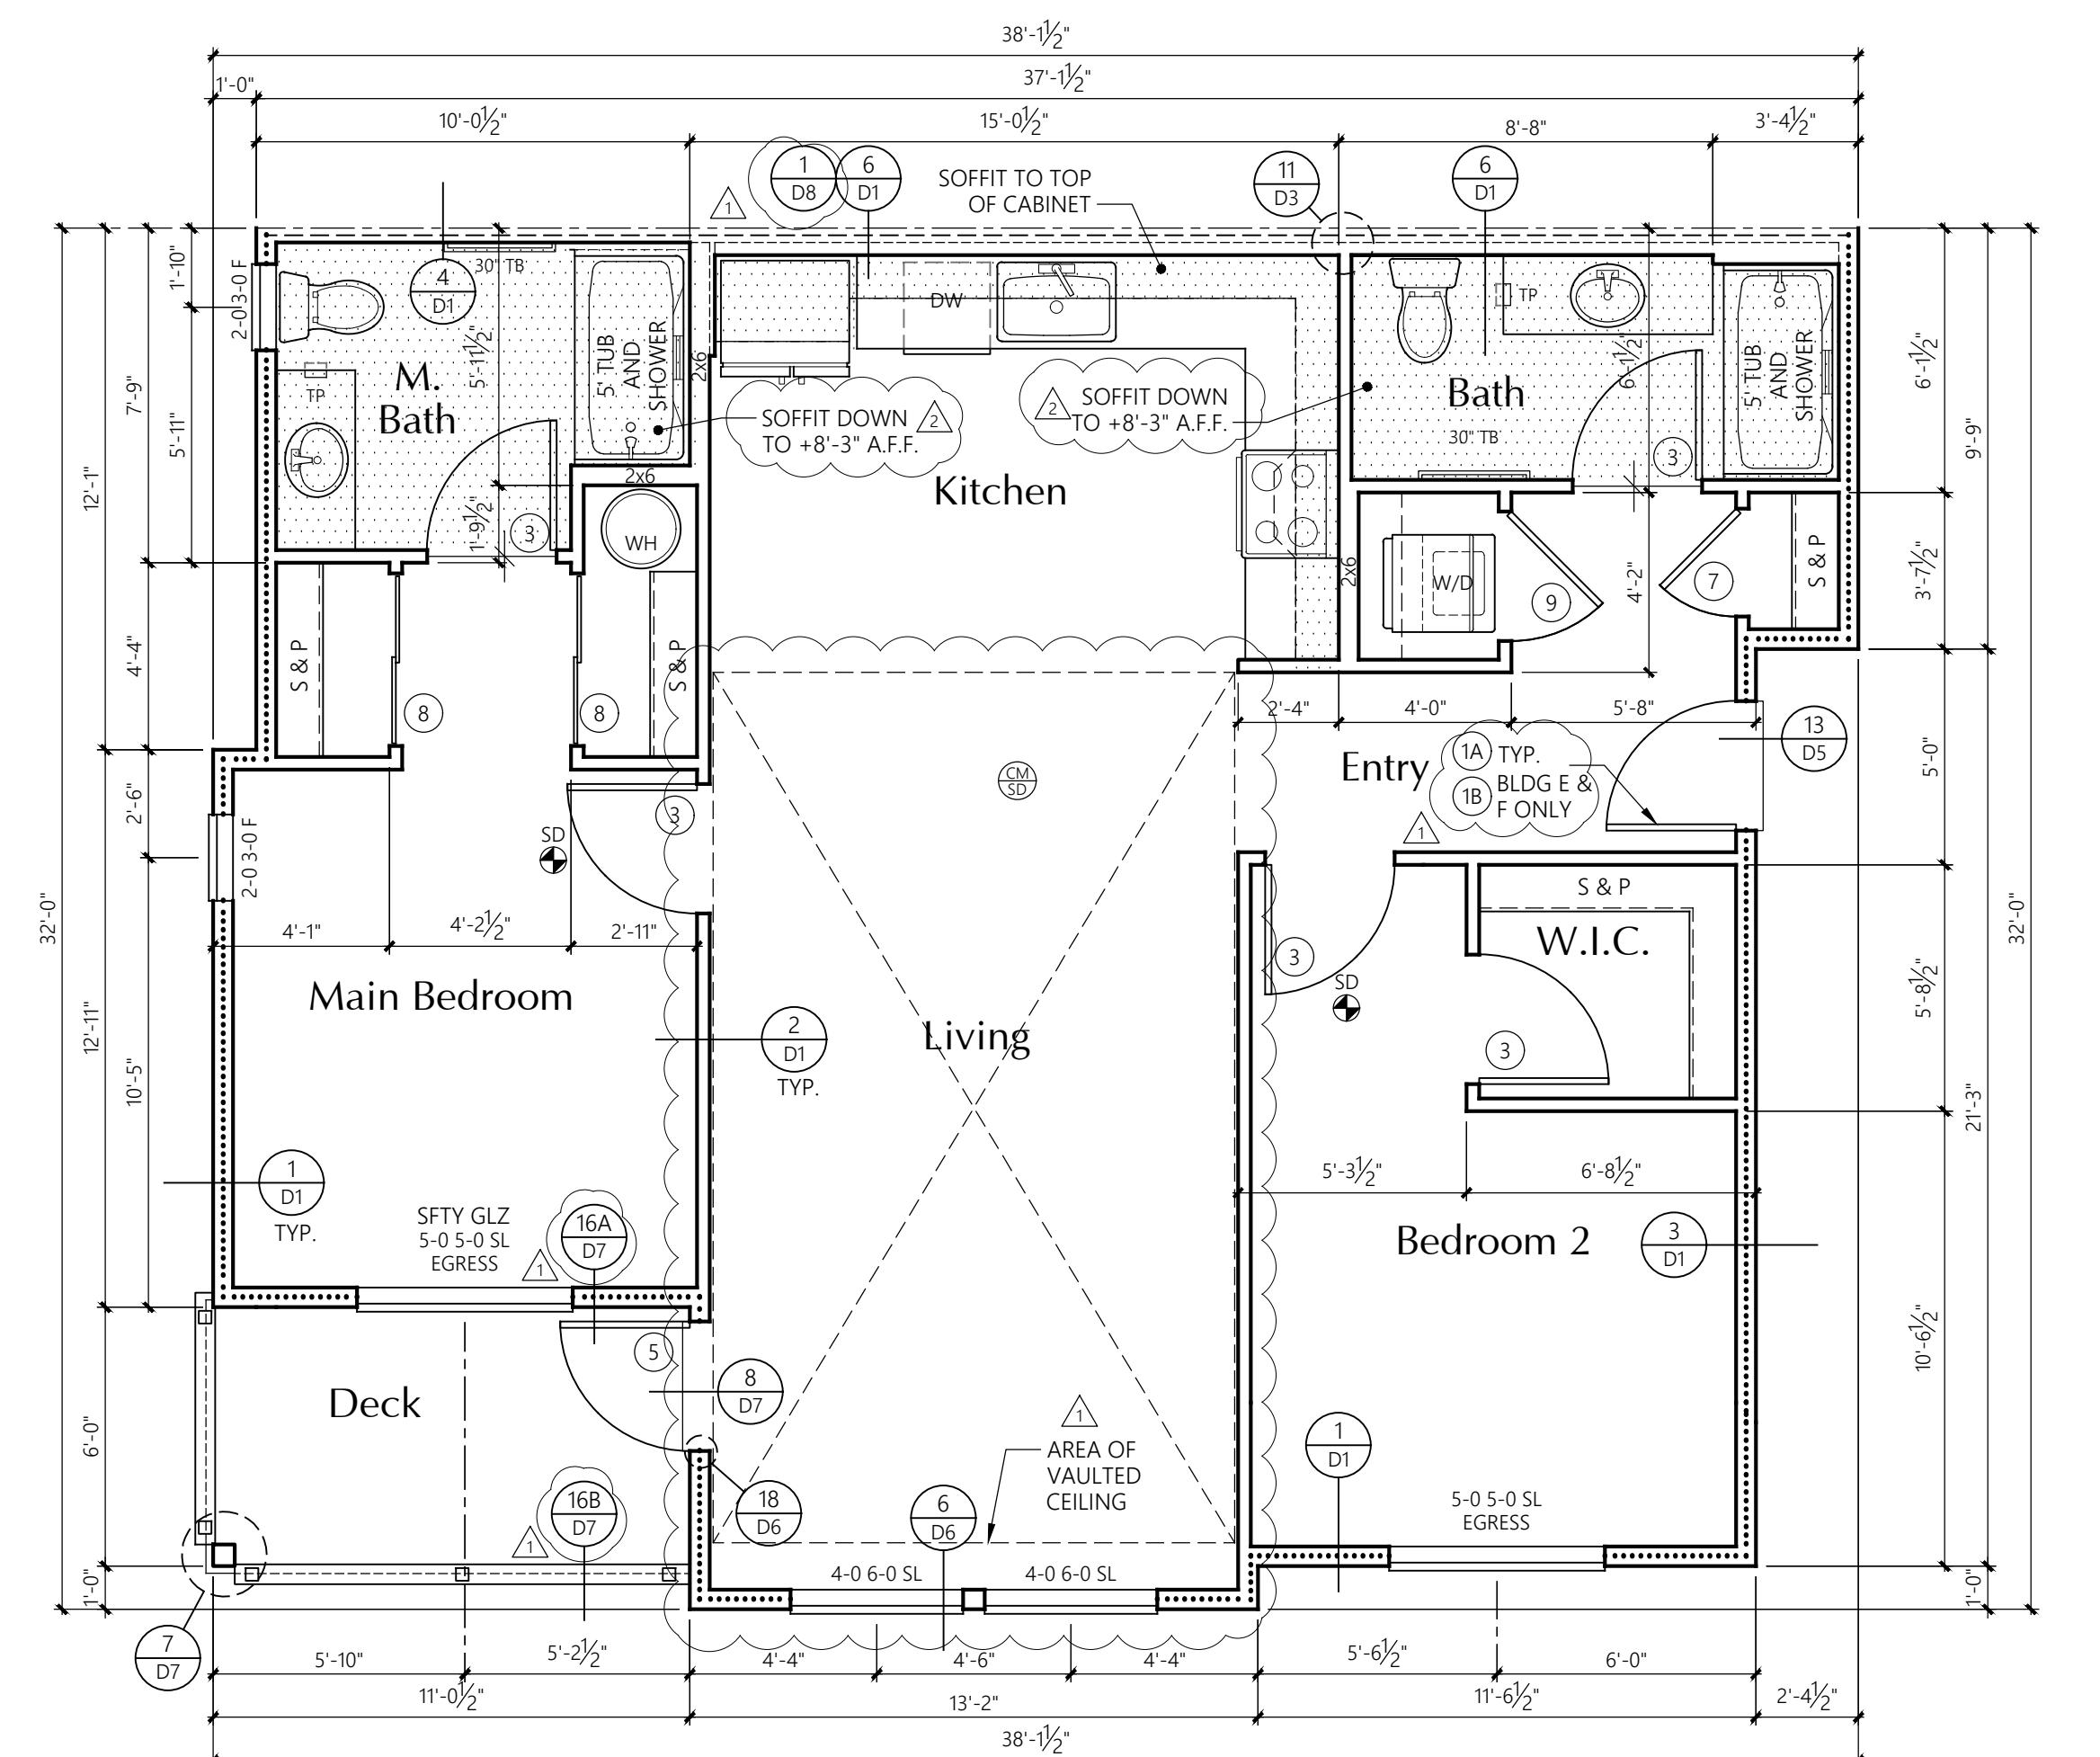


2-BED UNIT

1/4" = 1'-0"

NON-ACCESSIBLE
3rd LEVEL FLOOR PLAN

AREA SUMMARY		
	Heated SF	Patio/Deck SF
Total SF	1019	66

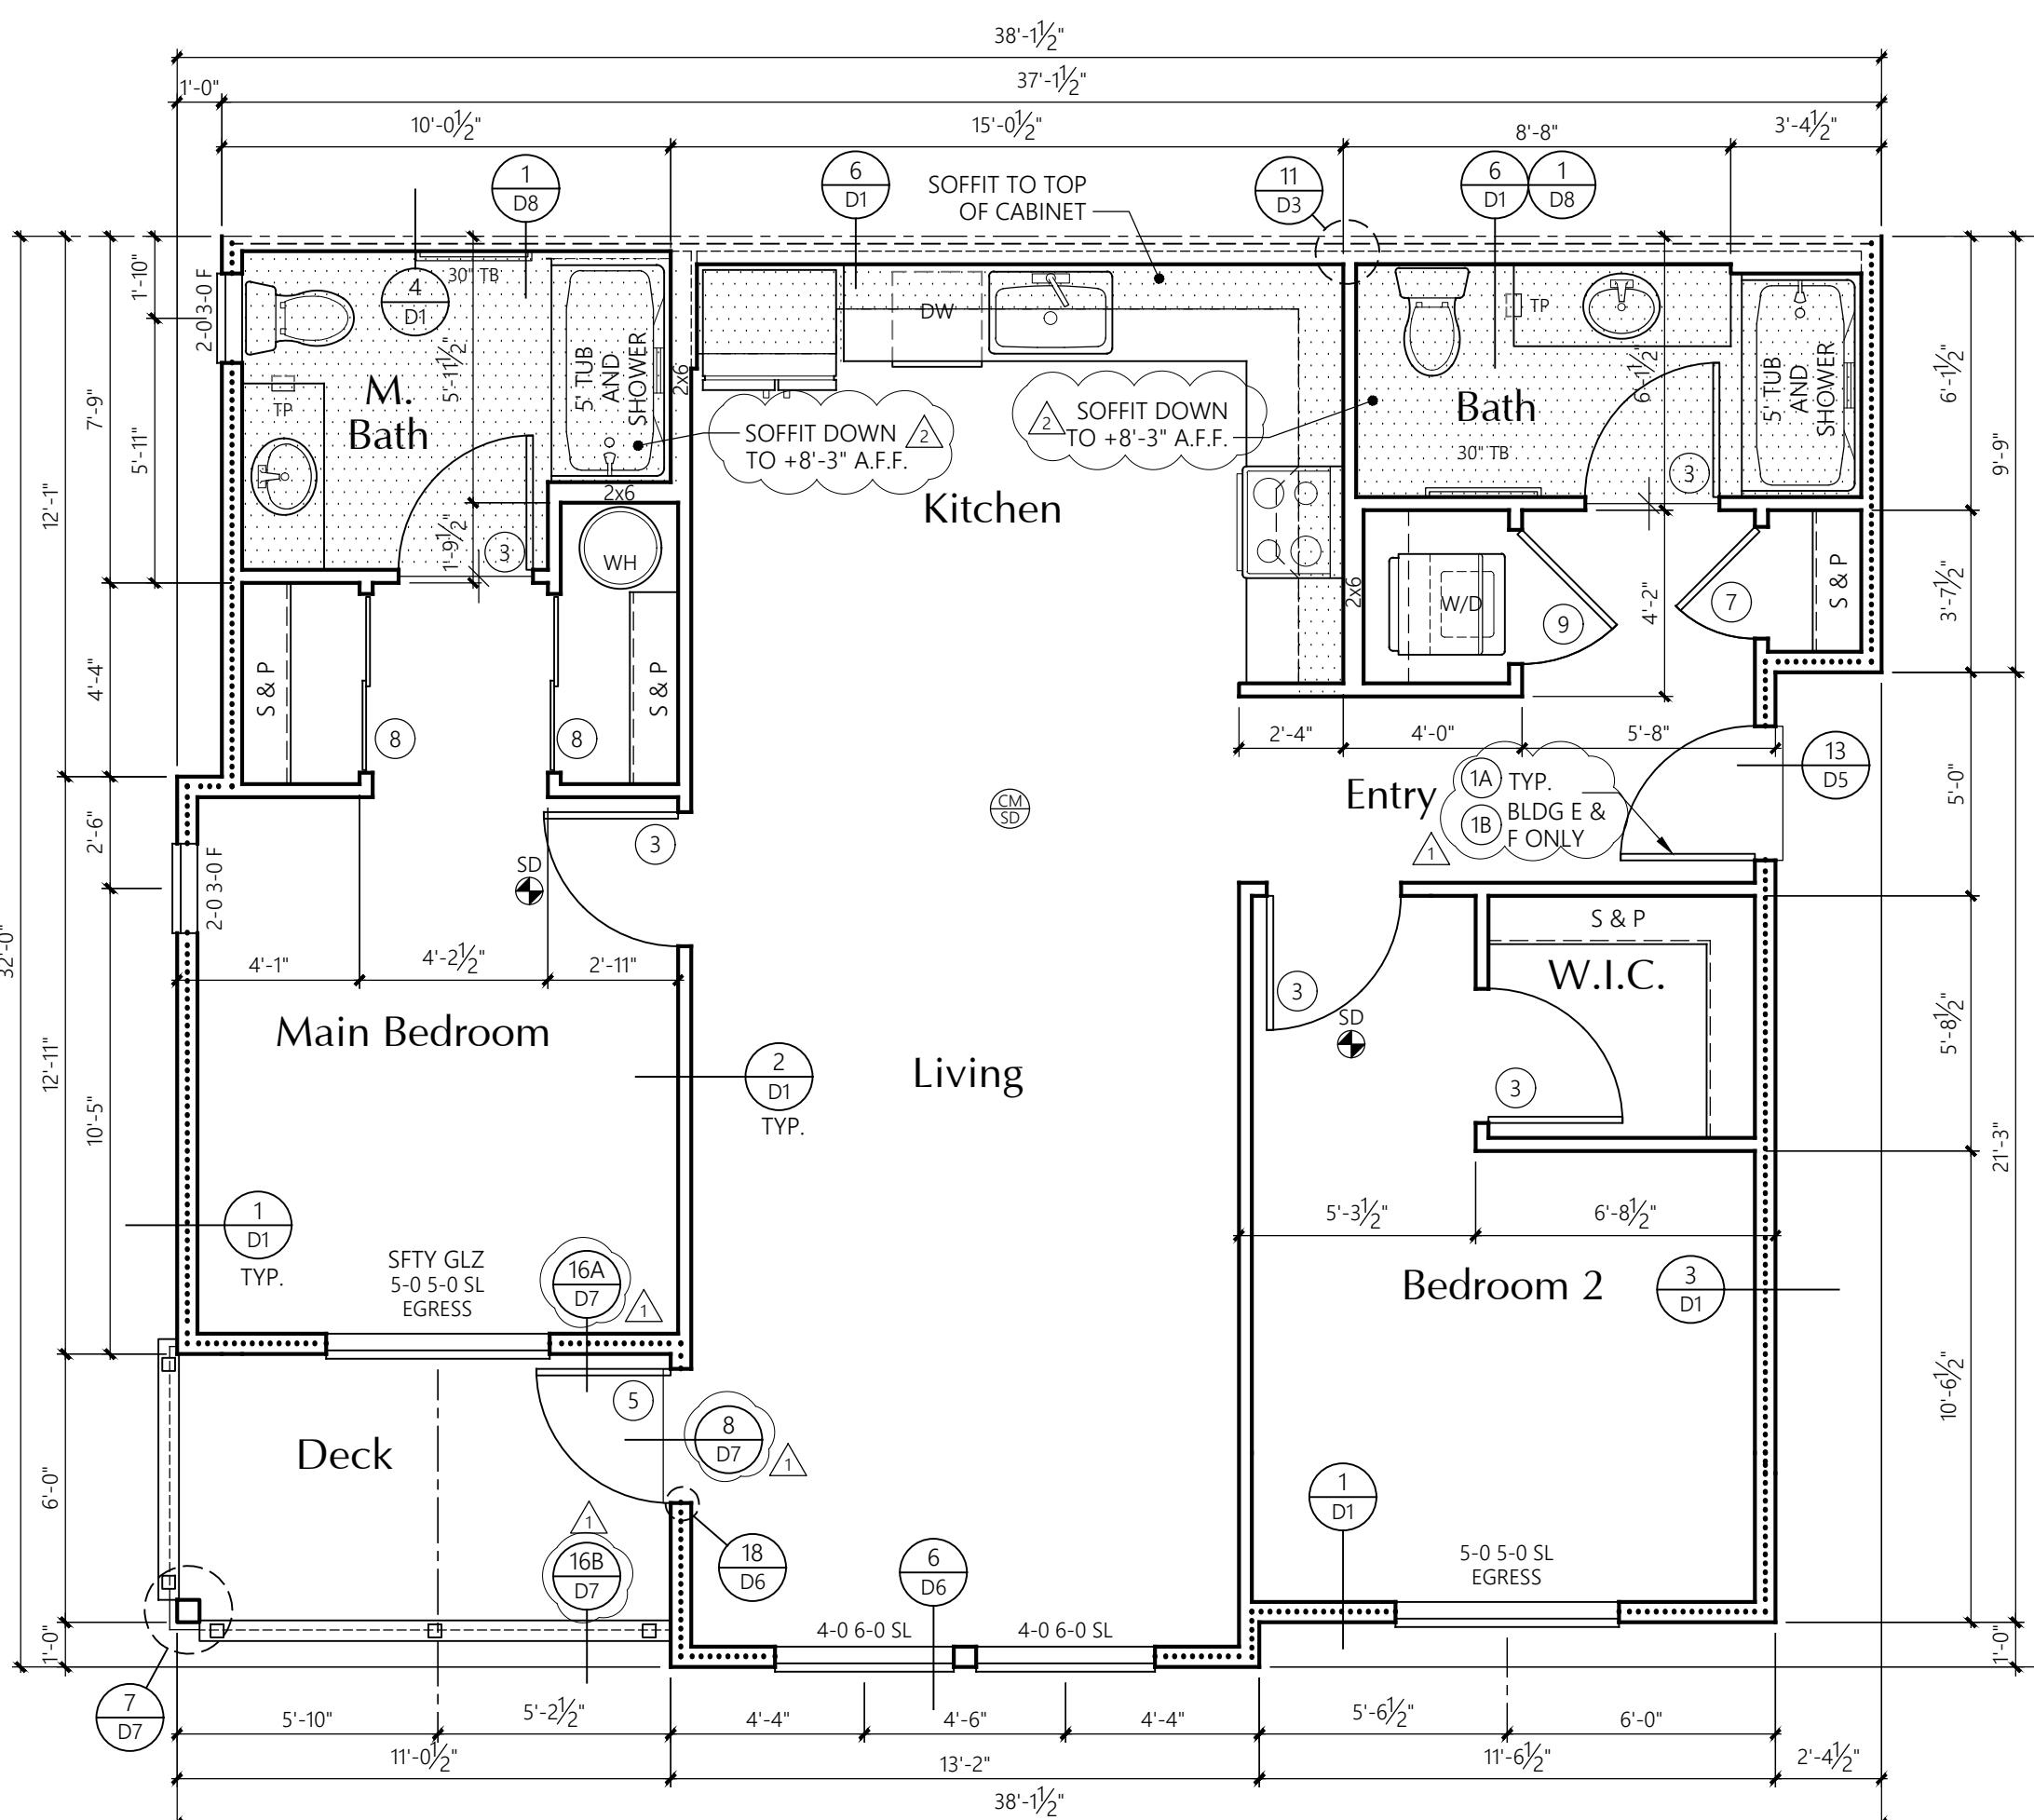

2-BED UNIT

1/4" = 1'-0"

NON-ACCESSIBLE
2nd LEVEL FLOOR PLAN

AREA SUMMARY		
	Heated SF	Patio/Deck SF
Total SF	1019	66

UNIT PLAN NOTES

FRAMING:
2x6's AT EXTERIOR WALLS
2x4's AT INTERIOR WALLS
UNLESS NOTED OTHERWISE.

PROVIDE WATER RESISTANT GYPSUM WALLBOARD
BEHIND TUB AND SHOWER ENCLOSURE MATERIALS TO A
HEIGHT OF 70" MINIMUM ABOVE THE DRAIN INLET.

ALL BEDROOM AND BATHROOM DOORS SHALL BE UNDERCUT
A MINIMUM OF 1/2" ABOVE THE ADJACENT FLOOR COVERING.
THE FRONT DOOR SHALL BE OPENABLE FROM THE INSIDE
WITHOUT THE USE OF A KEY OR ANY SPECIAL KNOWLEDGE OR
EFFORT. IT MAY BE PROVIDED WITH A NIGHT LATCH DEAD
BOLT OR SECURITY CHAIN, PROVIDED SUCH DEVICES ARE
OPENABLE FROM THE INSIDE WITHOUT THE USE OF A KEY OR
TOOL, AND MOUNTED NOT TO EXCEED 48" ABOVE THE
FINISHED FLOOR.

SD
SMOKE DETECTOR

CARBON MONOXIDE/SMOKE DETECTOR

CONCEALED SPACES SHALL BE FIRESTOPPED IN BOTH
DIRECTIONS AT 10'-0" ON CENTER AND AT FLOORS. TYPICAL.

ALL ESCAPE OR RESCUE WINDOWS FROM SLEEPING ROOMS
SHALL HAVE A MINIMUM NET CLEAR OPENING OF 5.7 SQUARE
FEET. THE MINIMUM CLEAR OPENING HEIGHT DIMENSION
SHALL BE 24". MINIMUM CLEAR OPENING WIDTH DIMENSION
SHALL BE 20". EMERGENCY ESCAPE AND RESCUE OPENINGS
SHALL HAVE THE BOTTOM OF CLEAR OPENING NOT GREATER
THAN 44 INCHES MEASURED FROM THE FLOOR.

WHERE THE OPENING OF THE SILL PORTION OF AN OPERABLE
WINDOW IS LOCATED MORE THAN 72 INCHES ABOVE THE
FINISHED GRADE OR OTHER SURFACE BELOW, THE LOWEST
PART OF THE CLEAR OPENING OF THE WINDOW SHALL BE AT
A HEIGHT NOT LESS THAN 36 INCHES ABOVE THE FINISHED
FLOOR SURFACE OF THE ROOM IN WHICH THE WINDOW IS
LOCATED. OPERABLE SECTION OF THE WINDOW SHALL NOT
PERMIT OPERATING AT A LOW PASSAGE OF 4.4 INCH
DIAMETER SPHERES WHERE SUCH OPENINGS ARE LOCATED
WITHIN 36 INCHES OF THE FINISHED FLOOR.

ALL GLAZING SHALL CONFORM TO THE 2018 IBC.
CHAPTER 24, SEC. 2406. SAFETY GLAZING. GLAZING IN ALL
DOORS SHALL BE SAFETY TYPE AND ALL GLAZING WITHIN A
24" ARC OF EITHER VERTICAL EDGE SHALL BE SAFETY TYPE.

PROVIDE $\frac{3}{8}$ TYPE X (MIN) GYPSUM SHEATHING ON WALLS
BEHIND TUB/SHOWERS TO SATISFY FIRE REQUIREMENTS AT
PARTYWALL CONDITION. PROVIDE $\frac{3}{8}$ PLWOOD UNDER TUB
IN PLACE OF THE GYPCRETE. SEE DETAIL 14/D1

DOOR KEY:
△ X DOOR TAG, SEE SHEET U14 FOR SCHEDULE

WINDOW KEY:

TYPE:
FIX = FIXED/PICTURE
SL = SLIDER
SH = SINGLE HUNG
SGD = SLIDING GLASS DOOR

GYPSUM WALLBOARD SCHEDULE

EXCEPT WHERE NOTED OTHERWISE, $\frac{3}{8}$ TYPE X GYPSUM
WALLBOARD SHALL BE USED THROUGHOUT
ON INTERIOR NON-RATED WALLS, EXTERIOR WALLS,
CORRIDOR WALLS, AND 1-HOUR AND 2-HOUR FIRE-DEVELOPED
WALLS.

STANDARD PLATE
HEIGHT: 9'-1"

SEE ELEVATION SHEETS FOR
FLOOR TO FLOOR HEIGHTS

WINDOW HDR IS 8'-0"
UNLESS NOTED OTHERWISE

SEE SHEET U9 FOR INTERIOR ELEVATIONS

INSULATION

FOUNDATION PERIMETER - R-10 RIGID INSULATION
TO A DEPTH OF 24" OR TO TOP OF FOOTING AT
HEATED PERIMETER

EXTERIOR WALLS: FIBERGLASS BATT OR BLANKETS
2x6 WALLS - R-21

FLOORS OVER UNHEATED SPACES - R-30


ATTICS AND ROOF ASSEMBLIES - R-49
FULL HEIGHT OF UNCOMPRESSED INSULATION
EXTENDS OVER THE WALL TOP PLATE AT
THE EAVES

EXTERIOR DOORS: MAIN ENTRY U=0.20

ALL OTHERS U=0.40

WINDOWS: MILGARD VINYL
TYPE (VINYL) MODEL U-VALUE
SLIDING 6110 ARGON/LoE 0.24 or BETTER
FIXED 6110 ARGON/LoE 0.24 or BETTER
SINGLE HUNG 6210 ARGON/LoE 0.24 or BETTER
DBL. SLIDER 8125 ARGON/LoE 0.24 or BETTER
SGD 6610 ARGON/LoE 0.24 or BETTER

NOTE: ALL CONCEALED OR EXPOSED INSULATION
SHALL HAVE A FLAME SPREAD INDEX OF NOT
MORE THAN 25 AND A SMOKE-DEVELOPED
INDEX OF NOT MORE THAN 450

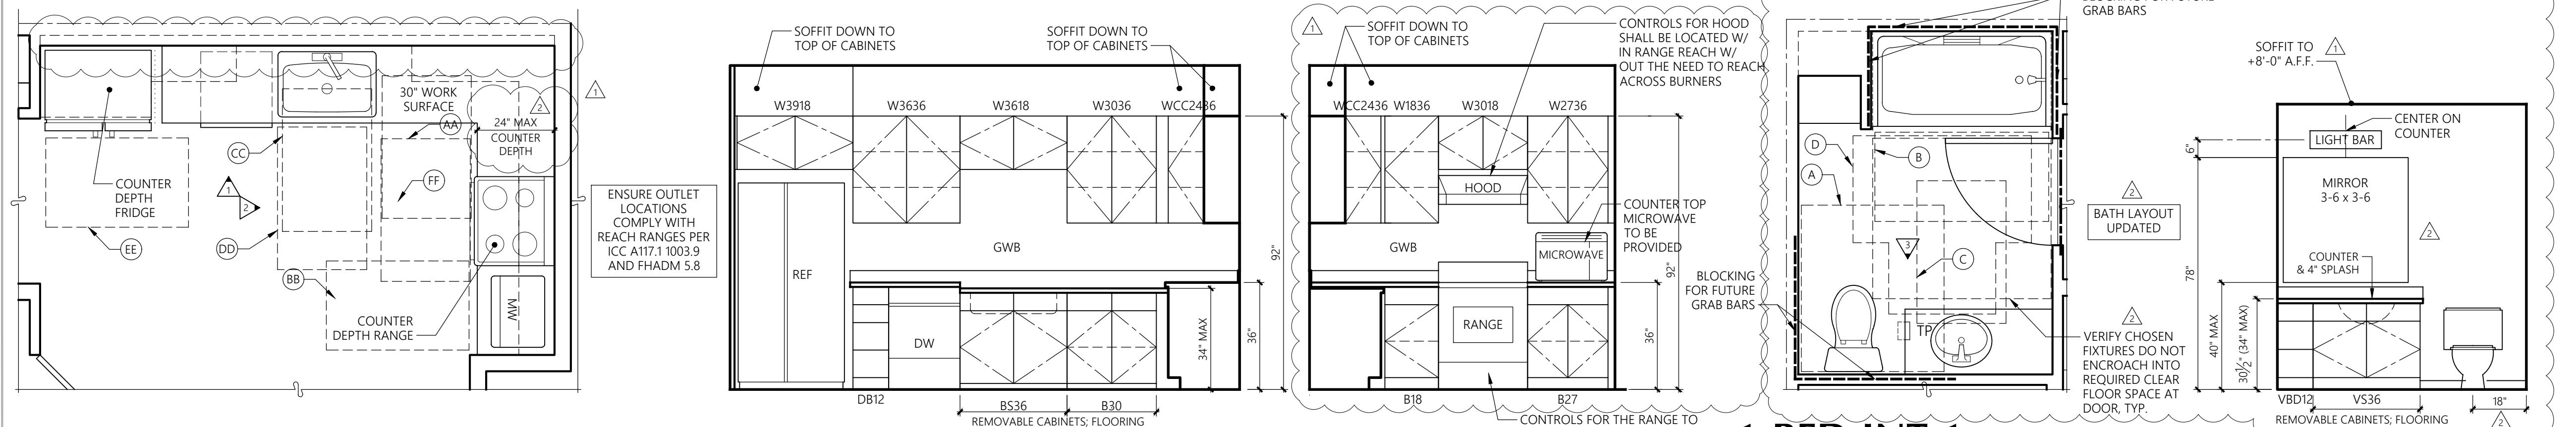


1-BED-INT-1 & 1-BED-INT-2 KITCHEN PLAN

3/8" = 1'-0"

TYPE 'A' KITCHEN

SEE 11/J20

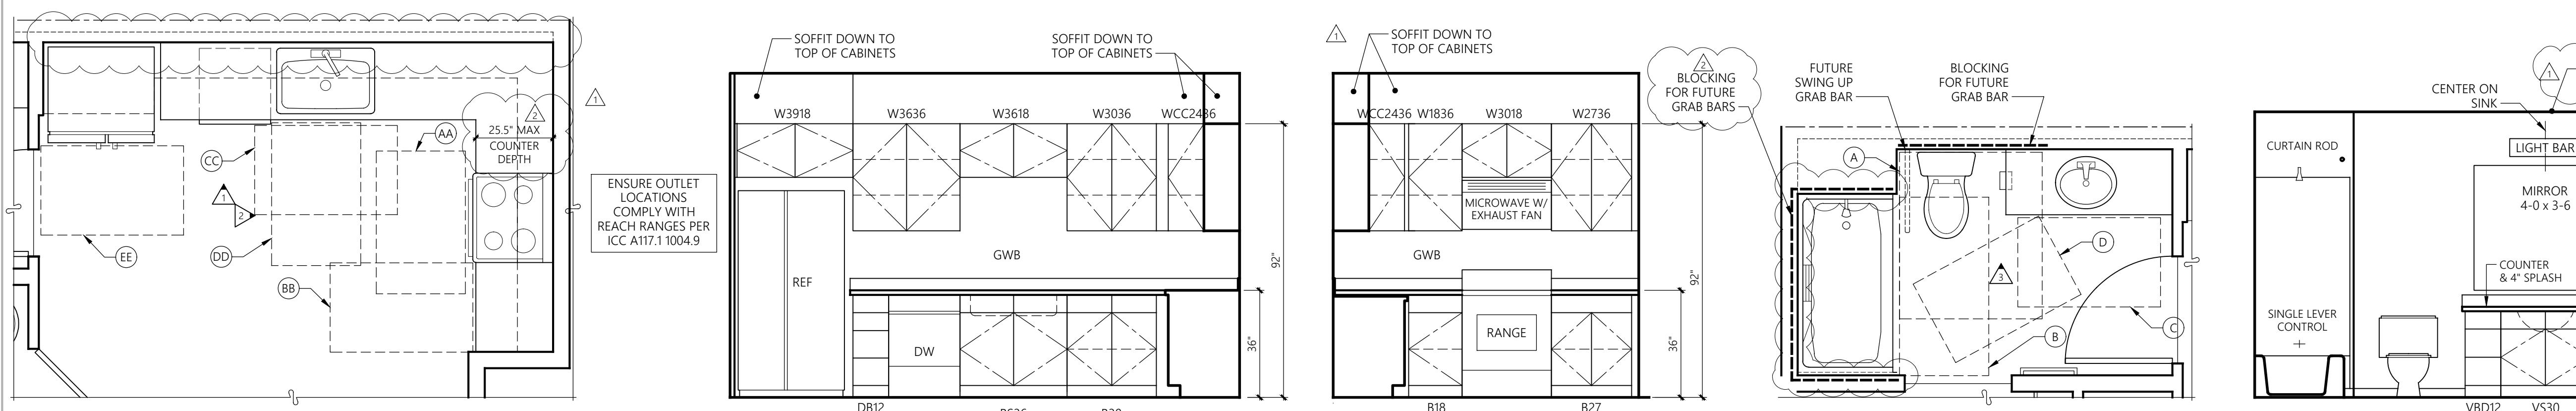


1-BED-INT-1 & 1-BED-INT-2 KITCHEN PLAN

3/8" = 1'-0"

TYPE 'B' KITCHEN

SEE 11/J20

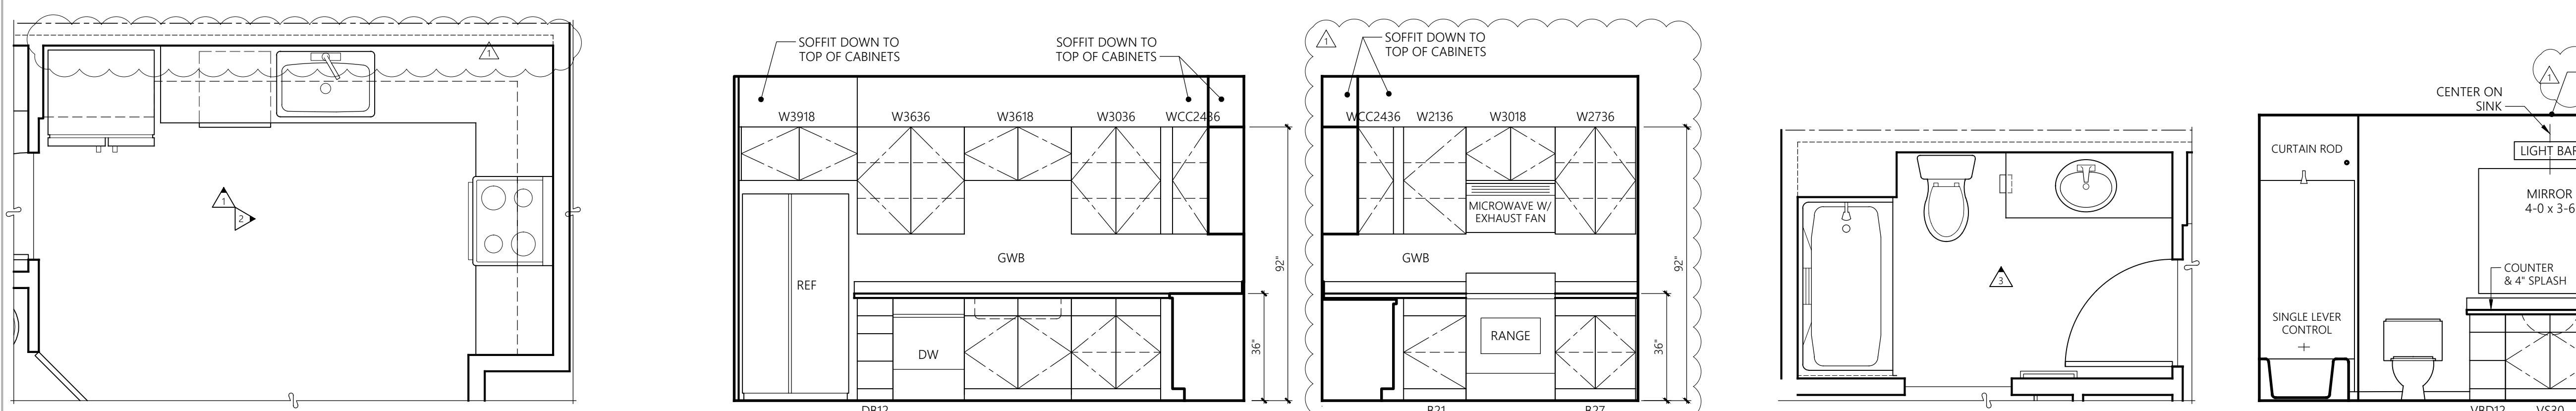


1-BED-INT-1, 2, ALT-1 & ALT-2

3/8" = 1'-0"

NON-ACCESSIBLE KITCHEN PLAN



SEE 11/J20

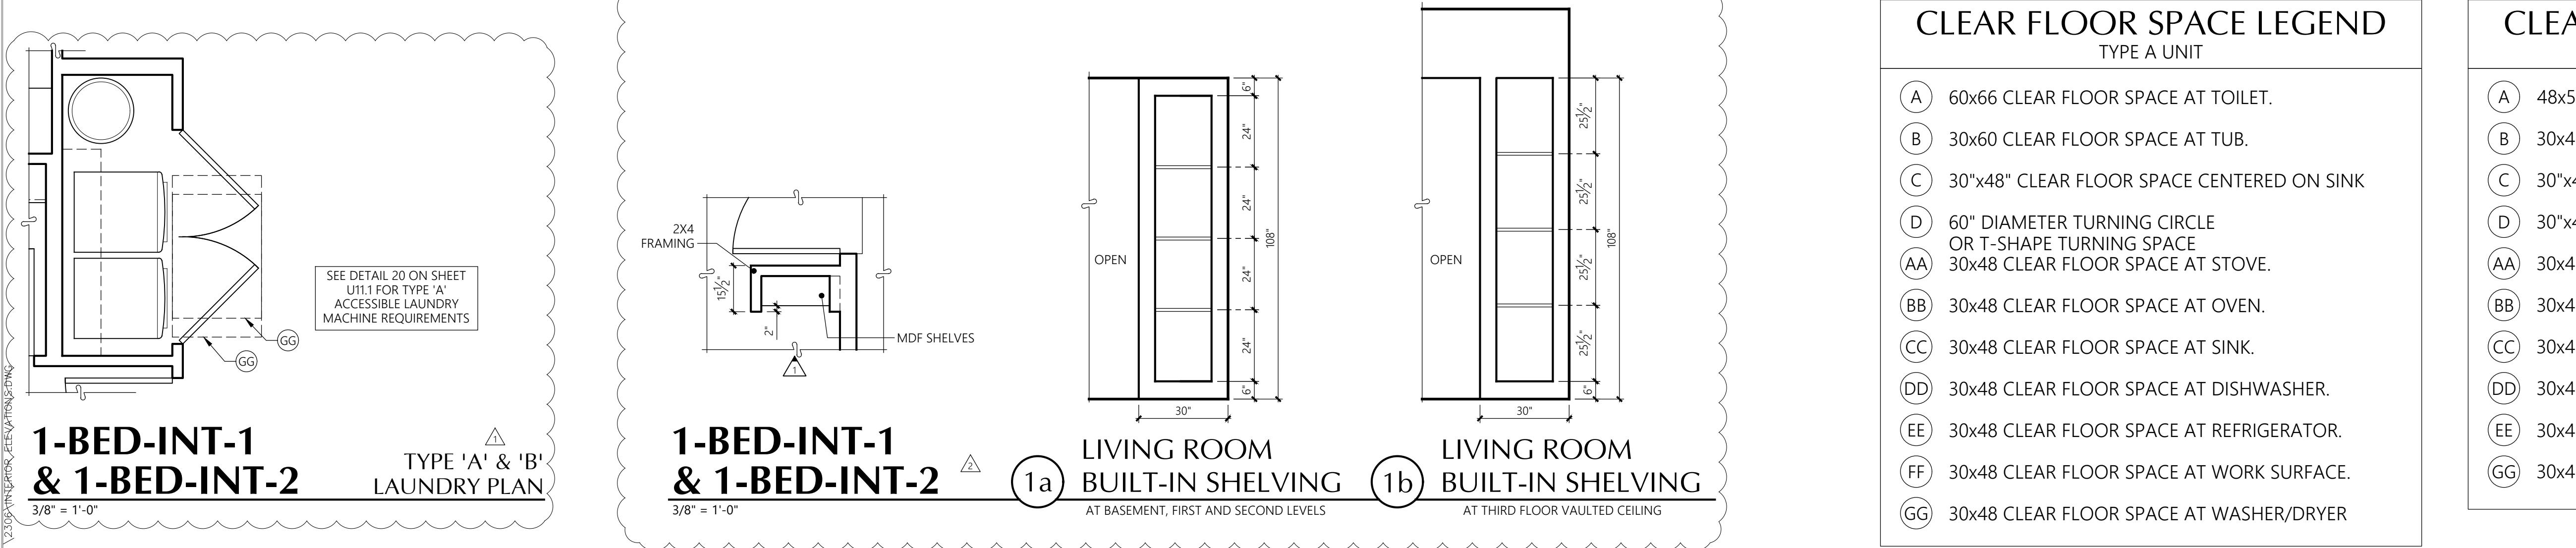

1-BED-INT-1 & 1-BED-INT-2

3/8" = 1'-0"

TYPE 'A' & 'B' LAUNDRY PLAN

H: 2309 INTERIOR ELEVATIONS

1-BED-INT-1 & 1-BED-INT-2

3/8" = 1'-0"

1a LIVING ROOM BUILT-IN SHELVING

AT BASEMENT, FIRST AND SECOND LEVELS

1b LIVING ROOM BUILT-IN SHELVING


AT THIRD FLOOR VAULTED CEILING

CLEAR FLOOR SPACE LEGEND
TYPE A UNIT

- (A) 60x66 CLEAR FLOOR SPACE AT TOILET.
- (B) 30x60 CLEAR FLOOR SPACE AT TUB.
- (C) 30"x48" CLEAR FLOOR SPACE CENTERED ON SINK
- (D) 60" DIAMETER TURNING CIRCLE OR T-SHAPE TURNING SPACE
- (AA) 30x48 CLEAR FLOOR SPACE AT STOVE.
- (BB) 30x48 CLEAR FLOOR SPACE AT OVEN.
- (CC) 30x48 CLEAR FLOOR SPACE AT SINK.
- (DD) 30x48 CLEAR FLOOR SPACE AT DISHWASHER.
- (EE) 30x48 CLEAR FLOOR SPACE AT REFRIGERATOR.
- (FF) 30x48 CLEAR FLOOR SPACE AT WORK SURFACE.
- (GG) 30x48 CLEAR FLOOR SPACE AT WASHER/DRYER

CLEAR FLOOR SPACE LEGEND
TYPE B UNIT

- (A) 48x56 CLEAR FLOOR SPACE AT TOILET.
- (B) 30x48 CLEAR FLOOR SPACE AT TUB.
- (C) 30"x48" CLEAR FLOOR SPACE CENTERED ON SINK
- (D) 30"x48" CLEAR FLOOR SPACE BEYOND ARC OF DOOR.
- (AA) 30x48 CLEAR FLOOR SPACE AT STOVE.
- (BB) 30x48 CLEAR FLOOR SPACE AT OVEN.
- (CC) 30x48 CLEAR FLOOR SPACE AT SINK.
- (DD) 30x48 CLEAR FLOOR SPACE AT DISHWASHER.
- (EE) 30x48 CLEAR FLOOR SPACE AT REFRIGERATOR.
- (GG) 30x48 CLEAR FLOOR SPACE AT WASHER/DRYER

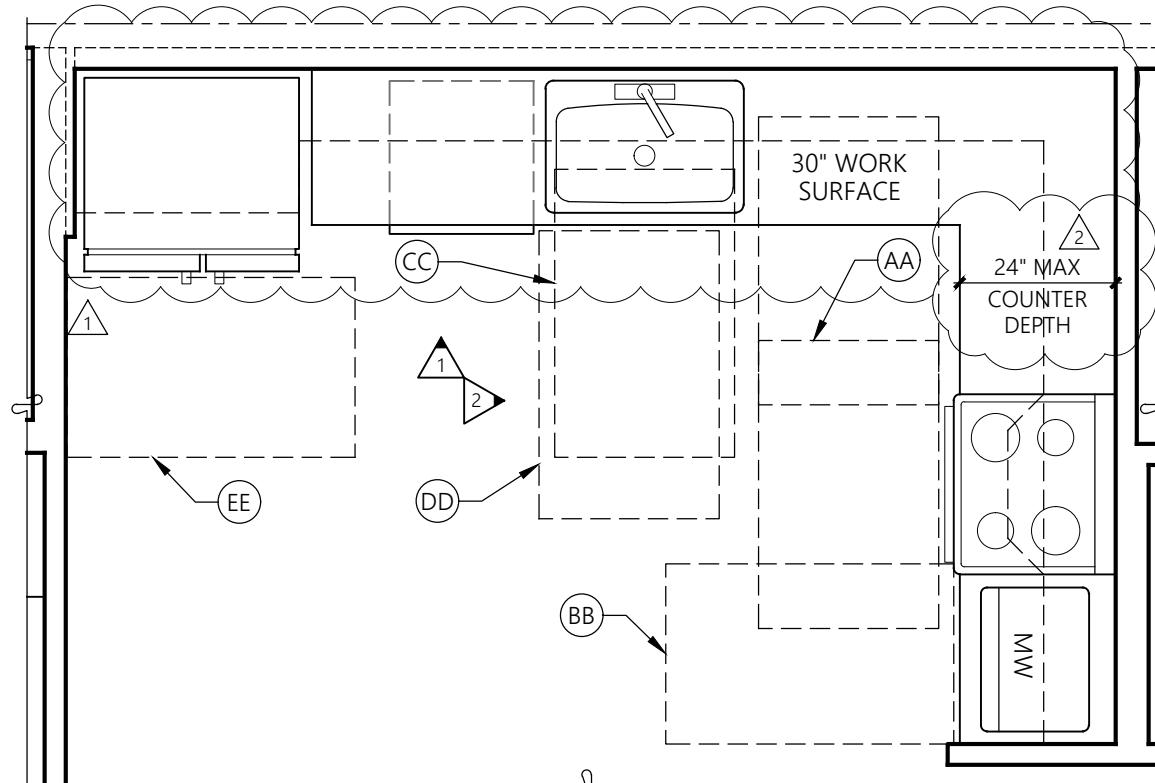

2-BED & 2-BED-ALT


TYPE 'A'
KITCHEN PLAN

1 KITCHEN

3/8" = 1'-0"

2 KITCHEN

3/8" = 1'-0"

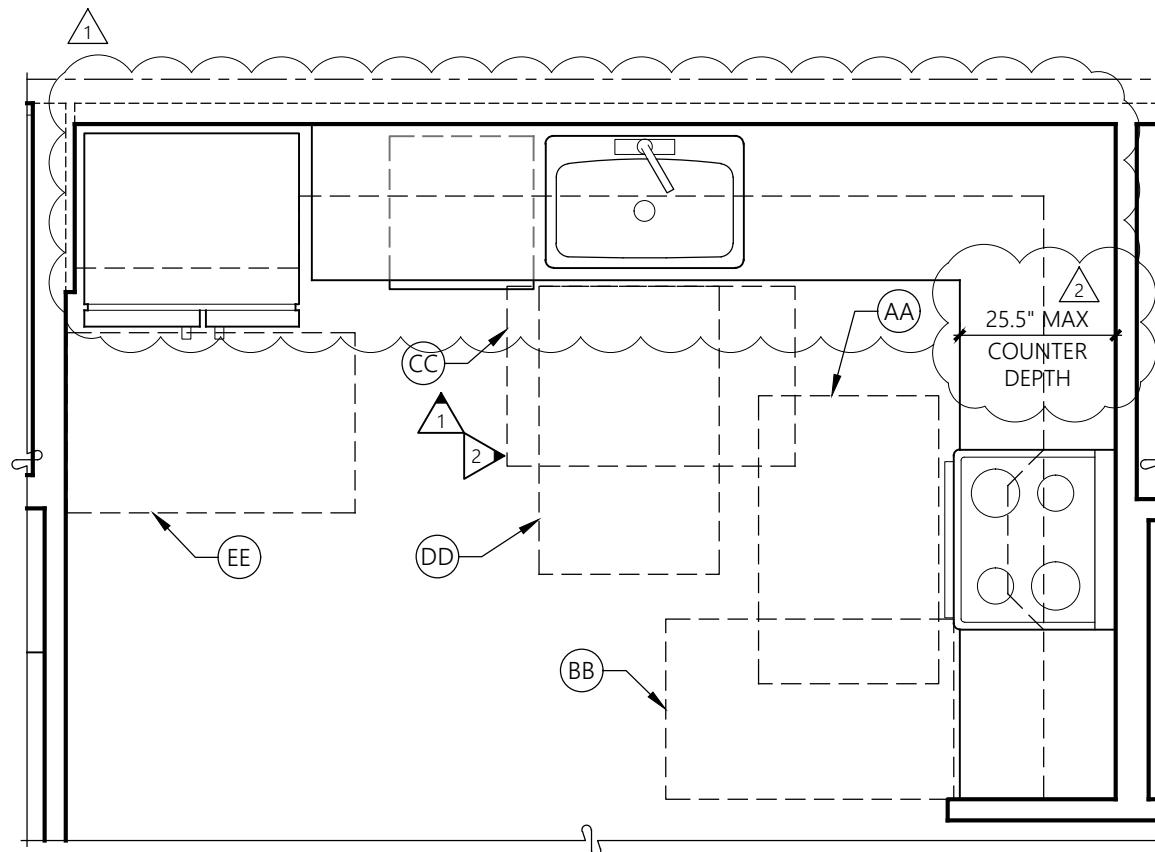

2-BED & 2-BED-ALT


TYPE 'B'
KITCHEN PLAN

1 KITCHEN

3/8" = 1'-0"

2 KITCHEN

3/8" = 1'-0"

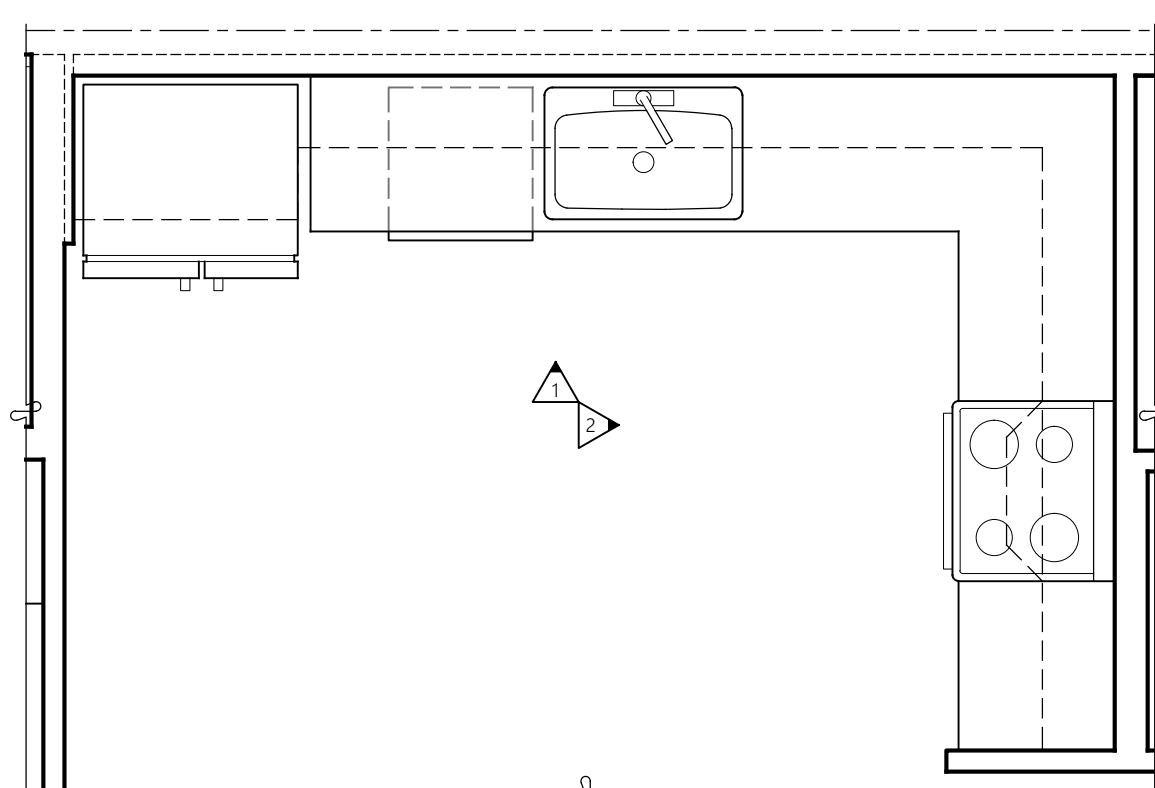

2-BED & 2-BED-ALT


NON-ACCESSIBLE
KITCHEN PLAN

1 KITCHEN

3/8" = 1'-0"

2 KITCHEN

3/8" = 1'-0"

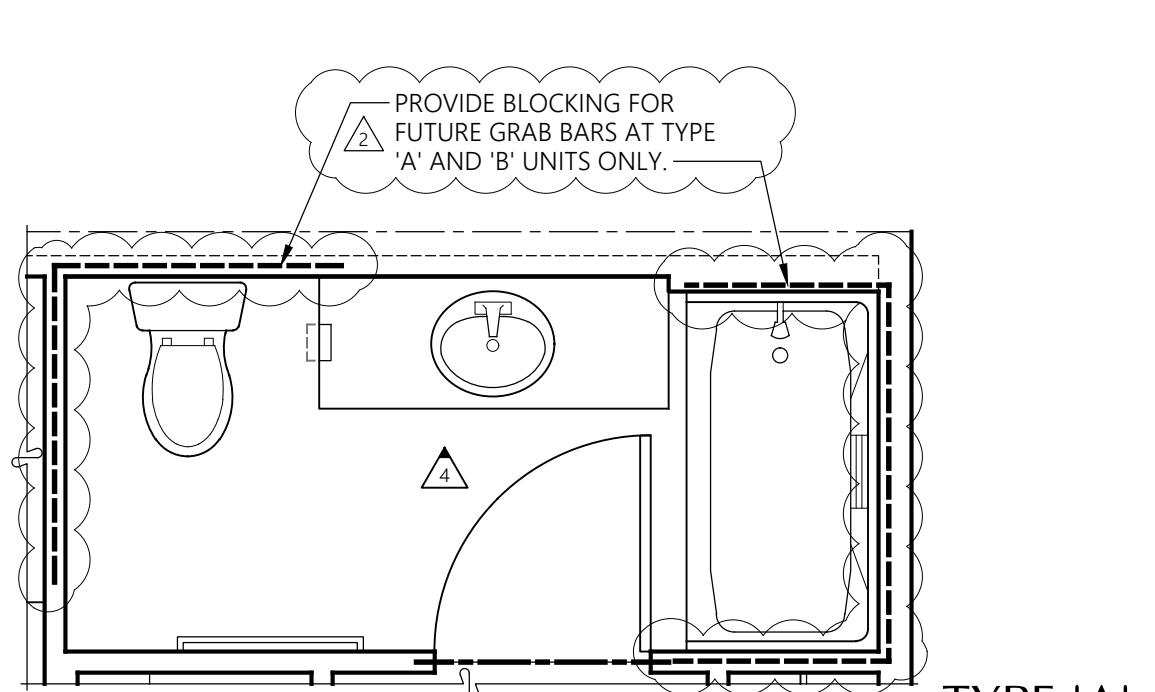


2-BED & 2-BED-ALT

NON-ACCESSIBLE
SECONDARY BATH PLAN

4 SECONDARY BATH

3/8" = 1'-0"

3/8" = 1'-0"

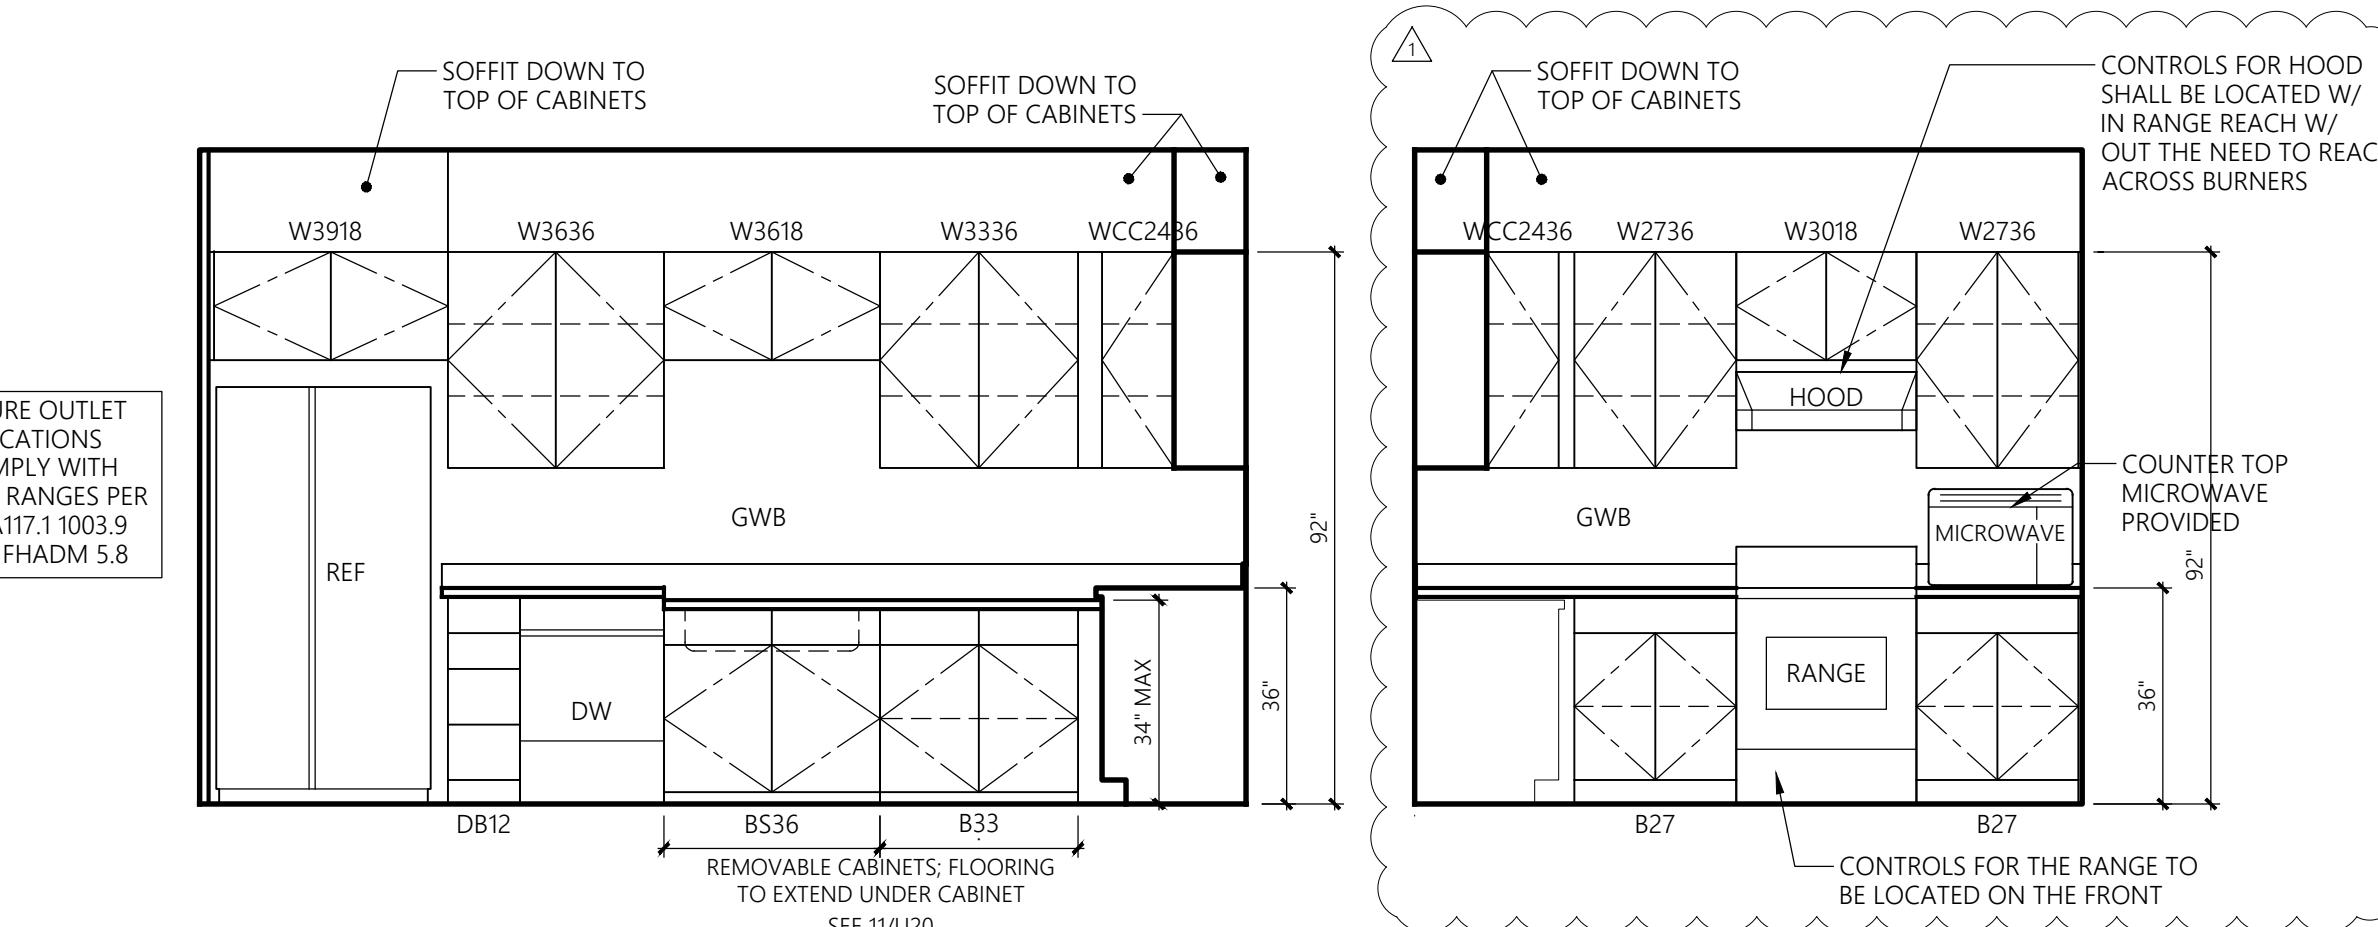


2-BED & 2-BED-ALT

TYPE 'A'
M. BATH PLAN

3 MAIN BATH

3/8" = 1'-0"

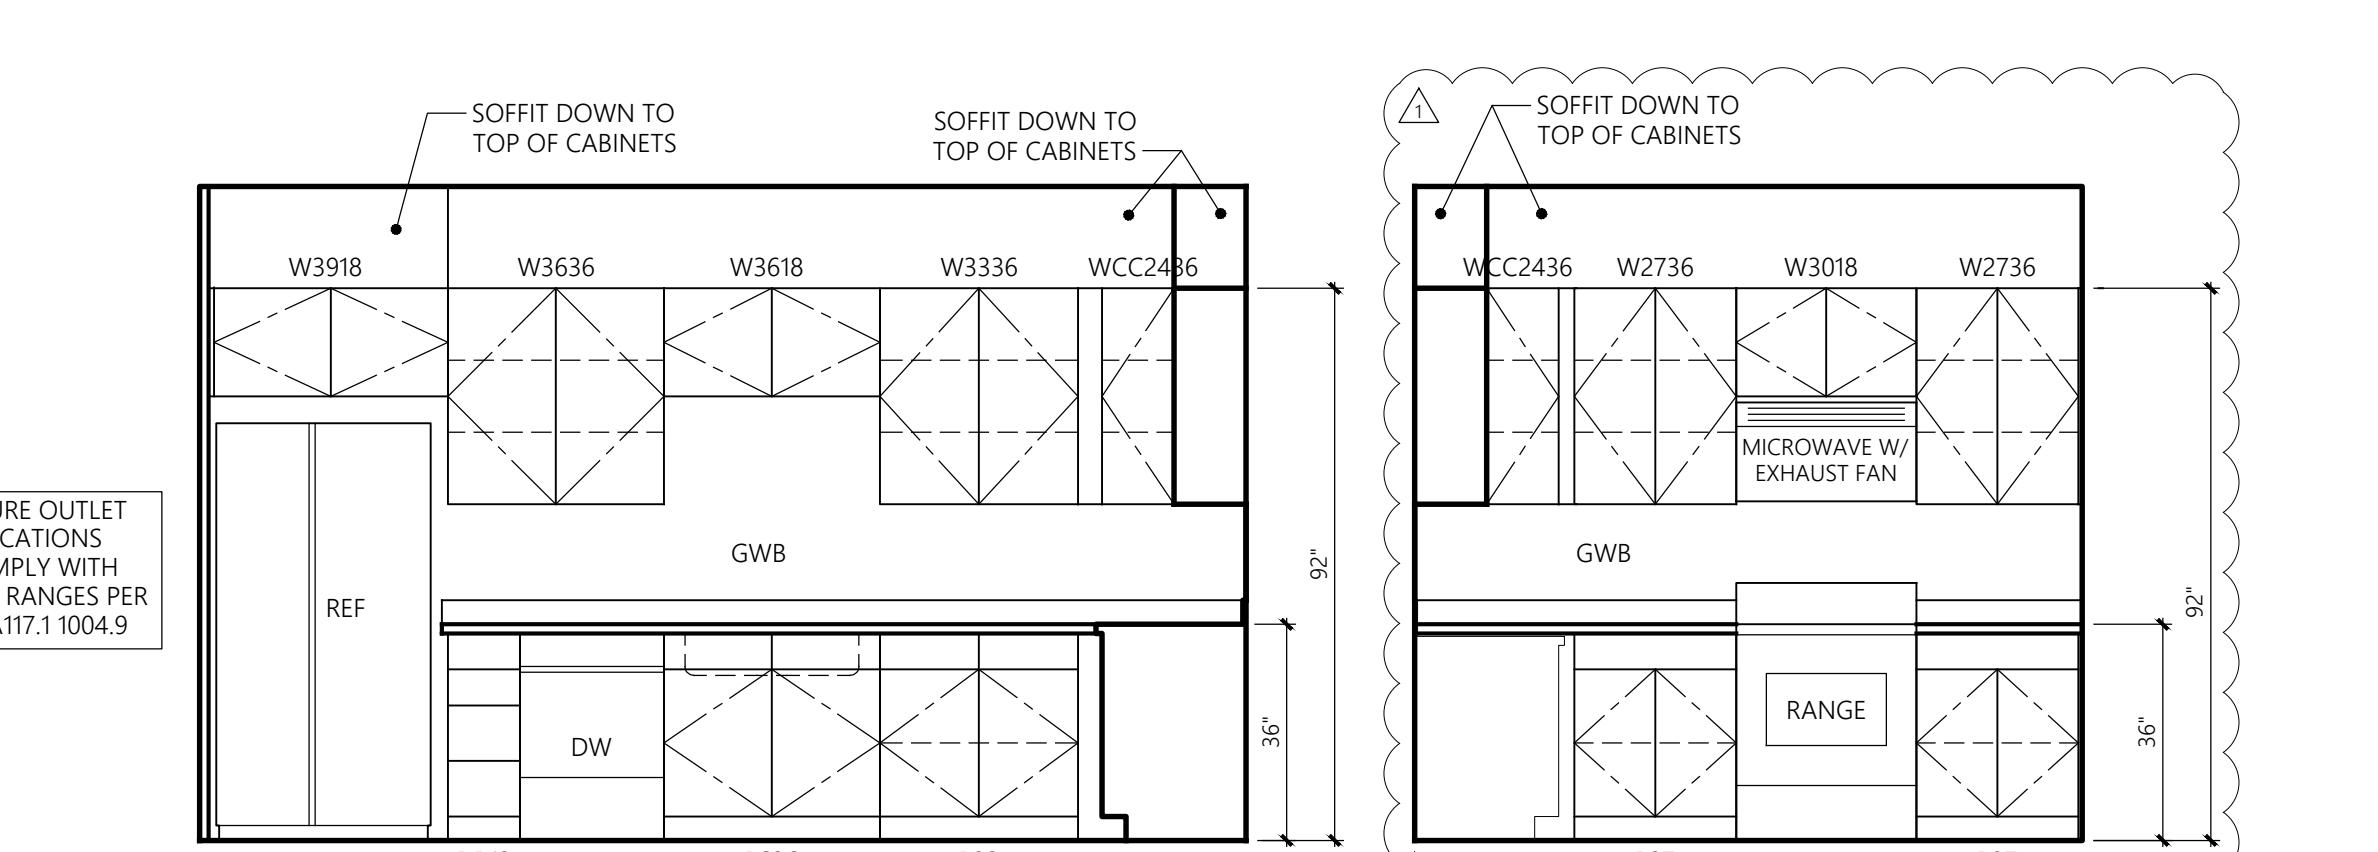


2-BED & 2-BED-ALT

TYPE 'B'
M. BATH PLAN

3 MAIN BATH

3/8" = 1'-0"

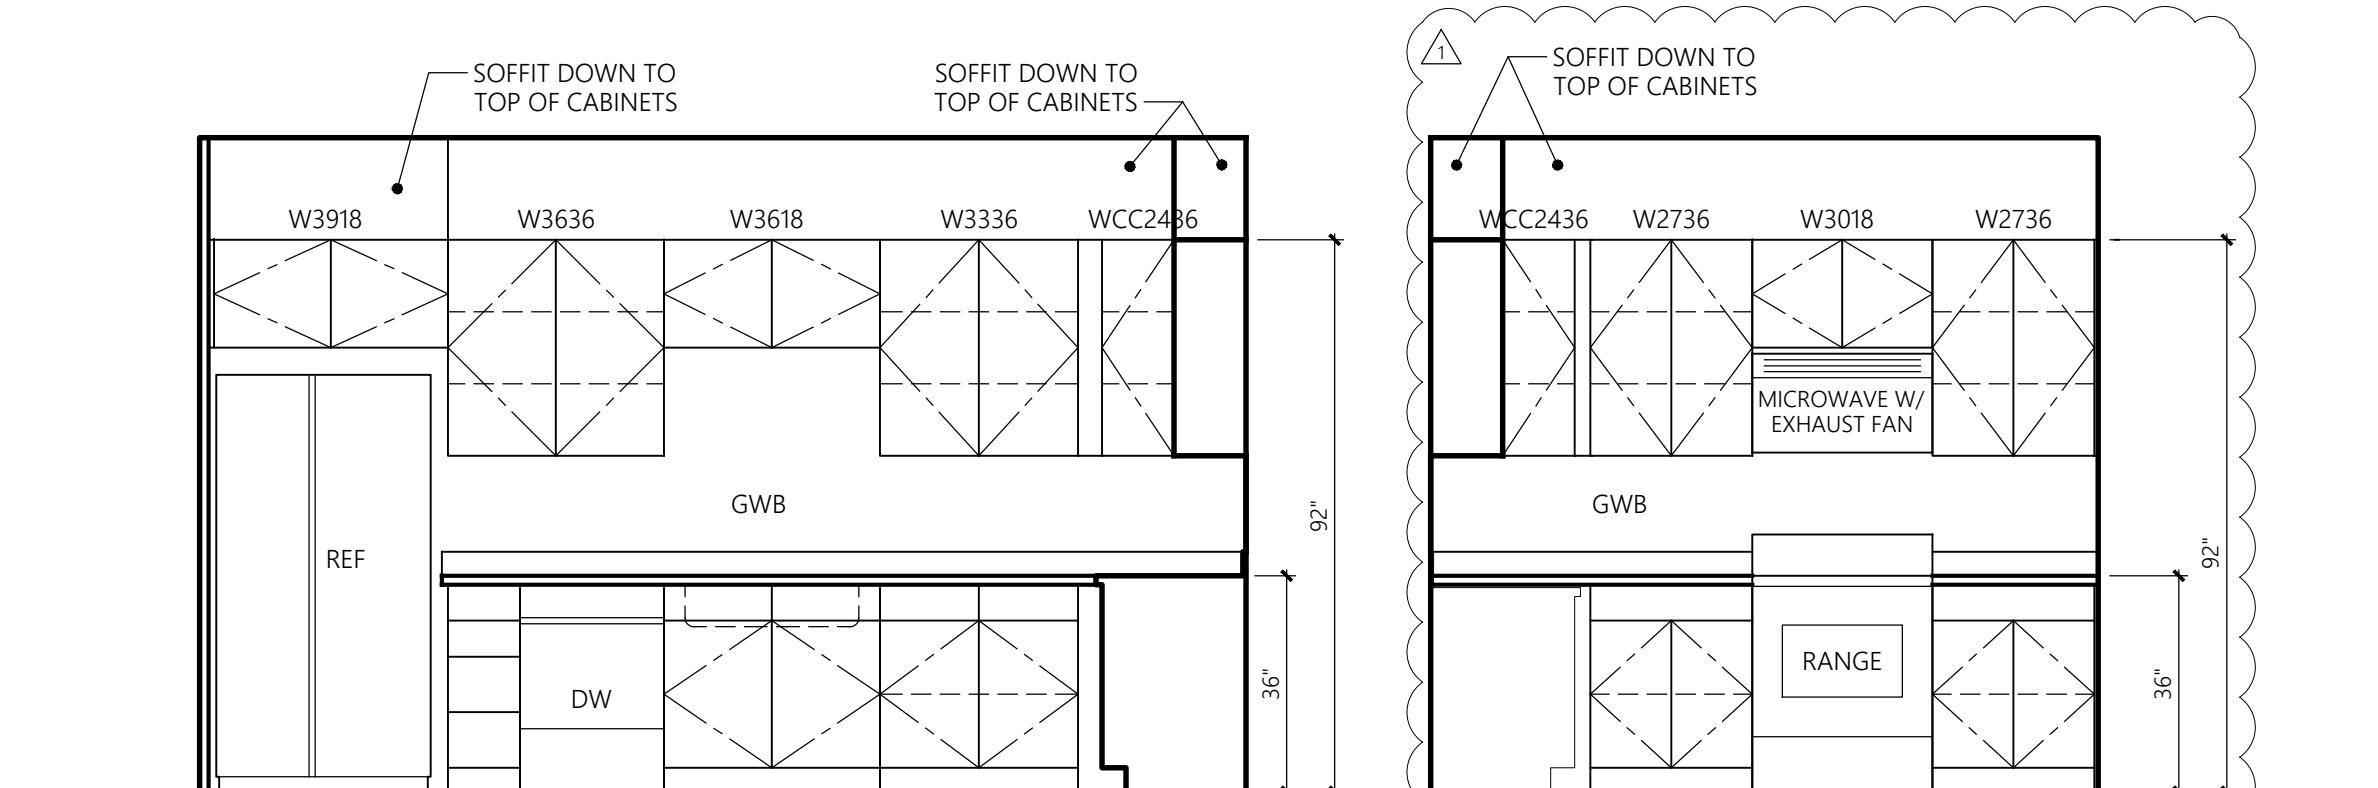


2-BED & 2-BED-ALT

NON-ACCESSIBLE
M. BATH PLAN

3 MAIN BATH

3/8" = 1'-0"

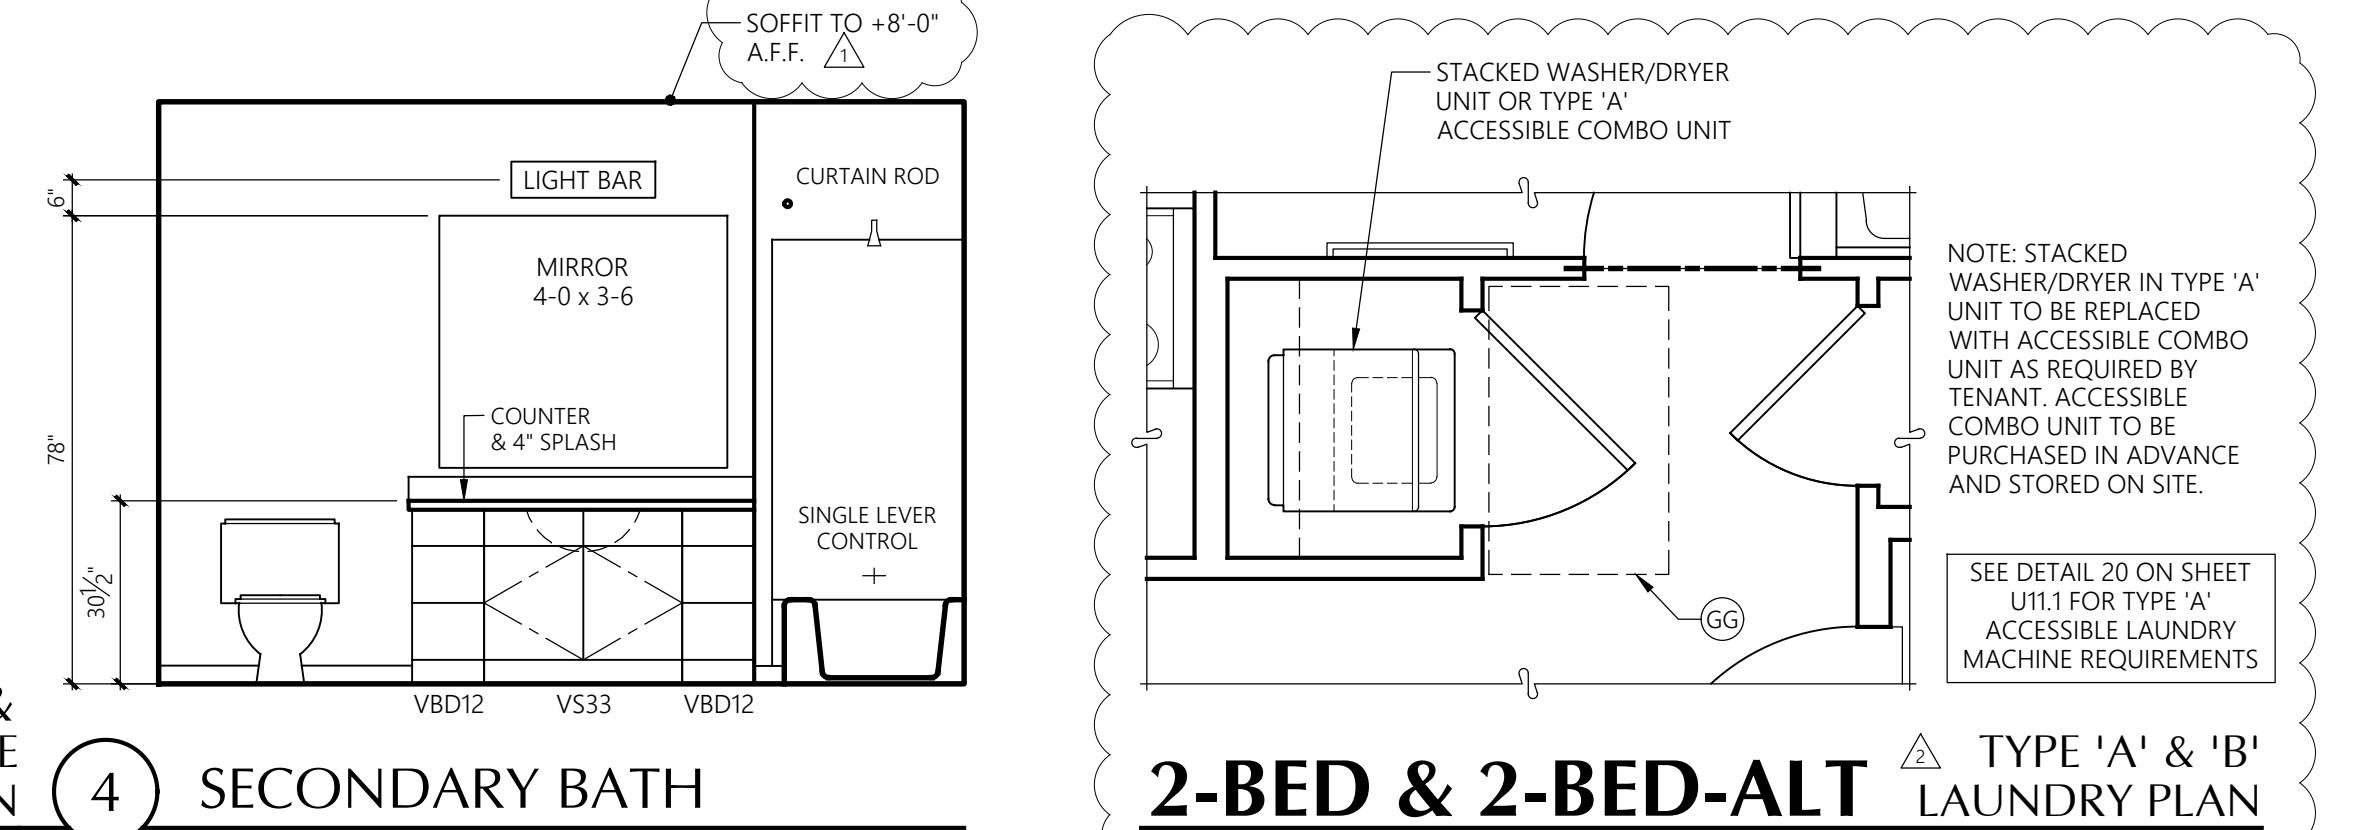

2-BED & 2-BED-ALT

LAUNDRY PLAN

3/8" = 1'-0"

CLEAR FLOOR SPACE LEGEND
TYPE A UNIT

- (A) 60x66 CLEAR FLOOR SPACE AT TOILET.
- (B) 30x60 CLEAR FLOOR SPACE AT TUB.
- (C) 30"x48" CLEAR FLOOR SPACE CENTERED ON SINK
- (D) 60" DIAMETER TURNING CIRCLE
OR T-SHAPE TURNING SPACE
- (AA) 30x48 CLEAR FLOOR SPACE AT STOVE.
- (BB) 30x48 CLEAR FLOOR SPACE AT OVEN.
- (CC) 30x48 CLEAR FLOOR SPACE AT SINK.
- (DD) 30x48 CLEAR FLOOR SPACE AT DISHWASHER.
- (EE) 30x48 CLEAR FLOOR SPACE AT REFRIGERATOR.
- (FF) 30x48 CLEAR FLOOR SPACE AT WORK SURFACE.
- (GG) 30x48 CLEAR FLOOR SPACE AT WASHER/DRYER

CLEAR FLOOR SPACE LEGEND
TYPE B UNIT


- (A) 48x56 CLEAR FLOOR SPACE AT TOILET.
- (B) 30x48 CLEAR FLOOR SPACE AT TUB.
- (C) 30"x48" CLEAR FLOOR SPACE CENTERED ON SINK
- (D) 30"x48" CLEAR FLOOR SPACE BEYOND ARC OF DOOR.
- (AA) 30x48 CLEAR FLOOR SPACE AT STOVE.
- (BB) 30x48 CLEAR FLOOR SPACE AT OVEN.
- (CC) 30x48 CLEAR FLOOR SPACE AT SINK.
- (DD) 30x48 CLEAR FLOOR SPACE AT DISHWASHER.
- (EE) 30x48 CLEAR FLOOR SPACE AT REFRIGERATOR.
- (GG) 30x48 CLEAR FLOOR SPACE AT WASHER/DRYER


WASHING MACHINES AND CLOTHES DRYERS
CLEAR FLOOR SPACE: A 30"X48" CLEAR FLOOR SPACE FOR A PARALLEL APPROACH SHALL BE PROVIDED. FOR TOP LOADING MACHINES, THE CLEAR FLOOR SPACE SHALL BE CENTERED ON THE APPLIANCE. FOR FRONT LOADING MACHINES, THE CENTERLINE OF THE CLEAR FLOOR SPACE SHALL BE OFFSET 24" MAX. FROM THE CENTERLINE OF THE DOOR OPENING.

OPERABLE PARTS: OPERABLE PARTS INCLUDING DOORS, LINT SCREENS, DETERGENT & BLEACH COMPARTMENTS, SHALL BE WITHIN ACCESSIBLE REACH RANGES & MEET THE REQUIREMENTS FOR OPERABLE PARTS. (See detail 4 sheet A3 & 32 sheet U1)


HEIGHT: TOP LOADING MACHINES SHALL HAVE THE DOOR TO THE LAUNDRY COMPARTMENT 36" MAX. AND THE FRONT LOADING MACHINES SHALL HAVE THE BOTTOM OF THE OPENING TO THE LAUNDRY COMPARTMENT 15" MIN. & 36" MAX. ABOVE THE FLOOR

△ 20 LAUNDRY FACILITIES
NTS

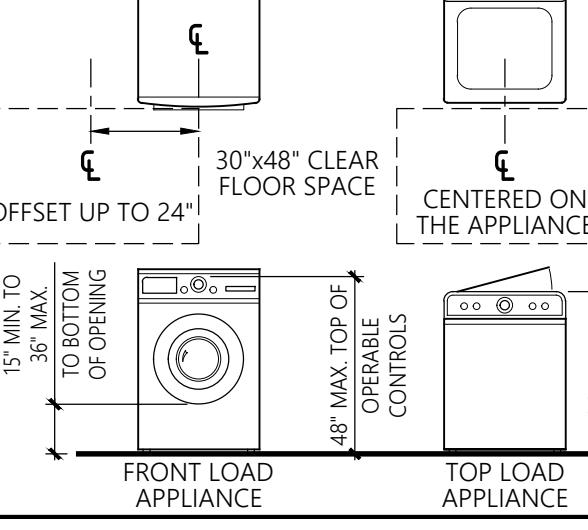


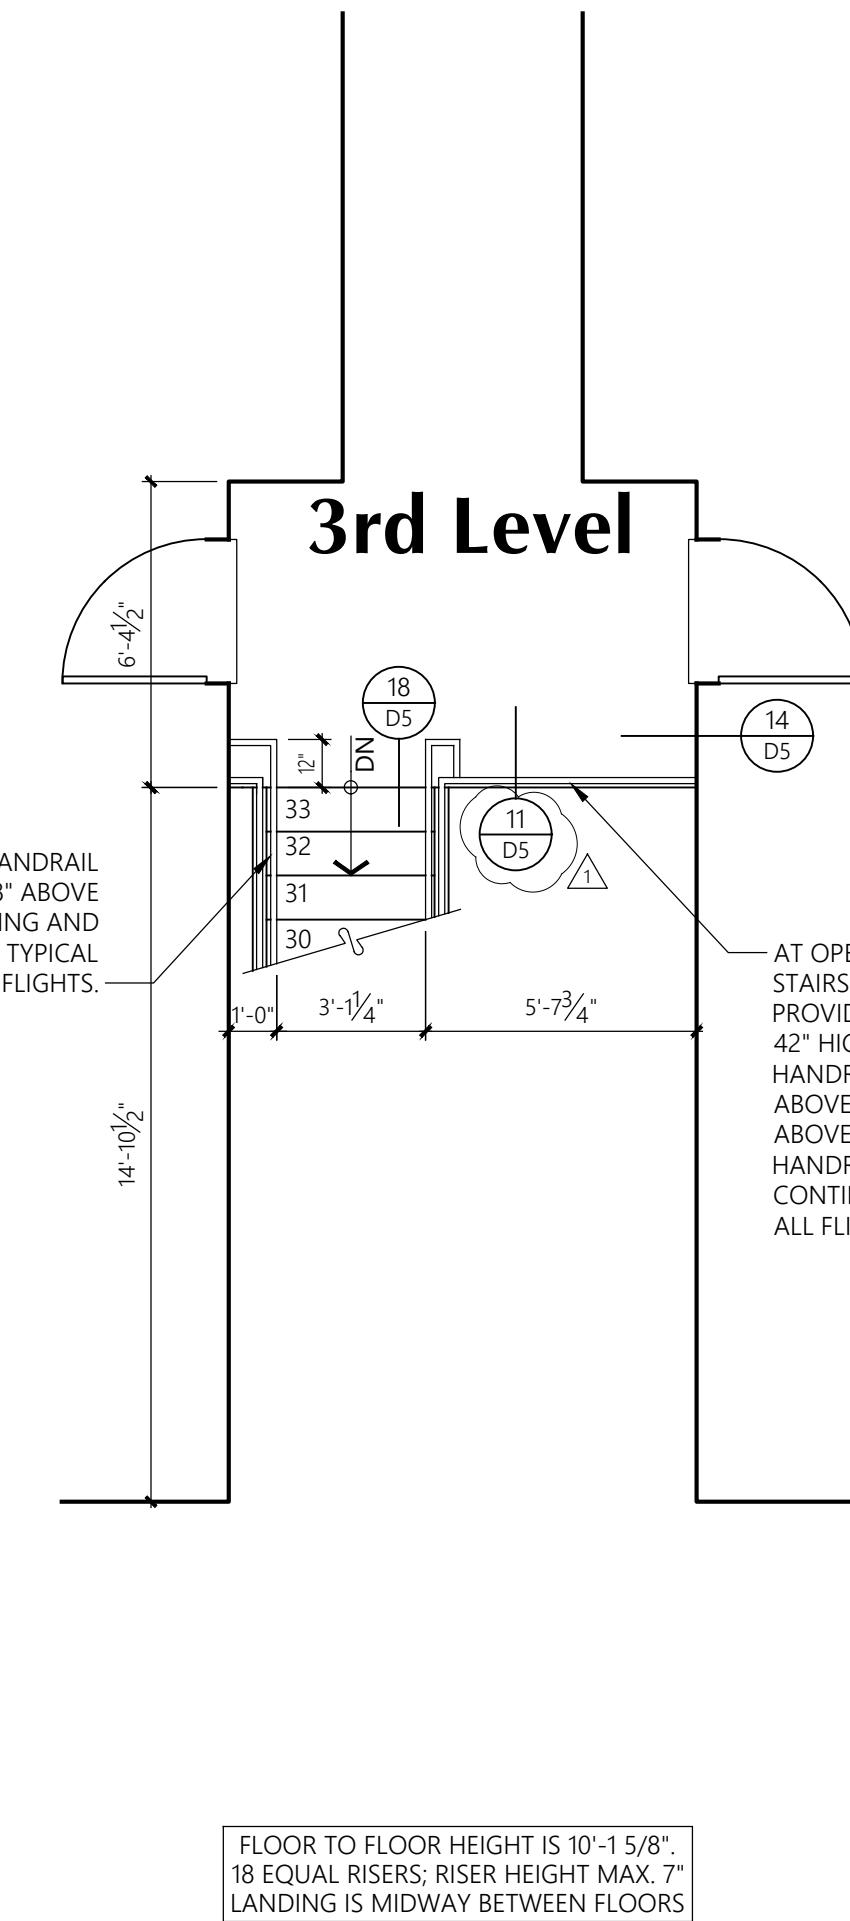


STAIR 1 3RD LEVEL FLOOR PLAN
1/4" = 1'-0"

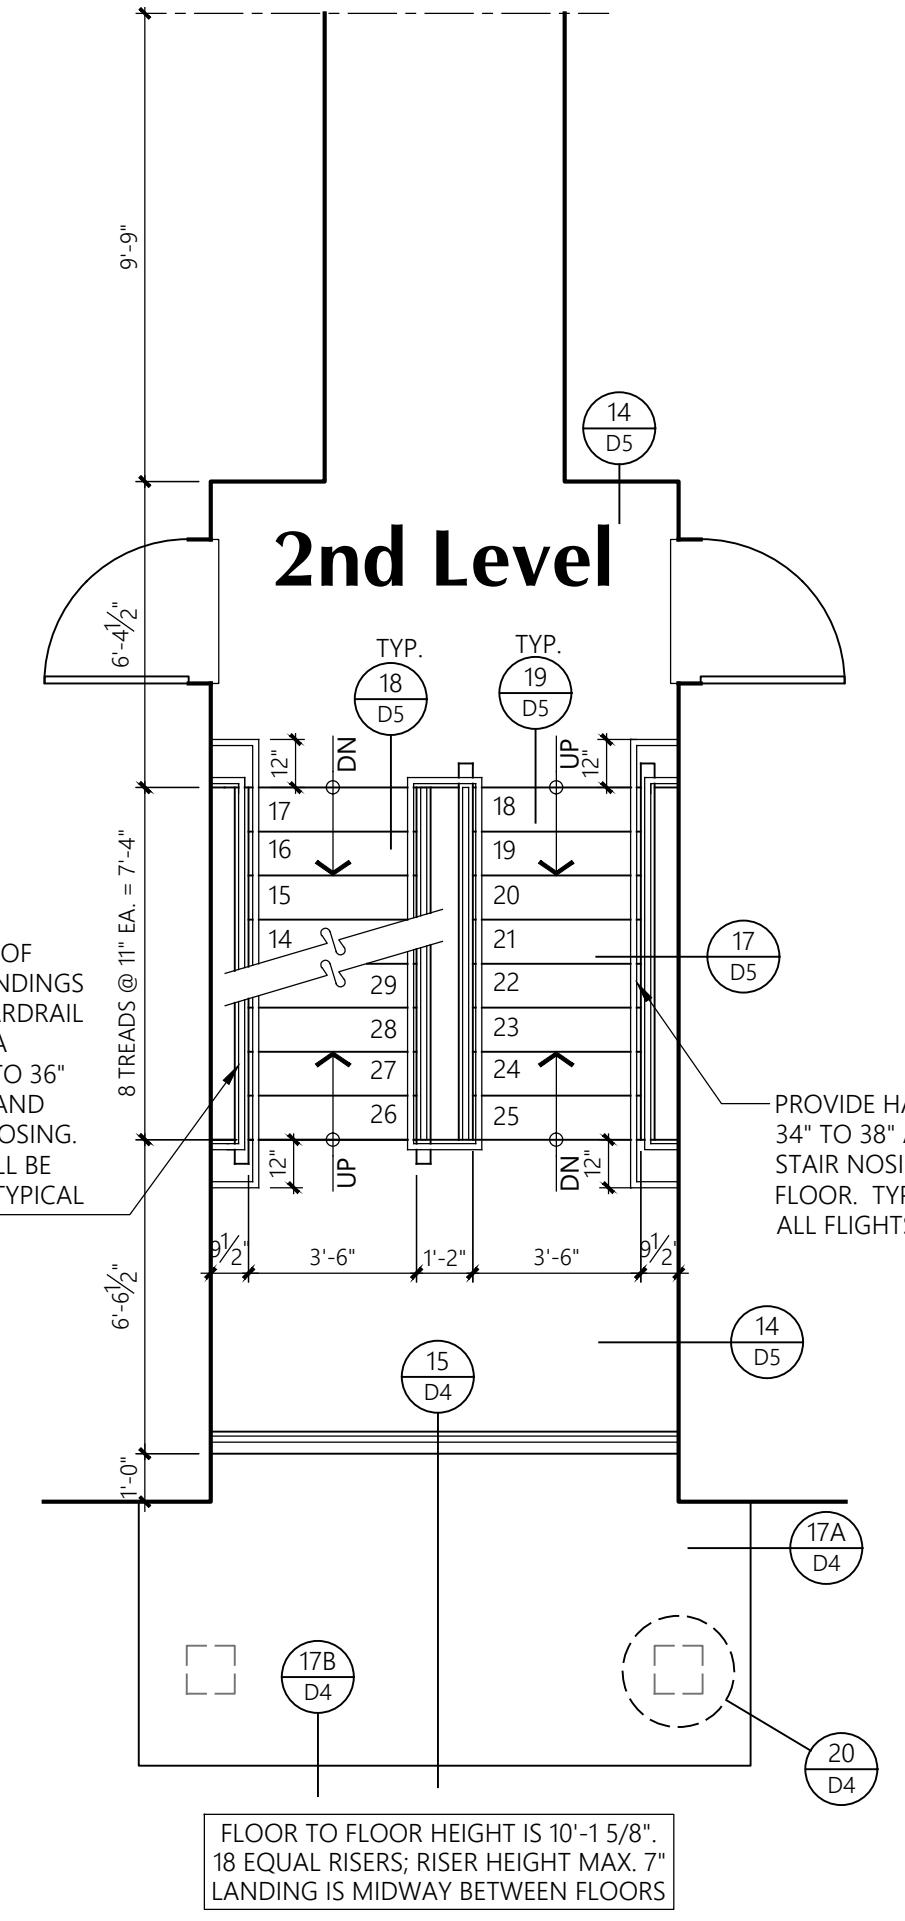


STAIR 1 2ND LEVEL FLOOR PLAN
1/4" = 1'-0"

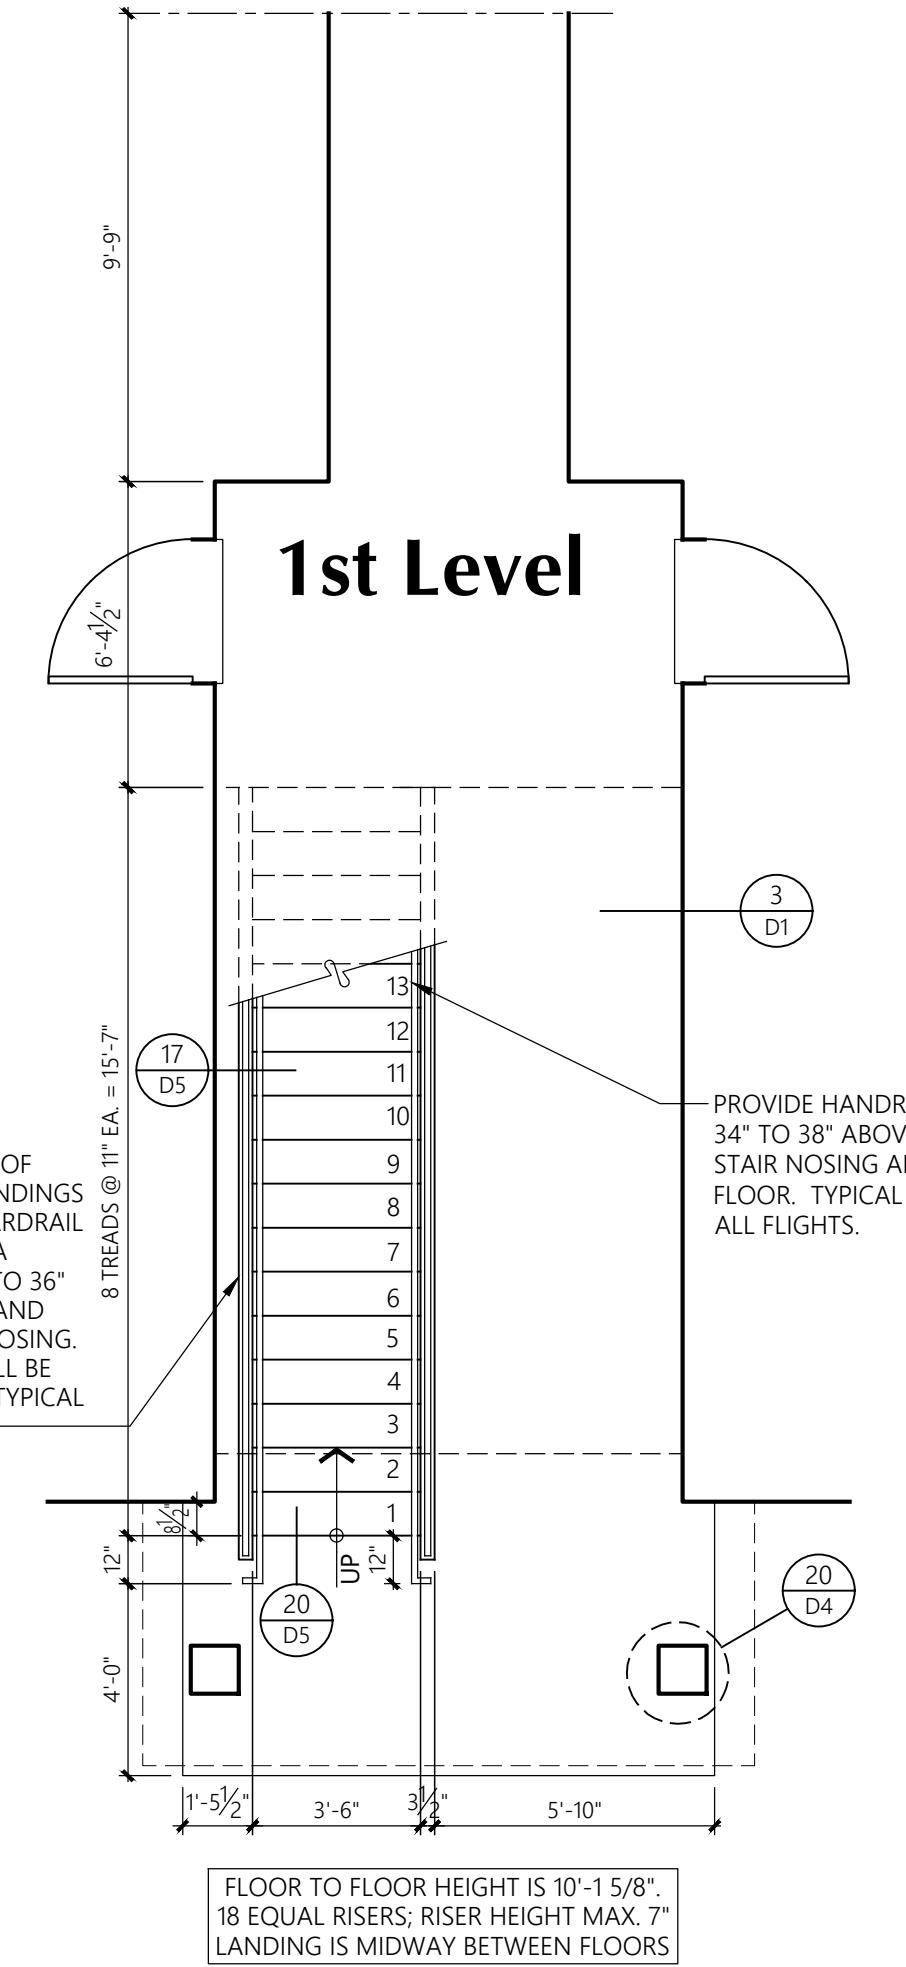

STAIR 1 1ST LEVEL FLOOR PLAN
1/4" = 1'-0"

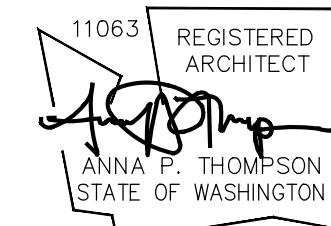

Door Schedule

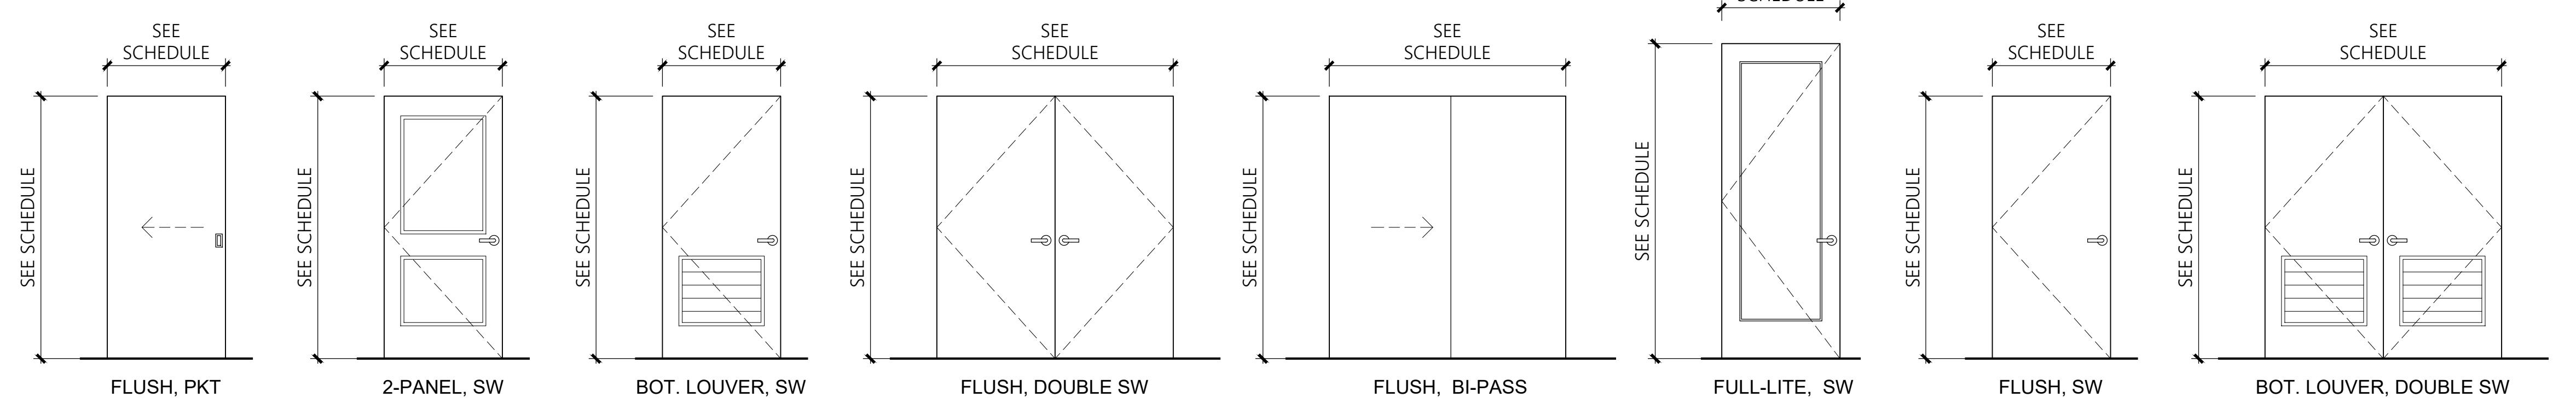

Door Schedule - Units

Door No.	Type	Size	Thickness	Construct	Finish	Fire Rating	Frame or Head/Jamb		Remarks	Min. U Factor	Max. SHGC
							Construct.	Finish			
1A	2-Panel, SW	3'-0" x 8'-0"	1-3/4"	INSUL MTL	PP	20 min.	Wood	PP	Keylock, Dead Bolt w/Thumb, Self Closure/Smoke Seal, Flush Threshold, Weatherstrip, Ext. Grade Door, Peep Sight, Self Closing	0.24	-
1B	2-Panel, SW	3'-0" x 8'-0"	1-3/4"	INSUL MTL	PP	90 min.	MTL	PP	Keylock, Dead Bolt w/Thumb, Self Closure/Smoke Seal, Flush Threshold, Weatherstrip, Ext. Grade Door, Peep Sight, Self Closing	0.24	-
2	2-Panel, PKT	3'-0" x 6'-8"	1-3/8"	HCW	PP		Wood	PP	Privacy Lock @ Bath	-	-
3	2-Panel, SW	3'-0" x 6'-8"	1-3/8"	HCW	PP		Wood	PP	Privacy Lock @ Bath	-	-
4	Bot. Louver Dbl, SW	6'-0" x 6'-8"	1-3/8"	HCW	PP		Wood	PP		-	-
5	Full-Lite, SW	3'-0" x 8'-0"	1-3/4"	INSUL FBGL	PP		Wood	PP	Keylock, Safety Glass, Flush Threshold, Weatherstrip, Ext. Grade Door	0.24	0.61
6	2-Panel, SW	2'-4" x 6'-8"	1-3/8"	HCW	PP		Wood	PP		-	-
7	2-Panel, SW	2'-6" x 6'-8"	1-3/8"	HCW	PP		Wood	PP		-	-
8	BP	4'-0" x 6'-8"	1-3/8"	HCW	PP		GWB	PP		-	-
9	Bot. Louver, SW	3'-0" x 6'-8"	1-3/8"	HCW	PP		Wood	PP		-	-
10	BP	5'-0" x 6'-8"	1-3/8"	HCW	PP		GWB	PP		-	-
11	2-Panel, SW	2'-0" x 6'-8"	1-3/8"	HCW	PP		Wood	PP		-	-
12	Flush, SW	3'-0" x 8'-0"	1-3/8"	MTL	PP	90 min.	Wood	PP	Lockable from outside, Ext. Grade Door	-	-
13	Flush, Dbl SW	6'-0" x 6'-8"	1-3/8"	INSUL MTL	PP	20 min.	MTL	PP	Lockable from outside, Ext. Grade Door	0.24	-
14	Flush, SW	3'-0" x 8'-0"	1-3/8"	MTL	PP		MTL	PP	Lockable from outside, Ext. Grade Door	-	-

DOOR KEY:

TYPE:
SCW = SOLID CORE WOOD
HCW = HOLLOW CORE WOOD
MTL = METAL
FBGL = FIBERGLASS
SW = SWING
DBL SW = DOUBLE SWING
SOHD = SECTIONAL OVERHEAD DOOR
PP = PRIME & PAINT
FF = FACTORY FINISH

Bradley Heights Apartments

Puyallup, Wa

Timberlane Partners

Revisions

No. Date Description
 8-30-24 Owner Changes/ Permit Corrections

PRMU20240280

Initial Publish Date:

Date Plotted: 5-1-25


Job No.: Drawn By:

23-06 APT/HDM/TMK

Sheet No.:


SHEET ADDED

U14

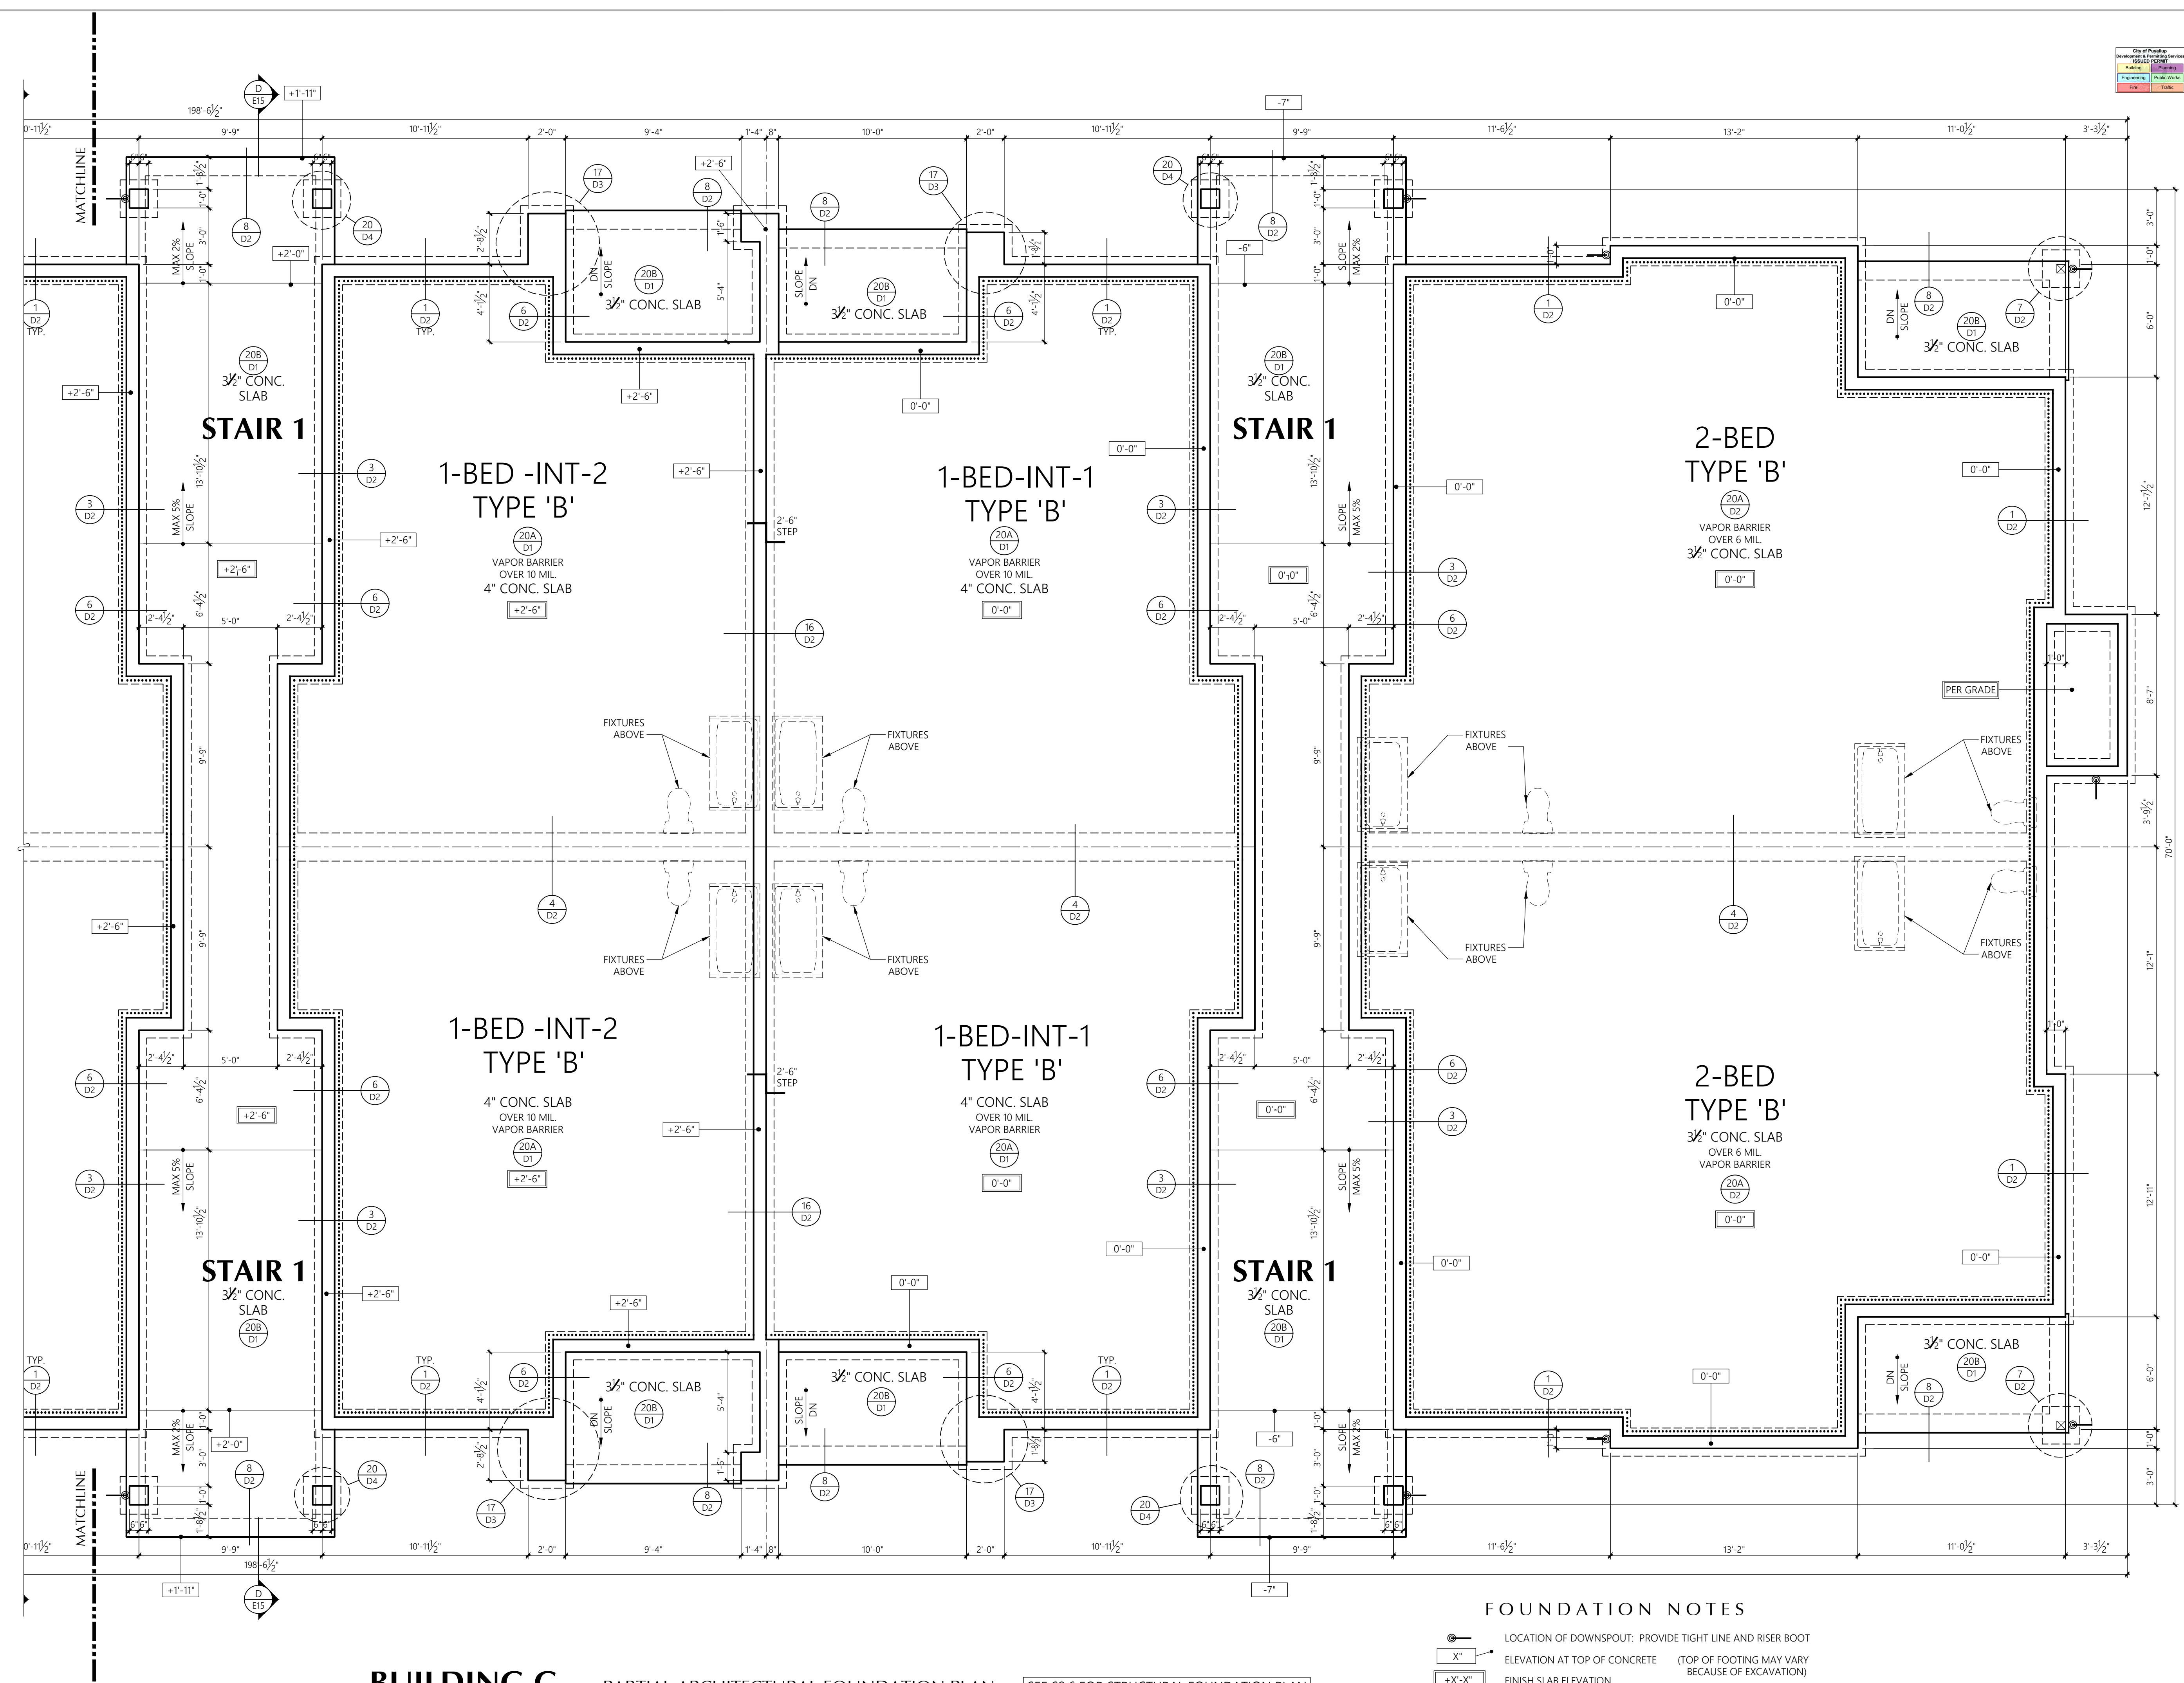

Building G


Roof Plan

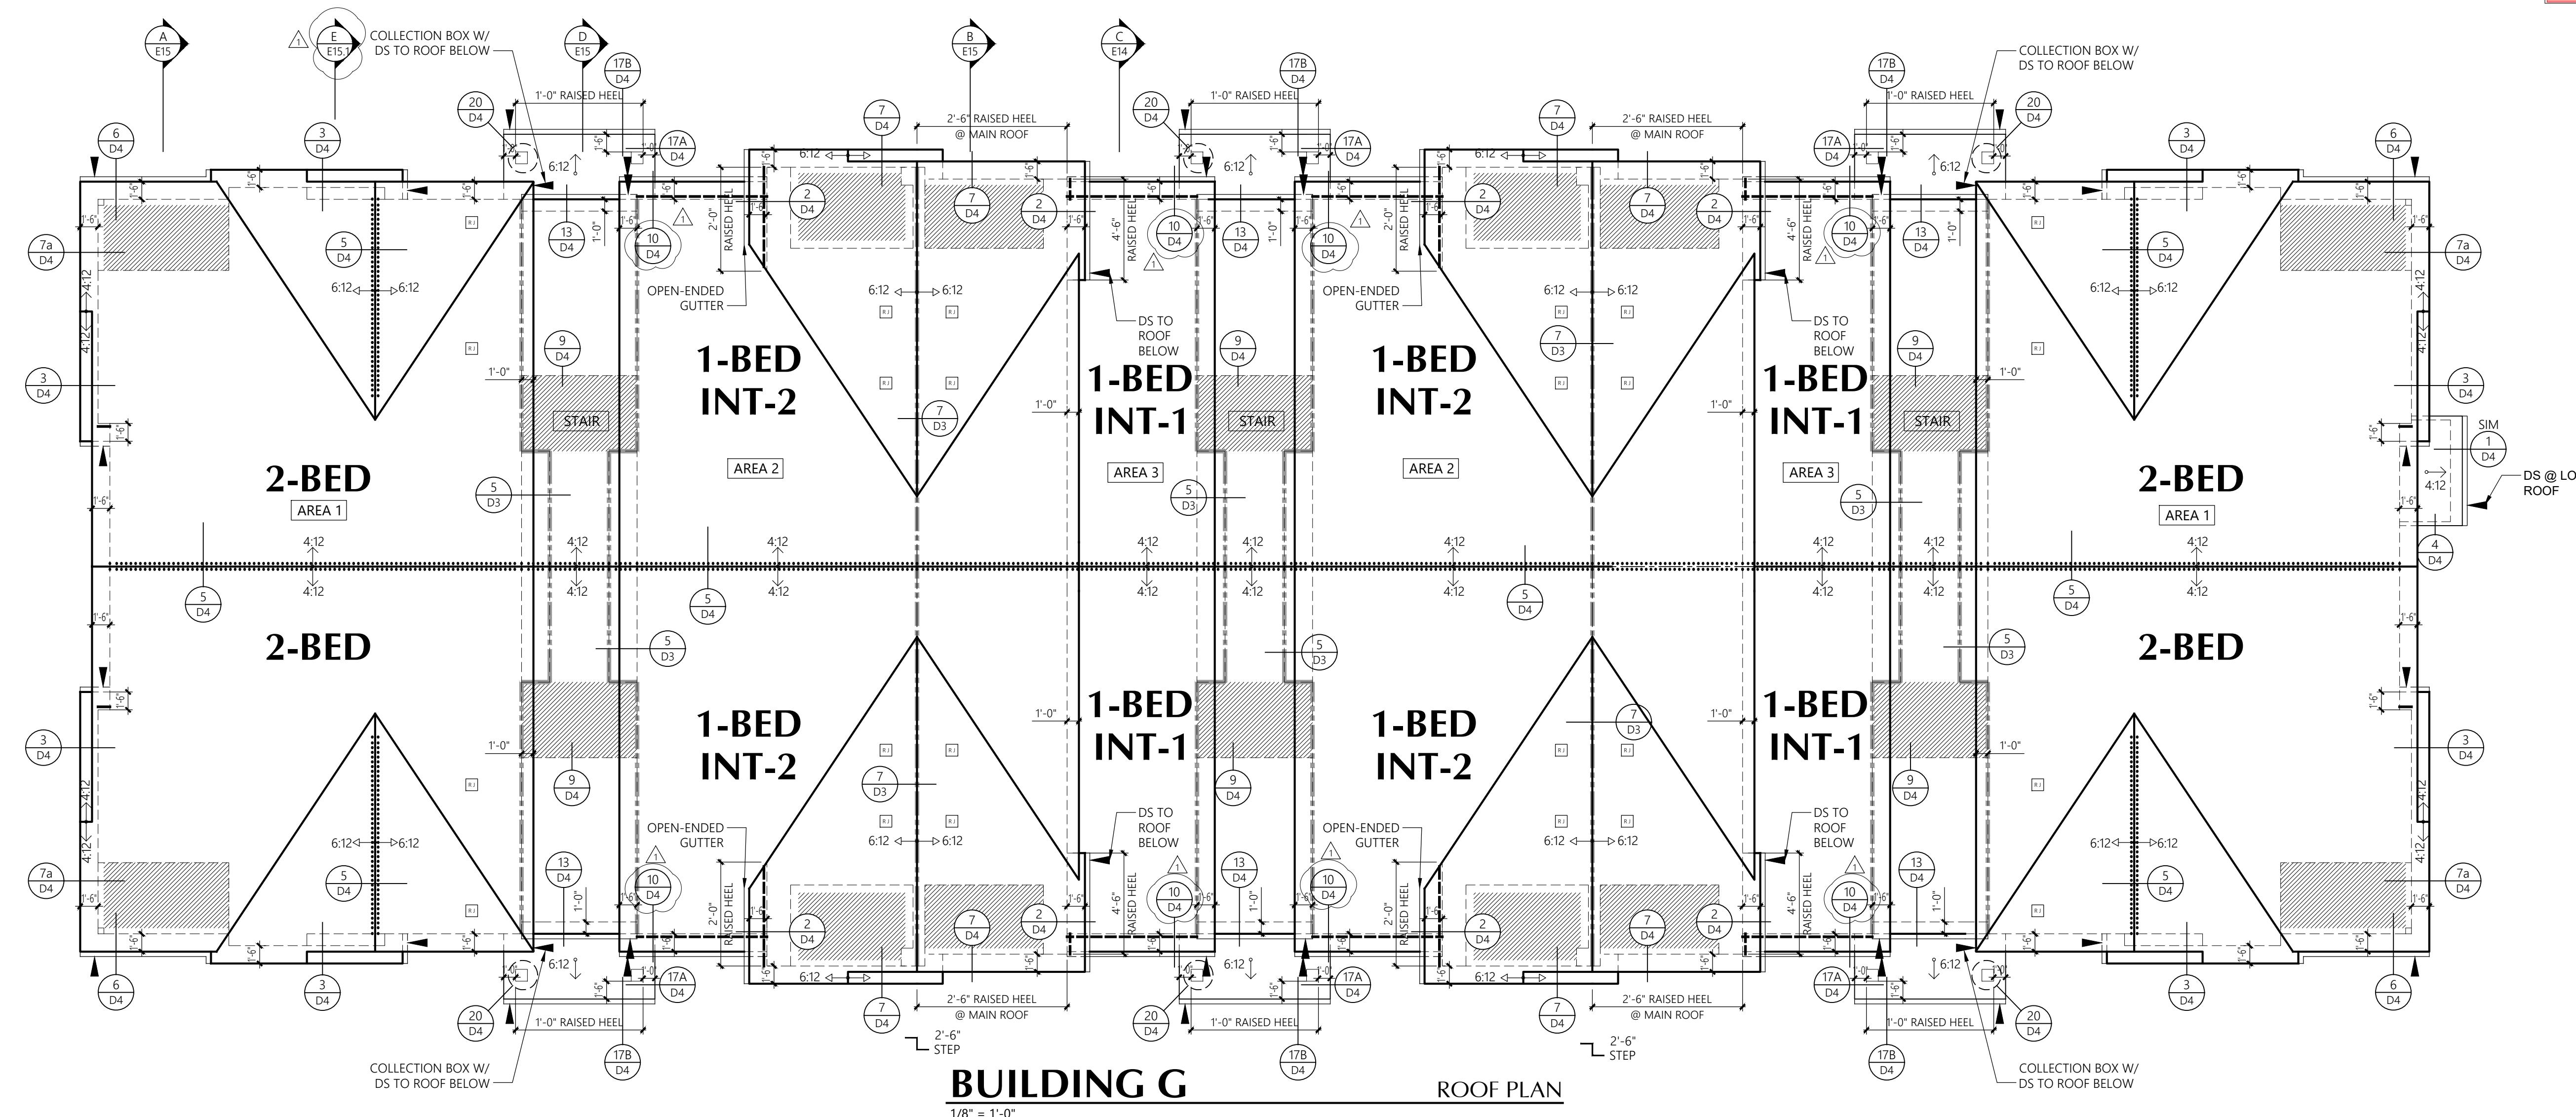

CONTRACTOR NOTE

Attic spaces will be draft stopped per 2021 Washington State Building Code, Section 708.4.2.

In Group R-2 occupancies up to and including four stories in height in buildings not exceeding 60 feet (18 288 mm) in height above grade plane, the attic space shall be subdivided by draftstops into areas not exceeding 3,000 square feet (279 m²) or above every two dwelling units, whichever is smaller.

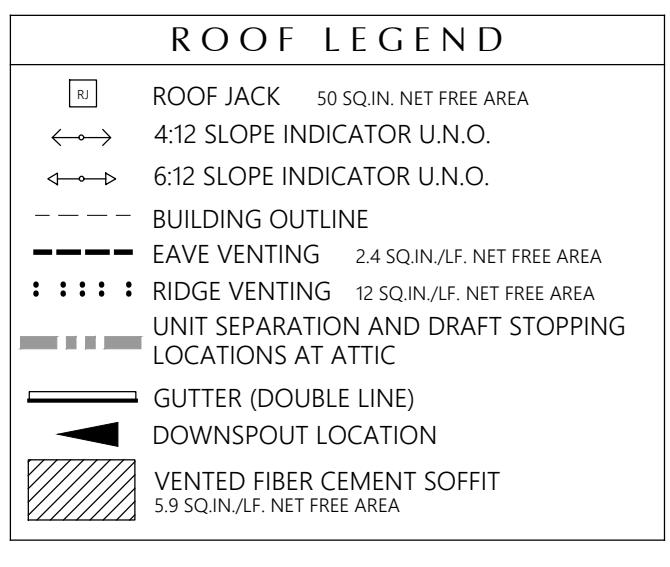

Building G

Exterior Elevations



BUILDING G

FRONT ELEVATION

1/8" = 1'-0"

WINDOW HDR HEIGHT
8'-0" A.F.F. UNO



BUILDING G

REAR ELEVATION

1/8" = 1'-0"

Bradley Heights Apartments

Puyallup, Wa

Timberlane Partners

Revisions

No. Date Description
 1 8-30-24 Owner Changes/ Permit Corrections
 2 4-24-25 Permit Corrections

PRMU20240280


Initial Publish Date:

Date Plotted: 5-6-25


Job No.: 23-06 Drawn By:

Sheet No.: APT/HDM/TMK


E14

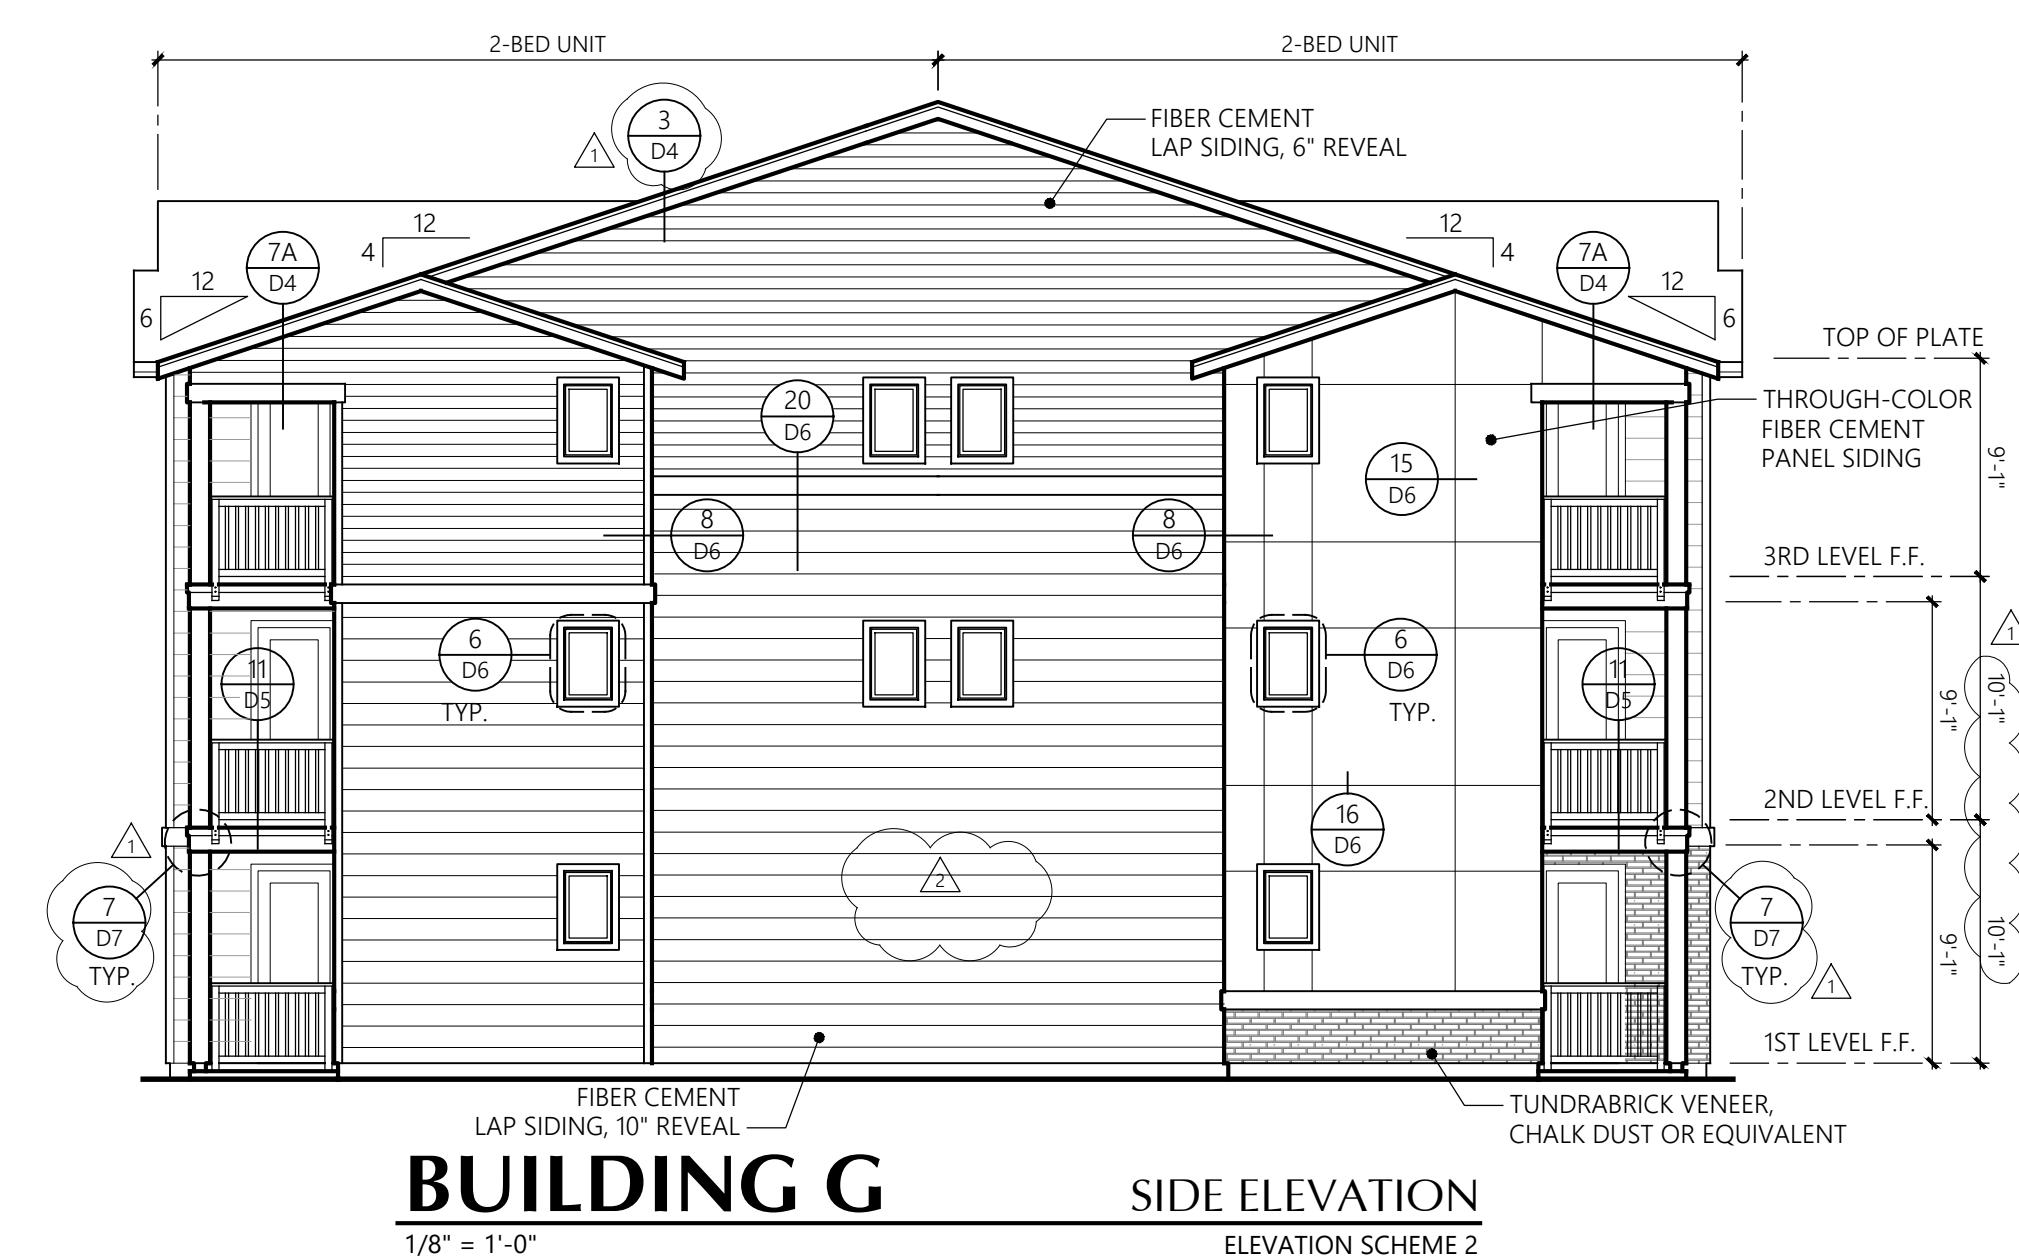


BUILDING G
SIDE ELEVATION
ELEVATION SCHEME 2

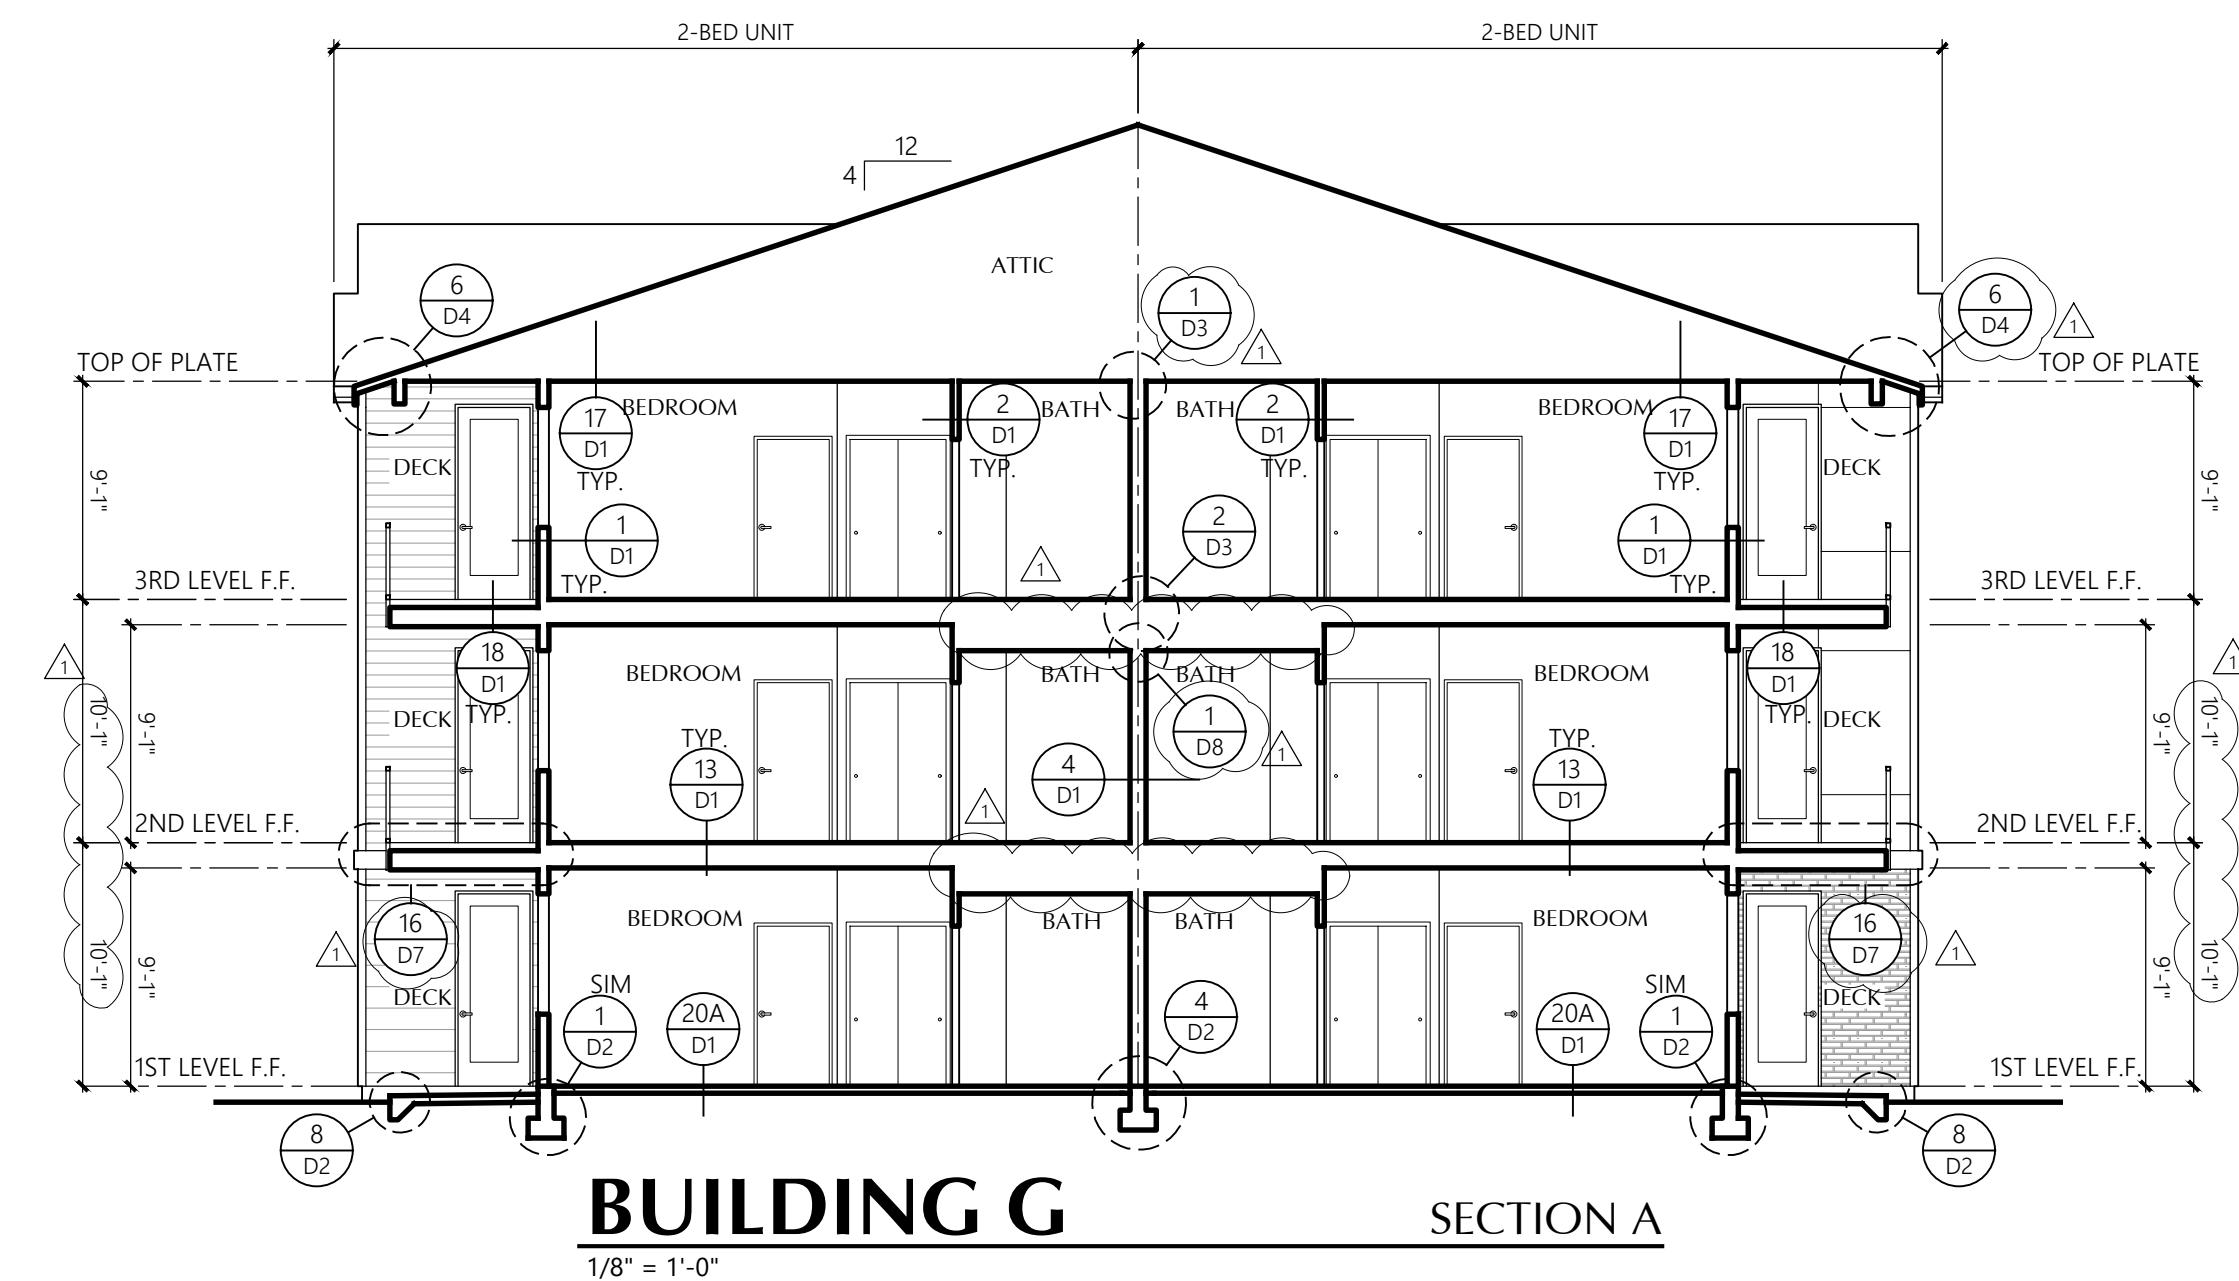


BUILDING G
SECTION A

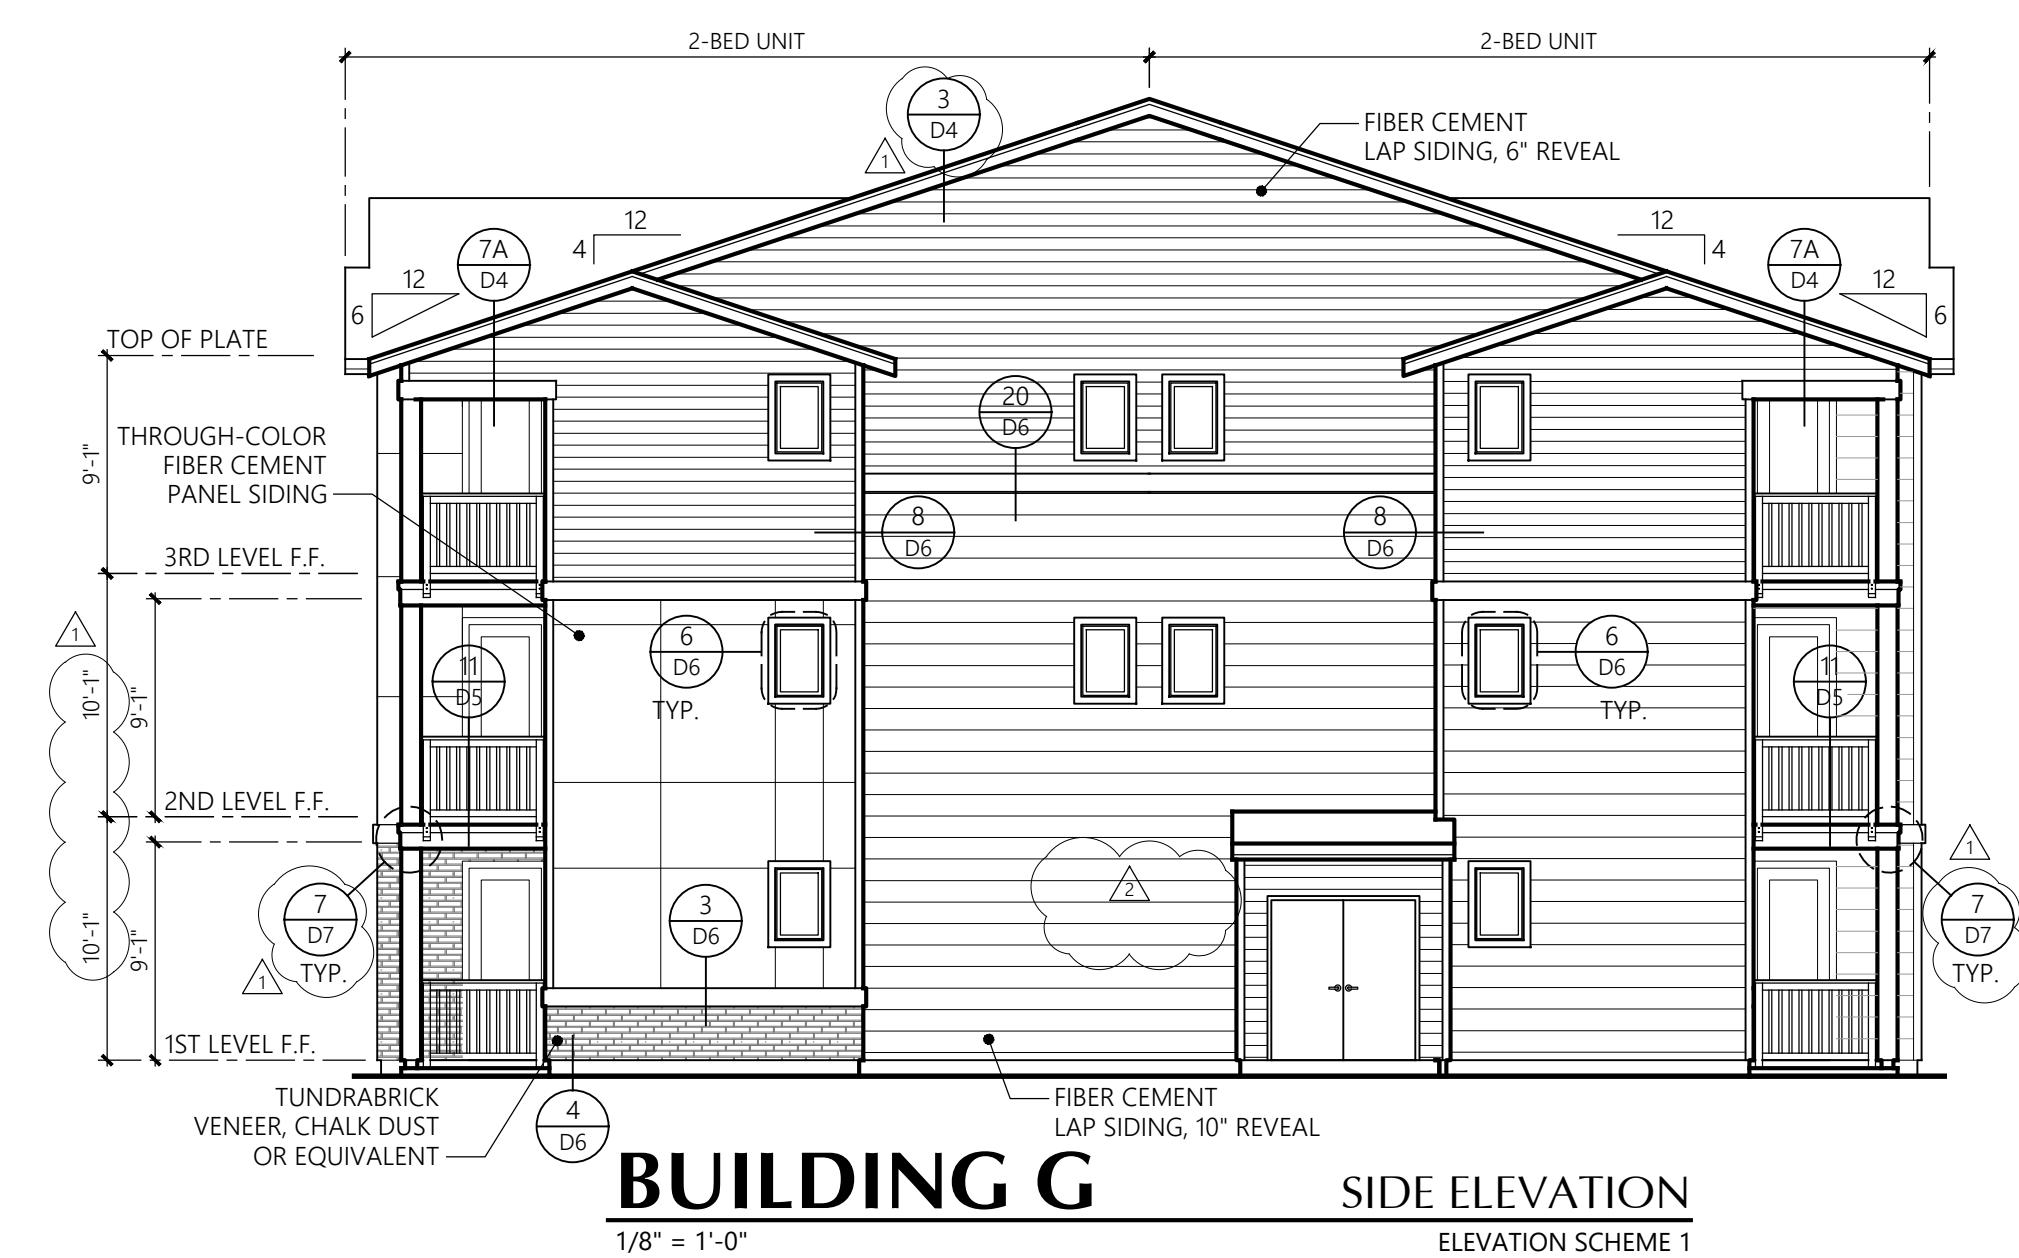


BUILDING G
SIDE ELEVATION
ELEVATION SCHEME 1

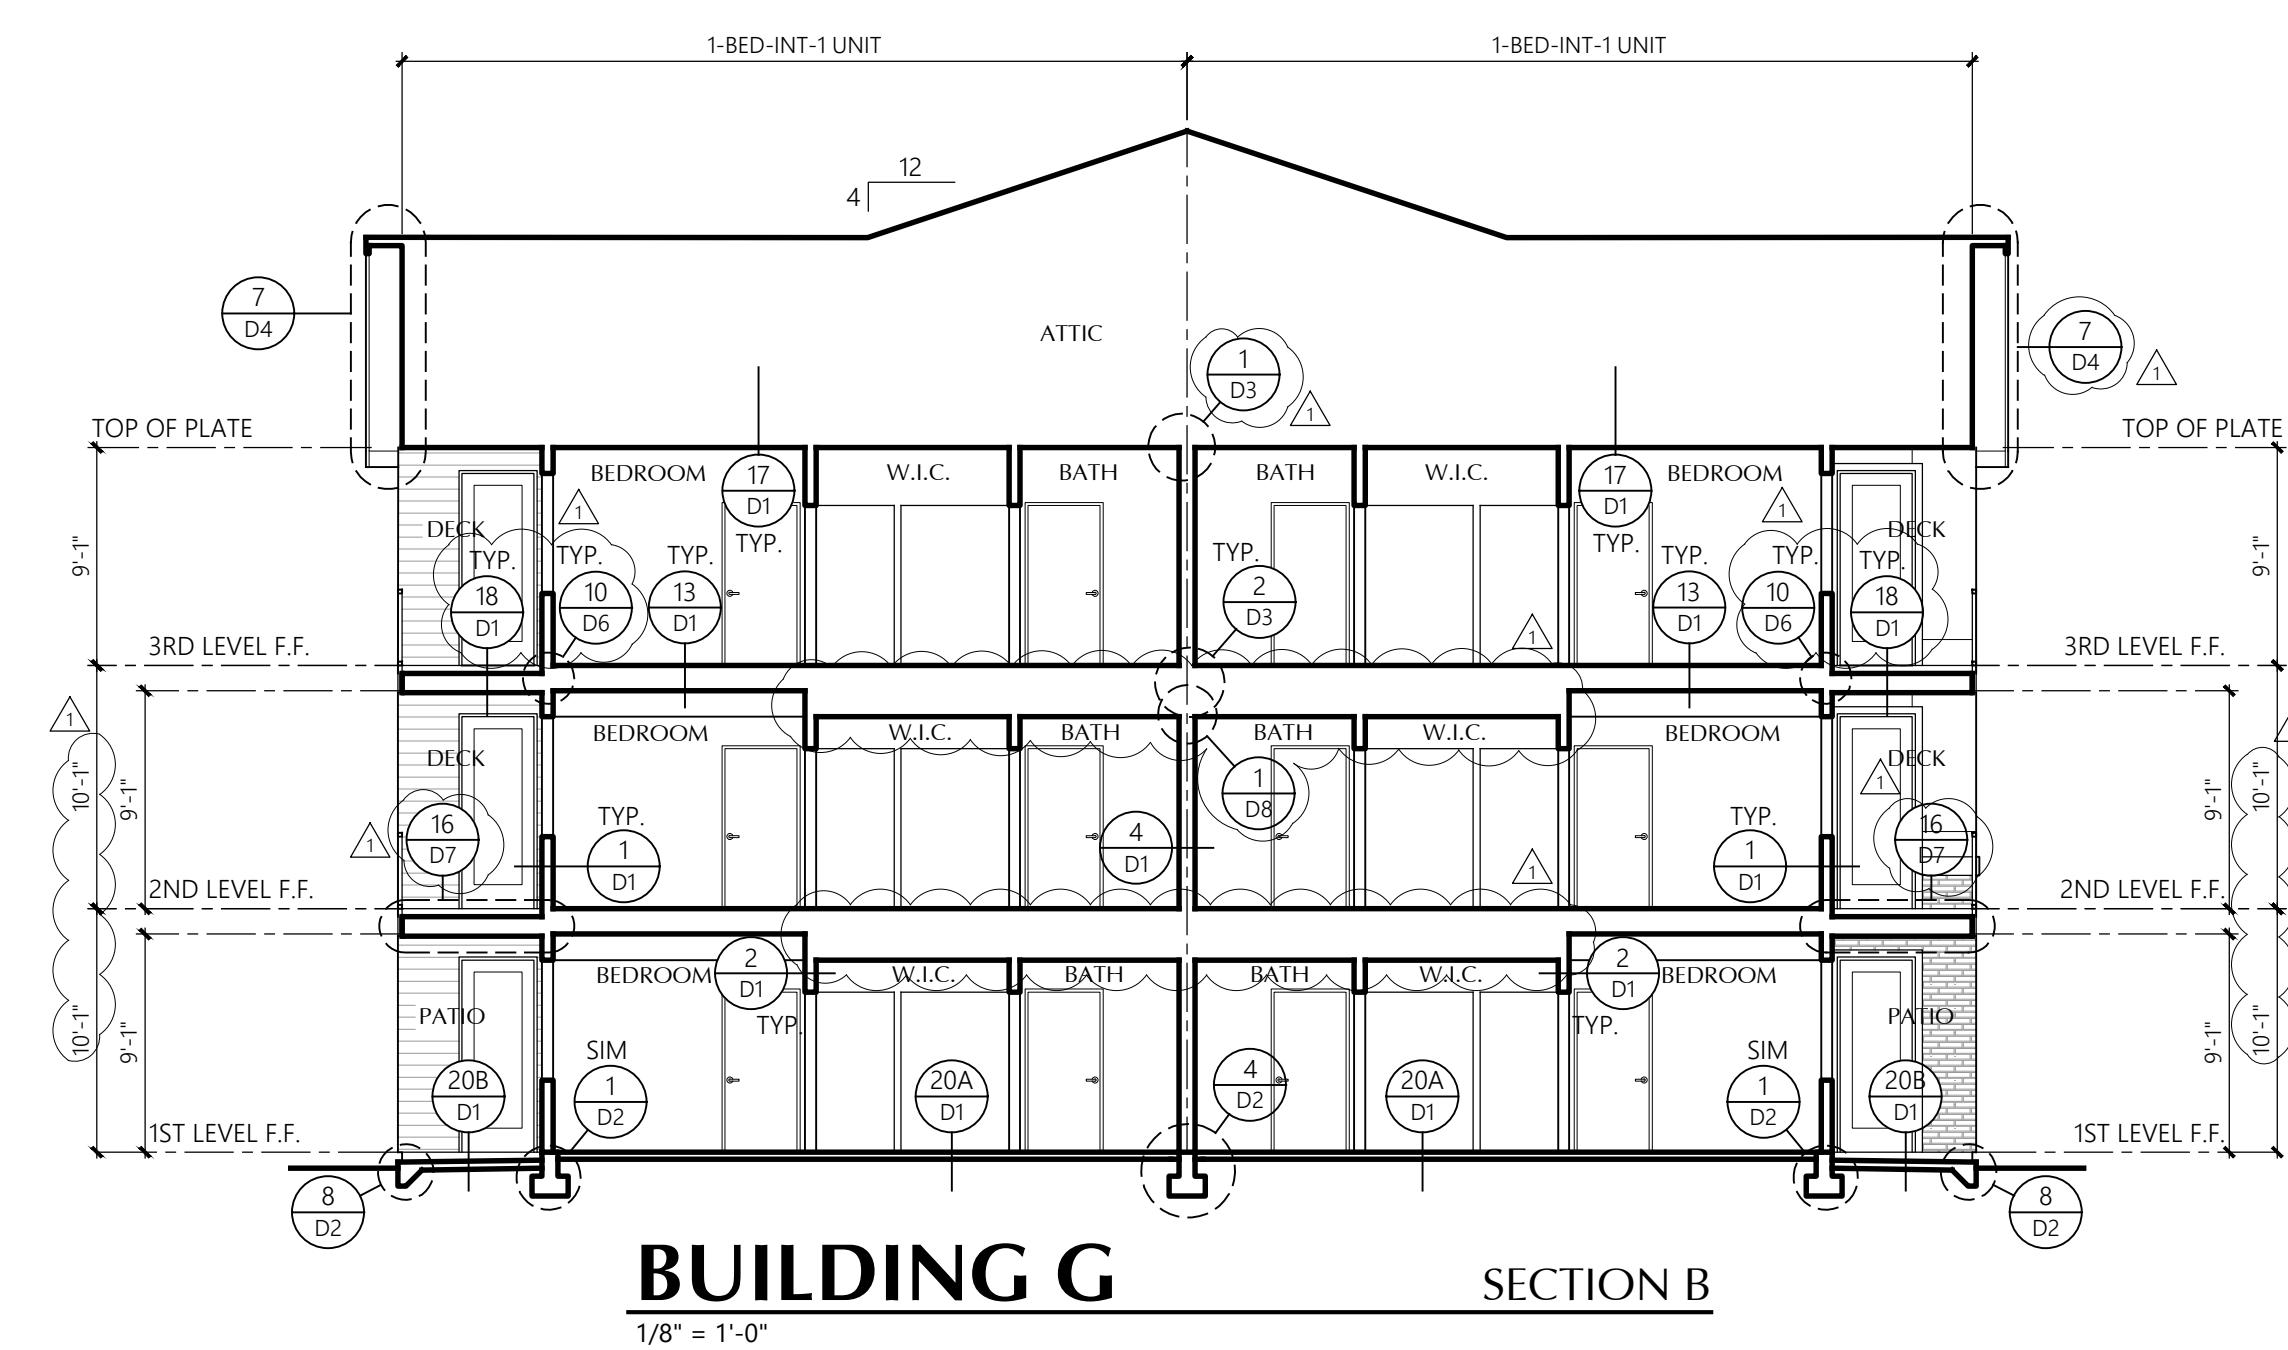


BUILDING G
SECTION B

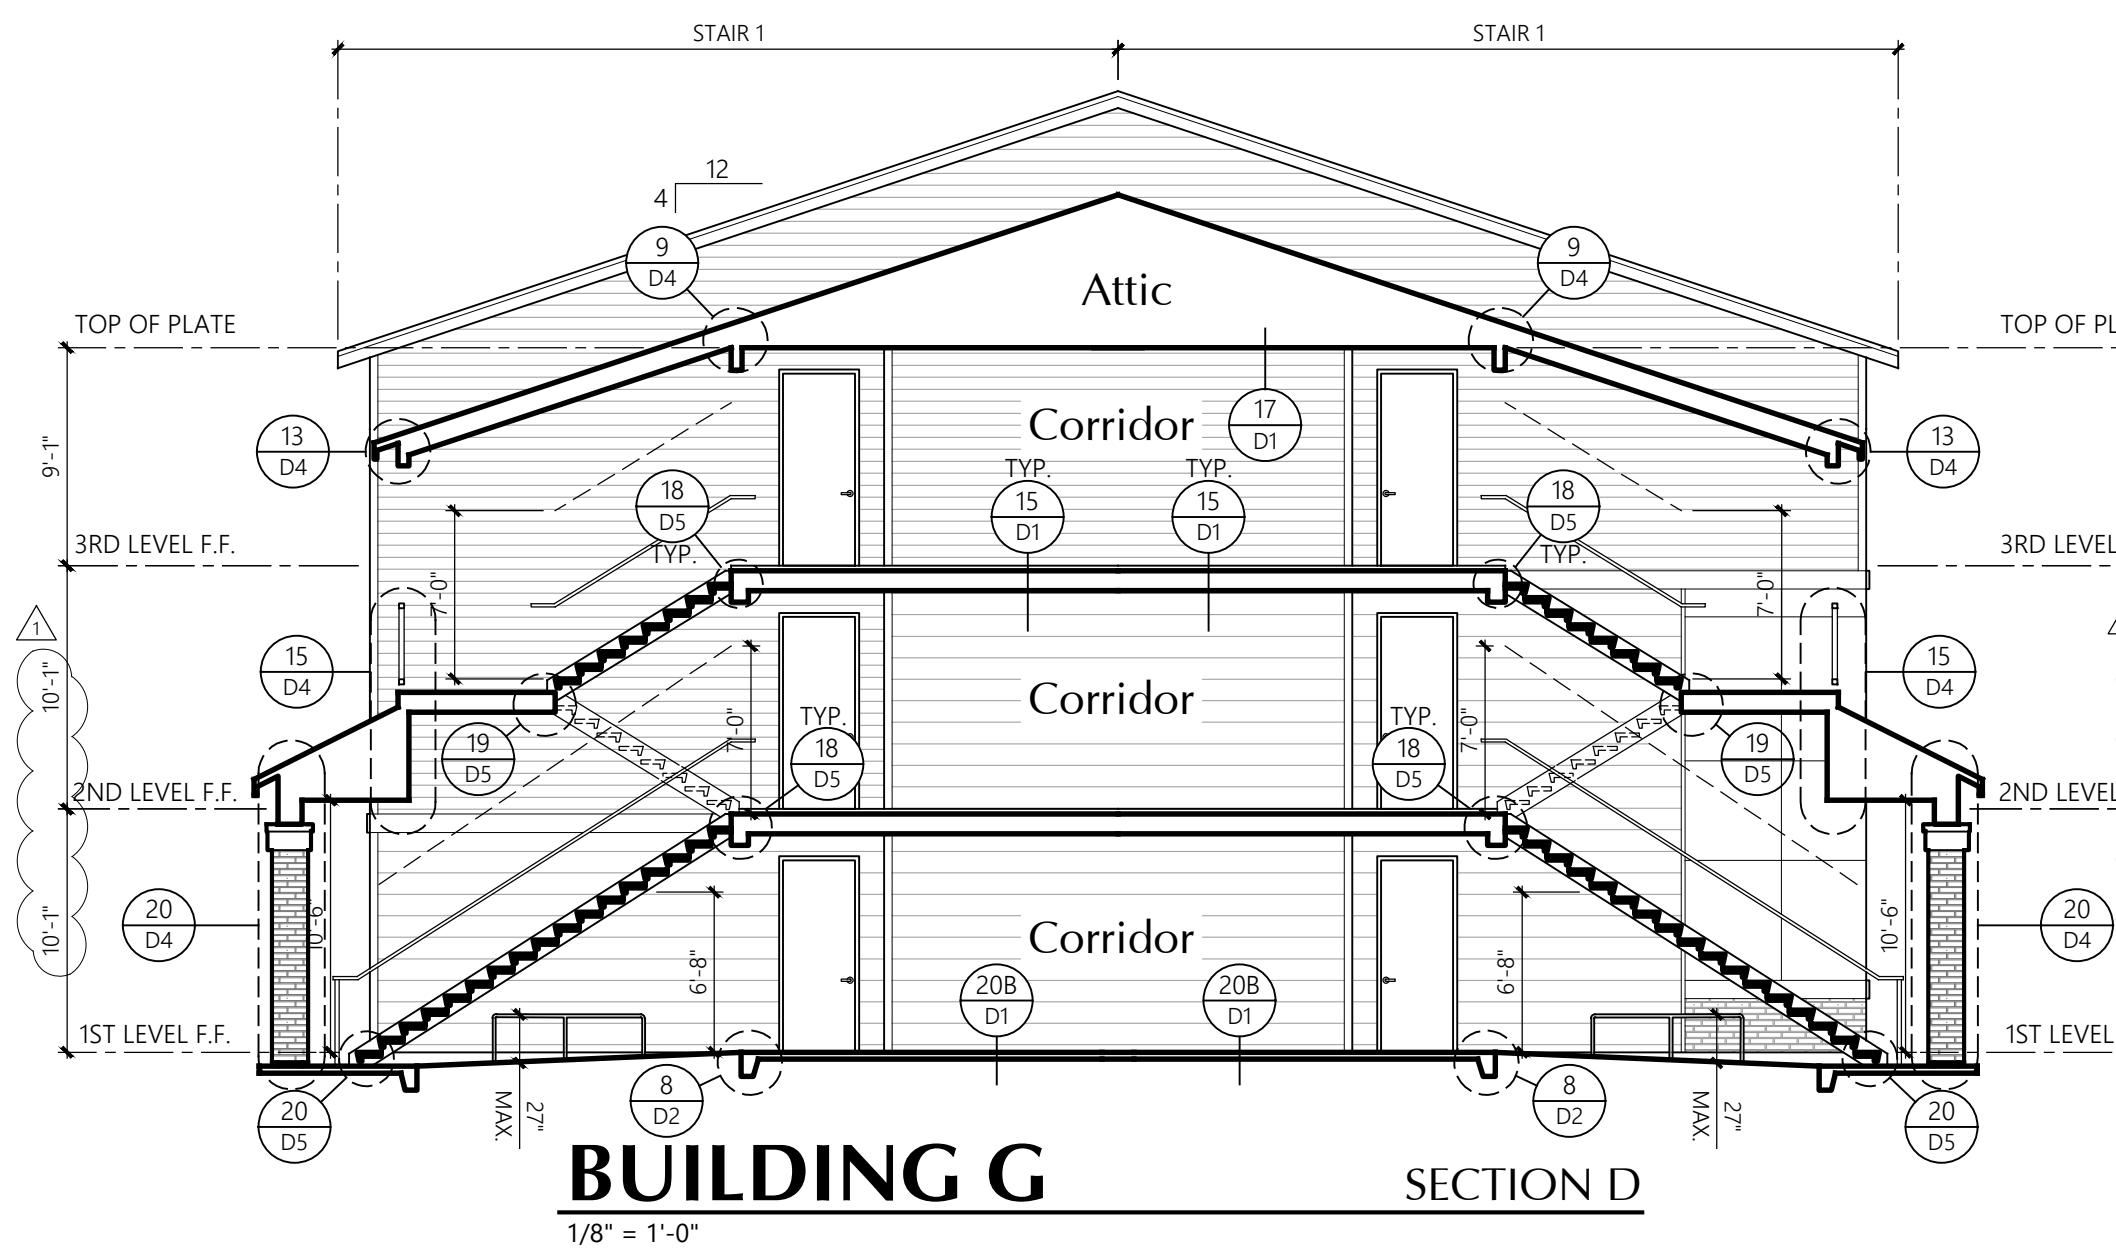

BUILDING G
SECTION D

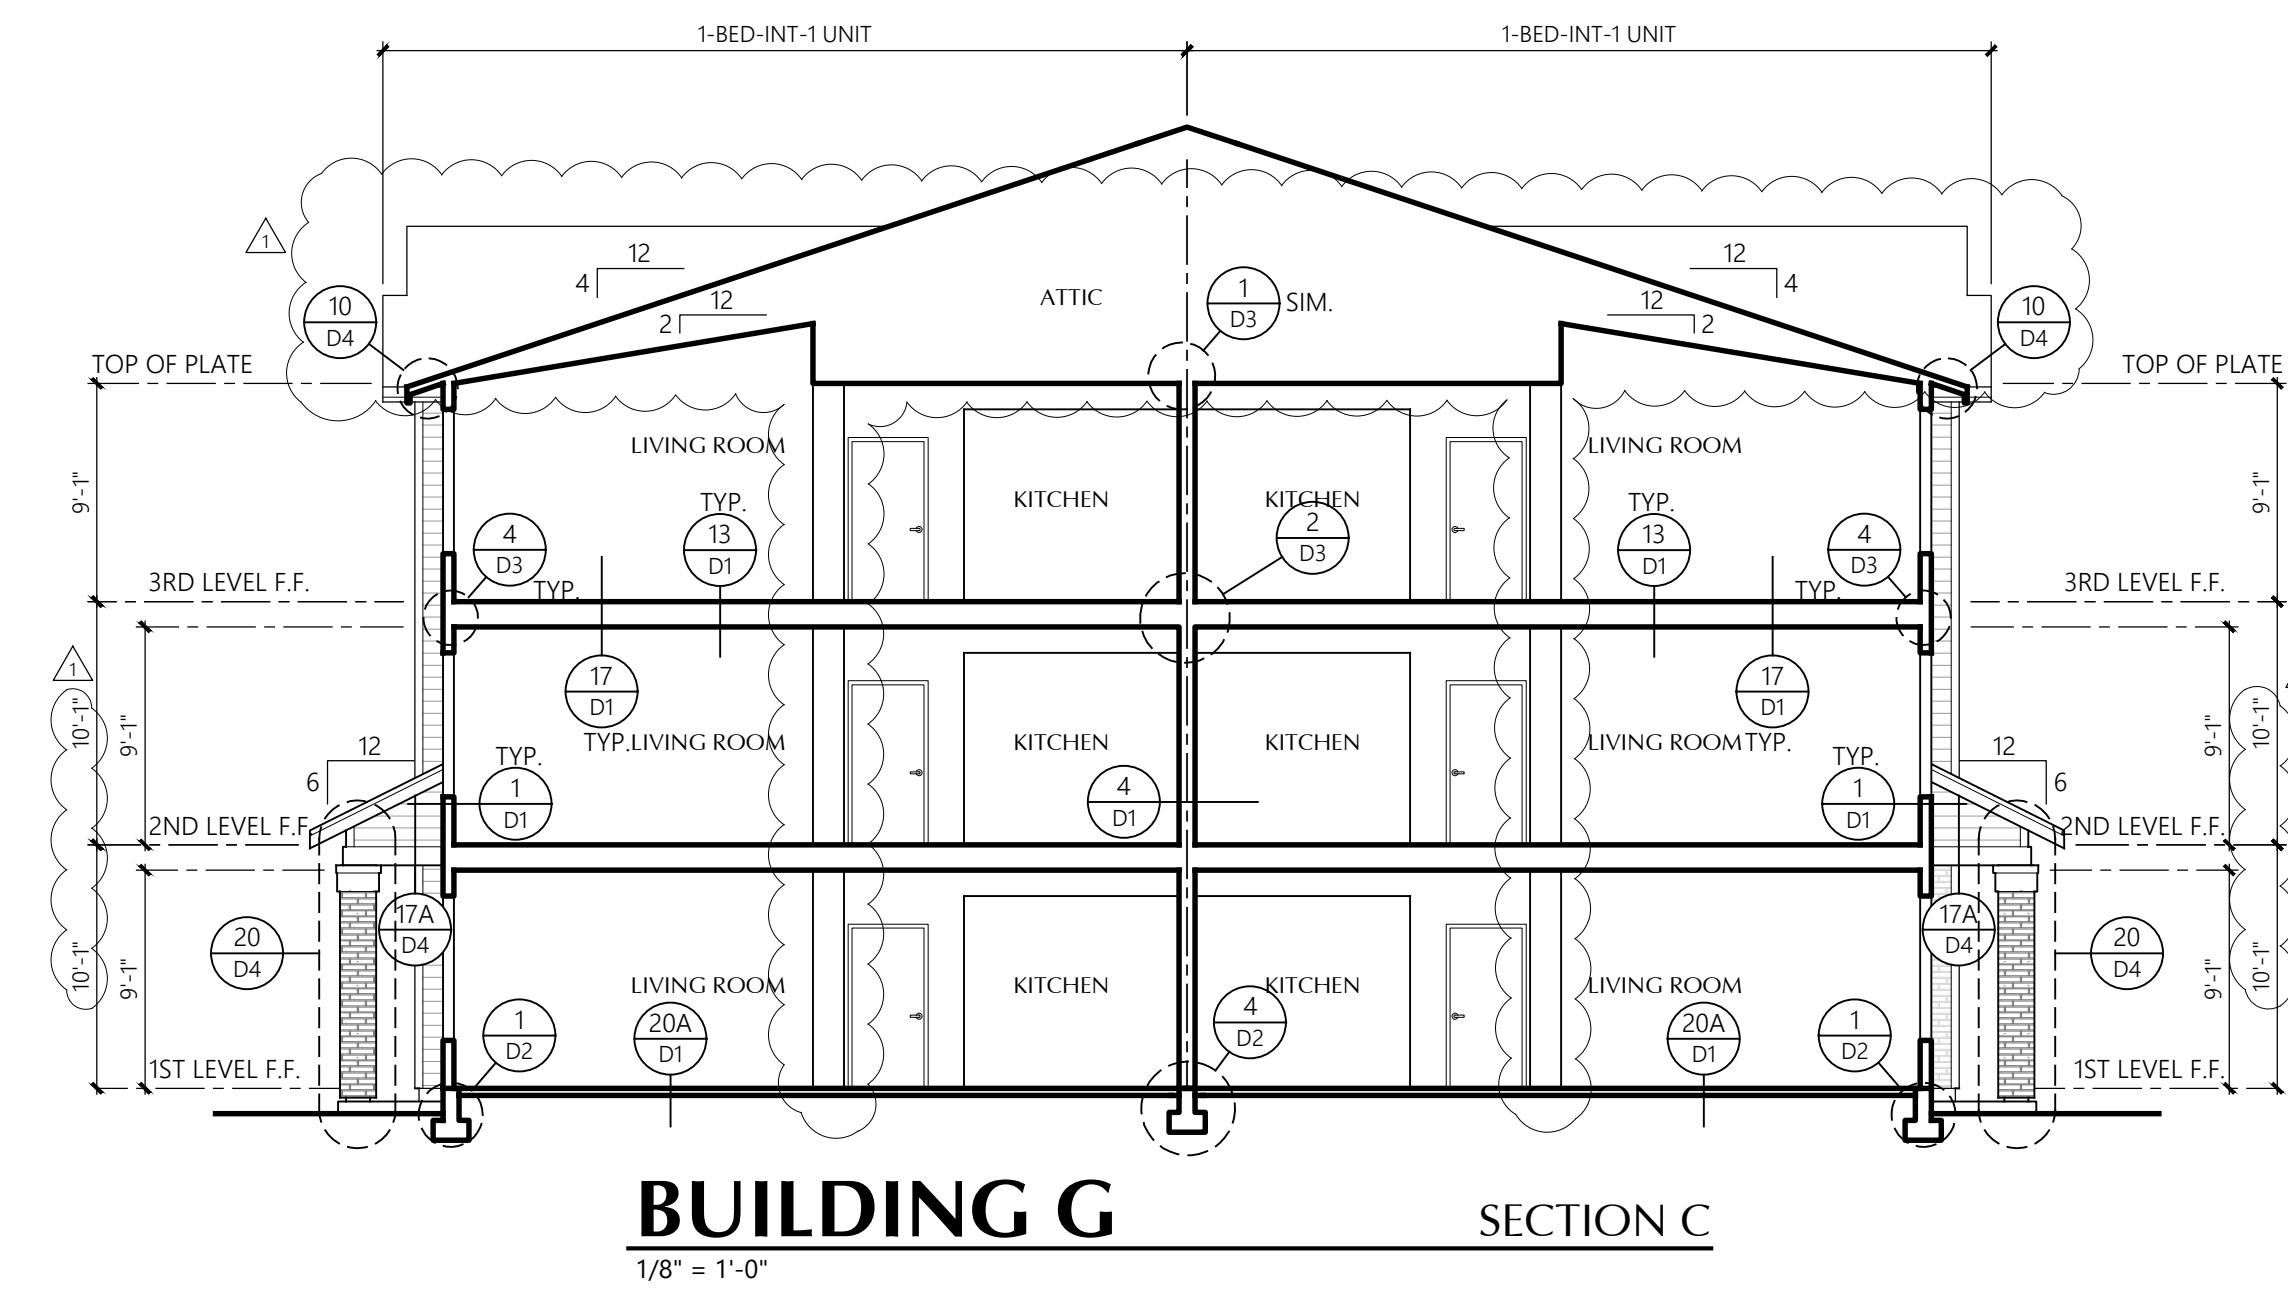


BUILDING G
SECTION C

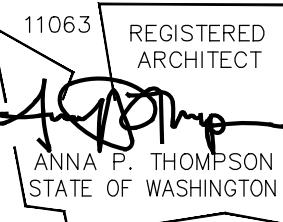

Building G

Building Section

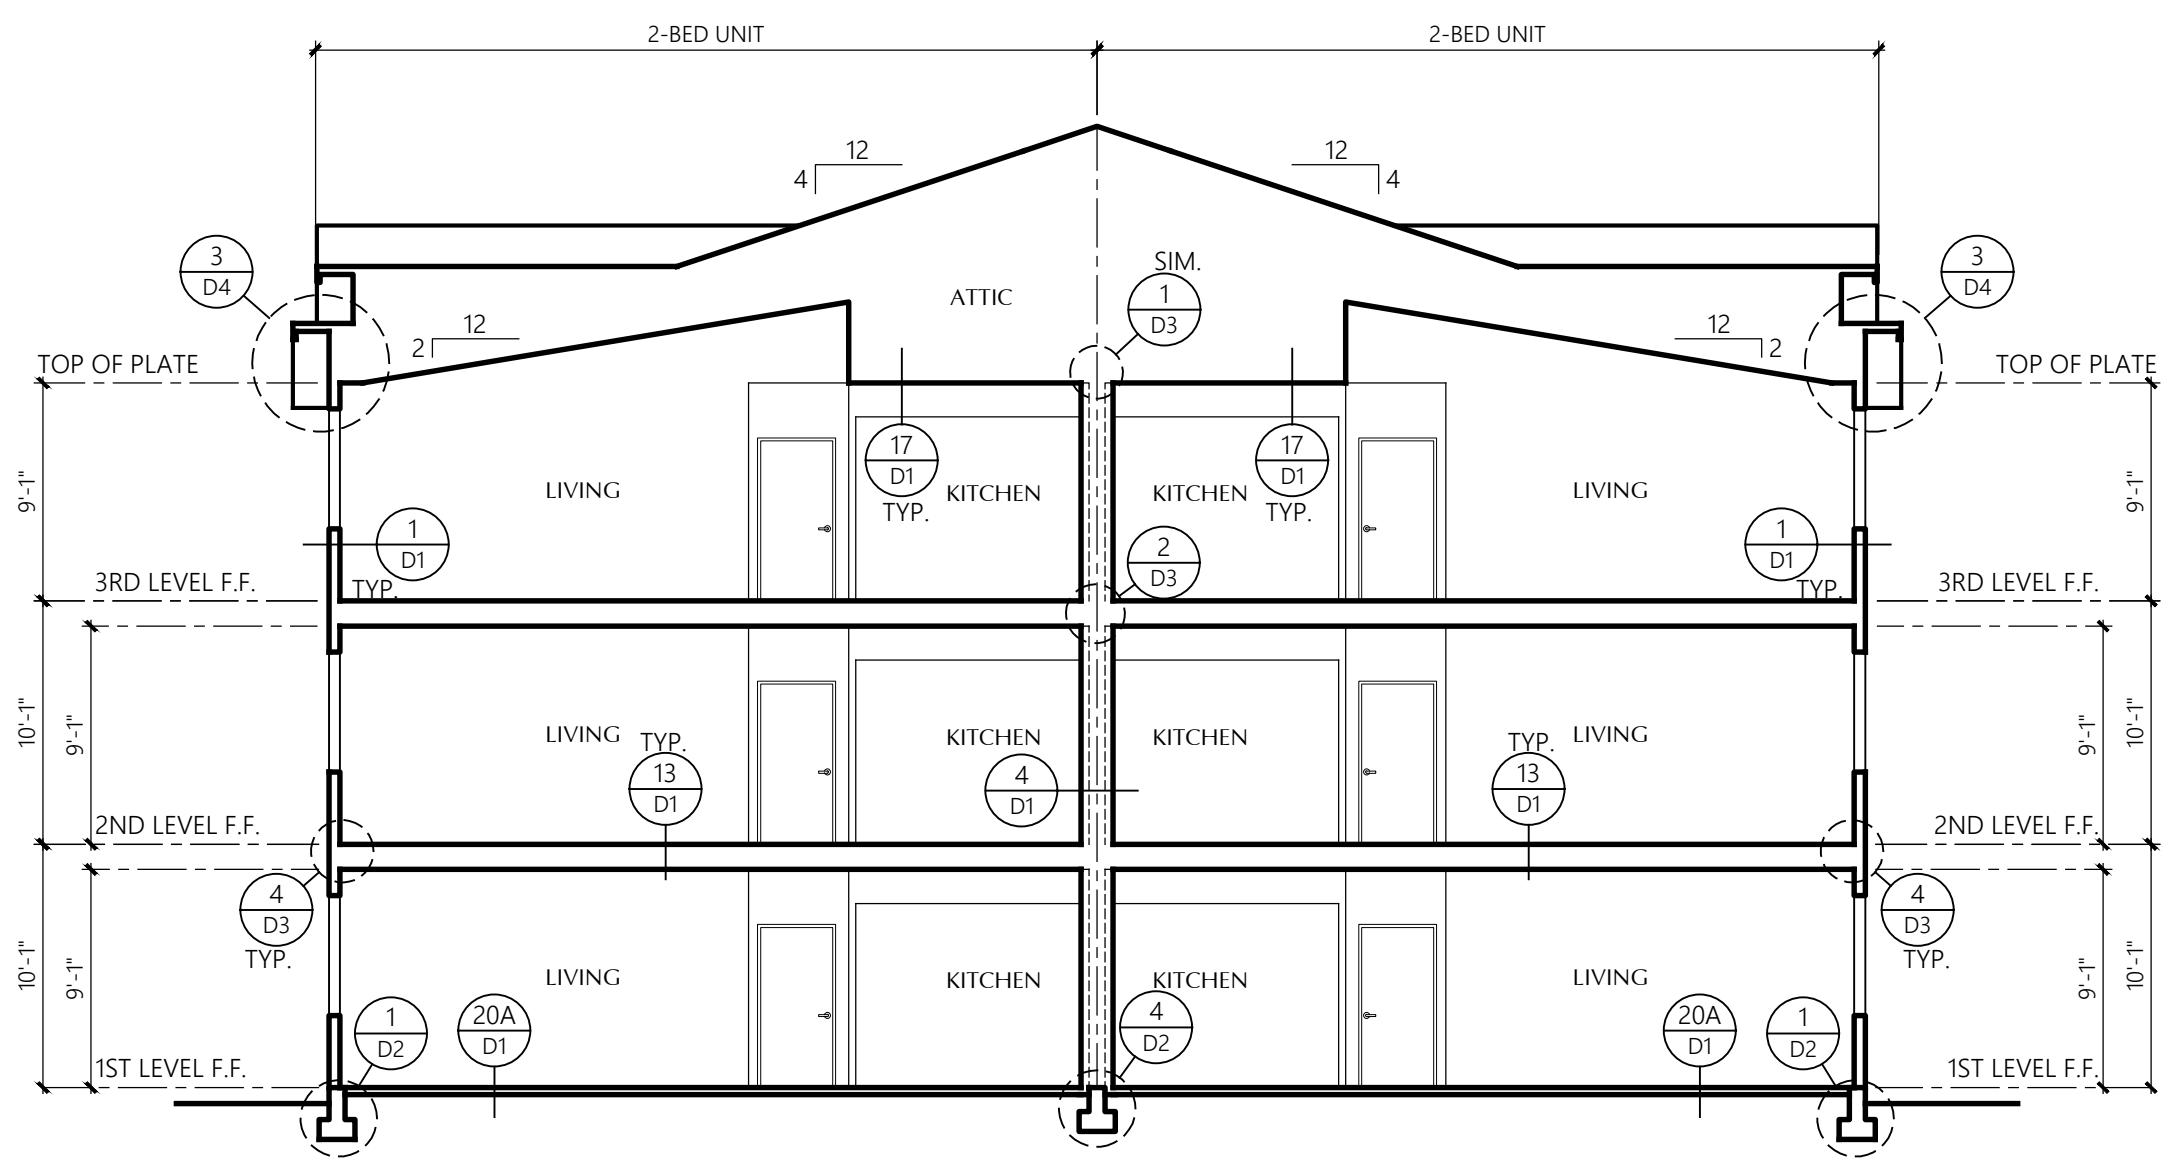

BUILDING G SECTION E

CONTRACTOR NOTE

Studs shall be continuous from support at sole plate to a support at the top plate, per Washington State Building Code 2308.5.1

Bradley Heights Apartments

Puyallup, Wa

Timberlane Partners

Revisions

No. Date Description
8-30-24 Owner Changes/ Permit Corrections

PRMU20240280

Initial Publish Date:
Date Plotted: 5-1-25

Job No.: Drawn By:
23-06 APT/HDM/TMK

Sheet No.:

SHEET ADDED

E15.1

Building Glazing Diagram

Building G

Bradley Heights Apartments


Puyallup, Wa

Timberlane Partners

Revisions

PRMU20240280

Initial Publish Date: 5-1-25
Date Plotted: 5-1-25
Job No.: 23-06 Drawn By: APT/DJV/JLL
Sheet No.: E16

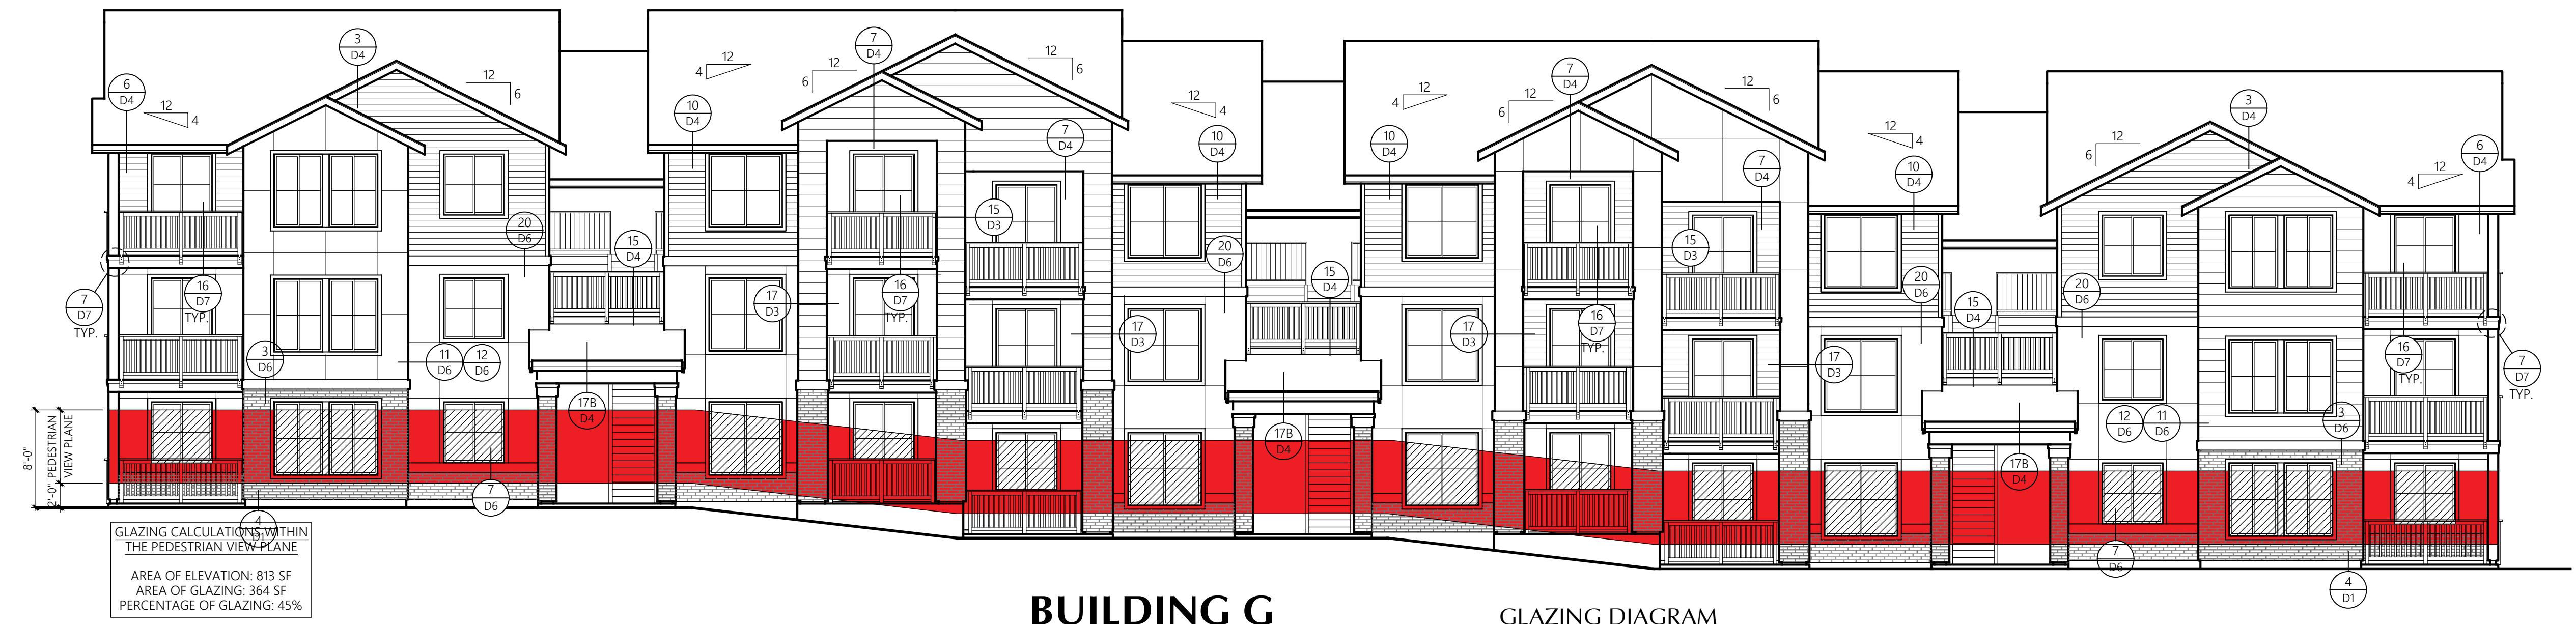

Structural Notes																																																													
<p>1.0 GENERAL</p> <p>THESE STRUCTURAL NOTES SUPPLEMENT THE SPECIFICATIONS, ANY DISCREPANCY FOUND AMONG THE DRAWINGS, SPECIFICATIONS, THESE NOTES, AND THE SITE CONDITIONS SHALL BE REPORTED TO THE ARCHITECT, WHO SHALL CORRECT SUCH DISCREPANCY IN WRITING. ANY WORK DONE BY THE CONTRACTOR THAT IS NOT IN ACCORDANCE WITH THESE NOTES SHALL BE DONE AT THE CONTRACTOR'S RISK. THE CONTRACTOR SHALL VERIFY AND COORDINATE THE DIMENSIONS AMONG ALL DRAWINGS PRIOR TO PROCEEDING WITH ANY WORK OR FABRICATION. THE CONTRACTOR IS RESPONSIBLE FOR ALL BRACING AND SHORING DURING CONSTRUCTION.</p> <p>1.1 CODES</p> <p>ALL METHODS, MATERIALS AND WORKMANSHIP SHALL CONFORM TO THE REQUIREMENTS OF THE 2018 INTERNATIONAL BUILDING CODE (IBC), AS AMENDED AND ADOPTED BY THE STATE OF WASHINGTON, A.C.I. 318-14; A.I.S.C. 14TH EDITION, A.W.S. D1.1-06; A.I.S.C. 2ND EDITION; NDS 2018 WITH 2018 WND & SEISMIC PROVISIONS AND A.I.S.C. 2012 EDITION.</p> <p>1.2 DESIGN CRITERIA</p> <p>A. VERTICAL LOADS</p> <table border="1"> <tr> <td>ROOF (SNOW)</td> <td>Is = 1.0</td> <td>25 PSF</td> </tr> <tr> <td>FLOORS (RESIDENTIAL)</td> <td></td> <td>40 PSF</td> </tr> <tr> <td>DECKS (RESIDENTAL POST/BAL SUPPORT)</td> <td></td> <td>60 PSF</td> </tr> <tr> <td>STAIRS/EXITS</td> <td></td> <td>100 PSF</td> </tr> </table> <p>B. DEAD LOADS</p> <table border="1"> <tr> <td>ROOF</td> <td>22 PSF</td> </tr> <tr> <td>FLOORS (RESIDENTIAL)</td> <td>26 PSF</td> </tr> <tr> <td>DECKS</td> <td>47 PSF</td> </tr> <tr> <td>BREEZEWAY</td> <td>47 PSF</td> </tr> </table> <p>C. LATERAL LOADS:</p> <p>LATERAL FORCES ARE TRANSMITTED BY DIAPHRAGM ACTION OF THE FLOORS TO SHEAR WALLS. LOADS ARE THEN TRANSFERRED TO THE FOOTINGS, WHERE ULTIMATE DISPLACEMENT IS RESISTED BY PASSIVE PRESSURE OF EARTH AND SLIDING FRICTION OF EARTH. OVERTURNING IS RESISTED BY THE DEAD LOAD OF THE STRUCTURE.</p> <p>1. WIND: EXPOSURE B ELEVATION = 388 FEET BASIC WIND SPEED = 97 MPH. (3 SECOND GUST, ULTIMATE). IMPORTANCE FACTOR, I_w = 1.0 SIMPLE DIAPHRAGM BUILDING, ENCLOSED $K_1 = 1.0$</p> <p>2. SEISMIC: IMPORTANCE FACTOR, I_e = 1.0 OCCUPANCY CATEGORY II MAPPED SPECTRAL RESPONSE COEFFICIENTS, $S_2 = 1.263$ AND $S_1 = 0.435$ SOIL CLASS = C SPECTRAL RESPONSE COEFFICIENTS, $S_2 = 1.010$ AND $S_1 = 0.435$ SEISMIC DESIGN CATEGORY = D SEISMIC RESPONSE COEFFICIENT $C_s = 0.2021$ (ULTIMATE STRENGTH) RESPONSE MODIFICATION FACTOR $R = 6.5$</p> <p>1.3 SHOP DRAWINGS</p> <p>SUBMIT SUFFICIENT COPIES OF SHOP DRAWINGS TO ARCHITECT/ENGINEER FOR THE FOLLOWING:</p> <ol style="list-style-type: none"> 1. REINFORCING STEEL (CONCRETE / MASONRY) 2. CONCRETE / GROUT MIX DESIGNS (CONCRETE / MASONRY) 3. COMPOSITE FLOOR/ROOF JOISTS 4. P.F. ROOF/FLOOR TRUSSES 5. GLUE-LAMINATED MEMBERS <p>DO NOT FABRICATE PRIOR TO ARCHITECT'S/ENGINEER'S APPROVAL. ALL SHOP DRAWINGS SUBMITTED TO THE ARCHITECT/ENGINEER BEAR THE CONTRACTOR'S LOGO. THE CONTRACTOR, SHOP DRAWING APPROVAL BY ANOTHER/OUT-OF-STATE STRUCTURAL ENGINEERS SHALL NOT APPLY THAT THE PROJECT MAY BE BUILT FROM THE SHOP DRAWINGS. RATHER, THE PROJECT PLANS SHALL BE USED FOR CONSTRUCTION. ALL PERMANENT BRACINGS FOR TRUSSES SHALL BE DETAILED AND DESIGNED BY THE TRUSS SUPPLIER. CONTRACTOR SHALL REVIEW SHOP DRAWINGS AND STAMP INDICATING THIS PRIOR TO REVIEW BY ENGINEER OF RECORD.</p> <p>2.0 SITE WORK</p> <p>2.1 SOIL DATA (PER GEOTECHNICAL REPORT DATED FEBRUARY 10, 2022 PREPARED BY GEO RESOURCES #0419036006)</p> <p>FOR LOCATIONS SEE SOIL REPORT. SOIL BEARING @ 0' = 2000 PSF. ACTIVE AND PASSIVE PRESSURES ARE 35 PCF AND 300 PCF RESPECTIVELY. WHERE GEOTECHNICAL REPORT HAS NOT BEEN PROVIDED, THE ABOVE VALUES ARE ASSUMED AND THESE VALUES SHALL BE FIELD VERIFIED.</p> <p>2.2 EXCAVATION</p> <p>EXCAVATE PER GEOTECH REPORT, PROGRESS SUBGRADES TO ATLEAST 92% MDD PER ASTM D1557 TEST METHOD FOR FOOTINGS DOWN TO DEPTH SHOWN ON DRAWINGS OR TO FIRM UNDISTURBED MATERIAL. AREAS OVER-EXCAVATED SHALL BE BACKFILLED WITH LEAN CONCRETE ($I_c = 2000$ PSI), OR BE STRUCTURALLY FILLED PER SECTION 2.3 AND SHALL BE AT THE CONTRACTOR'S EXPENSE.</p> <p>2.3 BACKFILL AND COMPACTION</p> <p>BACKFILL SHALL NOT BE PLACED UNTIL AFTER THE REMOVAL OF ALL FORMS, SCREEDS, OTHER WOOD FORMING, ETC. TO A MAXIMUM DEPTH OF 12 INCHES. BACKFILL SHALL BE APPROVED FOR BACKFILL. IN AREAS UNDER SLABS OR FOOTINGS, MATERIAL SHALL BE GRANULAR IN NATURE, PLACED IN 6-INCH LIFTS AND COMPACTION TO AT LEAST 95% OF MAXIMUM DRY DENSITY AS DETERMINED BY AASHTO COMPACTION TEST, PROCEDURE T-180. THE FILL SHOULD BE LIMITED TO CLEAN, GRANULAR MATERIAL.</p> <p>3.0 CONCRETE</p> <p>3.1 GENERAL</p> <p>NORMAL WEIGHT CONCRETE MEETING THE REQUIREMENTS OF ACI 301-05 ESTABLISH PROPORTIONS OF CEMENT, COARSE AND FINE AGGREGATES, WATER, AND ADMIXTURES TO PRODUCE THE PROPERTIES SPECIFIED FOR EACH CONCRETE MIX TYPE PER ACI-301 ON THE BASIS OF PREVIOUS AND EXPERIENCE OF THE CONTRACTOR. CONCRETE SHALL BE IN ACCORDANCE WITH THE MANUFACTURER'S SPECIFICATIONS. USE AMOUNTS OF WATERREDUCING ADMIXTURE THAT WILL PERMIT PLACING WITHOUT SEPARATION, HONEYCOMBING OR ROCK POKETS. THE SLUMPS SPECIFIED ARE THE SLUMPS REQUIRED AT THE POINT OF PLACEMENT INTO THE STRUCTURE. USE INTERIOR MECHANICAL VIBRATORS WITH 7000 RPM MINIMUM FREQUENCY. DO NOT OVER-VIBRATE. DO NOT MOVE THE CONCRETE HORIZONTALLY USING THE VIBRATOR. CONCRETE SHALL BE POURED MONOLITHICALLY BETWEEN CONSTRUCTION CONTROL JOINTS. PROTECT EXPOSED PLATES, PLUGS, TUBING, AND MASTERS FROM DRIPPING AND EXCESSIVE HOT OR COLD TEMPERATURES FOR SEVEN DAYS AFTER POURING. PROVIDE ENGINEER WITH PROPOSED CONSTRUCTION OR CONTROL JOINT LOCATIONS FOR HIS APPROVAL, OR USE JOINTS AS SHOWN ON THE DRAWINGS. ALL REINFORCEMENT TIE WIRES AND FORM ANCHORS SHALL BE CUT OFF FLUSH WITH THE SURFACE; SURFACES WHERE EXPOSED SHALL BE SMOOTH AND FREE FROM IRREGULARITIES.</p> <p>3.2 STRENGTH</p> <p>DESIGN MIXES TO PROVIDE NORMAL WEIGHT CONCRETE WITH THE FOLLOWING PROPERTIES:</p> <table border="1"> <thead> <tr> <th>APPLICATION</th> <th>W/C RATIO</th> <th>DESIGN STRENGTH F'c (PSI)</th> <th>F'c PER ACI</th> </tr> </thead> <tbody> <tr> <td>FOOTINGS</td> <td>.45</td> <td>2500</td> <td>4500²</td> </tr> <tr> <td>FOUNDATION WALLS</td> <td>.45</td> <td>2500</td> <td>4500²</td> </tr> <tr> <td>EXT. SLABS ON GRADE</td> <td>.45</td> <td>2500</td> <td>4500²</td> </tr> <tr> <td>INT. SLABS ON GRADE</td> <td>.50</td> <td>2500</td> <td>3000</td> </tr> </tbody> </table> <p>NOTES:</p> <ol style="list-style-type: none"> 1. CONCRETE EXPOSED TO WEATHER FOR EXPOSURE CLASS F2 AND SLABS ON GRADE SHALL HAVE A MIN F'c PER P.D. AND HAVE 5X AIR ENTRAINMENT. 2. DESIGN STRENGTH F'c (USED IN DESIGN), F'c PER ACI TABLE 19.3.2.1 FOR F2 EXPOSURE CLASS. 3. PER IBC 1705.3 SPECIAL INSPECTION STRENGTH TESTS NOT REQUIRED FOR CONCRETE F'c>2500 WHERE STRENGTH IS INCREASED FOR DURABILITY. <p>3.3 MATERIAL - CEMENT, WATER & AGGREGATES PER ACI 301</p> <ol style="list-style-type: none"> A. CEMENT MUST CONFORM TO ASTM C-150, TYPE I OR TYPE II. ENGINEER'S APPROVAL IS REQUIRED FOR USE OF TYPE III CEMENT. B. WATER TO BE CLEAN AND POTABLE. C. COARSE AND FINE AGGREGATES TO CONFORM TO ASTM-C33. <p>3.4 MATERIALS</p> <ol style="list-style-type: none"> A. WATER REDUCING ADMIXTURES: CONCRETE USING POZZOLITH ADMIXTURES TO PRODUCE FLOWABLE CONCRETE MAY BE USED WITH THE ENGINEER'S APPROVAL AND MUST CONFORM TO ASTM-C494, POZZOLITH POLYHEX, POZZOLITH 100X, OR POZZUTECH 20. POZZOLITH SHALL BE INCORPORATED INTO ALL CONCRETE IN EXACT ACCORDANCE WITH THE MANUFACTURER'S INSTRUCTIONS. ADMIXTURES AND DOSAGES WILL VARY DEPENDING ON CLIMATIC CONDITIONS AND THE CONTRACTOR'S WORKSITE REQUIREMENTS. MAXIMUM SLUMP FOR SUCH CONCRETE SHALL NOT EXCEED 8" WITH A MINIMUM OF 10 OUNCES OF POLYHEX PER 100 OUNCES OF CEMENT. USE IN ACCORDANCE WITH MANUFACTURER'S RECOMMENDATIONS. B. AIR ENTRAINMENT: CONFORM TO ASTM-C260 AND ASTM-C494, MBVR OR MICRO-AIR BY MASTER BUILDER. NO AIR ENTRAINMENT IN COLUMNS WITHOUT PRIOR WRITTEN PERMISSION BY ENGINEER OF RECORD. ENTRAIN 5% +/- 1% AIR BY VOLUME IN ALL EXPOSED CONCRETE. C. OTHER ADMIXTURE: NO OTHER ADMIXTURES PERMITTED UNLESS PRIOR APPROVAL IS GIVEN BY THE ENGINEER. NO ADMIXTURES CONTAINING CHLORIDES ARE PERMITTED. <p>3.5 REINFORCING STEEL</p> <p>DETAIL, FABRICATE AND PLACE PER ACI-315 AND ACI-318. SUPPORT REINFORCEMENT WITH APPROVED CHAIRS, SPACERS, OR TIES.</p> <ol style="list-style-type: none"> A. STEEL REINFORCEMENT SHALL BE NEW, DEFORMED BILLET STEEL, MEETING ASTM STANDARD A-615, A-708 AT BOUNDARY ELEMENTS, GRADE 60 FOR #3 AND LARGER BARS UNLESS NOTED OTHERWISE ON THE PLANS. SHOP DRAWINGS SHALL BE MARKED ACCORDINGLY AND SUBMITTED TO THE ENGINEER FOR REVIEW PRIOR TO FABRICATION. GRADE 60 REBARS SHALL NOT BE BENT IN FIELD AFTER CONCRETE PLACEMENT. ALL BEND SHALL BE PER ACI. B. REINFORCEMENT IN ALL WALLS, SLABS, AND FOOTINGS SHALL BE CONTINUOUS AROUND CORNERS OR CORNER BARS PROVIDED, BOTH VERTICAL AND HORIZONTAL. C. LAPS: ALL TENSION SPlices ARE ACCORDING TO ACI 318, CLASS B AND ALL COMPRESSION SPlices ARE 30 DIAMETERS FOR F'c GREATER THAN 3000 PSI AND ARE 40 DIAMETERS FOR F'c WHICH IS LESS THAN 3000 PSI, UNLESS NOTED OTHERWISE. SEE DETAIL 17/S3.0 FOR TYPICAL SPLICE AMOUNTS BASE ON BAR SIZE. D. TRIM REINFORCING: AROUND ALL OPENINGS SHALL BE A MINIMUM #5 TOP AND BOTTOM, EXTENDING 2"-6" BEYOND OPENING AT EACH CORNER. SEE TYPICAL DETAILS. E. WELDING: TACK WELDING OF REBAR IS NOT PERMITTED UNLESS CALLED FOR AND APPROVED BY THE ENGINEER. F. MINIMUM REINFORCING: WHERE REINFORCEMENT IS NOT SHOWN ON THE DRAWINGS, THE "BUILDING CODE REQUIREMENTS FOR REINFORCED CONCRETE" (ACI 318) SHALL BE REFERRED TO FOR PROPER REINFORCEMENT. G. REBAR COVER: PROVIDE CONCRETE PROTECTION FOR REINFORCEMENT AS FOLLOWS: <table border="1"> <thead> <tr> <th>COVER</th> <th>CONDITION</th> </tr> </thead> <tbody> <tr> <td>2"</td> <td>CONCRETE DEPOSITED AGAINST EARTH</td> </tr> <tr> <td>2"</td> <td>CONCRETE DEPOSITED AGAINST FORMS BUT EXPOSED TO EARTH</td> </tr> <tr> <td>1-1/2"</td> <td>MAIN REINFORCING IN BEAMS</td> </tr> <tr> <td>1-1/2"</td> <td>TO TIES IN COLUMNS, AND TIED REBAR IN WALLS</td> </tr> <tr> <td>1-1/2"</td> <td>FOR BARS IN SLABS ON GROUND</td> </tr> <tr> <td>3/4"</td> <td>FOR BARS IN SLABS ON FORMS</td> </tr> </tbody> </table> <p>H. WELDED WIRE FABRIC: ASTM-A185 AND ASTM-A82</p> <ol style="list-style-type: none"> I. DEFORMED BAR ANCHORS: ASTM-A496 K. FIBREMESH: PROVIDE FIBREMESH STRANDS WITHIN CONCRETE PER THE MANUFACTURER'S SPECIFICATION (1.5#/CU. YARD TYPICALLY) WHERE REQUIRED BY THE OWNER IN LIEU OF UTILIZING WELDED WIRE FABRIC WITHIN SLABS ON GRADE. <p>3.6 EPOXY DOED REINFORCEMENT</p> <ol style="list-style-type: none"> A. ALL REINFORCEMENT WHICH IS TO BE DOED INTO EXISTING CONCRETE SHALL BE INSTALLED USING THE SIMPSON SET-XP ADHESIVE ANCHORING SYSTEM PER ICC REPORT ESR-2508 OR APPROVED EQUAL. ADHESIVE ANCHORS SHALL BE INSTALLED PER THE MANUFACTURER'S SPECIFICATIONS OR APPROVED EQUAL. B. EPOXY SHALL BE MIXED, APPLIED, AND CURED IN ACCORDANCE WITH THE MANUFACTURER'S GUIDELINES. REINFORCEMENT AND CONCRETE SHALL BE CLEAN AND FREE OF IRREGULARITY. EPOXY SHALL NOT BE MIXED OR CURED IN AIR AND / OR CONCRETE TEMPERATURES BELOW MINIMUM PER MANUFACTURER'S SPECIFICATIONS. C. EPOXY DOEWING OF REINFORCEMENT IN OVERHEAD APPLICATIONS SHALL NOT BE ALLOWED WITHOUT PRIOR WRITTEN APPROVAL FROM THE ENGINEER OF RECORD. <p>4.0 METALS</p> <p>4.1 WELDING</p> <ol style="list-style-type: none"> A. ALL WELDING SHALL BE IN ACCORDANCE WITH AWS D1.1 "STRUCTURAL WELDING CODE" & D1.3 "STRUCTURAL WELDING CODE - SHEET STEEL." B. ALL WELDING SHALL BE DONE BY AWS/WABO (WASHINGTON STATE ASSOCIATION OF BUILDER OFFICIALS) CERTIFIED WELDERS. FOR ALL MOMENT FRAMES WELDERS SHALL HAVE ADDITIONAL QUALIFICATION SHOWING QUALIFIED IN ACCORDANCE WITH AWS D1.8, SECTION 5, WELDER QUALIFICATION, THE SUPPLEMENTAL WELDER QUALIFICATION FOR RESTRICTED ACCESS WELDING. <p>5.0 STRUCTURE STEEL</p> <p>A. ALL DETAILING, FABRICATION, AND ERECTION SHALL CONFORM TO THE AISC "MANUAL OF STEEL CONSTRUCTION." STEEL SHALL CONFORM TO THE FOLLOWING, UNO:</p> <table border="1"> <tr> <td>ALL STEEL, UNO</td> <td>ASTM A992.</td> </tr> </table> <p>ASTM A572, GRADE 50, A447, $F_y = 50$ KSI OR A588 $F_y = 50$ KSI ONLY W/ PRIOR APPROVAL OF ENGINEER OF RECORD.</p> <p>ANGLES ASTM A36, $F_y = 36$ ksi</p> <p>CHANNELS, EMBEDMENTS IN CONCRETE AND MISC. METALS, UNO ASTM A35. $F_y = 36$ ksi OR STEEL TYPES LISTED UNDER "ALL STEEL."</p> <p>SQUARE AND RECTANGULAR STRUCTURAL TUBES ASTM A500, GRADE B, $F_y = 46$ ksi</p> <p>STEEL PIPE DIAMETER LESS THAN OR EQUAL TO 12" NOM ASTM A53, TYPE E OR S, GRADE B, $F_y = 35$ ksi</p> <p>B. ALL WORK SHALL BE IN ACCORDANCE WITH THE AISC SPECIFICATION. SHOP DRAWINGS SHALL BE SUBMITTED TO THE ARCHITECT/ENGINEER BEFORE COMMENCING FABRICATION. ALL STEEL AND TUBES AND TIES AND OTHER MEMBERS EMBEDDED IN CONCRETE OR MASONRY SHALL BE USED UNLESS OTHERWISE DIMENSIONAL TOLERANCE FOR BUILD-UP MEMBERS SHALL BE PER AWS D1.8. GENERAL NOTES FOR STEEL CONNECTIONS SHALL APPLY TO ALL STEEL CONNECTIONS, UNO.</p> <p>7.7 PLYWOOD/OSB SHEATHING</p> <p> EACH SHEET SHALL BEAR THE TRADEMARK OF THE AMERICAN PLYWOOD ASSOCIATION. ALL GRADING AND INSTALLATION SHALL CONFORM TO THE MOST CURRENT VERSION OF PS2 FOR OSB. USE THICKNESS AND NAILING AS SHOWN ON THE DRAWINGS. SHEATHING SHALL HAVE EXPOSURE RATING AS APPROPRIATE FOR THE CONTRACTOR'S CONSTRUCTION AND WEATHER CONDITIONS SPECIFIED BY CONTRACTOR. EXCEPT AS OTHERWISE SHOWN OR NOTED, PROVIDE 0.13" DIA P-NAILS OR 8d COMMON NAILS AT 6" O.C. ON CENTER @ SUPPORTED PANEL EDGES AND 0.13" DIA P-NAILS OR 8d COMMON NAILS AT 12" O.C. ON CENTER ON OTHER SUPPORTING MEMBERS FOR WALLS AND ROOFS. FOR FLOORS, USE THE SAME SPACING PATTERN AS STATED FOR WALLS OR ROOF EXCEPT USE 0.14" DIA P-NAILS OR 10d COMMON NAILS.</p> <p>NOTE: EQUIVALENT RATED PLYWOOD MAY BE USED IN LIEU OF OSB CALLED OUT. ALL THICKNESS AND GRADING SHALL CONFORM TO PSI OR PS2. SHEATHING SHALL HAVE EXPOSURE RATING AS APPROPRIATE FOR THE CONTRACTOR'S CONSTRUCTION AND WEATHER CONDITIONS SPECIFIED BY CONTRACTOR.</p> <p>ROOF DIAPHRAGM: 1/2" MIN OSB (MIN PANEL INDEX = 24/16), WITH 0.13" DIA P-NAILS OR 8d COMMON NAILS AT 6" O.C. AT SUPPORTED PANEL EDGES AND AT 12" O.C. AT FIELD TYPICAL UNLESS NOTED OTHERWISE ON PLAN. SHEATHING SHALL BE GLUE-NAILED TO FRAMING WITH APPROVED ADHESIVE PER THE ARCHITECT. FIELD NAILING SHALL BE 6" O.C. AT ALL INTERIOR SHEARWALL LOCATIONS INSTEAD OF TYPICAL 12" O.C. SPACING.</p> <p>7.8 MANUFACTURED TIMBER BEAMS</p> <p>A. GLULAMINATED TIMBER BEAMS (GLULAM BEAMS)</p> <p>ALL STRUCTURAL GLUE-LAMINATED TIMBER, MATERIALS, MANUFACTURE AND QUALITY CONTROL SHALL BE IN CONFORMANCE WITH VOLUNTARY PRODUCT STANDARD P.S.56 "STRUCTURAL GLUED LAMINATED TIMBER", AND ALL MEMBERS SHALL BE MARKED WITH A GRADE MARK AND GRADE NUMBER. THE GRADE MARK AND GRADE NUMBER ARE AS SHOWN ON THE DRAWINGS. ALL MEMBERS SHALL BE EITHER COMBINATION 24F-V4 (SIMPLE SPAN) OR 24F-V8 (CANTILEVERED OR CONTINUOUS SPAN) AS APPLICABLE. ALL MEMBERS SHALL BE ARCHITECTURAL APPEARANCE AND SHALL BE GLUED WITH WATERPROOF ADHESIVE PER P.S. 56. ARCHES SHALL BE COMBINATION 24F-V8 AND HAVE EXTERIOR GLUE, ARCHITECTURAL GRADE.</p> <p>7.9 SHRINKAGE</p> <p>WOOD MEMBERS WERE EVALUATED USING KILN DRIED (KD) OR SURFACE DRIED (SD) LUMBER (HEM-FIR WITH MOISTURE CONTENT = 19% OR LESS). THE FLOOR TO FLOOR COMPRESSION OF SUCH WOOD MEMBERS (PLATES AND JOISTS TOTALING 12.5") DUE TO A MOISTURE CONTENT CHANGE OF 10% WILL BE APPROXIMATELY 3/8 INCHES PER FLOOR. ADDITIONAL FLOOR TO FLOOR COMPRESSION OF WOOD STUDS DUE TO FULL COMPRESSIVE LOAD WILL BE APPROXIMATELY 1/32 INCHES PER FLOOR. ADDITIONAL COMPRESSION OF WOOD FRAMING MAY OCCUR DUE TO FRAMING TECHNIQUES AND LOCAL STRESS CONCENTRATIONS. ALL FULL HEIGHT ELECTRICAL, MECHANICAL, AND PLUMBING SYSTEMS AS WELL AS EGRESS FINISHES SHALL BE DESIGNED TO ACCOMMODATE THESE MOVEMENTS. USE OF WOOD STUDS, PLATES & JOISTS WHICH WILL HAVE MOISTURE CONTENT CHANGES GREATER THAN 10% WILL EXPERIENCE GREATER MOVEMENT. FLOOR ASSEMBLIES UTILIZING DEPTHS GREATER THAN THOSE ASSUMED ABOVE MAY EXPERIENCE GREATER MOVEMENTS. LOCALIZED HEADERS MAY EXPERIENCE SIMILAR SHRINKAGE AS DESCRIBED ABOVE.</p> <p>7.10 PRESERVATIVE TREATMENT</p> <p>A. PRESERVATIVE TREATMENTS</p> <p>SEE ARCH FOR ALL PRESERVATIVE TREATED REQUIREMENTS AND FINISHES OF EXPOSED TIMBER MEMBERS AND AT EXTERIOR CONDITIONS.</p> <p>ALL EXPOSED FRAMING LUMBER, PLYWOOD AND DECK MATERIALS SHALL BE PRESSURE TREATED PER AWPA SPECIFICATION P-5 OR OTHER APPROVED TREATMENT. ALL CUTTING AND BORING AFTER PRESSURE TREATMENT SHALL BE CARED FOR IN ACCORDANCE WITH AWPA SPECIFICATION M-4.</p> <p>ACIA PRESERVATIVE TREATMENT SHALL NOT BE PERMITTED EXCEPT WHERE HARDWARE (INCLUDING NAILS) IN CONTACT WITH THE TREATED PRODUCT IS COMPOSED ENTIRELY OF STAINLESS STEEL AND PLYWOOD AND PLATE HARDWARE SUBSTITUTED FOR HDG PRODUCTS SHALL MEET OR EXCEED THE STRENGTH AND PERFORMANCE OF THE SUBSTITUTED HDG PRODUCT ORIGINALLY SPECIFIED.</p> <p>B. GALVANIZATION OF HARDWARE (EXPOSED OR IN CONTACT WITH PRESERVATIVE TREATED WOOD)</p> <p>1. PROTECTED ENVIRONMENT</p> <p>ALL HARDWARE (HANGERS, NAILS, BOLTS, LAC SCREWS, FLASHING ETC.) SHALL BE HOT-DIP GALVANIZED (HDG) TO A MINIMUM COATING LEVEL OF C165 (1.85 oz./12" OF ZINC) WHEN IN CONTACT WITH PRESERVATIVE TREATED WOOD CONTAINING PRODUCTS SUCH AS, BUT NOT LIMITED TO: CCA, ACQ, OR CBA. HDG PRODUCTS SHALL CONFORM TO THE FOLLOWING ASTM STANDARDS AS APPLICABLE: ASTM A165, ASTM A123, AND ASTM A153. WHEN USING STAINLESS STEEL OR HOT-DIP GALVANIZED CONNECTORS, THE CONNECTORS AND FASTENERS SHALL BE OF THE SAME MATERIAL.</p> <p>2. EXPOSED ENVIRONMENT</p> <p>ALL HARDWARE (INCLUDING CONNECTORS) IN CONTACT WITH PRESSURE TREATED WOOD IN AN EXPOSED OR POTENTIAL TO BE EXPOSED ENVIRONMENT (HAVING POTENTIAL FOR WIND BLOWN RAIN TO REACH) SHALL BE STAINLESS STEEL.</p> <p>8.0 MECHANICAL AND EPOXY FASTENERS</p> <p>A. MECHANICAL FASTENERS (PRE-DRILLED ANCHORS)</p> <ol style="list-style-type: none"> 1. TYPICAL MECHANICAL ANCHORS WHICH ARE INSTALLED IN CONCRETE SHALL BE AS MANUFACTURED BY THE SIMPSON, INC. AND SHALL BE INSTALLED IN CONFORMITY WITH THE MANUFACTURER'S GUIDELINES AND PER ICC REPORT ESR-1771 FOR WEDGE ANCHORS OR PER ICC REPORT ESR-2713 FOR SCREW TYPE ANCHORS OR APPROVED EQUALS. 2. SPECIAL CARE SHALL BE TAKEN DURING THE DRILLING / INSTALLATION OF FASTENERS WITHIN POST-TENSIONED CONCRETE. ANCHORS SHALL BE INSTALLED IN SUCH A MANNER SO AS NOT TO INTERFERE WITH / DAMAGE REINFORCEMENT. <p>B. EPOXY CONNECTIONS (PRE-DRILLED ANCHORS)</p> <ol style="list-style-type: none"> 1. ADHESIVE ANCHORS SHALL BE OF THE SIZE AND LENGTH AS CALLED OUT ON THE PLANS USING THE SIMPSON SET-XP ADHESIVE ANCHORING SYSTEM PER ICC REPORT ESR-2508 OR APPROVED EQUAL. ADHESIVE ANCHORS SHALL BE INSTALLED PER THE MANUFACTURER'S SPECIFICATIONS. 2. ALL EPOXY ANCHORS OR FASTENERS REQUIRE SPECIAL INSPECTION. 3. ANCHORS SHALL BE INSTALLED IN SUCH A MANNER SO AS NOT TO INTERFERE WITH / DAMAGE REINFORCEMENT. <p>9.0 SPECIAL INSPECTIONS:</p> <p>SPECIAL INSPECTIONS SHALL CONFORM TO SECTION 1704 OF THE 2018 IBC AND ARE REQUIRED DURING THE FOLLOWING:</p> <ol style="list-style-type: none"> A. THE EXCAVATION OF FOOTINGS PRIOR TO CONCRETE PLACEMENT, B. THE TAKING OF CONCRETE TEST SPECIMENS SEE PARAGRAPH 3.2, NOTE 4 FOR EXCEPTION WITH F'c GREATER THAN 2500 PSI. C. THE PLACEMENT OF REINFORCING STEEL OF ALL STRUCTURAL FOOTINGS, COLUMNS, WALLS, SLABS AND APPENDAGES, D. THE CONSTRUCTION OF THE LATERAL WOOD SYSTEM TO VERIFY APPROPRIATE ELEMENTS, NAILING, HARDWARE & CONNECTIONS PRIOR TO FINAL APPROVAL. E. ALL EPOXY DOED APPLICATIONS. <p>PRIOR TO CONSTRUCTION THE CONTRACTOR SHALL BE RESPONSIBLE TO COORDINATE A SCHEDULE OF REQUIRED INSPECTIONS AND SHALL SUBMIT THIS SCHEDULE TO THE ARCHITECT AND ENGINEER FOR APPROVAL.</p> <p>INSPECTION IS INSPECTION PERFORMED BY THE BUILDING OFFICIAL AT VARIOUS STAGES OF A PROJECT AS OUTLINED IN IBC SECTION 109 TO ENSURE COMPLIANCE TO THE BUILDING CODE. SPECIAL INSPECTION SHALL BE DONE BY AN INDEPENDENT 3RD PARTY INSPECTOR BY OWNER, WHERE IBC CHAPTER 17 (REF SECTION 1704) REQUIRES SPECIAL EXPERTISE TO ENSURE COMPLIANCE WITH THE APPROVED CONSTRUCTION DOCUMENTS.</p> <p>STRUCTURAL OBSERVATION SHALL BE PERFORMED BY A REGISTERED DESIGN PROFESSIONAL FOR GENERAL CONFORMANCE WITH THE APPROVED CONSTRUCTION DOCUMENTS AS DEFINED IN IBC SECTION 1702. STRUCTURAL OBSERVATION DOES NOT INCLUDE OR WAIVE THE RESPONSIBILITY FOR INSPECTION AS REQUIRED BY IBC.</p> <p>10.0 MISCELLANEOUS</p> <p>VERIFY ALL DIMENSIONS AND CONDITIONS PRIOR TO PROCEEDING. PROVIDE ERECTION BRACING AS NECESSARY UNTIL PERMANENT SUPPORT AND STIFFNESS ARE INSTALLED. REFER TO ARCHITECTURAL PLANS FOR WALL OPENING, ARCHITECTURAL TREATMENT AND DIMENSIONS NOT SHOWN. REFER TO MECHANICAL AND ELECTRICAL PLANS FOR SIZE AND LOCATION OF ALL OPENINGS FOR DUCTS, PIPES, CONDUITS, ETC., NOT SHOWN.</p>						ROOF (SNOW)	Is = 1.0	25 PSF	FLOORS (RESIDENTIAL)		40 PSF	DECKS (RESIDENTAL POST/BAL SUPPORT)		60 PSF	STAIRS/EXITS		100 PSF	ROOF	22 PSF	FLOORS (RESIDENTIAL)	26 PSF	DECKS	47 PSF	BREEZEWAY	47 PSF	APPLICATION	W/C RATIO	DESIGN STRENGTH F'c (PSI)	F'c PER ACI	FOOTINGS	.45	2500	4500 ²	FOUNDATION WALLS	.45	2500	4500 ²	EXT. SLABS ON GRADE	.45	2500	4500 ²	INT. SLABS ON GRADE	.50	2500	3000	COVER	CONDITION	2"	CONCRETE DEPOSITED AGAINST EARTH	2"	CONCRETE DEPOSITED AGAINST FORMS BUT EXPOSED TO EARTH	1-1/2"	MAIN REINFORCING IN BEAMS	1-1/2"	TO TIES IN COLUMNS, AND TIED REBAR IN WALLS	1-1/2"	FOR BARS IN SLABS ON GROUND	3/4"	FOR BARS IN SLABS ON FORMS	ALL STEEL, UNO	ASTM A992.
ROOF (SNOW)	Is = 1.0	25 PSF																																																											
FLOORS (RESIDENTIAL)		40 PSF																																																											
DECKS (RESIDENTAL POST/BAL SUPPORT)		60 PSF																																																											
STAIRS/EXITS		100 PSF																																																											
ROOF	22 PSF																																																												
FLOORS (RESIDENTIAL)	26 PSF																																																												
DECKS	47 PSF																																																												
BREEZEWAY	47 PSF																																																												
APPLICATION	W/C RATIO	DESIGN STRENGTH F'c (PSI)	F'c PER ACI																																																										
FOOTINGS	.45	2500	4500 ²																																																										
FOUNDATION WALLS	.45	2500	4500 ²																																																										
EXT. SLABS ON GRADE	.45	2500	4500 ²																																																										
INT. SLABS ON GRADE	.50	2500	3000																																																										
COVER	CONDITION																																																												
2"	CONCRETE DEPOSITED AGAINST EARTH																																																												
2"	CONCRETE DEPOSITED AGAINST FORMS BUT EXPOSED TO EARTH																																																												
1-1/2"	MAIN REINFORCING IN BEAMS																																																												
1-1/2"	TO TIES IN COLUMNS, AND TIED REBAR IN WALLS																																																												
1-1/2"	FOR BARS IN SLABS ON GROUND																																																												
3/4"	FOR BARS IN SLABS ON FORMS																																																												
ALL STEEL, UNO	ASTM A992.																																																												

Abbreviations					
AB.	ANCHOR BOLT	F.D.	FLOOR DRAIN	P.L.	PROPERTY LINE
AGG.	AGGREGATE	F.DN.	FOUNDATION	PLY	

STRUCTURAL NOTES - TABLES

WIND PRESSURE TABLE FOR COMPONENTS & CLADDING (ASD)						
EFFECTIVE WIND AREA	ROOF SURFACES ¹			WALL SURFACES		
	POSITIVE PRESSURE (PSF)		NEGATIVE PRESSURE (PSF)		POSITIVE PRESSURE (PSF)	
	1	2	3	1	2	3
10 SF	7.80	7.80	7.80	-12.39	-21.56	-31.89
20 SF	7.04	7.04	7.04	-12.01	-19.65	-29.59
50 SF	6.27	6.27	6.27	-11.62	-17.74	-27.30
100 SF	5.51	5.51	5.51	-11.24	-15.83	-25.01
500 SF	5.51	5.51	5.51	-11.24	-15.83	-25.01
WALL SURFACES						
EFFECTIVE WIND AREA	POSITIVE PRESSURE (PSF)			NEGATIVE PRESSURE (PSF)		
	4	5	4	5		
10 SF	12.18	12.18	12.18	-13.21	-16.31	
20 SF	11.56	11.56	11.56	-12.59	-15.07	
50 SF	10.94	10.94	10.94	-11.98	-13.83	
100 SF	10.32	10.32	10.32	-11.36	-12.57	
500 SF	9.08	9.08	9.08	-10.12	-10.12	

- NET WIND PRESSURES AT ROOF SURFACES = VALUE FROM TABLE ABOVE +/2/3 DEAD LOAD (DEAD LOAD REDUCES NEGATIVE PRESSURE + ADDS TO POSITIVE PRESSURES)
- ZONES ARE DEFINED BY FIGURE 30.6-1 ASCE/SEI 07-10 FOR ROOF AND WALL ELEMENTS

2018 International Building Code - Statement of Special Inspection

SOIL & FOUNDATIONS						
MATERIAL/ TYPE INSPECTION	IBC CODE REFERENCE	REFERENCE STANDARD	FREQUENCY APPLICABLE TO THIS PROJECT			SCOPE OF SERVICE
			CONT.	PERIODIC	REQUIRED	
Site Preparation	Table 1705.6 Item 5		-	-	X	N/A
Prepared Fill - During Fill Preparation	Table 1705.6 Item 4		-	X	-	YES
Evaluation of in-place Density	Table 1705.6 Item 3		-		X	YES
Footings and Foundations	1805.1 - 1805.9 Table 1705.6 Item 1		-	-	X	YES
Foundation Depth	Table 1705.6 Table 1705.6 Item 2		-	-	X	YES

2018 International Building Code - Statement of Special Inspection

CONCRETE CONSTRUCTION						
MATERIAL/ TYPE INSPECTION	IBC CODE REFERENCE	REFERENCE STANDARD	FREQUENCY APPLICABLE TO THIS PROJECT			SCOPE OF SERVICE
			CONT.	PERIODIC	REQUIRED	
Materials	1705.3.1, Table 1705.3 Item 1	Applicable ASTM material spec.; AISC 360, Section A3.3	-	X	YES	Manufacturer's Certificates of Compliance or Tests per Chapter 3 of ACI 318, per ASTM A 706, and per 1705.3.1
Installation of Reinforcing Steel	1910.4 Table 1705.3 Item 1	ACI 318:3.5; 7.1 - 7.7	-	X	YES	Inspection to confirm compliance with details shown on approved Construction Documents, Shop Drawings, ACI 318 and Code Section 1910.4
Welding of Reinforcing Steel	Table 1705.3 Item 2	AWS D1.4, ACI 318:3.5.2	-	-	N/A	Observation of reinforcing steel welding in accordance with Table 1705.2.2, Item 2, (see attached steel construction table).
Bolt Installation	1908.5, 1901.1 Table 1705.3 Item 3	ACI 318: 8.1.3, 21.2.8	X	-	YES	Observation of anchor bolts to be installed in concrete prior to and during placement of concrete where allowable loads have been increased.
Formwork	Table 1705.3 Item 12	ACI 318:6.1.1	-	X	YES	Inspection of compliance with ACI 318, Section 6.1, 6.2, for shape, location and dimensions of concrete member being formed.
Concrete Strength	1910.10, 1910.2, 1910.3 Table 1705.3 Item 6	ASTM C 172, ASTM C 31, ACI 318:5.6, 5.8	-	X	NO	Evolution of Concrete strength in accordance with ACI 318, Section 5.6 and in accordance with the requirements of IBC 1905.6.
Concrete Mixes	1904.2, 1910.2, 1910.3 Table 1705.3 Item 5	ACI 318: 4, 5.2-5.4	-	X	YES	Inspection for use of proper mix proportions and techniques, ACI 318, Chapter 4, Sections 5.2 - 5.4.
-	-	-	-	-	-	-
Concrete Sampling	1910.10 Table 1705.3 Item 6	ASTM C 172, ASTM C 31, ACI 318:5.6, 5.8	X	-	NO	Inspection for proper application techniques; ACI 318, Sections 5.9 and 5.10.
Concrete Placement	1910.6, 1910.7, 1910.8, Table 1705.3 Item 7	ACI 318:5.9, 5.10	X	-	YES	Inspection for maintenance of curing temperatures and techniques; ACI 318, Sections 5.11, 5.12 and 5.13.
Curing Temperatures and Techniques	1910.9 Table 1705.3 Item 8	ACI 318: 5.11-5.13	-	X	NO	Field inspections of precast concrete members in accordance with ACI 318, Section 18.20.
Prestressed Concrete: Application of Prestressing Forces	Table 1705.3 Item 9a	ACI 318: 18.20, ACI 18.18.4	X	-	NO	Field inspections of precast concrete members in accordance with ACI 318, Chapter 18.18.4.
Prestressed Concrete: Grouting of unbonded prestressing tendons in seismic-force-resisting system	Table 1705.3 Item 9b	ACI 318: 18.20, ACI 18.18.4	X	-	NO	Certificate of Independent Agency and current agreement for periodic (minimum 6 month intervals) in-plant quality assurance inspections.
Manufacture of Precast Concrete	1704.2.1	-	-	X	NO	Verification of in-situ concrete strength, prior to stressing of tendons in post-tensioned concrete and prior to removal of shores and forms for beams and structural slabs in accordance with ACI 318, Section 6.2.
Erection of Precast Concrete	Table 1705.3 Item 10	ACI 318: 16	-	X	NO	Verification of in-situ concrete strength, prior to stressing of tendons in post-tensioned concrete and prior to removal of shores and forms for beams and structural slabs in accordance with ACI 318, Chapter 16.
Post Tensioning	Table 1705.3 Item 11	ACI 318: 6.2	-	X	NO	Verification of anchors post installed in hardened concrete members.
Post Installed Anchors	1909.1, Table 1705.3 Item 11	ACI 318: 3.8.6, 8.1.3, 21.1.8	-	X	YES	Verification of anchors post installed in hardened concrete members.

2018 International Building Code - Statement of Special Inspection

WOOD CONSTRUCTION						
MATERIAL/ TYPE INSPECTION	IBC CODE REFERENCE	REFERENCE STANDARD	FREQUENCY APPLICABLE TO THIS PROJECT			SCOPE OF SERVICE
			CONT.	PERIODIC	REQUIRED	
Fabrication - Inspection of Fabricator's Quality Control Procedures	1704.2.5	-	-	X	YES	Certificate from Independent Agency and current agreement for periodic (minimum 6 month intervals) in-plant quality assurance inspections.

2018 International Building Code - Statement of Special Inspection

SPECIAL INSPECTIONS FOR SEISMIC RESISTANCE						
MATERIAL/ TYPE INSPECTION	IBC CODE REFERENCE	REFERENCE STANDARD	FREQUENCY APPLICABLE TO THIS PROJECT			SCOPE OF SERVICE
			CONT.	PERIODIC	REQUIRED	
Structural Steel	1705.11.1	AISC 341	X	-	N/A	Observation of structural welding in accordance with AISC Seismic. Not required for 5/16" single pass fillet welds or welding of metal deck.
Structural Wood: Inspection of field gluing operations of elements of the seismic force resisting system.	1705.11.2	-	X	-	N/A	Inspection of field gluing operations of elements of the seismic force resisting system.
Structural Wood: Inspection of nailing, bolting, anchoring and other fastening components of the seismic force resisting system, including drag struts, braces and hold-downs.	1705.11.2	-	-	X	YES	Inspection of nailing, bolting, anchoring and other fastening components within the seismic force resisting system, including drag struts, braces and hold-downs. Not required for nailing o.c. spacing greater than 4" o.c.
Cold-formed Steel Framing	1705.11.3	-	-	X	NO	Inspection of welding operations of elements of the seismic force resisting system.
Cold-formed Steel Framing	1705.11.3	-	-	X	NO	Inspection of screw attachments, bolting, anchoring and other fastening components within the seismic force resisting system, including struts, braces and hold-downs.


2018 International Building Code - Statement of Special Inspection

STRUCTURAL: OBSERVATIONS						
MATERIAL/ TYPE INSPECTION	IBC CODE REFERENCE	REFERENCE STANDARD	FREQUENCY APPLICABLE TO THIS PROJECT			SCOPE OF SERVICE
			CONT.	PERIODIC	REQUIRED	
Structural Observations	1704.5	-	-	-	X	If required by jurisdiction Structural observations to be preformed to observe general conformance to the construction documents.

S1.1

STRUCTURAL NOTES - TABLES

STRUCTURAL NOTES - TABLES

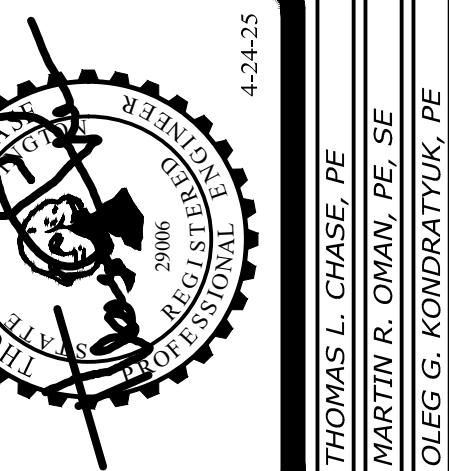

Revisions to this sheet:

PRMU20240280

Puyallup, Washington 98374
Ph: 253-314-9822
www.solutionsstructures.com

Bradley Heights Apartments
202 27th Ave SE
Puyallup, Washington


Solutions (4) Structures
A Structural Engineering Corporation

PROJECT NO. : 23-007
DESIGNED BY : TLC, OGK, MRO
DRAWN BY : RSO
ISSUE DATE : 2-20-24


LATEST REV. : △ 4-24-25
OF DWG. SET : △

THESE DRAWINGS ARE SUBJECT TO REVISIONS
PENDING LOCAL JURISDICTIONAL REVIEW.


SUBMITTAL SET ONLY NOT FOR
CONSTRUCTION

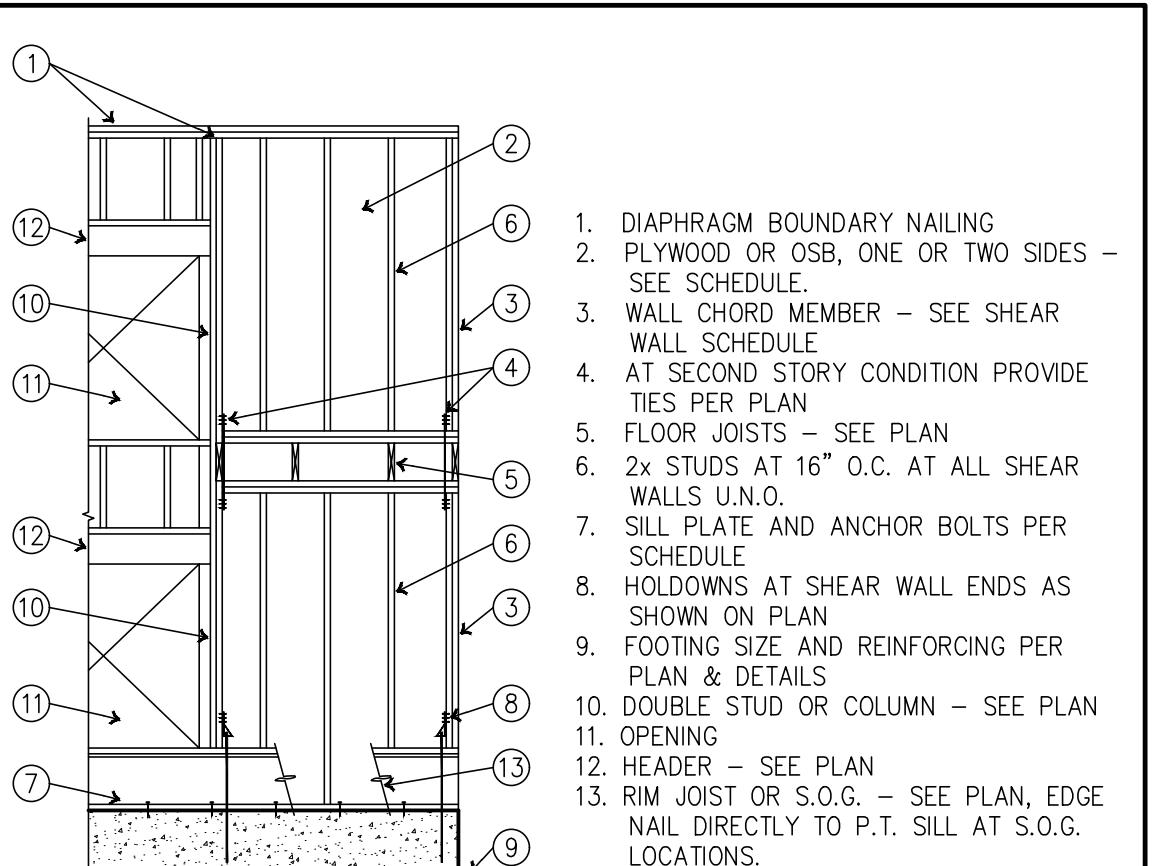


10 TYPICAL SHEAR WALL ELEVATION

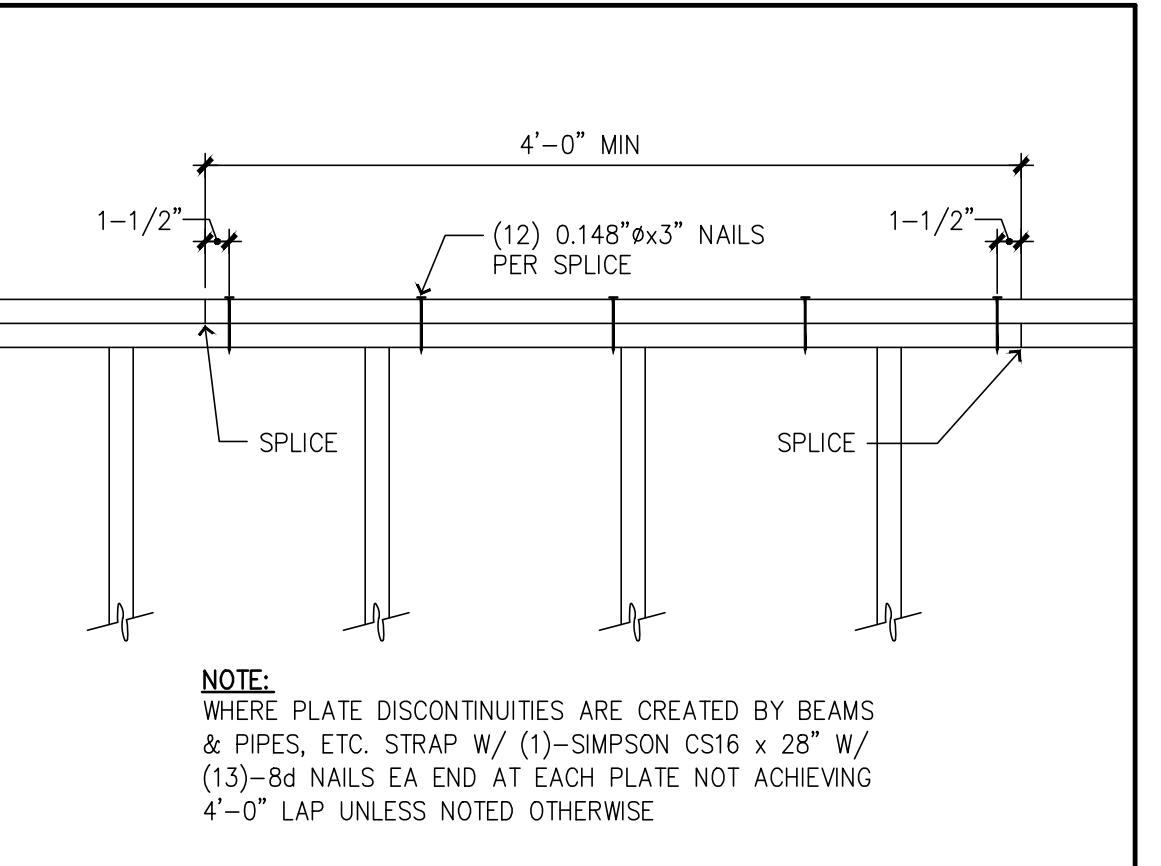

7 TYPICAL TOP CHORD SPICE

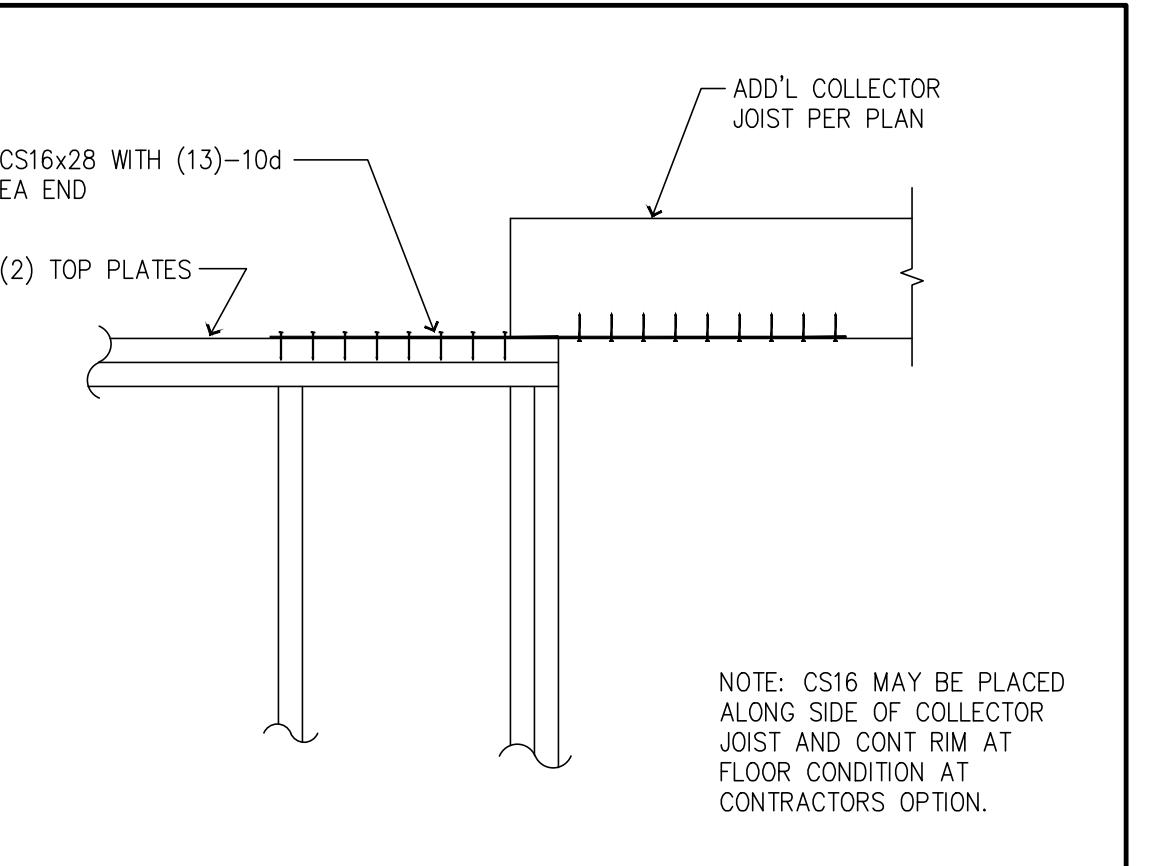


6 STRAP @ BEAM TO TOP PLATE


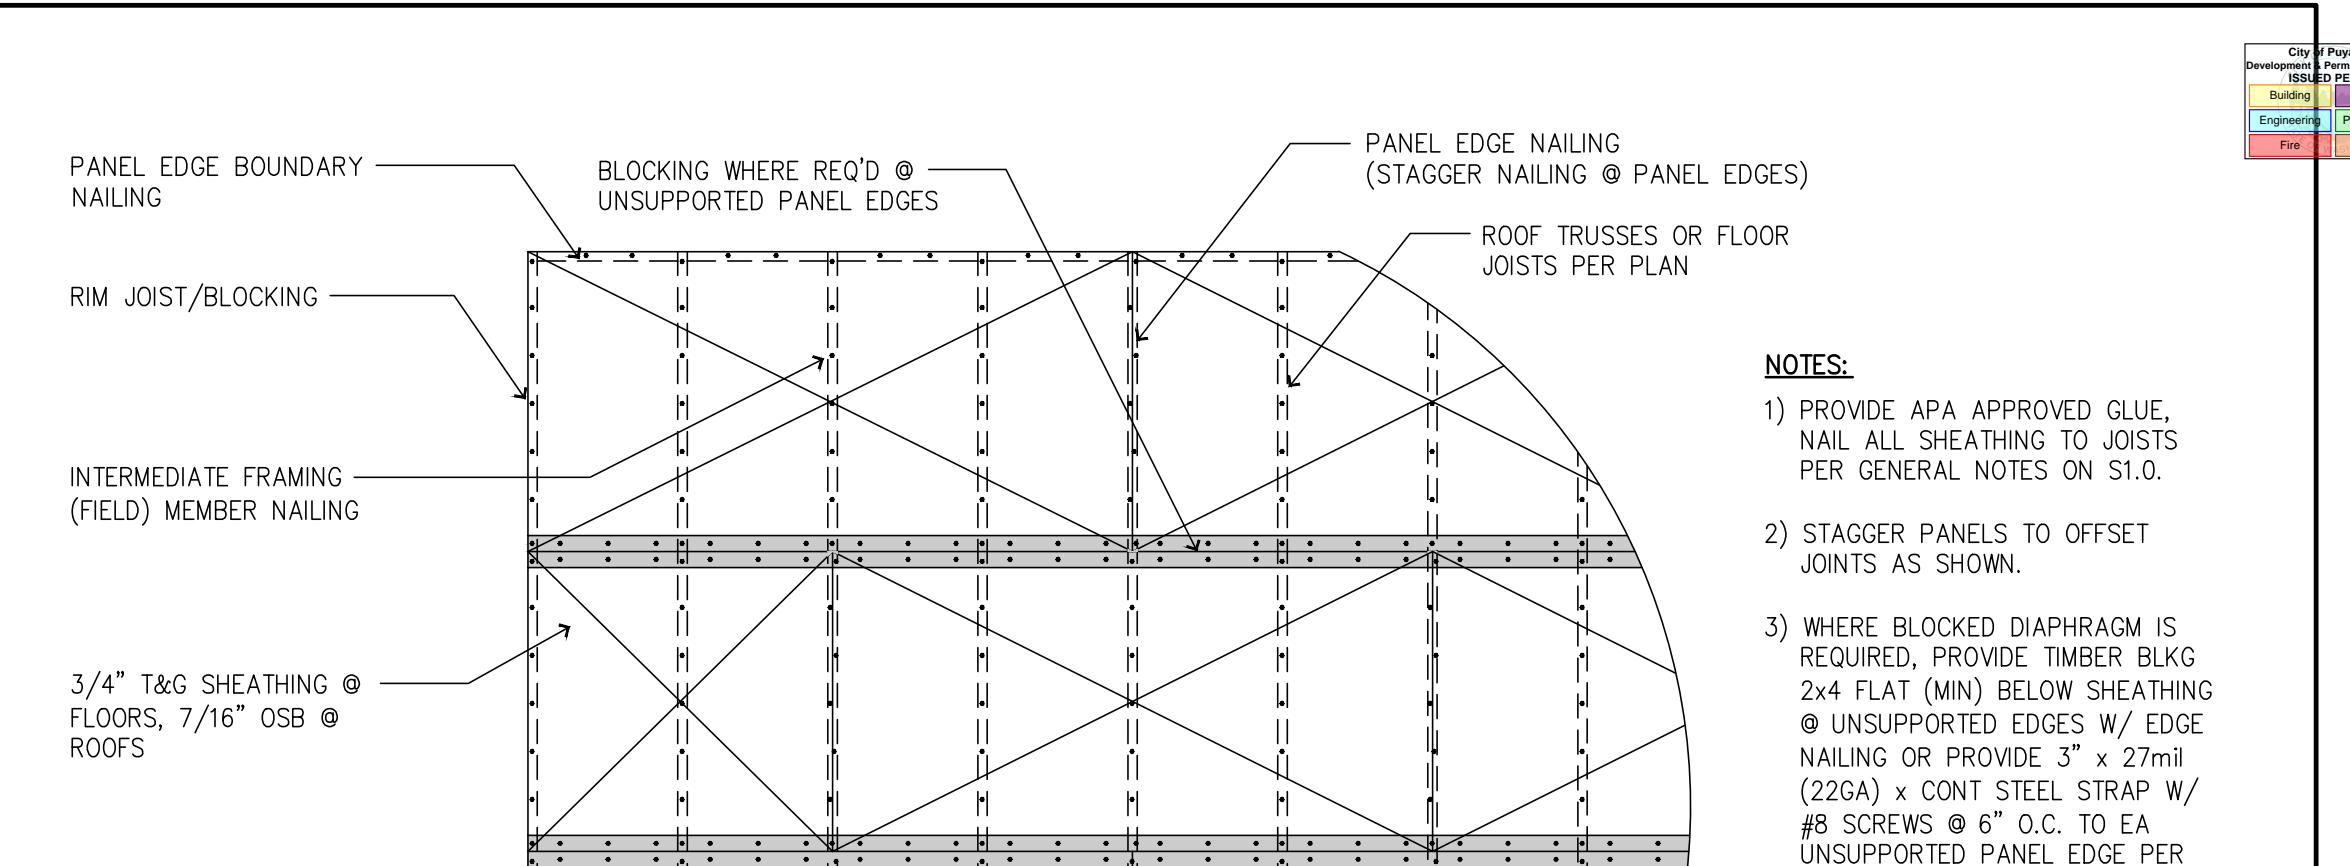


3 TYPICAL HORIZONTAL SHEATHING DIAPHRAGM LAYOUT

N.T.S.

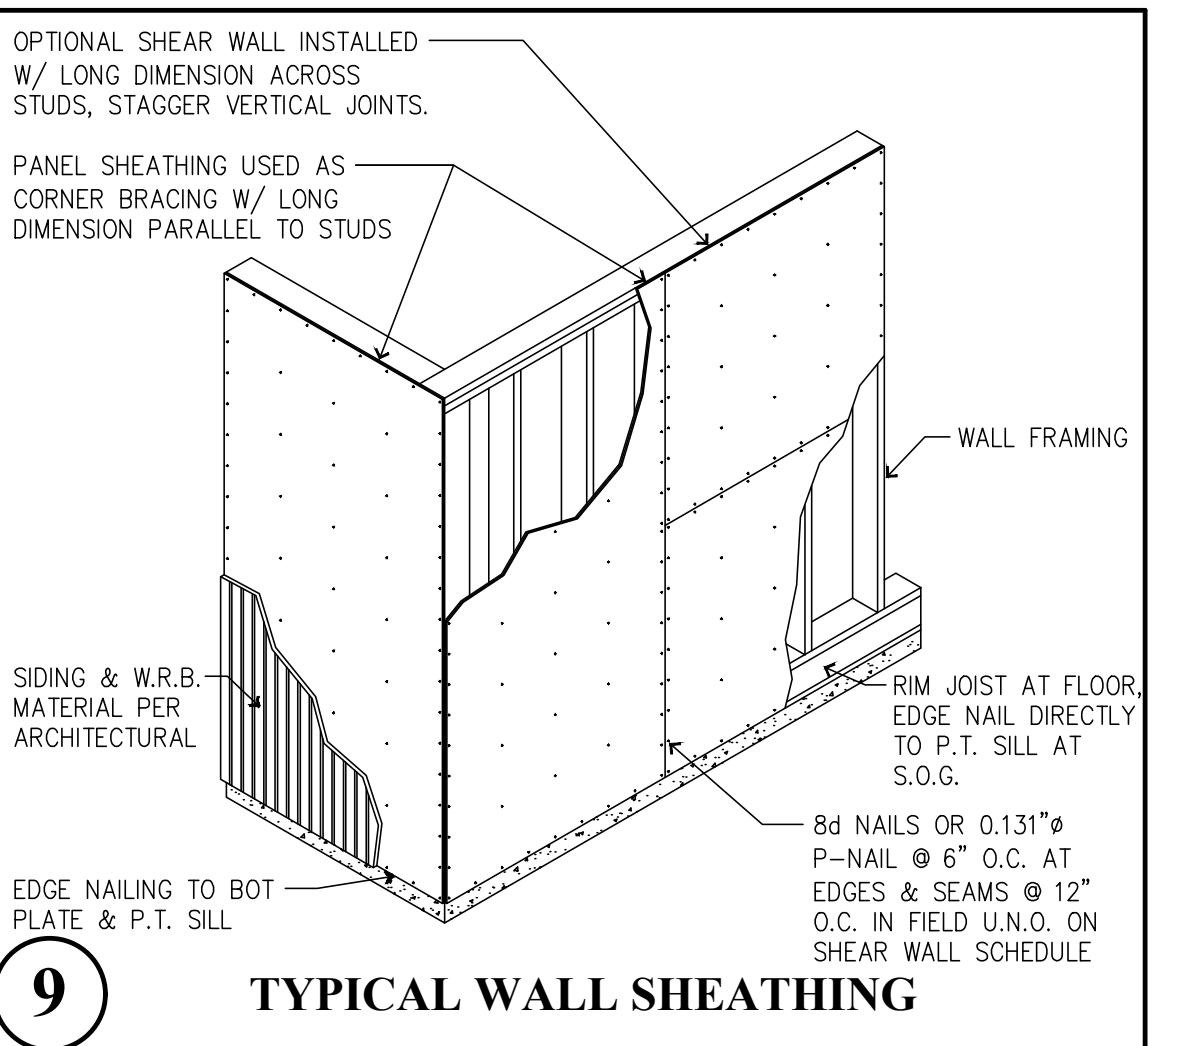

9 TYPICAL WALL SHEATHING

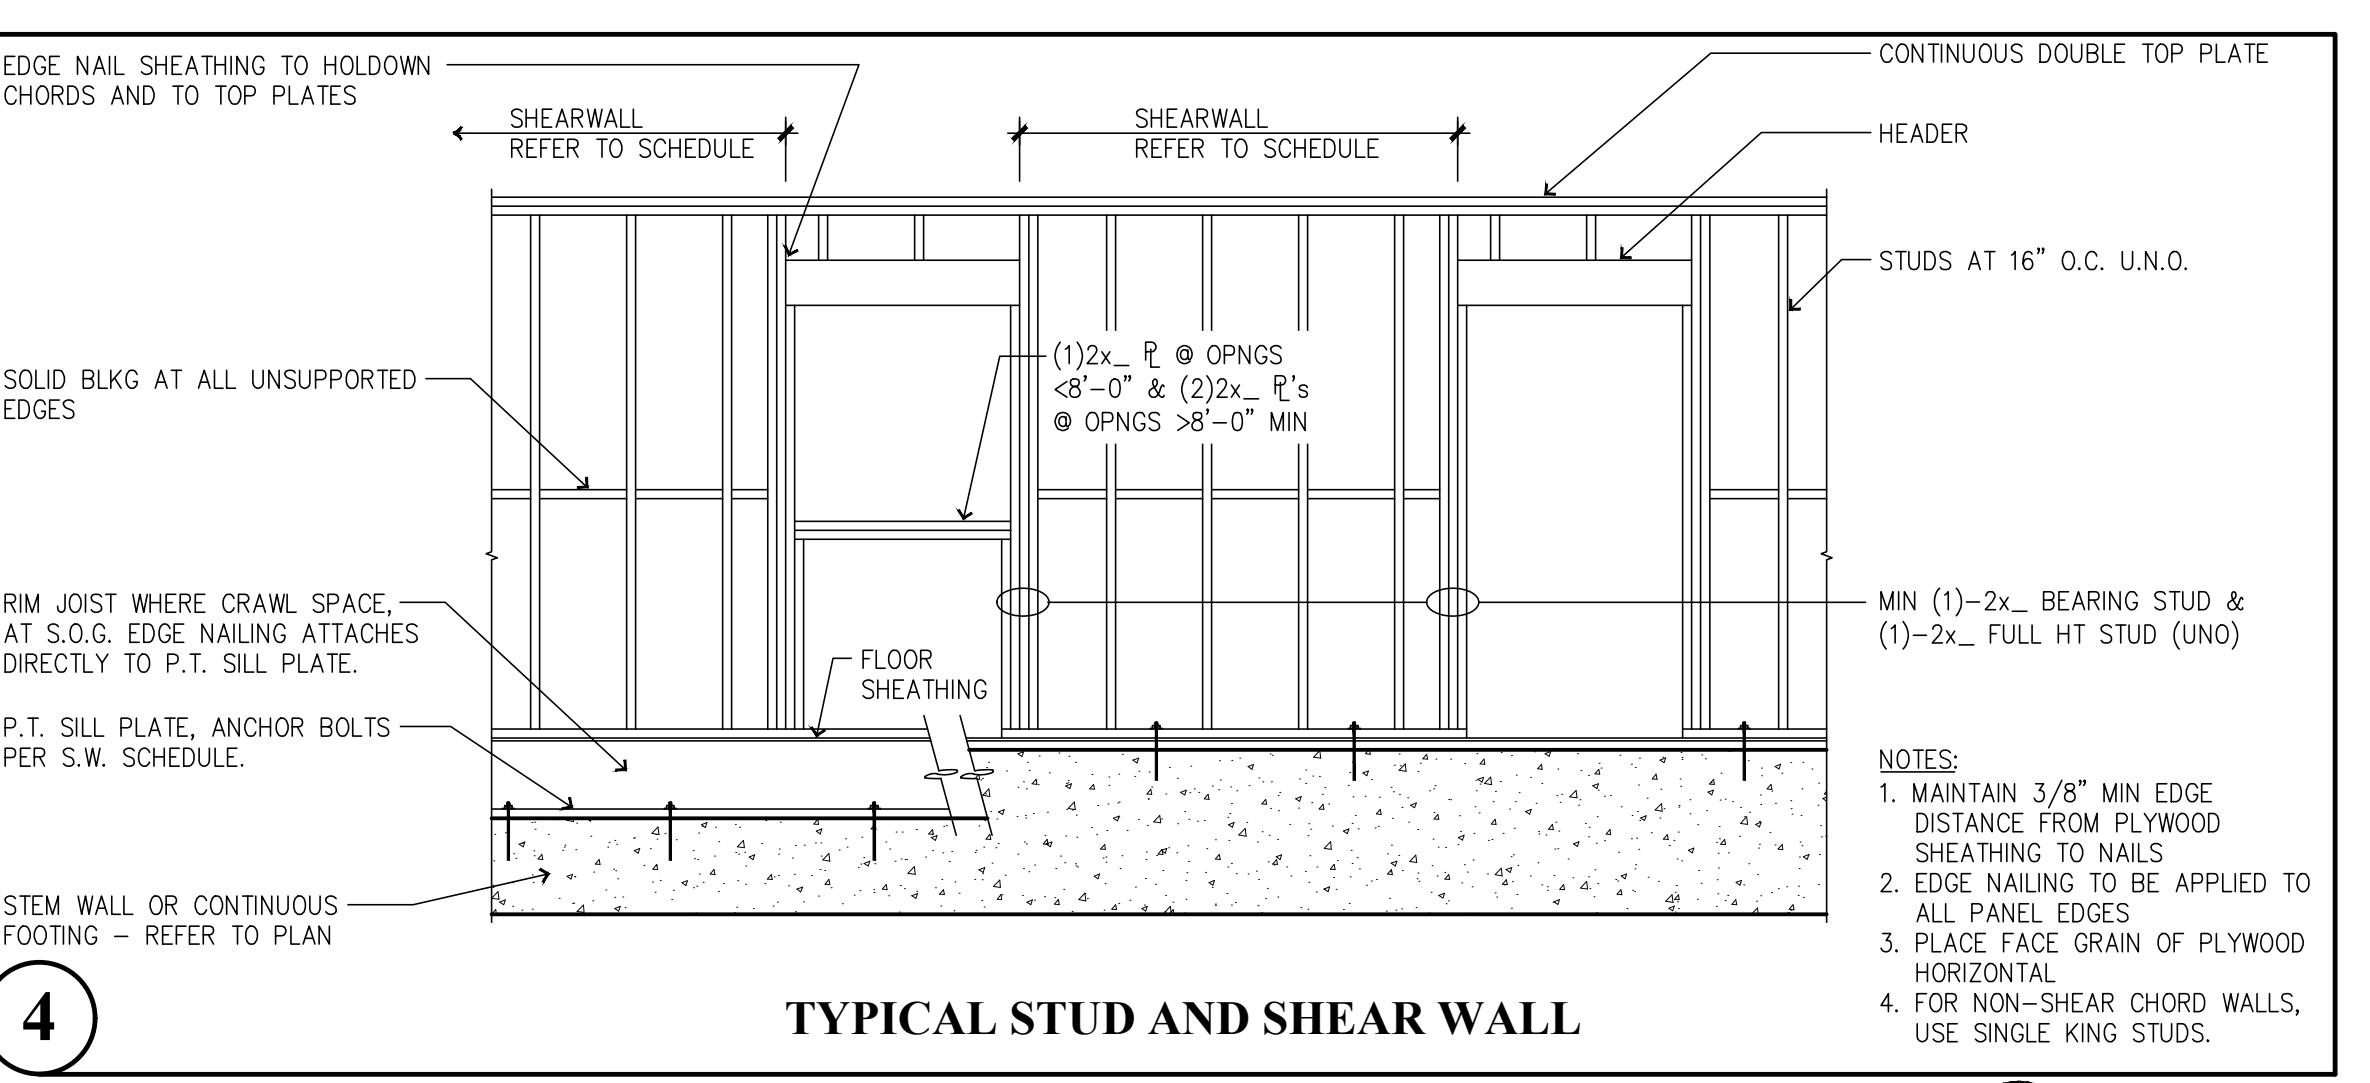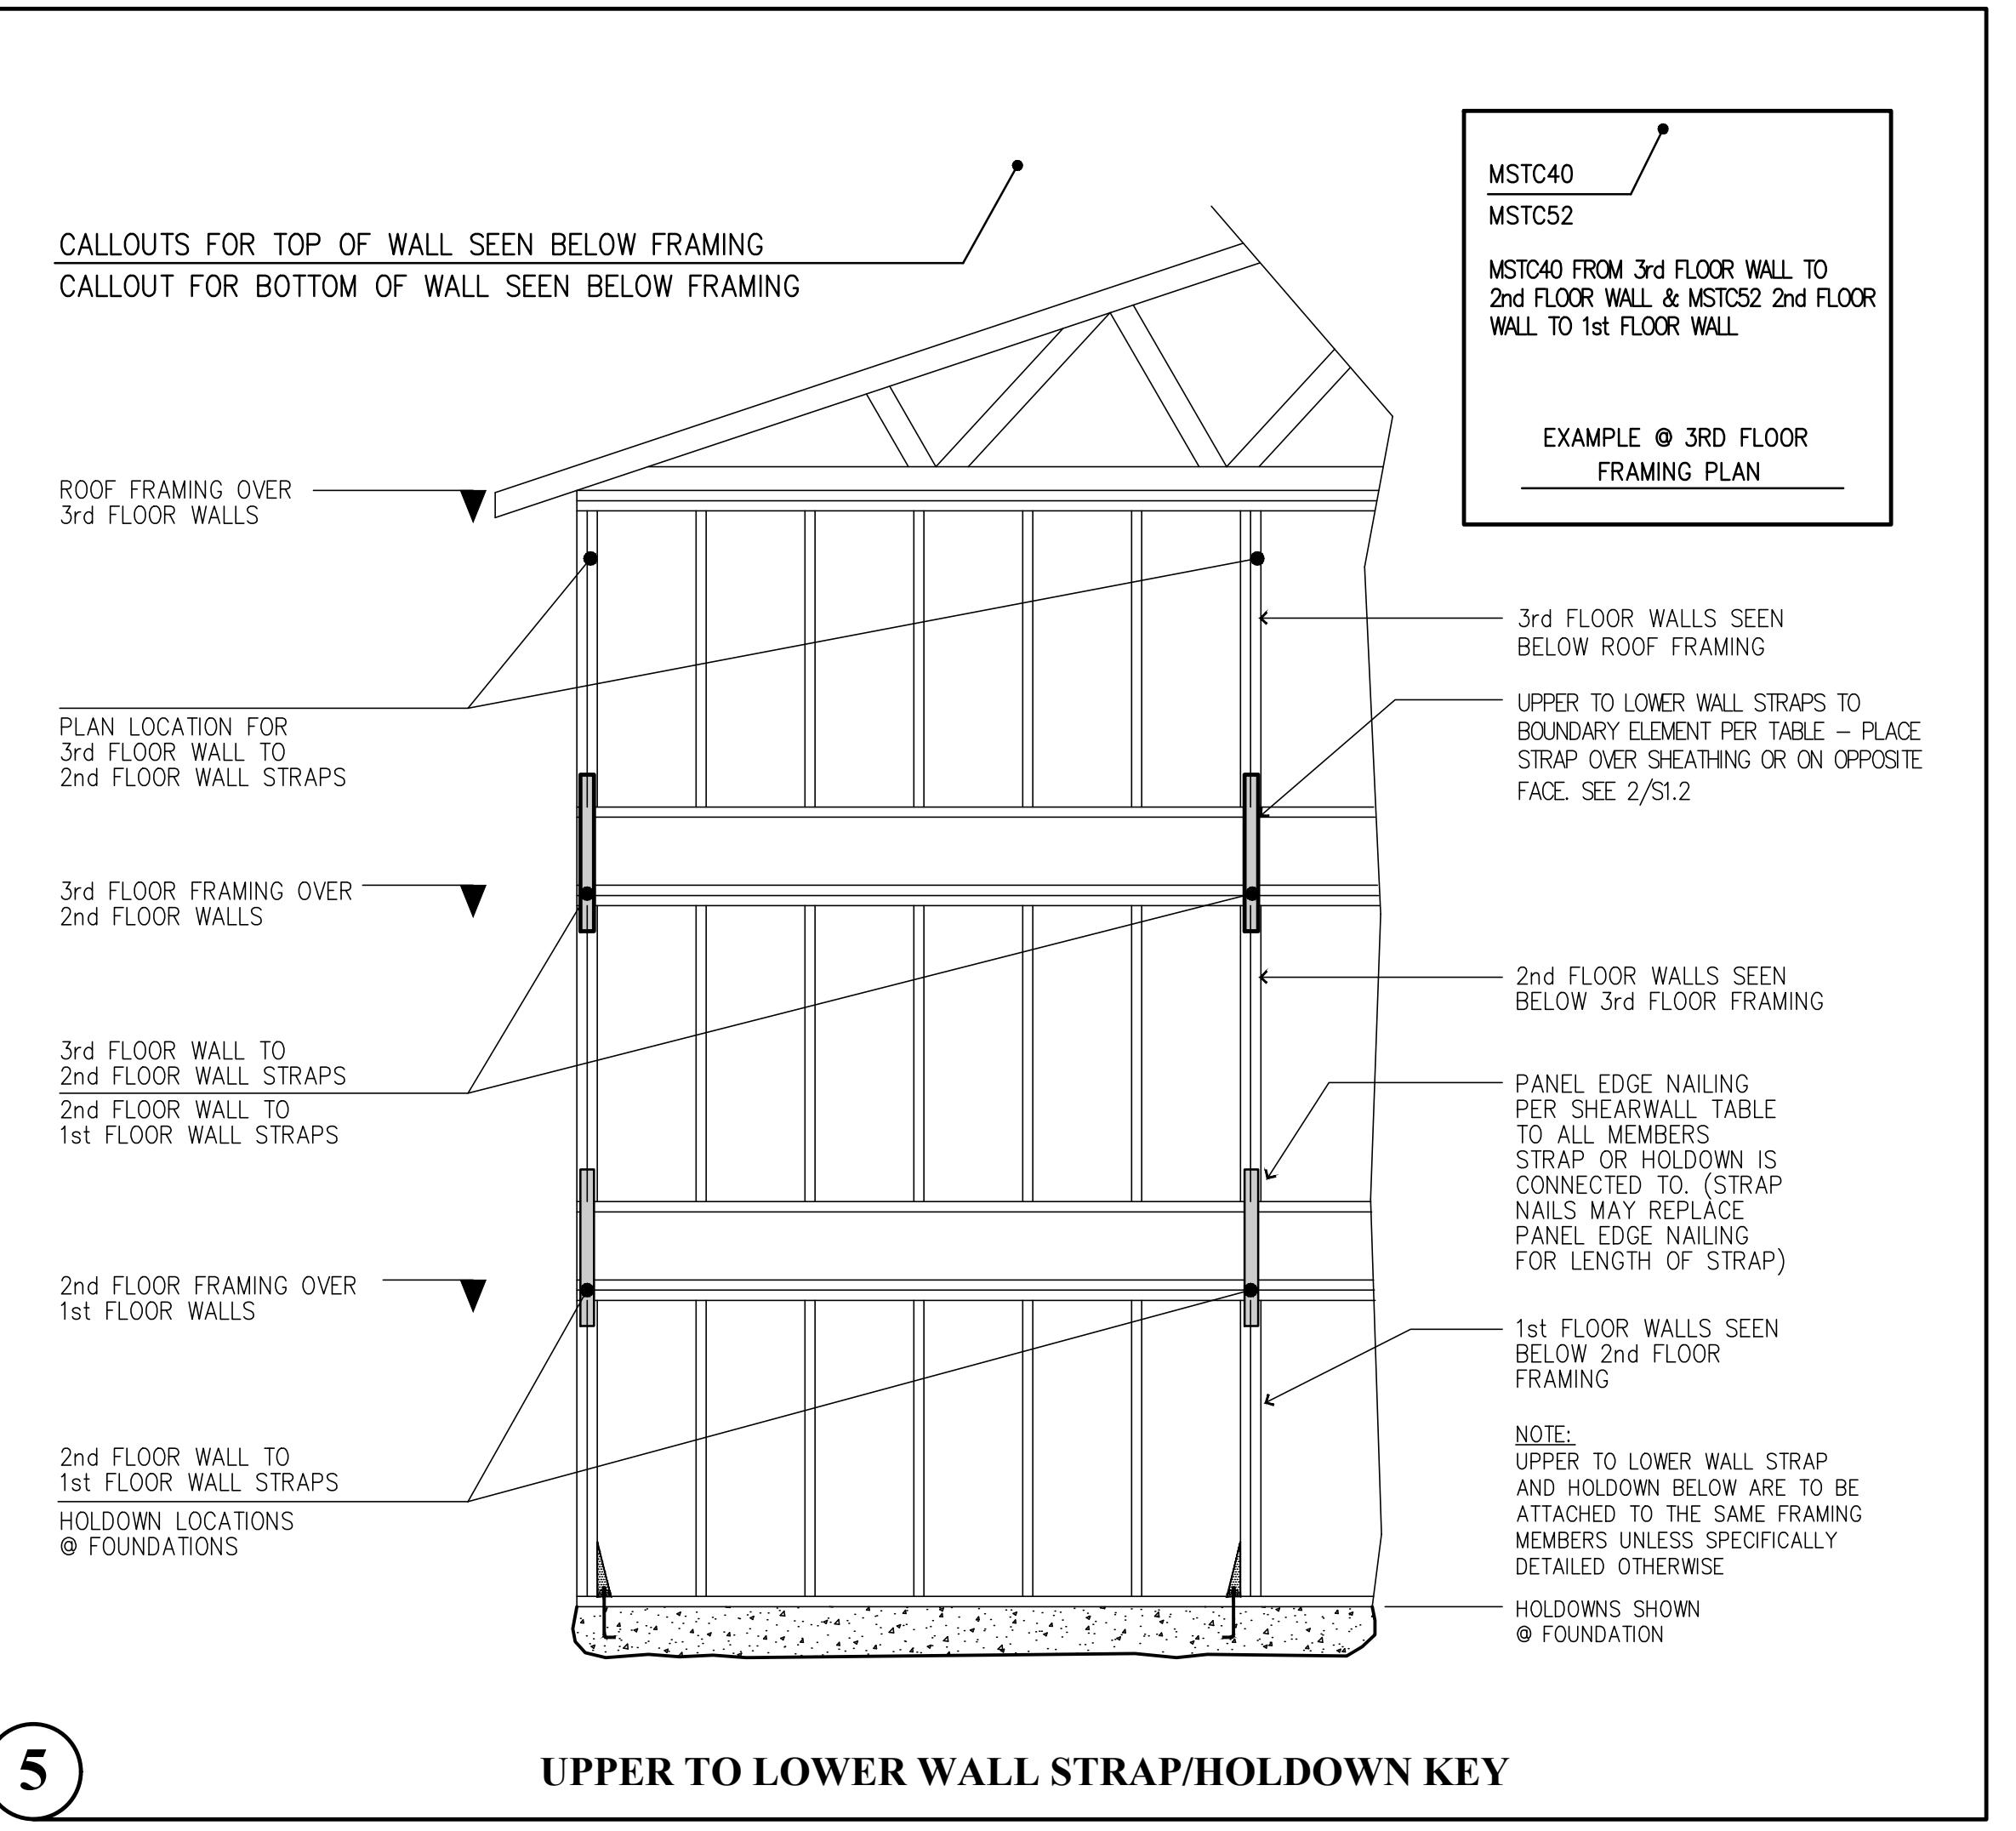

8 SPECIAL SHEARWALL WITH OPENINGS

MARK	BOUNDARY ELEMENT		TOTAL FASTENERS	ANCHOR DIAMETER	ANCHOR EMBEDMENT	MIN EDGE DISTANCE WITHOUT ADD'L REINF
	2x4 WALL	2x6 WALL				
MST37	4x6 #2 HF	4x6 #2 HF	(20) 16d	N/A	N/A	N/A
MST48	4x6 #2 HF	4x6 #2 HF	(32) 16d	N/A	N/A	N/A
(2)MST48	4x6 #2 HF	6x6 #2 HF	(46) 16d	N/A	N/A	N/A
MST60	4x6 #2 HF	4x6 #2 HF	(64) 16d	N/A	N/A	N/A
(2)MST60	4x6 #2 HF	6x6 #2 DF	PER MFR	N/A	N/A	N/A
HDU2	4x4 #2 HF	4x6 #2 HF	PER MFR	5/8"	8"	4"
HDU4	4x4 #2 HF	4x6 #2 HF	PER MFR	5/8"	8"	4"
HDU5	4x6 #2 HF	4x6 #2 HF	PER MFR	5/8"	8"	8"
HDU8	4x6 #2 DF	6x6 #2 DF	PER MFR	7/8"	12"	8"
HDU11	4x6 #2 DF	6x6 #2 DF	PER MFR	1"	12"	12"
HDU14	4x8 #2 DF	6x6 #2 DF	PER MFR	1"	12"	16"

NOTES:


- 1) STRAP HOLDOWNS MAY BE APPLIED DIRECTLY TO BOUNDARY MEMBER ON OPPOSITE SIDE OF SHEATHING OR APPLIED DIRECTLY OVER PWD/OSB SHEATHING. DO NOT LOCATE STRAPS UNDER WOOD SHEATHING OF ANY TYPE OR OVER GYPSUM SHEATHING. (DO NOT INSTALL MSTC TYPE STRAPS OVER SHEATHING, SEE 4/S1.3)
- 2) NAIL SHEATHING PER SHEARWALL TABLE TO EACH BOUNDARY ELEMENT PER TABLE ABOVE.
- 3) ALIGN FLOOR TO FLOOR STRAPS WITH HOLDOWNS AT FOUNDATION, TYP. (SEE DETAIL 5/S1.2)
- 4) HOLDOWNS/STRAPS MUST BE ATTACHED TO FULL HEIGHT MEMBERS UNLESS NOTED OTHERWISE. BOUNDARY ELEMENTS ARE IN ADDITION TO TRIMMER/BEARING STUDS CALLED OUT ON PLAN (SEE DETAILS 1.2 & 3/S1.3)
- 5) ANCHOR BOLTS SHALL BE CAST IN PLACE AND ALL ANCHORS EXCEPT HDU2 AND HDU4 REQUIRE ADDITIONAL REBAR IF EMBEDDED IN STEMWALLS OR IF MIN EDGE DISTANCE IS LESS THAN AS NOTED USE A STANDARD WASHER WITH A STANDARD NUT ON EACH SIDE AT BOTTOM OF ANCHOR. ADDITIONAL REINFORCEMENT SHALL BE PER DETAILS 1.2, & 3/S1.3.
- 6) THREADED RODS/ANCHORS ARE ASTM A307 OR ASTM F1554 U.N.O.
- 7) STRAPS/HOLDOWNS SHALL BE INSTALLED WITH THE FASTENERS SPECIFIED BY THE MANUFACTURER TO ACHIEVE THE MAXIMUM TABULATED LOAD & AS INDICATED IN THE TABLE ABOVE.
- 8) INSTALL HALF OF SPECIFIED FASTENERS EACH END OF STRAPS PER SIMPSON STRONGTIE.
- 9) SEE DETAIL 4/S1.3 FOR MSTC - HOLDOWN STRAPS FROM SHEARWALL TO BEAM & DETAIL 6/S1.3 FOR MSTC - HOLDOWN STRAPS @ END OF BEAM TO POST/COLUMN. (*) SYMBOL AT END OF MSTC STRAP CALLOUT (i.e. (2)MSTC48B3*) INDICATES STRAP IS INVERTED AND ATTACHES END OF BEAM TO POST BELOW PER 6/S1.3

2 SHEARWALL COMPONENT TABLE
















MARK	MARK ¹⁴	COMPONENTS		1/2" A.B. PL TO CONCRETE SPACING (IN)	5/8" A.B. PL TO CONCRETE SPACING (IN)	10d COMMON PL TO PL SPACING (IN)	SIMPSON A35 CLIP ANGLE SPACING (IN)	SIMPSON LTP4 CLIP ANGLE SPACING (IN)
		W1	W1P					
W1	W1P	7/16" PWD OR OSB, BLOCKED, W/ 8d NAILS @ 6" O.C. @ PANEL EDGES AND @ 12" O.C. @ FIELD.		47" O.C.	68" O.C.	8.1" O.C.	30" O.C.	29" O.C.
W2	W2P	7/16" PWD OR OSB, BLOCKED, W/ 8d NAILS @ 4" O.C. @ PANEL EDGES AND @ 12" O.C. @ FIELD.		32" O.C.	47" O.C.	5.5" O.C.	20" O.C.	20" O.C.
W3	W3P	7/16" PWD OR OSB, BLOCKED, W/ 8d NAILS @ 3" O.C. @ PANEL EDGES AND @ 12" O.C. @ FIELD. SEE NOTE 2		25" O.C.	36" O.C.	4.3" O.C.	16" O.C.	15" O.C.
W4	W4P	7/16" PWD OR OSB, BLOCKED, W/ 8d NAILS @ 2" O.C. @ PANEL EDGES AND @ 12" O.C. @ FIELD. SEE NOTE 2		19" O.C.	28" O.C.	6.6" (2) ROWS 6.6" O.C. EA ROW	12" O.C.	12" O.C.
W5	W5P	7/16" PWD OR OSB, BLOCKED, W/ 10d NAILS @ 2" O.C. @ PANEL EDGES AND @ 12" O.C. @ FIELD. SEE NOTE 2		16" O.C.	23" O.C.	5.6" (2) ROWS 5.6" O.C. EA ROW	10" O.C.	10" O.C.
W6	W6P	15/32" PWD OR OSB, (2) LAYERS (ONE EACH SIDE), BLOCKED, W/ 10d NAILS @ 3" O.C. @ PANEL EDGES AND @ 12" O.C. @ FIELD. SEE NOTE 2, 3 & 15		12" O.C.	18" O.C.	4.3" (2) ROWS 4.3" O.C. EA ROW	8" O.C.	8" O.C.
W7	W7P	15/32" PWD OR OSB, (2) LAYERS (ONE EACH SIDE), BLOCKED, W/ 10d NAILS @ 2" O.C. @ PANEL EDGES AND @ 12" O.C. @ FIELD. SEE NOTE 2, 3 & 15		9" O.C.	14" O.C.	3" O.C. EA ROW STAGGERED	5" O.C.	5" O.C.

NOTES:

- 1) ALL NAILING PER ANSI/AF & PA SDPWS - 2018 TABLE 4.3A
- 2) USE 3x STUDS AT ALL ABUTTING PANEL EDGES. NAILS SHALL BE STAGGERED WHERE NAILS ARE SPACED AT 2" O.C.
- 3) IF CALLOUT REQUIRES BLOCKING, SHEATHING MAY BE PLACED WITH THE LONGITUDINAL DIRECTION VERTICAL STUDS AND PLATES WILL BE CONSIDERED TO ACT AS BLOCKING.
- 4) WALL SHEATHING CALLED OUT SHALL EXTEND FOR ENTIRE WALL LENGTH AT THAT ELEVATION AND SHALL BE CONTINUOUS AROUND OPENINGS TYPICALLY.
- 5) 8d NAILS ARE TO BE 131/2" AND 2-1/2" IN LENGTH. 10d NAILS ARE TO BE 148/8" AND A MINIMUM OF 3" IN LENGTH. 16d NAILS ARE TO BE .162" AND 3-1/4" IN LENGTH. NAILS SHALL BE INSTALLED SO AS NOT TO SPLIT THE TIMBER FRAMING.
- 6) SIMPSON A35 OR LTP4 CLIP ANGLES SHALL BE INSTALLED WITH THE APPROPRIATE FASTENERS PER THE MANUFACTURER'S SPECIFICATIONS.
- 7) USE 3/8" x 229" PLATE WASHERS AT ALL ANCHOR BOLTS PER SECTION 4.3.6.4.3
- 8) SPACING SHOWN ABOVE FOR ANCHOR BOLTS, NAILING AND CLIPS IS MAXIMUM AMOUNT ALLOWED.
- 9) FRAMING AT SHEARWALLS SHALL BE SPACED NO FARTHER THAN 16" O.C.
- 10) MINIMUM NAIL SPACING IN A SINGLE ROW SHALL BE 4 INCHES ON CENTER. USE (2) ROWS IF SPACING LESS THAN THIS. USE 2ND RIM BOARD, RIM JOIST OR BLOCKING WHERE THREE ROWS OF NAILING CALLED OUT.
- 11) EXTEND SHEATHING UP TO DOUBLE TOP PLATES AND INSTALL NAILS THROUGH SHEATHING INTO UPPER TOP PLATE PER TYPICAL DETAILS. NO PLATE TO PLATE NAILING REQUIRED IN DOUBLE TOP PLATES WITH THIS CONFIGURATION.
- 12) OPTIONAL TO USE (2) ROWS IN PLACE OF SINGLE 3x IN SHEARWALLS W3, W4 AND W5 W/ STITCH NAILING.
13. (2) ROWS OF 0.148" x 3" STITCH NAILING (2)2x STUDS TOGETHER @ 10" O.C. FOR W3 SHW, 8" O.C. FOR W4 SHW & 6" O.C. FOR W5 SHW PER SECTION 4.37 NOTE 4.
14. THE "W_P" INDICATES SHEAR WALL TYPE WITH OPENINGS. PROVIDE SHEATHING AROUND ALL OPENINGS AND ABOVE AND BELOW ALL OPENINGS. PROVIDE HORIZONTAL STRAPS & NAILING AT OPENINGS PER 8/S1.2

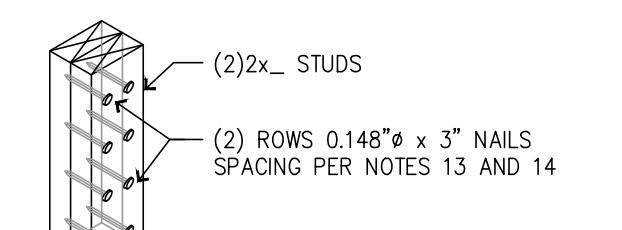

1

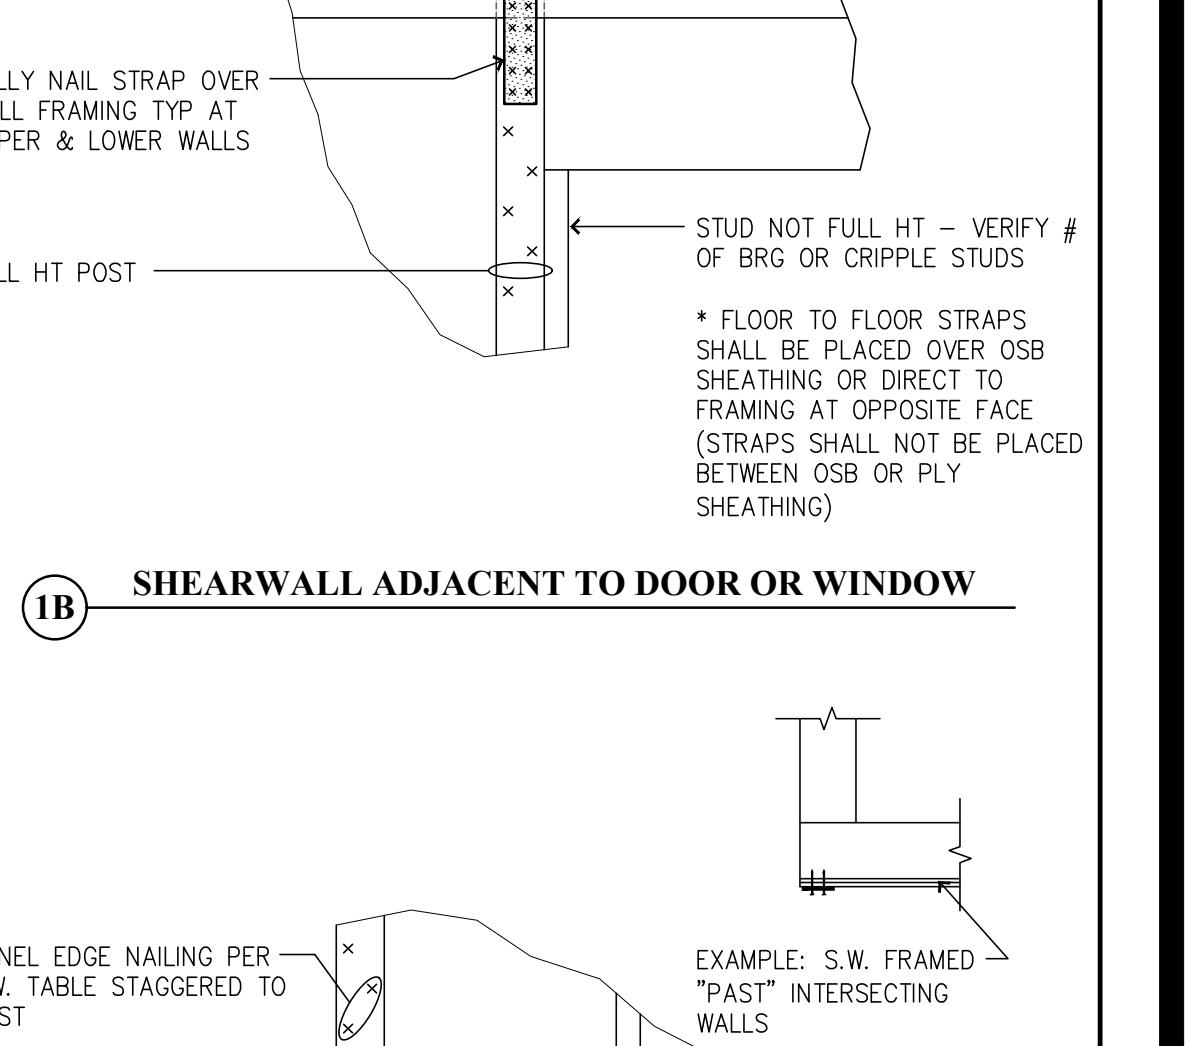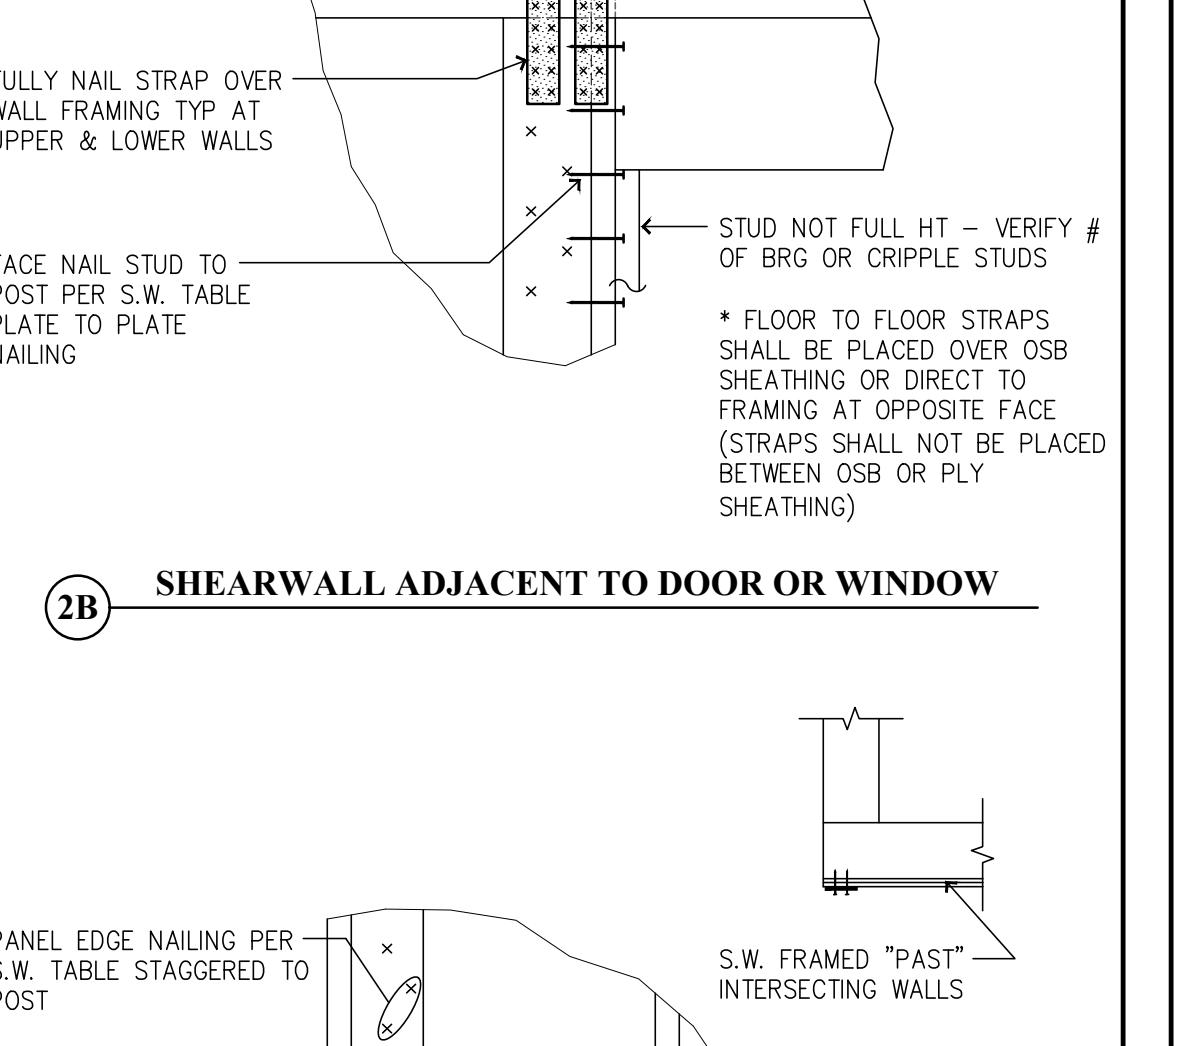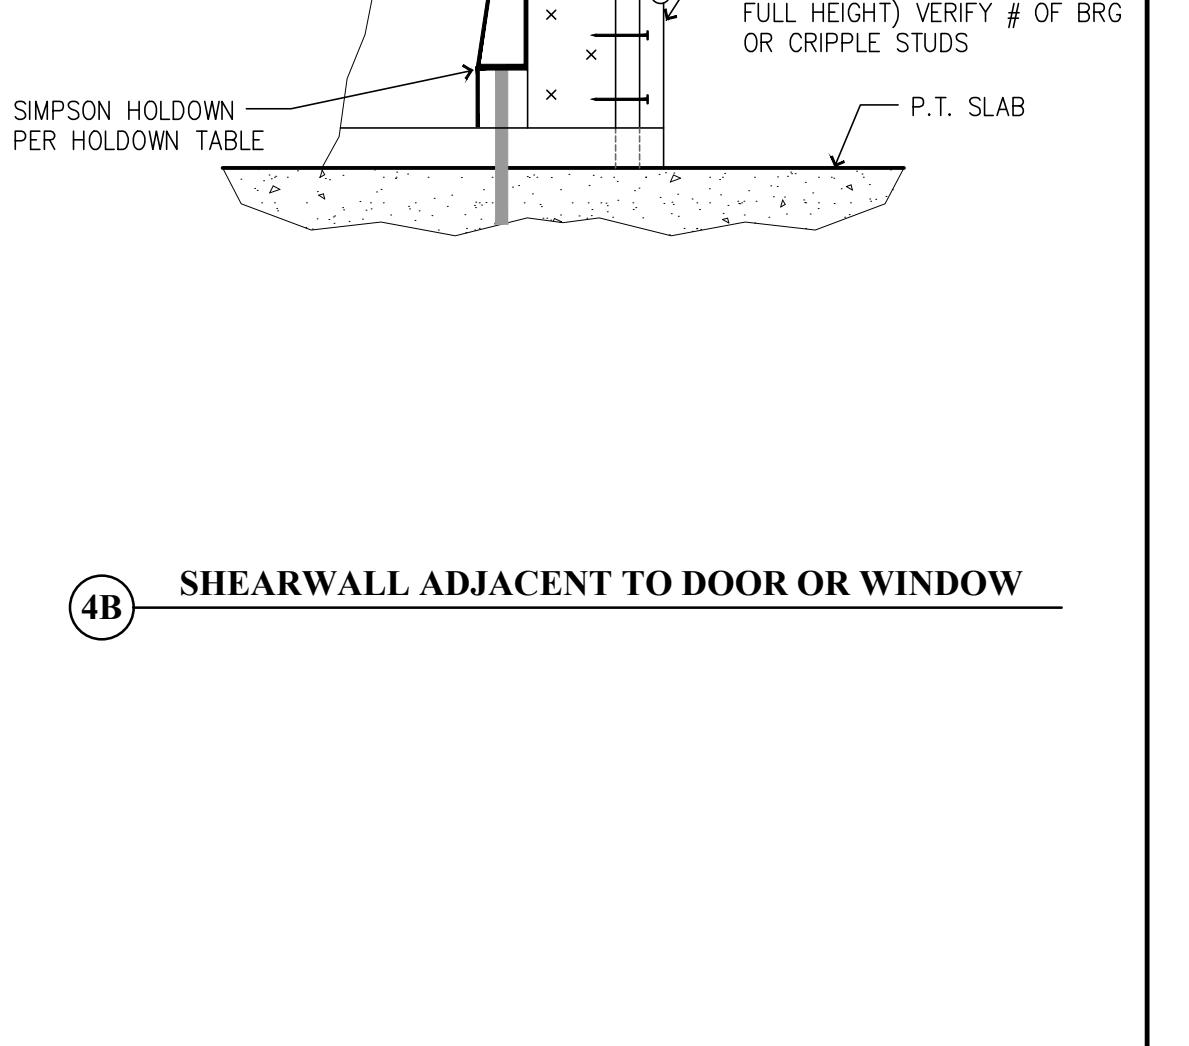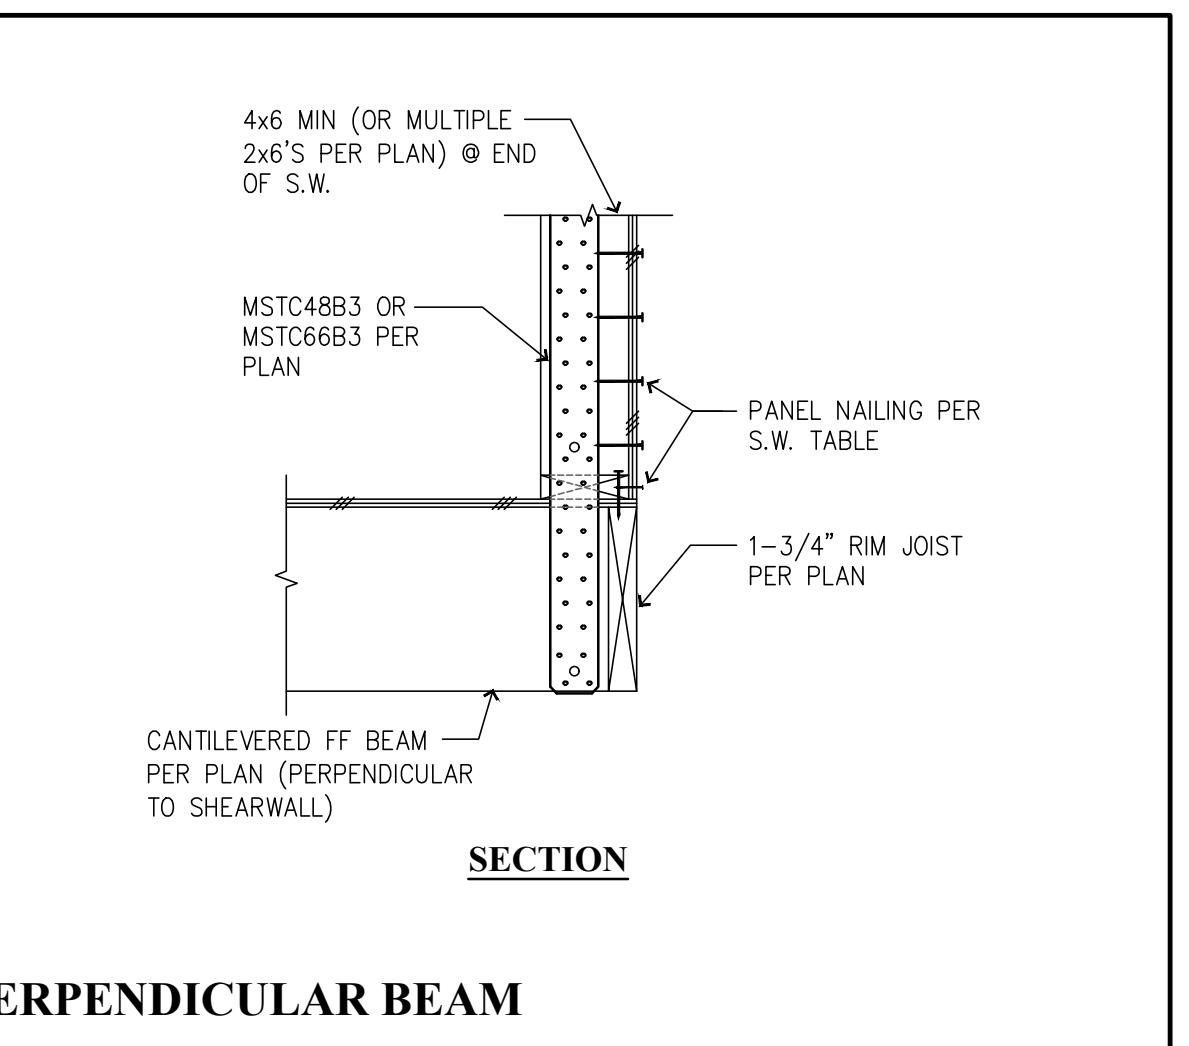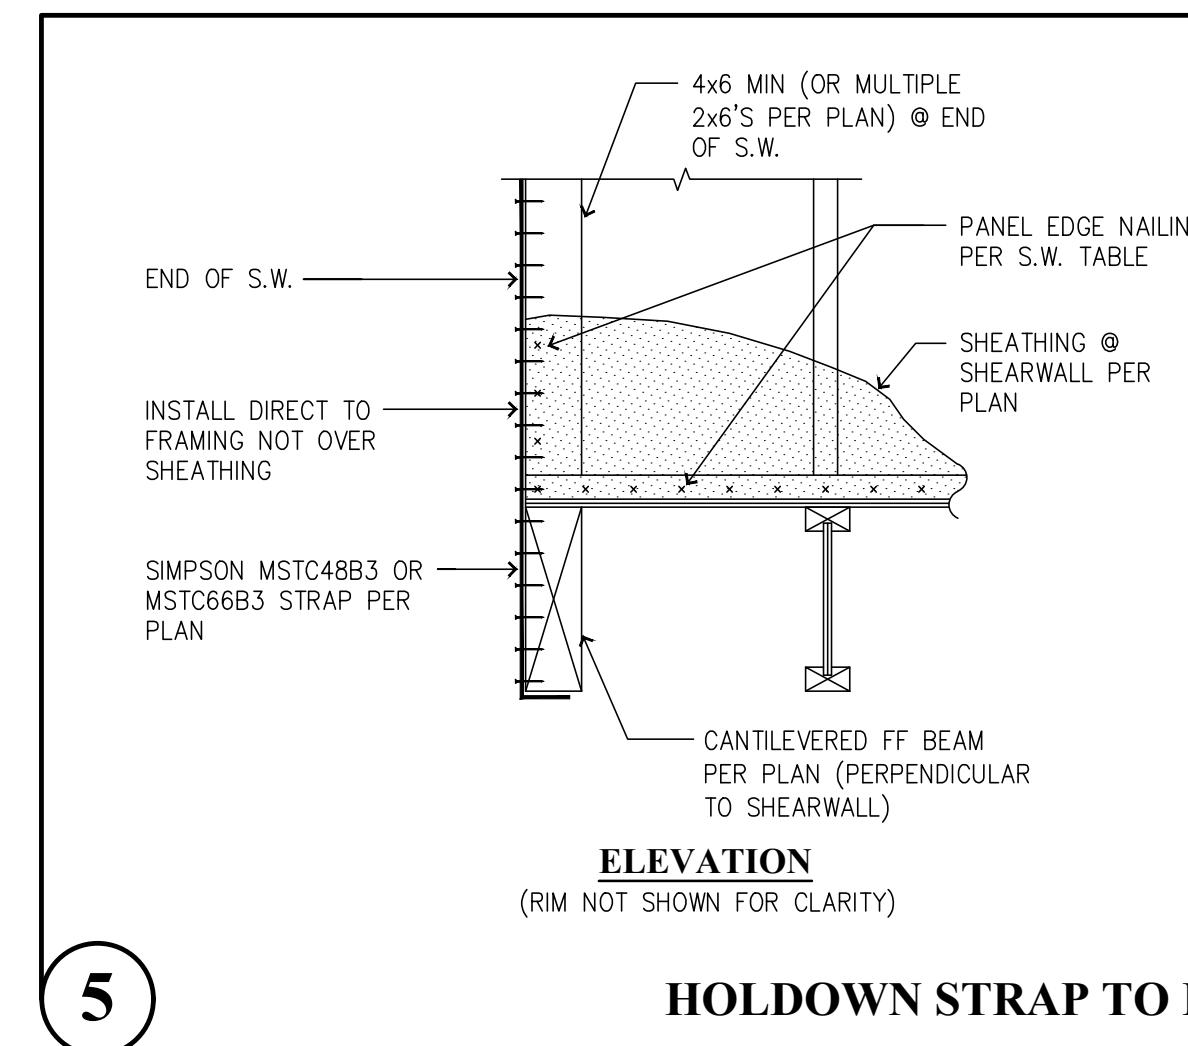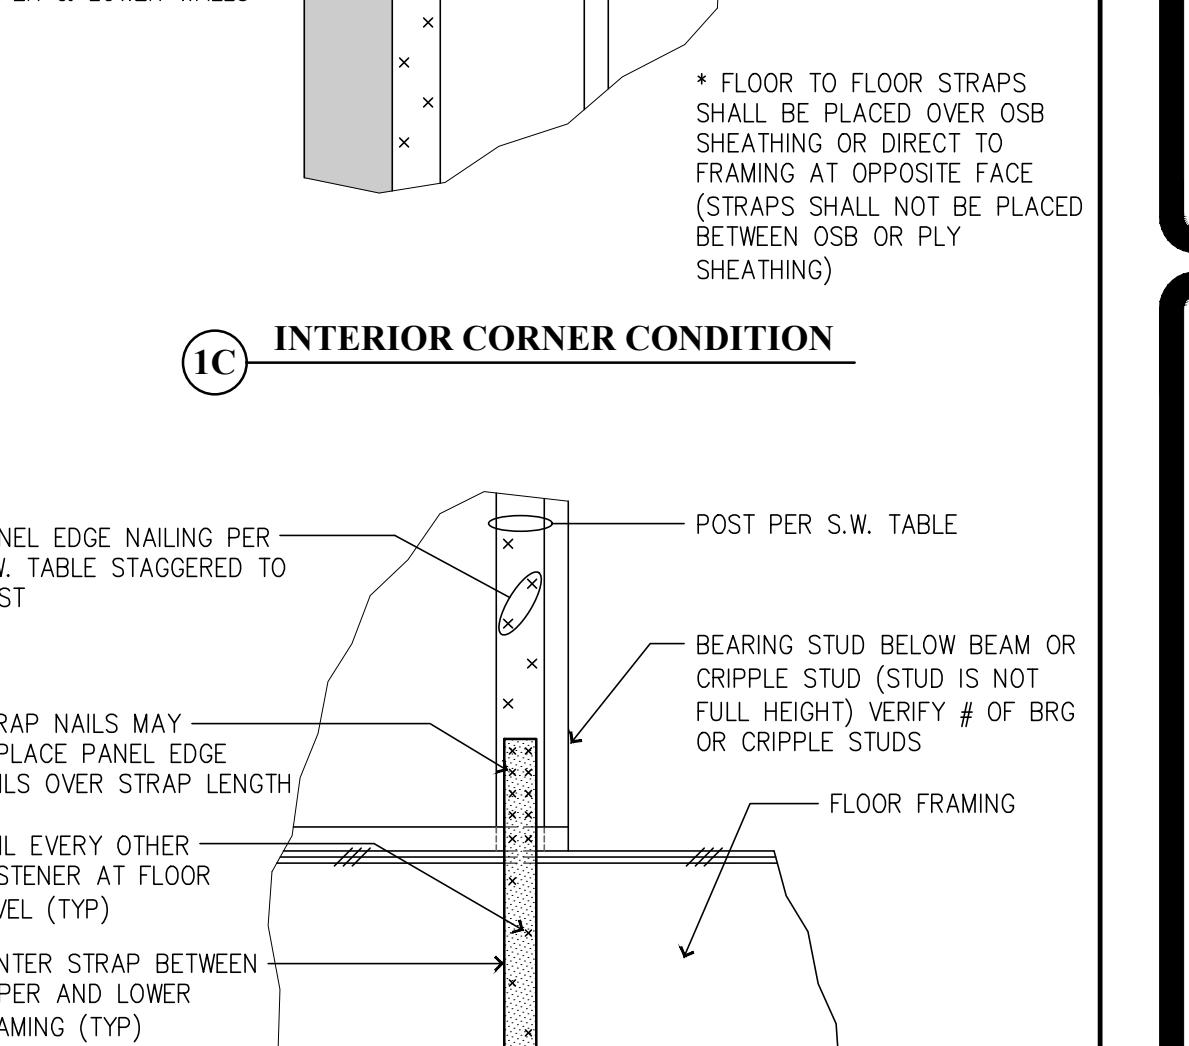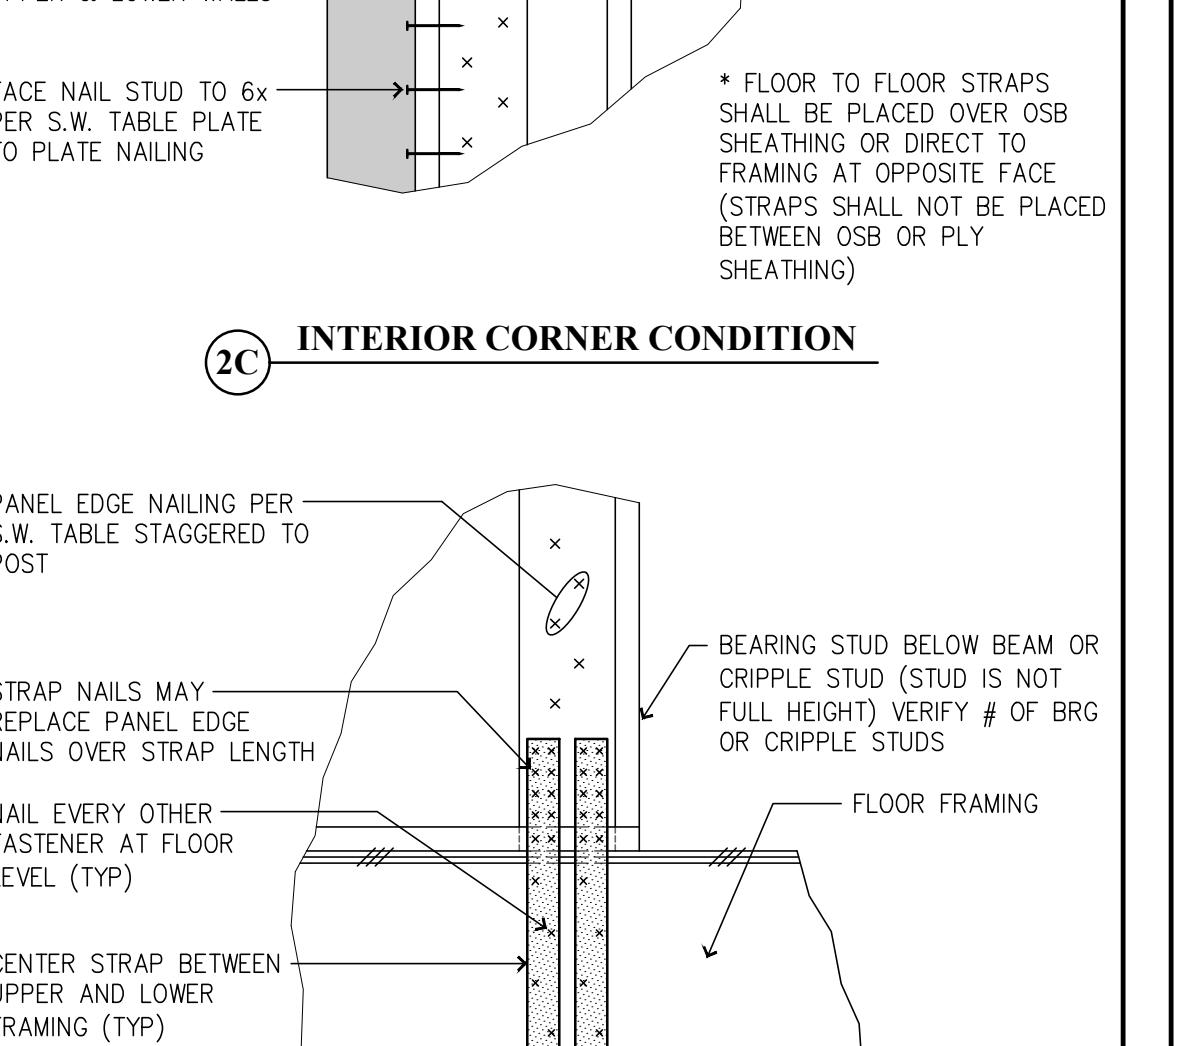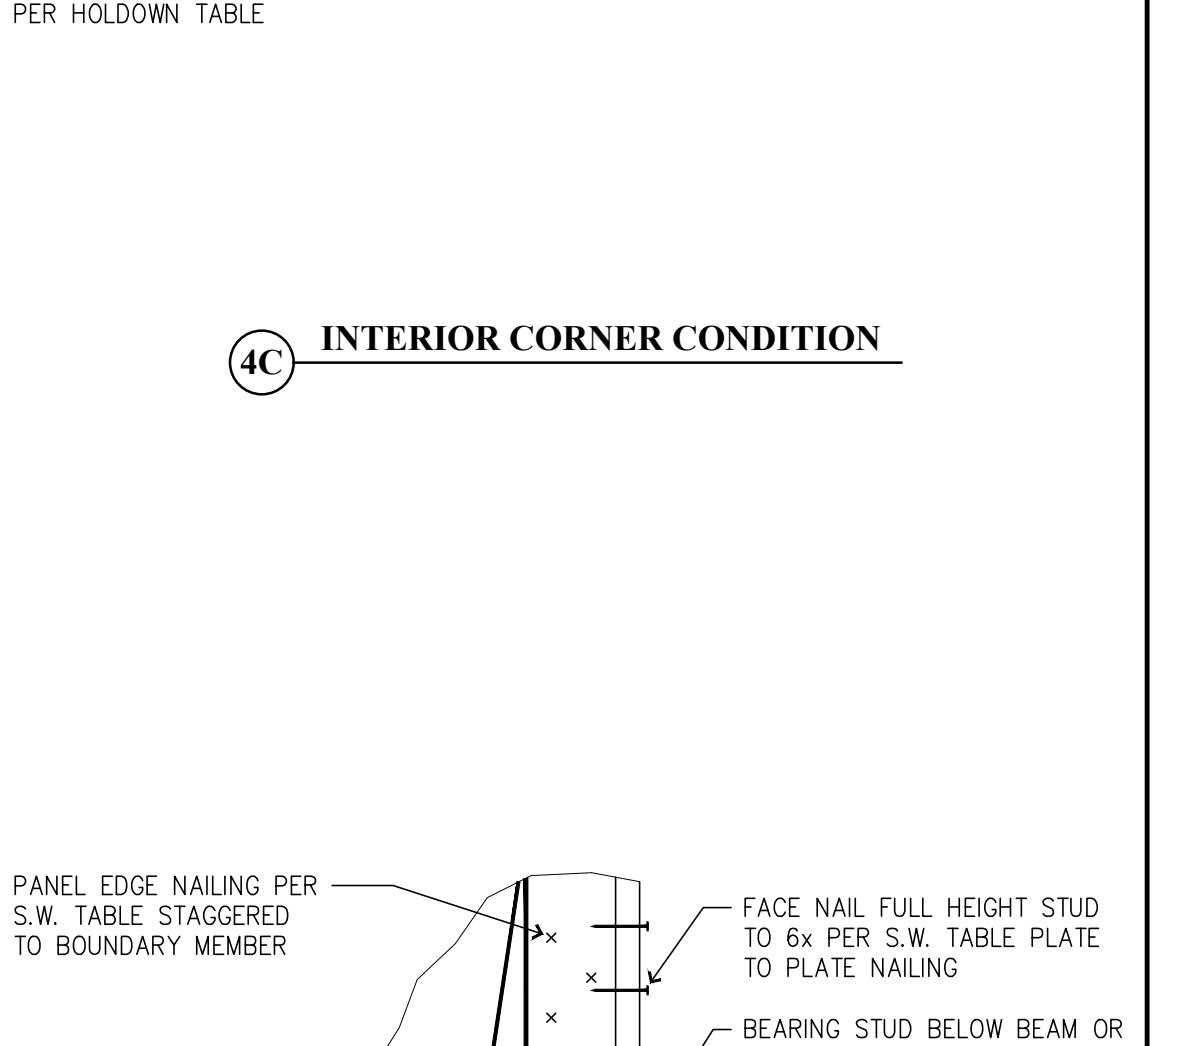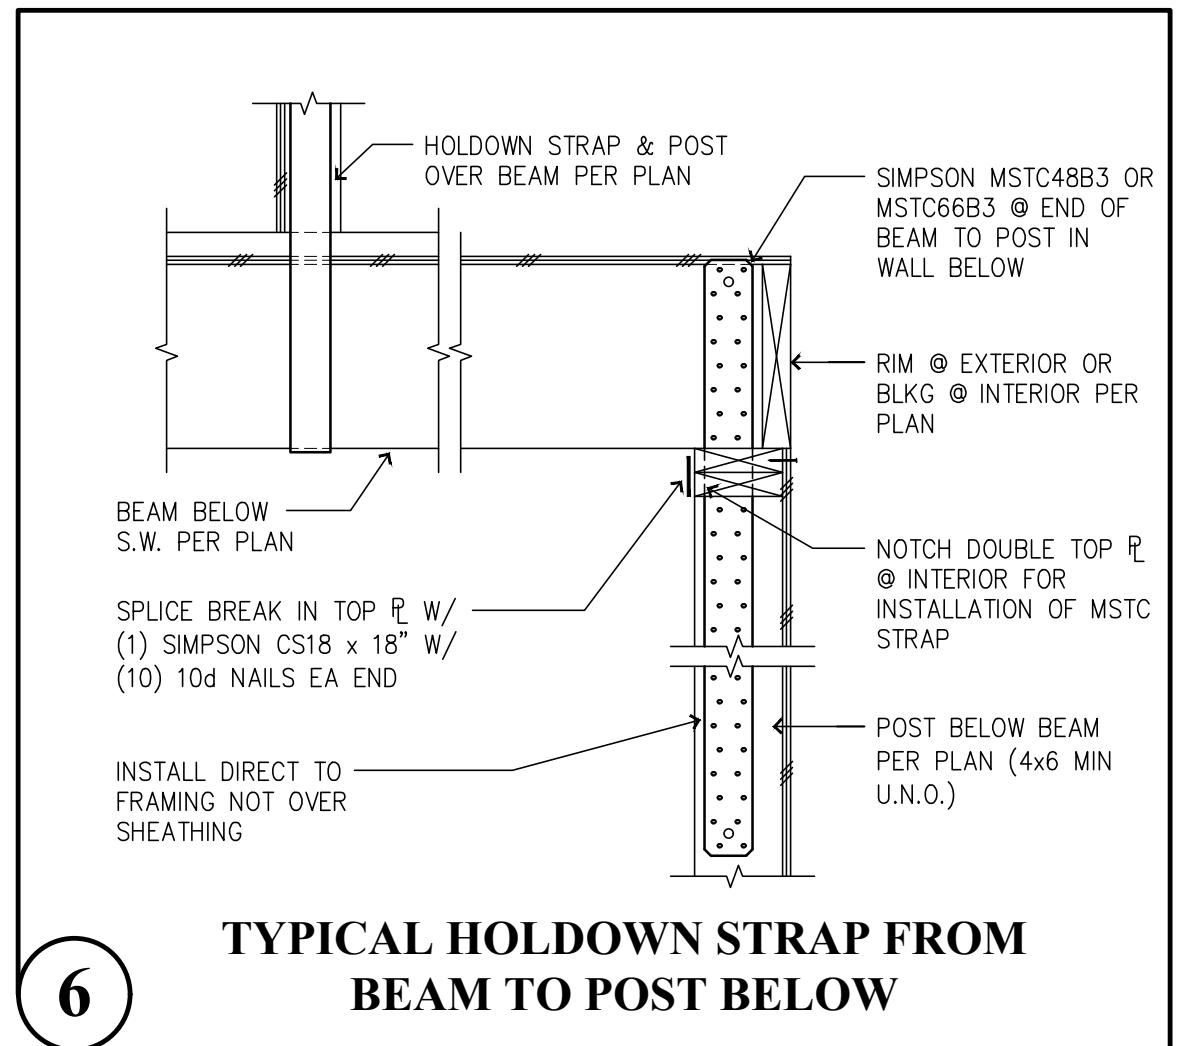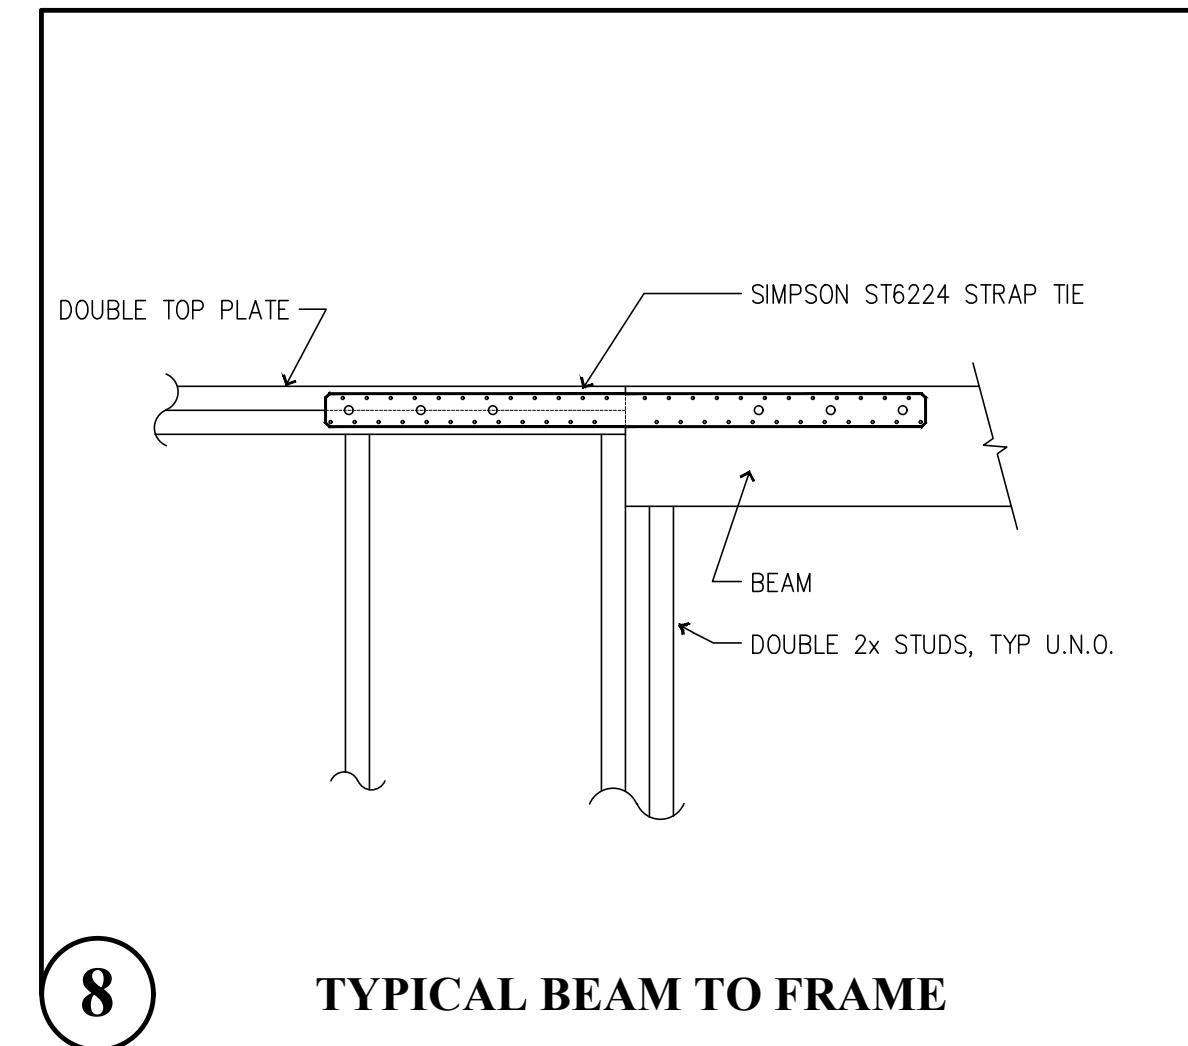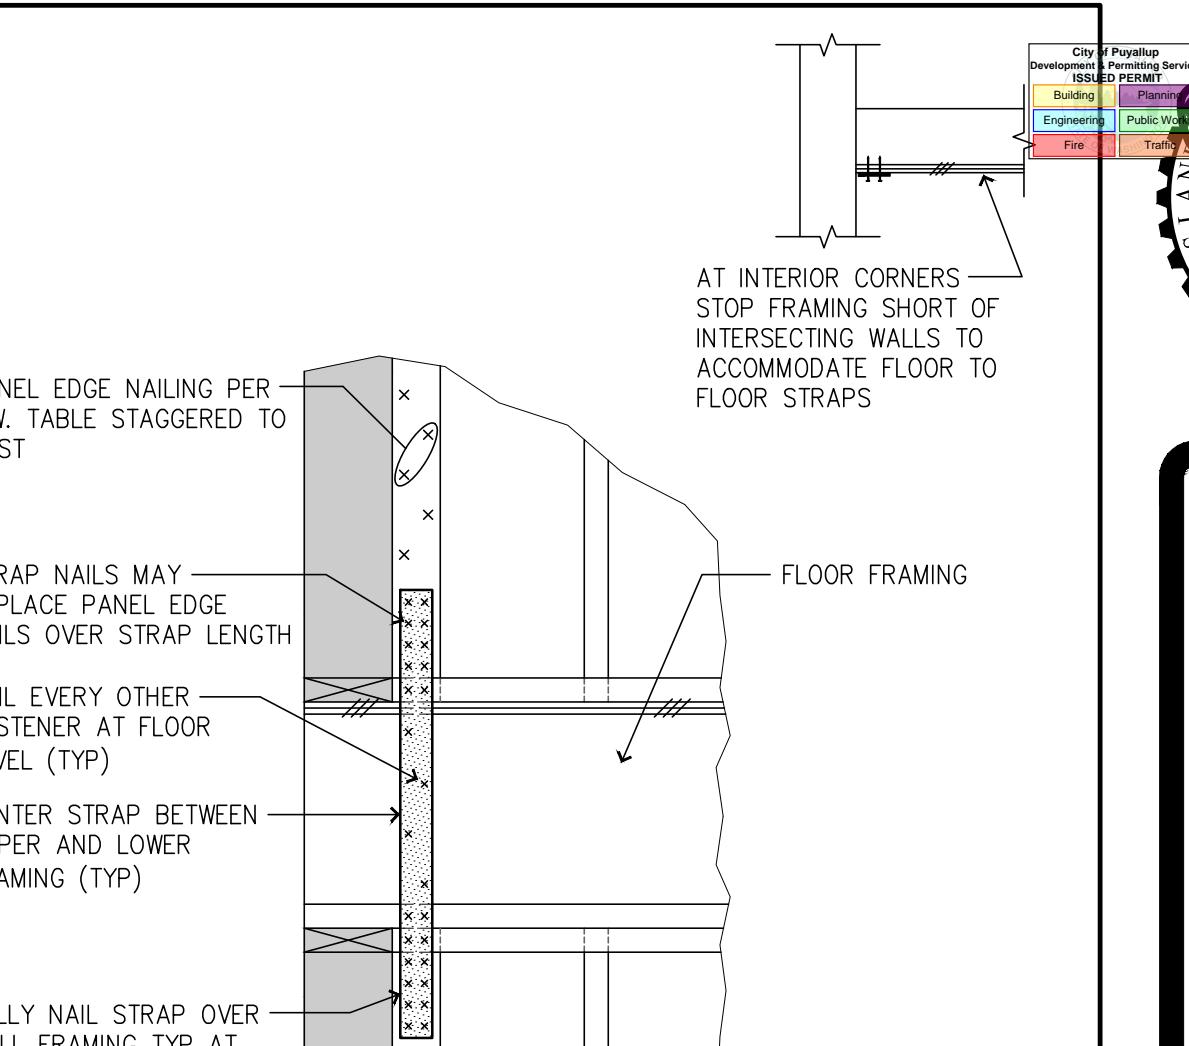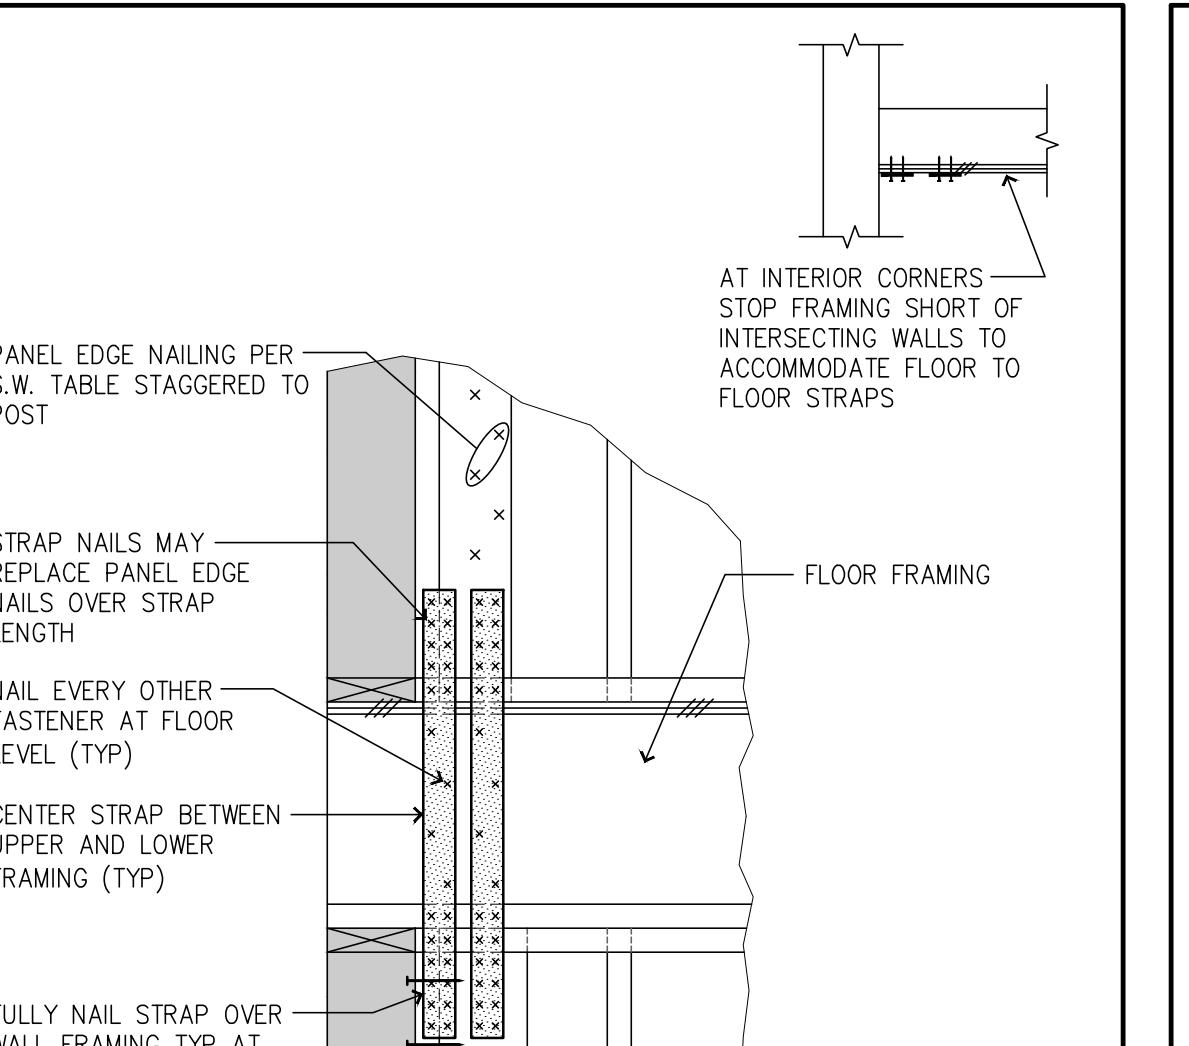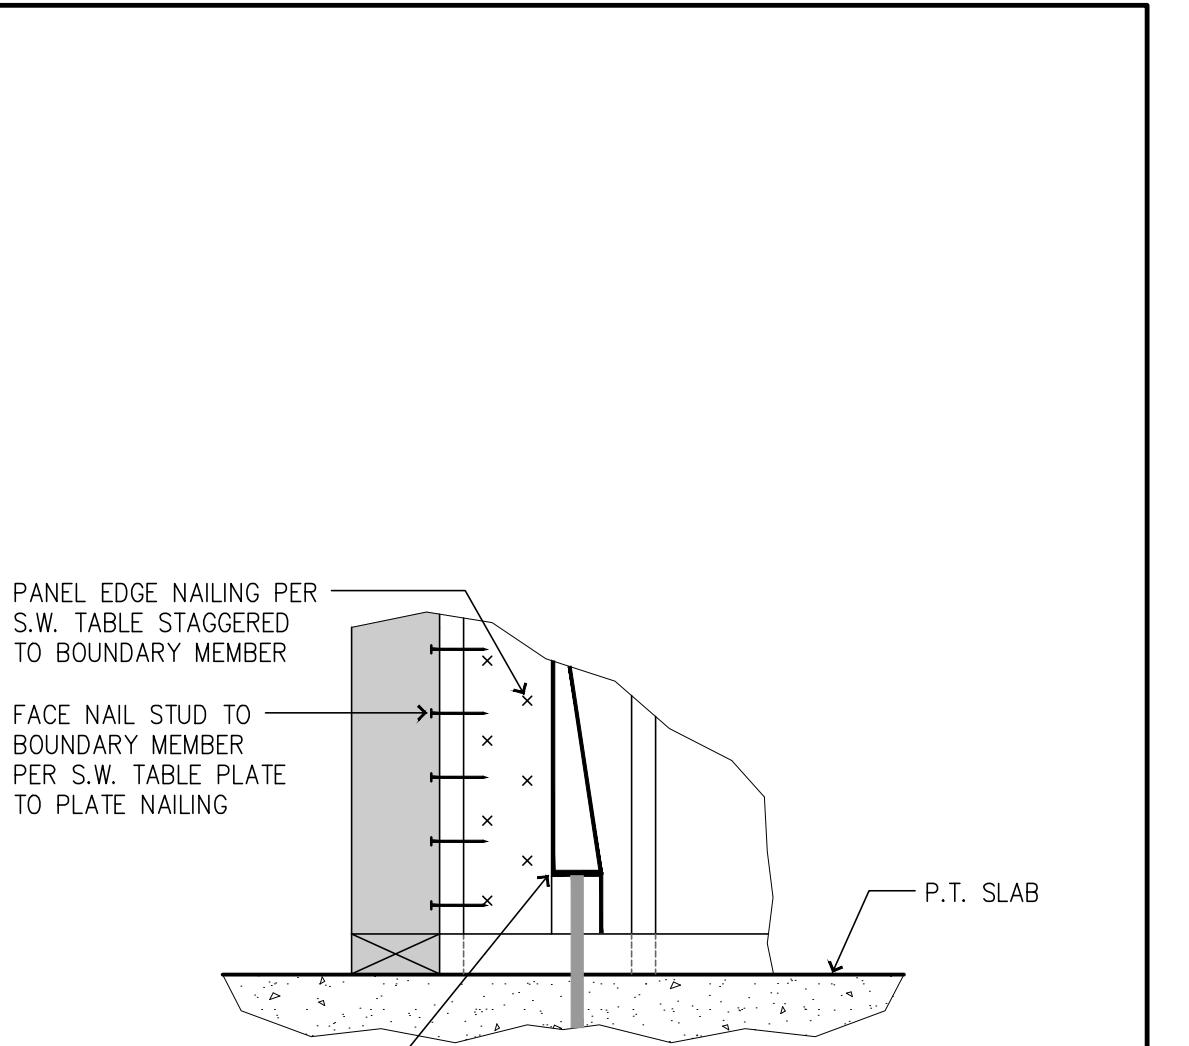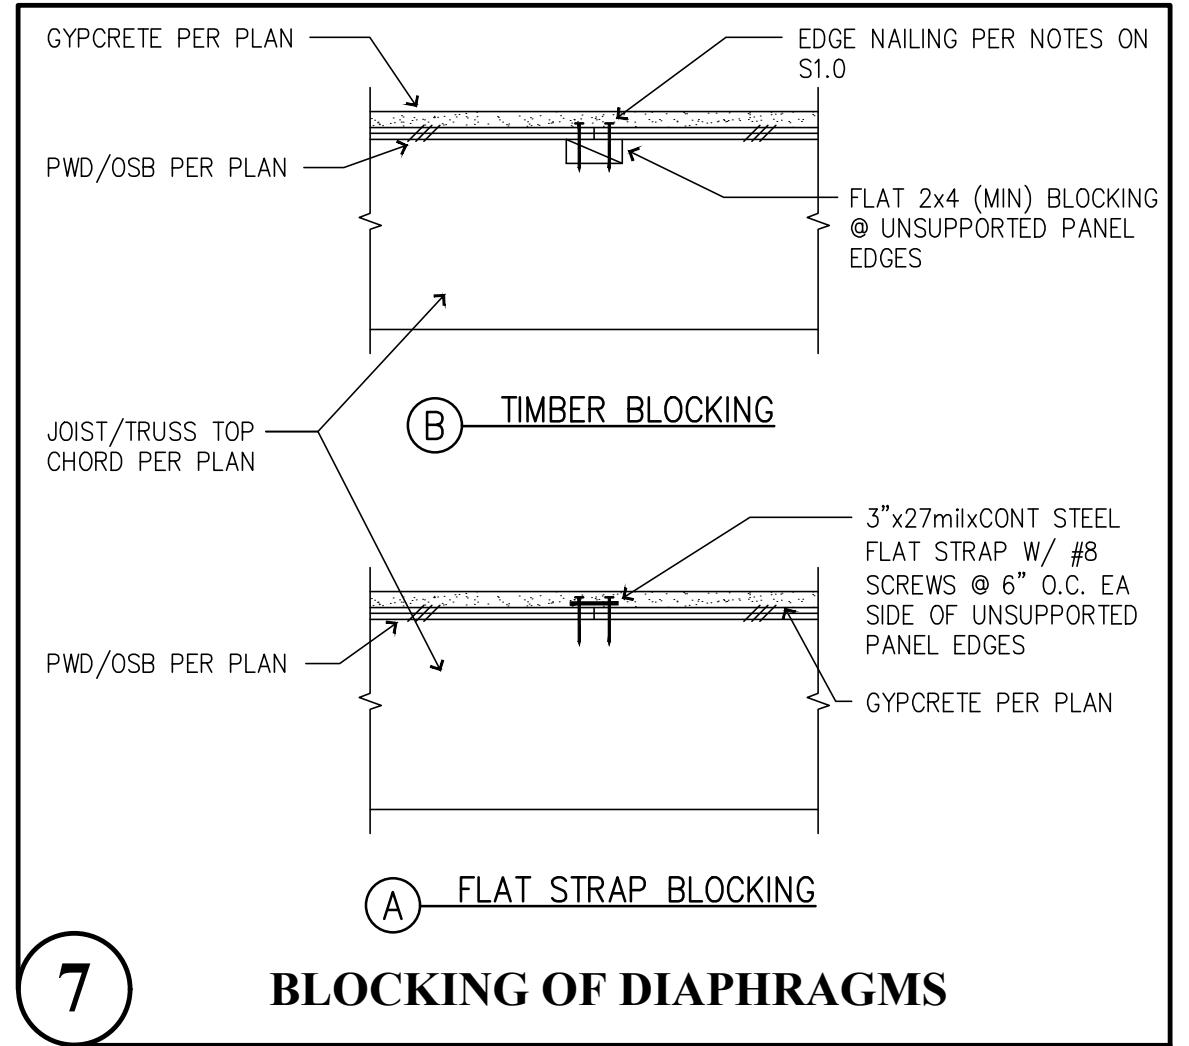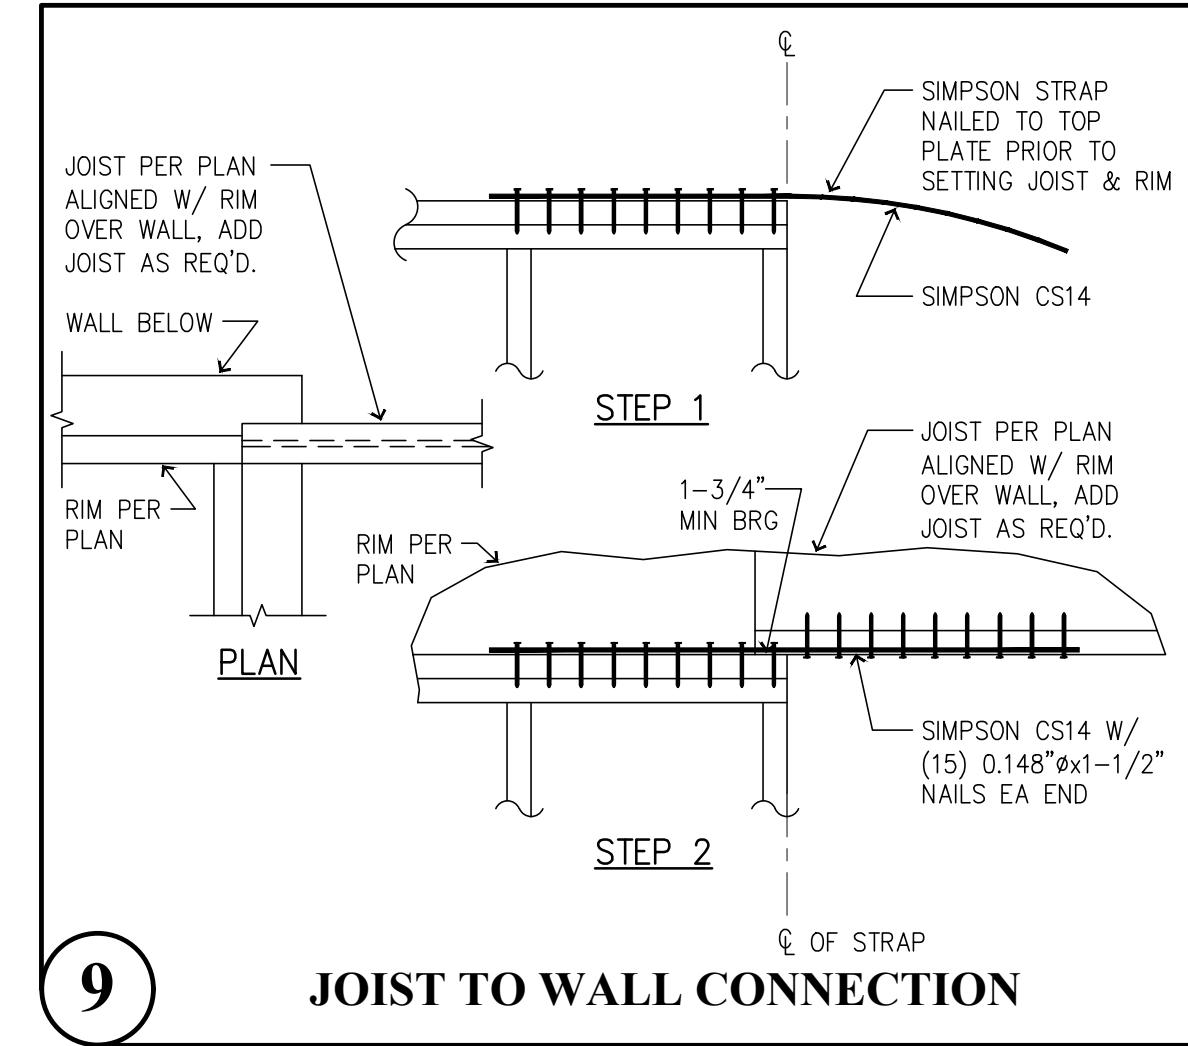


Bradley Heights Apartments

202 27th Ave SE
Puyallup, Washington


Puyallup, Washington 98374
Ph: 253-314-9822
www.solutions4structures.com

Revisions to this sheet:
PRMU20240280

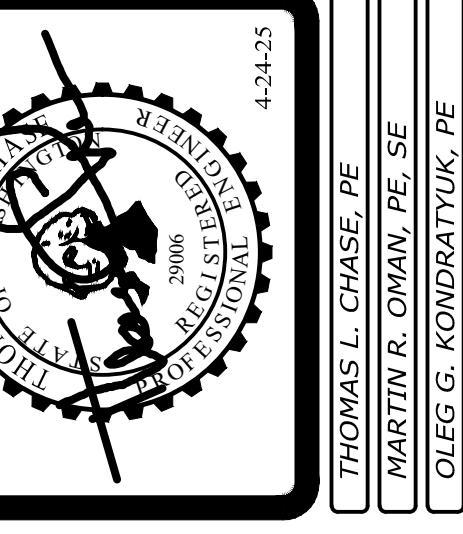


SEE SHEET S1.2 FOR SHEARWALL AND HOLDOWN TABLES

SEE SHEET S2.14 FOR FOUNDATION, ROOF & FLOOR FRAMING NOTES & TABLES

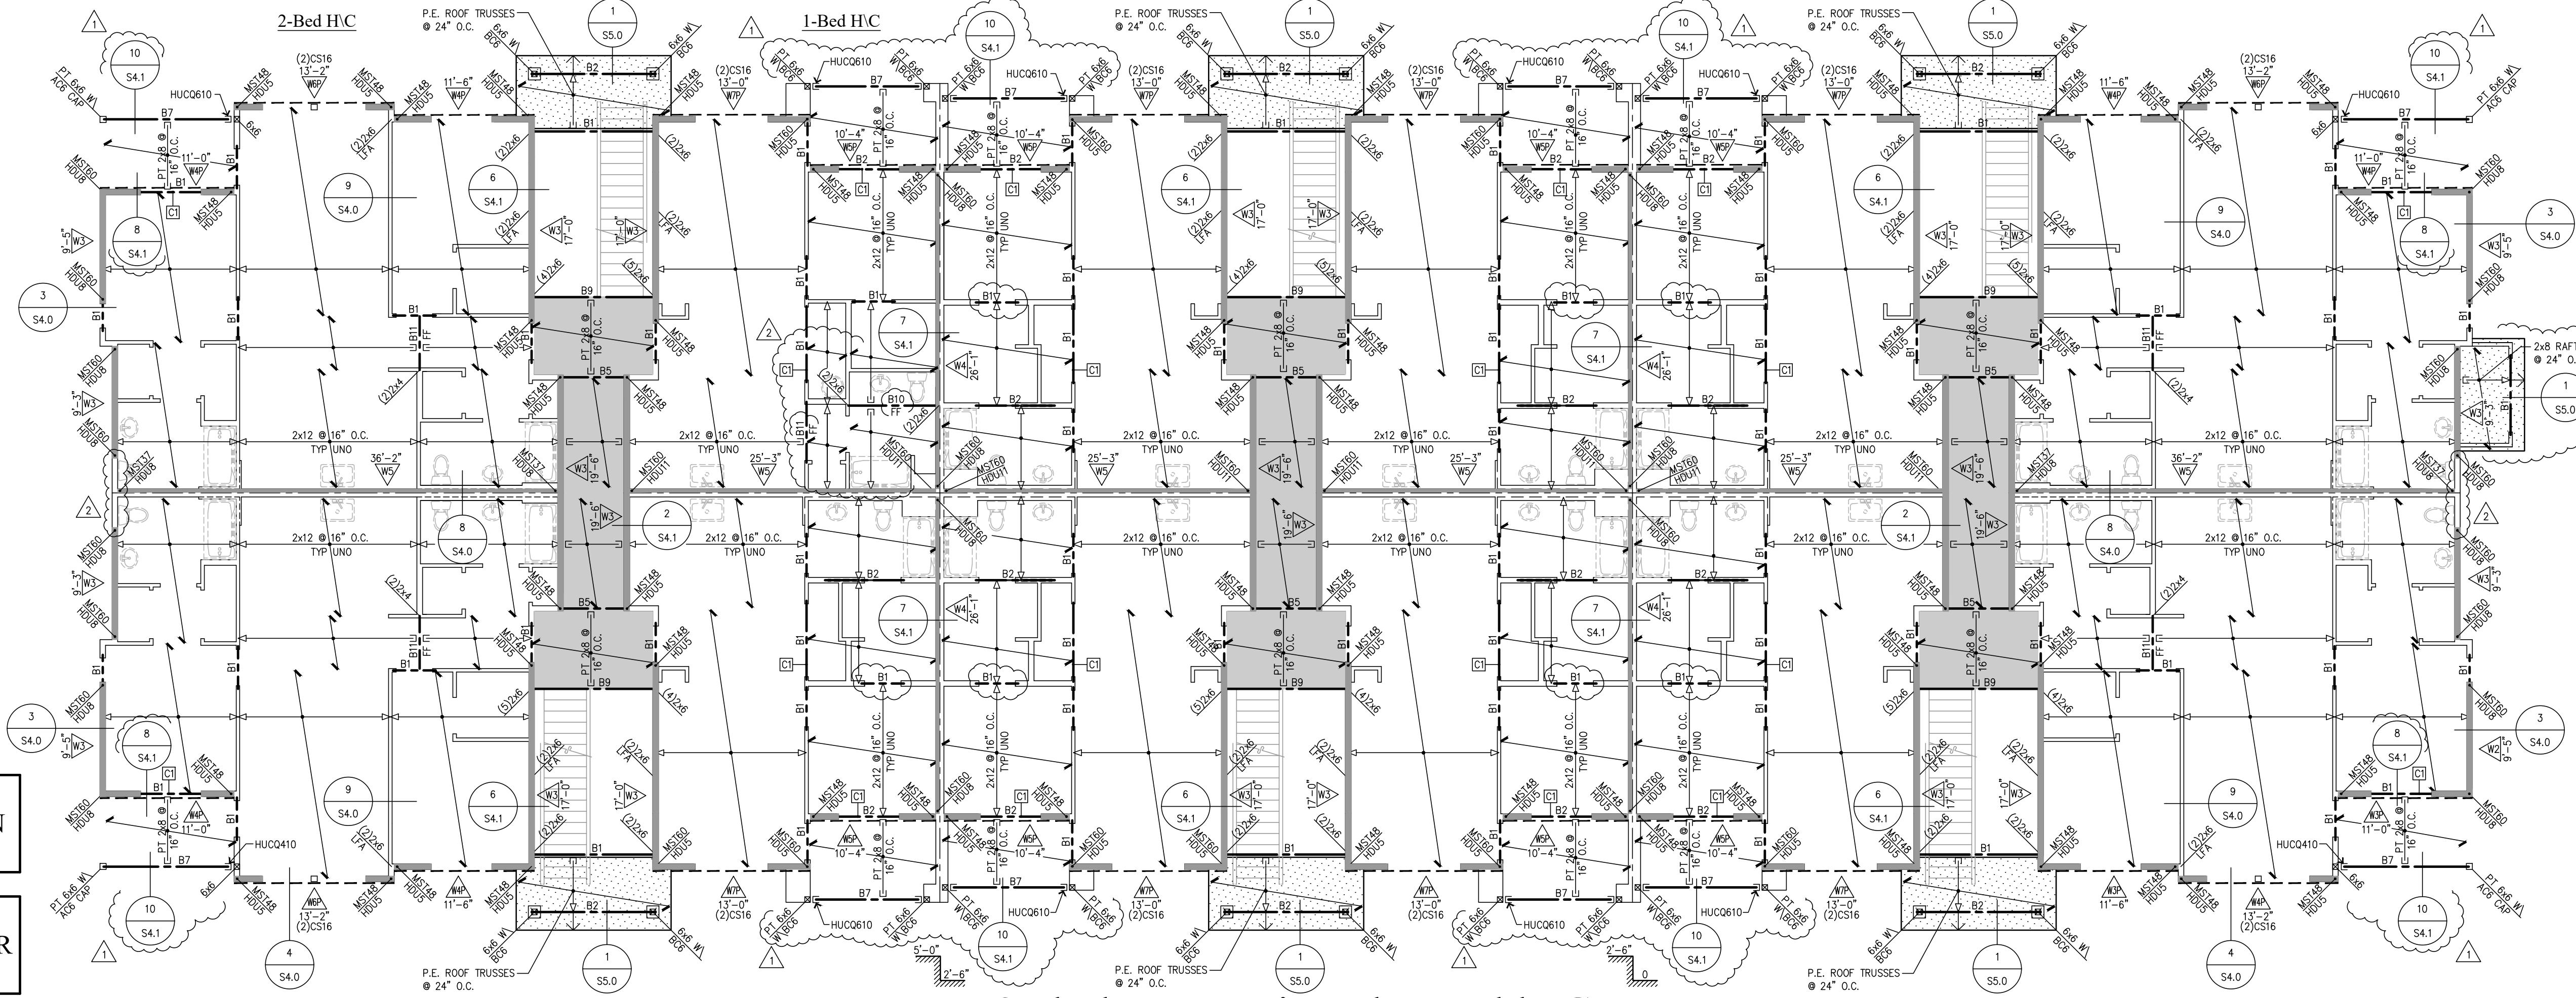

2nd Floor Framing Plan - Bldg G

SCALE 1/8"=1'-0"

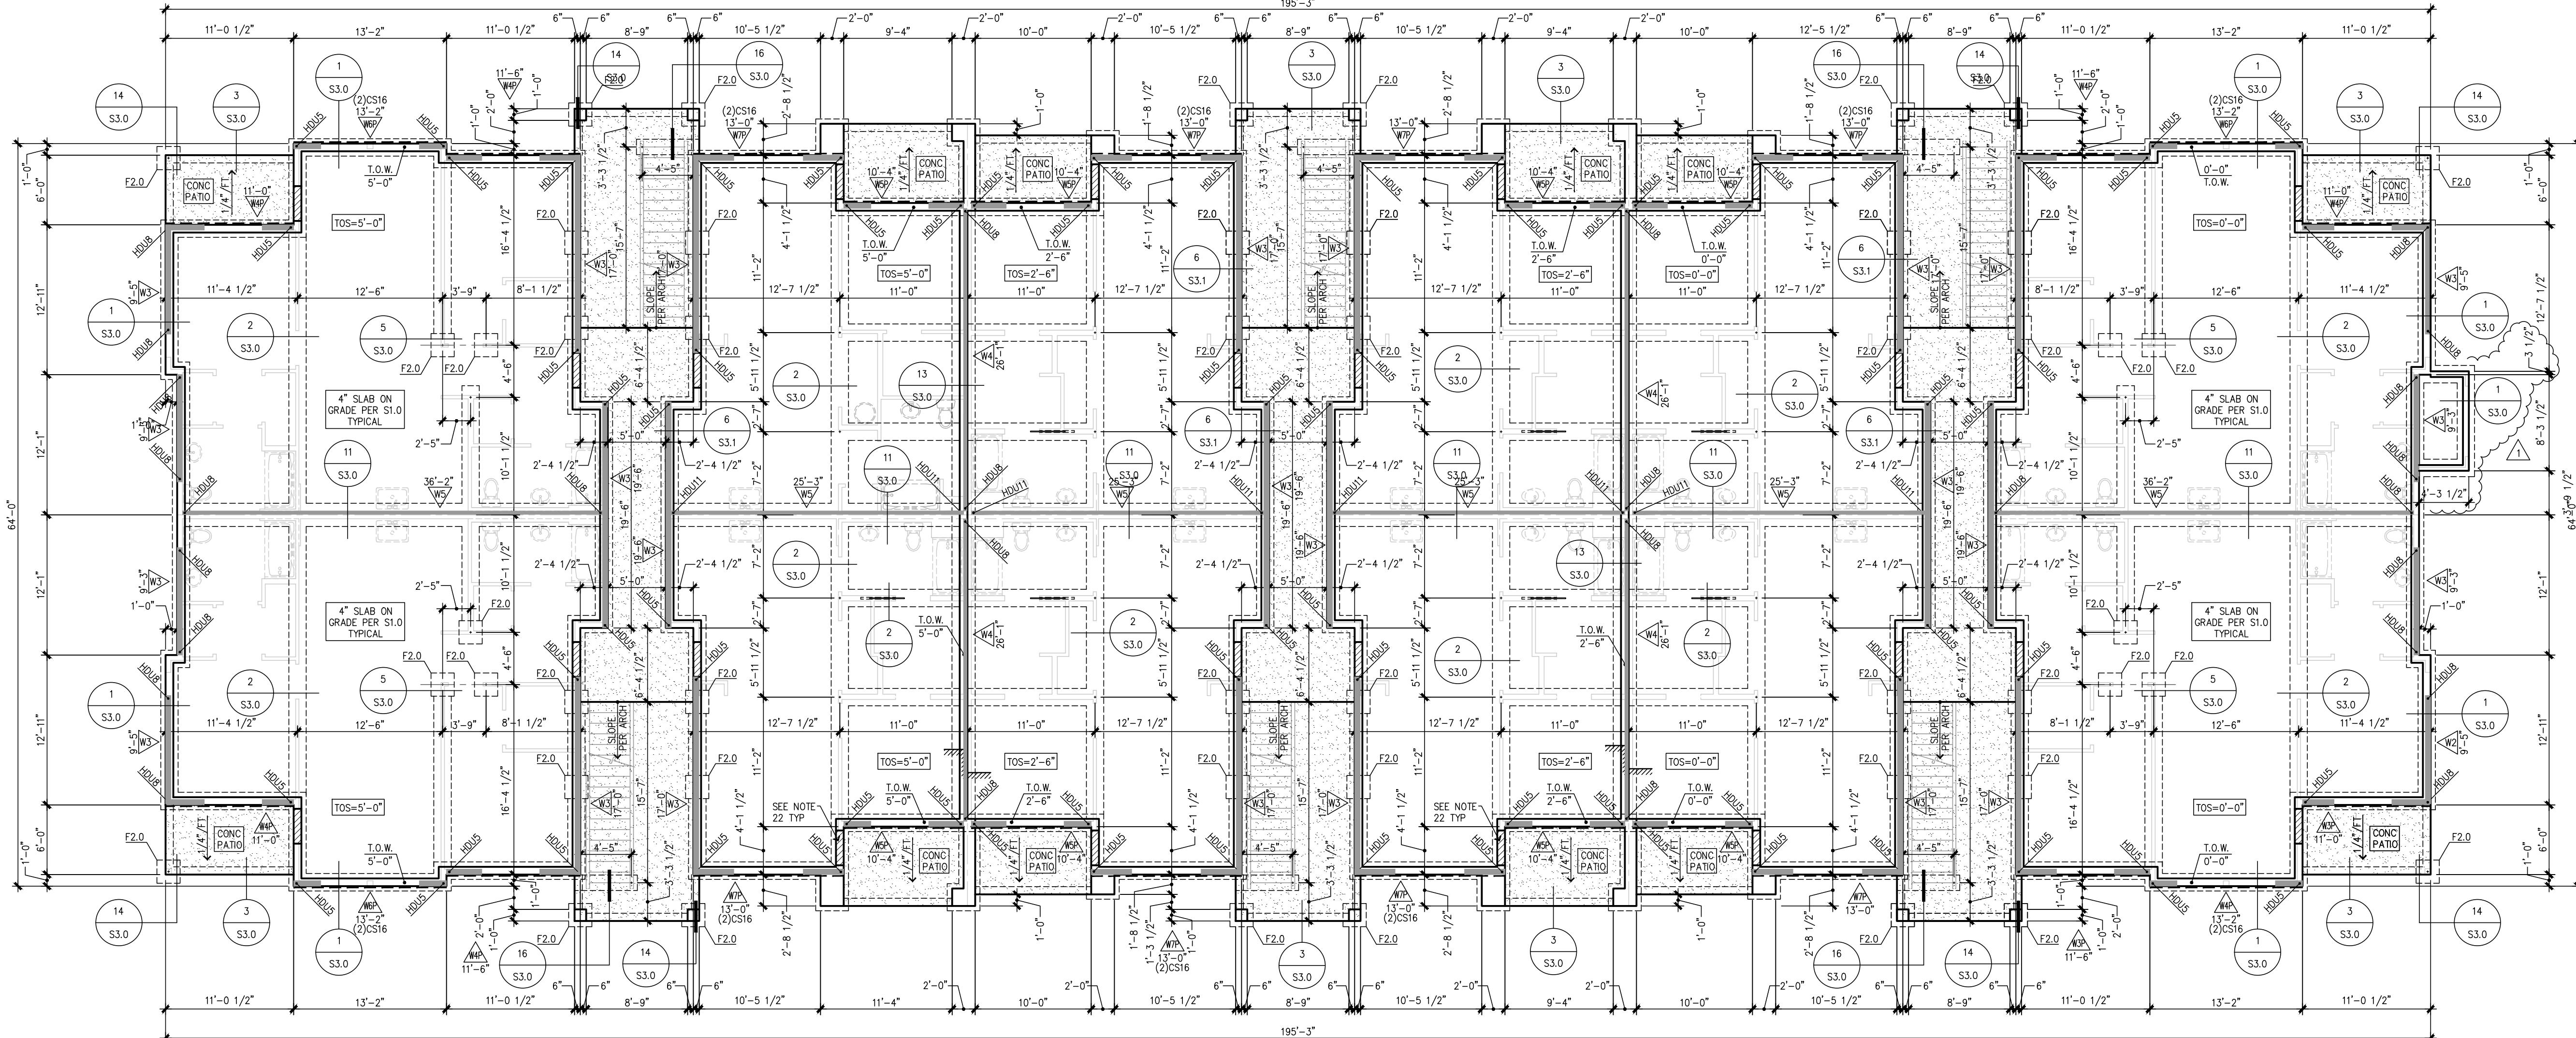

Foundation Plan - Bldg G

SCALE 1/8"=1'-0"

PROJECT NO. : 23-007
DESIGNED BY : TLC, OGK, MRO
DRAWN BY : RSO
ISSUE DATE : 2-20-24
LATEST REV. : △ 4-24-25
DWG. SET : △ 4-24-25


SUBMITTAL SET ONLY NOT FOR CONSTRUCTION
THESE DRAWINGS ARE SUBJECT TO REVISIONS
PENDING LOCAL JURISDICTIONAL REVIEW.

Bradley Heights Apartments
202 27th Ave SE
Puyallup, Washington
Solutions 4 Structures
A Structural Engineering Corporation

Revisions to this sheet:
△ 8-30-24 PERMIT CORRECTIONS & OWNER CHANGES
△ 4-24-25 PERMIT CORRECTIONS & OWNER CHANGES

PRMU20240280


Puyallup, Washington 98374
Ph 253-314-9822
www.solutions4structures.com

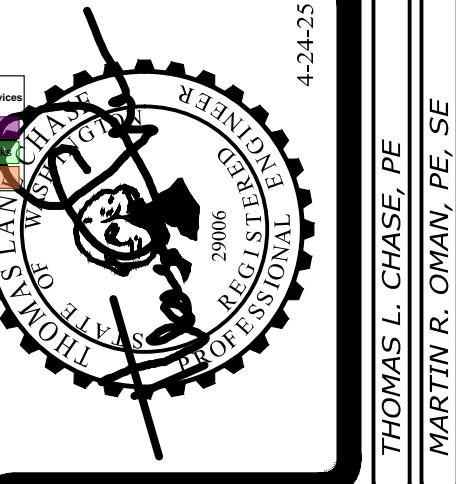

4-24-25
4-24-25
4-24-25
4-24-25


SEE SHEET S1.2 FOR
SHEARWALL AND HOLDOWN
TABLES

SEE SHEET S2.14 FOR
FOUNDATION, ROOF & FLOOR
FRAMING NOTES & TABLES

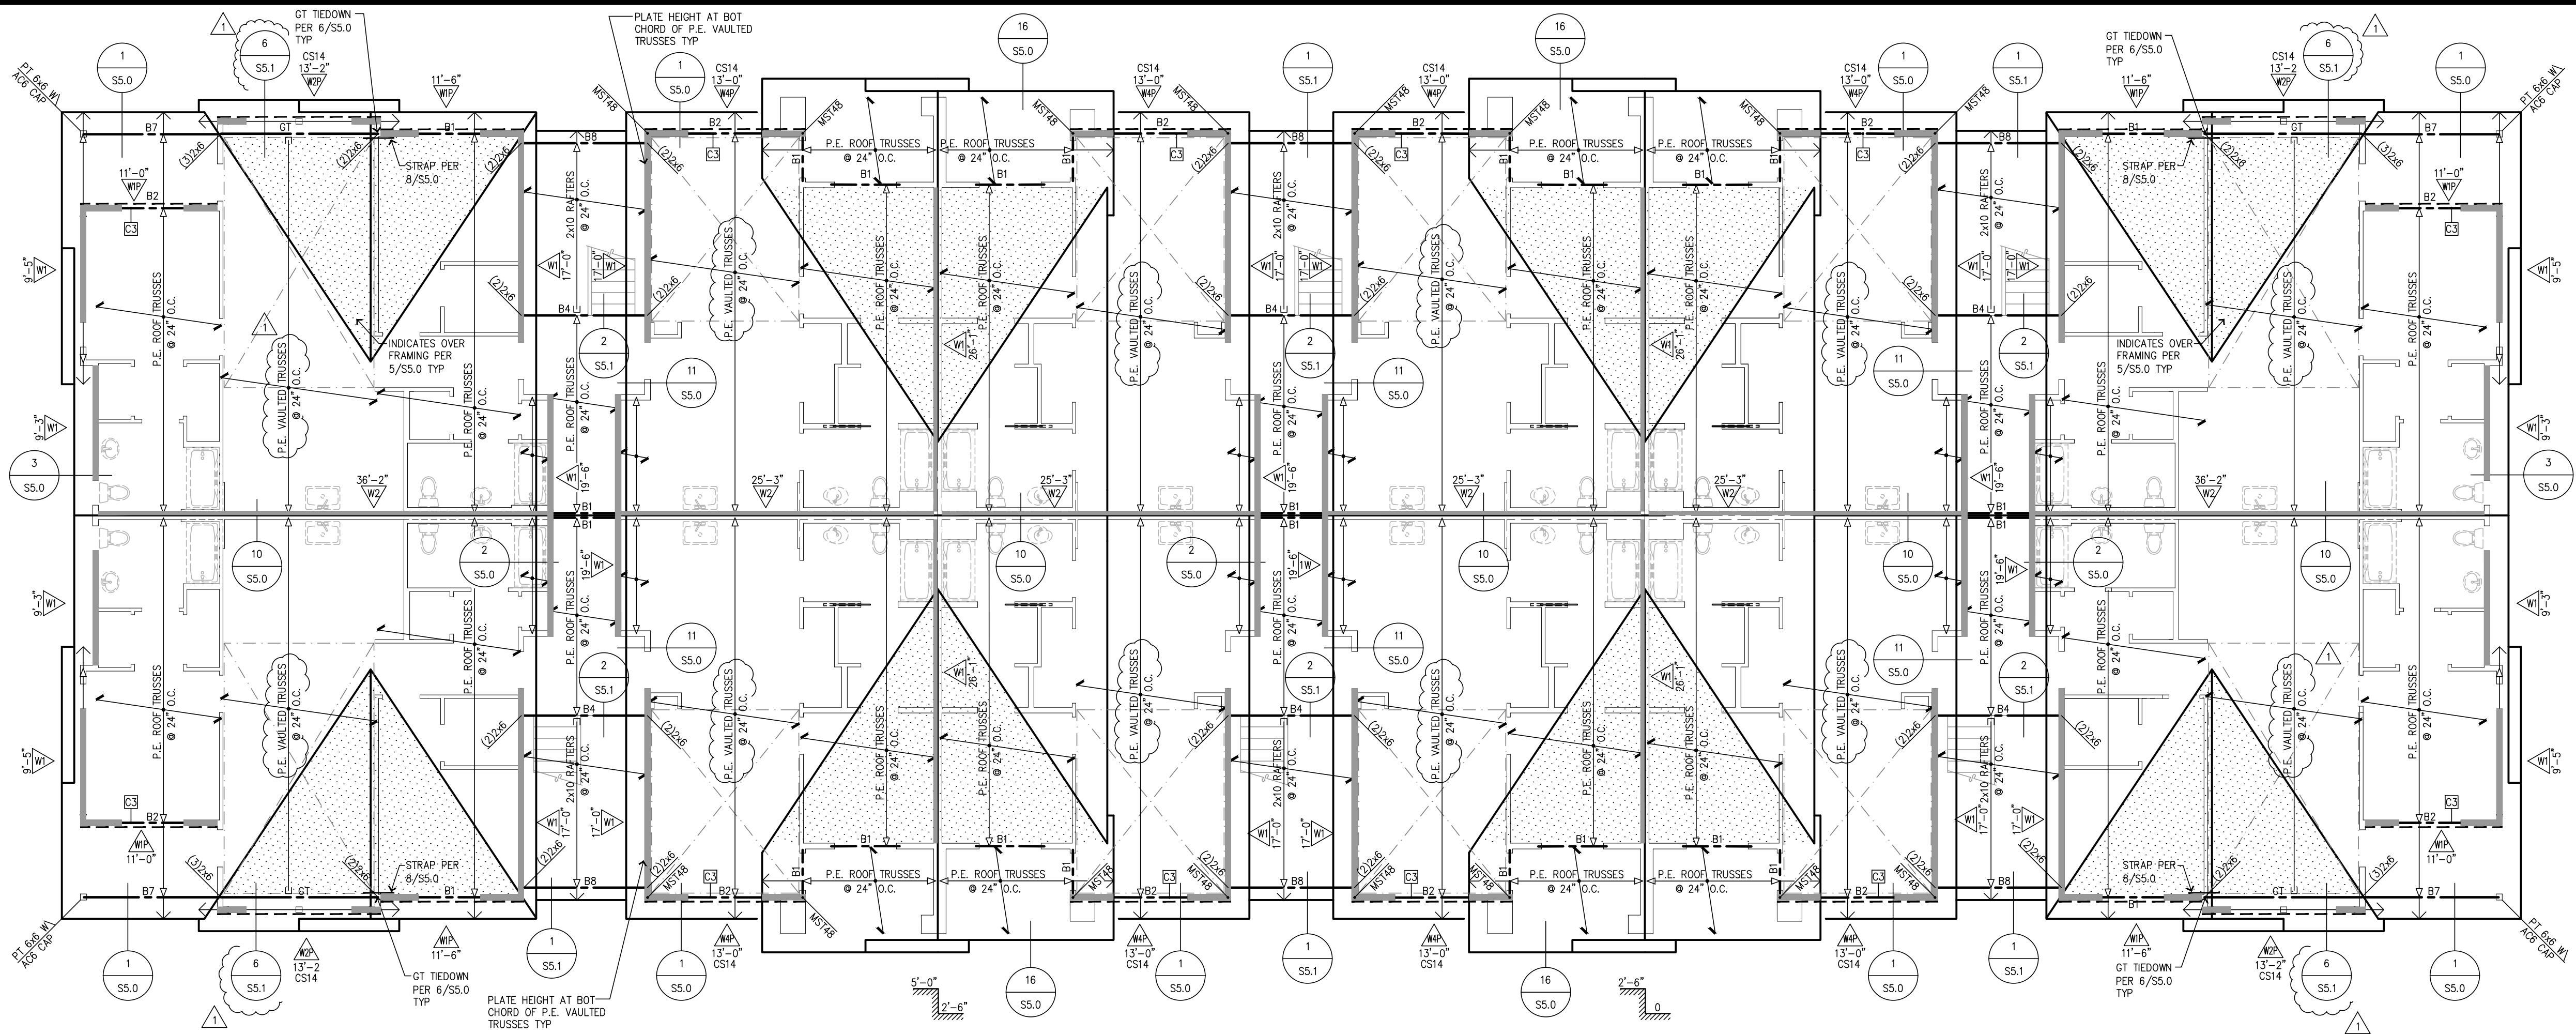

Roof Framing Plan - Bldg G

SCALE 1/8"=1'-0"

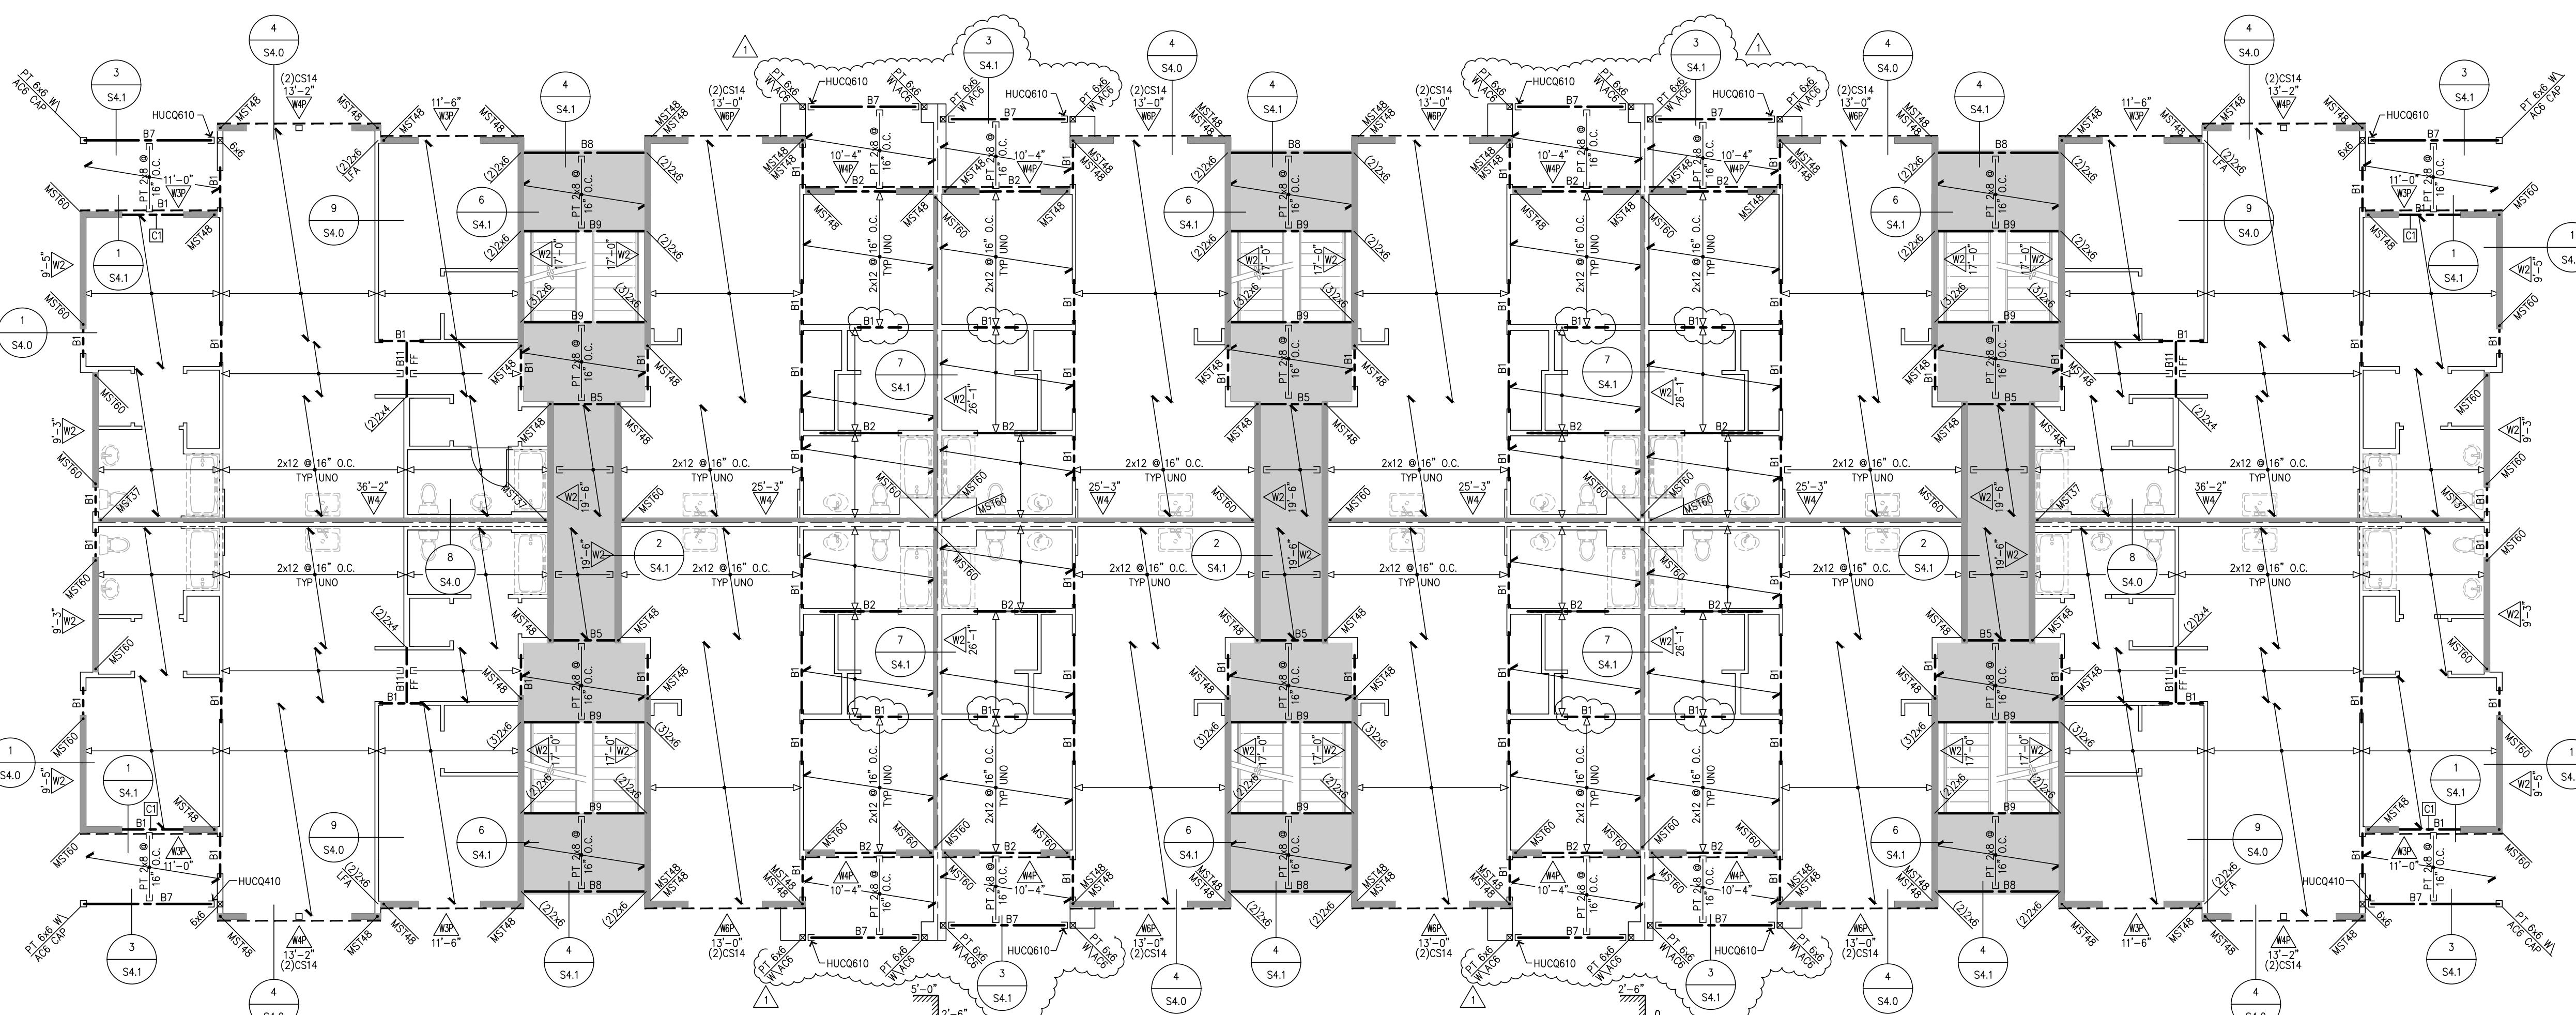

3rd Floor Framing Plan - Bldg G

SCALE 1/8"=1'-0"


PROJECT NO. : 23-007
DESIGNED BY : TLC, OGK, MRO
DRAWN BY : RSO
ISSUE DATE : 2-20-24
LATEST REV. : △ 4-24-25
OF DWG. SET : △ 4-24-25

SUBMITTAL SET ONLY NOT FOR
CONSTRUCTION
THESE DRAWINGS ARE SUBJECT TO REVISIONS
PENDING LOCAL JURISDICTIONAL REVIEW.

Bradley Heights Apartments
202 27th Ave SE
Puyallup, Washington
Solutions **4** Structures
A Structural Engineering Corporation

Revisions to this sheet:
△ 8-30-24 PERMIT CORRECTIONS & OWNER CHANGES
PRMU20240280

City of Puyallup
Development Services Department
1800 2nd Street, Suite 100
Engineering, Planning, Public Works, Fire
20606
THOMAS L. CHASE, PE
MARTIN R. ORMAN, PE
OLEG G. KONDRAKOV, PE
4-24-25

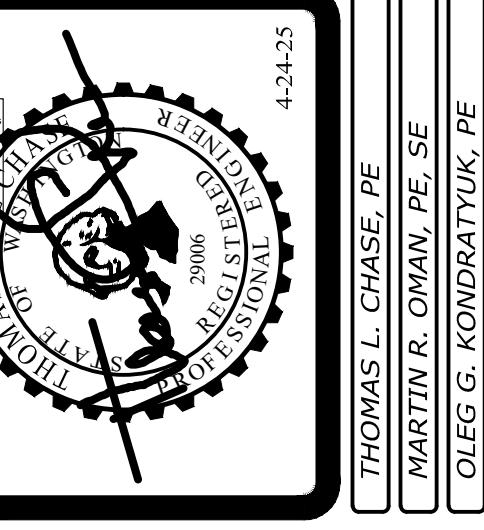

PRMU20240280


Bradley Heights Apartments

202 27th Ave SE
Puyallup, Washington


Solutions 4^{inc} Structures
A Structural Engineering Corporation

Puyallup, Washington 98374
Ph. 253-314-9822
www.solutionsstructures.com


Revisions to this sheet:

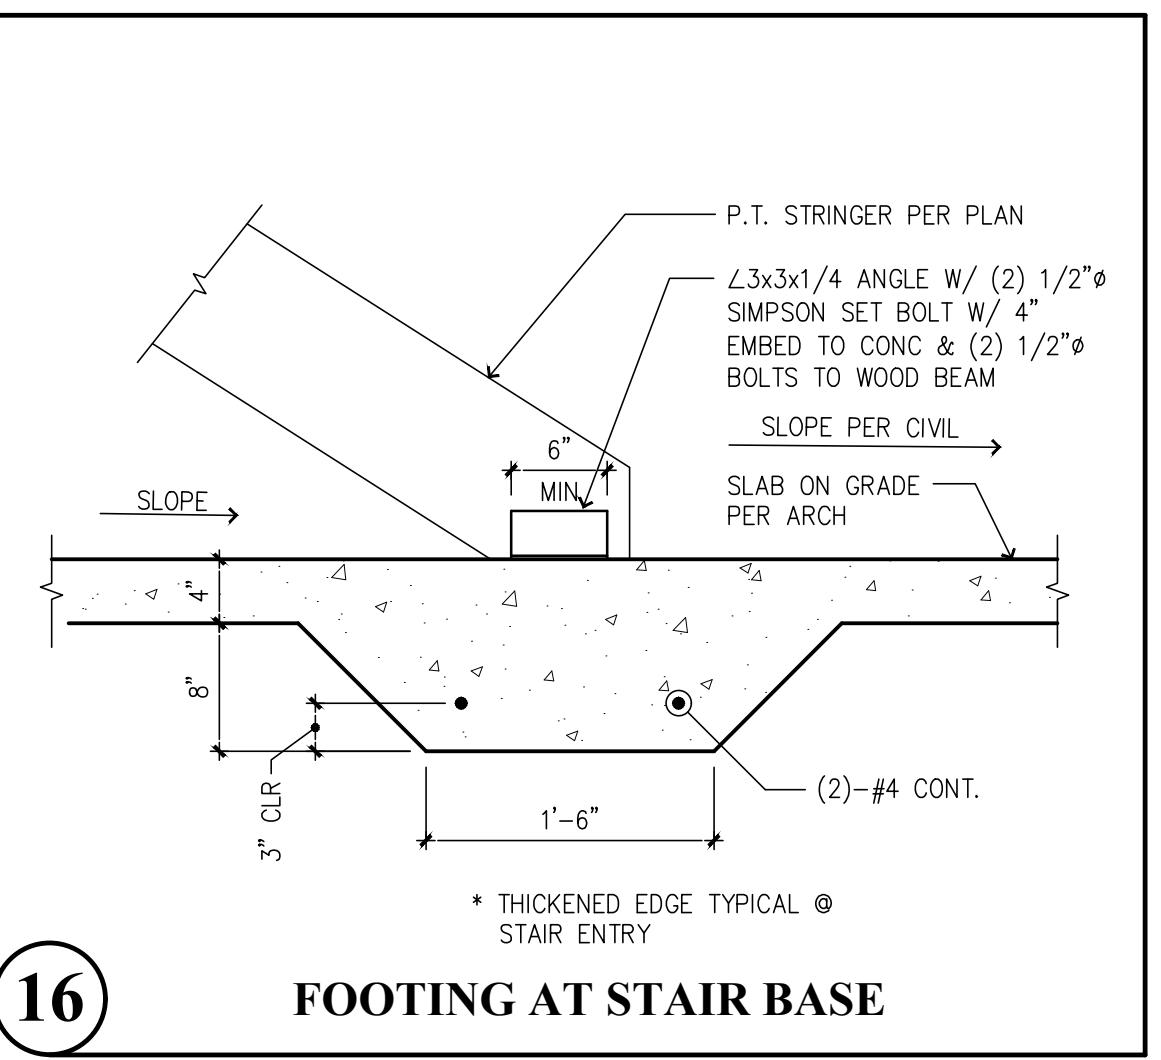


FOOTING AT STAIR BASE

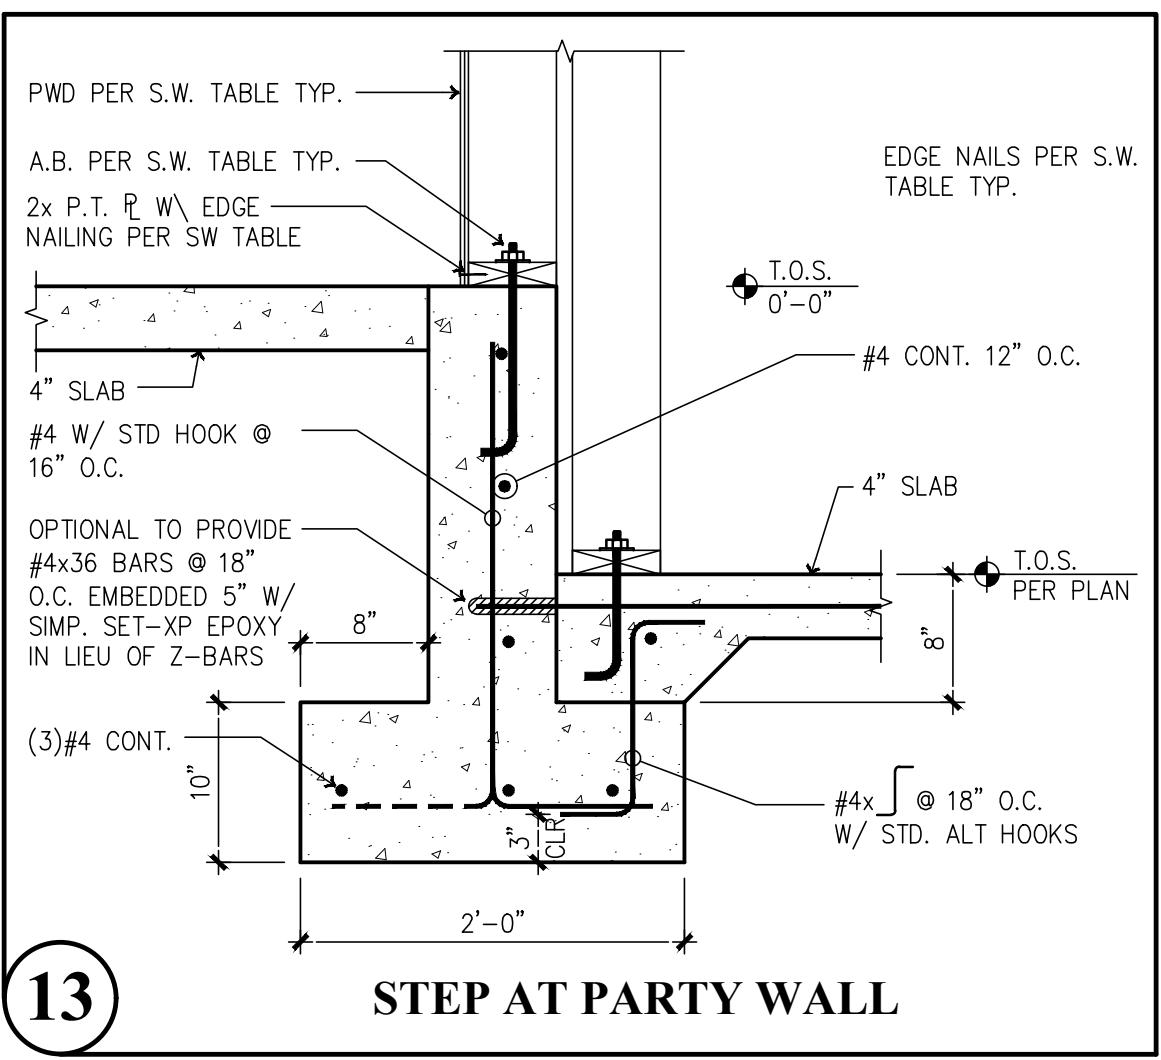


STEP AT PARTY WALL

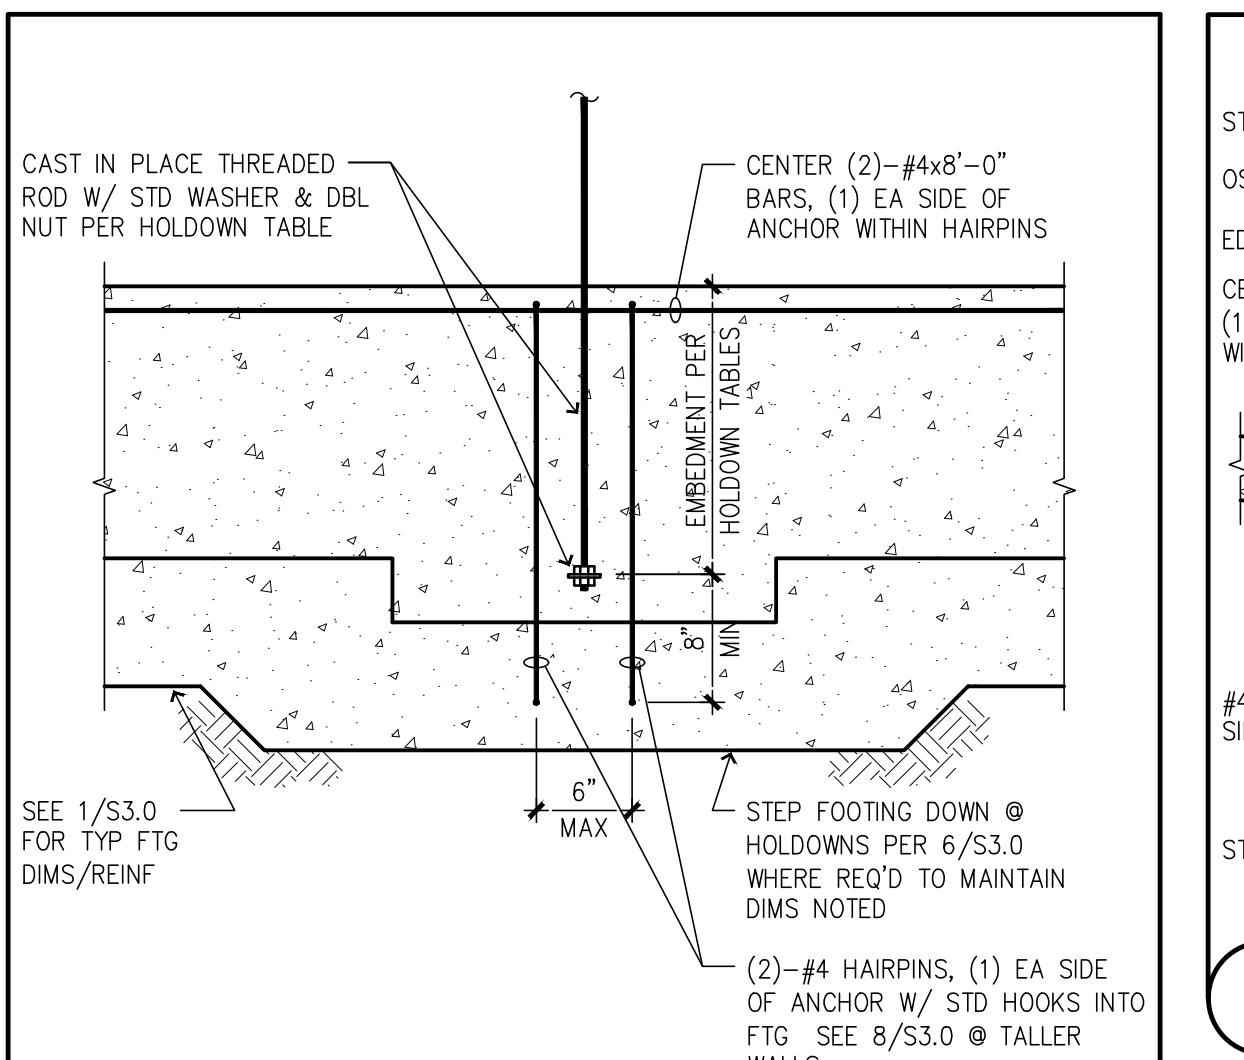


ANCHORS @ TALL STEMWALL CONDITION

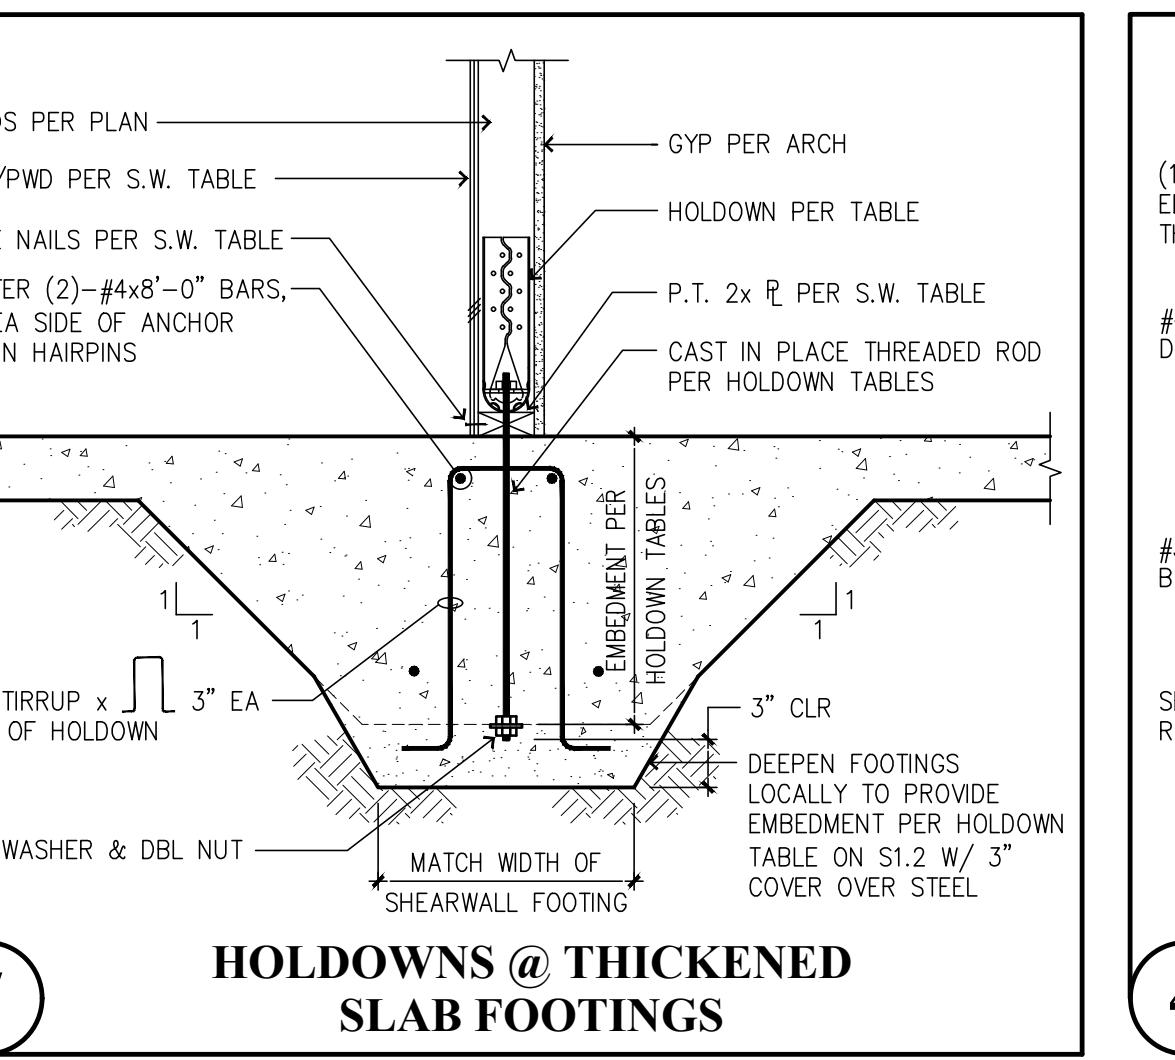


HOLDOWNS @ THICKENED SLAB FOOTINGS

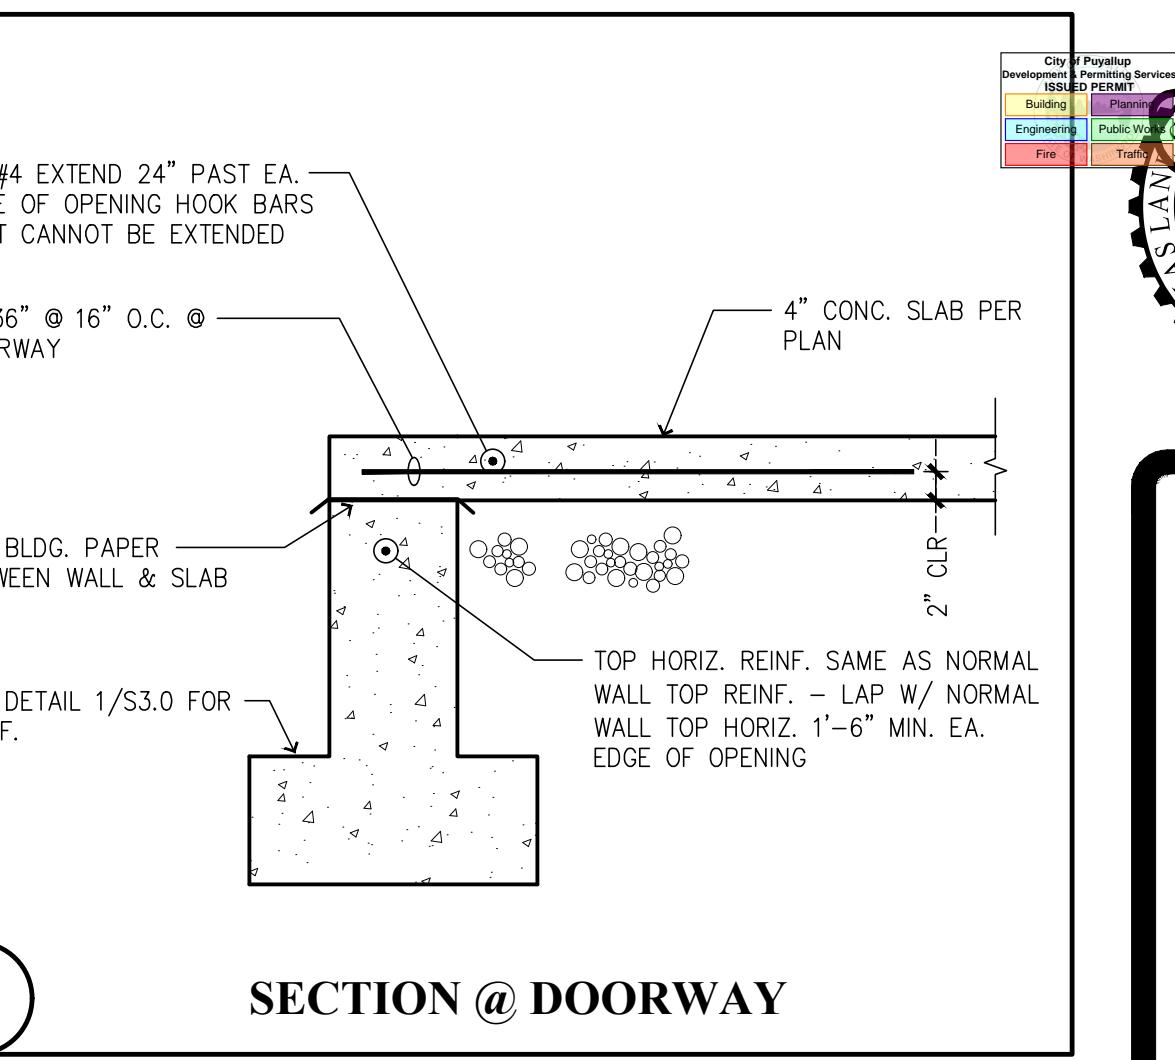


SECTION @ DOORWAY

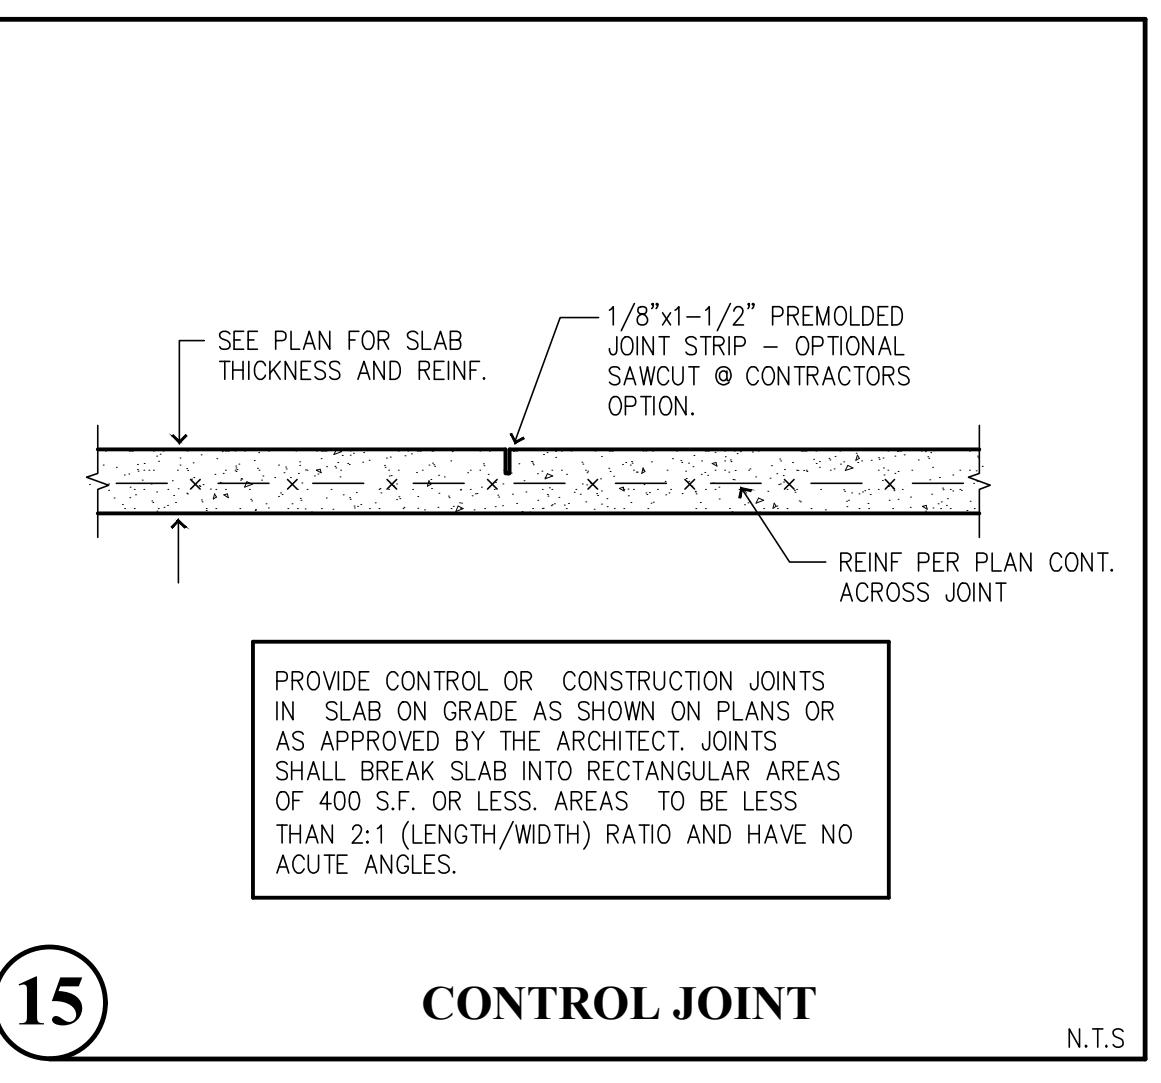


CONTROL JOINT

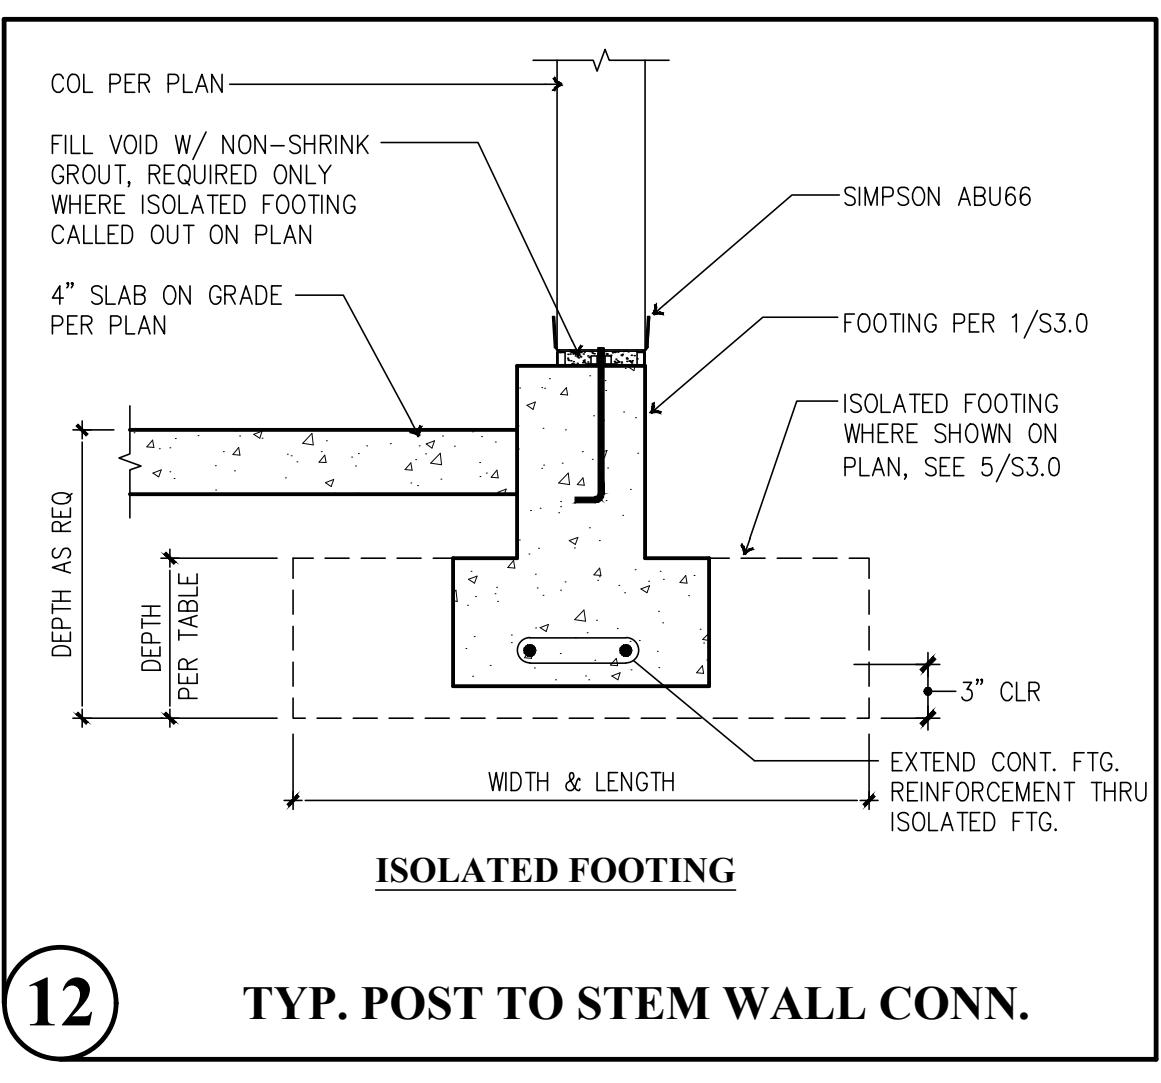


TYP. POST TO STEM WALL CONN.

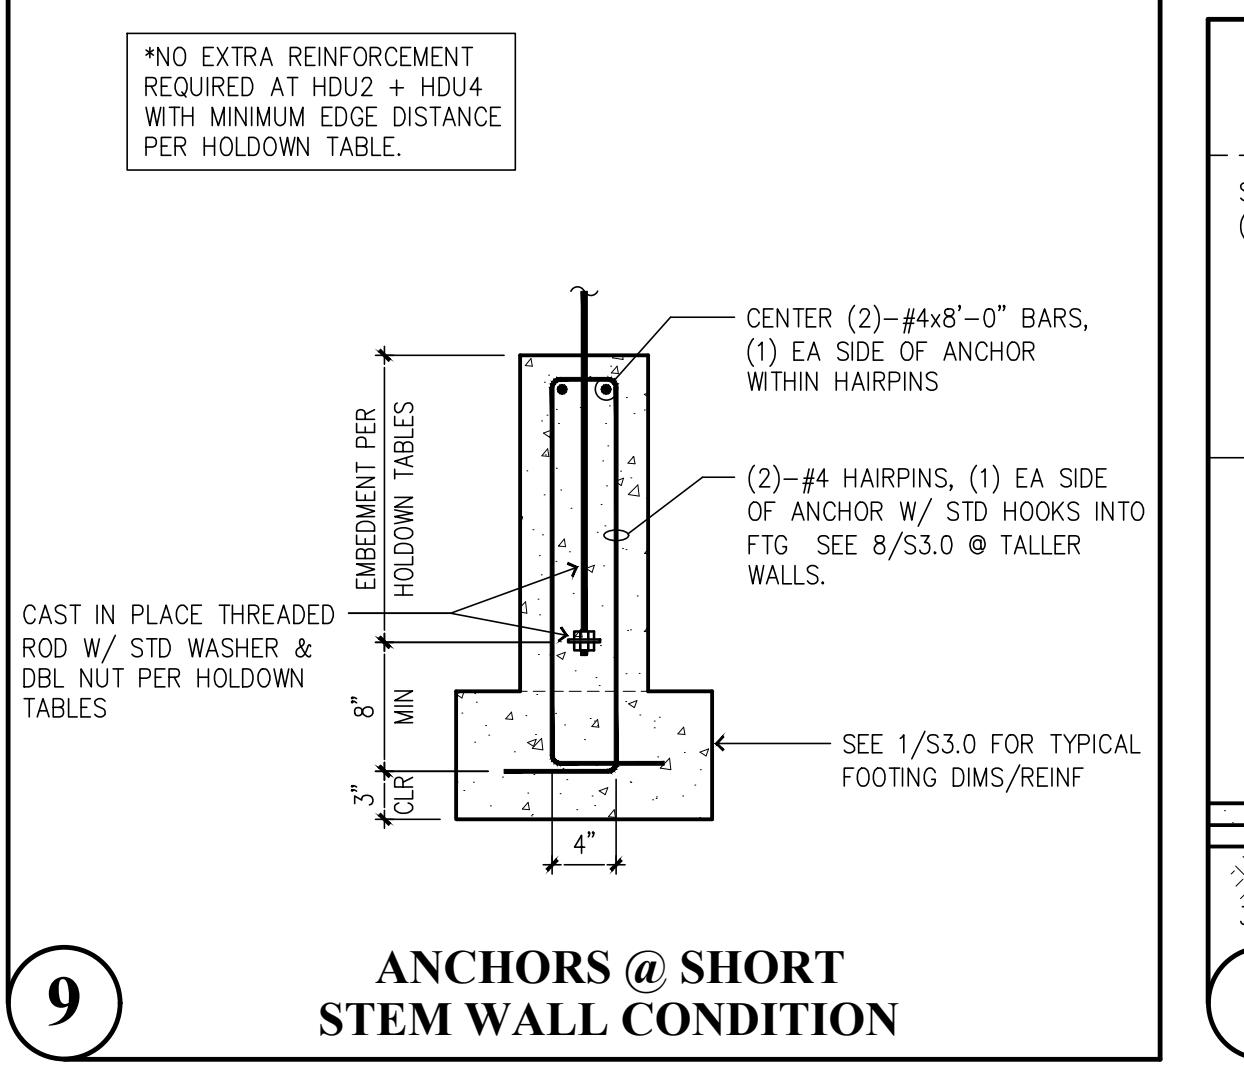


ANCHORS @ SHORT STEM WALL CONDITION

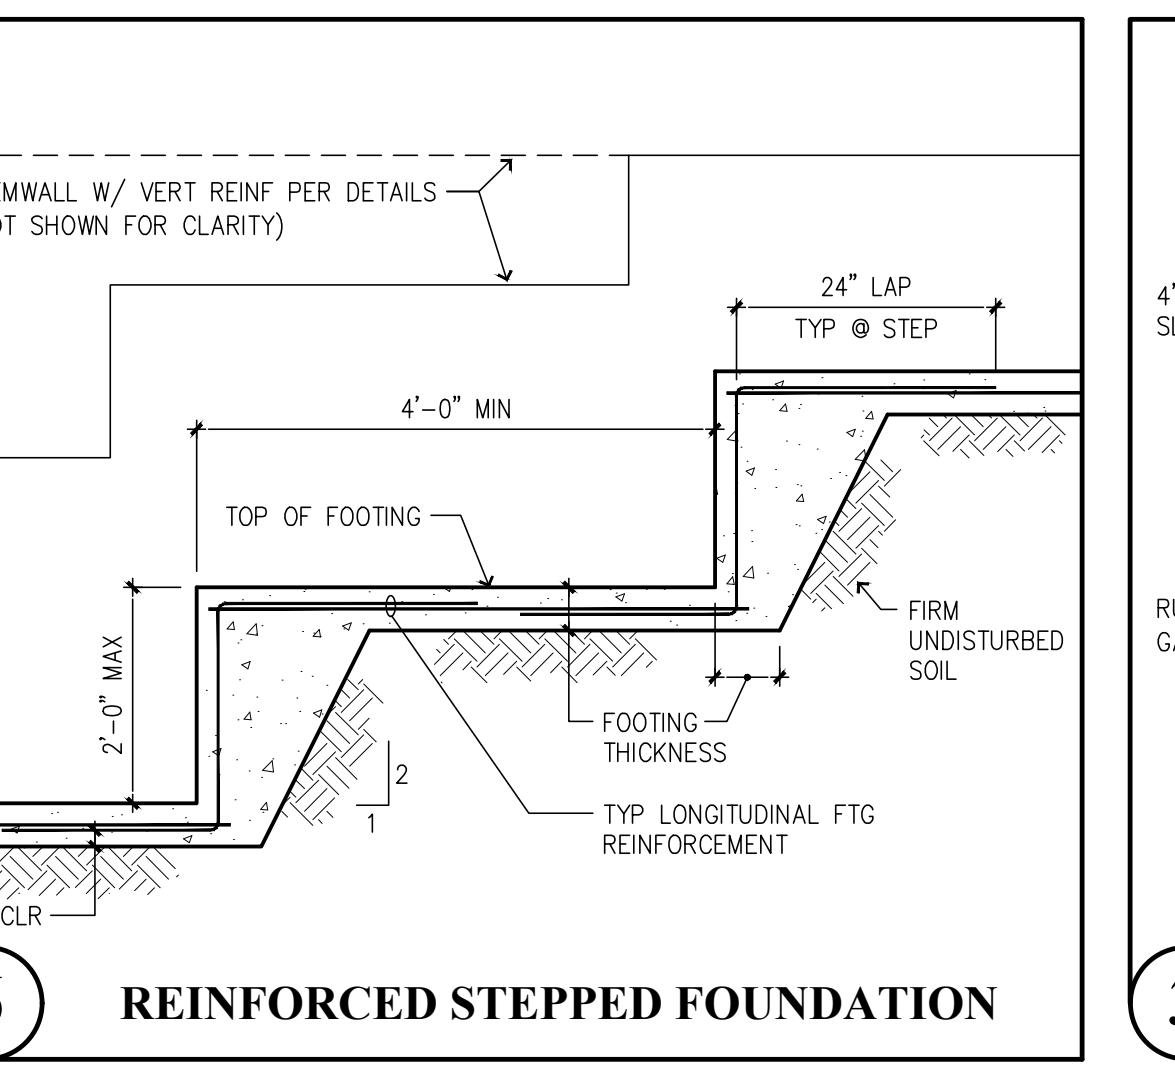


REINFORCED STEPPED FOUNDATION

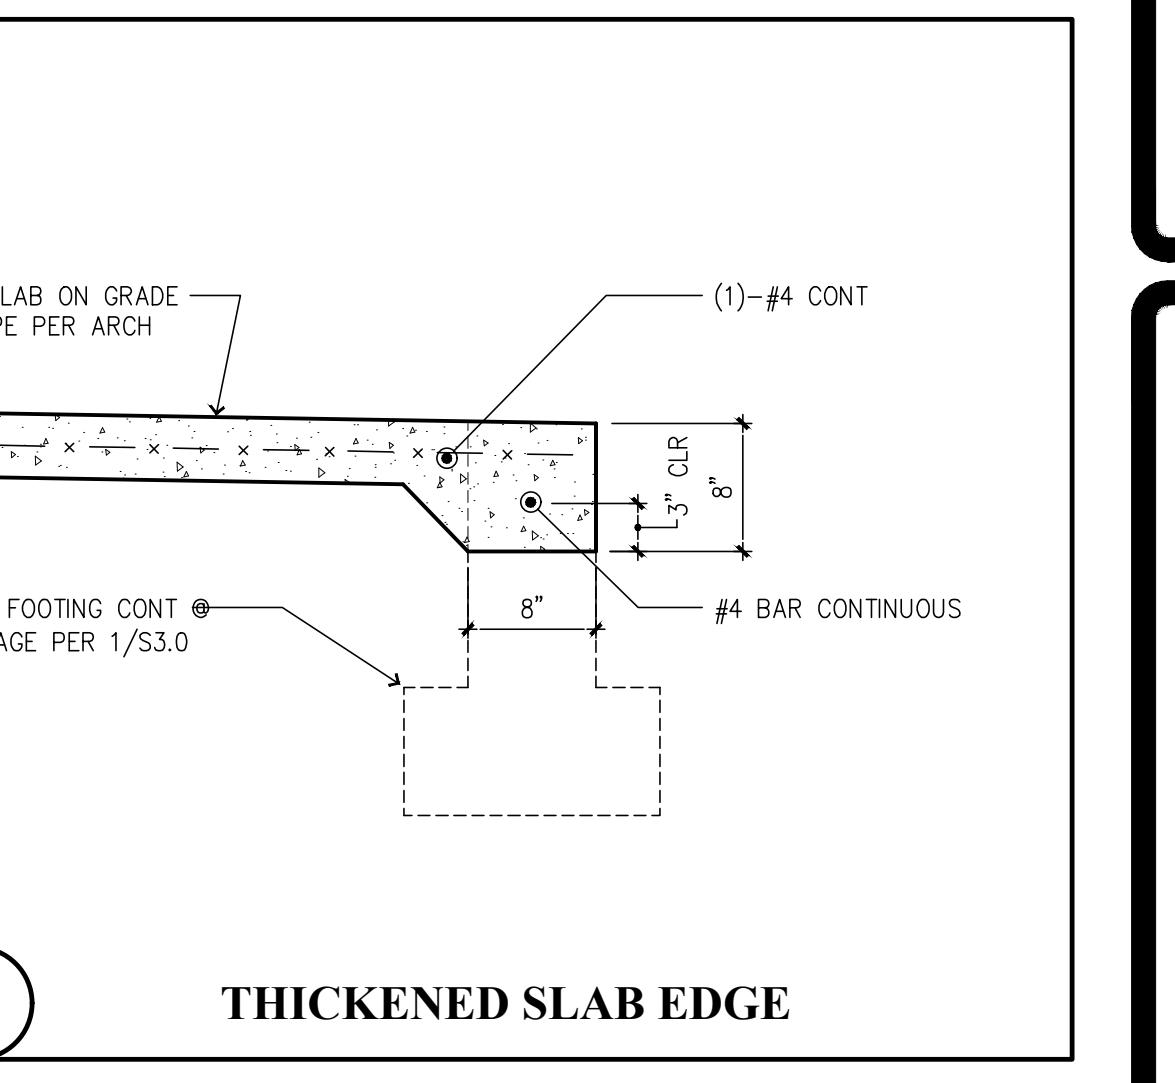


THICKENED SLAB EDGE

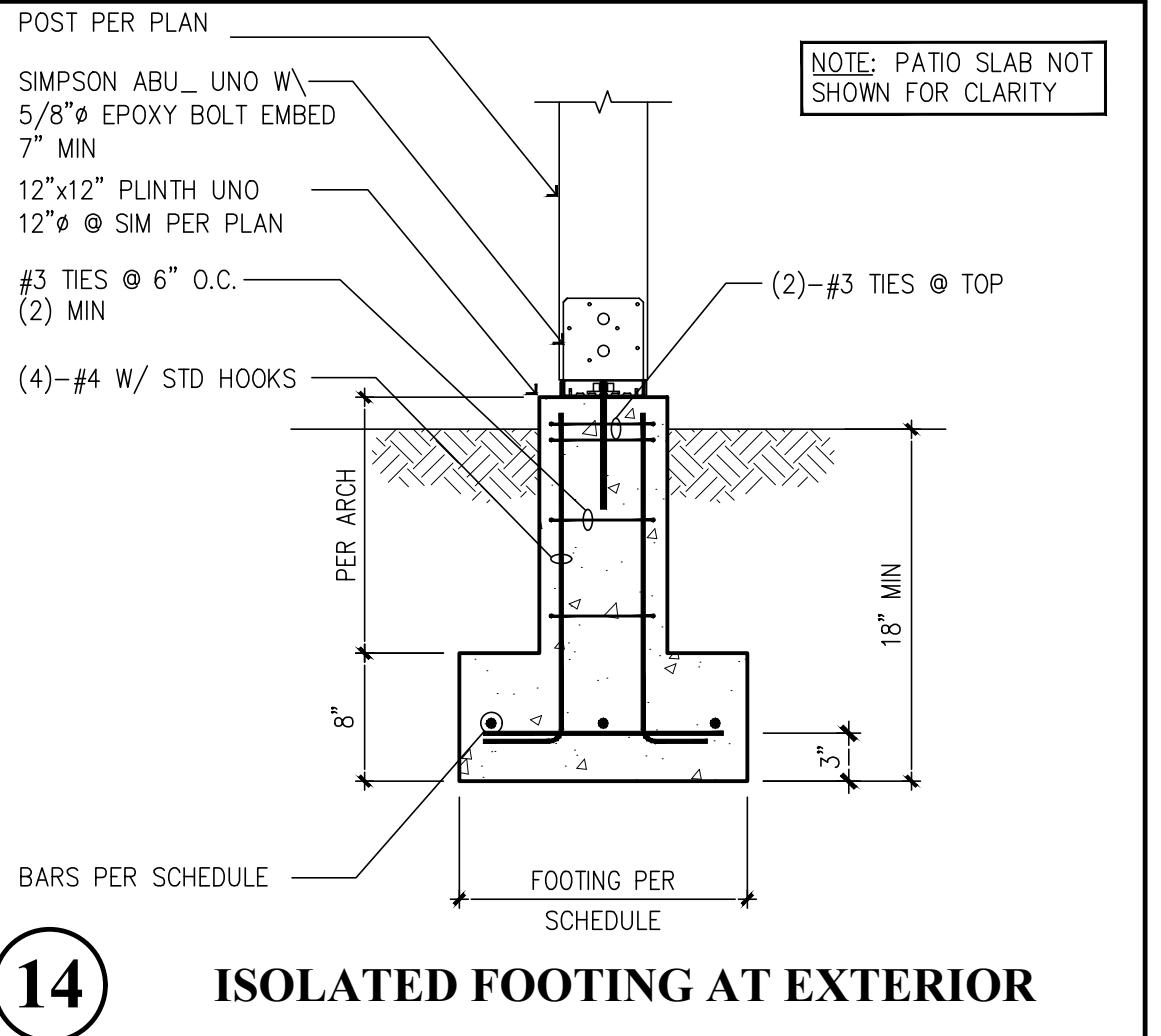


ISOLATED FOOTING AT EXTERIOR

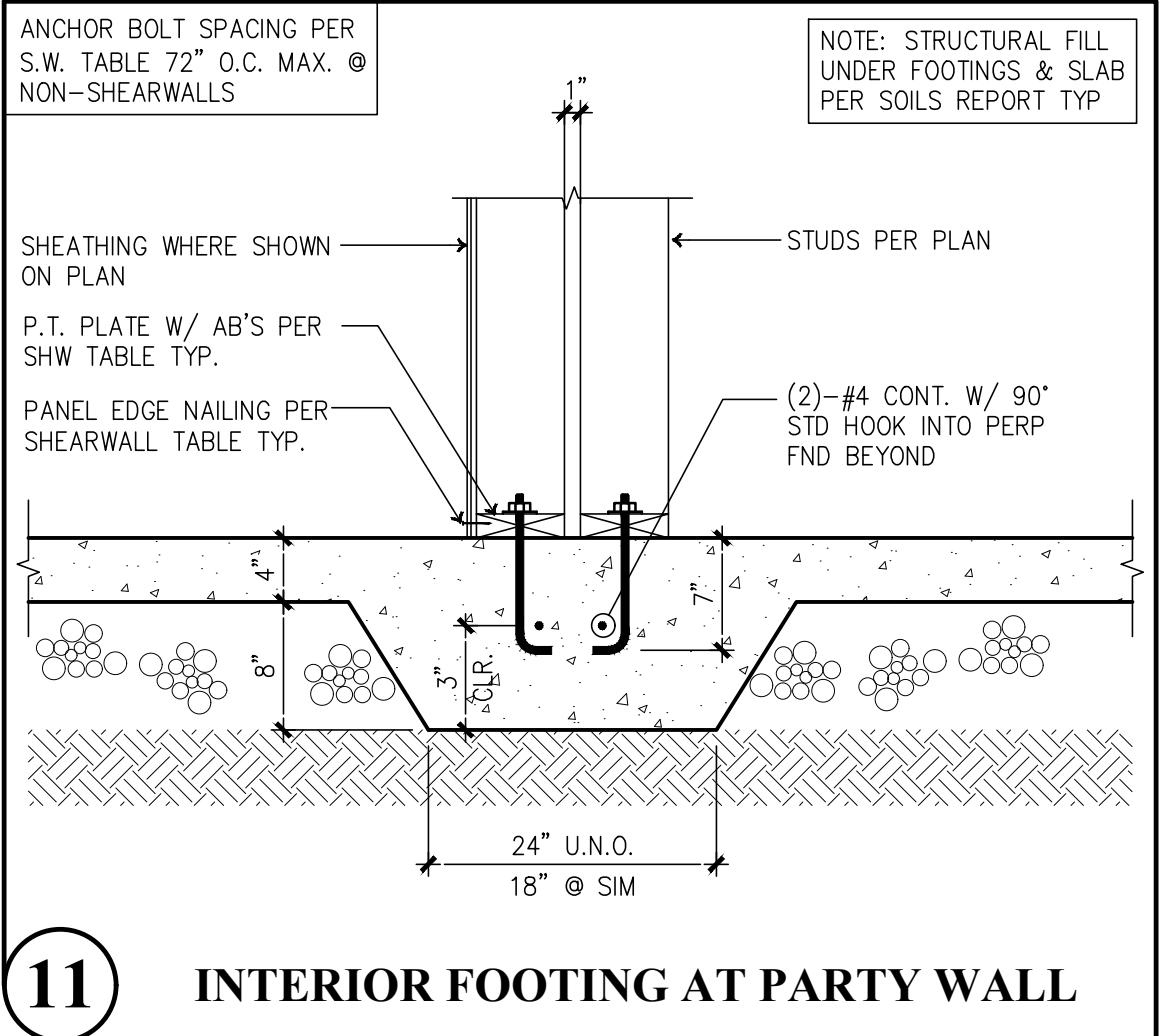


INTERIOR FOOTING AT PARTY WALL

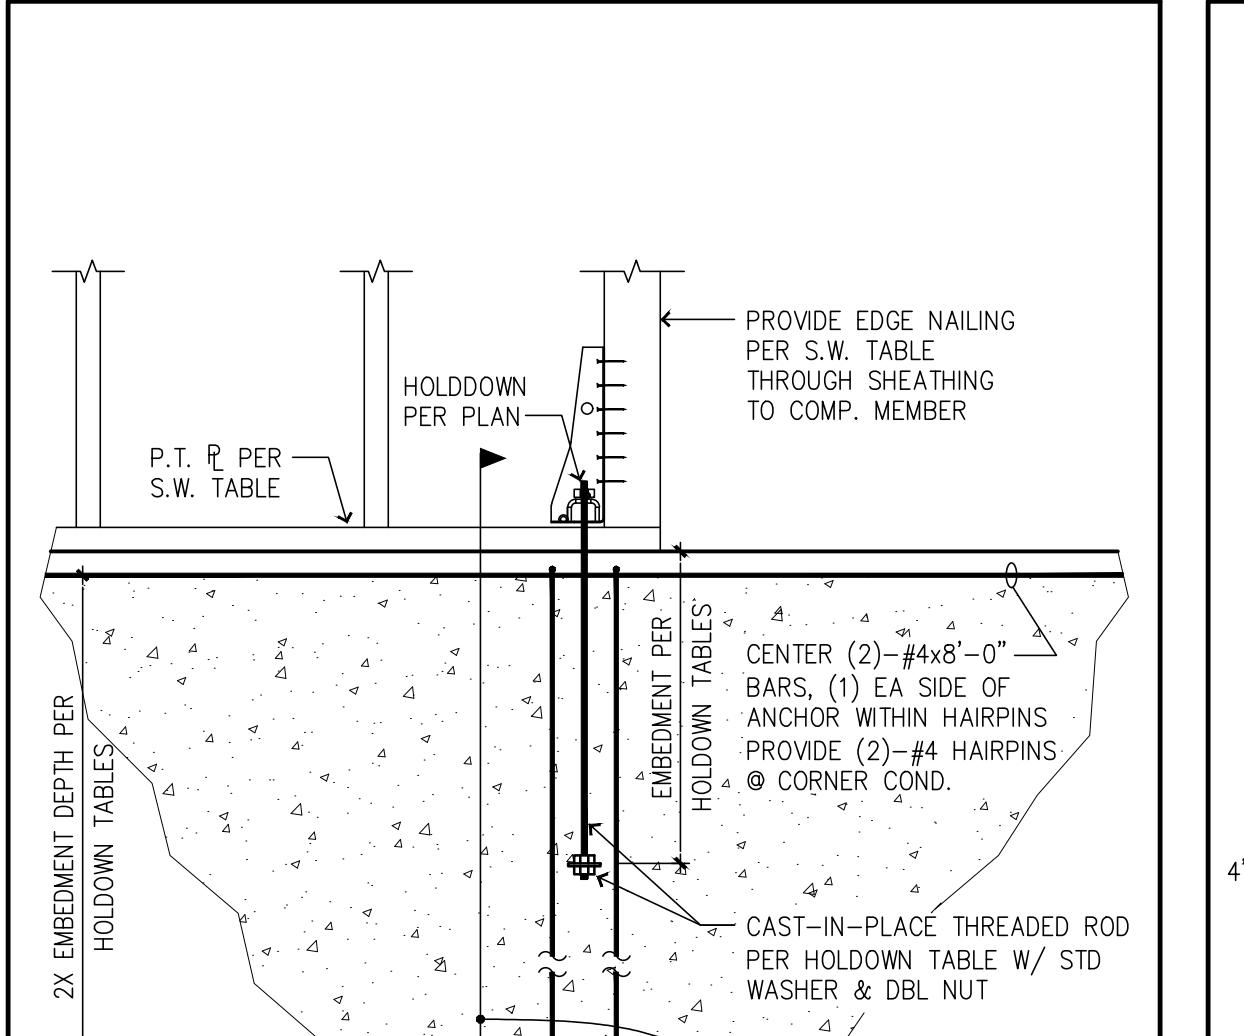


ANCHORS @ TALL STEMWALL CONDITION

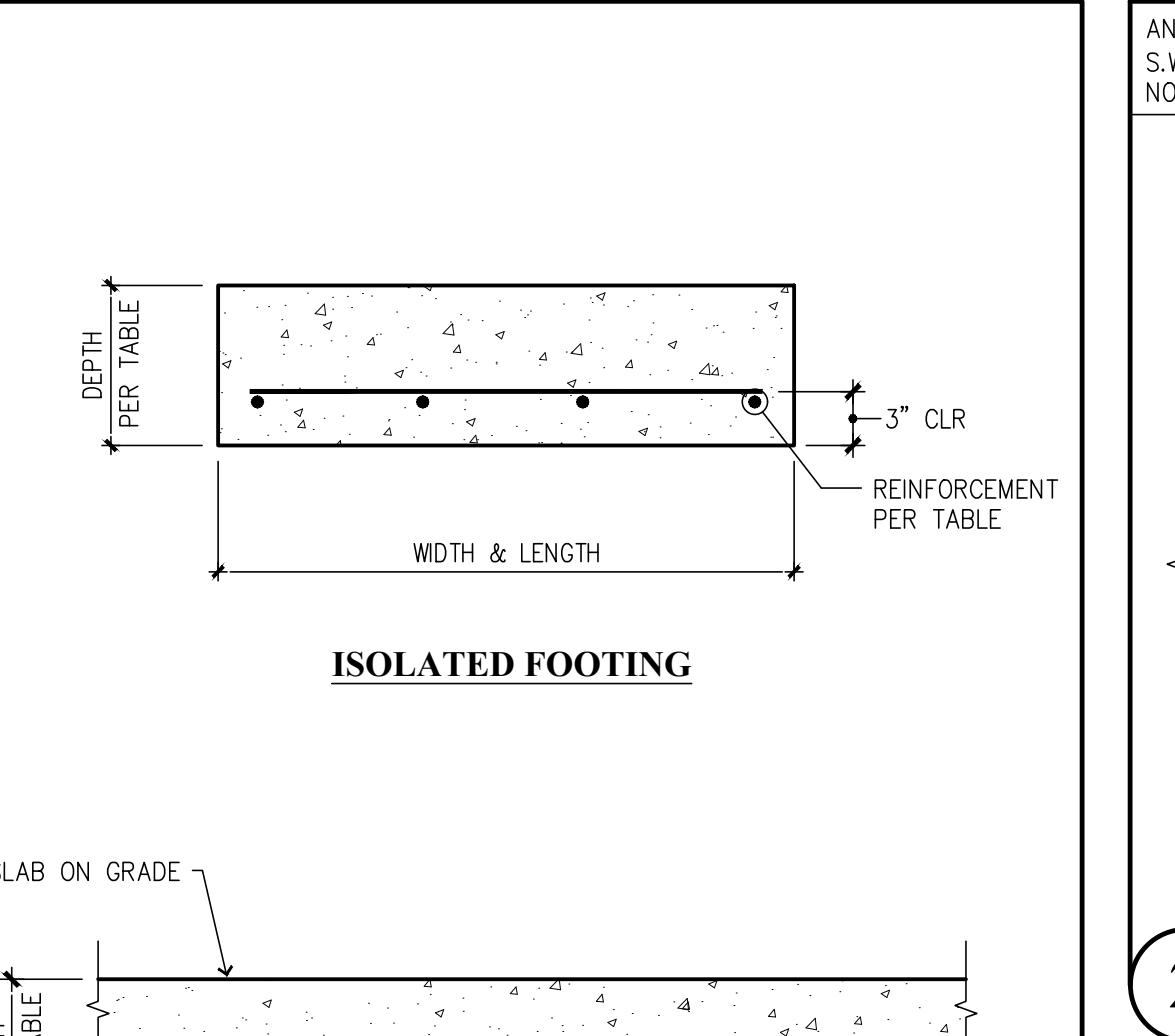



ISOLATED FOOTING

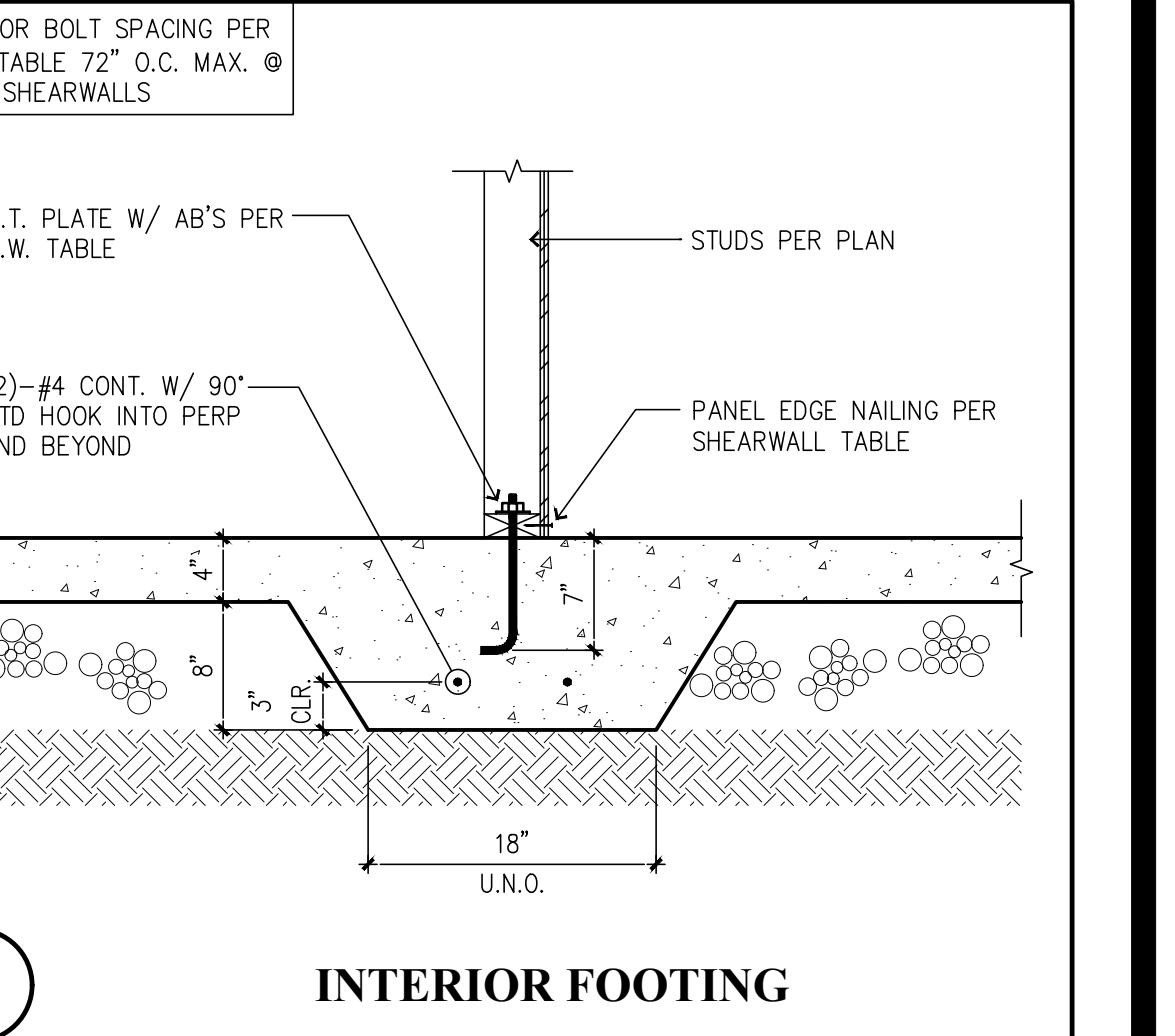


INTERIOR FOOTING

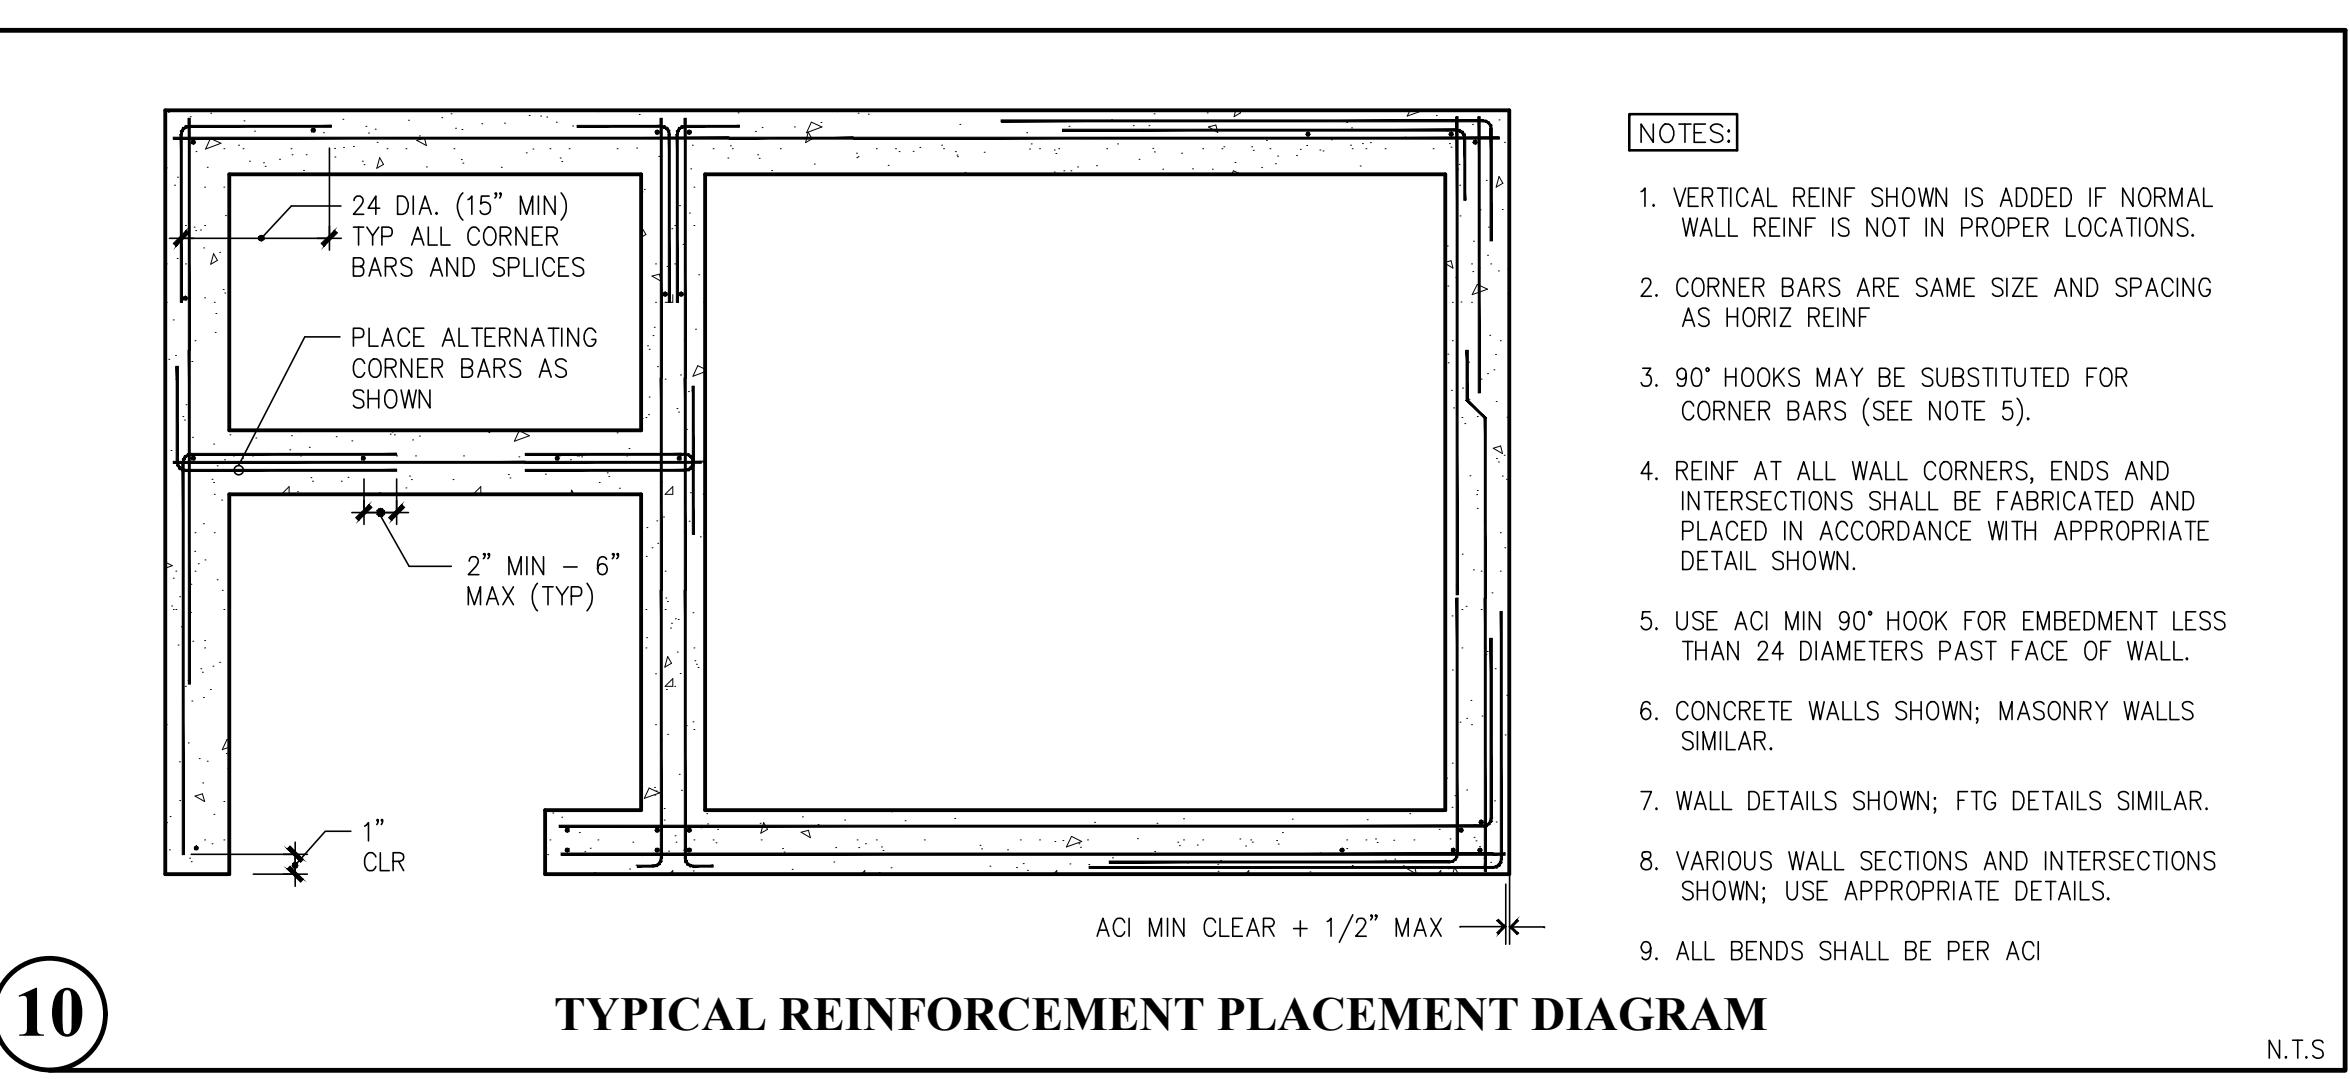


TYPICAL REINFORCEMENT PLACEMENT DIAGRAM

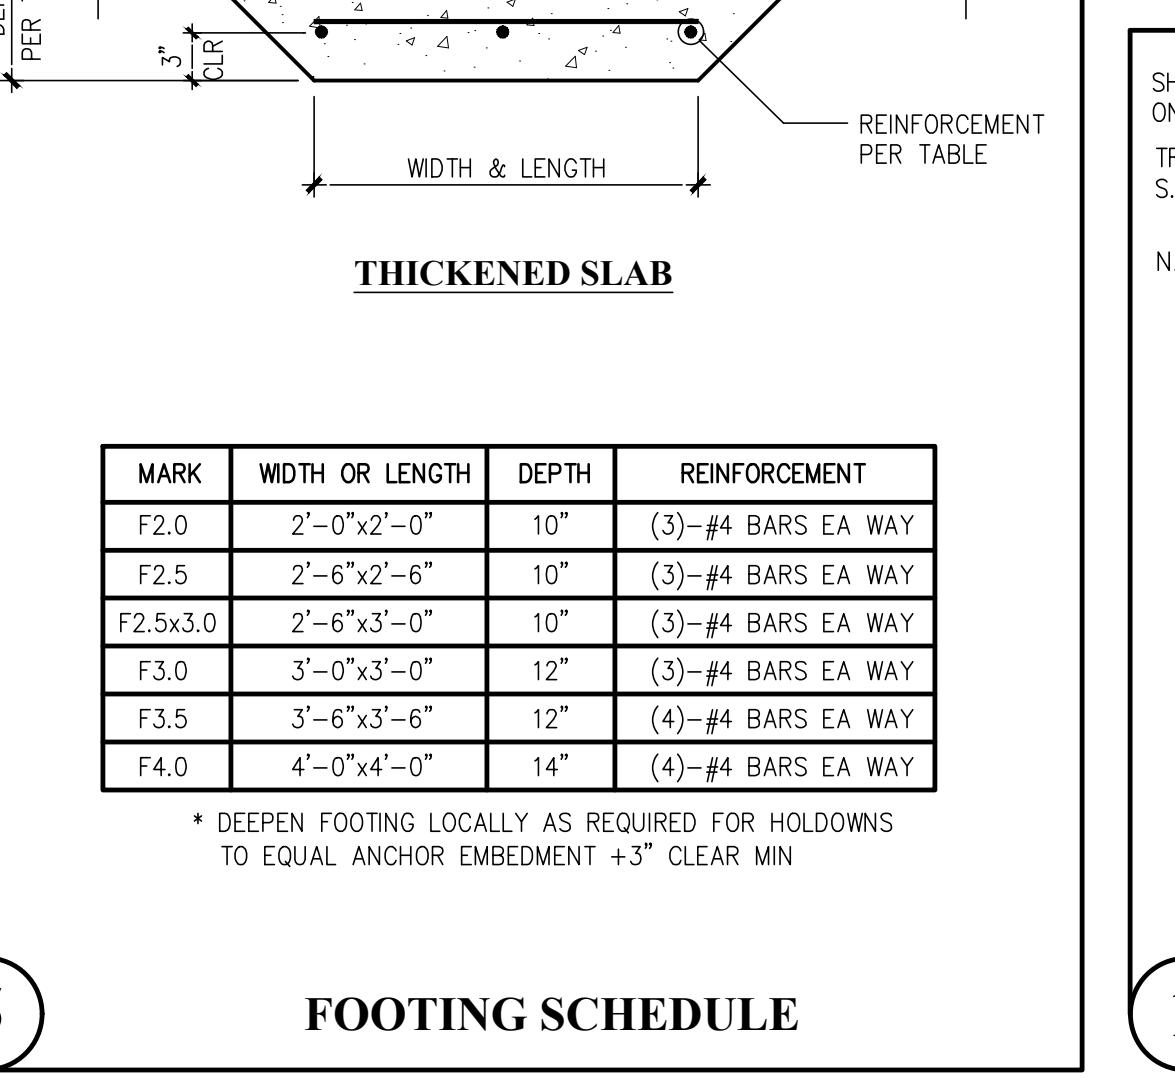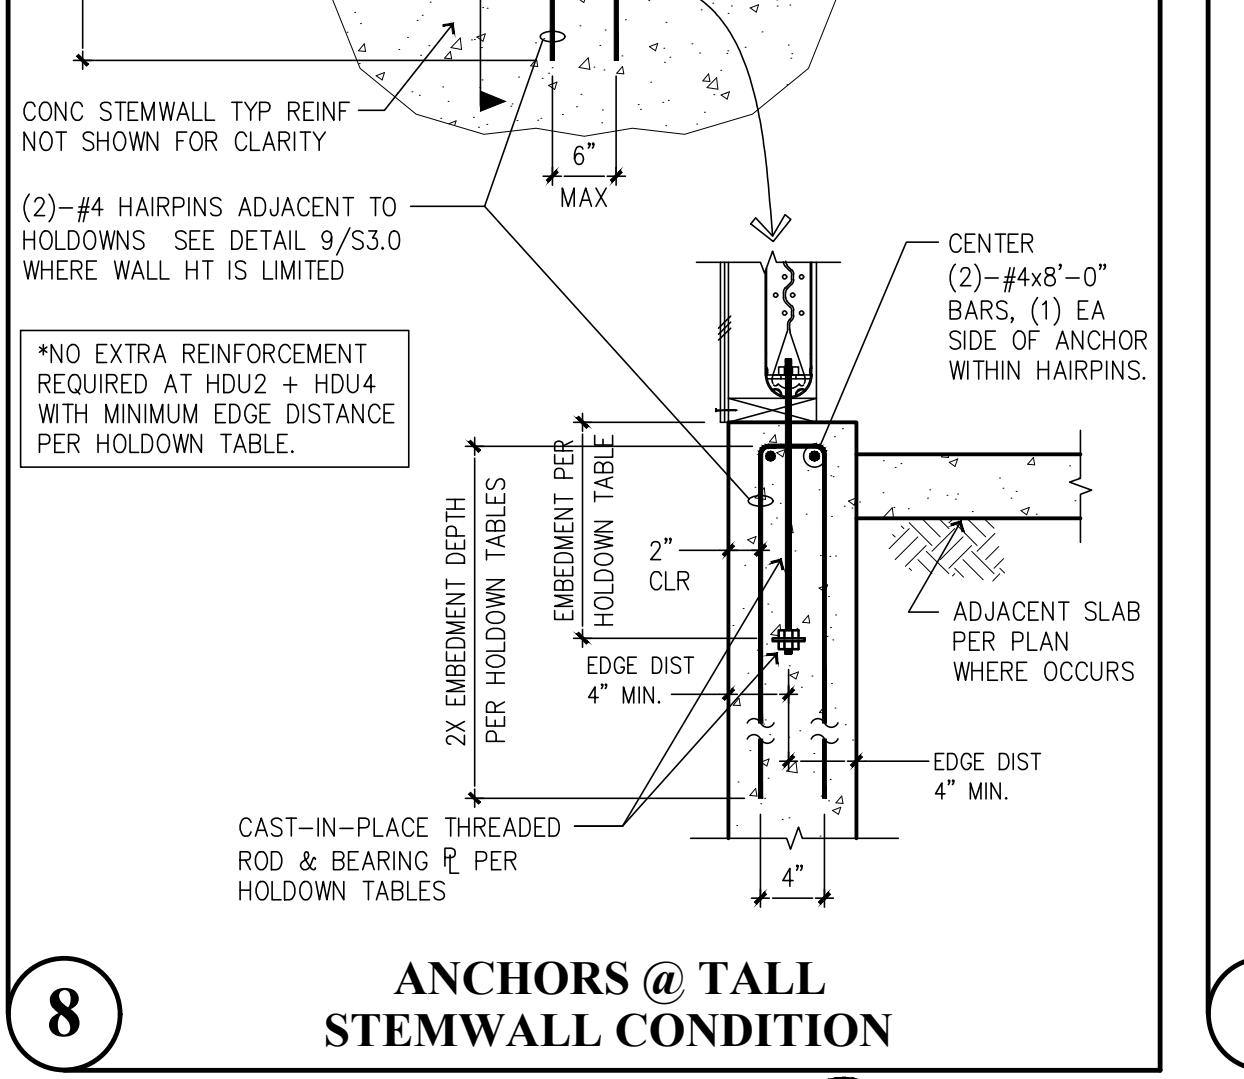


FOOTING SCHEDULE

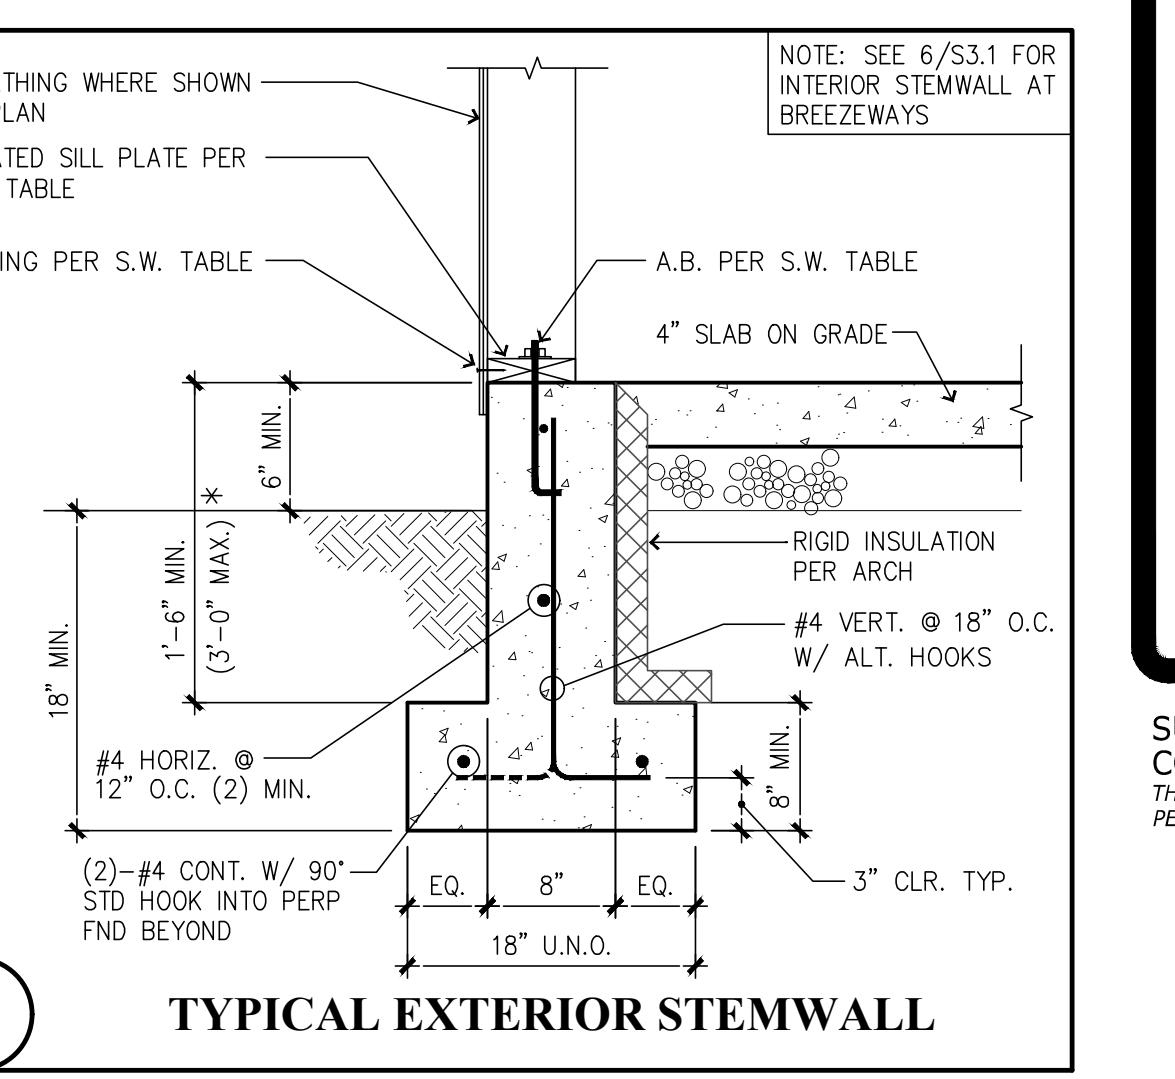


TYPICAL EXTERIOR STEMWALL

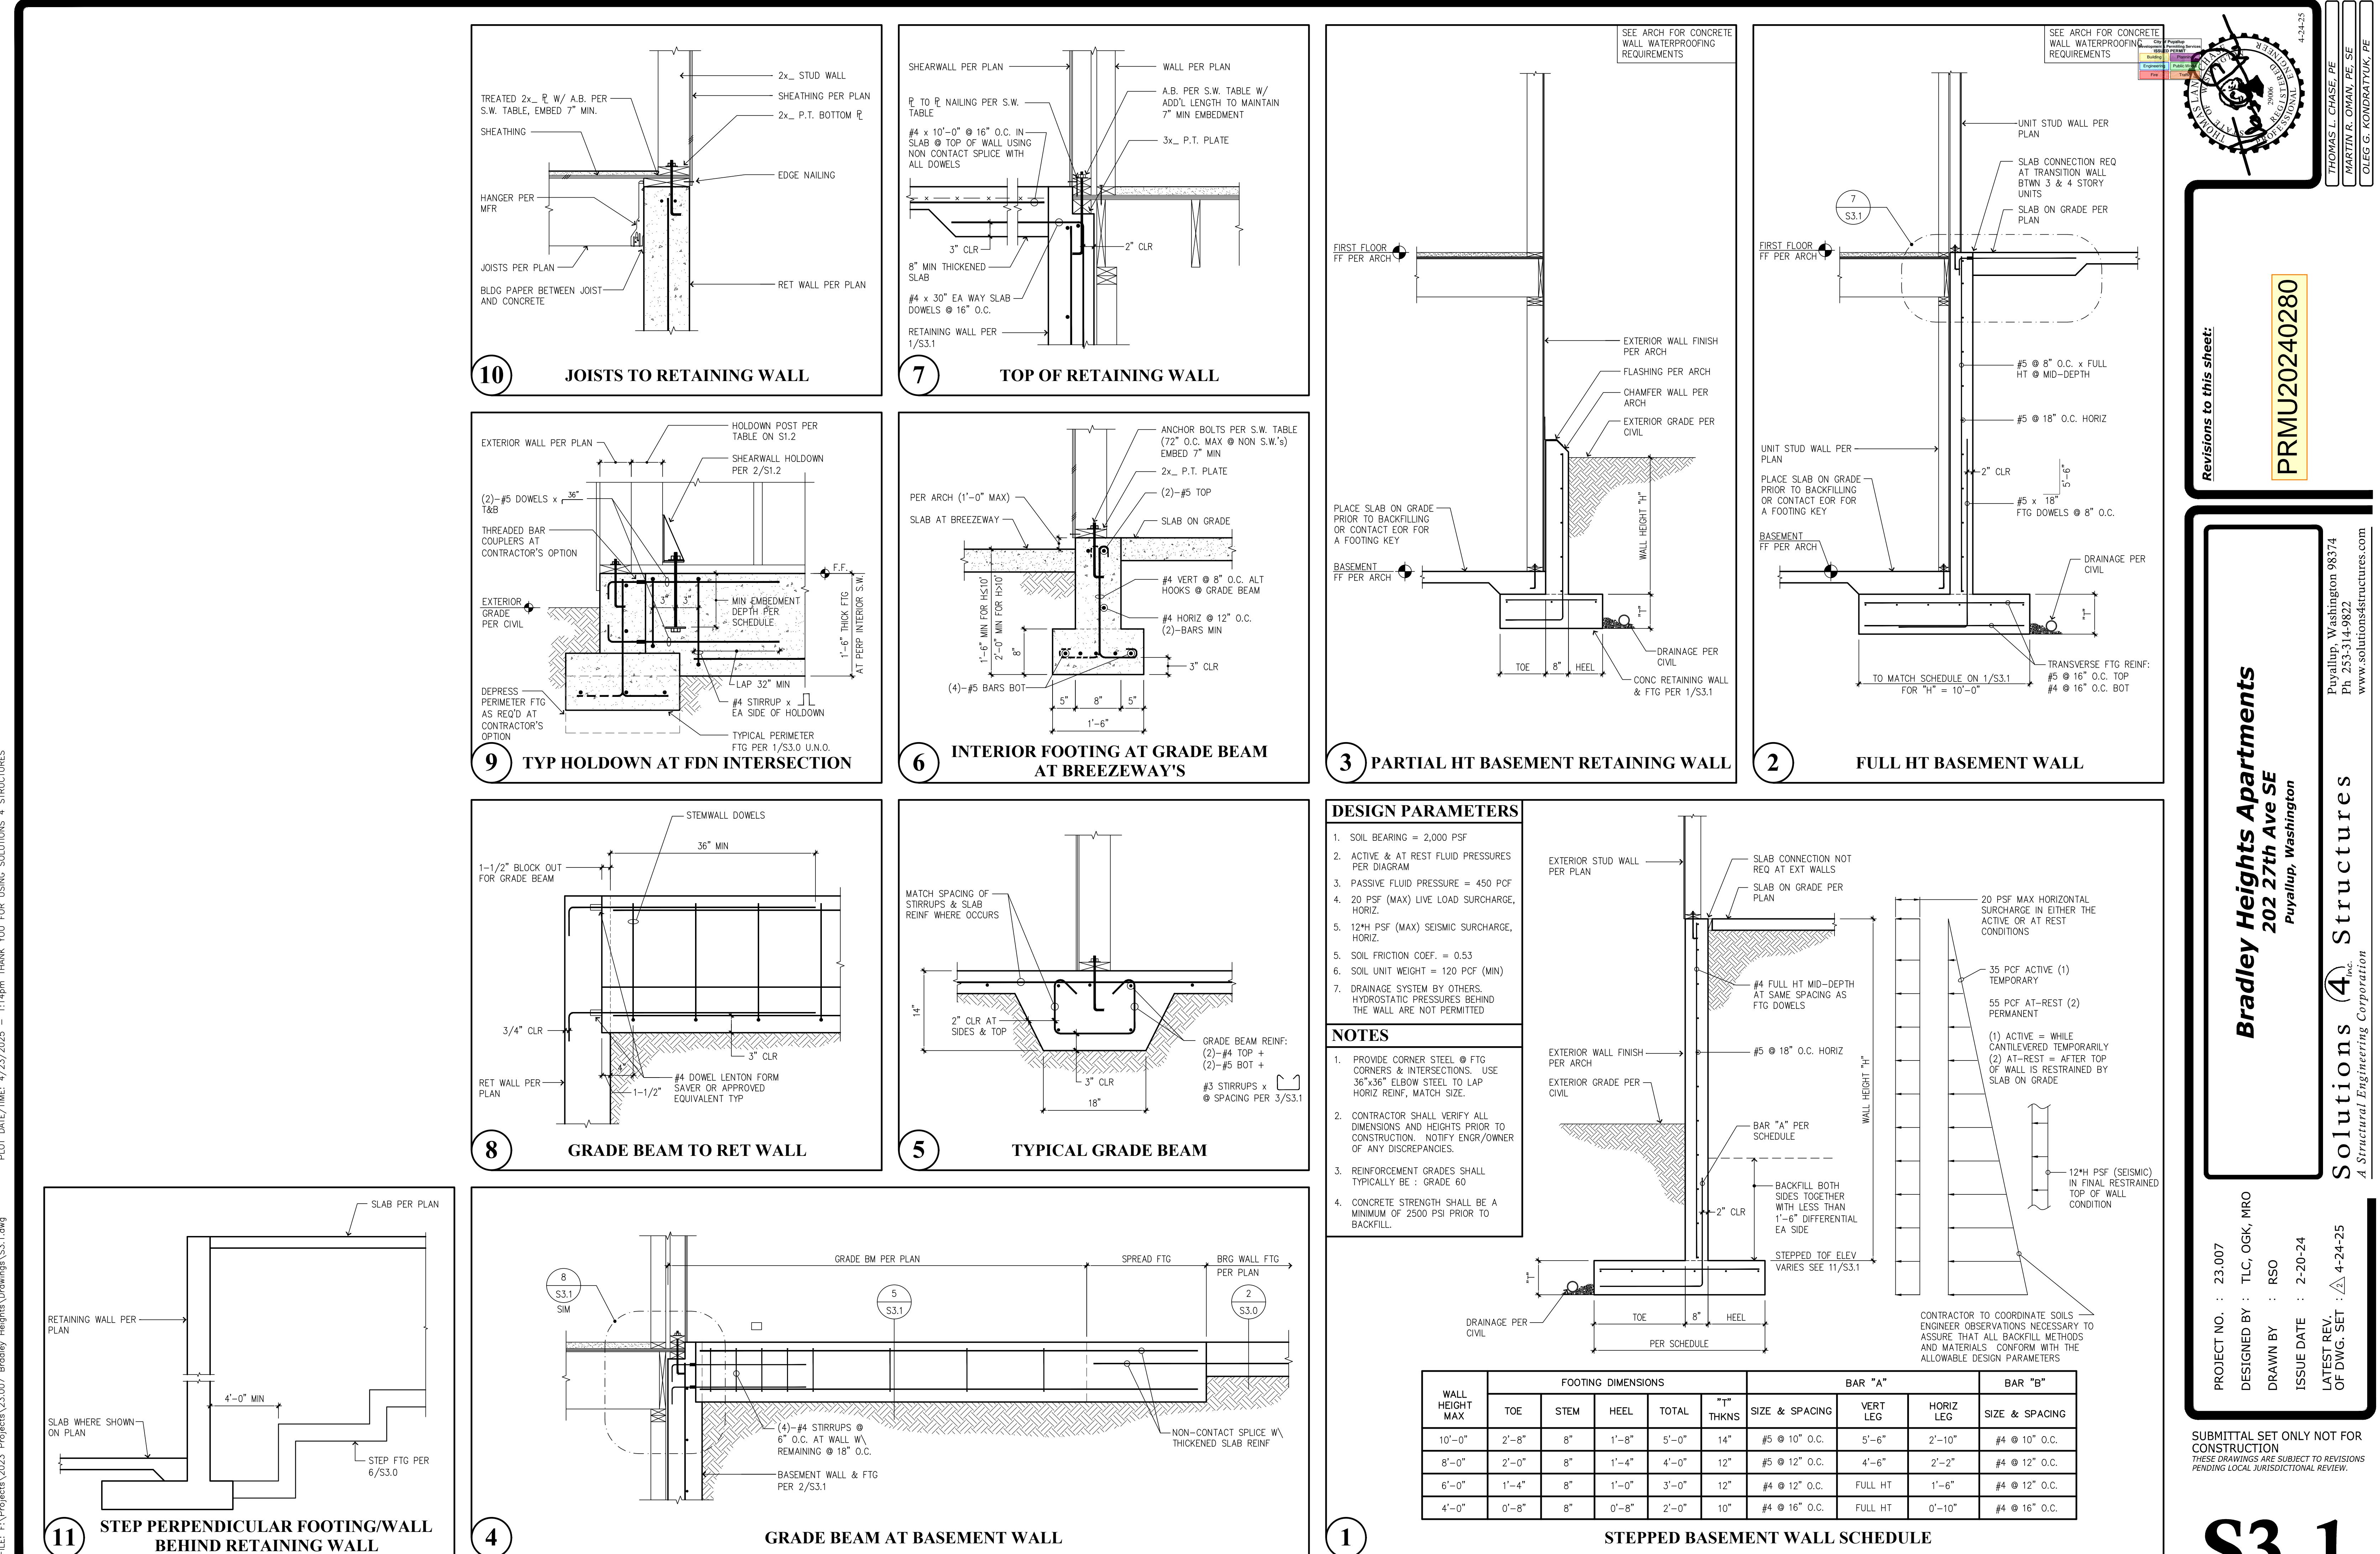


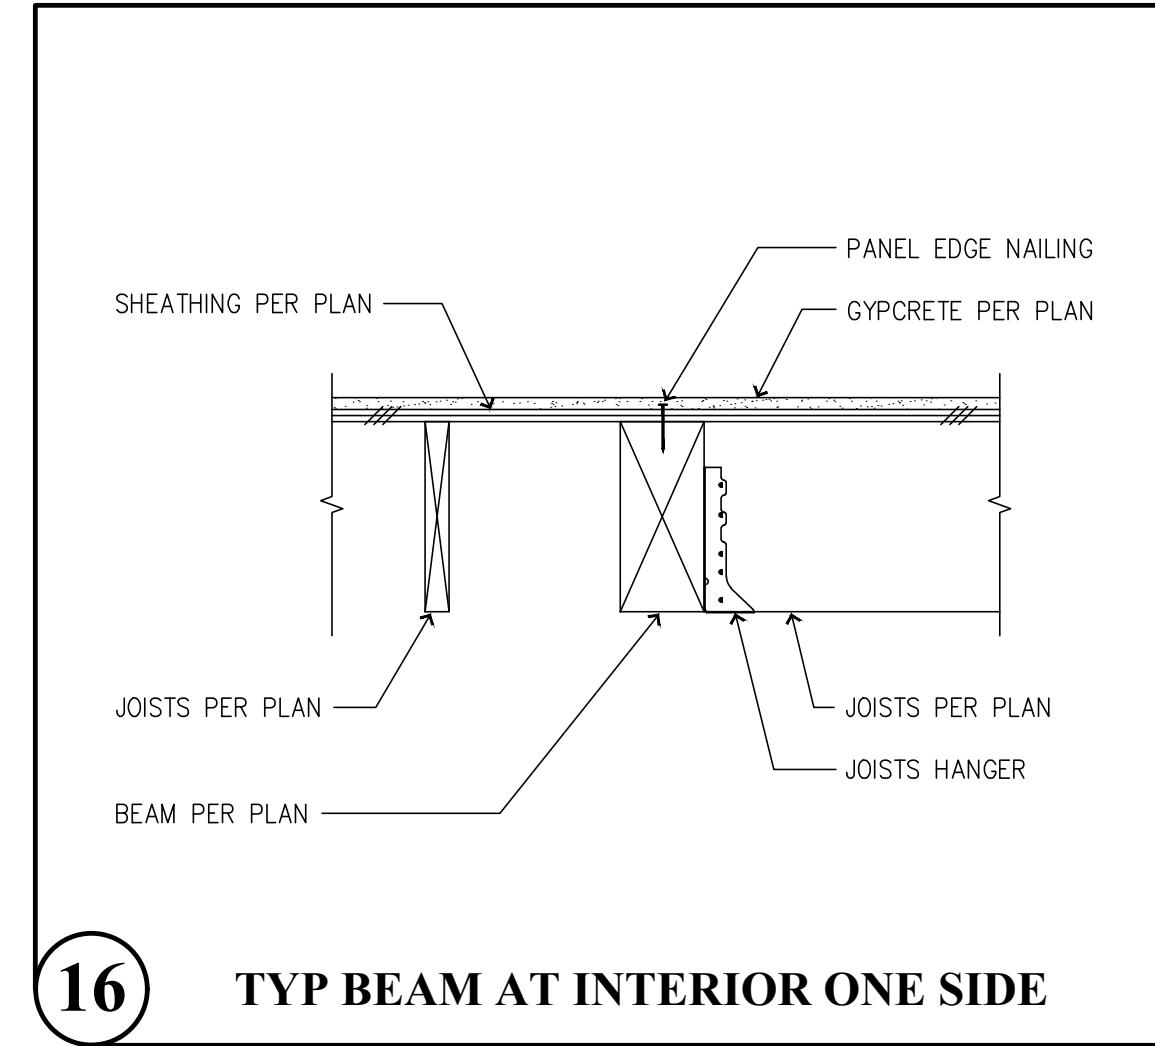


16 TYP BEAM AT INTERIOR ONE SIDE

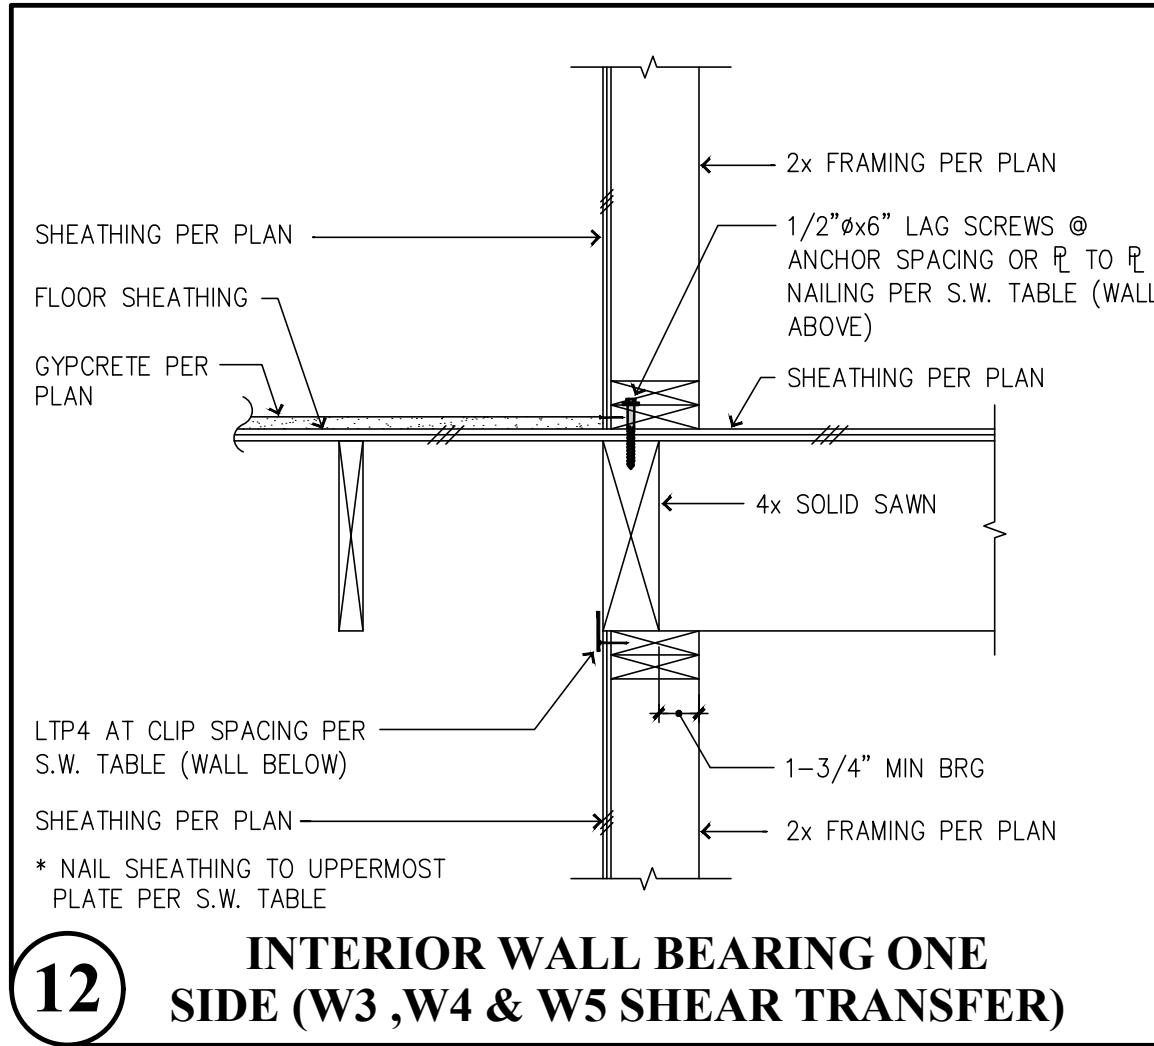


12 INTERIOR WALL BEARING ONE SIDE (W3, W4 & W5 SHEAR TRANSFER)

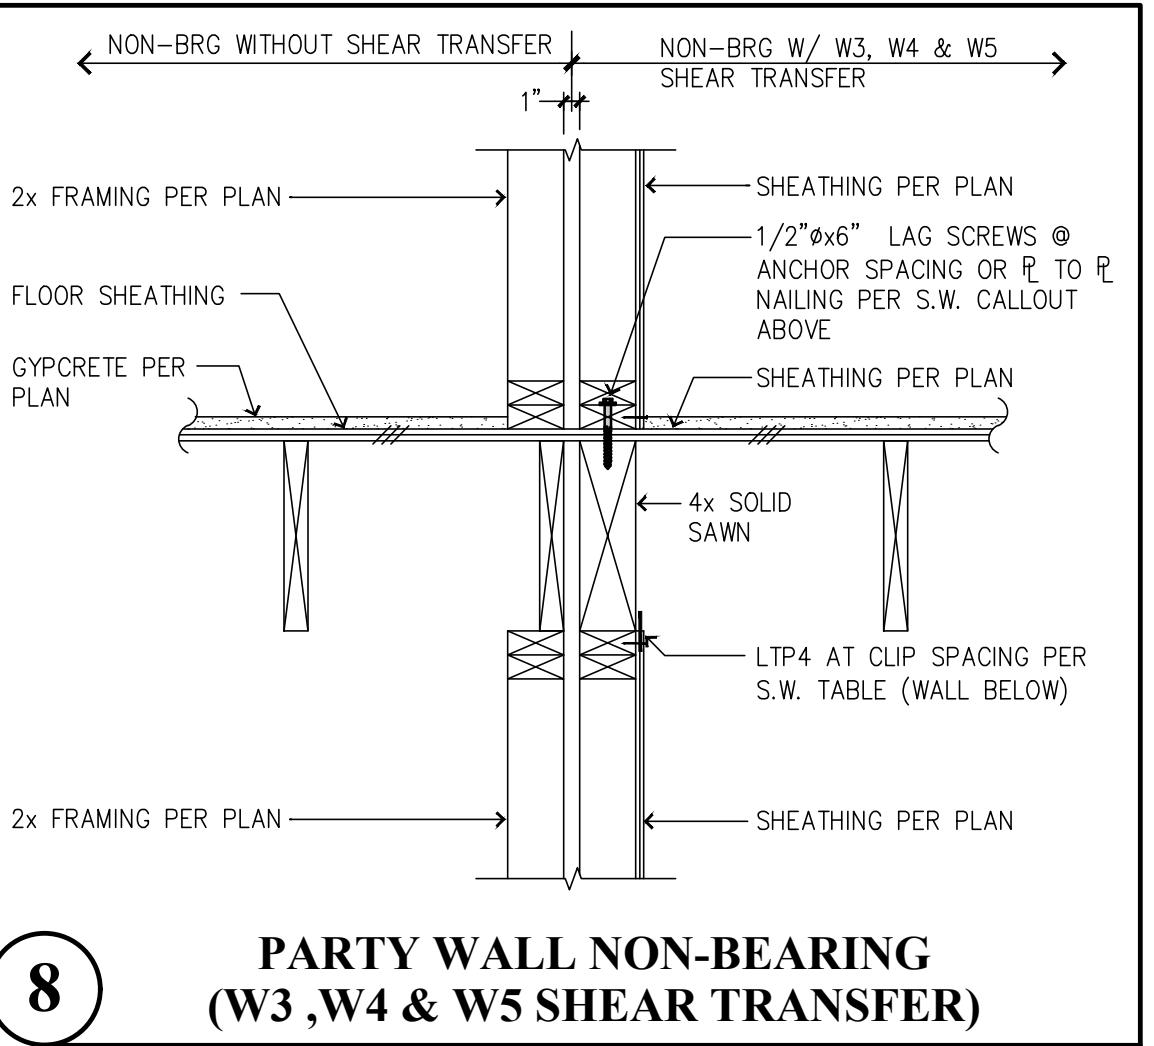


8 PARTY WALL NON-BEARING (W3, W4 & W5 SHEAR TRANSFER)

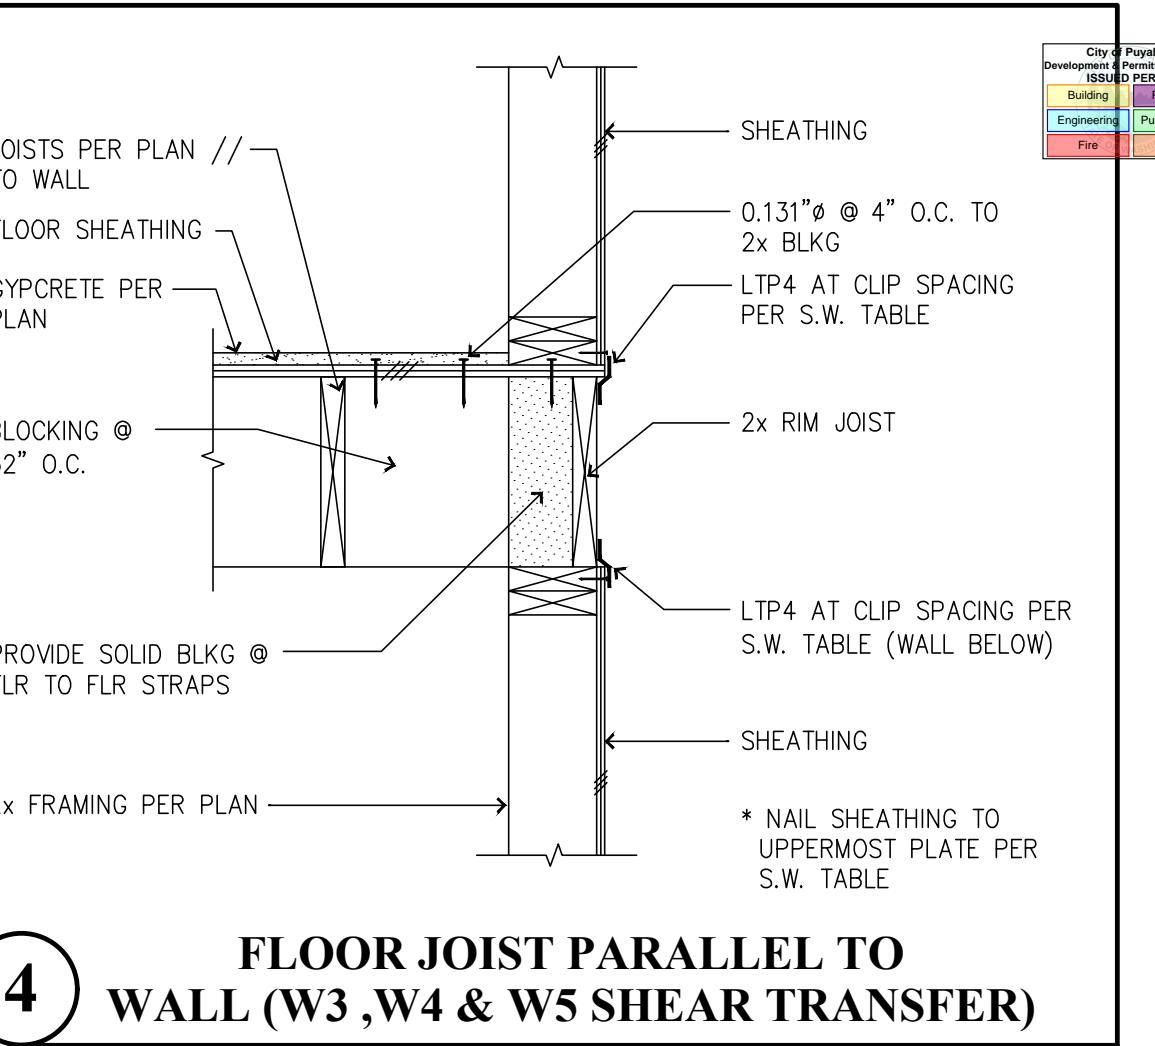


4 FLOOR JOIST PARALLEL TO WALL (W3, W4 & W5 SHEAR TRANSFER)

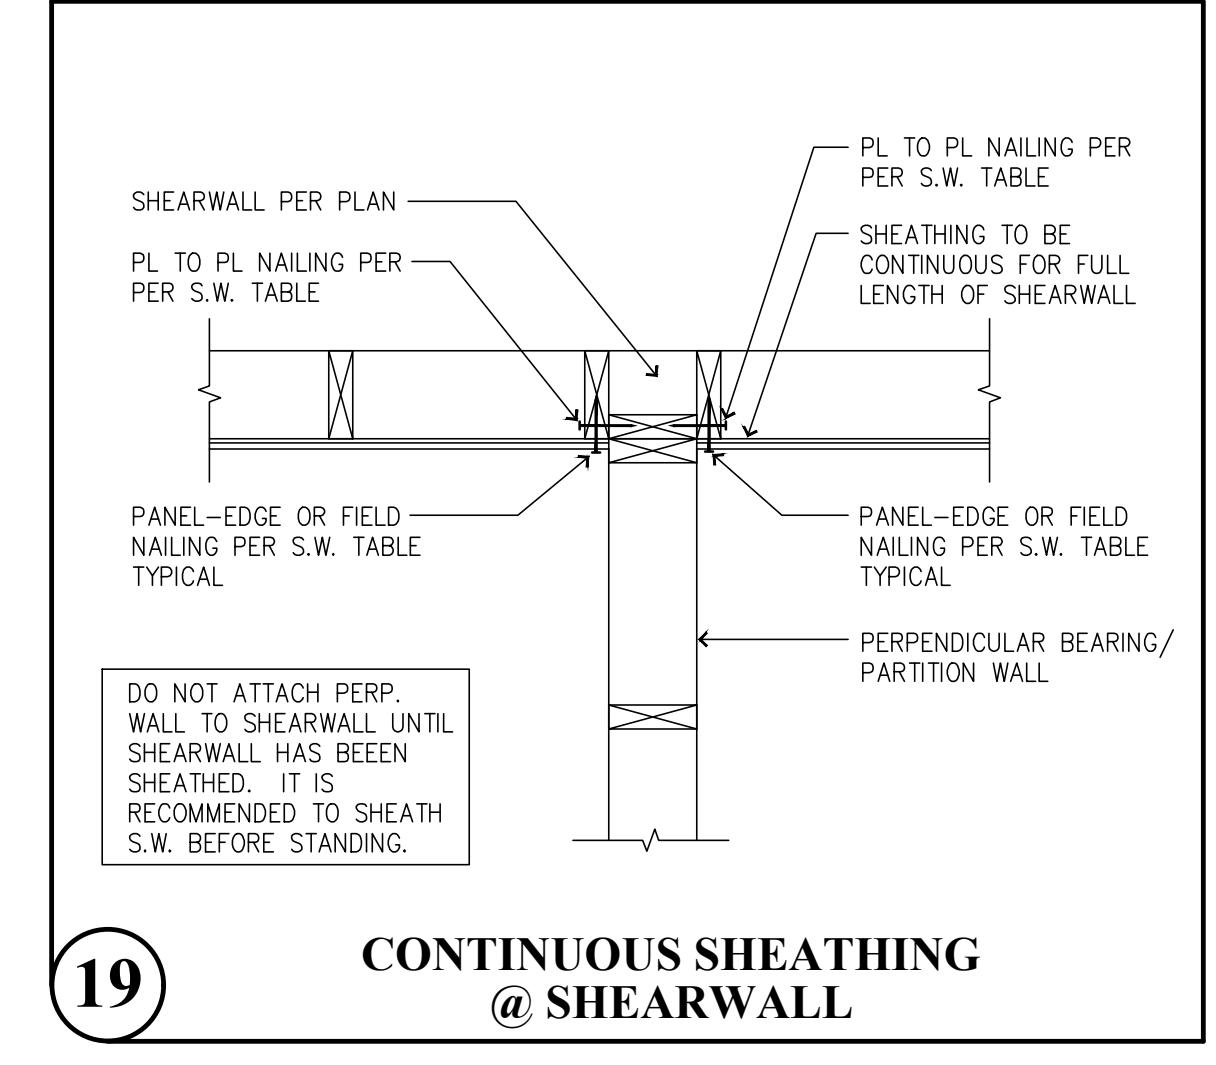


19 CONTINUOUS SHEATHING @ SHEARWALL

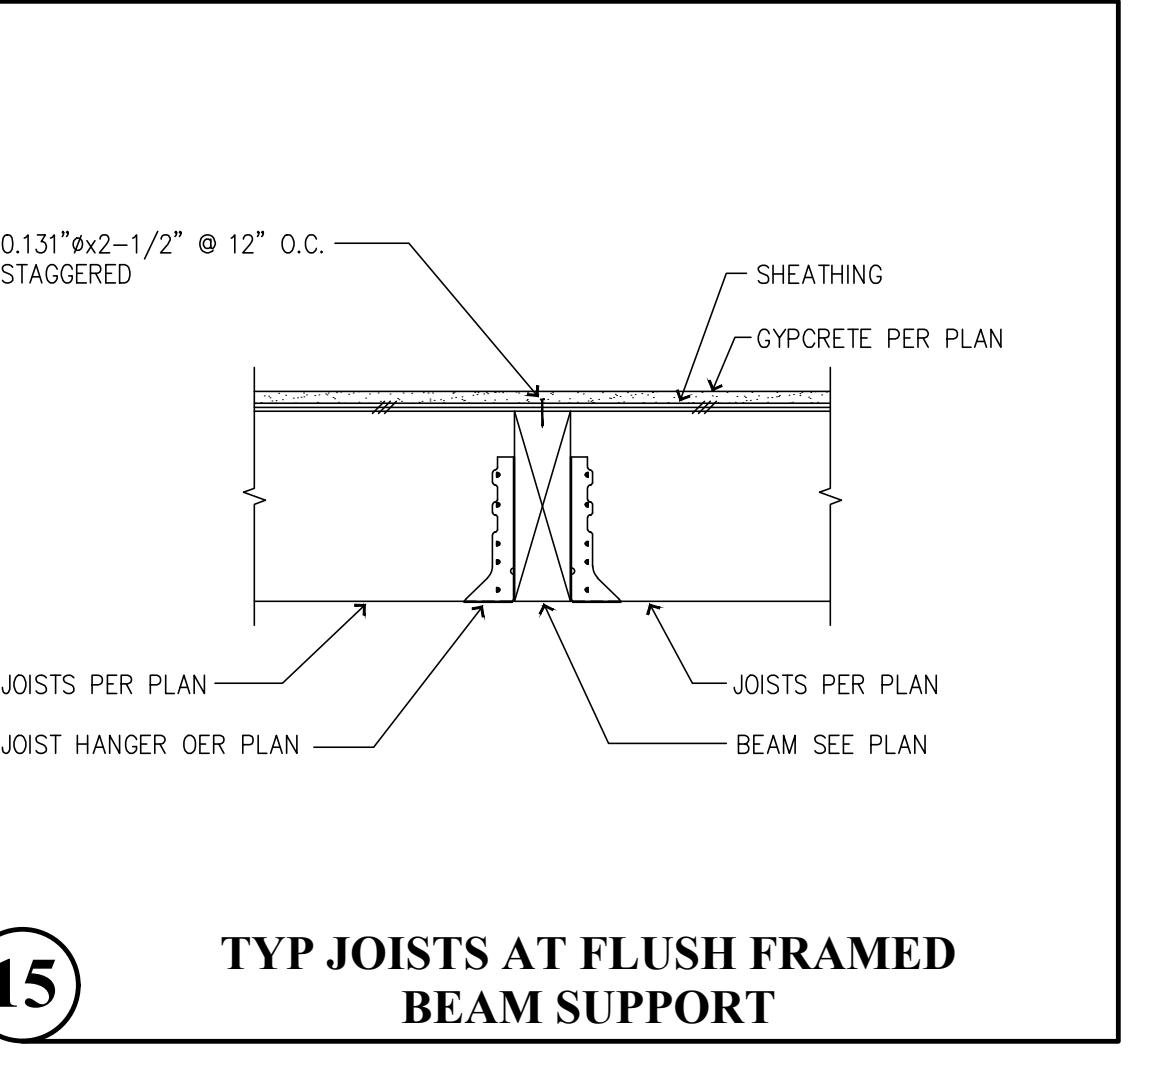


15 TYP JOISTS AT FLUSH FRAMED BEAM SUPPORT

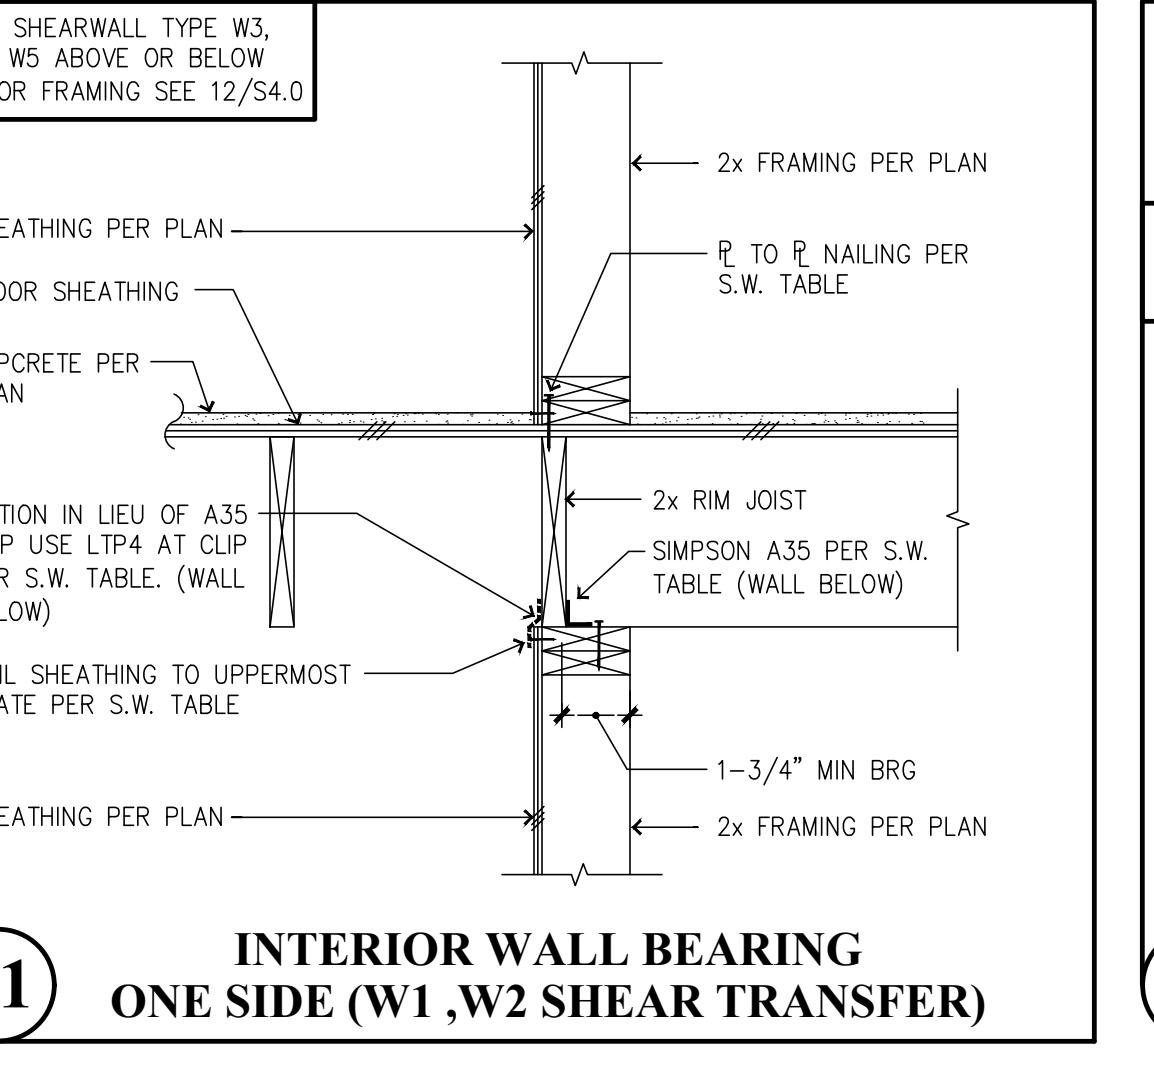


11 INTERIOR WALL BEARING ONE SIDE (W1, W2 SHEAR TRANSFER)

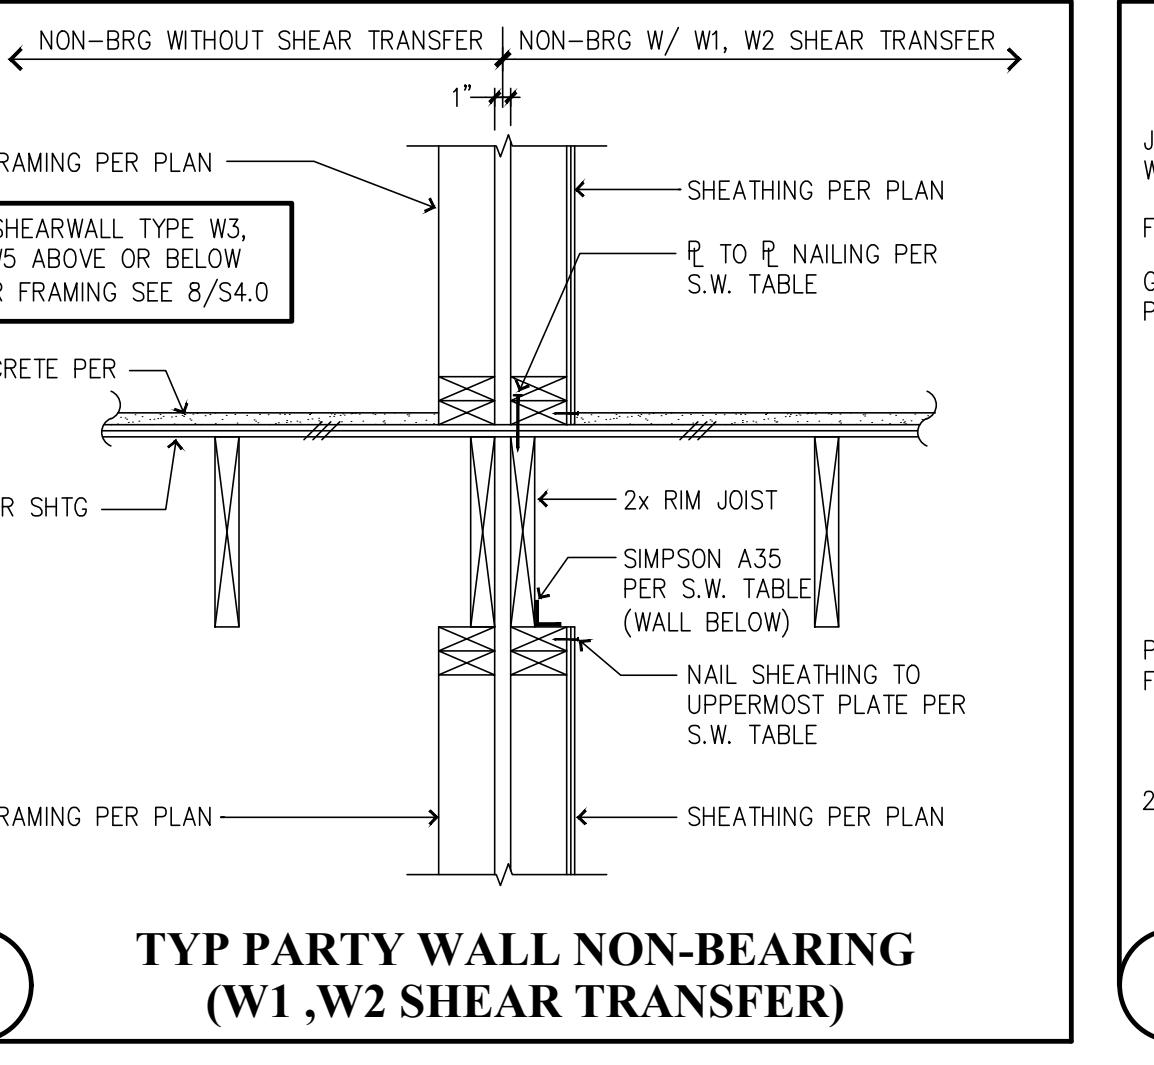


7 TYP PARTY WALL NON-BEARING (W1, W2 SHEAR TRANSFER)

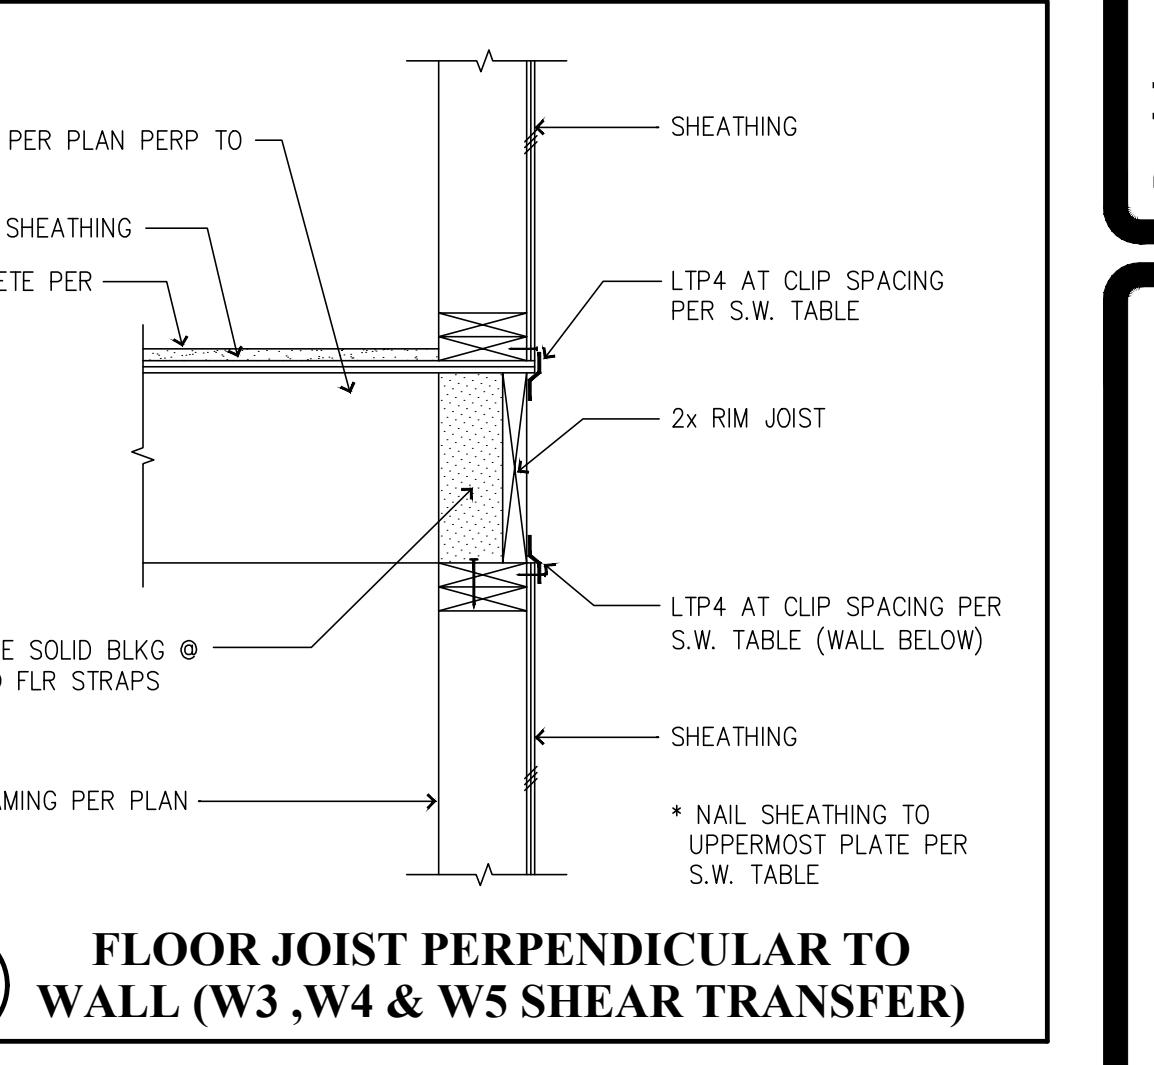


3 FLOOR JOIST PERPENDICULAR TO WALL (W3, W4 & W5 SHEAR TRANSFER)

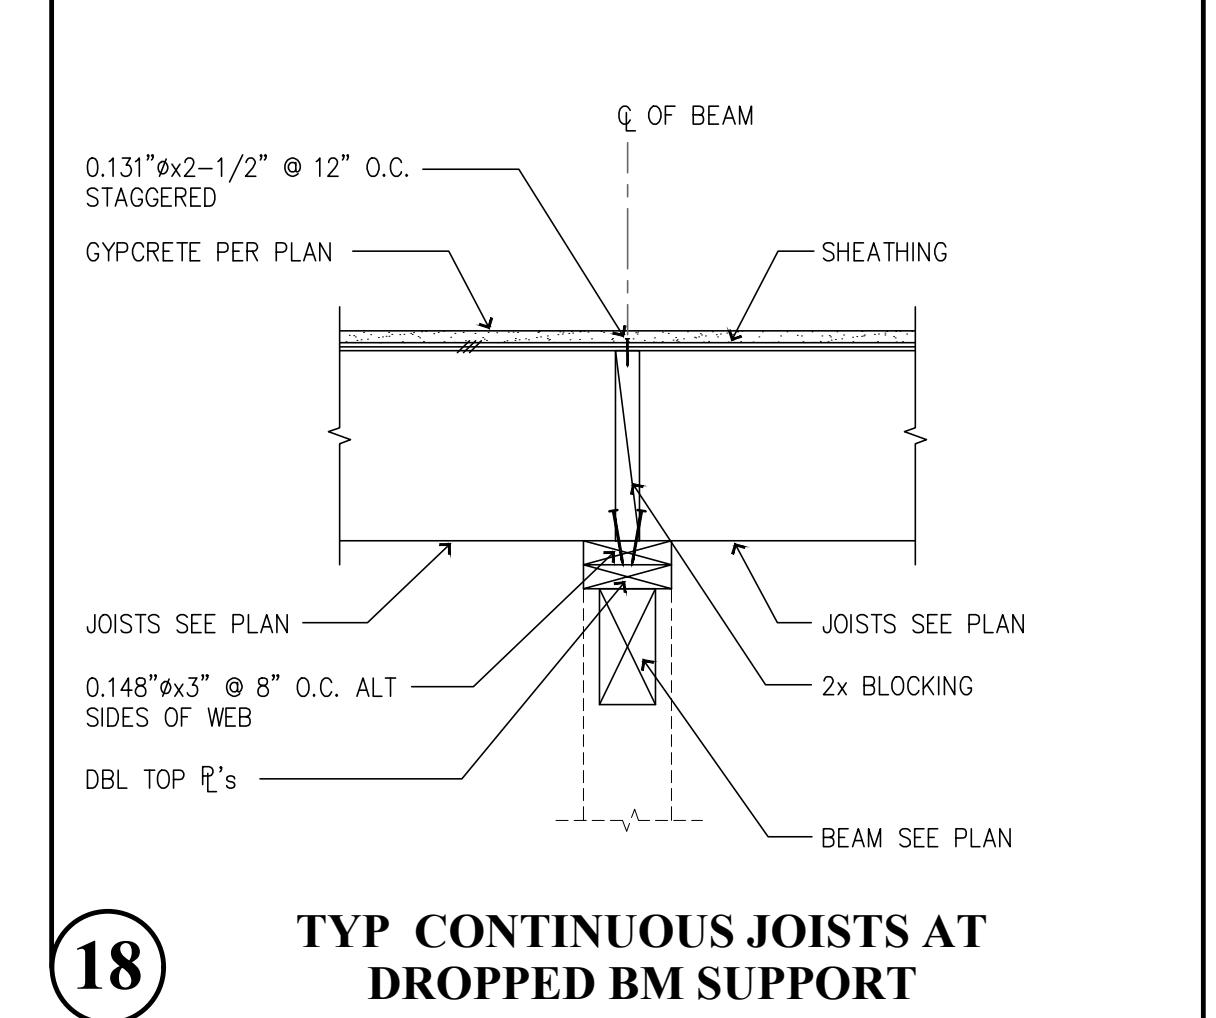


18 TYP CONTINUOUS JOISTS AT DROPPED BM SUPPORT

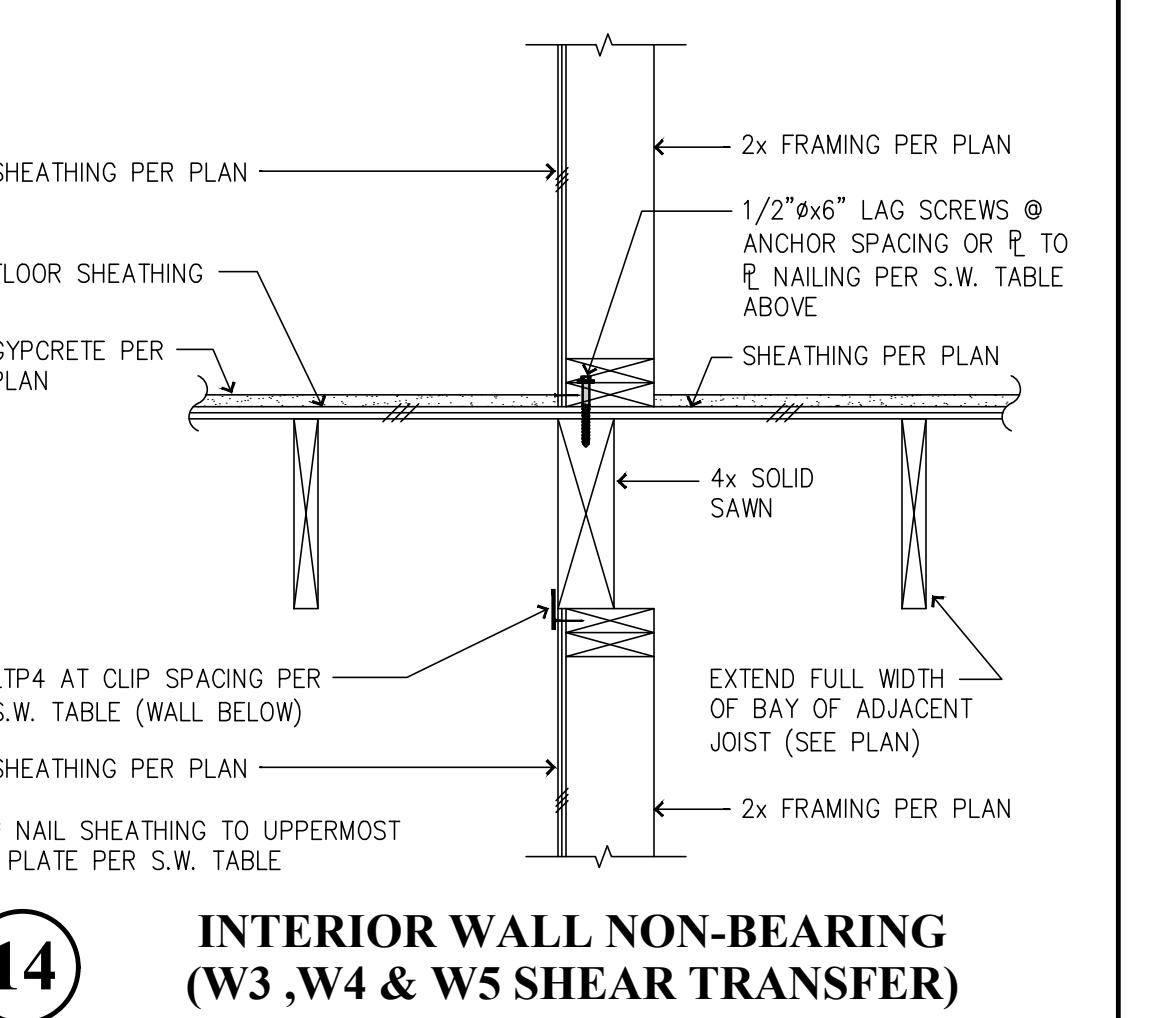


14 INTERIOR WALL NON-BEARING (W3, W4 & W5 SHEAR TRANSFER)

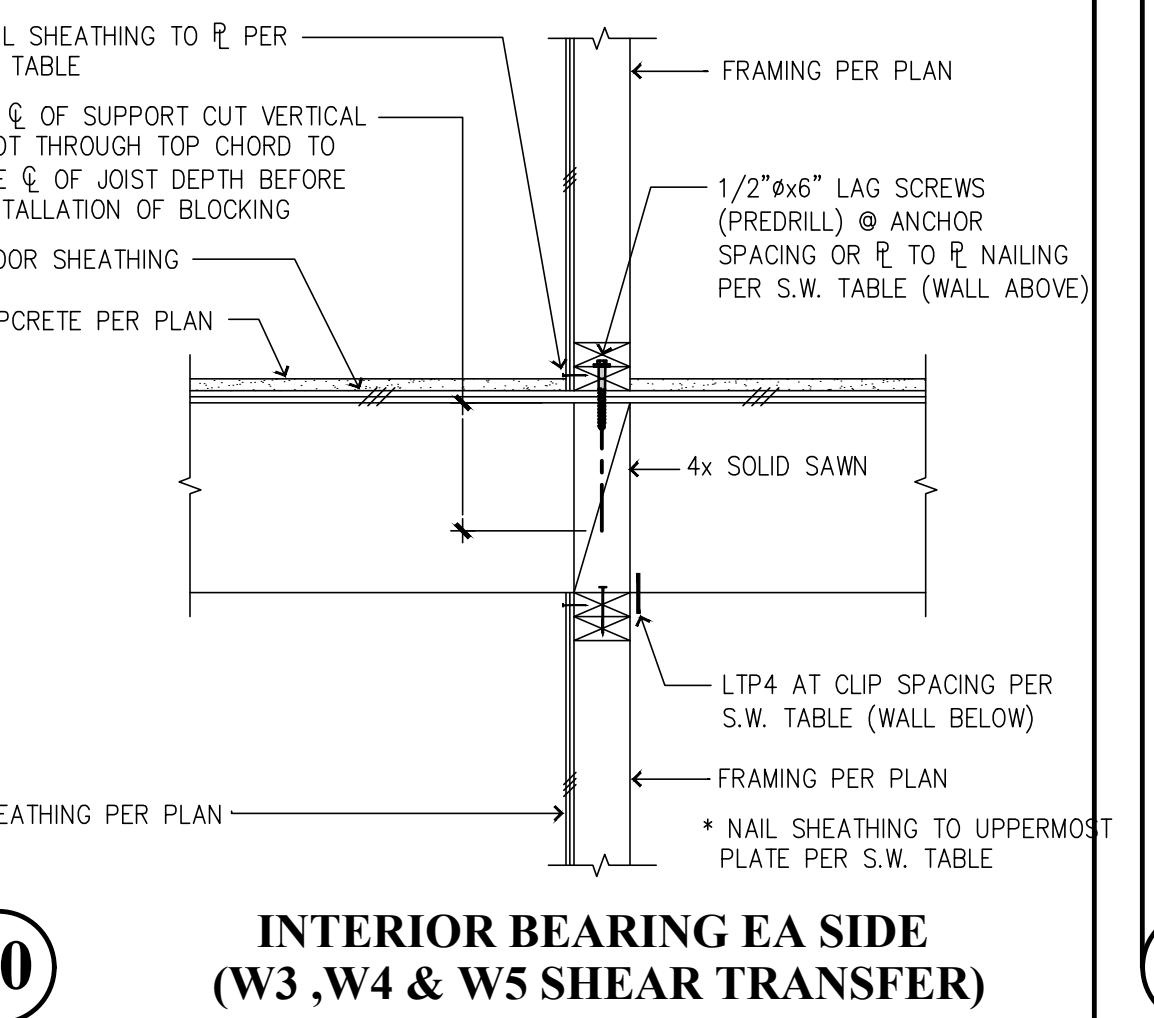


10 INTERIOR BEARING EA SIDE (W3, W4 & W5 SHEAR TRANSFER)

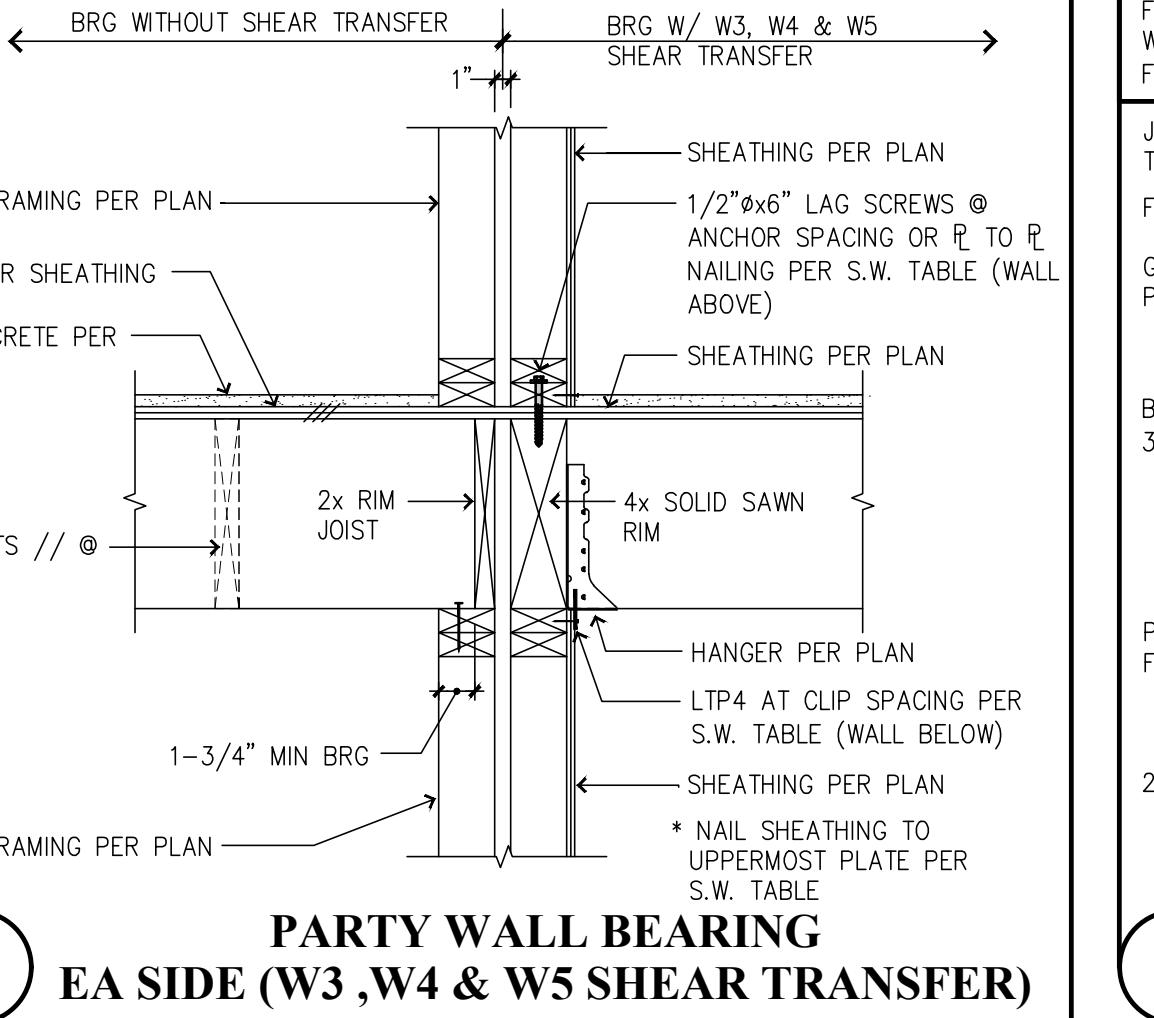


6 PARTY WALL BEARING EA SIDE (W3, W4 & W5 SHEAR TRANSFER)

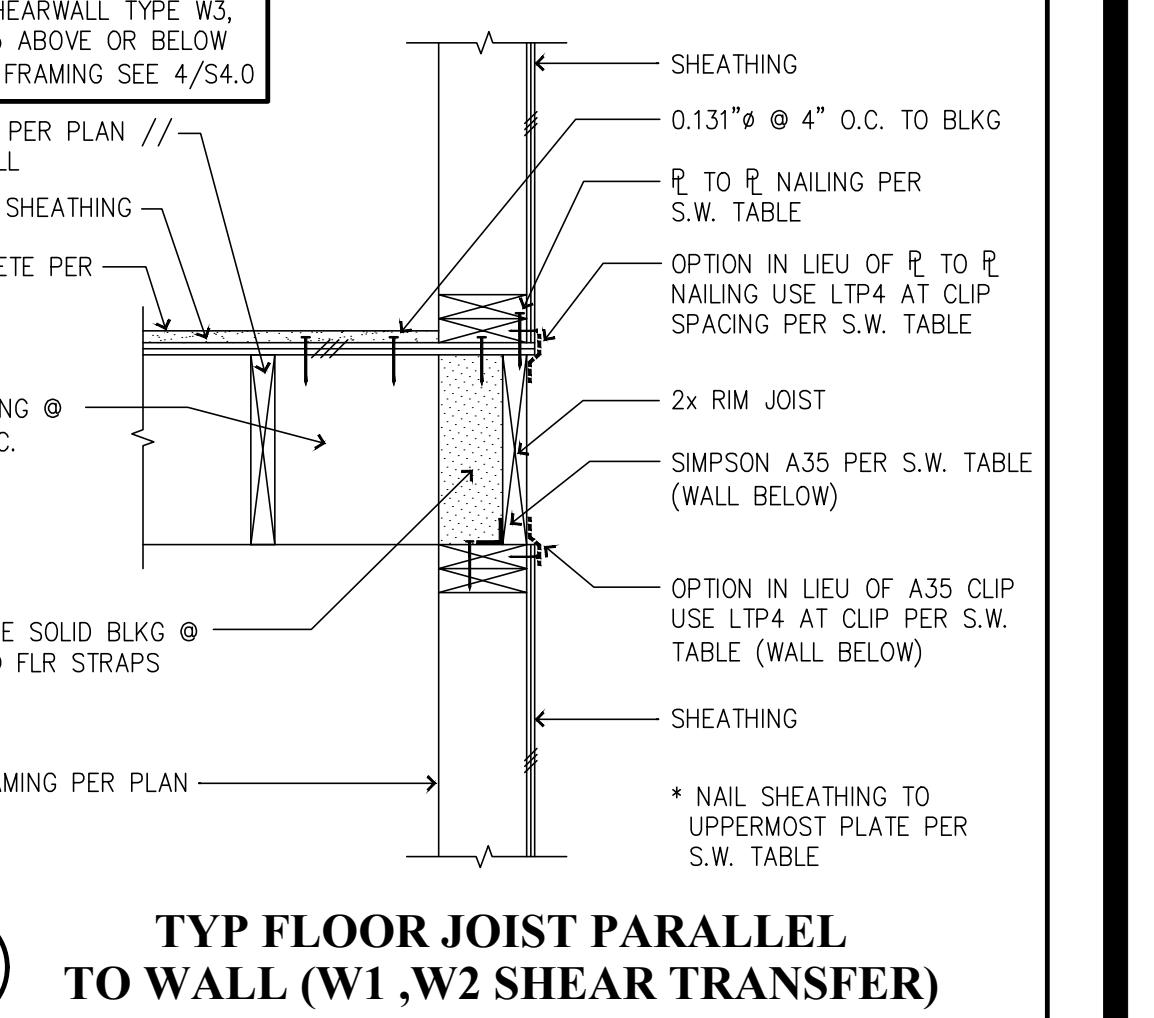


2 TYP FLOOR JOIST PARALLEL TO WALL (W1, W2 SHEAR TRANSFER)

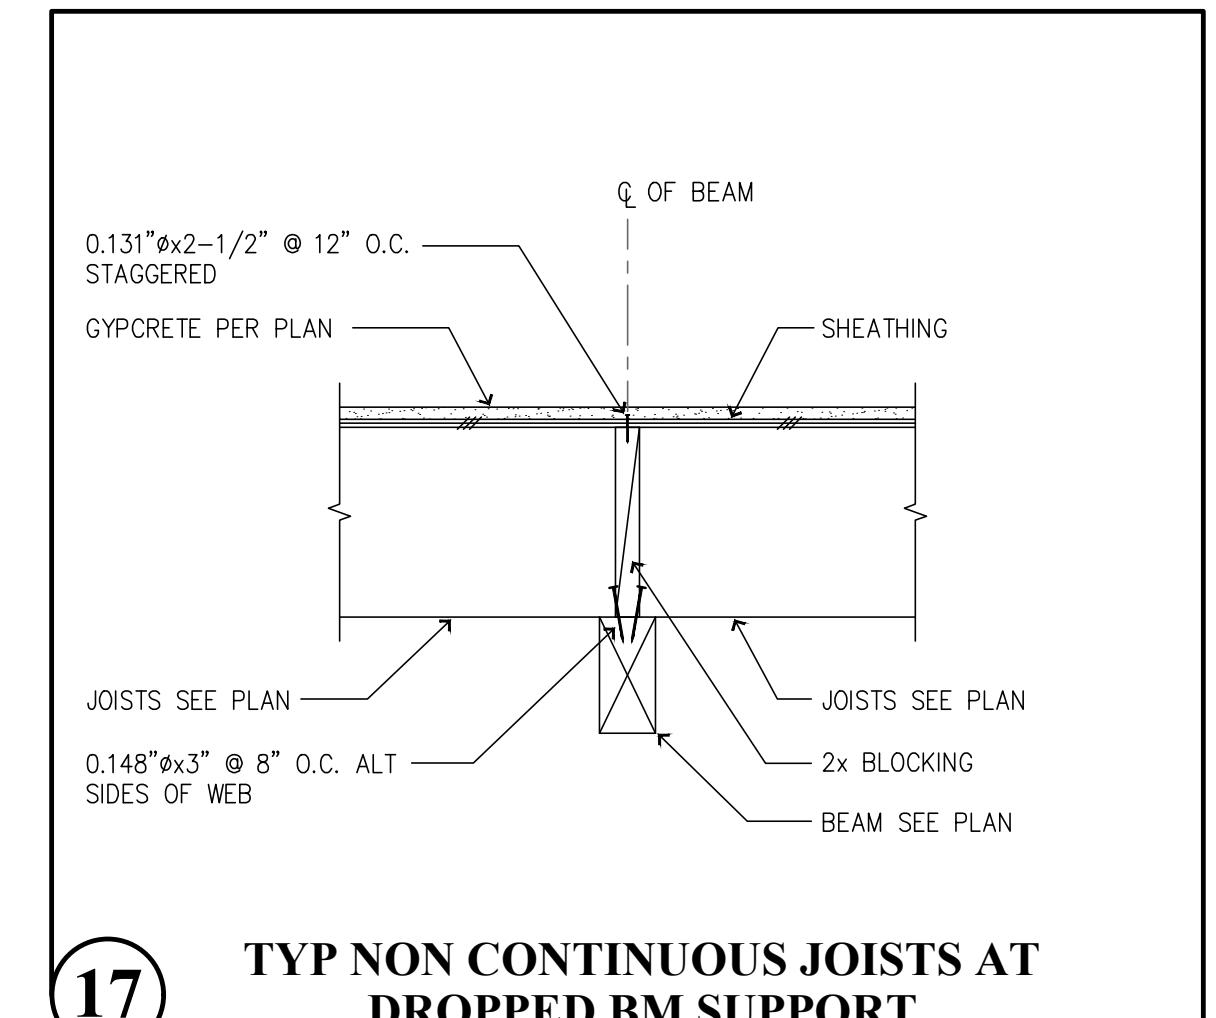


17 TYP NON CONTINUOUS JOISTS AT DROPPED BM SUPPORT

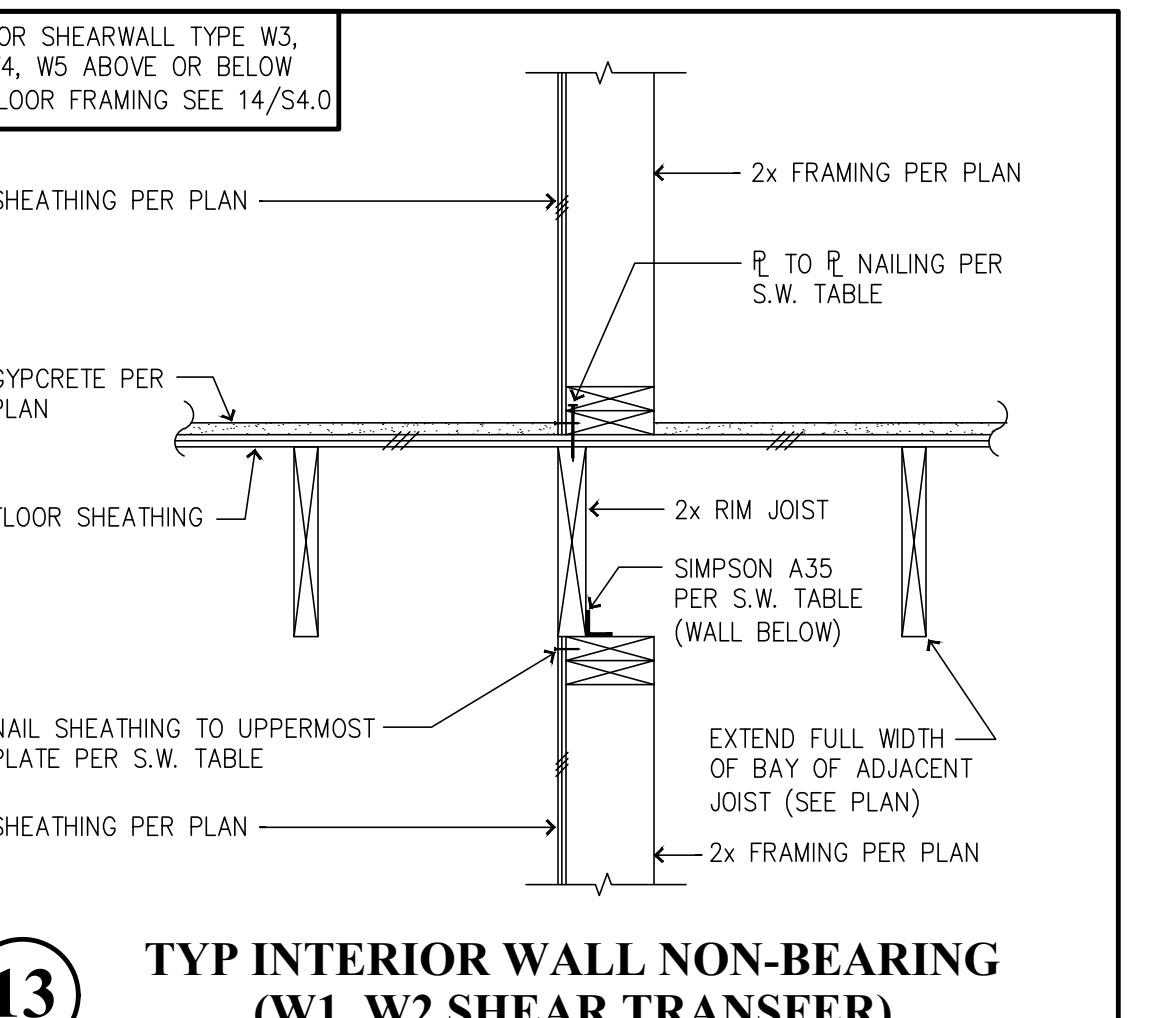


13 TYP INTERIOR WALL NON-BEARING (W1, W2 SHEAR TRANSFER)

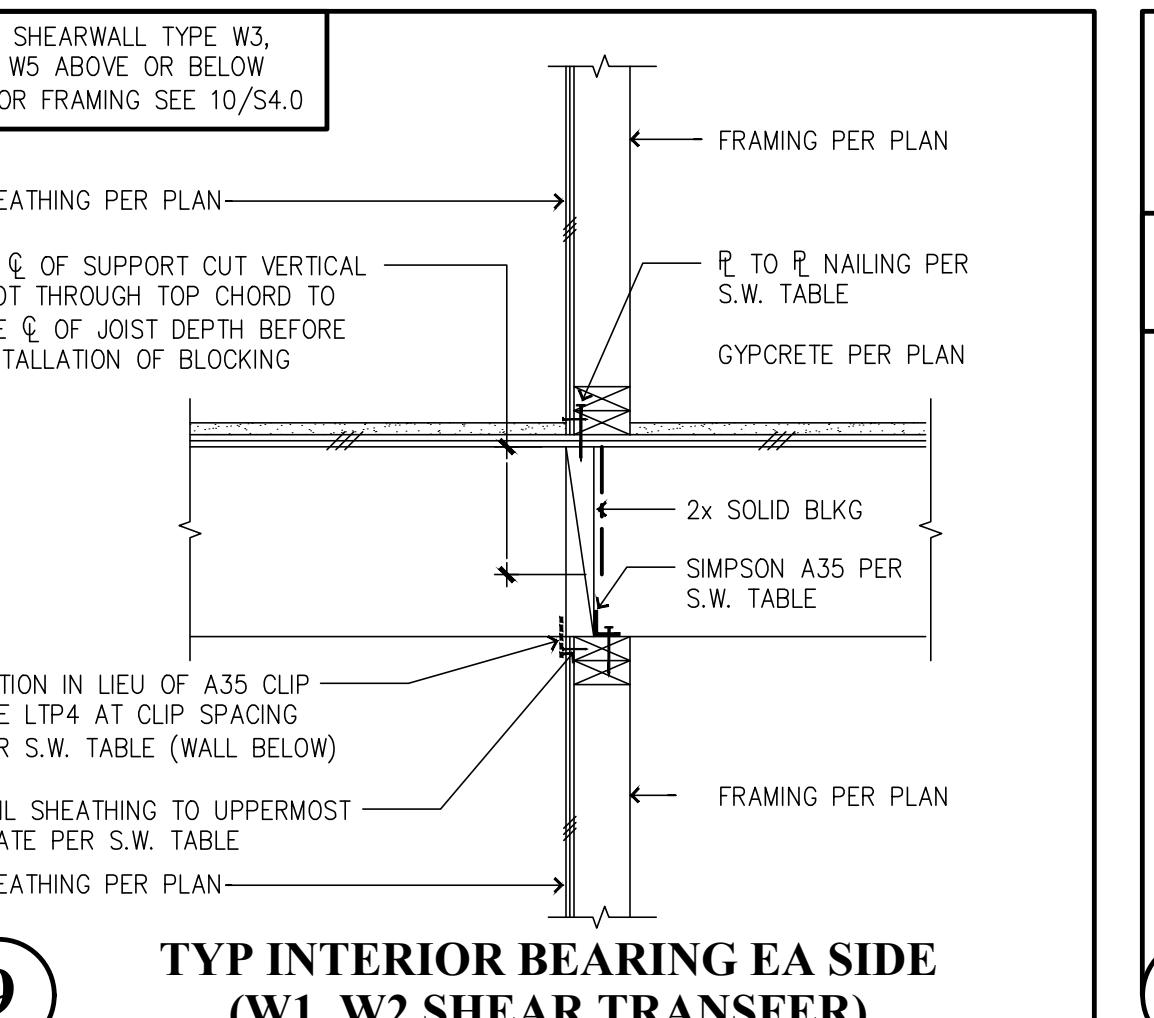


9 TYP INTERIOR BEARING EA SIDE (W1, W2 SHEAR TRANSFER)

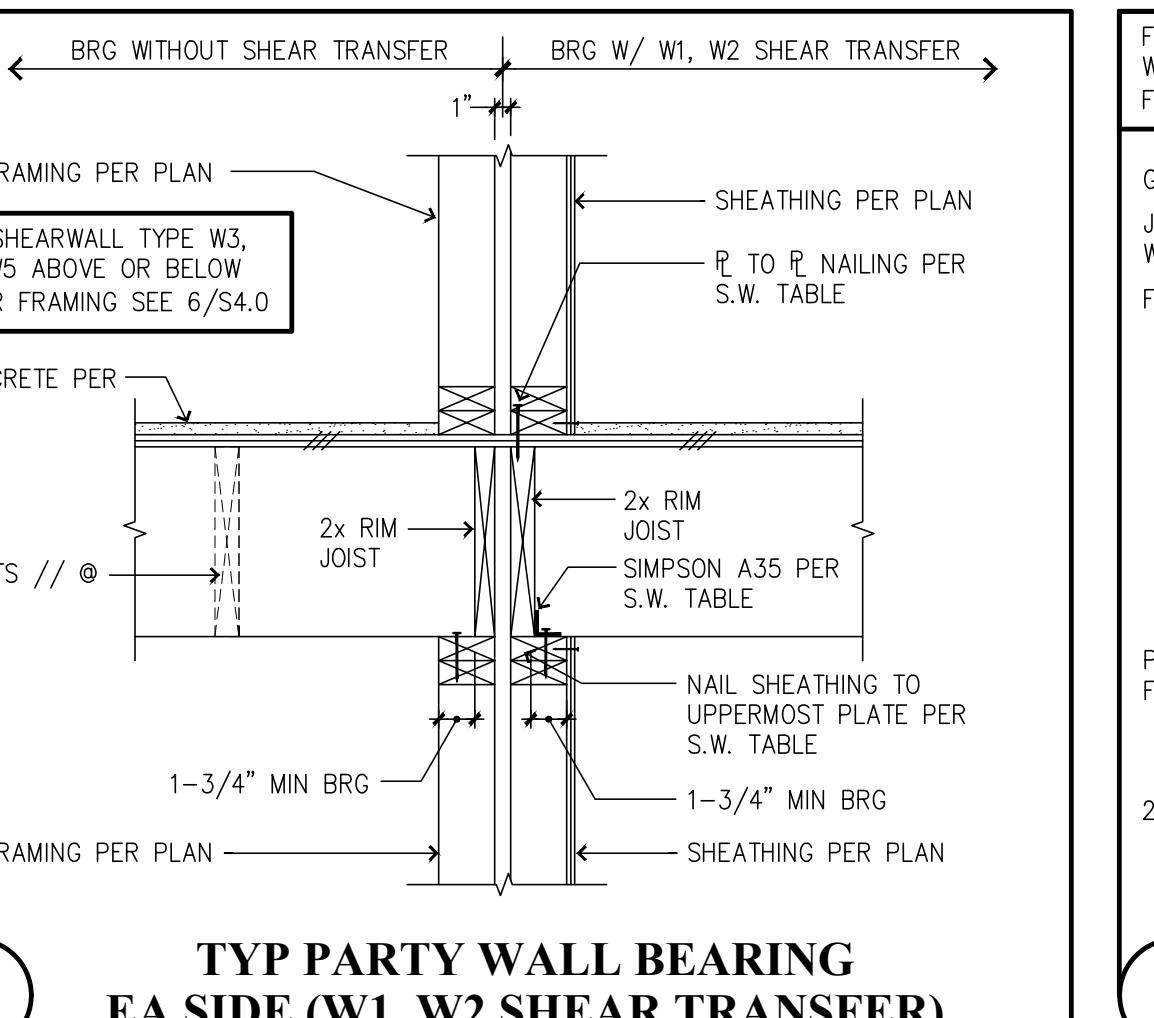

5 TYP PARTY WALL BEARING EA SIDE (W1, W2 SHEAR TRANSFER)

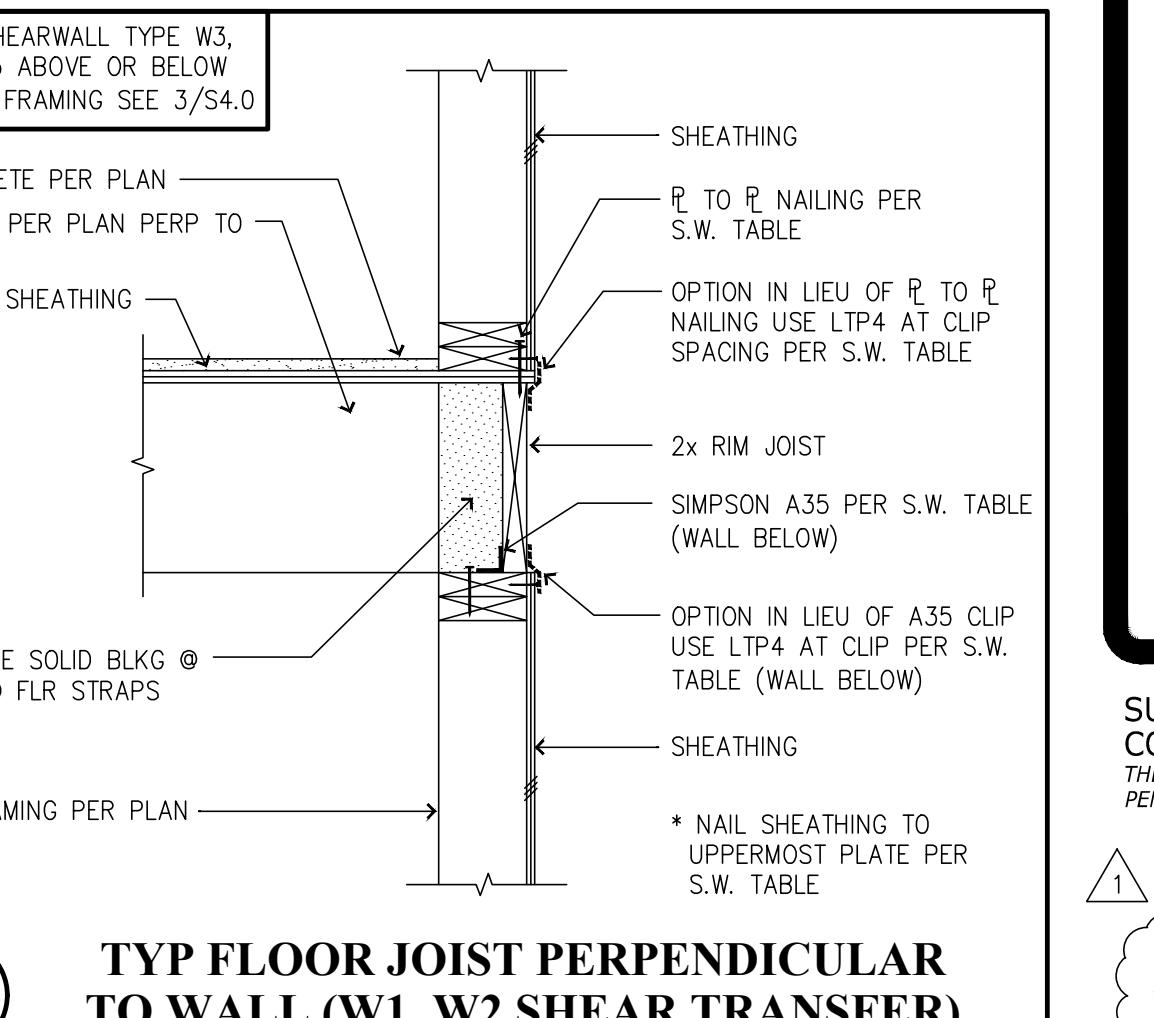


1 TYP FLOOR JOIST PERPENDICULAR TO WALL (W1, W2 SHEAR TRANSFER)

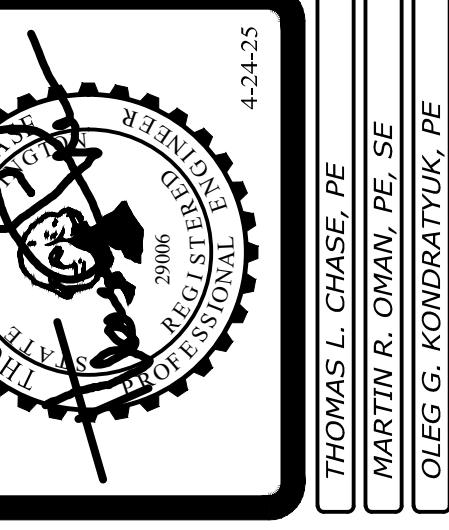
Revisions to this sheet:
△ 8-30-24 PERMIT CORRECTIONS & OWNER CHANGES

PRMU20240280


Bradley Heights Apartments
202 27th Ave SE
Puyallup, WashingtonSolutions 4 Structures
A Structural Engineering Corporation
Puyallup, Washington
Ph: 253-314-9822
www.solutions4structures.comPROJECT NO. : 23-007
DESIGNED BY : TLC, OGK, MRO
DRAWN BY : RSO
ISSUE DATE : 2-20-24
LATEST REV. : △ 4-24-25
OF DWG. SET : △ 4-24-25SUBMITTAL SET ONLY NOT FOR CONSTRUCTION
THESE DRAWINGS ARE SUBJECT TO REVISIONS
PENDING LOCAL JURISDICTIONAL REVIEW.

S4.0

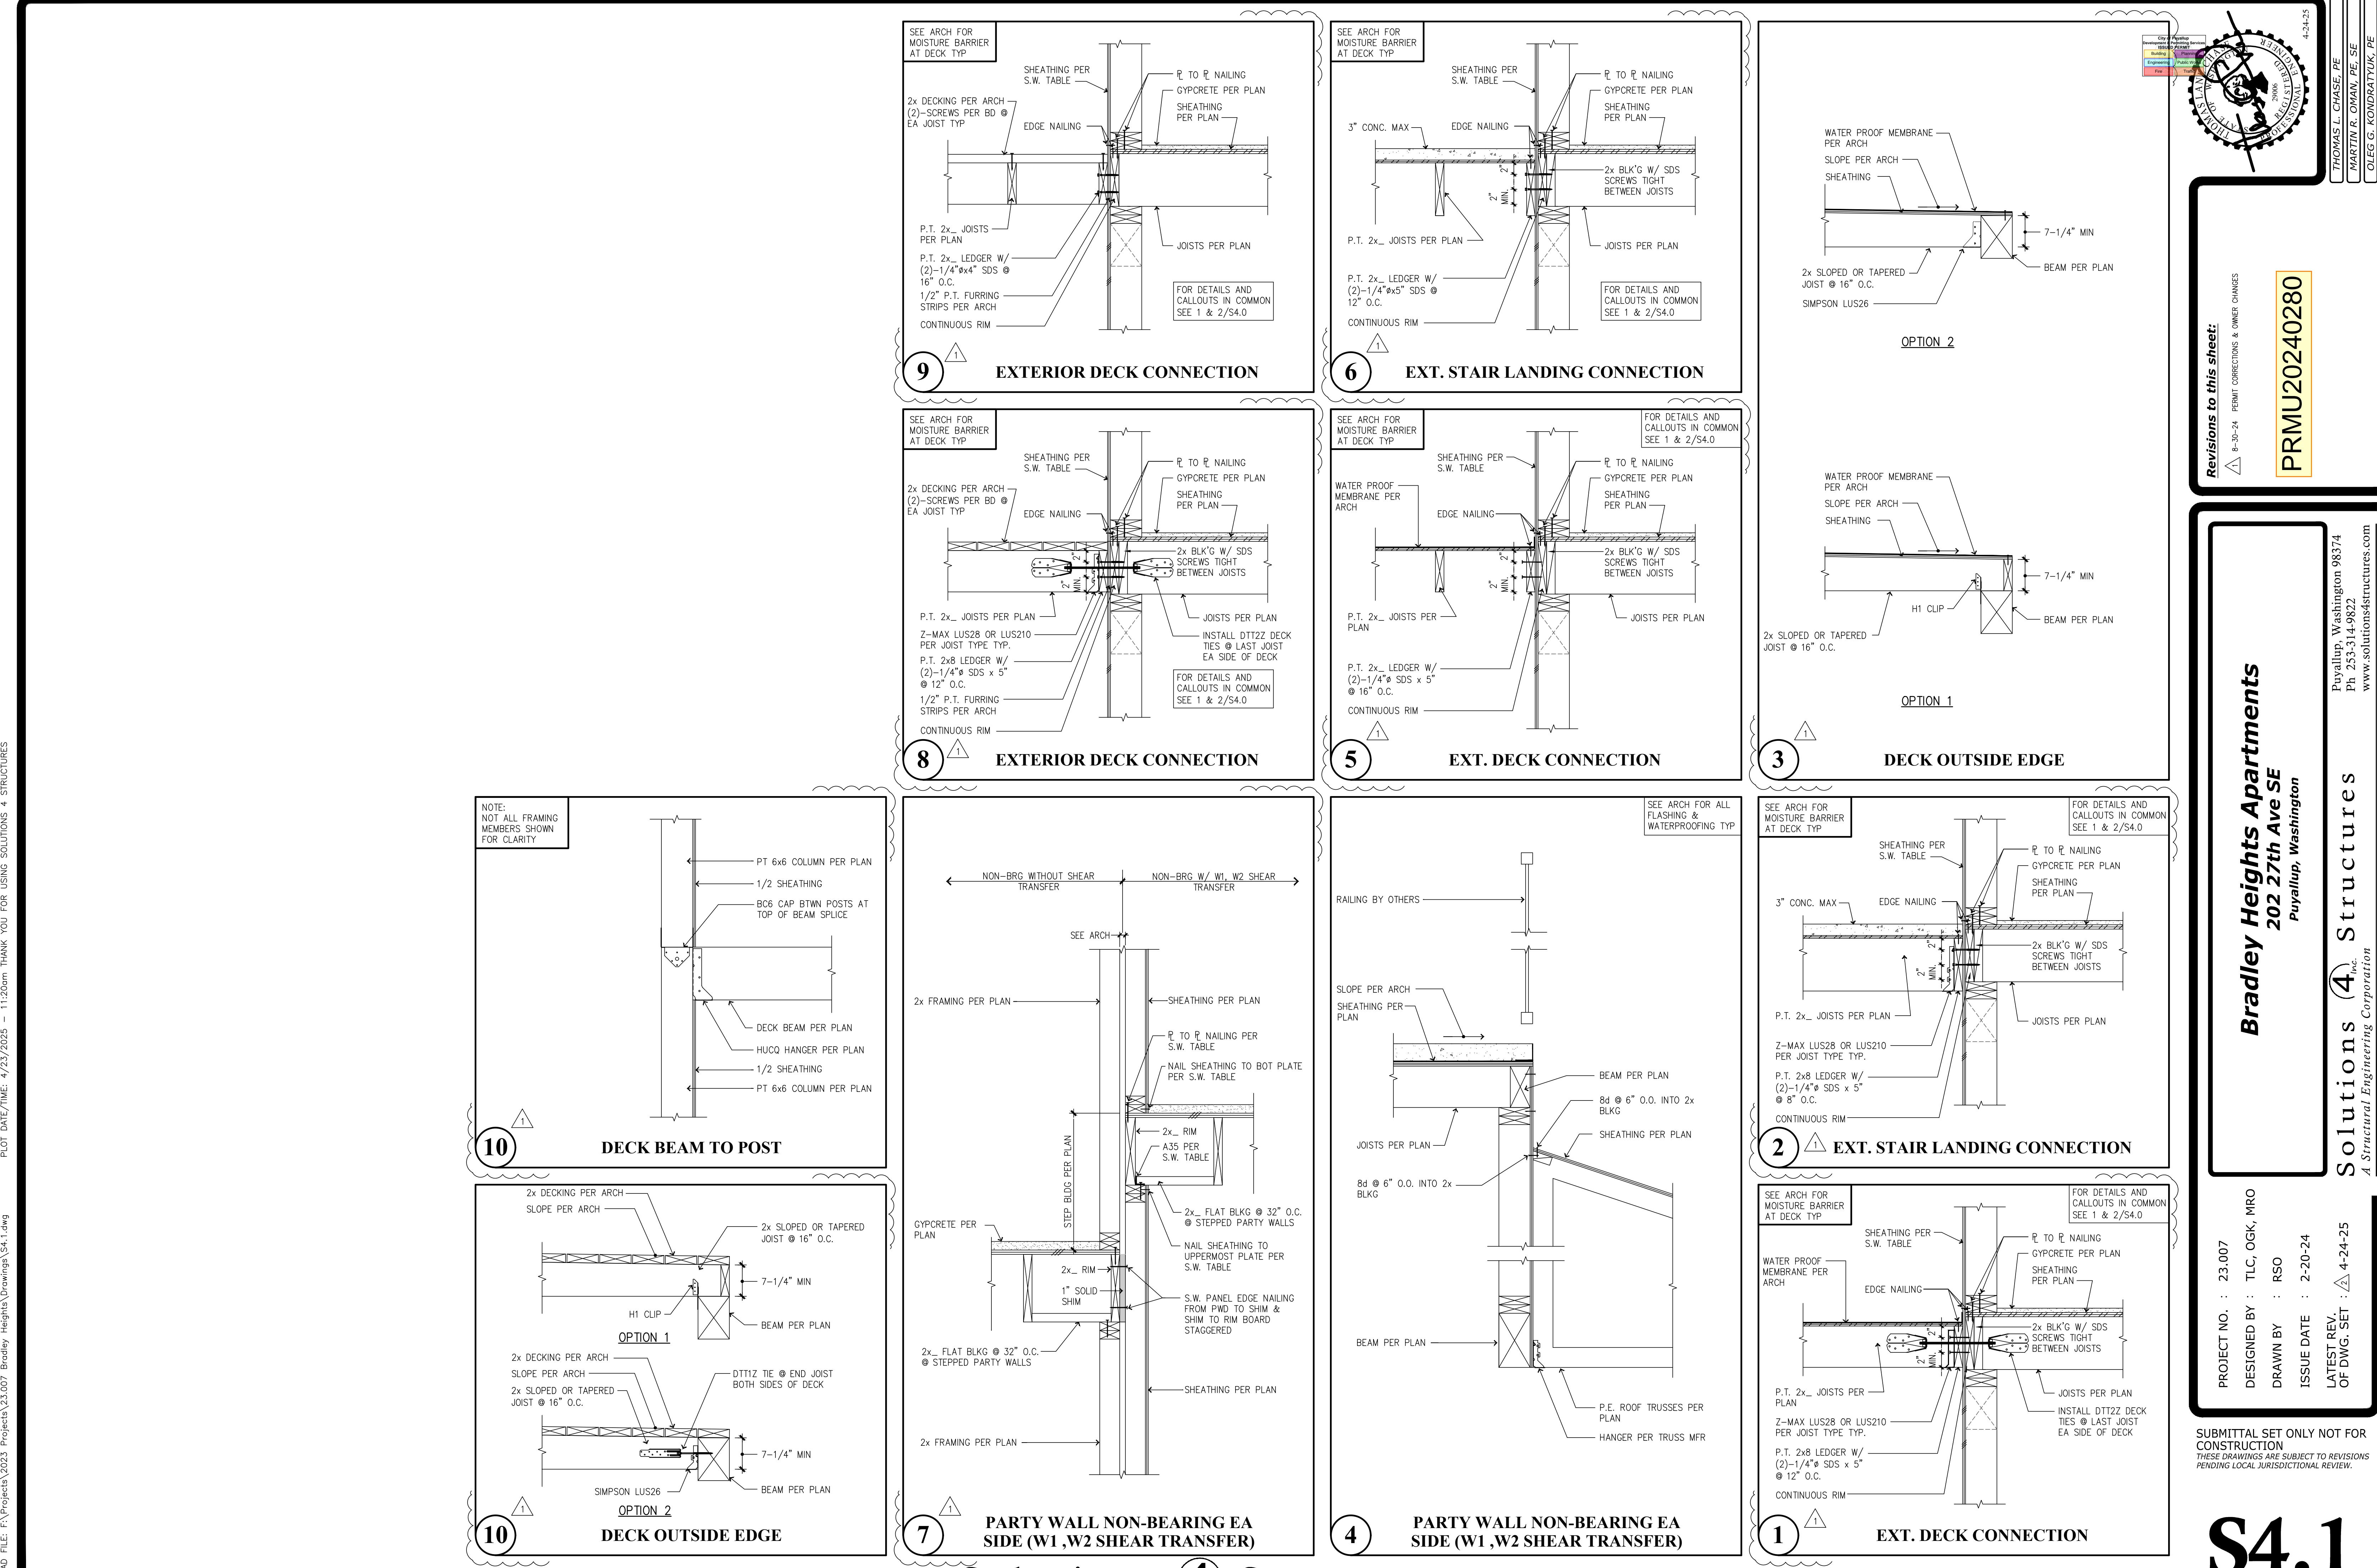


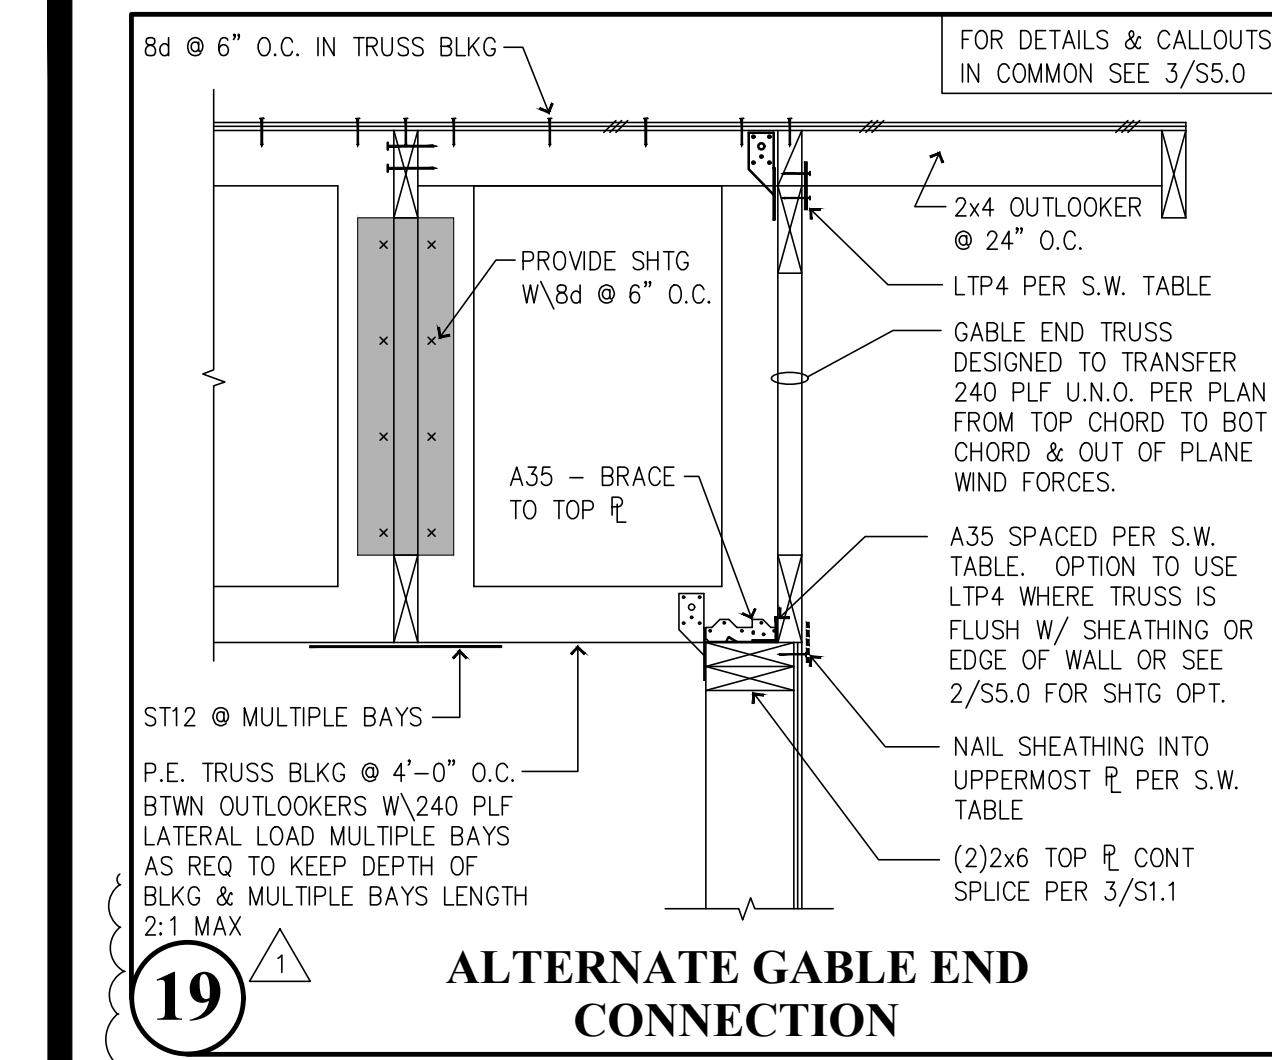


19 ALTERNATE GABLE END CONNECTION

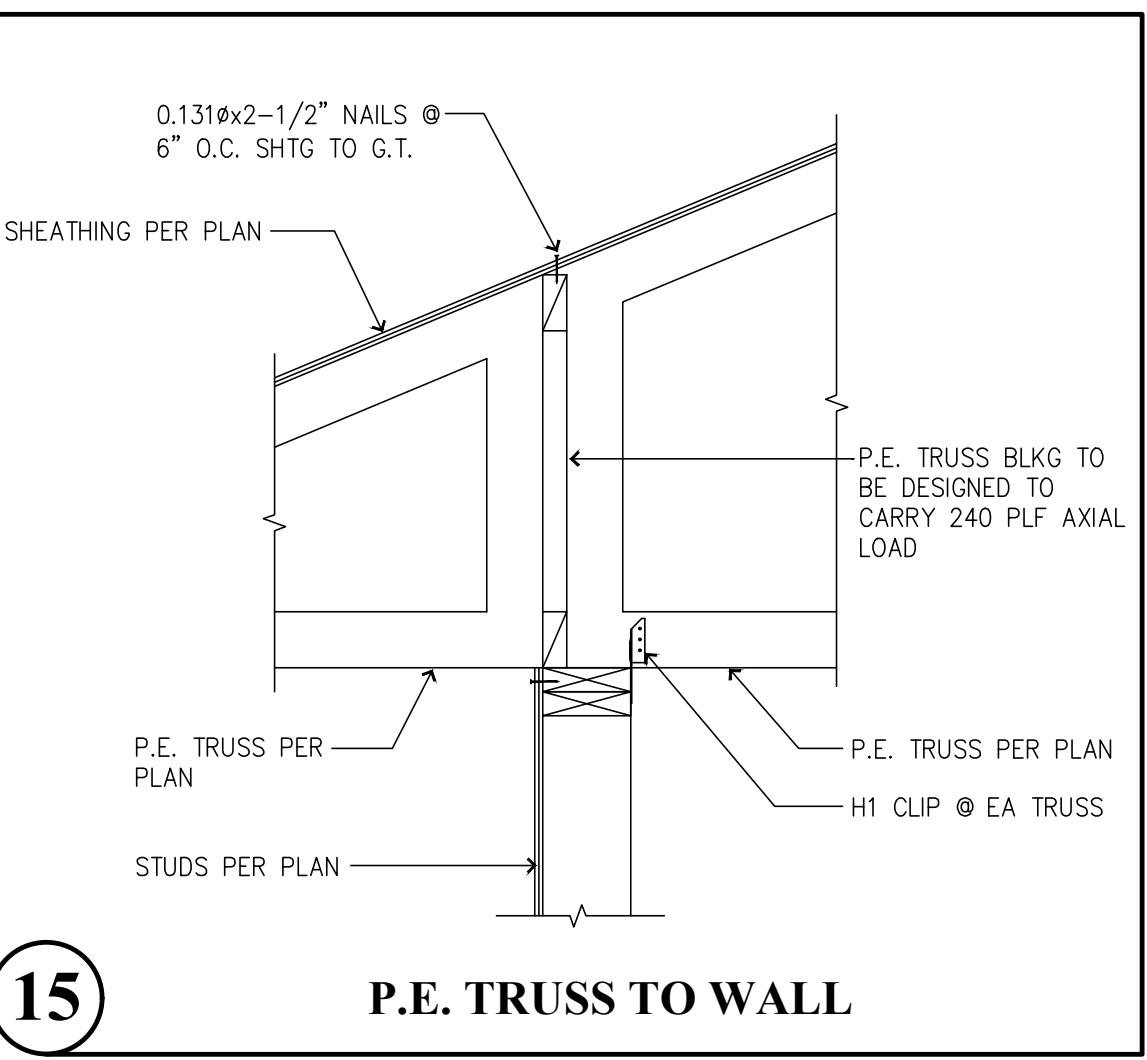


15 P.E. TRUSS TO WALL

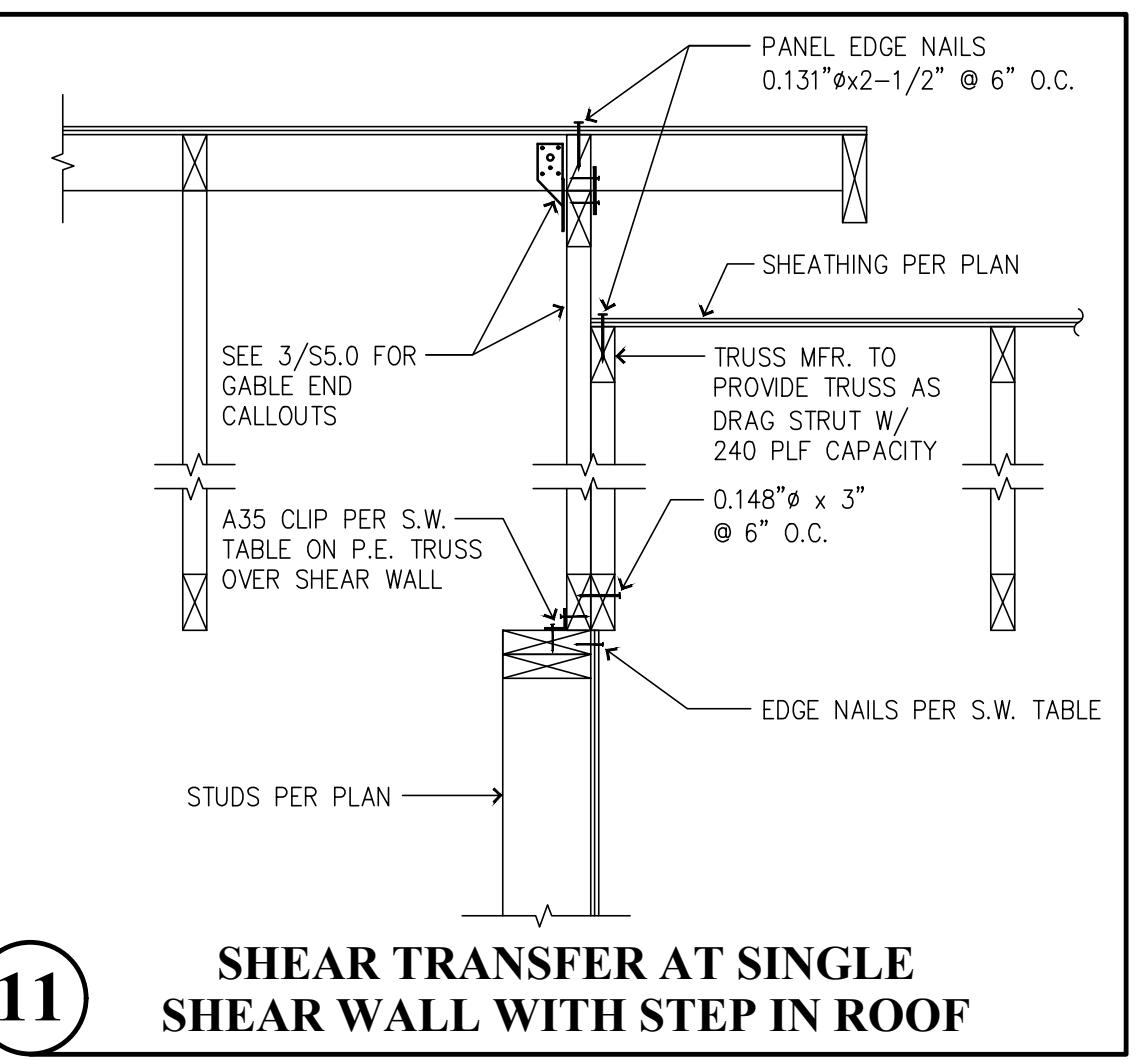


11 SHEAR TRANSFER AT SINGLE SHEAR WALL WITH STEP IN ROOF

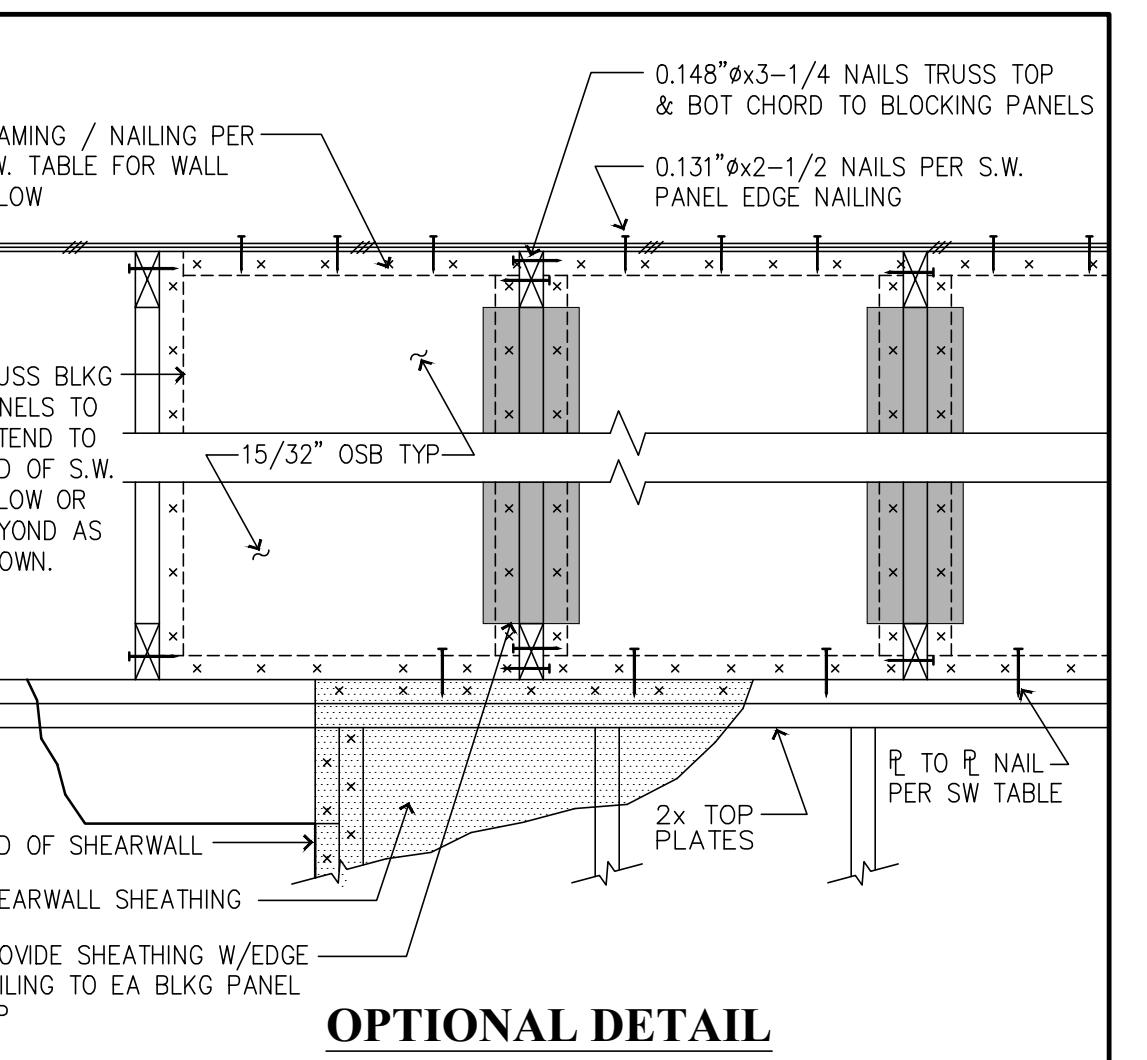


4 2x_BRACE TO ROOF CONNECTION

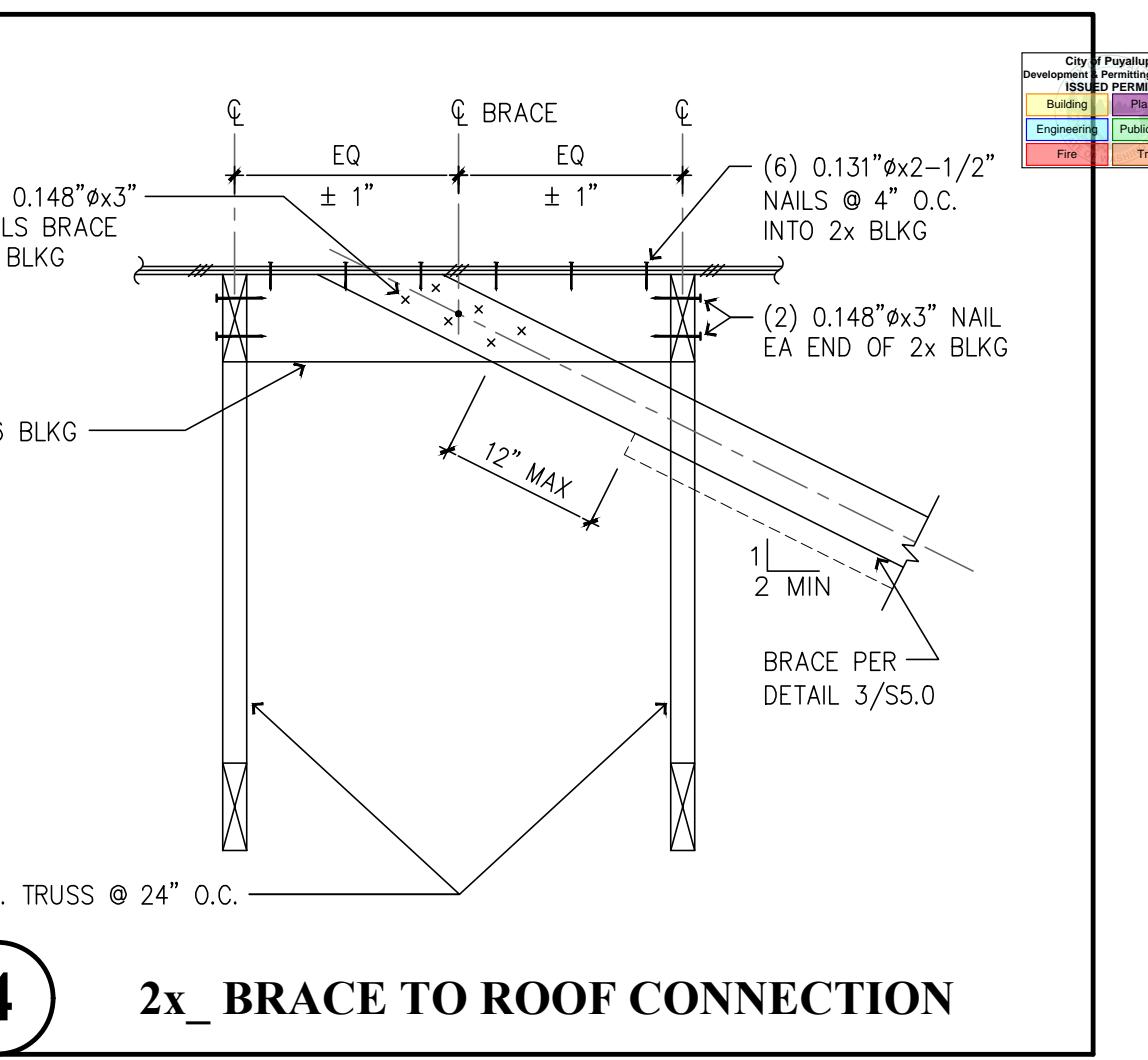


4 2x_BRACE TO ROOF CONNECTION

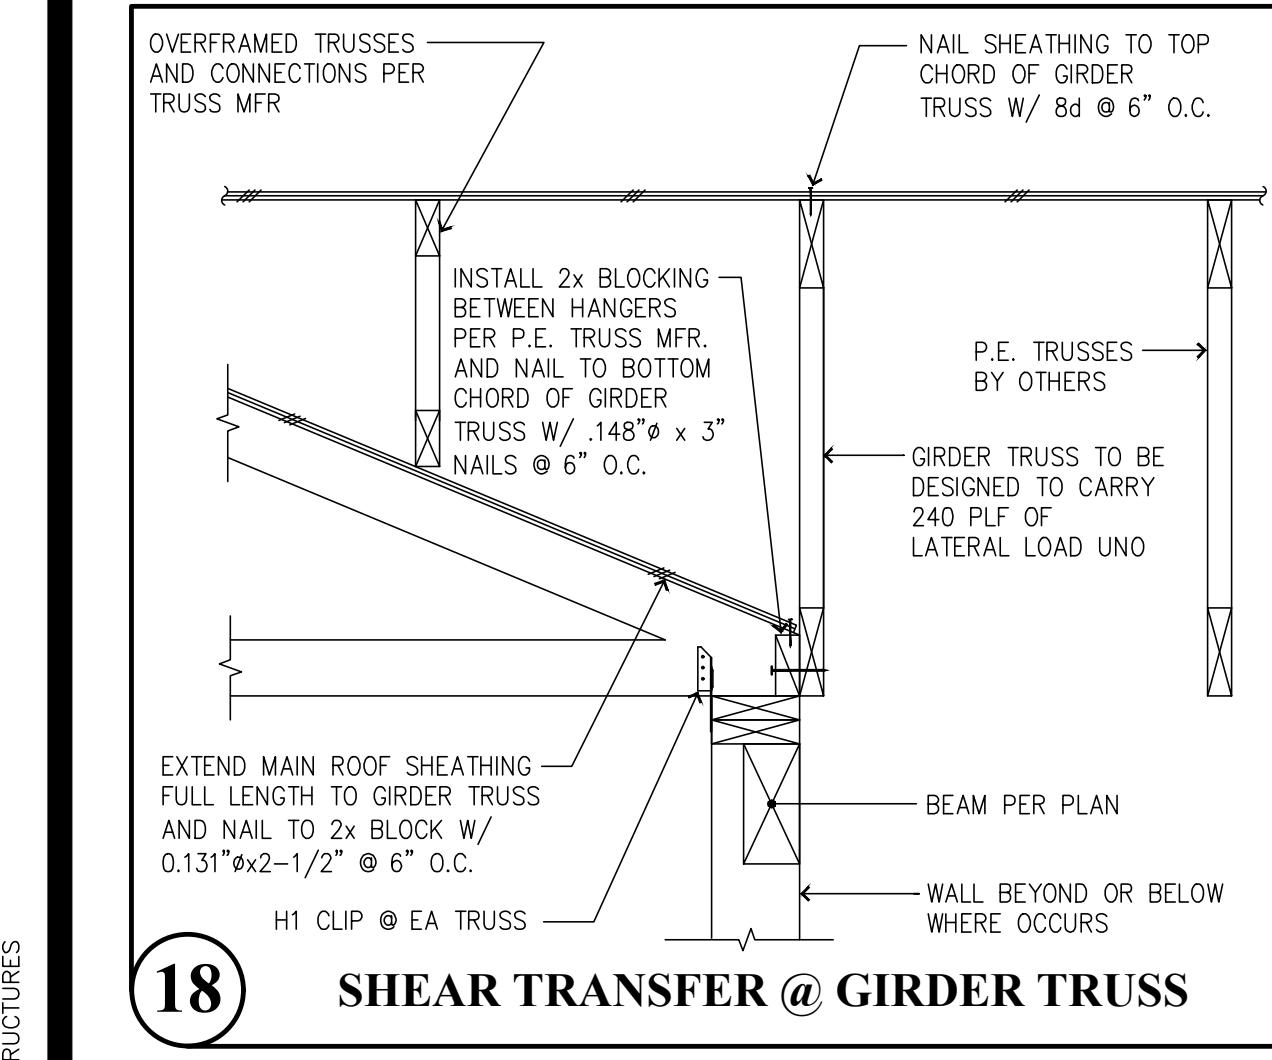


18 SHEAR TRANSFER @ GILDER TRUSS

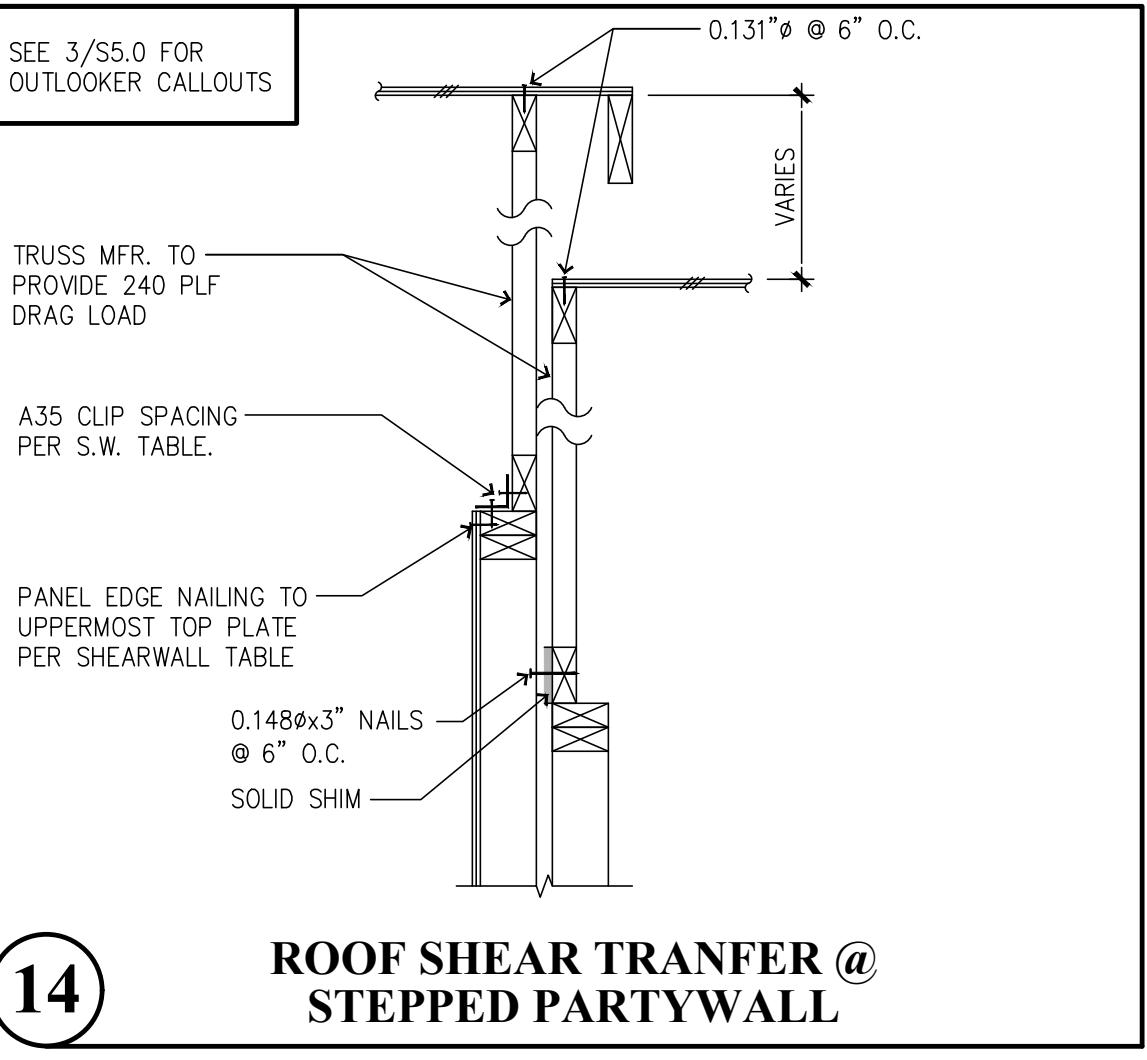


14 ROOF SHEAR TRANSFER @ STEPPED PARTYWALL

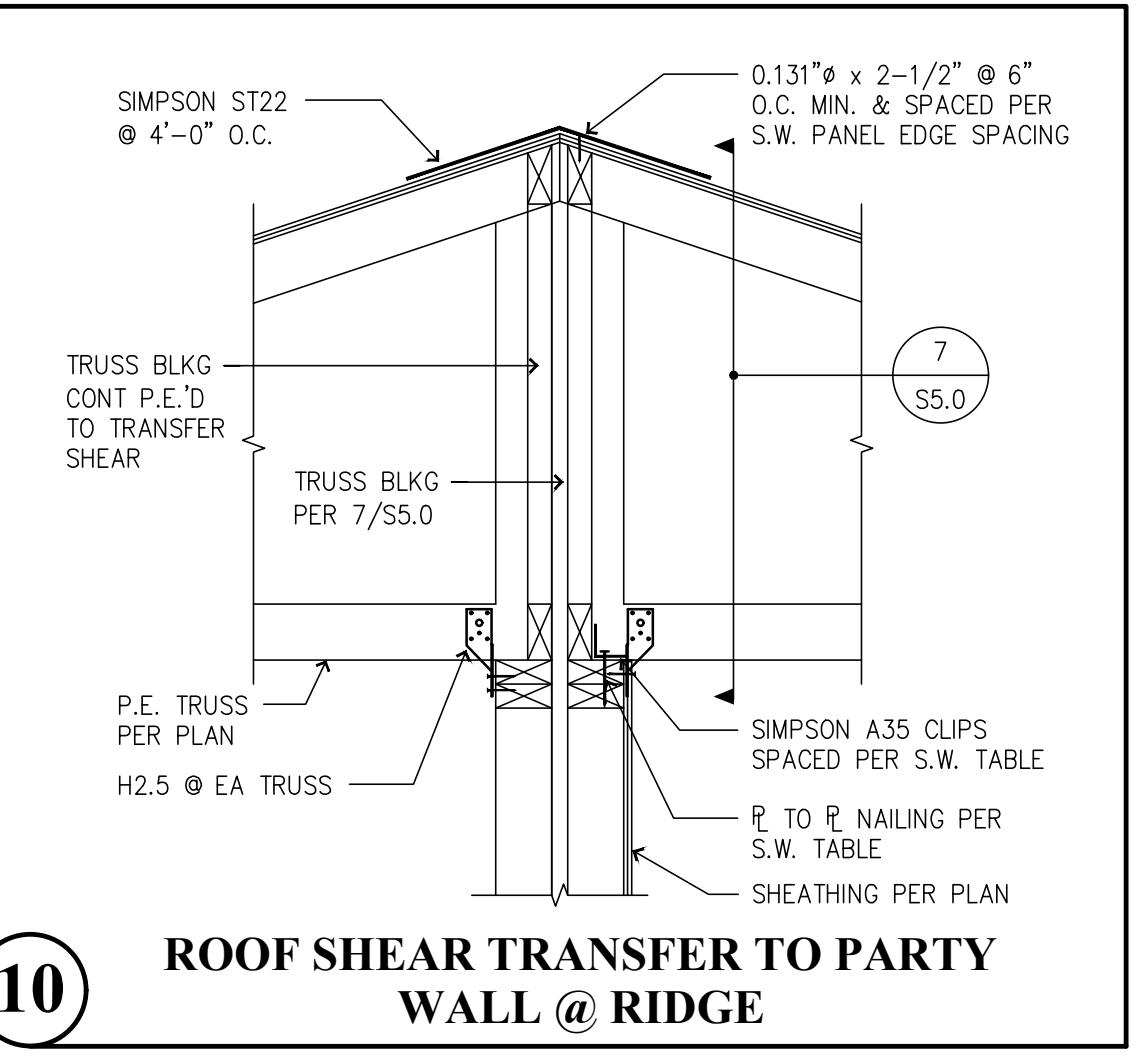


10 ROOF SHEAR TRANSFER TO PARTY WALL @ RIDGE

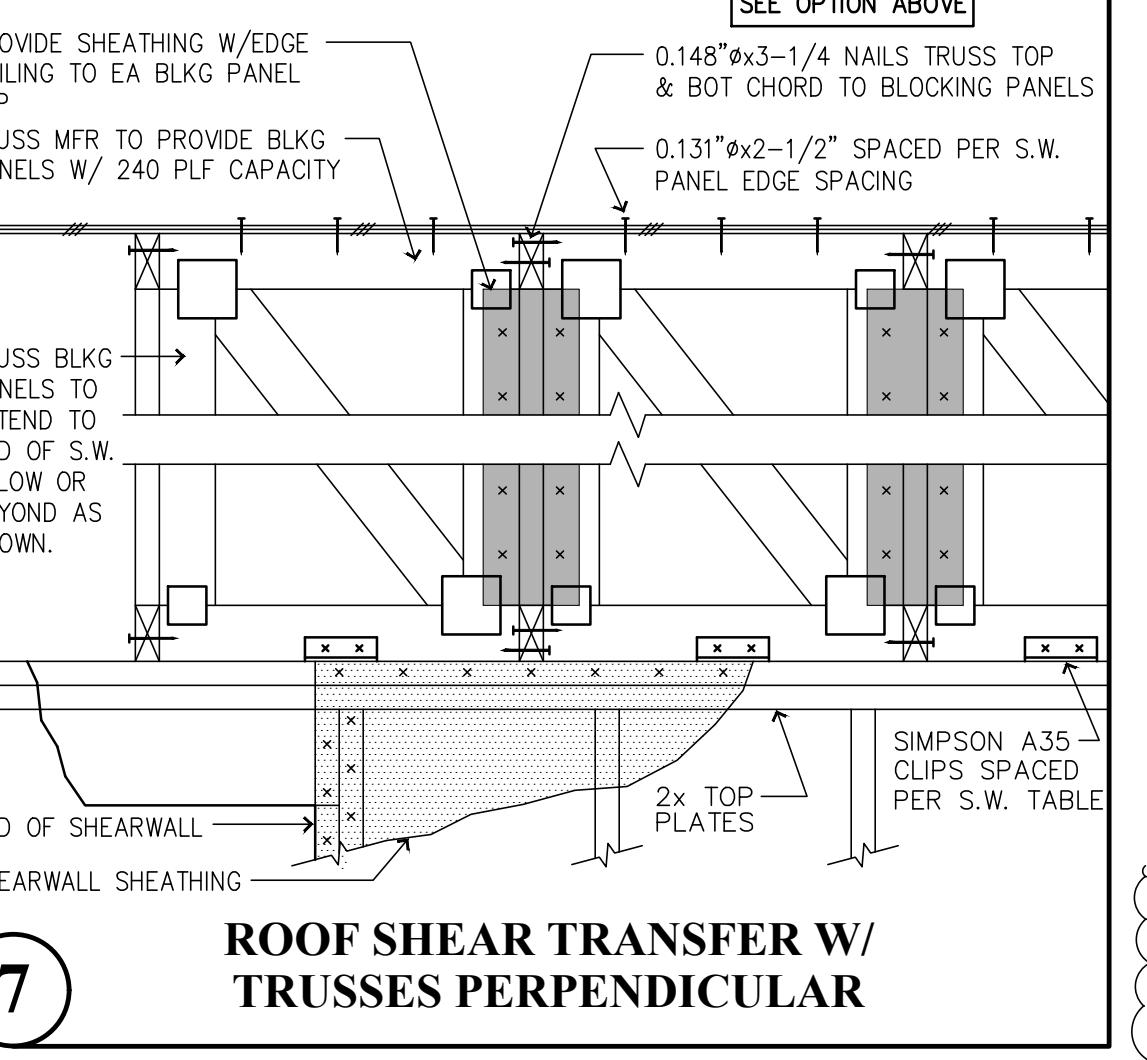


7 ROOF SHEAR TRANSFER W/ TRUSSES PERPENDICULAR

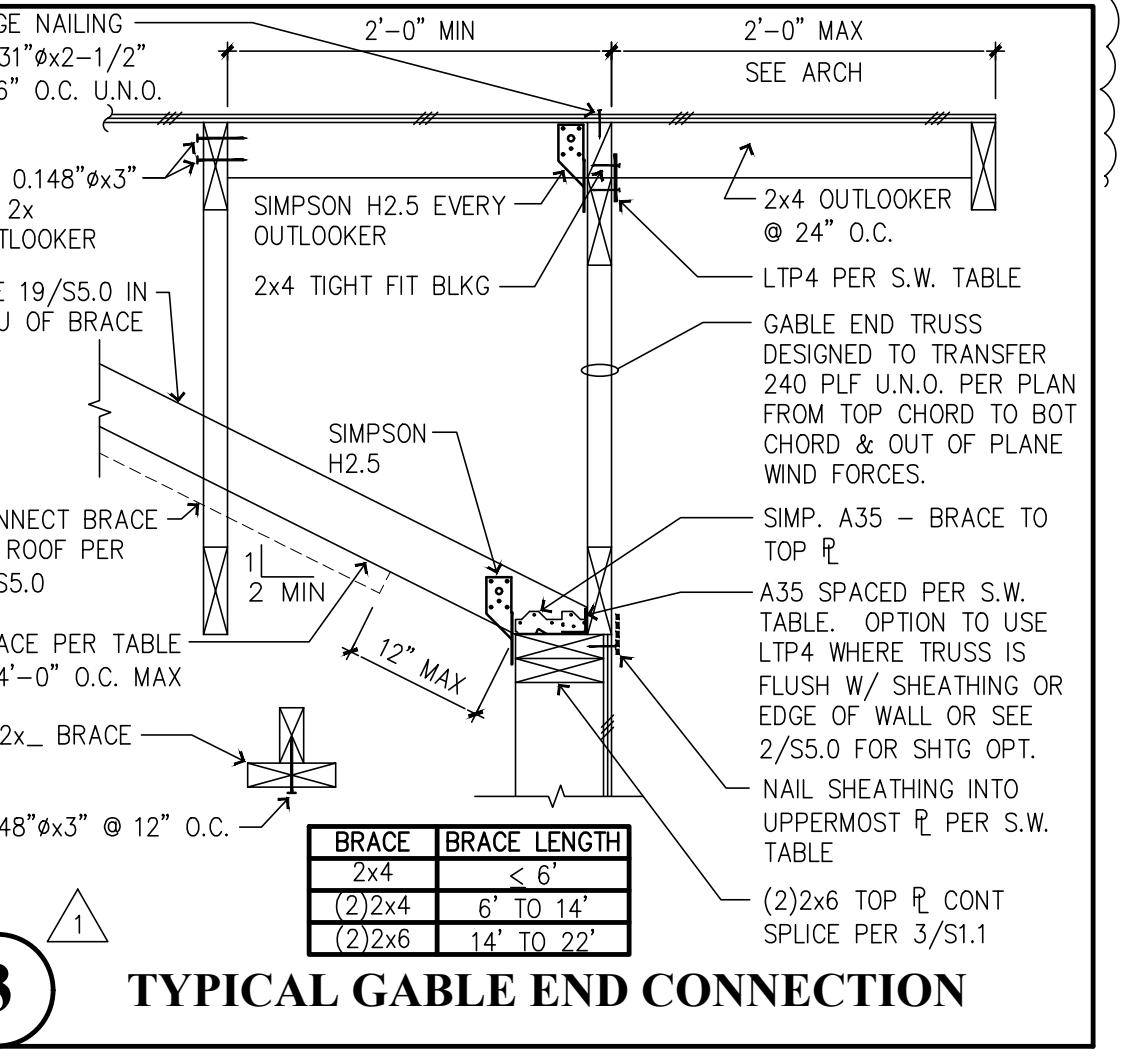


3 TYPICAL GABLE END CONNECTION

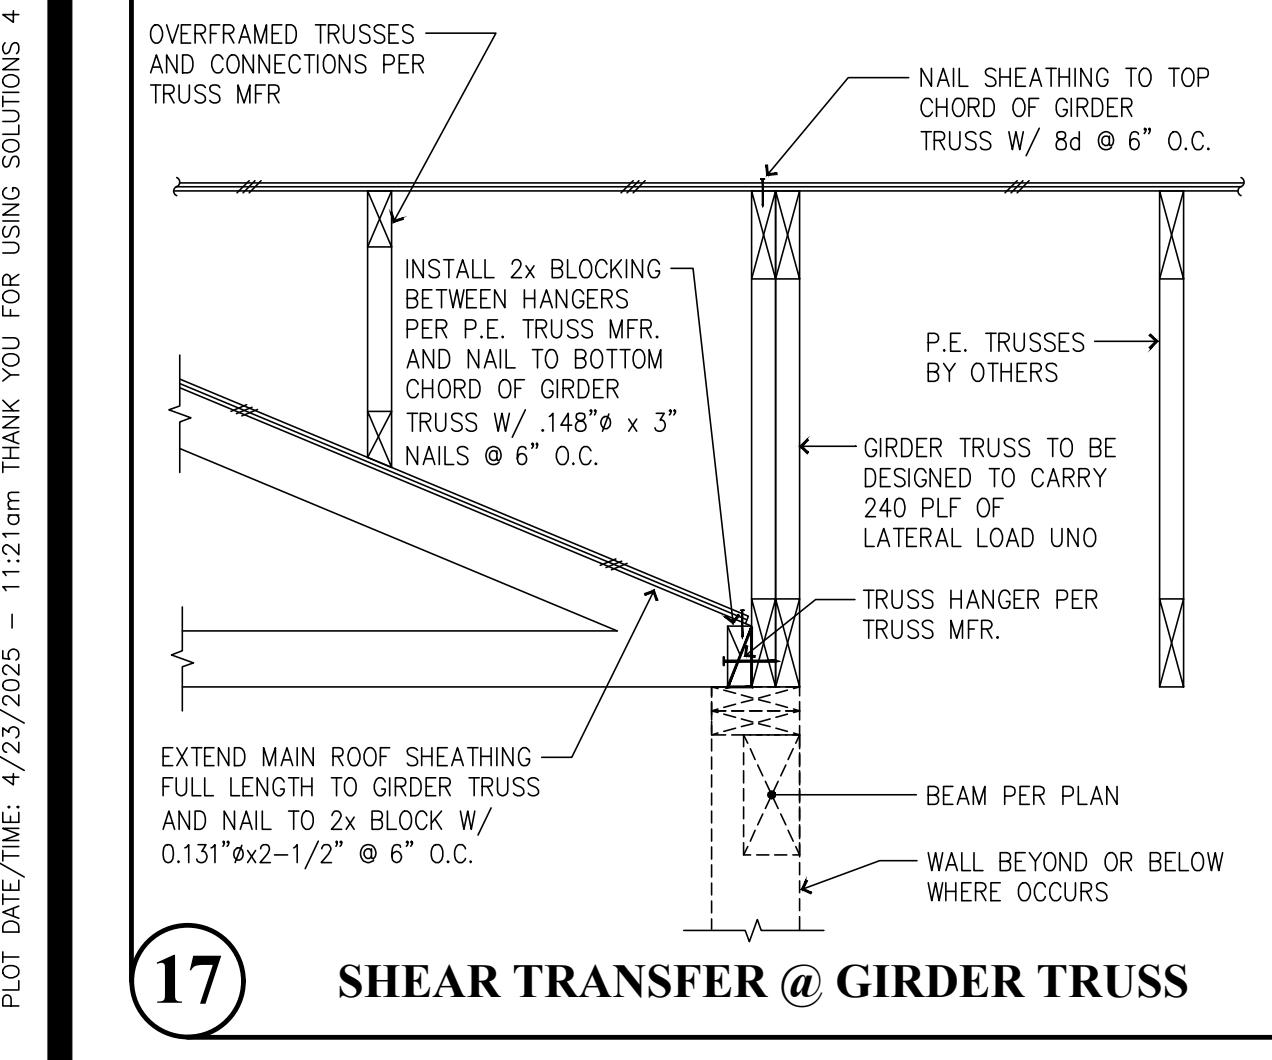


17 SHEAR TRANSFER @ GILDER TRUSS

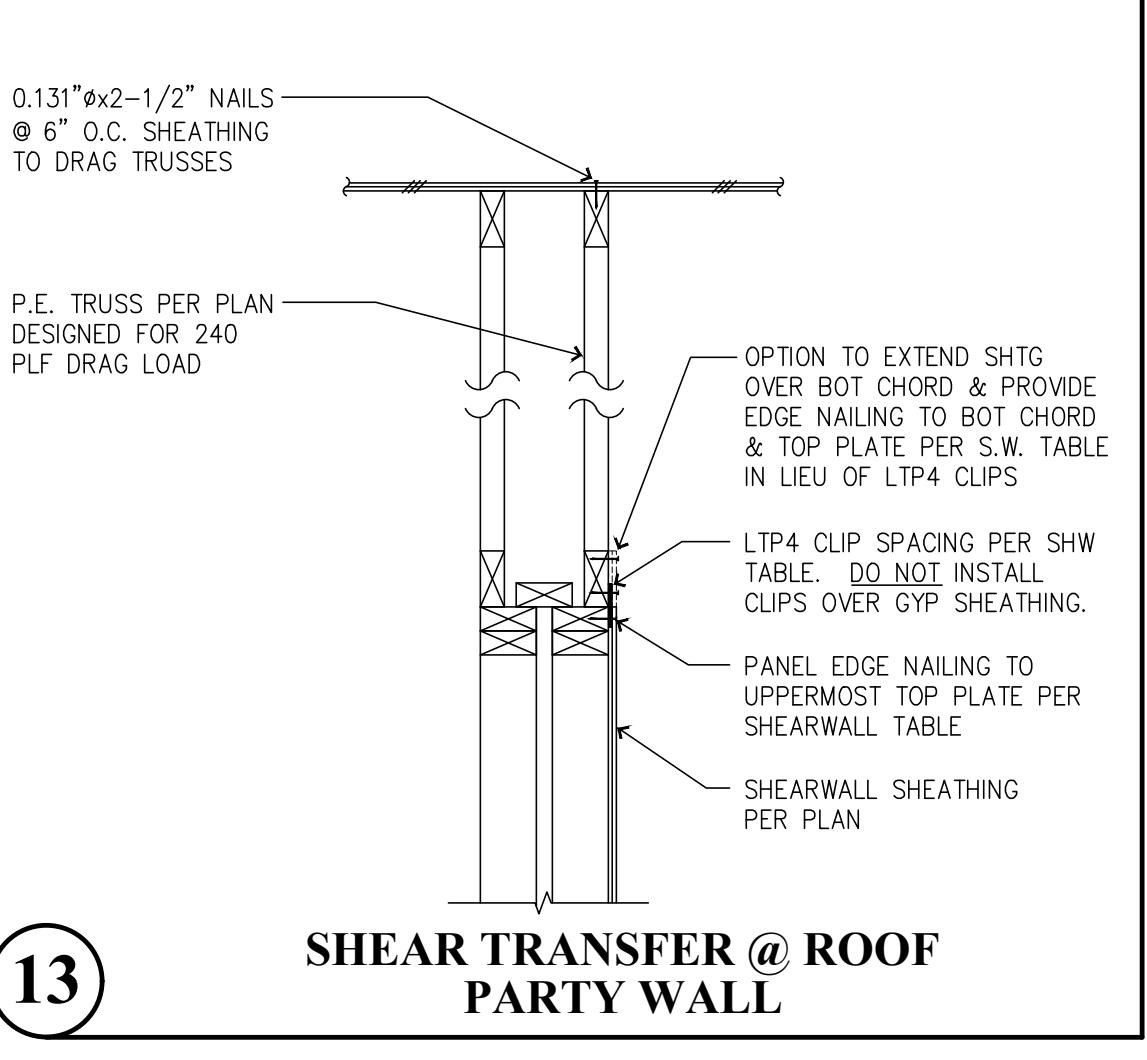


13 SHEAR TRANSFER @ ROOF PARTY WALL

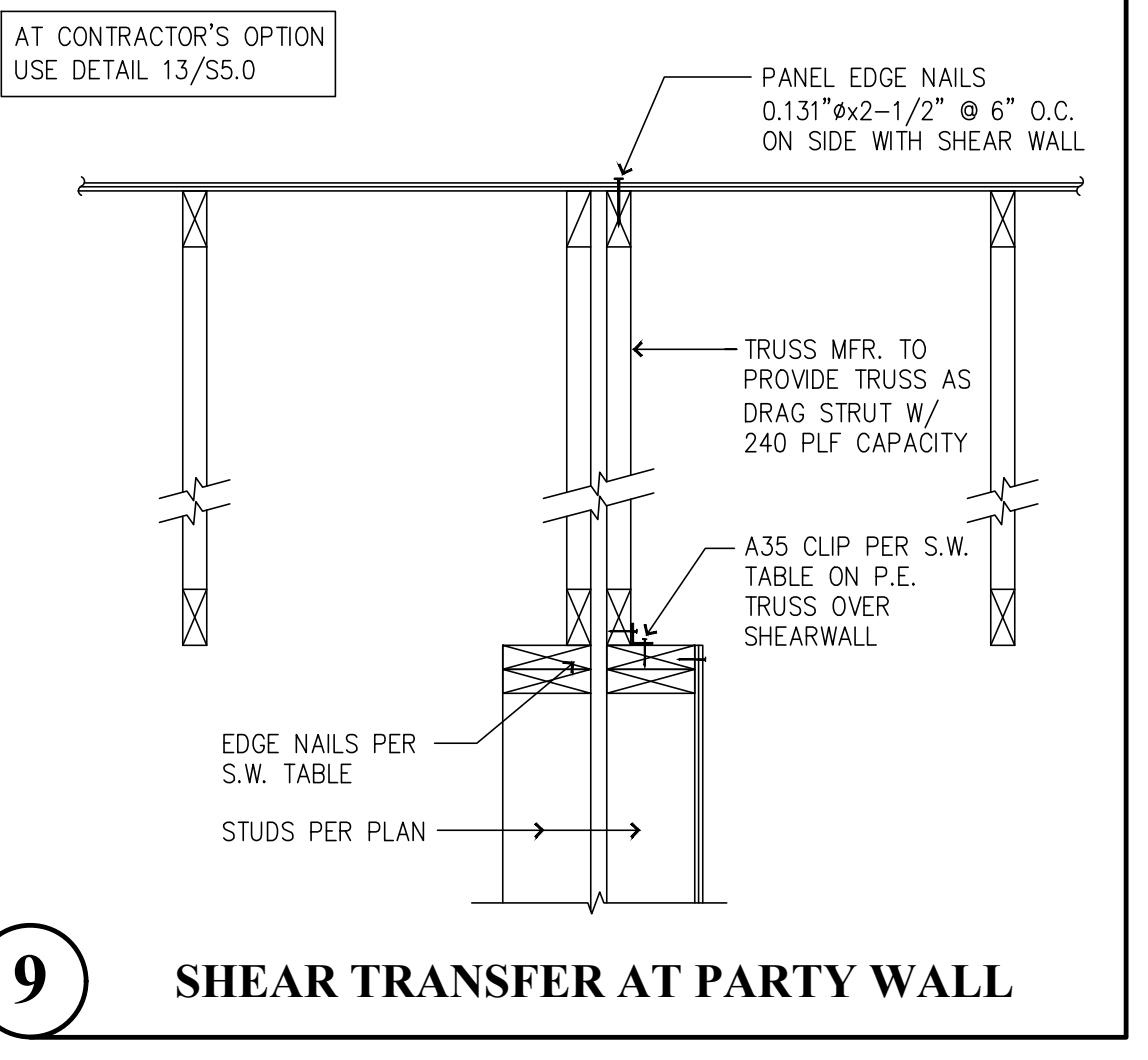


9 SHEAR TRANSFER AT PARTY WALL

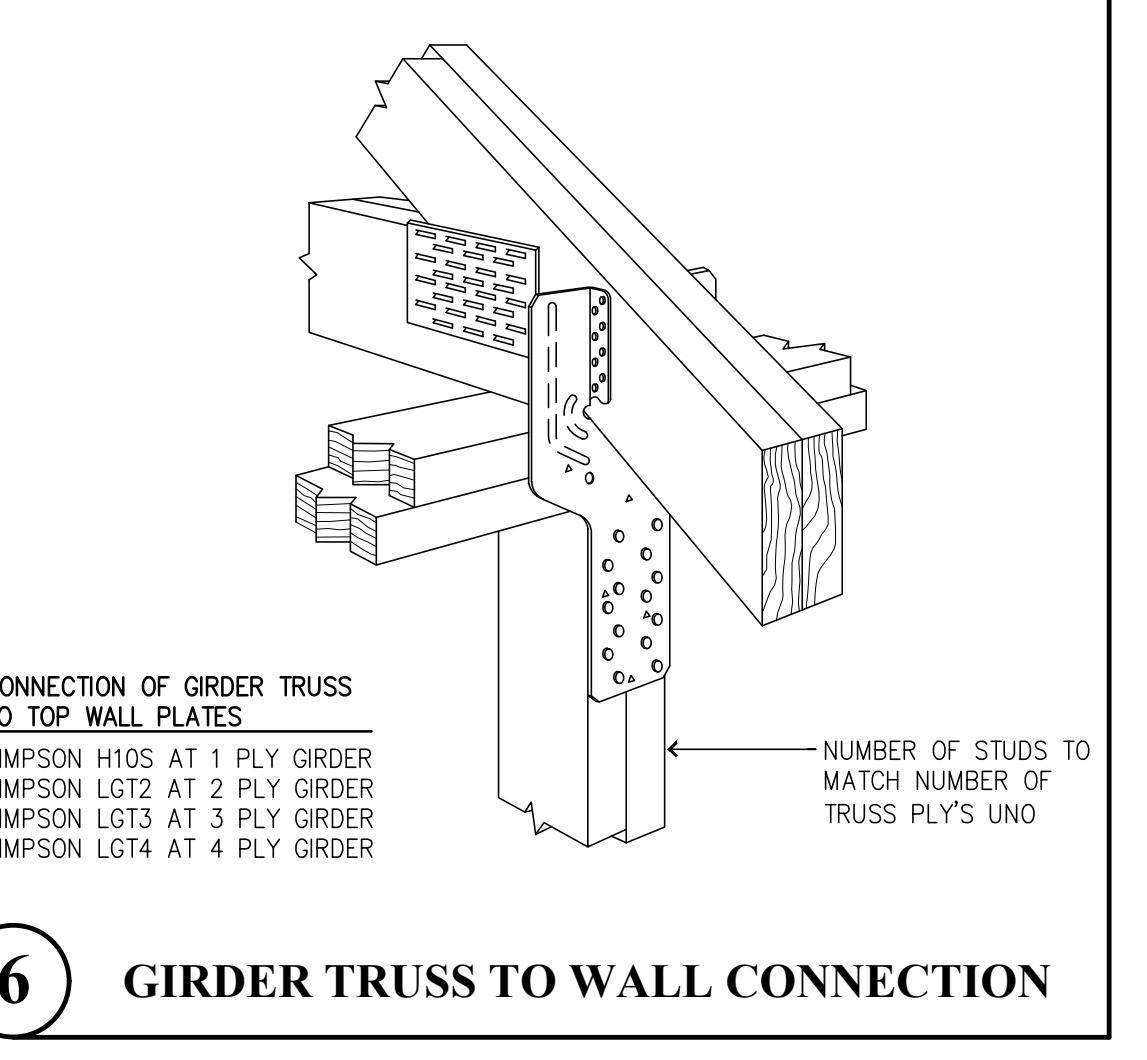


6 GIRDER TRUSS TO WALL CONNECTION

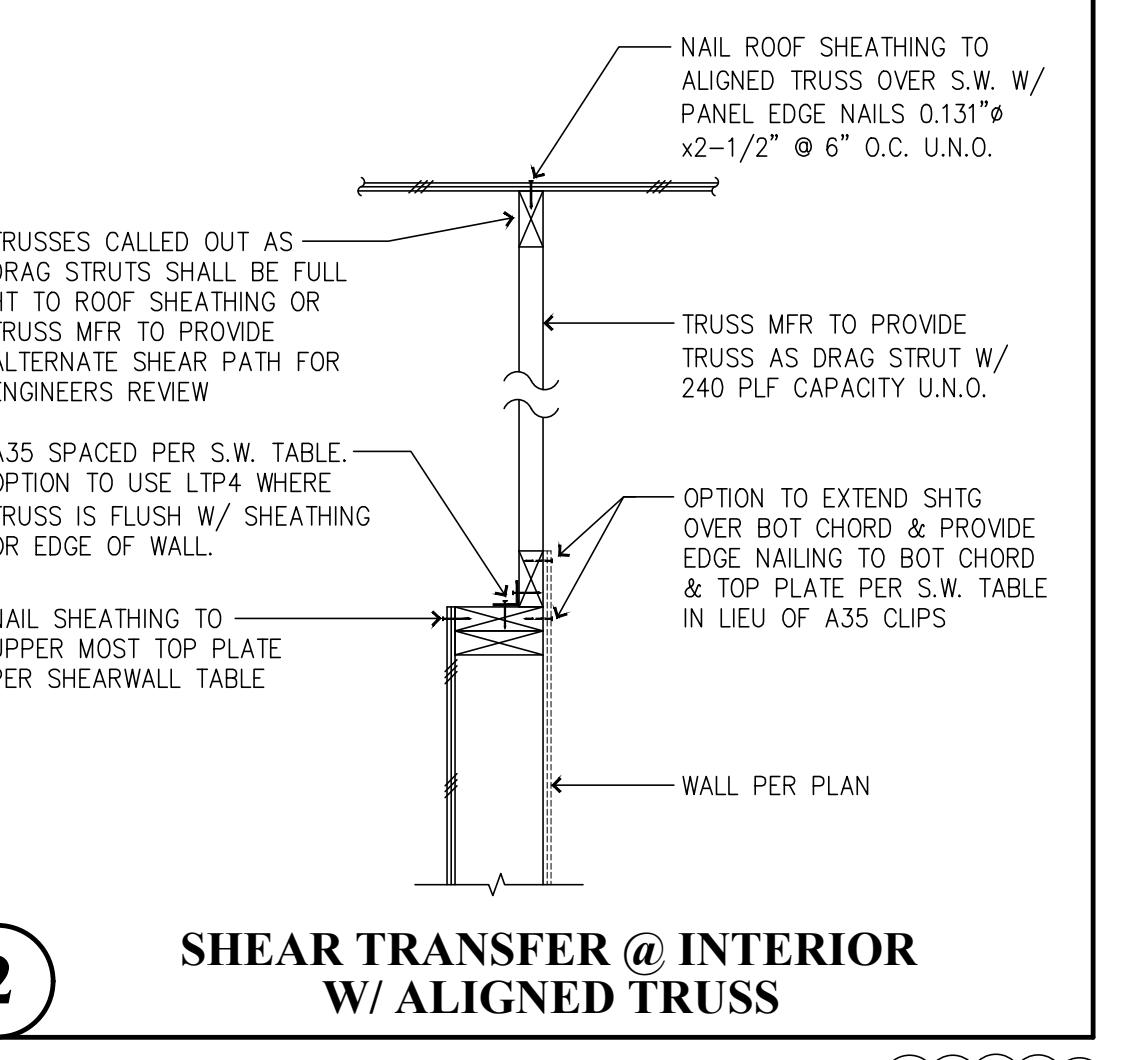


2 SHEAR TRANSFER @ INTERIOR W/ ALIGNED TRUSS

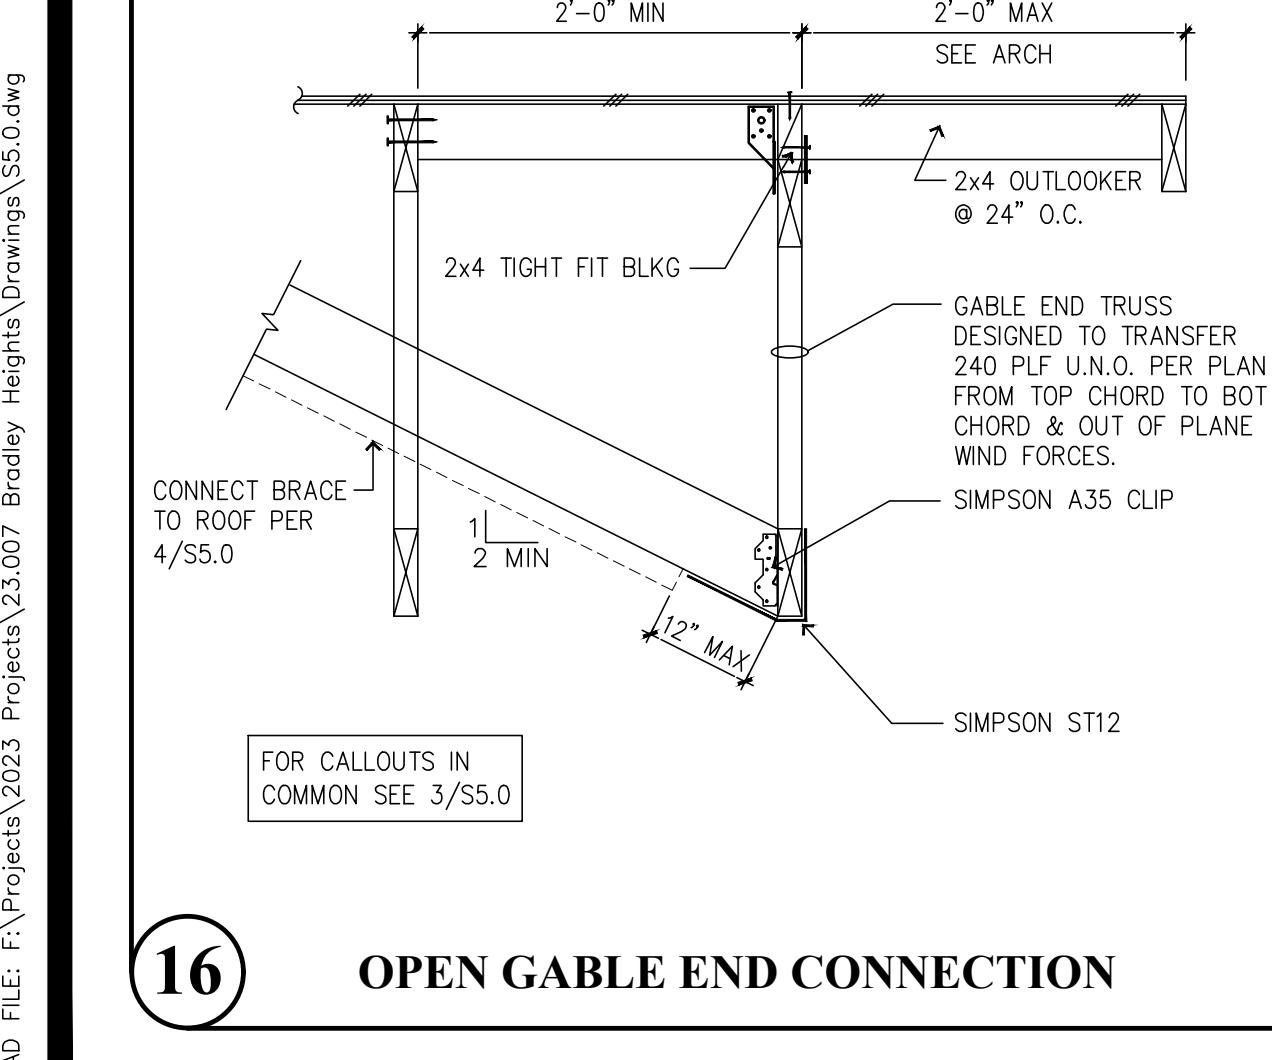


16 OPEN GABLE END CONNECTION

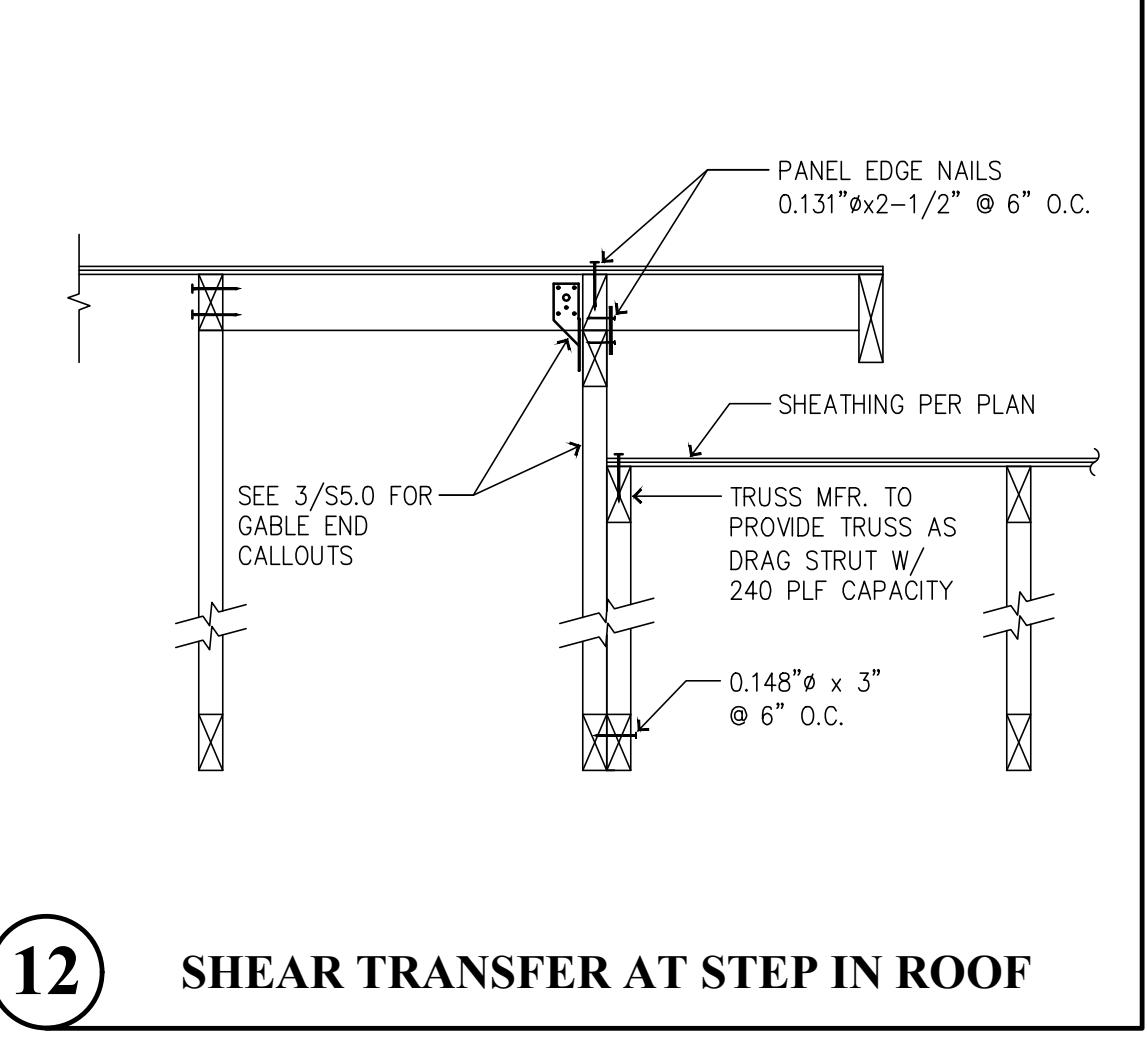


12 SHEAR TRANSFER AT STEP IN ROOF

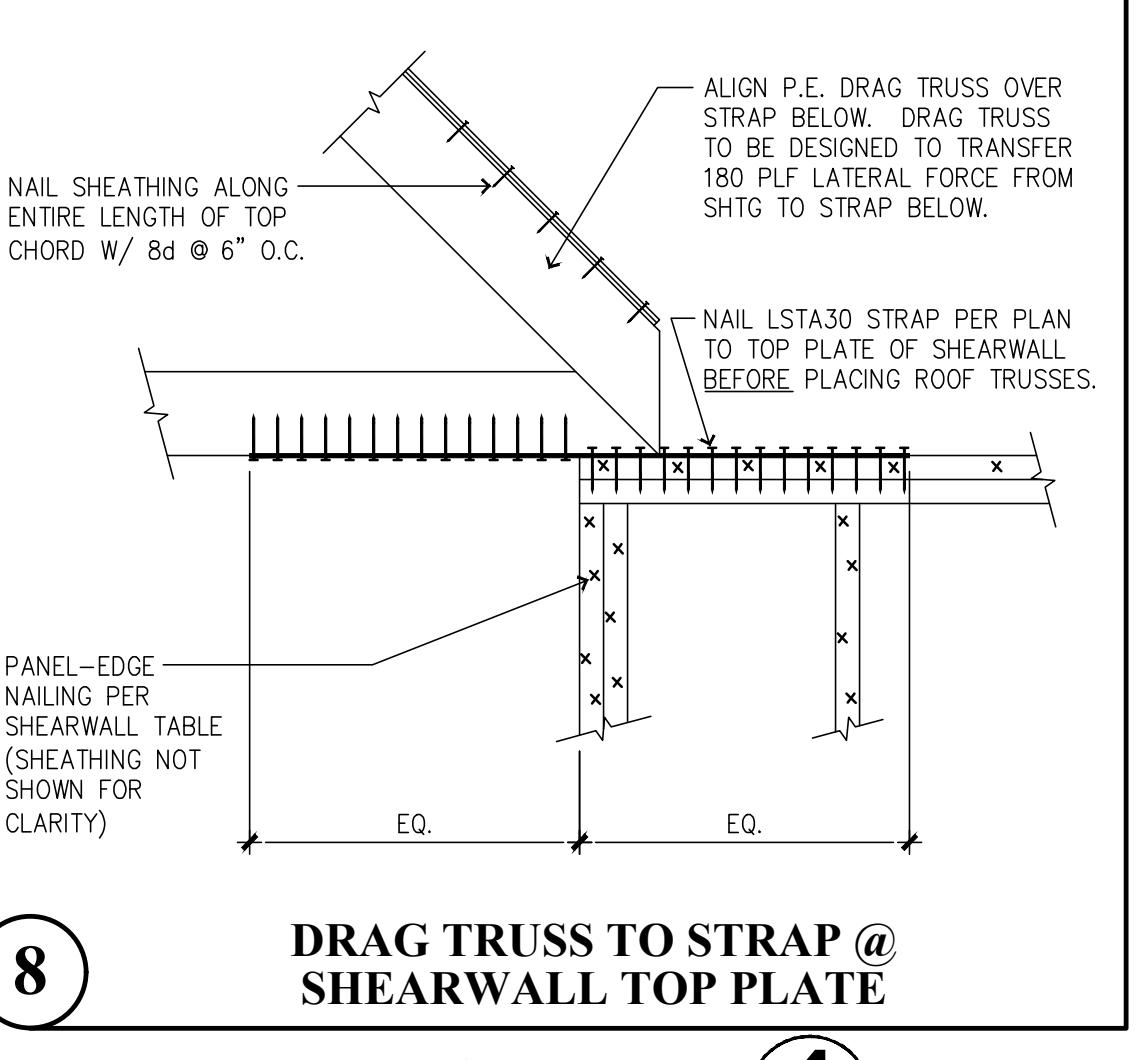

8 DRAG TRUSS TO STRAP @ SHEARWALL TOP PLATE

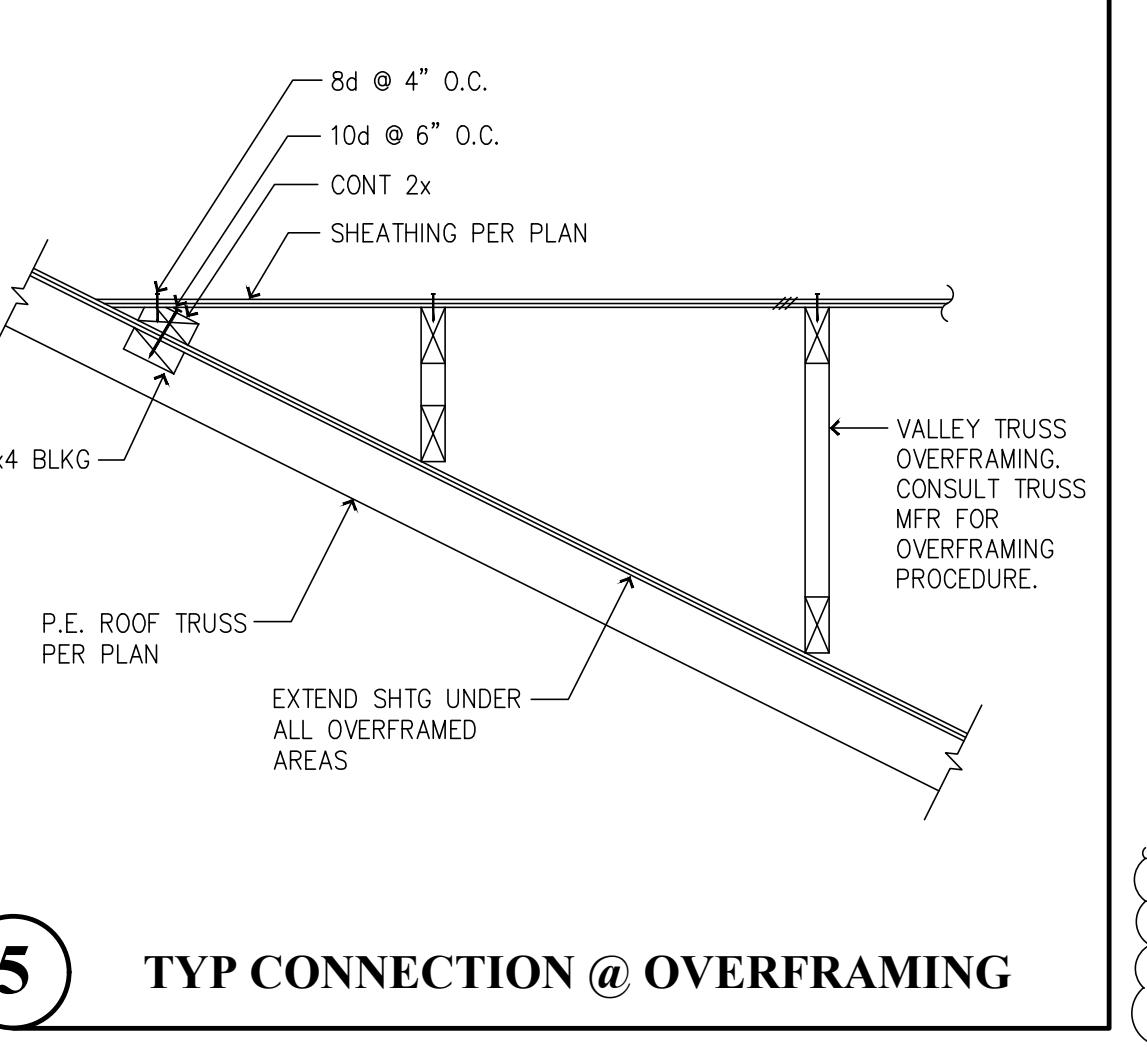

5 TYP CONNECTION @ OVERFRAMING

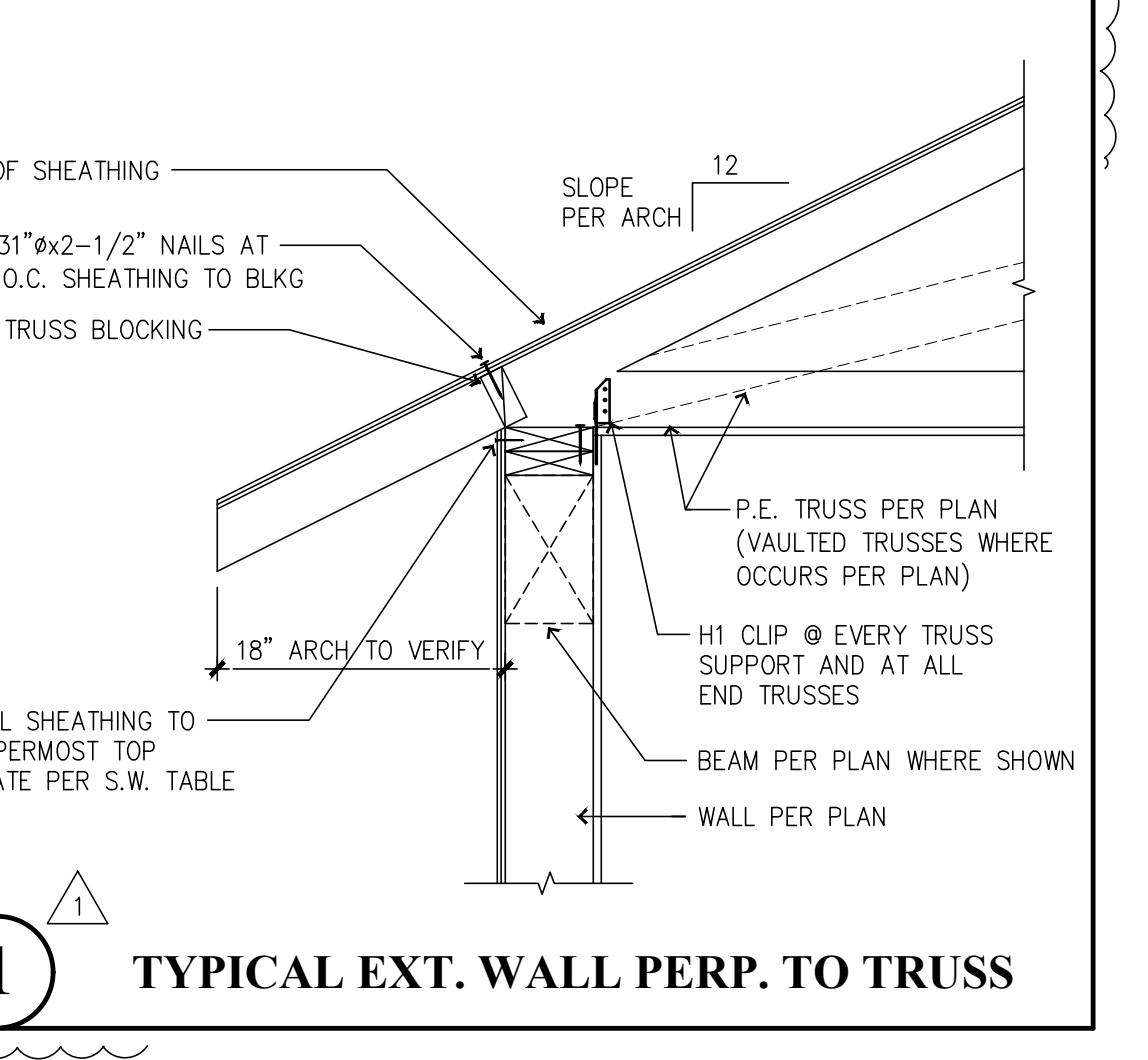

1 TYPICAL EXT. WALL PERP. TO TRUSS

PROJECT NO. : 23-007
DESIGNED BY : TLC, OGK, MRO
DRAWN BY : RSO
ISSUE DATE : 2-20-24
LATEST REV. OF DWG. SET : 4-24-25

SUBMITTAL SET ONLY NOT FOR CONSTRUCTION
THESE DRAWINGS ARE SUBJECT TO REVISIONS
PENDING LOCAL JURISDICTIONAL REVIEW.



S5.0


Revisions to this sheet:
8-30-24 PERMIT CORRECTIONS & OWNER CHANGES
PRMU20240280

Bradley Heights Apartments
202 27th Ave SE
Seattle, Washington
www.solutions4structures.com

Solutions 4_{inc} Structures
A Structural Engineering Corporation

City of Seattle
Development Services
Permitting
Engineering
Fire
Public Works
Planning
Transportation
Utilities
Zoning
Thomas L. Chase, PE
Martin R. Oran, PE
Oleg G. Kondratic, PE
4-24-25

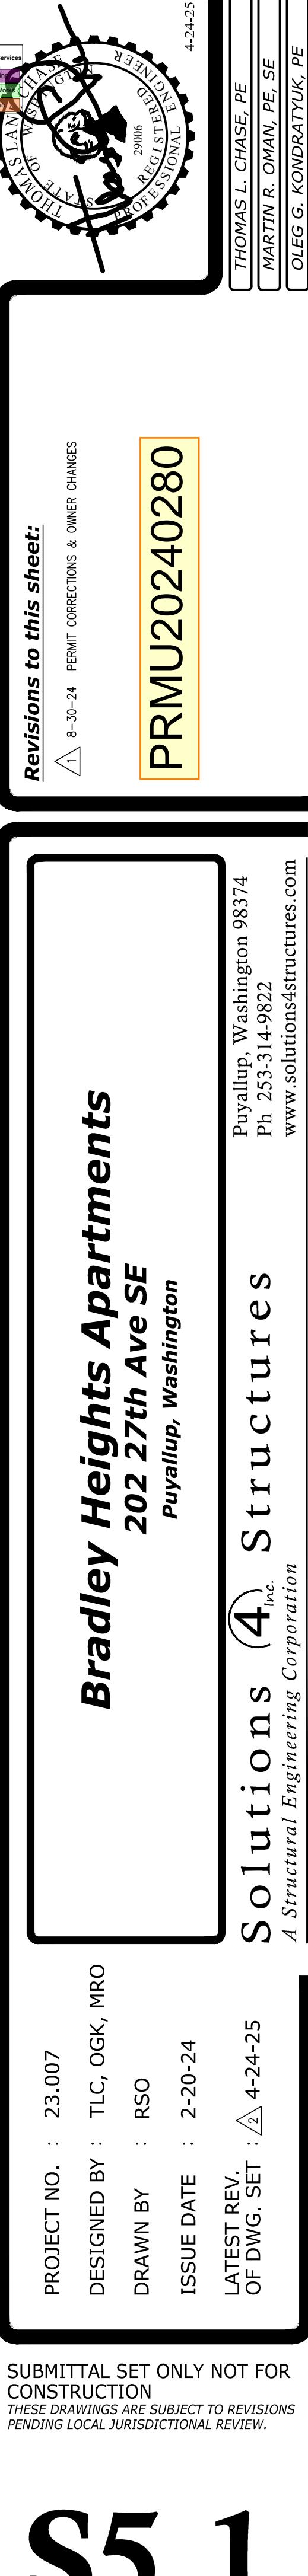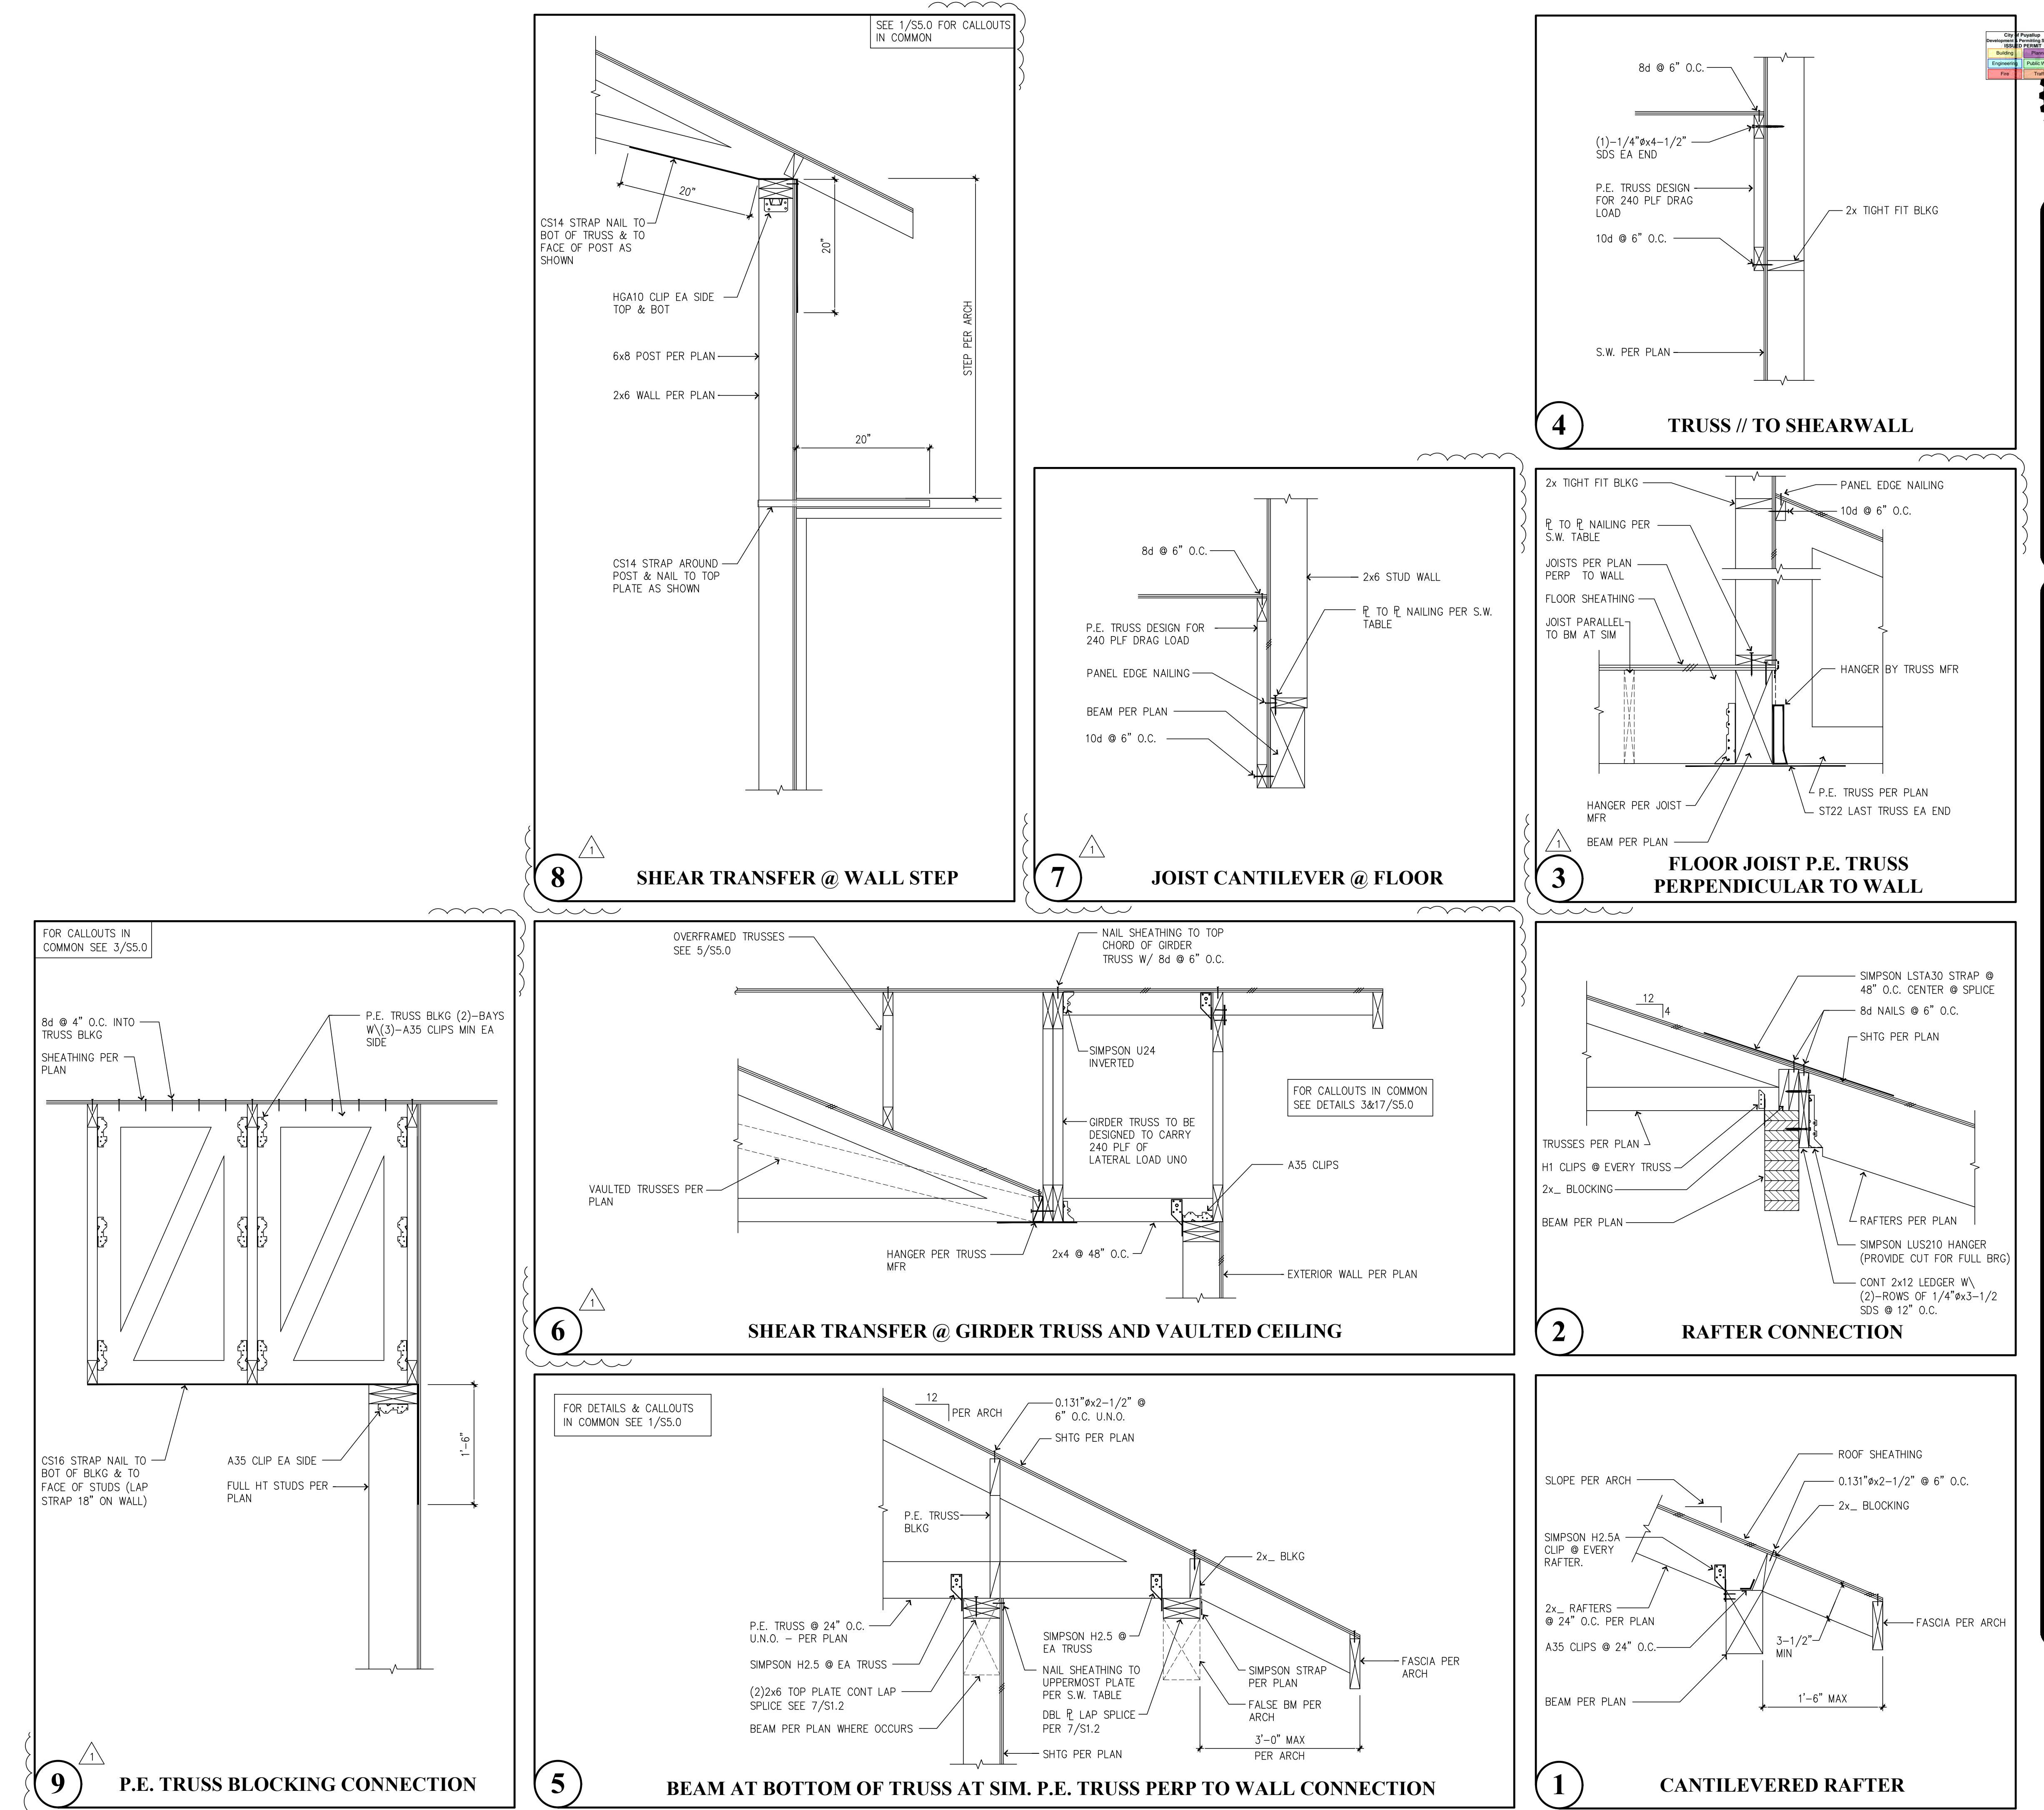

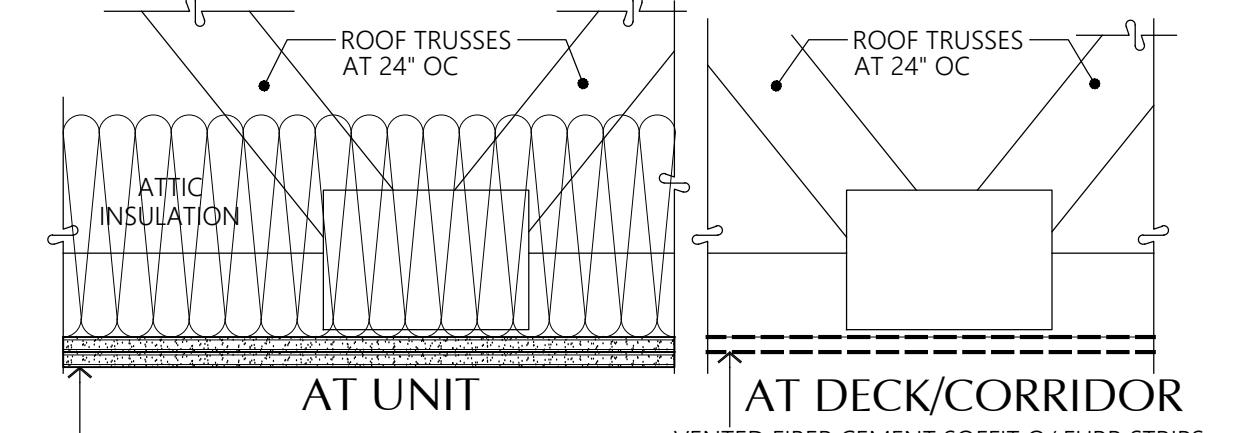

1 HR. UL L514 SYSTEM 9

Finish Flooring - Floor Topping Mixture* - Min. 3/4 in. thickness of floor topping mixture having a minimum compressive strength of 1500 psi. Refer to manufacturer's instructions accompanying the material for specific mix design.

Formulated Materials LLC - Types FR-25, FR-30 and SiteMix
Vapor Barrier - (Optional) Commercial asphalt saturated felt 0.030 in. thick.
Sub-flooring - 15/32" thick plywood or grade "C-D" of Sheathing. Face grain of plywood to be perpendicular to joists with joints staggered.

Alternate Floor Material - (Optional) Resilient material nominal 2-95 mm thick loose laid over subfloor with a top layer thickness that is a minimum of 3/4 in.

Formulated Materials LLC - Types M1, M2, M3, Elite, Duo, R1 and R2

2. Wood Joists - Min. 2 by 10, spaced 16" o.c., fastened

3. Cross Bridging - 1 by 3 in. or min. 2x10 solid blocking

5. Resilient Channels - Formed of 25 MSG galv steel, spaced 24 in. o.c. perpendicular to joists. Channels overlapped at splices 4 in. and fastened to each joist with 1 1/4 in. long, furring channel screw.

6. Gypsum Board* - Nom. 5/8 in. thick, 4 ft wide, installed with long dimension perpendicular to resilient channels and the side edges of the board located between joists. Fastened to resilient channels with 1 in. long Type S bugle head screws spaced 8 in. o.c. End joints of wallboard similarly fastened to additional pieces of resilient channel to extend a min. of 1 in. beyond ends of butt joint. Screw located 3/4 in. in distance from sides and 1/2 in. min from ends of wallboard sheets.

7. Finish System - Vinyl, dry or premixed joint compound, applied in two coats to joints and screw-heads. Nom. 2 in. wide paper tape embedded in first layer of compound over all joints. As an alternate, nom. 3/32 in. thick veneer plaster may be applied to the entire surface of gypsum board.

Ceiling provides one hour fire resistance protection for trusses.

1-HR GA File No. RC 2602


Base layer 5/8" type X gypsum wallboard applied at right angles to wood roof trusses 24" o.c. with 1/2" Type W or drywall screws 24" o.c. Face layer 5/8" type X gypsum wallboard or gypsum veneer base applied at right angles to trusses with 1/4" Type W or drywall screws 12" o.c. at joints and intermediate and 1/2" Type G drywall screws 12" o.c. placed 2" back on either side of end joints. Joints offset 1/4" and furred. Gypsum board is applied to wood structural panels applied at right angles to trusses with 8d nails. Appropriate roof covering. Ceiling provides one hour fire resistance protection for trusses.

17 TYPICAL 1-HR ROOF/CEILING SECTION

1-1/2" = 1'-0"

13 TYPICAL FLOOR SECTION

1 1/2" = 1'-0"

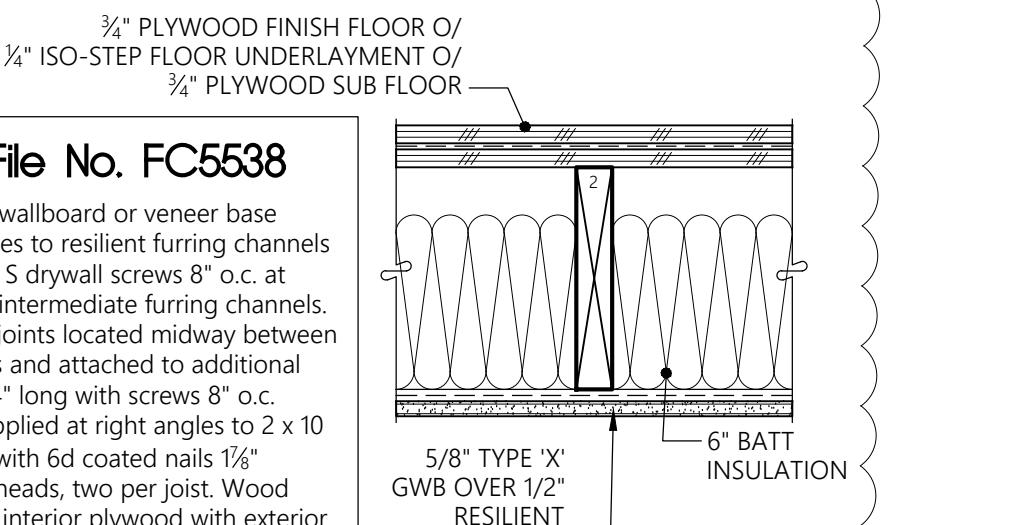

1 HR. GA File No. FC5538


1/2" type X gypsum wallboard or veneer base applied at right angles to resilient furring channels 24" o.c. with 1" Type S drywall screws 8" o.c. at ends and 12" o.c. at intermediate furring channels. Gypsum board end joints located midway between continuous channels and attached to additional pieces of channel 64" long with screws 8" o.c. Resilient channels applied at right angles to 2 x 10 wood joists 16" o.c. with 6d coated nails 1/4" long, .085 shank, 1/2" heads, two per joist. Wood joists supporting 5/8" particle board, 15 psf 3/8" glass fiber insulation batts, 7 pcf, friction fit in joist cavities supported alternately every 12" by wire rods and resilient channels.

SOUND

51 STC TL 03-061a
61 IIC
(BASED ON ENGINEERING ANALYSIS OF
TL 03-027 WITH THE ADDITION OF 1/4"
ISO-STEP UNDERLayment
(42 IIC + 19 IIC)


14 FLOOR BENEATH TUB SECTION

1 1/2" = 1'-0"

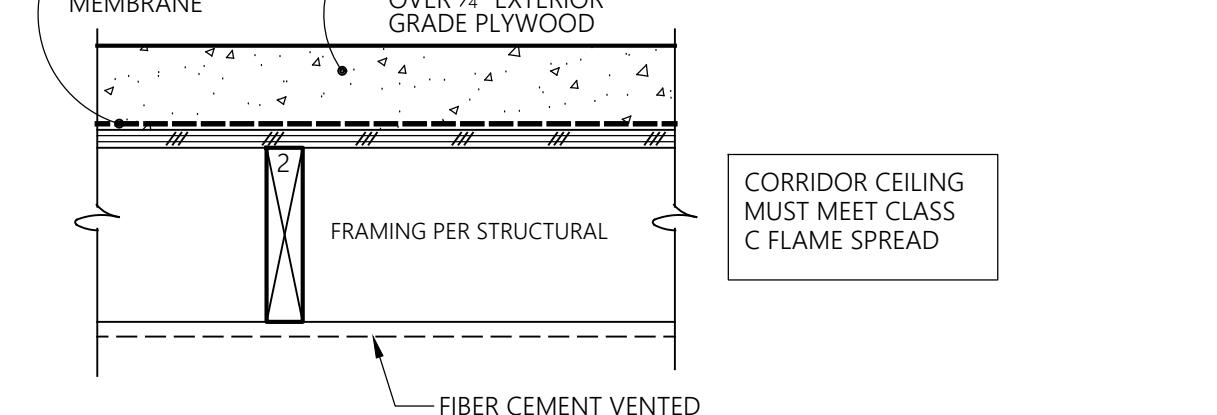


18 SPACED DECKING FLOOR SECTION

1 1/2" = 1'-0"

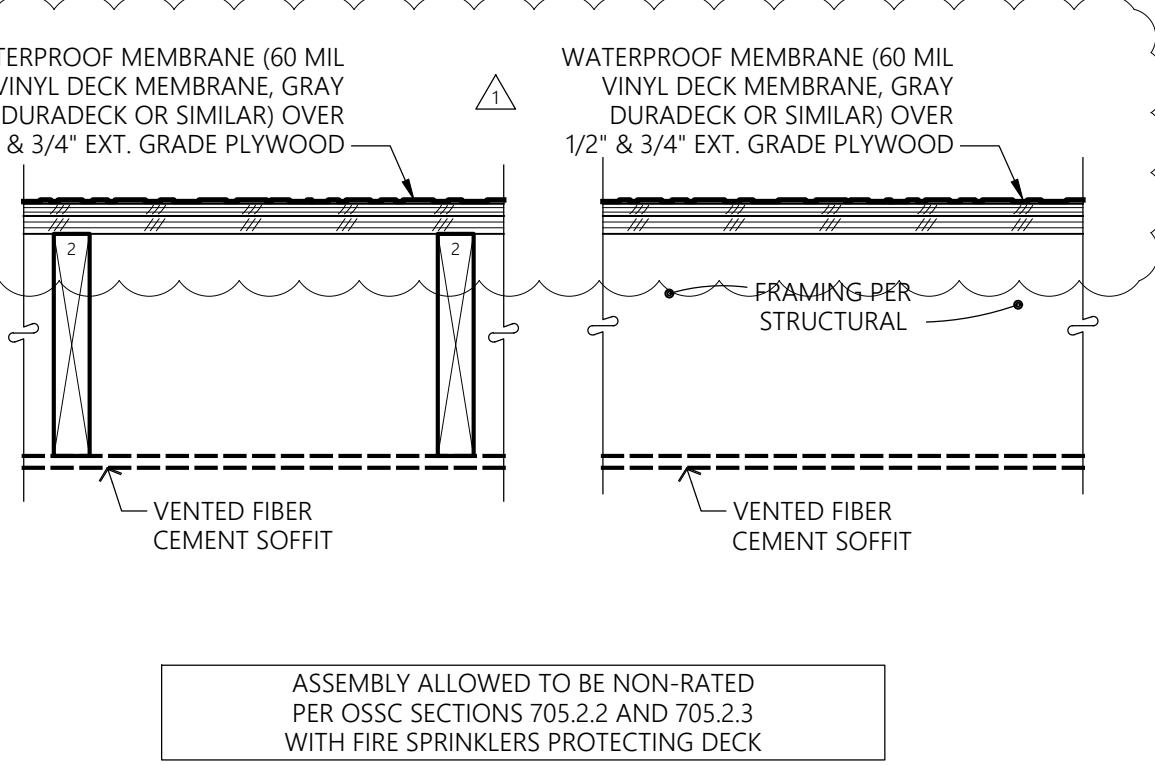


19 WATERPROOF DECK FLOOR SECTION

1 1/2" = 1'-0"

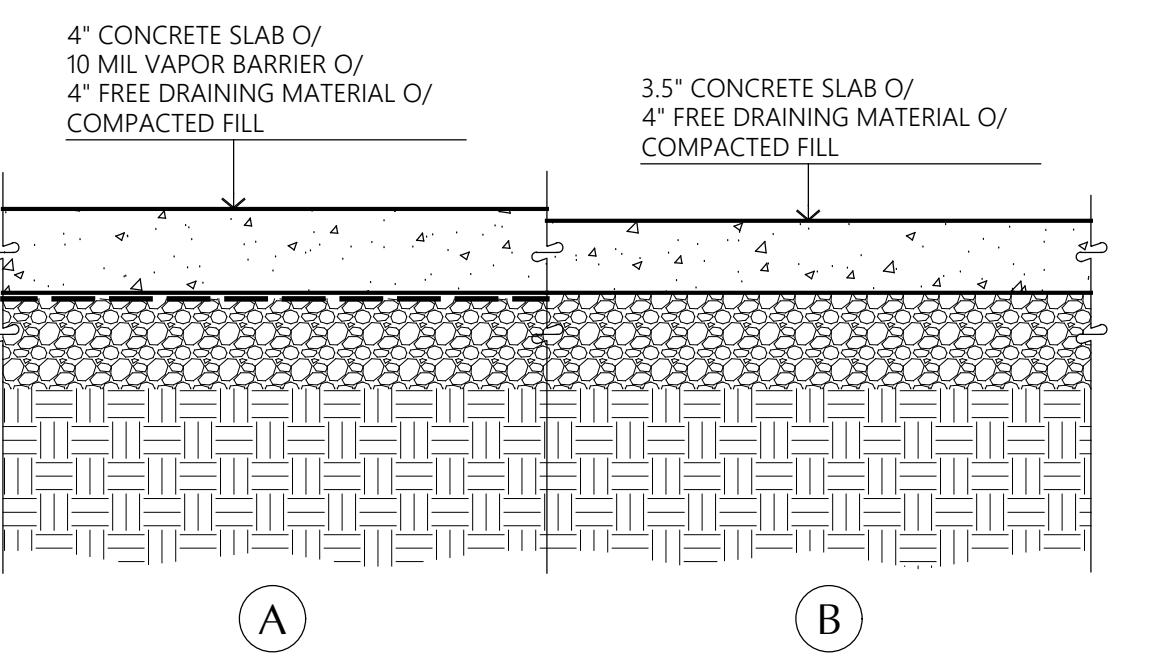

20 TYP. SLAB-ON-GRADE SECTION

1 1/2" = 1'-0"

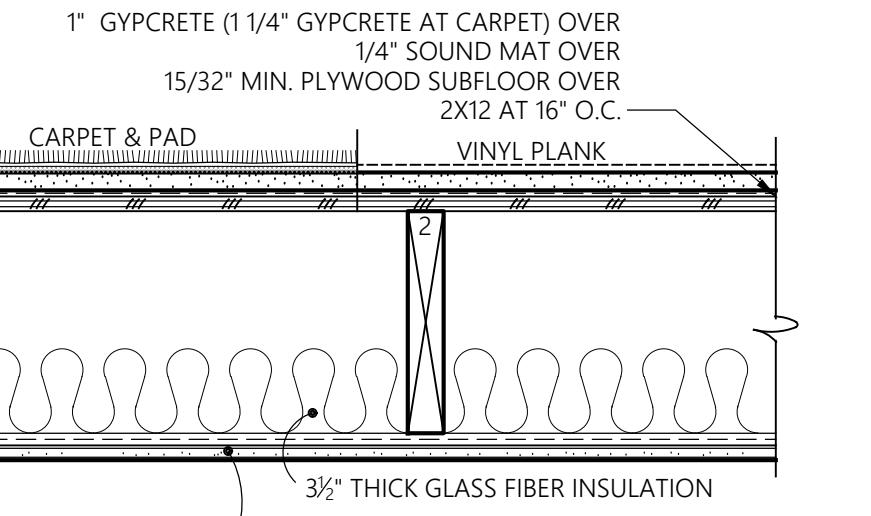

1" GYPCRETE (1 1/4" GYPCRETE AT CARPET) OVER
1/4" SOUND MAT OVER
15/32" MIN. PLYWOOD SUBFLOOR OVER
2X12 AT 16" O.C.

CARPET & PAD
VINYL PLANK

3/8" THICK GLASS FIBER INSULATION

TYVEK COMMERCIAL W.R.B.
EXTERIOR SHEATHING PER STRUCTURAL

EXTERIOR

EXTERIOR

INTERIOR

INTERIOR</p

Details

Bradley Heights Apartments

Puyallup, Wa

Timberlane Partners

Revisions

PRMU20240280

Initial Publish Date:

Date Plotted:

5-1-25

Job No.:


23-06

Drawn By:


APT/HDM

Sheet No.:


D2

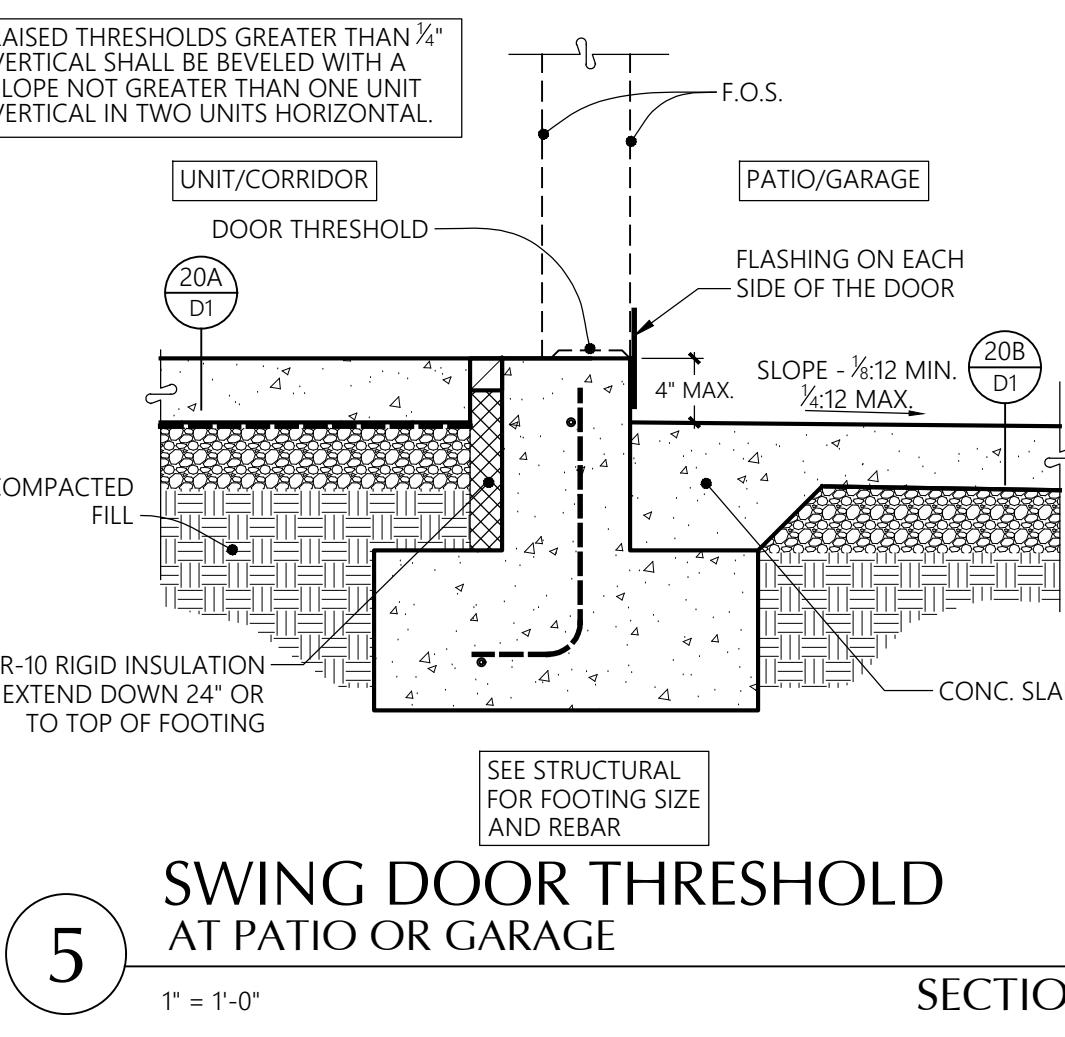


5 SWING DOOR THRESHOLD
AT PATIO OR GARAGE
SECTION
1" = 1'-0"

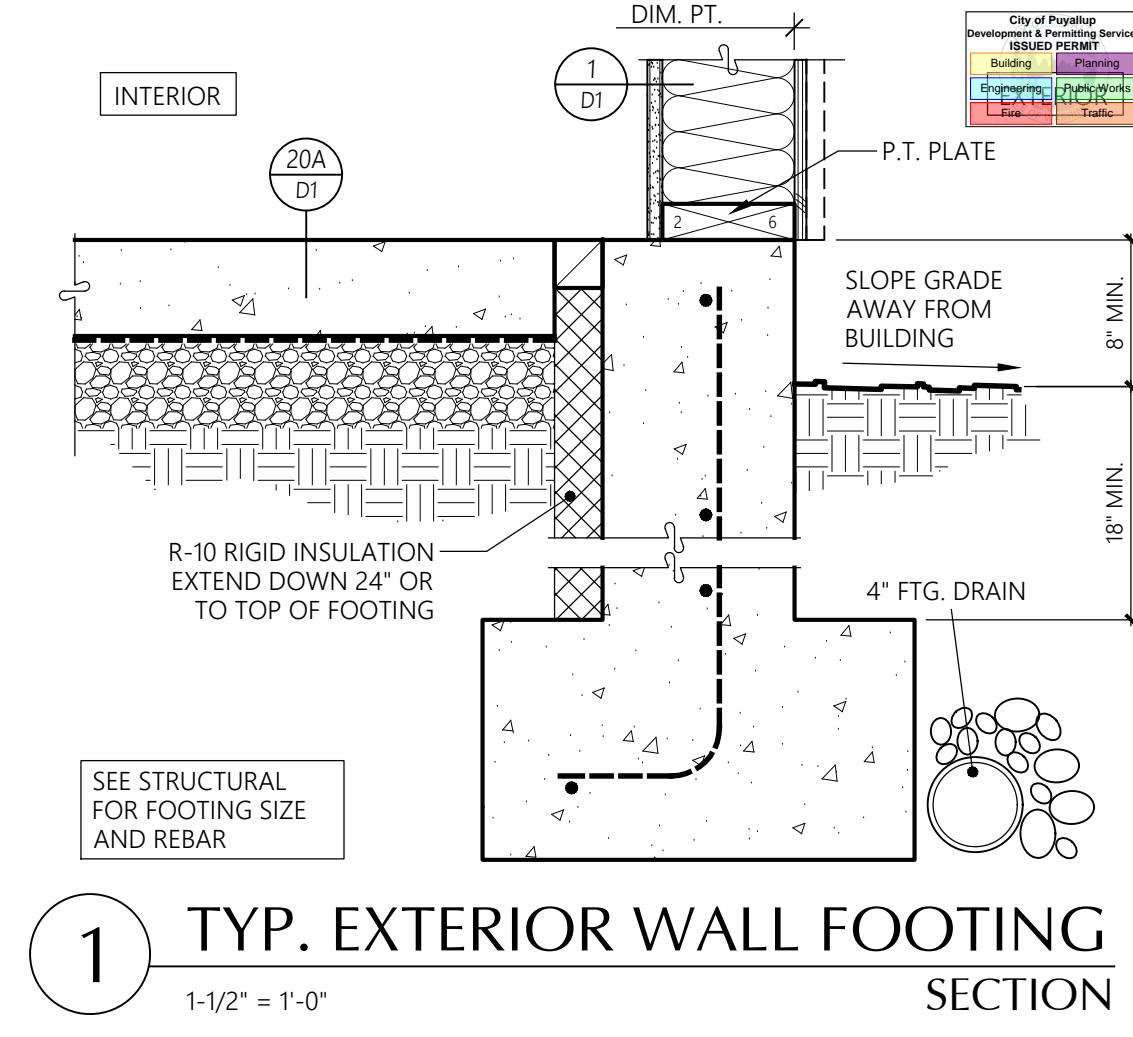


1 TYP. EXTERIOR WALL FOOTING
SECTION
1-1/2" = 1'-0"

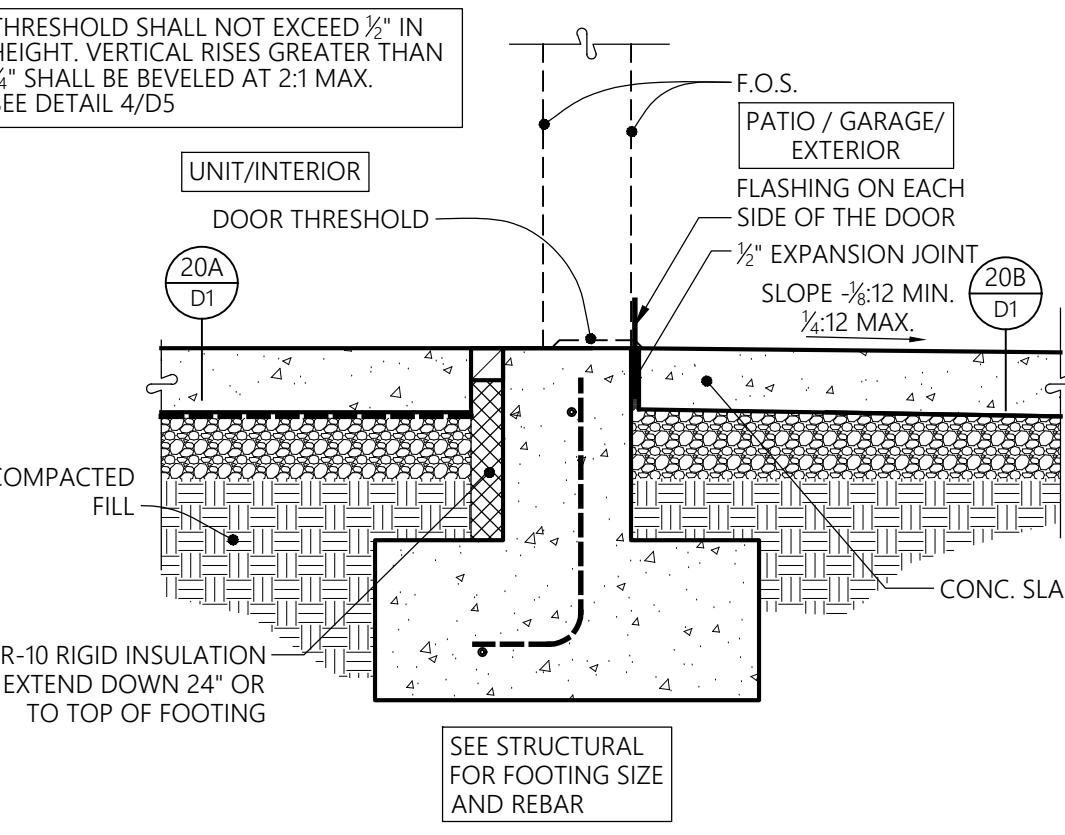


6 SWING DOOR THRESHOLD
AT ACCESSIBLE ENTRANCE
SECTION
1" = 1'-0"

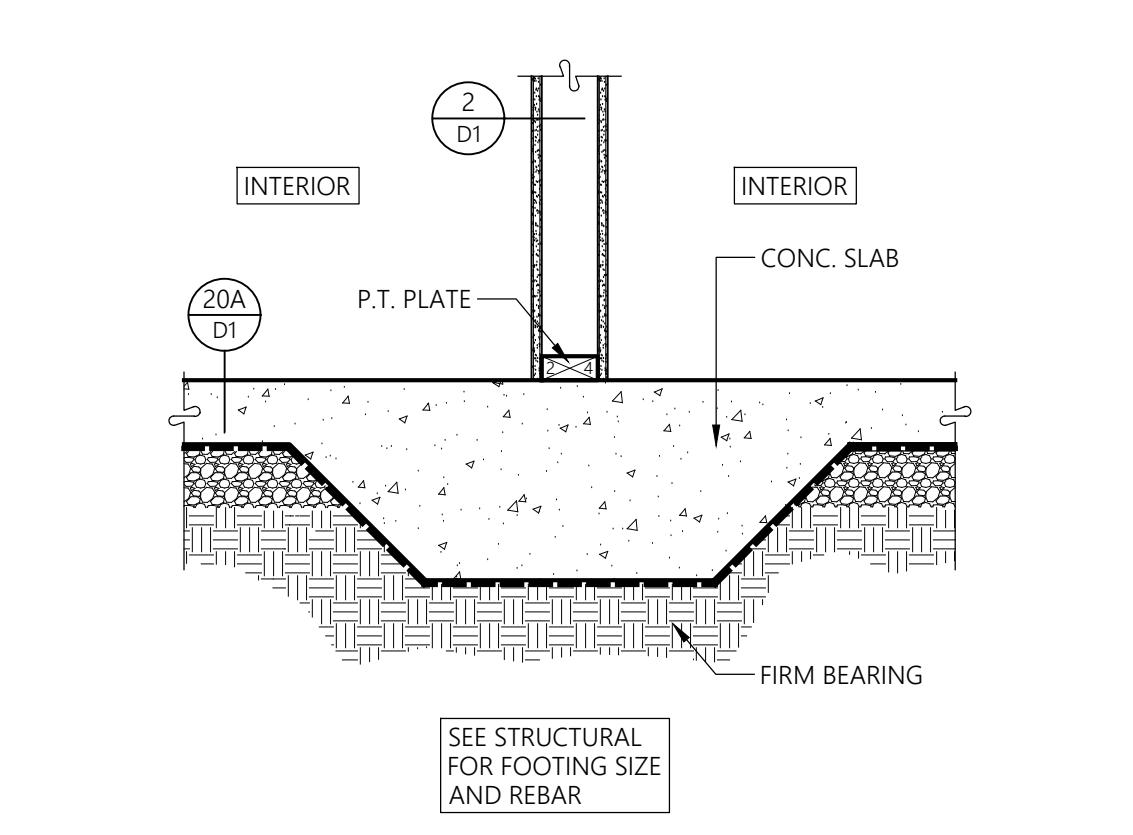


2 INTERIOR WALL FOOTING
SECTION
1" = 1'-0"

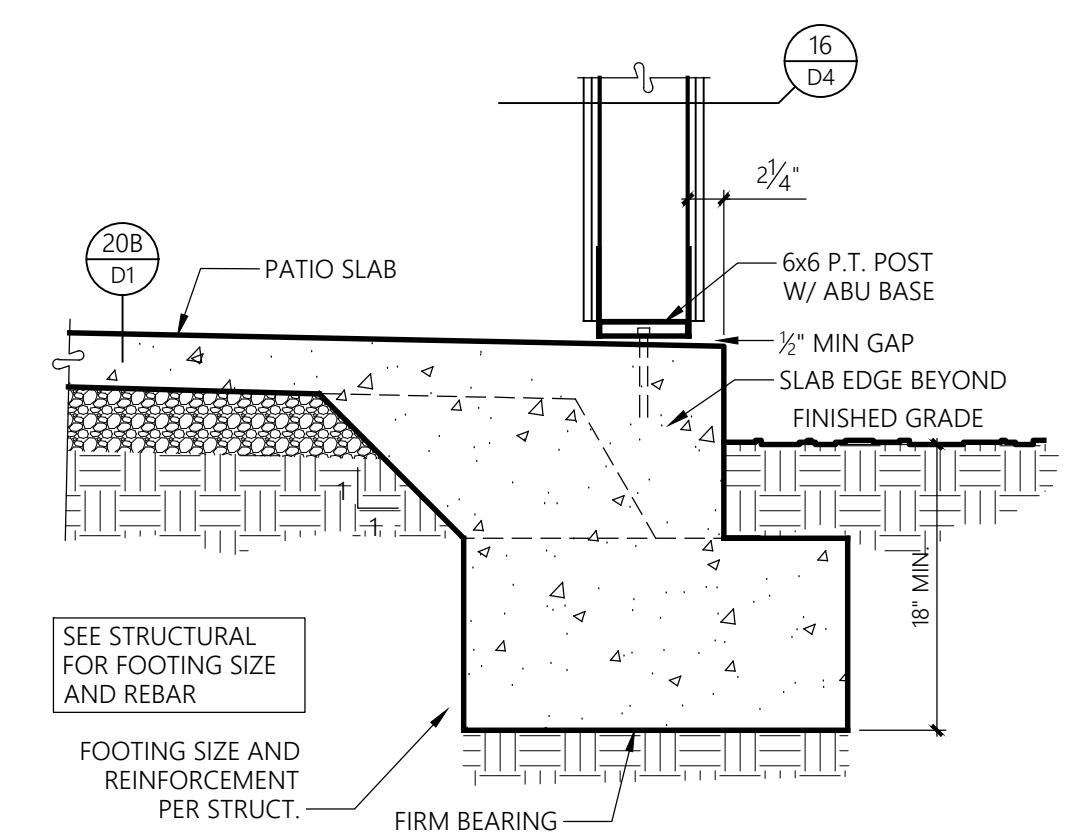


7 POST FOOTING AT PATIO
SECTION
1" = 1'-0"

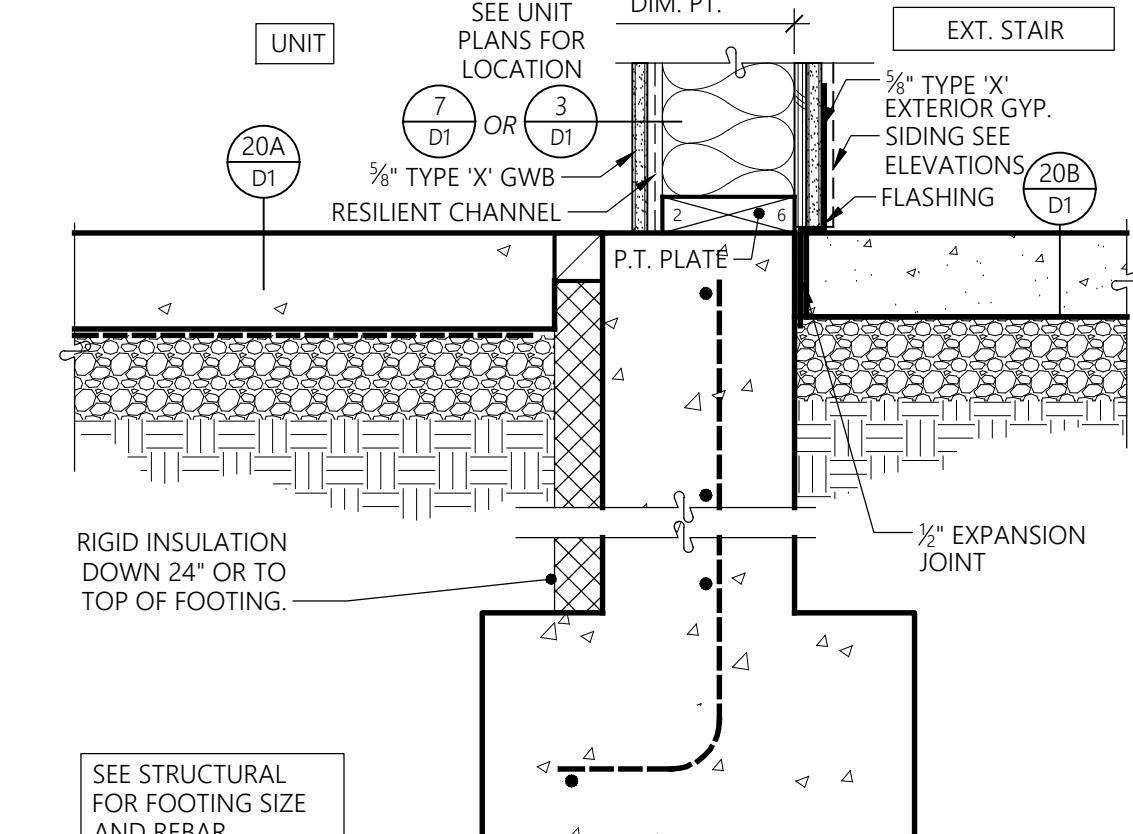


3 TYP. STAIR WALL FOOTING
SECTION
1 1/2" = 1'-0"

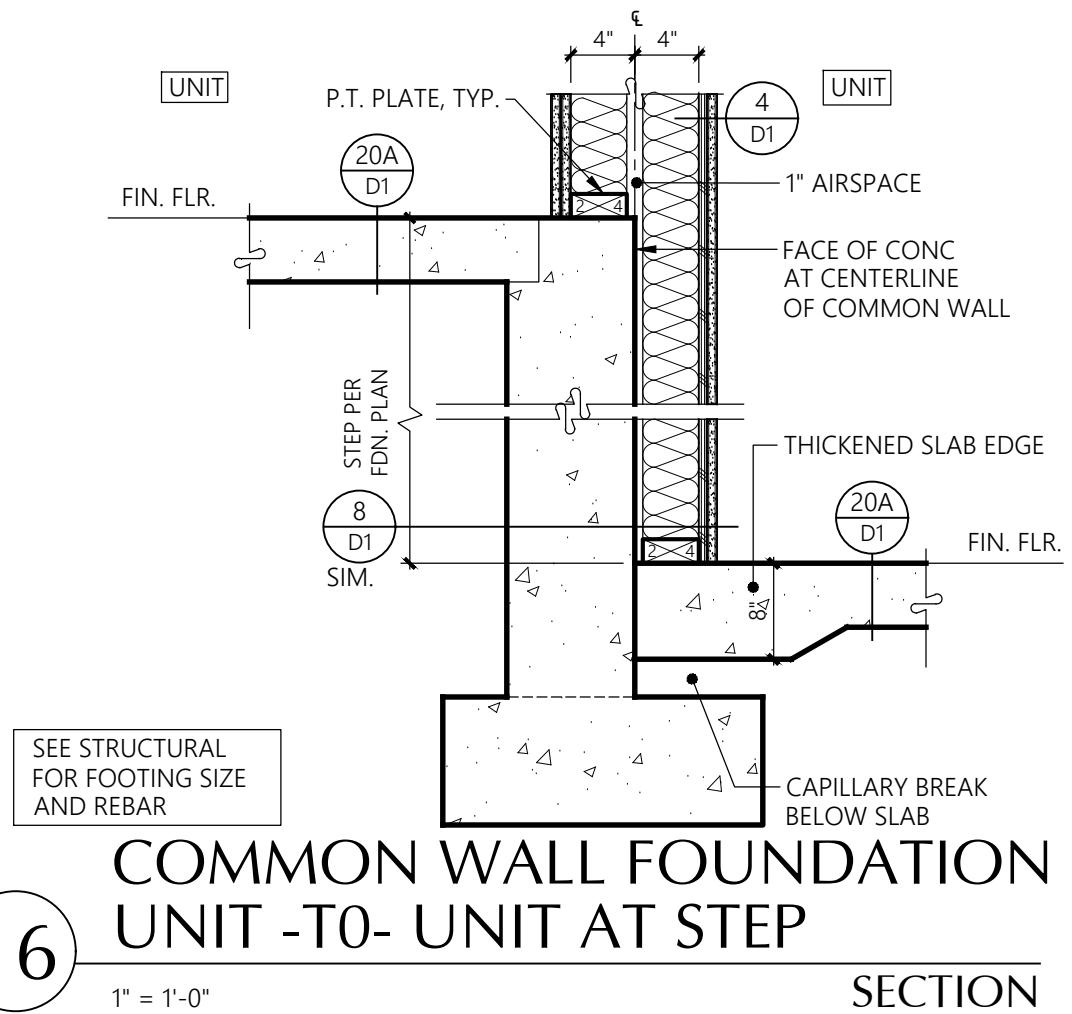


16 COMMON WALL FOUNDATION
UNIT -TO- UNIT AT STEP
SECTION
1" = 1'-0"

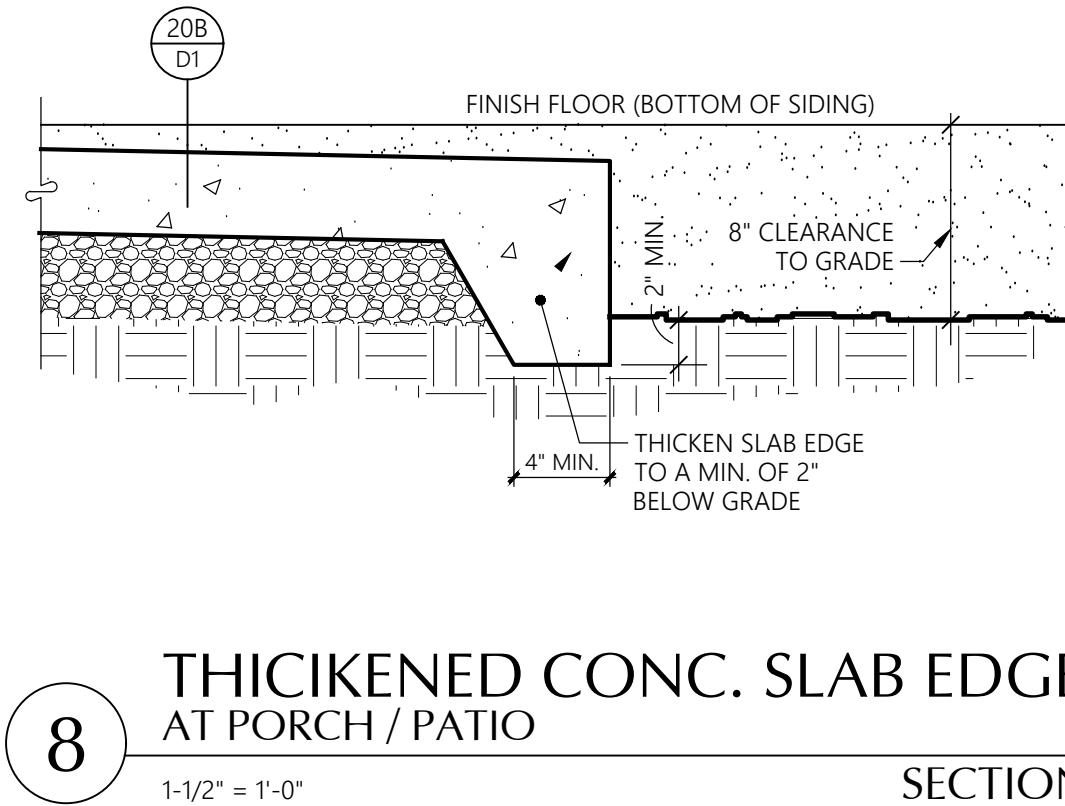

8 THICKENED CONC. SLAB EDGE
AT PORCH / PATIO
SECTION
1-1/2" = 1'-0"

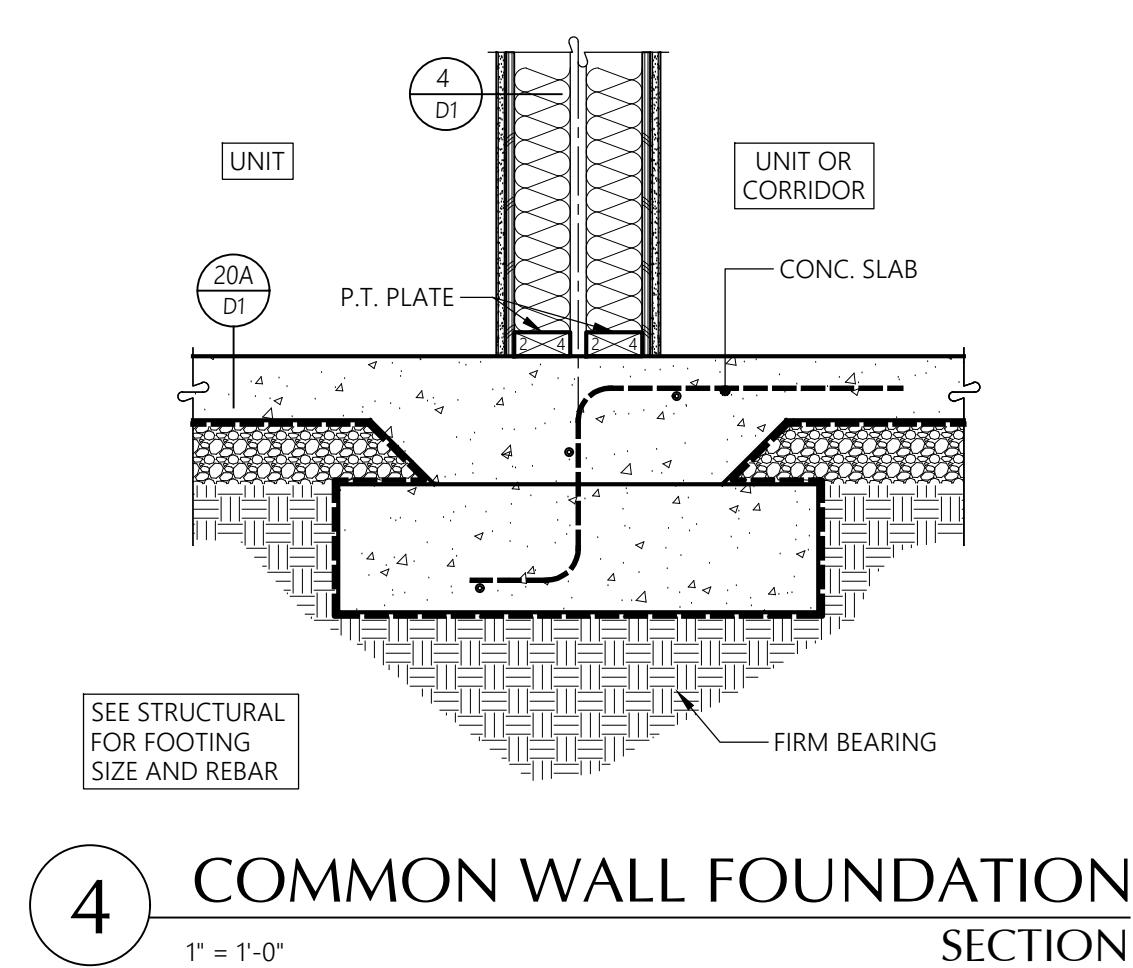

4 COMMON WALL FOUNDATION
SECTION
1" = 1'-0"

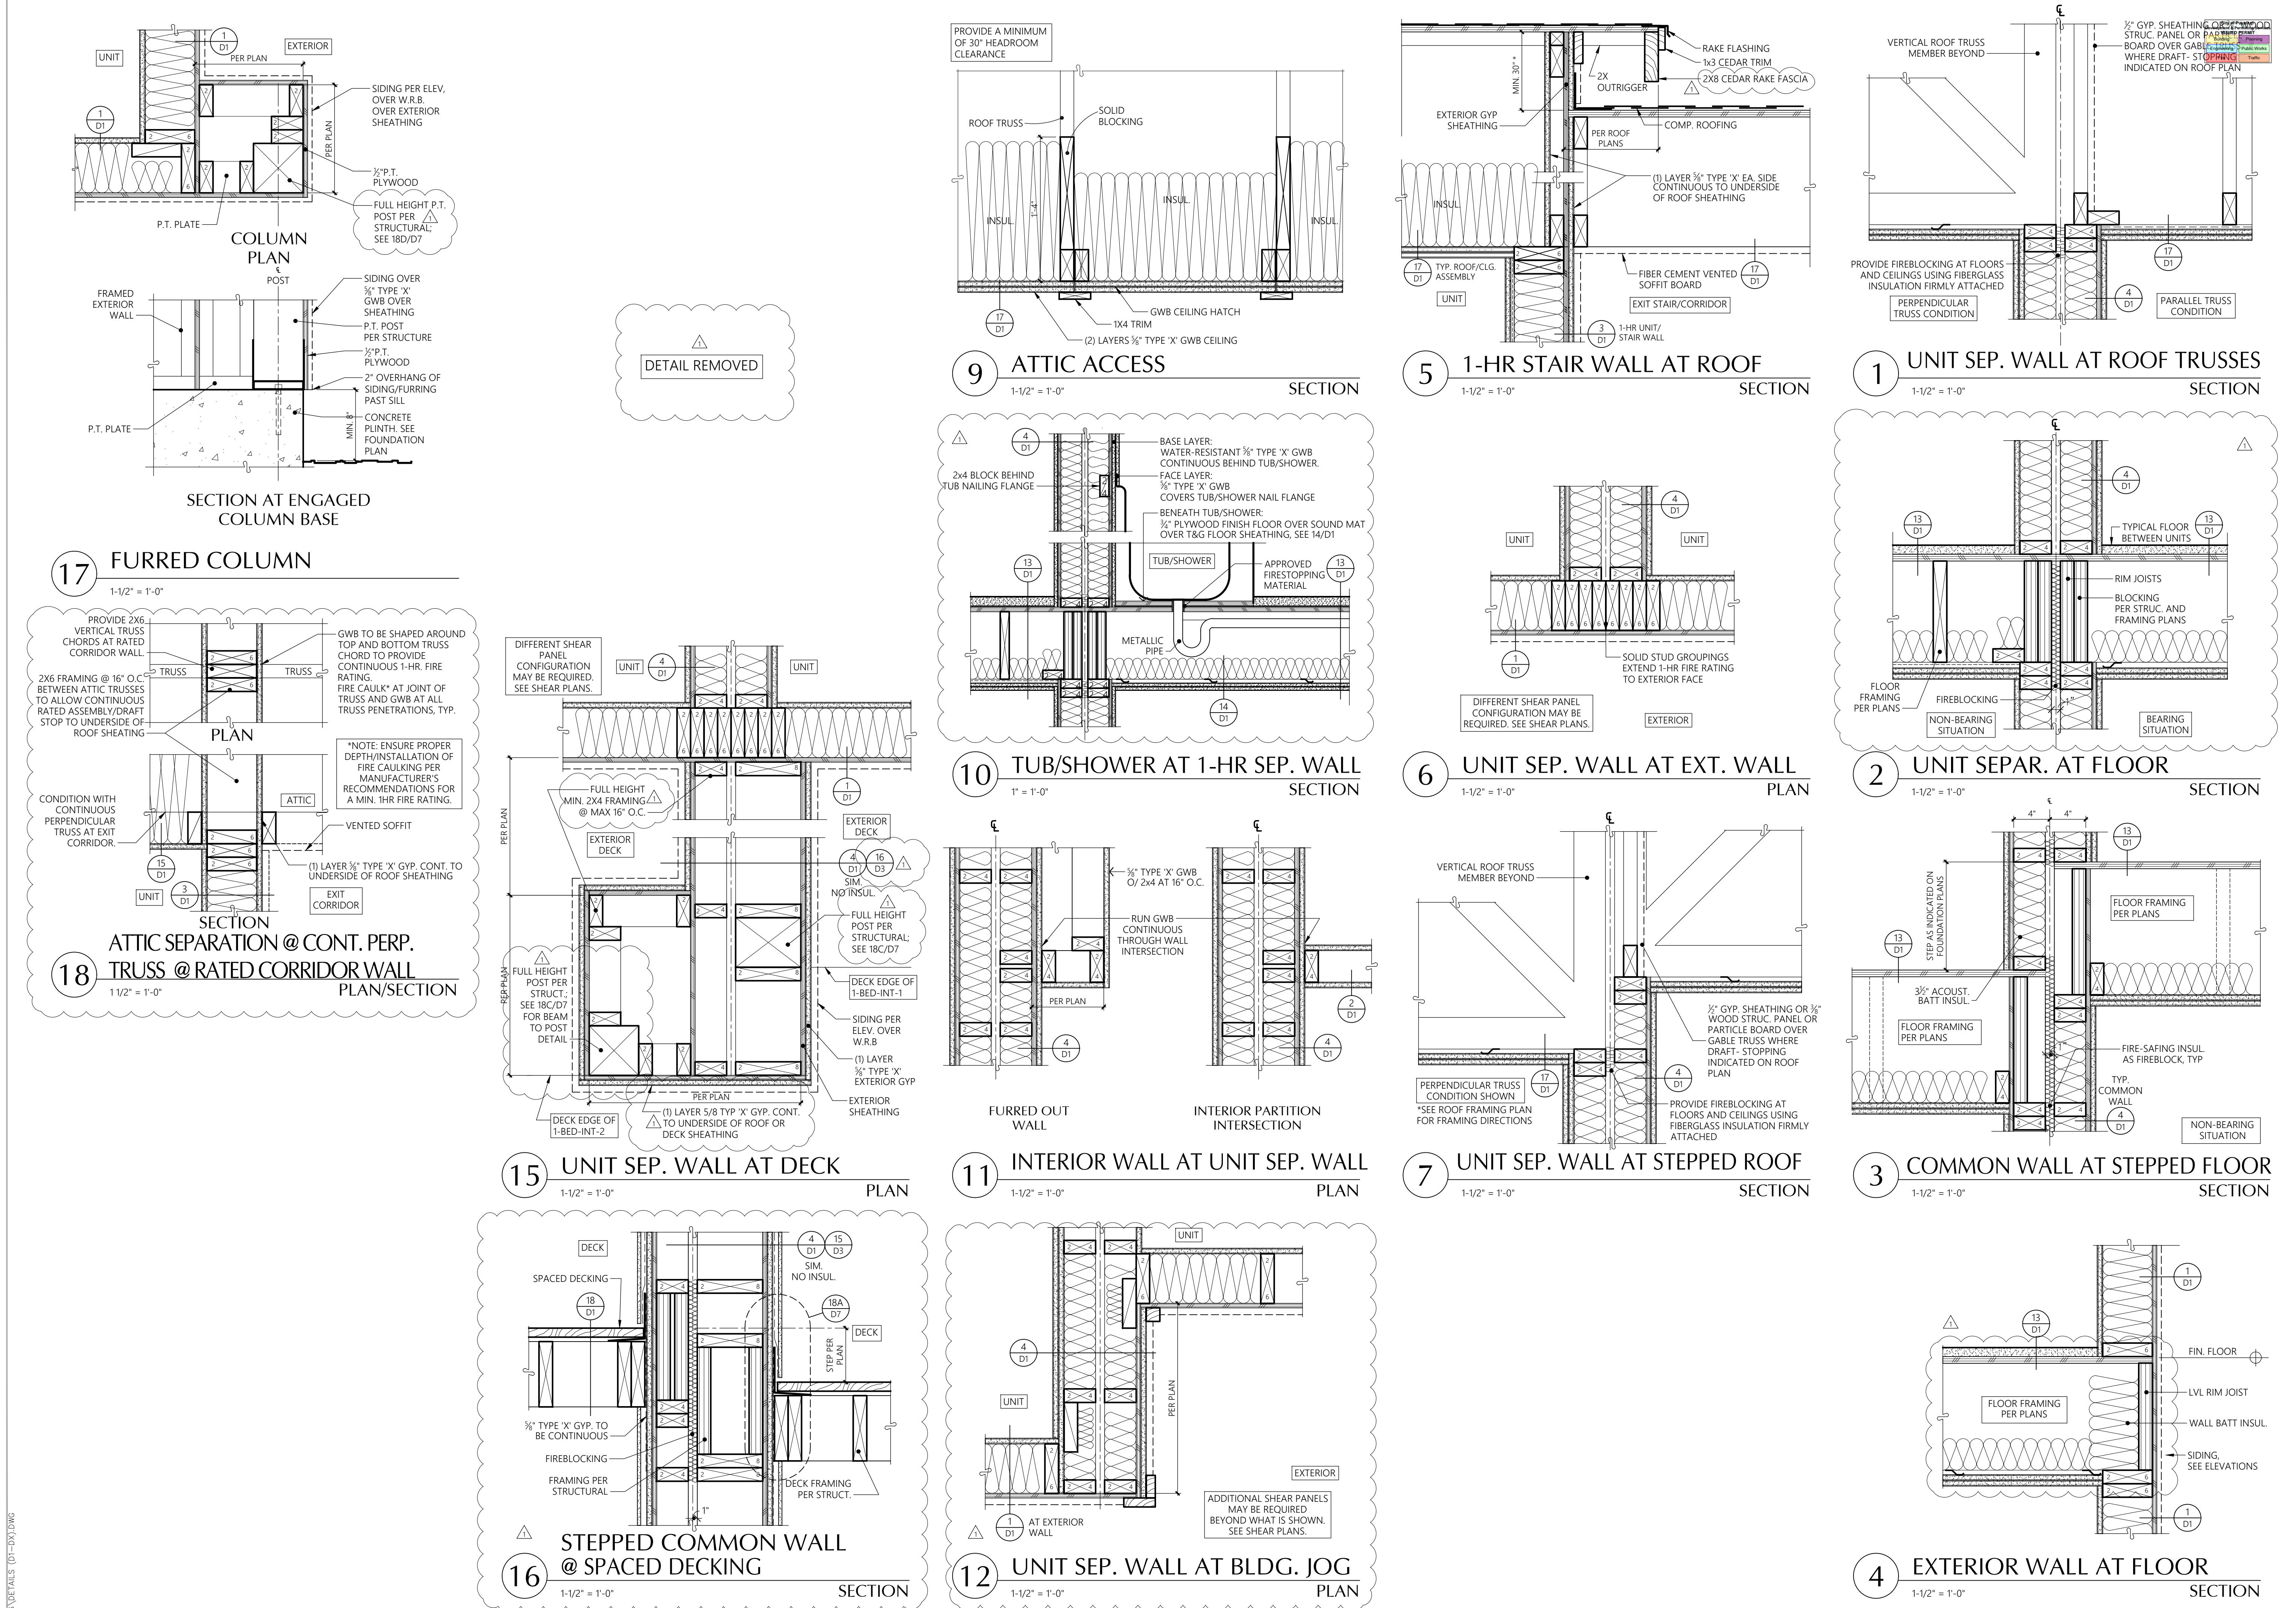

Details

Bradley Heights Apartments

Puyallup, Wa

Timberlane Partners






Revisions

No. Date Description
8-30-24 Owner Changes/Permit Corrections

PRMU20240280


Initial Publish Date:
Date Plotted: 5-1-25
Job No.: 23-06 Drawn By: APT/HDM
Sheet No.: SPRK./ELEC. ROOM RAKE

D4

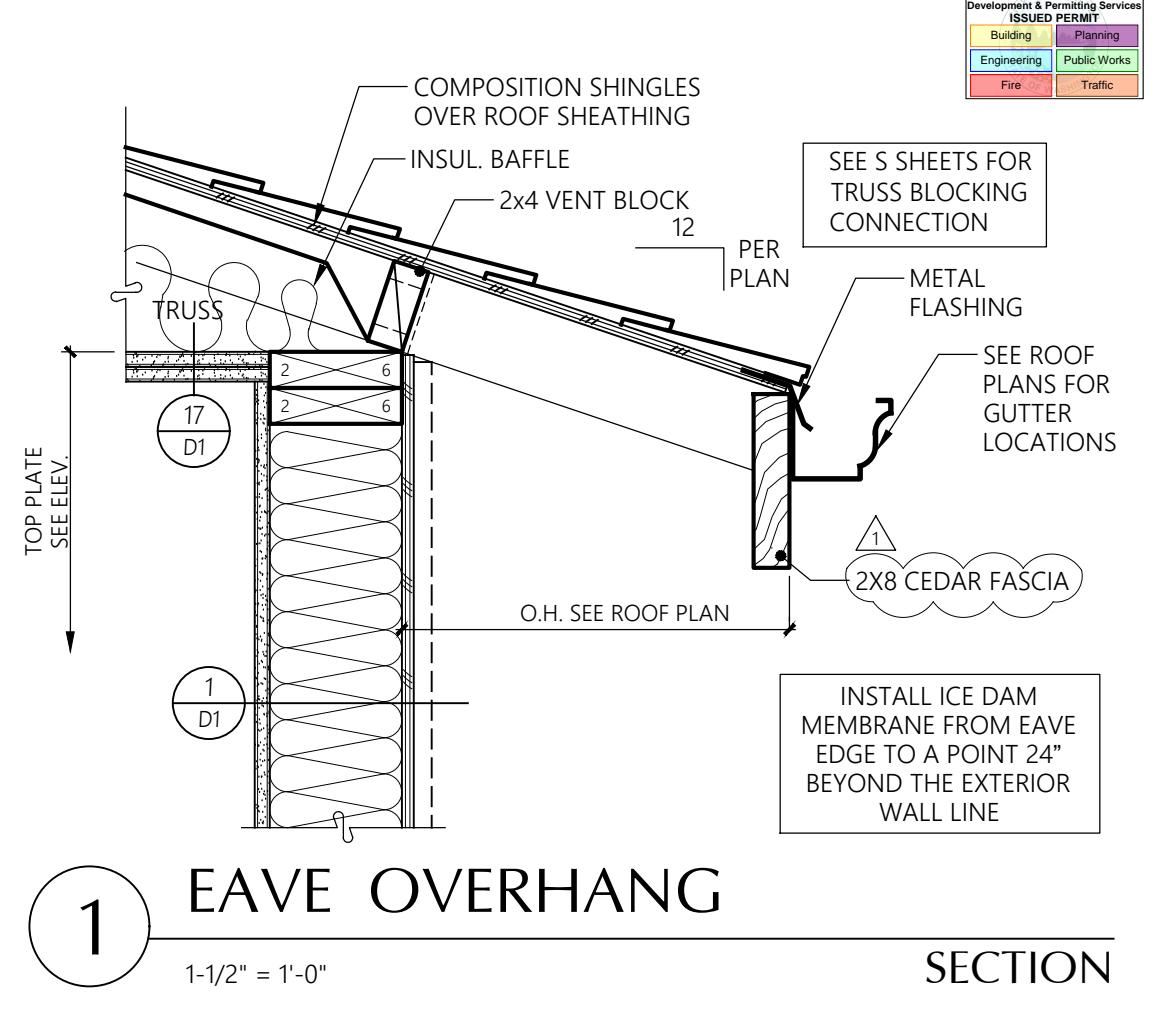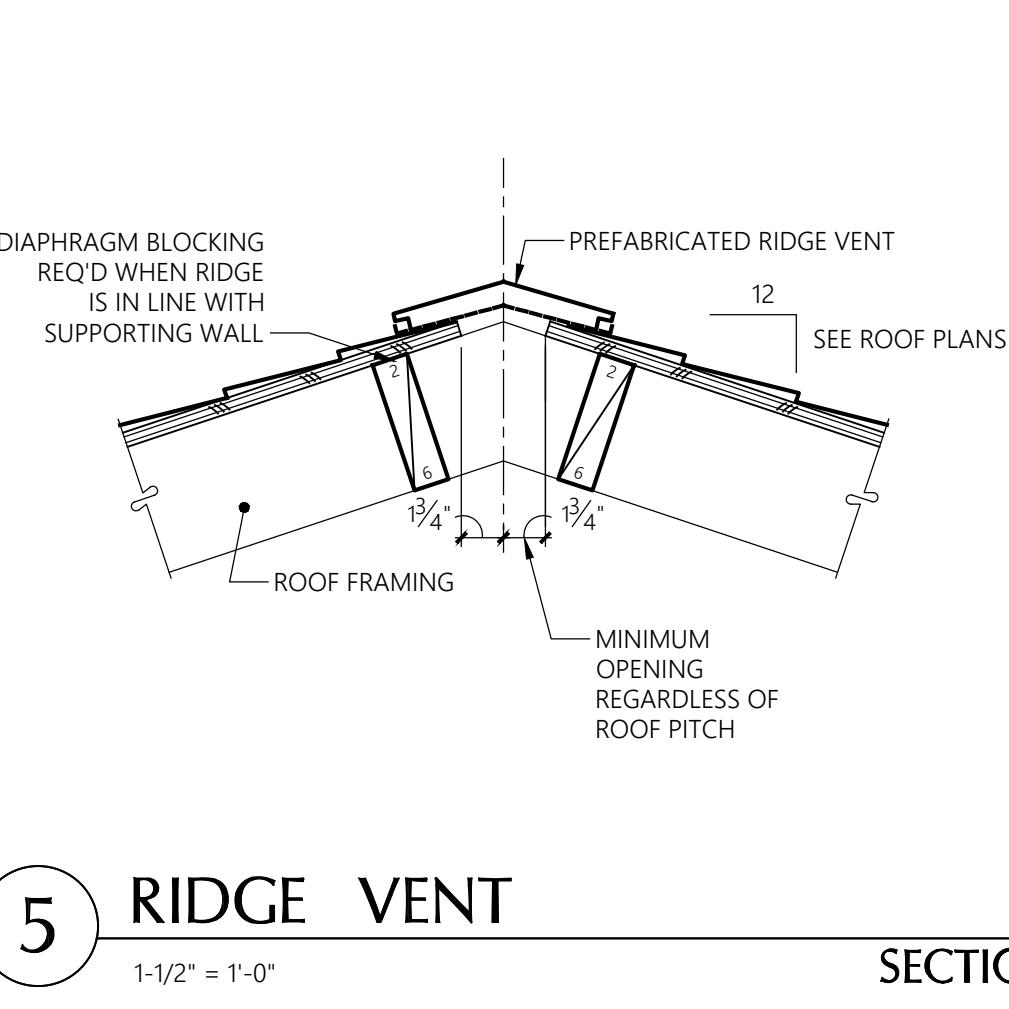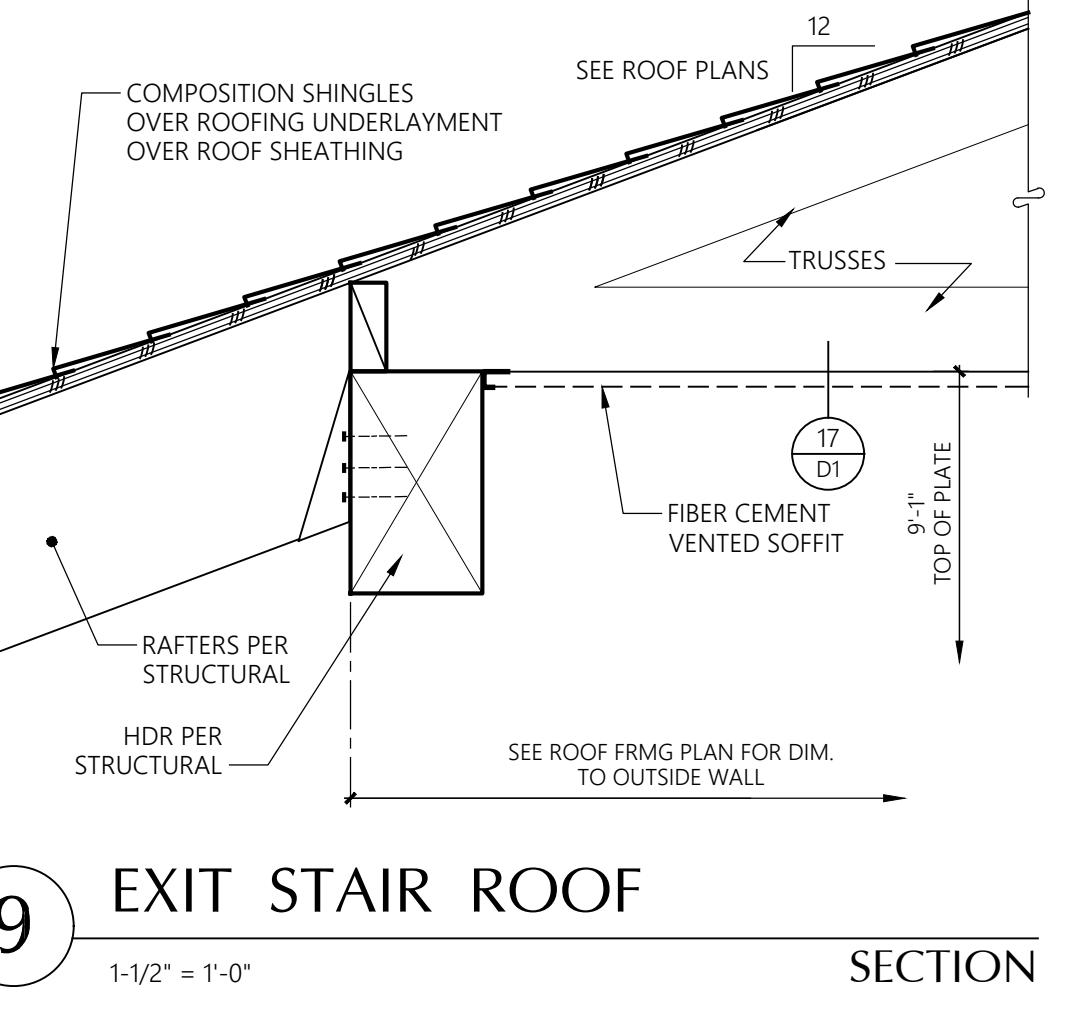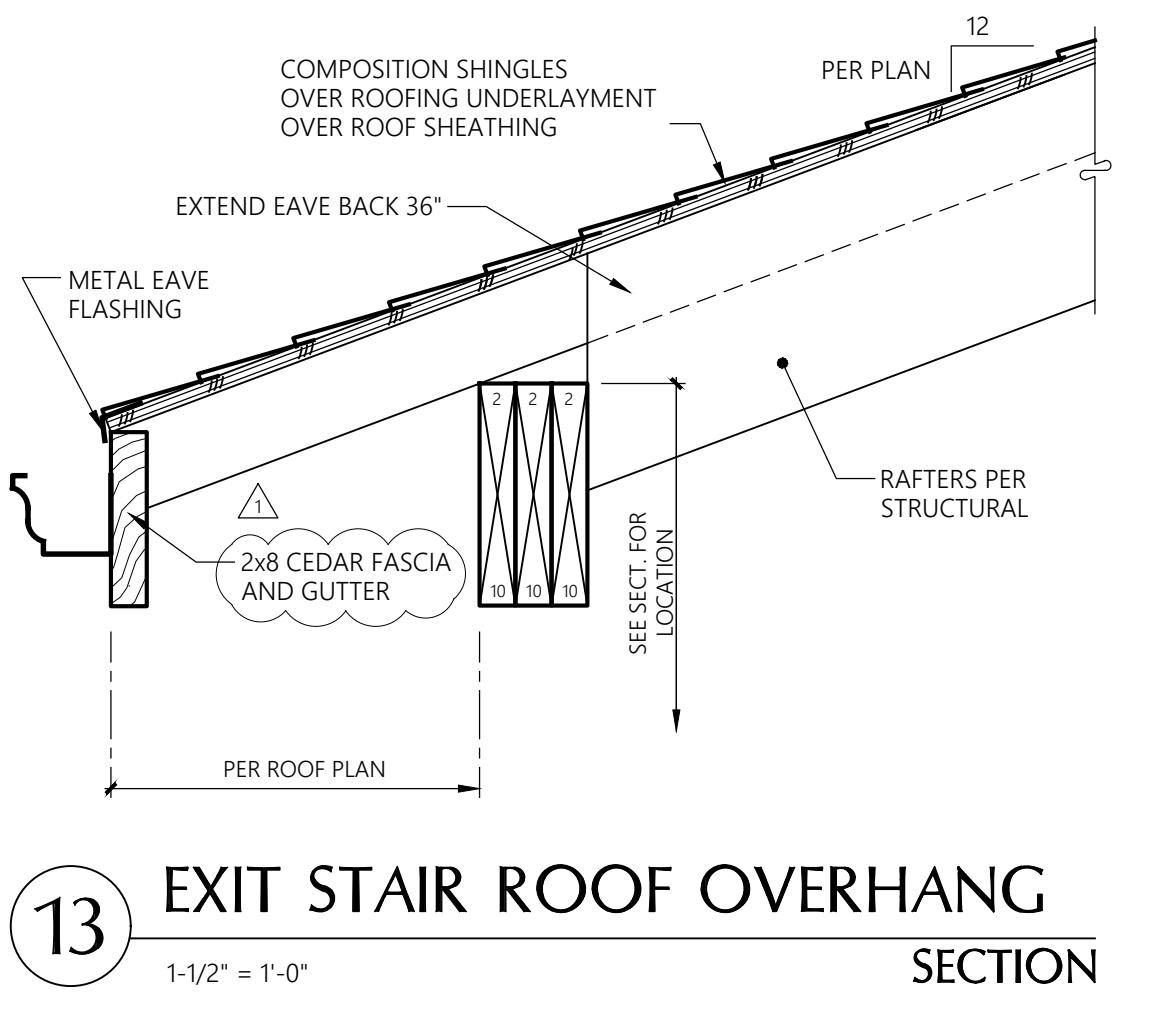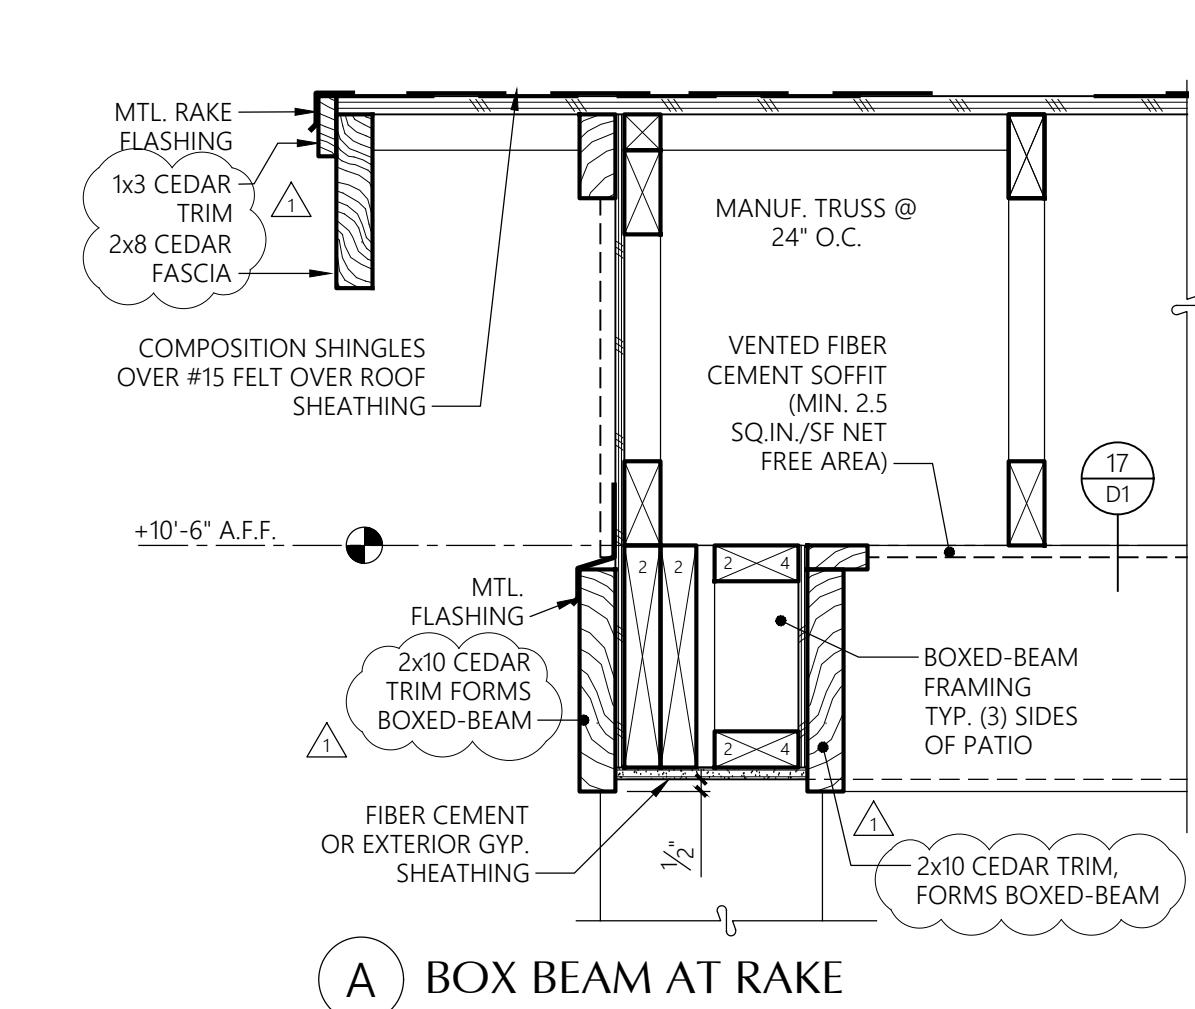



A BOX BEAM AT RAKE

13 EXIT STAIR ROOF OVERHANG
SECTION
1-1/2" = 1'-0"

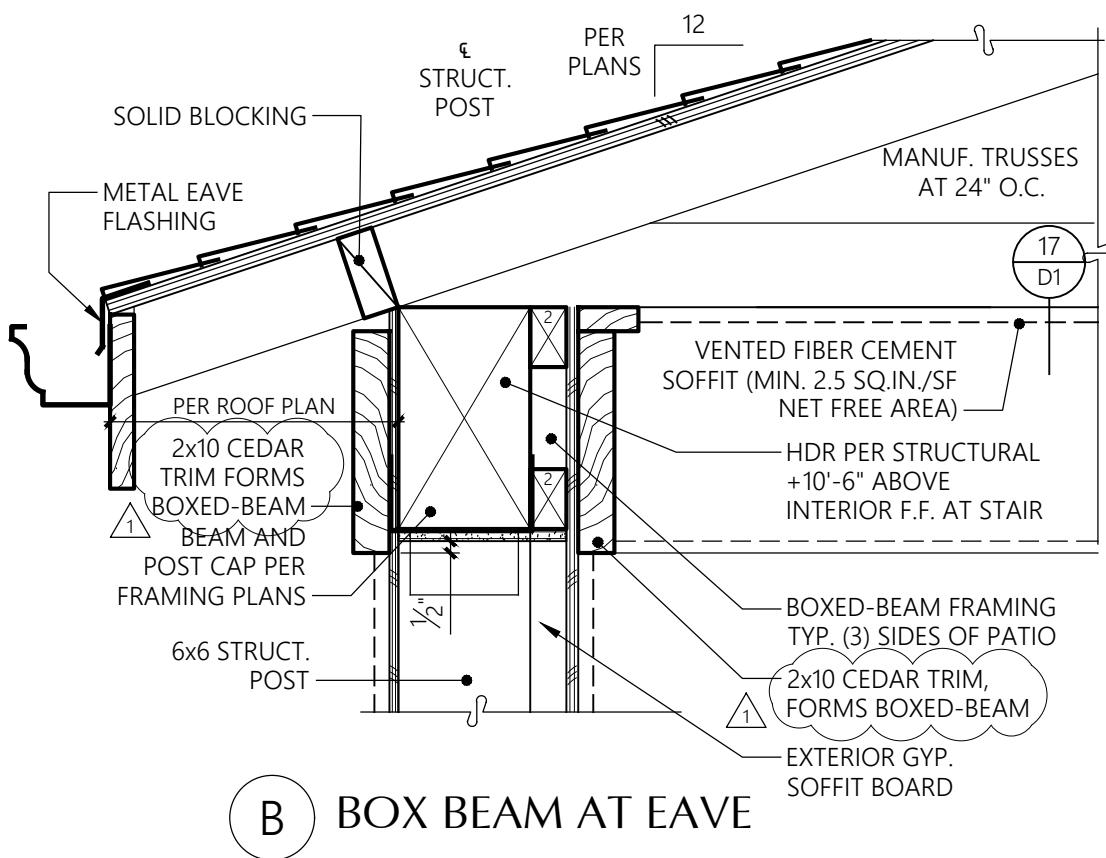


B BOX BEAM AT EAVE


17 ENTRY BOX-BEAM DETAILS
SECTION
1-1/2" = 1'-0"

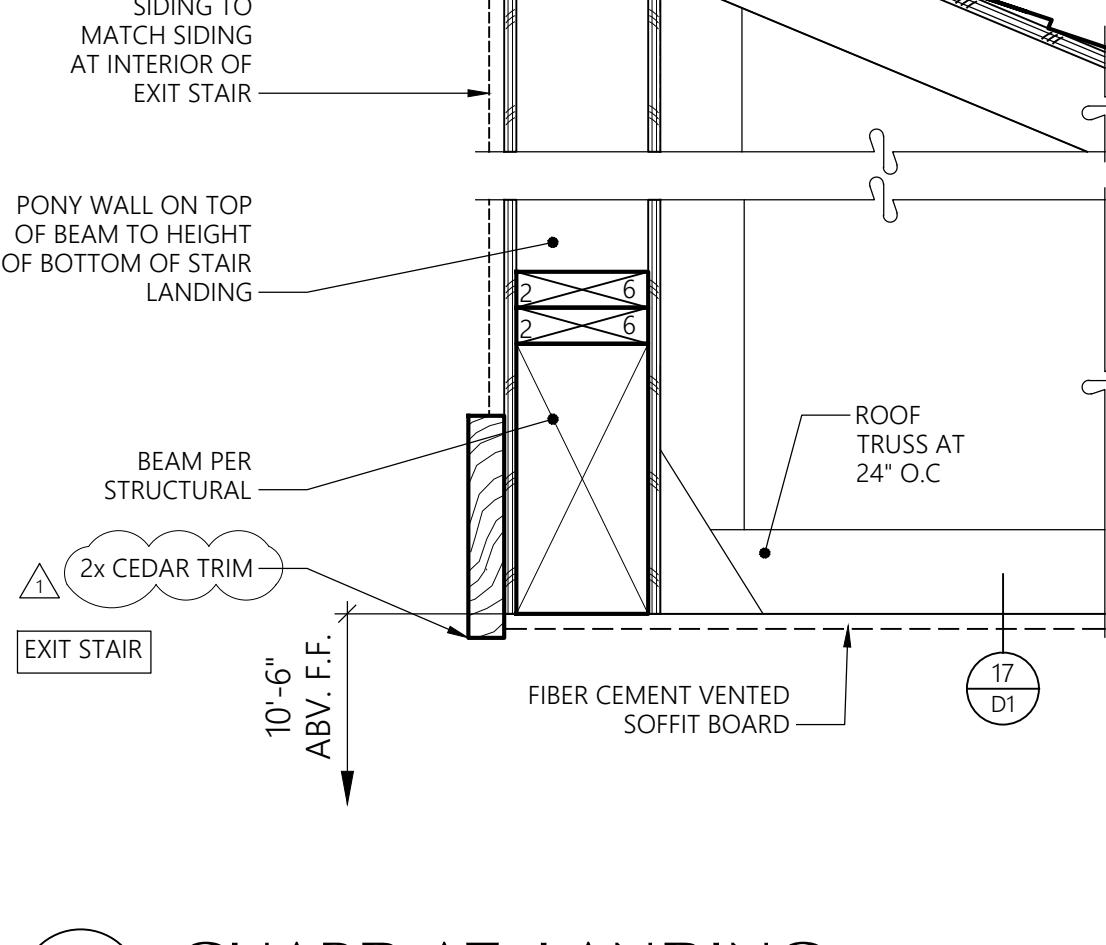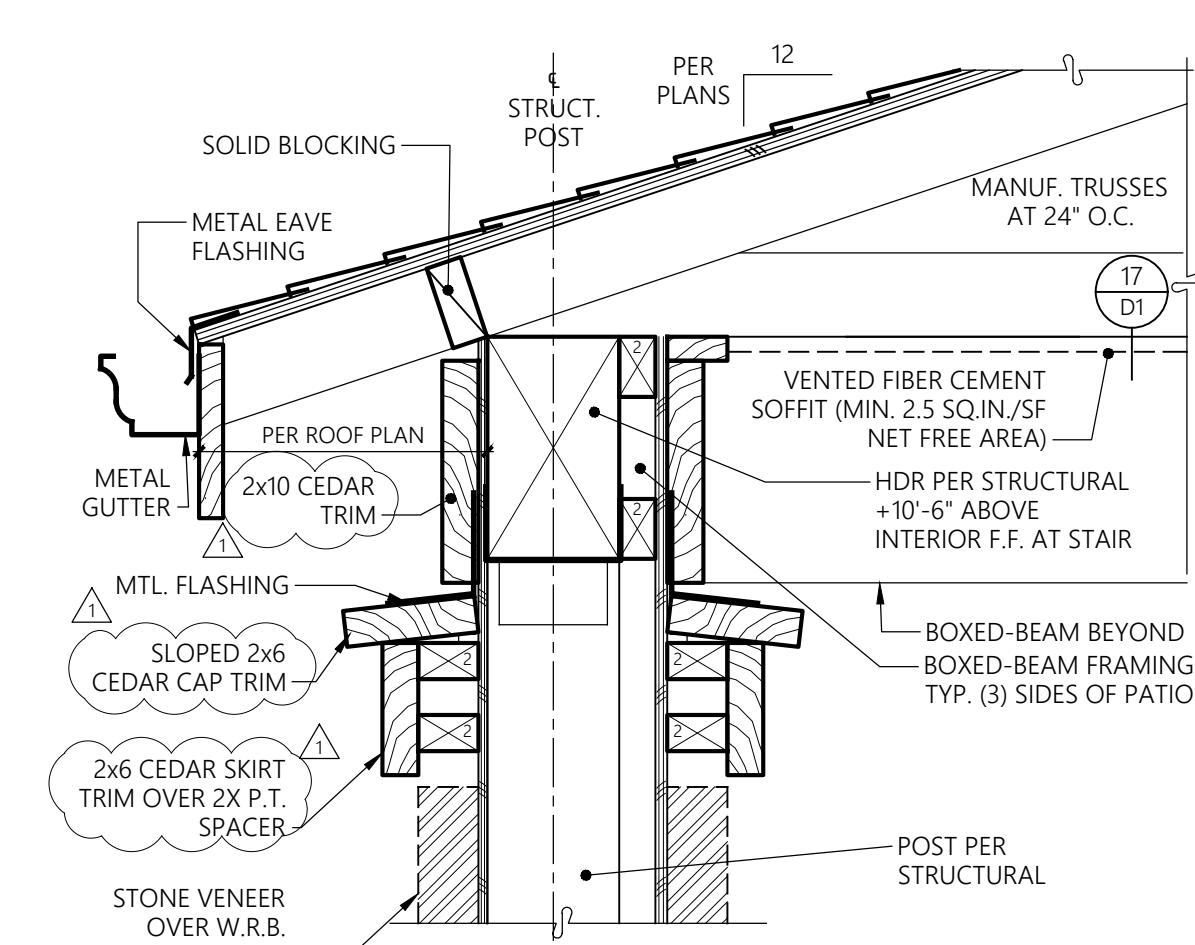


15 GUARD AT LANDING
SECTION
1-1/2" = 1'-0"

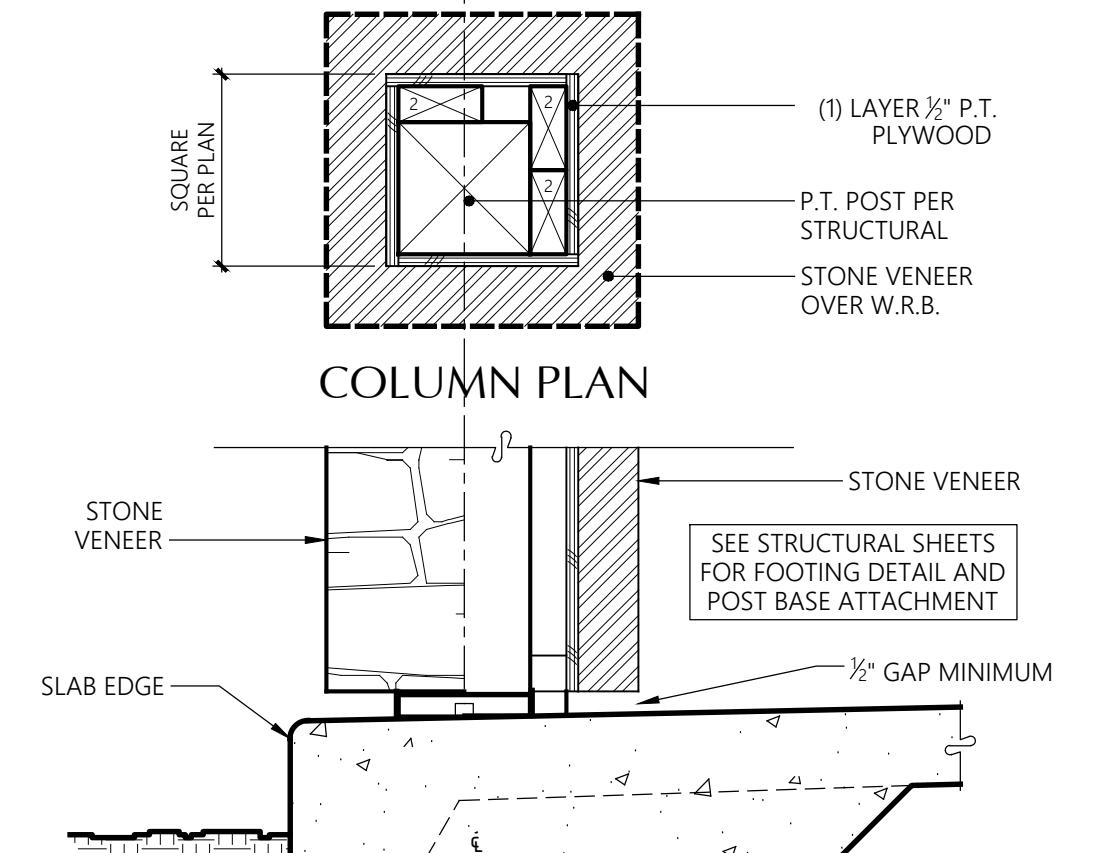


20 ENTRY COLUMN AND LOW ROOF
SECTION
1-1/2" = 1'-0"

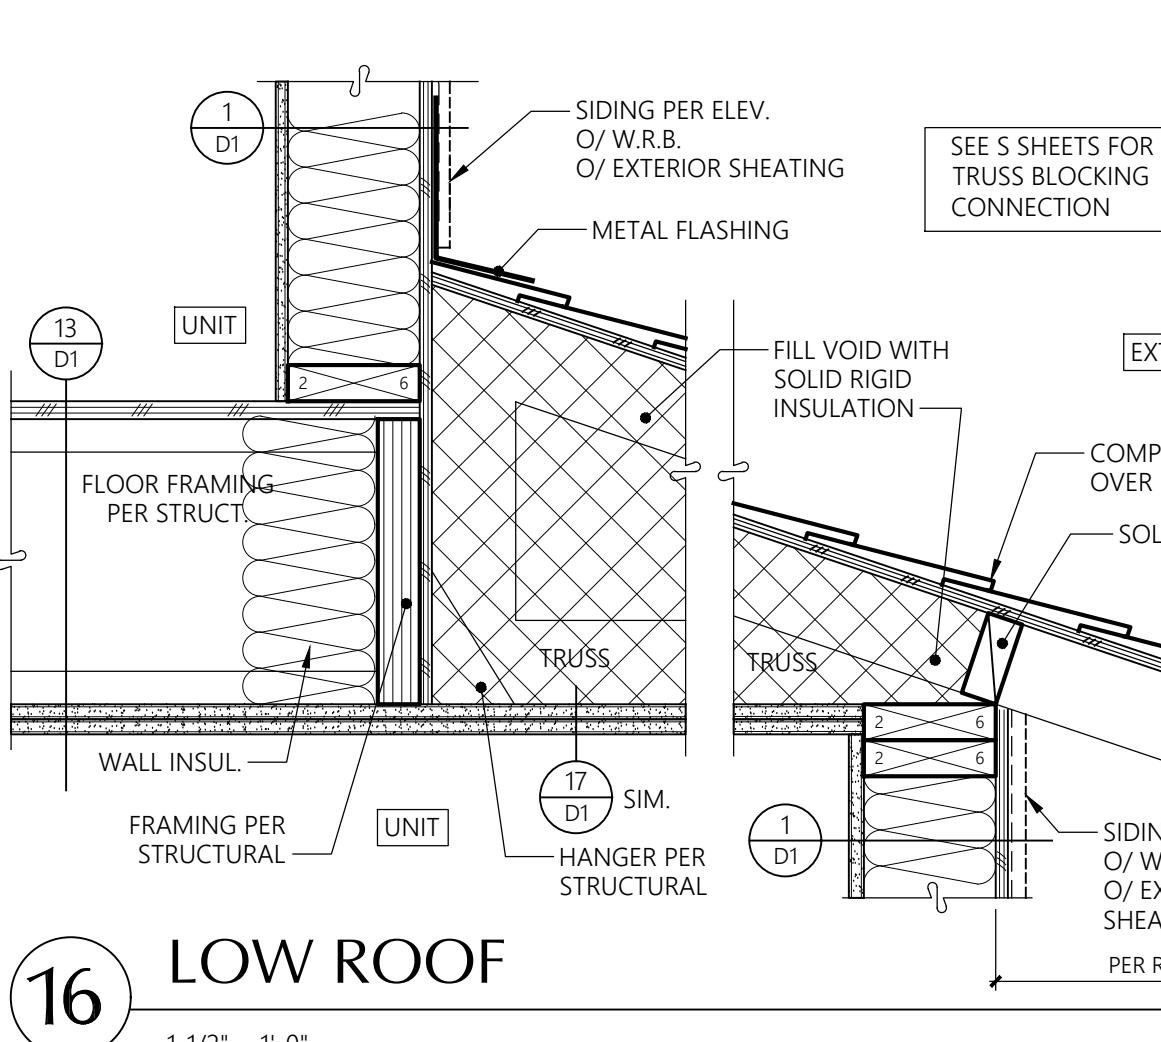


16 LOW ROOF
SECTION
1-1/2" = 1'-0"

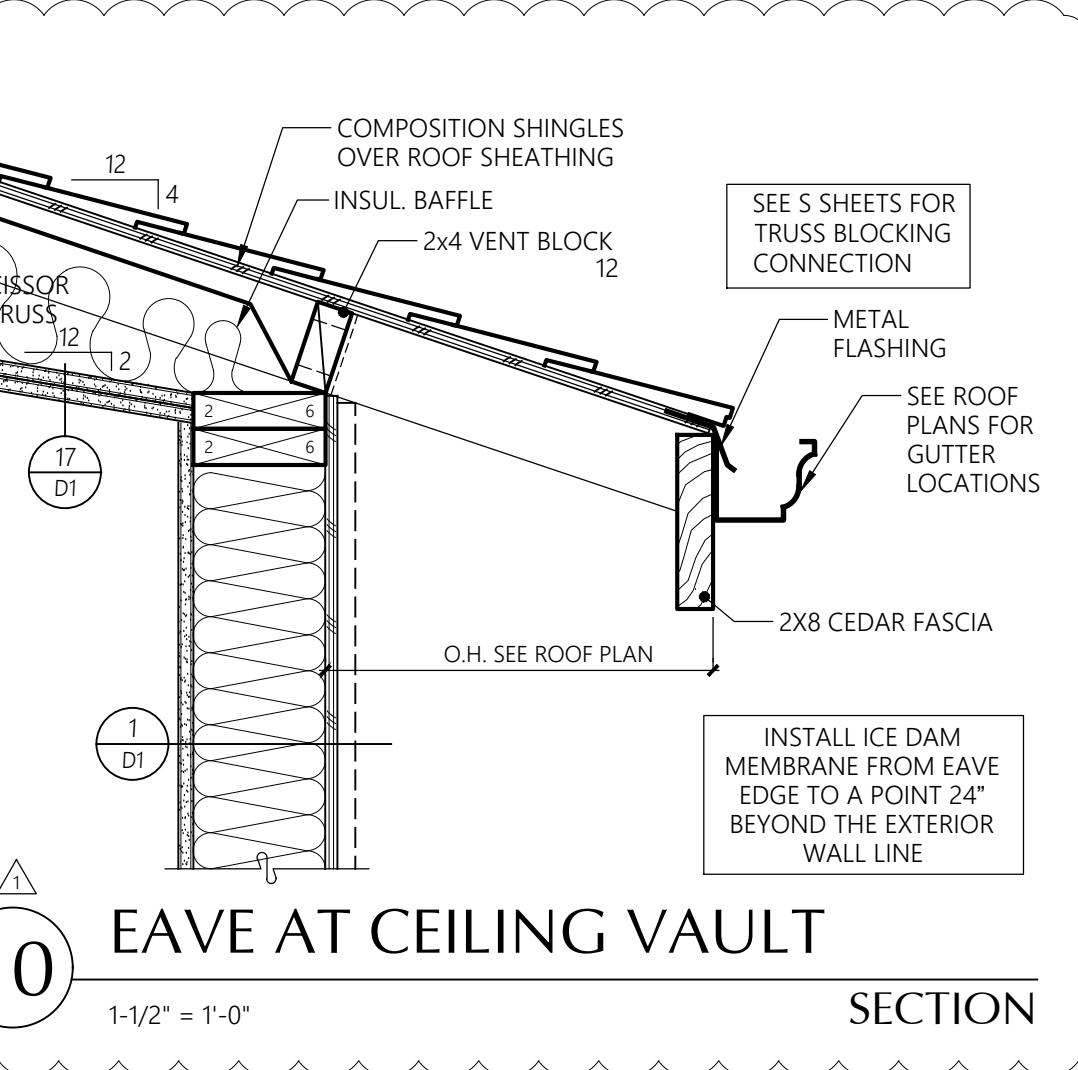


9 EXIT STAIR ROOF
SECTION
1-1/2" = 1'-0"

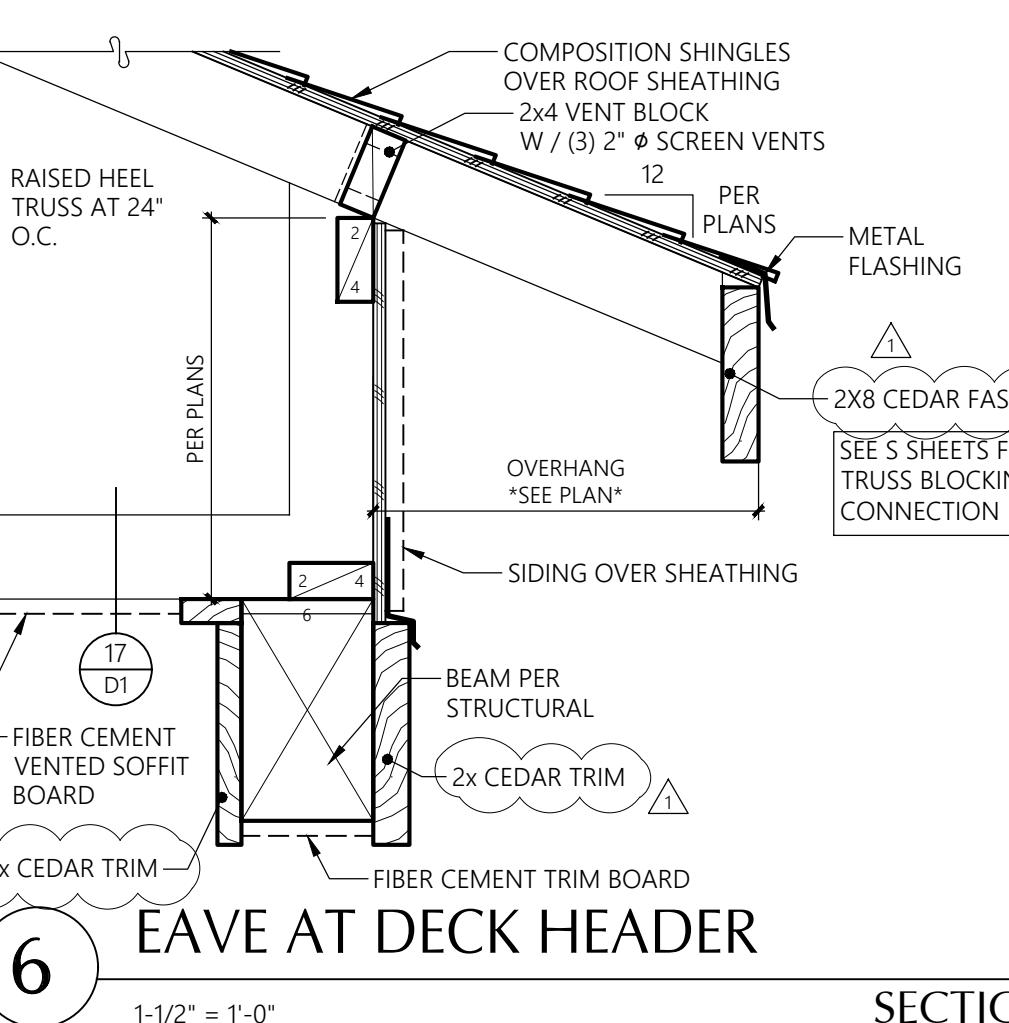


5 RIDGE VENT
SECTION
1-1/2" = 1'-0"

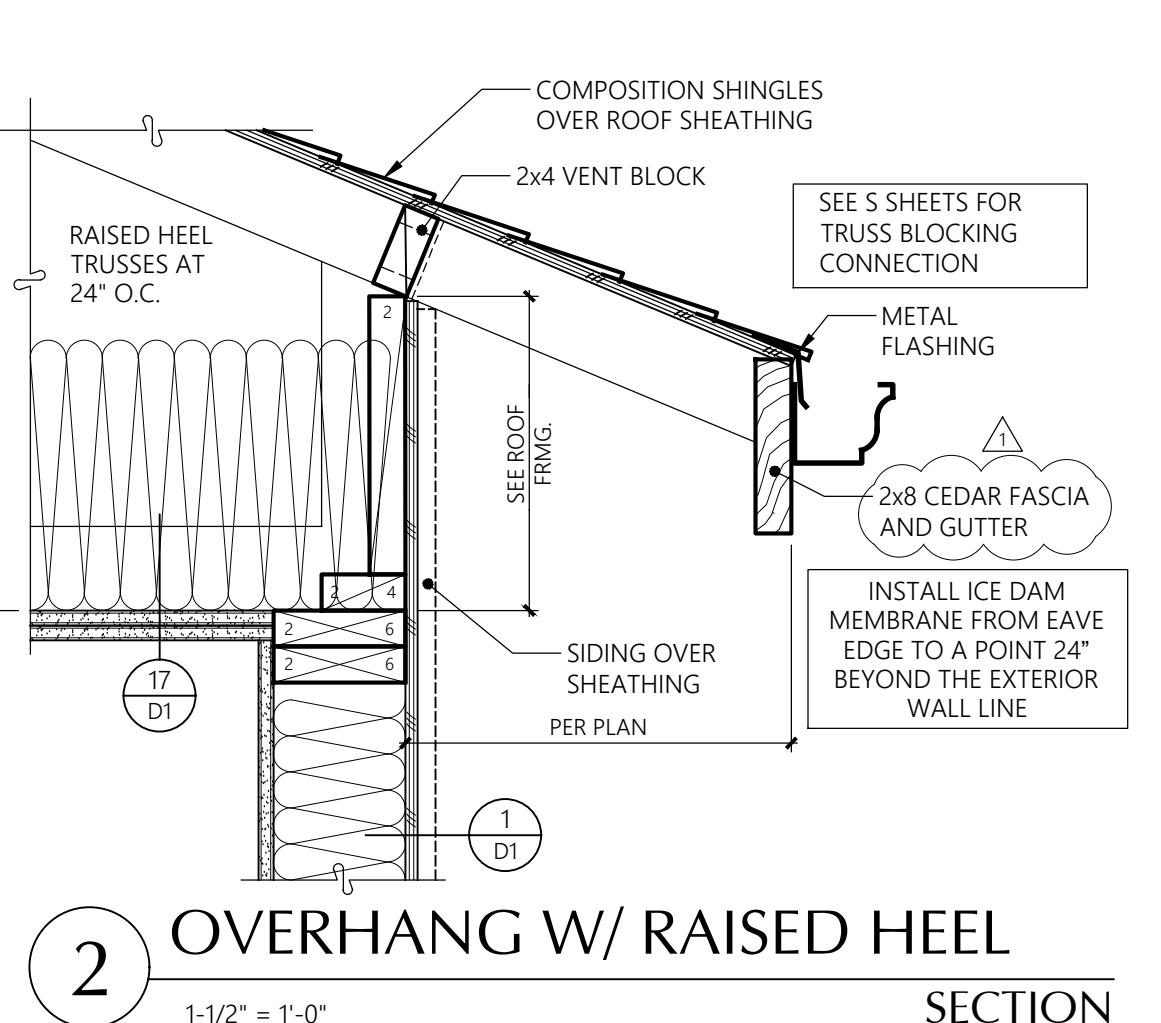


1 EAVE OVERHANG
SECTION
1-1/2" = 1'-0"

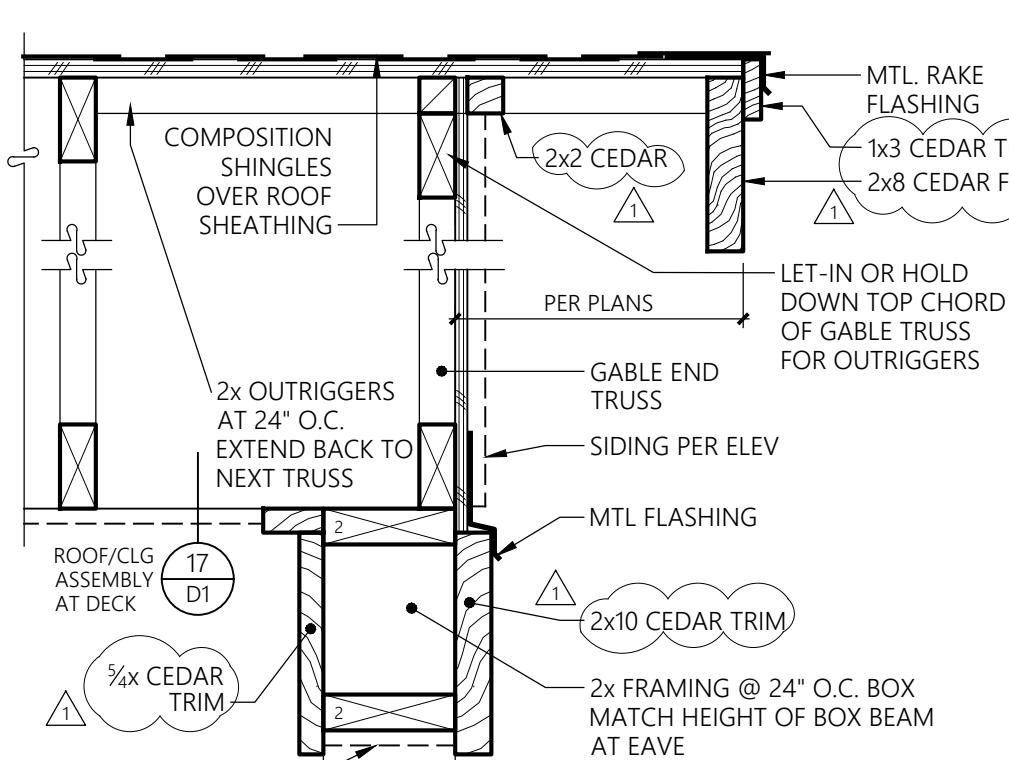


6 EAVE AT DECK HEADER
SECTION
1-1/2" = 1'-0"

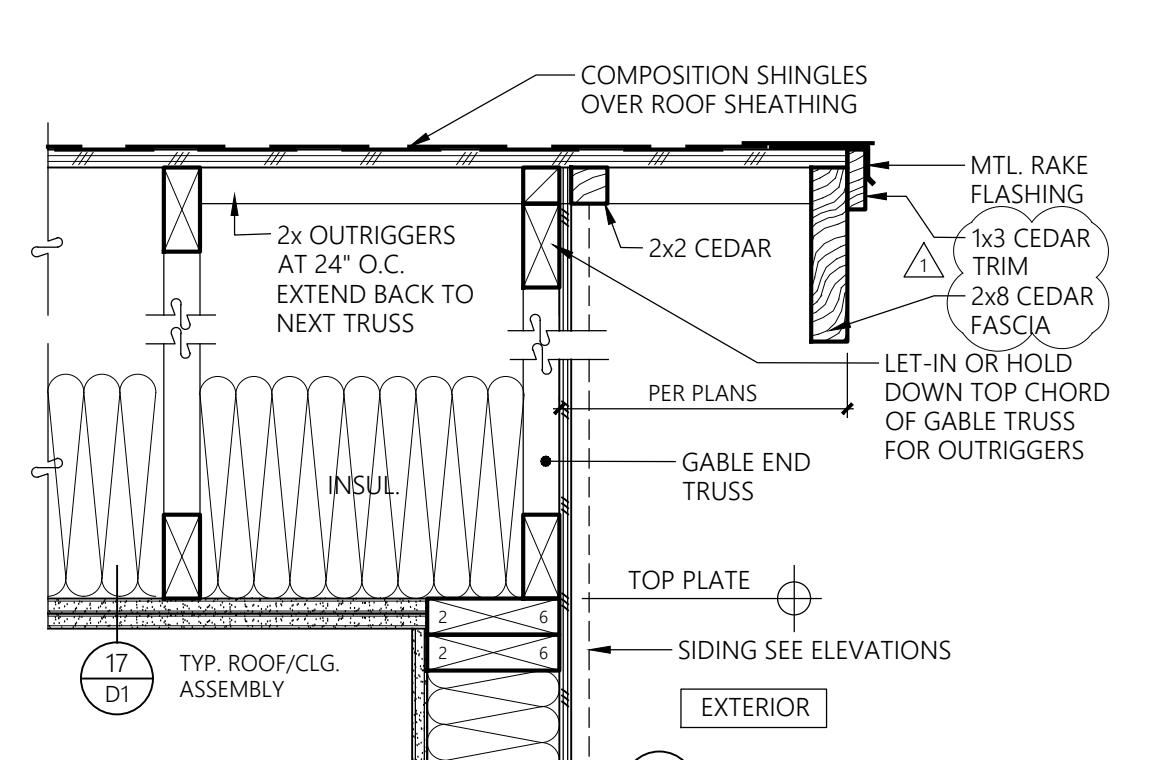


2 OVERHANG W/ RAISED HEEL
SECTION
1-1/2" = 1'-0"

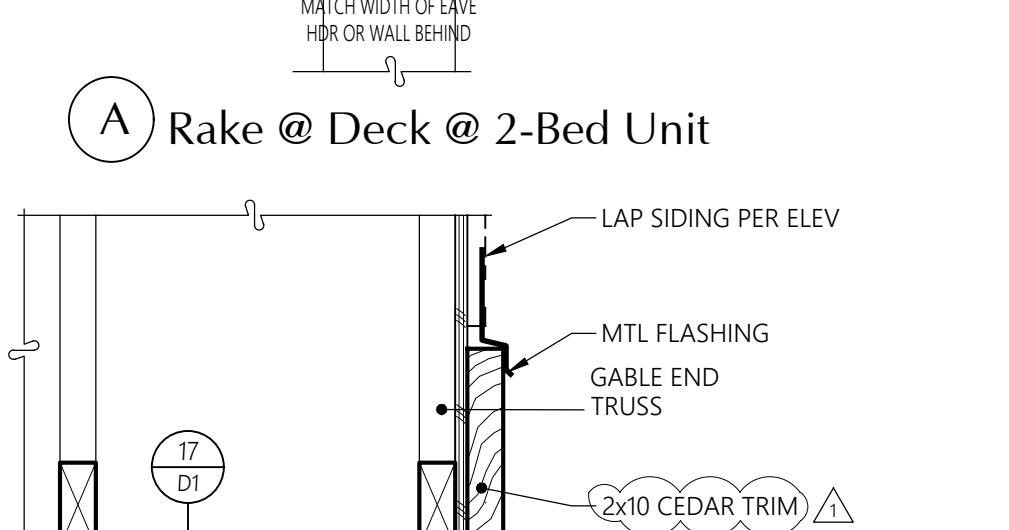

3 EXTERIOR WALL AT ROOF
SECTION
1-1/2" = 1'-0"

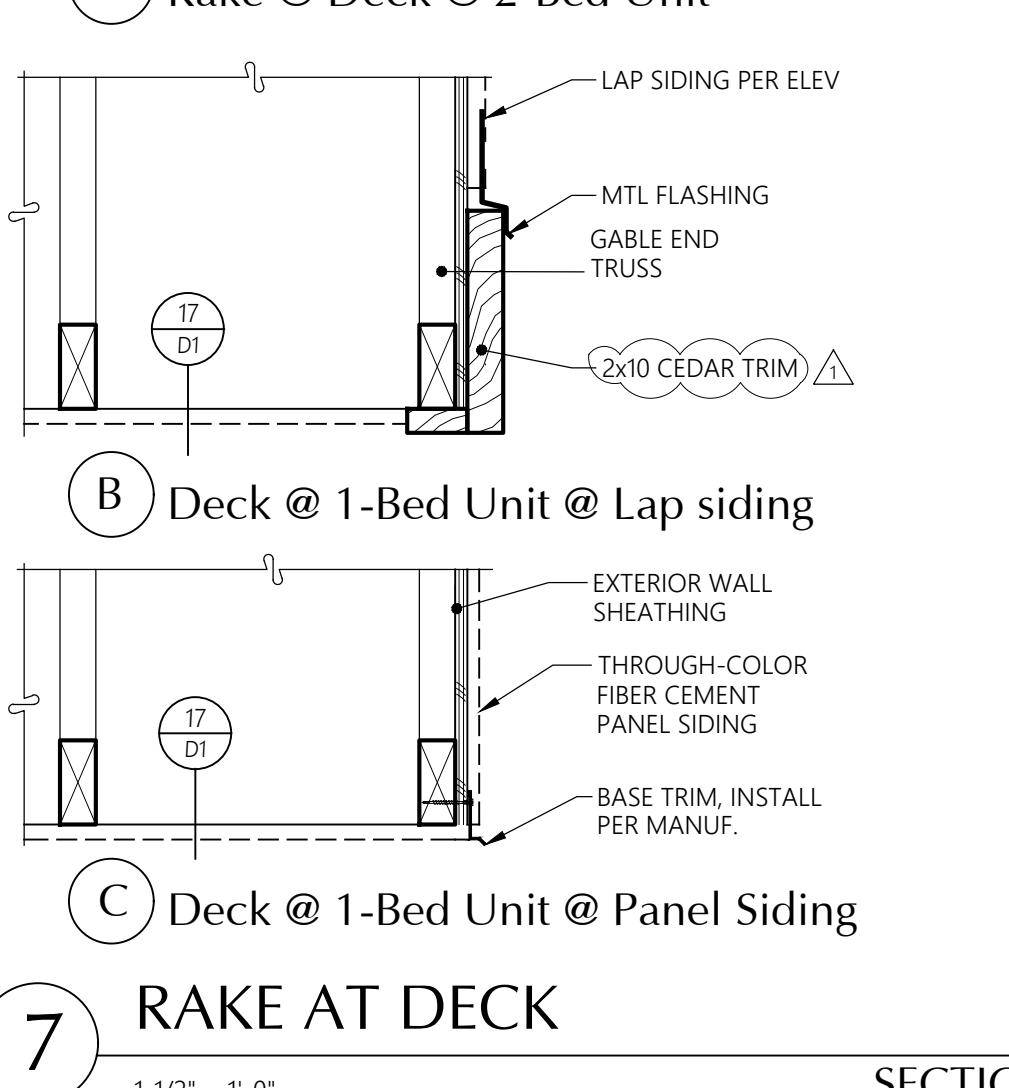

7 RAKE AT DECK
SECTION
1-1/2" = 1'-0"

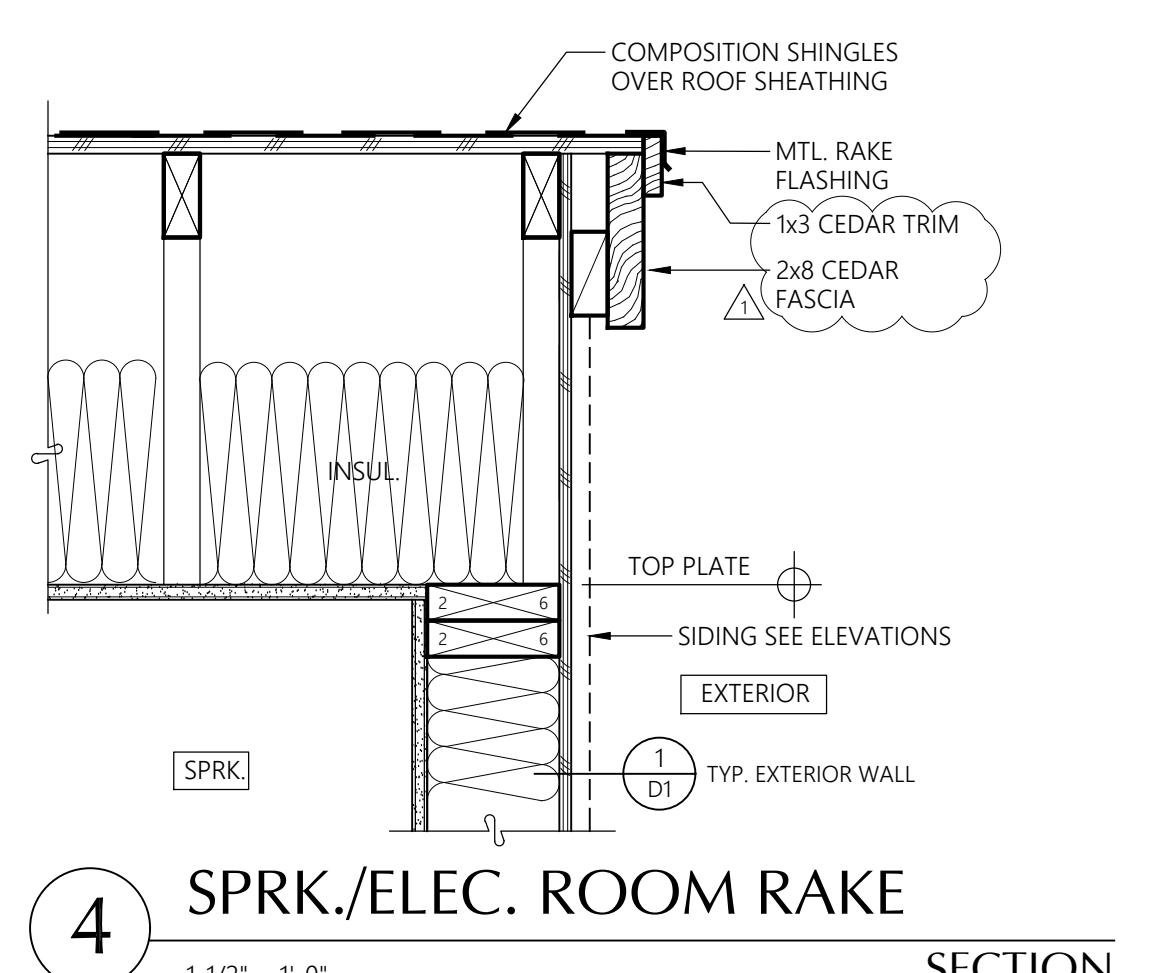

4 SPRK./ELEC. ROOM RAKE
SECTION
1-1/2" = 1'-0"

Details

Bradley Heights Apartments
Puyallup, Wa

Timberlane Partners

Revisions

No. Date Description
8-30-24 Owner Changes/Permit Corrections

PRMU20240280


Initial Publish Date:

Date Plotted: 5-1-25


Job No: 23-06 Drawn By: APT/HDM

Sheet No.: D5


D5

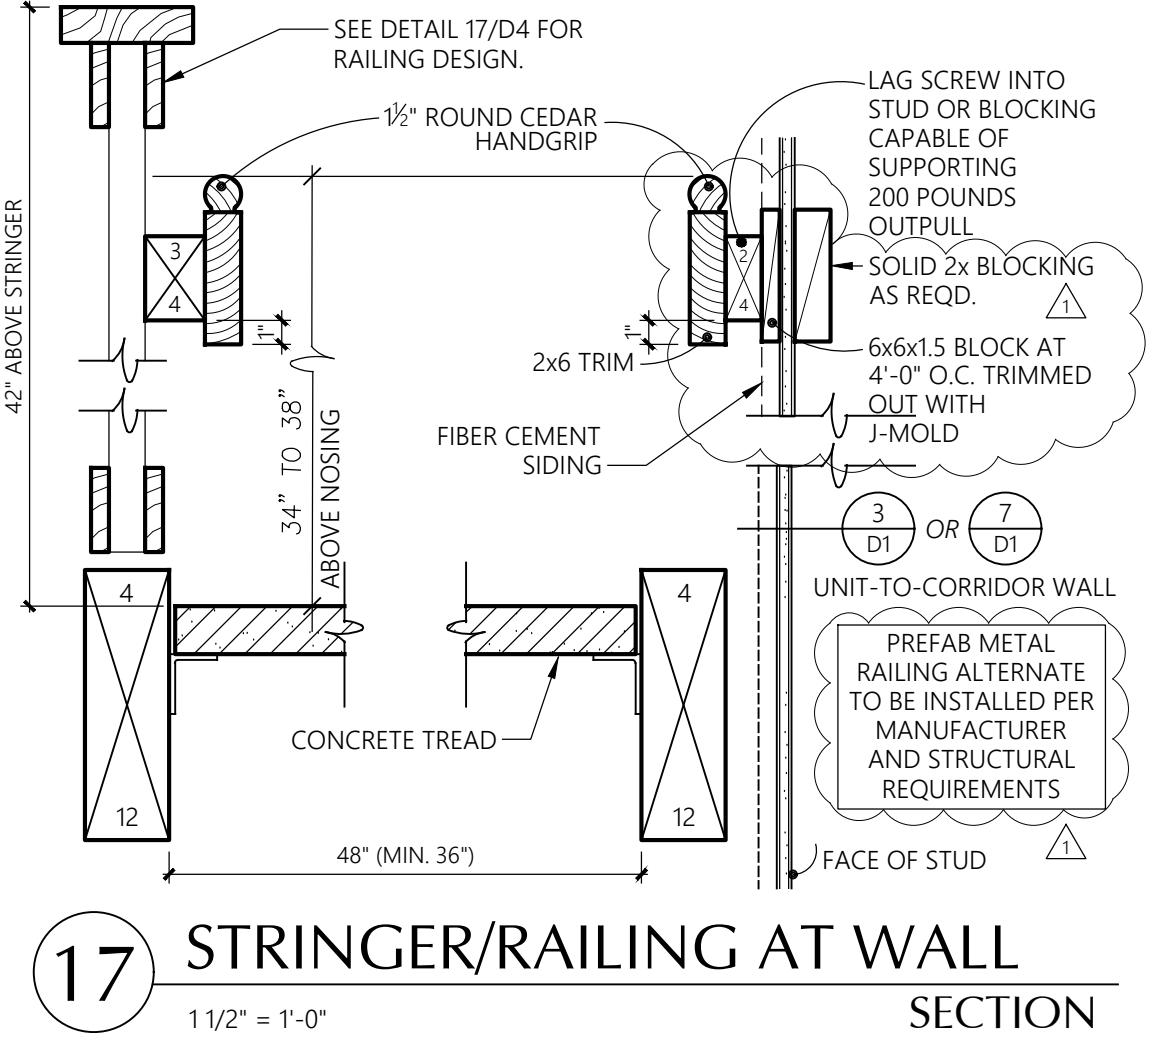


17 STRINGER/RAILING AT WALL
SECTION
1 1/2" = 1'-0"

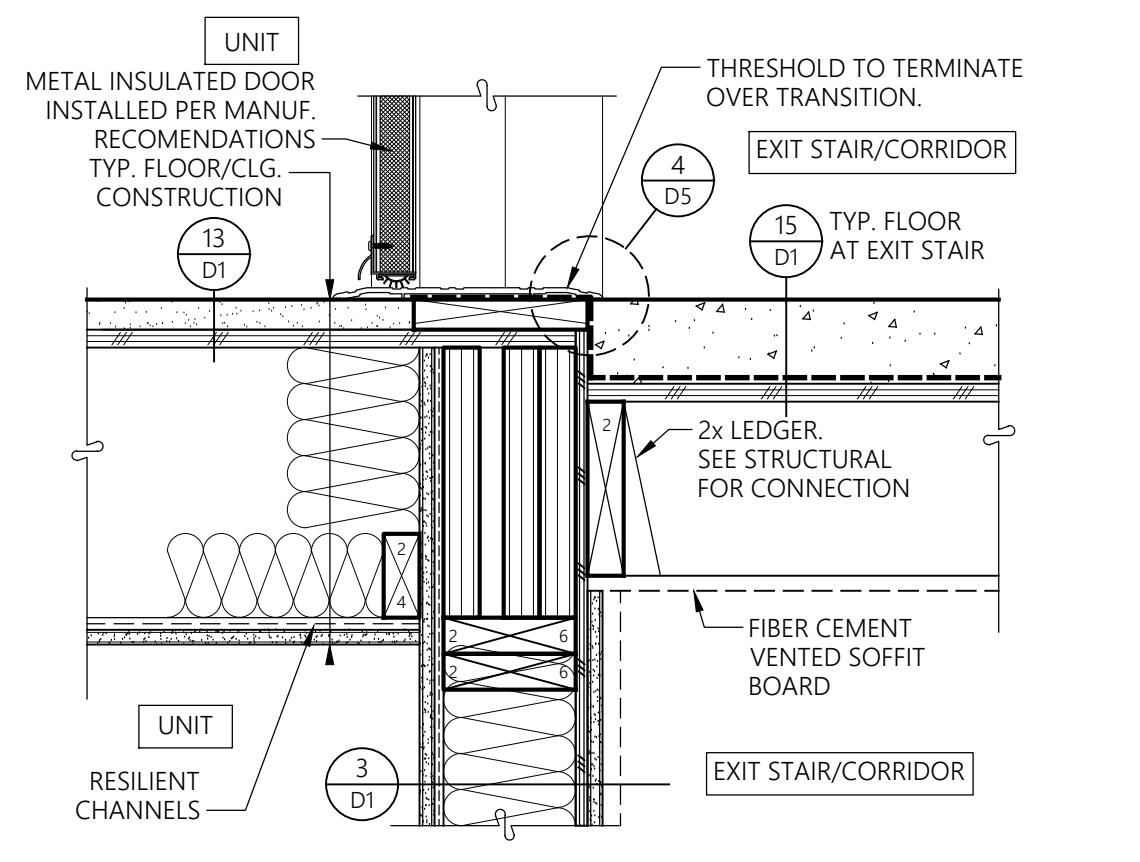


13 ENTRY DOOR THRESHOLD
SECTION
1 1/2" = 1'-0"

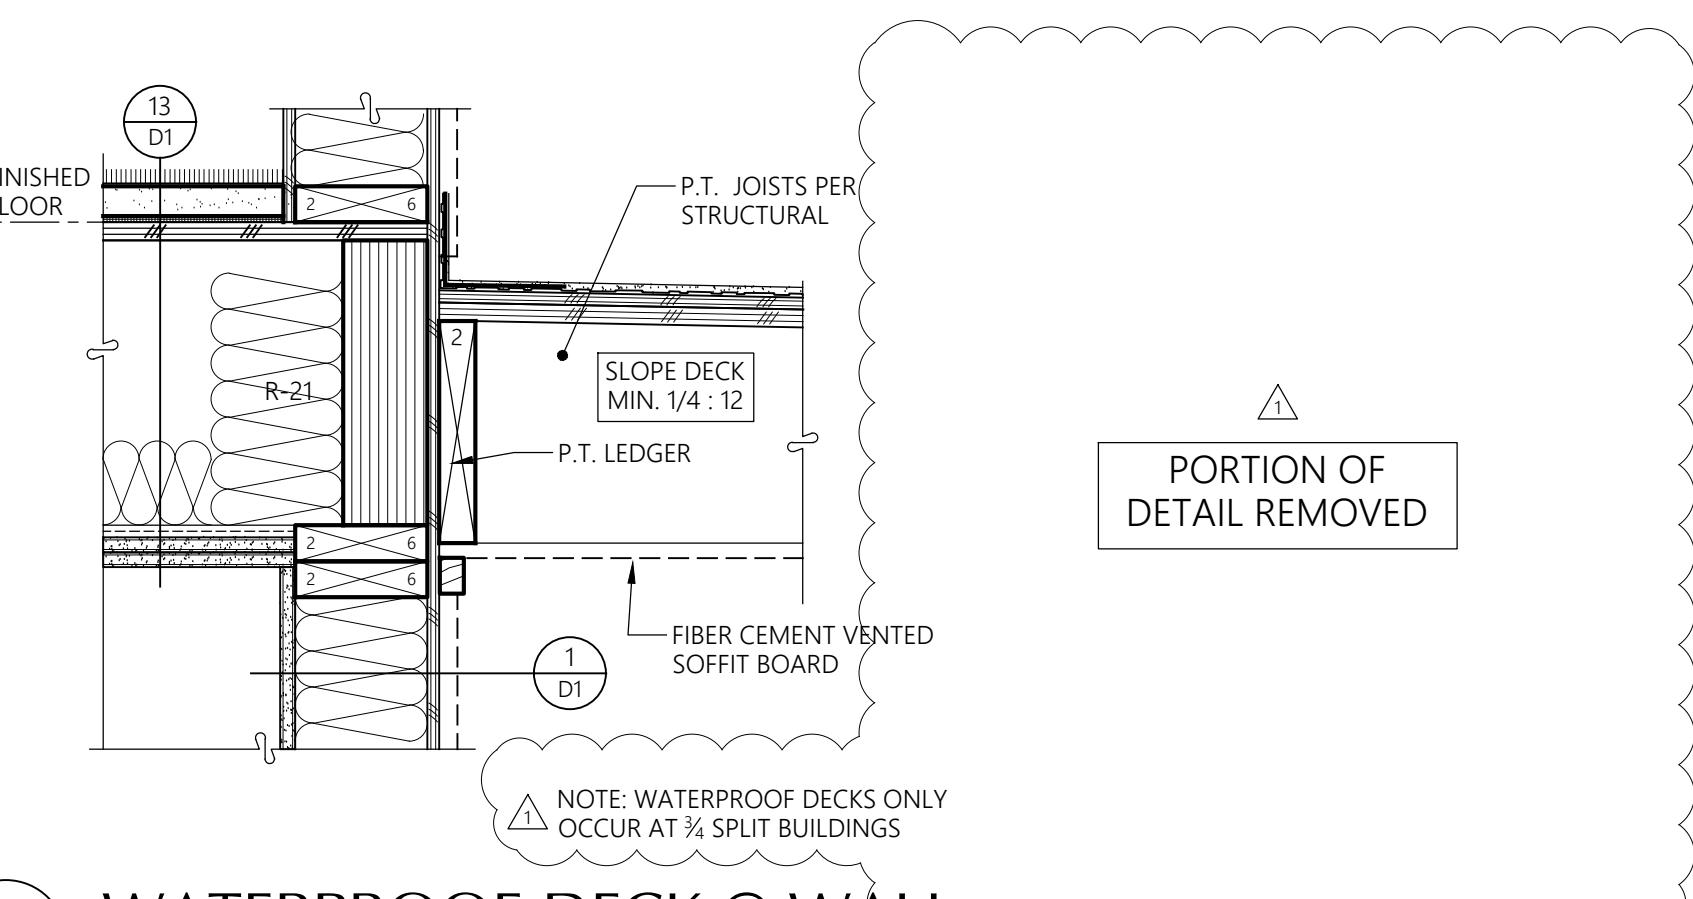


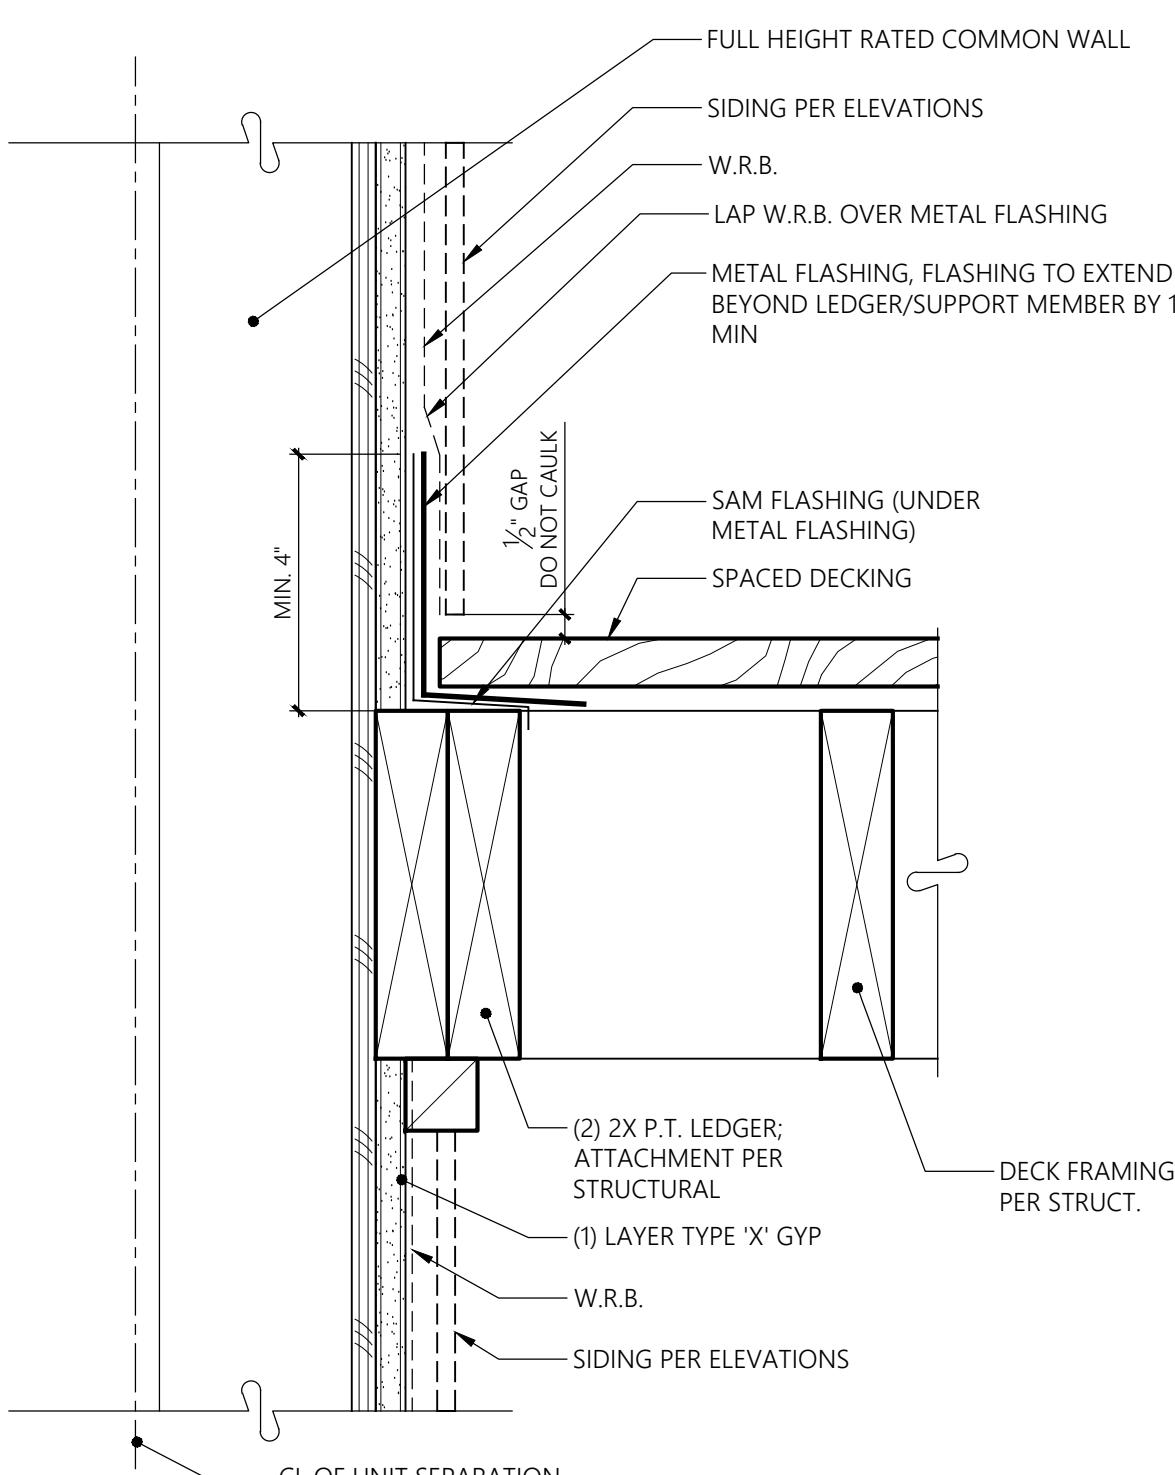


A DECK AT RATED WALL

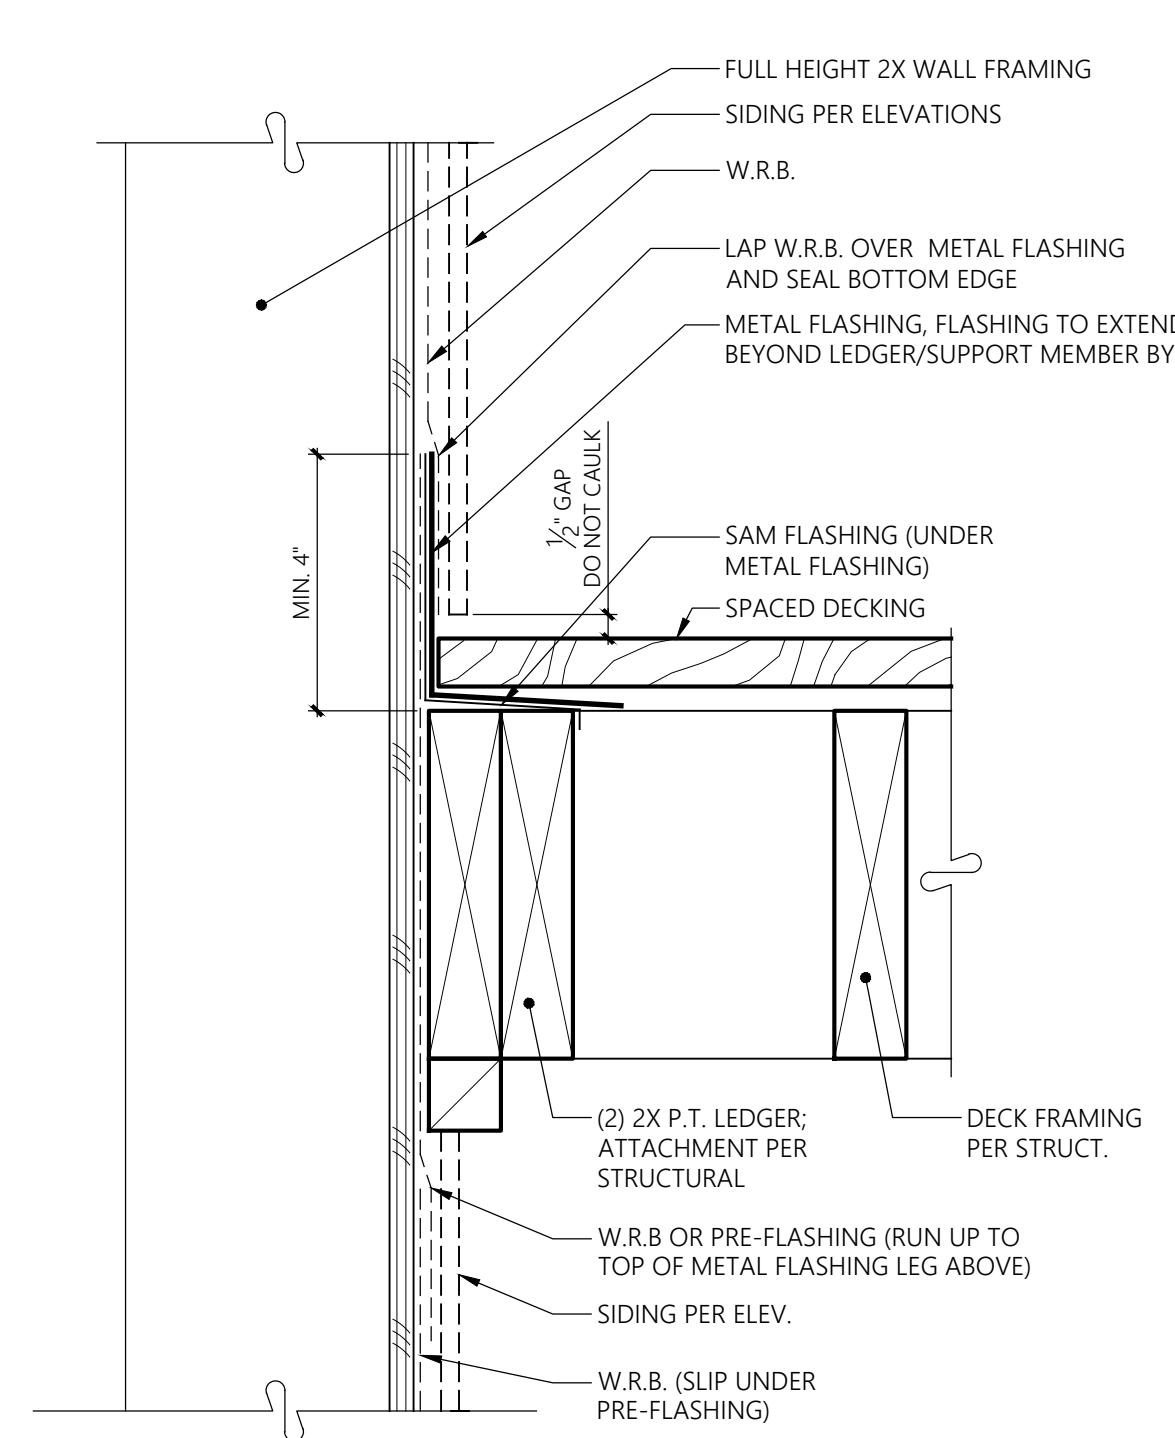

B DECK AT UN-RATED WALL

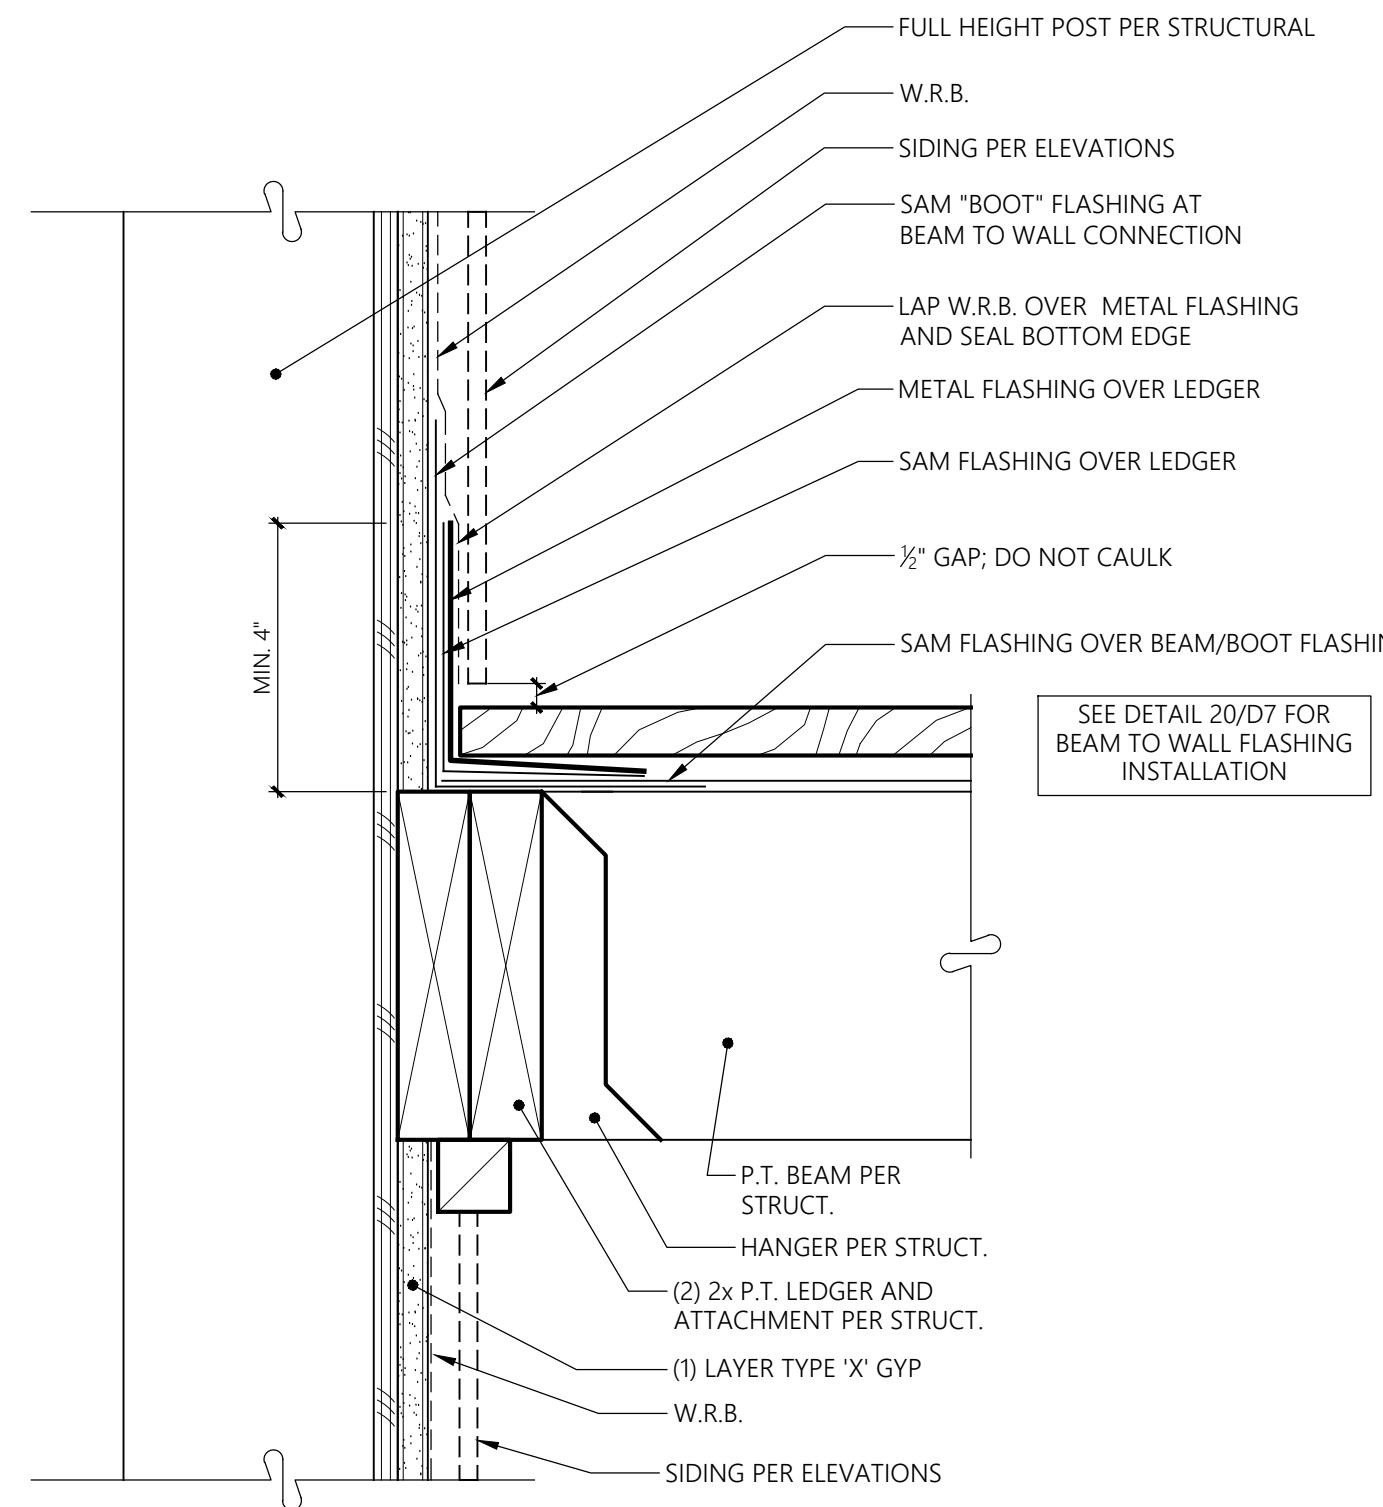


C BEAM AT RATED COLUMN

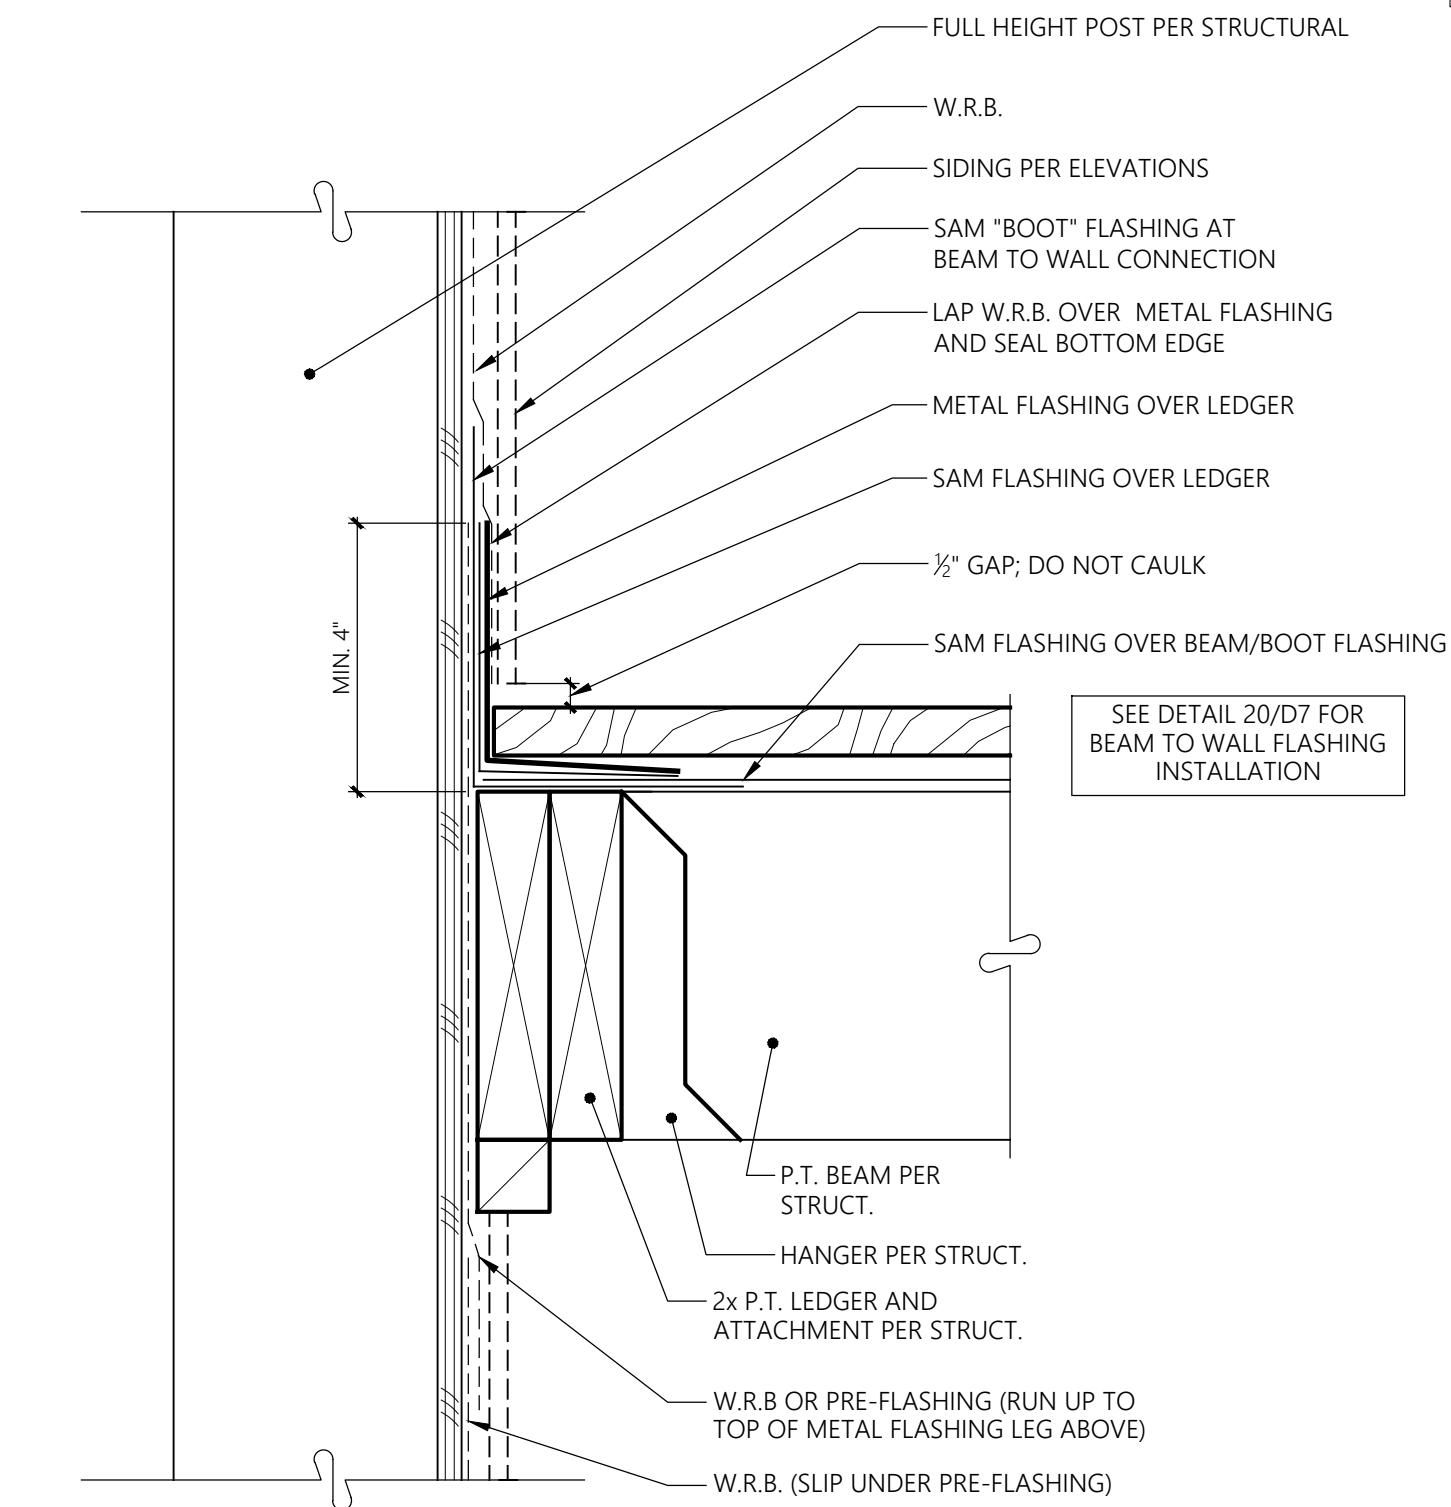


D BEAM AT UN-RATED COLUMN

18 SPACED DECKING TO WALL

3" = 1'-0"

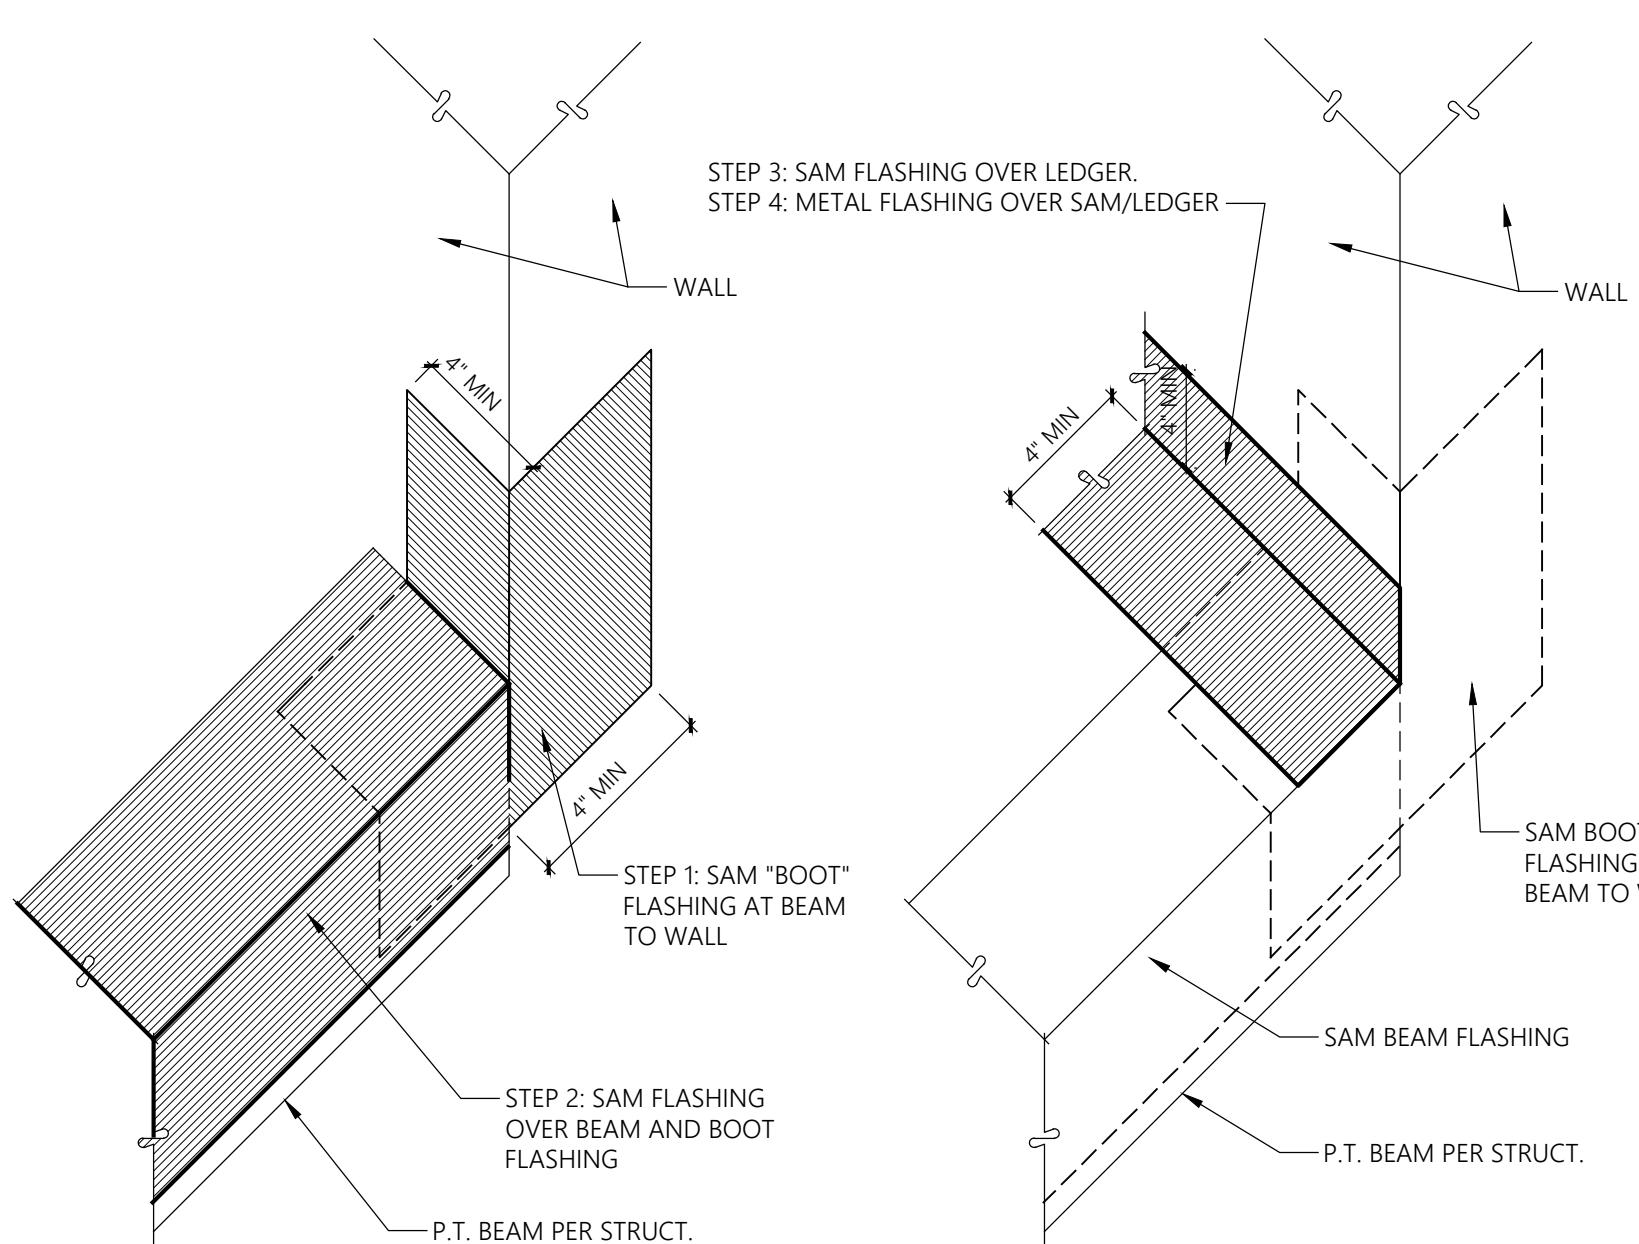


SHEET ADDED WITH
SPACED DECKING
DETAILS

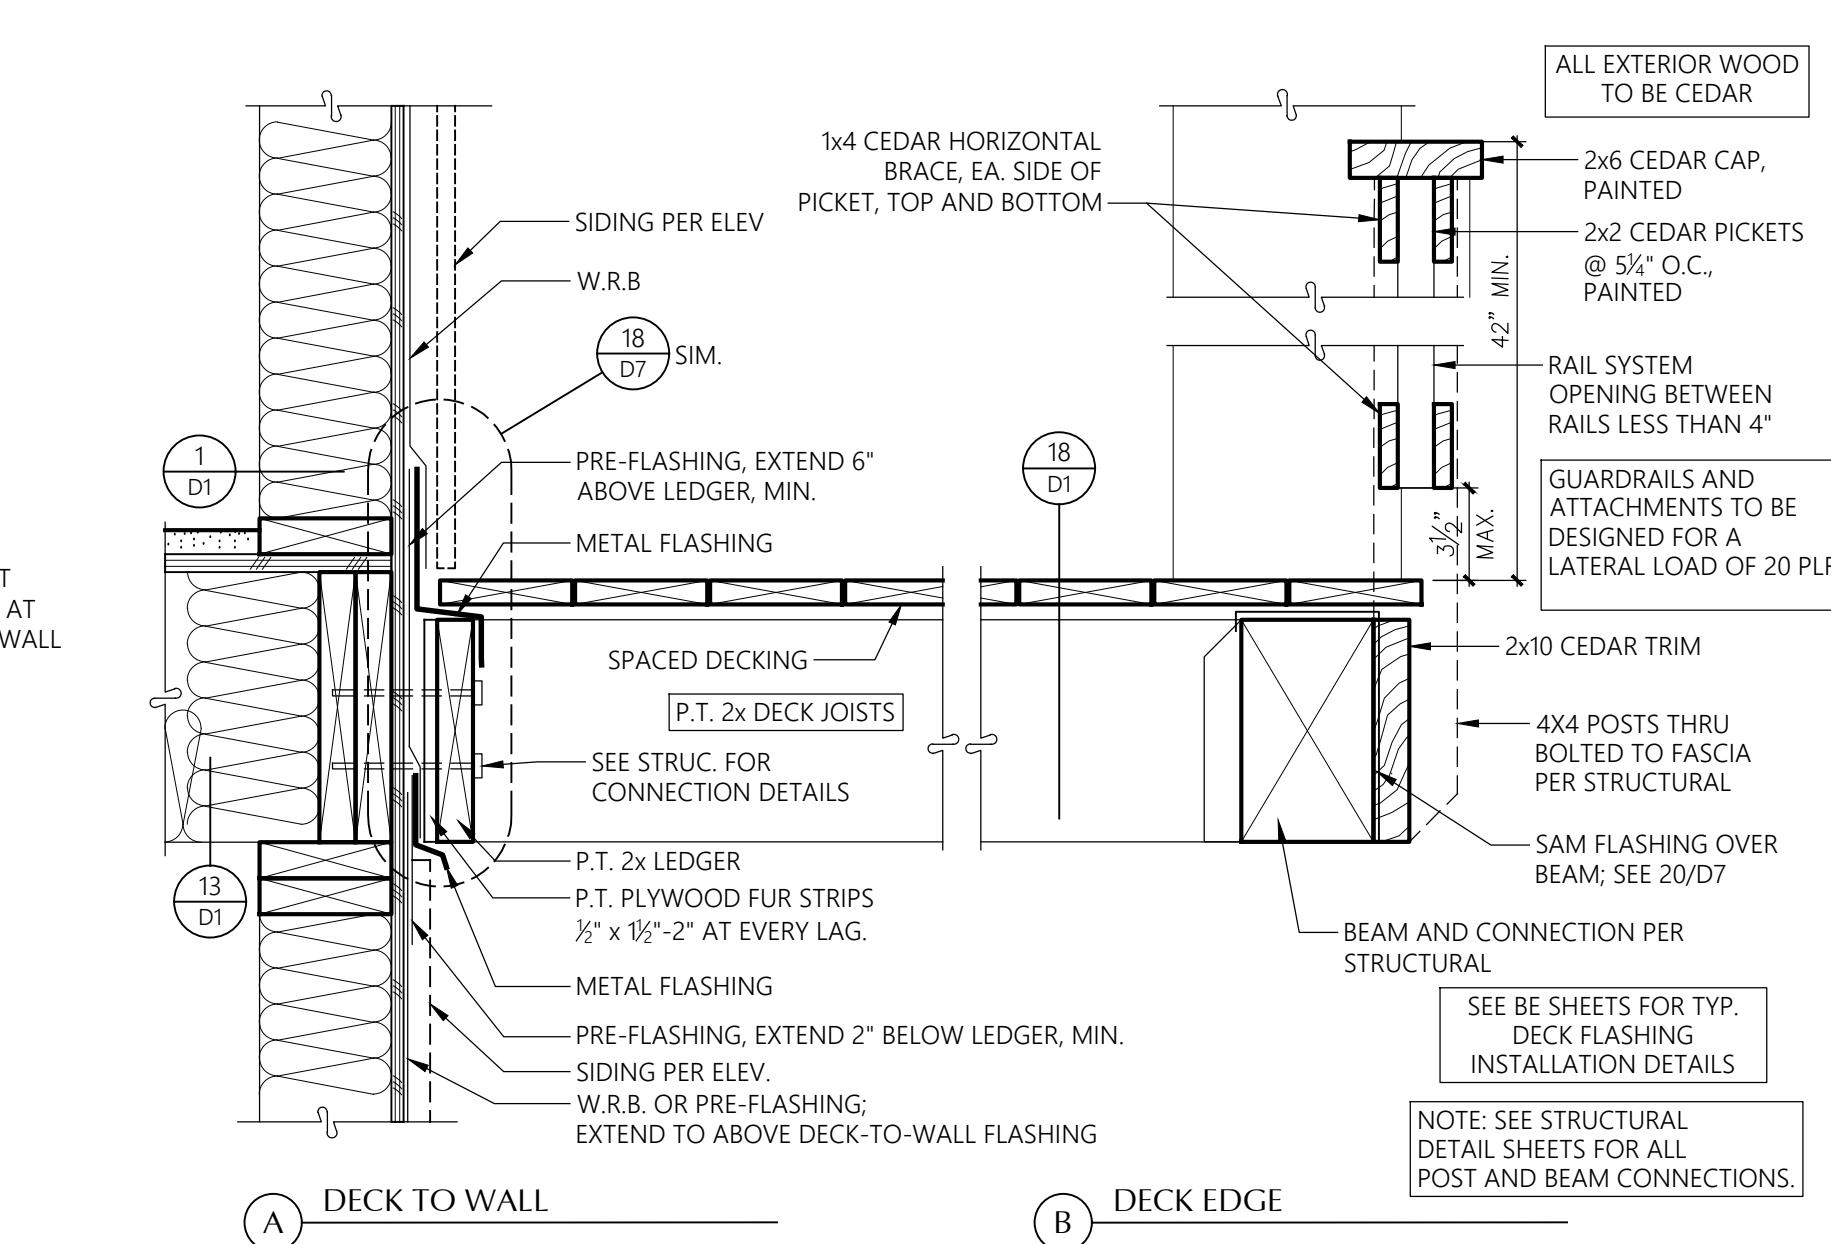


20 BEAM TO WALL FLASHING

16 TYP. SPACED DECKING DETAILS

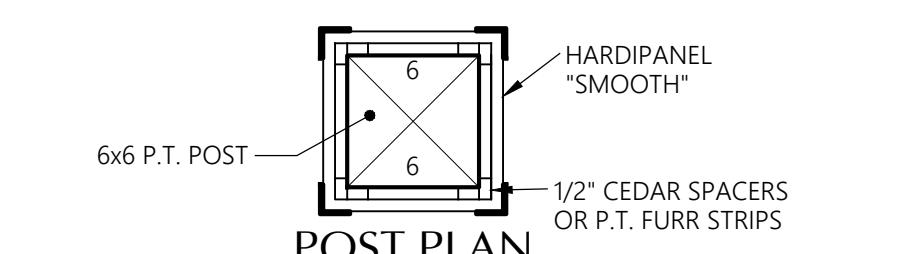


7 POST AT SPACED DECKING

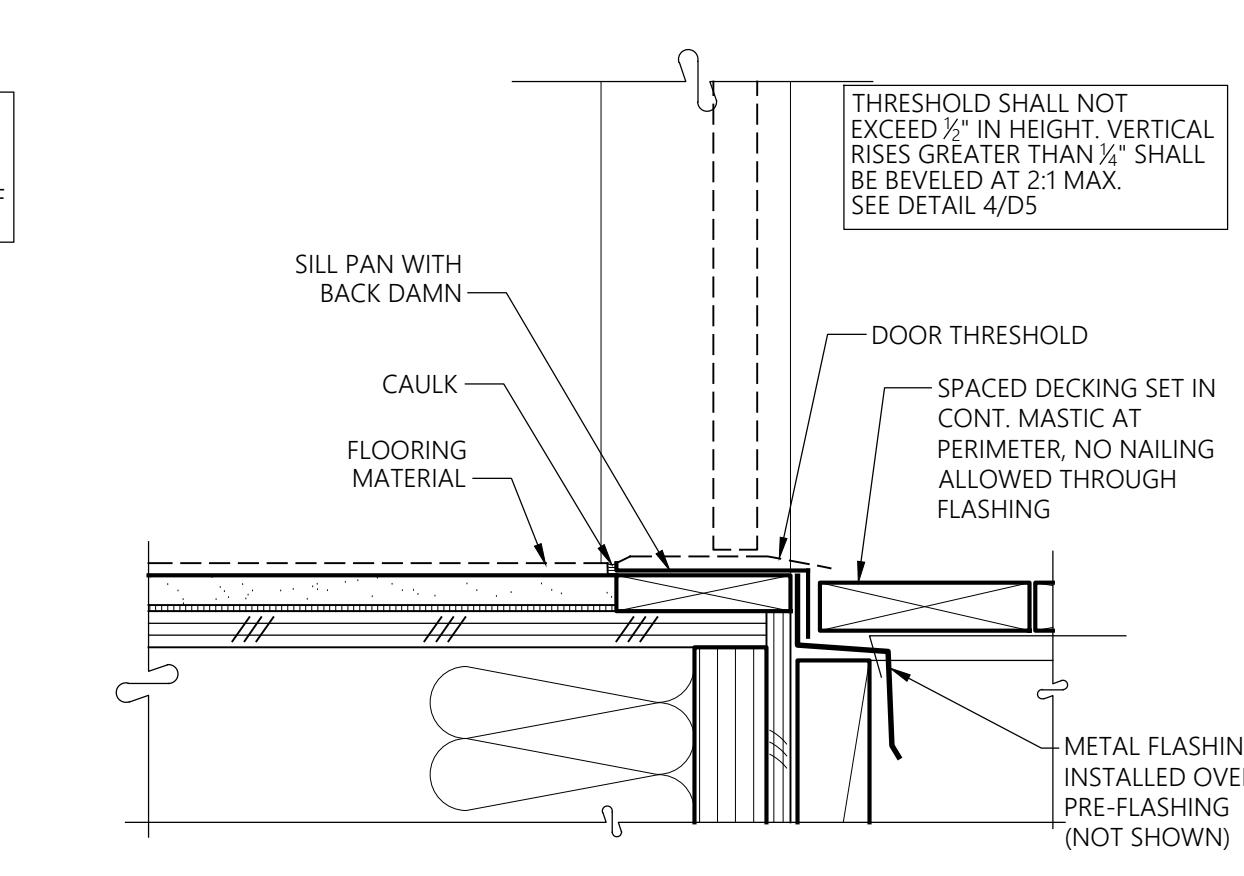

8 SPACED DECKING @ DOOR THRESHOLD

SECTION


3" = 1'-0"

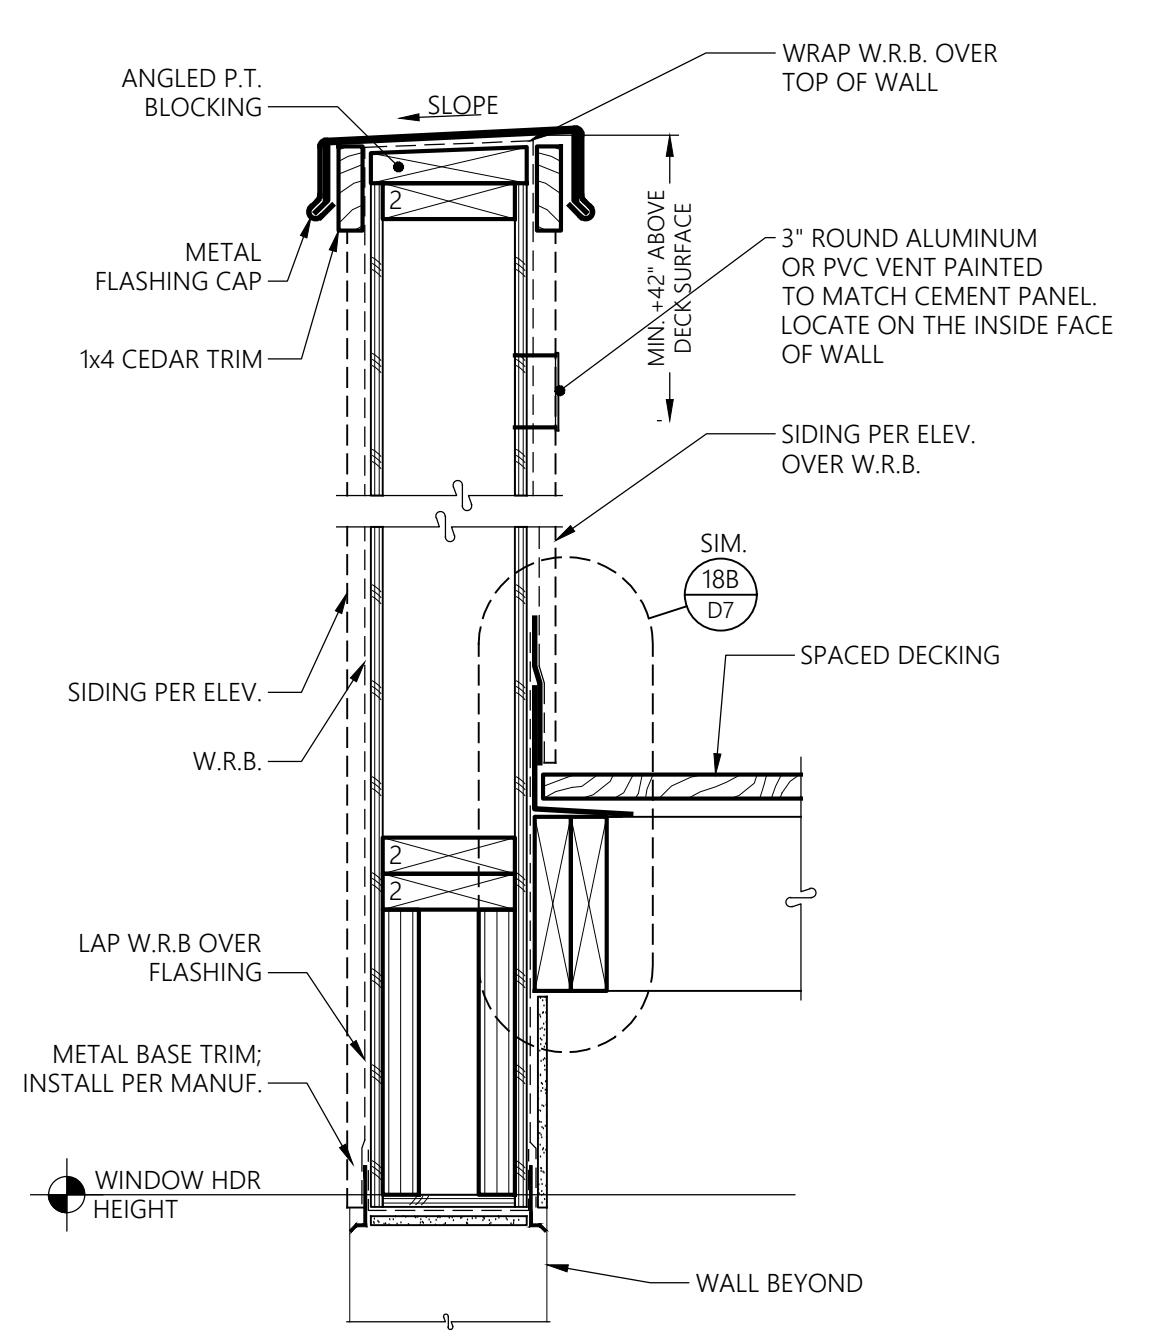

4 WALL @ SPACED DECKING


SECTION

1-1/2" = 1'-0"

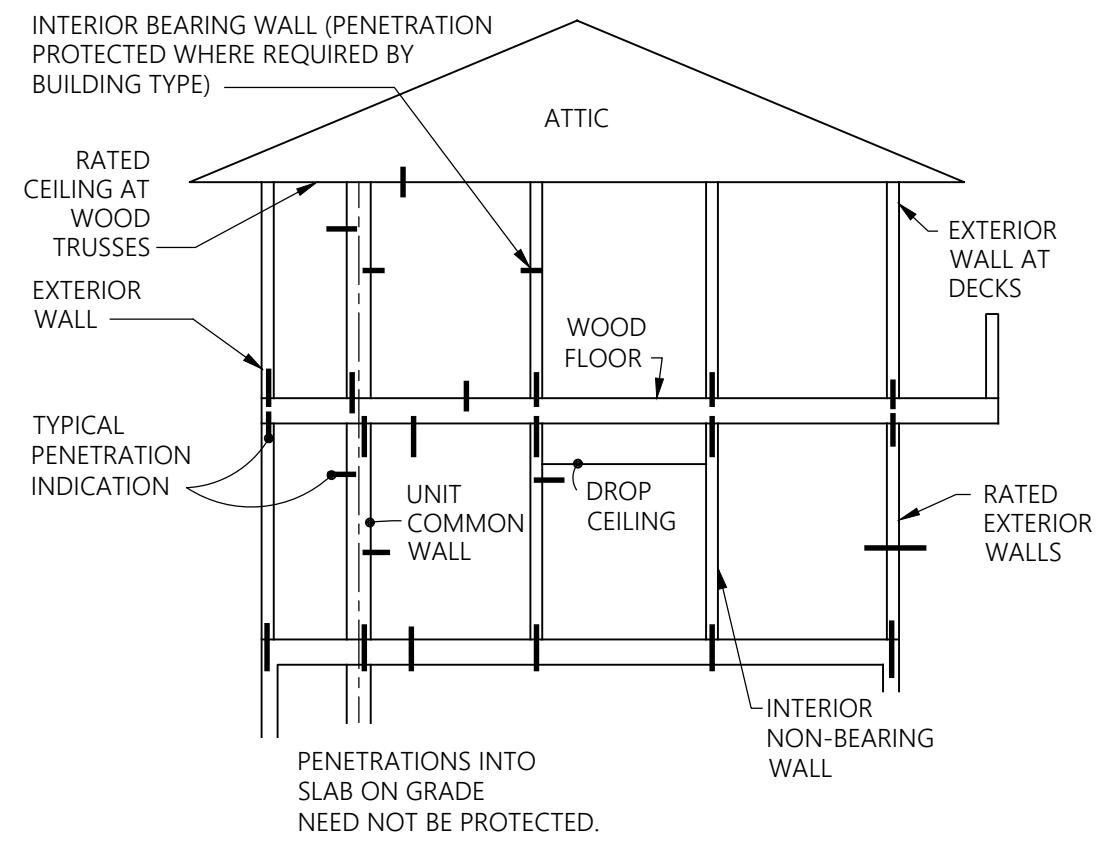


17 PENETRATION LOCATIONS FOR FIRESTOPPING
SECTION
NO SCALE


THE PURPOSES OF THIS DETAIL IS TO INDICATE TYPES OF LOCATIONS OF WALL, CEILING AND FLOOR PENETRATIONS THAT NEED TO BE FIRESTOPPED IN ACCORDANCE WITH 706, 708, 711, 713, 714 AND 717 OF THE 2018 INTERNATIONAL BUILDING CODE. THE THICK LINES IN THE DETAIL INDICATE A PENETRATION BY A PIPE, CONDUIT, VENT, ETC., WHETHER PLASTIC (COMBUSTIBLE) OR NON-COMBUSTIBLE. IN GENERAL THESE PENETRATIONS (OR THE ANNULAR SPACE AROUND THEM) WOULD COMPROMISE THE INTEGRITY OF THE FIRE-RATED ASSEMBLY UNLESS IT WERE CLOSED OFF AND PROTECTED DURING A FIRE. COMMON WALLS BETWEEN UNITS ARE FIRE-RATED WALLS. UNRATED WALLS WITHIN UNITS (EVEN THOUGH THEY MAY HAVE FIBERGLASS WALLBOARD) NEED NOT BE PROTECTED. HOWEVER, PENETRATION OF THE TOP AND BOTTOM PLATES OF UNRATED WALLS INTO THE RATED FLOOR ASSEMBLY NEEDS TO BE FIRESTOPPED. THE CONTRACTOR SHALL DETERMINE FIRESTOPPING FOR EACH SITUATION AND TESTED ASSEMBLIES SHALL BE SUBMITTED TO THE ARCHITECT AND THE CITY IN ACCORDANCE WITH THE "DEFERRED SUBMITTALS" SECTION ON THE COVER SHEET.

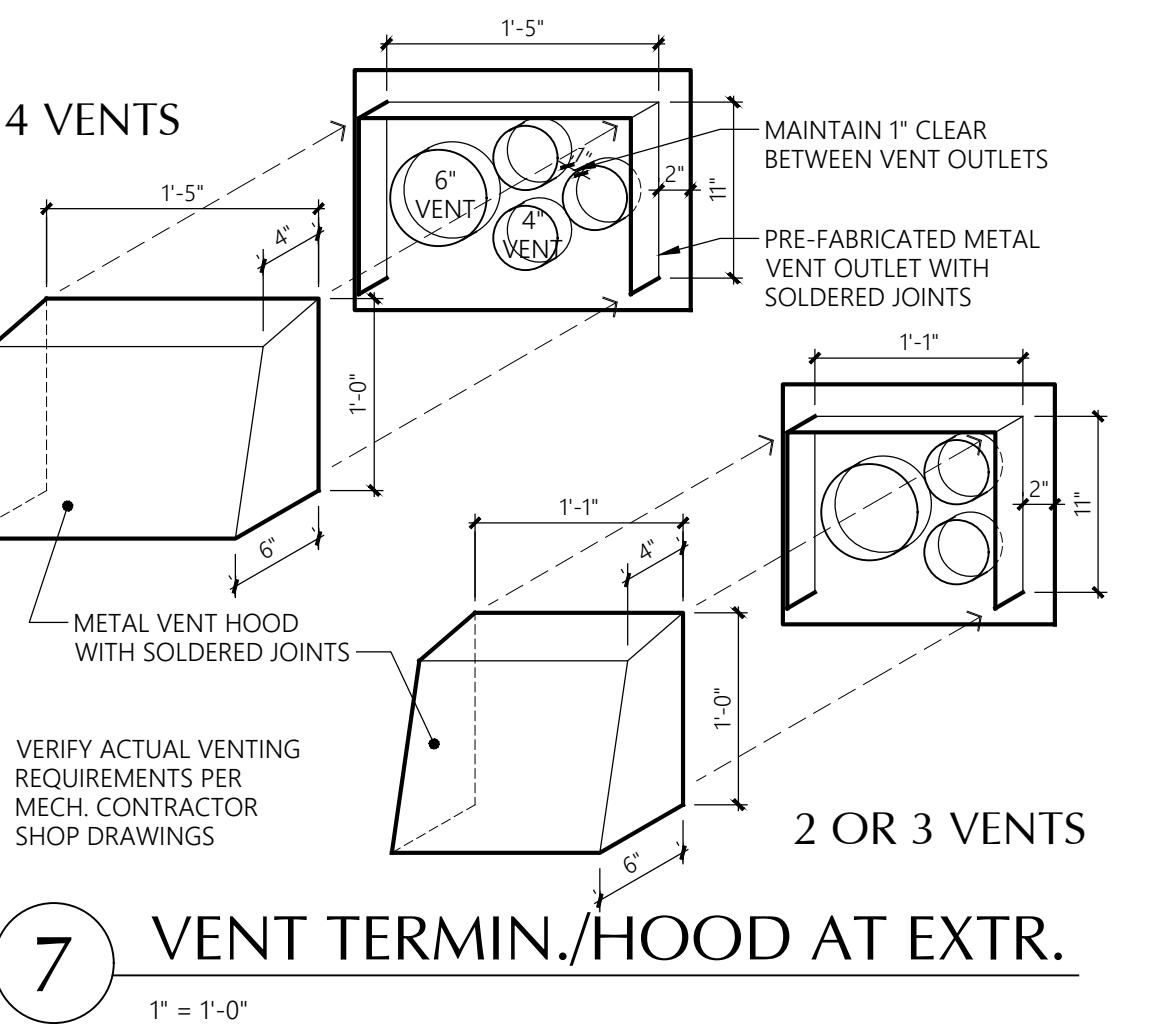

7 VENT TERMIN./HOOD AT EXTR.
SECTION
1' = 1'-0"

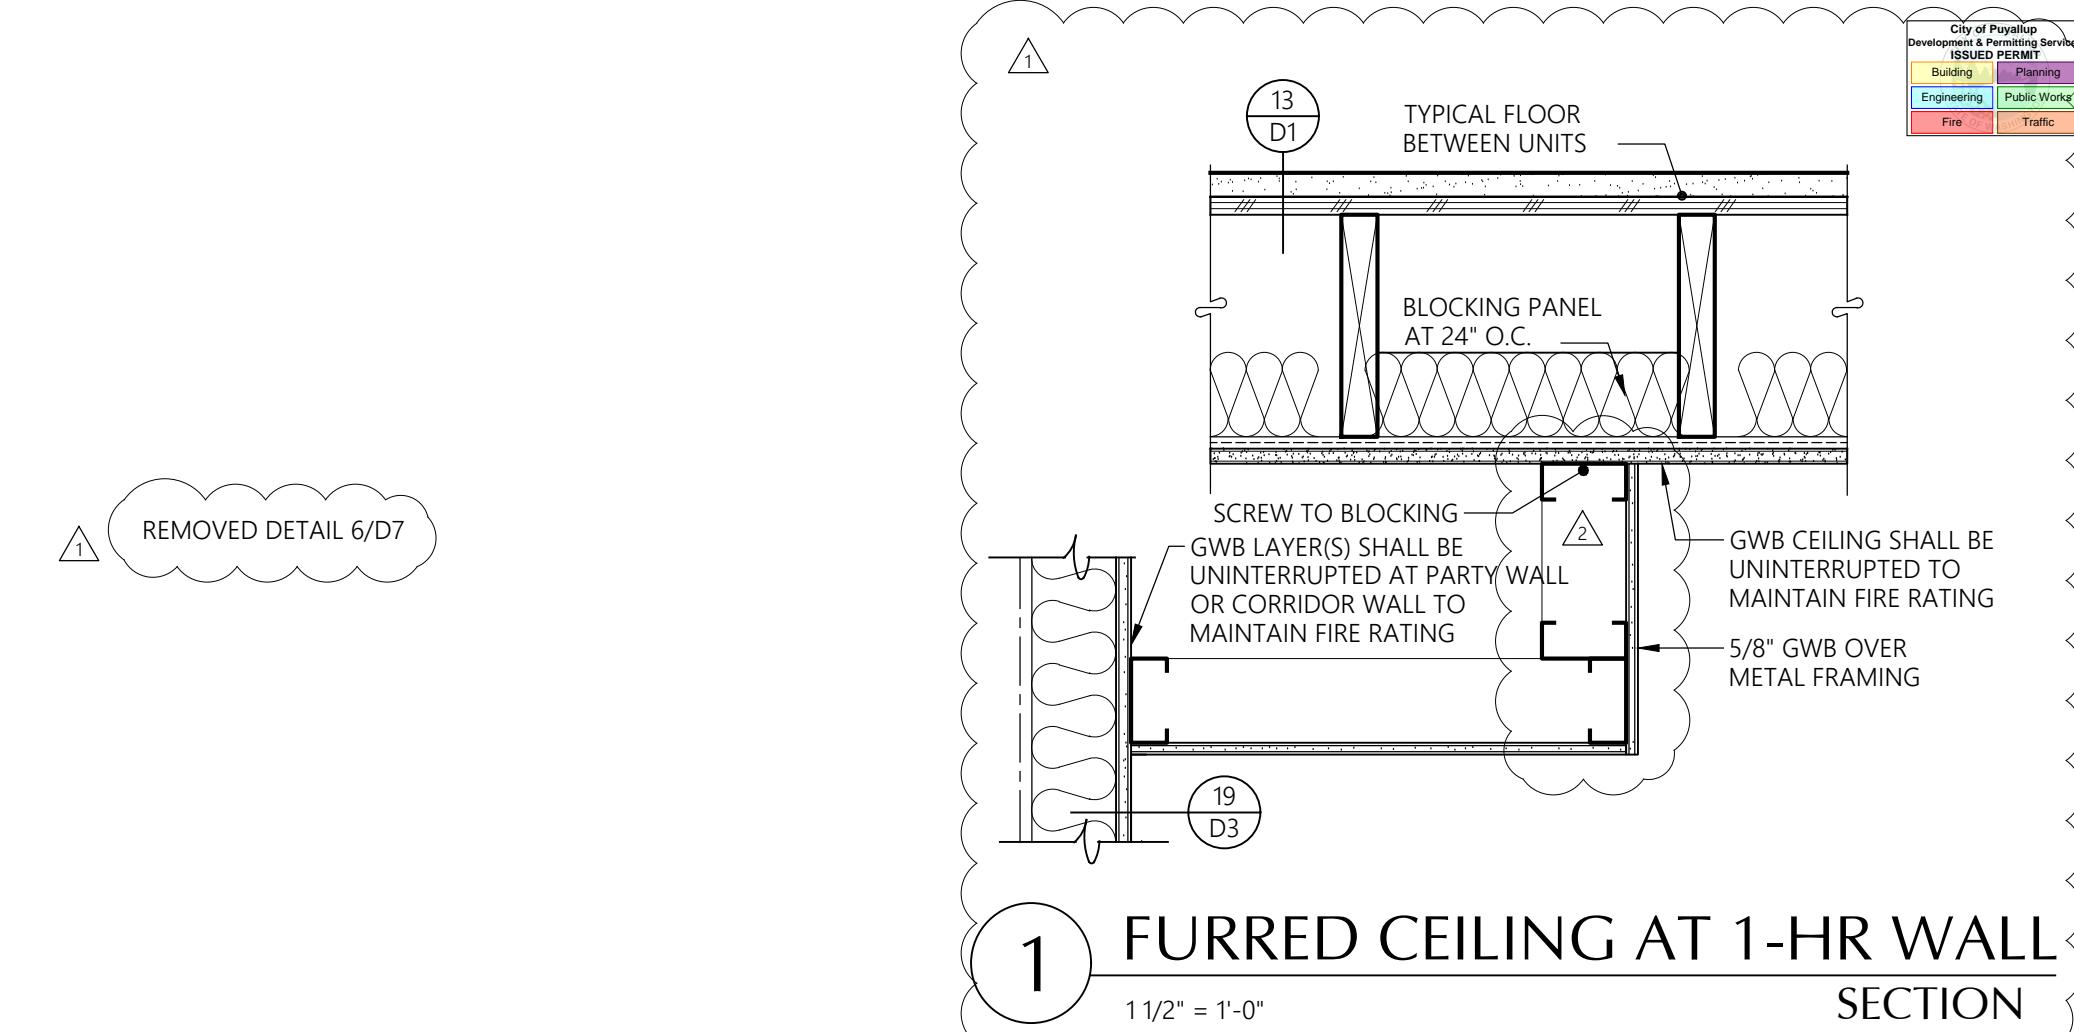


1 FURRED CEILING AT 1-HR WALL
SECTION
1 1/2" = 1'-0"

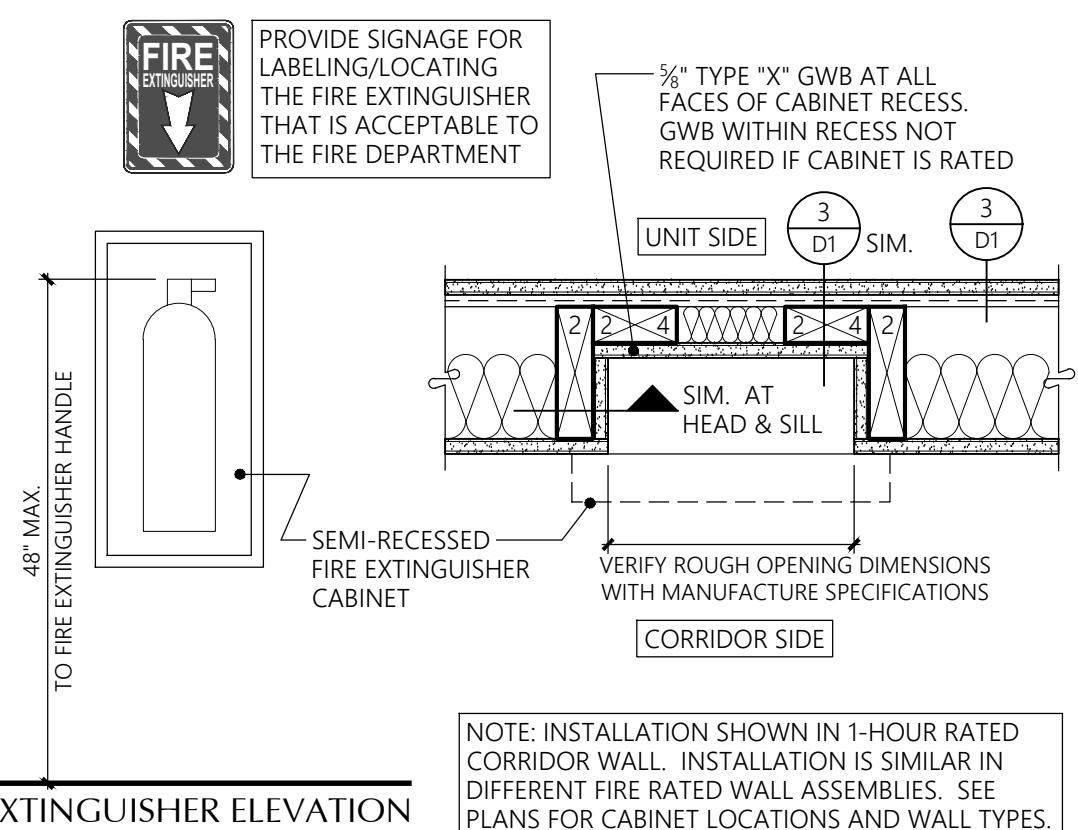

2 SEMI-RECESSED FIRE EXT. CAB.
PLAN
1-1/2" = 1'-0"



18 TYP. FIRESTOP AT PENETRATION
SECTION
1-1/2" = 1'-0"

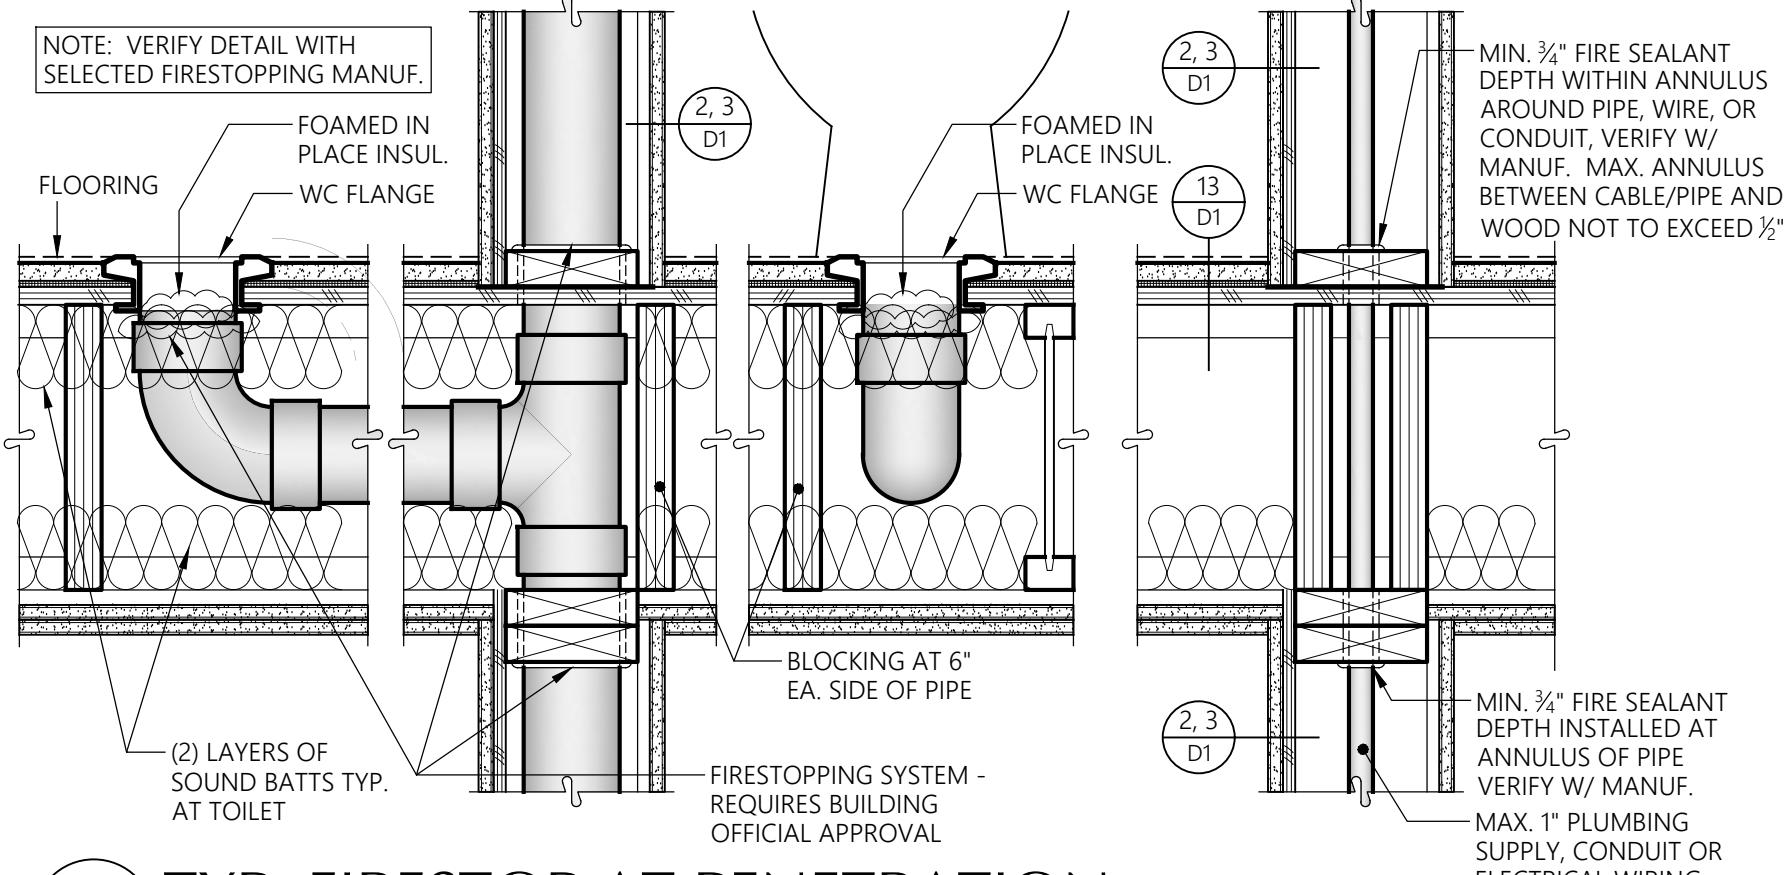

INSULATION AND ENERGY NOTES

Insulation - General

All insulation materials shall be installed according to the manufacturer's instructions to achieve proper densities, and maintain uniform R-values. Substantial contact of the insulation with the surface being insulated is required.

Where required, insulation shall be installed with clearances according to manufacturer's specifications. Insulation shall be installed so that required ventilation is unobstructed. For blown or poured loose fill insulation clearances shall be maintained through installation of a permanent retainer.

Slab on Grade

R-10 slab on grade insulation shall be installed inside the foundation walls.

Insulated Floors

Floor insulation shall be installed in a permanent manner in substantial contact with the surface being insulated. Insulation supports shall be installed so spacing is no more than twenty-four inches on center.

Floors separating conditioned space from unconditioned space shall have a vapor barrier installed. Vapor barrier shall be installed on the warm side of the insulation. The vapor barrier shall have a one perm dry cup rating or less (i.e. four mil polyethylene or kraft faced material). The floor sheathing may be used as the vapor barrier if rated (and so stamped) at one perm (max). Otherwise place vapor barrier on top of joists before placing sheathing.

Exterior Walls

All wall insulation shall fill the entire cavity. Exterior wall cavities isolated during framing shall be fully insulated to the levels of the surrounding walls. All faced insulation shall be face stapled to avoid compression.

Walls separating conditioned space from unconditioned space shall have a vapor barrier installed. Faced batt insulation shall be face stapled. Vapor barrier shall be installed on the warm side of the insulation.

Air Leakage

These air leakage notes apply to those locations separating outdoor ambient conditions from interior spaces that are heated or mechanically cooled.

Exterior joints around windows and door frames, between wall cavities and window or door frames, openings between walls and foundation, between walls and floor panels; openings at penetrations of utility services through walls, floors and roof; and all other openings in the building envelope shall be sealed, caulked, gasketed, or weatherstripped to limit air leakage in a manner approved by the building official.

Doors

All exterior doors or doors serving as access to an enclosed unheated area shall be weatherstripped to limit leakage around their perimeter when in a closed position.

The thermal transfer characteristics of insulated doors shall be determined per NFRC 100-91.

Windows:

Glazing U-values shall be determined in accordance with NFRC 100-91.

Windows and SGD shall be double glazed vinyl type with the U-values indicated on the unit plans.

Windows shall be furnished with outdoor air inlet as indicated on the Unit Electrical plans. Inlets shall have a controllable and secure opening and be capable of a total opening area of not less than four (4) square inches and tested by a nationally recognized standard or approved agency and located to avoid drafts. Inlets shall be screened or otherwise protected from entry by insects, leaves, or other material.

Roof/Ceilings:

Roof/Ceiling insulation: Open-Blown or poured loose fill insulation may be used in attic spaces where the slope of the ceiling is more than 4° in 12 and there is at least 44 inches of clear distance from the top of the bottom chord of the truss or ceiling joist to the underside of the sheathing. When eave vents are installed, baffling of the vent openings shall be provided so as to deflect the incoming air above the surface of the insulation.

Baffles shall be rigid material, resistant to wind driven moisture. When feasible, the baffles shall be installed from the top of the outside of the exterior wall, extending inward, to a point six inches vertically above the height of noncompressed insulation, and twelve inches vertically above loose fill insulation. Baffles shall be in place at the time of framing inspection.

Where the ventilation space above the insulation is less than an average of twelve inches roof/ceiling assemblies shall be provided with a vapor barrier having a 0.5 perm cup rating or less. Faced batt insulation where used as a vapor barrier shall be face stapled.

Vapor barriers shall not be required in roof/ceiling assemblies where the ventilation space above the insulation averages twelve inches or greater.

Vapor barriers shall be installed on the warm side of the insulation.

Details

Bradley Heights Apartments

Puyallup, Wa

Timberlane Partners

Revisions

No. Date Description
8-30-24 Owner Changes/ Permit Corrections

Initial Publish Date: _____
Date Plotted: 5-1-25
Job No.: 23-06 Drawn By: APT/HDM
Sheet No.: D9

NOTE: ALL DETAILS ON THIS SHEET ARE RECOMMENDED FIRE RATED PENETRATION DETAILS BASED ON PRODUCTS LISTED IN 12/D9. OTHER PRODUCTS MEETING THE SAME LEVEL OF ASSEMBLY SHALL BE DEEMED ACCEPTABLE.

PENETRATING ITEM	FIRE ASSEMBLY	RATING	SYSTEM	PROD	ASSOCIATED DETAIL
METAL PIPE/CONDUIT	GYP. WALLS	1,2&3 HR	WL1001	CP25WB+	1/D9 △
MULTIPLE METAL	GYP. WALLS	182 HR	WL1016	CP25WB+	2/D9 △
INSULATED PIPE	GYP. WALLS	182 HR	WL5039	CP25WB+	4/D9 △
HVAC DUCTS	GYP. WALLS	182 HR	WL7008	CP25WB+	6/D9 △
BUND CABLES	GYP. WALLS	182 HR	WL3031	MOLDABLE PUTTY	7/D9 △
ELEC. OUTLET BOXES	GYP. WALLS	182 HR	ANSI UL263	MOLDABLE PUTTY	8/D9 △
CABLE TRAYS	GYP. WALLS	182 HR	WL4004	CP25WB+ CS195+	10/D9 △

MATRIX OF UL TESTED SYSTEMS FOR FIRESTOPPING
12 NTS

17 WL2128
3" = 1'-0"
SECTION





- 1 TYP. FIRE RATED WALL ASSEMBLY, SEE SHEET D1 FOR DETAILS
- 2 METALLIC SLEEVE - OPTIONAL - SEE MANUFACTURER INFORMATION FOR ACCEPTABLE METALLIC SLEEVES
- 3 ONE NONMETALLIC PIPE WITHIN FIRESTOP SYSTEM. PIPE MAY BE INSTALLED AT AN ANGLE NOT GREATER THAN 45 DEGREES FROM PERPENDICULAR. PIPE TO BE RIGIDLY SUPPORTED ON BOTH SIDES OF THE WALL ASSEMBLY. THE SPACE BETWEEN THE PIPE AND PERIPHERY OF THE OPENING SHALL BE MIN. $\frac{1}{2}$ " TO MAX $\frac{3}{8}$ ". SEE MANUFACTURER INFORMATION FOR ACCEPTABLE PIPE TYPES AND SIZES.
- 4 FOR 1 HR F RATING, MIN $\frac{3}{8}$ " THICKNESS OF FILL MATERIAL APPLIED WITHIN THE ANNULUS, FLUSH WITH BOTH SURFACES OF THE WALL. FOR 2 HOUR F RATING, MIN 1-1/4" THICKNESS OF FILL MATERIAL APPLIED WITHIN ANNULUS, FLUSH WITH BOTH SURFACES OF WALL. HILTI FS-ONE OR FS-ONE MAX INTUMESCENT SEALANT

- 1 TYP. FIRE RATED WALL ASSEMBLY, SEE SHEET D1 FOR DETAILS
- 2 NOM. 36" X 30" (OR SMALLER) NO. 24 GAUGE (OR HEAVIER) GALV. STEEL DUCT TO BE INSTALLED EITHER CONCENTRICALLY OR ECCENTRICALLY WITHIN THE FIRESTOP SYSTEM. AN ANNULUS SPACE OF MIN 0" TO MAX 2" IS REQUIRED WITHIN THE FIRESTOP SYSTEM.
- 3 PACKING MATERIAL (OPTIONAL) - POLYETHYLENE BACKER ROD, MINERAL WOOL BATT INSULATION OR FIBERGLASS BATT INSULATION FRICTION-FIT INTO ANNULUS SPACE FOR 2 HR RATED WALL ASSEMBLIES ONLY. PACKING MATERIAL TO BE RECESSED FROM BOTH SURFACES OF WALL TO ACCOMMODATE THE REQUIRED THICKNESS OF FILL MATERIAL (ITEM 3B).
- 4 MIN. $\frac{3}{8}$ " THICKNESS OF FILL MATERIAL APPLIED WITHIN ANNULUS, FLUSH WITH BOTH SURFACES OF WALL AT THE POINT CONTACT LOCATION BETWEEN DUCT AND WALLBOARD. A MIN $\frac{1}{2}$ " DIA. BEAD OF SEALANT SHALL BE APPLIED AT THE WALLBOARD/DUCT INTERFACE ON BOTH SURFACES OF WALL ASSEMBLY.
- 5 MIN. 16 GAUGE GALV. STEEL ANGLES SIZED TO LAP DUCT A MIN OF 2" AND LAP WALL SURFACES OF A MIN OF 1". ANGLES ATTACHED TO DUCT ON BOTH SIDES OF WALL WITH MIN $\frac{1}{2}$ " LONG, NO. 10 (OR LARGER) SHEET METAL SCREWS SPACED A MAX OF 1" FROM EACH END OF DUCT AND SPACED A MAX OF 6" OC.
- 6 RIGID ALUMINUM FOIL-FACED SHEET WITH GALV. STEEL BACKER. SHEETS CUT TO TIGHTLY FOLLOW THE CONTOURS OF THE CABLES AROUND THE ENTIRE PERIMETER OF THE CABLE TRAY AND CABLE FILL. SHEETS CUT TO LAP A MIN. OF 2" ON THE WALL ON ALL SIDES OF THE OPENING ON BOTH SIDES OF THE WALL.

SEE MANUF. INFORMATION FOR USE OF PUTTY AS CAULKING ALTERNATIVE.

10 WL4004
3" = 1'-0"
SECTION


- 1 TYP. FIRE RATED WALL ASSEMBLY, SEE SHEET D1 FOR DETAILS
- 2 CABLES - MAX 4 IN. DIAM TIGHT BUNDLE OF CABLES CENTERED IN CIRCULAR CUTOUTS IN GWB AND RIGIDLY SUPPORTED ON BOTH SIDES OF THE WALL ASSEMBLY. SEE MANUFACTURER INFORMATION FOR ACCEPTABLE TYPES AND SIZES CABLES.
- 3 WRAP STRIP - NOM $\frac{1}{2}$ " THICK INTUMESCENT MATERIAL FACED ON ONE SIDE WITH ALUMINUM FOIL, SUPPLIED IN NOM 2 IN. WIDE STRIP TIGHTLY WRAPPED AROUND CABLE BUNDLE (FOIL SIDE OUT) WITH SEAM BUTTED. WRAP STRIP SECURELY BOUND WITH STEEL WIRE TIE AND SLID INTO ANGULAR SPACE APPROX 1-1/4" SUCH THAT APPROX $\frac{1}{2}$ " OF THE WRAP WIDTH PROTRUDES FROM WALL SURFACE ON EACH SIDE OF ASSEMBLY
- 4 MIN. $\frac{1}{2}$ " THICKNESS DIAM OF MOLDABLE PUTTY APPLIED TO THE WRAP STRIP/WALL INTERFACE AND TO THE EXPOSED EDGE OF WRAP STRIP APPROX $\frac{1}{2}$ " FROM WALL SURFACE ON EITHER SIDE OF ASSEMBLY. PUTTY TO BE FORCED INTO INTERSTICES OF CABLE BUNDLE TO MAX EXTENT POSSIBLE WITHIN CONFINES OF THE WRAP STRIP EACH SIDE OF ASSEMBLY

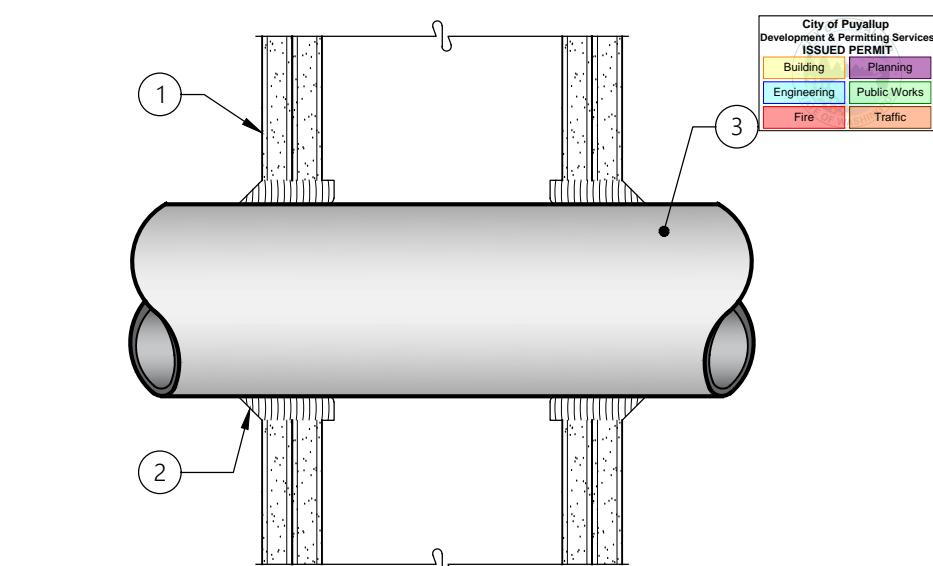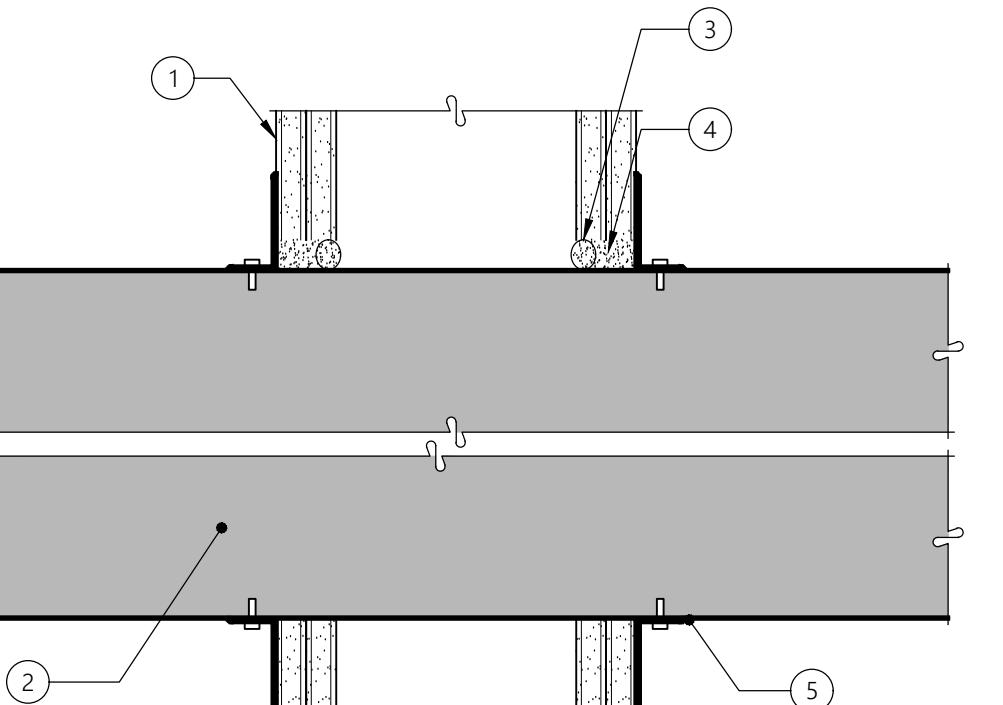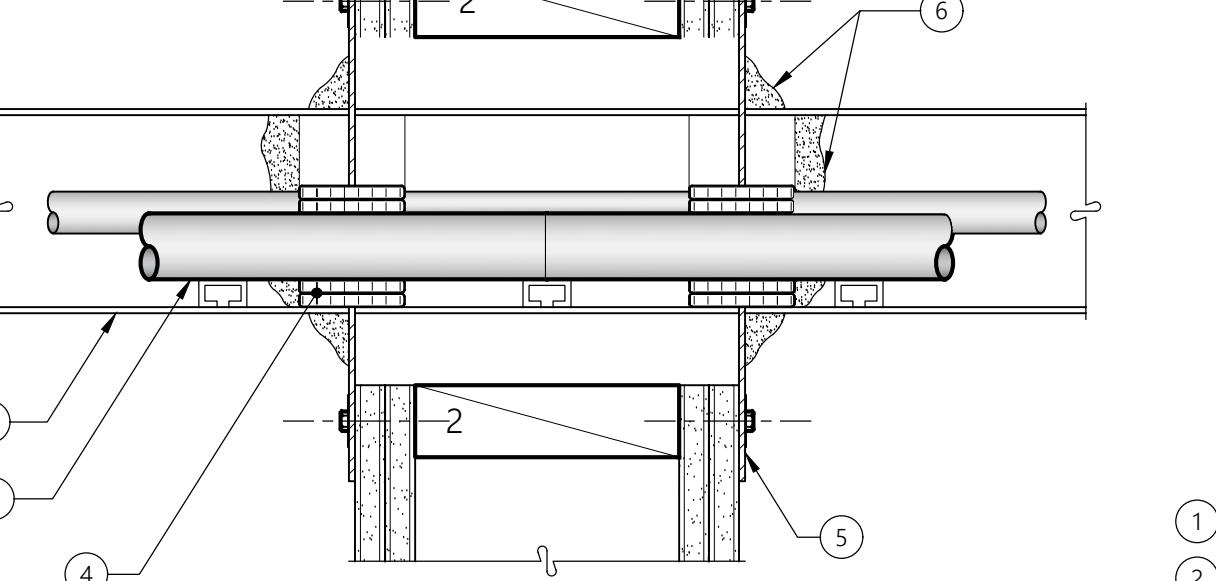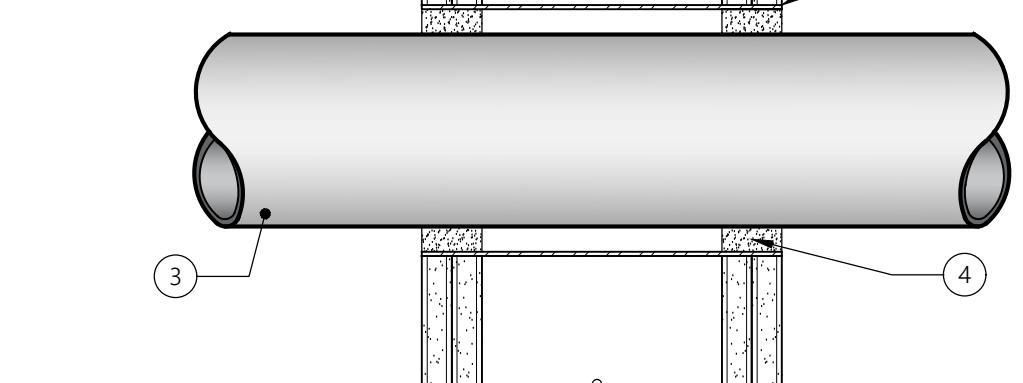

- 1 TYP. FIRE RATED WALL ASSEMBLY, SEE SHEET D1 FOR DETAILS
- 2 MIN. $\frac{3}{8}$, $\frac{1}{2}$, $\frac{3}{4}$ " THICKNESS OF CAULK FOR 1, 2, 3 HOUR, RESPECTIVELY, APPLIED WITHIN ANNULUS, FLUSH WITH BOTH SURFACES OF WALL. MIN $\frac{1}{2}$ " DIA. BEAD OF CAULK APPLIED TO GYPSUM BOARD/PERENTRANT INTERFACE AT POINT CONTACT LOCATION ON BOTH SIDES OF WALL.
- 3 METALLIC PIPE, CONDUIT OR TUBING INSTALLED EITHER CONCENTRICALLY OR ECCENTRICALLY WITHIN THE FIRESTOP SYSTEM. ANNULUS SPACE BETWEEN PIPE, CONDUIT OR TUBING AND PERIPHERY OF OPENING SHALL BE MIN OF 0 IN. (POINT CONTACT) TO MAX 2 IN.

1 WL1001


3" = 1'-0"
SECTION

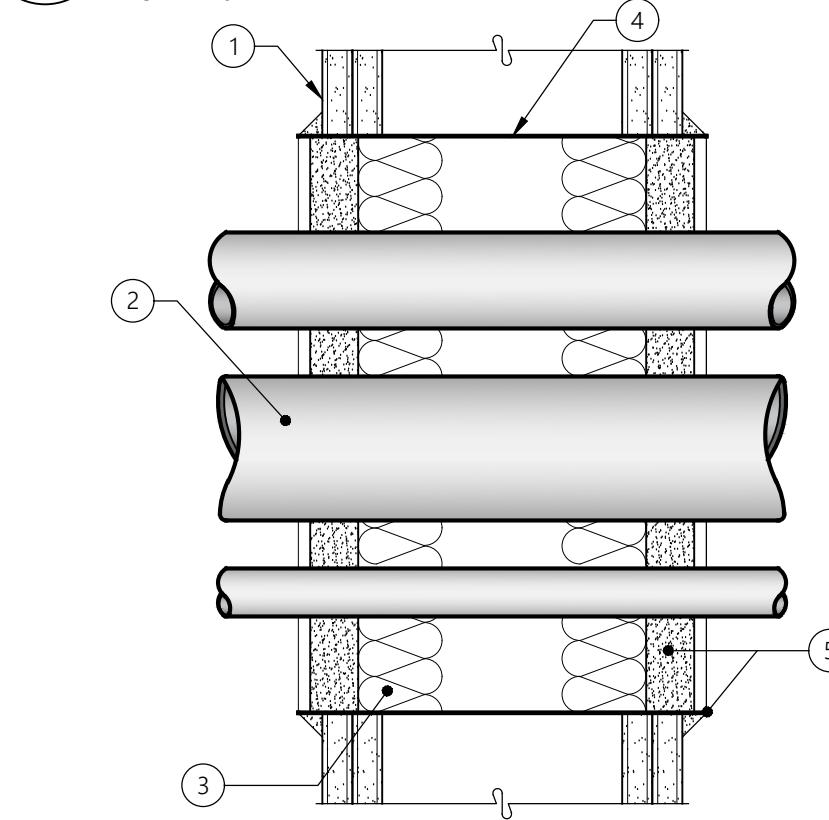

- 1 TYP. FIRE RATED WALL ASSEMBLY, SEE SHEET D1 FOR DETAILS
- 2 NOM. 3 IN. DIAM (OR SMALLER) SCHEDULE 10 (OR HEAVIER) STEEL PIPE, STEEL CONDUIT OR STEEL ELECTRICAL METALLIC TUBING. MULTIPLE PIPES AND/OR CONDUIT PERMITTED IN SLEEVING OPENING PROVIDED A MIN SEPARATION OF $\frac{1}{2}$ " IS MAINTAINED BETWEEN PIPES OR CONDUITS.
- 3 MIN. 1" THICKNESS OF RIGID GLASS FIBER INSULATION OR MINERAL WOOL BATT INSULATION FIRMLY PACKED INTO STEEL SLEEVE ON BOTH SIDES OF WALL ASSEMBLY AS A PERMANENT FORM. PACKING MATERIAL TO BE RECESSED MIN. $\frac{3}{8}$ " FROM SURFACE OF WALL ON BOTH SIDES OF WALL ASSEMBLY.
- 4 NO. .28 GAUGE GALV. SHEET STEEL FORMED INTO MAX 12 IN. DIA. OR MAX 12 IN. BY 9 IN. SLEEVE WITH NOM 2 IN. OVERLAP AT SEAM. LENGTH OF SLEEVE TO BE APPROX 1 IN. GREATER THAN OVERALL THICKNESS OF WALL ASSEMBLY, SUCH THAT, WHEN INSTALLED, THE ENDS OF THE SLEEVE WILL PROJECT APPROX 1/2 IN. BEYOND THE SURFACE OF THE WALL ON BOTH SIDES OF THE WALL ASSEMBLY.
- 5 CAULK OR SEALANT APPLIED TO FILL THE STEEL SLEEVE TO A MIN. DEPTH OF 1" ON BOTH SIDES OF WALL ASSEMBLY. A NOM. $\frac{1}{2}$ " DIA. CONTINUOUS BEAD OF CAULK SHALL BE APPLIED AROUND THE CIRCUMFERENCE OF THE STEEL SLEEVE AT ITS EGRESS FROM THE GYPSUM WALLBOARD LAYERS ON BOTH SIDES OF THE WALL ASSEMBLY.

2 WL1016


3" = 1'-0"
SECTION

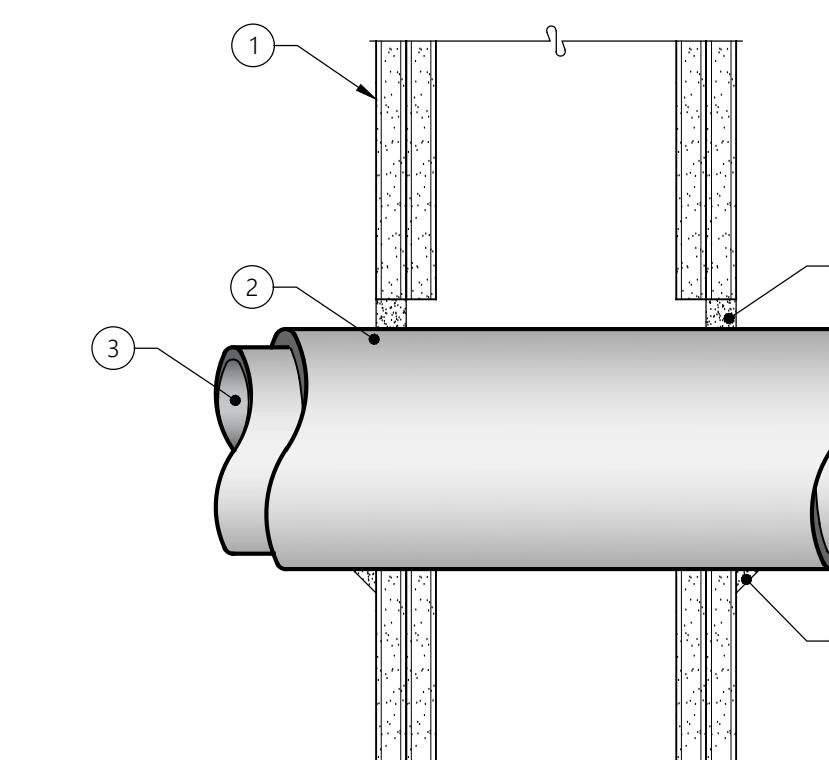

- 1 TYP. FIRE RATED WALL ASSEMBLY, SEE SHEET D1 FOR DETAILS
- 2 NOM. $\frac{1}{2}$ TO 2" THICK HOLLOW CYLINDRICAL HEAVY DENSITY (MIN 3.5 PCF) GLASS FIBER UNITS FOR 1 HR RATED ASSEMBLIES, NOM. $\frac{1}{2}$ TO $\frac{3}{4}$ " THICK CYLINDRICAL HEAVY DENSITY GLASS FIBER UNITS FOR 2 HR RATED ASSEMBLIES, JACKETED ON THE OUTSIDE WITH AN ALL SERVICE JACKET. THE ANNULUS SPACE BETWEEN THE INSULATED PIPE AND THE EDGE OF THE THROUGH OPENING SHALL BE MIN 0" TO MAX $\frac{1}{2}$ "
- 3 ONE METALLIC PIPE OR TUBE TO BE INSTALLED EITHER CONCENTRICALLY OR ECCENTRICALLY WITHIN THE FIRESTOP SYSTEM. PIPE TO BE RIGIDLY SUPPORTED ON BOTH SIDES OF WALL ASSEMBLY.
- 4 MIN. $\frac{3}{8}$ " THICKNESS OF CAULK APPLIED WITHIN ANNULUS SPACE FLUSH WITH EACH SURFACE OF WALL. A MIN. $\frac{1}{2}$ " DIA. BEAD OF CAULK SHALL BE APPLIED TO THE PIPE INSULATION/ WALLBOARD INTERFACE AT THE POINT CONTACT LOCATION ON BOTH SIDES OF WALL.

4 WL5039

3" = 1'-0"
SECTION

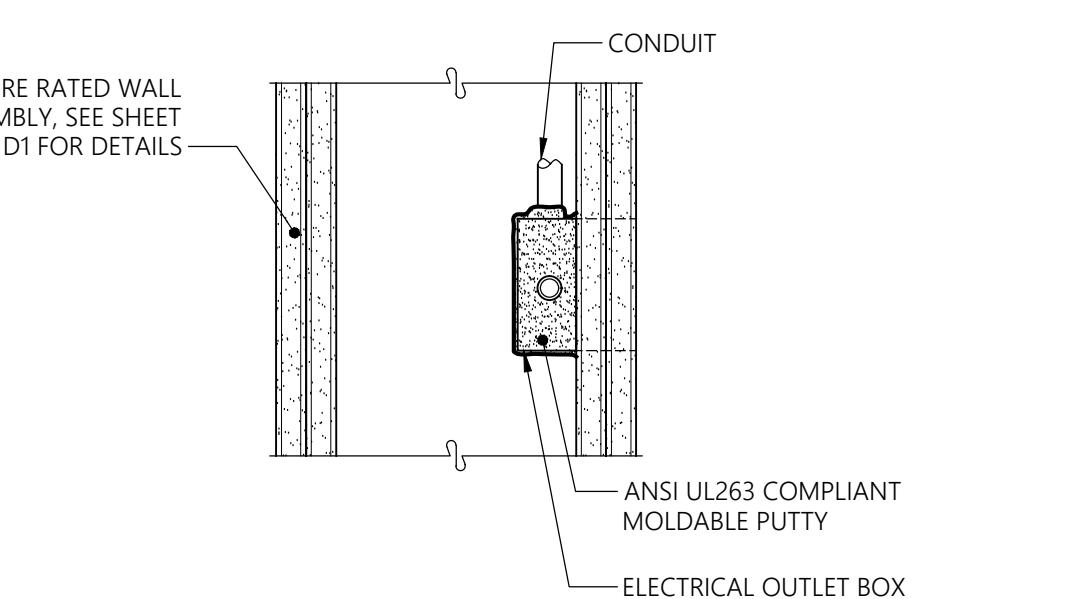

- 1 TYP. FIRE RATED WALL ASSEMBLY, SEE SHEET D1 FOR DETAILS
- 2 NOM. $\frac{1}{2}$ TO 2" THICK HOLLOW CYLINDRICAL HEAVY DENSITY (MIN 3.5 PCF) GLASS FIBER UNITS FOR 1 HR RATED ASSEMBLIES, NOM. $\frac{1}{2}$ TO $\frac{3}{4}$ " THICK CYLINDRICAL HEAVY DENSITY GLASS FIBER UNITS FOR 2 HR RATED ASSEMBLIES, JACKETED ON THE OUTSIDE WITH AN ALL SERVICE JACKET. THE ANNULUS SPACE BETWEEN THE INSULATED PIPE AND THE EDGE OF THE THROUGH OPENING SHALL BE MIN 0" TO MAX $\frac{1}{2}$ "
- 3 ONE METALLIC PIPE OR TUBE TO BE INSTALLED EITHER CONCENTRICALLY OR ECCENTRICALLY WITHIN THE FIRESTOP SYSTEM. PIPE TO BE RIGIDLY SUPPORTED ON BOTH SIDES OF WALL ASSEMBLY.
- 4 MIN. $\frac{3}{8}$ " THICKNESS OF CAULK APPLIED WITHIN ANNULUS SPACE FLUSH WITH EACH SURFACE OF WALL. A MIN. $\frac{1}{2}$ " DIA. BEAD OF CAULK SHALL BE APPLIED TO THE PIPE INSULATION/ WALLBOARD INTERFACE AT THE POINT CONTACT LOCATION ON BOTH SIDES OF WALL.

8 ANSI / UL 263

3" = 1'-0"
SECTION

City of Puyallup
Development Services
ISSUED BY: Planning
Engineering
Fire
Public Works

25 Central Way, Suite 210
Kirkland, WA 98033
P: 425.454.7150 F: 425.658.1150
Web: www.milbrandtarch.com

© Copyright 2023
Milbrandt Architects, Inc., P.S.
All rights reserved

11063 REGISTERED ARCHITECT
ANNA P. THOMPSON
STATE OF WASHINGTON


Initial Publish Date:

Date Plotted: 5-1-25

Job No.: 23-06 Drawn By: APT/HDM


Sheet No.: D9

Revised 8-30-24 Owner Changes/ Permit Corrections

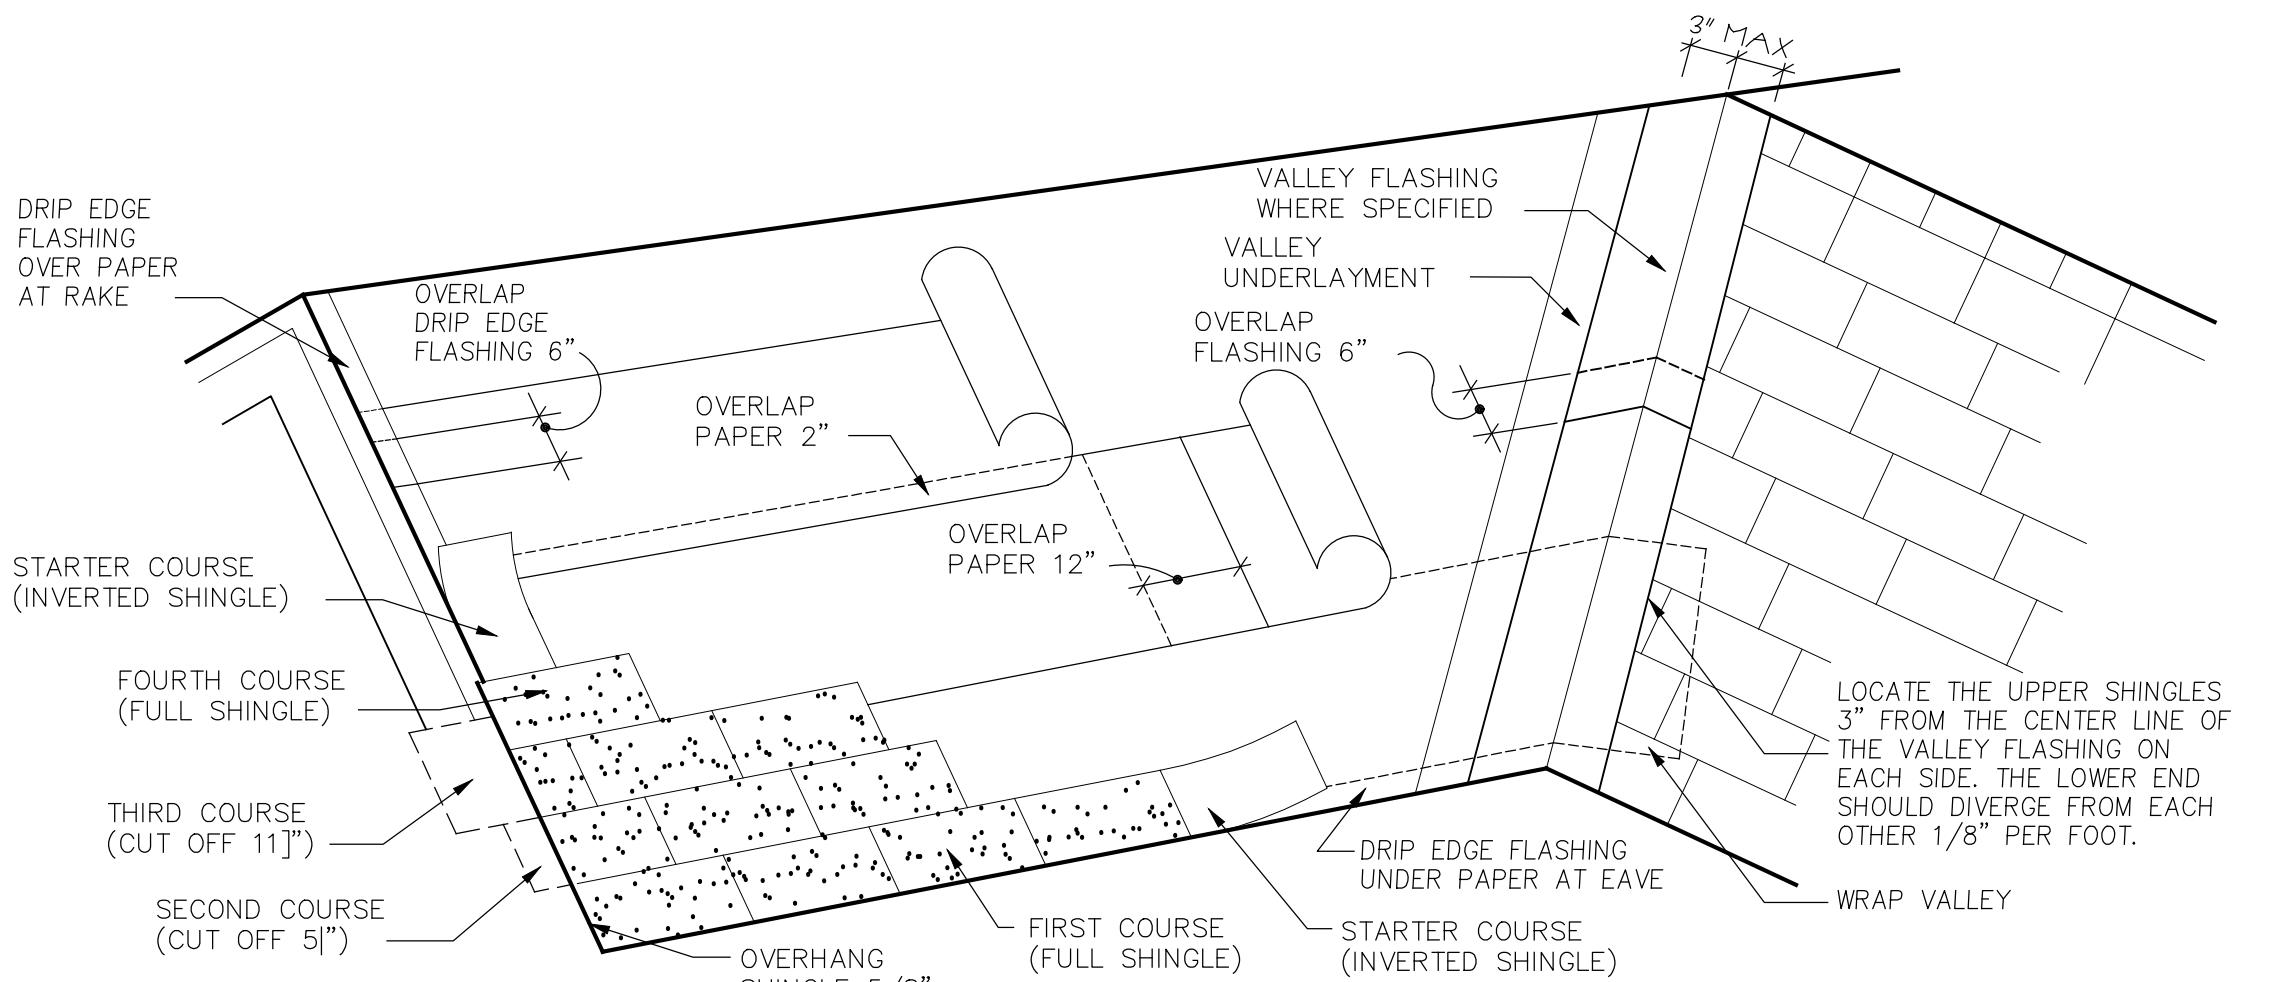

17 ROOF AND VALLEY INSTALLATION

NO SCALE

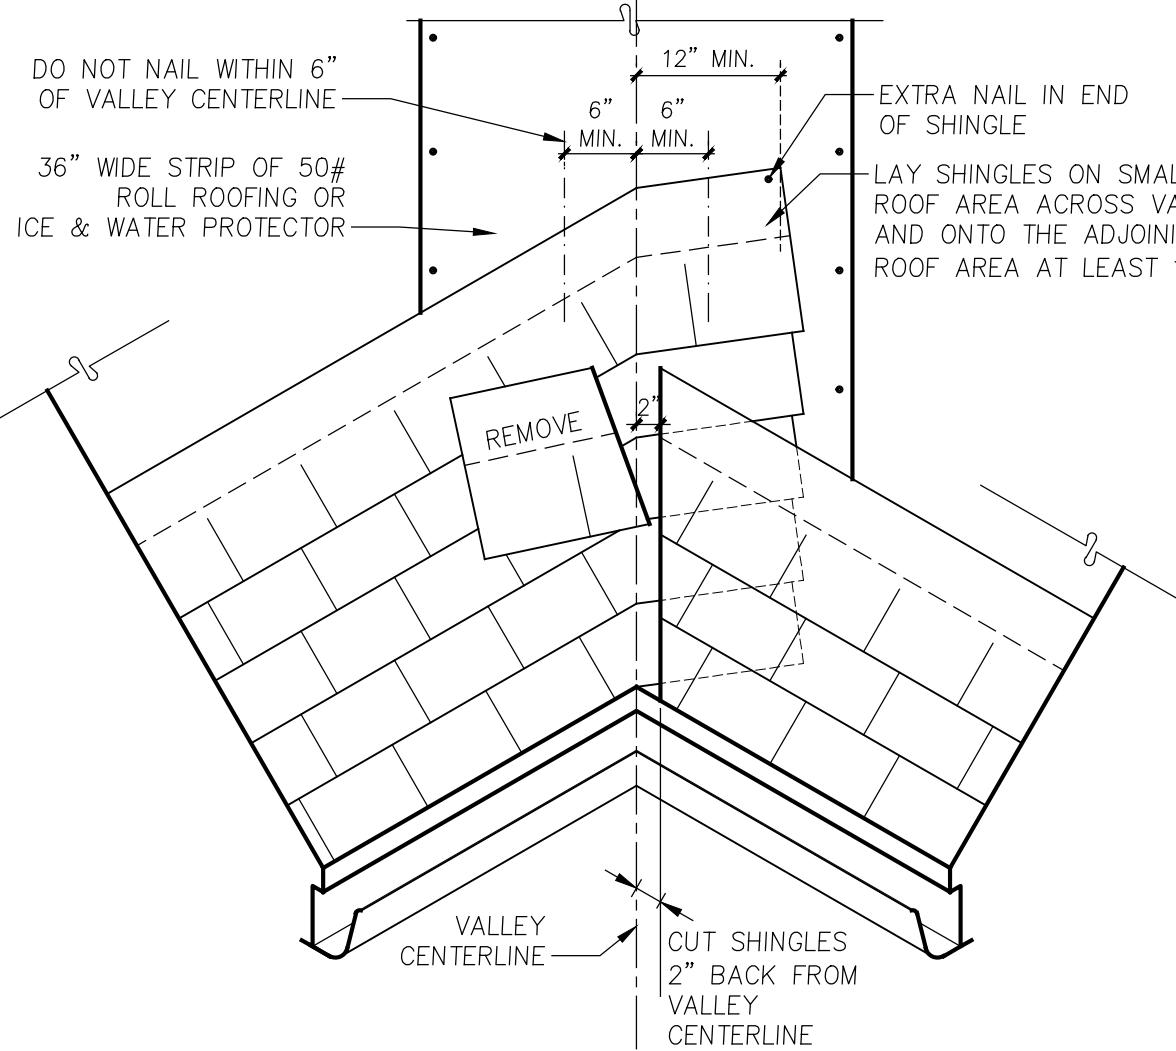


14 ROOF PENETRATION

NO SCALE


18 NON METAL VALLEY INSTALLATION

NO SCALE

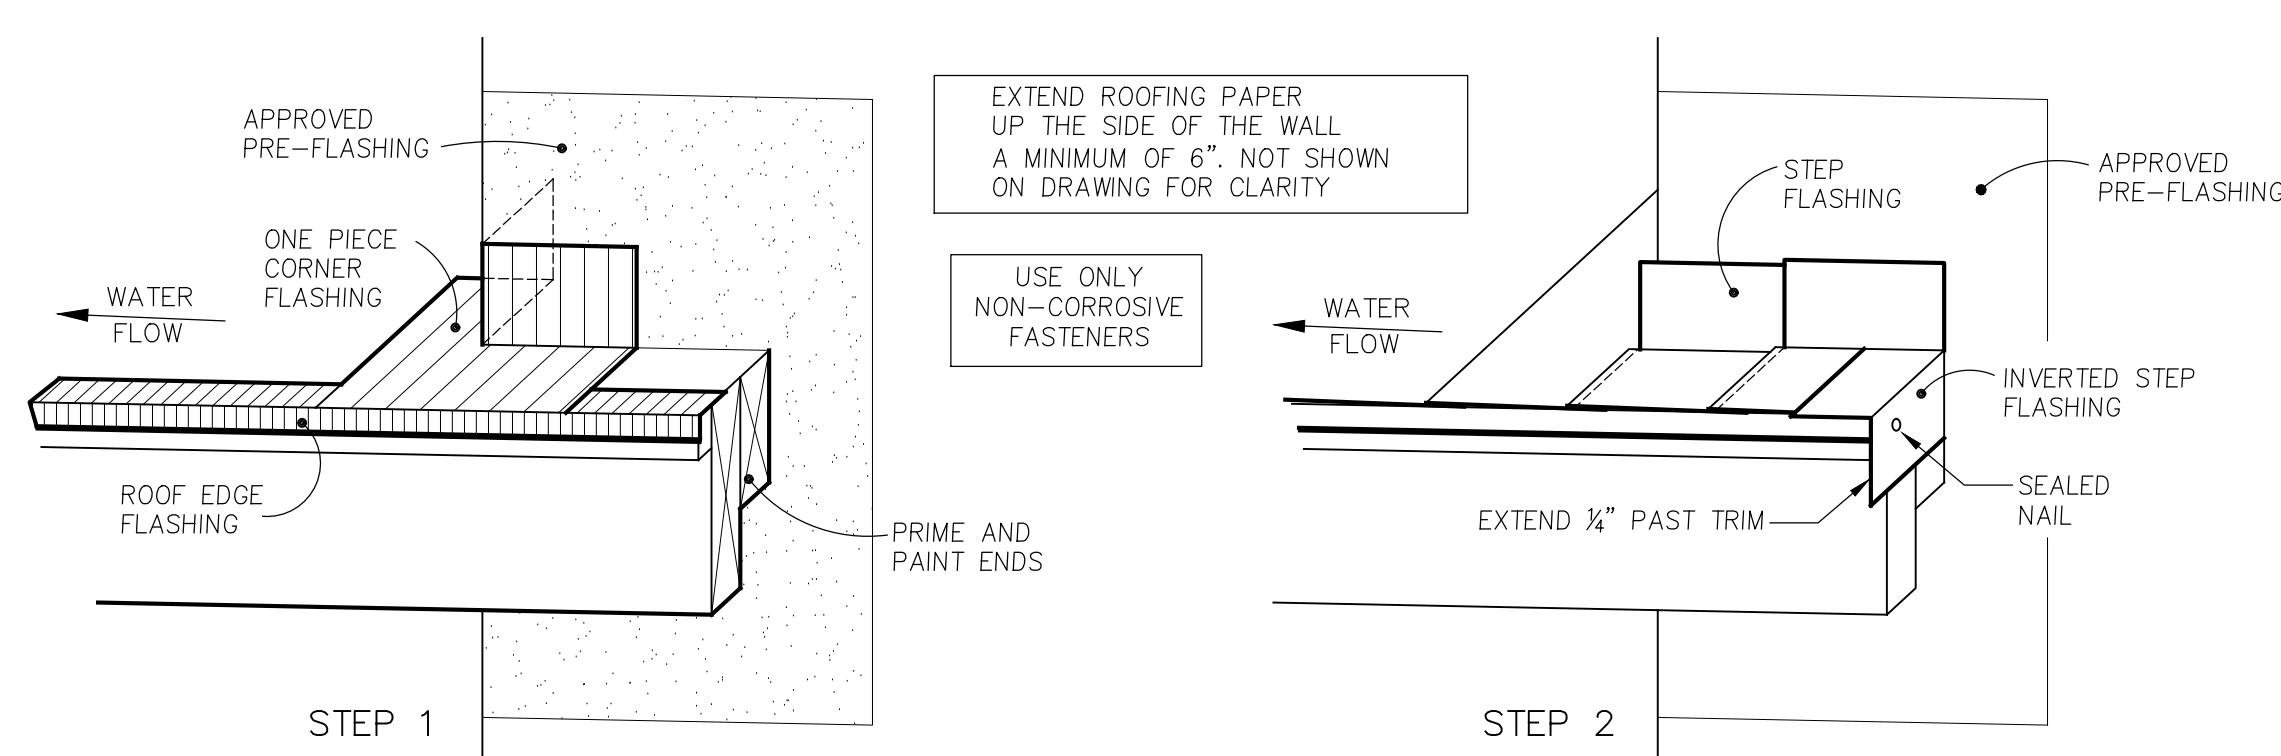


19 ROOF / CORNER OVERLAP

1-1/2" = 1'-0"

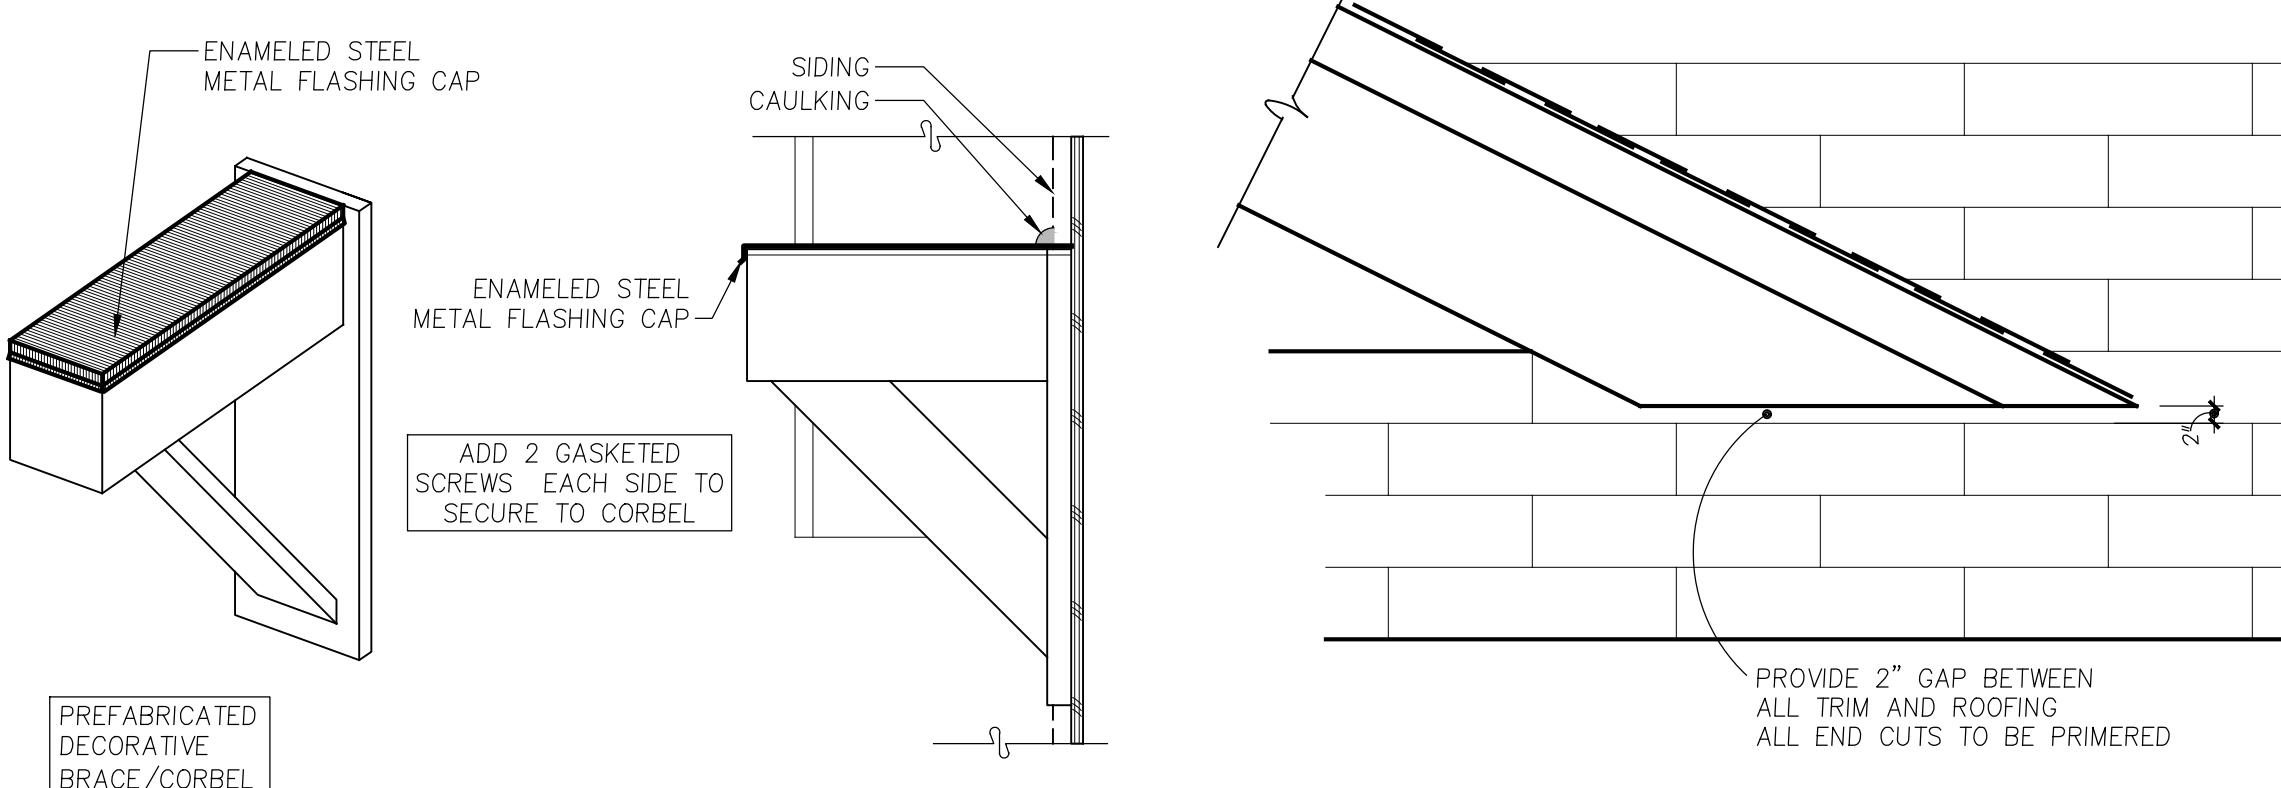


20 DECORATIVE CORBEL/BRACE

NO SCALE

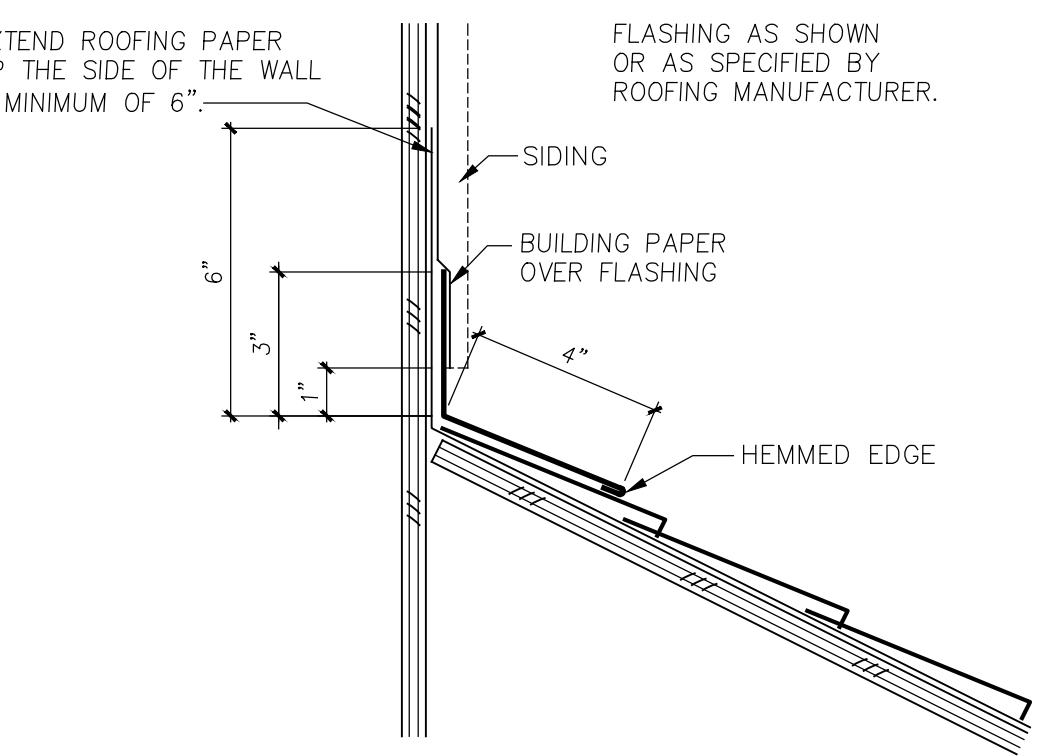


9 ROOF TO WALL

3" = 1'-0"

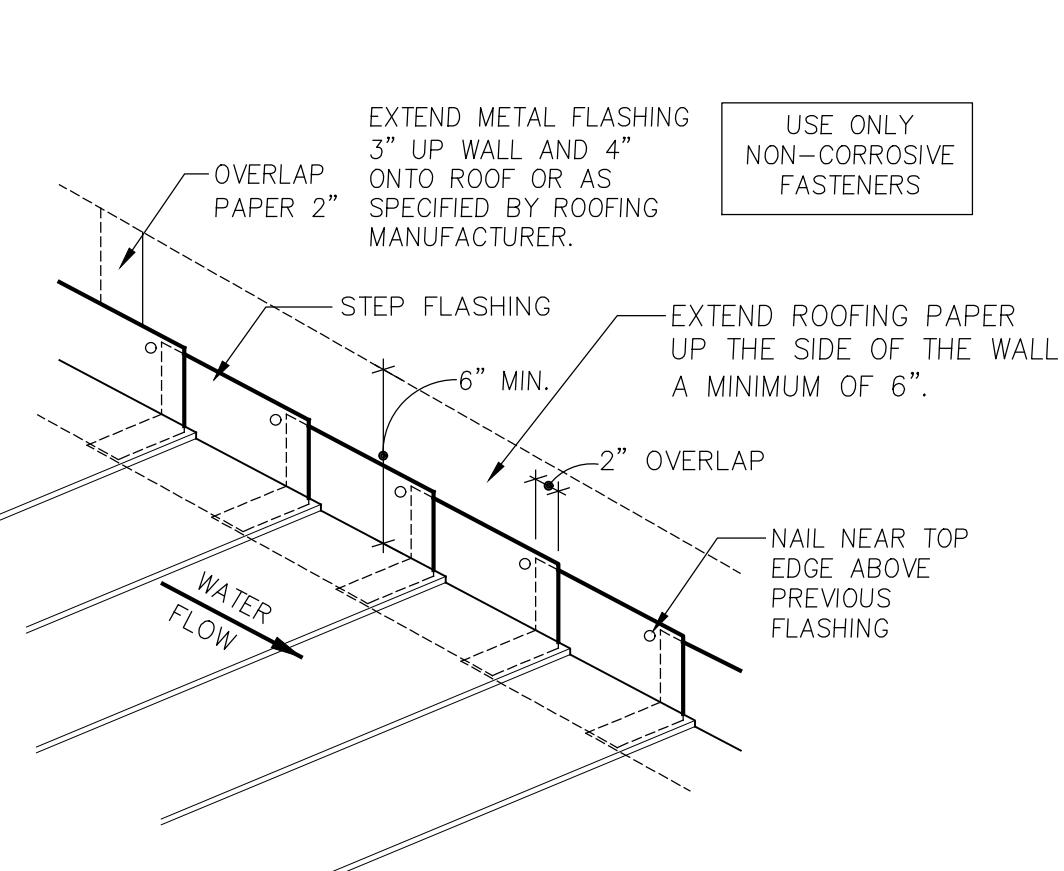


10 STEP FLASHING

NO SCALE

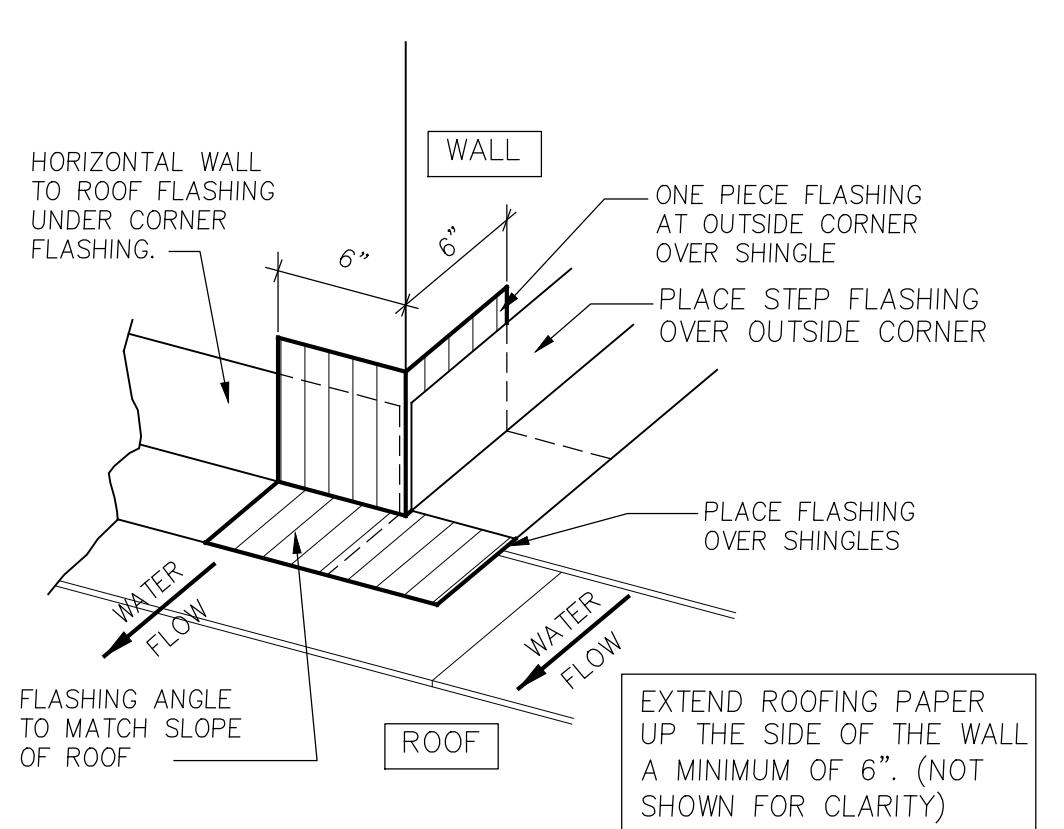


11 OUTSIDE CORNER

NO SCALE

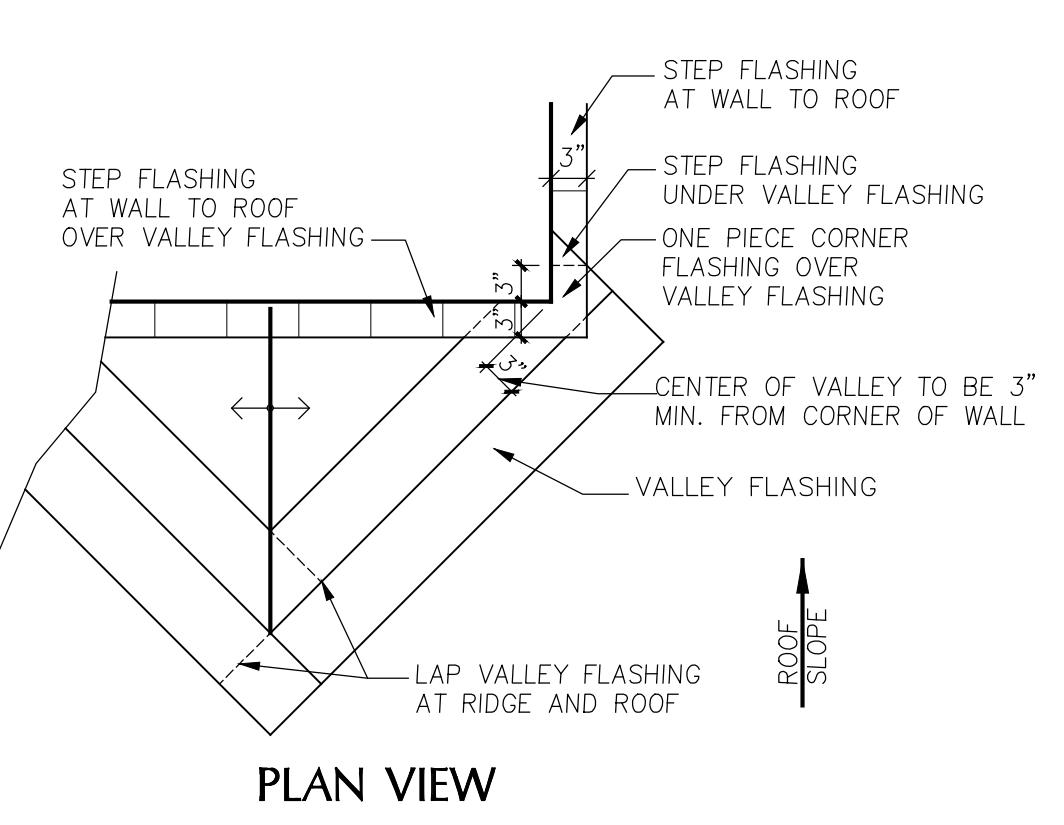


12 CRICKET DETAIL

3/4" = 1'-0"

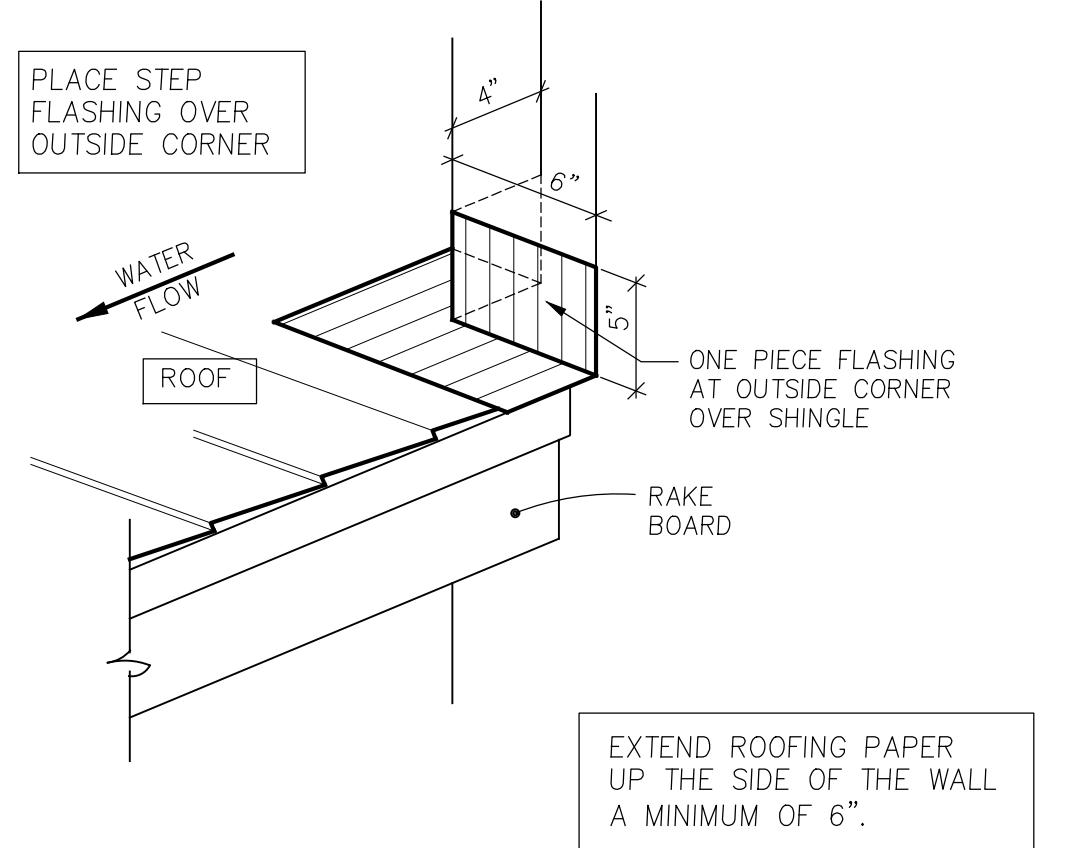


5 ROOF / OUTSIDE CORNER

1-1/2" = 1'-0"

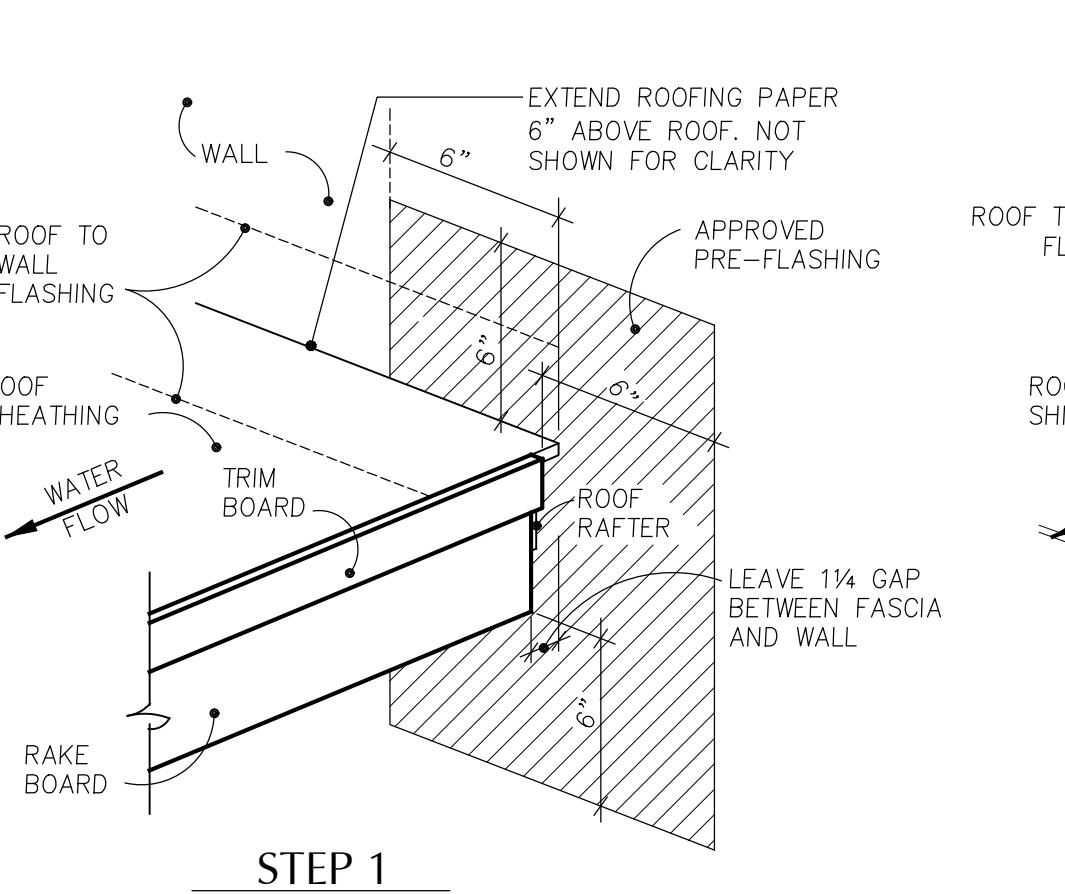


6 SHED ROOF TO WALL

NO SCALE

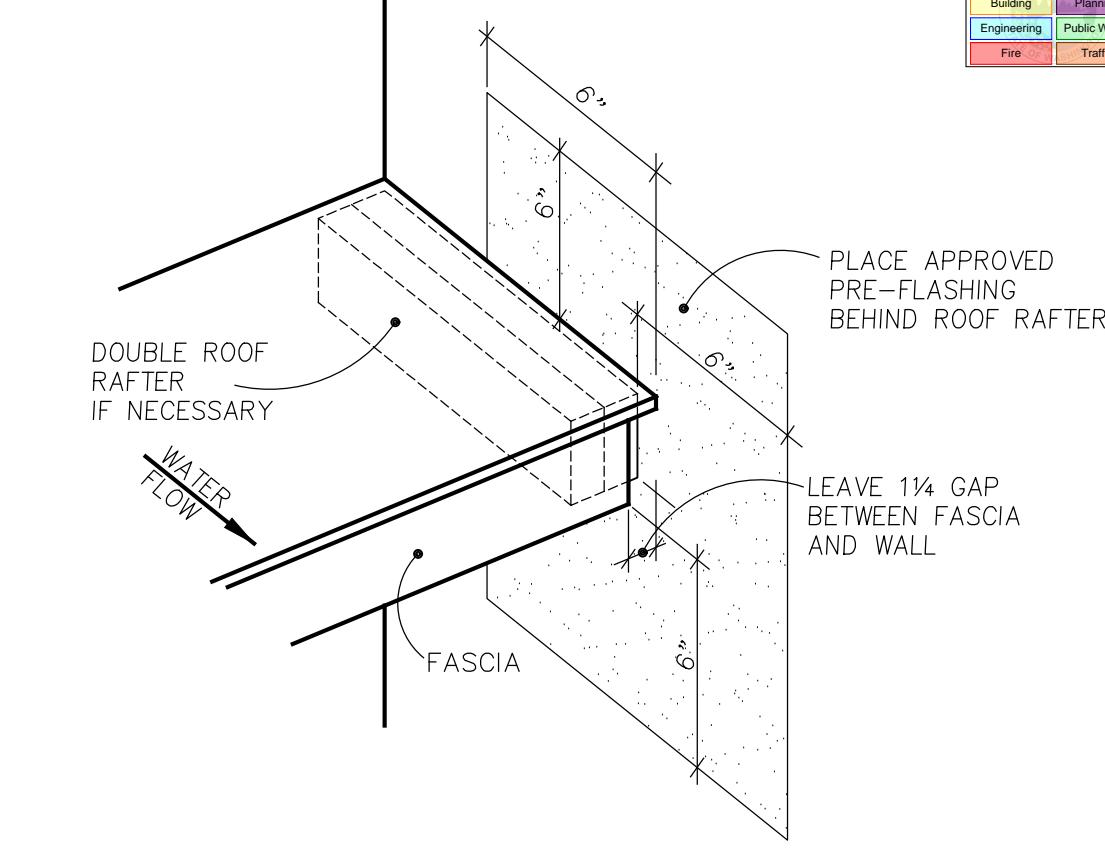


1 ROOF TO WALL

NO SCALE

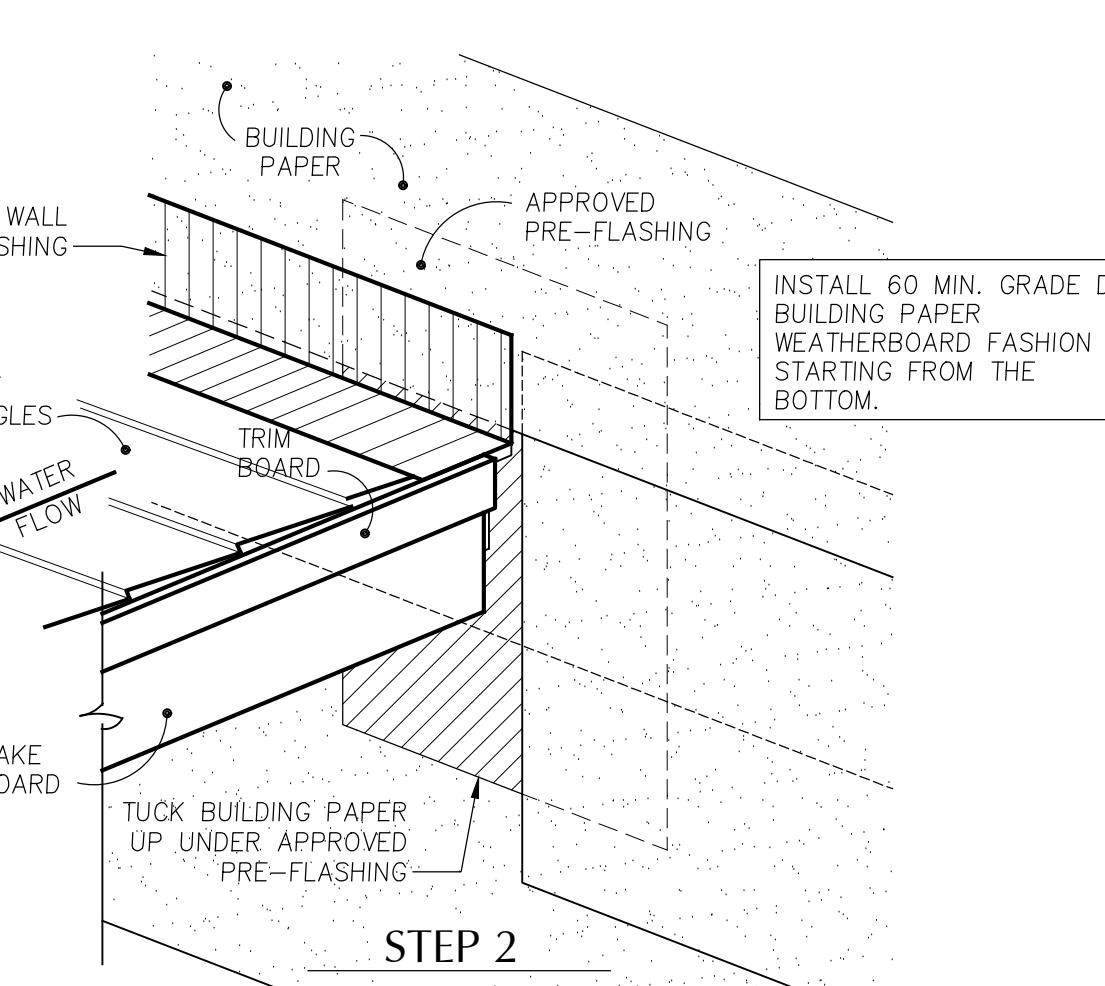


7 INSIDE CORNER AT ROOF

NO SCALE

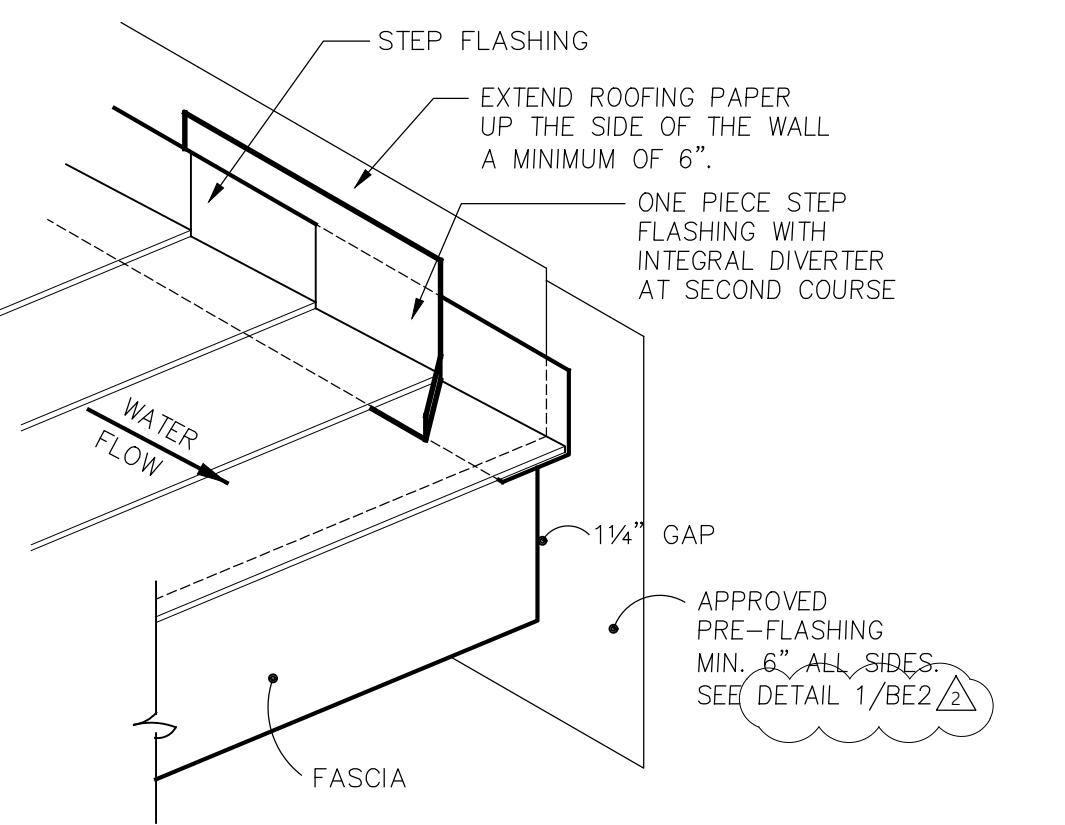

8 ROOF DIVERTER

NO SCALE

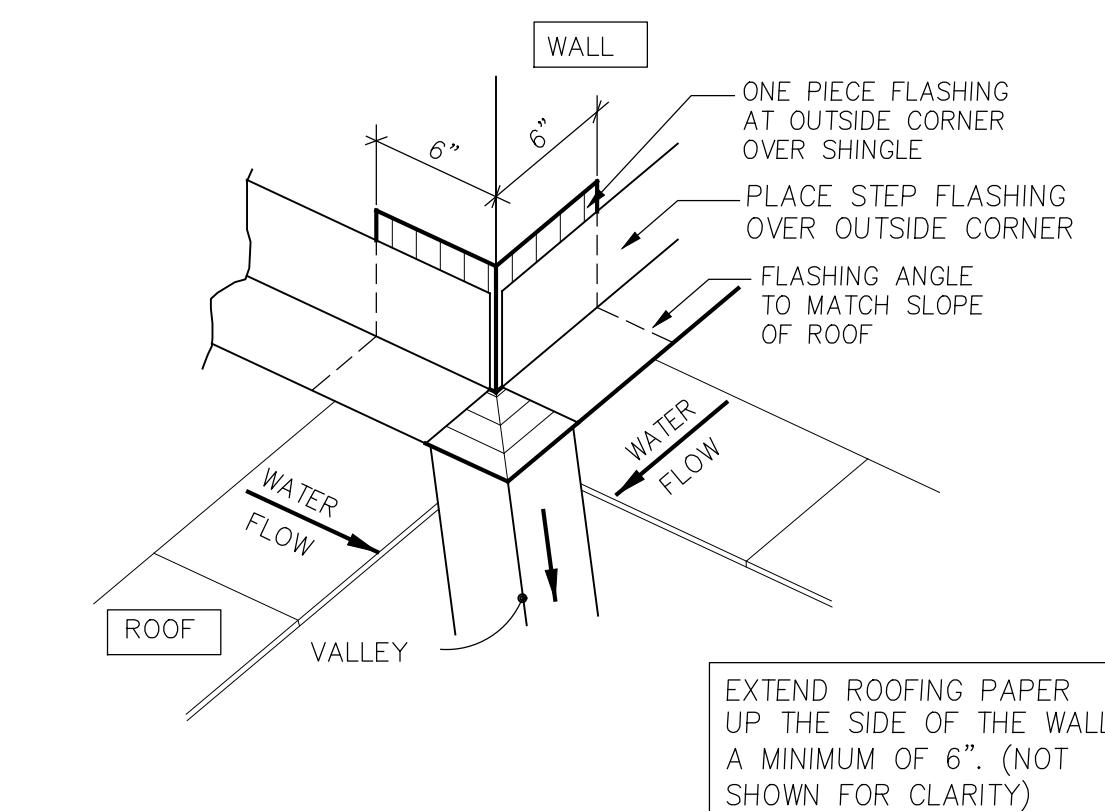

3 OUTSIDE CORNER AT VALLEY

NO SCALE

BE-Sheet Disclaimer

The details in the BE-Sheets are intended to meet or exceed all manufacturer recommended installation instructions, any letters of approval provided by a manufacturer to the Contractor, local codes, standards set by specific associations, best practices set by the industry or any other group or organization as acknowledged by the industry.

All manufacturer recommendations should be followed when installing specific materials.

If a Subcontractor or installer finds a situation where the BE-Sheet details conflict or fall below any standards set forth by the organizations mentioned above, it will be the responsibility of the Subcontractor to seek appropriate and written clarification from the Contractor before proceeding. The Contractor reserves its right to add, change, modify or update any of the details at any time.

**All components, sealants, fasteners, or materials shall be approved for specific use or application described by the designs, and shall be compatible with all material with which each component comes in contact with.*

Building Envelope Details

Bradley Heights Apartments

Puyallup, Wa

Timberlane Partners

Revisions

No. Date Description

PRMU20240280


Initial Publish Date:

Date Plotted: 5-1-25

Job No.: 23-06 Drawn By: REW/DJV


Sheet No.:

BE3

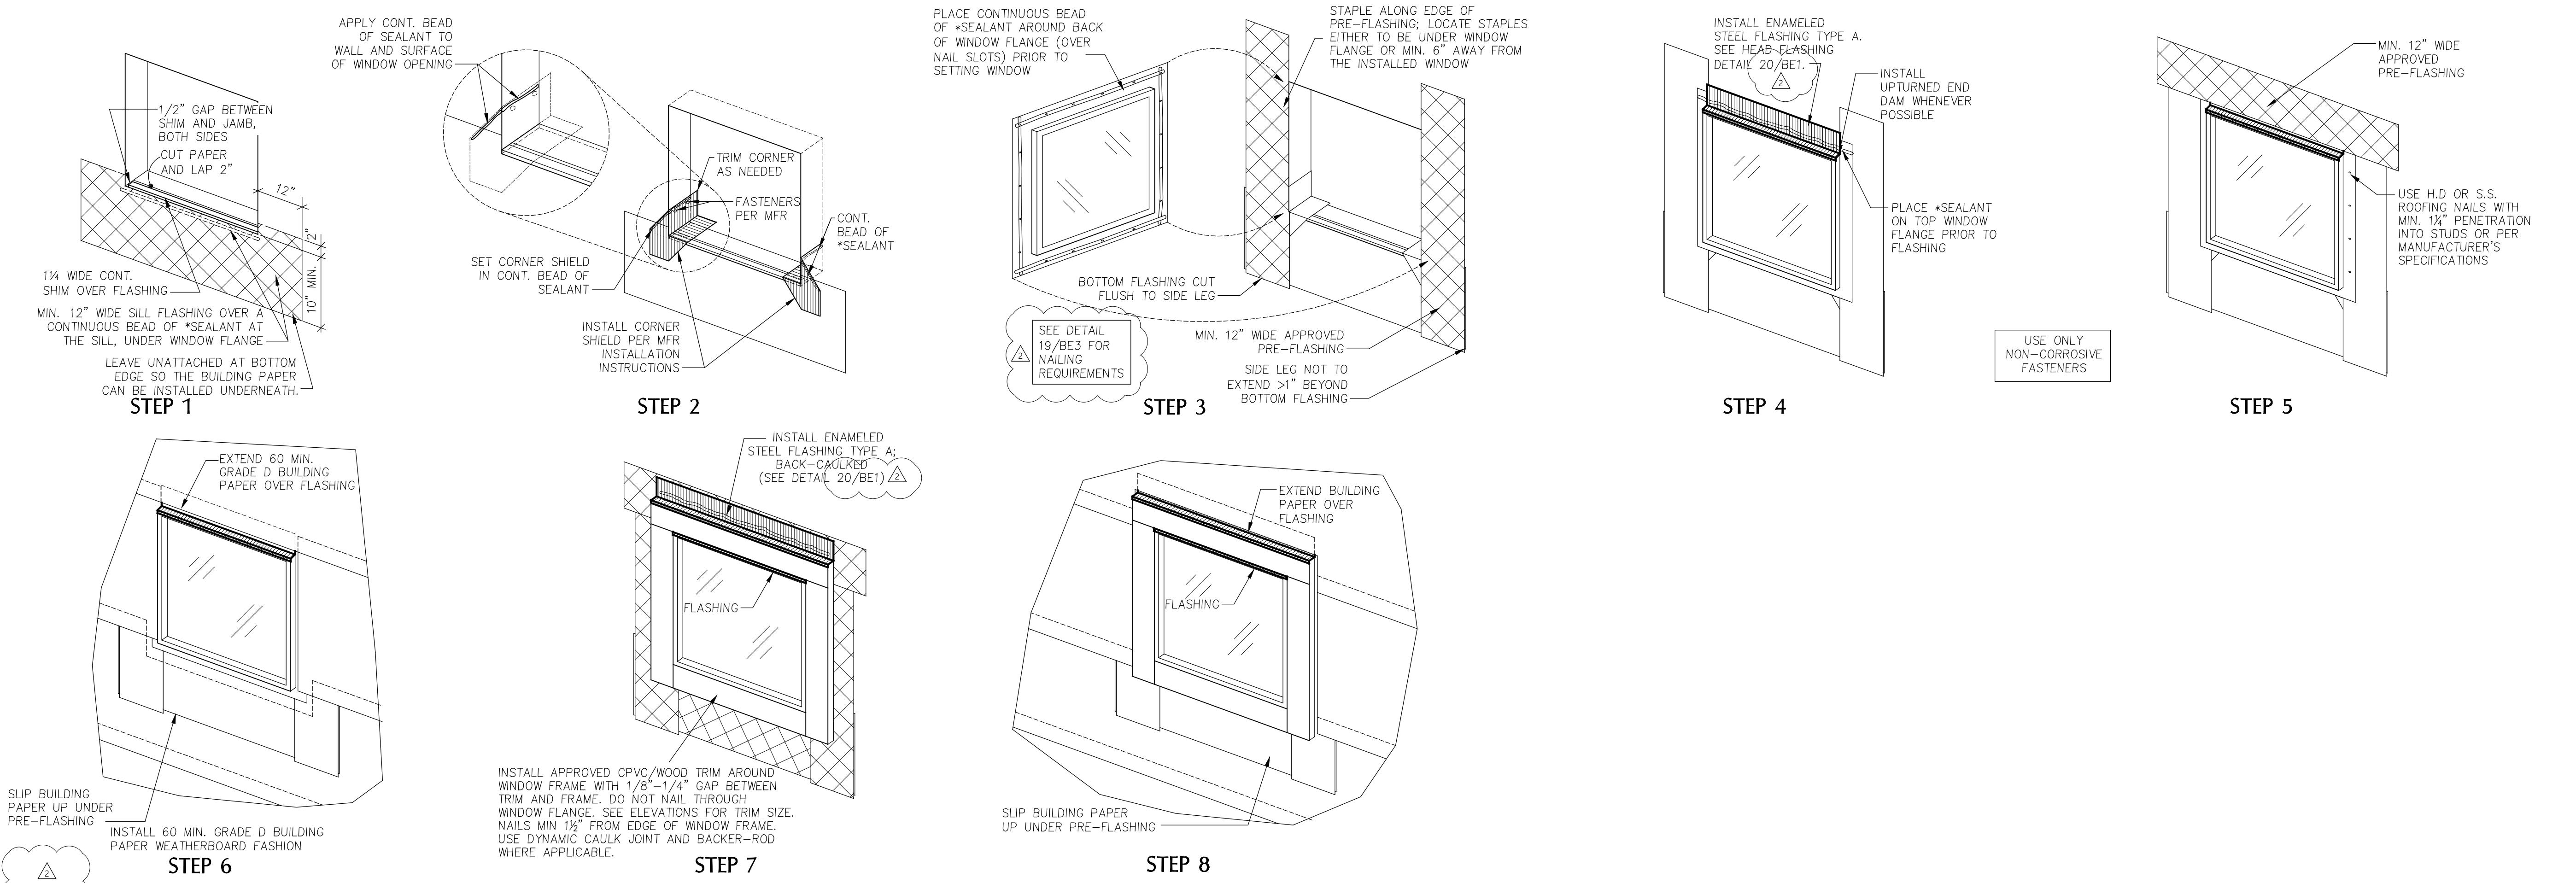


18 WINDOW INSTALLATION WITH WOOD TRIM

NO SCALE

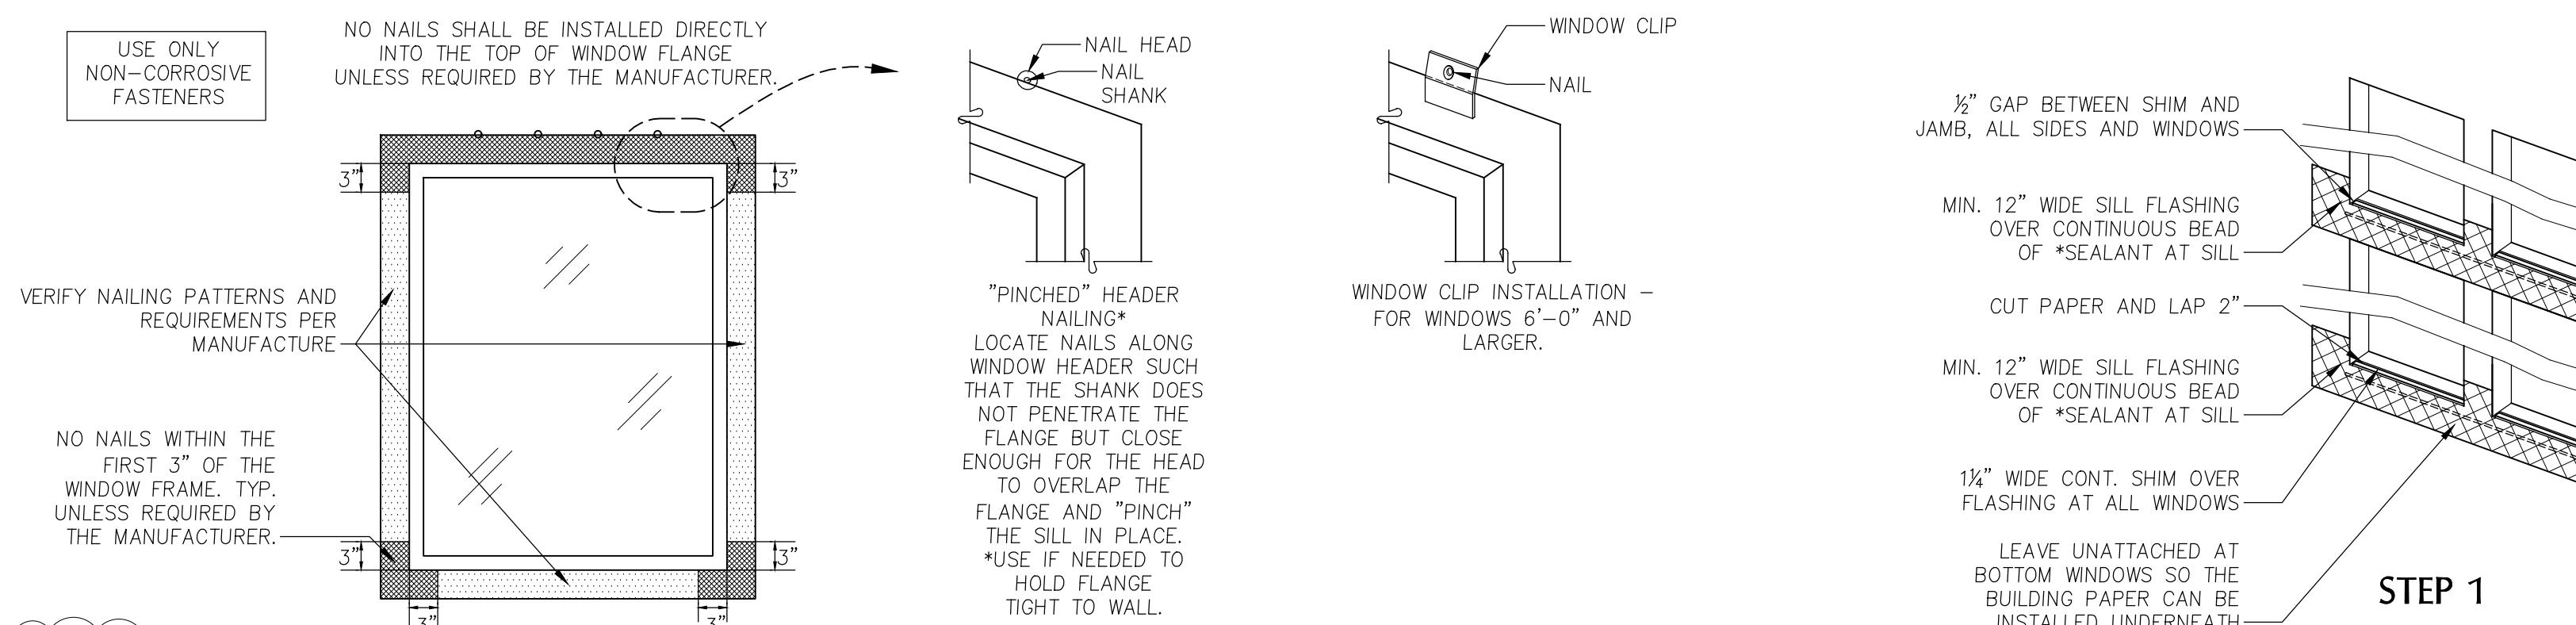


19 TYPICAL WINDOW FLANGE NAILING

NO SCALE

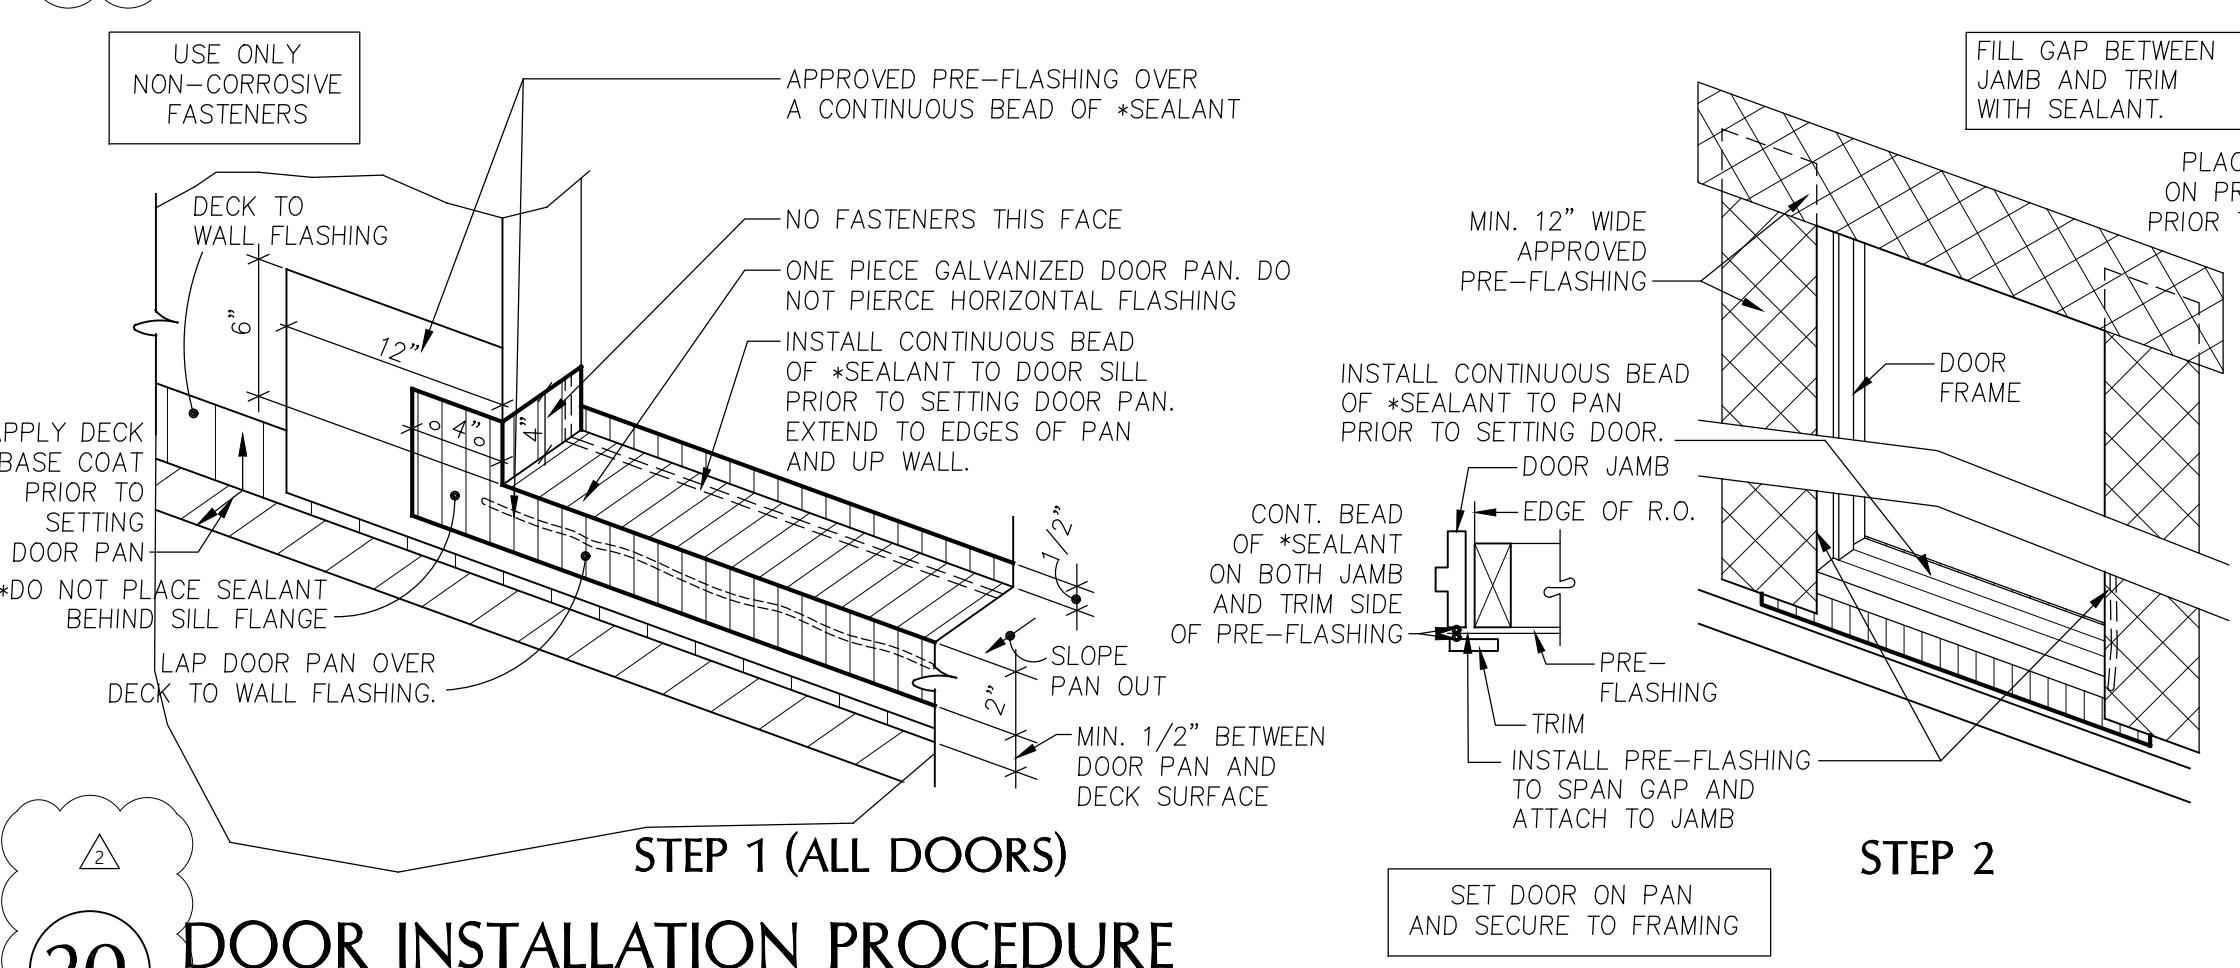


20 DOOR INSTALLATION PROCEDURE

NO SCALE

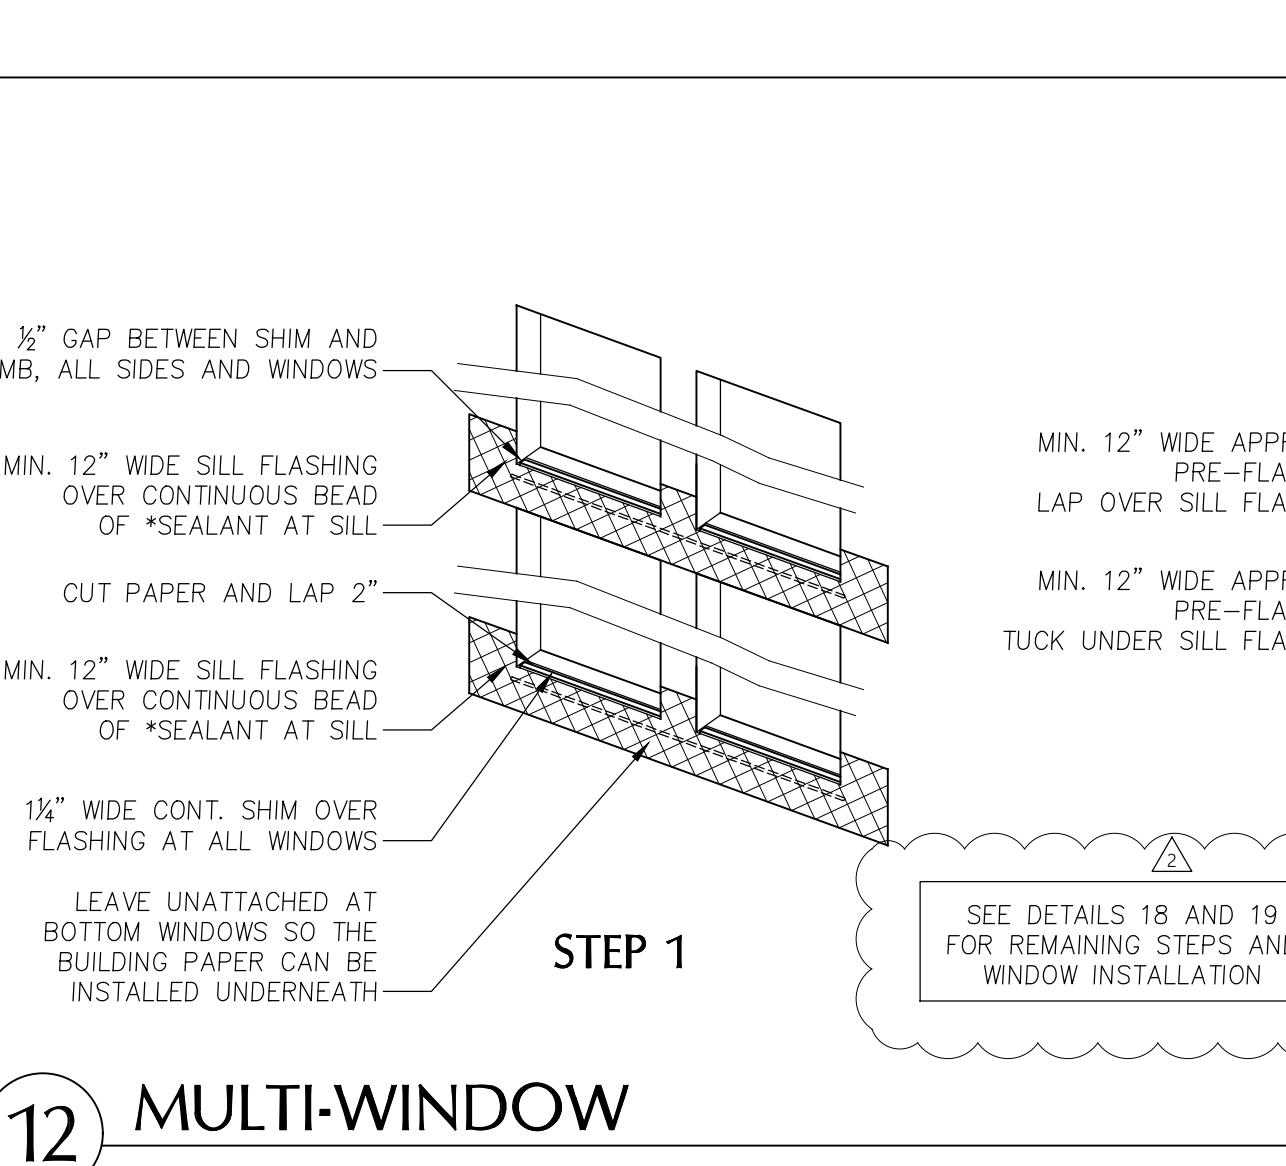

12 MULTI-WINDOW

NO SCALE

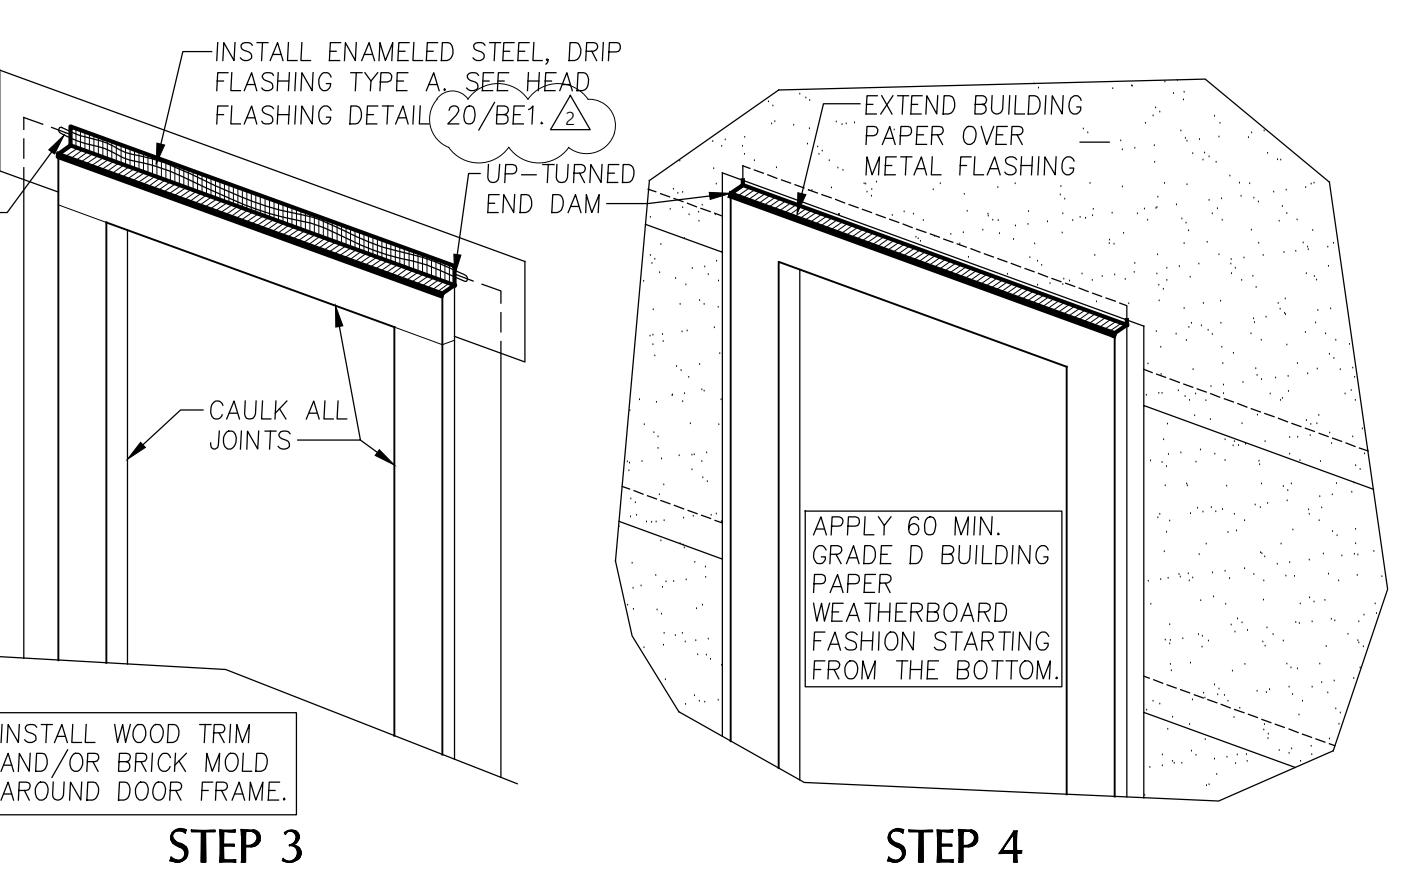

BE-Sheet Disclaimer

The details in the BE-Sheets are intended to meet or exceed all manufacturer recommended installation instructions, any letters of approval provided by a manufacturer to the Contractor, local codes, standards set by specific associations, best practices set by the industry or any other group or organization as acknowledged by the industry.

All manufacturer recommendations should be followed when installing specific materials.

If a Subcontractor or installer finds a situation where the BE-Sheet details conflict or fall below any standards set forth by the organizations mentioned above, it will be the responsibility of the Subcontractor to seek appropriate and written clarification from the Contractor before proceeding. The Contractor reserves its right to add, change, modify or update any of the details at any time.

*All components, sealants, fasteners, or materials shall be approved for specific use or application described by the designs, and shall be compatible with all material with which each component comes in contact with.

Building Envelope Details

Bradley
Heights
Apartments

Puyallup,
Wa

Timberlane
Partners

Revisions

No. Date Description

PRMU20240280



Initial Publish Date:

Date Plotted: 5-1-25

Job No.: 23-06 Drawn By: REW/DJV

Sheet No.:

BE4

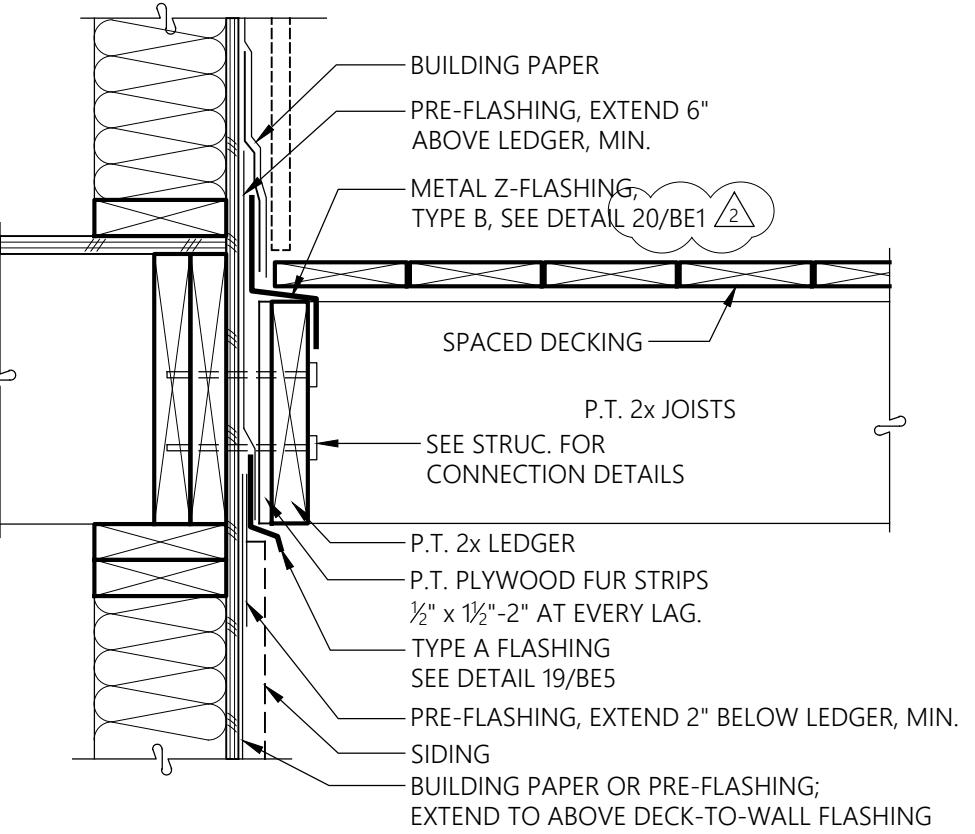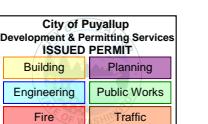


2 DECK TO WALL FLASHING
SPACED DECKING
SECTION
1-1/2" = 1'-0"

BE-Sheet Disclaimer
The details in the BE-Sheets are intended to meet or exceed all manufacturer recommended installation instructions, any letters of approval provided by a manufacturer to the Contractor, local codes, standards set by specific associations, best practices set by the industry or any other group or organization as acknowledged by the industry.


All manufacturer recommendations should be followed when installing specific materials.

If a Subcontractor or installer finds a situation where the BE-Sheet details conflict or fall below any standards set forth by the organizations mentioned above, it will be the responsibility of the Subcontractor to seek appropriate and written clarification from the Contractor before proceeding. The Contractor reserves its right to add, change, modify or update any of the details at any time.


**All components, sealants, fasteners, or materials shall be approved for specific use or application described by the designs, and shall be compatible with all material with which each component comes in contact with.*

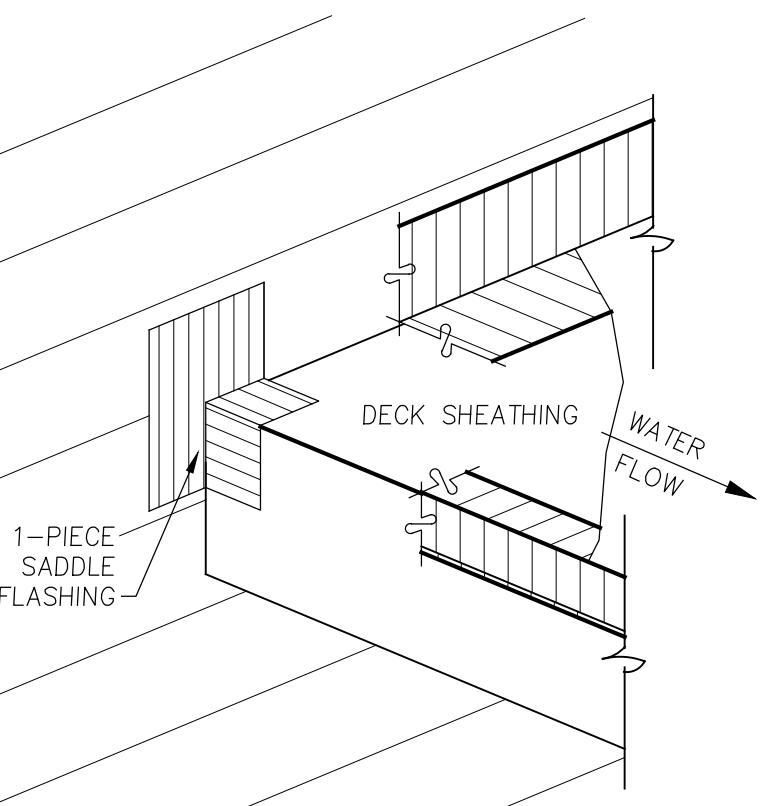


14 1-PIECE DECK SADDLE FLASHING
NO SCALE

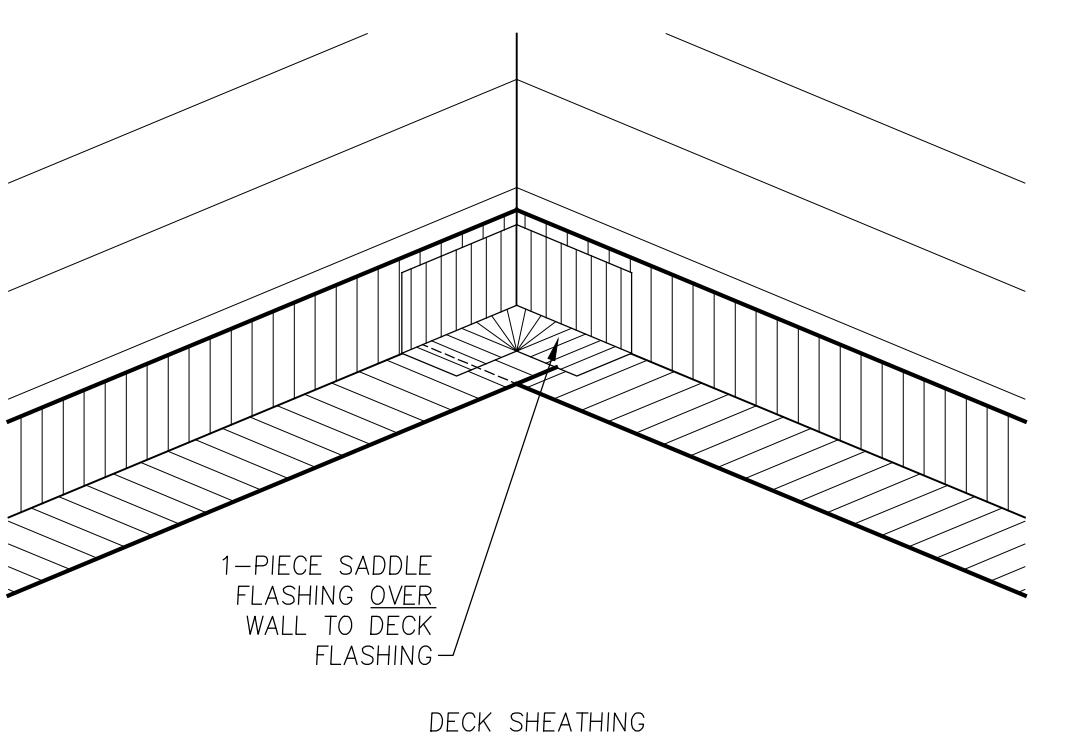

15 DECK FLASHING - INSIDE CORNER
NO SCALE

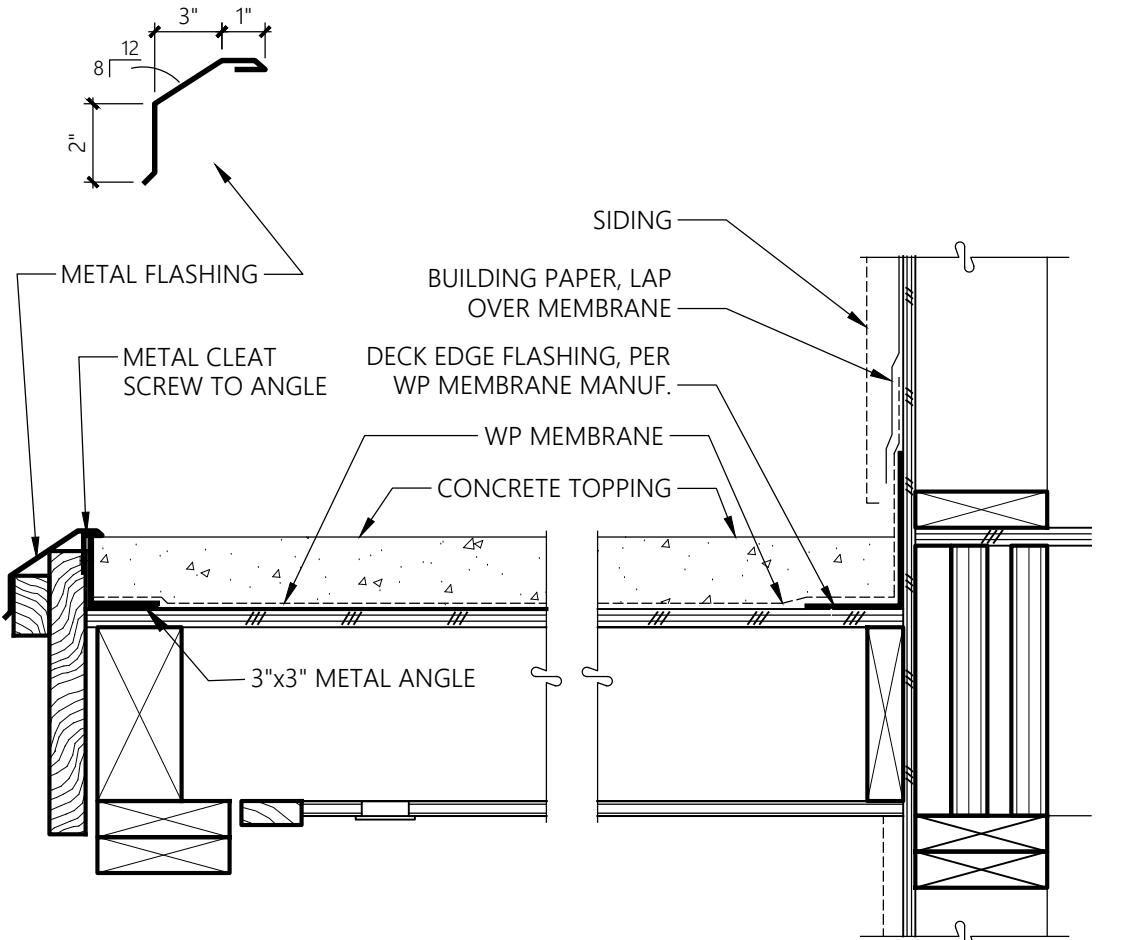

20 DECK DETAILS
NO SCALE

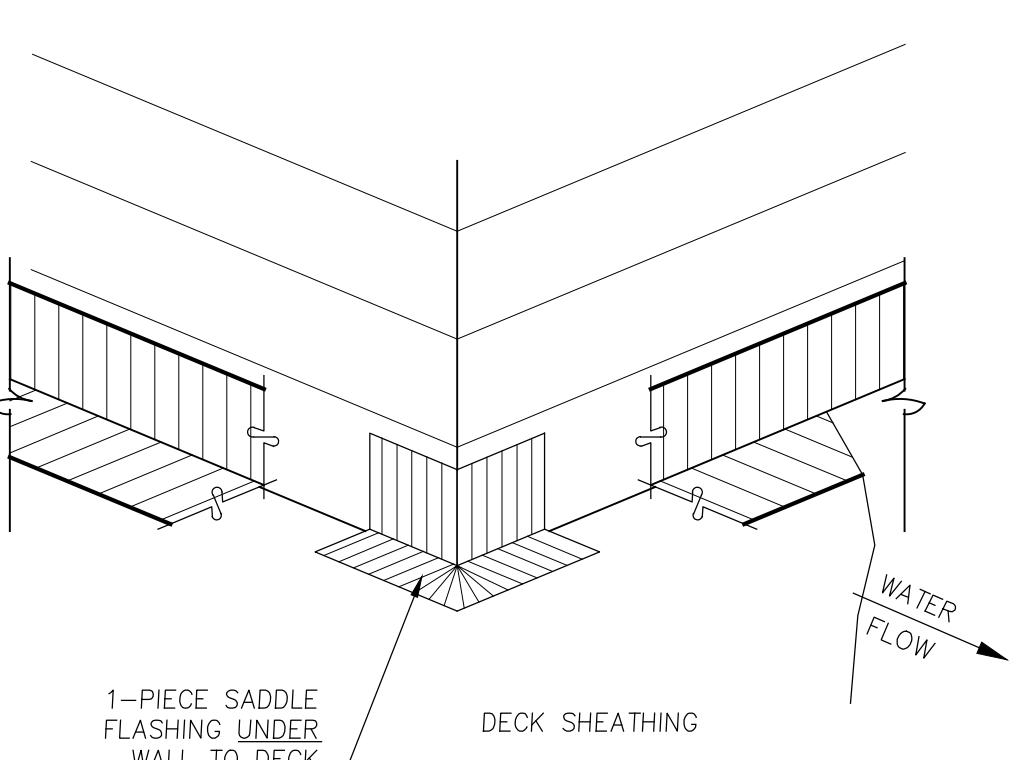

16 DECK FLASHING - OUTSIDE CORNER
NO SCALE

Building Envelope Details

Bradley Heights Apartments

Puyallup, Wa

Timberlane Partners

Revisions

No. Date Description


PRMU20240280

Initial Publish Date:
Date Plotted: 5-1-25


Job No.: 23-06 Drawn By: REW/DJV

Sheet No.:


BE5

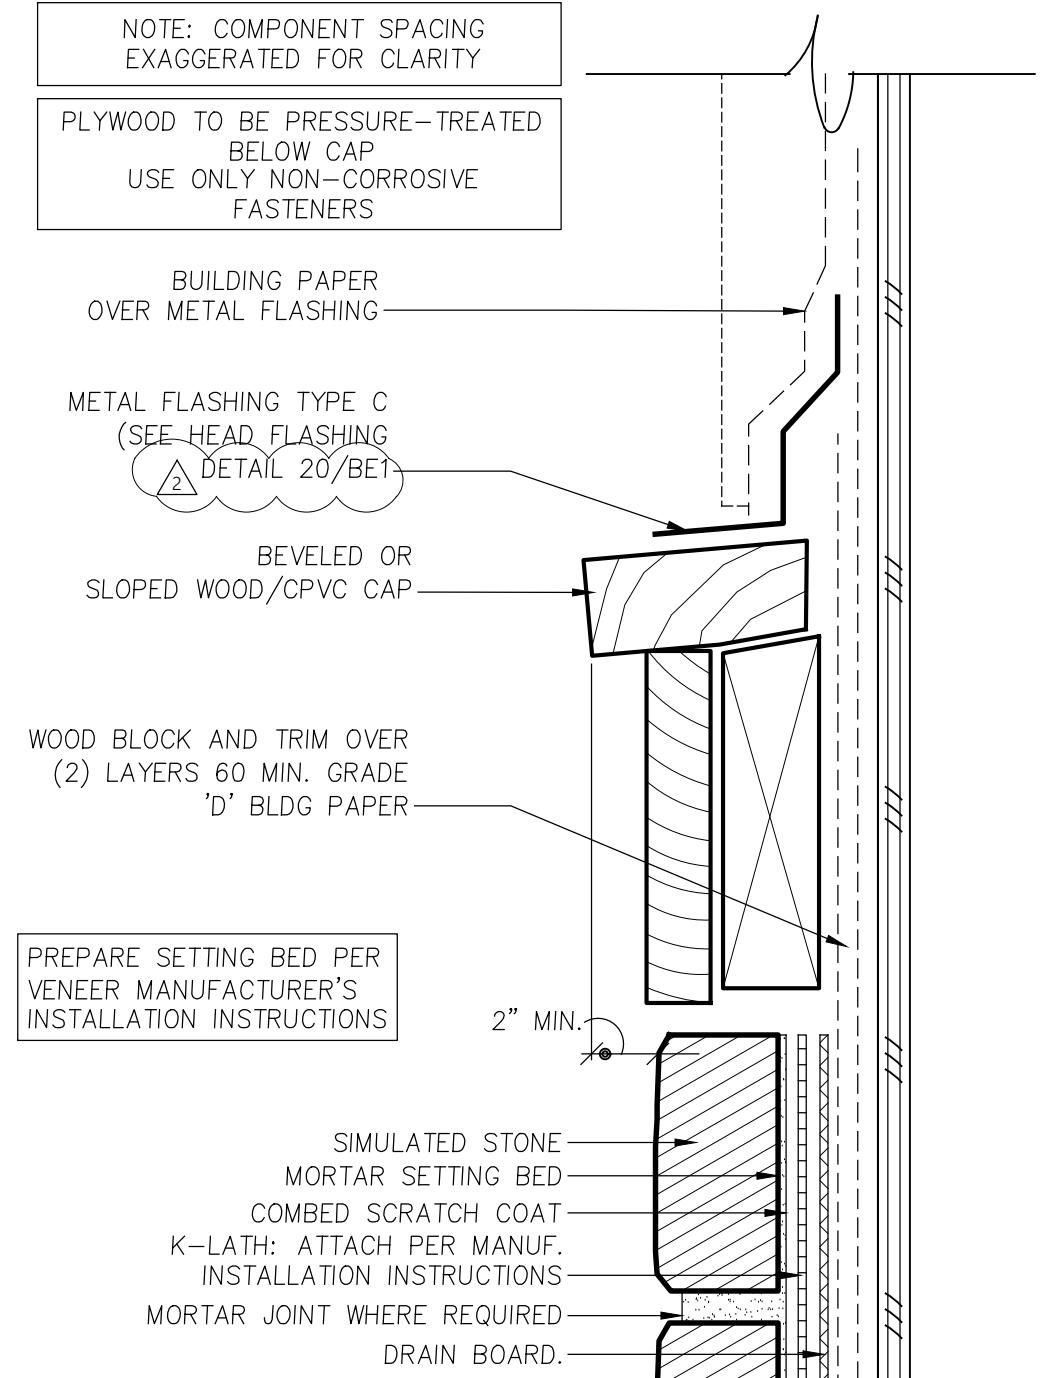


18 TYPICAL WATERTABLE TRIM
SECTION
4" = 1'-0"

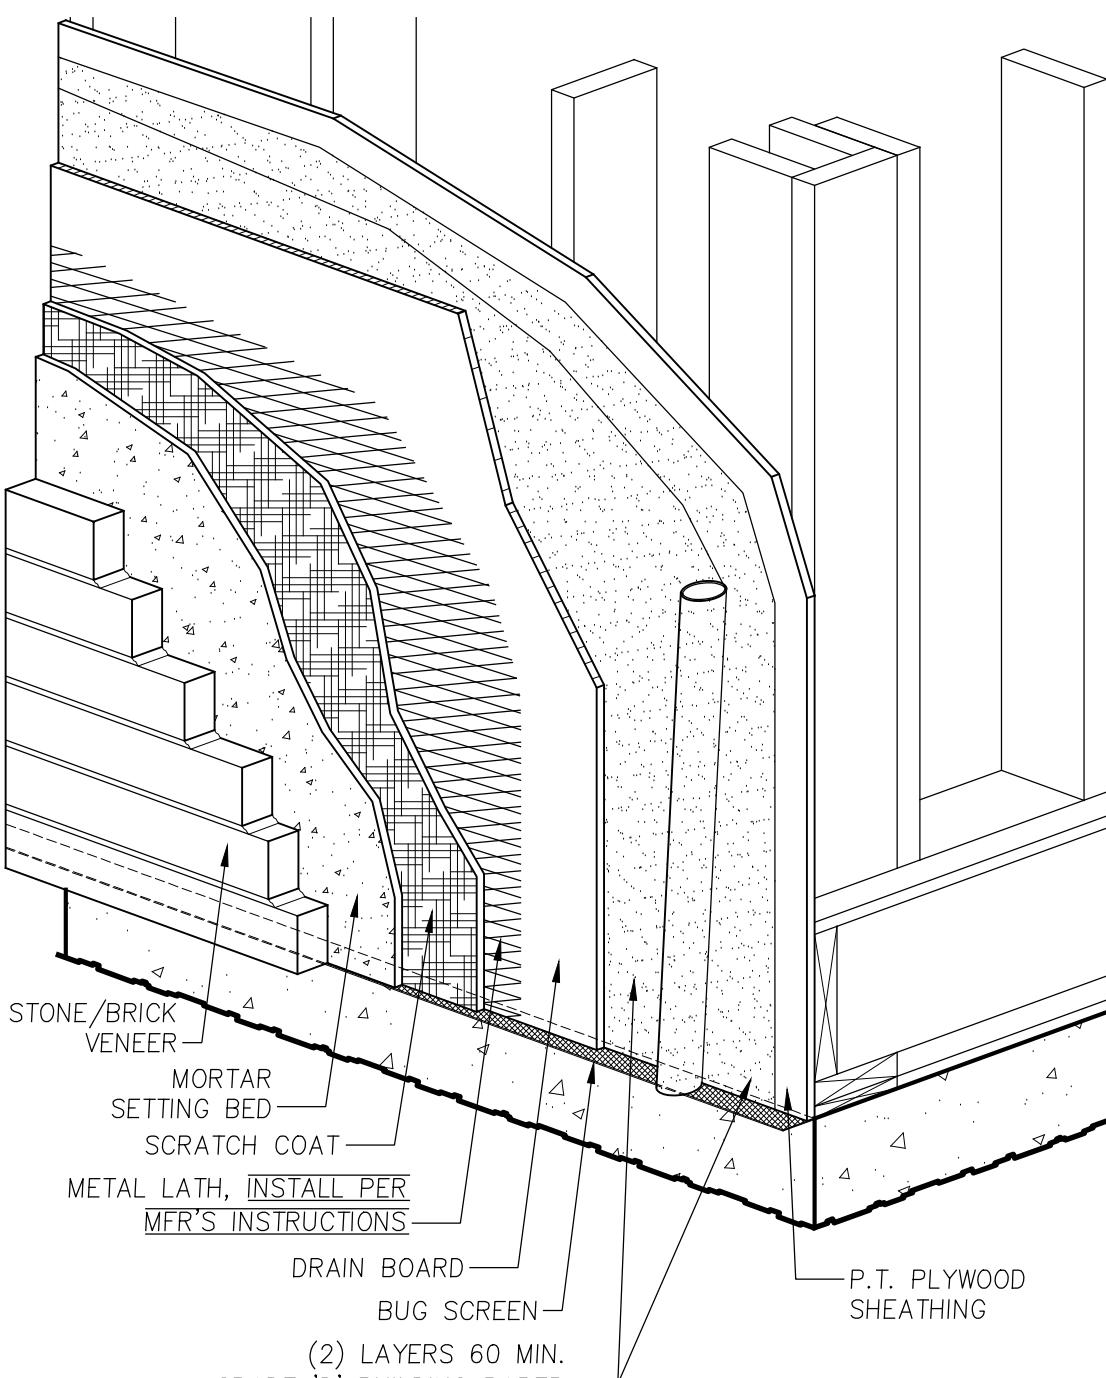


14 STONE VENEER INSTALLATION
SECTION
NO SCALE

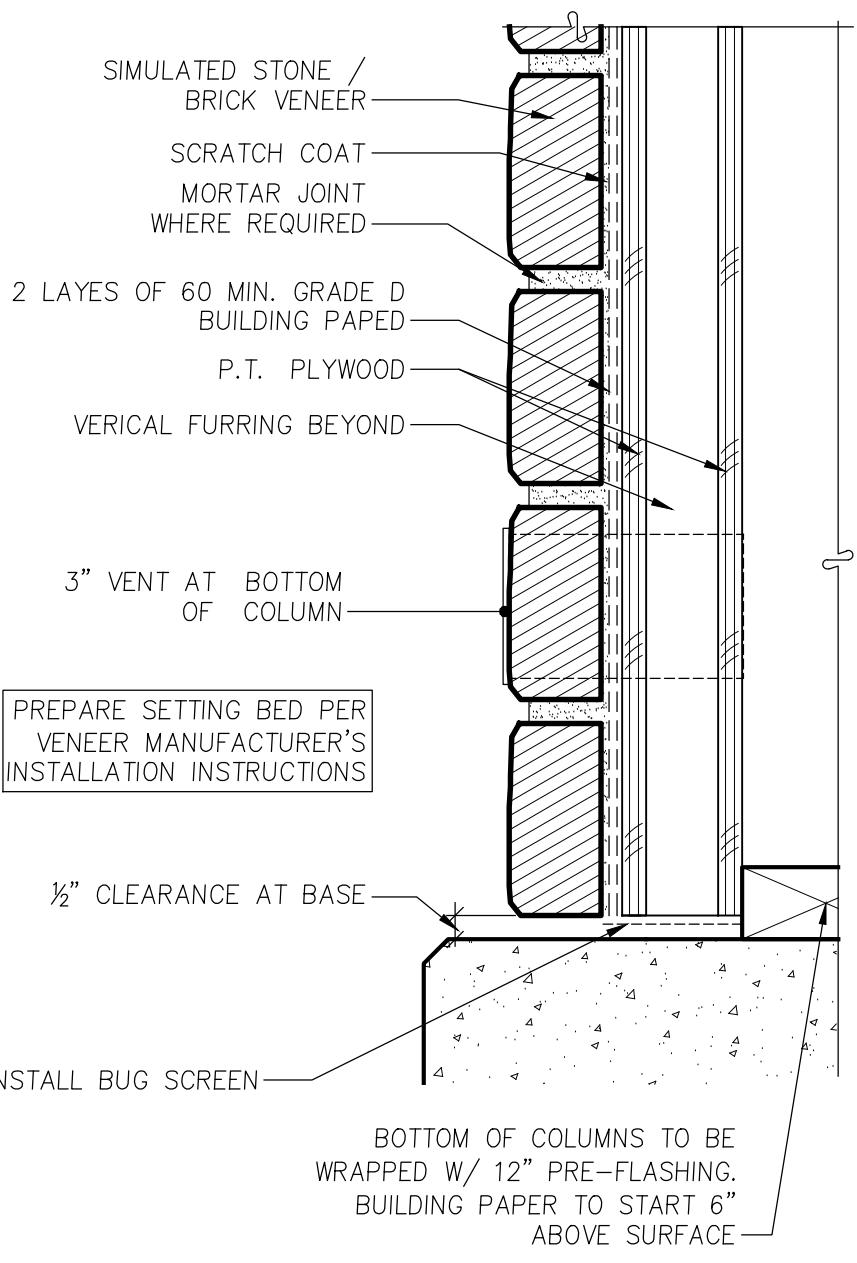


10 BRICK VENEER AT COLUMN BASE
SECTION
3" = 1'-0"

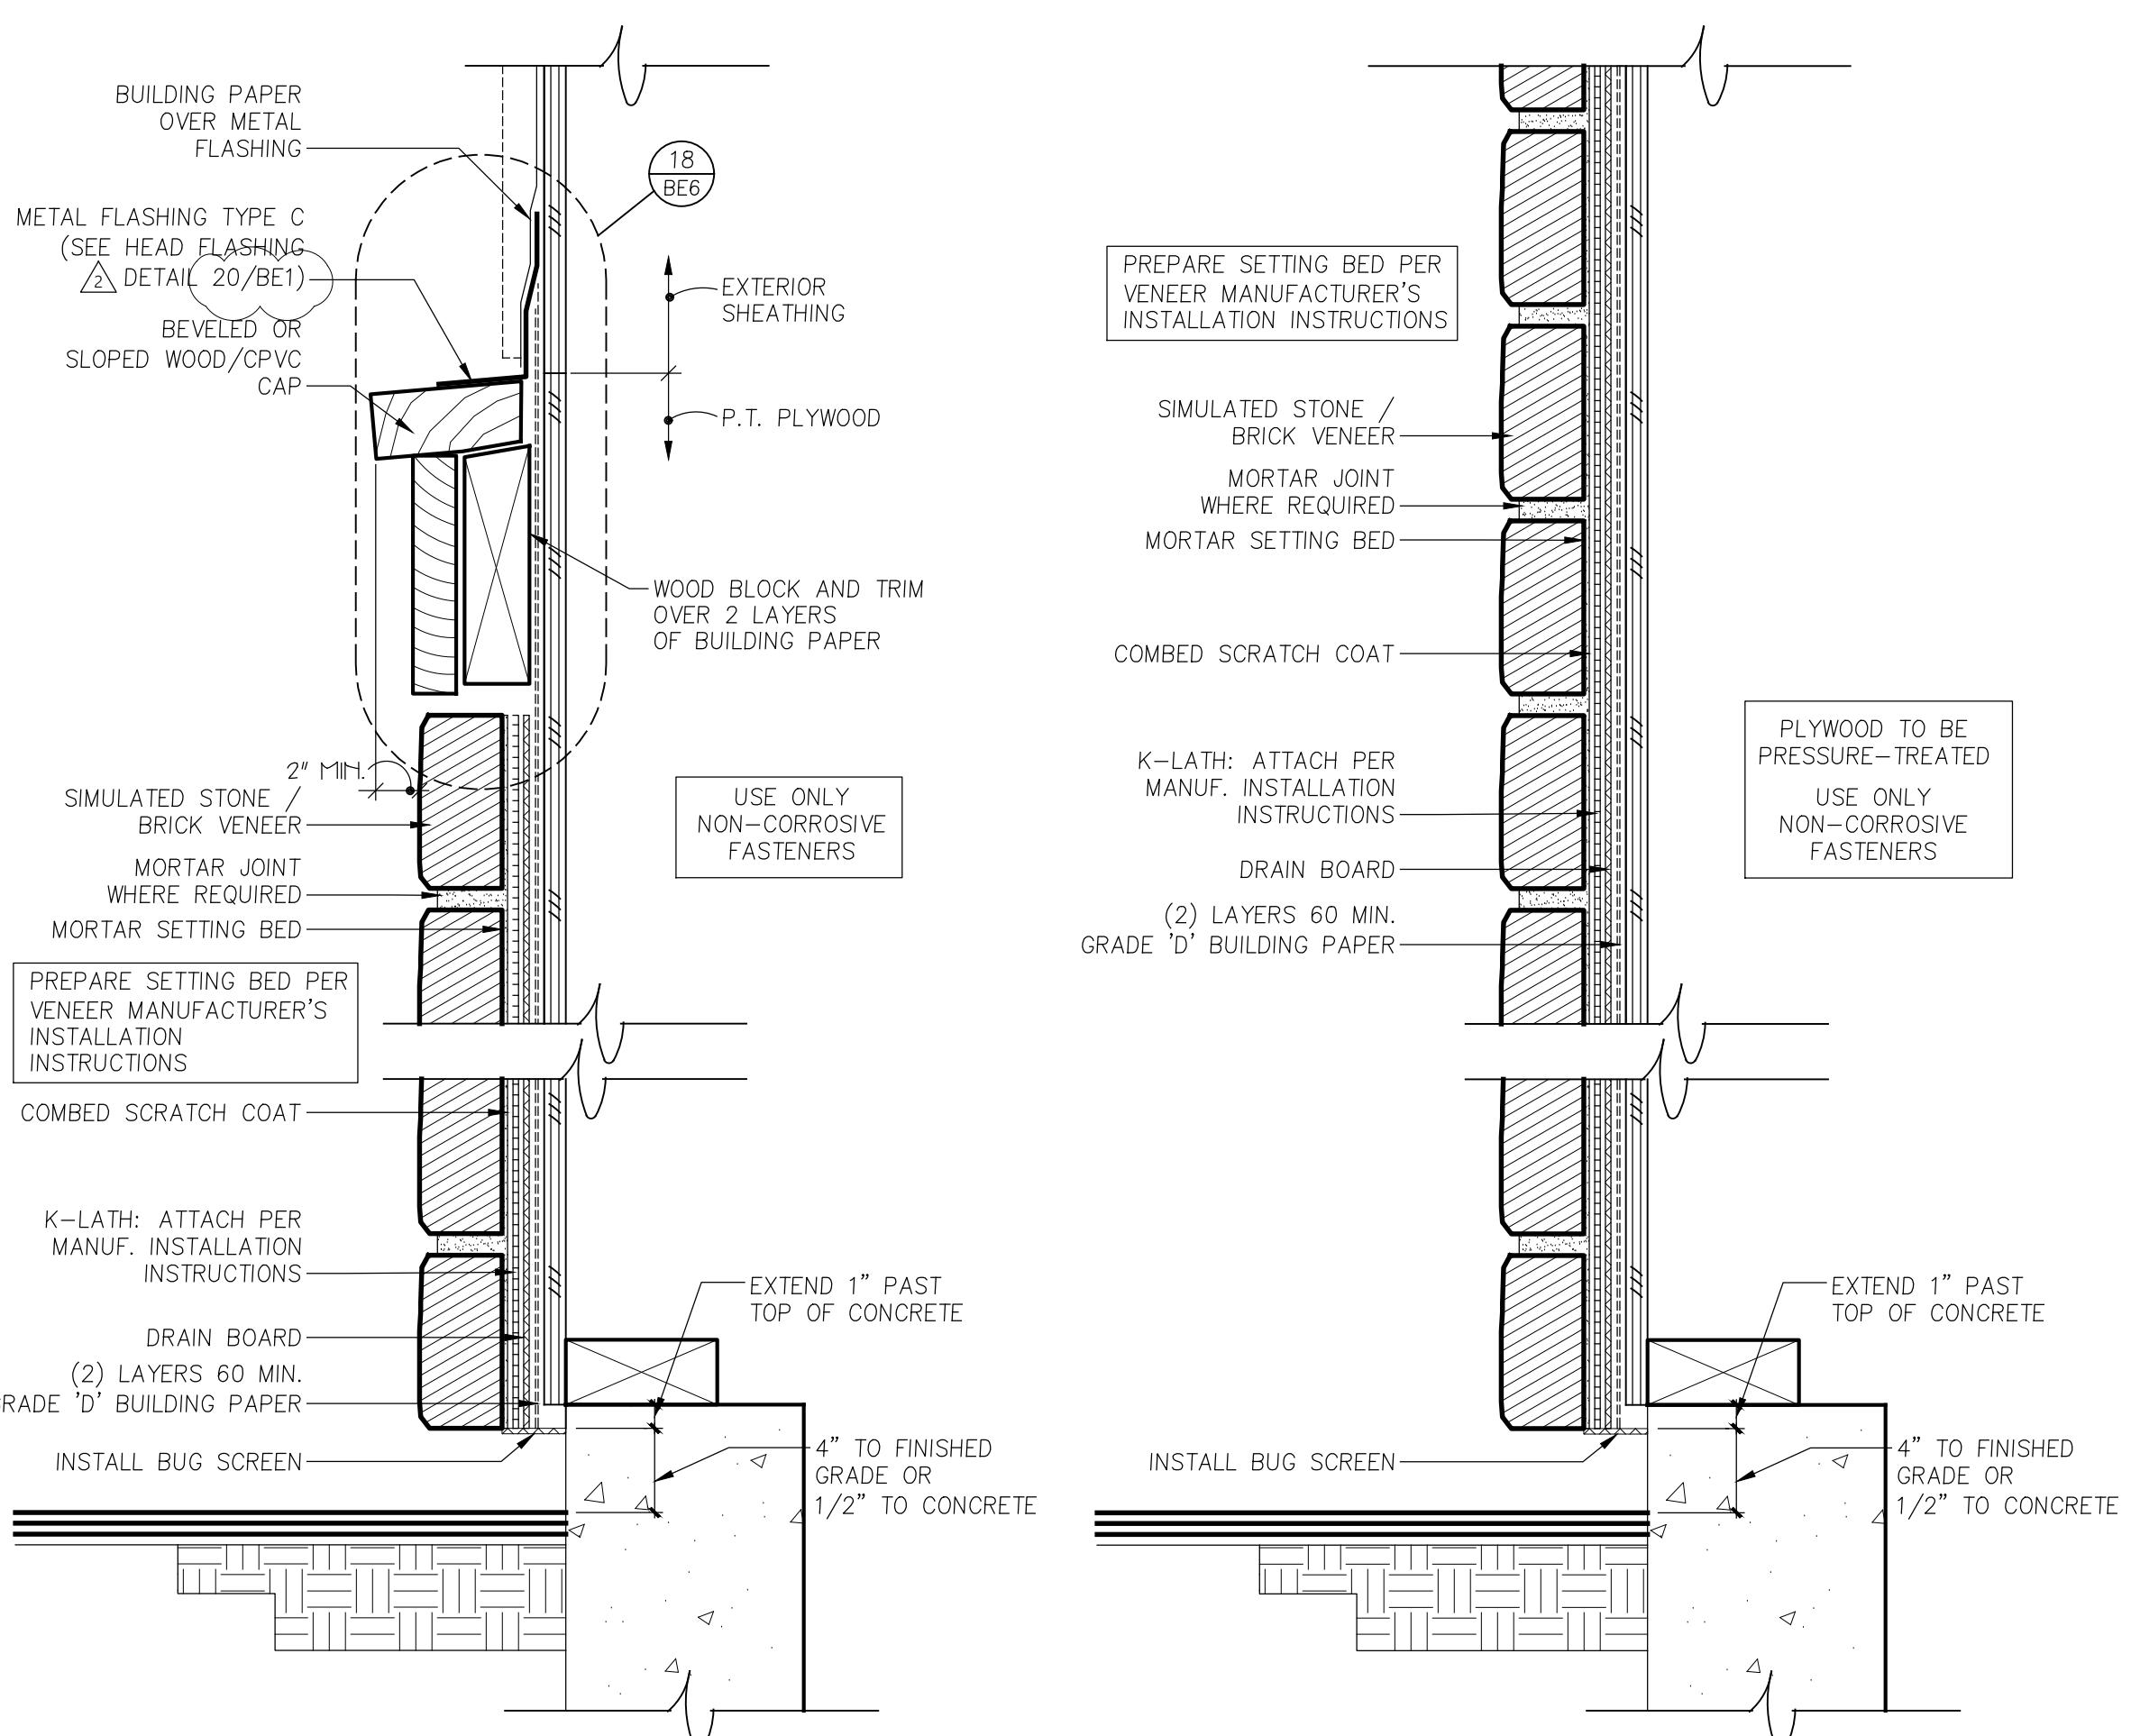



20 STONE WATERTABLE ON FRAMING
SECTION
3" = 1'-0"

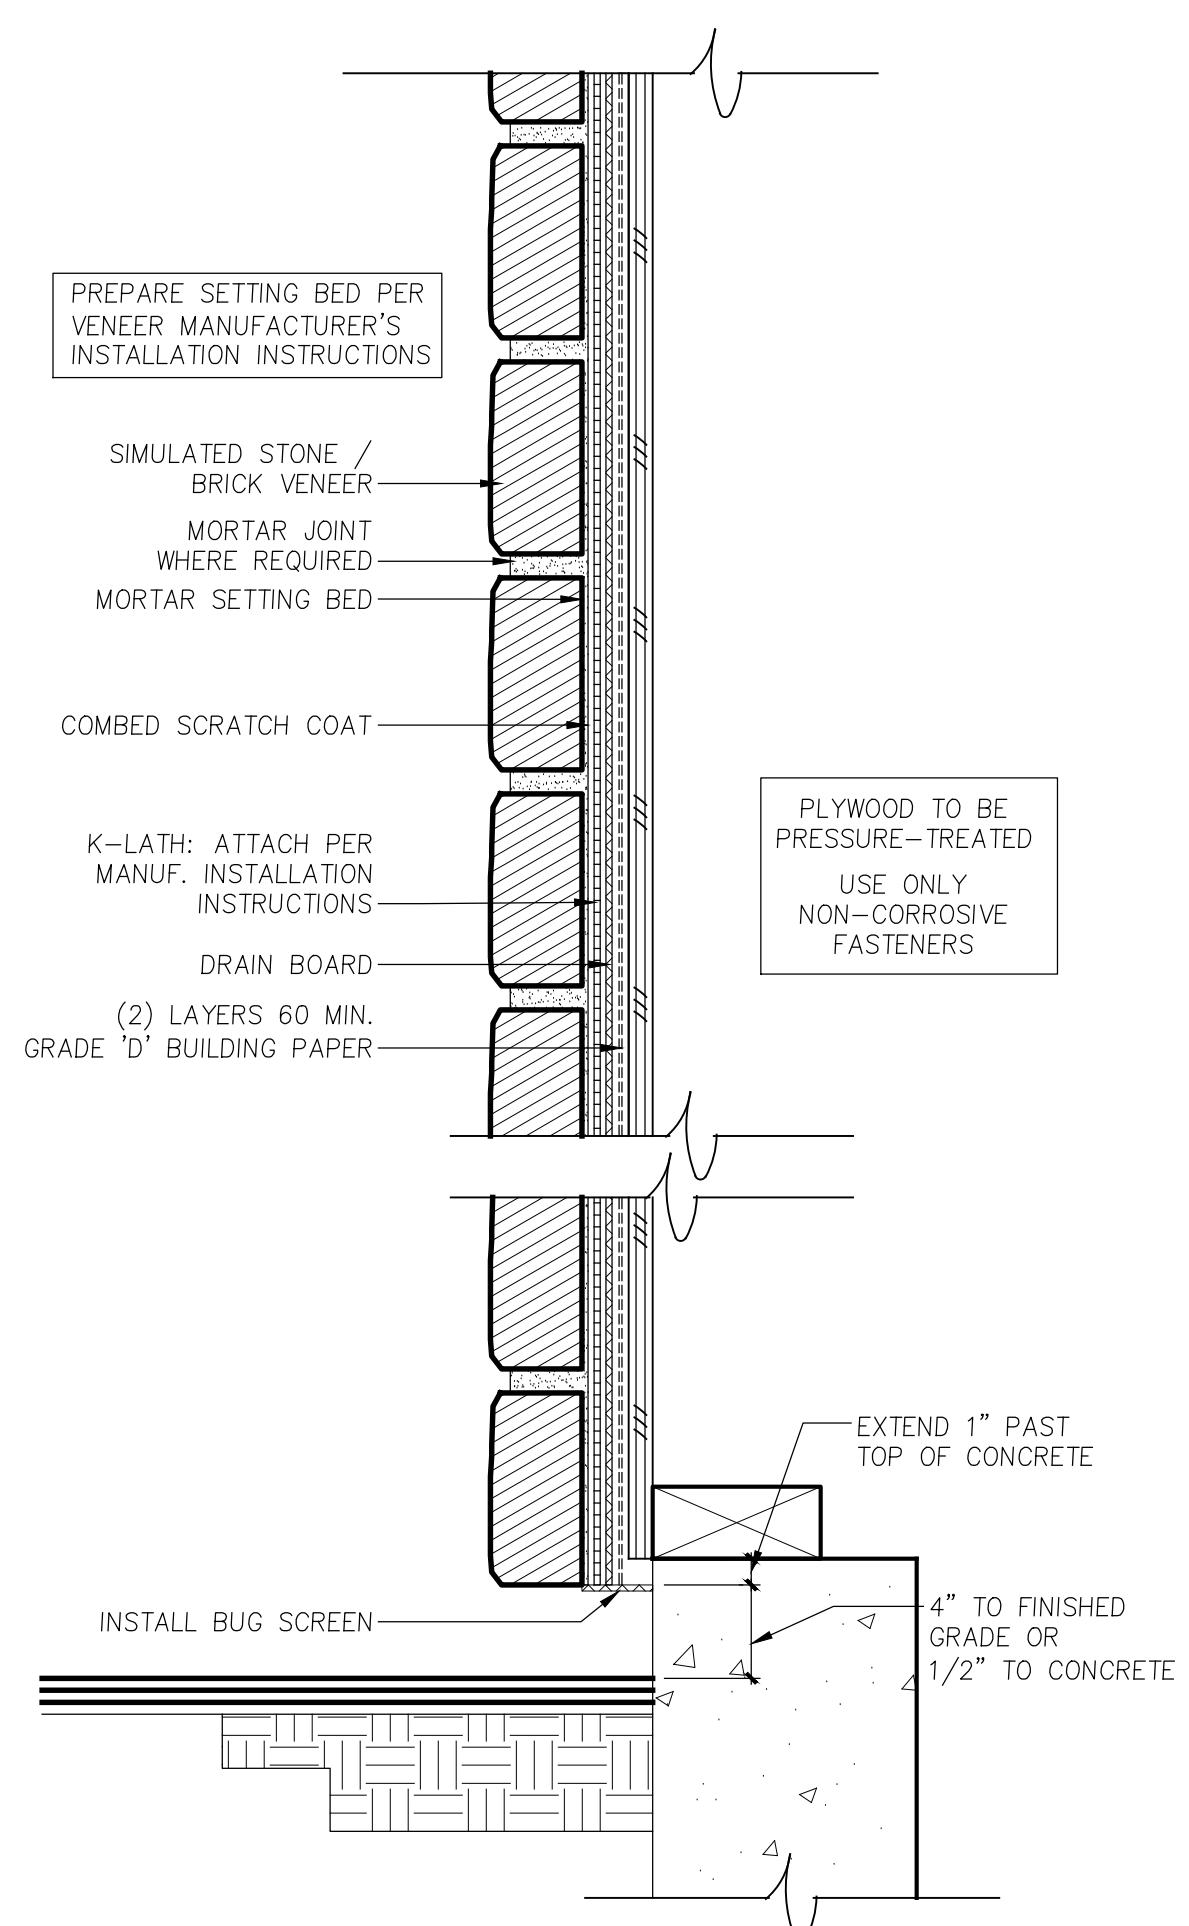

16 STONE ON FRAMING (FULL-HEIGHT)
SECTION
3" = 1'-0"

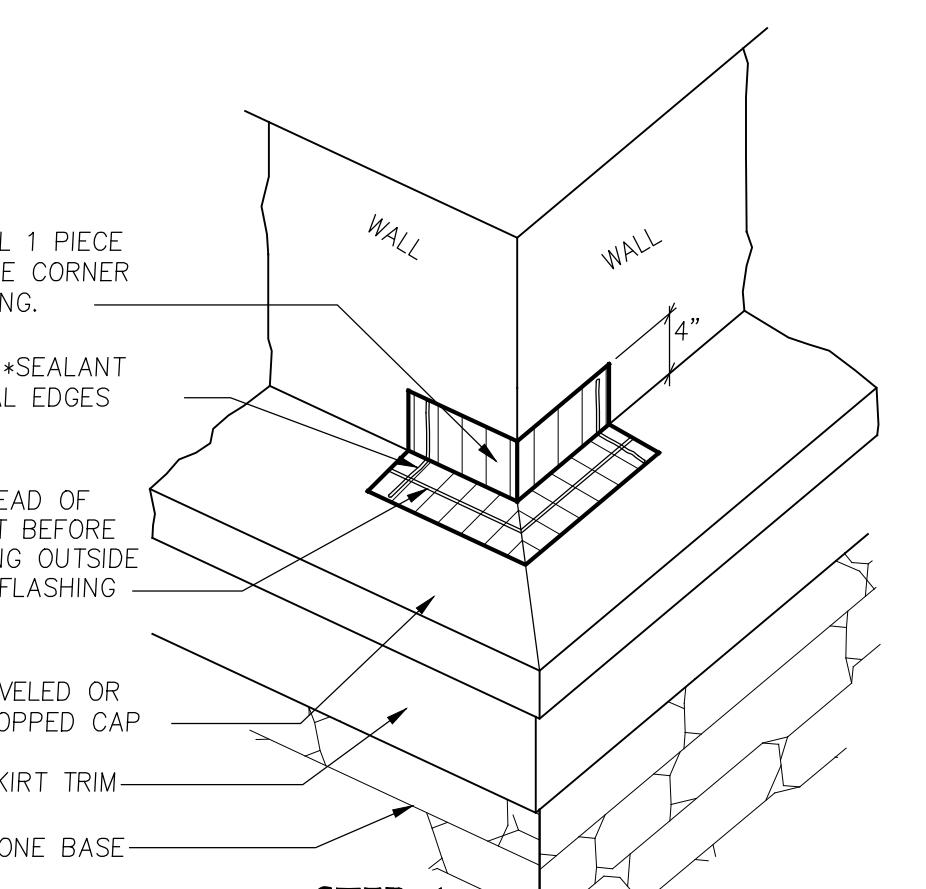

12 STONE TRIM FLASHING (WATERTABLE TRIM)
SECTION
NO SCALE

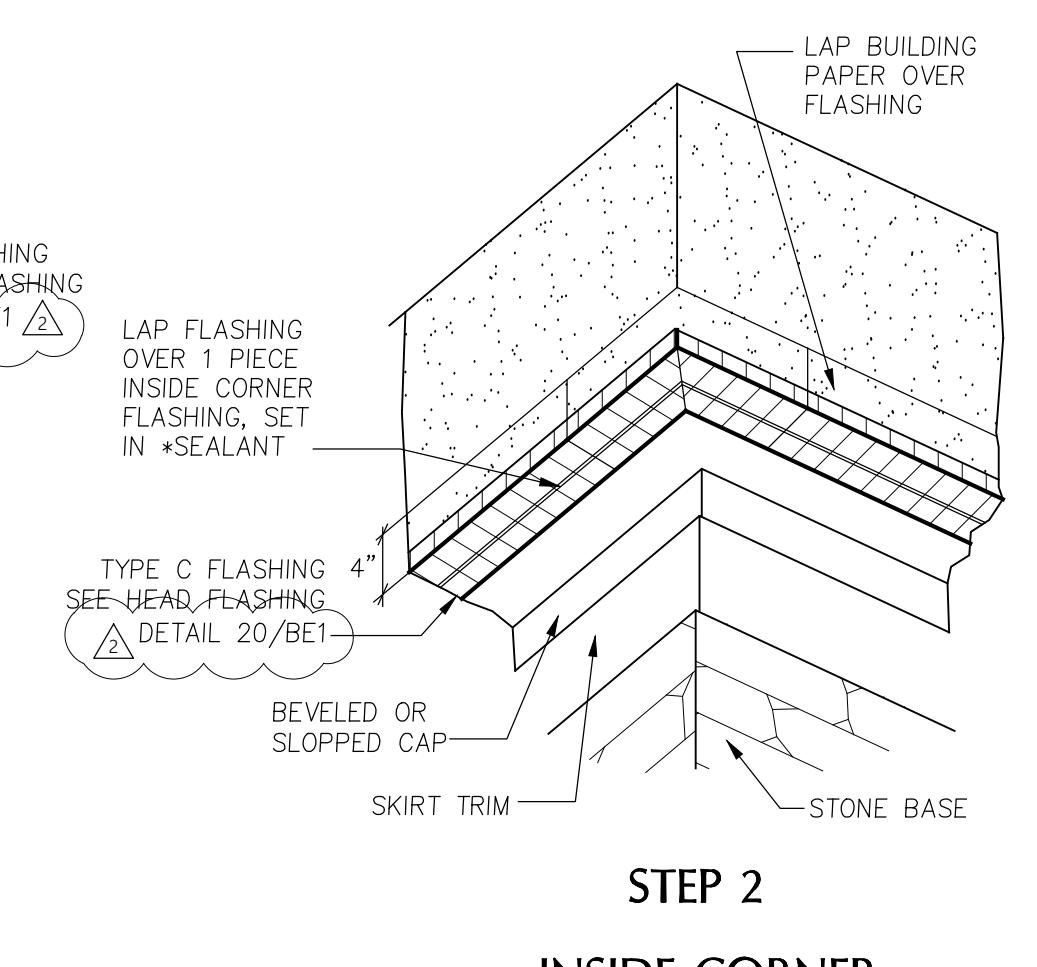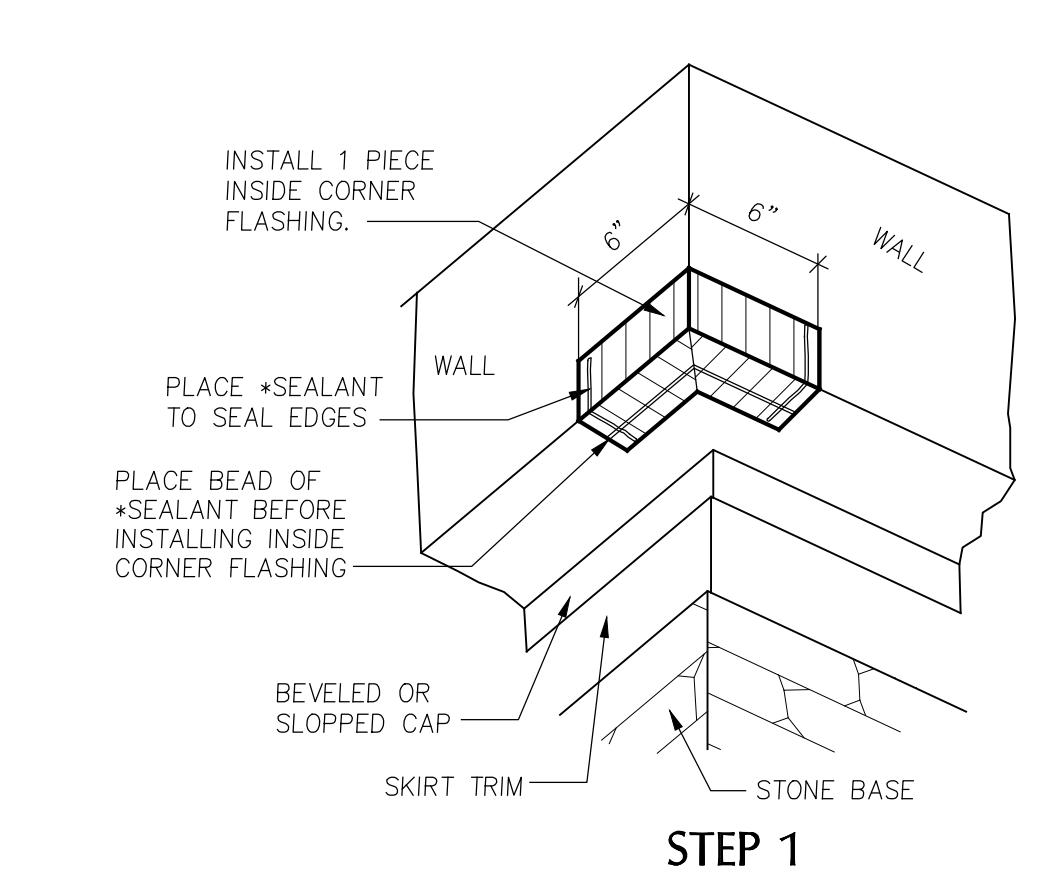

BE-Sheet Disclaimer

The details in the BE-Sheets are intended to meet or exceed all manufacturer recommended installation instructions, any letters of approval provided by a manufacturer to the Contractor, local codes, standards set by specific associations, best practices set by the industry or any other group or organization as acknowledged by the industry.

All manufacturer recommendations should be followed when installing specific materials.

If a Subcontractor or installer finds a situation where the BE-Sheet details conflict or fall below any standards set forth by the organizations mentioned above, it will be the responsibility of the Subcontractor to seek appropriate and written clarification from the Contractor before proceeding. The Contractor reserves its right to add, change, modify or update any of the details at any time.

*All components, sealants, fasteners, or materials shall be approved for specific use or application described by the designs, and shall be compatible with all material with which each component comes in contact with.

GENERAL NOTES

GENERAL NOTES - MECHANICAL

- REFERENCE TO RELATED WORK: "REF" INDICATIONS DENOTE WORK COVERED ELSEWHERE (ARCHITECTURAL, STRUCTURAL, CIVIL, ELECTRICAL, LANDSCAPE, OR KITCHEN), OR ITEM BASED ON A SPECIFIC MANUFACTURER'S DIMENSIONS (VERIFY).
- ELECTRICAL CHARACTERISTICS: REFER TO ELECTRICAL DRAWINGS FOR ELECTRICAL CHARACTERISTICS (VOLTAGES, ETC. OF MECHANICAL EQUIPMENT, UNLESS OTHERWISE INDICATED).
- CODES: COMPLETE INSTALLATION OF THE MECHANICAL SYSTEM SHALL BE PER THE APPLICABLE BUILDING, MECHANICAL, ENERGY, PLUMBING, FIRE, AND WATER CODES AND REGULATIONS AS ADOPTED BY THE LOCAL AHJ.
- PREPARE AND SUBMIT FOR REVIEW A SHOP DRAWING BASED ON FINAL STRUCTURAL SHOP DRAWINGS FOR LOCATING AND ROUTING ALL DUCTWORK, DAMPERS, EQUIPMENT, PIPING, ETC.
- A. COORDINATE FLOOR AND BEAM PENETRATIONS WITH STRUCTURAL.
- B. COORDINATE FINAL LOCATION AND ROUTING WITH CEILING, LIGHTS, WALLS, FIRE SPRINKLER PIPING, AND OTHER TRADES WORK.
- C. INCLUDE ADDITIONAL OFFSETS, ELBOWS, ROUTING, EQUIVALENT DUCT SIZING EXCHANGE, RELOCATING, ETC. AS REQUIRED FOR A COMPLETE OPERATING MECHANICAL SYSTEM.
- D. PROVIDE SHOP DRAWINGS AT NO ADDITIONAL COST TO THE OWNER.
- MECHANICAL CONTRACTOR SHALL LOCATE AND COORDINATE EXACT LOCATION OF ALL MECHANICAL EQUIPMENT WITHIN THE STRUCTURE.
- ACCESS DOORS: COORDINATE WITH ARCHITECT AND LOCATE ALL ACCESS DOORS ON SHOP DRAWINGS PRIOR TO BEGINNING OF CONSTRUCTION. ACCESS DOORS IN FIRE RATED STRUCTURE SHALL BE FIRE RATED. VERIFY ACCESS DOOR LOCATIONS WITH GENERAL CONTRACTOR PRIOR TO BIDDING.
- RATED PENETRATION: DUCT PENETRATIONS THROUGH RATED ENCLOSURES SHALL BE FIRE/SMOKE DAMPERED PER THE LATEST EDITION OF THE UNDERWRITERS LABORATORIES(UL) FIRE RESISTANCE WITH HOURLY RATINGS FOR THROUGH-PENETRATION FIRE STOPS SYSTEM VOLUME #2, OR SHALL BE INSTALLED IN STRICT ACCORDANCE WITH THE MANUFACTURER'S UL LISTINGS (3M OR EQUIVALENT), DETERMINE REQUIREMENTS WITH GENERAL CONTRACTOR PRIOR TO BID.
- EXHAUST OUTLETS: SOURCE-SPECIFIC FANS SHALL BE VENTED TO OUTDOORS WITH A MINIMUM 3' CLEARANCE BETWEEN VENT OUTLETS AND BUILDING OPENINGS, AND 10' MINIMUM BETWEEN VENT OUTLETS AND MECHANICAL AIR INTAKES.
- ROOF PENETRATIONS: SEE ARCHITECTURAL DRAWINGS FOR ROOF CAP, ROOF CURB, ROOF DRAIN, AND VTR DETAILS.
- EXPOSED PIPING: PROVIDE CHROME PLATING FOR EXPOSED PIPING IN FINISHED ROOMS.
- PENETRATIONS: PROVIDE ESCUTCHEON PLATES FOR EXPOSED PIPING PENETRATIONS AND SHEET METAL FLASHING FOR EXPOSED DUCTWORK PENETRATIONS.
- SHAFT AND PLENUM CONNECTIONS: SEAL CONNECTIONS TO AIR SHAFTS AIRTIGHT. PROVIDE AIRTIGHT SEAL AROUND PENETRATIONS IN AIR PLENUMS.
- LIGHT FIXTURE CLEARANCE: COORDINATE LOCATIONS OF MECHANICAL WORK TO PROVIDE CLEARANCES OVER LIGHTING FIXTURES FOR REMOVAL AND REPLACEMENT.
- MOTORS: COMPLY WITH ENERGY CODE ENFORCED BY AHJ FOR MINIMUM EFFICIENCIES UNDER FULL LOAD.
- ACCESS CLEARANCES FOR MAINTENANCE AND REPLACEMENT: VERIFY PHYSICAL DIMENSIONS OF EQUIPMENT TO ENSURE THAT ACCESS CLEARANCES CAN BE MET. COORDINATE LOCATIONS OF MECHANICAL WORK AND WORK OF OTHER TRADES TO PROVIDE ACCESS CLEARANCES FOR SERVICE AND MAINTENANCE.

COORDINATION REQUIREMENTS

- PIPING: COORDINATE WITH STRUCTURAL FOR EXACT LOCATION OF ALL STRUCTURAL FRAMING AND FOOTINGS AND FINALIZE THE EXACT ROUTING OF ALL PIPES WITH STRUCTURAL AND AT THE SITE PRIOR AND DURING THE CONSTRUCTION.
- DUCTWORK: LOCATE AND COORDINATE THE EXACT LOCATION OF DUCTWORK WITH STRUCTURAL PLANS AND WITH THE GENERAL CONTRACTOR PRIOR TO INSTALLATION OF ANY STRUCTURE OR EQUIPMENT. COORDINATE WITH FRAMING CONTRACTOR TO ASSURE JOIST SPACES LINE UP WHEN DUCTWORK MUST PASS THROUGH DIFFERENT JOIST SPACES.
- ADJUSTMENTS: ALL EQUIPMENT, MOTORS, FANS GAS BURNERS, IGNITION DEVICES, DRIVES, ETC. SHALL BE ADJUSTED AND BALANCED TO OPERATE AT SPECIFIED RATINGS AS REQUIRED FOR THIS PROJECT SITE AND ACCOUNTING FOR ELEVATION ABOVE SEA LEVEL.
- APPROVALS: MECHANICAL AND PLUMBING EQUIPMENT SHALL BE APPROVED FOR INSTALLATION IN THE PROJECT LOCATION AND SHALL HAVE ALL CERTIFICATIONS AND RATINGS TO MEET ALL ENERGY, POLLUTION, ENVIRONMENTAL, SEISMIC, ETC. CODES AND REGULATIONS. THE CONTRACTOR SHALL COORDINATE WITH HIS MANUFACTURE SUPPLIERS AND SHALL INCLUDE ALL COSTS REQUIRED TO MEET THESE REQUIREMENTS IN HIS BID.
- FIRE PROTECTION: CONTRACTOR SHALL PROVIDE A FULLY DESIGNED FIRE PROTECTION SPRINKLER SYSTEM IN COMPLIANCE WITH NFPA AND LOCAL CODES. PROVIDE DESIGN, PERMITS, MATERIALS, INSTALLATION, TESTING AND ALL OTHER FOR A FULLY OPERATIONAL SYSTEM. LOCATION OF ALL PIPING TO BE COORDINATED WITH OTHER TRADES.

PIPING NOTES

- DISASSEMBLY PROVISIONS: PROVIDE UNIONS OR FLANGES AT PIPING CONNECTIONS TO EQUIPMENT, COILS, TRAPS, CONTROL VALVES, AND OTHER COMPONENTS TO ALLOW DISASSEMBLY FOR MAINTENANCE.
- REDUCERS: PROVIDE AS REQUIRED FROM LINE PIPE SIZE TO EQUIPMENT TRAP, COIL, AND CONTROL VALVE CONNECTION SIZES.
- OFFSETS: PROVIDE FOR BRANCH LINES TO EQUIPMENT.
- Dielectric Unions: PROVIDE AT CONNECTIONS OF DISSIMILAR PIPE.
- REFRIGERANT PIPING: PROVIDE SIZING & INSTALLATION IN STRICT ACCORDANCE WITH MANUFACTURER'S INSTRUCTIONS.
- CONDENSATE DRAIN: PROVIDE A P-TRAP FOR EACH HVAC UNIT CONDENSATE PAN WITH PLUG TEES FOR CLEANING. CONDENSATE DRAINS SHALL BE DISCHARGED TO AN INDIRECT WASTE OR OUTSIDE.

INSULATION/LINING NOTES

- ENERGY CODE: AS A MINIMUM, COMPLY WITH THICKNESSES AND TYPES LISTED IN ENERGY CODE ENFORCED BY AHJ.
- EXTENT OF INTERNAL DUCT LINING:
 - GRILLE AND DIFFUSER BOXES AND BOOTS.
 - TRANSFER DUCTS.
 - THE FIRST 10 FEET OF SUPPLY AND RETURN DUCTWORK FROM THE AIR HANDLER.
- EXTENT OF EXTERNAL DUCT INSULATION:
 - SUPPLY AND RETURN AIR IN UNCONDITIONED SPACES, MECHANICAL ROOMS, ELECTRICAL ROOMS, AND EQUIPMENT ROOMS NOT SPECIFIED TO BE INTERNALLY LINED.
 - SUPPLY AIR ABOVE CEILINGS OR EXPOSED NOT SPECIFIED TO BE INTERNALLY LINED.
 - OUTDOOR AIR INTAKE.
- MISCELLANEOUS DUCT FITTINGS (CONICAL TAKEOFFS, ETC.): WRAP WITH INSULATION FOR CONDENSATION CONTROL.

PLAN NOTES

- DUCTWORK SHALL BE METALLIC DUCTWORK
- TEST AND BALANCE WORK SHALL BE PERFORMED BY AN INDEPENDENT TEST AND BALANCE AGENCY. PROVIDE (3) COPIES OF TEST AND BALANCE REPORT TO OWNER.
- COORDINATE DUCTWORK WITH MISCELLANEOUS OBSTRUCTIONS IN CEILING SPACE.
- RESTROOM EXHAUST SHALL BE A MINIMUM OF 10' FROM ANY MECHANICAL OUTSIDE AIR INTAKES.
- ROUTE DUCTWORK UNDERNEATH JOISTS UON.
- TRANSITION DUCT UNDER BEAMS AND DUCTS. FIELD VERIFY AVAILABLE CEILING CAVITY DIMENSIONS.
- COORDINATE MOUNTING HEIGHT OF DIFFUSERS WITH ARCHITECTURAL PLANS.

Sheet Metal Notes

- REFERENCE: SMACNA HVAC DUCT CONSTRUCTION STANDARDS, METAL AND FLEXIBLE, CURRENT EDITION.
- CLEARANCE: COORDINATE DUCTWORK WITH MISCELLANEOUS OBSTRUCTIONS IN CEILING SPACE.
- ROUND ELBOWS AND OFFSETS: FULL RADIUS (R/D = 1.5, 5-PIECE SEGMENTED OR STAMPED. REFER TO SMACNA HVAC FIG 2-7, 3-3. DO NOT USE ANGLED OFFSET (TYPE 1). MITERED OFFSET (TYPE 2) MAY BE USED UP TO 30 DEGREE OFFSET ANGLE.
- ROUND TEES AND LATERALS: CONICAL TEE PER SMACNA HVAC FIG 3-5; DO NOT USE STRAIGHT TEE; DO NOT USE CONICAL SADDLE TAP FOR EXPOSED DUCTWORK IN FINISHED SPACES. 90-DEGREE TEE WITH OVAL TO ROUND TAP, LATERAL, AND 45-DEGREE RECTANGULAR LEAD-IN PER SMACNA HVAC FIG 3-4.
- RECTANGULAR ELBOWS AND OFFSETS: FULL RADIUS WHERE SPACE PERMITS, R/W = 1.5; OTHERWISE USE SQUARE CORNER ELBOW WITH TURNING VANES.
- RECTANGULAR DIVIDED FLOW FITTINGS: USE GENERALLY, EXCEPT BRANCHES TO TERMINALS; SMACNA HVAC FIG 2-5, TYPES 1, 2, 4A, AND 4B. DO NOT USE TYPE 3.
- TURNING VANES: H.E.P. MANUFACTURER OR APPROVED HIGH EFFICIENCY PROFILE AIRFOIL TYPE FOR RECTANGULAR SCARE THROAT ELBOWS. ACOUSTICAL TYPE FOR RETURN AIR MITERED ELBOWS.
- TAKEOFFS TO OPENINGS: CONICAL TYPE WITH VOLUME DAMPER FOR ROUND DUCT BRANCHES PER SMACNA HVAC FIG 2-6, MINIMUM INLET DIAMETER 2 INCHES LARGER THAN DUCT SIZE. 45 DEGREE ENTRY FITTING FOR RECTANGULAR DUCT BRANCHES PER SMACNA HVAC FIG 2-6.
- FLEXIBLE CONNECTIONS: PROVIDE AT EACH DUCT CONNECTION TO FANS, PACKAGED HVAC EQUIPMENT, EXTERNALLY ISOLATED AIR HANDLING UNITS, FAN COIL UNITS, AND SIMILAR EQUIPMENT. EXCEPTION: EQUIPMENT IN CORRIDOR CEILING SPACES WHERE FIRE RATING IS REQUIRED.
- ALL DUCT WORK SHALL BE CLASSIFIED FOR LOW PRESSURE SYSTEMS PER IMC SECTION 603.
- ALL DUCTS AND JOINTS SHALL BE SEALED PER IMC SECTION 603.

HVAC NOTES

- ATTACHMENTS: AIR DISTRIBUTION OUTLETS AND LOUVERS

SHALL HAVE ALL REQUIRED ACCESSORIES AND ATTACHMENTS FOR A COMPLETE CONNECTION TO THE SPECIFIC TYPE OF STRUCTURE THAT THEY ARE BEING ATTACHED TO. THIS INCLUDES, BUT IS NOT LIMITED TO, EXTERIOR BRICKS, GWB WALLS, GWB CEILING, ETC.

- DUCTWORK: DUCTWORK SHALL BE SMOOTH SHEET METAL (CLASS-1). DUCTWORK THROUGH FIRE RATED STRUCTURE AND FLOOR SHALL BE MIN. 26 GA. STEEL. MAXIMUM LENGTH OF FLEXIBLE DUCTS SHALL BE 5'-0", UNLESS OTHERWISE NOTED ON DRAWINGS. DUCTWORK SIZES SHOWN ARE INSIDE CLEAR DIMENSIONS.
- SEISMIC: PROVIDE SEISMIC RESTRAINTS FOR MECHANICAL EQUIPMENT, PIPING, AND DUCTWORK PER SMACNA AND LOCAL REGULATIONS.
- REFRIGERANT PIPING: PROVIDE SIZING & INSTALLATION IN STRICT ACCORDANCE WITH MANUFACTURER'S INSTRUCTIONS.
- DUCTWORK AND PIPING OUTSIDE OF MECHANICAL ROOMS SHALL BE CONCEALED, COORDINATE WITH THE GENERAL CONTRACTOR TO FUR-OUT AS REQUIRED.

6. FIRE RATINGS: RATED FLOOR/CEILING JOINT SPACES HAVING DUCTWORK INSIDE THEM SHALL BE FIRE/SMOKE PROTECTED TO MAINTAIN THE 1-HOUR FLOOR/CEILING RATING PER LOCAL JURISDICTIONS. EXHAUST DUCTWORK PENETRATING THE 1-HOUR ROOF/CEILING OR FLOOR/CEILING ASSEMBLY SHALL HAVE ACCESSIBLE CEILING FIRE DAMPERS. ALTERNATIVELY, THE EXHAUST DUCTWORK SHALL BE ROUTED INSIDE A RATED SHAFT TO PROTECT THE CEILING/ROOF RATING PER THE LOCAL JURISDICTIONS.

7. FIRESTOP: PIPE, DUCT AND CONDUIT PENETRATIONS THROUGH RATED ASSEMBLIES SHALL BE FIRE AND SMOKE STOPPED PER CODE.

- DUCTWORK: DUCTWORK SHALL BE SMOOTH SHEET METAL (CLASS-1). DUCTWORK THROUGH FIRE RATED STRUCTURE AND FLOOR SHALL BE MIN. 26 GA. STEEL. MAXIMUM LENGTH OF FLEXIBLE DUCTS SHALL BE 5'-0" UNLESS OTHERWISE NOTED ON DRAWINGS. DUCTWORK SIZES SHOWN ARE INSIDE CLEAR DIMENSIONS.

9. VOLUME DAMPERS: PROVIDE AN ACCESSIBLE MANUAL VOLUME DAMPER FOR EACH SUPPLY, RETURN, OSA AND EXHAUST OPENING, LOCATED AS FAR UPSTREAM AS POSSIBLE FROM THE OPENING. PROVIDE A MANUAL VOLUME DAMPER FOR BRANCH MAINS SERVING MORE THAN ONE OPENING. VOLUME DAMPERS IN NON-ACCESSIBLE CEILING SHALL HAVE A CONTROL ARM EXTENDED TO AN ACCESSIBLE LOCATION. PROVIDE "YOUNG" REGULATOR OR EQUAL. EXACT LOCATION OF CONTROL DEVICES VISIBLE IN FINISHED SPACES SHALL BE COORDINATED WITH THE ARCHITECT.

10. CORRIDOR THERMOSTAT: PROVIDE TAMPERPROOF THERMOSTATS IN CORRIDORS. DO NOT PROVIDE PLASTIC GUARDS TO MAKE THE THERMOSTATS TAMPERPROOF. PROVIDE BLANK SECURABLE THERMOSTAT COVERS.

APPLICABLE CODE

BUILDING CODE:

2018 WASHINGTON STATE ENERGY CODE-RESIDENTIAL BY WASHINGTON ADMINISTRATIVE CODE CHAP 51-50 (WSEC)

2018 INTERNATIONAL RESIDENTIAL CODE WITH ADMINISTRATIVE CODE CHAP 51-51 (WSRC)

2018 INTERNATIONAL MECHANICAL CODE WITH ADMINISTRATIVE CODE CHAP 51-52 (WMC)

DRAWINGS ARE DIAGRAMMATIC, SHOWING THE GENERAL LOCATION, TYPE, LAYOUT, AND EQUIPMENT REQUIRED. THE DRAWINGS SHALL NOT BE SCALED FOR EXACT MEASUREMENT. REFER TO ARCHITECTURAL DRAWINGS FOR DIMENSIONS. REFER TO MANUFACTURER'S STANDARD INSTALLATION DRAWINGS FOR EQUIPMENT CONNECTIONS AND INSTALLATION REQUIREMENTS. PROVIDE DUCTWORK, CONNECTIONS, ACCESSORIES, OFFSETS, AND MATERIALS NECESSARY FOR A COMPLETE SYSTEM.

PRE-CON MEETING NOTES


CONTRACTORS SHALL ATTEND A PRE-CONSTRUCTION MEETING WITH THE ENGINEER FOR THE PURPOSE OF REVIEWING THE WORK PRIOR TO ORDERING ANY EQUIPMENT OR PERFORMING ANY WORK. THE MEETING SHALL BE LOCATED AT THE PROJECT SITE ON A DATE AND TIME TO BE MUTUALLY AGREED. THE MEETING WILL BE A WORKING SESSION. THE MEETING WILL BE FACILITATED BY THE ENGINEER AND THE AGENDA WILL INCLUDE A DETAILED REVIEW OF THE PLANS AND SPECIFICATIONS, CROSS CHECK WITH OTHER TRADES FOR COORDINATION ISSUES, REVIEW OF PROPOSED PRODUCTS, REVIEW OF PLANNED MEANS AND METHODS, AND ON-SITE INVESTIGATION OF FIELD CONDITIONS RELATIVE TO EXISTING CONDITIONS THAT COULD AFFECT THE WORK. PERSONS ATTENDING THE MEETING SHALL BE KNOWLEDGEABLE OF THE PROJECT AND SHALL BE THE SPECIFIC PERSONS INTENDED TO CONTINUE WITH THE PROJECT THROUGH TO COMPLETION. IF REQUIRED, REVISED PLANS WILL BE ISSUED THROUGH OFFICIAL CHANNELS. CHANGES IN THE BID PRICE WILL BE DISCUSSED, BUT NO CHANGE ORDERS WILL BE ISSUED UNLESS PROCESSED THOUGH OFFICIAL CHANNELS. IT SHALL BE UNDERSTOOD THAT THE ENGINEER HAS NO AUTHORITY TO ISSUE CHANGE ORDERS.

THE FOLLOWING TRADES SHALL BE REPRESENTED FOR THE MINIMUM TIME INDICATED:

MECHANICAL SHEET METAL 4 HOURS
PLUMBING/PIPEING 4 HOURS
ELECTRICAL 4 HOURS
SPRINKLER 2 HOURS
GENERAL CONTRACTOR ALL SESSIONS

ANNOTATIONS

DUCTWORK

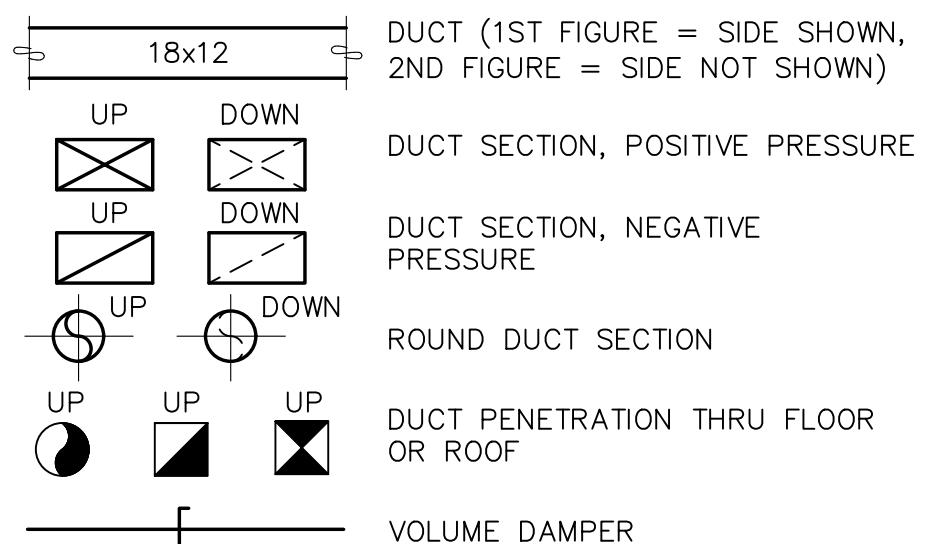

DUCT (1ST FIGURE = SIDE SHOWN, 2ND FIGURE = SIDE NOT SHOWN)

DUCT SECTION, POSITIVE PRESSURE

DUCT SECTION, NEGATIVE PRESSURE

ROUND DUCT SECTION

DUCT PENETRATION THRU FLOOR OR ROOF

VOLUME DAMPER

FIRE/SMOKE DAMPER (---▲ = HORIZ DUCT, ---◆ = VERT DUCT), 2-HR RATED, UON

FIRE DAMPER (---▲ = HORIZ DUCT, ---◆ = VERT DUCT), 2-HR RATED, UON

90° ELBOW, R/D OR R/W=1.5

SQUARE CORNER ELBOW WITH TURNING VANES

90° TAKE-OFF OR TEE

90° CONICAL TAKE-OFF

45° LATERAL TAKE-OFF

TRANSITION OR REDUCER (FOT = FLAT ON TOP, FOB = FLAT ON BOTTOM)

WYE FITTING

90° RECTANGULAR TAKE-OFF WITH 45° TAPER

90° DIVERGING RECTANGULAR TEE, EITHER RADIUS OR TURNING VANES

PARALLEL FLOW BRANCH CONNECTION, EITHER RADIUS OR TURNING VANES

FLEXIBLE DUCT

ROUND DUCT INDICATOR

SYMBOLS

EQUIPMENT

TYPICAL EQUIPMENT DESIGNATION (EXHAUST FAN SHOWN)

DUCT SMOKE DETECTOR

ROOM THERMOSTAT OR TEMPERATURE TRANSMITTER

ROOM HUMIDISTAT OR HUMIDITY TRANSMITTER

CARBON MONOXIDE SENSOR

SMOKE DETECTOR

TERMINALS

DIFFUSER/GRILLE TYPE, AND NUMBER OR SIZE

DESIGN CFM (WHERE APPLICABLE)

CEILING DIFFUSER (FLOW ARROWS SHOWN FOR NON SYMMETRICAL AIRFLOW)

CEILING RETURN/EXHAUST GRILLE

LINEAR DIFFUSER, CEILING OR WALL MOUNTED (FLOW ARROWS SHOWN FOR NON SYMMETRICAL AIRFLOW)


WALL SUPPLY GRILLE (SG)

WALL RETURN/EXHAUST GRILLE (RG, EG)

TRANSFER GRILLE (TG), DUCT CONNECTED, WALL MOUNTED W/ OPTIONAL CFM SHOWN

TRANSFER GRILLE, CEILING MOUNTED WITH FULL-SIZED LINED DUCT CONNECTION

City of Poulsbo Development Services	
ISSUED BY STAFF	
Engineering	Public Works
Fire	Utility
5/2/25	
PERMIT RESUBMITTAL #1	
NO DATE	

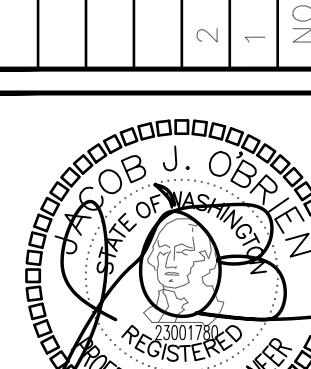

DRAWN:	OP
DESIGNED:	ABE
CHECKED:	ABE
APPROVED:	JOB

PROJECT: BRADLEY HEIGHT APARTMENTS - BUILDING G
202 27TH AVE SE
PUYALLUP, WA 98374
PHONE: (206)364-3343

ROBISON
ENGINEERING, INC.
19401 40TH AVE W SUITE 302
LYNNWOOD, WA 98036
PHONE: (206)364-3343

DATE: 05/01/2025

SHEET TITLE:
LEGEND,
GENERAL NOTES,
& DRAWING
INDEX

SHEET NO.
M0.0

DRAWING INDEX

Sheet Number	Sheet Title	PERMIT SET 02/15/2024	PERMIT RESUBMITTAL SET 02/04/2025	PERMIT RESUBMITTAL 2 SET 5/2/2025</th

ENERGY CODE NOTES

WASHINGTON STATE ENERGY CODE

1. HVAC THERMOSTATS SHALL BE SET TO MAINTAIN A MINIMUM DEADBAND OF 5°F IN AREAS SERVED AS REQUIRED PER WSEC C403.2.4.2.

2. PER WSEC, ALL DUCTS SHALL BE INSULATED AS FOLLOWS:

DUCT INSULATION SCHEDULE				
CODE	DUCT SYSTEM	DUCT LOCATION AND USE (1)(2)(3)	MATERIAL	R-VALUE (MIN. INSTALLED)
WSEC TABLE C403.10.1.1	OUTSIDE AIR (4)	>= 2800 CFM INSIDE CONDITION SPACE AND UPSTREAM OF AUTOMATIC SHUTOFF DAMPER	MINERAL-WOOL BLANKET	16.0
		>= 2800 CFM INSIDE CONDITION SPACE AND DOWNSTREAM OF AUTOMATIC SHUTOFF DAMPER TO HVAC UNIT UNIT OR ROOM	MINERAL-WOOL BLANKET	8.0
		< 2800 CFM INSIDE CONDITION SPACE	MINERAL-WOOL BLANKET	7.0
WSEC TABLE C403.10.1.2	SUPPLY AIR & RETURN AIR (4)	OUTSIDE THE BUILDING (OUTDOOR AND EXPOSED TO WEATHER) WHICH INCLUDE ATTICS ABOVE INSULATION CEILINGS, PARKING GARAGE AND CRAWL SPACE	MINERAL-WOOL BLANKET	8.0
		UNCONDITIONED SPACE (ENCLOSED BUT NOT IN THE BUILDING CONDITIONED ENVELOPE)	MINERAL-WOOL BLANKET	6.0
		UNCONDITIONED SPACE WHERE THE DUCT CONVEYS AIR THAT IS WITHIN 15°F OF THE AIR TEMPERATURE OF THE SURROUNDING UNCONDITIONED SPACE (5)	MINERAL-WOOL BLANKET	3.3
	SUPPLY AIR (4)	WHERE LOCATED IN THE BUILDING ENVELOPE ASSEMBLY	MINERAL-WOOL BLANKET	16.0
		WITHIN CONDITIONED SPACE WHERE SUPPLY DUCT CONVEYS AIR <55°F OR >105°F	MINERAL-WOOL BLANKET	3.3
		WITHIN CONDITIONED SPACE THAT THE DUCT DIRECTLY SERVES WHERE SUPPLY DUCT CONVEYS AIR <55°F OR >105°F	MINERAL-WOOL BLANKET	0.0
	SUPPLY AIR (4)	WITHIN CONDITIONED SPACE WHERE SUPPLY DUCT CONVEYS AIR >55°F OR <105°F	MINERAL-WOOL BLANKET	0.0
		RETURN OR EXHAUST AIR	MINERAL-WOOL BLANKET	8.0
		RELIEF OR EXHAUST AIR	MINERAL-WOOL BLANKET	16
		NOTES (1) DUCT INSULATION SHALL COMPLY WITH WSEC (2) INSULATION SHALL HAVE A MAXIMUM FLAME SPREAD INDEX OF 25 AND MAXIMUM SMOKE DEVELOPED INDEX OF 50 PER WSEC 604.3 (3) EXTERNAL DUCT INSULATION IS IDENTIFIABLE PER WSEC 604.7 (4) VAPOR RETARDER IS INSTALLED ON SUPPLY AND OUTSIDE AIR DUCT PER WSEC 604.11 (5) CONDENSATION CONTROL FOR DUCTWORK		
3.		MOTORIZED DAMPERS: PER WSEC C403.7.8.1 PROVIDE MOTORIZED DAMPERS ON ALL OUTSIDE AIR INTAKES, EXHAUST OUTLETS AND RELIEF OUTLETS SERVING CONDITIONED SPACES WHICH CLOSE AUTOMATICALLY WHEN THE SYSTEM IS OFF. RETURN AIR DAMPERS SHALL BE EQUIPPED WITH MOTORIZED DAMPERS. SEE WSEC C402.4.5.2 FOR EXCEPTIONS AND ADDITIONAL REQUIREMENTS.		

RESIDENTIAL ENERGY CODE

1. WHOLE-HOUSE FAN EFFICACY PER TABLE R403.6.1.
2. EQUIPMENT AND APPLIANCE SIZING PER R403.7, HEATING AND COOLING EQUIPMENT AND APPLIANCES SHALL BE SIZED IN ACCORDANCE WITH ACCA MANUAL S OR OTHER APPROVED SIZING METHODOLOGIES BASED ON BUILDING LOADS CALCULATED IN ACCORDANCE WITH ACCA MANUAL J OR OTHER APPROVED HEATING AND COOLING CALCULATION METHODOLOGIES
3. ELECTRIC RESISTANCE ZONE PER R403.7.1, ELECTRIC ZONAL HEATING AS PRIMARY HEAT SOURCE SHALL INSTALL DUCTLESS MINI-SPLIT HEAT PUMP IN THE LARGEST ZONE IN THE DWELLING UNLESS TOTAL INSTALLED HEATING CAPACITY OF 2 KW PER DWELLING OR LESS.
4. PROVIDED ONE THERMOSTAT FOR EACH HEATING AND COOLING SYSTEM PER R403.1
5. PER R403.3.6, SUPPLY AND RETURN DUCTS IN CEILING INSULATION SHALL HAVE MIN R-8 INSULATION ALL AROUND. THE SUM OF THE CEILING INSULATION OF THE TOP AND BELOW OF THE DUCT SHALL BE MIN R-19, EXCLUDING THE R-VALUE OF THE DUCT INSULATION
6. MECHANICAL SYSTEM PIPING CARRYING FLUIDS ABOVE 105°F OR BELOW 55°F SHALL BE INSULATED WITH MIN R-6 PER R403.4. INSULATION SHALL BE PROTECTED FROM DAMAGE AND SHALL PROVIDE SHIELDING FROM SOLAR RADIATION. ADHESIVE TAPE SHALL NOT BE PERMITTED.

WHOLE HOUSE VENTILATION NOTES

OUTSIDE AIR

OUTSIDE AIR TO EACH RESIDENTIAL UNIT IS PROVIDED BY THE WHOLE HOUSE VENTILATION FAN (BEF-1). DATA WERE OBTAINED FROM TABLE 403.8.1. AIR PROVIDED THROUGH OPERABLE OPENINGS INSTALLED WITHIN THE WINDOW SYSTEM (TRICKLE VENTS). THE QUANTITY OF 4 SQUARE INCH TRICKLE VENTS ARE IDENTIFIED IN THE WHOLE HOUSE VENTILATION CRITERIA SCHEDULE. TRICKLE VENTS MAY BE COMBINED INTO LARGER VENT OF EQUIVALENT AREA. EACH EXTERIOR OCCUPYABLE LIVING SPACE SHALL BE PROVIDED WITH AT LEAST ONE TRICKLE VENT.

THE BATHROOM EXHAUST FAN SHALL BE USED AS THE WHOLE HOUSE EXHAUST FAN. WHOLE HOUSE FAN TO BE EQUIPPED WITH AN ECM MOTOR AND 2-SPEED MOTOR. FAN TO RUN CONTINUOUSLY ON LOW SPEED AND HIGH SPEED SHALL BE ACTIVATED BY A FACTORY MOUNTED MOTION SENSOR. WHOLE HOUSE VENTILATION FANS SHALL OPERATE CONTINUOUSLY.

EXHAUST FAN ONLY VENTILATION SYSTEMS SHALL BE PROVIDED WITH OUTDOOR AIR TO EACH OCCUPIED SPACE, AND OR ANY SPACE THAT CAN BE OCCUPIED THROUGH ONE OF THE FOLLOWING METHODS:

OUTDOOR AIR MAY BE DRAWN THROUGH AIR INLETS INSTALLED IN EXTERIOR WALLS OR WINDOWS. THE AIR INLETS SHALL COMPLY WITH ALL OF THE FOLLOWING: IMC W/WASHINGTON AMENDMENTS 403.8.6.1

1. INLETS SHALL HAVE CONTROLLABLE, SECURE OPENINGS AND SHALL BE DESIGNED TO NOT COMPROMISE THE THERMAL PROPERTIES OF THE BUILDING ENVELOPES.
2. INLETS SHALL BE ACCESSIBLE TO OCCUPANTS INCLUDING COMPLIANCE WITH THE BARRIER FREE CODE.
3. INLETS SHALL BE SCREENED OR OTHERWISE PROTECTED FROM ENTRY BY INSECTS, LEAVES OR OTHER MATERIAL.
4. INLETS SHALL PROVIDE NOT LESS THAN 4 SQUARE INCHES OF NET FREE AREA FOR EACH 10 CFM OF OUTDOOR AIR REQUIRED.
5. ANY INLET WHICH PROVIDES 10 CFM AT 10 PASCALS AS IN ACCORDANCE WITH HVI 916 HOME VENTILATION INSTITUTE AIR FLOW TEST PROCEDURE, AND HVI 920 HOME VENTILATION INSTITUTE PRODUCT PERFORMANCE CERTIFICATION PROCEDURE ARE DEEMED EQUIVALENT TO 4 SQUARE INCHES OF NET FREE AREA.
6. EACH OCCUPIABLE SPACE SHALL HAVE A MINIMUM OF ONE AIR INLET THAT HAS A MINIMUM OF 4 SQUARE INCHES OF NET FREE AREA.

CALCULATIONS

RESIDENTIAL VENTILATION CALCULATIONS

UNIT TYPE	UNIT SQUARE FOOTAGE	NUMBER OF BEDROOMS	2018 IMC CRITERIA (1)			VENTILATION QUALITY ADJUSTMENT COEFFICIENT (3)	MINIMUM WHOLE HOUSE VENTILATION RATE, CFM	TOTAL CFM PROVIDED BY WHOLE HOUSE FAN SYSTEM
			FLOOR AREA, SQFT	NUMBER OF BEDROOMS	REQUIRED CFM (2)			
1 BEDROOM	660	1	500 - 1,000	1	30	1.5	45	55
2 BEDROOM	1000	2	500 - 1,000	2	35	1.5	53	55

NOTE:
(1) VENTILATION CRITERIA IS PER THE 2018 IMC, TABLE 403.4.2.
(2) MINIMUM OSA FOR CONTINUOUSLY OPERATING FAN(S).
(3) ADJUSTMENT COEFFICIENT IS PER 2018 IMC, TABLE 403.4.3 FOR A BALANCED, AND DISTRIBUTED WHOLE HOUSE VENTILATION SYSTEM.

RANGE HOOD VENTILATION NOTES

RESIDENTIAL UNIT NOTES:

1. PENETRATIONS OF THE RATED WALL ASSEMBLIES SHALL BE PROTECTED IN ACCORDANCE WITH IBC SECTION 717. REFER TO ARCHITECTURAL PLANS FOR PENETRATION DETAILS.
2. PER OWNER, THE FOLLOWING RANGE HOODS ARE BEING INSTALLED: STANDARD UNITS (MICRO/HOOD COMBO): WHIRLPOOL WMH31017H PER THE MANUFACTURER'S INSTALLATION INSTRUCTIONS, DUCT CONNECTION TO HOODS ARE 6". MINIMUM SIZE ROUND DUCT FOR HOOD VENTING SHALL BE 7".

STANDARD HOOD:
WHIRLPOOL
WMH31017H

MAXIMUM LENGTH (FT)

140

HOOD VENT LENGTH CALCULATION


UNIT TYPE	DRYER VENT LENGTH	RECTANGULAR TO ROUND TRANSITION	NUMBER OF 45° ELBOWS	NUMBER OF 90° ELBOWS	WALL CAP	TOTAL LENGTH
1-BED-END	30	1	0	2	1	95
1-BED-INT-2	55	1	0	3	1	130
2-BED	33	1	2	2	1	108
2-BED (BLDG E&F)	14	1	0	2	1	79

NOTE: (1) PER THE MANUFACTURER'S INSTALLATION INSTRUCTIONS EQUIVALENT LENGTH OF DUCT FITTINGS ARE AS FOLLOWS:

FITTING	EQUIVALENT VENT LENGTH (FT)
RECTANGULAR TO ROUND TRANSITION	5
90° ELBOW	10
45° ELBOW	5
WALL CAP	40

City of Poulsbo
Development Services
ISSUED BY: Planning
Signed: _____
Engineering _____
Fire _____
Public Works _____
Traffic _____

PERMIT SUBMITTAL #1
PERMIT RESUBMITTAL #2
DATE: 5/2/25
NO. 2
REVISIONS

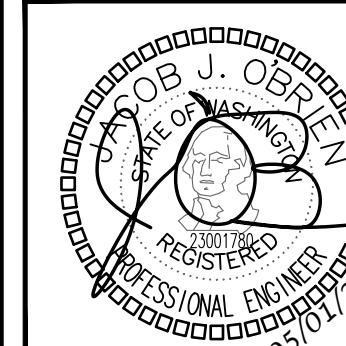

ROBISON
ENGINEERING, INC.
19401 40TH AVE W SUITE 302
LYNNWOOD, WA 98036
PHONE: (206)364-3343
FAX: (206)364-3343










PROJECT: BRADLEY HEIGHT APARTMENTS - BUILDING G
202 227TH AVE SE
PUYALLUP, WA 98374

DATE: 05/01/2025


SHEET TITLE:
PROJECT NOTES & CALCULATIONS

SHEET NO.

M0.1

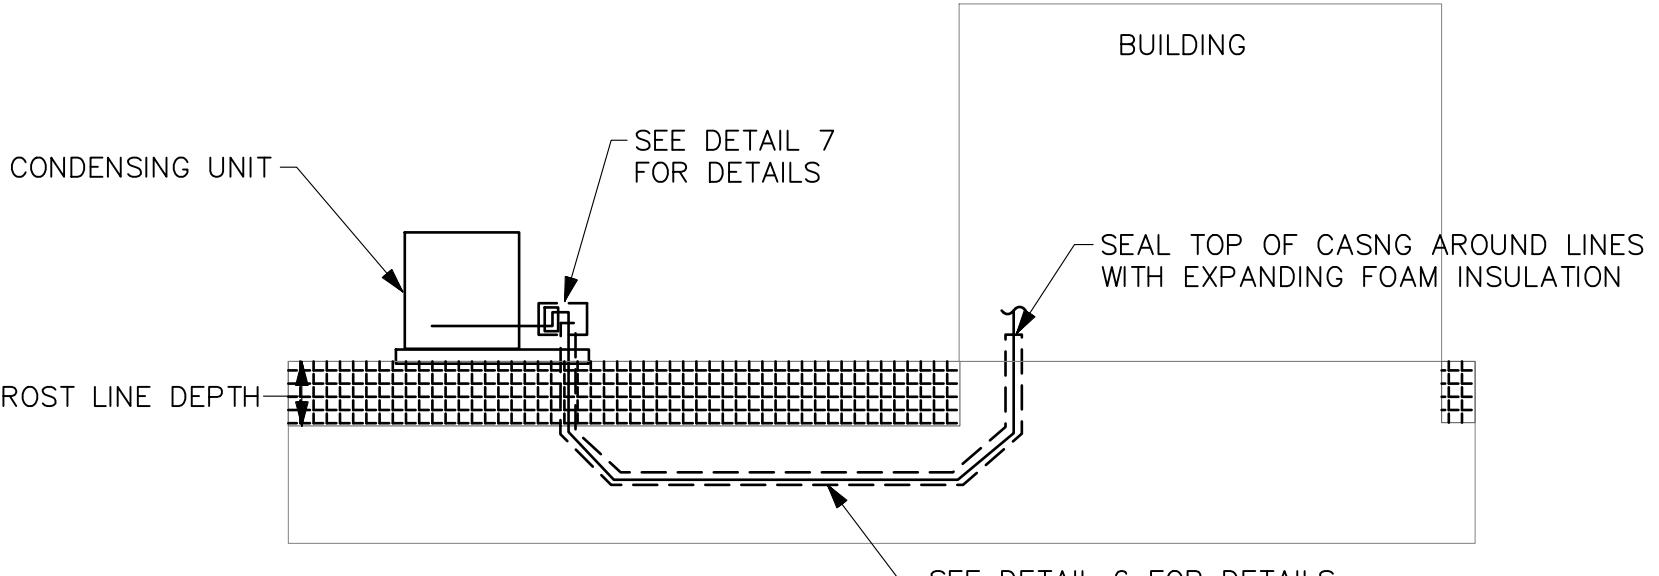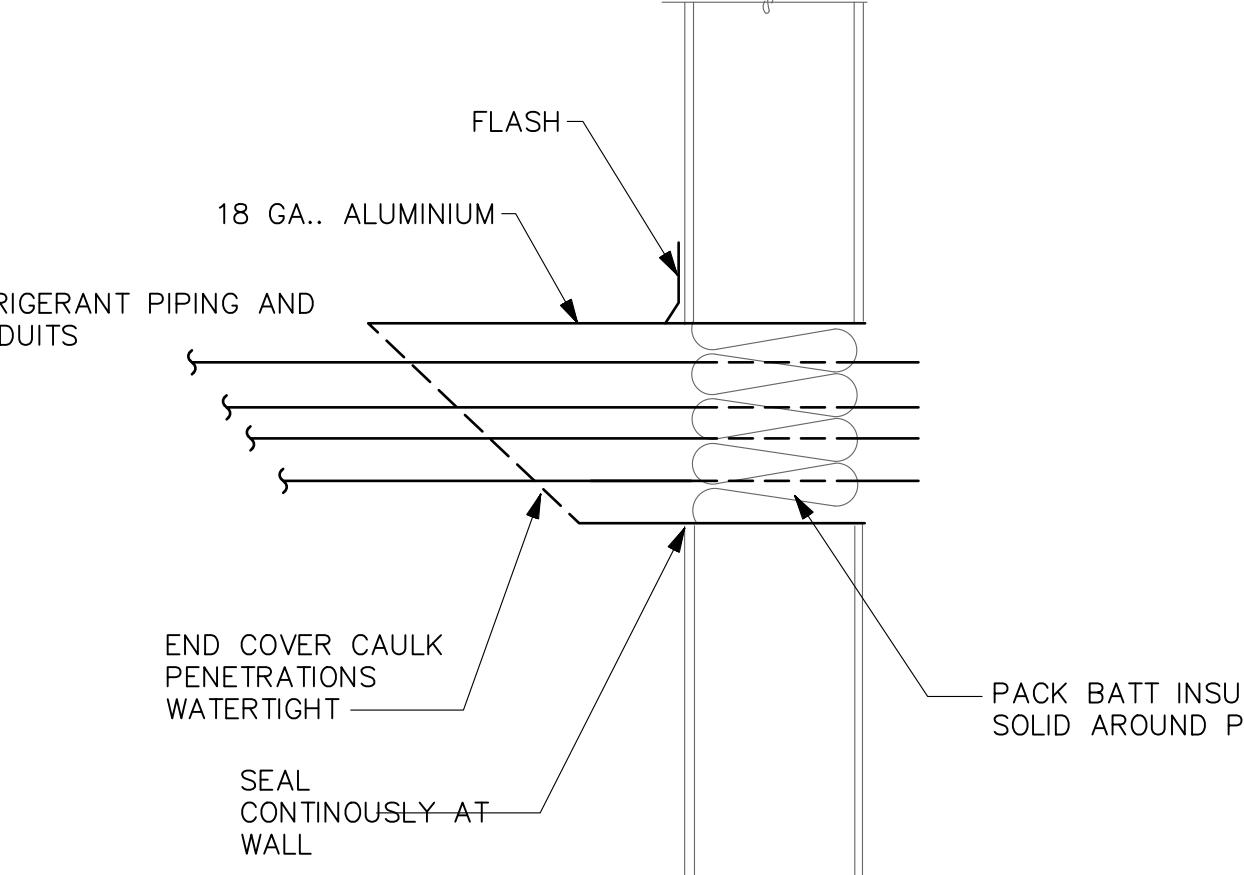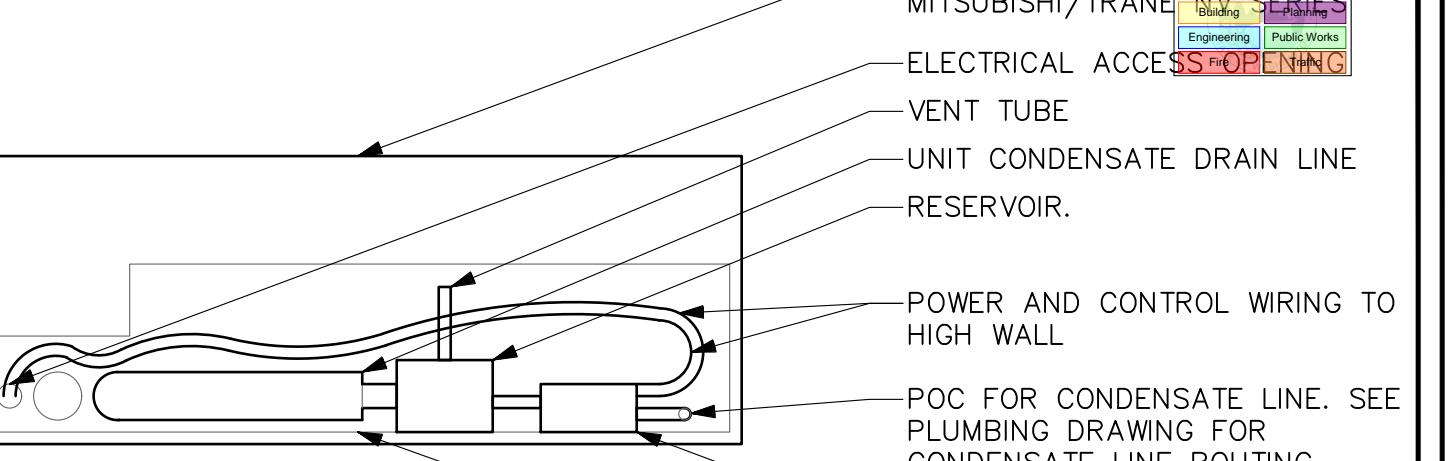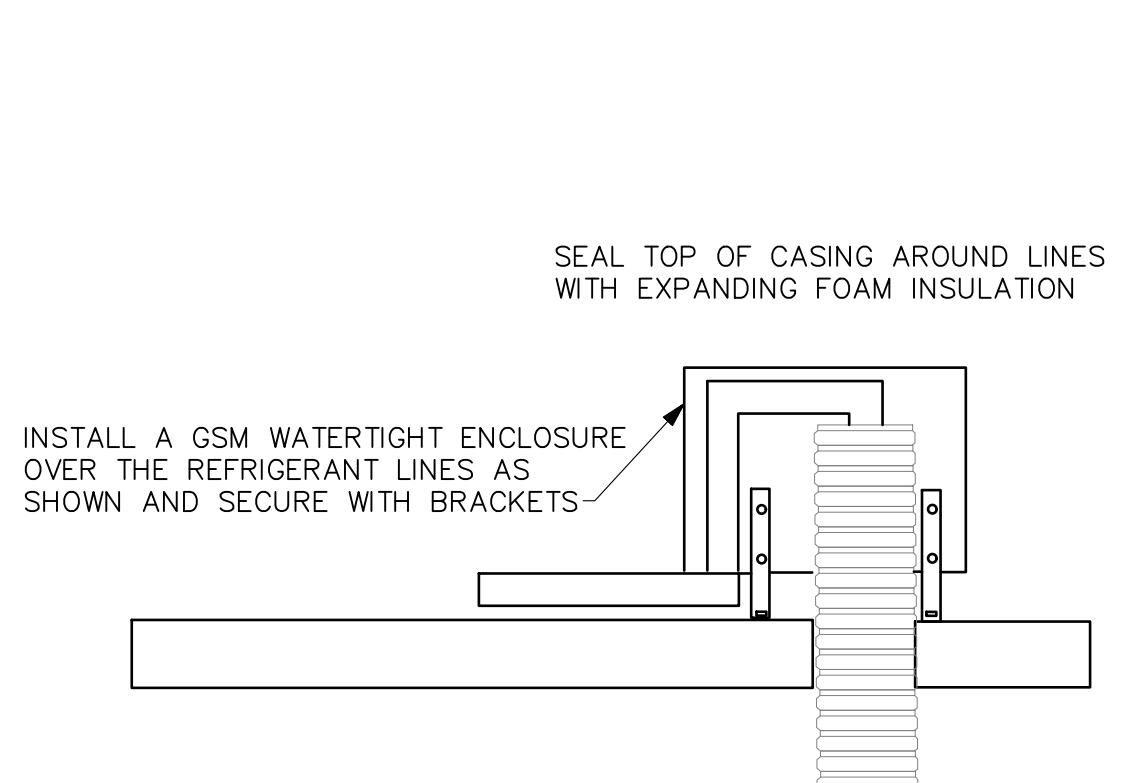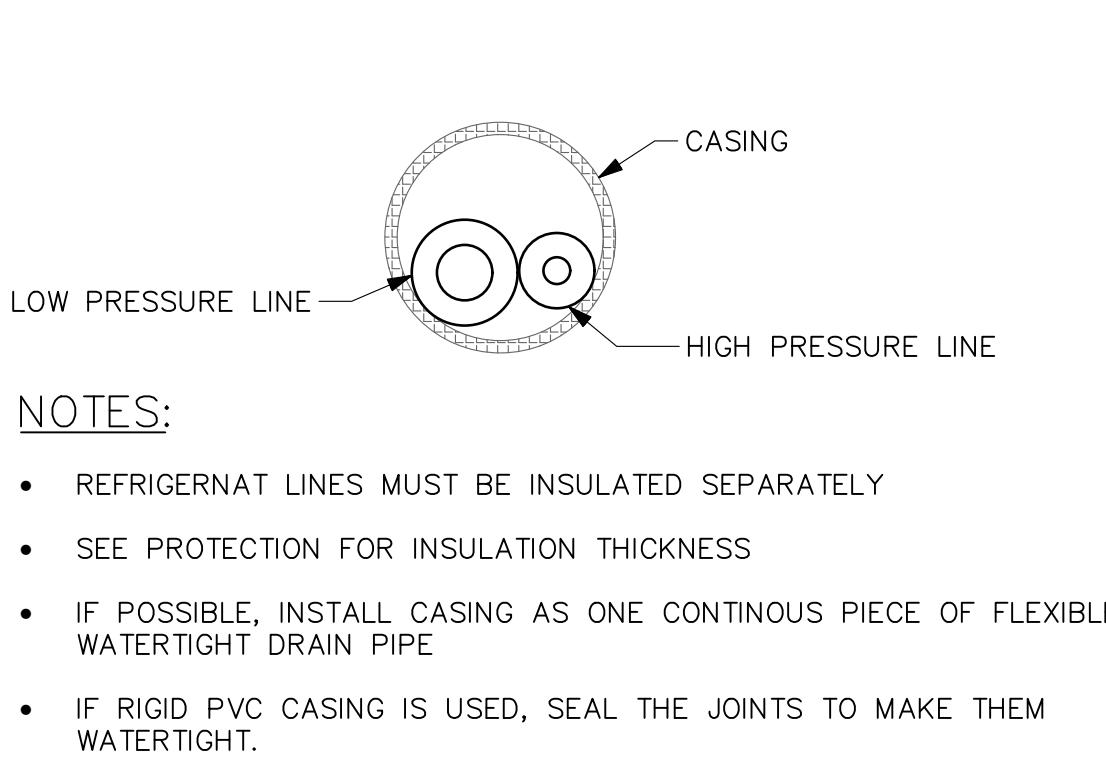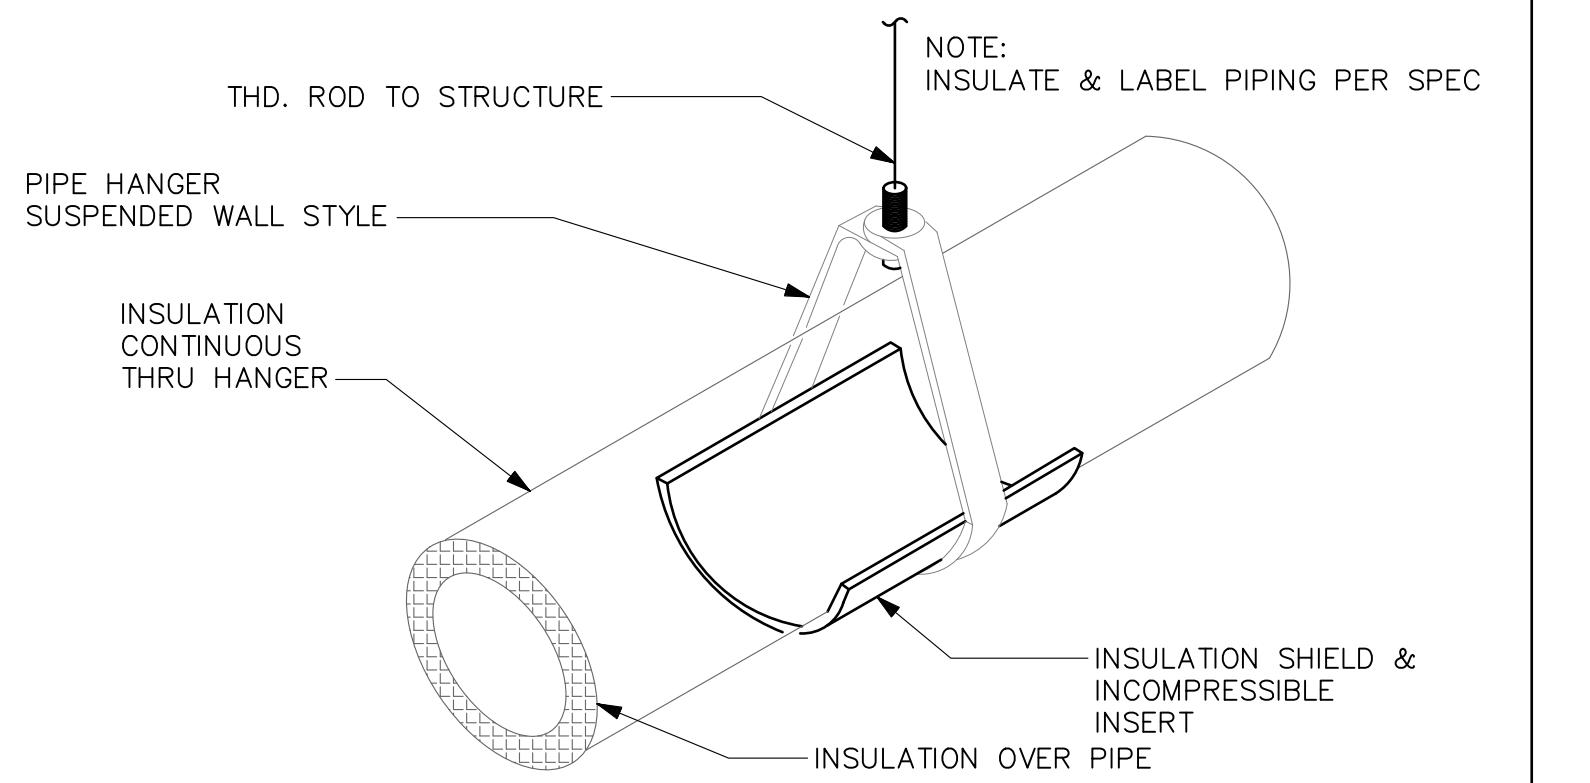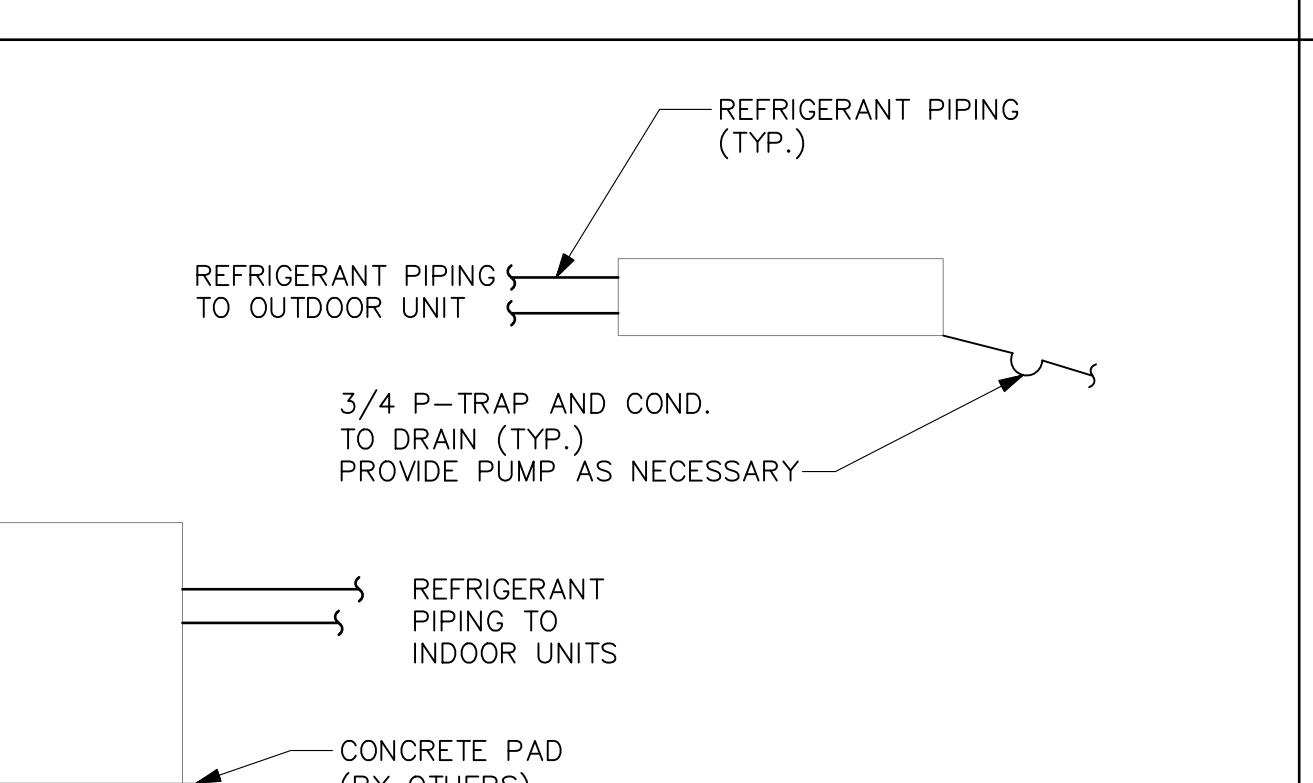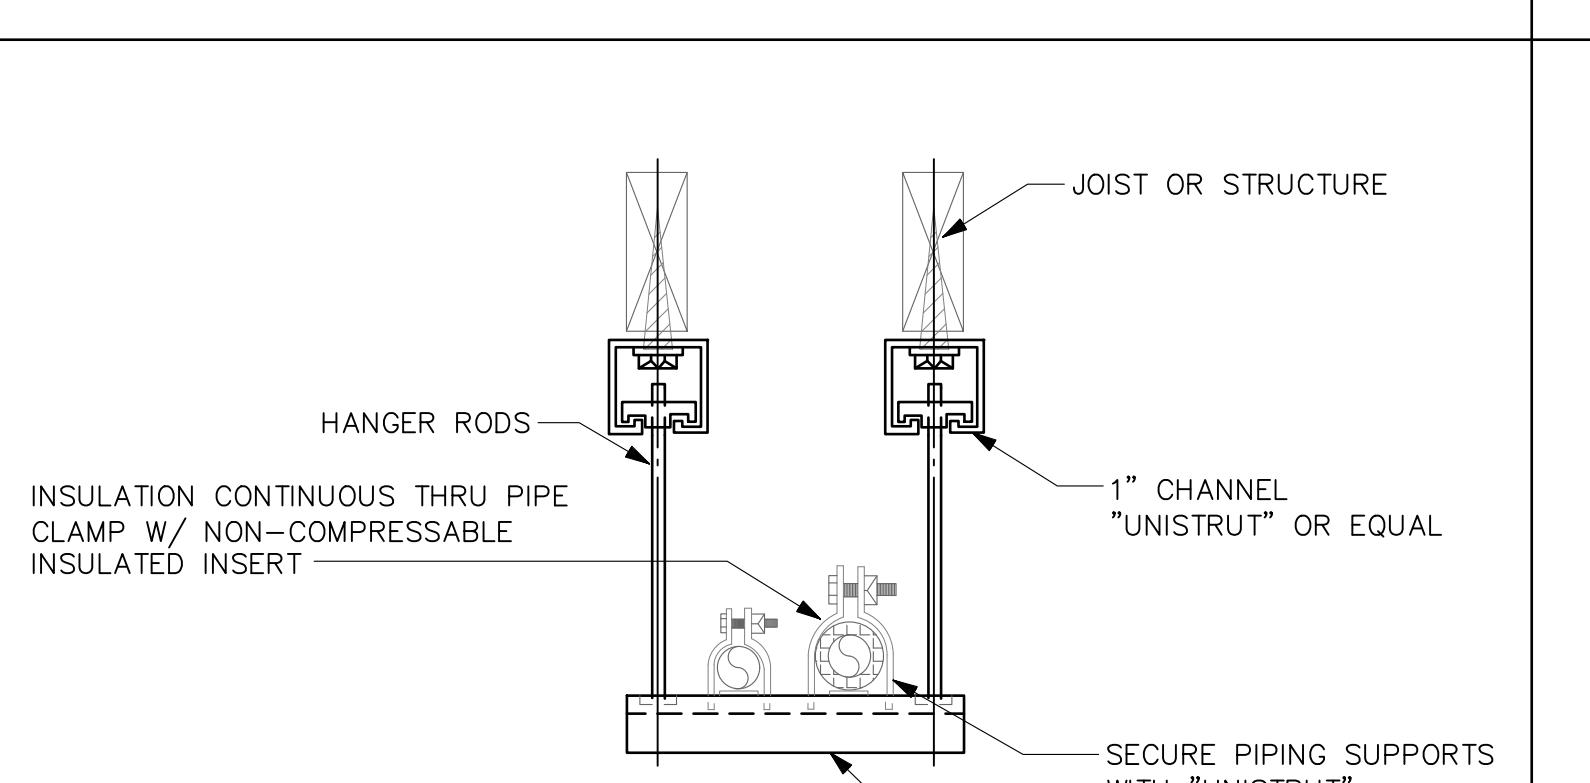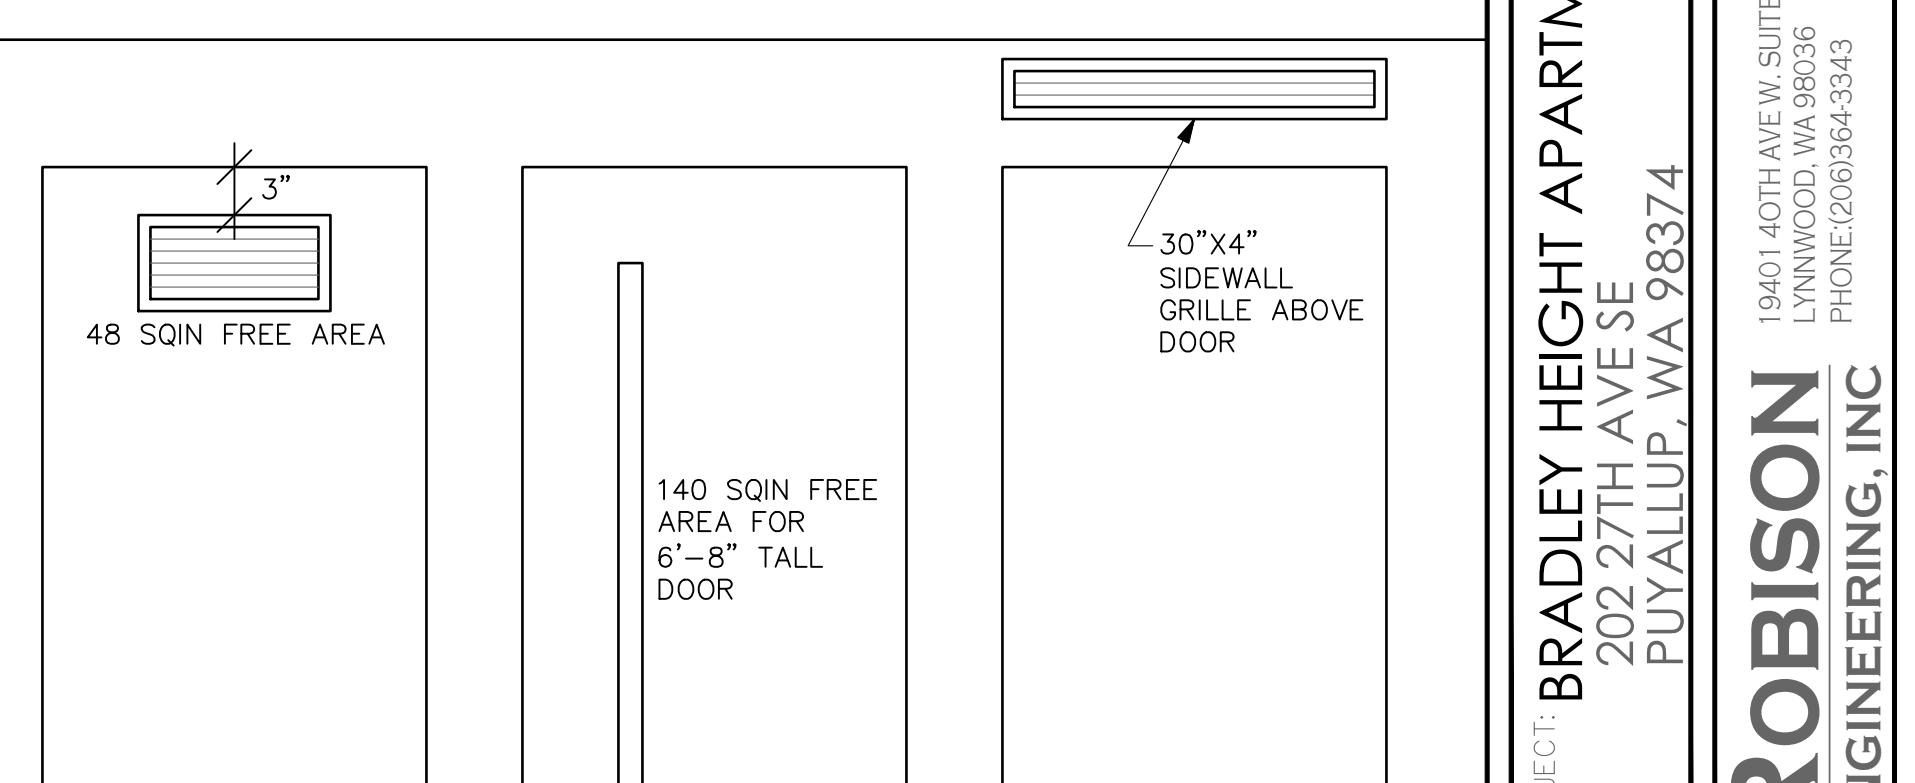 <p>NOTES:</p> <ol style="list-style-type: none"> 1. REFRIGERANT LINES MUST BE INSTALLED BELOW THE FROST LINES (24" MINIMUM). INCREASE MINIMUM DEPTH FOOT OR VEHICLE TRAFFIC OVER THE REFRIGERANT LINE PATH TO 36" MINIMUM. 2. USE 45° ELBOWS TO SIMPLIFY COVERING THE REFRIGERANT LINES WITH CASING FOR REFRIGERANT PIPING WITH OUTSIDE DIAMETERS OF UP TO $\frac{3}{4}$", SOFT TUBING CAN BE USED AND LARGE SWEEPING CURVES CAN BE BENT BY HAND. 3. PRESSURE-TEST REFRIGERANT PIPING BEFORE INSULATION AND COVERING WITH CASING. 4. IF MORE THAN ONE SYSTEM IS INSTALLED, USE A SEPARATE CASING FOR EACH SET OF REFRIGERANT PIPING. 5. CAUTION: CASING MUST BE WATERTIGHT. IF ANY MOISTURE ENTERS THE CASING, SYSTEM PERFORMANCE WILL BE REDUCED, AND EQUIPMENT FAILURE MAY OCCUR. IF THIS OCCURS, THE WARRANTY OF THE EQUIPMENT IS NO LONGER VALID. <p>SEE DETAIL 7 FOR DETAILS SEE DETAIL 6 FOR DETAILS CONDENSING UNIT BUILDING FROST LINE DEPTH SEAL TOP OF CASING AROUND LINES WITH EXPANDING FOAM INSULATION</p> <p>UNDERGROUND INSTALLATION OF REFRIGERANT PIPING DETAIL SCALE: NONE</p>	 <p>NOTES:</p> <p>FLASH 18 GA. ALUMINUM REFRIGERANT PIPING AND CONDUITS END COVER CAULK PENETRATIONS WATERTIGHT SEAL CONTINUOUSLY AT WALL PACK BATT INSULATION SOLID AROUND PIPING</p> <p>WALL PIPE PENETRATION DETAIL SCALE: NONE</p>	 <p>NOTES:</p> <ol style="list-style-type: none"> 1. BOD: RECTORSEAL MINI AQUA UNIVOLT. FOLLOW OTHER CONDENSATE PUMP MANUFACTURE'S INSTRUCTION FOR INSTALLATION REQUIREMENT. <p>HIGH WALL FAN COIL UNIT BOD: MITSUBISHI/TRANSPORT SYSTEMS ELECTRICAL ACCESS OPENING VENT TUBE UNIT CONDENSATE DRAIN LINE RESERVOIR POWER AND CONTROL WIRING TO HIGH WALL POC FOR CONDENSATE LINE. SEE PLUMBING DRAWING FOR CONDENSATE LINE ROUTING. CONDENSATE PUMP, BOD: RECTORSEAL MINI AQUA UNIVOLT CLEAR SPACE FOR INSTALLATION</p> <p>EXTERNAL CONDENSATE PUMP IN HIGH WALL DETAIL SCALE: NONE</p>
 <p>SEAL TOP OF CASING AROUND LINES WITH EXPANDING FOAM INSULATION INSTALL A GFM WATERTIGHT ENCLOSURE OVER THE REFRIGERANT LINES AS SHOWN AND SECURE WITH BRACKETS</p> <p>WATERTIGHT PIPING ENCLOSURE DETAIL SCALE: NONE</p>	 <p>CASING LOW PRESSURE LINE HIGH PRESSURE LINE NOTES:</p> <ul style="list-style-type: none"> • REFRIGERANT LINES MUST BE INSULATED SEPARATELY • SEE PROTECTION FOR INSULATION THICKNESS • IF POSSIBLE, INSTALL CASING AS ONE CONTINUOUS PIECE OF FLEXIBLE WATERTIGHT DRAIN PIPE • IF RIGID PVC CASING IS USED, SEAL THE JOINTS TO MAKE THEM WATERTIGHT. <p>TYPICAL CROSS SECTION OF PIPING DETAIL SCALE: NONE</p>	 <p>THD. ROD TO STRUCTURE PIPE HANGER SUSPENDED WALL STYLE INSULATION CONTINUOUS THRU HANGER INSULATION OVER PIPE INSULATION SHIELD & INCOMPRESSIBLE INSERT NOTE: INSULATE & LABEL PIPING PER SPEC</p> <p>REFRIGERANT PIPE HANGER DETAIL SCALE: NONE</p>
 <p>REFRIGERANT PIPING (TYP.) REFRIGERANT PIPING TO OUTDOOR UNIT 3/4 P-TRAP AND COND. TO DRAIN (TYP.) PROVIDE PUMP AS NECESSARY REFRIGERANT PIPING TO INDOOR UNITS CONCRETE PAD (BY OTHERS) NOTES:</p> <ol style="list-style-type: none"> 1. INSULATE BOTH LIQUID AND VAPOR LINES THRU OUT SYSTEM 2. SECURE OUTDOOR UNIT TO CONCRETE PAD 3. SIZE REFRIGERANT LINES BASED ON MITSUBISHI SYSTEM CALCULATIONS 4. CONTRACTOR TO FIELD VERIFY ROUTING FOR REFRIGERANT PIPING AND CONDENSATE DRAINS <p>SPLIT SYSTEM INSTALLATION DETAIL SCALE: NONE</p>	 <p>JOIST OR STRUCTURE HANGER RODS INSULATION CONTINUOUS THRU PIPE CLAMP W/ NON-COMPRESSABLE INSULATED INSERT 1" CHANNEL "UNISTRUT" OR EQUAL SECURE PIPING SUPPORTS WITH "UNISTRUT" PIPE CLAMP OR EQUAL 1 1/2" P-1001 "UNISTRUT" CHANNEL OR EQUAL 3"</p> <p>SUSPENDED REFRIGERANT PIPE SUPPORT DETAIL SCALE: NONE</p>	 <p>48 SQIN FREE AREA 24 SQIN FREE AREA 140 SQIN FREE AREA FOR 6'-8" TALL DOOR 30"X4" SIDEWALL GRILLE ABOVE DOOR 1" UNDERCUT DOOR ALT#1 DOOR VENT. BASIS OF DESIGN: WHIRLPOOL DRYER. SEE MANUFACTURE'S INSTRUCTION FOR SPECIFIC REQUIREMENT. ALT#2 DOOR VENT. BASIS OF DESIGN: SIDEWALL GRILLE AND DOOR UNDERCUT. ALT#3 DOOR VENT. BASIS OF DESIGN: FULLY LOUVERED DOOR. NOT SHOWN ON DETAIL.</p> <p>LAUNDRY ROOM AND CLOSET DOOR DETAIL SCALE: NONE</p>

HIGH WALL FAN COIL UNIT BOD: MITSUBISHI/TRANSPORT SYSTEMS ELECTRICAL ACCESS OPENING VENT TUBE UNIT CONDENSATE DRAIN LINE RESERVOIR POWER AND CONTROL WIRING TO HIGH WALL POC FOR CONDENSATE LINE. SEE PLUMBING DRAWING FOR CONDENSATE LINE ROUTING. CONDENSATE PUMP, BOD: RECTORSEAL MINI AQUA UNIVOLT CLEAR SPACE FOR INSTALLATION
NOTE: 1. BOD: RECTORSEAL MINI AQUA UNIVOLT. FOLLOW OTHER CONDENSATE PUMP MANUFACTURE'S INSTRUCTION FOR INSTALLATION REQUIREMENT.
2 5/2/25 1 2/4/25 NO DATE
PERMIT RESUBMITTAL #1 REVISIONS

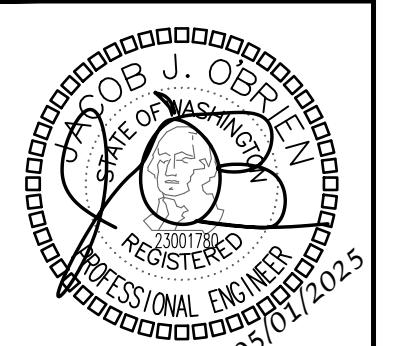

BRADLEY HEIGHT APARTMENTS - BUILDING G
202 27TH AVE SE
PUYALLUP, WA 98374
PRMU20240280

ROBISON
ENGINEERING, INC.
19401 40TH AVE W, SUITE 302
LYNNWOOD, WA 98036
PHONE: (206)364-3343

DATE: 05/01/2025
SHEET TITLE: DETAILS
SHEET NO. M0.2

MECHANICAL SCHEDULES

City of Puyallup
Development Services
ISSUED PER
Building, Fire, Planning
Engineering, Public Works
Permit, Traffic

EQUIP NO.	SERVICE	MOUNTING/ DISCHARGE	HEATING		ELECTRICAL		BASIS OF DESIGN (3)
			KW	VOLTAGE	HP	VOLTAGE	
EWH-1	APARTMENT UNIT	WALL	1.0	208V/1P			(1)(2)
EWH-2	APARTMENT UNIT	WALL	1.5	208V/1P			(1)(2)

NOTES: (1) BROAN, KING, CADET OR EQUIVALENT.
(2) PROVIDE REMOTE THERMOSTAT. COORDINATE FINAL LOCATION WITH ELECTRICAL DRAWINGS.
(3) ALL ELECTRIC HEATERS TO BE FURNISHED AND INSTALLED BY ELECTRICAL CONTRACTOR.

EQUIP NO.	SERVICE	TYPE	AIRFLOW, CFM	ESP. IN WG	ELECTRICAL		OPERATION	WEIGHT, LBS	BASIS OF DESIGN (1)(2)(3)
					VOLTAGE	HP			
BEF-1	RESTROOM	CEILING MOUNTED	55/80	0.5	115V/1P	FHP	CONTINUOUS	10	GREENHECK SP-AP0511W (4)
BEF-2	RESTROOM	CEILING MOUNTED	50	0.5	115V/1P	FHP	(2)	10	GREENHECK SP-AP0511W
KEF-1	KITCHEN	CEILING MOUNTED	30	0.5	115V/1P	FHP	CONTINUOUS	10	GREENHECK SP-AP0511W

NOTES: (1) PROVIDE BACKDRAFT DAMPERS ON EXHAUST FANS.
(2) 1.0 SONES MAXIMUM.
(3) VIBRATION ISOLATION: FANS < 125 LBS RUBBER ISOLATORS, FANS > 125 LBS SPRING ISOLATORS
(4) FAN SHALL BE 2-SPEED: 35 CFM CONTINUOUS LOW SETTING AND 80 CFM HIGH SPEED ACTIVATED BY INTEGRAL OCCUPANCY SENSOR ON GRILLE.


EQUIP NO.	SERVICE	MOUNTING/ DISCHARGE	FAN		ELECTRICAL			BASIS OF DESIGN (1)(2)(4)	CONNECTED OUTDOOR UNIT
			AIRFLOW, CFM	ESP. IN WG	VOLTAGE	MCA	MOCP		
FCU-1-X	RES. UNIT	HIGH WALL	473	N/A	(3)	(3)	(3)	DAIKIN FTXB12BXVJU	HP-1-X
FCU-2-X	RES. UNIT	HIGH WALL	716	N/A	(3)	(3)	(3)	DAIKIN FTXB18BXVJU	HP-2-X

NOTES: (1) INSTALL IN ACCORDANCE WITH MANUFACTURER'S INSTALLATION REQUIREMENTS.
(2) PROVIDE MANUFACTURER'S OPTIONAL CONDENSATE PUMP WITH RESERVOIR AND SENSOR.
(3) INDOOR UNIT POWERED FROM OUTDOOR UNIT.
(4) "X" DENOTES THE UNIT BEING SERVED.

EQUIP NO.	SERVICE	CAPACITY, TONS	TOTAL COOLING CAPACITY, BTUH	SEER2	TOTAL HEATING CAPACITY, BTUH	HSPF2	ELECTRICAL			WEIGHT, LBS	BASIS OF DESIGN (1)(2)(3)(4)(5)(6)	CONNECTED FAN COIL UNIT
							VOLTAGE	MCA	MOCP			
HP-1-X	RES. UNIT	1.0	11,000	18.0	11,300	9.0	208V/1P	12.40	15	62	DAIKIN RXB12BXVJU	FCU-1
HP-2-X	RES. UNIT	1.5	18,000	18.0	17,900	8.5	208V/1P	16.55	20	97	DAIKIN RXB18BXVJU	FCU-1


NOTES: (1) INSTALL IN ACCORDANCE WITH MANUFACTURER'S INSTALLATION REQUIREMENTS.
(2) ARI LISTED WITH ALL STANDARD FEATURES. INSTALLATION ACCESSORIES AND COMPRESSOR SHORT CYCLING PROTECTION, FILTER DRIVER, REFRIGERANT LINE FILTER, LIQUID SOLENOID VALVE, AND SAFETY PRESSURE SWITCHES. INSTALL REFRIGERANT TUBING AND LENGTH IN STRICT ACCORDANCE WITH MANUFACTURER'S RECOMMENDATIONS.
(3) NOT USED
(4) ROUTING OF REFRIGERANT LINES FROM INDOOR TO OUTDOOR UNITS NOT SHOWN ON PLANS. CONTRACTOR TO FIELD COORDINATE ROUTING.
(5) REFRIGERANT SHALL BE R-410A.
(6) "X" DENOTES THE UNIT BEING SERVED.

PROJECT: BRADLEY HEIGHT APARTMENTS - BUILDING G	DRAWN: OP
202 27TH AVE SE	DESIGNED: ABE
PUYALLUP, WA 98374	CHECKED: ABE
19401 40TH AVE W, SUITE 302	APPROVED: JOB
LYNNWOOD, WA 98036	
PHONE: (206)364-3343	
ROBISON ENGINEERING, INC.	
DATE: 05/01/2025	
SHEET TITLE: MECHANICAL SCHEDULES & WSEC FORMS	
SHEET NO. M0.3	

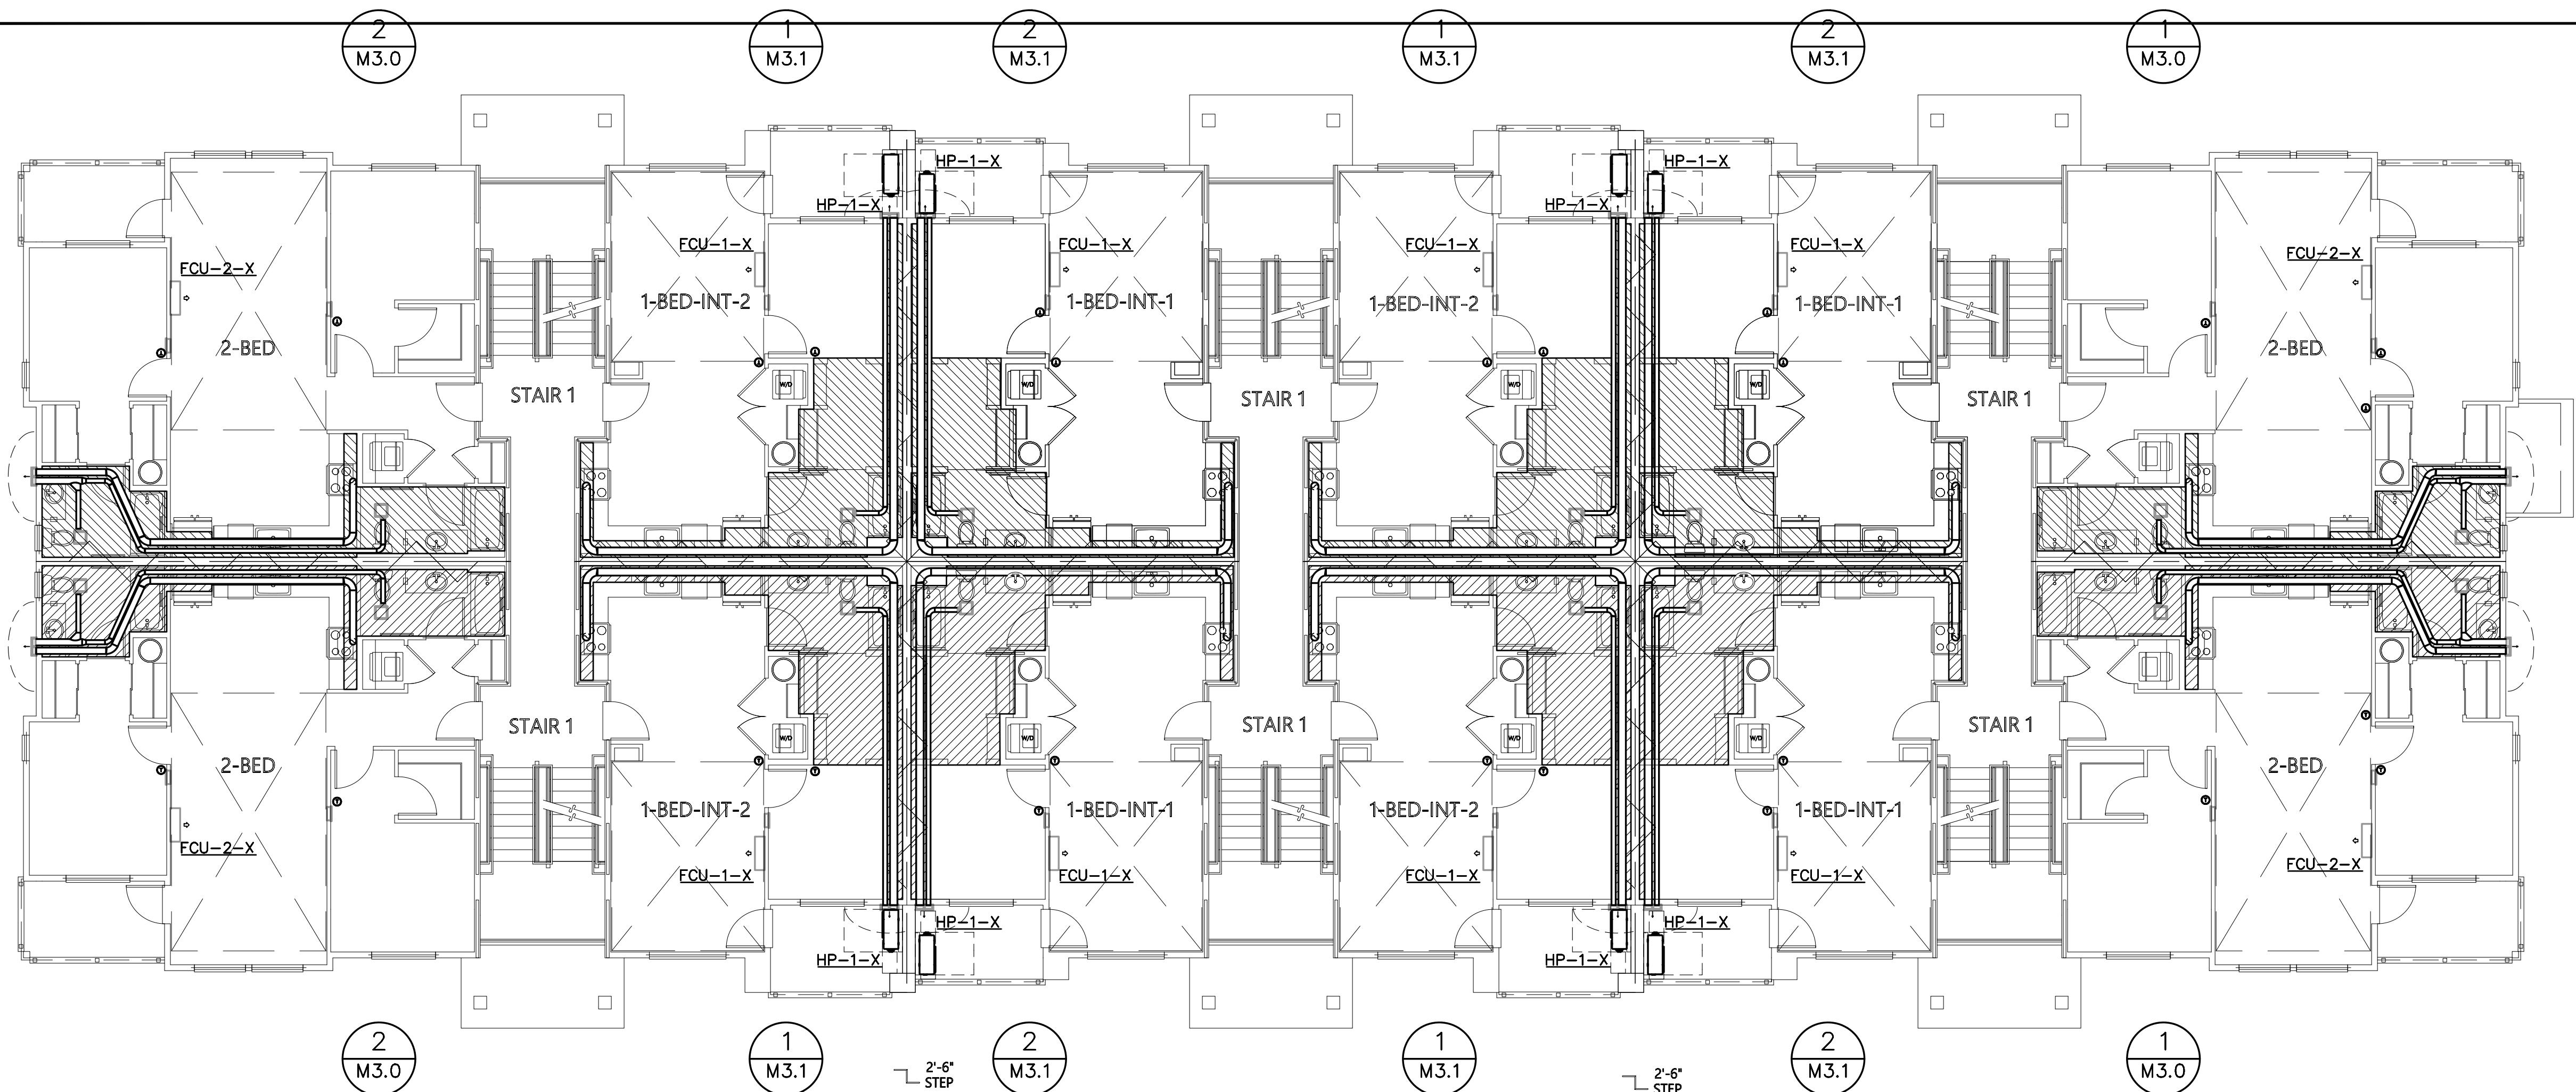

BUILDING G

1/8" = 1'-0" 3-STORY, 36-UNIT BUILDING

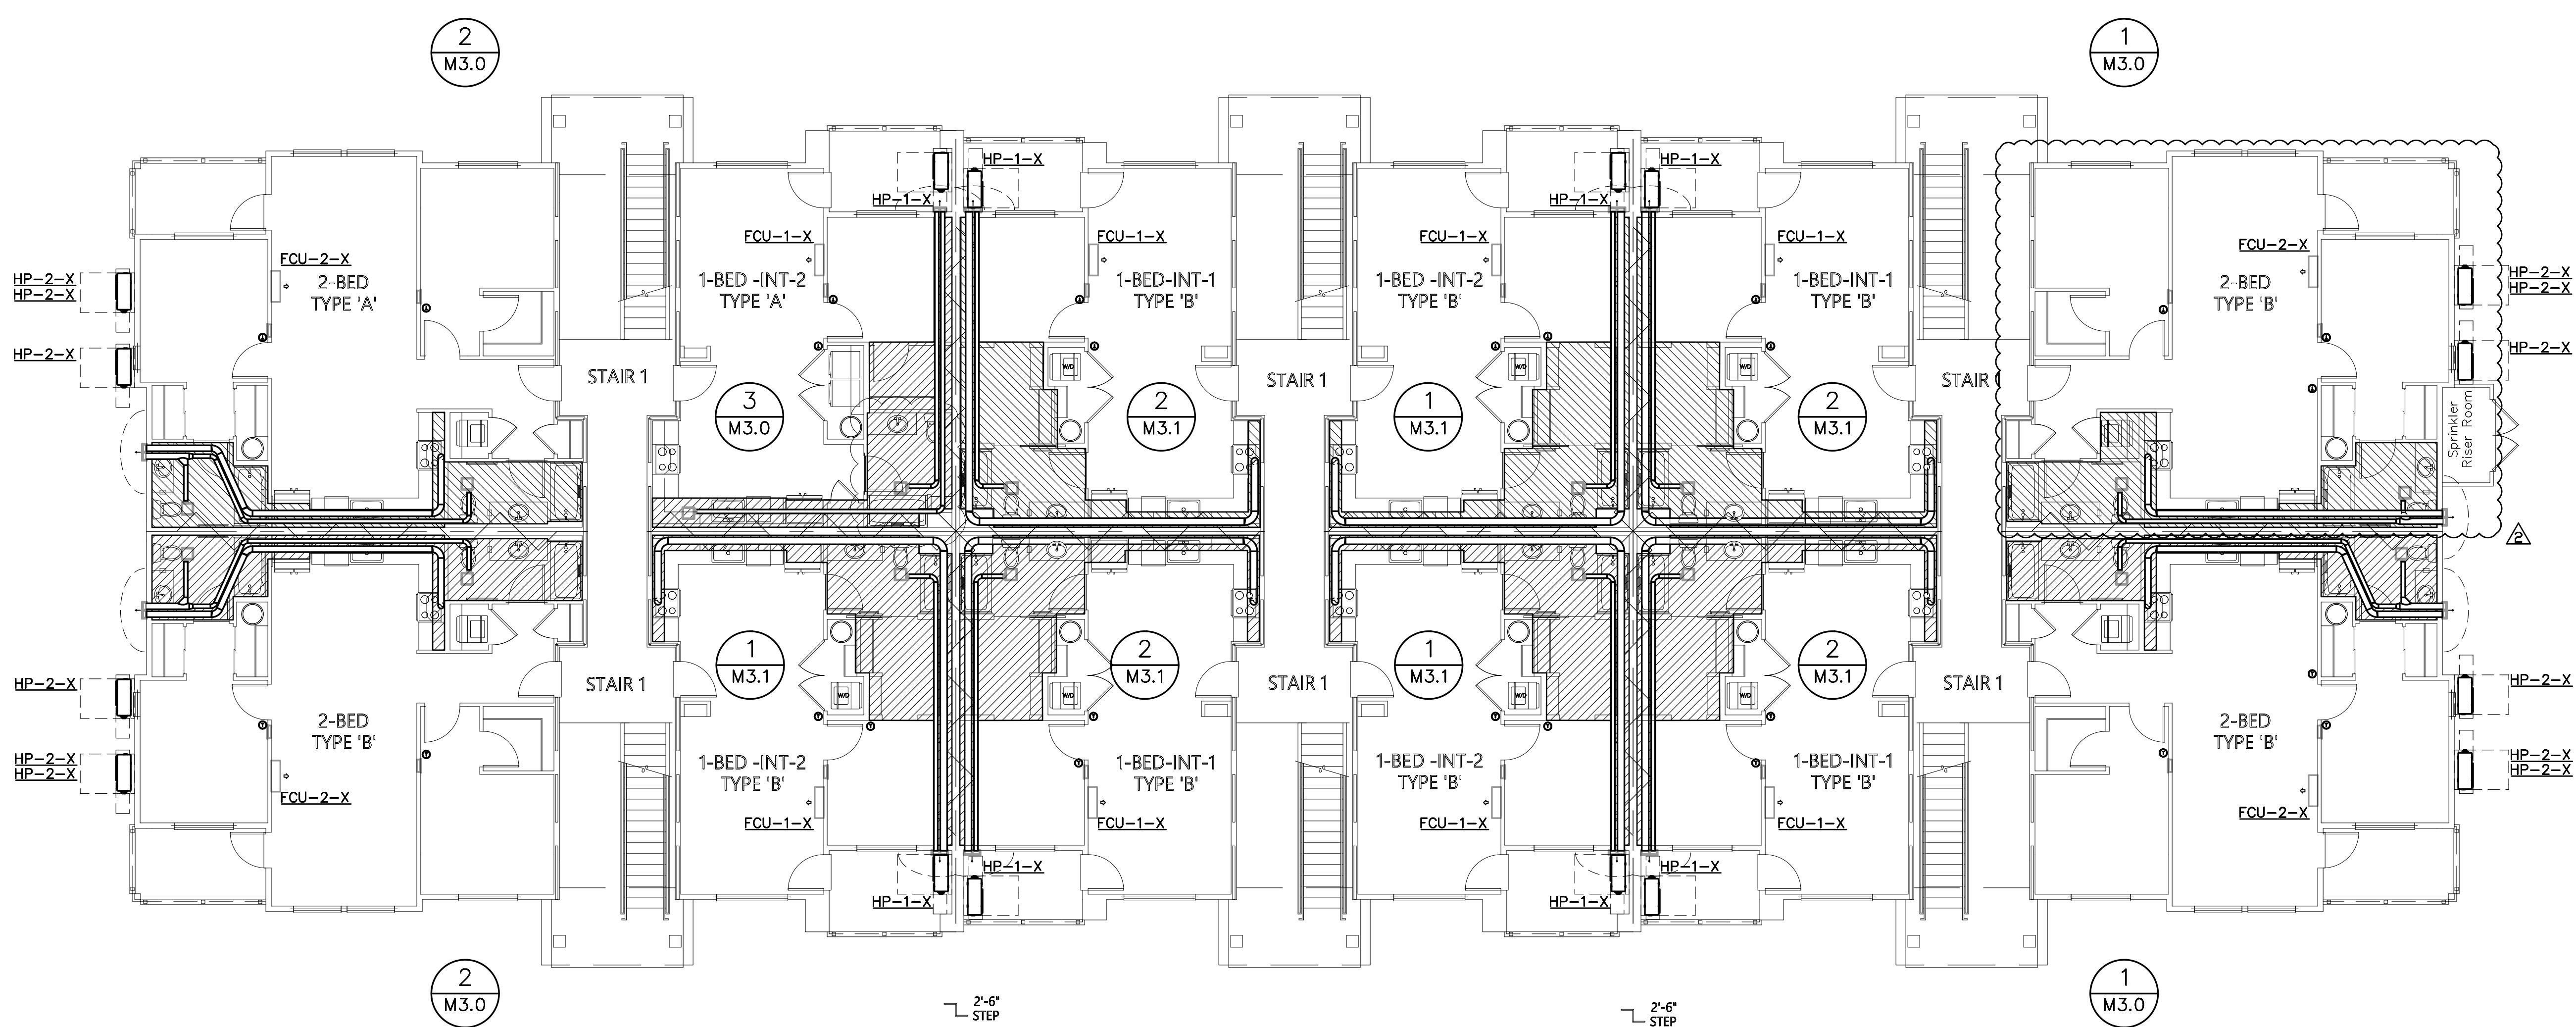

BUILDING G

1st LEVEL PLAN

3-STORY, 36-UNIT BUILDING

RESIDENTIAL UNIT NOTES:

 1 =REFER TO DWG M3.0, DETAIL 1.



FOR DUCT SIZES WITHIN THE RESIDENTIAL UNITS, REFER TO THE ENLARGED UNIT PLANS ON DWGS M3.0-M303

DATE: 07/01/2022

SHEET TITLE:
**HVAC PLAN -
FLOOR PLANS**

SHEET NO.

M2.0

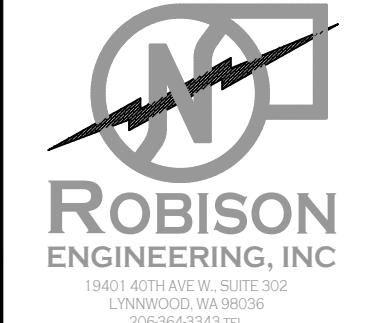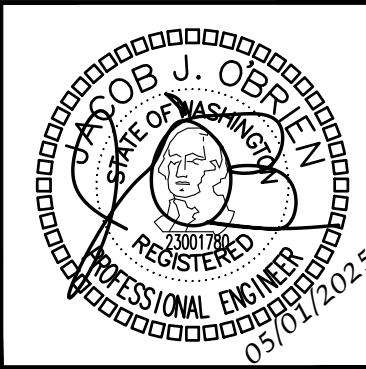

DRAWN:	OP
DESIGNED:	ABE
CHECKED:	ABE
APPROVED:	JOB

PROJECT: BRADLEY HEIGHT APARTMENTS - BUILDING G
202 27TH AVE SE
PUYALLUP, WA 98374

ROBISON
ENGINEERING, INC.


19401 40TH AVE W. SUITE 302
LYNNWOOD, WA 98036
PHONE: (206)364-3343

PRMU2024028

PP
DATE: 05/01/2025

SHEET TITLE:
**HVAC PLAN -
FLOOR PLANS**

SHEET NO.

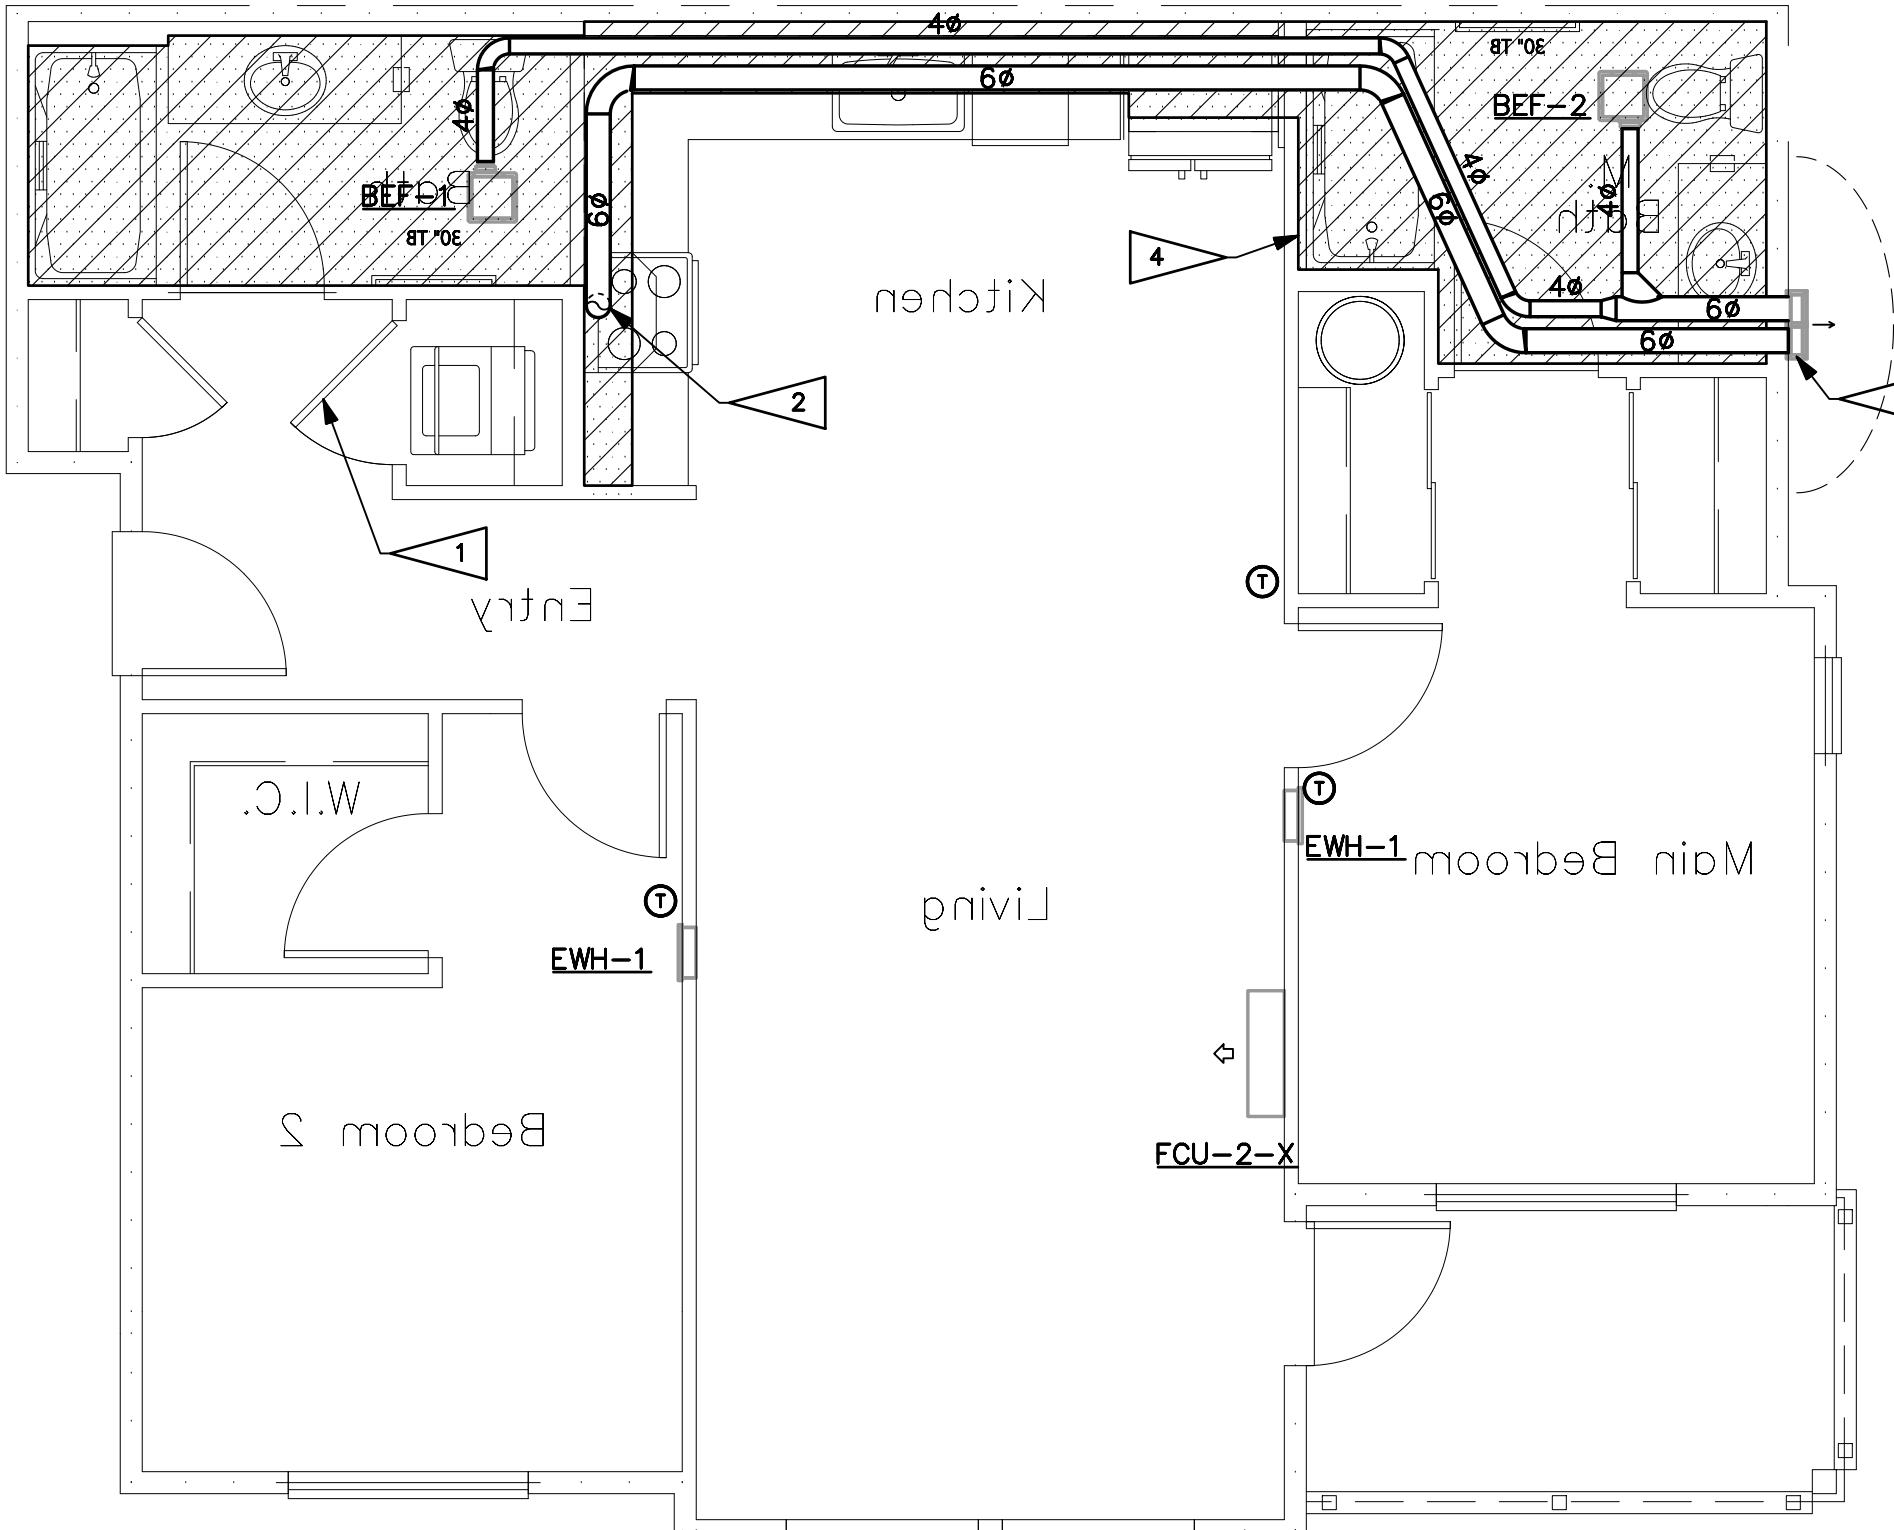


HVAC ENLARGED PLANS

2-BED MIRROR

SCALE: 1/4" = 1'-0"

1
M3.0

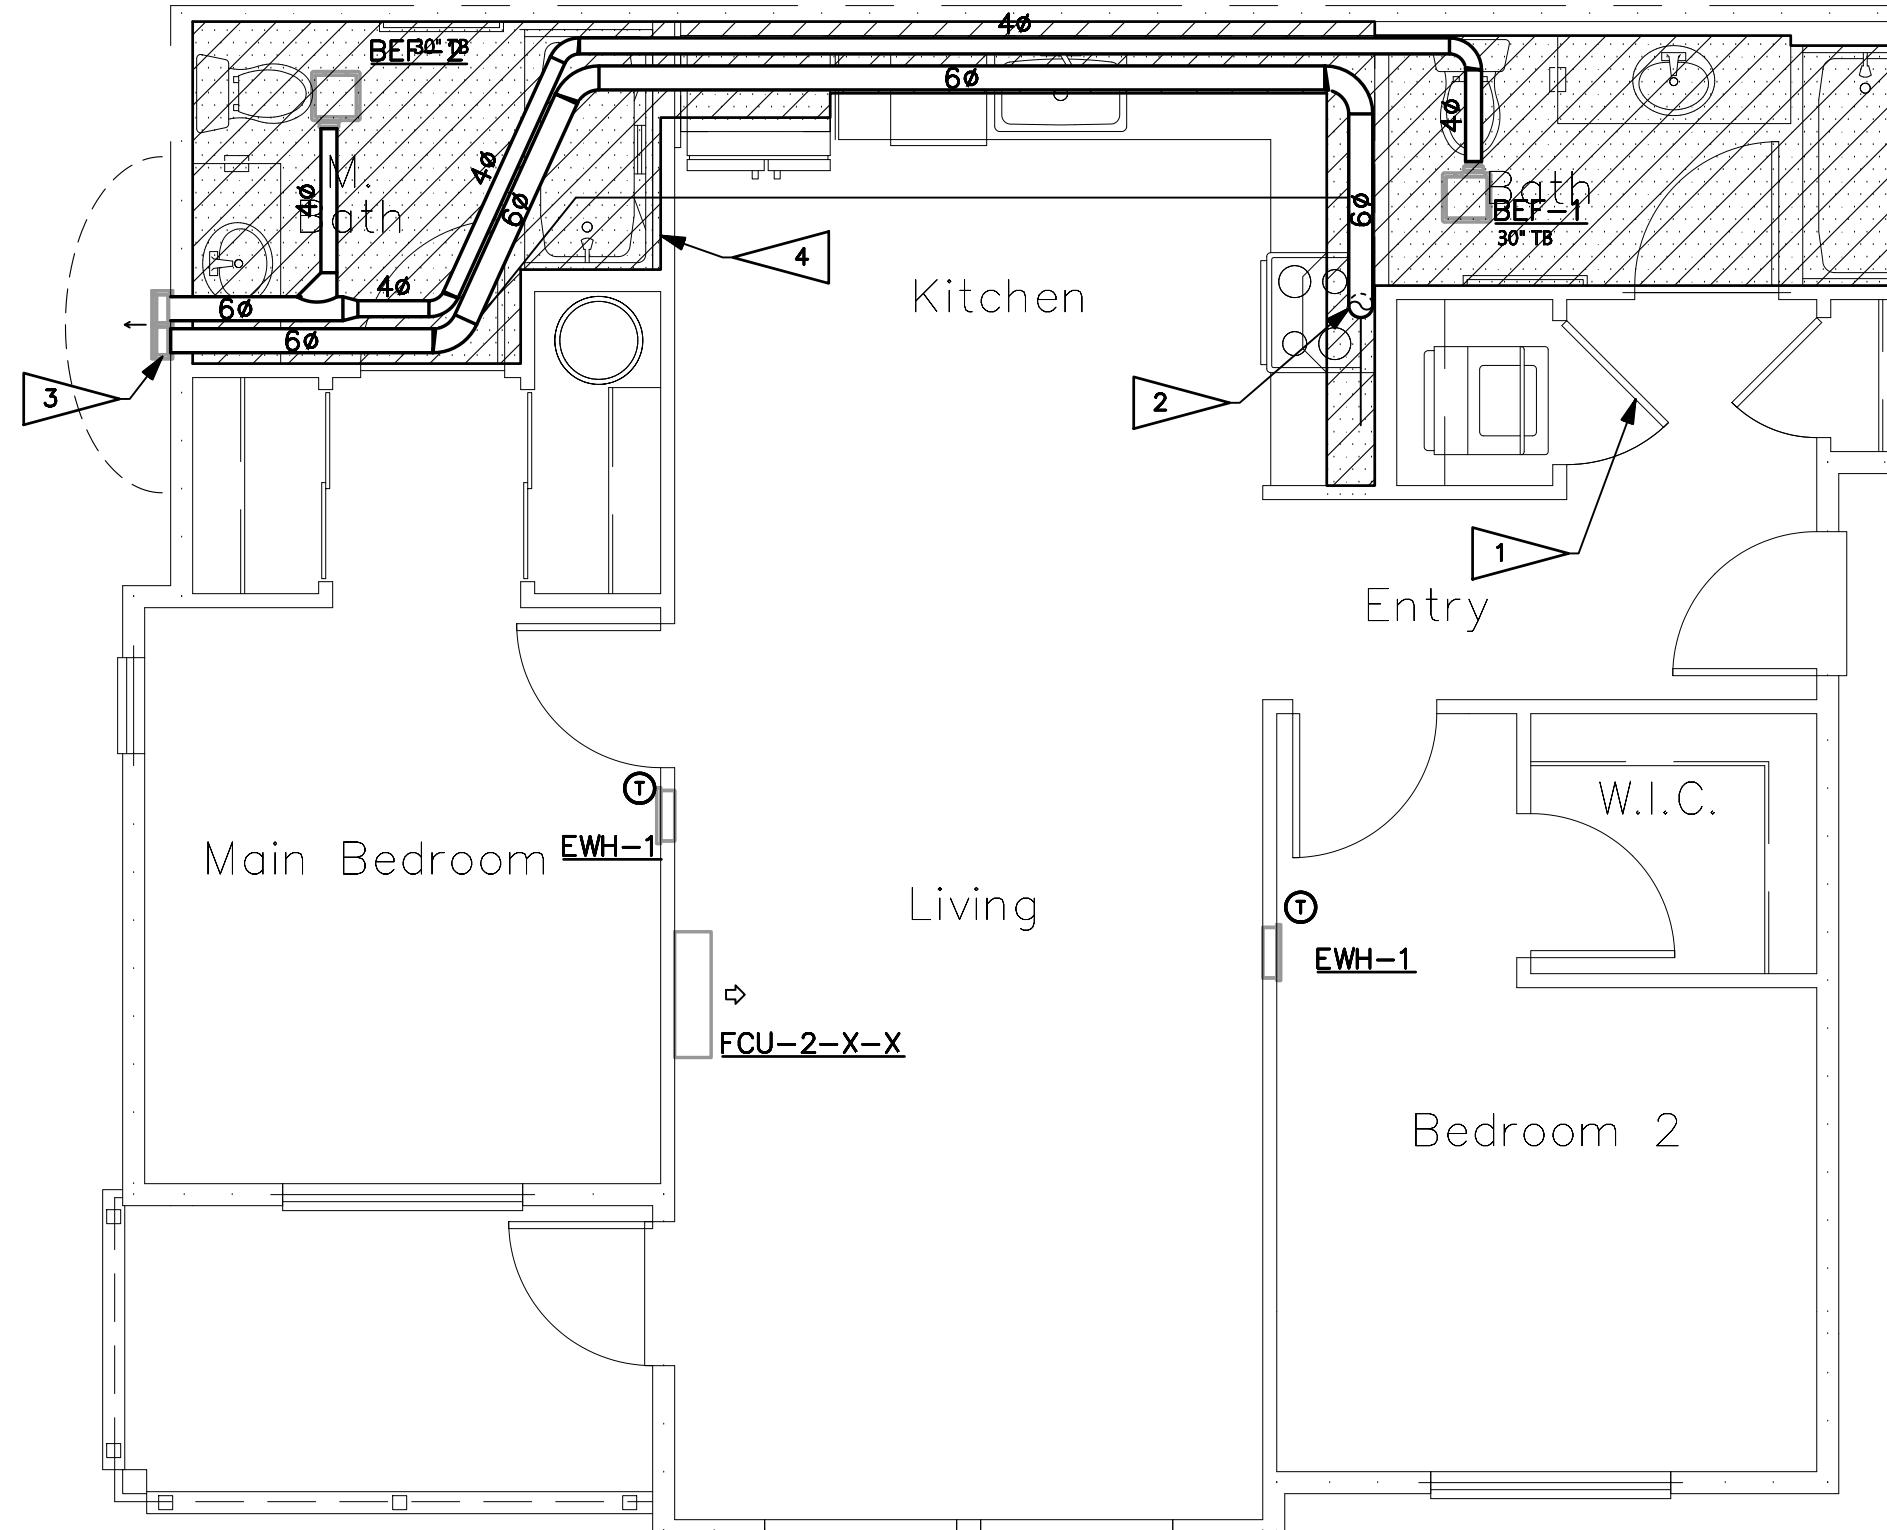


HVAC ENLARGED PLANS

2-BED

SCALE: 1/4" = 1'-0"

2
M3.0

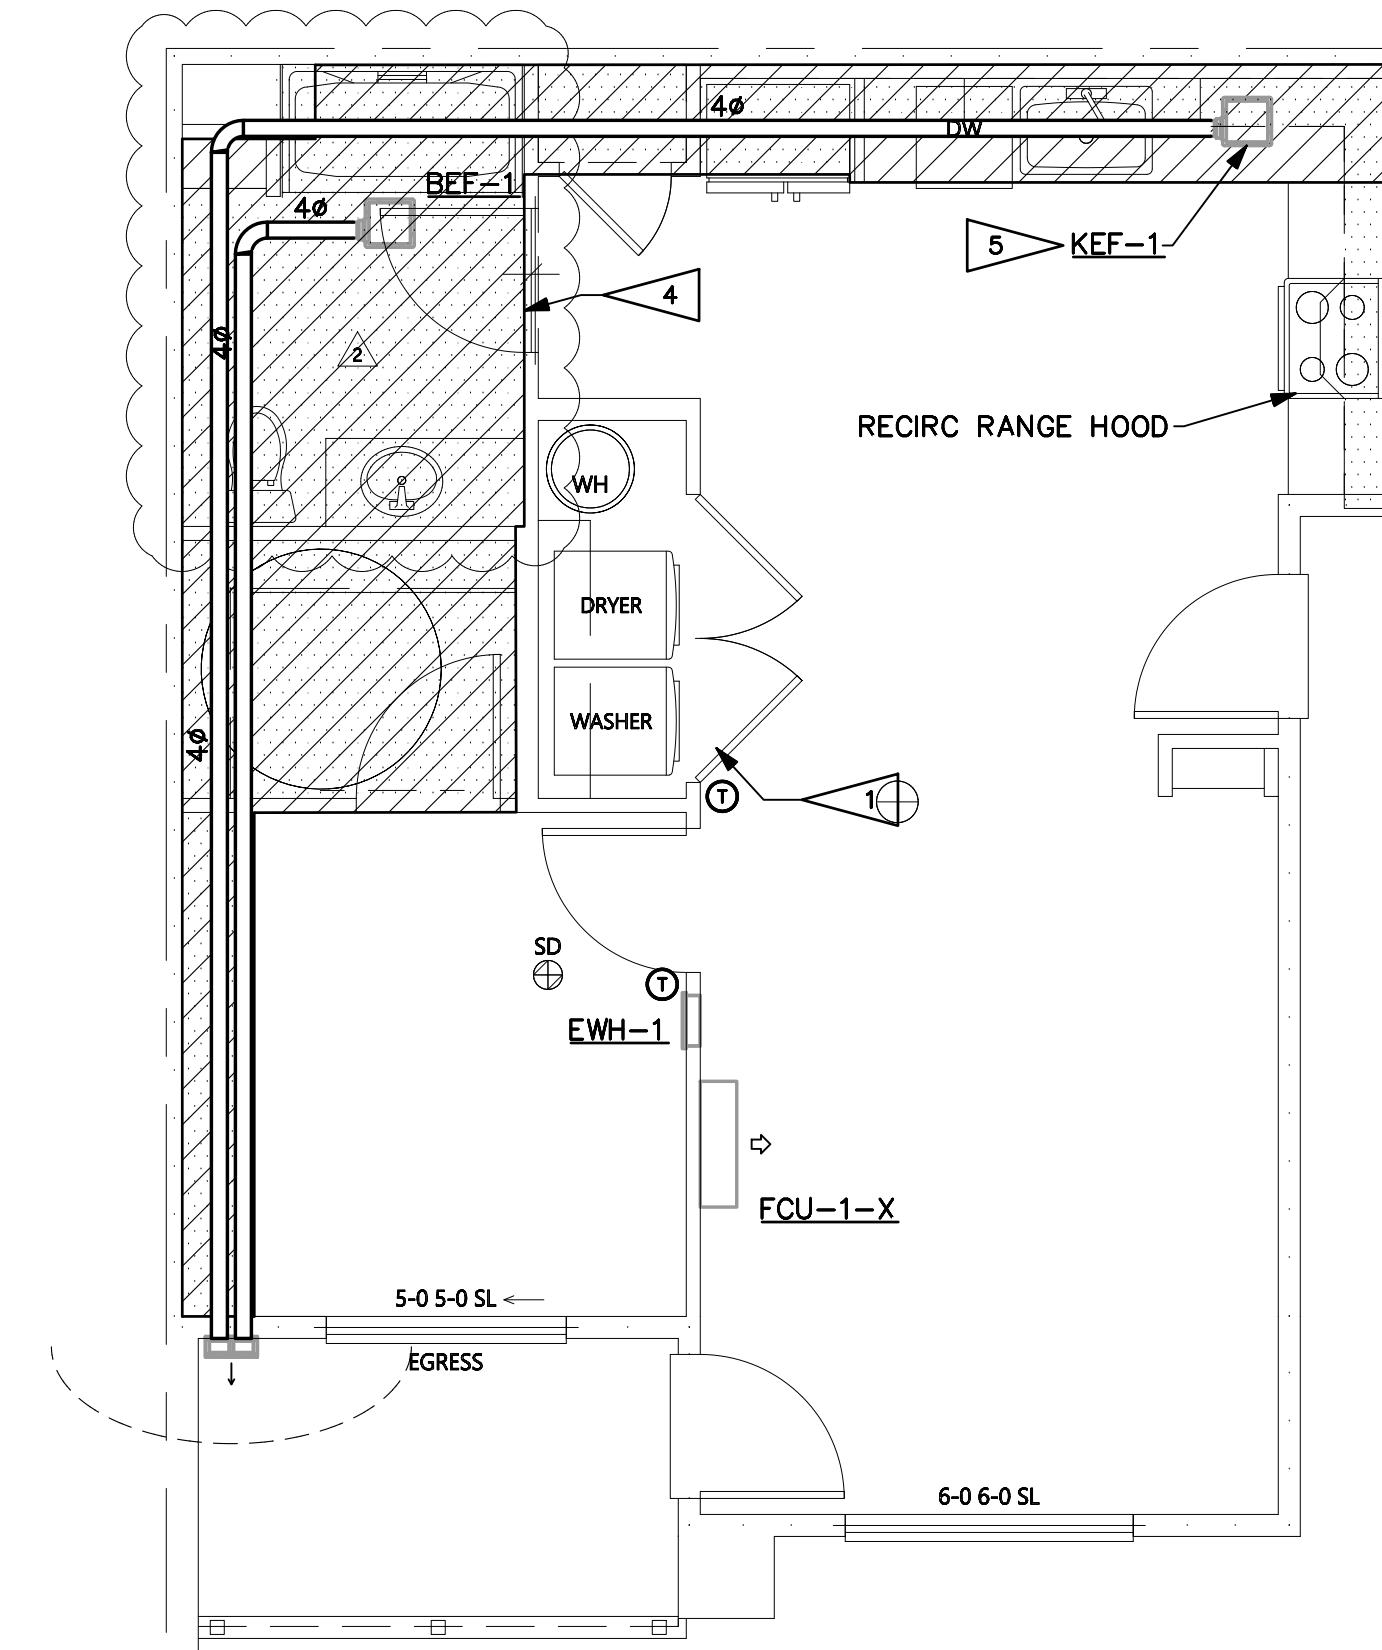

HVAC ENLARGED PLANS

1-BED-INT ACCESSIBLE

SCALE: 1/4" = 1'-0"

3
M3.0

GENERAL NOTES:


- ENVIRONMENTAL EXHAUST TERMINATIONS: MAINTAIN 3 FOOT SEPARATION FROM PROPERTY LINES AND OPERABLE OPENINGS INTO BUILDING, 10 FEET FROM MECHANICAL AIR INTAKES.
- MOUNT REMOTE THERMOSTATS 48" AFF. PER WSEC C403.4.9, AT LEAST ONE THERMOSTAT SHALL BE PROGRAMMABLE ON A 5-2 SCHEDULE.
- UNDERCUT ALL BATHROOM DOORS BY MINIMUM 1/2" TO ALLOW TRANSFER OF MAKEUP AIR FOR BATHROOM EXHAUST.
- ELECTRIC WALL HEATERS SHALL BE RECESSED IN WALL UNLESS FIRE RATED OR EXTERIOR WALL. FOR HEATERS MOUNTED ON SUCH WALL, PROVIDE SURFACE-MOUNT WALL CAN.
- PROVIDE ACCESSIBLE MANUAL VOLUME DAMPERS AT BRANCHES OR OPPOSED-BLADE DAMPERS AT GRILLES FOR AIR BALANCING PER VOLUME DAMPERS NOTE ON SHEET M0.00.

FLAG NOTES: #

- CLOSETS CONTAINING DRYERS SHALL BE PROVIDED WITH LOUVERED DOOR OR 100 SQ. IN. FREE-AREA OPENING ABOVE DOOR. OPENING PROVIDES PATH FOR EXHAUST AIR DURING WASHER OPERATION PER WSMC TABLE 403.3.1.1 NOTE (i) AND MAKEUP AIR DURING DRYER OPERATION PER 504.6.
- POC TO DOMESTIC KITCHEN RANGE HOOD. SEE PLANS FOR SIZE. DUCT SHALL REMAIN SEPARATE FROM OTHER EXHAUST SYSTEMS UP TO TERMINATION.
- DOMESTIC KITCHEN RANGE HOOD EXHAUST TERMINATION WALL CAP WITH SCREEN. PROVIDE BACKDRAFT DAMPER AT TERMINATION. CLEARANCES PER GENERAL NOTE 1.
- LOWERED SOFFIT FOR MECHANICAL EQUIPMENT.
- KEF-1 TO OPERATE CONTINUOUSLY TO PROVIDE GENERAL EXHAUST TO KITCHEN PER WSMC 403.4.7. KITCHEN RANGE HOOD SHALL BE SET TO RECIRC MODE.

City of Puyallup
Development Services
Building, Fire, Planning
Engineering, Public Works
Police, Traffic

PERMIT RESUBMITTAL #2	PERMIT RESUBMITTAL #1
5/2/25	5/4/25
2	1
NO. DATE	DESCRIPTION
	REVISIONS

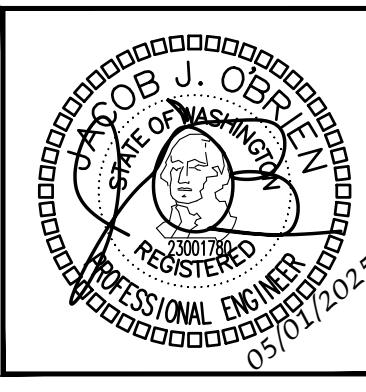

ROBISON
ENGINEERING, INC.
10401 40TH AVE W, SUITE 302
LYNNWOOD, WA 98036
(425) 255-1000
REPROJECT NO. 777006
CONTACT: ANGELA ESPINEL

DRAWN: OP
DESIGNED: ABE
CHECKED: ABE
APPROVED: JOB

PRMU20240280

PROJECT: BRADLEY HEIGHT APARTMENTS - BUILDING G
202 27TH AVE SE
PUYALLUP, WA 98374

19401 40TH AVE W SUITE 302
LYNNWOOD, WA 98036
PHONE: (425) 255-1000
ROBISON
ENGINEERING, INC.

DATE: 05/01/2025

SHEET TITLE:
HVAC
ENLARGED
PLANS

SHEET NO.

M3.0

ENTIRE SHEET HAS
BEEN UPDATED

PERMIT RESUBMITTAL #2	PERMIT RESUBMITTAL #1
2	1
5/2/25	2/4/25
NO. DATE	DESCRIPTION
	REVISIONS



DRAWN: OP	DESIGNED: ABE	CHEKED: ABE	APPROVED: JOB
-----------	---------------	-------------	---------------

PROJECT: BRADLEY HEIGHT APARTMENTS - BUILDING G	19401 40TH AVE SE
202 27TH AVE SE	LYNNWOOD, WA 98036
PUYALLUP, WA 98374	PHONE: (206) 364-3343


ROBISON
ENGINEERING, INC.

DATE: 05/01/2025

SHEET TITLE:
HVAC
ENLARGED
PLANS

SHEET NO.

M3.1

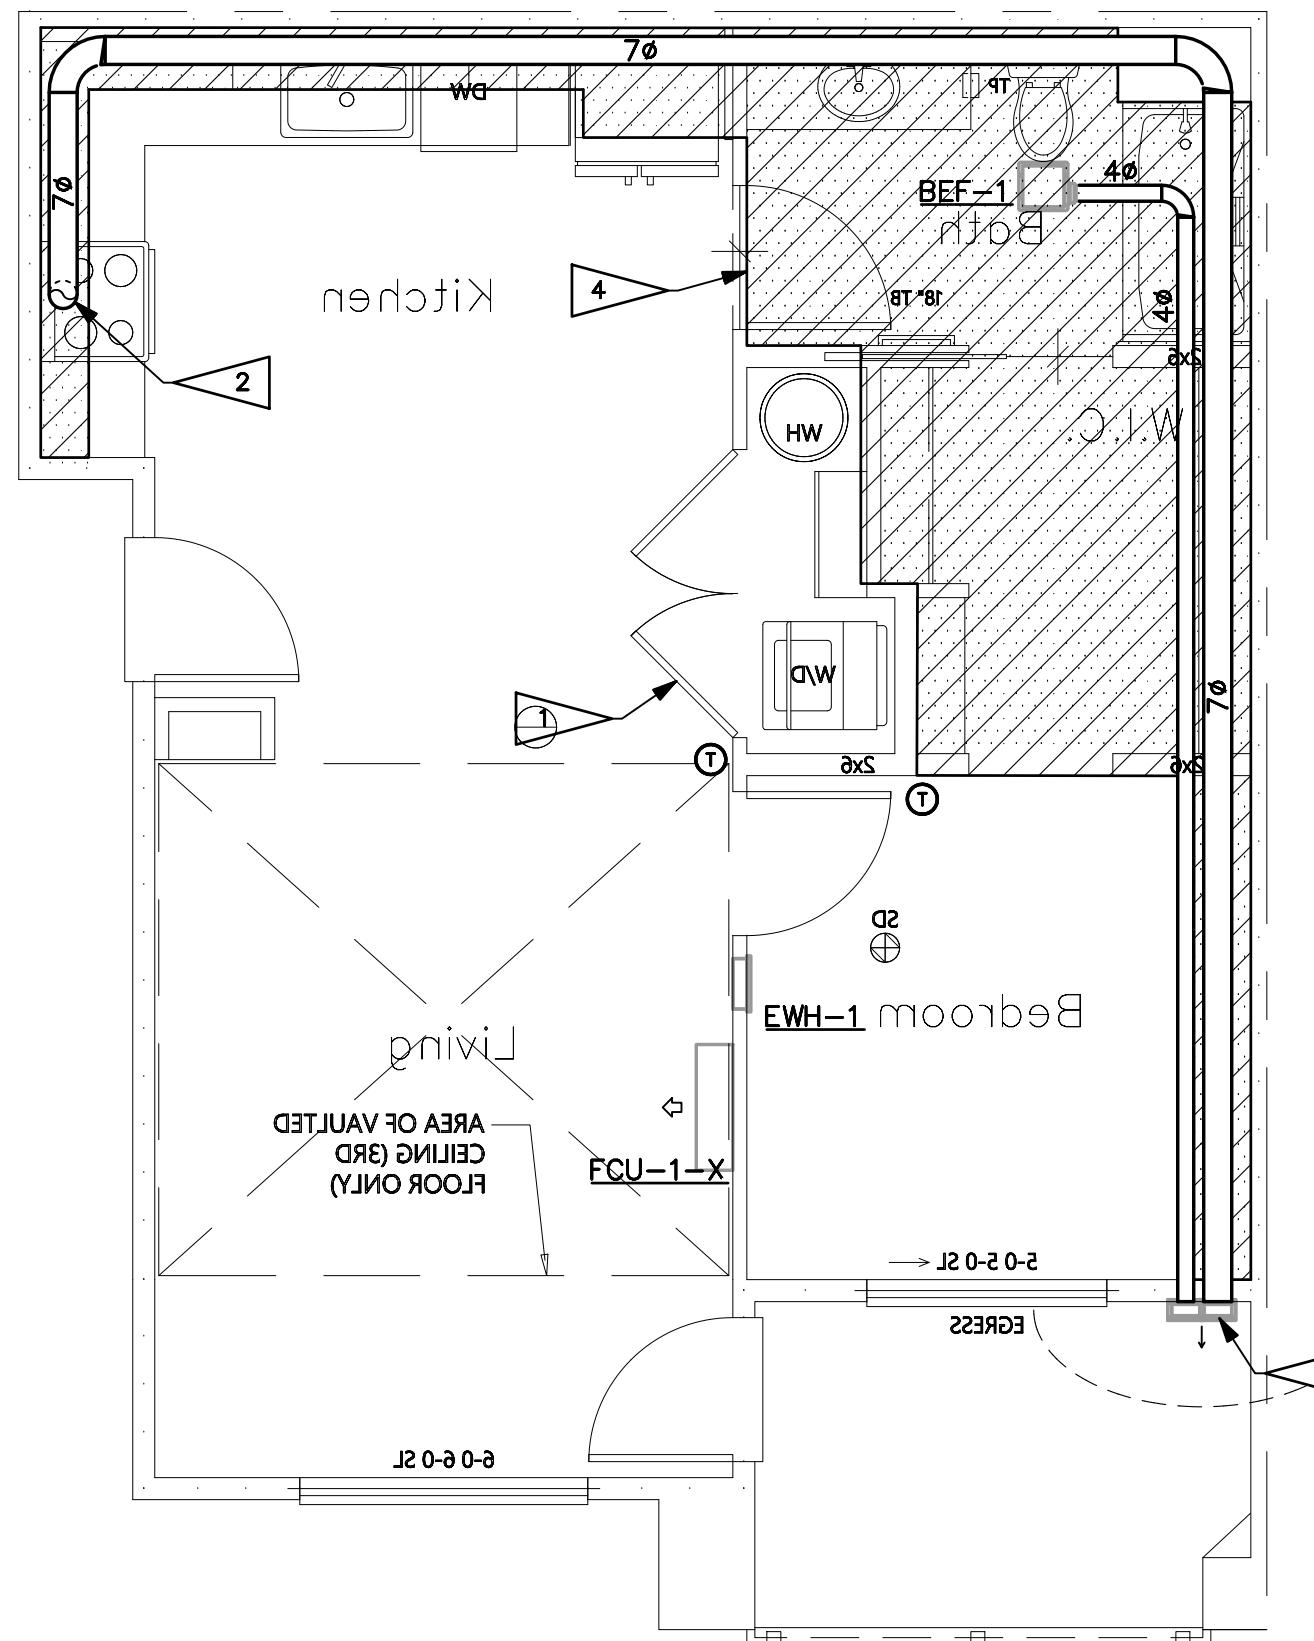


HVAC ENLARGED PLANS

1-BED-INT-2-MIRROR

SCALE: 1/4" = 1'-0"

1
M3.1

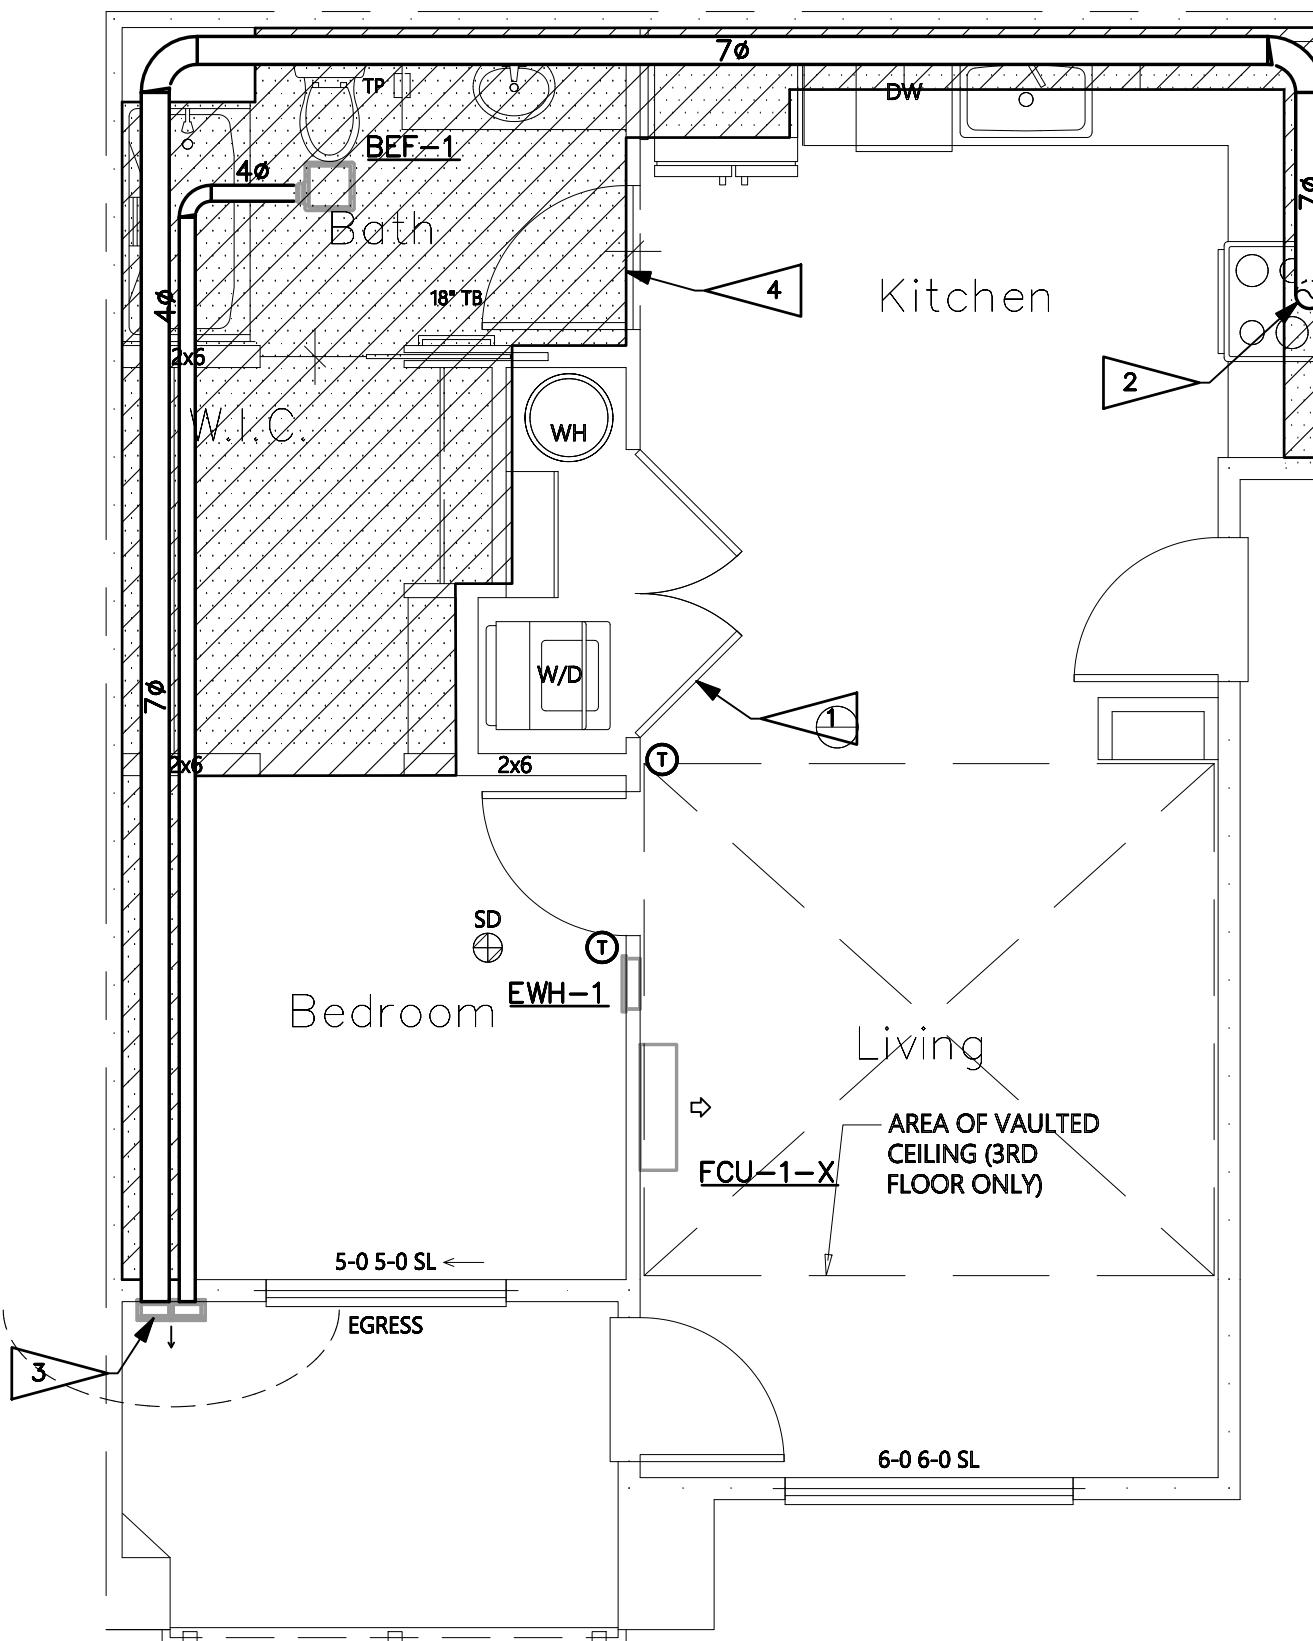


HVAC ENLARGED PLANS

1-BED-INT-2

SCALE: 1/4" = 1'-0"

2
M3.1

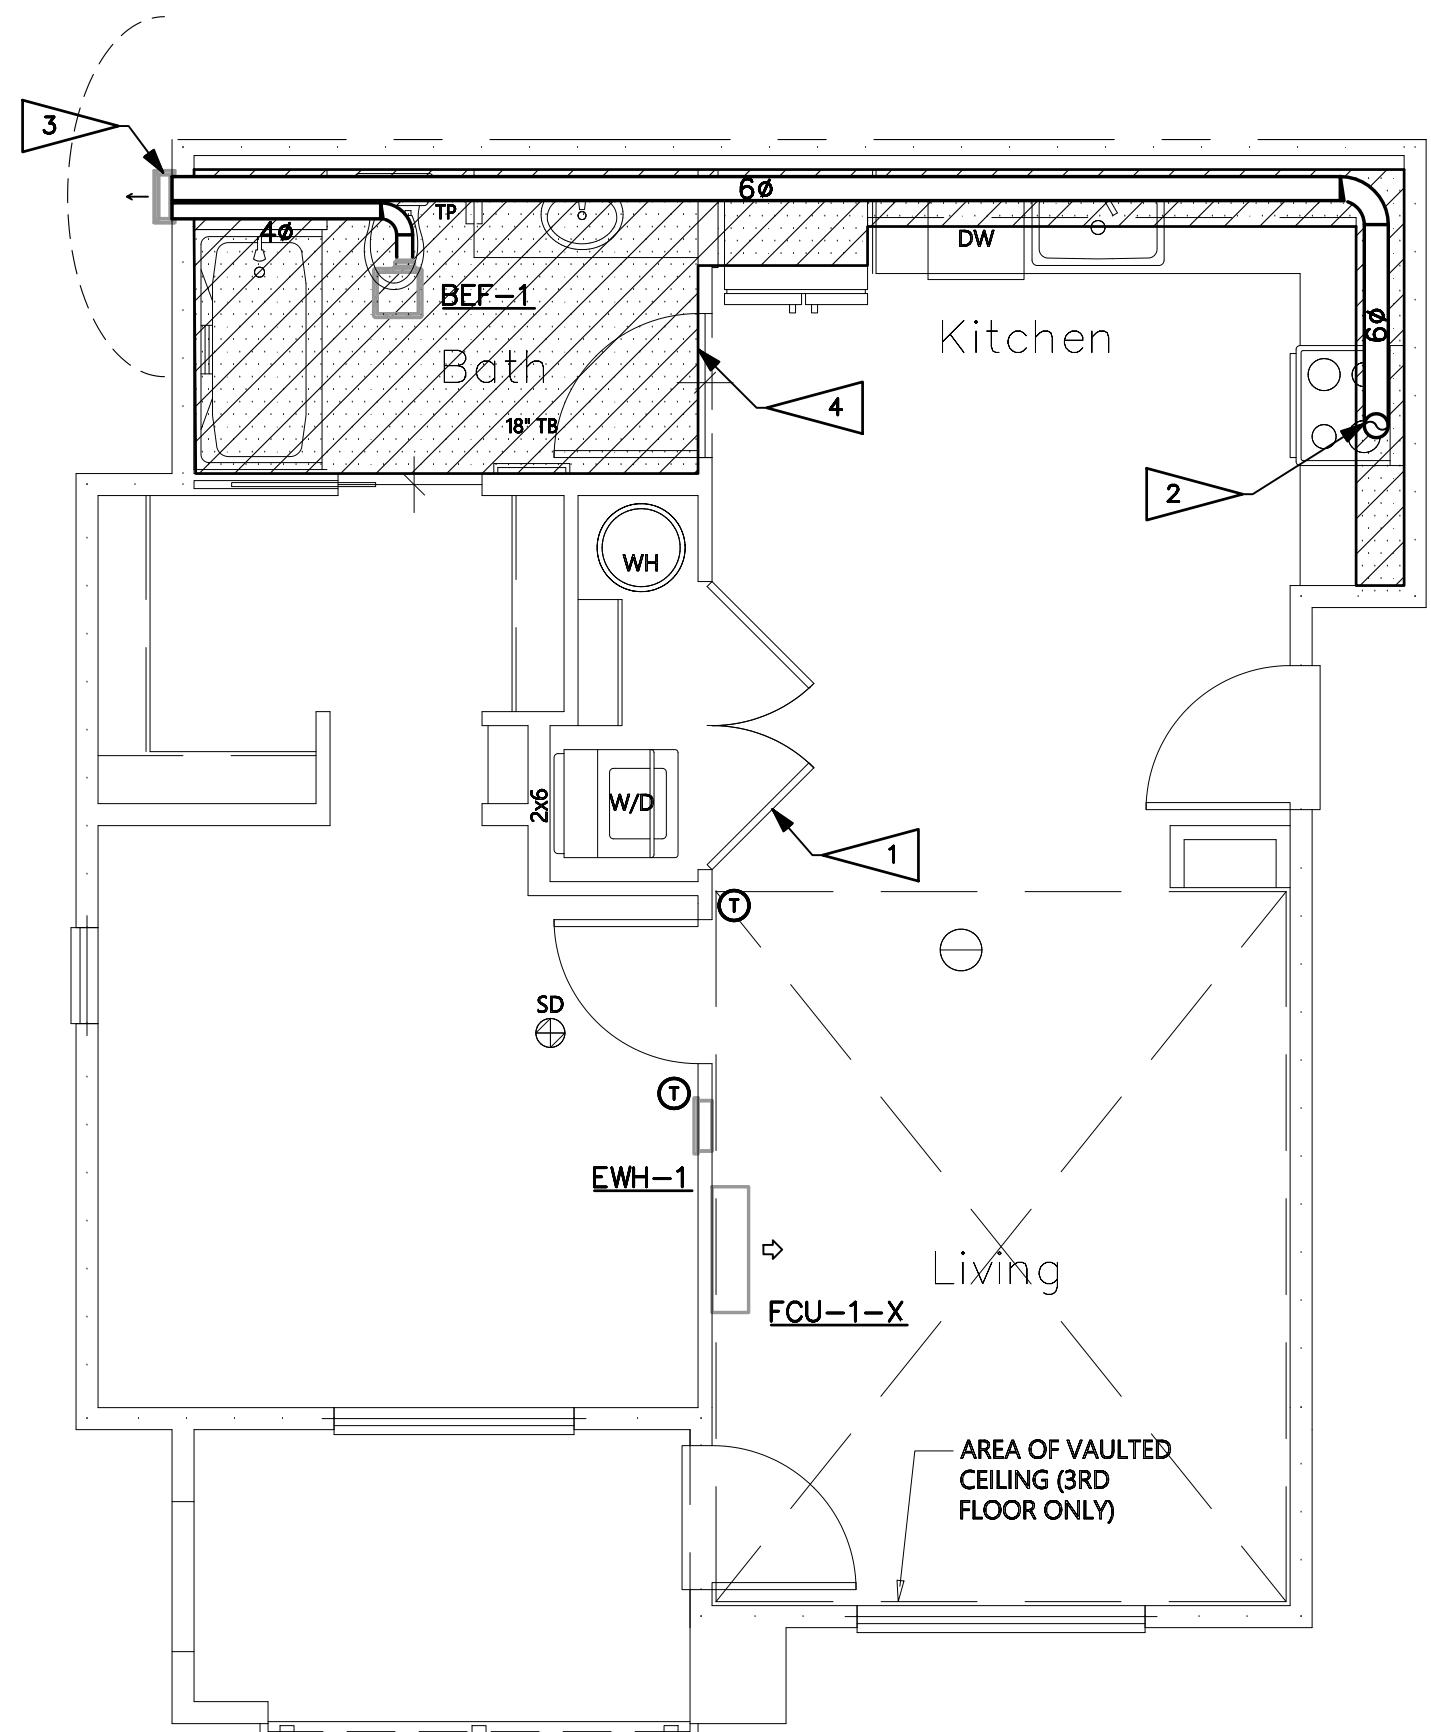

HVAC ENLARGED PLANS

1-BED-END

SCALE: 1/4" = 1'-0"

3
M3.1

GENERAL NOTES:

- ENVIRONMENTAL EXHAUST TERMINATIONS: MAINTAIN 3 FOOT SEPARATION FROM PROPERTY LINES AND OPERABLE OPENINGS INTO BUILDING, 10 FEET FROM MECHANICAL AIR INTAKES.
- OUNT REMOTE THERMOSTATS 48" AFF. PER WSEC C403.4.9, AT LEAST ONE THERMOSTAT SHALL BE PROGRAMMABLE ON A 5-2 SCHEDULE.
- UNDERCUT ALL BATHROOM DOORS BY MINIMUM 1/2" TO ALLOW TRANSFER OF MAKEUP AIR FOR BATHROOM EXHAUST.
- ELECTRIC WALL HEATERS SHALL BE RECESSED IN WALL UNLESS FIRE RATED OR EXTERIOR WALL. FOR HEATERS MOUNTED ON SUCH WALL, PROVIDE SURFACE-MOUNT WALL CAN.
- PROVIDE ACCESSIBLE MANUAL VOLUME DAMPERS AT BRANCHES OR OPPOSED-BLADE DAMPERS AT GRILLES FOR AIR BALANCING PER VOLUME DAMPERS NOTE ON SHEET M0.00.

FLAG NOTES: #

- CLOSETS CONTAINING DRYERS SHALL BE PROVIDED WITH LOUVERED DOOR OR 100 SQ. IN FREE-AREA OPENING ABOVE DOOR. OPENING PROVIDES PATH FOR EXHAUST AIR DURING WASHER OPERATION PER WSMC TABLE 403.3.1.1 NOTE (i) AND MAKEUP AIR DURING DRYER OPERATION PER 504.6.
- POC TO DOMESTIC KITCHEN RANGE HOOD. SEE PLANS FOR SIZE. DUCT SHALL REMAIN SEPARATE FROM OTHER EXHAUST SYSTEMS UP TO TERMINATION.
- DOMESTIC KITCHEN RANGE HOOD EXHAUST TERMINATION WALL CAP WITH SCREEN. PROVIDE BACKDRAFT DAMPER AT TERMINATION. CLEARANCES PER GENERAL NOTE 1.
- LOWERED SOFFIT FOR MECHANICAL EQUIPMENT.









ENTIRE SHEET HAS
BEEN UPDATED



ENTIRE SHEET HAS
BEEN UPDATED

ENTIRE SHEET HAS
BEEN UPDATED

SYMBOLS	ABBREVIATIONS	GENERAL NOTES																																																																																																																														
<p><u>GENERAL</u></p> <p><u>DETAIL IDENTIFICATION</u></p> <p><u>SWITCHES</u></p> <p><u>RECEPTACLES</u></p> <p><u>MISCELLANEOUS</u></p> <p><u>SIGNAL/COMMUNICATION</u></p> <p><u>POWER</u></p> <p><u>PART OF THE DESIGN/BUILD FIRE ALARM SYSTEM</u></p>	<p><u>NAME</u></p> <p><u>FLAG NOTE</u></p> <p><u>REVISION NOTE</u></p> <p><u>REVISION DEFINITION</u>, AREA ENCIRCLED CONTAINS DRAWING CHANGES MADE SUBSEQUENT TO PREVIOUS ISSUE</p> <p><u>SWITCH, SINGLE POLE; WITH SWITCHING SUBSCRIPT</u></p> <p><u>OCCUPANCY SENSOR SWITCH</u></p> <p><u>SWITCH, SINGLE POLE; WITH SWITCHING SUBSCRIPT "D" INDICATES WALLBOX DIMMER</u></p> <p><u>CEILING MOUNTED OCCUPANCY SENSOR</u></p> <p><u>SWITCH, TIMER.</u></p> <p><u>SWITCH, THREE WAY.</u></p> <p><u>SINGLE RECEPTACLE</u></p> <p><u>DUPLEX RECEPTACLE: WALL MOUNTED, +18" AFF</u></p> <p><u>CONTROLLED AND NON CONTROLLED DUPLEX RECEPTACLE (SPLIT WIRED RECEPTACLE)</u></p> <p><u>DUPLEX RECEPTACLE - ABOVE COUNTER</u></p> <p><u>DUPLEX GFCI ABOVE COUNTER</u></p> <p><u>DUPLEX RECEPTACLE, WITH HEIGHT ABOVE FINISHED FLOOR INDICATED</u></p> <p><u>CEILING MOUNTED DUPLEX RECEPTACLE</u></p> <p><u>DOUBLE DUPLEX RECEPTACLE: WALL MOUNTED, +18" AFF</u></p> <p><u>FLOOR BOX ONE DUPLEX RECEPTACLE</u></p> <p><u>FLOOR BOX ONE DUPLEX RECEPTACLE + ONE DATA</u></p> <p><u>FLOOR BOX ONE DUPLEX RECEPTACLE + ONE DATA + ONE VOICE</u></p> <p><u>SPECIAL PURPOSE RECEPTACLE, AS NOTED</u></p> <p><u>JUNCTION BOX: 4SQ MOUNTED</u></p> <p><u>JUNCTION BOX: 4SQ WALL MOUNTED</u></p> <p><u>JUNCTION BOX: 4SQ TRACK</u></p> <p><u>CONNECTION FOR LIGHTED MIRROR COORDINATE LOCATION AND ELEVATION WITH ARCHITECT PRIOR TO ROUGH-IN</u></p> <p><u>THERMOSTAT</u></p> <p><u>DATA OUTLET: WALL MOUNTED @ +18" AFF U.O.N.</u></p> <p><u>TELEPHONE/DATA OUTLET: WALL MOUNTED @ +18" AFF U.O.N.</u></p> <p><u>TELEVISION OUTLET: WALL MOUNTED @ +18" AFF U.O.N.</u></p> <p><u>PANELBOARD</u></p> <p><u>NON-FUSED DISCONNECT SWITCH (WP = NEMA 3R WHERE APPROPRIATE)</u></p> <p><u>FUSED DISCONNECT SWITCH</u></p> <p><u>MAU-1,5HP,480,3</u></p> <p><u>EF-1,12KVA,208,1</u></p> <p><u>TRANSFORMER, DRY TYPE, SHOWN TO SCALE</u></p> <p><u>KW METER AND BASE</u></p> <p><u>FIRE ALARM SYSTEM CONTROL PANEL</u></p> <p><u>FIRE ALARM SYSTEM PULL STATION</u></p> <p><u>FIRE ALARM SYSTEM STROBE/SPEAKER</u></p> <p><u>FIRE ALARM PHOTOELECTRIC SMOKE DETECTOR AND SPEAKER.</u></p> <p><u>FIRE ALARM COMBINATION PHOTOELECTRIC SMOKE DETECTOR, CARBON MONOXIDE DETECTOR, AND SPEAKER, GUESTROOM.</u></p> <p><u>CARBON MONOXIDE DETECTOR.</u></p> <p><u>ELECTRO-MAGNETIC DOOR HOLDER</u></p> <p><u>DUCT SMOKE DETECTOR</u></p>	<p><u>A</u> AMPERE</p> <p><u>AC</u> ALTERNATING CURRENT, ABOVE COUNTER</p> <p><u>AFF</u> ABOVE FINISHED FLOOR</p> <p><u>AIC</u> AMP-INTERRUPTING CAPACITY</p> <p><u>AL</u> ALUMINUM</p> <p><u>AMP</u> AMPERE</p> <p><u>AWG</u> AMERICAN WIRE GAUGE</p> <p><u>BKR</u> BREAKER</p> <p><u>BLDG</u> BUILDING</p> <p><u>C</u> COIL OR CONDUIT</p> <p><u>CKT</u> CIRCUIT</p> <p><u>CO</u> CONDUIT/RACEWAY ONLY</p> <p><u>CT</u> CURRENT TRANSFORMER</p> <p><u>Cu</u> COPPER</p> <p><u>CW</u> COOL WHITE</p> <p><u>D</u> DIMMER</p> <p><u>DED</u> DEDICATED</p> <p><u>EC</u> ELECTRICAL CONTRACTOR</p> <p><u>EF</u> EXHAUST FAN</p> <p><u>ELEC</u> ELECTRICAL</p> <p><u>EMT</u> ELECTRICAL METALLIC TUBING</p> <p><u>EQUIP</u> EQUIPMENT</p> <p><u>EXIST</u> EXISTING</p> <p><u>FAA</u> FIRE ALARM ANNUNCIATOR</p> <p><u>FACP</u> FIRE ALARM CONTROL PANEL</p> <p><u>FLUOR</u> FLUORESCENT</p> <p><u>GC</u> GENERAL CONTRACTOR</p> <p><u>GFCI</u> GROUND FAULT CIRCUIT INTERRUPTER</p> <p><u>GND</u> GROUND</p> <p><u>GRS</u> GALVANIZED RIGID STEEL</p> <p><u>HID</u> HIGH INTENSITY DISCHARGE</p> <p><u>HP</u> HORSEPOWER</p> <p><u>IG</u> ISOLATED GROUND</p> <p><u>KCML</u> THOUSAND CIRCULAR MILLS</p> <p><u>KVA</u> KILOVOLT AMPERES</p> <p><u>KW</u> KILOWATT</p> <p><u>LTG</u> LIGHTING</p> <p><u>LV</u> LOW VOLTAGE</p> <p><u>MFR</u> MANUFACTURER</p> <p><u>MIN</u> MINIMUM</p> <p><u>MLO</u> MAIN LUGS ONLY</p> <p><u>N</u> NEUTRAL</p> <p><u>NEC</u> NATIONAL ELECTRICAL CODE (NFPA-70)</p> <p><u>NEMA</u> NATIONAL ELECTRICAL MANUFACTURERS ASSOCIATION</p> <p><u>NTS</u> NOT TO SCALE</p> <p><u>PNL</u> PANEL</p> <p><u>POC</u> POINT OF CONNECTION</p> <p><u>PT</u> POTENTIAL TRANSFORMER</p> <p><u>PVC</u> POLYVINYL CLORIDE</p> <p><u>PWR</u> POWER</p> <p><u>QTY</u> QUANTITY</p> <p><u>RECEPT</u> RECEPTACLE</p> <p><u>REF</u> REFERENCE</p> <p><u>RI</u> ROUGH-IN</p> <p><u>RM</u> ROOM</p> <p><u>RO</u> RACEWAY ONLY</p> <p><u>SHT</u> SHEET</p> <p><u>SPEC</u> SPECIFICATIONS</p> <p><u>SW</u> SWITCH</p> <p><u>SWBD</u> SWITCHBOARD</p> <p><u>SWGR</u> SWITCHGEAR</p> <p><u>TP</u> TYPICAL</p> <p><u>UG</u> UNDERGROUND</p> <p><u>UL</u> UNDERWRITERS LABORATORIES</p> <p><u>UON</u> UNLESS OTHERWISE NOTED</p> <p><u>V</u> VOLTS</p> <p><u>W</u> WATTS</p> <p><u>WW</u> WARM WHITE</p> <p><u>WP</u> WEATHERPROOF</p> <p><u>W/</u> WITH</p> <p><u>W/O</u> WITHOUT</p> <p><u>XFRM</u> TRANSFORMER</p> <p><u>XFR</u> TRANSFER</p> <p><u>Z</u> IMPEDANCE OR ZONE</p>	<p><u>GENERAL</u></p> <ol style="list-style-type: none"> 1. PROVIDE ELECTRICAL INSTALLATION IN ACCORDANCE WITH THE GOVERNING ELECTRICAL CODE, LOCAL CODES, ORDINANCES AND REQUIREMENTS OF UTILITY COMPANIES FURNISHING SERVICES TO INSTALLATION. 2. PROVIDE ALL WORK AND ITEMS NECESSARY FOR COMPLETE AND FUNCTIONAL ELECTRICAL SYSTEMS. THE ELECTRICAL DRAWINGS ARE DIAGRAMMATIC AND DO NOT NECESSARILY SHOW EVERY CONDUIT, BOX, CONDUCTOR OR SIMILAR ITEMS FOR A COMPLETE INSTALLATION. 3. THE CONTRACTOR SHALL VISIT THE SITE PRIOR TO BID AND DETERMINE CONDITIONS WHICH MAY AFFECT BID. ANY ITEMS NOT FULLY UNDERSTOOD SHALL BE BROUGHT TO THE ATTENTION OF THE ARCHITECT PRIOR TO BIDDING. 4. "REF" INDICATIONS DENOTE WORK COVERED ELSEWHERE (ARCHITECTURAL, STRUCTURAL, OR MECHANICAL). 5. REFERENCE ARCHITECTURAL DRAWING FOR EXACT LOCATION OF DEVICES. QUESTIONS CONCERNING THE LOCATION OF DEVICES AND EQUIPMENT SHALL BE DIRECTED TO THE ARCHITECT. FAILURE TO COORDINATE REQUIREMENTS SHALL IN NO WAY RESULT IN ADDITIONAL COMPENSATION BEING PROVIDED TO THE CONTRACTOR. 6. WHEREVER THE WORD "PROVIDE" IS USED, IT MEANS, "FURNISH AND INSTALL COMPLETE AND READY FOR USE." 7. COORDINATE LOCATION OF ELECTRICAL WITH OTHER TRADES. 8. REFER TO EQUIPMENT DRAWINGS FOR MECHANICAL CHARACTERISTICS (SIZE, LOCATION, ETC.) OF MECHANICAL EQUIPMENT, UNLESS OTHERWISE INDICATED. COORDINATE INSTALLATION AND LOCATION OF ALL EQUIPMENT WITH MECHANICAL CONTRACTOR. VERIFY ALL FUSE RATINGS, WIRE SIZES AND DISCONNECT SIZES PRIOR TO INSTALLATION. <p><u>MATERIALS AND METHODS</u></p> <ol style="list-style-type: none"> 1. PROVIDE RACEWAY AND WIRING ROUTED CONCEALED WITHIN BUILDING STRUCTURE WHERE POSSIBLE. WHERE RACEWAY CANNOT BE CONCEALED, IT SHALL BE INSTALLED PER PROJECT MANAGER'S DIRECTION. ALL CONDUIT SHALL BE INSTALLED IN NEAT SYMMETRICAL LINES HORIZONTAL OR PERPENDICULAR TO BUILDING COLUMNS AND ROOF LINES. CONDUITS SHALL BE GROUPED ON COMMON SUPPORTS WHEREVER POSSIBLE. 2. EXPOSED CONDUIT ROUTING: CONDUITS MAY BE ROUTED EXPOSED IN MECHANICAL AND ELECTRICAL ROOMS ONLY. EXPOSED CONDUITS SHALL BE SECURED A MINIMUM OF 6" ABOVE FLOOR. 3. OUTDOOR EXPOSED CONDUIT ROUTING: CONDUITS ROUTED ON ROOF OR EXPOSED TO WEATHER SHALL BE GRC, PVC OR LIQUID-TIGHT FLEX. PROVIDE WATER-TIGHT CONNECTIONS AND FITTINGS. 4. CLEARANCES: VERIFY PHYSICAL DIMENSIONS OF EQUIPMENT TO ENSURE THAT ACCESS CLEARANCES CAN BE MET. 5. CONNECTIONS: PROVIDE GRS, METALLIC FLEX, OR LIQUIDTITE FLEX CONDUITS FOR CONNECTIONS TO MOTORS OR MOTORIZED EQUIPMENT. 6. WIRING: PROVIDE MINIMUM #12 AWG WIRE SIZE. IF CONDUIT IS TO BE USED MINIMUM IS TO BE 1/2". FLEXIBLE CONDUIT AND FLEXIBLE CABLE IS PERMISSIBLE THROUGHOUT THE BUILDING. <p><u>LIGHTING</u></p> <ol style="list-style-type: none"> 1. PROVIDE LIGHT FIXTURES WITH PROPER FITTING FLANGES, MOUNTING SUPPORTS, AND ACCESSORY ITEMS, UL LISTED FOR CONDITIONS OF USE. 2. PROVIDE LOW VOLTAGE TRANSFORMERS IN NEARBY ACCESSIBLE CEILING SPACE. 3. PROVIDE LOW VOLTAGE CONDUCTORS SIZED PER MANUFACTURER'S GUIDELINES TO MINIMIZE VOLTAGE DROP. <p><u>LIGHTING CONTROL</u></p> <ol style="list-style-type: none"> 1. THE MAXIMUM LIGHTING POWER THAT MAY BE CONTROLLED FROM A SINGLE SWITCH OR AUTOMATIC CONTROL SHALL NOT EXCEED THAT WHICH IS PROVIDED BY A TWENTY AMPERE CIRCUIT LOADED TO NOT MORE THAN EIGHTY PERCENT. A MASTER CONTROL MAY BE INSTALLED PROVIDED THE INDIVIDUAL SWITCHES RETAIN THEIR CAPABILITY TO FUNCTION INDEPENDENTLY. 2. EMERGENCY FIXTURES: EMERGENCY BATTERY/CHARGER SHALL BE CONNECTED TO AN UNSWITCHED LEG OF THE DESIGNATED CIRCUIT. 																																																																																																																													
		<p><u>GENERAL</u></p> <ol style="list-style-type: none"> 7. WIRING: PROVIDE MINIMUM #10 AWG COPPER CONDUCTOR SIZE IN 120V BRANCH CIRCUIT RUNS OVER 75' IN LENGTH. <p><u>SITE ELECTRICAL</u></p> <ol style="list-style-type: none"> 1. TRENCHING: COORDINATE ALL TRENCHING WORK WITH OTHER UTILITY LOCATIONS AND DRAINAGE TRENCHES. 2. UNDERGROUND CONDUITS: PROVIDE PVC, SCHEDULE 40, 3/4" MINIMUM. PROVIDE GRC CONDUIT TRANSITION ELBOW WHEN TURNING UP TO ABOVE GRADE. 3. DIRECT-BURIED CONDUITS: CONDUIT FOR BRANCH CIRCUITS OUTSIDE BUILDINGS NOT BENEATH DRIVEWAYS OR PARKING AREAS SHALL BE DIRECTLY BURIED WITHOUT CONCRETE ENCASEMENT. THE DEPTH TO THE TOP OF BURIED CONDUITS SHALL BE 36". PROVIDE MARKER TAPE 12" BELOW GRADE. 4. BELOW SLAB: CONDUIT ROUTED BELOW ON-GRADE FLOOR SLABS SHALL BE INSTALLED PRIOR TO FLOOR SLAB POUR. ROUTE CONDUITS BELOW SLAB AS STRAIGHT AS POSSIBLE TO MINIMIZE BENDS. 5. ALL CONDUITS PENETRATING THE BUILDING ENVELOPE BELOW GRADE SHALL FOLLOW WATERPROOFING REQUIREMENTS IN THE ARCHITECTURAL DRAWINGS. <p><u>NEUTRALS</u></p> <ol style="list-style-type: none"> 1. AT CONTRACTOR'S OPTION, NEUTRALS MAY BE SHARED ON COMBINED HOMERUNS UNLESS THE CIRCUIT HAS A GFCI BREAKER, AN ISOLATED GROUND, OR IS FROM A PANEL WITH TVSS PROTECTION. ANY NEUTRAL DOWNSTREAM FROM A DIMMER SHALL BE DEDICATED TO THE DIMMED LOAD. 2. NEUTRAL WIRES SHOWN FOR TWO AND THREE POLE MECHANICAL AND KITCHEN EQUIPMENT MAY BE OMITTED UPON VERIFICATION THAT THEY ARE NOT REQUIRED EITHER FOR OPERATION OR CONTROL CIRCUITS PER MANUFACTURER'S SPECIFICATIONS. <p><u>LIGHTING</u></p> <ol style="list-style-type: none"> 1. PROVIDE LIGHT FIXTURES WITH PROPER FITTING FLANGES, MOUNTING SUPPORTS, AND ACCESSORY ITEMS, UL LISTED FOR CONDITIONS OF USE. 2. PROVIDE LOW VOLTAGE TRANSFORMERS IN NEARBY ACCESSIBLE CEILING SPACE. 3. PROVIDE LOW VOLTAGE CONDUCTORS SIZED PER MANUFACTURER'S GUIDELINES TO MINIMIZE VOLTAGE DROP. <p><u>LIGHTING CONTROL</u></p> <ol style="list-style-type: none"> 1. THE MAXIMUM LIGHTING POWER THAT MAY BE CONTROLLED FROM A SINGLE SWITCH OR AUTOMATIC CONTROL SHALL NOT EXCEED THAT WHICH IS PROVIDED BY A TWENTY AMPERE CIRCUIT LOADED TO NOT MORE THAN EIGHTY PERCENT. A MASTER CONTROL MAY BE INSTALLED PROVIDED THE INDIVIDUAL SWITCHES RETAIN THEIR CAPABILITY TO FUNCTION INDEPENDENTLY. 2. EMERGENCY FIXTURES: EMERGENCY BATTERY/CHARGER SHALL BE CONNECTED TO AN UNSWITCHED LEG OF THE DESIGNATED CIRCUIT. 																																																																																																																														
		<p><u>GENERAL REQUIREMENTS</u></p> <p><u>CONTRACTOR SUBSTITUTIONS & REVISIONS</u></p> <p><u>PRE-CON MEETING NOTES</u></p>																																																																																																																														
		<p><u>DRAWING INDEX</u></p> <table border="1"> <thead> <tr> <th colspan="7">INCLUDED IN SET</th> </tr> <tr> <th>DWG</th> <th>DESCRIPTION</th> <th>PERMIT REVIEW SET 01/06/23</th> <th>PERMIT SET 02/15/24</th> <th>PROGRESS SET 08/16/2024</th> <th>OWNER</th> <th>CHANGES/PERMIT CORRECTIONS 08/30/24</th> </tr> </thead> <tbody> <tr> <td>E0.00</td> <td>LEGEND, GENERAL NOTES, DRAWING INDEX</td> <td>X</td> <td>X</td> <td>X</td> <td>X</td> <td>X</td> </tr> <tr> <td>E0.01</td> <td>PROJECT NOTES</td> <td>X</td> <td>X</td> <td>X</td> <td>X</td> <td>X</td> </tr> <tr> <td>E0.10</td> <td>SITE POWER PLAN - EAST</td> <td>X</td> <td>X</td> <td>X</td> <td>X</td> <td>X</td> </tr> <tr> <td>E0.11</td> <td>SITE POWER PLAN - WEST</td> <td>X</td> <td>X</td> <td>X</td> <td>X</td> <td>X</td> </tr> <tr> <td>E0.12</td> <td>SITE LIGHTING PLAN - EAST</td> <td>X</td> <td>X</td> <td>X</td> <td>X</td> <td>X</td> </tr> <tr> <td>E0.13</td> <td>SITE LIGHTING PLAN - WEST</td> <td>X</td> <td>X</td> <td>X</td> <td>X</td> <td>X</td> </tr> <tr> <td>E1.00</td> <td>LIGHTING & PHOTOMETRIC PLAN-1ST FLOOR</td> <td>X</td> <td>X</td> <td>X</td> <td>X</td> <td>X</td> </tr> <tr> <td>E1.01</td> <td>LIGHTING PLAN - 2ND & 3RD FLOOR</td> <td>X</td> <td>X</td> <td>X</td> <td>X</td> <td>X</td> </tr> <tr> <td>E1.50</td> <td>LIGHTING NOTES & LUMINAIRE SCHEDULES</td> <td>X</td> <td>X</td> <td>X</td> <td>X</td> <td>X</td> </tr> <tr> <td>E3.00</td> <td>POWER PLAN - 1ST & 2ND FLOOR</td> <td>X</td> <td>X</td> <td>X</td> <td>X</td> <td>X</td> </tr> <tr> <td>E3.01</td> <td>POWER PLAN - 3RD FLOOR</td> <td>X</td> <td>X</td> <td>X</td> <td>X</td> <td>X</td> </tr> <tr> <td>E5.00</td> <td>UNIT PLANS NOTES</td> <td>X</td> <td>X</td> <td>X</td> <td>X</td> <td>X</td> </tr> <tr> <td>E5.01</td> <td>UNIT PLANS & SCHEDULES</td> <td>X</td> <td>X</td> <td>X</td> <td>X</td> <td>X</td> </tr> <tr> <td>E5.02</td> <td>UNIT PLANS & SCHEDULES</td> <td>X</td> <td>X</td> <td>X</td> <td>X</td> <td>X</td> </tr> <tr> <td>E6.00</td> <td>ONE-LINE DIAGRAM & NOTES</td> <td>X</td> <td>X</td> <td>X</td> <td>X</td> <td>X</td> </tr> <tr> <td>E6.01</td> <td>PANELS SCHEDULES</td> <td>X</td> <td>X</td> <td>X</td> <td>X</td> <td>X</td> </tr> </tbody> </table> <p><u>PROJECT: BRADLEY HEIGHTS APARTMENTS BUILDING C 27TH AVE SE AND 5TH ST SE PUYALLUP, WA</u></p> <p><u>DATE: 05/02/2025</u></p> <p><u>SHEET TITLE: LEGEND, GENERAL NOTES, DRAWING INDEX</u></p> <p><u>SHEET NO. E0.00</u></p>	INCLUDED IN SET							DWG	DESCRIPTION	PERMIT REVIEW SET 01/06/23	PERMIT SET 02/15/24	PROGRESS SET 08/16/2024	OWNER	CHANGES/PERMIT CORRECTIONS 08/30/24	E0.00	LEGEND, GENERAL NOTES, DRAWING INDEX	X	X	X	X	X	E0.01	PROJECT NOTES	X	X	X	X	X	E0.10	SITE POWER PLAN - EAST	X	X	X	X	X	E0.11	SITE POWER PLAN - WEST	X	X	X	X	X	E0.12	SITE LIGHTING PLAN - EAST	X	X	X	X	X	E0.13	SITE LIGHTING PLAN - WEST	X	X	X	X	X	E1.00	LIGHTING & PHOTOMETRIC PLAN-1ST FLOOR	X	X	X	X	X	E1.01	LIGHTING PLAN - 2ND & 3RD FLOOR	X	X	X	X	X	E1.50	LIGHTING NOTES & LUMINAIRE SCHEDULES	X	X	X	X	X	E3.00	POWER PLAN - 1ST & 2ND FLOOR	X	X	X	X	X	E3.01	POWER PLAN - 3RD FLOOR	X	X	X	X	X	E5.00	UNIT PLANS NOTES	X	X	X	X	X	E5.01	UNIT PLANS & SCHEDULES	X	X	X	X	X	E5.02	UNIT PLANS & SCHEDULES	X	X	X	X	X	E6.00	ONE-LINE DIAGRAM & NOTES	X	X	X	X	X	E6.01	PANELS SCHEDULES	X	X	X	X	X
INCLUDED IN SET																																																																																																																																
DWG	DESCRIPTION	PERMIT REVIEW SET 01/06/23	PERMIT SET 02/15/24	PROGRESS SET 08/16/2024	OWNER	CHANGES/PERMIT CORRECTIONS 08/30/24																																																																																																																										
E0.00	LEGEND, GENERAL NOTES, DRAWING INDEX	X	X	X	X	X																																																																																																																										
E0.01	PROJECT NOTES	X	X	X	X	X																																																																																																																										
E0.10	SITE POWER PLAN - EAST	X	X	X	X	X																																																																																																																										
E0.11	SITE POWER PLAN - WEST	X	X	X	X	X																																																																																																																										
E0.12	SITE LIGHTING PLAN - EAST	X	X	X	X	X																																																																																																																										
E0.13	SITE LIGHTING PLAN - WEST	X	X	X	X	X																																																																																																																										
E1.00	LIGHTING & PHOTOMETRIC PLAN-1ST FLOOR	X	X	X	X	X																																																																																																																										
E1.01	LIGHTING PLAN - 2ND & 3RD FLOOR	X	X	X	X	X																																																																																																																										
E1.50	LIGHTING NOTES & LUMINAIRE SCHEDULES	X	X	X	X	X																																																																																																																										
E3.00	POWER PLAN - 1ST & 2ND FLOOR	X	X	X	X	X																																																																																																																										
E3.01	POWER PLAN - 3RD FLOOR	X	X	X	X	X																																																																																																																										
E5.00	UNIT PLANS NOTES	X	X	X	X	X																																																																																																																										
E5.01	UNIT PLANS & SCHEDULES	X	X	X	X	X																																																																																																																										
E5.02	UNIT PLANS & SCHEDULES	X	X	X	X	X																																																																																																																										
E6.00	ONE-LINE DIAGRAM & NOTES	X	X	X	X	X																																																																																																																										
E6.01	PANELS SCHEDULES	X	X	X	X	X																																																																																																																										

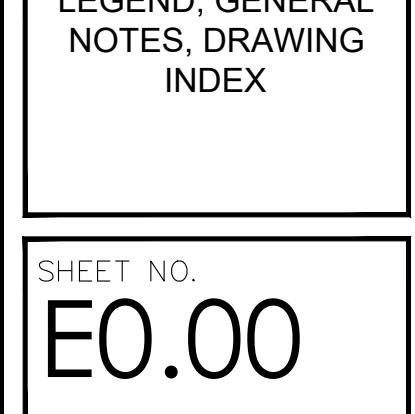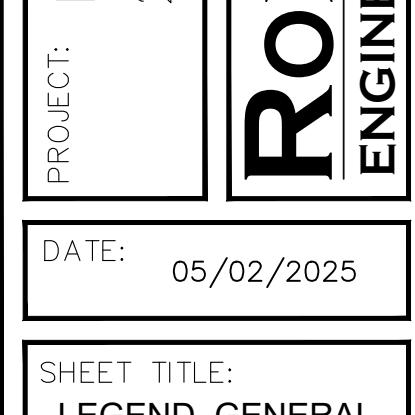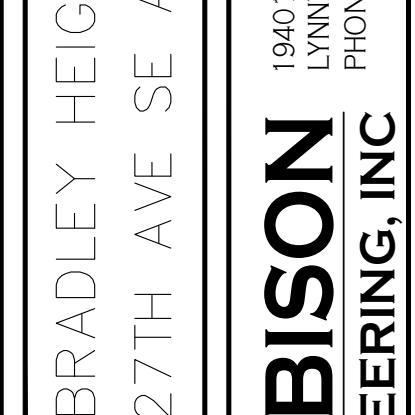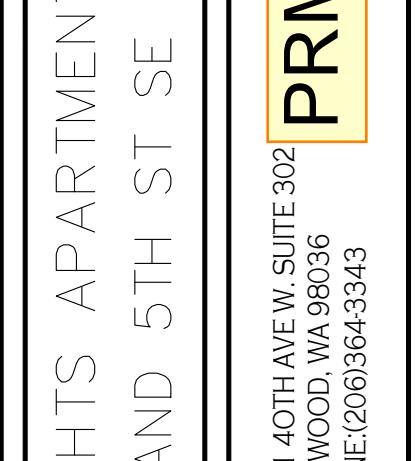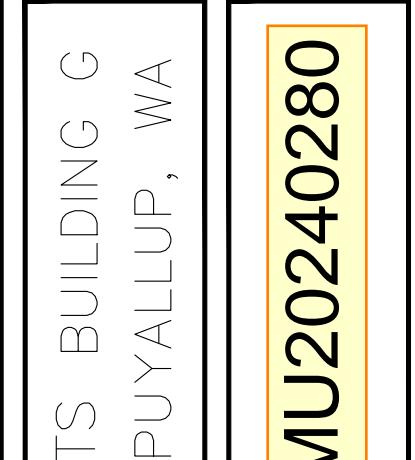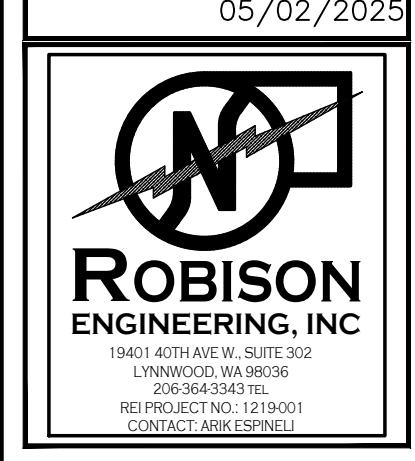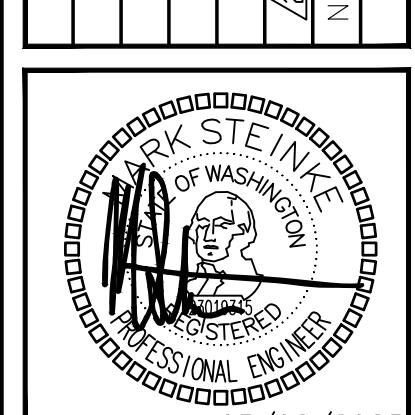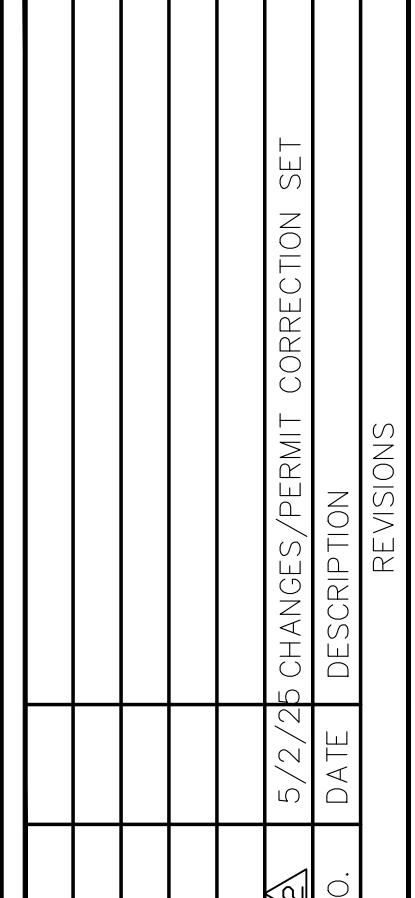

APPLICABLE CODES

THE FOLLOWING PROJECT DESIGN IS BASED ON THE FOLLOWING CODES:

- 2020 NATIONAL ELECTRICAL CODE (NEC)
- 2018 WASHINGTON STATE ENERGY CODE (WSEC)
- 2018 INTERNATIONAL BUILDING CODE (IBC) & WASHINGTON STATE AMENDMENTS
- 2018 INTERNATIONAL FIRE CODE (IFC) & WASHINGTON STATE AMENDMENTS
- 2018 INTERNATIONAL MECHANICAL CODE (IMC) & WASHINGTON STATE AMENDMENTS
- 2018 UNIFORM PLUMBING CODE (UPC) & WASHINGTON STATE AMENDMENTS

VIBRATION AND ACOUSTICAL ISOLATION

THE FOLLOWING MEASURES SHALL BE TAKEN TO MINIMIZE VIBRATION AND NOISE TRANSMISSION FROM MECHANICAL AND ELECTRICAL EQUIPMENT TO THE INTERIOR SPACES:

TRANSFORMERS:

- A) PROVIDE FLEXIBLE CONDUIT OR MC CABLE AT EQUIPMENT CONNECTION.
- B) MOUNT TRANSFORMERS ON NEOPRENE GROMMET ISOLATORS.

SUBDUCT EXHAUST FANS:

- A) PROVIDE FLEXIBLE CONDUIT OR MC CABLE AT EQUIPMENT CONNECTION.

ENCLOSED GARAGE EXHAUST FANS:

- A) PROVIDE FLEXIBLE CONDUIT OR MC CABLE AT EQUIPMENT CONNECTION.

ROOFTOP AIR HANDLERS:

- A) PROVIDE FLEXIBLE CONDUIT OR MC CABLE AT EQUIPMENT CONNECTION.

FAN COIL UNITS:

- A) PROVIDE FLEXIBLE CONDUIT OR MC CABLE AT EQUIPMENT CONNECTION.

ROOF MOUNTED CONDENSERS:

- A) PROVIDE FLEXIBLE CONDUIT OR MC CABLE AT EQUIPMENT CONNECTION.

FLEXIBLE CONDUIT OR MC CABLE CONNECTIONS FOR VIBRATION ISOLATION SHALL BE A MINIMUM OF TWO FEET LONG.

TEMPERATURE LIMITATION OF CONDUCTORS

ADDITIONAL ADJUSTMENTS FOR CONDUITS EXPOSED TO SUNLIGHT ON OR ABOVE ROOFTOPS SHALL BE FACORED PER NEC TABLE 310.15(B)(2)(C)


CONDUIT & CONDUCTOR FIRE RATING

1. CONDUIT FOR ELECTRICAL CONDUCTORS BY THE FACP OR FIRE ALARM SYSTEM SHALL BE IN 2 HOUR RATED ENCLOSURES OR ENCASED IN 2-INCH OF CONCRETE AND RATED CABLE ASSEMBLIES, OR BE CONDUCTORS IN 2 HOUR-RATED RACEWAYS PER NFPA 72.
2. THE EQUIPMENT AND CONTROL WIRING SHALL BE ENCLOSED BY FIRE BARRIERS CONSTRUCTED IN ACCORDANCE WITH IBC SECTION 707 OR HORIZONTAL ASSEMBLIES CONSTRUCTED IN ACCORDANCE WITH IBC SECTION 711, OR USING A 2 HR RATED CABLE SYSTEM OR ENCLOSED WITHIN 2" OF CONCRETE.
3. FIRE ALARM WIRING SHALL COMPLY WITH IBC 907.6.1. WIRING SHALL COMPLY WITH THE REQUIREMENTS OF NFPA 70.
4. RACEWAYS FOR THE DEDICATED BRANCH CIRCUIT(S) REQUIRED FOR PRIMARY POWER TO THE FIRE ALARM CONTROL PANEL (FACP) SHALL BE IN 2 HOUR RATED ENCLOSURES OR ENCASED IN 2-INCH OF CONCRETE AND RATED CABLE ASSEMBLIES, OR BE CONDUCTORS IN 2 HOUR-RATED RACEWAYS PER IBC 907 AND NFPA 72 SECTION 10.6.11.3.1.3

Separate Electrical Permit is required with the Washington State Department of Labor & Industries.
<https://lni.wa.gov/licensing-permits/electrical/electrical-permits-fees-and-inspections>
 or call for Licensing Information: 1-800-647-0982

Building	Planning
Engineering	Public Works
Fire	Traffic

5/2/25 CHANGES/PERMIT CORRECTION SET
 NO. DATE DESCRIPTION
 REVISIONS

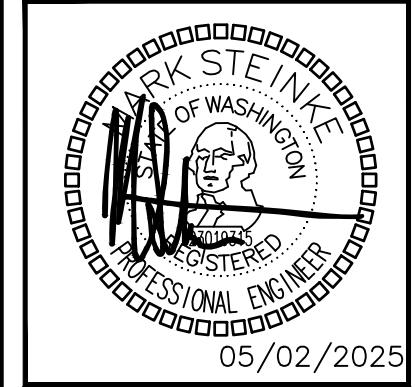

DRAWN: KL	DESIGNED: MHS
CHECKED: PSR	APPROVED: JAY


PROJECT: BRADLEY HEIGHTS APARTMENTS BUILDING C 27TH AVE SE AND 5TH ST SE PUYALLUP, WA	DATE: 05/02/2025
PRMU20240280	

19401 40TH AVE W SUITE 302 LYNNWOOD, WA 98036 PHONE: (206)364-3343	DATE: 05/02/2025
ROBISON ENGINEERING, INC.	

SHEET TITLE: LEGEND, GENERAL NOTES, DRAWING INDEX

SHEET NO.
E0.01

5/2/25 CHANGES/PERMIT CORRECTION SET	
NO.	DATE

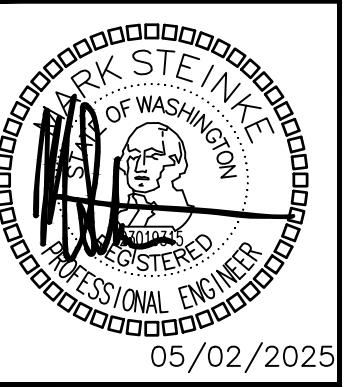

DRAWN: KL	DESIGNED: MHS
CHECKED: PSR	APPROVED: JAY
05/02/2025	


PROJECT: BRADLEY HEIGHTS APARTMENTS BUILDING C
27TH AVE SE AND 5TH ST SE PUYALLUP, WA
PHONE: (206)364-3343

PROJECT: 19401 40TH AVE W, SUITE 302
LYNNWOOD, WA 98036
PHONE: (206)364-3343

DATE: 05/02/2025

SHEET TITLE:
SITE POWER -
EAST SITE
PLAN

SHEET NO.
E0.10

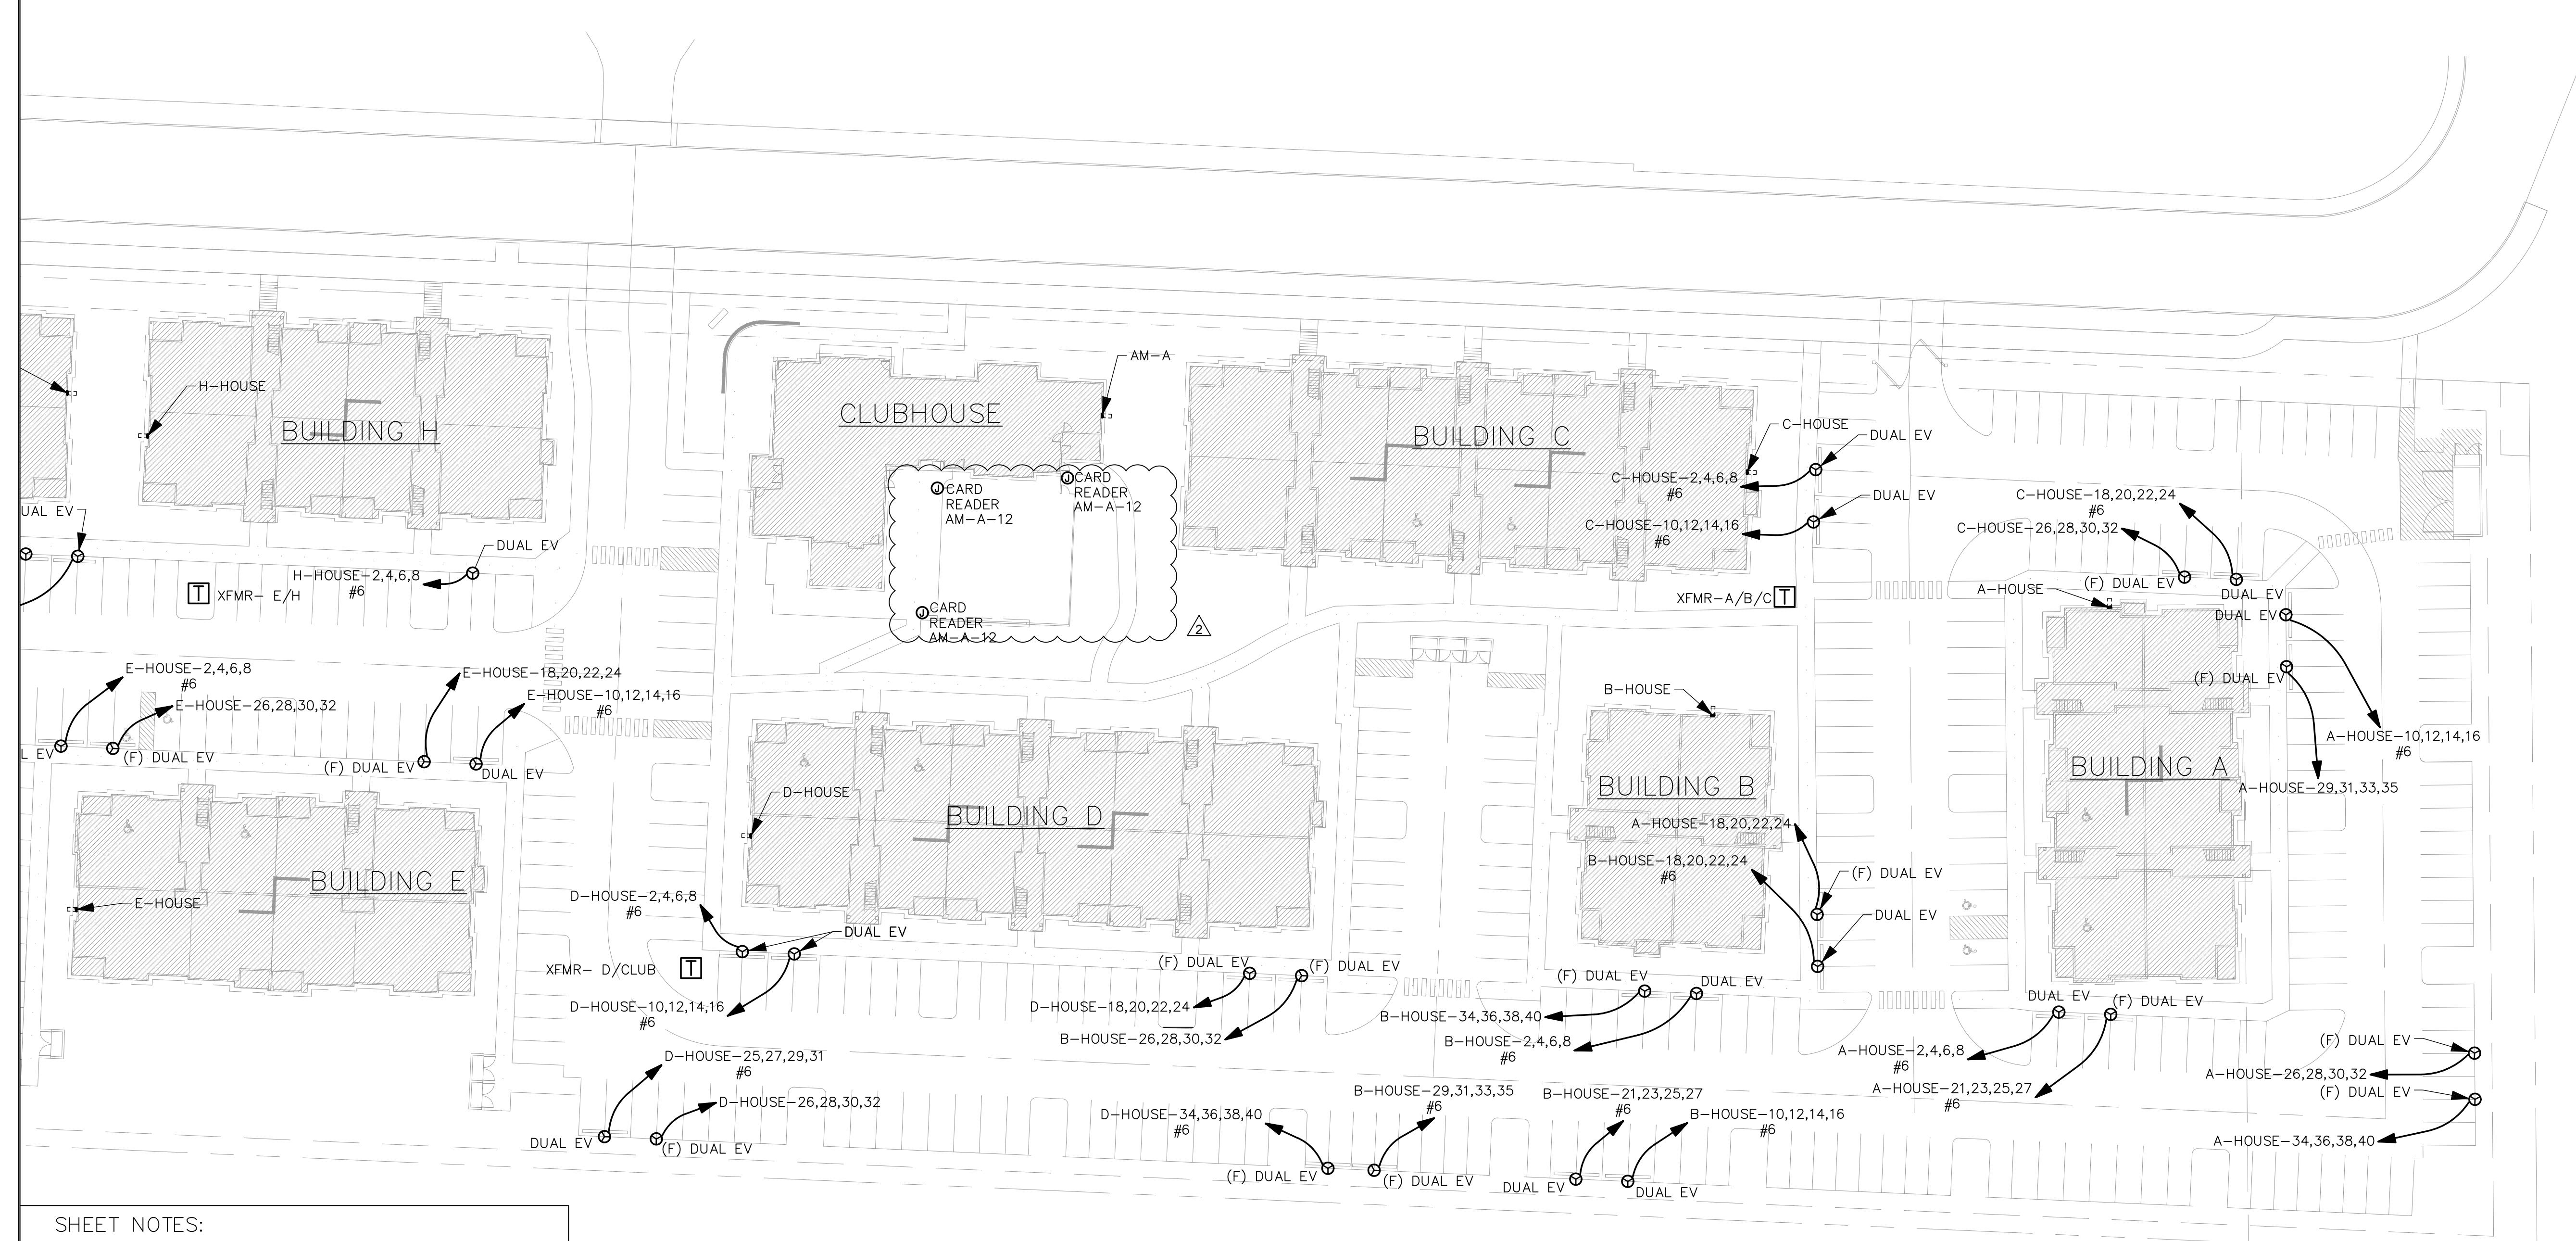

SHEET NOTES:

- EV CHARGER LOCATIONS:
 1. PROVIDE PRE-FABRICATED EV CHARGING STATION. BOD: PULSAR 40A DUAL EV CHARGERS. PROVIDE (2) 50A CIRCUITS TO EACH DUAL CHARGER.
 2. FOUNDATION TO INCLUDE ACCESSIBLE UNDERGROUND PULLBOX, CONDUIT ENTRY PORTS AND COVERPLATE DESIGNED FOR DIRECT-MOUNTING EV CHARGER PEDESTAL.
 3. PROVIDE FOUNDATION PRODUCTS BY BREEZE-EV, EV-BLOCKS OR EQUIVALENT.
 4. IF FOUNDATION IS INSTALLED LESS THAN 2'-0" FROM THE EDGE OF THE CURB, THEN PROIDE A BOLLARD AT EACH CORNER OF THE FOUNDATION THAT COMPLIES WITH 2018 IBC 1607.9
- (F) DUAL EV CHARGING STATIONS:
 1. PROVIDE 1-1/4" CONDUIT WITH PULL WIRE FROM EV PANEL(S) IN ELECTRICAL ROOM AS INDICATED.
- DUAL EV CHARGING STATIONS:
 1. PROVIDE AND INSTALL 1-1/4" CONDUIT, CONDUCTORS, AND REQUIRED BREAKERS FOR DUAL EV CHARGING STATIONS.

SITE POWER PLAN - EAST

SCALE: 1/32" = 1'-0"

5/2/25 CHANGES/PERMIT CORRECTION SET	
NO.	DATE



ROBISON
ENGINEERING, INC.
19401 40TH AVE W, SUITE 302
LYNNWOOD, WA 98036
PHONE: (206)364-3343
FAX: (206)364-3901
CONTACT: MARK ESPENELL


DRAWN: KL
DESIGNED: MHS
CHECKED: PSR
APPROVED: JAY

PROJECT: BRADLEY HEIGHTS APARTMENTS BUILDING C
27TH AVE SE AND 5TH ST SE PUYALLUP, WA
PHONE: (206)364-3343

DATE: 05/02/2025
ROBISON
ENGINEERING, INC.
19401 40TH AVE W, SUITE 302
LYNNWOOD, WA 98036
PHONE: (206)364-3343

SHEET TITLE: SITE POWER - WEST SITE PLAN

SHEET NO. E0.11

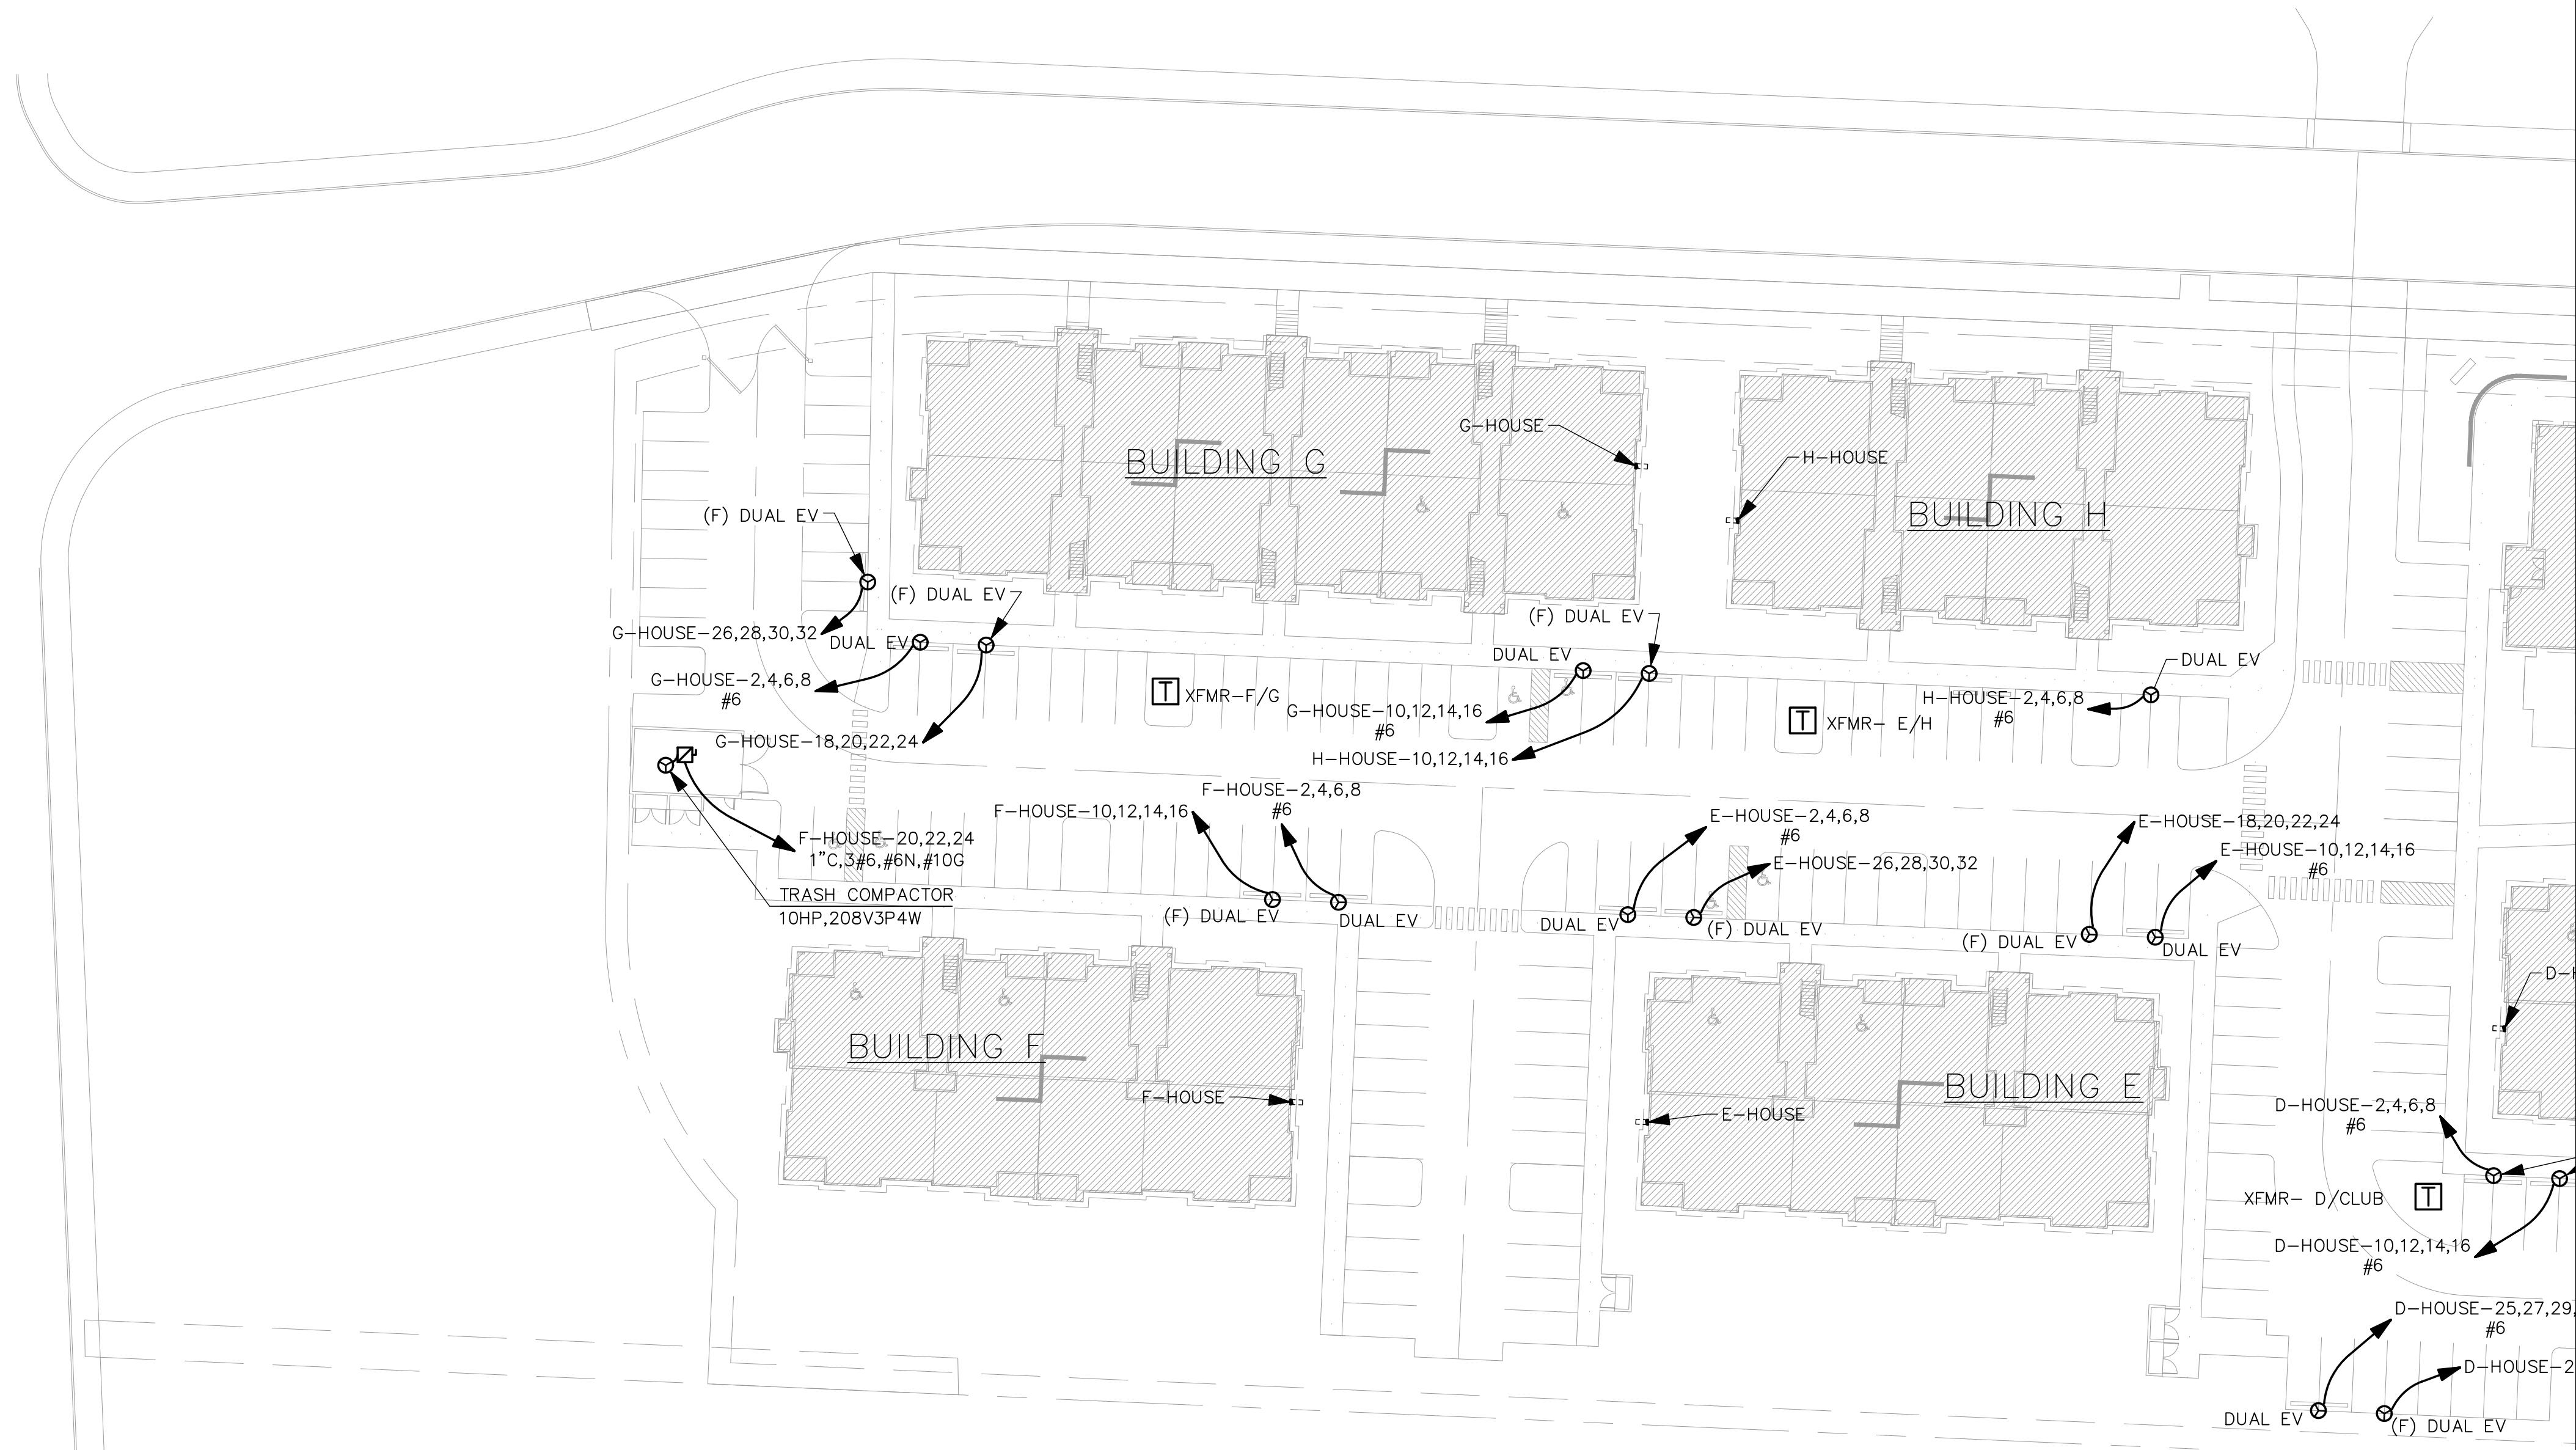



SITE POWER PLAN - WEST

SCALE: 1/32" = 1'-0"

SHEET NOTES:

- EV CHARGER LOCATIONS:
 - PROVIDE PRE-FABRICATED EV CHARGING STATION. BOD: PULSAR 40A DUAL EV CHARGERS. PROVIDE (2) 50A CIRCUITS TO EACH DUAL CHARGER.
 - FOUNDATION TO INCLUDE ACCESSIBLE UNDERGROUND PULLBOX, CONDUIT ENTRY PORTS AND COVERPLATE DESIGNED FOR DIRECT-MOUNTING EV CHARGER PEDESTAL.
 - PROVIDE FOUNDATION PRODUCTS BY BREEZE-EV, EV-BLOCKS OR EQUIVALENT.
 - IF FOUNDATION IS INSTALLED LESS THAN 2'-0" FROM THE EDGE OF THE CURB, THEN PROVIDE A BOLLARD AT EACH CORNER OF THE FOUNDATION THAT COMPLIES WITH 2018 IBC 1607.9
- (F) DUAL EV CHARGING STATIONS:
 - PROVIDE 1-1/4" CONDUIT WITH PULL WIRE FROM EV PANEL(S) IN ELECTRICAL ROOM AS INDICATED.
- DUAL EV CHARGING STATIONS:
 - PROVIDE AND INSTALL 1-1/4" CONDUIT, CONDUCTORS, AND REQUIRED BREAKERS FOR DUAL EV CHARGING STATIONS.

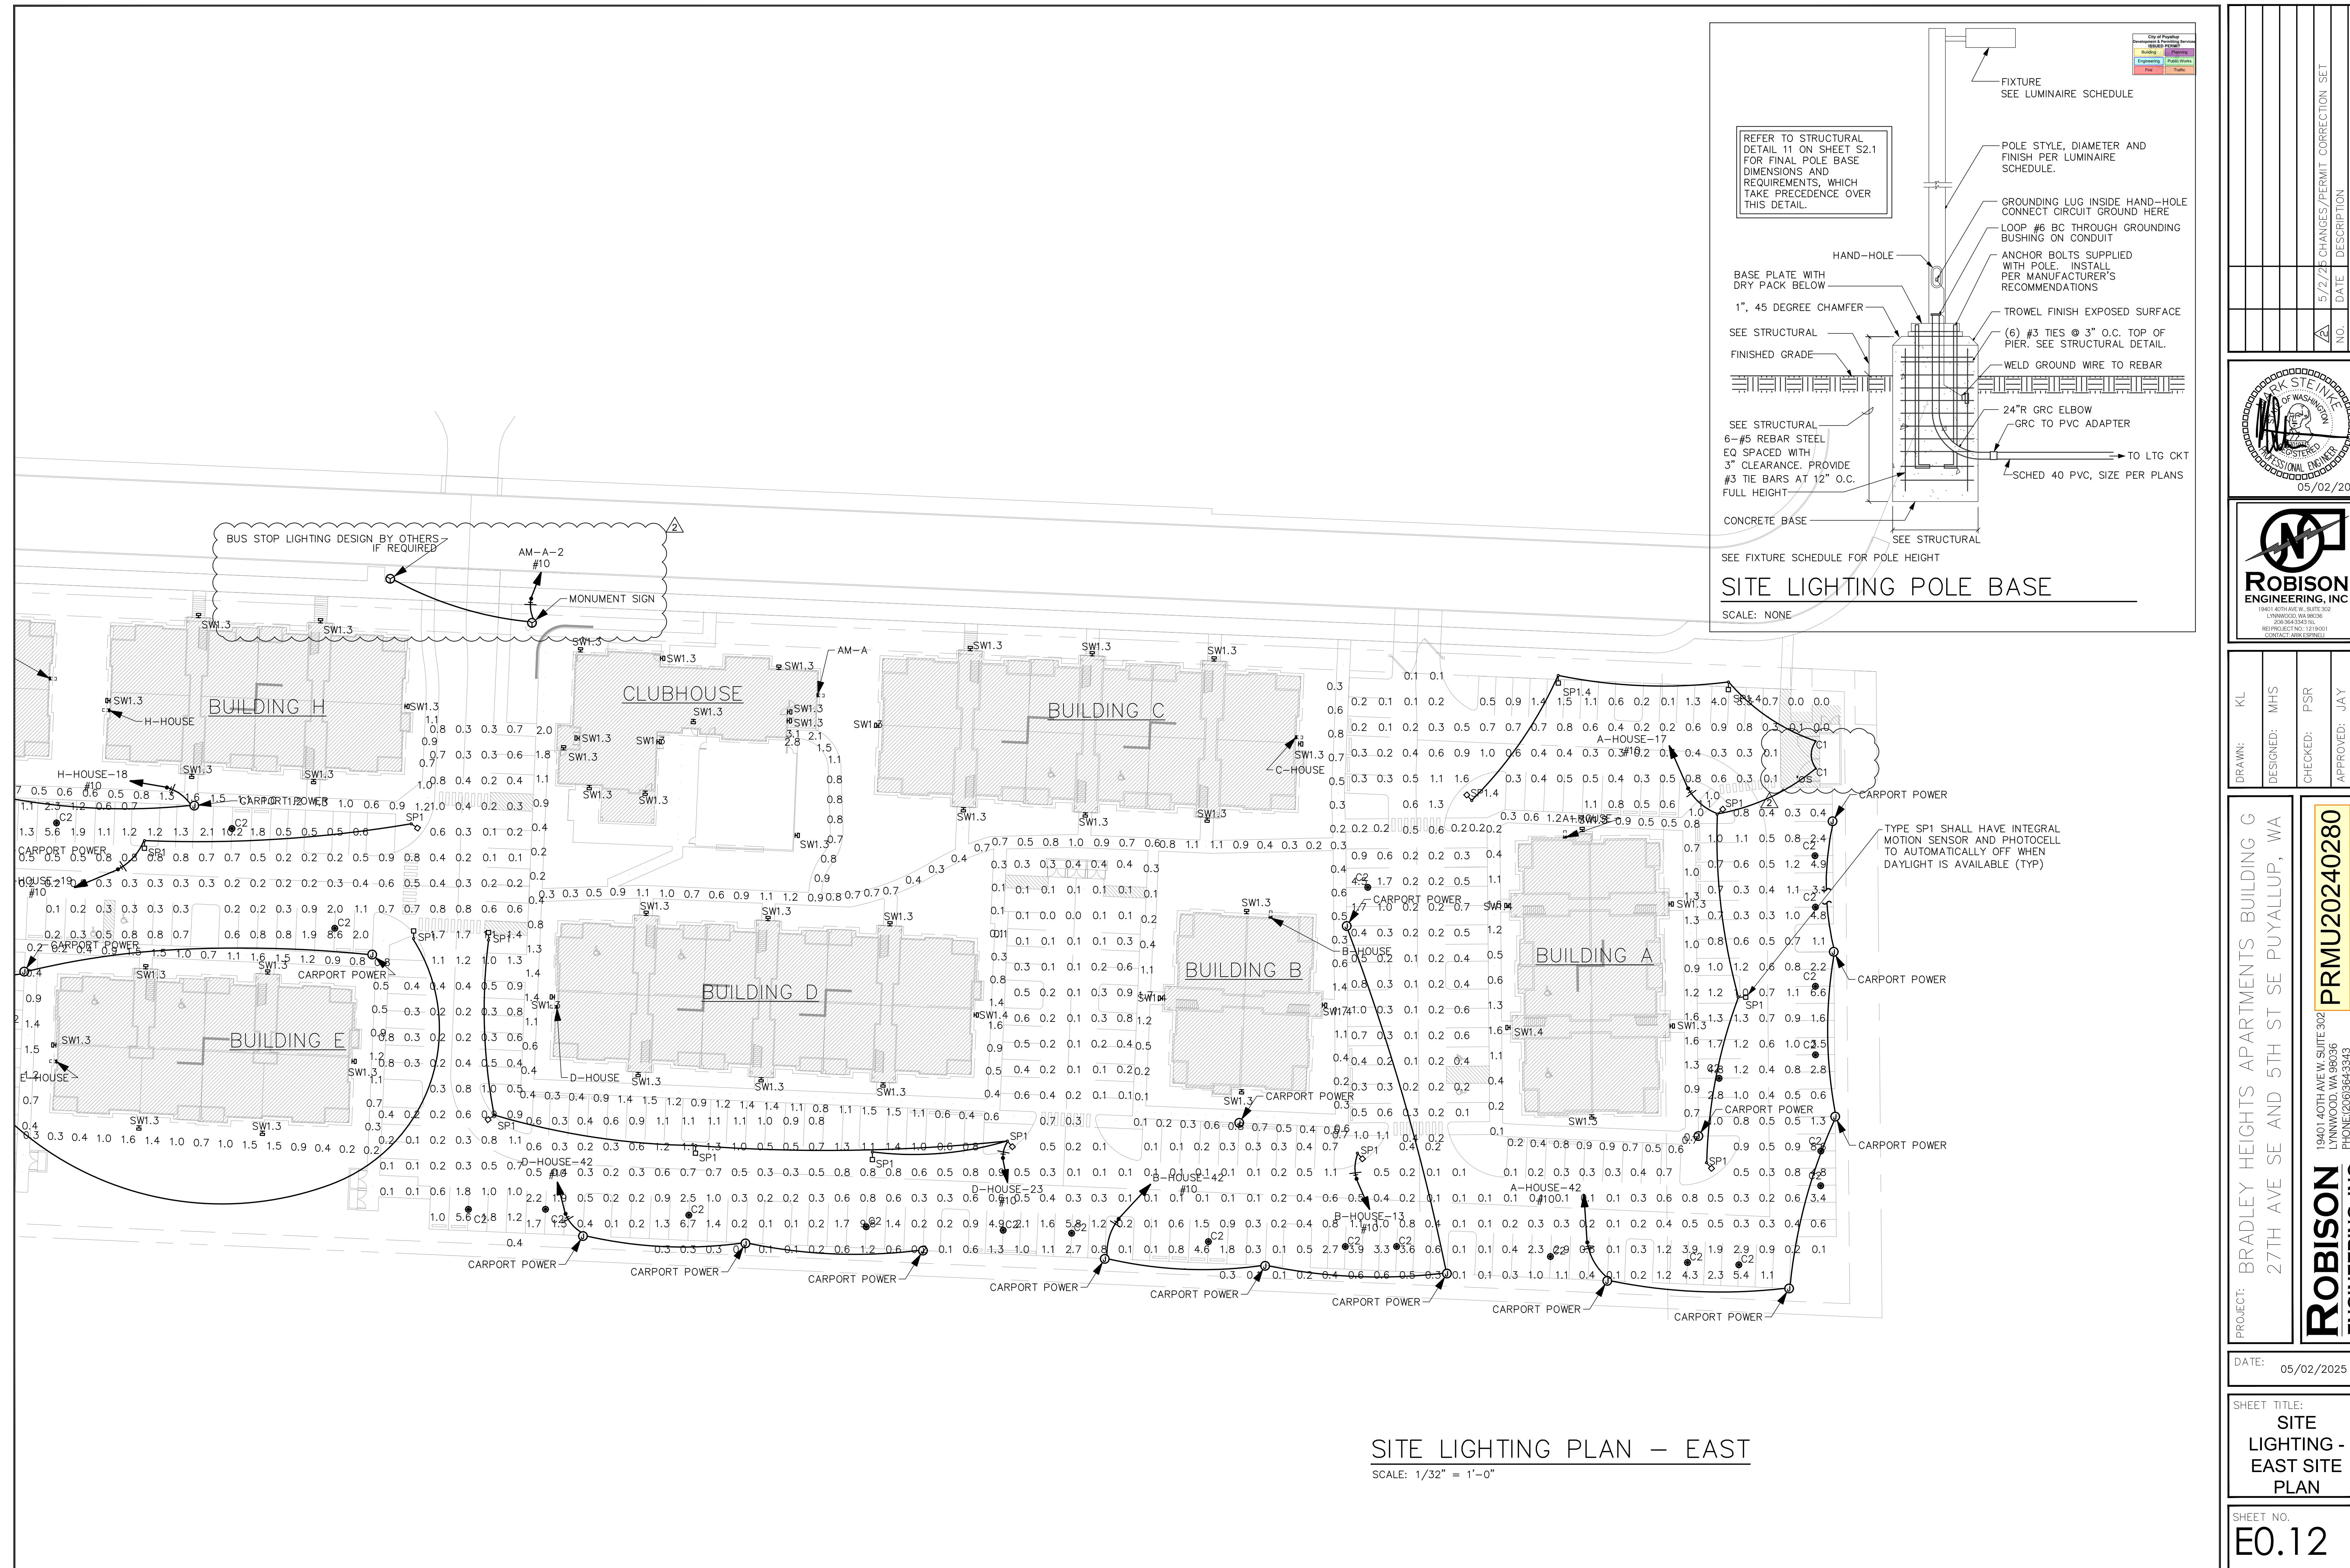

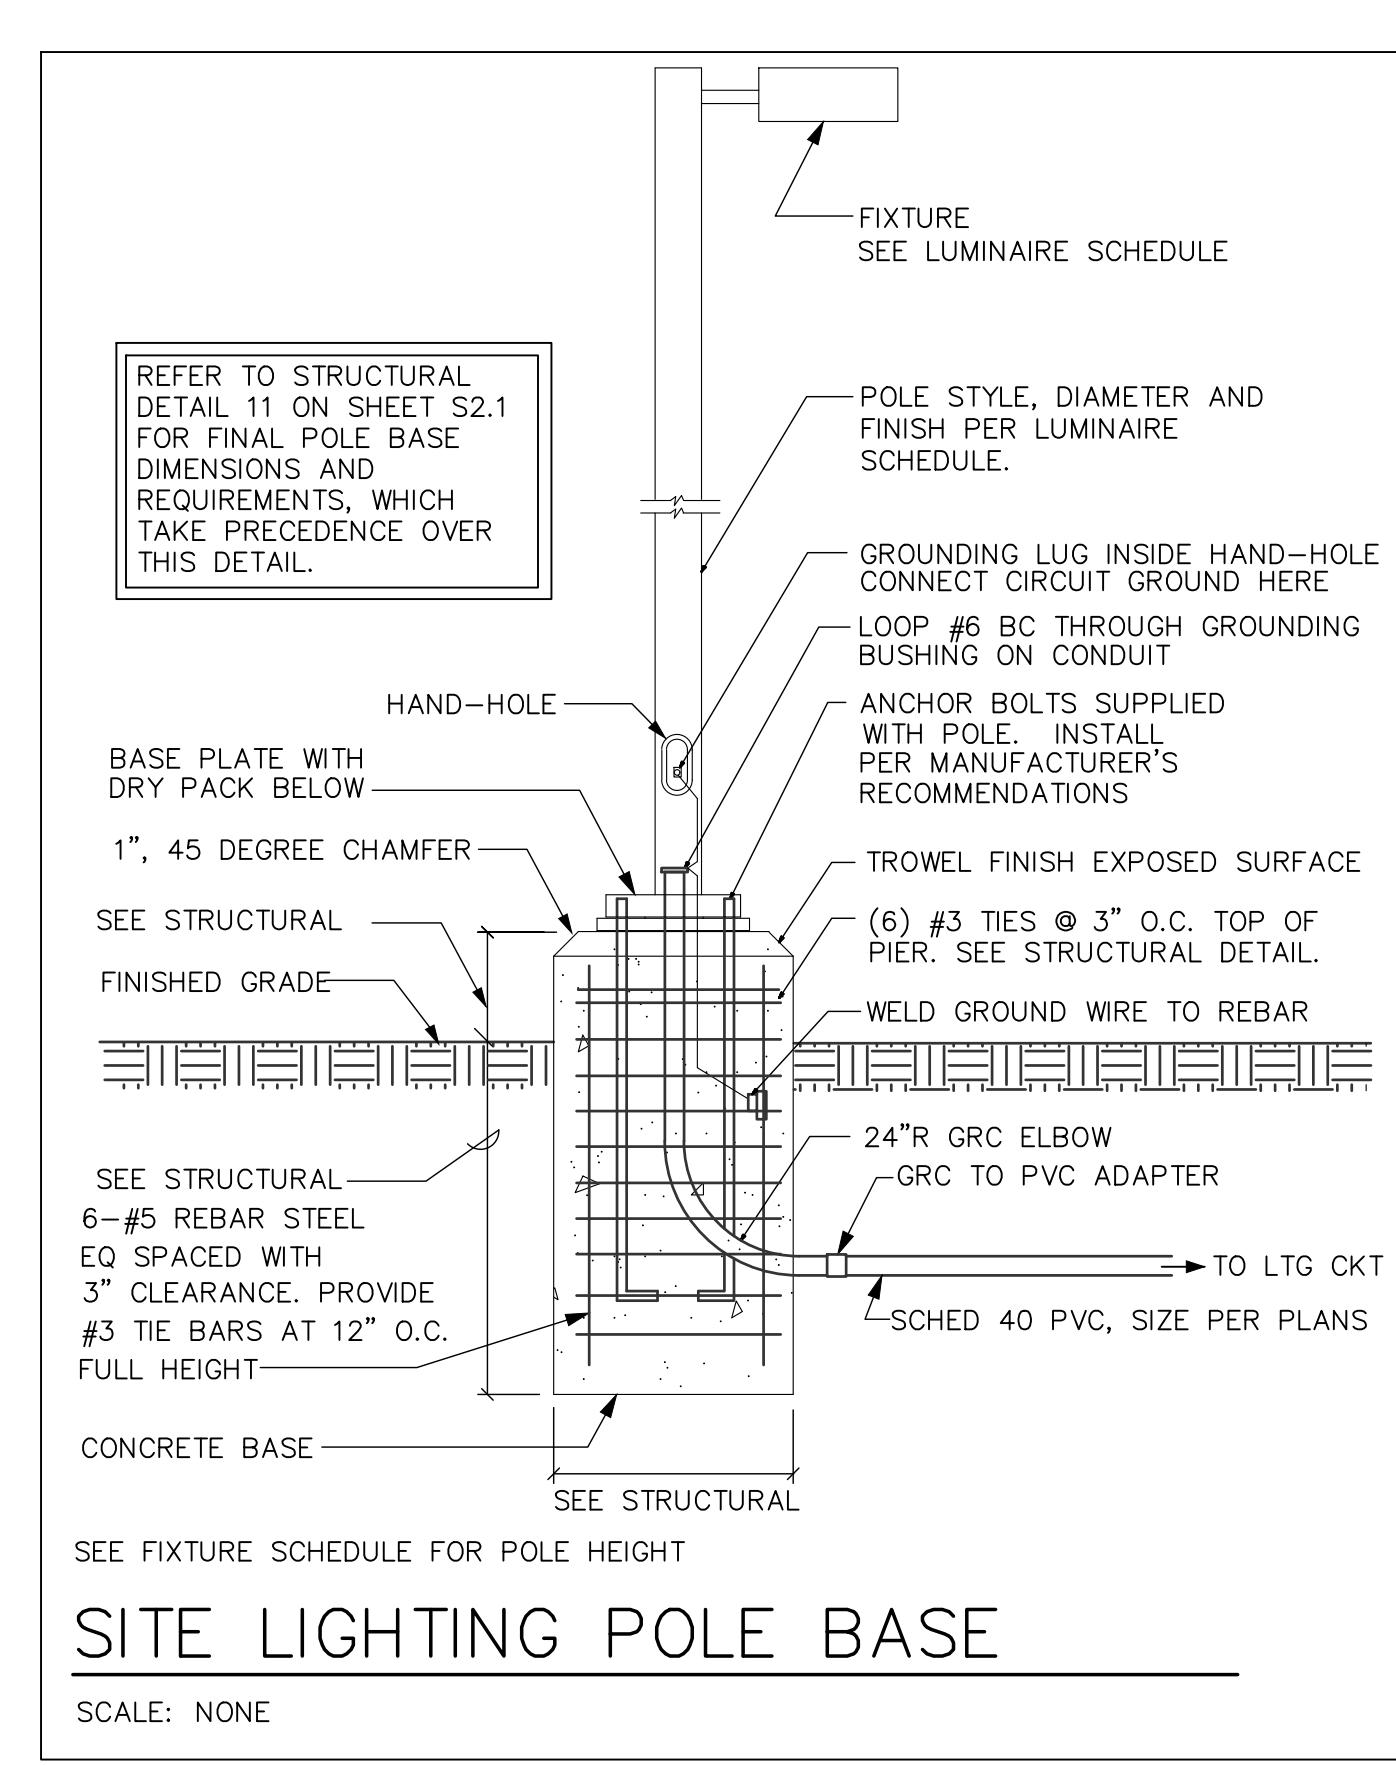

SITE LIGHTING POLE BASE


SCALE: NONE

Drive Aisle Photometric Schedule

AVERAGE FOOT-CANDLES	0.74
MAXIMUM FOOT-CANDLES	10.5
MINIMUM FOOT-CANDLES	0.0
MAXIMUM TO MINIMUM FC RATIO	912.07
AVERAGE TO MINIMUM FC RATIO	64.31




Walkway Photometric Schedule


AVERAGE FOOT-CANDLES	0.82
MAXIMUM FOOT-CANDLES	3.1
MINIMUM FOOT-CANDLES	0.1
MAXIMUM TO MINIMUM FC RATIO	41.68
AVERAGE TO MINIMUM FC RATIO	11.02

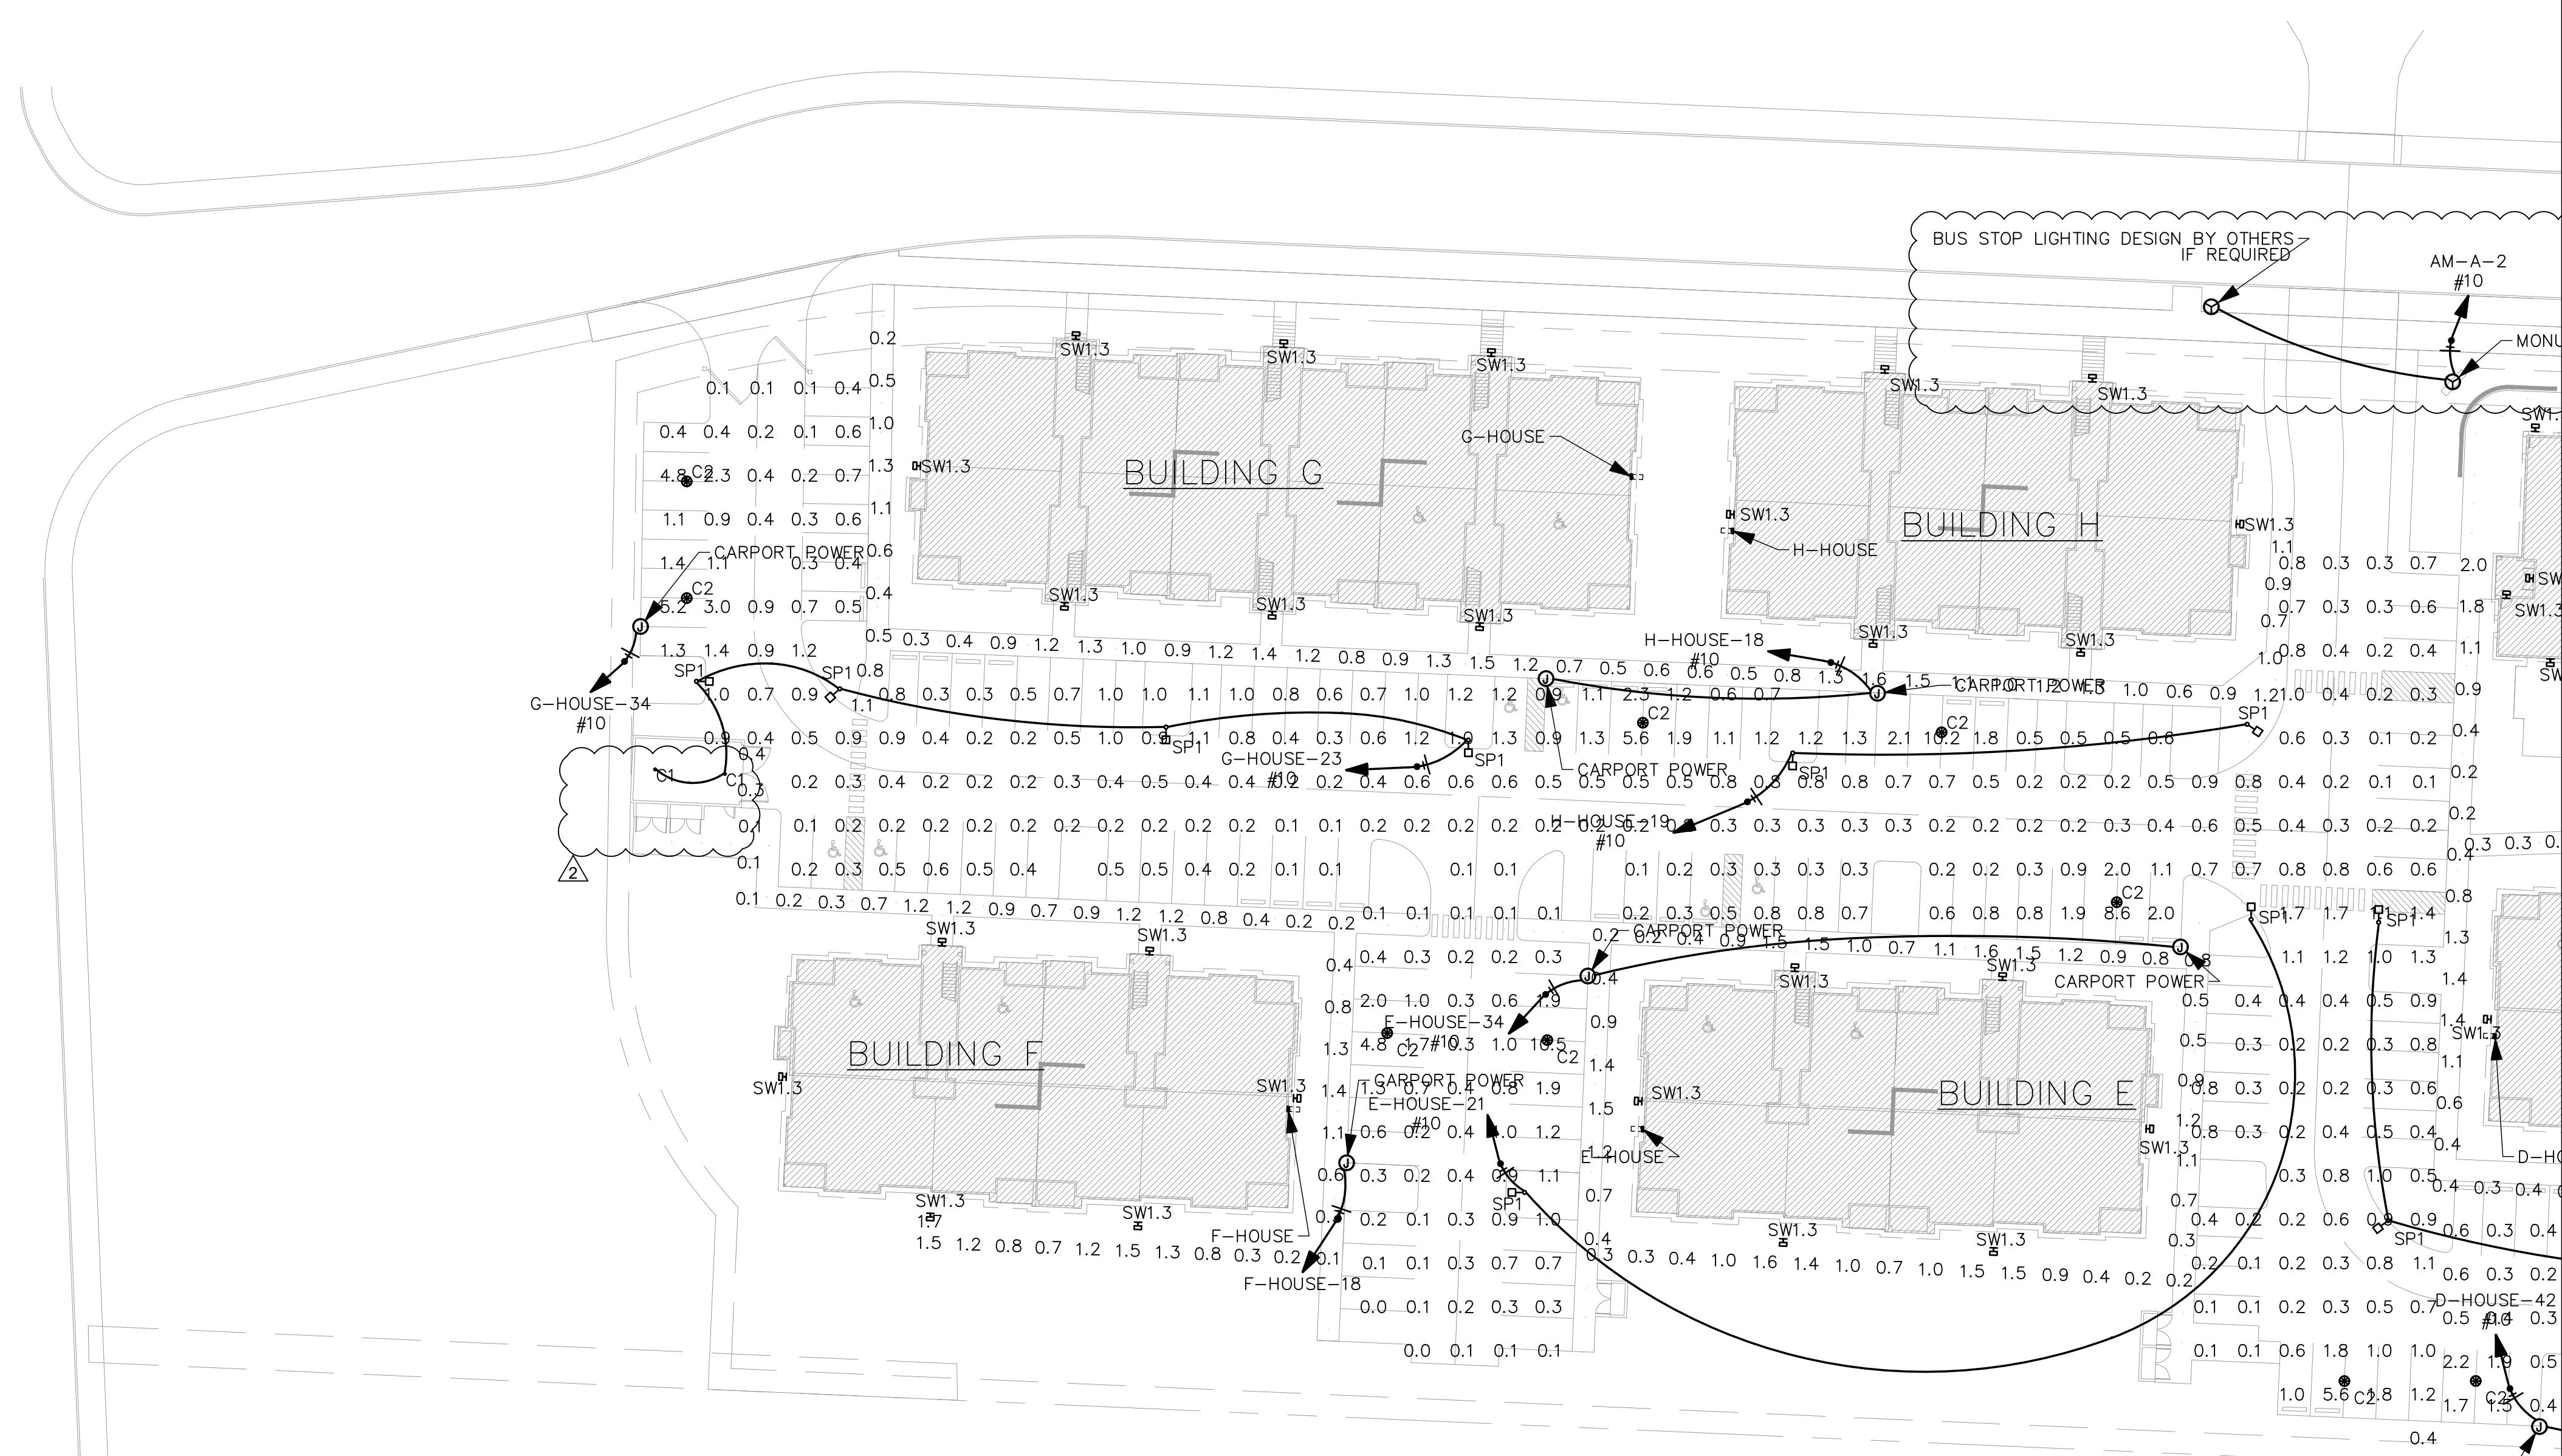

SITE LIGHTING PLAN – WEST


SCALE: 1/32" = 1'-0"

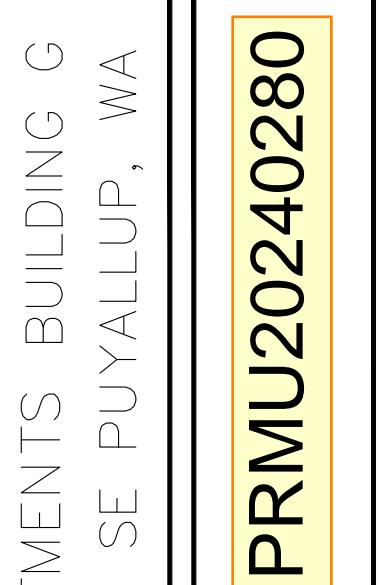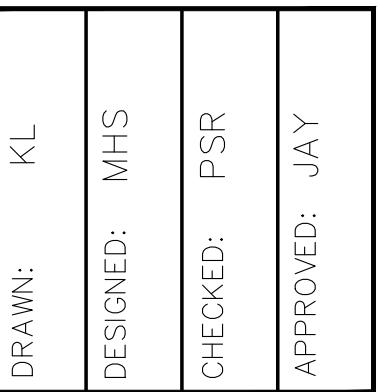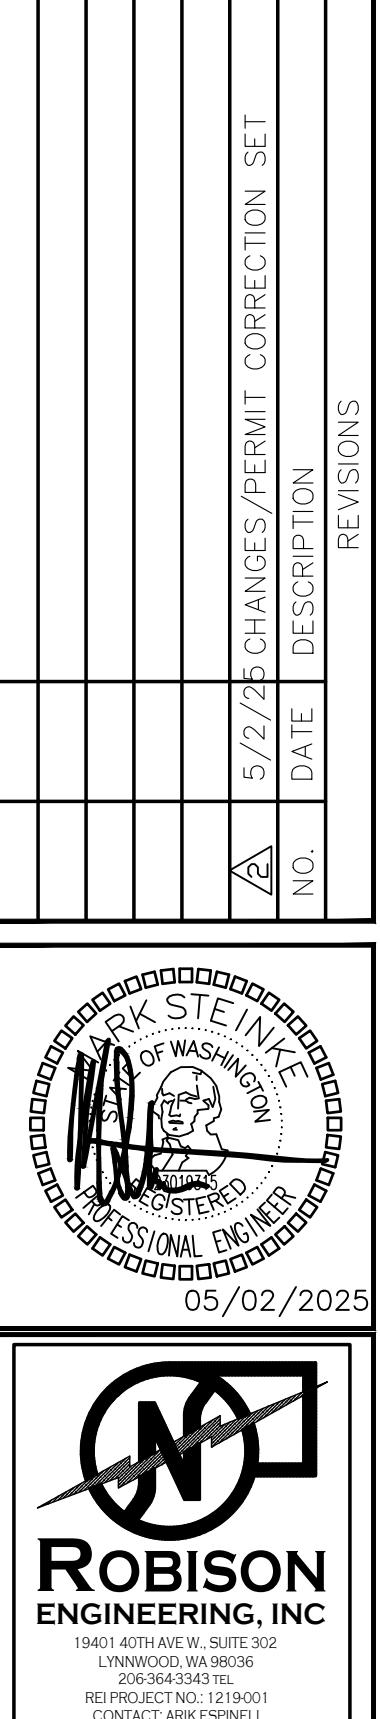

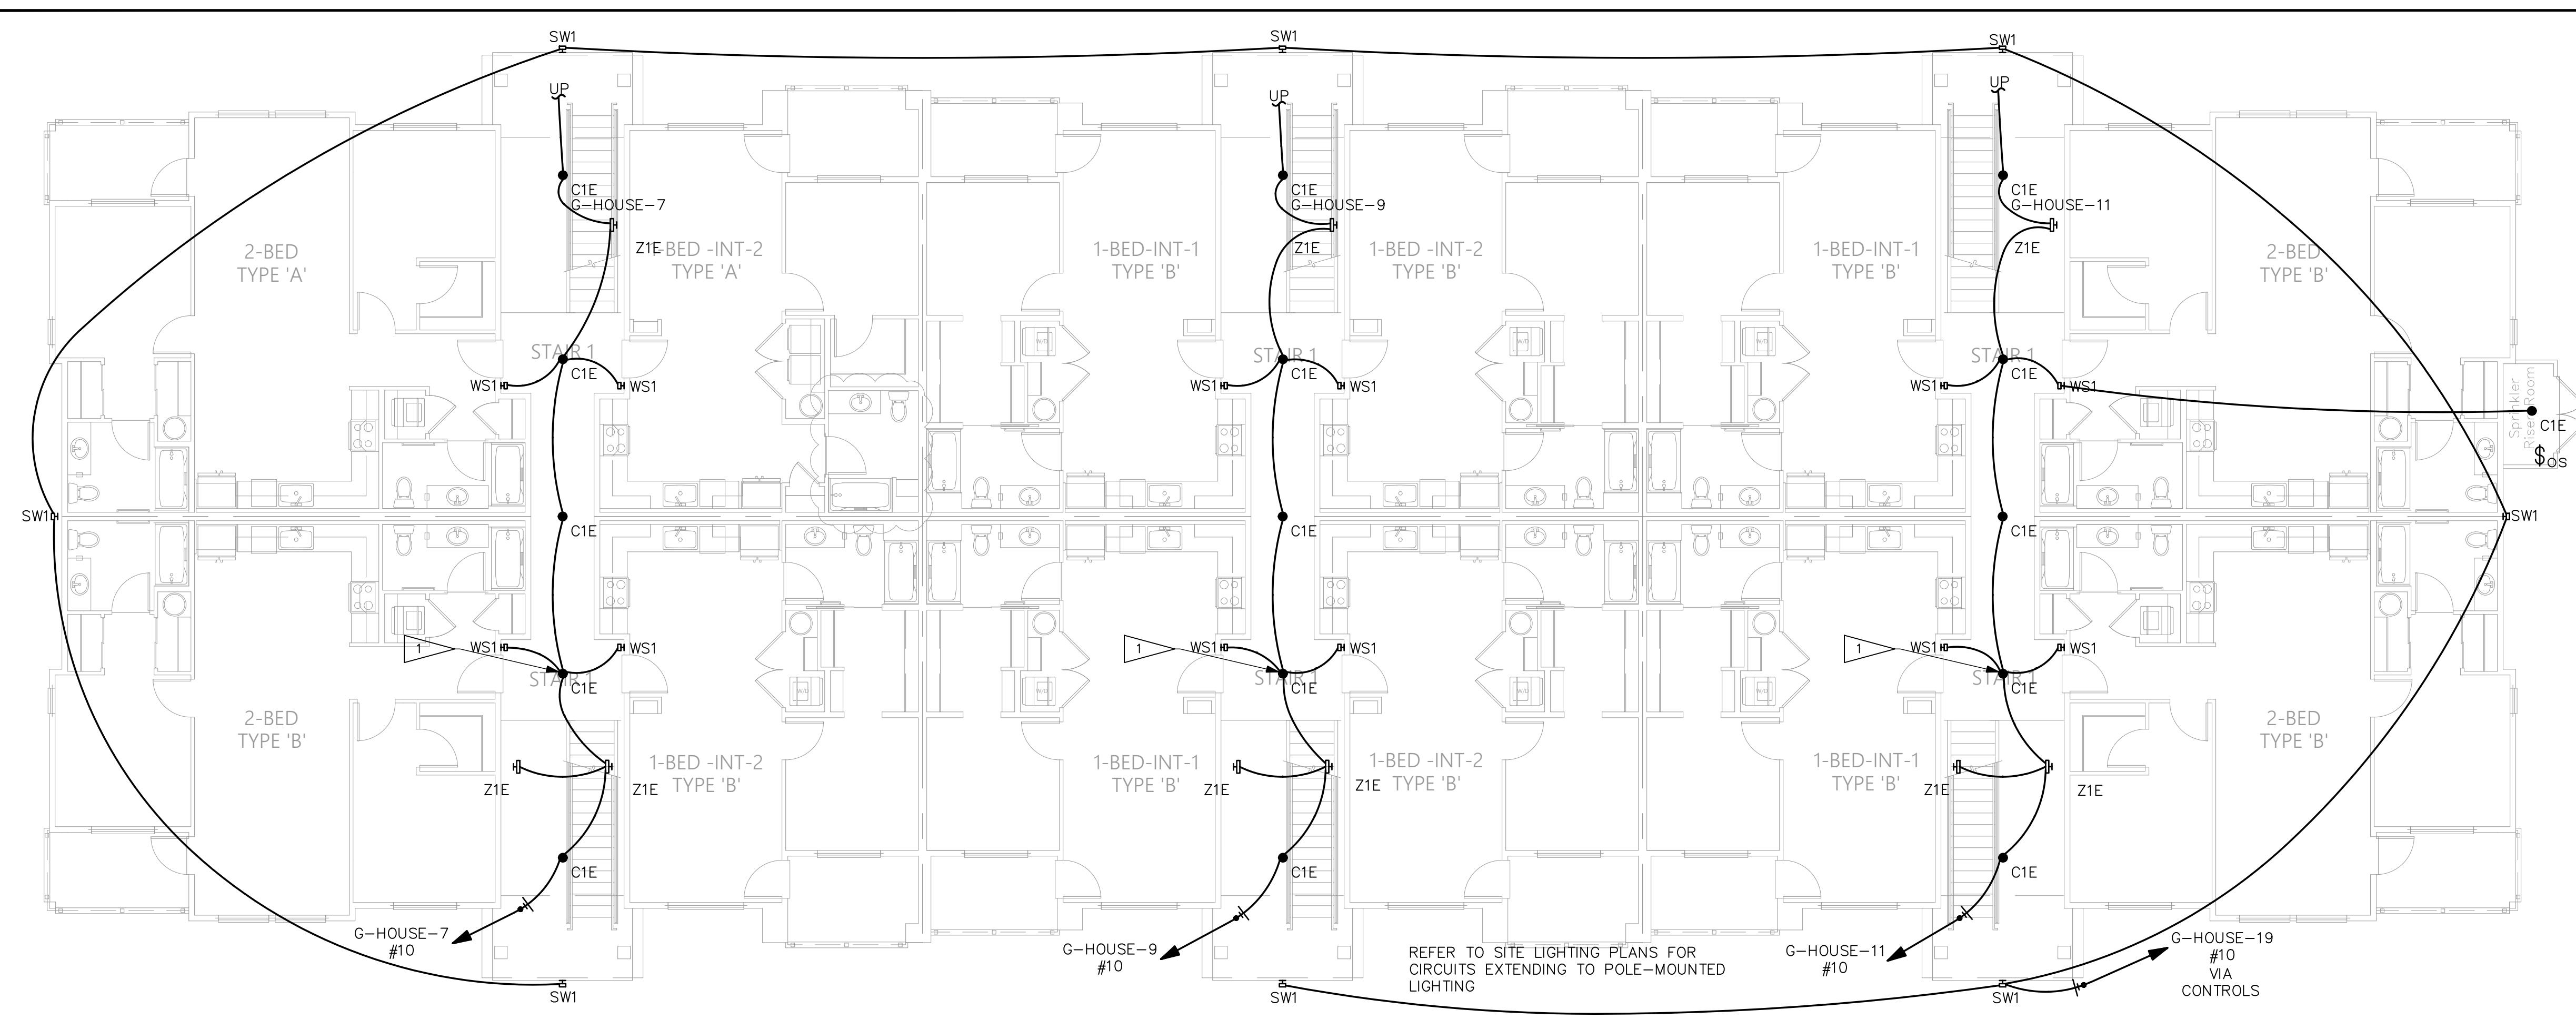

Egress Stair #1 Photometric Schedule

AVERAGE FOOT-CANDLES	11.69
MAXIMUM FOOT-CANDLES	17.5
MINIMUM FOOT-CANDLES	5.7
MINIMUM TO MAXIMUM FC RATIO	0.33
MAXIMUM TO MINIMUM FC RATIO	3.07
AVERAGE TO MINIMUM FC RATIO	2.05

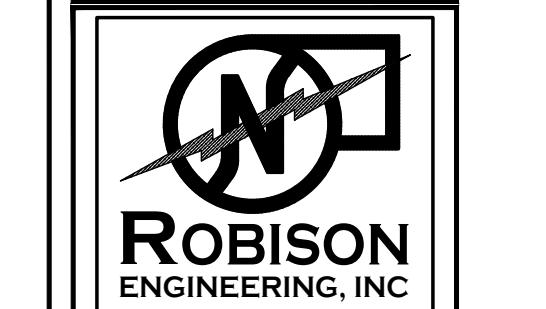


ROBISON
ENGINEERING, INC.

19401 40TH AVE W, SUITE 302
LYNNWOOD, WA 98036
PHONE: (206)364-3343

05/02/2025


Egress Photometric Schedule

AVERAGE FOOT-CANDLES	4.06
MAXIMUM FOOT-CANDLES	6.6
MINIMUM FOOT-CANDLES	1.6
MINIMUM TO MAXIMUM FC RATIO	0.25
MAXIMUM TO MINIMUM FC RATIO	4.03
AVERAGE TO MINIMUM FC RATIO	2.48

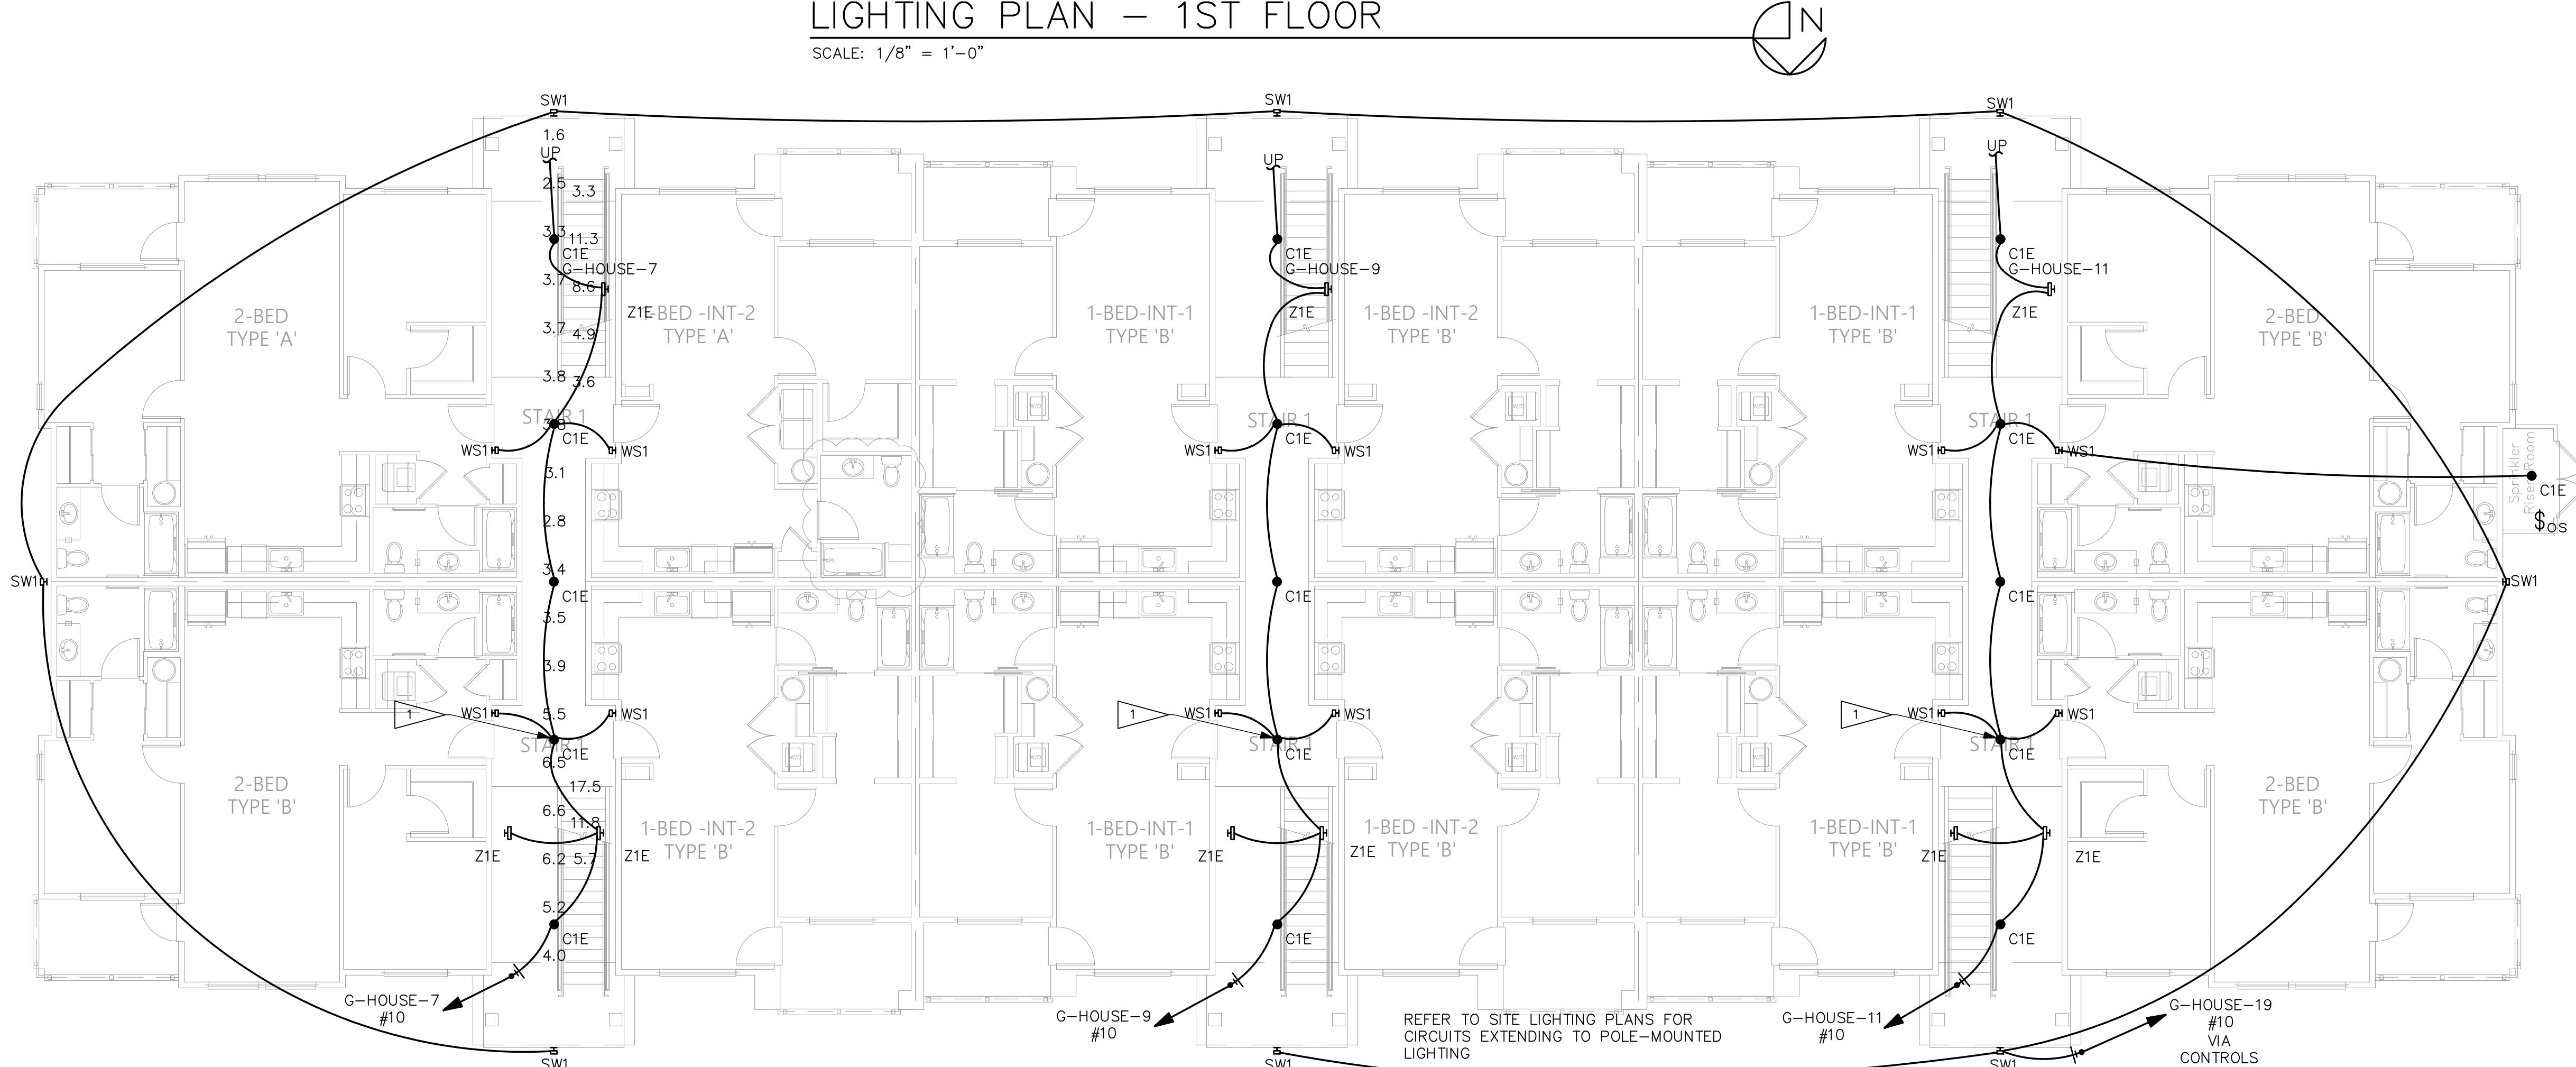

Egress Stair #2 Photometric Schedule

AVERAGE FOOT-CANDLES	6.35
MAXIMUM FOOT-CANDLES	11.3
MINIMUM FOOT-CANDLES	3.3
MINIMUM TO MAXIMUM FC RATIO	0.30
MAXIMUM TO MINIMUM FC RATIO	3.38
AVERAGE TO MINIMUM FC RATIO	1.90

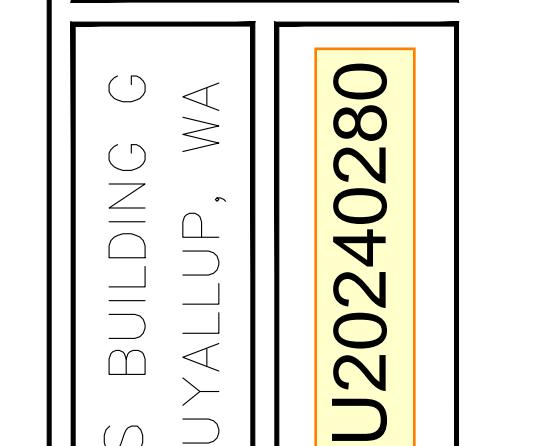

PRMU20240280

19401 40TH AVE W, SUITE 302
LYNNWOOD, WA 98036
PHONE: (206)364-3343

05/02/2025

ROBISON
ENGINEERING, INC.

19401 40TH AVE W, SUITE 302
LYNNWOOD, WA 98036
PHONE: (206)364-3343


05/02/2025

PROJECT: BRADLEY HEIGHTS APARTMENTS BUILDING C
27TH AVE SE AND 5TH ST SE PUYALLUP, WA

DATE: 05/02/2025



SHEET TITLE: LIGHTING & PHOTOMETRIC PLAN - 1ST FLOOR

SHEET NO. E1.00

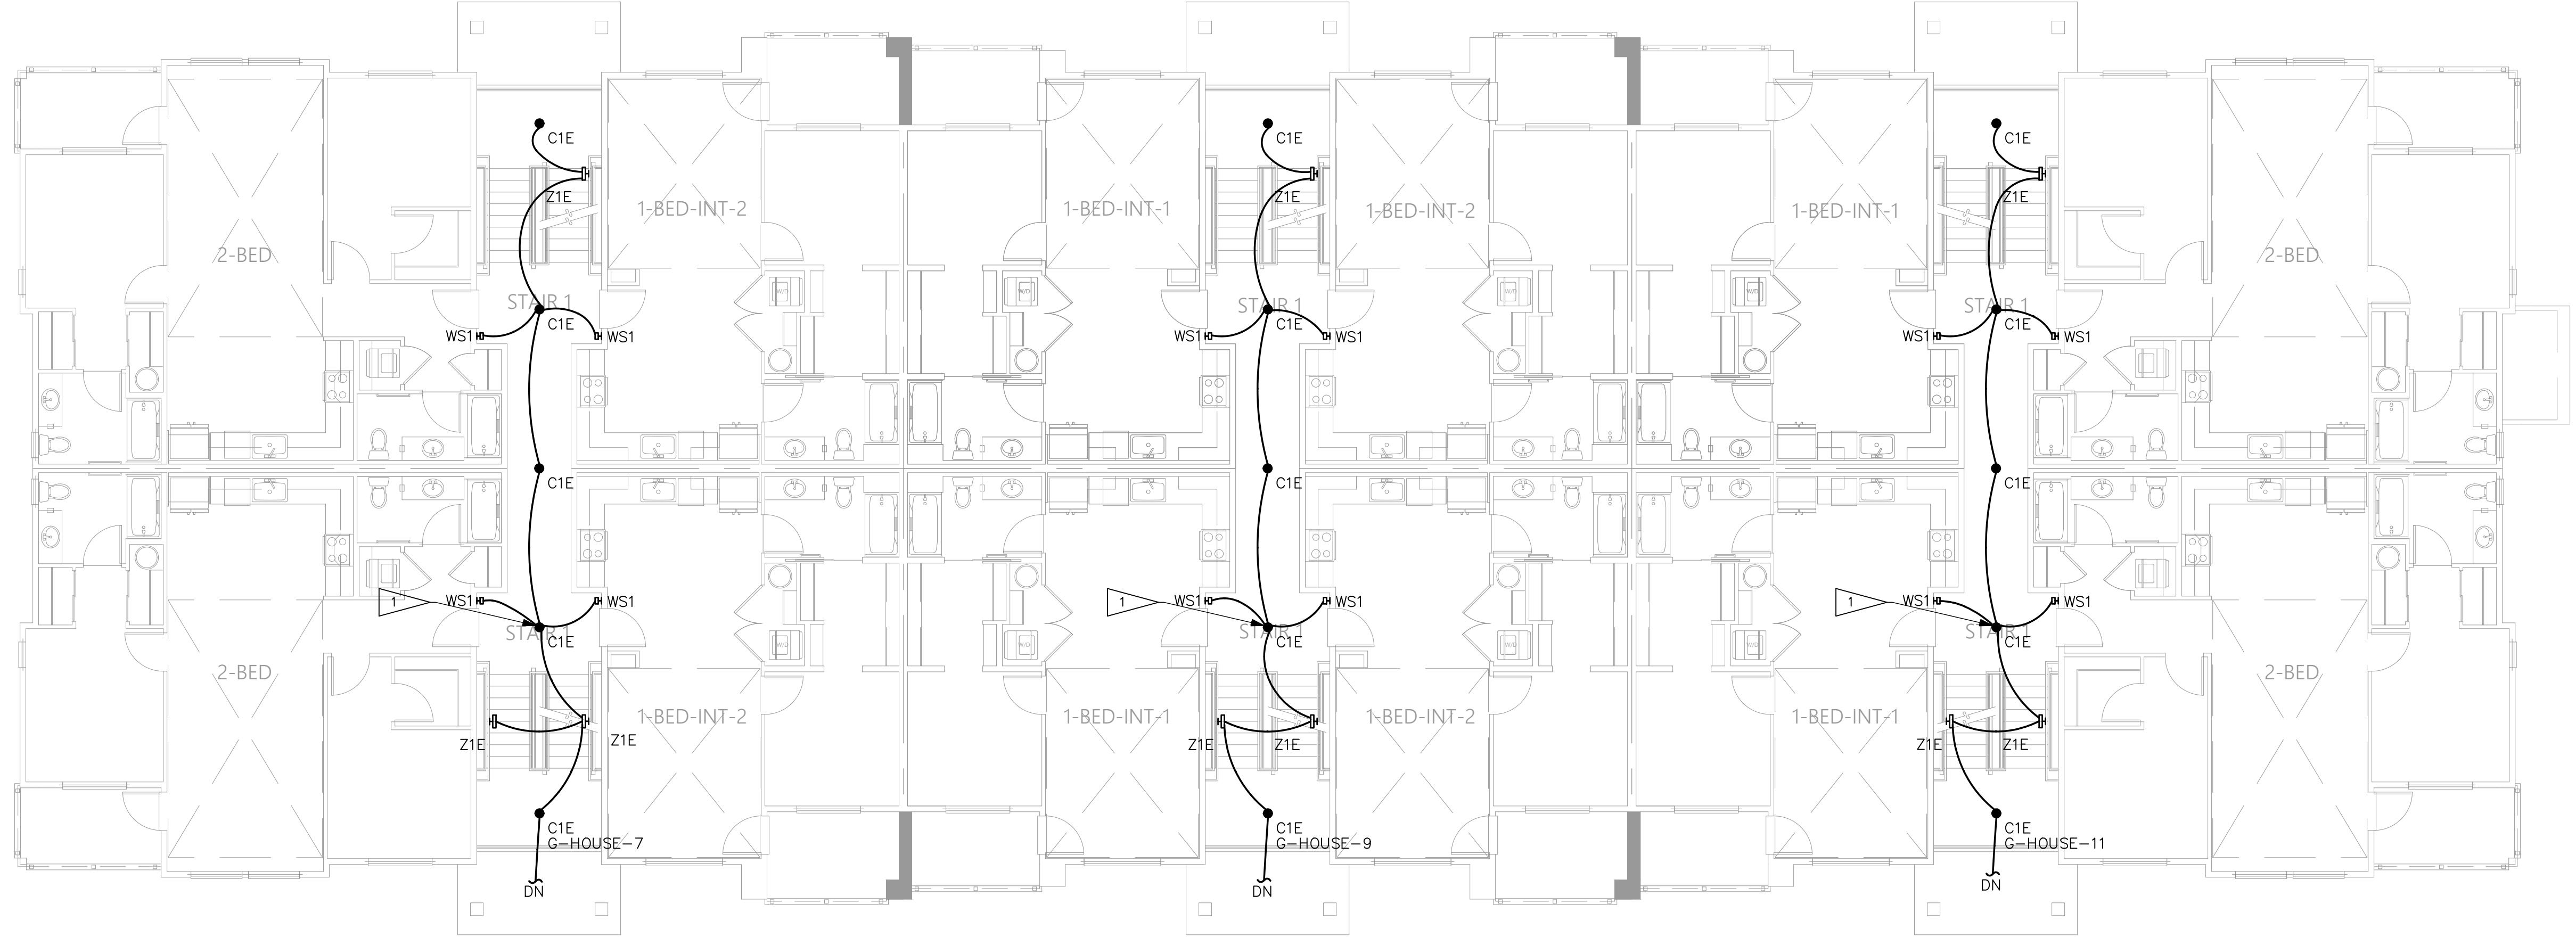

LIGHTING PLAN - 3RD FLOOR

SCALE: 1/8" = 1'-0"

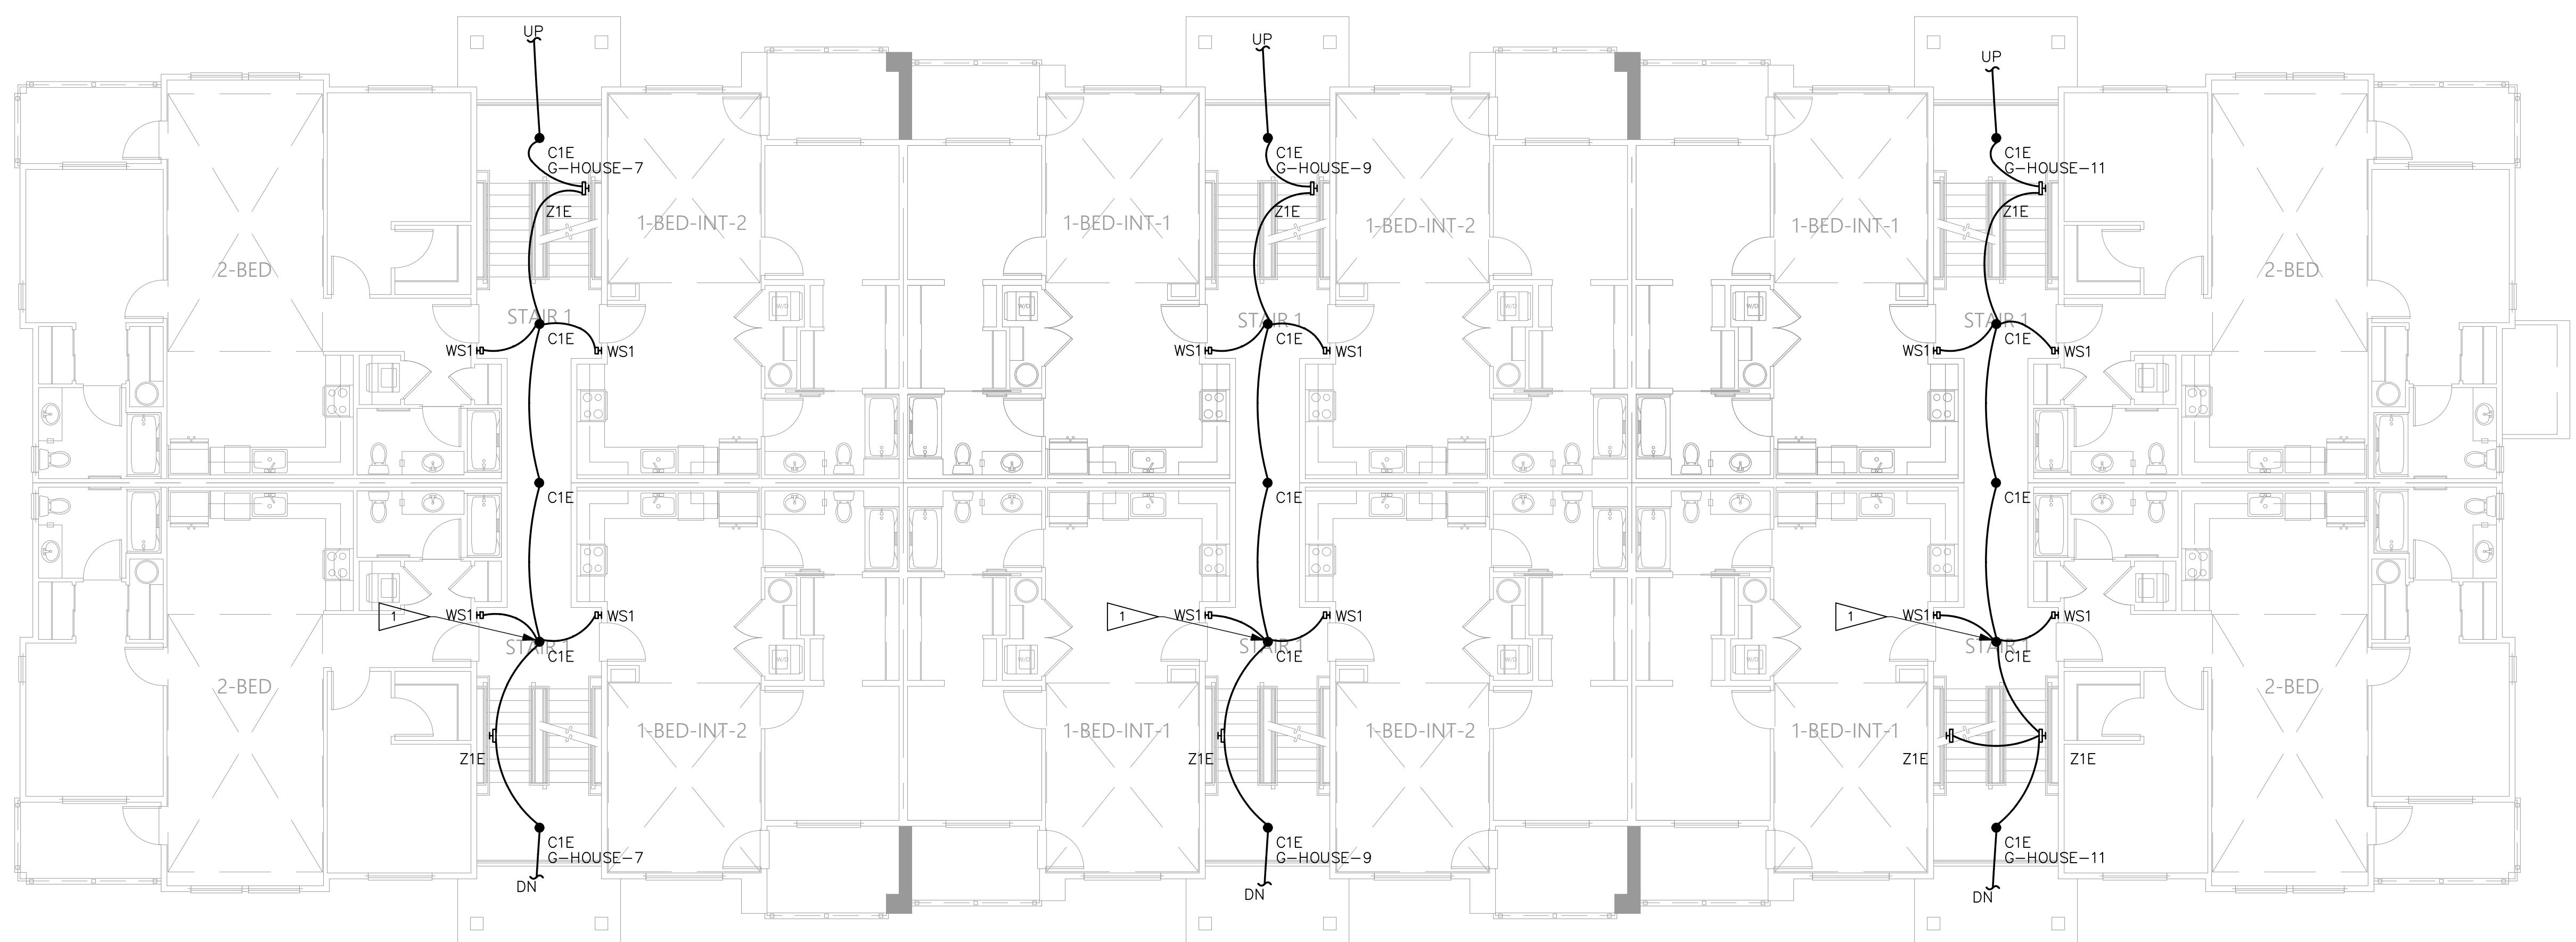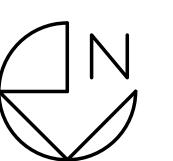

LIGHTING PLAN - 2ND FLOOR

SCALE: 1/8" = 1'-0"



GENERAL NOTES

1. EMERGENCY EGRESS LIGHTING: EMERGENCY LUMINAIRE 90 MINUTE BATTERY BACKUP.
2. REFER TO SERIES E500 DRAWINGS FOR TYPICAL UNIT PLANS SHOWING ELECTRICAL AND LIGHTING LAYOUT.
3. SEE SHEET E1.50 FOR LUMINAIRE SCHEDULE AND LIGHTING NOTES.

FLAG NOTES

1. CIRCUIT STAIRS VERTICALLY. LUMINAIRE(S) IN STAIRWELL
2. EXIT SIGNS: PROVIDE UNSWITCHED HOT.

City of Puyallup Development Services	Building Powering
Emergency Luminaire	Fire Protection
Traffic	

5/2/25 CHANGES/PERMIT CORRECTION SET

NO. DATE DESCRIPTION

REVISIONS



DRAWN: KL
DESIGNED: MHS
CHECKED: PSR
APPROVED: JAY

PROJECT: BRADLEY HEIGHTS APARTMENTS BUILDING C
27TH AVE SE AND 5TH ST SE PUYALLUP, WA
PHONE: (206)364-3343

19401 40TH AVE W, SUITE 302
LYNNWOOD, WA 98036
PHONE: (206)364-3343

PRMU20240280



DATE: 05/02/2025

SHEET TITLE: LIGHTING PLAN - 2ND & 3RD FLOOR

SHEET NO. E1.01

EXTERIOR LUMINAIRE SCHEDULE

CALLOUT	SYMBOL	MOUNTING	DESCRIPTION	MODEL	VOLTAGE	TYPE	CRI / CCT	LAMPING	WATTAGE
SP1		16' POLE	POLE LIGHT - PARKING & DRIVE AISLE - COMFORT OPTICS - B2 U0 G2	GARDCO: P20 C A02 830 T1S AR1 120 BL30-MW PCB	MULTIPLE	INTEGRAL CONTROLS	80 / 3000K	(1) 36W LED	36
SW1		SURFACE - 12' AFF	WALL SCONCE - AREA LIGHT - B1 U0 G1	GARDCO: GWM A06 830 T3M 120 MW30 PCB	120	INTEGRAL CONTROLS	80 / 3000K	(1) 16W LED	16

NOTES:

1. CONTRACTOR TO FURNISH AND INSTALL ALL FIXTURES.
2. LUMINAIRE SCHEDULE IS BOD ONLY. CONTRACTOR TO SUBMIT FIXTURE MODEL OR EQUIVALENT. CONTRACTOR TO COORDINATE FIXTURE FINISHES WITH ARCHITECT/OWNER.
3. FIXTURE CATALOG NUMBERS DO NOT NECESSARILY DENOTE SPECIFIC MOUNTING ACCESSORIES. CONTRACTOR TO PROVIDE ALL NECESSARY ACCESSORIES TO SUCCESSFULLY COMPLETE THE INSTALLATION.
4. 'BUG' RATING ON EXTERIOR FIXTURES INDICATES 'BACKLIGHT', 'UPLIGHT', AND 'GLARE' AS STANDARDS IN CLASSIFYING OUTDOOR LIGHT FIXTURES.

GENERAL LUMINAIRE SCHEDULE

CALLOUT	SYMBOL	MOUNTING	DESCRIPTION	MODEL	VOLTAGE	TYPE	CRI / CCT	LAMPING	WATTAGE
B1		SURFACE	4' NARROW WRAP - BOH	DAY-BRITE CFI: FSW440L835 UNV DIM	120	0-10V DIMMING	80 / 3000K	(1) 31.4W LED	31.4
C1E		SURFACE	4" SURFACE DOWNLIGHT	DMF: DRDH N JO 70S EM / DRD5S 4 R 07 9 30 EM	120	0-10V DIMMING	90 / 3000K	(1) 9W LED	9
D1		RECESSED	RECESSED DOWNLIGHT - SLOPED CEILING	DMF: DRD4M 10 9 30 FL X 0 / DRDH N JS 1004	120	0-10V DIMMING	90 / 3000K	(1) 12W LED	12
P1		PENDANT	STEM MOUNT DOWNLIGHT - SLOPED CEILING - 4' STEM	DMF: DCR T4 S X A 30 FL 0 00 30 XX 0 00 [FINISH]	120	0-10V DIMMING	90 / 3000K	(1) 40W LED	40
WS1		SURFACE	WALL SCONCE - EM BATTERY BACKUP	TBD	120	TBD DIMMING	TBD / TBD	(1) 5W LED	5
X1		SURFACE	EXIT SIGN - EMERGENCY BATTERY BACKUP - HATCH INDICATES LIT FACE	LSI: EMS WB SERIES (OR EQUAL)	MULTIPLE	EM	EM / EM	(1) 5W EM	5
X2		SURFACE	COMBO EXIT SIGN	LSI: CEC (OR EQUAL)	MULTIPLE	EM	EM / EM	(1) 5W EM	5
X3		SURFACE	EMERGENCY LIGHT - EMERGENCY BATTERY BACKUP - DAMP LOCATION RATED - MAX 35' SPACING	LITHONIA: ELM2LF (OR EQUAL)	120	EM	EM / EM	(1) 5W EM	5
X4		WALL	EXTERIOR EMERGENCY LIGHT - EMERGENCY ON ONLY - MAX SPACING 35'	NORA LIGHTING: NE-902LED	120	EM	35' MAX SPACING	(1) 5W LED	5
Z1E		WALL	WALL PACK	LITHONIA: WPX1 LED P1 30K MVOLT	120	EM	70 / 3000K	(1) 11W LED	11

NOTES:

1. CONTRACTOR TO FURNISH AND INSTALL ALL FIXTURES.
2. LUMINAIRE SCHEDULE IS BOD ONLY. CONTRACTOR TO SUBMIT FIXTURE MODEL OR EQUIVALENT. CONTRACTOR TO COORDINATE FIXTURE FINISHES WITH ARCHITECT/OWNER.
3. FIXTURE CATALOG NUMBERS DO NOT NECESSARILY DENOTE SPECIFIC MOUNTING ACCESSORIES. CONTRACTOR TO PROVIDE ALL NECESSARY ACCESSORIES TO SUCCESSFULLY COMPLETE THE INSTALLATION.

LIGHTING CONTROLS LEGEND

SYMBOL	CONTROL TYPE	CONTROL FUNCTION
	TOGGLE SWITCH	MANUAL ON/OFF LIGHTING CONTROL. SUBSCRIPT INDICATES WHICH FIXTURES ARE TO BE CONTROLLED BY WHICH SWITCH (WSEC C405.2.3), SUBSCRIPT 'k' INDICATES TAMPER RESISTANT KEYED SWITCH FOR USE BY AUTHORIZED PERSONNEL ONLY.
	DIMMER SWITCH	MANUAL MULTI-LEVEL LIGHTING CONTROL. SWITCH SHALL ALSO HAVE MANUAL ON/OFF FUNCTIONALITY. SUBSCRIPT INDICATES WHICH FIXTURES ARE TO BE CONTROLLED BY WHICH DIMMER. (C405.2.3)
	TOGGLE/DIMMER SWITCH WITH OCCUPANCY SENSOR	SWITCHES LABELED 'os' OR 'vs' SHALL TURN OFF ALL CONNECTED LUMINAIRES WITHIN 20 MINUTES OF SPACE BEING VACANT. (C405.2.1.1)
	CONTROL STATION; SEE LIGHTING CONTROL ZONE TABLE ON PLANS.	MANUAL LOCAL LIGHTING CONTROL (C405.2.1.1). CONTROL STATION SHALL HAVE CAPACITY TO CONTROL MULTIPLE ZONES AND MULTIPLE SCENES AS NEEDED. SUBSCRIPT CORRESPONDS TO 'LIGHTING CONTROLS' TABLE ON PLANS.
	SURFACE MOUNTED OCCUPANCY SENSOR	AUTOMATIC LIGHTING CONTROL SHALL TURN OFF ALL CONNECTED LUMINAIRES WITHIN 20 MINUTES OF SPACE BEING VACANT. (C404.2.1.1)
	MULTIZONE PHOTOSENSOR	AUTOMATIC LIGHTING CONTROL SHALL AUTOMATICALLY ADJUST THE LIGHT OUTPUT OF ALL CONNECTED LUMINAIRES BASED ON THE DAYLIGHT LEVEL IN THE PRIMARY AND SECONDARY ZONES (C405.2.4). SUBSCRIPT INDICATES WHICH FIXTURES ARE TO BE CONTROLLED BY ZONE; 'x' INDICATES MULTIPLE ZONE CONTROL.

GENERAL LIGHTING NOTES

1. LIGHTING CONTROLS SHALL BE INSTALLED WHICH MEET ALL REQUIREMENTS OF LOCAL ENERGY CODE.
2. EMERGENCY LIGHT FIXTURES: IN ADDITION TO SWITCH-LEG, PROVIDE UNSWITCHED HOT TO SERVE INTERNAL BATTERY AND CHARGER.
3. LOCATIONS OF OCCUPANCY SENSORS, PHOTO SENSORS, DIMMERS, AND SWITCHES ARE DIAGRAMMATIC. CONTRACTOR TO COORDINATE QUANTITIES AND OPTIMAL LOCATIONS WITH LIGHTING CONTROL MANUFACTURER AND ARCH/OWNER.
4. AUTOMATIC LIGHTING SHUT-OFF CONTROLS SHALL BE PROVIDED BY LOCAL OCCUPANCY SENSORS UNLESS OTHERWISE NOTED. PUBLIC SPACES ARE ACTIVE 24/7 AND THEREFORE EXEMPT FROM AUTOMATIC LIGHTING SHUT-OFF REQUIREMENTS FOR SECURITY. (WSEC C405.2)
5. DAYLIGHT ZONES ARE SHOWN ON PLANS AS DEFINED BY WASHINGTON STATE ENERGY CODE (WSEC) C405.2.4.2. SIDELIGHT DAYLIGHT ZONES ARE REFERRED TO AS 'PRIMARY' AND 'SECONDARY' ON PLANS AND DENOTED BY DASHED LINES.
6. FOR CUSTOM FF&E FIXTURES, IT IS THE MANUFACTURER'S RESPONSIBILITY TO FURNISH PRODUCTS WHICH ARE COMPLIANT WITH ALL REQUIREMENTS OF LOCAL ENERGY CODES, AS WELL AS MATCH THE ELECTRICAL SPECIFICATIONS PROVIDED IN THE LUMINAIRE SCHEDULES. PROVIDE SUBMITTAL SHOP DRAWINGS WITHIN 30 DAYS OF RECEIVING FIXTURE ORDER. SUBMITTALS SHALL CLEARLY INDICATE LAMPING AND MAXIMUM WATTAGE RATING OF LAMP SOCKETS. NON-COMPLIANT FIXTURES REJECTED BY ELECTRICAL INSPECTOR SHALL BE RETURNED TO THE MANUFACTURER FOR REWORKING AND/OR RE-LABELING.
7. ALL FIXTURES SHALL BE INSTALLED ACCORDING TO THE MANUFACTURER'S INSTRUCTIONS.
8. CONTRACTOR SHALL BE RESPONSIBLE TO ORDER ALL NECESSARY HARDWARE, ELECTRICAL CABLE, TIMERS, TRANSFORMERS, ETC., AS REQUIRED FOR COMPLETION OF INSTALLATION OF A FULLY FUNCTIONING SYSTEM.
9. CONTRACTOR SHALL BE RESPONSIBLE FOR EQUIPPING ALL FIXTURES WITH THE EXACT LAMPS SPECIFIED IN THE FIXTURE SCHEDULE.
10. WHERE FIXTURES REQUIRE REMOTE TRANSFORMERS OR BALLASTS, THE CONTRACTOR SHALL DETERMINE LOCATIONS AS REQUIRED FOR EVEN LOAD DISTRIBUTION, SERVICE ACCESS, AND VENTILATION.
11. THE CONTRACTOR SHALL COORDINATE WITH THE ELECTRICAL ENGINEER FOR EXACT LOCATIONS OF TIMERS AND/OR PHOTO CELLS, IF ANY.
12. WHERE APPLICABLE, THE CONTRACTOR SHALL AIM AND ADJUST LIGHTING FIXTURES AS DIRECTED BY THE LIGHTING DESIGNER UPON COMPLETION OF THE INSTALLATION.

SPECIAL NOTE TO THE CONTRACTOR:

1. FIXTURE SUBMITTALS THAT DO NOT INCLUDE LAMP SPECIFICATIONS WILL BE CONSIDERED INCOMPLETE AND WILL NOT BE REVIEWED.

LIGHTING CONTROL SYSTEM REQUIREMENTS

1. CONTRACTOR TO PROVIDE A FULLY OPERATIONAL LIGHTING CONTROL SYSTEM.
2. CONTRACTOR SHALL VERIFY THE COMPATIBILITY OF DIMMING AND CONTROL MODULES WITH FIXTURE TYPES PRIOR TO INSTALLATION.
3. ELECTRICAL CONTRACTOR SHALL COORDINATE WITH A LIGHTING CONTROLS VENDOR TO OBTAIN LIGHTING CONTROL SYSTEM PACKAGE COMPLETE WITH DEVICES, WIRING DIAGRAMS, ANNOTATED PLANS INDICATING WHICH DEVICE TO BE USED IN EACH LOCATION, CONNECTION REQUIREMENTS, SET UP INSTRUCTIONS, COMMISSIONING AND CHECK-OUT FOLLOWING COMPLETION. PROVIDE ALL LOW VOLTAGE WIRING AS REQUIRED FOR CONTROL DEVICE INTERCONNECTIONS.
4. INSTALLER QUALIFICATIONS: TECHNICIAN INSTALLING AND WIRING THE LIGHTING CONTROL SYSTEM SHALL HAVE INSTALLED THIS SAME SYSTEM AT LEAST ONCE PREVIOUSLY. TECHNICIAN SHALL HAVE RECEIVED TRAINING BY FACTORY REPRESENTATIVE ON THE SYSTEM BEING INSTALLED.
5. PROVIDE LIGHTING CONTROL SYSTEM TO PERFORM THE FUNCTIONS DESCRIBED BELOW:
 1. LIGHTING CONTROL SCHEDULE: PROVIDE SEPARATE SWITCHING AND DIMMING CONTROL FOR LIGHTING ZONES AS INDICATED.
 2. AUTOMATIC LIGHTING CONTROLS:
 1. UNLESS OTHERWISE NOTED ON PLANS, OCCUPANCY SENSORS SHALL AUTOMATICALLY TURN OFF ALL CONNECTED LIGHTING WITHIN 20 MINUTES OF SPACE BEING UNOCCUPIED. OCCUPANCY SENSORS SHALL EITHER BE MANUAL ON OR SHALL BE CONTROLLED TO AUTOMATICALLY TURN THE LIGHTING ON TO NOT MORE THAN 50 PERCENT POWER EXCEPT WHERE MANUAL ON WOULD ENDANGER THE SAFETY OR SECURITY OF THE ROOM OR BUILDING OCCUPANTS. (C405.2.1)
 2. MULTI-ZONE PHOTO-SENSORS SHALL PROVIDE SEPARATE CONTROL FOR LUMINAIRES IN EACH TYPE OF DAYLIGHT ZONE. (C405.2.4.1)
 3. EXTERIOR LIGHTING CONTROLS SHALL AUTOMATICALLY TURN OFF ALL EXTERIOR LIGHTING AS A FUNCTION OF AVAILABLE DAYLIGHT. BUILDING FAÇADE AND LANDSCAPE LIGHTING SHALL HAVE CONTROLS THAT AUTOMATICALLY SHUT OFF THE LIGHTING FOR A MINIMUM OF 6 HOURS PER NIGHT OR NOT LATER THAN ONE HOUR AFTER BUSINESS CLOSING TO NOT EARLIER THAN ONE HOUR BEFORE BUSINESS OPENING, WHICHEVER IS LESS. OTHER LIGHTING SHALL HAVE CONTROLS CONFIGURED TO AUTOMATICALLY REDUCE THE CONNECTED LIGHTING POWER BY AT LEAST 30 PERCENT FROM NO LATER THAN 12 MIDNIGHT TO 6 AM OR FROM ONE HOUR AFTER BUSINESS CLOSING TO ONE HOUR BEFORE BUSINESS OPENING OR DURING ANY PERIOD WHEN NO ACTIVITY HAS BEEN DETECTED FOR A TIME OF NO LONGER THAN 15 MINUTES. (C405.2.6)
 6. MEANS OF EGRESS ILLUMINATION: AT ANY TIME THE BUILDING IS OCCUPIED, THE MEANS OF EGRESS SHALL BE ILLUMINATED AT AN INTENSITY OF NOT LESS THAN 1 FOOTCANDLE AT FLOOR LEVEL. (IBC 1008.2.1)
 7. DURING EMERGENCY CONDITIONS EMERGENCY LIGHTING CIRCUITS SHALL BYPASS ALL LIGHTING CONTROLS IN ORDER TO ENERGIZE ALL CONNECTED LUMINAIRES AT FULL CAPACITY. PROVIDE UL924 RELAYS AS REQUIRED TO BYPASS AREA CONTROLS.
 - 7.1. EMERGENCY PATHWAY EGRESS LIGHTING: ILLUMINATION PROVIDED ALONG THE EGRESS PATH AT FLOOR LEVEL SHALL AVERAGE AT LEAST 1 FOOT CANDLE. (IBC 1008.3.5)
 - 7.2. EMERGENCY LIGHTING SHALL BE SUPPLIED BY: ELECTRICAL CONTRACTOR

EXIT SIGN NOTES

DURING CONSTRUCTION UPON COMPLETION OF A TYPICAL FLOOR FRAMING AND BEFORE WALL COVER, ELECTRICAL CONTRACTOR SHALL WALK THE EGRESS PATHS WITH THE LOCAL INSPECTOR (AHJ) TO CONFIRM THAT ALL THE EXIT SIGNS ARE LOCATED PER THE AHJ'S SATISFACTION AND IDENTIFY ANY ADDITIONAL EXIT SIGNS THAT THE AHJ WISHES TO BE INSTALLED (IBC 1013.1). CONTRACTOR SHALL PROVIDE UP TO 10% ADDITIONAL EXIT SIGNS AT NO ADDITIONAL COST.

PRMU20240280


PROJECT: BRADLEY HEIGHTS APARTMENTS BUILDING C
27TH AVE SE AND 5TH ST SE PUYALLUP, WA
PHONE: (206)364-3343
ROBISON ENGINEERING, INC.


DATE: 05/02/2025
SHEET TITLE: LIGHTING PLAN - 3RD FLOOR
SHEET NO. E1.50

City of Lynnwood
Engineering & Public Works
Engineering Public Works
5/2/25 CHANGES/PERMIT CORRECTION SET
NO. DATE DESCRIPTION
REVISIONS

05/02/2025


ROBISON
ENGINEERING, INC.
19401 40TH AVE W SUITE 302
LYNNWOOD, WA 98036
PHONE: (206)364-3343
CONTACT: ARK ESPENL

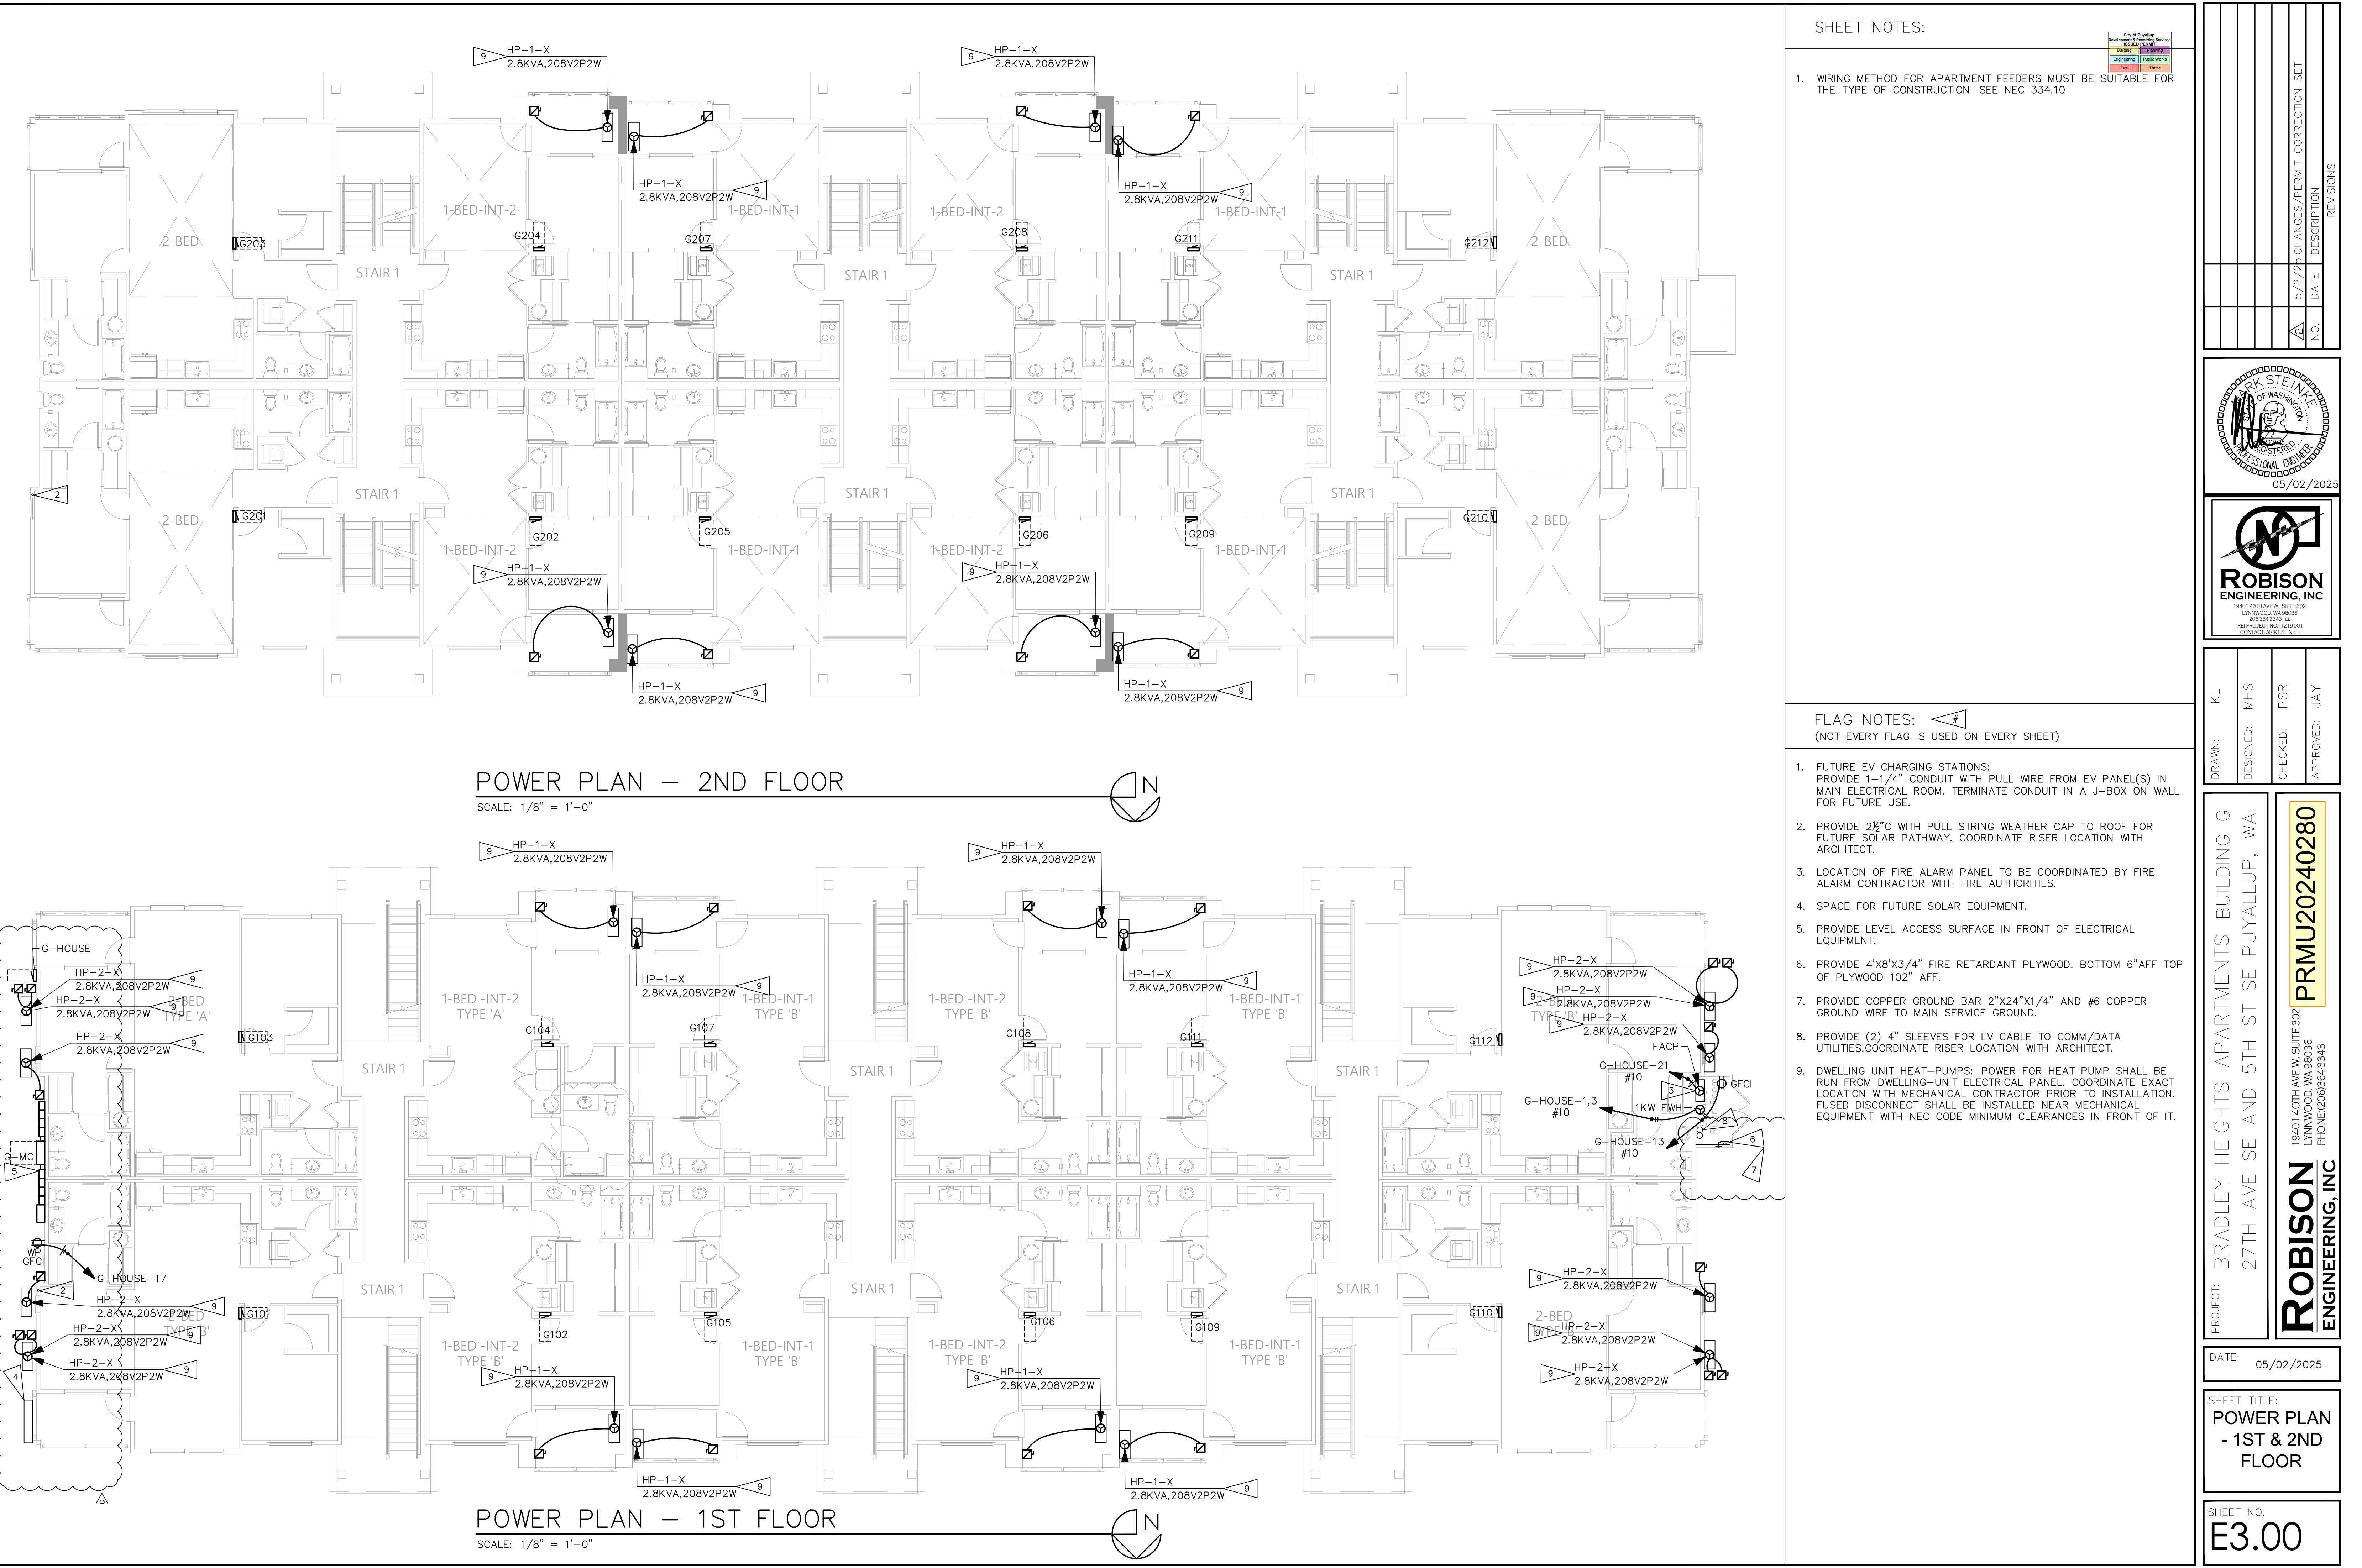

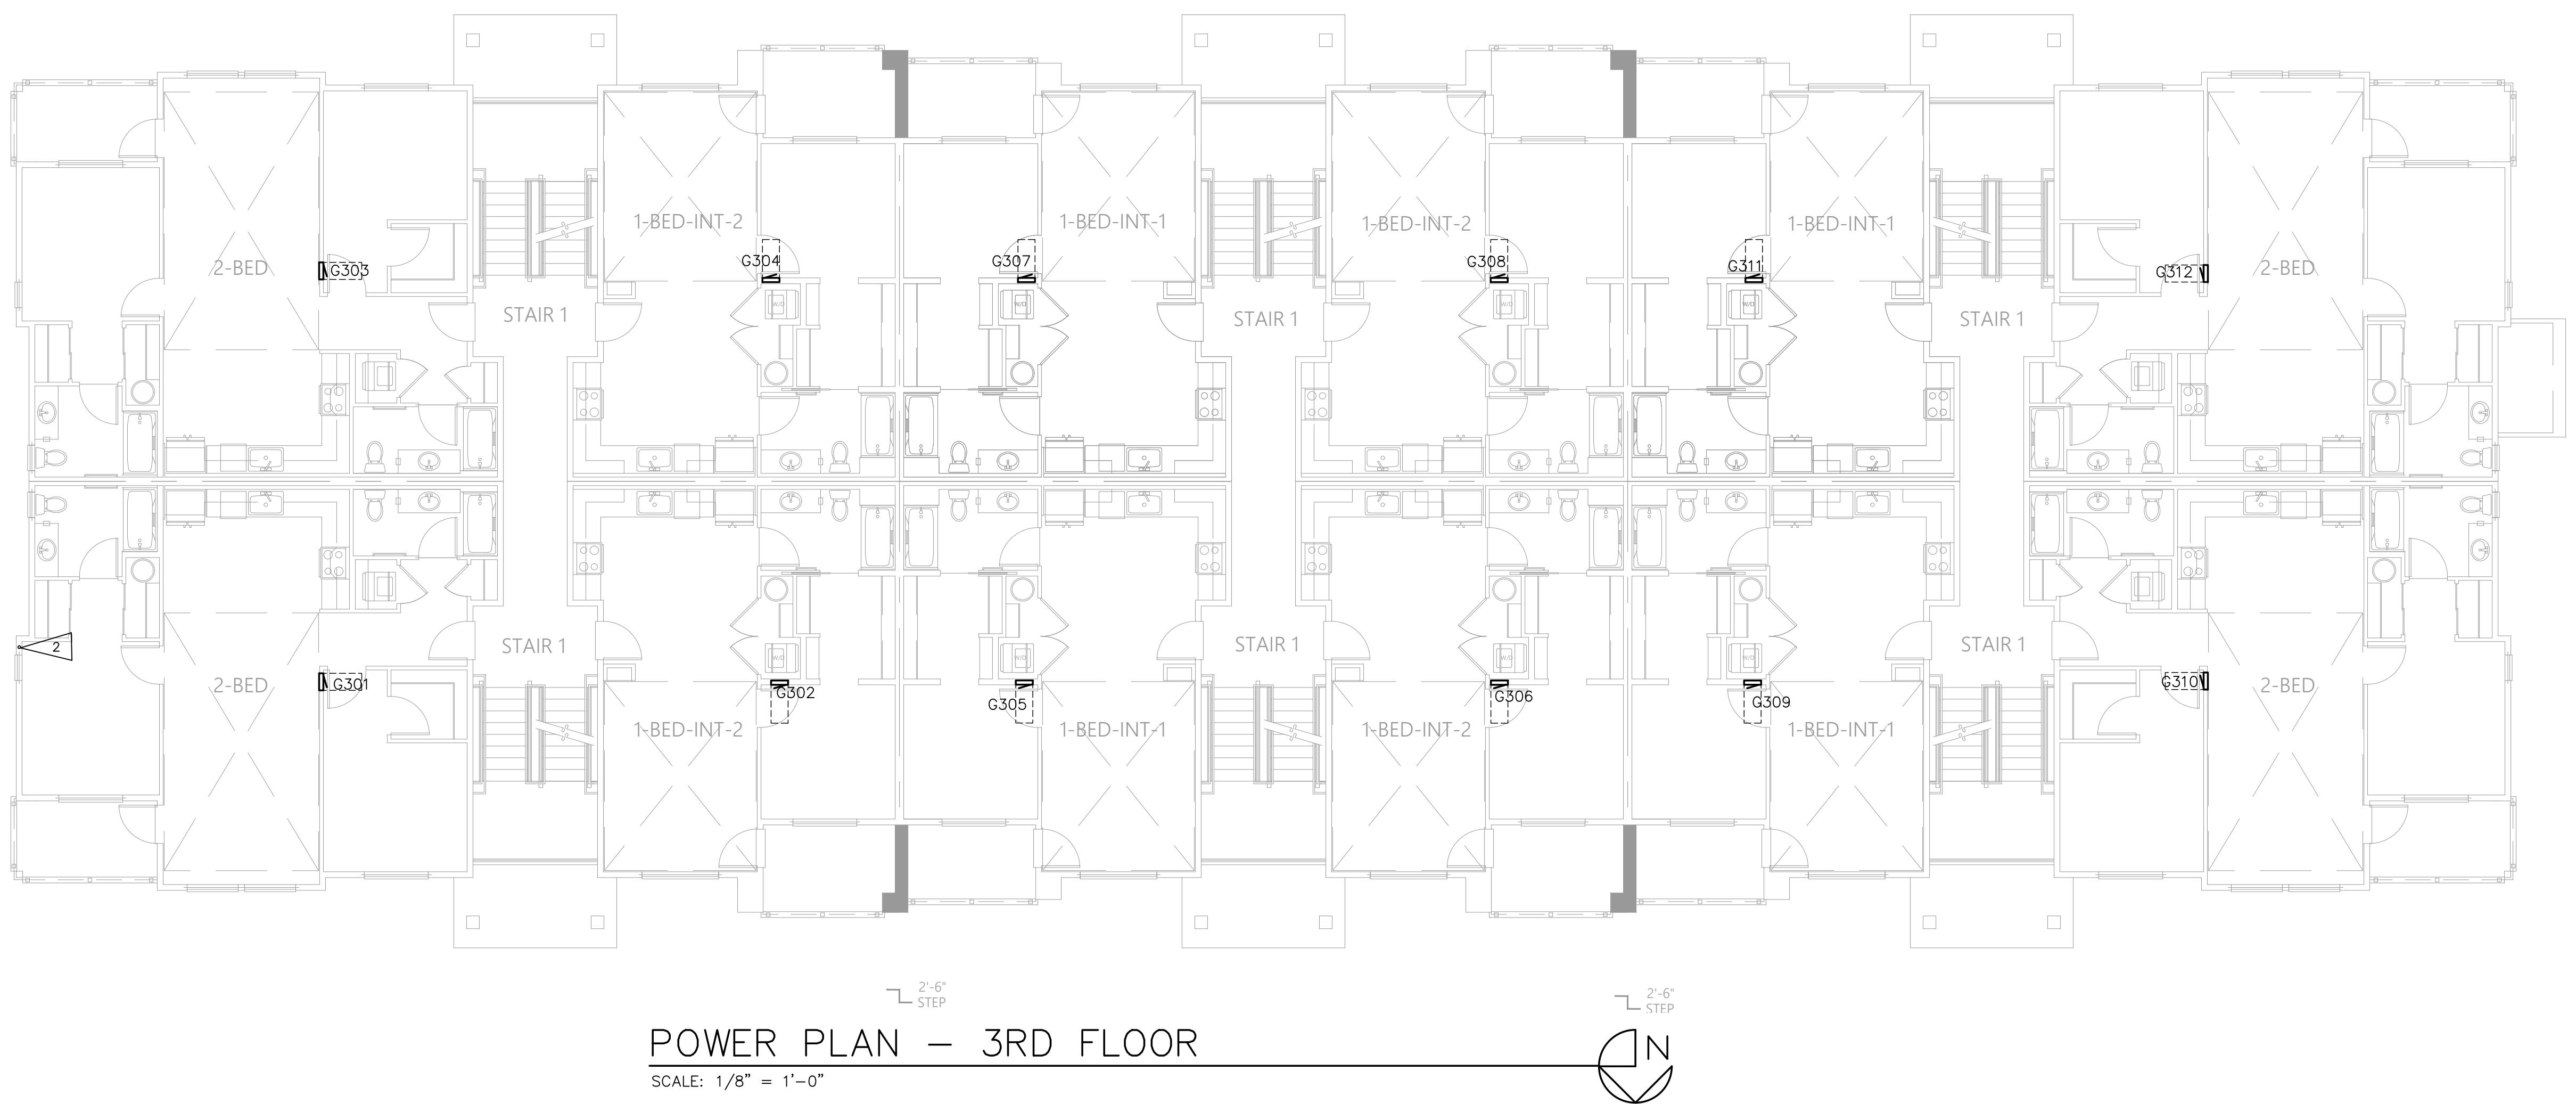

SHEET NOTES:	
1. WIRING METHOD FOR APARTMENT FEEDERS MUST BE SUITABLE FOR THE TYPE OF CONSTRUCTION. SEE NEC 334.10	

City of Puyallup Development Services ISSUED BY Staff Building Planning Engineering Fire Public Works
5/2/25 CHANGES/PERMIT CORRECTION SET
NO. DATE DESCRIPTION
REVISIONS

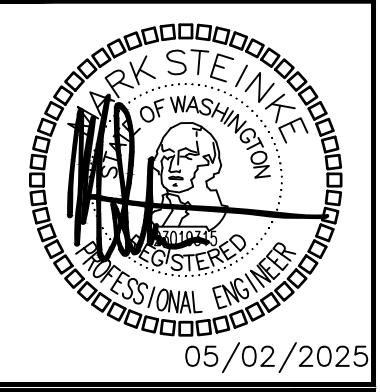

DRAWN: KL
DESIGNED: MHS
CHECKED: PSR
APPROVED: JAY

PROJECT: BRADLEY HEIGHTS APARTMENTS BUILDING C 27TH AVE SE AND 5TH ST SE PUYALLUP, WA
DATE: 05/02/2025
SHEET TITLE: POWER PLAN - 3RD FLOOR

PROJECT: 19401 40TH AVE W, SUITE 302 LYNNWOOD, WA 98036 PHONE: (206)364-3343
DATE: 05/02/2025
SHEET TITLE: PRMU20240280

SHEET NO. E3.01

UNIT LUMINAIRE SCHEDULE


CALLOUT	SYMBOL	MOUNTING	DESCRIPTION	MODEL	VOLTAGE	TYPE	LAMPING	WATTAGE	NOTES
U1	○	CEILING	4" DOWNLIGHT	DMF: DRD5S-4-R-10-9-30-0	120	0-10V DIMMING	(1) 12W LED 3000K	12	
U2	○	CEILING	4" DOWNLIGHT WET RATED	DMF: DRD5S-4-S-10-9-30-0	120	0-10V DIMMING	(1) 12W LED 3000K	12	
U3	□	WALL	24" VANITY LIGHT	MAXIM - 52102	120	ELV DIMMING	(1) 16W LED 3000K	16	
U4	IO	WALL	SLIM BALCONY LIGHT	MAXIM - 26106BK	120	NON DIMMING	(1) 10W LED 3000K	10	
U5	○	SURFACE	6" FLUSH MOUNT DOWNLIGHT	MAXIM - 57413WTWT	120	0-10V DIMMING	(1) 11W LED 3000K	11	

ACCESSIBILITY NOTES:

- ALL SWITCHES AND CONTROLS – 15" MIN; 48" MAX TO CONTROL.
- GENERAL OUTLETS MIN 18" AFF.
- ALL SWITCHES/CONTROLS ABOVE COUNTERTOPS 48" MAX.
- ELECTRICAL SUB-PANELS IN UNITS MUST COMPLY WITH ABOVE REACH RANGES.
- SWITCHES FOR EXHAUST HOODS AND GARBAGE DISPOSALS MUST COMPLY WITH ABOVE REACH RANGES. INSTALL SWITCHES ON FACE OF CABINETS IF REQUIRED TO COMPLY.

APARTMENT NOTES:


- ALL ELECTRICAL WORK SHALL COMPLY WITH ALL AND NATIONAL CODES.
- DEVICE BOXES ON OPPOSITE SIDES OF DEMISING WALLS SHALL BE IN SEPARATE STUD BAYS. PROVIDE BACKING EQUIVALENT TO LOWRY'S OUTLET BOX PADS. CONDUIT FROM ONE UNIT SHALL NOT PASS THROUGH STUDS OF A SHARED WALL(DOUBLE STUDS) FROM AN ADJACENT UNIT(BRIDGING).
- PROVIDE ARC-FAULT PROTECTION, TAMPER PROOF AND GFCI RECEPTACLES AS REQUIRED BY CODE AND LOCAL AHJ. ARC-FAULT PROTECTION MUST BE PROVIDED FOR CIRCUITS IN THE AREAS LISTED IN NEC 210.12(A).
- PROVIDE SUFFICIENT DUPLEX RECEPTACLES TO MEET NEC 210.52.
- THERMOSTATS SHALL NOT INTERFERE WITH DOOR SWINGS.
- ELECTRICAL CONTRACTOR SHALL MAKE ALL FINAL CONNECTIONS FOR KITCHEN APPLIANCES. COORDINATE ALL J-BOX LOCATIONS WITH APPLIANCE INSTALLATION INSTRUCTIONS PRIOR TO ROUGH-IN.
- ELECTRICAL CONTRACTOR SHALL FURNISH AND INSTALL CORD AND PLUG ASSEMBLY FOR EACH DISPOSER.
- PROVIDE A DEDICATED 20 AMP CIRCUIT TO EACH UNIT BATHROOM RECEPTACLE. BATHROOM LIGHTS, FAN TO BE ON SAME CIRCUIT PER 210.11(C)(3) EXCEPTION.
- HOME RUNS AND LOOPS CONNECTING LIGHT FIXTURES, WIRING DEVICES, AND HVAC EQUIPMENT ON PLANS INDICATE CIRCUITING SCHEME. SEE TYPICAL PANEL SCHEDULES FOR ACTUAL CIRCUIT NUMBERS FOR TYPICAL APARTMENT.
- LIGHTS WITHIN 3' HORIZONTAL OF SHOWER OR TUB TO BE WET LOCATION RATED AND HAVE FULLY ENCLOSED TRIMS. PROVIDE GFCI PROTECTION IF THE LUMINAIRE INSTALLATION MANUAL STATES IT IS REQUIRED.
- PROVIDE SMOKE DETECTORS AND CO ALARMS AS REQUIRED. DETECTORS AND ALARMS TO BE HARDWIRED AND PROVIDED WITH BATTERY BACKUP.
- ELECTRICAL CONTRACTOR SHALL INSTALL RECEPTACLES AND TV, DATA/PHONE OUTLETS UNDER COMMON COVER PLATE WHERE POSSIBLE. PROVIDE AND INSTALL DIVIDERS AS REQUIRED FOR CABLE/POWER SEPARATION.
- SEE ARCHITECTURAL DRAWINGS FOR DIMENSIONS AND LAYOUTS OF ALL DEVICES.
- ALL WALL PENETRATIONS SHALL BE CAULKED WITH APPROVED MATERIAL TO MAINTAIN THE FIRE RATING OF ALL WALLS AND FLOORS.
- ALL CONDUIT SHALL BE INSTALLED IN NEAT SYMMETRICAL LINES HORIZONTAL OR PERPENDICULAR TO BUILDING COLUMNS AND ROOF LINES. CONDUITS SHALL BE GROUPED ON COMMON SUPPORTS WHEREVER POSSIBLE.
- REFERENCE MECHANICAL DRAWINGS FOR EXACT LOCATION OF ALL MECHANICAL EQUIPMENT.
- ELECTRICAL CONTRACTOR SHALL VERIFY ALL FUSE RATING WIRE SIZES AND DISCONNECT SIZES WITH EQUIPMENT SERVED ON THE JOB PRIOR TO INSTALLATION.
- SEE ARCHITECTURAL DRAWINGS AND ELEVATIONS FOR ADDITIONAL DETAILS AND CASEWORK DIMENSIONS.
- DEVICE LOCATIONS IN 1ST DWELLING/RESIDENT UNIT SHALL BE REVIEWED AND APPROVED BY OWNER PRIOR TO ROUGH-IN OF REMAINING UNITS
- CONFIRM FINAL LOCATION OF HEATERS AND THERMOSTATS IN FIELD PRIOR TO ROUGH-IN

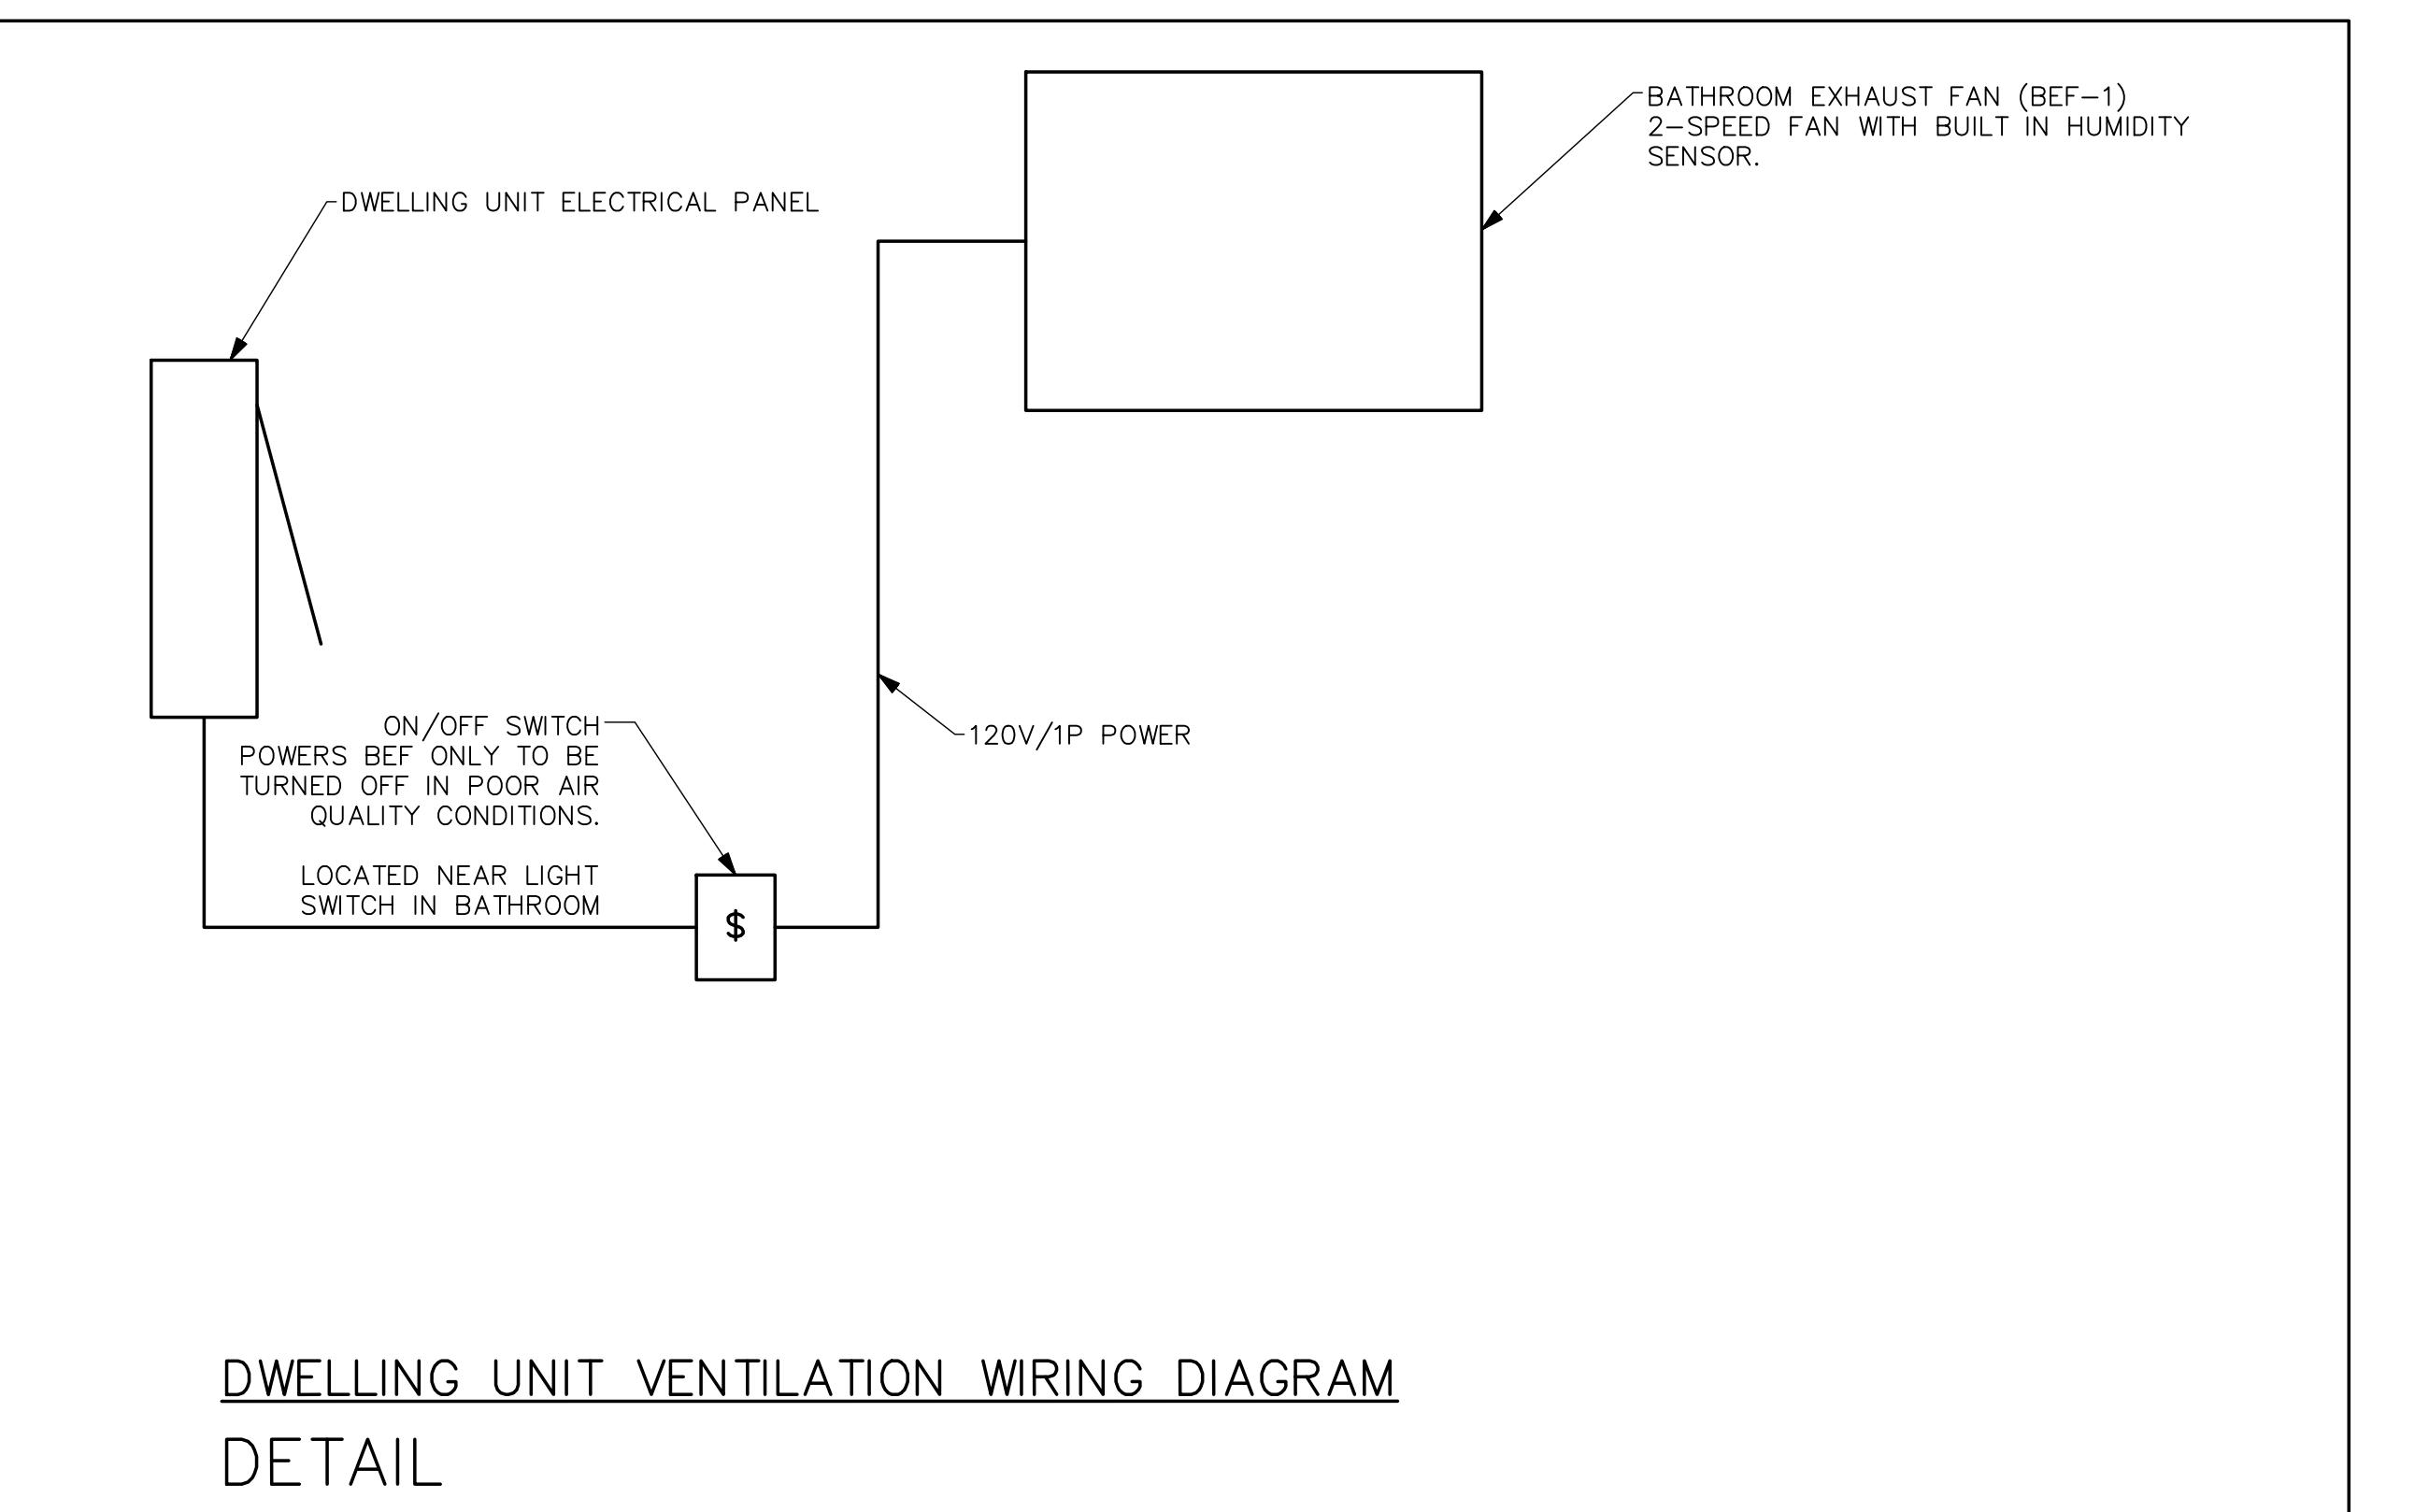


ELECTRIC HEATERS					
EQUIP NO.	SERVICE	MOUNTING/ DISCHARGE	HEATING KW	ELECTRICAL VOLTAGE	BASIS OF DESIGN
EWH-1	BEDROOM	WALL	1	208V/1P	(1)
EWH-2	LIVING ROOM	WALL	1.5	208V/1P	(1)

NOTES:
(1) BROAN, CADET OR EQUIVALENT.
(2) PROVIDE REMOTE THERMOSTAT.

City of Puyallup Development Services	Building	Planning
Engineering	Permit	Code
Fire	Traffic	

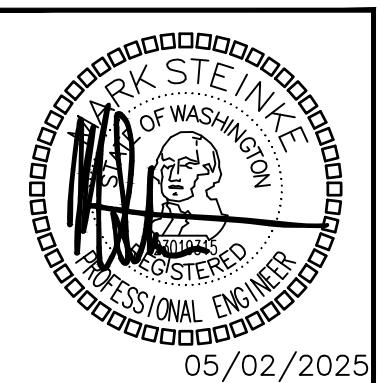


DRAWN: KL	DESIGNED: MHS	CHECKED: PSR	APPROVED: JAY
-----------	---------------	--------------	---------------

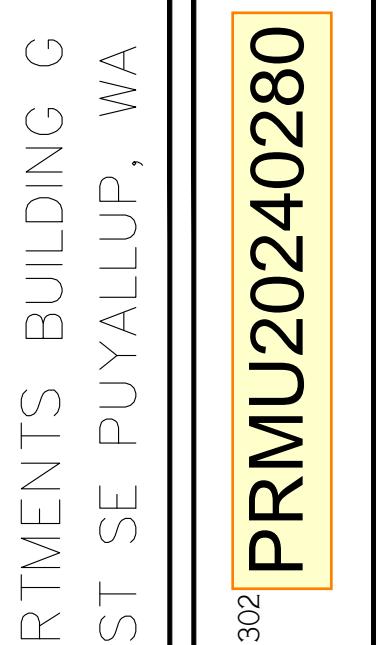

DATE: 05/02/2025
SHEET TITLE: UNIT PLANS NOTES

SHEET NO.
E5.00

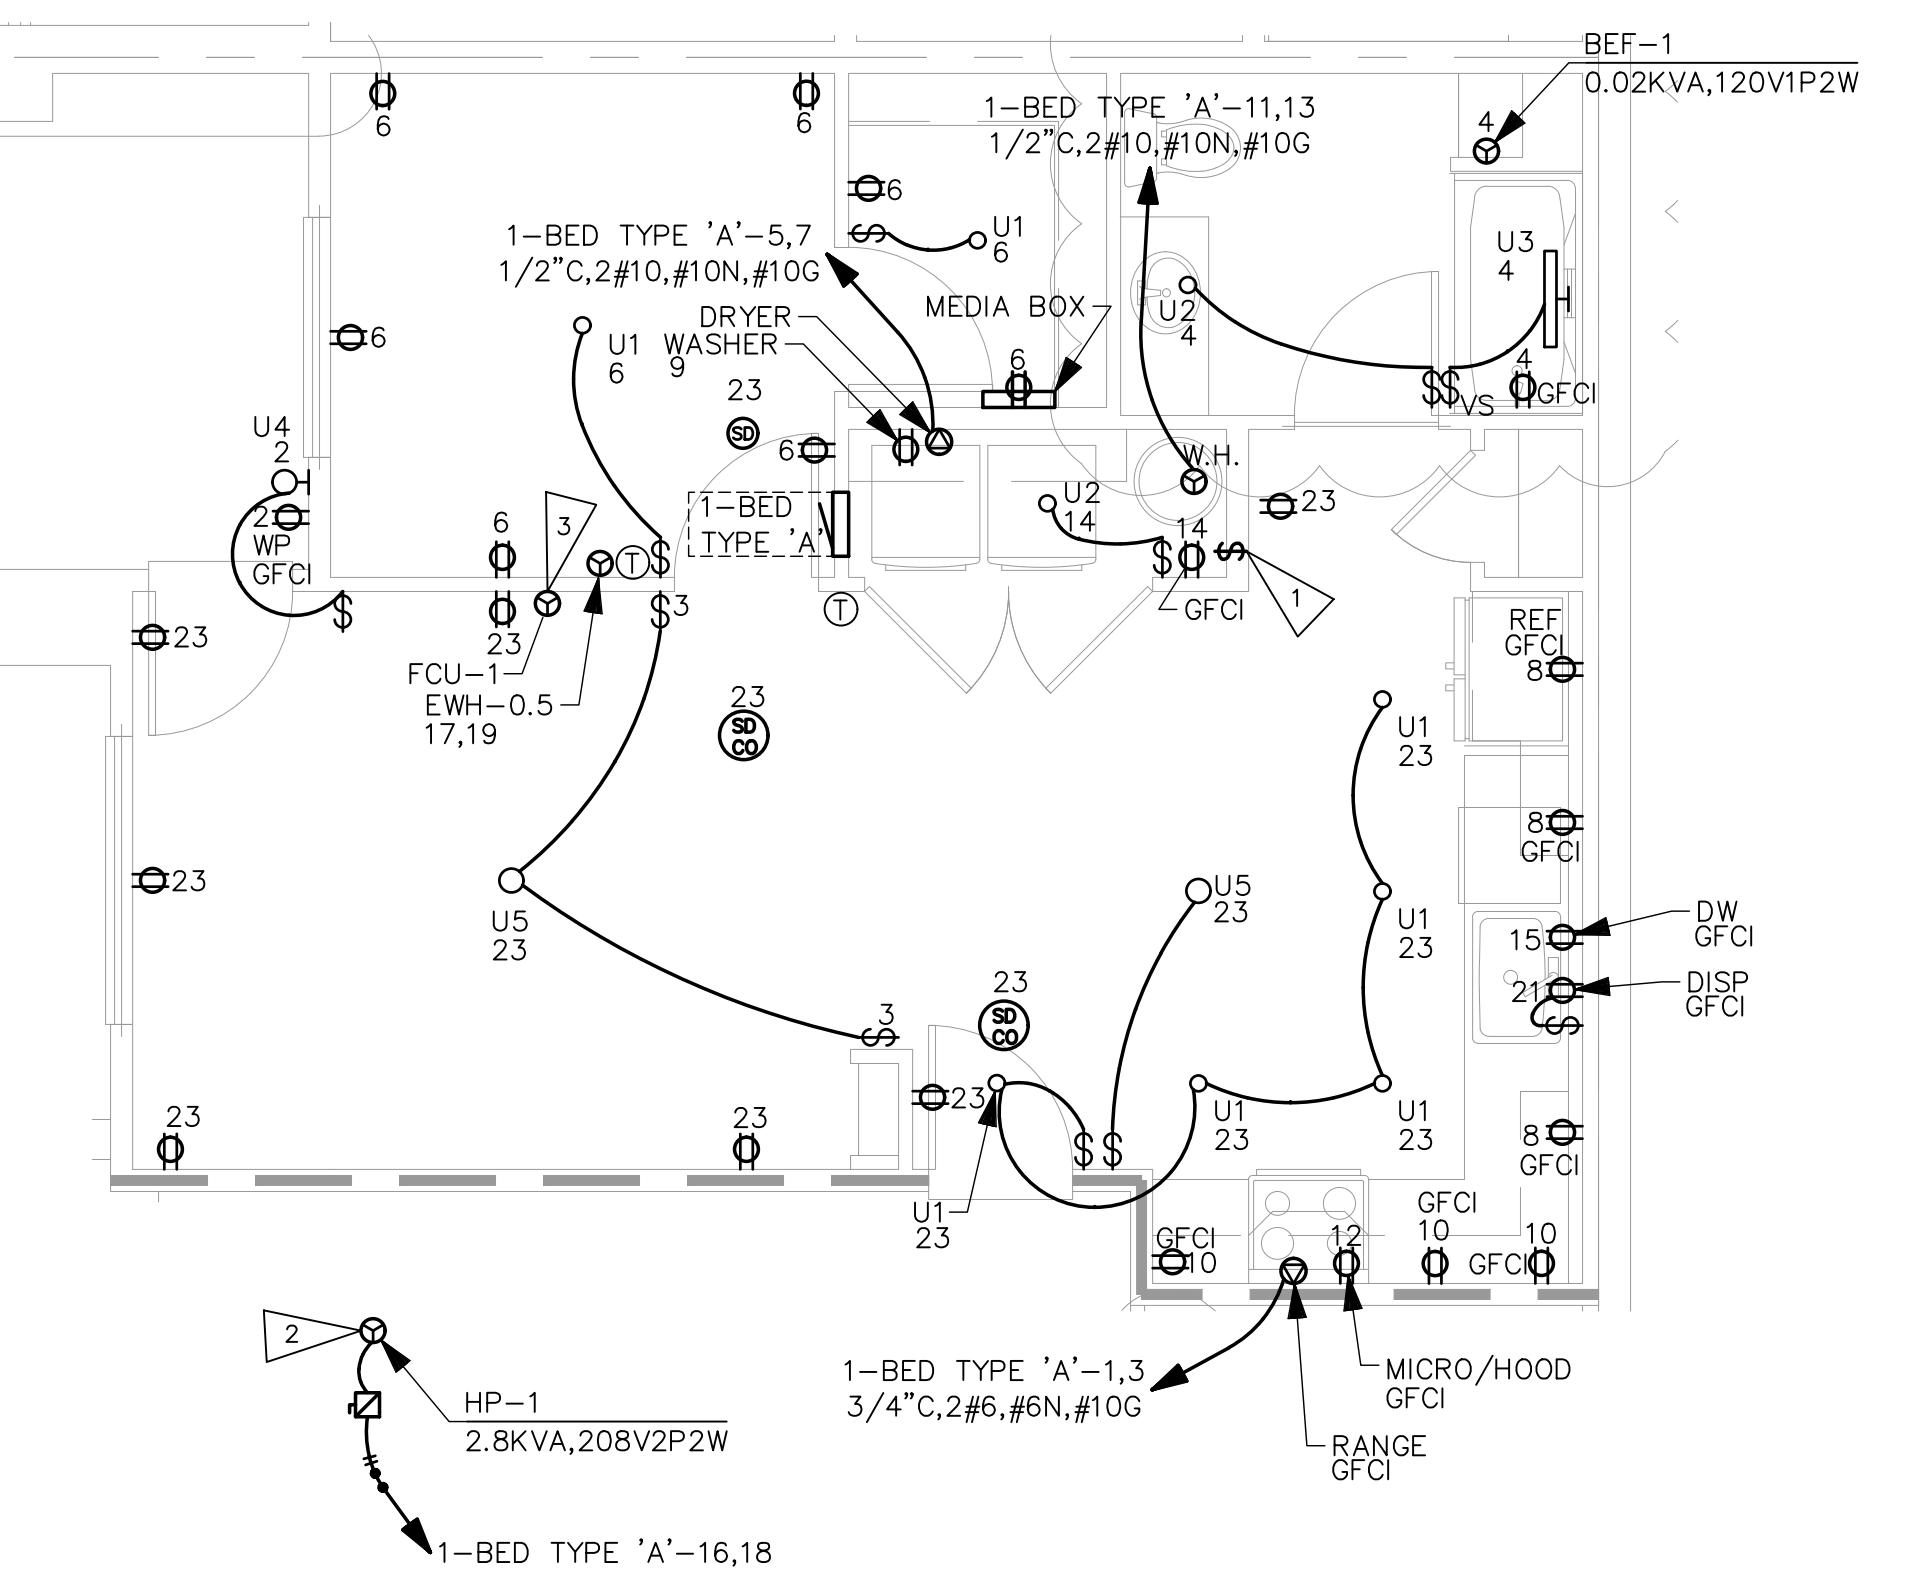


UNIT TYPICALS

1-BED-INT-2 TYPE 'A'

SCALE: 1/4" = 1'-0"

ROOM MOUNTING FLUSH FED FROM NOTE				VOLTS 208/120V 2P 3W BUS AMPS 125 NEUTRAL 100%				AIC 22,000 MAIN BKR MLO LUGS STANDARD			
CKT #	CKT BKR	LOAD KVA	CIRCUIT DESCRIPTION	CKT #	CKT BKR	LOAD KVA	CIRCUIT DESCRIPTION				
1	50/2	8	RANGE	a 2	20/1	0.19	LIGHTING, RECEPTACLE				
3				b 4	20/1	0.23	BEF-1, LIGHTING, RECEPTACLE				
5	30/2	4.99	DRYER	a 6	20/1	1.28	LIGHTING, MEDIA BOX, RECEPTACLE				
7				b 8	20/1	1.5	SMALL APPLIANCE				
9	20/1	1.5	WASHER	a 10	20/1	1.5	SMALL APPLIANCE				
11	30/2	4.4	WATER HEATER	b 12	20/1	1.58	MICRO/HOOD				
13				a 14	20/1	0.192	LIGHTING, RECEPTACLE				
15	20/1	1.2	DISHWASHER	b 16	20/2	2.8	HP-1				
17	20/2	0.5	WALL HEATER	a 18							
19				b 20	-/1	0	SPACE				
21	20/1	0.7	DISPOSAL	a 22	-/1	0	SPACE				
23	20/1	1.49	LIGHTING, RECEPTACLE, SDCO	b 24	-/1	0	SPACE				

OPTIONAL DWELLING UNIT CALCULATION (NEC 220.82)											
				CONN KVA				CONN KVA CALC KVA			
LIGHTING AND RECEPTACLES		<u>2.61</u>	871 SF (3 VA/SF)	GENERAL LOAD							
SMALL-APPLIANCE		<u>3</u>		UP TO 10 KVA	<u>10</u>	<u>10</u>	<u>(100%)</u>				
LAUNDRY		<u>1.5</u>		OVER 10 KVA	<u>13.6</u>	<u>5.43</u>	<u>(40%)</u>				
APPLIANCES		<u>8.47</u>									
ELECTRIC COOKING		<u>8</u>		MAX HEATING OR COOLING		<u>3.19</u>	<u>(220.82(C)(4))</u>				
TOTAL GENERAL LOAD		<u>23.6</u>									
				TOTAL LOAD		<u>18.6</u>					
				BALANCED LOAD		<u>89.5</u>	A				
				PHASE A		<u>98.3%</u>					
				PHASE B		<u>102%</u>					

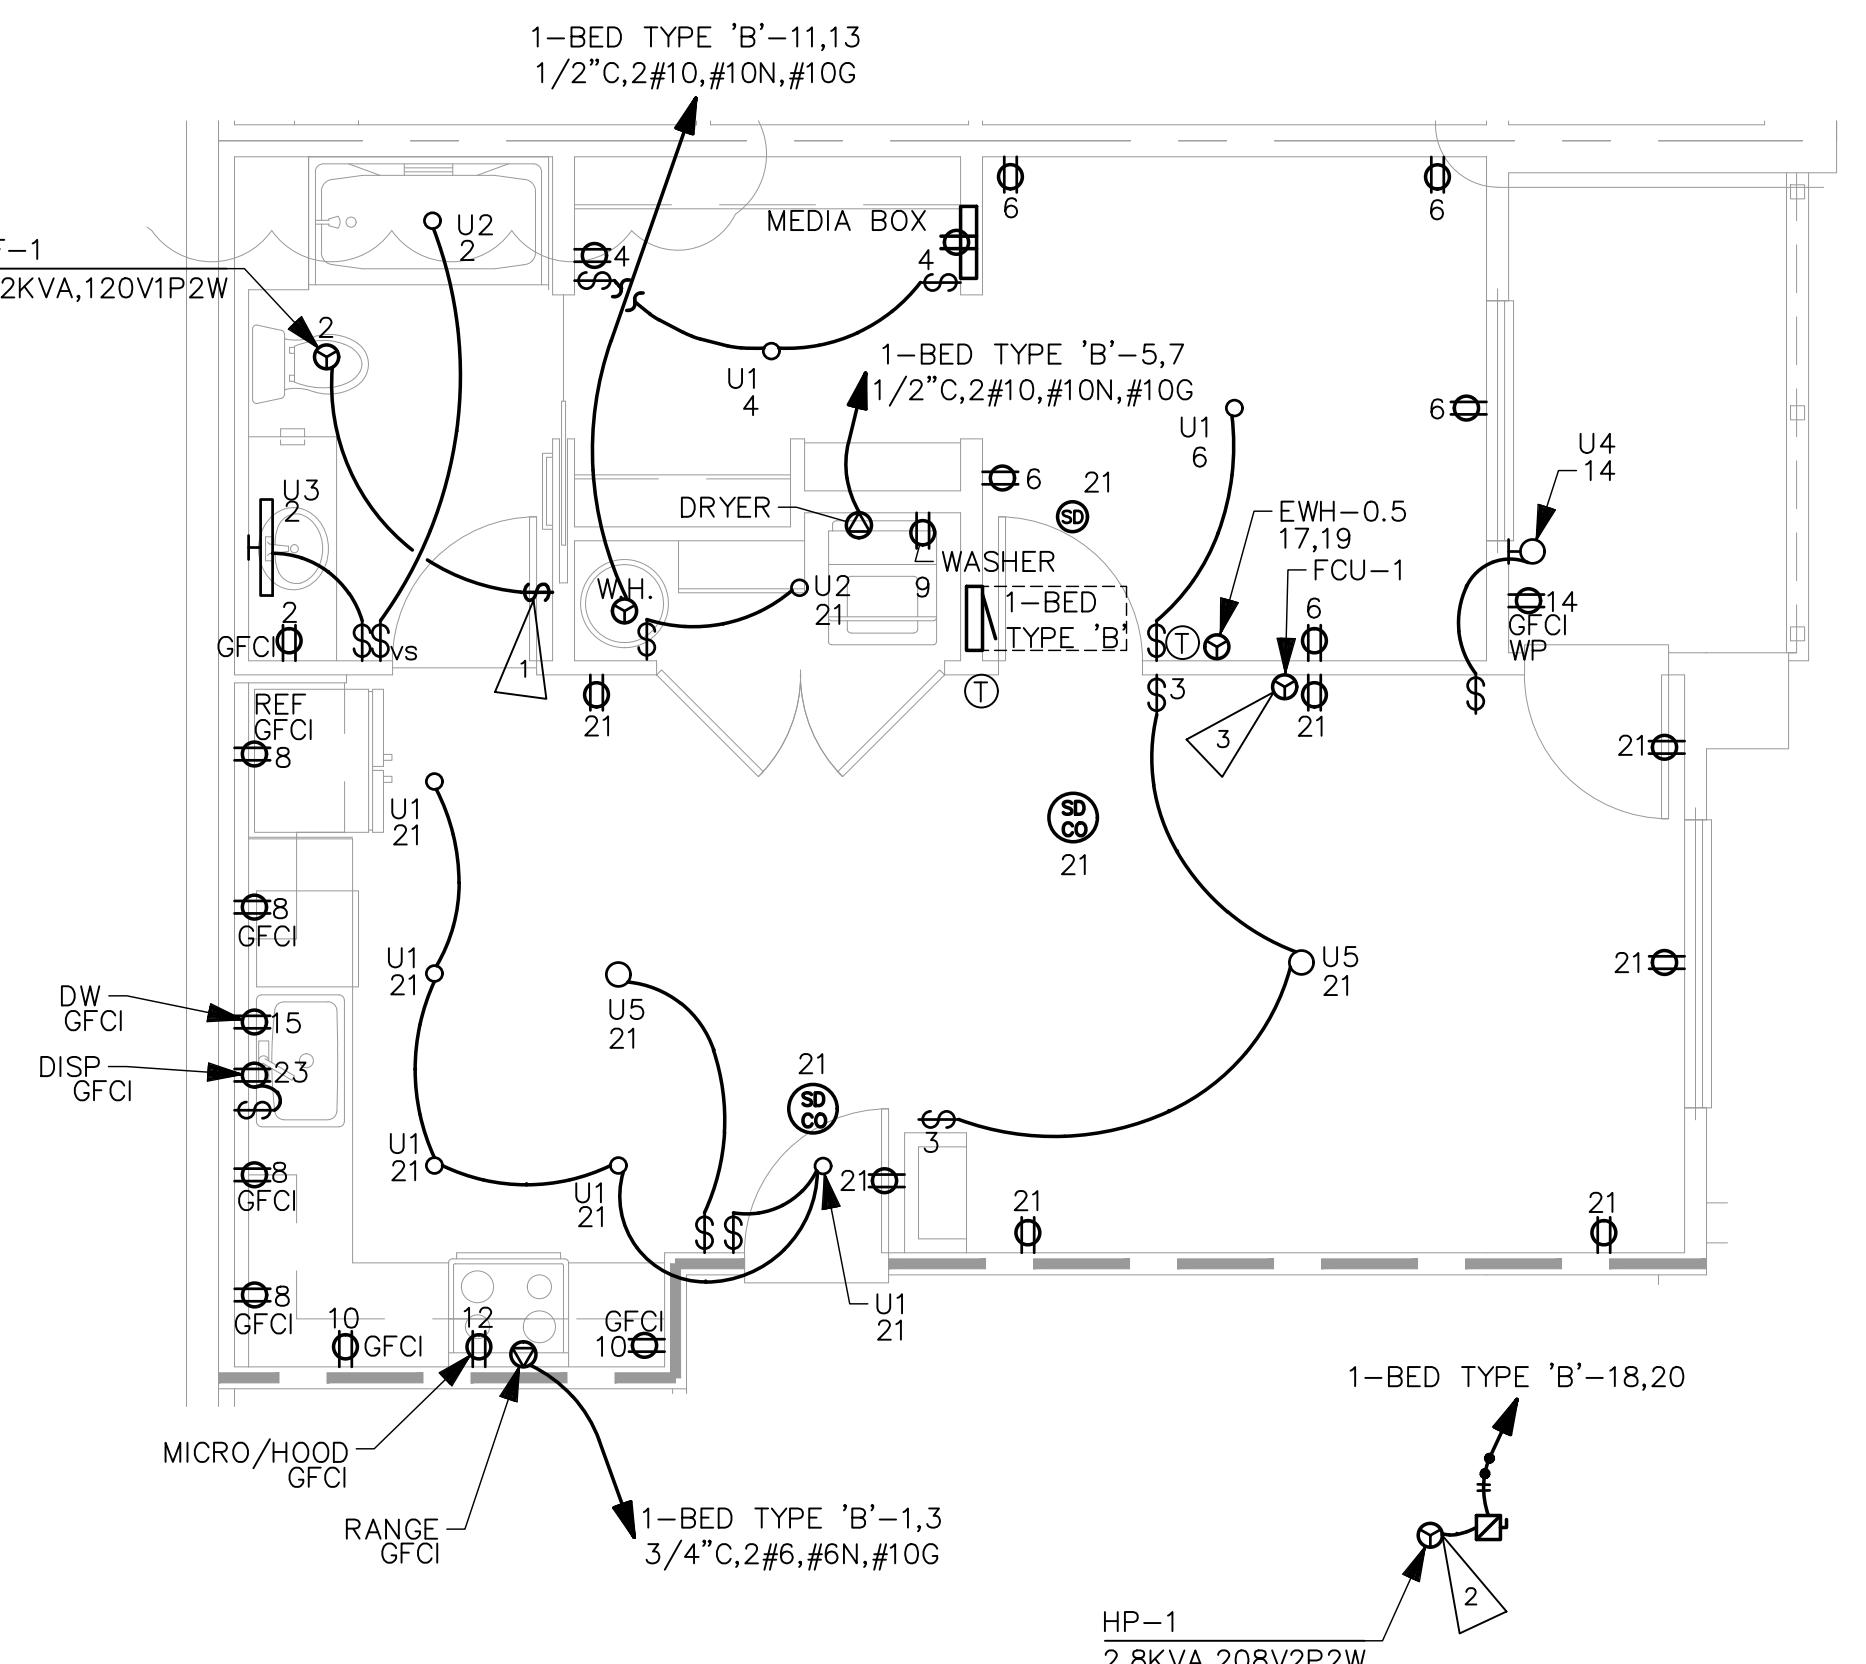

UNIT TYPICALS

-BED-INT-1 TYPE 'B'

SCALE: $1/4'' = 1'-0''$

ROOM MOUNTING FLUSH ATED FROM NOTE				VOLTS 208/120V 2P 3W BUS AMPS 125 NEUTRAL 100%				AIC 22,000 MAIN BKR MLO LUGS STANDARD	
T	CKT BKR	LOAD KVA	CIRCUIT DESCRIPTION		CKT #	CKT BKR	LOAD KVA	CIRCUIT DESCRIPTION	
50/2	8	RANGE		a 2	20/1	0.23	BEF-1, LIGHTING, RECEPTACLE		
				b 4	20/1	0.372	LIGHTING, MEDIA BOX, RECEPTACLE		
30/2	4.99	DRYER		a 6	20/1	0.912	LIGHTING, RECEPTACLE		
				b 8	20/1	1.5	SMALL APPLIANCE		
20/1	1.5	WASHER		a 10	20/1	1.5	SMALL APPLIANCE		
30/2	4.4	WATER HEATER		b 12	20/1	1.58	MICRO/HOOD		
				a 14	20/1	0.19	LIGHTING, RECEPTACLE		
20/1	1.2	DISHWASHER		b 16	20/1	0.38	RECEPTACLE, SDCO		
20/2	0.5	WALL HEATER		a 18	20/2	2.8	HP-1		
				b 20	—				
20/1	1.5	LIGHTING, RECEPTACLE, SDCO		a 22	—/1	0	SPACE		
20/1	0.7	DISPOSAL		b 24	—/1	0	SPACE		
OPTIONAL DWELLING UNIT CALCULATION (NEC 220.82)									
		CONN KVA			CONN KVA		CALC KVA		
LIGHTING AND RECEPTACLES		2.61	871 SF (3 VA/SF)	GENERAL LOAD					
SMALL-APPLIANCE		3		UP TO 10 KVA	10	10	(100%)		
LAUNDRY APPLIANCES		1.5		OVER 10 KVA	13.6	5.43	(40%)		
ELECTRIC COOKING		8.47		MAX HEATING OR COOLING		3.19	(220.82(C)(4))		
TOTAL GENERAL LOAD		8							
		23.6		TOTAL LOAD		18.6			
				BALANCED LOAD		89.5 A			
				PHASE A		100%			
				PHASE B		99.7%			

GENERAL NOTES:

COORDINATE FINAL LOCATION OF THERMOSTATS, SWITCHES, RECEPTACLES, DATA, PHONE, LIGHT FIXTURES AND J-BOXES WITH ARCHITECTURAL ELEVATIONS AND INTERIOR DESIGN PLANS PRIOR TO ROUGH-IN.

ADA UNITS SHALL HAVE HOOD CONTROLS INSTALLED IN THE FACE OF THE LOWER CABINET WORK.

PROVIDE TAMPER RESISTANT RECEPTACLES PER NEC 406.12.

ALL UNITS: PROVIDE SWITCH CONTROLLING GARBAGE DISPOSAL TO BE LOCATED ABOVE BACKSPLASH NEXT TO SINK OR ON COUNTER. SEE ARCHITECTURE.

BATHROOM GFCI RECEPTACLES TO HAVE INTEGRAL NIGHTLIGHT.

RECESSED CEILING LIGHT IN BATHROOM SHALL BE LED RATED FOR WET LOCATIONS W/ SHATTER PROOF LENS.

ALL RECEPTACLES SHALL MEET REQUIREMENTS OF NEC ARTICLE 210.

PROVIDE TELEPHONE & CABLE T.V. MEDIA TERMINATION ENCLOSURE (MEDIA BOX): PROVIDE LEVITON COMPACT MEDIA ENCLOSURE OR EQUIVALENT IN WALL WITH TOP NO HIGHER THAN 60" AFF WITH 120V RECEPTACLE ADJACENT.

PROVIDE COMBINATION HARDWIRED 120VAC PHOTOELECTRIC SMOKE DETECTOR AND CARBON MONOXIDE DETECTOR WITH BATTERY-BACKUP

- DETECTOR SHALL BE MINIMUM 6' HORIZONTAL DISTANCE FROM PERMANENT COOKING APPLIANCE PER CFC 90.2.11.8.
- DETECTOR SHALL BE MINIMUM 3' HORIZONTAL DISTANCE FROM THE DOOR OF A BATHROOM THAT CONTAINS A BATHTUB OR SHOWER PER CFC 90.2.11.8.
- PROVIDE INTERCONNECTION WIRING SUCH THAT ACTUATION OF ONE ALARM WILL ACTIVATE ALL ALARMS IN THE DWELLING UNIT.
- COORDINATE WITH AHJ ON INTERCONNECTING EACH DWELLING UNIT INTO THE FIRE ALARM SYSTEM FOR THE BUILDING.
- COORDINATE WITH AHJ AS TO THE NUMBER AND LOCATION OF DEVICES PRIOR TO ROUGH-IN. DEVICES SHOWN ARE DIAGRAMMATIC.
- DISHWASHER OUTLET SHALL BE ACCESSIBLE. RECEPTACLE SHALL BE LOCATED IN SPACE ADJACENT TO THE DISHWASHER.

PROVIDE 7-DAY PROGRAMMABLE THERMOSTAT FOR THE LIVING ROOM.



ROBISON
ENGINEERING, INC.

19401 40TH AVE W., SUITE 302
LYNNWOOD, WA 98036
206-364-3343 TEL
REI PROJECT NO: 1219-001
CONTACT: ARIK ESPINEL I

DRAWN
DESIGN
CHECKED
APPROVED

FLAG NOTES

INTERLOCK ERV/BEF TO ON/OFF SWITCH. PROVIDE PERMANENT LABEL SAYING, "WHOLE HOUSE VENTILATION. LEAVE ON UNLESS OUTDOOR AIR QUALITY IS VERY POOR." ADHERE PERMANENT LABEL TO WALL ABOVE WALL SWITCH.

COORDINATE OUTDOOR LOCATION OF INDIVIDUAL HP UNITS WITH MECHANICAL PLANS.

POWERED FROM OUTDOOR UNIT.

AFCI/GFCI REQUIREMENTS FOR DWELLING UNITS:

ALL 15 AND 20A, 120V SINGLE PHASE CIRCUITS NOT INCLUDING THE BATHROOM SHALL BE AFCI PROTECTED (210.12).

ALL DWELLING UNIT CIRCUITS IN BATHROOMS, GARAGES, OUTDOORS, KITCHENS, LAUNDRY AREAS, AND AREAS WITHIN 6' OF A SINK SHALL BE GFCI PROTECTED (210.8).


1. BATHROOM CIRCUIT TO BE GFCI PROTECTED VIA A GFCI RECEPTACLE, WHILE OTHER CIRCUITS SHALL BE PROTECTED AT THE BREAKER.

UTILIZE "DUAL FUNCTION" BREAKER WHEN BOTH AFCI AND GFCI PROTECTION IS REQUIRED.

DATE: 05/02/2025

SHEET TITLE:
UNIT PLANS &
SCHEDULES

SHEET NO.
E5.01

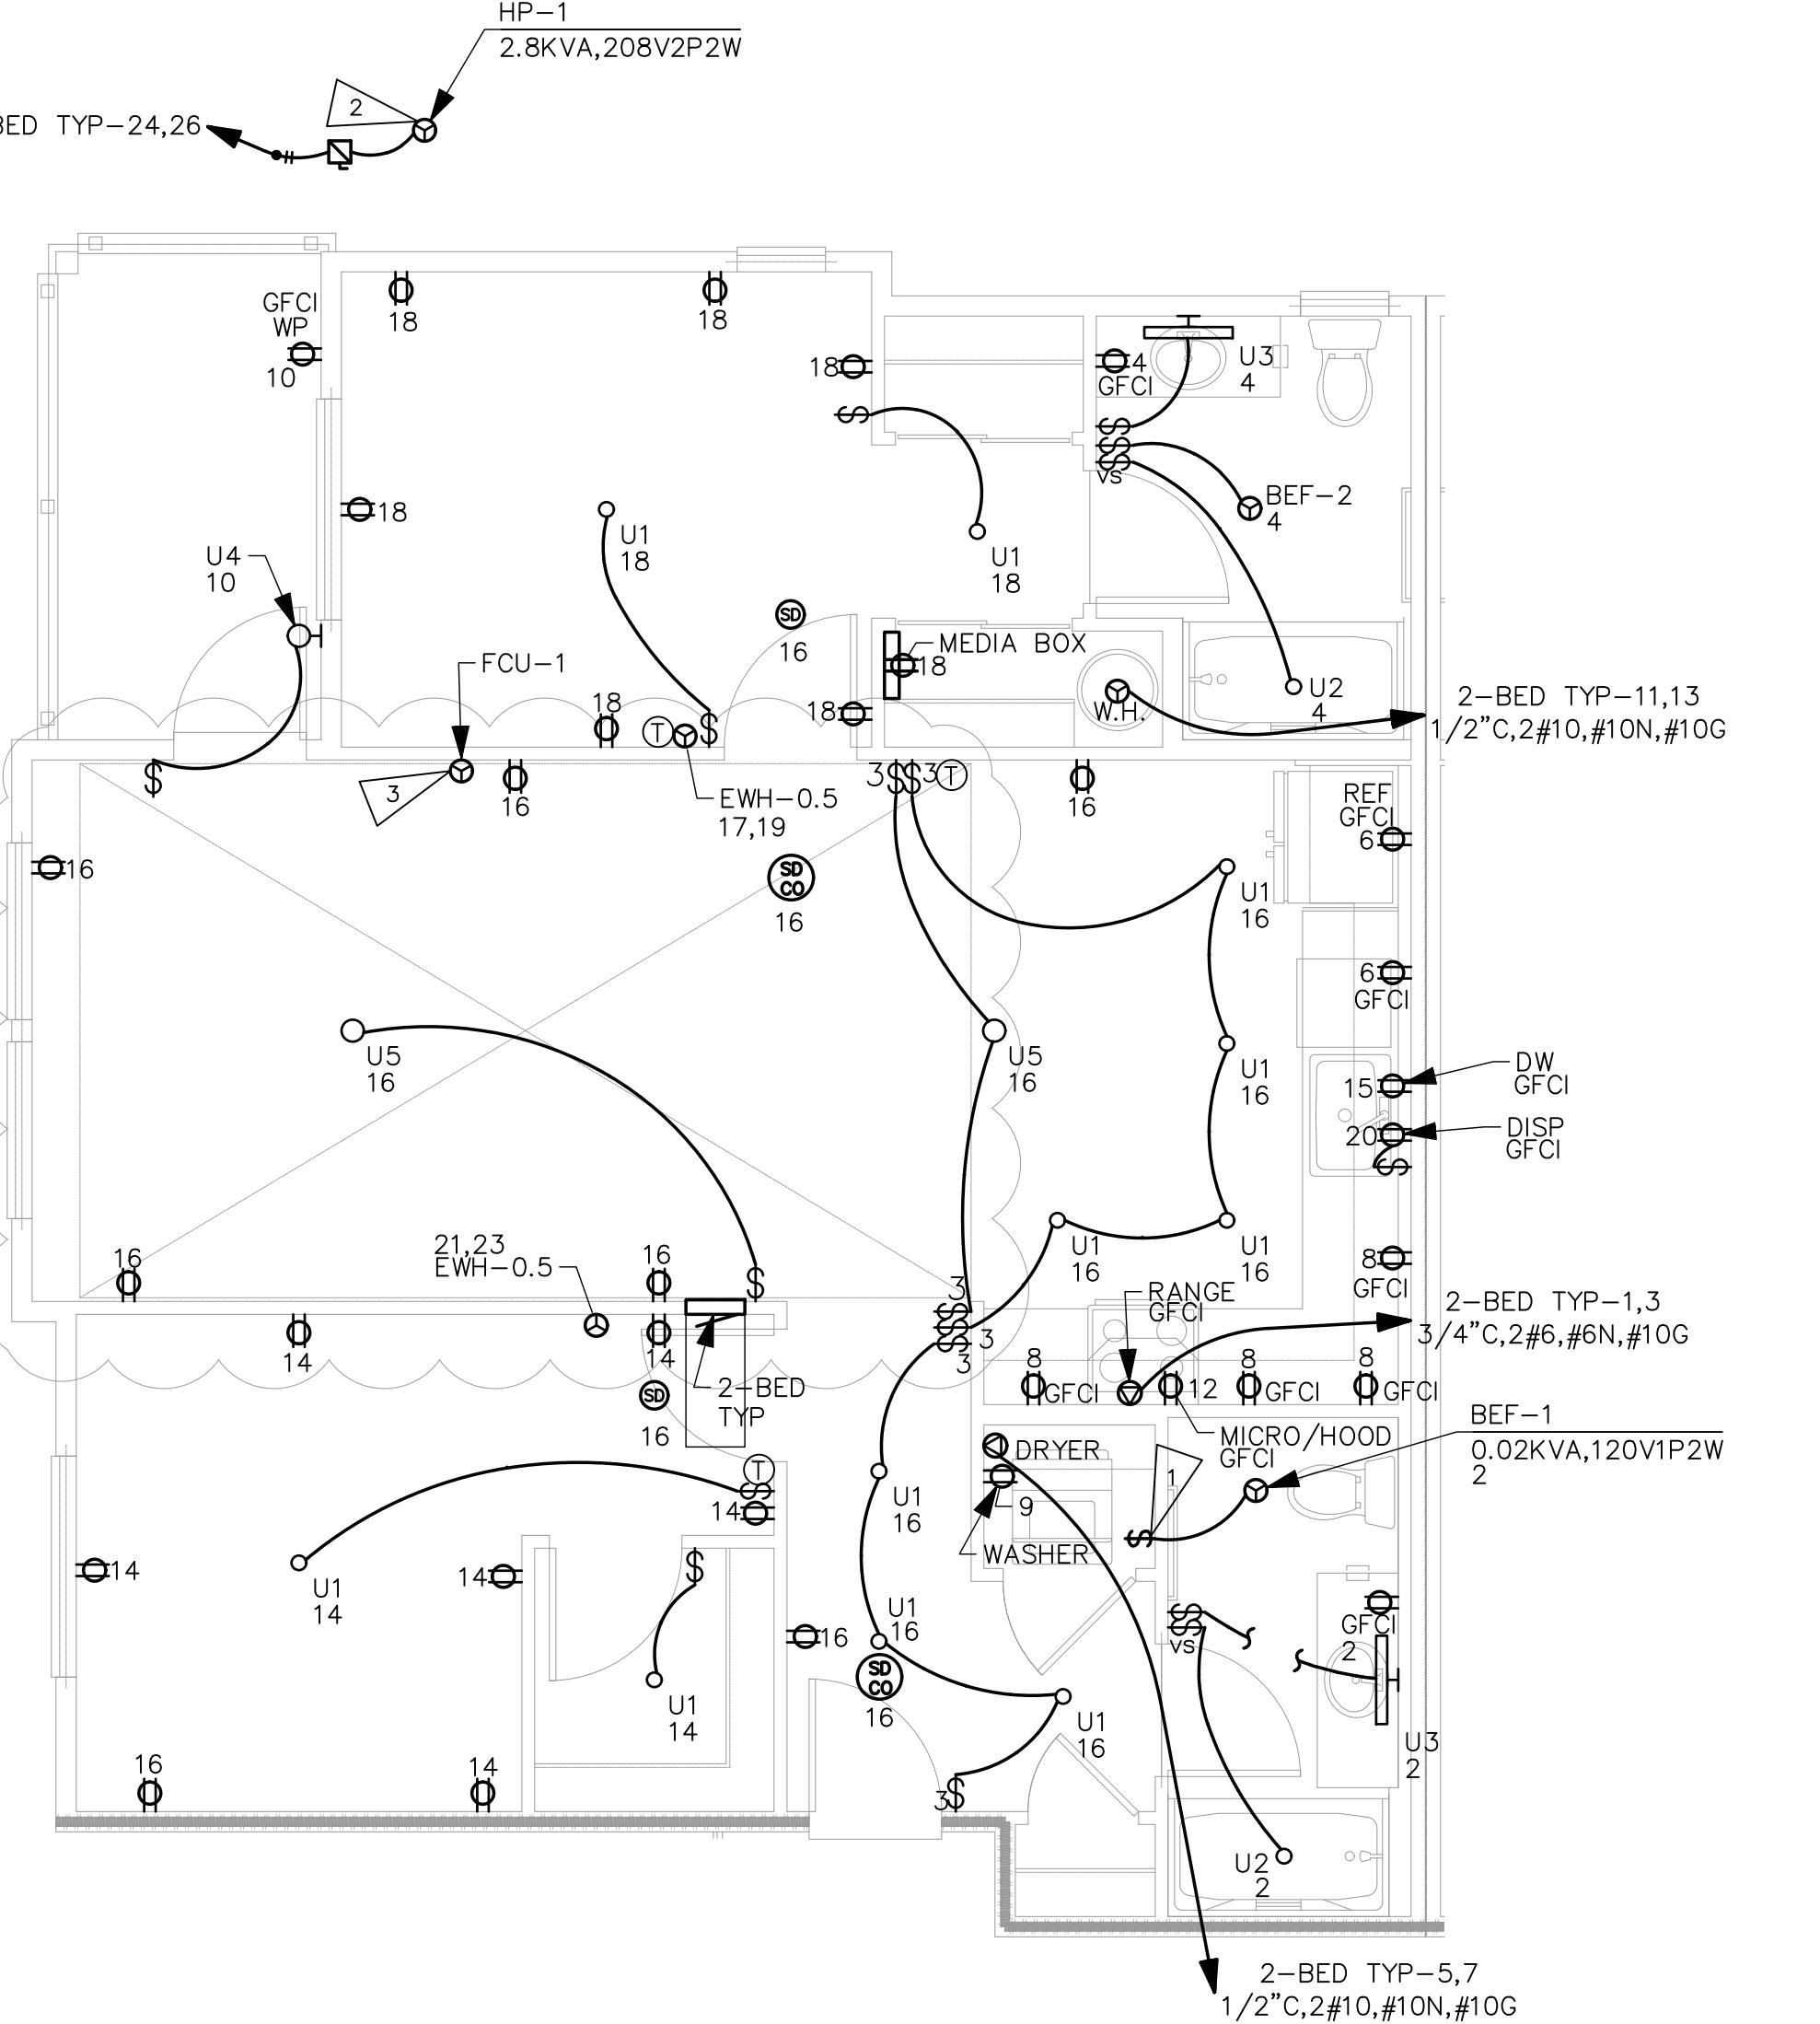

UNIT TYPICALS

2-BED TYP

SCALE: 1/4" = 1'-0"

2-BED TYP

ROOM MOUNTING FLUSH FED FROM NOTE			VOLTS 208/120V 2P 3W			AIC 22,000					
			BUS AMPS 125			MAIN BKR MLO LUGS STANDARD					
CKT #	CKT #	LOAD KVA	CIRCUIT DESCRIPTION			CKT #	CKT #	LOAD KVA	CIRCUIT DESCRIPTION		
1	50/2	8	RANGE			a	20/1	0.23	BEF-1, LIGHTING, RECEPTACLE		
3	1					b	4	0.308	BATH EX FAN, LIGHTING, RECEPTACLE		
5	30/2	4.99	DRYER			a	6	20/1	1.5	SMALL APPLIANCE	
7	1					b	8	20/1	1.5	SMALL APPLIANCE	
9	20/1	1.5	WASHER			a	10	20/1	0.19	LIGHTING, RECEPTACLE	
11	30/2	4.4	WATER HEATER			b	12	20/1	1.58	MICRO/HOOD	
13	1					a	14	20/1	1.1	LIGHTING, RECEPTACLE	
15	20/1	1.2	DISHWASHER			b	16	20/1	1.19	LIGHTING, RECEPTACLE	
17	20/2	0.5	WALL HEATER			a	18	20/1	1.28	LIGHTING, MEDIA BOX, RECEPTACLE	
19	1					b	20	20/1	0.7	DISPOSAL	
21	20/2	0.5	WALL HEATER			b	22	20/1	0.2	SDCO	
23	1					b	24	20/2	2.8	HP-1	
25	-/1	0	SPACE			a	26	1			
OPTIONAL DWELLING UNIT CALCULATION (NEC 220.82)											
LIGHTING AND RECEPTACLES			3.52	CONN KVA 1,173 SF (3 VA/SF)		GENERAL LOAD UP TO 10 KVA			10	10	(100%)
SMALL-APPLIANCE			3			OVER 10 KVA			6.49	2.6	(40%)
LAUNDRY APPLIANCES			1.5			MAX HEATING OR COOLING			3.51	(220.82(C)(4))	
TOTAL GENERAL LOAD			8.47			TOTAL LOAD			16.1		
			16.5			BALANCED LOAD			77.4 A		
						PHASE A			98.8%		
						PHASE B			101%		

GENERAL NOTES:

1. COORDINATE FINAL LOCATION OF THERMOSTATS, SWITCHES, RECEPTACLES, DATA, PHONE, LIGHT FIXTURES AND J-BOXES WITH ARCHITECTURAL ELEVATIONS AND INTERIOR DESIGN PLANS PRIOR TO ROUGH-IN.
2. ADA UNITS SHALL HAVE HOOD CONTROLS INSTALLED IN THE FACE OF THE LOWER CABINET WORK.
3. PROVIDE TAMPER RESISTANT RECEPTACLES PER NEC 406.12.
4. ALL UNITS: PROVIDE SWITCH CONTROLLING GARBAGE DISPOSAL TO BE LOCATED ABOVE BACKSPLASH NEXT TO SINK OR ON COUNTER. SEE ARCHITECTURE.
5. BATHROOM GFCI RECEPTACLES TO HAVE INTEGRAL NIGHTLIGHT.
6. RECESSED CEILING LIGHT IN BATHROOM SHALL BE LED RATED FOR WET LOCATIONS W/ SHATTER PROOF LENS.
7. ALL RECEPTACLES SHALL MEET REQUIREMENTS OF NEC ARTICLE 210.
8. PROVIDE TELEPHONE & CABLE T.V. MEDIA TERMINATION ENCLOSURE (MEDIA BOX): PROVIDE LEVITON COMPACT MEDIA ENCLOSURE OR EQUIVALENT IN WALL WITH TOP NO HIGHER THAN 60" AFF WITH 120V RECEPTACLE ADJACENT.
9. PROVIDE COMBINATION HARDWIRED 120VAC PHOTOELECTRIC SMOKE DETECTOR AND CARBON MONOXIDE DETECTOR WITH BATTERY-BACKUP
10. DETECTOR SHALL BE MINIMUM 6' HORIZONTAL DISTANCE FROM PERMANENT COOKING APPLIANCE PER CFC 90.2.11.8.
11. DETECTOR SHALL BE MINIMUM 3' HORIZONTAL DISTANCE FROM THE DOOR OF A BATHROOM THAT CONTAINS A BATHTUB OR SHOWER PER CFC 90.2.11.8. SUCH THAT ACTUATION OF ONE ALARM WILL ACTIVATE ALL ALARMS IN THE DWELLING UNIT.
12. COORDINATE WITH AHJ ON INTERCONNECTING EACH DWELLING UNIT INTO THE FIRE ALARM SYSTEM FOR THE BUILDING.
13. COORDINATE WITH AHJ AS TO THE NUMBER AND LOCATION OF DEVICES PRIOR TO ROUGH-IN. DEVICES SHOWN ARE DIAGRAMMATIC.
14. DISHWASHER OUTLET SHALL BE ACCESSIBLE. RECEPTACLE SHALL BE LOCATED IN SPACE ADJACENT TO THE DISHWASHER.
15. PROVIDE 7-DAY PROGRAMMABLE THERMOSTAT FOR THE LIVING ROOM.

City of Puyallup
Development Services Department
ISSUED BY: Planning
Engineering
Fire
Public Works
Traffic

5/2/25 CHANGES/PERMIT CORRECTION SET
NO. DATE DESCRIPTION REVISIONS



ROBISON
ENGINEERING, INC.
19401 40TH AVE W, SUITE 302
LYNNWOOD, WA 98036
PHONE: (206)364-3343
CONTACT: ARK ESPENELI

DRAWN: KL
DESIGNED: MHS
CHECKED: PSR
APPROVED: JAY

FLAG NOTES

1. INTERLOCK ERV/BEF TO ON/OFF SWITCH. PROVIDE PERMANENT LABEL SAYING, "WHOLE HOUSE VENTILATION. LEAVE ON UNLESS OUTDOOR AIR QUALITY IS VERY POOR." ADHERE PERMANENT LABEL TO WALL ABOVE WALL SWITCH.
2. COORDINATE OUTDOOR LOCATION OF INDIVIDUAL HP UNITS WITH MECHANICAL PLANS.
3. POWERED FROM OUTDOOR UNIT.

AFCI/GFCI REQUIREMENTS FOR DWELLING UNITS:

1. ALL 15 AND 20A, 120V SINGLE PHASE CIRCUITS NOT INCLUDING THE BATHROOM SHALL BE AFCI PROTECTED (210.12).
2. ALL DWELLING UNIT CIRCUITS IN BATHROOMS, GARAGES, OUTDOORS, KITCHENS, LAUNDRY AREAS, AND AREAS WITHIN 6' OF A SINK SHALL BE GFCI PROTECTED (210.8).
 1. BATHROOM CIRCUIT TO BE GFCI PROTECTED VIA A GFCI RECEPTACLE, WHILE OTHER CIRCUITS SHALL BE PROTECTED AT THE BREAKER.
3. UTILIZE "DUAL FUNCTION" BREAKER WHEN BOTH AFCI AND GFCI PROTECTION IS REQUIRED.

PROJECT: BRADLEY HEIGHTS APARTMENTS BUILDING C
27TH AVE SE AND 5TH ST SE PUYALLUP, WA
PHONE: (206)364-3343
ROBISON
ENGINEERING, INC.

DATE: 05/02/2025

SHEET TITLE: UNIT PLANS & SCHEDULES

SHEET NO.

E5.02

REQUIRED ELECTRIC VEHICLE CHARGING INFRASTRUCTURE WAC 427:

- WHERE PARKING IS PROVIDED, TEN PERCENT OF PARKING SPACES SHALL BE PROVIDED WITH ELECTRIC VEHICLE CHARGING INFRASTRUCTURE.
- ELECTRICAL ROOM(S) SERVING PARKING AREAS SHALL BE DESIGNED TO ACCOMMODATE THE ELECTRICAL EQUIPMENT AND DISTRIBUTION REQUIRED TO SERVE A MINIMUM OF 20 PERCENT OF THE TOTAL PARKING SPACES WITH 208/240 V 40-AMP ELECTRIC VEHICLE CHARGING INFRASTRUCTURE.
- MINIMUM ONE ACCESSIBLE PARKING SPACE SHALL BE SERVED BY ELECTRIC VEHICLE CHARGING INFRASTRUCTURE.

TOTAL NUMBER OF PARKING SPACES = 354
AVERAGE NUMBER OF PARKING SPACES PER BUILDING = 354/8 = 45 ;
45 x 0.2 = 9
5 OUTDOOR EV CHARGERS WITH INFRASTRUCTURE
4 CONDUITS TO FUTURE EV CHARGING LOCATIONS
CAPACITY FOR 9 CHARGERS x 208V/1PH x 40A = 74.9 KVA = (208)A 3 PHASE POWER @ 120/208V
UTILIZING LOAD MANAGEMENT INFRASTRUCTURE, EV LOAD CAN BE REDUCED BY 50%. 208A/2 = 37.5KVA (104)A @ 208V 3 PHASE

PER WAC 427, ELECTRICAL INFRASTRUCTURE FOR EACH BUILDING SHALL BE DESIGNED TO ACCOMMODATE 104 AMPS OF EV ELECTRICAL LOAD.

GROUNDING NOTES AND REQUIREMENTS:

THE ELECTRICAL CONTRACTOR SHALL COORDINATE WITH THE GENERAL CONTRACTOR, POWER COMPANY, PHONE COMPANY, INTERNET COMPANY, CABLE TV COMPANY, AND THE SATELLITE TV COMPANY TO ENSURE REQUIRED GROUNDING IS INSTALLED FOR EACH SYSTEM.

THIS SHALL BE DONE PRIOR TO AND DURING INSTALLATION OF FOUNDATION RE-BAR AND CONTINUE DURING THE CONSTRUCTION PHASES, TO ENSURE EACH SYSTEM HAS IT'S REQUIRED GROUNDING INSTALLED FOR PROPER OPERATION OF THE SYSTEM.

- THE ELECTRICAL CONTRACTOR SHALL COORDINATE AND PROVIDE WHAT IS REQUIRED TO DO THE FOLLOWING:
- FOOTING GROUND RE-BAR COMES UP IN THE ELECTRICAL ROOM AND THE RE-BAR IS SNUGLY SECURED TO THE FOOTING RE-BAR.
- THE MSB GROUNDING TIES TO THE FOOTING RE-BAR, COUNTERPOISE, BUILDING STEEL, AND WATER PIPING.
- THE GROUND WIRE FOR THE COUNTERPOISE SHALL BE STRANDED, INSULATED WIRE IN CONDUIT UNTIL IT REACHES THE FIRST BAR OF THE COUNTERPOISE. BETWEEN THE COUNTERPOISE BARS IT SHALL BE A STRANDED BARE COPPER WIRE.

GENERAL FEEDER SCHEDULE

ID	FEEDER AMPS	CONDUIT AND FEEDER	FEEDING THESE DEVICES
①	100	1-1/2" C, #1/0 AL, #1/0 AL N, #6 AL G	POOL
②	125	2" C, #2/0 AL, #2/0 AL N, #4 AL G	AM-B
③	200	2" C, #3/0, #3/0 N, #6 G	A-HOUSE, B-HOUSE, C-HOUSE, D-HOUSE, E-HOUSE, F-HOUSE, G-HOUSE, H-HOUSE
④	400	(2) 2-1/2" C, #250kcmil AL, #250kcmil AL N, #1/0 AL G	AM-CT
⑤	400	(2) 2-1/2" C, #250kcmil AL, #250kcmil AL N, #1 AL G	AM-DISC
⑥	400	3-1/2" C, #500kcmil AL, #500kcmil AL N, #2 G	AM-A
⑦	800	(3) 3" C, #400kcmil AL, #400kcmil AL N, #4/0 AL G	B-MC
⑧	1000	(4) 3" C, #350kcmil AL, #350kcmil AL N, #4/0 AL G	H-MC
⑨	1200	(4) 3-1/2" C, #500kcmil AL, #500kcmil AL N, #250kcmil AL G	A-MC, C-MC, D-MC, E-MC, F-MC, G-MC
⑪	125	1-1/2" C, #2/0 AL, #2/0 AL N, #4 AL G	A-001, A-002, A-003, A-004, A-101, A-102, A-103, A-104, A-105, A-106, A-107, A-108, A-201, A-202, A-203, A-204, A-205, A-206, A-207, A-208, A-301, A-302, A-303, A-304, A-305, A-306, A-307, A-308, B-001, B-002, B-101, B-102, B-103, B-104, B-201, B-202, B-203, B-204, B-301, B-302, B-303, B-304, C-101, C-102, C-103, C-104, C-105, C-106, C-107, C-108, C-109, C-110, C-111, C-112, C-201, C-202, C-203, C-204, C-205, C-206, C-207, C-208, C-209, C-210, C-211, C-212, C-301, C-302, C-303, C-304, C-305, C-306, C-307, C-308, C-309, C-310, C-311, C-312, D001, D002, D003, D004, D005, D006, D101, D102, D103, D104, D105, D106, D107, D108, D109, D110, D111, D112, D201, D202, D203, D204, D205, D206, D207, D208, D209, D210, D211, D212, D301, D302, D303, D304, D305, D306, D307, D308, D309, D310, D311, D312, E001, E002, E003, E004, E101, E102, E103, E104, E105, E106, E107, E108, E201, E202, E203, E204, E205, E206, E207, E208, E301, E302, E303, E304, E305, E306, E307, E308, F001, F002, F003, F004, F101, F102, F103, F104, F105, F106, F107, F108, F201, F202, F203, F204, F205, F206, F207, F208, F301, F302, F303, F304, F305, F306, F307, F308, G101, G102, G103, G104, G105, G106, G107, G108, G109, G110, G111, G112, G201, G202, G203, G204, G205, G206, G207, G208, G209, G210, G211, G212, G301, G302, G303, G304, G305, G306, G307, G308, G309, G310, G311, G312, H101, H102, H103, H104, H105, H106, H107, H108, H201, H202, H203, H204, H205, H206, H207, H208, H301, H302, H303, H304, H305, H306, H307, H308

SIZING METHOD: COPPER, 60°C #12 THROUGH #1, 75°C 1/0 AND ABOVE

FEEDER SCHEDULE NOTES:

CONDUIT FILL:

* FOR CONDUIT SIZES 1-1/2" AND BELOW, FILL IS BASED ON EMT.

* FOR CONDUIT SIZES 2" AND ABOVE, FILL IS BASED ON SCHEDULE 40 PVC.

IN LOCATIONS APPROVED FOR THE PURPOSE, CONTRACTOR MAY USE MC CABLE. IN LOCATIONS APPROVED FOR THE PURPOSE CONTRACTOR MAY USE OTHER CONDUIT TYPES, INCLUDING RMC, FMC AND LFMC. CONTRACTOR REQUIRED TO ENSURE CONDUIT FILL DOES NOT EXCEED 40%.

CONTRACTOR RESPONSIBLE TO ENSURE TERMINATION/LUG CAPACITY FOR ALL SCHEDULED FEEDERS.

XHHW/THHN/THWN SHALL BE USED FOR INSULATION OF THE CONDUCTOR.

COORDINATION AND ARC FLASH STUDIES:

IMMEDIATELY UPON SELECTION OF ACTUAL EQUIPMENT BEING PROVIDED FOR THE PROJECT, THE ELECTRICAL CONTRACTOR SHALL PERFORM AN ARC FLASH ANALYSIS AND COORDINATION STUDY ON THE STANDBY DISTRIBUTION BASED ON ACTUAL EQUIPMENT TO BE PROVIDED, CONDUCTOR TYPES/SIZES/LENGTHS, ETC. COORDINATION SHALL BE CONFIRMED BASED ON FAULT NUMBERS SHOWN ON THIS DRAWING.

STUDIES SUBMITTED SHALL BE STAMPED BY A PROFESSIONAL ELECTRICAL ENGINEER HOLDING A CURRENT LICENSE FROM THE STATE OF WA.

PRELIMINARY ARC FLASH AND COORDINATION STUDIES ARE TO BE SUBMITTED WITH THE SUBMITTALS FOR THE PROTECTIVE DEVICES, PANELBOARDS, SWITCHBOARDS, AND OTHER ELECTRICAL EQPT.

THE ELECTRICAL CONTRACTOR SHALL SUBMIT THE STAMPED AND SIGNED ARC FLASH AND COORDINATION STUDY TO THE AHJ AS REQUIRED.

THE ELECTRICAL CONTRACTOR SHALL PROVIDE AND INSTALL PERMANENT LABELS INDICATING ARC FLASH HAZARD RISK CATEGORIES ON ALL DISTRIBUTION POINTS (SWITCHBOARDS, PANELBOARDS, VFDs, DISCONNECT SWITCHES, ETC). LABELS SHALL COMPLY WITH NFPA 70E.

SHEET NOTES:

A. CONTRACTOR TO OBTAIN UTILITY APPROVAL OF ALL SERVICE AND METERING EQUIPMENT PRIOR TO ORDERING.

B. DISTRIBUTION SYSTEM AS DESIGNED IS FULLY RATED. CONTRACTOR WILL BE RESPONSIBLE FOR ENGINEERING IF SERIES RATED SYSTEMS ARE SUBMITTED, THE SUBMITTED SYSTEM SHALL MEET NEC 240.86(B) REQUIREMENTS FOR TESTED COMBINATIONS, AND SHALL NOT BE USED IF MOTOR CONTRIBUTION EXCEEDS LIMITS PER 240.86(C). NEC 110.22 MARKING REQUIREMENTS MUST BE MET.

C. PROVIDE PERMANENT WARNING LABELS FOR ARC FLASH AND PPE REQUIREMENTS FOR THE SERVICE EQUIPMENT AND PANELS.

FLAG NOTES:

1. GROUNDING ELECTRODE CONDUCTOR AND SYSTEM GROUNDING SIZED PER N.E.C. 230

2. PROVIDE ARC ENERGY REDUCTION: ENERGY REDUCING MAINTENANCE SWITCH PER NEC 240.87(B)(3)


3. PROVIDE A LISTED SURGE PROTECTIVE DEVICE FOR DWELLING UNITS AS REQUIRED BY NEC 230.67. CONTRACTOR TO CONFIRM LOCATION IS ACCEPTABLE TO AUTHORITY HAVING JURISDICTION. OBTAIN PRICING FOR OPTION TO HAVE SPDs LOCATED IN UNIT PANELS VS UPSTREAM.

4. METER ELEVATIONS AND METERS PER STACK SHALL BE INSTALLED PER UTILITY ELECTRICAL PROVIDER REQUIREMENTS. METER SOCKET IN ELECTRICAL ROOM. VERIFY EXACT LOCATION AND REQUIREMENTS WITH ELECTRIC UTILITY (TYPICAL)

5. PROVIDE (1) 2 1/2" CONDUITS FOR SOLAR READY PATHWAY AND RESERVE SPACE IN THE MAIN ELECTRIC ROOM FOR FUTURE SOLAR EQUIPMENT. RESERVE SPACE FOR INSTALLATION OF FUTURE SOLAR CIRCUIT BREAKER AND PERMANENTLY MARK THIS LOCATION AS "FOR FUTURE SOLAR ELECTRIC".

City of Puyallup
Development Services
ISSUED BY STAFF
Engineering
Fire
Public Works
Traffic

5/2/25 CHANGES/PERMIT CORRECTION SET NO.	DATE	DESCRIPTION

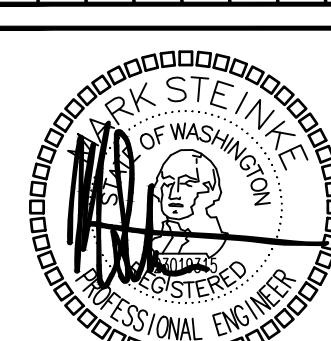

DRAWN: KL
DESIGNED: MHS
CHECKED: PSR
APPROVED: JAY




PROJECT: BRADLEY HEIGHTS APARTMENTS BUILDING C
LYNNWOOD, WA 98036
PHONE: (206)364-3343


ROBISON
ENGINEERING, INC.

DATE: 05/02/2025
SHEET TITLE: ONE-LINE
DIAGRAM &
NOTES

SHEET NO. E6.00

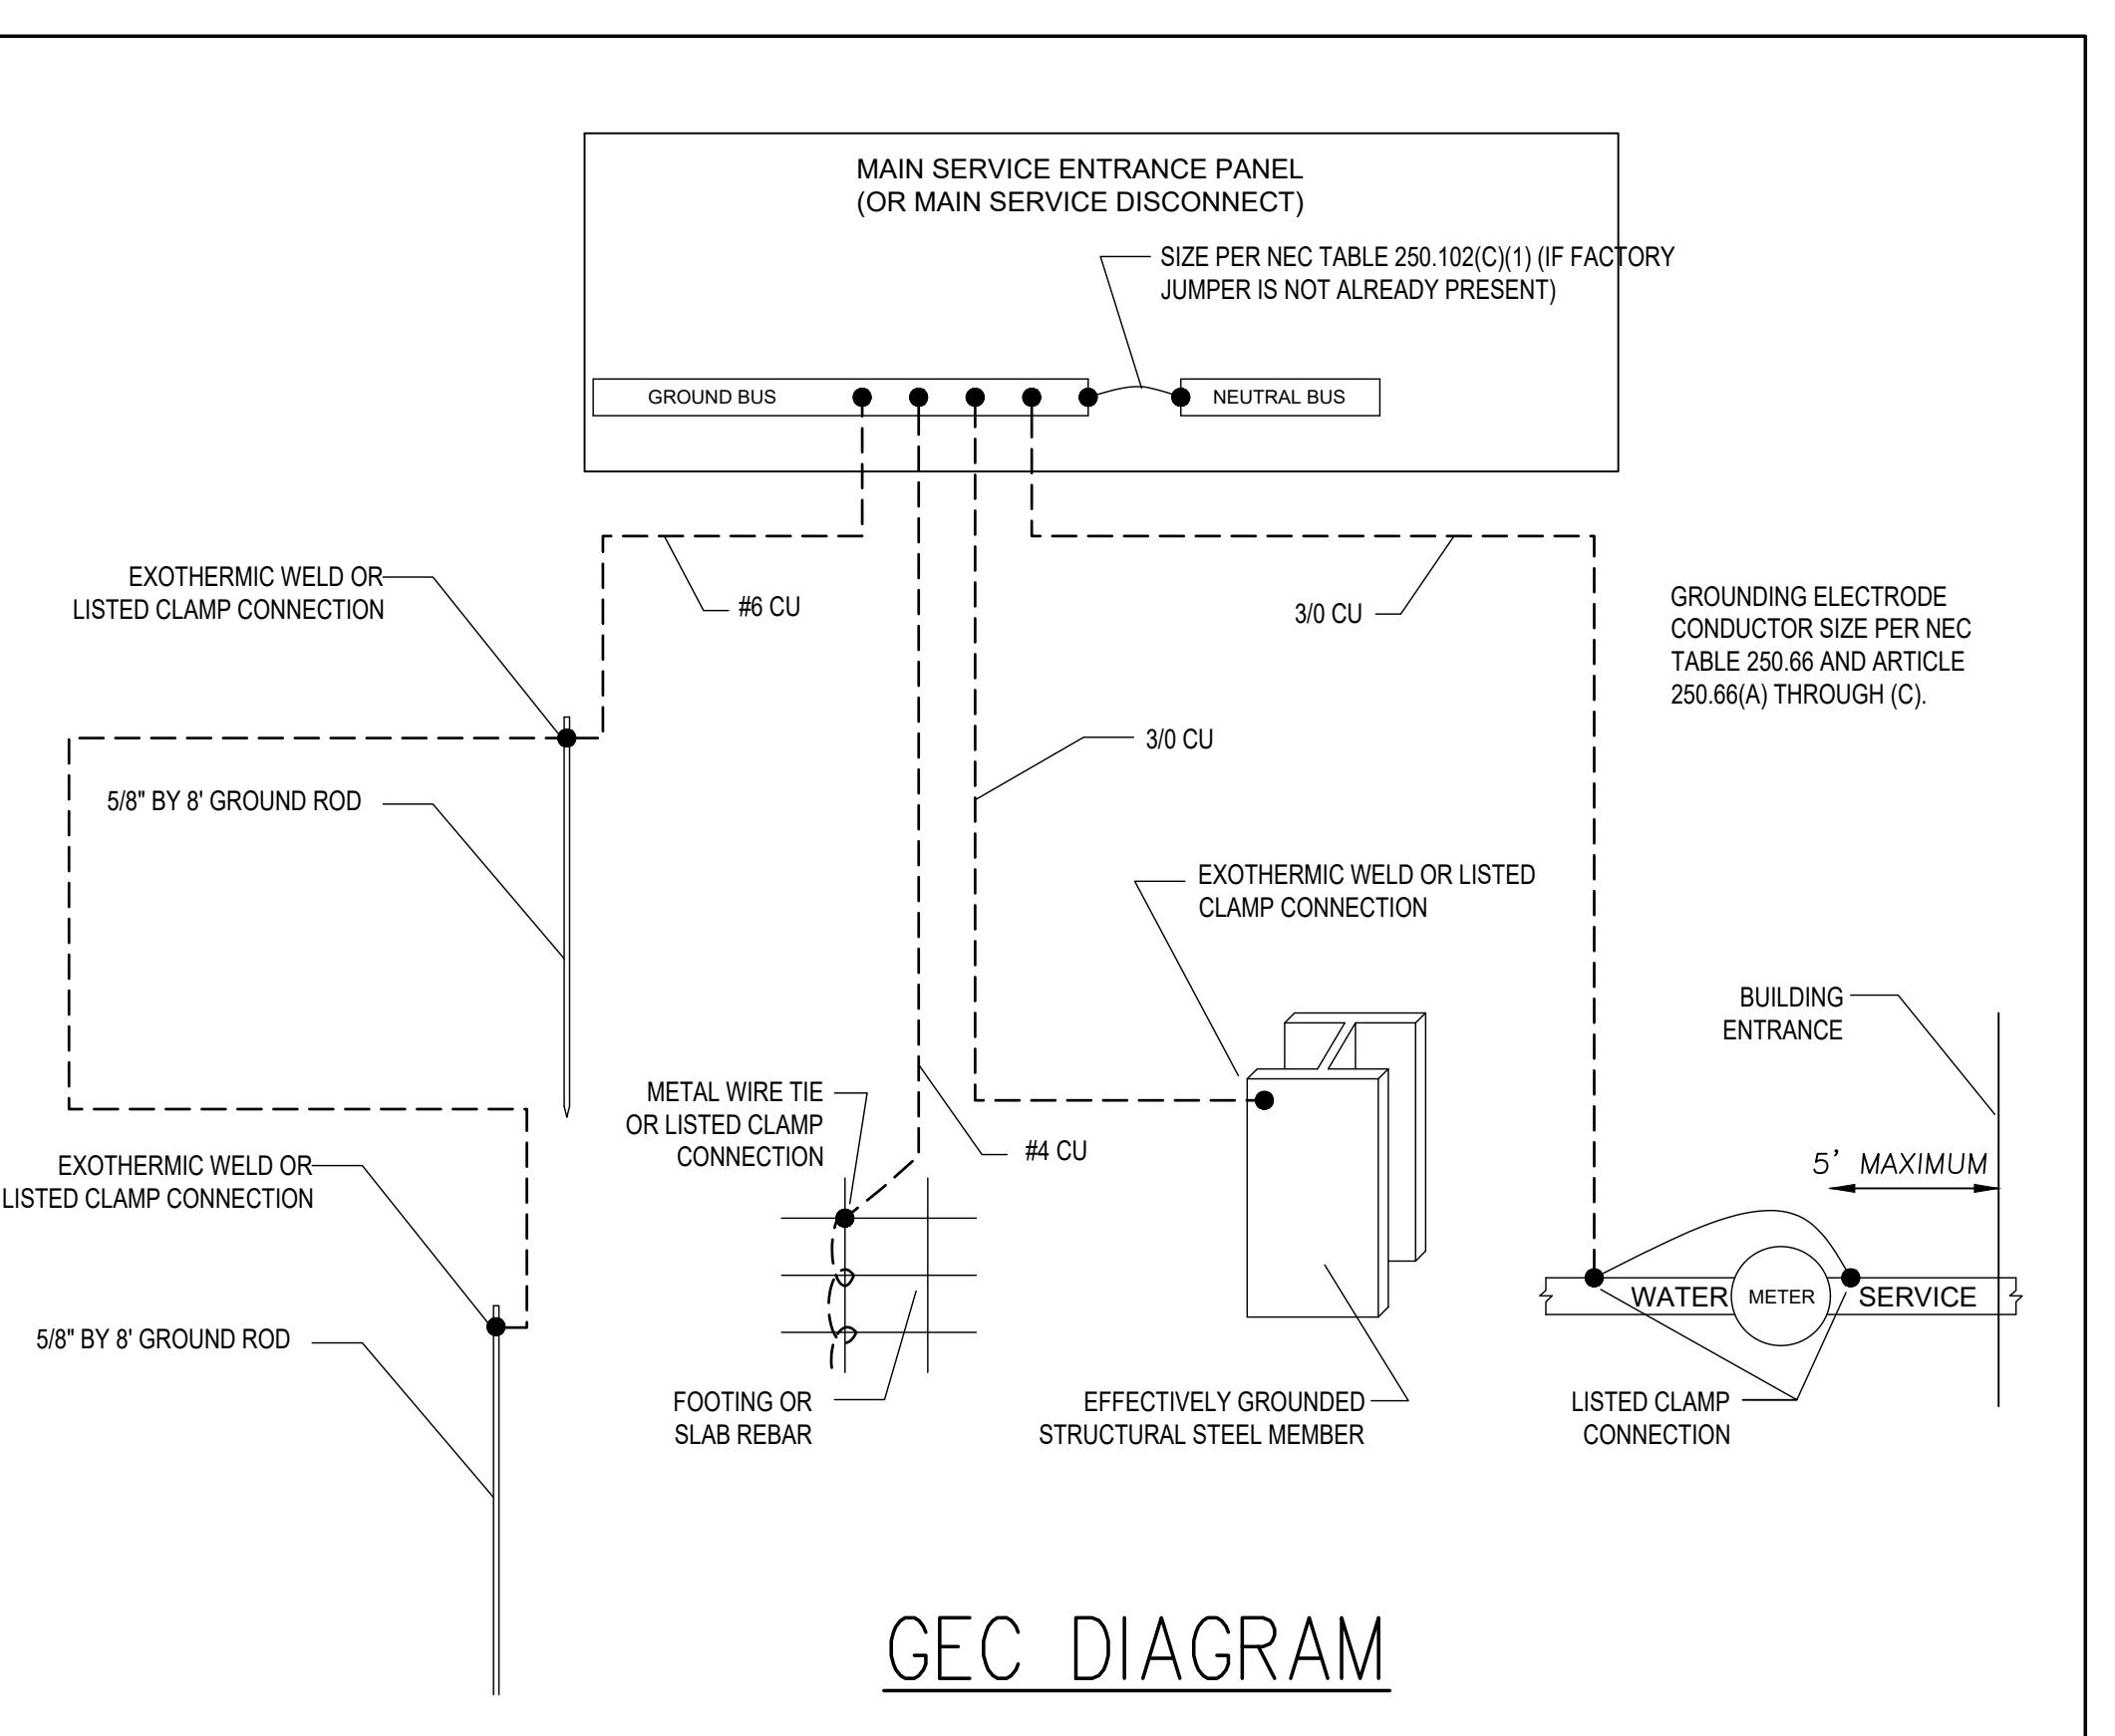

GEC DIAGRAM

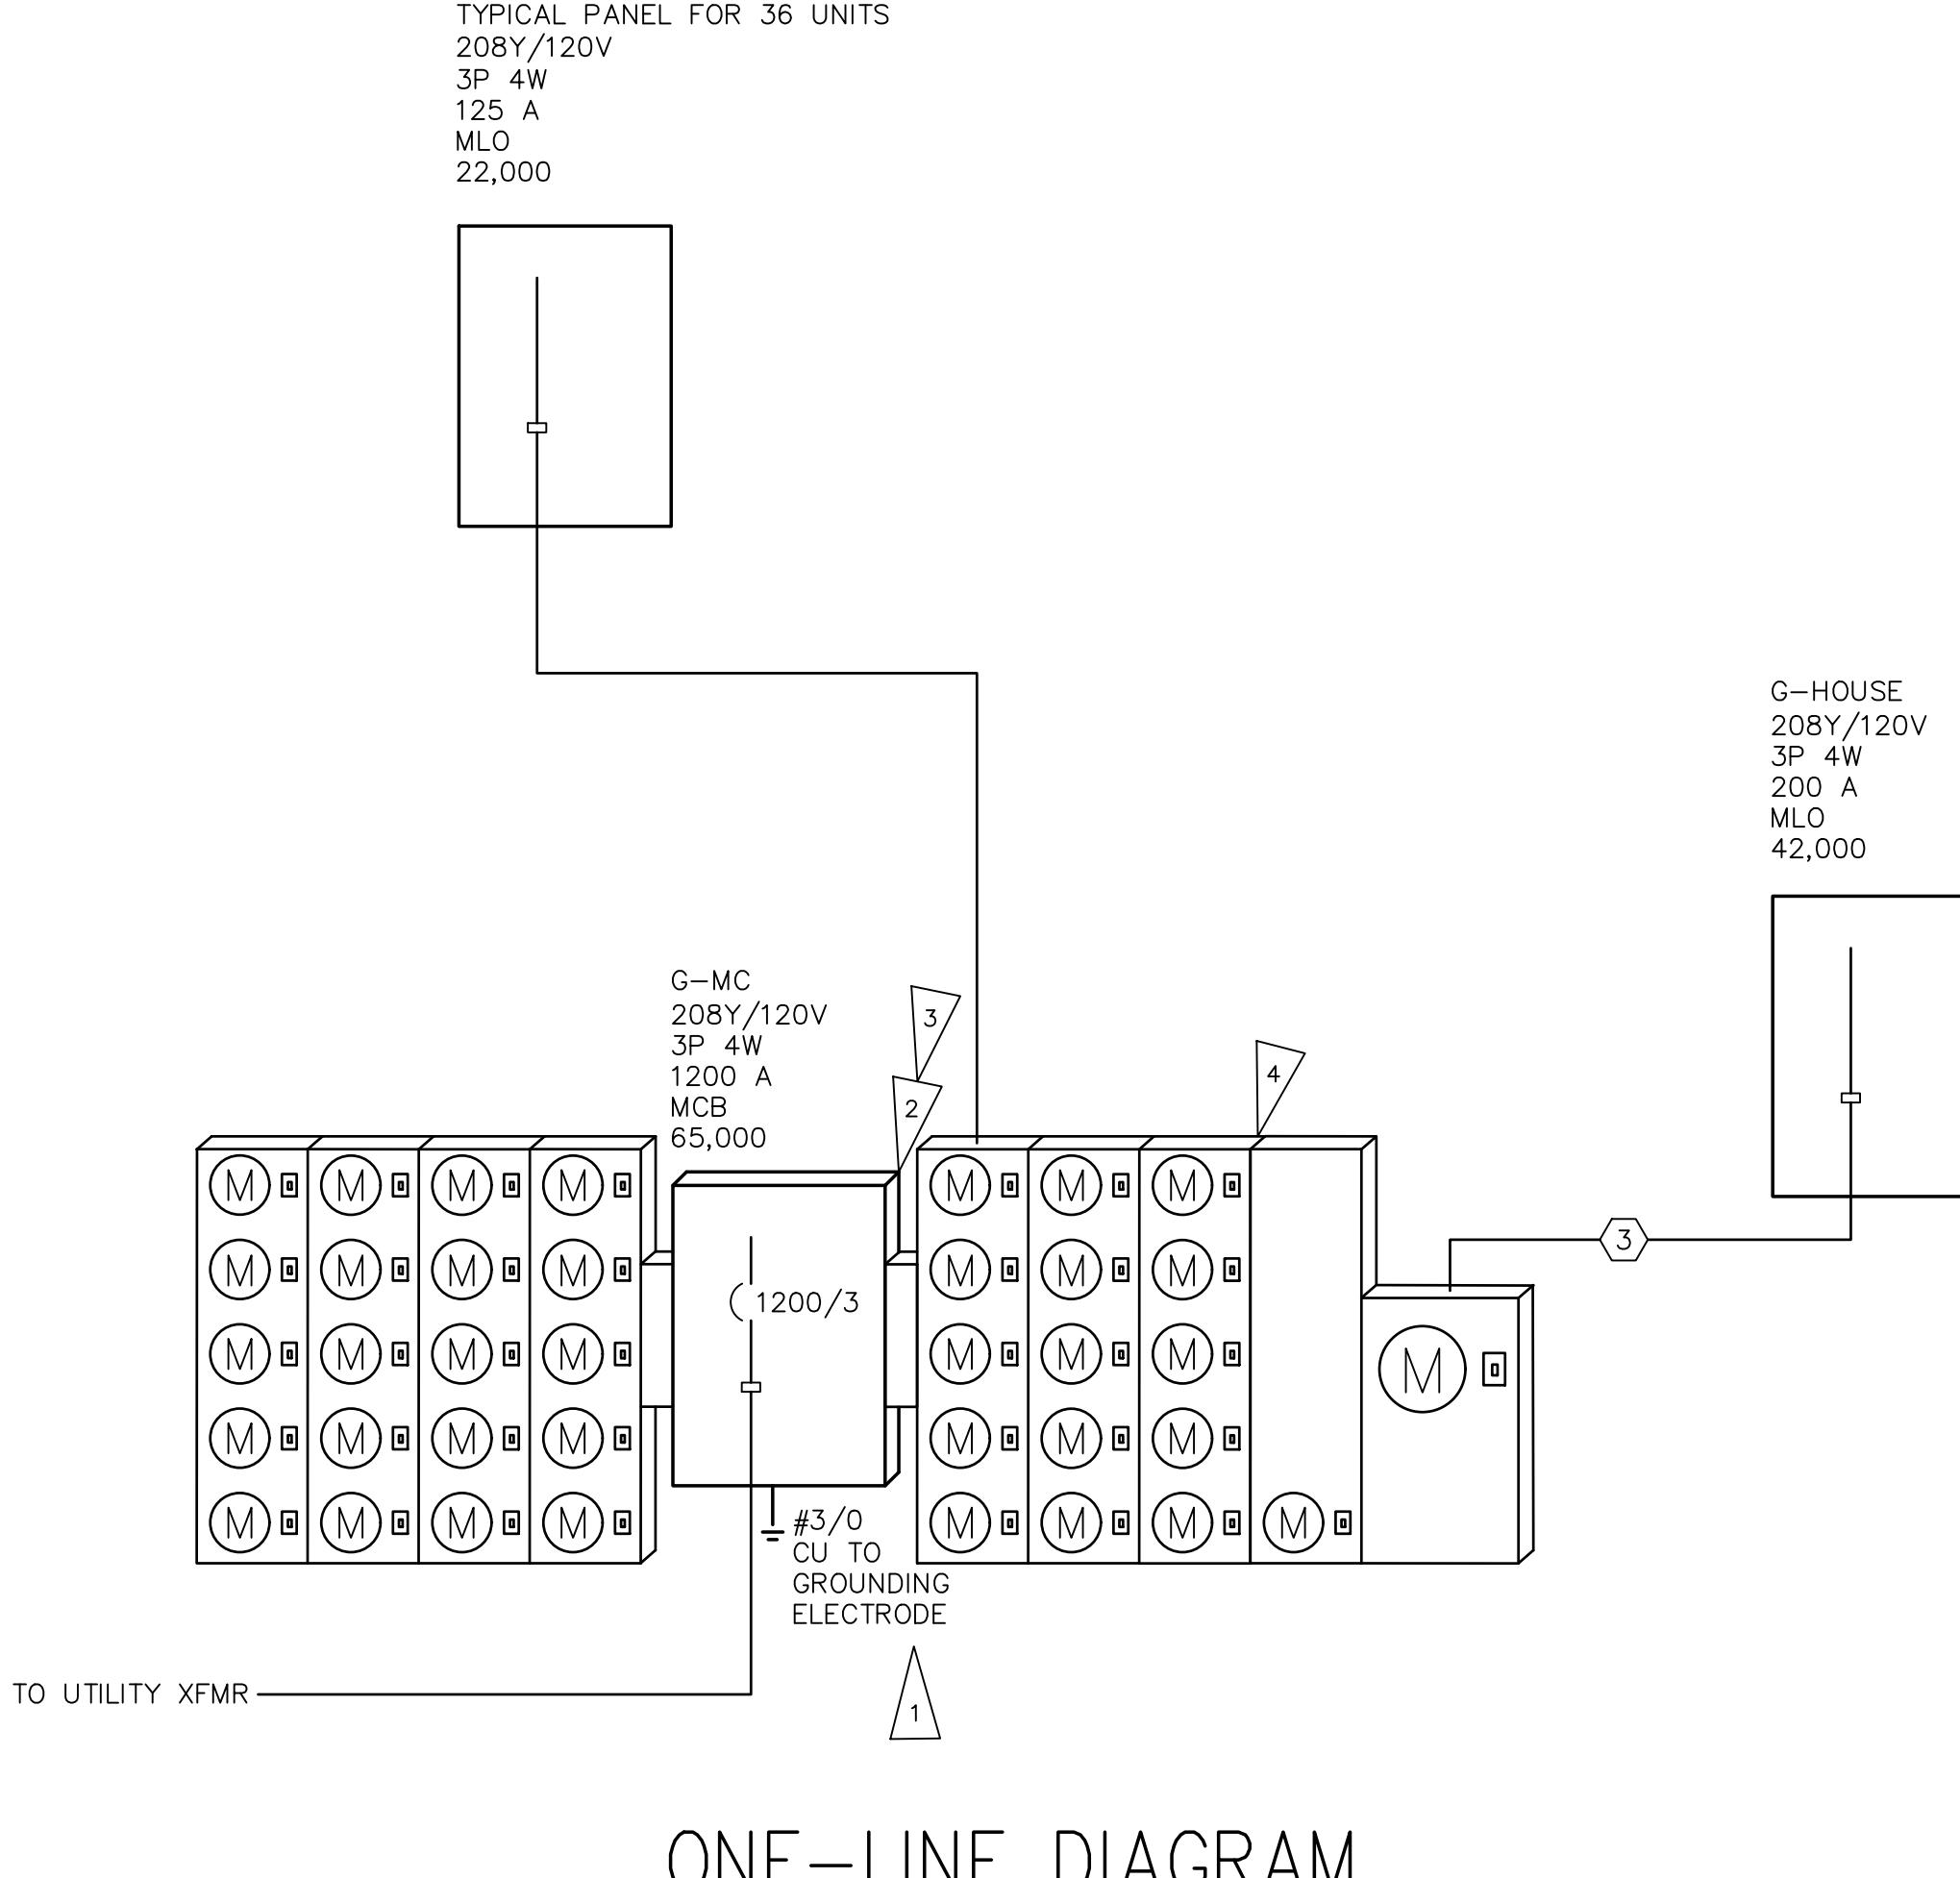



ONE-LINE DIAGRAM

VOLTAGE DROP SCHEDULE						
DEVICE	FEEDER		BRANCH CIRCUIT		TOTAL VOLTAGE DROP	
	VOLTAGE DROP	WIRE SIZE	MAX VOLTAGE DROP	WIRE SIZE		
XFMR A/B/C	0%		-	-	0%	
A-MC	1.61%	(4) #500kcmil AL	-	-	1.61%	
A-HOUSE	1.93%	#3/0	1.06% (CKT 19)	#10	2.99%	
B-MC	0.51%	(3) #400kcmil AL	-	-	0.51%	
B-HOUSE	0.79%	#3/0	1.4% (CKT 3)	#10	2.18%	
C-MC	0.74%	(4) #500kcmil AL	-	-	0.74%	
C-HOUSE	0.91%	#3/0	1.56% (CKT 7)	#10	2.48%	
XFMR D/CLUB	0%		-	-	0%	
AM-CT	0.35%	(2) #250kcmil AL	-	-	0.35%	
AM-DISC	0.57%	(2) #250kcmil AL	-	-	0.57%	
AM-A	0.85%	#500kcmil	1.95% (CKT 41)	#12	2.79%	
AM-B	2.33%	#2/0 AL	2.18% (CKT 33,35)	#8	4.51%	
POOL	0.89%	#1/0 AL-1	0.28% (CKT 1)	#12	1.18%	
D-MC	2.76%	(5) #600kcmil AL	-	-	2.76%	
D-HOUSE	3.01%	#3/0	1.52% (CKT 21)	#10	4.53%	
XFMR E/H	0%		-	-	0%	
E-MC	0.64%	(4) #500kcmil AL	-	-	0.64%	
E-HOUSE	0.82%	#3/0	1.1% (CKT 19)	#10	1.92%	
H-MC	0.97%	(4) #350kcmil AL	-	-	0.97%	
H-HOUSE	1.11%	#3/0	1.1% (CKT 17)	#10	2.21%	
XFMR F/G	0%		-	-	0%	
F-MC	1.6%	(4) #500kcmil AL	-	-	1.6%	
F-HOUSE	1.85%	#3/0	1.1% (CKT 19)	#10	2.95%	
G-MC	0.54%	(4) #500kcmil AL	-	-	0.54%	
G-HOUSE	0.71%	#3/0	1.52% (CKT 21)	#10	2.23%	

G-HOUSE						
ROOM MOUNTING	SURFACE	VOLTS 208Y/120V 3P 4W	AIC 42,000			
FED FROM	G-MC	BUS AMPS 200	MAIN BKR MLO			
NOTE		NEUTRAL 100%	LUGS STANDARD			
CKT #	CKT BKR	LOAD KVA	CIRCUIT DESCRIPTION	CKT #	CKT BKR	LOAD KVA
1	20/2	1	EWH	2	50/2	8.3
3	-/1	0	SPACE	4	50/2	8.3
5	-/1	0	SPACE	6	50/2	8.3
7	20/1	0.283	LIGHTING	8	50/2	8.3
9	20/1	0.283	LIGHTING	10	50/2	8.3
11	20/1	0.294	LIGHTING	12	50/2	8.3
13	20/1	0.18	RECEPTACLE	14	50/2	8.3
15	-/1	0	SPACE	16	-/1	0
17	20/1	0.18	RECEPTACLE	18	50/2	8.3
19	20/1	0.128	LIGHTING	20	-/1	0
21	20/1	0.5	FACP	22	50/2	8.3
23	20/1	0.144	SITE LIGHTING	24	-/1	0
25	-/1	0	SPACE	26	50/2	8.3
27	-/1	0	SPACE	28	-/1	0
29	-/1	0	SPACE	30	50/2	8.3
31	-/1	0	SPACE	32	-/1	0
33	-/1	0	SPACE	34	20/1	0.05
35	-/1	0	SPACE	36	-/1	0
37	-/3	0	SOLAR BREAKER	38	-/1	0
39	-/1	0		40	-/1	0
41	-/1	0		42	-/1	0
CONN KVA						
LIGHTING	1.13	1.42	(125%)	CONTINUOUS	0.5	0.625
RECEPTACLES	0.36	0.36	(50%>10)	NONCONTINUOUS	0.05	0.05
EV LOAD	66.4	41.5	(63%)	HEATING	1	(100%)
CONN KVA						
LIGHTING	1.13	1.42	(125%)	CONTINUOUS	0.5	0.625
RECEPTACLES	0.36	0.36	(50%>10)	NONCONTINUOUS	0.05	0.05
EV LOAD	66.4	41.5	(63%)	HEATING	1	(100%)
TOTAL LOAD						
BALANCED 3-PHASE LOAD						
PHASE A		112%				
PHASE B		95.7%				
PHASE C		92.5%				
TOTAL LOAD						
45						
TOTAL CONNECTED KVA BY PHASE						
420 414 411						
OPTIONAL MULTIFAMILY DWELLING CALCULATION (NEC 220.84)						
DWELLING UNIT LOADS						
KVA						
LIGHTING AND RECEPTACLES	104	34,661 SF (3 VA/SF)	CONNECTED LOAD		953	
SMALL-APPLIANCE	108		DWELLING UNITS		36	
LAUNDRY	54		DEMAND FACTOR		(30%)	
APPLIANCES	305		CALCULATED LOAD		286	
ELECTRIC COOKING	200					
HEATING	182	(100%)				
HOUSE LOADS						
CONN KVA						
LIGHTING	1.13	1.42	(125%)	CONTINUOUS	0.5	0.625
RECEPTACLES	0.36	0.36	(50%>10)	NONCONTINUOUS	0.05	0.05
EV LOAD	66.4	41.5	(63%)	HEATING	1	(100%)
TOTAL HOUSE LOAD						
45						
TOTAL LOAD						
KVA						
TOTAL DWELLING UNIT LOAD	286		TOTAL LOAD		331	
TOTAL HOUSE LOAD	45		BALANCED 3-PHASE LOAD		918 A	

G-MC						
ROOM MOUNTING	SURFACE	VOLTS 208Y/120V 3P 4W	AIC 65,000			
FED FROM	G-MC	BUS AMPS 1200	MAIN BKR 1200			
NOTE		NEUTRAL 100%	LUGS STANDARD			
CKT #	BREAKER TRIP/POLES	CIRCUIT DESCRIPTION		LOAD KVA	A	B
1	125/2	PANEL G101		16.6	17.1	
2	125/2	PANEL G102		16.2	16.1	1-1/2" C, 2#2/0 AL, #2/0 AL N, #4 AL G
3	125/2	PANEL G103		17.1	16.6	1-1/2" C, 2#2/0 AL, #2/0 AL N, #4 AL G
4	125/2	PANEL G104		16.2	16.1	1-1/2" C, 2#2/0 AL, #2/0 AL N, #4 AL G
5	125/2	PANEL G105		16.2	16.1	1-1/2" C, 2#2/0 AL, #2/0 AL N, #4 AL G
6	125/2	PANEL G106		16.1	16.2	1-1/2" C, 2#2/0 AL, #2/0 AL N, #4 AL G
7	125/2	PANEL G107		15.7	16.3	1-1/2" C, 2#2/0 AL, #2/0 AL N, #4 AL G
8	125/2	PANEL G108		16.3	16.1	1-1/2" C, 2#2/0 AL, #2/0 AL N, #4 AL G
9	125/2	PANEL G109		16.1	16.2	1-1/2" C, 2#2/0 AL, #2/0 AL N, #4 AL G
10	125/2	PANEL G110		16.6	17.1	1-1/2" C, 2#2/0 AL, #2/0 AL N, #4 AL G
11	125/2	PANEL G111		15.7	16.3	

GENERAL NOTES		SYMBOLS		ABBREVIATIONS	
1. REFERENCE TO RELATED WORK: "REF" INDICATIONS DENOTE WORK COVERED ELSEWHERE (ARCHITECTURAL, STRUCTURAL, CIVIL, ELECTRICAL, LANDSCAPE, OR KITCHEN), OR ITEM BASED ON A SPECIFIC MANUFACTURER'S DIMENSIONS (VERIFY).					
2. ELECTRICAL CHARACTERISTICS: REFER TO ELECTRICAL DRAWINGS FOR ELECTRICAL CHARACTERISTICS (VOLTAGES, ETC. OF MECHANICAL EQUIPMENT, UNLESS OTHERWISE INDICATED).					
3. CODES: COMPLETE INSTALLATION OF THE PLUMBING SYSTEM SHALL BE PER THE APPLICABLE BUILDING, MECHANICAL, ENERGY, PLUMBING, FIRE, AND HEALTH CODES AND REGULATIONS AS ADOPTED BY THE LOCAL AHJ.					
4. PREPARE AND SUBMIT FOR REVIEW A SHOP DRAWING BASED ON FINAL STRUCTURAL SHOP DRAWINGS FOR LOCATING AND ROUTING ALL EQUIPMENT, PIPING, ETC.					
A. COORDINATE FLOOR AND BEAM PENETRATIONS WITH STRUCTURAL PIPING, AND OTHER TRADES WORK.					
B. COORDINATE FINAL LOCATION AND ROUTING WITH CEILING, LIGHTS, WALLS, FIRE SPRINKLER					
C. INCLUDE ADDITIONAL OFFSETS, ELBOWS, ROUTING, EQUIVALENT DUCT SIZING EXCHANGE, RELOCATING, ETC. AS REQUIRED FOR A COMPLETE OPERATING MECHANICAL SYSTEM.					
D. PROVIDE SHOP DRAWINGS AT NO ADDITIONAL COST TO THE OWNER.					
5. PLUMBING CONTRACTOR SHALL LOCATE AND COORDINATE EXACT LOCATION OF ALL PLUMBING EQUIPMENT WITHIN THE STRUCTURE.					
6. ACCESS DOORS: COORDINATE WITH ARCHITECT AND LOCATE ALL ACCESS DOORS ON SHOP DRAWINGS PRIOR TO BEGINNING OF CONSTRUCTION. ACCESS DOORS IN FIRE RATED STRUCTURE SHALL BE FIRE RATED. VERIFY ACCESS DOOR LOCATIONS WITH GENERAL CONTRACTOR PRIOR TO BIDDING.					
7. ROOF PENETRATIONS: SEE ARCHITECTURAL DRAWINGS FOR ROOF CAP, ROOF CURB, ROOF DRAIN, OVERFLOW DRAINS AND VTR DETAILS.					
8. EXPOSED PIPING: PROVIDE CHROME PLATING FOR EXPOSED PIPING IN FINISHED ROOMS.					
9. PENETRATIONS: PROVIDE ESCUTCHEON PLATES FOR EXPOSED PIPING PENETRATIONS AND SHEET METAL FLASHING FOR EXPOSED DUCTWORK PENETRATIONS.					
10. SHAFT AND PLENUM CONNECTIONS: SEAL CONNECTIONS TO AIR SHAFTS AIRTIGHT. PROVIDE AIRTIGHT SEAL AROUND PENETRATIONS IN AIR PLENUMS.					
11. LIGHT FIXTURE CLEARANCE: COORDINATE LOCATIONS OF MECHANICAL WORK TO PROVIDE CLEARANCES OVER LIGHTING FIXTURES FOR REMOVAL AND REPLACEMENT.					
12. CABLE TRAYS: PIPING INSTALLED ADJACENT TO ELECTRICAL CABLE TRAYS SHALL ALLOW MINIMUM ACCESS OF 6" ABOVE AND TO THE SIDE OF CABLE TRAYS.					
13. MOTORS: COMPLY WITH ENERGY CODE ENFORCED BY AHJ FOR MINIMUM EFFICIENCIES UNDER FULL LOAD.					
14. ACCESS CLEARANCES FOR MAINTENANCE AND REPLACEMENT: VERIFY PHYSICAL DIMENSIONS OF EQUIPMENT TO ENSURE THAT ACCESS CLEARANCES CAN BE MET. COORDINATE LOCATIONS OF MECHANICAL WORK AND WORK OF OTHER TRADES TO PROVIDE ACCESS CLEARANCES FOR SERVICE AND MAINTENANCE.					
COORDINATION REQUIREMENTS					
1. IRRIGATION SYSTEM: COORDINATE IRRIGATION WATER DEMAND, MINIMUM WATER PRESSURE REQUIREMENTS & CONTROL CABINET LOCATIONS WITH IRRIGATION CONTRACTOR.					
2. GAS: CONTRACTOR/GAS COMPANY SHALL FINALIZE GAS METER AND GAS SERVICE LOCATIONS. INSTALL SEISMIC GAS SHUT OFF VALVE PER GAS COMPANY REGULATIONS.					
3. UTILITIES: COORDINATE WITH SITE UTILITY CONTRACTOR AND CIVIL DRAWINGS FOR UTILITY CONNECTIONS AND EXTENSIONS.					
4. ROOF DRAINAGE: COORDINATE WITH GENERAL CONTRACTOR FOR ROOF DRAIN AND OVERFLOWS, SCUPPER DRAINS, AND CONDENSATE DRAINS.					
5. PLUMBING FIXTURES & EQUIPMENT: COORDINATE EXACT LOCATION OF ALL PLUMBING FIXTURES & EQUIPMENT WITH ARCHITECTURAL AND OTHER TRADES DOCUMENTS.					
6. PIPING: COORDINATE EXACT LOCATION OF ALL STRUCTURAL FRAMING & FOOTINGS AND FINALIZE THE EXACT ROUTING OF ALL PIPES WITH STRUCTURAL ENGINEER AT THE SITE PRIOR TO AND DURING THE CONSTRUCTION. COORDINATE UNDER GRADE PIPING & FOUNDATION DRAINAGE PIPING WITH CIVIL ENGINEER.					
7. ADJUSTMENTS: ALL EQUIPMENT, MOTORS, FANS GAS BURNERS, IGNITION DEVICES, DRIVES, ETC. SHALL BE ADJUSTED AND BALANCED TO OPERATE AT SPECIFIED RATINGS AS REQUIRED FOR THIS PROJECT SITE AND ACCOUNTING FOR ELEVATION ABOVE SEA LEVEL.					
8. APPROVALS: MECHANICAL AND PLUMBING EQUIPMENT SHALL BE APPROVED FOR INSTALLATION IN THE PROJECT LOCATION AND SHALL HAVE ALL CERTIFICATIONS AND RATINGS TO MEET ALL ENERGY, POLLUTION, ENVIRONMENTAL, SEISMIC, APPLICABLE CODES AND REGULATIONS. THE CONTRACTOR SHALL COORDINATE WITH MANUFACTURE SUPPLIERS AND SHALL INCLUDE ALL COSTS REQUIRED TO MEET THE BID DOCUMENTS.					
9. FIRE PROTECTION: CONTRACTOR SHALL PROVIDE A FULLY DESIGNED FIRE PROTECTION SPRINKLER SYSTEM IN COMPLIANCE WITH NFPA AND LOCAL CODES. PROVIDE DESIGN, PERMITS, MATERIALS, INSTALLATION, TESTING AND ALL OTHER FOR A FULLY OPERATIONAL SYSTEM. LOCATION OF ALL PIPING TO BE COORDINATED WITH OTHER TRADES.					
10. PRIOR TO PIPING INSTALLATION: PLUMBING CONTRACTOR TO COORDINATE PIPING LAYOUT WITH ALL OTHER TRADES.					
11. ACCESS: COORDINATE ALL ACCESS LOCATIONS WITH GENERAL CONTRACTOR AND ARCHITECT TO ENSURE ALL REQUIRED ACCESS HATCHES, ACCESS PANELS & ACCESS COVERS ARE PROVIDED.					
12. PROVIDE WATER TIGHT SEALS FOR ANY PIPING PENETRATING THE EXTERIOR FOUNDATION WALLS OR SLABS.					
13. ANY DISCREPANCIES SHOULD BE REPORTED TO THE ARCHITECT IMMEDIATELY.					
14. PROVIDE FIRE PROOFING FOR ALL PIPING PENETRATING FIRE BARRIER WALLS OR FLOOR SLABS.					
DISINFECTION OF POTABLE WATER SYSTEM REQUIREMENTS					
1. NEW OR REPAIRED POTABLE WATER SUPPLY SYSTEMS SHALL BE DISINFECTED PRIOR TO USE.					
2. INITIAL COLIFORM SAMPLE IS REQUIRED PRIOR TO ADMINISTERING WATER-CHLORINE SOLUTION.					
3. SECTION 609.9 ITEMS #2 OR #3 CAN BE USED PRECEDED BY AND FOLLOWED BY ITEM #1.					
3.1. NOTE FILL PORT TO ADD CHLORINE MUST BE WHERE WATER SUPPLY ENTERS BUILDING AND A FLOW METER TO MEASURE SOLUTION.					
4. AFTER WATER-CHLORINE SOLUTION IS INCORPORATED INTO THE NEW OR REPAIRED WATER SUPPLY SYSTEM A 48 HOUR WAITING PERIOD MUST BE OBSERVED PRIOR TO BACTERIOLOGICAL TEST.					
5. BACTERIOLOGICAL TEST SHALL BE CONDUCTED BY A LABORATORY CERTIFIED FOR DRINKING WATER IN WASHINGTON STATE AFFIRMING WATER QUALITY CONTAINS NO COLIFORM BY SAMPLE TESTING THE FURTHEST FIXTURE FROM PUBLIC WATER SOURCE AND NOT LESS THAN TWO OTHER LOCATIONS PART OF THE WATER SUPPLY SYSTEM.					
6. CHLORINE LEVEL IN THE NEW OR REPAIRED WATER SUPPLY SYSTEM SHALL NOT BE LESS THAN THE MEAN AVERAGE OF THE AREA IN RELATIONSHIP FROM THE WATER PURVEYOR SOURCE.					
7. WARNING: IN CASE A WATER SOFTENER IS PART OF THE COLD WATER SYSTEM, CONTRACTOR TO ENSURE THE WATER SOFTENER IS CONNECTED AND OPERATIONAL BEFORE STARTING THE DISINFECTION PROCESS. FAILURE TO FOLLOW THE INSTRUCTIONS WILL VOID THE WATER HEATER OR HEAT PUMP WARRANTY.					
GENERAL					
ARCHITECTURAL BACKGROUND (THIN LINE)		BALL VALVE		ABV	ABOVE
NEW PIPING (HEAVY LINE)		GLOBE VALVE		AD	AREA DRAIN
EXISTING PIPING (THIN LINE)		CHECK VALVE		AFF	ABOVE FINISHED FLOOR
EXISTING WORK TO BE REMOVED		BALANCING OR PLUG VALVE		AHU	AUTHORITY HAVING JURISDICTION
MATCHLINE OR PROPERTY LINE		BUTTERFLY VALVE		BFP	BELLOW FINISHED FLOOR
SECTION IDENTIFICATION		FLEXIBLE CONNECTION IN PIPING		BTUH	BRITISH THERMAL UNIT PER HOUR
INDICATES DIRECTION OF CUTTING PLANE		PRESSURE REDUCING VALVE (PRV)		BV	BALANCING VALVE
LETTER INDICATES SECTION (NO. INDICATES DETAIL)		AUTOMATIC CONTROL VALVE, 2-WAY		COM	COMBINATION
INDICATES DIRECTION OF CUTTING PLANE		RELIEF VALVE		CONT	CONTINUE
LETTER INDICATES SECTION (NO. INDICATES DETAIL)		BALANCING/METERING VALVE		CONTR	CONTRACTOR
INDICATES DIRECTION OF CUTTING PLANE		REDUCER		COTG	CIRCUITANTS TO GRADE
LETTER INDICATES SECTION (NO. INDICATES DETAIL)		DIRECTION OF FLOW		CV	CHECK VALVE
INDICATES DIRECTION OF CUTTING PLANE		PIPE ANCHOR		CW	COLD WATER
LETTER INDICATES SECTION (NO. INDICATES DETAIL)		PIPE ALIGNMENT GUIDE		D	DIAMETER
INDICATES DIRECTION OF CUTTING PLANE		PIPE SUPPORT		DB	DRY BULB, DEGREES
LETTER INDICATES SECTION (NO. INDICATES DETAIL)		VALVE STATION OR ASSEMBLY		DF	DRY BULB, DEGREES
INDICATES DIRECTION OF CUTTING PLANE		INDIRECT DRAIN, PIPE TO DRAIN		DU	DRY BULB, DEGREES
LETTER INDICATES SECTION (NO. INDICATES DETAIL)		POINT OF CONNECTION		HW	HOT WATER
INDICATES DIRECTION OF CUTTING PLANE		ROOF DRAIN, OVERFLOW DRAIN		HWC	HOT WATER RE-CIRCULATION
LETTER INDICATES SECTION (NO. INDICATES DETAIL)		FLOOR DRAIN		HWP	HOT WATER CIRCULATION PUMP
INDICATES DIRECTION OF CUTTING PLANE		HOSE BIBB		HWT	HOT WATER THERMOMETER
LETTER INDICATES SECTION (NO. INDICATES DETAIL)		BREAK IN PIPING OR DUCTWORK		HWST	HOT WATER STORAGE TANK
INDICATES DIRECTION OF CUTTING PLANE		GAS METER		ID	HORIZONTAL
LETTER INDICATES SECTION (NO. INDICATES DETAIL)		INLINE WATER METER		IE	INDIRECT
INDICATES DIRECTION OF CUTTING PLANE		PUMP		IEH	INDIRECT ELEVATION
LETTER INDICATES SECTION (NO. INDICATES DETAIL)		PRESSURE GAUGE		IN	INDUSTRIAL
INDICATES DIRECTION OF CUTTING PLANE		THERMOMETER		IP	INDUSTRIAL HOT WATER
LETTER INDICATES SECTION (NO. INDICATES DETAIL)		PRESSURE/TEMPERATURE TEST PORT		IP/T	INDUSTRIAL HOT WATER
INDICATES DIRECTION OF CUTTING PLANE		REDUCED PRESSURE BACKFLOW PREVENTER		IPBP	INDUSTRIAL HOT WATER
LETTER INDICATES SECTION (NO. INDICATES DETAIL)		DOUBLE CHECK VALVE ASSEMBLY		DCVA	INDUSTRIAL HOT WATER
INDICATES DIRECTION OF CUTTING PLANE		CATCH BASIN - SAND/OIL INTERCEPTOR		IRR	IRRIGATION (NON POTABLE)
LETTER INDICATES SECTION (NO. INDICATES DETAIL)		TRENCH DRAIN		F	FIRE MAIN
INDICATES DIRECTION OF CUTTING PLANE		EMERGENCY GAS SHUT-OFF VALVE		FOR	FIRE OIL FILL
LETTER INDICATES SECTION (NO. INDICATES DETAIL)		SEISMIC GAS SHUT-OFF VALVE		FOV	FIRE OIL RETURN
INDICATES DIRECTION OF CUTTING PLANE		WASHER BOX		FOV	FIRE OIL VENT
LETTER INDICATES SECTION (NO. INDICATES DETAIL)		GREASE INTERCEPTOR		RV	RELIEF VENT
INDICATES DIRECTION OF CUTTING PLANE				G	LOW PRESSURE NATURAL GAS
LETTER INDICATES SECTION (NO. INDICATES DETAIL)				MPG	MEDIUM PRESSURE NATURAL GAS
INDICATES DIRECTION OF CUTTING PLANE				IRR	IRRIGATION (NON POTABLE)
LETTER INDICATES SECTION (NO. INDICATES DETAIL)				F	FIRE MAIN
PIPE SYMBOLS					
TOP PIPE CONNECTION					
BOTTOM PIPE CONNECTION					
PIPE TURNING UP					
PIPE TURNING DOWN/DROP					
PIPE CAP					
PIPE PLUG					
UNION	<img alt="Union symbol: a line with a small circle at the end and a leader line pointing				

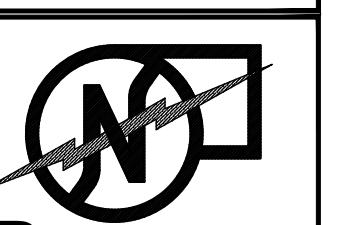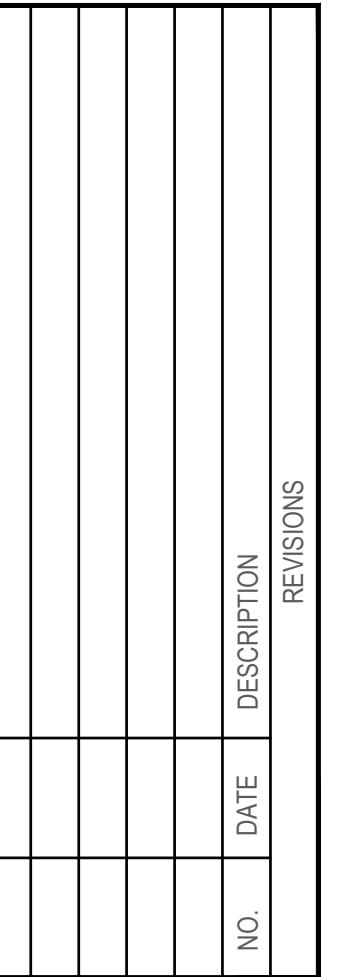

PRMU20240280



E: 04/25/2025

SET TITLE:
GEND GENERAL
OTES AND
RAWING INDEX

ET NO.

•0G.00

PLUMBING TABLES

PIPE INSULATION SCHEDULE

SERVICE	OPTION 1		OPTION 2		VAPOR RETARDER REQUIRED	NOTES
	MATERIAL	THICKNESS	MATERIAL	THICKNESS		
DOMESTIC COLD WATER, IRRIGATION WATER, CONDENSATE DRAINS, STORM DRAIN (IN CONDITIONED SPACE)	MINERAL-FIBER WITH JACKET	ALL SIZES: $\frac{1}{2}$ "	PVC/NBR	ALL SIZES: $\frac{3}{8}$ "	YES	12,13
DOMESTIC COLD WATER, IRRIGATION WATER, CONDENSATE DRAINS, WASTE (OUTSIDE THE CONDITIONED SPACE)	MINERAL-FIBER WITH JACKET	(R-3) $\frac{1}{2}$ " PIPE: $\frac{1}{2}$ " ALL OTHER SIZES: 1"	PVC/NBR	(R-3) $\frac{1}{2}$ " PIPE: $\frac{1}{2}$ " ALL OTHER SIZES: $\frac{3}{8}$ "	YES	7,8,10
ROOF DRAIN BODIES	MINERAL-FIBER OR CELLULAR GLASS WITH JACKET	1"	PVC/NBR	1"	YES	12
DOMESTIC HOT WATER AND RECIRCULATED HOT WATER (RESIDENTIAL)	MINERAL-FIBER WITH JACKET	(R-3) $\frac{1}{2}$ " PIPE: $\frac{1}{2}$ " ALL OTHER SIZES: 1"	PVC/NBR	(R-3) $\frac{1}{2}$ " PIPE: $\frac{1}{2}$ " ALL OTHER SIZES: $\frac{3}{8}$ "	NO	2,10
DOMESTIC HOT WATER AND RECIRCULATED HOT WATER (NONRESIDENTIAL)	MINERAL-FIBER WITH JACKET	$\frac{1}{2}$ "- $\frac{1}{4}$ " PIPE: 1" $\frac{1}{2}$ "-4" PIPE: 1.5"	PVC/NBR	$\frac{1}{2}$ "- $\frac{1}{4}$ " PIPE: 1" $\frac{1}{2}$ "-4" PIPE: 1.5"	NO	3,9
EXPOSED SANITARY DRAINS AND DOMESTIC WATER SUPPLIES AND STOPS FOR ADA FIXTURES.	TRUEBRO LAV-GUARD	N/A	N/A	N/A	NO	11

NOTES:

1. PIPING INSULATION EXPOSED TO THE WEATHER SHALL BE PROTECTED FROM DAMAGE. CONTRACTOR SHALL PROVIDE SHIELDING FROM SOLAR RADIATION THAT CAN CAUSE DEGRADATION OF THE MATERIAL. ADHESIVE TAPE SHALL NOT BE PERMITTED.
2. PER 2018 WSEC SECTION R403.5.3 (RESIDENTIAL) INSULATION FOR HOT WATER PIPE SHALL HAVE A MINIMUM R-VALUE OF R-3.
3. PIPING FROM WATER HEATER TO THE TERMINATION OF HEATED WATER SUPPLY PIPE SHALL BE INSULATED IN ACCORDANCE WITH TABLE C403.2.9.
4. ON BOTH THE INLET AND OUTLET PIPING OF A STORAGE HOT WATER HEATER, THE FIRST 8 FEET OF PIPING OR PIPING FROM WATER HEATER TO HEAT TRAP SHALL BE INSULATED.
5. HEAT TRACED PIPING SHALL BE INSULATED IN THE SAME MANNER AS NON HEAT TRACED PIPING OR PER THE HEAT TRACE MANUFACTURER'S INSTRUCTIONS.
6. TUBULAR PIPING INSULATION SHALL NOT BE REQUIRED FOR THE FOLLOWING:
 - 6.1. THE TUBING FROM THE CONNECTION AT THE TERMINATION OF THE FIXTURE SUPPLY PIPING TO A PLUMBING FIXTURE OR PLUMBING APPLIANCE.
 - 6.2. VALVES, PUMPS, STRAINERS, AND THREADED UNIONS IN PIPING THAT IS 1 INCH OR LESS IN NOMINAL DIAMETER.
 - 6.3. PIPING FROM USER-CONTROLLED SHOWER AND BATH MIXING VALVES TO THE WATER OUTLETS.
 - 6.4. COLD WATER PIPING OF A DEMAND RECIRCULATION WATER SYSTEM.
 - 6.5. TUBING FROM A HOT DRINKING-WATER HEATING UNIT TO THE WATER OUTLET.
 - 6.6. PIPING AT LOCATIONS WHERE A VERTICAL SUPPORT OF THE PIPING IS INSTALLED.
 - 6.7. PIPING SURROUNDED BY BUILDING INSULATION WITH A THERMAL RESISTANCE (R-VALUE) OF NOT LESS THAN R-3.
 - 6.8. HOT WATER PIPING THAT IS PART OF THE FINAL PIPE RUN TO THE PLUMBING FIXTURE AND IS NOT PART OF THE HEATED-WATER CIRCULATION SYSTEM CIRCULATION PATH IS NOT REQUIRED TO MEET THE MINIMUM INSULATION REQUIREMENTS OF C404.6.
7. PER 2018 UPC SECTION 312.6 NO WATER, SOIL, OR WASTE PIPE SHALL BE INSTALLED OR PERMITTED OUTSIDE OF A BUILDING, IN ATTICS OR CRAWL SPACES, OR IN AN EXTERIOR WALL UNLESS, WHERE NECESSARY, ADEQUATE PROVISION IS MADE TO PROTECT SUCH PIPE FROM FREEZING. ALL HOT AND COLD WATER PIPES OUTSIDE THE CONDITIONED SPACE SHALL BE PROVIDED WITH INSULATION WITH A MINIMUM R-VALUE OF R-3.
8. HEAT TRACING SHALL BE PROVIDED FOR COLD WATER AND IRRIGATION WATER IN UNCONDITIONED SPACES. CONTACT ENGINEERING IF NECESSARY. PER 2018 WSEC SECTION C403.12.3 FREEZE PROTECTION SYSTEMS, SUCH AS HEAT TRACING OF OUTDOOR PIPING, SHALL INCLUDE AUTOMATIC CONTROLS CONFIGURED TO SHUT OFF THE SYSTEMS WHEN OUTDOOR AIR TEMPERATURES ARE ABOVE 40°F.
9. PER 2018 WSEC TABLE C403.2.9 INSULATION FOR HOT WATER AND HOT WATER RECIRCULATION SHALL HAVE A THERMAL CONDUCTIVITY OF 0.21–0.28 (BTU/IN.H.FT².F) AT OPERATING TEMPERATURE.
10. INSULATION R-VALUE SHALL MEET THE MINIMUM REQUIREMENT. THICKNESS IS BASED ON GRAINGER SAMPLE DATA FOR K-FLEX(PVC/NBR) AND OWENS CORNING(FIBER GLASS).
11. ALL ADA P-TRAPS, HOT WATER SUPPLY TUBING, AND SHUT-OFF COCKS SHALL BE PROTECTED WITH APPROVED COVERS TO PREVENT SCALDING.
12. REQUIRED BY ENGINEERING BASED ON BEST PRACTICE.
13. INSULATION IS NOT REQUIRED ON PLASTIC COLD WATER PIPING.

HANGER SPACING FOR WATER PIPING

ALL SUSPENDED WATER SUPPLY PIPE SHALL BE SUPPORTED AS FOLLOWS PER 2018 UPC TABLE 313.3:		
	MAX. HORIZONTAL SPACING	MAX. VERTICAL SPACING
COPPER PIPE $\leq 1\frac{1}{2}$ "	6 FT.	10 FT.
COPPER PIPE $>2"$	10 FT.	10 FT.
COPPER TUBING $\leq 1\frac{1}{2}$ "	6 FT.	10 FT.
COPPER TUBING $>2"$	10 FT.	10 FT.
CPVC $\leq 1"$	3 FT.	10 FT.
CPVC $>1\frac{1}{4}"$	4 FT.	10 FT.

HANGER SPACING FOR WASTE AND VENT PIPING

ALL SUSPENDED SANITARY AND VENT PIPE SHALL BE SUPPORTED AS FOLLOWS PER 2018 UPC TABLE 313.3:		
	MAX. HORIZ. MAX. VERT. SPACING	SPACING
ABS	4 FT.	10 FT.
PVC (TYPE DWV)	4 FT.	10 FT.
CAST-IRON HUBLESS*	EVERY OTHER JOINT	15 FT.
*CAST-IRON OVER 4'	SHALL BE SUPPORTED AT EVERY JOINT	

NOTE TO CONTRACTOR

DRAWINGS ARE DIAGRAMMATIC, SHOWING THE GENERAL LOCATION, TYPE, LAYOUT, AND EQUIPMENT REQUIRED. THE DRAWINGS SHALL NOT BE SCALED FOR EXACT MEASUREMENT. REFER TO ARCHITECTURAL DRAWINGS FOR DIMENSIONS. REFER TO MANUFACTURER'S STANDARD INSTALLATION DRAWINGS FOR EQUIPMENT CONNECTIONS AND INSTALLATION REQUIREMENTS. PROVIDE DUCTWORK, CONNECTIONS, ACCESSORIES, OFFSETS, AND MATERIALS NECESSARY FOR A COMPLETE SYSTEM.

CONTRACTOR SUBSTITUTIONS & REVISIONS

PLEASE SUBMIT PROPOSALS FOR SUBSTITUTIONS OR REVISIONS FOR REVIEW AND APPROVAL PRIOR TO ORDERING MATERIAL OR DOING WORK FOR EQUIPMENT THAT IS SCHEDULED BY MANUFACTURER'S NAME AND CATALOG DESIGNATIONS, THE MANUFACTURER'S PUBLISHED DATA AND/OR SPECIFICATION FOR THAT ITEM ARE CONSIDERED PART OF SPECIFICATION. ENGINEERING COSTS FOR REVISING MEP PLANS SHALL BE ADDRESSED IN THE COST ANALYSIS OF THE SUBSTITUTION PROPOSAL. CONTRACTOR TO COORDINATE WITH ENGINEER AND DETERMINE ASSOCIATED DESIGN AND PERMITTING COSTS. CONTRACTOR SHALL BE RESPONSIBLE FOR OTHER COSTS ASSOCIATED WITH UNFORESEEN ISSUES RESULTING FROM SUBSTITUTIONS OR REVISIONS.

PLUMBING FIXTURE FLOW RATES PER 2018 UPC CH. 4

Fixture Type	Flow Rate	Notes
SHOWERHEADS	1.8 GPM @ 80 PSI	
LAVATORY FAUCETS, RESIDENTIAL	1.2 GPM @ 60 PSI	1
LAVATORY FAUCETS, NON-RESIDENTIAL	0.5 GPM @ 60 PSI	2
KITCHEN FAUCETS	1.8 GPM @ 60 PSI	3
GRAVITY TANK-TYPE WATER CLOSETS	1.28 GALLONS/FLUSH	4
FLUSHOMETER TANK WATER CLOSETS	1.28 GALLONS/FLUSH	4
FLUSHOMETER VALVE WATER CLOSETS	1.28 GALLONS/FLUSH	4
ELECTROMECHANICAL HYDRAULIC WATER CLOSETS	1.28 GALLONS/FLUSH	4
URINALS	0.5 GALLONS/FLUSH	

NOTES:

1. LAVATORY FAUCETS SHALL NOT HAVE A FLOW RATE LESS THAN 0.8 GPM AT 20 PSI.
2. WHERE COMPLYING FAUCETS ARE UNAVAILABLE, AERATORS RATED AT 0.35 GPM OR OTHER MEANS MAY BE USED TO ACHIEVE REDUCTION.
3. KITCHEN FAUCETS MAY TEMPORARILY INCREASE FLOW ABOVE THE MAXIMUM RATE, BUT NOT ABOVE 2.2 GPM @ 60 PSI AND MUST DEFAULT TO A MAXIMUM FLOW RATE OF 1.8 GPM @ 60 PSI.
4. INCLUDES SINGLE AND DUAL FLUSH WATER CLOSETS WITH AN EFFECTIVE FLUSH OF 1.6 GALLONS OR LESS. SINGLE FLUSH TOILETS – THE EFFECTIVE FLUSH VOLUME SHALL NOT EXCEED 1.6 GALLONS. THE EFFECTIVE FLUSH VOLUME IS THE AVERAGE FLUSH VOLUME WHEN TESTED IN ACCORDANCE WITH ASME A112.19.2 DUAL FLUSH TOILETS – THE EFFECTIVE FLUSH VOLUME SHALL NOT EXCEED 1.6 GALLONS. THE EFFECTIVE FLUSH VOLUME IS DEFINED AS THE COMPOSITE, AVERAGE FLUSH VOLUME OF TWO REDUCED FLUSHES AND ONE FULL FLUSH. FLUSH VOLUMES WILL BE TESTED IN ACCORDANCE WITH ASME A112.19.2 AND ASME A112.19.14.

PRE-CONSTRUCTION MEETING NOTES

CONTRACTORS SHALL ATTEND A PRE-CONSTRUCTION MEETING WITH THE ENGINEER FOR THE PURPOSE OF REVIEWING THE WORK PRIOR TO ORDERING ANY EQUIPMENT OR PERFORMING ANY WORK. THE MEETING SHALL BE LOCATED AT THE PROJECT SITE ON A DATE AND TIME TO BE MUTUALLY AGREED. THE MEETING WILL BE A WORKING SESSION. THE MEETING WILL BE FACILITATED BY THE ENGINEER AND THE AGENDA WILL INCLUDE A DETAILED REVIEW OF THE PLANS AND SPECIFICATIONS, CROSS CHECK WITH OTHER TRADES FOR COORDINATION ISSUES, REVIEW OF PROPOSED PRODUCTS, REVIEW OF PLANNED MEANS AND METHODS, AND ON-SITE INVESTIGATION OF FIELD CONDITIONS RELATIVE TO EXISTING CONDITIONS THAT COULD AFFECT THE WORK. PERSONS ATTENDING THE MEETING SHALL BE KNOWLEDGEABLE OF THE PROJECT AND SHALL BE THE SPECIFIC PERSONS INTENDED TO CONTINUE WITH THE PROJECT THROUGH COMPLETION. IF REQUIRED, REVISED PLANS WILL BE ISSUED THROUGH OFFICIAL CHANNELS. CHANGES IN THE BID PRICE WILL BE DISCUSSED, BUT NO CHANGE ORDERS WILL BE ISSUED UNLESS PROCESSED THROUGH OFFICIAL CHANNELS. IT SHALL BE UNDERSTOOD THAT THE ENGINEER HAS NO AUTHORITY TO ISSUE CHANGE ORDERS.

THE FOLLOWING TRADES SHALL BE REPRESENTED FOR THE MINIMUM TIME INDICATED:

MECHANICAL SHEET METAL	4 HOURS
PLUMBING/PIPEING	4 HOURS
ELECTRICAL	4 HOURS
SPRINKLER	2 HOURS
GENERAL CONTRACTOR	ALL SESSIONS

PLUMBING NOTES

City of Poulsbo
Development Services
ISSUED BY: PLUMBING
SIGNED BY: PLUMBING
Engineering Public Works

1. CONNECTIONS: PROVIDE PLUMBING FIXTURE CONNECTIONS TO BUILDING WASTE, VENT, COLD WATER, AND HOT WATER SYSTEM IN ACCORDANCE WITH DRAWINGS, MANUFACTURER'S RECOMMENDATIONS, AND LOCAL CODES. CONNECT TO EACH FIXTURE, EQUIPMENT, ETC. WITH ALL ACCESSORIES, VALVES, VACUUM BREAKERS, REGULATORS, UNIONS, ETC. AS REQUIRED AND AS RECOMMENDED BY THE MANUFACTURERS. REFER TO PLUMBING FIXTURE CONNECTION SCHEDULE ON PLANS.
2. HOT AND COLD: WATER PIPING CONNECTION TO EACH FIXTURE SHALL BE COLD WATER ON THE RIGHT HAND SIDE AND HOT WATER ON THE LEFT HAND SIDE.
3. HOT WATER: NON-CIRCULATING HOT WATER PIPE SHALL NOT EXCEED 10' UNLESS OTHERWISE SHOWN ON DRAWINGS.
4. VENT STACKS: COORDINATE VENT STACK WITH HVAC EQUIPMENT TO MAINTAIN MINIMUM 10' CLEARANCE FROM OUTSIDE AIR INTAKES.
5. CLEANOUTS: PROVIDE CLEANOUTS PER CURRENT UPC AND AS REQUIRED BY LOCAL JURISDICTIONS. CLEANOUTS SHALL BE LOCATED IN WALLS/FLOORS WHERE THEY ARE NOT HIGHLY VISIBLE. FLOOR CLEANOUTS IN CARPETED AREAS TO BE FITTED WITH CARPET INSERTS. LOCATIONS SHALL BE SUBMITTED TO ARCHITECT FOR APPROVAL. NOTE: NOT ALL CLEANOUTS ARE SHOWN ON THE PLUMBING DRAWINGS.
6. SUDS RELIEF: PROVIDE SUDS RELIEF IN ACCORDANCE WITH 2018 UPC SECTION 711.0, STATE AND LOCAL CODES.
7. SHUT-OFFS: PROVIDE 1/4 TURN BALL VALVE ANGLE STOP SHUT-OFF VALVES AND BRAIDED STAINLESS STEEL FLEX CONNECTORS AT HOT AND COLD WATER SUPPLY TO EACH FIXTURE. EXCEPTION: PROVIDE SCREWDRIVER STOPS AT BATH/SHOWERS.
8. TUB SPOUTS SHALL BE THREADED (NO PUSH-ON FITTINGS).
9. TRAP ARMS: PROVIDE TRAP ARMS SUCH THAT THE MAXIMUM LENGTH WILL NOT EXCEED CODE REQUIREMENTS.
10. ADA INSULATION: AT PLUMBING PIPING EXPOSED UNDER LAVATORIES, INSULATE THE EXPOSED PIPING AND TRAPS WITH PRODUCT SPECIFICALLY DESIGNED FOR THIS APPLICATION MEETING ADA REQUIREMENTS. PROVIDE HANDI-LAV GUARD OR EQUIVALENT. OFFSET P-TRAPS TO CLEAR WHEELCHAIR ACCESS.
11. GAS EQUIPMENT: GAS EQUIPMENT SHALL BE INSTALLED PER EQUIPMENT LISTINGS, APPLICABLE SFCC, SPC, LOCAL CODES & NFPA STANDARDS.
12. GAS CONNECTIONS: INSTALL FLEXIBLE QUICK DISCONNECT ASSEMBLIES FOR ALL GAS FIRED KITCHEN EQUIPMENT PER APPLICABLE SFCC, SPC, LOCAL CODES & NFPA STANDARDS. PROVIDE LOCKABLE GAS SHUT-OFF VALVES FOR FIREPLACES & BBQS IN UNATTENDED PUBLIC LOCATIONS IN THE BUILDING.
13. GAS PIPING CONNECTIONS TO WATER HEATERS, BOILERS AND FURNACES SHALL HAVE DIRT LEGS AND UNIONS PROVIDED ON APPLIANCE SIDE OF SHUTOFF VALVE.
14. GAS PIPING INSTALLATION: STEEL OR MALLEABLE IRON FUEL LINES 2" OR SMALLER SHALL BE ASSEMBLED USING THREAD SEALANT SUITABLE FOR NATURAL GAS. GAS PIPING LARGER THAN 2" SHALL HAVE WELDED FITTINGS.
15. GAS PIPING UNDERGROUND: WHERE INSTALLED BELOW GRADE THROUGH THE OUTER FOUNDATION OR BASEMENT WALL OF A BUILDING, SHALL BE ENCASED IN A PROTECTIVE PIPE SLEEVE. THE ANNUAL SPACE BETWEEN THE GAS PIPING AND THE SLEEVE SHALL BE SEALED.
16. GAS PIPING ABOVE GROUND: WHERE PASSING THROUGH AN OUTSIDE WALL, GAS PIPING SHALL BE PROTECTED AGAINST CORROSION BY COATING OR WRAPPING WITH AN INERT MATERIAL. WHERE PIPING IS ENCASED IN A PROTECTIVE PIPE SLEEVE, THE ANNUAL SPACE BETWEEN THE PIPING AND THE SLEEVE SHALL BE SEALED.
17. GAS PIPE SUPPORT: FUEL LINES SHALL BE SUPPORTED OR STRAPPED, AND SHALL BE PLUMB AND SQUARE.
18. GAS PIPING ON ROOFTOPS SHALL BE SUPPORTED AND ANCHORED TO THE ROOF.
19. GAS PIPING SHALL NOT BE BURIED UNDER A BUILDING, SLAB OR OTHER STRUCTURE.
20. GAS PIPING PROTECTIVE COATING: PAINT ALL EXTERIOR EXPOSED GAS PIPING WITH TWO COATS OF RUST INHIBITIVE PAINT. COLOR: GRAY.
21. WATER HAMMER ARRESTORS: PROVIDE AT THE END OF HOT AND COLD WATER LINES SERVING TWO OR MORE FIXTURES; SIZE IN ACCORDANCE WITH PLUMBING AND DRAINAGE INSTITUTE (PDI) REQUIREMENTS. WATER HAMMER ARRESTORS ARE REQUIRED FOR QUICK CLOSING VALVES, SUCH AS LAUNDRY WASHERS, FLUSH VALVES (PUBLIC TOILETS), ETC.
22. TRAP PRIMERS AS SPECIFIED: PROVIDE TRAP PRIMERS AND PIPING FOR FLOOR DRAINS, FLOOR SINKS, AREA DRAINS & HUB DRAINS. ARRANGE PIPING TO ACHIEVE EQUAL FLOW TO EACH DRAIN AND FLOOR SINK FOR TRAP PRIMERS SERVING MULTIPLE DRAINS AND FLOOR SINKS. COORDINATE EXACT LOCATIONS WITH ARCHITECT & ELECTRICAL ENGINEER.
23. P-TRAPS: ALL EXPOSED P-TRAPS SHALL BE CHROME-PLATED BRASS. P-TRAPS SERVING HANDICAPPED COUNTER TOP LAVATORIES SHALL BE INSULATED.
24. THROUGHOUT THE PROJECT PROVIDE BALL VALVES. GATE VALVES SHALL NOT BE USED. NO EXCEPTIONS.
25. HOT WATER RECIRCULATING BALANCING VALVES SHOULD BE BELL & GOSSETT CIRCUIT SETTER (WATTS OR EQUAL) WITH INTEGRAL READOUT PORTS, ADJUSTMENT KNOB, DRAIN CONNECTION, AND POSITIVE SHUTOFF.


THE FOLLOWING PROJECT DESIGN IS BASED ON THE FOLLOWING CODES:

- 2018 INTERNATIONAL BUILDING CODE (IBC)
- 2018 INTERNATIONAL MECHANICAL CODE (IMC)
- 2018 UNIVERSAL PLUMBING CODE (UPC)
- 2018 WASHINGTON STATE ENERGY CODE (WSEC) – COMMERCIAL PROVISIONS

BRADLEY HEIGHT APARTMENTS - BUILDING G

19401 40TH AVE NW, SUITE 302
LYNNWOOD, WA 98036
PHONE: (206)364-3

PLUMBING CALCULATIONS

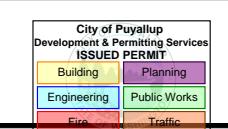

Water Demand Calculator® (WDC v2.2)																																																																																						
PROJECT NAME :	Bradley Heights - Building G		Total Number of Apartments in the Building →		36																																																																																	
Click for Drop-down Menu →		Multi-Family Building		Total Apartments in this Calculation →																																																																																		
				36																																																																																		
				36																																																																																		
<table border="1"> <thead> <tr> <th>Fixture Groups</th> <th>Fixture</th> <th>Enter Total Number of Fixtures</th> <th>Probability of Use (%)</th> <th>Enter Fixture Flow Rate (GPM)</th> <th>Maximum Recommended Fixture Flow Rate (GPM)</th> </tr> </thead> <tbody> <tr> <td rowspan="6">Bathroom Fixtures</td> <td>1 Bathtub (no Shower)</td> <td>0</td> <td>0.49</td> <td>5.5</td> <td>5.5</td> </tr> <tr> <td>2 Bidet</td> <td>0</td> <td>0.58</td> <td>2.0</td> <td>2.0</td> </tr> <tr> <td>3 Combination Bath/Shower</td> <td>48</td> <td>1.86</td> <td>5.5</td> <td>5.5</td> </tr> <tr> <td>4 Faucet, Lavatory</td> <td>48</td> <td>1.29</td> <td>1.5</td> <td>1.5</td> </tr> <tr> <td>5 Shower, per head (no Bathtub)</td> <td>0</td> <td>1.26</td> <td>2.0</td> <td>2.0</td> </tr> <tr> <td>6 Water Closet, 1.28 GPF Gravity Tank</td> <td>48</td> <td>0.58</td> <td>3.0</td> <td>3.0</td> </tr> <tr> <td rowspan="2">Kitchen Fixtures</td> <td>7 Dishwasher</td> <td>36</td> <td>0.35</td> <td>1.3</td> <td>1.3</td> </tr> <tr> <td>8 Faucet, Kitchen Sink</td> <td>36</td> <td>1.29</td> <td>2.2</td> <td>2.2</td> </tr> <tr> <td rowspan="2">Laundry Room Fixtures</td> <td>9 Clothes Washer</td> <td>36</td> <td>1.78</td> <td>3.5</td> <td>3.5</td> </tr> <tr> <td>10 Faucet, Laundry</td> <td>0</td> <td>1.29</td> <td>2.0</td> <td>2.0</td> </tr> <tr> <td>Bar/Prep Fixtures</td> <td>11 Faucet, Bar Sink</td> <td>0</td> <td>1.29</td> <td>1.5</td> <td>1.5</td> </tr> <tr> <td rowspan="3">Other Fixtures</td> <td>12 Fixture 1</td> <td>0</td> <td>0.00</td> <td>0.0</td> <td>6.0</td> </tr> <tr> <td>13 Fixture 2</td> <td>0</td> <td>0.00</td> <td>0.0</td> <td>6.0</td> </tr> <tr> <td>14 Fixture 3</td> <td>0</td> <td>0.00</td> <td>0.0</td> <td>6.0</td> </tr> </tbody> </table>						Fixture Groups	Fixture	Enter Total Number of Fixtures	Probability of Use (%)	Enter Fixture Flow Rate (GPM)	Maximum Recommended Fixture Flow Rate (GPM)	Bathroom Fixtures	1 Bathtub (no Shower)	0	0.49	5.5	5.5	2 Bidet	0	0.58	2.0	2.0	3 Combination Bath/Shower	48	1.86	5.5	5.5	4 Faucet, Lavatory	48	1.29	1.5	1.5	5 Shower, per head (no Bathtub)	0	1.26	2.0	2.0	6 Water Closet, 1.28 GPF Gravity Tank	48	0.58	3.0	3.0	Kitchen Fixtures	7 Dishwasher	36	0.35	1.3	1.3	8 Faucet, Kitchen Sink	36	1.29	2.2	2.2	Laundry Room Fixtures	9 Clothes Washer	36	1.78	3.5	3.5	10 Faucet, Laundry	0	1.29	2.0	2.0	Bar/Prep Fixtures	11 Faucet, Bar Sink	0	1.29	1.5	1.5	Other Fixtures	12 Fixture 1	0	0.00	0.0	6.0	13 Fixture 2	0	0.00	0.0	6.0	14 Fixture 3	0	0.00	0.0	6.0
Fixture Groups	Fixture	Enter Total Number of Fixtures	Probability of Use (%)	Enter Fixture Flow Rate (GPM)	Maximum Recommended Fixture Flow Rate (GPM)																																																																																	
Bathroom Fixtures	1 Bathtub (no Shower)	0	0.49	5.5	5.5																																																																																	
	2 Bidet	0	0.58	2.0	2.0																																																																																	
	3 Combination Bath/Shower	48	1.86	5.5	5.5																																																																																	
	4 Faucet, Lavatory	48	1.29	1.5	1.5																																																																																	
	5 Shower, per head (no Bathtub)	0	1.26	2.0	2.0																																																																																	
	6 Water Closet, 1.28 GPF Gravity Tank	48	0.58	3.0	3.0																																																																																	
Kitchen Fixtures	7 Dishwasher	36	0.35	1.3	1.3																																																																																	
	8 Faucet, Kitchen Sink	36	1.29	2.2	2.2																																																																																	
Laundry Room Fixtures	9 Clothes Washer	36	1.78	3.5	3.5																																																																																	
	10 Faucet, Laundry	0	1.29	2.0	2.0																																																																																	
Bar/Prep Fixtures	11 Faucet, Bar Sink	0	1.29	1.5	1.5																																																																																	
Other Fixtures	12 Fixture 1	0	0.00	0.0	6.0																																																																																	
	13 Fixture 2	0	0.00	0.0	6.0																																																																																	
	14 Fixture 3	0	0.00	0.0	6.0																																																																																	
<table border="1"> <thead> <tr> <th colspan="6">COMPUTED RESULTS FOR PEAK PERIOD CONDITIONS</th> </tr> </thead> <tbody> <tr> <td colspan="6">Total No. of Fixtures in Calculation</td> </tr> <tr> <td colspan="6">N = 252</td> </tr> <tr> <td colspan="6">99th Percentile Demand Flow</td> </tr> <tr> <td colspan="6">Q = 25.5 GPM</td> </tr> <tr> <td colspan="6">Hunter Number</td> </tr> <tr> <td colspan="6">H(n,p) = 3.02</td> </tr> <tr> <td colspan="6">Stagnation Probability</td> </tr> <tr> <td colspan="6">Pr[Zero Demand] = 5%</td> </tr> <tr> <td colspan="6">Method of Computation</td> </tr> <tr> <td colspan="6">Modified Wistort's Method</td> </tr> </tbody> </table>						COMPUTED RESULTS FOR PEAK PERIOD CONDITIONS						Total No. of Fixtures in Calculation						N = 252						99 th Percentile Demand Flow						Q = 25.5 GPM						Hunter Number						H(n,p) = 3.02						Stagnation Probability						Pr[Zero Demand] = 5%						Method of Computation						Modified Wistort's Method																				
COMPUTED RESULTS FOR PEAK PERIOD CONDITIONS																																																																																						
Total No. of Fixtures in Calculation																																																																																						
N = 252																																																																																						
99 th Percentile Demand Flow																																																																																						
Q = 25.5 GPM																																																																																						
Hunter Number																																																																																						
H(n,p) = 3.02																																																																																						
Stagnation Probability																																																																																						
Pr[Zero Demand] = 5%																																																																																						
Method of Computation																																																																																						
Modified Wistort's Method																																																																																						

NOTES:
1. ADD 4 GPM FLOW RATE FOR HOSE BIBBS - TOTAL FLOW IS 29.5 GPM.

**BRADLEY HEIGHTS APARTMENTS - WATER SUPPLY PRESSURE
CALCULATIONS ARE BASED ON 2018 UPC APPENDIX A**

FROM STREET TO RPBP


STREET PRESSURE, PSI		75
MINIMUM STREET PRESSURE, PSI		75
ASSUME +/- 5 PSI FLUCTUATION		
EQUIPMENT LOSSES, PSI		
WATER METER LOSS		4
BACKFLOW PREVENTER		10
SITE SERVICE LINE (ESTIMATE)		
PIPING SYSTEM LENGTH, FEET	50	
FITTING ALLOWANCE, FEET	12.5	
FROM STREET TO RPBP		
ZONE FRICTION LOSS FACTOR, PSI/100'	3.0	
TOTAL ZONE FRICTION LOSS, PSI		1.88
MINIMUM PRESSURE AT RPBP, PSI		59.13

FROM RPBP TO FURTHEST APARTMENT UNIT

MINIMUM PRESSURE AT END PREVIOUS ZONE, PSI		59.1
EQUIPMENT LOSSES, PSI		
THERMOSTATIC MIXING VALVE LOSS		4
STATIC HEAD, PSI		
TOTAL ELEVATION GAIN, FT	30	13.0
PIPING FRICTION LOSSES		
PIPING SYSTEM LENGTH, FEET	150	
FITTING ALLOWANCE, FEET	22.5	
ZONE FRICTION LOSS FACTOR, PSI/100'	3.0	
TOTAL ZONE FRICTION LOSS, PSI		5.175
MINIMUM PRESSURE AT FURTHEST APARTMENT UNIT, PSI		37.0

FROM FURTHEST APARTMENT UNIT TO FURTHEST FIXTURE

MINIMUM PRESSURE AT FURTHEST APARTMENT UNIT, PSI		37.0
PIPING FRICTION LOSSES		
RISER TO MANIFOLD, FEET	4	
FITTING ALLOWANCE, FEET	6	
FROM MANIFOLD TO FURTHEST FIXTURE	35	
ZONE FRICTION LOSS FACTOR, PSI/100'	14.0	
TOTAL ZONE FRICTION LOSS, PSI		6.3
MINIMUM PRESSURE AT FURTHEST FIXTURE, PSI		29.7

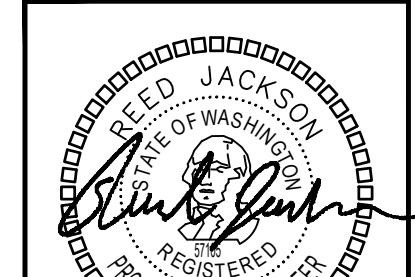

ROBISON ENGINEERING, INC

BRADLEY HEIGHT APARTMENTS - BUILDING G
202 27TH AVE SE
PUYALLUP, WA 98374

PROJECT: RO ENGINE

DATE:

PLUMBING CALCULATIONS

SHEET NO.
POG.02

PLUMBING SCHEDULES

City of Lynnwood
Development Services
Building & Planning
Engineering Public Works

PIPE MATERIALS			
PIPE TYPE	MATERIAL	JOINT	NOTES
WATER DISTRIBUTION PIPING	COPPER, TYPE L.	SOLDERED	2
APARTMENT WATER PIPING	PEX-A	EXPANSION OR PUSH-FIT FITTINGS	2
WASTE AND VENT PIPING	SCHEDULE 40 SOLID CORE PVC	SOLVENT CEMENT	1,3
CONDENSATE DRAIN PIPING	COPPER, TYPE M.	SOLDERED OR PROGRESS FITTINGS	

NOTES:

1. ALL SANITARY SYSTEM MATERIALS SHALL BE LISTED BY AN APPROVED LISTING AGENCY.
2. PROVIDE THERMAL EXPANSION LOOPS FOR ALL WATER PIPING IN ACCORDANCE WITH MANUFACTURER INSTRUCTIONS.
3. PROVIDE CAST IRON PIPING FOR WASTE DISCHARGE EXCEEDING 110 DEGREES FAHRENHEIT.

PIPE SIZE	COLD WATER, FLUSH TANK			HOT WATER		
	Fixture Units	Flow, GPM	Velocity, FPS	Fixture Units	Flow, GPM	Velocity, FPS
1/2"	0.8	1.8	2.4	1.0	2.0	2.8
3/4"	5.5	4.7	3.1	6.5	5.5	3.6
1"	12.8	9.8	3.8	15.2	11.2	4.4
1-1/4"	25.5	17.3	4.4	29.3	19.6	5.0
1-1/2"	46.6	27.7	5.0	46.8	27.7	5.0
2"	166.0	58.2	6.0	116.9	48.2	5.0
2-1/2"	395.0	104.0	7.0	246.9	74.4	5.0
3"	735.1	167.3	7.9	405.8	106.2	5.0
4"	1782.4	303.2	8.0	872.0	189.5	5.0
6"	6381.3	669.1	8.0	2847.0	418.2	5.0

PIPE SIZE	COLD WATER, FLUSH TANK			HOT WATER		
	Fixture Units	Flow, GPM	Velocity, FPS	Fixture Units	Flow, GPM	Velocity, FPS
1/2"	1.9	2.9	5.3	3.4	3.4	6.2
3/4"	9.0	7.5	6.8	11.2	8.6	7.8
1"	21.2	14.7	8.1	20.9	14.6	8.0
1-1/4"	40.8	25.3	9.3	33.5	21.8	8.0
1-1/2"	76.3	37.9	10.0	53.3	30.3	8.0
2"	199.8	65.0	10.0	134.8	52.0	8.0
2-1/2"	369.5	98.9	10.0	270.6	79.1	8.0
3"	588.9	141.0	10.0	439.0	112.8	8.0

ELECTRIC WATER HEATER										
EQUIP NO.	SERVICE	GPH RECOVERY AT 100°F TR	STORAGE (GAL)	INLET/OUTLET CONNECTION	OPERATING WEIGHT (LBS)	ELECTRICAL			BASIS OF DESIGN	NOTES
						VOLTAGE	AMPS	HEATER KW		
WH-1	APARTMENTS	16	50	¾"	550	208V/3P	18.75	4.5	BRADFORD WHITE RE250T6-1NCWW	1,2,3,4,5

NOTES:

1. PROVIDE CONDENSATE NEUTRALIZER. VENT PER MANUFACTURER'S INSTRUCTIONS.
 2. FOR WATER HEATER PIPING SEE DETAIL 2/P7G.00.
 3. UNITS SHALL BE CERTIFIED IN THE AIR QUALITY MANAGEMENT DISTRICT HAVING JURISDICTION.
 4. FACTORY AUTHORIZED START-UP AND OWNERS TRAINING REQUIRED. OWNER, ENGINEER, AND CONTRACTOR TO RECEIVE A COPY OF START UP REPORT.
 5. ALL DOMESTIC WATER EQUIPMENT SHALL BE NSF-61 LISTED.


EXPANSION TANK								
EQUIP NO.	SERVICE	CAPACITY GAL.	PRE-CHARGE PRESSURE, PSI	TANK SIZE		OPERATING WEIGHT, LBS	BASIS OF DESIGN	NOTES
				DIAMETER	HEIGHT			
ET-1	DOMESTIC HOT WATER	4.5	50	11	15	9	THERM-X-TROL ST-12	1

NOTES:

1. INSTALL PER MANUFACTURER'S RECOMMENDATIONS


PROJECT: BRADLEY HEIGHT APARTMENTS - BUILDING G	DRAWN: JM
DESIGNED: JM	CHECKED: RJ
APPROVED: JR	
SHEET TITLE: PLUMBING SCHEDULES	
SHEET NO. POG.03	
DATE: 04/25/2025	
ROBISON ENGINEERING, INC.	
19401 40TH AVE SE LYNNWOOD, WA 98036 PHONE: (206)364-3343	
19401 40TH AVE SE PUYALLUP, WA 98374 PHONE: (206)364-3343	

KEY PLAN

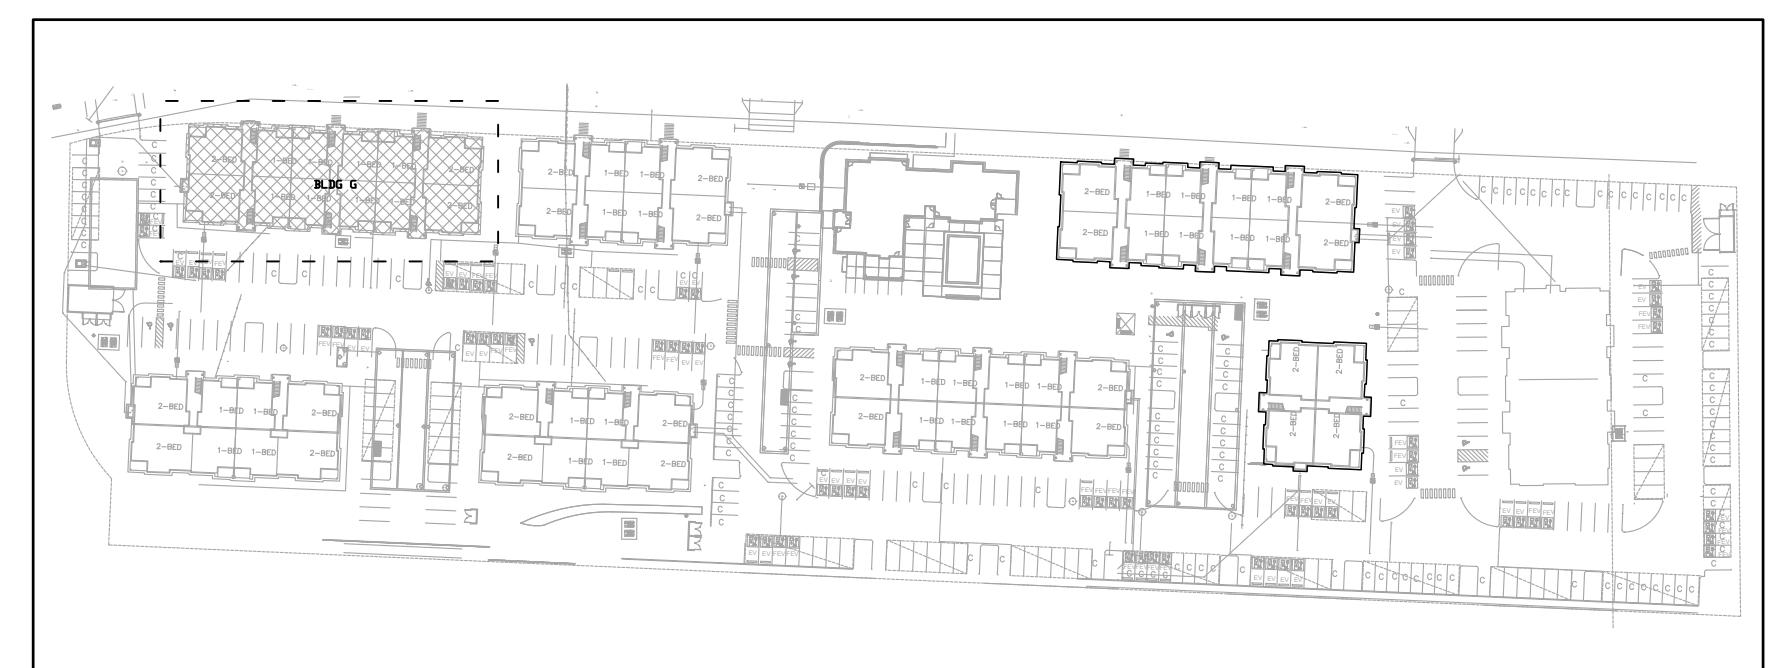

GENERAL NOTES:

1. COORDINATE SANITARY SEWER AND DOMESTIC WATER POINTS OF CONNECTION WITH CIVIL. REFER TO PERMIT PRCCP20240845.

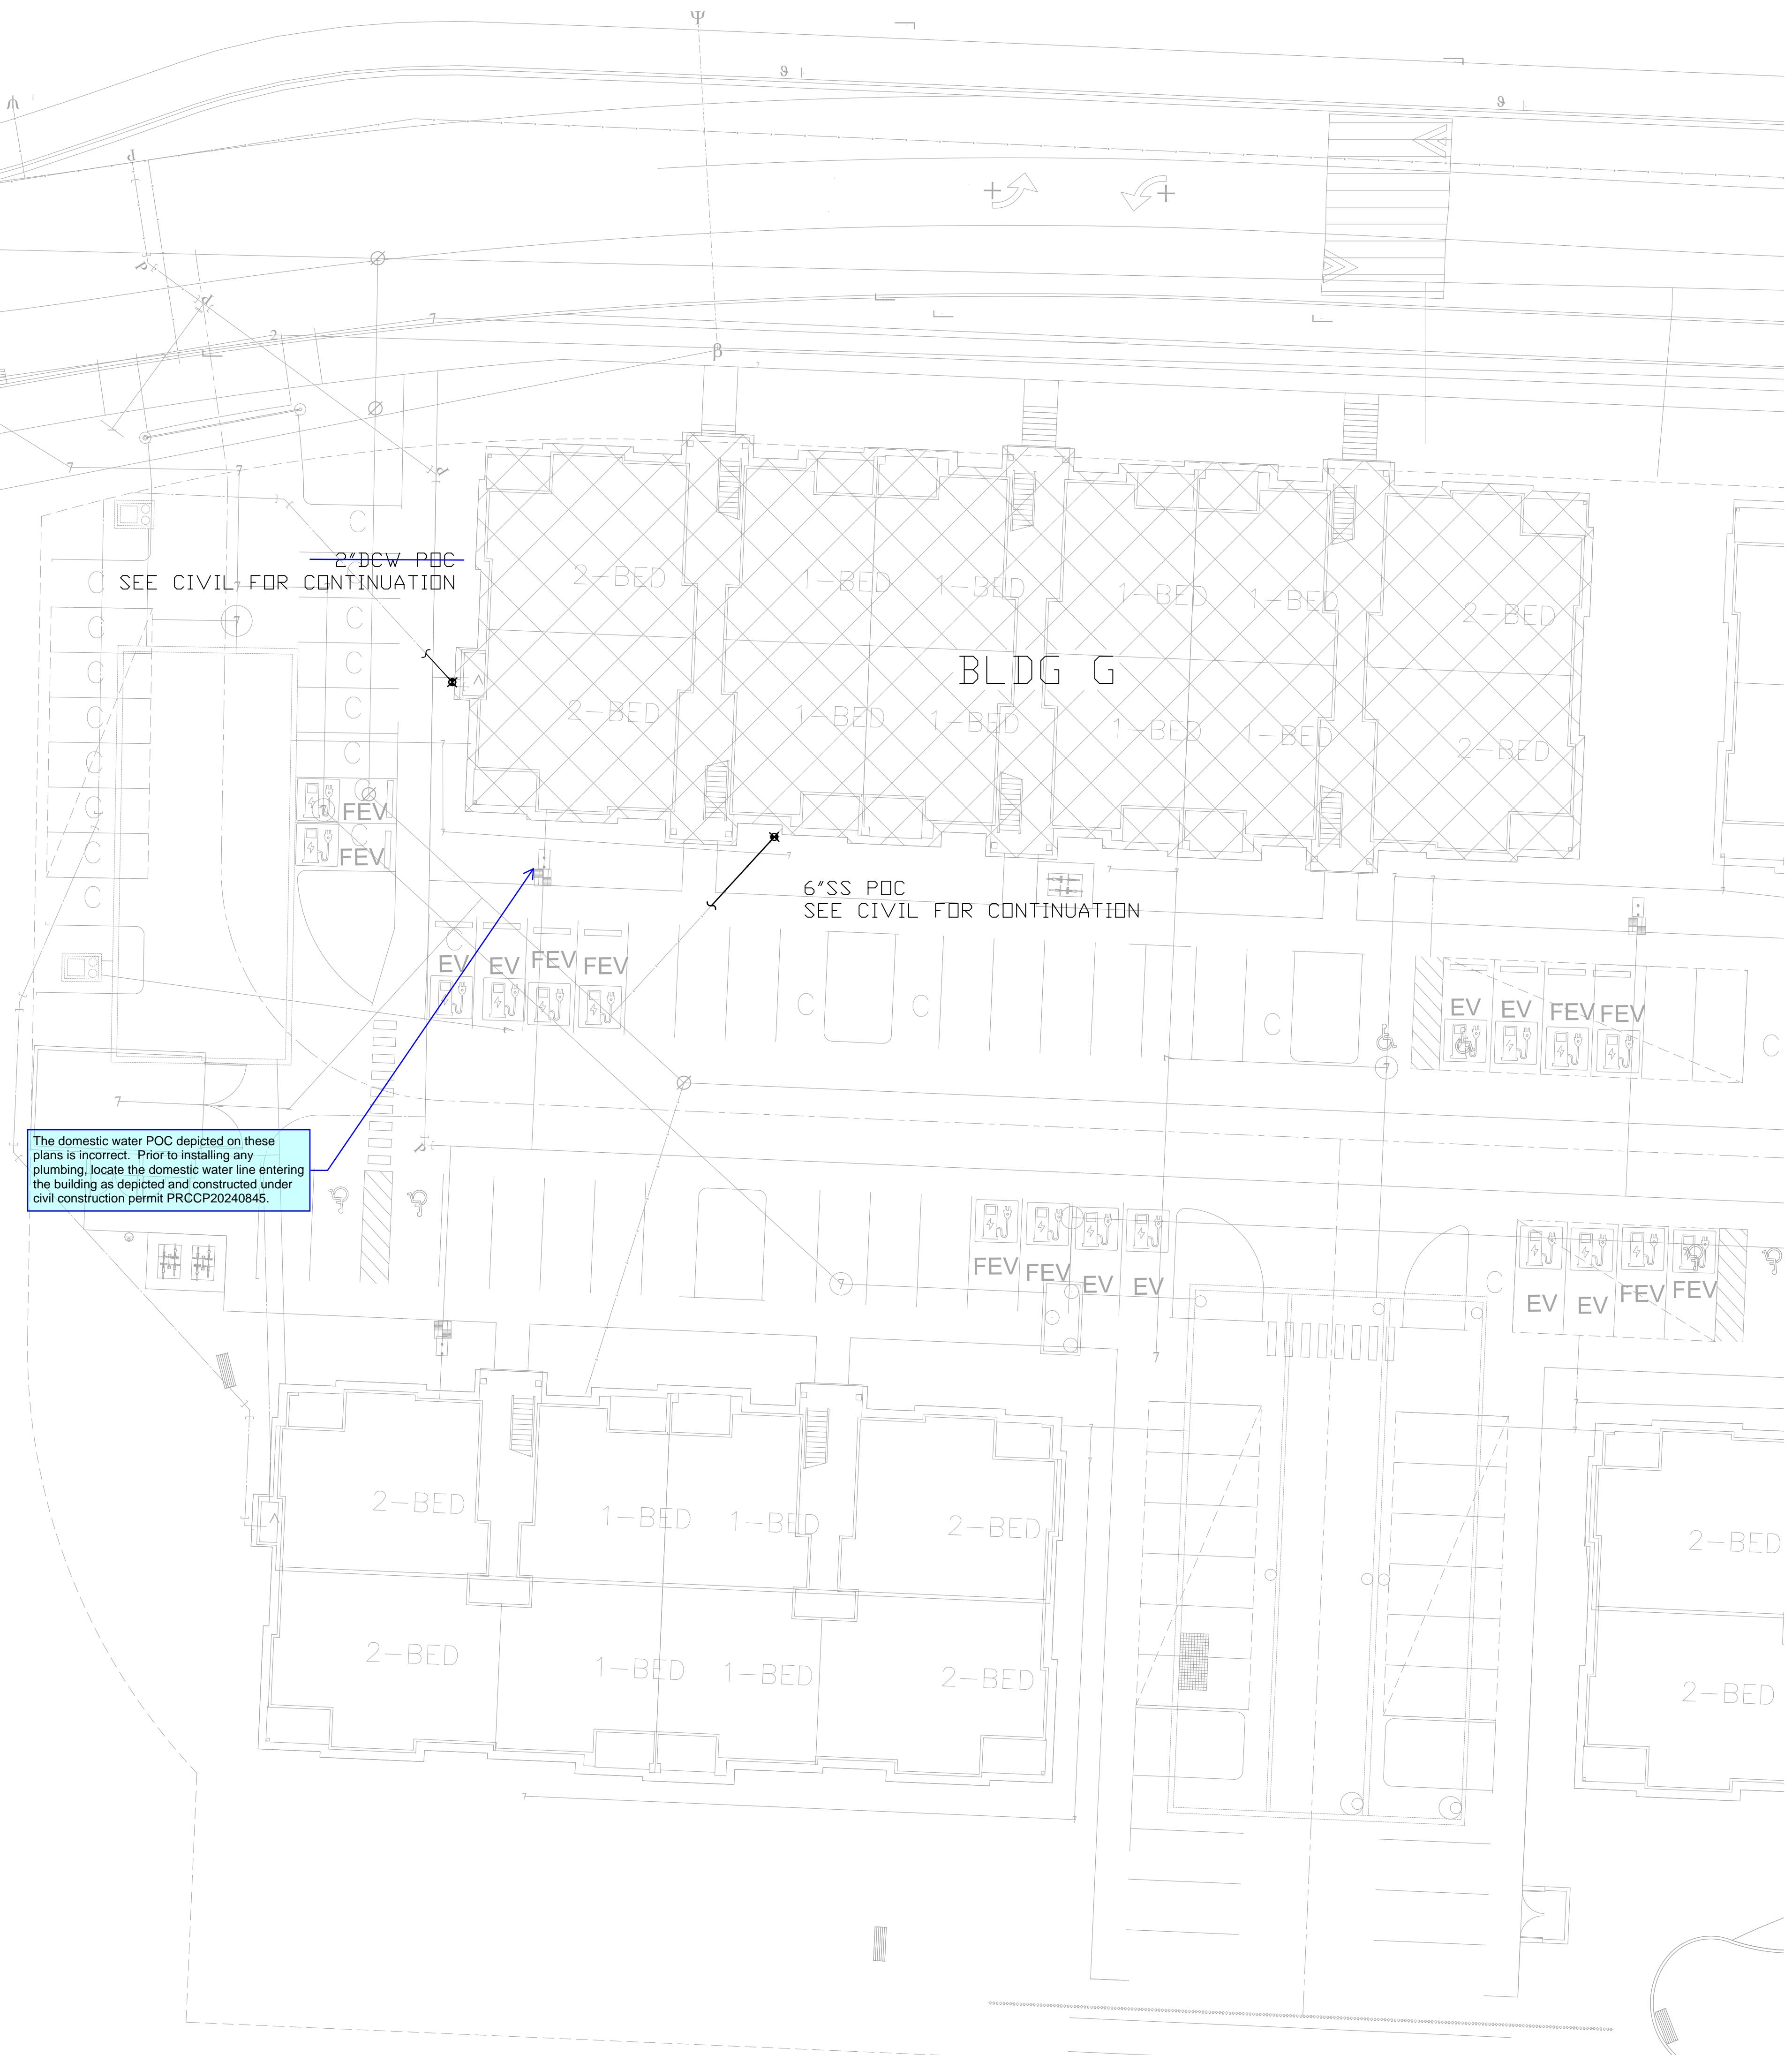

BUILDING G SITE PLAN

SCALE: 3/4" = 1'-0"

PROJECT: BRADLEY HEIGHT APARTMENTS - BUILDING G
19401 40TH AVE W, SUITE 302
202 27TH AVE SE
PUYALLUP, WA 98374
PHONE: (206)364-3343

DATE: 04/25/2025
SHEET TITLE: BUILDING G SITE PLAN

SHEET NO. P1G.00

NO. DATE DESCRIPTION
REVISIONS


JACKSON
REGISTERED
PROFESSIONAL ENGINEER
Signature

ROBISON
ENGINEERING, INC.
19401 40TH AVE W, SUITE 302
LYNNWOOD, WA 98036
206-364-3343
REF ID: 123456789
CONTACT: JEFF MAGILLIVRAY

DRAWN: JM
DESIGNED: JM
CHECKED: RJ
APPROVED: JR

PRMU20240280

NO.	DATE	DESCRIPTION	REVISIONS

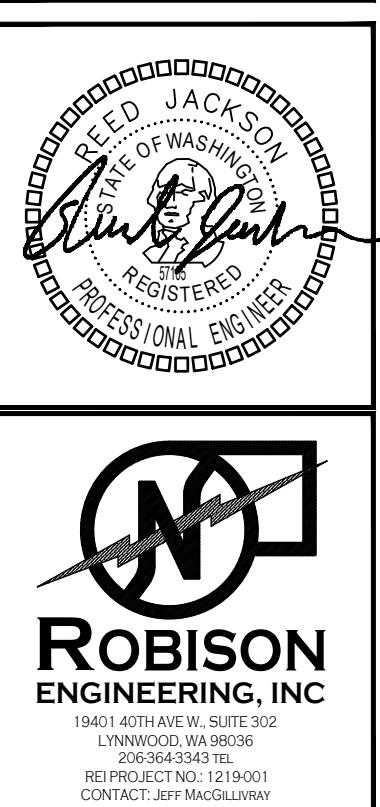


DRAWN:	JM
DESIGNED:	JM
CHECKED:	RJ

APPROVED:	JR
-----------	----

PROJECT:	BRADLEY HEIGHT APARTMENTS - BUILDING G
LYNNWOOD, WA 98036	202 27TH AVE SE
PHONE: (206)364-3343	PUYALLUP, WA 98374

DATE:	04/25/2025
SHEET TITLE:	UNDERSLAB WASTE & VENT PLAN
SHEET NO.	P2G.00

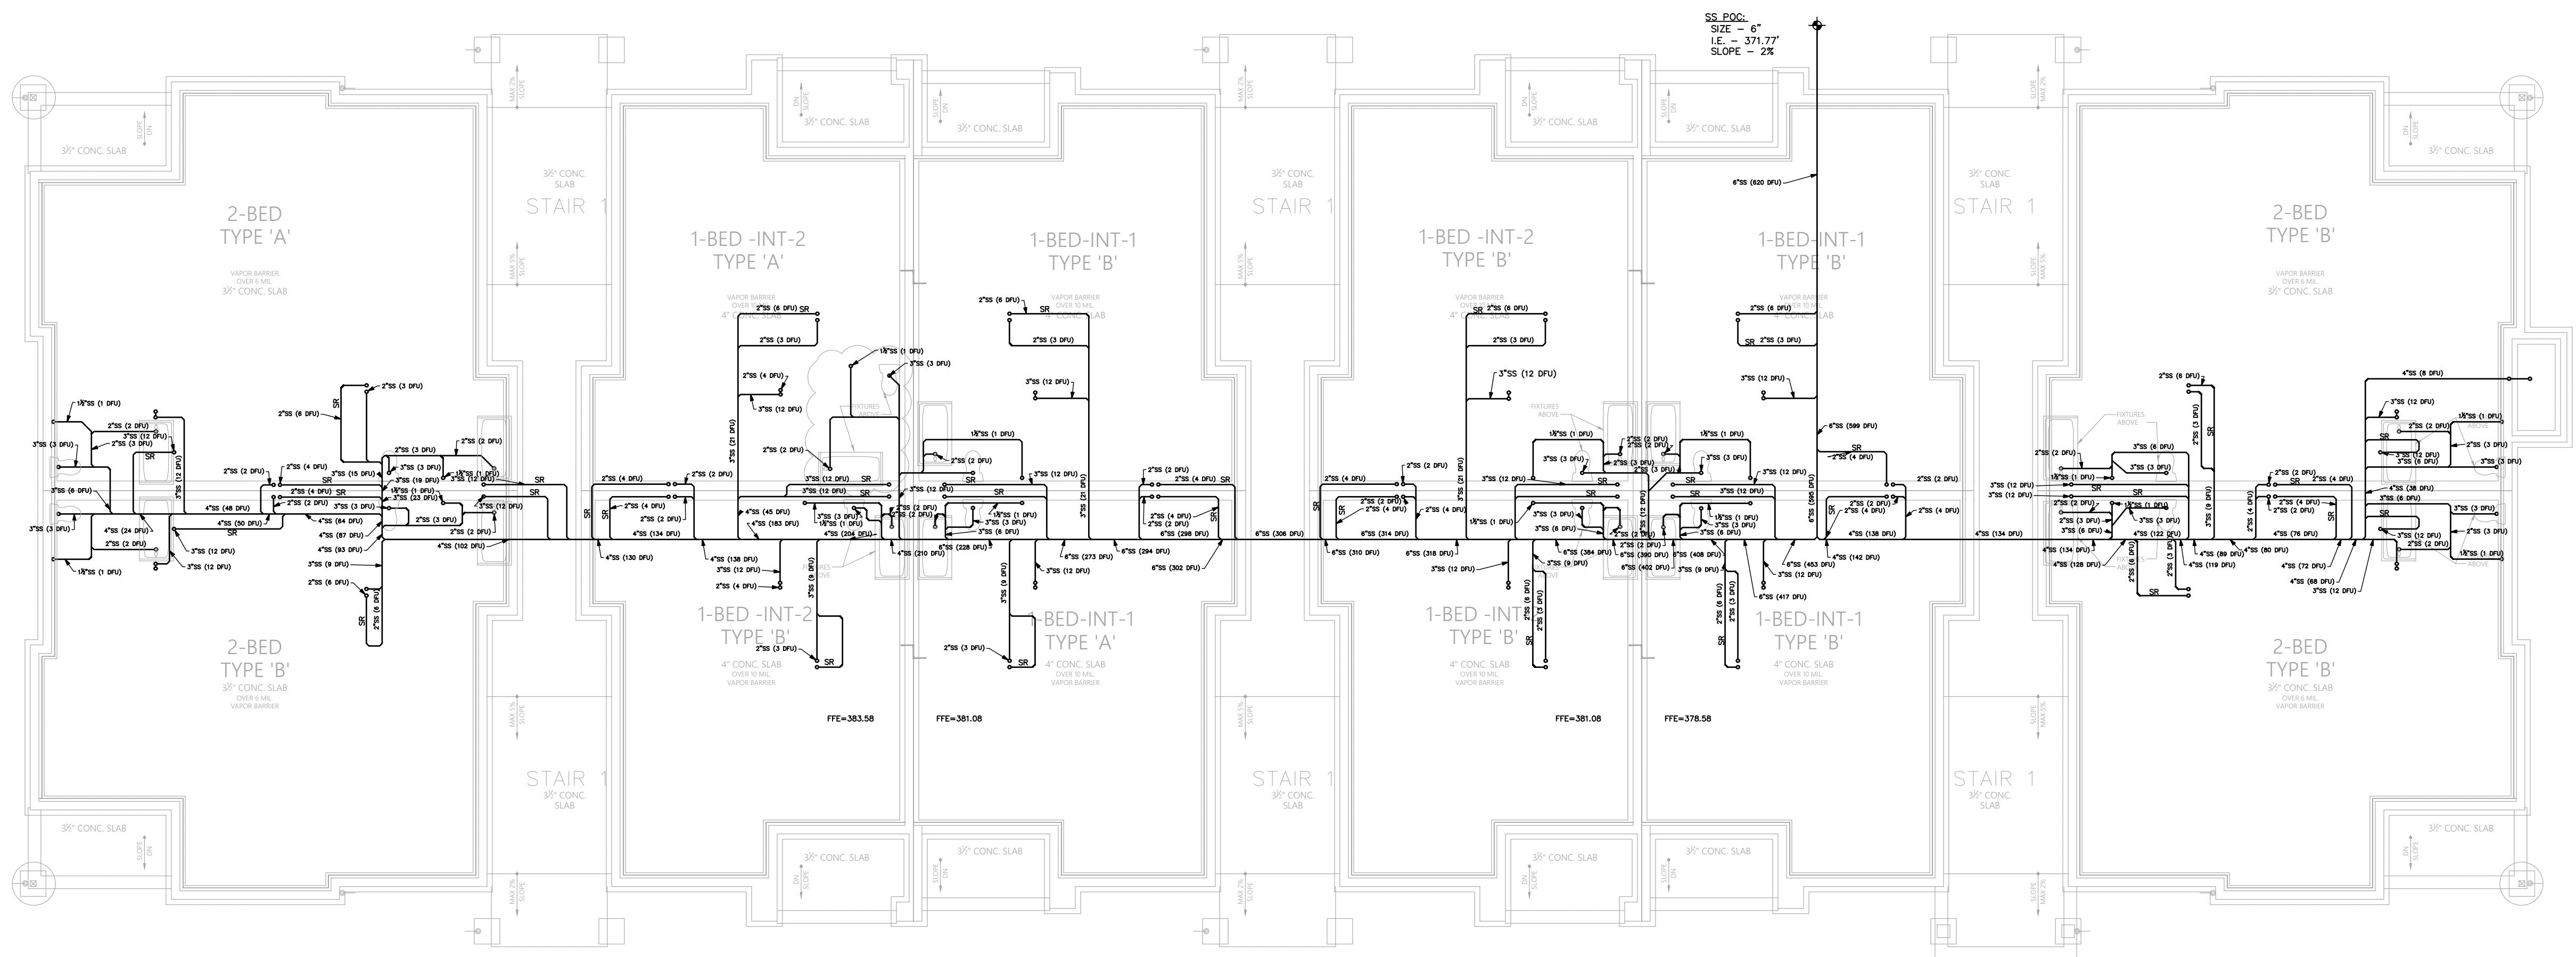

GENERAL NOTES

1. PROVIDE TRAP PRIMERS FOR ALL FLOOR DRAINS PER 2018 UPC 1007.1. SEE DETAIL 5/P7G.01.
2. WASTE & VENT SIZING: WASTE & VENT PIPING IS SIZED PER 2018 UPC TABLE 703.2. DRAINAGE PIPING SHALL BE SLOPED AT 1/4" PER FOOT OR 2%. WHERE IT IS IMPRACTICAL TO OBTAIN A SLOPE OF 2% DUE TO THE DEPTH OF THE STREET SEWER OR TO STRUCTURAL FEATURES OF THE BUILDING, DRAINAGE PIPING 4" AND LARGER MAY BE SLOPED AT 1/8" PER FOOT OR 1% WITH APPROVAL FROM THE AHJ.

PIPE SIZE	VERTICAL	HORIZONTAL	VENT
1 1/2"	2 DFU	1 DFU	8 DFU
2"	16 DFU	8 DFU	24 DFU
3"	48 DFU	35 DFU	84 DFU
4"	256 DFU	172 DFU	256 DFU
6"	1,380 DFU	576 DFU	1,380 DFU
8"	3,600 DFU	2,112 DFU	3,600 DFU

FLAG NOTES


NOT USED

BACKWATER VALVE ANALYSIS – SS POC:

IF UPSTREAM MANHOLE RIM ELEVATION IS HIGHER THAN FINISH FLOOR ELEVATION CONTACT ENGINEER FOR FURTHER EVALUATION.


UNDERSLAB WASTE & VENT PLAN

SCALE: 1/8" = 1'-0"

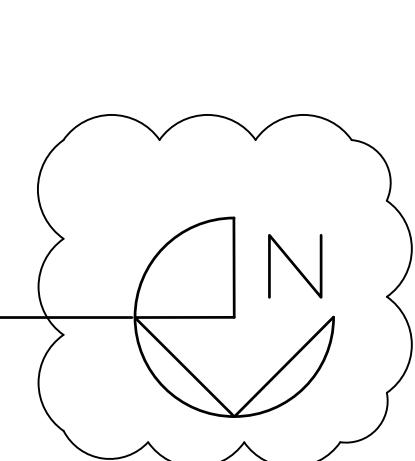

P2G.00

NO.	DATE	DESCRIPTION	REVISIONS

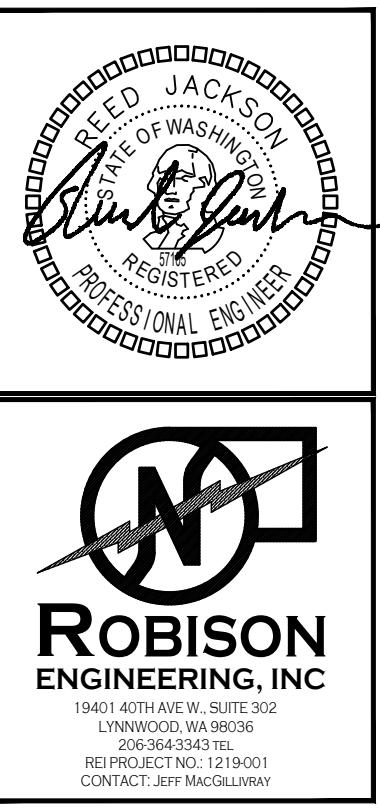


DRAWN:	JM
DESIGNED:	JM
CHECKED:	RJ
APPROVED:	JR

BRADLEY HEIGHT APARTMENTS - BUILDING G	
PROJECT:	19401 40TH AVE W, SUITE 302 LYNNWOOD, WA 98036
DATE:	04/25/2025

ROBISON	
PROJECT:	202 27TH AVE SE PUYALLUP, WA 98374
DATE:	PHONE: (206)364-3343

SHEET NO.	LEVEL 1 WASTE & VENT PLAN
P2G.01	

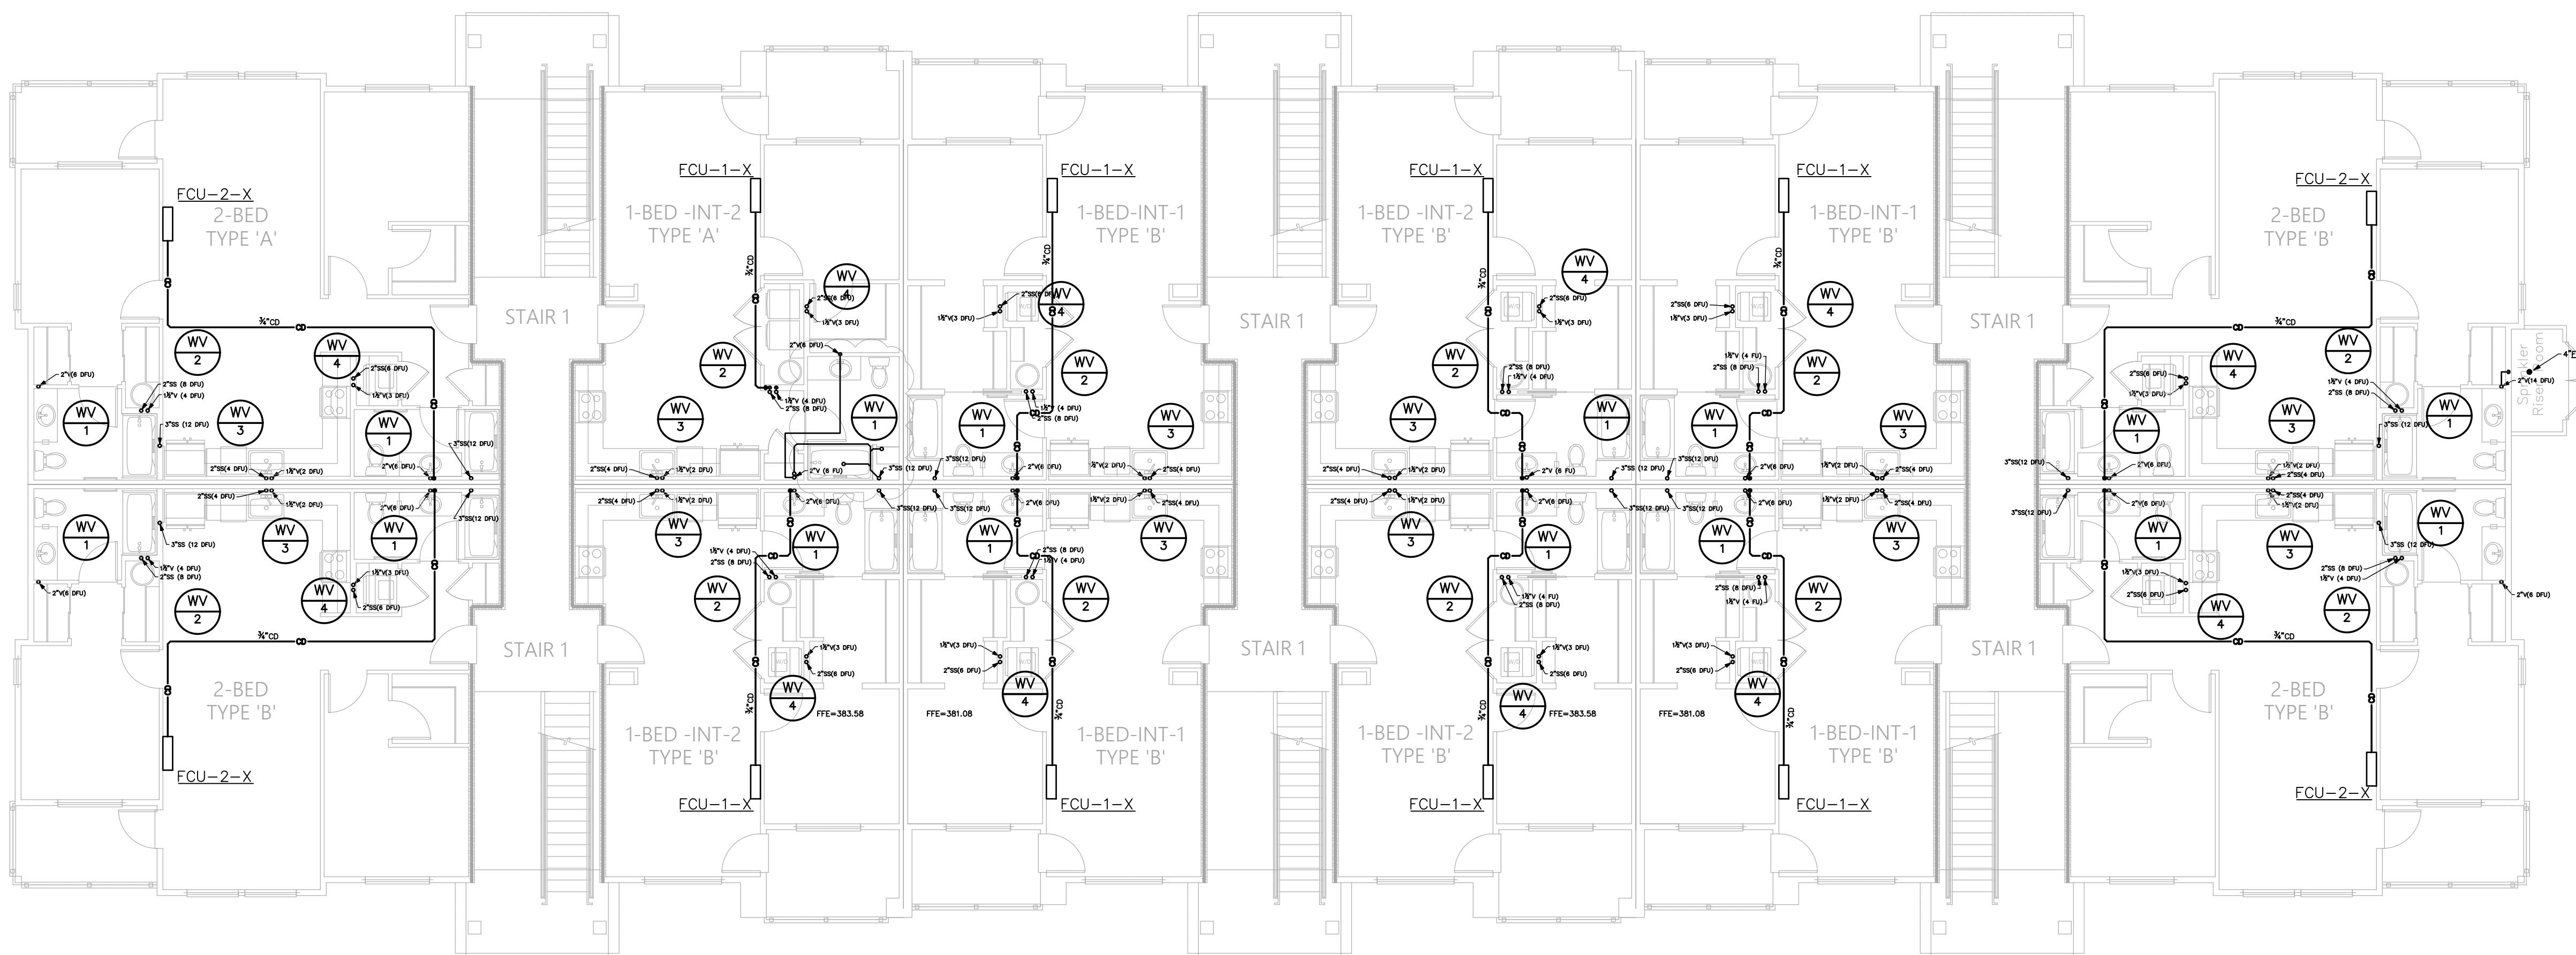

GENERAL NOTES


1. PROVIDE TRAP PRIMERS FOR ALL FLOOR DRAINS PER 2018 UPC 1007.1. SEE DETAIL 5/P7G.01.
2. WASTE & VENT SIZING: WASTE & VENT PIPING IS SIZED PER 2018 UPC TABLE 703.2. DRAINAGE PIPING SHALL BE SLOPED AT 1/4" PER FOOT OR 2%. WHERE IT IS IMPRACTICAL TO OBTAIN A SLOPE OF 2% DUE TO THE DEPTH OF THE STREET SEWER OR TO STRUCTURAL FEATURES OF THE BUILDING, DRAINAGE PIPING 4" AND LARGER MAY BE SLOPED AT 1/8" PER FOOT OR 1% WITH APPROVAL FROM THE AHJ.

PIPE SIZE	VERTICAL	HORIZONTAL	VENT
1½"	2 DFU	1 DFU	8 DFU
2"	16 DFU	8 DFU	24 DFU
3"	48 DFU	35 DFU	84 DFU
4"	256 DFU	172 DFU	256 DFU
6"	1,380 DFU	576 DFU	1,380 DFU
8"	3,600 DFU	2,112 DFU	3,600 DFU

FLAG NOTES


NOT USED

LEVEL 1 WASTE & VENT PLAN
SCALE: 1/8" = 1'-0"

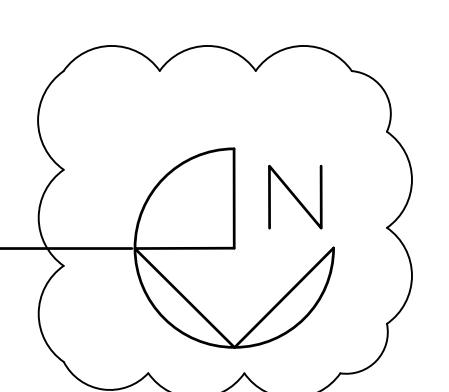

SHEET NO.
P2G.01

NO.	DATE	DESCRIPTION	REVISIONS

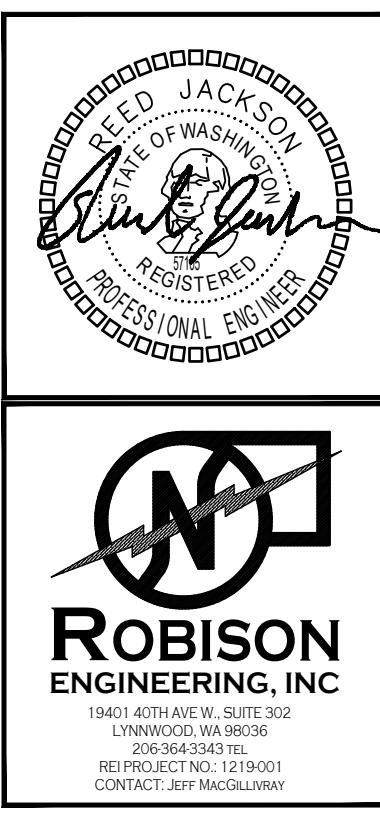


ROBISON
ENGINEERING, INC.
19401 40TH AVE. W. SUITE 302
LYNNWOOD, WA 98036
PHONE: (206) 364-3343

DRAWN: JM
DESIGNED: JM
CHECKED: RJ
APPROVED: JR
PRMU20240280

PROJECT: BRADLEY HEIGHT APARTMENTS - BUILDING G
19401 40TH AVE. SE
PUYALLUP, WA 98374
PHONE: (206) 364-3343

DATE: 04/25/2025
SHEET TITLE: LEVEL 2 WASTE & VENT PLAN
SHEET NO. P2G.02

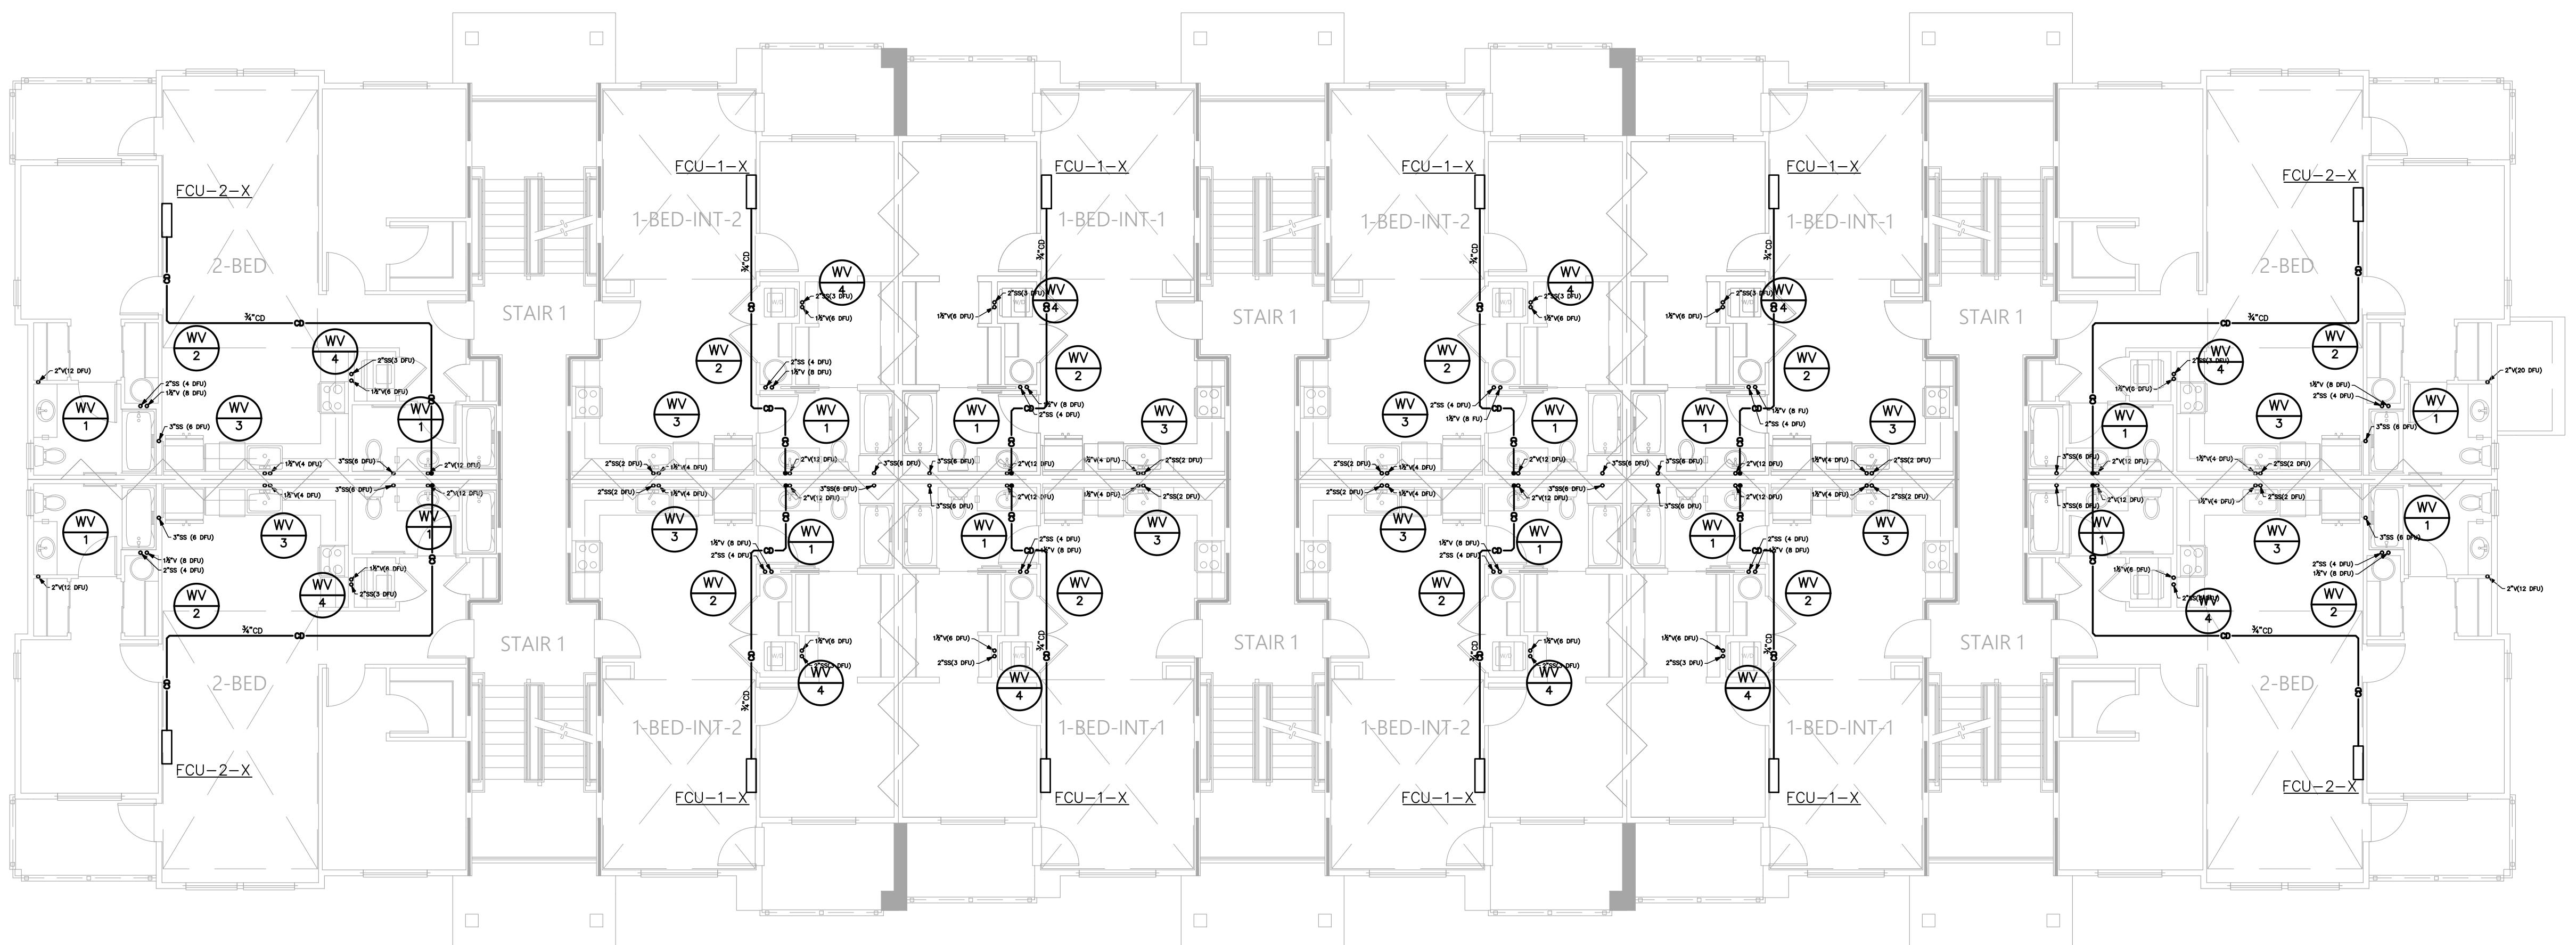

GENERAL NOTES

1. PROVIDE TRAP PRIMERS FOR ALL FLOOR DRAINS PER 2018 UPC 1007.1. SEE DETAIL 5/P7G.01.
2. WASTE & VENT SIZING: WASTE & VENT PIPING IS SIZED PER 2018 UPC TABLE 703.2. DRAINAGE PIPING SHALL BE SLOPED AT 1/4" PER FOOT OR 2%. WHERE IT IS IMPRACTICAL TO OBTAIN A SLOPE OF 2% DUE TO THE DEPTH OF THE STREET SEWER OR TO STRUCTURAL FEATURES OF THE BUILDING, DRAINAGE PIPING 4" AND LARGER MAY BE SLOPED AT 1/8" PER FOOT OR 1% WITH APPROVAL FROM THE AHJ.


PIPE SIZE	VERTICAL	HORIZONTAL	VENT
1 1/2"	2 DFU	1 DFU	8 DFU
2"	16 DFU	8 DFU	24 DFU
3"	48 DFU	35 DFU	84 DFU
4"	256 DFU	172 DFU	256 DFU
6"	1,380 DFU	576 DFU	1,380 DFU
8"	3,600 DFU	2,112 DFU	3,600 DFU

FLAG NOTES

NOT USED


LEVEL 2 WASTE & VENT PLAN

SCALE: 1/8" = 1'-0"

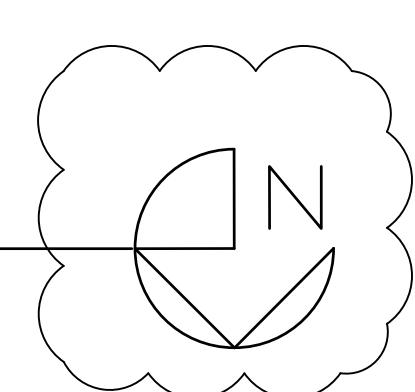

SHEET NO. P2G.02

NO.		DATE		DESCRIPTION	
REVISIONS					

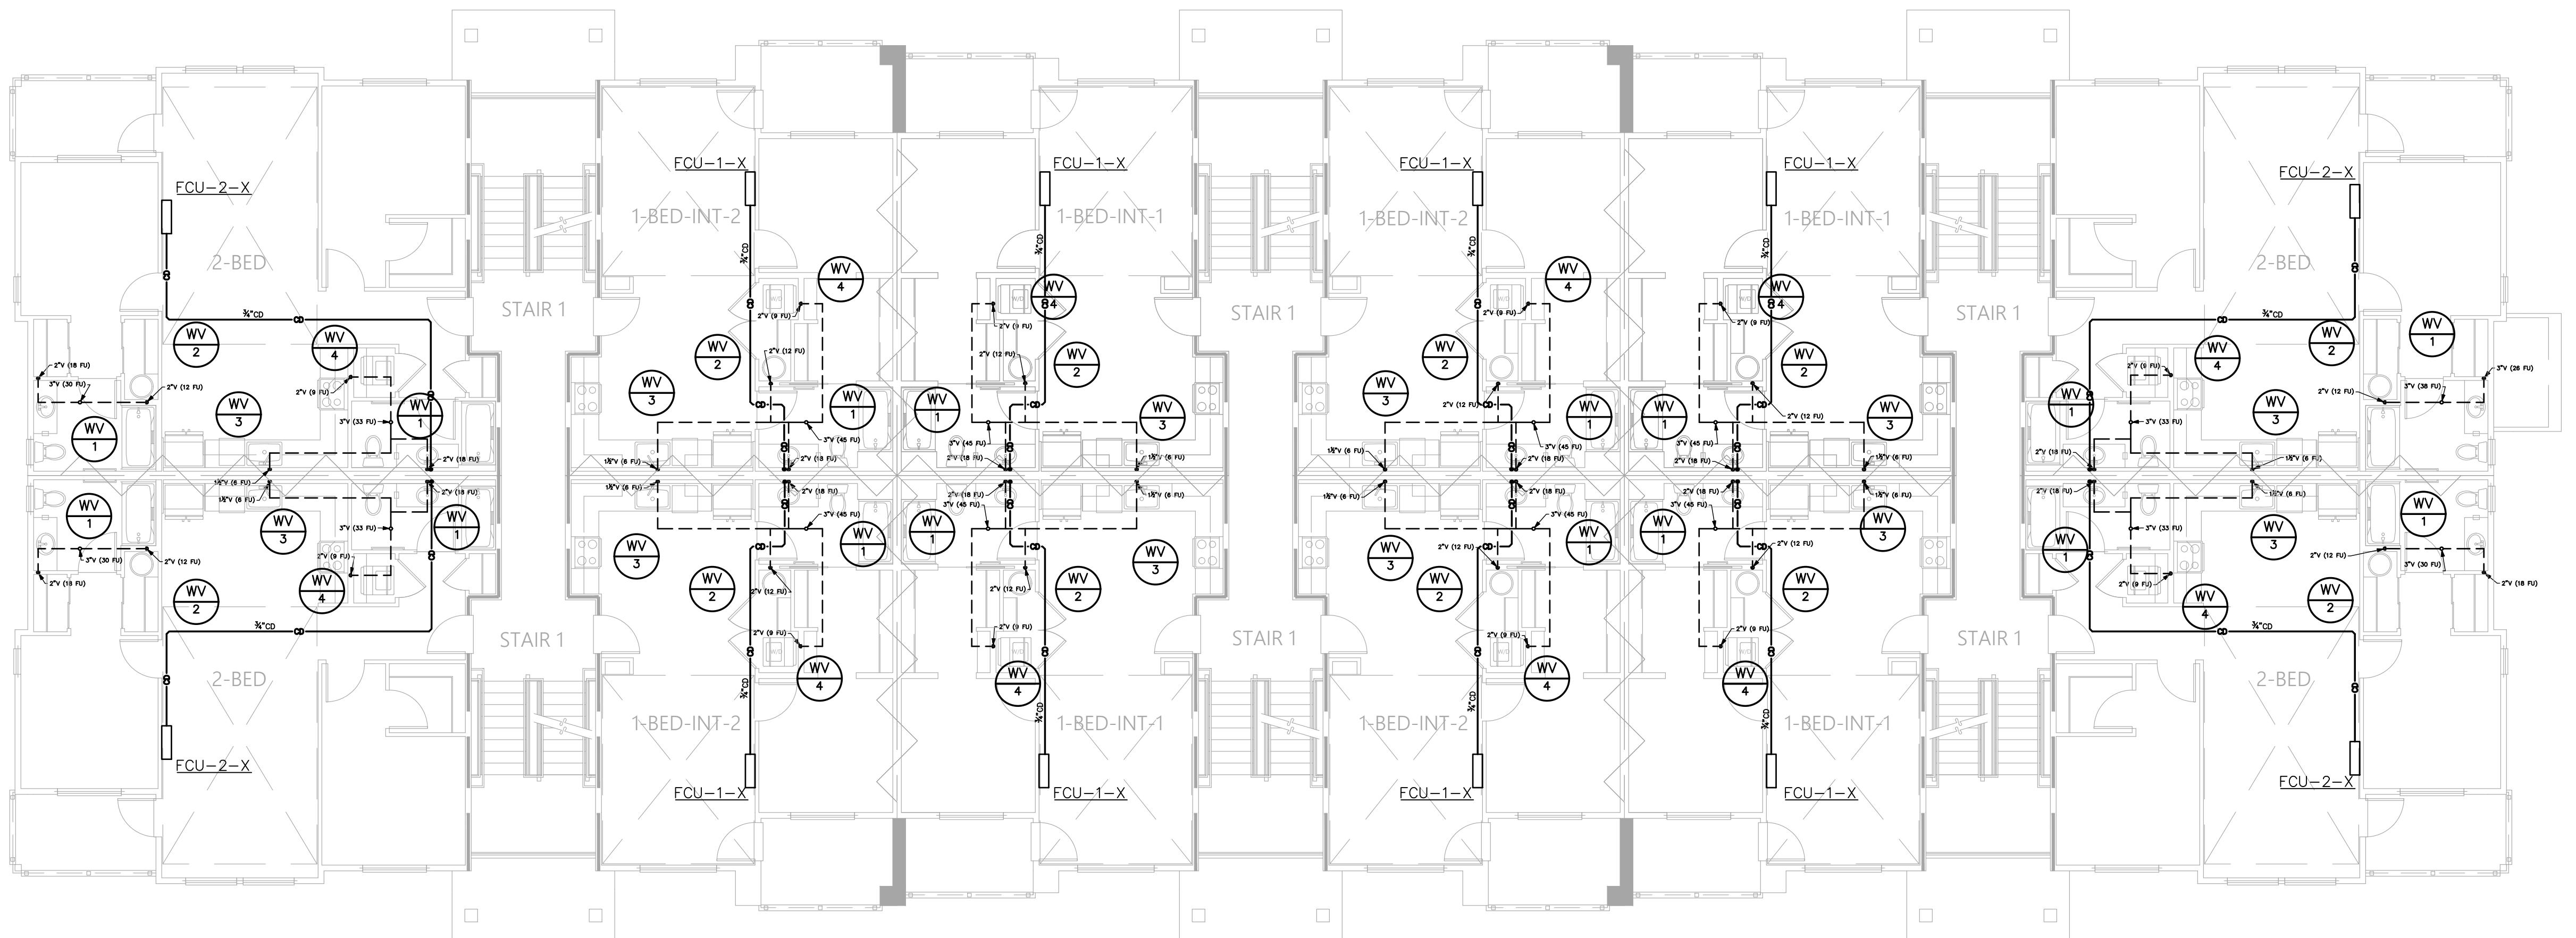

GENERAL NOTES

1. PROVIDE TRAP PRIMERS FOR ALL FLOOR DRAINS PER 2018 UPC 1007.1. SEE DETAIL 5/P7G.01.
2. WASTE & VENT SIZING: WASTE & VENT PIPING IS SIZED PER 2018 UPC TABLE 703.2. DRAINAGE PIPING SHALL BE SLOPED AT 1/4" PER FOOT OR 2%. WHERE IT IS IMPRACTICAL TO OBTAIN A SLOPE OF 2% DUE TO THE DEPTH OF THE STREET SEWER OR TO STRUCTURAL FEATURES OF THE BUILDING, DRAINAGE PIPING 4" AND LARGER MAY BE SLOPED AT 1/8" PER FOOT OR 1% WITH APPROVAL FROM THE AHJ.

PIPE SIZE	VERTICAL	HORIZONTAL	VENT
1½"	2 DFU	1 DFU	8 DFU
2"	16 DFU	8 DFU	24 DFU
3"	48 DFU	35 DFU	84 DFU
4"	256 DFU	172 DFU	256 DFU
6"	1,380 DFU	576 DFU	1,380 DFU
8"	3,600 DFU	2,112 DFU	3,600 DFU

FLAG NOTES

NOT USED

LEVEL 3 WASTE & VENT PLAN


SCALE: 1/8" = 1'-0"

PROJECT: BRADLEY HEIGHT APARTMENTS - BUILDING G	
202 27TH AVE SE	
PUYALLUP, WA 98374	
PHONE: (206)364-3343	
19401 40TH AVE W, SUITE 302	
LYNNWOOD, WA 98036	
PHONE: (206)364-3343	

ROBISON
ENGINEERING, INC.

DATE: 04/25/2025
SHEET TITLE: LEVEL 3 WASTE & VENT PLAN
SHEET NO. P2G.03

REVISIONS	

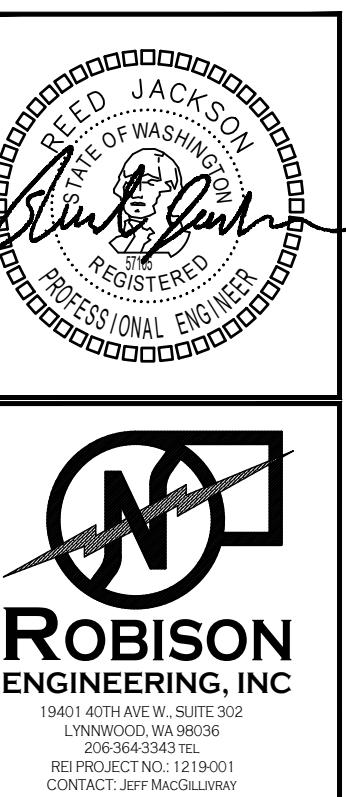

DRAWN:	JM
DESIGNED:	JM
CHECKED:	RJ
APPROVED:	JR

PROJECT: BRADLEY HEIGHT APARTMENTS - BUILDING G
19401 40TH AVE W, SUITE 302
LYNNWOOD, WA 98036
PHONE: (206)364-3343

PRMU20240280


PROJECT: BRADLEY HEIGHT APARTMENTS - BUILDING G
202 27TH AVE SE
PUYALLUP, WA 98374

ROBISON
ENGINEERING, INC.

DATE: 04/25/2025

SHEET TITLE: LEVEL 4 WASTE & VENT PLAN

SHEET NO. P2G.04

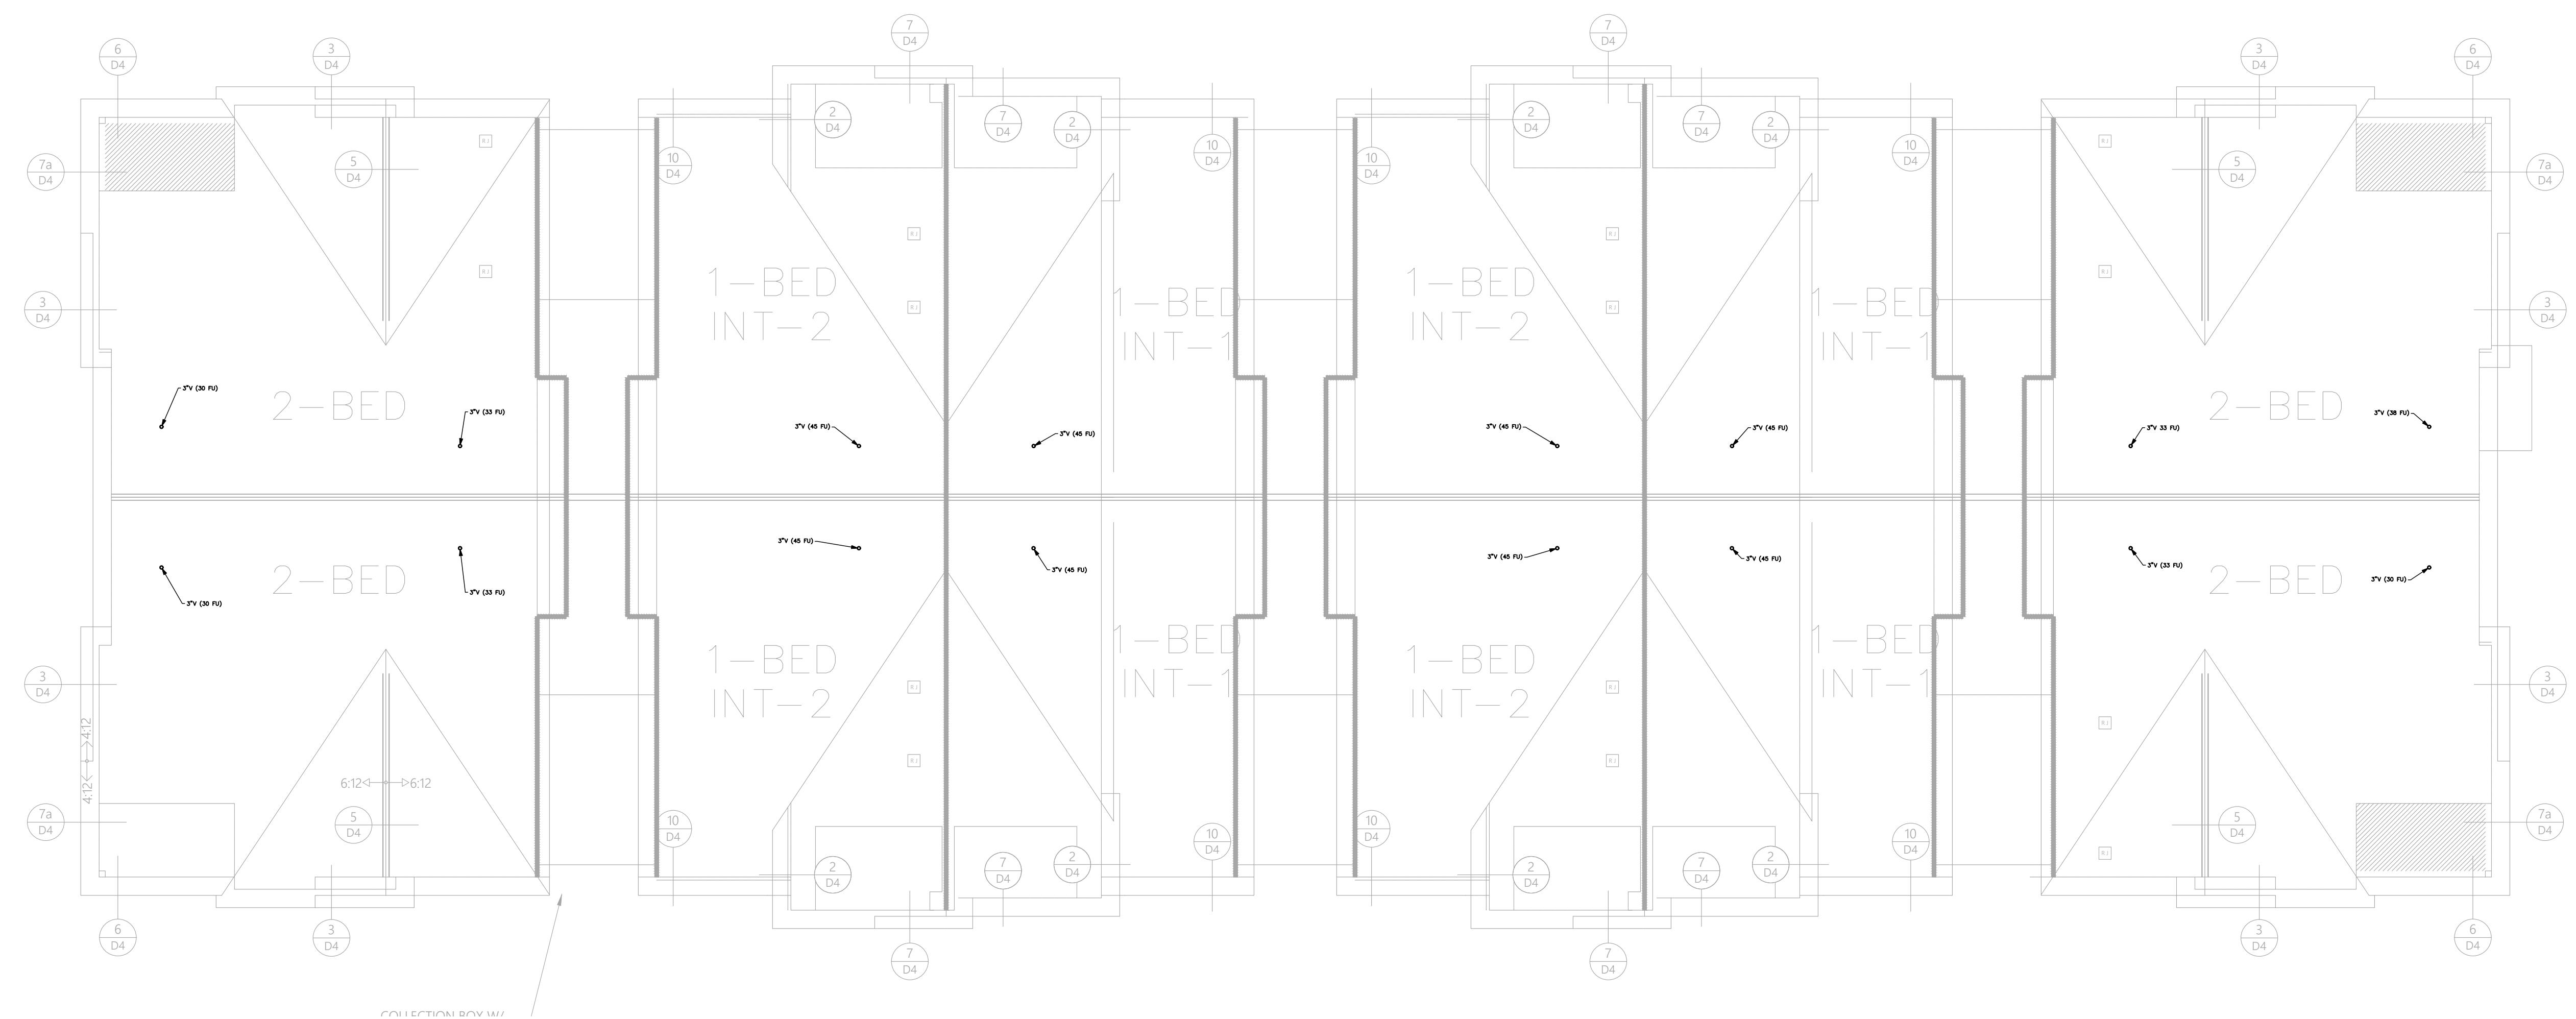

GENERAL NOTES

1. PROVIDE TRAP PRIMERS FOR ALL FLOOR DRAINS PER 2018 UPC 1007.1. SEE DETAIL 5/P7G.01.
2. WASTE & VENT SIZING: WASTE & VENT PIPING IS SIZED PER 2018 UPC TABLE 703.2. DRAINAGE PIPING SHALL BE SLOPED AT 1/4" PER FOOT OR 2%. WHERE IT IS IMPRACTICAL TO OBTAIN A SLOPE OF 2% DUE TO THE DEPTH OF THE STREET SEWER OR TO STRUCTURAL FEATURES OF THE BUILDING, DRAINAGE PIPING 4" AND LARGER MAY BE SLOPED AT 1/8" PER FOOT OR 1% WITH APPROVAL FROM THE AHJ.


PIPE SIZE	VERTICAL	HORIZONTAL	VENT
1½"	2 DFU	1 DFU	8 DFU
2"	16 DFU	8 DFU	24 DFU
3"	48 DFU	35 DFU	84 DFU
4"	256 DFU	172 DFU	256 DFU
6"	1,380 DFU	576 DFU	1,380 DFU
8"	3,600 DFU	2,112 DFU	3,600 DFU

FLAG NOTES


NOT USED

ROOF WASTE & VENT PLAN

SCALE: 1/8" = 1'-0"

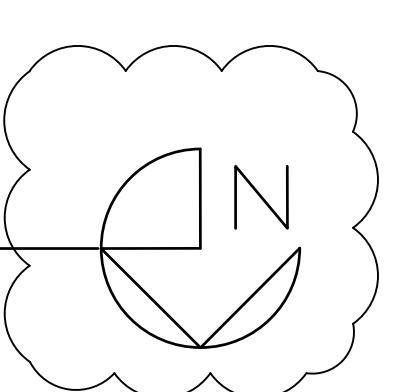

P2G.04

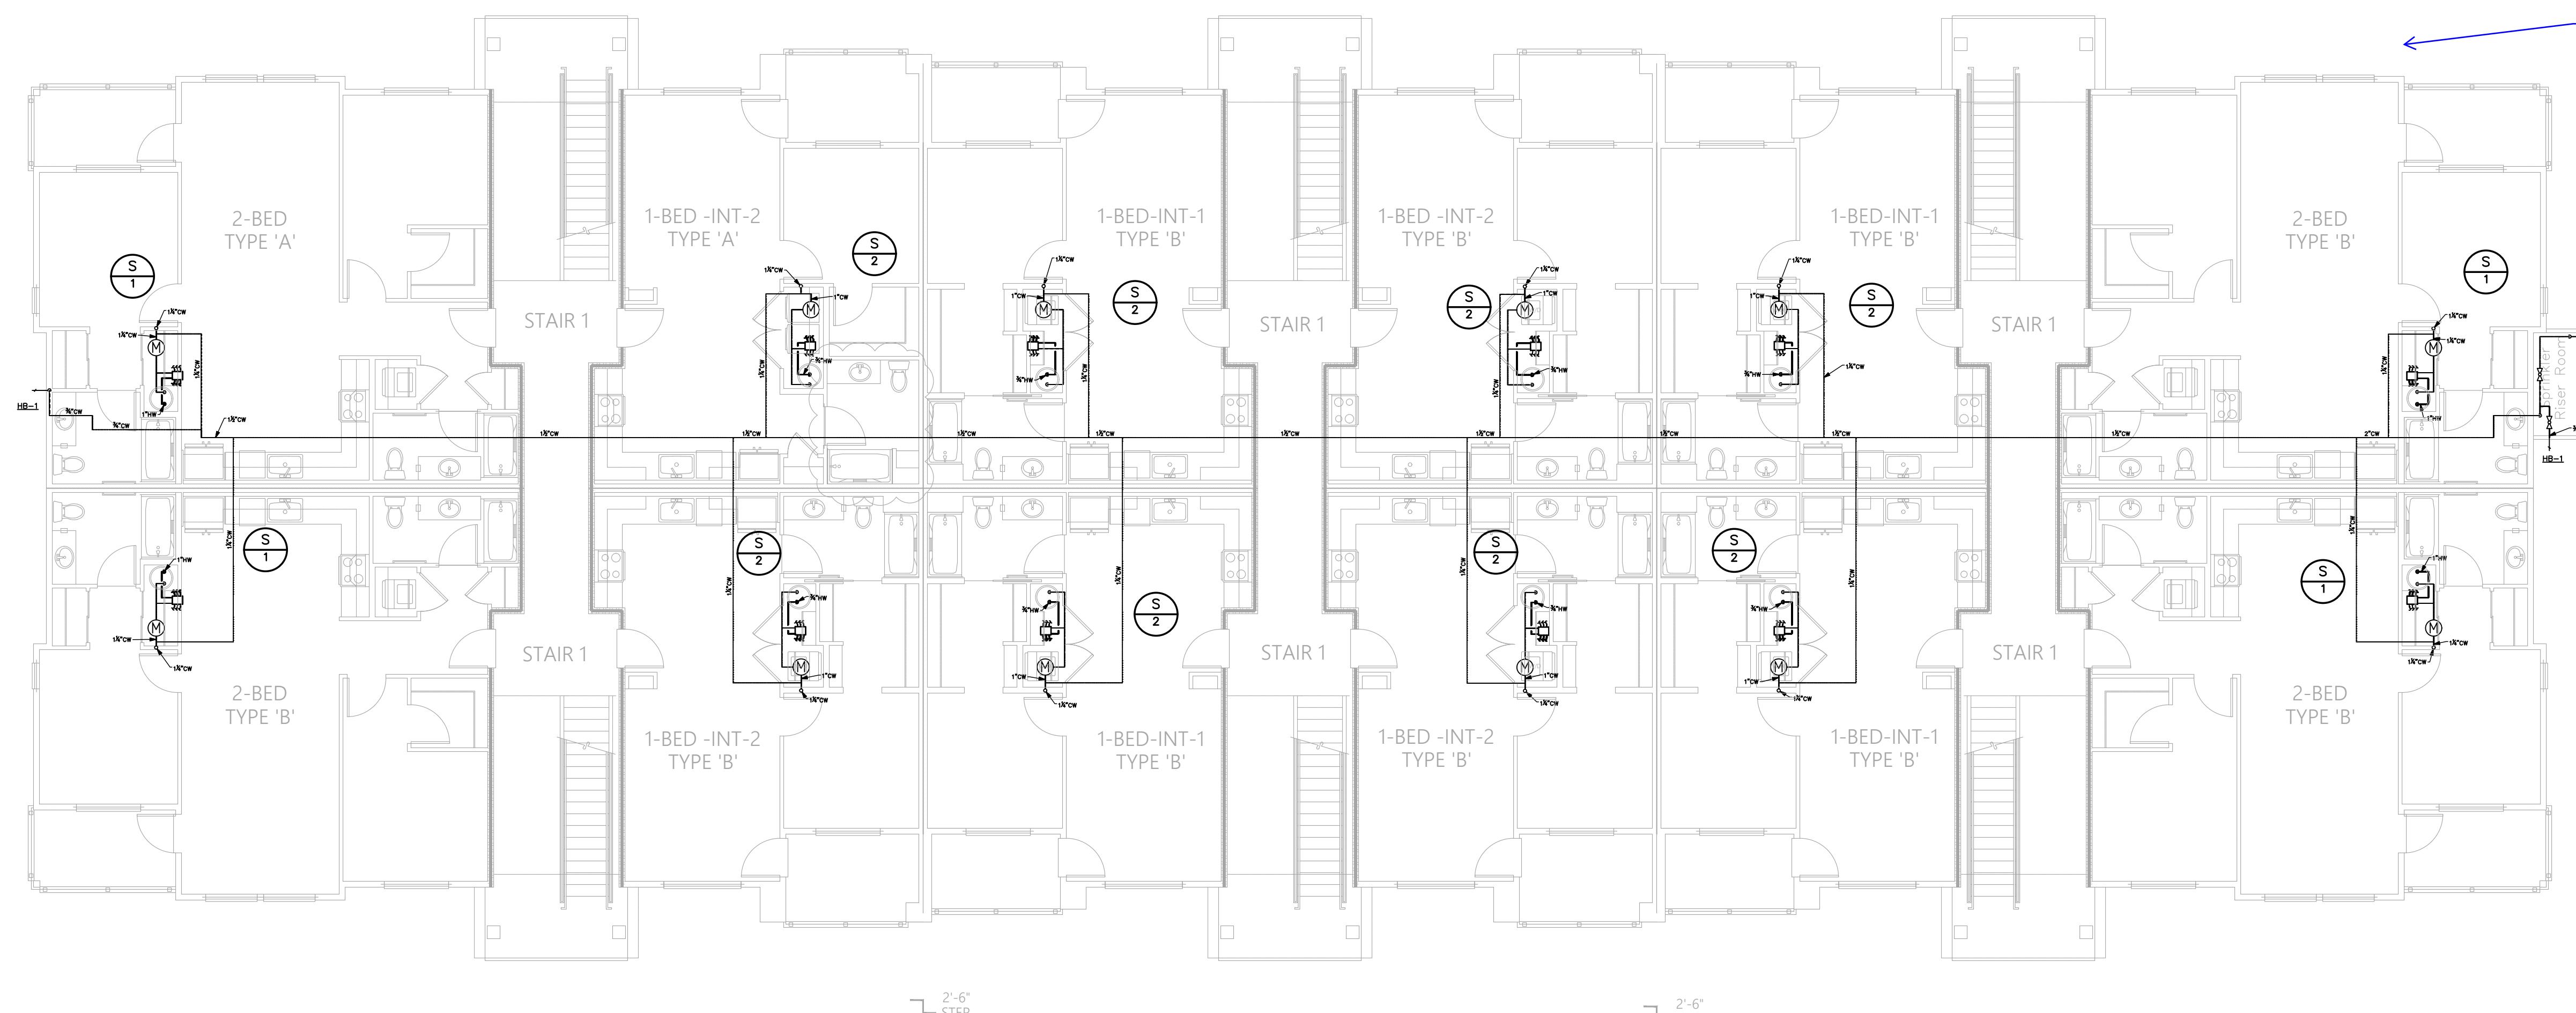

GENERAL NOTES

1. PROVIDE EXPANSION LOOPS FOR ALL WATER PIPING PER THE MANUFACTURER'S INSTRUCTIONS. SEE DETAIL 3/P7G.01.
2. INSTALL HEAT TRACE ON SUPPLY PIPE IN NON CONDITIONED SPACES.

FLAG NOTES

NOT USED

LEVEL 1 PLUMBING SUPPLY PLAN

SCALE: 1/8" = 1'-0"

PROJECT: BRADLEY HEIGHT APARTMENTS - BUILDING G

202 27TH AVE SE
PUYALLUP, WA 98374


19401 40TH AVE W, SUITE 302
LYNNWOOD, WA 98036
PHONE: (206)364-3343

DATE: 04/25/2025

SHEET TITLE: LEVEL 1
PLUMBING
SUPPLY PLAN

SHEET NO. P3G.01


NO. DATE DESCRIPTION REVISIONS

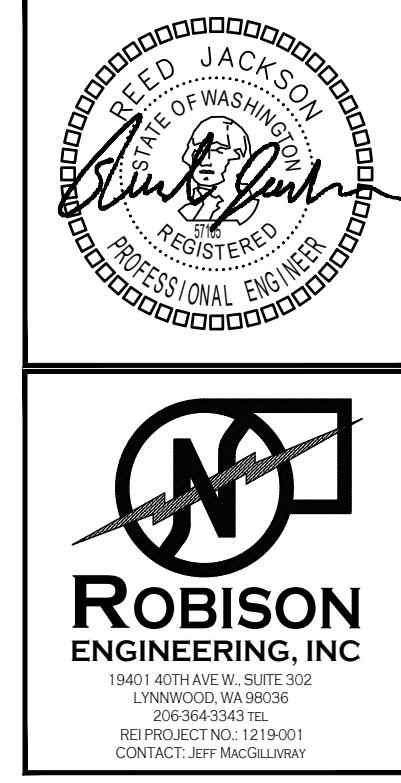

DRAWN: JM
DESIGNED: JM
CHECKED: RJ
APPROVED: JR

PRMU20240280

ROBISON
ENGINEERING, INC.

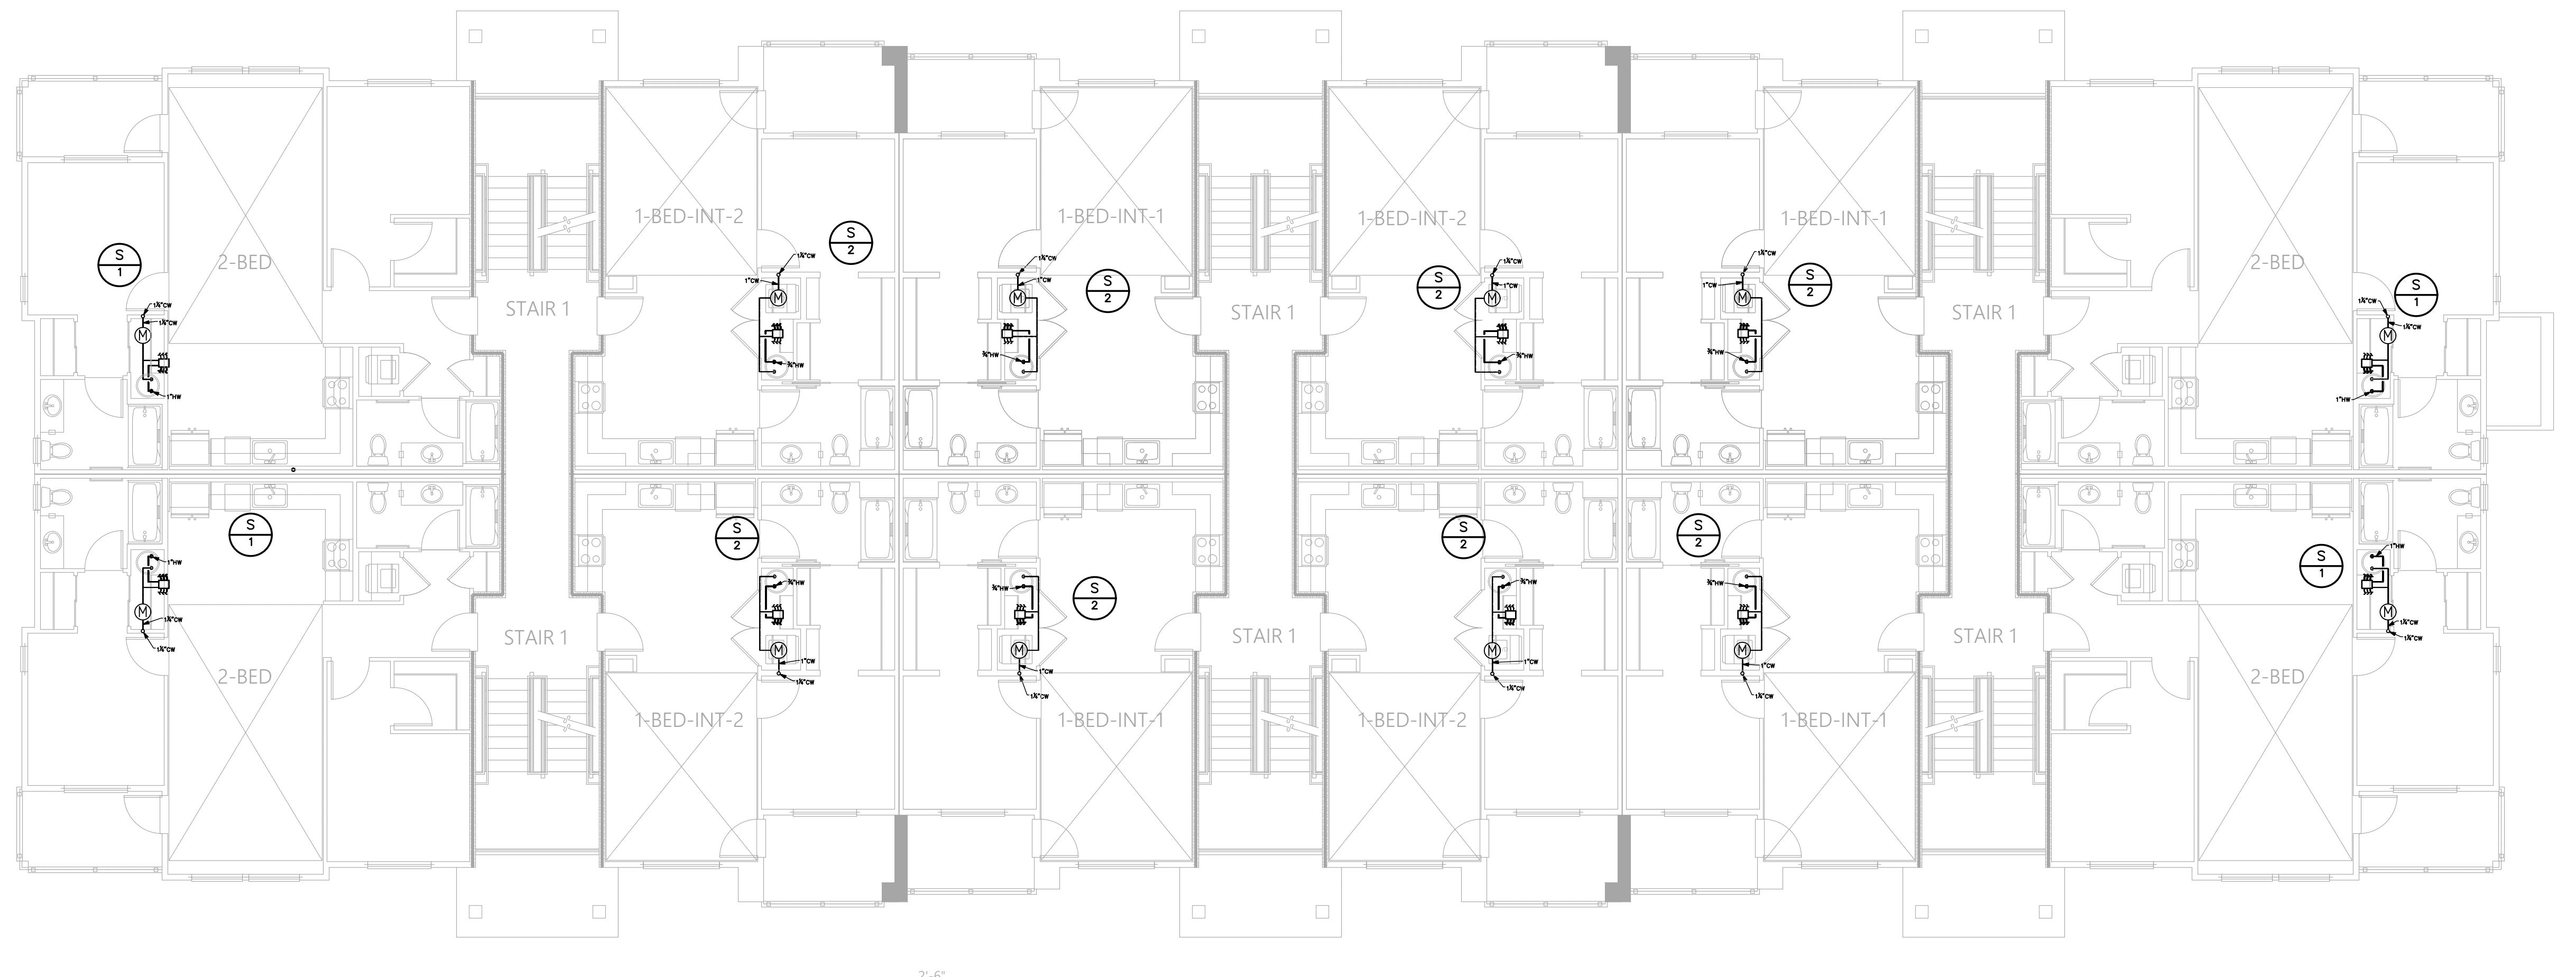

GENERAL NOTES

1. PROVIDE EXPANSION LOOPS FOR ALL WATER PIPING PER THE MANUFACTURER'S INSTRUCTIONS. SEE DETAIL 3/P7G.01.
2. INSTALL HEAT TRACE ON SUPPLY PIPE IN NON CONDITIONED SPACES.

FLAG NOTES

NOT USED

EVEL 2 PLUMBING SUPPLY PLAN

SCALE: 1/8" = 1'-0"


PROJECT: BRADLEY HEIGHT APARTMENTS - BUILDING G
202 27TH AVE SE

DATE: 04/25/2025

SHEET TITLE:
**LEVEL 2
PLUMBING
SUPPLY PLAN**

SHEET NO.
P3G.02

NO.	DATE	DESCRIPTION	REVISIONS

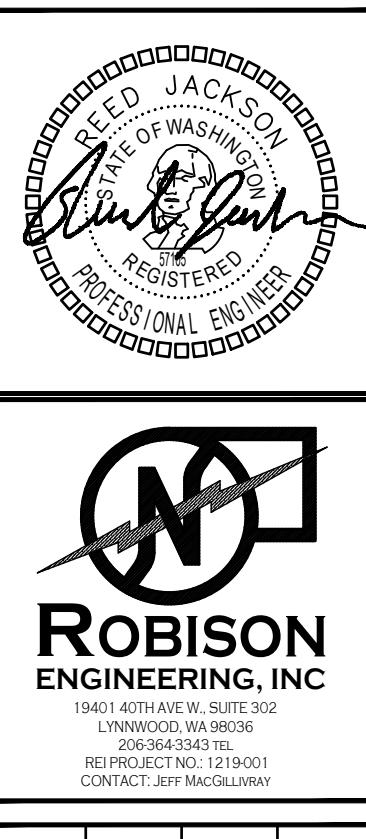


ROBISON
ENGINEERING, INC.
19401 40TH AVE W, SUITE 302
LYNNWOOD, WA 98036
PHONE: (206)364-3343
REPRESENTATIVE: JR
CONTACT: JEFF MAGILLIVRAY

DRAWN: JM
DESIGNED: JM
CHECKED: RJ
APPROVED: JR

PROJECT: BRADLEY HEIGHT APARTMENTS - BUILDING G
19401 40TH AVE W, SUITE 302
LYNNWOOD, WA 98036
PHONE: (206)364-3343
ROBISON
ENGINEERING, INC.

DATE: 04/25/2025
SHEET TITLE: LEVEL 3 PLUMBING SUPPLY PLAN
SHEET NO. P3G.03
SCALE: 1/8" = 1'-0"

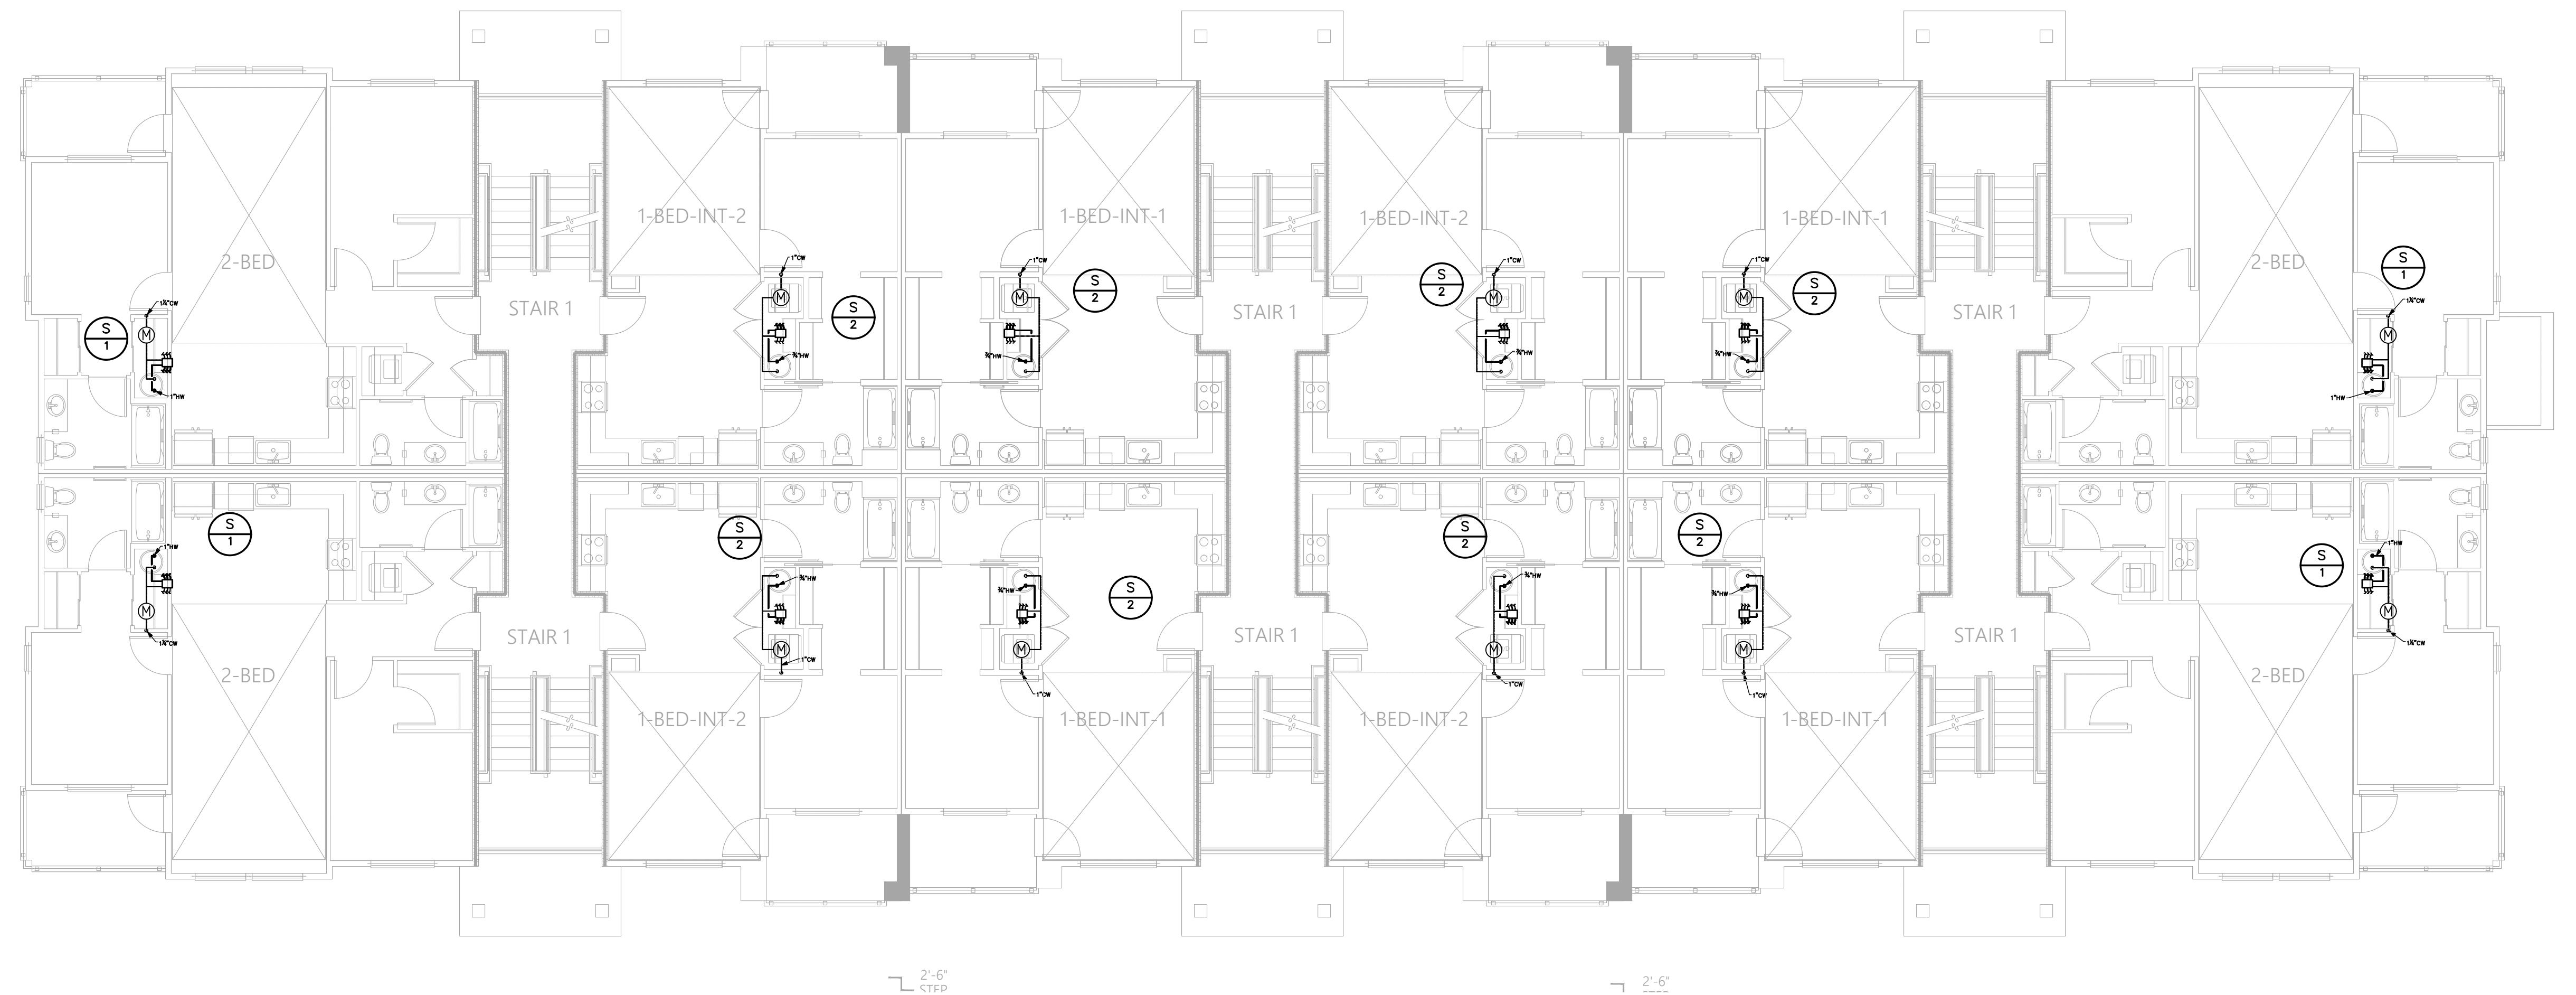

GENERAL NOTES

1. PROVIDE EXPANSION LOOPS FOR ALL WATER PIPING PER THE MANUFACTURER'S INSTRUCTIONS. SEE DETAIL 3/P7G.01.
2. INSTALL HEAT TRACE ON SUPPLY PIPE IN NON CONDITIONED SPACES.


FLAG NOTES

NOT USED

LEVEL 3 PLUMBING SUPPLY PLAN

SCALE: 1/8" = 1'-0"

SHEET NO. P3G.03

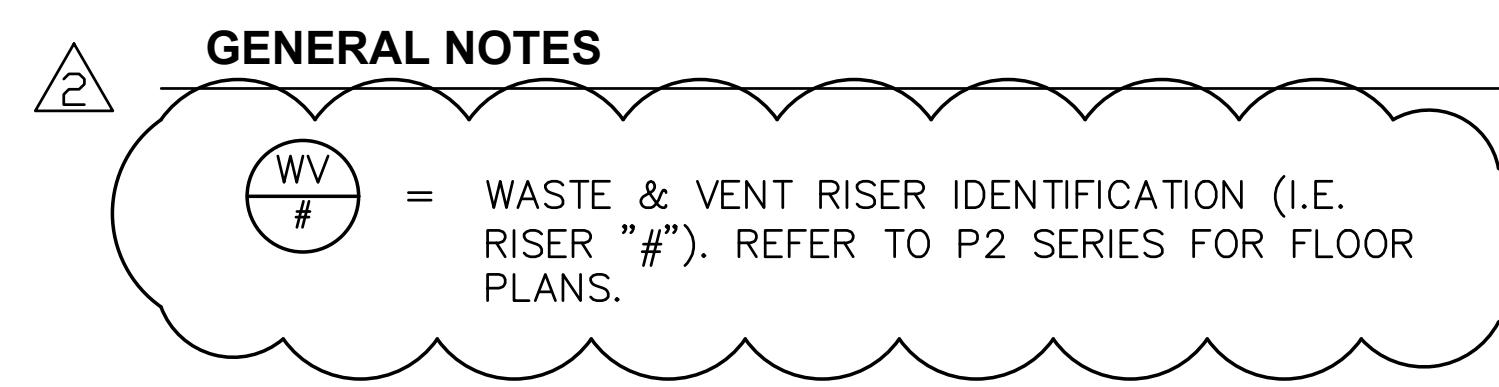


1. SUD RELIEF PIPING WITH LENGTH OF 8FT WILL BE USED.
2. WASTE & VENT SIZING: WASTE & VENT PIPING IS SIZED PER 2018 UPC TABLE 703.2. DRAINAGE PIPING SHALL BE SLOPED AT 1/4" PER FOOT OR 2%. WHERE IT IS IMPRACTICAL TO OBTAIN A SLOPE OF 2% DUE TO THE DEPTH OF THE STREET SEWER OR TO STRUCTURAL FEATURES OF THE BUILDING, DRAINAGE PIPING 4" AND LARGER MAY BE SLOPED AT 1/8" PER FOOT OR 1% WITH APPROVAL FROM THE AHJ.


PIPE SIZE	VERTICAL	HORIZONTAL	VENT
1½"	2 DFU	1 DFU	8 DFU
2"	16 DFU	8 DFU	24 DFU
3"	48 DFU	35 DFU	84 DFU
4"	256 DFU	216 DFU	256 DFU
6"	1,380 DFU	720 DFU	1,380 DFU
8"	3,600 DFU	2,640 DFU	3,600 DFU

ABBREVIATION LEGEND:

LV = LAVATORY	(1 DFU)
BT = BATHTUB	(2 DFU)
SH = SHOWER	(2 DFU)
KS = KITCHEN SINK WITH DISHWASHER	(2 DFU)
WM = WASHING MACHINE	(3 DFU)
WC = WATER CLOSET	(3 DFU)
UR = URINAL	(2 DFU)
FD = FLOOR DRAIN	(2 DFU)
FS = FLOOR SINK	(4 DFU)
HD = HUB DRAIN	(4 DFU)

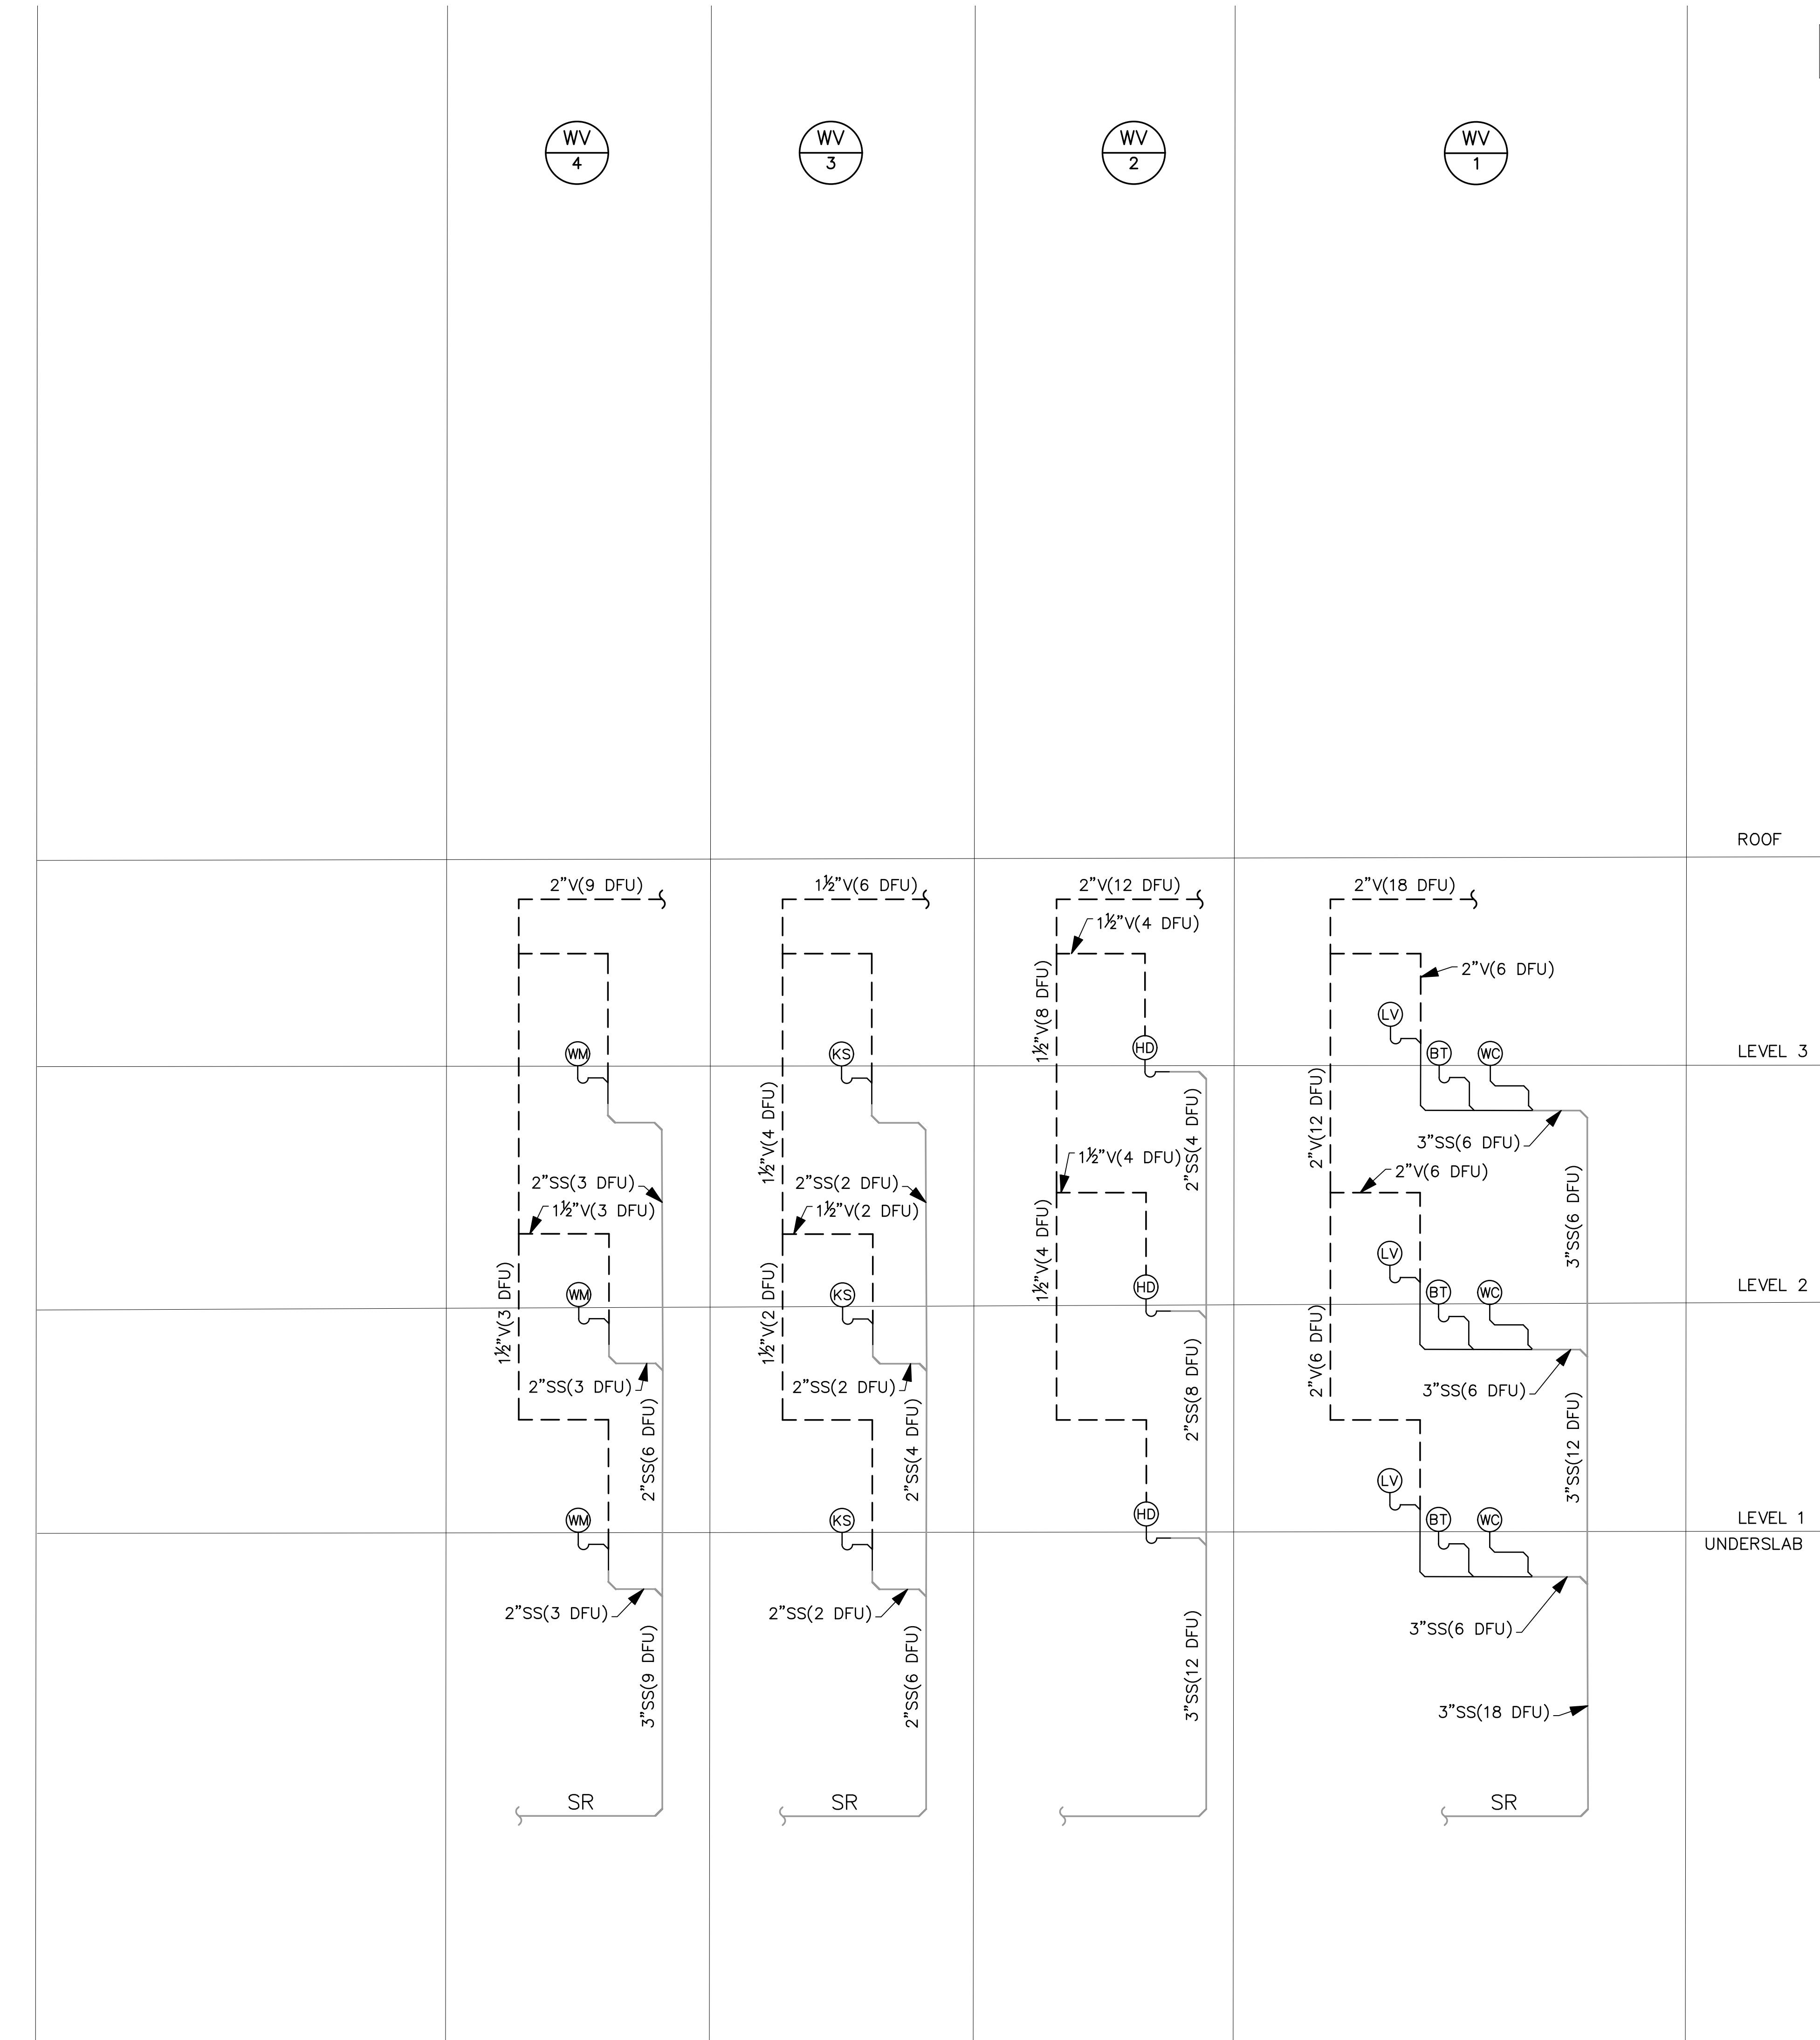

NO.	DATE	DESCRIPTION	REVISIONS

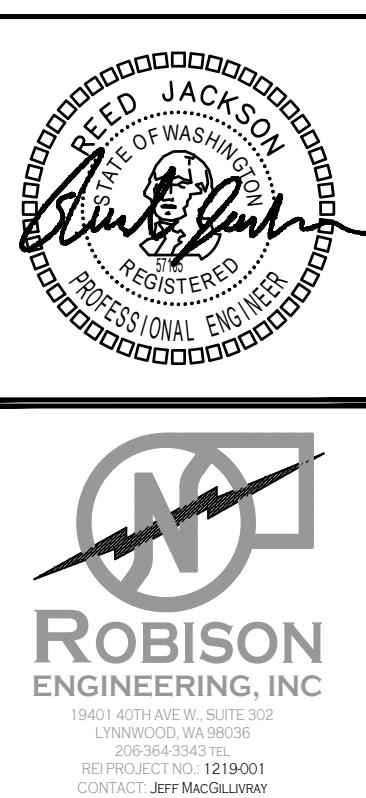

DRAWN:	JM
DESIGNED:	JM
CHECKED:	RJ
APPROVED:	JR

PRMU20240280

PROJECT: BRADLEY HEIGHT APARTMENTS - BUILDING G
202 27TH AVE SE
PUYALLUP, WA 98374
19401 40TH AVE W. SUITE 302
LYNNWOOD, WA 98036
PHONE: 206-364-3343


ROBISON
ENGINEERING, INC.

DATE: 04/25/2025

SHEET TITLE:
WASTE RISER DIAGRAMS

SHEET NO.
P4G.00

NO.	DATE	DESCRIPTION	REVISIONS

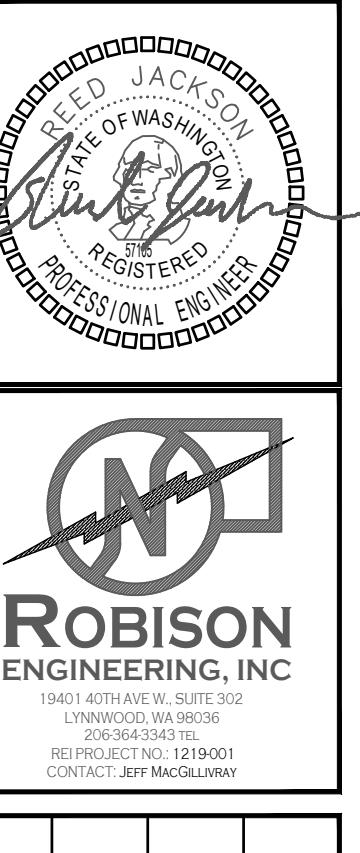

ROBISON
ENGINEERING, INC.
19401 40TH AVE W, SUITE 302
LYNNWOOD, WA 98036
PHONE: (206)364-3343
REF ID: 1219001
CONTACT: JEFF McCULLY


BRADLEY HEIGHT APARTMENTS - BUILDING G
19401 40TH AVE W, SUITE 302
LYNNWOOD, WA 98036
PHONE: (206)364-3343
PRMU20240280

PROJECT:
202 27TH AVE SE
PUYALLUP, WA 98374


ROBISON
ENGINEERING, INC.
19401 40TH AVE W, SUITE 302
LYNNWOOD, WA 98036
PHONE: (206)364-3343
DATE: 04/25/2025

SHEET TITLE:
SUPPLY RISER
DIAGRAMS

SHEET NO.
P5G.00

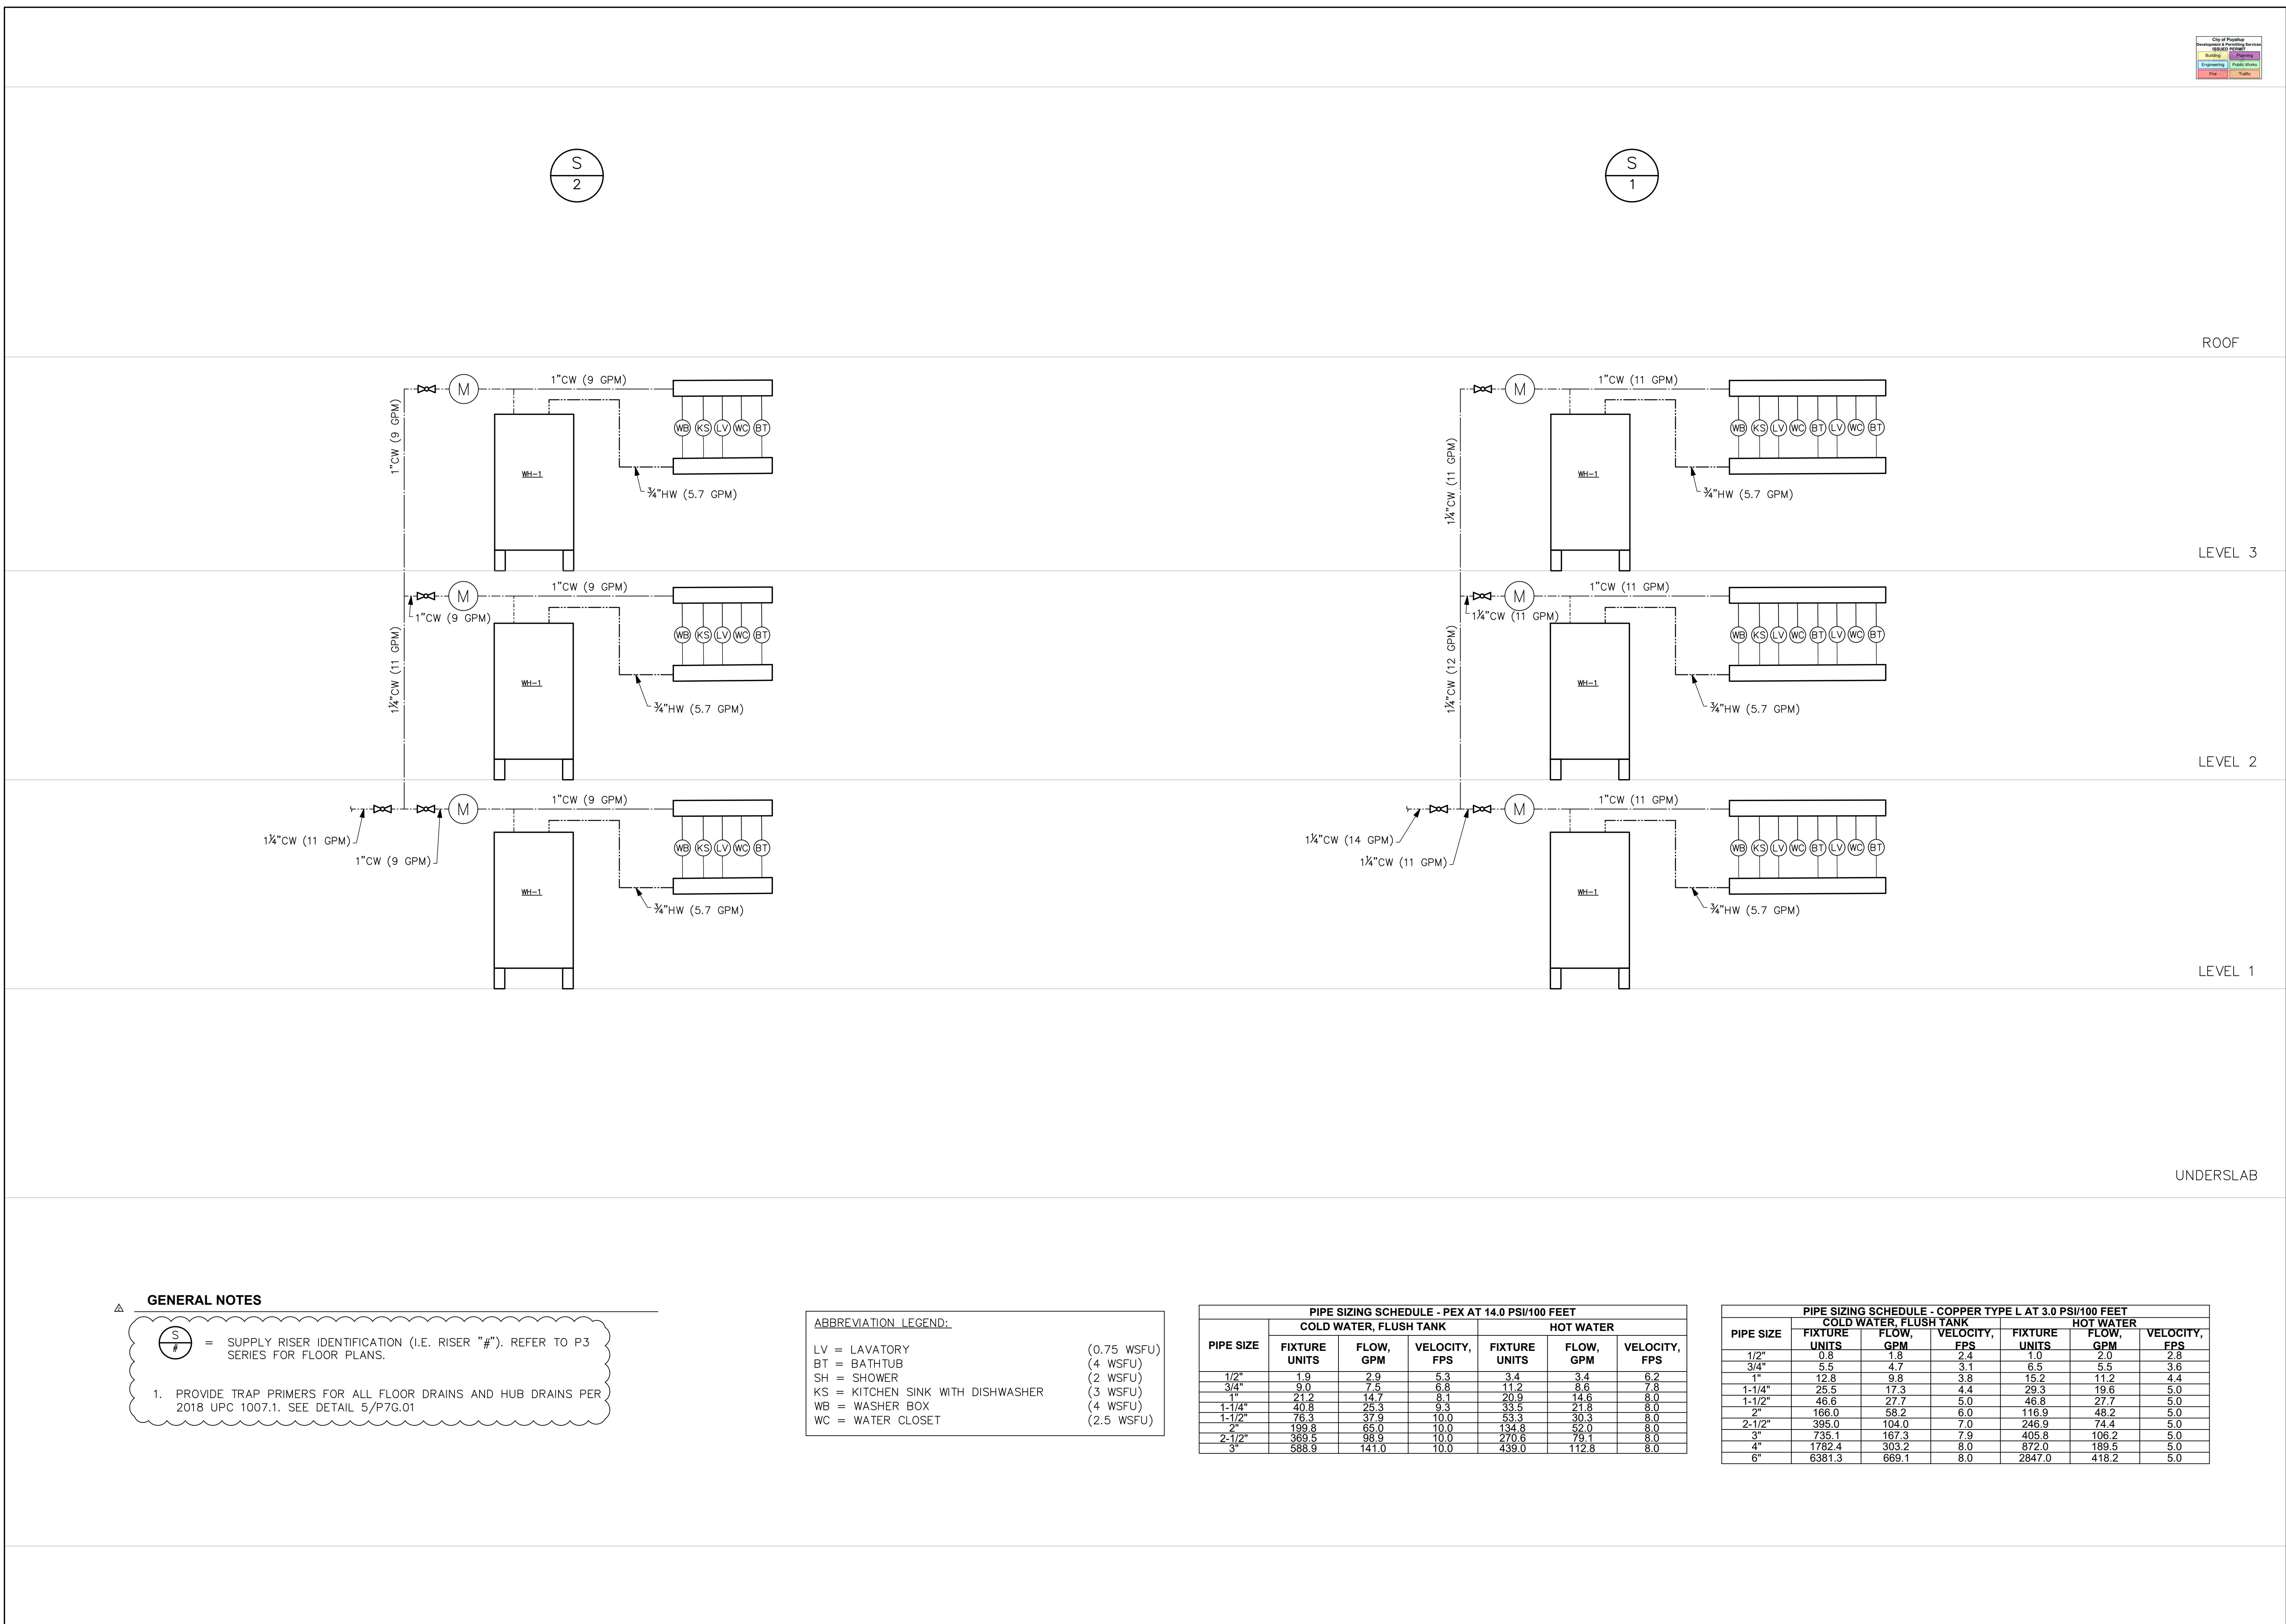

NO.	DATE	DESCRIPTION	REVISIONS

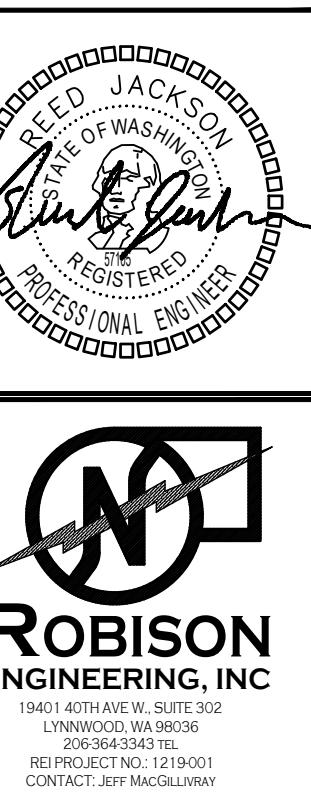






BRADLEY HEIGHT APARTMENTS - BUILDING G
PRMU20240280

PROJECT: 19401 40TH AVE W, SUITE 302
LYNNWOOD, WA 98036
PHONE: (206)364-3343
ROBISON
ENGINEERING, INC.

DATE: 04/25/2025

SHEET TITLE:
DETAILS

SHEET NO.
P7G.00

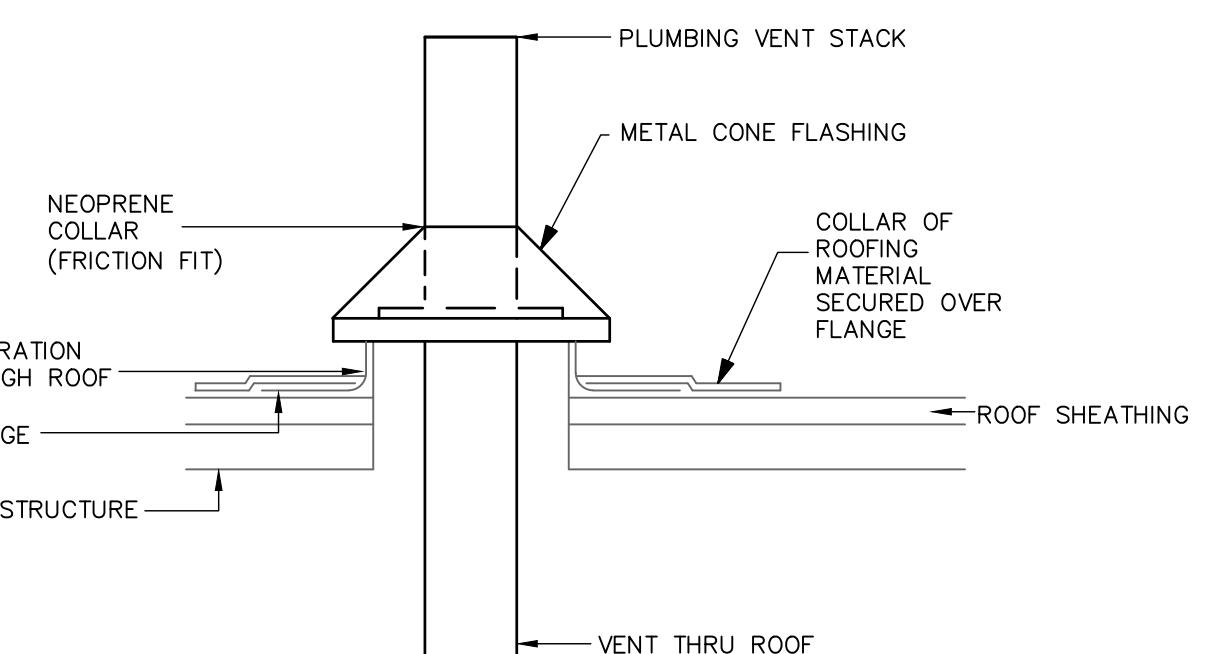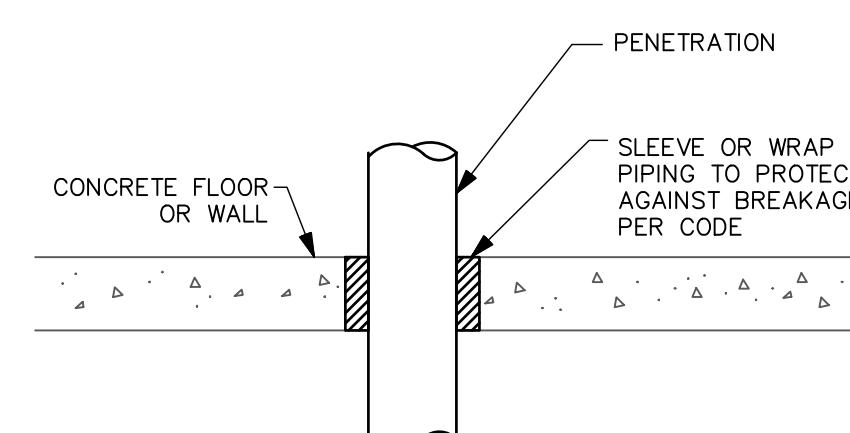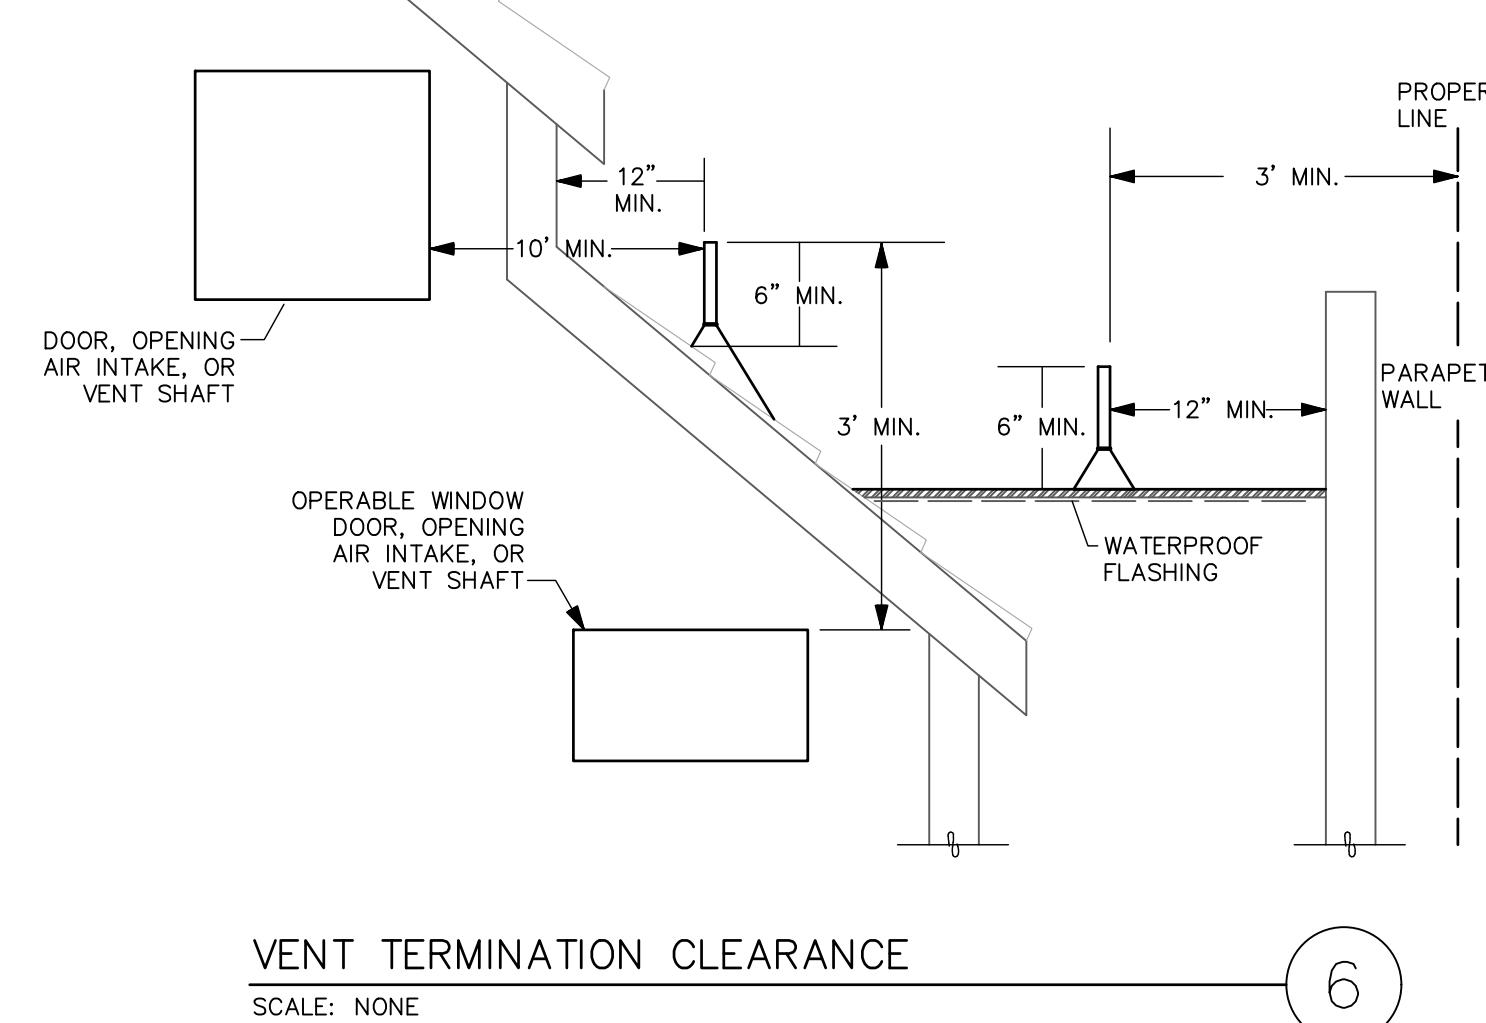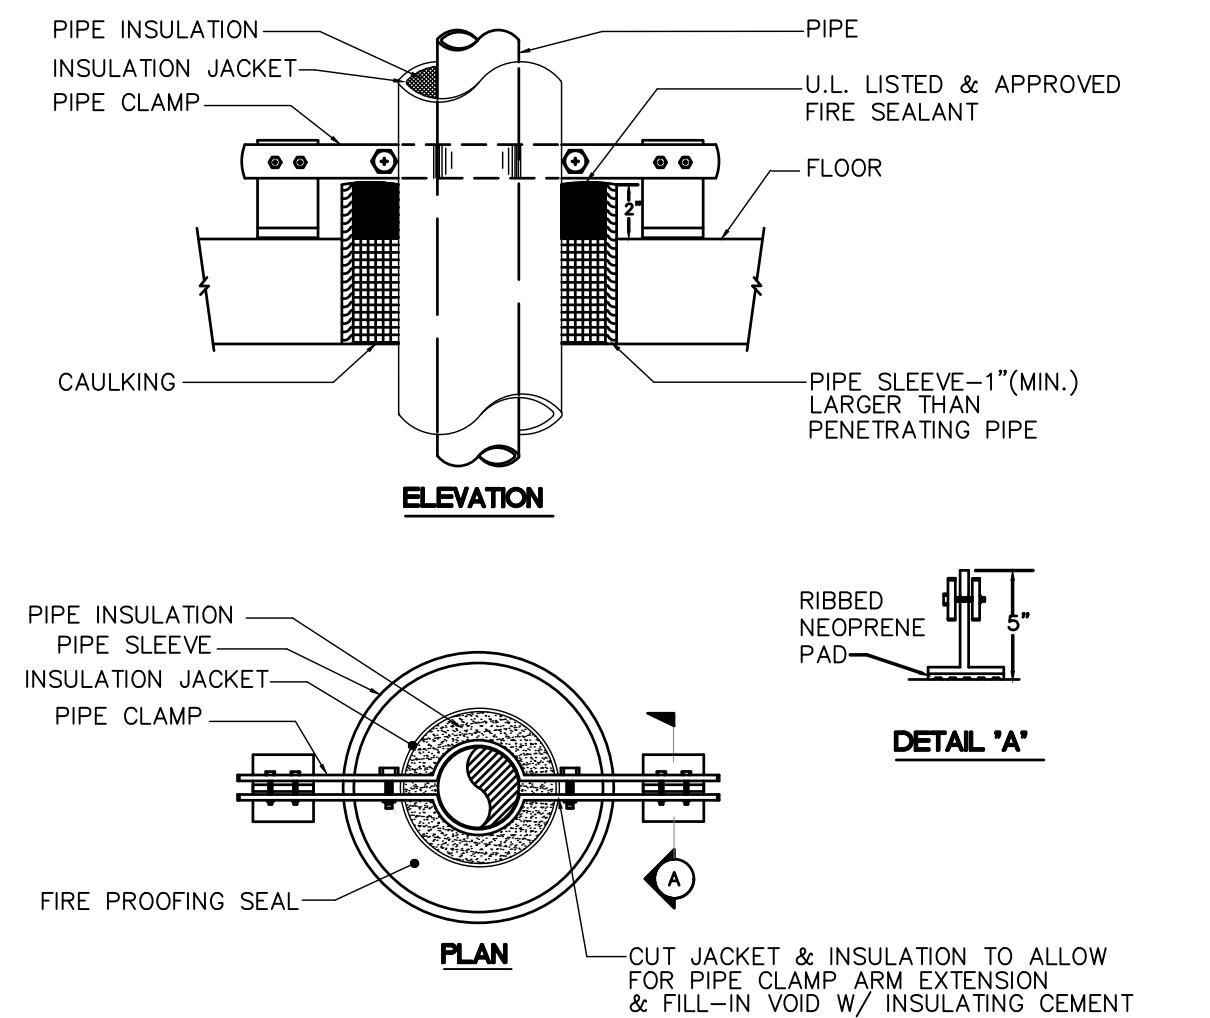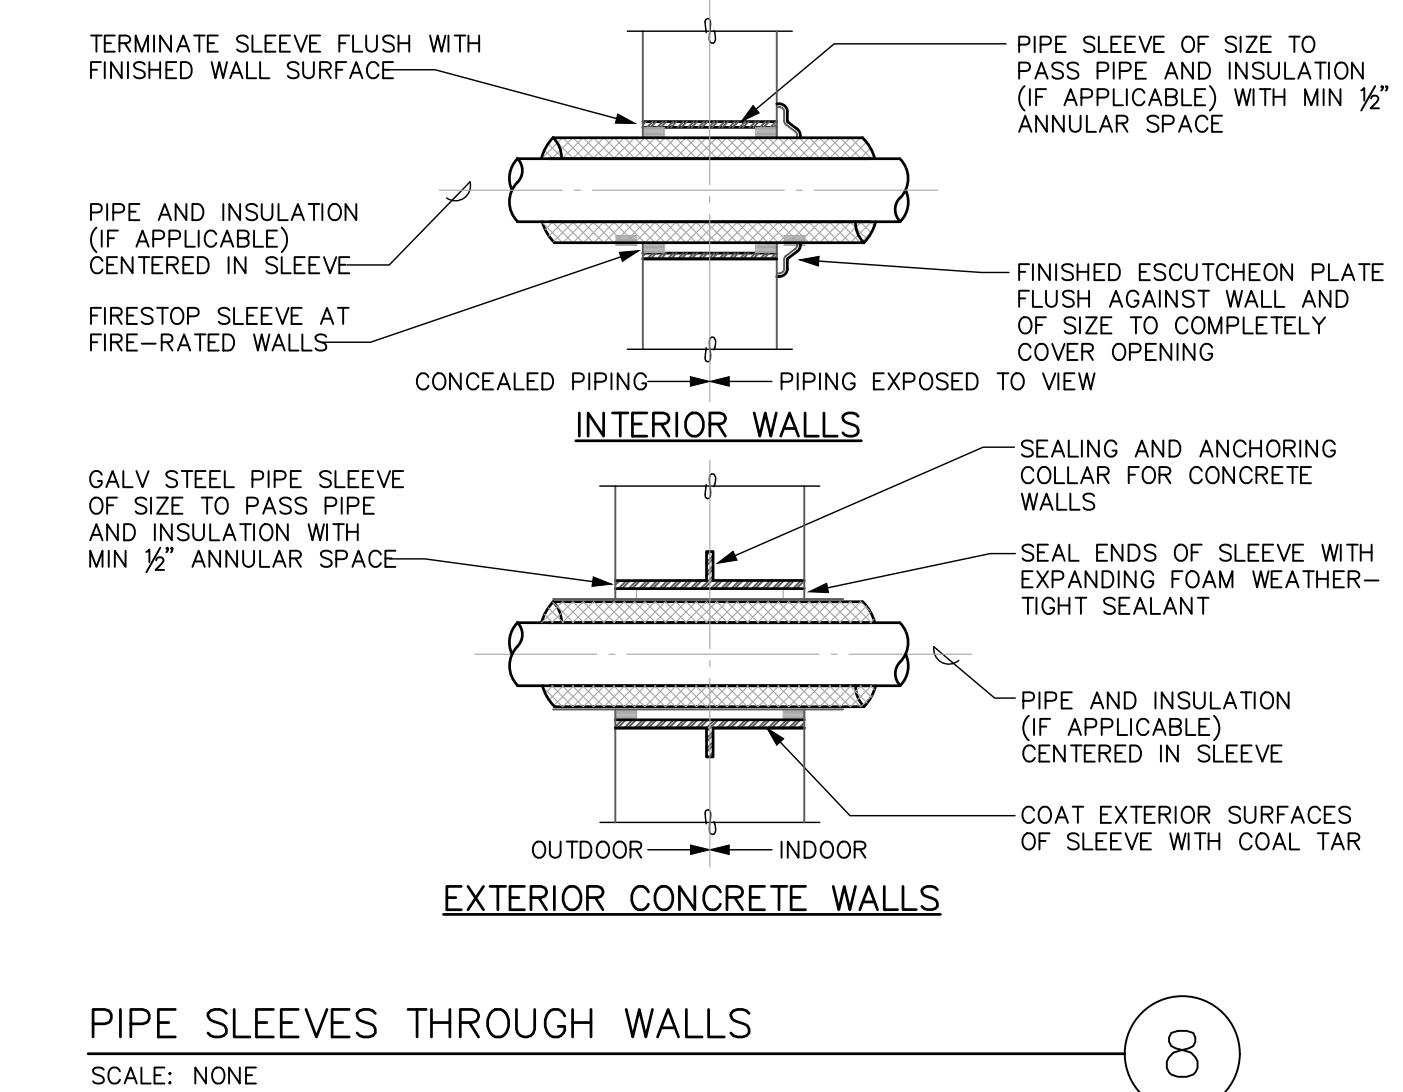

EQUIPMENT SCHEDULE

WATER METERS (NEXT CENTURY MULTI-JET
WATER METER MODEL M201CH, 3/4")

TRANSCIVER: WIRELESS METERING DATA
TRANSCIVER DUAL INPUT WITH DISPLAY, WITH
BATTERIES, TEHAMA WIRELESS MODEL
TW-165A-PP.

WIRELESS REPEATERS: TEHAMA COMPATIBLE
REPEATERS; QUANTITY TWO, TEHAMA WIRELESS
TW-191X.



DATA CONCENTRATING ACCESS POINT (DCAP):

- DCAP TO BE INSTALLED ON MAIN
COMM/DATA BOARD AND POWER SUPPLY
PLUGGED INTO RECEPTACLE.
- PROVIDE ETHERNET OR WIFI ACCESS FOR
INTERNET ACCESS TO DCAP.

DUAL-INPUT METERING DATA
TRANSCIVER WITH DISPLAY,
COORDINATE LOCATION WITH
ARCHITECT.

NOTES:

1. PROVIDE COLD WATER METER AND REMOTE TRANSCIVER FOR EACH APARTMENT.
2. SECURE METER TO FLOOR/CEILING ASSEMBLY.
3. REFER TO P5 SERIES FOR PIPE SIZES.
4. TRANSITION TO PEX PIPING WITHIN EACH UNIT.

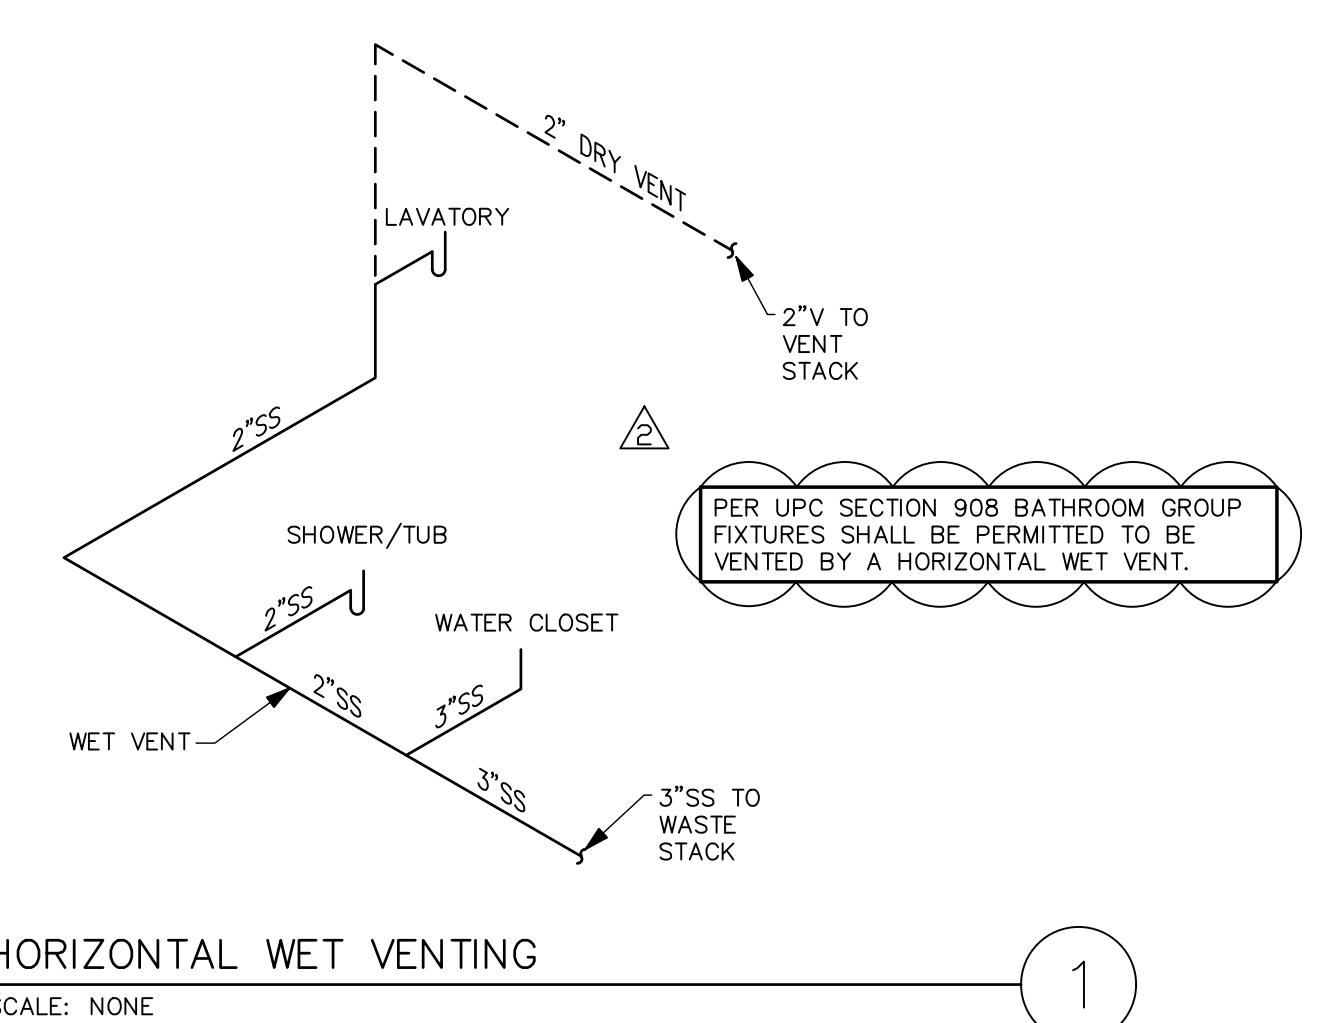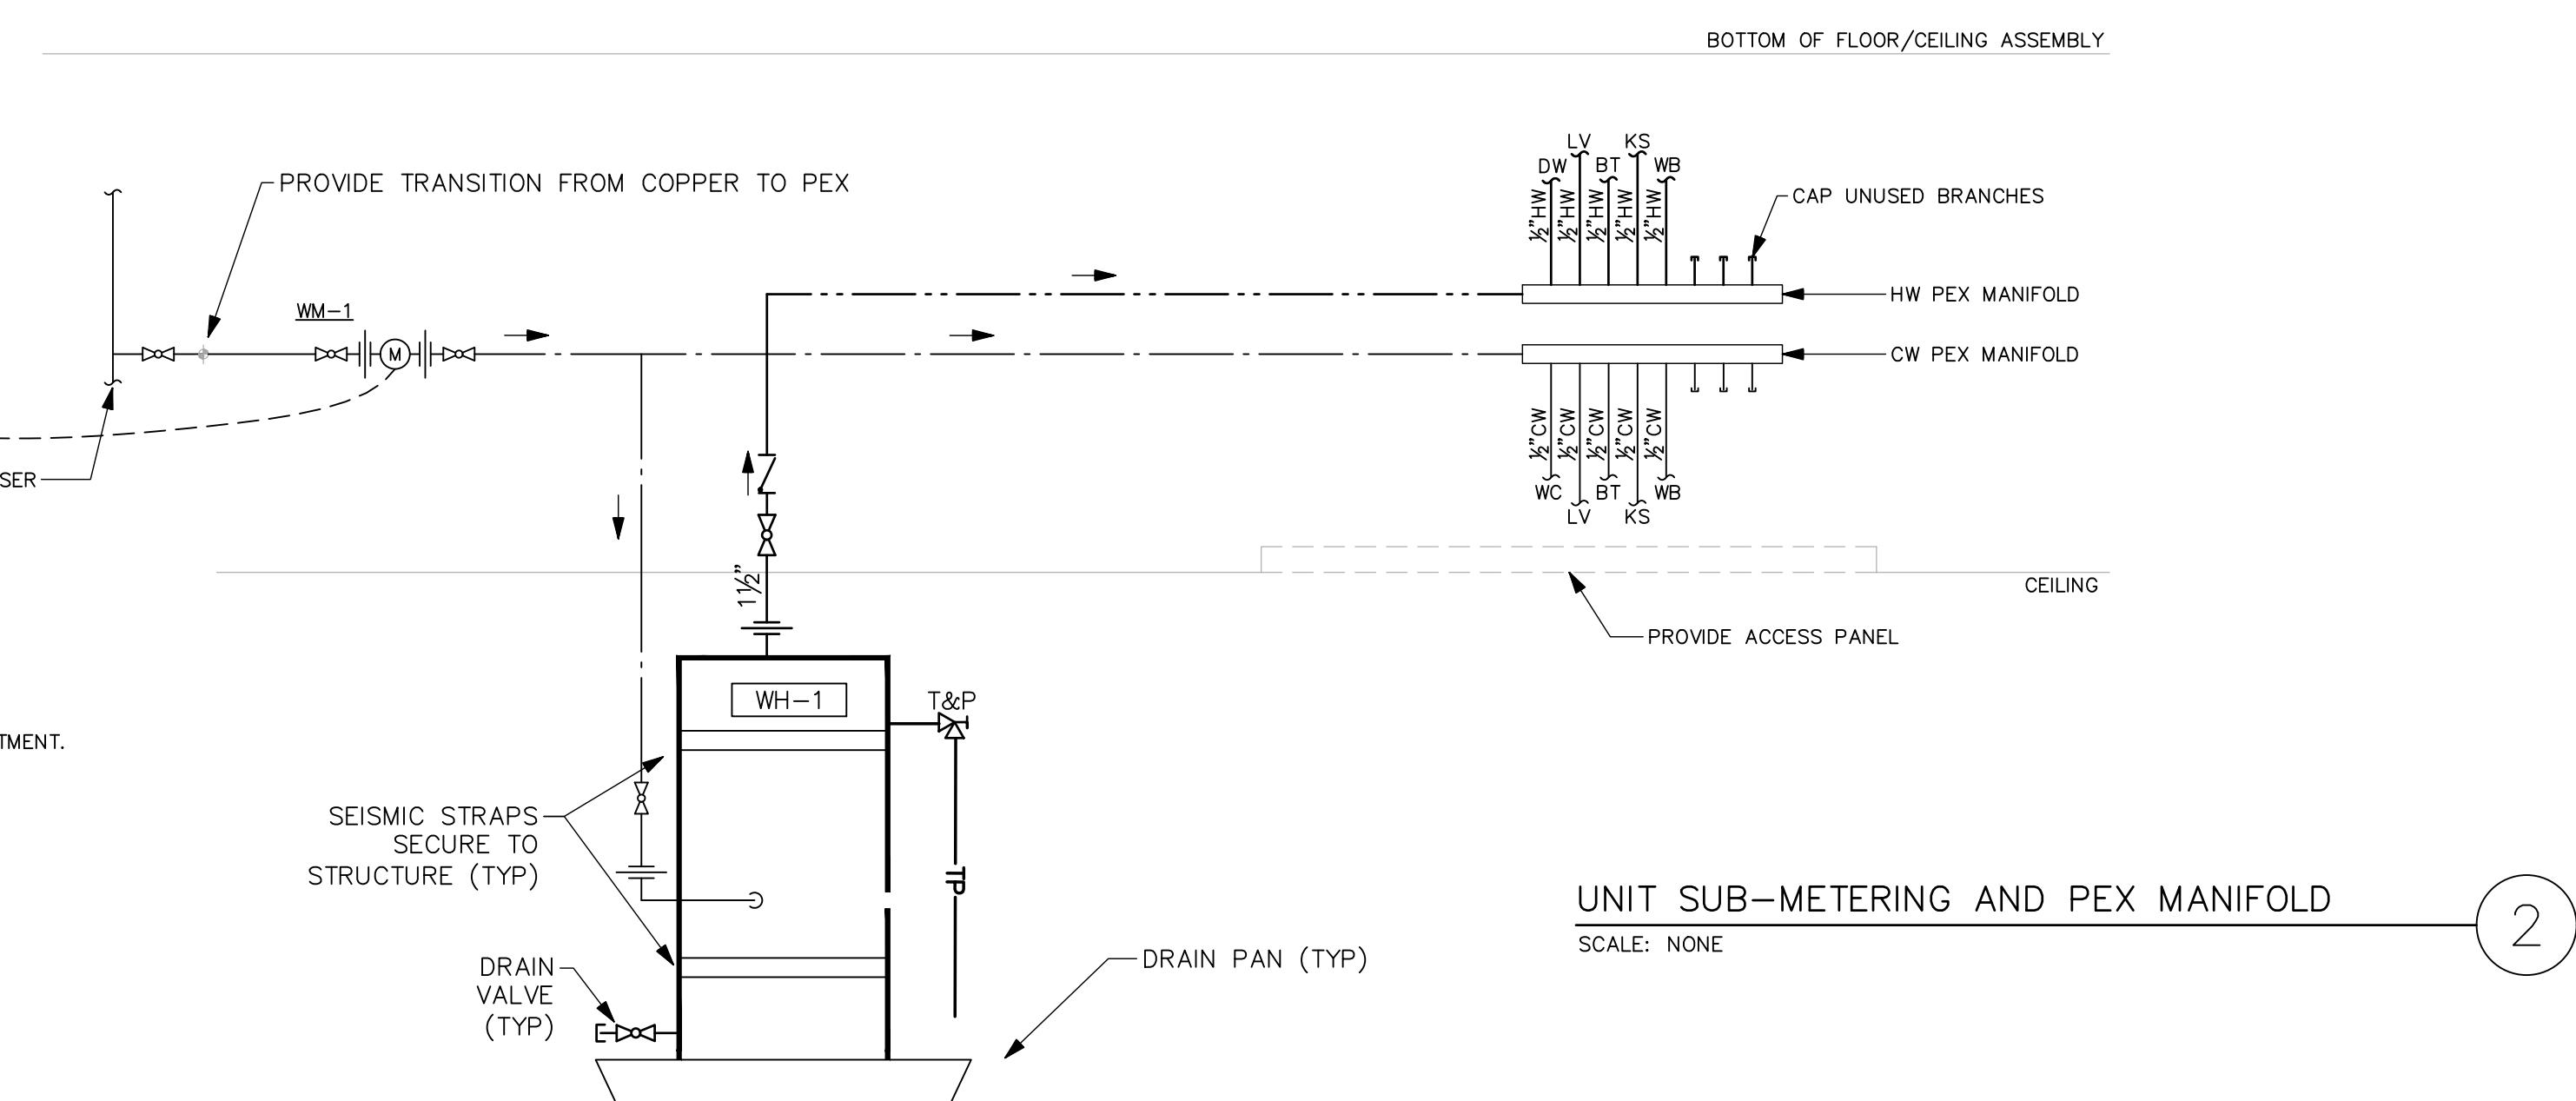

NO.	DATE	DESCRIPTION	REVISIONS



ROBISON
ENGINEERING, INC.

19401 40TH AVE W, SUITE 302
LYNNWOOD, WA 98036
PHONE: (206)364-3343

BRADLEY HEIGHT APARTMENTS - BUILDING G
PRMU20240280

PROJECT: 19401 40TH AVE W, SUITE 302
202 27TH AVE SE
PUYALLUP, WA 98374
PHONE: (206)364-3343







ROBISON
ENGINEERING, INC.

DATE: 04/25/2025

SHEET TITLE:
DETAILS

SHEET NO.

P7G.01

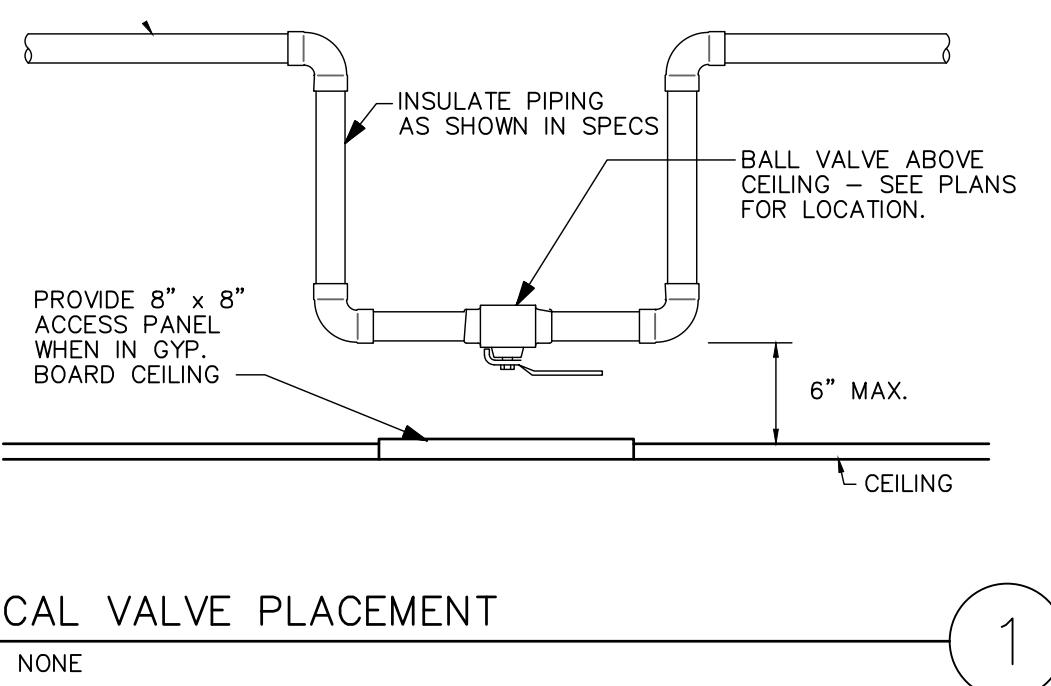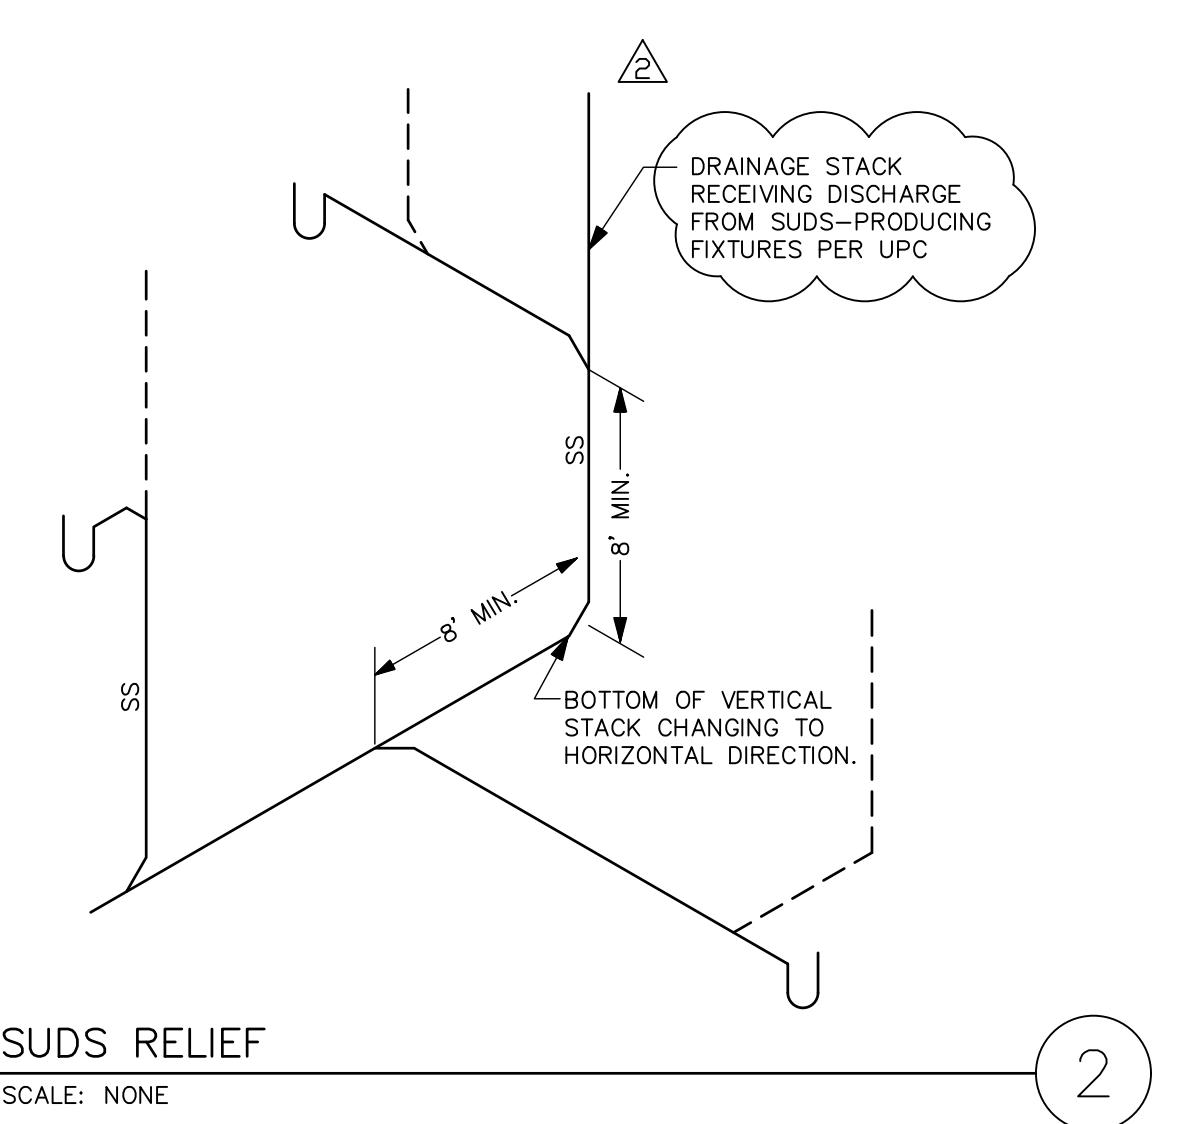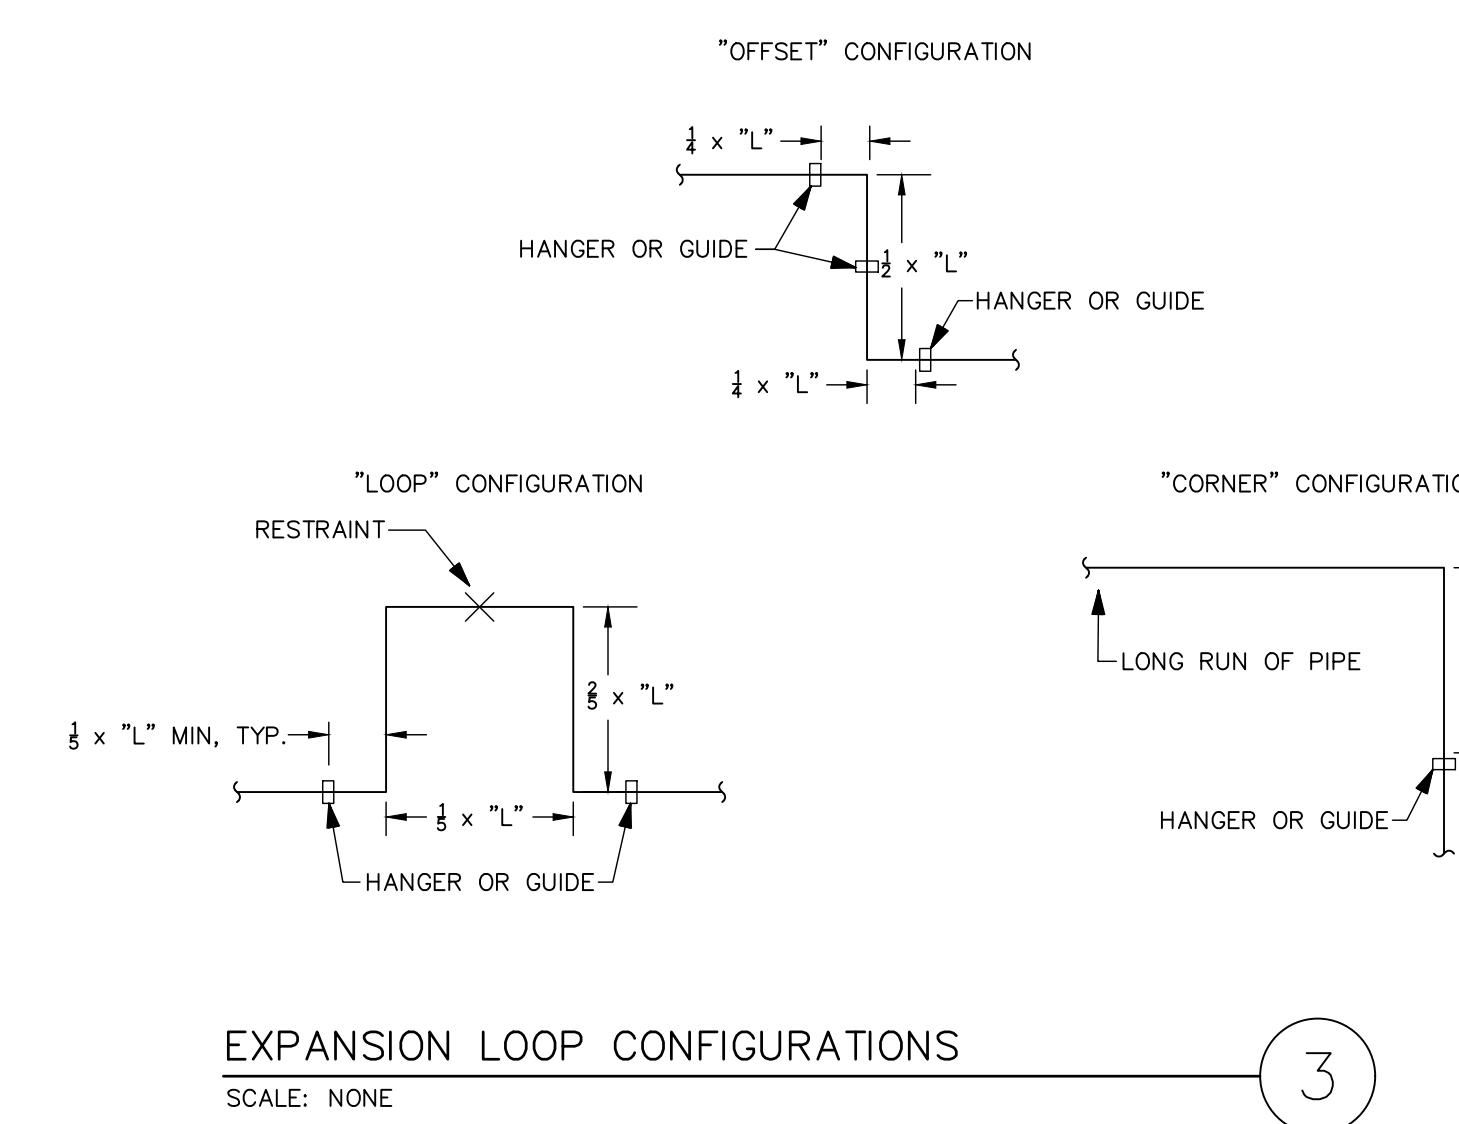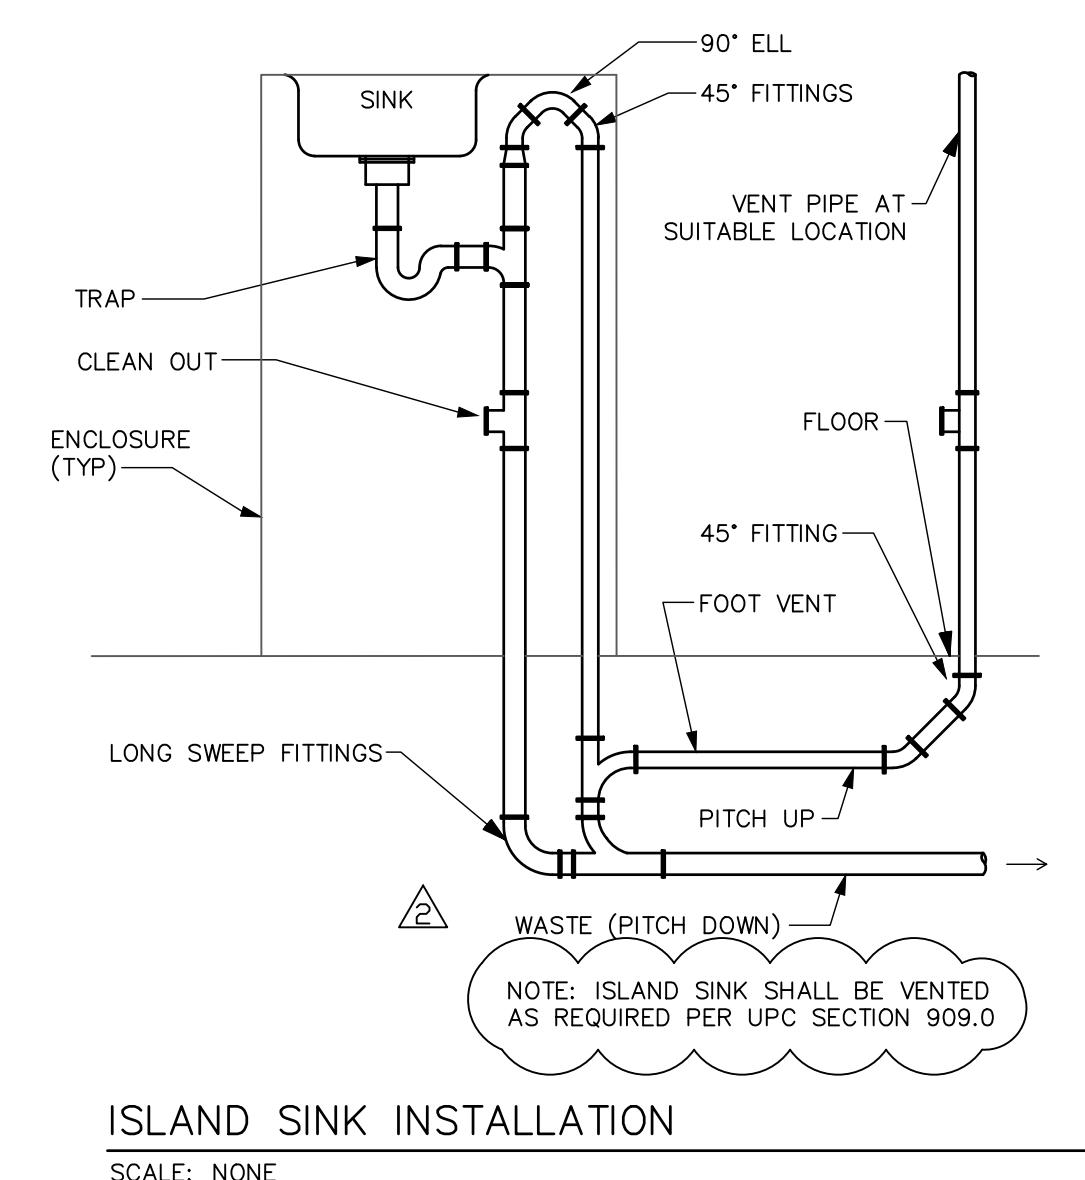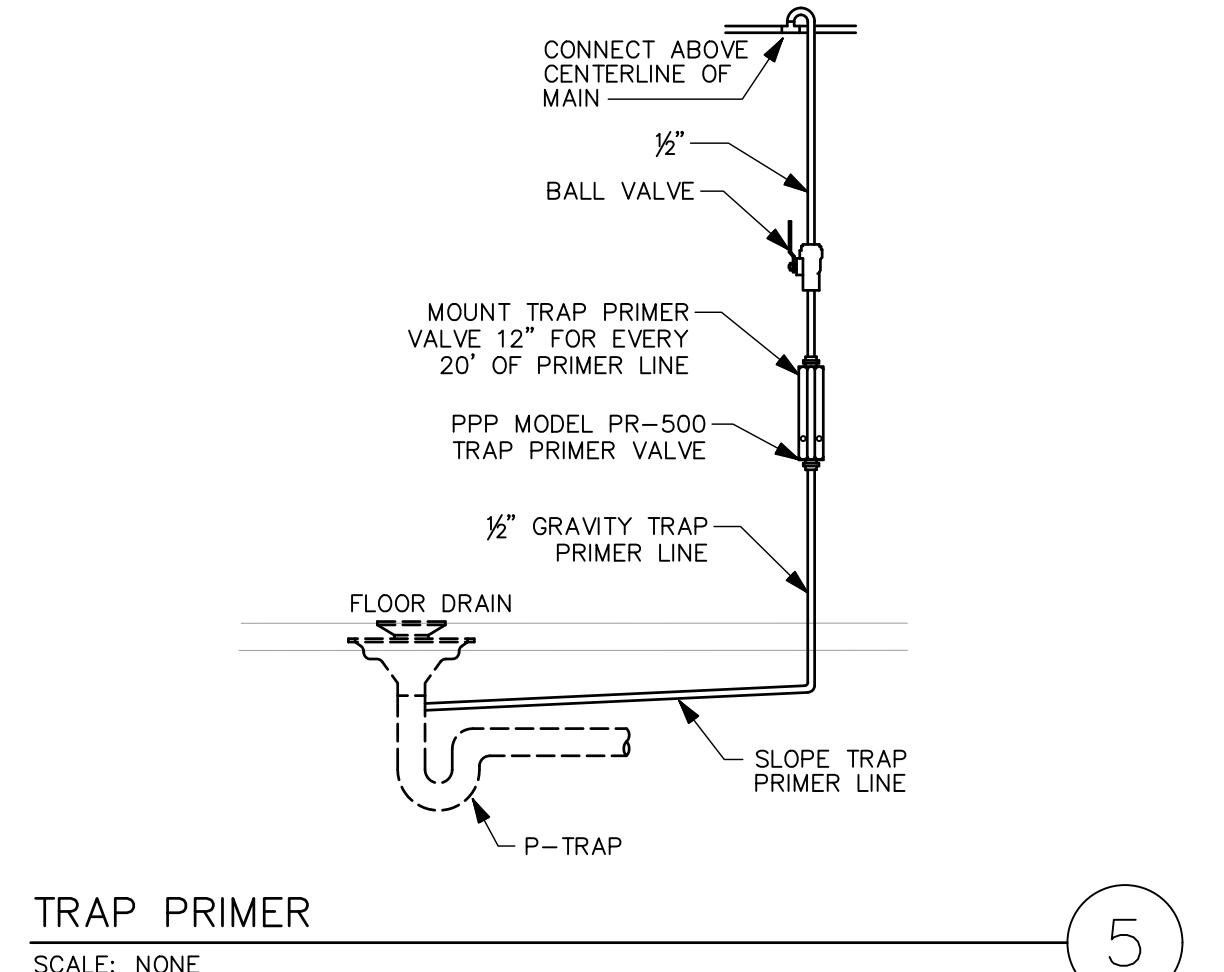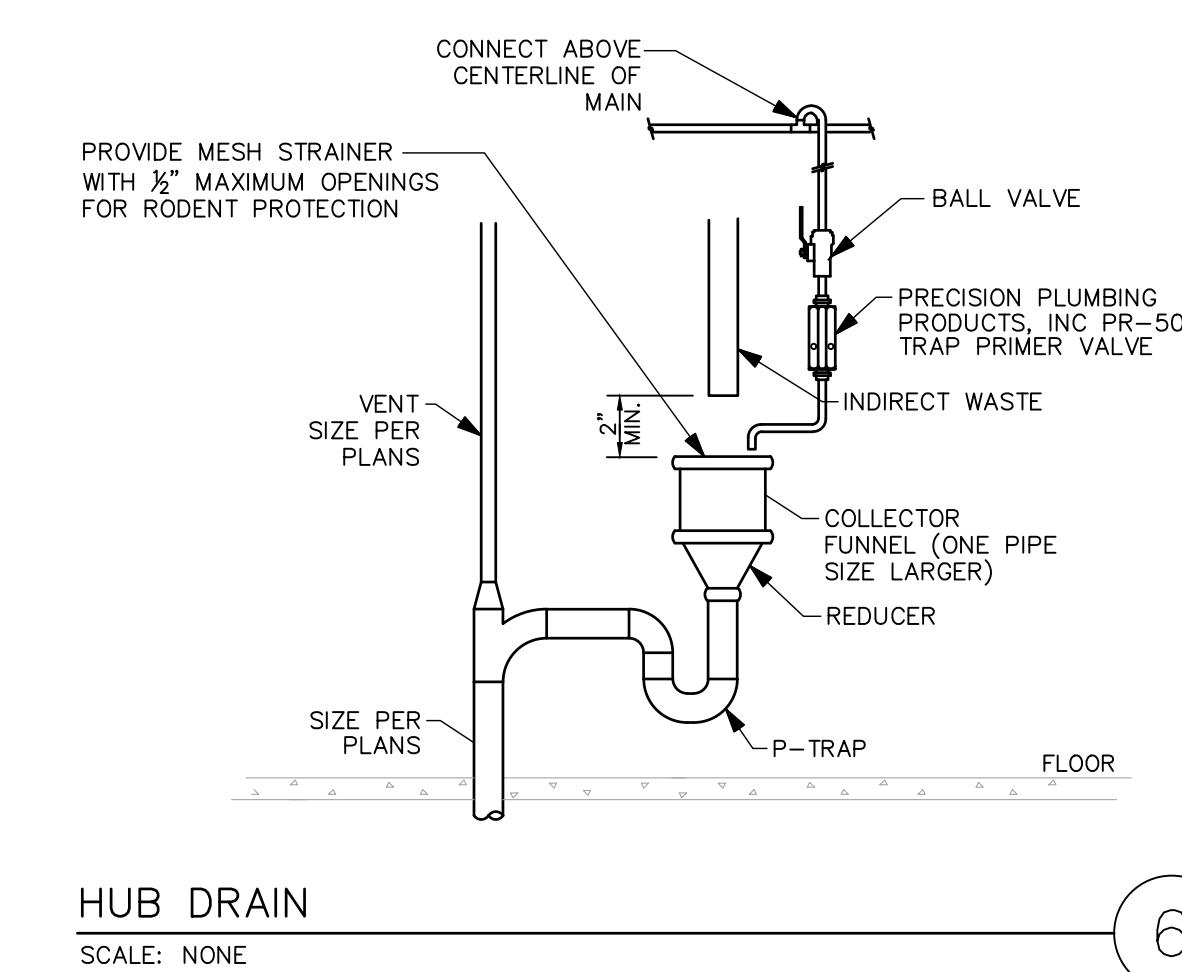

SHEET NO.

P7G.01