


ATTENTION

TRIANGLE SHAPE ▲ = LEFT SIDE INDICATOR
RED MARK ON TRUSS IS LEFT SIDE
TRIANGLE SHAPE ▲ = INDICADOR DE LADO IZQUIERDO
MARCA ROJA EN ARMADURA ES LADO IZQUIERDO

PRCNC20250692



MKM LEGACY
EAST TOWN
CROSSING
CLUB HOUSE

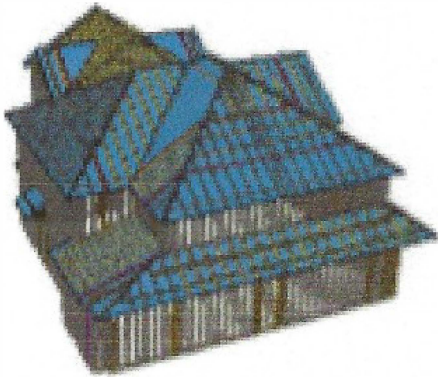


SHOP DRAWING / SUBMITTAL REVIEW

☒ APPROVED
☐ REVISE & RESUBMIT
☐ APPROVED AS NOTED
☐ REJECTED

SUBMITTAL WAS REVIEWED FOR DESIGN CONFORMITY AND GENERAL CONFORMANCE TO CONTRACT DOCUMENTS ONLY. THE CONTRACTOR IS RESPONSIBLE FOR CONFIRMING AND CORRELATING DIMENSIONS AT JOBSITE FOR TOLERANCE, CLEARANCE, QUANTITIES, FABRICATION PROCESSES AND TECHNIQUES OF CONSTRUCTION, COORDINATION OF HIS WORK WITH OTHER TRADES AND FULL COMPLIANCE WITH CONTRACT DOCUMENTS

BY: *CHOW*
PIERUCCIONI DATE: *5/14/2025*
PIERUCCIONI E&C, LLC

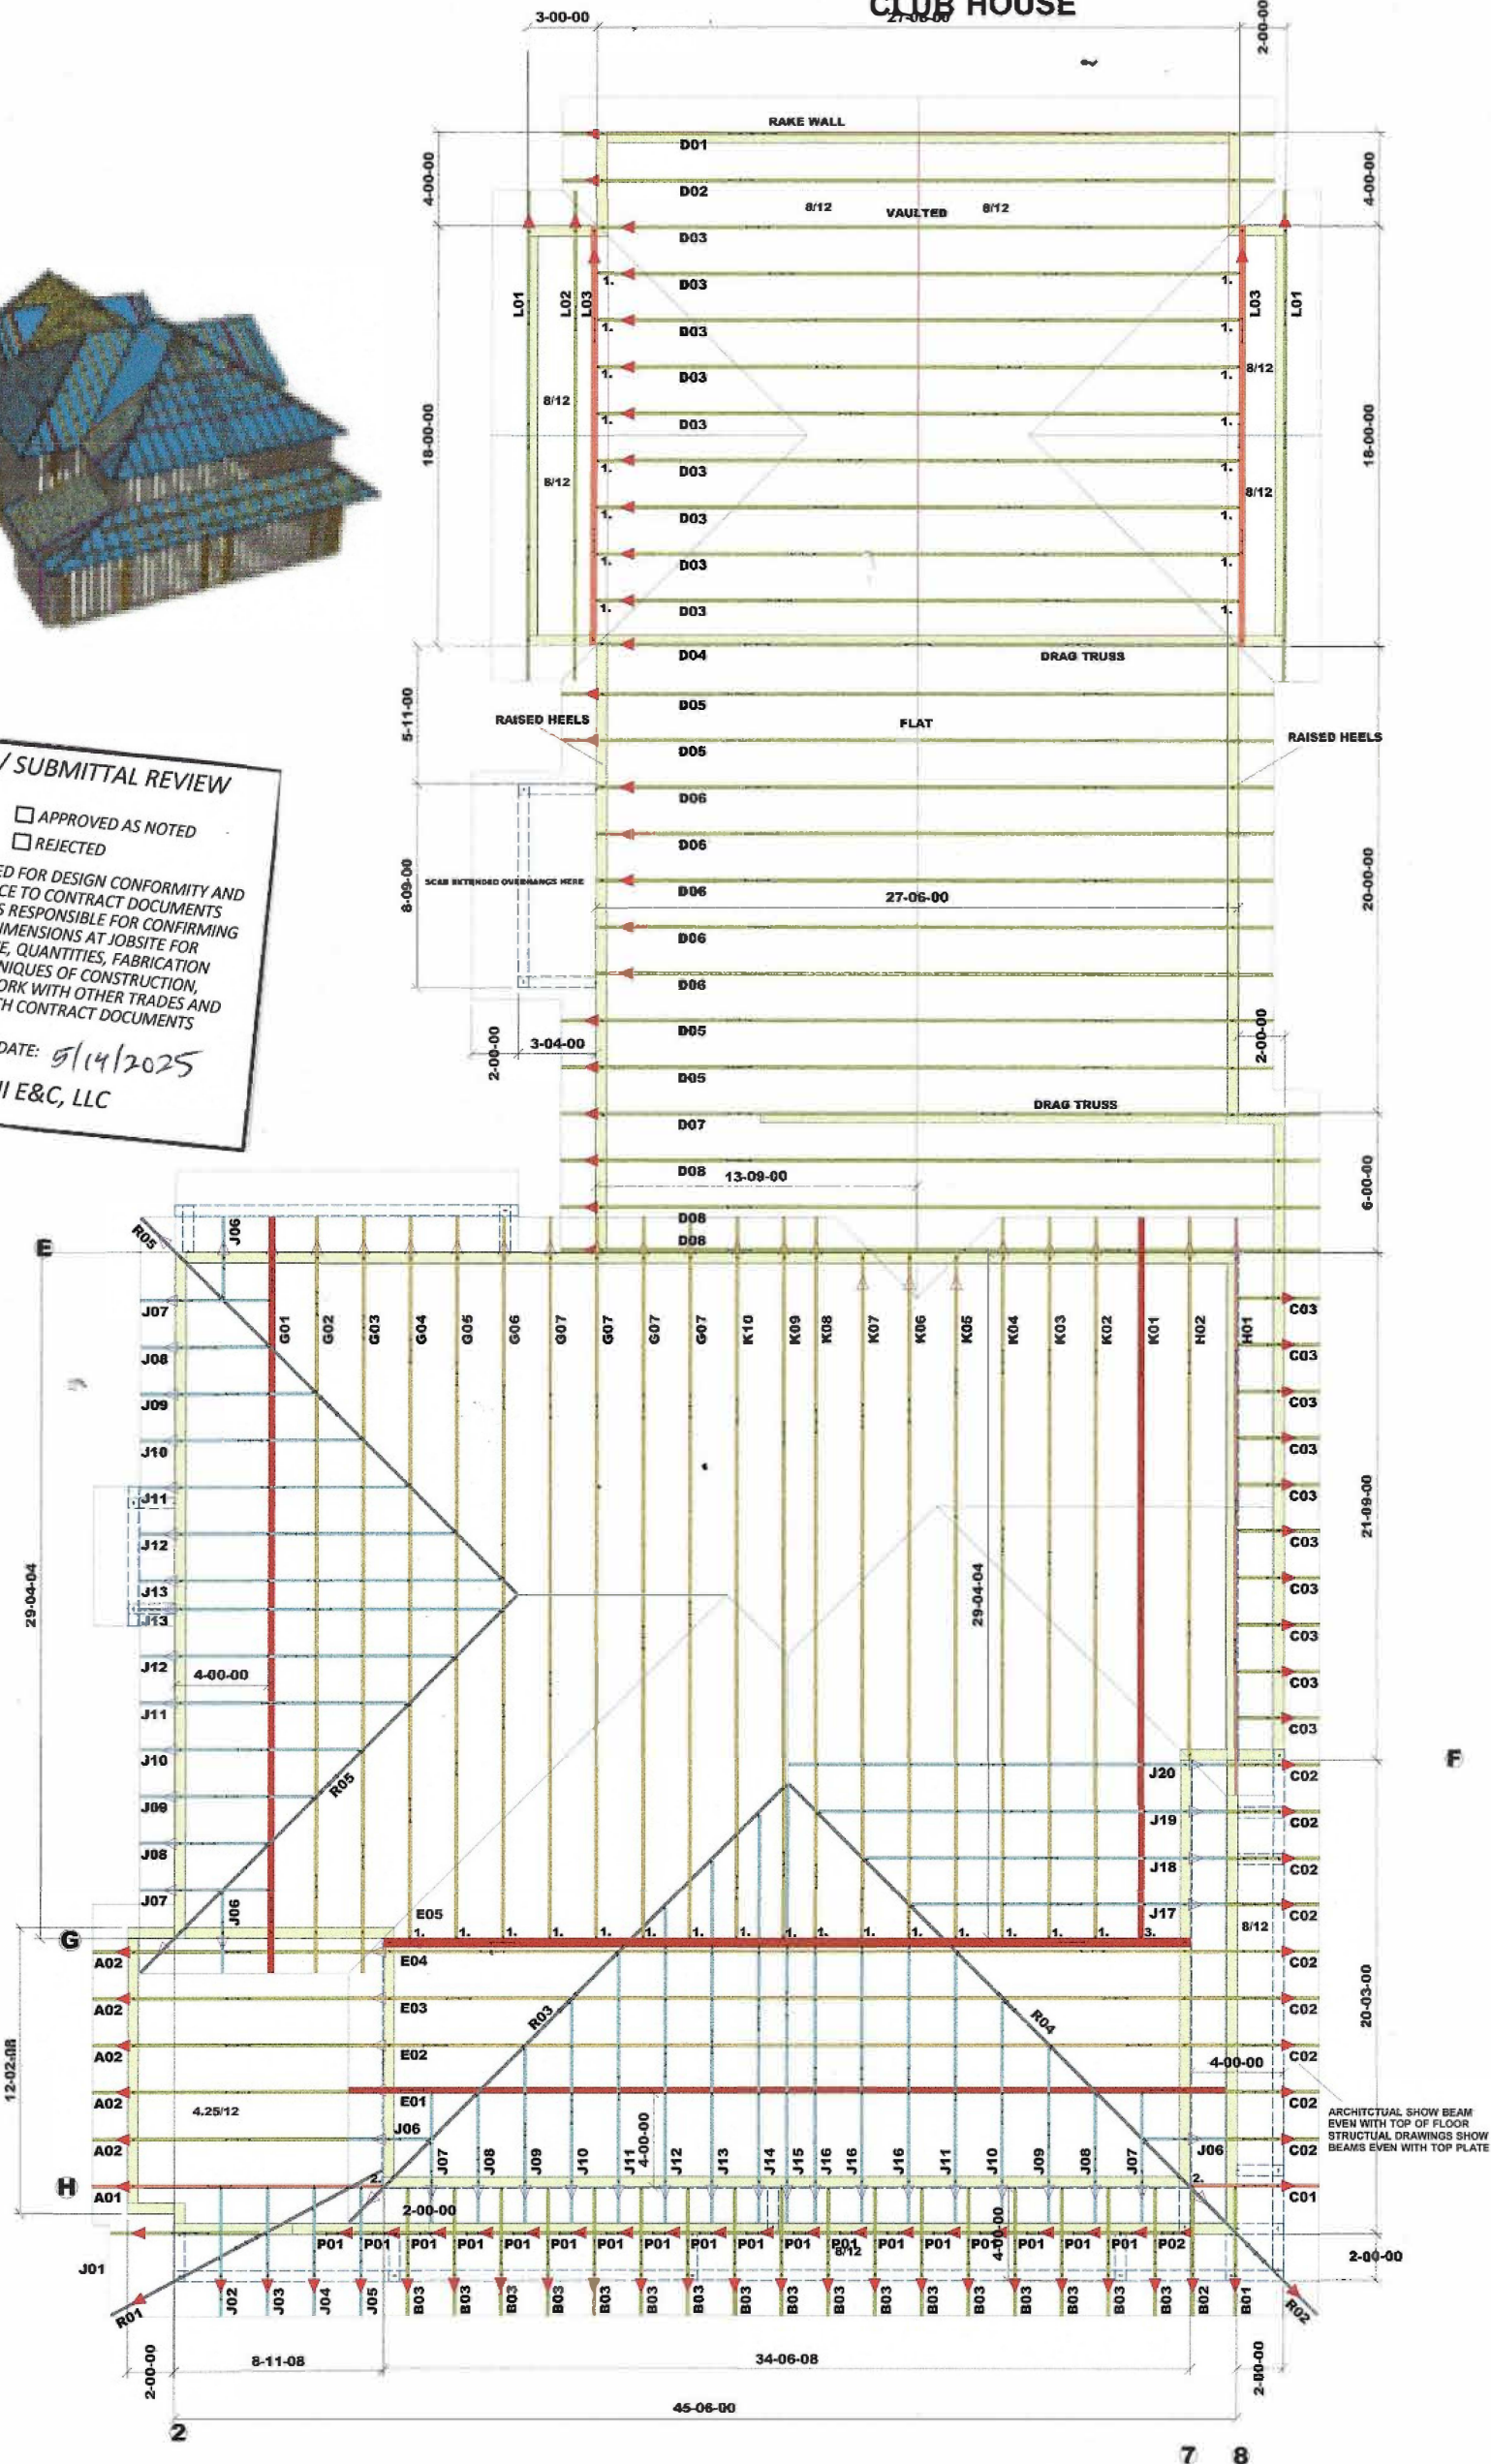

HANGER SCHEDULE		
ID	HANGER MODEL	QTY
1.	HUS26	33
2.	LUC26	2
3.	H6US26-2	1
ALL OTHERS NOT LISTED LUS24		
BLOCKING SCHEDULE		
TYPE	QTY	
2x4 VENT5	160	



ROOF TRUSS PLACEMENT LAYOUT
Puget Sound Market Trusses

BUILDER: MKM LEGACY
PLAN: CLUB HOUSE EAST TOWN CROSSING
ADDRESS: 3002 E Pioneer Way, Puyallup WA 98372

DATE:
SCALE: NTS
SALES: DOUG F.
APPWRIGHT/ MBA #: 4623837

DESIGNER: JEFF C.
CITY, STATE:

THIS IS A TRUSS PLACEMENT DIAGRAM ONLY. These trusses are designed as individual building components to be incorporated into the building design at the specification of the building designer. See the individual design sheets for each truss design identified in the placement drawing. The building designer is responsible for temporary and permanent bracing of the roof and floor system and for the overall structure. The design of the truss support structure including headers, beams, walls, and columns is the responsibility of the building designer. For general guidance regarding bracing, consult "Bracing of wood trusses" available from the Truss Plate Institute, 583 D'Amfrio Drive, Madison, WI 53179