

DO NOT CUT, DRILL, NOTCH OR MODIFY TRUSS MEMBERS WITHOUT PRIOR APPROVAL FROM Builders FirstSource Truss


ATTENTION

TRIANGLE SHAPE ▲ = LEFT SIDE INDICATOR
RED MARK ON TRUSS IS LEFT SIDE
TRIANGLE SHAPE ▲ = INDICADOR DE LADO IZQUIERDO
MARCA ROJA EN ARMADURA ES LADO IZQUIERDO

PRCNC20250094

MKM LEGACY
EAST TOWN CROSSING LOT 1# REV 1#
5' & 8' PARAPET FROM BOTTOM CHORD MAX

THIS IS A TRUSS PLACEMENT DIAGRAM ONLY. These trusses are designed as individual building components to be incorporated into the building design at the specification of the building designer. See the individual design sheets for each truss design identified on the placement drawing. The building designer is responsible for temporary and permanent bracing of the roof and floor system and for the overall structure. The design of the truss support structure including headers, beams, walls, and columns is the responsibility of the building designer. For general guidance regarding bracing, consult "Bracing of wood trusses" available from the Truss Plate Institute, 583 D'Ombino Drive, Madison, WI 53179

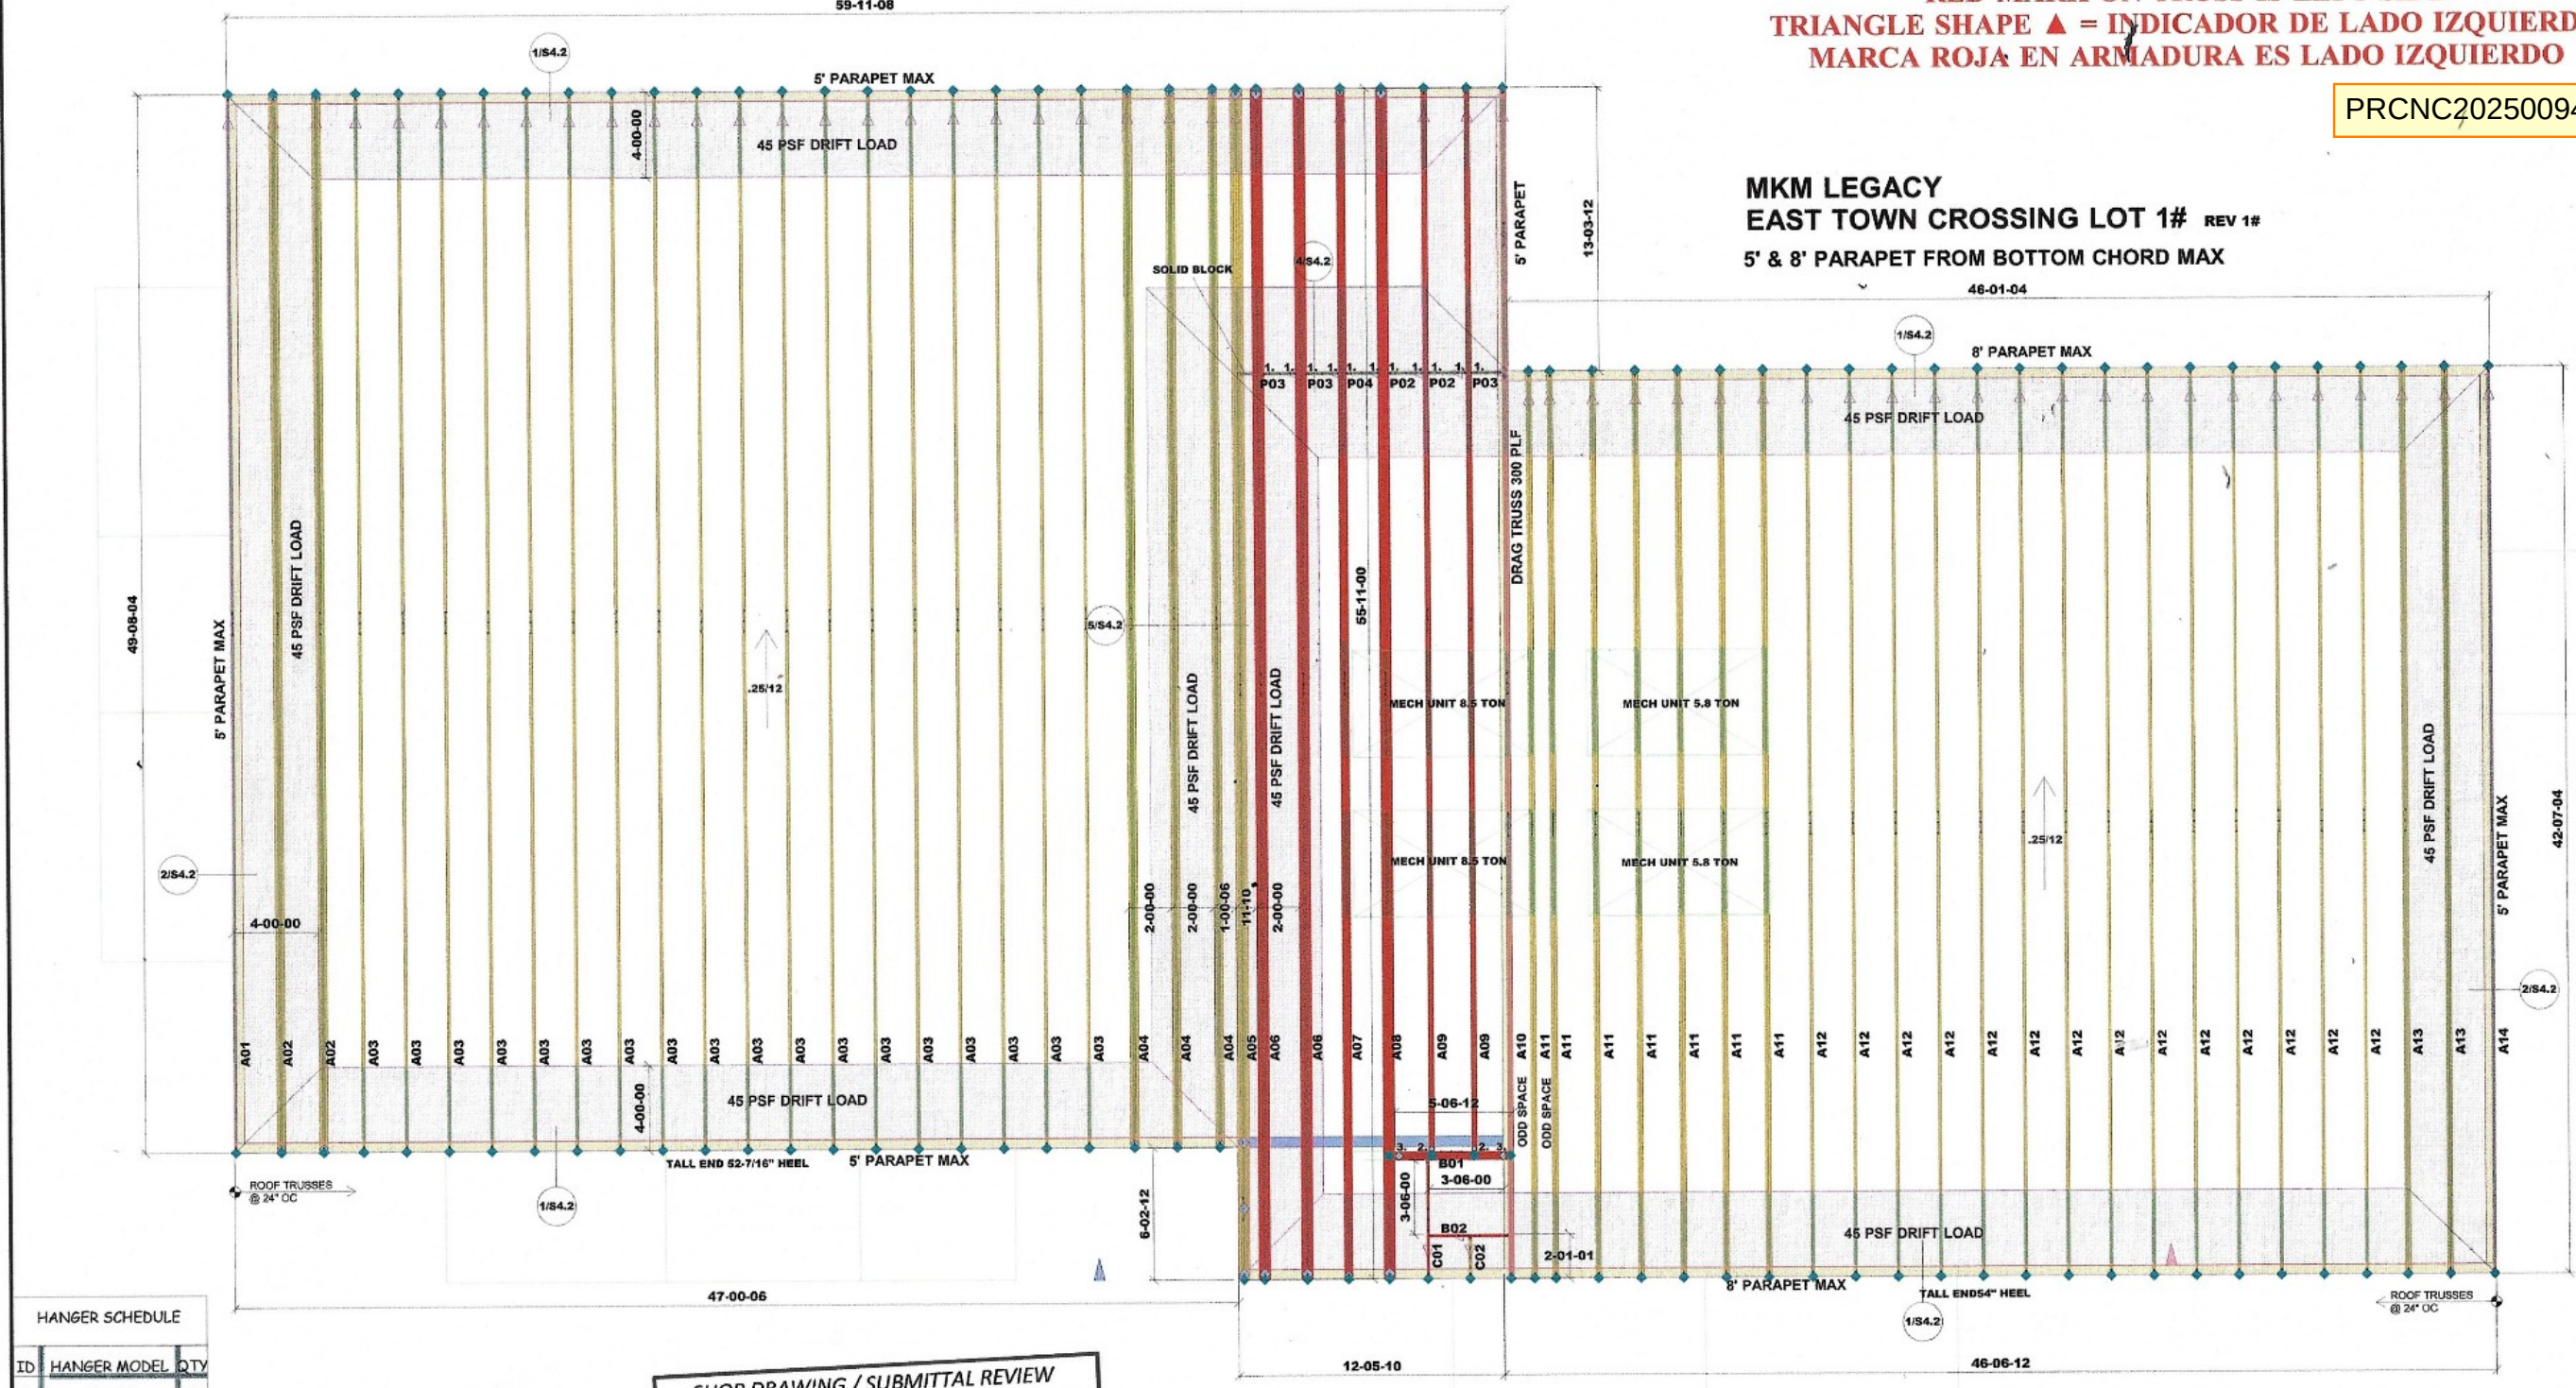

HANGER SCHEDULE

ID	HANGER MODEL	QTY
1.	LUS24	11
2.	HGUS28-2	2
3.	HGUS210-3	2

BLOCKING SCHEDULE

TYPE	QTY
2x8 SOLIDS	216

SHOP DRAWING / SUBMITTAL REVIEW

☒ APPROVED ☐ APPROVED AS NOTED
☐ REVISE & RESUBMIT ☐ REJECTED
SUBMITTAL WAS REVIEWED FOR DESIGN CONFORMITY AND GENERAL CONFORMANCE TO CONTRACT DOCUMENTS ONLY. THE CONTRACTOR IS RESPONSIBLE FOR CONFIRMING AND CORRELATING DIMENSIONS AT JOBSITE FOR TOLERANCE, CLEARANCE, QUANTITIES, FABRICATION PROCESSES AND TECHNIQUES OF CONSTRUCTION, COORDINATION OF HIS WORK WITH OTHER TRADES AND FULL COMPLIANCE WITH CONTRACT DOCUMENTS

BY: CHOW PERUWATE 5/23/25
PIERUCCIONI E&C, LLC

ROOF TRUSS PLACEMENT LAYOUT

Puget Sound Market Trusses

SCALE: NTS

DATE:

SALES: DOUG F.

APPROVING/ MSA #:

4623747

DESIGNER:

JEFF C.

CITY, STATE:

PLAN & LOT

EAST TOWN CROSSING LOT 1# REV 1#

BUILDER: MKM LEGACY

PLAN: EAST TOWN CROSSING LOT 1# REV 1#

ADDRESS:

