



COVER SHEET


PUYALLUP CORPORATE PARK

A PORTION OF THE NE1/4 OF THE SW1/4 OF SEC. 26, TWP. 20 NORTH, RGE. 4 EAST, W.M. CITY OF PUYALLUP, PIERCE COUNTY, WASHINGTON RECORD DRAWING

BCE GENERAL SITE NOTES:

- 1. The contractor shall obtain and have available copies of the applicable governing agency standards at THE JOB SITE DURING THE RELATED CONSTRUCTION OPERATIONS.
- 2. CONTRACTOR SHALL ASSURE THAT ALL NECESSARY PERMITS HAVE BEEN OBTAINED PRIOR TO COMMENCING WORK.
- 3. THE CONTRACTOR SHALL BE RESPONSIBLE FOR VERIFYING THE LOCATION. DIMENSION AND DEPTH OF ALL EXISTING UTILITIES PRIOR TO CONSTRUCTION WHETHER SHOWN ON THESE PLANS OR NOT. UTILITIES OTHER THAN THOSE SHOWN MAY EXIST ON THIS SITE. ONLY THOSE UTILITIES WITH EVIDENCE OF THEIR INSTALLATION VISIBLE AT GROUND SURFACE OR SHOWN ON RECORD DRAWING PROVIDED BY OTHERS ARE SHOWN HEREON. EXISTING UNDERGROUND UTILITY LOCATIONS SHOWN ARE APPROXIMATE ONLY AND ARE SUBJECT TO A DEGREE OF UNKNOWN VARIATION. SOME UNDERGROUND LOCATIONS SHOWN HEREON MAY HAVE BEEN TAKEN FROM PUBLIC RECORDS. BARGHAUSEN CONSULTING ENGINEERS, INC. ASSUMES NO LIABILITY FOR THE ACCURACY OF PUBLIC RECORDS OR RECORDS OF OTHERS. IF CONFLICTS SHOULD OCCUR, THE CONTRACTOR SHALL CONSULT BARGHAUSEN CONSULTING ENGINEERS, INC. TO RESOLVE ALL PROBLEMS PRIOR TO PROCEEDING WITH CONSTRUCTION.
- 4. IT IS THE RESPONSIBILITY OF THE CONTRACTOR TO REVIEW ALL OF THE DRAWINGS AND SPECIFICATIONS ASSOCIATED WITH THE PROJECT WORK SCOPE PRIOR TO THE INITIATION OF CONSTRUCTION. SHOULD THE CONTRACTOR FIND A CONFLICT WITH THE DOCUMENTS RELATIVE TO THE SPECIFICATIONS OR THE RELATIVE CODES. IT IS THE CONTRACTOR'S RESPONSIBILITY TO NOTIFY THE PROJECT ENGINEER OF RECORD IN WRITING PRIOR TO THE START OF CONSTRUCTION. FAILURE BY THE CONTRACTOR TO NOTIFY THE PROJECT ENGINEER SHALL CONSTITUTE ACCEPTANCE OF FULL RESPONSIBILITY BY THE CONTRACTOR TO COMPLETE THE SCOPE OF WORK AS DEFINED BY THE DRAWINGS AND IN FULL COMPLIANCE WITH LOCAL REGULATIONS AND CODES.
- 5. IT SHALL BE THE CONTRACTOR'S RESPONSIBILITY TO NOTIFY THE APPROPRIATE UTILITIES INVOLVED PRIOR TO CONSTRUCTION.
- 6. INSPECTION OF SITE WORK WILL BE ACCOMPLISHED BY A REPRESENTATIVE OF THE GOVERNING JURISDICTION. INSPECTION OF PRIVATE FACILITIES WILL BE ACCOMPLISHED BY A REPRESENTATIVE OF THE OWNER. IT SHALL BE THE CONTRACTOR'S RESPONSIBILITY TO NOTIFY THE INSPECTOR 24 HOURS IN ADVANCE OF BACKFILLING ALL
- 7. PRIOR TO ANY CONSTRUCTION OR DEVELOPMENT ACTIVITY THE CONTRACTOR SHALL CONTACT THE AGENCY AND/OR UTILITY INSPECTION PERSONNEL AND ARRANGE ANY REQUIRED PRE-CONSTRUCTION MEETING(S). CONTRACTOR SHALL PROVIDE ONE WEEK MINIMUM ADVANCE NOTIFICATION TO OWNER, FIELD ENGINEER AND ENGINEER OF PRE-CONSTRUCTION MEETINGS.
- 8. THE CONTRACTOR IS RESPONSIBLE FOR WORKER AND SITE SAFETY AND SHALL COMPLY WITH THE LATEST OSHA STANDARDS AND REGULATIONS, OR ANY OTHER AGENCY HAVING JURISDICTION FOR EXCAVATION AND TRENCHING PROCEDURES. THE CONTRACTOR IS RESPONSIBLE FOR DETERMINING THE "MEANS AND METHODS" REQUIRED TO MEET THE INTENT AND PERFORMANCE CRITERIA OF OSHA, AS WELL AS ANY OTHER ENTITY THAT HAS JURISDICTION FOR EXCAVATION AND/OR TRENCHING PROCEDURES.
- THE CONTRACTOR SHALL BE RESPONSIBLE FOR PROVIDING ADEQUATE SAFEGUARDS, SAFETY DEVICES, PROTECTIVE EQUIPMENT. FLAGGERS, AND ANY OTHER NEEDED ACTIONS TO PROTECT THE LIFE, HEALTH, AND SAFETY OF THE PUBLIC. AND TO PROTECT PROPERTY IN CONNECTION WITH THE PERFORMANCE OF WORK COVERED BY THE CONTRACTOR, ANY WORK WITHIN THE TRAVELED RIGHT-OF-WAY THAT MAY INTERRUPT NORMAL TRAFFIC FLOW SHAI REQUIRE AT LEAST ONE FLAGGER FOR EACH LANE OF TRAFFIC AFFECTED
- 10. PROTECTIVE MEASURES SHALL BE TAKEN BY THE CONTRACTOR TO PROTECT ALL ADJACENT PUBLIC AND PRIVATE PROPERTIES AT ALL TIMES DURING CONSTRUCTION. THE CONTRACTOR SHALL BE RESPONSIBLE FOR PROTECTION OF ALL EXISTING UTILITY SERVICES THAT ARE TO REMAIN OPERATIONAL WITHIN THE CONSTRUCTION AREA WHETHER SHOWN OR NOT SHOWN ON THE PLANS.
- 11. TWO (2) COPIES OF THESE APPROVED PLANS MUST BE ON THE JOB SITE WHENEVER CONSTRUCTION IS IN PROGRESS. ONE (1) SET WITH RECORDS OF AS-BUILT INFORMATION SHALL BE SUBMITTED TO BARGHAUSEN CONSULTING ENGINEERS, INC. AT COMPLETION OF PROJECT.
- 12. CONTRACTOR SHALL OBTAIN SERVICES OF A LICENSED LAND SURVEYOR TO STAKE HORIZONTAL CONTROL FOR ALL NEW IMPROVEMENTS. STAKING CONTROL SHALL BE TAKEN FROM ELECTRONIC PLAN FILES PROVIDED BY BARGHAUSEN
- 13. CONTRACTOR SHALL REQUEST FROM BARGHAUSEN CONSULTING ENGINEERS, INC., PRIOR TO ANY CONSTRUCTION STAKING OR CONSTRUCTION WORK, A FORMAL CONSTRUCTION RELEASE PLAN SET OR SPECIFIC RELEASE IN WRITING. THE APPROVED AGENCY PERMIT DRAWINGS WILL NOT BE CONSIDERED CONSTRUCTION RELEASE PLANS BY BARGHAUSEN CONSULTING ENGINEERS, INC. UNLESS BARGHAUSEN CONSULTING ENGINEERS, INC. HAS GIVEN A FORMAL WRITTEN RELEASE OR ISSUED A CONSTRUCTION RELEASE PLAN SET.

	LEGEND:	
SURVEY MONUMENT	PROPOSED TYPE II CATCH BASIN	
EX. POWER VAULT	PROPOSED TYPE I CATCH BASIN	VELASQUEZ RICK ET. AL. 2401 INTER LLC
EX. LUMINAIRE (LUM.)	PROPOSED STORM DRAIN FLOW ARROW	APN.2105200140 APN.2105200150
EX. LOT LIGHT	PROPOSED STORM DRAINAGE LINE	i
EX. POWER POLE	PROPOSED TRENCH DRAIN	
EX. TOWER TOLE	PROPOSED SANITARY SEWER LINE	SOILS REPORT NOTES:
EX. JUNCTION BOX	PROPOSED SANITARY SEWER CLEANOUT -	
EX. CATCH BASIN (CB)	PROPOSED WATERMAIN	THE FOLLOWING SOILS REPORT FOR THE SITE SHALL BE CONSIDERED PART OF THESE CONSTRUCTION DOCUMENTS:
EX. CATCH BASIN (CB) TYPE 2	PROPOSED FIRE HYDRANT	SOILS REPORT: GEOTECHNICAL REPORT
EX. SANITARY SEWER MANHOLE (SSMH)	PROPOSED WATER VALVE ————	SOILS REPORT: GEOTECHNICAL REPORT PROJECT NUMBER: T-8222 DATE: APRIL 6, 2020
EX. GAS METER	PROPOSED CONCRETE BLOCKING	PREPARED BY: TERRA ASSOCIATES, INC.
EX. GAS VALVE	PROPOSED 90° BEND	12220 113TH AVENUE NE
EX. WATER VALVE (WV)	PROPOSED SPOT ELEVATIONS 23.20	KIRKLAND, WA 98034 (425) 821-7777
EX. FIRE HYDRANT (FH)	1	2. IT SHALL BE THE RESPONSIBILITY OF THE CONTRACTOR TO ENSURE THAT
MAIL BOX	EXISTING SPOT ELEVATIONS	ALL PROVISIONS OF THE SOILS REPORT FOR THE SITE BE OBSERVED AND COMPLIED WITH DURING ALL PHASES OF THE SITE PREPARATION, GRADING
EX. WATER METER $\qquad \qquad \boxplus$	EXISTING CONTOURS	OPERATIONS, FOUNDATION, SLAB, AND PAVING CONSTRUCTION.
EX. SIGN	PROPOSED CONTOURS	3. ANY PROVISIONS OF THE SOILS REPORT WHICH CONFLICT WITH
EX. WATER LINE — -w-	- -W	INFORMATION SHOWN ELSEWHERE ON THESE DRAWINGS, OR WHICH REQUIRE FURTHER CLARIFICATION, SHALL BE BROUGHT TO THE ATTENTION OF THE
EX. SANITARY SEWER LINE ss	PROPOSED LIGHT-DUTY	ARCHITECT/ENGINEER FOR DETERMINATION.
EX. STORM DRAINAGE LINE 50	ASPHALT PAVEMENT	4. A REPRESENTATIVE OF THE SOILS ENGINEER SHALL BE AVAILABLE TO
EX. POWER UNDERGROUND P(UG)	PROPOSED HEAVY-DUTY ASPHALT PAVEMENT	OBSERVE AND APPROVE THE EARTHWORK OPERATIONS AND TO VERIFY FIELD CONDITIONS AS WORK PROCEEDS. THE SOILS ENGINEER SHALL SUBMIT FIELD REPORTS CERTIFYING THAT THE METHODS AND MATERIALS OF THE
EX. POWER OVERHEAD	PROPOSED CONCRETE	EARTHWORK OPERATIONS WERE IN ACCORDANCE WITH THE
EX. METAL FENCE ***	PAVEMENT	RECOMMENDATIONS OF THE SOILS INVESTIGATION AND THAT THE WORK WAS PERFORMED TO HIS/HER SATISFACTION.
EX. WOOD FENCE	PROPOSED GRIND AND OVERLAY	5. THE SOILS ENGINEER SHOULD BE NOTIFIED AT LEAST FIVE (5) WORKING DAYS PRIOR TO ANY SITE CLEARING OR GRADING.

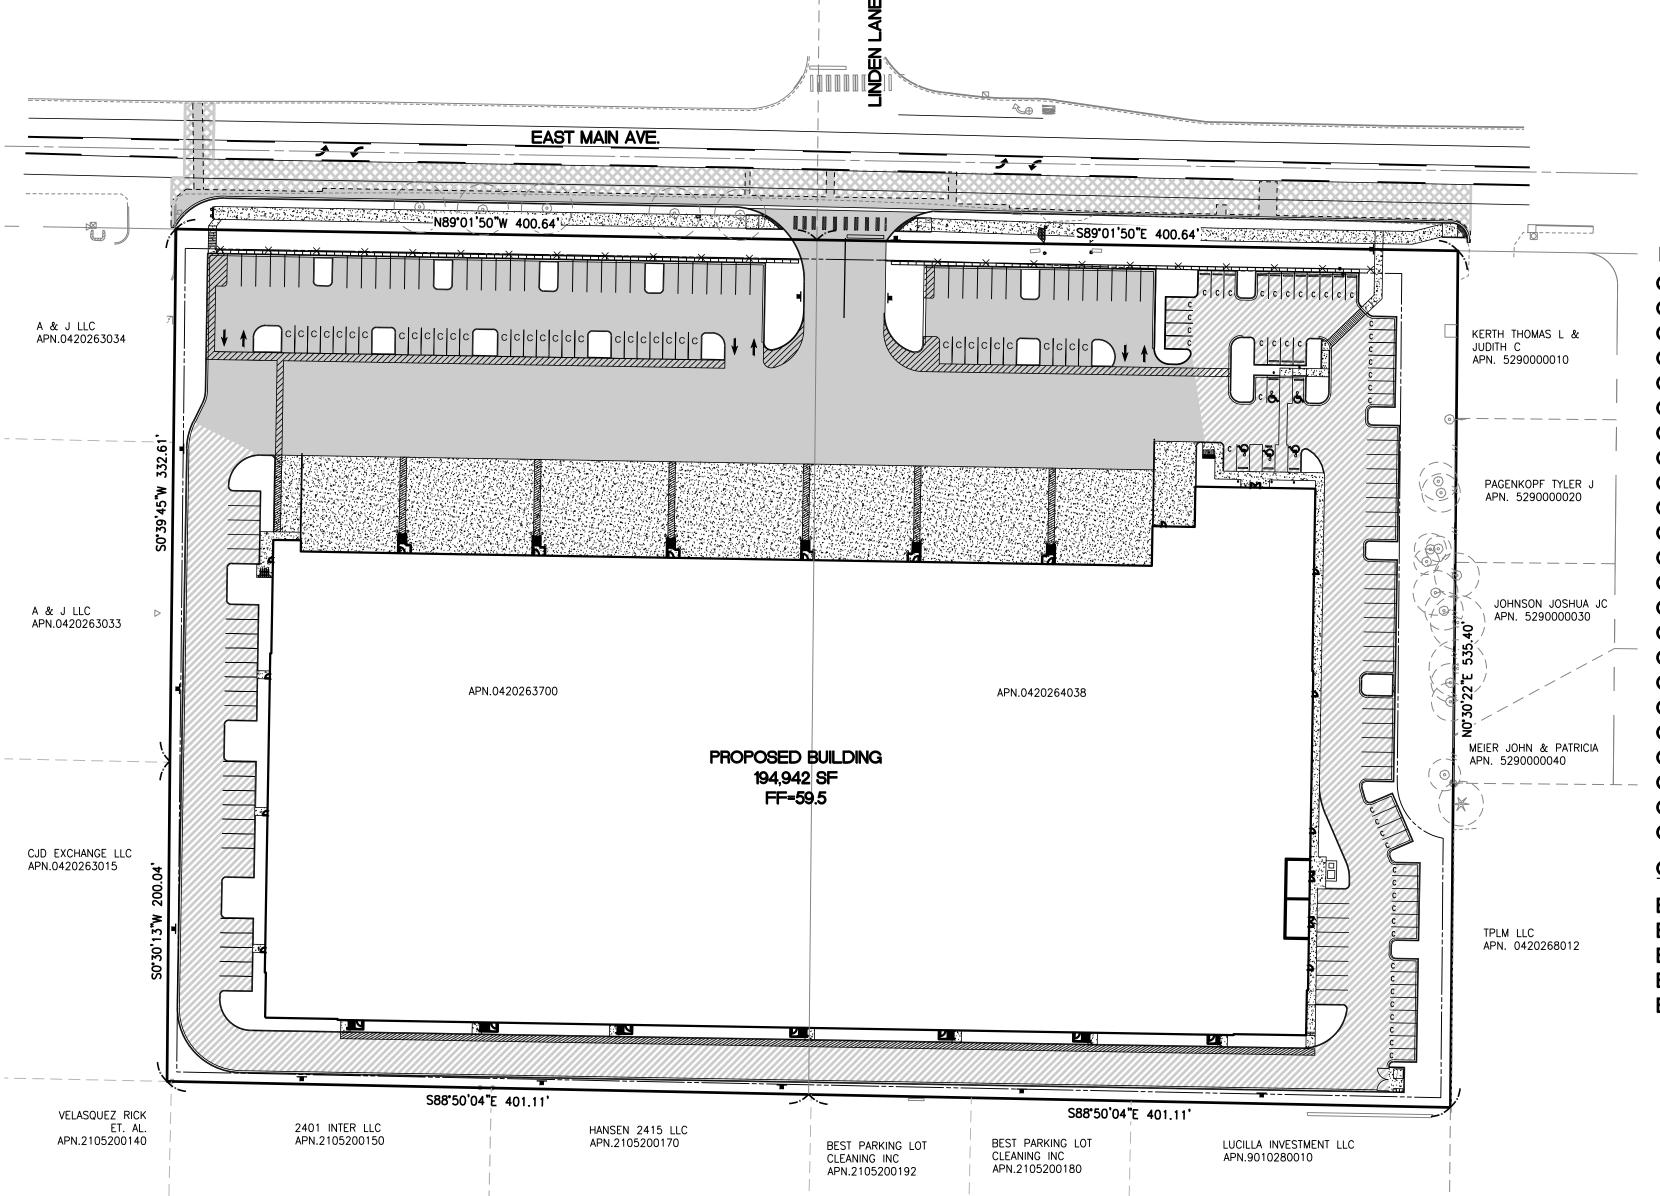

BRIDGE ST VICINITY MAP (NOT-TO-SCALE) **SURVEYOR**

DEVELOPER/OWNER PANATTONI DEVELOPMENT COMPANY, INC.

900 SW 16TH STREET, SUITE 330 RENTON, WA 98057 CONTACT: BRIAN MATTSON

ENGINEER

BARGHAUSEN CONSULTING ENGINEERS, INC. 18215 72ND AVE S KENT WA, 98032 PH: (425) 251-6222 CONTACT: BEN ELDRIDGE, P.E. EMAIL: BELDRIDGE@BARGHAUSEN.COM

BARGHAUSEN CONSULTING ENGINEERS, INC. 18215 72ND AVE S KENT WA, 98032 CONTACT: BRIAN GILLOOLY, P.L.S. EMAIL: BGILLOOLY@BARGHAUSEN.CO

TERRA ASSOCIATES, INC. 12220 113TH AVE NE, KIRKLAND, WA 98034 PH: (425) 821-7777

GEOTECHNICAL

CONTACT: CAROLYN DECKER

INDEX TO SHEETS:

COVER SHEET EXISTING CONDITIONS NOTES EXISTING CONDITIONS MAP GRADING AND DRAINAGE PLAN **GRADING PLAN - ADA ROUTES** FRONTAGE IMPROVEMENTS PLAN AND PROFILE FRONTAGE IMPROVEMENTS PLAN AND PROFILE WATER AND SANITARY SEWER PLAN CONSTRUCTION NOTES AND DETAILS DETENTION VAULT SECTIONS AND DETAILS OF 23 CHANNELIZATION PLAN

OF 23 CHANNELIZATION PLAN SIGHT DISTANCE EXHIBIT INGRESS TRUCK TURN EXHIBIT

EGRESS TRUCK TURN EXHIBIT FIRE TRUCK TURN EXHIBIT OF 23 FIRE LANE AND STRIPING PLAN

GRADE AND FILL SHEETS (SEE PERMIT E-20-0302):

OF 5 GRADE, FILL, AND T.E.S.C. COVER SHEET

OF 5 GRADE, FILL, AND T.E.S.C. PLAN GRADE, FILL, AND T.E.S.C. NOTES AND DETAILS GRADE, FILL, AND T.E.S.C. NOTES AND DETAILS


GRADE, FILL, AND T.E.S.C. SECTIONS

PANA 900 SV

CO.

LOPMENT (ET, SUITE A 98057

OVER

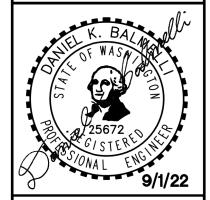



APPROVED

NOTE: THIS APPROVAL IS VOID AFTER 1 AND/OR OMISSIONS ON THESE FIELD CONDITIONS MAY DICTATE CHANGES TO THESE PLANS AS

CITY OF PUYALLUP ENGINEERING SERVICES

SITE PLAN HAS BEEN PROVIDED BY NELSON WORLDWIDE. BARGHAUSEN CONSULTING

ENGINEERS, INC. HAS NOT VERIFIED THE ACCURACY OF THE SITE PLAN.

LOT COVERAGE SUMMARY

BUILDINGS: 194,942 S.F. = 4.48 AC (46.52%) 176,320 S.F. = 4.05 AC (38.98%) ASPHALT/CONCRETE: LANDSCAPE / UNDISTURBED: 56,270 S.F. = 1,29 AC (14,50%) 427,532 S.F. = 9.82 AC (100%)

UTILITY CONFLICT NOTE:

SITE PLAN NOTE:

CAUTION:

ESTIMATED EARTH WORK QUANTITIES

EARTHWORK QUANTITIES ARE FOR PERMITTING PURPOSES ONLY AND

SHALL NOT BE USED FOR BIDDING PURPOSES. CONTRACTOR SHALL

PERFORM AN INDEPENDENT ANALYSIS FOR THE PURPOSES OF

CUT = 10,500 CUBIC YARDS

FILL = 16,500 CUBIC YARDS

PREPARING THEIR BID.

PRELOAD = 16,000 CUBIC YARDS

NET IMPORT/EXPORT = 27,000 CUBIC YARDS (IMPORT)

OF ALL EXISTING UTILITIES WHETHER SHOWN ON THESE PLANS OR NOT BY POTHOLING THE UTILITIES AND SURVEYING THE HORIZONTAL AND VERTICAL LOCATION PRIOR TO CONSTRUCTION. THIS SHALL INCLUDE CALLING UTILITY LOCATE @ 811 AND THEN POTHOLING ALL OF THE EXISTING UTILITIES AT LOCATIONS OF NEW UTILITY CROSSINGS TO PHYSICALLY VERIFY WHETHER OR NOT CONFLICTS EXIST. LOCATIONS OF SAID UTILITIES AS SHOWN ON THESE PLANS ARE BASED UPON THE UNVERIFIED PUBLIC INFORMATION AND ARE SUBJECT TO VARIATION. IF CONFLICTS SHOULD OCCUR, THE CONTRACTOR SHALL CONSULT BARGHAUSEN CONSULTING ENGINEERS. INC. TO RESOLVE ALL PROBLEMS PRIOR TO PROCEEDING WITH

THE CONTRACTOR SHALL BE RESPONSIBLE FOR VERIFYING THE LOCATION, DIMENSION, AND DEPTH

OLYMPIA, WASHINGTON 98504-7060 UPON COMPLETION OF CONSTRUCTION, ALL MONUMENTS DISPLACED, REMOVED, OR DESTROYED SHALL BE REPLACED BY A REGISTERED LAND SURVEYOR, AT THE COST AND AT THE DIRECTION OF THE CONTRACTOR, PURSUANT TO THESE REGULATIONS. THE APPROPRIATE FORMS FOR REPLACEMENT OF SAID MONUMENTATION SHALL ALSO BE THE RESPONSIBILITY OF THE CONTRACTOR.

CONTRACTOR SHALL BE FULLY RESPONSIBLE FOR OBTAINING PERMITS FROM THE

REPLACING ALL SURVEY MONUMENTATION THAT MAY BE AFFECTED BY CONSTRUCTION

ACTIVITY, PURSUANT TO WAC 332-120. APPLICATIONS MUST BE COMPLETED BY A

REGISTERED LAND SURVEYOR. APPLICATIONS FOR PERMITS TO REMOVE MONUMENTS

RESOURCES, OR BY CONTACTING THEIR OFFICE BY TELEPHONE AT (206) 902-1190.

WASHINGTON STATE DEPARTMENT OF NATURAL RESOURCES FOR REMOVING AND

MAY BE OBTAINED FROM THE WASHINGTON STATE DEPARTMENT OF NATURAL

WASHINGTON STATE DEPARTMENT OF NATURAL RESOURCES

PUBLIC LAND SURVEY OFFICE

1111 WASHINGTON STREET S.E.

P.O. BOX 47060

YEAR FROM APPROVAL DATE. THE CITY WILL NOT BE RESPONSIBLE FOR ERRORS DETERMINED BY THE ENGINEERING SERVICES MANAGER.



EXISTING CONDITIONS NOTES

FOR

PUYALLUP CORPORATE PARK

A PORTION OF THE NE1/4 OF THE SW1/4 OF SEC. 26, TWP. 20 NORTH, RGE. 4 EAST, W.M. CITY OF PUYALLUP, PIERCE COUNTY, WASHINGTON

RECORD DRAWING

SURVEY INFORMATION:

HORIZONTAL DATUM: BASIS OF BEARING:

NAD 83/91 SOUTH 62°15'02" EAST BETWEEN PIERCE COUNTY CONTROL MONUMENT NO. 406, BEING A BRASS MONUMENT WITH STAMPED "X" IN THE PARKING LOT OF THE BUSINESS AT 1618 E. MAIN CITY OF PUYALLUP & PIERCE COUNTY CONTROL MONUMENT NO. 86, BEING A STONE MONUMENT WITH CHISELED "X" 2 FT. BELOW GRADE ON THE EAST SHOULDER OF PIONEER WAY.

HELD THE RECORD ELEVATION LIST FOR THE PIERCE COUNTY CONTROL NO.406 HAVING A RECORD ELEVATION OF 42.50 FEET

DATUM CONVERSION FORMULA: NAVD88 = NGVD29 + 3.491'

DATES OF SURVEY:

FIELD SURVEY BY BARGHAUSEN CONSULTING ENGINEERS, INC. CONDUCTED IN APRIL 2019. ALL MONUMENTS SHOWN AS FOUND WERE VISITED AT THAT TIME, UNLESS OTHERWISE NOTED.

PROCEDURE / NARRATIVE:

A FIELD TRAVERSE USING A TOPCON GT ROBOTIC TOTAL STATION, A TOPCON GR-5 GPS, AND A TOPCON FC500 DATA COLLECTOR WITH MAGNET SOFWATER WAS PERFORMED. ESTABLISHING THE ANGULAR AND DISTANCE RELATIONSHIPS BETWEEN THE MONUMENTS. PROPERTY LINES AND IMPROVEMENTS. THE RESULTING DATA MEETS OR EXCEEDS THE STANDARDS FOR LAND BOUNDARY SURVEYS AS SET FORTH IN WAC 332-130-090.

TAX PARCEL NUMBER(S): APN.042026-370-0

APN.042026-403-8

XXXX E. MAIN ST., PUYALLUP, WA 98372

FLOOD ZONE: SITE LIES WITHIN "FLOOD ZONE X - UNSHADED", PER FEMA FIRM MAP NUMBER 53053C0334E, MAP PANEL 334 OF 1375, FOR PIERCE COUNTY, WASHINGTON, AND INCORPORATED AREAS.

"FLOOD ZONE X - UNSHADED" ARE "AREAS DETERMINED TO BE OUTSIDE THE 0.2% ANNUAL CHANCE FLOODPLAIN, PER THE LEGEND ON SAID FEMA

GROSS LAND AREA:

FIRM MAP PANEL.

428,227± S.F. (9.831± AC.)

SURVEYOR'S NOTES: 1. ALL MEASUREMENTS ARE IN U.S. SURVEY FEET. 2. NO BUILDINGS ON SITE

3. NO STRIPED PARKING ON SITE 4. THERE IS NO EVIDENCE OF RECENT EARTH MOVING WORK, BUILDING CONSTRUCTION, OR BUILDING ADDITIONS OBSERVED IN THE PROCESS OF CONDUCTING THE FIFI DWORK 5. THERE IS NO EVIDENCE OF A FIELD DELINEATION OF WETLANDS BY A QUALIFIED SPECIALIST OBSERVED IN THE PROCESS OF CONDUCTING THE FIELDWORK. NO WETLAND MARKERS WERE FOUND IN THE PROCESS OF

LEGAL DESCRIPTION:

CONDUCTING THE FIELDWORK.

(PER FIRST AMERICAN TITLE INSURANCE COMPANY COMMITMENT FILE NO. NCS-938254-WA1 DATED DECEMBER 04, 2018 AT 8:00 AM)

THE LAND REFERRED TO HEREIN BELOW IS SITUATED IN THE COUNTY OF PIERCE, STATE OF WASHINGTON, AND IS DESCRIBED AS FOLLOWS: THAT PORTION OF SECTION 26, TOWNSHIP 20 NORTH RANGE 04 EAST OF THE W.M., IN PIERCE COUNTY, WASHINGTON, DESCRIBED AS

COMMENCING AT THE NORTHEAST CORNER OF ACKERSON'S 2ND ADDITION ON THE EAST LINE OF R NIX DONATION LAND CLAIM; THENCE ON NORTH LINE OF SAID ADDITION SOUTH 89°30'20" WEST 400 FEET TO POINT OF BEGINNING: THENCE NORTH 01°09'05" WEST 1,353.45 FEET; THENCE SOUTH 89°30'20" WEST 400 FEET: THENCE SOUTH 01°09'05" EAST 1,353.45 FEET TO NORTH LINE OF THENCE NORTH 89°30'20" EAST 400 FEET TO THE POINT OF

BEGINNING. EXCEPT STATE HIGHWAY;

AND EXCEPT PROPERTY DESCRIBED IN DEED RECORDED FEBRUARY 19, 2010 UNDER RECORDING NO. 201002190078.

(PER FIRST AMERICAN TITLE INSURANCE COMPANY COMMITMENT FILE

1. ANY DEFECT, LIEN, ENCUMBRANCE, ADVERSE CLAIM, OR OTHER MATTER THAT APPEARS FOR THE FIRST TIME IN THE PUBLIC RECORDS OR IS CREATED, ATTACHES, OR IS DISCLOSED BETWEEN THE COMMITMENT DATE AND THE DATE ON WHICH ALL OF THE SCHEDULE B. PART I-REQUIREMENTS ARE MET.

NO. NCS-938254-WA1 DATED DECEMBER 04, 2018 AT 8:00 AM)

(NOT SURVEY RELATED) 2. TAXES OR ASSESSMENTS WHICH ARE NOT SHOWN AS EXISTING LIENS BY THE RECORDS OF ANY TAXING AUTHORITY THAT LEVIES TAXES OR ASSESSMENTS ON REAL PROPERTY OR BY THE PUBLIC

(NOT SURVEY RELATED)

3. ANY FACTS, RIGHTS, INTERESTS, OR CLAIMS WHICH ARE NOT SHOWN BY THE PUBLIC RECORDS BUT WHICH COULD BE ASCERTAINED BY AN INSPECTION OF THE LAND OR BY MAKING INQUIRY OF PERSONS IN POSSESSION THEREOF. (NOT SURVEY RELATED)

4. EASEMENTS, CLAIMS OF EASEMENT OR ENCUMBRANCES WHICH ARE NOT SHOWN BY THE PUBLIC RECORDS. (NOT SURVEY RELATED)

5. DISCREPANCIES, CONFLICTS IN BOUNDARY LINES, SHORTAGE IN AREA, ENCROACHMENTS, OR ANY OTHER FACTS WHICH A CORRECT SURVEY WOULD DISCLOSE, AND WHICH ARE NOT SHOWN BY THE PUBLIC RECORDS. (NOT SURVEY RELATED)

6. (A) UNPATENTED MINING CLAIMS; (B) RESERVATIONS OR EXCEPTIONS IN PATENTS OR IN ACTS AUTHORIZING THE ISSUANCE THEREOF; (C) WATER RIGHTS, CLAIMS OR TITLE TO WATER; WHETHER OR NOT THE MATTERS EXCEPTED UNDER (A), (B) OR (C) ARE SHOWN BY THE PUBLIC RECORDS; (D) INDIAN TRIBAL CODES OR REGULATIONS, INDIAN TREATY OR ABORIGINAL RIGHTS, INCLUDING EASEMENTS OR EQUITABLE SERVITUDES. (NOT SURVEY RELATED)

7. ANY LIEN, OR RIGHT TO A LIEN, FOR SERVICES, LABOR OR MATERIALS OR MEDICAL ASSISTANCE HERETOFORE OR HEREAFTER FURNISHED, IMPOSED BY LAW AND NOT SHOWN BY THE PUBLIC

(NOT SURVEY RELATED)

8. ANY SERVICE, INSTALLATION, CONNECTION, MAINTENANCE, CONSTRUCTION. TAP OR REIMBURSEMENT CHARGES/COSTS FOR SEWER, WATER, GARBAGE OR ELECTRICITY. (NOT SURVEY RELATED)

9. LIEN OF THE REAL ESTATE EXCISE SALES TAX AND SURCHARGE UPON ANY SALE OF SAID PREMISES, IF UNPAID. AS OF THE DATE HEREIN, THE EXCISE TAX RATE FOR THE CITY OF PUYALLUP IS AT

LEVY/AREA CODE: 096 FOR ALL TRANSACTIONS RECORDED ON OR AFTER JULY 1, 2005: ·A FEE OF \$10.00 WILL BE CHARGED ON ALL EXEMPT TRANSACTIONS; • A FEE OF \$5.00 WILL BE CHARGED ON ALL TAXABLE TRANSACTIONS IN ADDITION TO THE EXCISE TAX DUE. (NOT SURVEY RELATED)

10. POTENTIAL CHARGES. FOR THE KING COUNTY SEWAGE TREATMENT CAPACITY CHARGE, AS AUTHORIZED UNDER RCW 35.58 AND KING COUNTY CODE 28.84.050. SAID CHARGES COULD APPLY FOR ANY PROPERTY THAT CONNECTED TO THE KING COUNTY SEWER SERVICE AREA ON OR AFTER FEBRUARY 1, 1990. NOTE: PROPERTIES LOCATED IN SNOHOMISH COUNTY AND PIERCE COUNTY MAY BE SUBJECT TO THE KING COUNTY SEWAGE TREATMENT CAPACITY CHARGES. TO VERIFY CHARGES CONTACT: (206) 296-1450 OR CAPCHARGEESCROW@KINGCOUNTY.GOV. (NOT SURVEY RELATED)

11. THE EFFECT OF A DOCUMENT ENTITLED "PERSONAL REPRESENTATIVE'S DEED", RECORDED AUGUST 10, 2007 AS RECORDING NO. 200708100174 OF OFFICIAL RECORDS. SAID DOCUMENT CONTAINS AN ERRONEOUS LEGAL DESCRIPTION. (NOT SURVEY RELATED)

12. TERMS AND CONDITIONS OF THE PAUL F. NIX CREDIT TRUST, UNDER WHICH TITLE IS VESTED. A COPY OF THE TRUST AGREEMENT AND ALL AMENDMENTS SHOULD BE SUBMITTED PRIOR TO CLOSING. (NOT SURVEY RELATED)

13. EVIDENCE OF THE AUTHORITY OF THE INDIVIDUAL(S) TO EXECUTE THE FORTHCOMING DOCUMENT FOR PDC SEATTLE LPIV, LLC, A DELAWARE LIMITED LIABILITY COMPANY. COPIES OF THE CURRENT OPERATING AGREEMENT SHOULD BE SUBMITTED PRIOR TO CLOSING. (NOT SURVEY RELATED)

14. ANY CLAIM THAT THE TITLE IS SUBJECT TO A TRUST OR LIEN CREATED UNDER THE PERISHABLE AGRICULTURAL COMMODITIES ACT, 1930 (7 U.S.C. §§499A, ET SEQ.) OR THE PACKERS AND STOCKYARDS ACT (7 U.S.C. §§181 ET SEQ.) OR UNDER SIMILAR STATE LAWS. (NOT SURVEY RELATED)

15. MATTERS OF EXTENDED OWNER/PURCHASER COVERAGE WHICH ARE DEPENDENT UPON AN INSPECTION AND AN ALTA SURVEY OF THE PROPERTY FOR DETERMINATION OF INSURABILITY. PLEASE SUBMIT A COPY OF THE ALTA SURVEY AT YOUR EARLIEST CONVENIENCE FOR REVIEW. OUR INSPECTION WILL BE HELD PENDING OUR REVIEW OF THE ALTA SURVEY AND THE RESULT OF SAID INSPECTION WILL BE FURNISHED BY SUPPLEMENTAL REPORT. (NOT SURVEY RELATED)

16. UNRECORDED LEASEHOLDS, IF ANY, RIGHTS OF VENDORS AND SECURITY AGREEMENT ON PERSONAL PROPERTY AND RIGHTS OF TENANTS, AND SECURED PARTIES TO REMOVE TRADE FIXTURES AT THE EXPIRATION OF THE TERM. (NOT SURVEY RELATED)

17. PRIOR TO ISSUANCE OF AN EXTENDED COVERAGE POLICY. THE COMPANY WILL REQUIRE AN OWNER'S AFFIDAVIT BE COMPLETED AND SUBMITTED TO THE COMPANY FOR APPROVAL PRIOR TO CLOSING. THE COMPANY RESERVES THE RIGHT TO MAKE ANY ADDITIONAL REQUIREMENT AS WARRANTED.

(NOT SURVEY RELATED)

EAST W.M., IN PIERCE COUNTY,

ASSIGNEE: HERITAGE BANK

LEGAL DESCRIPTION: (PER FIRST AMERICAN TITLE INSURANCE COMPANY COMMITMENT NO. NCS-976964-WA1, DATED AUGUST 20, 2019 AT 8:00 AM)

THAT PORTION OF THE FOLLOWING DESCRIBED PROPERTY LYING SOUTH OF THE SOUTH LINE OF STATE HIGHWAY

BEGINNING AT THE NORTHEAST CORNER OF ACKERSON'S SECOND ADDITION ON THE EAST LINE OF THE R. NIX DONATION LAND CLAIM IN SECTION 26, TOWNSHIP 20 NORTH, RANGE 4

THENCE ON THE NORTH LINE OF SAID ADDITION SOUTH 89'30'20" WEST THENCE PARALLEL TO SAID EAST LINE OF CLAIM NORTH 1'09'05" WEST

1353.45 FEET; THENCE NORTH 89°30'20" EAST 20 FEET; THENCE SOUTH 1'09'05" EAST 137 FEET;

THENCE NORTH 89'30'20" EAST 380 FEET TO SAID EAST LINE OF CLAIM; THENCE SOUTH 1'09'05" EAST 1216.45 FEET TO POINT OF BEGINNING.

(PER FIRST AMERICAN TITLE INSURANCE COMPANY COMMITMENT NO.

NCS-976964-WA1, DATED AUGUST 20, 2019 AT 8:00 AM) ITEMS 1 THROUGH 12 ARE NOT SURVEY RELATED.

13. ASSIGNMENT OF LEASES AND/OR RENTS AND THE TERMS AND CONDITIONS THEREOF: ASSIGNOR: TPLM, LLC AND/OR ASSIGNS


RECORDED: JANUARY 23, 2015 RECORDING INFORMATION: 201501230207 THE EFFECT OF A DOCUMENT ENTITLED "RELEASE OF ASSIGNMENT OF LEASES AND RENTS", RECORDED APRIL 30, 2018 AS RECORDING NO. 201804300358 OF OFFICIAL RECORDS. (NOT PLOTTABLE, DOCUMENT GRANTS BLANKET ACCESS TO COLLECT AND RECEIVE RENTS AND TO MAINTAIN THE PROPERTY.)

14. EVIDENCE OF THE AUTHORITY OF THE INDIVIDUAL(S) TO EXECUTE THE FORTHCOMING DOCUMENT FOR TPLM, LLC, A WASHINGTON LIMITED LIABILITY COMPANY, COPIES OF THE CURRENT OPERATING AGREEMENT SHOULD BE SUBMITTED PRIOR TO CLOSING.

15. EVIDENCE OF THE AUTHORITY OF THE INDIVIDUAL(S) TO EXECUTE THE FORTHCOMING DOCUMENT FOR PDC SEATTLE LPIV BB/TH, LLC, A DELAWARE LIMITED LIABILITY COMPANY, COPIES OF THE CURRENT OPERATING AGREEMENT SHOULD BE SUBMITTED PRIOR TO CLOSING.

16. UNRECORDED LEASEHOLDS, IF ANY, RIGHTS OF VENDORS AND SECURITY AGREEMENT ON PERSONAL PROPERTY AND RIGHTS OF TENANTS AND SECURED PARTIES TO REMOVE TRADE FIXTURES AT THE EXPIRATION


17. PRIOR TO ISSUANCE OF AN EXTENDED COVERAGE POLICY, THE COMPANY WILL REQUIRE AN OWNER'S AFFIDAVIT BE COMPLETED AND SUBMITTED TO THE COMPANY FOR APPROVAL PRIOR TO CLOSING. THE COMPANY RESERVES THE RIGHT TO MAKE ANY ADDITIONAL REQUIREMENT AS WARRANTED.

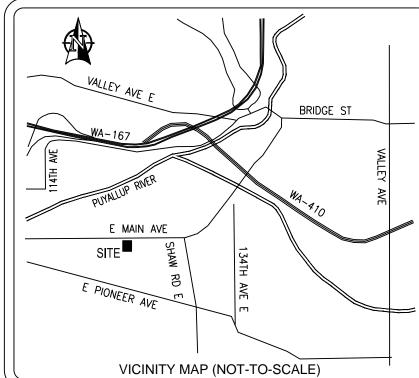

CONDI TING

> CO. LOPMENT (EET, SUITE /A 98057 TONI DEVELO 1 16TH STREE RENTON. WA PANATT 900 SW 1 RI

FO OR

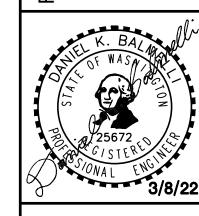

n Engin Barghauser Consulting

APPROVED


CITY OF PUYALLUP ENGINEERING SERVICES


NOTE: THIS APPROVAL IS VOID AFTER 1 YEAR FROM APPROVAL DATE. THE CITY WILL NOT BE RESPONSIBLE FOR ERRORS AND/OR OMISSIONS ON THESE FIELD CONDITIONS MAY DICTATE

CHANGES TO THESE PLANS AS

ENGINEERING SERVICES MANAGER.

DETERMINED BY THE

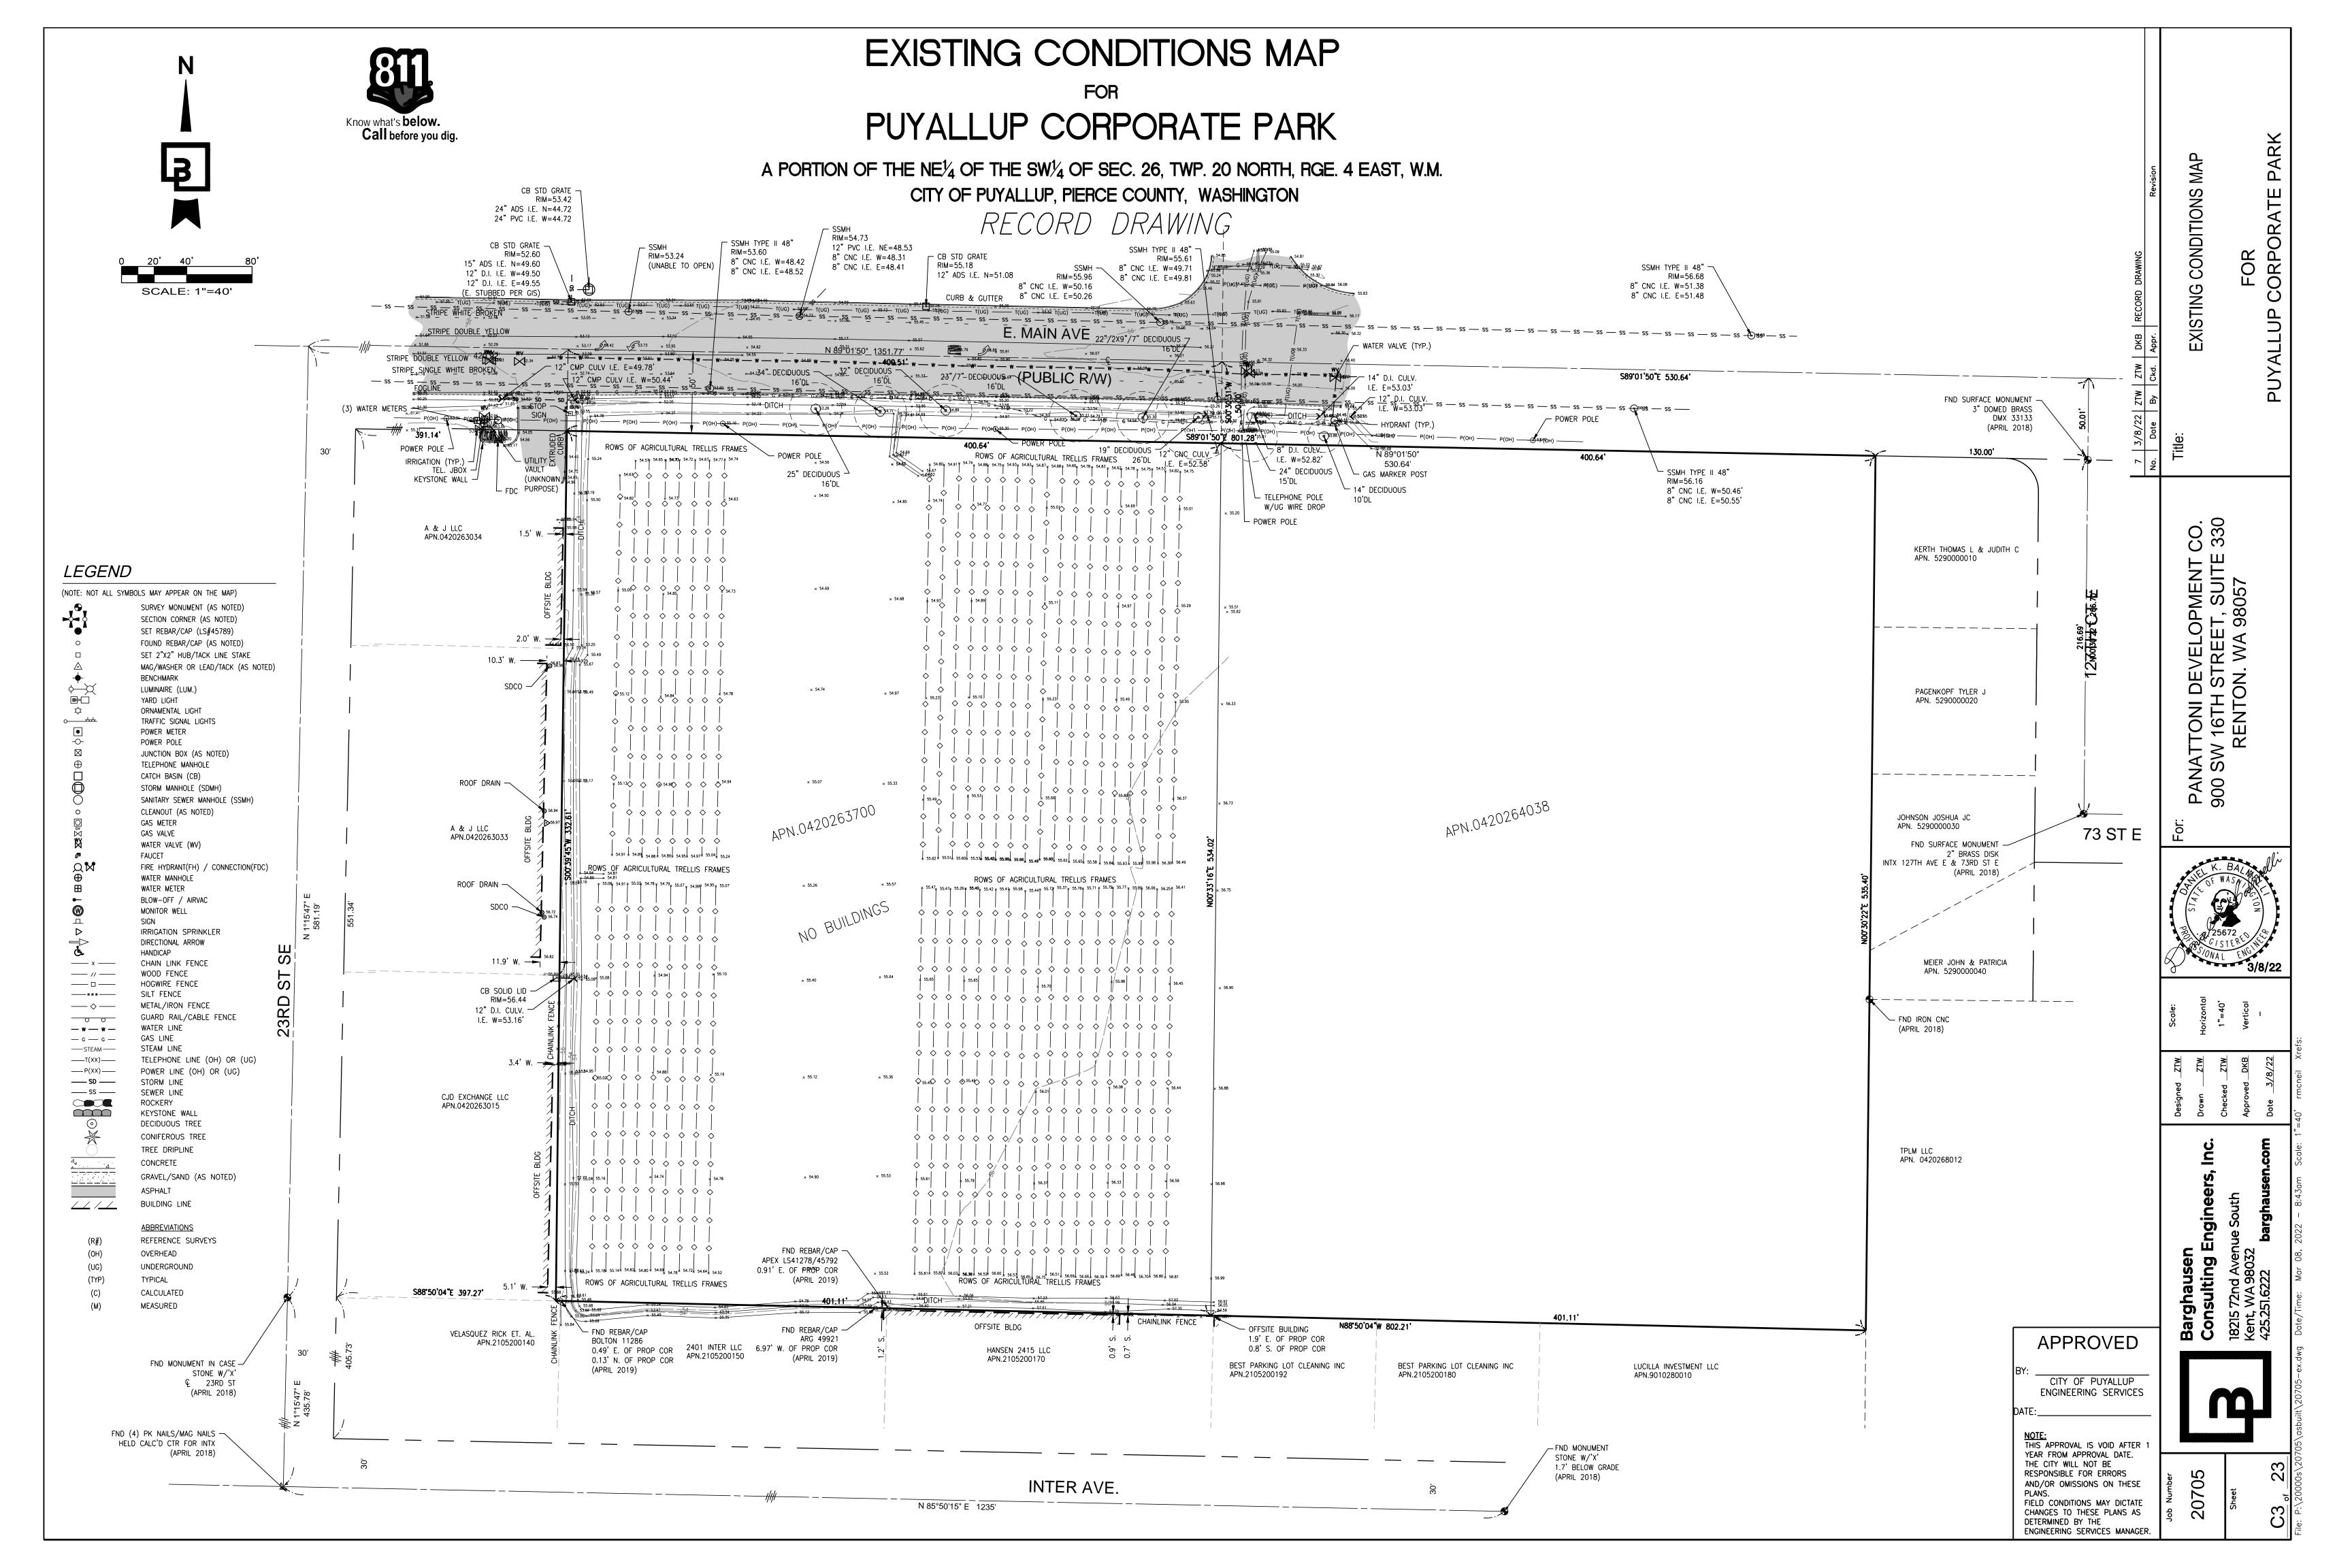

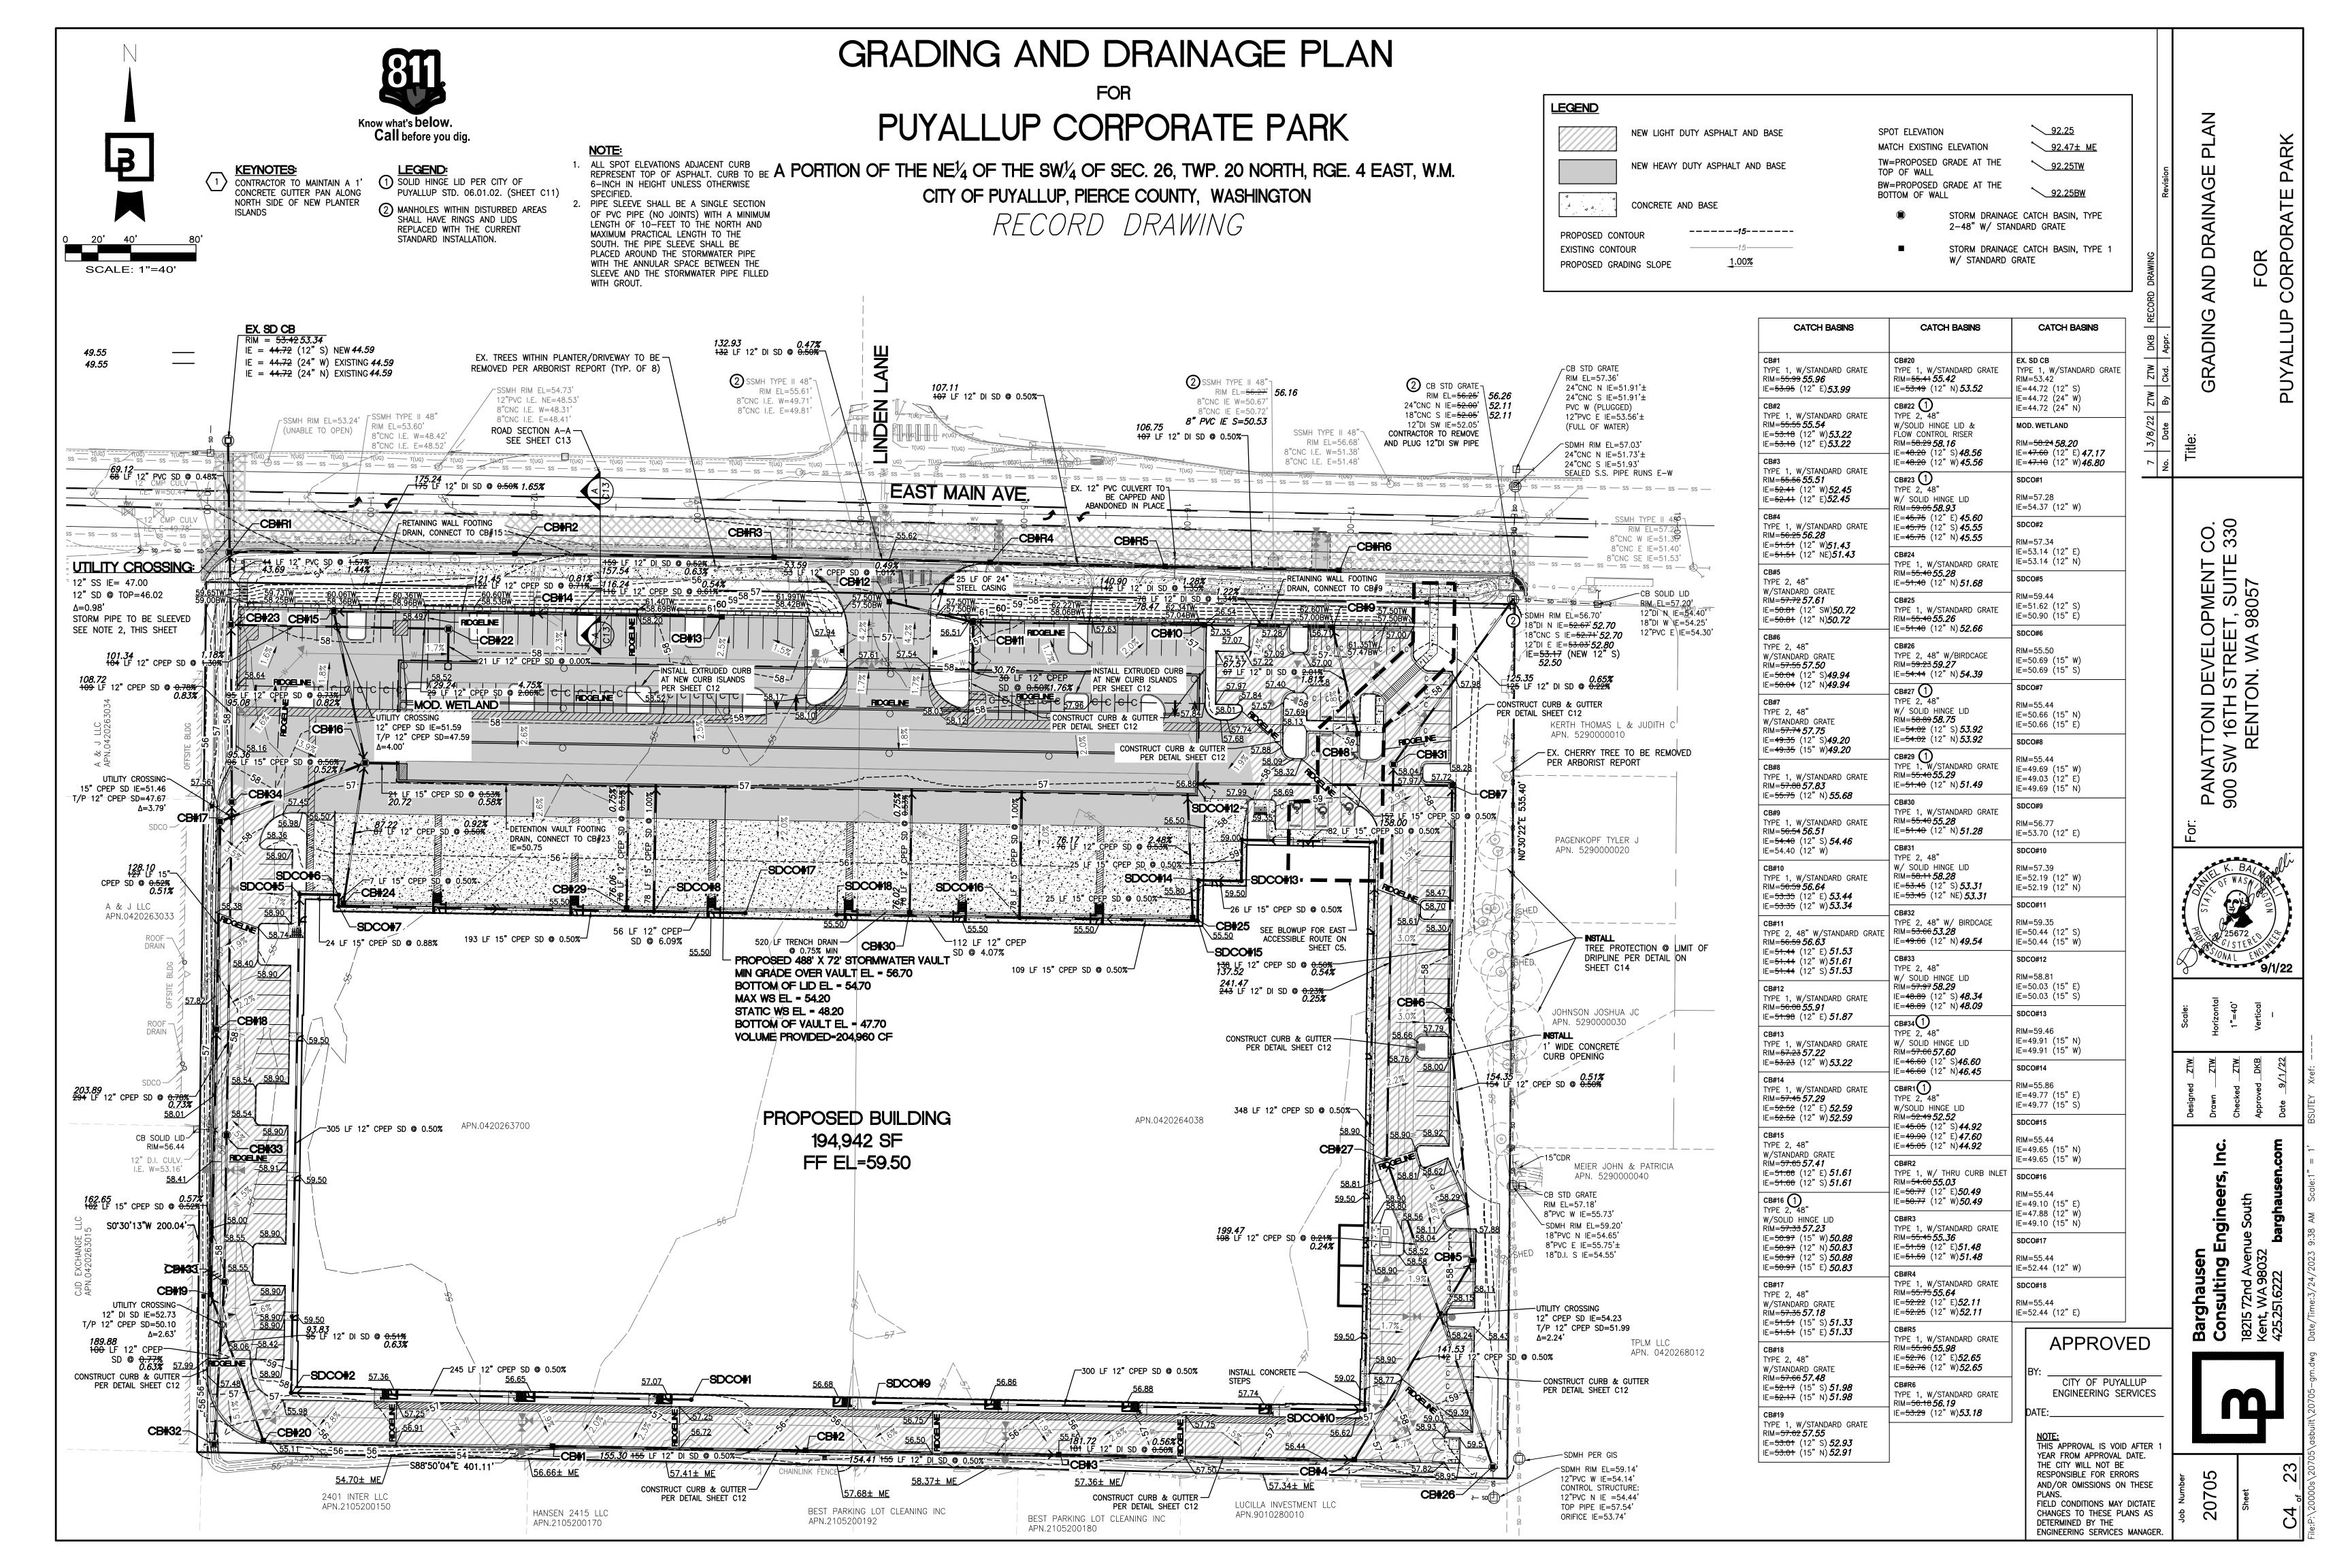





GRADING PLAN - ADA ROUTES

PUYALLUP CORPORATE PARK

A PORTION OF THE NE $\frac{1}{4}$ OF THE SW $\frac{1}{4}$ OF SEC. 26, TWP. 20 NORTH, RGE. 4 EAST, W.M. CITY OF PUYALLUP, PIERCE COUNTY, WASHINGTON

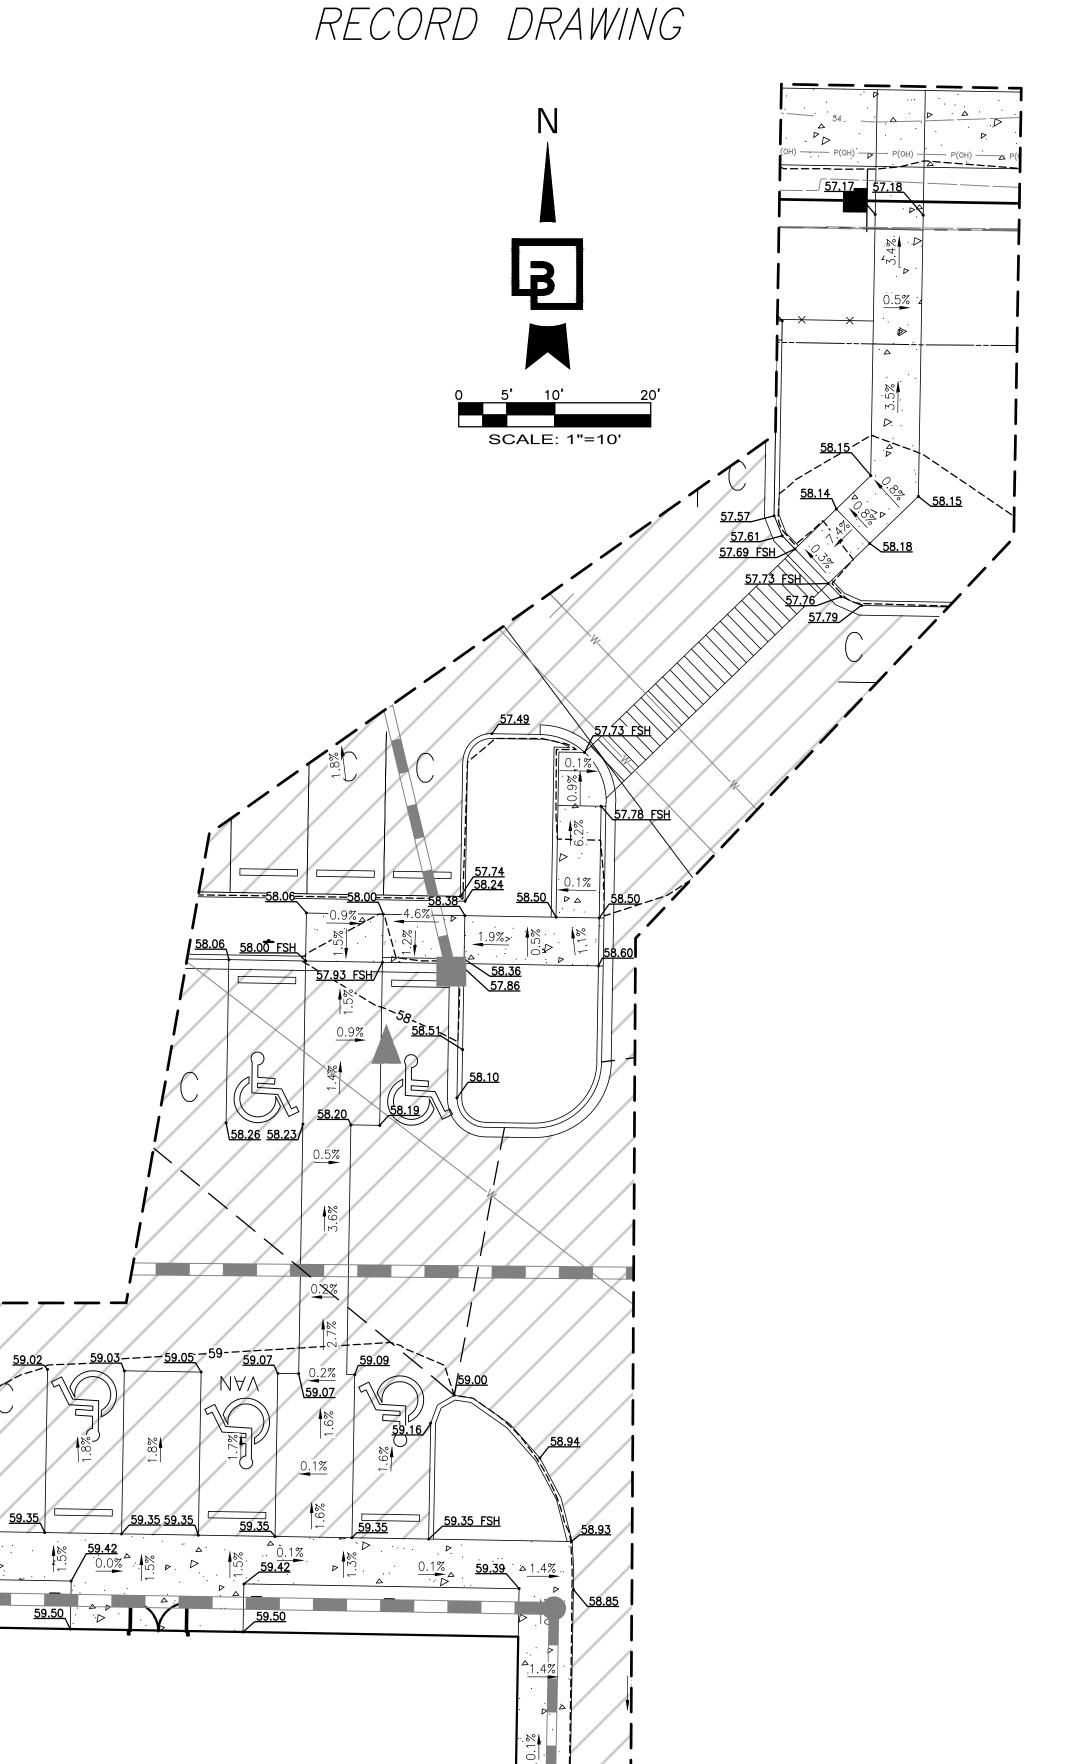


1 EAST ACCESSIBLE ROUTE
C5 SCALE: 1"=10"

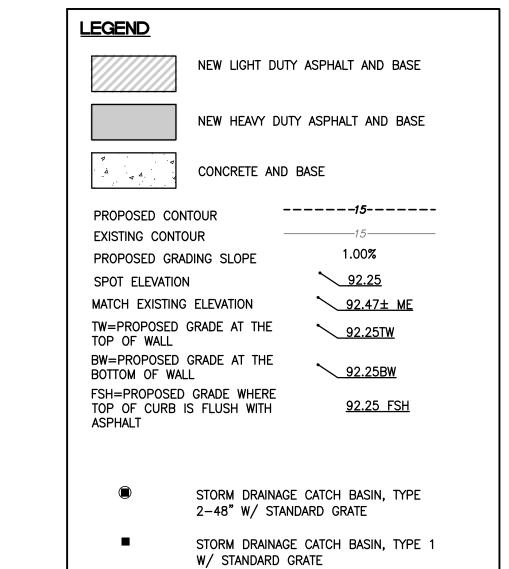

7 3/8/22 ZTW ZTW DKB RE lo. Date By Ckd. Appr. PANATTONI DEVELOPMENT CO. 900 SW 16TH STREET, SUITE 330 RENTON. WA 98057

ADA

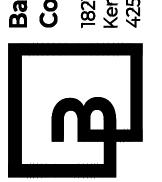

20705

NOTE: THIS APPROVAL IS VOID AFTER 1 YEAR FROM APPROVAL DATE. THE CITY WILL NOT BE RESPONSIBLE FOR ERRORS AND/OR OMISSIONS ON THESE FIELD CONDITIONS MAY DICTATE CHANGES TO THESE PLANS AS DETERMINED BY THE ENGINEERING SERVICES MANAGER.

APPROVED


CITY OF PUYALLUP ENGINEERING SERVICES



FRONTAGE IMPROVEMENTS PLAN AND PROFILE


PUYALLUP CORPORATE PARK

A PORTION OF THE NE $\frac{1}{4}$ OF THE SW $\frac{1}{4}$ OF SEC. 26, TWP. 20 NORTH, RGE. 4 EAST, W.M.

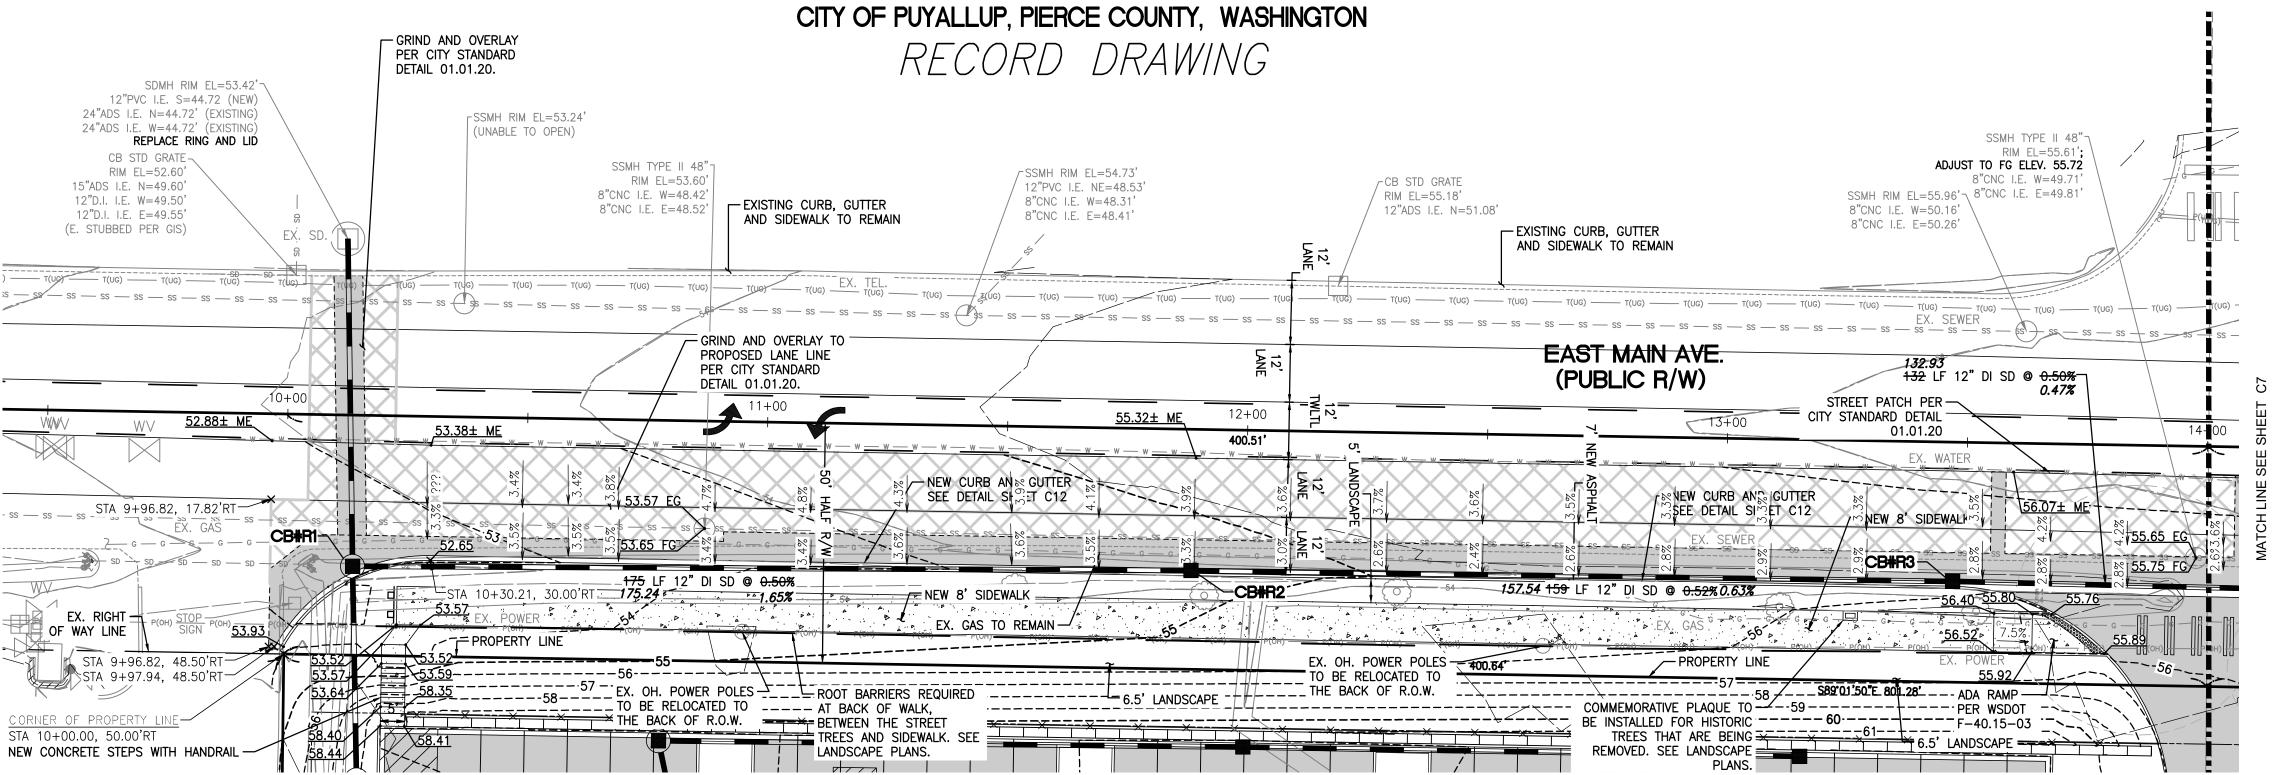

EAST MAIN AVE PLAN VIEW STA 9+50 TO 14+00

SCALE: 1"=20'

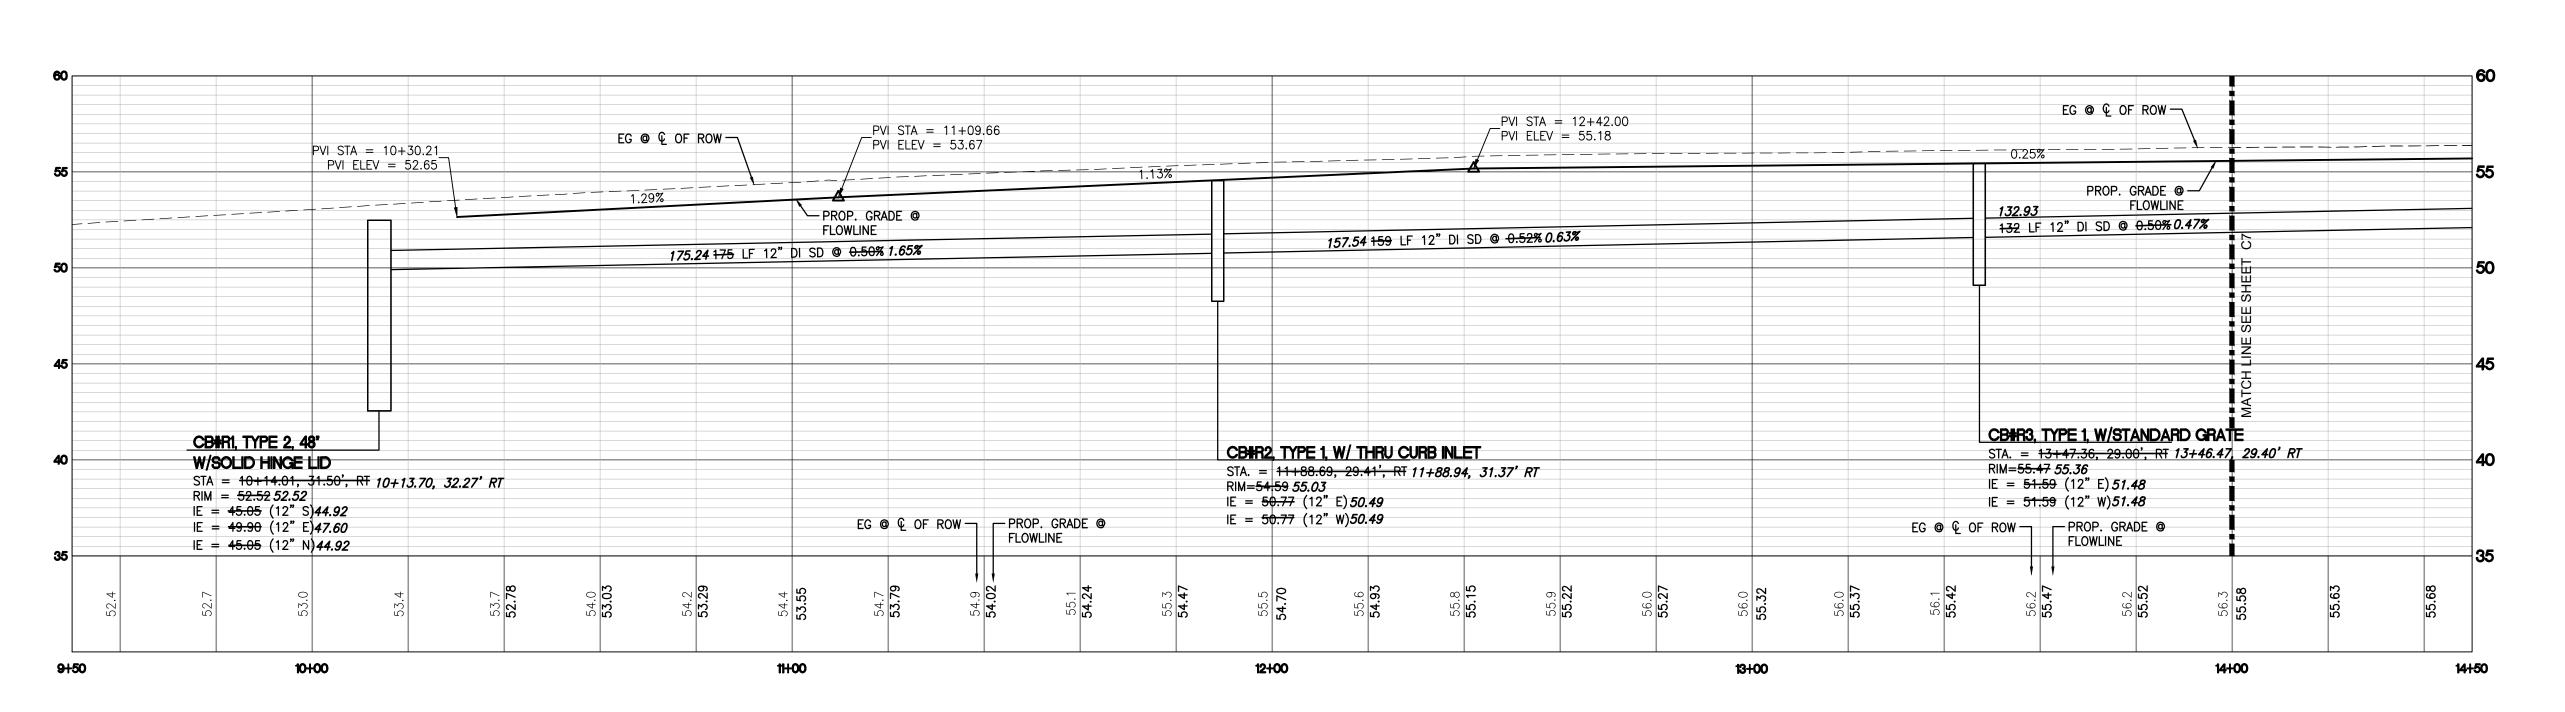

EAST MAIN AVE PROFILE VIEW STA 9+50 TO 14+00

SCALE: HORIZ. 1"=20' VERT. 1"=5'

GRIND AND OVERLAY NOTE: IF THE GRIND AND OVERLAY OF THE EXISTING PAVEMENT RESULTS IN A REDUCTION IN THE OVERALL PAVEMENT THICKNESS, A PORTION OF FULL DEPTH ASPHALT RESTORATION MAY BE REQUIRED. COORDINATE WITH THE CITY INSPECTOR ON SITE.

APPROVED

CITY OF PUYALLUP **ENGINEERING SERVICES**

NOTE:
THIS APPROVAL IS VOID AFTER YEAR FROM APPROVAL DATE. THE CITY WILL NOT BE RESPONSIBLE FOR ERRORS AND/OR OMISSIONS ON THESE FIELD CONDITIONS MAY DICTATE CHANGES TO THESE PLANS AS DETERMINED BY THE ENGINEERING SERVICES MANAGER.


05

CO.

PANATTONI DEVELOPMENT 900 SW 16TH STREET, SUITE RENTON. WA 98057

207

FRONTAGE IMPROVEMENTS PLAN AND PROFILE PUYALLUP CORPORATE PARK Know what's below. Call before you dig. A PORTION OF THE NE $\frac{1}{4}$ OF THE SW $\frac{1}{4}$ OF SEC. 26, TWP. 20 NORTH, RGE. 4 EAST, W.M. SCALE: 1"=5' CITY OF PUYALLUP, PIERCE COUNTY, WASHINGTON RIM EL=57.36' - EXISTING CURB, GUTTER RECORD DRAWING 24"CNC N IE=51.91'± AND SIDEWALK TO REMAIN 24"CNC S IE=51.91'± PVC W (PLUGGED) SDMH RIM EL=57.03'\ 24"CNC N IE=51.73'± 12"PVC E IE=53.56'± (FULL OF WATER) 24"CNC S IE=51.93" EXISTING CURB, GUTTER AND SIDEWALK TO REMAIN SEALED S.S. PIPE RUNS E-W | RIM EL=56.27 RIM EL=56.68' 8"CNC IE W=50.67" 8"CNC I.E. W=51.38' 8"PVC IE S=50.77' (NEW) EX. SD. ROOT BARRIER REQUIRED AT BACK OF WALK, BETWEEN THE GRIND AND OVERLAY TO PROPOSED LANE LINE RIM EL=56.25'; ADJUST _EX. WATER VALVE (TYP.) CITY STANDARD DETAIL EAST MAIN AVE. BE RELOCATED TO GUTTER IF NEEDED BACK OF R.O.W. (PUBLIC R/W) 18"CNC S IE=52.05' DESIGN BY OTHERS. 132.93 (7) 0.47% 132 LF 12" DI SD @ 0.50% EX. SW PIPE TO BE REMOVED 56.53± ME - NEW CURB AND GUTTER. B DRIVEWAY CROSSWALK SEE DETAIL SHEET C12 56.27 EG 56.29 FG - NEW CURB AND GUTER \56.69± ME SE DETAIL SHEET 12 - NEW 8' SIDEWALK 18"DI N IE=52.67' 8"CNC W IE=51.30' 18"CNC S IE=52.71" 8"CNC E IE=51.40' 12"DI E IE=53.03'± 8"CNC SE IE=51.53' <u> 56.26</u> — ss — ss — ss — ss — ss — ss — SHALL BE RELOCATED UNDER -RIM-EL=5¹7.20' EX. RIGHT — 12"DI N IE=54.40' **OF WAY LINE** 18"DI W IE=54.25' 12"PVC E IE=54.30' POLES TO BE RELOCATED TO - PROPOSED PVI STA = 17+91.43PVI STA = 17 + 54.76r EG ◎ € OF ROW

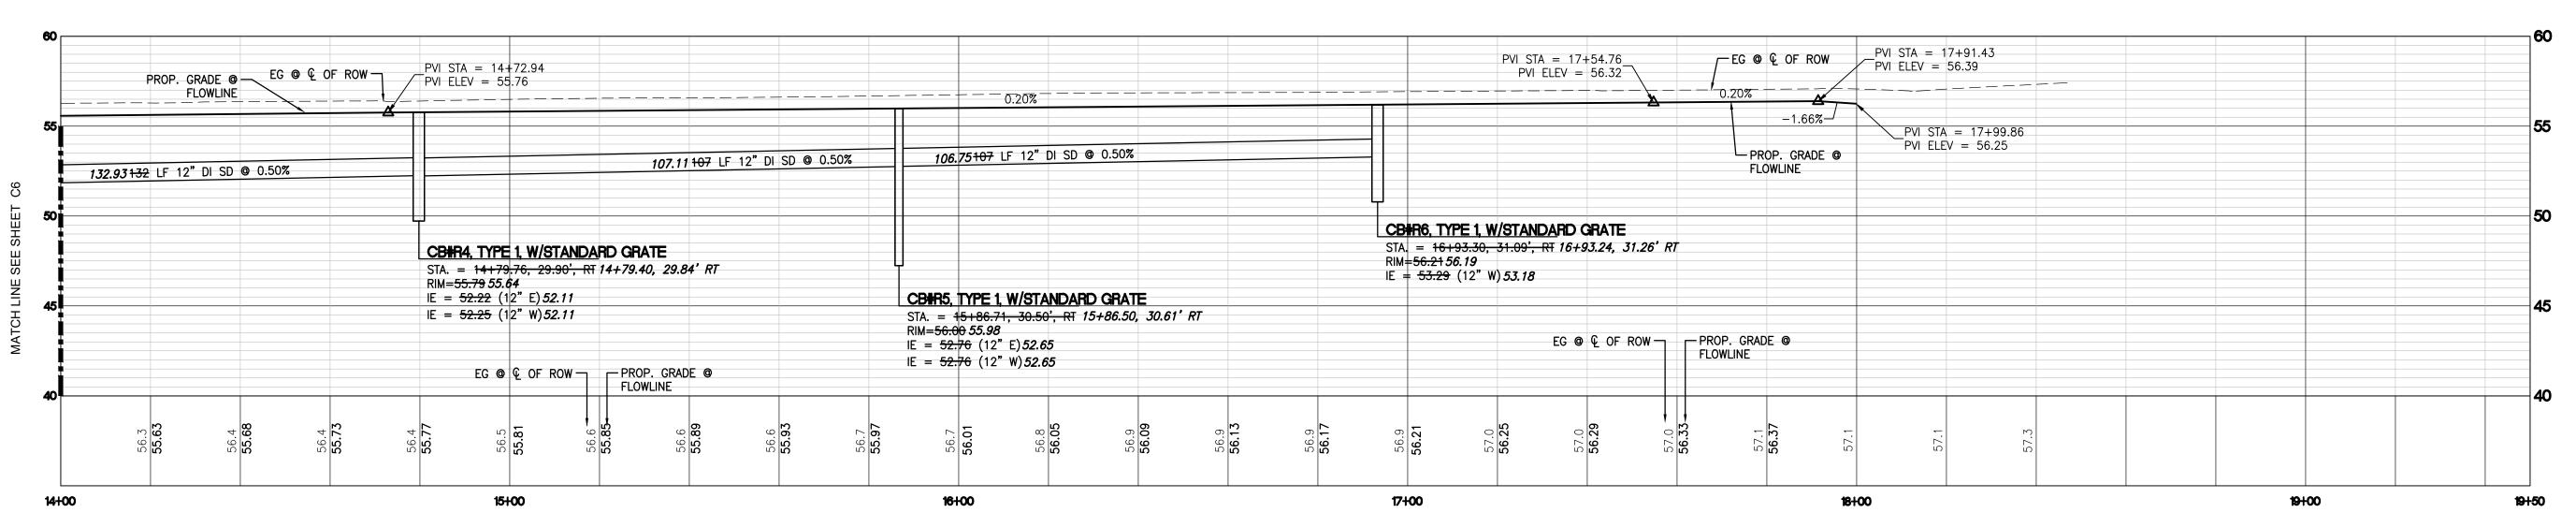

EAST MAIN AVE PROFILE VIEW STA 14+00 TO 19+50

SCALE: HORIZ. 1"=20' VERT. 1"=5'

GRIND AND OVERLAY NOTE: IF THE GRIND AND OVERLAY OF THE EXISTING PAVEMENT RESULTS IN A REDUCTION IN THE OVERALL PAVEMENT THICKNESS, A PORTION OF FULL DEPTH ASPHALT RESTORATION MAY BE REQUIRED. COORDINATE WITH THE CITY INSPECTOR ON SITE.

APPROVED CITY OF PUYALLUP **ENGINEERING SERVICES** NOTE:
THIS APPROVAL IS VOID AFTER YEAR FROM APPROVAL DATE. THE CITY WILL NOT BE RESPONSIBLE FOR ERRORS 05 AND/OR OMISSIONS ON THESE FIELD CONDITIONS MAY DICTATE

CHANGES TO THESE PLANS AS

ENGINEERING SERVICES MANAGER.


DETERMINED BY THE

Barghausen Consulting Engine

19+31

CO. PANATTONI DEVELOPMENT 900 SW 16TH STREET, SUITE RENTON. WA 98057


207

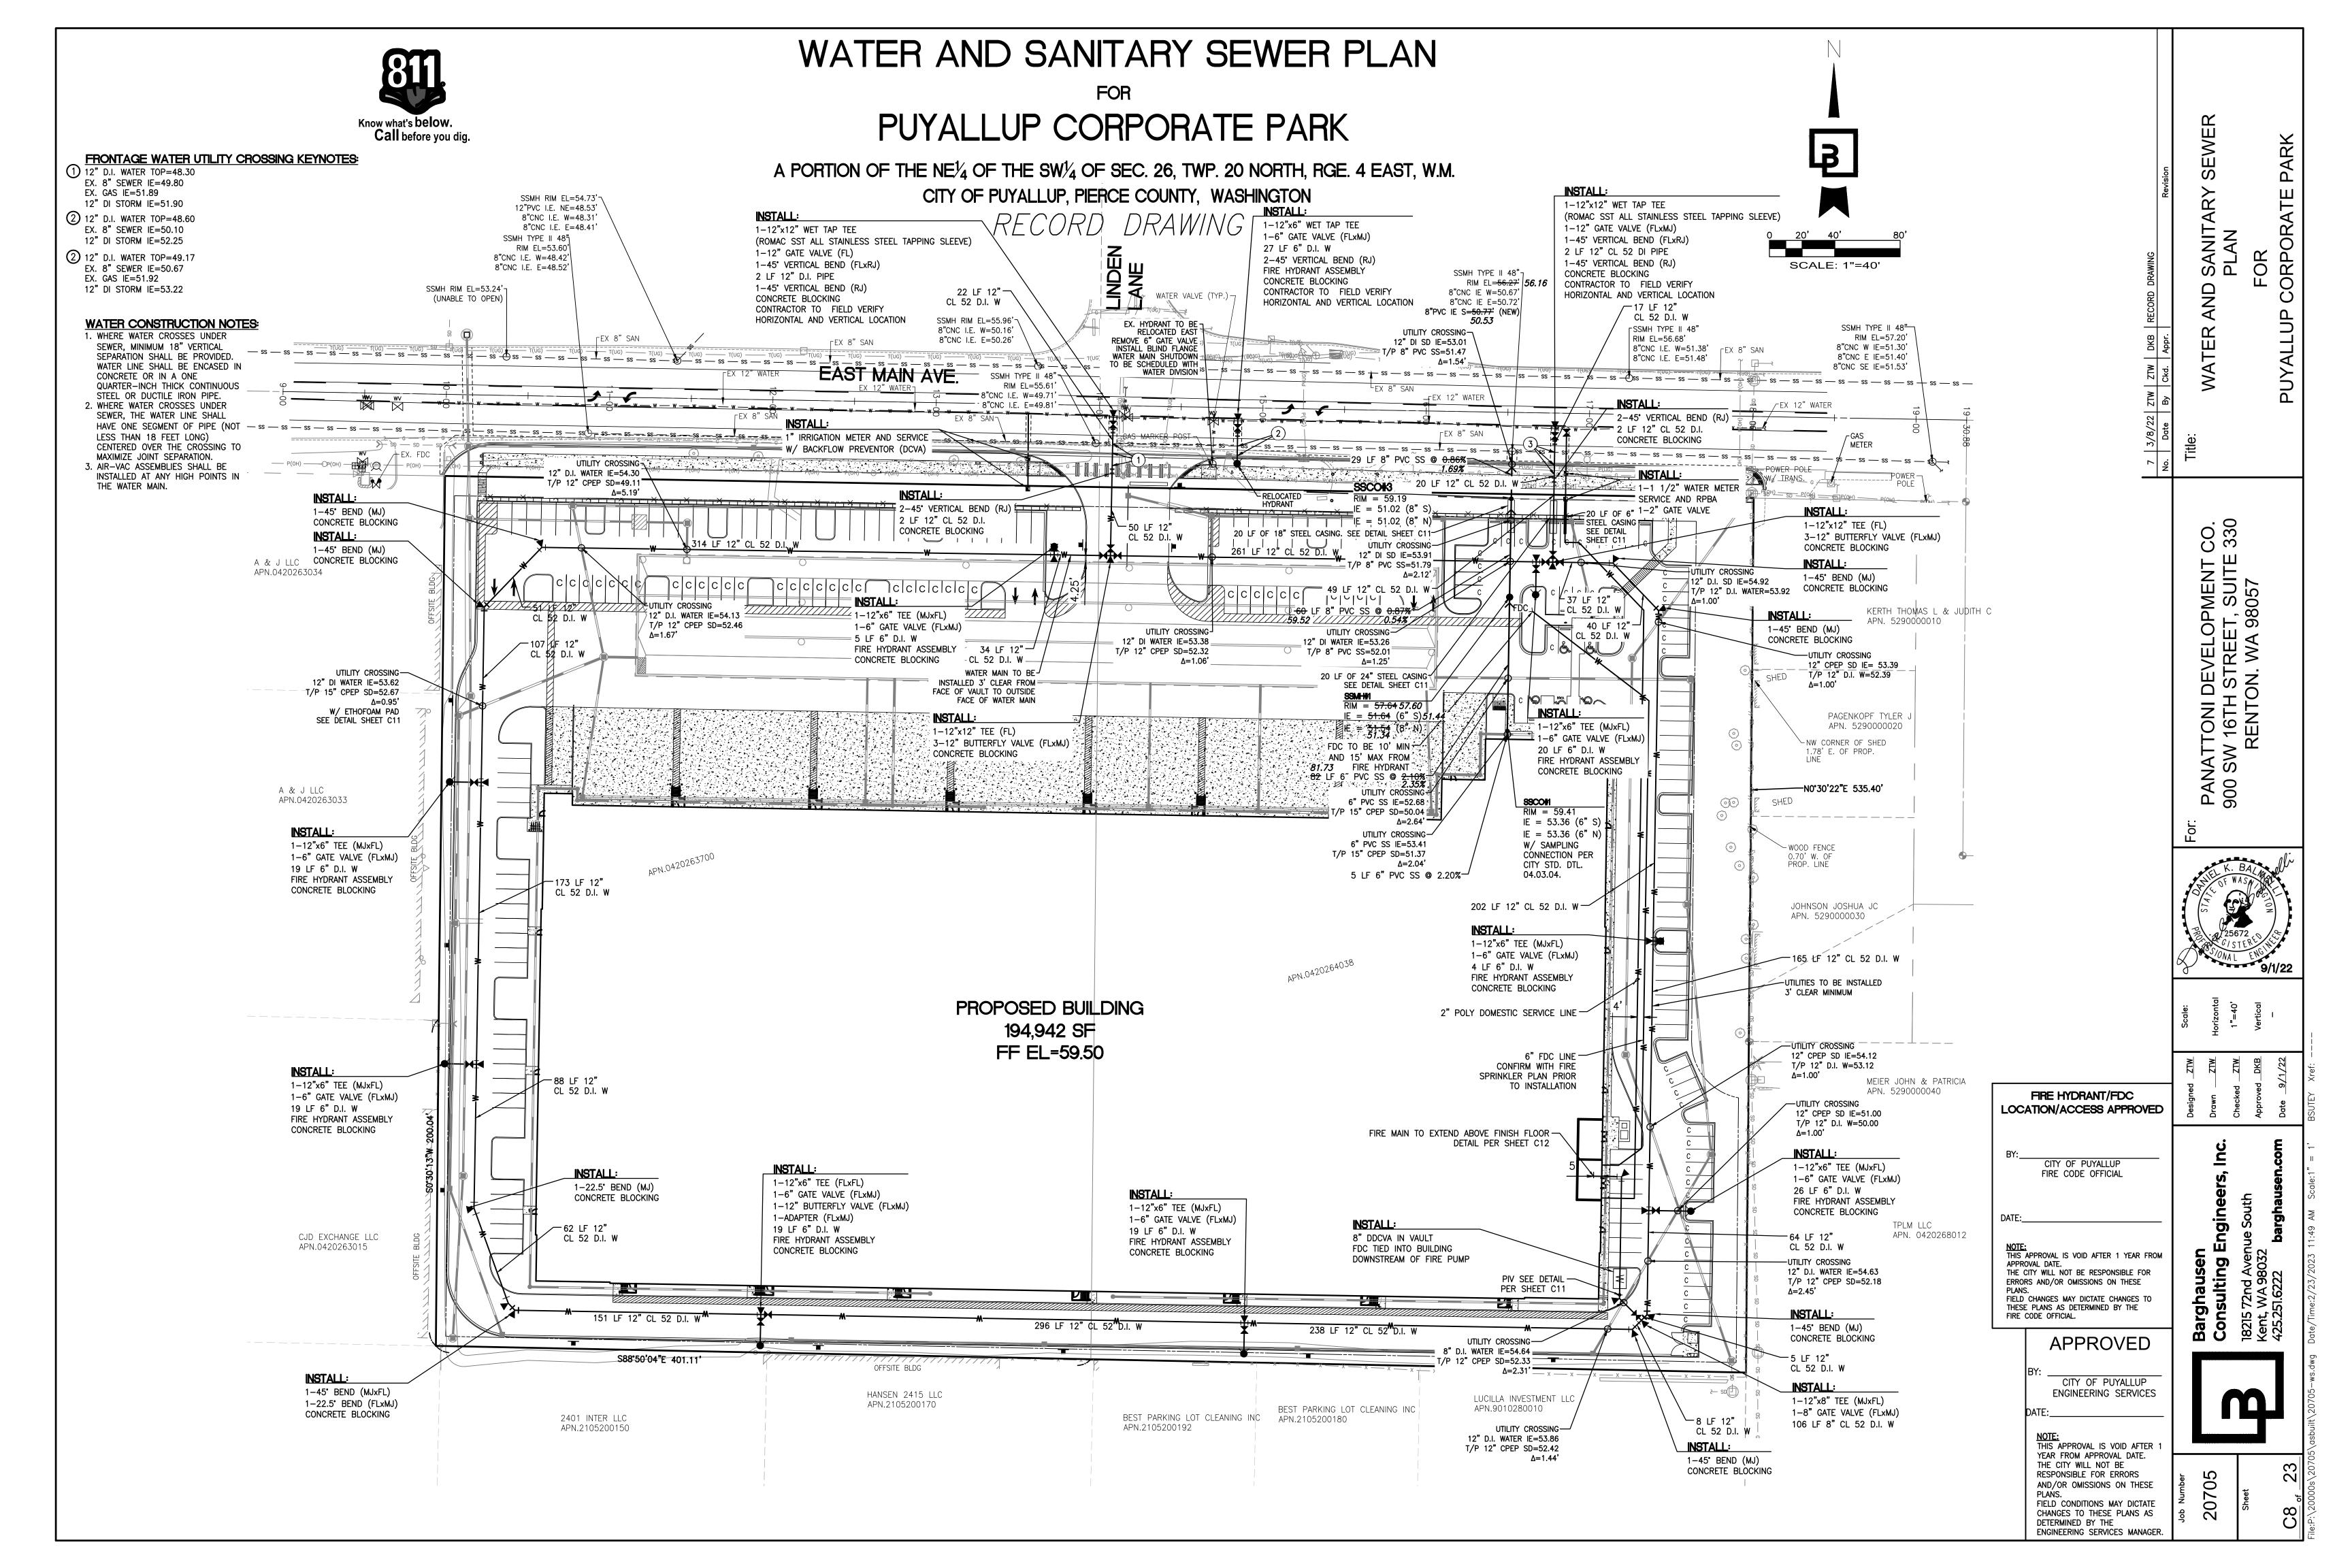


PUYALLUP CORPORATE PARK

A PORTION OF THE NE¹/₄ OF THE SW¹/₄ OF SEC. 26, TWP. 20 NORTH, RGE. 4 EAST, W.M. CITY OF PUYALLUP, PIERCE COUNTY, WASHINGTON


RECORD DRAWING

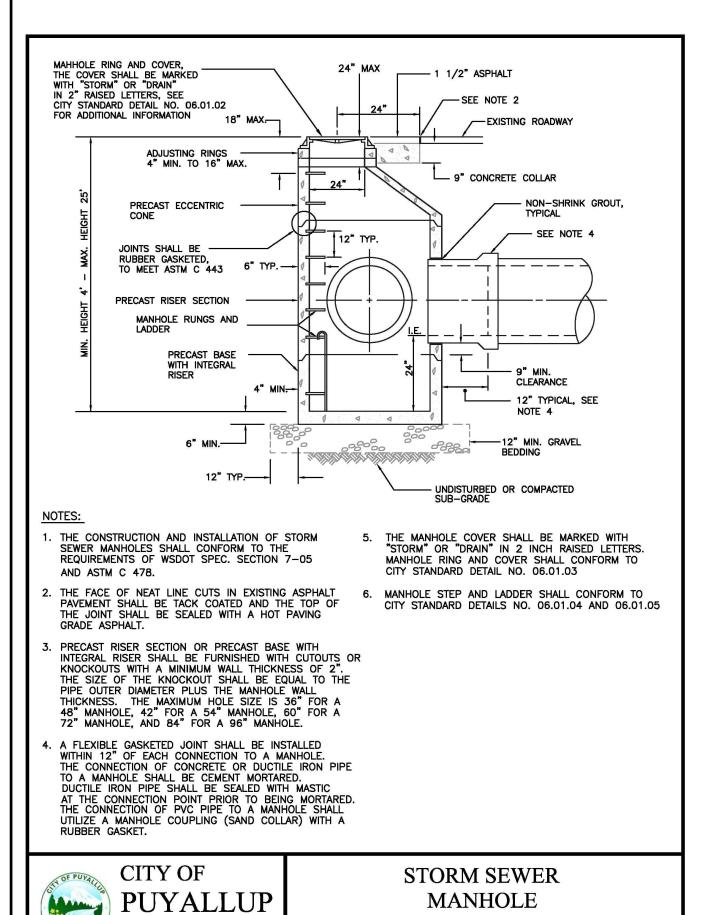



OFFICE

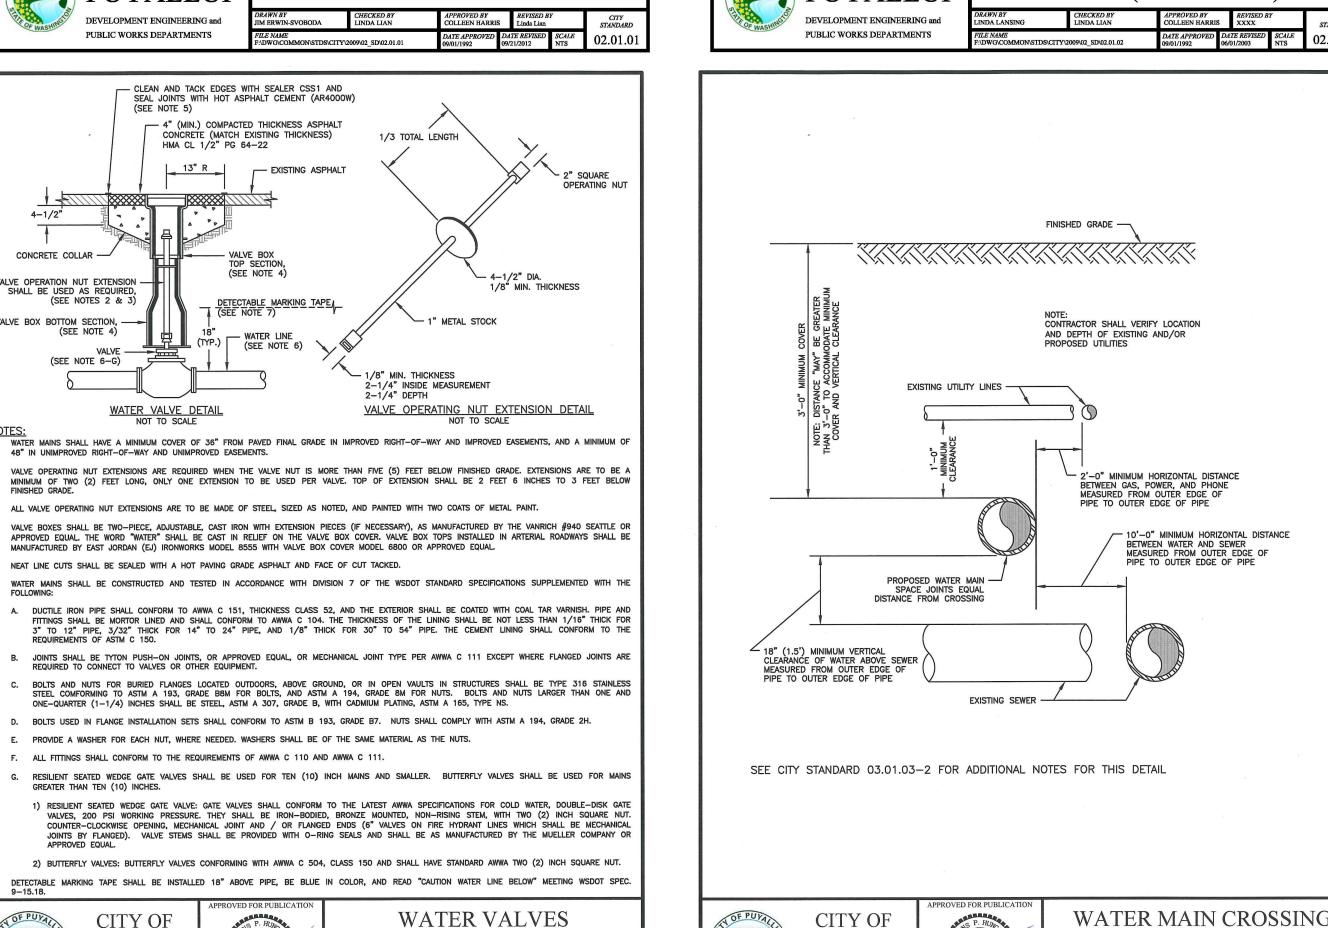



03.01.01

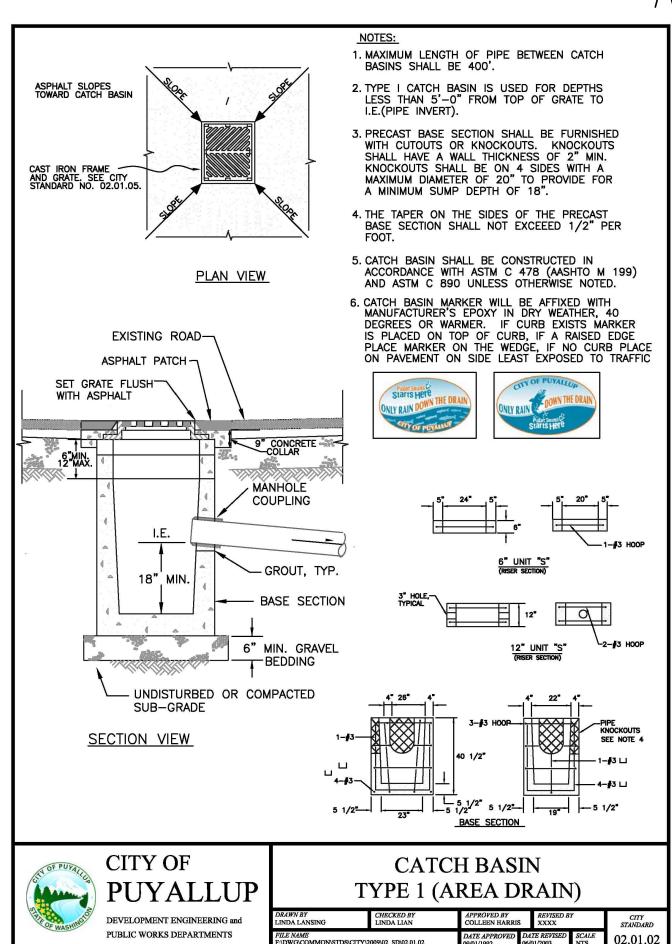


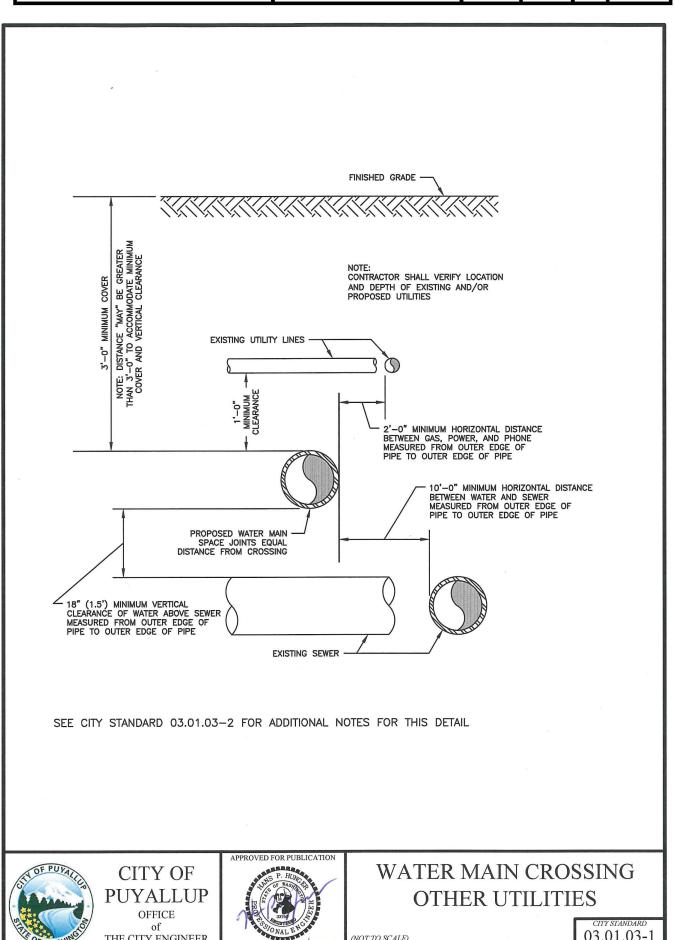

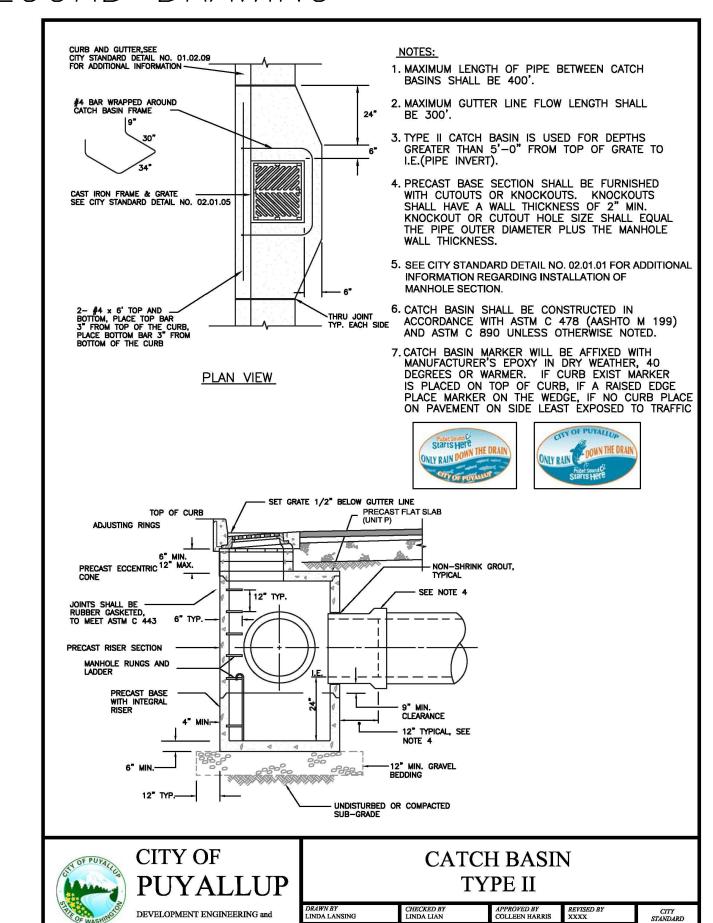

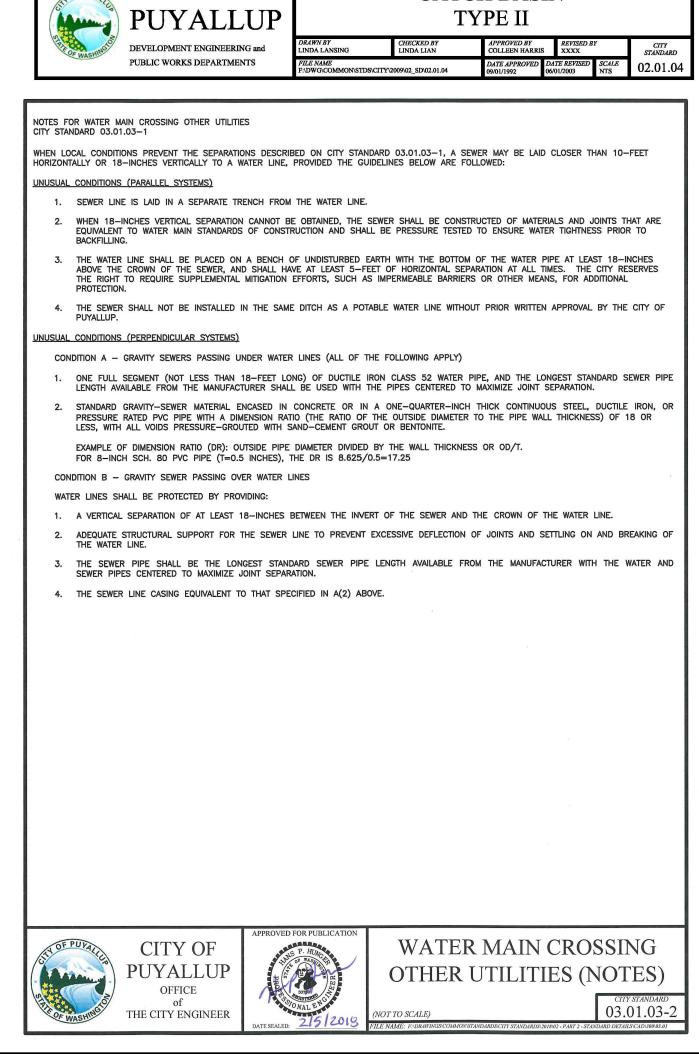

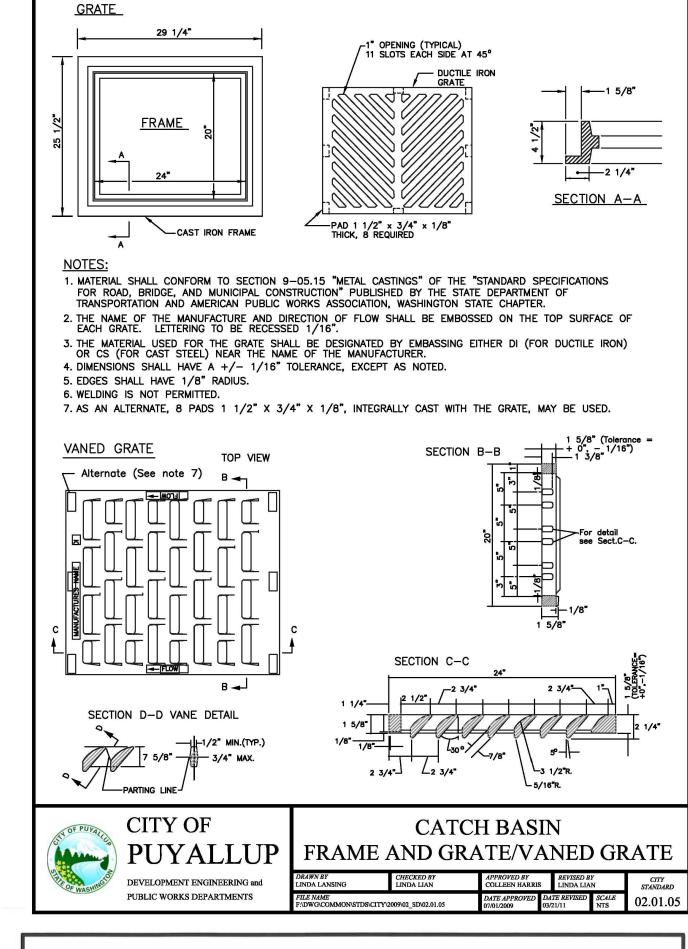

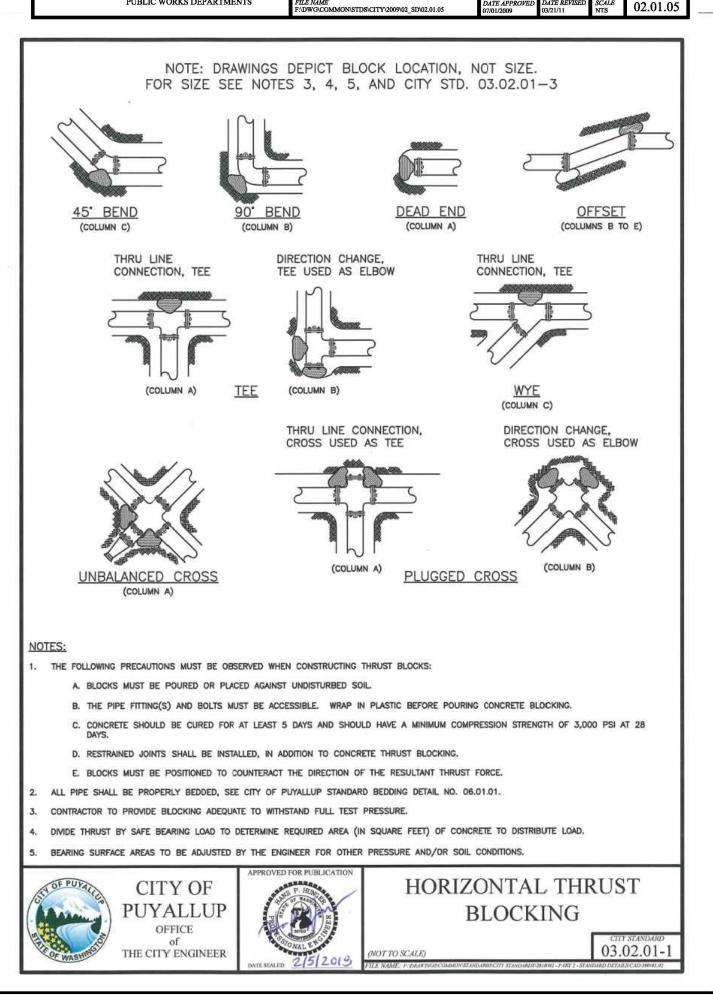



CITY OF PUYALLUP ENGINEERING SERVICES

YEAR FROM APPROVAL DATE. THE CITY WILL NOT BE

THIS APPROVAL IS VOID AFTER RESPONSIBLE FOR ERRORS AND/OR OMISSIONS ON THESE FIELD CONDITIONS MAY DICTATE CHANGES TO THESE PLANS AS DETERMINED BY THE ENGINEERING SERVICES MANAGER.


05

I DEVELOPMENT (H STREET, SUITE FON. WA 98057

PUYALLUP CORPORATE PARK

A PORTION OF THE NE1/4 OF THE SW1/4 OF SEC. 26, TWP. 20 NORTH, RGE. 4 EAST, W.M. CITY OF PUYALLUP, PIERCE COUNTY, WASHINGTON

RECORD DRAWING

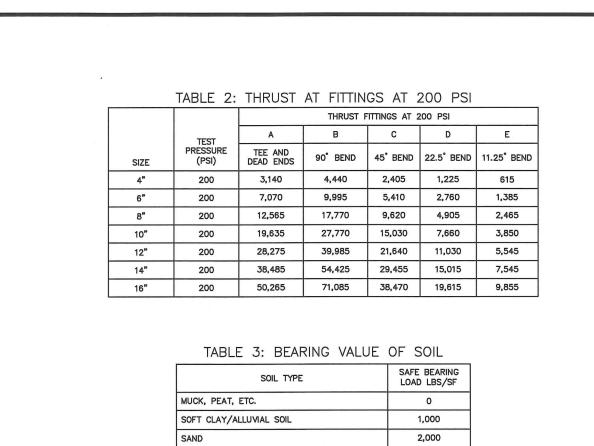

SEE CITY STANDARDS 03.02.01-1 AND 03.02.01-2 FOR ADDITIONAL INFORMATION


SAND AND GRAVEL CEMENTED WITH CLAY

3,000


4,000


- 1 TO DETERMINE THRUST AT PRESSURES OTHER THAN PSI SHOWN, MULTIPLY THE THRUST OBTAINED IN TABLE 2 BY THE RATIO OF THE PRESSURE

- ② TO DETERMINE THE BEARING AREA OF THE THRUST BLOCK IN SQUARE FEET (SF): SEE TABLE 3, BEARING VALUE OF SOIL
- FOR SAND AND GRAVEL BEARING VALUE FROM TABLE 3 IS 3,000 LBS/SF
- 3 CONTRACTOR TO PROVIDE BLOCKING ADEQUATE TO WITHSTAND FULL TEST PRESSURE AREAS SHALL BE ADJUSTED FOR OTHER PRESSURE CONDITIONS.
- S no water main shall dead end against a main line valve. Dead end water mains shall be blocked against a restrained mechanical

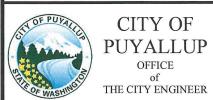



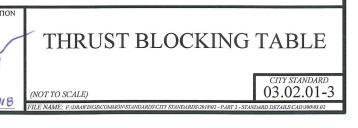

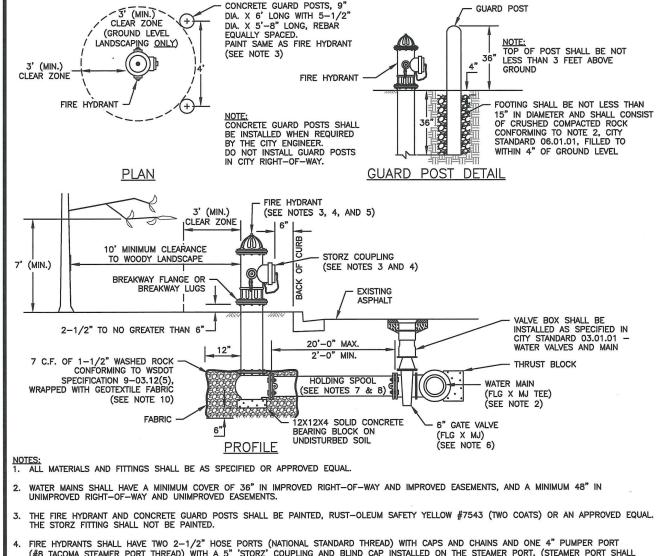


- FIRE HYDRANTS SHALL HAVE TWO 2-1/2" HOSE PORTS (NATIONAL STANDARD THREAD) WITH CAPS AND CHAINS AND ONE 4 POMPER PORT (#8 TACOMA STEAMER PORT THREAD) WITH A 5" STORZ' COUPLING AND BLIND CAP INSTALLED ON THE STEAMER PORT, (STEAMER PORT SHALL FACE THE STREET), 1-1/4" PENTAGONAL OPERATING NUT (COUNTER-CLOCKWISE OPENING), 0-RING TYPE STUFFING BOX, AUTOMATIC BARREL DRAINS AND 5-1/4" MAIN VALVE OPENING. HYDRANTS SHALL BE DESIGNED IN A MANNER THAT WILL PREVENT BARREL BREAKAGE WHEN STRUCK BY A VEHICLE. HYDRANTS SHALL CONFORM TO THE LATEST REVISION OF AWWA SPECIFICATIONS NO. C 502-73 FOR FIRE HYDRANTS FOR ORDINARY WATER SERVICE. FIRE HYDRANTS SHALL INCLUDE THE ENTIRE ASSEMBLY COMPLETE, INCLUDING HYDRANT, GATE VALVE AND BOX, CONNECTING PIPING, FITTINGS, AND ACCESSORIES.
- FIRE HYDRANTS SHALL BE AVK, CLOW MEDALLION, M & H 929, MUELLER CENTURION, OR WATEROUS.
- GATE VALVES SHALL CONFORM TO THE LATEST AWWA SPECIFICATIONS FOR COLD WATER, RESILIENT SEATED WEDGE GATE VALVES, 200 PSI WORKING PRESSURE. THEY SHALL BE IRON—BODIED BRONZE—MOUNTED, NON—RISING STEM, COUNTER—CLOCKWISE OPENING, MECHANICAL JOINT BY FLANGED. VALVE STEMS SHALL BE PROVIDED WITH 0—RING SEALS AND SHALL BE AS MANUFACTURED BY THE MUELLER COMPANY OR APPROVED
- THE HOLDING SPOOL SHALL BE A MECHANICAL-JOINT (M.J.) HOLDING SPOOL, WITH THE USE OF MEGA-LUG CONNECTORS OR APPROVED EQUAL WITH CLASS 52 DUCTILE IRON PIPE.
- . IF DISTANCE BETWEEN WATER MAIN AND FIRE HYDRANT IS GREATER THAN 17 FEET, A RESTRAINED JOINT IS REQUIRED ON ADDITIONAL JOINT. MAXIMUM HYDRANT RUN ALLOWED IS 20 FEET.
- 10. THE CONTRACTOR SHALL PLACE A 6 OZ. GEOTEXTILE FABRIC AROUND THE WASHED ROCK AREA, ENDS TO OVERLAP.
- 1. A FLUORESCENT ORANGE BAG MUST COVER AND BE SECURED TO THE FIRE HYDRANT UNTIL APPROVED FOR USE BY CITY ENGINEER. 2. A MINIMUM THREE FOOT (3') RADIUS UNOBSTRUCTED CLEAR ZONE (WORK AREA) SHALL BE PROVIDED AROUND ALL FIRE HYDRANTS. ADDITIONALLY, NO WOODY LANDSCAPE SHALL BE PLANTED WITHIN TEN FEET (10') OF ANY FIRE HYDRANT. OVERREACHING BRANCHES OF TREES ADJACENT TO HYDRANTS SHALL HAVE A MAINTAINED VERTICAL CLEARANCE OF SEVEN (7') FEET ABOVE FINISHED GRADE OF THE FIRE HYDRANT.





FIRE HYDRANT ASSEMBLY

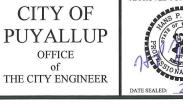

CITY STANDARD 03.10.01-2 COVERS ADDITIONAL NOTES FOR THIS DETAIL

VALVE ASSEMBLY

COPPERSETTER: FORD 1-1/2"

THE WATER SERVICE LINE SHALL BE BEDDED IN WASHED SAND WITH 36" OF COVER BELOW FINISHED GRADE WITHIN THE RIGHT-OF-WAY. THE

THE STAINLESS STEEL METER FLANGE BOLTS SHALL BE 5/8" DIAMETER FOR THE 1-1/2" METER, AND 3/4" DIAMETER FOR THE 2" METER,

3/4" BRASS 90" (DOWN) —

03.10.01-2, NOTE 9)

(SEE CITY STANDARD 03.10.03 FOR ADDITIONAL INFORMATION)

(SEE CITY STANDARD

FOR 1-1/2" SERVICE INSTALL

FORD PACK JOINT COUPLING — C86-77 OR APPROVED EQUAL

OFFICE

3.10.01-2, NOTE 13)

(SEE CITY STANDARD 03.10.01-2, NOTE 8)

(SEE CITY STANDARD 03.11.01)

ALTERNATIVE EXTERIOR VAULT INSTALLATION.


2" POLY PIPE WATER SERVICE LINE


DOUBLE DETECTOR-CHECK 03.10.01-1

TO BLDG. --

- FLOW FROM FIRE DEPARTMENT

(SEE CITY STANDARDS 03.10.01-2 NOTES 12 AND 13, AND 03.10.02)

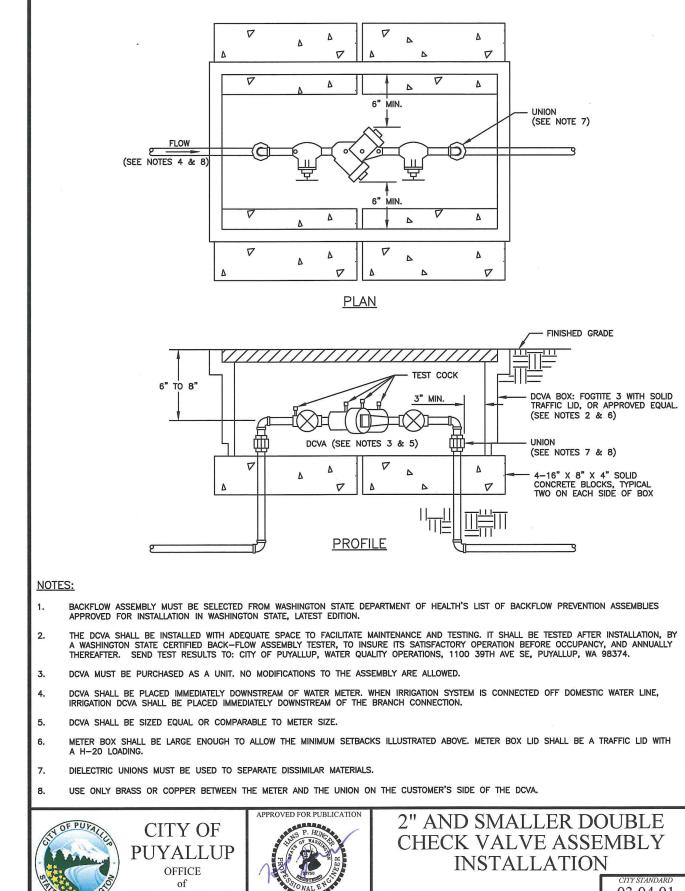

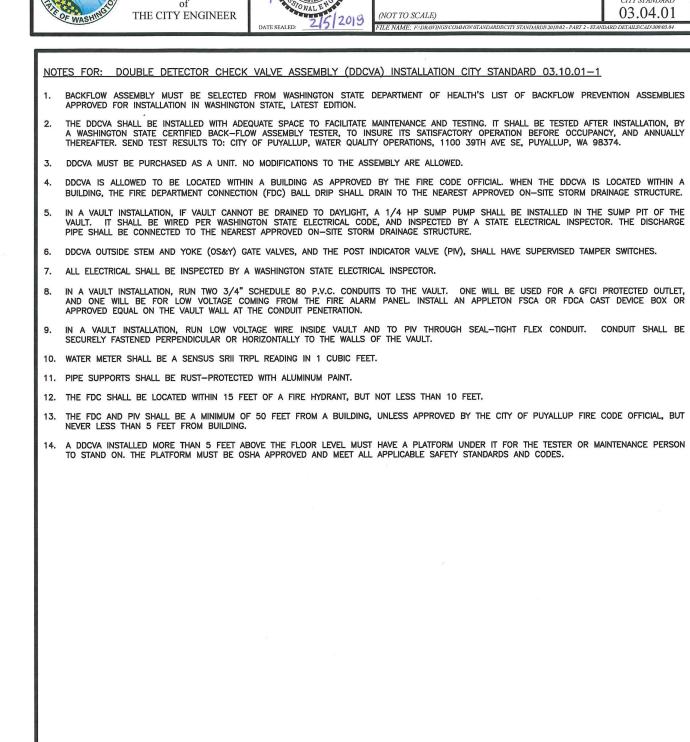


OFFICE


THE CITY ENGINEER

DOUBLE DETECTOR-CHECK

VALVE ASSEMBLY

INSTALLATION (NOTES)

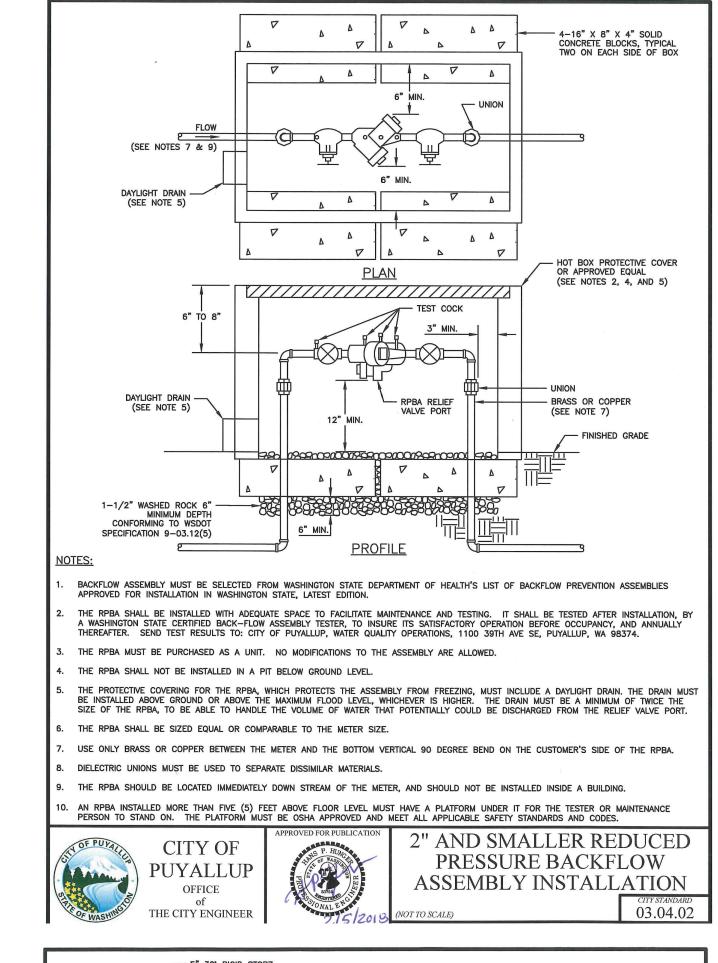

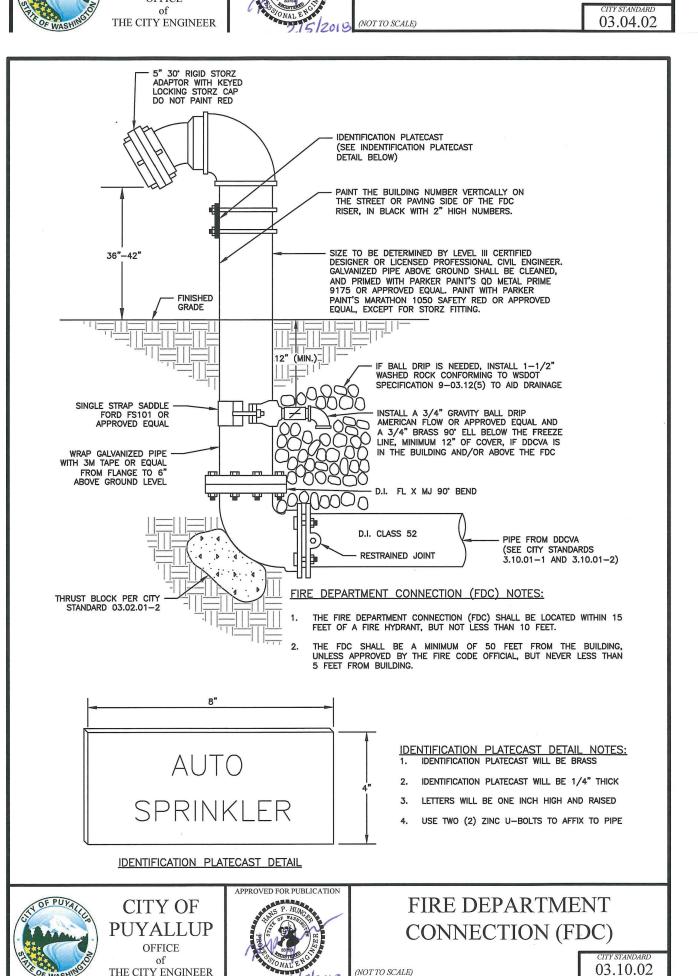



CITY OF PUYALLUP ENGINEERING SERVICES

THIS APPROVAL IS VOID AFTER YEAR FROM APPROVAL DATE. THE CITY WILL NOT BE RESPONSIBLE FOR ERRORS AND/OR OMISSIONS ON THESE FIELD CONDITIONS MAY DICTATE CHANGES TO THESE PLANS AS DETERMINED BY THE

ENGINEERING SERVICES MANAGER.

I DEVELOPMENT 4 STREET, SUITE 70N. WA 98057





=OR


PUYALLUP CORPORATE PARK


A PORTION OF THE NE¹/₄ OF THE SW¹/₄ OF SEC. 26, TWP. 20 NORTH, RGE. 4 EAST, W.M. CITY OF PUYALLUP, PIERCE COUNTY, WASHINGTON


RECORD DRAWING

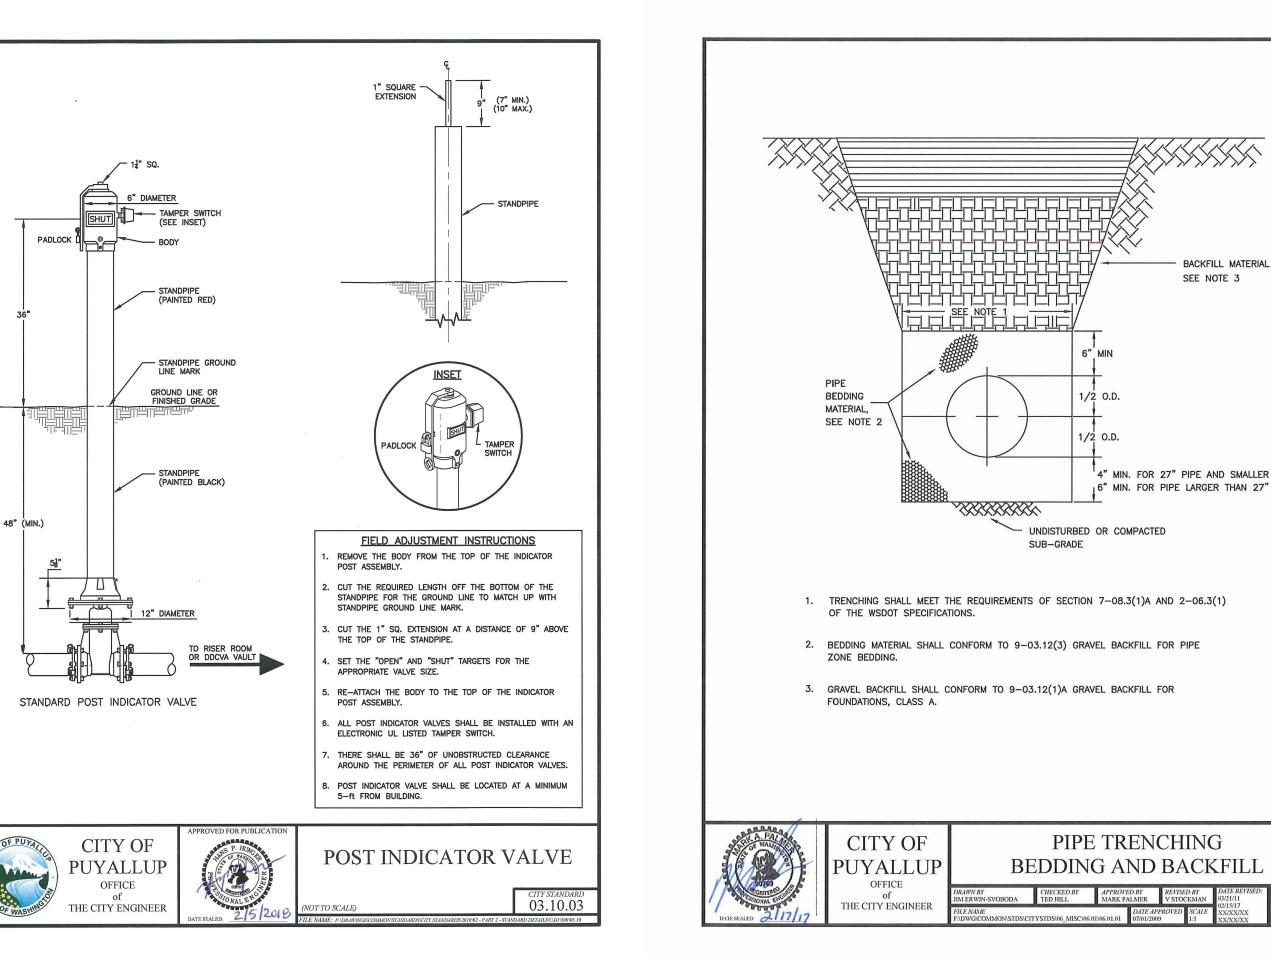

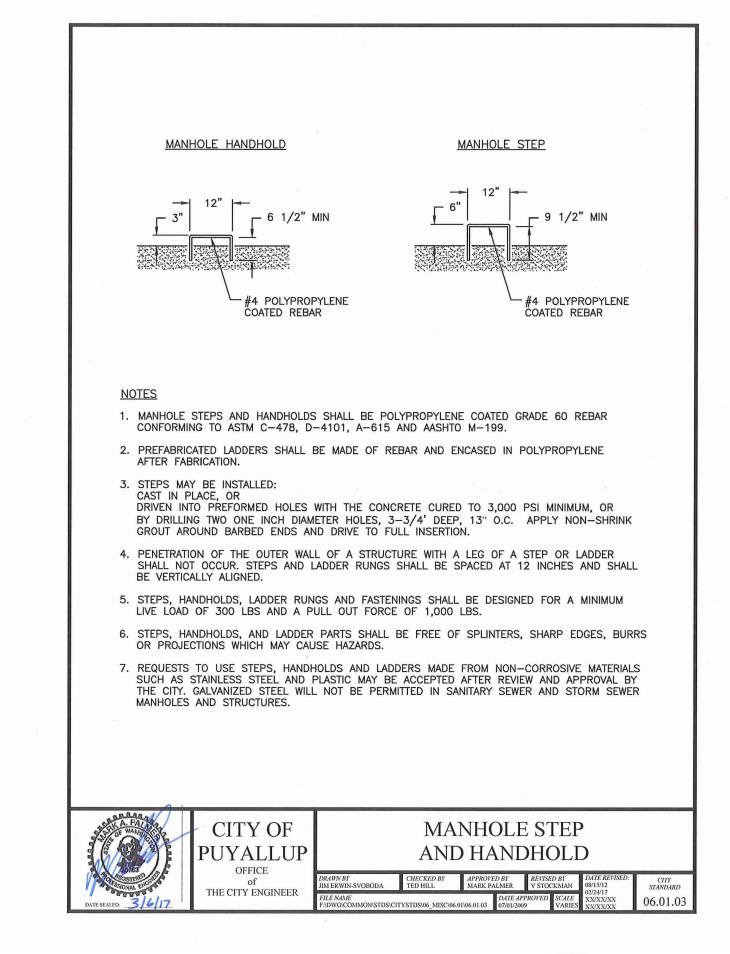

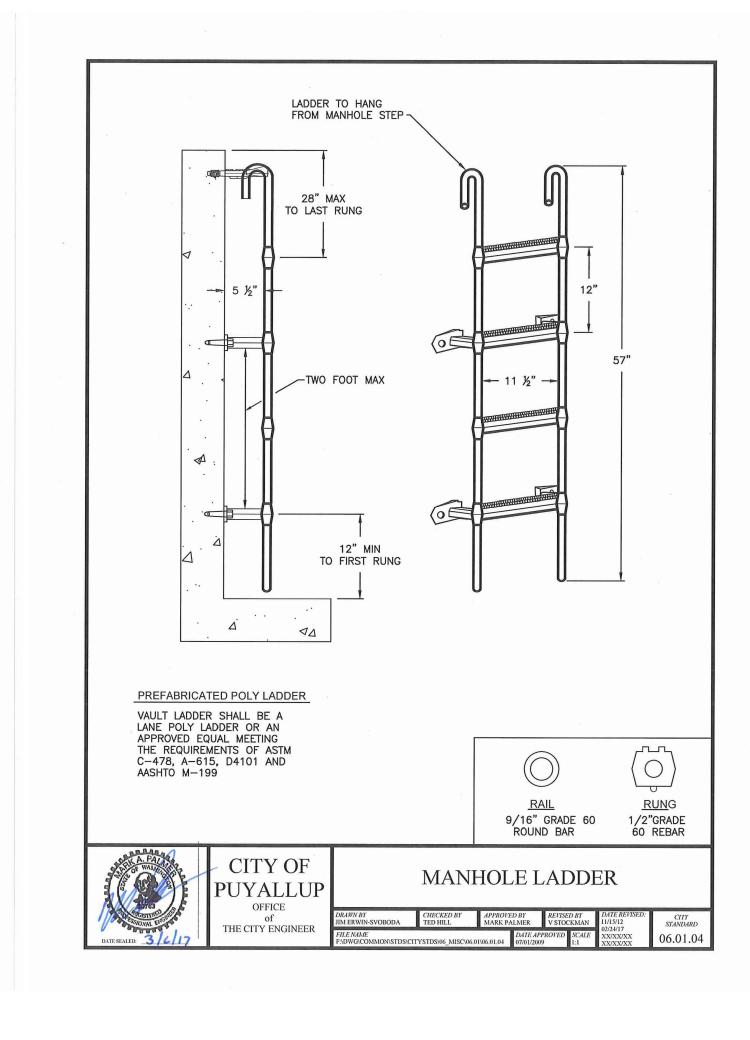


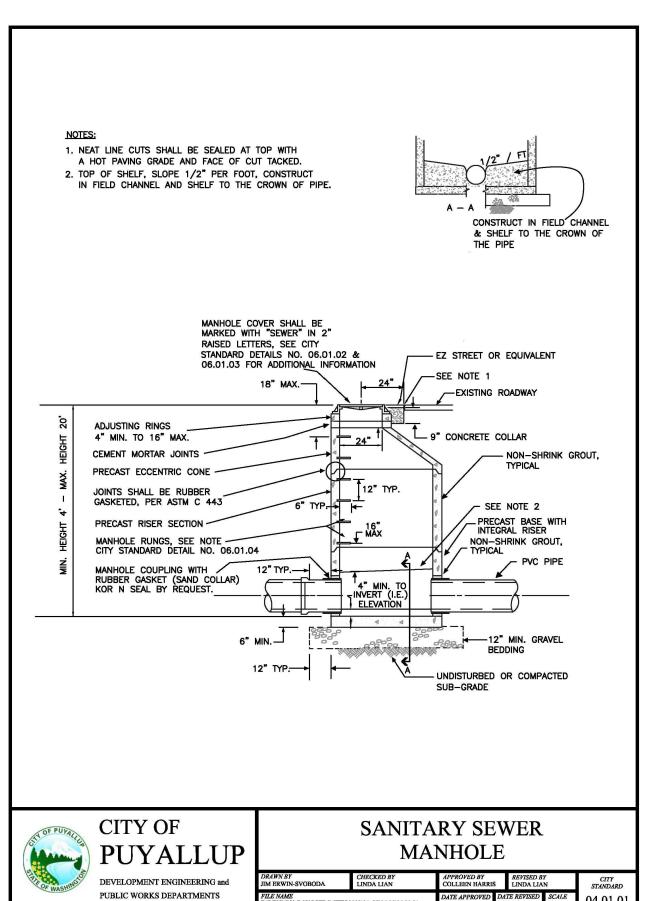


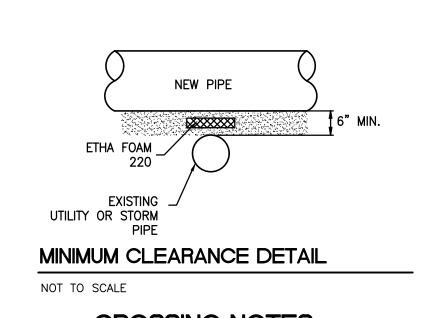

CROSSING NOTES:


FOR CROSSINGS WITH LESS THAN 1' OF VERTICAL SEPARATION. A 3"X48"X108" SHEET OF ETHAFOAM 220 WILL BE PLACED BETWEEN THE PIPES WITH SAND PLACED AROUND THE CROSSING PIPES AND THE ETHAFOAM SHEFT.

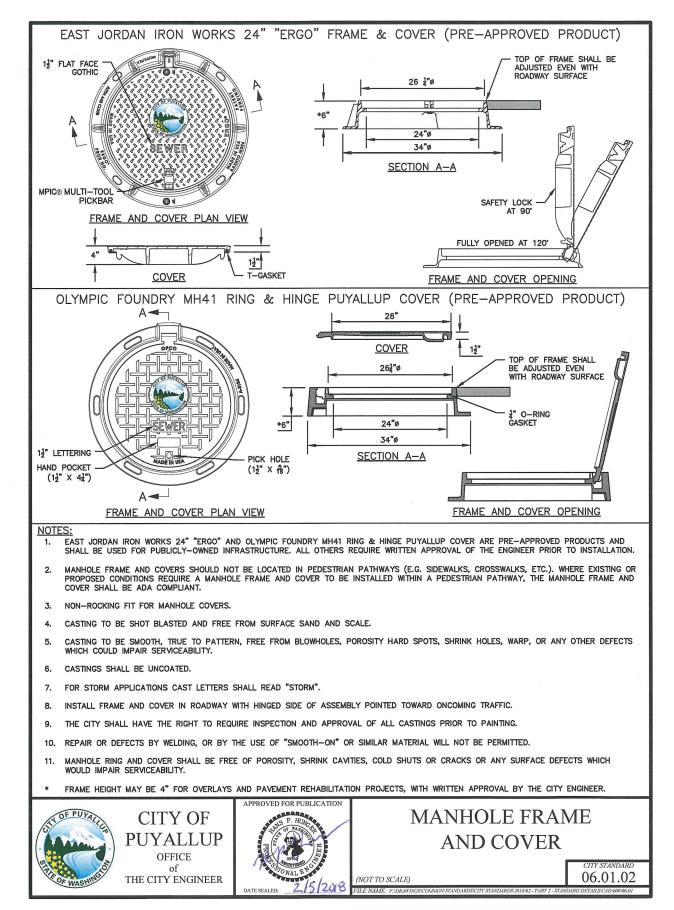

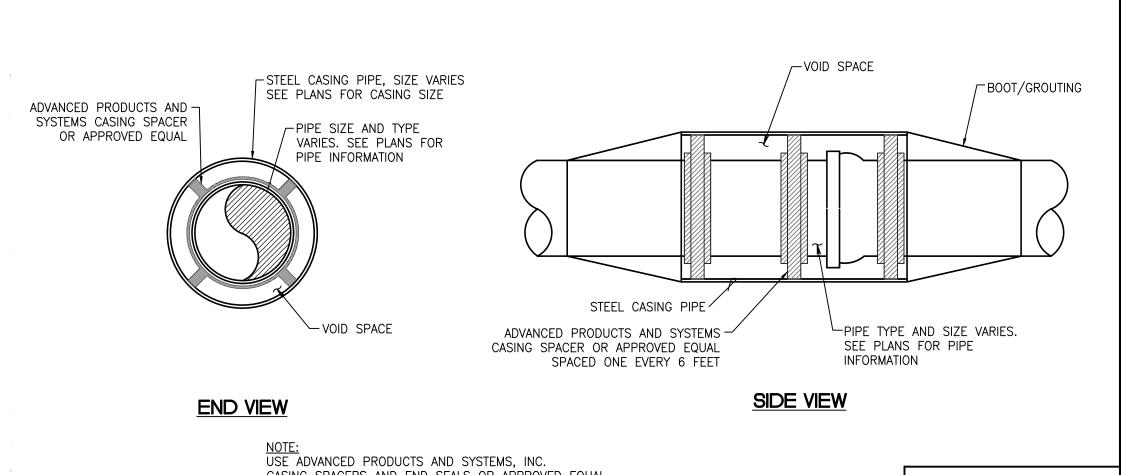

CASING SPACERS AND END SEALS OR APPROVED EQUAL

STEEL CASING DETAIL

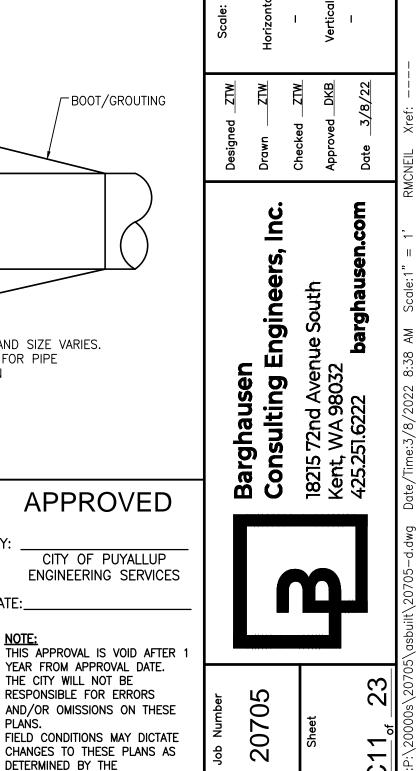

ENGINEERING SERVICES MANAGER.

I DEVELOPMENT (H STREET, SUITE FON. WA 98057




PUYALLUP CORPORATE PARK

A PORTION OF THE NE $\frac{1}{4}$ OF THE SW $\frac{1}{4}$ OF SEC. 26, TWP. 20 NORTH, RGE. 4 EAST, W.M. CITY OF PUYALLUP, PIERCE COUNTY, WASHINGTON

FIRE PROTECTION SPRINKLER SYSTEM NOTES:


A. BACKFLOW PREVENTER, FIRE DEPARTMENT CONNECTION AND CONNECTION TO SPRINKLER SYSTEM IS SUBJECT TO SEPARATE PERMIT AND INSPECTION. CONNECTION AND SIZES ARE SUBJECT TO CHANGE BY FIRE PROTECTION SPRINKLER ENGINEER AND FIRE MARSHALL. REPRESENTATION HEREON IS INTENDED FOR LOCATION AND


SYSTEMS AND/OR FIRE MAIN FOR HYDRANT PLACEMENT MUST BE INSTALLED AND CERTIFIED BY A LICENSED CONTRACTOR WHO HAS ACHIEVED A STATE LEVEL "U" CERTIFICATION. SUBCONTRACTING OF SUCH WORK TO PERSONS OR FIRMS NOT CURRENTLY LICENSED AS A FIRE PROTECTION SPRINKLER SYSTEM CONTRACTOR I

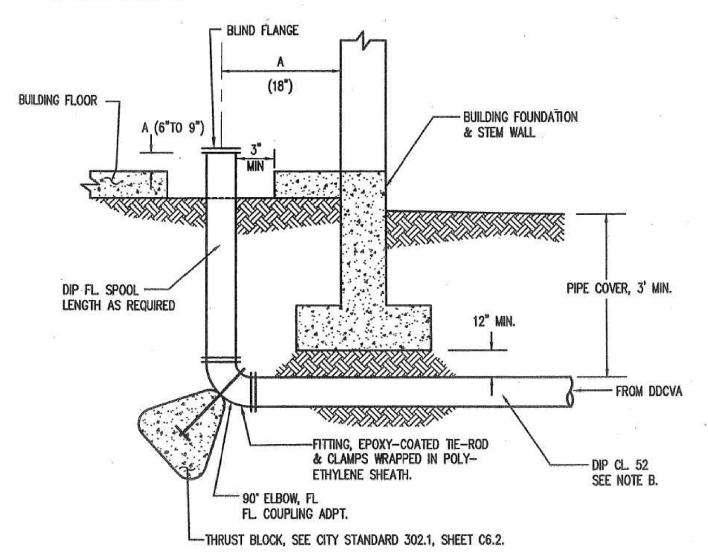



A. FOR DIMENSIONS, COORDINATE WITH BUILDING FIRE SPRINKLER CONTRACTOR. B. SEE FIRE PROTECTION PLAN FOR PIPE SIZE.


BUILDING SPRINKLER PIPE RISER

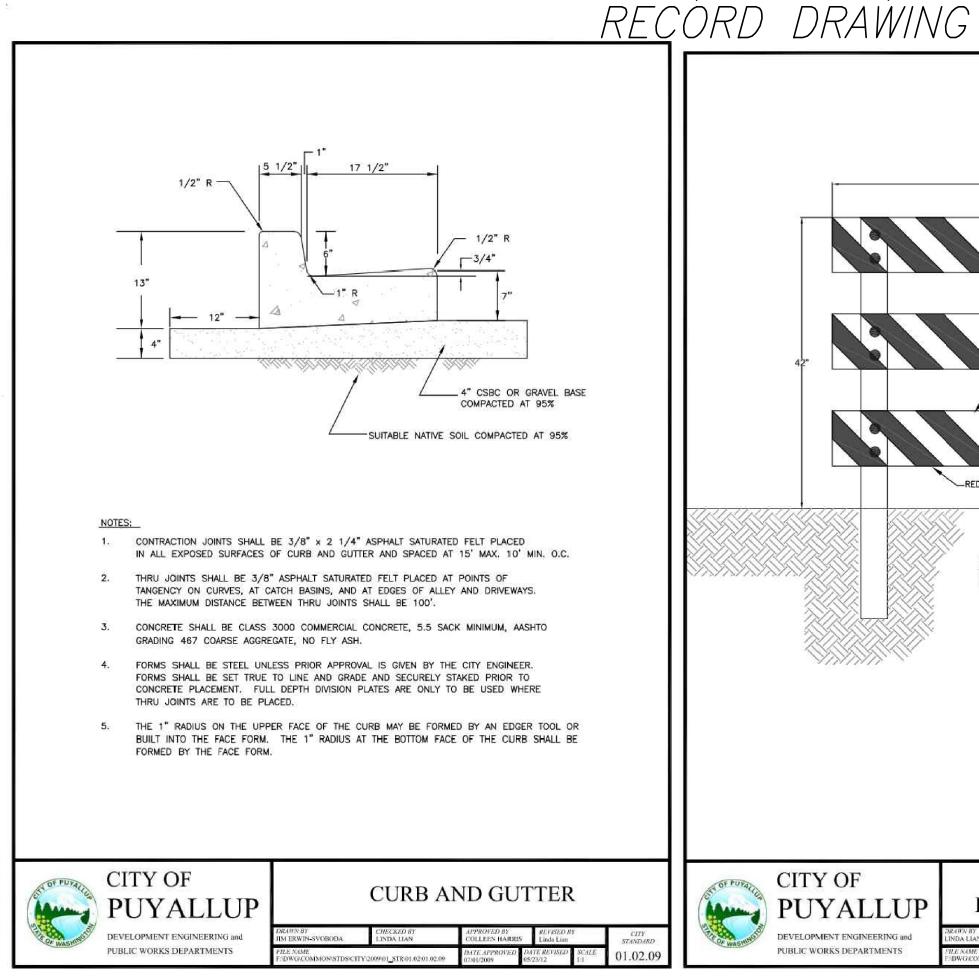

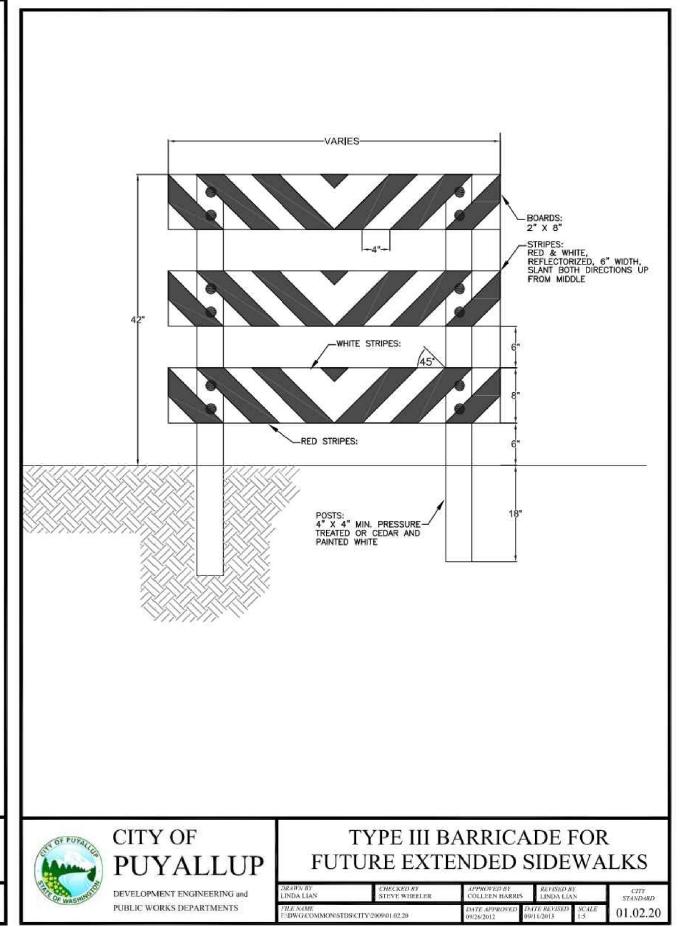


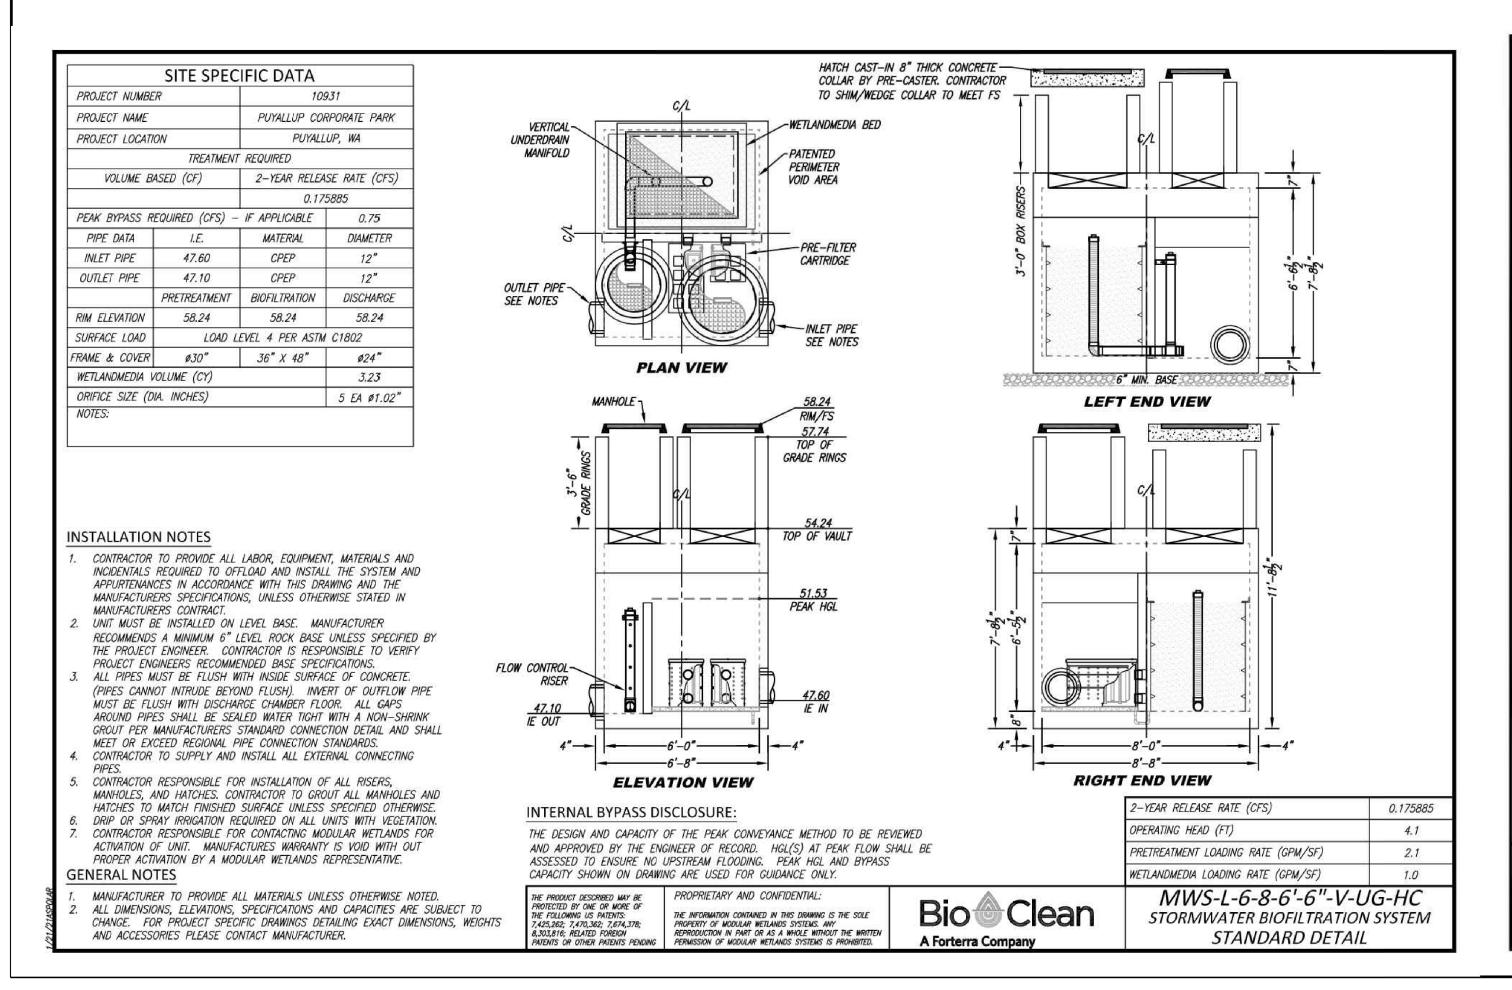


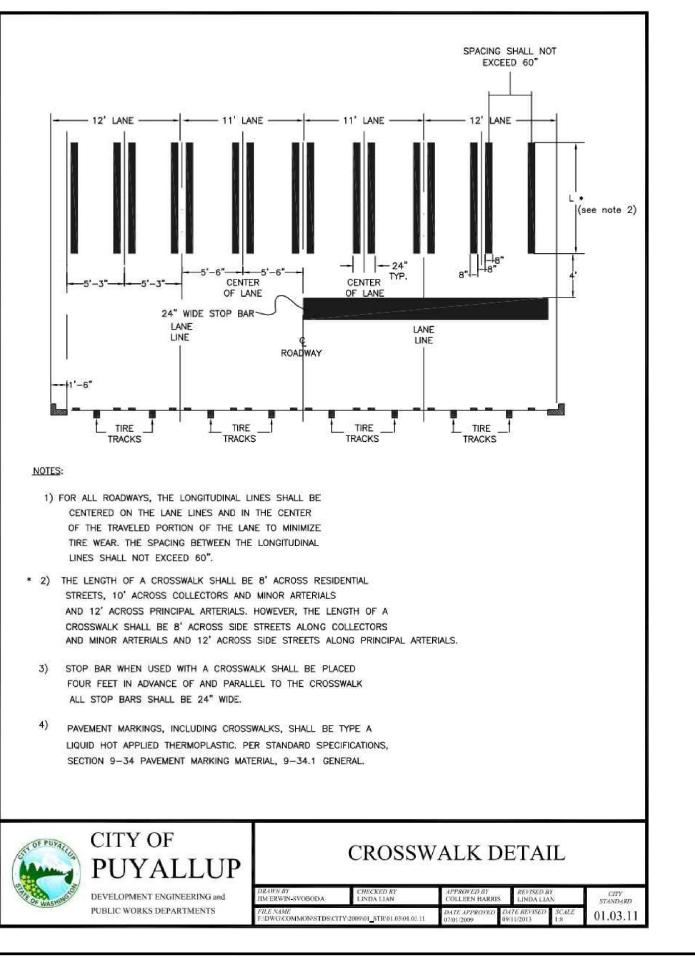

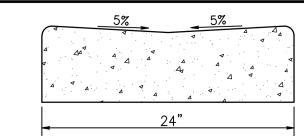




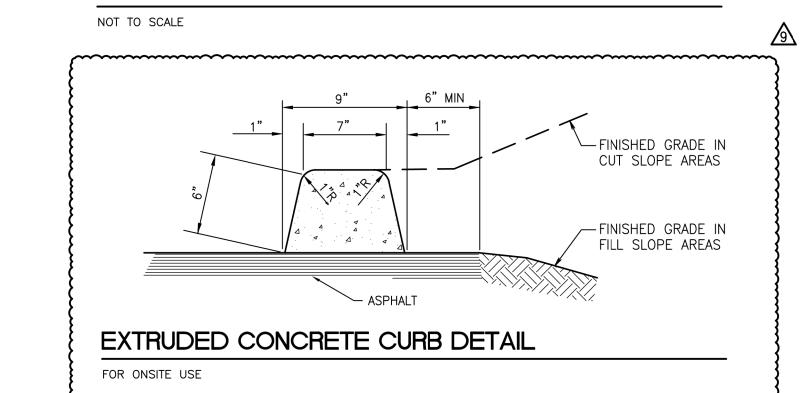

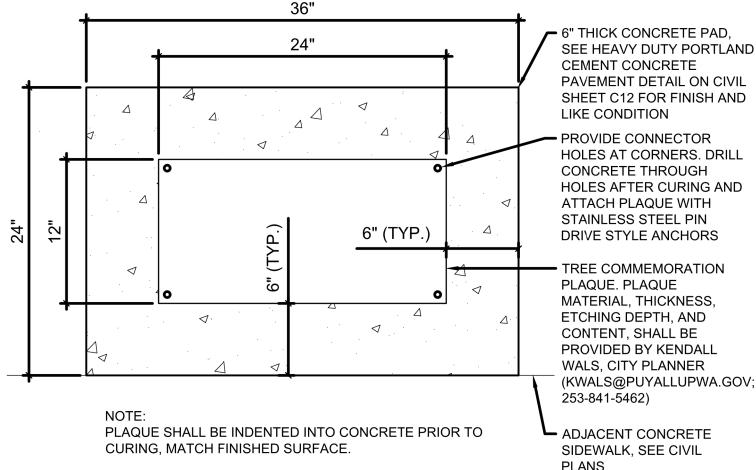


TREE COMMEMORATION PLAQUE

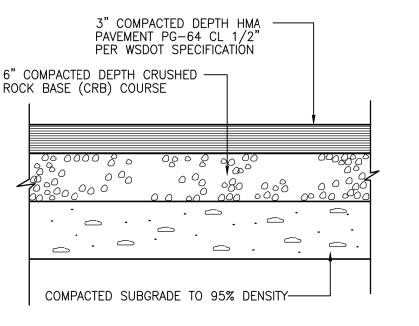

HMA ASPHALT HEAVY DUTY PAVEMENT SECTION

NOTE: PAVEMENT SECTION TO BE IN ACCORDANCE WITH RECOMMENDATIONS OF THE GEOTECHNICAL REPORT DATED JULY 13, 2020, PREPARED BY TERRA ASSOCIATES, INC.

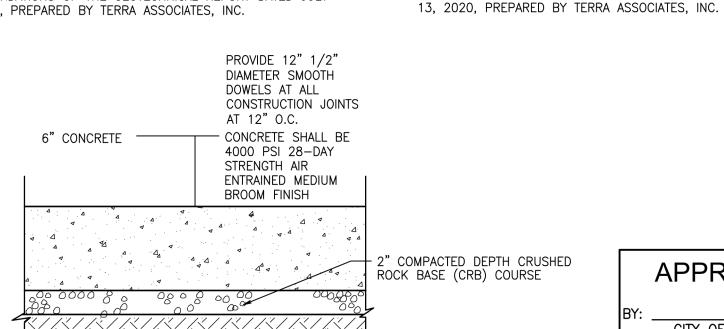

COMPACTED SUBGRADE——

HEAVY DUTY PORTLAND CEMENT

RECOMMENDATIONS OF THE GEOTECHNICAL REPORT DATED JULY

NOTE: PAVEMENT SECTION TO BE IN ACCORDANCE WITH

13, 2020, PREPARED BY TERRA ASSOCIATES, INC.

CONCRETE PAVEMENT

NOT TO SCALE

TO 95% DENSITY

ROCK BASE (CRB) COURSE

PAVEMENT PG-64 CL 1/2'

PER WSDOT SPECIFICATION

COMPACTED SUBGRADE TO 95% DENSITY-

LIGHT DUTY PAVEMENT SECTION

RECOMMENDATIONS OF THE GEOTECHNICAL REPORT DATED JULY

NOTE: PAVEMENT SECTION TO BE IN ACCORDANCE WITH

4" COMPACTED DEPTH CRUSHED -

HMA ASPHALT

NOT TO SCALE

ROCK BASE (CRB) COURSE

CITY OF PUYALLUP ENGINEERING SERVICES

THIS APPROVAL IS VOID AFTER YEAR FROM APPROVAL DATE. THE CITY WILL NOT BE RESPONSIBLE FOR ERRORS AND/OR OMISSIONS ON THESE FIELD CONDITIONS MAY DICTATE CHANGES TO THESE PLANS AS DETERMINED BY THE ENGINEERING SERVICES MANAGER

APPROVED

Ö

CO.

I DEVELOPMENT CH STREET, SUITE STON. WA 98057

GENERAL NOTES

- 1. ALL WORK IN CITY RIGHT-OF-WAY REQUIRES A PERMIT FROM THE CITY OF PUYALLUP, PRIOR TO ANY WORK COMMENCING, THE GENERAL CONTRACTOR SHALL ARRANGE FOR A PRECONSTRUCTION MEETING AT THE DEVELOPMENT SERVICES CENTER TO BE ATTENDED BY ALL CONTRACTORS THAT WILL PERFORM WORK SHOWN ON THE APPROVED ENGINEERING PLANS, REPRESENTATIVES FROM ALL APPLICABLE UTILITY COMPANIES, THE PROJECT OWNER AND APPROPRIATE CITY STAFF. CONTACT ENGINEERING SERVICES AT (253-841-5568) TO SCHEDULE THE MEETING. THE CONTRACTOR IS RESPONSIBLE TO HAVE THEIR OWN SET OF APPROVED PLANS
- AFTER COMPLETION OF ALL ITEMS SHOWN ON THESE PLANS AND BEFORE ACCEPTANCE OF THE PROJECT THE CONTRACTOR SHALL OBTAIN A "PUNCH LIST" PREPARED BY THE CITY'S INSPECTOR DETAILING REMAINING ITEMS OF WORK TO BE COMPLETED. ALL ITEMS OF WORK SHOWN ON THESE PLANS SHALL BE COMPLETED TO THE SATISFACTION OF THE CITY PRIOR TO ACCEPTANCE OF THE WATER SYSTEM AND PROVISION OF SANITARY SEWER SERVICE.
- 3. ALL MATERIALS AND WORKMANSHIP SHALL CONFORM TO THE STANDARD SPECIFICATIONS FOR ROAD, BRIDGE, AND MUNICIPAL CONSTRUCTION (HEREINAFTER REFERRED TO AS THE "STANDARD SPECIFICATIONS"), WASHINGTON STATE DEPARTMENT OF TRANSPORTATION AND AMERICAN PUBLIC WORKS ASSOCIATION. WASHINGTON STATE CHAPTER, LATEST EDITION, UNLESS SUPERSEDED OR AMENDED BY THE CITY OF PUYALLUP CITY STANDARDS FOR PUBLIC WORKS ENGINEERING AND CONSTRUCTION (HEREINAFTER REFERRED TO AS THE "CITY STANDARDS").
- 4. A COPY OF THESE APPROVED PLANS AND APPLICABLE CITY DEVELOPER SPECIFICATIONS AND DETAILS SHALL BE ON SITE
- 5. ANY REVISIONS MADE TO THESE PLANS MUST BE REVIEWED AND APPROVED BY THE DEVELOPER'S ENGINEER AND THE CITY PRIOR TO ANY IMPLEMENTATION IN THE FIELD. THE CITY SHALL NOT BE RESPONSIBLE FOR ANY ERRORS AND/OR OMISSIONS ON THESE
- 6. THE CONTRACTOR SHALL HAVE ALL UTILITIES VERIFIED ON THE GROUND PRIOR TO ANY CONSTRUCTION. CALL AT LEAST TWO WORKING DAYS IN ADVANCE. THE OWNER AND HIS/HER ENGINEER SHALL BE CONTACTED IMMEDIATELY IF A CONFLICT EXISTS.
- 7. ANY STRUCTURE AND/OR OBSTRUCTION THAT REQUIRES REMOVAL OR RELOCATION RELATING TO THIS PROJECT SHALL BE DONE SO AT THE DEVELOPER'S EXPENSE.
- 8. LOCATIONS OF EXISTING UTILITIES ARE APPROXIMATE, IT SHALL BE THE CONTRACTOR'S RESPONSIBILITY TO DETERMINE THE TRUE ELEVATIONS AND LOCATIONS OF HIDDEN UTILITIES. ALL VISIBLE
- 9. THE CONTRACTOR SHALL INSTALL, REPLACE, OR RELOCATE ALL SIGNS. AS SHOWN ON THE PLANS OR AS AFFECTED BY CONSTRUCTION, PER CITY STANDARDS.

ITEMS SHALL BE THE ENGINEER'S RESPONSIBILITY.

- 10. POWER, STREET LIGHT, CABLE, AND TELEPHONE LINES SHALL BE IN A TRENCH LOCATED WITHIN A 10-FOOT UTILITY EASEMENT ADJACENT TO PUBLIC RIGHT-OF-WAY. RIGHT-OF-WAY CROSSINGS SHALL HAVE A MINIMUM HORIZONTAL SEPARATION FROM OTHER UTILITIES (SEWER, WATER, AND STORM) OF 5 FEET.
- 11. ALL CONSTRUCTION SURVEYING FOR EXTENSIONS OF PUBLIC FACILITIES SHALL BE DONE UNDER THE DIRECTION OF A WASHINGTON STATE LICENSED LAND SURVEYOR OR A WASHINGTON STATE LICENSED PROFESSIONAL CIVIL ENGINEER.
- 12. DURING CONSTRUCTION, ALL PUBLIC STREETS ADJACENT TO THIS PROJECT SHALL BE KEPT CLEAN OF ALL MATERIAL DEPOSITS RESULTING FROM ON-SITE CONSTRUCTION, AND EXISTING STRUCTURES SHALL BE PROTECTED AS DIRECTED BY THE CITY.
- 13. CERTIFIED RECORD DRAWINGS ARE REQUIRED PRIOR TO PROJECT
- 14. A NPDES STORMWATER GENERAL PERMIT MAY BE REQUIRED BY THE DEPARTMENT OF ECOLOGY FOR THIS PROJECT. FOR INFORMATION CONTACT THE DEPARTMENT OF ECOLOGY, SOUTHWEST REGION OFFICE AT (360)407-6300.
- 15. ANY DISTURBANCE OR DAMAGE TO CRITICAL AREAS AND ASSOCIATED BUFFERS. OR SIGNIFICANT TREES DESIGNATED FOR PRESERVATION AND PROTECTION SHALL BE MITIGATED IN ACCORDANCE WITH A MITIGATION PLAN REVIEWED AND APPROVED BY THE CITY'S PLANNING DIVISION. PREPARATION AND IMPLEMENTATION OF THE MITIGATION PLAN SHALL BE AT THE DEVELOPER'S EXPENSE.

STORMWATER NOTES:

- ALL WORK IN CITY RIGHT-OF-WAY REQUIRES A PERMIT FROM THE CITY OF PUYALLUP. PRIOR TO ANY WORK COMMENCING, THE GENERAL CONTRACTOR SHALL ARRANGE FOR A PRECONSTRUCTION MEETING AT THE DEVELOPMENT SERVICES CENTER TO BE ATTENDED BY ALL CONTRACTORS THAT WILL PERFORM WORK SHOWN ON THE ENGINEERING PLANS. REPRESENTATIVES FROM ALL APPLICABLE UTILITY COMPANIES, THE PROJECT OWNER AND APPROPRIATE CITY STAFF. CONTACT ENGINEERING SERVICES TO SCHEDULE THE MEETING (253) 841-5568. THE CONTRACTOR IS RESPONSIBLE TO HAVE THEIR OWN APPROVED SET OF PLANS AT THE MEETING.
- 2. AFTER COMPLETION OF ALL ITEMS SHOWN ON THESE PLANS AND BEFORE ACCEPTANCE OF THE PROJECT, THE CONTRACTOR SHALL OBTAIN A "PUNCH LIST" PREPARED BY THE CITY'S INSPECTOR DETAILING REMAINING ITEMS OF WORK TO BE COMPLETED. ALL ITEMS OF WORK SHOWN ON THESE PLANS SHALL BE COMPLETED TO THE SATISFACTION OF THE CITY PRIOR TO ACCEPTANCE OF THE WATER SYSTEM AND PROVISION OF SANITARY SEWER
- 3. ALL MATERIALS AND WORKMANSHIP SHALL CONFORM TO THE STANDARD SPECIFICATIONS FOR ROAD, BRIDGE, AND MUNICIPAL CONSTRUCTION (HEREINAFTER REFERRED TO AS THE "STANDARD SPECIFICATIONS") WASHINGTON STATE DEPARTMENT OF TRANSPORTATION AND AMERICAN PUBLIC WORKS ASSOCIATION, WASHINGTON STATE CHAPTER, LATEST EDITION, UNLESS SUPERSEDED OR AMENDED BY THE CITY OF PUYALLUF CITY STANDARDS FOR PUBLIC WORKS ENGINEERING AND CONSTRUCTION (HEREINAFTER REFERRED TO AS THE "CITY STANDARDS").
- 4. A COPY OF THESE APPROVED PLANS AND APPLICABLE CITY DEVELOPER SPECIFICATIONS AND DETAILS SHALL BE ON SITE DURING CONSTRUCTION.
- 5. ANY REVISIONS MADE TO THESE PLANS MUST BE REVIEWED AND APPROVED BY THE DEVELOPER'S ENGINEER AND THE ENGINEERING SERVICES STAFF PRIOR TO ANY IMPLEMENTATION IN THE FIELD. THE CITY SHALL NOT BE RESPONSIBLE FOR ANY ERRORS AND/OR OMISSIONS ON
- 6. THE CONTRACTOR SHALL HAVE ALL UTILITIES VERIFIED ON THE GROUND PRIOR TO ANY CONSTRUCTION. CALL (811) AT LEAST TWO WORKING DAYS IN ADVANCE. THE OWNER AND HIS/HER ENGINEER SHALL BE CONTACTED IMMEDIATELY IF A CONFLICT EXISTS.
- ANY STRUCTURE AND/OR OBSTRUCTION WHICH REQUIRE REMOVAL OR RELOCATION RELATING TO THIS PROJECT, SHALL BE DONE SO AT THE DEVELOPER'S EXPENSE.
- 8. DURING CONSTRUCTION, ALL EXISTING AND NEWLY INSTALLED DRAINAGE STRUCTURES SHALL BE PROTECTED FROM SEDIMENTS.
- 9. ALL STORM MANHOLES SHALL CONFORM TO CITY STANDARD DETAIL NO. 02.01.01. FLOW CONTROL MANHOLE/OIL WATER SEPARATOR SHALL

CONFORM TO CITY STANDARD DETAIL NO. 02.01.06 AND 02.01.07.

- 10. MANHOLE RING AND COVER SHALL CONFORM TO CITY STANDARD DETAIL 06.01.02 AND 06.01.03. THE COVER SHALL BE MARKED WITH "STORM" OR "DRAIN" IN 2-INCH RAISED LETTERS. MINIMUM WEIGHT OF THE FRAME SHALL BE 210 POUNDS, MINIMUM WEIGHT OF THE COVER SHALL BE 150
- 11. CATCH BASINS TYPE I SHALL CONFORM TO CITY STANDARD DETAIL NO.02.01.02 AND 02.01.03 AND SHALL BE USED ONLY FOR DEPTHS LESS THAN 5 FEET FROM TOP OF THE GRATE TO THE INVERT OF THE STORM PIPE. CITY OF PUYALLUP - CITY STANDARDS STORM REVISED 3/14/2016 200-17.
- 12. CATCH BASINS TYPE II SHALL CONFORM TO CITY STANDARD DETAIL FROM TOP OF THE GRATE TO THE INVERT OF THE STORM PIPE.
- 13. CAST IRON OR DUCTILE IRON FRAME AND GRATE SHALL CONFORM TO CITY STANDARD DETAIL NO.02.01.05. GRATE SHALL BE MARKED WITH "DRAINS TO STREAM". SOLID CATCH BASIN LIDS (SQUARE UNLESS NOTED AS SHALL CONFORM TO WSDOT STANDARD PLAN B-2 (OLYMPIC FOUNDRY NO. SM60 OR EQUAL), VANED GRATES SHALL CONFORM TO WSDOT STANDARD PLAN B-2A (OLYMPIC FOUNDRY NO. SM60V OR EQUAL).
- 14. STORMWATER PIPE SHALL BE ONLY PVC, CONCRETE OR DUCTILE IRON
- a. THE USE OF ANY OTHER TYPE SHALL BE REVIEWED AND APPROVED BY THE ENGINEERING SERVICES STAFF PRIOR TO INSTALLATION.
- b. PVC PIPE SHALL BE PER ASTM D3034, SDR 35 FOR PIPE SIZE 15-INCH AND SMALLER AND F679 FOR PIPE SIZES 18 TO 27 INCH. MINIMUM COVER ON PVC PIPE SHALL BE 3.0 FEET.
- c. CONCRETE PIPE SHALL CONFORM TO THE WSDOT STANDARD SPECIFICATIONS FOR CONCRETE UNDERDRAIN PIPE. MINIMUM COVER ON CONCRETE PIPE SHALL NOT LESS THAN 3.0 FEET.
- d. DUCTILE IRON PIPE SHALL BE CLASS 50, CONFORMING TO AWWA C151. MINIMUM COVER ON DUCTILE IRON PIPE SHALL BE 1.0 FOOT.
- f. POLYPROPYLENE PIPE (PP) SHALL BE DUAL WALLED, HAVE A SMOOTH INTERIOR AND EXTERIOR CORRUGATIONS AND MEET WSDOT 9-05.24(1). 12-INCH THROUGH 30"-INCH PIPE SHALL MEET OR EXCEED ASTM F2736 AND AASHTO M330, TYPE S, OR TYPE D. 36-INCH THROUGH 60-INCH PIPE SHALL MEET OR EXCEED ASTM F2881 AND AASHTO M330, TYPE S, OR TYPE D. TESTING SHALL BE PER ASTM F1417. MINIMUM COVER OVER POLYPROPYLENE PIPE SHALL BE 3-FEET.
- 15. TRENCHING, BEDDING, AND BACKFILL FOR PIPE SHALL CONFORM TO CITY STANDARD DETAIL NO. 06.01.01.


16. STORM PIPE SHALL BE A MINIMUM OF 10 FEET AWAY FROM BUILDING


- FOUNDATIONS AND/OR ROOF LINES.
- 17. ALL STORM DRAIN MAINS SHALL BE VIDEO INSPECTED BY THE CITY OF PUYALLUP COLLECTIONS DIVISION PRIOR TO FINAL ACCEPTANCE BY THE
- 18. AFTER ALL OTHER UTILITIES ARE INSTALLED AND PRIOR TO ASPHALT WORK, ALL STORM PIPE SHALL PASS A LOW PRESSURE AIR TEST IN ACCORDANCE WITH SECTION 7-04.3(4)D OF THE STANDARD SPECIFICATIONS. PRODUCTS USED TO SEAL THE INSIDE OF THE PIPE ARE NOT TO BE USED TO OBTAIN THE AIR TEST.
- 19. ALL STORM DRAIN MAINS SHALL BE MANDRELLED.
- 20. ALL TEMPORARY SEDIMENTATION AND EROSION CONTROL MEASURES, AND PROTECTIVE MEASURES FOR CRITICAL AREAS AND SIGNIFICANT TREES SHALL BE INSTALLED PRIOR TO INITIATING ANY CONSTRUCTION ACTIVITIES.

CONSTRUCTION NOTES AND DETAILS

PUYALLUP CORPORATE PARK

A PORTION OF THE NE¹/₄ OF THE SW¹/₄ OF SEC. 26, TWP. 20 NORTH, RGE. 4 EAST, W.M.

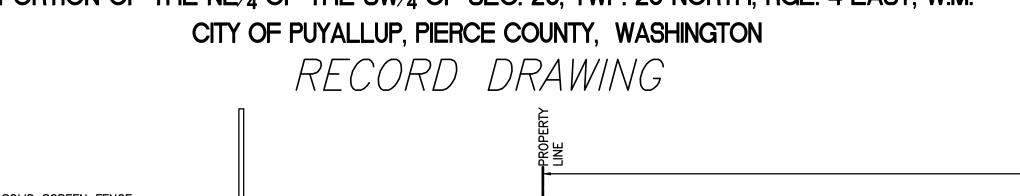

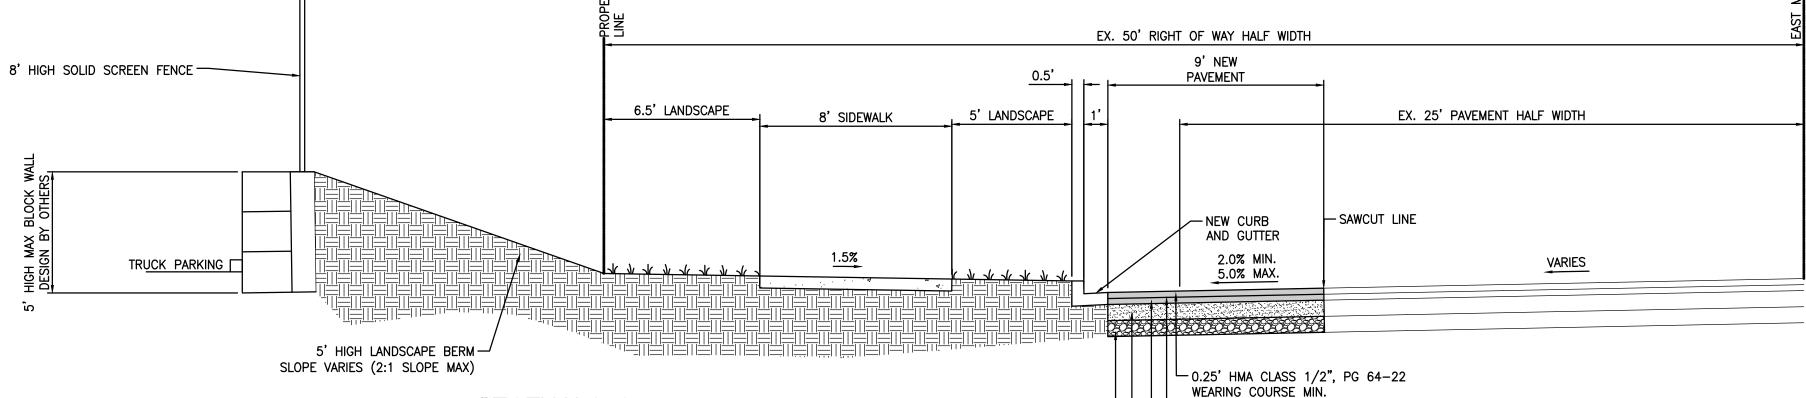

EAST MAIN AVE PROPOSED ROAD SECTION

SECTION A-A

WATER SYSTEM NOTES:

- ALL WORK IN CITY RIGHT-OF-WAY REQUIRES A PERMIT FROM THE CITY OF PUYALLUP. PRIOR TO ANY WORK COMMENCING, THE GENERAL CONTRACTOR SHALL ARRANGE FOR A PRECONSTRUCTION MEETING AT THE DEVELOPMENT SERVICES CENTER TO BE ATTENDED BY ALL CONTRACTORS THAT WILL PERFORM WORK SHOWN ON THE ENGINEERING PLANS, REPRESENTATIVES FROM ALL APPLICABLE UTILITY COMPANIES. THE PROJECT OWNER AND APPROPRIATE CITY STAFF. CONTACT ENGINEERING SERVICES TO SCHEDULE THE MEETING 841-5568. THE CONTRACTOR IS RESPONSIBLE TO HAVE THEIR OWN APPROVED SET OF PLANS AT THE MEETING.
- AFTER COMPLETION OF ALL ITEMS SHOWN ON THESE PLANS AND BEFORE ACCEPTANCE OF THE PROJECT. THE CONTRACTOR SHALL OBTAIN A "PUNCH LIST" PREPARED BY THE CITY'S INSPECTOR DETAILING REMAINING ITEMS OF WORK TO BE COMPLETED. ALL ITEMS OF WORK SHOWN ON THESE PLANS SHALL BE COMPLETED TO THE SATISFACTION OF THE CITY PRIOR TO ACCEPTANCE OF THE WATER SYSTEM AND PROVISION OF SANITARY SEWER
- 3. ALL MATERIALS AND WORKMANSHIP SHALL CONFORM TO THE STANDARD (HEREINAFTER REFERRED TO AS THE "STANDARD SPECIFICATIONS" WASHINGTON STATE DEPARTMENT OF TRANSPORTATION AND AMERICAN PUBLIC WORKS ASSOCIATION. WASHINGTON STATE CHAPTER. LATEST EDITION. UNLESS SUPERSEDED OR AMENDED BY THE CITY OF PUYALLUP CITY STANDARDS FOR PUBLIC WORKS ENGINEERING AND CONSTRUCTION (HEREINAFTER REFERRED TO AS THE "CITY STANDARDS"), OR AS DIRECTED BY FRUITLAND MUTUAL WATER COMPANY (FMWC), VALLEY WATER (VW), OR TACOMA CITY WATER (TCW) IS THE PURVEYOR.
- 4. A COPY OF THESE APPROVED PLANS AND APPLICABLE CITY DEVELOPER SPECIFICATIONS AND DETAILS SHALL BE ON SITE DURING CONSTRUCTION.
- 5. ANY REVISIONS MADE TO THESE PLANS MUST BE REVIEWED AND APPROVED BY THE DEVELOPER'S ENGINEER AND THE ENGINEERING SERVICES STAFF, AND THE FMWC. VW OR TCW WHEN SERVED BY THAT PURVEYOR. PRIOR TO ANY IMPLEMENTATION IN THE FIELD. THE CITY SHALL NOT BE RESPONSIBLE FOR ANY ERRORS AND/OR OMISSIONS ON THESE PLANS.
- 6. THE CONTRACTOR SHALL HAVE ALL UTILITIES VERIFIED ON THE GROUND PRIOR TO ANY CONSTRUCTION. CALL AT LEAST TWO WORKING DAYS IN ADVANCE. THE OWNER AND HIS/HER ENGINEER SHALL BE CONTACTED IMMEDIATELY IF A CONFLICT EXISTS.
- 7. ANY STRUCTURE AND/OR OBSTRUCTION WHICH REQUIRES REMOVAL OR RELOCATION RELATING TO THIS PROJECT SHALL BE DONE SO AT THE DEVELOPER'S EXPENSE.
- 8. BACTERIOLOGICAL (COLIFORM AND IRON BACTERIA) TEST SAMPLES WILL BE TAKEN BY THE CITY (OR FMWC, VW OR TCW WHEN SERVED BY THAT PURVEYOR) AND PAID FOR BY THE CONTRACTOR. 9. WATER MAINS SHALL HAVE A MINIMUM COVER OF 36 INCHES FROM PAVED
- A MINIMUM OF 48 INCHES IN UNIMPROVED RIGHT-OFWAY AND UNIMPROVED 10. PIPE FOR WATER MAINS SHALL BE DUCTILE IRON CONFORMING TO SECTION 7-09 OF THE STANDARD SPECIFICATIONS, CLASS 52 WITH TYTON OR

APPROVED EQUAL JOINTS. PIPE SHALL BE CEMENT LINED IN ACCORDANCE

WITH A.S.A. SPECIFICATION A 21.4-1964.

FINAL GRADE IN IMPROVED RIGHT-OF-WAY AND IMPROVED EASEMENTS. AND

- 11. CONNECTIONS TO EXISTING WATER MAINS TYPICALLY SHALL BE WET TAPS THROUGH A TAPPING TEE AND TAPPING VALVE AND SHALL BE MADE BY A CITY APPROVED CONTRACTOR. THE TAPPING SLEEVE SHALL BE ROMAC SST ALL STAINLESS STEEL TAPPING SLEEVE OR APPROVED EQUAL. A TWO-PIECE EPOXY COATED OR DUCTILE IRON TAPPING SLEEVE MAY BE USED ON DUCTILE IRON PIPE, WHEN THE TAP IS SMALLER THAN THE WATER MAIN SIZE I.E. 6 INCH TAP ON 8 INCH PIPE. THE CITY (OR FMWC, VW OR TCW WHEN SERVED BY THAT PURVEYOR) SHALL APPROVE THE TIME AND LOCATION FOR THESE CONNECTIONS.
- 12. ALL WATER MAINS AND APPURTENANCES SHALL BE HYDROSTATICALLY TESTED AT 200 PSI IN ACCORDANCE WITH CITY STANDARDS. PRESSURE TESTING SHALL NOT BE PERFORMED UNTIL SATISFACTORY PURITY SAMPLES HAVE BEEN RECEIVED, EXCEPT WHEN NEW WATER MAINS ARE INSTALLED INDEPENDENTLY FROM THE WATER SYSTEM PIPING.
- 13. FIRE HYDRANTS SHALL BE INSTALLED IN ACCORDANCE WITH CITY STANDARD DETAIL 03.05.01 AND AS DIRECTED BY THE CITY OF PUYALLUP FIRE CODE
- 14. VALVE MARKER POSTS SHALL BE INSTALLED WHERE VALVE BOXES ARE HIDDEN FROM VIEW OR IN UNPAVED THE INSTALLATION SHALL BE IN ACCORDANCE WITH CITY STANDARD DETAIL 03.01.02.
- 15. RESILIENT SEATED WEDGE GATE VALVES SHALL BE USED FOR 10-INCH MAINS AND SMALLER. BUTTERFLY VALVES SHALL BE USED FOR MAINS GREATER THAN 10 INCHES.
- 16. PIPE FITTING FOR WATER MAINS SHALL BE DUCTILE IRON AND SHALL BE MECHANICAL JOINT CONFORMING TO AWWA SPECIFICATION C111-72.
- 17. WATER MAIN PIPE AND SERVICE CONNECTIONS SHALL BE A MINIMUM OF 10 FEET AWAY FROM BUILDING FOUNDATIONS AND/OR ROOF LINES.

- 18. WHERE A WATER MAIN CROSSES THE NORTHWEST GAS PIPELINE, THE WATER LINE SHALL BE CASED WITH PVC PIPE A MINIMUM OF 10 FEET BEYOND EACH SIDE OF THE GAS LINE EASEMENT. CONTACT WILLIAMS NORTHWEST PIPELINE BEFORE THE CROSSING IS MADE.
- 19. TRENCHING, BEDDING, AND BACKFILL FOR WATER MAINS SHALL BE INSTALLED IN ACCORDANCE WITH CITY STANDARD DETAIL 06.01.01.
- 20. ALL COMMERCIAL AND INDUSTRIAL DEVELOPMENTS, IRRIGATION SYSTEMS. AND MULTI-FAMILY WATER SERVICE CONNECTIONS SHALL BE PROTECTED BY A DOUBLE CHECK VALVE ASSEMBLY OR A REDUCED PRESSURE BACKFLOW ASSEMBLY AS DIRECTED BY THE CITY (OR FMWC, VW OR TCW WHEN SERVED BY THAT PURVEYOR) CONFORMING TO CITY STANDARD DETAILS 03.04.01 AND 03.04.02-1, 03.04.02-2 AND 03.04.03.
- 21. ANY LEAD JOINT FITTING DISTURBED DURING CONSTRUCTION SHALL BE REPLACED WITH A MECHANICAL JOINTFITTING AT THE CONTRACTOR'S
- 22. WHEN HYDRAULIC FIRE FLOW MODELING IS REQUIRED FOR A PROJECT, THE CITY WILL ISSUE A PERMIT. THEHYDRAULIC MODELING CRITERIA IS BASED ON THE PROJECTED 2030 WATER DEMAND, WHILE MAINTAINING CITY OF PUYALLUP - CITY STANDARDS WATER REVISED 2/2/2017 300-7. A MINIMUM SYSTEM PRESSURE OF 20 POUNDS PER SQUARE INCH AND A MAXIMUM VELOCITY OF 10 FEET PER SECOND.
- 23. WHEN FILLING A NEW WATER MAIN FOR PURITY WITH HIGHLY CONCENTRATED CHLORINE WATER, THAT "SUPER" CHLORINATED WATER CANNOT SIT INSIDE THE NEW WATER MAIN FOR GREATER THAN 5 DAYS.
- 24. WHEN USING A FIRE HYDRANT FOR NON-FIREFIGHTING PURPOSES. A CITY HYDRANT METER MUST BE USED. COORDINATE THE ACQUISITION OF THE HYDRANT METER WITH THE CITY'S UTILITY BILLING DIVISION AT PUYALLUP CITY HALL. A CITY APPROVED BACKELOW PROTECTION ASSEMBLY SHALL BE INSTALLED BY THE PERSON REQUESTING USE OF A FIRE HYDRANT. THE ASSEMBLY SHALL BE ACCOMPANIED BY A CURRENT BACKFLOW ASSEMBLY TEST REPORT. THE TEST REPORT SHALL BE AVAILABLE AT THE SITE FOR THE DURATION OF THE HYDRANT USE.

SANITARY SEWER NOTES:

- . ALL WORK IN CITY RIGHT-OF-WAY REQUIRES A PERMIT FROM THE CITY OF PLIYALLUP PRIOR TO ANY WORK COMMENCING THE GENERAL CONTRACTOR SHALL ARRANGE FOR A PRECONSTRUCTION MEETING AT THE DEVELOPMENT SERVICES CENTER TO BE ATTENDED BY ALL CONTRACTORS THAT WILL PERFORM WORK SHOWN ON THE ENGINEERING PLANS, REPRESENTATIVES FROM ALL APPLICABLE UTILITY COMPANIES, THE PROJECT OWNER AND APPROPRIATE CITY STAFF, CONTACT ENGINEERING SERVICES TO SCHEDULE THE MEETING 841-5568. THE CONTRACTOR IS RESPONSIBLE TO HAVE THEIR OWN APPROVED SET OF PLANS AT THE
- AFTER COMPLETION OF ALL ITEMS SHOWN ON THESE PLANS AND BEFORE ACCEPTANCE OF THE PROJECT, THE CONTRACTOR SHALL OBTAIN A "PUNCH LIST" PREPARED BY THE CITY'S INSPECTOR DETAILING REMAINING ITEMS OF WORK TO BE COMPLETED. ALL ITEMS OF WORK SHOWN ON THESE PLANS SHALL BE COMPLETED TO THE SATISFACTION OF THE CITY PRIOR TO ACCEPTANCE OF THE WATER SYSTEM AND PROVISION OF SANITARY SEWER SERVICE.
- 3. ALL MATERIALS AND WORKMANSHIP SHALL CONFORM TO THE STANDARD SPECIFICATIONS FOR ROAD, BRIDGE, AND MUNICIPAL CONSTRUCTION (HEREINAFTER REFERRED TO AS THE "STANDARD SPECIFICATIONS"), WASHINGTON STATE DEPARTMENT OF TRANSPORTATION AND AMERICAN PUBLIC WORKS ASSOCIATION, WASHINGTON STATE CHAPTER, LATEST EDITION, UNLESS SUPERSEDED OR AMENDED BY THE CITY OF PUYALLUP CITY STANDARDS FOR PUBLIC WORKS ENGINEERING AND CONSTRUCTION (HEREINAFTER REFERRED TO AS THE "CITY STANDARDS").
- 4. A COPY OF THESE APPROVED PLANS AND APPLICABLE CITY DEVELOPER SPECIFICATIONS AND DETAILS SHALL BE ON SITE DURING CONSTRUCTION.
- 5. ANY REVISIONS MADE TO THESE PLANS MUST BE REVIEWED AND APPROVED BY THE DEVELOPER'S ENGINEER AND THE ENGINEERING SERVICES STAFF PRIOR TO ANY IMPLEMENTATION IN THE FIELD. THE CITY SHALL NOT BE RESPONSIBLE FOR ANY ERRORS AND/OR OMISSIONS ON THESE PLANS.
- THE CONTRACTOR SHALL HAVE ALL UTILITIES VERIFIED ON THE GROUND PRIOR TO ANY CONSTRUCTION. CALL AT LEAST TWO WORKING DAYS IN ADVANCE. THE OWNER AND HIS/HER ENGINEER SHALL BE CONTACTED IMMEDIATELY IF A CONFLICT EXISTS.
- ANY STRUCTURE AND/OR OBSTRUCTION WHICH REQUIRE REMOVAL OR RELOCATION RELATING TO THIS PROJECT SHALL BE DONE SO AT THE DEVELOPER'S EXPENSE
- MINIMUM GRADE ON ALL 4 INCH RESIDENTIAL SIDE SEWERS SHALL BE 2 PERCENT AND 6 INCH COMMERCIAL SIDE SEWERS SHALL BE 1 PERCENT; MAXIMUM SHALL BE 8 PERCENT. ALL SIDE SEWERS SHALL BE 6 INCHES WITHIN CITY RIGHT-OF-WAY.
- SIDE SEWERS SHALL BE INSTALLED IN ACCORDANCE WITH CITY STANDARD NOS. 04.03.01. 04.03.02. 04.03.03 AND 04.03.04. SIDE SEWER INSTALLATION WORK SHALL BE DONE IN ACCORDANCE WITH THE WASHINGTON INDUSTRIAL SAFETY AND HEALTH ACT (WISHA).

10. ALL SEWER PIPE SHALL BE PVC, POLYPROPYLENE, OR DUCTILE IRON. PVC SEWER PIPE SHALL CONFORM TO ASTM D-3034, SDR35 FOR PIPE SIZES 15-INCH AND SMALLER AND ASTM F679 FOR PIPE SIZES 18-27 INCH, DUCTILE IRON PIPE SHALL BE CLASS 51 OR GREATER, LINED WITH PROTECTO 401TM EPOXY LINING OR EQUIVALENT, UNLESS OTHERWISE NOTED. 12-INCH THROUGH 30-INCH POLYPROPYLENE PIPE (PP) SHALL BE DUAL WALLED, HAVE A SMOOTH INTERIOR AND EXTERIOR CORRUGATIONS AND MEET WSDOT 9-05.24(2). IT SHALL MEET OR EXCEED ASTM F2764. PP SHALL HAVE A MINIMUM PIPE STIFFNESS OF 46 PII WHEN TESTED IN ACCORDANCE WITH ASTM D2412. TESTING SHALL BE PER ASTM F1417. TRENCHING, BEDDING, AND BACKFILL SHALL BE IN ACCORDANCE WITH CITY STANDARD NO. 06.01.01. MINIMUM COVER ON PVC AND PP PIPE SHALL BE 3.0 FEET. MINIMUM COVER ON DUCTILE IRON PIPE SHALL BE 1.0 FEET.

-0.25' HMA CLASS 1/2", PG 58V-22

-BASE CAN BE COMBINATION OF ATB AND/OR CRUSHED

SURFACING TOP COURSE MIN. THICKNESS OF 0.67' IF

ONLY CRUSHED SURFACING TOP COURSE IS USED.

SUBBASE SHALL BE GRAVEL BASE W/ THICKNESS TO

LEVELING COURSE MIN.

BE DETERMINED BY DESIGN

- 11. SANITARY SEWER MANHOLES FRAMES AND COVERS SHALL CONFORM TO CITY STANDARD NO. 06.01.02.
- 12. SANITARY SEWER MANHOLES SHALL CONFORM TO CITY STANDARD NOS. 04.01.01, 04.01.02, 04.01.03 AND 04.01.04. ALL MANHOLES SHALL BE CHANNELED FOR FUTURE LINES AS SPECIFIED ON THESE PLANS. MANHOLE STEPS AND LADDER SHALL CONFORM TO STANDARD NO.
- 13. SANITARY SEWER PIPE AND SIDE SEWERS SHALL BE 10 FEET AWAY FROM BUILDING FOUNDATIONS AND/OR ROOF LINES WITH THE EXCEPTION OF SIDE SEWERS THAT PROVIDE SERVICE TO A SINGLE-FAMILY RESIDENCE. AT THE DISCRETION OF THE REVIEW ENGINEER. A LICENSED ENGINEER WILL BE REQUIRED TO STAMP THE DESIGN TO ACCOUNT FOR DEPTH OR PROXIMITY TO FOUNDATION, STEEP SLOPES, OR OTHER FACTORS.
- 14. NO SIDE SEWERS SHALL BE CONNECTED TO ANY HOUSE OR BUILDING UNTIL ALL MANHOLES ARE ADJUSTED TO THE FINISHED GRADE OF THE COMPLETED ASPHALT ROADWAY AND THE ASPHALT PATCH AND SEAL AROUND THE RING ARE ACCEPTED.
- 15. FOR COMMERCIAL DEVELOPMENTS IN WHICH SOURCES OF GREASE AND/OR OILS MAY BE INTRODUCED TO THE CITY SANITARY SEWER SYSTEM, A CITY APPROVED GREASE INTERCEPTOR SHALL BE INSTALLED DOWNSTREAM FROM THE SOURCE.
- 16. ONCE SEWER AND ALL OTHER UTILITY CONSTRUCTION IS COMPLETED, ALL SANITARY SEWER MAINS AND SIDE SEWERS SHALL BE TESTED PER SECTION 406 OF THE CITY STANDARDS.

ROADWAY NOTES:

- 1. ALL WORK IN CITY RIGHT-OF-WAY REQUIRES A PERMIT FROM THE CITY OF PUYALLUP. PRIOR TO ANY WORK COMMENCING. THE GENERAL CONTRACTOR SHALL ARRANGE FOR A PRECONSTRUCTION MEETING AT THE DEVELOPMENT SERVICES CENTER TO BE ATTENDED BY ALL CONTRACTORS THAT WILL PERFORM WORK SHOWN ON THE ENGINEERING PLANS, REPRESENTATIVES FROM ALL APPLICABLE UTILITY COMPANIES, THE PROJECT OWNER AND APPROPRIATE CITY STAFF. CONTACT ENGINEERING SERVICES TO SCHEDULE THE MEETING (253) 841- 5568. THE CONTRACTOR IS RESPONSIBLE TO HAVE THEIR OWN APPROVED SET OF PLANS AT THE MEETING.
- AFTER COMPLETION OF ALL ITEMS SHOWN ON THESE PLANS AND BEFORE ACCEPTANCE OF THE PROJECT, THE CONTRACTOR SHALL OBTAIN A "PUNCH LIST" PREPARED BY THE CITY'S INSPECTOR DETAILING REMAINING ITEMS OF WORK TO BE COMPLETED. ALL ITEMS OF WORK SHOWN ON THESE PLANS SHALL BE COMPLETED TO THE SATISFACTION OF THE CITY PRIOR TO ACCEPTANCE OF THE WATER SYSTEM AND PROVISION OF SANITARY SEWER SERVICE.
- ALL MATERIALS AND WORKMANSHIP SHALL CONFORM TO THE STANDARD SPECIFICATIONS FOR ROAD, BRIDGE, AND MUNICIPAL CONSTRUCTION (HEREINAFTER REFERRED TO AS THE "STANDARD SPECIFICATIONS"), WASHINGTON STATE DEPARTMENT OF TRANSPORTATION AND AMERICAN PUBLIC WORKS ASSOCIATION, WASHINGTON STATE CHAPTER, LATEST EDITION, UNLESS SUPERSEDED OR AMENDED BY THE CITY OF PUYALLUP CITY STANDARDS FOR PUBLIC WORKS ENGINEERING AND CONSTRUCTION (HEREINAFTER REFERRED TO AS THE "CITY STANDARDS").

- 4. A COPY OF THESE APPROVED PLANS AND APPLICABLE CITY DEVELOPER SPECIFICATIONS AND DETAILS SHALL BE ON SITE DURING CONSTRUCTION
- 5. ANY REVISIONS MADE TO THESE PLANS MUST BE REVIEWED AND APPROVED BY THE DEVELOPER'S ENGINEER AND THE ENGINEERING SERVICES STAFF PRIOR TO ANY IMPLEMENTATION IN THE FIELD. THE CITY SHALL NOT BE RESPONSIBLE FOR ANY ERRORS AND OR OMISSIONS ON
- 6. THE CONTRACTOR SHALL HAVE ALL UTILITIES VERIFIED ON THE GROUND PRIOR TO ANY CONSTRUCTION. CALL (811) AT LEAST TWO WORKING DAYS IN ADVANCE. THE OWNER AND HIS/HER ENGINEER SHALL BE CONTACTED IMMEDIATELY IF A CONFLICT EXISTS.
- 7. ANY STRUCTURE AND/OR OBSTRUCTION WHICH REQUIRES REMOVAL OR RELOCATION RELATING TO THIS PROJECT SHALL BE DONE SO AT THE DEVELOPER'S EXPENSE.
- 8. MONUMENTS SHALL BE INSTALLED AT ALL STREET INTERSECTIONS, AT ANGLE POINTS, AND POINTS OF CURVATURE IN EACH STREET. ALL BOUNDARY MONUMENTS MUST BE INSTALLED ACCORDING TO THE WASHINGTON STATE SUBDIVISION LAWS.
- 9. CURB AND GUTTER INSTALLATION SHALL CONFORM TO CITY STANDARD DETAIL 01.02.09.
- 10. SIDEWALKS AND DRIVEWAYS SHALL BE INSTALLED AS LOTS ARE BUILT ON. SIDEWALKS AND DRIVEWAYS SHALL CONFORM TO CITY STANDARD DETAIL 01.02.01, 01.02.02 AND 01.02.12. IF ASPHALT IS DAMAGED DURING REPLACEMENT OF CURB AND GUTTER, THE REPAIR SHALL CONFORM TO CITY STANDARD DETAIL 01.02.10.
- 11. THE SURROUNDING GROUND (5 FEET BEYOND THE BASE) FOR ALL POWER TRANSFORMERS, TELEPHONE/TV PEDESTALS, AND STREET LIGHT MAIN DISCONNECTS SHALL BE GRADED TO A POSITIVE 2 PERCENT SLOPE FROM TOP OF CURB.
- 12. SIGNAGE AND TRAFFIC CONTROL DEVICES ARE SAFETY ITEMS AND SHALL BE INSTALLED PRIOR TO ISSUANCE OF ANY CERTIFICATE OF OCCUPANCY OR PLAT APPROVAL. HOWEVER, IN LARGER DEVELOPMENTS, EXACT LOCATIONS OF STOP AND YIELD SIGNS MAY NEED TO BE DETERMINED AFTER FULL BUILDOUT WHEN TRAFFIC PATTERNS HAVE BEEN ESTABLISHED. IN THIS CASE. CONTRACTOR SHALL PROVIDE INDICATED "CITY-PLACED" SIGNS, SIGNPOSTS, AND BRACKETS TO THE CITY SIGN SPECIALIST (253) 841-5471 FOR LATER INSTALLATION BY THE CITY. ALI SIGNAGE SHALL BE IN ACCORDANCE WITH THE MANUAL ON UNIFORM TRAFFIC CONTROL DEVICES (MUTCD).
- 13. PRIOR TO ANY SIGN OR STRIPING INSTALLATION OR REMOVAL THE CONTRACTOR SHALL CONTACT THE CITY SIGN SPECIALIST (253) 841-5471 TO ARRANGE FOR AN ON-SITE MEETING TO DISCUSS PLACEMENT AND UNIFORMITY.
- 14. NEW OR REVISED STOP SIGNS OR YIELD SIGNS SHALL BE ADVANCE WARNED USING THE PROCEDURE OUTLINED IN THE MUTCD. ADVANCE WARNING SIGNS AND FLAGS SHALL BE MAINTAINED BY INSTALLER FOR 30 DAYS AND THEN REMOVED.

APPROVED

CITY OF PUYALLUP ENGINEERING SERVICES

THIS APPROVAL IS VOID AFTER YEAR FROM APPROVAL DATE. THE CITY WILL NOT BE RESPONSIBLE FOR ERRORS AND/OR OMISSIONS ON THESE FIELD CONDITIONS MAY DICTATE CHANGES TO THESE PLANS AS DETERMINED BY THE ENGINEERING SERVICES MANAGER.

AND

ONSTRUCTION

CO 33(

VELOPMENT TREET, SUITE WA 98057

TONI / 16TH RENT(


PANA 900 SV

 \Box

PUYALLUP CORPORATE PARK

A PORTION OF THE NE¹/₄ OF THE SW¹/₄ OF SEC. 26, TWP. 20 NORTH, RGE. 4 EAST, W.M. CITY OF PUYALLUP, PIERCE COUNTY, WASHINGTON

RECORD DRAWING

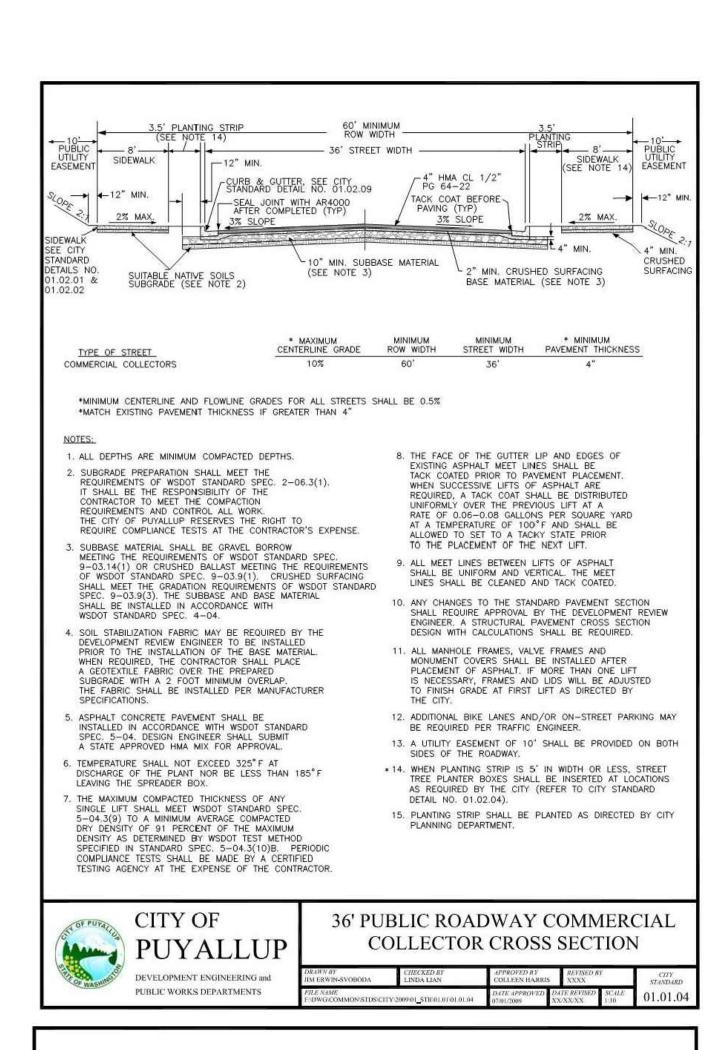

4" MAXIMUM (TYP)-

5'(RS ZONES) SINGLE FAMILY RESIDENTIAL

8'(RM ZONES) MEDIUM AND HIGH DENSIT

8'(CG, CBD ZONES) COMMERCIAL AREAS

8'(PF ZONES) PUBLIC FACILITIES AREAS

8'(ML ZONES) INDUSTRIAL AREAS

8'(F ZONES) FAIR AREAS

SIDEWALK WIDTH

AREAS (DETACHED DWELLINGS)
8'(RS ZONES) COMMERCIAL USES, WHEN REQUIRED

* MATCH GREATEST WIDTH FOR ANY ADJACENT ZONE

PUBLIC WORKS DEPARTMENTS

BY DEVELOPMENT SERVICES MANAGER

MULTI-FAMILY RESIDENTIAL AREAS

CONTRACTION JOINTS SHALL BE 3/8" x 1/2" ASPHALT SATURATED FELT PLACED 15' O.C.

2. THRU JOINTS SHALL BE $3/8" \times 4"$ ASPHALT SATURATED FELT PLACED AT DRIVEWAYS, ALLEY RETURNS AND WHEELCHAIR RAMPS

3. V-GROOVEMARKS SHALL BE 1/8" DEEP AND 1/4" WIDE PLACED AT 5' O.C. FOR 5' SIDEWALKS AND 7.5' O.C. FOR 8' SIDEWALKS.

4. ALL JOINTS SHALL BE CLEAN AND EDGED TO A 1/4" RADIUS. JOINTS SHALL BE FLUSH

5. ALL UTILITY POLES AND STREET SIGN POSTS

SQUARE SECTION OF CONCRETE SURROUNDED BY 3/8" EXPANSION JOINT MATERIAL

6. FORMS SHALL BE EITHER WOOD OR STEEL AND SHALL MEET ALL REQUIREMENTS OF THESE SPECIFICATIONS.

7. CONCRETE SHALL BE CLASS 3000 COMMERCIAL CONCRETE, 5.5 SACK MINIMUM,

AASHTO GRADING 467 COARSE AGGREGATE,

CABLE VAULTS, PULL BOXES AND OTHER

MATCH THE GRADE OF THE SIDEWALK.

TO THE MAXIMUM EXTENT FEASIBLE

SIDEWALK WITH

PLANTING STRII

OF THE CURB

8. SIDEWALK MINIMUM UNOBSTRUCTED CLEAR

WIDTH SHALL BE 4', EXCLUSIVE OF THE WIDTH

APPURTENANCES WITHIN THE SIDEWALK (RIGHT OF

WAY) MUST HAVE SLIP RESISTANT SURFACES AND

10. CURB RAMPS SHALL BE CONSTRUCTED AT

INTERSECTIONS USING A DESIGN PREPARED BY A LICENSED PROFESSIONAL ENGINEER. WHEN A RAMF


DESIGN FAILS TO MEET ALL APPLICABLE DESIGN


STANDARDS, THE ENGINEER SHALL DOCUMENT WHY THE PROPOSED RAMP ACHIEVES DESIGN STANDARDS

GRATINGS, ACCESS COVERS, JUNCTION BOXES,


WITH THE FINISHED SURFACE.


IN SIDEWALK AREA NOT REQUIRED

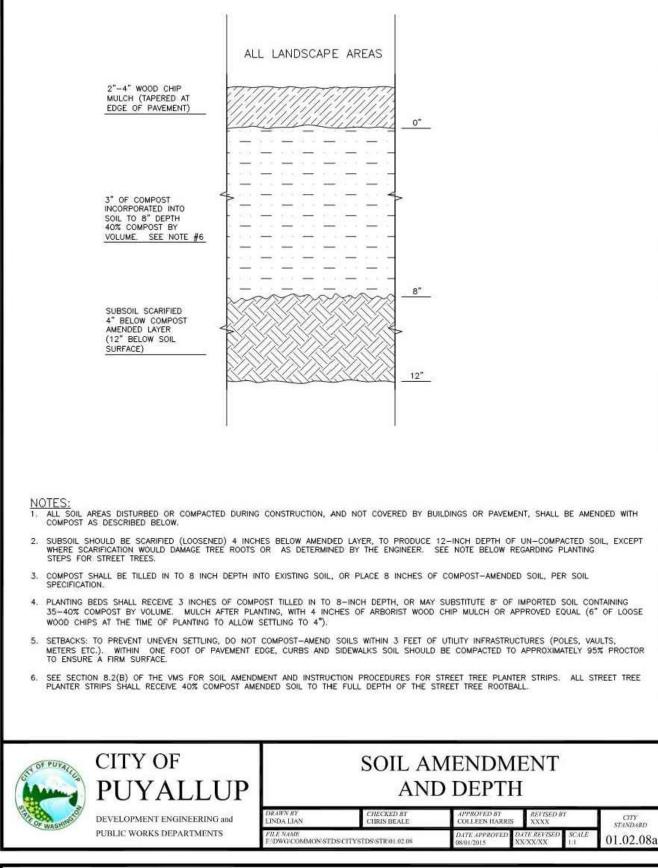

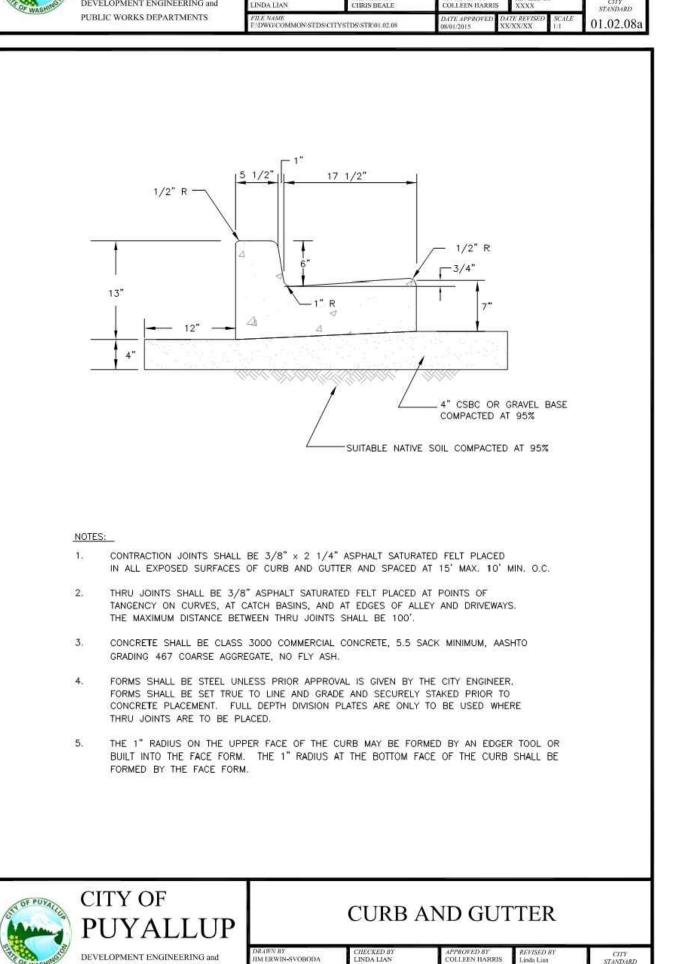


PUBLIC WORKS DEPARTMENTS

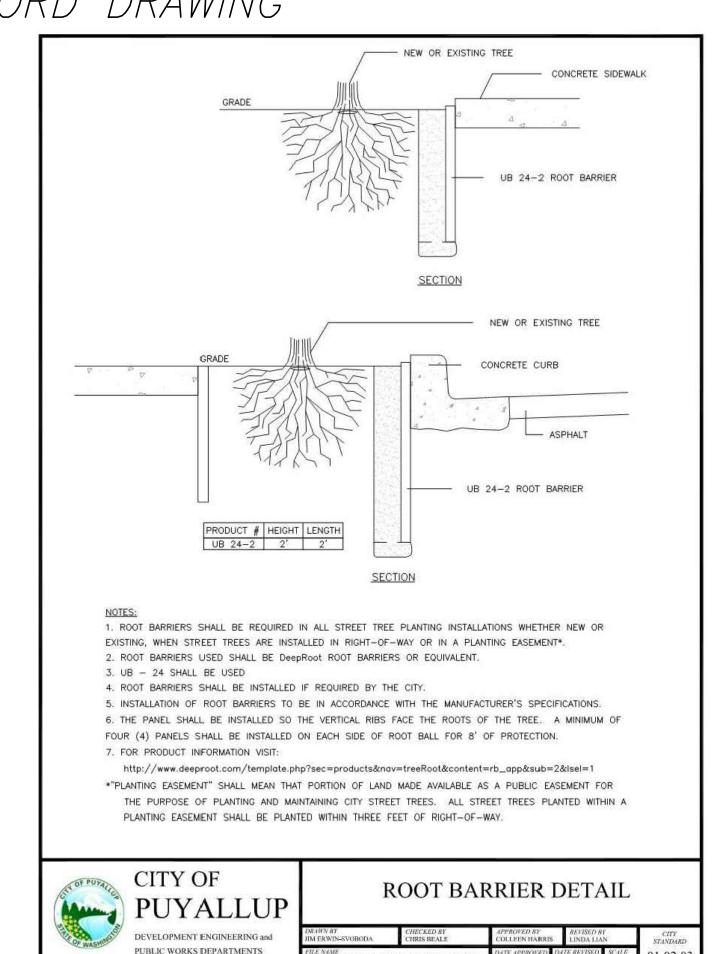


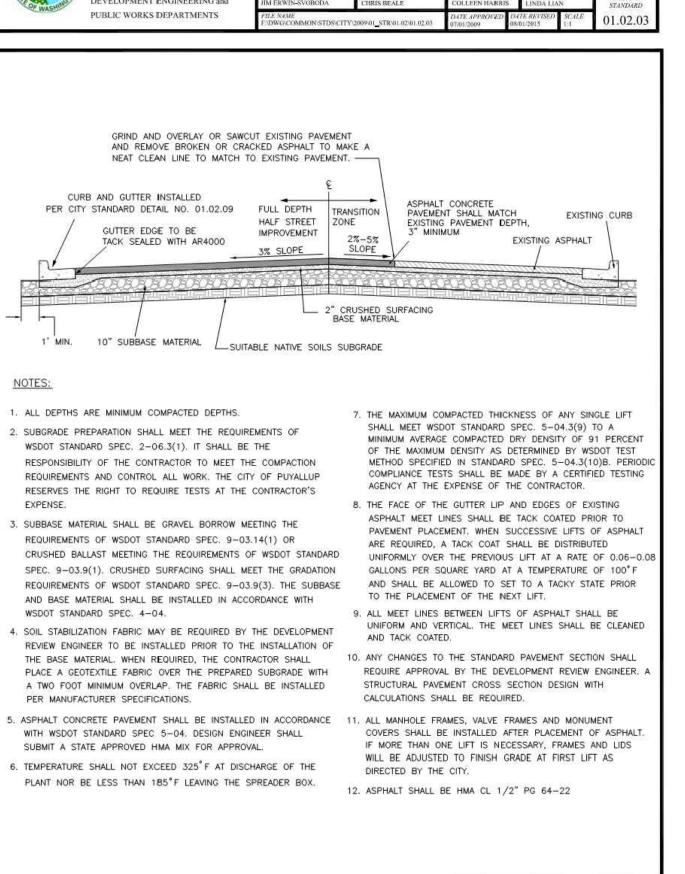

PUBLIC WORKS DEPARTMENTS

HALF STREET IMPROVEMENT

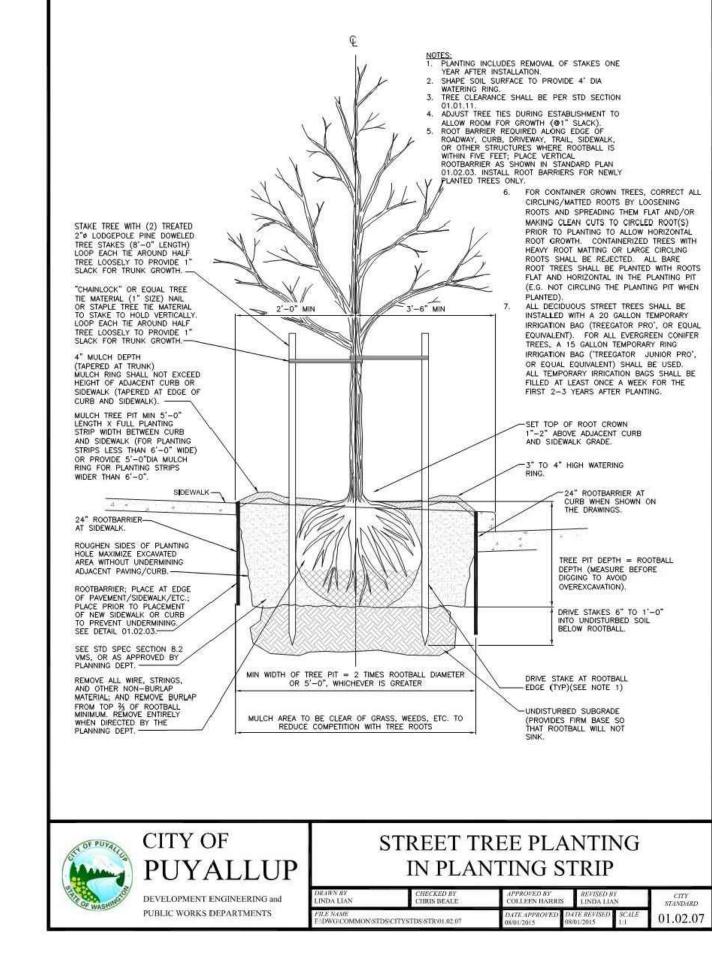

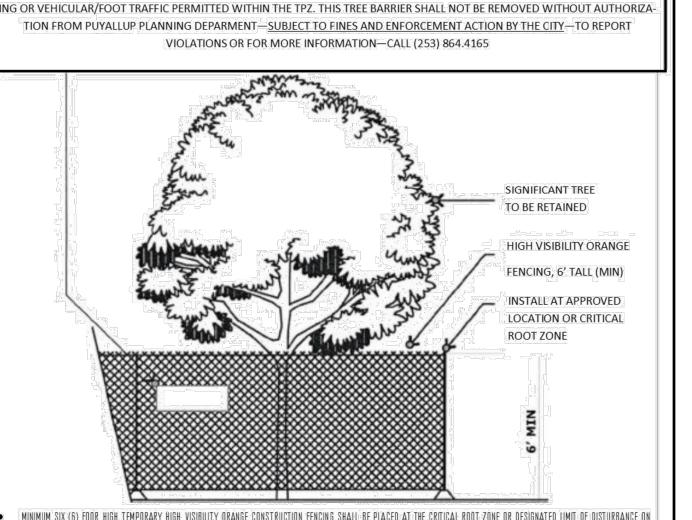

TREE PROTECTION ZONE (TPZ)

IO ENTRY. NO GRADE CHANGES, STORAGE/STOCKPILING OF MATERIALS OR EQUIPMENT, PLACEMENT OF FILL OR TOP SOIL, TRENCH

MINIMUM, SIX (6) FOOR HIGH, TEMPORARY, HIGH. VISIBILITY ORANGE CONSTRUCTION FENCING SHALL BE PLACED AT THE CRITICAL ROOT-ZONE OR DESIGNATED LIMIT OF DISTURBANCE ON APPROVED FINAL LANDSCAPE PLAN SET: FENCING SHALL BE INSTALLED USING POSTS DRIVEN INTO GROUND PIER BLOCKS SHALL NOT BE USED. AVOID POSTS DRIVEN INTO ROOTS LARGER THAN I" DIAMETER - FENCING SHALL-BE INSTALLED PRIOR: TO WORK COMMENCING ON SITE AND REMAIN IN PLACE THROUGHOUT ALL PHASES ON CONSTRUCTION - CALL THE CITY'S PLANNING DIVISION WITH REQUESTS TO MODIFY THE LOCATION OF THE TREE PROTECTION FENCING—(253) 864-4165

TREATMENT OF ROOTS EXPOSED DURING CONSTRUCTION: FOR ROOTS OVER ONE (I) INCH DIAMETER DAMAGED DURING CONSTRUCTION, MAKE A CLEAN STRAIGHT OUT TO REMOVE DAMAGED PORTION OF ROOT. ALL EXPOSED ROOTS SHALL BE TEMPORARILY COVERED WITH DAMP BURLAP TO PREVENT DRYING AND COVERED WITH SOIL AS SOON AS POSSIBLE. OTHER PRE-TREATMENT MEASURES MAY BE REQUIRED TO PROTECT ROOT SYSTEM—SEE APPROVED TREE PROTECTION OR FINAL LANDSCAPE PLAN FOR FURTHER DETAILS.

NO STOCKPILING OF MATERIALS, VEHICULAR TRAFFIC, PLACEMENT OF TOP SOIL OR FILL MATERIALS STORAGE OF EQUIPMENT OR MACHINERY SHALL BE ALLOWED WITHIN THE LIIMITS OF THE ESTABLISHED FENCING. FENCING SHALL NOT BE MOVED OR REMOVED UNLESS APPROVED BY THE CITY PLANNING DIVISION, WORK WIHTIN PROTECTION FENCE SHALL BE DONE MANUALLY UNDER THE SUPERVISION OF THE ON-SITE PARBORIST WITH PRIOR WRITTEN APPROVAL BY THE CITY PLANNING DIVISION.

THE ABOVE REFERENCED TPZ SIGNS SHALL BE PLACED EVERY 15 FEET ALONG THE FENCING AND SHALL REMAIN IN PLACETHROUGHOUT ALL PHASES OF CONSTRUCTION.





CITY OF PUYALLUP ENGINEERING SERVICES

THIS APPROVAL IS VOID AFTER YEAR FROM APPROVAL DATE. THE CITY WILL NOT BE RESPONSIBLE FOR ERRORS AND/OR OMISSIONS ON THESE FIELD CONDITIONS MAY DICTATE CHANGES TO THESE PLANS AS DETERMINED BY THE

ENGINEERING SERVICES MANAGER

05

NOIT

33(

'ELOPMENT REET, SUITE


DEVI


FOR


PUYALLUP CORPORATE PARK


A PORTION OF THE NE¹/₄ OF THE SW¹/₄ OF SEC. 26, TWP. 20 NORTH, RGE. 4 EAST, W.M. CITY OF PUYALLUP, PIERCE COUNTY, WASHINGTON


RECORD DRAWING

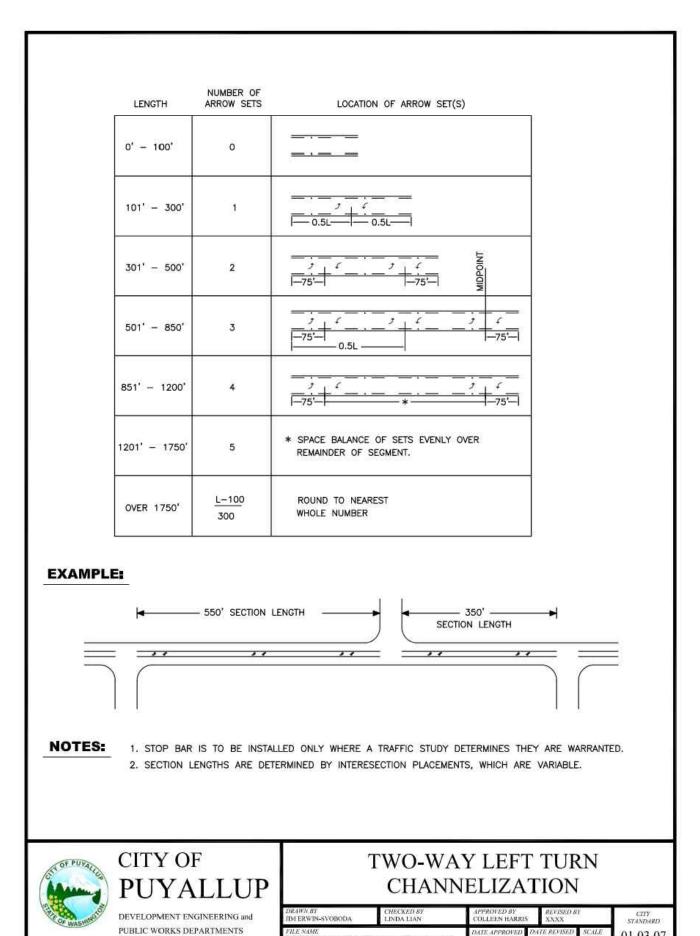


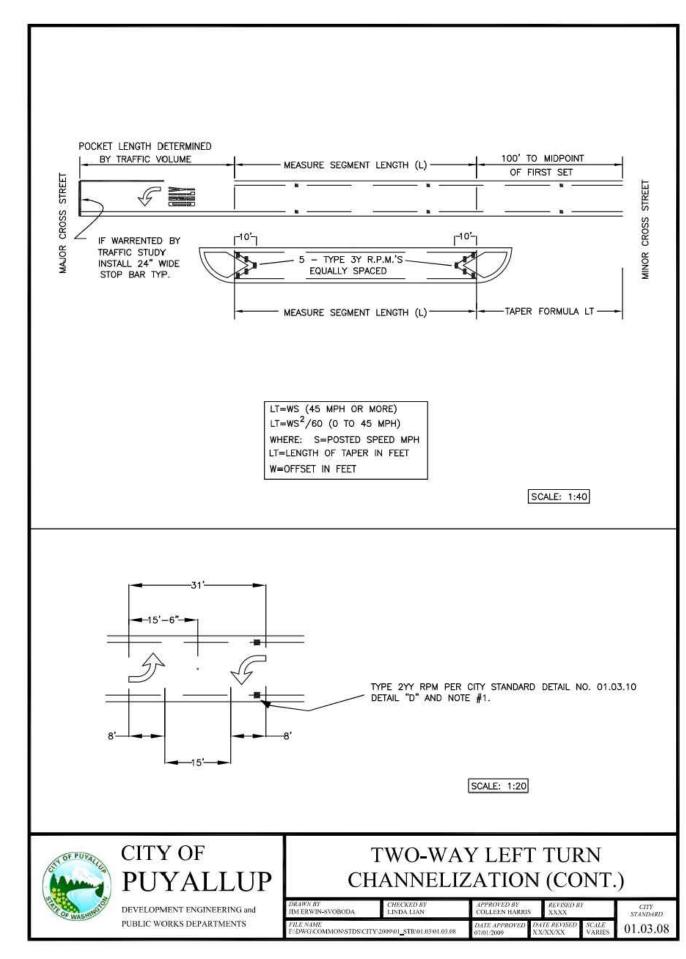

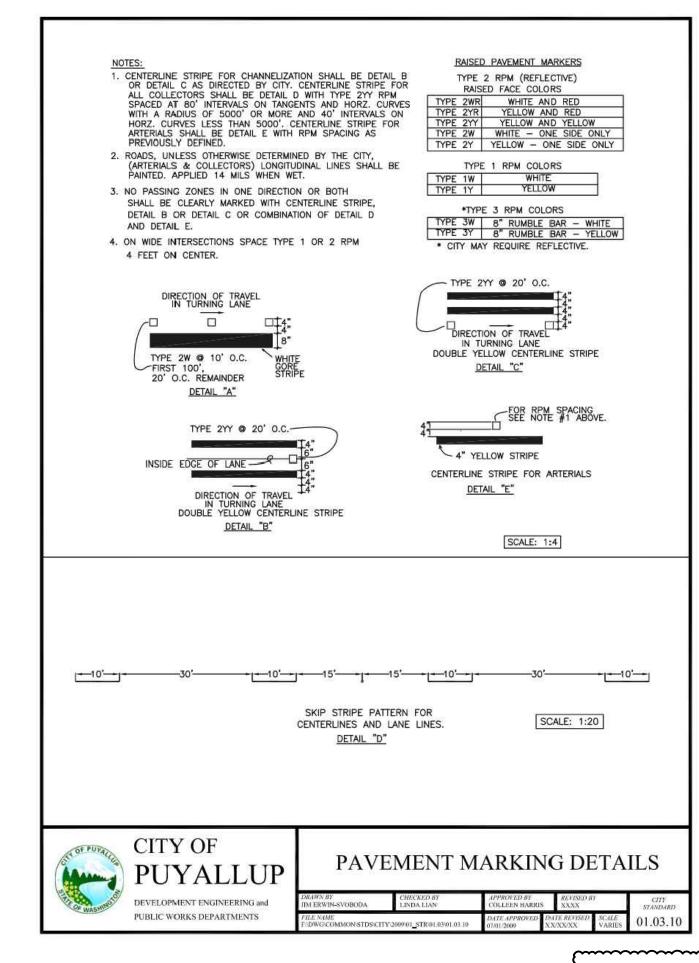


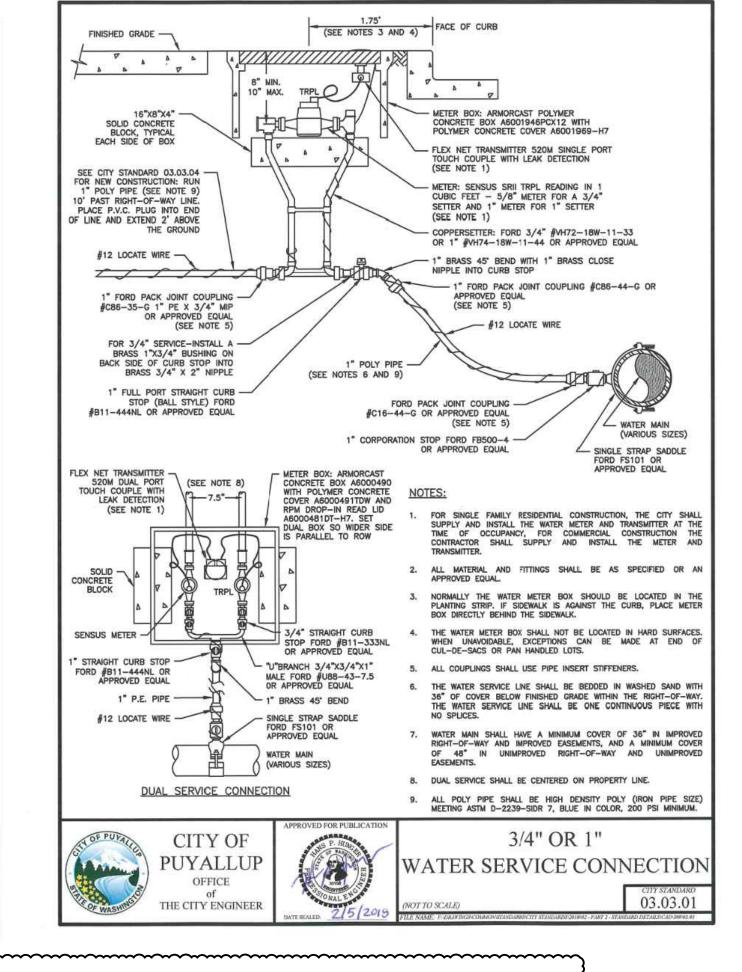


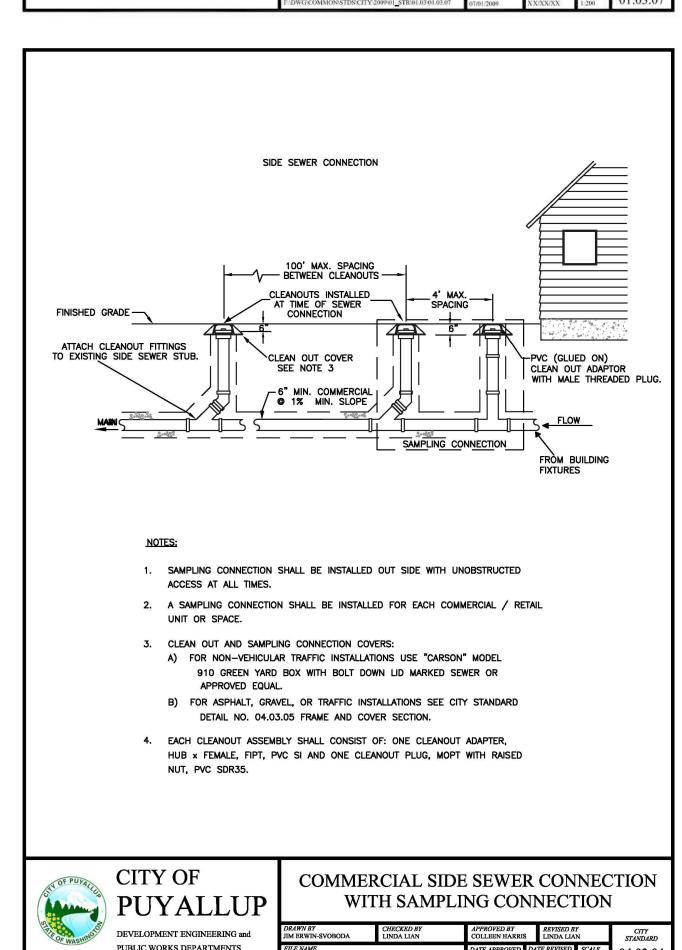


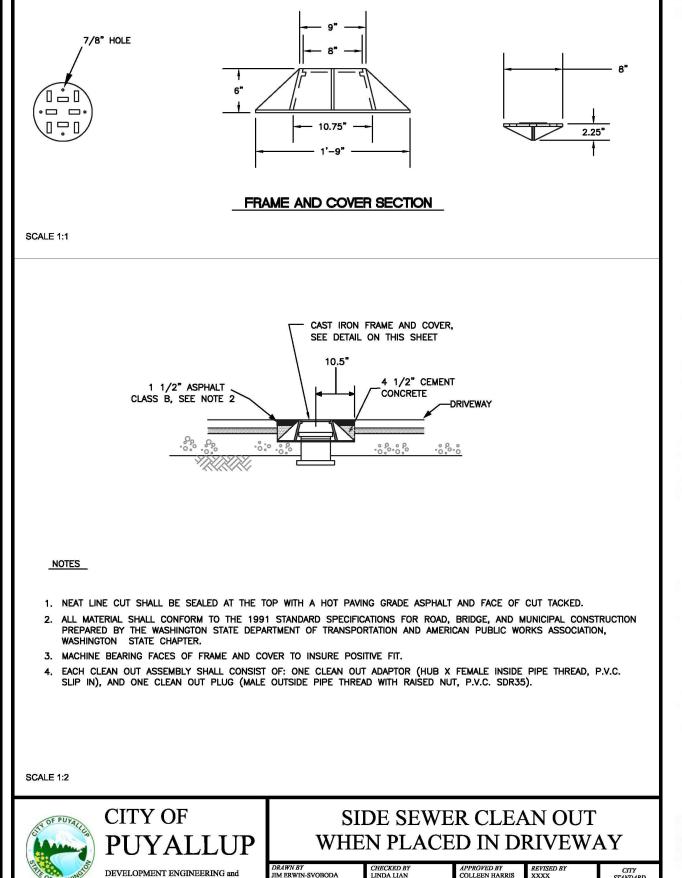

PUBLIC WORKS DEPARTMENTS

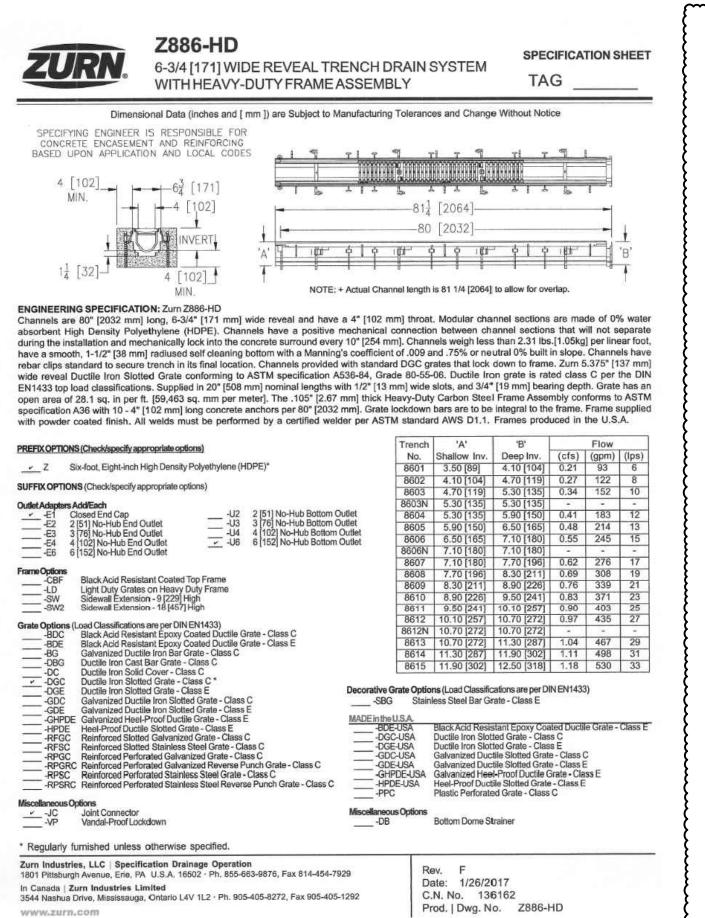

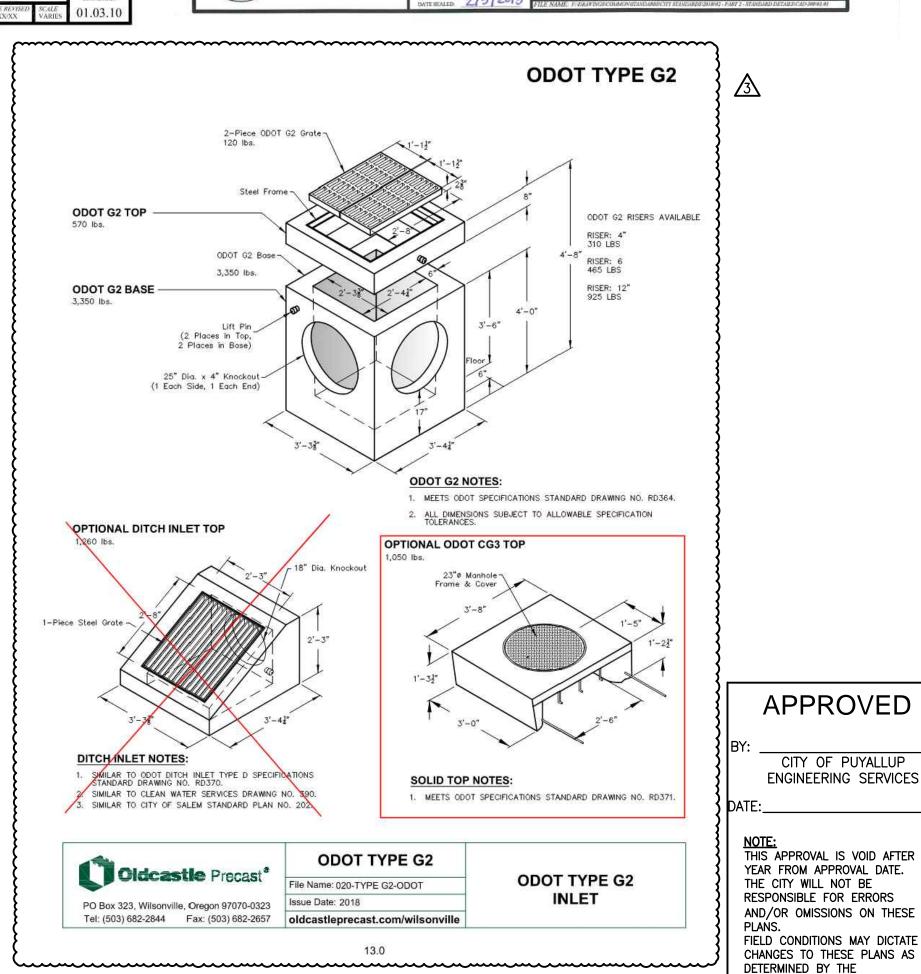


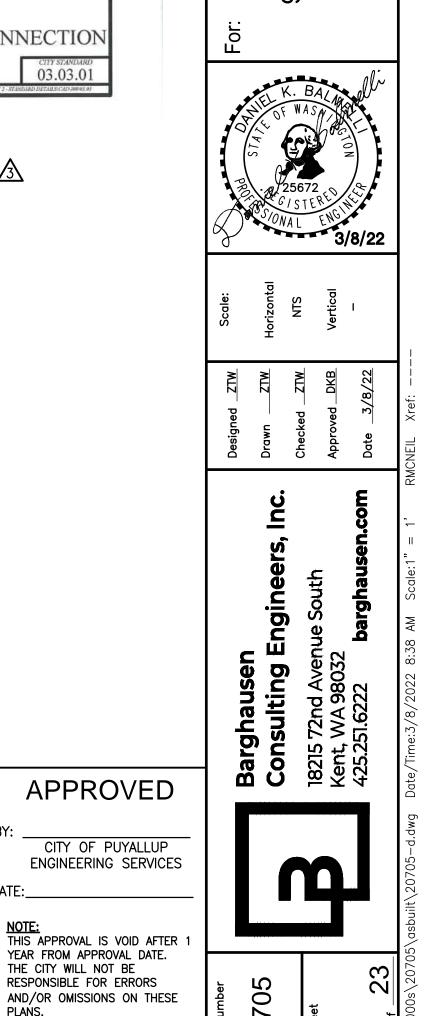


ENGINEERING SERVICES MANAGER.

33(

TTONI DEVELOPMENT C N 16TH STREET, SUITE 3 RENTON. WA 98057

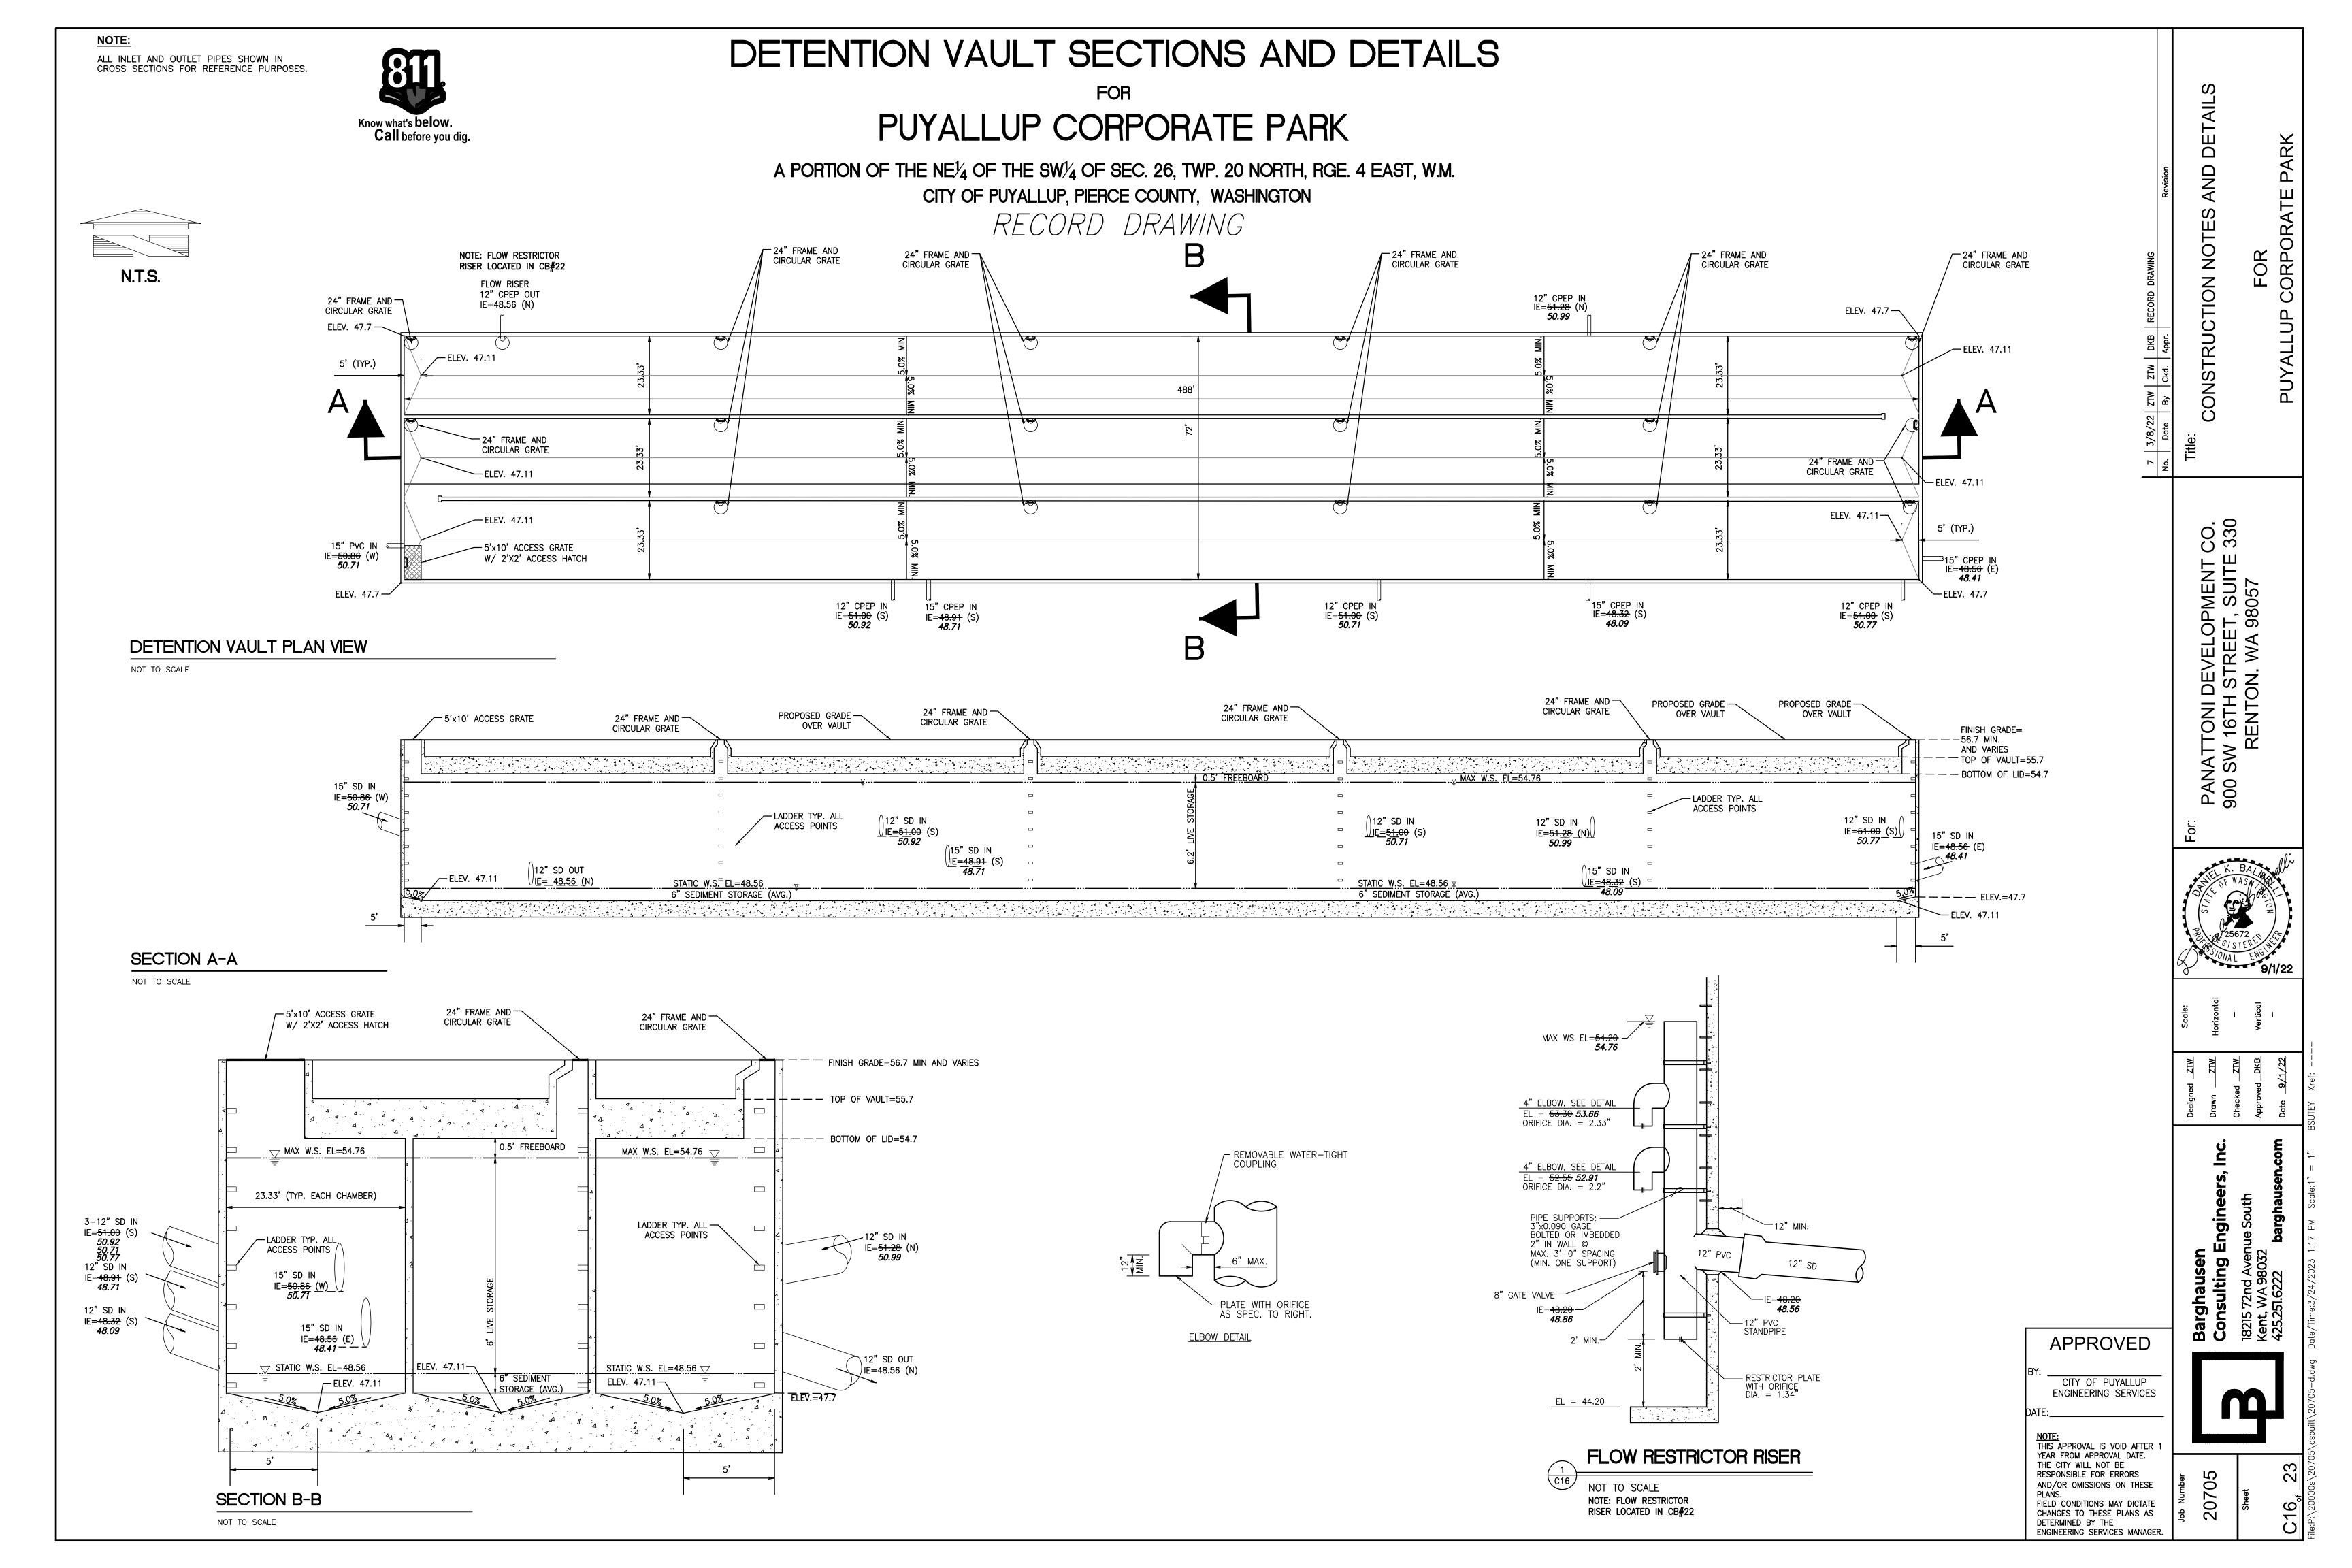

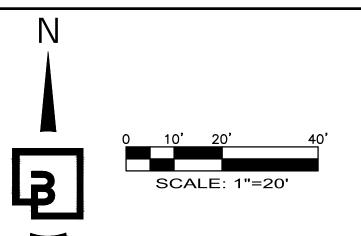





CHANNELIZATION PLAN

OR

PUYALLUP CORPORATE PARK

A PORTION OF THE NE $\frac{1}{4}$ OF THE SW $\frac{1}{4}$ OF SEC. 26, TWP. 20 NORTH, RGE. 4 EAST, W.M. CITY OF PUYALLUP, PIERCE COUNTY, WASHINGTON RECORD DRAWNG

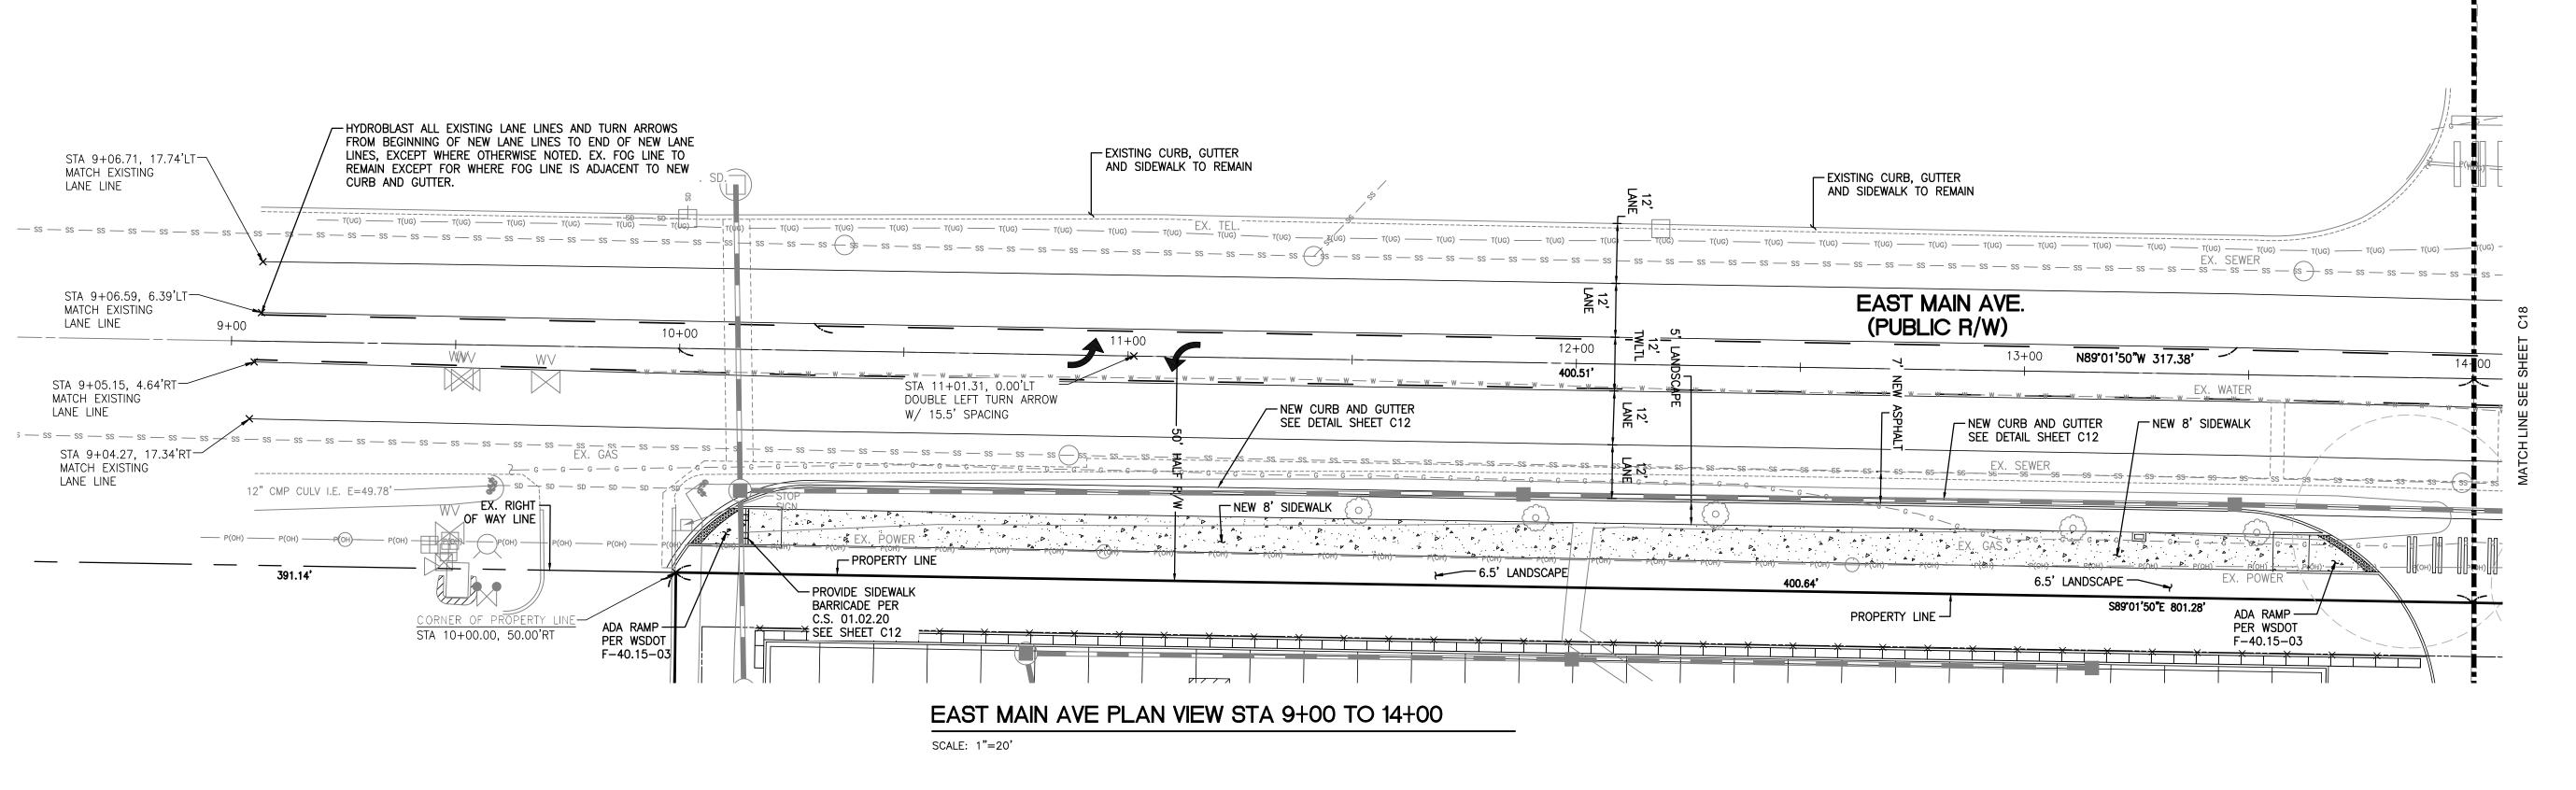

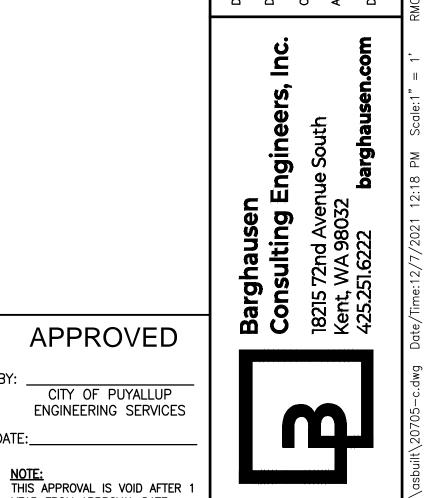

05


207

YEAR FROM APPROVAL DATE. THE CITY WILL NOT BE RESPONSIBLE FOR ERRORS

AND/OR OMISSIONS ON THESE

FIELD CONDITIONS MAY DICTATE CHANGES TO THESE PLANS AS DETERMINED BY THE ENGINEERING SERVICES MANAGER.

PANATTONI DEVELOPMENT CO. 900 SW 16TH STREET, SUITE 330 RENTON. WA 98057

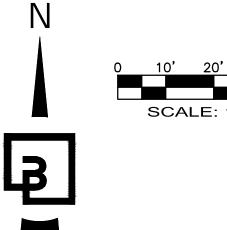







CHANNELIZATION PLAN

PUYALLUP CORPORATE PARK

A PORTION OF THE NE $\frac{1}{4}$ OF THE SW $\frac{1}{4}$ OF SEC. 26, TWP. 20 NORTH, RGE. 4 EAST, W.M. CITY OF PUYALLUP, PIERCE COUNTY, WASHINGTON RECORD DRAWING

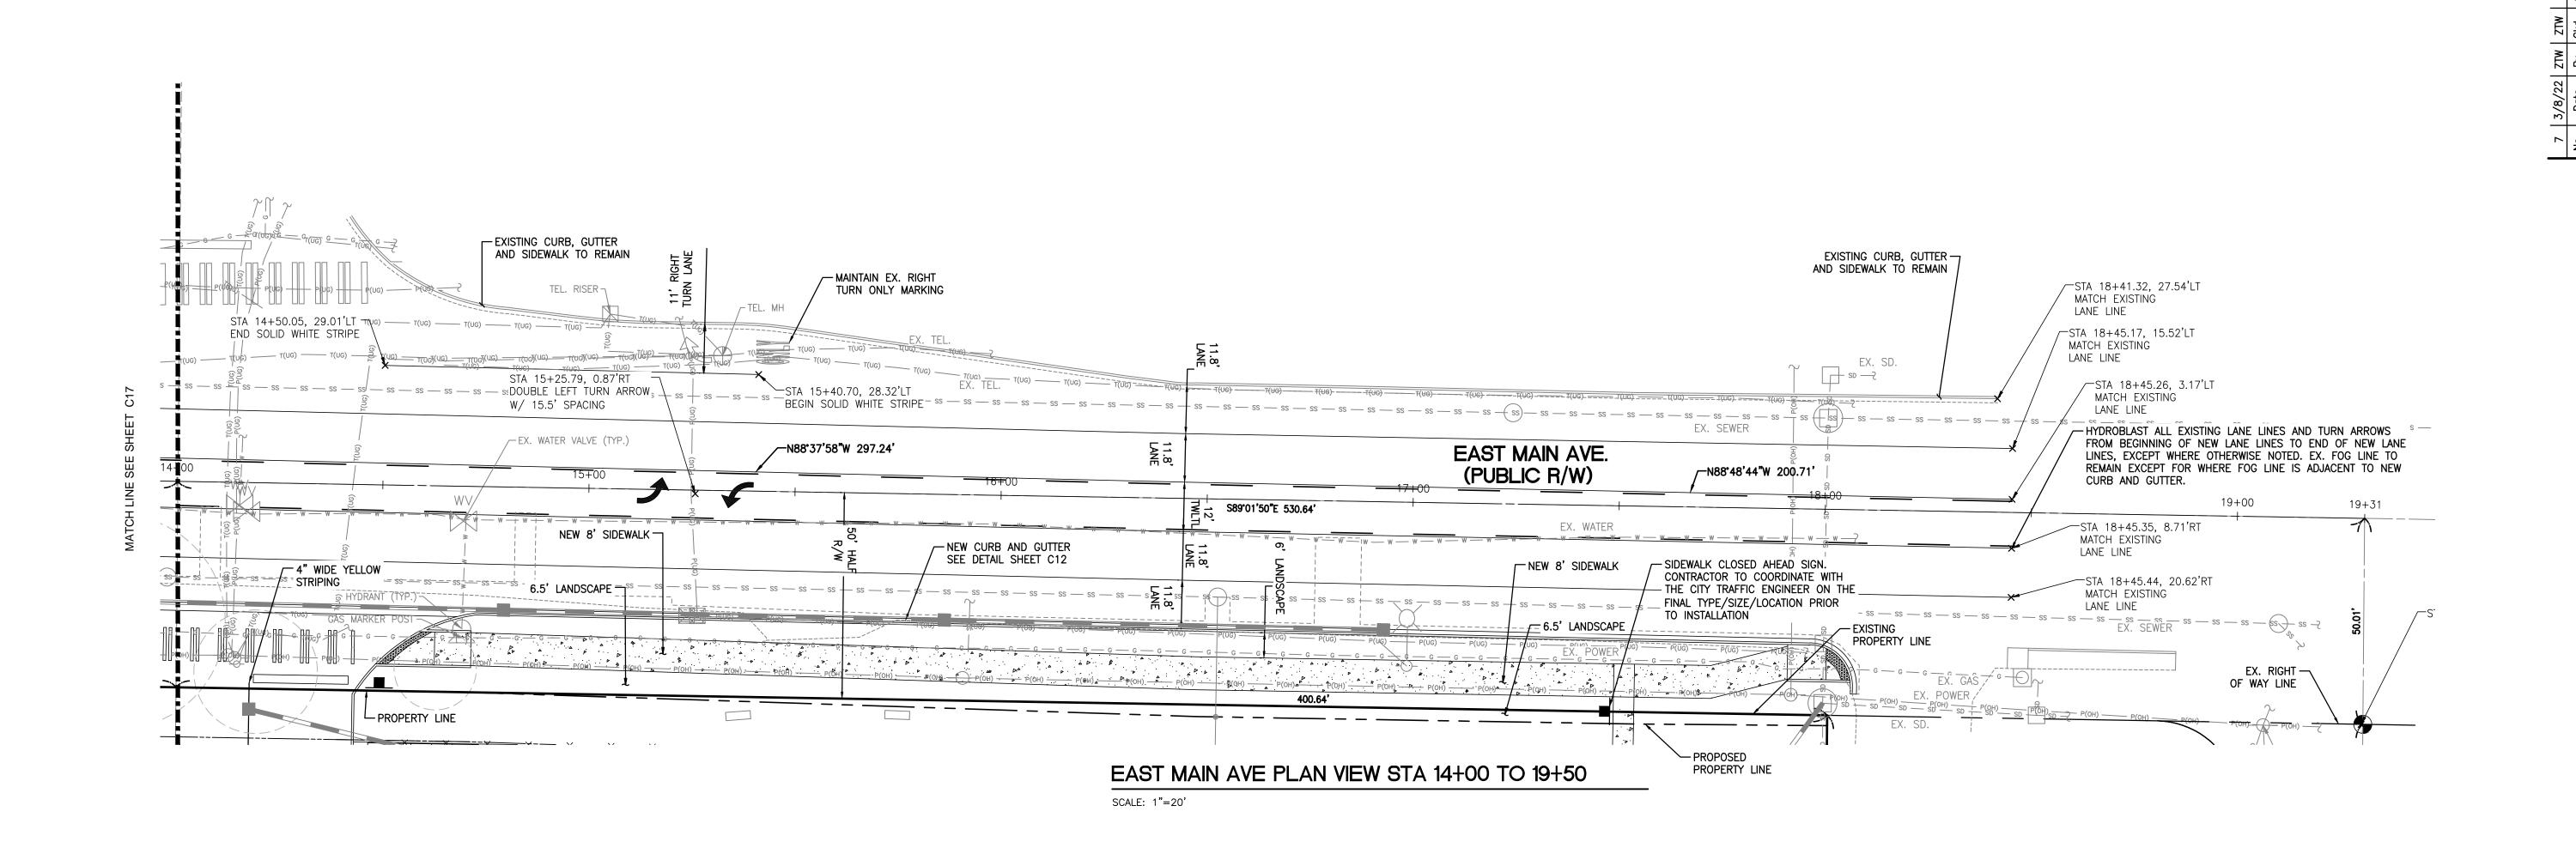


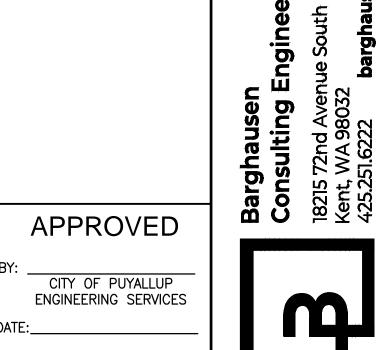

NOTE: THIS APPROVAL IS VOID AFTER 1 YEAR FROM APPROVAL DATE. THE CITY WILL NOT BE RESPONSIBLE FOR ERRORS AND/OR OMISSIONS ON THESE FIELD CONDITIONS MAY DICTATE CHANGES TO THESE PLANS AS DETERMINED BY THE ENGINEERING SERVICES MANAGER.

207

PANATTONI DEVELOPMENT CO. 900 SW 16TH STREET, SUITE 330 RENTON. WA 98057

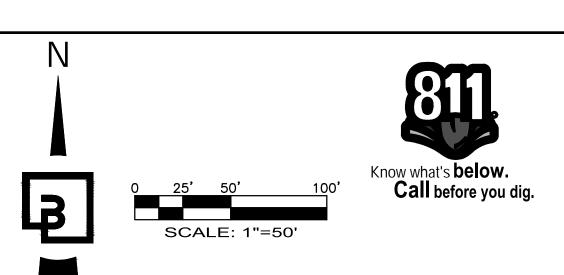


SIGHT DISTANCE EXHIBIT

PUYALLUP CORPORATE PARK

A PORTION OF THE NE $\frac{1}{4}$ OF THE SW $\frac{1}{4}$ OF SEC. 26, TWP. 20 NORTH, RGE. 4 EAST, W.M. CITY OF PUYALLUP, PIERCE COUNTY, WASHINGTON RECORD DRAWING

- SIGHT DISTANCE TRIANGLE S89°01′50″E 801.28′ NEW 50' DRIVEWAY

PANATTONI DEVELOPMENT CO. 900 SW 16TH STREET, SUITE 330 RENTON. WA 98057

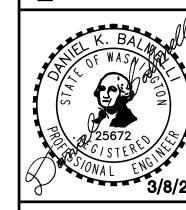

Barghausen
Consulting Enginee
18215 72nd Avenue South
Kent, WA 98032
425.251.6222 barghaus

APPROVED

CITY OF PUYALLUP ENGINEERING SERVICES

NOTE: THIS APPROVAL IS VOID AFTER 1 YEAR FROM APPROVAL DATE.

PLANS.
FIELD CONDITIONS MAY DICTATE
CHANGES TO THESE PLANS AS
DETERMINED BY THE
ENGINEERING SERVICES MANAGER.

THE CITY WILL NOT BE RESPONSIBLE FOR ERRORS AND/OR OMISSIONS ON THESE

