



Owner/Developer: Krista Linden Farm 12 3303 8th Ave SE A Puyallup, WA 98372 kristalinden@stepbystfamily.org
Engineer: JMJ TEAM Justin Jones JMJ Team 905 Main Street, Suite #200 Sumner, WA 98390 (206) 596-2020
Project: Farm 12 Parking Lot Revision
506 33rd St SE Puyallup, WA 98372
Civil Site Permit
JUSTIN M. JONES STATE OF WASHINGTON 41829 PROFESSIONAL ENGINEER 12/12/2023
REV DATE DESCRIPTION
0 40 80 FEET
SHEET TITLE: Existing Site Plan
PROJ.NO: 1616-001 DATE: December 12, 2023 DRAWN BY: MO DESIGN BY: JJ SHEET NUMBER: C-02
CALL TWO BUSINESS DAYS BEFORE YOU DIG 1-800-424-5555 UTILITIES UNDERGROUND LOCATION CENTER
DWG. 2 OF 7



LEGEND

A legend for a site plan, listing seven symbols with their corresponding labels:

- A pattern of small dots in a rectangular box: Existing Gravel
- A pattern of large, overlapping diamond shapes: Landscape to be Cleared & Grubbed
- A horizontal line with an 'X' in the center: Silt Fence
- A horizontal line with a dotted pattern: Existing Ditch Line
- A horizontal line with a dashed pattern: Property Line
- A solid gray horizontal bar: Clearing Limit

Owner/Developer:
Crista Linden
P.O. Box 12
303 8th Ave SE A
Benton City, WA 98372
cristalinden@stepbystepfamily.org

The logo for UJM TEAM. It features a stylized green 'U' and 'J' stacked together, followed by the text 'JMTEAM' in a bold, red, sans-serif font.

ject:
arm 12
arking Lot Revision

96 33rd St SE
Lacey, WA 98372

ONE INCH AT FULL SCALE.
IF NOT, SCALE ACCORDINGLY

• TESC NOTES

Contractor to install TESC measures as necessary to ensure stormwater leaving the site is free of settleable solids.

Existing gravel driveway to be used as construction entrance. Maintain construction entrance per City of Puyallup Standard Detail 05.01.01 and install wheel wash as needed per Washington DOE BMP C106.

Install silt fence per City of Puyallup Standard Detail 02.03.02 Silt Fence to mark clearing limits in the field.

Roads shall be cleared thoroughly as needed to protect stormwater infrastructure and downstream water resources. Sediment shall be removed from roads by shoveling or pickup sweeping and transported to a controlled sediment disposal area.

Exposed soils shall be watered as necessary to prevent dust from leaving the site.

Disturbed soils to be amended per DOE BMP T5.13

If necessary, alternative sediment control methods shall be submitted by the contractor for review and approval prior to construction.


A CESCL shall be present on-site or on-call for the duration of construction operations.

DEMOLITION NOTES


Vegetation to be Removed: 25,280 SF

EARTHWORK

Cut: 150 CY
Fill: 760 CY
Net: 610 CY (Fill)

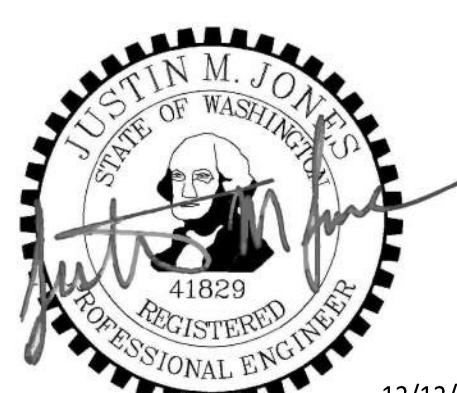

REV. DATE DESCRIPTION

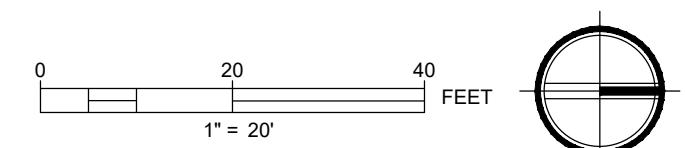


NET TITLE.

TESC Plan

APPROVED	
BY	_____
CITY OF PUYALLUP	
DEVELOPMENT ENGINEERING	
DATE	_____
NOTE: THIS APPROVAL IS VOID AFTER 180 DAYS FROM APPROVAL DATE.	
THE CITY WILL NOT BE RESPONSIBLE FOR ERRORS AND/OR OMISSIONS ON THESE PLANS.	
FIELD CONDITIONS MAY DICTATE CHANGES TO THESE PLANS AS DETERMINED BY THE DEVELOPMENT ENGINEERING MANAGER.	

NOTE: THIS APPROVAL IS VOID
AFTER 180 DAYS FROM APPROVAL
DATE.
THE CITY WILL NOT BE
RESPONSIBLE FOR ERRORS
AND/OR OMISSIONS ON THESE
PLANS.
FIELD CONDITIONS MAY DICTATE
CHANGES TO THESE PLANS AS
DETERMINED BY THE
DEVELOPMENT ENGINEERING
MANAGER.

CALL TWO BUSINESS DAYS
BEFORE YOU DIG

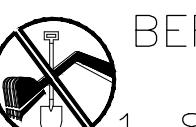

Owner/Developer:
Krista Linden
Farm 12
3303 8th Ave SE A
Puyallup, WA 98372
kristalinden@stepbystepfamily.org

Engineer:

Justin Jones
JM Team
905 Main Street, Suite #200
Summer, WA 98390
(206) 596-2020

Project:
Farm 12
Parking Lot Revision




506 33rd St SE
Puyallup, WA 98372

ONE INCH AT FULL SCALE,
IF NOT, SCALE ACCORDINGLY

Civil Site Permit



12/12/2023

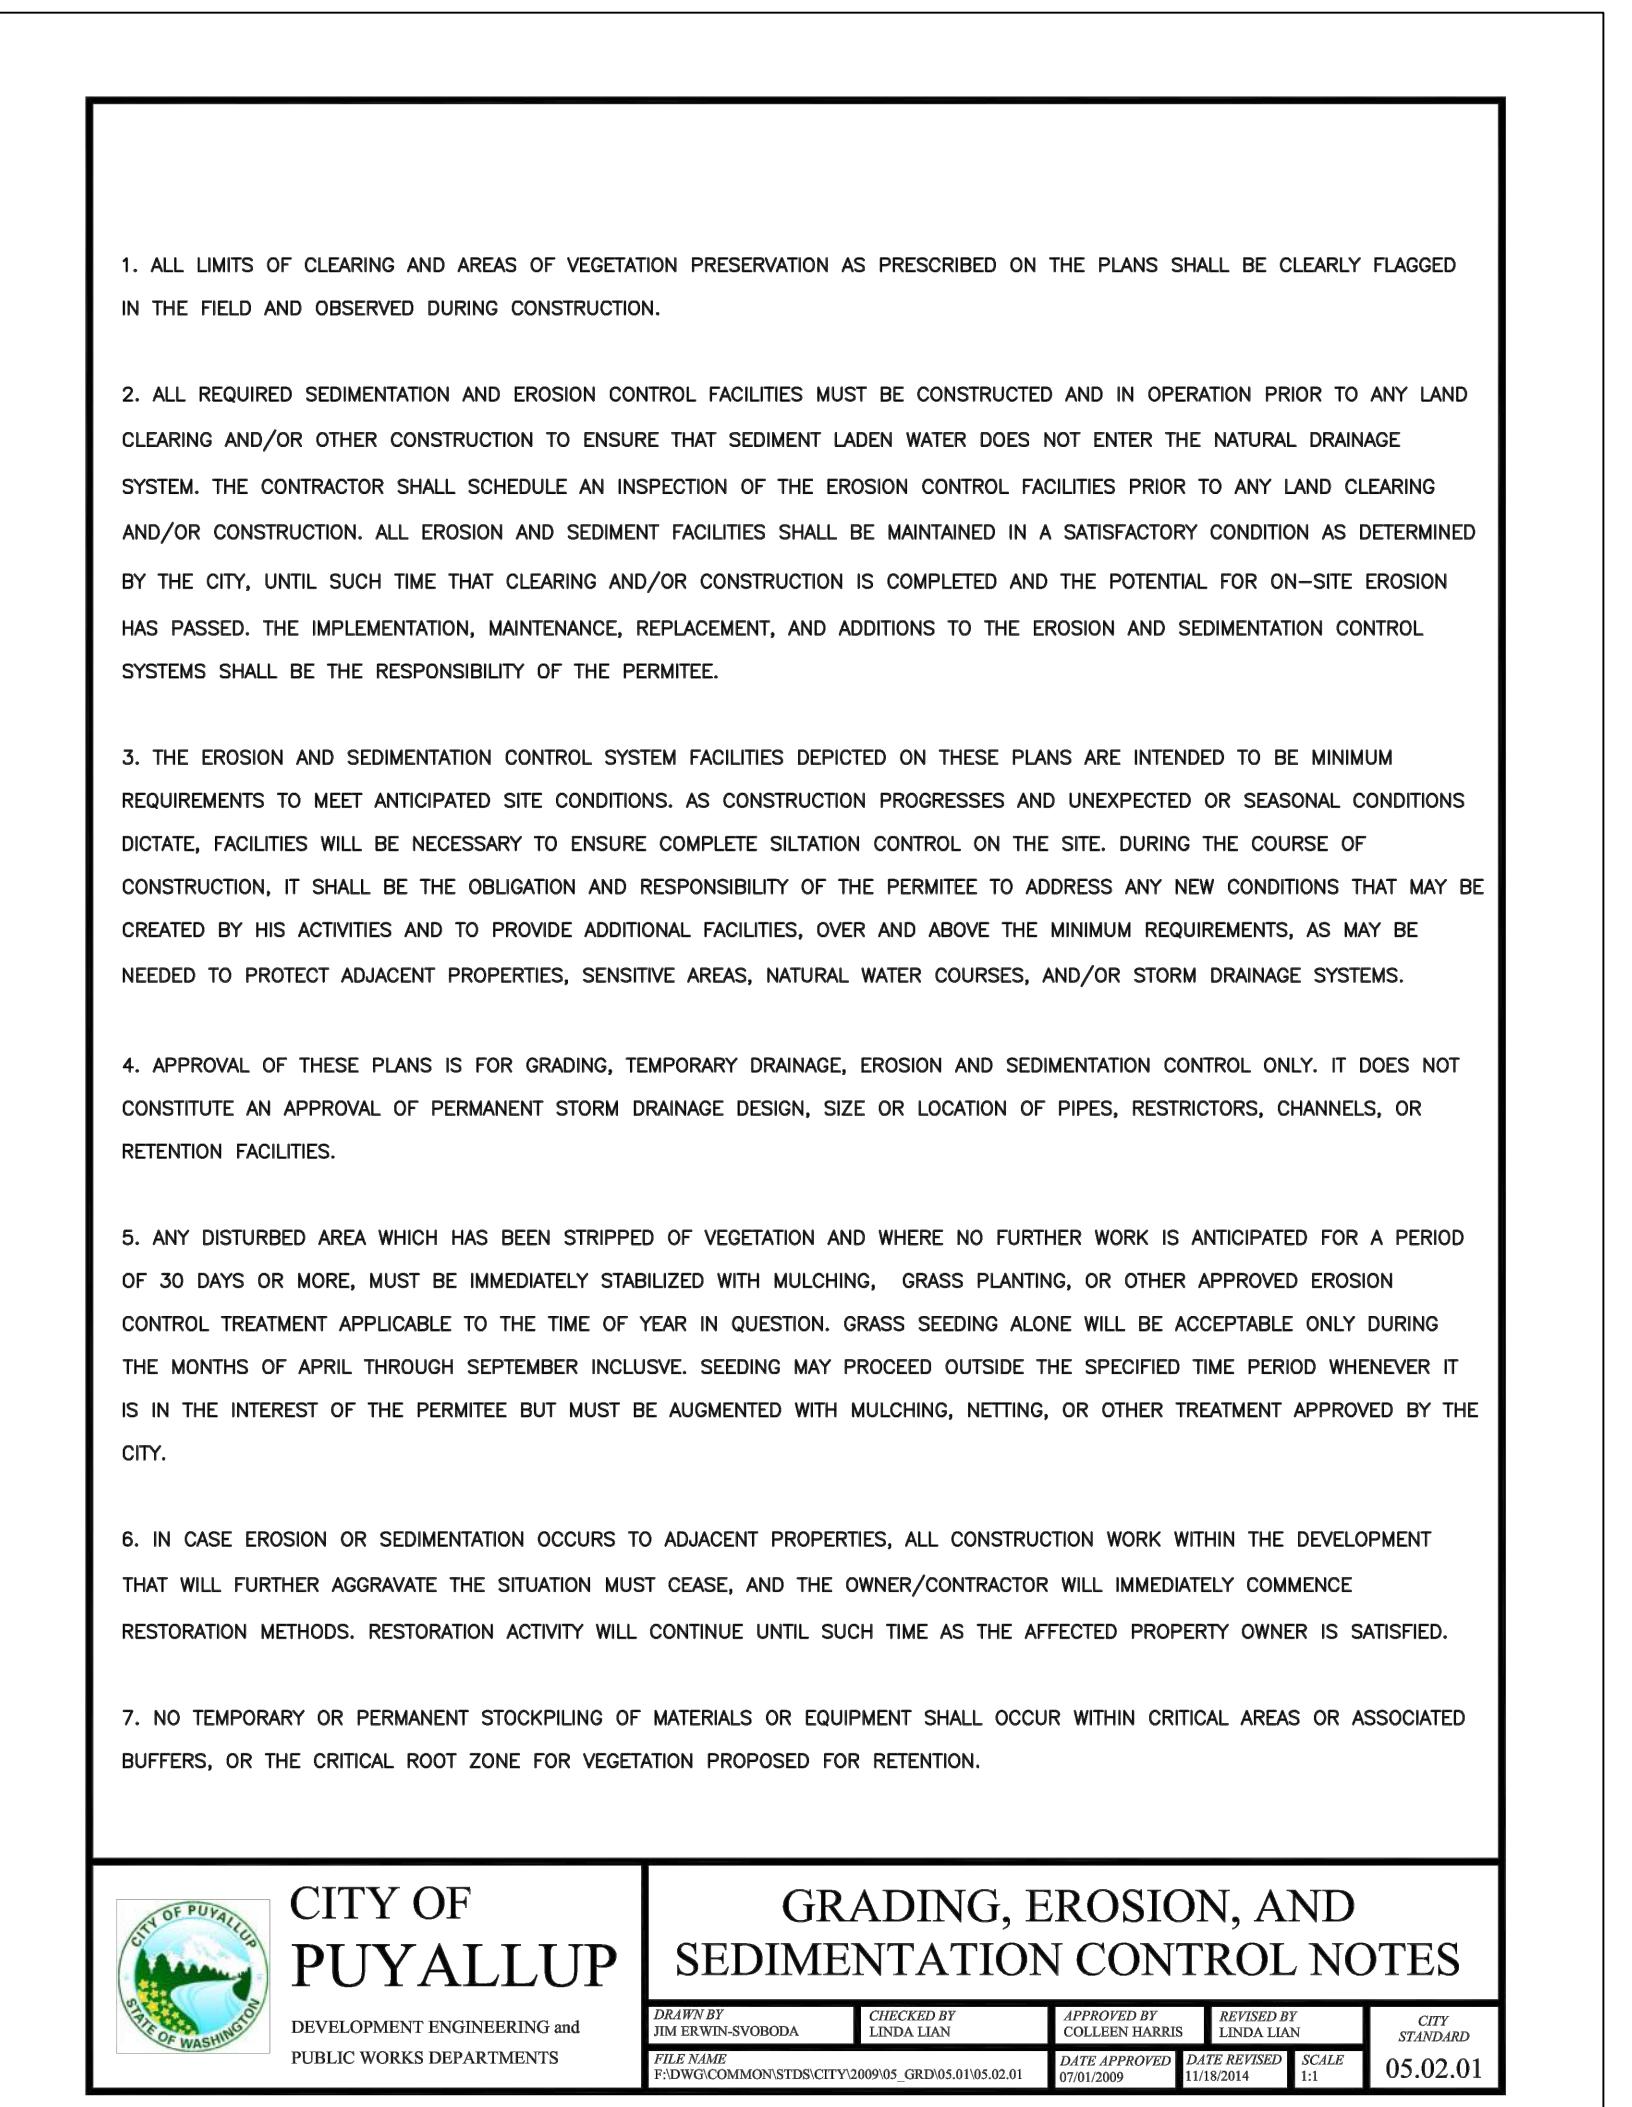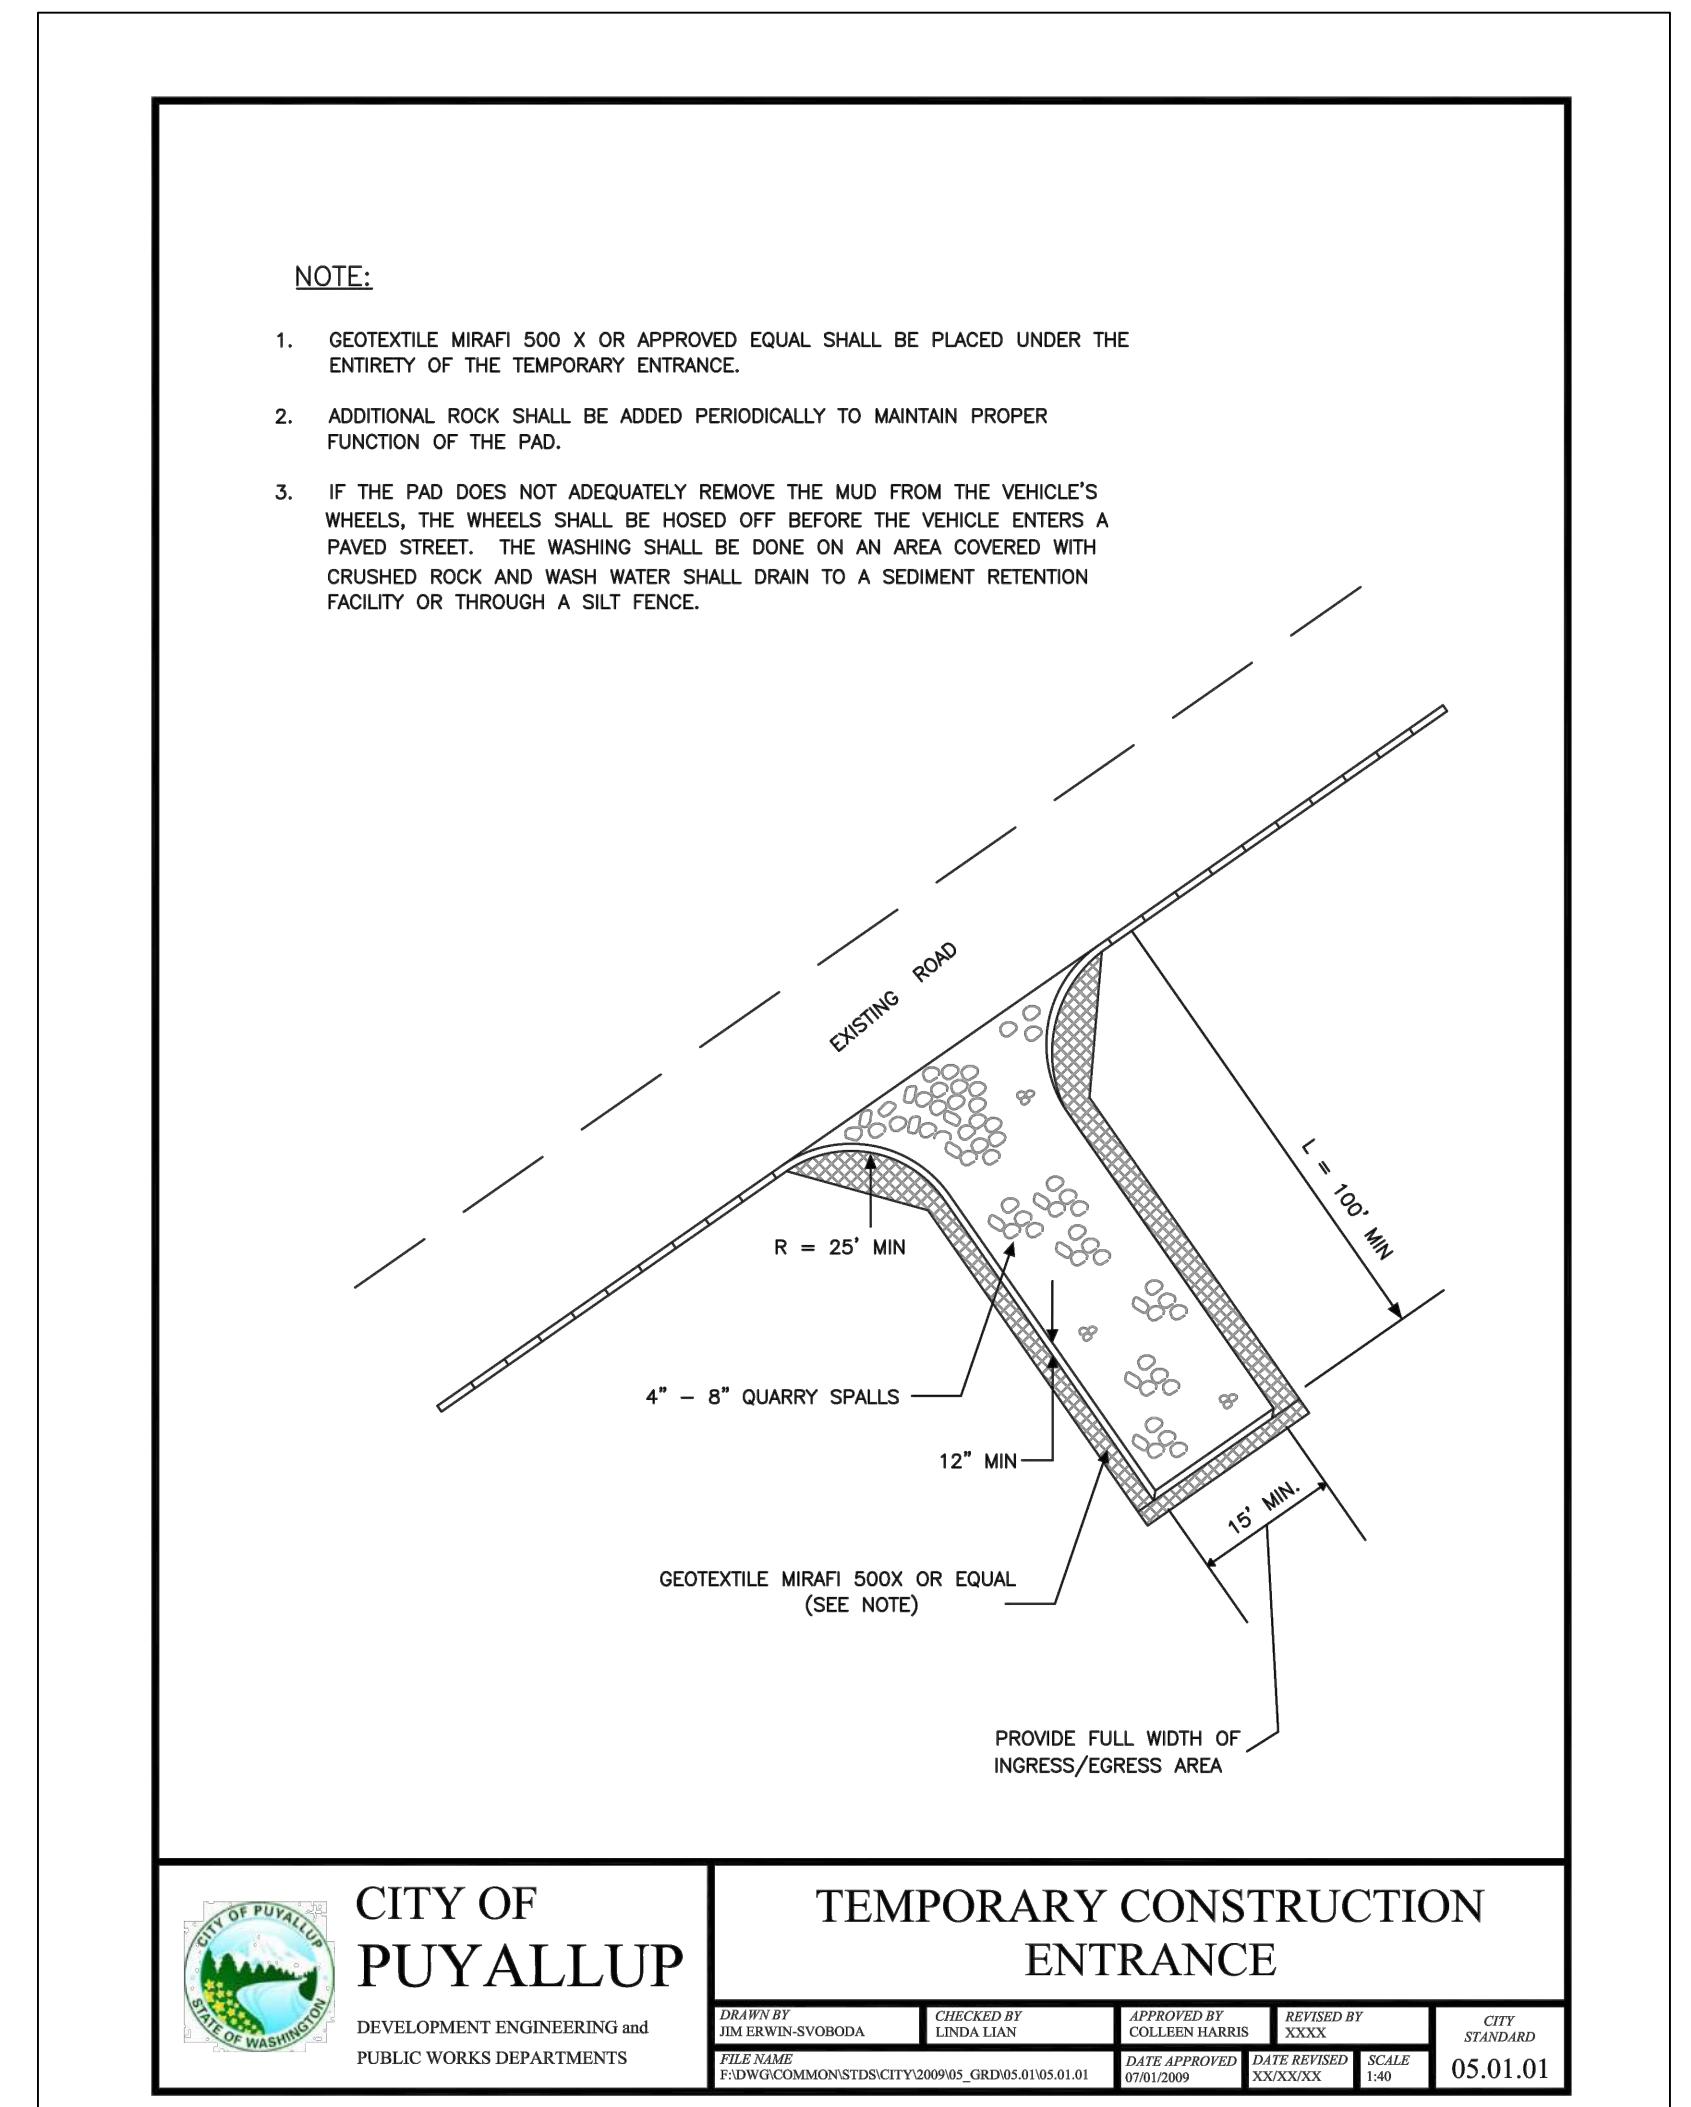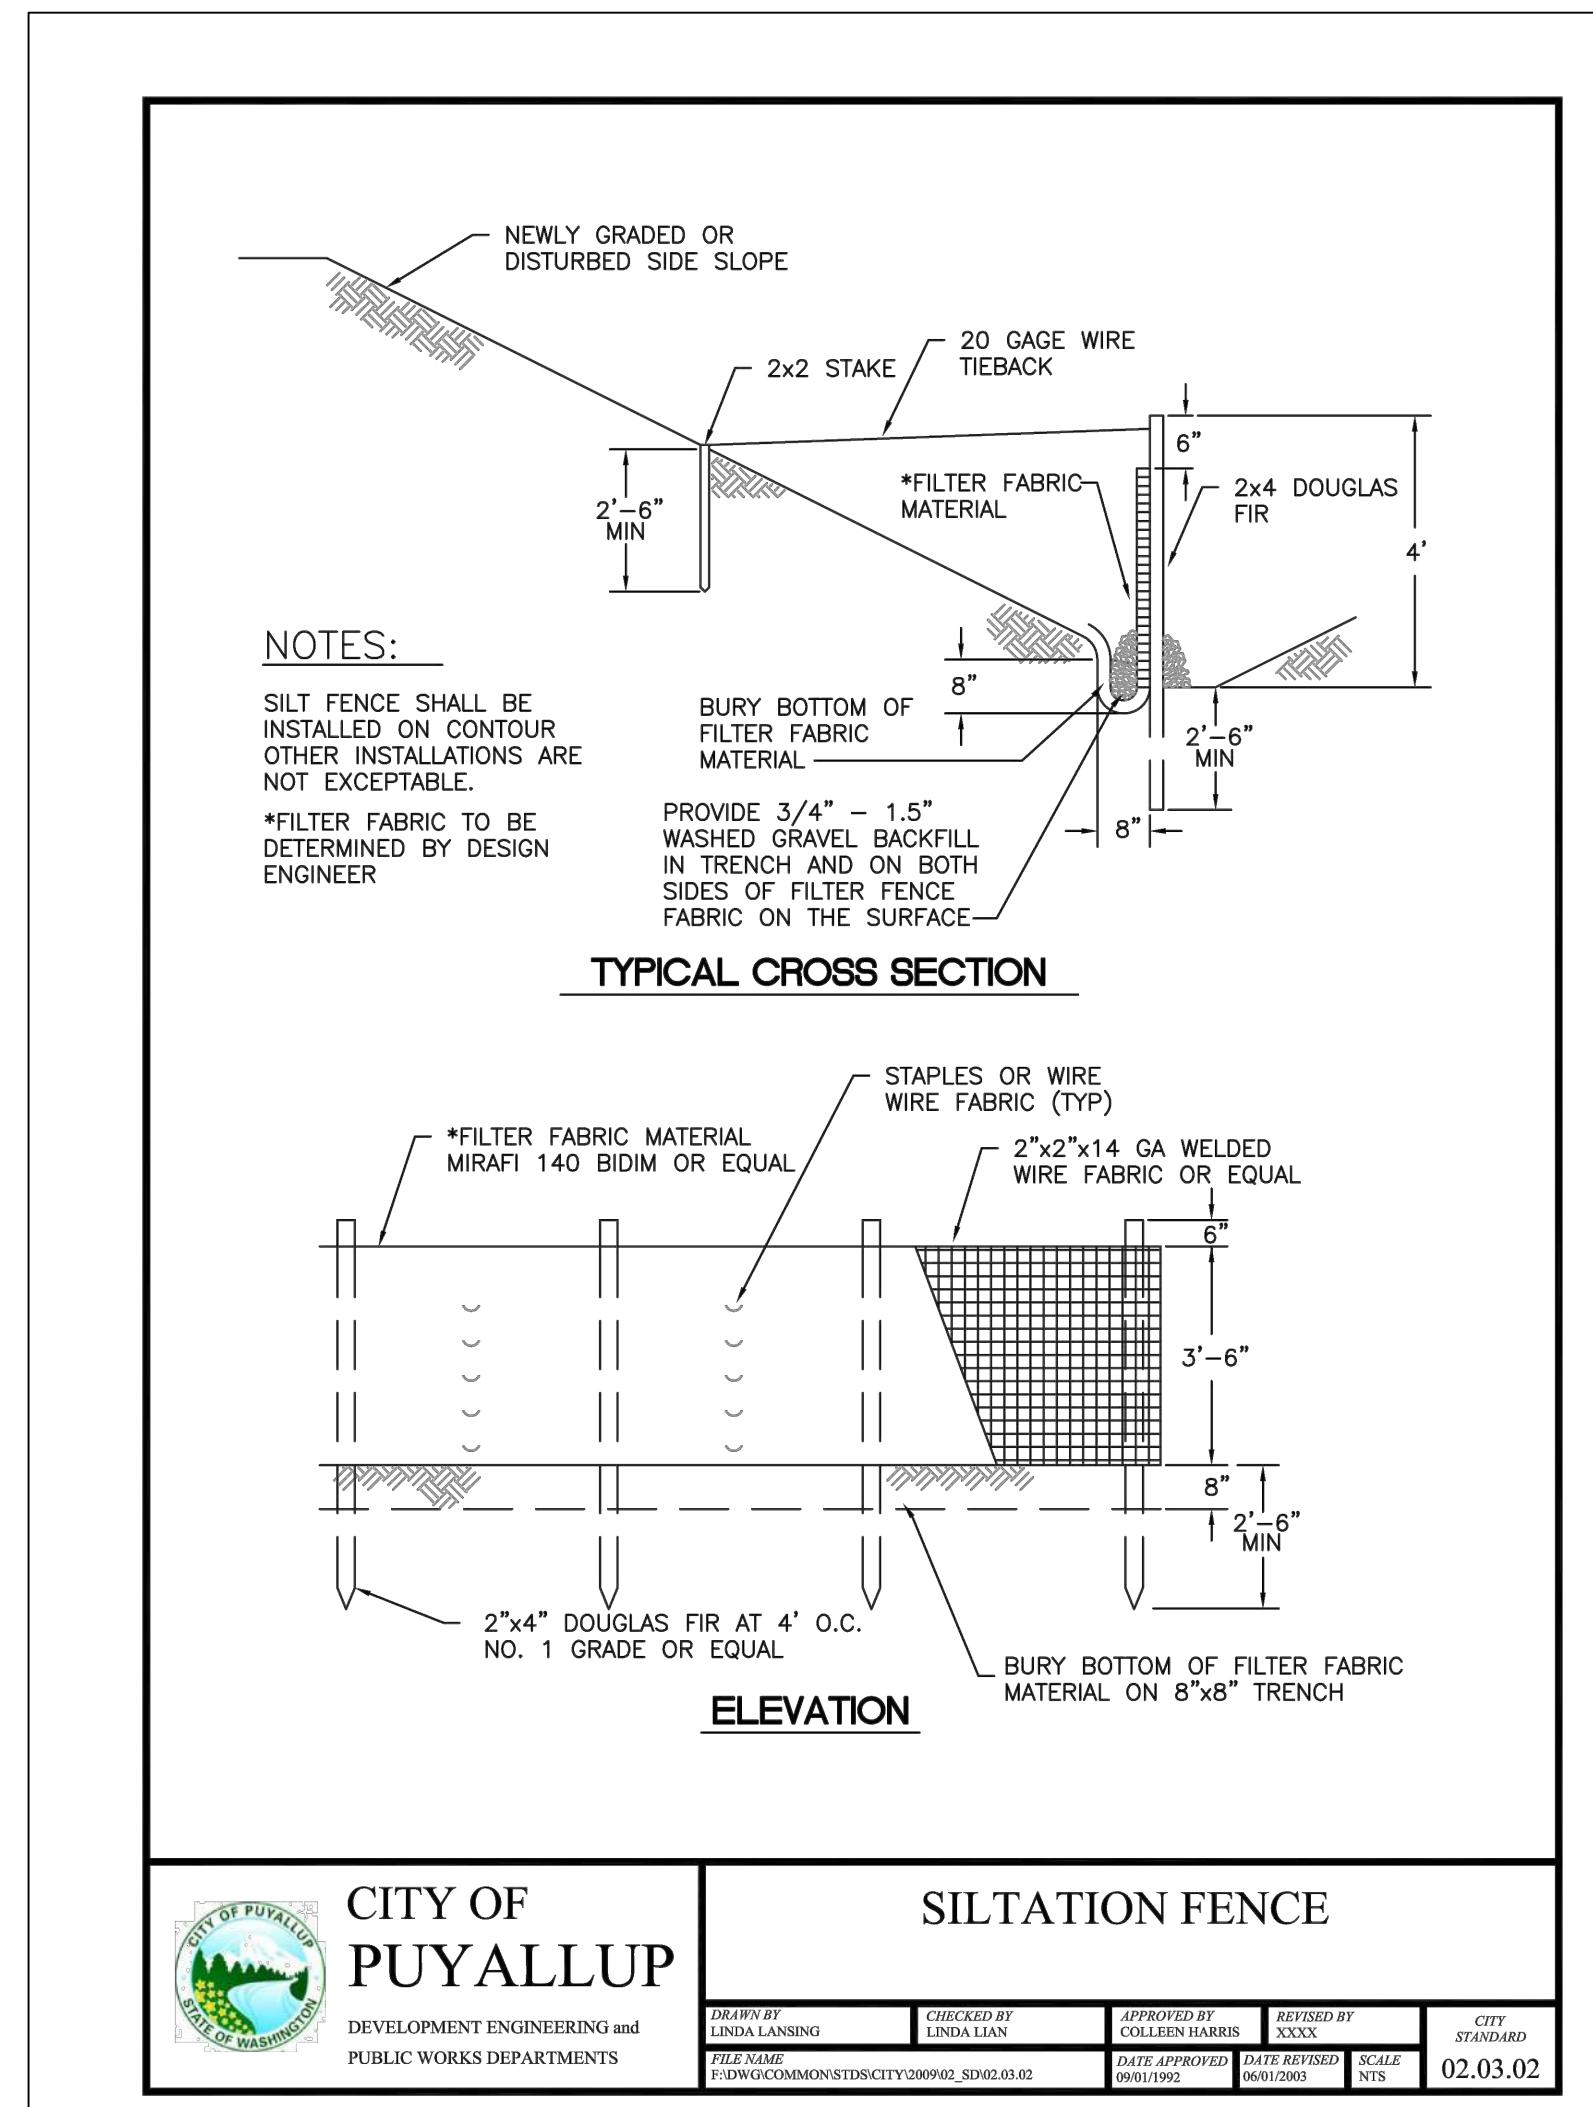

PROJ. NO.: 1616-001
DATE: December 12, 2023

DRAWN BY: MO DESIGN BY: JJ


SHEET NUMBER:

C-04

DWG. 4 OF 7

File: 161600C- TESC D1.dwg Path: J:\1616 - Form 12\001 - Farm 12\001 - Fruit Stand Parking\CAD\

Potted by: Powriso Date: 12-Dec-23 11:17:27 am

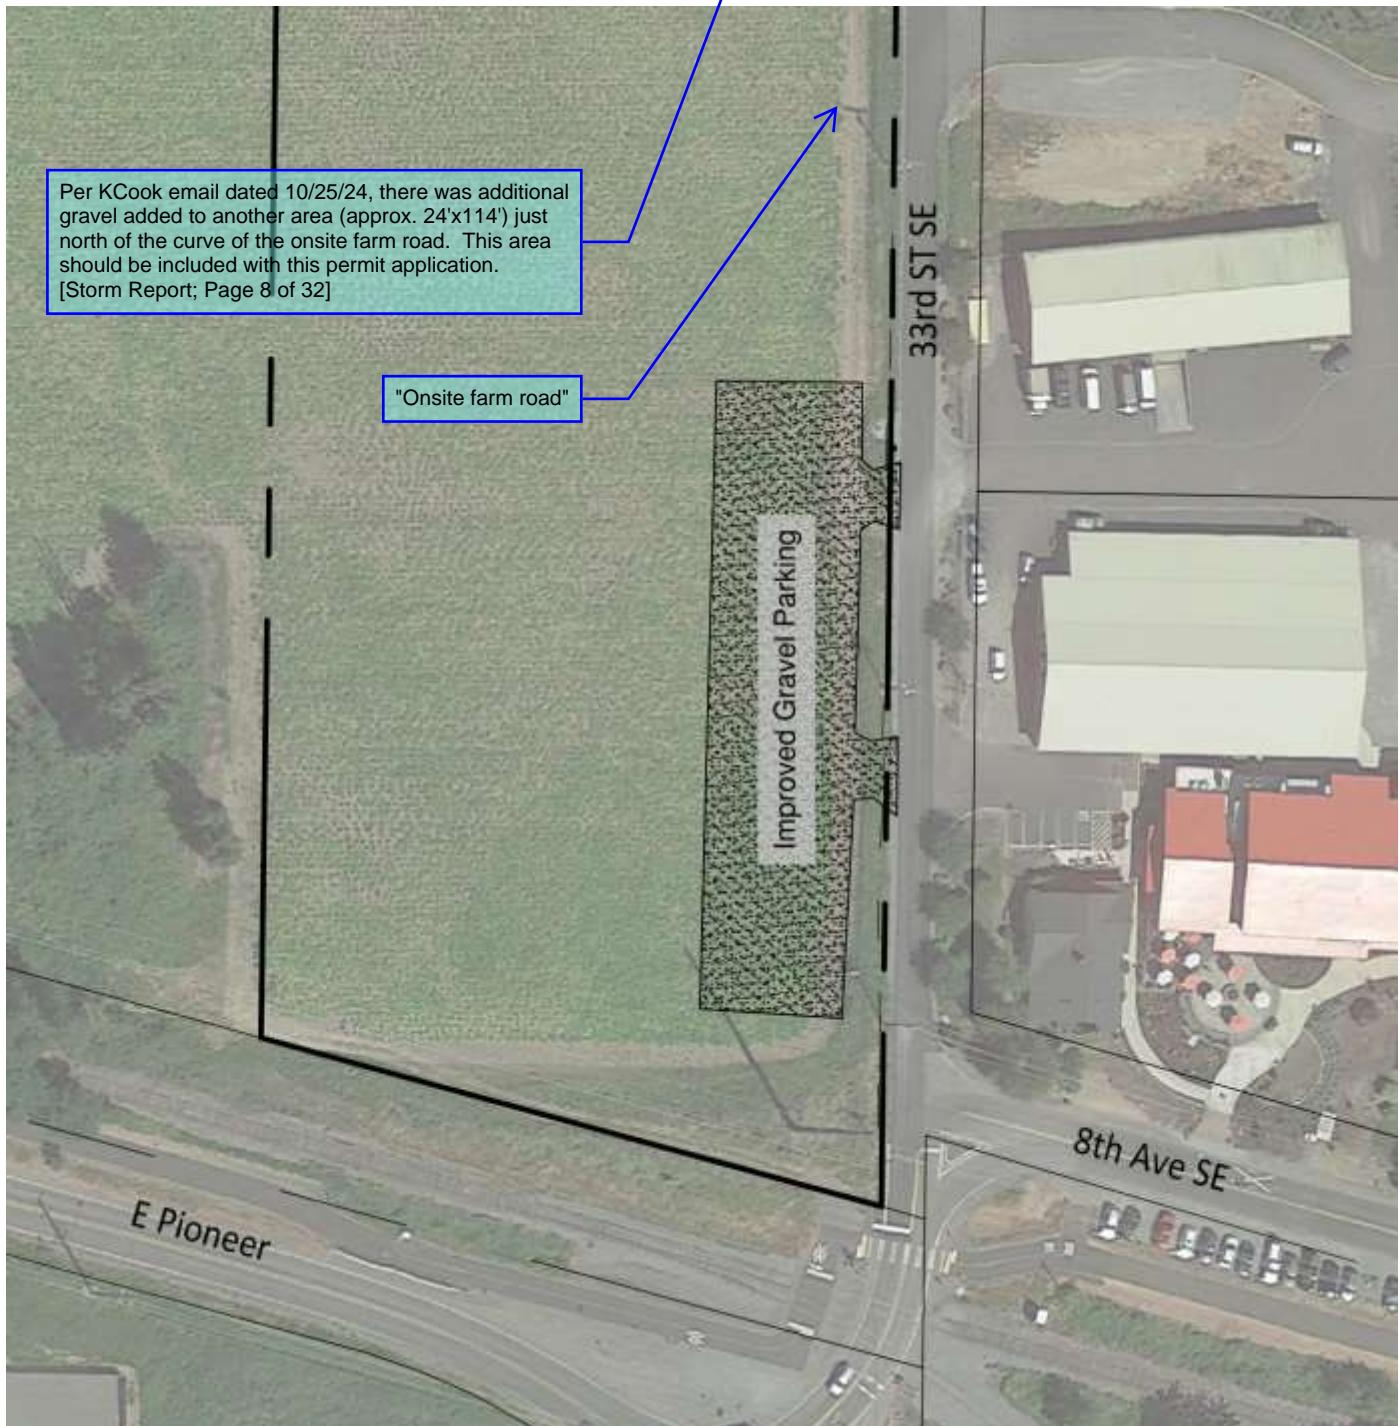

Proposed Site Map

EXISTING CONDITIONS SUMMARY

The Farm 12 Parking Lot Revision project site area is 254,473 SF (5.94 acres). The existing site consists of grass vegetation and an existing gravel parking lot abutting 33rd Street SE. The site is fairly flat and has a slight slope towards the east side of the property.

The existing storm system consists of a ditch along the eastern property line that is part of the City's MS4 system. This ditch is part of the Southeast Puyallup Basin, that direct discharges to the Puyallup River. Runoff from 33rd Street SE sheet flows to the ditch and is eventually conveyed towards the Puyallup River located north of site. Runoff from existing gravel parking pad sheet flows towards the grass vegetation and existing ditch.

USDA Soil Survey Map was utilized to analyze existing soils on-site, see Appendix B for maps. On-site soils are predominantly Briscot loam (Group C soils).

The site is located within Lahar Hazard area.

There are no critical areas within site.

Adjust quantities for the additional 24'x114' gravelled area (See Page 8 comment). [Storm Report; Page 9 of 32]

QUANTITIES UPDATED TO INCLUDE 24x114 GRAVEL AREA.

PROPOSED CONDITIONS SUMMARY

The proposed development is to improve the existing gravel parking lot so that it meets the City of Puyallup Design and stormwater management standards. Improvements include the re-grade of existing gravel parking lot and implementation of stormwater management practices.

The proposed development will result in 19,940 SF of replaced impervious surfaces within the project site area. Total land disturbing activity to be approximately 45,960 SF. Minimum requirements 1-9 will apply to this project. Lot Coverage Table has been provided in the report following.

The stormwater approach for this project is to sheet flow runoff from the replaced gravel lot to disperse and receive treatment through amended soil. Runoff will then follow a natural drainage pattern and be conveyed towards an existing ditch east of site where it will eventually discharge into the Puyallup River.

LOT COVERAGE

The following tables show the existing and proposed lot coverage for the project site.

Adjust quantities for the additional 24'x114' gravelled area (See Page 8 comment).
[Storm Report; Page 10 of 32]

QUANTITIES UPDATED TO
INCLUDE 24x114 GRAVEL AREA.

Existing Lot Coverage (258,473 SF Site Area)			
Coverage	Area (SF)	Area (Acres)	% of Site
Impervious			
Existing Gravel Parking	19,940	0.46	
Total Site Impervious	19,940	0.46	7.7%
Pervious			
Grass Vegetation	238,533	5.47	
Total Site Pervious	238,533	5.47	92.3%

Proposed Lot Coverage (258,473 SF Site Area)			
Coverage	Area (SF)	Area (Acres)	% of Site
Impervious			
Replaced Gravel Parking	19,940	0.46	
Total Replaced Impervious	19,940	0.46	
Total Site Impervious	19,940	0.46	7.7%
Pervious			
Grass Vegetation	238,533	5.47	
Total Site Pervious	238,533	5.47	92.3%

QUANTITIES UPDATED TO
INCLUDE 24x114 GRAVEL AREA.

MINIMUM REQUIREMENT 1: PREPARATION OF STORMWATER SITE PLANS

Stormwater Site Plan drawings have been prepared per the City of Puyallup development codes and the 2019 Stormwater Management Manual for Western Washington (DOE Manual), see Appendix A.

MINIMUM REQUIREMENT 2: CONSTRUCTION STORMWATER POLLUTION PREVENTION

A Temporary Erosion and Sediment Control Plan has been prepared per the City of Puyallup development codes and the 2019 DOE Manual and is included in this report, see Appendix A. Construction Stormwater Pollution Prevention measures may include storm drain inlet protection; construction entrance; silt fence and a sediment trap.

MINIMUM REQUIREMENT 3: SOURCE CONTROL OF POLLUTION

Source control BMPs will be implemented to minimize stormwater contamination and help comply with the DOE Manual. BMP's for the project may include:

- *Inspect and clean treatment BMPs, conveyance systems, and catch basins as needed, and determine necessary O & M Improvements.*
- Clean catch basins when the depth of deposits reaches 60-percent of the sump depth as measured from the bottom of basin to the invert of the lowest pipe into or out of the basin.
- Clean woody debris in a catch basin as frequently as needed to ensure proper operation of the catch basin.

MINIMUM REQUIREMENT 4: PRESERVATION OF NATURAL DRAINAGE SYSTEMS AND OUTFALLS

This site is fairly flat and has a natural drainage pattern towards an MS4 ditch along the east side of the site. The project proposes to maintain drainage pattern so that overall site continues to drain east of site.

It does not appear that there are any catch basins associated with this project. Perhaps language such as:
- "Maintain, swales, ditches and culverts at an appropriate frequency to ensure that plugging, erosion, and flooding does not occur."
- "Provide maintenance and cleaning of debris, sediments, and other pollutants from the stormwater collection, conveyance, and treatment systems to maintain proper operation."
- "Reseed bare turf areas until the vegetation fully covers the ground surface."
[Storm Report; Page 12 of 32]

A REVISED DRAINAGE REPORT
WAS PROVIDED FOR REVIEW.
IN PARTICULAR THE CATCH BASIN
CLEANING LANGUAGE WAS
REMOVED.

Construction Stormwater General Permit (CSWGP)

CECIL &
ASSOCIATEAS
DATE: 10-06-2025
BY: JOHN FARLEIGH

Stormwater Pollution Prevention Plan (SWPPP)

for
Farm 12


Prepared for:
Department of Ecology
City of Puyallup

Permittee / Owner	Developer	Operator / Contractor
Krista Linden		TBD

506 33rd ST SE Puyallup, WA 98372

Certified Erosion and Sediment Control Lead (CESCL)

Name	Organization	Contact Phone Number

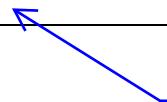

Please add "TBD".
[CSWPPP; Page 1 of 32]

DONE

SWPPP Prepared By

Name	Organization	Contact Phone Number
Mirissa Ochoa	JMJ Team	(206) 596-2020

SWPPP Preparation Date

12 / 12 / 2023

Project Construction Dates

Activity / Phase	Start Date	End Date
Begin Construction	TBD	TBD

Project Information (1.0)

Project/Site Name: Farm 12
Street/Location: 506 33rd St SE
City: Puyallup State: WA Zip code: 98372
Subdivision:
Receiving waterbody: Puyallup River

Existing Conditions (1.1)

Total acreage (including support activities such as off-site equipment staging yards, material storage areas, borrow areas).

Total acreage: 1.06 Acres

Disturbed acreage: 1.06 Acres

Existing structures: None

Landscape topography: Flat


Drainage patterns: Overland Flow to Existing Ditch

Existing Vegetation: Grass

Critical Areas (wetlands, streams, high erosion risk, steep or difficult to stabilize slopes):

None

Puyallup River Fecal Coliform TMDL.
[CSWPPP; Page 4 of 32]

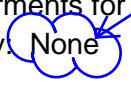List of known impairments for 303(d) listed or Total Maximum Daily Load (TMDL) for the receiving waterbody. 

DONE. SEE
PAGE 4 OF 250

Table 1 includes a list of suspected and/or known contaminants associated with the construction activity.

Table 1 – Summary of Site Pollutant Constituents

Constituent (Pollutant)	Location	Depth	Concentration
None	N/A	N/A	N/A

Discharges to 303(d) or Total Maximum Daily Load (TMDL) Waterbodies (5.0)

303(d) Listed Waterbodies (5.1)

Is the receiving water 303(d) (Category 5) listed for turbidity, fine sediment, phosphorus, or pH?



List the impairment(s):

[Insert text here]

Please complete.
[CSWPPP; Page 28 of 32]

UPDATED: PLEASE
REVIEW PAGE 39 OF
250

The receiving waterbody, **insert waterbody name**, is impaired for: **insert impairment**. All stormwater and dewatering discharges from the site are subject to an **effluent limit** of **8.5 su for pH and/or 25 NTU for turbidity**.

List and describe BMPs:

[Insert text here]

TMDL Waterbodies (5.2)

Waste Load Allocation for CWSGP discharges:

[Insert text here]

List and describe BMPs:

[Insert text here]

Discharges to TMDL receiving waterbodies will meet in-stream water quality criteria at the point of discharge.

The Construction Stormwater General Permit Proposed New Discharge to an Impaired Water Body form is included in Appendix F.