



PRSC20220184

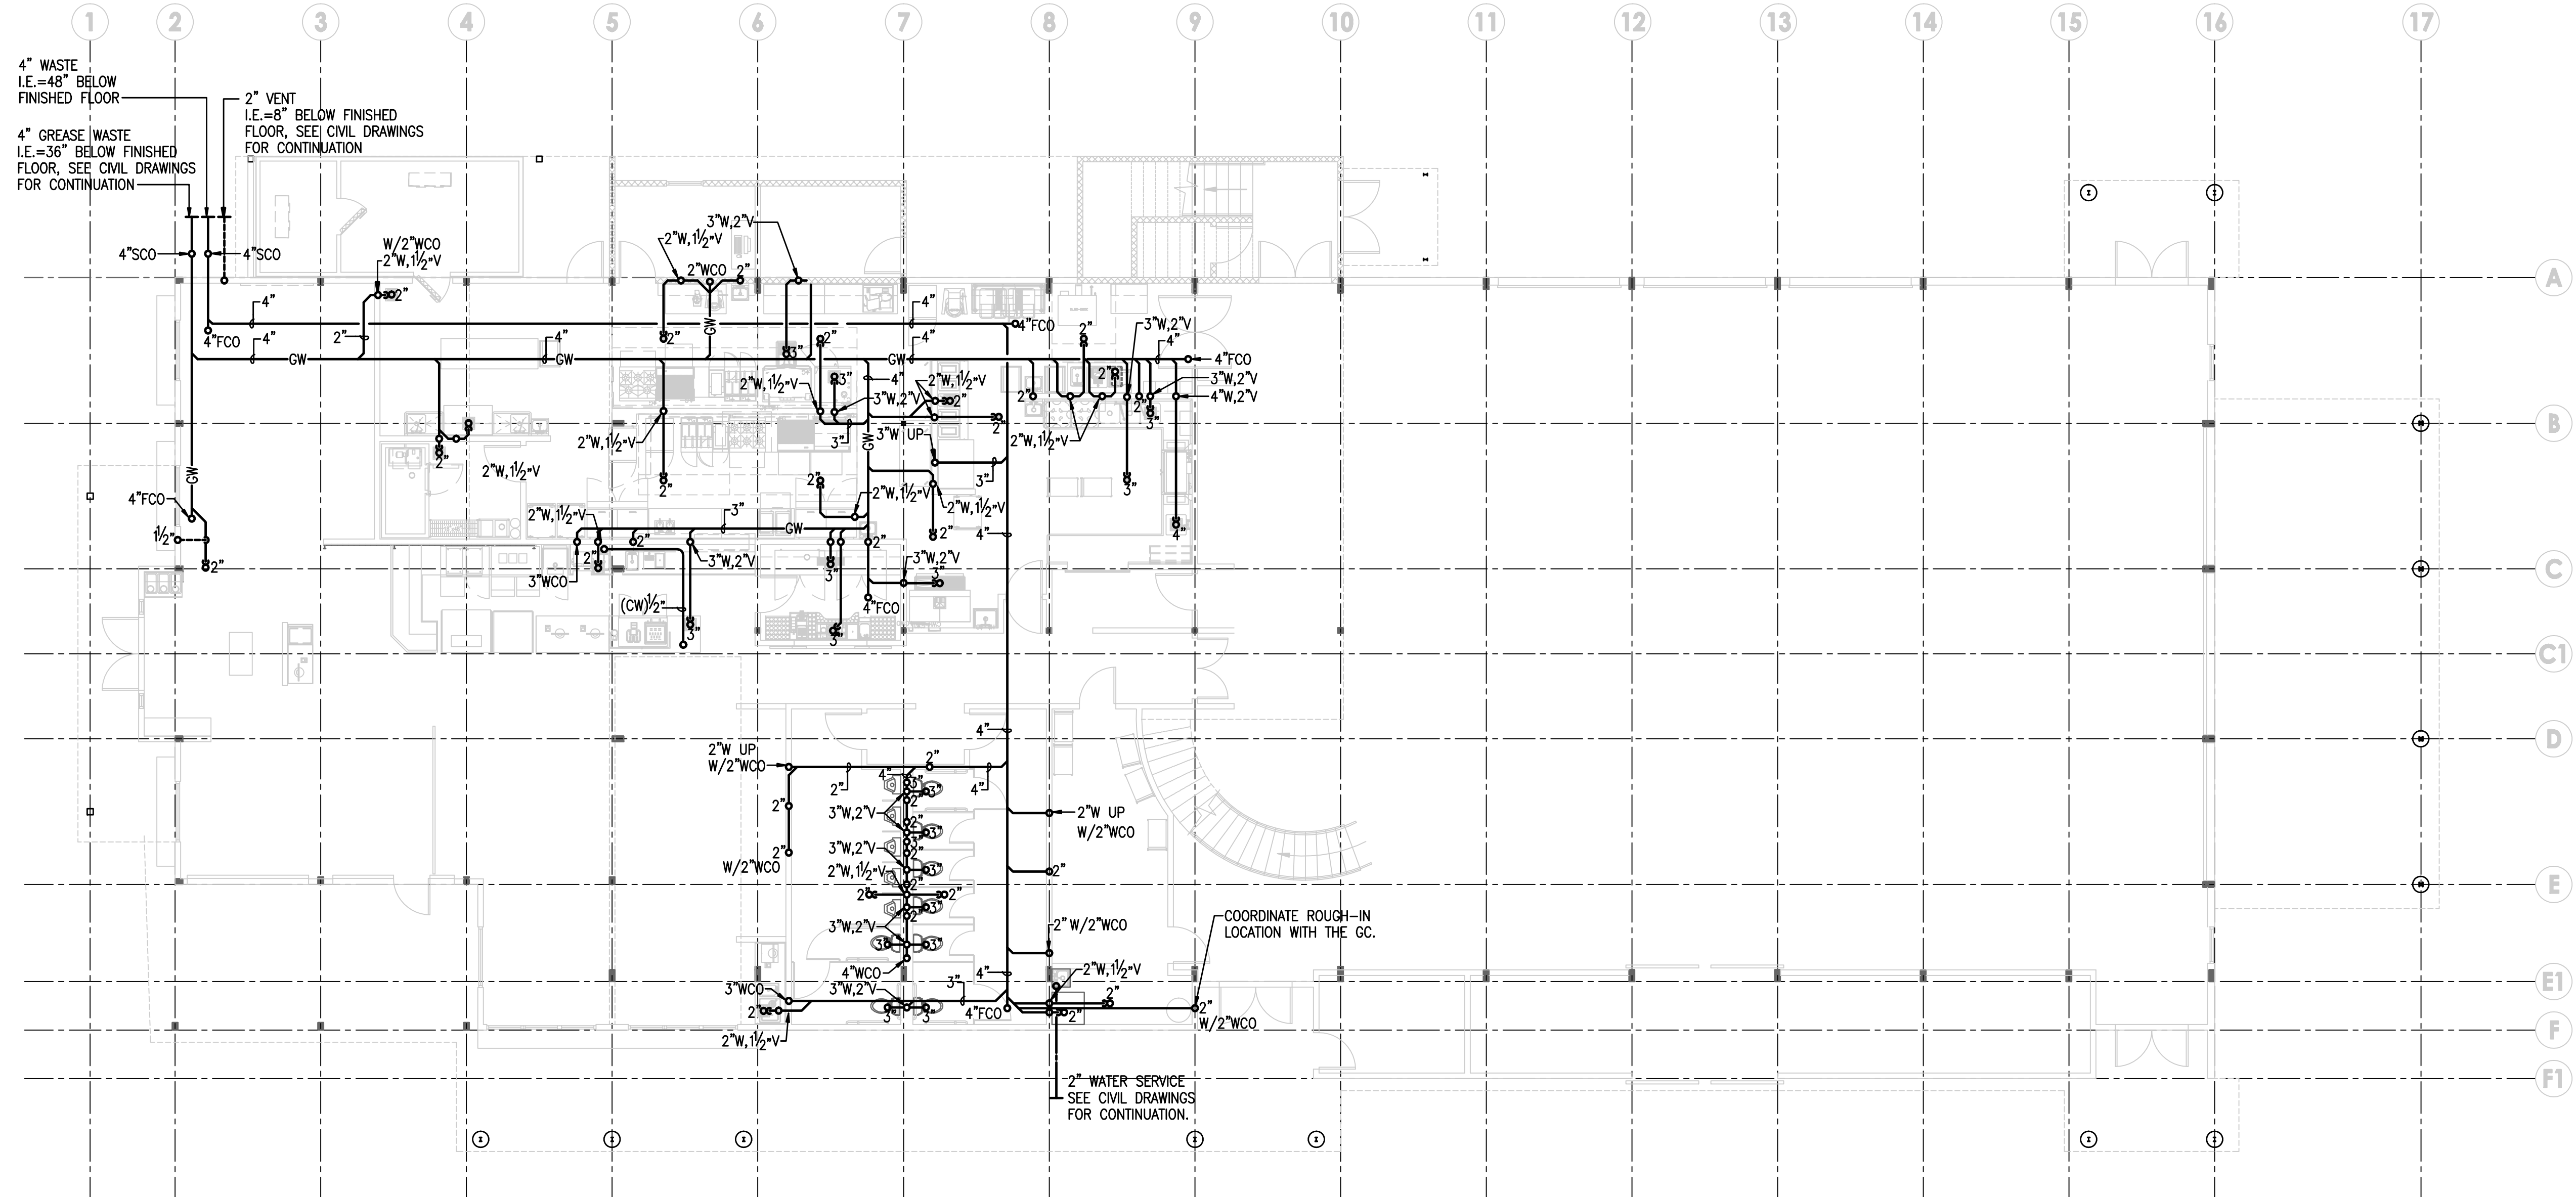


FOUNDATION PLAN - PLUMBING
 SCALE: 1/8"=1'-0"

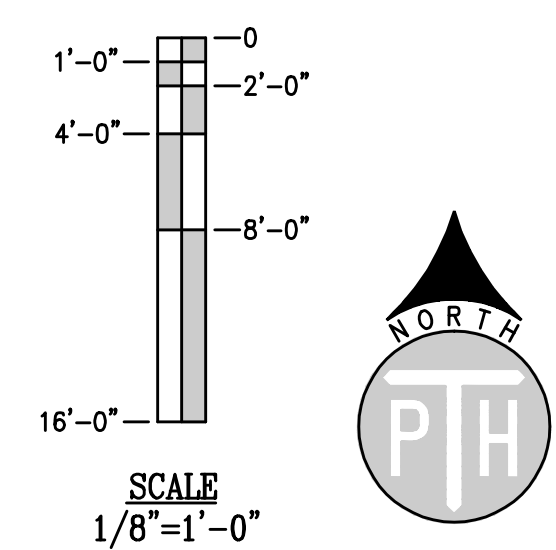

City of Puyallup
 Development & Permitting Services
ISSUED PERMIT

Building	Planning
Engineering	Public Works
Fire	Traffic

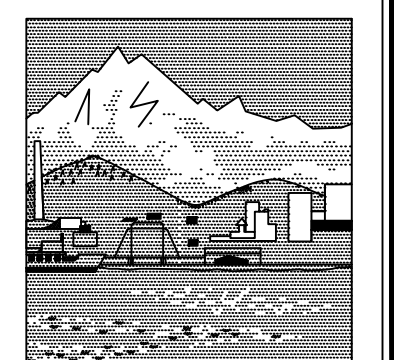

TACOMA PLUMBING and HEATING, Inc.
 DESIGN BUILD
 COMMERCIAL
 INDUSTRIAL
 UTILITIES
 1817-112th Street East
 Suite G
 Tacoma, Washington
 98445
 Tacoma, Washington
 98444
 (253) 531-3444
 INFO@TACOMAPLUMBING.COM
 WWW.TACOMAPLUMBING.COM

**STEP BY STEP
 COMMUNITY
 BUILDING**

13407 80TH ST E
 PUYALLUP, WA 98372

**FOUNDATION
 PLAN -
 PLUMBING**


THIS DOCUMENT IS PROPERTY OF TACOMA PLUMBING AND HEATING INC. UNAUTHORIZED ALTERATION OF ANY OF THE INFORMATION ON THIS DOCUMENT WILL INVALIDATE THE DOCUMENT. DOCUMENT IS NOT CREATED FOR BIDDING AND SHALL NOT BE USED FOR BIDDING PURPOSES WITHOUT THE WRITTEN AUTHORIZATION OF TACOMA PLUMBING AND HEATING, INCORPORATED.

DESIGNED:	B.COLE
DRAWN:	B.COLE
REVIEWED:	C.COMBS
DATE:	12-05-2019
JOB NUMBER:	17029
REVISION:	
△ AGENCY REVIEW	10-06-2017
△ REVISED AGENCY REVIEW	02-14-2018
△ REVISED GREASE WASTE	09-19-2018
△ REVISED SANITARY SEWER	10-15-2018
△ REVISED KITCHEN	11-08-2018

PC1.01

AS-BUILT
 12-05-2019


PRSC20220184

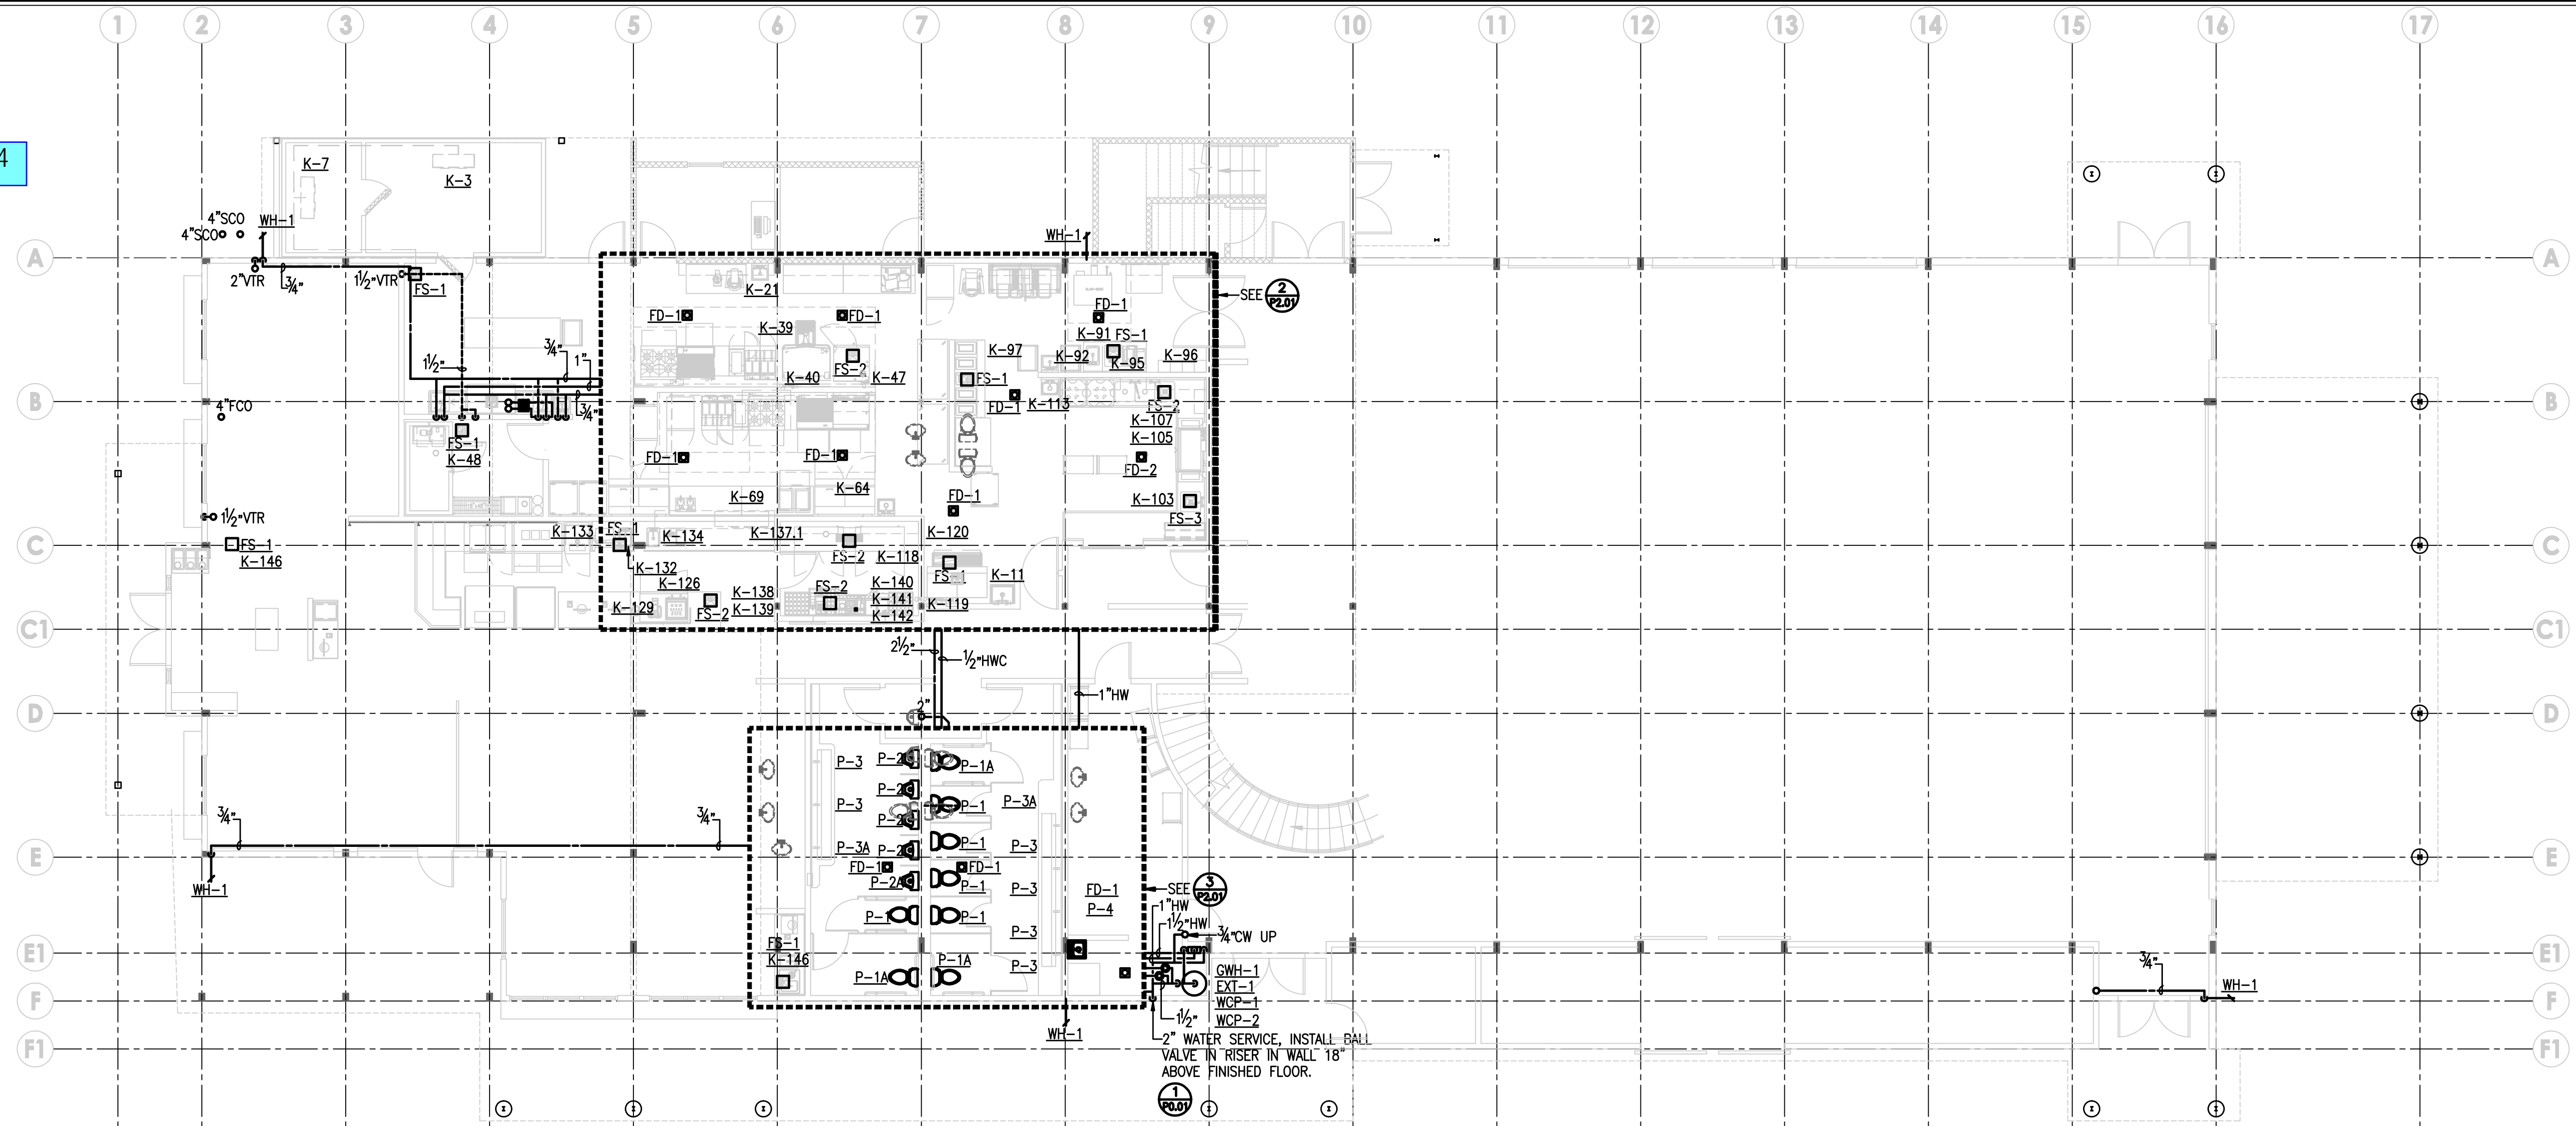


LOWER FLOOR PLAN - PLUMBING ①
 SCALE: 1/8"=1'-0"

City of Puyallup
 Development & Permitting Services
ISSUED PERMIT



Building	Planning
Engineering	Public Works
Fire	Traffic

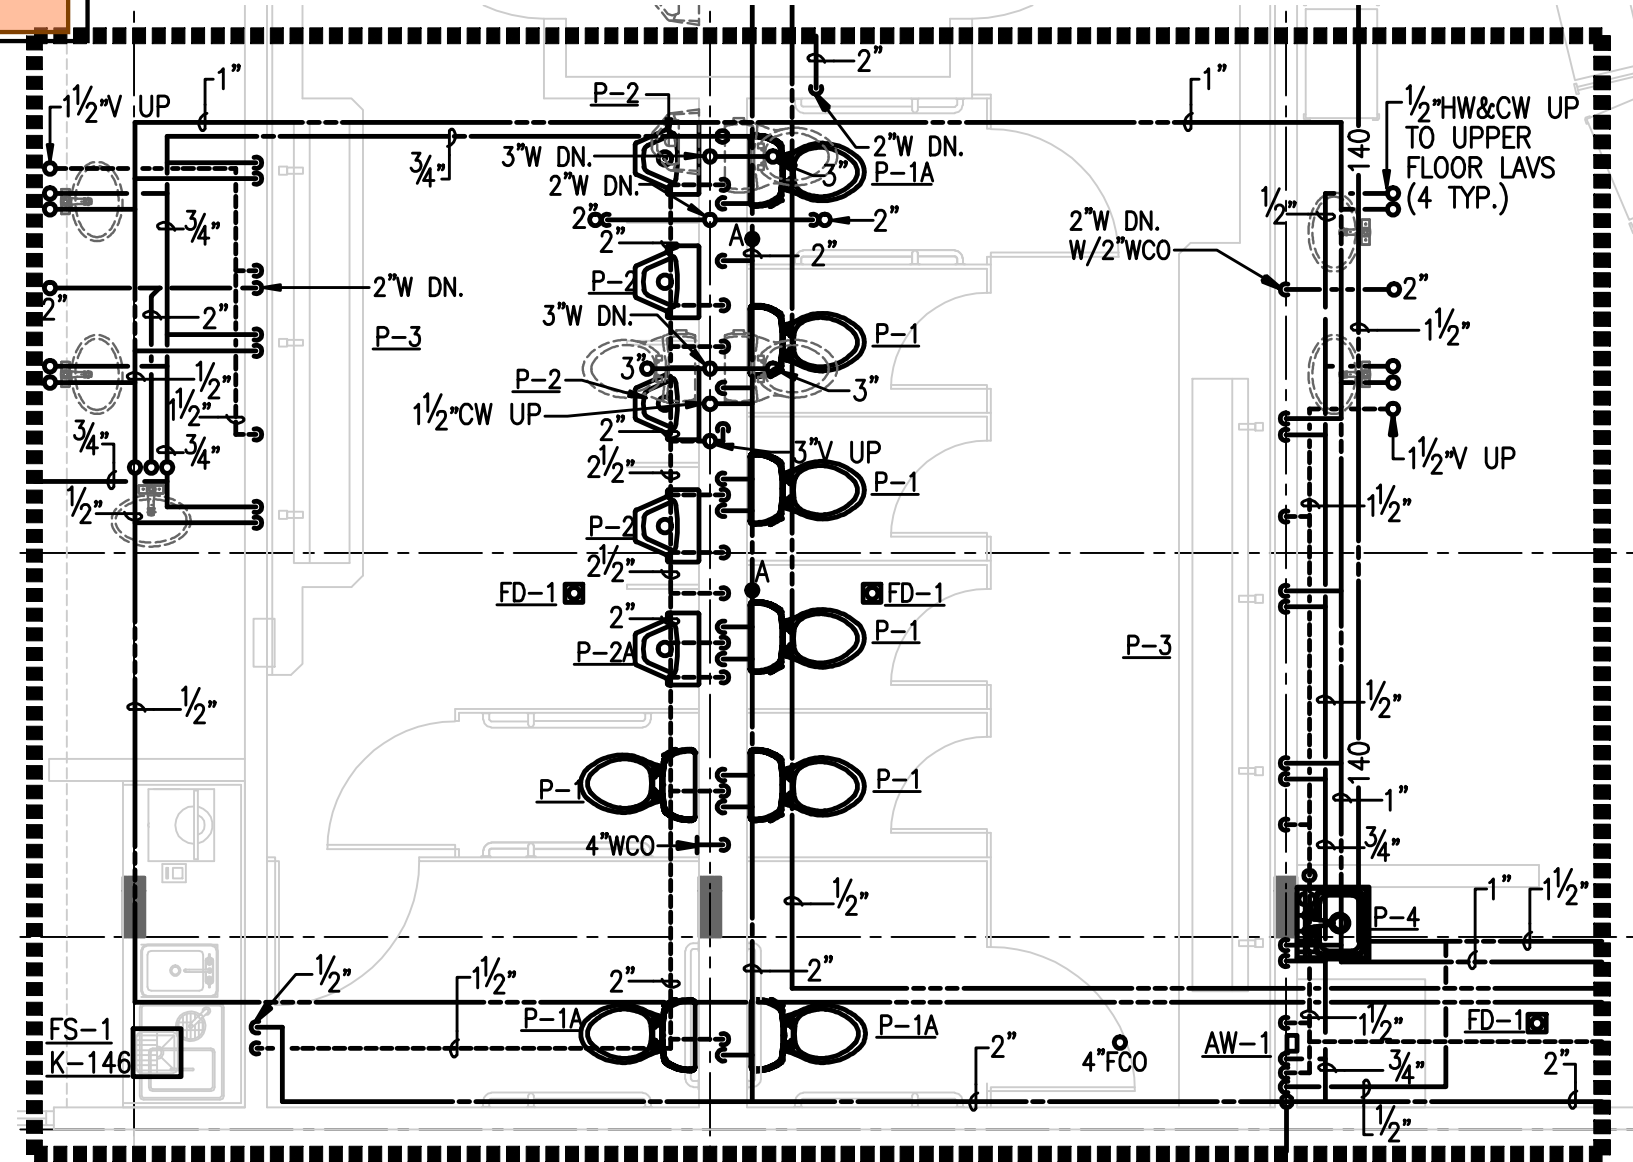

PARTIAL LOWER FLOOR PLAN - PLUMBING ③
 SCALE: 1/4"=1'-0"

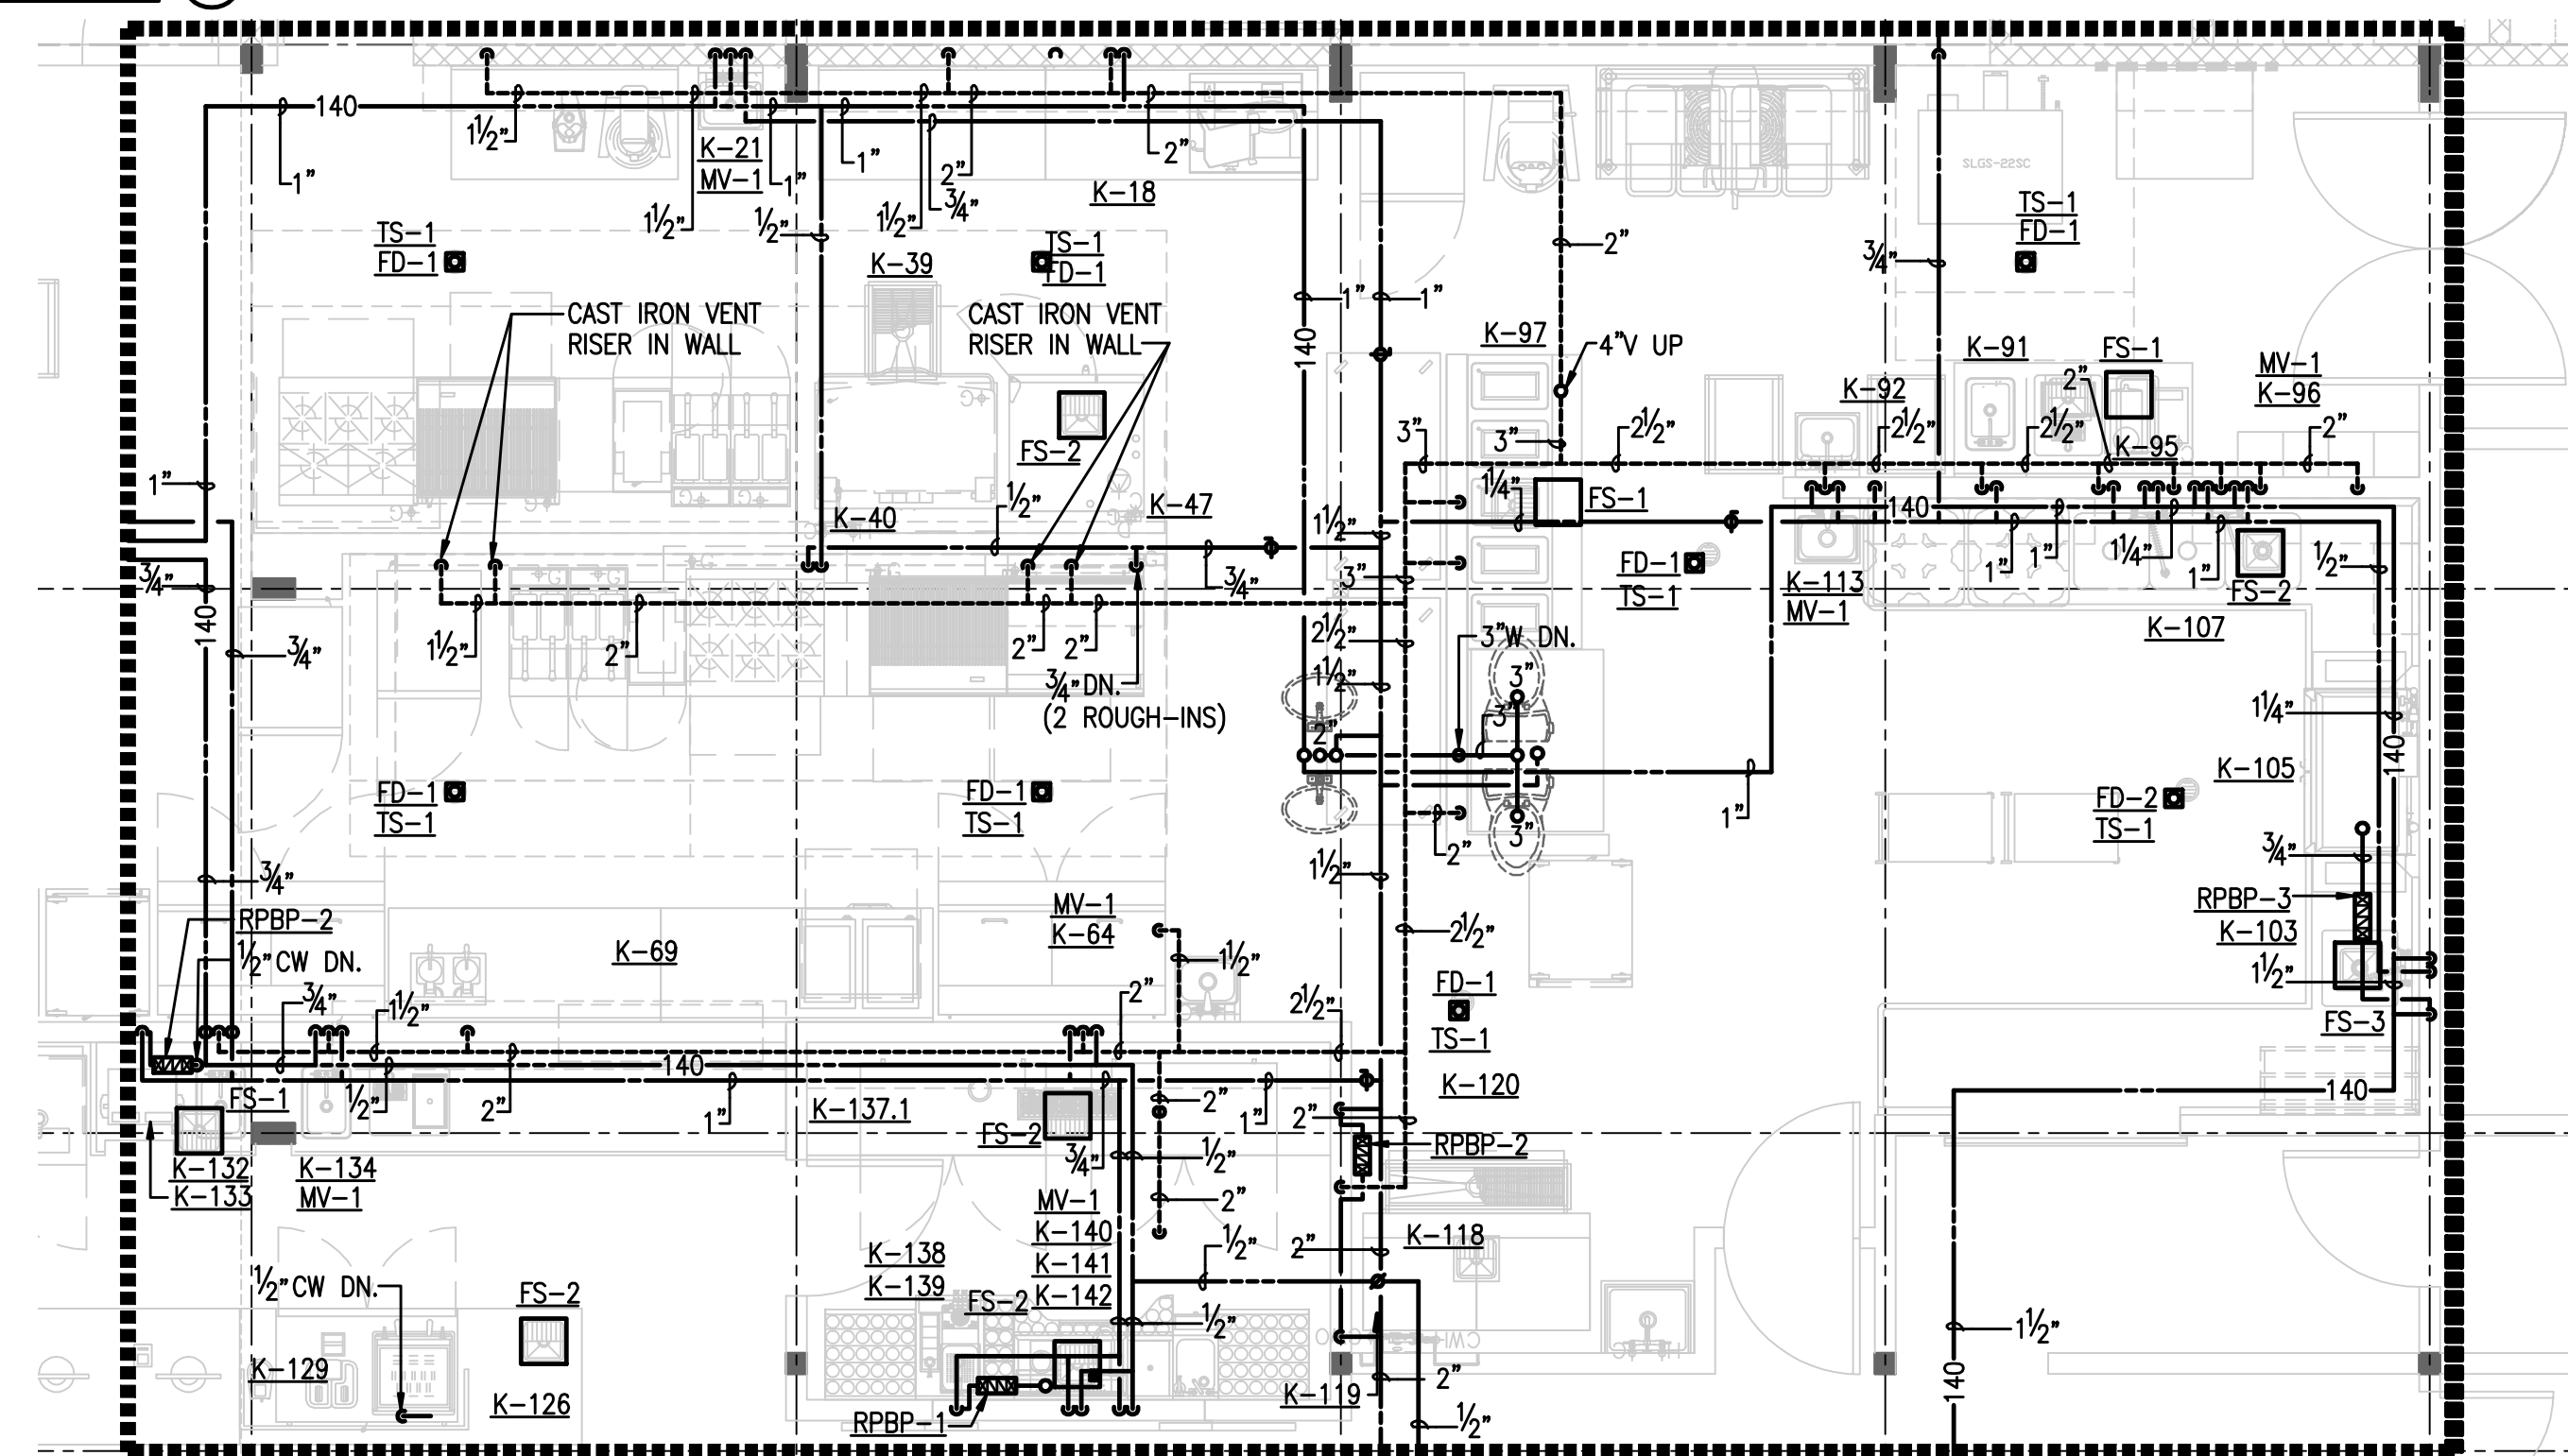

PARTIAL LOWER FLOOR PLAN - PLUMBING ②
 SCALE: 1/4"=1'-0"

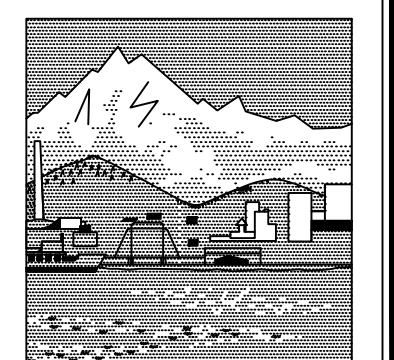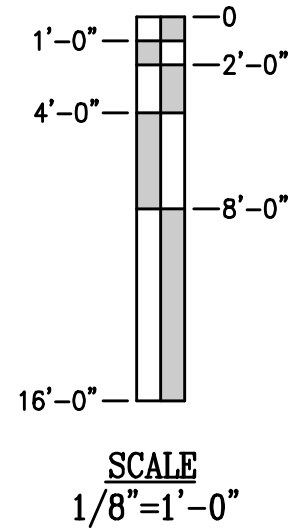

TACOMA PLUMBING and HEATING, Inc.
 DESIGN BUILD
 COMMERCIAL
 INDUSTRIAL
 UTILITIES
 1817-112th Street East
 Suite G
 Tacoma, Washington
 98445
 Tacoma, Washington
 98444
 (253) 531-3444
 INFO@TACOMAPLUMBING.COM
 WWW.TACOMAPLUMBING.COM

**STEP BY STEP
 COMMUNITY
 BUILDING**

**13407 80TH ST E
 PUYALLUP, WA 98372**

**LOWER FLOOR
 PLAN -
 PLUMBING**


THIS DOCUMENT IS PROPERTY OF TACOMA PLUMBING AND HEATING, INC. UNAUTHORIZED ALTERATION OF ANY OF THE INFORMATION ON THIS DOCUMENT WILL INVALIDATE THE DOCUMENT. DOCUMENT IS NOT CREATED FOR BIDDING AND SHALL NOT BE USED FOR BIDDING PURPOSES WITHOUT THE WRITTEN AUTHORIZATION OF TACOMA PLUMBING AND HEATING, INCORPORATED.

DESIGNED:	B. COLE
DRAWN:	B. COLE
REVIEWED:	C. COMBS
DATE:	12-05-2019
JOB NUMBER:	17029
REVISION:	
△ AGENCY REVIEW	10-06-2017
△ REVISED AGENCY REVIEW	02-14-2018
△ REVISED GREASE WASTE	09-19-2018
△ REVISED SANITARY SEWER	10-15-2018
△ REVISED KITCHEN	11-08-2018

PC2.01

AS-BUILT
 12-05-2019

PRSC20220184


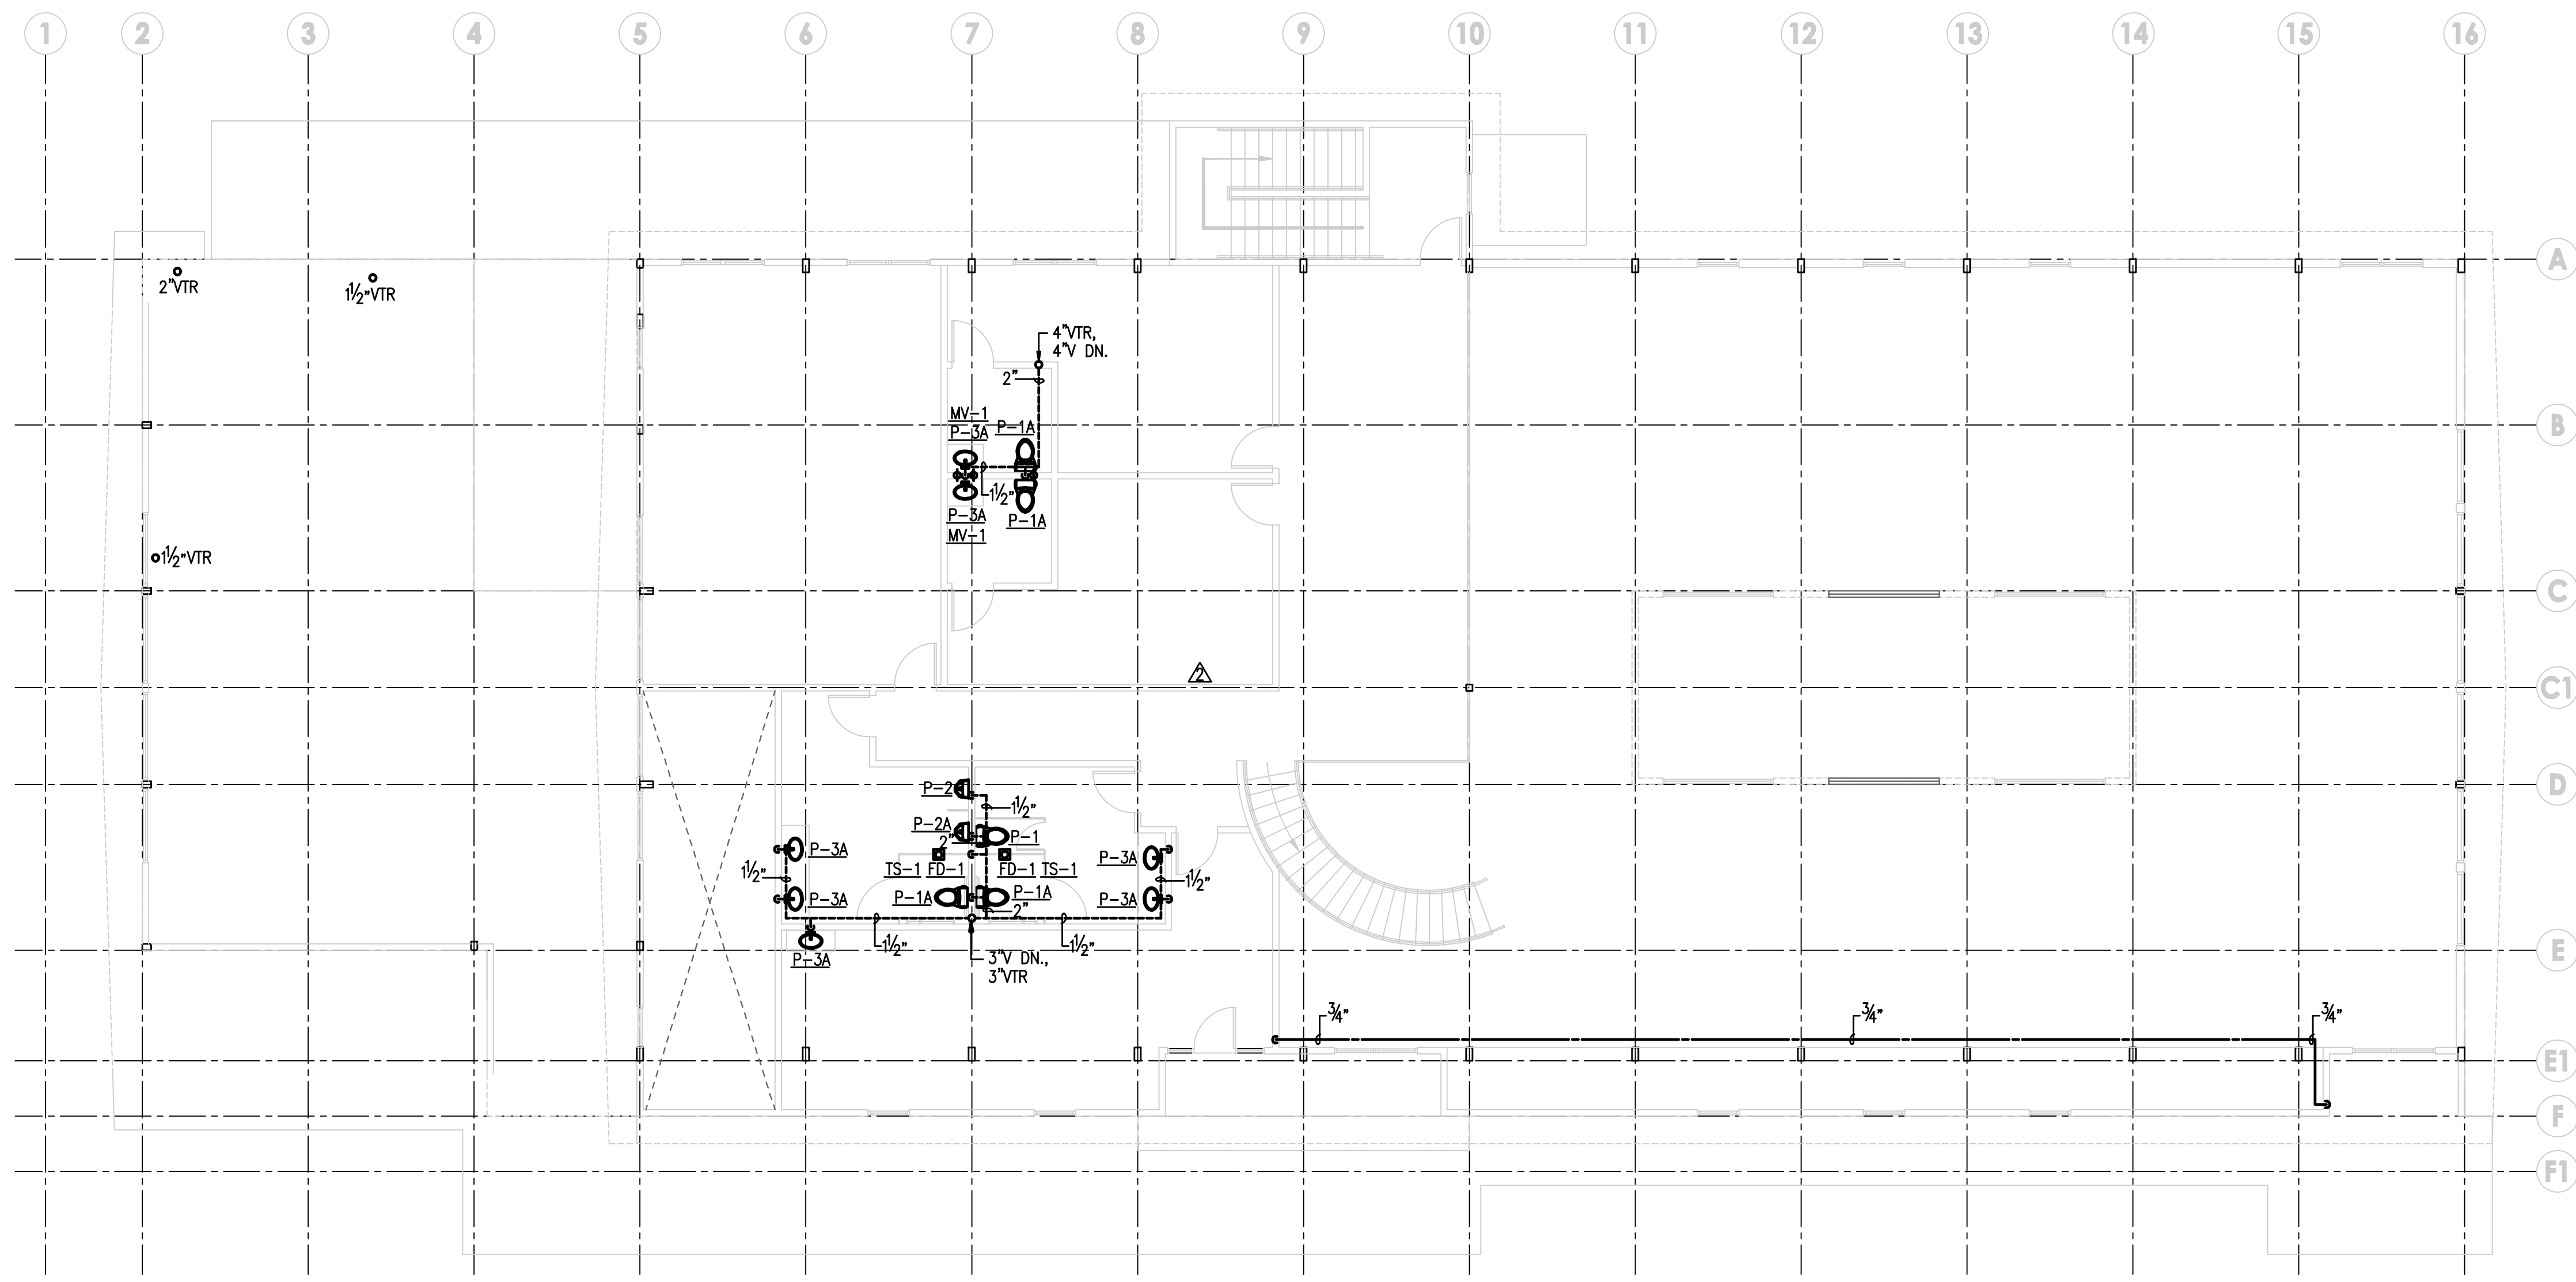


City of Puyallup
Development & Permitting Services

ISSUED PERMIT

Building	Planning
Engineering	Public Works
Fire	Traffic

**UPPER
FLOOR PLAN – PLUMBING**
SCALE: 1/8"=1'-0"

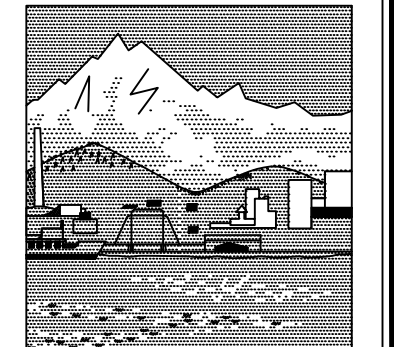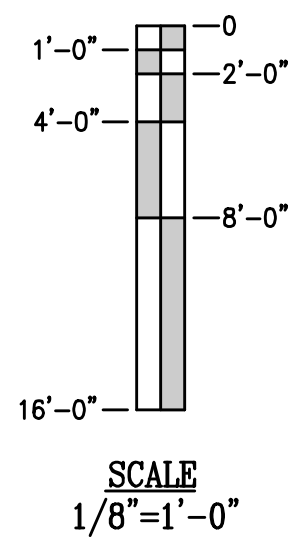

**TACOMA PLUMBING
and HEATING, Inc.**
DESIGN BUILD
COMMERCIAL
INDUSTRIAL
UTILITIES
1817-112th Street East
Suite G
Tacoma, Washington
98445

Tacoma, Washington
98444
(253) 531-3444
INFO@TACOMAPLUMBING.COM
WWW.TACOMAPLUMBING.COM

**STEP BY STEP
COMMUNITY
BUILDING**

13407 80TH ST E
PUYALLUP, WA 98372

**UPPER FLOOR
PLAN –
PLUMBING**

THIS DOCUMENT IS PROPERTY OF TACOMA PLUMBING AND HEATING, INC. UNAUTHORIZED ALTERATION OF ANY OF THE INFORMATION ON THIS DOCUMENT WILL INVALIDATE THE DOCUMENT. DOCUMENT IS NOT CREATED FOR BIDDING AND SHALL NOT BE USED FOR BIDDING PURPOSES WITHOUT THE WRITTEN AUTHORIZATION OF TACOMA PLUMBING AND HEATING, INCORPORATED.

DESIGNED: B.COLE
DRAWN: B.COLE
REVIEWED: C.COMBS
DATE: 12-05-2019
JOB NUMBER: 17029
REVISION:
△ AGENCY REVIEW
10-06-2017
△ REVISED AGENCY REVIEW
02-14-2018
△ REVISED GREASE WASTE
09-19-2018
△ REVISED SANITARY
SEWER 10-15-2018
△ REVISED KITCHEN
11-08-2018

PC2.02

AS-BUILT
12-05-2019