


1 FOUNDATION PLAN
SCALE: 1/4" = 1'-0"
PP501 PP501 PP501 PP501 PP501 PP501

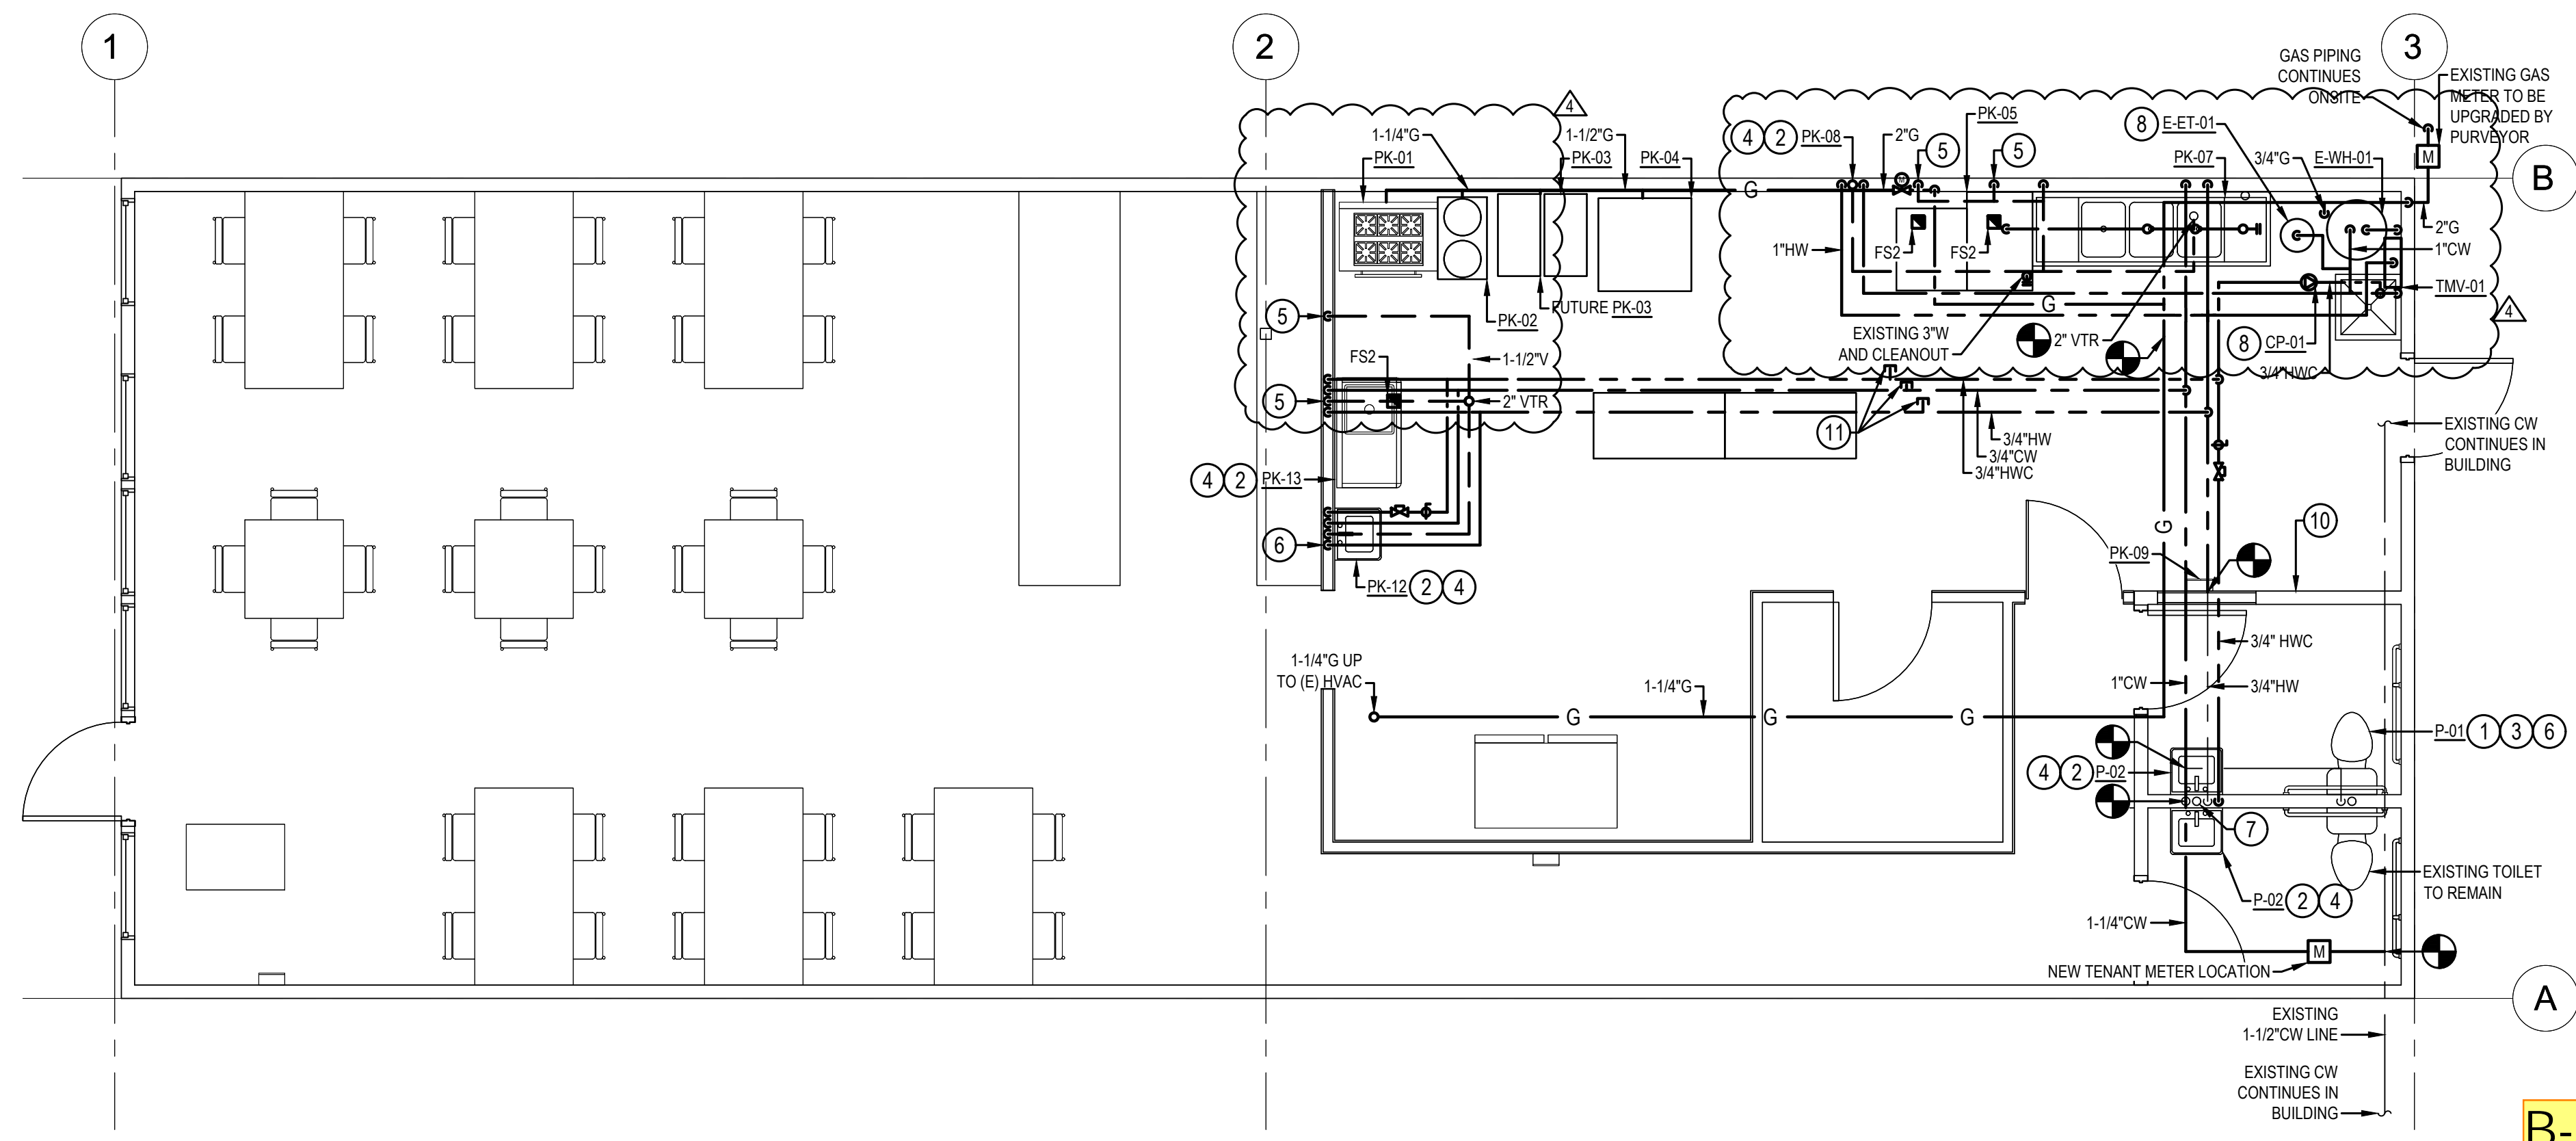

2 PLUMBING PLAN
SCALE: 1/4" = 1'-0"
PP501 PP501 PP501 PP501 PP501 PP501 PP501 PP501 PP501 PP502 PP502 PP502

GENERAL NOTES

1. PIPING IS SCHEMATIC IN NATURE CONTRACTOR TO PROVIDE ADDITIONAL FITTINGS AND OFFSETS AS REQUIRED TO INSTALL A COMPLETE AND FUNCTIONING SYSTEM.
2. THIS DRAWING WAS CREATED FROM AS BUILT DOCUMENTATION AND FIELD NOTES AND MAY NOT REPRESENT ACTUAL AS BUILT CONDITIONS. CONTRACTOR TO VERIFY SCOPE PRIOR TO COMMENCING WORK.
3. LINES AND EQUIPMENT SHOWN DARK AND DASHED IS TO BE DEMOLISHED. LINES AND EQUIPMENT SHOWN LIGHT AND SOLID IS TO REMAIN.
4. ALL NEW WASTE PIPING SHALL BE SLOPED AT 1/4" PER FOOT.

PLAN NOTES

- ① 4"W, 2"V
- ② 2"W, 1-1/2"V
- ③ 3/4" CW
- ④ 3/4" HW, 3/4 CW
- ⑤ 1-1/2"V DN
- ⑥ ROUTE 3/4"HWC TO WITHIN 6" OF HOT WATER PLUMBING STOP.
- ⑦ EXISTING VENTS UP TO VTR.
- ⑧ UNIT IS SUPPORTED BY PIPING AND STRUCTURE.
- ⑨ VERIFY INVERT ELEVATION BEFORE COMMENCING WORK.
- ⑩ REMOTE METER READ OUT LOCATION.
- ⑪ PROVIDE CAPPED 3/4" PIPE FOR ANY FUTURE CONNECTION.
- ⑫ ABANDON EXISTING WASTE IN THIS AREA AND CAP WASTE PIPE ROUTING TOWARDS KITCHEN. PROVIDE NEW WASTE ROUTING AS SHOWN ROUTED INDEPENDENTLY OF KITCHEN GREASE WASTE SYSTEM.

THE APPROVED CONSTRUCTION PLANS, DOCUMENTS AND ALL ENGINEERING MUST BE POSTED ON THE JOB AT ALL INSPECTIONS IN A VISIBLE AND READILY ACCESSIBLE LOCATION.

FULL SIZED LEDGIBLE COLOR PLANS ARE REQUIRED TO BE PROVIDED BY THE PERMITEE ON SITE FOR INSPECTION

City of Puyallup
Development & Permitting Services
ISSUED PERMIT

Building	Planning
Engineering	Public Works
Fire	Traffic

City of Puyallup
Building
ACCEPTED

JMontgomery
03/01/2022
6:09:12 AM

B-21-0544 - REVISIONS
SEE ORIGINAL PLANS FOR ALL INFORMATION.

REVISIONS

NO	DESCRIPTION	DATE
4	REVISION	2/04/2022

DRAWN BY: RPG
CHECKED BY: BSM
PROJECT MANAGER: BSM

REUSE OF DOCUMENTS
THESE DOCUMENTS ARE THE PROPERTY OF MIDDLEBROOK ENGINEERING, LLC AND SHALL NOT BE COPIED, REPRODUCED WITHOUT WRITTEN PERMISSION