


BUILDING DATA	
ZONING	ML - LIMITED MANUFACTURING
BUILDING AREA	355 SF
OCCUPANCY TYPE	F-2
TYPE OF CONSTRUCTION	V-B
HAZARDOUS MATERIAL STORAGE	EXISTING 140 GALLON GENERATOR SUBBASE DIESEL FUEL TANK

SITE DATA	
PUMP STATION EASEMENT AREA	2,000 SF
PARKING	N/A
IMPERVIOUS SURFACE AREA PUMP STATION EASEMENT (EXISTING)	1,826 SF
IMPERVIOUS SURFACE AREA PUMP STATION EASEMENT (PROPOSED)	1,477 SF
LANDSCAPED AREA	374 SF
LANDSCAPED AREA AS PERCENTAGE OF TOTAL EASEMENT AREA	19%

- LEGEND:**
- RIGHT-OF-WAY
 - PROPERTY BOUNDARY
 - OHWM SETBACK
 - EXISTING CONTOUR LINE
 - PROPOSED CONTOUR LINE
 - EXISTING ASPHALT PAVEMENT
 - EXISTING GRAVEL SURFACING
 - EXISTING CONCRETE SURFACING
 - EXISTING FENCE
 - NEW FENCE
 - DIRECTION OF SLOPE
 - NEW ASPHALT PAVEMENT SURFACE
 - LANDSCAPING


STATE OF WASHINGTON
103,673 SF

0420214064

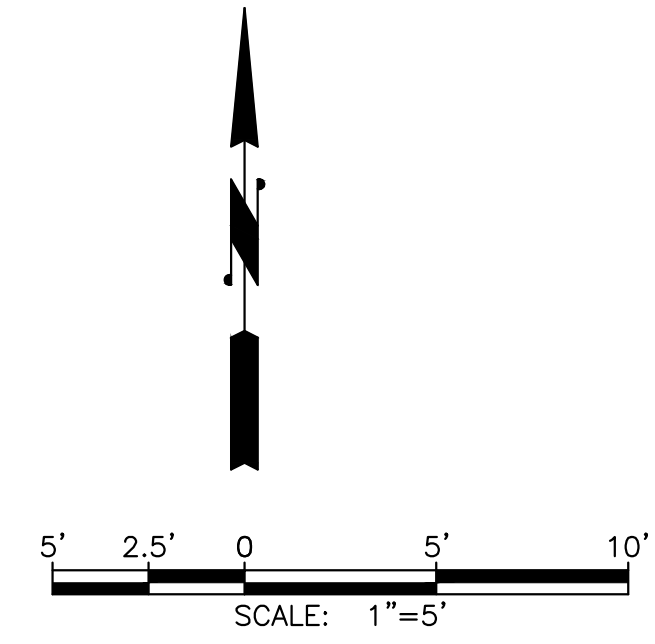

PIERCE COUNTY PUBLIC WORKS
76,256 SF
117 NORTH LEVEE ROAD
6021320010

PIERCE COUNTY PUBLIC WORKS
152,460 SF
219 NORTH LEVEE ROAD
042021406

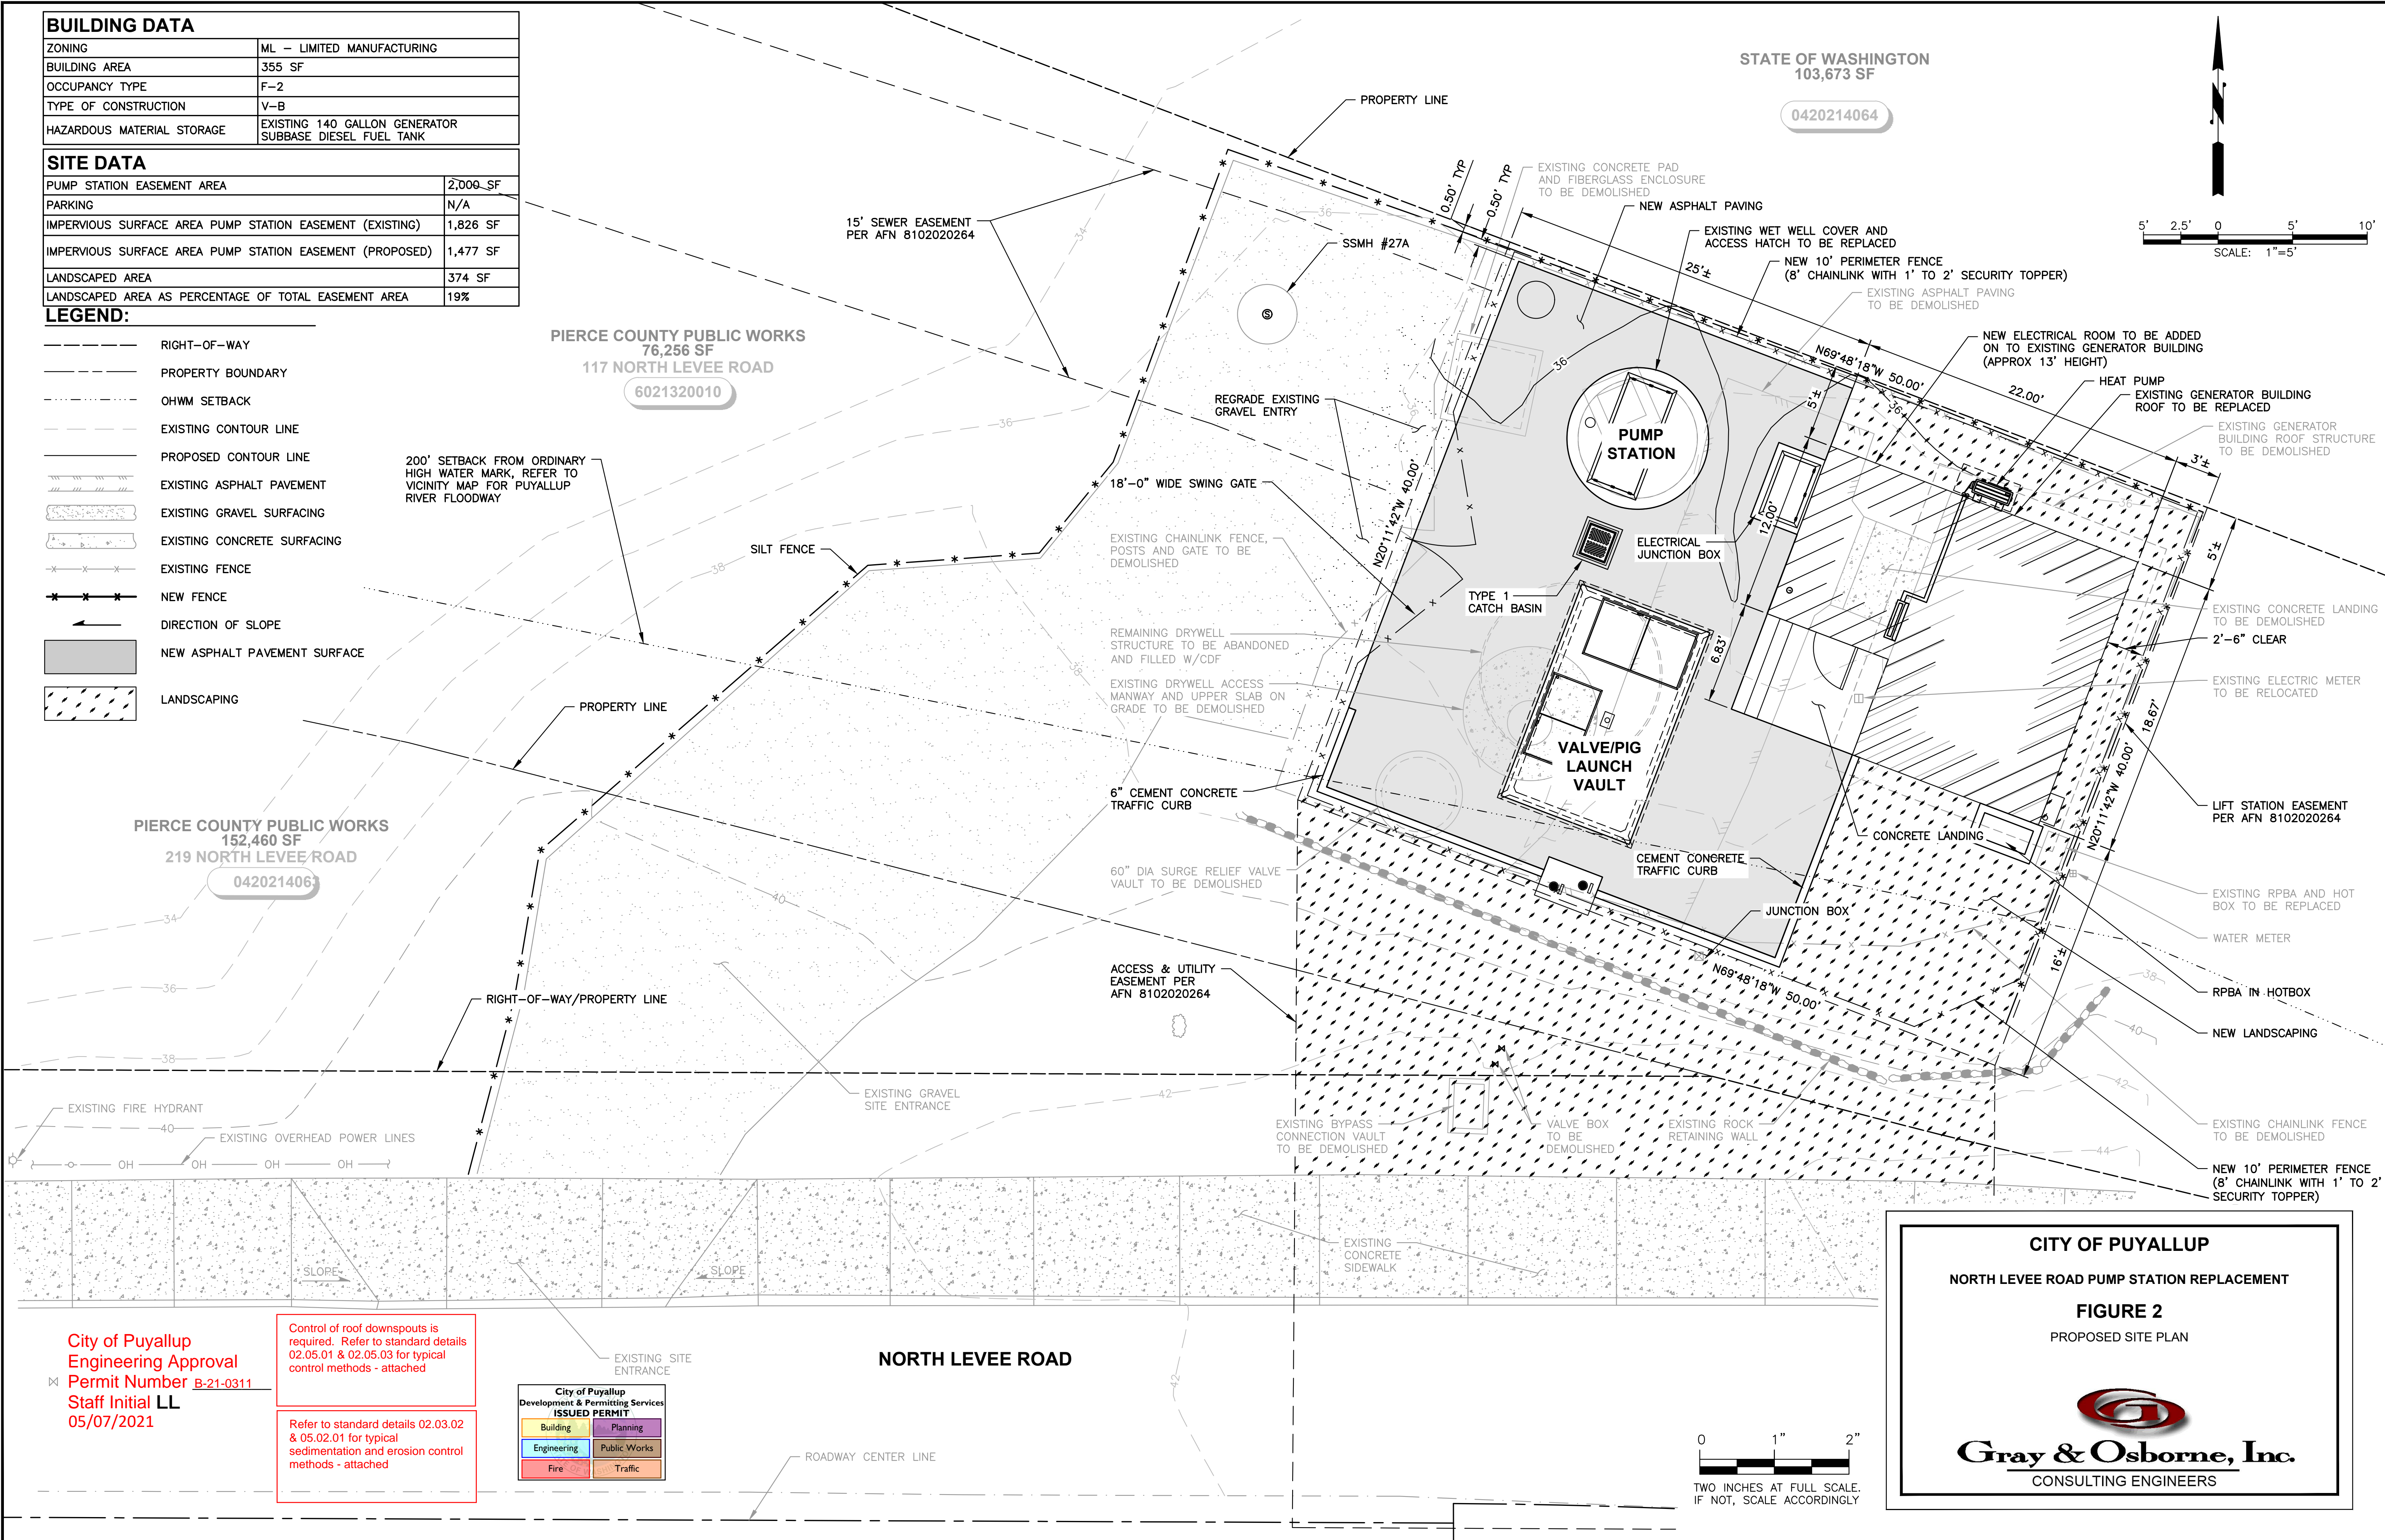


M:\PUYALLUP\20503 - north levee road pump station\02 planset\FIGURES\FIGURE_SITE.dwg, 2/25/2021 2:26 PM, CHARLEY REID


City of Puyallup
Engineering Approval
Permit Number B-21-0311
Staff Initial LL
05/07/2021

Control of roof downspouts is required. Refer to standard details 02.05.01 & 02.05.03 for typical control methods - attached

Refer to standard details 02.03.02 & 05.02.01 for typical sedimentation and erosion control methods - attached

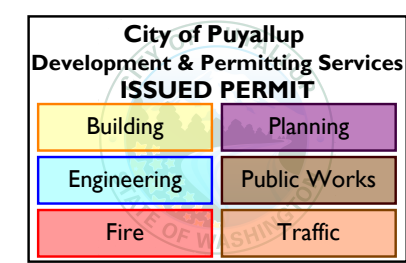

NORTH LEVEE ROAD

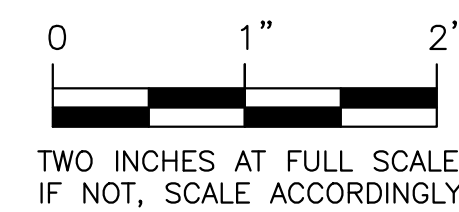

CITY OF PUYALLUP
NORTH LEVEE ROAD PUMP STATION REPLACEMENT
FIGURE 2
PROPOSED SITE PLAN


Gray & Osborne, Inc.
CONSULTING ENGINEERS

LAYOUT: C1
 PATH: U:\Puy\Projects\Clients\1895-City of Puyallup\214-1895-047-Puy050-CAD\Phase 46 -N Levee Rd Lift Sta\DWG\
 PLOTTED BY: betzvojlh DATE: Thursday, August 16, 2012 3:08:53 PM

HORIZONTAL DATUM:
 WASHINGTON STATE PLANE COORDINATE SYSTEM, SOUTH ZONE, NAD 83/07
 DERIVED FROM GLOBAL POSITIONING SATELLITE TIES USING THE WASHINGTON
 STATE REFERENCE SYSTEM.

BASIS OF BEARING:
 BETWEEN MONUMENT 103 AND 105 BEARS N89°45'11"W, 596.00 FEET

VERTICAL DATUM:
 NGVD29 BASED ON THE CITY OF PUYALLUP VERTICAL CONTROL BENCHMARKS.
 BENCHMARK: POINT#9024
 FOUND A 2-1/2" BRASS DISK IN THE TOP OF CONCRETE CURB STAMPED CITY
 OF PUYALLUP BENCHMARK NO. SEPIO-17 IN THE SOUTHEAST QUADRANT OF THE
 INTERSECTION OF EAST PIONEER AND 17TH STREET SE. ELEVATION=55.68

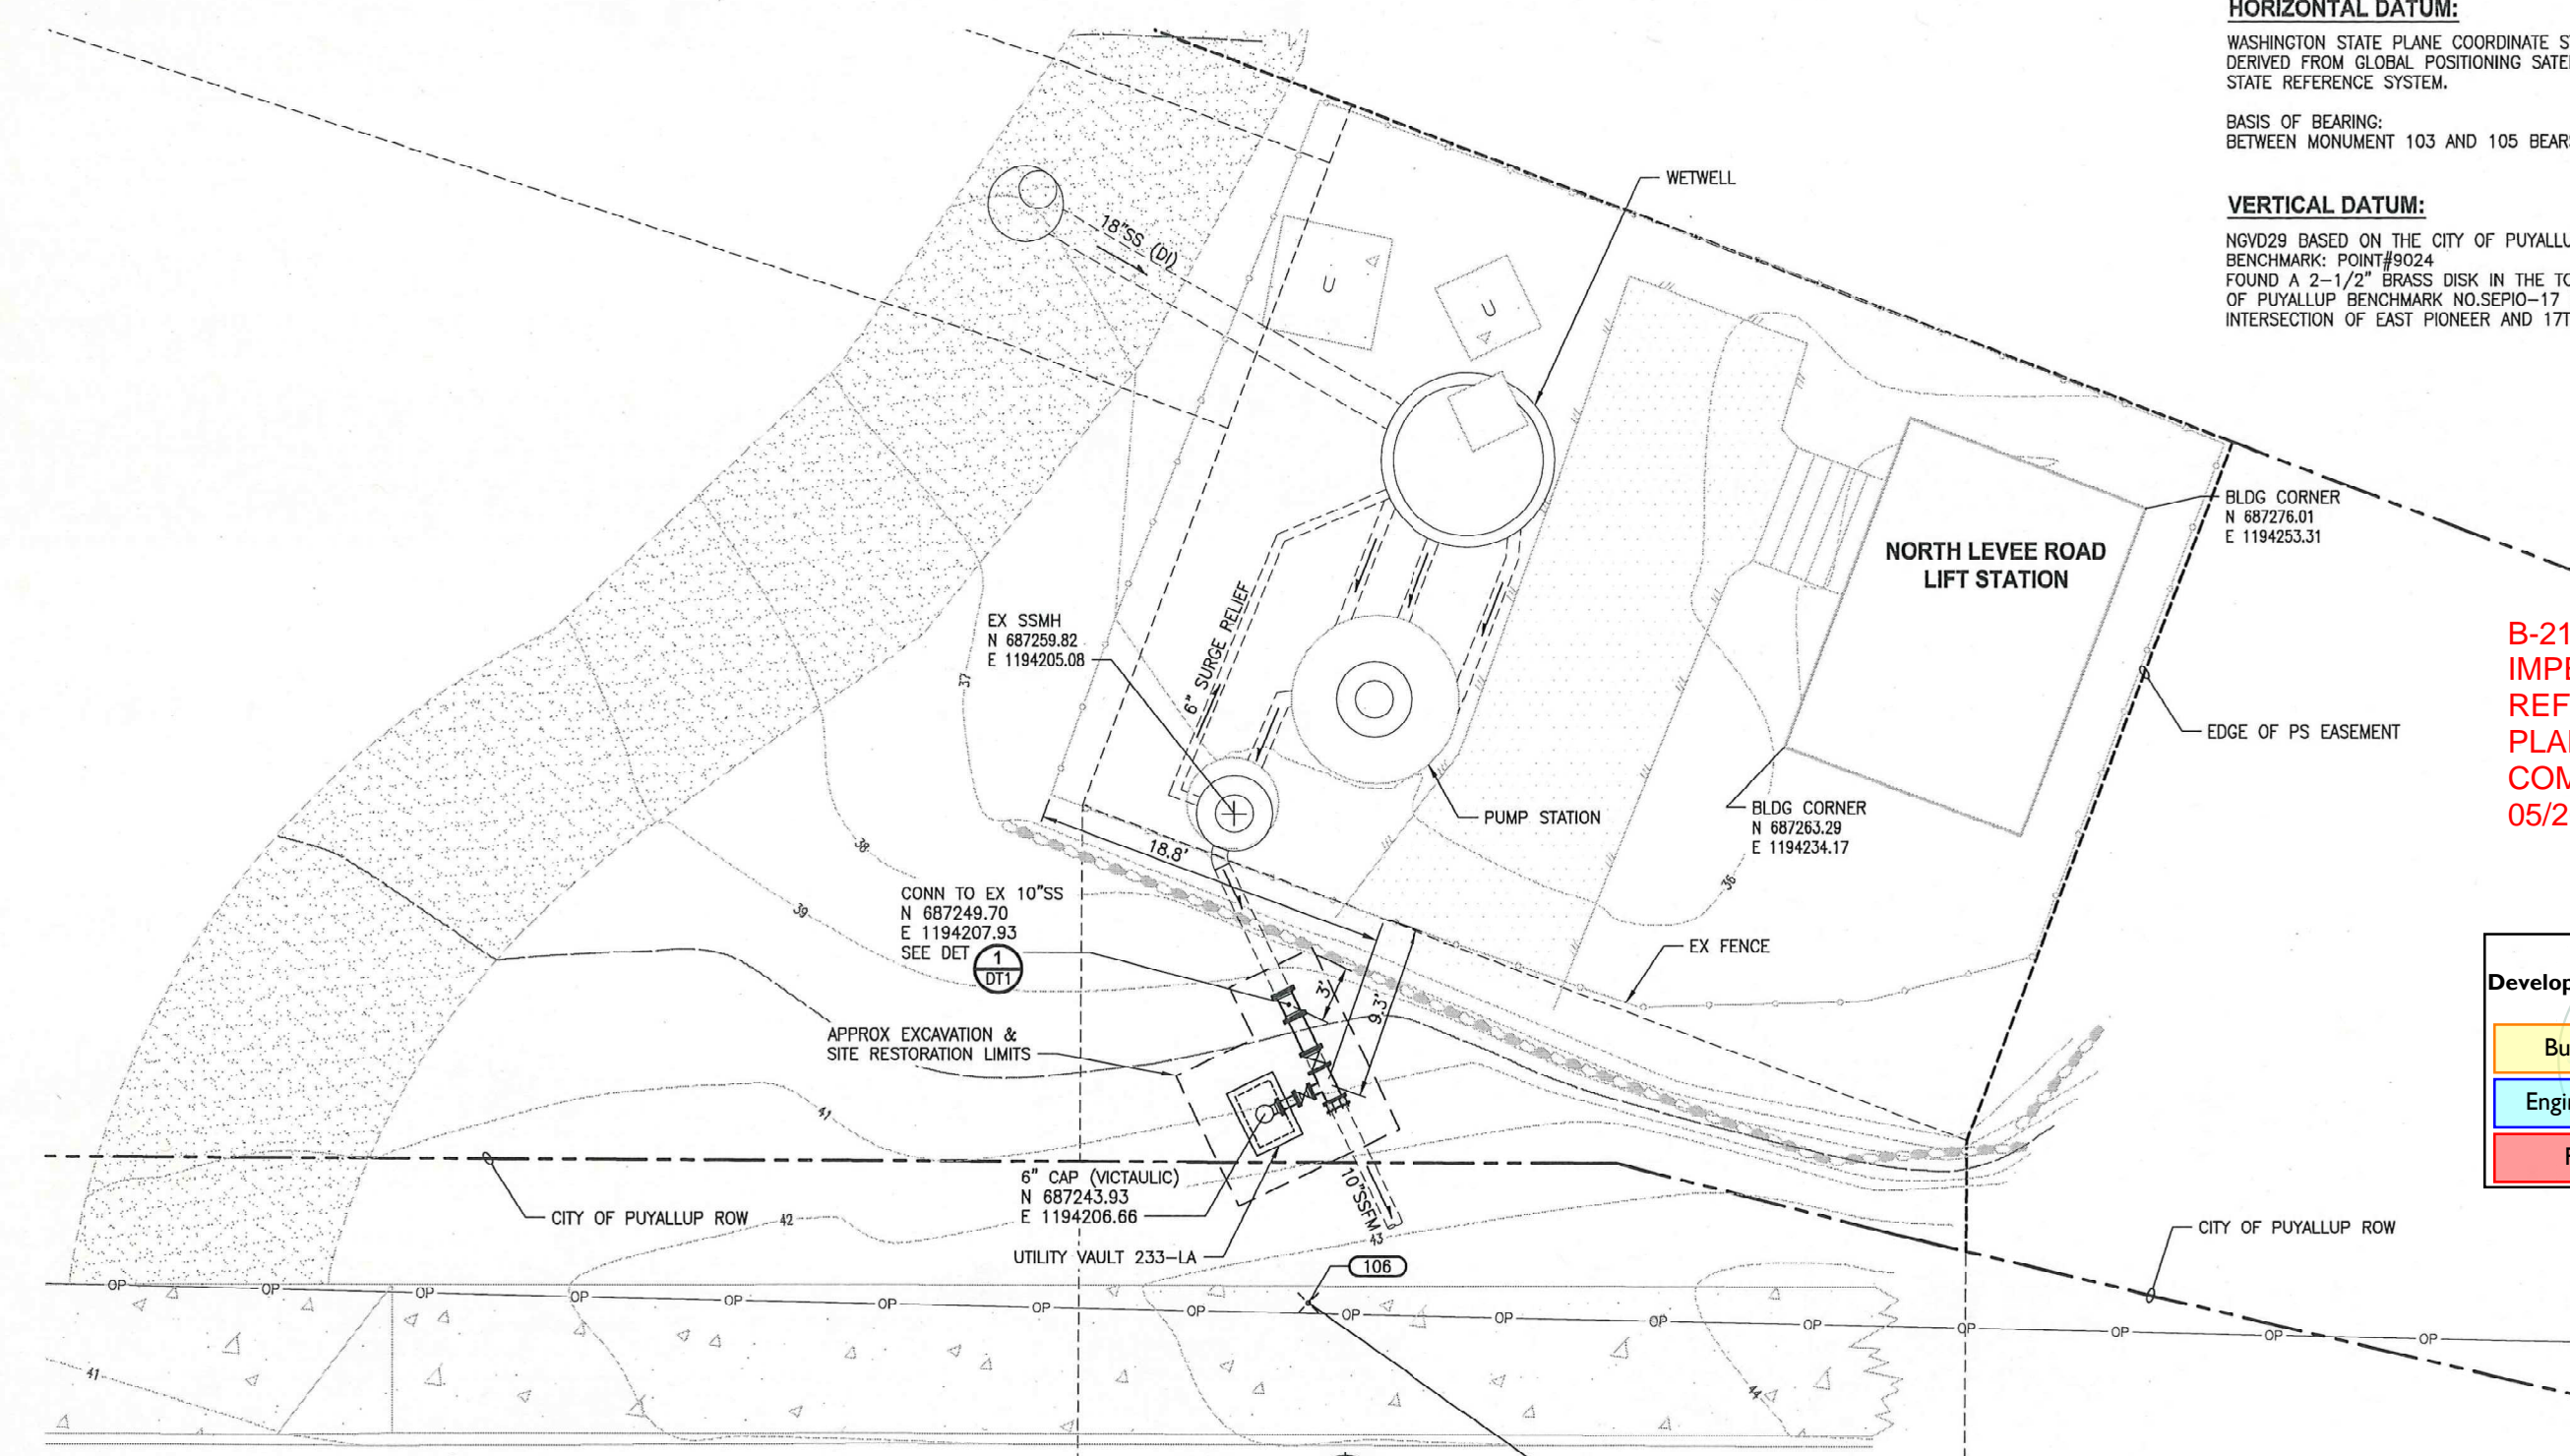


B-21-0311
IMPERVIOUS SURFACE
REFERENCE USED FOR
PLAN REVIEW AND
COMPARISON. LL
05/20/2021

City of Puyallup
Development & Permitting Services
ISSUED PERMIT

Building	Planning
Engineering	Public Works
Fire	Traffic

CONTROL POINTS				
NUMBER	NORTHING	EASTING	ELEVATION	DESCRIPTION
103	687211.33	1194240.92	42.94	MONUMENT IN CASE
105	687213.90	1193644.92	39.81	MONUMENT IN CASE
106	687233.88	1194208.95	43.30	SET MAG NAIL

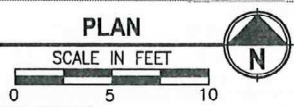

REVISIONS	DATE	BY	DESIGNED
			R. HERMES
			DRAWN J. BETZVOG
			CHECKED <i>J. Maas</i>
			APPROVED <i>D.R.</i>

ONE INCH AT FULL SCALE,
 IF NOT, SCALE ACCORDINGLY

FILE NAME
 PU1895047P46C-1

JOB No.
 214-1895-047 (46)

DATE
 AUGUST 2012



Parametrix
 ENGINEERING . PLANNING . ENVIRONMENTAL SCIENCES

1010 39TH AVENUE SE, SUITE 100
 PUYALLUP, WASHINGTON 98374
 T. 253.604.6000 F. 253.604.6799
 www.parametrix.com

PROJECT NAME
CITY OF PUYALLUP
NORTH LEVEE ROAD LIFT STATION
BYPASS PIPING IMPROVEMENTS
 PUYALLUP, WA

CIVIL SITE PLAN

SHEET NO.
 3 OF 4
C1



Fact Sheet

Construction Stormwater Pollution Prevention for Projects that disturb less than 2,000 SF

This Worksheet is for projects that create and/or replace less than 2,000 square feet of hard surfaces or disturb less than 7,000 square feet of pervious surfaces. Projects that meet this threshold are not required to submit a Construction Stormwater Pollution Prevention Plan, but are required to follow the 13 Elements outlined below.



Hard Surfaces = Impervious surfaces, green roofs, and permeable pavement.

Pervious Surface = lawn, landscape, native vegetation, etc.

Element 1 **Preserve Vegetation and Mark Clearing Limits**

- Before you begin construction, mark the limits of the area that is to be disturbed. Make sure to clearly mark trees that are to remain and any sensitive areas (e.g. wetlands, streams) to protect them from being disturbed during construction.

Element 2 **Establish Construction Access**

- Typically, restricting construction traffic to an already paved driveway is acceptable to meet this element. Less commonly, a stone construction entrance and/or a wheel wash may be necessary depending on site conditions. It is important to work with your contractor to make sure you are not tracking sediment and debris offsite during construction.

Element 3 **Control Flow Rates**

- Ensure that dirty water is not leaving the construction area and that you are not increasing the amount of water that would typically leave the project area. (E.g. do not use a garden hose to wash sediment off of a driveway into the nearest storm inlet)

Element 4 **Install Sediment Controls**

- City Standard details for common sediment controls (silt fence and inlet protection) are included in this worksheet. Sometimes, additional controls such as gravel filter berms, vegetated strips, and wattles (straw rolls) are needed. Consult with your contractor to ensure that appropriate controls are being provided.

Element 5 **Stabilize Soils**

- Soils cannot be exposed and unworked for longer than 7 days during the dry season (May 1 - September 30) or 2 days in the wet season (October 1 - April 30). Soils can be stabilized in a number of ways, including temporary or permanent seeding, mulching, net and blankets, plastic coverings, sodding, and topsoiling/composting.

Element 6 **Protect Slopes**

- If you have steep slopes on your site (greater than 15%), you should coordinate with a contractor or engineer to ensure that you are adequately protecting those areas and are not potentially creating issues for yourself or adjacent property owners.

Element 7 **Protect Drain Inlets**

- Ensure that dirty water is not entering any nearby storm inlets. A City standard detail for inlet protection is included in this worksheet.

Element 8 **Stabilize Channels and Outlets**

- Typically, stabilizing channels and outlets is not necessary for small projects. If your property has surface waters such as a stream or wetland, you should consult a professional engineer to ensure that you are properly protecting those areas.

Element 9 **Control Pollutants**

- For small projects, controlling pollutants is primarily related to concrete handling to ensure that tools are washed in formed areas or containers such as Eco-pans. If there will be harmful chemicals that will be used during construction, consult a professional contractor or engineer to prepare a pollution prevention plan.

Element 10 **Control De-Watering**

- Small projects typically do not require dewatering. If you plan to excavate a large pit that may trap stormwater (like excavating a hole for an in-ground pool), consult a professional engineer to prepare a dewatering plan.

Element 11 **Maintain BMPs**



- Ensure that BMPs (e.g. silt fence, inlet protection, etc.) are properly functioning throughout the duration of construction. For example, silt fence should be upright and should not have sediment build up greater than one third of the height of the fence. Similarly, inlet protection (typically a piece of fabric inserted into a catch basin) should be cleaned regularly to avoid sediment build up and clogging of the inlet.
- Temporary Erosion and sediment control BMPs can be removed 30 days after the site is stabilized (no exposed soils) or after they are no longer needed.

Element 12 **Manage the Project**


- Think about what time of year construction is anticipated to occur and if any adjustments are needed to accommodate weather patterns. Clearing, grading, and soil disturbing should be avoided or limited from October 1st through April 30th if possible.

Element 13 **Protect Low Impact Development (LID) Best Management Practices (BMPs)**

- If there is already an LID practice installed where construction activities will occur (e.g. rain garden, permeable pavement, infiltration trench, etc.), it is important to protect them from being damaged or inundated with sediment during construction.

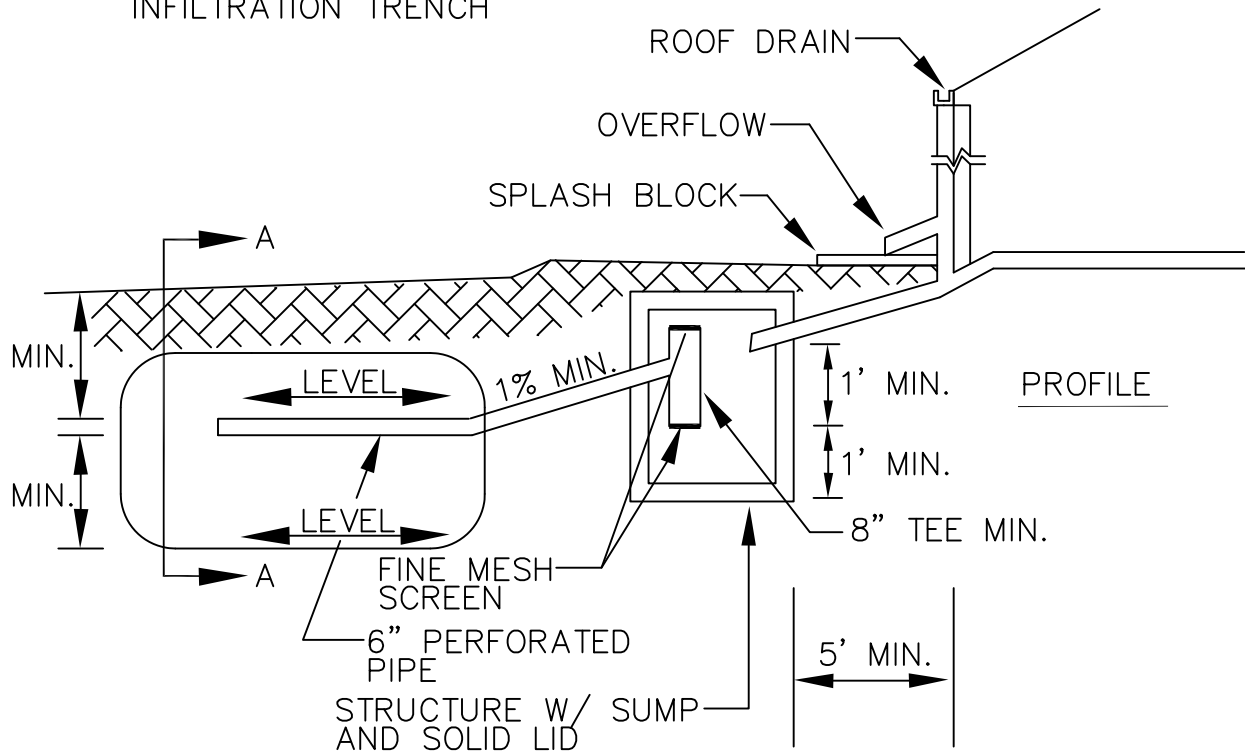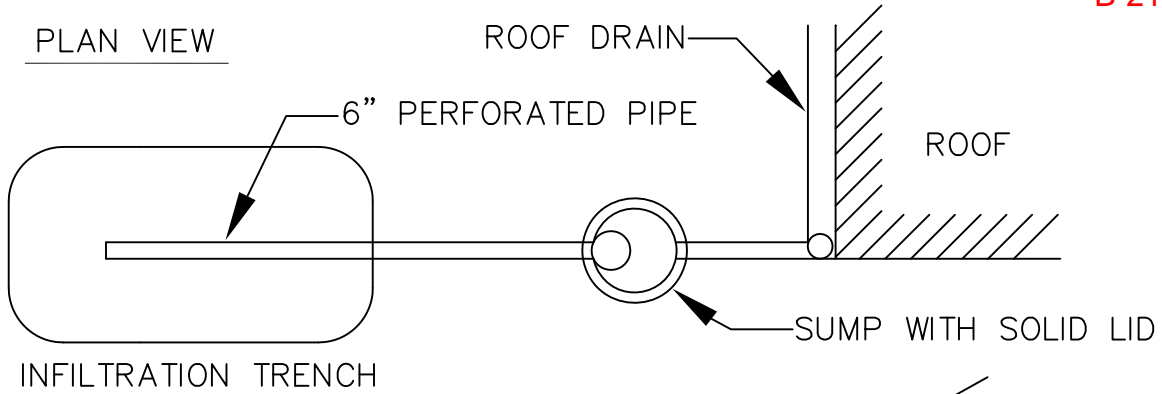

SEE CITY STANDARD NO. 02.05.03 NOTES

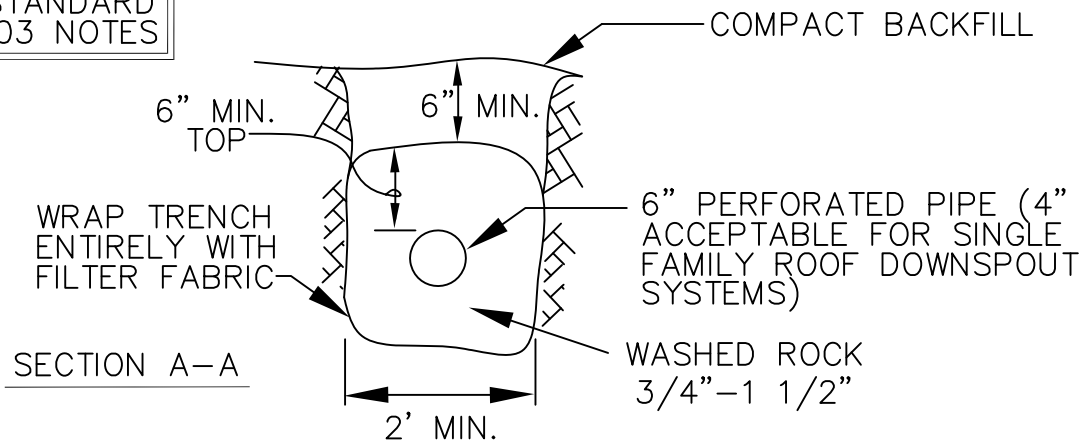

CITY OF PUYALLUP

DEVELOPMENT ENGINEERING and PUBLIC WORKS DEPARTMENTS

INDIVIDUAL ROOF DOWNSPOUT SYSTEM

<small>DRAWN BY</small> LINDA LANSING	<small>CHECKED BY</small> LINDA LIAN	<small>APPROVED BY</small> COLLEEN HARRIS	<small>REVISED BY</small> LINDA LIAN	<small>CITY STANDARD</small>
<small>FILE NAME</small> F:\DWG\COMMON\STDS\CITY\2009\02_SD\02.05.01	<small>DATE APPROVED</small> 09/01/1992	<small>DATE REVISED</small> 02/19/2014	<small>SCALE</small> NTS	02.05.01

NOTE:

SOIL CONDITIONS, INFILTRATION RATES, AND TRENCH SIZING SHALL BE PERFORMED BY A LICENSED PROFESSIONAL ENGINEER.

GENERAL NOTES:

1. THE FOLLOWING MINIMUM LENGTHS (LINEAR FEET) PER 1,000 SQUARE FEET OF ROOF AREA BASED ON SOIL TYPE MAY BE USED FOR SIZING DOWNSPOUTS INFILTRATION TRENCHES.

COARSE SANDS AND COBBLES	20 LF
MEDIUM SAND	30 LF
FINE SAND, LOAMY SAND	75 LF
SANDY LOAM	125 LF
LOAM	190 LF

2. MAXIMUM LENGTH OF TRENCH SHALL NOT EXCEED 100 FEET FROM THE INLET SUMP.

3. MINIMUM SPACING BETWEEN TRENCH CENTER LINES SHALL BE 6 (SIX) FEET.




**CITY OF
PUYALLUP**

DEVELOPMENT ENGINEERING and
PUBLIC WORKS DEPARTMENTS

INDIVIDUAL ROOF DOWNSPOUT SYSTEM NOTES

<small>DRAWN BY</small> LINDA LANSING	<small>CHECKED BY</small> LINDA LIAN	<small>APPROVED BY</small> COLLEEN HARRIS	<small>REVISED BY</small> XXXX	<small>CITY STANDARD</small>
<small>FILE NAME</small> F:\DWG\COMMON\STDS\CITY\2009\02_SD\02.05.03	<small>DATE APPROVED</small> 09/01/1992	<small>DATE REVISED</small> 06/01/2003	<small>SCALE</small> NTS	02.05.03

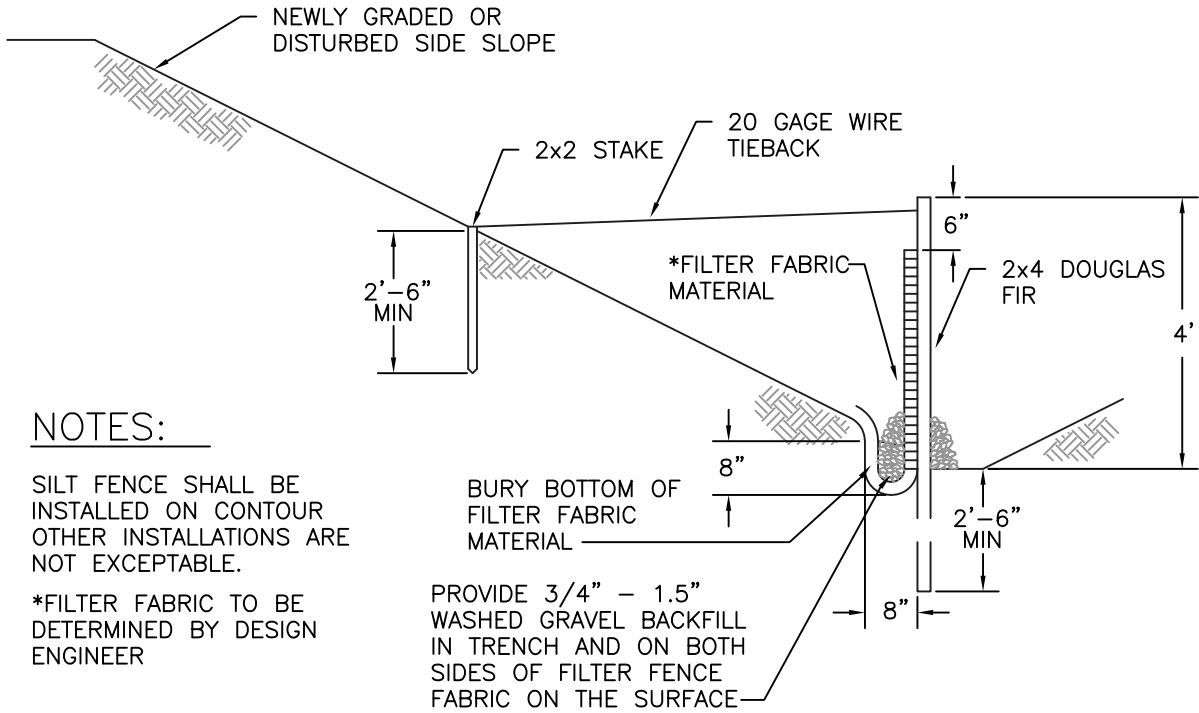


NOTES:

SILT FENCE SHALL BE INSTALLED ON CONTOUR OTHER INSTALLATIONS ARE NOT EXCEPTABLE.

*FILTER FABRIC TO BE DETERMINED BY DESIGN ENGINEER

TYPICAL CROSS SECTION

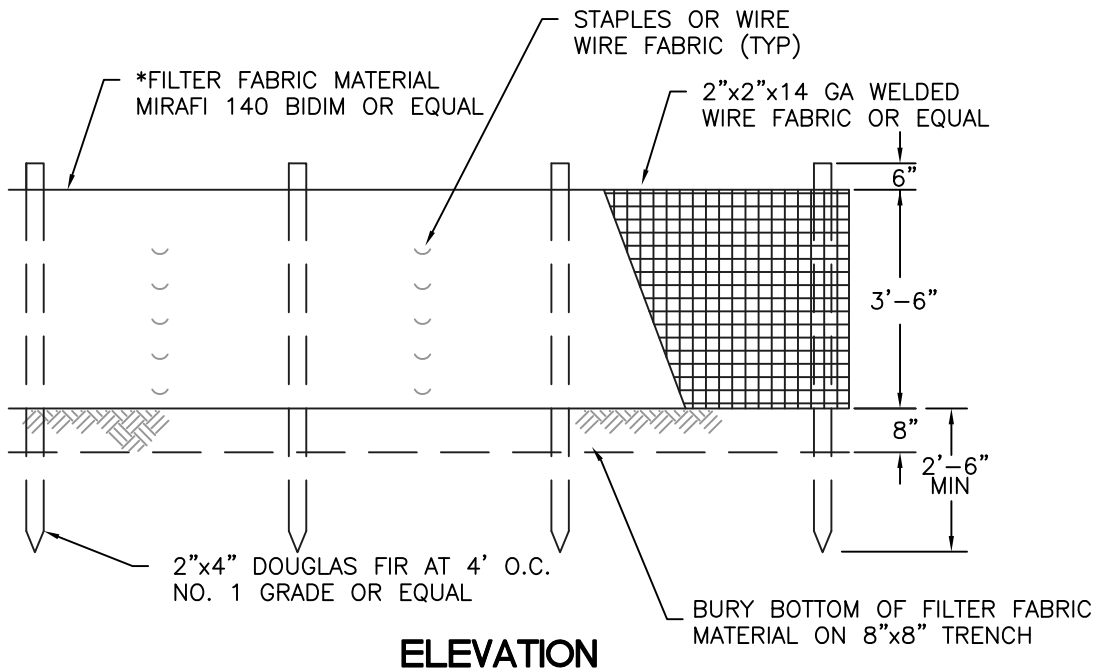

CITY OF PUYALLUP

DEVELOPMENT ENGINEERING and PUBLIC WORKS DEPARTMENTS

SILTATION FENCE

<small>DRAWN BY</small> LINDA LANSING	<small>CHECKED BY</small> LINDA LIAN	<small>APPROVED BY</small> COLLEEN HARRIS	<small>REVISED BY</small> XXXX	<small>CITY STANDARD</small> 02.03.02
<small>FILE NAME</small> F:\DWG\COMMON\STDS\CITY\2009\02_SD\02.03.02	<small>DATE APPROVED</small> 09/01/1992	<small>DATE REVISED</small> 06/01/2003	<small>SCALE</small> NTS	

1. ALL LIMITS OF CLEARING AND AREAS OF VEGETATION PRESERVATION AS PRESCRIBED ON THE PLANS SHALL BE CLEARLY FLAGGED IN THE FIELD AND OBSERVED DURING CONSTRUCTION.
2. ALL REQUIRED SEDIMENTATION AND EROSION CONTROL FACILITIES MUST BE CONSTRUCTED AND IN OPERATION PRIOR TO ANY LAND CLEARING AND/OR OTHER CONSTRUCTION TO ENSURE THAT SEDIMENT LADEN WATER DOES NOT ENTER THE NATURAL DRAINAGE SYSTEM. THE CONTRACTOR SHALL SCHEDULE AN INSPECTION OF THE EROSION CONTROL FACILITIES PRIOR TO ANY LAND CLEARING AND/OR CONSTRUCTION. ALL EROSION AND SEDIMENT FACILITIES SHALL BE MAINTAINED IN A SATISFACTORY CONDITION AS DETERMINED BY THE CITY, UNTIL SUCH TIME THAT CLEARING AND/OR CONSTRUCTION IS COMPLETED AND THE POTENTIAL FOR ON-SITE EROSION HAS PASSED. THE IMPLEMENTATION, MAINTENANCE, REPLACEMENT, AND ADDITIONS TO THE EROSION AND SEDIMENTATION CONTROL SYSTEMS SHALL BE THE RESPONSIBILITY OF THE PERMITEE.
3. THE EROSION AND SEDIMENTATION CONTROL SYSTEM FACILITIES DEPICTED ON THESE PLANS ARE INTENDED TO BE MINIMUM REQUIREMENTS TO MEET ANTICIPATED SITE CONDITIONS. AS CONSTRUCTION PROGRESSES AND UNEXPECTED OR SEASONAL CONDITIONS DICTATE, FACILITIES WILL BE NECESSARY TO ENSURE COMPLETE SILTATION CONTROL ON THE SITE. DURING THE COURSE OF CONSTRUCTION, IT SHALL BE THE OBLIGATION AND RESPONSIBILITY OF THE PERMITEE TO ADDRESS ANY NEW CONDITIONS THAT MAY BE CREATED BY HIS ACTIVITIES AND TO PROVIDE ADDITIONAL FACILITIES, OVER AND ABOVE THE MINIMUM REQUIREMENTS, AS MAY BE NEEDED TO PROTECT ADJACENT PROPERTIES, SENSITIVE AREAS, NATURAL WATER COURSES, AND/OR STORM DRAINAGE SYSTEMS.
4. APPROVAL OF THESE PLANS IS FOR GRADING, TEMPORARY DRAINAGE, EROSION AND SEDIMENTATION CONTROL ONLY. IT DOES NOT CONSTITUTE AN APPROVAL OF PERMANENT STORM DRAINAGE DESIGN, SIZE OR LOCATION OF PIPES, RESTRICTORS, CHANNELS, OR RETENTION FACILITIES.
5. ANY DISTURBED AREA WHICH HAS BEEN STRIPPED OF VEGETATION AND WHERE NO FURTHER WORK IS ANTICIPATED FOR A PERIOD OF 30 DAYS OR MORE, MUST BE IMMEDIATELY STABILIZED WITH MULCHING, GRASS PLANTING, OR OTHER APPROVED EROSION CONTROL TREATMENT APPLICABLE TO THE TIME OF YEAR IN QUESTION. GRASS SEEDING ALONE WILL BE ACCEPTABLE ONLY DURING THE MONTHS OF APRIL THROUGH SEPTEMBER INCLUSIVE. SEEDING MAY PROCEED OUTSIDE THE SPECIFIED TIME PERIOD WHENEVER IT IS IN THE INTEREST OF THE PERMITEE BUT MUST BE AUGMENTED WITH MULCHING, NETTING, OR OTHER TREATMENT APPROVED BY THE CITY.
6. IN CASE EROSION OR SEDIMENTATION OCCURS TO ADJACENT PROPERTIES, ALL CONSTRUCTION WORK WITHIN THE DEVELOPMENT THAT WILL FURTHER AGGRAVATE THE SITUATION MUST CEASE, AND THE OWNER/CONTRACTOR WILL IMMEDIATELY COMMENCE RESTORATION METHODS. RESTORATION ACTIVITY WILL CONTINUE UNTIL SUCH TIME AS THE AFFECTED PROPERTY OWNER IS SATISFIED.
7. NO TEMPORARY OR PERMANENT STOCKPILING OF MATERIALS OR EQUIPMENT SHALL OCCUR WITHIN CRITICAL AREAS OR ASSOCIATED BUFFERS, OR THE CRITICAL ROOT ZONE FOR VEGETATION PROPOSED FOR RETENTION.



CITY OF PUYALLUP

DEVELOPMENT ENGINEERING and
PUBLIC WORKS DEPARTMENTS

GRADING, EROSION, AND SEDIMENTATION CONTROL NOTES

<i>DRAWN BY</i> JIM ERWIN-SVOBODA	<i>CHECKED BY</i> LINDA LIAN	<i>APPROVED BY</i> COLLEEN HARRIS	<i>REVISED BY</i> LINDA LIAN	<i>CITY STANDARD</i>
<i>FILE NAME</i> F:\DWG\COMMON\STDS\CITY\2009\05_GRD\05.01\05.02.01	<i>DATE APPROVED</i> 07/01/2009	<i>DATE REVISED</i> 11/18/2014	<i>SCALE</i> 1:1	05.02.01