



City Engineering  
333 S. Meridian  
Puyallup, WA 98371  
Tel: (253) 864-4165  
Fax: (253) 840-6678

## PLAN CHANGE REQUEST 2

DATE: 03/03/2022 PERMIT NO./REF NO: E-20-0612

1. PROJECT: Furrucci Junior High Addition ADDRESS: 3213 Wildwood Park Drive
2. OWNER: Puyallup School District EMAIL: vandelj@puyallup.k12.wa.us
3. DESIGN ENGINEER: Sitts & Hill Engineers, Inc. EMAIL: rickh@sittshill.com
4. CONTRACTOR: Pease & Sons, Inc. EMAIL: brandon@peaseandsons.com
5. ORIGINATOR OF REQUEST:  
☒ OWNER ☒ DESIGN ENGINEER ☒ CONTRACTOR ☐ CITY OF PUYALLUP
6. DOES THIS REQUEST REQUIRE A DEVIATION FROM AN EXISTING CITY STANDARD? ☐ YES ☒ NO
7. IF YES, PLEASE SUBMIT AN ALTERNATIVE METHODS FOR CONSTRUCTION MATERIALS REQUEST APPLICATION (AMR).
8. IF NO, PLEASE COMPLETE THE FOLLOWING:
9. APPROVED CIVIL PLAN SHEET NUMBERS AFFECTED: C7.01, C7.02
10. WHAT PART OF THE CITY AND/OR DEVELOPMENT INFRASTRUCTURE IS BEING AFFECTED?  
☒ ROAD ☐ STORM ☐ WATER ☐ SANITARY ☐ GRADING ☐ EROSION CONTROL
11. DESCRIBE THE CHANGE BEING REQUESTED: (ATTACH ADDITIONAL INFORMATION AS NECESSARY)

Correct the plan horizontal offset locations so that the pole base location is behind the back of walk versus in the walk. The revised locations comply with standard City detail 01.05.04 requirements on Sheet C7.04.

12. ALL SIGNATURES ARE REQUIRED TO PROCESS THIS REQUEST UNLESS INITIATED BY THE CITY. FINAL APPROVAL/DENIAL WILL BE MADE BY THE CITY ENGINEER. ALL CHANGES WILL BE FULLY APPROVED/DENIED PRIOR TO ANY WORK ON REQUESTED CHANGES. ANY WORK COMPLETED PRIOR TO APPROVAL IS AT THE RISK OF THE DEVELOPER/CONTRACTOR AND MAY NOT BE APPROVED BY THE CITY ENGINEER.

  
OWNER

  
DESIGN ENGINEER

  
CONTRACTOR

  
CITY INSPECTOR

  
CITY REVIEWER

APPROVED DENIED

03-10-2022

DATE



## REQUEST FOR INFORMATION

Pease &amp; Sons R.F.I. No.: 157

Project Name: FERRUCCI JR HIGH ADDITION & REMODELJob No: 8043.Contractor: Pease & Sons, Inc.

Contract No: \_\_\_\_\_

Date: 2/9/2022 UTCResponse Needed By: 2/16/2022 UTCCost Item ☒ TBD ☐ YES ☐ NODrawing Sheet #: N/ASchedule Impact: ☒ TBD ☐ YES ☐ NOSpec #: N/A

Issue #: \_\_\_\_\_

Subject: Street Light Pole Base Conflict with Existing Conditions

The six light poles have been laid out on site, and all bases conflict with existing conditions. Bases will conflict below grade with existing power mains, communication mains, water mains, and/or existing/future sidewalk. Please provide direction.

Pease & Sons Inc 2/9/2022 UTC  
SUBCONTRACTOR DATE

BRANDON HASKINS, PROJECT MANAGER  
PEASE & SONS, INC.

ATTACHED SHEETS ☐ YES ☒ NO

LIST: \_\_\_\_\_

REPLY:

Date: \_\_\_\_\_

Comply with contract City of Puyallup standard drawing detail:

1. 12' mast arms.
2. Position the back of luminaire 2' from face of curb at specified stations.
3. Revise the pole base offset locations to comply with above and City requirements. Pole offset locations have been revised per the attached sheets C7.01 and C7.02.
4. If the existing fiber optic utility is in conflict with the proposed locations, relocate the fiber utility to avoid the pole locations.
5. Limb selected trees to comply with City requirements.

R. Hand/Sitts & Hill Engineers, Inc

ARCHITECT / ENGINEER / OWNER

2-14-2022 revised 03-09-2022DATE r. hand

NOTE: This is not an authorization to proceed with work involving additional costs and/or time. Notification must be given in accordance with the Contract Documents if any response causes changes to the Contracted scope of work.



- LEGEND**
- PROPOSED FEATURES-
- STREET LIGHT
  - 2" SCH 80 PVC CONDUIT
  - BP SPARE CONDUIT WITH PULL CORD
  - SERVICE CABINET
  - J-BOX

- GENERAL NOTES**
- STREET LIGHT INSTALLATION SHALL COMPLY TO CITY OF PUYALLUP DETAILS ON SHEETS C7.04 & C7.05.
  - LUMINAIRE CLASSIFICATION SHALL COMPLY WITH COLLECTOR ARTERIAL REQUIREMENTS.
  - PHOTO CELL SHALL COMPLY WITH DETAIL 01.05.10/C7.05.
  - STREET LIGHT FIXTURES SHALL BE LEOTEK GCM1-60J-MV-2R-40K-GY-105-XX.

- KEY NOTES**
- SERVICE CABINET, SEE DETAILS 01.05.03/C7.04, 01.05.05/C7.04, 01.06.05/C7.05
  - STREET LIGHT POLE AND BASE, SEE DETAILS 01.05.04/C7.04, 01.05.05/C7.04, 01.06.02/C7.05
  - 2" SCH 80 PVC CONDUIT, 2#8, 1#8G, XLP TYP PER SHEET E1.02.
  - POWER SOURCE
  - J-BOX, SEE DETAIL 01.06.01/C7.05
  - SPARE 2" CONDUIT WITH PULL CORD

**POLE SCHEDULE**

POLE NUMBER	STA	OFFSET	MAST ARM LENGTH
POLE 01	10+10.29	17.10' LT	12'
POLE 02	11+59.91	17.67' LT	12'
POLE 03	13+09.93	15.06' LT	12'

APPROVED


BY \_\_\_\_\_

CITY OF PUYALLUP  
DEVELOPMENT ENGINEERING

DATE \_\_\_\_\_

NOTE:  
THIS APPROVAL IS VOID AFTER 180 DAYS FROM APPROVAL DATE. THE CITY WILL NOT BE RESPONSIBLE FOR ERRORS AND/OR OMISSIONS ON THESE PLANS. FIELD CONDITIONS MAY DICTATE CHANGES TO THESE PLANS AS DETERMINED BY THE DEVELOPMENT ENGINEERING MANAGER.

E-20-0612 - PCR 002 -  
Ferrucci Jr. High  
Addition. March 2022.

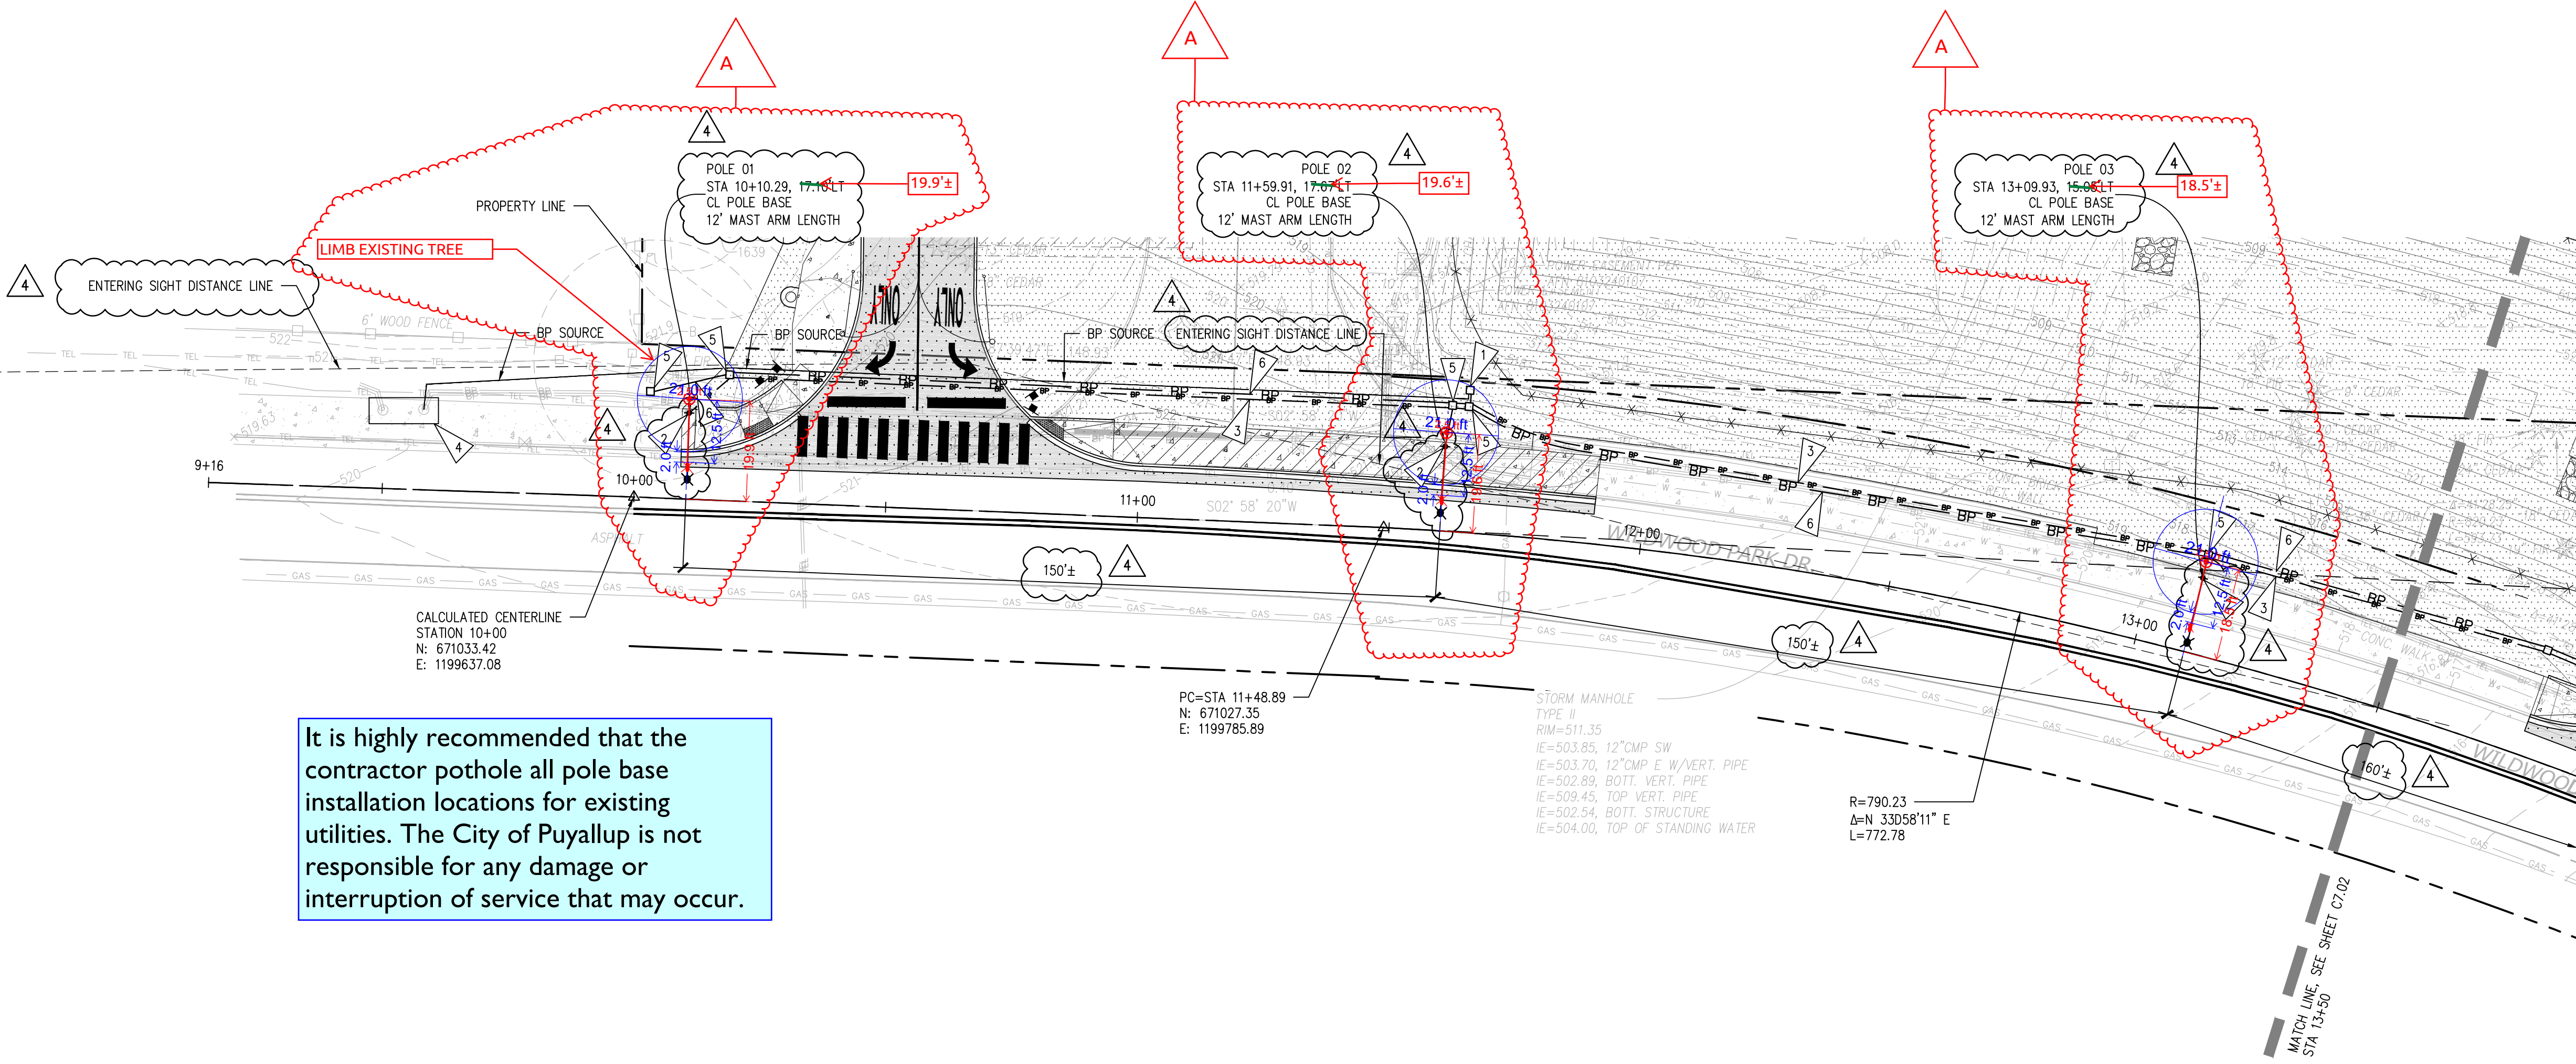

It is highly recommended that the contractor pothole all pole base installation locations for existing utilities. The City of Puyallup is not responsible for any damage or interruption of service that may occur.

RFI 157 Proposed Light Pole Locations  
R. Hand 02-24-2022  
revised 03-09-2022



HORIZONTAL SCALE: 1"=20'

20 0 20 40

**811** Call 811  
two business days  
before you dig

**sh** **sitts & hill**

CIVIL | STRUCTURAL | SURVEY

4815 CENTER STREET | TACOMA, WA 98409  
PHONE: (253) 474-9449 | FAX: (253) 474-0163  
http://www.sitts-hill.com/

Project No.:	18711	Project Mgr.:	RCH
Proj. Engineer:	VMS	Proj. Drafter:	VMS


**WILDWOOD PARK DRIVE STREET LIGHT PLAN - WEST**

SCALE: 1"=20'

REVISIONS

CONFORMED  
SET

PUYALLUP SCHOOL DISTRICT PROJECT NO. 30-03-19  
**FERRUCCI JUNIOR HIGH ADDITION**  
3213 WILDWOOD PARK DR. PUYALLUP, WA 98374

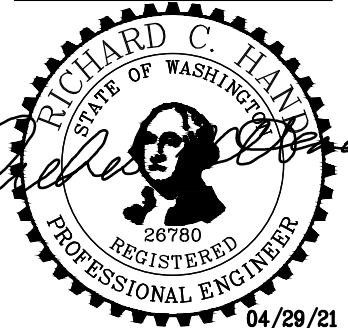

**NAC**  
ARCHITECTURE  
nacarchitecture.com

2021 1ST AVENUE  
SEATTLE WA 98121  
P:206.441.4522

NAC NO 121-19038  
DRAWN VMS  
CHECKED RCH  
DATE 04/29/2021

WILDWOOD PARK  
DRIVE STREET LIGHT  
PLAN - WEST

SHEET 38 OF 45

**C7.01**



**LEGEND**

PROPOSED FEATURES:

- STREET LIGHT
- 2" SCH 80 PVC CONDUIT
- BP SPARE CONDUIT WITH PULL CORD
- SERVICE CABINET
- J-BOX

**GENERAL NOTES**

- STREET LIGHT INSTALLATION SHALL COMPLY TO CITY OF PUYALLUP DETAILS ON SHEET C7.04 & C7.05.
- LUMINAIRE CLASSIFICATION SHALL COMPLY WITH COLLECTOR ARTERIAL REQUIREMENTS.
- PHOTO CELL SHALL COMPLY WITH DETAIL 01.05.10/C7.05.
- STREET LIGHT FIXTURES SHALL BE LEOTEK GCM1-60J-MV-2R-40K-GY-105-XX.

**KEY NOTES**

- NOT USED
- STREET LIGHT POLE AND BASE, SEE DETAILS 01.05.04/C7.04, 01.05.05/C7.04, 01.06.02/C7.05
- 2" SCH 80 PVC CONDUIT, 2#8, 1#6G, XLP TYP PER SHEET E1.02
- NOT USED
- J-BOX, SEE DETAIL 01.06.01/C7.05
- SPARE 2" CONDUIT WITH PULL CORD

**POLE SCHEDULE**

POLE NUMBER	STA	OFFSET	MAST ARM LENGTH
POLE 04	14+69.72	18.9'±	12'
POLE 05	15+69.95	21.9'±	12'
POLE 06	17+08.00	20.4'±	12'

APPROVED


BY CITY OF PUYALLUP  
DEVELOPMENT ENGINEERING

DATE

NOTE:  
THIS APPROVAL IS VOID AFTER 180 DAYS FROM APPROVAL DATE. THE CITY WILL NOT BE RESPONSIBLE FOR ERRORS AND/OR OMISSIONS ON THESE PLANS. FIELD CONDITIONS MAY DICTATE CHANGES TO THESE PLANS AS DETERMINED BY THE DEVELOPMENT ENGINEERING MANAGER.

E-20-0612 - PCR 002 -  
Ferrucci Jr. High  
Addition. March 2022.

It is highly recommended that the contractor pothole all pole base installation locations for existing utilities. The City of Puyallup is not responsible for any damage or interruption of service that may occur.

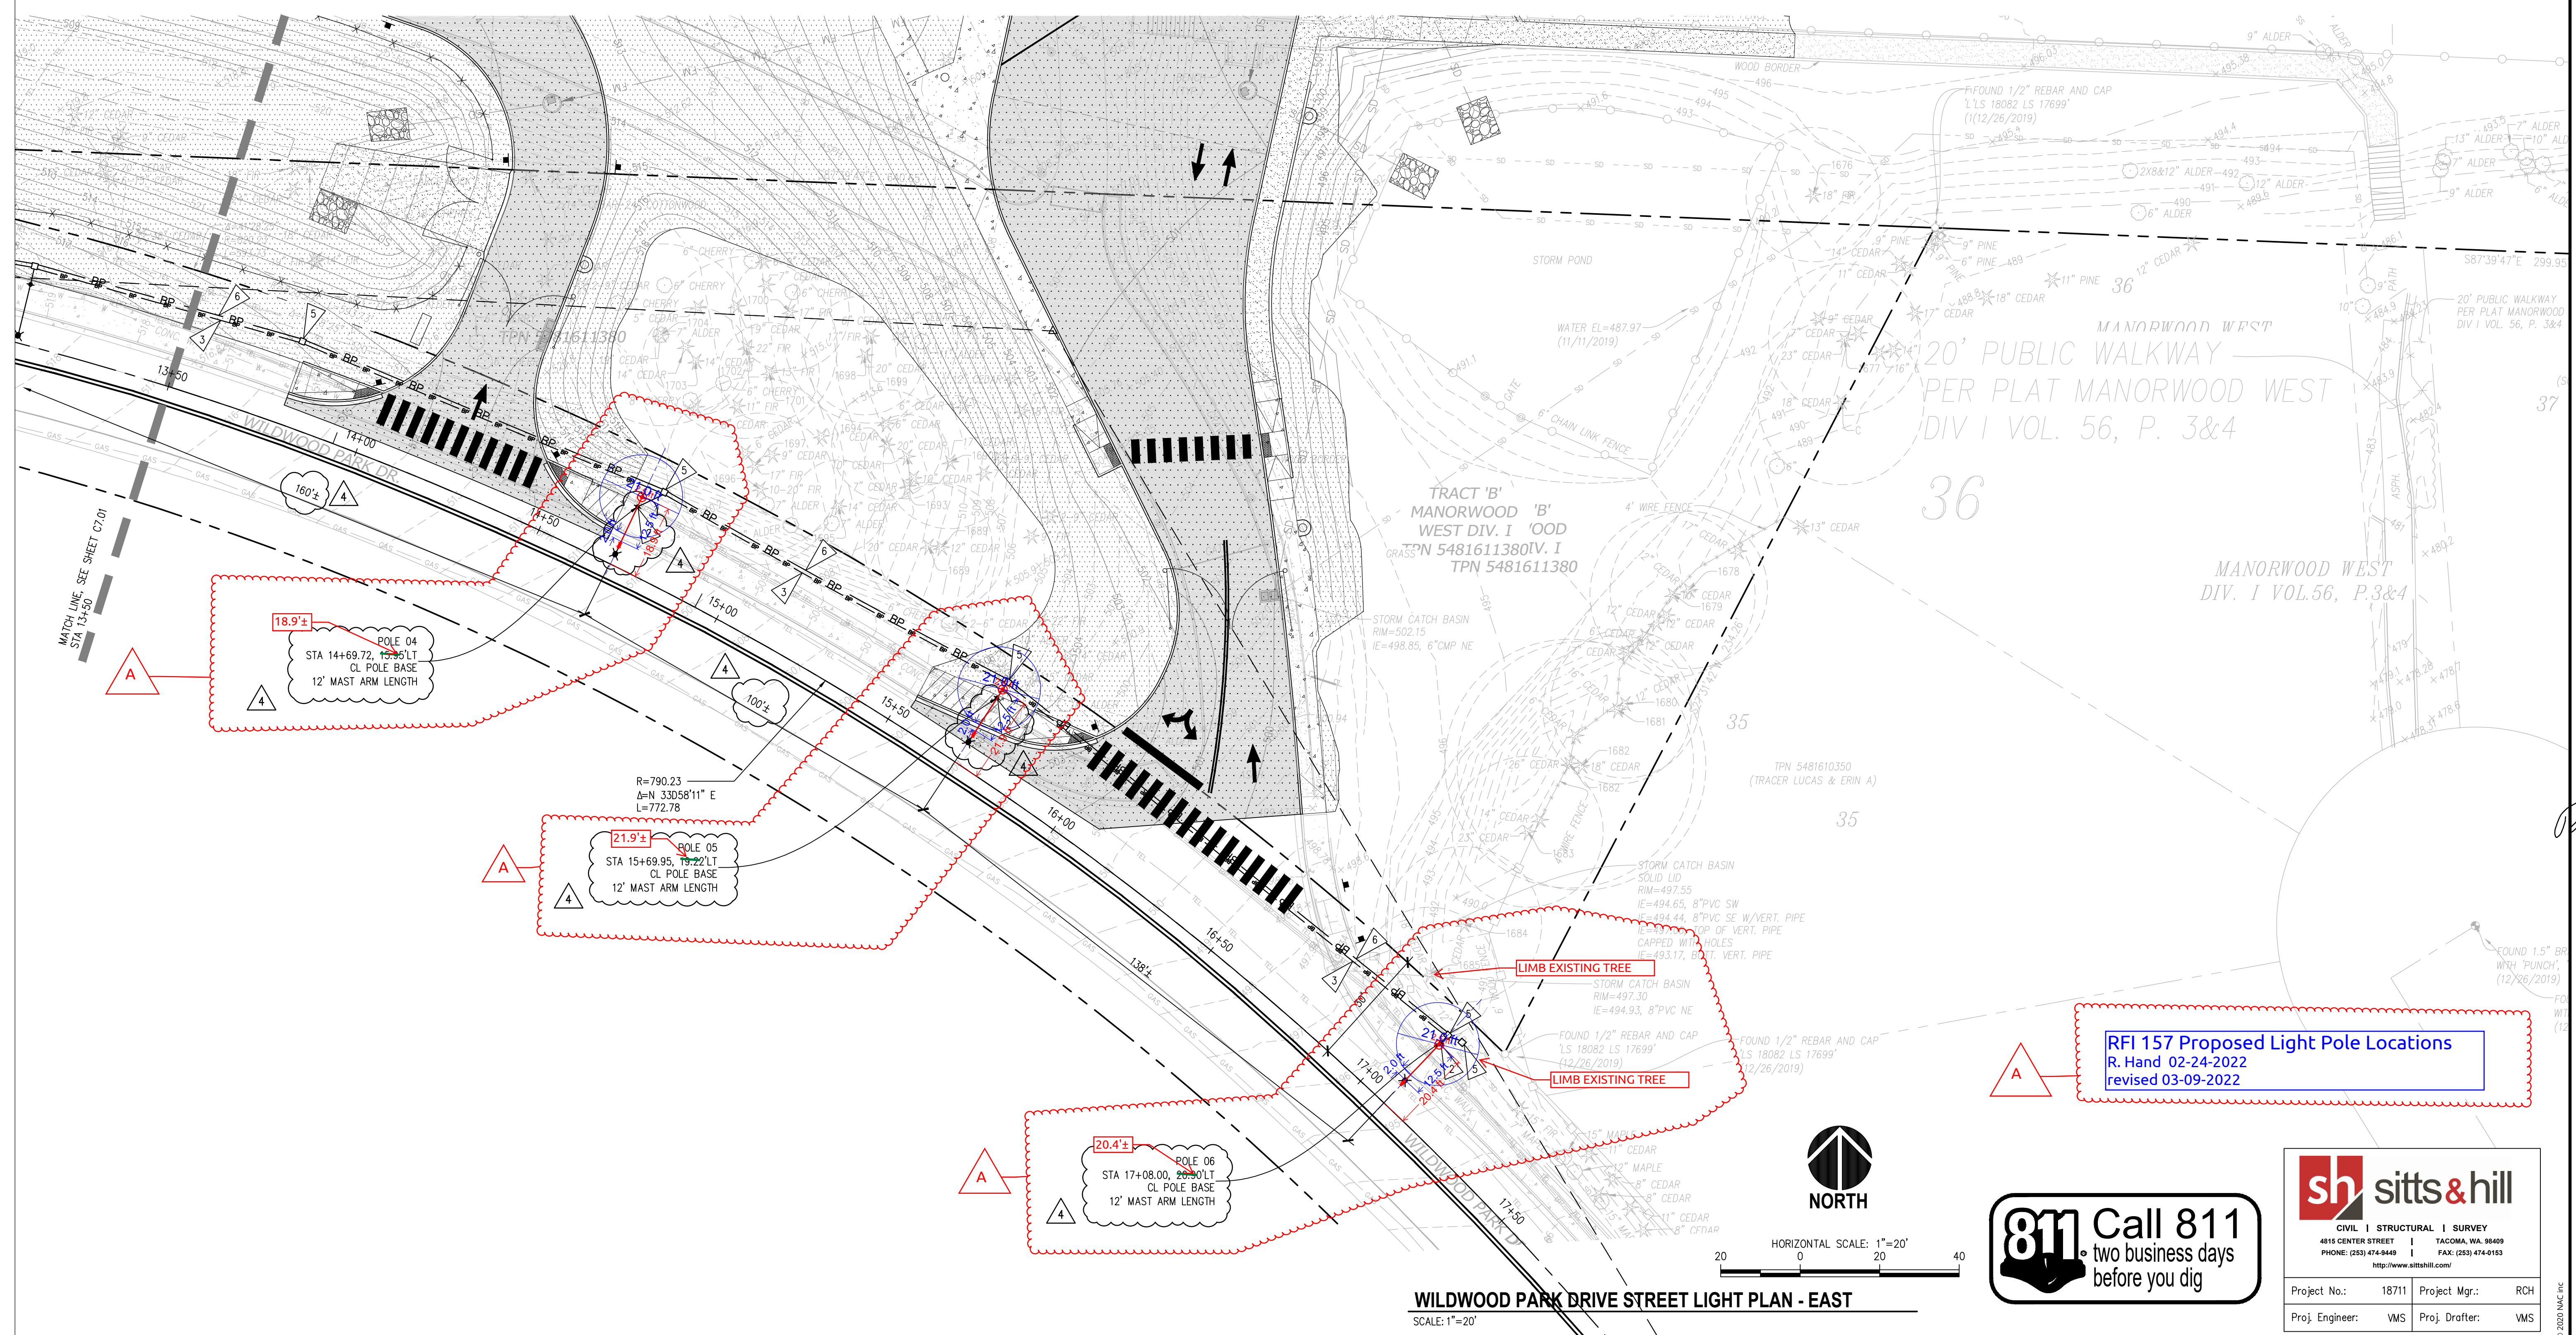

RFI 157 Proposed Light Pole Locations  
R. Hand 02-24-2022  
revised 03-09-2022

**sitts & hill**

CIVIL | STRUCTURAL | SURVEY

4815 CENTER STREET I TACOMA, WA. 98409  
PHONE: (253) 474-9449 I FAX: (253) 474-0163  
http://www.sittshill.com/

Project No.:	18711	Project Mgr.:	RCH
Proj. Engineer:	VMS	Proj. Drafter:	VMS

REVISIONS

CONFORMED SET

PUYALLUP SCHOOL DISTRICT PROJECT NO. 30-03-19  
**FERRUCCI JUNIOR HIGH ADDITION**  
3213 WILDWOOD PARK DR PUYALLUP, WA 98374

**NAC**  
ARCHITECTURE  
nacarchitecture.com  
2021 1ST AVENUE  
SEATTLE WA 98121  
P.206.441.4522

04/29/21

121-19038  
VMS  
RCH  
04/29/2021

WILDWOOD PARK DRIVE STREET LIGHT PLAN - EAST

SHEET 39 OF 45

**C7.02**