

SIGNAGE SPECIFICATIONS

(A) Face/Halo Lit Channel Letters on Raceway with Contour Backer - QTY: 1

SPEC: CHANNEL LETTERS ON RACEWAY
 LED ILLUMINATED
 ACRYLIC FACE BLACK TRIM CAP
 BLACK RETURN
 RACEWAY TO BE PAINTED TO MATCH WALL COLOR

LOGO= 2.8 SQ. FT.
CRAWFISH CHEF = 20.4
TAGLINE = 5.02
TOTAL SIGN SQ. FT. 28.22
SIGN WEIGHT = 75LBS
TENANT STORE FRONT = 1000 SQ. FT.

Please show lineal feet of building wall.
 Planning Comment.



**4301 SOUTH MERIDIAN
 SUITE F3
 PUYALLUP, WA 98373**

SIGN LOCATION

**NOTE: CONCEPTUAL IMAGE ONLY
 VERIFY ARTWORK AND DIMENSIONS
 PRIOR TO FABRICATION**



Date: _____
 Salesperson: TL
 Coordinator: TL
 Designer: JT
 Scale: 3/8"=1'

Revisions	
△	△
△	△
△	△
△	△

CUSTOMER APPROVAL

Customer Signature _____ Date _____
COPY, COLORS & SIZES

**US SIGN does NOT provide primary
 electrical to sign location-
 RESPONSIBILITY OF OTHERS!**

Customer Signature _____ Date _____
This design is the exclusive property of US SIGN
 and cannot be reproduced in whole or in part,
 without their prior written approval


File Name: _____
 Page: ## _____
 Of: ## _____



SITE PLAN

Please show measurement of lineal feet of building wall that the sign will be attached on site plan. Planning Correction

Please see PMC 20.60.047 (1) (b) to measure the size of the tenant space.

Correction, Site Plan, Pg. 2

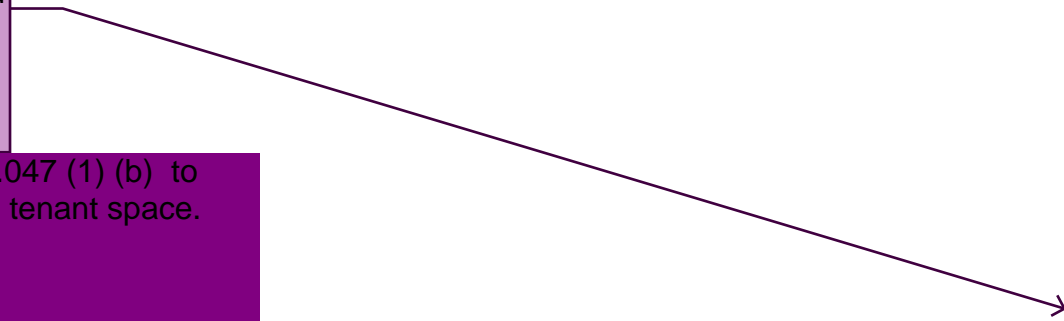

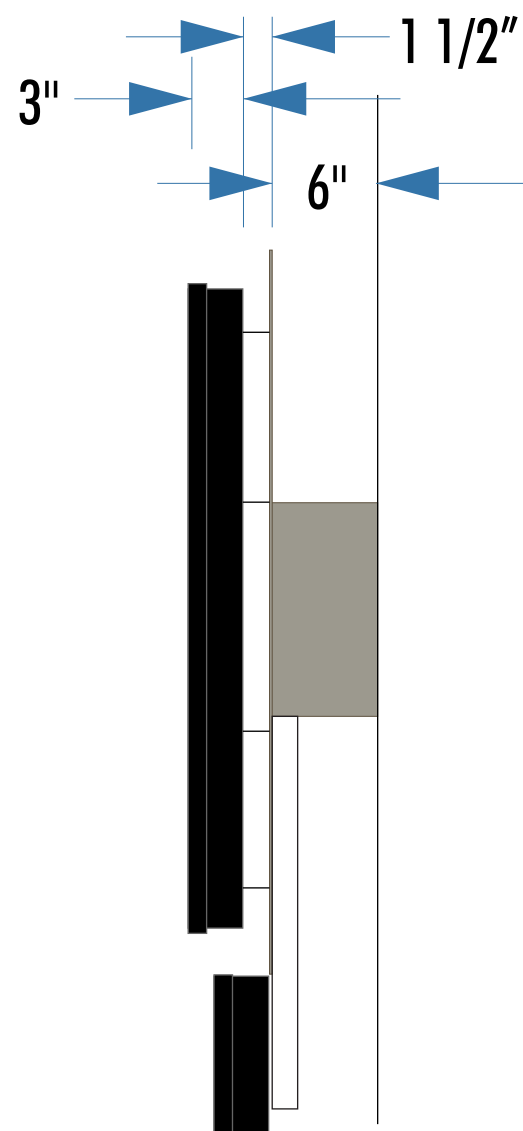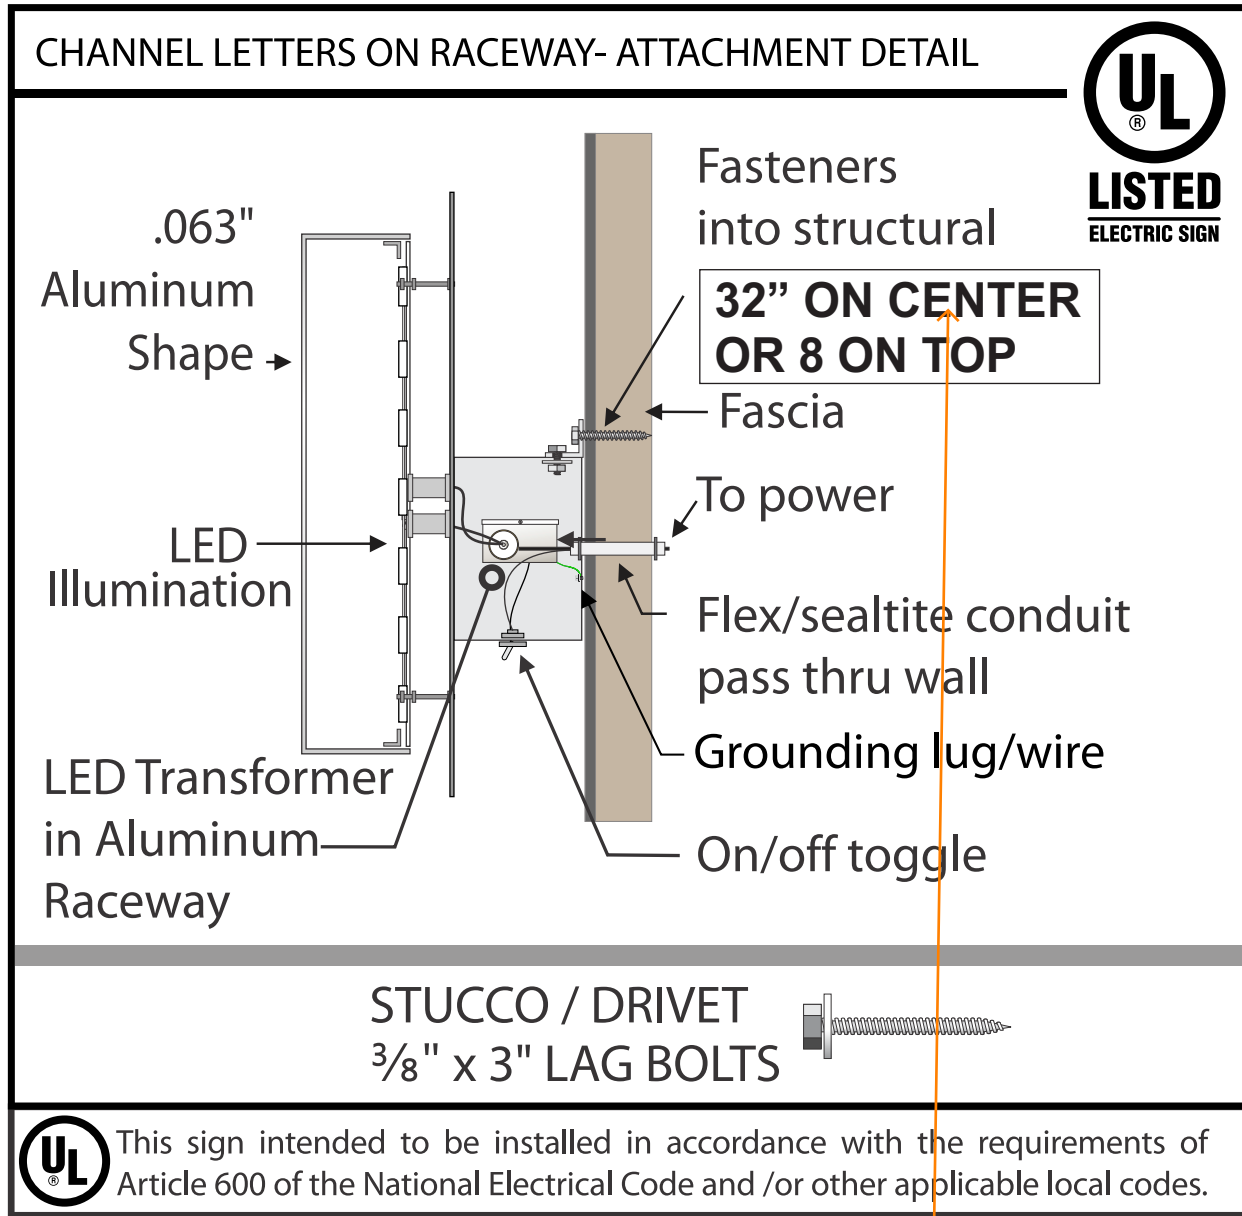

FASTENER SCHEDULE	
<p>Thru-Bolt Mounting</p>	<p>3/8" THREADED ROD FOR USE IN THRU BOLT APPLICATIONS</p>
<p>Hanger Bolts</p>	<p>3/8" LAG SCREW FOR USE IN WOOD BLOCKING 1 1/2" MIN PENETRATION</p>
<p>Masonry Lag Bolt Mounting</p>	<p>MASONRY EXPANSION BOLT w/ADHESIVE EMBED 2" MIN</p>

WHITE ACRYLIC FACE
WITH 3M POPPY RED
VINYL OVERLAY
3/4" BLACK TRIM
CAP AND BLACK
RETURN 040 ALUMINUM

SIGN WILL BE ILLUMINATED
WITH HANLEY 1 WATT PER
MODULE LED WHITE WITH
60 WATTS
POWER SUPPLY CLASS 2




U.L. LABELS REQUIRED
INSTALL IN ACCORDANCE W/
NATIONAL ELECTRIC CODES

If you are saying this length of sign only needs 4 fasteners then need to show exactly where they are to be located especially in this seismic zone. And they should be galvanized or stainless since located outside. Attachment page of plans.



LOGO= 2.8 SQ. FT.
CRAWFISH CHEF = 20.4
TAGLINE = 5.02
TOTAL SIGN SQ. FT. 28.22
SIGN WEIGHT = 75LBS

ATTACHMENT DETAIL

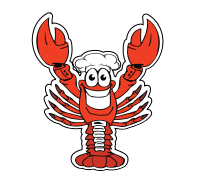

Date: _____
Salesperson: TL
Coordinator: TL
Designer: JT
Scale: 3/8"=1'

Revisions	
△	△
△	△
△	△
△	△

CUSTOMER APPROVAL

Customer Signature _____ Date _____
COPY, COLORS & SIZES

US SIGN does NOT provide primary electrical to sign location-
RESPONSIBILITY OF OTHERS!

Customer Signature _____ Date _____
This design is the exclusive property of US SIGN and cannot be reproduced in whole or in part, without their prior written approval.

File Name: _____

Page: ##

Of: ##



ATTACHMENT

