WASHINGTON STATE FAIR SILLYVILLE TRAIN EXPANSION

APPLICANT

WASHINGTON STATE FAIR 110 9TH AVENUE SW PUYALLUP, WA 98371 (253) 841–5356 CONTACT: RENEE MCCLAIN, CFO

CIVIL ENGINEER

JMJ TEAM 905 MAIN ST SUITE. 200 SUMNER, WA 98390 (206) 596–2020 CONTACT: JUSTIN JONES, PE

SURVEYOR

PARAMETRIX – PUYALLUP OFFICE 1019 39th AVENUE SE PUYALLUP, WA 98374 (360) 459–3609 CONTACT: KATHLEEN CASSOU, PLS

SITE INFORMATION:

SITE ADDRESS:	110 9th AVENUE SW, PUYALLUP, WA 98371
TAX PARCEL NUMBER(S):	042033-1134
ZONING:	FAIR
TOTAL PROJECT AREA:	0.54 ACRES

CONTROL INFORMATION:

BASIS OF BEARING:	HORIZONTAL DATUM FOR THIS SURVEY IS NAD 1983(91), WASHINGTON STATE PLANE SOUTH ZONE COORDINATE SYSTEM, U.S. SURVEY FEET. THE HORIZONTAL DATUM IS BASED ON PUBLISHED INFORMATION FROM WSDOT, POINT DESIGNATION GP27512-18AZ.
	POINT DESIGNATION: GP27512-18AZ NORTHING: 678467.150 EASTING: 1194300.731
VERTICAL DATUM:	VERTICAL DATUM IS NGVD29 BASED ON PUBLISHED INFORMATION FROM WSDOT, POINT DESIGNATION GP27512−18AZ Conversion from NGVD29 to NAVD88: NAVD88≈NGVD29+3.6
	POINT DESIGNATION: GP27512-18AZ
	ELEVATION: 77.073

SURVEY DATE:

JANUARY, 2022

LEGAL DESCRIPTION:

ABBREVIATED:

Ptn NE1/4, 33-20-4

SERVICE PROVIDERS:

WATER:	CITY OF PUYALLUP
SEWER:	CITY OF PUYALLUP
POWER:	PUGET SOUND ENERGY
GAS:	PUGET SOUND ENERGY
COMMUNICATIONS:	CENTURYLINK
FIRE PROTECTION:	CENTRAL PIERCE FIRE & RESCUE

CIVIL CONSTRUCTION PERMIT



110 9th Ave SW, Puyallup, WA 98371



 $\frac{Puyallup Fair Map}{Scale: 1'' = 400'}$

THIS DRAWING AND/OR SPECIFICATION DOCUMENT HAS BEEN REVISED TO REFLECT INFORMATION PROVIDED BY THE CONSTRUCTION CONTRACTOR (AND OTHERS) DEFINING KNOWN DIFFERENCES BETWEEN THE FACILITIES SHOWN CONSTRU(CTION DOCUMENTS TO THOSE CONSTRUCTED. THE INFORMATION PROVIDE ON THESE RECORDS, HAS BEEN ASSUMED TO BE CORRECT AND HAS VERIFIED BY THE ENGINEER, WHO IS UNDER NO OBLIGATION SUCH ACCURACY AND/OR COMPL PROFESSIONAL SEAL ON THIS DRAWING, REVISION(S) TO VERIF THAT THE CHANGES AS DEFINED BY THESE ADVERSE TO THE PLANNED USE SIGN. THERI ASSURANCE THAT <u>ALL</u> DIFFERENCES TO THE ORIGINAL DRAWING AND/OR SPECIFICATION DOCUMENT HAVE BEEN IDENTIFIED.

INDEX TO DRAWINGS

Page #	Sheet #	Sheet Name
1	C1-001	Cover Sheet
2	C1-002	General Notes
3	C1-003	General Notes
4	C1-100	Boundary & Topographic Survey
5	C1-101	Washington State Fair Site Plan
6	C1-102	Site Plan
7	C1-201	Existing Site Plan
8	C2-101	Temporary Erosion & Sediment Control Plan
9	C2-102	Temporary Erosion & Sediment Control Plan
10	C2-201	Temporary Erosion & Sediment Control Details
11	C2-301	Demolition Plan
12	C3-101	Stormwater Plan
13	C3-201	Stormwater Details
14	C3-302	Track Plan & Profile
15	C3-303	Track Plan & Profile
16	C3-304	Track Plan & Profile
17	C3-401	Hardscape Details
18	C3-501	Grading Plan
19	C4-101	Sanitary Sewer Plan
20	C4-201	Sanitary Sewer Details
21	C5-101	Water Plan
22	C5-201	Water Details
23	C5-202	Water Details

Project Disturbed Area

Existi	ing Surfac	es	Proposed	Surfaces	
Surface	Area (sf)	Area (ac)	Surface	Area (sf)	Area (ac)
Landscaping	4,169	0.096	Landscaping	112	0.003
Gravel	8,987	0.206	Gravel	1,593	0.037
Asphalt	4,021	0.092	Asphalt	854	0.020
Ballast	853	0.020	Permeable Asphalt	7,039	0.162
Total	18,030	0.414	Ballast	8,432	0.194
			Total	18,030	0.414

Project Cut and Fill Volumes

Cut		Fill	
Surface	Vol. (cyd)	Surface	Vol. (cyd)
Proposed Path	297	Proposed Path	216
Proposed Ballast	144	Proposed Ballast	133
Porposed Gravel	37	Proposed Gravel	34
Porposed Landscaping	2	Proposed Landscaping	4
Total	480	Total	387

APPROVED
BY CITY OF PUYALLUP DEVELOPMENT ENGINEERING
DATE
NOTE: THIS APPROVAL IS VOID AFTER 180 DAYS FROM APPROVAL DATE. THE CITY WILL NOT BE RESPONSIBLE FOR ERRORS AND/OR OMISSIONS ON THESE PLANS. FIELD CONDITIONS MAY DICTATE CHANGES TO THESE PLANS AS DETERMINED BY THE DEVELOPMENT ENGINEERING MANAGER.

CALL TWO BUSINESS DAYS BEFORE YOU DIG 1-800-424-5555 UTILITIES UNDERGROUND LOCATION CENTER

	Washington STATE FAIR PUYALLUP	
T L D	Washington State Fair 110 9th Ave SW Puyallup, WA 98371 (253) 841-5356	
-γ	Architect:	
E	Engineer:	
	JUSTICAM Justin Jones, PE 905 Main St. Suite 200 Sumner, WA 98390 (206) 596-2020	
	Project: SillyVille Train Expansion	_
	ONE INCH AT FULL SCALE. IF NOT, SCALE ACCORDINGLY	
	These plans are record drawings , and the information shown accurately reflects existing field conditions as of this date: 08-24-2022.	
	41829 Attagent Attage	
	REV DATE DESCRIPTION	_
		_
		_
		_
		_
	DRAWN BY: DNA DESIGN BY: U	_
	DRAWN B1. DM DESIGN B1. JJ PR0J. NO: 1507-002-08	
	DATE: August 24, 2022 SHEET NAME	-
	Cover Sheet	
	DWG. C1-001 01 OF 23	

Owner/Developer:

General Plan Notes

- All work in City right-of-way requires a permit from the City of Puyallup. Prior to any work commencing, the general contractor shall arrange for a preconstruction meeting at the Development Services Center to be attended by all contractors that will perform work shown on the approved engineering plans, representatives from all applicable utility companies, the project owner and appropriate city staff. Contact Engineering Services at (253-841-5568) to schedule the meeting. The contractor is responsible to have their own set of approved plans at the meeting.
- 2. After completion of all items shown on these plans and before acceptance of the project the contractor shall obtain a "punch list" prepared by the City's inspector detailing remaining items of work to be completed. All items of work shown on these plans shall be completed to the satisfaction of the City prior to acceptance of the water system and provision of sanitary sewer service.
- 3. All materials and workmanship shall conform to the Standard Specifications for Road, Bridge, and Municipal Construction (hereinafter referred to as the "Standard Specifications"), Washington State Department of Transportation and American Public Works Association, Washington State Chapter, latest edition, unless superseded or amended by the City of Puyallup City Standards for Public Works Engineering and Construction (hereinafter referred to as the "City Standards").
- 4. A copy of these approved plans and applicable city developer specifications and details shall be on site during construction.
- 5. Any revision made to these plans must be reviewed and approved by the developer's engineer and the City prior to any implementation in the field. The City shall not be responsible for any errors and/or omissions on these plans.
- 6. The contractor shall have all utilities verified on the ground prior to any construction. Call (811) at least two working days in advance. The owner and his/her engineer shall be contacted immediately if a conflict exists.
- 7. Any structure and/or obstruction that requires removal or relocation relating to this project shall be done so at the developer's expense.
- 8. Locations of existing utilities are approximate. It shall be the contractor's responsibility to determine the true elevations and locations of hidden utilities. All visible items shall be the engineer's responsibility.
- 9. The contractor shall install, replace, or relocate all signs, as shown on the plans or as affected by construction, per City Standards.
- 10. Power, street light, cable, and telephone lines shall be in a trench located within a 10-foot utility easement adjacent to public right-of-way. Right-of-way crossings shall have a minimum horizontal separation from other utilities (sewer, water, and storm) of 5 feet.
- 11. All construction surveying for extensions of public facilities shall be done under the direction of a Washington State licensed land surveyor or a Washington State licensed professional civil engineer.
- 12. During construction, all public streets adjacent to this project shall be kept clean of all material deposits resulting from on-site construction, and existing structures shall be protected as directed by the City.
- 13. Certified record drawings are required prior to project acceptance.
- 14. A NPDES Stormwater General Permit may be required by the Department of Ecology for this project. For information contact the Department of Ecology, Southwest Region Office as (360) 407-6300.
- 15. Any disturbance or damage to Critical Areas and associated buffers, or significant trees designated for preservation and protection shall be mitigated in accordance with a Mitigation Plan reviewed and approved by the City's Planning Division. Preparation and implementation of the Mitigation Plan shall be at the developer's expense.

Stormwater Notes

- All work in City right-of-way requires a permit from the City of Puyallup. Prior to any work commencing, the general contractor shall arrange for a preconstruction meeting at the Development Services Center to be attended by all contractors that will perform work shown on the engineering plans, representatives from all applicable Utility Companies, the project owner and appropriate City staff. Contact Engineering Services to schedule the meeting (253) 841-5568. The contractor is responsible to have their own approved set of plans at the meeting.
- 2. After completion of all items shown on these plans and before acceptance of the project, the contractor shall obtain a "punch list" prepared by the City's inspector detailing remaining items of work to be completed. All items of work shown on these plans shall be completed to the satisfaction of the City prior to acceptance of the water system and provision of sanitary sewer service.
- 3. All materials and workmanship shall conform to the Standard Specifications for Road, Bridge, and Municipal Construction (hereinafter referred to as the "Standard Specifications"), Washington State Department of Transportation and American Public Works Association, Washington State Chapter, latest edition, unless superseded or amended by the City of Puyallup City Standards for Public Works Engineering and Construction (hereinafter referred to as the "City Standards").
- 4. A copy of these approved plans and applicable city developer specifications and details shall be on site during construction.
- 5. Any revisions made to these plans must be reviewed and approved by the developer's engineer and the Engineering Services Staff prior to any implementation in the field. The City shall not be responsible for any errors and/or omissions on these plans.
- 6. The contractor shall have all utilities verified on the ground prior to any construction. Call (811) at least two working days in advance. The owner and his/her engineer shall be contacted immediately if a conflict exists.
- 7. Any structure and/or obstruction which require removal or relocation relating to this project, shall be done so at the developer's expense.
- 8. During construction, all existing and newly installed drainage structures shall be protected from sediments.
- All storm manholes shall conform to City Standard Detail No. 02.01.01. Flow control manhole/oil water separator shall conform to City Standard Detail No. 02.01.06 and 02.01.07.
- 10. Manhole ring and cover shall conform to City Standard Detail 06.01.02.
- 11. Catch basins Type I shall conform to City Standard Detail No.02.01.02 and 02.01.03 and shall be used only for depths less than 5 feet from top of the grate to the invert of the storm pipe.
- 12. Catch basins Type II shall conform to City Standard Detail No.02.01.04 and shall be used for depths greater than 5 feet from top of the grate to the invert of the storm pipe.
- 13. Cast iron or ductile iron frame and grate shall conform to City Standard Detail No.02.01.05. Grate shall be marked with "drains to stream". Solid catch basin lids (square unless noted as round) shall conform to WSDOT Standard Plan B-30.20-04 (Olympic Foundry No. SM60 or equal). Vaned grates shall conform to WSDOT Standard Plan B-30.30-03 (Olympic Foundry No. SM60V or equal).
- 14. Stormwater pipe shall be only PVC, concrete, ductile iron, or dual walled Polypropylene
- The use of any other type shall be reviewed and approved by the Engineering Services Staff prior to installation.
- b. PVC pipe shall be per ASTM D3034, SDR 35 for pipe size 15-inch and smaller and F679 for pipe sizes 18 to 27 inch. Minimum cover on PVC pipe shall be 3.0 feet.
- c. Concrete pipe shall conform to the WSDOT Standard Specifications for concrete
- underdrain pipe. Minimum cover on concrete pipe shall not less than 3.0 feet. d. Ductile iron pipe shall be Class 50, conforming to AWWA C151. Minimum cover on
- ductile iron pipe shall be 1.0 foot.
 e. Polypropylene Pipe (PP) shall be dual walled, have a smooth interior and exterior corrugations and meet WSDOT 9-05.24(1). 12-inch through 30-inch pipe shall meet or exceed ASTM F2736 and AASHTO M330, Type S, or Type D. 36-inch through 60-inch pipe shall meet or exceed ASTM F2881 and AASHTO M330, Type S, or Type S, or Type D. Testing shall be per ASTM F1417. Minimum cover over Polypropylene pipe shall be 3-feet.
- 15. Trenching, bedding, and backfill for pipe shall conform to City Standard Detail No. 06.01.01.

16. Storm pipe shall be a minimum of 10 feet away from building foundations and/or roof lines.

- All storm drain mains shall be tested and inspected for acceptance as outlined in Section 406 of the City of Puyallup Sanitary Sewer System Standards.
- 18. All temporary sedimentation and erosion control measures, and protective measures for critical areas and significant trees shall be installed prior to initiating any construction activities.

Sanitary Sewer Notes

- 1. All work in City right-of-way requires a permit from the City of Puyallup. Prior to any work commencing, the general contractor shall arrange for a preconstruction meeting at the Development Services Center to be attended by all contractors that will perform work shown on the engineering plans, representatives from all applicable Utility Companies, the project owner and appropriate City staff. Contact Engineering Services to schedule the meeting (253) 841-5568. The contractor is responsible to have their own approved set of plans at the meeting.
- 2. After completion of all items shown on these plans and before acceptance of the project, the contractor shall obtain a "punch list" prepared by the City's inspector detailing remaining items of work to be completed. All items of work shown on these plans shall be completed to the satisfaction of the City prior to acceptance of the sewer system and provision of sanitary sewer service.
- 3. All materials and workmanship shall conform to the Standard Specifications for Road, Bridge, and Municipal Construction (hereinafter referred to as the "Standard Specifications"), Washington State Department of Transportation and American Public Works Association, Washington State Chapter, latest edition, unless superseded or amended by the City of Puyallup City Standards for Public Works Engineering and Construction (hereinafter referred to as the "City Standards").
- A copy of these approved plans and applicable city developer specifications and details shall be on site during construction.
- 5. Any revisions made to these plans must be reviewed and approved by the developer's engineer and the Engineering Services Staff prior to any implementation in the field. The City shall not be responsible for any errors and/or omissions on these plans.
- The contractor shall have all utilities verified on the ground prior to any construction. Call (811) at least two working days in advance. The owner and his/her engineer shall be contacted immediately if a conflict exists.
- 7. Any structure and/or obstruction which require removal or relocation relating to this project shall be done so at the developer's expense.
- 8. Minimum grade on all 4 inch residential side sewers shall be 2 percent and 6 inch commercial side sewers shall be 1 percent; maximum shall be 8 percent. All side sewers shall be 6 inches within City right-of-way.
- Side sewers shall be installed in accordance with City Standard Nos. 04.03.01, 04.03.02, 04.03.03 and 04.03.04. Side sewer installation work shall be done in accordance with the Washington Industrial Safety and Health Act (WISHA).
- 10. All sewer pipe shall be PVC, Polypropylene, or Ductile Iron. PVC sewer pipe shall conform to ASTM D-3034, SDR35 for pipe sizes 15-inch and smaller and ASTM F679 for pipe sizes 18-to 27-inch, ductile iron pipe shall be Class 51 or greater, lined with Protecto 401TM epoxy lining or equivalent, unless otherwise noted. 12-inch through 30-inch Polypropylene Pipe (PP) shall be dual walled, have a smooth interior and exterior corrugations and meet WSDOT 9-05.24(2). It shall meet or exceed ASTM F2764. 36-inch through 60-inch PP pipe shall be triple walled and meet WSDOT 9-05.24(2). It shall meet or exceed ASTM F2764. PP shall have a minimum pipe stiffness of 46 pii when tested in accordance with ASTM D2412. Testing shall be per ASTM F1417. Trenching, bedding, and backfill shall be in accordance with City Standard No. 06.01.01. Minimum cover on PVC and PP pipe shall be 3.0 feet. Minimum cover on ductile iron pipe shall be 1.0 foot.
- 11. Sanitary sewer manhole frames and covers shall conform to City Standard No. 06.01.02.
- 12. Sanitary sewer manholes shall conform to City Standard Nos. 04.01.01, 04.01.02, 04.01.03 and 04.01.04. All manholes shall be channeled for future lines as specified on these plans. Manhole steps and ladder shall conform to Standard No. 06.01.03.
- 13. Sanitary sewer pipe and side sewers shall be 10 feet away from building foundations and/or roof lines with the exception of side sewers that provide service to a single-family residence. At the discretion of the review engineer, a Licensed Professional Engineer will be required to stamp the design to account for depth or proximity to foundation, steep slopes, or other factors.
- 14. No side sewers shall be connected to any house or building until all manholes are adjusted to the finished grade of the completed asphalt roadway and the asphalt patch and seal around the ring are accepted.
- 15. For commercial developments in which sources of grease and/or oils may be introduced to the City sanitary sewer system, a City approved grease interceptor shall be installed downstream from the source.
- 16. Once sewer and all other utility construction is completed, all sanitary sewer mains and side sewers shall be tested per Section 406 of the City Standards.

Grading, Erosion, and Sediment Control Plan Notes

- 1. All work in City right-of-way requires a permit from the City of Puyallup. Prior to any work commencing, the general contractor shall arrange for a preconstruction meeting at the Development Services Center to be attended by all contractors that will perform work shown on the approved engineering plans, representatives from all applicable utility companies, the project owner and appropriate city staff. Contact Engineering Services at (253-841-5568) to schedule the meeting. The contractor is responsible to have their own set of approved plans at the meeting.
- 2. After completion of all items shown on these plans and before acceptance of the project the contractor shall obtain a "punch list" prepared by the City's inspector detailing remaining items of work to be completed. All items of work shown on these plans shall be completed to the satisfaction of the City prior to acceptance of the water system and provision of sanitary sewer service.
- 3. All materials and workmanship shall conform to the Standard Specifications for Road, Bridge, and Municipal Construction (hereinafter referred to as the "Standard Specifications"), Washington State Department of Transportation and American Public Works Association, Washington State Chapter, latest edition, unless superseded or amended by the City of Puyallup City Standards for Public Works Engineering and Construction (hereinafter referred to as the "City Standards"), or as directed by Fruitland Mutual Water Company (FMWC), Valley Water (VW), or Tacoma City Water (TCW) is the purveyor.
- 4. A copy of these approved plans and applicable city developer specifications and details shall be on site during construction.
- 5. Any revision made to these plans must be reviewed and approved by the developer's engineer and the Engineering Services Staff, and the FMWC, VW, or TCW when served by that purveyor, prior to any implementation in the field. The City shall not be responsible for any errors and/or omissions on these plans.
- The contractor shall have all utilities verified on the ground prior to any construction. Call (811) at least two working days in advance. The owner and his/her engineer shall be contacted immediately if a conflict exists.
- 7. All limits of clearing and areas of vegetation preservation as prescribed on the plans shall be clearly flagged in the field and observed during construction.
- 8. All required sedimentation and erosion control facilities must be constructed and in operation prior to any land clearing and/or other construction to ensure that sediment laden water does not enter the natural drainage system. The contractor shall schedule an inspection of the erosion control facilities PRIOR to any land clearing and/or other construction. All erosion and sediment facilities shall be maintained in a satisfactory condition as determined by the City, until such time that clearing and/or construction is completed and the potential for on-site erosion has passed. The implementation, maintenance, replacement, and additions to the erosion and sedimentation control systems shall be the responsibility of the permittee.
- 9. The erosion and sedimentation control system facilities depicted on these plans are intended to be minimum requirements to meet anticipated site conditions. As construction progresses and unexpected or seasonal conditions dictate, facilities will be necessary to ensure complete situation control on the site. During the course of construction, it shall be the obligation and responsibility of the permittee to address any new conditions that may be created by his activities and to provide additional facilities, over and above the minimum requirements, as may be needed to protect adjacent properties, sensitive areas, natural water courses, and/or storm drainage systems.
- 10. Approval of these plans is for grading, temporary drainage, erosion, and sedimentation control only. It does not constitute an approval of permanent storm drainage design, size or location of pipes, restrictors, channels, or retention facilities.
- 11. Any disturbed area which has been stripped of vegetation and where no further work is anticipated for a period of 30 days or more, must be immediately stabilized with mulching, grass planting, or other approved erosion control treatment applicable to the time of year in question. Grass seeding alone will be acceptable only during the months of April through September inclusive. Seeding may proceed outside the specified time period whenever it is in the interest of the permittee but must be augmented with mulching, netting, or other treatment approved by the City.
- 12. In case erosion or sedimentation occurs to adjacent properties, all construction work within the development that will further aggravate the situation must cease, and the owner/contractor will immediately commence restoration methods. Restoration activity will continue until such time as the affected property owner is satisfied.
- 13. No temporary or permanent stockpiling of materials or equipment shall occur within critical areas or associated buffers, or the critical root zone for vegetation proposed for retention.

Owr	ner/Develo	oper:
0.01		
		Pashington
	STA	ATE FAIR
1	P	UYALLUP
		n State Fair
110	9th Ave	
	7anup, M 3) 841-5	
	nitect:	
1		
1		
1		
Engi	neer:	
J	JTE	AM
	tin Jones	s, PE t. Suite 200
Sur	nner, W	A 98390
(20	6) 596-2	020
Proj	ect.	
		e Train Expansion
	'y ville	. паш слранзюн
1		
1		
ON		CH AT FULL SCALE.
IFI	NOT, S	CALE ACCORDINGLY
		s are record drawings ,
		ormation shown reflects existing field
cor	nditions	as of this date:
08-	-24-2022	2.
	AST.	IN M. JO
	Contraction of the second s	IN M. JOA
	A CONTRACT	IN M. JOH OF WASHING US
-		OF WASHING TO
		OF WASHING TO
		41829 STONAL ENGINE
		OF WASHING TO
REV	The short is	OF WASHING TO THE TOTOL TOTOL TO THE TOTOL
REV		41829 STONAL ENGINE
REV	The short is	OF WASHING TO THE TOTOL TOTOL TO THE TOTOL
REV	The short is	OF WASHING TO THE TOTOL TOTOL TO THE TOTOL
	The short is	OF WASHING TO THE TOTOL TOTOL TO THE TOTOL
	The short is	OF WASHING TO THE TOTOL TOTOL TO THE TOTOL TO THE TOTOL
	DATE	DF WASER OF WASER OF WASER OF WASER OF WASER OF
	DATE	DECIGN DV.
DRAV	DATE	DF WASER OF WASER OF WASER OF WASER OF WASER OF
DRAV PROJ. DATE:	DATE	OF WASER OF ALSO OF WASER OF WASER OF ALSO OF
DRAV PROJ. DATE:	DATE	DESCRIPTION DESCR
DRAV PROJ. DATE:	DATE	OF WASER OF ALSO OF WASER OF WASER OF ALSO OF
DRAV PROJ. DATE:	DATE	DESCRIPTION DESCR
DRAV PROJ. DATE:	DATE	DESCRIPTION DESCR
DRAV PROJ. DATE: SHEET		DESCRIPTION DESCR
DRAV PROJ. DATE: SHEET	DATE	DESCRIPTION DESCR

APPROVED

CITY OF PUYALLUP DEVELOPMENT ENGINEERING

DATE _

NOTE: THIS APPROVAL IS VOID AFTER 180 DAYS FROM APPROVAL DATE. THE CITY WILL NOT BE RESPONSIBLE FOR ERRORS AND/OR OMISSIONS ON THESE

PLANS. FIELD CONDITIONS MAY DICTATE CHANGES TO THESE PLANS AS DETERMINED BY THE DEVELOPMENT ENGINEERING MANAGER.



Water Notes

- 1. All work in City right-of-way requires a permit from the City of Puyallup. Prior to any work commencing, the general contractor shall arrange for a preconstruction meeting at the Development Services Center to be attended by all contractors that will perform work shown on the engineering plans, representatives from all applicable Utility Companies, the project owner and appropriate City staff. Contact Engineering Services to schedule the meeting (253) 841-5568. The contractor is responsible to have their own approved set of plans at the meeting.
- 2. After completion of all items shown on these plans and before acceptance of the project, the contractor shall obtain a "punch list" prepared by the City's inspector detailing remaining items of work to be completed. All items of work shown on these plans shall be completed to the satisfaction of the City prior to acceptance of the water system and provision of sanitary sewer service.
- 3. All materials and workmanship shall conform to the Standard Specifications for Road, Bridge, and Municipal Construction (hereinafter referred to as the "Standard Specifications"), Washington State Department of Transportation and American Public Works Association, Washington State Chapter, latest edition, unless superseded or amended by the City of Puyallup City Standards for Public Works Engineering and Construction (hereinafter referred to as the "City Standards"), or as directed by Fruitland Mutual Water Company (FMWC), Valley Water (VW), or Tacoma City Water (TCW) is the purveyor.
- 4. A copy of these approved plans and applicable city developer specifications and details shall be on site during construction.
- 5. Any revisions made to these plans must be reviewed and approved by the developer's engineer, the Engineering Services Staff, and the FMWC, VW or TCW when served by that purveyor, prior to any implementation in the field. The City shall not be responsible for any errors and/or omissions on these plans.
- 6. The contractor shall have all utilities verified on the ground prior to any construction. Call (811) at least two working days in advance. The owner and his/her engineer shall be contacted immediately if a conflict exists.
- 7. Any structure and/or obstruction which requires removal or relocation relating to this project shall be done so at the developer's expense.
- 8. Bacteriological (Coliform and Iron Bacteria) test samples will be taken by the City (or FMWC, VW or TCW when served by that purveyor) and paid for by the contractor, except for Capital Improvement Projects (CIP) which shall be paid for by the City.
- 9. Water mains shall have a minimum cover of 36 inches from paved final grade in improved right-of-way and improved easements, and a minimum of 48 inches in unimproved right-of- way and unimproved easements.
- 10. Pipe for water mains shall be ductile iron conforming to Section 7-09 of the Standard Specifications, Class 52 with tyton or approved equal joints. Pipe shall be cement lined in accordance with A.S.A. Specification A 21.4-1964.
- 11. Connections to existing water mains typically shall be wet taps through a tapping tee and tapping valve and shall be made by a city approved contractor. The tapping sleeve shall be Romac SST all stainless steel tapping sleeve or approved equal. A two-piece epoxy coated or ductile iron tapping sleeve may be used on ductile iron pipe, when the tap is smaller than the water main size i.e. 6-inch tap on 8-inch pipe. The City (or FMWC, VW or TCW when served by that purveyor) shall approve the time and location for these connections.
- 12. All water mains and appurtenances shall be hydrostatically tested at 200 psi in accordance with Standard Specification 7-09.3(23). Pressure testing shall not be performed until satisfactory purity samples have been received, except when new water mains are installed independently from the water system piping.
- 13. Fire hydrants shall be installed in accordance with City Standard Detail 03.05.01 and as directed by the City of Puyallup Fire Code Official.
- 14. Valve marker posts shall be installed where valve boxes are hidden from view or in unpaved areas. The installation shall be in accordance with City Standard Detail 03.01.02.
- 15. Resilient seated wedge gate valves shall be used for 10-inch mains and smaller. Butterfly valves shall be used for mains greater than 10 inches.
- 16. Pipe fitting for water mains shall be ductile iron and shall be mechanical joint conforming to AWWA Specification C111-72.
- 17. Water main pipe and service connections shall be a minimum of 10 feet away from building foundations and/or roof lines
- 18. Where a water main crosses the Northwest Gas pipeline, the water line shall be cased with PVC pipe a minimum of 10 feet beyond each side of the gas line easement. Contact Williams Northwest Pipeline before the crossing is made.
- 19. Trenching, bedding, and backfill for water mains shall be installed in accordance with City Standard Detail 06.01.01.
- 20. All commercial and industrial developments, irrigation systems, and multi-family water service connections shall be protected by a double check valve assembly or a reduced pressure backflow assembly as directed by the City (or FMWC, VW or TCW when served by that purveyor) conforming to City Standard Details 03.04.01, 03.04.02, and 03.04.03.
- 21. Any lead joint fitting disturbed during construction shall be replaced with a mechanical joint fitting at the contractor's expense.
- 22. When hydraulic fire flow modeling is required for a project, the City will issue a permit. The hydraulic modeling criteria is based on the projected 2030 water demand, while maintaining a minimum system pressure of 20 pounds per square inch and a maximum velocity of 10 feet per second.
- 23. When using a fire hydrant for non-firefighting purposes, a city hydrant meter must be used. Coordinate the acquisition of the hydrant meter with the City's Utility Billing Division at Puyallup City Hall. A city approved backflow protection assembly shall be installed by the person requesting use of a fire hydrant. The assembly shall be accompanied by a current backflow assembly test report. The test report shall be available at the site for the duration of the hydrant use.
- 24. Should a break occur on any City water main, the Contractor shall follow the City's adopted "Water Main Break Procedure" issued to them at the Pre-Construction Meeting and notify those connected to the system in the impacted area as outlined in the Procedure.
- 25. Water Main Repairs (References: AWWA C651-14 and WSDOT Standard Specification Section 7-09)

(Note: A planned water main repair shall be approved by the City Inspector and/or Water Division Supervisor prior to commencing work.)

a. Repair without depressurization - Small leaks shall be repaired using repair bands while maintaining positive pressure in the water main. Valves surrounding the leak will be partially shut by the City Water Department to reduce the flow and pressure to the area. Blowoffs and hydrants in the reduced pressure area may be opened as needed to further reduce the pressure. The water main trench shall be over-excavated to allow water in the trench to be pumped out and maintained below the level of the water main. The repair shall be completed with the water main pressure remaining positive. After the repair is made, the system shall be fully pressurized and a visual leak inspection will be completed. The water main in the affected area shall be flushed to achieve three pipe volumes pulled from the pipe (distance measured from valve opened for flushing to the exit hydrant or blowoff).

b. Repair/cut-in with depressurization - Trench shall be over excavated and dewatered below the water main. Flush water from pipe from each direction until it runs clear. Immediately prior to installation of a new pipe section for repair or cut in tee, all new fittings and pipe spools shall be swabbed with a five percent (5%) chlorine solution (minimum). The interior of the existing pipe shall be swabbed with a five percent (5%) chlorine solution at least 6 feet in each direction from exposed cut ends. The water main in the affected area shall be flushed to achieve three pipe volumes pulled from the pipe (distance measured from the valve opened for flushing to the exit hydrant or blowoff). Customers shall be notified after the water main is flushed and repairs have been completed, as outlined in the "Water Main Break Procedure."

26. New Water Main Installation:

a. Each new water main section shall be delivered, stacked and stored onsite with ends plugged. The plugs shall remain in the pipe until each particular section is installed. National Sanitation Foundation (NSF) approved sixty-five percent (65%) calcium hypochlorite shall be added to the upstream end of each pipe section, and at each hydrant tee in the amount given in the table below (or per approved manufacturer specifications). The minimum amount of calcium hypochlorite added should be sufficient to achieve a 50 mg/L concentration within the impacted area.

	Pipe Volume	5-gram	Hypochlori	te Granules	Maximum
Pipe Diameter	per 18 feet	tablets per	Ounces per	Teaspoons	Fill Rate
(Inches)	(gal)	pipe section	500 feet	per 18 feet	(gpm)_
4	35	1	1.7	0.2	40
6	53	1	3.8	0.4	90
8	70	2	6.7	0.7	150
12	106	4	15.1	1.4	350
16	141	6	27	2.5	600

- b. New water mains shall be filled using an approved backflow prevention assembly. The water main shall be filled from the lower elevation end so that as the water main is filled, the chorine is contacted, dissolved and spread relatively uniform through the length of the new water main. The fill rate shall be minimized so that the velocity of the water is less than 1 ft/sec (see table above). Successful pressure test and bacteriological tests shall be completed and provided to the City prior to any new mater main connection to the existing water system.
- c. The chlorinated water will be allowed to remain in contact with the new water main system for 24 to 72 hours. After 24 hours, water may be added to the water main for the purposes of pressure testing. The water in the main used for pressure testing must remain in the water main until pressure test is completed. If necessary, liquid chlorine shall be injected into the water main with fill water to maintain a concentration in the water main above 50 mg/L. Under no circumstance shall "super" chlorinated water be allowed to sit within a new water main for more than 5 days.
- d. Pressure testing includes testing against new valves and hydrants. Each valve shall be tested by closing each in turn and reducing the pressure beyond the valve. The pressure on the back side of the valve should not be eliminated. Care must be taken that, during this process, positive pressure remains throughout the system being tested at all times. All hydrant foot valves shall be open during pressure testing so that the pressure test is against the hydrant valve. Pressure testing will not be allowed against any existing valves.
- e. After successful pressure testing, the water main shall be thoroughly flushed to remove all "super" chlorinated water from the new water main. Flushing of new or extended water mains shall be conducted per WSDOT Specification 7-09.3(24)A with a minimum velocity developed within the pipe while flushing of 2.5 feet per second (fps). All flushed water shall be dechlorinated prior to disposal. The Contractor shall be responsible for disposal of all chlorinated water flushed from mains. The City shall approve the disposal method prior to implementation in the field. The Contractor shall utilize on- site disposal methods, if available. Disposal of flush water to the sanitary sewer system shall not be allowed without written permission from the Water Pollution Control Plant (WPCP) Supervisor. Any planned discharge to a stormwater system shall be dechlorinated to a concentration of 0.1 ppm or less, pH adjusted (if necessary) to be between 6.5 and 8.5, and volumetrically and velocity controlled to prevent any resuspension of sediments. The City will require independent testing throughout the water discharge process to ensure compliance of these standards are met.
- f. Samples for bacteriological analysis shall be collected after flushing and again 24 hours after the first set of samples.
- g. All closure/final connection fittings shall be sprayed clean and then swabbed with a five percent (5%) chlorine solution immediately prior to installation per AWWA Standard C651. Additional samples for bacteriological analysis shall be collected from the immediate vicinity of the new or replaced water main and analyzed after the final connections are made. If necessary, additional flushing shall be conducted and additional samples shall be collected until satisfactory results are obtained.

Owr	ner/Develo	oper:
		Pashington
		ATE FAIR
	P	PUYALLUP
\٨/~	shington	n State Fair
110	9th Ave	e SW
	• ·	/A 98371
(25	3) 841-5	0000
Arch	nitect:	
Engi	neer:	
Ы	JTE	AM
	tin Jone	
		t. Suite 200 A 98390
	6) 596-2	
Proj		
Sil	lyVille	e Train Expansion
	JE INC NOT, S	CH AT FULL SCALE.
		s are record drawings , formation shown
		reflects existing field
	nditions ·24-2022	as of this date:
08-	-24-2022	2.
		NM.JO
	JST S	OF WASHING
-	A ST	OF WASHING SU
	NO ST	OF WASHING OF
		OF WASHING CO
		OF WASHING CO
		OF WASHING CO 41829 DECISTERED STONAL ENGINE
		OF WASHING CO
REV	THE STORES	OF WASHING OF 41829 BECISTERED ING FONAL ENCINES 08-24-22
REV		OF WASHING CO 41829 DECISTERED STONAL ENGINE
REV	THE STORES	OF WASHING OF 41829 BECISTERED ING YONAL ENGINE 08-24-22
REV	THE STORES	OF WASHING OF 41829 BECISTERED ING YONAL ENGINE 08-24-22
	THE STORES	OF WASHING OF 41829 BECISTERED ING FONAL ENCINES 08-24-22
	THE STORES	
	DATE	DF WASHINGTON 41829 CISTERED 08-24-22 DESCRIPTION 08-24-22
	DATE	
DRAW	DATE	DF WASHINGTON 41829 CISTERED 08-24-22 DESCRIPTION 08-24-22 DESCRIPTION DESCR
DRAV PROJ.	DATE	DESCRIPTION
DRAV PROJ. SHEET	DATE	DESCRIPTION DESCRIPTION DESCRIPTION DESCRIPTION DESCRIPTION DESIGN BY: JJ 1507-002-08 August 24, 2022
DRAV PROJ. SHEET	DATE	DESCRIPTION
DRAV PROJ. SHEET	DATE	DESCRIPTION DESCRIPTION DESCRIPTION DESCRIPTION DESCRIPTION DESIGN BY: JJ 1507-002-08 August 24, 2022
DRAV PROJ. SHEET	DATE	DESCRIPTION DESCRIPTION DESCRIPTION DESCRIPTION DESCRIPTION DESIGN BY: JJ 1507-002-08 August 24, 2022
DRAV PROJ. DATE:	DATE	DESCRIPTION DESCRIPTION DESCRIPTION DESCRIPTION DESCRIPTION DESIGN BY: JJ 1507-002-08 August 24, 2022
DRAV PROJ. DATE: SHEET		VASION VA
DRAV PROJ. DATE: SHEET	DATE	VASION VA
DRAV PROJ. DATE: SHEET		DM DESIGN BY: JJ 1507-002-08 August 24, 2022

APPROVED


CITY OF PUYALLUP DEVELOPMENT ENGINEERING


DATE

NOTE: THIS APPROVAL IS VOID AFTER 180 DAYS FROM APPROVAL DATE. THE CITY WILL NOT BE RESPONSIBLE FOR ERRORS AND/OR OMISSIONS ON THESE

PLANS. FIELD CONDITIONS MAY DICTATE CHANGES TO THESE PLANS AS DETERMINED BY THE DEVELOPMENT ENGINEERING MANAGER.

CALL TWO BUSINESS DAYS BEFORE YOU DIG UTILITIES UNDERGROUND LOCATION CENTER

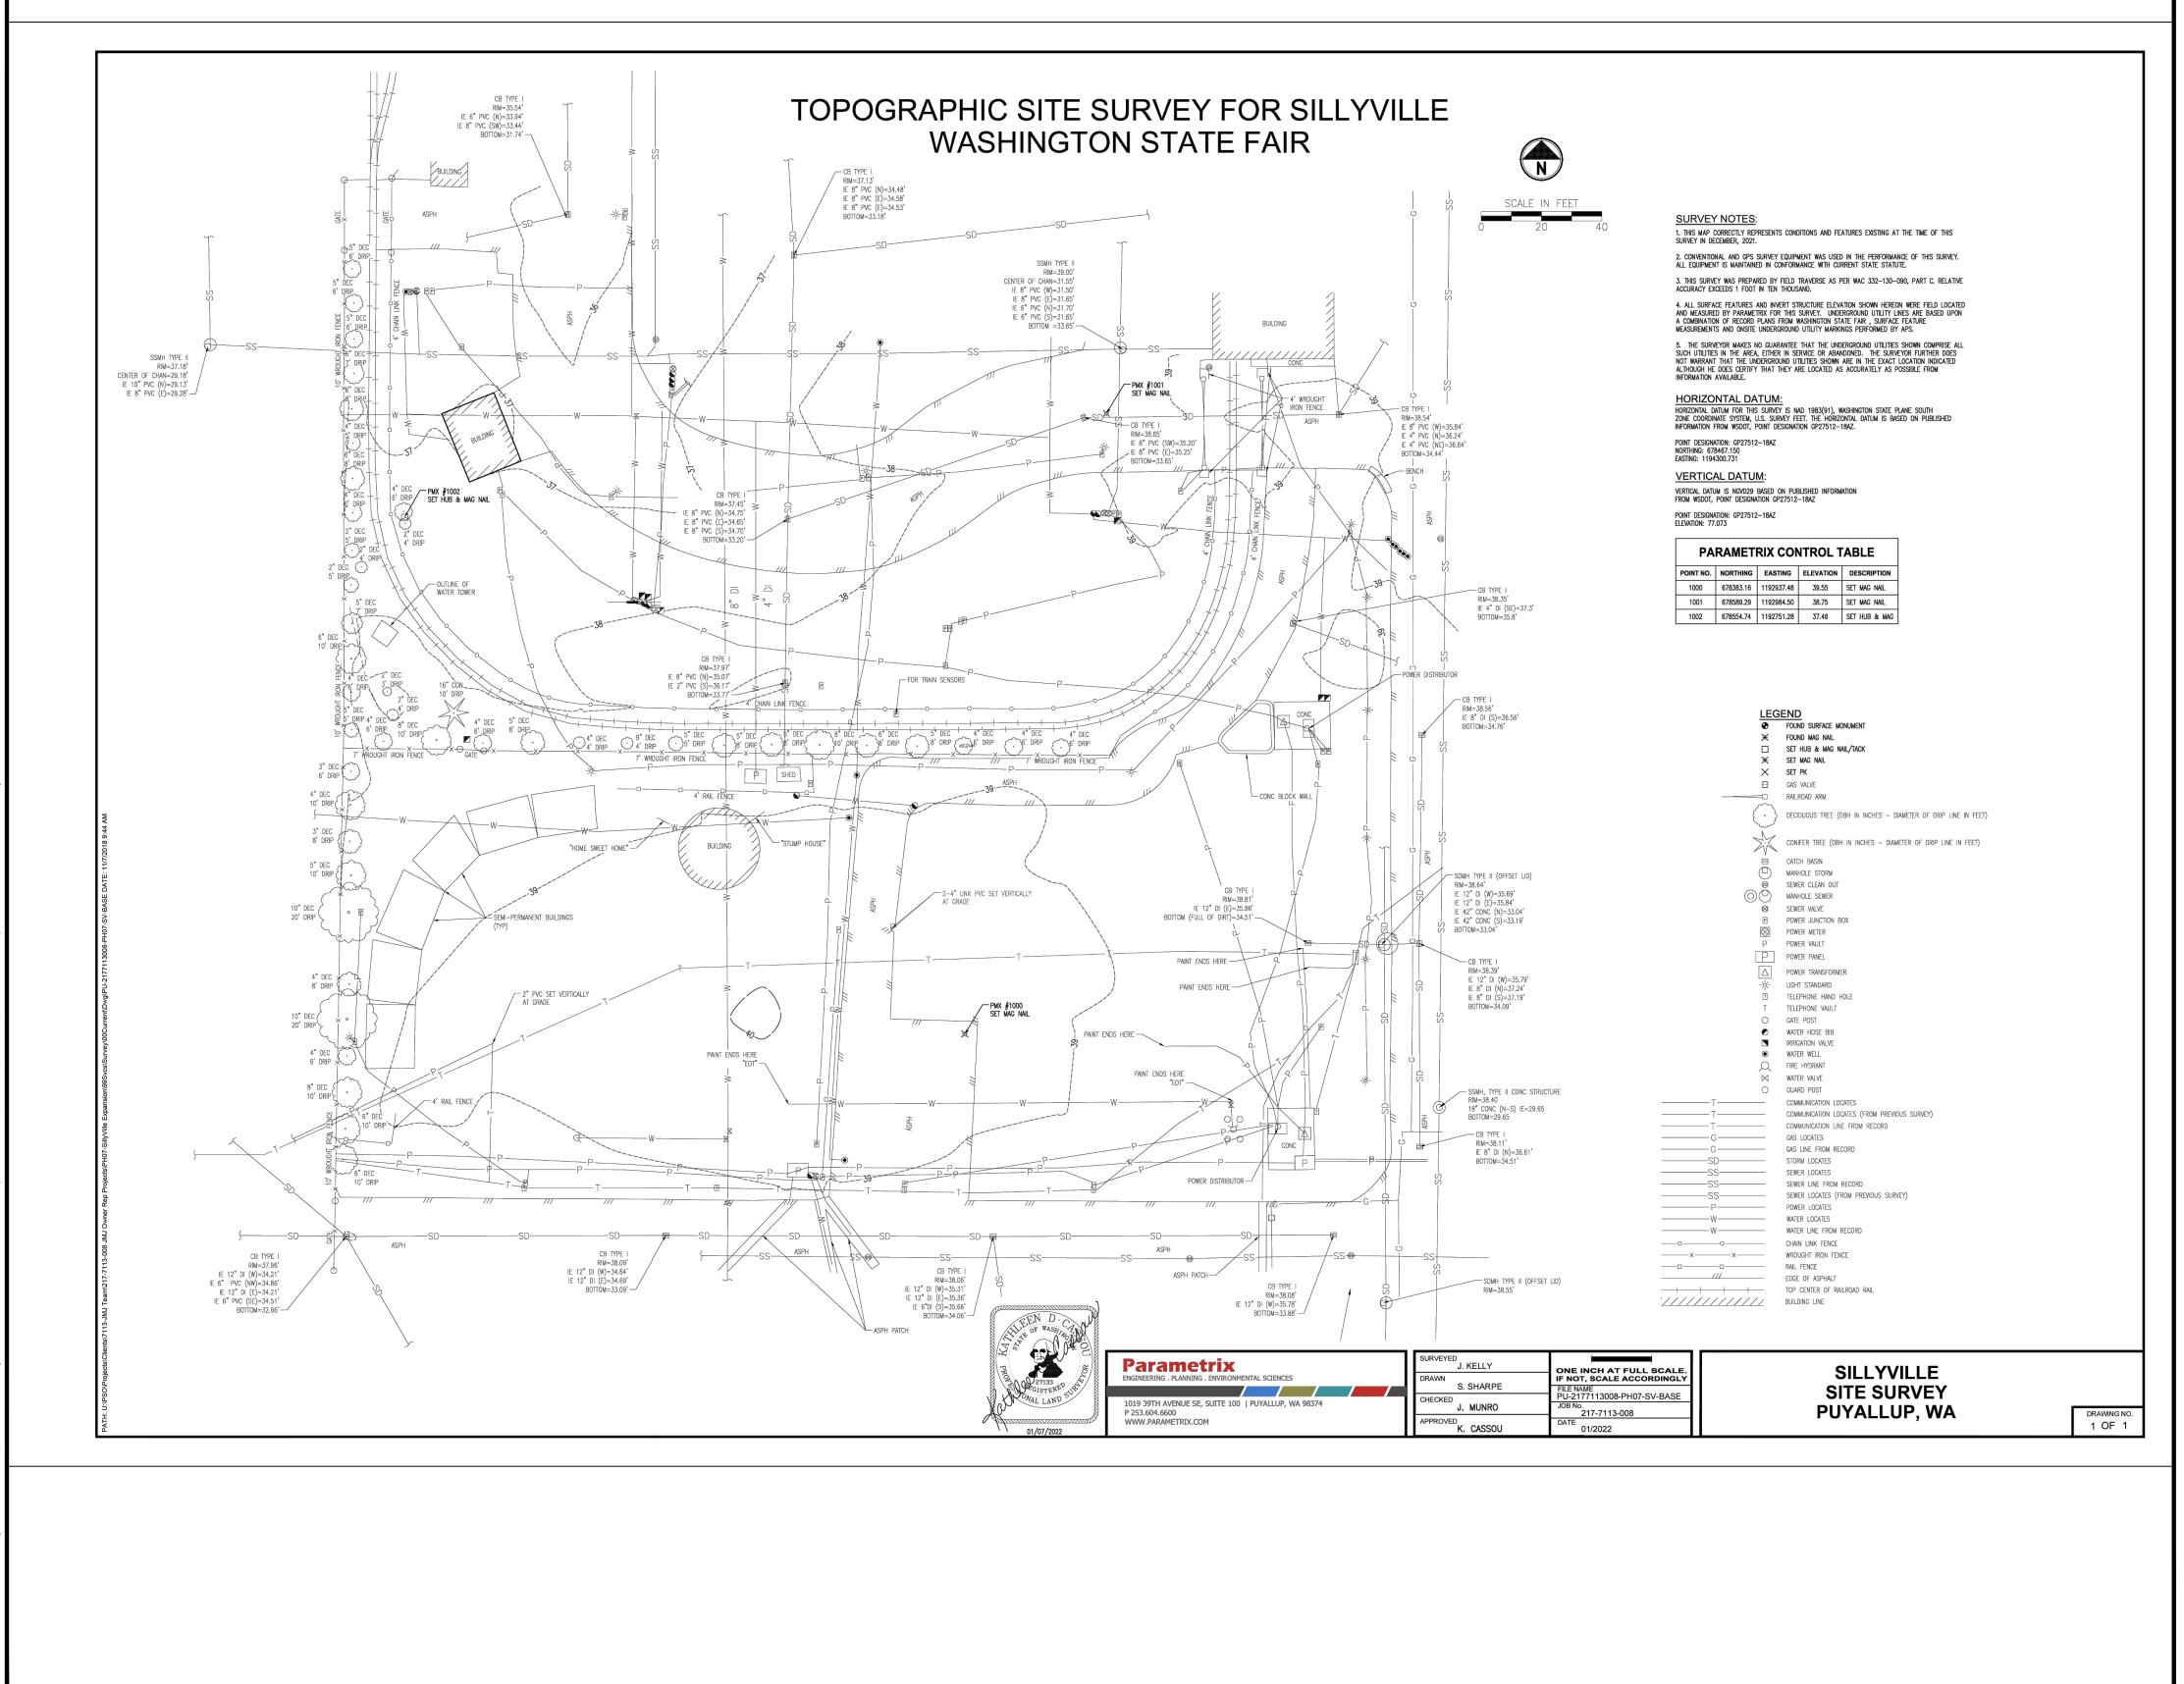

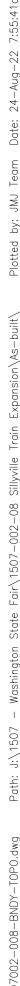

Owr	ner/Develo	oper:		
	Washington			
	STATE FAIR			
	P	UYAL	LUP	
	shingto		Fair	
Puy) 9th Ave vallup, W	/A 9837	'1	
(25	3) 841-5	356		
Arch	nitect:			
Engi	neer:			
J	JTE	EAM		
	tin Jone:			
Sur	5 Main S nner, W	A 9839		
	6) 596-2			
Proj	ect:			
		e Trai	n Expansior	ו
ON IF I	NE INC	cale	FULL SCALE	Y
			cord drawings,	
and	d the inf	ormatio	on shown	
cor	nditions	as of th	existing field is date:	
08-	-24-2022	2.		
	•		La.a.	
		IN M. OF WA	JON	
	No Contraction	IN M.	JON SS	
	A CONTRACT	IN M. OF WA	JON SS	
	A COL	OF WA	N M	
	CONTRACT OF THE OWNER	OF WAL	RED NEW	
	A STREET	OF WA	N M	~
REV	DATE	OF WAL	RED ING ENCITED 08-24-22	
REV		OF WAL	RED ING ENCITED 08-24-22	~
REV		OF WAL	RED ING ENCITED 08-24-22	
REV		OF WAL	RED ING ENCITED 08-24-22	
		OF WAL	RED ING ENCITED 08-24-22	
		ALBESCRIP	DESIGN BY:	
	DATE	ALBESCRIP	DESIGN BY: JJ 1507-002-0	
DRAV PROJ. DATE:	DATE	ALBESCRIP	DESIGN BY:	
DRAV PROJ. DATE: SHEET	DATE	A1829	DESIGN BY: JJ 1507-002-0 August 24, 2022	
DRAV PROJ. DATE: SHEET	DATE	A1829	DESIGN BY: JJ 1507-002-0 August 24, 2022	
DRAV PROJ. DATE: SHEET	DATE	A1829 CISTE STONAL DESCRIP	DESIGN BY: JJ 1507-002-0 August 24, 2022	
DRAV PROJ. DATE: SHEET	DATE	A1820 CISTE STONAL DESCRIP	DESIGN BY: JJ 1507-002-0 August 24, 2022	
DRAV PROJ. DATE: SHEET		A1820 CISTE STONAL DESCRIP	DESIGN BY: JJ 1507-002-0 August 24, 2022	
DRAV PROJ. DATE: SHEET		A1820 CISTE STONAL DESCRIP	DESIGN BY: JJ 1507-002-0 August 24, 2022	
DRAV PROJ. DATE: SHEET		A1820 CISTE STONAL DESCRIP	DESIGN BY: JJ 1507-002-0 August 24, 2022	
DRAV PROJ. DATE: SHEET		AIB2C AIB2C CISTE STONAL DESCRIP D	DESIGN BY: JJ 1507-002-0 August 24, 2022	

BY ______ CITY OF PUYALLUP DEVELOPMENT ENGINEERING

DATE ____

NOTE: THIS APPROVAL IS VOID AFTER 180 DAYS FROM APPROVAL DATE. THE CITY WILL NOT BE RESPONSIBLE FOR ERRORS AND/OR OMISSIONS ON THESE PLANS.


FIELD CONDITIONS MAY DICTATE CHANGES TO THESE PLANS AS DETERMINED BY THE DEVELOPMENT ENGINEERING MANAGER.


CALL TWO BUSINESS DAYS BEFORE YOU DIG 1-800-424-5555 UTILITIES UNDERGROUND LOCATION CENTER





••••	an/Davala	
Owr	ner/Develo	oper:
	0	In chinaton
	STA	Pashington
	514	TE FAIR
ĺ	Р	UYALLUP
	-	
Wa	shingtor	n State Fair
	9th Ave	
		/A 98371
-	3) 841-5	
· ·	- / -	
Arch	nitect:	
Engi	neer:	
J		AM
Jus	tin Jones	s, PE
		t. Suite 200
	nner, W	
(20	6) 596-2	020
Proj	ect:	
		Train Expansion
1 211	iy v IIIE	e Train Expansion
ĺ		
Í		
Í		
ĺ		
ĺ		
Í		
ĺ		
ĺ		
-		
ON	IE INC	CH AT FULL SCALE.
IF	NOT, S	CALE ACCORDINGLY
71		
		s are record drawings ,
		ormation shown
		reflects existing field as of this date:
	24-2022	
08-	24-2022	
		ARRA .
		IN M. JOAN
	SST ST	N.M. JON
	A CT	IN M. JOAN
		N.M. JON
	A COL	N.M. JOHON
	A Star	OF WASHING OF
1111	A Star	OF WASHING OF
	A Star	OF WASHING OF
	ROATS	OF WASHING COL
	ROATS	AIB29 AIB29 CISTERED NEW MONAL ENGINE
REV	ROATS	AIB29 AIB29 CISTERED NEW MONAL ENGINE
REV	REC TROPESS	OF WASHING OF 41829 ECISTERED NONAL ENGINE 08-24-22
REV	REC TROPESS	OF WASHING OF 41829 ECISTERED NONAL ENGINE 08-24-22
	REC TROPESS	OF WASHING OF 41829 ECISTERED NONAL ENGINE 08-24-22
REV	REC TROPESS	OF WASHING OF 41829 ECISTERED NONAL ENGINE 08-24-22
	REC TROPESS	OF WASHING OF 41829 ECISTERED NONAL ENGINE 08-24-22
	REC TROPESS	OF WASHING OF 41829 ECISTERED NONAL ENGINE 08-24-22
		OF WASHING OF 41829 ECISTERED NONAL ENGINE 08-24-22
		DESCRIPTION
	DATE	
DRAW	DATE	DIF WASHINGTON 41829 CISTERED DESCRIPTION DESCRIPTION DESCRIPTION DESCRIPTION DESCRIPTION DESCRIPTION DESCRIPTION JJ 1507-002-08
DRAW PROJ.	DATE	DESCRIPTION
DRAW	DATE	DIF WASHINGTON 41829 CISTERED DESCRIPTION DESCRIPTION DESCRIPTION DESCRIPTION DESCRIPTION DESCRIPTION DESCRIPTION JJ 1507-002-08
DRAW PROJ. DATE:	DATE	DIVERSION DESIGN BY: JJ DESCRIPTION DESIGN BY: JJ 1507-002-08 August 24, 2022
DRAW PROJ. DATE:	DATE	DIF WASHINGTON 41829 CISTERED DESCRIPTION DESCRIPTION DESCRIPTION DESCRIPTION DESCRIPTION DESCRIPTION DESCRIPTION JJ 1507-002-08
DRAW PROJ. DATE: SHEET		DM DESIGN BY: JJ 1507-002-08 August 24, 2022
DRAW PROJ. DATE: SHEET		DIVERSION DESIGN BY: JJ DESCRIPTION DESIGN BY: JJ 1507-002-08 August 24, 2022
DRAW PROJ. DATE: SHEET		DIVERSION ALLENCINESSION OB-24-22
DRAW PROJ. DATE: SHEET	DATE	AIB29 AI
DRAW PROJ. DATE: SHEET	DATE	AIB29 AI
DRAW PROJ. DATE: SHEET	DATE	DESIGN BY: JJ 1507-002-08 August 24, 2022 DESCRIPTION DESIGN BY: JJ 1507-002-08 August 24, 2022
DRAW PROJ. DATE: SHEET	DATE	AIB29 AI

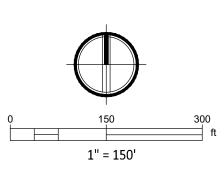

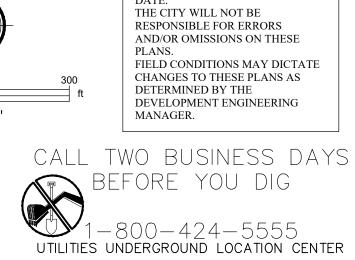


DEVELOPMENT ENGINEERING


NOTE: THIS APPROVAL IS VOID AFTER 180 DAYS FROM APPROVAL

DATE ____

DATE.

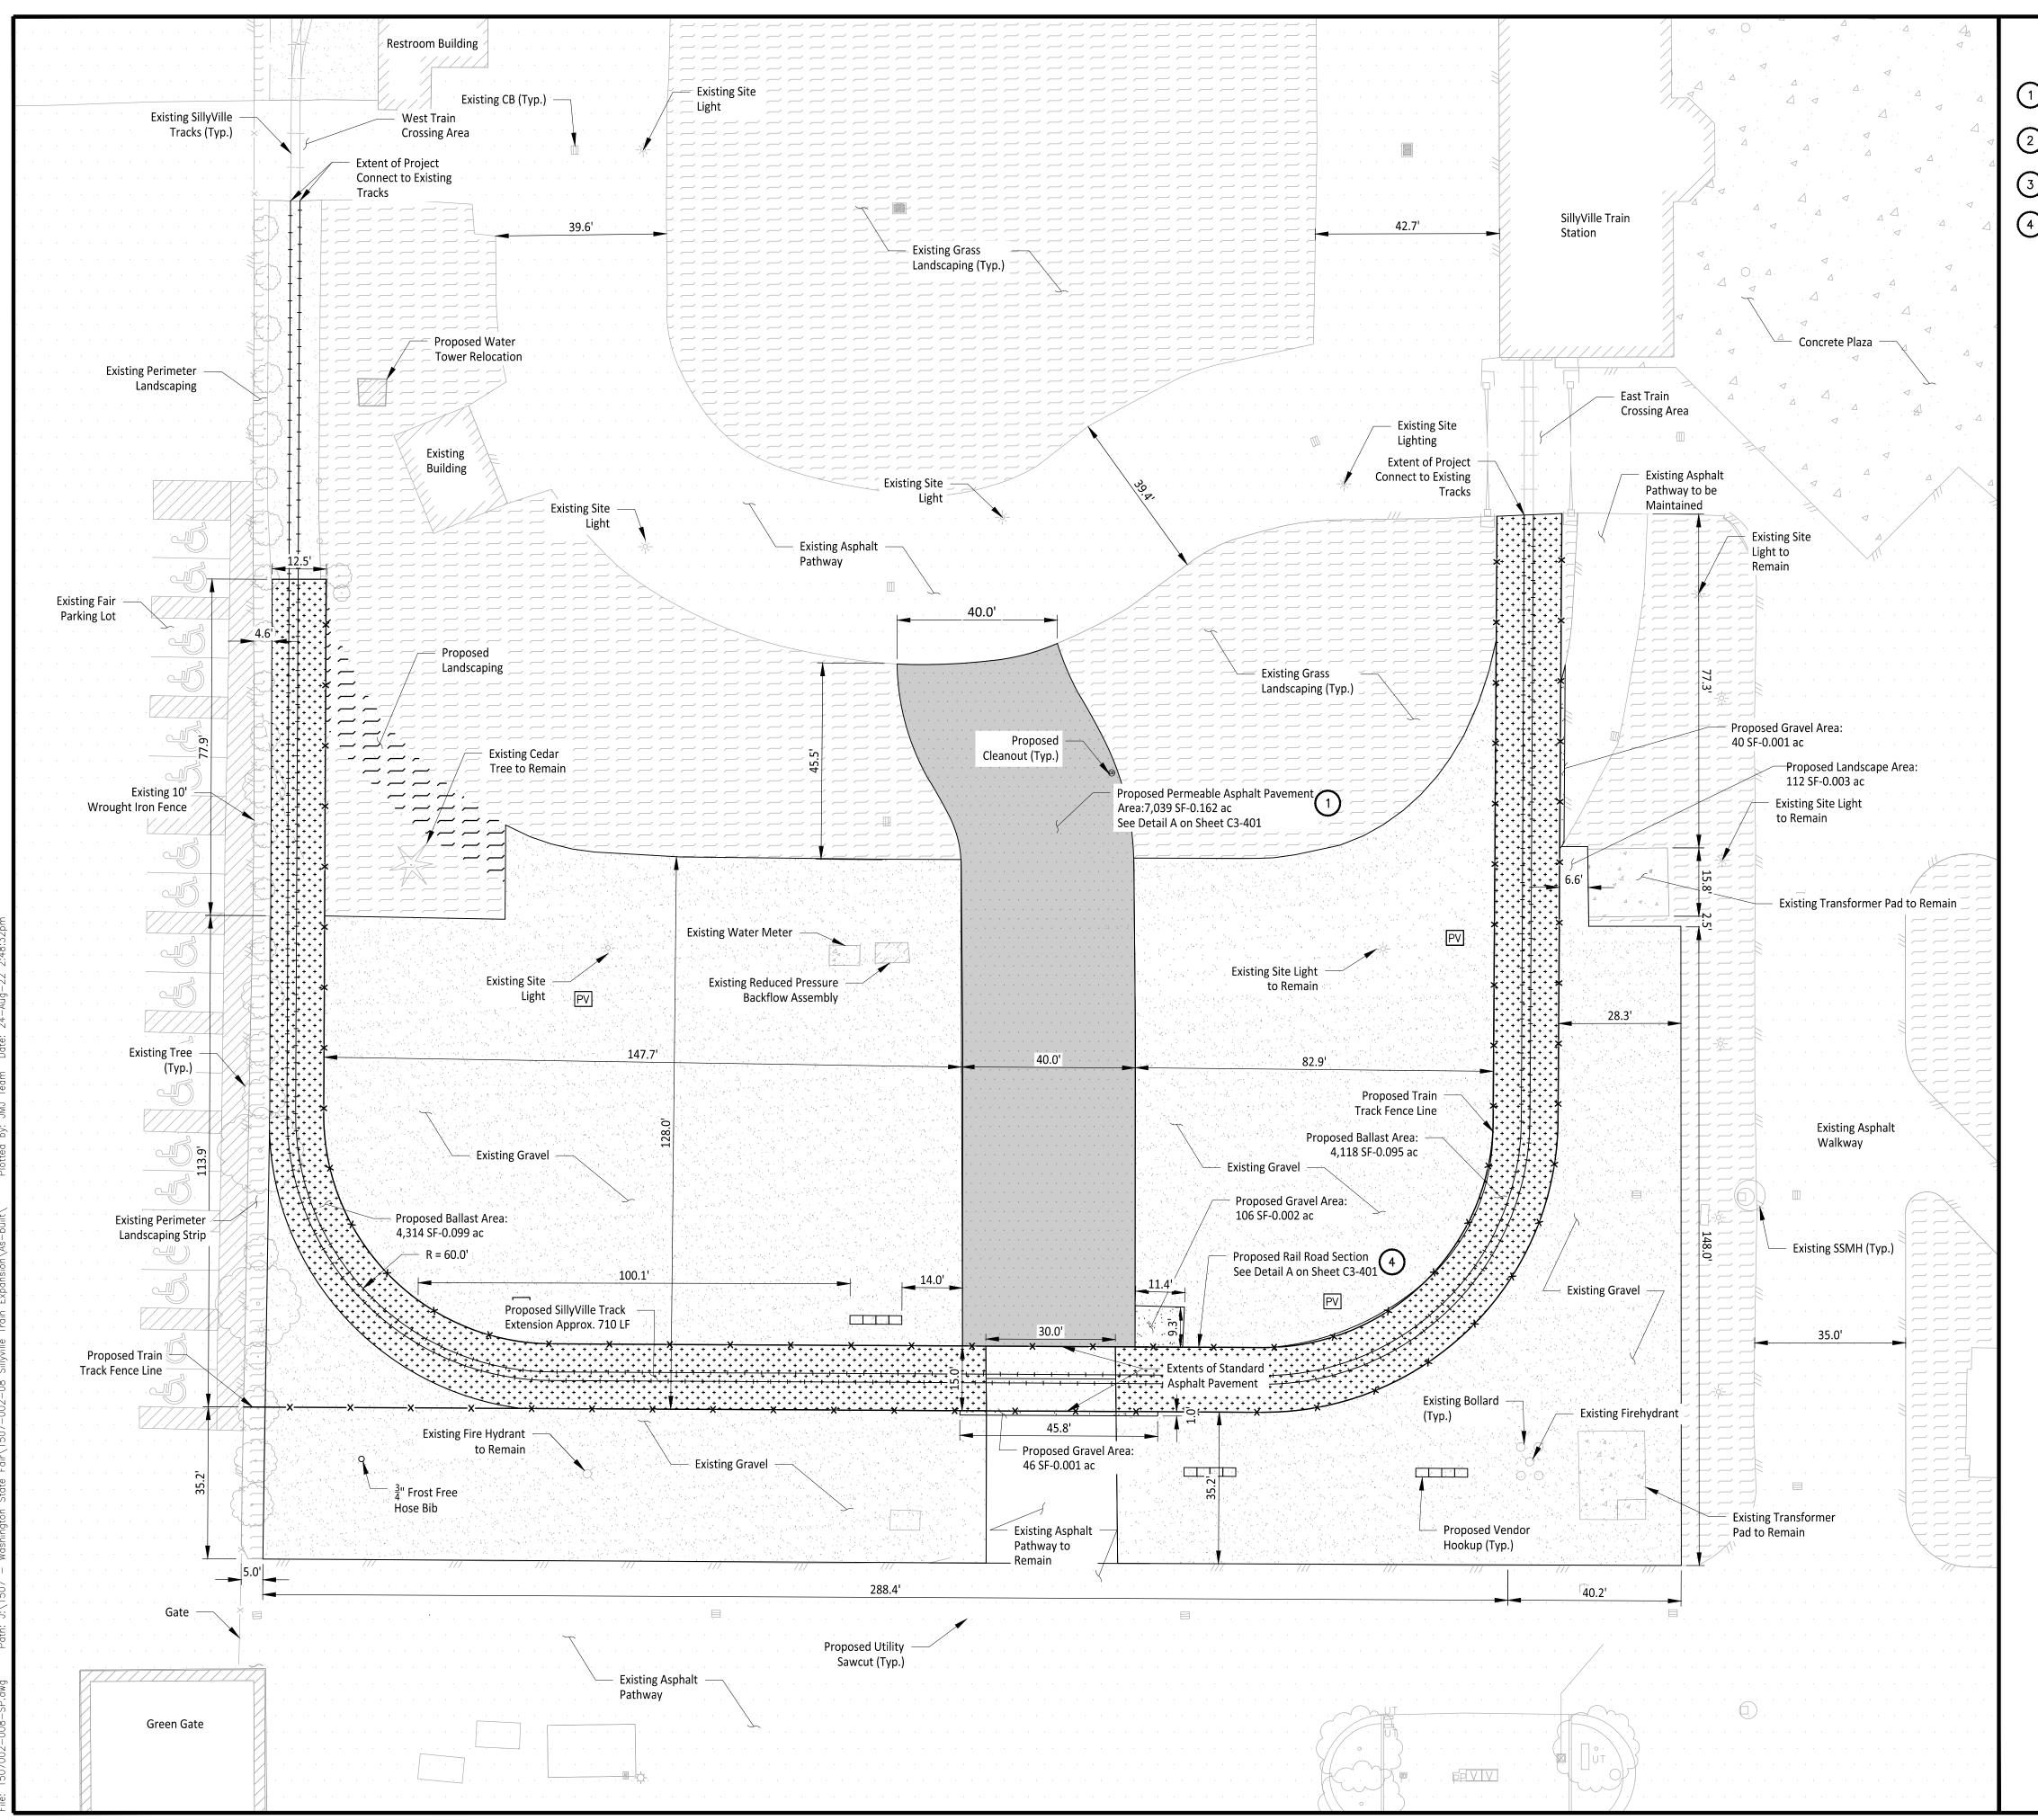

			Owner/Developer:
CONSTRUCTIO)N NOTES		
Permable Asphalt Pavement to k		over 1" AASHTO #57 Stone and	Washington STATE FAIR
5" Permeable Ballast. See Detail	A on Sheet C3-401 for Se	ection.	PUYALLUP
Landscaped Areas to be installed Detail B on Sheet C3-401 for Sec		ndard Detail 01.02.08. See	Washington State Fair 110 9th Ave SW Puyallup, WA 98371
Install Permeable Asphalt Transit per Detail C on Sheet C3-401.	tion between Permeable	e Asphalt and Existing Asphalt	(253) 841-5356
Rail Road to be Shoulder Ballast See Detail D on Sheet C3-401 for		natching to grade on both sides.	Architect.
LEGEND			
· · · · · · · · · · · · · · · · · · ·	Existing Asphalt Pavemer	nt	
	Existing Landscaping Area	a	
	Existing Concrete Pavem	ent	Justin Jones, PE 905 Main St. Suite 200
in the second	Existing Gravel Area		Sumner, WA 98390 (206) 596-2020
	Existing Ballast Area		Project: SillyVille Train Expansion
· · · · · · · · · · · · ·	Proposed Permeable Asp	bhalt Area	
	Proposed Landscaping Ar	rea	
	Proposed Gravel Area		
+ + + + + + + + + + + + + + + + + + +	Proposed Ballast Area		
- 	Proposed Train Tracks Lir	ne	
xx	Proposed Fence Line		ONE INCH AT FULL SCALE IF NOT, SCALE ACCORDINGLY
	Existing Train Tracks Line	2	These plans are record drawings , and the information shown
	Existing Fence Line Sawcut Existing Pavemer		accurately reflects existing field conditions as of this date: 08-24-2022.
Proposed	l Surfaces		STIN M. JOAN
Surface	Area (sf) Area	a (ac)	STER OF MASHING ON
Landscaping	112 0.00		the find
Gravel	1,593 0.03	37	TO HEGISTERED LE
Asphalt	854 0.02	20	BSYONAL ENGIN
Permeable Asphalt			
Ballast	8,432 0.19		REV DATE DESCRIPTION
Total	18,030 0.41	4	
		APPROVED	
		BY CITY OF PUYALLUP DEVELOPMENT ENGINEERING	
		DATE	DRAWN BY: DM DESIGN BY: JJ
	()	NOTE: THIS APPROVAL IS VOID	PROJ. NO: 1507-002-08
		AFTER 180 DAYS FROM APPROVAL DATE.	DATE: August 24, 2022
0 2	20 40	THE CITY WILL NOT BE RESPONSIBLE FOR ERRORS	SHEET NAME
	ft	AND/OR OMISSIONS ON THESE PLANS.	
1" =	= 20'	FIELD CONDITIONS MAY DICTATE CHANGES TO THESE PLANS AS DETERMINED BY THE DEVELOPMENT ENGINEERING MANAGER.	Site Plan
		WO BUSINESS DAYS	
		FORE YOU DIG	DWG.
	UTILITIES UN	800-424-5555 NDERGROUND LOCATION CENTER	C1-102

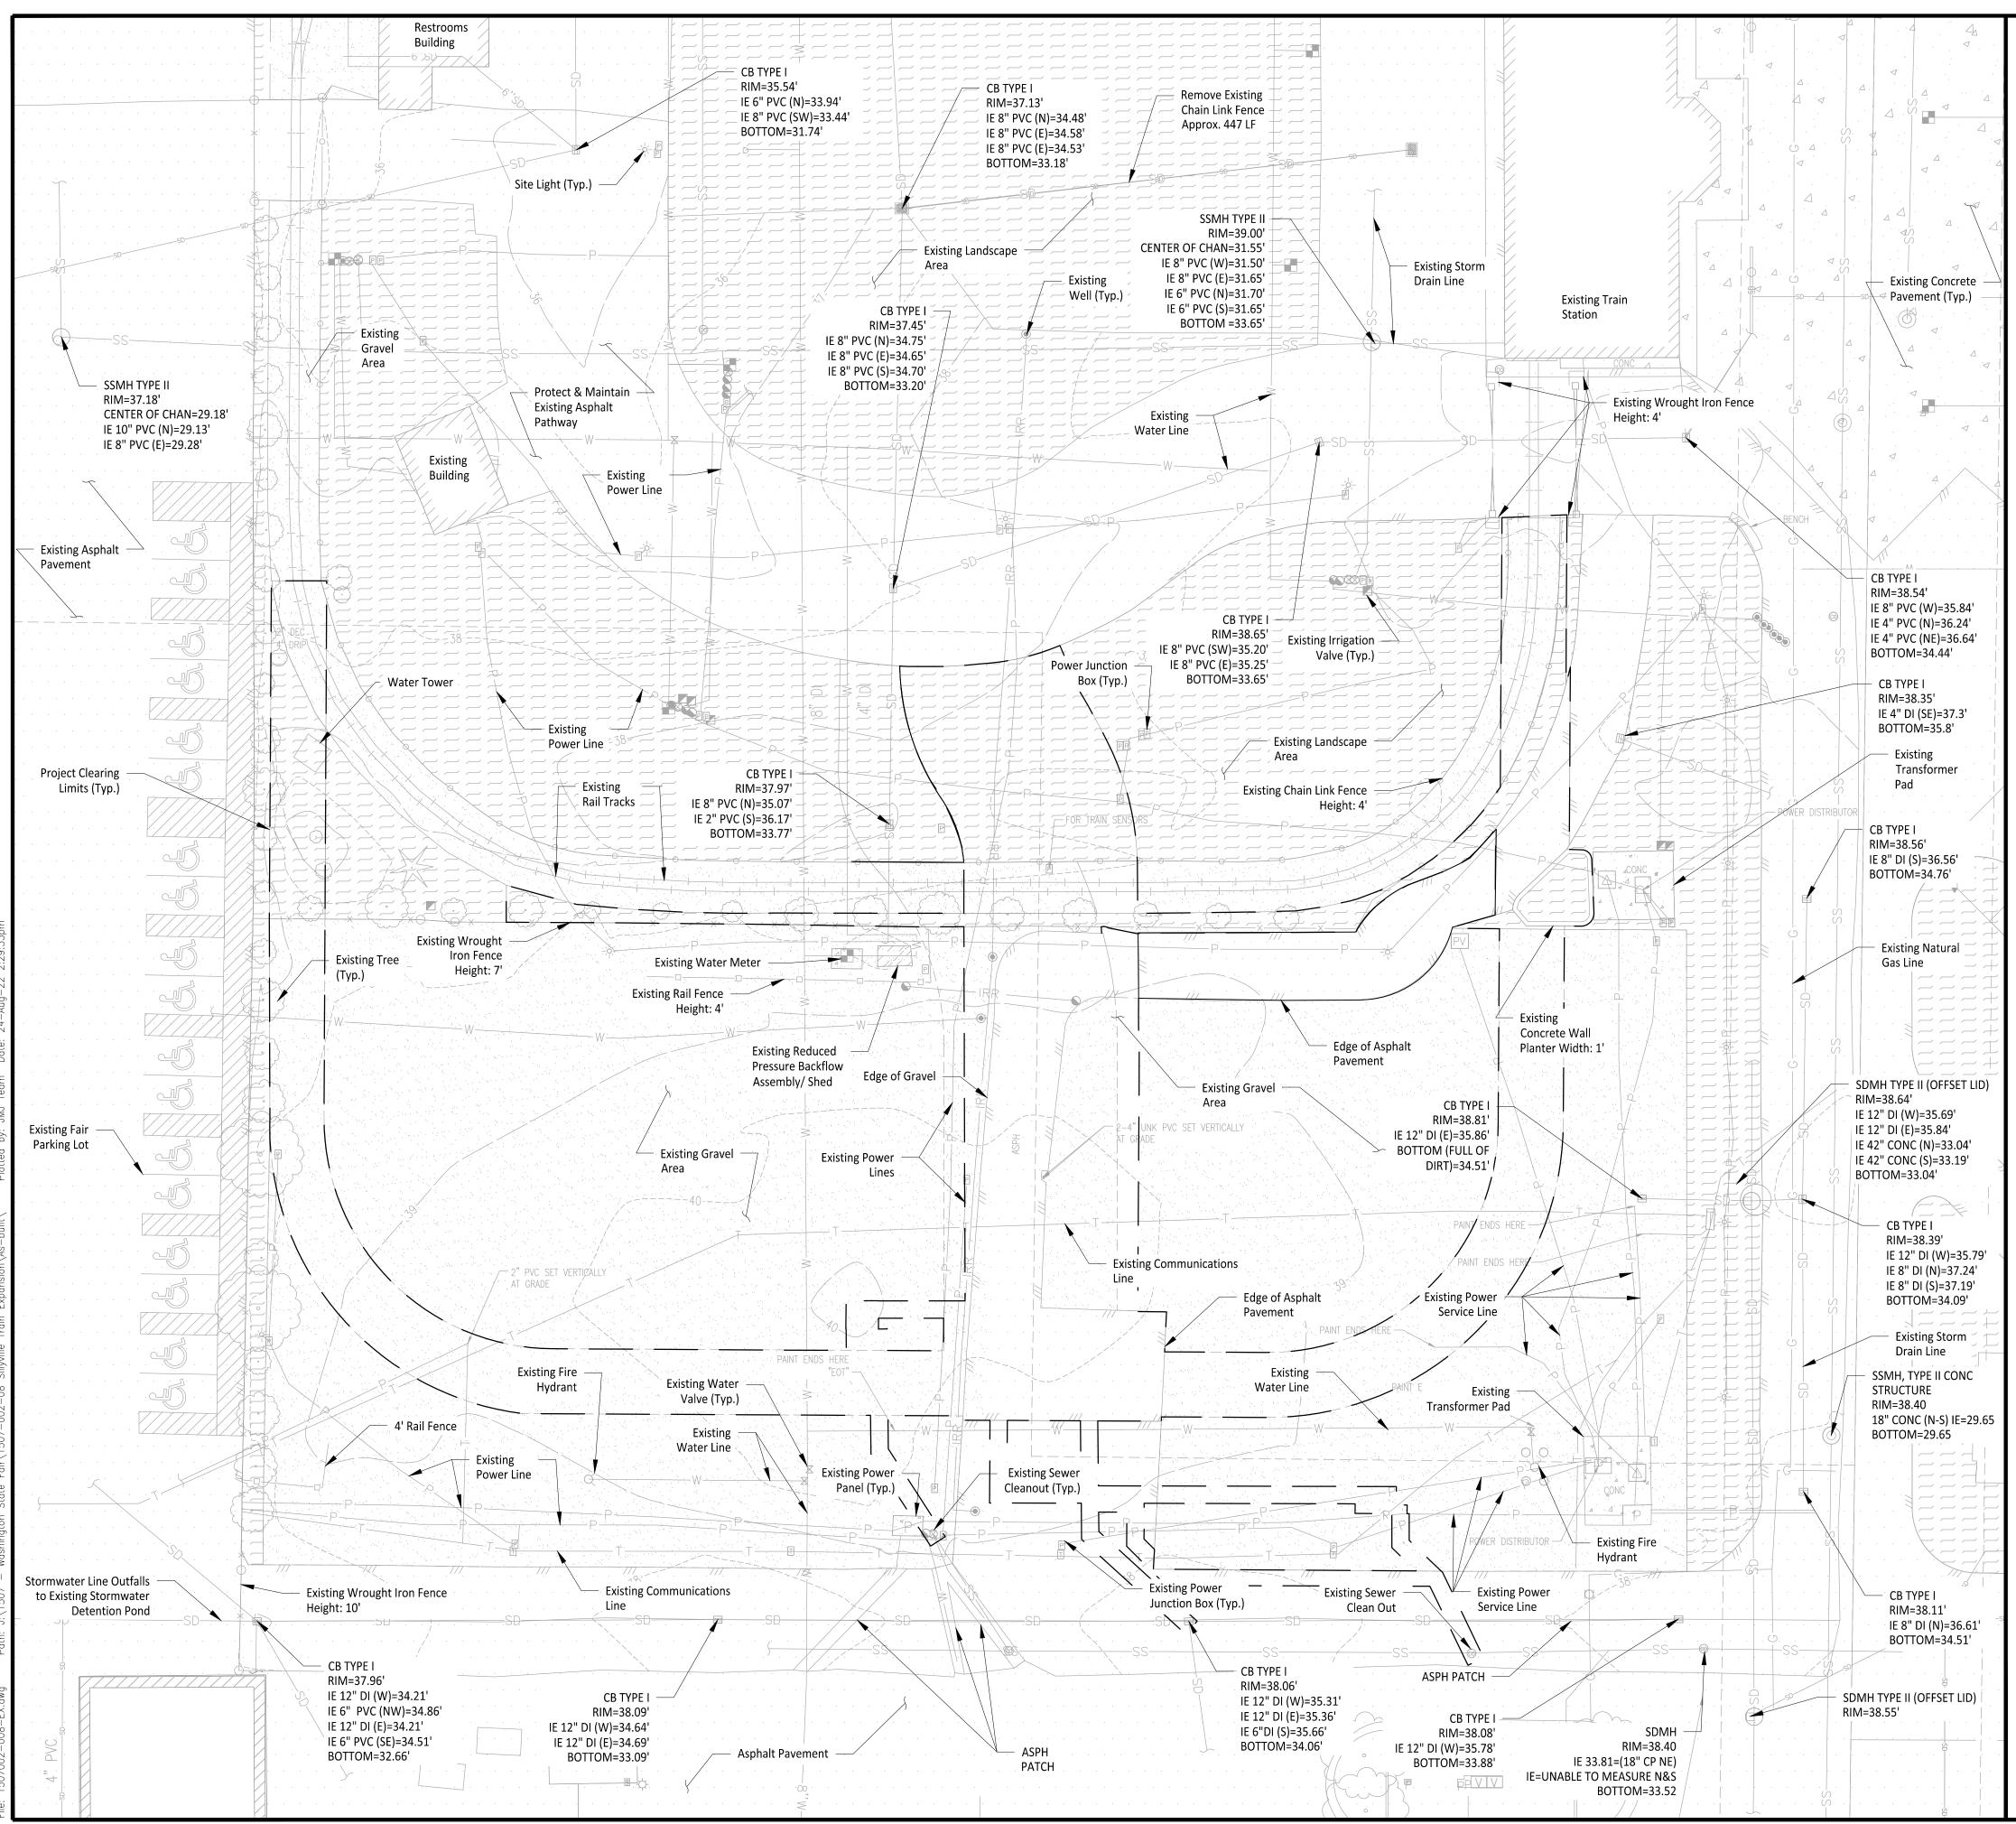

GENERAL NOTES

1. Contractor to Pothole, Locate Horizontal and Vertical Utilities and Verify with Engineer prior to any Utility Work.

LEGEND

d


60)


⊡ SET HUB i ≫ SET MAG NAIL 🔀 🛛 SET PK) SET NAIL SET SPIKE/PMX SIGN AS NOTED COLUMN ECOLOGY BLOCK GAS METER \ominus GAS VALVE DECIDUOUS TREE CONIFER TREE CATCH BASIN AREA DRAIN \ominus CATCH BASIN SOLID \boxtimes STORM CLEAN OUT (\Box) MANHOLE STORM ROOF DRAIN SEWER CLEAN OUT 0 \bigcirc MANHOLE UNKNOWN \bigcirc MANHOLE SEWER

Ρ	POWER VAULT
Р	POWER JUNCTION BOX
\mathbb{P}	POWER MANHOLE
Ρ	POWER PANEL
TR	TELEPHONE RISER
Π	TELEPHONE HAND HOLE
\bigcirc	TELEPHONE MANHOLE
\bigcirc	GATE POST
() ()	HEDGE
\bigotimes	TEST BORING PIT
Ø	WATER HOSE BIB
	IRRIGATION VALVE
SP	STAND PIPE
Q	FIRE HYDRANT
Η	WATER VENDOR HOOKUP
(\mathbb{W})	WATER MANHOLE
W	WATER VAULT
\bowtie	WATER VALVE
\leftarrow	POWER GUY ANCHOR
->	LIGHT STANDARD
	POWER POLE WITH LIGHT
	POWER POLE WITH LIGHT AND DROP LINE
\circ'	CONC POST
	SQUARE POST
\bigcirc	STEEL POST
	WOOD POST

— IRR —

Existing Landscaping Area Existing Asphalt Pavement **Existing Gravel Area** Existing Concrete Pavement **Existing Building** Existing Balast Existing Storm Drain Line Existing Sanitary Sewer Line Existing Water Line Line Existing Irrigation Line Existing Power Service Line Existing Site Lighting Circuit Existing Communication Line Existing Natural Gas Line Clearing Limits

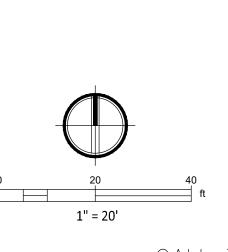


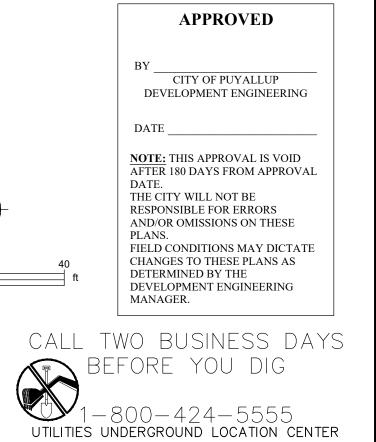

STATE FAIR PUYALLUP Washington State Fair 110 9th Ave SW Puyallup, WA 98371 (253) 841-5356 Architect: Engineer: Justin Jones, PE 905 Main St. Suite 200 Sumner, WA 98390 (206) 596-2020 Project: SillyVille Train Expansion ONE INCH AT FULL SCALE IF NOT, SCALE ACCORDINGLY These plans are record drawings, and the information shown accurately reflects existing field conditions as of this date: 08-24-2022. ALLA. PEGISTE BORTESSIONAL ENC 41829 08-24-22 REV DATE DESCRIPTION DRAWN BY: DESIGN BY: DM 1507-002-08 PROJ. NO: August 24, 2022 DATE: SHEET NAME **Existing Site Plan** DWG. C1-201

Owner/Developer:

Washington

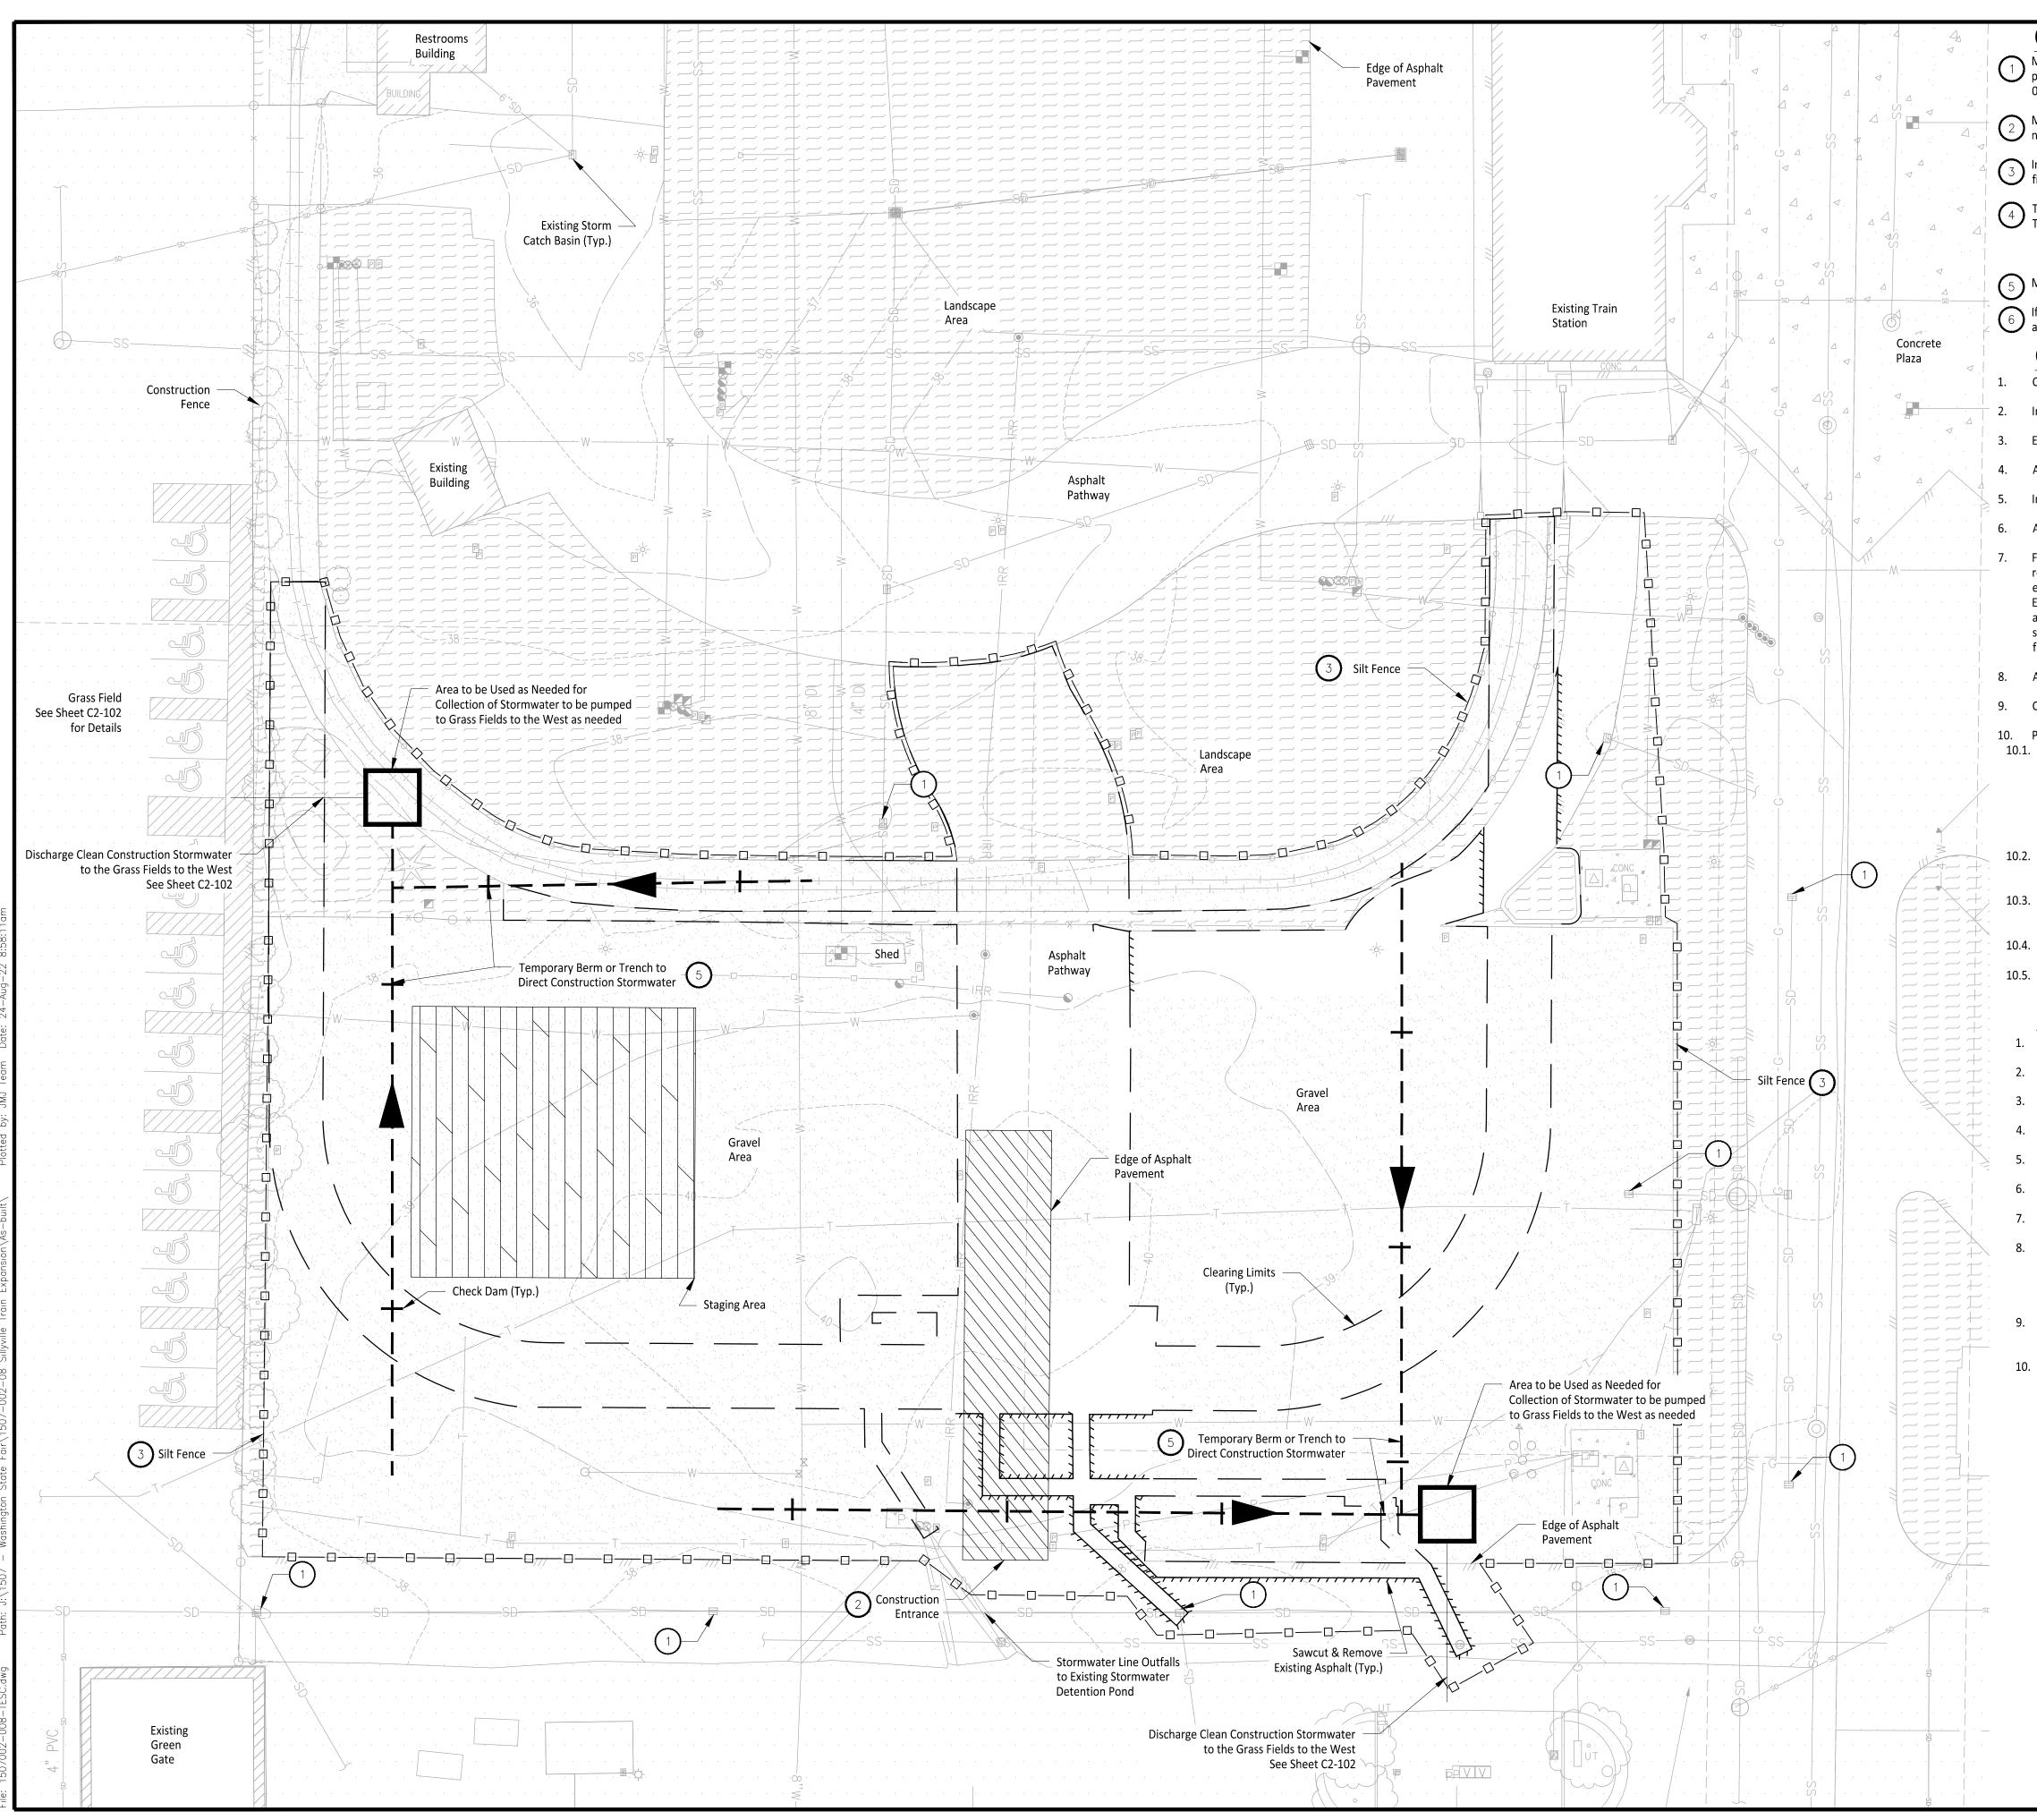

Maintain and Install storm drain inlet protection in all existing catch basins within the project vicinity per WSDOT Standard Plan I-40.20-00 and storm drain barriers per City of Puyallup Standard Details 02.03.05 and 02.03.06.

2 Maintain construction entrance per City of Puyallup Standard Detail 05.01.01 and install wheel wash a needed per Washington DOE BMP C106.

Install silt fence per City of Puyallup Standard Detail 02.03.02. Silt Fence to mark clearing limits in the field.

Turbidity monitoring point. Additional treatment may be needed to meet stormwater discharge limits Treatment options include:

- Chemical Treatment per DOE BMP C250 - Filtration per DOE BMP C251

5 Maintain temporary ditch to gravity flow stormwater to Collection Area.

 \bigcirc If necessary, alternative sediment control methods shall be submitted by the contractor for review an approval prior to construction.

GENERAL NOTES

1. Construct Pipe trench bedding and backfill as necessary per City of Puyallup Standard Detail 06.01.01

Install straw bale barriers, wattles, and other necessary TESC measures as required.

Exposed soils shall be watered as necessary to prevent dust from leaving the site.

4. All concrete handling and equipment washing shall be in accordance with Washington DOE BMP C152

Install high visibility construction fence where silt fence is not required as shown per DOE BMP C103.

6. A CESCL shall be available on-site or on-call for the duration of construction operations.

7. From April 1 to October 31 all disturbed areas at final grade & all exposed areas that are scheduled to remain unworked for 30+ days shall be stabilized within 10 days. From November 1 to March 31 all exposed soils at final grade shall be stabilized immediately using permanent or temporary measures. Exposed soils with an area +5,000 sqft that are scheduled to remain unworked for more than 24 hrs and exposed areas of less than 5,000 sqft that will remain unworked for more than 7 days shall be stabilized immediately. All disturbed areas which are not planned to be constructed on within 90 day from time of clearing & grading shall be revegetated with the native vegetation.

All BMP's per City of Puyallup standards and protection CSWPPP.

Contractor to instill protection devices for trees proposed for retention

10. Protect Low Impact Development BMPs

- 10.1. Protect all Permeable Pavement and Infiltration Areas from sedimentation through installation and maintenance of erosion and sediment control BMPs on portions of the site that utilize infiltration BMPs. Leave infiltration areas high and/or place silt fence around the areas to ensure runoff will not accumulate silt within the subgrade. Restore the BMPs to their fully functioning condition if they accumulate sediment during construction. Restoring the BMP must include removal of sediment and any sediment-laden Bioretention/rain garden soils, and replacing the removed soils with soils meeting the design specification.
 - Prevent compacting Permeable Pavement and Infiltration BMPs by excluding construction equipment and foot traffic. Protect completed lawn and landscaped areas from compaction due to construction equipment.
 - Control erosion and avoid introducing sediment from surrounding land uses onto permeable pavements. Do not allow muddy construction equipment on the base material or pavement. Do not allow sediment-laden runoff onto permeable pavements or base materials.
 - Pavement fouled with sediments or no longer passing an initial infiltration test must be cleaned using procedures in accordance with this manual or the manufacturer's procedures. Keep all heavy equipment off existing soils under LID facilities that have been excavated to final grade to retain the infiltration rate of the soils.

CONSTRUCTION SEQUENCE

1. Hold a preconstruction meeting with the City and obtain required permits.

2. Establish clearing and grading limits.

3. Construct temporary construction entrance.

4. Construct perimeter ditches, silt fences, and other erosion control devices as shown.

5. Construct protection devices for critical areas and significant trees proposed for retention.

6. Schedule an erosion control inspection with the City.

7. Construct storm drainage retention/detention facilities. Provide emergency overflow as applicable.

All ditches and swales as shown shall be provided to direct all surface water to the retention/detention and sedimentation pond as clearing and grading progresses. No uncontrolled surface water shall be allowed to leave the site or be discharged to a critical area at any time during the grading operations.

9. Clearly state at what point grading activities can begin, usually only after all drainage and erosion control measures are in place.


10. Identify erosion control measures which require regular maintenance.

LEGEND		APPROVED
$\left(\begin{array}{c} \\ \\ \end{array} \right)$	Remove Existing Tree	BY CITY OF PUYALLUP
	Silt Fence	DEVELOPMENT ENGINEERING
		DATE
	Clearing Limits	NOTE: THIS APPROVAL IS VOID AFTER 180 DAYS FROM APPROVAL DATE. THE CITY WILL NOT BE RESPONSIBLE FOR ERRORS AND/OR OMISSIONS ON THESE PLANS. FIELD CONDITIONS MAY DICTATE
0 2 1" =	0 40 == 20'	CHANGES TO THESE PLANS AS DETERMINED BY THE DEVELOPMENT ENGINEERING MANAGER.
		NO BUSINESS DAYS
	$\bigcup_{1-\epsilon}$	FORE YOU DIG 300-424-5555 IDERGROUND LOCATION CENTER

		ST/	TE	FAI	R
as		P	UYAI	LUP	
		shingtoi 9th Ave		Fair	
	Puy	vallup, W 3) 841-5	/A 9837	/1	
:s.		nitect:			
nd					
lu	E				
	905	tin Jone 5 Main S	t. Suite		
1		nner, W 6) 596-2		0	
1.	Proj	ect:			
			e Tra	in Expa	nsion
0					
5					
'S					
				FULLS	
е				ACCORI	
	and	d the inf	ormati	cord drav	
	cor	nditions	as of th	s existing f nis date:	ield
9	08-	-24-2022	2.		
)					
		AND	OF WA	REED HER	-24-22
		DATE	DECODIE	TION	
	REV	DATE	DESCRIF	IUN	
g					
	עאפח	VN BY:		DESIGN BY:	
	UKAV	VIN D1.	DM]]
	PROJ.	NO:			7-002-08
	DATE: SHEET	NAME		August 2	24, 2022
		iem	nor	arv	
		irosi		-	
		Sedir			
		Cont			
	_				
	DWG.				
		2-1	01		

Owner/Developer:

Washington

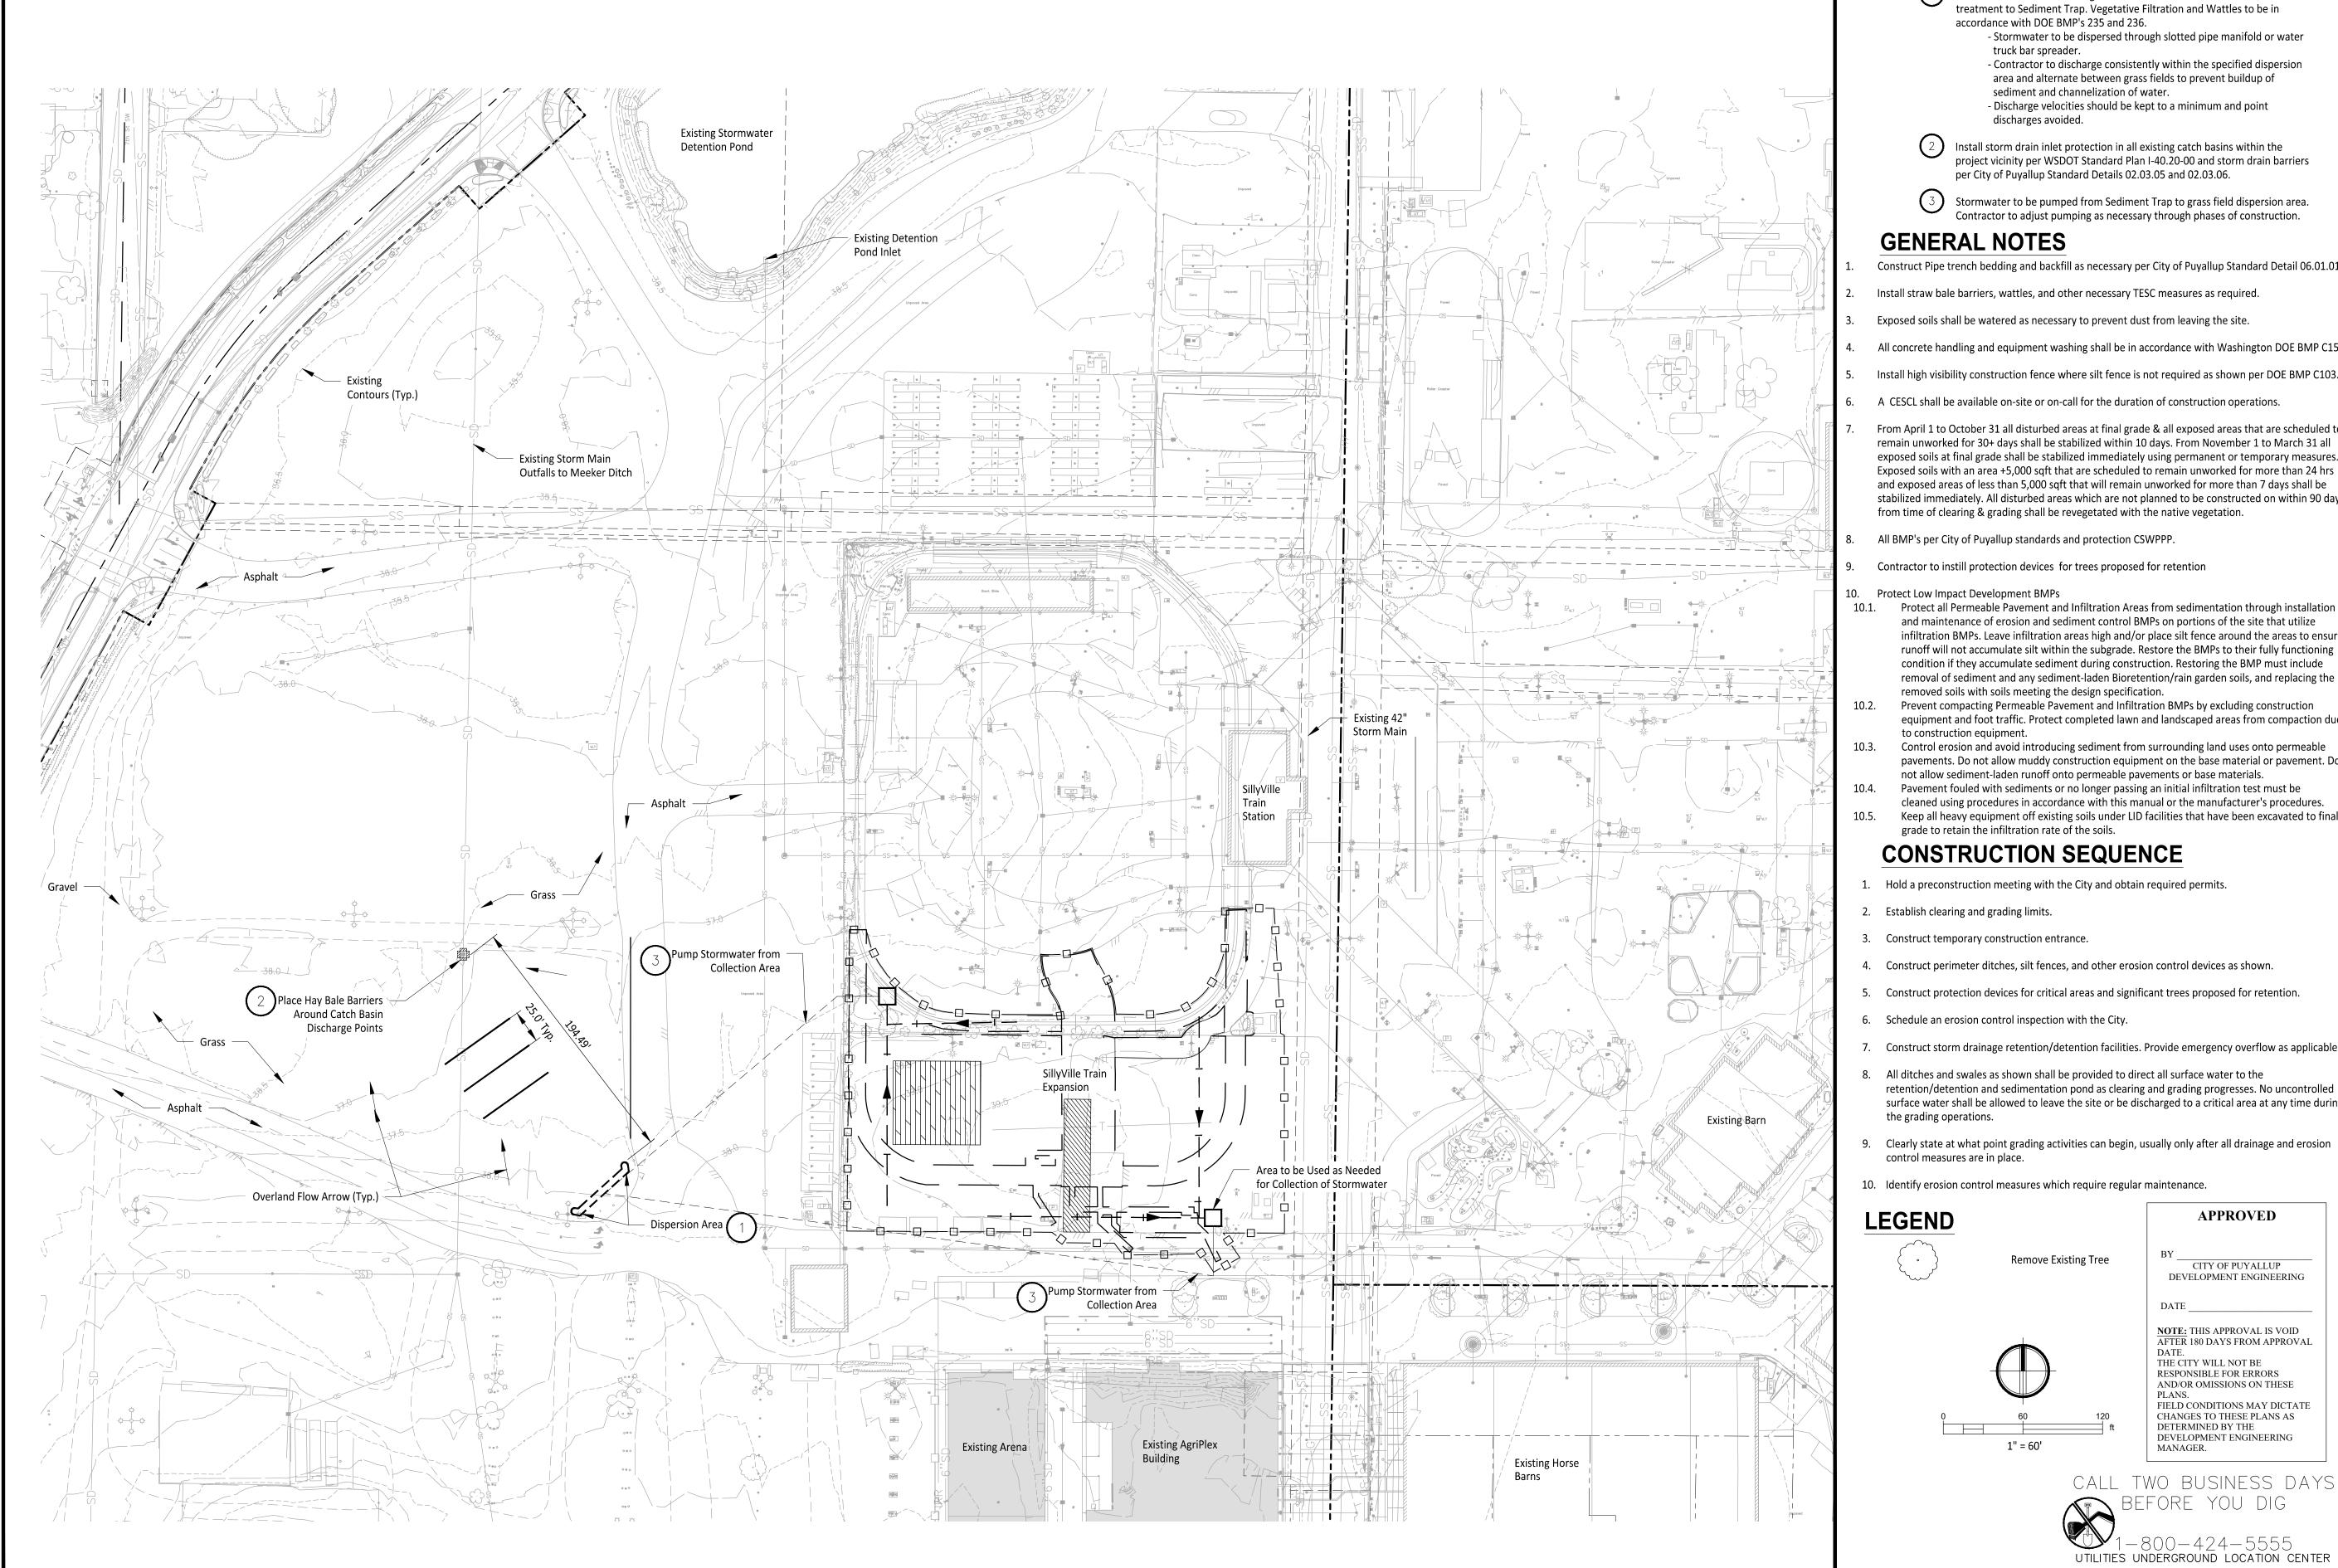

Grass fields to be used for Vegetative Filtration as additional or alternative




- runoff will not accumulate silt within the subgrade. Restore the BMPs to their fully functioning


retention/detention and sedimentation pond as clearing and grading progresses. No uncontrolled surface water shall be allowed to leave the site or be discharged to a critical area at any time durin

	Washington STATE FAIR				
	PUYALLUP				=
		shingto		Fair	
	Puy	9th Av allup, V 3) 841-!	VA 983	71	
	Arch	iitect:			
	Engi	neer:			
01.	J	JTE	ΞΑΜ		
		tin Jone Main S		200	
151.	Sun	nner, W 6) 596-2	/A 9839		
151. 3.		-			
	Proje Sil		e Tra	in Expa	nsion
to					
es. s					
s ays					
,-					
n		•	_	_	
ure g				F FULL S ACCORI	
e				e cord drav on shown	/ings,
	асс	urately	reflect	s existing f his date:	ield
ue		24-202			
Do					
al			IN M	aaa.	
			OF WA	SHINES	
		100		TA ha	
	7		4182 REGIST	9 TRED TEST	F
	0	E'S	SIONAL	9 ERED INER ENGINER	-24-22
	REV	DATE	DESCRI		
	- 1\ ∟ V	UNIE			
le.					
d					
ing					
	DRAW	'N BY:	DM	DESIGN BY:	IJ
	PROJ.I	VO:			7-002-08
	DATE: SHEET	NAME		August 2	24, 2022
		em	por	arv	
		rosi	-	-	
		edi			
$\hat{\mathbf{D}}$				Plan	
	DWC				
	DWG.	2-1	በን		
			UZ	OF 23	


Owner/Developer

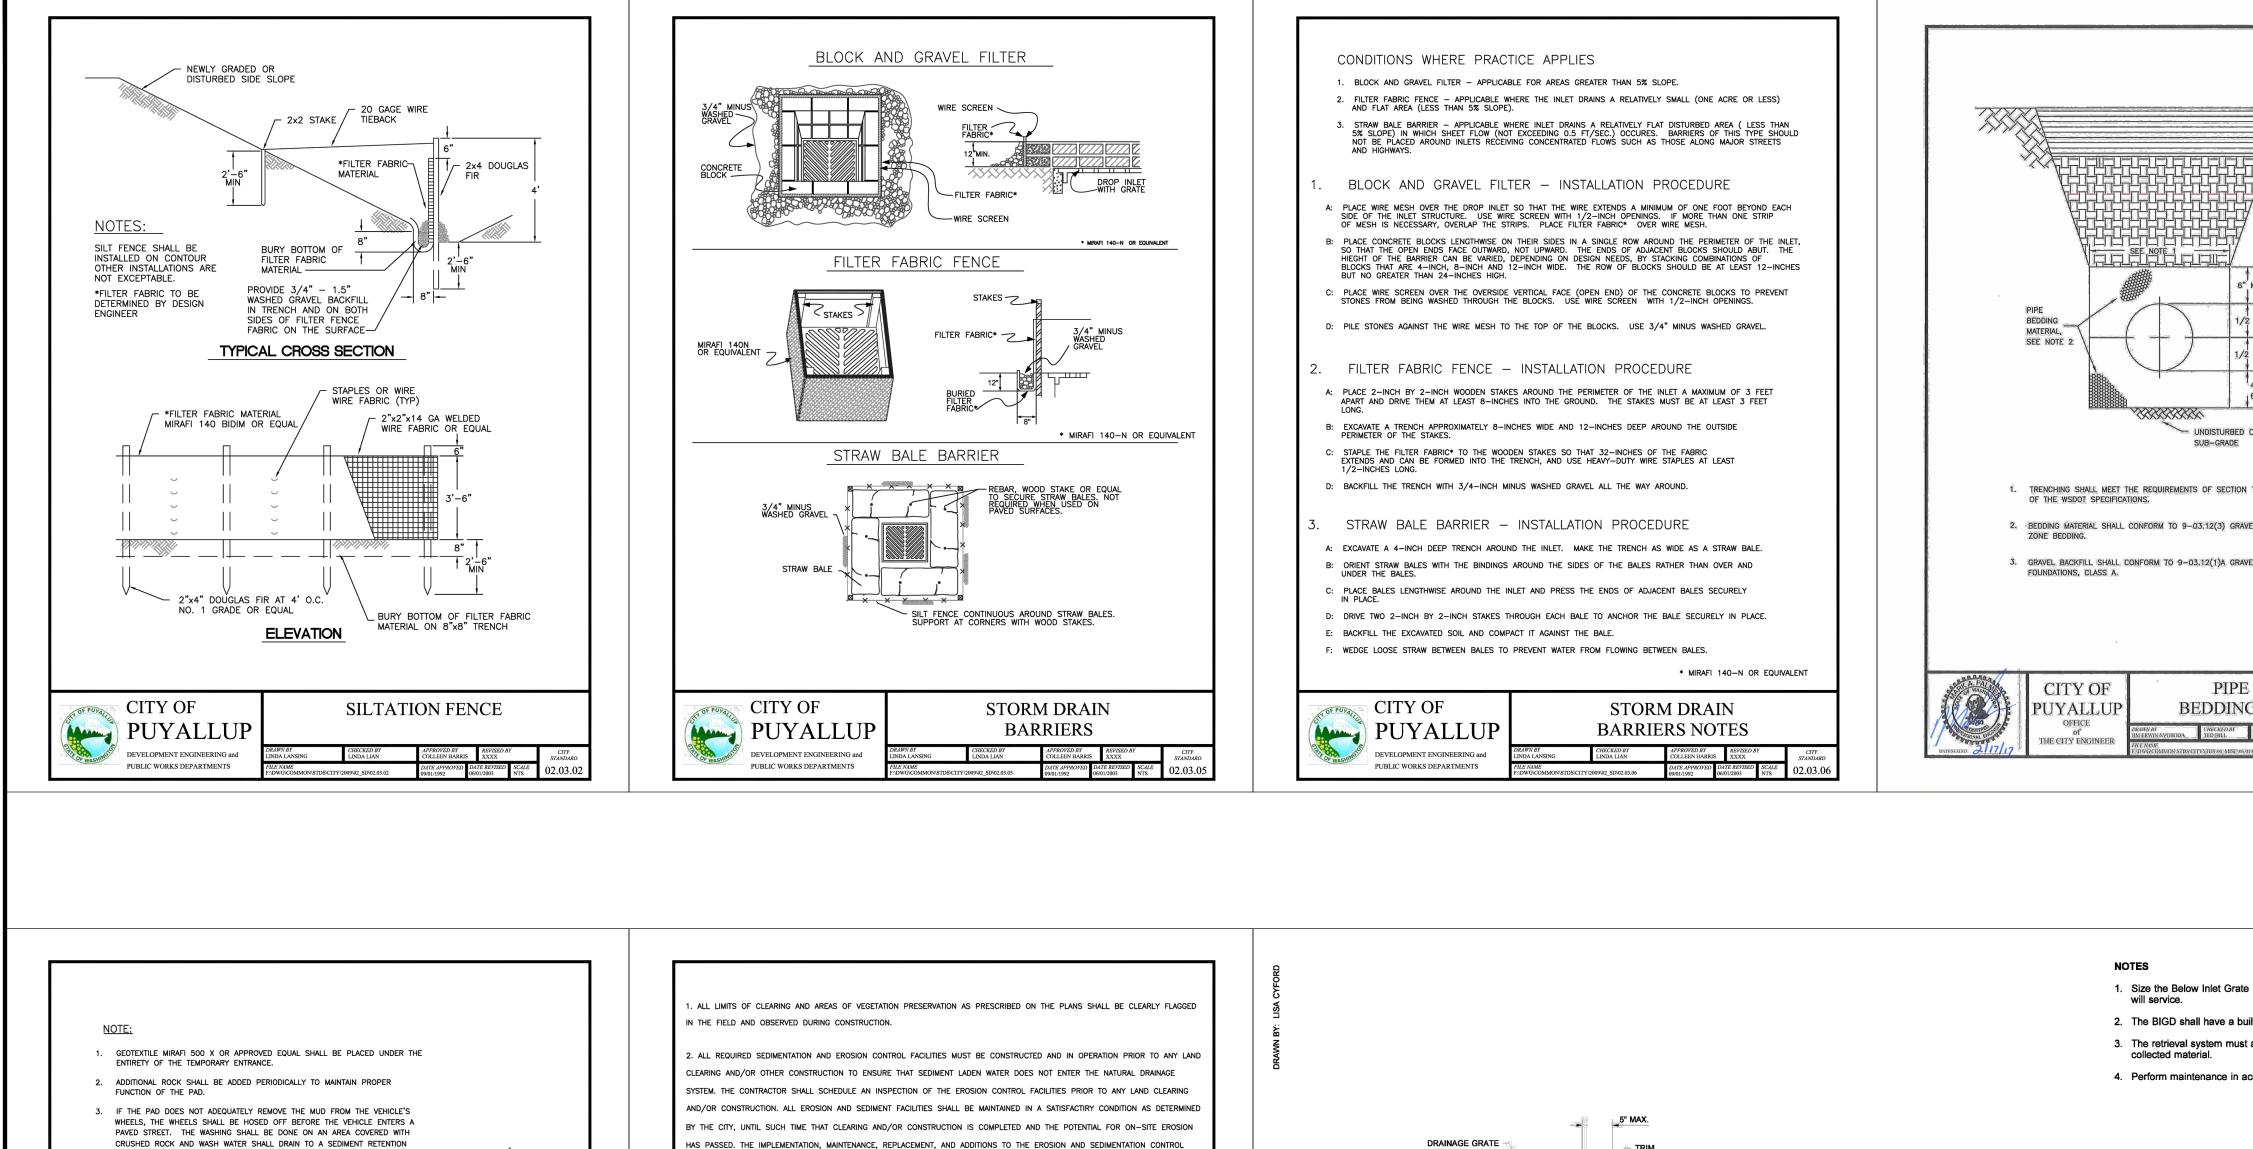



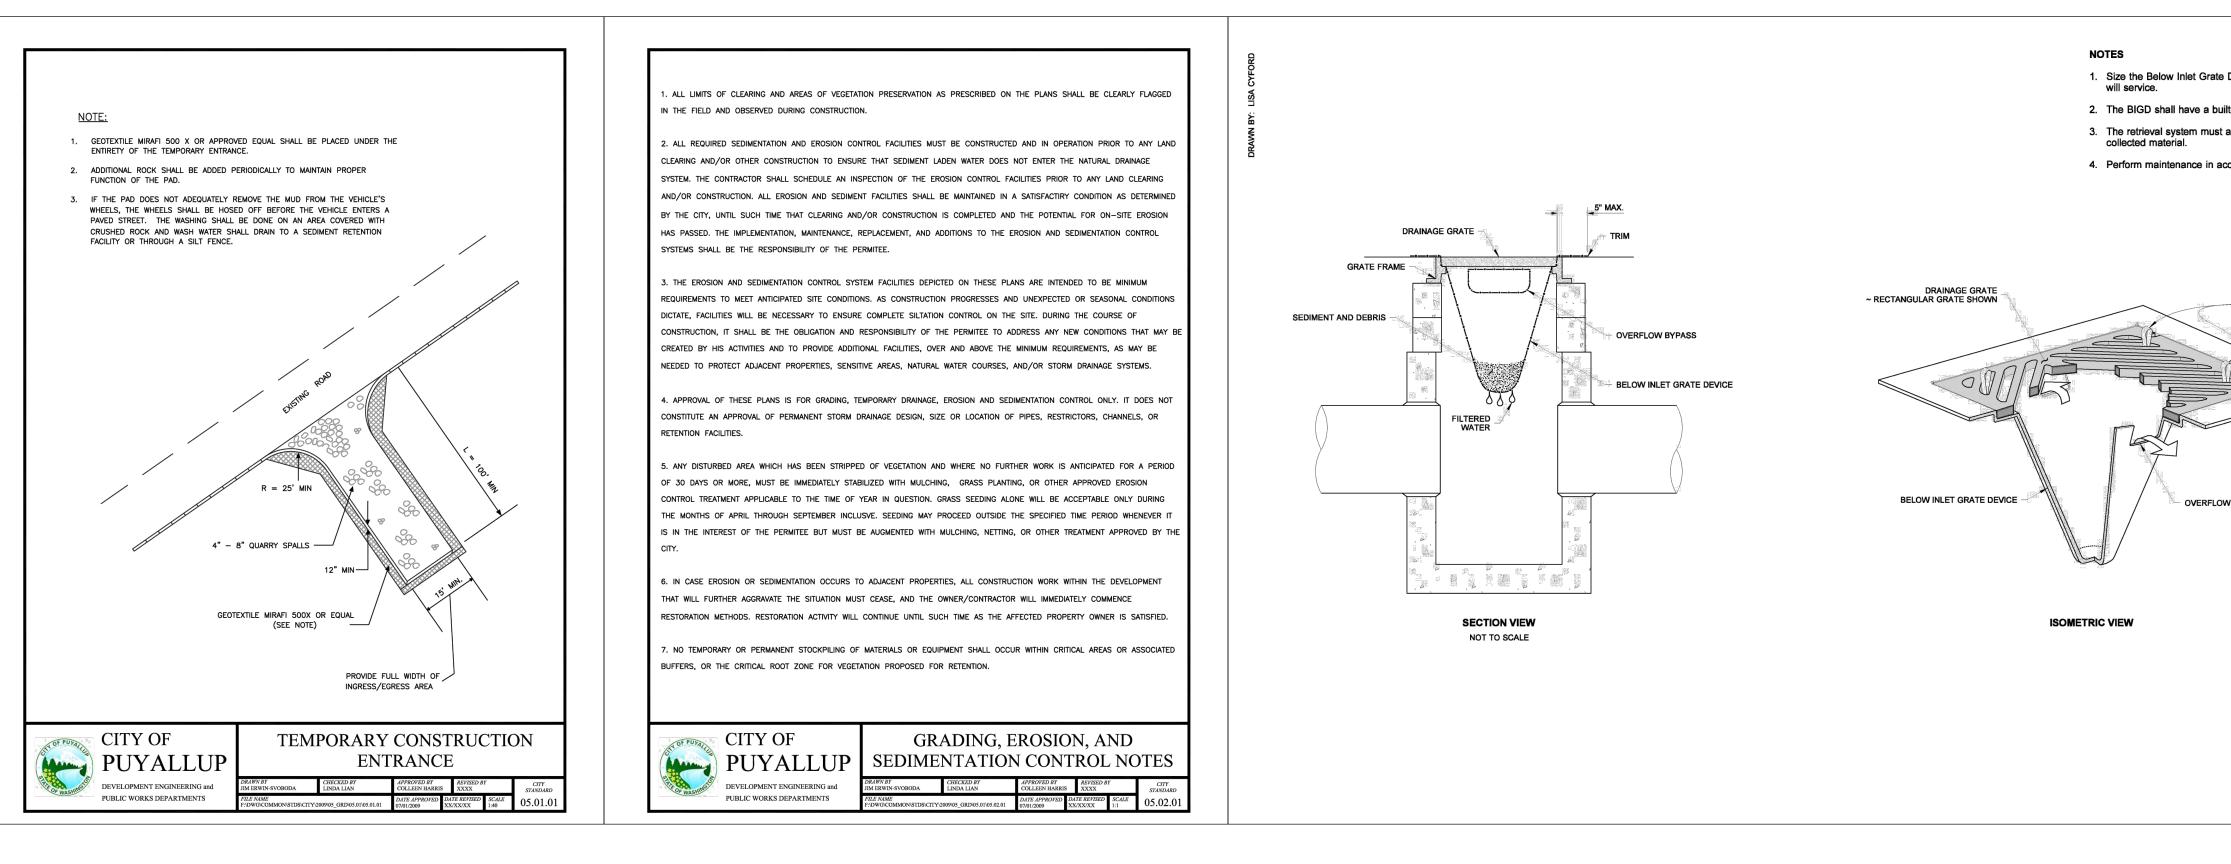


		Owner/Developer:
		Washington STATE FAIR
		PUYALLUP
		Washington State Fair 110 9th Ave SW Puyallup, WA 98371
		(253) 841-5356 Architect:
BACKFILL MATERIAL SEE NOTE 3		
Ň		
D.,		Engineer:
D. MIN. FOR 27" PIPE AND SMALLER		JMJTEAM
MIN. FOR PIPE LARGER THAN 27"		Justin Jones, PE 905 Main St. Suite 200
		Sumner, WA 98390 (206) 596-2020
08.3(1)A AND 2-06.3(1) BACKEILL FOR PIPE		Project:
BACKFILL FOR		SillyVille Train Expansion
RENCHING		
AND BACKFILL REPARE REFISED BY STOCKMAN DATE APPROVED SCAFE MAXXXXX MAXXXXX MAXXXXX MAXXXXXX MAXXXXX MAXXXXXX MAXXXXX MAXXXXX MAXXXXXX MAXXXXX MAXXXXX MAXXXXXX MAXXXXX MAXXXXXX MAXXXXXX MAXXXXXX MAXXXXXXXXXX		
Date APPROVED NGARE XVNXXXX 06.01.01		
		ONE INCH AT FULL SCALE. IF NOT, SCALE ACCORDINGLY
		These plans are record drawings , and the information shown
		accurately reflects existing field conditions as of this date:
		08-24-2022.
evice (BIGD) for the storm water structure it		
in high-flow relief system (overflow bypass). low removal of the BIGD without spilling the		STIN M. JON
ordance with Standard Specification 8-01.3(15).		South of the second second
		41829
		10 RECISTERED NET
RETRIEVAL SYSTEM (TYP.)		REV DATE DESCRIPTION
IYPASS (TYP.)		
STATE OF WASHINGTON REGISTERED LANDSCAPE ARCHITECT		
MARK W. MAURER CERTIFICATE NO. 000598	APPROVED	
NOTE: THIS FLAM IS NOT A LEGAL ENGINEERING DOCU- MENT BUT AN ELECTRONIC DUPLICATE. THE ORIGINAL, SIGNED BY THE ENGINEERING TO APPROVED FOR PUBLICATION, IS KEPT ON FILE AT THE WASHINGTON STATE DEPART- MENT OF TRANSPORTATION. A COPY MAY BE OBTAINED UPON REQUEST. STORM DRAIN	BY	
STORM DRAIN INLET PROTECTION STANDARD PLAN I-40.20-00	DEVELOPMENT ENGINEERING DATE	DRAWN BY: DM DESIGN BY: JJ
SHEET 1 OF 1 SHEET APPROVED FOR PUBLICATION Pasco Bakotich III 09-20-07	NOTE: THIS APPROVAL IS VOID AFTER 180 DAYS FROM APPROVAL	PROJ. NO: 1507-002-08
STATE DESIGN ENGINEER DATE Washington State Department of Transportation	DATE. THE CITY WILL NOT BE RESPONSIBLE FOR ERRORS AND/OR OMISSIONS ON THESE	DATE: August 24, 2022 SHEET NAME
	AND/OR OMISSIONS ON THESE PLANS. FIELD CONDITIONS MAY DICTATE CHANGES TO THESE PLANS AS	Temporary
	DETERMINED BY THE DEVELOPMENT ENGINEERING MANAGER.	Erosion &
СА	LL TWO BUSINESS DAYS	Sediment Control Details
	BEFORE YOU DIG	DWG.
UTIL	1-800-424-5555	C2-201

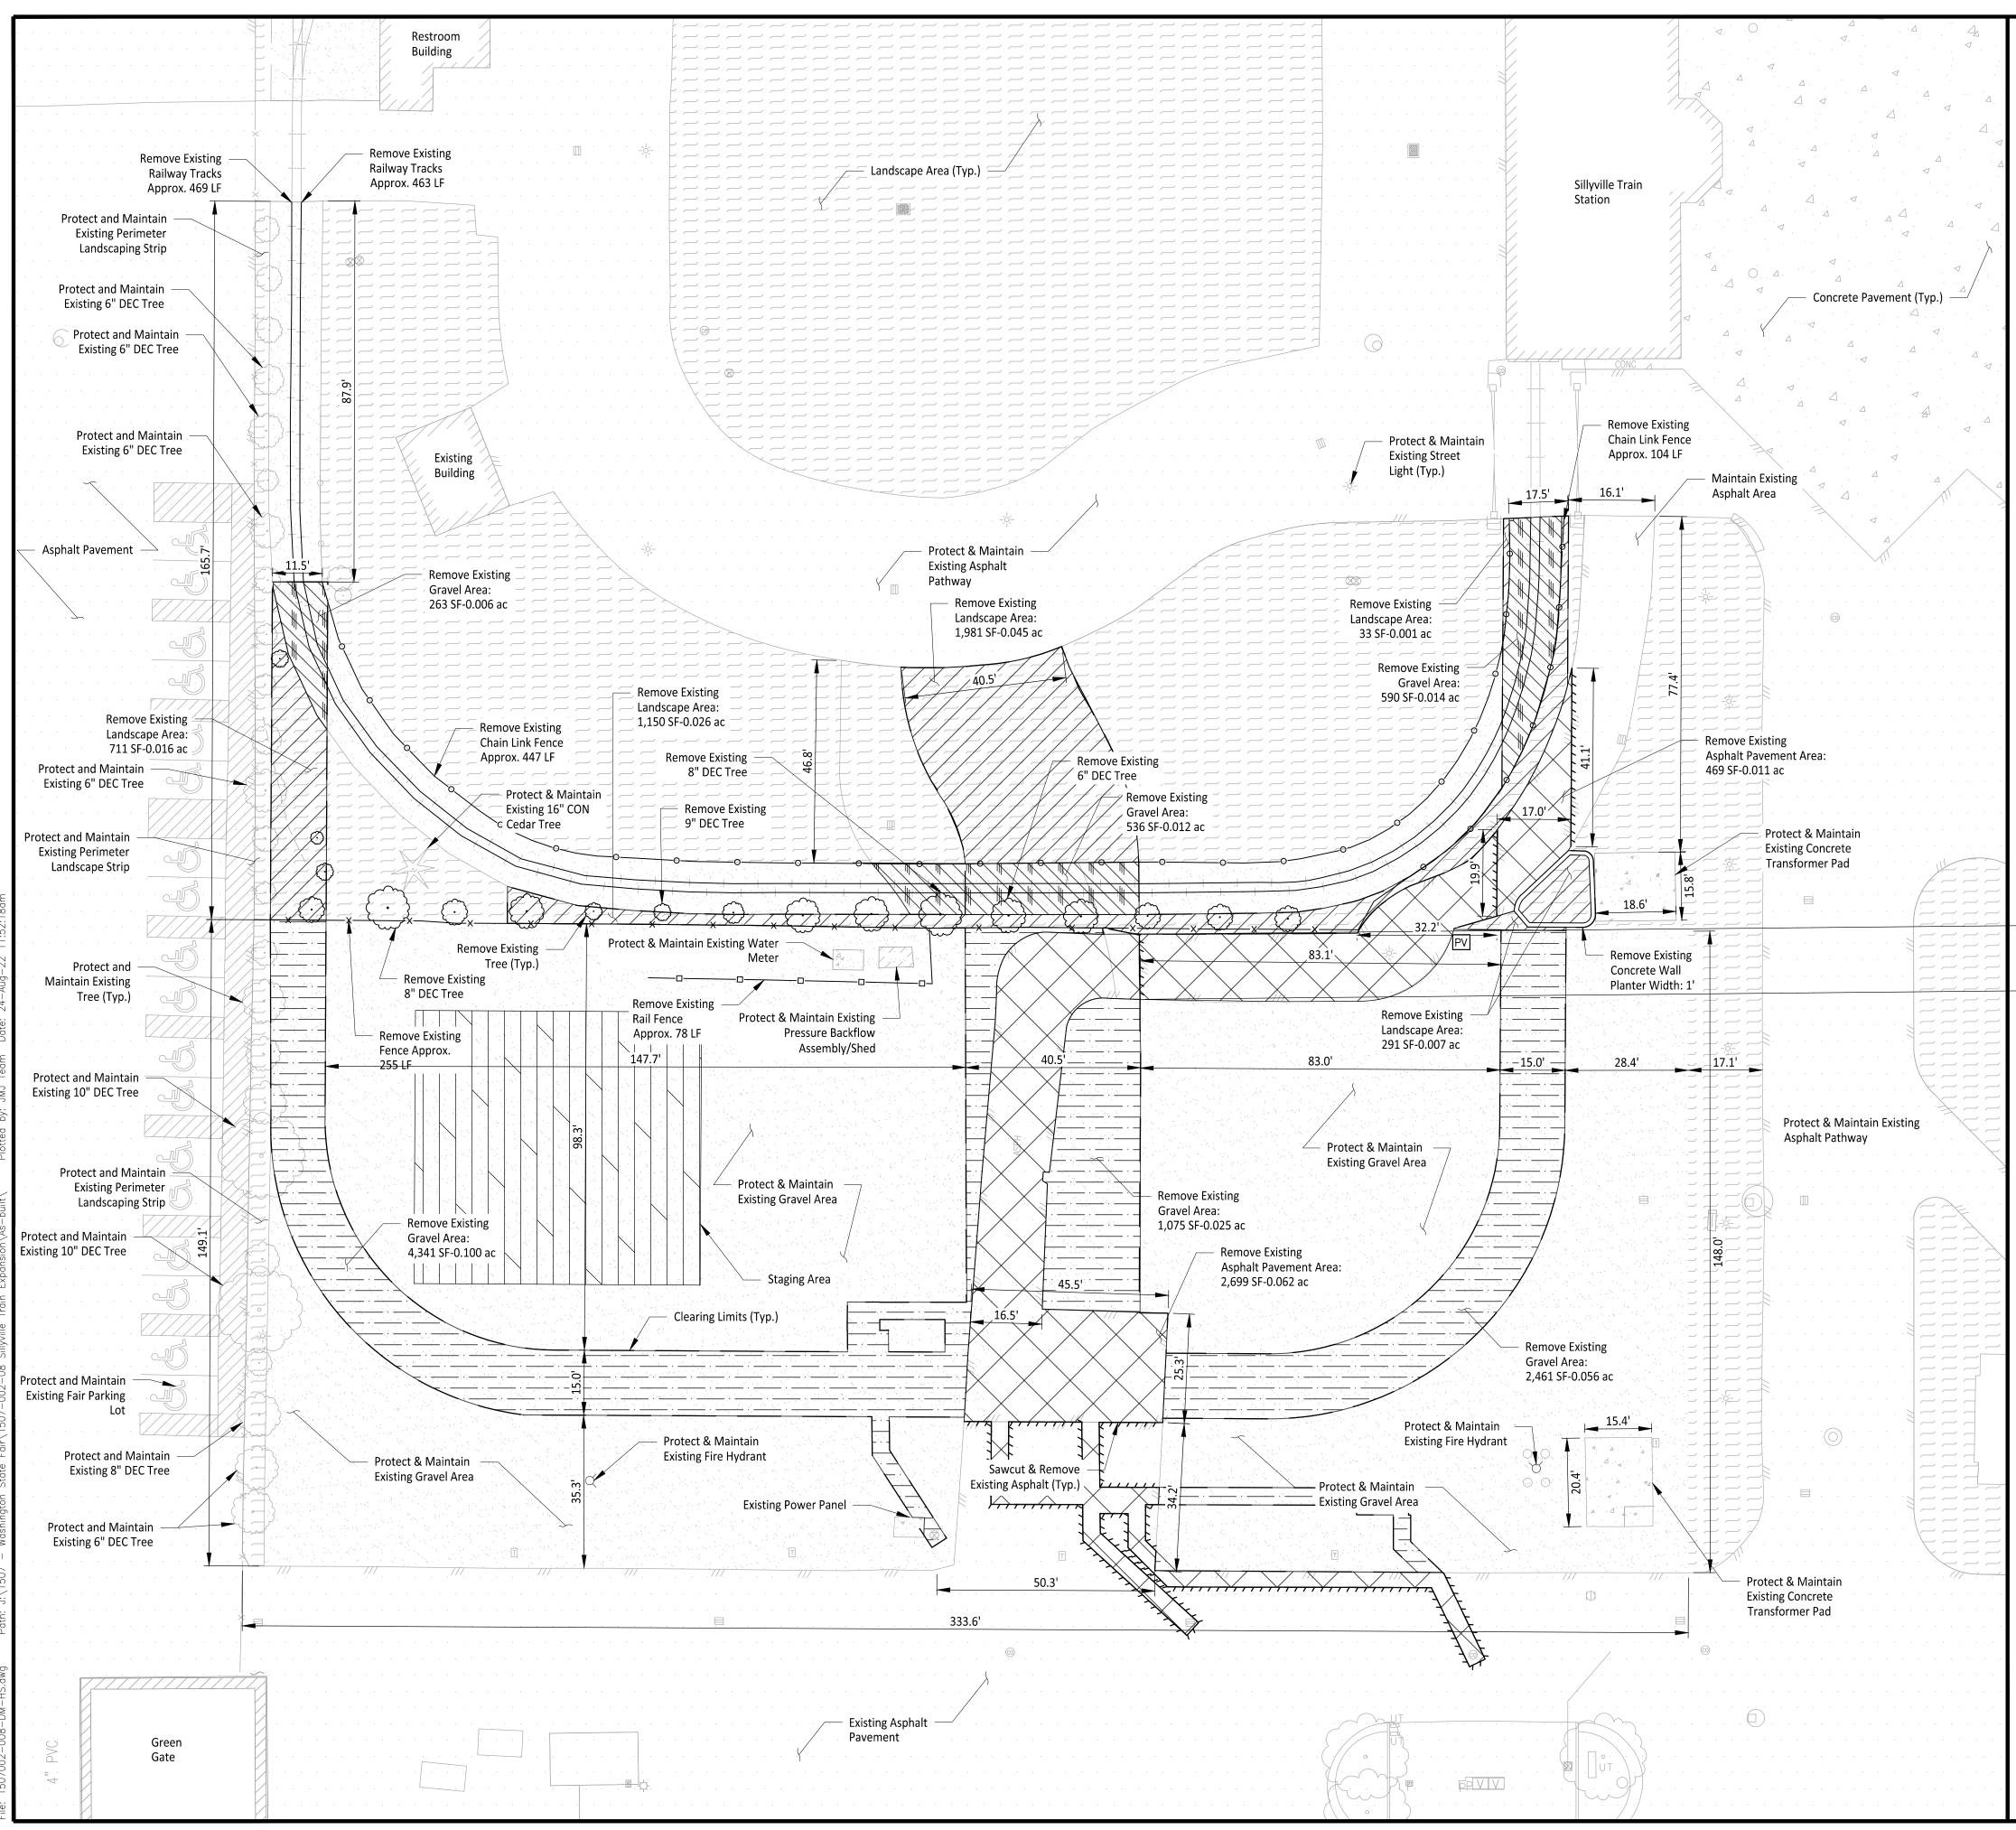


	GENERAL NOTES Contractor to instill protection devices for trees proposed for retention		
LEGEND		Washington State Fair 110 9th Ave SW Puyallup, WA 98371 (253) 841-5356	
	Remove Existing Asphalt Pavement	Architect:	
	Remove Existing Landscaping Area		
· · · · ·	Remove Existing Gravel Area		
	Remove Existing Concrete Pavement		
	Existing Landscaping Area		
	Existing Asphalt Pavement	Justin Jones, PE 905 Main St. Suite 200	
	Existing Gravel Area	Sumner, WA 98390 (206) 596-2020	
	Existing Concrete Pavement	Project: SillyVille Train Expar	
	Existing Building		
	Staging Area		
-00	Remove Existing Chain Link Fence		
XX	Remove Existing Fence		
	Remove Existing Train Tracks		
	Sawcut Existing Pavement	ONE INCH AT FULL SO IF NOT, SCALE ACCORD	
	Clearing Limits	These plans are record drawi	
$\left(\begin{array}{c} \\ \\ \\ \\ \\ \end{array} \right)$	Remove Existing Tree	and the information shown accurately reflects existing fie conditions as of this date: 08-24-2022.	


Owner/Developer:


 Existing Surfaces to be Removed		
Surface	Area (sf)	Area (ac)
 Landscaping	4,169	0.096
Gravel	8,987	0.206
Asphalt	4,021	0.092
Ballast	853	0.020
Total	18,030	0.414

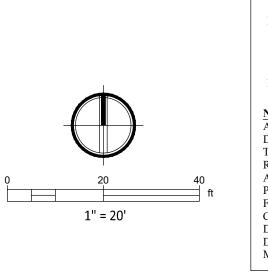

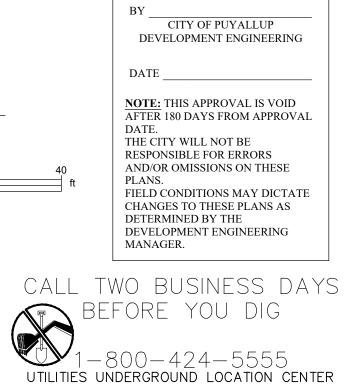

APPROVED

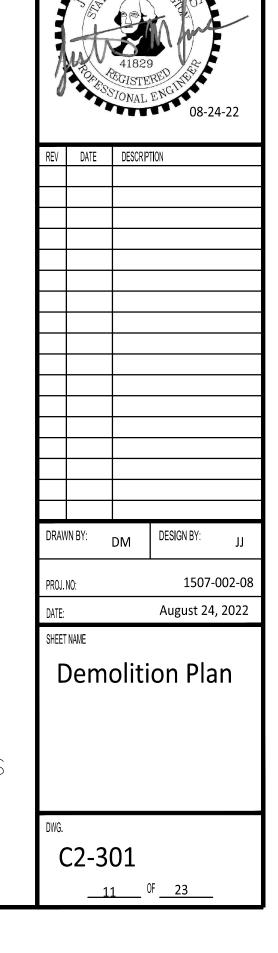

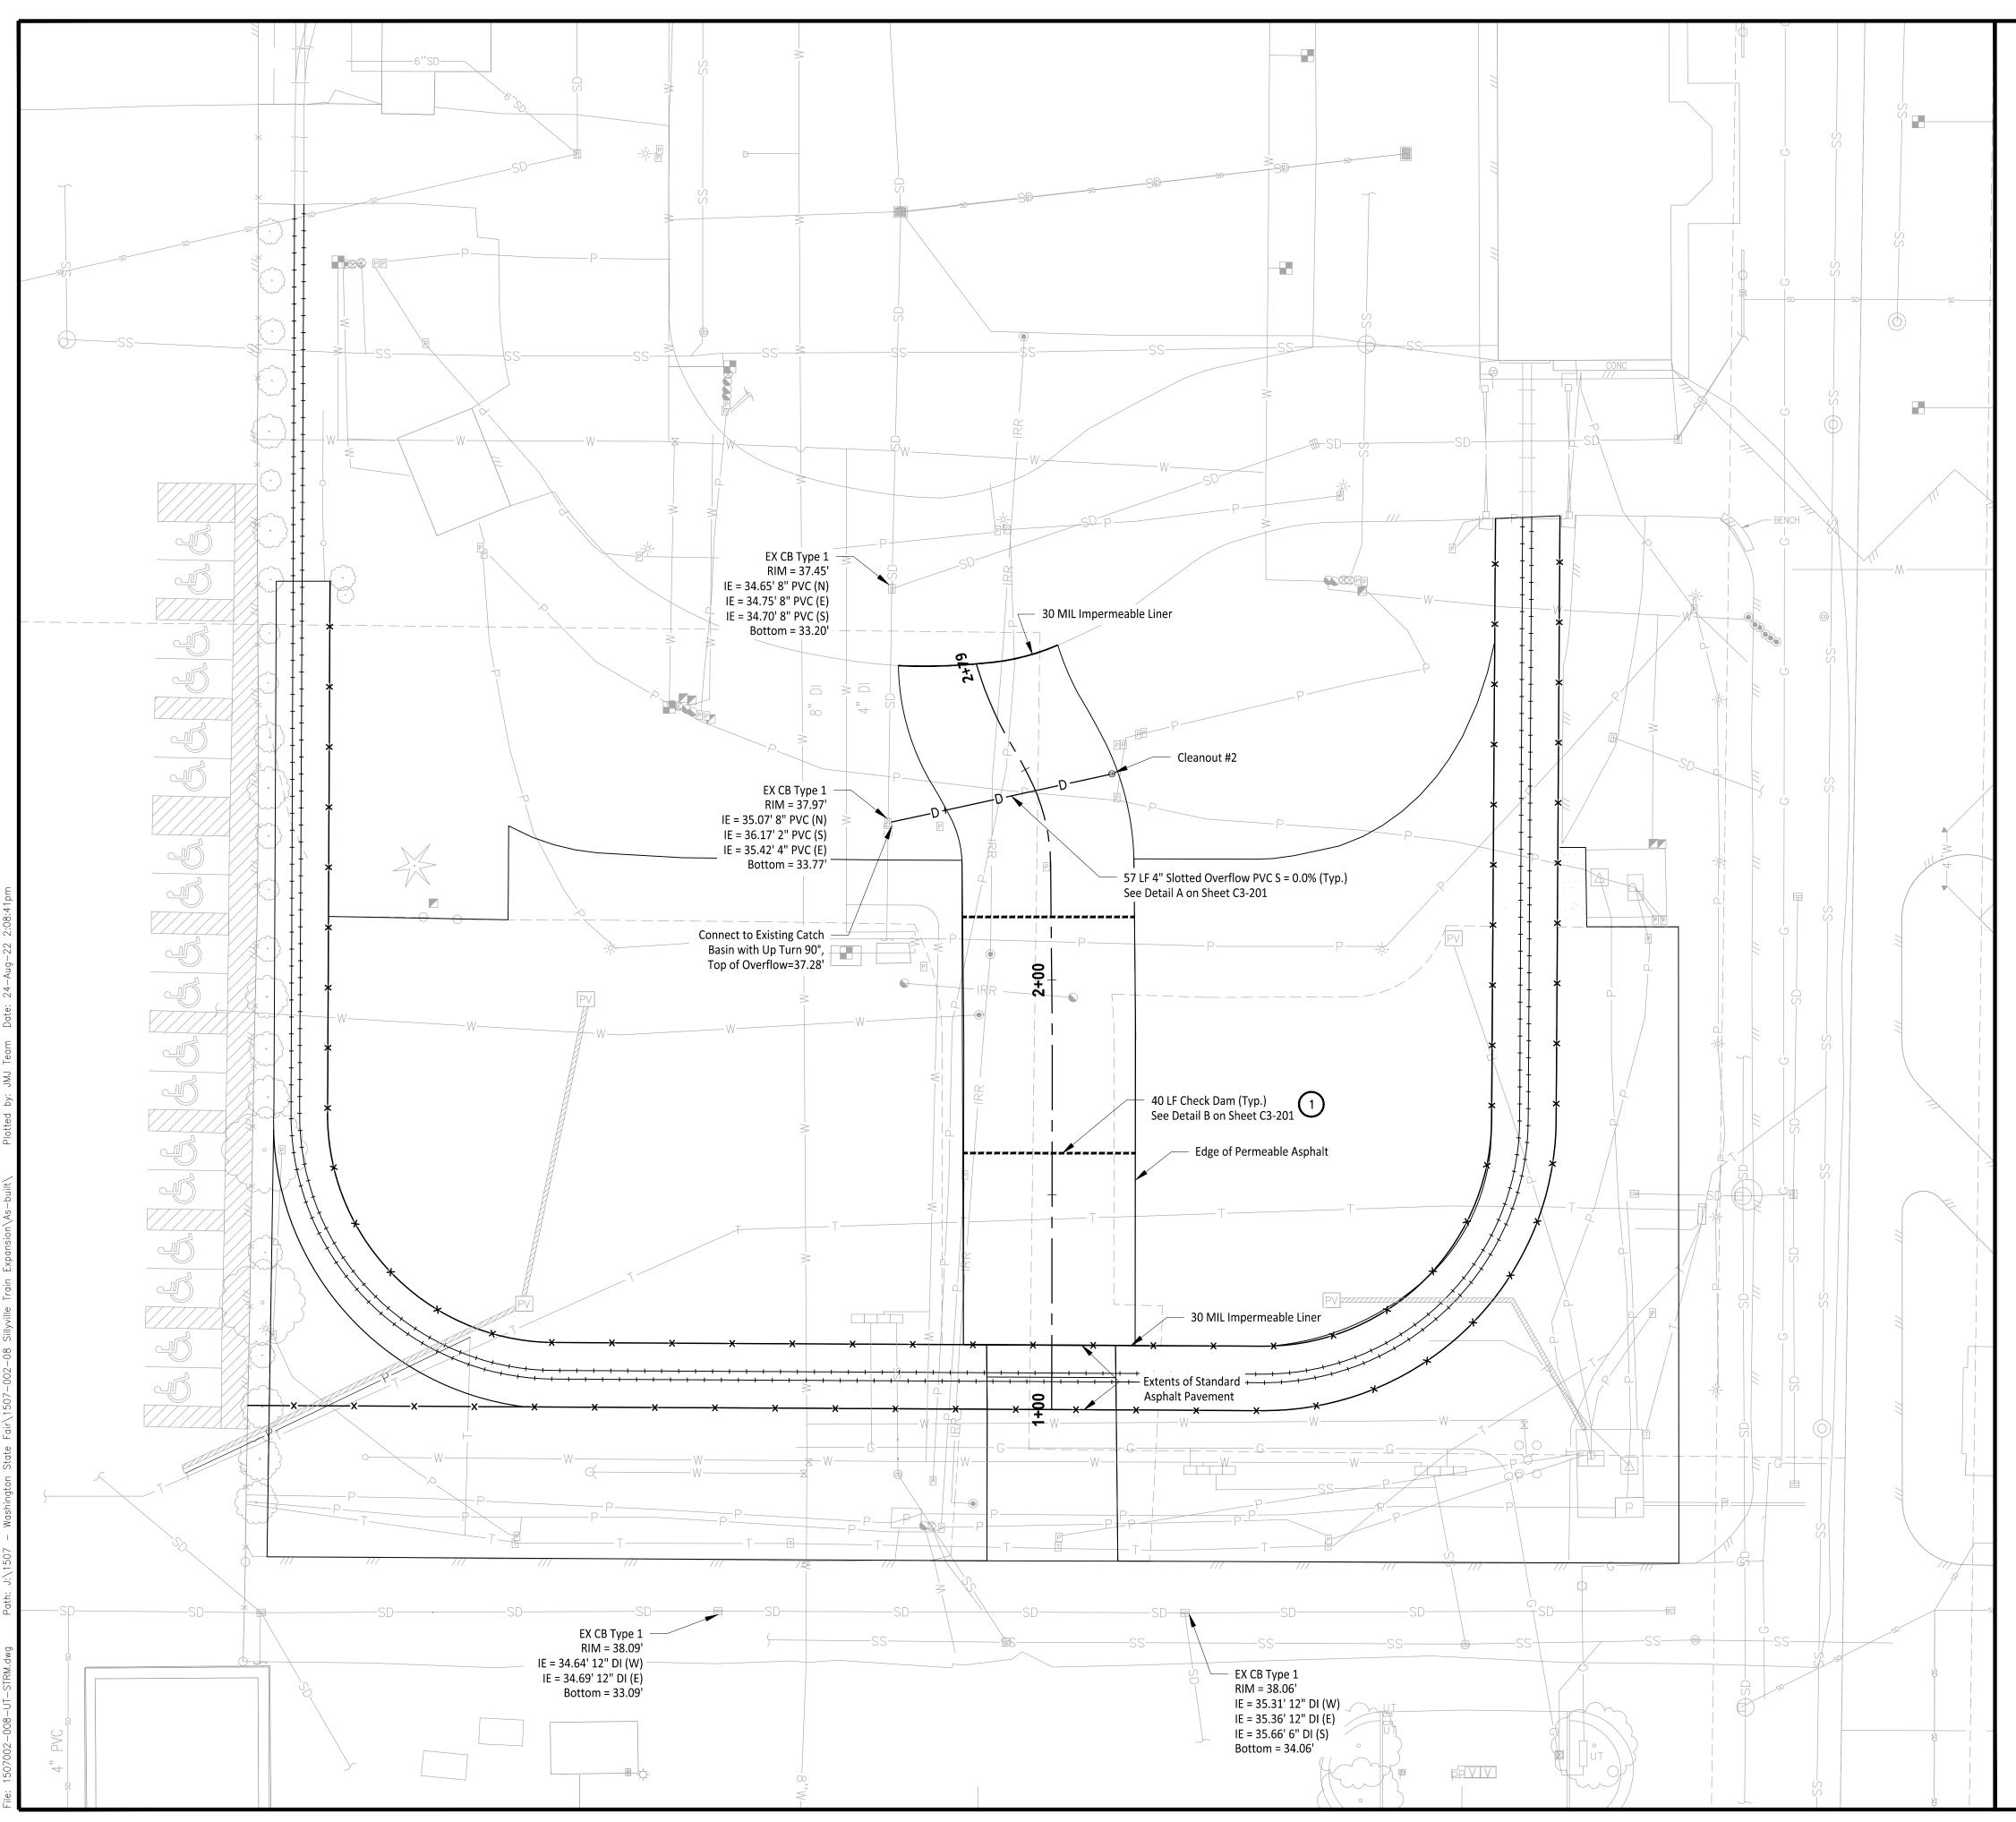

1 Check Dam to be installed under Permeable Pavement to maintain stormwater separation in pathways. See section B on Sheet C3-201.


2 Permeable Pavements to include 4" Slotted PVC underdrains with Solid Wall PVC connection to Catch Basins. See Section A on Sheet C3-201 for Details.


3 See Permable Path Profile on Sheet C3-201 for Check Dam Elevations.


GENERAL NOTES

- 1. Contractor to Pothole, locate Horizontal and Vertical Utilities and Verify with Engineer prior to any Utility Work.
- 2. Cleanouts shall be Installed at each change of direction greater than 45 degrees in storm lines. Where more than one change of direction occurs in a run of piping, only one cleanout shall be required for each 40 feet of developed length of drainage piping.

Storm Structure Table				
Elevation Point	Rim Elevation (ft)	Invert Elevation (ft)		
Cleanout #1	38.03	35.38		
Cleanout #2	38.51	36.54		
Cleanout #3	38.87	36.98		
Cleanout #4	39.32	37.32		
Cleanout #5	39.26	38.00		
Cleanout #6	39.39	37.89		

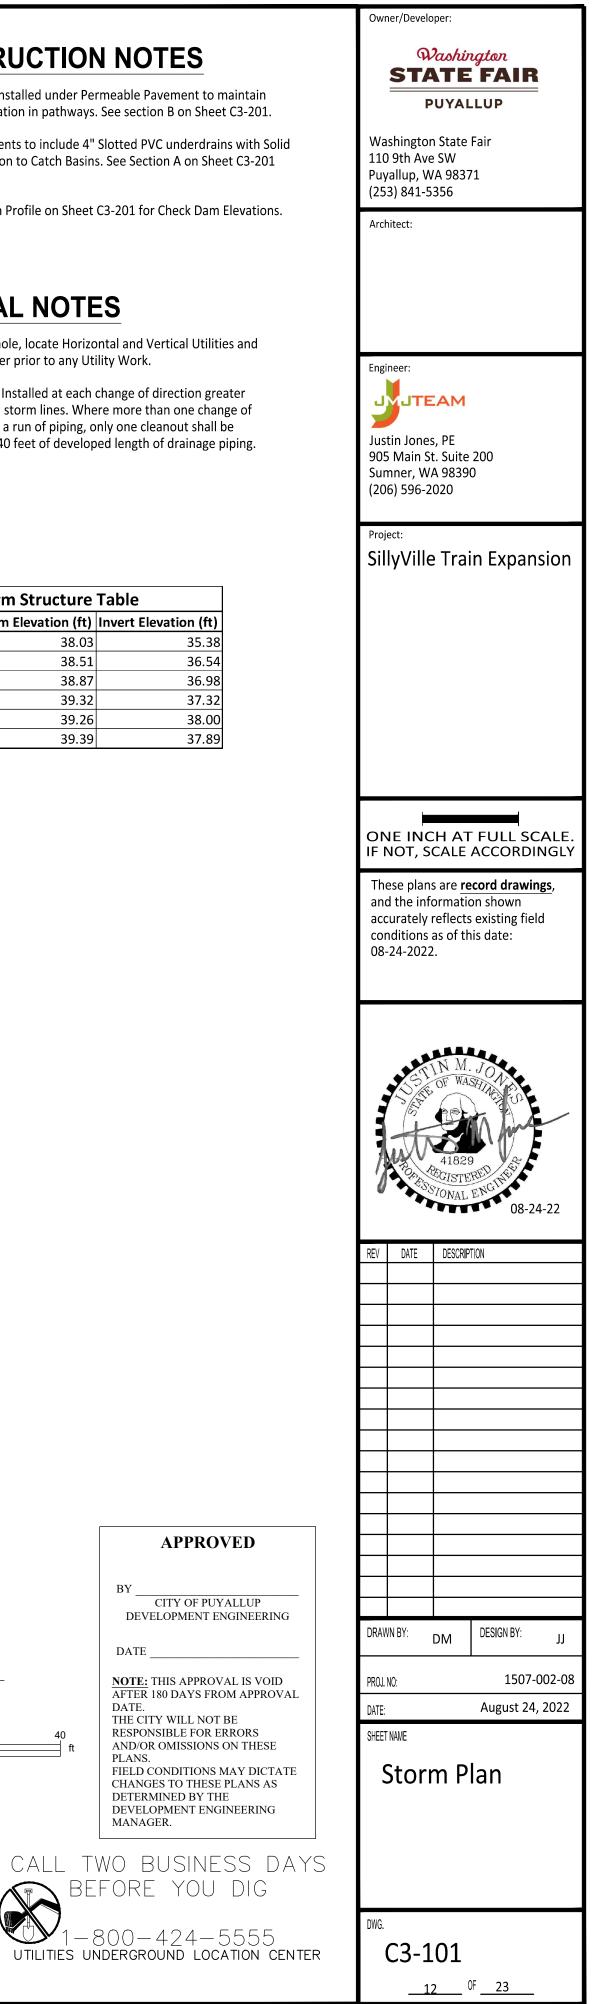

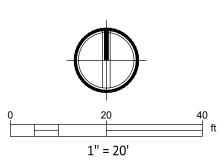


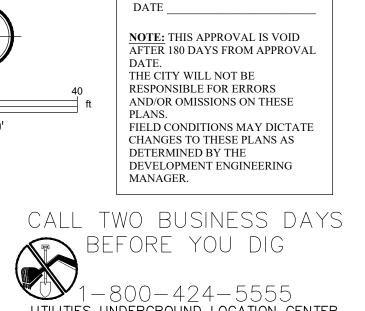

APPROVED


DEVELOPMENT ENGINEERING


BY ______ CITY OF PUYALLUP

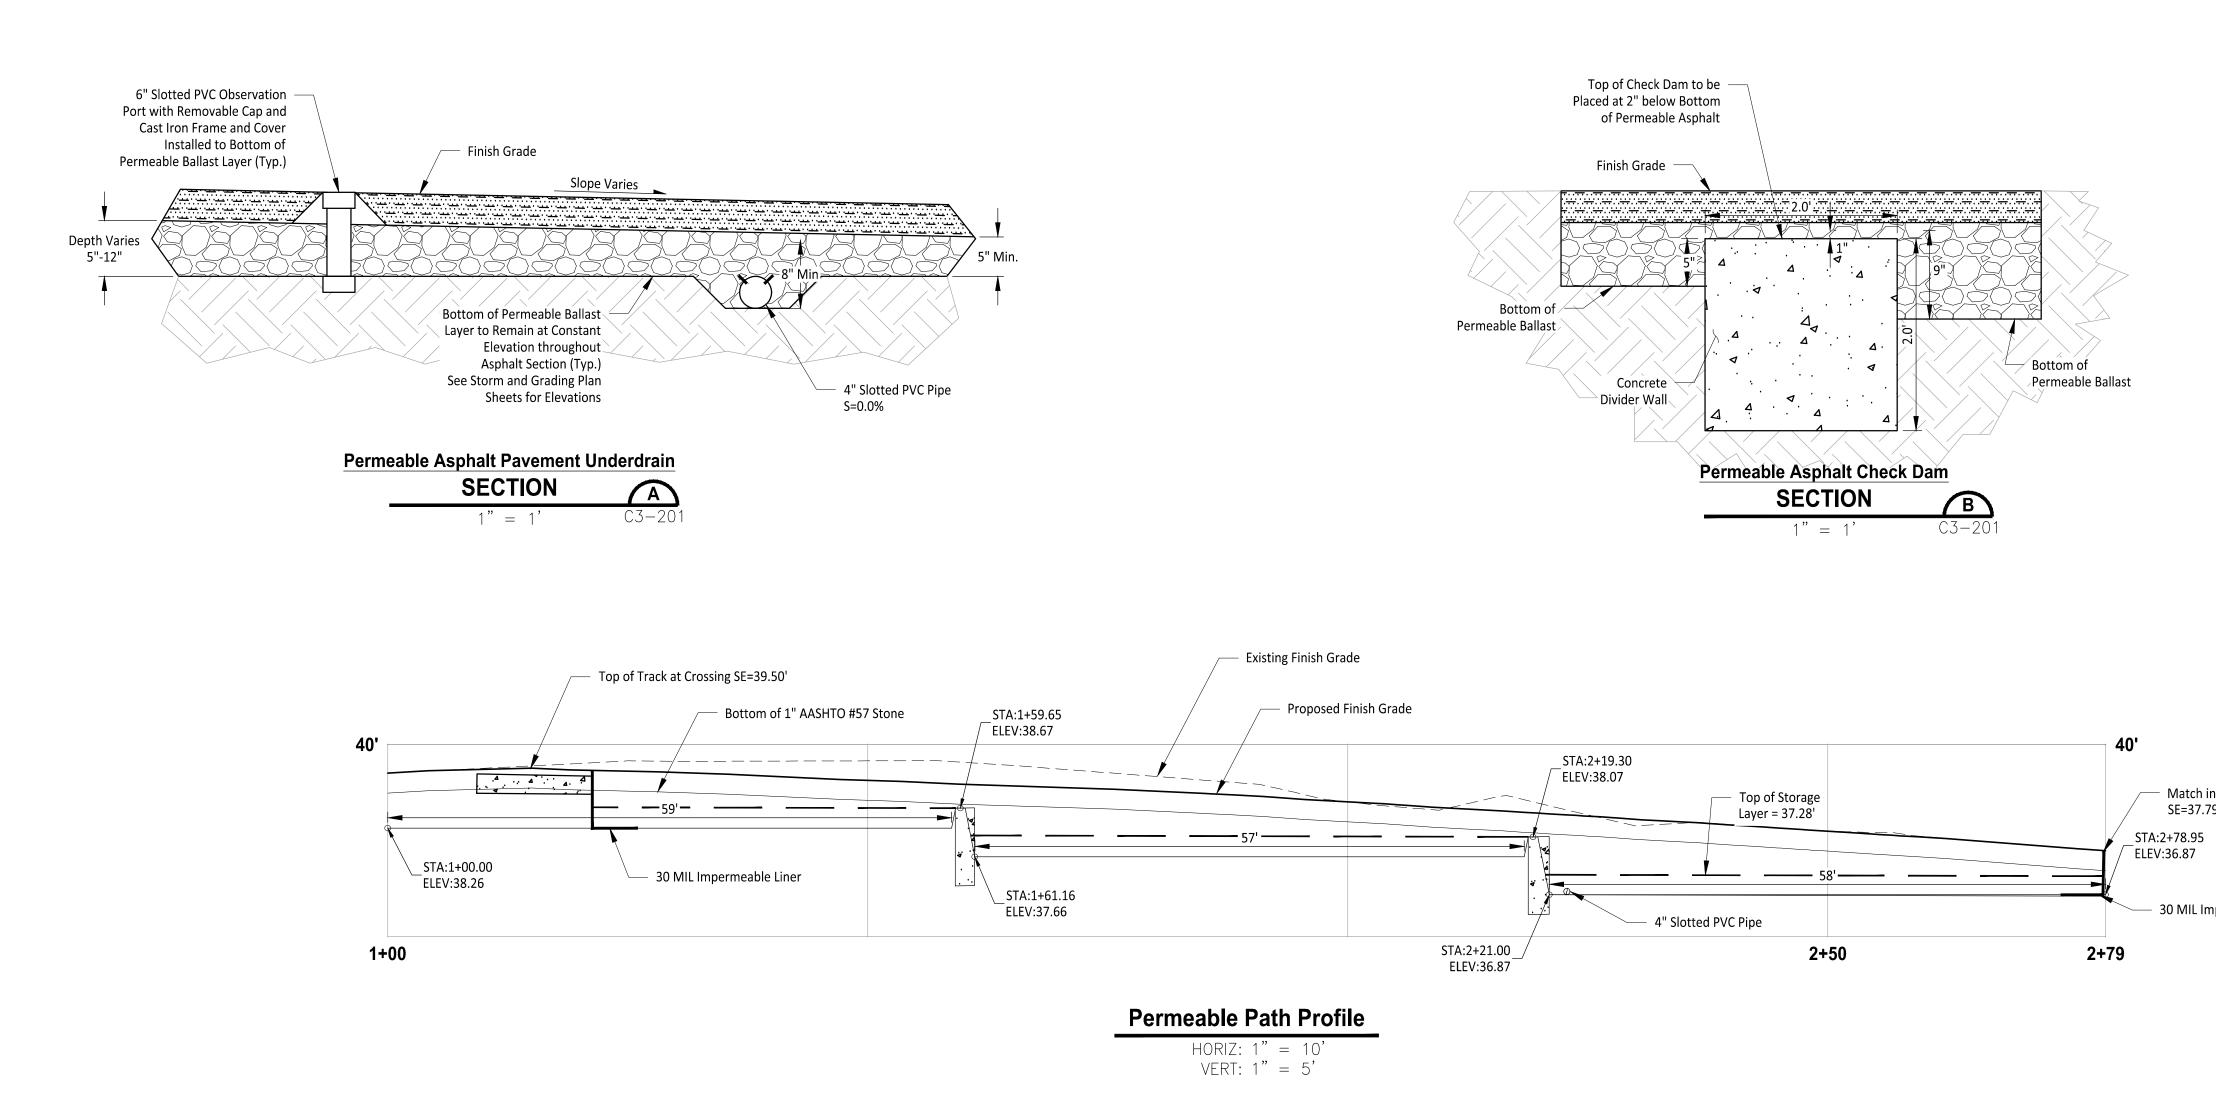


	Washington STATE FAIR PUYALLUP
	Washington State Fair 110 9th Ave SW Puyallup, WA 98371 (253) 841-5356
	Architect:
	Engineer: Justin Jones, PE 905 Main St. Suite 200 Sumner, WA 98390 (206) 596-2020 Project: SillyVille Train Expansion
Match into Existing SE=37.79'	ONE INCH AT FULL SCALE. IF NOT, SCALE ACCORDINGLY These plans are <u>record drawings</u> ,
STA:2+78.95 ELEV:36.87 — 30 MIL Impermeable Liner	and the information shown accurately reflects existing field conditions as of this date: 08-24-2022.
	41829 ATTEN
	REV DATE DESCRIPTION Image: I
BY	
DATE	DRAWN BY: DM DESIGN BY: JJ PROJ. NO: 1507-002-08 DATE: August 24, 2022 SHEET NAME Storm Details
CALL TWO BUSINESS DAYS BEFORE YOU DIG 1-800-424-5555 UTILITIES UNDERGROUND LOCATION CENTER	DWG. C3-201 13 ^{OF} 23


Owner/Developer:

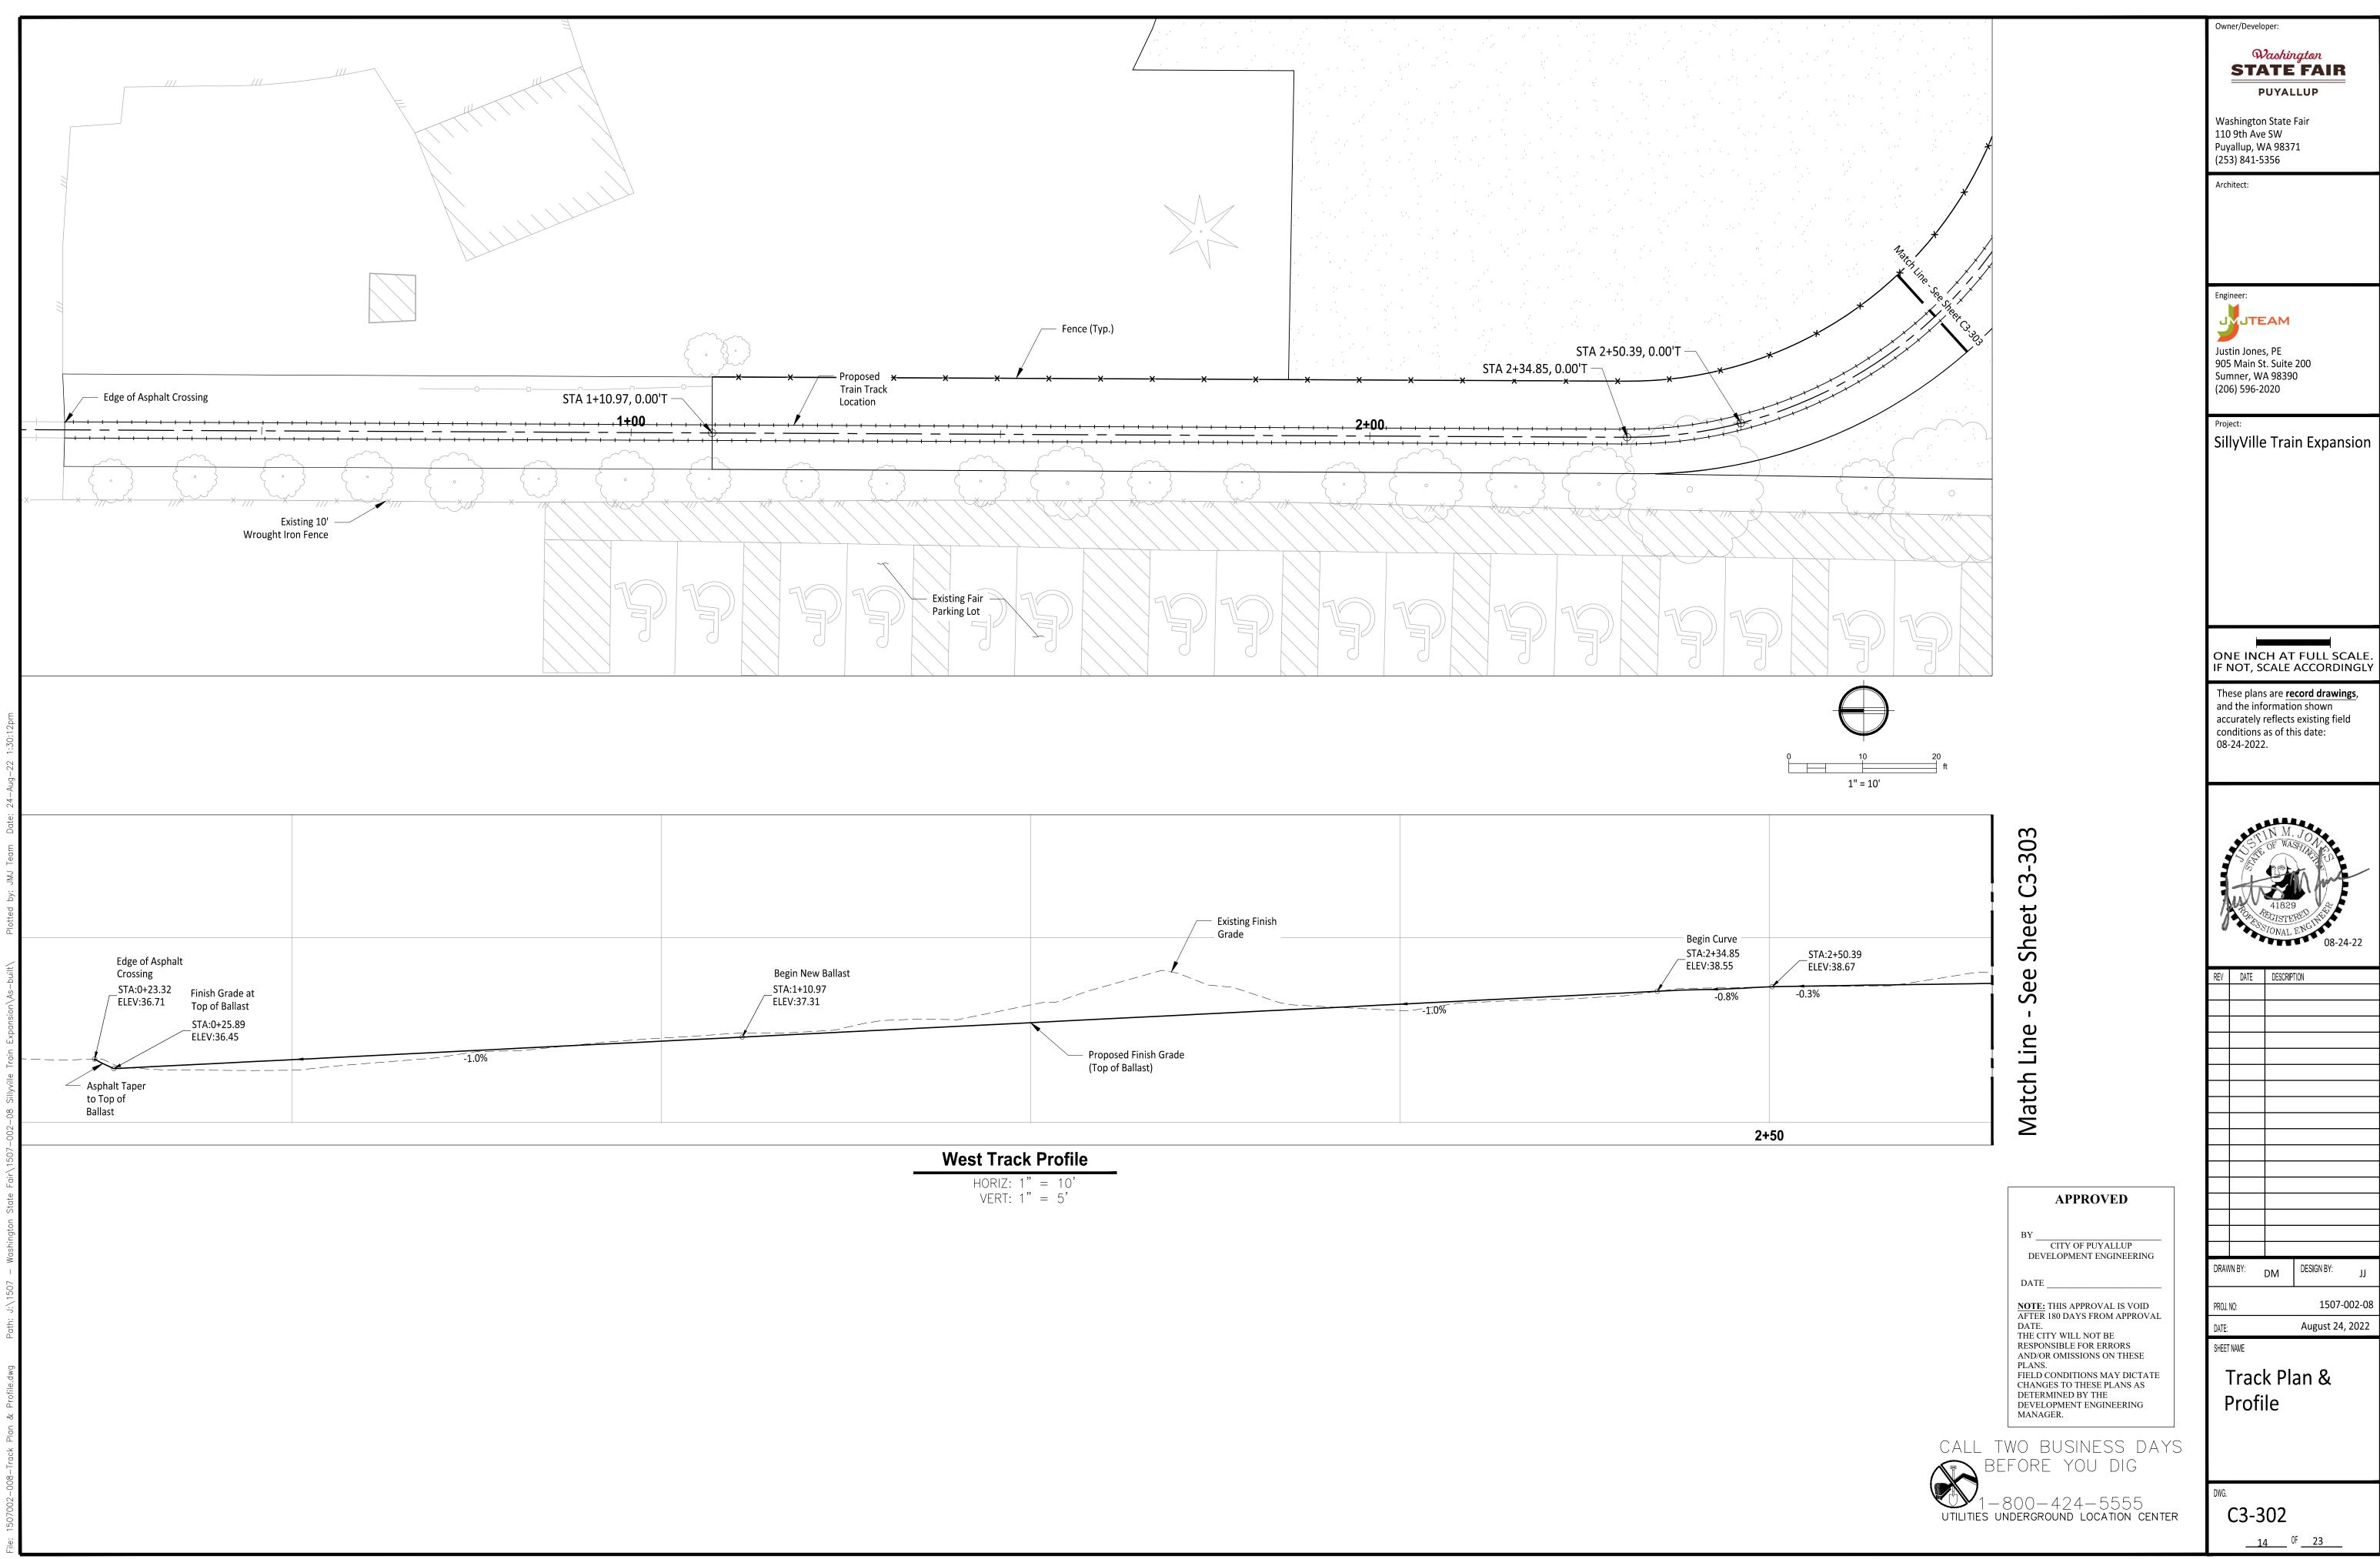

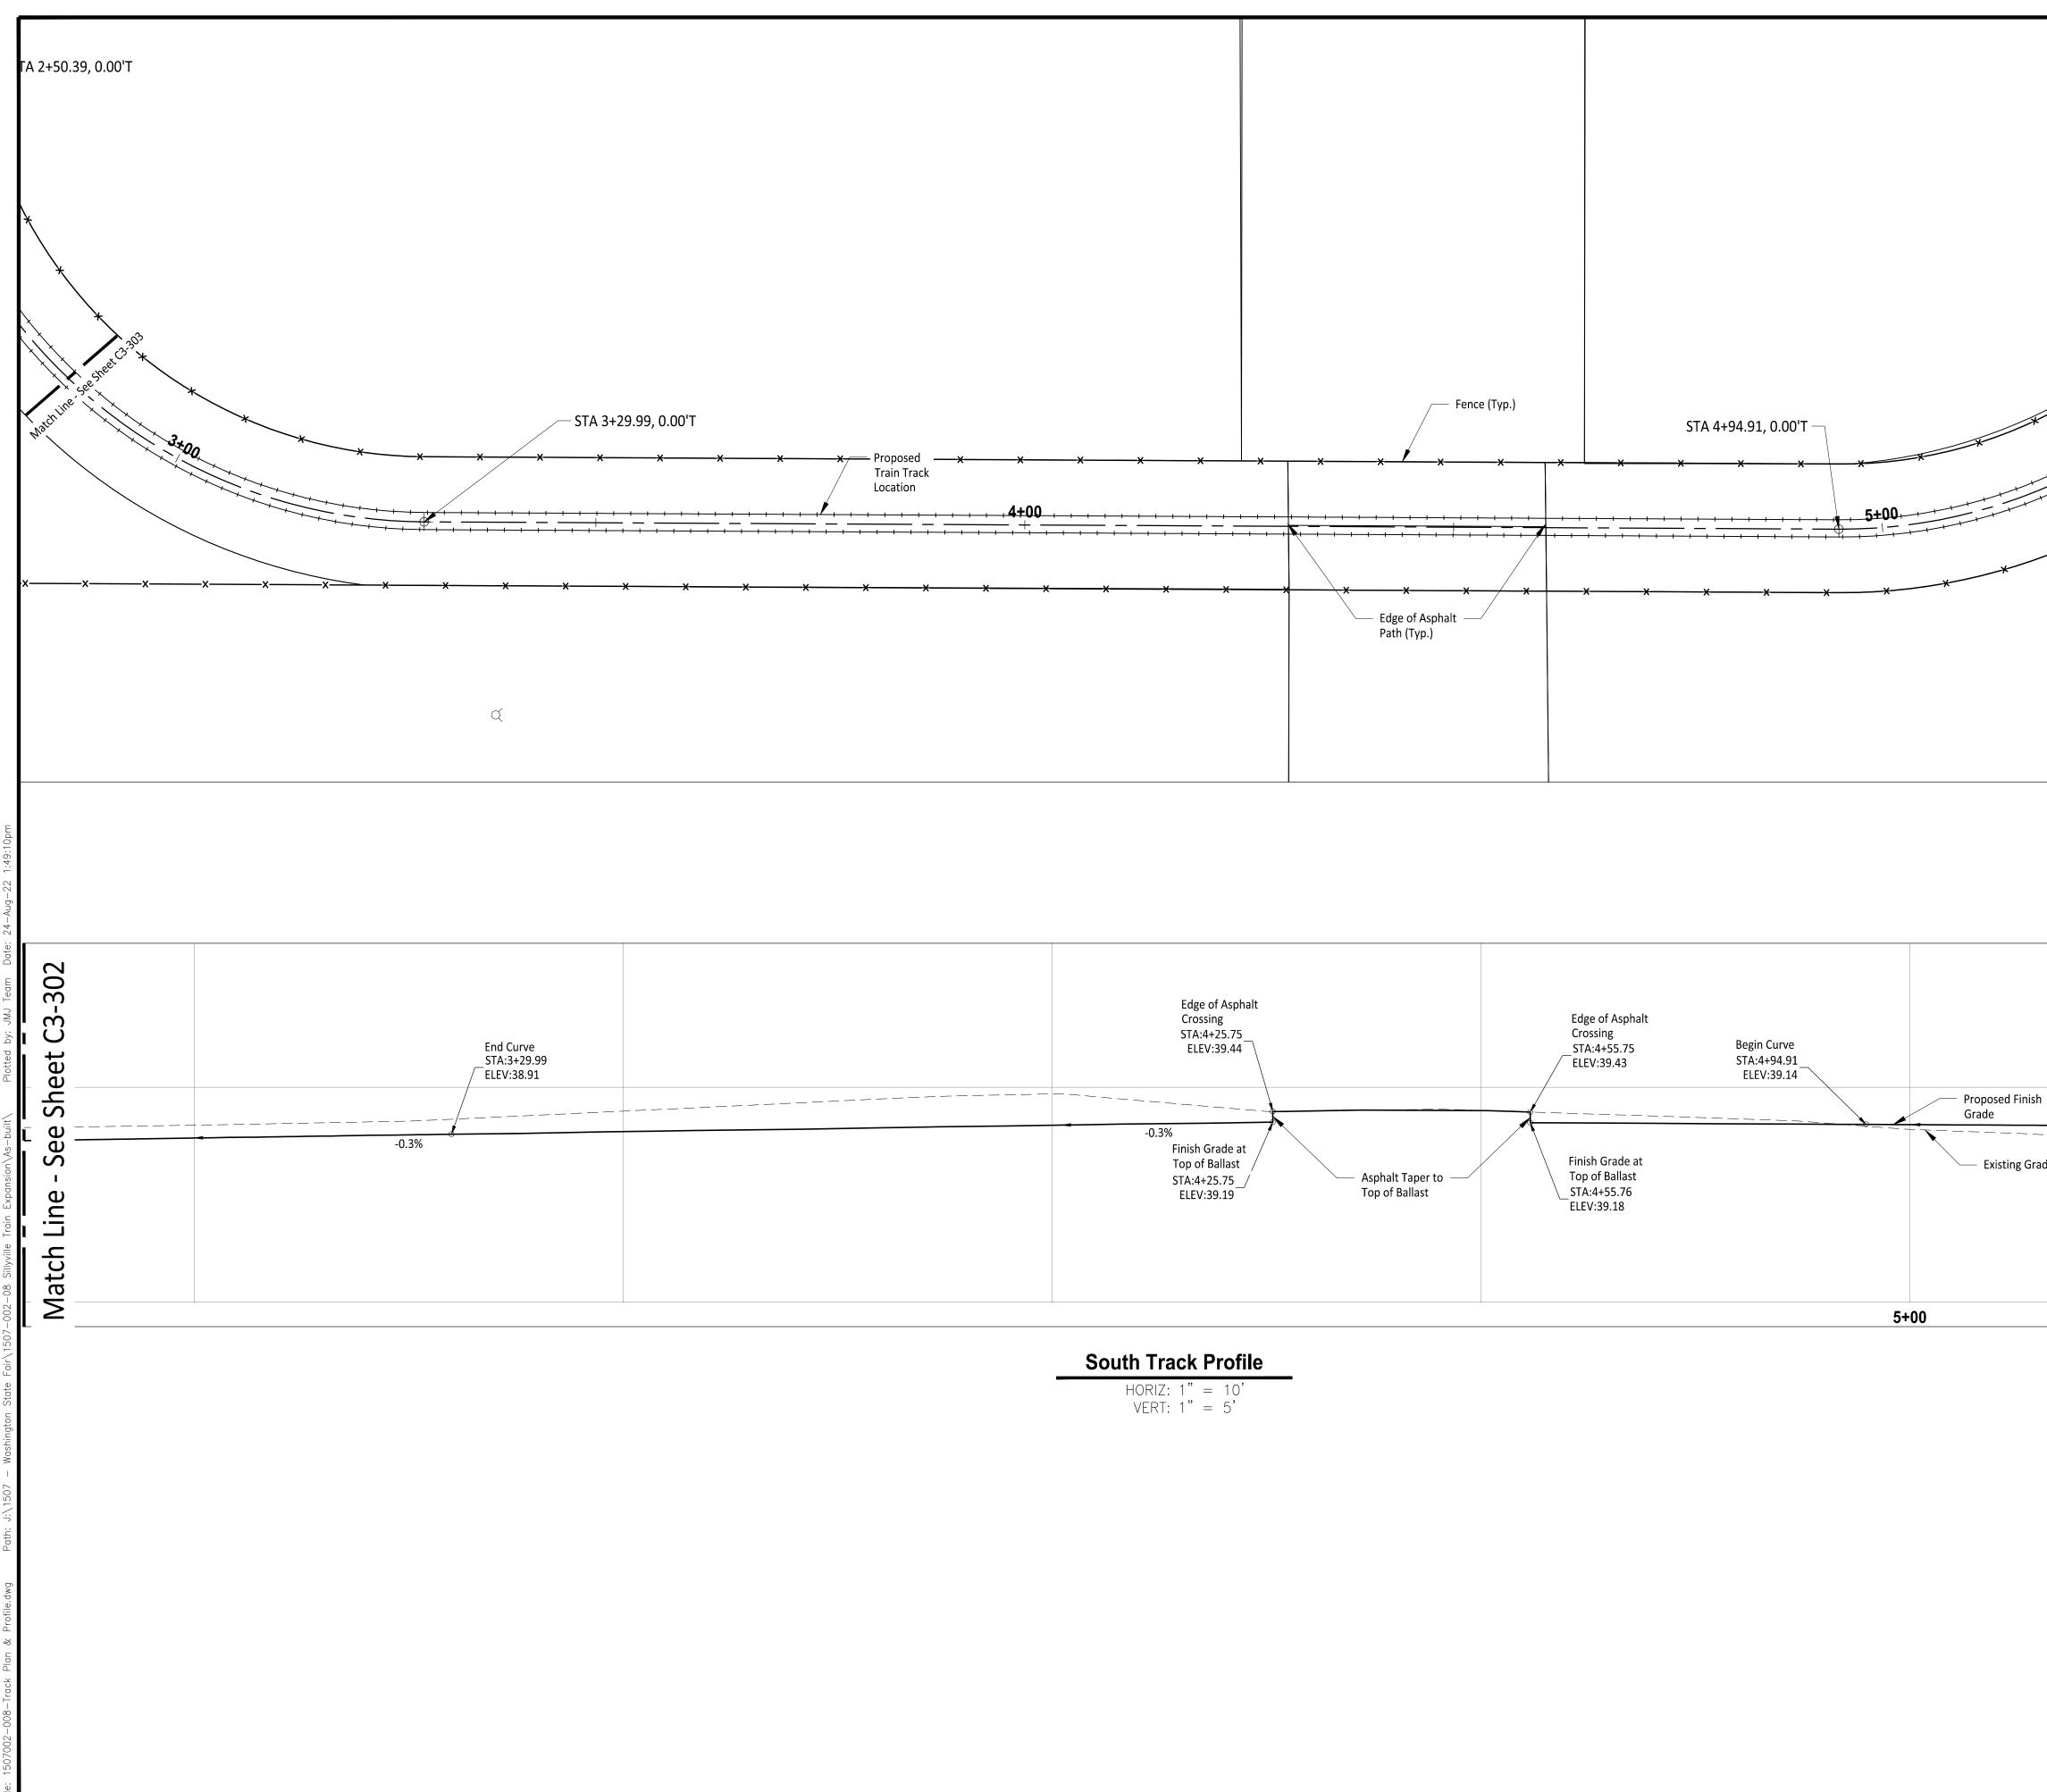


		Owner/Developer: STATE FAIR PUYALLUP Washington State Fair 110 9th Ave SW Puyallup, WA 98371 (253) 841-5356 Architect: Engineer: Justin Jones, PE 905 Main St. Suite 200 Sumner, WA 98390 (206) 596-2020 Project: SillyVille Train Expansion
h	sheet C3-303	ONE INCH AT FULL SCALE. IF NOT, SCALE ACCORDINGLY These plans are record drawings, and the information shown accurately reflects existing field conditions as of this date: 08-24-2022.
0.1%i	Match Line - See She	REV DATE DESCRIPTION Image: I
	APPROVED BY	DRAWN BY: DM DESIGN BY: JJ PROJ. NO: 1507-002-08 DATE: August 24, 2022 SHEET NAME Track Plan & Profile
	TWO BUSINESS DAYS EFORE YOU DIG -800-424-5555 underground location center	DWG. C3-303 15 ^{OF} 23

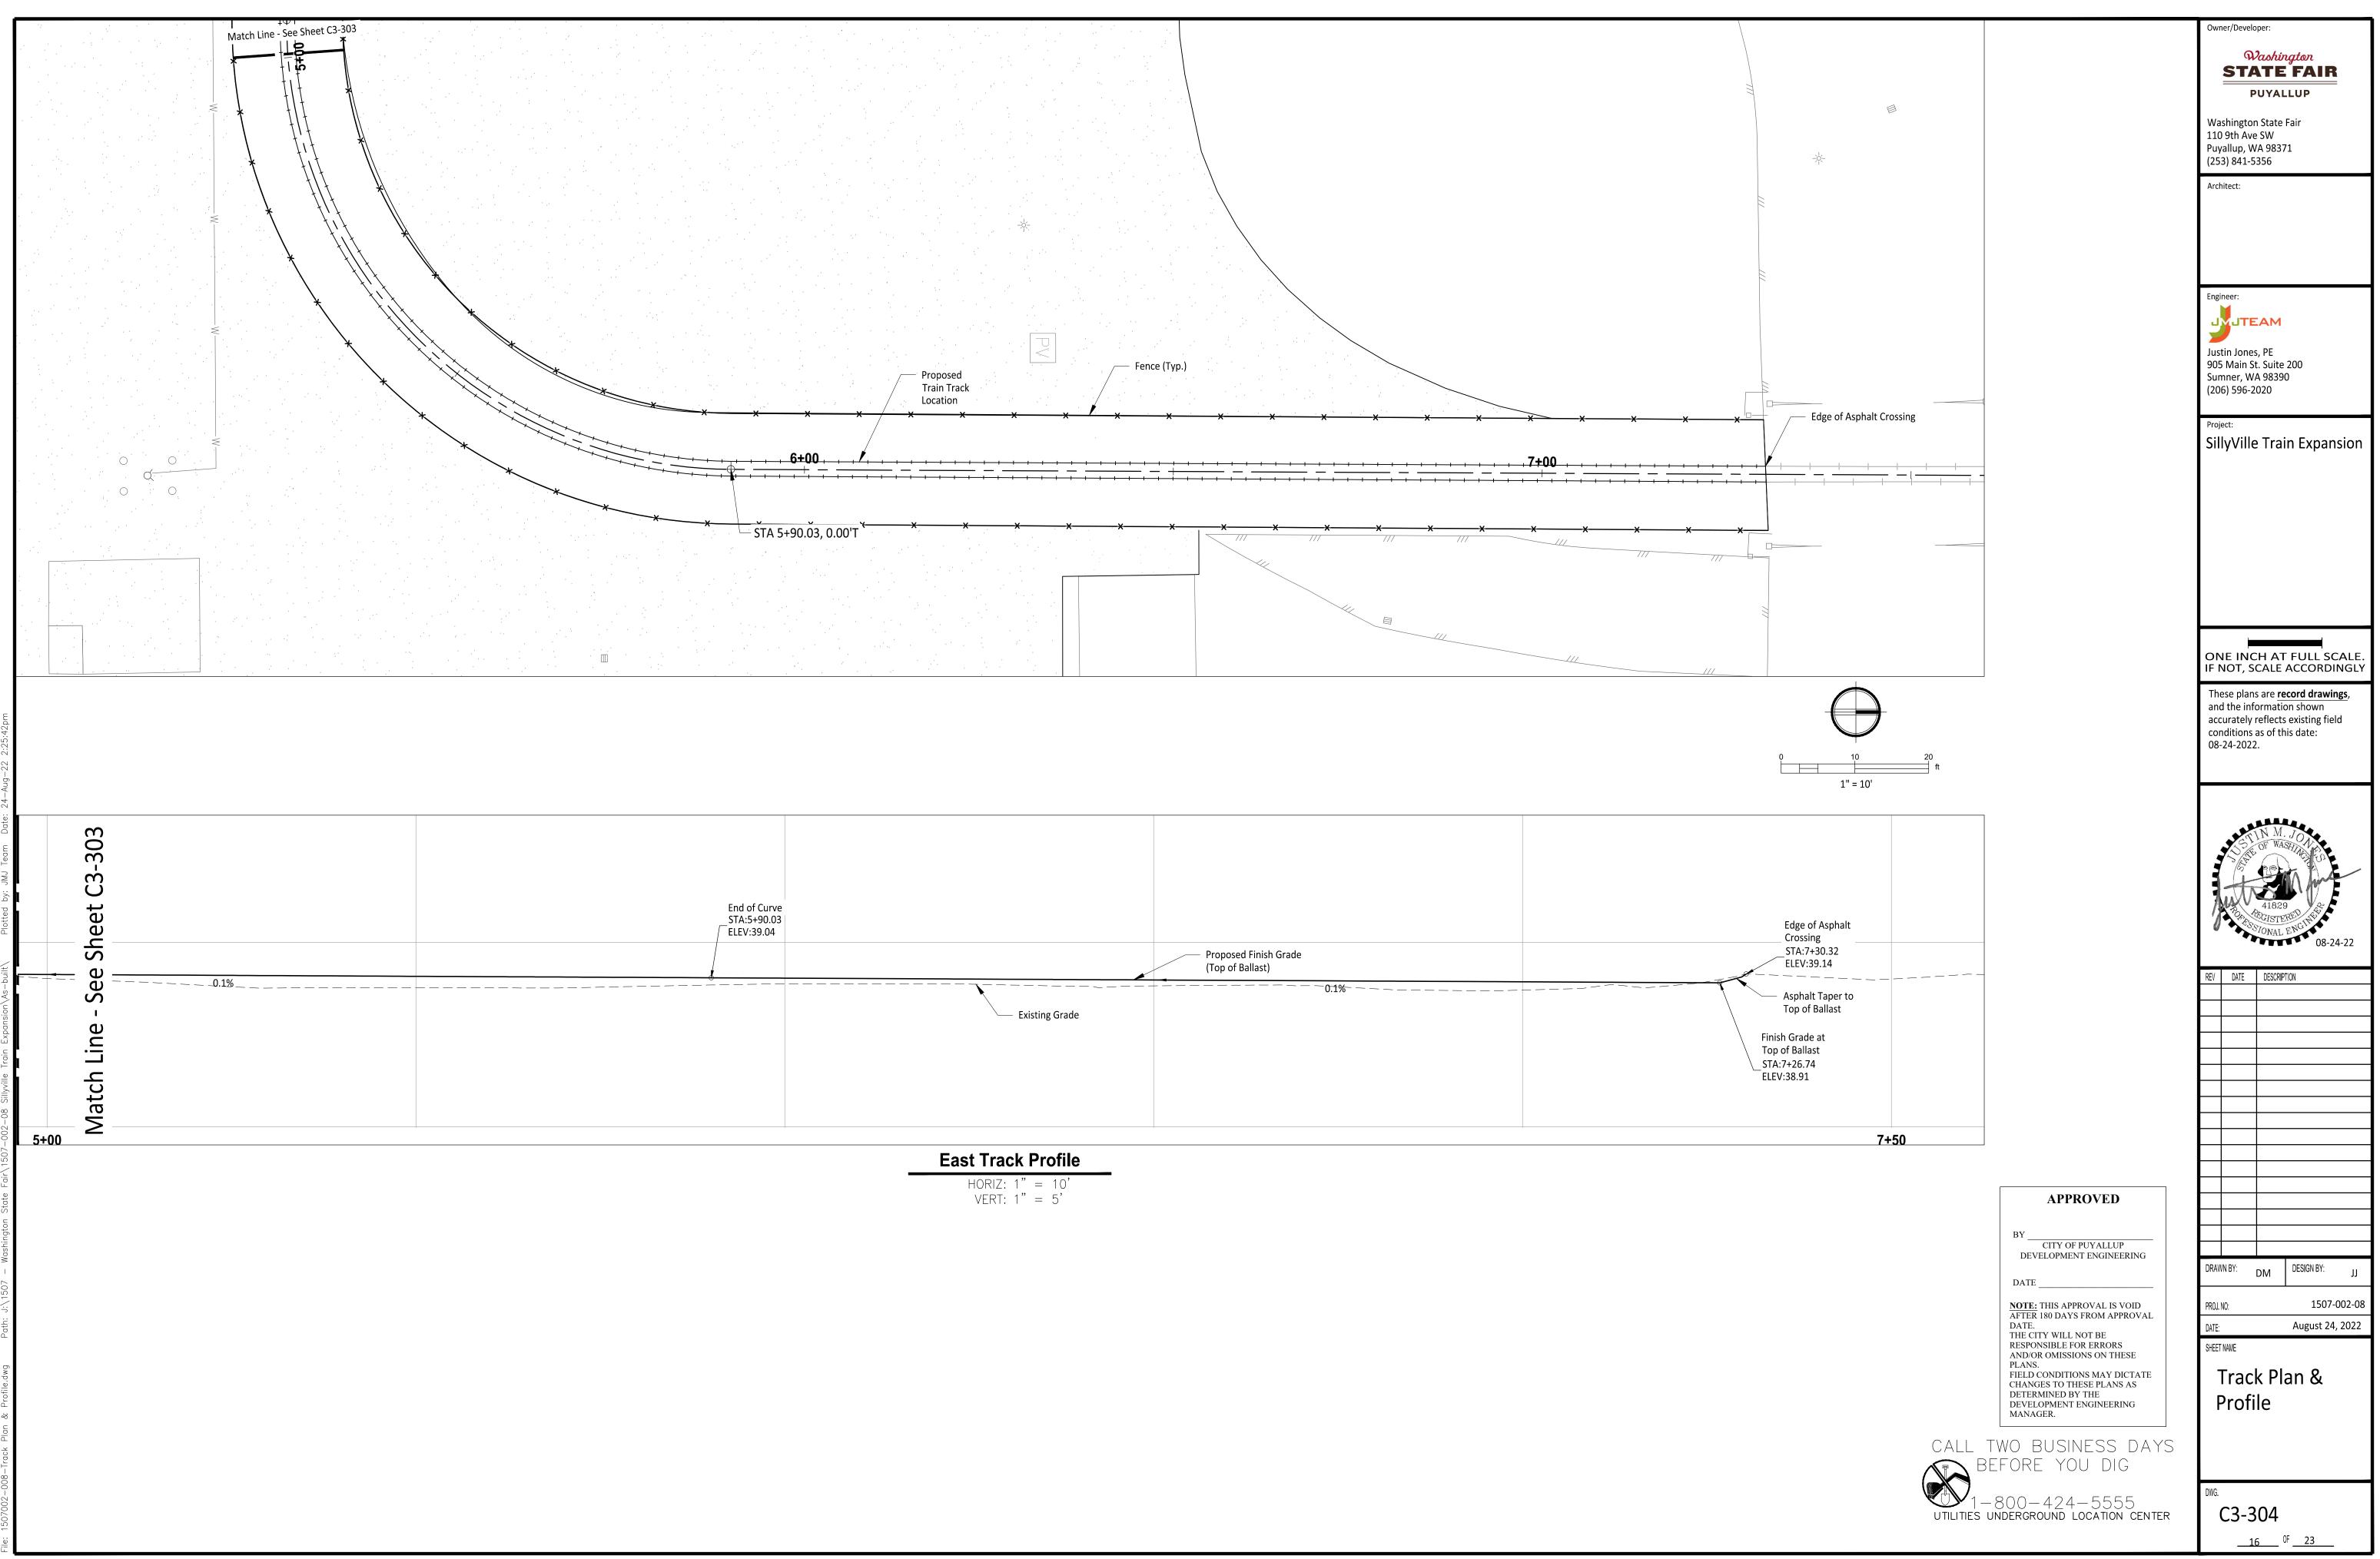

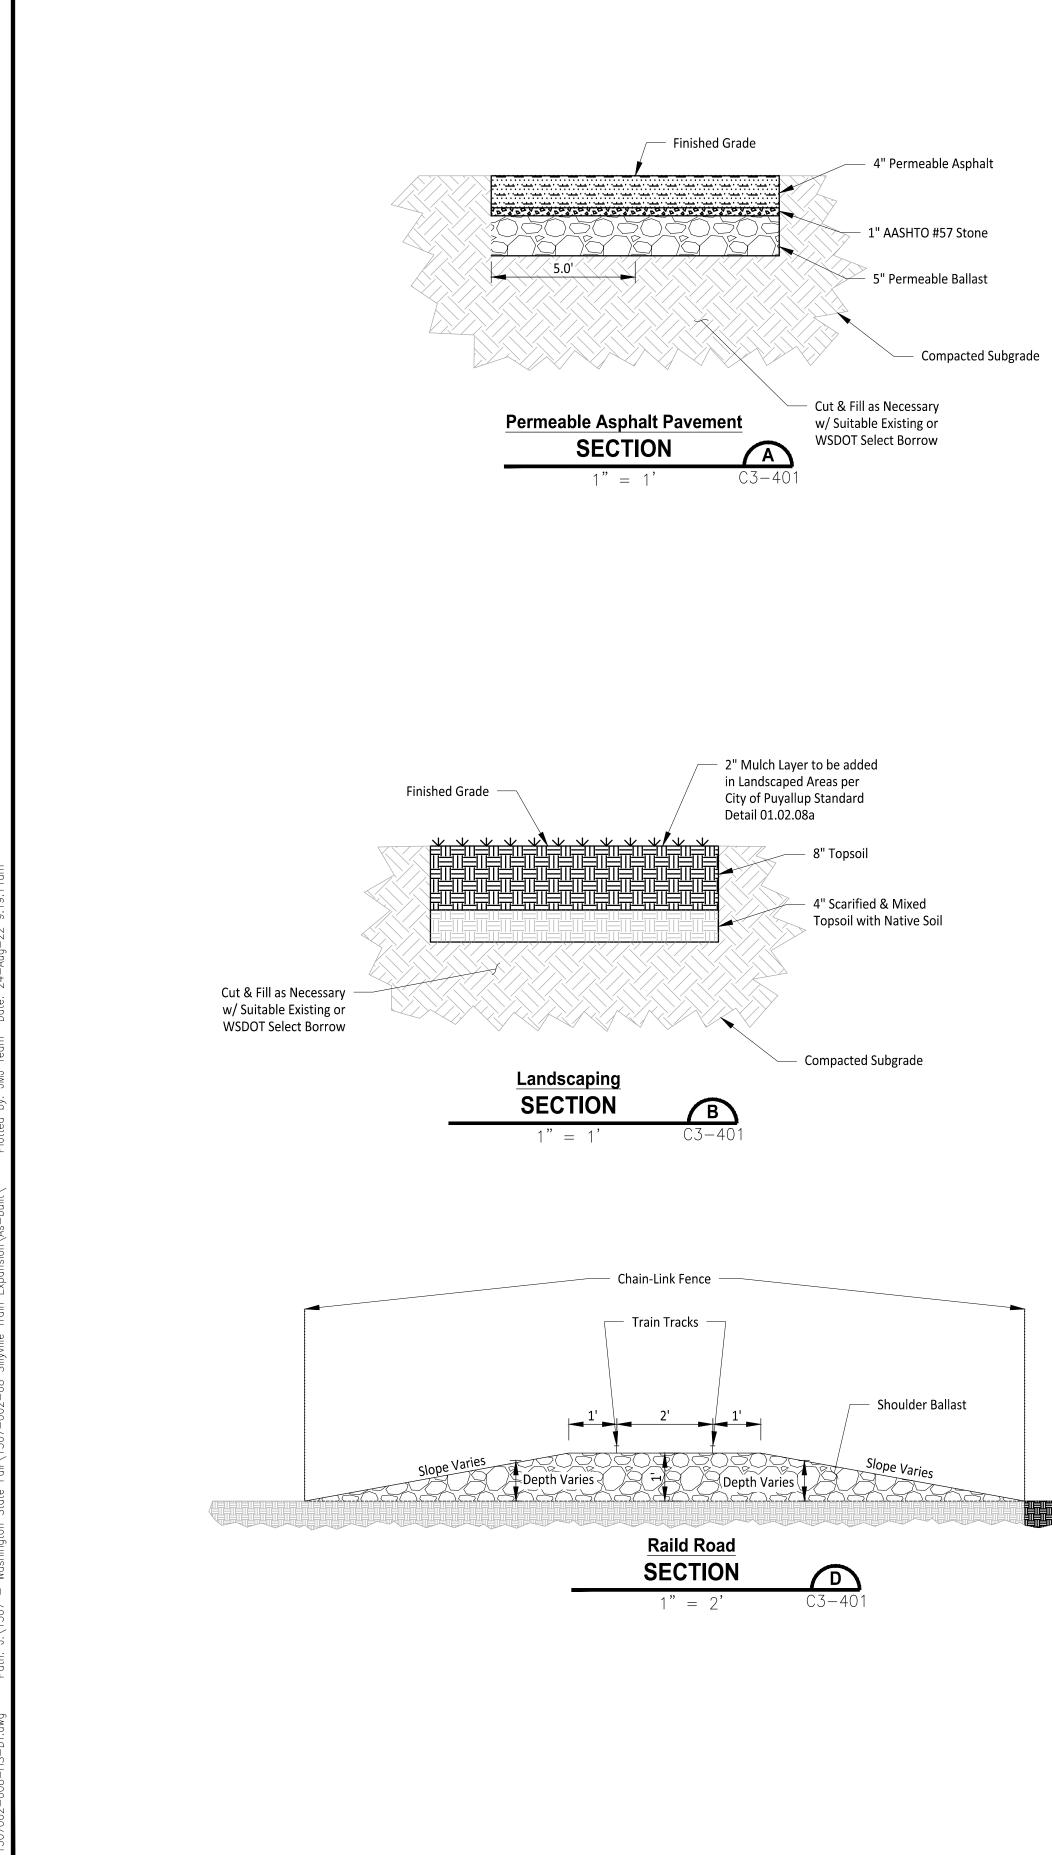



37002-008-HS-DT.dwa Path: J:\1507 - Washington State Fair\1507-002-08 Sillvville Train Expansion\As-built\ Plotted by: JMJ Team Date: 24-Aug-22 9:

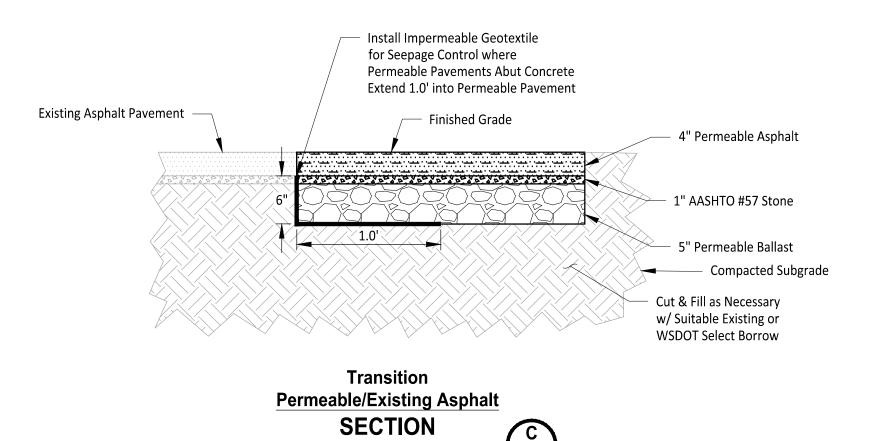

1" = 1'

C3-401

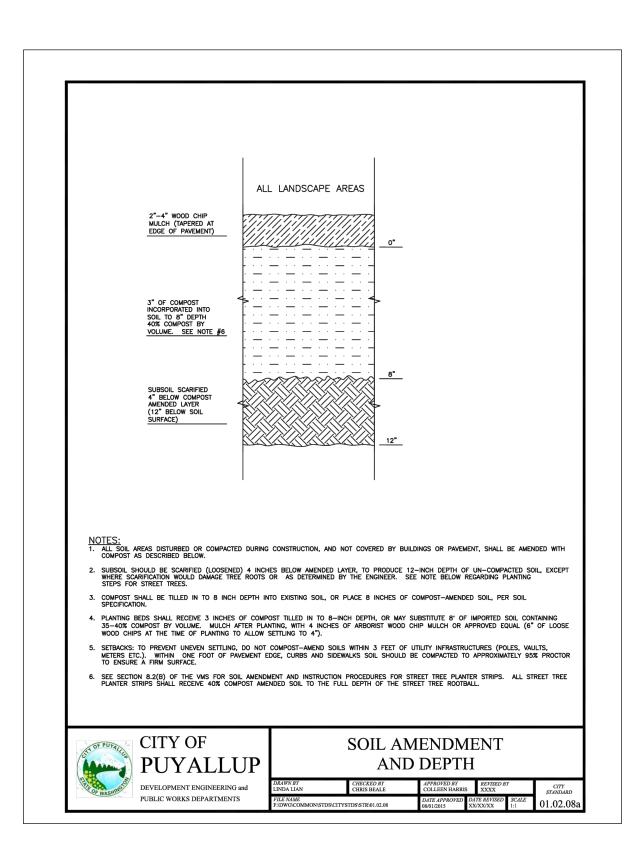

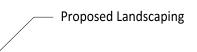

Owner/Developer:		
owner/beveloper.		
Washington		
STATE FAIR		
PUYALLUP		
Washington State Fair		
110 9th Ave SW Puyallup, WA 98371		
(253) 841-5356		
Architect:		
Engineer:		
JTEAM		
Justin Jones, PE		
905 Main St. Suite 200 Sumner, WA 98390		
(206) 596-2020		
Duciest		
Project: Silly/illo Train Expansion		
SillyVille Train Expansion		
ONE INCH AT FULL SCALE.		
IF NOT, SCALE ACCORDINGLY		
These plans are record drawings ,		
and the information shown		
accurately reflects existing field		
conditions as of this date: 08-24-2022.		
TIN M. JOA		
STIN M. JON		
DETIN M. JON DETIN M. JON STERIOF WASHING SO		
JUSTIN M. JON		
J.S. OF WASHINE TO		
J.S. OF WASHINE TO		
J. S. OF WASHINE TO		
41829 Alberto Alberto		
41829 Alberto Alberto		
41829 41829 AUSTICISTERED AUSTICISTERED 08-24-22		
41829 41829 AUSTICISTERED AUSTICISTERED 08-24-22		
REV DATE DESCRIPTION Image: Strate of the strat		
REV DATE DESCRIPTION I I I		
REV DATE DESCRIPTION I I I		
A1B29 A1B29 A1B29 O8-24-22 REV DATE DESCRIPTION I I IIIIIIIIIIIIIIIIIIIIIIIIIIIIIIIIIIII		
Image: Structure of the st		
A1B29 A1B29 A1B29 O8-24-22 REV DATE DESCRIPTION I I IIIIIIIIIIIIIIIIIIIIIIIIIIIIIIIIIIII		


APPROVED

BY CITY OF PUYALLUP DEVELOPMENT ENGINEERING


DATE ____


- NOTE: THIS APPROVAL IS VOID AFTER 180 DAYS FROM APPROVAL DATE. THE CITY WILL NOT BE RESPONSIBLE FOR ERRORS AND/OR OMISSIONS ON THESE
- PLANS. FIELD CONDITIONS MAY DICTATE CHANGES TO THESE PLANS AS DETERMINED BY THE DEVELOPMENT ENGINEERING MANAGER.



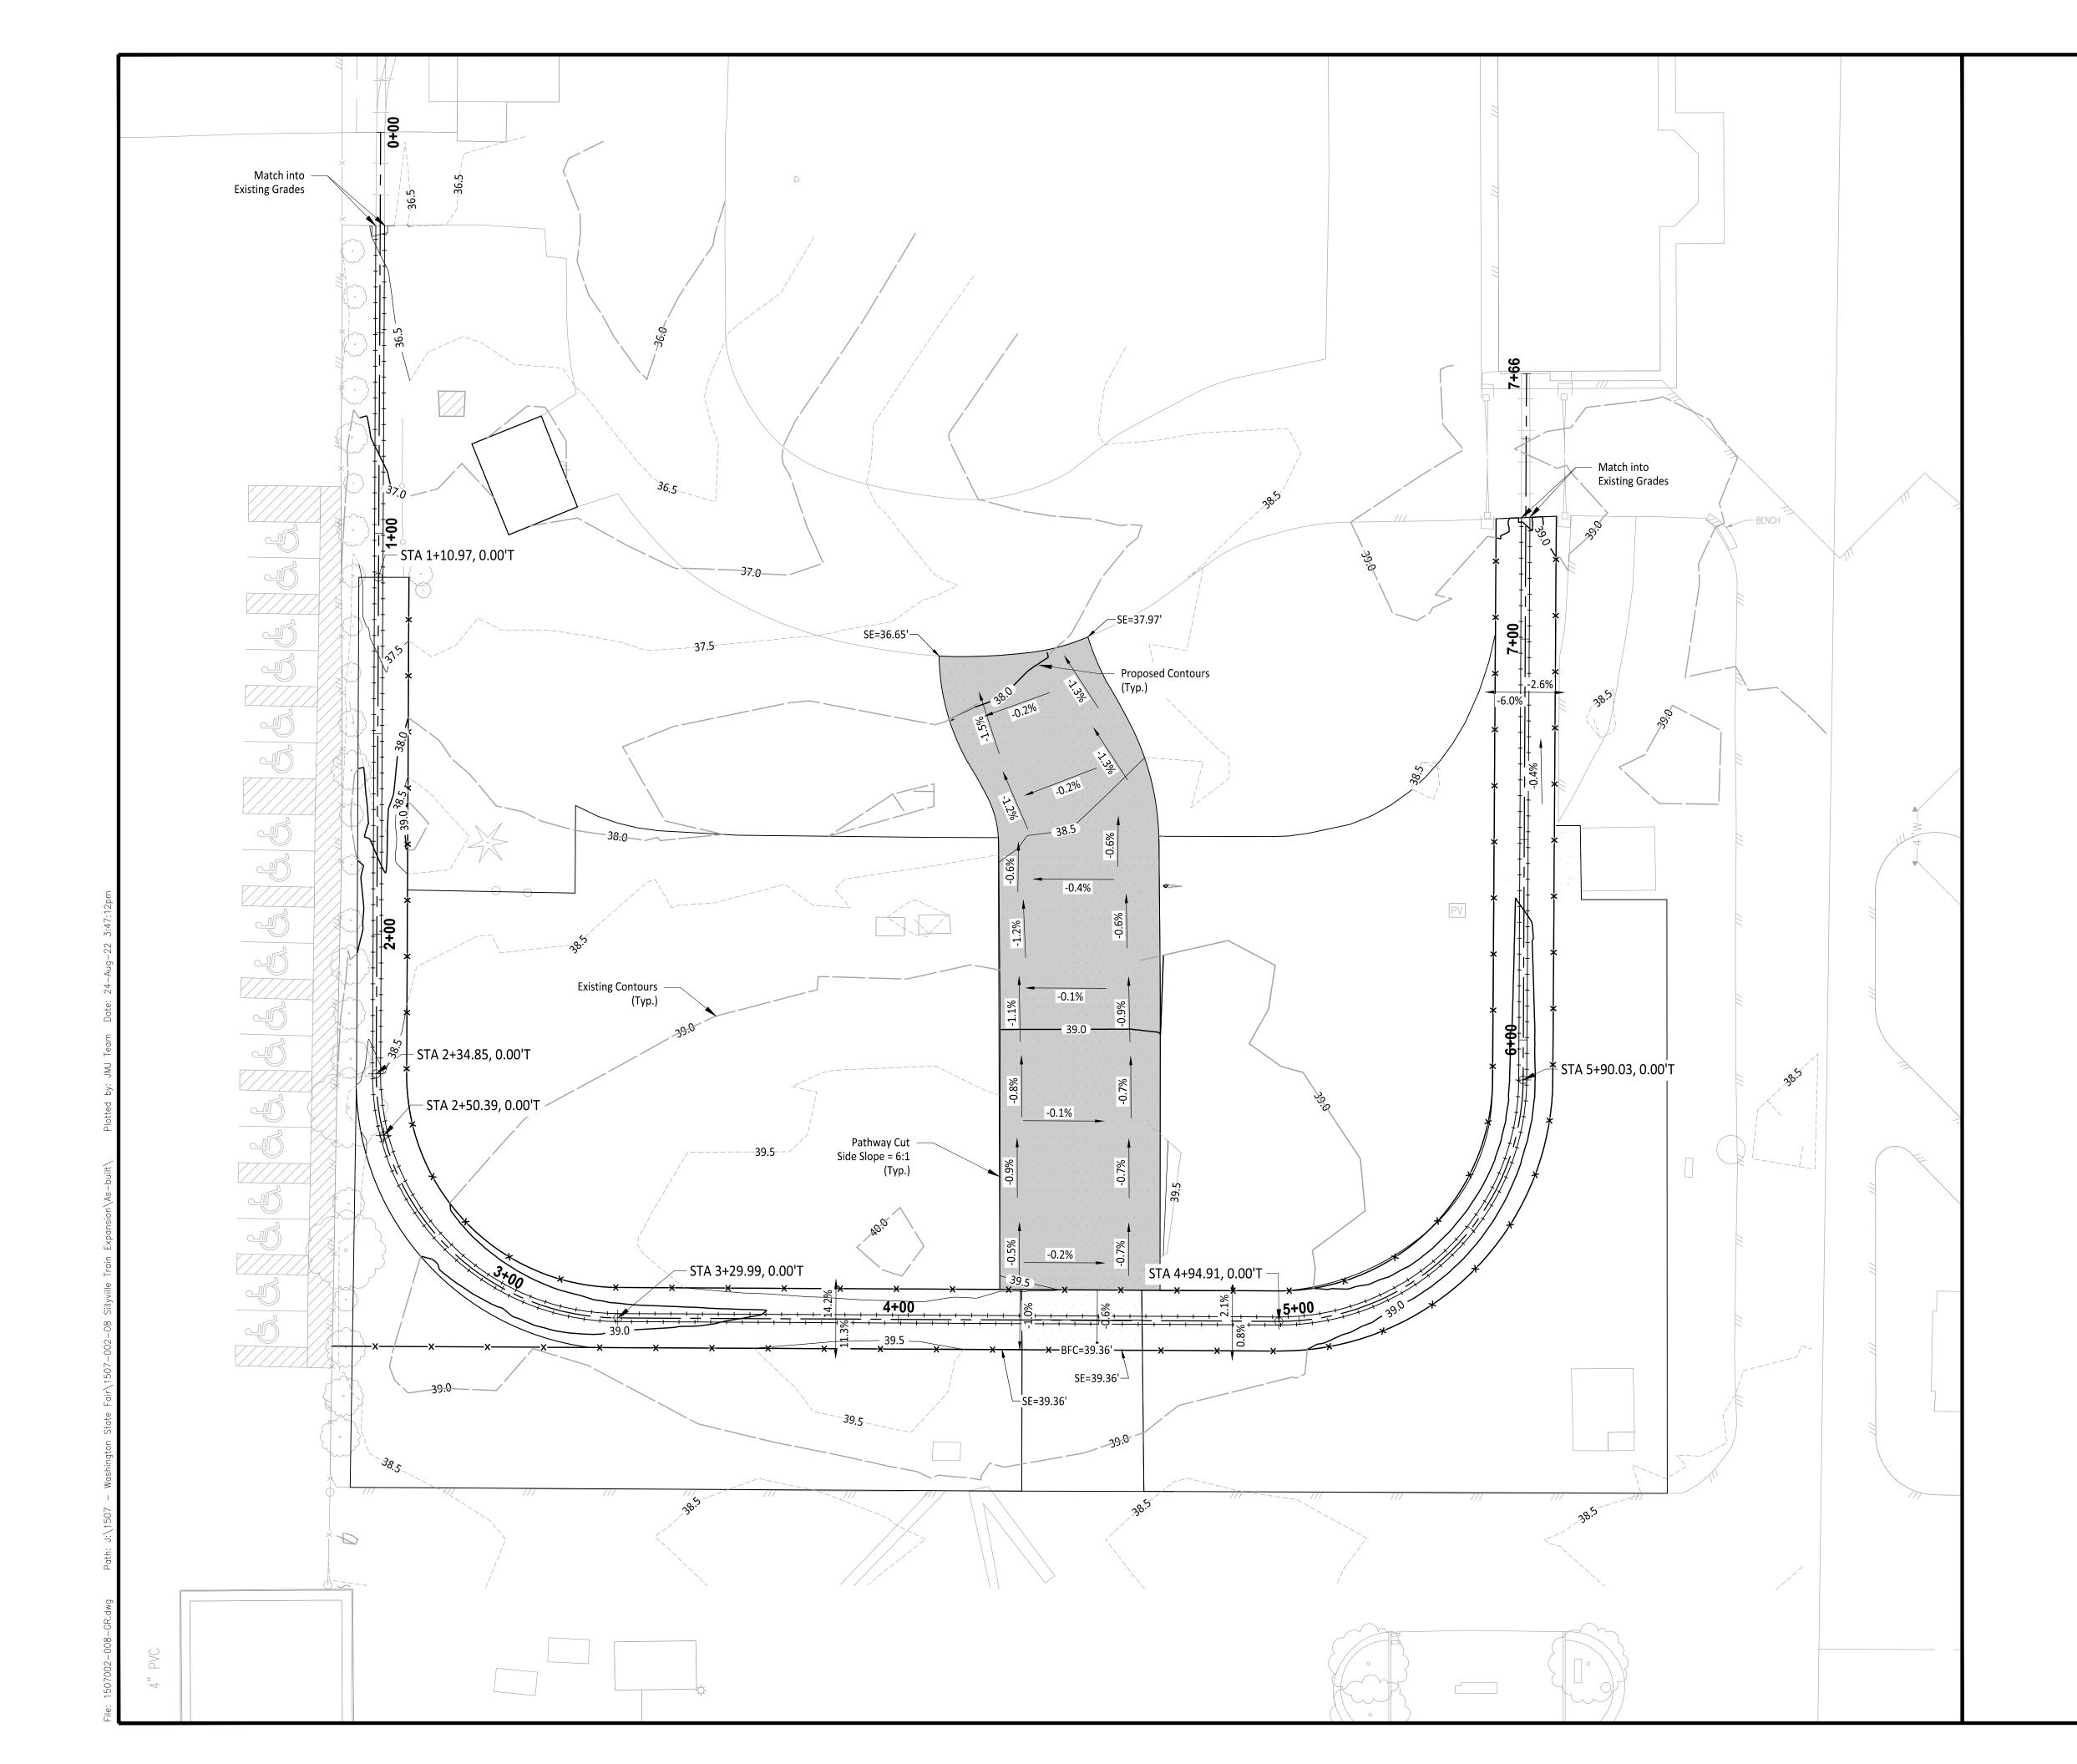


Owner/Developer:		
Dashington		
Washington STATE FAIR		
PUYALLUP		
Washington State Fair		
110 9th Ave SW		
Puyallup, WA 98371 (253) 841-5356		
(253) 841-5356		
Architect:		
- ·		
Engineer:		
2		
Justin Jones, PE		
905 Main St. Suite 200 Sumner, WA 98390		
(206) 596-2020		
Project:		
SillyVille Train Expansion		
ONE INCH AT FULL SCALE. IF NOT, SCALE ACCORDINGLY		
II NOT, SCALE ACCORDINGET		
These plans are record drawings ,		
and the information shown		
accurately reflects existing field conditions as of this date:		
08-24-2022.		
A BARRA		
STIN M. JON		
USTIN M. JON		
JAS OF WASDE VAN		
USTIN M. JO USTIN OF WASHING LED		
STATE OF WASHINGTON		
41829 Atl		
STATE OF WASHINGTON		
41829 Atl		
AIB29 AIB29 ONAL ENCIDENCIDE OB-24-22		
41829 Atl		
REV DATE DESCRIPTION I I I		
AIB29 AIB29 ONAL ENCIDENCIDE OB-24-22		
REV DATE DESCRIPTION I I I		
REV DATE DESCRIPTION I I I		
REV DATE DESCRIPTION I I I		
REV DATE DESCRIPTION I I I		
REV DATE DESCRIPTION I I I I		
REV DATE DESCRIPTION I I I		
REV DATE DESCRIPTION I I I		
REV DATE DESCRIPTION AIB 29 08-24-22 REV DATE DESCRIPTION AIB 4 AIB 4 REV DATE DESCRIPTION AIB 4 AIB 4 REV DATE DESCRIPTION OB-24-22 REV DATE DATE DESCRIPTION OB-24-22 AIB 4 OB-24-22 OB		
REV DATE DESCRIPTION I I I		
REV DATE DESCRIPTION AIB 29 08-24-22 REV DATE DESCRIPTION AIB 4 AIB 4 REV DATE DESCRIPTION AIB 4 AIB 4 REV DATE DESCRIPTION OB-24-22 REV DATE DATE DESCRIPTION OB-24-22 AIB 4 OB-24-22 OB-24-2		

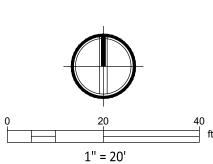

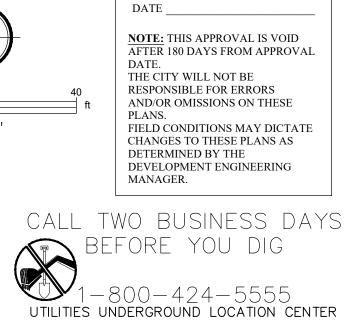

BY _____ CITY OF PUYALLUP DEVELOPMENT ENGINEERING

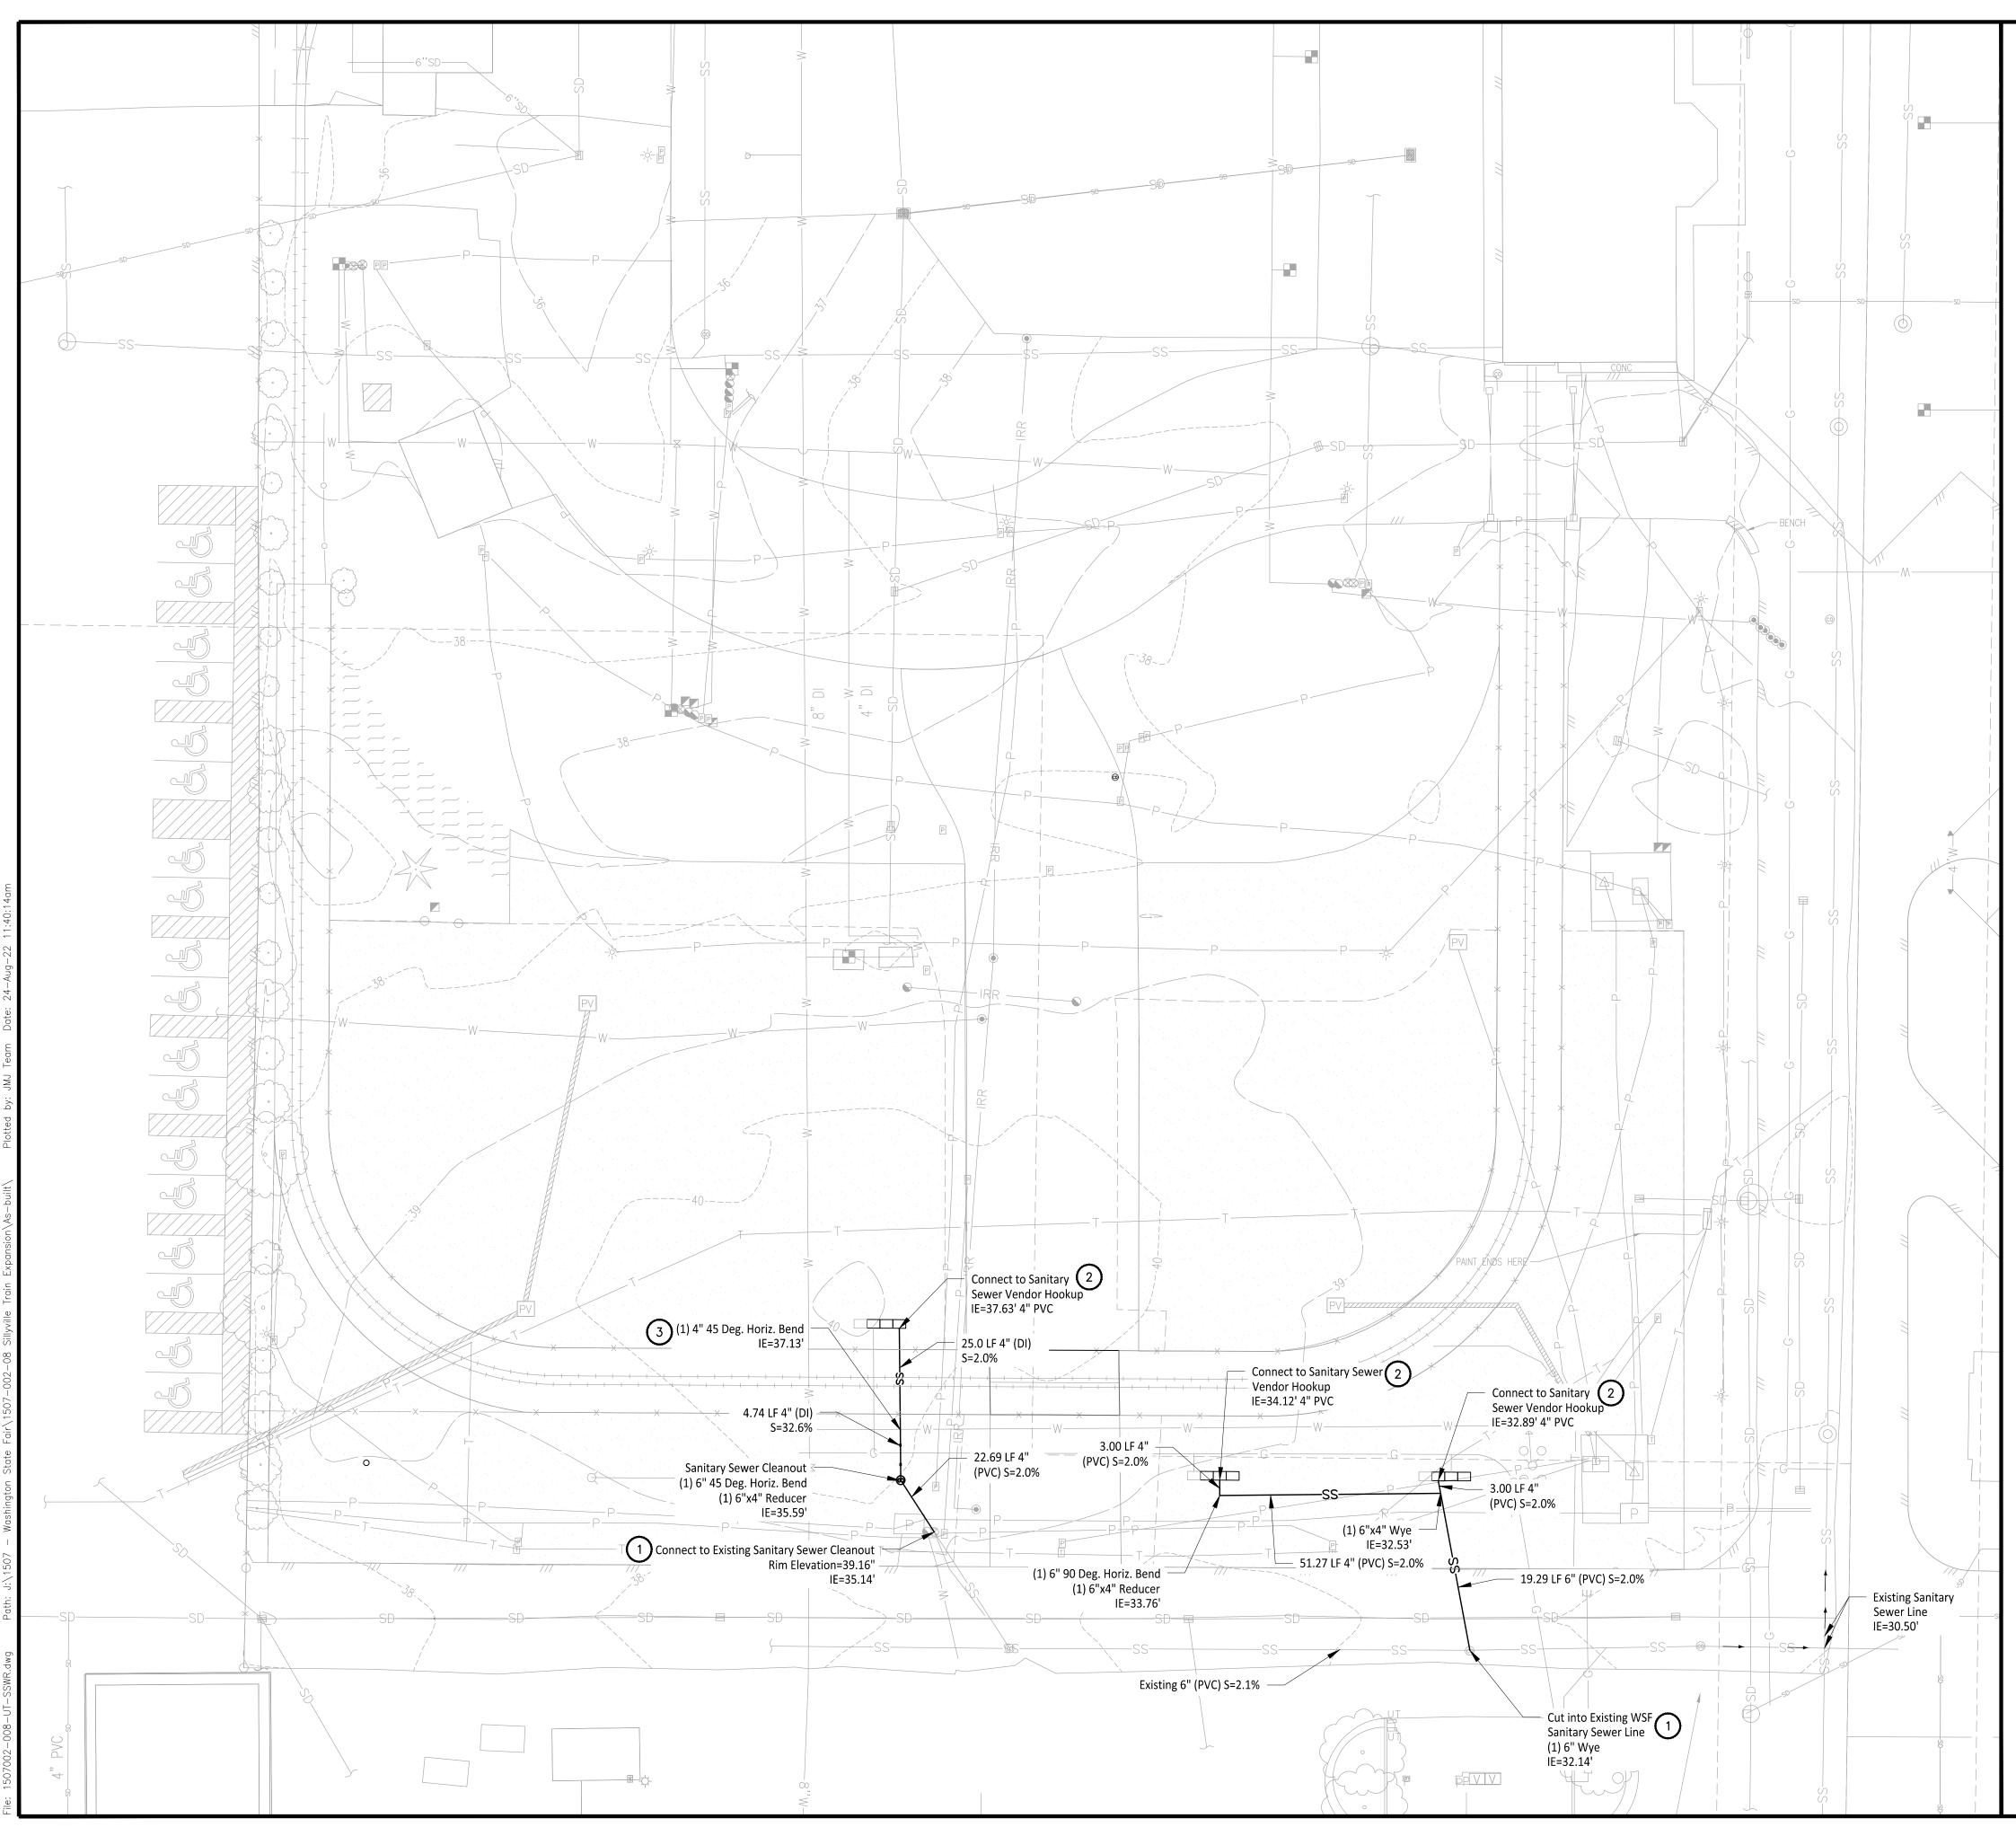

- 1 Install Commercial Side Sewer Connection per City of Puyallup Standard Detail 04.03.04 on Sheet C4-201.
- 2 Domestic Water Service and Sanitary Sewer Vendor Hook Ups to be Installed per Detail A on Sheet C4-201.


3 Contractor to install foam pad between pipe crossings with less than 18" of vertical clearance. The pad shall be O.D. x O.D. x 2.5 inches thick minimum or as required to protect the pipes. Above O.D. is equal to the outside diameter of the larger pipe. The pad shall be a polyethylene foam plank (Dow Plastics Ethafoam 220), or approved equal. See Detail B on Sheet C4-201 for detail, and Sheet C5-202 for City of Puyallup Utility Crossing Standard Details.


GENERAL NOTES

1. Contractor to Pothole, Locate Horizontal and Vertical Utilities and Verify with Engineer prior to any Utility Work.

Washington **STATE FAIR** PUYALLUP Washington State Fair 110 9th Ave SW Puyallup, WA 98371 (253) 841-5356 Architect: Engineer: Justin Jones, PE 905 Main St. Suite 200 Sumner, WA 98390 (206) 596-2020 Project: SillyVille Train Expansion ONE INCH AT FULL SCALE. IF NOT, SCALE ACCORDINGLY These plans are **record drawings**, and the information shown accurately reflects existing field conditions as of this date: 08-24-2022. 1 ALLA 41829 PORT VOIONAL P 08-24-22 REV DATE DESCRIPTION DRAWN BY: DESIGN BY: DM 1507-002-08 PROJ. NO: August 24, 2022 SHEET NAME Sanitary Sewer Plan DWG. C4-101 <u>19</u>^{0F} 23

Owner/Developer:

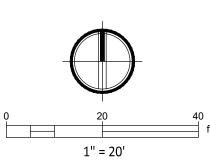

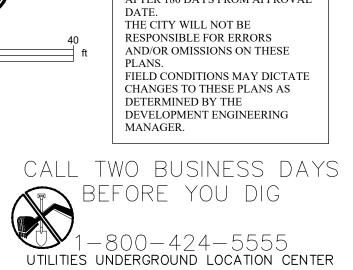


APPROVED

BY _____ CITY OF PUYALLUP DEVELOPMENT ENGINEERING

NOTE: THIS APPROVAL IS VOID


AFTER 180 DAYS FROM APPROVAL

DATE

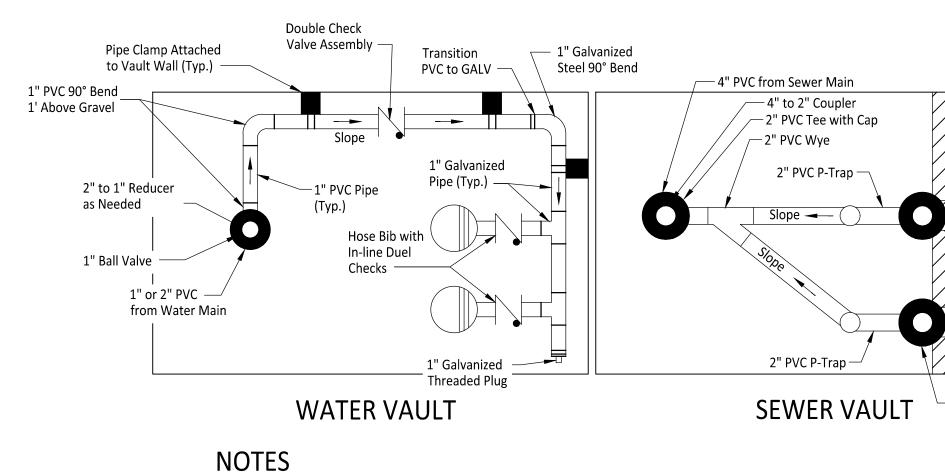

- 1. Hose bibs and sewer connections to be no more than 6" below vault lid.
- 2. Water vault lid to have two inch hole above each hose bib.
- 3. Sewer vault lid to have to have four-inch hole directly above 2" to 4" PVC reducer.
- 4. Vault to be Type 3 24" by 36" with one 12" riser and two diamond plate double hinged H20 rated lids.
- 5. Bottom of vault to be backfilled with pea gravel.
- 6. All pipe clamps to be stainless steel.



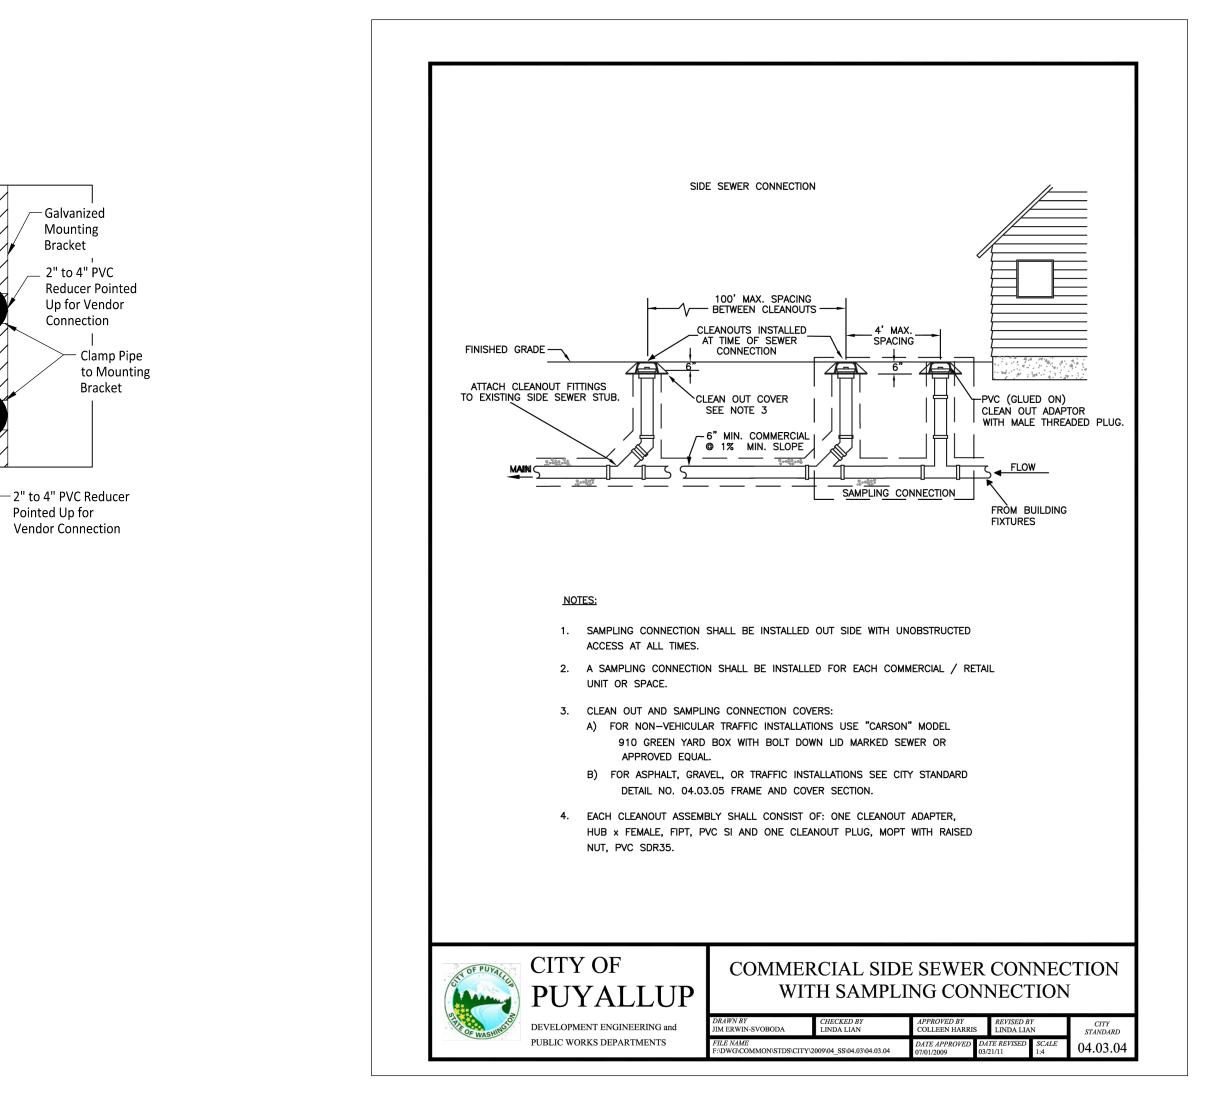

Owner/Developer:			
Washington			
STATE FAIR			
PUYALLUP			
Washington State Fair			
Washington State Fair 110 9th Ave SW			
Puyallup, WA 98371 (253) 841-5356			
	-		
Arch	nitect:		
Engi	ineer:		
905	Justin Jones, PE 905 Main St. Suite 200		
	nner, W/ 6) 596-2		
(20	0/ 390-2	020	
Proj	ect:		
		Train Expansion	
	iy vine		
	_		
		H AT FULL SCALE.	
IF	NOT, S	CALE ACCORDINGLY	
Th	ese plans	s are record drawings ,	
and	d the info	ormation shown	
		reflects existing field as of this date:	
-	-24-2022		
		N.M. JON	
	CONT	N. M. JOAN	
5	NOT STREET	N.M. JON	
	A CONT	N M. JON	
		OF WASHING CO	
THUR I		OF WASHING CO	
	HROFFESS	OF WASTING CO	
Thursday.	HROFFESS	41829 GISTERED MASHINA 41829 CONAL ENGINE	
REV	HROFFESS	41829 GISTERED MASHINA 41829 CONAL ENGINE	
REV	The second secon	41829 GISTERED VONAL ENGTHEN 08-24-22	
REV	The second secon	41829 GISTERED VONAL ENGTHEN 08-24-22	
	DATE	A1829 A1829 CISTERED IONAL ENGINE IONAL	
		41829 GISTERED VONAL ENGTHEN 08-24-22	
	DATE	AIB29 AIB29 CISTERED NALENGINES OB-24-22 DESCRIPTION DESCRIPTION DESCRIPTION DESCRIPTION DESCRIPTION JJ	
	DATE	AIB29 AIB29 CISTERED NALENGINES OB-24-22 DESCRIPTION DESCRIPTION DESCRIPTION DESCRIPTION DESCRIPTION DESCRIPTION JJ 1507-002-08	
	DATE	AIB29 AIB29 CISTERED NALENGINES OB-24-22 DESCRIPTION DESCRIPTION DESCRIPTION DESCRIPTION DESCRIPTION JJ	
DRAV PROJ. DATE:	DATE	AIB29 AIB29 CISTERED NALENGINES OB-24-22 DESCRIPTION DESCRIPTION DESCRIPTION DESCRIPTION DESCRIPTION DESCRIPTION JJ 1507-002-08	
DRAV PROJ. DATE:	DATE	VASIANCE NET CONTRACTOR OF WASHINGTON OF WASHINGTON OF CONTRACTOR OF CON	
DRAV PROJ. DATE: SHEET		AIB29 AIB29 CISTERED INAL ENGLINE OB-24-22 DESCRIPTION DESCRIPTION DESCRIPTION DESCRIPTION DESCRIPTION JUNAL ENGLINE INAL ENGLINE	
DRAV PROJ. DATE: SHEET	DATE	AIB29 AIB29 CISTERED INAL ENGLINE OB-24-22 DESCRIPTION DESCRIPTION DESCRIPTION DESCRIPTION DESCRIPTION JUNAL ENGLINE INAL ENGLINE	
DRAV PROJ. DATE: SHEET		AIB29 AIB29 CISTERED INAL ENGLINE OB-24-22 DESCRIPTION DESCRIPTION DESCRIPTION DESCRIPTION DESCRIPTION JUNAL ENGLINE INAL ENGLINE	
DRAV PROJ. DATE: SHEET		AIB29 AIB29 CISTERED INAL ENGLINE OB-24-22 DESCRIPTION DESCRIPTION DESCRIPTION DESCRIPTION DESCRIPTION JUNAL ENGLINE INAL ENGLINE	
DRAV PROJ. DATE: SHEET		AIB29 AIB29 CISTERED ONAL ENCINE OB-24-22 DESCRIPTION DESCRIPTION DESCRIPTION J J 1507-002-08 August 24, 2022 COMMINE August 24, 2022	
DRAV PROJ. DATE: SHEET		AIB29 OSTERTED OS-24-22 DESCRPTION OS-24-22 DESCRPTION OS-24-22 OS-24	


BY _____ CITY OF PUYALLUP DEVELOPMENT ENGINEERING


DATE _____


NOTE: THIS APPROVAL IS VOID AFTER 180 DAYS FROM APPROVAL DATE. THE CITY WILL NOT BE RESPONSIBLE FOR ERRORS AND/OR OMISSIONS ON THESE PLANS.


FIELD CONDITIONS MAY DICTATE CHANGES TO THESE PLANS AS DETERMINED BY THE DEVELOPMENT ENGINEERING MANAGER.



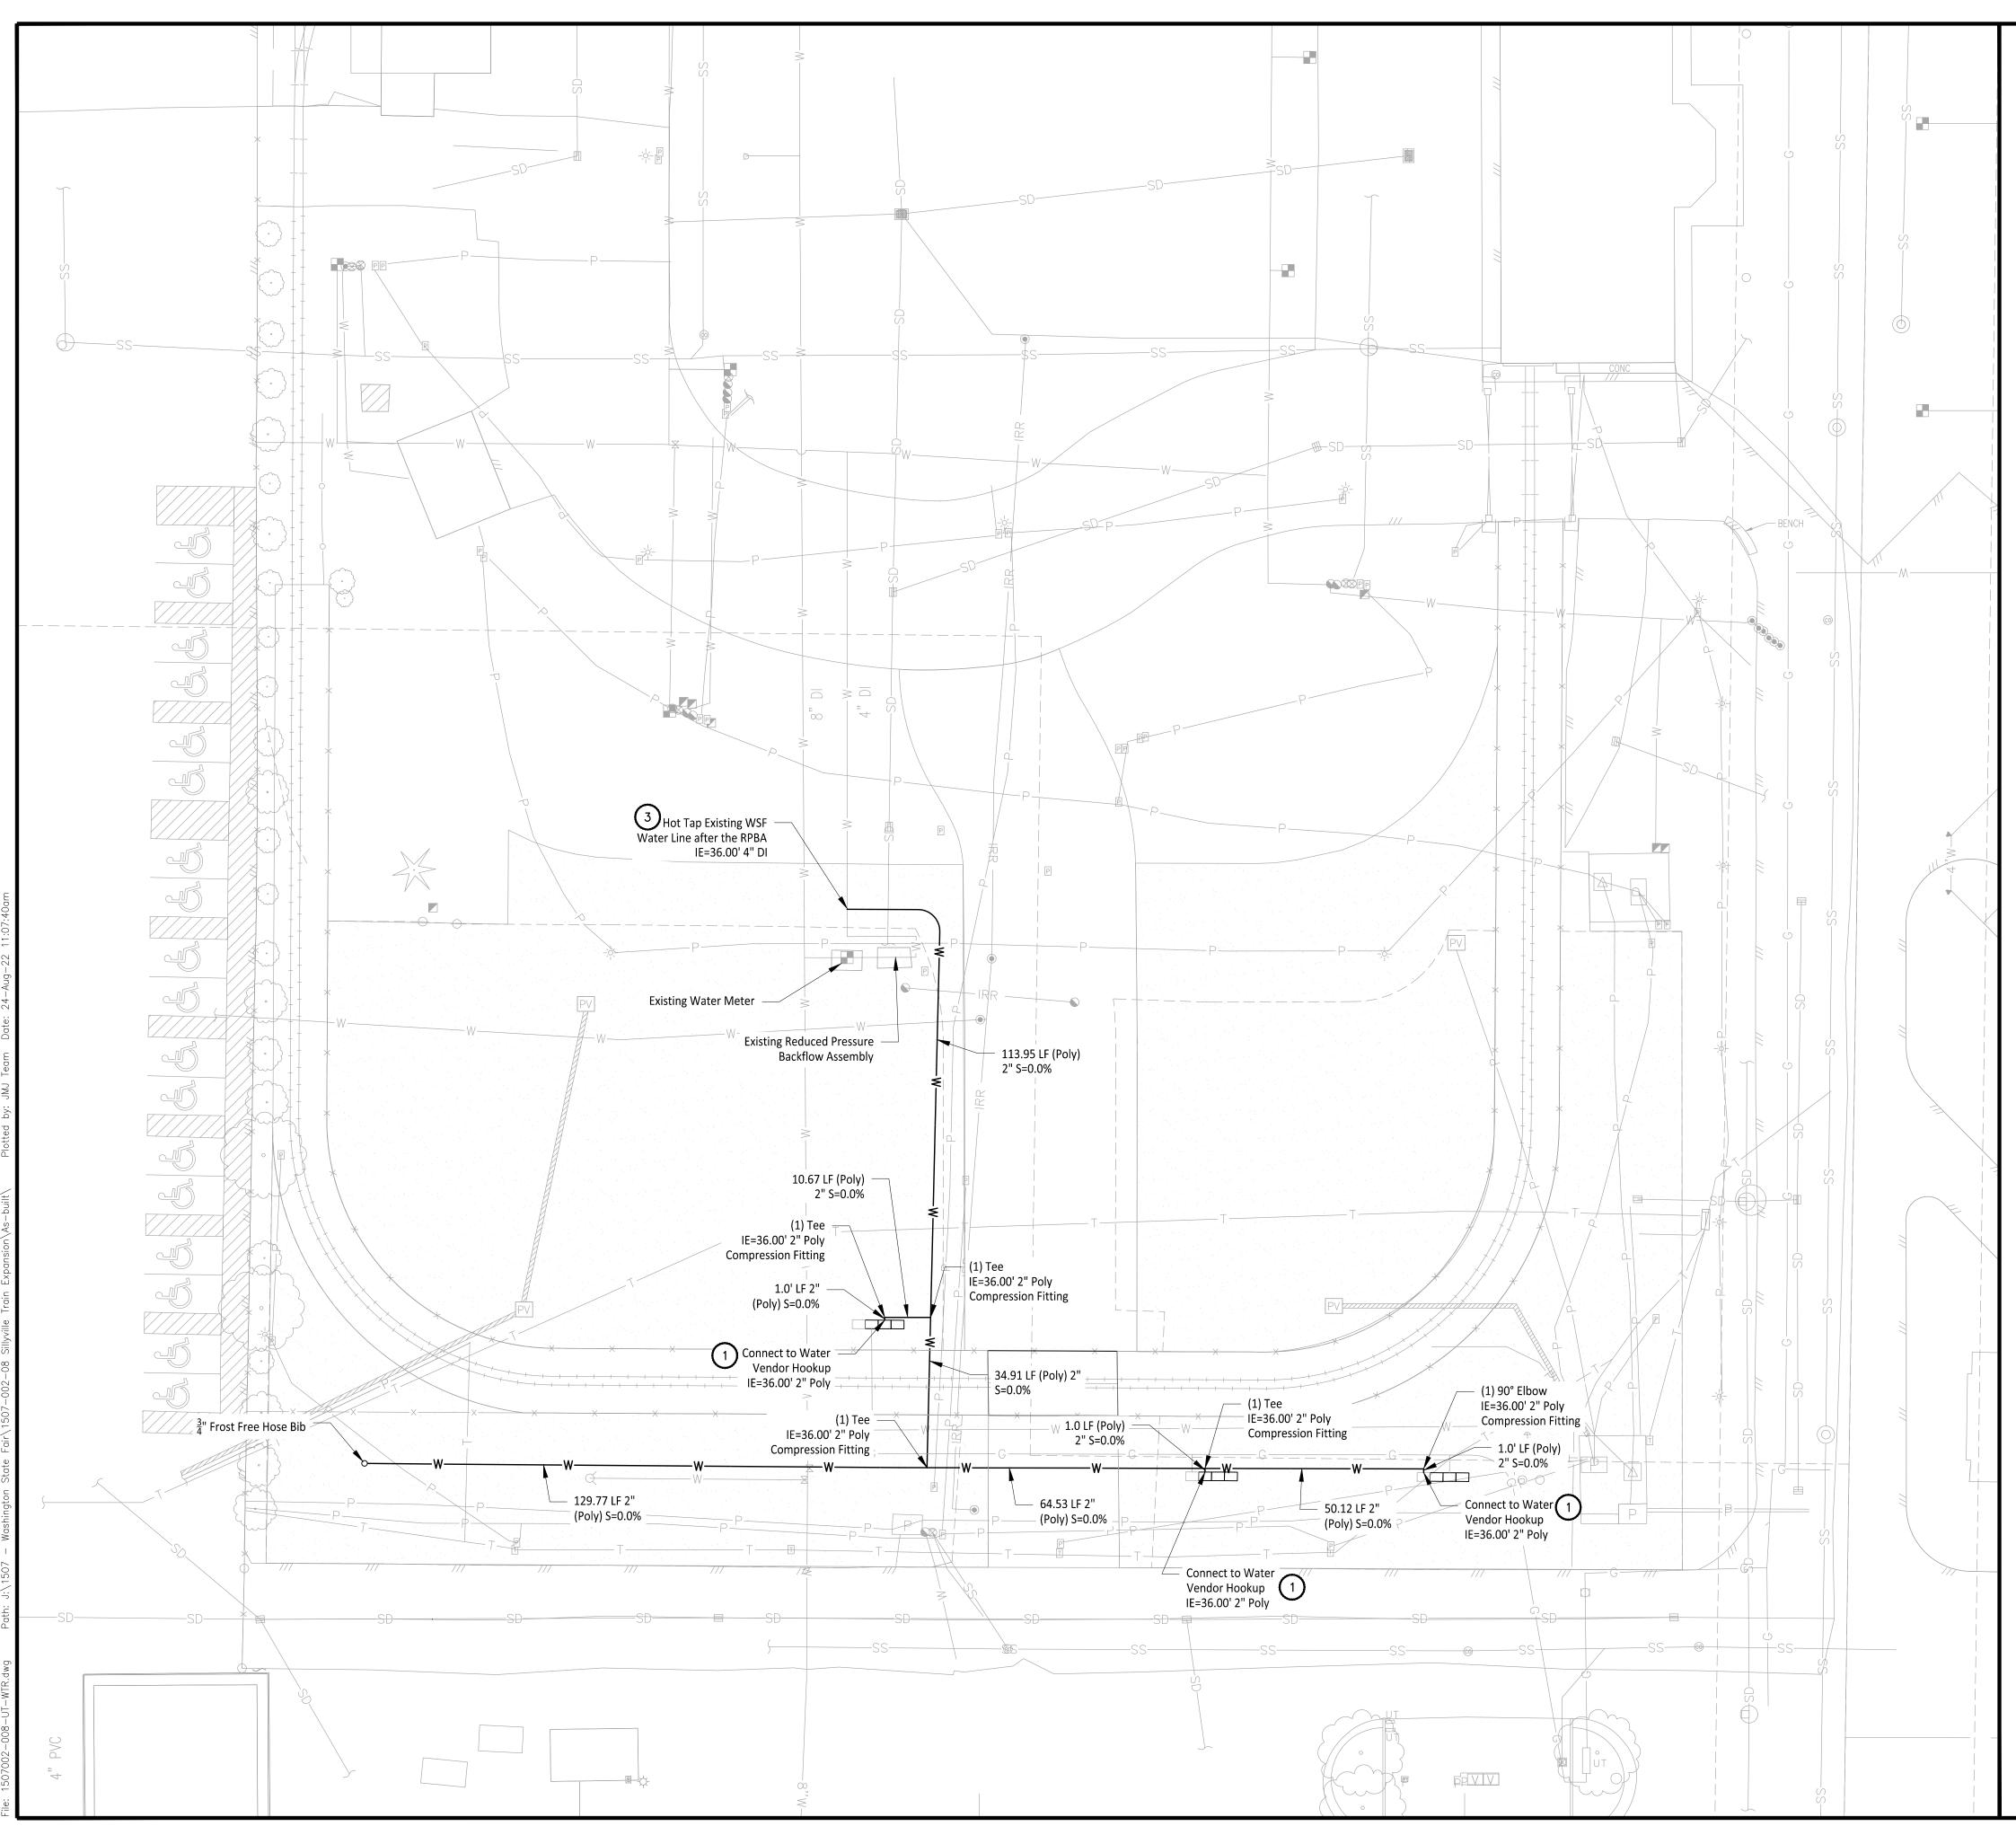

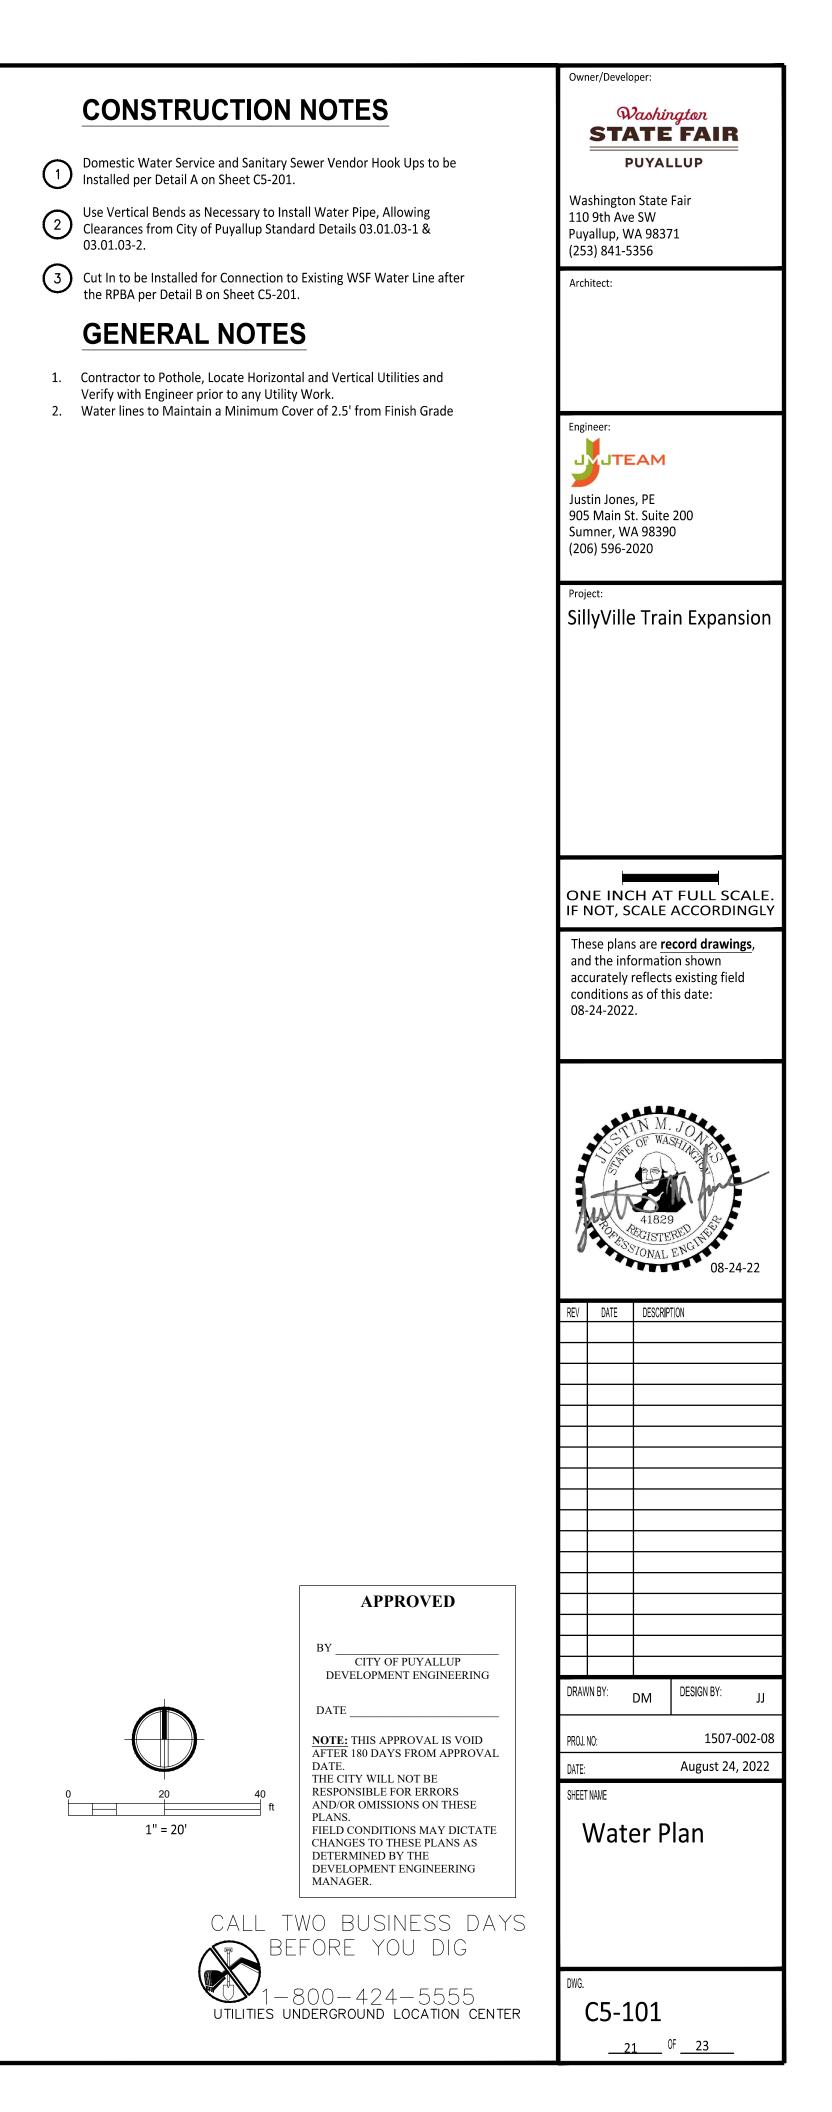

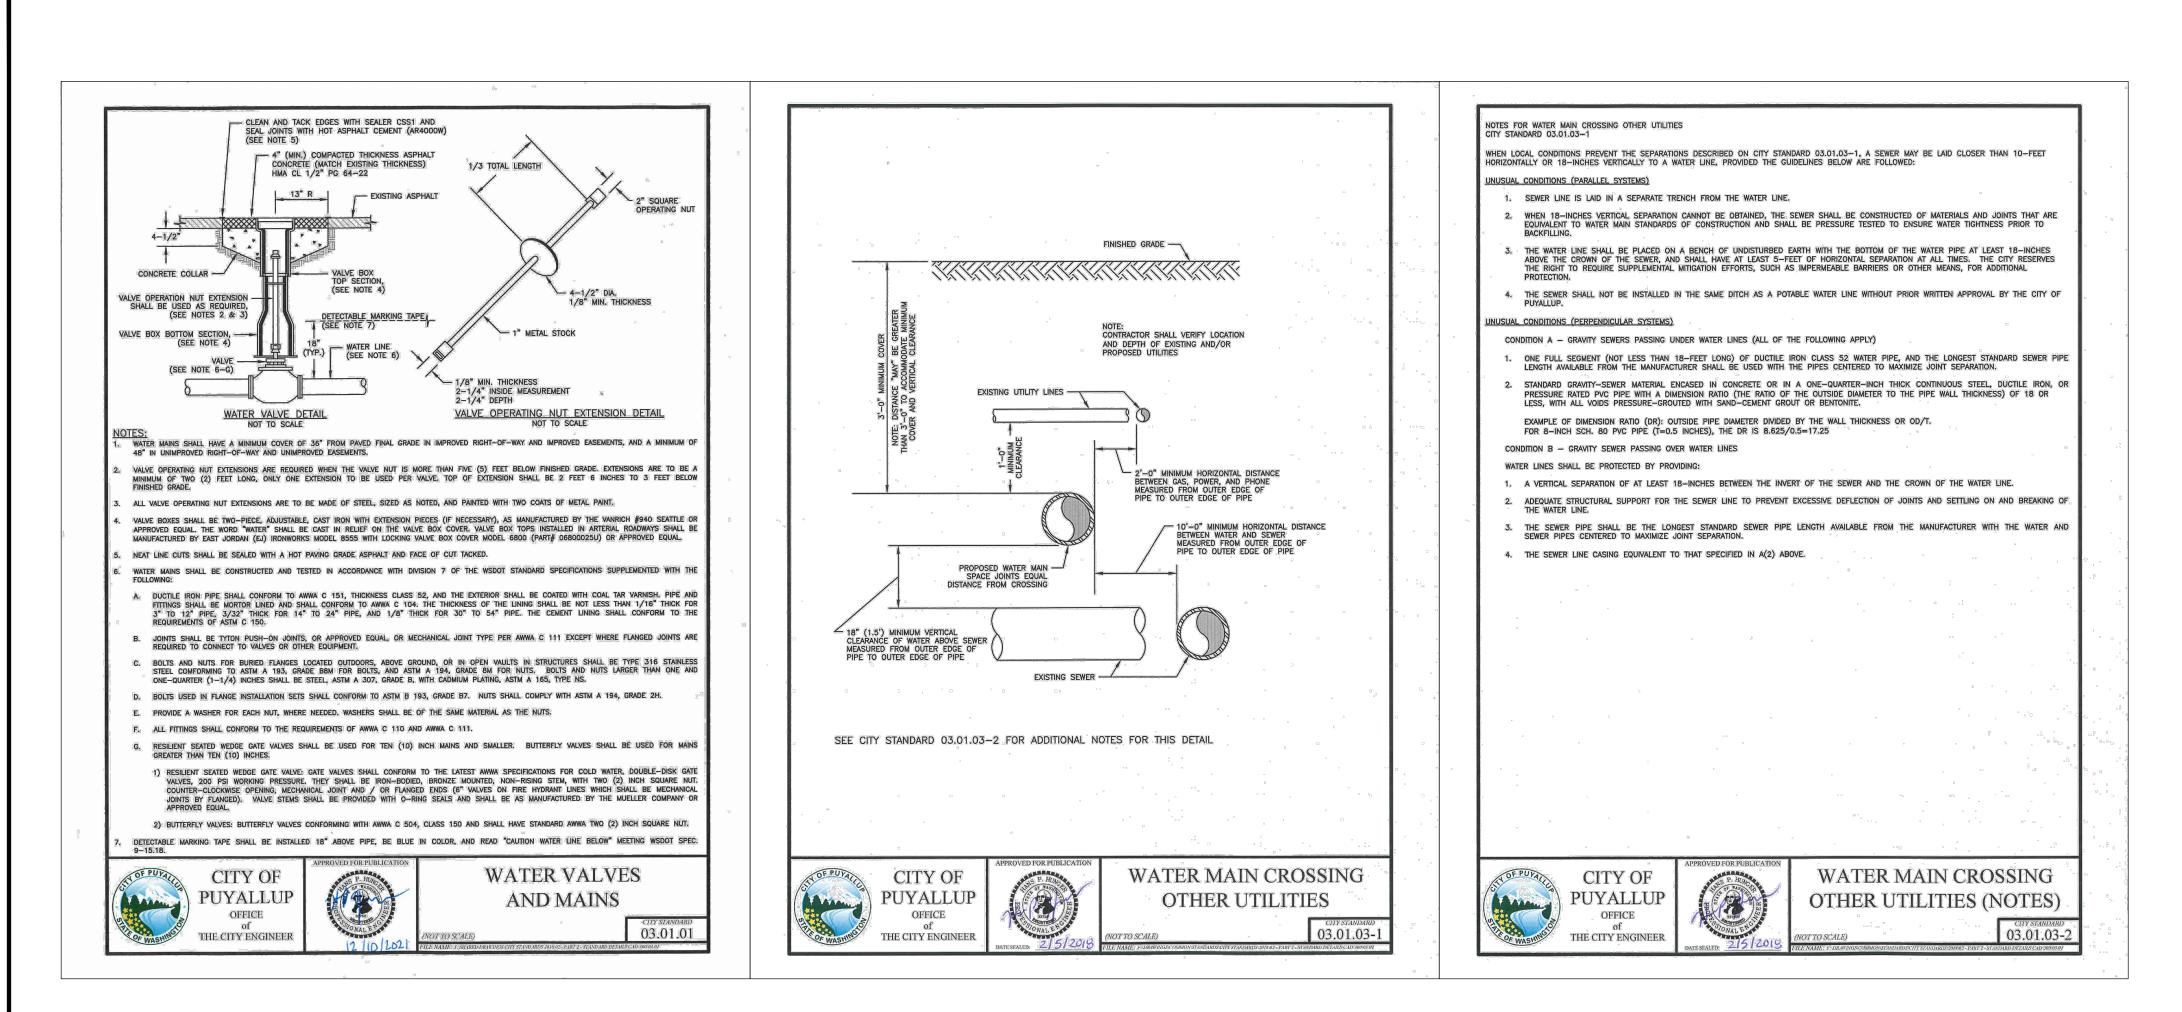

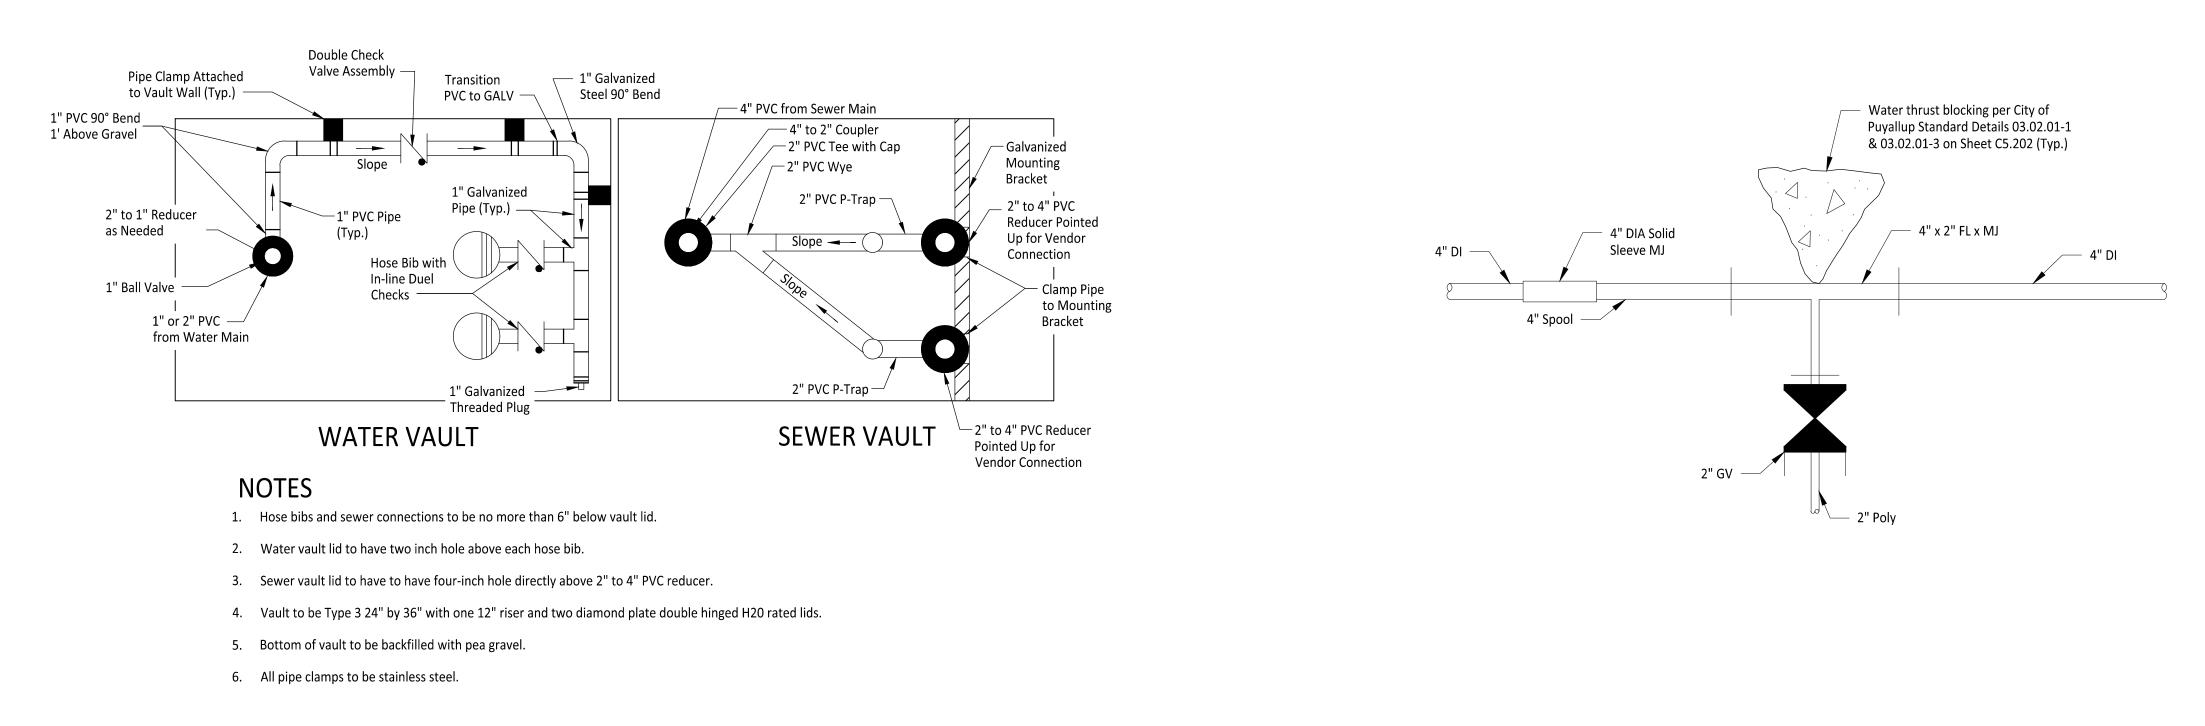

WATER & SEWER VENDOR CONNECTIONDETAIL $\widehat{\mathbf{DETAIL}}$ 1" = 1'C5-201

 $\begin{array}{c} \hline \textbf{CUT-IN TO EXISTING MAIN} \\ \hline \textbf{DETAIL} \\ 1" = 1' \\ \hline \textbf{C5-201} \end{array}$

Owner/Developer:				
Washington STATE FAIR				
PUYALLUP				
Washington State Fair 110 9th Ave SW				
Puyallup, WA 98371 (253) 841-5356				
Architect:				
Artifitett.				
Engi	neer:			
JMJTEAM				
Justin Jones, PE				
905 Main St. Suite 200				
	Sumner, WA 98390 (206) 596-2020			
Proj	ect:			
		e Trai	n Expans	sion
			·	
ON IF 1	IE INC NOT, S	CALE	FULL SC	ALE. IGLY
			cord drawing	gs,
			on shown existing field	
cor	nditions : 24-2022	as of th		•
08-	-24-2022			
		N M.		
	NOT THE	N M. OF WA	JONNES	
	20011 20011	N M. OF WA	JOANSS	
			n	
1111 C			n	/
	Window Window		n	-22
DEV	ARONALSS	41829 EGISTE	RED INGINEST	-22
REV	Window Window	41829 EGISTE	RED INGINEST	-22
REV	ARONALSS	41829 EGISTE	RED INGINEST	-22
REV	ARONALSS	41829 EGISTE	RED INGINEST	-22
		41829 EGISTE	RED INGINEST	-222
		41829	DESIGN BY:	
DRAW		41829	DESIGN BY: 1507-0	JJ 02-08
DRAW PROJ.		41829	DESIGN BY:	JJ 02-08
DRAW PROJ. DATE: SHEET	DATE	A1829	DESIGN BY: 1507-0 August 24,	JJ 02-08
DRAW PROJ. DATE: SHEET	DATE	A1829	DESIGN BY: 1507-0	JJ 02-08
DRAW PROJ. DATE: SHEET	DATE	A1829	DESIGN BY: 1507-0 August 24,	JJ 02-08
DRAW PROJ. DATE: SHEET	DATE	A1829	DESIGN BY: 1507-0 August 24,	JJ 02-08
DRAW PROJ. DATE: SHEET	DATE	A1829	DESIGN BY: 1507-0 August 24,	JJ 02-08
DRAW PROJ. DATE: SHEET	DATE	A1829	DESIGN BY: 1507-0 August 24,	JJ 02-08
DRAW PROJ. DATE: SHEET			DESIGN BY: 1507-0 August 24,	JJ 02-08
DRAW PROJ. DATE: SHEET	DATE		DESIGN BY: 1507-0 August 24,	JJ 02-08

APPROVED


BY CITY OF PUYALLUP DEVELOPMENT ENGINEERING

DATE _

NOTE: THIS APPROVAL IS VOID AFTER 180 DAYS FROM APPROVAL DATE. THE CITY WILL NOT BE RESPONSIBLE FOR ERRORS AND/OR OMISSIONS ON THESE PLANS.

FIELD CONDITIONS MAY DICTATE CHANGES TO THESE PLANS AS DETERMINED BY THE DEVELOPMENT ENGINEERING MANAGER.



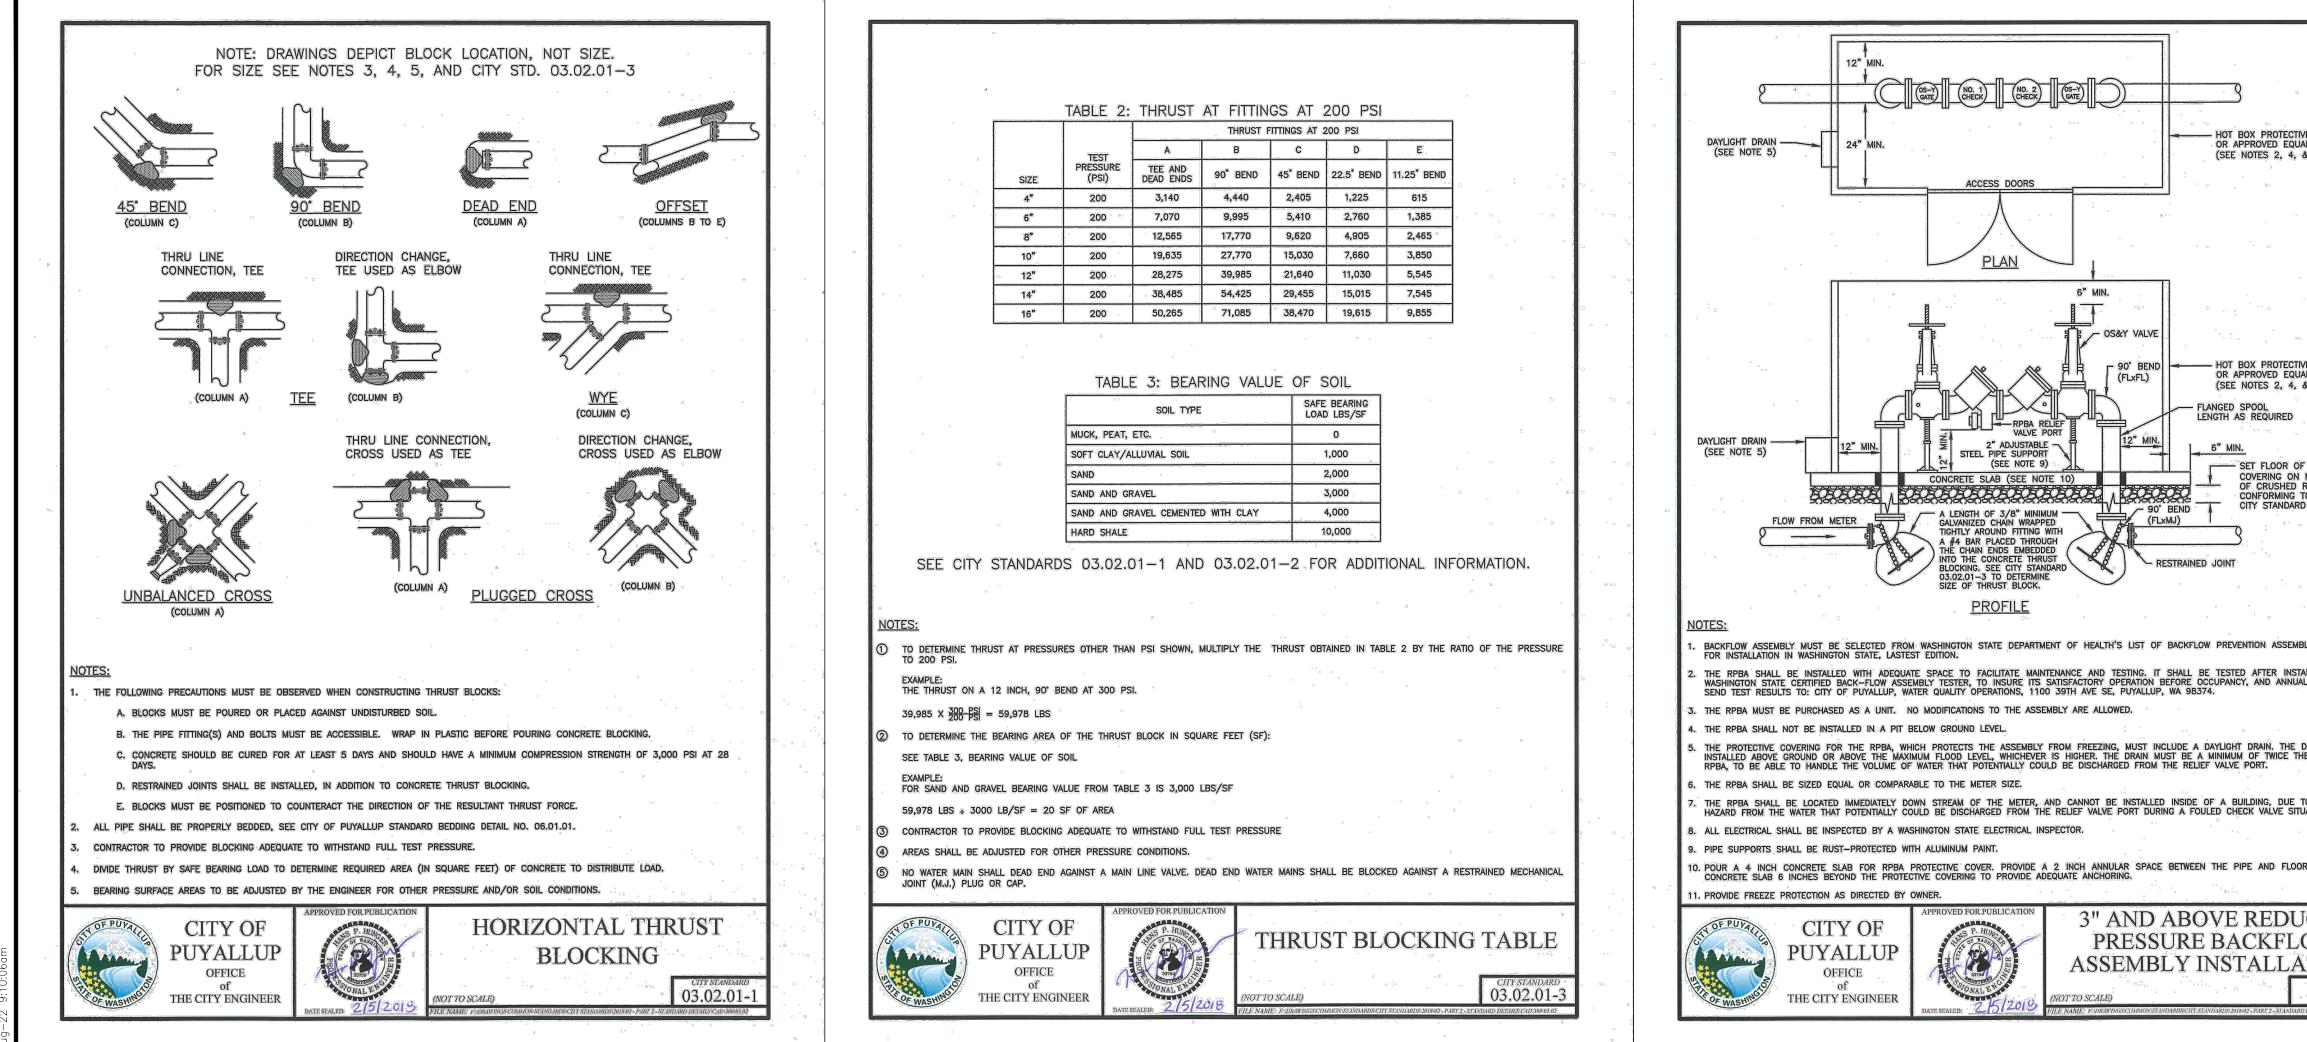

		Owner/Developer:
L L		Washington STATE FAIR
а - п		PUYALLUP
		Washington State Fair
IVE COVER JAL & 5)		110 9th Ave SW Puyallup, WA 98371
·		(253) 841-5356
		Architect:
n		
IVE COVER JAL & 5)		Engineer:
		JUJTEAM
		Justin Jones, PE 905 Main St. Suite 200 Summer WA 08200
F PROTECTIVE I MINIMUM 6" ROCK		Sumner, WA 98390 (206) 596-2020
ROCK TO NOTE 2, RD 06.01.01		Project:
		SillyVille Train Expansion
، ، ۵ ، ۵		
а в с		
BLIES APPROVED		
TALLATION, BY A ALLY THERAFTER.		
DRAIN MUST BE HE SIZE OF THE		
		ONE INCH AT FULL SCALE. IF NOT, SCALE ACCORDINGLY
OR. EXTEND THE		These plans are record drawings ,
		and the information shown accurately reflects existing field
		conditions as of this date: 08-24-2022.
ATION CITY STANDARD		
- 03.04.03		
т ту с ай а а с ай а а		TIN M. JO
		SS OF WASHING
		1 Contract
		41829 70 Hittinger (S) (S)
		OPESSIONAL ENGINE
		REV DATE DESCRIPTION
	APPROVED	
	BY	
	CITY OF PUYALLUP DEVELOPMENT ENGINEERING	DRAWN BY: DNA DESIGN BY: LL
	DATE	
	NOTE: THIS APPROVAL IS VOID AFTER 180 DAYS FROM APPROVAL	PROJ. NO: 1507-002-08
	DATE. THE CITY WILL NOT BE RESPONSIBLE FOR ERRORS	DATE: August 24, 2022 SHEET NAME
	AND/OR OMISSIONS ON THESE PLANS. FIELD CONDITIONS MAY DICTATE	Water Details
	CHANGES TO THESE PLANS AS DETERMINED BY THE DEVELOPMENT ENGINEERING MANAGER.	vvaler Details
	CALL TWO BUSINESS DAYS	
	1-800-424-5555	DWG.
	UTILITIES UNDERGROUND LOCATION CENTER	C5-202