

WALKER HIGH SCHOOL SITE UTILITIES PROJECT


5715 MILWAUKEE AVE E
PUYALLUP, WA 98374

RECORD DRAWING
RECORD DRAWING INFORMATION IS
PROVIDED BY NORTHWEST CASCADE, INC.
RECORD DRAWING INFORMATION WAS
REVIEWED BY R. HAND OF SITTS & HILL
ENGINEERS AND THE INSTALLATION
SUBSTANTIALLY CONFORMS TO APPROVED
PLANS.



APPROVED
BY *[Signature]*
CITY OF PUYALLUP
DEVELOPMENT SERVICES
DATE **07/26/2021**

NOTE: THIS APPROVAL IS VOID
AFTER 180 DAYS FROM
APPROVAL DATE.
THE CITY WILL NOT BE
RESPONSIBLE FOR ERRORS
AND/OR OMISSIONS ON THESE
PLANS.
FIELD CONDITIONS MAY DICTATE
CHANGES TO THESE PLANS AS
DETERMINED BY THE CITY
ENGINEER

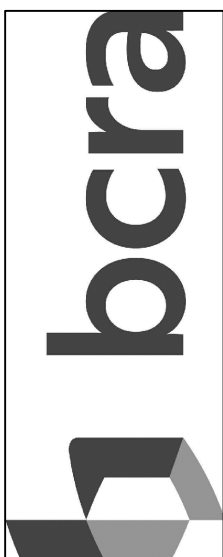

T 253.627.4367 F 253.627.4365 WWW.BCRADESIGN.COM
2108 PACIFIC AVENUE, SUITE 300, TACOMA, WA 98402



VICINITY MAP:

SCALE: 1"=1000'



OWNER:

PUYALLUP SCHOOL DISTRICT NO. 3

323 12TH ST NW

PUYALLUP, WA 98371

CONTACT: FRANKIE TOPASNA, (253) 841-8641

PREPARED BY:



CIVIL ■ STRUCTURAL ■ SURVEYING

4815 CENTER STREET, TACOMA, WA. 98409 (253) 474-9449 FAX (253) 474-0153

CONTACT: RICK HAND, SENIOR PROJECT MANAGER

INDEX OF DRAWINGS:

DRAWING No.	SHEET No.	TITLE - DESCRIPTION	DRAWING No.	SHEET No.	TITLE - DESCRIPTION
PORTABLE RELOCATION DRAWING SET (PIERCE COUNTY)			SITE UTILITIES DRAWING SET (CITY OF PUYALLUP)		
T1.0W	SHEET 1 OF 27	PORTABLE RELOCATION COVER SHEET	C10.0W	SHEET 14 OF 27	SITE UTILITIES COVER SHEET
C1.0W	SHEET 2 OF 27	PIERCE COUNTY GENERAL NOTES	C11.0W	SHEET 15 OF 27	CITY OF PUYALLUP GENERAL NOTES
C1.1W	SHEET 3 OF 27	LEGEND AND ABBREVIATIONS	C11.1W	SHEET 16 OF 27	CITY OF PUYALLUP GENERAL NOTES
C2.0W	SHEET 4 OF 27	TOPOGRAPHIC SURVEY	C11.2W	SHEET 17 OF 27	CITY OF PUYALLUP GENERAL NOTES
C3.0W	SHEET 5 OF 27	OVERALL PROJECT DEMOLITION AND TESC PLAN	C11.3W	SHEET 18 OF 27	LEGEND AND ABBREVIATIONS
C3.1W	SHEET 6 OF 27	PORTABLE RELOCATION DEMOLITION AND TESC PLAN	C12.0W	SHEET 19 OF 27	TOPOGRAPHIC SURVEY
C4.0W	SHEET 7 OF 27	OVERALL PROJECT SURFACING AND LAYOUT PLAN	C13.0W	SHEET 20 OF 27	SITE UTILITIES DEMOLITION AND TESC PLAN
C4.1W	SHEET 8 OF 27	PORTABLE RELOCATION SURFACING AND LAYOUT PLAN	C14.0W	SHEET 21 OF 27	SITE UTILITIES SURFACING AND LAYOUT PLAN
C5.0W	SHEET 9 OF 27	PORTABLE RELOCATION GRADING AND DRAINAGE PLAN	C15.0W	SHEET 22 OF 27	SITE UTILITIES WATER PLAN
C6.0W	SHEET 10 OF 27	PORTABLE RELOCATION DETAILS	C16.0W	SHEET 23 OF 27	SITE UTILITIES SANITARY SEWER PROFILE 1
C6.1W	SHEET 11 OF 27	PORTABLE RELOCATION DETAILS	C16.1W	SHEET 24 OF 27	SITE UTILITIES SANITARY SEWER PROFILE 2
C6.2W	SHEET 12 OF 27	PORTABLE RELOCATION DETAILS	C17.0W	NOT USED	
C6.3W	SHEET 13 OF 27	PORTABLE RELOCATION DETAILS	C17.1W	SHEET 25 OF 27	SITE UTILITIES DETAILS
			C17.2W	SHEET 26 OF 27	SITE UTILITIES DETAILS
			C17.3W	SHEET 27 OF 27	SITE UTILITIES DETAILS

PREPARED FOR:



2106 PACIFIC AVE, SUITE 300

TACOMA, WA 98402

CONTACT: CHRISTINE PHILLIPS, (253) 627-4367

PROJECT INFORMATION:

SITE ADDRESS:	5715 MILWAUKEE AVE E, PUYALLUP, WA 98374														
PARCEL NO.	7705000171 (3.38 ACRES)														
ZONING:	EC (EMPLOYMENT CENTER)														
OWNER CONTACT:	PUYALLUP SCHOOL DISTRICT NO. 3 323 12TH ST NW PUYALLUP, WA 98371														
LAND USE:	HIGH SCHOOL														
100-YEAR FLOODPLAIN: N/A - ZONE 'X' PER FEMA MAP PANEL NUMBER 53053C0600E															
SCOPE OF WORK:	INSTALLATION OF SITE UTILITIES FOR PORTABLE CLASSROOM CONNECTION TO PUBLIC SEWER AND WATER														
IMPERVIOUS SURFACE:	PORTABLE BUILDING RELOCATION PROJECT <table><tr><td>ROOF</td><td>1,728 S.F.</td></tr><tr><td>NEW HARD SURFACE</td><td>180 S.F.</td></tr><tr><td>TOTAL</td><td>1,908 S.F.</td></tr></table> SANITARY SEWER PROJECT (ALL SURFACES ARE REPLACED IN KIND) <table><tr><td>ASPHALT</td><td>5,281 S.F.</td></tr><tr><td>CONCRETE</td><td>462 S.F.</td></tr><tr><td>LANDSCAPE/GRAVEL</td><td>6,346 S.F.</td></tr><tr><td>TOTAL</td><td>12,089 S.F.</td></tr></table>	ROOF	1,728 S.F.	NEW HARD SURFACE	180 S.F.	TOTAL	1,908 S.F.	ASPHALT	5,281 S.F.	CONCRETE	462 S.F.	LANDSCAPE/GRAVEL	6,346 S.F.	TOTAL	12,089 S.F.
ROOF	1,728 S.F.														
NEW HARD SURFACE	180 S.F.														
TOTAL	1,908 S.F.														
ASPHALT	5,281 S.F.														
CONCRETE	462 S.F.														
LANDSCAPE/GRAVEL	6,346 S.F.														
TOTAL	12,089 S.F.														

ONLY WATER AND SEWER UTILITIES
ARE BEING REVIEWED BY THE CITY
OF PUYALLUP FOR THIS PLAN SET

THE CITY OF PUYALLUP IS NOT
REVIEWING COMPLIANCE FOR THE
GENERAL NOTES AND KEY NOTES
ON SHEETS C13.0W AND C14.0W



SITTS & HILL ENGINEERS, INC.			
CIVIL ■ STRUCTURAL ■ SURVEYING			
4815 CENTER STREET TACOMA, WA. 98409			
PHONE: (253) 474-9449 FAX: (253) 474-0153			
http://www.sitts-hill-engineers.com/			
Project No.:	19,034	Project Mgr.:	R.H.
Proj. Engineer:	S.A.J.	Proj. Drafter:	S.A.J.

PROJECT:
PUYALLUP SCHOOL DISTRICT
WALKER HIGH SCHOOL SITE UTILITIES
5715 MILWAUKEE AVE E
PUYALLUP, WA 98372

REVISIONS
5-10-21 PERMIT SUBMITTAL
6-14-21 PERMIT RESUBMITTAL
6-23-21 BID SET
6-25-21 CITY RESUBMITTAL
7-23-21 CITY RESUBMITTAL
10-04-22 RECORD DRAWINGS

DATE	1.19.2021
BCRA NO.	20160.00.00
DRAWN BY:	
REVIEWED BY:	
SHEET TITLE	SITE UTILITIES COVER SHEET




C10.0W

CITY OF PUYALLUP
GENERAL NOTES

1. ALL WORK IN CITY RIGHT-OF-WAY REQUIRES A PERMIT FROM THE CITY OF PUYALLUP. PRIOR TO ANY WORK COMMENCING, THE GENERAL CONTRACTOR SHALL ARRANGE FOR A PRECONSTRUCTION MEETING AT THE DEVELOPMENT SERVICES CENTER TO BE ATTENDED BY ALL CONTRACTORS THAT WILL PERFORM WORK SHOWN ON THE APPROVED ENGINEERING PLANS, REPRESENTATIVES FROM ALL APPLICABLE UTILITY COMPANIES, THE PROJECT OWNER AND APPROPRIATE CITY STAFF. CONTACT ENGINEERING SERVICES AT (253-841-5568) TO SCHEDULE THE MEETING. THE CONTRACTOR IS RESPONSIBLE TO HAVE THEIR OWN SET OF APPROVED PLANS AT THE MEETING.
2. AFTER COMPLETION OF ALL ITEMS SHOWN ON THESE PLANS AND BEFORE ACCEPTANCE OF THE PROJECT THE CONTRACTOR SHALL OBTAIN A PUNCH LIST PREPARED BY THE CITY'S INSPECTOR DETAILING REMAINING ITEMS OF WORK TO BE COMPLETED. ALL ITEMS OF WORK SHOWN ON THESE PLANS SHALL BE COMPLETED TO THE SATISFACTION OF THE CITY PRIOR TO ACCEPTANCE OF THE WATER SYSTEM AND PROVISION OF SANITARY SEWER SERVICE.
3. ALL MATERIALS AND WORKMANSHIP SHALL CONFORM TO THE STANDARD SPECIFICATIONS FOR ROAD, BRIDGE, AND MUNICIPAL CONSTRUCTION (HEREINAFTER REFERRED TO AS THE STANDARD SPECIFICATIONS), WASHINGTON STATE DEPARTMENT OF TRANSPORTATION AND AMERICAN PUBLIC WORKS ASSOCIATION, WASHINGTON STATE CHAPTER, LATEST EDITION, UNLESS SUPERSEDED OR AMENDED BY THE CITY OF PUYALLUP CITY STANDARDS FOR PUBLIC WORKS ENGINEERING AND CONSTRUCTION (HEREINAFTER REFERRED TO AS THE 'CITY STANDARDS').
4. A COPY OF THESE APPROVED PLANS AND APPLICABLE CITY DEVELOPER SPECIFICATIONS AND DETAILS SHALL BE ON SITE DURING CONSTRUCTION.
5. ANY REVISIONS MADE TO THESE PLANS MUST BE REVIEWED AND APPROVED BY THE DEVELOPER'S ENGINEER AND THE CITY PRIOR TO ANY IMPLEMENTATION IN THE FIELD. THE CITY SHALL NOT BE RESPONSIBLE FOR ANY ERRORS AND/OR OMISSIONS ON THESE PLANS.
6. THE CONTRACTOR SHALL HAVE ALL UTILITIES VERIFIED ON THE GROUND PRIOR TO ANY CONSTRUCTION. CALL (811) AT LEAST TWO WORKING DAYS IN ADVANCE. THE OWNER AND HIS/HER ENGINEER SHALL BE CONTACTED IMMEDIATELY IF A CONFLICT EXISTS.
7. ANY STRUCTURE AND/OR OBSTRUCTION THAT REQUIRES REMOVAL OR RELOCATION RELATING TO THIS PROJECT SHALL BE DONE SO AT THE DEVELOPER'S EXPENSE.
8. LOCATIONS OF EXISTING UTILITIES ARE APPROXIMATE. IT SHALL BE THE CONTRACTOR'S RESPONSIBILITY TO DETERMINE THE TRUE ELEVATIONS AND LOCATIONS OF HIDDEN UTILITIES. ALL VISIBLE ITEMS SHALL BE THE ENGINEER'S RESPONSIBILITY.
9. THE CONTRACTOR SHALL INSTALL, REPLACE, OR RELOCATE ALL SIGNS, AS SHOWN ON THE PLANS OR AS AFFECTED BY CONSTRUCTION, PER CITY STANDARDS.
10. POWER, STREET LIGHT, CABLE, AND TELEPHONE LINES SHALL BE IN A TRENCH LOCATED WITHIN A 10-FOOT UTILITY EASEMENT ADJACENT TO PUBLIC RIGHT-OF-WAY. RIGHT-OF-WAY CROSSINGS SHALL HAVE A MINIMUM HORIZONTAL SEPARATION FROM OTHER UTILITIES (SEWER, WATER, AND STORM) OF 5 FEET.
11. ALL CONSTRUCTION SURVEYING FOR EXTENSIONS OF PUBLIC FACILITIES SHALL BE DONE UNDER THE DIRECTION OF A WASHINGTON STATE LICENSED LAND SURVEYOR OR A WASHINGTON STATE LICENSED PROFESSIONAL CIVIL ENGINEER.
12. DURING CONSTRUCTION, ALL PUBLIC STREETS ADJACENT TO THIS PROJECT SHALL BE KEPT CLEAN OF ALL MATERIAL DEPOSITS RESULTING FROM ON-SITE CONSTRUCTION, AND EXISTING STRUCTURES SHALL BE PROTECTED AS DIRECTED BY THE CITY.
13. CERTIFIED RECORD DRAWINGS ARE REQUIRED PRIOR TO PROJECT ACCEPTANCE.
14. A NPDES STORMWATER GENERAL PERMIT MAY BE REQUIRED BY THE DEPARTMENT OF ECOLOGY FOR THIS PROJECT. FOR INFORMATION CONTACT THE DEPARTMENT OF ECOLOGY, SOUTHWEST REGION OFFICE AT (360)407-6300.
15. ANY DISTURBANCE OR DAMAGE TO CRITICAL AREAS AND ASSOCIATED BUFFERS, OR SIGNIFICANT TREES DESIGNATED FOR PRESERVATION AND PROTECTION SHALL BE MITIGATED IN ACCORDANCE WITH A MITIGATION PLAN REVIEWED AND APPROVED BY THE CITY'S PLANNING DIVISION. PREPARATION AND IMPLEMENTATION OF THE MITIGATION PLAN SHALL BE AT THE DEVELOPER'S EXPENSE.

CONSTRUCTION SEQUENCE

1. OBTAIN SITE DEVELOPMENT PERMIT FROM PIERCE COUNTY. SCHEDULE PRE-CONSTRUCTION MEETINGS WITH THE COUNTY INSPECTOR, OWNER, CONTRACTOR AND DESIGN TEAM. SUBMIT ALL SUBMITTALS TO ARCHITECT.
2. WHEN MORE THAN ONE CONTRACTOR IS ONSITE PERFORMING CONSTRUCTION ACTIVITIES, THE TWO CONTRACTORS SHALL COORDINATE WORK TO ENSURE NO CONFLICTS OCCUR BETWEEN THE TWO CONSTRUCTION WORK SITES.
3. CONTRACTOR TO MAINTAIN AT LEAST ONE LANE ACCESS TO SCHOOL SITE AT ALL TIMES.
4. CONTRACTOR TO MAINTAIN EMERGENCY VEHICLE ACCESS TO THE SCHOOL SITE AT ALL TIMES.
5. PROVIDE TESC MEASURES (EROSION CONTROL PLANS AND DETAIL SHEETS). COORDINATE WITH PROJECT WORK TIME PERIODS & PROJECT MILESTONE COMPLETION DATES.
6. CONTRACTOR SHALL KEEP EXISTING ONSITE SEWER SYSTEM OPERATIONAL UNTIL NEW GRAVITY SEWER IS INSTALLED AND CERTIFICATE OF OCCUPANCY HAS BEEN ISSUED.
7. OBTAIN APPROVED TRAFFIC CONTROL PLAN FROM PIERCE COUNTY.
8. PERFORM REQUIRED SITE DEMOLITION WORK.
9. PROVIDE TEMPORARY UTILITIES AND SERVICES NECESSARY FOR CONSTRUCTION ACTIVITIES.
10. CONTRACTOR TO POT HOLE EX UTILITIES AND SANITARY SEWER IN FRONT OF MAIN BUILDING PRIOR TO INSTALLATION OF NEW UTILITIES.
11. REPORT HORIZONTAL AND VERTICAL POSITIONS TO ENGINEER. ALLOW 3 BUSINESS DAYS TIME FOR ENGINEER DESIGN VERIFICATION PRIOR TO COMMENCING SANITARY SEWER WORK.
12. COMMENCE SANITARY SEWER AND CONSTRUCTION ACTIVITIES.
13. COORDINATE WORK WITH THE PORTABLE CONTRACTOR
14. COMPLETE SANITARY SEWER INSTALLATION
15. COMPLETE SURFACING RESTORATION.
16. CLEAN SEDIMENTS FROM EXISTING STORM DRAINAGE STRUCTURES AND PIPING IF AFFECTED. PROVIDE DOCUMENTATION CLEANING WAS PERFORMED BY A LICENSED/BONDED COMPANY.
17. FINAL SITE INSPECTIONS. SEE CONTRACT PLANS FOR MILESTONE INSPECTIONS REQUIRED BY OWNER AND PERMITTING AGENCY.
18. CERTIFICATE OF OCCUPANCY ISSUED.
19. DECOMMISSION EXISTING SEPTIC TANK SYSTEM IN ACCORDANCE TO PIERCE COUNTY HEALTH DEPARTMENT REQUIREMENTS.

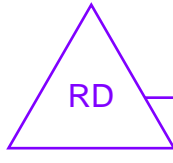


RECORD DRAWING
RECORD DRAWING INFORMATION IS
PROVIDED BY NORTHWEST CASCADE, INC.
RECORD DRAWING INFORMATION WAS
REVIEWED BY R. HAND OF SITTS & HILL
ENGINEERS AND THE INSTALLATION
SUBSTANTIALLY CONFORMS TO APPROVED
PLANS.




APPROVED
BY *Richard C. Hill*
CITY OF PUYALLUP
DEVELOPMENT SERVICES
DATE 07/26/2021

NOTE: THIS APPROVAL IS VOID
AFTER 180 DAYS FROM
APPROVAL DATE.
THE CITY WILL NOT BE
RESPONSIBLE FOR ERRORS
AND/OR OMISSIONS ON THESE
PLANS.
FIELD CONDITIONS MAY DICTATE
CHANGES TO THESE PLANS AS
DETERMINED BY THE CITY
ENGINEER

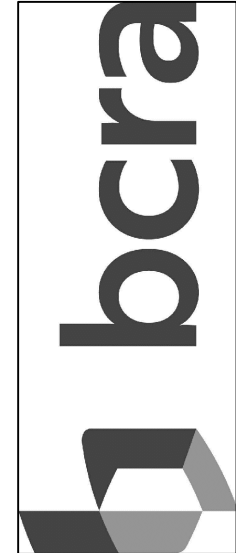

T 253.627.4367 F 253.627.4365 WWW.BCRADESIGN.COM
2108 PACIFIC AVENUE, SUITE 300, TACOMA, WA 98402

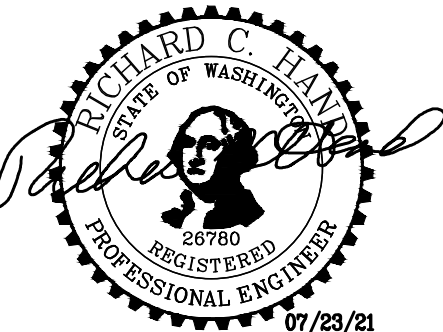

PROJECT:
PUYALLUP SCHOOL DISTRICT
WALKER HIGH SCHOOL SITE UTILITIES
5715 MILWAUKEE AVE E
PUYALLUP, WA 98372

REVISIONS
5-10-21 PERMIT SUBMITTAL
6-14-21 PERMIT RESUBMITTAL
6-23-21 BID SET
6-25-21 CITY RESUBMITTAL
7-23-21 CITY RESUBMITTAL
10-04-22 RECORD DRAWINGS

DATE
1.19.2021
BCRA NO.
20160.00.00
DRAWN BY:
REVIEWED BY:
SHEET TITLE
CITY OF PUYALLUP
GENERAL NOTES



Know what's below.
Call before you dig.

**SITTS & HILL
ENGINEERS, INC.**
CIVIL • STRUCTURAL • SURVEYING

4015 CENTER STREET | TACOMA, WA 98409
PHONE: (253) 474-9448 | FAX: (253) 474-0153
<http://www.sitts-hill-engineers.com/>

Project No.:	19,034	Project Mgr.:	R.H.
Proj. Engineer:	S.A.J.	Proj. Drafter:	S.A.J.

bcra
© COPYRIGHT 2019 - BCRA, INC. ALL RIGHTS RESERVED.
SHEET 15 OF 27

C11.0W

CITY OF PUYALLUP
SANITARY SEWER NOTES:

- ALL WORK IN CITY RIGHT-OF-WAY REQUIRES A PERMIT FROM THE CITY OF PUYALLUP. PRIOR TO ANY WORK COMMENCING, THE GENERAL CONTRACTOR SHALL ARRANGE FOR A PRECONSTRUCTION MEETING AT THE DEVELOPMENT SERVICES CENTER TO BE ATTENDED BY ALL CONTRACTORS THAT WILL PERFORM WORK SHOWN ON THE ENGINEERING PLANS, REPRESENTATIVES FROM ALL APPLICABLE UTILITY COMPANIES, THE PROJECT OWNER AND APPROPRIATE CITY STAFF. CONTACT ENGINEERING SERVICES TO SCHEDULE THE MEETING (253) 841-5568. THE CONTRACTOR IS RESPONSIBLE TO HAVE THEIR OWN APPROVED SET OF PLANS AT THE MEETING.
- AFTER COMPLETION OF ALL ITEMS SHOWN ON THESE PLANS AND BEFORE ACCEPTANCE OF THE PROJECT, THE CONTRACTOR SHALL OBTAIN A "PUNCH LIST" PREPARED BY THE CITY'S INSPECTOR DETAILING REMAINING ITEMS OF WORK TO BE COMPLETED. ALL ITEMS OF WORK SHOWN ON THESE PLANS SHALL BE COMPLETED TO THE SATISFACTION OF THE CITY PRIOR TO ACCEPTANCE OF THE SEWER SYSTEM AND PROVISION OF SANITARY SEWER SERVICE.
- ALL MATERIALS AND WORKMANSHIP SHALL CONFORM TO THE STANDARD SPECIFICATIONS FOR ROAD, BRIDGE, AND MUNICIPAL CONSTRUCTION (HEREINAFTER REFERRED TO AS THE "STANDARD SPECIFICATIONS"), WASHINGTON STATE DEPARTMENT OF TRANSPORTATION AND AMERICAN PUBLIC WORKS ASSOCIATION, WASHINGTON STATE CHAPTER, LATEST EDITION, UNLESS SUPERSEDED OR AMENDED BY THE CITY OF PUYALLUP CITY STANDARDS FOR PUBLIC WORKS ENGINEERING AND CONSTRUCTION (HEREINAFTER REFERRED TO AS THE "CITY STANDARDS").
- A COPY OF THESE APPROVED PLANS AND APPLICABLE CITY DEVELOPER SPECIFICATIONS AND DETAILS SHALL BE ON SITE DURING CONSTRUCTION.
- ANY REVISIONS MADE TO THESE PLANS MUST BE REVIEWED AND APPROVED BY THE DEVELOPER'S ENGINEER AND THE ENGINEERING SERVICES STAFF PRIOR TO ANY IMPLEMENTATION IN THE FIELD. THE CITY SHALL NOT BE RESPONSIBLE FOR ANY ERRORS AND/OR OMISSIONS ON THESE PLANS.
- THE CONTRACTOR SHALL HAVE ALL UTILITIES VERIFIED ON THE GROUND PRIOR TO ANY CONSTRUCTION. CALL (811) AT LEAST TWO WORKING DAYS IN ADVANCE. THE OWNER AND HIS/HER ENGINEER SHALL BE CONTACTED IMMEDIATELY IF A CONFLICT EXISTS.
- ANY STRUCTURE AND/OR OBSTRUCTION WHICH REQUIRE REMOVAL OR RELOCATION RELATING TO THIS PROJECT SHALL BE DONE SO AT THE DEVELOPER'S EXPENSE.
- MINIMUM GRADE ON ALL 4 INCH RESIDENTIAL SIDE SEWERS SHALL BE 2 PERCENT AND 6 INCH COMMERCIAL SIDE SEWERS SHALL BE 1 PERCENT; MAXIMUM SHALL BE 8 PERCENT. ALL SIDE SEWERS SHALL BE 6 INCHES WITHIN CITY RIGHT-OF-WAY.
- SIDE SEWERS SHALL BE INSTALLED IN ACCORDANCE WITH CITY STANDARD NOS. 04.03.01, 04.03.02, 04.03.03 AND 04.03.04. SIDE SEWER INSTALLATION WORK SHALL BE DONE IN ACCORDANCE WITH THE WASHINGTON INDUSTRIAL SAFETY AND HEALTH ACT (WISHA).
- ALL SEWER PIPE SHALL BE PVC, POLYPROPYLENE, OR DUCTILE IRON. PVC SEWER PIPE SHALL CONFORM TO ASTM D-3034, SDR35 FOR PIPE SIZES 15-INCH AND SMALLER AND ASTM F679 FOR PIPE SIZES 18"- TO 27-INCH. DUCTILE IRON PIPE SHALL BE CLASS 51 OR GREATER, LINED WITH PROTECTO 401TM EPOXY LINING OR EQUIVALENT, UNLESS OTHERWISE NOTED. 12-INCH THROUGH 30-INCH POLYPROPYLENE PIPE (PP) SHALL BE DUAL WALLED, HAVE A SMOOTH INTERIOR AND EXTERIOR CORRUGATIONS AND MEET WSDOT 9-05.24(2). IT SHALL MEET OR EXCEED ASTM F2764. 36-INCH THROUGH 60-INCH PP PIPE SHALL BE TRIPLE WALLED AND MEET WSDOT 9-05.24(2). IT SHALL MEET OR EXCEED ASTM F2764. PP SHALL HAVE A MINIMUM PIPE STIFFNESS OF 46 PPI WHEN TESTED IN ACCORDANCE WITH ASTM D2412. TESTING SHALL BE PER ASTM F1417. TRENCHING, BEDDING, AND BACKFILL SHALL BE IN ACCORDANCE WITH CITY STANDARD NO. 06.01.01. MINIMUM COVER ON PVC AND PP PIPE SHALL BE 3.0 FEET. MINIMUM COVER ON DUCTILE IRON PIPE SHALL BE 1.0 FOOT.
- SANITARY SEWER MANHOLE FRAMES AND COVERS SHALL CONFORM TO CITY STANDARD NO. 06.01.02.
- SANITARY SEWER MANHOLES SHALL CONFORM TO CITY STANDARD NOS. 04.01.01, 04.01.02, 04.01.03 AND 04.01.04. ALL MANHOLES SHALL BE CHanneLED FOR FUTURE LINES AS SPECIFIED ON THESE PLANS. MANHOLE STEPS AND LADDER SHALL CONFORM TO STANDARD NO. 06.01.03.
- SANITARY SEWER PIPE AND SIDE SEWERS SHALL BE 10 FEET AWAY FROM BUILDING FOUNDATIONS AND/OR ROOF LINES WITH THE EXCEPTION OF SIDE SEWERS THAT PROVIDE SERVICE TO A SINGLE-FAMILY RESIDENCE. AT THE DISCRETION OF THE REVIEW ENGINEER, A LICENSED PROFESSIONAL ENGINEER WILL BE REQUIRED TO STAMP THE DESIGN TO ACCOUNT FOR DEPTH OR PROXIMITY TO FOUNDATION, STEEP SLOPES, OR OTHER FACTORS.
- NO SIDE SEWERS SHALL BE CONNECTED TO ANY HOUSE OR BUILDING UNTIL ALL MANHOLES ARE ADJUSTED TO THE FINISHED GRADE OF THE COMPLETED ASPHALT ROADWAY AND THE ASPHALT PATCH AND SEAL AROUND THE RING ARE ACCEPTED.
- FOR COMMERCIAL DEVELOPMENTS IN WHICH SOURCES OF GREASE AND/OR OILS MAY BE INTRODUCED TO THE CITY SANITARY SEWER SYSTEM, A CITY APPROVED GREASE INTERCEPTOR SHALL BE INSTALLED DOWNSTREAM FROM THE SOURCE.
- ONCE SEWER AND ALL OTHER UTILITY CONSTRUCTION IS COMPLETED, ALL SANITARY SEWER MAINS AND SIDE SEWERS SHALL BE TESTED PER SECTION 406 OF THE CITY STANDARDS.

PLAN SET SANITARY SEWER NOTE REVISIONS
NOTE 9: DETAILS 04.03.01 AND 04.03.03 ARE NOT APPLICABLE
NOTE 12: DETAILS 04.01.02, 04.01.03 AND 04.01.04 ARE NOT APPLICABLE

CITY OF PUYALLUP
SANITARY SEWER NOTES:

SECTION 406- TESTING REQUIREMENTS

SECTION 406 – TESTING REQUIREMENTS

GRAVITY SANITARY SEWER CLEANING AND TESTING REQUIREMENTS SHALL BE AS OUTLINED IN WSDOT SECTION 7-17.3(2). SANITARY SEWER CLEANING AND TESTING SHALL BE COMPLETED TO THE SATISFACTION OF THE OFFICE OF THE CITY ENGINEER AND/OR PUBLIC WORKS DEPARTMENT PRIOR TO FINAL ACCEPTANCE. AFTER COMPLETION OF ALL PROJECT UTILITY WORK (SEWER, WATER, STORM, ETC.) AND ASSOCIATED UTILITY TRENCH BACKFILL AND COMPACTION, SEWER LINES SHALL BE CLEANED AND TESTED BY THE CONTRACTOR PRIOR TO FINAL PROJECT ACCEPTANCE. AS OUTLINED IN SECTION 406.1 THROUGH 406.4. AT THE END OF THE MAINTENANCE AND WARRANTY PERIOD, THE CITY WILL PERFORM A FINAL CCTV INSPECTION PER 406.4 TO VERIFY THAT THE WORK PERFORMED CONFORMS TO CITY STANDARDS PRIOR TO BOND RELEASE.

406.1 CLEANING

PHYSICAL CONNECTION TO THE EXISTING CITY SEWER SYSTEM SHALL NOT BE ALLOWED UNTIL ALL PIPES HAVE BEEN THOROUGHLY CLEANED BY JETTING AND/OR PIGGING TO REMOVE ANYSOLIDS OR CONSTRUCTION DEBRIS THAT MAY HAVE ENTERED THE PIPE.

THE CONTRACTOR SHALL ARRANGE TO HAVE THE WATER ACCUMULATED DURING CONSTRUCTION AND SANITARY SYSTEM CLEANING OPERATIONS REMOVED FROM THE SEWER SYSTEM BY A VACTOR TRUCK.

WATER FROM THE NEW SEWER EXTENSION SHALL NOT BE PERMITTED TO ENTER THE EXISTING CITY SYSTEM UNTIL FINAL PROJECT APPROVAL. SEDIMENT OR DEBRIS INTRODUCED TO EXISTING CITY SEWERS AS A RESULT OF ANY CONSTRUCTION ACTIVITY SHALL BE REMOVED IMMEDIATELY BY THE CONTRACTOR IN CONFORMANCE WITH WSDOT SECTION 7-17.

406.2 DEFLECTION TESTING

GRAVITY SANITARY SEWERS SHALL BE TESTED FOR DEFLECTION PRIOR TO VISUAL INSPECTION. THERMOPLASTIC PIPE SHALL BE TESTED FOR DEFLECTION NOT LESS THAN 30 DAYS AFTER THE TRENCH BACKFILL AND COMPACTION HAS BEEN COMPLETED. DEFLECTION TESTING SHALL BE CONDUCTED BY PULLING A MANDREL (RIGID OR ADJUSTABLE) WITH A DIAMETER NOT LESS THAN 95 PERCENT OF THE NORMAL DIAMETER OF THE PIPE BEING TESTED. MANDREL TESTING SHALL BE CONDUCTED IN CONFORMANCE WITH WSDOT SECTION 7-17.3(2)G.

406.3 LEAKAGE TESTING

ALL NEW GRAVITY SANITARY SEWER MAINS AND THE RIGHT-OF-WAY LATERALS SHALL BE SUBJECT TO A LOW-PRESSURE AIR TEST PER WSDOT SECTION 7-17.3(2)F. LOW PRESSURE AIR TESTING SHALL BE CONDUCTED AFTER BACKFILLING IS COMPLETED AND THE BACKFILL MATERIAL HAS BEEN COMPACTED IN CONFORMANCE WITH THE APPROVED PLANS. CONFORMING COMPACTION SHALL BE VERIFIED BY NUCLEAR GAUGE TESTING AND/OR PROOF ROLLING AT THE DISCRETION OF ENGINEERING STAFF. THE CITY ENGINEER OR DESIGNEE SHALL OBSERVE ALL TESTING TO VERIFY SATISFACTORY COMPLETION. THE CITY ENGINEER OR DESIGNEE MAY REQUIRE THAT AIR TEST PRESSURE BE MAINTAINED AT 4.0 PSIG WITH NO DROP FOR 15 MINUTES FOR A PASSING LEAKAGE TEST WHERE GROUNDWATER PRESSURE IS DEEMED NEGLIGIBLE, OR AT THE CITY ENGINEER'S OR DESIGNEE'S DISCRETION.

THE CONTRACTOR SHALL FURNISH ALL NECESSARY EQUIPMENT AND PERSONNEL FOR CONDUCTING THE PRESSURE TEST. THE CONTRACTOR SHALL PROVIDE CERTIFICATION FROM A CERTIFIED/ACCREDITED LABORATORY THAT TESTING EQUIPMENT IS ACCURATE. ALL EQUIPMENT AND PERSONNEL SHALL BE SUBJECT TO APPROVAL BY THE CITY ENGINEER OR DESIGNEE.

IF ANY PORTION OF THE SANITARY SYSTEM FAILS TO MEET THE TESTING REQUIREMENTS, THE CONTRACTOR SHALL DETERMINE, AT THEIR OWN EXPENSE, THE SOURCE OF LEAKAGE AND SHALL REPAIR OR REPLACE ALL DEFECTIVE MATERIALS OR WORKMANSHIP. THE COMPLETED PIPE INSTALLATION SHALL MEET THE MINIMUM TESTING REQUIREMENTS BEFORE BEING CONSIDERED ACCEPTABLE.

406.4 TELEVISION INSPECTION

ALL NEW GRAVITY SANITARY SEWER EXTENSIONS SHALL BE VISUALLY INSPECTED IN CONFORMANCE WITH WSDOT SECTION 7-17.3(2)H, FOLLOWING SATISFACTORY TRENCH COMPACTION TESTING, FLUSHING, LOW PRESSURE AIR TESTING, AND DEFLECTION TESTING. ALL MANHOLES SHALL BE CHanneLED AND GRADE RINGS SET IN PLACE PRIOR TO SEWER VIDEO INSPECTION.

THE REMOTE CAMERA USED IN SEWER VISUAL INSPECTION SHALL BE ONE SPECIFICALLY DESIGNED FOR SUCH AN APPLICATION, WITH THE ABILITY TO ROTATE THE CAMERA 180 DEGREES AND LIGHTING SUITABLE TO ALLOW A CLEAR PICTURE OF THE ENTIRE PERIPHERY OF THE PIPE. THE CAMERA SHALL PROCEED THROUGH THE PIPE AT A SUFFICIENTLY SLOW VELOCITY TO ALLOW ADEQUATE INSPECTION OF ALL PIPE JOINTS. ALL SEWER LATERAL FITTINGS AND JOINTS AND SUSPECT PIPE JOINTS SHALL BE CLOSELY INSPECTED BY ROTATING THE CAMERA AS NEEDED TO PROVIDE A CLEAR VIEW.

THE CONTRACTOR SHALL INTRODUCE WATER TO THE NEW SEWER SYSTEM IMMEDIATELY PRIOR TO THE VISUAL INSPECTION BY ADDING WATER TO THE UPSTREAM MANHOLE UNTIL WATER IS SEEN FLOWING IN THE LOWEST MANHOLE. VIDEO INSPECTION OF THE LINE SHALL BEGIN WHEN FLOW IN THE LOWEST MANHOLE HAS STOPPED. A 1-INCH SEWER BALL SHALL BE ATTACHED TO THE FRONT OF THE CAMERA TO PROVIDE A BASIS FOR ESTIMATING THE DEPTH OF THE PONDING WITHIN THE SEWER PIPE.


TELEVISION INSPECTION ACCEPTANCE CRITERIA:

- ANY PONDING WITHIN A PIPE SHALL BE LESS THAN ONE-HALF INCH (1/2") IN DEPTH.
- THE TOTAL ACCUMULATED PONDING LENGTH, REGARDLESS OF DEPTH, FROM MANHOLE TO MANHOLE SHALL BE LESS THAN TEN (10) PERCENT OF THE TOTAL LENGTH FROM MANHOLE TO MANHOLE. ANY SEWER PIPE THAT EXCEEDS EITHER OF THE ABOVE ACCEPTANCE CRITERIA WILL BE REJECTED AND REQUIRE REPAIR AND/OR REPLACEMENT BY THE CONTRACTOR.

THE CONTRACTOR SHALL BEAR ALL COSTS FOR THE CORRECTION OF ANY DEFICIENCIES FOUND DURING TV INSPECTION, INCLUDING THE COSTS FOR ADDITIONAL TV INSPECTION AND LEAKAGE TESTING NEEDED TO VERIFY THE DEFICIENCIES WERE CORRECTED. ALL COMPONENTS OF THE VIDEO AND RECORDING EQUIPMENT SHALL BE SUFFICIENT TO PROVIDE PICTURE QUALITY TO THE SATISFACTION OF THE CITY ENGINEER OR DESIGNEE.

UPON COMPLETION OF THE VIDEO INSPECTION, THE DIGITAL VIDEO, OF COMMON FORMAT, AND WRITTEN INSPECTION REPORT SHALL BE SUBMITTED TO THE CITY FOR REVIEW. AT A MINIMUM, THE INSPECTION REPORT SHALL CONTAIN THE FOLLOWING INFORMATION:

- SIZE, LENGTH, AND MATERIAL TYPE OF THE SEWER MAIN.
- LOCATION OF ALL LATERAL CONNECTIONS.
- ESTIMATED DEPTH AND LOCATION OF ALL PONDING OVER 1/4 INCH IN DEPTH
- MANHOLE NUMBERS THAT CORRESPOND TO THE APPROVED PLANS
- STREET NAME AND/OR LOCATION OF SEWER MAIN

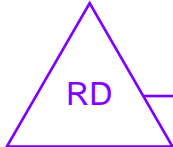


RECORD DRAWING
RECORD DRAWING INFORMATION IS PROVIDED BY NORTHWEST CASCADE, INC. RECORD DRAWING INFORMATION WAS REVIEWED BY R. HAND OF SITTS & HILL ENGINEERS AND THE INSTALLATION SUBSTANTIALLY CONFORMS TO APPROVED PLANS.



APPROVED
BY *Richard C. Hand*
CITY OF PUYALLUP
DEVELOPMENT SERVICES
DATE 07/26/2021

NOTE: THIS APPROVAL IS VOID AFTER 180 DAYS FROM APPROVAL DATE. THE CITY WILL NOT BE RESPONSIBLE FOR ERRORS AND/OR OMISSIONS ON THESE PLANS. FIELD CONDITIONS MAY DICTATE CHANGES TO THESE PLANS AS DETERMINED BY THE CITY ENGINEER

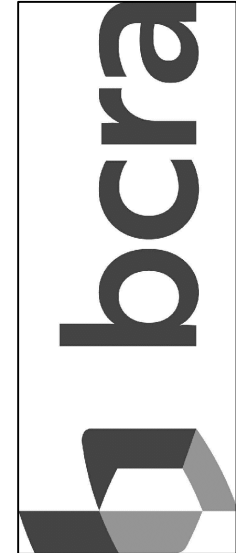

T 253.627.4367 F 253.627.4395 WWW.BCRADESIGN.COM
2108 PACIFIC AVENUE, SUITE 300, TACOMA, WA 98402

SEAL



PROJECT:
PUYALLUP SCHOOL DISTRICT
WALKER HIGH SCHOOL SITE UTILITIES
5715 MILWAUKEE AVE E
PUYALLUP, WA 98372

REVISIONS
5-10-21 PERMIT SUBMITTAL
6-14-21 PERMIT RESUBMITTAL
6-23-21 BID SET
6-25-21 CITY RESUBMITTAL
7-23-21 CITY RESUBMITTAL
10-04-22 RECORD DRAWINGS

DATE
1.19.2021
BCRA NO.
20160.00.00
DRAWN BY:
REVIEWED BY:
SHEET TITLE
CITY OF PUYALLUP
GENERAL NOTES



© COPYRIGHT 2019 - BCRA, INC. ALL RIGHTS RESERVED.
SHEET 16 OF 27

C11.1W



Know what's below.
Call before you dig.

**SITTS & HILL
ENGINEERS, INC.**

CIVIL • STRUCTURAL • SURVEYING
4815 CENTER STREET | TACOMA, WA 98409
PHONE: (253) 474-9448 | FAX: (253) 474-0153
<http://www.sitts-hill-engineers.com/>

Project No.:	19,034	Project Mgr.:	R.H.
Proj. Engineer:	S.A.J.	Proj. Drafter:	S.A.J.

IF SHEET MEASURES LESS THAN 24"X36", IT IS A REDUCED PRINT. REDUCE SCALE ACCORDINGLY

CITY OF PUYALLUP
WATER NOTES:

- ALL WORK IN CITY RIGHT-OF-WAY REQUIRES A PERMIT FROM THE CITY OF PUYALLUP. PRIOR TO ANY WORK COMMENCING, THE GENERAL CONTRACTOR SHALL ARRANGE FOR A PRECONSTRUCTION MEETING AT THE DEVELOPMENT SERVICES CENTER TO BE ATTENDED BY ALL CONTRACTORS THAT WILL PERFORM WORK SHOWN ON THE ENGINEERING PLANS, REPRESENTATIVES FROM ALL APPLICABLE UTILITY COMPANIES, THE PROJECT OWNER AND APPROPRIATE CITY STAFF. CONTACT ENGINEERING SERVICES TO SCHEDULE THE MEETING (253) 841-5568. THE CONTRACTOR IS RESPONSIBLE TO HAVE THEIR OWN APPROVED SET OF PLANS AT THE MEETING.
- AFTER COMPLETION OF ALL ITEMS SHOWN ON THESE PLANS AND BEFORE ACCEPTANCE OF THE PROJECT, THE CONTRACTOR SHALL OBTAIN A PUNCH LIST PREPARED BY THE CITY'S INSPECTOR DETAILING REMAINING ITEMS OF WORK TO BE COMPLETED. ALL ITEMS OF WORK SHOWN ON THESE PLANS SHALL BE COMPLETED TO THE SATISFACTION OF THE CITY PRIOR TO ACCEPTANCE OF THE WATER SYSTEM AND PROVISION OF SANITARY SEWER SERVICE.
- ALL MATERIALS AND WORKMANSHIP SHALL CONFORM TO THE STANDARD SPECIFICATIONS FOR ROAD, BRIDGE, AND MUNICIPAL CONSTRUCTION (HEREINAFTER REFERRED TO AS THE "STANDARD SPECIFICATIONS"), WASHINGTON STATE DEPARTMENT OF TRANSPORTATION AND AMERICAN PUBLIC WORKS ASSOCIATION, WASHINGTON STATE CHAPTER, LATEST EDITION, UNLESS SUPERSEDED OR AMENDED BY THE CITY OF PUYALLUP CITY STANDARDS FOR PUBLIC WORKS ENGINEERING AND CONSTRUCTION (HEREINAFTER REFERRED TO AS THE "CITY STANDARDS"), OR AS DIRECTED BY FRUITLAND MUTUAL WATER COMPANY (FMWC), VALLEY WATER (VW), OR TACOMA CITY WATER (TCW) IS THE PURVEYOR.
- A COPY OF THESE APPROVED PLANS AND APPLICABLE CITY DEVELOPER SPECIFICATIONS AND DETAILS SHALL BE ON SITE DURING CONSTRUCTION.
- ANY REVISIONS MADE TO THESE PLANS MUST BE REVIEWED AND APPROVED BY THE DEVELOPER'S ENGINEER, THE ENGINEERING SERVICES STAFF, AND THE FMWC, VW OR TCW WHEN SERVED BY THAT PURVEYOR, PRIOR TO ANY IMPLEMENTATION IN THE FIELD. THE CITY SHALL NOT BE RESPONSIBLE FOR ANY ERRORS AND/OR OMISSIONS ON THESE PLANS.
- THE CONTRACTOR SHALL HAVE ALL UTILITIES VERIFIED ON THE GROUND PRIOR TO ANY CONSTRUCTION. CALL (811) AT LEAST TWO WORKING DAYS IN ADVANCE. THE OWNER AND HIS/HER ENGINEER SHALL BE CONTACTED IMMEDIATELY IF A CONFLICT EXISTS.
- ANY STRUCTURE AND/OR OBSTRUCTION WHICH REQUIRES REMOVAL OR RELOCATION RELATING TO THIS PROJECT SHALL BE DONE SO AT THE DEVELOPER'S EXPENSE.
- BACTERIOLOGICAL (COLIFORM AND IRON BACTERIA) TEST SAMPLES WILL BE TAKEN BY THE CITY (OR FMWC, VW OR TCW WHEN SERVED BY THAT PURVEYOR) AND PAID FOR BY THE CONTRACTOR, EXCEPT FOR CAPITAL IMPROVEMENT PROJECTS (CIP) WHICH SHALL BE PAID FOR BY THE CITY.
- WATER MAINS SHALL HAVE A MINIMUM COVER OF 36 INCHES FROM PAVED FINAL GRADE IN IMPROVED RIGHT-OF-WAY AND IMPROVED EASEMENTS, AND A MINIMUM OF 48 INCHES IN UNIMPROVED RIGHT-OF-WAY AND UNIMPROVED EASEMENTS.
- PIPE FOR WATER MAINS SHALL BE DUCTILE IRON CONFORMING TO SECTION 7-09 OF THE STANDARD SPECIFICATIONS, CLASS 52 WITH TYTON OR APPROVED EQUAL JOINTS. PIPE SHALL BE CEMENT LINED IN ACCORDANCE WITH A.S.A. SPECIFICATION A 21.4-1964.
- CONNECTIONS TO EXISTING WATER MAINS TYPICALLY SHALL BE WET TAPS THROUGH A TAPPING TEE AND TAPPING VALVE AND SHALL BE MADE BY A CITY APPROVED CONTRACTOR. THE TAPPING SLEEVE SHALL BE ROMAC SST ALL STAINLESS STEEL TAPPING SLEEVE OR APPROVED EQUAL. A TWO-PIECE EPOXY COATED OR DUCTILE IRON TAPPING SLEEVE MAY BE USED ON DUCTILE IRON PIPE, WHEN THE TAP IS SMALLER THAN THE WATER MAIN SIZE I.E. 6-INCH TAP ON 8-INCH PIPE. THE CITY (OR FMWC, VW OR TCW WHEN SERVED BY THAT PURVEYOR) SHALL APPROVE THE TIME AND LOCATION FOR THESE CONNECTIONS.
- ALL WATER MAINS AND APPURTENANCES SHALL BE HYDROSTATICALLY TESTED AT 200 PSI IN ACCORDANCE WITH STANDARD SPECIFICATION 7-09.3(23). PRESSURE TESTING SHALL NOT BE PERFORMED UNTIL SATISFACTORY PURITY SAMPLES HAVE BEEN RECEIVED, EXCEPT WHEN NEW WATER MAINS ARE INSTALLED INDEPENDENTLY FROM THE WATER SYSTEM PIPING.
- FIRE HYDRANTS SHALL BE INSTALLED IN ACCORDANCE WITH CITY STANDARD DETAIL 03.05.01 AND AS DIRECTED BY THE CITY OF PUYALLUP FIRE CODE OFFICIAL.
- VALVE MARKER POSTS SHALL BE INSTALLED WHERE VALVE BOXES ARE HIDDEN FROM VIEW OR IN UNPAVED AREAS THE INSTALLATION SHALL BE IN ACCORDANCE WITH CITY STANDARD DETAIL 03.01.02.
- RESILIENT SEATED WEDGE GATE VALVES SHALL BE USED FOR 10-INCH MAINS AND SMALLER. BUTTERFLY VALVES SHALL BE USED FOR MAINS GREATER THAN 10 INCHES.
- PIPE FITTING FOR WATER MAINS SHALL BE DUCTILE IRON AND SHALL BE MECHANICAL JOINT CONFORMING TO AWWA SPECIFICATION C111-72.
- WATER MAIN PIPE AND SERVICE CONNECTIONS SHALL BE A MINIMUM OF 10 FEET AWAY FROM BUILDING FOUNDATIONS AND/OR ROOF LINES.
- WHERE A WATER MAIN CROSSES THE NORTHWEST GAS PIPELINE, THE WATER LINE SHALL BE CASED WITH PVC PIPE A MINIMUM OF 10 FEET BEYOND EACH SIDE OF THE GAS LINE EASEMENT. CONTACT WILLIAMS NORTHWEST PIPELINE BEFORE THE CROSSING IS MADE.
- TRENCHING, BEDDING, AND BACKFILL FOR WATER MAINS SHALL BE INSTALLED IN ACCORDANCE WITH CITY STANDARD DETAIL 06.01.01.
- ALL COMMERCIAL AND INDUSTRIAL DEVELOPMENTS, IRRIGATION SYSTEMS, AND MULTI-FAMILY WATER SERVICE CONNECTIONS SHALL BE PROTECTED BY A DOUBLE CHECK VALVE ASSEMBLY OR A REDUCED PRESSURE BACKFLOW ASSEMBLY AS DIRECTED BY THE CITY (OR FMWC, VW OR TCW WHEN SERVED BY THAT PURVEYOR) CONFORMING TO CITY STANDARD DETAILS 03.04.01, 03.04.02, AND 03.04.03.
- ANY LEAD JOINT FITTING DISTURBED DURING CONSTRUCTION SHALL BE REPLACED WITH A MECHANICAL JOINT FITTING AT THE CONTRACTOR'S EXPENSE.
- WHEN HYDRAULIC FIRE FLOW MODELING IS REQUIRED FOR A PROJECT, THE CITY WILL ISSUE A PERMIT. THE HYDRAULIC MODELING CRITERIA IS BASED ON THE PROJECTED 2030 WATER DEMAND, WHILE MAINTAINING A MINIMUM SYSTEM PRESSURE OF 20 POUNDS PER SQUARE INCH AND A MAXIMUM VELOCITY OF 10 FEET PER SECOND.
- WHEN USING A FIRE HYDRANT FOR NON-FIREFIGHTING PURPOSES, A CITY HYDRANT METER MUST BE USED. COORDINATE THE ACQUISITION OF THE HYDRANT METER WITH THE CITY'S UTILITY BILLING DIVISION AT PUYALLUP CITY HALL. A CITY APPROVED BACKFLOW PROTECTION ASSEMBLY SHALL BE INSTALLED BY THE PERSON REQUESTING USE OF A FIRE HYDRANT. THE ASSEMBLY SHALL BE ACCOMPANIED BY A CURRENT BACKFLOW ASSEMBLY TEST REPORT. THE TEST REPORT SHALL BE AVAILABLE AT THE SITE FOR THE DURATION OF THE HYDRANT USE.
- SHOULD A BREAK OCCUR ON ANY CITY WATER MAIN, THE CONTRACTOR SHALL FOLLOW THE CITY'S ADOPTED "WATER MAIN BREAK PROCEDURE" ISSUED TO THEM AT THE PRE-CONSTRUCTION MEETING AND NOTIFY THOSE CONNECTED TO THE SYSTEM IN THE IMPACTED AREA AS OUTLINED IN THE PROCEDURE.
- WATER MAIN REPAIRS (REFERENCES: AWWA C651-14 AND WSDOT STANDARD SPECIFICATION SECTION 7-09)


(NOTE: A PLANNED WATER MAIN REPAIR SHALL BE APPROVED BY THE CITY INSPECTOR AND/OR WATER DIVISION SUPERVISOR PRIOR TO COMMENCING WORK.)

CITY OF PUYALLUP
WATER NOTES:

(CONTINUED)

- REPAIR WITHOUT DEPRESSURIZATION** -SMALL LEAKS SHALL BE REPAIRED USING REPAIR BANDS WHILE MAINTAINING POSITIVE PRESSURE IN THE WATER MAIN. VALVES SURROUNDING THE LEAK WILL BE PARTIALLY SHUT BY THE CITY WATER DEPARTMENT TO REDUCE THE FLOW AND PRESSURE TO THE AREA. BLOWOFFS AND HYDRANTS IN THE REDUCED PRESSURE AREA MAY BE OPENED AS NEEDED TO FURTHER REDUCE THE PRESSURE. THE WATER MAIN TRENCH SHALL BE OVER-EXCAVATED TO ALLOW WATER IN THE TRENCH TO BE PUMPED OUT AND MAINTAINED BELOW THE LEVEL OF THE WATER MAIN. THE REPAIR SHALL BE COMPLETED WITH THE WATER MAIN PRESSURE REMAINING POSITIVE. AFTER THE REPAIR IS MADE, THE SYSTEM SHALL BE FULLY PRESSURIZED AND A VISUAL LEAK INSPECTION WILL BE COMPLETED. THE WATER MAIN IN THE AFFECTED AREA SHALL BE FLUSHED TO ACHIEVE THREE PIPE VOLUMES PULLED FROM THE PIPE (DISTANCE MEASURED FROM VALVE OPENED FOR FLUSHING TO THE EXIT HYDRANT OR BLOWOFF).
- REPAIR/CUT-IN WITH DEPRESSURIZATION** -TRENCH SHALL BE OVER EXCAVATED AND DEWATERED BELOW THE WATER MAIN. FLUSH WATER FROM PIPE FROM EACH DIRECTION UNTIL IT RUNS CLEAR. IMMEDIATELY PRIOR TO INSTALLATION OF A NEW PIPE SECTION FOR REPAIR OR CUT IN TEE, ALL NEW FITTINGS AND PIPE SPOOLS SHALL BE SWABBED WITH A FIVE PERCENT (5%) CHLORINE SOLUTION (MINIMUM). THE INTERIOR OF THE EXISTING PIPE SHALL BE SWABBED WITH A FIVE PERCENT (5%) CHLORINE SOLUTION AT LEAST 6 FEET IN EACH DIRECTION FROM EXPOSED CUT ENDS. THE WATER MAIN IN THE AFFECTED AREA SHALL BE FLUSHED TO ACHIEVE THREE PIPE VOLUMES PULLED FROM THE PIPE (DISTANCE MEASURED FROM THE VALVE OPENED FOR FLUSHING TO THE EXIT HYDRANT OR BLOWOFF). CUSTOMERS SHALL BE NOTIFIED AFTER THE WATER MAIN IS FLUSHED AND REPAIRS HAVE BEEN COMPLETED, AS OUTLINED IN THE "WATER MAIN BREAK PROCEDURE."
- NEW WATER MAIN INSTALLATION:**
- EACH NEW WATER MAIN SECTION SHALL BE DELIVERED, STACKED AND STORED ONSITE WITH ENDS PLUGGED. THE PLUGS SHALL REMAIN IN THE PIPE UNTIL EACH PARTICULAR SECTION IS INSTALLED. NATIONAL SANITATION FOUNDATION (NSF) APPROVED SIXTY-FIVE PERCENT (65%) CALCIUM HYPOCHLORITE SHALL BE ADDED TO THE UPSTREAM END OF EACH PIPE SECTION, AND AT EACH HYDRANT TEE IN THE AMOUNT GIVEN IN THE TABLE BELOW (OR PER APPROVED MANUFACTURER SPECIFICATIONS). THE MINIMUM AMOUNT OF CALCIUM HYPOCHLORITE ADDED SHOULD BE SUFFICIENT TO ACHIEVE A 50 MG/L CONCENTRATION WITHIN THE IMPACTED AREA.

65% CALCIUM HYPOCHLORITE ADDITION PER PIPE SECTION					
PIPE DIAMETER (INCHES)	PIPE VOLUME PER 18 FEET (GAL)	5-GRAM TABLETS PER PIPE SECTION	HYPOCHLORITE GRANULES		MAXIMUM FILL RATE (GPM)
			OUNCES PER 500 FEET	TEASPOONS PER 18 FEET	
4	35	1	1.70	0.20	40
6	53	1	3.80	0.10	90
8	70	2	6.70	0.70	150
12	106	4	15.10	1.40	350
16	141	6	27	2.50	600
- NEW WATER MAINS SHALL BE FILLED USING AN APPROVED BACKFLOW PREVENTION ASSEMBLY. THE WATER MAIN SHALL BE FILLED FROM THE LOWER ELEVATION END SO THAT AS THE WATER MAIN IS FILLED, THE CHLORINE IS CONTACTED, DISSOLVED AND SPREAD RELATIVELY UNIFORM THROUGH THE LENGTH OF THE NEW WATER MAIN. THE FILL RATE SHALL BE MINIMIZED SO THAT THE VELOCITY OF THE WATER IS LESS THAN 1 FT/SEC (SEE TABLE ABOVE). SUCCESSFUL PRESSURE TEST AND BACTERIOLOGICAL TESTS SHALL BE COMPLETED AND PROVIDED TO THE CITY PRIOR TO ANY NEW WATER MAIN CONNECTION TO THE EXISTING WATER SYSTEM.
- THE CHLORINATED WATER WILL BE ALLOWED TO REMAIN IN CONTACT WITH THE NEW WATER MAIN SYSTEM FOR 24 TO 72 HOURS. AFTER 24 HOURS, WATER MAY BE ADDED TO THE WATER MAIN FOR THE PURPOSES OF PRESSURE TESTING. THE WATER IN THE MAIN USED FOR PRESSURE TESTING MUST REMAIN IN THE WATER MAIN UNTIL PRESSURE TEST IS COMPLETED. IF NECESSARY, LIQUID CHLORINE SHALL BE INJECTED INTO THE WATER MAIN WITH FILL WATER TO MAINTAIN A CONCENTRATION IN THE WATER MAIN ABOVE 50 MG/L. UNDER NO CIRCUMSTANCE SHALL "SUPER"CHLORINATED WATER BE ALLOWED TO SIT WITHIN A NEW WATER MAIN FOR MORE THAN 5 DAYS.
- PRESSURE TESTING INCLUDES TESTING AGAINST NEW VALVES AND HYDRANTS. EACH VALVE SHALL BE TESTED BY CLOSING EACH IN TURN AND REDUCING THE PRESSURE BEYOND THE VALVE. THE PRESSURE ON THE BACK SIDE OF THE VALVE SHOULD NOT BE ELIMINATED. CARE MUST BE TAKEN THAT, DURING THIS PROCESS, POSITIVE PRESSURE REMAINS THROUGHOUT THE SYSTEM BEING TESTED AT ALL TIMES. ALL HYDRANT FOOT VALVES SHALL BE OPEN DURING PRESSURE TESTING SO THAT THE PRESSURE TEST IS AGAINST THE HYDRANT VALVE. PRESSURE TESTING WILL NOT BE ALLOWED AGAINST ANY EXISTING VALVES.
- AFTER SUCCESSFUL PRESSURE TESTING, THE WATER MAIN SHALL BE THOROUGHLY FLUSHED TO REMOVE ALL "SUPER"CHLORINATED WATER FROM THE NEW WATER MAIN. FLUSHING OF NEW OR EXTENDED WATER MAINS SHALL BE CONDUCTED PER WSDOT SPECIFICATION 7-09.3(24)A WITH A MINIMUM VELOCITY DEVELOPED WITHIN THE PIPE WHILE FLUSHING OF 2.5 FEET PER SECOND (FPS). ALL FLUSHED WATER SHALL BE DECHLORINATED PRIOR TO DISPOSAL. THE CONTRACTOR SHALL BE RESPONSIBLE FOR DISPOSAL OF ALL CHLORINATED WATER FLUSHED FROM MAINS. **THE CITY SHALL APPROVE THE DISPOSAL METHOD PRIOR TO IMPLEMENTATION IN THE FIELD.** THE CONTRACTOR SHALL UTILIZE ONSITE DISPOSAL METHODS, IF AVAILABLE. DISPOSAL OF FLUSH WATER TO THE SANITARY SEWER SYSTEM SHALL NOT BE ALLOWED WITHOUT WRITTEN PERMISSION FROM THE WATER POLLUTION CONTROL PLANT (WPCL) SUPERVISOR. ANY PLANNED DISCHARGE TO A STORMWATER SYSTEM SHALL BE DECHLORINATED TO A CONCENTRATION OF 0.1 PPM OR LESS, PH ADJUSTED (IF NECESSARY) TO BE BETWEEN 6.5 AND 8.5, AND VOLUMETRICALLY AND VELOCITY CONTROLLED TO PREVENT ANY RESUSPENSION OF SEDIMENTS. THE CITY WILL REQUIRE INDEPENDENT TESTING THROUGHOUT THE WATER DISCHARGE PROCESS TO ENSURE COMPLIANCE OF THESE STANDARDS ARE MET.
- SAMPLES FOR BACTERIOLOGICAL ANALYSIS SHALL BE COLLECTED AFTER FLUSHING AND AGAIN 24 HOURS AFTER THE FIRST SET OF SAMPLES.
- ALL CLOSURE/FINAL CONNECTION FITTINGS SHALL BE SPRAYED CLEAN AND THEN SWABBED WITH A FIVE PERCENT (5%) CHLORINE SOLUTION IMMEDIATELY PRIOR TO INSTALLATION PER AWWA STANDARD C651. ADDITIONAL SAMPLES FOR BACTERIOLOGICAL ANALYSIS SHALL BE COLLECTED FROM THE IMMEDIATE VICINITY OF THE NEW OR REPLACED WATER MAIN AND ANALYZED AFTER THE FINAL CONNECTIONS ARE MADE. IF NECESSARY, ADDITIONAL FLUSHING SHALL BE CONDUCTED AND ADDITIONAL SAMPLES SHALL BE COLLECTED UNTIL SATISFACTORY RESULTS ARE OBTAINED.

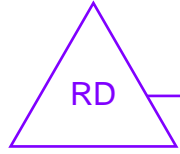


RECORD DRAWING
RECORD DRAWING INFORMATION IS PROVIDED BY NORTHWEST CASCADE, INC. RECORD DRAWING INFORMATION WAS REVIEWED BY R. HAND OF SITTS & HILL ENGINEERS AND THE INSTALLATION SUBSTANTIALLY CONFORMS TO APPROVED PLANS




APPROVED
BY *Richard C. Hand*
CITY OF PUYALLUP
DEVELOPMENT SERVICES
DATE **07/26/2021**

NOTE: THIS APPROVAL IS VOID AFTER 180 DAYS FROM APPROVAL DATE. THE CITY WILL NOT BE RESPONSIBLE FOR ERRORS AND/OR OMISSIONS ON THESE PLANS. FIELD CONDITIONS MAY DICTATE CHANGES TO THESE PLANS AS DETERMINED BY THE CITY ENGINEER

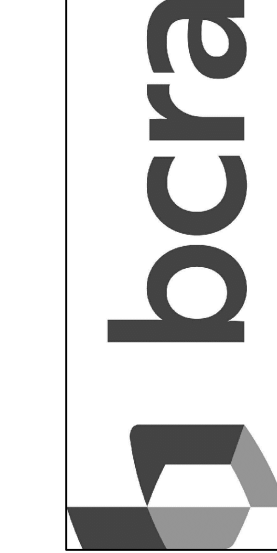


SEAL

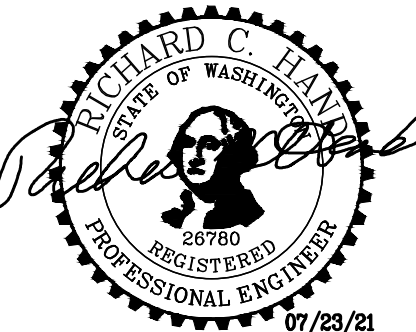

PROJECT:
PUYALLUP SCHOOL DISTRICT
WALKER HIGH SCHOOL SITE UTILITIES
5715 MILWAUKEE AVE E
PUYALLUP, WA 98372

REVISIONS
5-10-21 PERMIT SUBMITTAL
6-14-21 PERMIT RESUBMITTAL
6-23-21 BID SET
6-25-21 CITY RESUBMITTAL
7-23-21 CITY RESUBMITTAL
10-04-22 RECORD DRAWINGS

DATE
1.19.2021
BCRA NO.
20160.00.00
DRAWN BY:
REVIEWED BY:
SHEET TITLE
**CITY OF PUYALLUP
GENERAL NOTES**

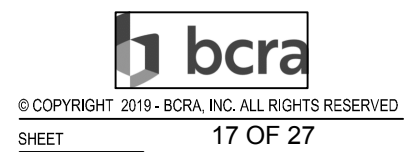

© COPYRIGHT 2019 - BCRA, INC. ALL RIGHTS RESERVED.
SHEET 17 OF 27

C11.2W



Know what's below.
Call before you dig.

**SITTS & HILL
ENGINEERS, INC.**

CIVIL • STRUCTURAL • SURVEYING

4815 CENTER STREET | TACOMA, WA 98409
PHONE: (253) 474-9448 | FAX: (253) 474-0153
http://www.sitts-hill-engineers.com/

Project No.: 19,034	Project Mgr.: R.H.
Proj. Engineer: S.A.J.	Proj. Drafter: S.A.J.

WASHINGTON STATE PLANE COORDINATE SYSTEM, SOUTH ZONE,
NAD 83/2011
BASED ON GPS OBSERVATION UTILIZING THE WASHINGTON
STATE REFERENCE NETWORK (WSRN)

NAVD 88
BASED ON GPS OBSERVATION UTILIZING THE WSRN WITH
NGS GEOID2018 LOADED

SITE TEMPORARY BENCHMARK (T.B.M.)
MAG NAIL IN ASPHALT, NORTH OF MAIN BUILDING
N: 687636.23
E: 1197398.27
ELEV: 56.52

MEASURED NORTH 15°57'37" EAST BETWEEN TWO FOUND
MONUMENTS ALONG MILWAUKEE AVE E.


TAX PARCEL NO. 7705000171
ADDRESS: 5715 MILWAUKEE AVE E, PUYALLUP, WA 98372
LAND AREA: 3.38 AC±


1. EQUIPMENT USED: TOPCON QS AND/OR CARLSON CR2+ ROBOTIC TOTAL STATION AND TOPCON GR3 RTK/GPS
2. THIS SURVEY WAS PERFORMED BY FIELD TRAVERSE WITH THE FINAL RESULTS MEETING OR EXCEEDING THE CURRENT TRAVERSE STANDARDS CONTAINED IN W.A.C. 332-130-090. ALL MEASUREMENTS WERE MADE WITH A TOPCON QS ROBOTIC TOTAL STATION IN ACCORDANCE WITH THE EQUIPMENT MANUFACTURER'S SPECIFICATIONS.
3. IN ACCORDANCE WITH THE REVISED CODE OF WASHINGTON (R.C.W.) 58.09 AND THE WASHINGTON ADMINISTRATIVE CODE (W.A.C.) 332-130, THIS SURVEY MAY DEPICT OCCUPATIONAL INDICATORS THAT DIFFER FROM THE DEEDED LOT LINES. THESE INDICATORS, IF AT ALL PRESENT, MAY REPRESENT A POTENTIAL FOR CLAIMS OF UNWRITTEN TITLE. THIS SURVEY DOES NOT PURPORT TO RESOLVE SUCH ITEMS.
4. FIELD WORK PERFORMED IN FEBRUARY 2021, UNDER SITTS & HILL JOB NUMBER 19159.
5. UTILITIES AS SHOWN HEREON ARE BASED ON FIELD SURVEY OBSERVATION OF UTILITY LOCATE SERVICES PERFORMED BY MT. VIEW LOCATING SERVICES LLC IN FEBRUARY 2021 FOR THIS SURVEY. THIS HAS BEEN SUPPLEMENTED BY RECORD INFORMATION PROVIDED BY PUGET SOUND ENERGY, CITY OF PUYALLUP WATER DIVISION, AND PIERCE COUNTY GCS. RECORD UTILITY LINES SHOWN HEREON ARE DEPICTED WITH A DASHED LINETYPE AS SHOWN IN THE LEGEND. UTILITIES OTHER THAN SHOWN MAY EXIST ON THE SITE. THE SURVEYOR DOES NOT WARRANT THAT THE UNDERGROUND UTILITIES SHOWN ARE IN THE EXACT LOCATION INDICATED. THE SURVEYOR DOES CERTIFY THAT THEY ARE SHOWN AS ACCURATELY AS POSSIBLE FROM FIELD SURVEY AND PAINTED UTILITY LOCATE LINES. COLLECTION AND DEPICTION OF EXISTING SUBSURFACE UTILITY DATA IS CONSISTENT WITH QUALITY LEVEL B OF THE ASCE STANDARD GUIDELINES 38-02.
6. SITTS & HILL ENGINEERS, INC. HAS RELIED UPON TITLE INFORMATION NOTED IN COMMITMENT FOR TITLE INSURANCE PREPARED BY CHICAGO TITLE INSURANCE COMPANY, GUARANTEE/CERTIFICATE NUMBER 210529-TC, DATED FEBRUARY 11, 2021. IN PREPARATION OF THIS SURVEY, SITTS AND HILL ENGINEERS, INC. HAS CONDUCTED NO INDEPENDENT TITLE SEARCH NOR IS SITTS AND HILL ENGINEERS, INC. AWARE OF ANY TITLE ISSUES AFFECTING THE SURVEYED PROPERTY OTHER THAN THOSE SHOWN ON THE MAP AND/OR DISCLOSED BY SAID TITLE COMPANY'S ORDER. SITTS & HILL ENGINEERS, INC. HAS RELIED WHOLLY ON SAID TITLE COMPANY'S REPORT AND THEREFORE QUALIFIES THE MAP'S ACCURACY AND COMPLETENESS TO THAT EXTENT.
7. THIS SURVEY COMPLIES WITH W.A.C. 332-130-145. THE CONTOURS DEPICTED HEREON ARE BASED ON DATA FROM DIRECT FIELD MEASUREMENTS. SPOT ELEVATIONS ARE BASED ON DIRECT FIELD MEASUREMENTS ARE DEPICTED FOR REFERENCE. THE PURPOSE OF THIS TOPOGRAPHIC SURVEY MAP IS TO SERVE AS A BASE MAP FOR COMPLEMENTED SITE IMPROVEMENTS AND DESIGN.

THAT PORTION OF LOTS 4 AND 5, SNELL'S PLAT OF PART OF THE ADAM BENSTON D.C., ACCORDING TO THE PLAT THEREOF, RECORDED IN VOLUME 7 OF PLATS, PAGE 87, RECORDS OF PIERCE COUNTY, DESCRIBED AS FOLLOWS:


BEGINNING AT A POINT ON THE SOUTH LINE OF SAID LOT 5, 229.72 FEET WEST OF THE SOUTHEAST CORNER THEREOF; THENCE CONTINUING WEST ALONG THE SOUTH LINE OF SAID LOT 5, 490.38 FEET, MORE OR LESS, TO THE WESTERLY OF MILWAUKEE AVENUE;

THENCE NORTHEASTERLY ALONG THE EASTERLY LINE OF SAID MILWAUKEE AVENUE 342 FEET; THENCE EAST ALONG A LINE PARALLEL WITH THE SOUTH LINE OF SAID LOT 5, 402 FEET; THENCE SOUTH ALONG A LINE PARALLEL WITH THE EAST LINE OF SAID LOT 5, 330 FEET TO THE POINT OF BEGINNING.

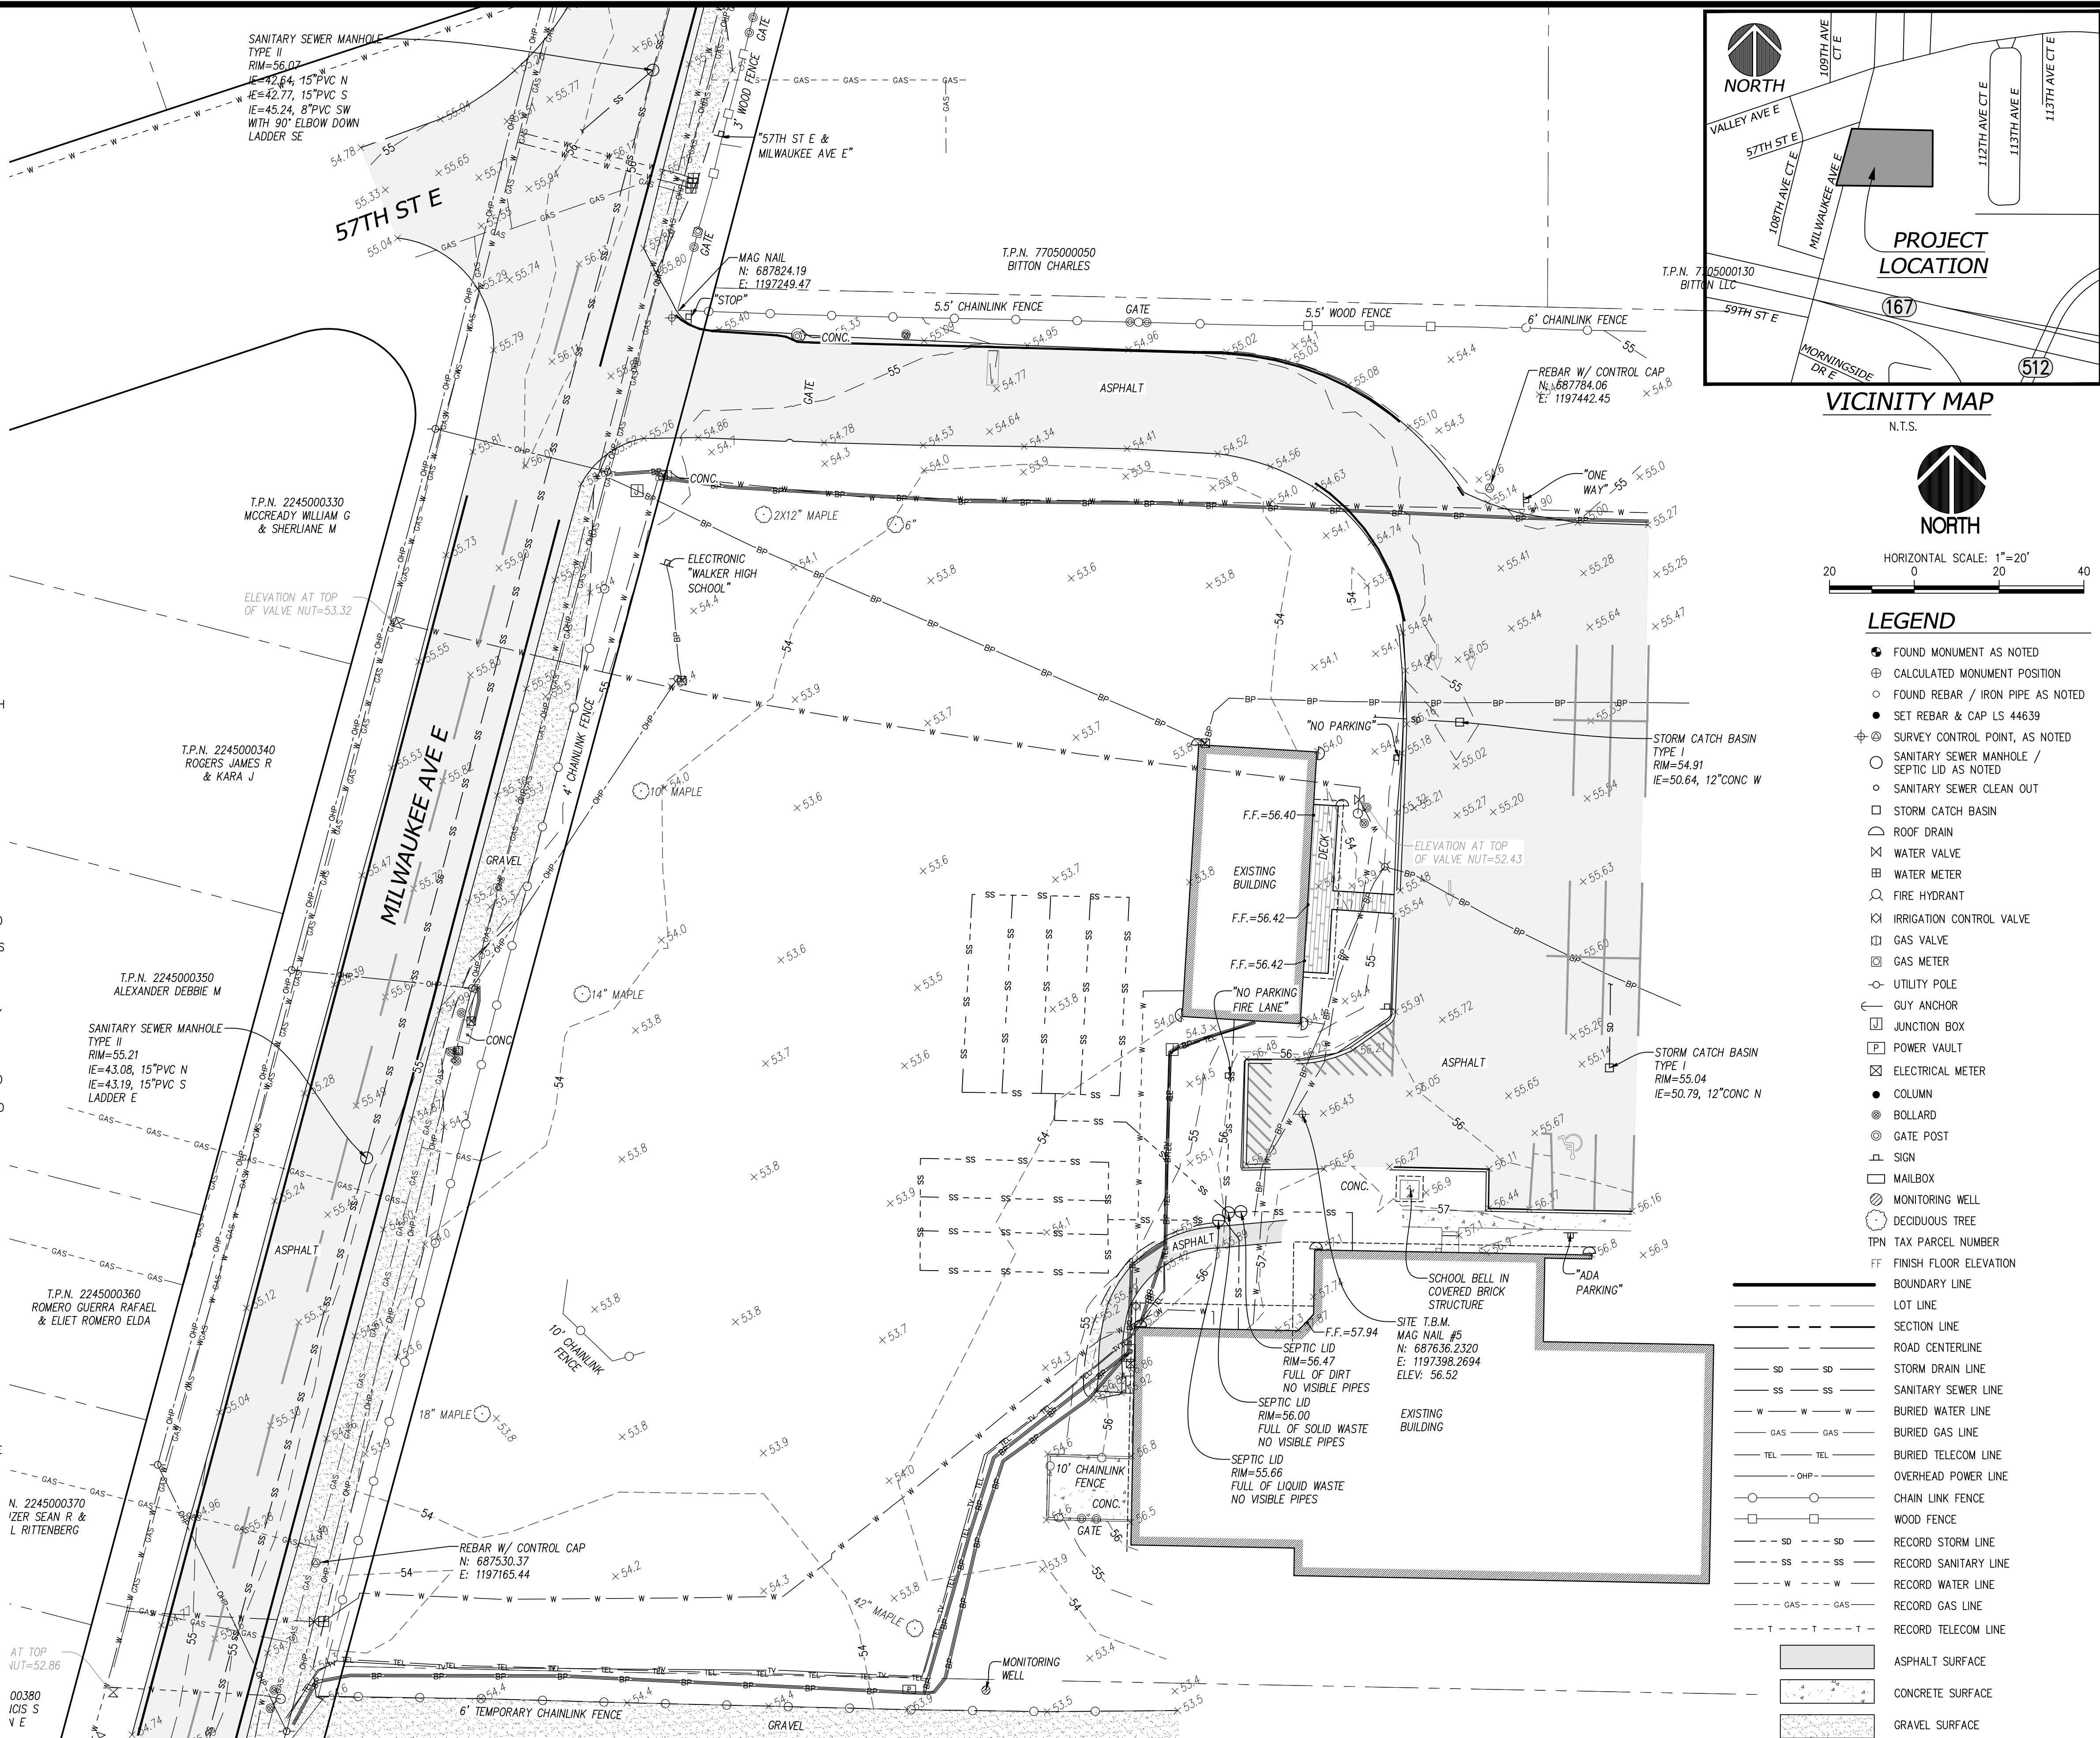


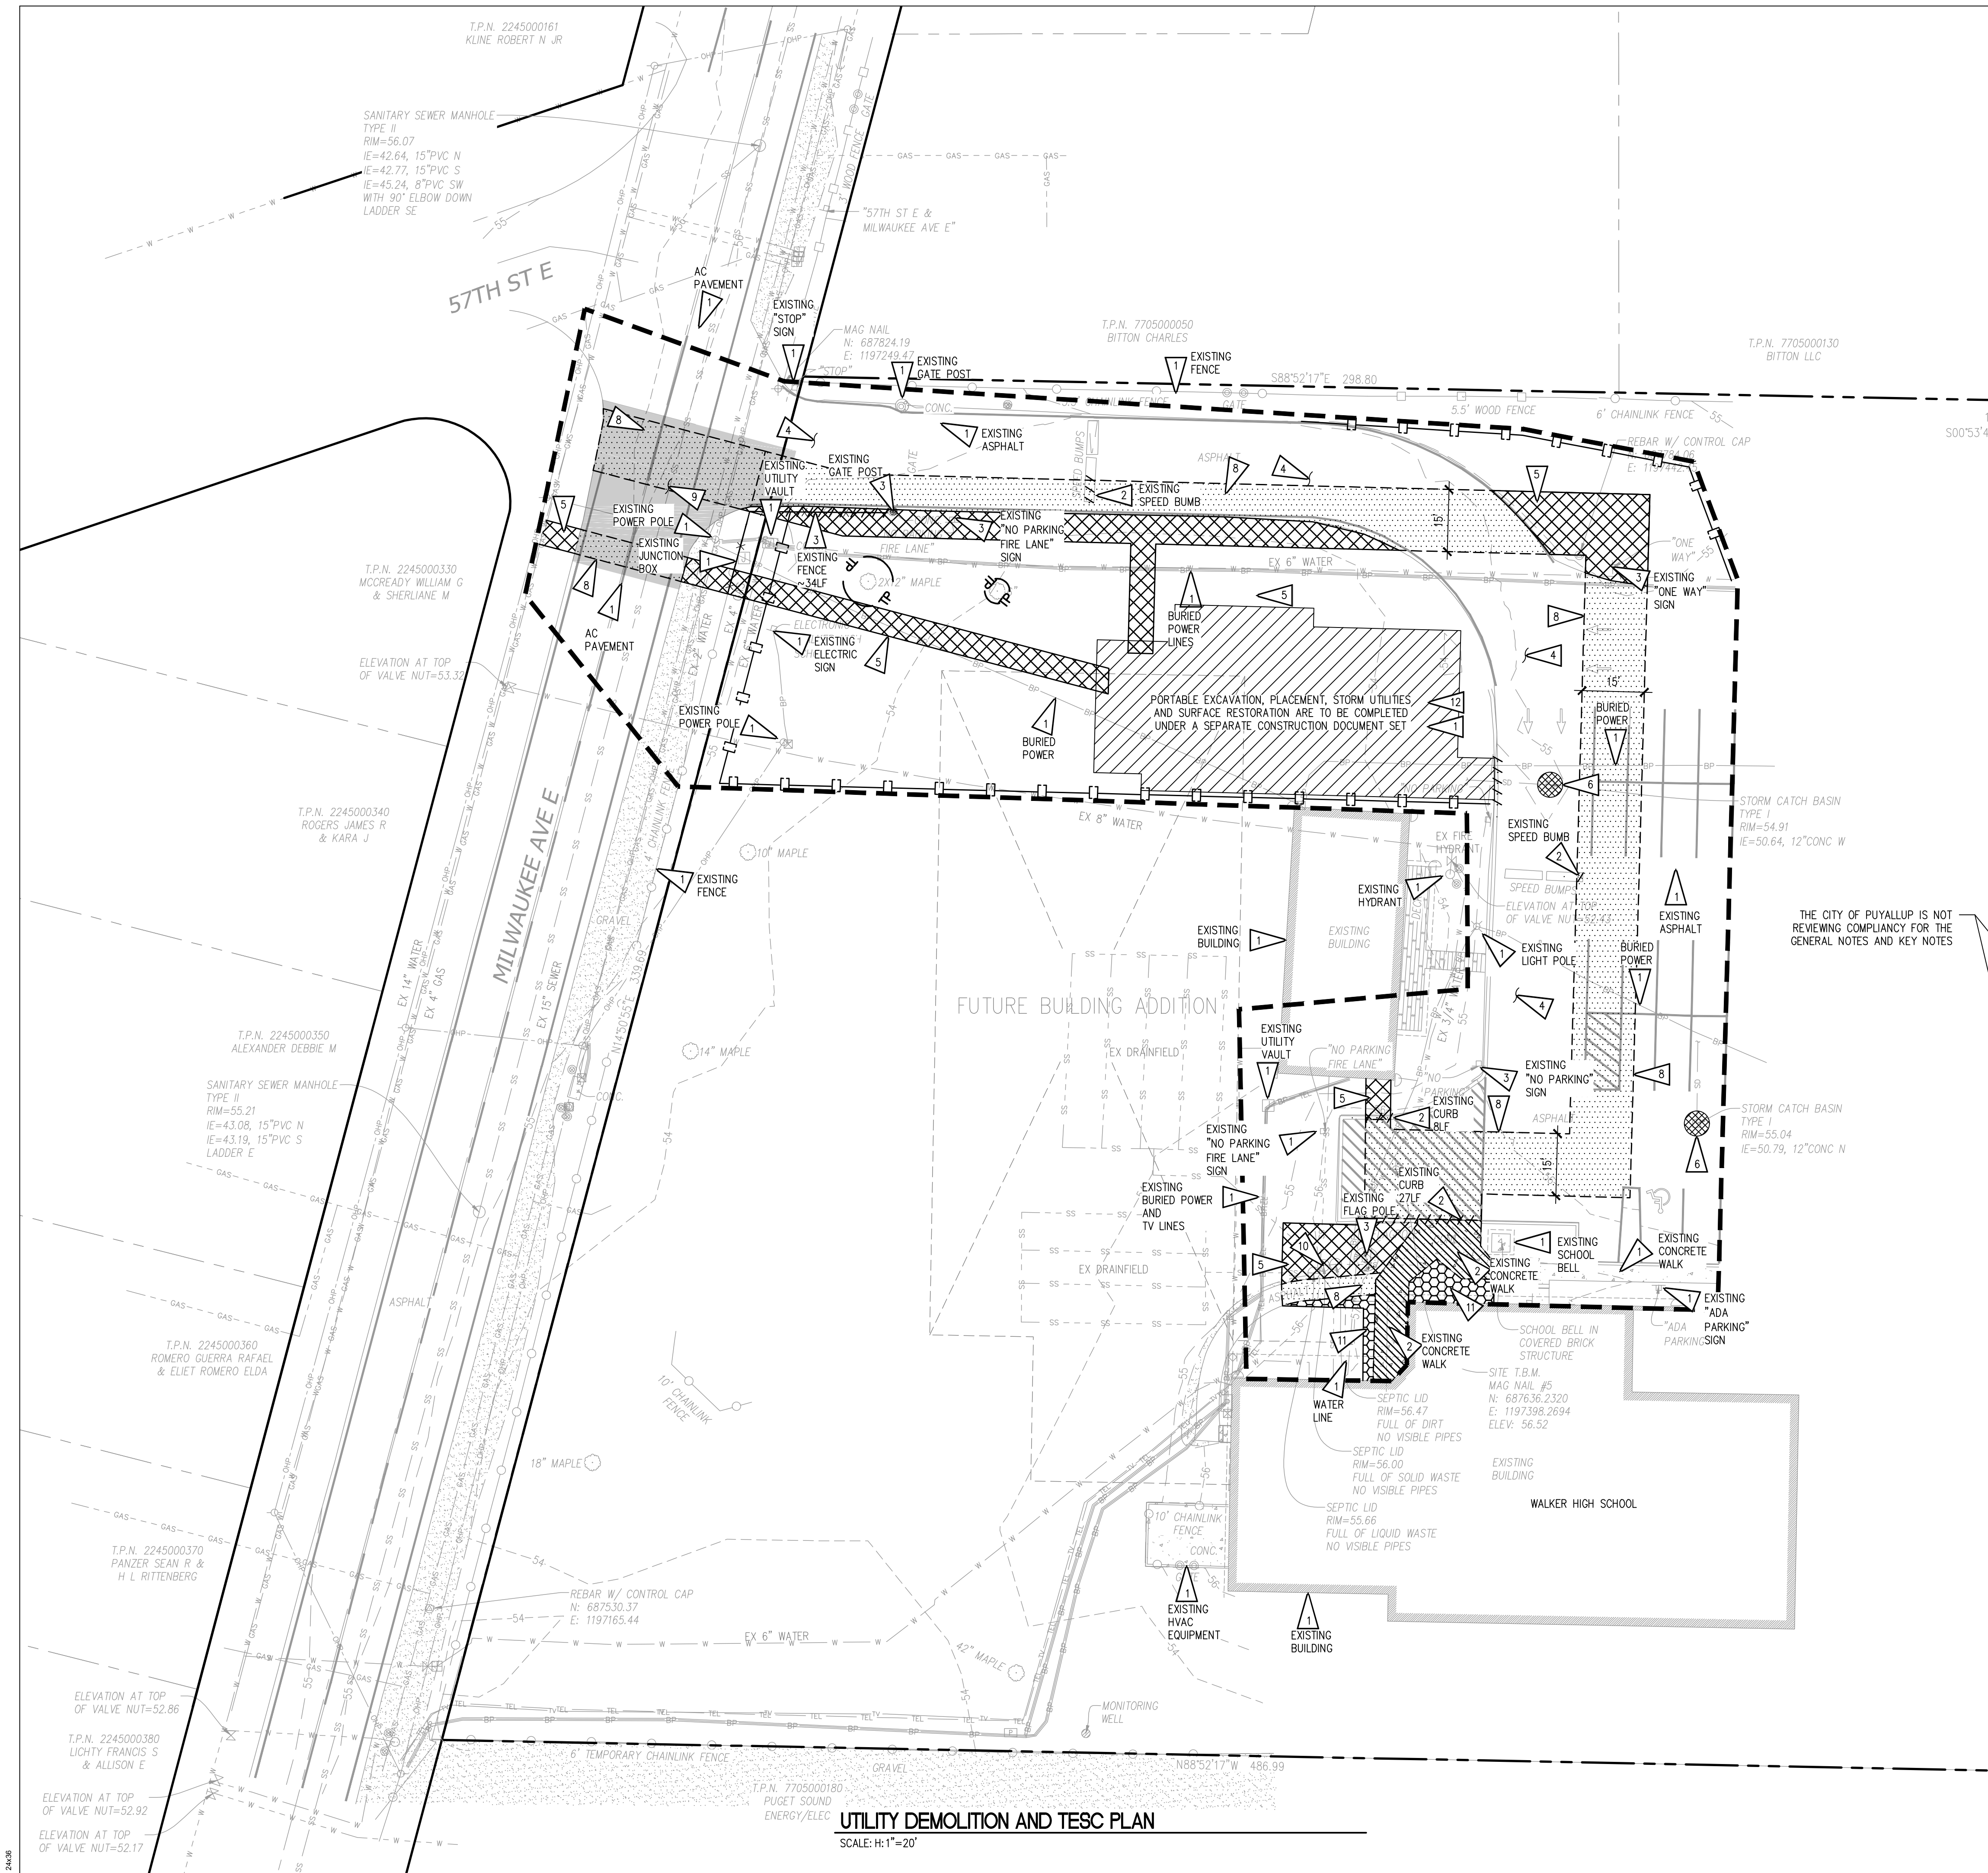

RECORD DRAWING
RECORD DRAWING INFORMATION IS PROVIDED BY NORTHWEST CASCADE, INC. RECORD DRAWING INFORMATION WAS REVIEWED BY R. HAND OF SITTS & HILL ENGINEERS AND THE INSTALLATION SUBSTANTIALLY CONFORMS TO APPROVED PLANS

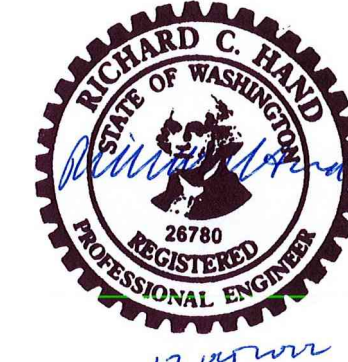

APPROVED
BY *[Signature]*
CITY OF PUYALLUP
DEVELOPMENT SERVICES
DATE **07/26/2021**
NOTE: THIS APPROVAL IS VOID AFTER 180 DAYS FROM APPROVAL DATE. THE CITY WILL NOT BE RESPONSIBLE FOR ERRORS AND/OR OMISSIONS ON THESE PLANS. FIELD CONDITIONS MAY DICTATE CHANGES TO THESE PLANS AS DETERMINED BY THE CITY ENGINEER

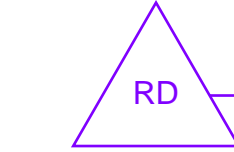

LEGEND

PROPOSED FEATURES

- DEMOLITION OF DESIGNATED ITEM
- TEMPORARY SOIL STOCKPILE
- SAWCUT PAVEMENT
- LIMITS OF WORK
- TREE PROTECTION FENCE, PER DETAIL B1/C6.0W
- SILT FENCE, PER DETAIL B3/C6.0W
- ASPHALT DEMOLITION
- GRASS REMOVAL
- CONCRETE REMOVAL
- AC GRIND
- LANDSCAPE REMOVAL

GENERAL NOTES

- SEE APPLICABLE CITY OF PUYALLUP GENERAL CIVIL NOTES ON SHEET C11.0W, C11.1W & C11.2W.
- CONSTRUCTION ACCESS SHALL BE FROM EXISTING ASPHALT SURFACES. IF ADDITIONAL MEASURES ARE NEEDED TO PREVENT TRACKING OF SEDIMENT ONTO PUBLIC ROADS, THE CONTRACTOR SHALL INSTALL A CONSTRUCTION ENTRANCE PER DETAIL B4/C6.0W.
- CONTRACTOR SHALL COVER ALL OPEN TRENCHES AT END OF WORK DAY.
- CONTRACTOR TO PROTECT EXISTING FEATURES BEYOND THE LIMITS OF WORK AND REPAIR ANY DAMAGE AT NO ADDITIONAL COST TO THE OWNER.
- CONTRACTOR SHALL MAINTAIN EMERGENCY VEHICLE ACCESS AND KEEP ONE LANE OF ONSITE ACCESS CLEAR AT ALL TIMES DURING CONSTRUCTION.
- CONTRACTOR SHALL FIELD VERIFY EXISTING CONDITIONS AND NOTIFY ENGINEER IMMEDIATELY IF THERE ARE ANY DISCREPANCIES AFFECTING THE NEW CONSTRUCTION.
- SEE ELECTRICAL PLAN FOR POWER AND LOW VOLTAGE CONNECTION REQUIREMENTS.
- CONTRACTOR SHALL PREPARE, SUBMIT AND OBTAIN AN APPROVED TRAFFIC CONTROL PLAN FROM PIERCE COUNTY PRIOR TO COMMENCING WORK IN RIGHT-OF-WAY.
- CONTRACTOR SHALL RETAIN EXISTING ONSITE SANITARY SEPTIC SYSTEM OPERATIONS UNTIL NEW SEWER SYSTEM CONNECTION APPROVAL IS OBTAINED.
- SEPTIC SYSTEM DECOMMISSION SHALL COMPLY WITH PIERCE COUNTY HEALTH DEPARTMENT REQUIREMENTS

KEY NOTES

- PROTECT EXISTING FEATURE TO REMAIN, AS NOTED.
- DEMOLISH EXISTING FEATURE, AS NOTED.
- SALVAGE EXISTING FEATURE, AS NOTED. COORDINATE RELOCATION WITH SCHOOL DISTRICT.
- TEMPORARY CONSTRUCTION ACCESS, SWEEP CLEAN AS REQUIRED. SEE GENERAL NOTE 2.
- REMOVE EXISTING GRASS AND SOIL. DISPOSE OF AT AN APPROVED OFF-SITE FACILITY.
- INSTALL CATCH BASIN PROTECTION PER DETAIL A2/C6.0W. PROVIDE CATCH BASIN PROTECTION AT ALL STORM DRAINAGE INLET SUBJECT TO SURFACE DRAINAGE FROM CONSTRUCTION AREA.
- NOT USED
- DEMOLISH ASPHALT PAVEMENT FULL DEPTH.
- 2" DEPTH GRIND IN PREPARATION OF FULL STREET OVERLAY, OVERLAY SHALL EXTEND A MINIMUM OF 2' BEYOND TRENCH LIMITS.
- DEMOLISH EXISTING SEPTIC TANK, SEE GENERAL NOTE 9 AND 10.
- REMOVE EXISTING PLANTINGS
- PORTABLE BUILDING CONTRACTOR WORK AREA




HORIZONTAL SCALE: 1"=20'
20 0 20 40



SITTS & HILL ENGINEERS, INC.
CIVIL • STRUCTURAL • SURVEYING

4815 CENTER STREET | TACOMA, WA. 98409
PHONE: (253) 474-9449 | FAX: (253) 474-0153
http://www.sitts-hill-engineers.com/

Project No.: 19,034 Project Mgr.: R.H.
Proj. Engineer: S.A.J. Proj. Drafter: S.A.J.

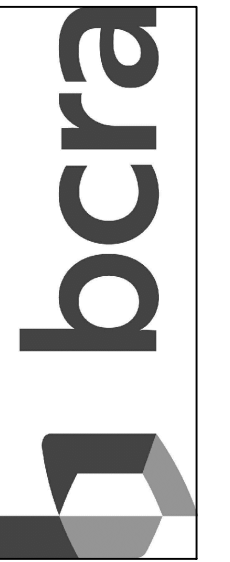

T. 253.627.4367 F. 253.627.4365 WWW.BCRADESIGN.COM
2108 PACIFIC AVENUE, SUITE 300, TACOMA, WA 98402



PROJECT:
PUYALLUP SCHOOL DISTRICT
WALKER HIGH SCHOOL SITE UTILITIES
5715 MILWAUKEE AVE E
PUYALLUP, WA 98372

REVISIONS
5-10-21 PERMIT SUBMITTAL
6-14-21 PERMIT RESUBMITTAL
6-23-21 BID SET
6-25-21 CITY RESUBMITTAL
7-23-21 CITY RESUBMITTAL
10-04-22 RECORD DRAWINGS


DATE
1.19.2021
BCRA NO.
20160.00.00
DRAWN BY:
REVIEWED BY:
SHEET TITLE
SITE UTILITIES DEMOLITION
AND TESC PLAN



© COPYRIGHT 2019, BCRA, INC. ALL RIGHTS RESERVED.
SHEET 20 OF 27

C13.0W


IF SHEET MEASURES LESS THAN 24"x36", IT IS A REDUCED PRINT. REDUCE SCALE ACCORDINGLY

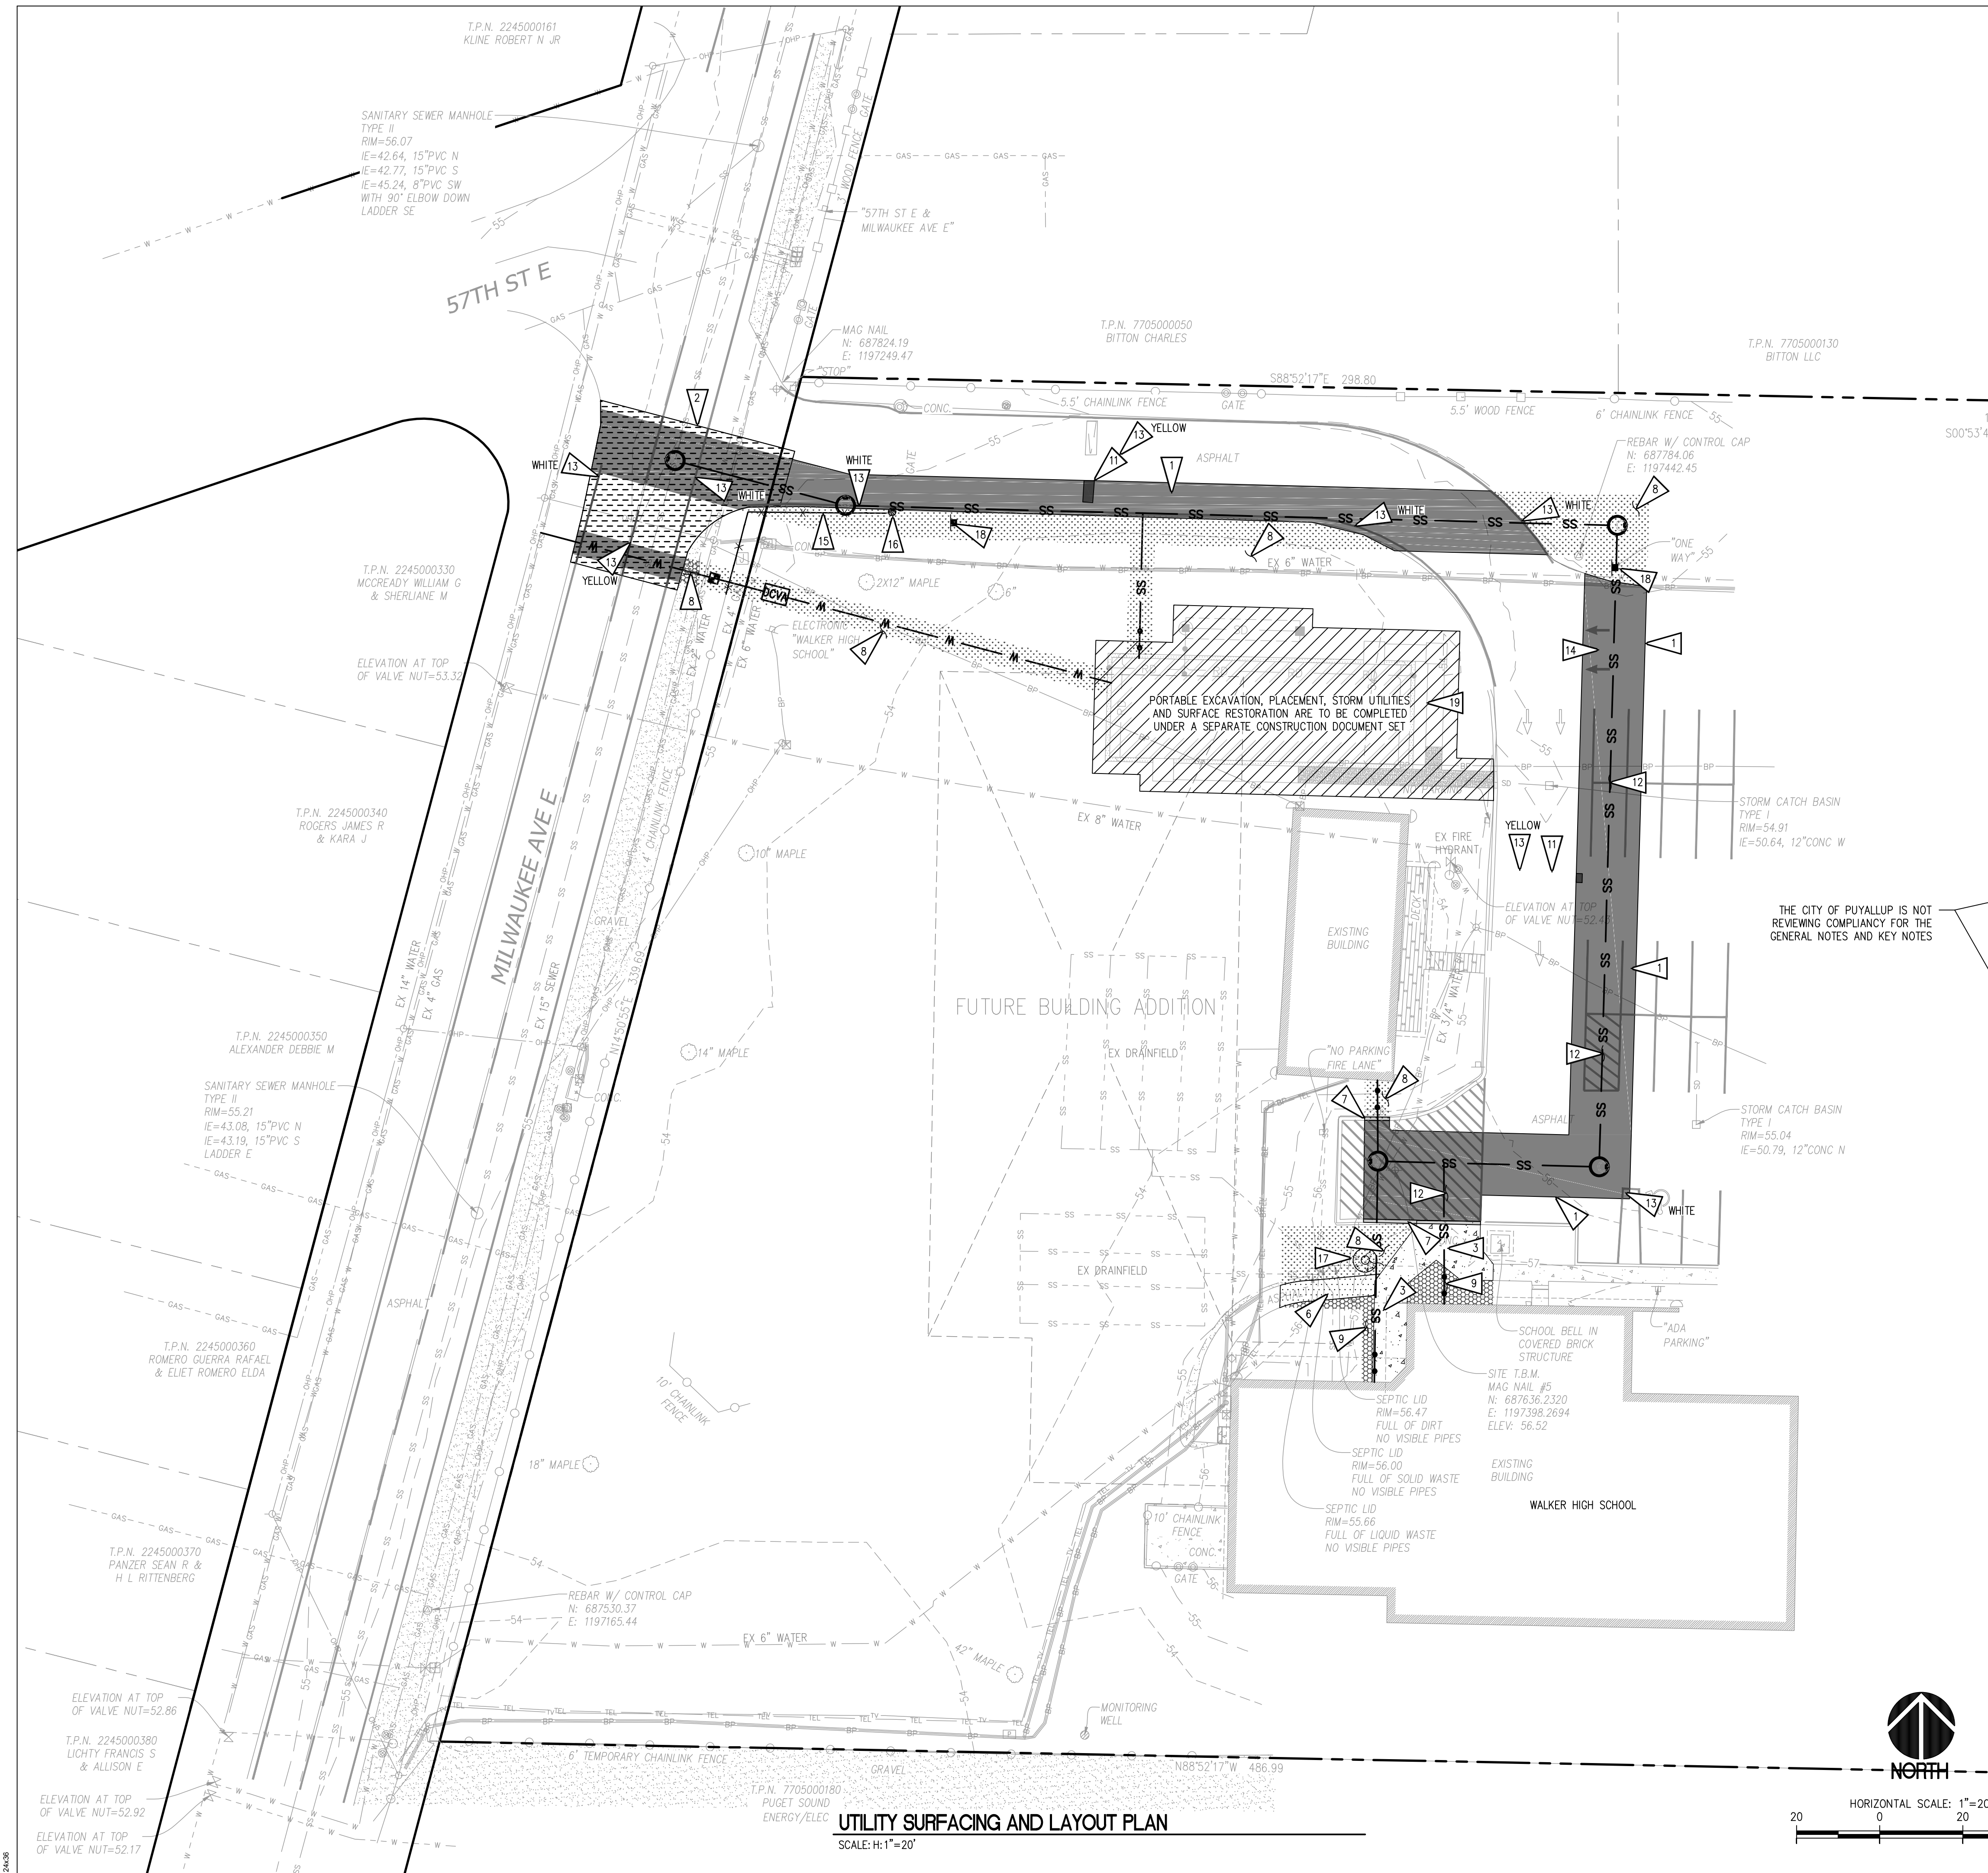

RECORD DRAWING
RECORD DRAWING INFORMATION IS PROVIDED BY NORTHWEST CASCADE, INC. RECORD DRAWING INFORMATION WAS REVIEWED BY R. HAND OF SITTS & HILL ENGINEERS AND THE INSTALLATION SUBSTANTIALLY CONFORMS TO APPROVED PLANS

APPROVED
BY *Richard C. Hand*
CITY OF PUYALLUP
DEVELOPMENT SERVICES
DATE **07/26/2021**

NOTE: THIS APPROVAL IS VOID AFTER 180 DAYS FROM APPROVAL DATE. THE CITY WILL NOT BE RESPONSIBLE FOR ERRORS AND/OR OMISSIONS ON THESE PLANS. FIELD CONDITIONS MAY DICTATE CHANGES TO THESE PLANS AS DETERMINED BY THE CITY ENGINEER

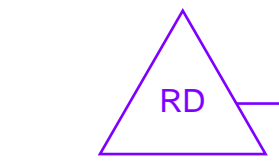

LEGEND
PROPOSED FEATURES

- CONCRETE CURB
- CHAINLINK FENCE
- SIGNAGE
- GATE POST
- FLAG POLE
- SPEED BUMP
- PAVEMENT STRIPING
- HEAVY DUTY ASPHALT RESTORATION
- LIGHT DUTY ASPHALT RESTORATION
- CONCRETE WALK RESTORATION
- GRASS RESTORATION
- 2" HMA OVERLAY
- PLANTING BED

GENERAL NOTES

- SEE APPLICABLE CITY OF PUYALLUP GENERAL CIVIL NOTES ON SHEET C11.0W, C11.1W AND C11.2W.
- SEE APPLICABLE PIERCE COUNTY GENERAL CIVIL NOTES ON SHEET C1.1W.
- CONTRACTOR IS RESPONSIBLE TO PROTECT EXISTING UTILITY/COVER BY ANY MEANS NECESSARY (SUCH AS METAL PLATES, ETC.) DURING INSTALLATION. DAMAGED SURFACE FEATURES OR UTILITIES SHALL BE REPLACED BY THE CONTRACTOR AT NO ADDITIONAL COST TO THE OWNER.
- SEE ELECTRICAL FOR BURIED POWER AND COMMUNICATION CONDUIT AND TRENCH INSTALLATION REQUIREMENTS.
- CONTRACTOR SHALL RESTORE ALL SURFACES DISTURBED AS A RESULT OF CONSTRUCTION ACTIVITIES, EXCLUDING THE BUILDING, GRAVEL PAD, ASPHALT OR GRAVEL SURFACES, AND LANDINGS. PROVIDE 8" DEPTH COMPOST AMENDED TOPSOIL PER DETAIL D1/C17.1W PRIOR TO SEEDING.
- CONTRACTOR TO PROVIDE TEMPORARY IRRIGATION FOR ALL SEEDED SURFACES AND PLANTINGS UNTIL VEGETATION IS ESTABLISHED.
- CONTRACTOR TO USE HORIZONTAL AND VERTICAL DATUM AS OUTLINED ON SHEET C12.0W.

KEY NOTES

- HEAVY DUTY ASPHALT PAVEMENT RESTORATION, SEE DETAIL A1/C17.1W
- 2" AC OVERLAY, SEE DETAIL A3/C17.1W
- CONCRETE WALK RESTORATION, SEE DETAIL B1/C17.1W & B2/C17.1W
- NOT USED
- NOT USED
- LIGHT DUTY ASPHALT RESTORATION, SEE DETAIL A2/C17.1W
- CONCRETE CURB, MATCH EXISTING, SEE DETAIL B4/C17.1W
- RESTORE DISTURBED LANDSCAPE AREA, SEE DETAIL C4/C17.1W
- PROVIDE PLANTING AND 4" BARK MULCH, PLANTING SIZE AND SPACING TO MATCH EXISTING.
- NOT USED
- AC SPEED BUMP, MATCH EXISTING, SEE DETAIL B3/C17.1W
- PAVEMENT STRIPING, SEE DETAIL D3/C17.1W
- PAVEMENT STRIPING, SEE PLANS FOR COLOR, SEE DETAIL D2/C17.1W
- PAVEMENT STRIPING, SEE DETAIL D1/C17.1W
- REINSTALL SALVAGED 4" HIGH CHAIN LINK FENCE, SEE DETAIL C2/C17.1W
- REINSTALL SALVAGED GATE POST, SEE DETAIL C1/C17.1W
- REINSTALL SALVAGED FLAG POLE, MATCH EXISTING
- REINSTALL SALVAGED SIGNAGE, SEE DETAIL C3/C17.1W
- PORTABLE BUILDING CONTRACTOR WORK AREA

THE CITY OF PUYALLUP IS NOT REVIEWING COMPLIANCY FOR THE GENERAL NOTES AND KEY NOTES



UTILITY SURFACING AND LAYOUT PLAN
SCALE: H:1"=20'

Know what's below.
Call before you dig.

SITTS & HILL ENGINEERS, INC.
CIVIL • STRUCTURAL • SURVEYING
4815 CENTER STREET | TACOMA, WA 98409
PHONE: (253) 474-9449 | FAX: (253) 474-0153
<http://www.sitts-hill-engineers.com/>

Project No.:	19,034	Project Mgr.:	R.H.
Proj. Engineer:	S.A.J.	Proj. Drafter:	S.A.J.

PROJECT:
PUYALLUP SCHOOL DISTRICT
WALKER HIGH SCHOOL SITE UTILITIES
5715 MILWAUKEE AVE E
PUYALLUP, WA 98372


REVISIONS
5-10-21 PERMIT SUBMITTAL
6-14-21 PERMIT RESUBMITTAL
6-23-21 BID SET
6-25-21 CITY RESUBMITTAL
7-23-21 CITY RESUBMITTAL
10-04-22 RECORD DRAWINGS

DATE: 1.19.2021
BCRA NO.: 20160.00.00
DRAWN BY:
REVIEWED BY:
SHEET TITLE: **SITE UTILITIES SURFACING AND LAYOUT PLAN**


© COPYRIGHT 2019, BCRA, INC. ALL RIGHTS RESERVED.
SHEET 21 OF 27

C14.0W

IF SHEET MEASURES LESS THAN 24"x36", IT IS A REDUCED PRINT. REDUCE SCALE ACCORDINGLY

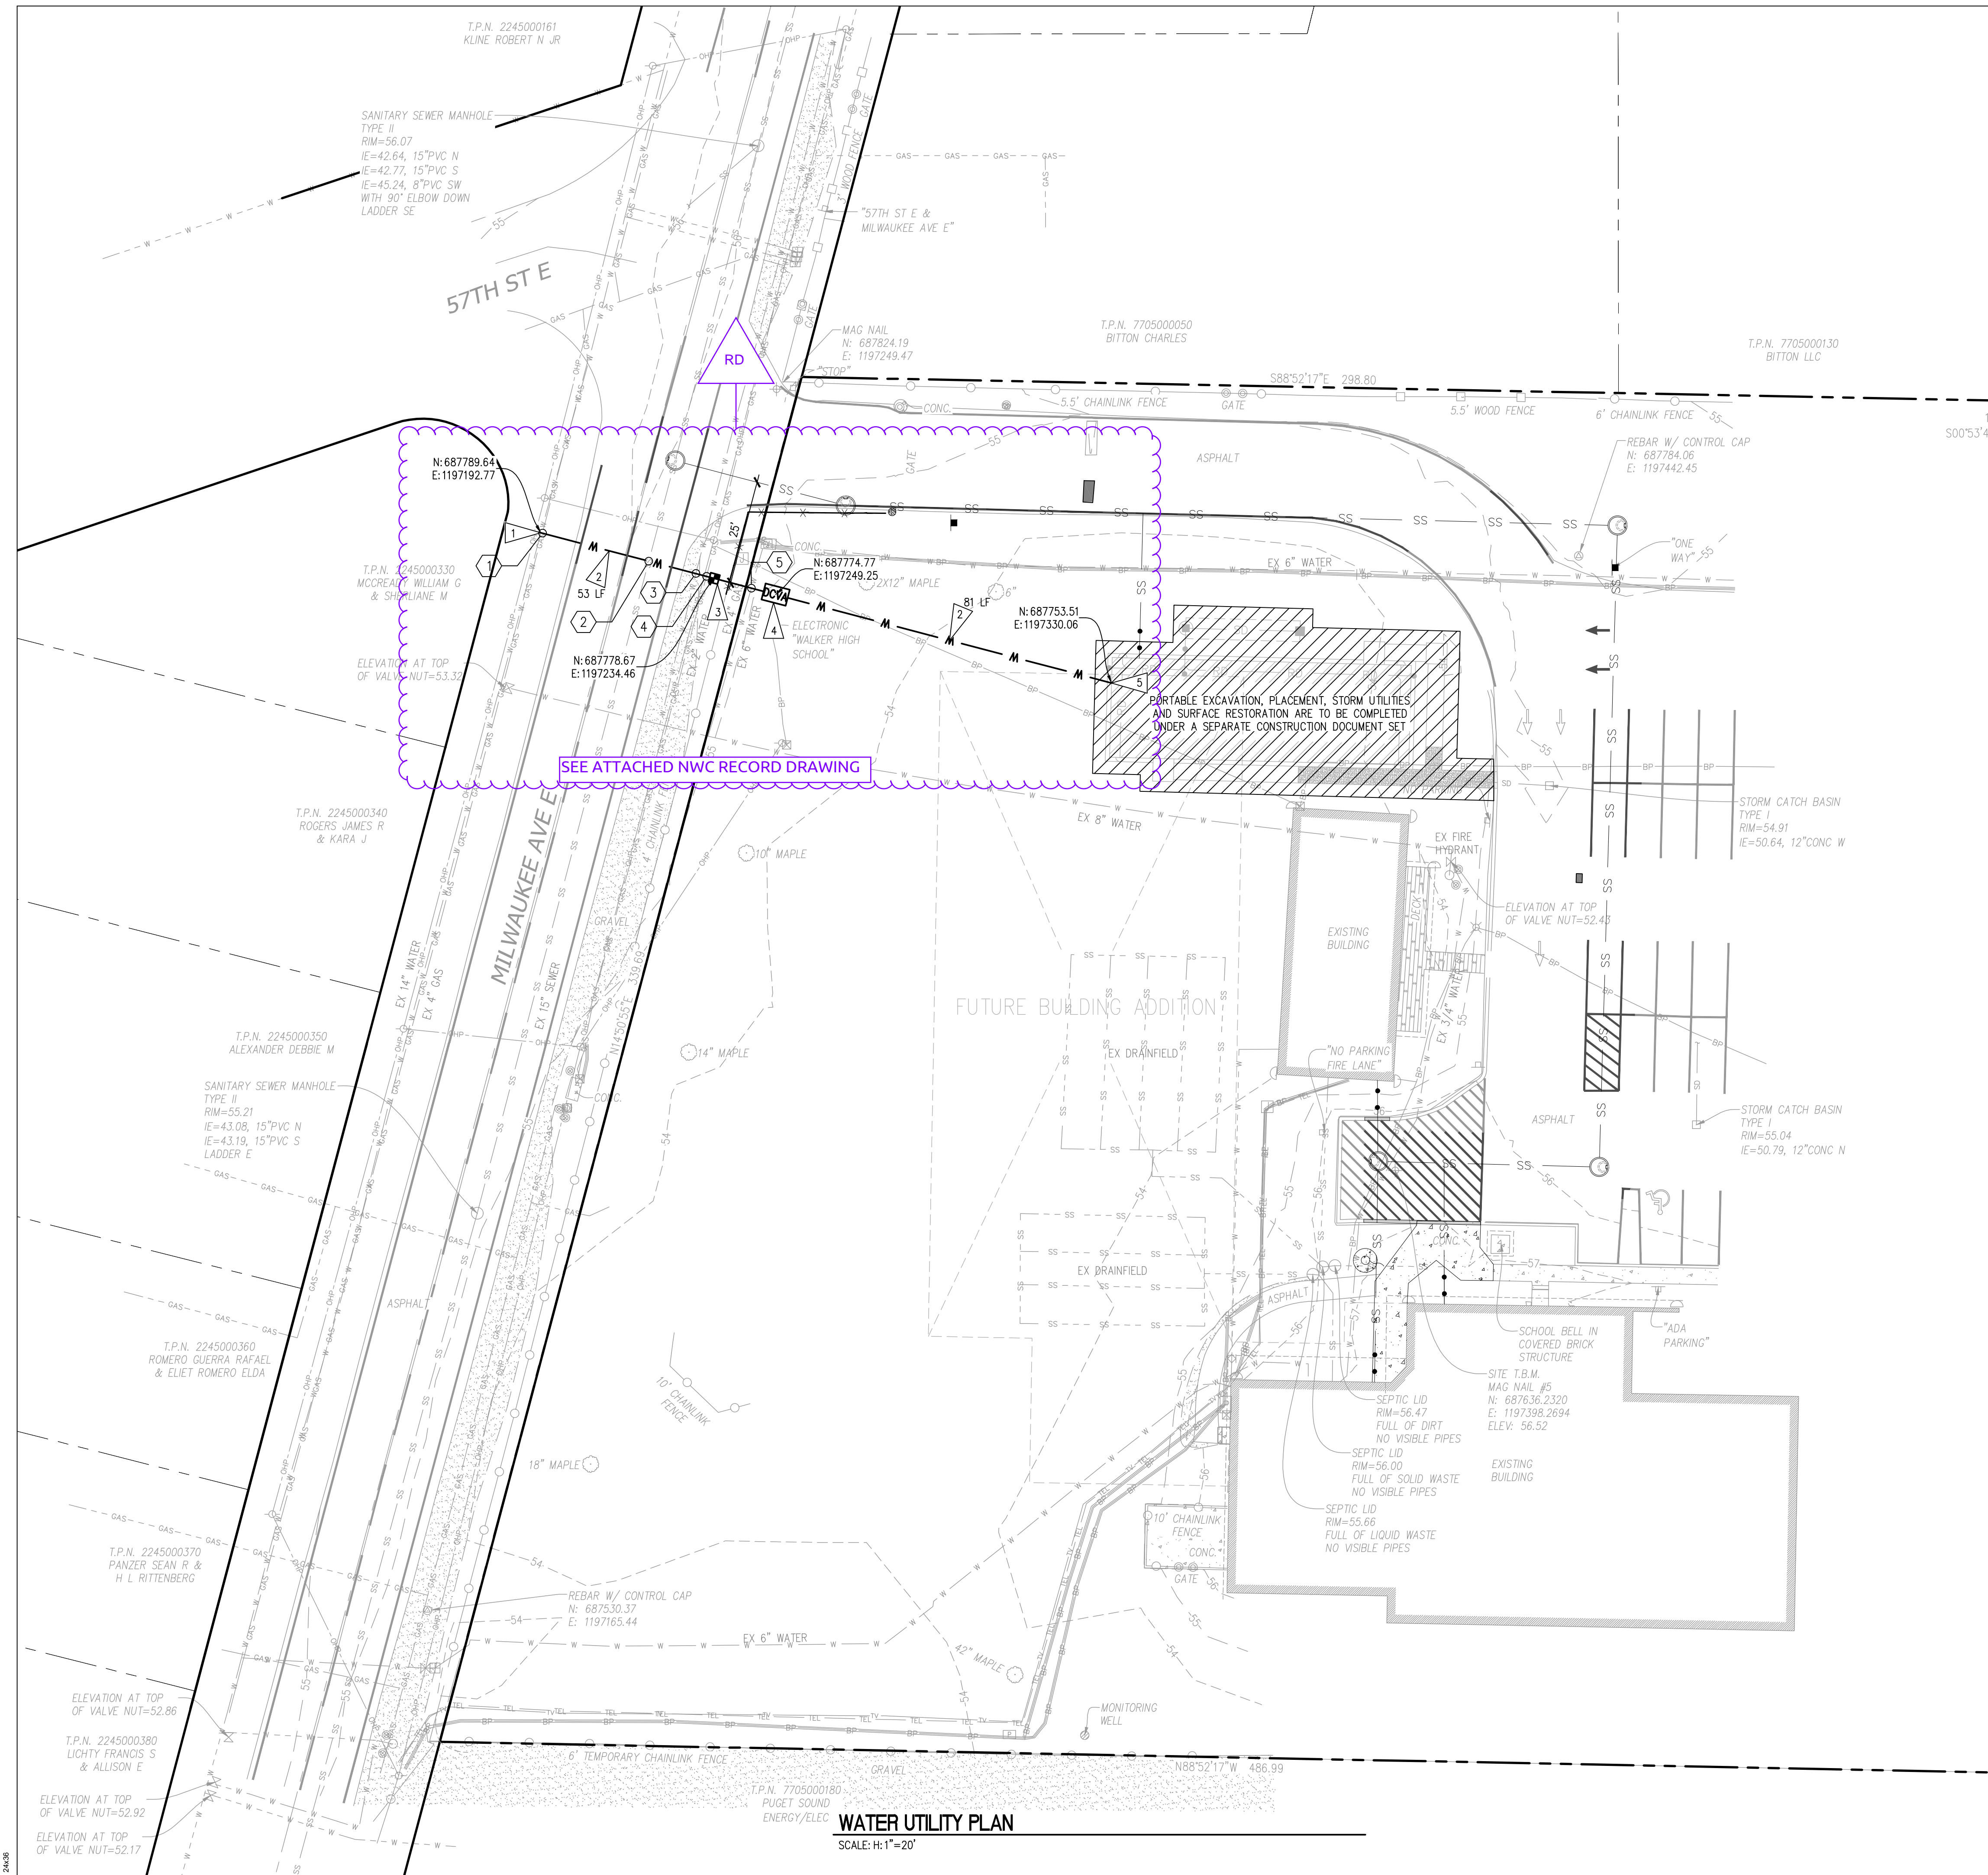

RECORD DRAWING
RECORD DRAWING INFORMATION IS PROVIDED BY NORTHWEST CASCADE, INC. RECORD DRAWING INFORMATION WAS REVIEWED BY R. HAND OF SITTS & HILL ENGINEERS AND THE INSTALLATION SUBSTANTIALLY CONFORMS TO APPROVED PLANS.

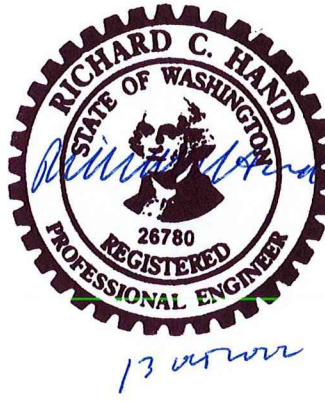


APPROVED
BY *[Signature]*
CITY OF PUYALLUP
DEVELOPMENT SERVICES
DATE **07/26/2021**

NOTE: THIS APPROVAL IS VOID AFTER 180 DAYS FROM APPROVAL DATE. THE CITY WILL NOT BE RESPONSIBLE FOR ERRORS AND/OR OMISSIONS ON THESE PLANS. FIELD CONDITIONS MAY DICTATE CHANGES TO THESE PLANS AS DETERMINED BY THE CITY ENGINEER

- GENERAL NOTES**
- SEE SHEET C11.0W, C11.1W AND C11.2W FOR APPLICABLE CIVIL CITY OF PUYALLUP GENERAL NOTES.
 - TYPICAL UTILITY TRENCH, EXCAVATION, BEDDING AND BACKFILL SHALL COMPLY WITH CITY OF PUYALLUP STANDARD DETAIL 06.01.01/C17.3W.
 - ADJUST OR SET FRAMES OF EXISTING AND PROPOSED UTILITY GRATES AND COVERS AS NECESSARY TO MATCH THE CROSS SLOPE OF THE PROPOSED FINISHED GRADE AND SUCH THAT NO PONDING OCCURS AROUND UTILITY GRATES AND COVERS.
 - COMPLY WITH WATER MAIN CLEARANCE REQUIREMENTS IN PER CITY OF PUYALLUP STANDARD DETAIL 03.01.03-1/C13.0W AND CITY OF PUYALLUP STANDARD DETAIL 03.01.03-2/C17.2W.
 - PROVIDE 3'-0" MINIMUM COVER OVER WATER PIPELINES UNLESS OTHERWISE SPECIFIED.
 - THE MINIMUM DISTANCE BETWEEN WATER AND SEWER LINES SHALL BE 10 FEET HORIZONTALLY AND 18" VERTICALLY. IF THIS CRITERION CANNOT BE MET, THE CONTRACTOR SHALL ISOLATE SEWER AND WATER LINES BY ENCASEMENT, SHIELDING, OR OTHER APPROVED METHODS.
 - THE CONTRACTOR SHALL EXPOSE THE 14 INCH CAST IRON WATER MAIN AND VERIFY THE PIPE O.D. THIS PIPE MAY BE UNDERSIZED WHERE A STANDARD TAPPING SADDLE FOR 14 INCH CAST IRON WILL NOT FIT.
 - CONTRACTOR TO USE HORIZONTAL AND VERTICAL DATUM AS OUTLINED ON SHEET C12.0W.


- KEY NOTES**
- CONNECT TO EXISTING 14" WATER MAIN, PER CITY OF PUYALLUP STANDARD DETAIL 03.01.01/C17.2W
 - 1" WATER SERVICE LINE, SEE PLANS FOR LENGTH.
 - 1" WATER METER, SEE CITY OF PUYALLUP STANDARD DETAIL 03.03.01/C17.2W.
 - 1" DOUBLE CHECK VALVE ASSEMBLY, PER CITY OF PUYALLUP STANDARD DETAIL 03.04.01/C17.2W.
 - WATER SERVICE CONNECTION, PER CITY OF PUYALLUP STANDARD DETAIL 03.03.04/C17.2W

- UTILITY CROSSING**
- TOP OF 1" WATER=52.73
ESTIMATED BTM OF 4" GAS=55.88
SEPARATION=3.17'
 - TOP OF 15" SEWER=42.89
BTM 1" WATER=52.72
SEPARATION=9.85'
 - TOP OF 1" WATER=51.95
ESTIMATED BTM OF EX 2" WATER=52.48
SEPARATION=0.53'
 - TOP OF 1" WATER=51.90
ESTIMATED BTM OF EX 4" GAS=52.59
SEPARATION=0.69'
 - TOP OF 1" WATER=51.85
ESTIMATED BTM OF EX 6" WATER=52.41
SEPARATION=0.44'

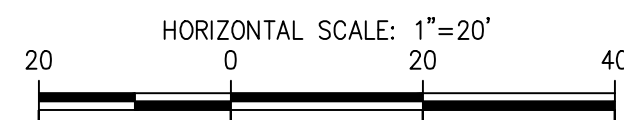

SITTS & HILL ENGINEERS, INC.
CIVIL • STRUCTURAL • SURVEYING
4815 CENTER STREET | TACOMA, WA. 98409
PHONE: (253) 474-9449 | FAX: (253) 474-0153
http://www.sitts-hill-engineers.com/

Project No.:	19,034	Project Mgr.:	R.H.
Proj. Engineer:	S.A.J.	Proj. Drafter:	S.A.J.

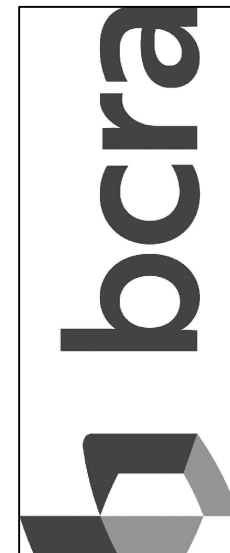

PROJECT:
PUYALLUP SCHOOL DISTRICT
WALKER HIGH SCHOOL SITE UTILITIES
5715 MILWAUKEE AVE E
PUYALLUP, WA 98372


REVISONS

5-10-21 PERMIT SUBMITTAL
6-14-21 PERMIT RESUBMITTAL
6-23-21 BID SET
6-25-21 CITY RESUBMITTAL
7-23-21 CITY RESUBMITTAL
10-04-22 RECORD DRAWINGS

DATE
1.19.2021

BCRA NO.
20760.00.00

DRAWN BY:
REVIEWED BY:
SHEET TITLE
**SITE UTILITIES
WATER PLAN**



© COPYRIGHT 2019, BCRA, INC. ALL RIGHTS RESERVED.
SHEET 22 OF 27


C15.0W

24x36

IF SHEET MEASURES LESS THAN 24"x36", IT IS A REDUCED PRINT. REDUCE SCALE ACCORDINGLY

Record Drawings

AMERICAN SURVEYING & ENVIRONMENTAL, LLC
CONDUCTED THE FINAL ASBUILT SURVEY ON AUGUST 31,
2022 AND PREPARED THESE FINAL RECORD DRAWINGS
WITH AVAILABLE INFORMATION FROM A FIELD SURVEY.
THE INFORMATION SHOWN ON THESE DRAWINGS
REFLECTS THE AS-CONSTRUCTED DATA AT THE TIME OF
SURVEY AND SHOULD BE FIELD VERIFIED FOR ANY
FUTURE USE. THE HORIZONTAL POSITIONS AND
ELEVATIONS REPORTED HEREON FOR THE SANITARY
SEWER STRUCTURES WERE FIELD SURVEYED AS STATED.

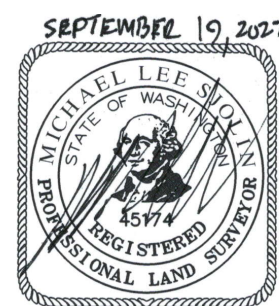

As Builts

LEGEND

PROPOSED FEATURES

- W 1" WATER PIPE
- WATER METER
- DOUBLE CHECK VALVE ASSEMBLY
- SANITARY SEWER PIPE
- C12.1W AND 12.2W
- TYPE 1 SEWER MANHOLE
- 6" SEWER CLEANOUT

PRIVATE IMPROVEMENTS

DEVELOPMENT ENGINEER
PIERCE COUNTY ORDINANCE NUMBER
DATE
1" WATER PIPE
WATER METER
DOUBLE CHECK VALVE ASSEMBLY
SANITARY SEWER PIPE
C12.1W AND 12.2W
TYPE 1 SEWER MANHOLE
6" SEWER CLEANOUT

APPROVED

PERMIT #
BY
CITY OF PUYALLUP
DEVELOPMENT ENGINEERING
DATE
NOTE: THIS APPROVAL IS VOID
AFTER 180 DAYS FROM APPROVAL
DATE
THE CITY WILL NOT BE
RESPONSIBLE FOR ERRORS
AND/OR OMISSIONS ON THESE
PLANS.
FIELD CONDITIONS MAY DICTATE
CHANGES TO THESE PLANS AS
DETERMINED BY THE
DEVELOPMENT ENGINEERING
MANAGER.

GENERAL NOTES

- SEE SHEET C11.0W, C11.1W AND C11.2W FOR APPLICABLE CIVIL CITY OF PUYALLUP GENERAL NOTES.
- TYPICAL UTILITY TRENCH, EXCAVATION, BEDDING AND BACKFILL SHALL COMPLY WITH CITY OF PUYALLUP STANDARD DETAIL 06.01.01/C17.3W.
- ADJUST OR SET FRAMES OF EXISTING AND PROPOSED UTILITY GRATES AND COVERS AS NECESSARY TO MATCH THE CROSS SLOPE OF THE PROPOSED FINISHED GRADE AND SUCH THAT NO PONDING OCCURS AROUND UTILITY GRATES AND COVERS.
- COMPLY WITH WATER MAIN CLEARANCE REQUIREMENTS IN PER CITY OF PUYALLUP STANDARD DETAIL 03.01.03-1/C13.0W AND CITY OF PUYALLUP STANDARD DETAIL 03.01.03-2/C17.2W.
- PROVIDE 3'-0" MINIMUM COVER OVER WATER PIPELINES UNLESS OTHERWISE SPECIFIED.
- THE MINIMUM DISTANCE BETWEEN WATER AND SEWER LINES SHALL BE 10 FEET HORIZONTALLY AND 18" VERTICALLY. IF THIS CRITERION CANNOT BE MET, THE CONTRACTOR SHALL ISOLATE SEWER AND WATER LINES BY ENCASEMENT, SHIELDING, OR OTHER APPROVED METHODS.
- THE CONTRACTOR SHALL EXPOSE THE 14 INCH CAST IRON WATER MAIN AND VERIFY THE PIPE O.D. THIS PIPE MAY BE UNDERSIZED WHERE A STANDARD TAPPING SADDLE FOR 14 INCH CAST IRON WILL NOT FIT.
- CONTRACTOR TO USE HORIZONTAL AND VERTICAL DATUM AS OUTLINED ON SHEET C12.0W.

KEY NOTES

- CONNECT TO EXISTING 14" WATER MAIN, PER CITY OF PUYALLUP STANDARD DETAIL 03.01.01/C17.2W
- 1" WATER SERVICE LINE, SEE PLANS FOR LENGTH.
- 1" WATER METER, SEE CITY OF PUYALLUP STANDARD DETAIL 03.03.01/C17.2W.
- 1" DOUBLE CHECK VALVE ASSEMBLY, PER CITY OF PUYALLUP STANDARD DETAIL 03.04.01/C17.2W.
- WATER SERVICE CONNECTION, PER CITY OF PUYALLUP STANDARD DETAIL 03.03.04/C17.2W

UTILITY CROSSING

- TOP OF 1" WATER=52.73
ESTIMATED BTM OF 4" GAS=55.88
SEPARATION=3.17'
- TOP OF 15" SEWER=42.89
BTM 1" WATER=52.72
SEPARATION=9.85'
- TOP OF 1" WATER=51.95
ESTIMATED BTM OF EX 2" WATER=52.48
SEPARATION=0.53'
- TOP OF 1" WATER=51.90
ESTIMATED BTM OF EX 4" GAS=52.59
SEPARATION=0.69'
- TOP OF 1" WATER=51.85
ESTIMATED BTM OF EX 6" WATER=52.41
SEPARATION=0.44'

WATER UTILITY PLAN

SCALE: H: 1"=20'



HORIZONTAL SCALE: 1"=20'
20 0 20 40



Know what's below.
Call before you dig.

SITTS & HILL ENGINEERS, INC.

CIVIL • STRUCTURAL • SURVEYING
4815 CENTER STREET | TACOMA, WA 98409
PHONE: (253) 474-9449 | FAX: (253) 474-0153
http://www.sitts-hill-engineers.com/

Project No.: 19,034 Project Mgr.: R.H.
Proj. Engineer: S.A.J. Proj. Drafter: S.A.J.

PROJECT:
PUYALLUP SCHOOL DISTRICT
WALKER HIGH SCHOOL SITE UTILITIES
5715 MILWAUKEE AVE E
PUYALLUP, WA 98372

REVISIONS
5-10-21 PERMIT SUBMITTAL
6-14-21 PERMIT RESUBMITTAL
6-23-21 BID SET
6-25-21 CITY RESUBMITTAL
7-23-21 CITY RESUBMITTAL


DATE
1.19.2021
BCRA NO.
20160.00.00
DRAWN BY:
REVIEWED BY:
SHEET TITLE
SITE UTILITIES
WATER PLAN



© COPYRIGHT 2019 - BCRA, INC. ALL RIGHTS RESERVED.
SHEET 22 OF 27

C15.0W

IF SHEET MEASURES LESS THAN 24"X36", IT IS A REDUCED PRINT. REDUCE SCALE ACCORDINGLY

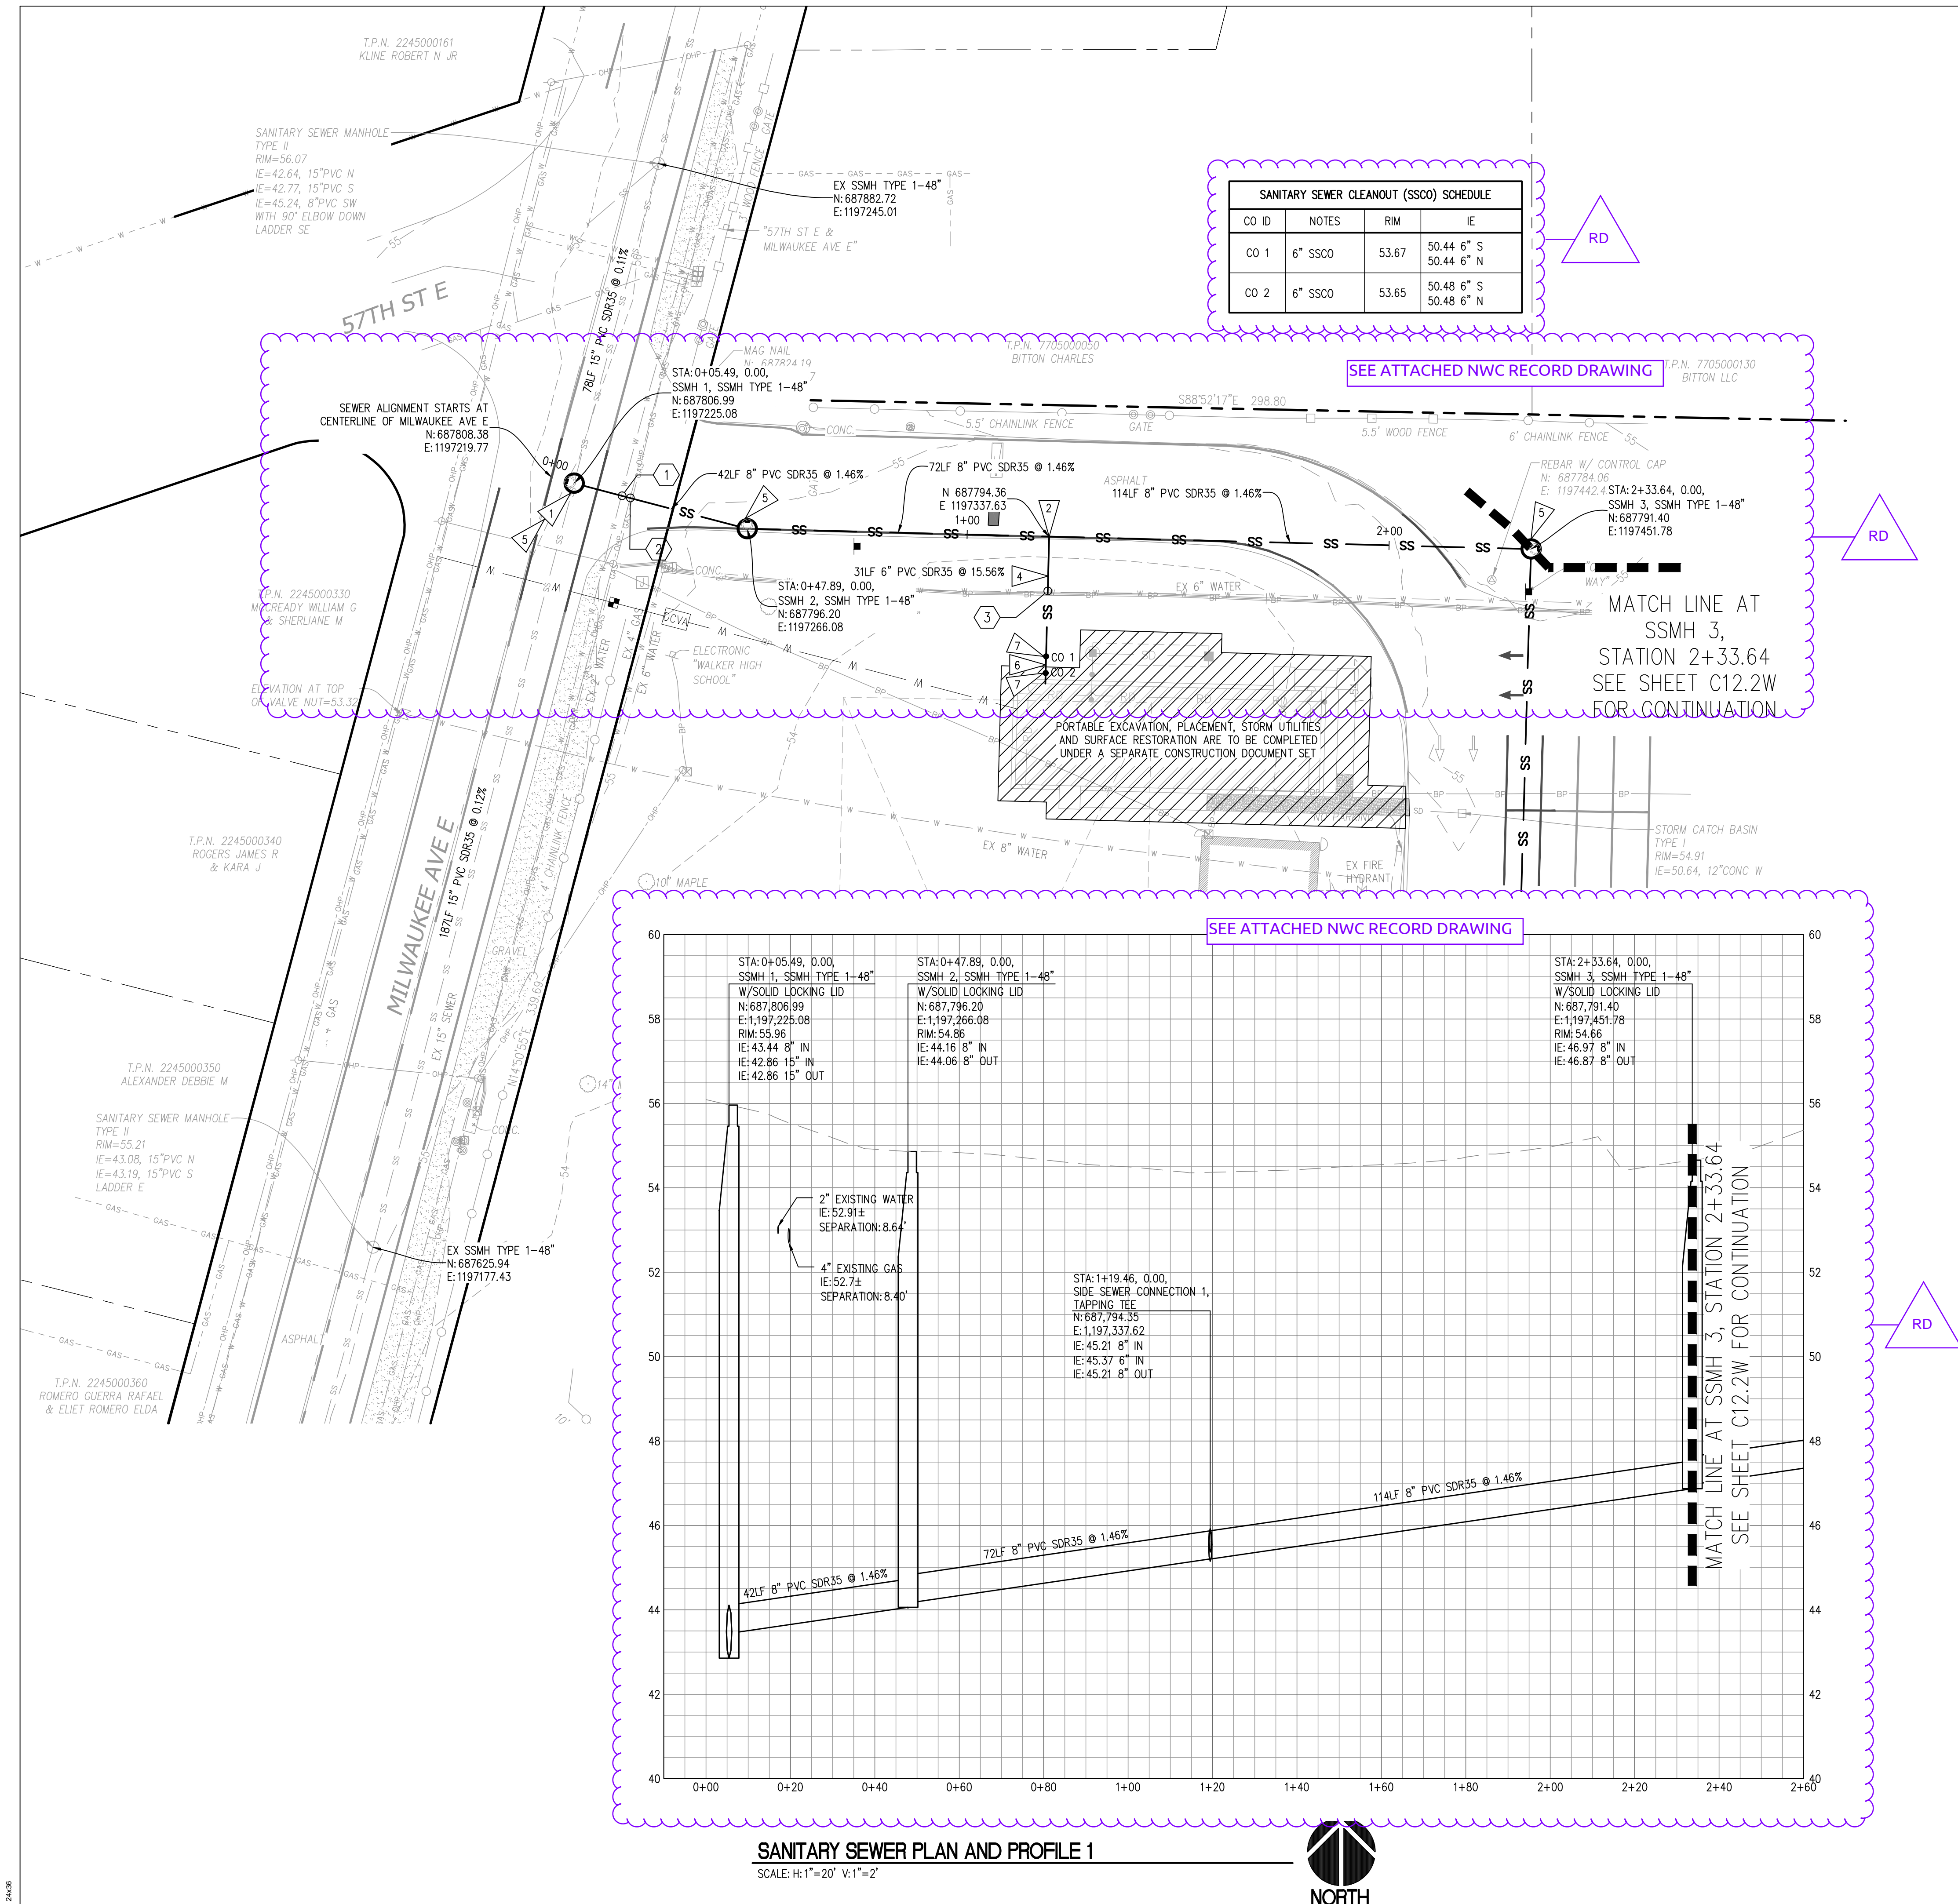

RECORD DRAWING
RECORD DRAWING INFORMATION IS PROVIDED BY NORTHWEST CASCADE, INC. RECORD DRAWING INFORMATION WAS REVIEWED BY R. HAND OF SITTS & HILL ENGINEERS AND THE INSTALLATION SUBSTANTIALLY CONFORMS TO APPROVED PLANS

APPROVED
BY: *[Signature]*
CITY OF PUYALLUP
DEVELOPMENT SERVICES
DATE: **07/26/2021**

NOTE: THIS APPROVAL IS VOID AFTER 180 DAYS FROM APPROVAL DATE. THE CITY WILL NOT BE RESPONSIBLE FOR ERRORS AND/OR OMISSIONS ON THESE PLANS. FIELD CONDITIONS MAY DICTATE CHANGES TO THESE PLANS AS DETERMINED BY THE CITY ENGINEER

RICHARD C. HEND
STATE OF WASHINGTON
REGISTERED PROFESSIONAL ENGINEER
26780
13 years


- LEGEND**
PROPOSED FEATURES
- W 1" WATER PIPE
 - WATER METER
 - DCVA DOUBLE CHECK VALVE ASSEMBLY
 - SS SANITARY SEWER PIPE
 - TYPE 1 SEWER MANHOLE
 - 6" SEWER CLEANOUT

- GENERAL NOTES**
- SEE SHEET C11.0W, C11.1W AND C11.2W FOR APPLICABLE CIVIL CITY OF PUYALLUP GENERAL NOTES.
 - TYPICAL UTILITY TRENCH, EXCAVATION, BEDDING AND BACKFILL SHALL COMPLY WITH CITY OF PUYALLUP STANDARD DETAIL 06.01.01 REQUIREMENTS. SEE CITY OF PUYALLUP STANDARD DETAIL 06.01.01/C17.3W.
 - ALL SEWER MANHOLE COMPONENTS SHALL BE PER CITY OF PUYALLUP STANDARD DETAILS
SANITARY SEWER MANHOLE: 04.01.01/C17.3W
FRAME AND COVER: 06.01.02/C17.4W
STEPS AND HANDHOLD: 06.01.03/C17.4W
 - ADJUST OR SET FRAMES OF EXISTING AND PROPOSED UTILITY GRATES AND COVERS AS NECESSARY TO MATCH THE CROSS SLOPE OF THE PROPOSED FINISHED GRADE AND SUCH THAT NO PONDING OCCURS AROUND UTILITY GRATES AND COVERS.
 - COMPLY WITH WATER MAIN CLEARANCE REQUIREMENTS IN PER CITY OF PUYALLUP STANDARD DETAIL 03.01.03-1/C17.2W AND CITY OF PUYALLUP STANDARD DETAIL 03.01.03-2/C17.2W.
 - NOT USED
 - THE MINIMUM DISTANCE BETWEEN WATER AND SEWER LINES SHALL BE 10 FEET HORIZONTALLY AND 18" VERTICALLY. IF THIS CRITERION CANNOT BE MET, THE CONTRACTOR SHALL ISOLATE SEWER AND WATER LINES BY ENCASEMENT, SHIELDING, OR OTHER APPROVED METHODS.
 - CONTRACTOR SHALL USE HORIZONTAL AND VERTICAL DATUM AS OUTLINED ON SHEET C12.0W.
 - CONTRACTOR SHALL POTHOLE EX UTILITIES IN FRONT OF MAIN BUILDING PRIOR TO INSTALLATION OF NEW UTILITIES. REPORT HORIZONTAL AND VERTICAL POSITIONS OF SANITARY SEWER TO ENGINEER. ALLOW 3 BUSINESS DAYS TIME FOR ENGINEER DESIGN VERIFICATION PRIOR TO COMMENCING SANITARY SEWER WORK
 - CONTRACTOR SHALL LOCATE HORIZONTAL AND VERTICAL POSITION OF EXISTING SEWER SERVICES. UTILIZE GPR DIE TESTING, TRACER WIRE AND POTHOLE EXCAVATION METHODS.
 - SIDE SEWER SERVICE INSTALLATION PER DETAIL 04.03.02/C17.3W UNLESS OTHERWISE STATED.

- KEY NOTES**
- CONNECT TO EXISTING 15" SEWER MAIN.
 - TAPPING TEE, SEE CITY OF PUYALLUP STANDARD DETAIL 04.02.01/C17.3W.
 - NOT USED
 - 6" SIDE SEWER PIPE, SEE PLANS FOR LENGTH.
 - TYPE 1 48" SEWER MANHOLE, SEE CITY OF PUYALLUP STANDARD DETAIL 04.01.01/C17.3W
 - SIDE SEWER SAMPLING STATION, SEE CITY OF PUYALLUP STANDARD DETAIL 04.03.04/C17.3W
 - 6" CLEANOUT, SEE DETAIL C3/C17.3W.

UTILITY CROSSING

- TOP OF 8" SEWER=44.27
ESTIMATED BTM OF EX 6" WATER=52.91
SEPARATION=8.64'
- TOP OF 8" SEWER=44.30
ESTIMATED BTM OF EX 4" GAS=52.7
SEPARATION=8.40'
- TOP OF 6" SEWER=45.73
ESTIMATED BTM OF EX 2" WATER=51.45
SEPARATION=5.71'

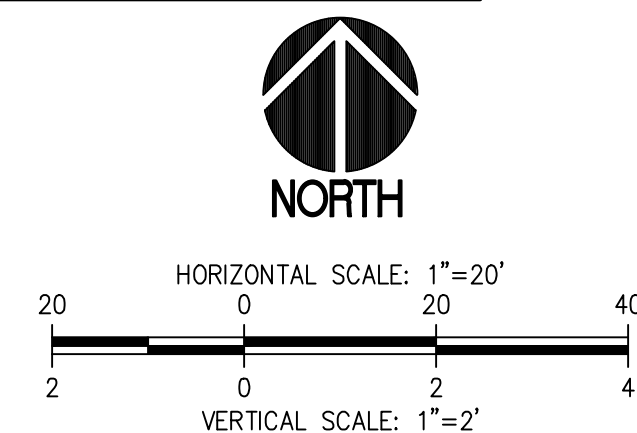

811
Know what's below.
Call before you dig.

SITTS & HILL ENGINEERS, INC.
CIVIL • STRUCTURAL • SURVEYING
4815 CENTER STREET | TACOMA, WA 98409
PHONE: (253) 474-9449 | FAX: (253) 474-9153
http://www.sitts-hill-engineers.com/

Project No.:	19,034	Project Mgr.:	R.H.
Proj. Engineer:	S.A.J.	Proj. Drafter:	S.A.J.

PROJECT:
PUYALLUP SCHOOL DISTRICT
WALKER HIGH SCHOOL SITE UTILITIES
5715 MILWAUKEE AVE E
PUYALLUP, WA 98372

REVISIONS

5-10-21 PERMIT SUBMITTAL
6-14-21 PERMIT RESUBMITTAL
6-23-21 BID SET
6-25-21 CITY RESUBMITTAL
7-23-21 CITY RESUBMITTAL
10-04-22 RECORD DRAWINGS

DATE: 1.19.2021
BCRA NO.: 20760.00.00
DRAWN BY:
REVIEWED BY:
SHEET TITLE: SITE UTILITIES
PLAN AND PROFILE 1

bcra
© COPYRIGHT 2019 - BCRA, INC. ALL RIGHTS RESERVED.
SHEET 23 OF 27

C16.0W

Record Drawings

PRIVATE IMPROVEMENTS		APPROVED	
DEVELOPMENT ENGINEER PIERCE COUNTY ORDINANCE NUMBER		BY CITY OF PUYALLUP DEVELOPMENT ENGINEERING	PERMIT #
1. CONTACT THE AREA INSPECTOR, AT 253-796- AND CARRY OUT INSPECTIONS. PRE-CONSTRUCTION MEETING SHALL BE REQUIRED CONSTRUCTION.		DATE OF DATE OF THE PRE-CONSTRUCTION MEETING NOTE: THIS APPROVAL IS VOID AFTER 180 DAYS FROM APPROVAL DATE: _____ THE CITY WILL NOT BE RESPONSIBLE FOR ERRORS AND/OR OMISSIONS ON THESE PLANS.	
2. APPOINT A CERTIFIED EROSION AND SEDIMENT CONTROL LEAD WHO SHALL PLAN & INSPECT SCHEDULE.		FIELD CONDITIONS MAY DICTATE CHANGES TO THESE PLANS AS DETERMINED BY THE DEVELOPMENT ENGINEERING MANAGER.	
3. FAILURE TO OBTAIN REQUIRED INSPECTIONS MAY ENDANGER OR DELAY PROJECT WORKS.			
4. ALL WORK IN THE PUBLIC RIGHT-OF-WAY REQUIRES A GENERAL RIGHT-OF-WAY PERMIT.			

SANITARY SEWER CLEANOUT (SSCO) SCHEDULE				
CO ID	NOTES	RIM	IE	
CO 1	6" SSCO	53.67	50.44 6" S	50.44 6" N
CO 2	6" SSCO	53.65	50.48 6" S	50.48 6" N

LEGEND

PROPOSED FEATURES

- W 1" WATER PIPE
- WATER METER
- DCVA DOUBLE CHECK VALVE ASSEMBLY
- SS SANITARY SEWER PIPE
- TYPE 1 SEWER MANHOLE
- 6" SEWER CLEANOUT

GENERAL NOTES

- SEE SHEET C11.0W, C11.1W AND C11.2W FOR APPLICABLE CIVIL CITY OF PUYALLUP GENERAL NOTES.
- TYPICAL UTILITY TRENCH, EXCAVATION, BEDDING AND BACKFILL SHALL COMPLY WITH CITY OF PUYALLUP STANDARD DETAIL 06.01.01 REQUIREMENTS. SEE CITY OF PUYALLUP STANDARD DETAIL 06.01.01/C17.3W.
- ALL SEWER MANHOLE COMPONENTS SHALL BE PER CITY OF PUYALLUP STANDARD DETAILS
SANITARY SEWER MANHOLE: 04.01.01/C17.3W
FRAME AND COVER: 06.01.02/C17.4W
STEPS AND HANDHOLD: 06.01.03/C17.4W
- ADJUST OR SET FRAMES OF EXISTING AND PROPOSED UTILITY GRATES AND COVERS AS NECESSARY TO MATCH THE CROSS SLOPE OF THE PROPOSED FINISHED GRADE AND SUCH THAT NO PONDING OCCURS AROUND UTILITY GRATES AND COVERS.
- COMPLY WITH WATER MAIN CLEARANCE REQUIREMENTS IN PER CITY OF PUYALLUP STANDARD DETAIL 03.01.03-1/C17.2W AND CITY OF PUYALLUP STANDARD DETAIL 03.01.03-2/C17.2W.
- NOT USED
- THE MINIMUM DISTANCE BETWEEN WATER AND SEWER LINES SHALL BE 10 FEET HORIZONTALLY AND 18" VERTICALLY. IF THIS CRITERION CANNOT BE MET, THE CONTRACTOR SHALL ISOLATE SEWER AND WATER LINES BY ENCASEMENT, SHIELDING, OR OTHER APPROVED METHODS.
- CONTRACTOR SHALL USE HORIZONTAL AND VERTICAL DATUM AS OUTLINED ON SHEET C12.0W.
- CONTRACTOR SHALL POTHOLE EX UTILITIES IN FRONT OF MAIN BUILDING PRIOR TO INSTALLATION OF NEW UTILITIES. REPORT HORIZONTAL AND VERTICAL POSITIONS OF SANITARY SEWER TO ENGINEER. ALLOW 3 BUSINESS DAYS TIME FOR ENGINEER DESIGN VERIFICATION PRIOR TO COMMENCING SANITARY SEWER WORK
- CONTRACTOR SHALL LOCATE HORIZONTAL AND VERTICAL POSITION OF EXISTING SEWER SERVICES. UTILIZE GPR DIE TESTING, TRACER WIRE AND POTHOLE EXCAVATION METHODS.
- SIDE SEWER SERVICE INSTALLATION PER DETAIL 04.03.02/C17.3W UNLESS OTHERWISE STATED.

KEY NOTES

- CONNECT TO EXISTING 15" SEWER MAIN.
- TAPPING TEE, SEE CITY OF PUYALLUP STANDARD DETAIL 04.02.01/C17.3W.
- NOT USED
- 6" SIDE SEWER PIPE, SEE PLANS FOR LENGTH.
- TYPE 1 48" SEWER MANHOLE, SEE CITY OF PUYALLUP STANDARD DETAIL 04.01.01/C17.3W
- SIDE SEWER SAMPLING STATION, SEE CITY OF PUYALLUP STANDARD DETAIL 04.03.04/C17.3W
- CLEANOUT, SEE DETAIL C3/C17.3W.

UTILITY CROSSING

- TOP OF 8" SEWER=44.27
ESTIMATED BTM OF EX 6" WATER=52.91
SEPARATION=8.64'
- TOP OF 8" SEWER=44.30
ESTIMATED BTM OF EX 4" GAS=52.7
SEPARATION=8.40'
- TOP OF 6" SEWER=45.73
ESTIMATED BTM OF EX 2" WATER=51.45
SEPARATION=5.71'



HORIZONTAL SCALE: 1"=20'
VERTICAL SCALE: 1"=2'

**SITTS & HILL
ENGINEERS, INC.**

CIVIL • STRUCTURAL • SURVEYING
4815 CENTER STREET | TACOMA, WA 98409
PHONE: (253) 474-9449 | FAX: (253) 474-0153
http://www.sitts-hill-engineers.com/

Project No.: 19,034 Project Mgr.: R.H.
Proj. Engineer: S.A.J. Proj. Drafter: S.A.J.



Know what's below.
Call before you dig.

PROJECT:
PUYALLUP SCHOOL DISTRICT
WALKER HIGH SCHOOL SITE UTILITIES
5715 MILWAUKEE AVE E
PUYALLUP, WA 98372

REVISIONS
[5-10-21] PERMIT SUBMITTAL
[6-14-21] PERMIT RESUBMITTAL
[6-23-21] BID SET
[6-25-21] CITY RESUBMITTAL
[7-23-21] CITY RESUBMITTAL


DATE
1.19.2021
BCRA NO.
20760.00.00
DRAWN BY:
REVIEWED BY:
SHEET TITLE

SITE UTILITIES
SANITARY SEWER
PLAN AND PROFILE 1

bcra
© COPYRIGHT 2019 - BCRA, INC. ALL RIGHTS RESERVED.
SHEET 23 OF 27

C16.0W

IF SHEET MEASURES LESS THAN 24"X36", IT IS A REDUCED PRINT. REDUCE SCALE ACCORDINGLY

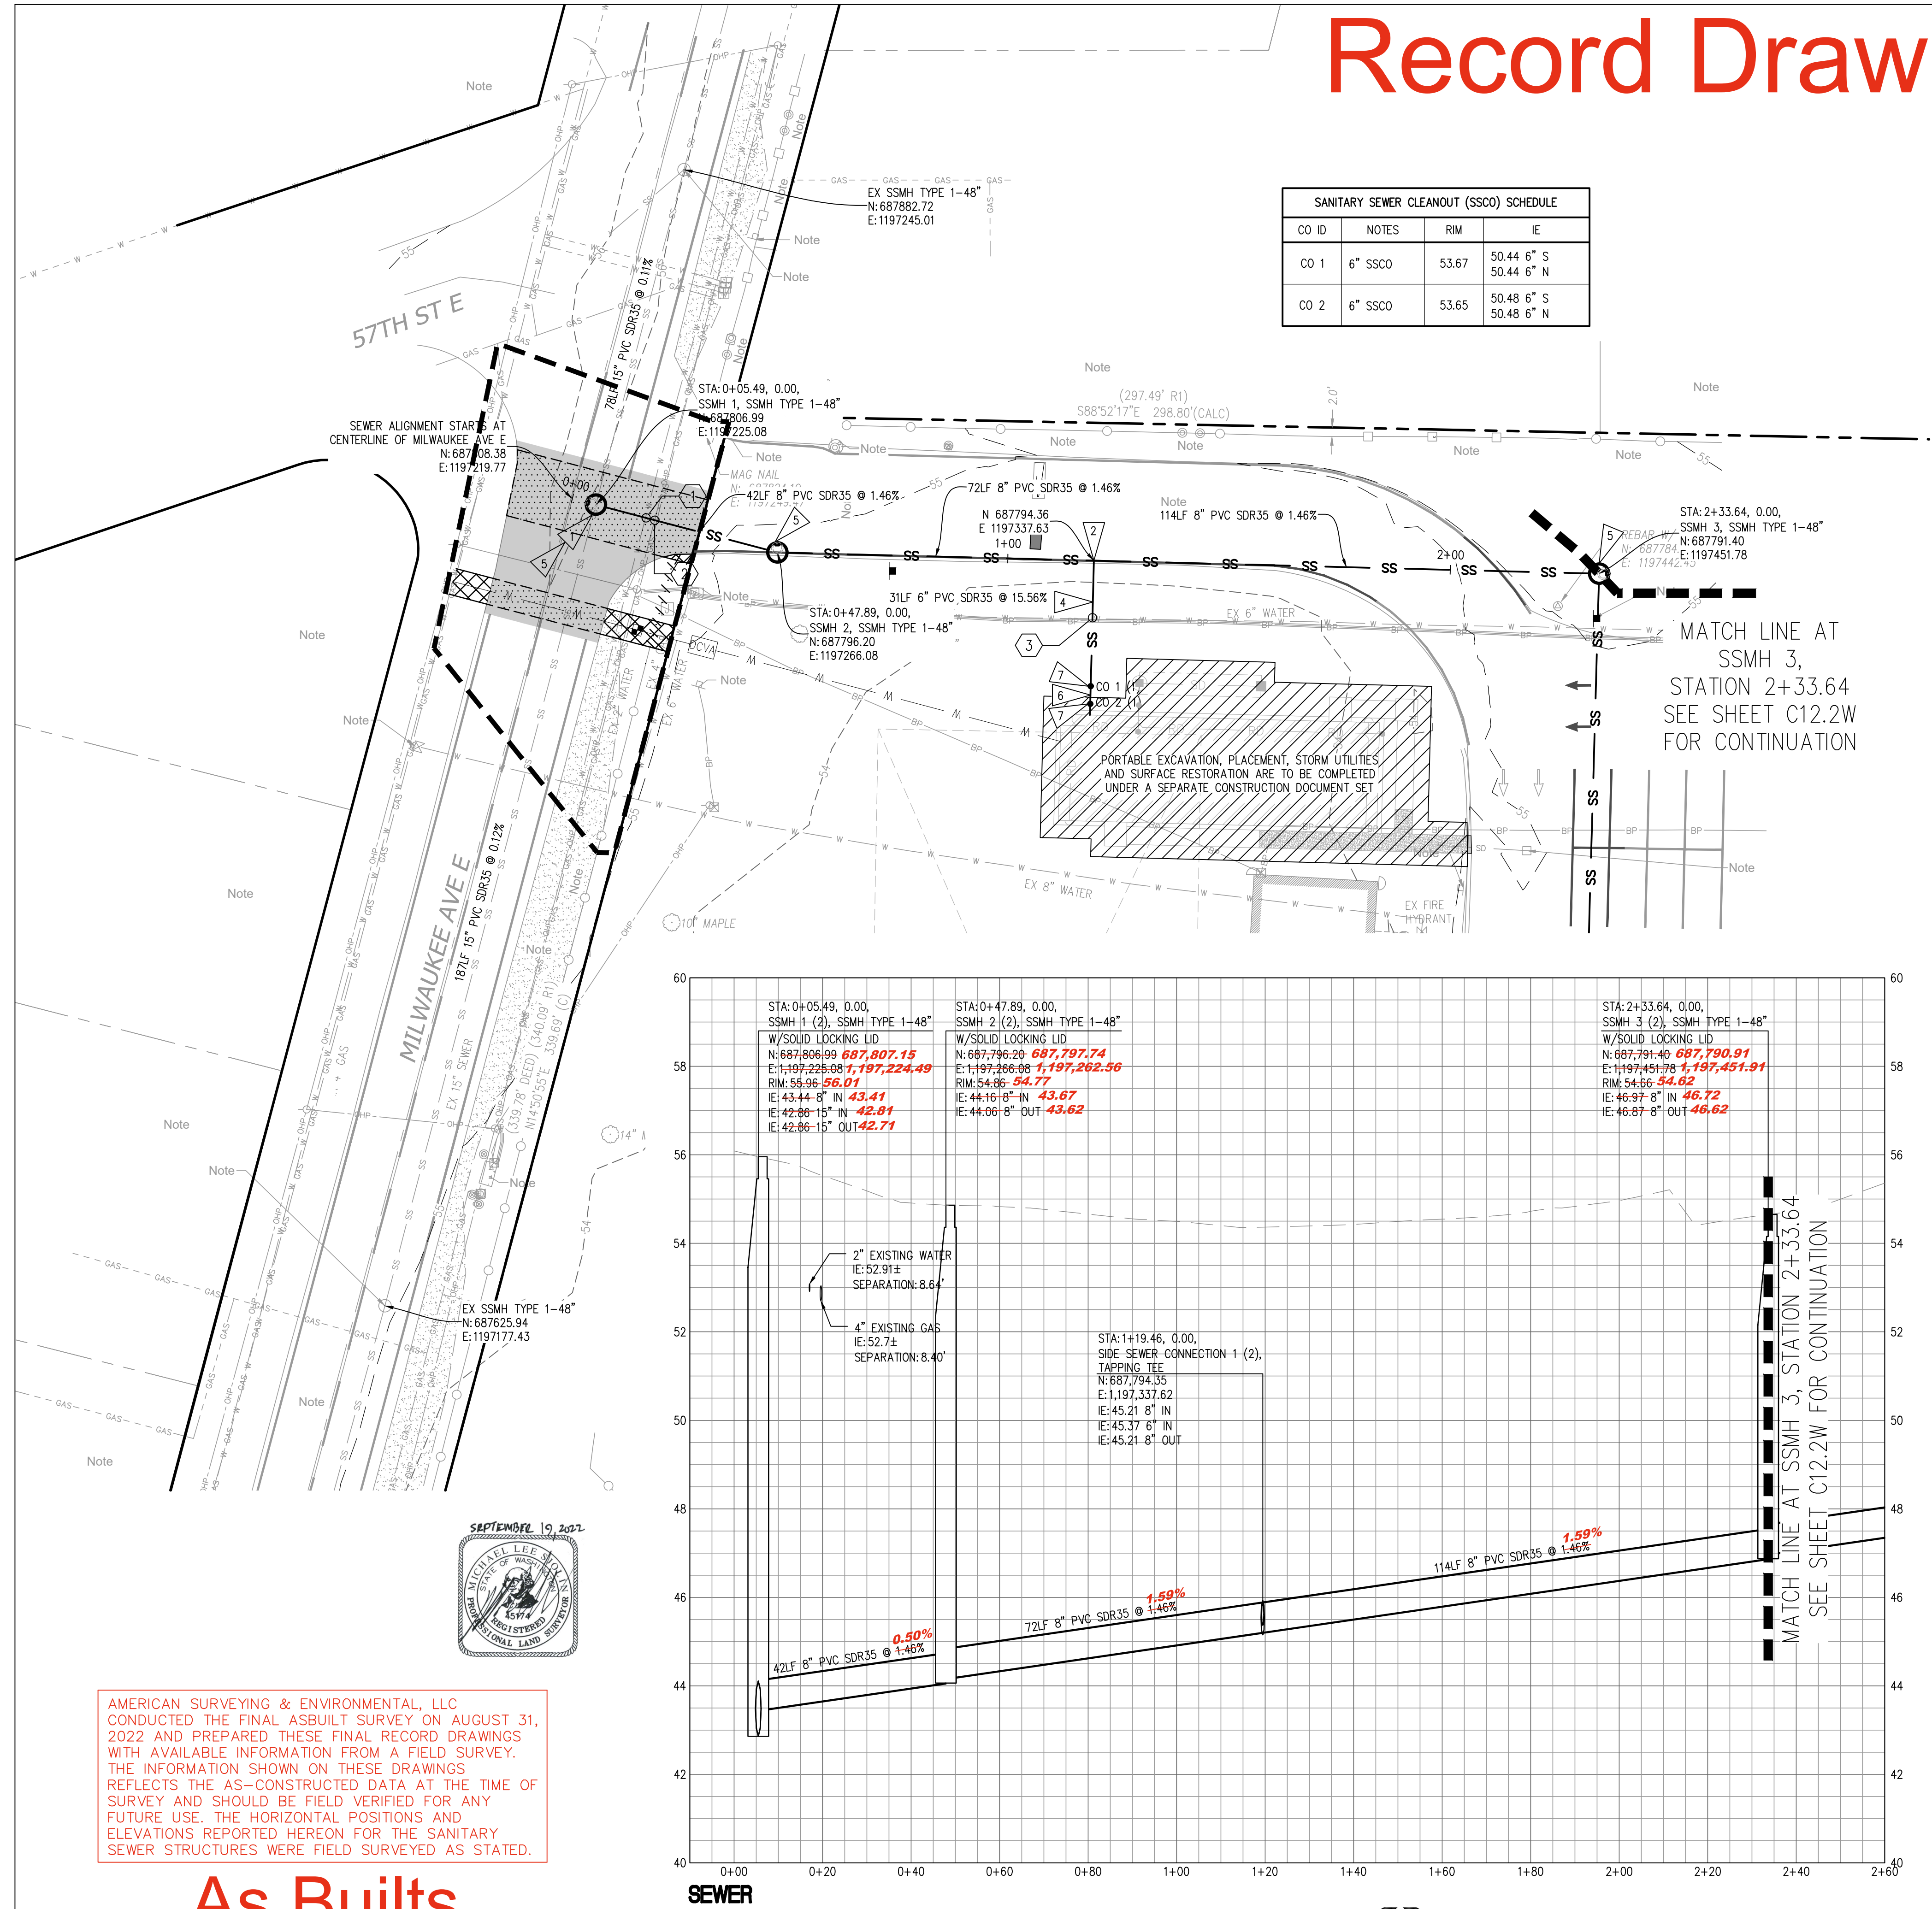


SANITARY SEWER PLAN AND PROFILE 1


SCALE: H:1"=20' V:1"=2'



As Builts

AMERICAN SURVEYING & ENVIRONMENTAL, LLC
CONDUCTED THE FINAL ASBUILT SURVEY ON AUGUST 31,
2022 AND PREPARED THESE FINAL RECORD DRAWINGS
WITH AVAILABLE INFORMATION FROM A FIELD SURVEY.
THE INFORMATION SHOWN ON THESE DRAWINGS
REFLECTS THE AS-CONSTRUCTED DATA AT THE TIME OF
SURVEY AND SHOULD BE FIELD VERIFIED FOR ANY
FUTURE USE. THE HORIZONTAL POSITIONS AND
ELEVATIONS REPORTED HEREON FOR THE SANITARY
SEWER STRUCTURES WERE FIELD SURVEYED AS STATED.

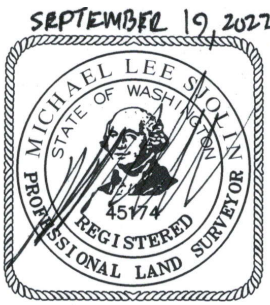

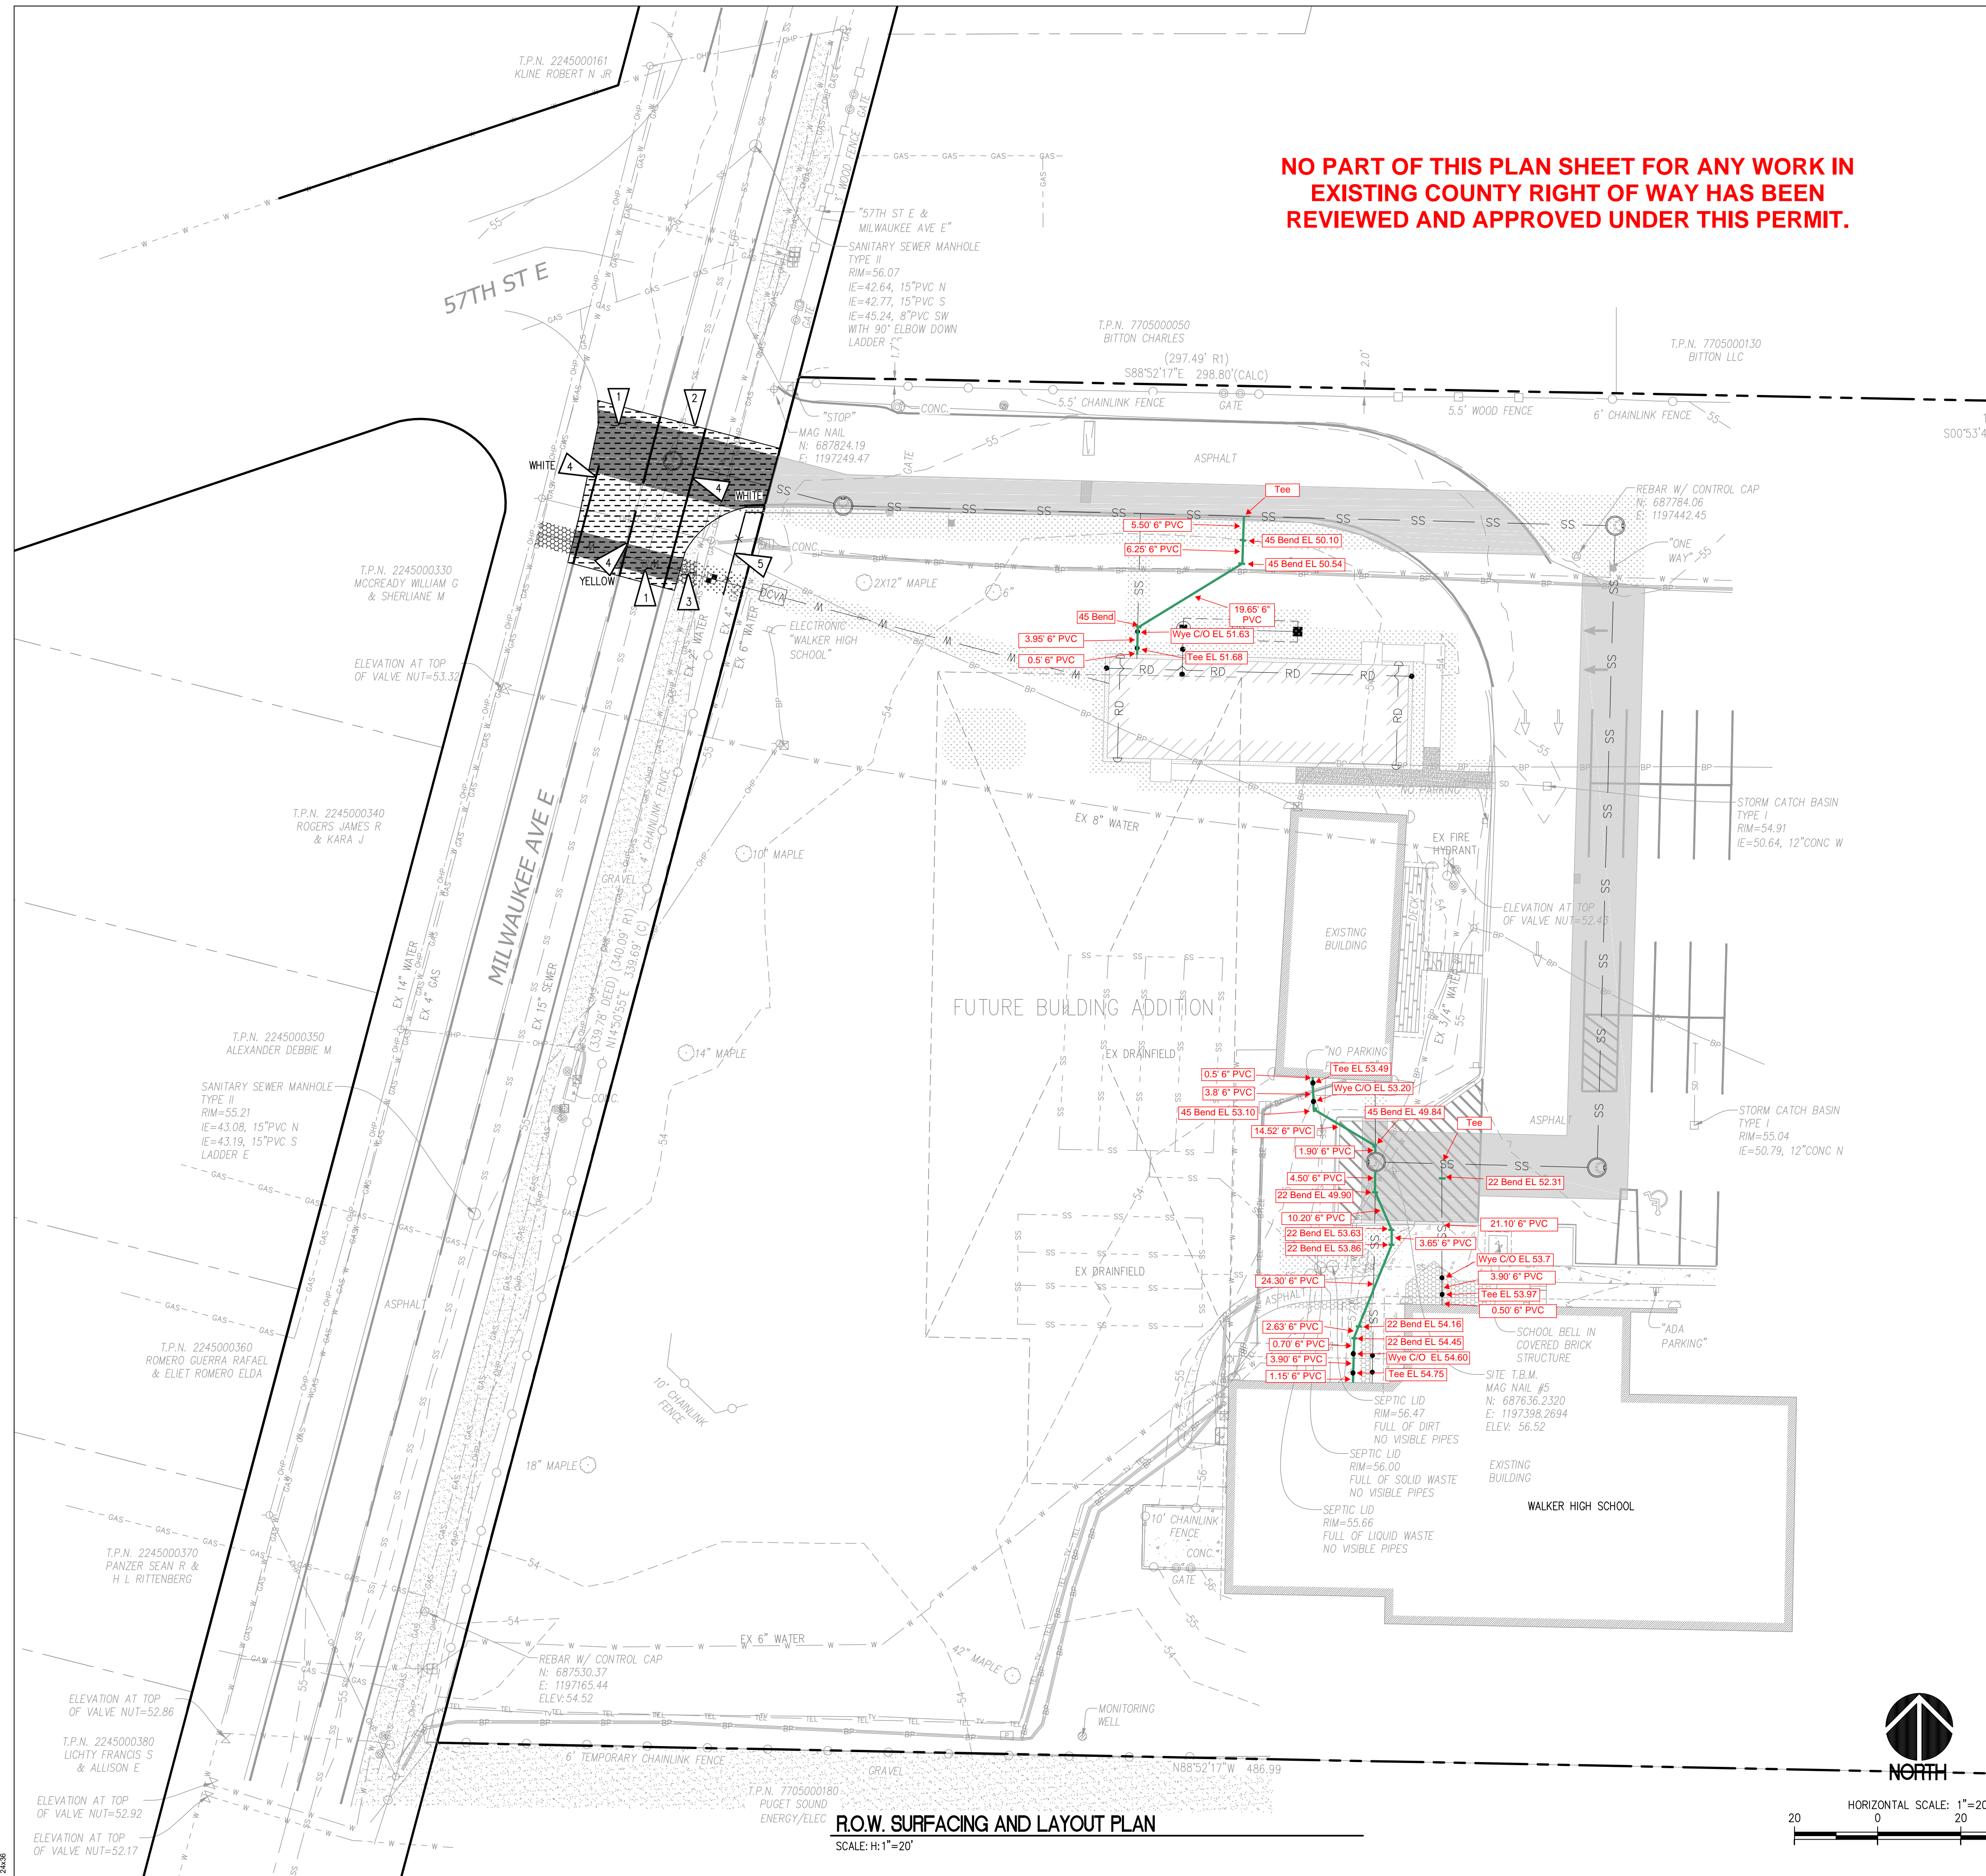

PRIVATE IMPROVEMENTS

DEVELOPMENT ENGINEER
PIERCE COUNTY ORDINANCE NUMBER

PERMIT #

DATE

- CONTACT THE AREA INSPECTOR, 360.796. TO COORDINATE THE PRE-CONSTRUCTION MEETING AND COUNTY INSPECTIONS. PRE-CONSTRUCTION MEETING SHALL BE REQUESTED AT LEAST 48 HOURS IN ADVANCE OF THE START OF CONSTRUCTION.
- APPOINT A CERTIFIED EROSION AND SEDIMENT CONTROL LEAD WHO SHALL BE PROVIDED A COPY OF THE SWPPP, EROSION CONTROL PLAN & INSPECTION SCHEDULE.
- FAILURE TO OBTAIN REQUIRED INSPECTIONS MAY ENDANGER OR DELAY PROJECT APPROVAL.
- ALL WORK IN THE PUBLIC RIGHT-OF-WAY REQUIRES A GENERAL RIGHT-OF-WAY PERMIT FROM PIERCE COUNTY PLANNING AND PUBLIC WORKS.

LEGEND

PROPOSED FEATURES

- CHAINLINK FENCE
- PAVEMENT STRIPING
- GRASS RESTORATION
- HEAVY DUTY ASPHALT RESTORATION
- 2" HMA OVERLAY

GENERAL NOTES

- SEE APPLICABLE PIERCE COUNTY GENERAL CIVIL NOTES ON SHEET C1.0W
- SEE SHEETS 1-13 FOR PRIVATE ONSITE IMPROVEMENTS
- CONSTRUCTION ACCESS SHALL BE FROM EXISTING ASPHALT SURFACES. IF ADDITIONAL MEASURES ARE NEEDED TO PREVENT TRACKING OF SEDIMENT ONTO PUBLIC ROADS, THE CONTRACTOR SHALL INSTALL A CONSTRUCTION ENTRANCE PER DETAIL B4/C6.0W.
- CONTRACTOR SHALL COVER ALL OPEN TRENCHES AT END OF WORK DAY.
- CONTRACTOR TO PROTECT EXISTING FEATURES BEYOND THE LIMITS OF WORK AND REPAIR ANY DAMAGE AT NO ADDITIONAL COST TO THE OWNER.
- CONTRACTOR SHALL MAINTAIN EMERGENCY VEHICLE ACCESS AND KEEP ONE LANE OF ONSITE ACCESS CLEAR AT ALL TIMES DURING CONSTRUCTION.
- CONTRACTOR SHALL FIELD VERIFY EXISTING CONDITIONS AND NOTIFY ENGINEER IMMEDIATELY IF THERE ARE ANY DISCREPANCIES AFFECTING THE NEW CONSTRUCTION.
- SEE ELECTRICAL PLAN FOR POWER AND LOW VOLTAGE CONNECTION REQUIREMENTS.
- CONTRACTOR SHALL PREPARE, SUBMIT AND OBTAIN AN APPROVED TRAFFIC CONTROL PLAN FROM PIERCE COUNTY PRIOR TO COMMENCING WORK IN RIGHT-OF-WAY.
- CONTRACTOR SHALL RESTORE ALL SURFACES DISTURBED AS A RESULT OF CONSTRUCTION ACTIVITIES, EXCLUDING THE BUILDING, GRAVEL PAD, ASPHALT OR GRAVEL SURFACES, AND LANDINGS. PROVIDE 8" DEPTH COMPOST AMENDED TOPSOIL PER DETAIL D1/C6.1W PRIOR TO SEEDING.
- CONTRACTOR SHALL USE HORIZONTAL AND VERTICAL DATUM AS OUTLINED ON SHEET C2.0W
- COMPLY WITH PIERCE COUNTY ROW PERMIT REQUIREMENTS

KEY NOTES

- HEAVY DUTY ASPHALT PAVEMENT RESTORATION, SEE DETAIL A1/C6.3W
- 2" AC OVERLAY, SEE DETAIL A3/C6.3W
- RESTORE DISTURBED LANDSCAPE AREA, SEE DETAIL D1/C6.1W & C4/C6.3W
- PAVEMENT STRIPING, SEE PLANS FOR COLOR, SEE DETAIL D3/C6.3W
- REINSTALL SALVAGED 4" HIGH CHAINLINK FENCE, SEE DETAIL C2/C6.3W

SEWER SERVICE INFORMATION PROVIDED BY
NORTHWEST CASCADE, INC.
R. HAND
10-13-2022

SITTS & HILL ENGINEERS, INC.

CIVIL • STRUCTURAL • SURVEYING
4815 CENTER STREET | TACOMA, WA 98409
PHONE: (253) 474-9449 | FAX: (253) 474-0153
http://www.sitts-hill-engineers.com/


Project No.: 19,034 Project Mgr.: R.H.
Proj. Engineer: S.A.J. Proj. Drafter: S.A.J.



Know what's below.
Call before you dig.



T 253.627.4367 F 253.627.4365 WWW.BCRADESIGN.COM
2108 PACIFIC AVENUE, SUITE 300, TACOMA, WA 98402

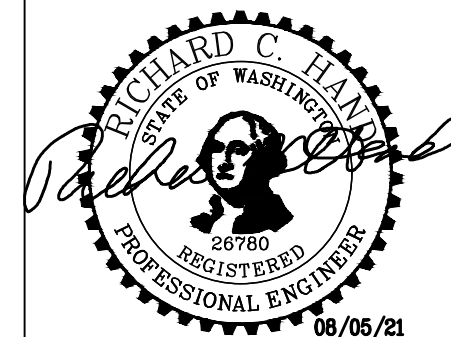

PROJECT:
PUYALLUP SCHOOL DISTRICT
WALKER HIGH SCHOOL PORTABLE
5715 MILWAUKEE AVE E
PUYALLUP, WA 98372

REVISIONS
5-10-21 PERMIT SUBMITTAL
6-14-21 PERMIT RESUBMITTAL
6-23-21 BID SET
7-09-21 COUNTY RESUBMITTAL
8-05-21 COUNTY RESUBMITTAL

DATE
1.19.2021
BCRA NO.
20160.00.00
DRAWN BY:
REVIEWED BY:
SHEET TITLE
R.O.W. SURFACING AND LAYOUT PLAN



© COPYRIGHT 2019, BCRA, INC. ALL RIGHTS RESERVED.
SHEET 2 OF 2

C8.2W

IF SHEET MEASURES LESS THAN 24"X36", IT IS A REDUCED PRINT. REDUCE SCALE ACCORDINGLY

Record Drawings

PRIVATE IMPROVEMENTS

APPROVED	
PERMIT # _____	
BY <u>CITY OF PUYALLUP</u>	
DEVELOPMENT ENGINEER	
DEVELOPMENT ENGINEER	PIERCE COUNTY ORDINANCE NUMBER _____
1. CONTACT AND COUNTY INSPECTIONS, PRE-CONSTRUCTION MEETING SHALL BE REQUIRED AT LEAST 10 BUSINESS DAYS PRIOR TO THE START OF CONSTRUCTION.	DATE: 08/04/2022
2. APPOINT A CERTIFIED EROSION AND SEDIMENT CONTROL LEAD WHO SHALL PLAN A INSPECTION SCHEDULE.	NOTE: THIS APPROVAL IS VOID AFTER 180 DAYS FROM APPROVAL DATE.
3. FAILURE TO OBTAIN REQUIRED INSPECTIONS MAY ENDANGER OR DELAY PROJECT.	THE CITY WILL NOT BE RESPONSIBLE FOR ERRORS AND/OR OMISSIONS ON THESE PLANS.
4. ALL WORK IN THE PUBLIC RIGHT-OF-WAY REQUIRES A GENERAL RIGHT-OF-WAY WORKS.	FIELD CONDITIONS MAY DICTATE CHANGES TO THESE PLANS AS DETERMINED BY THE DEVELOPMENT ENGINEERING MANAGER.

LEGEND

PROPOSED FEATURES

— W —	1" WATER PIPE
■	WATER METER
DCVA	DOUBLE CHECK VALVE ASSEMBLY
— SS —	SANITARY SEWER PIPE
⊙	TYPE 1 SEWER MANHOLE
•	6" SEWER CLEANOUT

GENERAL NOTES


- SEE SHEET C11.0W, C11.1W AND C11.2W FOR APPLICABLE CIVIL CITY OF PUYALLUP GENERAL NOTES.
- TYPICAL UTILITY TRENCH, EXCAVATION, BEDDING AND BACKFILL SHALL COMPLY WITH CITY OF PUYALLUP STANDARD DETAIL 06.01.01 REQUIREMENTS. SEE CITY OF PUYALLUP STANDARD DETAIL 06.01.01/C17.3W.
- ALL SEWER MANHOLE COMPONENTS SHALL BE PER CITY OF PUYALLUP STANDARD DETAILS
SSMH: 04.01.01/C17.3W
FRAME AND COVER: 06.01.02/C17.4W
STEPS AND HANDHOLD: 06.01.03/C17.4W
- ADJUST OR SET FRAMES OF EXISTING AND PROPOSED UTILITY GRATES AND COVERS AS NECESSARY TO MATCH THE CROSS SLOPE OF THE PROPOSED FINISHED GRADE AND SUCH THAT NO PONDING OCCURS AROUND UTILITY GRATES AND COVERS.
- COMPLY WITH WATER MAIN CLEARANCE REQUIREMENTS IN PER CITY OF PUYALLUP STANDARD DETAIL 03.01.03-1/C17.2W AND CITY OF PUYALLUP STANDARD DETAIL 03.01.03-2/C17.2W.
- NOT USED
- THE MINIMUM DISTANCE BETWEEN WATER AND SEWER LINES SHALL BE 10 FEET HORIZONTALLY AND 18" VERTICALLY. IF THIS CRITERION CANNOT BE MET, THE CONTRACTOR SHALL ISOLATE SEWER AND WATER LINES BY ENCASEMENT, SHIELDING, OR OTHER APPROVED METHODS.
- CONTRACTOR SHALL USE HORIZONTAL AND VERTICAL DATUM AS OUTLINED ON SHEET C12.0W.
- CONTRACTOR SHALL POTHOLE EX UTILITIES IN FRONT OF MAIN BUILDING PRIOR TO INSTALLATION OF NEW UTILITIES. REPORT HORIZONTAL AND VERTICAL POSITIONS OF SANITARY SEWER TO ENGINEER. ALLOW 3 BUSINESS DAYS TIME FOR ENGINEER DESIGN VERIFICATION PRIOR TO COMMENCING SANITARY SEWER WORK
- CONTRACTOR SHALL LOCATE HORIZONTAL AND VERTICAL POSITION OF EXISTING SEWER SERVICES. UTILIZE GPR DIE TESTING, TRACER WIRE AND POTHOLE EXCAVATION METHODS.
- SIDE SEWER SERVICE INSTALLATION PER DETAIL 04.03.02/C17.3W UNLESS OTHERWISE STATED.

KEY NOTES

- TAPPING TEE, SEE CITY OF PUYALLUP STANDARD DETAIL 04.02.01/C17.3W.
- NOT USED
- 8" SDR PVC SANITARY SEWER LINE, SEE PLANS FOR LENGTH.
- 6" SIDE SEWER PIPE, SEE PLANS FOR LENGTH.
- TYPE 1 48" SEWER MANHOLE, SEE CITY OF PUYALLUP STANDARD DETAIL 04.01.01/C17.3W
- SIDE SEWER SAMPLING STATION, SEE CITY OF PUYALLUP STANDARD DETAIL 04.03.04/C17.3W
- 6" CLEANOUT, SEE DETAIL C3/C17.3W.
- ABANDON EXISTING SANITARY SEWER UPON NEW SANITARY SEWER CONNECTION
- EXPOSE AND VERIFY EXISTING SANITARY SEWER LOCATION. REPORT FINDINGS TO ENGINEER. SEE GENERAL NOTES 9 AND 10.

UTILITY CROSSING

- TOP OF 8" SEWER=47.30
ESTIMATED BTM OF EX 6" WATER=52.24
SEPARATION=4.94
- TOP OF 8" SEWER=50.63
ESTIMATED BTM OF EX 2" WATER=53.51
SEPARATION=2.88'

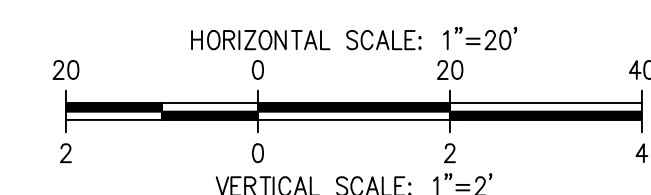

SITTS & HILL ENGINEERS, INC.


CIVIL • STRUCTURAL • SURVEYING
4815 CENTER STREET | TACOMA, WA 98409
PHONE: (253) 474-9449 | FAX: (253) 474-0153
http://www.sitts-hill-engineers.com/

Project No.:	19,034	Project Mgr.:	R.H.
Proj. Engineer:	S.A.J.	Proj. Drafter:	S.A.J.





Know what's below.
Call before you dig.

IF SHEET MEASURES LESS THAN 24"x36", IT IS A REDUCED PRINT. REDUCE SCALE ACCORDINGLY

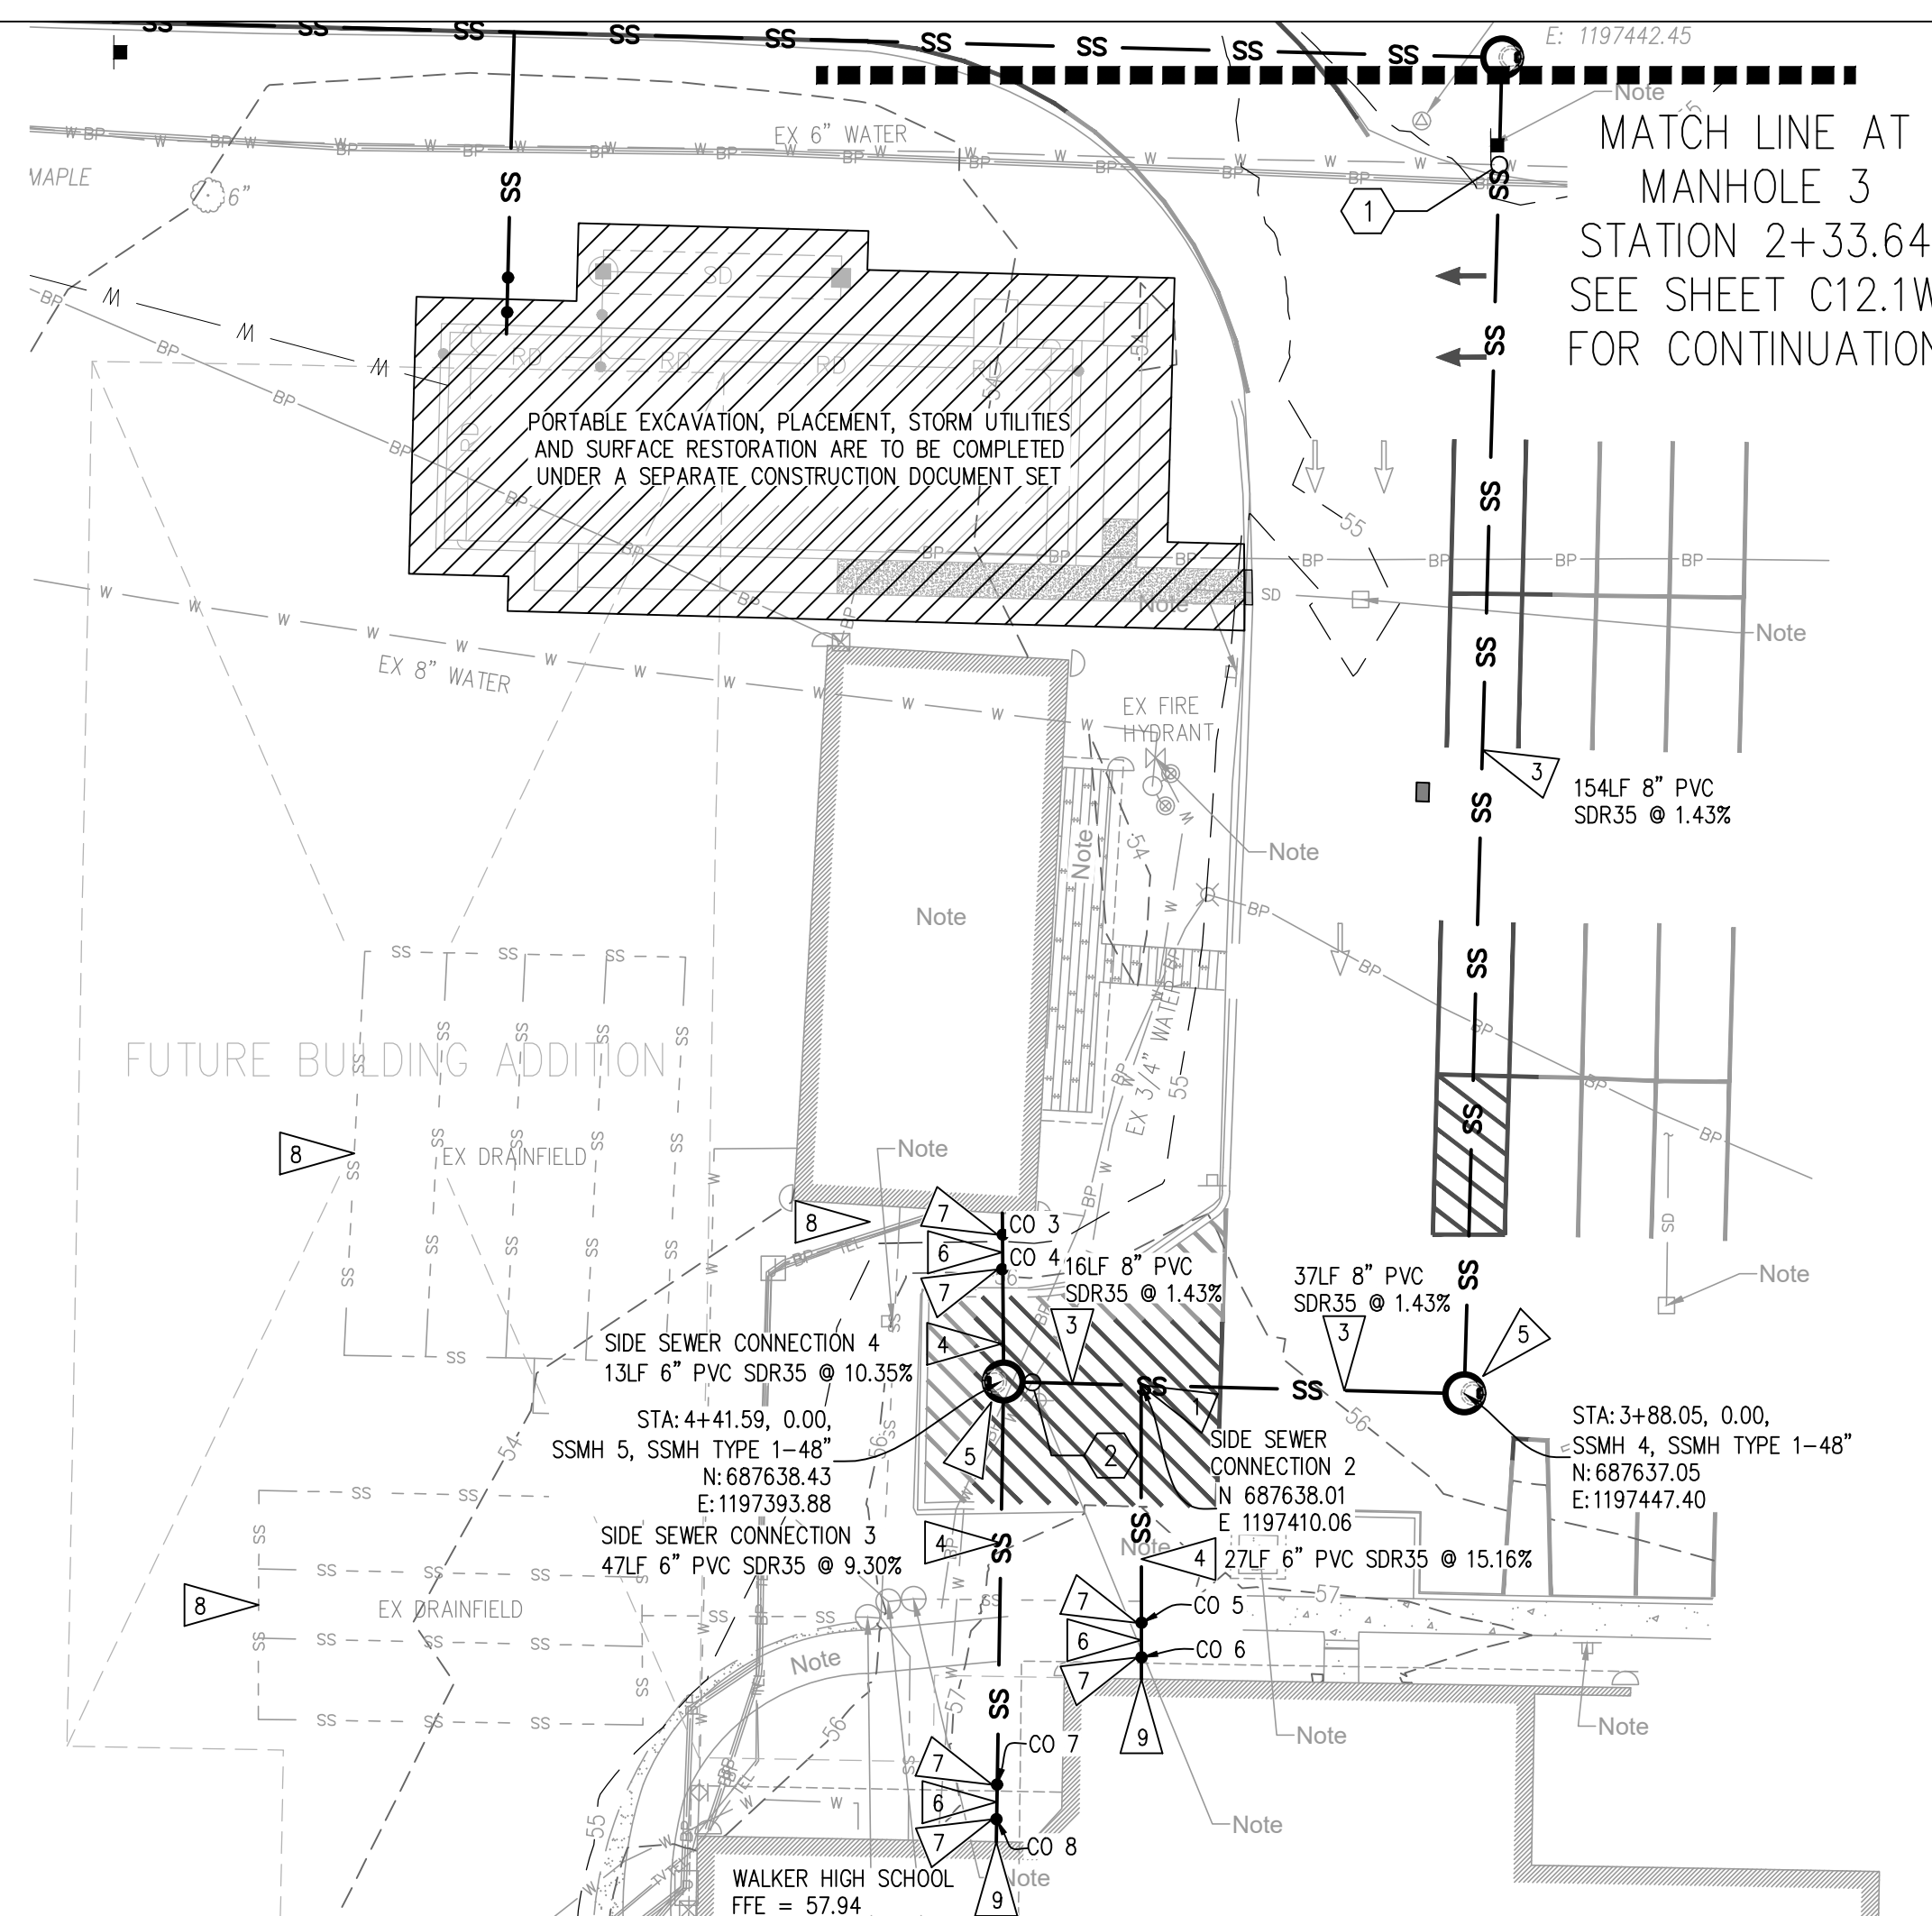

AMERICAN SURVEYING & ENVIRONMENTAL, LLC CONDUCTED THE FINAL ASBUILT SURVEY ON AUGUST 31, 2022 AND PREPARED THESE FINAL RECORD DRAWINGS WITH AVAILABLE INFORMATION FROM A FIELD SURVEY. THE INFORMATION SHOWN ON THESE DRAWINGS REFLECTS THE AS-CONSTRUCTED DATA AT THE TIME OF SURVEY AND SHOULD BE FIELD VERIFIED FOR ANY FUTURE USE. THE HORIZONTAL POSITIONS AND ELEVATIONS REPORTED HEREON FOR THE SANITARY SEWER STRUCTURES WERE FIELD SURVEYED AS STATED.

As Builts

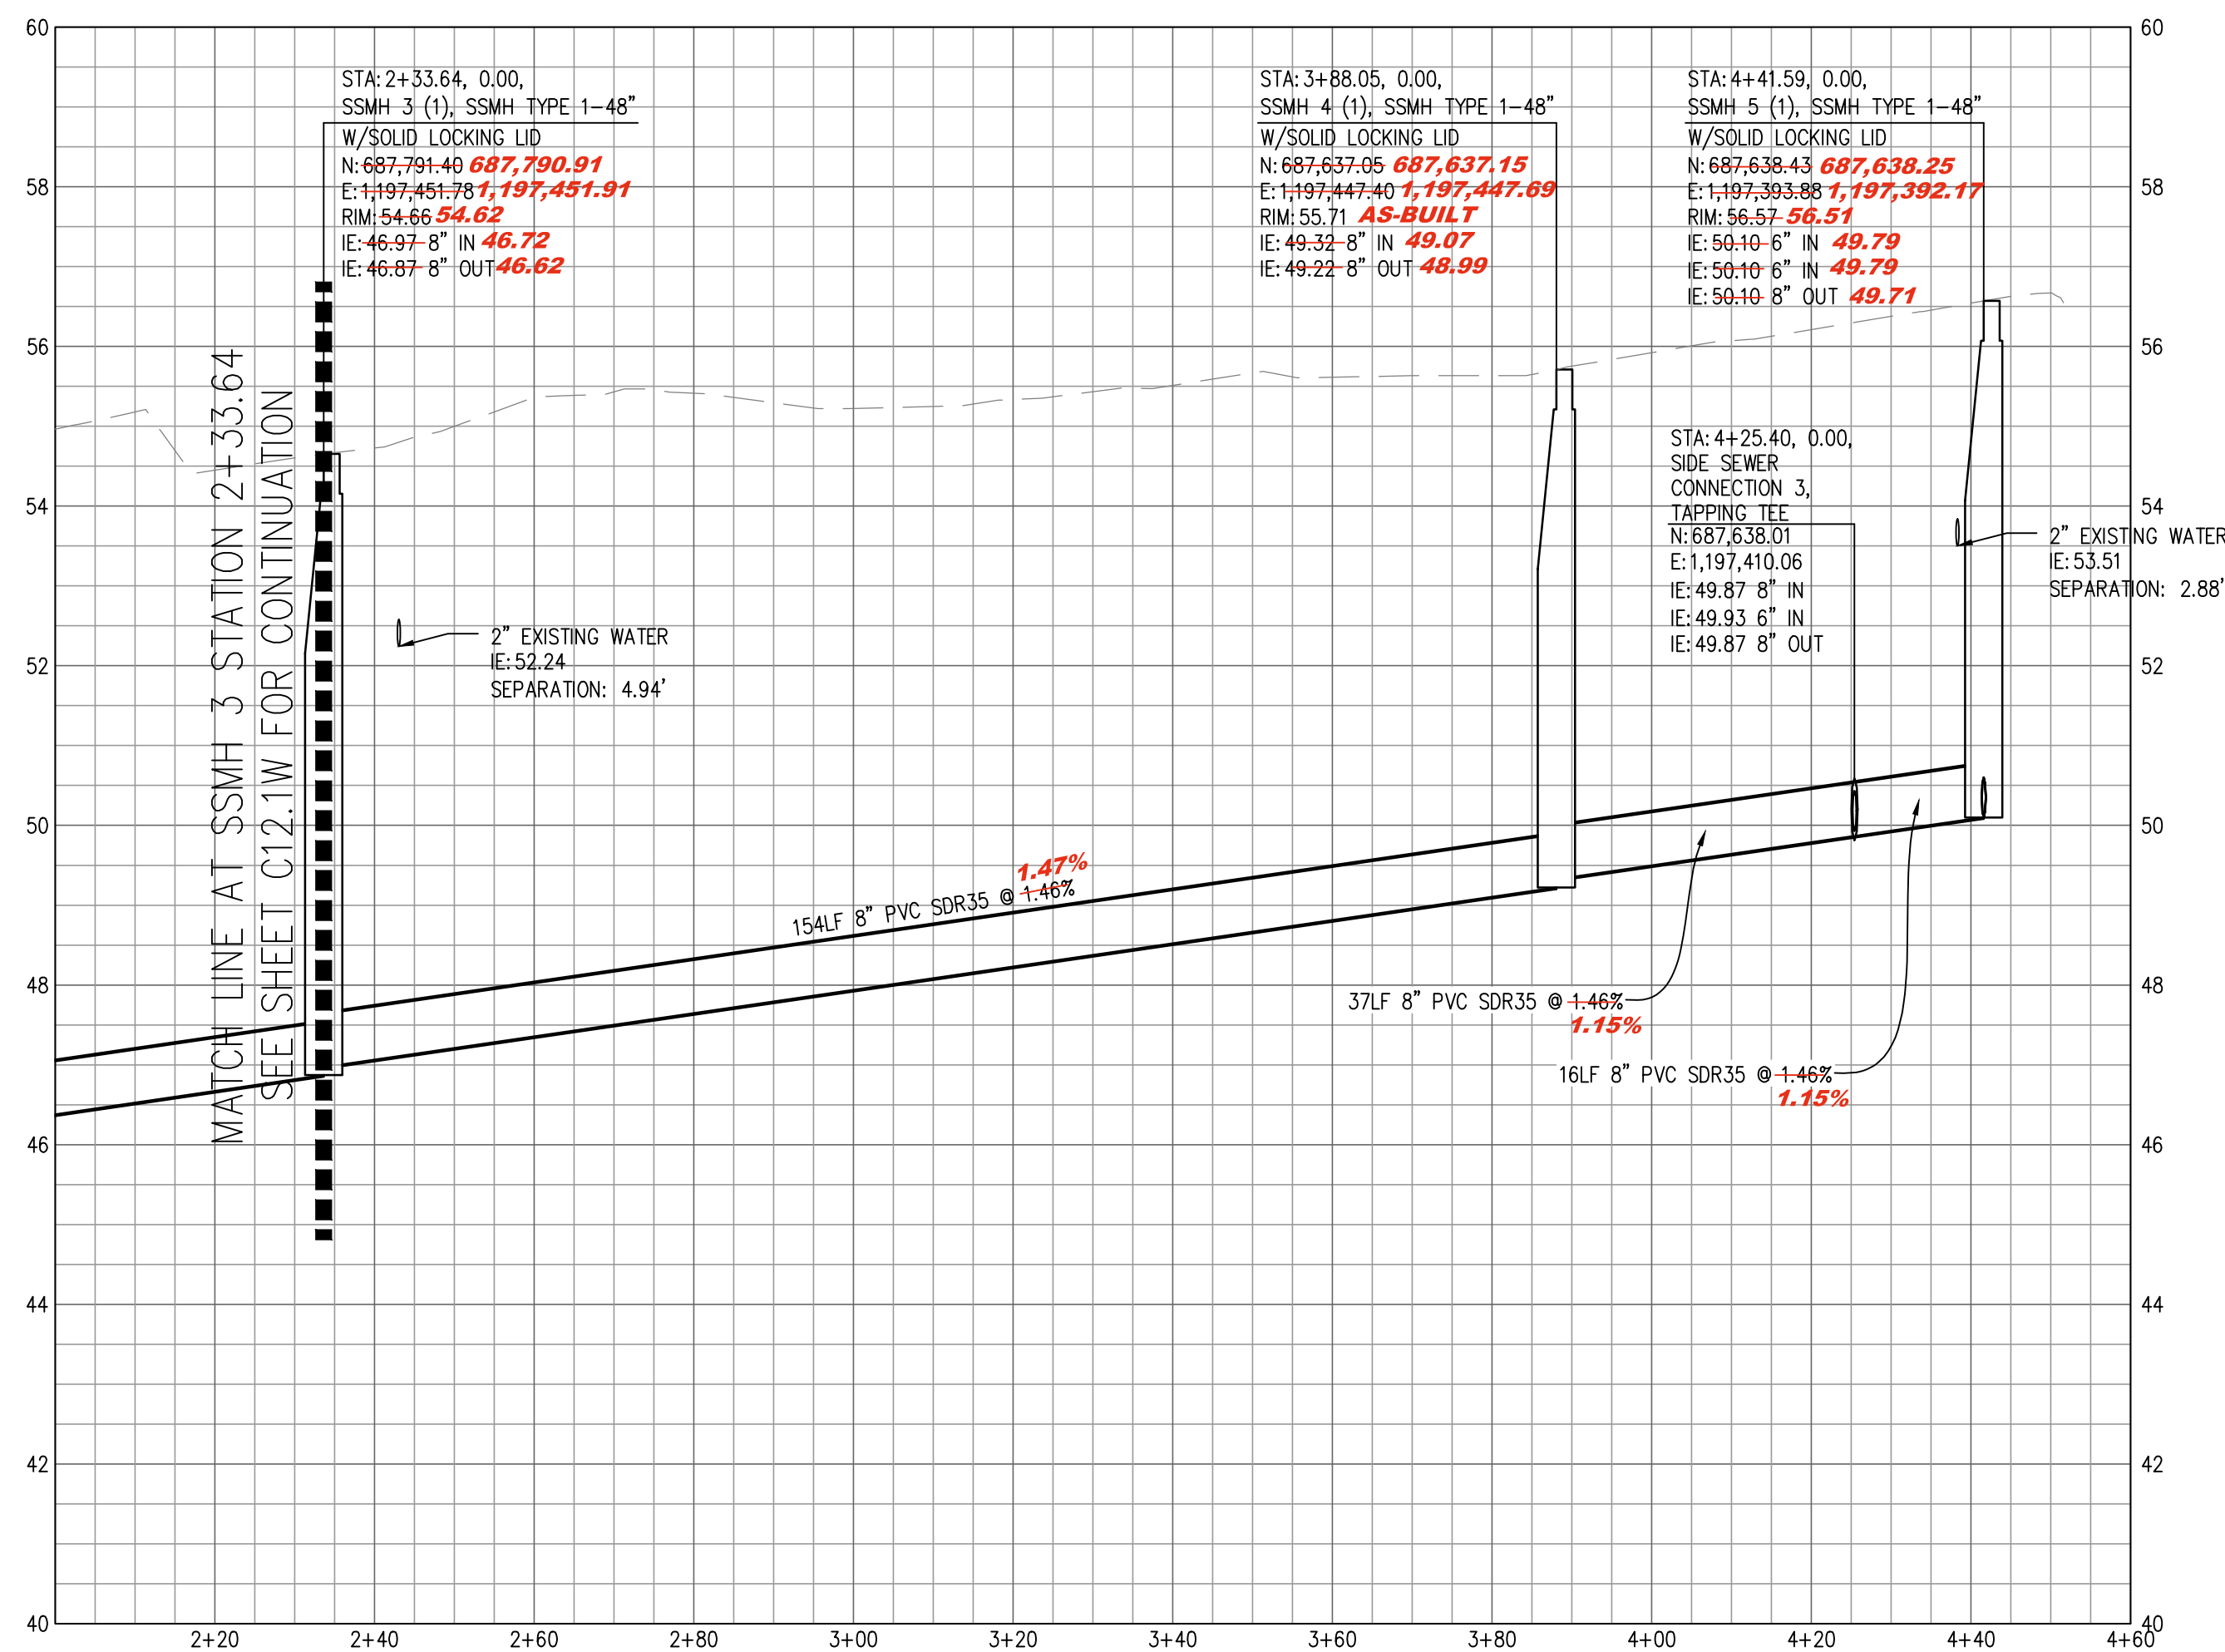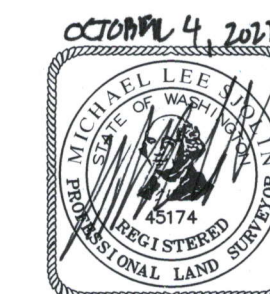

SEWER

SANITARY SEWER PLAN AND PROFILE 2

SCALE: H: 1"=20' V: 1"=2'


PROJECT:
PUYALLUP SCHOOL DISTRICT
WALKER HIGH SCHOOL SITE UTILITIES
5715 MILWAUKEE AVE E
PUYALLUP, WA 98372

REVISIONS
5-10-21 PERMIT SUBMITTAL
6-14-21 PERMIT RESUBMITTAL
6-23-21 BID SET
6-25-21 CITY RESUBMITTAL
7-23-21 CITY RESUBMITTAL

DATE	1.19.2021
BCRA NO.	20760.00.00
DRAWN BY:	
REVIEWED BY:	
SHEET TITLE	SITE UTILITIES SANITARY SEWER PLAN AND PROFILE 2

bcra
© COPYRIGHT 2019 - BCRA, INC. ALL RIGHTS RESERVED.
SHEET 24 OF 27

C16.1W

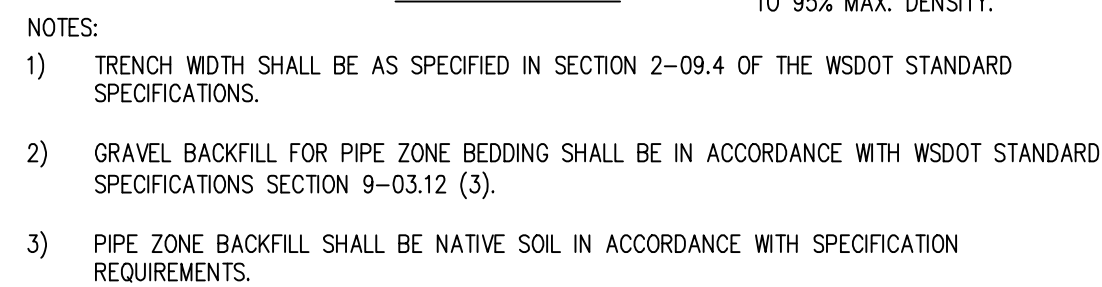

PROJECT _____
PUYALLUP SCHOOL DISTRICT
WALKER HIGH SCHOOL PORTABLE
5715 MILWAUKEE AVE E
PUYALLUP, WA 98372

DATE
1.19.2021

BCRA NO.
20160.00.00

DRAWN BY:

REVIEWED BY:

SHEET TITLE
SITE UTILITIES DETAILS

 bcra

© COPYRIGHT 2019 - BCRA, INC. ALL RIGHTS RESERVED

SHIFT 25 OF 27

C17 0W



811
Know what's below.
Call before you dig



SITTS & HILL ENGINEERS, INC.


CIVIL ■ STRUCTURAL ■ SURVEYING

4815 CENTER STREET | TACOMA, WA. 98409
PHONE: (253) 474-9449 | FAX: (253) 474-0153
<http://www.sitts-hill-engineers.com/>

Project No.:	19,034	Project Mgr.:	R.H.
Proj. Engineer:	S.A.J.	Proj. Drafter:	S.A.

IF SHEET MEASURES LESS THAN 24"X36", IT IS A REDUCED PRINT. REDUCE SCALE ACCORDINGLY.

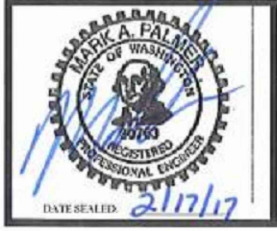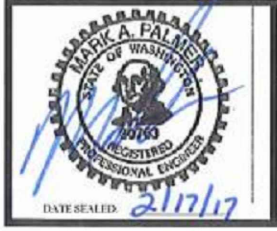

REVISIONS	
5-10-21	PERMIT SUBMITTAL
6-14-21	PERMIT RESUBMITTAL
6-23-21	BID SET
6-25-21	CITY RESUBMITTAL
7-23-21	CITY RESUBMITTAL
	10-04-22 RECORD DRAWINGS


 © COPYRIGHT 2019 - BCRA, INC. ALL RIGHTS RESERVED
 SHEET 26 OF 27

C17.2W

IF SHEET MEASURES LESS THAN 24"X36" IT IS A REDUCED PRINT. REDUCE SCALE ACCORDINGLY.

MANHOLE HANDHOLD

MANHOLE STEP

12"

3"

6 1/2" MIN

#4 POLYPROPYLENE COATED REBAR

12"

6"

9 1/2" MIN

#4 POLYPROPYLENE COATED REBAR

NOTES

1. MANHOLE STEPS AND HANDHOLDS SHALL BE POLYPROPYLENE COATED GRADE 60 REBAR CONFORMING TO ASTM C-476, D-4101, A-615 AND AASHTO M-199.

2. PREFABRICATED LADDERS SHALL BE MADE OF REBAR AND ENCASED IN POLYPROPYLENE AFTER FABRICATION.

3. STEPS MAY BE INSTALLED:
CAST IN PLACE, OR
DRIVEN INTO PREFORMED HOLES WITH THE CONCRETE CURED TO 3,000 PSI MINIMUM, OR
BY DRILLING TWO ONE INCH DIAMETER HOLES, 3-3/4" DEEP, 13" O.C. APPLY NON-SHRINK GROUT AROUND BARBED ENDS AND DRIVE TO FULL INSERTION.

4. PENETRATION OF THE OUTER WALL OF A STRUCTURE WITH A LEG OF A STEP OR LADDER SHALL NOT OCCUR. STEPS AND LADDER RUNGS SHALL BE SPACED AT 12 INCHES AND SHALL BE VERTICALLY ALIGNED.

5. STEPS, HANDHOLDS, LADDER RUNGS AND FASTENINGS SHALL BE DESIGNED FOR A MINIMUM LIVE LOAD OF 300 LBS AND A PULL OUT FORCE OF 1,000 LBS.

6. STEPS, HANDHOLDS, AND LADDER PARTS SHALL BE FREE OF SPLINTERS, SHARP EDGES, BURRS OR PROJECTIONS WHICH MAY CAUSE HAZARDS.

7. REQUESTS TO USE STEPS, HANDHOLDS AND LADDERS MADE FROM NON-CORROSIVE MATERIALS SUCH AS STAINLESS STEEL AND PLASTIC MAY BE ACCEPTED AFTER REVIEW AND APPROVAL BY THE CITY. GALVANIZED STEEL WILL NOT BE PERMITTED IN SANITARY SEWER AND STORM SEWER MANHOLES AND STRUCTURES.

CITY OF PUYALLUP

OFFICE of THE CITY ENGINEER

MANHOLE STEP AND HANDHOLD

DESIGNED BY: TIM ERWIN-SVORDIGA
CHECKED BY: TED MILL
APPROVED BY: SHANE PALMER
DESIGNED BY: Y STOCKMAN
DATE REVISION: 06/10/12
CITY STANDARD

FILE NAME: PUYALLUPCOUNMINDISTRICTYSTURM.MXD
DATE APPROVED: 3/16/17
SCALE: AS SHOWN
SHEET NO.: 06.01.03

EAST JORDAN IRON WORKS 24" "ERGO" FRAME & COVER (PRE-APPROVED PRODUCT)

12" FLAT FACE GOthic

MPIC® MULTI-TOOL PICKBAR

FRAME AND COVER PLAN VIEW

26 2/8"

24"

34"

SECTION A-A

TOP OF FRAME SHALL BE ADJUSTED EVEN WITH ROADWAY SURFACE

SAFETY LOCK AT 90°

FULLY OPENED AT 120°

FRAME AND COVER OPENING

OLYMPIC FOUNDRY MH41 RING & HINGE PUYALLUP COVER (PRE-APPROVED PRODUCT)

FRAME AND COVER PLAN VIEW

26"

26 1/8"

24"

34"

SECTION A-A

TOP OF FRAME SHALL BE ADJUSTED EVEN WITH ROADWAY SURFACE

3" O-RING GASKET

FRAME AND COVER OPENING

NOTES:

1. EAST JORDAN IRON WORKS 24" "ERGO" AND OLYMPIC FOUNDRY MH41 RING & HINGE PUYALLUP COVER ARE PRE-APPROVED PRODUCTS AND SHALL BE USED FOR PUBLICLY-OWNED INFRASTRUCTURE. ALL OTHERS REQUIRE WRITTEN APPROVAL OF THE ENGINEER PRIOR TO INSTALLATION.

2. MANHOLE FRAME AND COVERS SHOULD NOT BE LOCATED IN PEDESTRIAN PATHWAYS (E.G. SIDEWALKS, CROSSWALKS, ETC.) WHERE EXISTING OR PROPOSED CONDITIONS REQUIRE A MANHOLE FRAME AND COVER TO BE INSTALLED WITHIN A PEDESTRIAN PATHWAY, THE MANHOLE FRAME AND COVER SHALL BE ADA COMPLIANT.

3. NON-ROCKING FIT FOR MANHOLE COVERS.

4. CASTING TO BE SHOT BLASTED AND FREE FROM SURFACE SAND AND SCALE.

5. CASTING TO BE SMOOTH, TRUE TO PATTERN, FREE FROM BLOWHOLES, POROSITY HARD SPOTS, SHRINK HOLES, WARP, OR ANY OTHER DEFECTS WHICH COULD IMPAIR SERVICEABILITY.

6. CASTINGS SHALL BE UNCOATED.

7. FOR STORM APPLICATIONS CAST LETTERS SHALL READ "STORM".

8. INSTALL FRAME AND COVER IN ROADWAY WITH HINGED SIDE OF ASSEMBLY POINTED TOWARD ONCOMING TRAFFIC.

9. THE CITY SHALL HAVE THE RIGHT TO REQUIRE INSPECTION AND APPROVAL OF ALL CASTINGS PRIOR TO PAINTING.

10. REPAIR OR DEFECTS BY WELDING, OR BY THE USE OF "SMOOTH-ON" OR SIMILAR MATERIAL WILL NOT BE PERMITTED.

11. MANHOLE RING AND COVER SHALL BE FREE OF POROSITY, SHRINK CAVITIES, COLD SHUTS OR CRACKS OR ANY SURFACE DEFECTS WHICH WOULD IMPAIR SERVICEABILITY.

* FRAME HEIGHT MAY BE 4" FOR OVERLAYS AND PAYMENT REHABILITATION PROJECTS, WITH WRITTEN APPROVAL BY THE CITY ENGINEER.

CITY OF PUYALLUP

OFFICE of THE CITY ENGINEER

MANHOLE FRAME AND COVER

APPROVED FOR PUBLICATION

DATE REVISION: 06/01/02

FILE NAME: PUYALLUPCOUNMINDISTRICTYSTURM.MXD
DATE REVISION: 2/15/2018
SCALE: AS SHOWN
SHEET NO.: 06.01.02

RECORD DRAWING
RECORD DRAWING INFORMATION IS PROVIDED BY NORTHWEST CASCADE, INC. RECORD DRAWING INFORMATION WAS REVIEWED BY R. HAND OF SITTS & HILL ENGINEERS AND THE INSTALLATION SUBSTANTIALLY CONFORMS TO APPROVED PLANS.

APPROVED
BY: *[Signature]*
CITY OF PUYALLUP
DEVELOPMENT SERVICES
DATE: 07/26/2021
NOTE: THIS APPROVAL IS VOID AFTER 180 DAYS FROM APPROVAL DATE. THE CITY WILL NOT BE RESPONSIBLE FOR ERRORS AND/OR OMISSIONS ON THESE PLANS. FIELD CONDITIONS MAY DICTATE CHANGES TO THESE PLANS AS DETERMINED BY THE CITY ENGINEER

PROJECT:
PUYALLUP SCHOOL DISTRICT
WALKER HIGH SCHOOL SITE UTILITIES
5715 MILWAUKEE AVE E
PUYALLUP, WA 98372

5-10-21 PERMIT SUBMITTAL
6-14-21 PERMIT RESUBMITTAL
6-23-21 BID SET
6-25-21 CITY RESUBMITTAL
7-23-21 CITY RESUBMITTAL
10-04-22 RECORD DRAWINGS

DATE: 1.19.2021
BCRA NO.: 20160.00.00
DRAWN BY:
REVIEWED BY:
SHEET TITLE: SITE UTILITIES DETAILS

Know what's below.
Call before you dig.

SITTS & HILL ENGINEERS, INC.

CIVIL • STRUCTURAL • SURVEYING

4815 CENTER STREET | TACOMA, WA 98409

PHONE: (253) 474-9448 | FAX: (253) 474-0153

http://www.sitts-hill-engineers.com/

Project No.: 19,034

Project Mgr.: R.H.

Proj. Engineer: S.A.J.

Proj. Drafter: S.A.J.

bcra
© COPYRIGHT 2019 - BCRA, INC. ALL RIGHTS RESERVED.
SHEET 27 OF 27

C17.3W

IF SHEET MEASURES LESS THAN 24"x36", IT IS A REDUCED PRINT. REDUCE SCALE ACCORDINGLY