

Site Plan
SCALE: 1" = 100'

SURVEY NOTES
BASIS OF BEARING: MONUMENTED CENTERLINE OF 21ST STREET EAST, THAT BEING N0°37'53".
BENCHMARK USED: MONUMENT IN CASE WITH 3" BRASS DISK, 0.8' BELOW RIM, POINT NUMBER 501, ELEVATION=64.528.
SURVEY FIELD WORK PERFORMED DURING THE 3rd WEEK OF MARCH USING GPS EQUIPMENT BY ABBEY ROAD GROUP LAND DEVELOPMENT SERVICES COMPANY, LLC, ROBERT L. "LES" HILLEBRAND, PLS.

CONSULTANTS

OWNER:
CASCADE CHRISTIAN SCHOOLS
DON JOHNSON
815 21ST ST SE
PUYALLUP, WA 98372
(253) 841-1776

ARCHITECT:
JEFF BROWN ARCHITECTURE
JEFF BROWN, AIA NCARB
12181 C ST. S.
TACOMA, WA 98444
(253) 606-8324 W
JEFF@JEFFBROWNNARCHITECTURE.COM

LANDSCAPE ARCHITECT:
JGM LANDSCAPE ARCHITECTS INC. PS
CRAIG LEWIS, PLA
12610 N.E. 104TH STREET
KIRKLAND, WA 98033
(206) 795-3196 CELL
CRAIG@JGM-INC.COM

CIVIL ENGINEER:
VADER ENGINEERING
REBECCA VADER, PE
(253)363-2065
RVADER@VADERENGINEERING.COM

FIELD LIGHTING DESIGN:
MUSCO LIGHTING
TIM BUTZ
TIMBUTZ@MUSCO.COM

SURVEY:
ABBAY ROAD GROUP LAND
DEV. SERVICES COMPANY
LES HILLEBRAND
P.O. BOX 1224
PUYALLUP, WA 98371
(253) 435-3699 W
(206) 446-3159 F
LES.HILLEBRAND@ABBAYROADGROUP.COM

UTILITIES

SEWER:
CITY OF PUYALLUP
1100 39TH AVE SE
PUYALLUP, WA 98374
(253) 840-5550

WATER:
CITY OF PUYALLUP
1100 39TH AVE SE
PUYALLUP, WA 98374
(253) 840-5550

FIRE:
PUYALLUP FIRE
902 7TH ST NW
PUYALLUP, WA 98371
(253) 845-6666

CABLE:
COMCAST
2200 N 30TH ST
TACOMA, WA
(253) 572-1100

POWER:
PUGET SOUND ENERGY
MARK ENEBRAD
6906 S 228TH ST
KENT, WA 98032
(253) 395-6954

SCHOOL:
PUYALLUP SCHOOL DIST.
302 2ND ST E
PUYALLUP, WA 98371
(253) 841-1301

TELEPHONE:
QWEST
PHONE COMPANY
955 LIND SW
RENTON, WA 98055
(425) 228-6092

REFUSE:
DM DISPOSAL
3600 PORT OF TACOMA RD
SUITE 605
TACOMA, WA 98424
(253) 845-6955

GAS:
PUGET SOUND ENERGY
6905 S 228TH ST
KENT, WA 98032
(253) 395-6954

SITE SPECIFICATIONS (EXISTING)

SITE DATA:
ASSESSORS/TAX PARCEL NUMBER: 0420352148
PARCEL/SITE SIZE: 743,763.66 SF/17.07 ACRES
SECTION/TOWNSHIP/RANGE: 35/20/04
DEVELOPMENT JURISDICTION: CITY OF PUYALLUP
SITE ADDRESS: 815 21ST ST. SE
PUYALLUP, WA 98372
ZONING: RS-08/RS-04
DENSITY: 5 DU/8 DU PER ACRE
PRESENT USE: PRIVATE RELIGIOUS EDUCATION
SENSITIVE AREAS:
WETLANDS: NO
FLOOD PLAIN HAZARD AREAS: YES (FEMA 100 YEAR)
EROSION HAZARD AREAS: NO
LANDSLIDE HAZARD AREAS: NO
COAL MINE HAZARD AREAS: NO
SEISMIC HAZARD AREAS: YES
CREEKS/STREAMS: NO
LAKES: NO
STEEP SLOPES(10% OR GREATER): NO
VOLCANIC: YES
WILDLIFE HABITAT: NO
SHORELINE CLASSIFICATION: N/A
IMPERVIOUS AREAS: 8.58 ACRES (FROM ORIGINAL REPORT)
PERVIOUS AREAS: 8.5 ACRES (FROM ORIGINAL REPORT)
ADJACENT ZONING:
NORTH: RS-04
SOUTH: RS-08
EAST: RS-04/RS-08
WEST: RS-08

LEGAL DESCRIPTION

LEGAL DESCRIPTION: SECTION 35 TOWNSHIP 20 RANGE 04 QUARTER 21 :
PARCEL "A" OF DBLR 95-12-11-0261 COMMENCING AT THE INTERSECTION OF 21ST ST SE & 9TH AVE SE BEING ON SECTION LINE BETWEEN SECTIONS 26 & 35 THENCE EAST ALONG SAID SECTION LINE 30 FEET TO EASTERLY R/W LINE OF SAID 21ST ST SE & POINT OF BEGINNING THENCE CONTINUE EAST ALONG SAID SECTION LINE 181 FEET THENCE NORTH 01°11'52" WEST 88 FEET THENCE SOUTH 88°59'43" WEST 181 FEET TO EASTERLY R/W LINE OF 21ST ST SE THENCE NORTH ALONG SAID R/W LINE 91.25 FEET THENCE EAST PARALLEL WITH SECTION LINE 585 FEET THENCE NORTH 01°11'52" WEST 143.25 FEET THENCE EAST PARALLEL WITH SECTION LINE 672.34 FEET TO WESTERLY R/W OF 25TH ST SE THENCE SOUTH ALONG SAID R/W 322.5 FEET TO SECTION LINE THENCE CONTINUE ALONG SAID WESTERLY R/W LINE OF 25TH ST SE 215.97 FEET THENCE SOUTH 89°15'54" WEST 253.06 FEET THENCE SOUTH 01°01'12" EAST 312.48 FEET THENCE SOUTH 89°15'54" WEST 371 FEET TO EAST LINE OF NORTHWEST OF NORTHEAST OF NORTHWEST THENCE NORTH ALONG SAID SUBDIVISION 196.75 FEET TO SOUTHEAST CORNER OF NORTH 1/2 OF NORTHWEST OF NORTHEAST OF NORTHWEST THENCE WEST ALONG SAID SUBDIVISION 513.88 FEET TO SOUTHEAST CORNER OF SOUTH 1/4 FEET OF WEST 150 FEET OF NORTH 1/2 OF NORTHWEST OF NORTHEAST OF NORTHWEST THENCE N 00°5'06" WEST 144 FEET THENCE SOUTH 89°09' WEST 120 FEET TO SAID EASTERLY R/W OF 21ST ST SE THENCE NORTH ALONG 183.05 FEET TO POINT OF BEGINNING OUT OF 2-145, 2-010 & 04-20-26-3-007 SEG H-0611 JU 1/23/96JU

LEGEND

EXISTING	PROPOSED	EXISTING	PROPOSED
AC-ASPHALTIC CONCRETE SURFACE	ASPHALT	ROOF DRAIN CLEANOUT	ROOF DRAIN CLEANOUT
BR-BOTTOM OF ROCKERY	CATCH BASIN	SANITARY SEWER MANHOLE	SANITARY SEWER MANHOLE
BS-BOTTOM OF SWALE	CABLE RISER	SANITARY SEWER	SANITARY SEWER
CC-COMPACT PARKING STALL	CENTER LINE OF RIGHT OF WAY	SET IRON PIN WITH ID CAP	SET IRON PIN WITH ID CAP
CD-CONCRETE CURB	CLEARING LIMITS	SET TACK IN LEAD AS NOTED	SET TACK IN LEAD AS NOTED
CE-CONCRETE DRIVE	CONCRETE	SET TACK IN LEAD IN BRASS ID DISC	SET TACK IN LEAD IN BRASS ID DISC
CF-CONCRETE GUTTER	FENCE LINE	SET RR SPIKE WITH PUNCH MARK	SET RR SPIKE WITH PUNCH MARK
CG-CONCRETE SLAB	FILTER FABRIC FENCE	SLOPES 15% OR GREATER	SLOPES 15% OR GREATER
CH-CHANNEL	FIRE HYDRANT	STORM DRAIN LINE	STORM DRAIN LINE
CI-CONCRETE PIPE	FOUND MONUMENT AS NOTED	STORM DRAIN	STORM DRAIN
CL-CONCRETE WALK	GAS VALVE	STREET LIGHT	STREET LIGHT
CM-CONCRETE MANHOLE	GUY ANCHOR	SURVEY MONUMENT	SURVEY MONUMENT
DN-DUCTILE IRON	LIGHT STANDARD	TELEPHONE RISER	TELEPHONE RISER
ED-EDGE OF ASPHALT	LOT CORNERS	TRAFFIC FLOW	TRAFFIC FLOW
EP-EDGE OF PROPERTY	INTERCEPTOR SWALE	TRAFFIC LIGHT	TRAFFIC LIGHT
EQ-ELECTRIC CONDUIT	JUNCTION BOX	UTILITY ACCESS MANHOLE	UTILITY ACCESS MANHOLE
ER-ELECTRIC METER	PARKING COUNT	UTILITY POLE	UTILITY POLE
ET-ELECTRIC TRANSFORMER	POWER VAULT	YARD LIGHT	YARD LIGHT
EX-EXISTING	PROPERTY LINE	WATER	WATER
F-FINISH FLOOR	RETAINING WALL	WATER METER	WATER METER
FB-FINISH BASEMENT	RIGHT OF WAY	WATER VALVE	WATER VALVE
GC-GAS MAIN	RIP RAP PAD	WATER REDUCER	WATER REDUCER
HC-HANDICAP PARKING STALL	ROCK CHECK DAM	CENTERLINE	CENTERLINE
HE-HEAD ELEVATION	ROCKERY		
IS-LANDSCAPE			
OB-CURB			
OP-OPERATOR POWER			
P-PROPERTY LINE			
PT-POINT			
PVC-POLY VINYL CHLORIDE			
R-RAISED ELEVATION OF STRUCTURE			
ROW-RIGHT OF WAY			
SF-SQUARE FEET			
SS-SANITARY SEWER			
SCO-SANITARY SEWER CLEANOUT			
SM-SANITARY SEWER MANHOLE			
SO-SOLID			
TA-TOP OF ASPHALT			
TE-TELEPHONE CONDUIT			
TD-TOP OF DRIVEWAY			
TO-TOP OF SWALE			
T-TELEPHONE WIRE			
TR-TOP OF ROCKERY			
TS-TOP OF SIDEWALK			
TY-TYPICAL			
W-WATER			
VP-VENT PIPE			
(P)-PER PLAT UNDER RECORDING			
(M)-MEASURED DATA			
(R)-RECORD DATA			

PROJECT SPECIFICATIONS (PROPOSED)

PROJECT DATA:
PROJECT NAME: CASCADE CHRISTIAN TRACK AND FIELD
APPLICANT/AGENT: JEFF BROWN ARCHITECTURE
NAME: JEFF BROWN, AIA NCARB
12181 C ST. S.
TACOMA, WA 98444
(253) 606-8324 W
JEFF@JEFFBROWNNARCHITECTURE.COM
PHONE: 253-435-3699

OWNER/DEVELOPER: CASCADE CHRISTIAN SCHOOL
NAME: DON JOHNSON
ADDRESS: 815 21ST ST SE
PUYALLUP, WA 98372
PHONE: (253) 841-1776

PROJECT AREA:
PROPOSED USE: RESTROOM / CONCESSION BUILDING, TRACK AND FIELD SPORTS IMPROVEMENTS, COVERED BLEACHER, FIELD LIGHTING
SITE SIZE: 756,448 SF/17.37 ACRES
DISTURBED AREA: 188,500 SF / 4.33 ACRES
IMPERVIOUS AREA: 8.58 ACRES (FROM ORIGINAL REPORT)
PERVIOUS AREA: 8.5 ACRES (FROM ORIGINAL REPORT)
OPEN SPACE AREA:
PARKING (ASPHALT) AREA: 142,439.69 SF/3.27 ACRES
LANDSCAPE AREA: 97,922.55 SF/2.29 ACRES
MIN LOT SIZE: 8,000 SF/4,000 SF
MIN LOT DEPTH: 90/80'
MIN LOT WIDTH: 60/40'
MAX SITE COVERAGE: 45%/50%
SITE COVERAGE: 50%

PARKING (EXISTING)
STANDARD: 216
COMPACT: 174
HANDICAP: 9
TOTAL: 390

PROPOSED BUILDING:
SEE SEPARATE ARCHITECTURAL SUBMITTAL
FIRST FLOOR: 977 SF
TOTAL AREA: 977 SF
STORIES: 1


STORM DRAINAGE:
SEE CIVIL DRAWINGS - PROVIDED FOR AT FULL BUILD OUT
IMPERVIOUS AREA: 8.58 ACRES (FROM ORIGINAL REPORT)
PERVIOUS AREA: 8.5 ACRES (FROM ORIGINAL REPORT)
DETENTION PROVIDED: 55,461 CF (AS-BUILT)

SET BACKS:

	BUILDING	YARD
FRONT:	20/15'	30'
SIDE:	16/5'	30'
REAR:	20/15'	30'
SIDE STREET:	15/10'	12'
LOT WIDTH:	60/40'	
LOT LENGTH:	90/80'	

TABLE OF CONTENTS


SHEET 01 OF 29	L1.0 COVER SHEET
SHEET 02 OF 29	L2.0 EXISTING CONDITIONS & DEMO. PLAN
SHEET 03 OF 29	L3.0 GRADING & FIELD DRAINAGE PLAN
SHEET 04 OF 29	L4.0 SITE PLAN
SHEET 05 OF 29	L5.0 LAYOUT
SHEET 06 OF 29	L6.0 PLANTING PLAN
SHEET 07 OF 29	L7.0 IRRIGATION PLAN
SHEET 08 OF 29	L8.0 DETAIL SHEET 1
SHEET 09 OF 29	L9.0 DETAIL SHEET 2
SHEET 10 OF 29	L10.0 DETAIL SHEET 3
SHEET 11 OF 29	C1 CSWPP AND DEMO PLAN
SHEET 12 OF 29	C2 CSWPP AND DEMO PLAN
SHEET 13 OF 29	C3 CSWPP NOTES AND DETAILS
SHEET 14 OF 29	C4 CSWPP NOTES AND DETAILS
SHEET 15 OF 29	C5 DRAINAGE PLAN
SHEET 16 OF 29	C6 DRAINAGE PLAN
SHEET 17 OF 29	C7 GRADING PLANS
SHEET 18 OF 29	C8 GRADING PLANS
SHEET 19 OF 29	C9 GRADING SECTIONS
SHEET 20 OF 29	C10 DRAINAGE NOTES AND DETAILS
SHEET 21 OF 29	C11 DRAINAGE NOTES AND DETAILS
SHEET 22 OF 29	FIELD LIGHTING PROJECT SUMMARY
SHEET 23 OF 29	ILLUMINATION SUMMARY
SHEET 24 OF 29	ILLUMINATION SUMMARY
SHEET 25 OF 29	ILLUMINATION SUMMARY
SHEET 26 OF 29	ILLUMINATION SUMMARY
SHEET 27 OF 29	ILLUMINATION SUMMARY
SHEET 28 OF 29	ILLUMINATION SUMMARY
SHEET 29 OF 29	EQUIPMENT LAYOUT

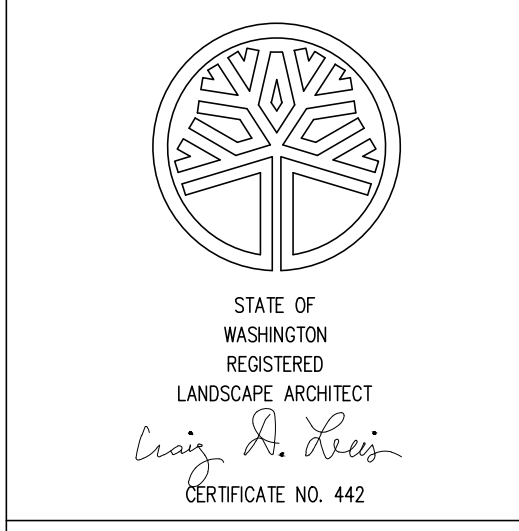

DATE: 12-2-2024
LAST UPDATE:
CAD FILE:

DRAWING TITLE
**COVER SHEET
RESUBMITTAL SET
5-20-2025**

SHEET NUMBER
L1.0

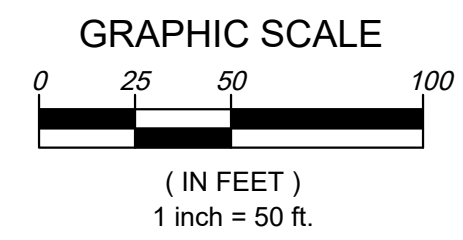


JGM
 LANDSCAPE ARCHITECTS
 INCORPORATED P.S.
 LANDSCAPE ARCHITECTURE
 URBAN DESIGN
 SITE PLANNING
 PARKS AND
 RECREATION PLANNING
 12610 NE 104TH ST.
 KIRKLAND WA 98033
 PH: 425.454.5723
 FX: 425.822.3525
 E: jgm@jgm-inc.com

**CASCADE CHRISTIAN
 ATHLETIC FIELDS
 PUYALLUP, WA**

REVISIONS/DRAWING ISSUES:
 1 11-28-2023
 2 12-2-2024
 3 5-20-2025

Drawn by: CL
 Checked by: CL

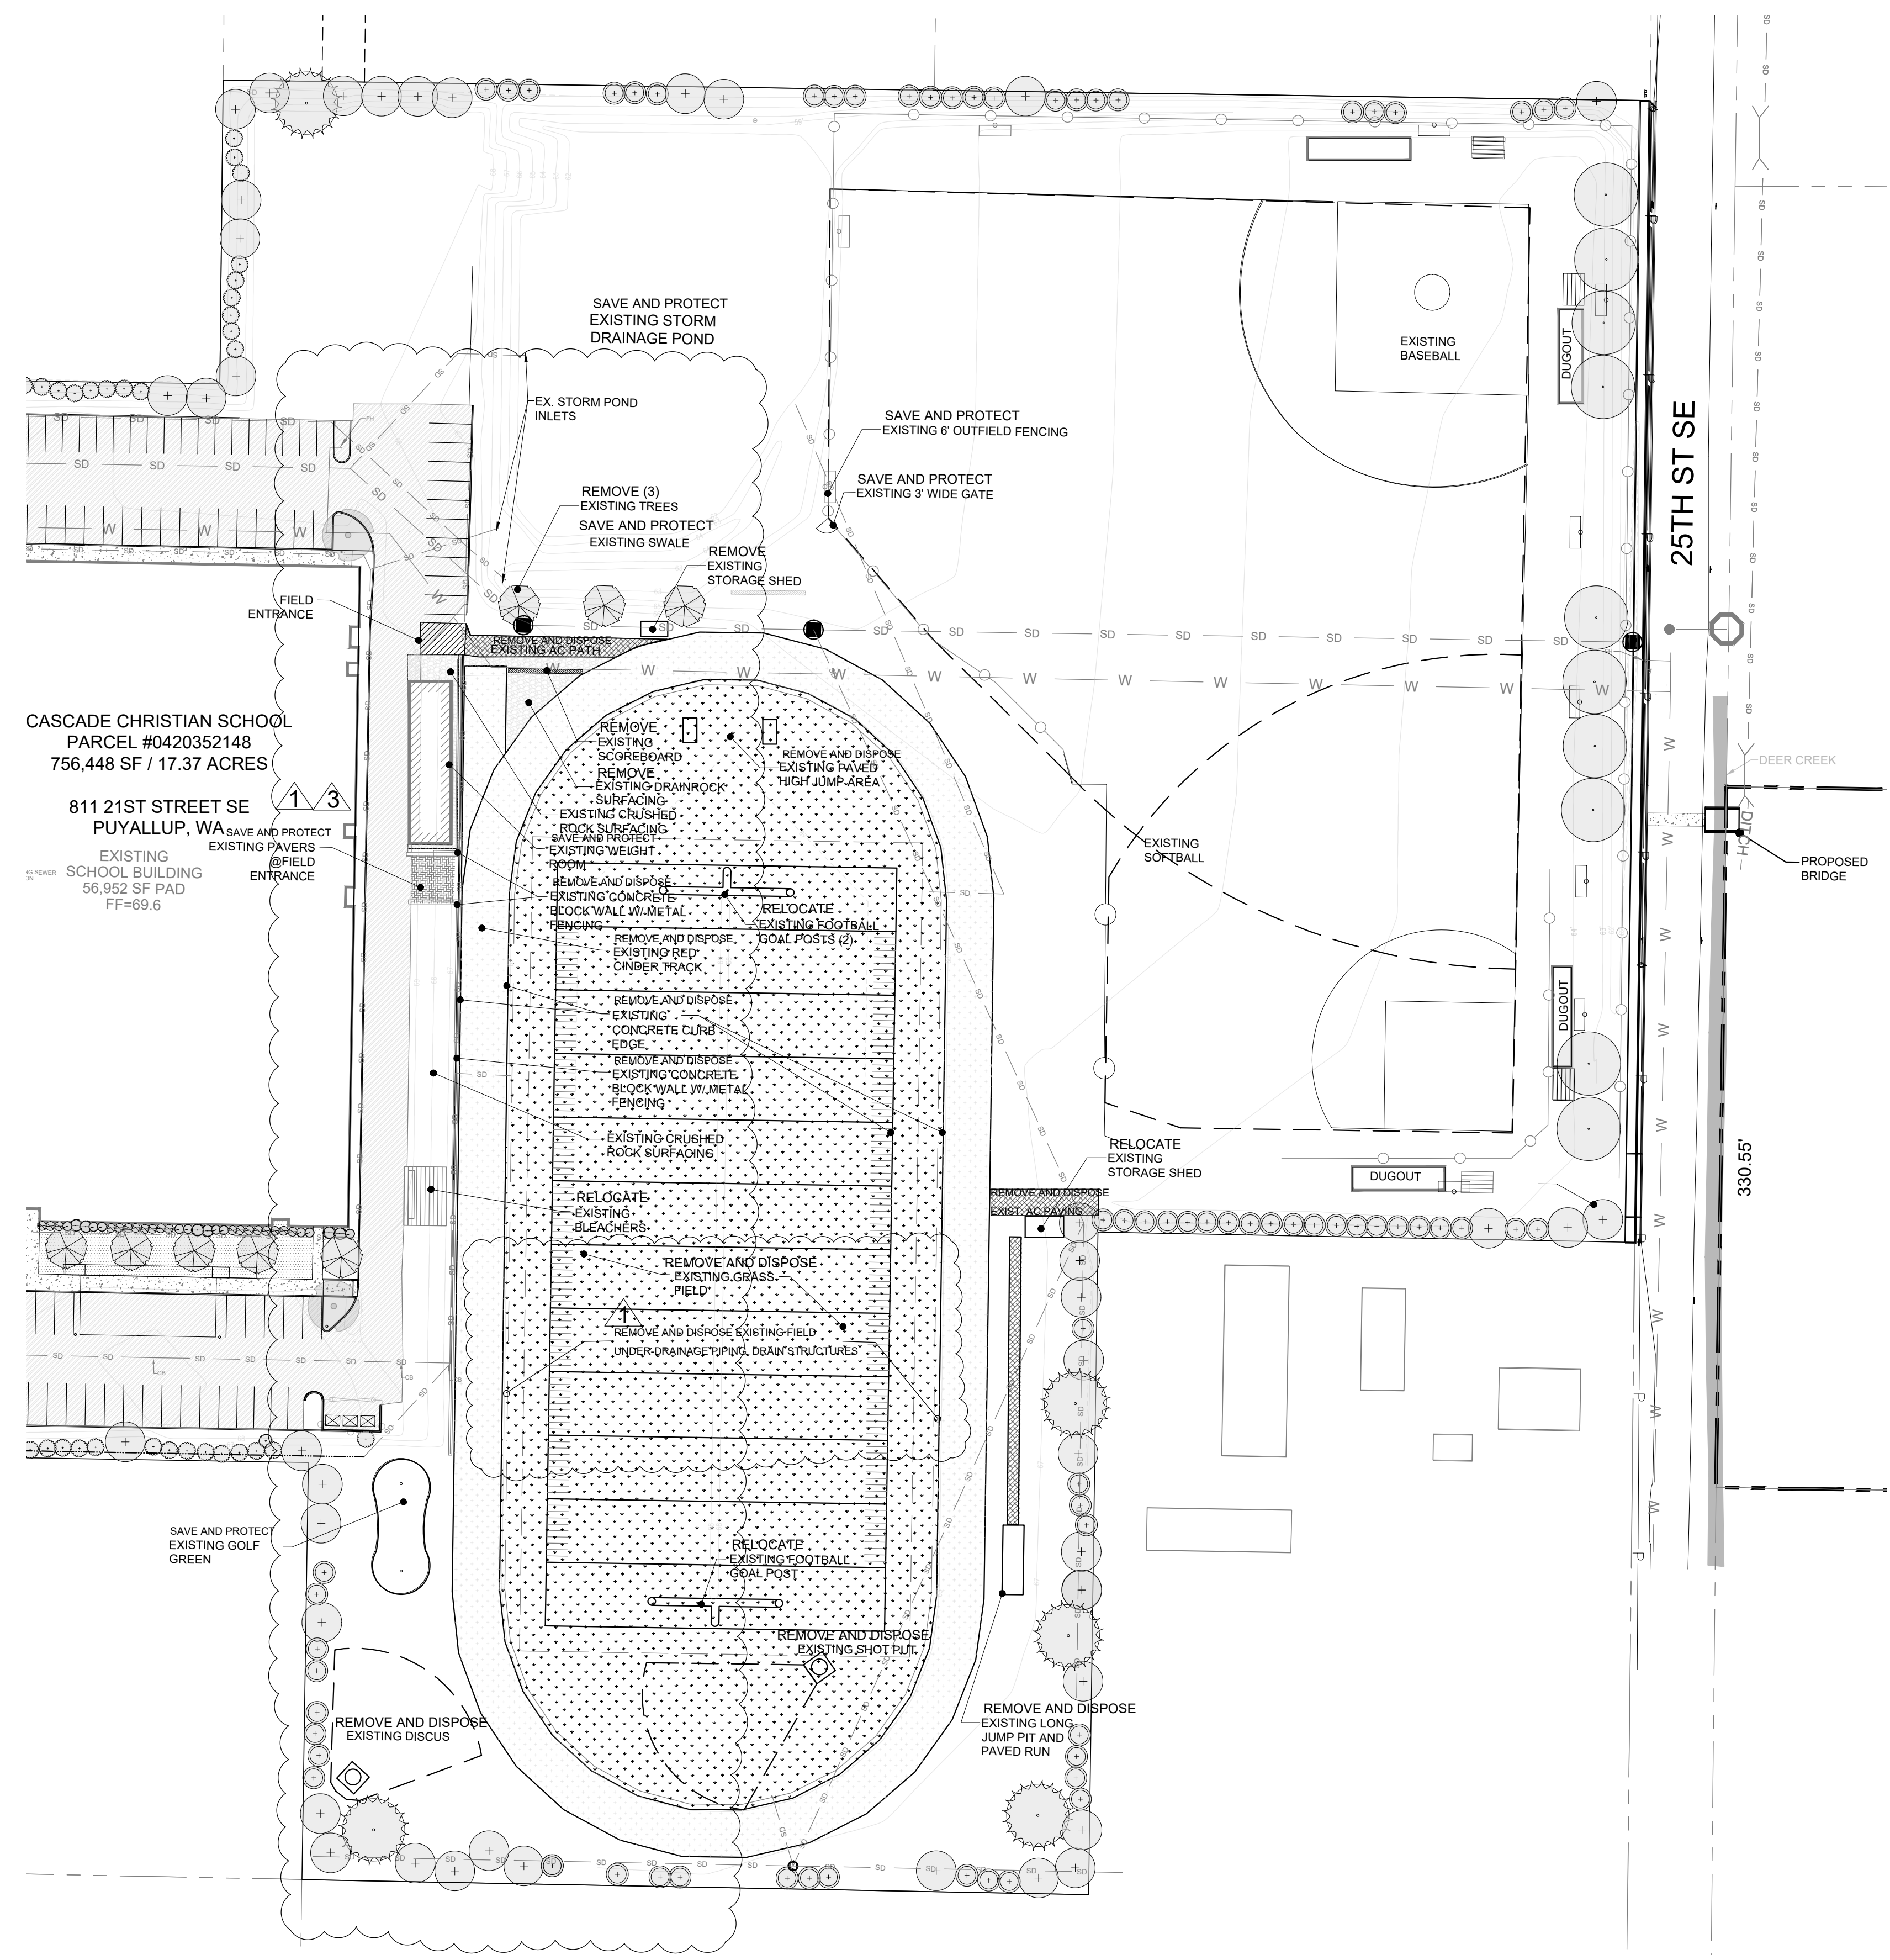

CASCADE CHRISTIAN SCHOOL
 PARCEL #0420352148
 756,448 SF / 17.37 ACRES
 811 21ST STREET SE
 PUYALLUP, WA
 EXISTING PAVERS @ FIELD ENTRANCE
 EXISTING SCHOOL BUILDING
 56,952 SF PAD
 FF=69.6

DEMOLITION LEGEND:


- EXISTING ASPHALT
- EXISTING ASPHALT TO BE REMOVED
- EXISTING CONCRETE PAVERS
- EXISTING CRUSHED ROCK TO REMAIN
- EXISTING DRAIN ROCK TO BE REMOVED
- EXISTING GRASS TO BE REMOVED
- EXISTING CINDER TRACK TO BE REMOVED
- EXISTING TREES TO SAVE AND PROTECT

NOTES:
 1. PROTECT ALL UTILITIES NOT NOTED TO BE REMOVED.
 2. AT ANY TIME DURING CONSTRUCTION OF THIS PROJECT/PLAT, IF MUD AND DEBRIS ARE BEING TRACKED ONTO PUBLIC STREETS WITH INSUFFICIENT CLEANUP AS DETERMINED BY THE CITY INSPECTOR/DEVELOPMENT ENGINEER, ALL WORK SHALL CEASE UNTIL A SOLUTION IS DETERMINED. THE CONTRACTOR/DEVELOPER SHALL IMMEDIATELY TAKE THE NECESSARY STEPS TO PREVENT FURTHER TRACKING, WHICH STEPS MAY INCLUDE A WHEEL WASH ON SITE.



DATE: 12-2-2024
 LAST UPDATE:
 CAD FILE:
 DRAWING TITLE
 EXISTING CONDITIONS
 AND DEMOLITION PLAN

SHEET NUMBER
L2.0

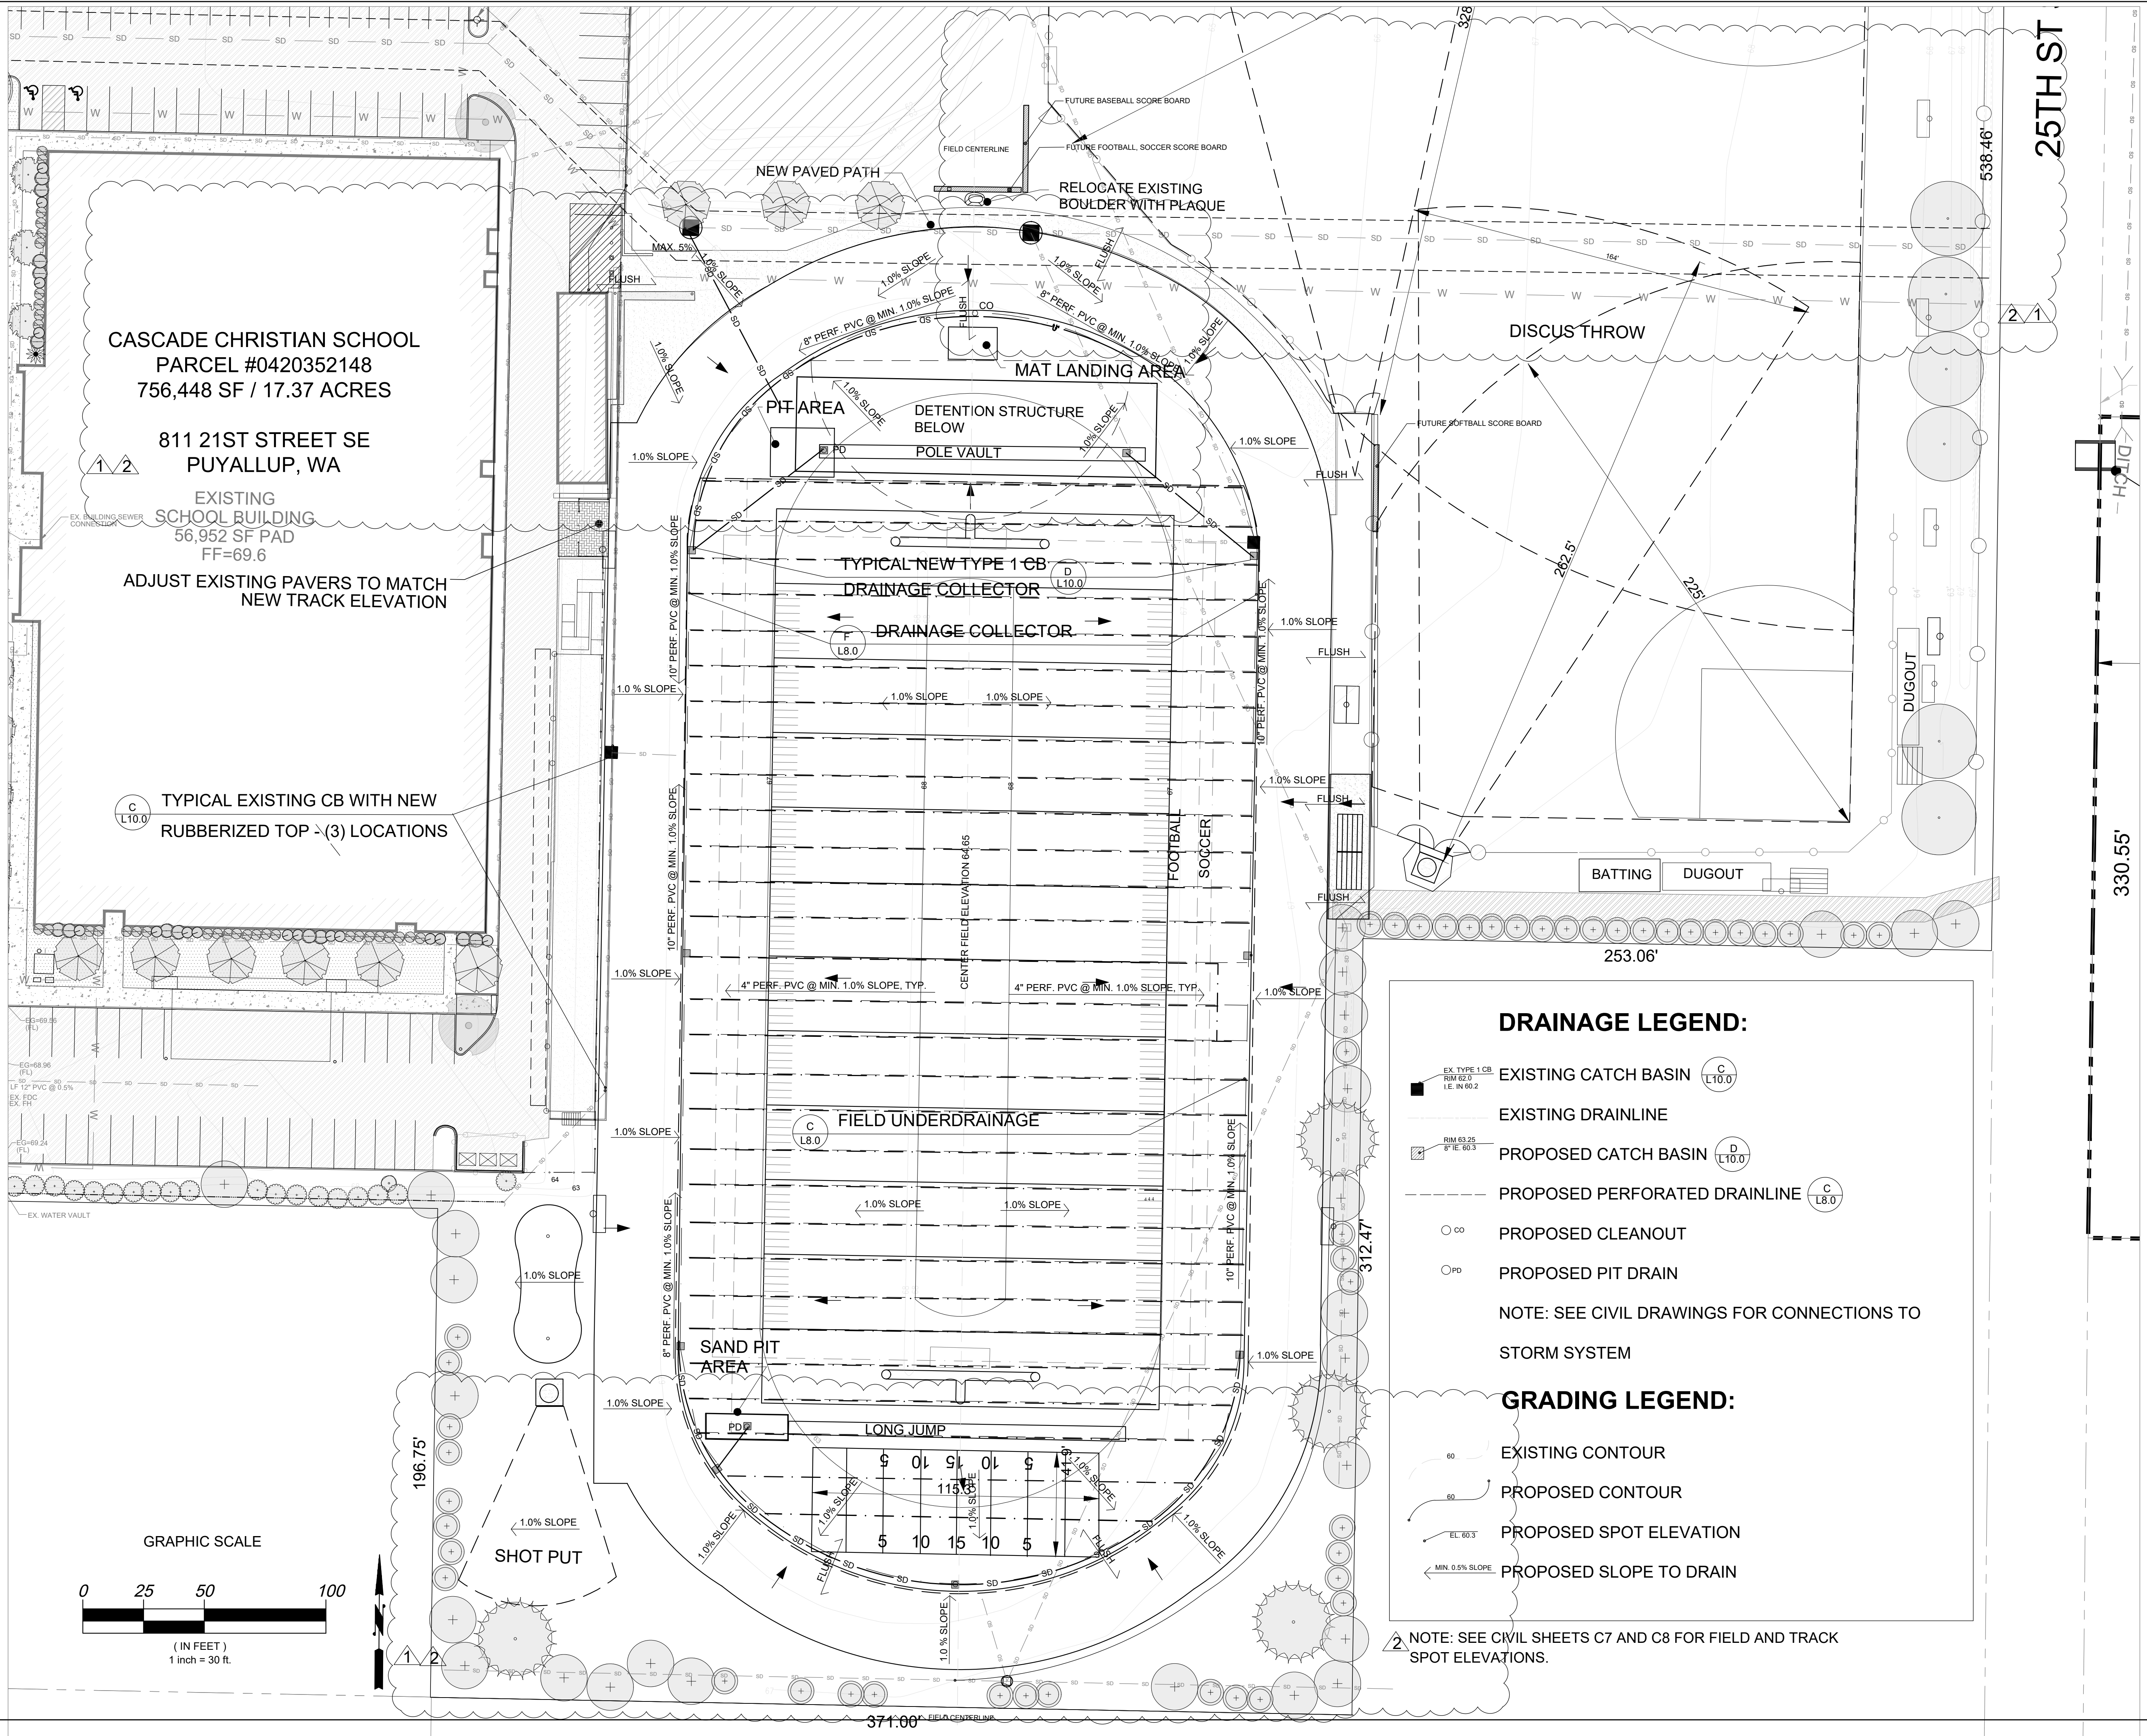

DRAINAGE LEGEND:


- EX. TYPE 1 CB (C L10.0)
- EXISTING DRAINLINE
- PROPOSED CATCH BASIN (D L10.0)
- PROPOSED PERFORATED DRAINLINE (C L8.0)
- PROPOSED CLEANOUT (CO)
- PROPOSED PIT DRAIN (PD)

NOTE: SEE CIVIL DRAWINGS FOR CONNECTIONS TO STORM SYSTEM

GRADING LEGEND:

- EXISTING CONTOUR
- PROPOSED CONTOUR
- PROPOSED SPOT ELEVATION
- PROPOSED SLOPE TO DRAIN

NOTE: SEE CIVIL SHEETS C7 AND C8 FOR FIELD AND TRACK SPOT ELEVATIONS.

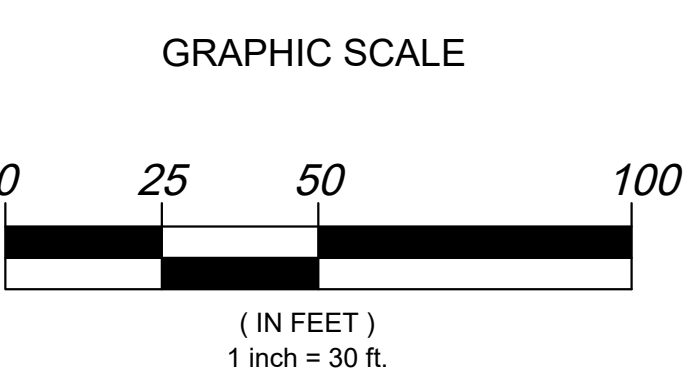

25TH ST



330.55'

**CASCADE CHRISTIAN
 ATHLETIC FIELDS
 PUYALLUP, WA**

REVISIONS/DRAWING ISSUES:

1	11-28-2023
2	12-2-2024
3	5-20-2025

Drawn by: CL
 Checked by: CL

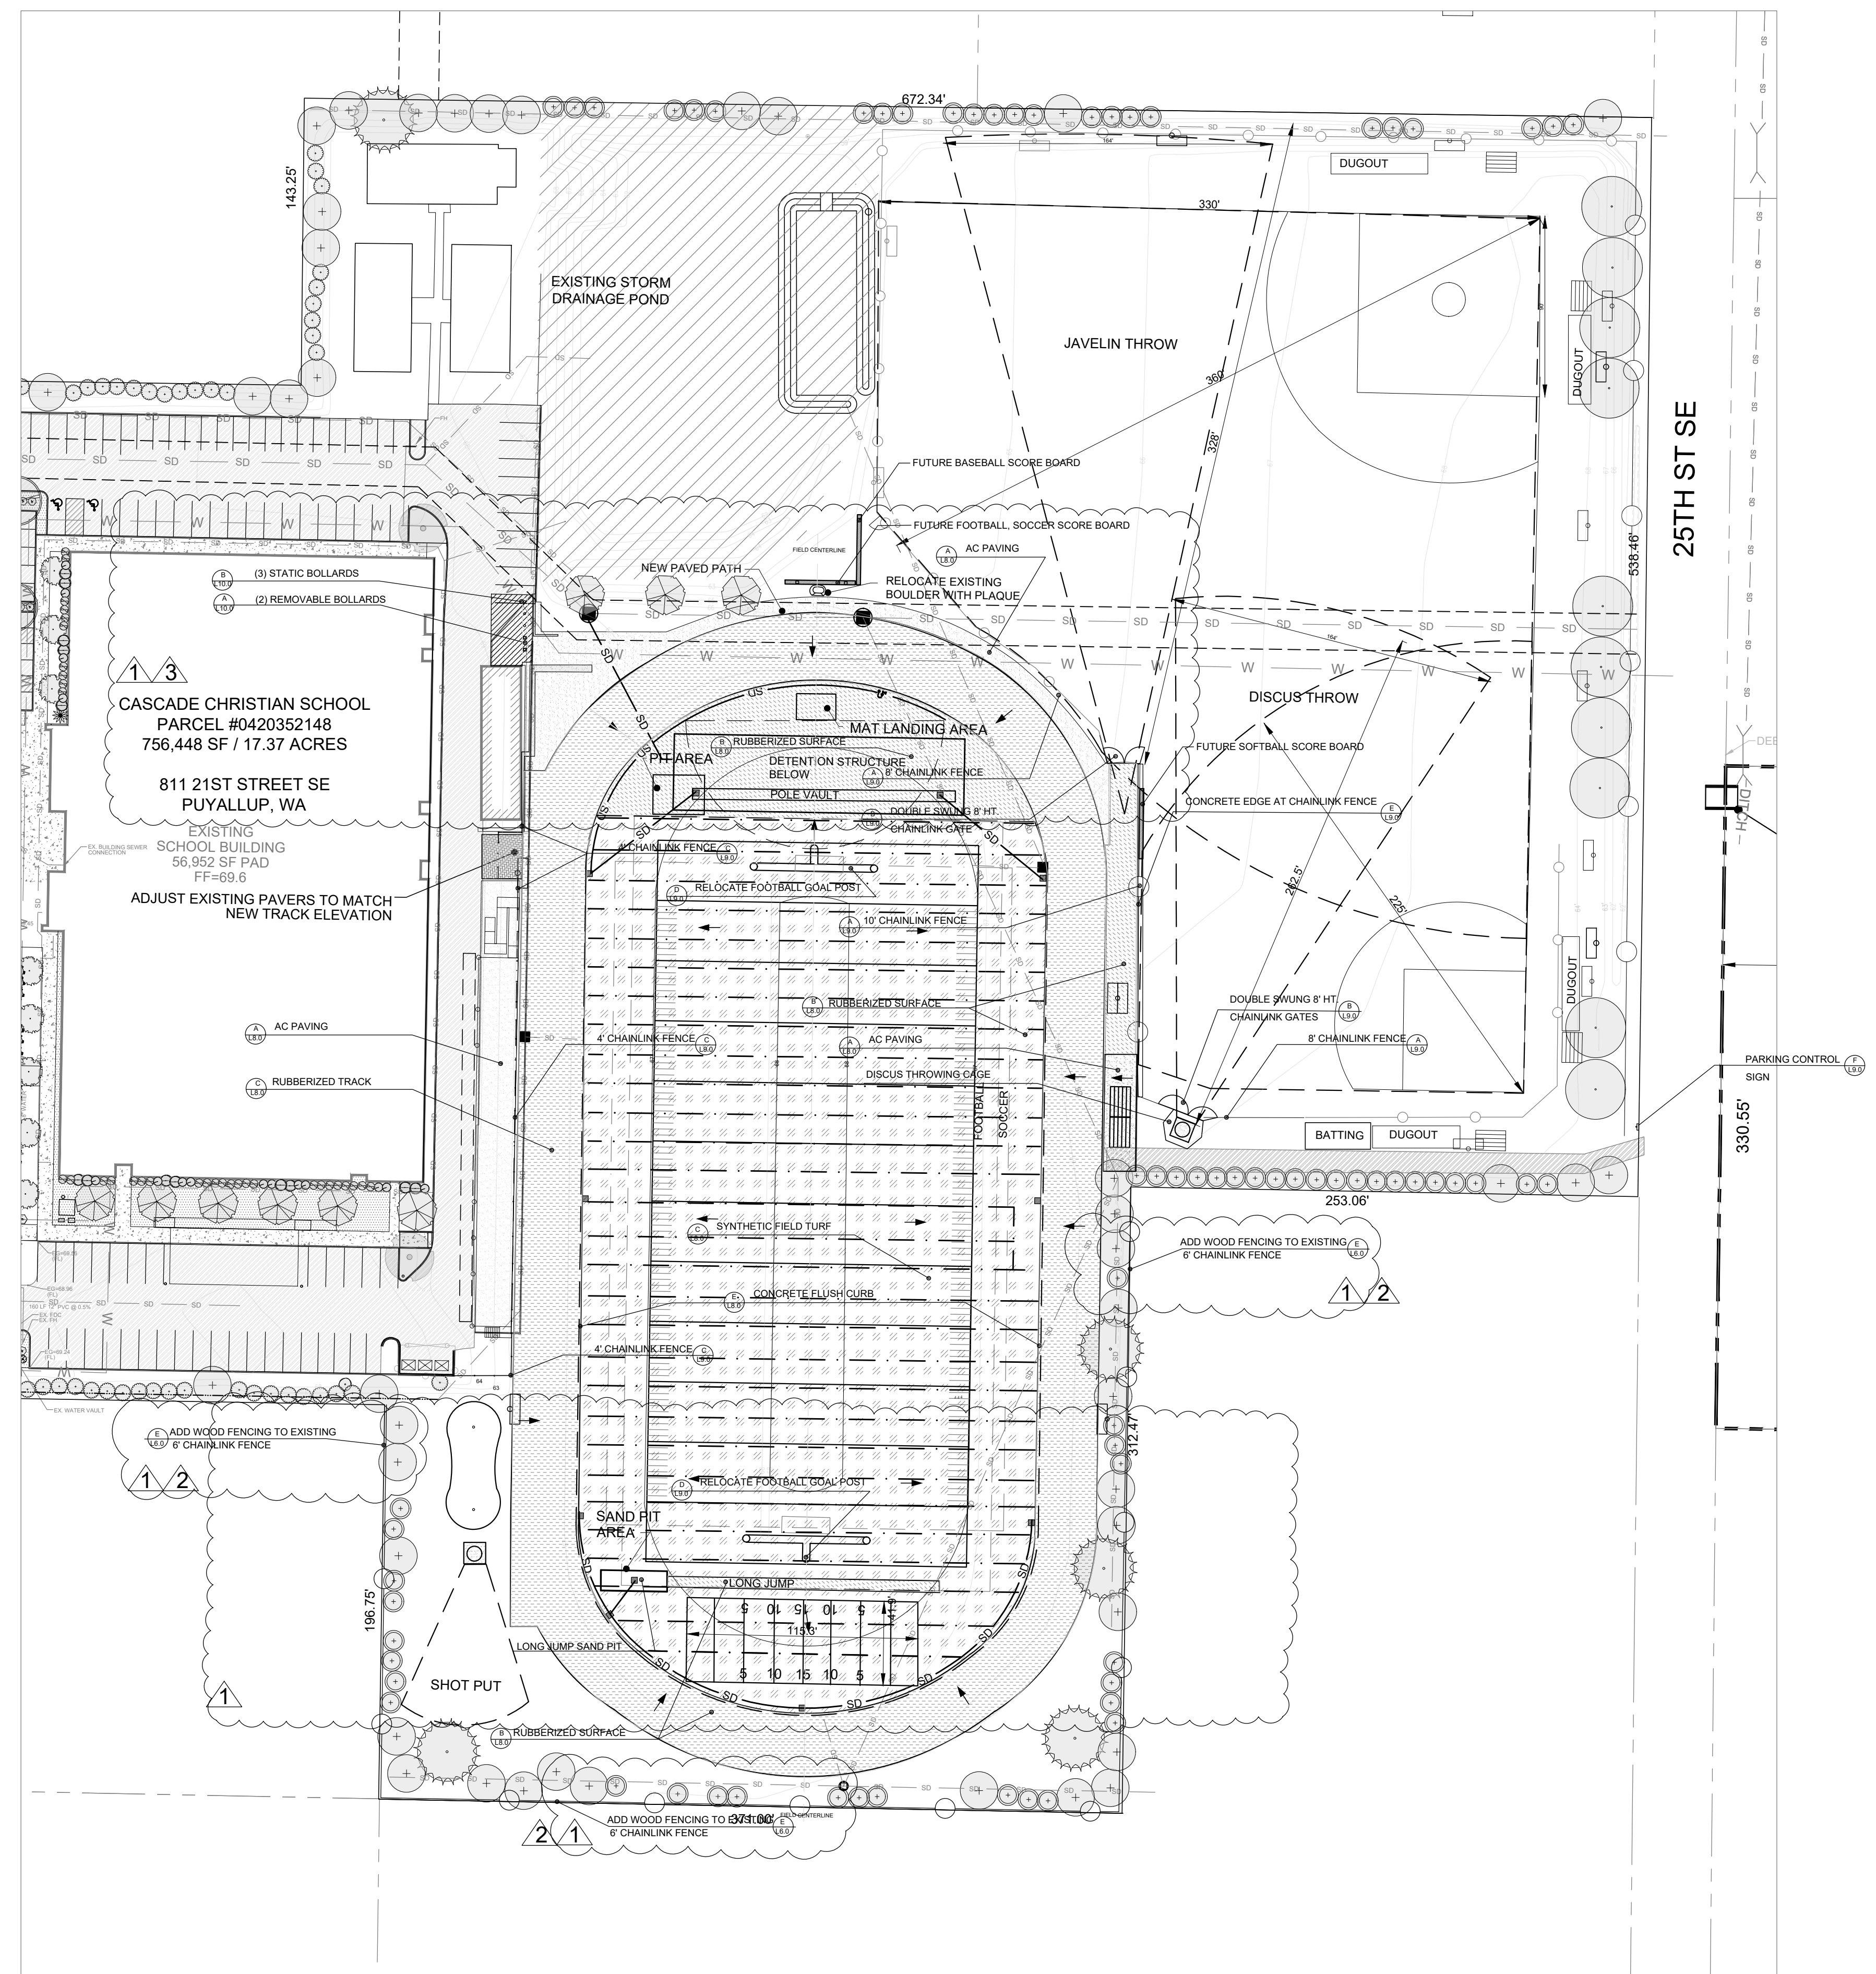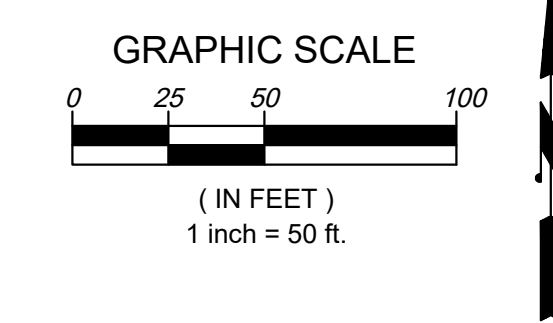

PROPOSED PAVING LEGEND:

	EXISTING ASPHALT	
	EXISTING CONCRETE PAVERS	
	PROPOSED GRASS	
	PROPOSED ASPHALT	(A) L8.0
	PROPOSED RUBBERIZED TRACK	(C) L8.0
	PROPOSED RUBBERIZED SURFACE	(B) L8.0
	PROPOSED SYNTHETIC FIELD TURF	(C) L8.0



DATE: 12-2-2024
 LAST UPDATE:
 CAD FILE:

DRAWING TITLE
 SITE PLAN

SHEET NUMBER
L4.0








PLANTING LEGEND:

SYMBOL	PLANT TYPE	SIZE AT PLANTING	SPACING	NATIVE / ADAPTIVE	QUAN.
TREES					
	EXISTING EVERGREEN SCREEN VEGETATION TO SAVE AND PROTECT				1/2
	THUJA PLICATA / WESTERN RED CEDAR	8" HT., B&B	10'-0" O.C.	YES	30
	PSEUDOTSUGA MENZIESII / DOUGLAS FIR	8" HT., B&B	10'-0" O.C.	YES	28
SHRUBS					
	MAHONIA AQUIFOLIUM / TALL OREGON GRAPE	3 GAL	4'-0" O.C.	YES	130
	MYRICA CALIFORNICA / PACIFIC WAX MYRTLE	3 GAL	4'-0" O.C.	YES	170
	EVERGREEN SHRUB	4" CONTAINER	1'-6" O.C.	YES	12,120
	WETLAND SEED MIX				12,500 S.F.
PLANTS					
	OEMLERIA CERASIFORMIS / OSOBERRY	3 GAL	3'-0" O.C.	YES	80
	LONICERA INVOLUCRATA / TWINBERRY	3 GAL	3'-0" O.C.	YES	57
	HOLODISCUS DISCOLOR / OCEANSPRAY	3 GAL	5'-0" O.C.	YES	22
	WETLAND SEED MIX				9,000 S.F.

PMC 20.26.500 requires three gallon evergreen shrub species only. Adjust shrub mix to provide additional evergreen plant materials. RFC is a deciduous native and does not meet code requirements [landscape sheets, L6.0]

NOTES

- ALL NEW PLANTING SHALL BE INSTALLED AS PER INSTALLATION STANDARDS DESCRIBED IN CITY OF PUYALLUP MUNICIPAL CODES.
- ALL NEW SEEDED AREAS SHALL RECEIVE MINIMUM 3" OF IMPORTED ORGANIC COMPOST TILLED INTO THE TOP 8" OF EXISTING STOCKPILED SOIL AS REQUIRED TO ACHIEVE 10% ORGANIC CONTENT (DRY WEIGHT). NEW AND EXISTING SCREENING TREE AREAS SHALL HAVE MINIMUM 3" OF WOOD CHIP MULCH APPLIED.
- ALL NEW PLANTING AREAS SHALL BE IRRIGATED BY AUTOMATIC IRRIGATION SYSTEM DURING ESTABLISHMENT PERIOD.

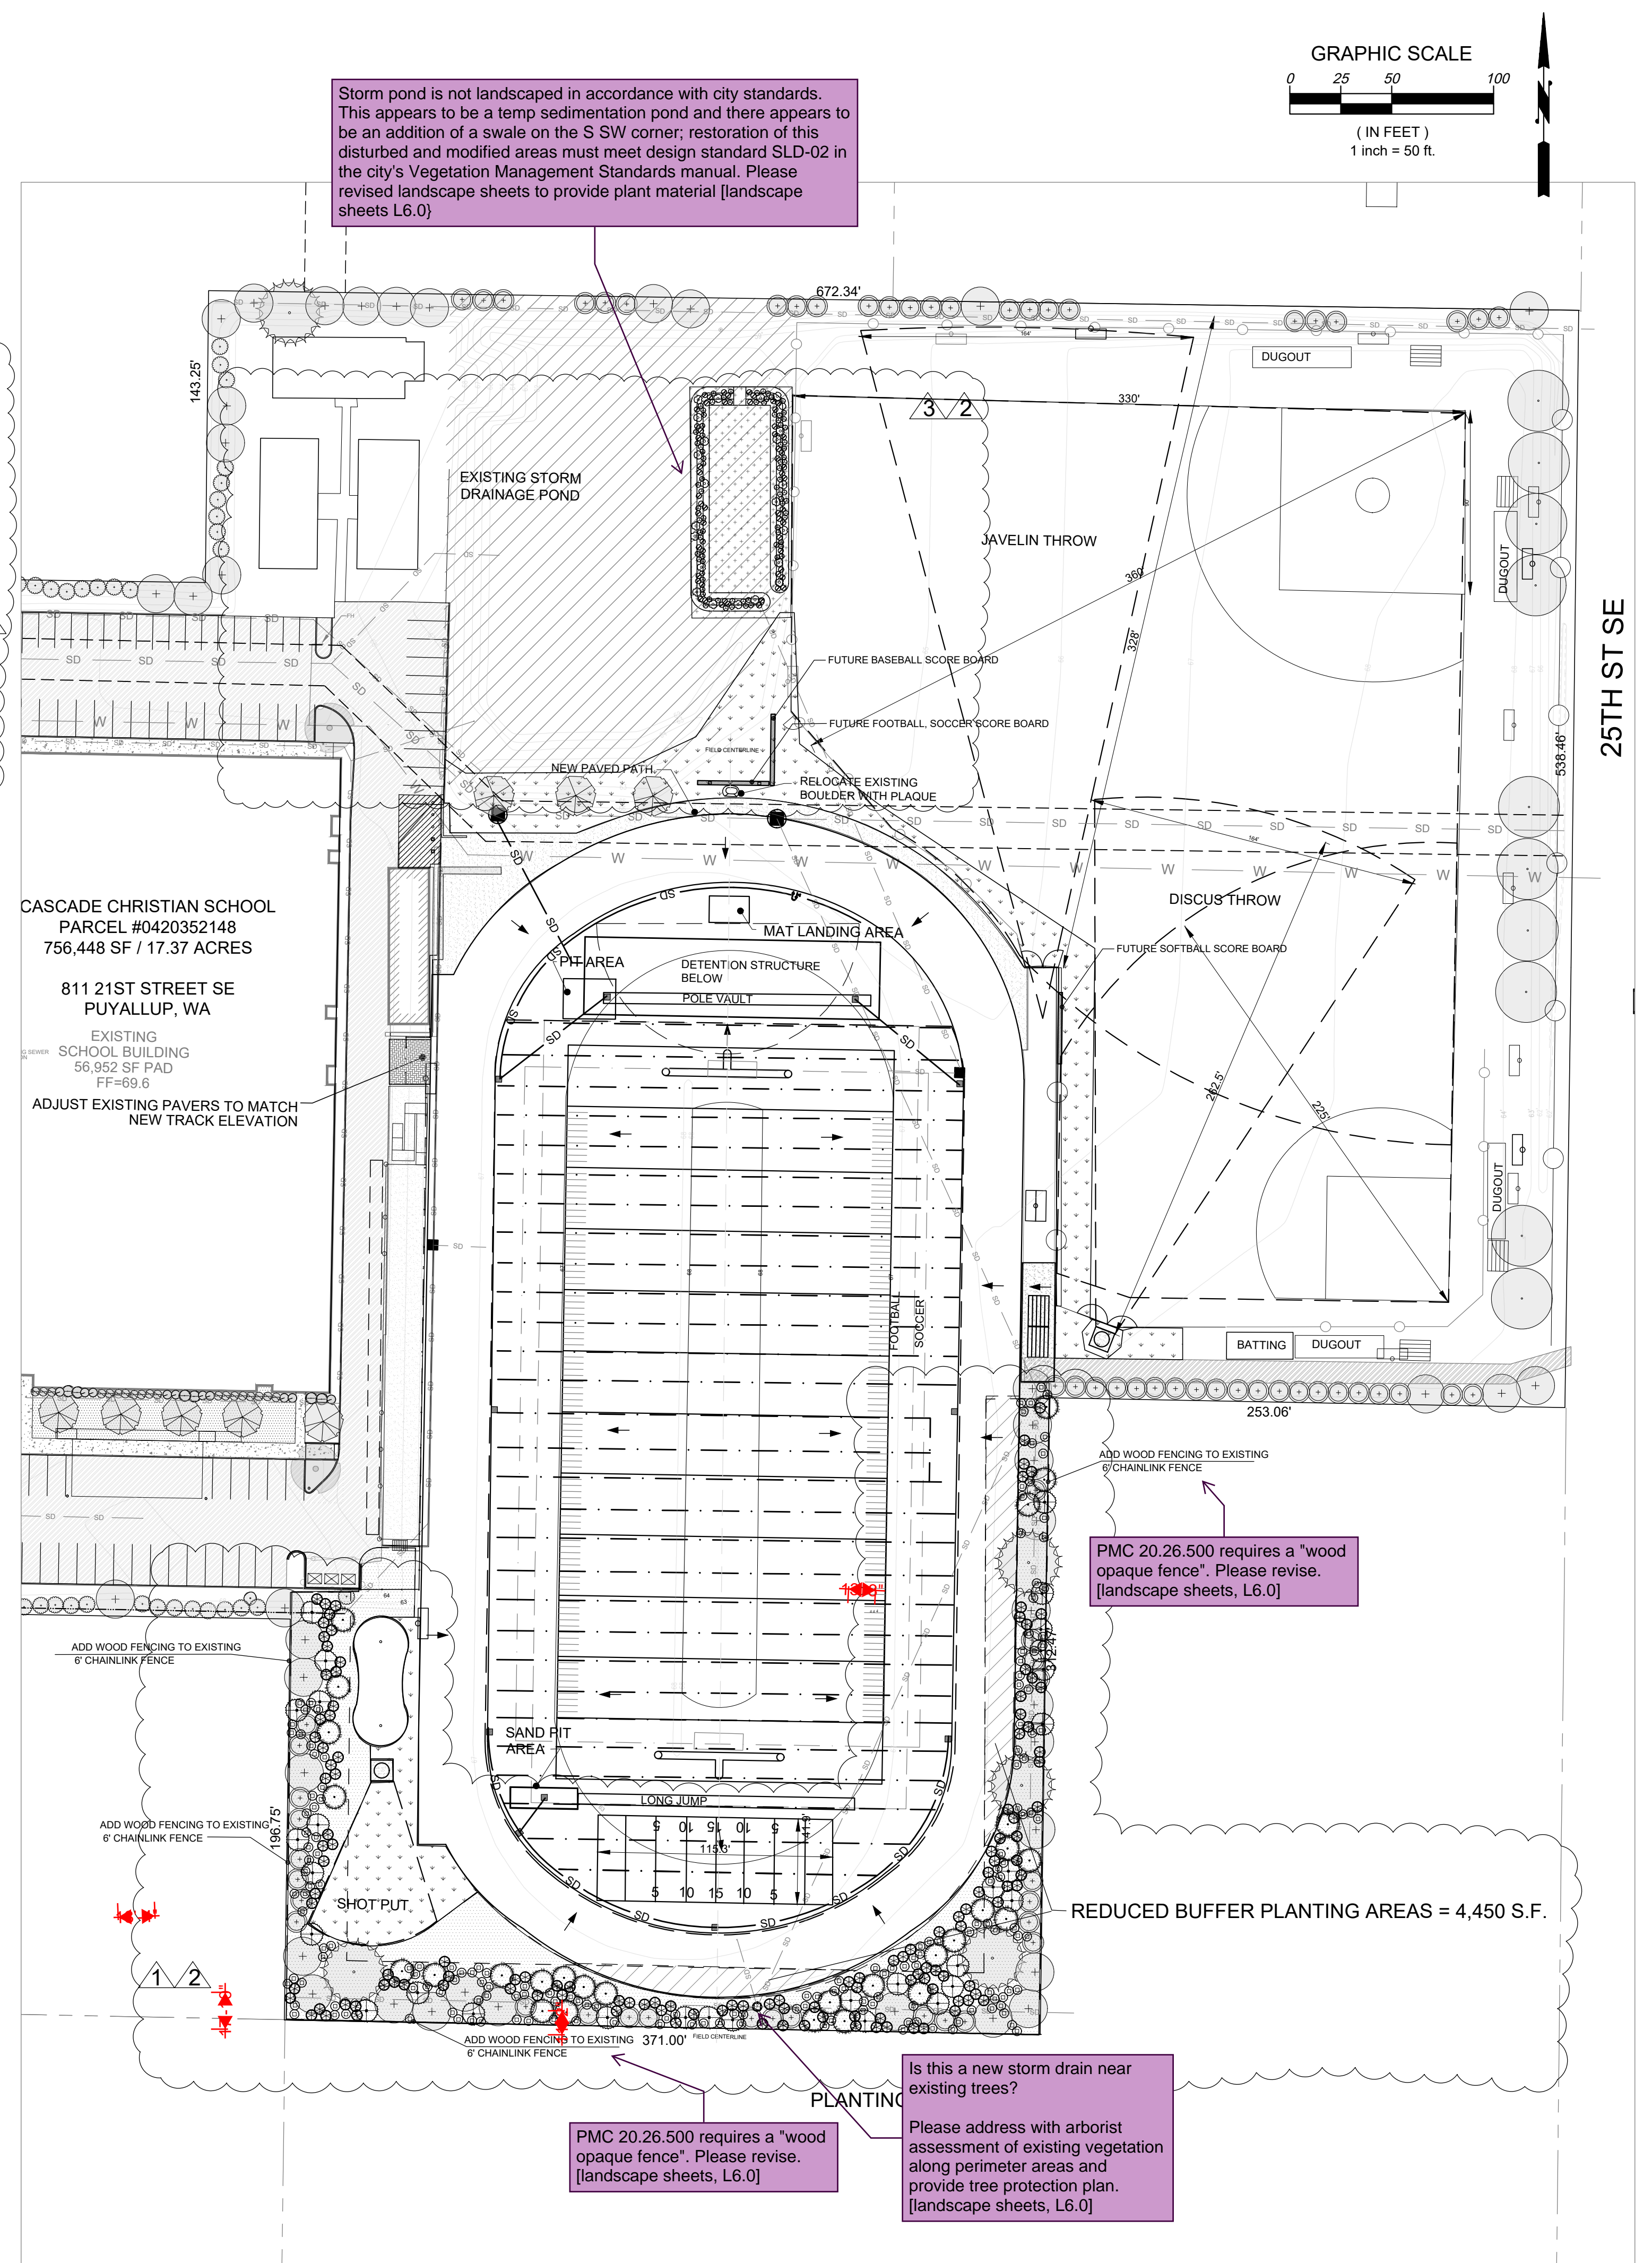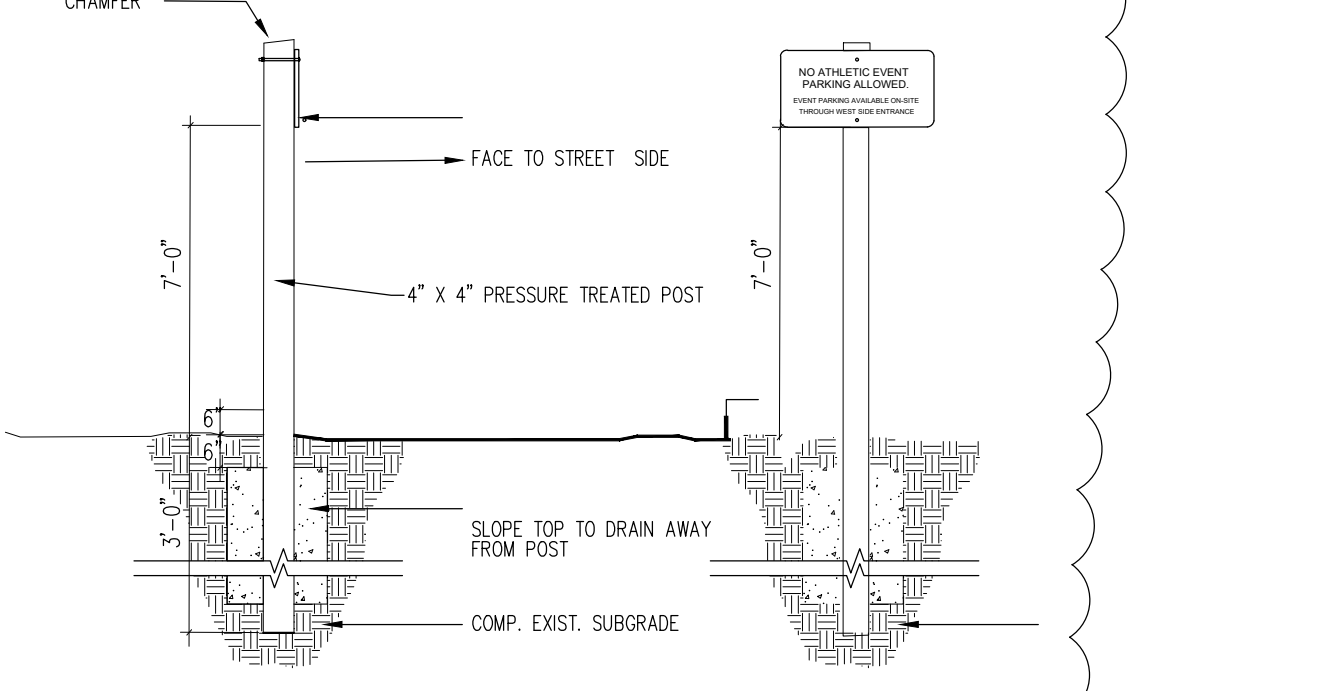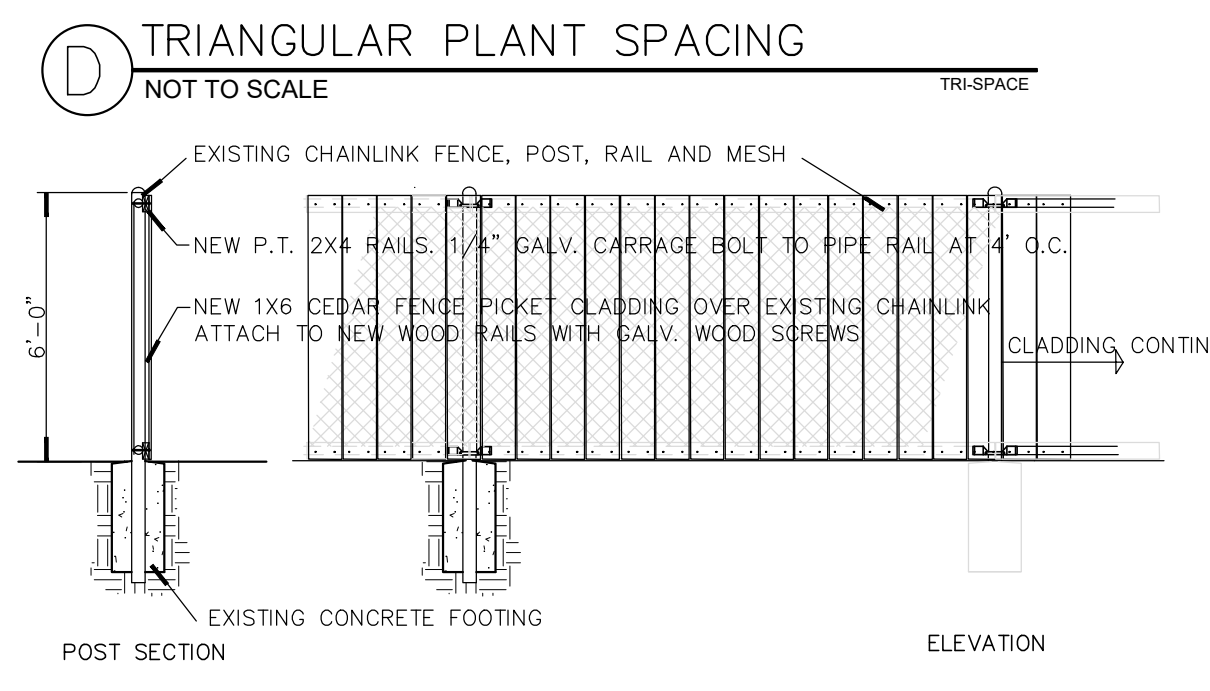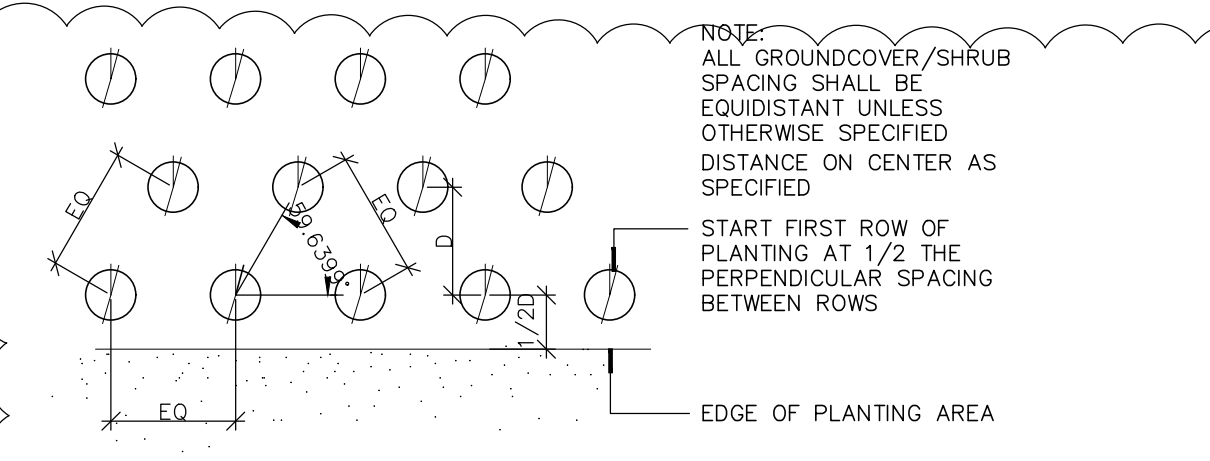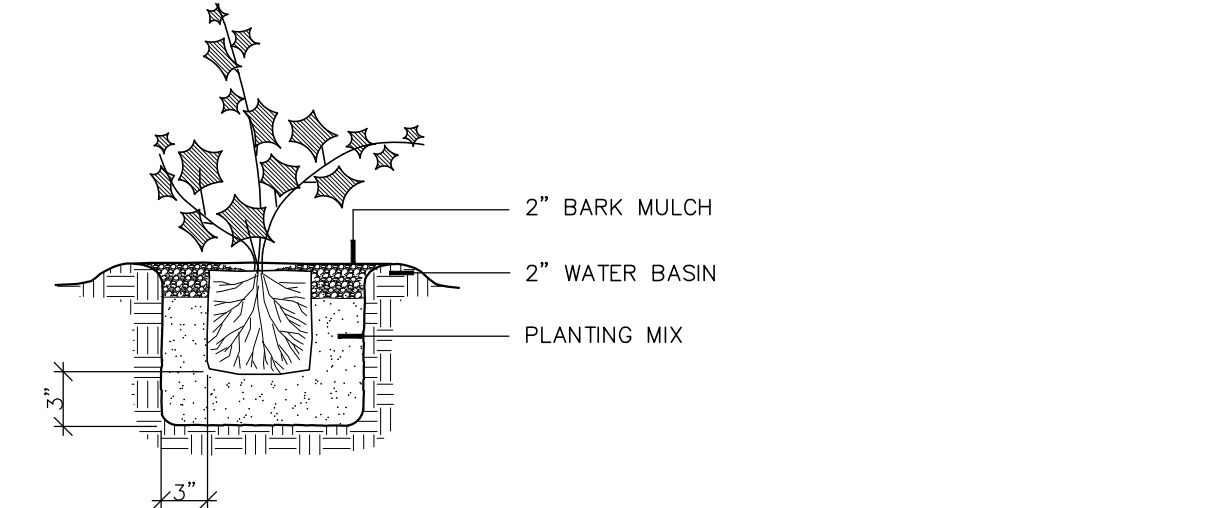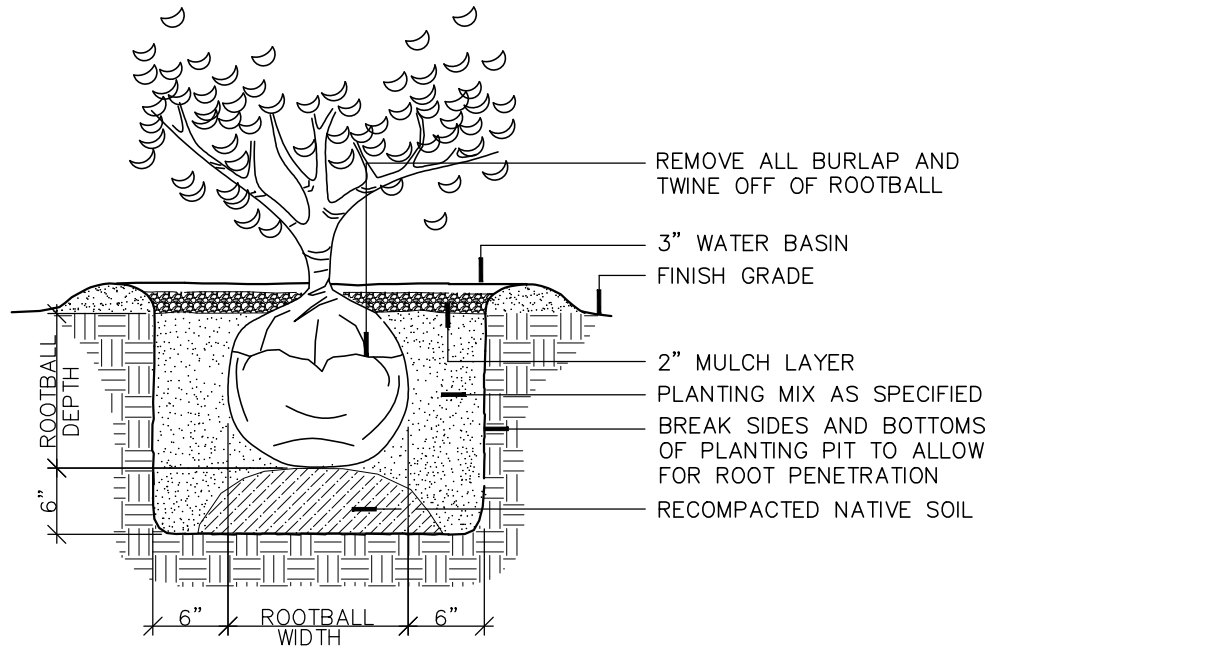
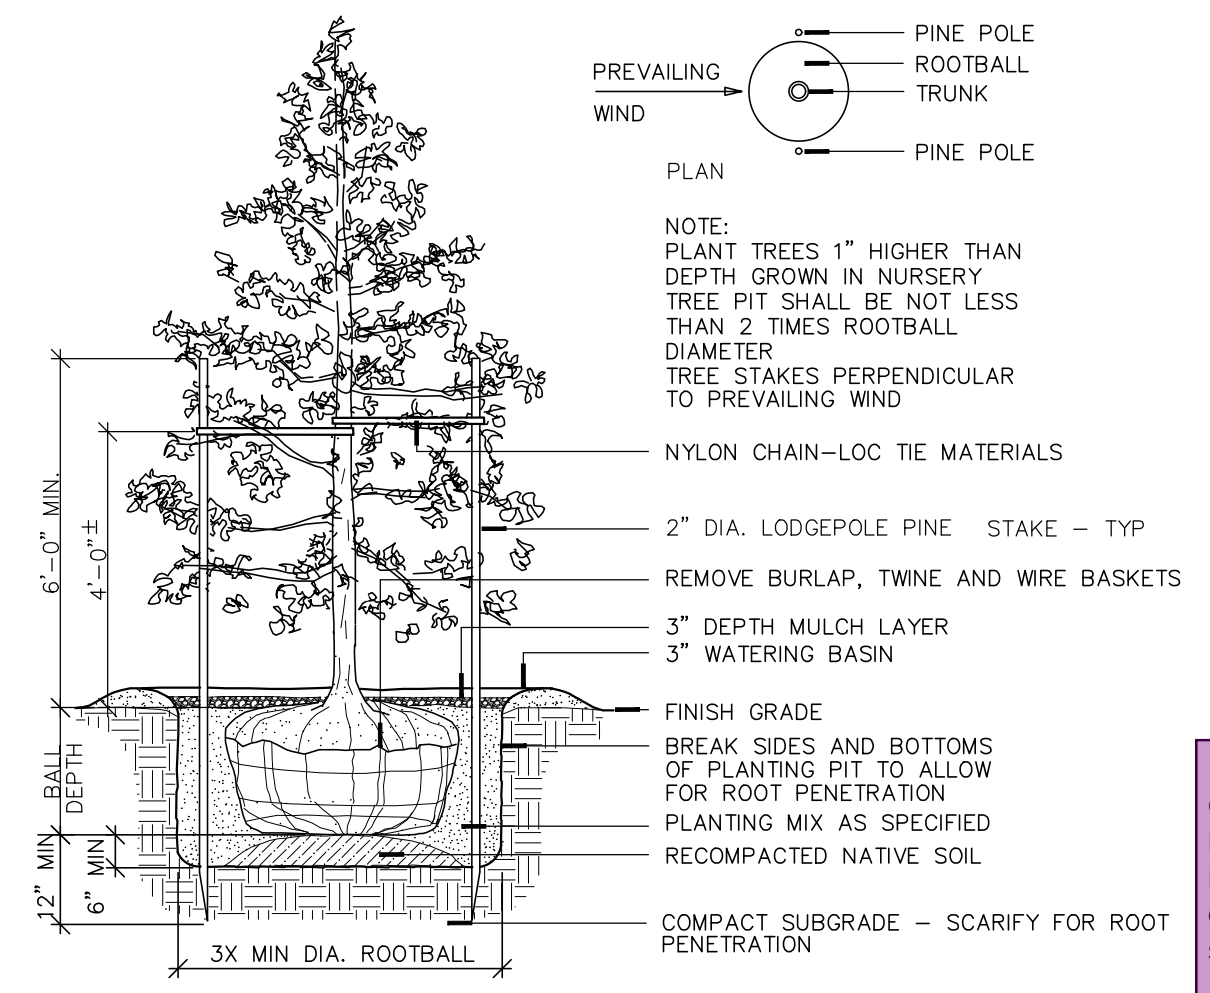


Storm pond is not landscaped in accordance with city standards. This appears to be a temp sedimentation pond and there appears to be an addition of a swale on the S SW corner; restoration of this disturbed and modified areas must meet design standard SLD-02 in the city's Vegetation Management Standards manual. Please revised landscape sheets to provide plant material [landscape sheets L6.0]

PMC 20.26.500 requires a "wood opaque fence". Please revise. [landscape sheets, L6.0]


PMC 20.26.500 requires a "wood opaque fence". Please revise. [landscape sheets, L6.0]

Is this a new storm drain near existing trees?
 Please address with arborist assessment of existing vegetation along perimeter areas and provide tree protection plan. [landscape sheets, L6.0]

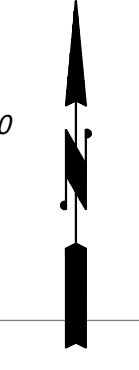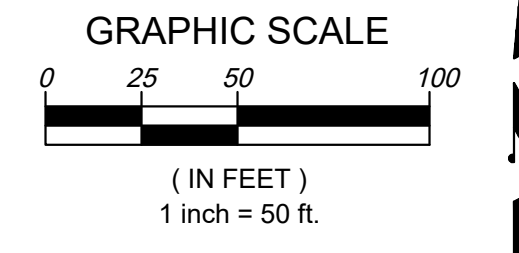


25TH ST SE


CASCADE CHRISTIAN SCHOOL
 PARCEL #0420352148
 756,448 SF / 17.37 ACRES
 811 21ST STREET SE
 PUYALLUP, WA
 EXISTING SCHOOL BUILDING
 58,992 SF PAD
 FF=89.6
 ADJUST EXISTING PAVERS TO MATCH
 NEW TRACK ELEVATION

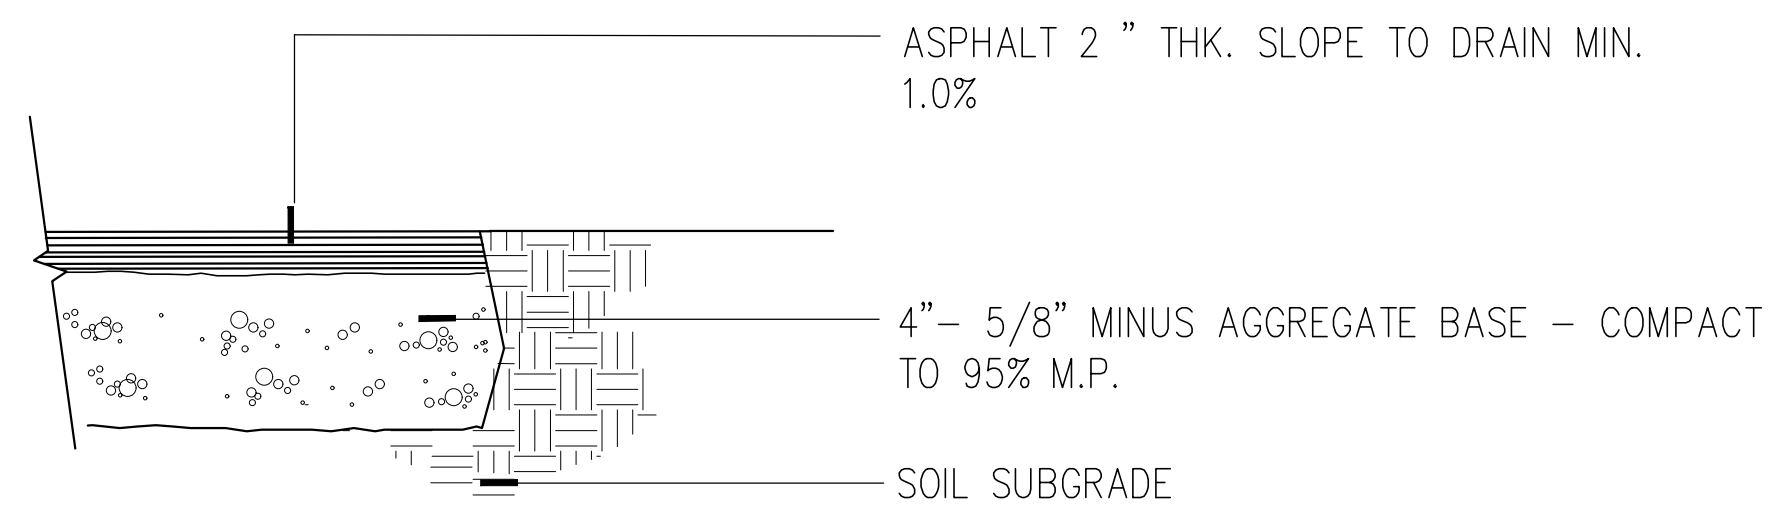


A ASPHALT PATH

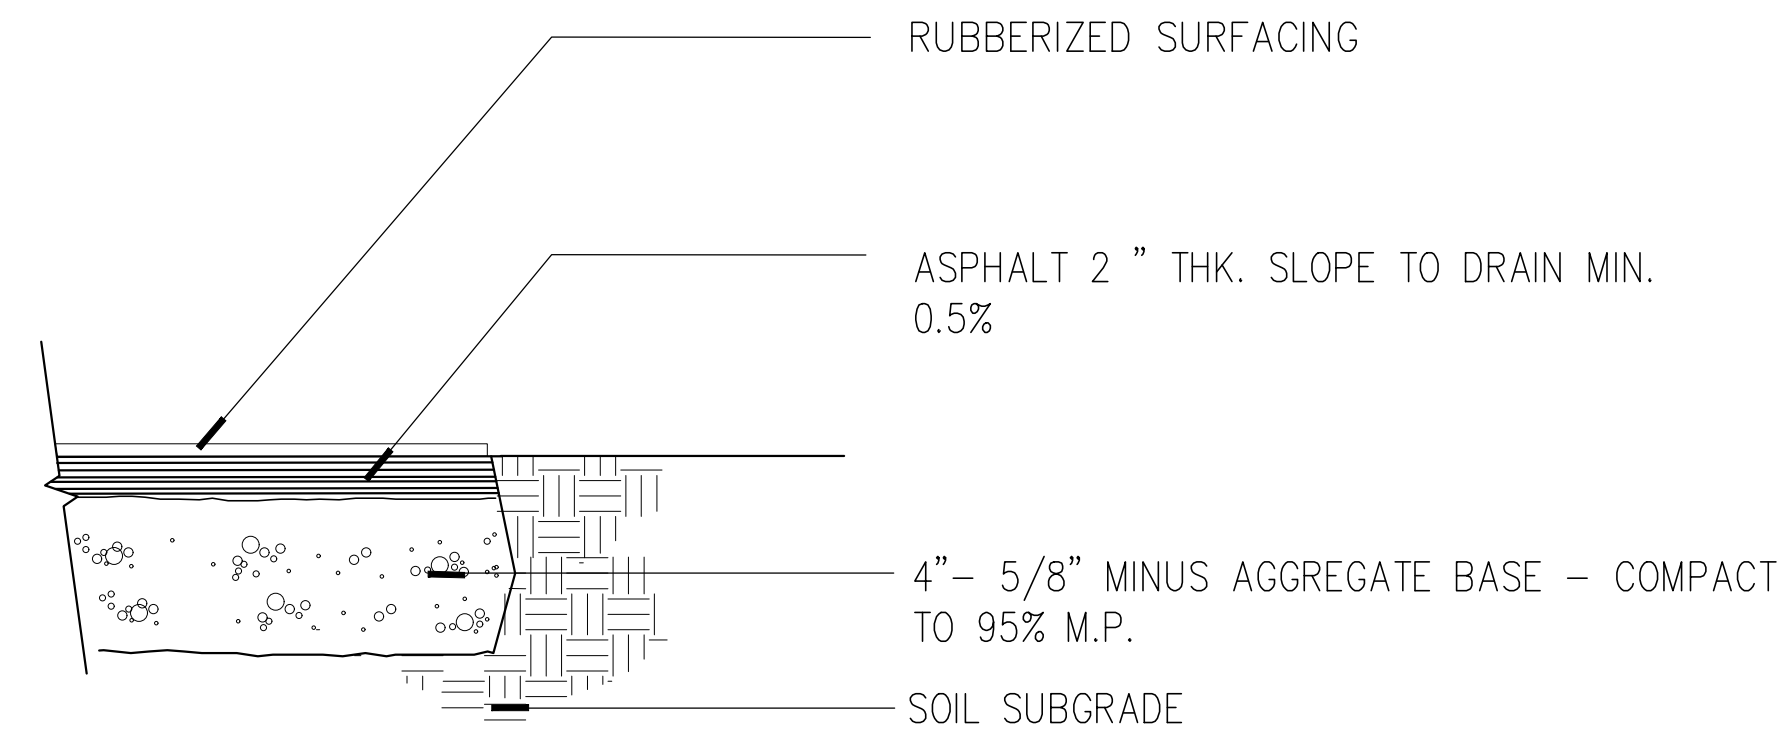


B ASPHALT PATH

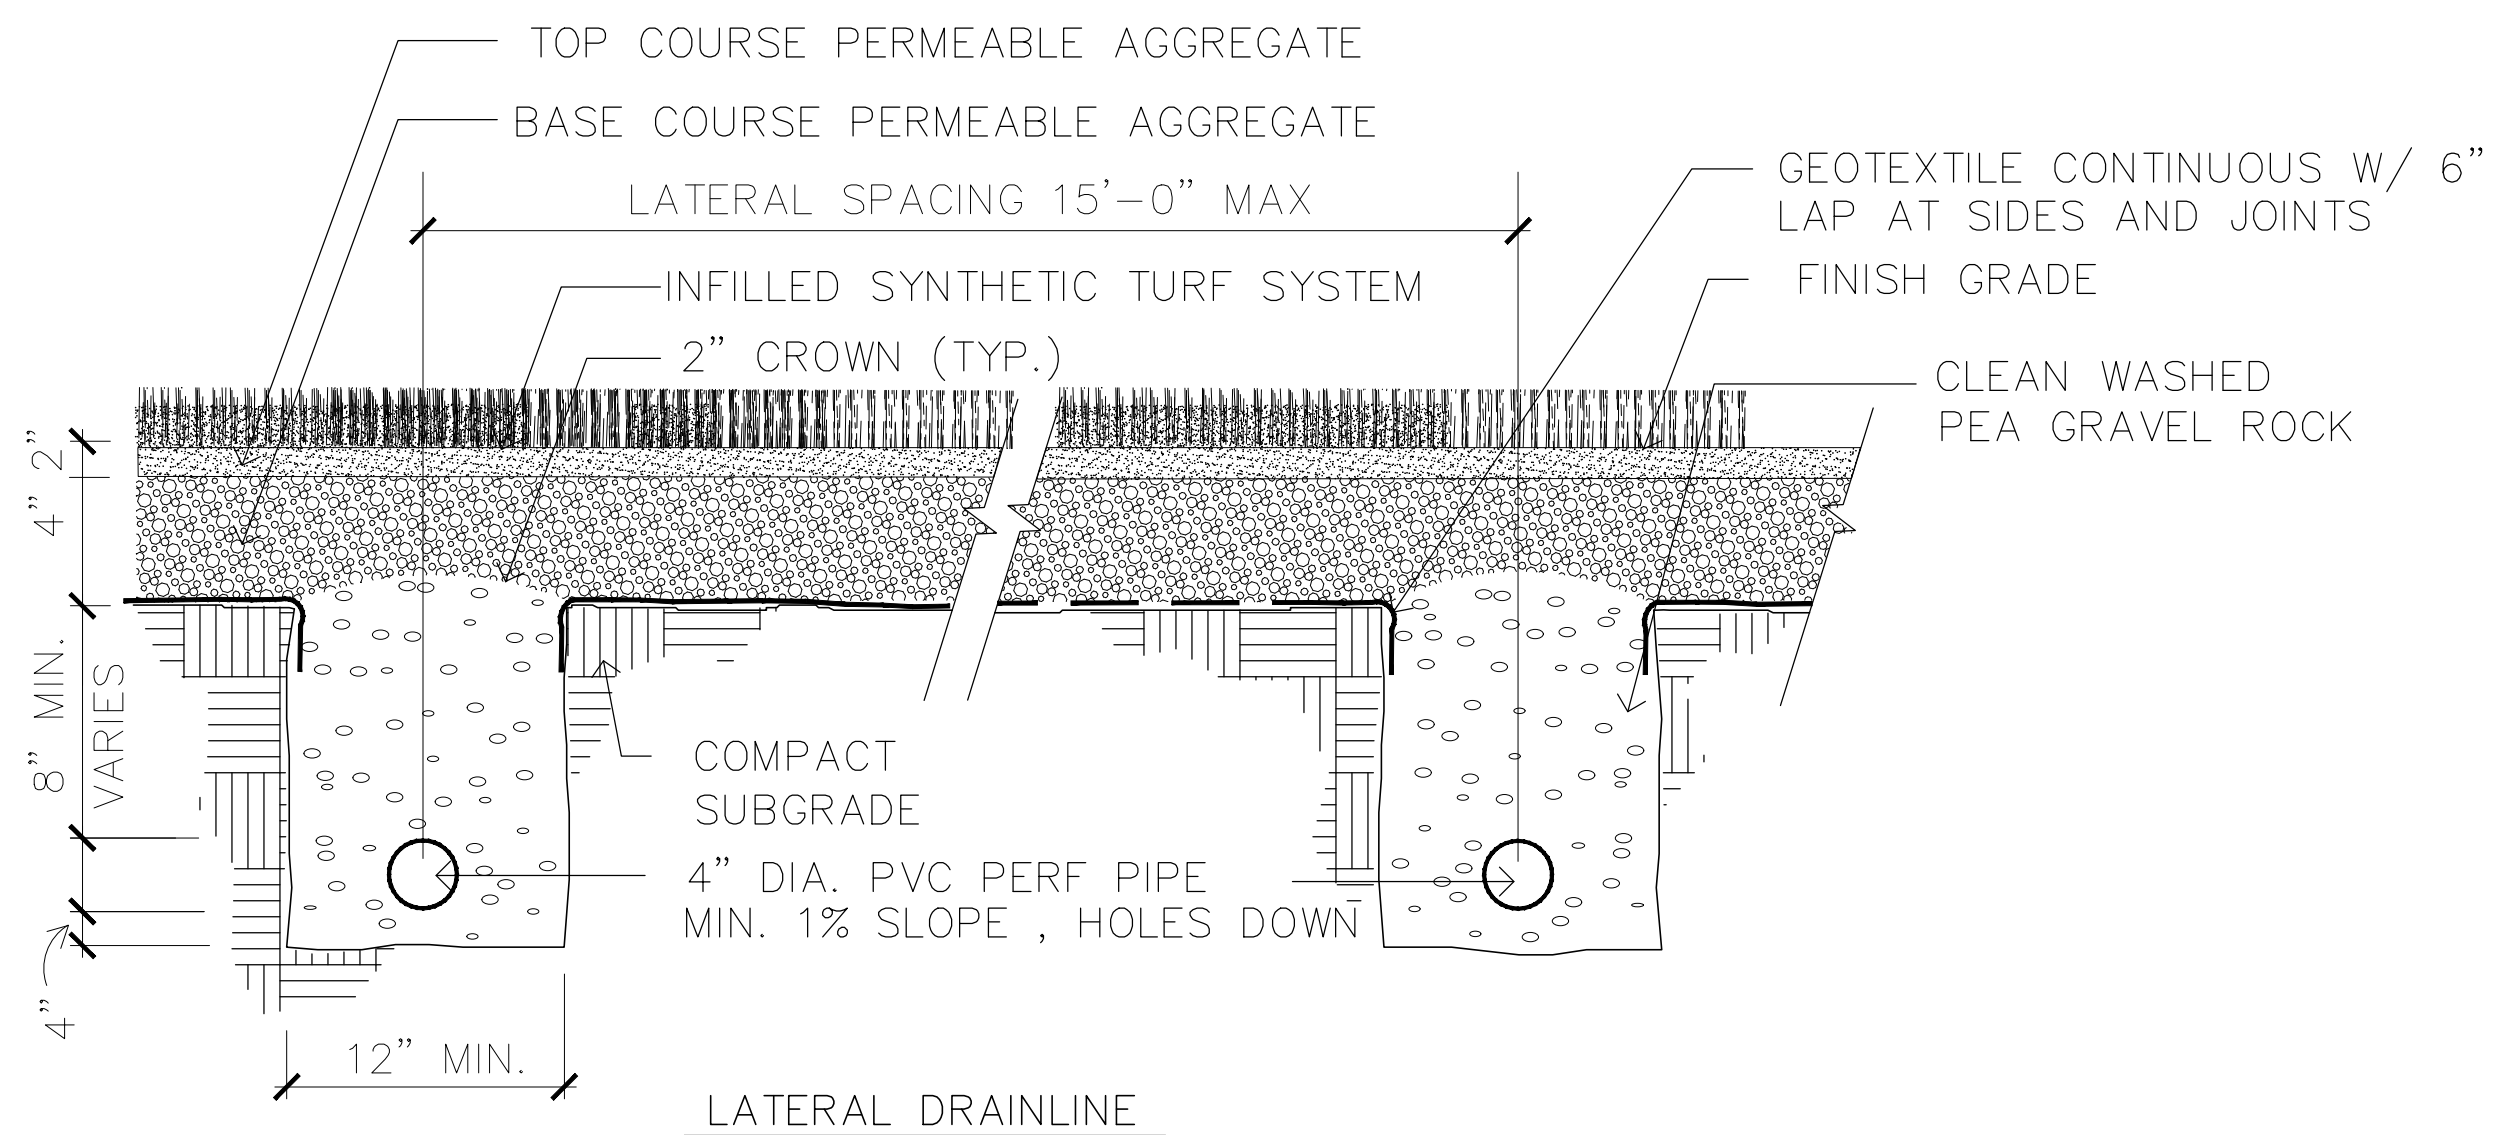


C TURF FIELD SUBDRAINAGE SECTION
NOT TO SCALE

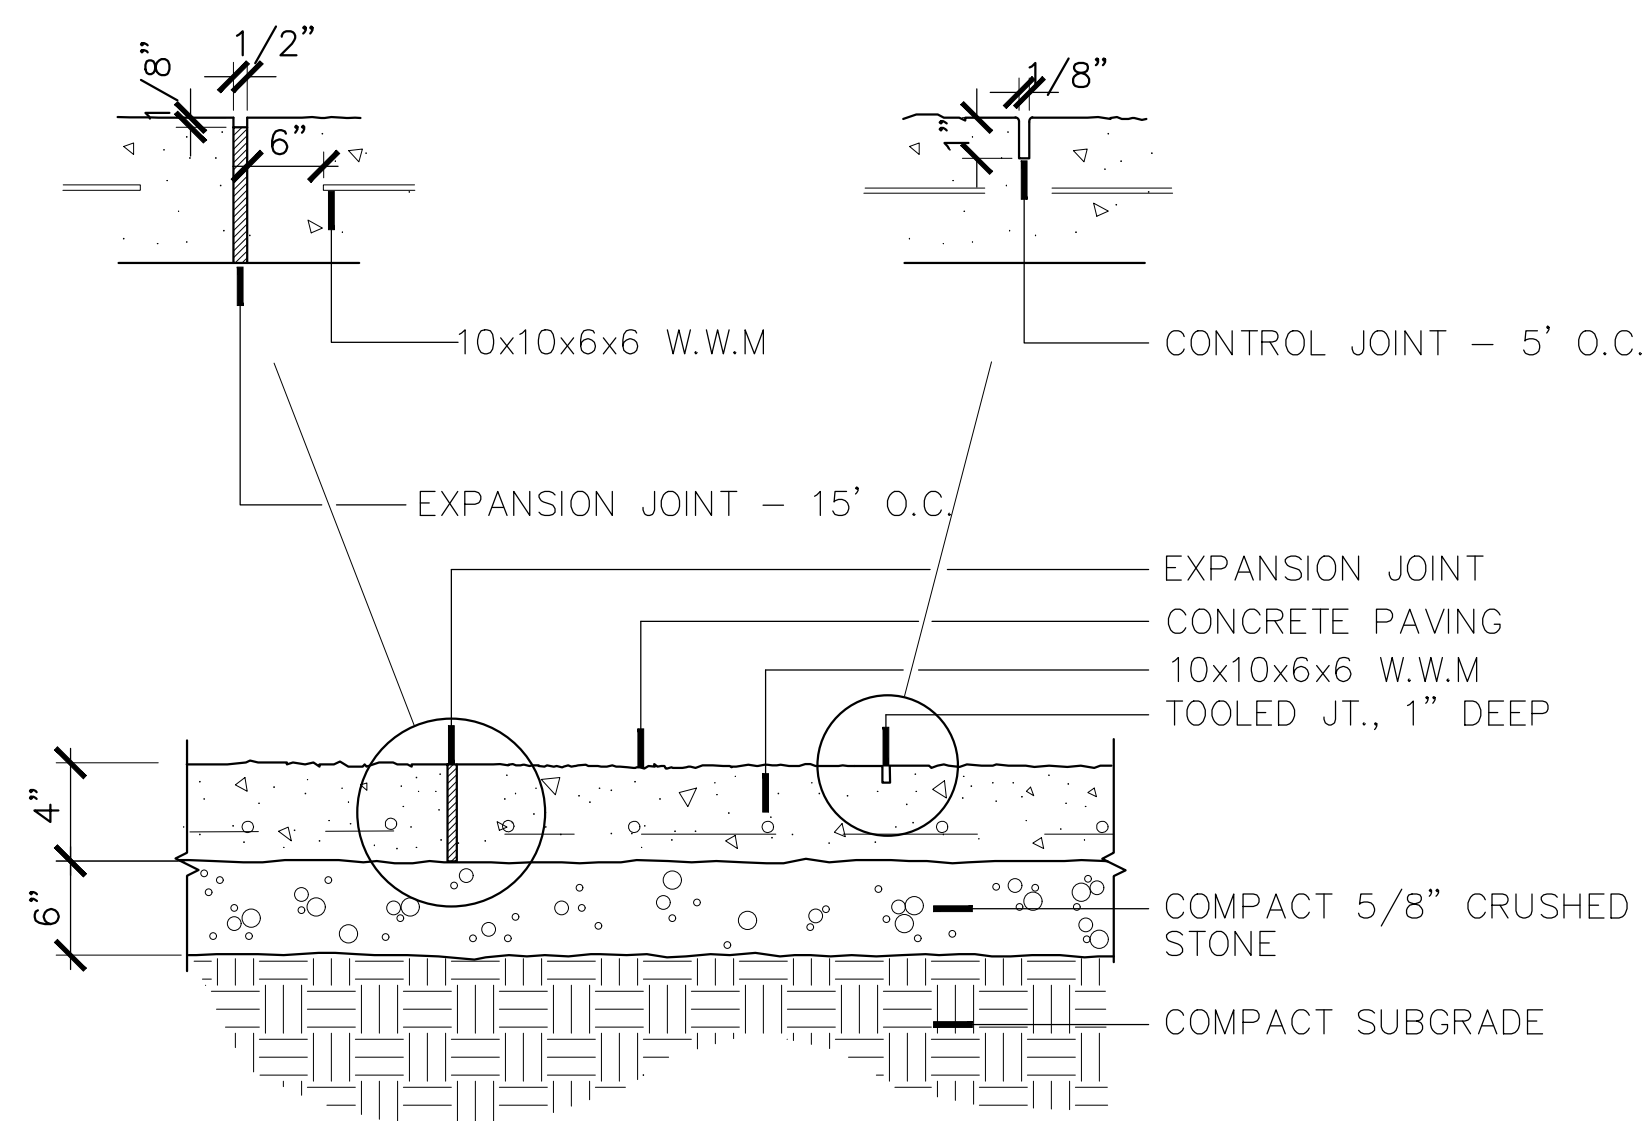


D TYPICAL CONCRETE PAVING
NOT TO SCALE

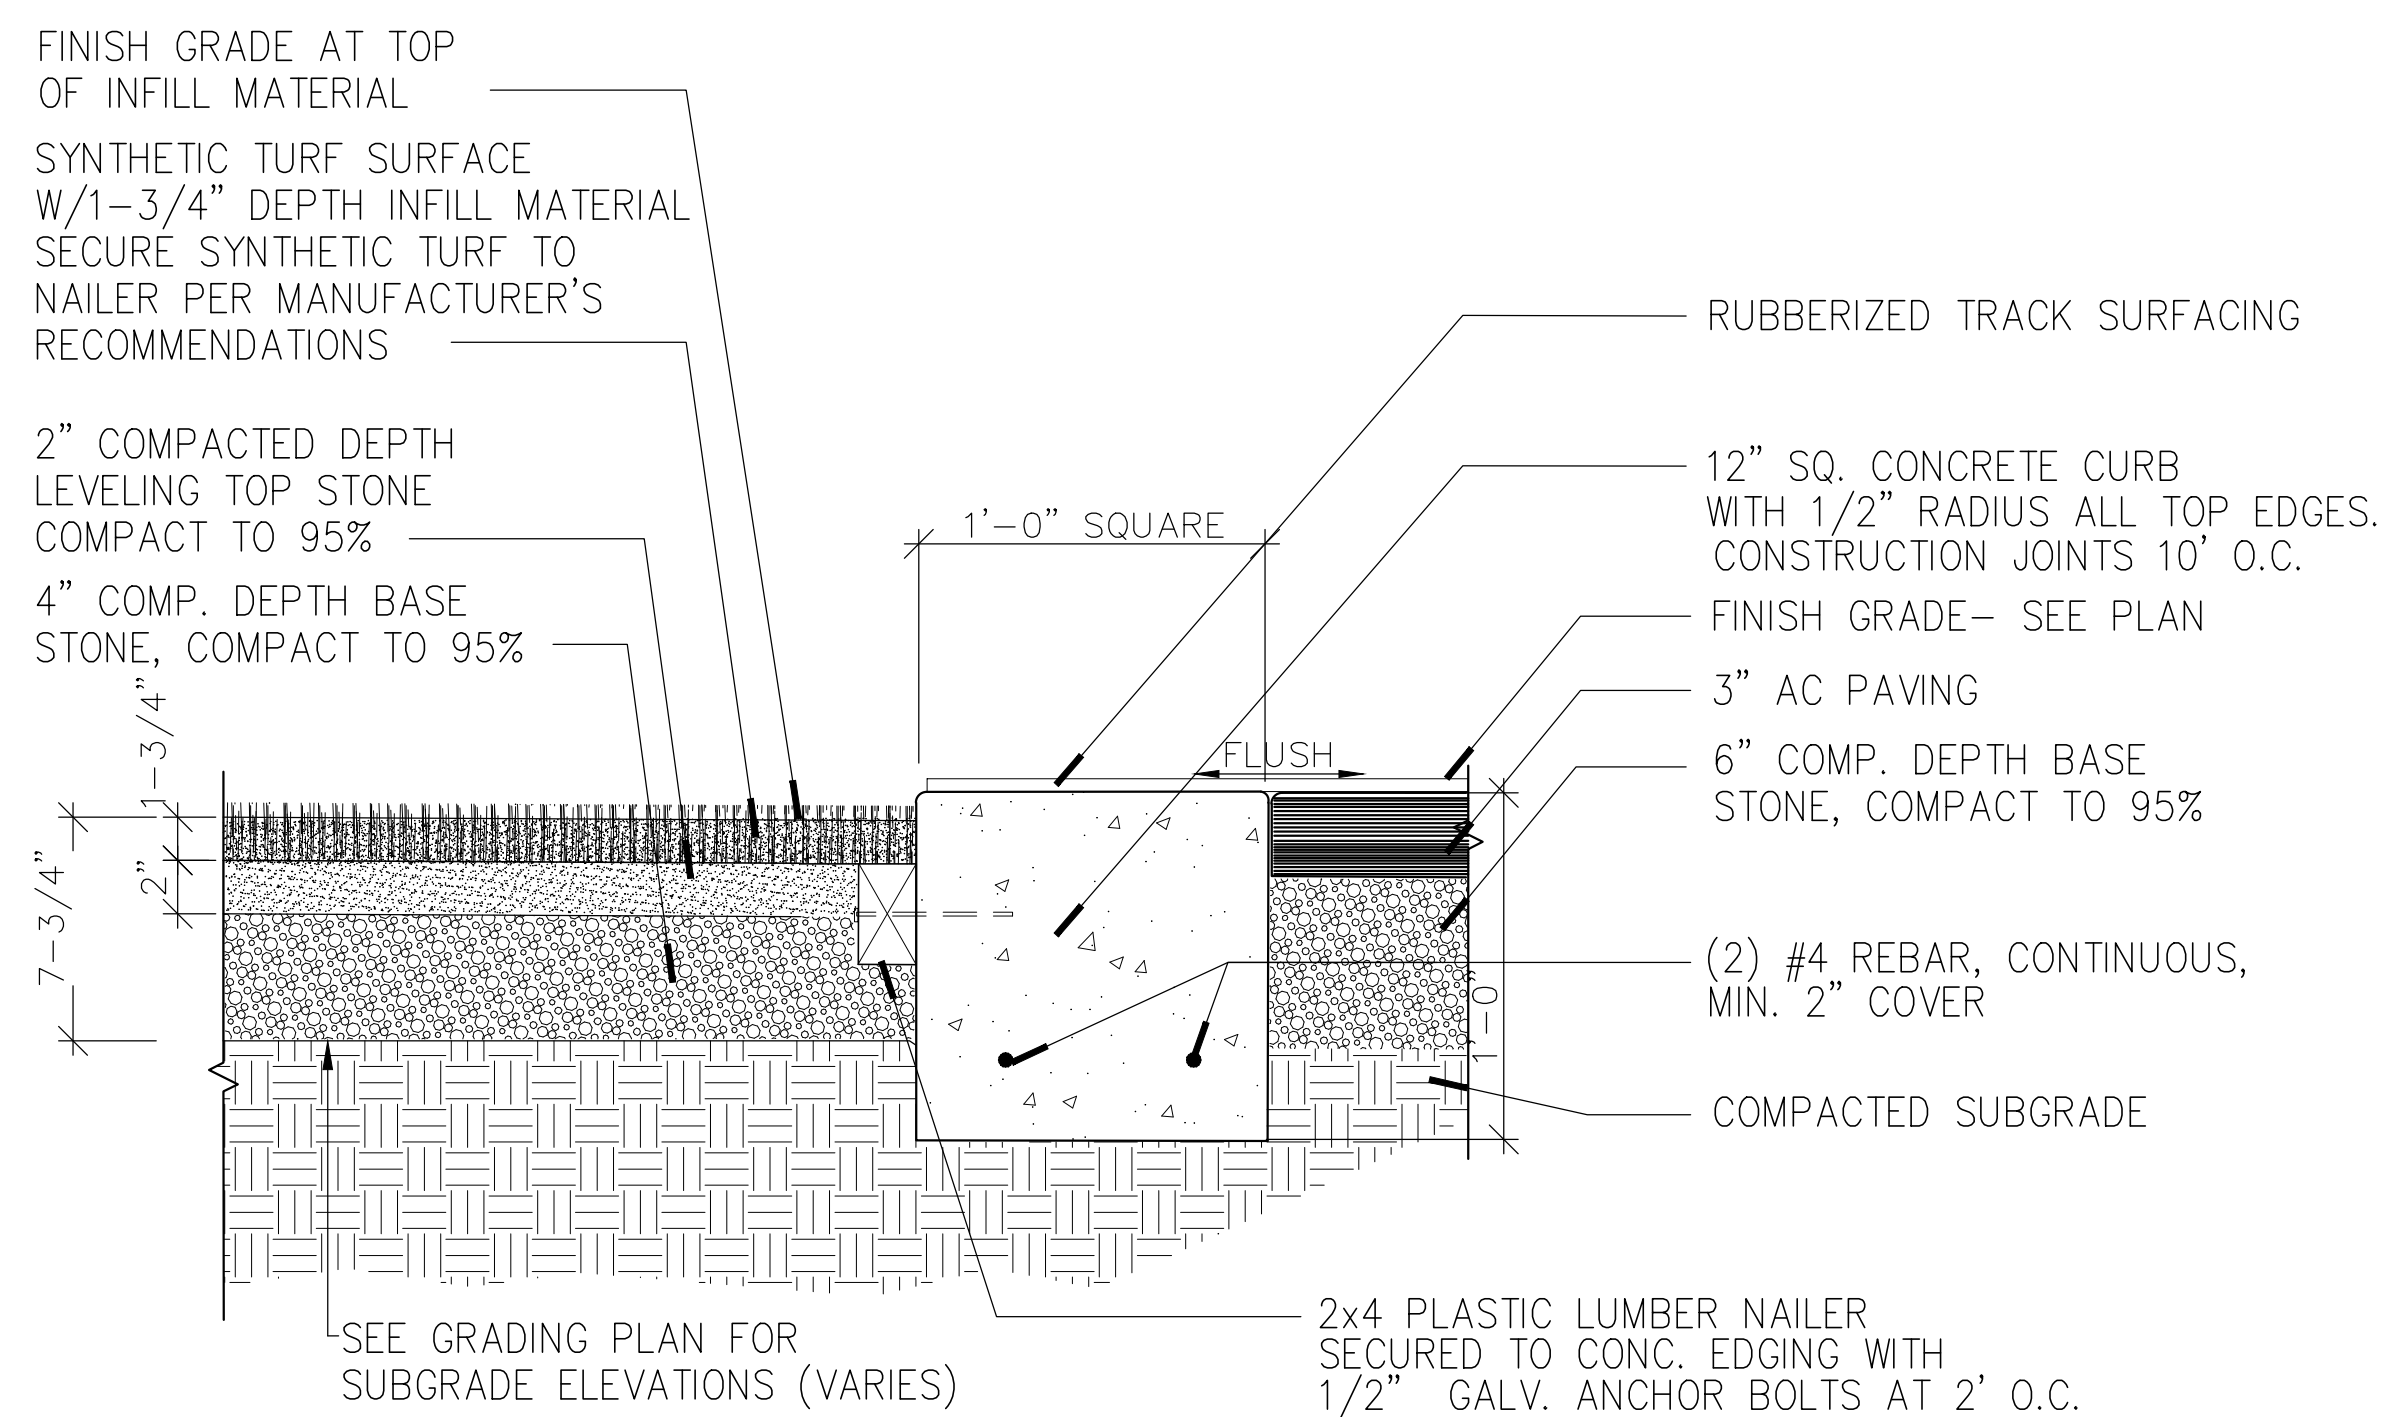


E SYNTH. TURF EDGE WITH FLUSH CONC. CURB
NOT TO SCALE

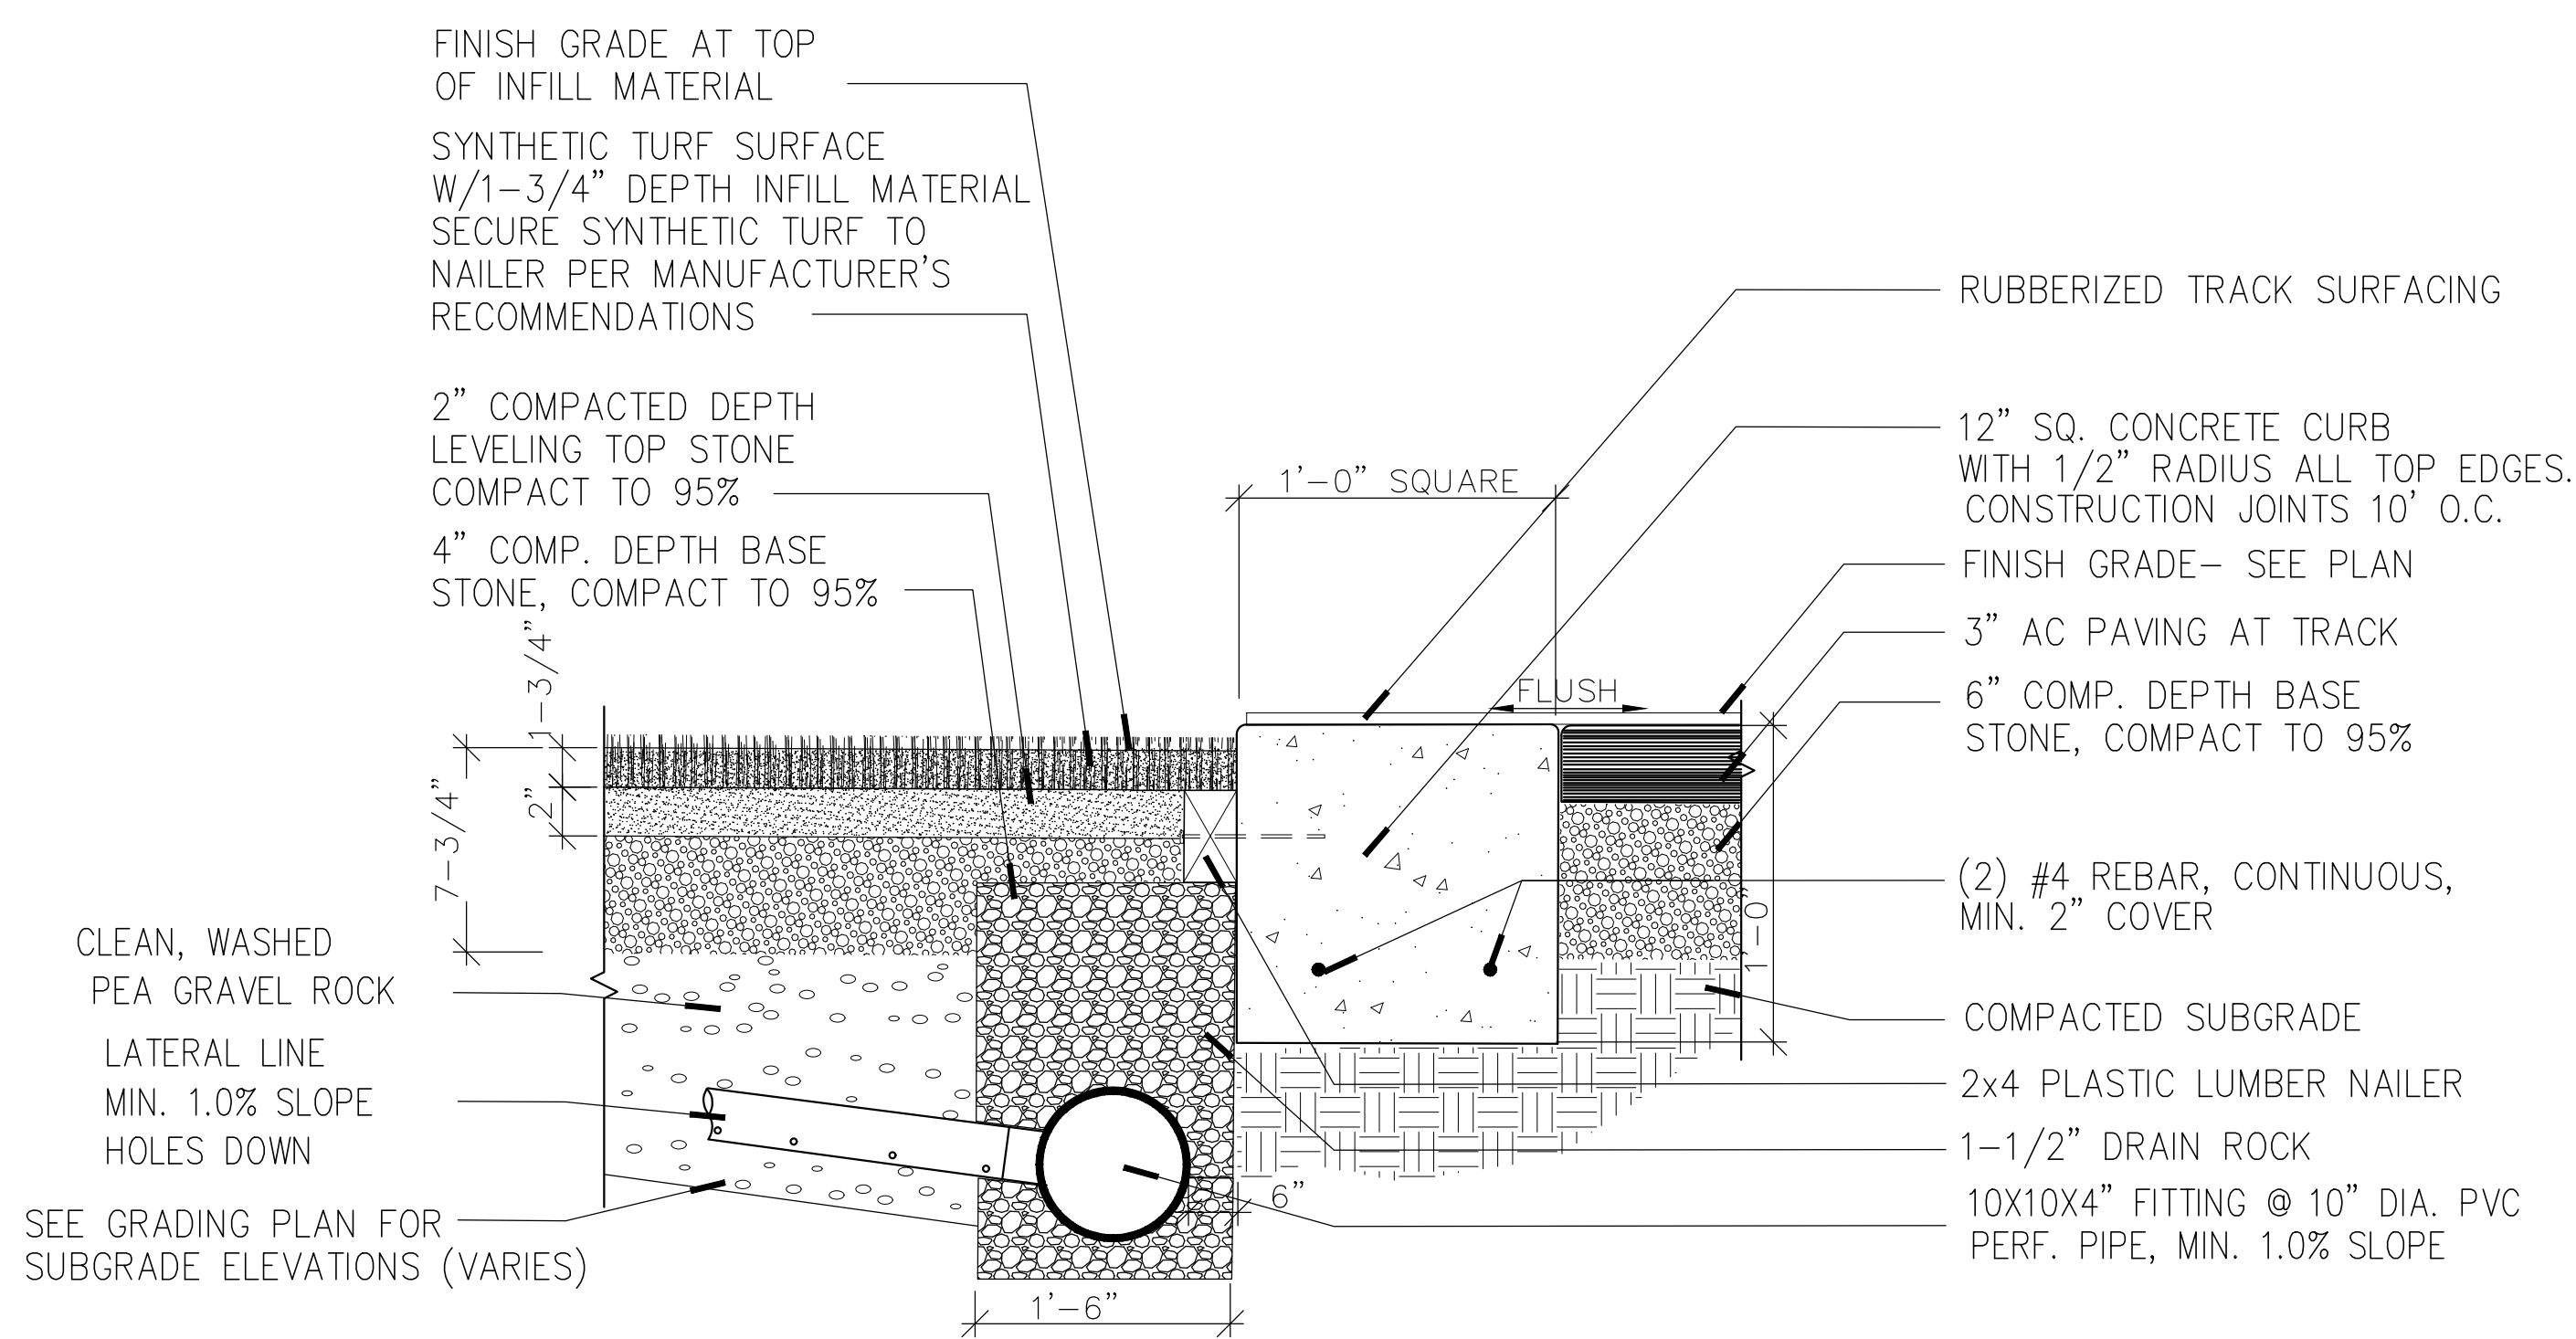


F SYNTH. TURF EDGE WITH DRAINLINE COLLECTOR
NOT TO SCALE


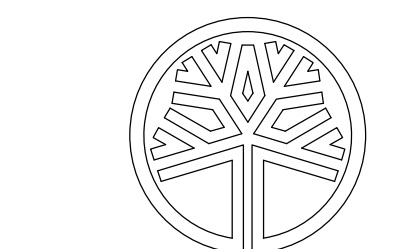


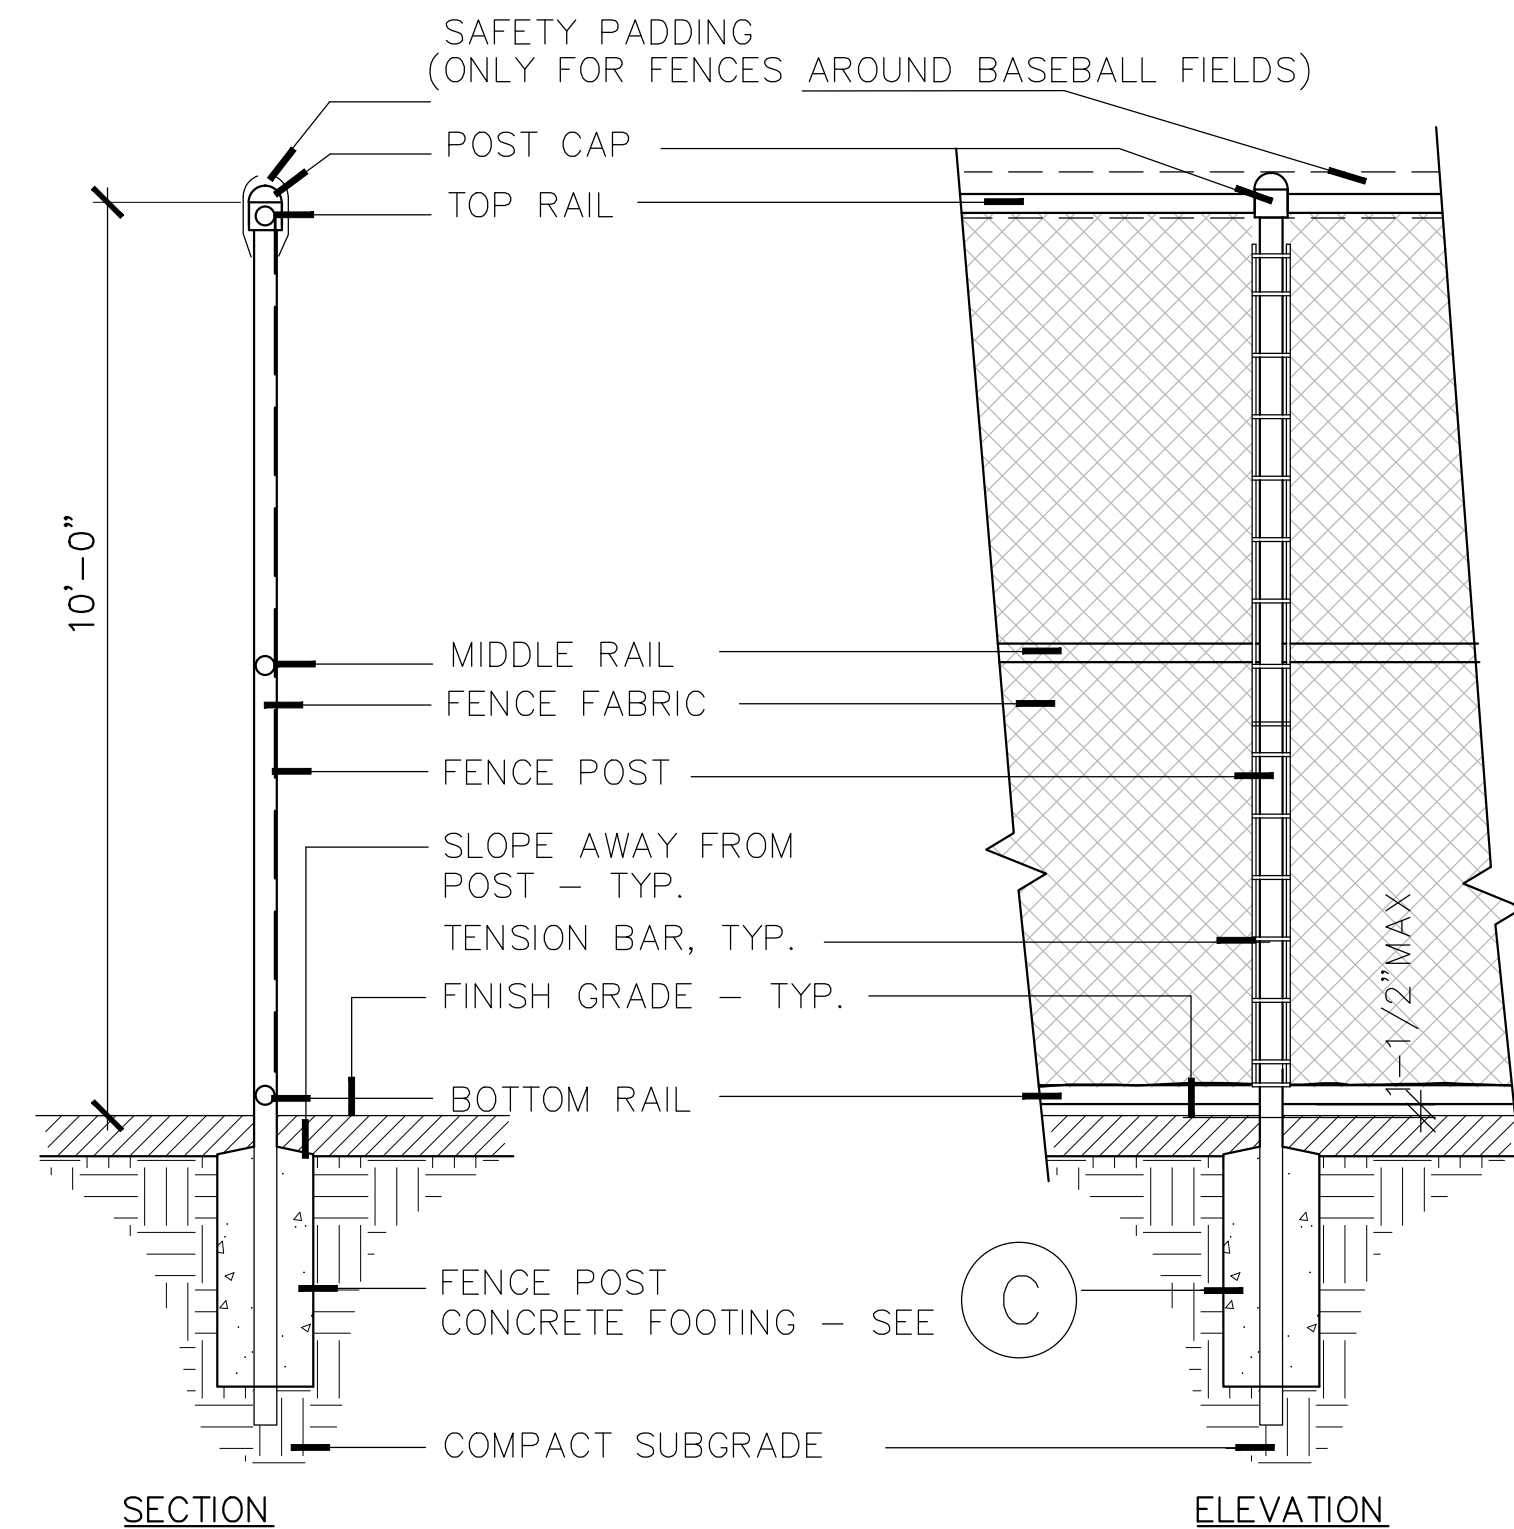


A CHAINLINK FENCE- 10' HIGH
 NOT TO SCALE

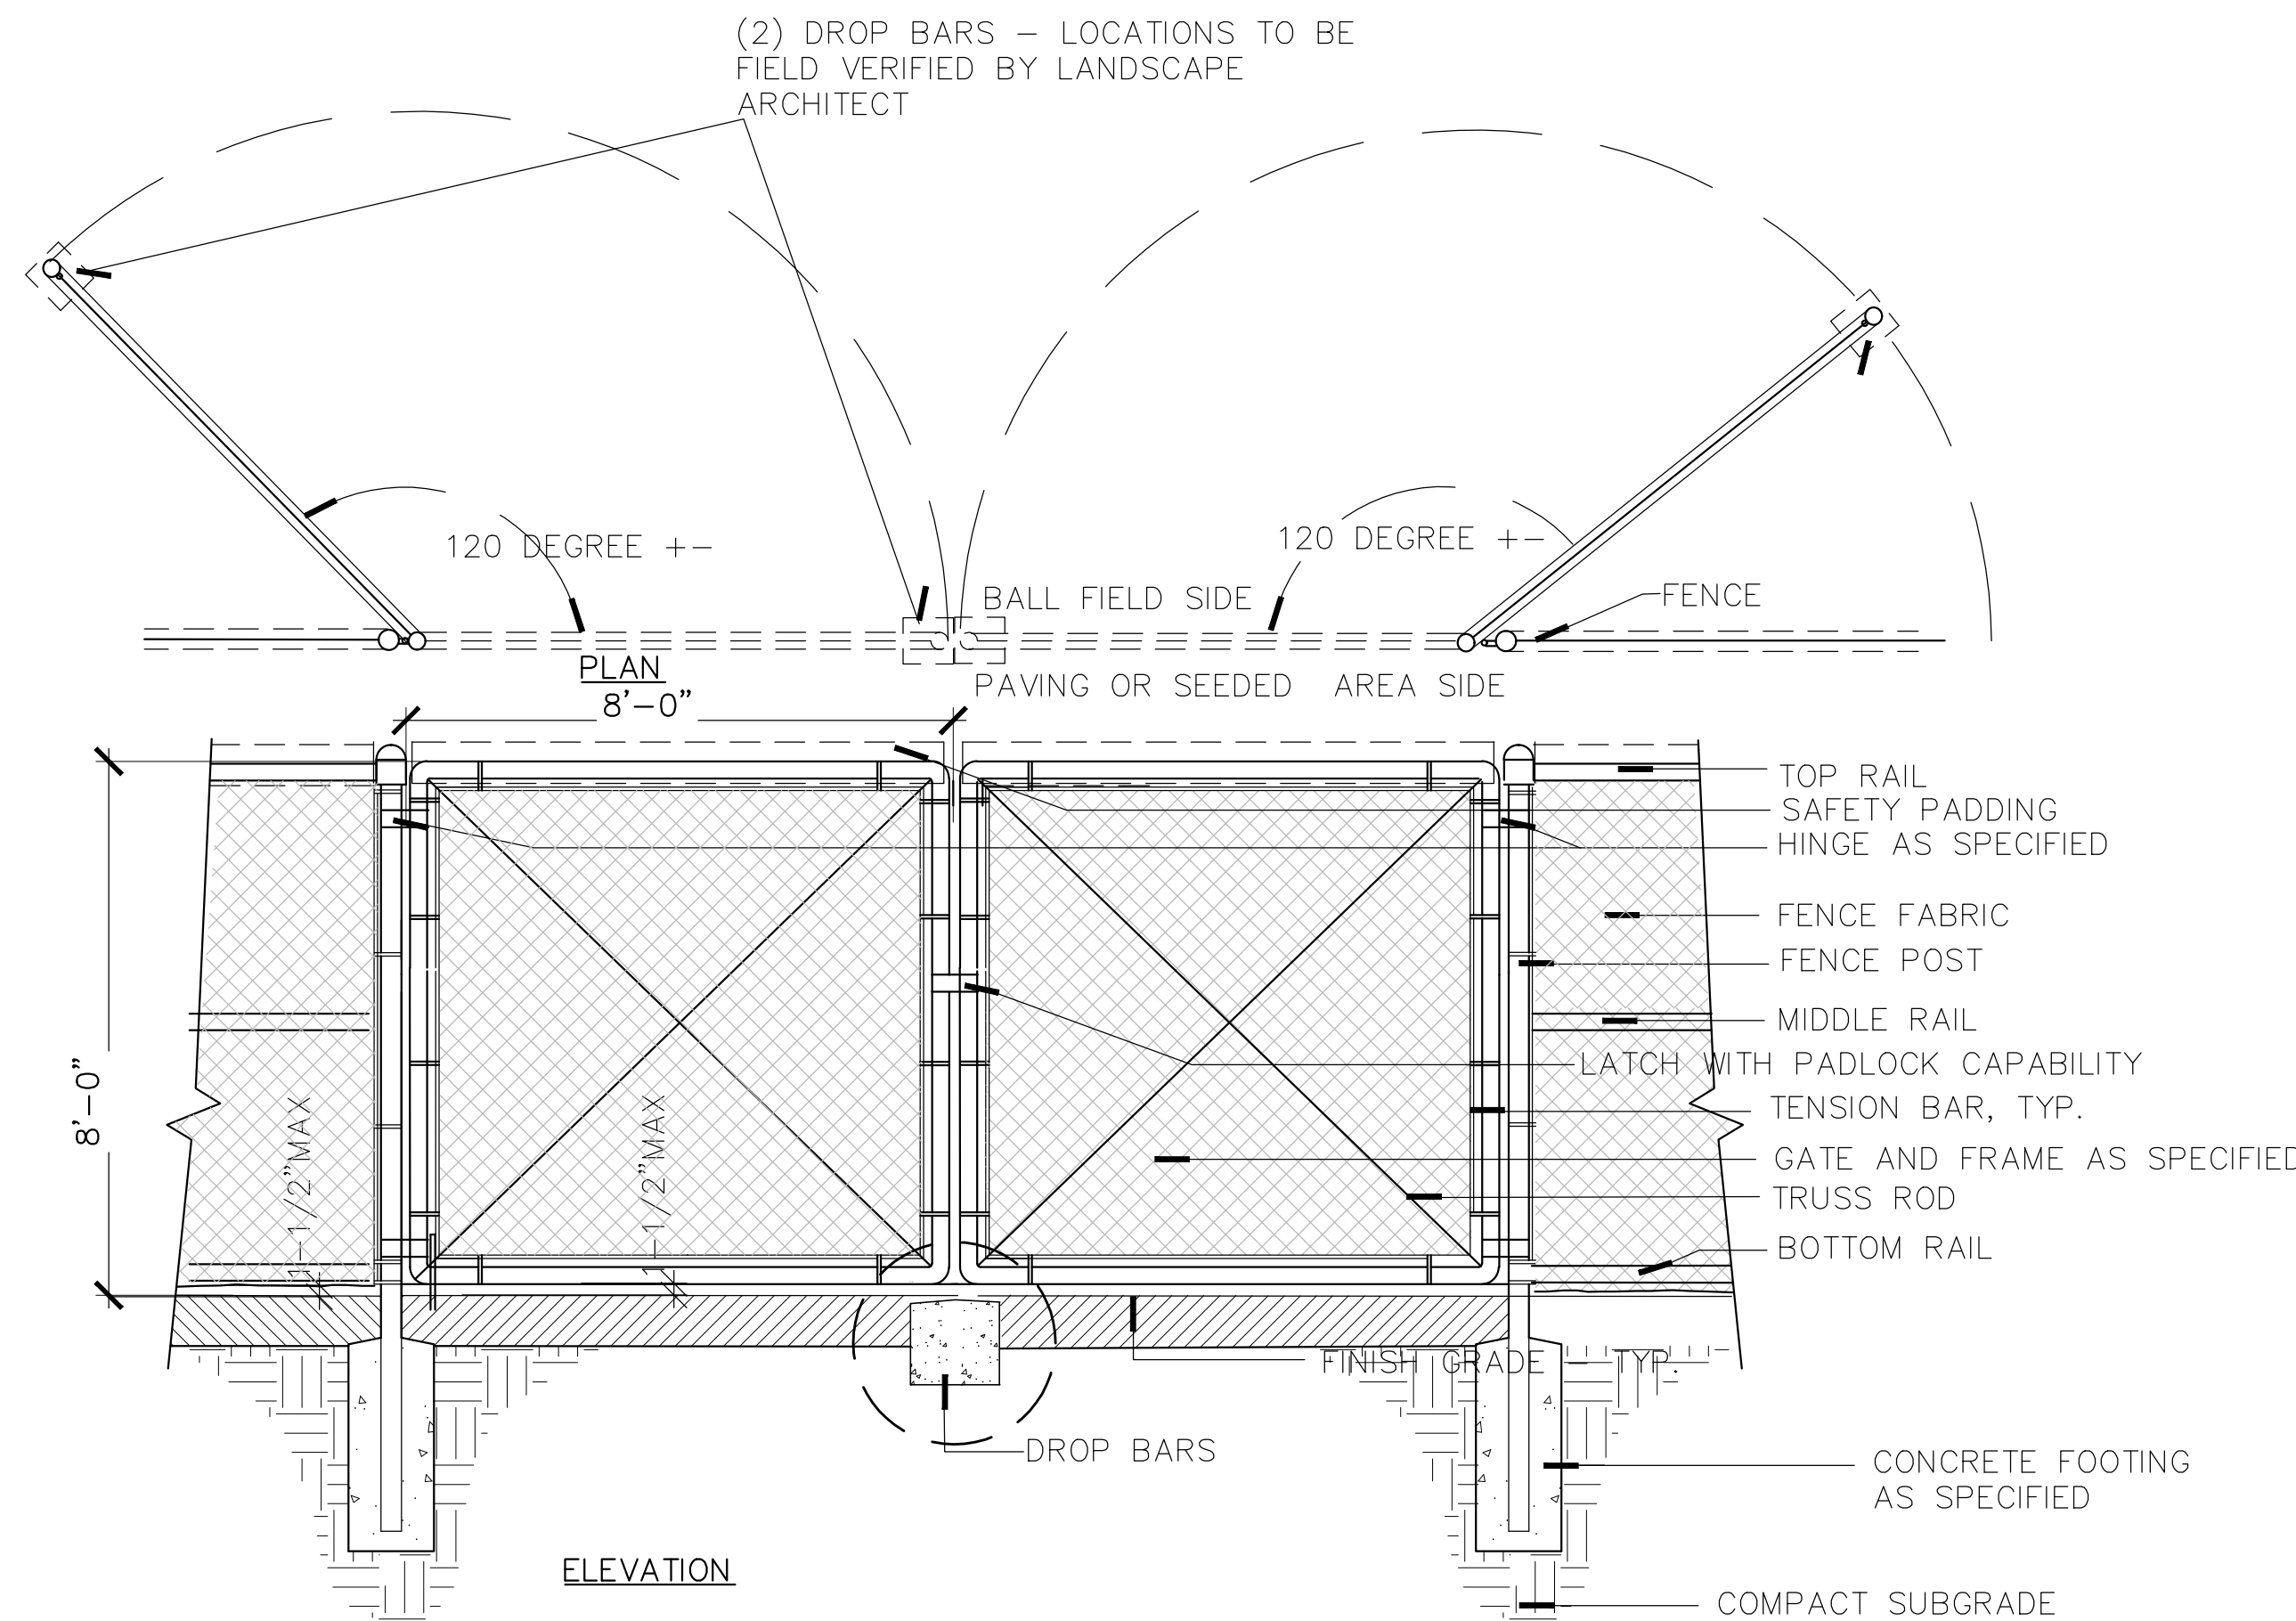


B 8' HT. DOUBLE SWUNG CHAINLINK GATE
 NOT TO SCALE

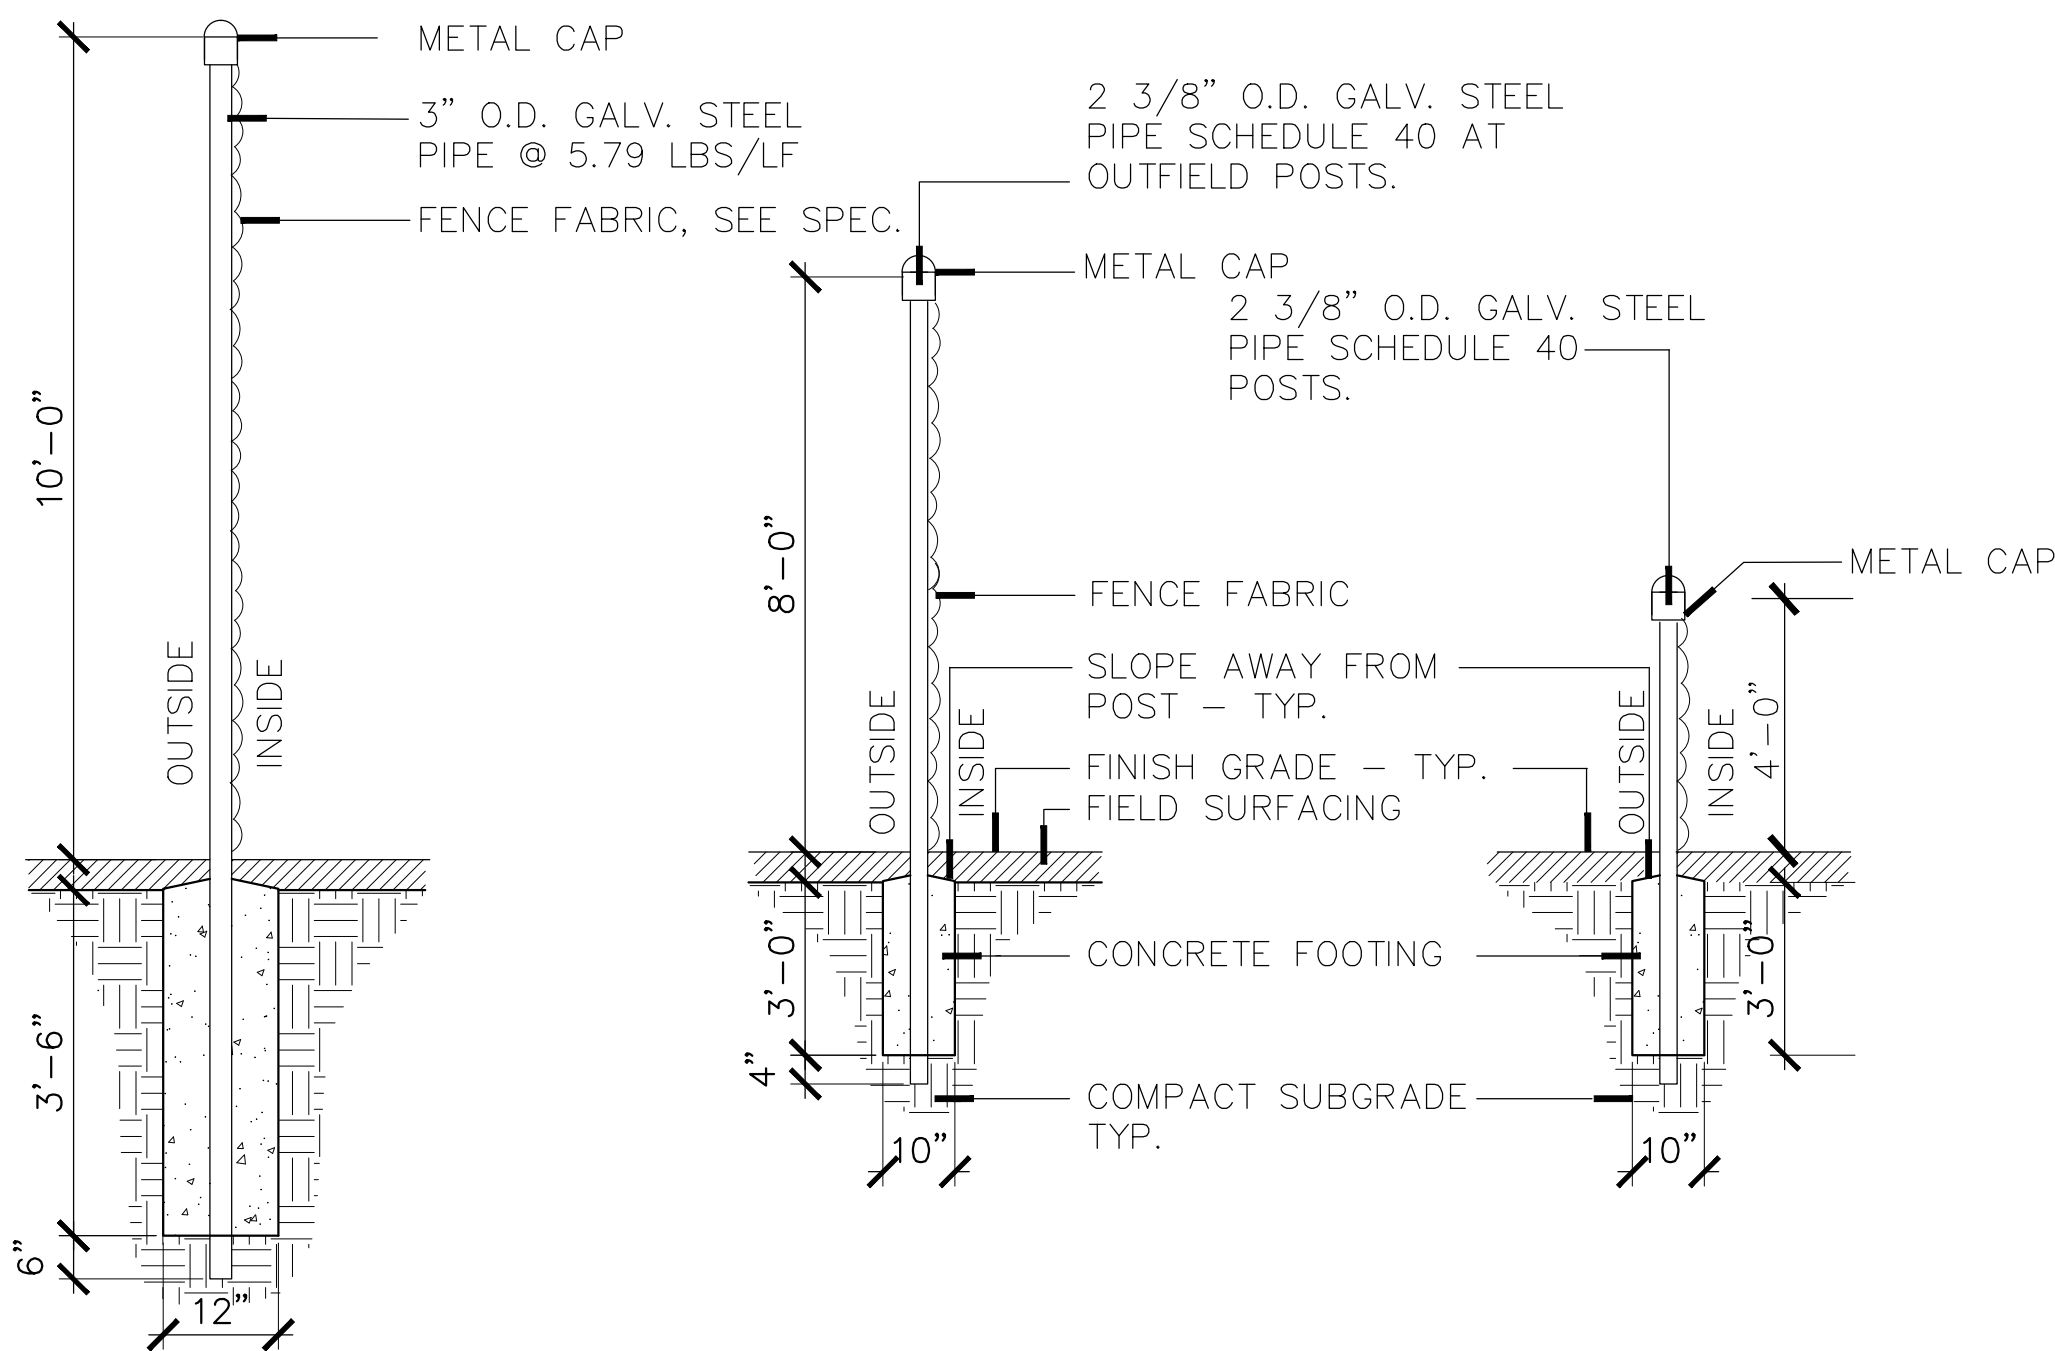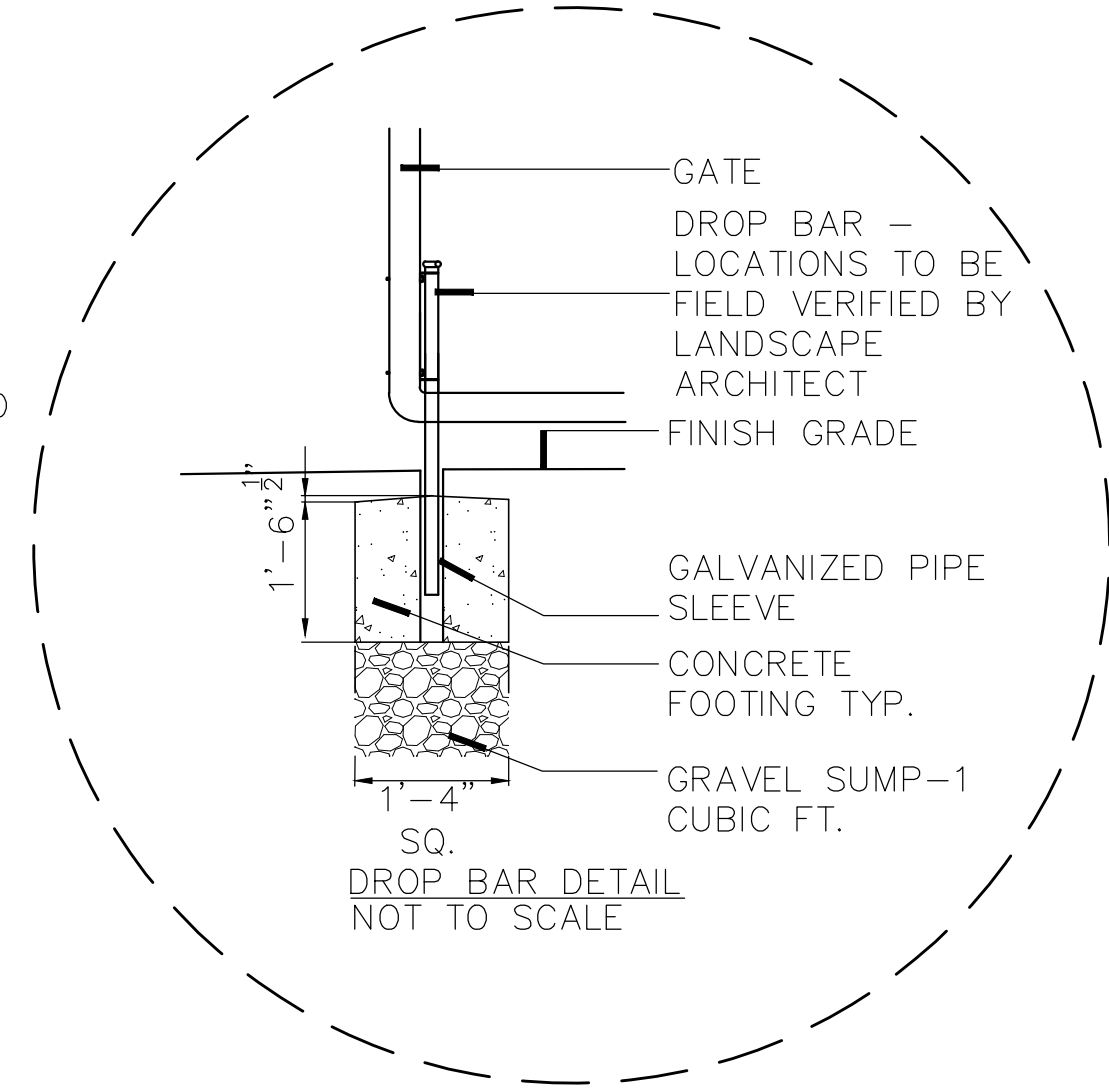


C TYPICAL LINE POST SETTING
 NOT TO SCALE

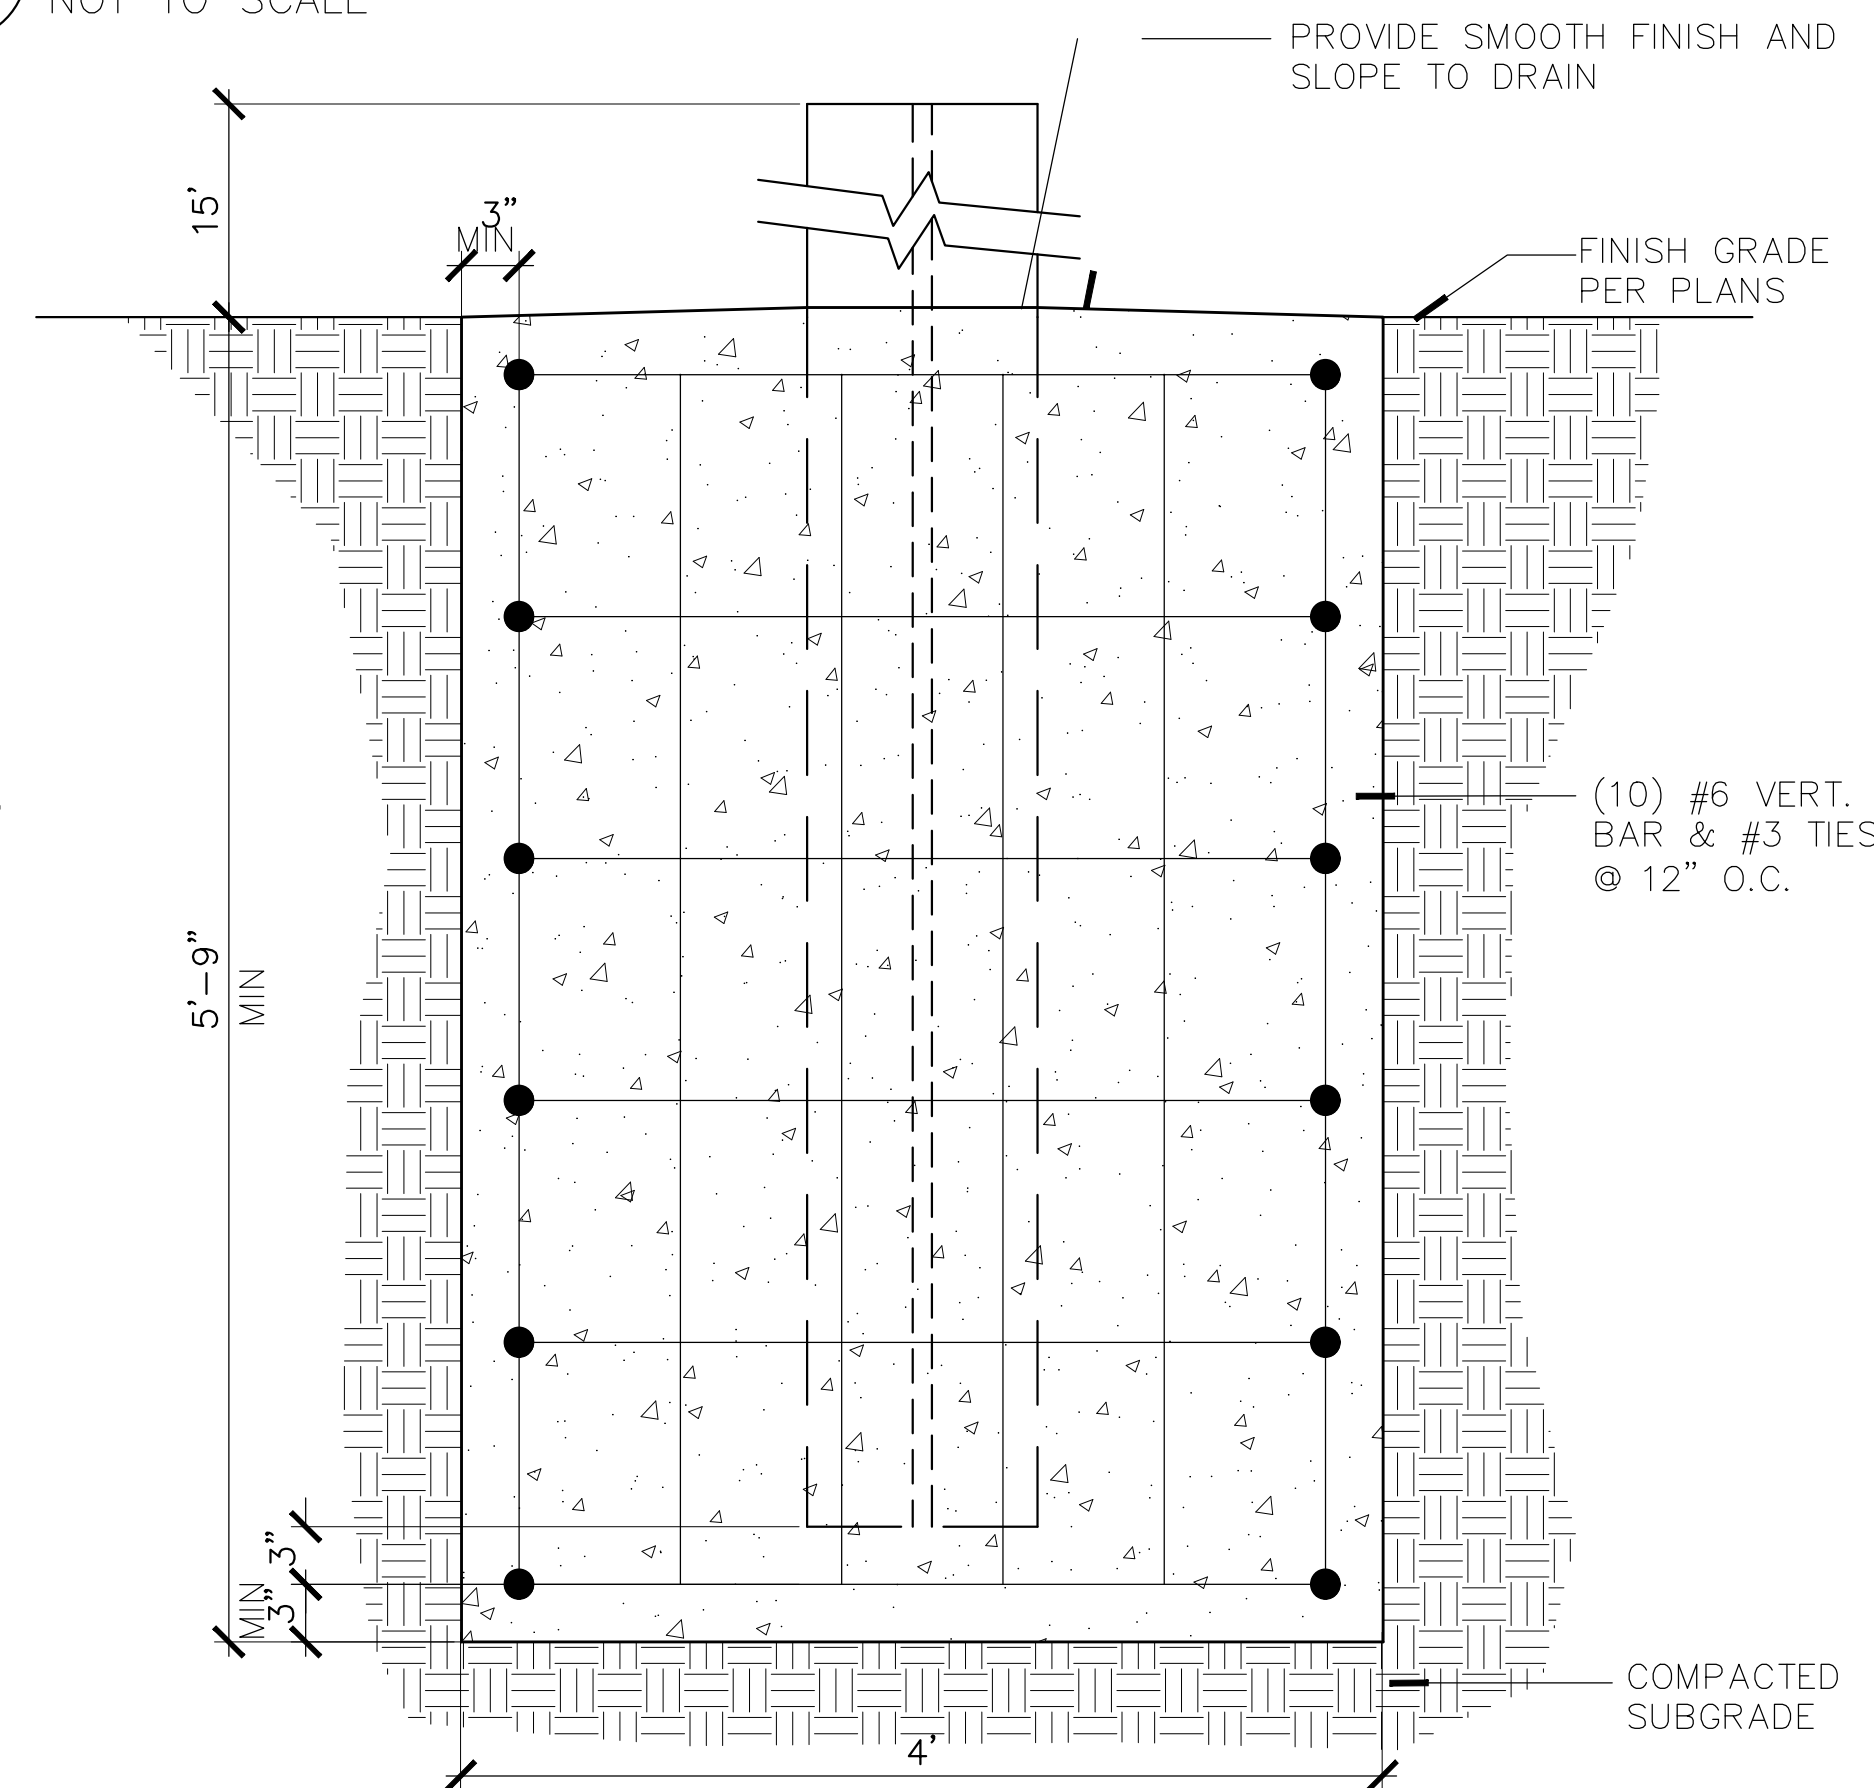


D SCOREBOARD AND FOOTBALL GOAL POST FOOTING
 NOT TO SCALE

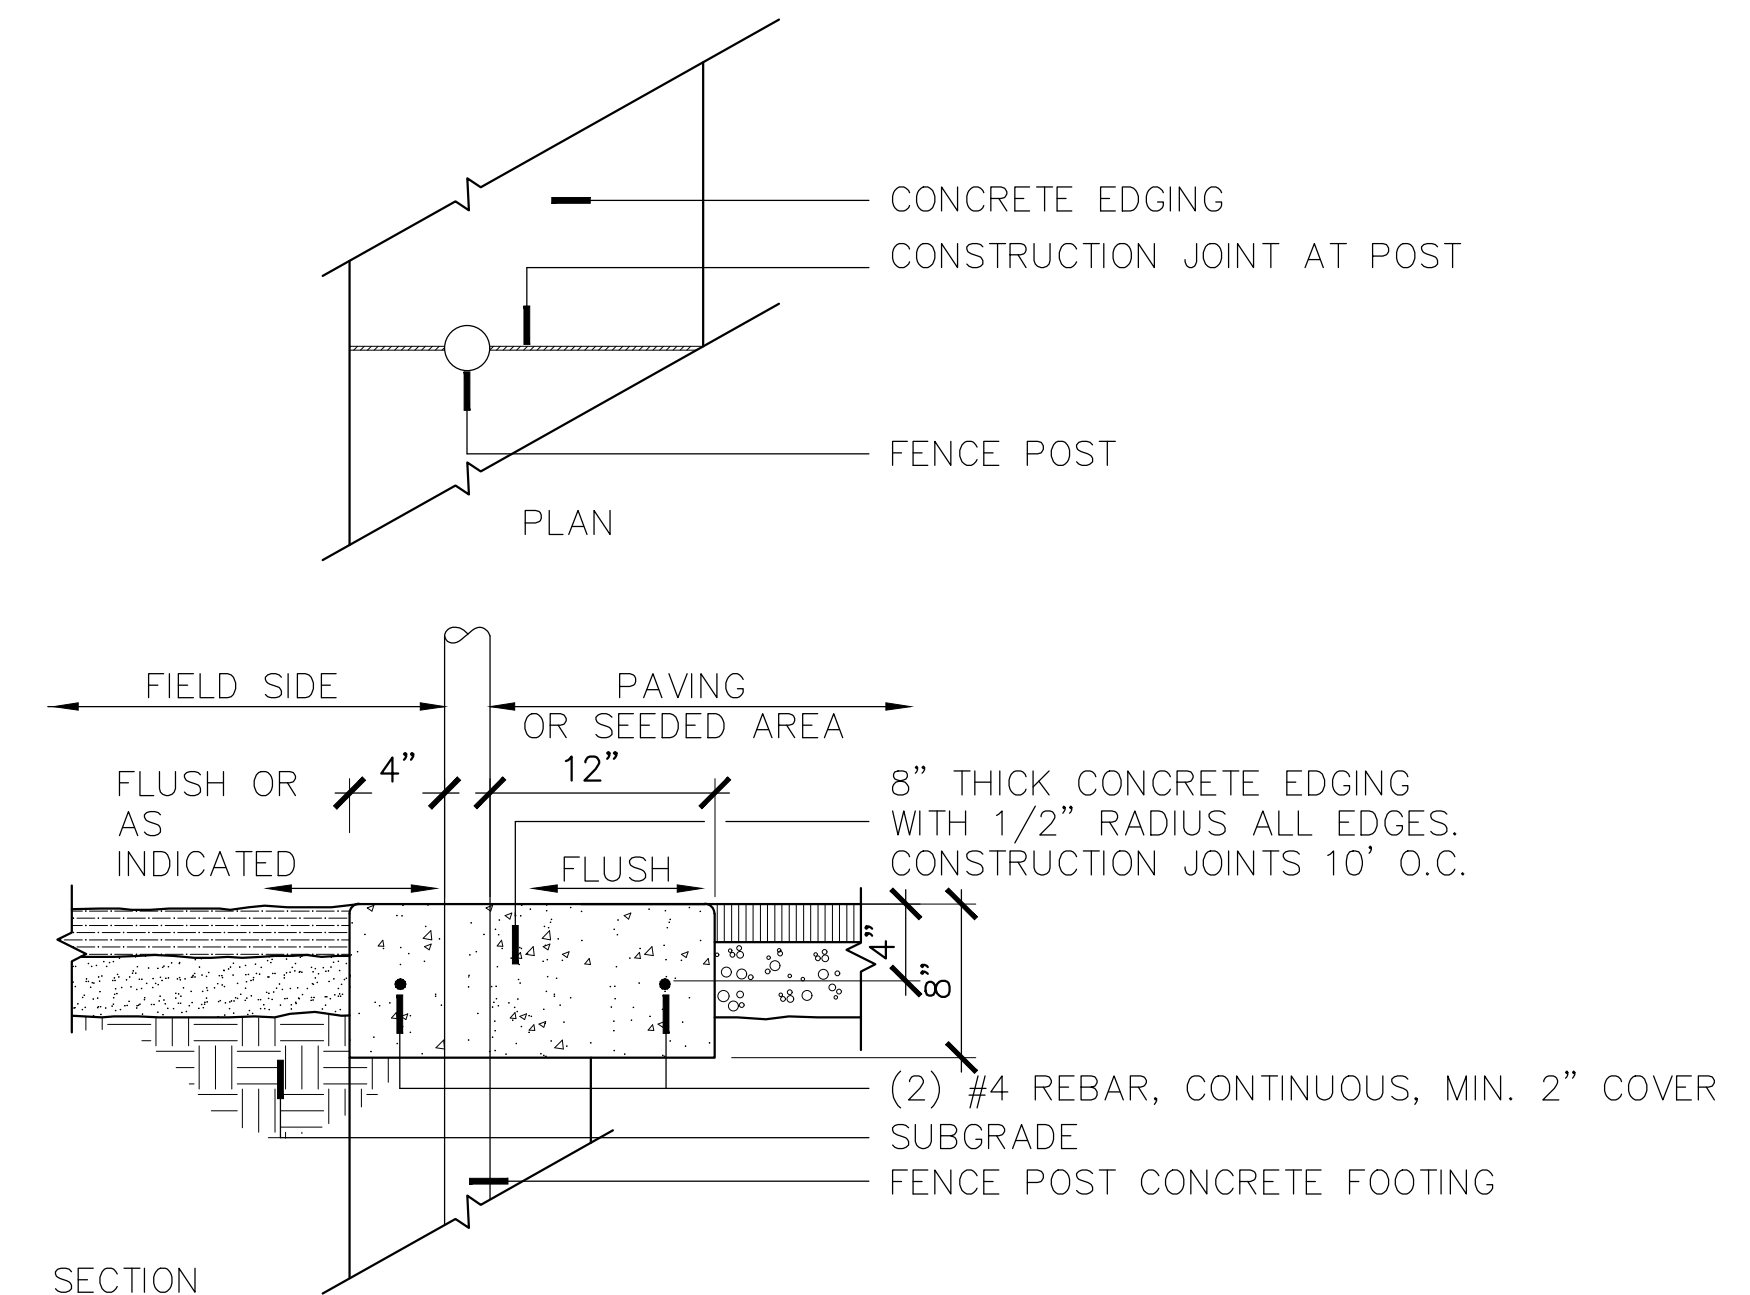


E TYPICAL CONCRETE EDGING
 NOT TO SCALE

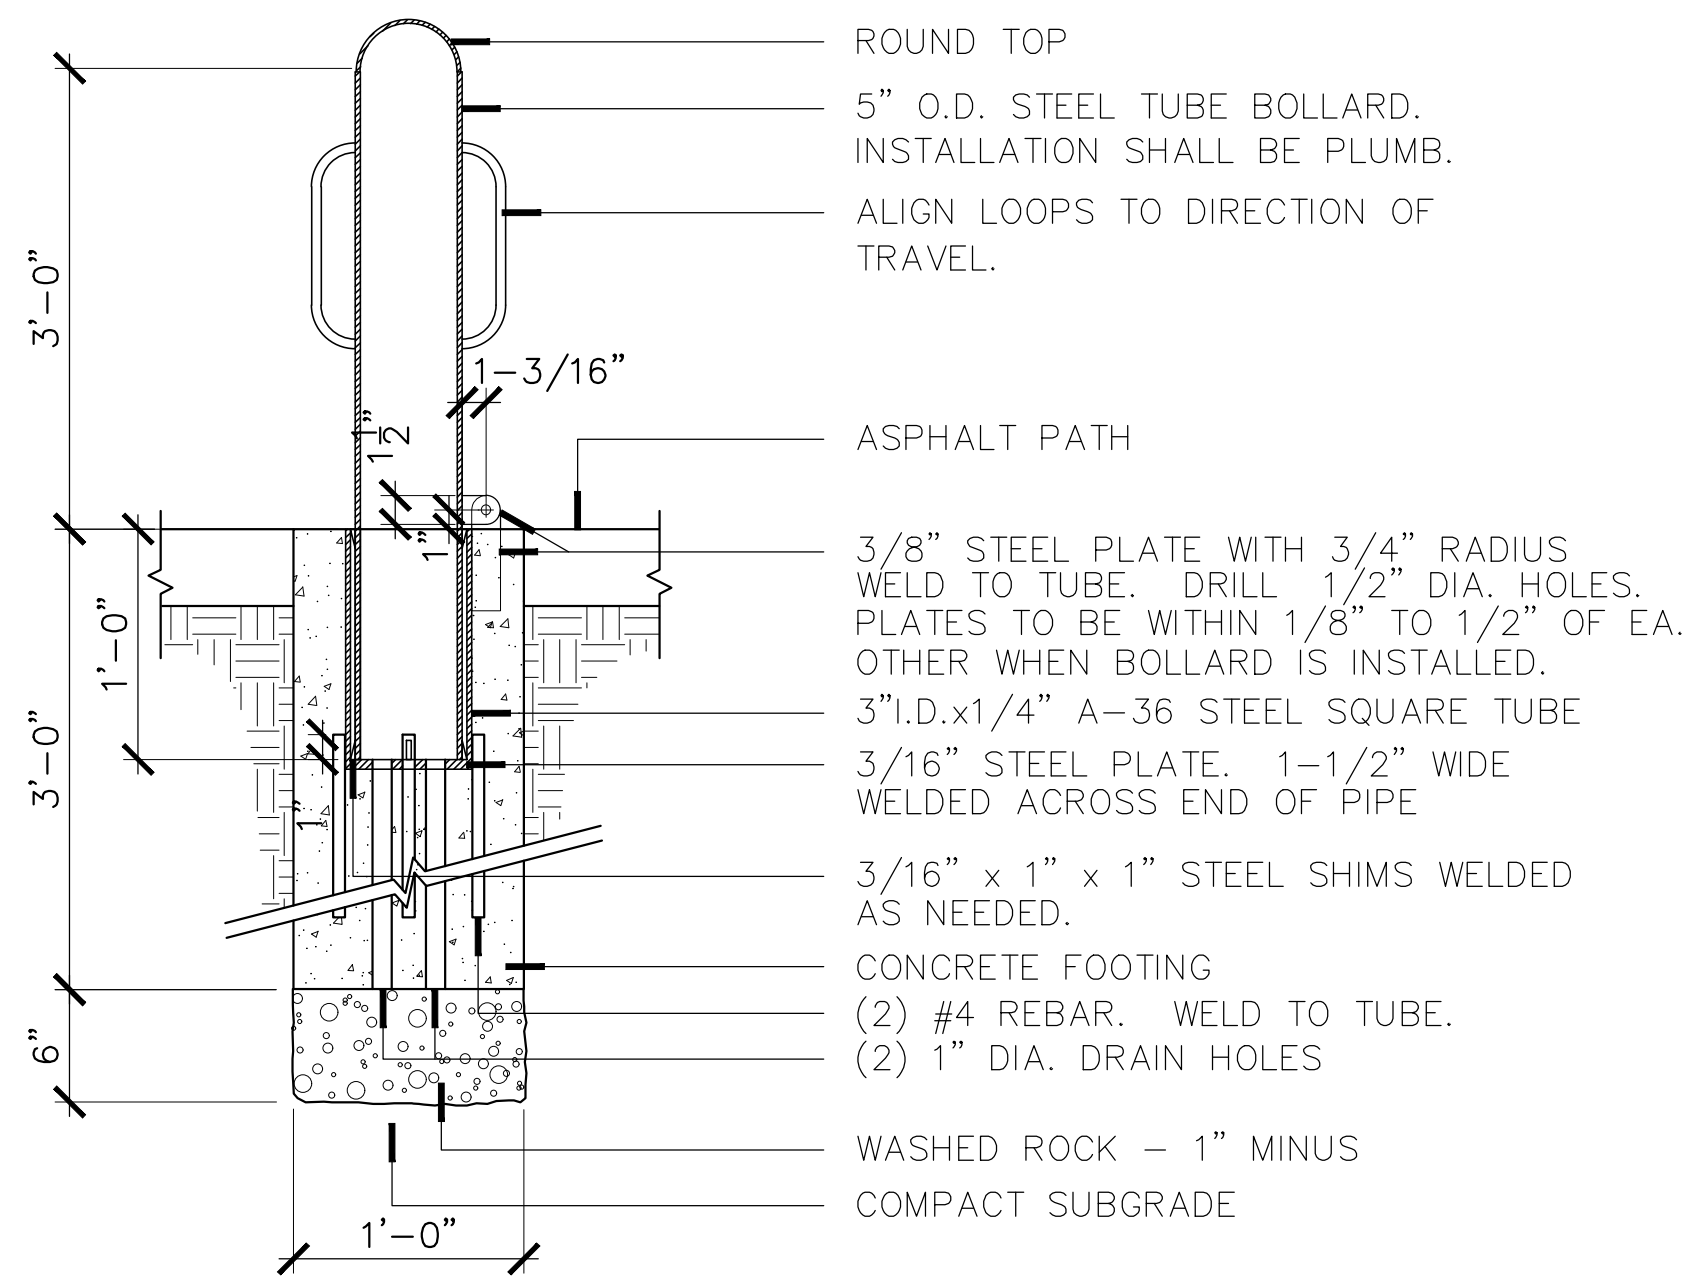


A TYPICAL REMOVABLE BOLLARD
 SCALE: 1" = 1'-0"
 BOLRD-REM2

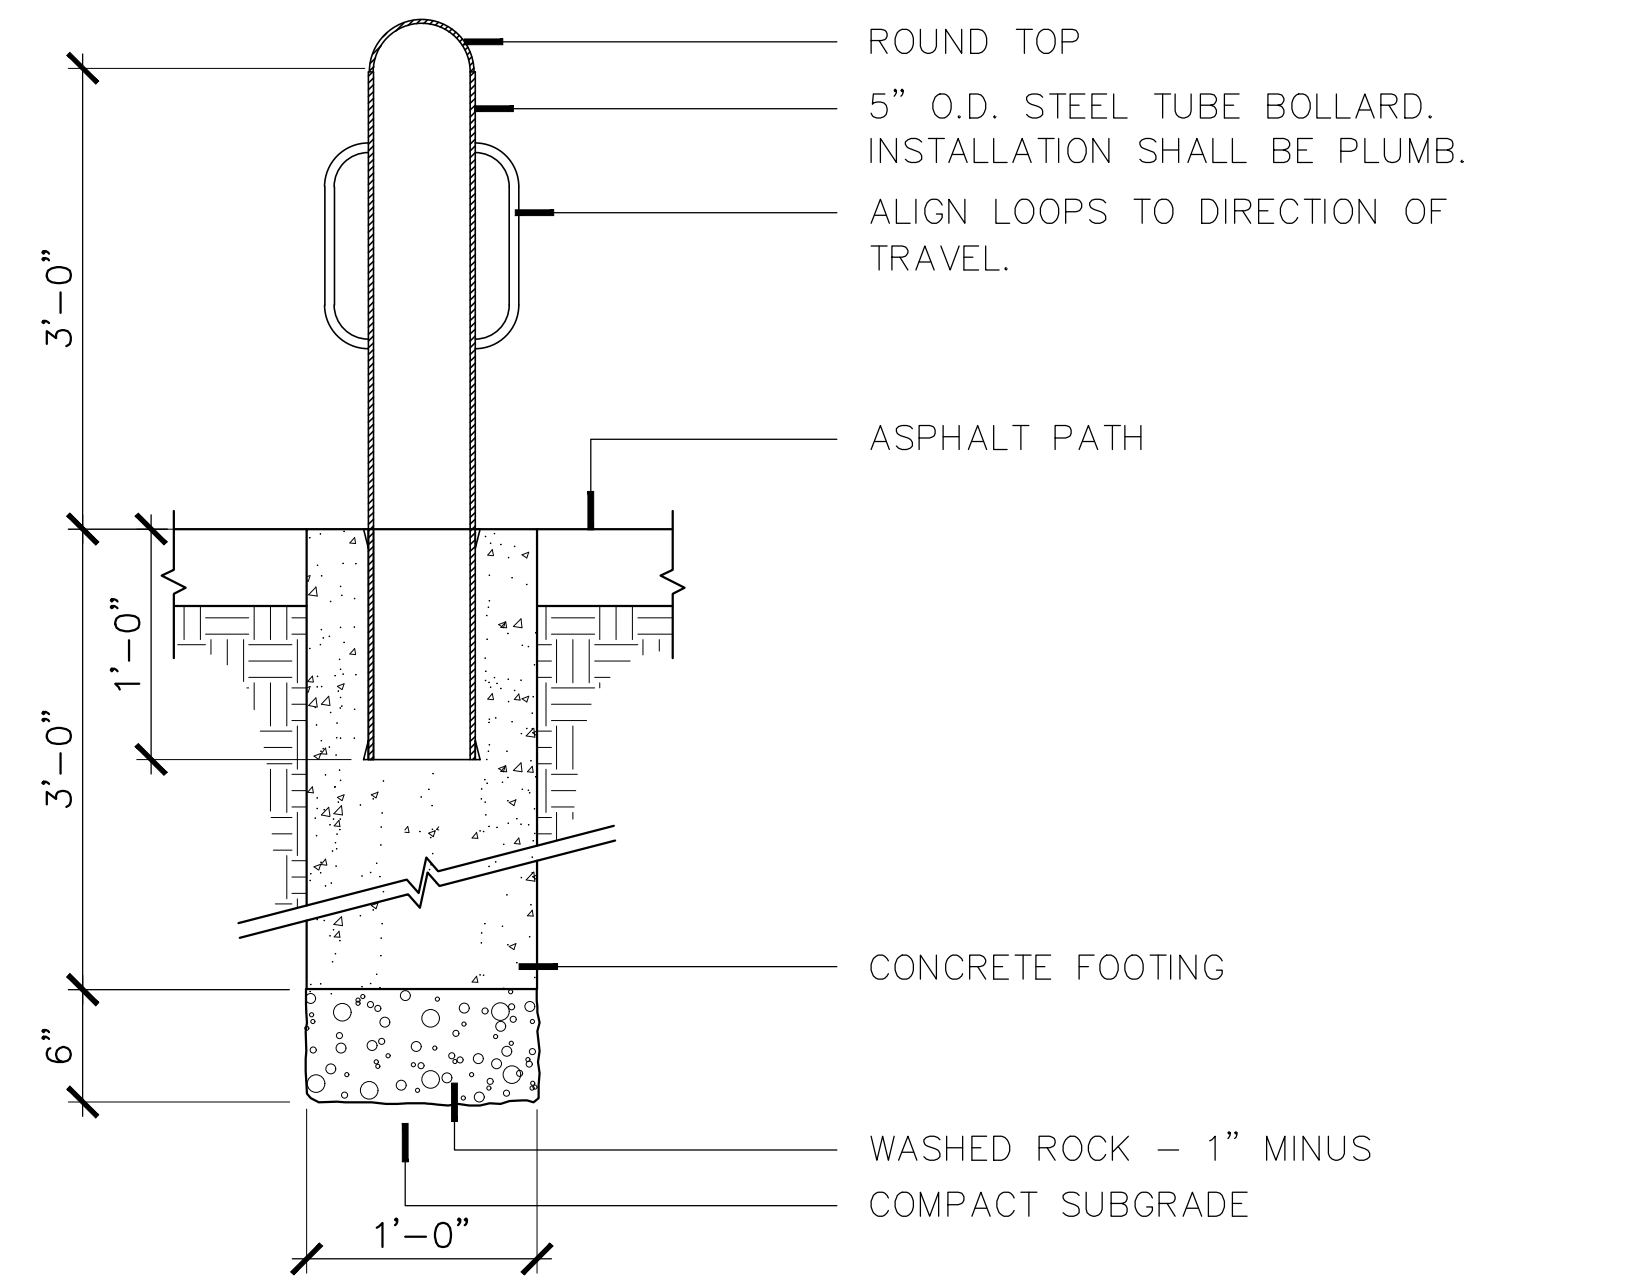

B TYPICAL FIXED BOLLARD
 SCALE: 1" = 1'-0"
 BOLRD-FIX2

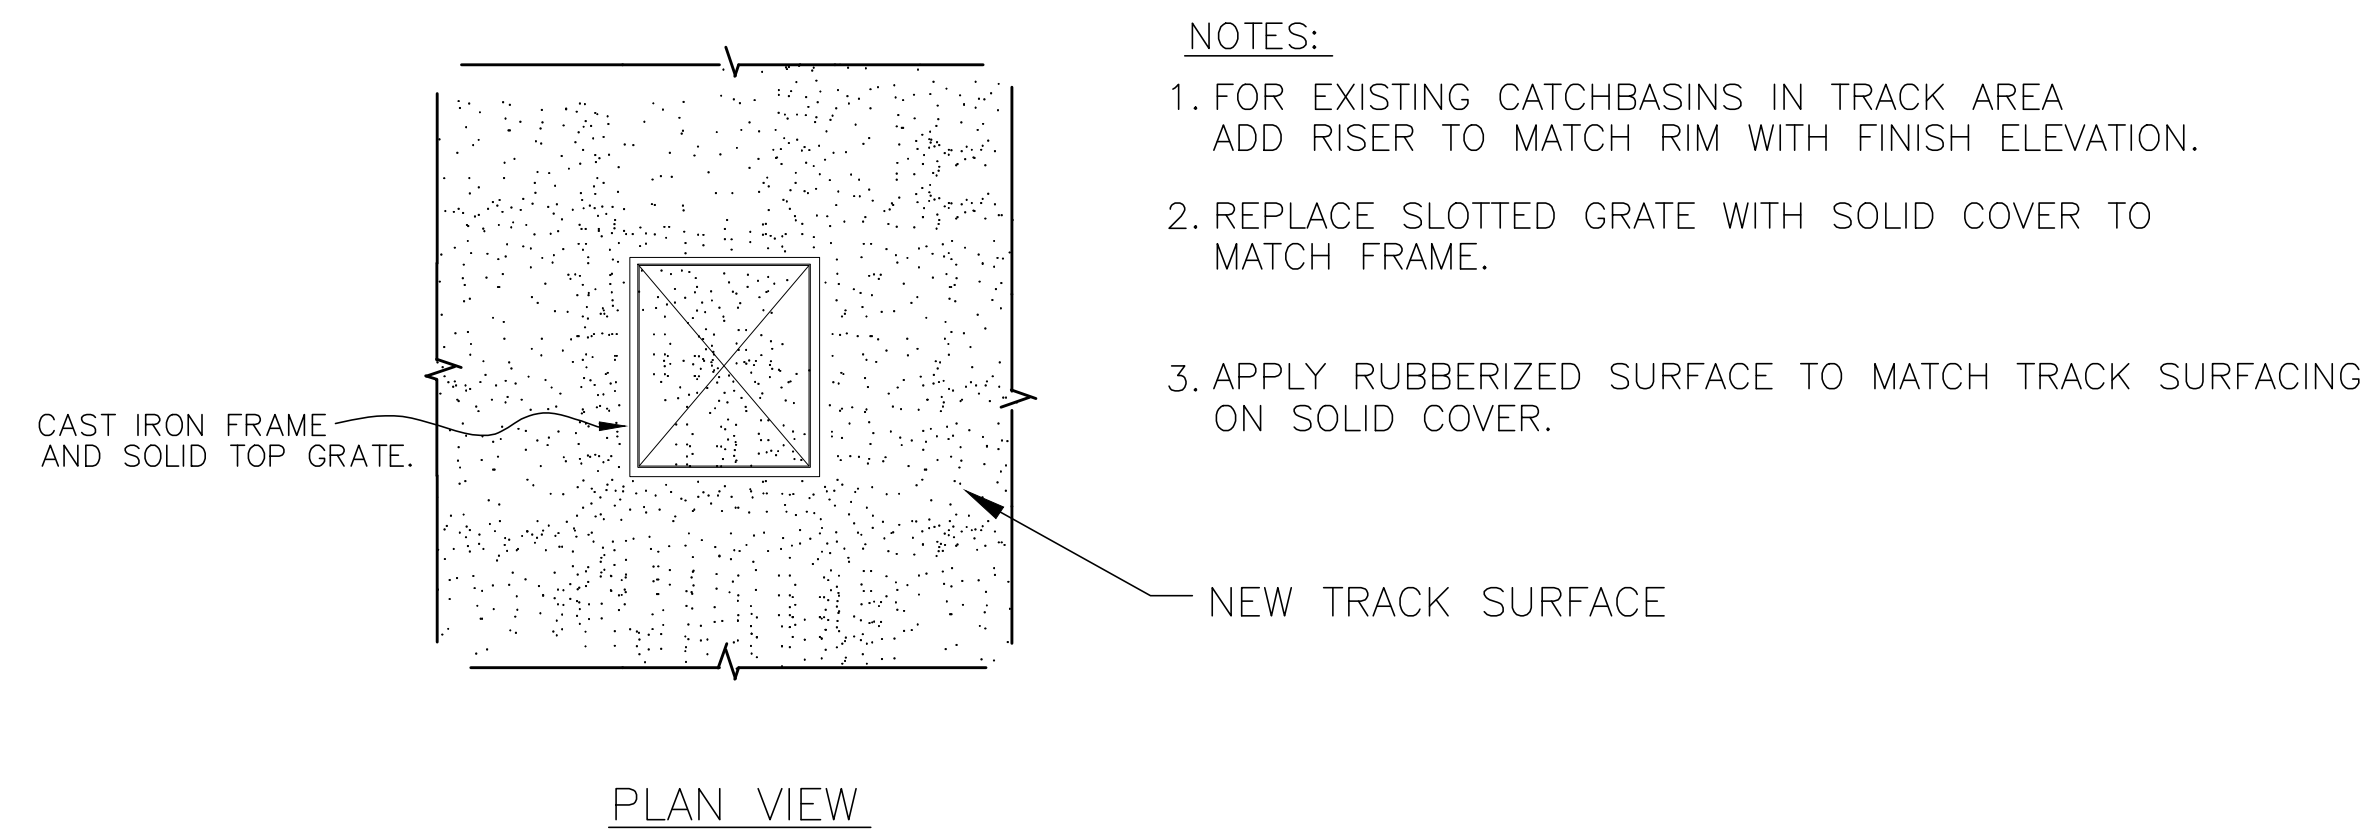

C TYPICAL RUBBERIZED TOP ON CATCH BASIN
 SCALE: 1" = 1'-0"
 CB RUBBER TOP

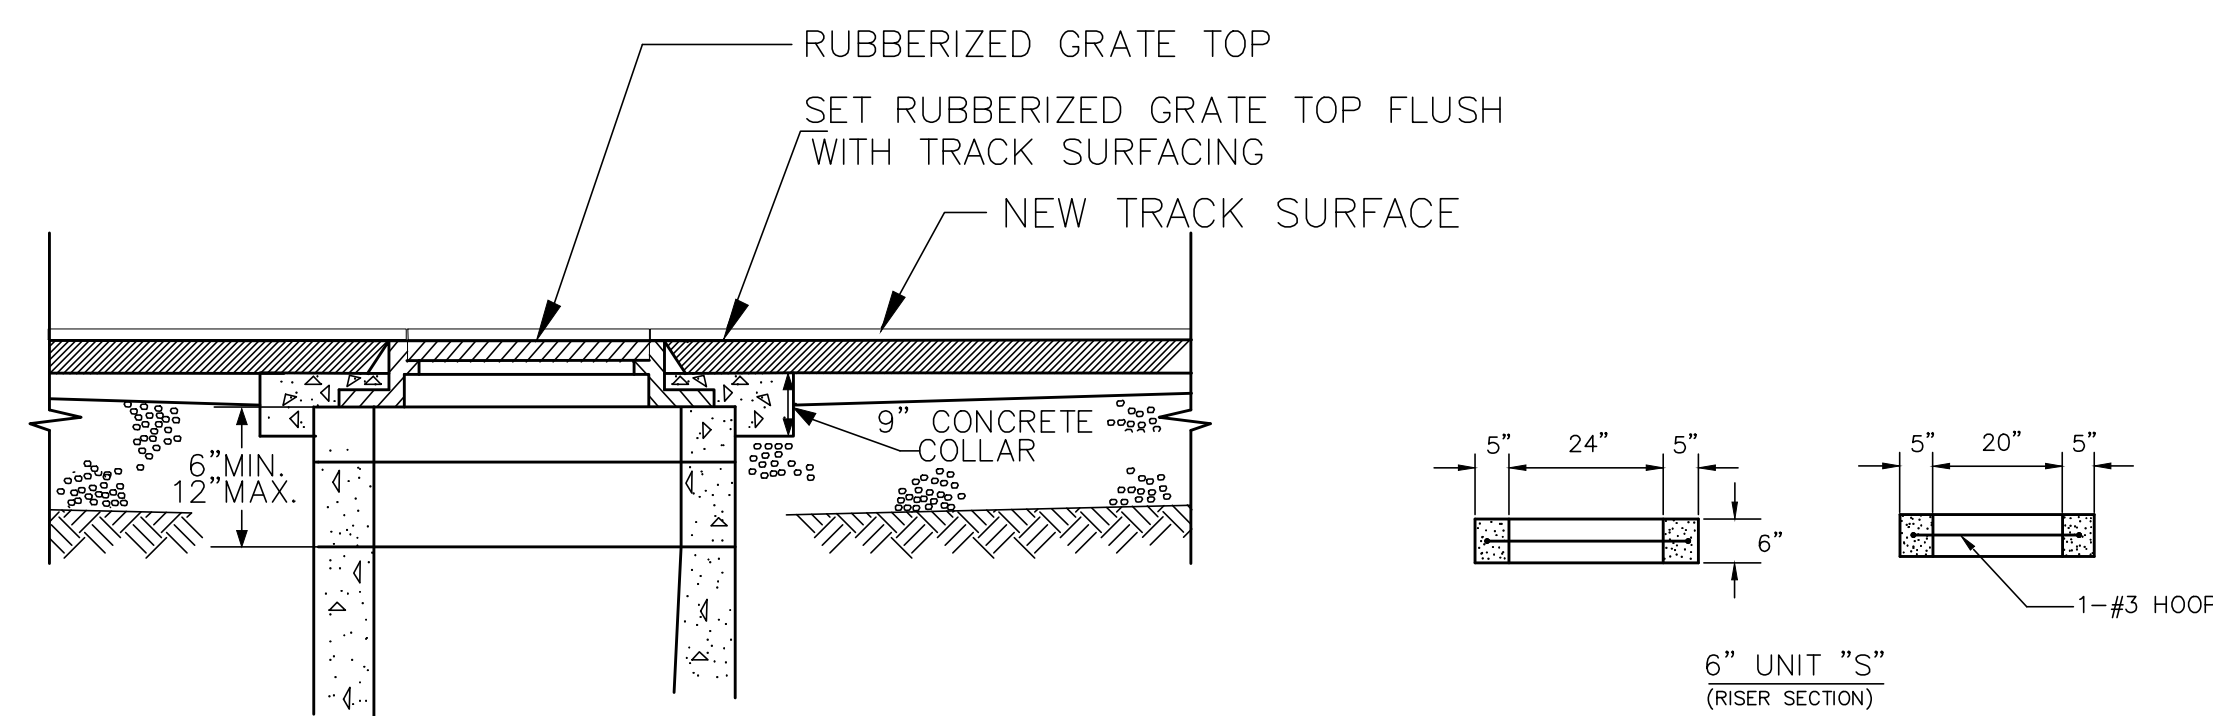

D TYPICAL TYPE I CATCH BASIN
 SCALE: 1" = 1'-0"
 CB RUBBER TOP

