

Residential Sewer Service As-built

Service Address: 4102 S. Meridian, Unit: E1


Subdivision: Planet Fitness Lot #: ✓

Permit No.: PRUSR20241718 Contractor: ARCHER CONSTRUCTION

Pipe Type: PVC Pipe Size: 6" No. of cleanouts: 1

Approved by: Jason Little, Engineering Inspector Date: 5.7.26

Inspector comments: _____

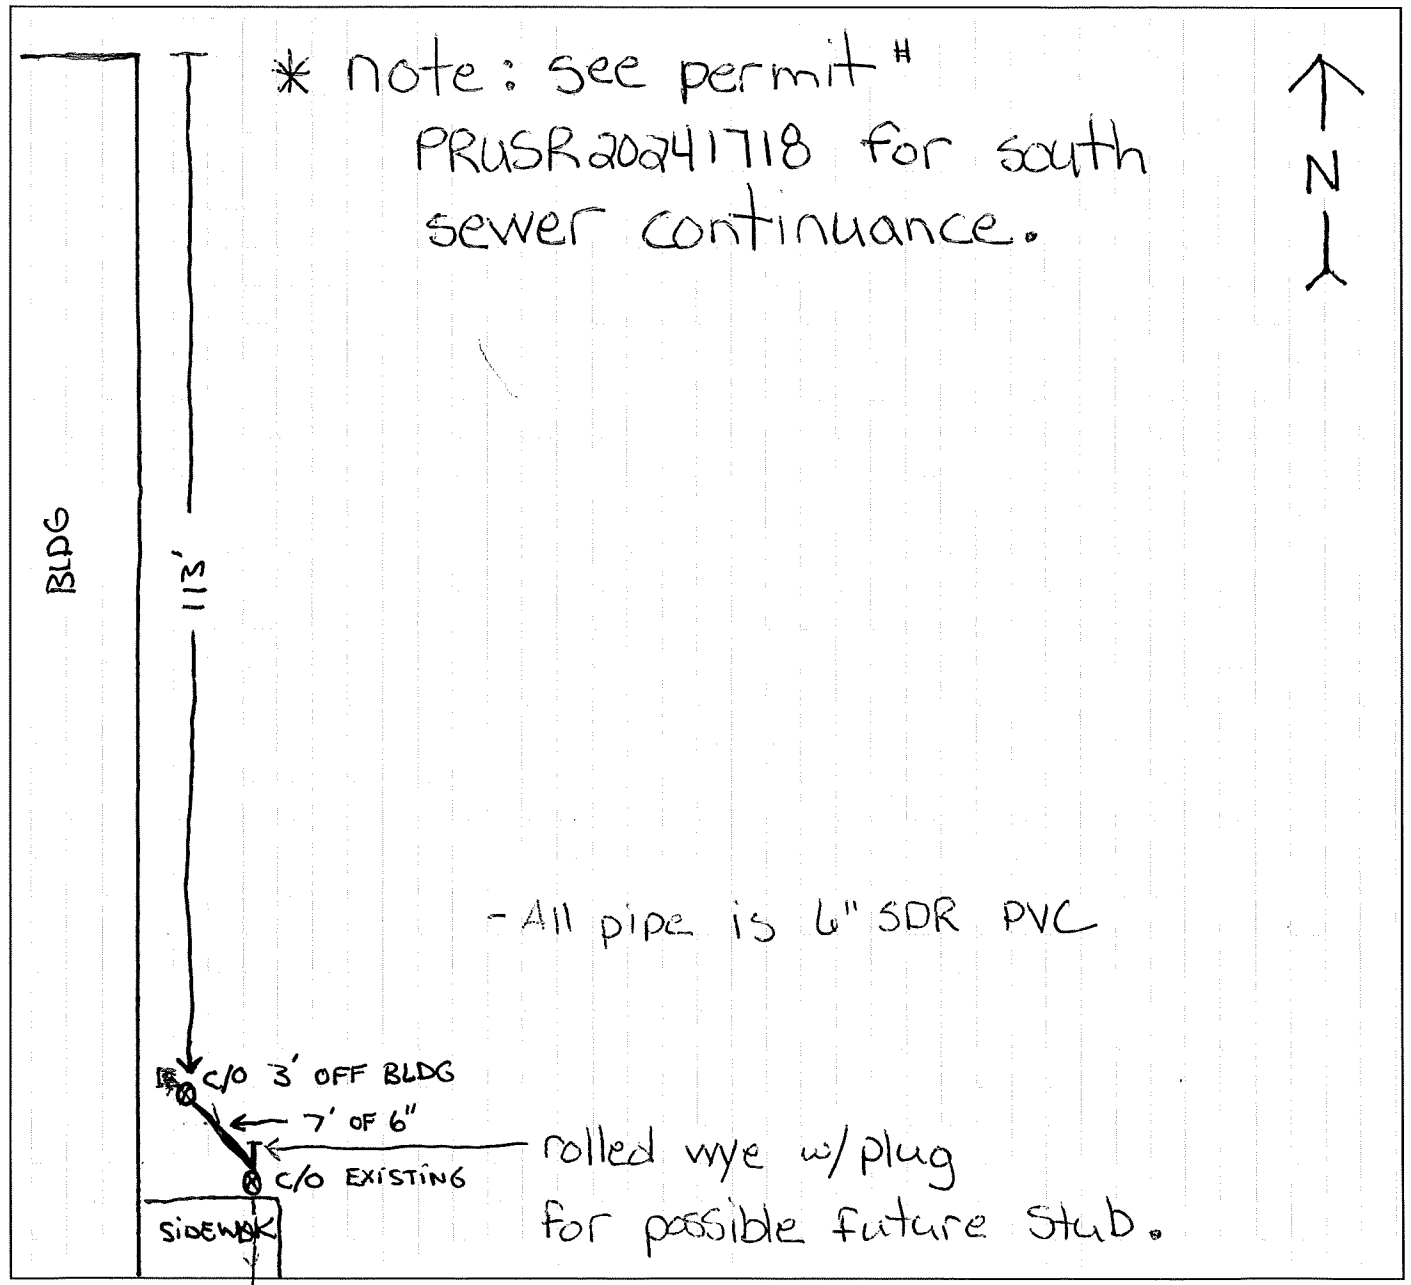

↓ * see note above.