

NORTH ELEVATION

ALL DIMENSIONS SHOWN HAVE BEEN ESTIMATED – SURVEY REQUIRED!

STANDARD SPECS ARE USED FOR THIS PROPOSAL

1 Approval of submitted plans is not an approval of omissions or oversights by this office or noncompliance with any applicable regulations of local government. The contractor is responsible for making sure that the building complies with all applicable codes and regulations of the local government.

City of Puyallup
Building
REVIEWED
FOR
COMPLIANCE

DLeahy
07/06/2022
6:40:59 AM



Face lit channel letters:

Blue day / white night

Tagline:

Black day / white night


LED illumination

3" deep alum. returns


25" or more: trimcap to be used

Flush mounted

PROPOSED
36" STACKED
FF-CL-36-BW
72.1 square feet

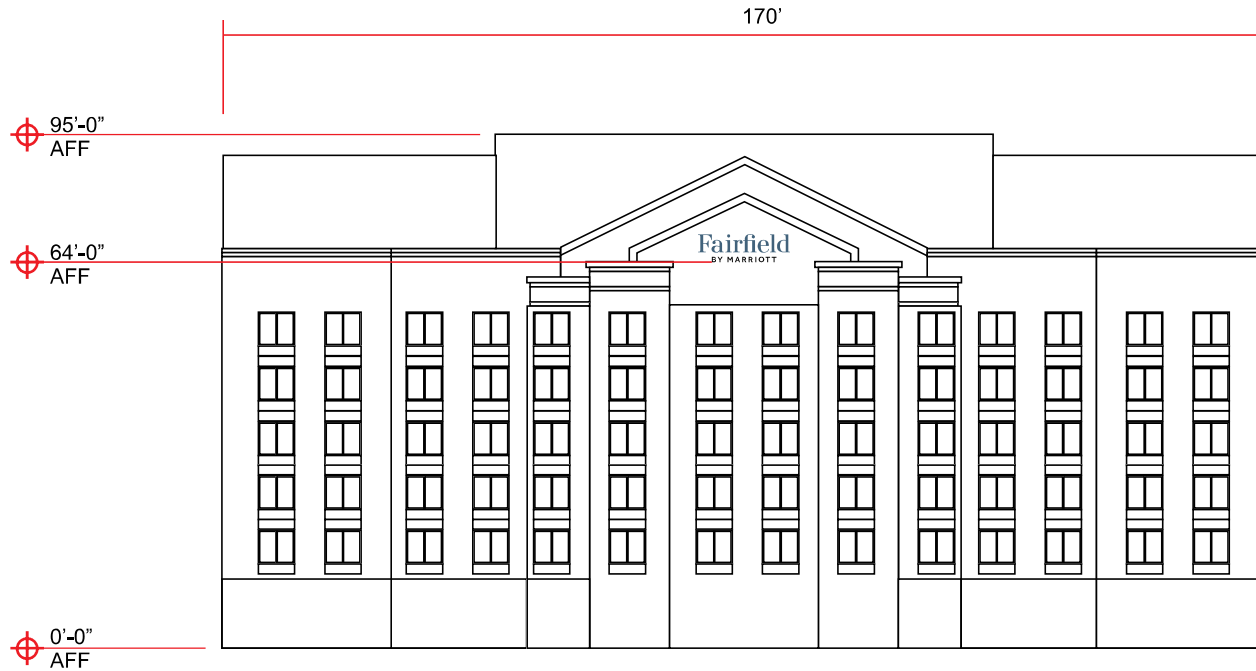

SOUTH ELEVATION SCALE: 1/32"=1'

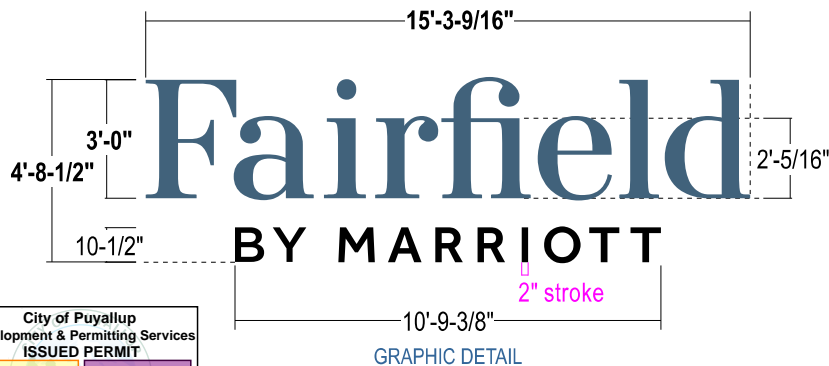

FULL SIZED LEDGIBLE COLOR PLANS ARE REQUIRED TO BE PROVIDED BY THE PERMITTEE ON SITE FOR ALL INSPECTIONS MIN. PLAN SIZE 11 X 17

City of Puyallup Development & Permitting Services ISSUED PERMIT	
Building	Planning
Engineering	Public Works
Fire	Traffic

PRSG20220884

APPROVAL BOX - PLEASE INITIAL	
CUSTOMER APPROVAL	Date

Customer: FAIRFIELD INN -E# 363209	Date: 11/17/21	Prepared By: DSG-AK	<small>Note: Color output may not be exact when viewing or printing this drawing. All colors used are PMS or the closest CMYK equivalent. If these colors are incorrect, please provide the correct PMS match and a revision to this drawing will be made.</small>
Location: 202 15TH AVE SW PUYALLUP, WA 98371	File Name: MARRIOTT/FAIRFIELD INN/2021/PA/Fairfield Inn_Puyallup		Eng: -

stratusunlimited.com
8959 Tyler Boulevard
Mentor, Ohio 44060
888.503.1569

WEST ELEVATION

ALL DIMENSIONS SHOWN HAVE BEEN ESTIMATED – SURVEY REQUIRED!

STANDARD SPECS ARE USED FOR THIS PROPOSAL

2

Face lit channel letters:

Blue day / white night

Tagline:

Black day / white night

LED illumination

3" deep alum. returns

25" or more: trimcap to be used



Flush mounted

PROPOSED

36" STACKED

FF-CL-36-BW

72.1 square feet

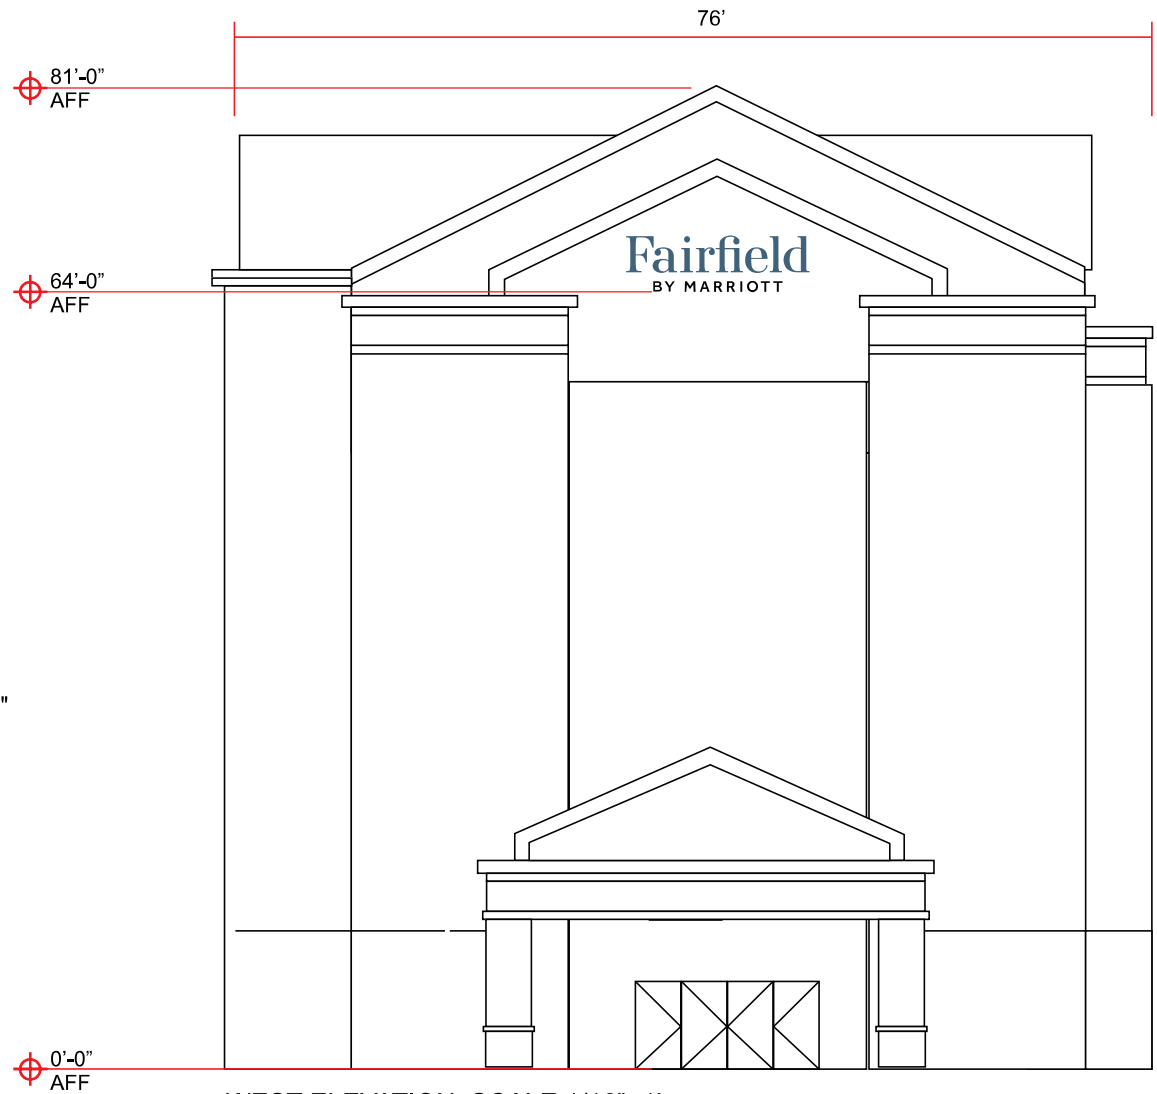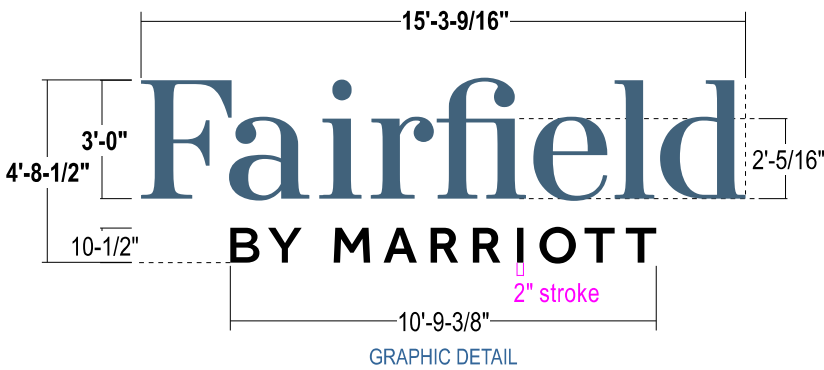

WEST ELEVATION: SCALE 1/16"=1'

City of Puyallup Development & Permitting Services ISSUED PERMIT	
Building	Planning
Engineering	Public Works
Fire	Traffic

PRSG20220884

APPROVAL BOX - PLEASE INITIAL	
CUSTOMER APPROVAL	Date

Customer: FAIRFIELD INN -E# 363209	Date: 11/17/21	Prepared By: DSG-AK	Note: Color output may not be exact when viewing or printing this drawing. All colors used are PMS or the closest CMYK equivalent. If these colors are incorrect, please provide the correct PMS match and a revision to this drawing will be made.
Location: 202 15TH AVE SW PUYALLUP, WA 98371	File Name: MARRIOTT/FAIRFIELD INN/2021/PA/Fairfield Inn_Puyallup		Eng: -

Stratus
stratusunlimited.com
8959 Tyler Boulevard
Mentor, Ohio 44060
888.503.1569

EAST ELEVATION

ALL DIMENSIONS SHOWN HAVE BEEN ESTIMATED – SURVEY REQUIRED!

STANDARD SPECS ARE USED FOR THIS PROPOSAL

3

Face lit channel letters:

Blue day / white night

Tagline:

Black day / white night

LED illumination

3" deep alum. returns

25" or more: trimcap to be used



Flush mounted

PROPOSED

36" STACKED

FF-CL-36-BW

72.1 square feet

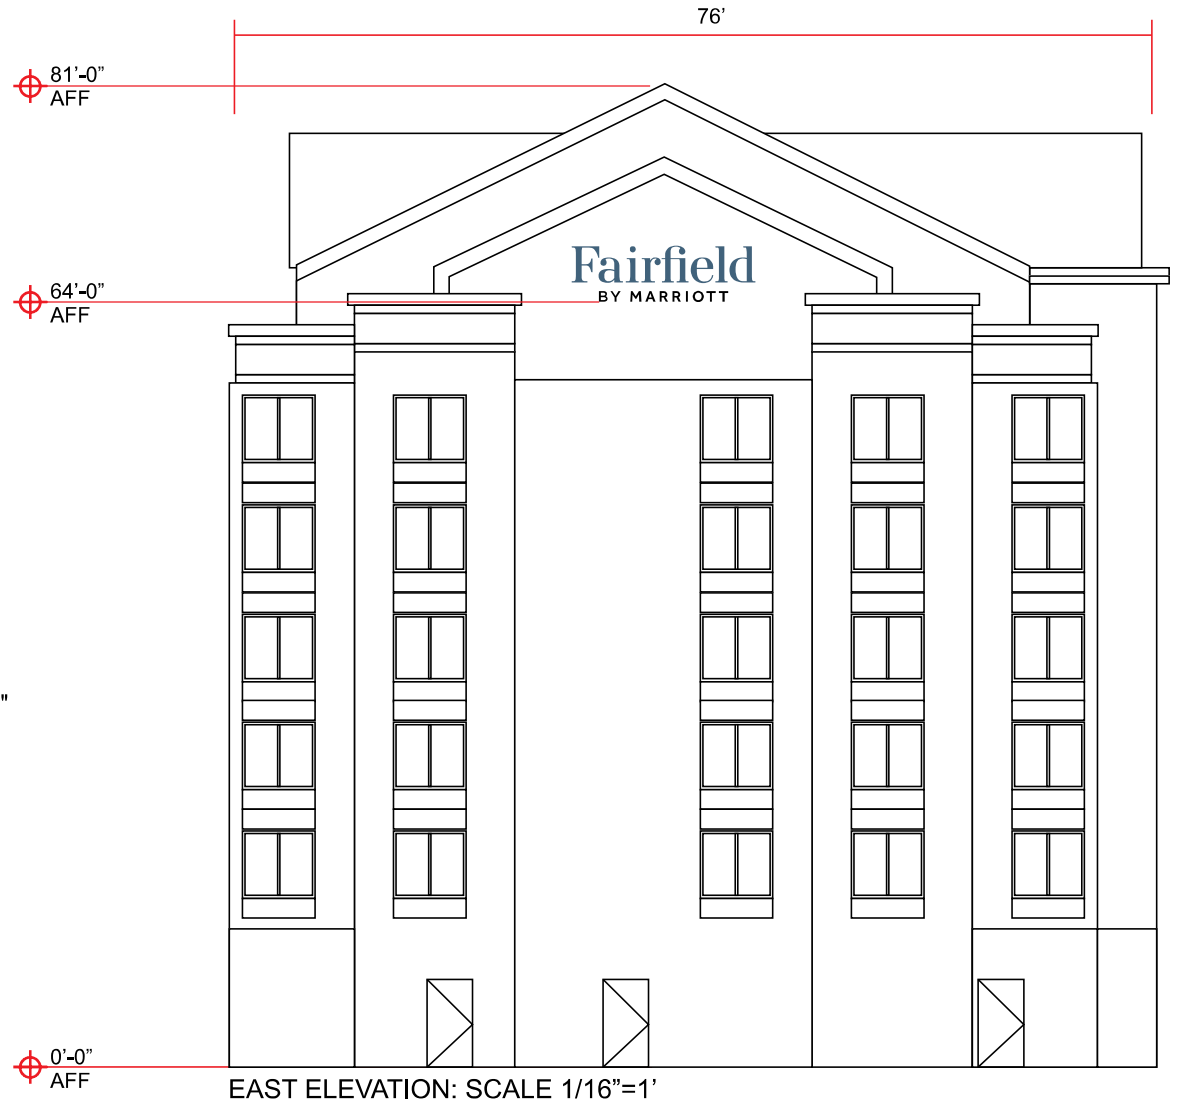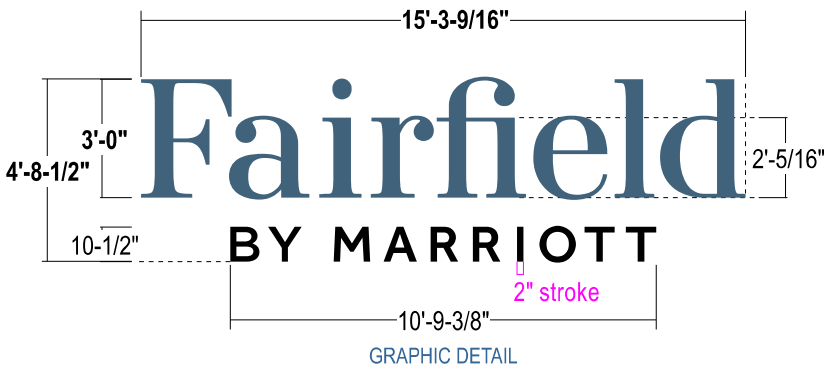

EAST ELEVATION: SCALE 1/16"=1'

City of Puyallup Development & Permitting Services ISSUED PERMIT	
Building	Planning
Engineering	Public Works
Fire	Traffic

PRSG20220884


APPROVAL BOX - PLEASE INITIAL	
CUSTOMER APPROVAL	Date

Customer: FAIRFIELD INN -E# 363209	Date: 11/17/21	Prepared By: DSG-AK	Note: Color output may not be exact when viewing or printing this drawing. All colors used are PMS or the closest CMYK equivalent. If these colors are incorrect, please provide the correct PMS match and a revision to this drawing will be made.
Location: 202 15TH AVE SW PUYALLUP, WA 98371	File Name: MARRIOTT/FAIRFIELD INN/2021/PA/Fairfield Inn_Puyallup		Eng: -

Stratus
stratusunlimited.com
8959 Tyler Boulevard
Mentor, Ohio 44060
888.503.1569

ATTACHMENT DETAIL

1 2 3

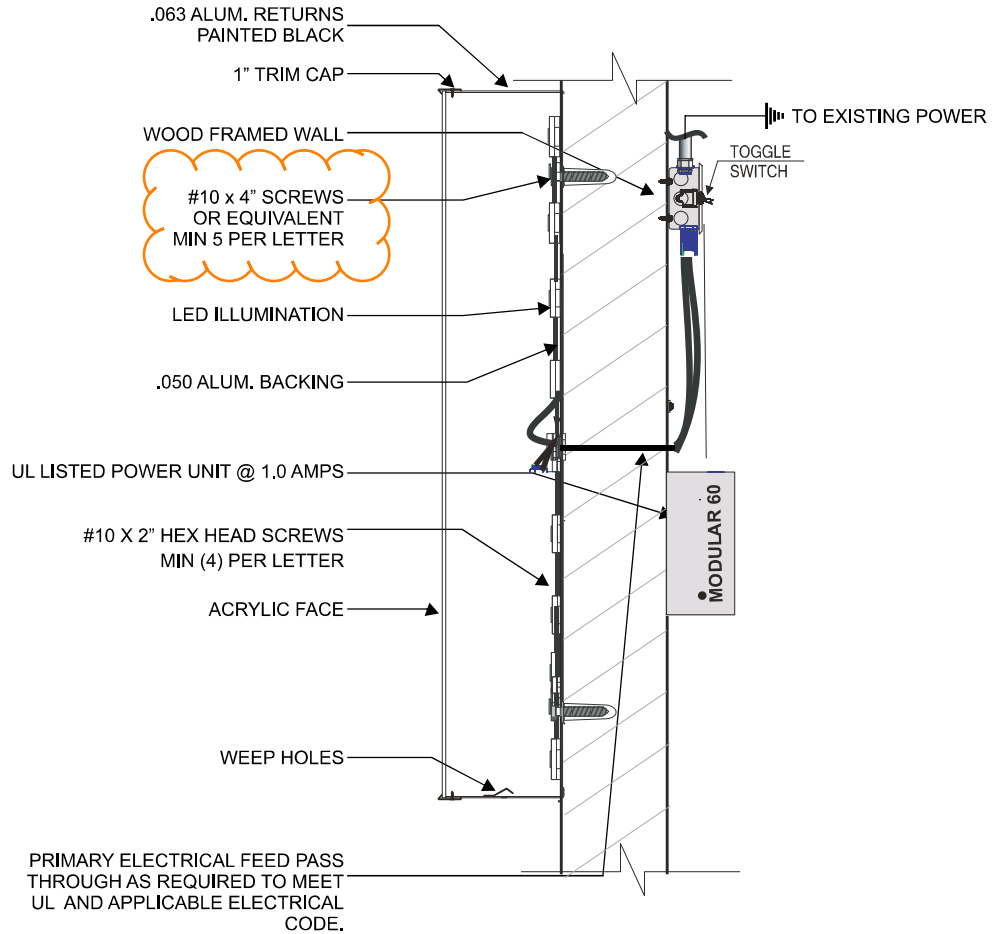

City of Puyallup Development & Permitting Services ISSUED PERMIT	
Building	Planning
Engineering	Public Works
Fire	Traffic

PRSG20220884

APPROVAL BOX - PLEASE INITIAL	
CUSTOMER APPROVAL	Date

Customer: FAIRFIELD INN -E# 363209	Date: 11/17/21	Prepared By: DSG-AK	Note: Color output may not be exact when viewing or printing this drawing. All colors used are PMS or the closest CMYK equivalent. If these colors are incorrect, please provide the correct PMS match and a revision to this drawing will be made.
Location: 202 15TH AVE SW PUYALLUP, WA 98371	File Name: MARRIOTT/FAIRFIELD INN/2021/PA/Fairfield Inn_Puyallup		Eng: -

stratusunlimited.com
8959 Tyler Boulevard
Mentor, Ohio 44060
888.503.1569