EXCEPTIONS 9-13 ARE EXCEPTIONS NOT RELATED TO THE SURVEY.

14. RESERVATIONS AND EXCEPTIONS, INCLUDING THE TERMS AND CONDITIONS THEREOF: RESERVING: THE RIGHT OF DRAINAGE ACROSS SAID PREMISES INTO THE PRIVATE DRAINAGE DITCHES AS NOW CONSTRUCTED

RESERVED BY: RONALD R. J. THACKERAY RECORDED: MARCH 30, 1950 RECORDING INFORMATION: 1548883 (AFFECTS PARCEL NO. B, D AND E)

[CAN NOT BE SHOWN BECAUSE IT IS BLANKET IN NATURE]

15. EASEMENT, INCLUDING TERMS AND PROVISIONS CONTAINED THEREIN: RECORDING INFORMATION: MARCH 17, 1955 UNDER RECORDING NO. 1713967

FOR: PIPELINE AFFECTS: PARCEL B [DOES AFFECT -AS SHOWN]

AFFECTS: PARCELS A AND E

[DOES AFFECT - AS SHOWN]

16. EASEMENT, INCLUDING TERMS AND PROVISIONS CONTAINED THEREIN:

RECORDING DATE: DECEMBER 18, 1956 RECORDING INFORMATION: 1775106

IN FAVOR OF: PACIFIC NORTHWEST PIPELINE CORPORATION, A DELAWARE CORPORATION, ITS SUCCESSORS AND ASSIGNS FOR: PIPELINE OR PIPELINES FOR TRANSPORTATION OF OIL AND GAS AND THE PRODUCTS THEREOF AFFECTS: PARCELS B, D AND E

[CAN NOT BE SHOWN BECAUSE IT IS BLANKET IN NATURE]

17. EASEMENT, INCLUDING TERMS AND PROVISIONS CONTAINED THEREIN: RECORDING DATE: NOVEMBER 12, 1980 RECORDING INFORMATION: 8011120241 IN FAVOR OF: FRUITLAND MUTUAL WATER COMPANY, INC. FOR: WATER LINES

THE TERMS AND PROVISIONS CONTAINED IN THE DOCUMENT ENTITLED "TERMINATION OF EASEMENT" RECORDED MAY 04. 2017 AS RECORDING NO. 201705040573 OF OFFICIAL RECORDS. [DOES NOT AFFECT SUBLECT PROPERTY]

18. EASEMENT, INCLUDING TERMS AND PROVISIONS CONTAINED THEREIN: RECORDING DATE: NOVEMBER 20, 1980

RECORDING INFORMATION: 8011200142 IN FAVOR OF: WINMAR COMPANY, INC., A CALIFORNIA CORPORATION FOR: A NON-EXCLUSIVE EASEMENT FOR INGRESS, EGRESS, AND UTILITIES

AFFECTS: PARCEL A [CAN NOT BE SHOWN BECAUSE IT IS BLANKET IN NATURE]

19. RESTRICTIONS, CONDITIONS, DEDICATIONS, NOTES, EASEMENTS AND PROVISIONS, IF ANY, AS CONTAINED AND/OR DELINEATED ON THE FACE OF THE PIERCE CO. LARGE LOT DIVISION NO. RECORDED MARCH 25, 1981 AS RECORDING NO. 8103250125, IN PIERCE COUNTY, WASHINGTON. [DOES AFFECT - AS SHOWN]

DOCUMENT(S) DECLARING MODIFICATIONS THEREOF RECORDED NOVEMBER 20, 1981 AS 8111200245 OF OFFICIAL RECORDS. [DOES AFFECT - AS SHOWN] (AFFECTS PARCELS A AND C)

20. EASEMENT, INCLUDING TERMS AND PROVISIONS CONTAINED THEREIN:

RECORDING DATE: MAY 11, 1981 RECORDING INFORMATION: 8105110249 IN FAVOR OF: WINMAR COMPANY, INC., A CALIFORNIA CORPORATION FOR: A NON-EXCLUSIVE EASEMENT FOR INGRESS, EGRESS, AND UTILITIES

AFFECTS: PARCEL A [CAN NOT BE SHOWN BECAUSE IT IS BLANKET IN NATURE]

21. EASEMENT, INCLUDING TERMS AND PROVISIONS CONTAINED THEREIN:

RECORDING DATE: MAY 11, 1981

RECORDING INFORMATION: 8105110250 IN FAVOR OF: WINMAR COMPANY, INCORPORATED, A CALIFORNIA CORPORATION AND THEIR HEIRS, SUCCESSORS AND

FOR: NON-EXCLUSIVE EASEMENT FOR INGRESS, EGRESS, AND UTILITIES, ROAD CONSTRUCTION, INSTALLATION, AND MAINTENANCE, TO INCLUDE THE RIGHT TO PHYSICALLY ALTER THE SLOPE, GRADE, LANDSCAPING OR TERRAIN IN ANY MANNER WHICH GRANTOR OR GRANTEE DEEMS NECESSARY FOR THE REASONABLE DEVELOPMENT OF ADJACENT PROPERTY AFFECTS: PARCELS A AND E

22. COVENANTS, CONDITIONS, RESTRICTIONS AND/OR EASEMENTS:

RECORDED: JANUARY 9, 1986 RECORDING NO.: 8601090099 (AFFECTS PARCEL NO. B AND D)

[DOES AFFECT - AS SHOWN]

[CAN NOT BE SHOWN - SPECIFIC DETAILS REFERENCES A "CERTAIN MAP OF DEFINITE LOCATION NOW ON RECORD AND ON FILE IN THE OFFICE OF THE SECRETARY OF TRANSPORTATION AT OLYMPIA AND BEARING DATE OF APPROVAL MARCH 25, 1985" SAID MAP NOT PROVIDED TO SURVEYOR.]

23. COVENANTS, CONDITIONS, RESTRICTIONS AND/OR EASEMENTS:

RECORDED: APRIL 29, 1988 RECORDING NO.: 8804290324 (AFFECTS PARCEL NO. B AND D)

[CAN NOT BE SHOWN BECAUSE IT IS BLANKET IN NATURE]

24. CONDITIONS, NOTES, EASEMENTS, PROVISIONS AND/OR ENCROACHMENTS CONTAINED AND/OR DELINEATED ON THE FACE OF THE SURVEY, RECORDED DECEMBER 18, 1995 UNDER RECORDING NO. 9512180148 OF SURVEYS, IN PIERCE COUNTY,

(AFFECTS PARCEL NO. B AND D) [DOES AFFECT — AS SHOWN]

25. DEED OF TRUST AND THE TERMS AND CONDITIONS THEREOF.

GRANTOR/TRUSTOR: WILLOWS FOUR, LLC, A WASHINGTON LIMITED LIABILITY COMPANY GRANTEE/BENEFICIARY: OLD STANDARD LIFE INSURANCE COMPANY

TRUSTEE: CHICAGO TITLE INSURANCE COMPANY FOR: \$7.500.000.00 RECORDED: MAY 1, 2000

RECORDING INFORMATION: 200005010753 (AFFECTS A PORTION OF SAID PREMISES AND OTHER PROPERTY)

[CAN NOT BE SHOWN - NOTHING TO PLOT]

THE DEED OF TRUST/MORTGAGE WAS PARTIALLY RECONVEYED AS TO AS DESCRIBED THEREIN BY INSTRUMENT RECORDED MARCH 24, 2003 UNDER RECORDING NO. 200303240204. [DOES NOT AFFECT — SHOWN ON THE FACE OF THE SURVEY AS EXISTING RIGHT OF WAY]

A DOCUMENT RECORDED JANUARY 09. 2019 AS RECORDING NO. 201901090086 OF OFFICIAL RECORDS PROVIDES THAT FIRST AMERICAN TITLE INSURANCE COMPANY WAS SUBSTITUTED AS TRUSTEE UNDER THE DEED OF TRUST. [NOTING TO PLOT-NOT SURVEY RELATED.]

THE DEED OF TRUST/MORTGAGE WAS PARTIALLY RECONVEYED AS TO LOT 1 OF CITY OF PUYALLUP BOUNDARY LINE REVISION NO. P-17-0095 RECORDED DECEMBER 21, 2017 UNDER RECORDING NO. 201712215007 BY INSTRUMENT RECORDED JANUARY 09, 2019 UNDER RECORDING NO. 201901090087. [DOES NOT AFFECT - NOTHING TO PLOT]

26. EASEMENT, INCLUDING TERMS AND PROVISIONS CONTAINED THEREIN: RECORDING DATE: DECEMBER 4, 2000 RECORDING INFORMATION: 200012040064 IN FAVOR OF: OWNERS OF PARCEL C

AFFECTS: PARCELS B AND D [DOES NOT AFFECT - EASEMENT IS NO LONGER IN EFFECT; THE EASEMENT PERIOD WAS ONLY FOR 6 MONTHS FROM THE DATE OF RECORDING.]

27. THE TERMS AND PROVISIONS CONTAINED IN THE DOCUMENT ENTITLED "AGREEMENT REGARDING STREET VACATION" RECORDED JULY 26, 2001 AS INSTRUMENT NO. 200107260120 OF OFFICIAL RECORDS. BY AND BETWEEN CITY OF PUYALLUP AND WILLOWS FOUR LLC AND NIC (US) CORPORATION

(AFFECTS PARCELS A, C, D, E AND F) [DOES AFFECT - THE PORTION THAT DOES NOT FALL WITH IN PUBLIC RIGHT OF WAY - AS SHOWN]

28. EASEMENT. INCLUDING TERMS AND PROVISIONS CONTAINED THEREIN: RECORDING DATE: AUGUST 27, 2001 RECORDING INFORMATION: 200108270797 IN FAVOR OF: PUGET SOUND ENERGY, INC., A WASHINGTON CORPORATION FOR: TRANSMISSION, DISTRIBUTION AND SALE OF GAS AFFECTS: PARCEL B [DOES AFFECT — AS SHOWN]

FOR: NON-EXCLUSIVE ACCESS

[DOES AFFECT - AS SHOWN]

[DOES AFFECT - AS SHOWN]

29. EASEMENT, INCLUDING TERMS AND PROVISIONS CONTAINED THEREIN: RECORDING DATE: AUGUST 27, 2001 RECORDING INFORMATION: 200108270798 IN FAVOR OF: PUGET SOUND ENERGY. INC., A WASHINGTON CORPORATION FOR: TRANSMISSION, DISTRIBUTION AND SALE OF GAS AFFECTS: PARCELS A, C, D AND E

THE TERMS AND PROVISIONS CONTAINED IN THE DOCUMENT ENTITLED "PARTIAL RELEASE OF EASEMENT" RECORDED OCTOBER 29, 2018 AS RECORDING NO. 201810290662 OF OFFICIAL RECORDS. [DOES NOT AFFECT SUBJECT PARCELS]

30. EASEMENT, INCLUDING TERMS AND PROVISIONS CONTAINED THEREIN: RECORDING INFORMATION: MARCH 11, 2003, RECORDING NO. 200303110111 FOR: A PERPETUAL NON-EXCLUSIVE EASEMENT, FOR DRAINAGE FACILITIES AFFECTS: PARCEL B

THIS EASEMENT IS BEING RECORDED TO SUPERCEDE THAT EASEMENT RECORDED FEBRUARY 12, 2003 UNDER AUDITOR FEE NO. 200302120789. [DOES AFFECT - AS SHOWN]

31. TERMS, COVENANTS, CONDITIONS, RESTRICTIONS AND EASEMENTS AS CONTAINED IN RECORDED LOT LINE ADJUSTMENT (BOUNDARY LINE REVISION) 01-81-013: RECORDED: APRIL 3, 2003 RECORDING INFORMATION: 200304035002 (AFFECTS PARCEL NO. B AND D)

[DOES AFFECT - AS SHOWN] 32. COVENANTS, CONDITIONS, RESTRICTIONS AND/OR EASEMENTS. RECORDED: SEPTEMBER 15, 2004

RECORDING NO.: 200409150258

(AFFECTS ALL PARCELS)

[DOES AFFECT — NOTHING TO PLOT] 33. THE TERMS AND PROVISIONS CONTAINED IN THE DOCUMENT ENTITLED "ORDER OF LIQUIDATION" RECORDED MAY 26, 2009 AS RECORDING NO. 200905260568 OF OFFICIAL RECORDS.

(AFFECTS ALL PARCELS) [DOES AFFECT - NOT SURVEY RELATED] 34. TERMS, COVENANTS, CONDITIONS, RESTRICTIONS AND EASEMENTS AS CONTAINED IN RECORDED LOT LINE ADJUSTMENT

(BOUNDARY LINE REVISION) P-13-0015 RECORDED: JULY 31, 2013 RECORDING INFORMATION: 201307315004 (AFFECTS PARCELS A THROUGH E) [DOES AFFECT - AS SHOWN]

[DOES AFFECT - AS SHOWN]

[DOES AFFECT - AS SHOWN]

35. THE TERMS AND PROVISIONS CONTAINED IN THE DOCUMENT ENTITLED "DEVELOPMENT AGREEMENT" RECORDED MAY 04. 2009 AS RECORDING NO. 200905040082 OF OFFICIAL RECORDS.

A MEMORANDUM OF SAID DEVELOPMENT AGREEMENT WAS RECORDED FEBRUARY 27. 2009 UNDER RECORDING NO.

THE TERMS AND PROVISIONS CONTAINED IN THE DOCUMENT ENTITLED "ASSIGNMENT OF DEVELOPMENT AGREEMENT AND STREET VACATION AGREEMENT" RECORDED NOVEMBER 10, 2014 AS RECORDING NO. 201411100755 OF OFFICIAL RECORDS. (AFFECTS ALL PARCELS) [DOES AFFECT - AS SHOWN]

36. RESTRICTIONS, CONDITIONS, DEDICATIONS, NOTES, EASEMENTS AND PROVISIONS, IF ANY, AS CONTAINED AND/OR DELINEATED ON THE FACE OF THE CITY OF PUYALLUP SHORT PLAT NO. P-18-0172 RECORDED DECEMBER 30, 2019 AS RECORDING NO. 201912305002, IN PIERCE COUNTY, WASHINGTON. (AFFECTS PARCEL B)

37. RESTRICTIONS, CONDITIONS, DEDICATIONS, NOTES, EASEMENTS AND PROVISIONS, IF ANY, AS CONTAINED AND/OR DELINEATED ON THE FACE OF THE CITY OF PUYALLUP SHORT PLAT NO. P-18-0175 RECORDED DECEMBER 30, 2019 AS RECORDING NO. 201912305005, IN PIERCE COUNTY, WASHINGTON. (AFFECTS PARCEL C)

EXCEPTIONS 38-41 ARE NOT SURVEY RELATED EXCEPTIONS EXCEPTIONS 42-51 REFER TO TAX INFORMATION AND HAVE NOTHING TO PLOT. 52. RIGHT TO MAKE NECESSARY SLOPES FOR CUTS OR FILLS UPON SAID PREMISES FOR 110TH ST. EAST, 104TH AVENUE EAST AND 112TH STREET EAST AS GRANTED BY DEED RECORDED OCTOBER 30, 1964 UNDER RECORDING NO. 2077107. (AFFECTS PARCELS E AND F) | DOES NOT AFFECT - AREAS DESCRIBED IN DOCUMENTS ARE VACATED ROAD RIGHT OF WAYS - NOT SHOWN]

53. RIGHT TO MAKE NECESSARY SLOPES FOR CUTS OR FILLS UPON SAID PREMISES FOR 112TH ST. EAST AS GRANTED BY DEED RECORDED NOVEMBER 31, 1964 UNDER RECORDING NO. 2077104.

[DOES NOT AFFECT — AREAS DESCRIBED IN DOCUMENTS ARE VACATED ROAD RIGHT OF WAYS -NOT SHOWN]

54. EASEMENT, INCLUDING TERMS AND PROVISIONS CONTAINED THEREIN: RECORDING INFORMATION: DECEMBER 5, 1977 UNDER RECORDING NO. 2782956 FOR: CONSTRUCTING SLOPES FOR NECESSARY CUTS AND FILLS

AFFECTS: PARCEL D [CAN NOT BE DETERMINED - DOCUMENT IS ELIGIBLE]

55. EASEMENT, INCLUDING TERMS AND PROVISIONS CONTAINED THEREIN: RECORDING DATE: JUNE 27, 1979

RECORDING INFORMATION: 2929859 IN FAVOR OF: HANS G. LINDSTROM AND ANN K. LINDSTROM, HUSBAND AND WIFE, AND PER A. LINDSTROM, AS HIS SEPARATE PROPERTY, AND WINMAR COMPANY, INC., A CALIFORNIA CORPORATION FOR: INGRESS, EGRESS, AND UTILITIES AND THE RIGHT TO PHYSICALLY ALTER THE SLOPE, GRADE, LANDSCAPING OR ALTER THE PROPERTY IN ANY MANNER WHICH GRANTOR AND GRANTEE DEEMS NECESSARY FOR DEVELOPMENT OF ADJACENT PROPERTY

AFFECTS: PARCEL E [DOES AFFECT - AS SHOWN]

56. EASEMENT, INCLUDING TERMS AND PROVISIONS CONTAINED THEREIN: RECORDING DATE: JANUARY 15, 1985 RECORDING INFORMATION: 8501150183 IN FAVOR OF: FRUITLAND MUTUAL WATER COMPANY FOR: WATERLINE AFFECTS: PARCEL D [DOES AFFECT - AS SHOWN]

57. COVENANTS, CONDITIONS AND REQUIREMENTS, AS SET FORTH IN SETTLEMENT AGREEMENT FILED IN SUPERIOR COURT CAUSE NO. 87-2-04250-8. (AFFECTS PARCELS E AND F)

[NOT SURVEY RELATED - NOT SHOWN]

58. COVENANTS, CONDITIONS, RESTRICTIONS AND/OR EASEMENTS: RECORDED: DECEMBER 20, 1993 RECORDING NO.: 9312201161 (AFFECTS PARCELS D, E AND F) [NOTHING TO PLOT IN REFERENCE TO AFFECTED PARCELS]

59. RESTRICTIONS, CONDITIONS, DEDICATIONS, NOTES, EASEMENTS AND PROVISIONS, IF ANY, AS CONTAINED AND/OR DELINEATED ON THE FACE OF THE SURVEY RECORDED AUGUST 29, 2000 AS RECORDING NO. 200008295004, IN PIERCE COUNTY, WASHINGTON. (AFFECTS PARCELS D AND E)

[NOTING TO PLOT - 39TH AVENUE SE HAS BEEN VACATED]

60. NOTICE OF ORDINANCE NO. 2690, RECORDED JULY 26, 2001 UNDER RECORDING NUMBER 200107260119, REGARDING VACATION OF A PORTION OF 39TH AVENUE SE. (AFFECTS PARCELS D AND E) [DOES AFFECT - AS SHOWN]

61. RESTRICTIONS, CONDITIONS, DEDICATIONS, NOTES, FASEMENTS AND PROVISIONS, IF ANY, AS CONTAINED AND/OR DELINEATED ON THE FACE OF THE CITY OF PUYALLUP SHORT PLAT RECORDED APRIL 4, 2003 AS RECORDING NO. 200304045006, IN PIERCE COUNTY, WASHINGTON. (AFFECTS PARCELS E AND F) [DOES AFFECT - AS SHOWN]

62. THE TERMS. PROVISIONS AND EASEMENT(S) CONTAINED IN THE DOCUMENT ENTITLED "RECIPROCAL SURFACE WATER DETENTION EASEMENT" RECORDED APRIL 4, 2003 AS RECORDING NO. 200304041511 OF OFFICIAL RECORDS. (AFFECTS PARCELS E AND F) [DOES AFFECT - AS SHOWN]

63. THE TERMS AND PROVISIONS CONTAINED IN THE DOCUMENT ENTITLED "ORDINANCE NO. 3086" RECORDED JULY 01. 2016 AS RECORDING NO. 201607010274 OF OFFICIAL RECORDS. (AFFECTS PARCEL D)

64. RESTRICTIONS, CONDITIONS, DEDICATIONS, NOTES, EASEMENTS AND PROVISIONS, IF ANY, AS CONTAINED AND/OR DELINEATED ON THE FACE OF THE SURVEY RECORDED AUGUST 18, 1986 AS 8608180375, IN PIERCE COUNTY, (AFFECTS PARCEL F)

[NOTHING SHOWN - 39TH AVENUE SE HAS BEEN VACATED]

[DOES AFFECT - AS SHOWN]

[DOES AFFECT - AS SHOWN]

65. THE TERMS AND PROVISIONS CONTAINED IN THE DOCUMENT ENTITLED "RECIPROCAL UTILITIES EASEMENT" RECORDED SEPTEMBER 15, 2004 AS 200409150257 OF OFFICIAL RECORDS.

DOCUMENT(S) DECLARING MODIFICATIONS THEREOF RECORDED MARCH 24, 2006 AS 200603241279 OF OFFICIAL RECORDS. (AFFECTS PARCEL F) [DOES AFFECT - AS SHOWN]

66. RESTRICTIONS, CONDITIONS, DEDICATIONS, NOTES, EASEMENTS AND PROVISIONS, IF ANY, AS CONTAINED AND/OR DELINEATED ON THE FACE OF THE CITY OF PUYALLUP SHORT PLAT NO. P-18-0173 RECORDED DECEMBER 30, 2019 AS 201912305003, IN PIERCE COUNTY, WASHINGTON. (AFFECTS PARCEL D)

67. RESTRICTIONS. CONDITIONS. DEDICATIONS. NOTES. EASEMENTS AND PROVISIONS. IF ANY. AS CONTAINED AND/OR DELINEATED ON THE FACE OF THE CITY OF PUYALLUP SHORT PLAT NO. P-18-0174 RECORDED DECEMBER 30, 2019 AS 201912305004, IN PIERCE COUNTY, WASHINGTON. (AFFECTS PARCEL E) [DOES AFFECT - AS SHOWN]

Legal Description

LOT 4 OF CITY OF PUYALLUP BOUNDARY LINE REVISION NO. P-13-0015, RECORDED JULY 31, 2013 UNDER RECORDING NO. 201307315004, PIERCE COUNTY, WASHINGTON.

PARCEL B: TRACT A AND LOT 1 OF CITY OF PUYALLUP SHORT PLAT NO. P-18-0172 RECORDED DECEMBER 30, 2019 UNDER

PARCEL C:

RECORDING NO. 201912305002, IN PIERCE COUNTY, WASHINGTON.

TRACT A AND LOT 1 OF CITY OF PUYALLUP SHORT PLAT NO. P-18-0175, RECORDED DECEMBER 30, 2019 UNDER RECORDING NO. 201912305005, IN PIERCE COUNTY, WASHINGTON.

PARCEL D: LOT 1 AND TRACT A OF CITY OF PUYALLUP SHORT PLAT NO. P-18-0173, RECORDED UNDER RECORDING NO.

201912305003, IN PIERCE COUNTY, WASHINGTON.

PARCEL E : LOT 1 AND TRACT A OF CITY OF PUYALLUP SHORT PLAT NO. P-18-0174, RECORDED UNDER RECORDING NO.

201912305004, IN PIERCE COUNTY, WASHINGTON.

RECORDS, IN PIERCE COUNTY, WASHINGTON;

LOT 3, CITY OF PUYALLUP SHORT PLAT RECORDED APRIL 4, 2003 UNDER RECORDING NO. 200304045006 OF OFFICIAL

EXCEPT THOSE PORTIONS DESCRIBED IN DEED TO THE CITY OF PUYALLUP RECORDED MARCH 21, 2003 UNDER RECORDING NO. 200303211005 OF OFFICIAL RECORDS;

AND EXCEPT ANY PORTION OF THE VACATED RIGHT OF WAY OF EXISTING 39TH AVENUE SOUTH EAST, LYING SOUTH OF AND ABUTTING THE SOUTH LINE OF SAID LOT 3, AS DESCRIBED IN DEED TO THE CITY OF PUYALLUP RECORDED AUGUST 11, 2009 UNDER RECORDING NO. 200908110760 OF OFFICIAL RECORDS.

THE LEGAL DESCRIPTION AND EXCEPTIONS WERE TAKEN FROM A TITLE POLICY PREPARED BY FIRST AMERICAN TITLE INSURANCE COMPANY BEARING A FILE NO. OF NCS-983231-OR1 WITH AN COMMITMENT DATE OF MAY 27, 2020 AT 8:00 AM. THIS TITLE POLICY WAS USED AS THE SOLE SOURCE OF RECORD ENCUMBRANCES AND LERGY SURVEYORS AND ENGINEERS INC ASSUMES NO LIABILITY FOR ERRORS OR OMISSIONS THEREIN.

SURVEYOR'S CERTIFICATION

1. NO OBSERVABLE EVIDENCE OF EARTH MOVING WORK, BUILDING CONSTRUCTION OR BUILDING ADDITIONS WITHIN RECENT MONTHS EXCEPT AS NOTED.

Surveyor's Notes

2. NO OBSERVABLE EVIDENCE OF CHANGES IN STREET RIGHT OF WAY LINES COMPLETED, AND AVAILABLE FROM THE CONTROLLING JURISDICTION AND NO OBSERVABLE EVIDENCE OF RECENT STREET OR SIDEWALK CONSTRUCTION OR REPAIRS.

3. NO OBSERVABLE EVIDENCE OF SITE USE AS A SOLID WASTE DUMP. SUMP OR SANITARY LANDFILL

4. ALL STATEMENTS WITHIN THE CERTIFICATION, AND OTHER REFERENCES LOCATED ELSEWHERE HEREON, RELATED TO: UTILITIES, IMPROVEMENTS, STRUCTURES, BUILDINGS, PARTY WALLS, PARKING, EASEMENTS, SERVITUDES, AND ENCROACHMENTS; ARE BASED SOLELY ON ABOVE GROUND, VISIBLE EVIDENCE, UNLESS ANOTHER SOURCE OF INFORMATION IS SPECIFICALLY REFERENCED HEREON.

5. SOME PARTS OF THIS MAP MAY BE SHOWN OUT OF SCALE FOR CLARITY.

6. THE PROPERTY HAS DIRECT PHYSICAL ACCESS AND MEANS OF INGRESS AND EGRESS TO 43RD AVENUE SE, 5TH STREET SE, 39TH AVENUE SE, 3RD STREET SE, 37TH AVENUE SE, PUBLIC STREETS; ON WHICH THE PROPERTY ABUTS.

8. THE ACCOMPANYING SURVEY WAS MADE ON THE GROUND AND CORRECTLY SHOWS THE LOCATION OF ALL BUILDINGS, STRUCTURES AND OTHER IMPROVEMENTS SITUATED ON THE ABOVE PREMISES; THERE ARE NOT VISIBLE ENCROACHMENTS ON THE SUBJECT PROPERTY OR UPON ADJACENT LAND ABUTTING SAID PROPERTY FXCEPT AS SHOWN HEREON AND WAS MADE IN ACCORDANCE WITH LAWS AND/OR MINIMUM STANDARDS OF THE STATE OF WASHINGTON.

9. THIS PROPERTY DOES CONTAIN WETLANDS AS SHOWN ON THE MAP (NOT SURVEYED BY LEROY SURVEYORS & ENGINEERS, BUT PROVIDED BY RECORDED SURVEYS.

10. LOT APPEARS TO BE SERVED BY UTILITIES, (ONLY OBSERVED EVIDENCE OF UTILITIES WHERE REQUIRED FOR THIS SURVEY, NO MARKINGS WHERE PROVIDED BY ANY STATE OR LOCAL AGENCIES. LEROY SURVEYORS AND ENGINEERS, INC. IS NOT LIABLE FOR ERRORS OR OMISSIONS IN REGARDS TO UTILITIES SHOWN OR NOT SHOWN ON THE FACE OF THE MAP.

Flood Notes

BY GRAPHIC PLOTTING ONLY, THIS PROPERTY IS LOCATED IN ZONE "X" OF THE FLOOD INSURANCE RATE MAP,

SPECIAL FLOOD HAZARD AREA. NO FIELD SURVEYING WAS PERFORMED TO DETERMINE THIS ZONE AND AN

COMMUNITY PANEL NO. 53053-0343-E, WHICH BEARS A EFFECTIVE DATE OF MARCH 7, 2017 AND IS NOT IN A

ELEVATION CERTIFICATE MAY BE NEEDED TO VERIFY THIS DETERMINATION OR APPLY FOR A VARIANCE FROM THE

11. DATE OF FIELD SURVEY: 06/10-12/2020, 06/15/2020, 06/18/2020

THIS SURVEY IS MADE FOR THE BENEFIT OF AND IS CERTIFIED TO:

ASSUMES NO LIABILITY FOR ERRORS OR OMISSIONS THEREIN.

DOS LAGOS ASSET LLC, A CALIFORNIA LIMITED LIABILITY COMPANY OSLIC HOLDINGS LLC, A WASHINGTON LIMITED LIABILITY COMPANY FIRST AMERICAN TITLE INSURANCE COMPANY:

I, PAUL KUHNLE, A REGISTERED LAND SURVEYOR IN THE STATE OF WASHINGTON, DO HEREBY CERTIFY TO THE AFORESAID PARTIES. THEIR SUCCESSORS AND ASSIGNS. AS OF THE DATE SET FORTH HEREON, THAT I HAVE MADE A CAREFUL SURVEY OF THE TRACT OF LAND DESCRIBED AND SHOWN HEREON.

37TH ÁVE. SE

43TH AVE. SE ARRAIT

VICINITY MAP

NOT TO SCALE

SEC. 10

Title Information

THE PROPERTY DESCRIBED HEREON IS THE SAME AS THE PROPERTY DESCRIBED IN FIRST AMERICAN TITLE

2020 AT 8:00 AM AND THAT EASEMENTS, COVENANTS AND RESTRICTIONS REFERENCED IN SAID TITLE

INSURANCE COMPANY TITLE POLICY, FILE NUMBER NCS-983231-OR1 HAVING A COMMITMENT DATE OF MAY 27,

COMMITMENT OR APPARENT FROM A PHYSICAL INSPECTION OF THE SITE OR OTHERWISE KNOWN TO HAVE BEEN

PLOTTED HEREON OR OTHERWISE NOTED AS TO THEIR EFFECT ON THE SUBJECT PROPERTY. THIS TITLE POLICY

WAS USED AS THE SOLE SOURCE OF RECORD ENCUMBRANCES AND LEROY SURVEYORS AND ENGINEERS. INC.

THE LAND SHOWN IN THIS SURVEY IS THE SAME AS THAT DESCRIBED IN TITLE POLICY REFERENCED ABOVE.

I FURTHER CERTIFY THAT:

1. THE SURVEY REFLECTED BY THIS PLAT WAS ACTUALLY MADE UPON THE GROUND AND THAT THIS PLAT OF SURVEY IS MADE AT LEAST IN ACCORDANCE WITH THE "MINIMUM STANDARD DETAIL REQUIREMENTS FOR ALTA/NSPS LAND TITLE SURVEYS" JOINTLY ESTABLISHED AND ADOPTED BY ALTA, NSPS AND NSPS IN 2011 AND MEETS THE ACCURACY STANDARDS (AS ADOPTED BY ALTA, NSPS AND NSPS AND IN EFFECT ON THE DATE OF THIS CERTIFICATION), WITH ACCURACY AND PRECISION REQUIREMENTS MODIFIED TO MEET CURRENT MINIMUM ANGULAR AND LINEAR TOLERANCE REQUIREMENTS OF THE STATE IN WHICH THE SUBJECT PROPERTY IS LOCATED. AND CONTAINS ITEMS 2, 3, 5, 7(A), 7(B)(1), 7(B)(2), 8, 9, 11, 13, 14, 16, 17, 18, AND 19 OF TABLE A

2. THE SURVEY CORRECTLY SHOWS THE LOCATION OF ALL BUILDINGS, STRUCTURES AND OTHER IMPROVEMENTS SITUATED ON THE "PROPERTY" DESCRIBED IN THE TITLE POLICY.

3. EXCEPT AS SHOWN, ALL UTILITIES SERVING THE PROPERTY ENTER THROUGH ADJOINING PUBLIC STREETS AND/OR EASEMENTS OF RECORD: THAT, EXCEPT AS SHOWN, THERE ARE NO VISIBLE EASEMENTS, OR RIGHTS OF WAY ACROSS SAID PROPERTY: THAT THE PROPERTY DESCRIBED HEREON IS THE SAME AS THE PROPERTY DESCRIBED IN FIRST AMERICAN TITLE INSURANCE COMPANY COMMITMENT NO. NCS-983231-OR1 AND ALL EASEMENTS. COVENANTS AND RESTRICTIONS REFERENCED IN SAID TITLE COMMITMENT. OR EASEMENTS OF WHICH THE UNDERSIGNED HAS BEEN ADVISED OR HAS KNOWLEDGE, HAVE BEEN PLOTTED OR OTHERWISE NOTED AS TO THEIR EFFECT ON THE SUBJECT PROPERTY.


4. EXCEPT AS SHOWN. THERE APPEARS TO BE NO ENCROACHMENTS ONTO ADJOINING PROPERTY. STREETS OR ALLEYS BY ANY BUILDINGS. STRUCTURES OR OTHER IMPROVEMENTS SITUATED ON ADJOINING PROPERTY ACROSS PROPERTY LINES ONTO SAID PROPERTY OR ACROSS ZONING RESTRICTION LINES IN EFFECT AS OF THE DATE OF THE SURVEY.

5. THE PROPERTY HAS DIRECT PHYSICAL ACCESS AND MEANS OF INGRESS AND EGRESS TO 43RD AVENUE SE. 5TH STREET SE, 39TH AVENUE SE, 3RD STREET SE, 37TH AVENUE SE, PUBLIC STREETS ON WHICH THE PROPERTY ABUTS.

6. THE NUMBER OF STRIPED PARKING SPACES LOCATED ON THE SUBJECT PROPERTY APPEARS TO BE O-REGULAR & O-HANDICAP FOR A TOTAL OF O-PARKING STALLS, AND TO THE EXTENT POSSIBLE, ARE GRAPHICALLY SHOWN HEREON.

REGISTRATION NO. 12944

IN THE STATE OF WASHINGTON DATE OF SIGNATURE: August 16. 2023 DATE OF FIELD SURVEY: JUNE 10, 11, 12, 15 & 18, 2020

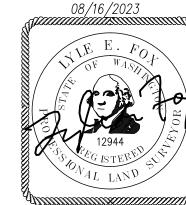

12896

1 OF 6




FEDERAL EMERGENCY MANAGEMENT AGENCY.

BEFORE ANY CONSTRUCTION CONTACT: CALL BEFORE YOU DIG @ 1-800-424-5555




Drawing No.: 12896-B 20230816.DW Date: 2023-08-1 GEOLOGY SEPTIC DESIGN GPS J. JACOBY GIS MAPPING Project: P. KUHNLE J. JACOBY

© LEROY SURVEYORS & ENGINEERS 08/16/23

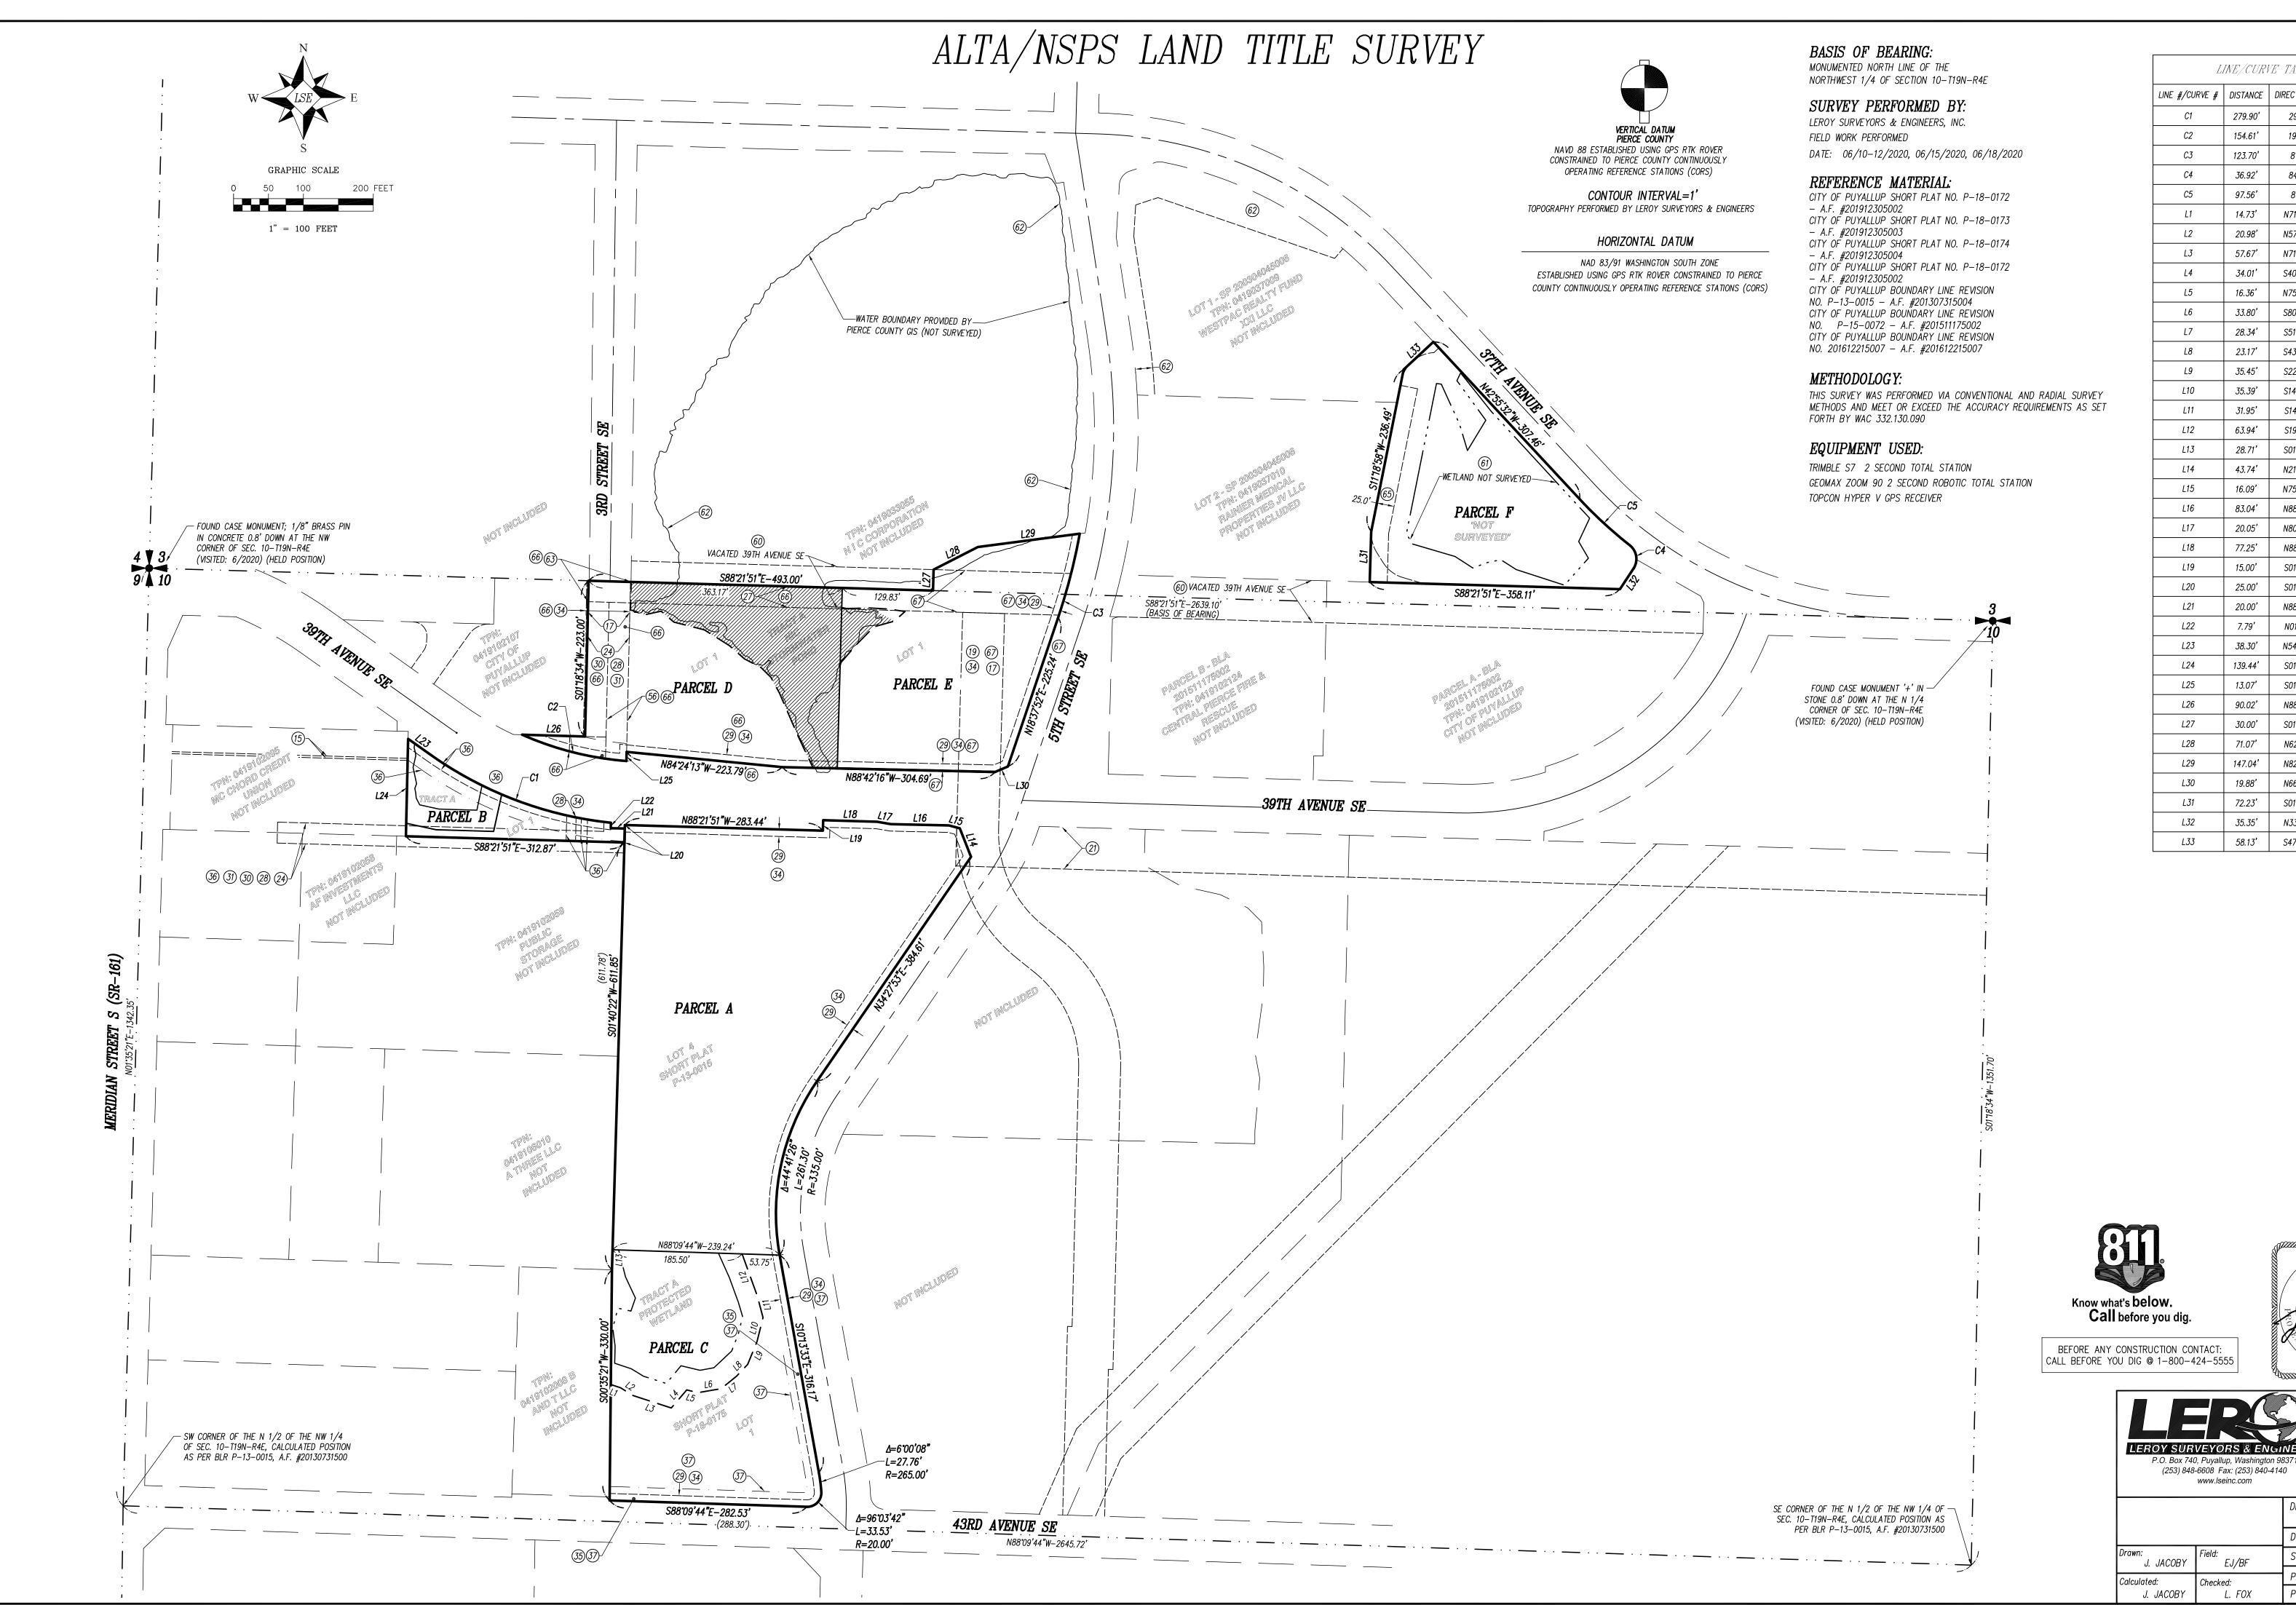

© LEROY SURVEYORS & ENGINEERS 08/16/23




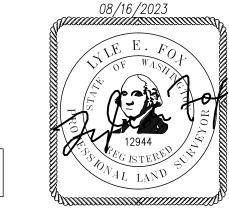



GEOLOGY SEPTIC DESIGN Drawing No.:

		12896-	-B 20230816.DWG
		Date:	2023-08-16
Drawn: J. JACOBY	Field: EJ/BF	Scale:	1"=100'.
Calculated:	Checked:	Project:	12896
J. JACOBY	L. FOX	Page:	2 OF 6

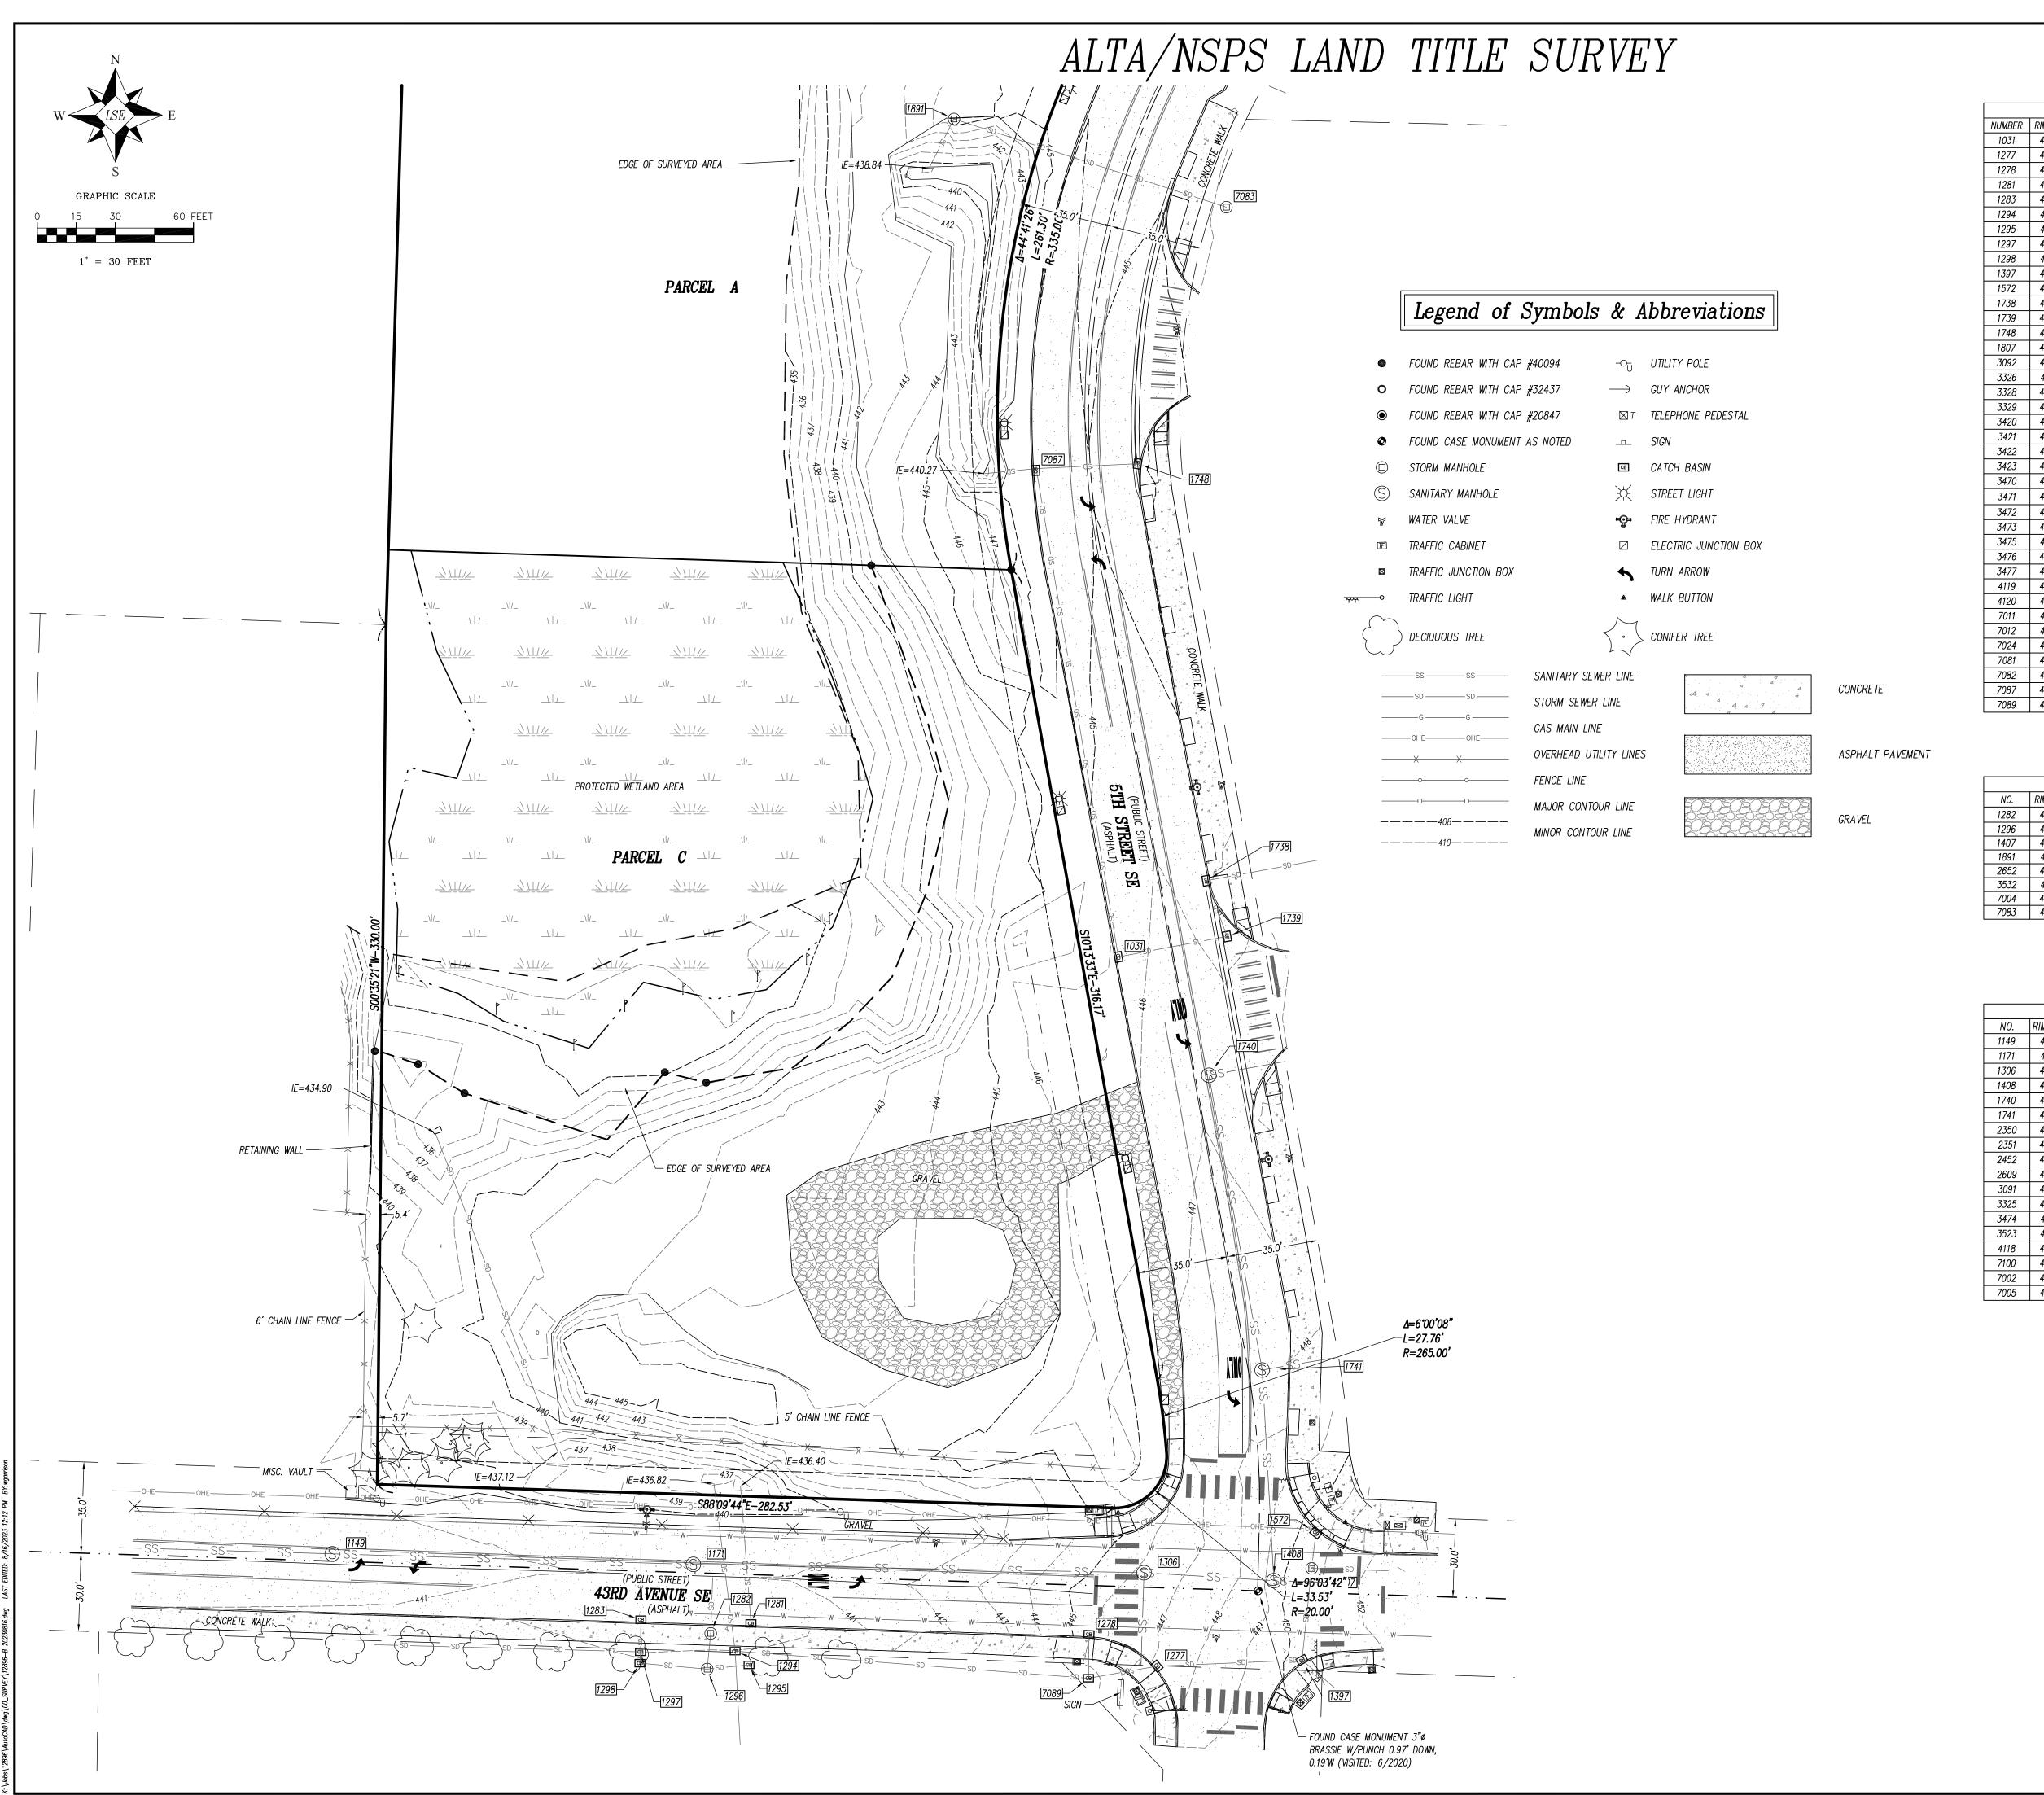


© LEROY SURVEYORS & ENGINEERS 08/16/23

CATCH BASIN ASBUILT INFORMATION									
NUMBER	RIM ELEV	TYPE	ΙΕ	DESCRIPTION	IE	DESCRIPTION	IE	DESCRIPTION	NOTES
1031		CATCH BASIN		12" DI N	441.20	12" DI E	"_	DESONII ITON	NOTES
1277		CATCH BASIN		12" PVC E		12" DI W			
1278	445.55	CATCH BASIN		12" DI S	770.02				
1281		CATCH BASIN		12" DI N					
1283		CATCH BASIN		12" CONC N					
1294		CATCH BASIN		12" DI N	438.70	12" PVC S			
1295		CATCH BASIN		12" DI N	437.53	12" DI E	437.43	12" DI W	
1297		CATCH BASIN		12" DI N	437.47	12" DI S		24" DI W	
1298	441.05	CATCH BASIN		12" DI N	437.45	24" DI E		24" DI W	
1397	450.56	CATCH BASIN		12" DI N		12" DI SE		12" PVC W	
1572	450.54	CATCH BASIN		12" DI S					
1738	445.49	CATCH BASIN		12" PVC E	441.64	12" DI S			
1739	445.87	CATCH BASIN	441.48	12" DI N	441.42	12" DI W			
1748	444.34	CATCH BASIN	440.54	12" PVC W					
1807	446.57	CATCH BASIN	442.27	12" ABS N	442.25	12" DI E			
3092	446.39	CATCH BASIN	442.49	12" DI W					
3326	439.61	CATCH BASIN	435.51	12" DI N	435.51	12" PVC S	435.56	12" PVC W	
3328	439.77	CATCH BASIN	435.72	12"PVC E					
3329	442.38	CATCH BASIN	438.18	12" E	438.28	12" S			
3420	436.44	CATCH BASIN		8" DI S					
3421	434.86	CATCH BASIN		8" DI S					
3422		CATCH BASIN		8" DI S					
3423		CATCH BASIN		8" DI S					
3470	436.82	CATCH BASIN		12" PVC SE	432.68	12" PVC NW			
3471	436.48	CATCH BASIN	432.53	12" DI W		12" PVC NW (GIS)		8" NE DI	CAN'T ID OTHER PIPES
3472	435.70	CATCH BASIN		12" PVC SE	432.20	12" PVC NW			
3473		CATCH BASIN		8" DI N	431.80	12" PVC E		12" DI NW	
3475	435.13	CATCH BASIN		18" DI S	431.67	12" DI E	431.71	12" DI W	
3476	435.87	CATCH BASIN		8" DI N	435.87	12" DI E	432.02	12" DI W	
3477	436.88	CATCH BASIN		8" DI N	432.13	12" DI W			
4119		CATCH BASIN		12" DI W					
4120		CATCH BASIN		12" DI SE					
7011		CATCH BASIN		8" DI N		8" DI S	439.94		
7012		CATCH BASIN		12" DI N		8" DI S	439.64	12" DI E	
7024		CATCH BASIN		12" DI N	437.66	12" DI S			
7081		CATCH BASIN		12" DI E					
7082		CATCH BASIN		12" DI S		12" DI W			
7087		CATCH BASIN		12" DI S		12" DI E		12" DI W	
7089	445.52	CATCH BASIN	441.82	12" DI N	441.82	12" DI E	441.63	12" DI W	

	STORM MANHOLE SYSTEM ASBUILT INFORMATION								
NO.	RIM ELEV	TYPE	ΙE	DESCRIPTION	ΙE	DESCRIPTION	ΙE	DESCRIPTION	NOTES
1282	440.65	STORM MH	437.13	18" DI N	433.05	SUMP CENTER		12" DI S (GIS)	TYPE II, 8" VERT, LADDER SE
1296	442.09	STORM MH	438.54	24" DI W	438.54	12" DI E	439.09	TOP OVERFLOW-N	
1407	450.66	STORM MH	448.21	12" DI N	448.16	12" DI E	448.21	12" DI S	
1891	445.81	STORM MH	438.96	24" ABS E	438.96	24" ABS S			LADDER N
2652	439.06	STORM MH	436.71	TOP OVERFLOW	435.71	IE 8" E	434.31	12" W - UNKNOWN	LADDER N
<i>3532</i>	435.91	STORM MH	429.22	18" DI N	429.21	12" PVC SE			
7004	436.67	STORM MH	433.12	12" DI W	434.27	12" DI VERTICAL			LADDER S
7083	446.32	STORM MH	439.63	24" ABS W	439.62	12" PVC SE			

	SANITARY SYSTEM ASBUILT INFORMATION								
NO.	RIM ELEV	TYPE	ΙΕ	DESCRIPTION	ΙE	DESCRIPTION	ΙE	DESCRIPTION	NOTES
1149	441.55	SANITARY MH	437.68	12" DI N	437.58	12" DI W			LADDER S
1171	440.71	SANITARY MH	438.34	12" DI E	438.24	12" DI W			NO LADDER
1306	446.26	SANITARY MH	440.71	8" PVC S	438.82	8" PVC E	438.71	12" DI W	LADDER N
1408	449.76	SANITARY MH	439.53	8" PVC N	439.51	8" PVC E	439.41	8" PVC W	LADDER S
1740	446.68	SANITARY MH	440.44	8" PVC S	440.56	8" PVC E			LADDER S & NW
1741	447.75	SANITARY MH	439.92	8" PVC N	439.82	8" PVC S	439.98	8" PVC E	LADDER NW
<i>2350</i>	437.09	SANITARY MH							DIRT FILLED
2351	437.77	SANITARY MH	432.14	12" PVC N	432.24	12" PVC S	432.31	12" DI E	LADDER S
2452	436.93	SANITARY MH	433.80	12" DI E	433.90	12" DI W			NO LADDER
2609	439.58	SANITARY MH	433.85	8" PVC N	433.98	8" PVC S	434.03	8" PVC E & W	NO LADDER
3091	447.62	SANITARY MH	437.61	8" PVC NE	437.72	8" PVC SE			LADDER SW
<i>3325</i>	443.66	SANITARY MH	435.65	8" PVC SW	435.52	8 PVC N			LADDER E
3474	435.31	SANITARY MH	433.10	12" DI N	433.21	12" DI S			NO LADDER
<i>3523</i>	435.15	SANITARY CLEAN OUT							
4118	435.82	SANITARY MH	433.64	12" DI W	433.51	12" DI N	433.68	UNKNOW-SE	NO LADDER
7100	436.64	SANITARY MH	430.71	8" PVC N	430.59	8" PVC S	430.49	6" PVC E	LADDER W
7002	440.79	SANITARY MH	431.74	8" PVC N	431.64	8" PVC S	431.54	6" PVC W	LADDER S
7005	438.09	SANITARY MH	434.52	12" DI E	434.42	12" DI W			NO LADDER

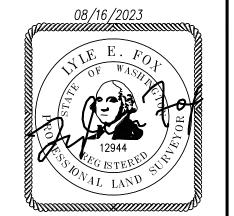





BEFORE ANY CONSTRUCTION CONTACT: CALL BEFORE YOU DIG @ 1-800-424-5555


LEROY SURVEYORS & ENGINEERS P.O. Box 740, Puyallup, Washington 98371 (253) 848-6608 Fax: (253) 840-4140 www.lseinc.com	SURVEYING ENGINEERING GEOLOGY SEPTIC DESIGN GPS GIS MAPPING

		Drawing No.: 12896-	Drawing No.: 12896-B 20230816.DWG		
		Date:	2023-08-16		
Drawn: J. JACOBY	Field: EJ/BF	Scale:	1"=30'.		
Calculated:	Checked:	Project:	12896		
J. JACOBY	L. FOX	Page:	3 OF 6		

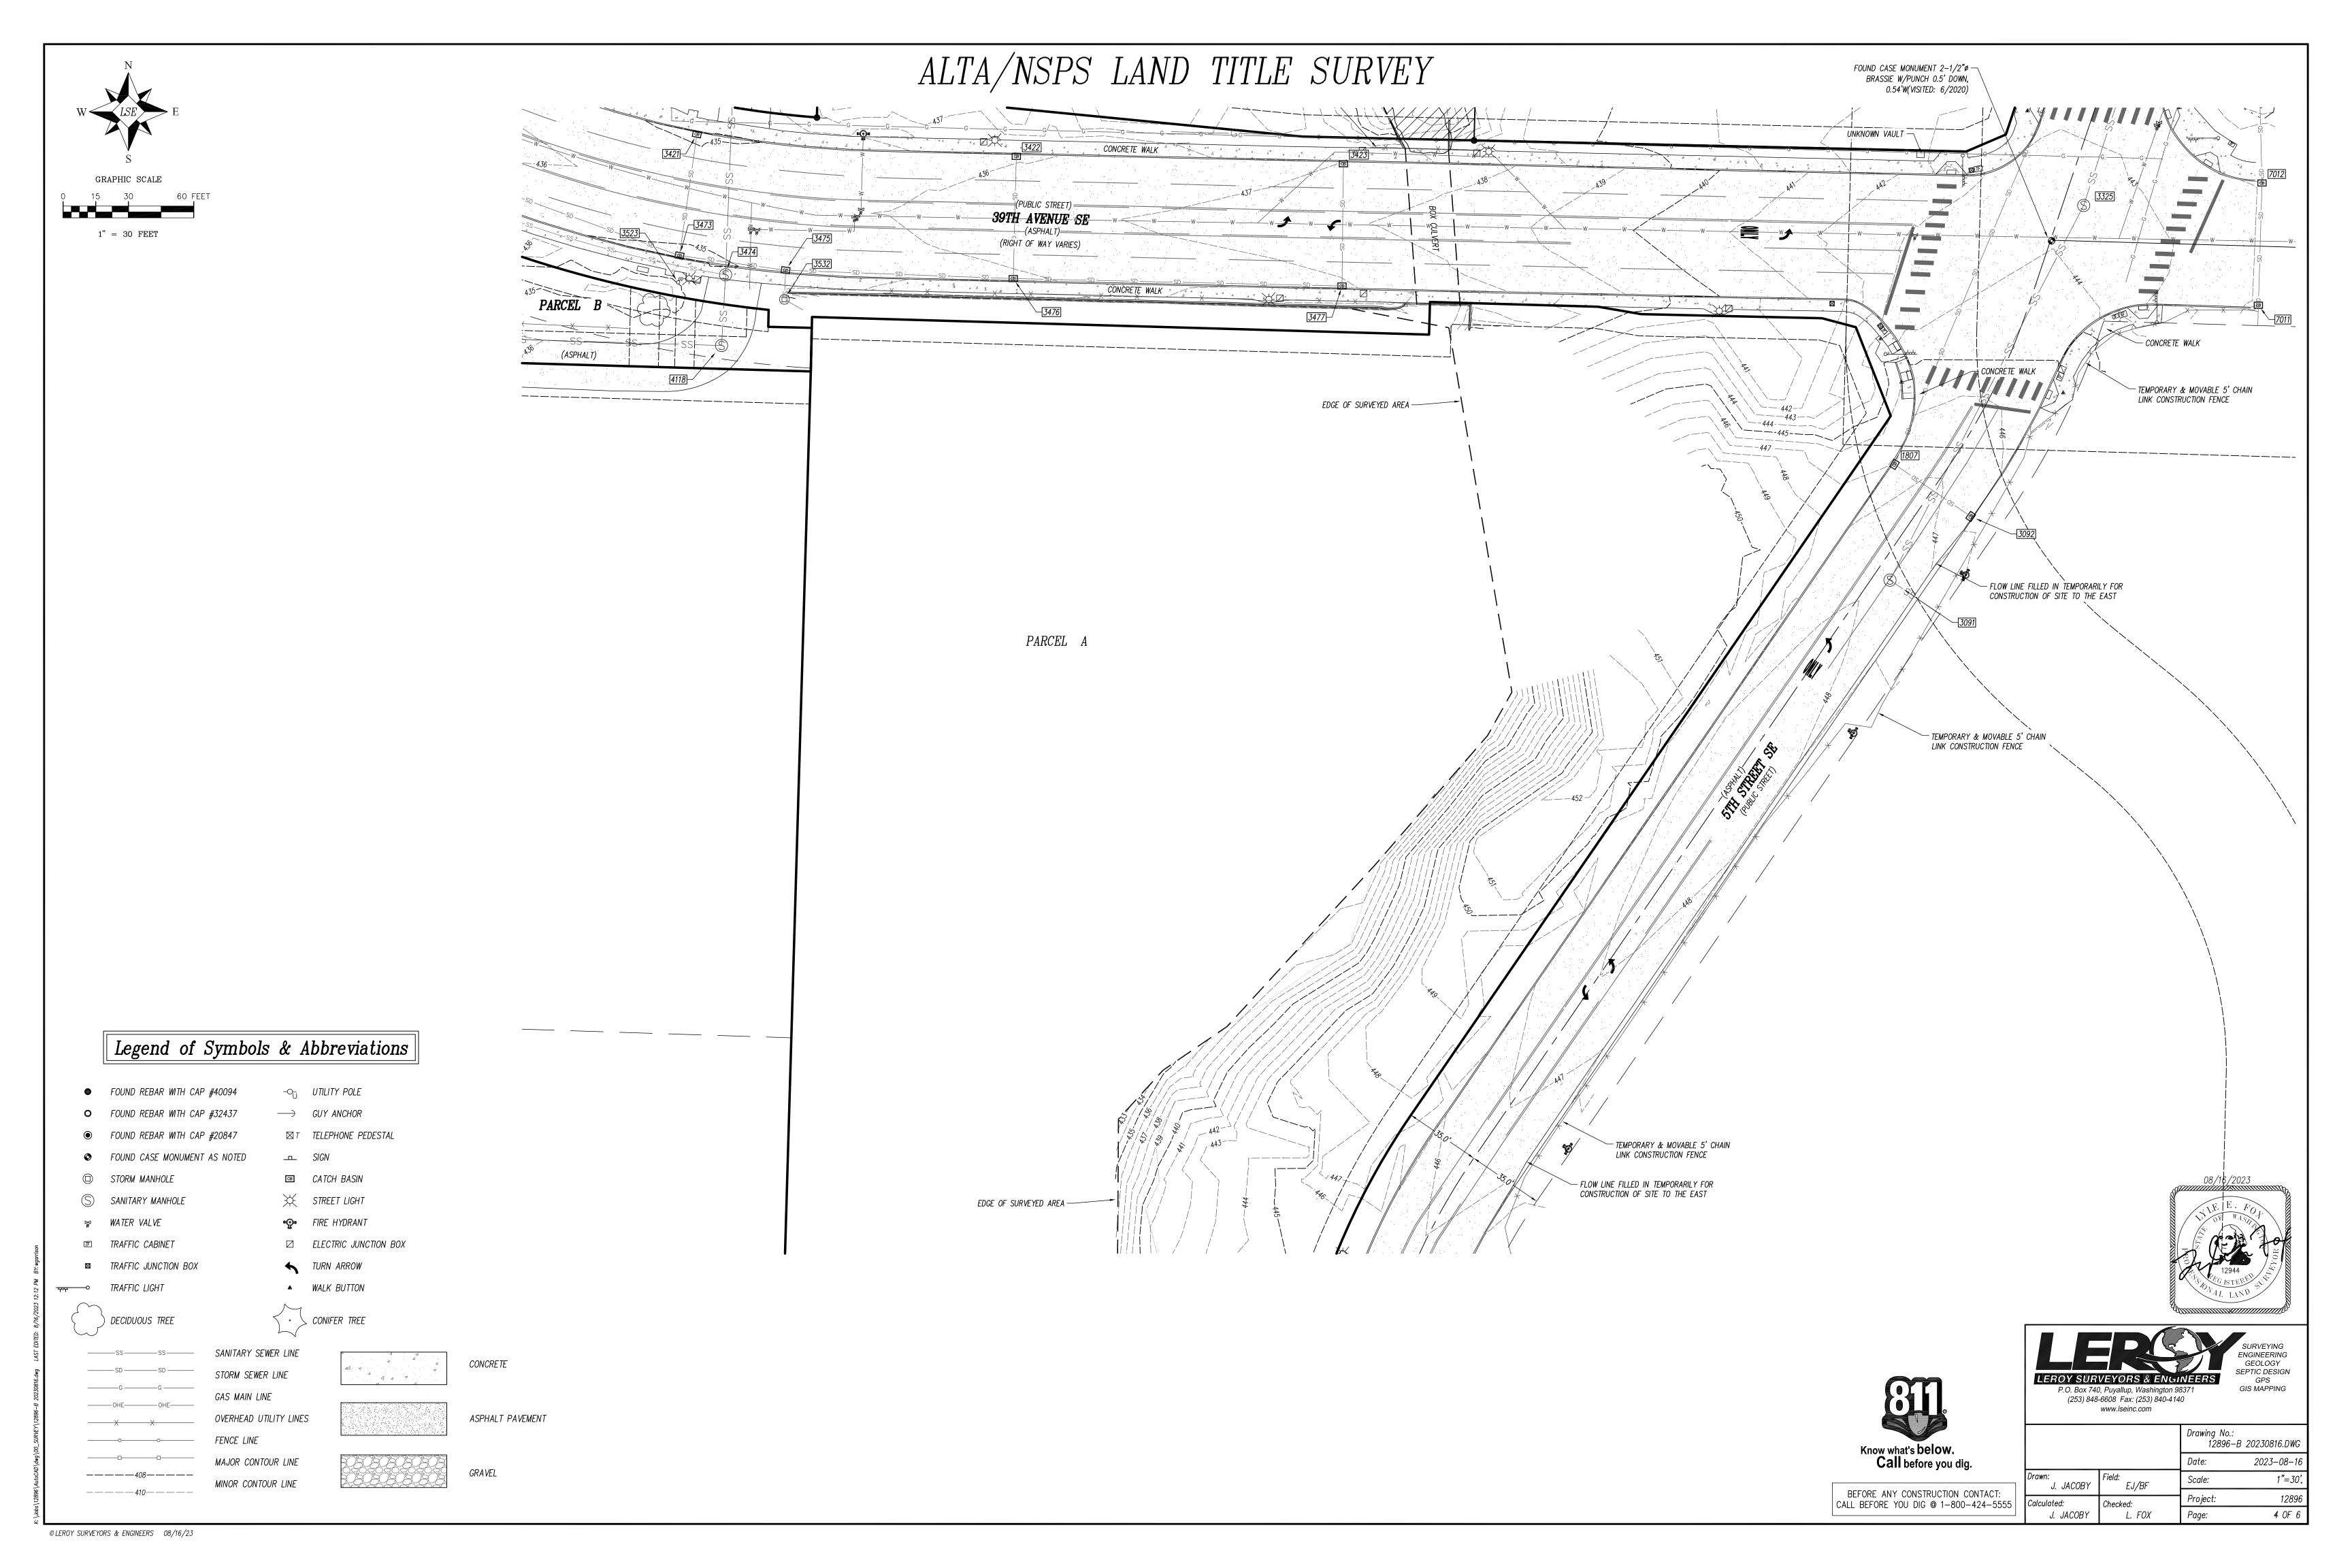

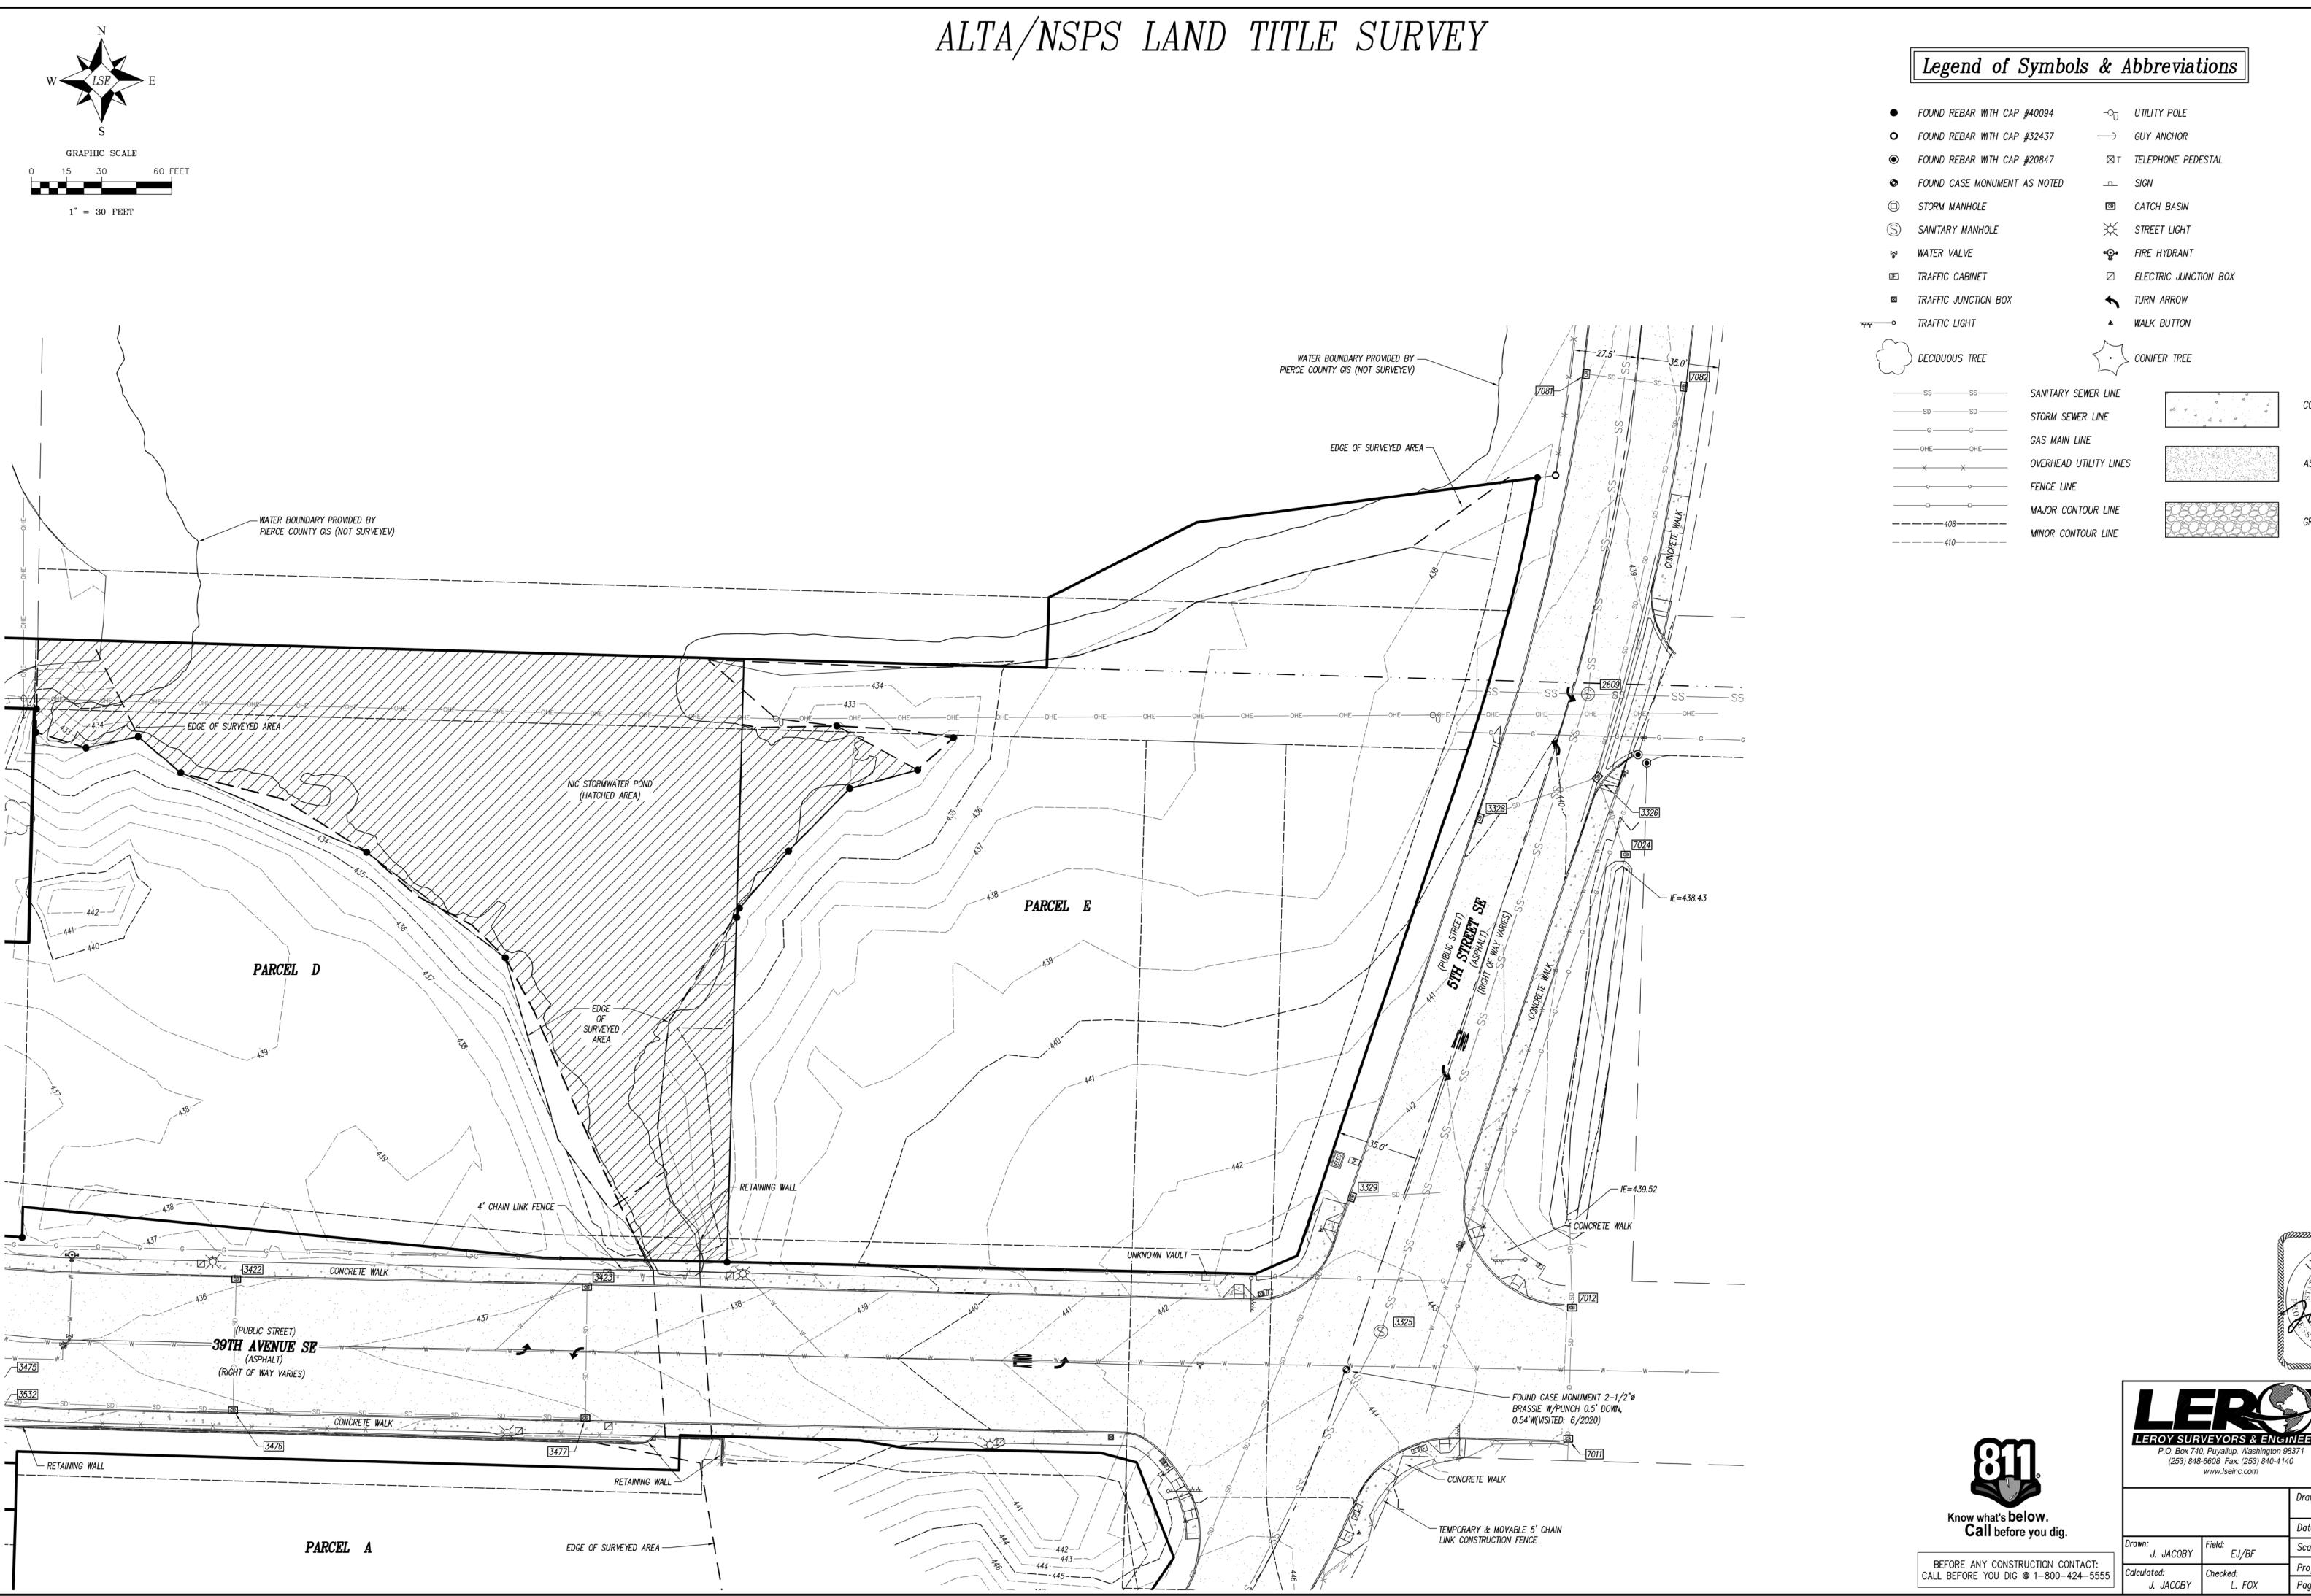

© LEROY SURVEYORS & ENGINEERS 08/16/23

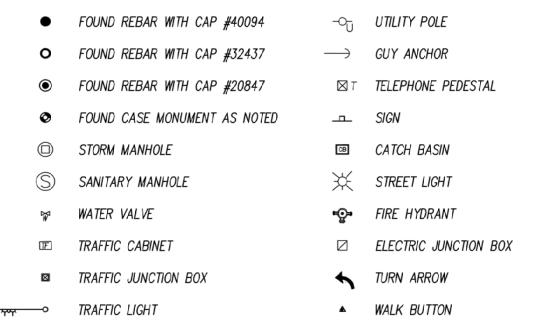

CONCRETE ASPHALT PAVEMENT



SEPTIC DESIGN

elow.			Drawing No.: 12896—E	3 20230816.D W G
re you dig.			Date:	2023-08-16
	Drawn: J. JACOBY	Field: EJ/BF	Scale:	1"=30'.

2023-08-16 L. FOX 5 OF 6

