


6'
PERIMETER
LANDSCAPE
BUFFER



13' R/W 7th St SW

10' PERIMETER
LANDSCAPE

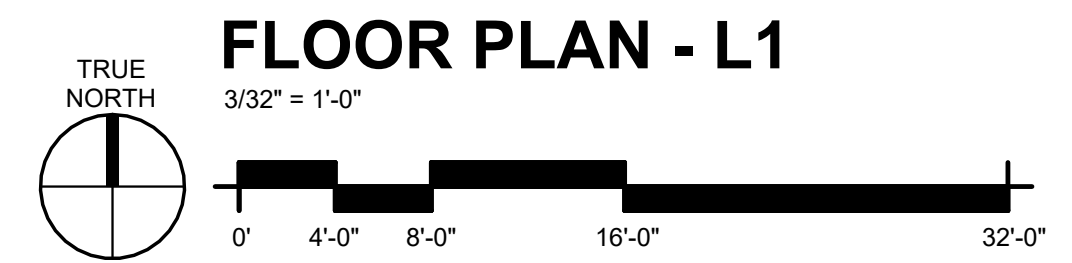

FLOOR PLAN - L1

(Floor Plan - L1 and Floor Plan L2(L3 Sim))Please provide a fully dimensioned floor plan to demonstrate the proposed building modulation. It appears that the patio and balconies may meet the modulation requirements however, the lengths of the exterior walls between patios/balconies and other areas of the facades are not dimensioned.

43rd AVE APARTMENTS

701 43RD AVE SW
PUYALLUP, WASHINGTON

FLOOR PLAN - LEVEL 1

LANDMARK HOMES



PR101

R D + A

ROSS DECKMAN & ASSOCIATES INC.
207 4th AVENUE SOUTHEAST
PUYALLUP, WASHINGTON 98372
P. 253.840.8405
F. 253.840.9503



FLOOR PLAN - L2 (L3 SIM.)

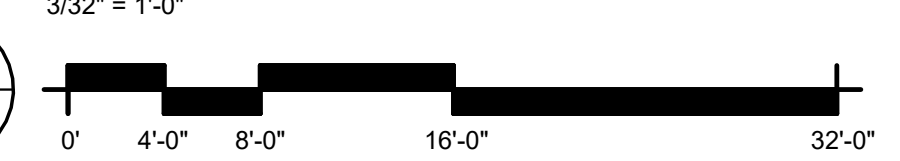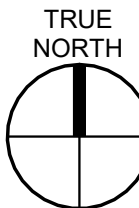

43rd AVE APARTMENTS

701 43RD AVE SW
PUYALLUP, WASHINGTON

FLOOR PLAN - LEVEL 2 (L3 SIM.)

LANDMARK HOMES

R D + A

ROSS DECKMAN & ASSOCIATES INC.

207 4th AVENUE SOUTHEAST
PUYALLUP, WASHINGTON 98372
P. 253.840.8405
F. 253.840.9503




7th St SW

43rd Ave SW



ROOF PLAN

3/32" = 1'-0"

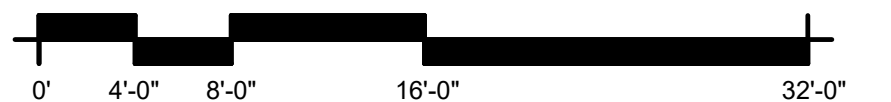

43rd AVE APARTMENTS

701 43RD AVE SW
PUYALLUP, WASHINGTON

ROOF PLAN

R D + A

LANDMARK HOMES

PR103

ROSS DECKMAN & ASSOCIATES INC.

207 4th AVENUE SOUTHEAST
PUYALLUP, WASHINGTON 98372
P. 253.840.8405
F. 253.840.9503




EAST ELEVATION (7th STREET SW)
1/8" = 1'-0"



SOUTH ELEVATION (43RD AVE SW)
1/8" = 1'-0"

MATERIALS						
IMAGE	TAG	MFR.	DESCRIPTION	COLOR	Material: Name	Material: Model
HIGH QUALITY						
	M1	MUTUAL MATERIALS	DRystack	PHEASANT	09 - Finishes - Drystack	HIGH QUALITY
	Q1	TAYLOR	METAL STANDING SEAM	GRAY	09 - Finishes - Metal Standing Seam Siding 10" - Gray	HIGH QUALITY
	Q2	TAYLOR	METAL STANDING SEAM	BEIGE	09 - Finishes - Metal Standing Seam Siding 10" - Beige	HIGH QUALITY
	Q3	TAYLOR	METAL STANDING SEAM	WHITE	09 - Finishes - Metal Standing Seam Siding 10" - White	HIGH QUALITY
	Q4	TAYLOR	METAL STANDING SEAM	BLUE	09 - Finishes - Metal Standing Seam Siding 10" - Blue	HIGH QUALITY
STANDARD						
	S1	JAMES HARDIE	CEMENTITIOUS BOARD -10" EXP	NIGHT GRAY	09 - Finishes - Hardieplank Lap Siding 5" - Rich Espresso	STANDARD
	S2	JAMES HARDIE	CEMENTITIOUS BOARD -10" EXP	NAVAJO BEIGE	09 - Finishes - Hardieplank Lap Siding 10" - Navajo Beige	STANDARD
	S3	JAMES HARDIE	CEMENTITIOUS BOARD -4" EXP	ARTIC WHITE	09 - Finishes - Hardieplank Lap Siding 5" - Arctic White	STANDARD
	S4	JAMES HARDIE	CEMENTITIOUS BOARD - BOARD & BATT	EVENING BLUE	09 - Finishes - Hardiepanel Verticle Siding - Blue	STANDARD
	S11	JAMES HARDIE	CEMENTITIOUS BOARD -10" EXP	AGED PEWTER	09 - Finishes - Hardieplank Lap Siding 10" - Rich Espresso	STANDARD
	S12	JAMES HARDIE	CEMENTITIOUS BOARD -4" EXP	NAVAJO BEIGE	09 - Finishes - Hardieplank Lap Siding 5" - Navajo Beige	STANDARD
	S13	JAMES HARDIE	CEMENTITIOUS BOARD -10" EXP	ARTIC WHITE	09 - Finishes - Hardieplank Lap Siding 10" - Arctic White	STANDARD

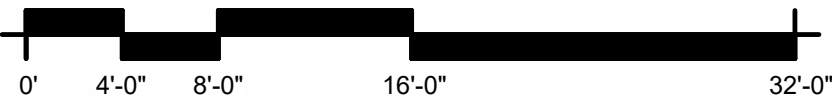

43rd AVE APARTMENTS

701 43RD AVE SW
PUYALLUP, WASHINGTON

ELEVATIONS (ALONG STREETS)

LANDMARK HOMES

PR201

R D + A



ROSS DECKMAN & ASSOCIATES INC.

207 4th AVENUE SOUTHEAST
PUYALLUP, WASHINGTON 98372
P. 253.840.8405
F. 253.840.9503



MATERIALS						
IMAGE	TAG	MFR.	DESCRIPTION	COLOR	Material: Name	Material: Model
HIGH QUALITY						
	M1	MUTUAL MATERIALS	DRystack	PHEASANT	09 - Finishes - Drystack	HIGH QUALITY
	Q1	TAYLOR	METAL STANDING SEAM	GRAY	09 - Finishes - Metal Standing Seam Siding 10" - Gray	HIGH QUALITY
	Q2	TAYLOR	METAL STANDING SEAM	BEIGE	09 - Finishes - Metal Standing Seam Siding 10" - Beige	HIGH QUALITY
	Q3	TAYLOR	METAL STANDING SEAM	WHITE	09 - Finishes - Metal Standing Seam Siding 10" - White	HIGH QUALITY
	Q4	TAYLOR	METAL STANDING SEAM	BLUE	09 - Finishes - Metal Standing Seam Siding 10" - Blue	HIGH QUALITY

STANDARD						
	S1	JAMES HARDIE	CEMENTITIOUS BOARD -10" EXP	NIGHT GRAY	09 - Finishes - Hardieplank Lap Siding 5" - Rich Espresso	STANDARD
	S2	JAMES HARDIE	CEMENTITIOUS BOARD -10" EXP	NAVAJO BEIGE	09 - Finishes - Hardieplank Lap Siding 10" - Navajo Beige	STANDARD
	S3	JAMES HARDIE	CEMENTITIOUS BOARD -4" EXP	ARTIC WHITE	09 - Finishes - Hardieplank Lap Siding 5" - Arctic White	STANDARD
	S4	JAMES HARDIE	CEMENTITIOUS BOARD - BOARD & BATT	EVENING BLUE	09 - Finishes - Hardiepanel Verticle Siding - Blue	STANDARD
	S11	JAMES HARDIE	CEMENTITIOUS BOARD -10" EXP	AGED PEWTER	09 - Finishes - Hardieplank Lap Siding 10" - Rich Espresso	STANDARD
	S12	JAMES HARDIE	CEMENTITIOUS BOARD -4" EXP	NAVAJO BEIGE	09 - Finishes - Hardieplank Lap Siding 5" - Navajo Beige	STANDARD
	S13	JAMES HARDIE	CEMENTITIOUS BOARD -10" EXP	ARTIC WHITE	09 - Finishes - Hardieplank Lap Siding 10" - Arctic White	STANDARD

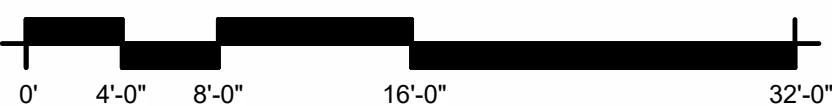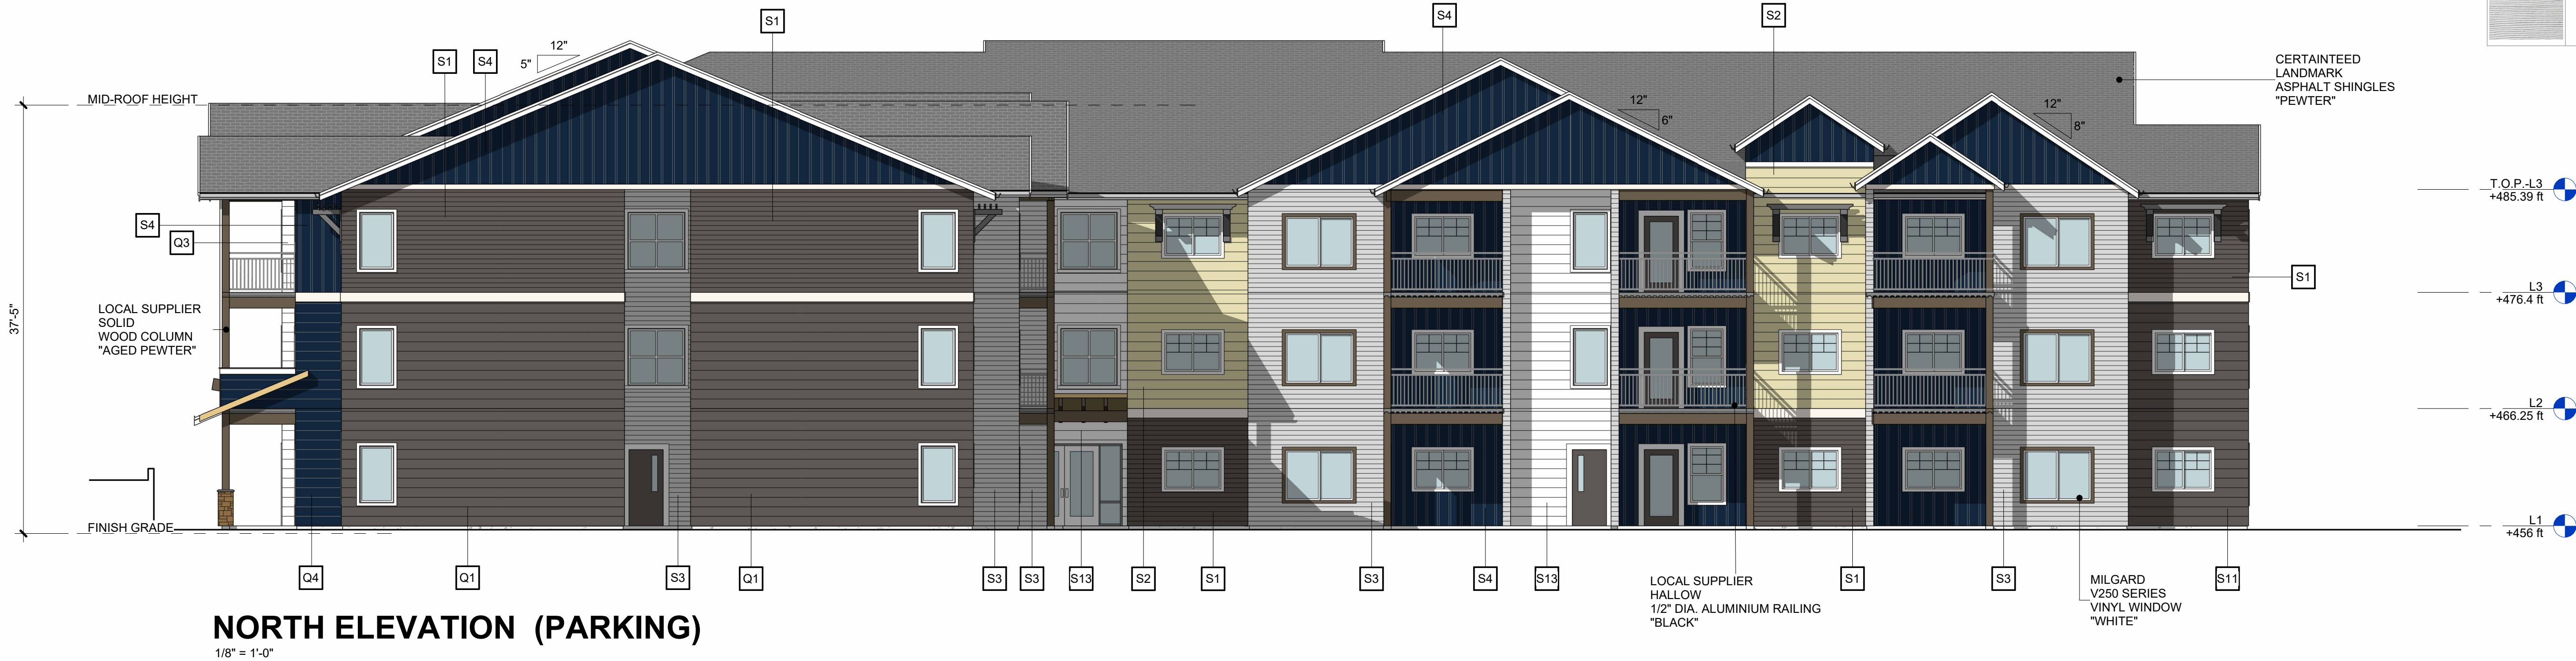

43rd AVE APARTMENTS

701 43RD AVE SW
PUYALLUP, WASHINGTON

ELEVATIONS (ALONG PARKING)


LANDMARK HOMES

PR202

R D + A

ROSS DECKMAN & ASSOCIATES INC.

207 4th AVENUE SOUTHEAST
PUYALLUP, WASHINGTON 98372
P. 253.840.8405
F. 253.840.9503

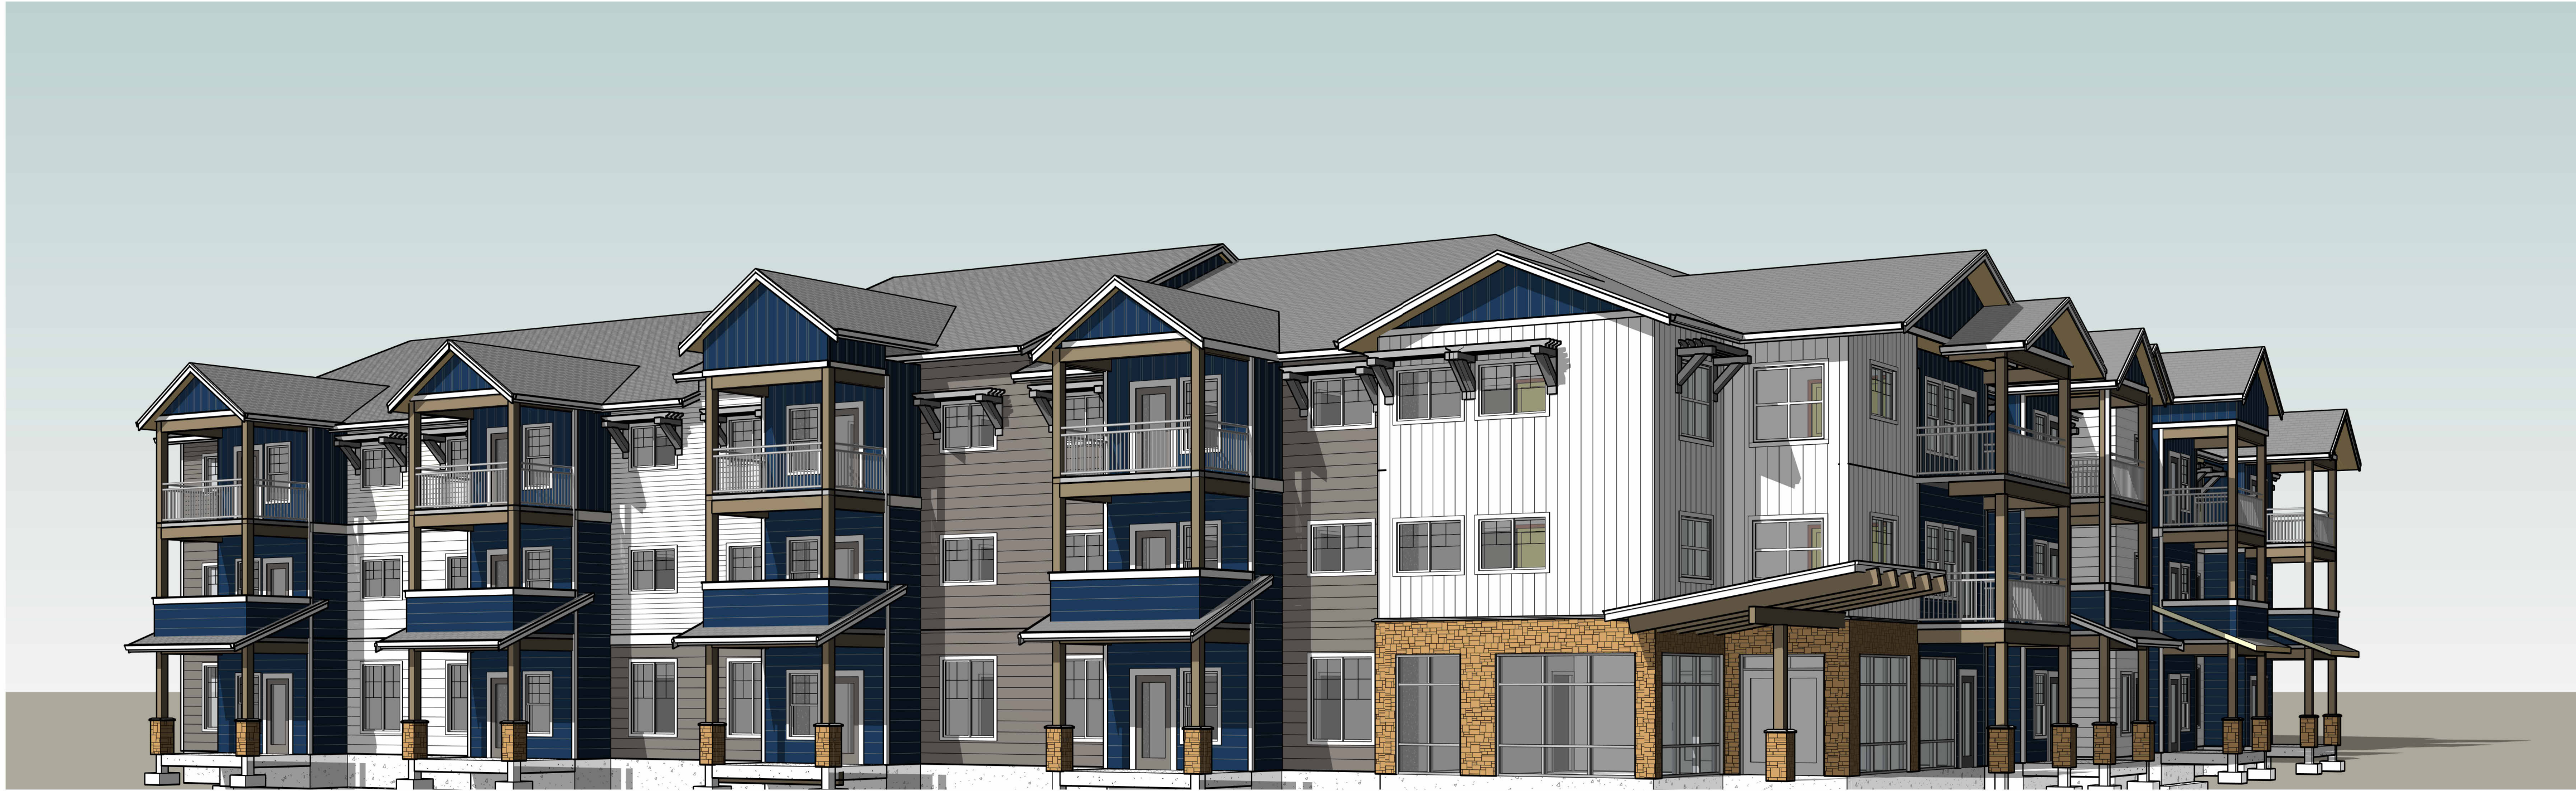

CORNER OF 43rd AVE SW & 7th STREET SW



INTERIOR COURTYARD PERSPECTIVE

43rd AVE APARTMENTS

701 43RD AVE SW
PUYALLUP, WASHINGTON

PERSPECTIVES

R D + A

LANDMARK HOMES

PR900

ROSS DECKMAN & ASSOCIATES INC.

207 4th AVENUE SOUTHEAST
PUYALLUP, WASHINGTON 98372
P. 253.840.8405
F. 253.840.9503



43rd AVE APARTMENTS

701 43RD AVE SW
PUYALLUP, WASHINGTON

EXTERIOR RENDER - OVERALL BUILDING

LANDMARK HOMES

PR902

R D + A

ROSS DECKMAN & ASSOCIATES INC.

207 4th AVENUE SOUTHEAST
PUYALLUP, WASHINGTON 98372
P. 253.840.8405
F. 253.840.9503



43rd AVE APARTMENTS

701 43RD AVE SW
PUYALLUP, WASHINGTON

EXTERIOR RENDER - FRONT ENTRANCE

LANDMARK HOMES

PR903

R D + A

ROSS DECKMAN & ASSOCIATES INC.

207 4th AVENUE SOUTHEAST
PUYALLUP, WASHINGTON 98372
P. 253.840.8405
F. 253.840.9503