

BRADLEY HEIGHTS

10' BUILDING SETBACK

Is this a retaining wall?
What is its height?
Provide height for all
retaining walls. Please
label feature.
[Preliminary Site Plan,
Pg. 3]

Is this a retaining wall?
Please label feature.
[Preliminary Site Plan,
Pg. 3]

EMERGENCY VEHICLES ONLY

Open Space 3

Open Space 4

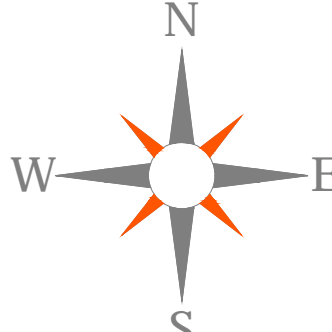
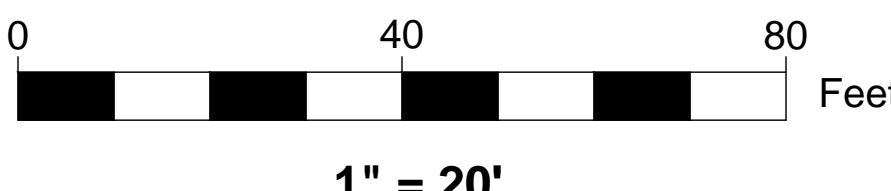
15' LANDSCAPE BUFFER

6' LANDSCAPE BUFFER

Is this a retaining wall?
Please label feature.
[Preliminary site plan,
Pg. 3]

LIGHTING

BOLLARD

LUMINARE 

1	2	3	100
---	---	---	---	---	---	---	---	---	----	----	-----

DATE:	4/6/2022
DESIGNED BY:	PEG
DRAWN BY:	PEG
CHECKED BY:	PEG
APPROVED BY: Paul Green	



SECRET

BRADLEY HEIGHTS

109 East Pioneer, Puyallup, WA 98372
Phone (253) 770-3144

RAWING

HEET
E