

SURVEYOR

MCINIS ENGINEERING
CONTACT: LARRY WALKER
202 E 34TH ST
TACOMA, WA 98404
OFFICE: 253-414-1992

ARCHITECT

SYNTHESIS 9, LLC
CONTACT: BRETT LINDSAY
2523 N. D. ST
TACOMA, WA 98403
OFFICE: 253-468-4117

CIVIL ENGINEER

AHBL INC.
2215 NORTH 30TH STREET, SUITE 300
TACOMA, WA 98403
PHONE: (253) 383-2422
CONTACT: TODD GAWLIN
OFFICE: 253-383-2572

SITE INFORMATION

PARCEL: 0420264021, 0420264054, 0420264053, 0420351066, 0420351030, 0420351029, 0420351028
ADDRESS: 2902 E PIONEER
FUYALLUP, WA 98372
ZONING: CO AND RM-20

SURVEYOR'S NOTES

- 1. HORIZONTAL DATUM: BASIS OF BEARING AND SURVEY DATA PER WASHINGTON STATE PLANE COORDINATE SYSTEM, SOUTH ZONE.
2. BASIS OF BEARING: HELD S 01° 21' 28" W OBSERVED ALONG THE EAST LINE OF THE NORTHEAST QUARTER OF SEC. 35, T. 20 N. R. 4 E. BETWEEN THE NORTHEAST CORNER OF THE NORTHEAST QUARTER MONUMENT AND THE SOUTHEAST CORNER OF THE NORTHEAST QUARTER MONUMENT OF THE SAID SECTION AS SHOWN HEREON.
3. VERTICAL DATUM: NAVD88
4. ALL UTILITY LOCATES HAVE BEEN DETERMINED BY SURFACE LOCATION ONLY EITHER BY PHYSICAL STRUCTURES OR PAINT MARKINGS
5. REFERENCE SURVEYS:
6. METHOD OF SURVEYING WAS:

TOPOGRAPHIC NOTE

THE EXISTING CULTURAL AND TOPOGRAPHICAL DATA SHOWN ON THESE DRAWINGS HAS BEEN PREPARED, IN PART, BASED UPON INFORMATION FURNISHED BY OTHERS. WHILE THIS INFORMATION IS BELIEVED TO BE RELIABLE, AHBL ENGINEERING CANNOT ENSURE ACCURACY AND THIS IS NOT RESPONSIBLE FOR THE ACCURACY OF THAT INFORMATION OR FOR ANY ERRORS OR OMISSIONS WHICH MAY HAVE BEEN INCORPORATED INTO THESE DRAWINGS AS A RESULT.

FILL SPECIFICATIONS

FILL MATERIAL SHALL NOT CONTAIN PETROLEUM PRODUCTS, OR SUBSTANCES WHICH ARE HAZARDOUS, DANGEROUS, TOXIC, OR WHICH OTHERWISE VIOLATE ANY STATE, FEDERAL, OR LOCAL LAW, ORDINANCE, CODE, REGULATION, RULE, ORDER, OR STANDARD.

FIRE SPRINKLER NOTE

FIRE LINE SHALL BE SIZED BY A LICENSED FIRE PROTECTION ENGINEER, A SEPARATE, DETAILED PLAN SHALL BE APPROVED BY THE FIRE MARSHALL AND INSTALLED BY A WASHINGTON CERTIFIED LEVEL "U" CONTRACTOR IN ACCORDANCE WITH WAC 210-09-010. A POST INDICATOR VALVE SHALL BE INSTALLED ON THE SPRINKLER LINE TO ISOLATE THE FIRE SYSTEM FROM THE WATER SYSTEM WHEN REQUIRED.

VERIFICATION NOTE

ALL EXISTING UTILITIES IN THE CONSTRUCTION AREA SHALL BE IDENTIFIED AND VERIFIED FOR DEPTH AND LOCATION PRIOR TO ANY CONSTRUCTION ACTIVITIES SO TO IDENTIFY ANY POTENTIAL CONFLICTS WITH PROPOSED CONSTRUCTION. CONTACT PROJECT ENGINEER IMMEDIATELY IF ANY CONFLICTS ARE IDENTIFIED.

TRENCH NOTES

IF WORKERS ENTER ANY TRENCH OR OTHER EXCAVATION FOUR OR MORE FEET IN DEPTH THAT DOES NOT MEET THE OPEN PIT REQUIREMENTS OF WSDOT SECTION 2-09.30(3), IT SHALL BE SHORED AND CRIBBED. THE CONTRACTOR IS ALONE RESPONSIBLE FOR WORKER SAFETY. ALL TRENCH SAFETY SYSTEMS SHALL MEET THE REQUIREMENTS OF THE WASHINGTON INDUSTRIAL SAFETY AND HEALTH ACT, CHAPTER 49.17 RCW.

CONSTRUCTION SEQUENCE

- 1. OBTAIN REQUIRED PERMITS AND HOLD A PRE-CONSTRUCTION MEETING WITH THE CITY
2. FLAG CLEARING LIMITS
3. INSTALL OR REPLACE SILT FENCE
4. INSTALL CONSTRUCTION ENTRANCE
5. PATCH/OLY ANY EXISTING UTILITIES FOR VERIFICATION OF DEPTH AND LOCATION. SEE VERIFICATION NOTE.
6. SCHEDULE EROSION CONTROL INSPECTION W/ CITY
7. GRADE SITE
8. MAINTAIN EROSION CONTROL, MEASURE AND RELOCATE SURFACE WATER CONTROLS AS NEEDED IN ACCORDANCE WITH CITY OF FUYALLUP REQUIREMENTS AND NPDES CONSTRUCTION STORMWATER GENERAL PERMIT
9. COVER ALL AREAS THAT WILL BE UNWORKED FOR MORE THAN FIVE DAYS DURING THE DRY SEASON OR TWO DAYS DURING THE WET SEASON
10. STABILIZE ALL AREAS WITHIN SEVEN DAYS OF REFINING FINAL GRADE
11. INSTALL TRUNGS
12. STABILIZE ALL DISTURBED AREAS AND REMOVE TRUNGS AND EROSION CONTROL MEASURES AS APPROPRIATE
13. ARRANGE FINAL INSPECTION WITH THE CITY.



CUT AND FILL ESTIMATES

CUT: 2,500 CY
FILL: 45,600 CY
NET IMPORT: 43,100 CY

CONDITIONS:

- 1. PRIOR TO PERMIT ISSUANCE, RIGHT-OF-WAY DEDICATION ALONG SHAW ROAD SHALL BE APPROVED AND RECORDED. RIGHT-OF-WAY ALONG EAST PIONEER SHALL BE APPROVED AND RECORDED PRIOR TO PHASE 2 CIVIL PERMIT.
2. PRIOR TO PERMIT ISSUANCE, THE APPLICANT SHALL CLARIFY WHETHER IT IS THE PROJECT'S INTENT TO DEDICATE RIGHT-OF-WAY OR GRANT AN EASEMENT FOR MAINTENANCE AND OPERATION OF THE SHAW ROAD TRAFFIC SIGNAL AND EQUIPMENT.
3. ALL PRIVATE STORM DRAINAGE FACILITIES SHALL BE COVERED BY A MAINTENANCE AGREEMENT PROVIDED BY THE CITY AND RECORDED WITH PIERCE COUNTY. UNDER THIS AGREEMENT, IF THE OWNER FAILS TO PROPERLY MAINTAIN THE FACILITIES, THE CITY, AFTER GIVING THE OWNER NOTICE, MAY PERFORM NECESSARY MAINTENANCE AT THE OWNER'S EXPENSE. PRIOR TO OCCUPANCY THE AGREEMENT SHALL BE APPROVED AND RECORDED.
4. PRIOR TO OCCUPANCY, A STREET MAINTENANCE COVENANT WILL BE REQUIRED TO ENSURE THAT PAVEMENT MARKINGS LOCATED ON PRIVATE PROPERTY AT THE DRIVE ENTRANCES WILL BE MAINTAINED.
5. AS MENTIONED DURING THE LAND USE APPLICATION (P-21-0034), THE EXISTING STORMWATER FACILITY SERVING THE OFFSITE PROPERTIES SOUTH OF THE PROJECT IS CURRENTLY IN VIOLATION OF NPDES REGULATIONS AND THE FUYALLUP MUNICIPAL CODE DUE TO LACK OF MAINTENANCE, BREACHING OF THE POND BERM, AND PASS-THROUGH OF A REGULATED STREAM THROUGH THE CONTROL STRUCTURE. HOWEVER, THE CITY IS WILLING TO ALLOW THE POND REMEDIATION TO OCCUR DURING PHASE 2, PROVIDED THE REMEDIATION IS ACCOMPLISHED PRIOR TO ANY OCCUPANCY OF PHASE 1 STRUCTURES.

**EAST TOWN CROSSING PHASE 1
SEC. 26,35/ TWP. 20 N./ RGE. 4 E., W.M.**

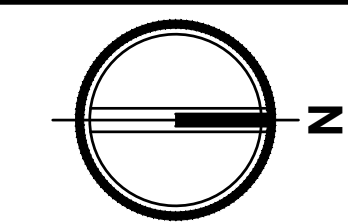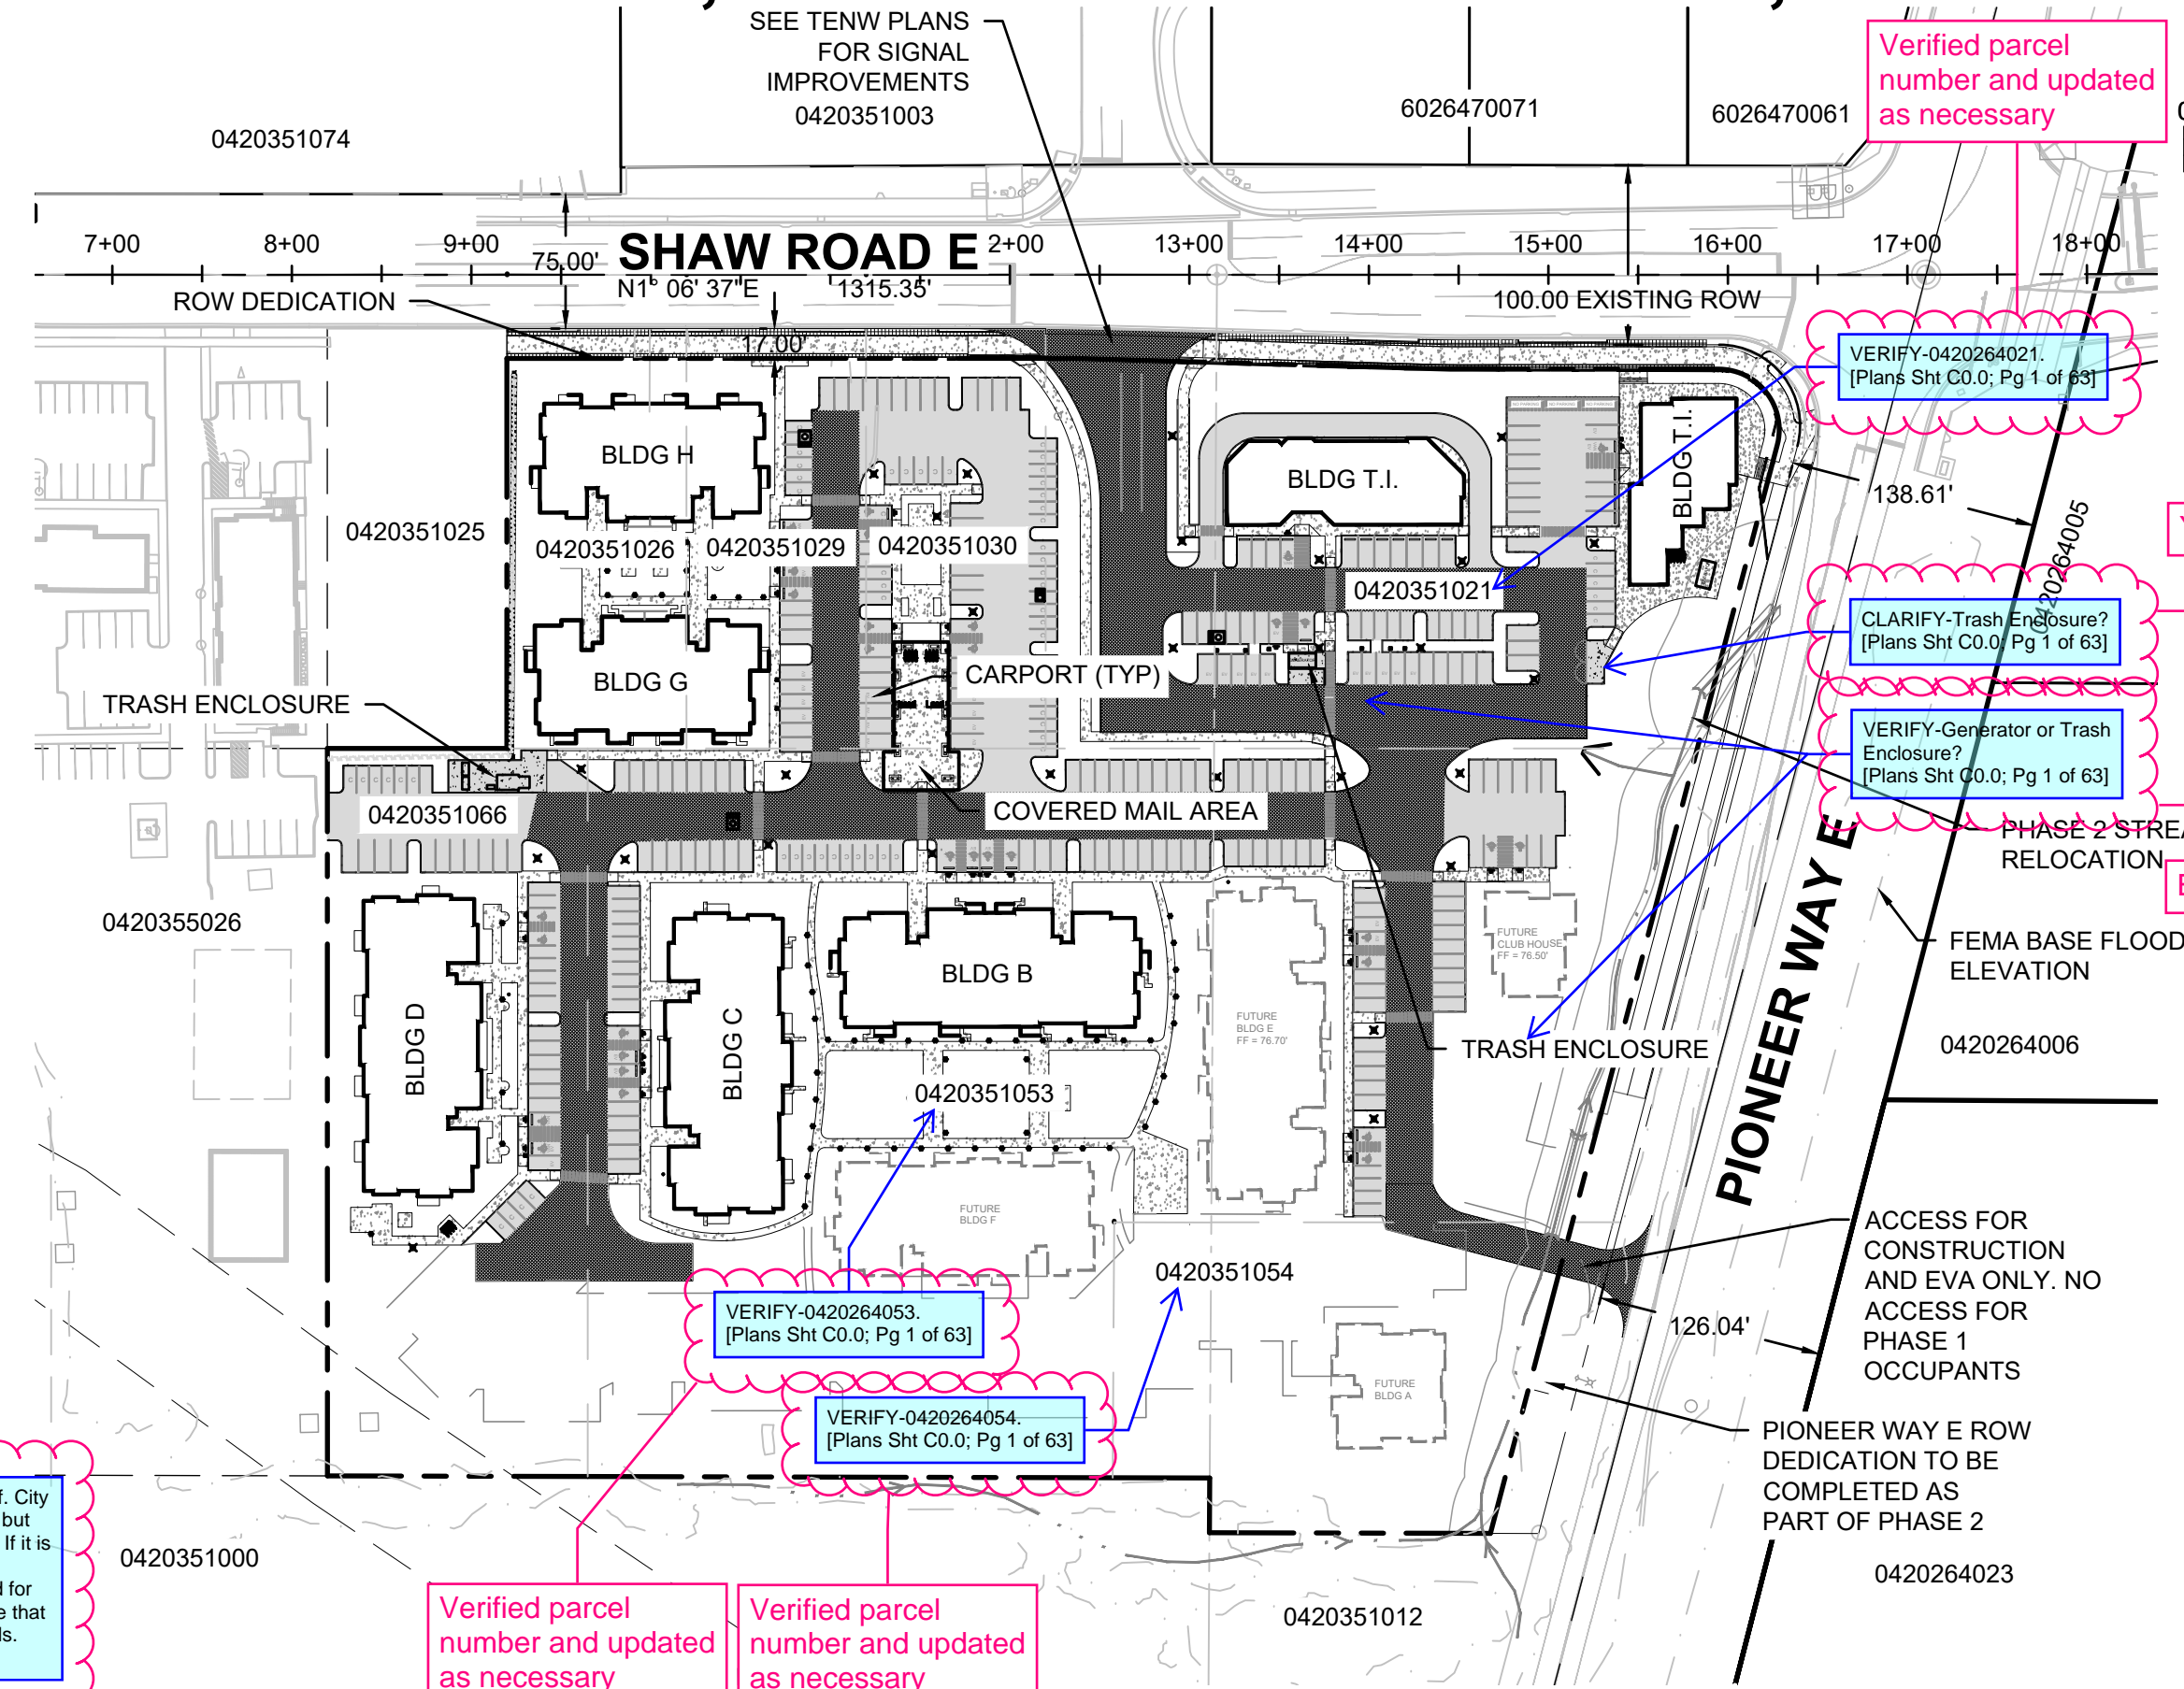


FLOOD PLAIN NOTE

THE FLOOD PLAIN INFORMATION SHOWN IN THE PLAN SET IS BASED ON THE REVISED PANEL 342 OF 1375 OF MAP 53053C03042E THAT WAS PART OF THE 09/08/22 LOMR. THE FLOOD ZONES AND BE'S SHOWN IN THE PLAN SET ARE DRAWN FROM A COMBINATION OF THE PDF MAP PANEL AND GIS DATA. THE INFORMATION SHOWN IN THE REVISED PANEL IS BASED ON AN ASSUMED RELOCATED STREAM LOCATION. ACTUAL FLOOD ZONE AND BE'S WILL BE BASED FINAL LOCATION AND ELEVATION OF RELOCATED STREAM.

APPROVED

BY: CITY OF FUYALLUP DEVELOPMENT ENGINEERING
DATE:
NOTE: THIS APPROVAL IS VOID AFTER 180 DAYS FROM APPROVAL DATE. THE CITY WILL NOT BE RESPONSIBLE FOR ERRORS AND/OR OMISSIONS ON THESE PLANS. FIELD CONDITIONS MAY DICTATE CHANGES TO THESE PLANS AS DETERMINED BY THE DEVELOPMENT ENGINEERING MANAGER.

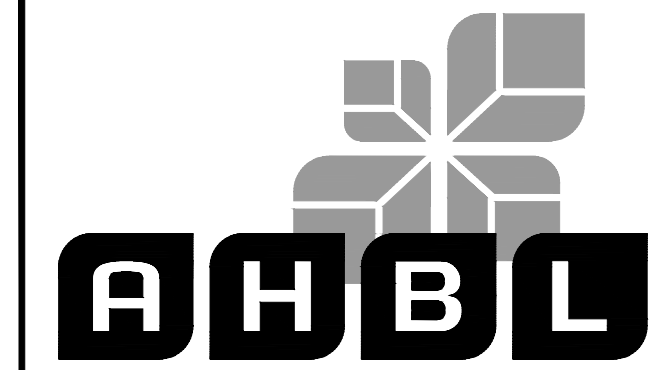

TACOMA • SEATTLE • SPOKANE • TRI-CITIES
2215 North 30th Street, Suite 300, Tacoma, WA 98403
253.383.2422 TEL 253.383.2572 FAX www.ahbl.com WEB


Sheet List Table

Table with columns: Sheet Number, Sheet Title. Lists sheets C0.0 through C4.20 including COVER SHEET, TESC PLAN, TESC NOTES AND DETAILS, HORIZONTAL CONTROL AND PAVING PLAN NW, etc.

Table with columns: Sheet Number, Sheet Title. Lists sheets C4.21 through C8.0 including R-TANK 2 NOTES AND DETAILS, R-TANK 2 NOTES AND DETAILS, R-TANK 2 NOTES AND DETAILS, etc.

LEGAL DESCRIPTION


TAX PARCEL NO. 0420264021; PER CW TITLE TITLE RESOURCES GUARANTY COMPANY SUBDIVISION GUARANTEE ORDER NO. 40249905-T35 DATED JANUARY 22, 2021 AT 8:00 A.M.
TAX PARCEL NO. 0420264054; PER CW TITLE TITLE RESOURCES GUARANTY COMPANY SUBDIVISION GUARANTEE ORDER NO. 40249905-T35 DATED JANUARY 22, 2021 AT 8:00 A.M.
TAX PARCEL NO. 0420351030; PER CW TITLE TITLE RESOURCES GUARANTY COMPANY SUBDIVISION GUARANTEE ORDER NO. 40249905-T35 DATED JANUARY 22, 2021 AT 8:00 A.M.
TAX PARCEL NO. 0420351029; PER CW TITLE TITLE RESOURCES GUARANTY COMPANY SUBDIVISION GUARANTEE ORDER NO. 40249905-T35 DATED JANUARY 22, 2021 AT 8:00 A.M.
TAX PARCEL NO. 0420351028; PER CW TITLE TITLE RESOURCES GUARANTY COMPANY SUBDIVISION GUARANTEE ORDER NO. 40249905-T35 DATED JANUARY 22, 2021 AT 8:00 A.M.
TAX PARCEL NO. 0420351066; PER CW TITLE TITLE RESOURCES GUARANTY COMPANY SUBDIVISION GUARANTEE ORDER NO. 40249905-T35 DATED JANUARY 22, 2021 AT 8:00 A.M.

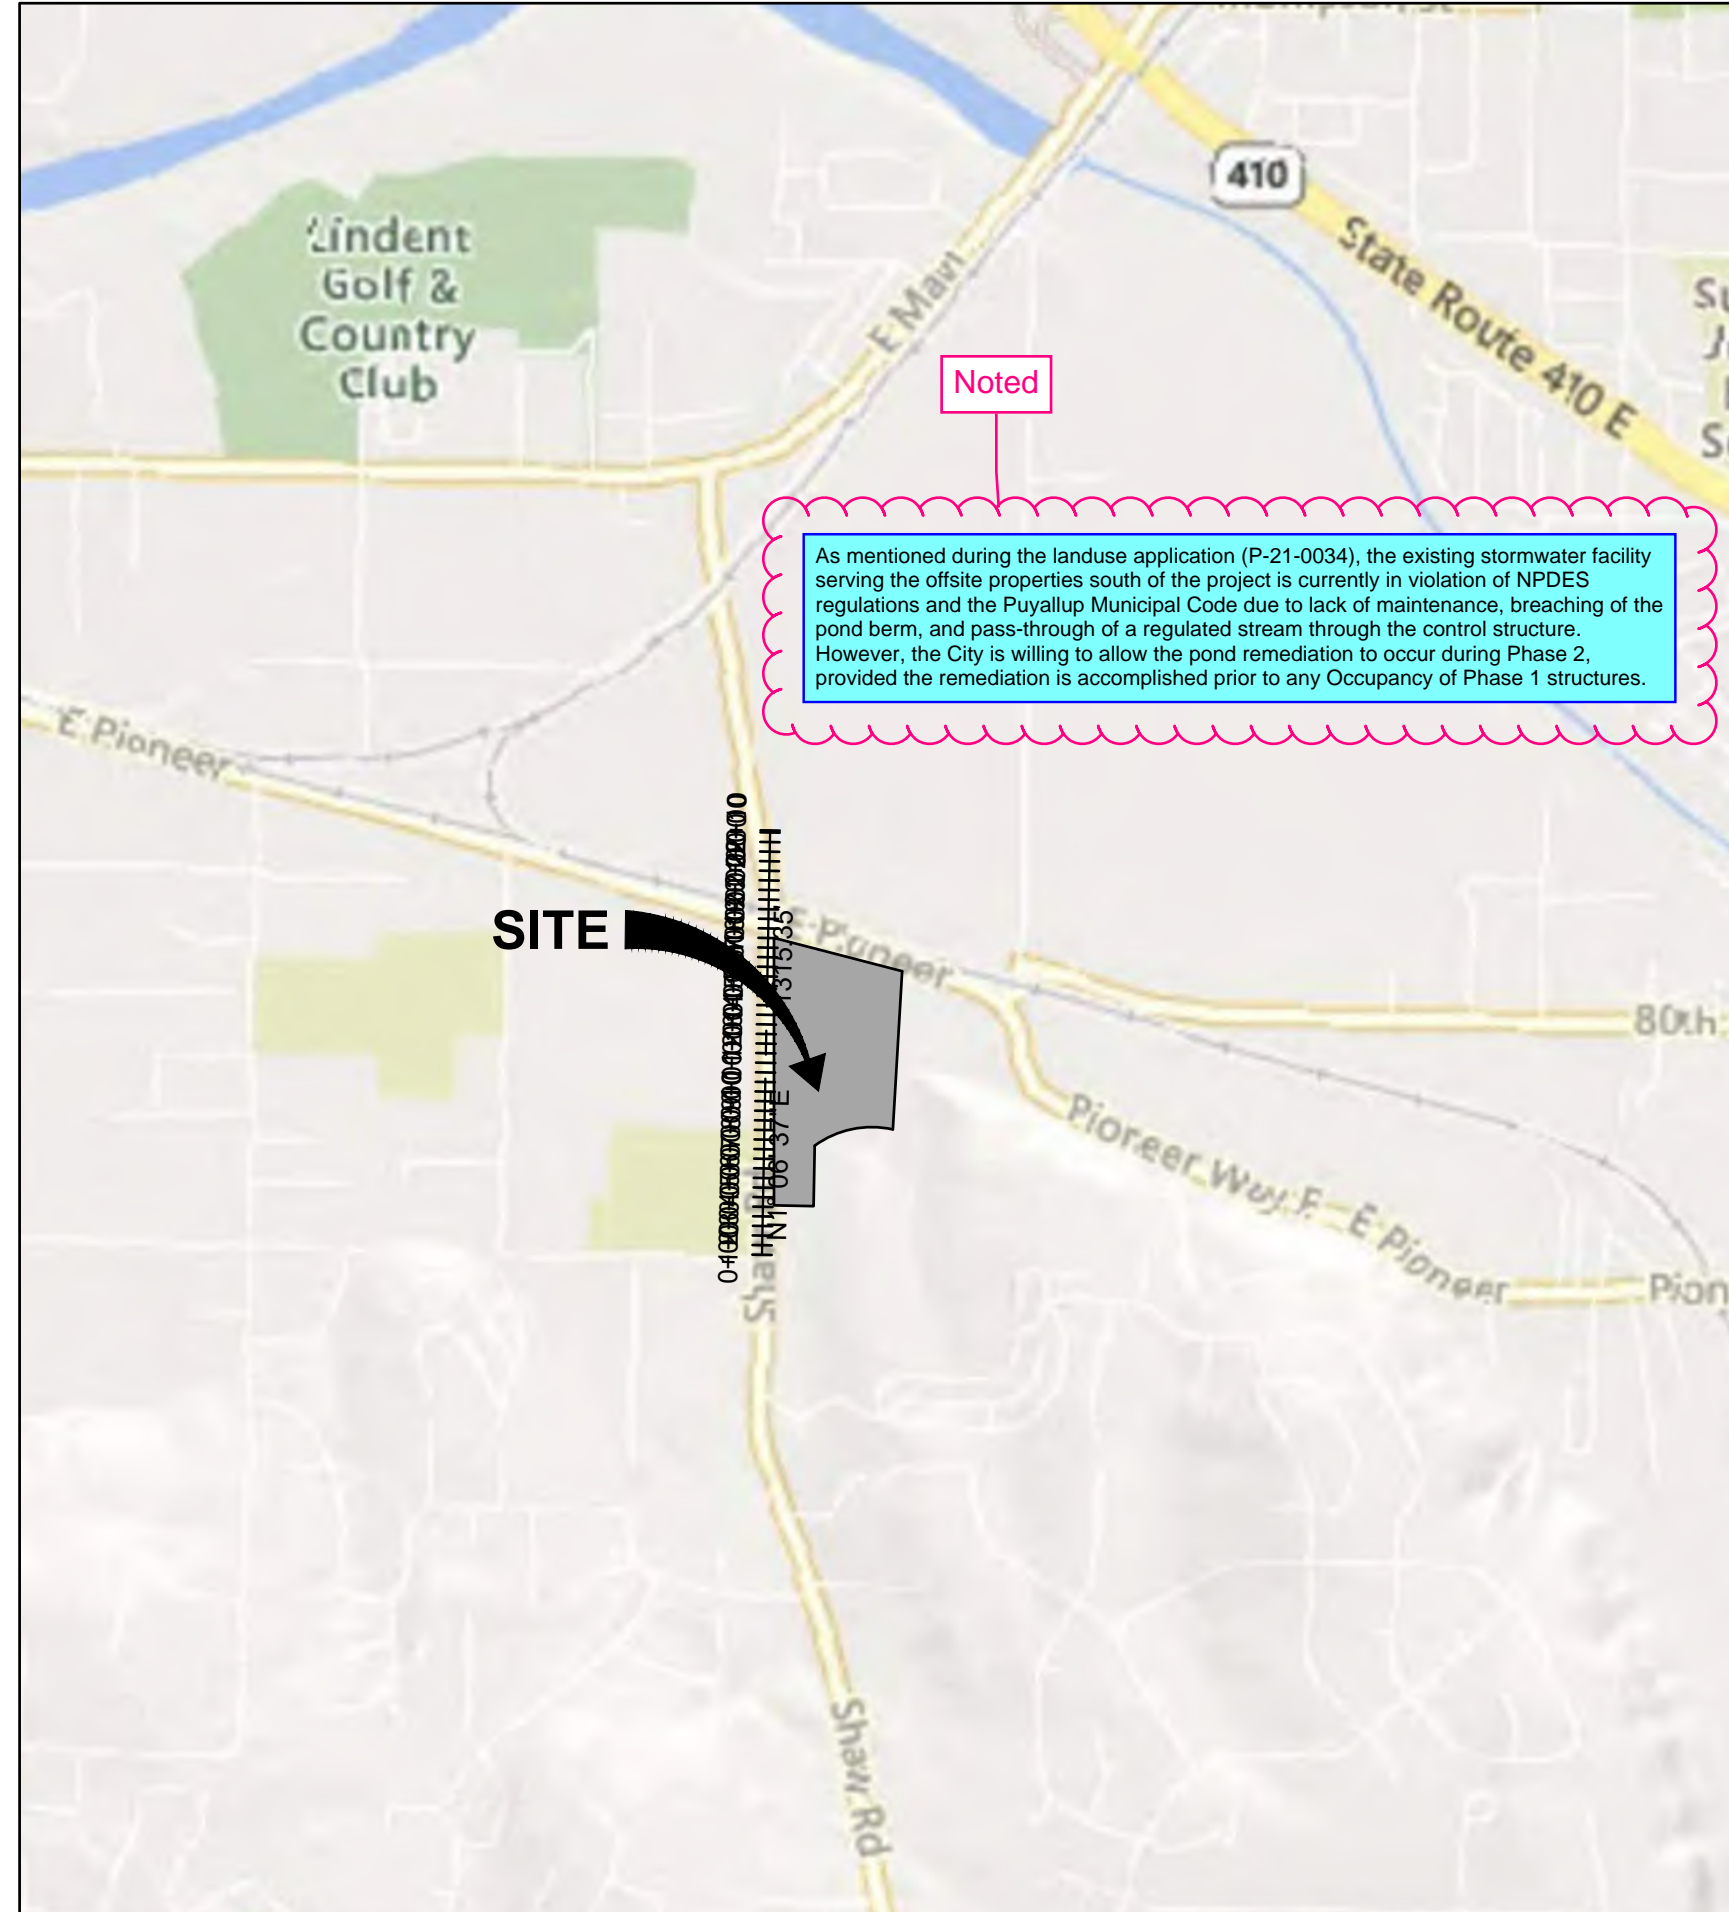

EAST TOWN CROSSING PHASE 1

Client: ASH DEVELOPMENT
GREG HELLE
GREG.HELLE@ASHNW.COM

Project No. 2230752
Issue Set & Date: PERMIT SUBMITTAL 11/20/2023

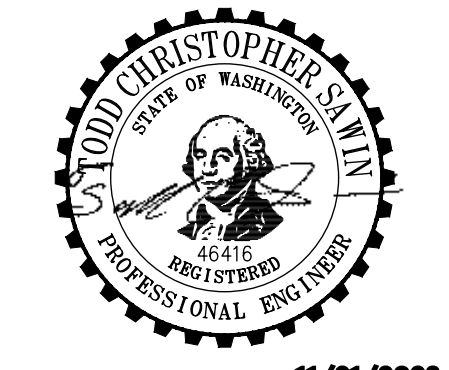

NOTICE: ALTERNATION OF THIS DOCUMENT SHALL INDICATE THE PROFESSIONAL SEAL AND SIGNATURE PUBLICATION OF THE DOCUMENT DOES NOT SIGNIFY THAT THE PROJECT HAS BEEN REVIEWED FOR THE PROJECT ENFORCED IN THE TITLE BLOCK AND IS NOT TO BE USED FOR BIDDING, OR ACTION TO THAT PROJECT FOR ANY OTHER PROJECT.

- Revisions:
Sheet Title:

Designed by: CW
Drawn by: SK
Checked by: JI

COVER SHEET

Sheet No. C0.0

1 of 63 Sheets



Know what's below. Call before you dig.

EAST TOWN CROSSING PHASE 1



SEC. 26,35/ TWP. 20 N./ RGE. 4 E., W.M.

APPROVED

BY: CITY OF PUYALLUP
DEVELOPMENT ENGINEERING

DATE:

NOTE: THIS APPROVAL IS VOID AFTER 180 DAYS FROM APPROVAL DATE. THE CITY WILL NOT BE RESPONSIBLE FOR ERRORS AND/OR OMISSIONS ON THESE PLANS. FIELD CONDITIONS MAY DICTATE CHANGES TO THESE PLANS AS DETERMINED BY THE DEVELOPMENT ENGINEERING MANAGER.

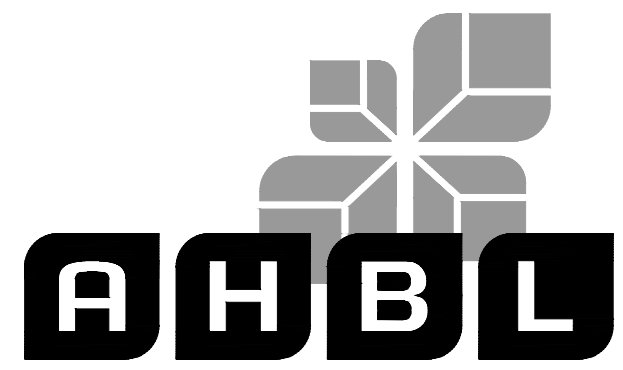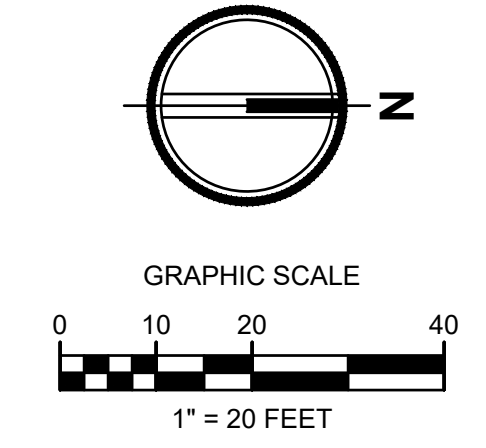

TACOMA · SEATTLE · SPOKANE · TRI-CITIES
2215 North 30th Street, Suite 300, Tacoma, WA 98403
253.383.2422 TEL 253.383.2572 FAX www.ahbl.com WEB


Project Title:
EAST TOWN CROSSING PHASE 1

Client:
ASH DEVELOPMENT

GREG HELLE
GREG.HELLE@ASHNW.COM


Project No.
2230752

Issue Set & Date:
PERMIT SUBMITTAL
11/20/2023

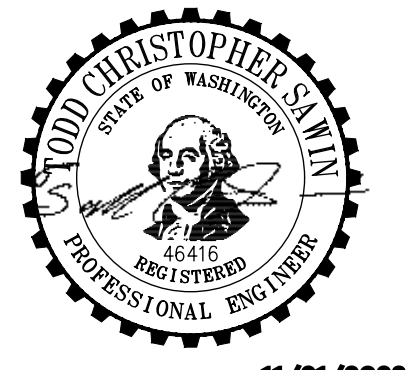

11/21/2023

NOTICE: ALTERATION OF THIS DOCUMENT SHALL INVALIDATE THE PROFESSIONAL SEAL AND SIGNATURE. PUBLICATION OF THIS DOCUMENT DOES NOT CONSTITUTE A GUARANTEE OR WARRANTY BY THE ENGINEER OR FOR THE ONLY FOR THE PROJECT EXHIBITED IN THE TITLE BLOCK AND IS NOT TO BE USED FOR OTHER PURPOSES OR ACTION TO THAT PROJECT OR FOR ANY OTHER PROJECT.

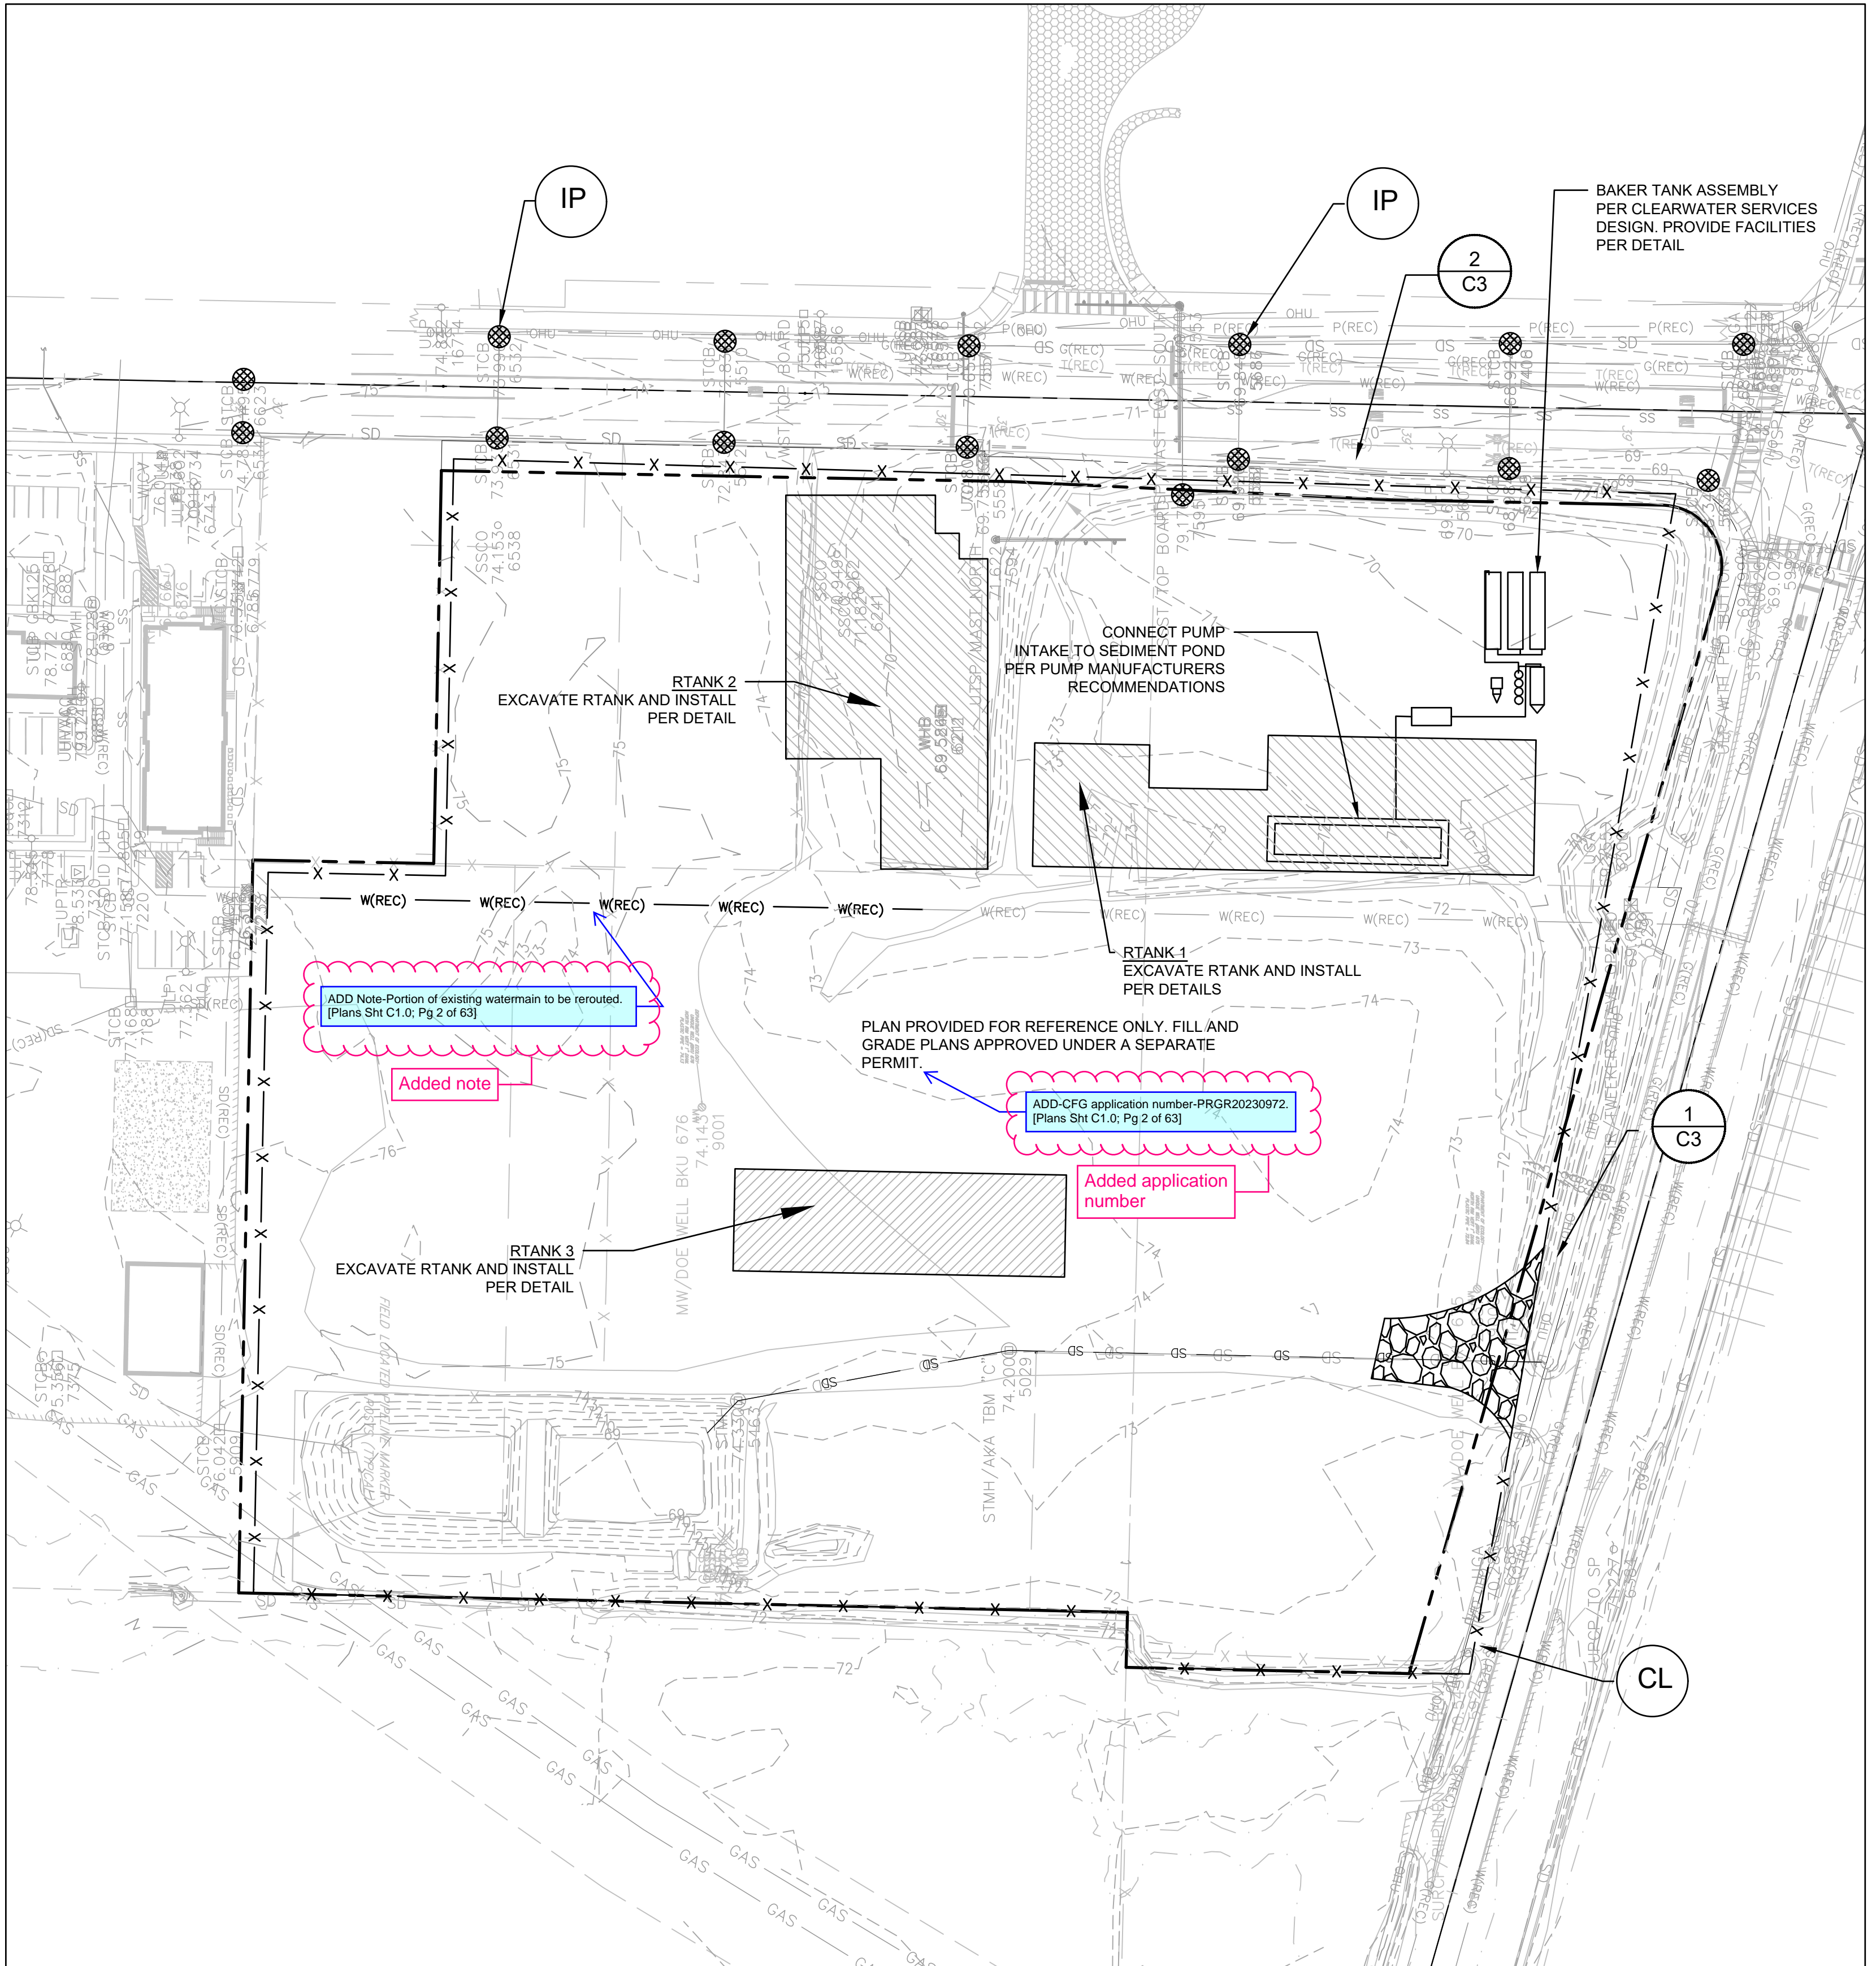

NOTE:

MAINTAIN SEDIMENT POND AND BAKER TANKS AS DESIGNED IN CLEAR, FILL AND GRADE PLANS

TESC LEGEND:

- CL --- CLEARING/ GRADING/ DISTURBED LIMITS
- X --- X --- X --- FILTER FABRIC FENCE SEE DETAIL
- CE --- CONSTRUCTION ENTRANCE
- IP --- INLET PROTECTION

Added application number

ADD CFG application number-PRGR20230972. [Plans Sht C1.0; Pg 2 of 63]

ADD Note-Portion of existing watermain to be rerouted. [Plans Sht C1.0; Pg 2 of 63]

Added note

ADD-CFG application number-PRGR20230972. [Plans Sht C1.0; Pg 2 of 63]

Added application number



Know what's below.
Call before you dig.

Revisions:

Sheet Title:

TESC PLAN

Designed by: CW Drawn by: SK Checked by: JI

Sheet No.

C1.0

2 of 63 Sheets

TESC INSPECTION NOTES:


- 1. INSPECT ALL INLET PROTECTION ON CATCH BASINS. CLEAN OR REPLACE IF FULL OF SEDIMENT /DEBRIS AND REPAIR/REPLACE AS NEEDED IF DAMAGED TO MAINTAIN PROTECTION.
2. INSPECT ALL PERMANENT AND TEMPORARY STABILIZED SLOPES. REPAIR ANY DAMAGED SECTIONS AND RE-VEGETATE AS NEEDED TO ENSURE THE ESTABLISHMENT OF VEGETATION AND THAT NO EROSION OF THE SLOPES OCCUR.
3. INSPECT ALL FILTER FABRIC FENCING FOR SIGNS OF EROSION, DAMAGE OR FAILURES. REPAIR AND/OR REPLACE AS NEEDED. SEE FILTER FABRIC NOTES. SEDIMENT BUILD-UP ALONG FENCE SHALL BE REMOVED WHEN REACHES 1/3 THE FENCE HEIGHT. IF EROSION IS OCCURRING, CONTRACTOR SHALL INSTALL ADDITIONAL EROSION CONTROL MEASURES AS NEEDED TO PREVENT EROSION.
4. ANY FILLCUT SLOPES SHALL BE INSPECTED FOR EROSION. IF SIGNS OF EROSION ARE PRESENT, INSTALL APPROPRIATE BMPS AS NEEDED TO STOP EROSION AND STABILIZE SLOPES.
5. TESC LEAD RESPONSIBLE FOR NOTIFYING ENGINEER IF ADDITIONAL MEASURES ARE WARRANTED.

PERMANENT STABILIZATION NOTES:

- 1. ALL EXPOSED SOILS AND SLOPES SHALL BE SEEDED OR OTHERWISE STABILIZED IMMEDIATELY AFTER CONSTRUCTION AND GRADING ACTIVITIES HAVE BEEN COMPLETED.
2. SILT FENCE, IF DEEMED APPROPRIATE, SHALL REMAIN FOR A MINIMUM OF 30 DAYS AFTER THE FINAL STABILIZATION OF THE SLOPES HAS OCCURRED.
3. ALL TEMPORARY EROSION CONTROL BMP'S SHALL BE REMOVED 30 DAYS AFTER FINAL STABILIZATION HAS OCCURRED AS DIRECTED BY CITY OR COUNTY INSPECTOR.
4. CONTRACTOR SHALL REFER TO THE CONSTRUCTION SWPPP FOR APPLICABLE BMPS.

CONSTRUCTION ENTRANCE NOTES:


- 1. MATERIAL SHALL BE 4" TO 8" QUARRY SPALLS (4 TO 6 INCH FOR RESIDENTIAL SINGLE FAMILY LOTS) AND MAY BE TOP-DRESSED WITH 1 TO 3 INCH ROCK.
2. THE ROCK PAD SHALL BE AT LEAST 12" THICK AND 100' LONG (REDUCED TO 20 FEET FOR SITES LESS THAN 1 ACRE OF DISTURBED SOIL) WIDTH SHALL BE FULL WIDTH OF INGRESS AND EGRESS AREA. SMALLER PADS MAY BE APPROVED FOR SINGLE-FAMILY RESIDENTIAL AND COMMERCIAL SITES.
3. ADDITIONAL ROCK SHALL BE ADDED PERIODICALLY TO MAINTAIN FUNCTION OF THE PAD.
4. IF THE PAD DOES NOT ADEQUATELY REMOVE MUD FROM THE VEHICLE WHEELS, THE WHEELS SHALL BE HOSED OFF BEFORE THE VEHICLE ENTERS A PAVED STREET. THE WASHING SHALL BE DONE ON AN AREA COVERED WITH CRUSHED ROCK AND WASH WATER SHALL DRAIN TO A SEDIMENT RETENTION FACILITY OR THROUGH A SILT FENCE.

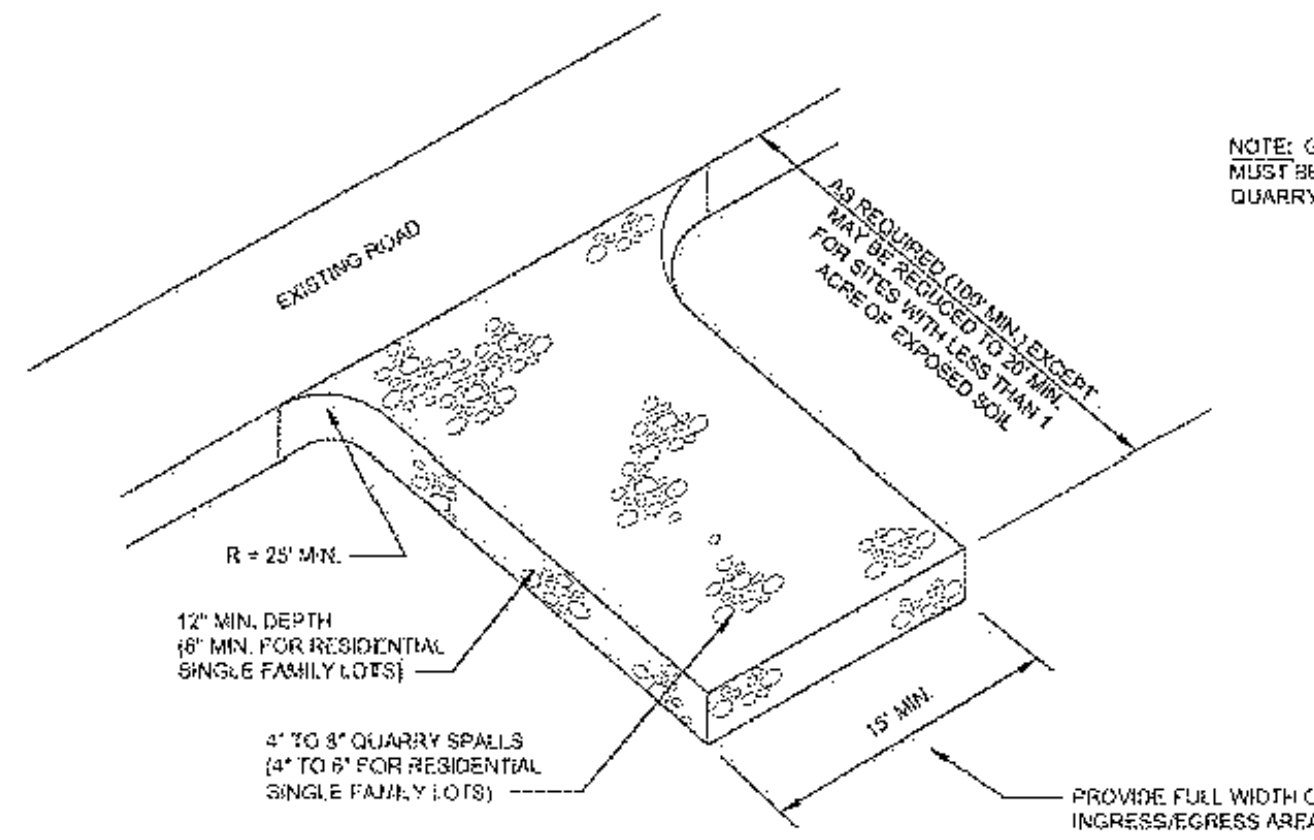

1 CONSTRUCTION ENTRANCE SCALE: NTS

FILTER FABRIC FENCE NOTES:

- 1. SUPPORT POST, WITH A MINIMUM 6-INCH OVERLAP, AND SECURELY FASTENED AT BOTH ENDS TO POSTS.
2. POSTS SHALL BE SPACED A MAXIMUM OF 6 FEET APART AND DRIVEN SECURELY INTO THE GROUND (MINIMUM OF 30 INCHES).
3. A TRENCH SHALL BE EXCAVATED APPROXIMATELY 8 INCHES WIDE AND 12 INCHES DEEP ALONG THE LINE OF POSTS AND UPSLOPE FROM THE BARRIER. THIS TRENCH SHALL BE BACKFILLED WITH WASHED GRAVEL.
4. WHEN STANDARD STRENGTH FILTER FABRIC IS USED, A WIRE MESH SUPPORT FENCE SHALL BE FASTENED SECURELY TO THE UPSLOPE SIDE OF THE TRENCH USING HEAVY-DUTY WIRE STAPLES AT LEAST 1 INCH LONG. THE WIRES OR HOG RINGS. THE WIRE SHALL EXTEND INTO THE TRENCH A MINIMUM OF 4 INCHES AND SHALL NOT EXTEND MORE THAN 24 INCHES ABOVE THE ORIGINAL GROUND SURFACE.
5. THE STANDARD STRENGTH FILTER FABRIC SHALL BE STAPLED OR WIRED TO THE FENCE, AND 20 INCHES OF THE FABRIC SHALL BE EXTENDED INTO THE TRENCH. THE FABRIC SHALL NOT EXTEND MORE THAN 24 INCHES ABOVE THE ORIGINAL GROUND SURFACE. FILTER FABRIC SHALL NOT BE STAPLED TO EXISTING TREES.
6. WHEN EXTRA-STRENGTH FILTER FABRIC AND CLOSER POST SPACING IS USED, THE WIRE MESH SUPPORT FENCE MAY BE ELIMINATED. IN SUCH A CASE, THE FILTER FABRIC IS STAPLED OR WIRED DIRECTLY TO THE POSTS WITH ALL OTHER PROVISIONS OF ABOVE NOTES APPLYING.
7. FILTER FABRIC FENCES SHALL NOT BE REMOVED BEFORE THE UPSLOPE AREA HAS BEEN PERMANENTLY STABILIZED.
8. FILTER FABRIC FENCES SHALL BE INSPECTED IMMEDIATELY AFTER EACH RAINFALL AND AT LEAST DAILY DURING PROLONGED RAINFALL. ANY REQUIRED REPAIRS SHALL BE MADE IMMEDIATELY.
9. SILT FENCES WILL BE INSTALLED PARALLEL TO ANY SLOPE CONTOURS.
10. CONTRIBUTING LENGTH TO FENCE WILL NOT BE GREATER THAN 100 FEET.
11. DO NOT INSTALL BELOW AN OUTLET PIPE OR WEIR.
12. INSTALL DOWNSLOPE OF EXPOSED AREAS.
13. INSTALL DOWNSLOPE OF FILL OVER SILT FENCES.
14. DO NOT DRIVE OVER OR FILL OVER SILT FENCES.

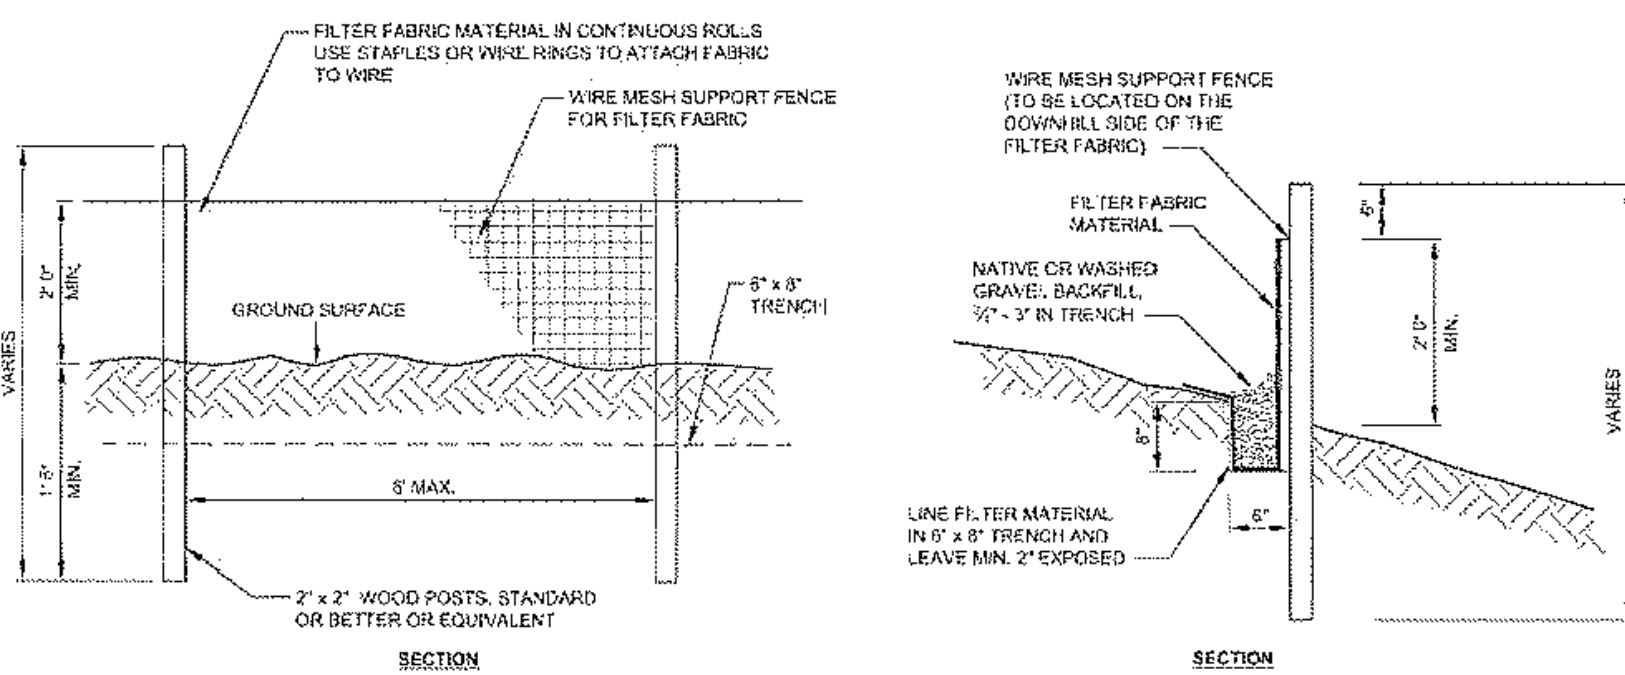

2 FILTER FABRIC FENCE SCALE: NTS



EAST TOWN CROSSING PHASE 1 SEC. 26,35/ TWP. 20 N./ RGE. 4 E., W.M.

AMENDED SOILS NOTES:

- SOIL AMENDMENTS ARE REQUIRED FOR ALL DISTURBED AREAS IN ACCORDANCE WITH BMP L613: POST-CONSTRUCTION SOIL QUALITY AND DEPTH OF THE 2021 SURFACE WATER MANAGEMENT MANUAL
• AMENDED SOILS SHALL BE A MINIMUM OF 8" (NON-COMPACTED) WITH SUBSOILS SCARIFIED AT LEAST 4" WITH INCORPORATION OF THE UPPER MATERIAL TO AVOID STRATIFIED LAYERS, WHERE FEASIBLE
• QUALITY OF COMPOST AND OTHER MATERIALS USED TO MEET THE ORGANIC CONTENT REQUIREMENTS ARE AS FOLLOWS:
a. THE ORGANIC CONTENT FOR "PRE-APPROVED" AMENDMENT RATES CAN BE MET ONLY USING COMPOST THAT MEETS THE DEFINITION OF "COMPOSTED MATERIALS" IN WAC 173-350-220. THE WAC IS AVAILABLE ONLINE AT: HTTP://WWW.ECY.WA.GOV/PROGRAMS/SWFA/FACILITIES/350.HTML. THE COMPOST MUST ALSO HAVE AN ORGANIC MATTER CONTENT OF 35% TO 65%, AND A CARBON TO NITROGEN RATIO BELOW 25:1. THE CARBON TO NITROGEN RATIO MAY BE AS HIGH AS 35:1 FOR PLANTINGS COMPOSED ENTIRELY OF PLANTS NATIVE TO THE PUGET SOUND LOWLANDS REGION.
b. CALCULATED AMENDMENT RATES MAY BE MET THROUGH USE OF COMPOSTED MATERIALS AS DEFINED ABOVE, OR OTHER ORGANIC MATERIALS AMENDED TO MEET THE CARBON TO NITROGEN RATIO REQUIREMENTS, AND MEETING THE CONTAMINANT STANDARDS OF GRADE A COMPOST.
• USE ONE OF THE FOLLOWING OPTIONS TO MEET THE POST CONSTRUCTION SOIL QUALITY AND DEPTH REQUIREMENTS. USE THE MOST RECENT VERSION OF "GUIDELINES FOR RESOURCES FOR IMPLEMENTING SOIL QUALITY AND DEPTH BMP 15.13" TO MEET THE REQUIREMENTS OF THIS BMP. THIS GUIDANCE CAN BE FOUND ONLINE AT WWW.SOILFORALMON.ORG
a. LEAVE NATIVE VEGETATION AND SOIL UNDISTURBED, AND PROTECT FROM COMPACTION DURING CONSTRUCTION
b. AMEND EXISTING SITE TOPSOIL OR SUBSOIL EITHER AT DEFAULT "PRE-APPROVED" RATES, OR AT CUSTOM CALCULATED RATES BASED ON SPECIFIC TESTS OF THE SOIL AND AMENDMENT
c. STOCKPILE EXISTING TOPSOIL DURING GRADING, AND REPLACE IT PRIOR TO PLANTING. STOCKPILED TOPSOIL MUST ALSO BE AMENDED IF NEEDED TO MEET THE ORGANIC MATTER OR DEPTH REQUIREMENTS, EITHER AT A DEFAULT "PRE-APPROVED" RATE OR AT A CUSTOM CALCULATED RATE.
d. IMPORT TOPSOIL WITH SUFFICIENT ORGANIC CONTENT AND DEPTH TO MEET THE REQUIREMENTS. MORE THAN ONE METHOD MAY BE USED ON DIFFERENT PORTIONS OF THE SAME SITE. SOIL THAT ALREADY MEETS THE DEPTH AND ORGANIC MATTER QUALITY STANDARDS, AND IS NOT COMPACTED, DOES NOT NEED TO BE AMENDED.
• AMENDED SOILS SHALL BE MAINTAINED AS FOLLOWS:
a. SOIL QUALITY AND DEPTH SHOULD BE ESTABLISHED TOWARD THE END OF CONSTRUCTION AND ONCE ESTABLISHED, SHOULD BE PROTECTED FROM COMPACTION, SUCH AS FROM LARGE MACHINERY USE, AND FROM EROSION.
b. SOIL SHOULD BE PLANTED AND MULCHED AFTER INSTALLATION.
c. PLANT DEBRIS OR ITS EQUIVALENT SHOULD BE LEFT ON THE SOIL SURFACE TO REPLENISH ORGANIC MATTER.
d. IMPORT TOPSOIL WITH SUFFICIENT ORGANIC CONTENT AND DEPTH TO MEET THE REQUIREMENTS. MORE THAN ONE METHOD MAY BE USED ON DIFFERENT PORTIONS OF THE SAME SITE. SOIL THAT ALREADY MEETS THE DEPTH AND ORGANIC MATTER QUALITY STANDARDS, AND IS NOT COMPACTED, DOES NOT NEED TO BE AMENDED.
• SEE PROJECT CONSTRUCTION SWPPP FOR ADDITIONAL INFORMATION OR SECTION 2.2.1.4 OF CHAPTER 2 OF VOLUME 6 OF THE 2021 SURFACE WATER MANAGEMENT MANUAL.

MULCHING NOTES:

- 1. MULCH MATERIALS USED SHALL BE STRAW OR HAY, AND SHALL BE APPLIED AT THE RATE OF 75-100 POUNDS PER 1000 SQ. FT. (APPX 2" THICK).
2. MULCH SHALL BE APPLIED IN ALL AREAS WITH EXPOSED SLOPES GREATER THAN 2: 1.
3. MULCHING SHALL BE USED IMMEDIATELY AFTER SEEDING OR IN AREAS WHICH CANNOT BE SEEDDED BECAUSE OF THE SEASON.
4. ALL AREAS NEEDING MULCH SHALL BE COVERED BY NOVEMBER 1.

CONTRACTOR NOTES:

- 1. INLET PROTECTION SHALL BE INSTALLED IN ALL NEWLY CONSTRUCTED CATCH BASINS AND ALONG ALL IMPACTED FRONTAGE AND OFFSITE AREAS PER THE REQUIREMENTS OF THE COUNTY INSPECTOR PER DETAIL 5 ON THIS SHEET 5.
2. CONSTRUCTION FENCE CAN BE UTILIZED IN PLACE OF FILTER FABRIC FENCE ONLY IN AREAS WHERE THE GRADES DO NOT ALLOW THE POTENTIAL FOR ANY STORMWATER TO LEAVE THE SITE.
3. ALL DEMOLISHED MATERIALS SHALL BE REMOVED FROM THE SITE AND DISPOSED OF AT A CITY APPROVED LOCATION AND IN A MANNER CONSISTENT WITH CURRENT REGULATIONS AND REQUIREMENTS.
4. ALL AREAS THAT WILL BE UNWORKED FOR MORE THAN SEVEN (7) DAYS DURING THE DRY SEASON OR TWO (2) DAYS DURING THE WET SEASON, SHALL BE COVERED WITH STRAW, WOOD FIBER MULCH, COMPOST, PLASTIC SHEETING, OR OTHER EQUIVALENT PER CURRENT CITY OR COUNTY STANDARDS. SEE SEEDING NOTES AND MULCHING NOTES ON THIS SHEET.
5. CONTRACTOR SHALL DESIGNATE A WASHINGTON DEPT OF ECOLOGY CERTIFIED EROSION CONTROL LEAD PERSON, AND SHALL COMPLY WITH THE CONSTRUCTION STORMWATER POLLUTION PREVENTION PLAN (SWPPP) PREPARED FOR THE PROJECT.
6. AT ANY TIME DURING CONSTRUCTION IT IS DETERMINED BY THE CITY OR COUNTY THAT MUD AND DEBRIS ARE BEING TRACKED ONTO PUBLIC STREETS WITH INSUFFICIENT CLEANUP, ALL WORK SHALL CEASE ON THE PROJECT UNTIL THIS CONDITION IS CORRECTED. THE CONTRACTOR AND/OR THE OWNER SHALL IMMEDIATELY TAKE ALL STEPS NECESSARY TO PREVENT FUTURE TRACKING OF MUD AND DEBRIS INTO THE PUBLIC ROW, WHICH MAY INCLUDE THE INSTALLATION OF A WHEEL WASH FACILITY ON-SITE.
7. SEDIMENT LADEN RUNOFF SHALL NOT BE ALLOWED TO DISCHARGE BEYOND THE LIMITS OF THE IMPROVEMENTS. ADDITIONAL MEASURES SHALL BE INSTALLED AS NEEDED.
8. SAND BAGS SHALL BE SECURELY PLACED AROUND INSTALLED CATCH BASINS WITH INLET PROTECTION AS FIELD AND WEATHER CONDITIONS WARRANT SO TO PROTECT ALL DISPERSION AND INFILTRATION TRENCHES SEDIMENT LADEN RUNOFF.
9. TREES WITHIN WORKING LIMITS TO BE SAVED, SHALL BE MARKED AS SUCH ON SITE AND PROTECTION FENCE PLACED AROUND EACH TREE.

SEEDING NOTES:

- 1. THE FOLLOWING SEED MIXTURE SHALL BE AS BELOW AND SHALL BE APPLIED AT THE RATE RECOMMENDED BY THE SUPPLIER.

TABLE D.3.2.B TEMPORARY EROSION CONTROL SEED MIX. Table with 4 columns: Seed Name, % WEIGHT, % PURITY, % GERMINATION. Rows include CHEWINGS OR RED FESCUE, ANNUAL OR PERENNIAL RYE, REDTOP OR COLONIAL BENTGRASS, and WHITE DUTCH CLOVER.


- 2. SEED BEDS PLANTED BETWEEN MAY 1 AND OCTOBER 31 WILL REQUIRE IRRIGATION AND OTHER MAINTENANCE AS NECESSARY TO FOSTER AND PROTECT THE ROOT STRUCTURE.
3. FOR SEED BEDS PLANTED BETWEEN OCTOBER 31 AND APRIL 30, ARMORING OF THE SEED BED WILL BE NECESSARY. (E.G., GEOTEXTILES, JUTE MAT, CLEAR PLASTIC COVERING).
4. BEFORE SEEDING, INSTALL NEEDED SURFACE RUNOFF CONTROL MEASURES SUCH AS GRADIENT TERRACES, INTERCEPTOR DIKES, SWALES, LEVEL SPREADERS AND SEDIMENT BASINS.
5. THE SEEDBED SHALL BE FIRM WITH A FAIRLY FINE SURFACE, FOLLOWING SURFACE ROUGHENING. PERFORM ALL OPERATIONS ACROSS OR AT RIGHT ANGLES TO THE SLOPE.
6. FERTILIZERS ARE TO BE USED ACCORDING TO SUPPLIER'S RECOMMENDATIONS. AMOUNTS USED SHOULD BE MINIMIZED, ESPECIALLY ADJACENT TO WATER BODIES AND WETLANDS.

APPROVED

BY: CITY OF PUYALLUP DEVELOPMENT ENGINEERING

DATE:

NOTE: THIS APPROVAL IS VOID AFTER 180 DAYS FROM APPROVAL DATE. THE CITY WILL NOT BE RESPONSIBLE FOR ERRORS AND/OR OMISSIONS ON THESE PLANS. FIELD CONDITIONS MAY DICTATE CHANGES TO THESE PLANS AS DETERMINED BY THE DEVELOPMENT ENGINEERING MANAGER.

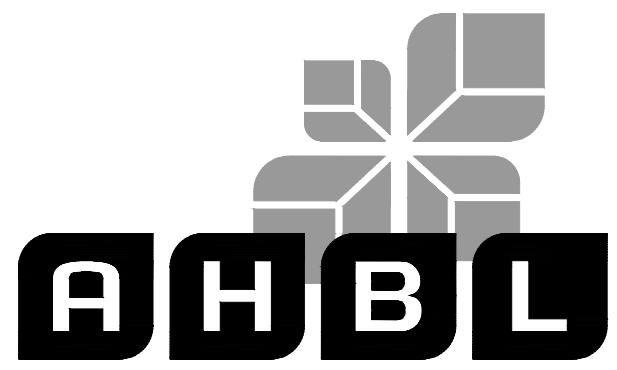

TACOMA · SEATTLE · SPOKANE · TRI-CITIES

2215 North 30th Street, Suite 300, Tacoma, WA 98403
253.383.2422 TEL 253.383.2572 FAX www.ahbl.com WEB

Project Title:

EAST TOWN CROSSING PHASE 1

Client: ASH DEVELOPMENT


GREG HELLE
GREG.HELLE@ASHNW.COM

Project No. 2230752

Issue Set & Date:


PERMIT SUBMITTAL

11/20/2023

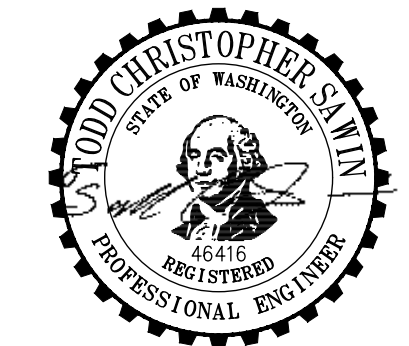

11/21/2023

NOTICE: A SIGNATURE OF THIS DOCUMENT SHALL VALIDATE THE PROFESSIONAL SEAL AND SIGNATURE. PUBLICATION OF THIS DOCUMENT DOES NOT CONSTITUTE A PROFESSIONAL ENGINEER'S OPINION ON THE PROJECT. THE ENGINEER'S OPINION IS ONLY FOR THE PROJECT DESCRIBED IN THE TITLE BLOCK AND IS NOT TO BE USED FOR OTHER PROJECTS OR ACTION TO THAT PROJECT OR FOR ANY OTHER PROJECT.

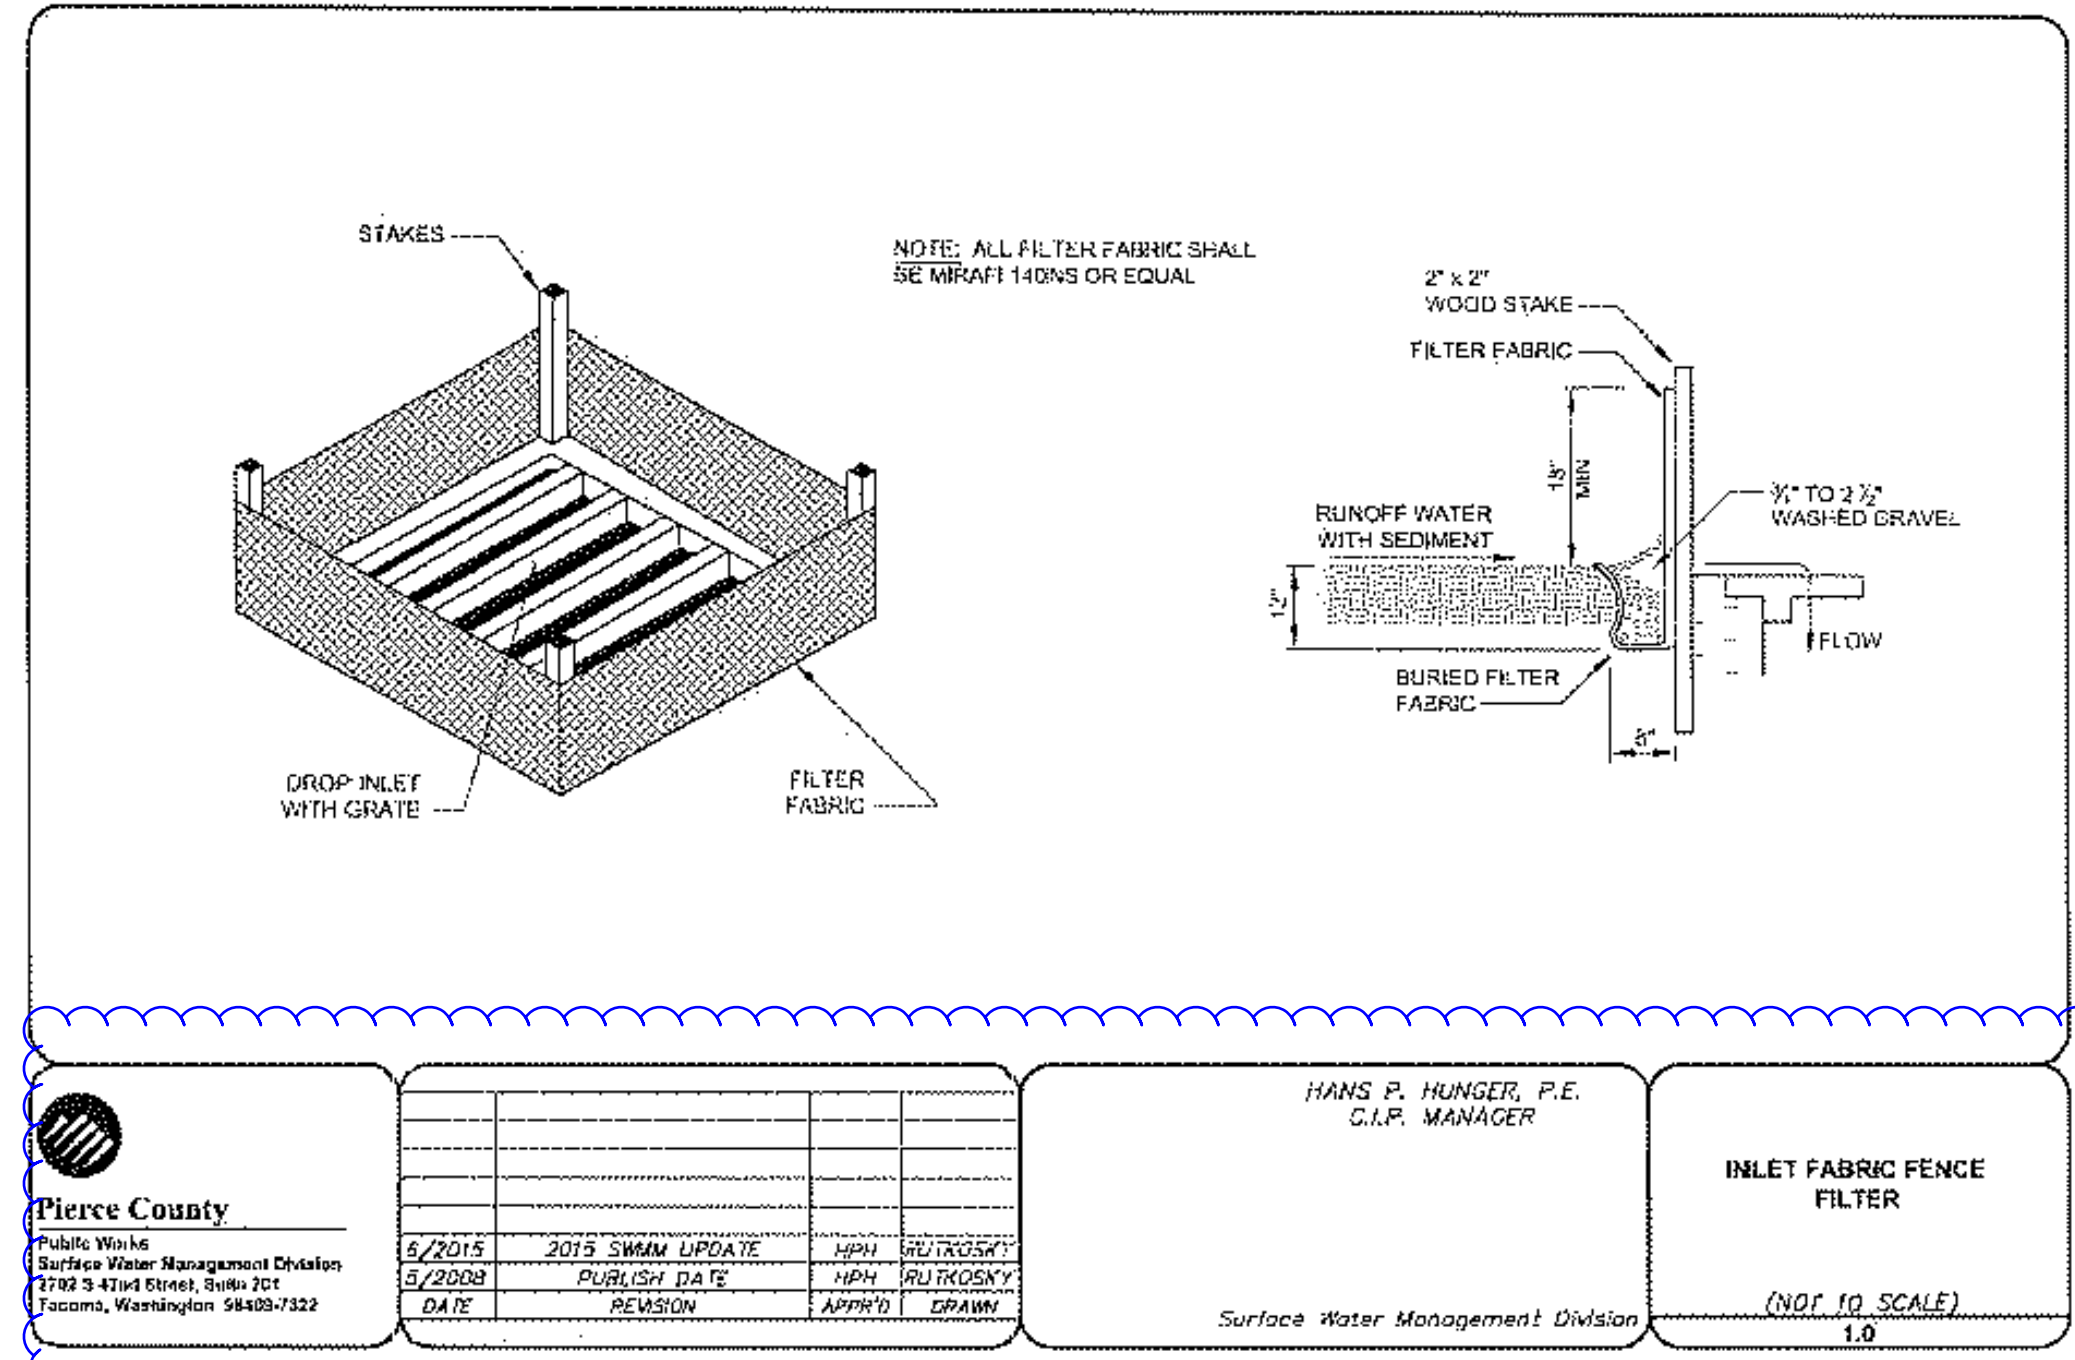

3 INLET PROTECTION SCALE: NTS

OK to use detail...please remove title block info [Plans Sht C1.1; Pg 3 of 63]

Removed title block info

Revisions table with columns for revision number, description, and date.

Sheet Title:

TESC NOTES AND DETAILS

Designed by: CW Drawn by: SK Checked by: JI

Sheet No.

C1.1

3 of 63 Sheets


EAST TOWN CROSSING PHASE 1

SEC. 26,35/ TWP. 20 N./ RGE. 4 E., W.M.

APPROVED



BY: CITY OF PUYALLUP
DEVELOPMENT ENGINEERING
DATE:

NOTE: THIS APPROVAL IS VOID AFTER 180 DAYS FROM APPROVAL DATE. THE CITY WILL NOT BE RESPONSIBLE FOR ERRORS AND/OR OMISSIONS ON THESE PLANS. FIELD CONDITIONS MAY DICTATE CHANGES TO THESE PLANS AS DETERMINED BY THE DEVELOPMENT ENGINEERING MANAGER.

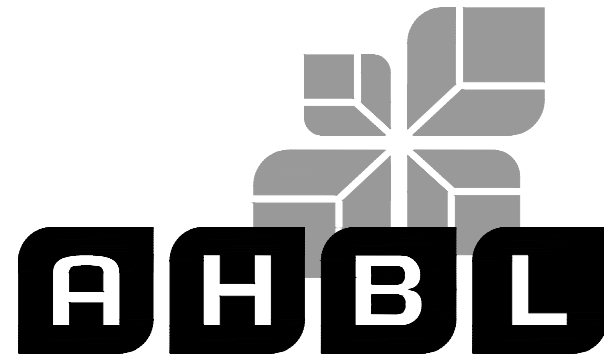

TACOMA · SEATTLE · SPOKANE · TRI-CITIES

2215 North 30th Street, Suite 300, Tacoma, WA 98403
253.383.2422 TEL 253.383.2572 FAX www.ahbl.com WEB

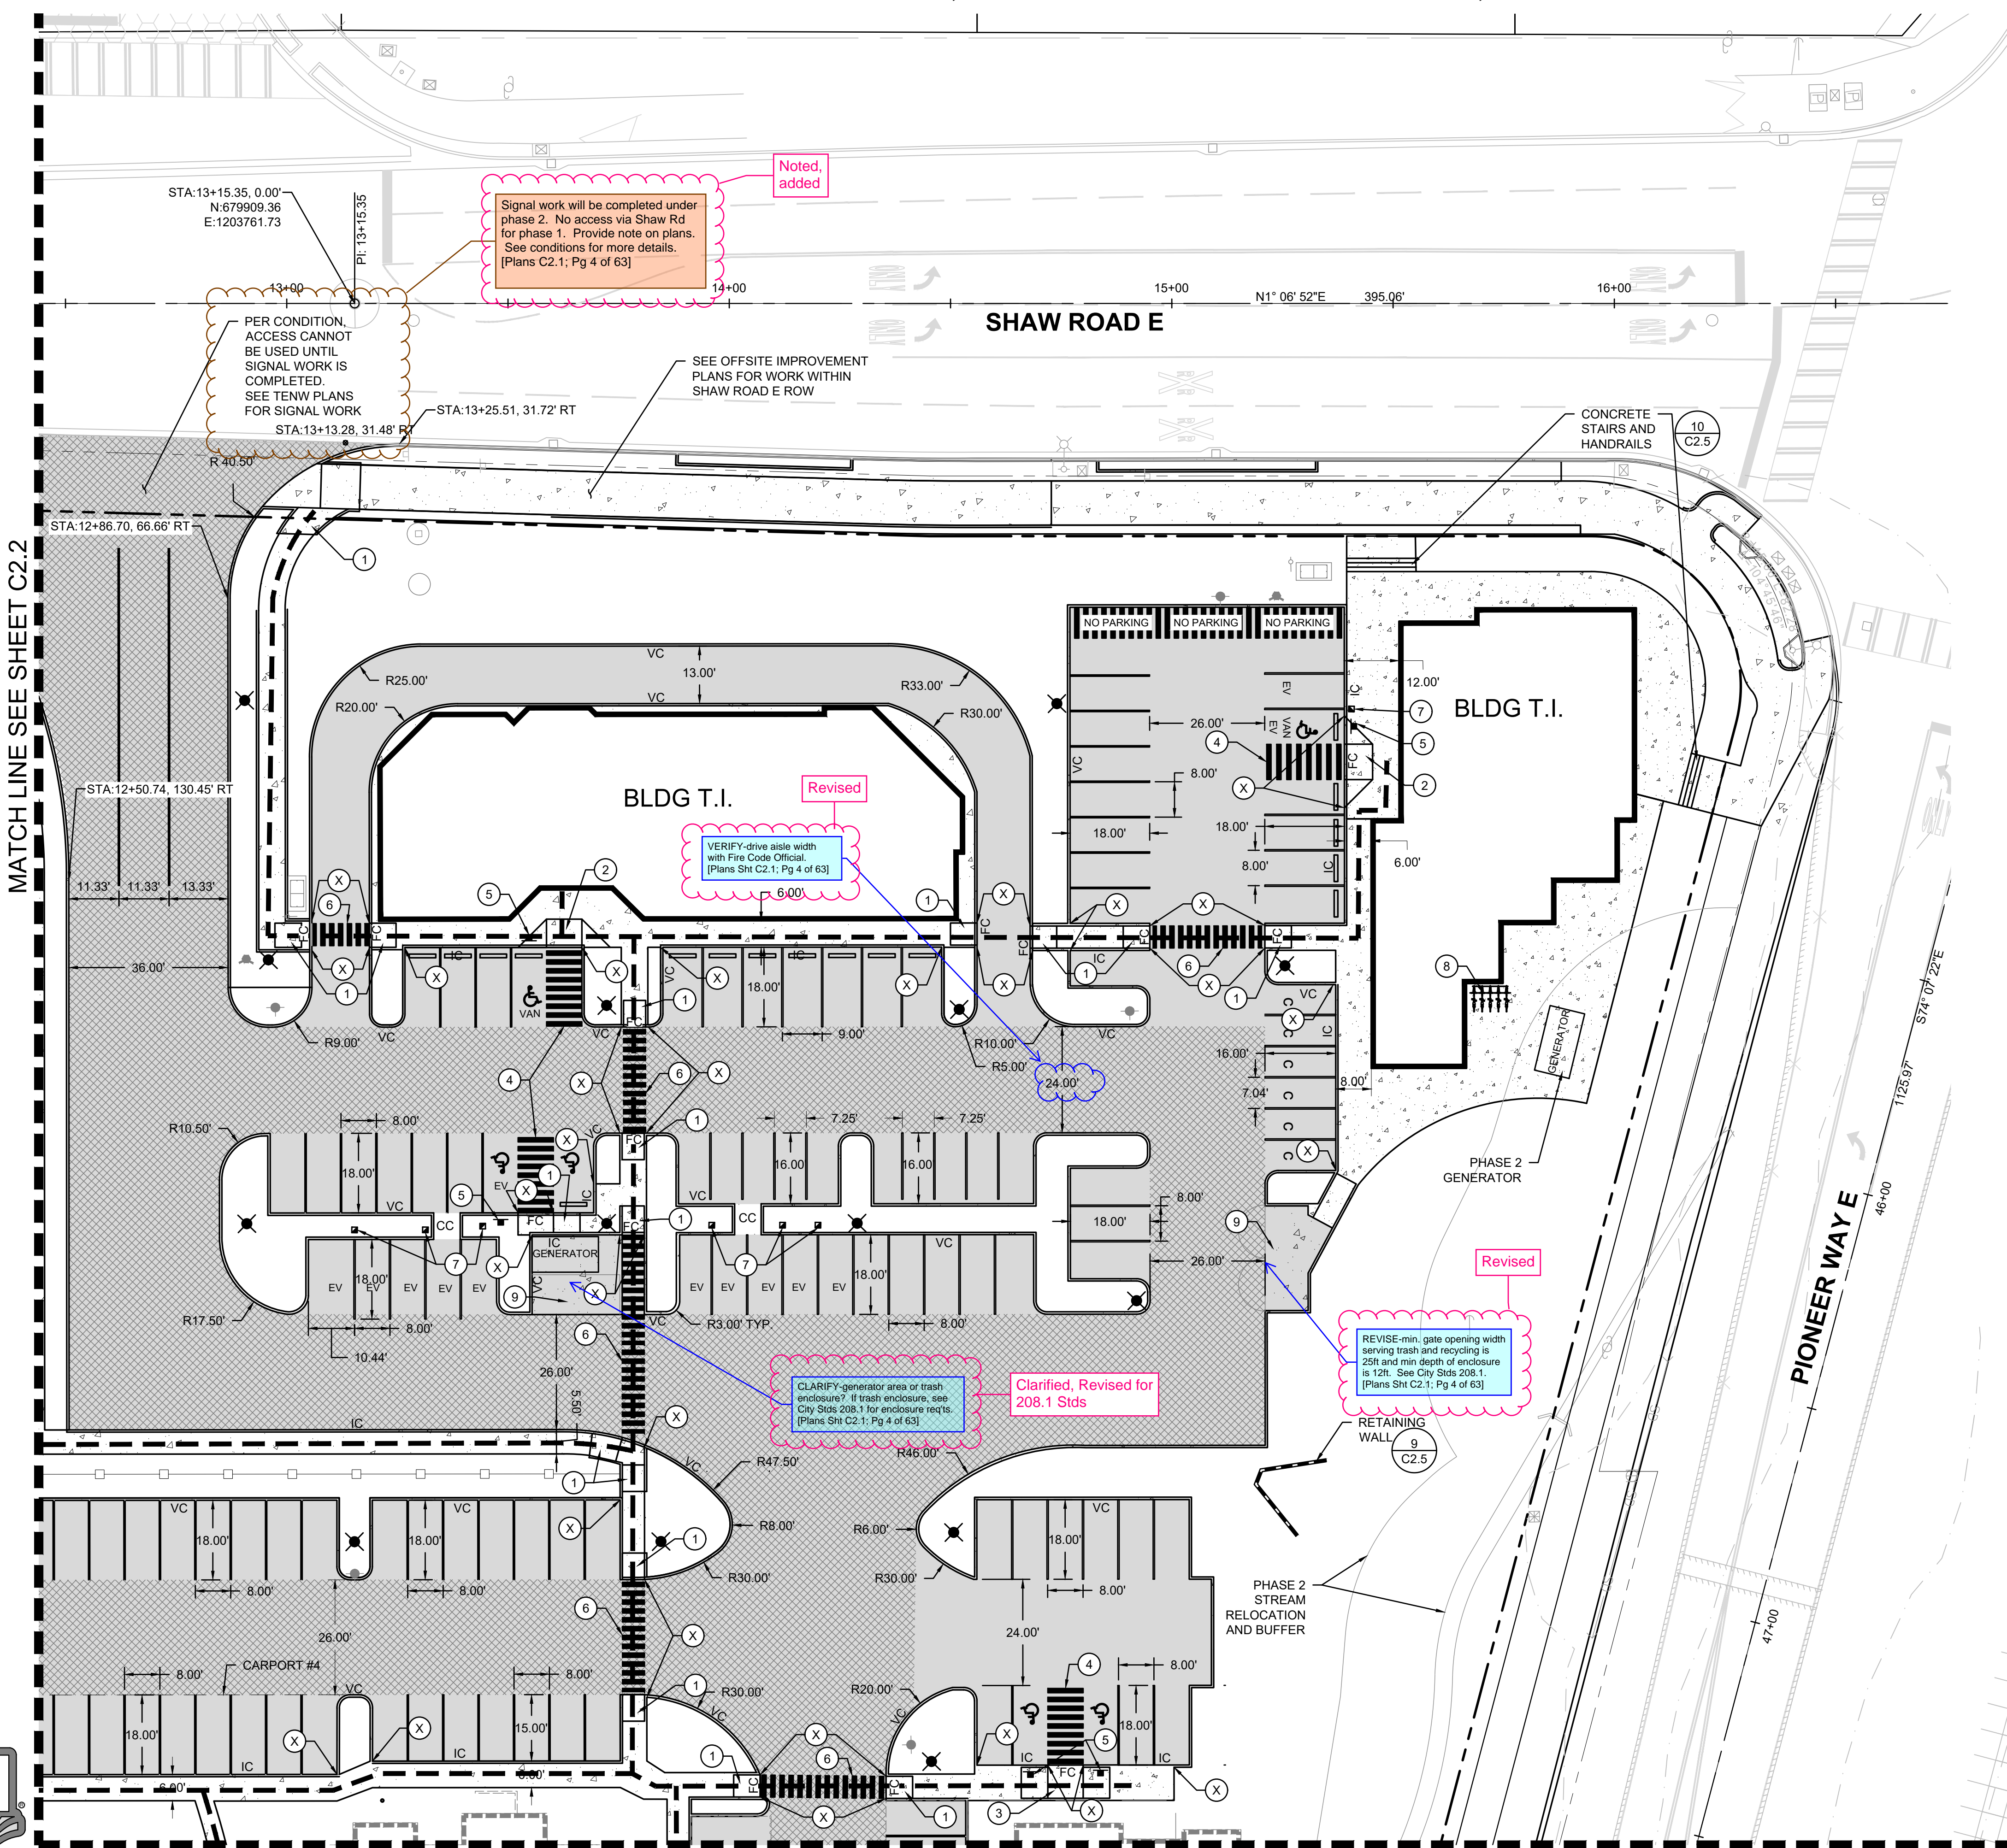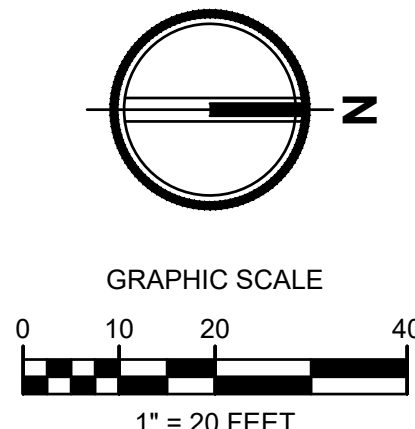


LEGEND:

- RIGHT-OF-WAY/PROPERTY LINE
- CENTERLINE
- PROPOSED BUILDING OUTLINE
- - - FENCING - REFER TO LANDSCAPE ARCHITECTS DRAWINGS.
- ACCESSIBLE PATH
- ASPHALT PAVEMENT - STANDARD DUTY (1) C2.5
- ASPHALT PAVEMENT - ATB (2) C2.5
- PERVIOUS CONCRETE SIDEWALK (3) C2.5
- CEMENT CONCRETE - HEAVY DUTY (4) C2.5
- BOLLARD PROTECTION
- CEMENT CONCRETE WHEEL STOP (7) C2.5
- LIGHTING - REFER TO ELECTRICAL PLANS
- ADA ACCESSIBLE PARKING STALL (5) C2.6
- CHANGE IN CURB TYPE / END CURB (X)
- CONCRETE EXTRUDED CURB (5) C2.5
- INTEGRAL CURB AND SIDEWALK (5) C2.5
- NO CURB (NC)
- CURB CUT (CC)
- VERTICAL CURB (VC)
- CONCRETE CURB AND GUTTER (CG)
- FLUSH CURB (FC)

KEYNOTES

- 1 ADA RAMP - SINGLE DIRECTIONAL (1) C2.6
- 2 ADA RAMP - PERPENDICULAR (3) C2.6
- 3 ADA RAMP - DEPRESSED SIDEWALK (2) C2.6
- 4 ADA STALL (5) C2.6
- 5 ADA SIGN (5) C2.6
- 6 CROSSWALK STRIPING
- 7 EV CHARGING - SEE ARCHITECTURAL PLANS
- 8 BIKE RACK, SEE ARCHITECTURAL PLANS
- 9 DUMPSTER ENCLOSURE, SEE ARCHITECTURAL PLANS

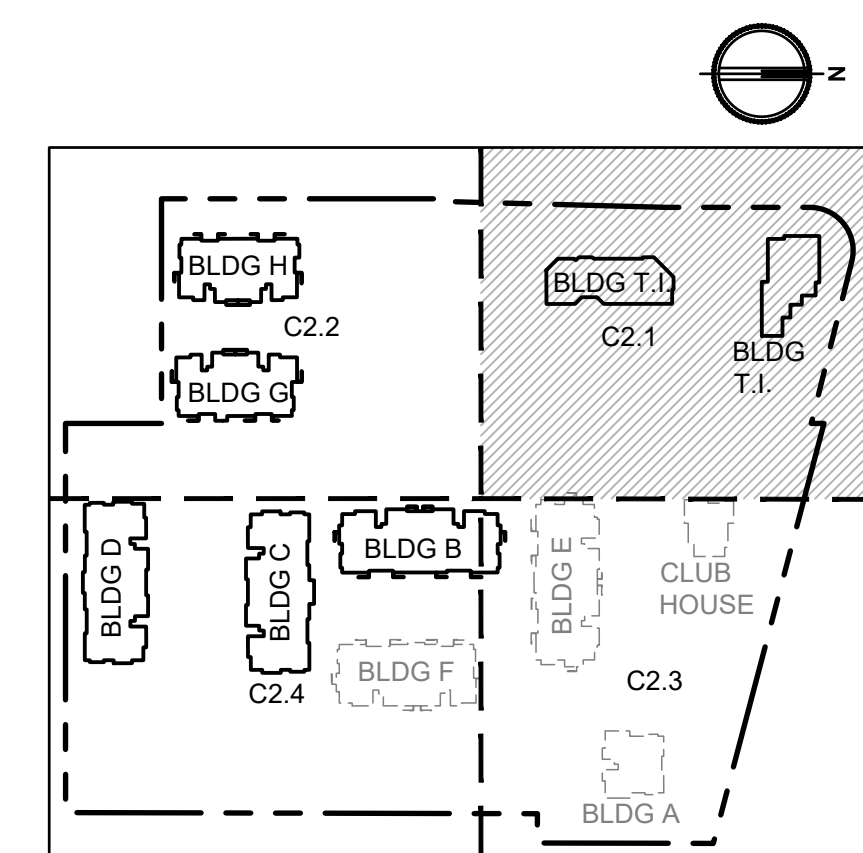

Project Title:

EAST TOWN CROSSING PHASE 1

Client:

ASH DEVELOPMENT

GREG HELLE

GREG.HELLE@ASHNW.COM

Project No.

2230752

Issue Set & Date:

PERMIT SUBMITTAL

11/20/2023



11/21/2023

NOTICE: ALTERATION OF THIS DOCUMENT SHALL INVALIDATE THE PROFESSIONAL SEAL AND SIGNATURE. PUBLICATION OF THIS DOCUMENT DOES NOT CONSTITUTE A REVIEW OF THE PROJECT BY THE ENGINEER OR ARCHITECT. THE ENGINEER OR ARCHITECT IS NOT TO BE HELD RESPONSIBLE FOR ANY CHANGES TO THIS PROJECT OR FOR ANY OTHER PROJECT.

Revisions:

Revisions:

Revisions:

Revisions:

Sheet Title:

HORIZONTAL CONTROL AND PAVING PLAN NW

Designed by: CW Drawn by: SK Checked by: JI

Sheet No.

C2.1



4 of 63 Sheets



Know what's below.
Call before you dig.

EAST TOWN CROSSING PHASE 1

SEC. 26,35/ TWP. 20 N./ RGE. 4 E., W.M.

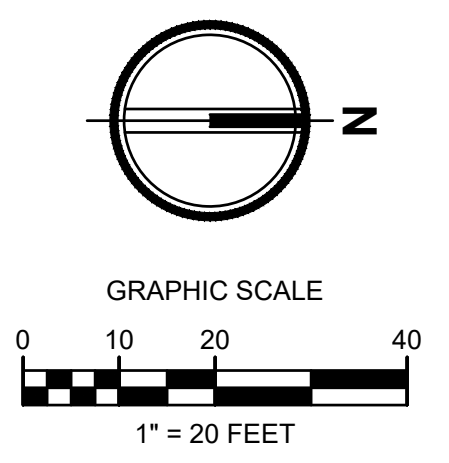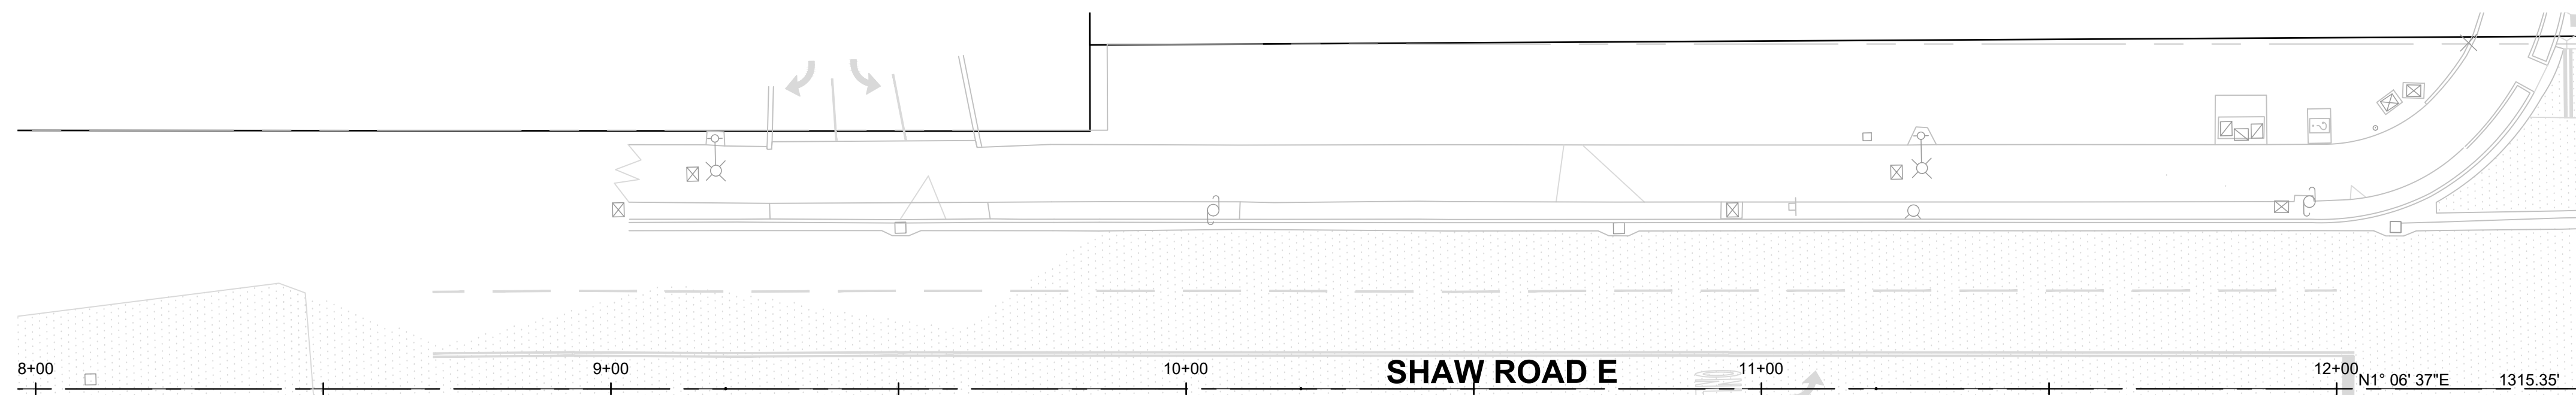

APPROVED

BY: CITY OF PUYALLUP
DEVELOPMENT ENGINEERING

DATE:

NOTE: THIS APPROVAL IS VOID AFTER 180 DAYS FROM APPROVAL DATE. THE CITY WILL NOT BE RESPONSIBLE FOR ERRORS AND/OR OMISSIONS ON THESE PLANS. FIELD CONDITIONS MAY DICTATE CHANGES TO THESE PLANS AS DETERMINED BY THE DEVELOPMENT ENGINEERING MANAGER.

TACOMA • SEATTLE • SPOKANE • TRI-CITIES

2215 North 30th Street, Suite 300, Tacoma, WA 98403
253.383.2422 TEL 253.383.2572 FAX www.ahbl.com WEB

Project Title:

EAST TOWN CROSSING PHASE 1

Client:

ASH DEVELOPMENT

GREG HELLE
GREG.HELLE@ASHNW.COM


Project No.

2230752

Issue Set & Date:

PERMIT SUBMITTAL

11/20/2023


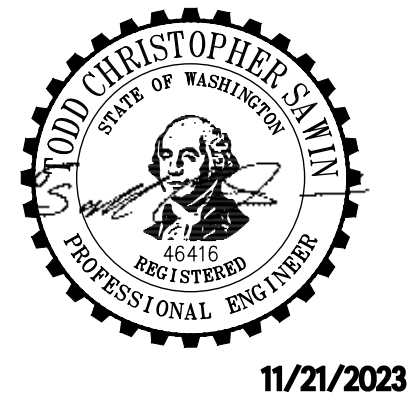


11/21/2023

NOTICE: ALTERATION OF THIS DOCUMENT SHALL INVALIDATE THE PROFESSIONAL SEAL AND SIGNATURE. PUBLICATION OF THIS DOCUMENT DOES NOT CONSTITUTE AN ENDORSEMENT OR GUARANTEE BY THE ENGINEER OR ARCHITECT. THE ENGINEER OR ARCHITECT IS NOT TO BE HELD RESPONSIBLE FOR ANY ERRORS OR OMISSIONS IN THIS DOCUMENT OR FOR ANY OTHER PROJECT.

- LEGEND:**
- RIGHT-OF-WAY/PROPERTY LINE
 - CENTERLINE
 - PROPOSED BUILDING OUTLINE
 - - - - - FENCING - REFER TO LANDSCAPE ARCHITECTS DRAWINGS.
 - - - - - ACCESSIBLE PATH
 - ASPHALT PAVEMENT - STANDARD DUTY (1) C2.5
 - ASPHALT PAVEMENT - ATB (2) C2.5
 - PERVIOUS CONCRETE SIDEWALK (3) C2.5
 - CEMENT CONCRETE - HEAVY DUTY (4) C2.5
 - BOLLARD PROTECTION
 - CEMENT CONCRETE WHEEL STOP (7) C2.5
 - LIGHTING - REFER TO ELECTRICAL PLANS
 - ADA ACCESSIBLE PARKING STALL (5) C2.6
 - CHANGE IN CURB TYPE / END CURB (X)
 - CONCRETE EXTRUDED CURB (5) C2.5
 - INTEGRAL CURB AND SIDEWALK (5) C2.5
 - NO CURB (8) C2.5
 - CURB CUT (6) C2.5
 - VERTICAL CURB (8) C2.5
 - CONCRETE CURB AND GUTTER (6) C2.5
 - FLUSH CURB (FC)

- KEYNOTES**
- 1 ADA RAMP - SINGLE DIRECTIONAL (1) C2.6
 - 2 ADA RAMP - PERPENDICULAR (2) C2.6
 - 3 ADA RAMP - DEPRESSED SIDEWALK (3) C2.6
 - 4 ADA STALL (5) C2.6
 - 5 ADA SIGN (5) C2.6
 - 6 CROSSWALK STRIPING
 - 7 EV CHARGING - SEE ARCHITECTURAL PLANS
 - 8 BIKE RACK, SEE ARCHITECTURAL PLANS
 - 9 DUMPSTER ENCLOSURE, SEE ARCHITECTURAL PLANS

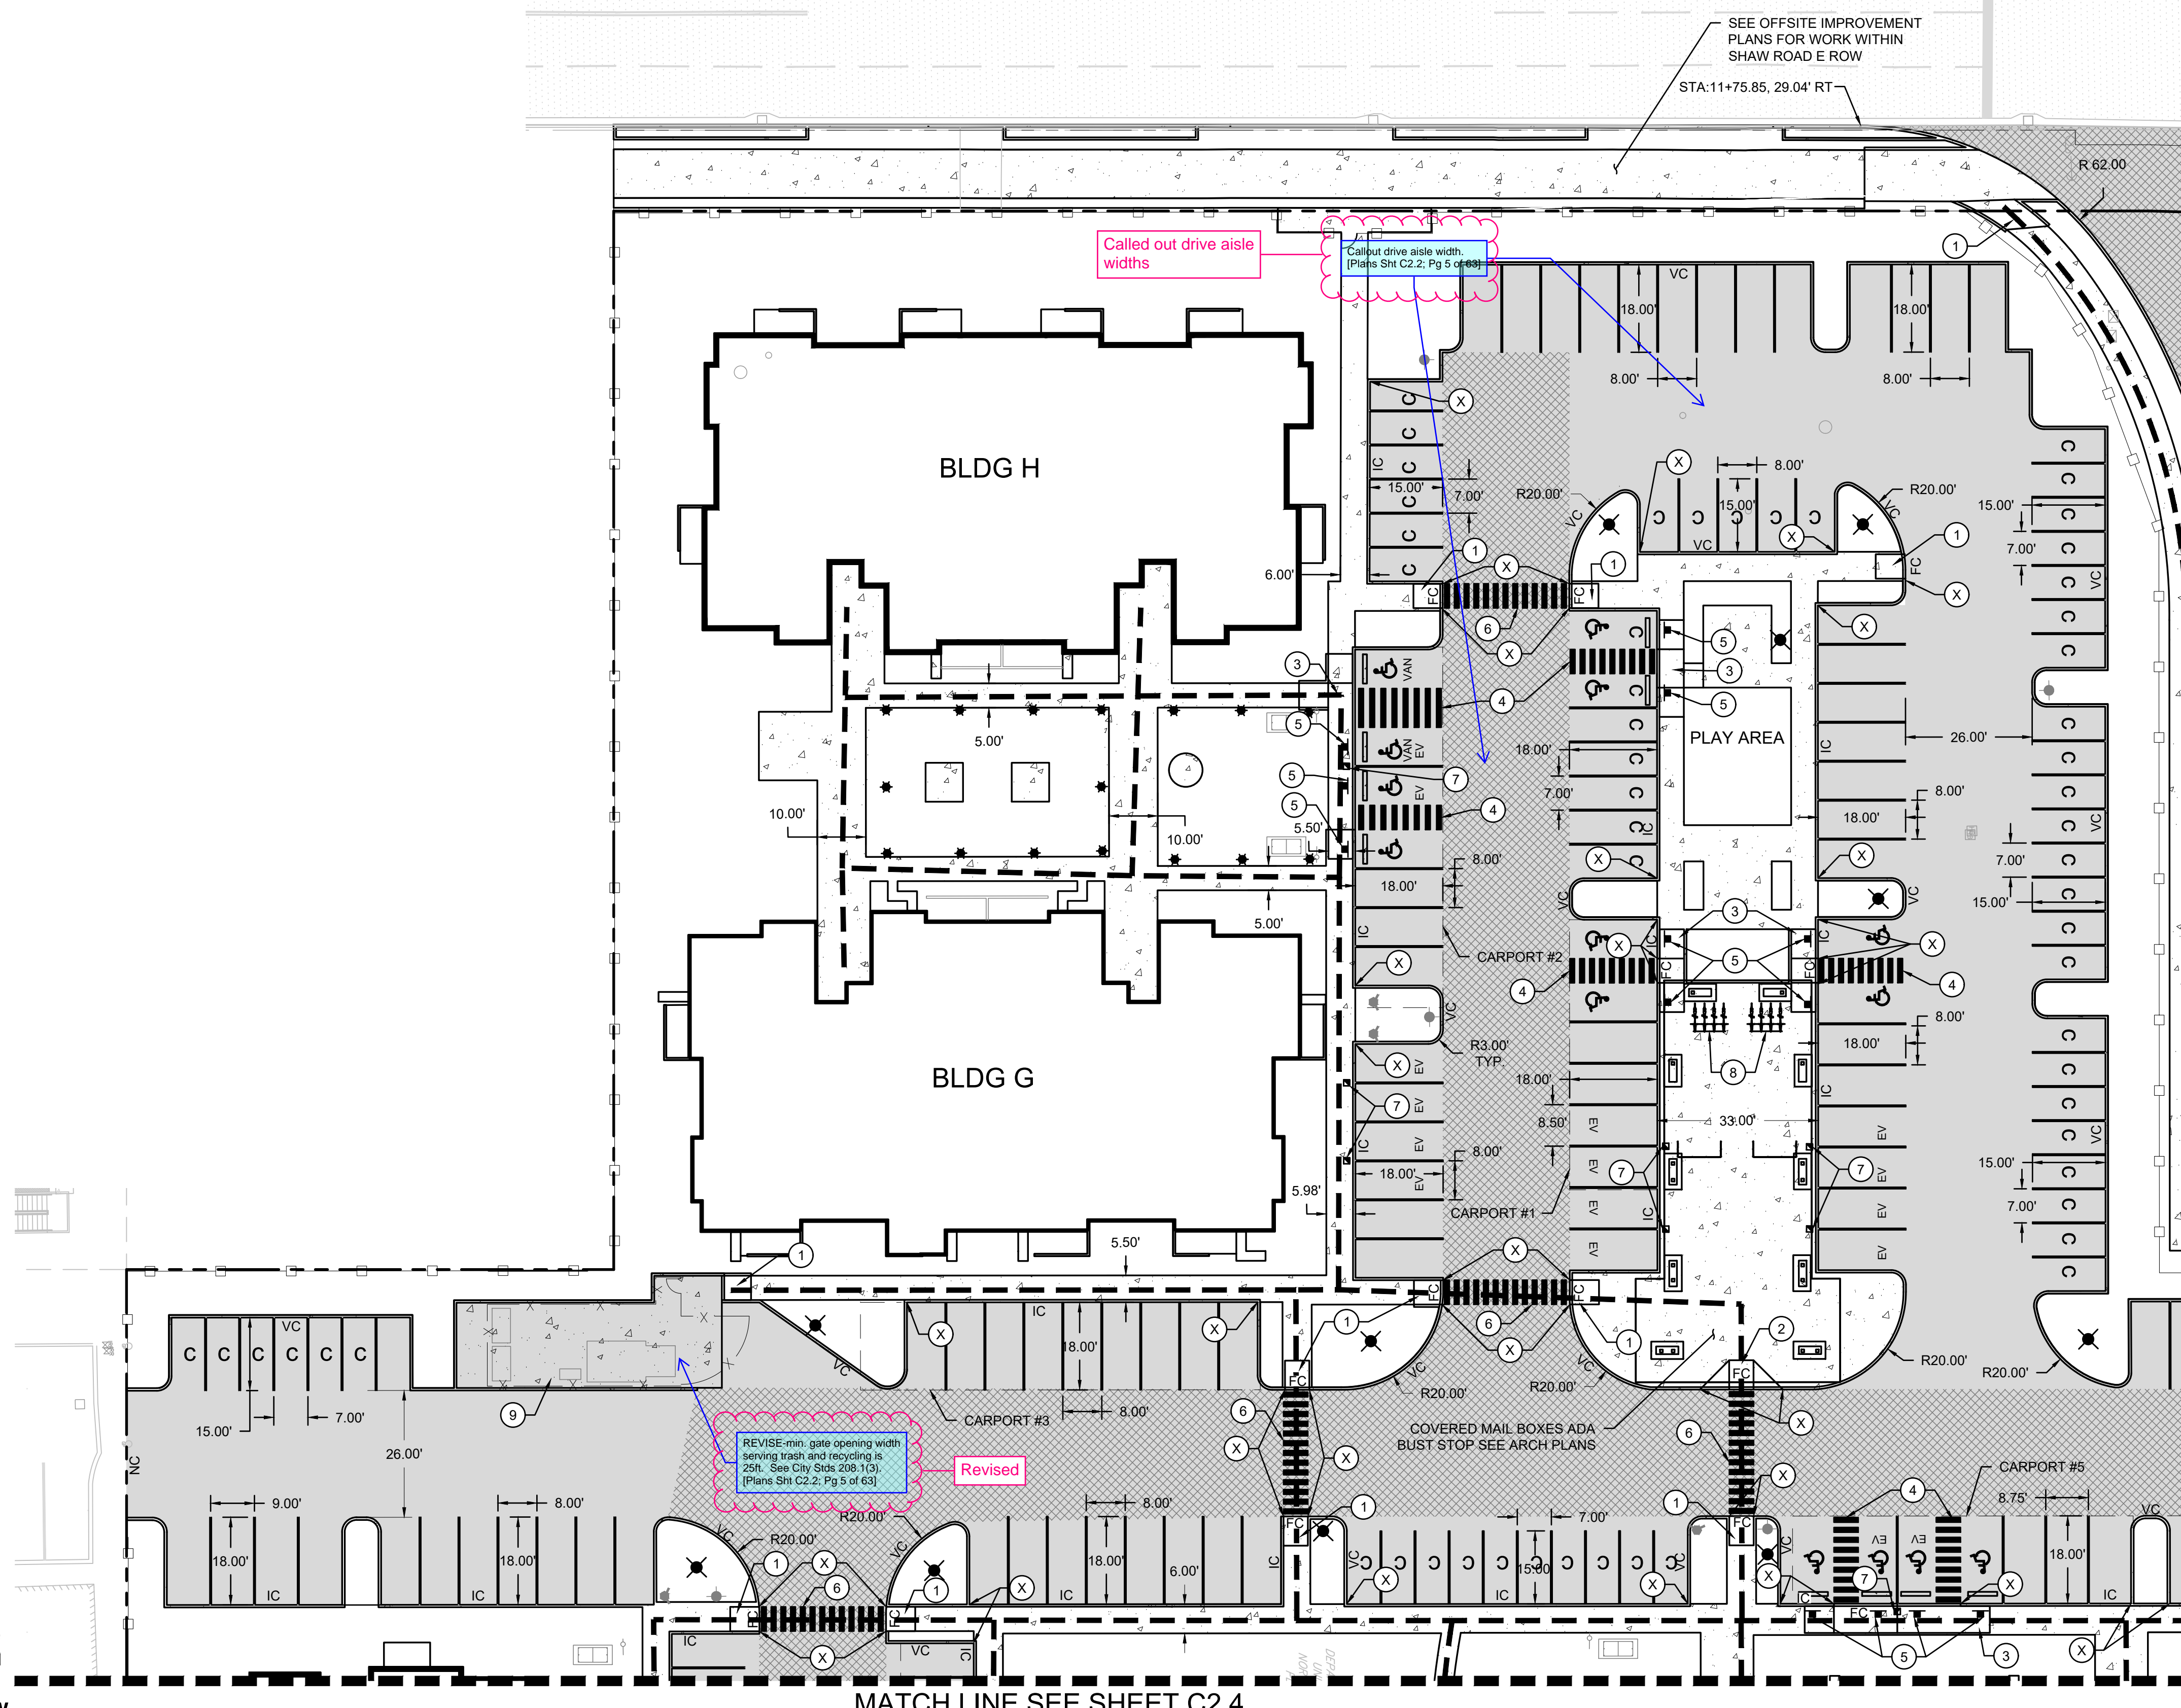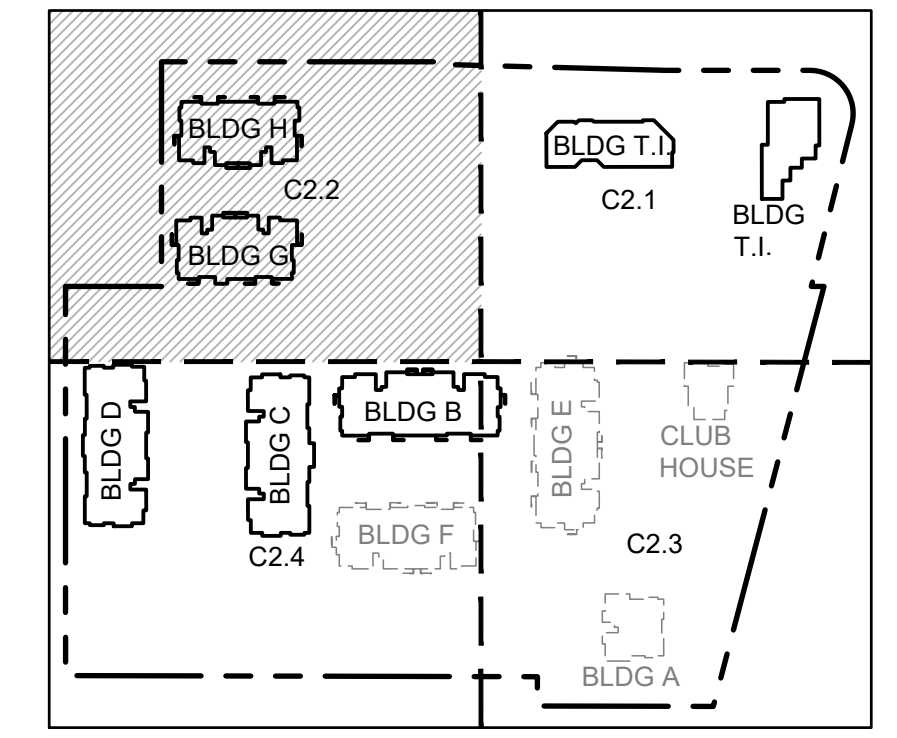

Know what's below.
Call before you dig.

Revisions:

Sheet Title:

HORIZONTAL CONTROL AND PAVING PLAN SW

Designed by: CW
Drawn by: SK
Checked by: JI

Sheet No.

C2.2

5 of 63 Sheets


EAST TOWN CROSSING PHASE 1

SEC. 26,35/ TWP. 20 N./ RGE. 4 E., W.M.

APPROVED

BY: CITY OF PUYALLUP
DEVELOPMENT ENGINEERING
DATE:

NOTE: THIS APPROVAL IS VOID AFTER 180 DAYS FROM APPROVAL DATE. THE CITY WILL NOT BE RESPONSIBLE FOR ERRORS AND/OR OMISSIONS ON THESE PLANS. FIELD CONDITIONS MAY DICTATE CHANGES TO THESE PLANS AS DETERMINED BY THE DEVELOPMENT ENGINEERING MANAGER.

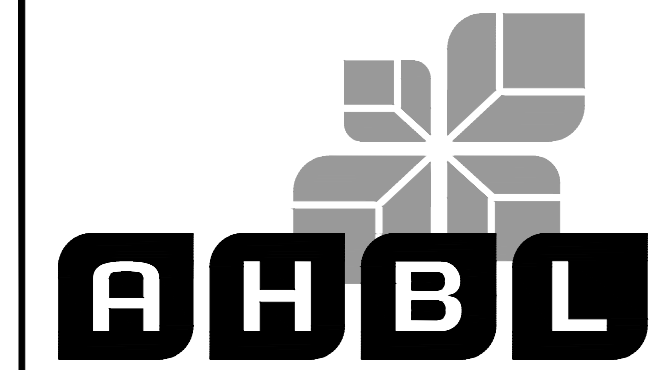

TACOMA · SEATTLE · SPOKANE · TRI-CITIES
2215 North 30th Street, Suite 300, Tacoma, WA 98403
253.383.2422 TEL 253.383.2572 FAX www.ahbl.com WEB

Project Title:
EAST TOWN CROSSING PHASE 1

Client:
ASH DEVELOPMENT
GREG HELLE
GREG.HELLE@ASHNW.COM

Project No.
2230752


Issue Set & Date:
PERMIT SUBMITTAL

11/20/2023



11/21/2023



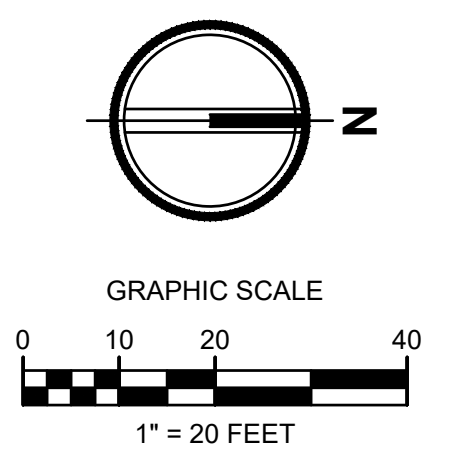


LEGEND:

	RIGHT-OF-WAY/PROPERTY LINE
	CENTERLINE
	PROPOSED BUILDING OUTLINE
	FENCING - REFER TO LANDSCAPE ARCHITECTS DRAWINGS.
	ACCESSIBLE PATH
	ASPHALT PAVEMENT - STANDARD DUTY (1 C2.5)
	ASPHALT PAVEMENT - ATB (2 C2.5)
	PERVIOUS CONCRETE SIDEWALK (3 C2.5)
	CEMENT CONCRETE - HEAVY DUTY (4 C2.5)
	BOLLARD PROTECTION
	CEMENT CONCRETE WHEEL STOP (7 C2.5)
	LIGHTING - REFER TO ELECTRICAL PLANS
	ADA ACCESSIBLE PARKING STALL (5 C2.6)
	CHANGE IN CURB TYPE / END CURB
	CONCRETE EXTRUDED CURB
	INTEGRAL CURB AND SIDEWALK (5 C2.5)
	NO CURB
	CURB CUT (8 C2.5)
	VERTICAL CURB (6 C2.5)
	CONCRETE CURB AND GUTTER
	FLUSH CURB

KEYNOTES

	ADA RAMP - SINGLE DIRECTIONAL (1 C2.6)
	ADA RAMP - PERPENDICULAR (3 C2.6)
	ADA RAMP - DEPRESSED SIDEWALK (2 C2.6)
	ADA STALL (5 C2.6)
	ADA SIGN (5 C2.6)
	CROSSWALK STRIPING
	EV CHARGING - SEE ARCHITECTURAL PLANS
	BIKE RACK, SEE ARCHITECTURAL PLANS
	DUMPSTER ENCLOSURE, SEE ARCHITECTURAL PLANS

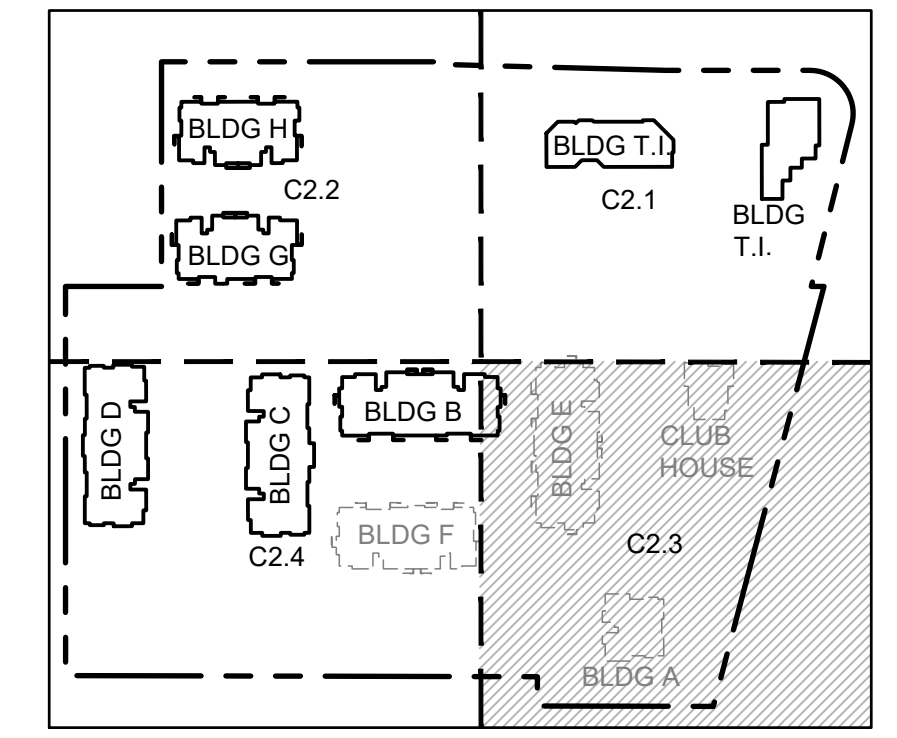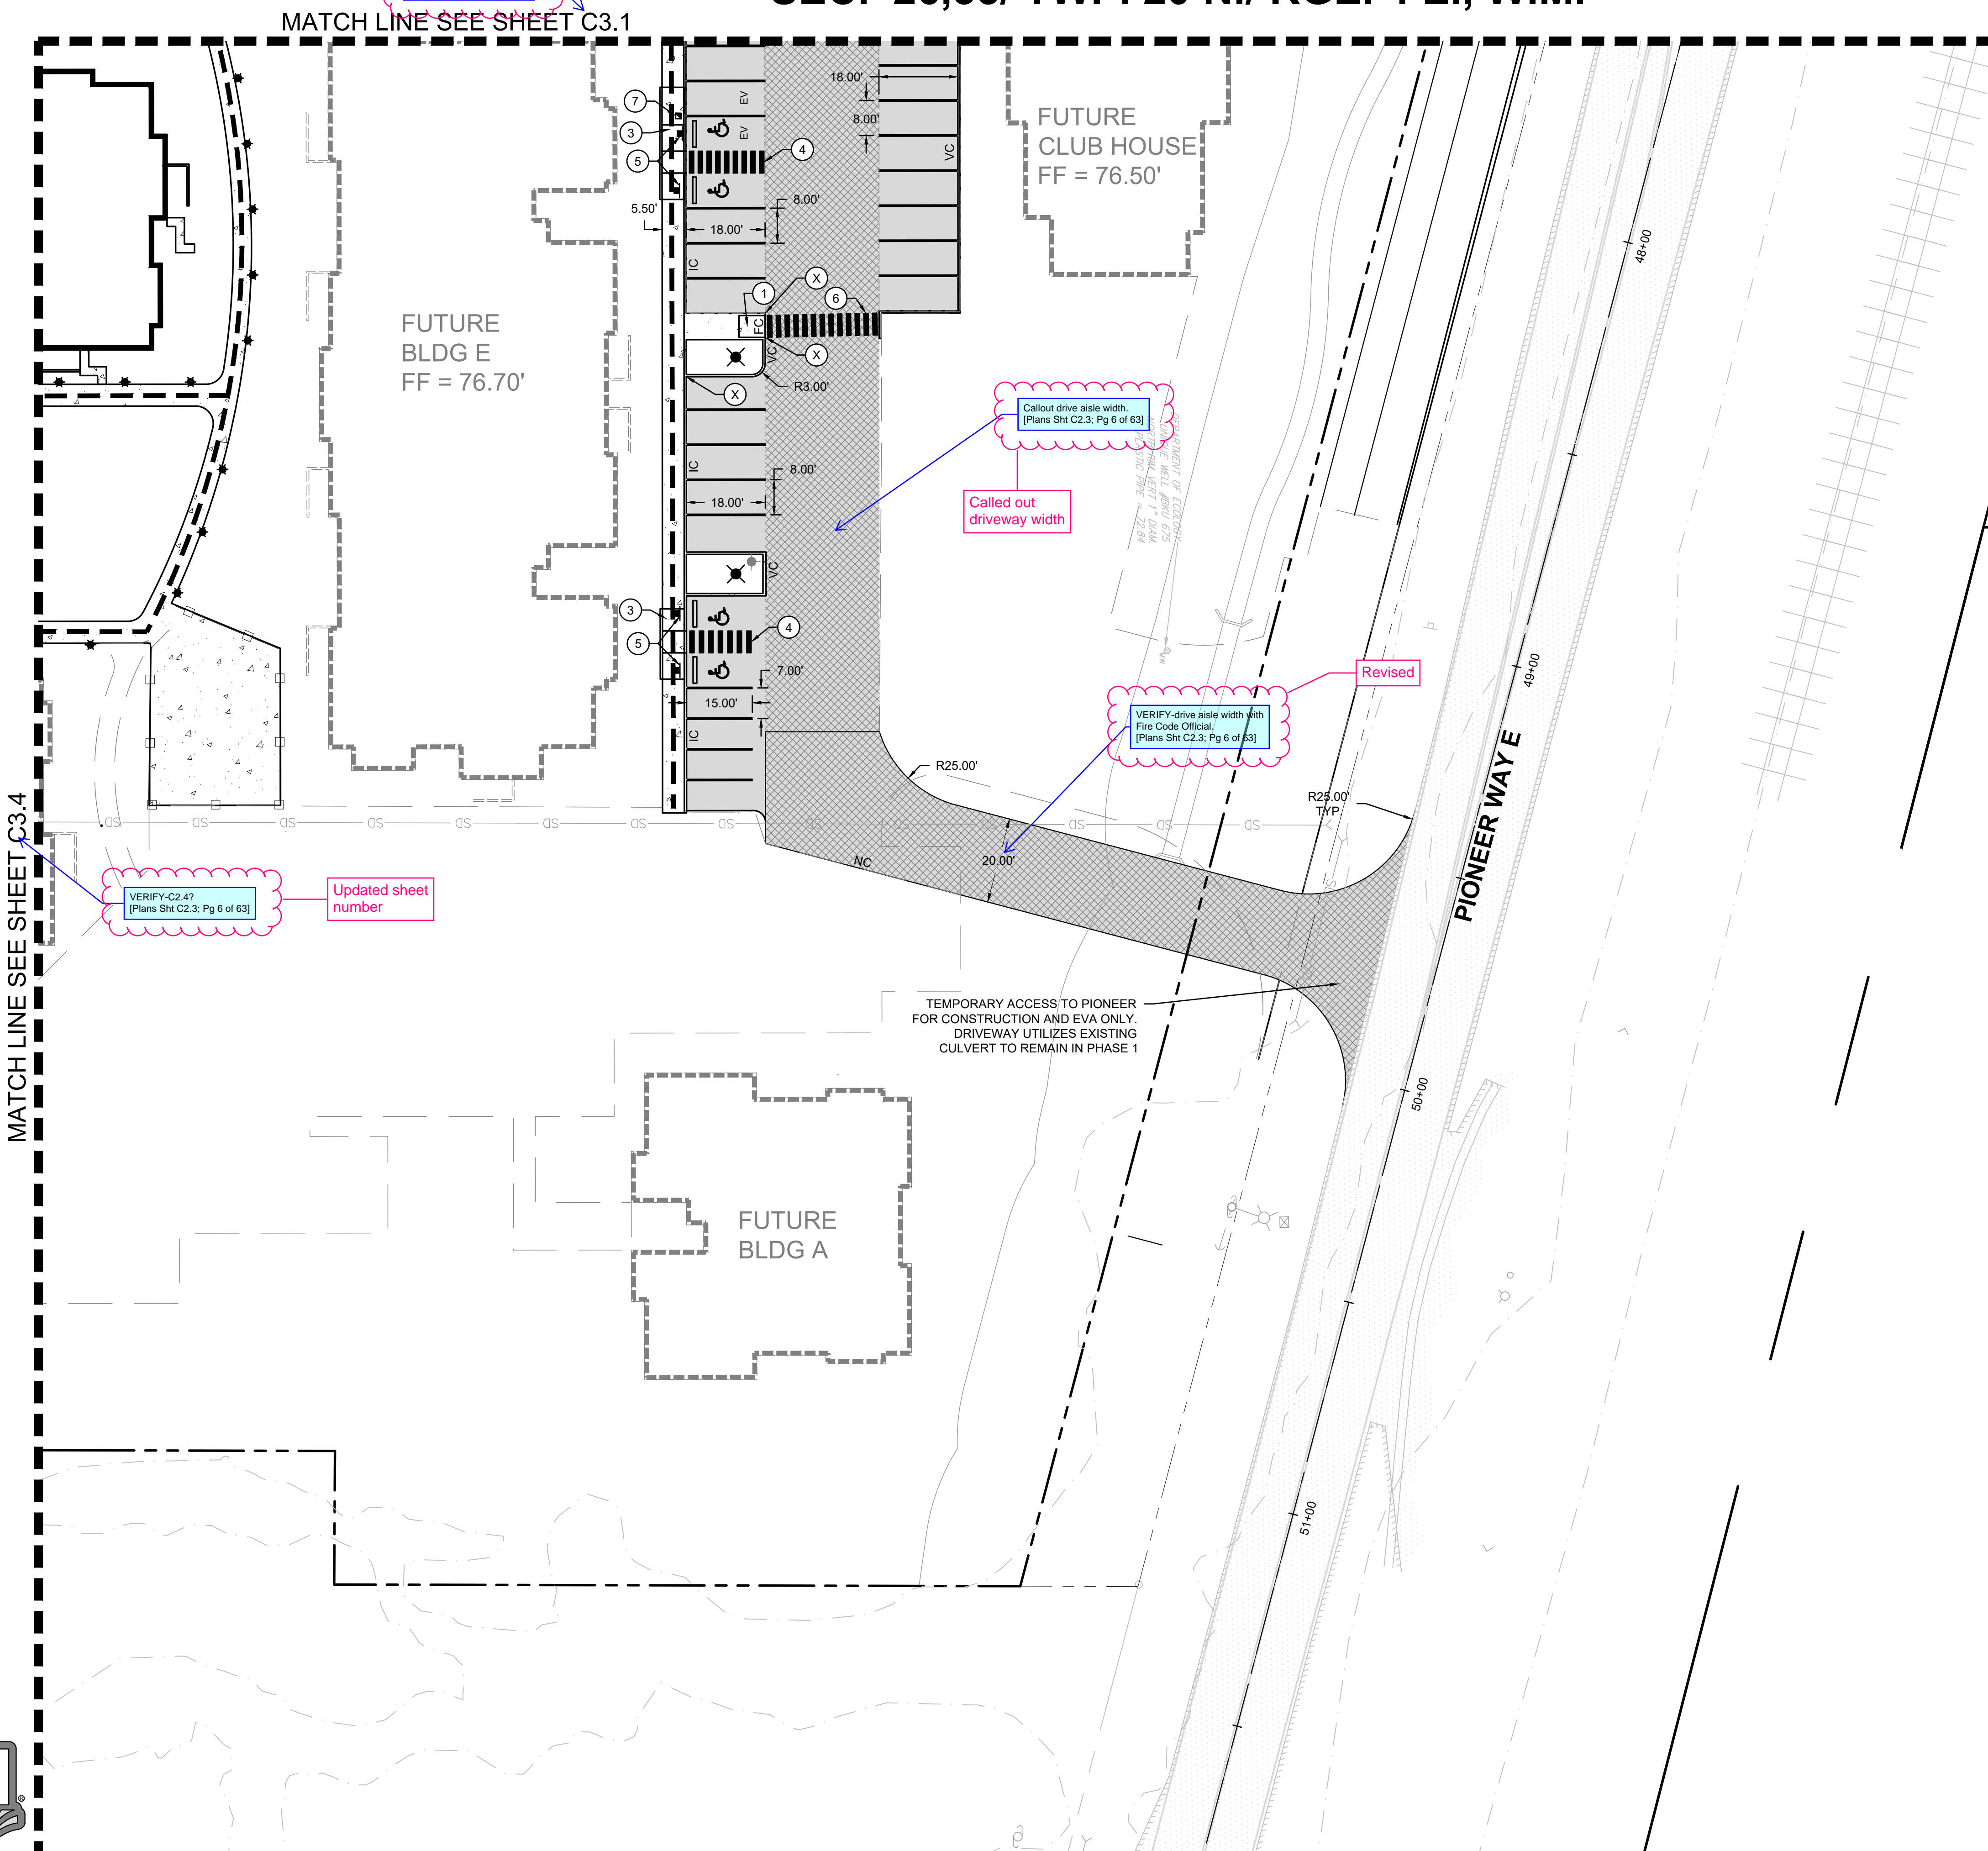

Revisions:

Sheet Title:
HORIZONTAL CONTROL AND PAVING PLAN NE

Designed by: CW Drawn by: SK Checked by: JI

Sheet No.
C2.3



EAST TOWN CROSSING PHASE 1

SEC. 26,35/ TWP. 20 N./ RGE. 4 E., W.M.


APPROVED

BY: CITY OF PUYALLUP
DEVELOPMENT ENGINEERING
DATE:

NOTE: THIS APPROVAL IS VOID AFTER 180 DAYS FROM APPROVAL DATE. THE CITY WILL NOT BE RESPONSIBLE FOR ERRORS AND/OR OMISSIONS ON THESE PLANS. FIELD CONDITIONS MAY DICTATE CHANGES TO THESE PLANS AS DETERMINED BY THE DEVELOPMENT ENGINEERING MANAGER.




TACOMA · SEATTLE · SPOKANE · TRI-CITIES
2215 North 30th Street, Suite 300, Tacoma, WA 98403
253.383.2422 TEL 253.383.2572 FAX www.ahbl.com WEB

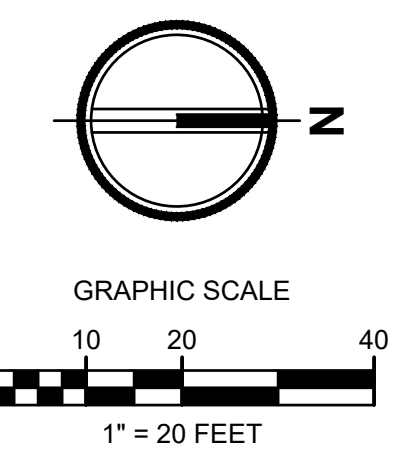

Updated sheet number
VERIFY-C2.2?
(Plans Sht C2.4, Pg 7 of 63)

Updated sheet number
VERIFY-C2.3?
(Plans Sht C2.4, Pg 7 of 63)

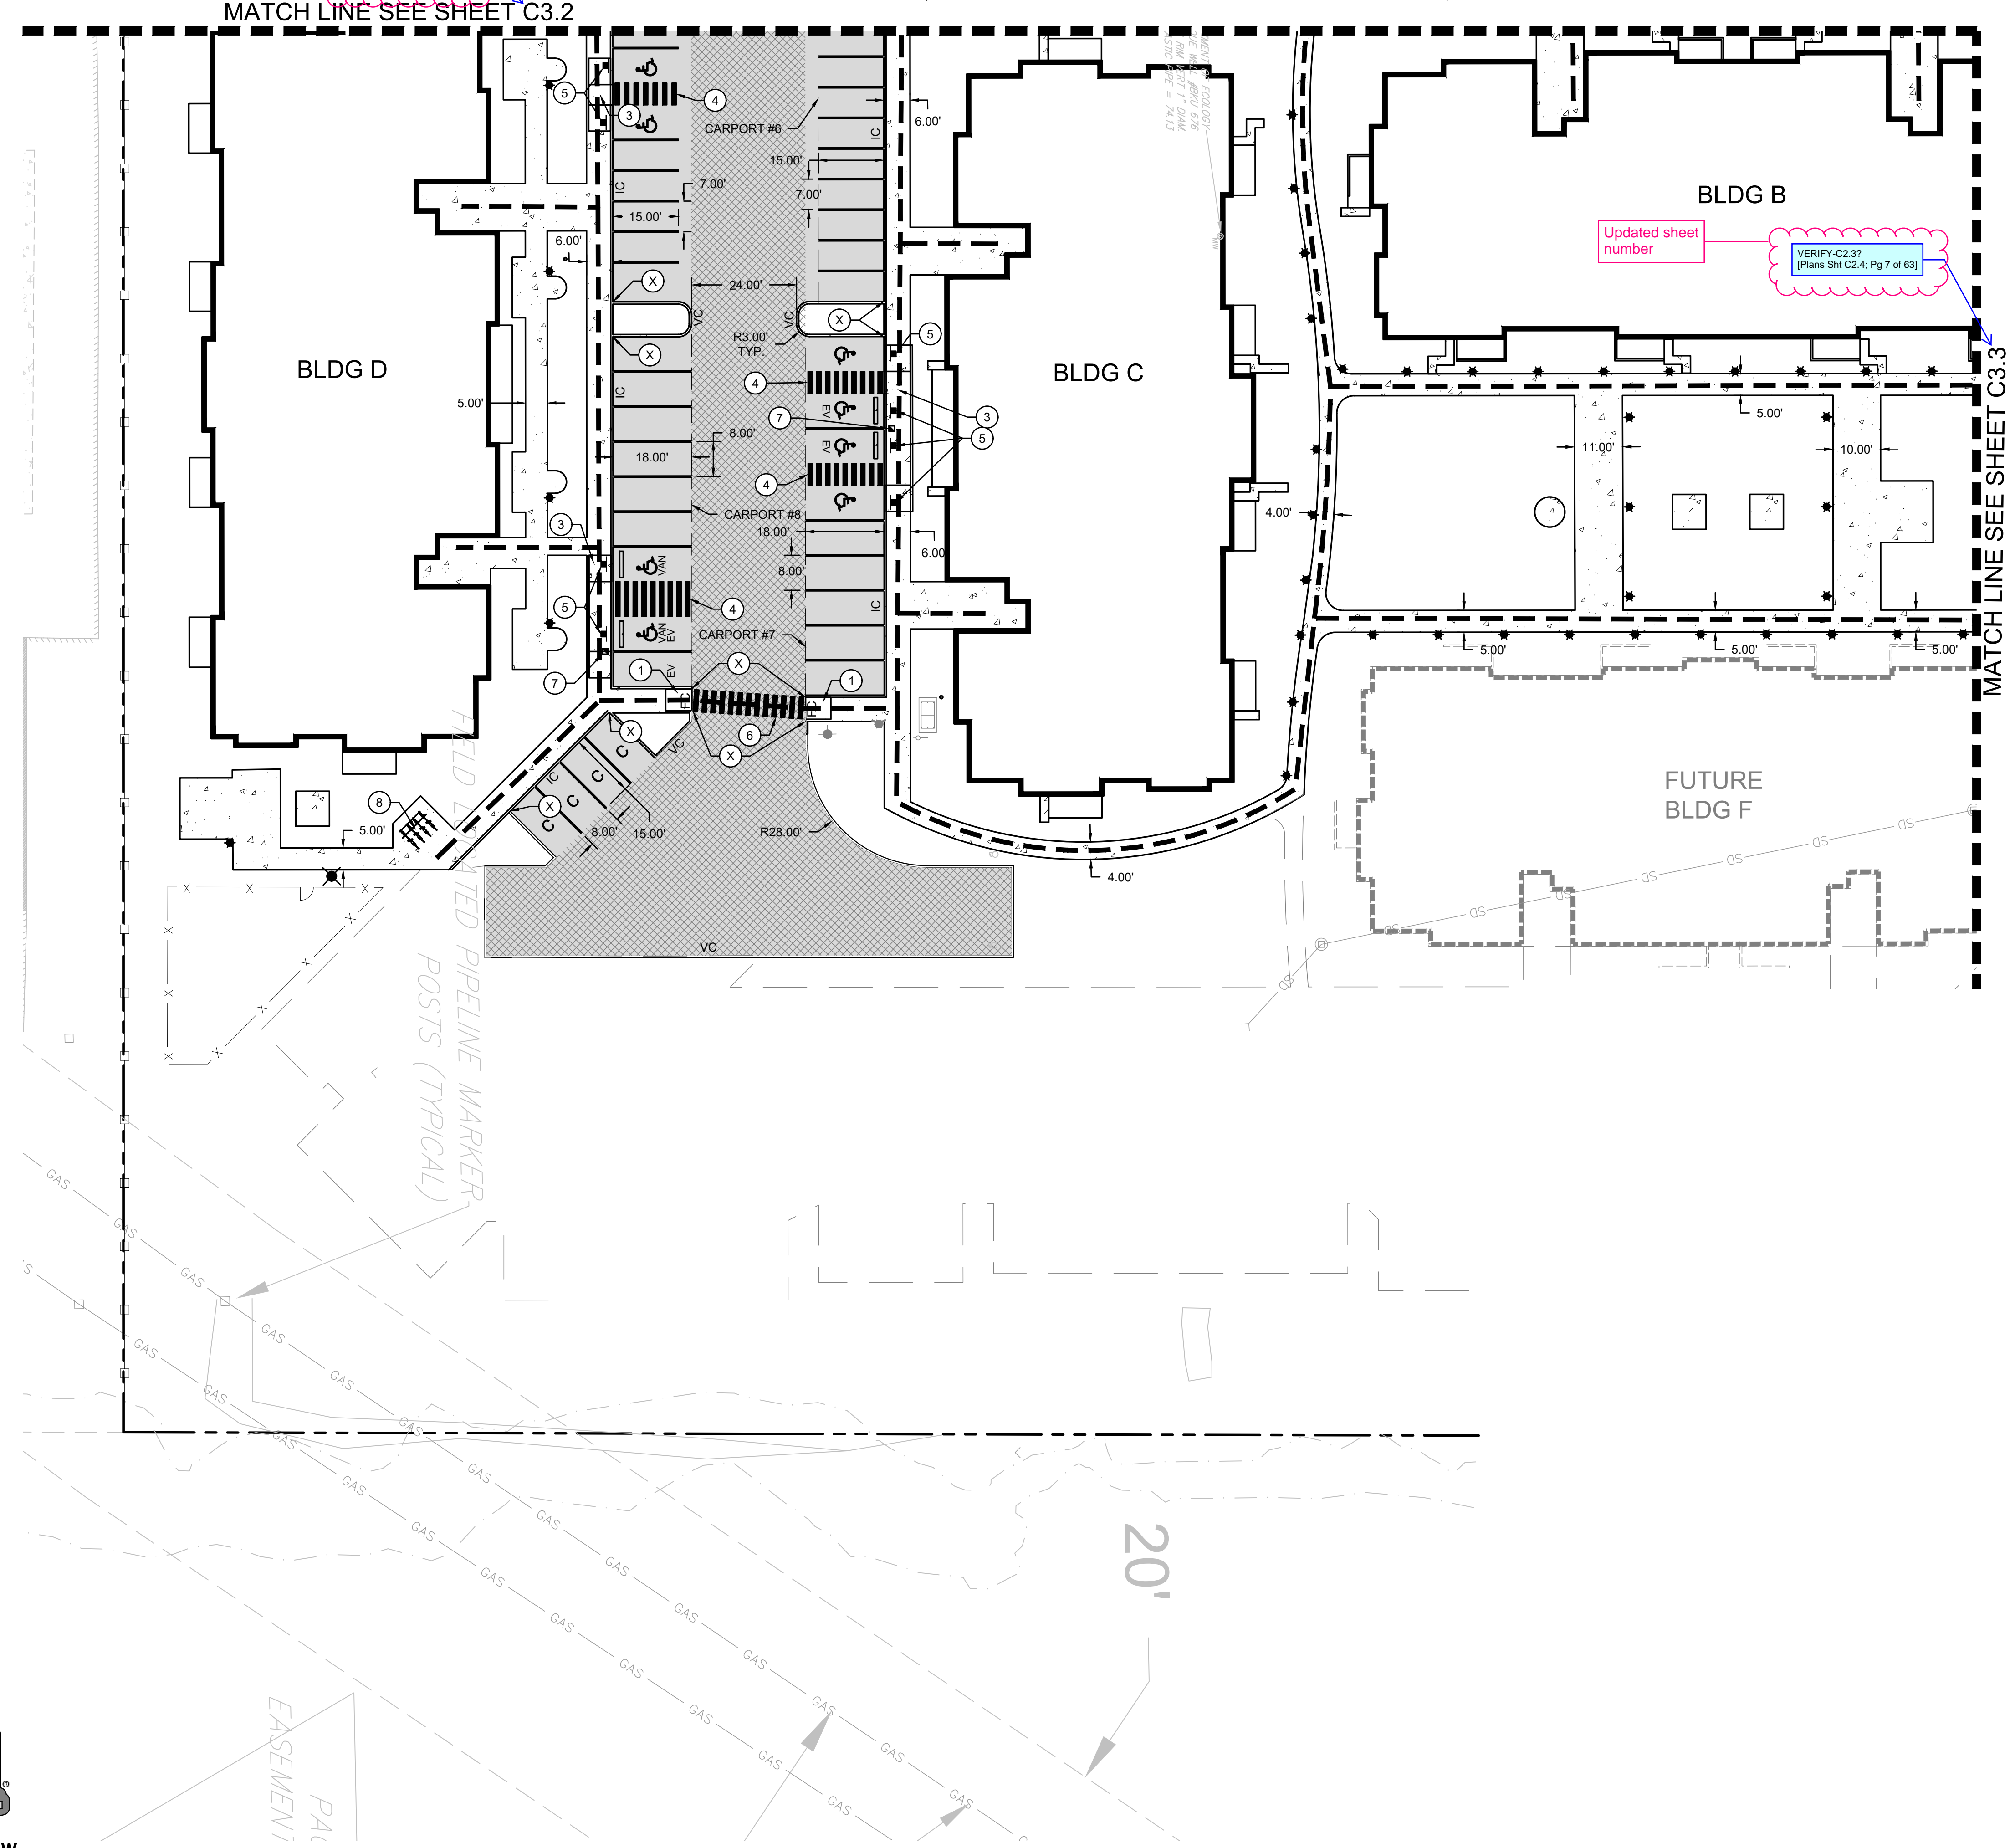

LEGEND:

	RIGHT-OF-WAY/PROPERTY LINE
	CENTERLINE
	PROPOSED BUILDING OUTLINE
	FENCING - REFER TO LANDSCAPE ARCHITECTS DRAWINGS.
	ACCESSIBLE PATH
	ASPHALT PAVEMENT - STANDARD DUTY (1 C2.5)
	ASPHALT PAVEMENT - ATB (2 C2.5)
	PERVIOUS CONCRETE SIDEWALK (3 C2.5)
	CEMENT CONCRETE - HEAVY DUTY (4 C2.5)
	BOLLARD PROTECTION
	CEMENT CONCRETE WHEEL STOP (7 C2.5)
	LIGHTING - REFER TO ELECTRICAL PLANS
	ADA ACCESSIBLE PARKING STALL (5 C2.6)
	CHANGE IN CURB TYPE / END CURB
	CONCRETE EXTRUDED CURB
	INTEGRAL CURB AND SIDEWALK (5 C2.5)
	NO CURB
	CURB CUT (8 C2.5)
	VERTICAL CURB (6 C2.5)
	CONCRETE CURB AND GUTTER
	FLUSH CURB

KEYNOTES


	ADA RAMP - SINGLE DIRECTIONAL (1 C2.6)
	ADA RAMP - PERPENDICULAR (3 C2.6)
	ADA RAMP - DEPRESSED SIDEWALK (2 C2.6)
	ADA STALL (5 C2.6)
	ADA SIGN (5 C2.6)
	CROSSWALK STRIPING
	EV CHARGING - SEE ARCHITECTURAL PLANS
	BIKE RACK, SEE ARCHITECTURAL PLANS
	DUMPSTER ENCLOSURE, SEE ARCHITECTURAL PLANS

Project Title:
EAST TOWN CROSSING PHASE 1

Client:
ASH DEVELOPMENT
GREG HELLE
GREG.HELLE@ASHNW.COM


Project No.
2230752

Issue Set & Date:
PERMIT SUBMITTAL
11/20/2023

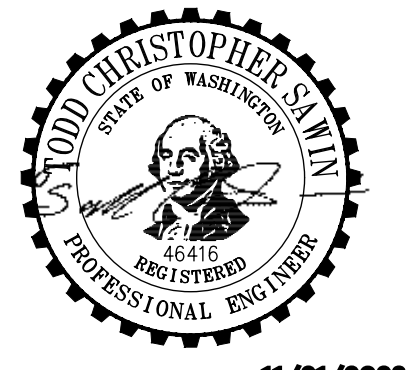

11/21/2023

NOTICE: ALTERATION OF THIS DOCUMENT SHALL INVALIDATE THE PROFESSIONAL SEAL AND SIGNATURE PUBLICATION OF THE DOCUMENT. THIS IS THE PROPERTY OF THE ENGINEER. NO PART OF THIS DOCUMENT IS TO BE REPRODUCED OR TRANSMITTED IN ANY FORM OR BY ANY MEANS, ELECTRONIC OR MECHANICAL, INCLUDING PHOTOCOPYING, RECORDING, OR BY ANY INFORMATION STORAGE AND RETRIEVAL SYSTEM, WITHOUT THE WRITTEN PERMISSION OF THE ENGINEER. THIS DOCUMENT IS NOT TO BE USED FOR ANY OTHER PROJECT OR FOR ANY OTHER PURPOSE.

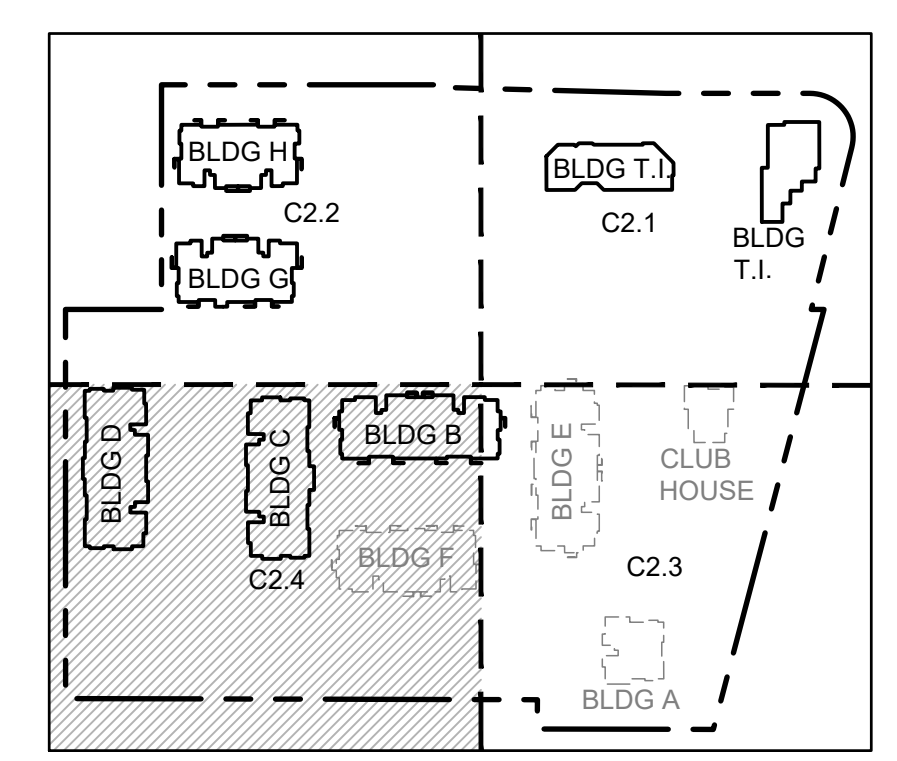

Revisions:

Sheet Title:
HORIZONTAL CONTROL AND PAVING PLAN SE

Designed by: CW
Drawn by: SK
Checked by: JI

Sheet No.
C2.4

9 of 63 Sheets




EAST TOWN CROSSING PHASE 1

SEC. 26,35/ TWP. 20 N./ RGE. 4 E., W.M.

APPROVED

BY: CITY OF PUYALLUP
DEVELOPMENT ENGINEERING

DATE: _____
 NOTE: THIS APPROVAL IS VOID AFTER 180 DAYS FROM APPROVAL DATE. THE CITY WILL NOT BE RESPONSIBLE FOR ERRORS AND/OR OMISSIONS ON THESE PLANS. FIELD CONDITIONS MAY DICTATE CHANGES TO THESE PLANS AS DETERMINED BY THE DEVELOPMENT ENGINEERING MANAGER.

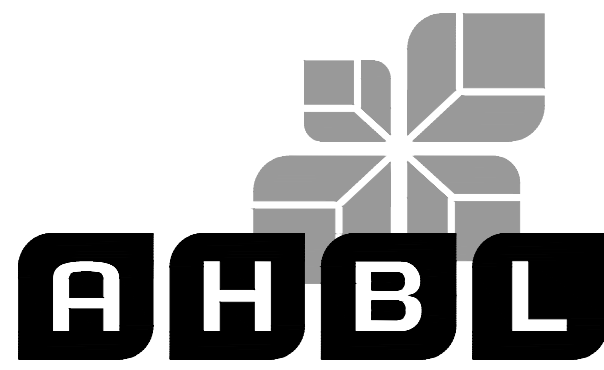

TACOMA • SEATTLE • SPOKANE • TRI-CITIES

2215 North 30th Street, Suite 300, Tacoma, WA 98403
253.383.2422 TEL 253.383.2572 FAX www.ahbl.com WEB

Project Title:

EAST TOWN CROSSING PHASE 1

Client:

ASH DEVELOPMENT

GREG HELLE

GREG.HELLE@ASHNW.COM

Project No.

2230752

Issue Set & Date:


PERMIT SUBMITTAL

11/20/2023



11/21/2023


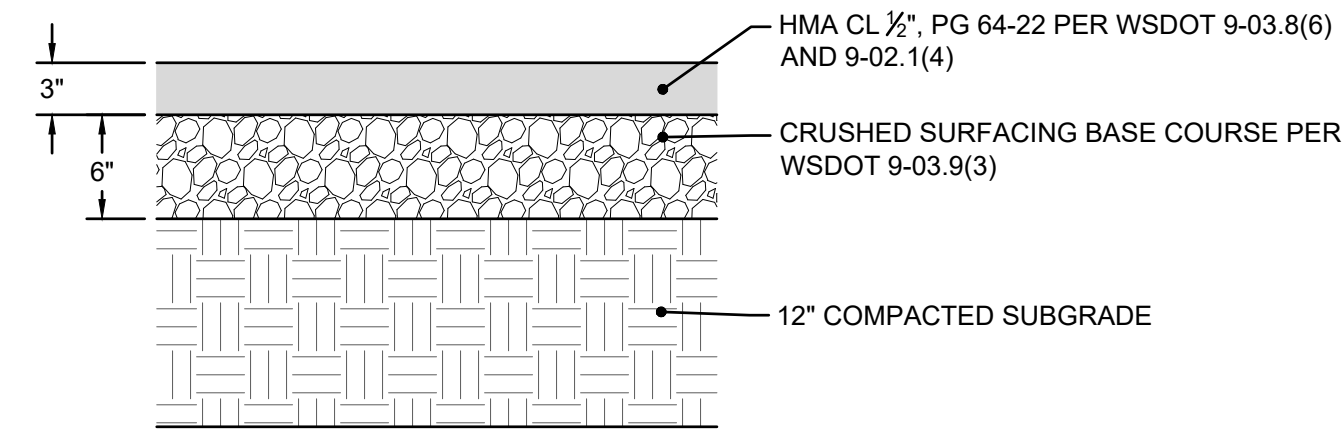


NOTES:

1. DEPTHS INDICATED ARE COMPACTED THICKNESS.
2. HMA SHALL BE COMPACTED TO A TARGET AVERAGE DENSITY OF 92% BASED ON THE RICE THEORETICAL MAXIMUM DENSITY PER ASTM D-2041. INDIVIDUAL LOCATIONS SHALL BE COMPACTED NOT LESS THAN 90% NOR MORE THAN 96%.
3. ALL ASPHALT BASE MATERIAL SHALL BE COMPACTED TO A MINIMUM DENSITY OF 95% BASED ON THE MODIFIED PROCTOR MAXIMUM DRY DENSITY PER ASTM D-1557.
4. SUBGRADE SHALL BE COMPACTED TO A FIRM AND UNYIELDING CONDITION PRIOR TO PLACEMENT OF ANY PAVEMENT LAYERS. ANY LOCALIZED ZONES OF SOFT, ORGANIC-RICH, OR DEBRIS-LADEN SOILS SHOULD BE OVEREXCAVATED AND REPLACED WITH STRUCTURAL FILL MATERIAL.
5. SEAL JOINTS WITH EMULSIFIED ASPHALT PER PROJECT SPECIFICATIONS.

1 ASPHALT PAVEMENT - STANDARD DUTY

NOT TO SCALE

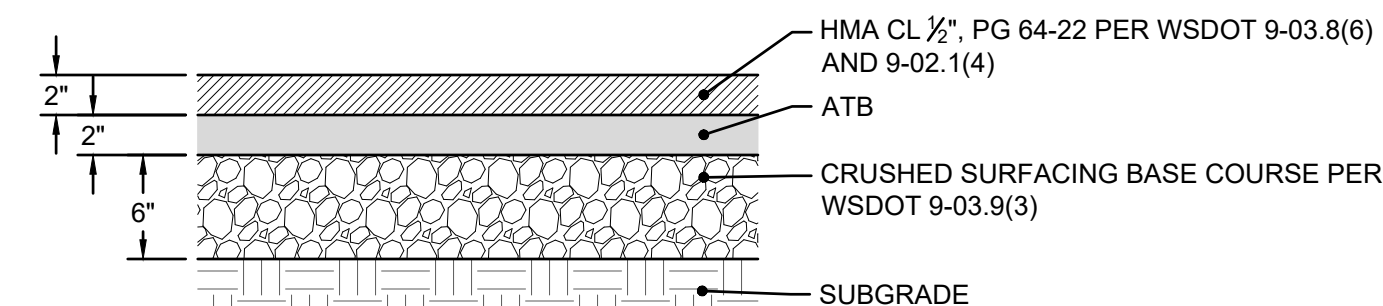


NOTES:

1. DEPTHS INDICATED ARE COMPACTED THICKNESS.
2. HMA SHALL BE COMPACTED TO A TARGET AVERAGE DENSITY OF 92% BASED ON THE RICE THEORETICAL MAXIMUM DENSITY PER ASTM D-2041. INDIVIDUAL LOCATIONS SHALL BE COMPACTED NOT LESS THAN 90% NOR MORE THAN 96%.
3. ALL ASPHALT BASE MATERIAL SHALL BE COMPACTED TO A MINIMUM DENSITY OF 95% BASED ON THE MODIFIED PROCTOR MAXIMUM DRY DENSITY PER ASTM D-1557.
4. SUBGRADE SHALL BE COMPACTED TO A FIRM AND UNYIELDING CONDITION PRIOR TO PLACEMENT OF ANY PAVEMENT LAYERS. ANY LOCALIZED ZONES OF SOFT, ORGANIC-RICH, OR DEBRIS-LADEN SOILS SHOULD BE OVEREXCAVATED AND REPLACED WITH STRUCTURAL FILL MATERIAL.
5. SEAL JOINTS WITH EMULSIFIED ASPHALT PER PROJECT SPECIFICATIONS.

2 ASPHALT PAVEMENT - ATB

NOT TO SCALE

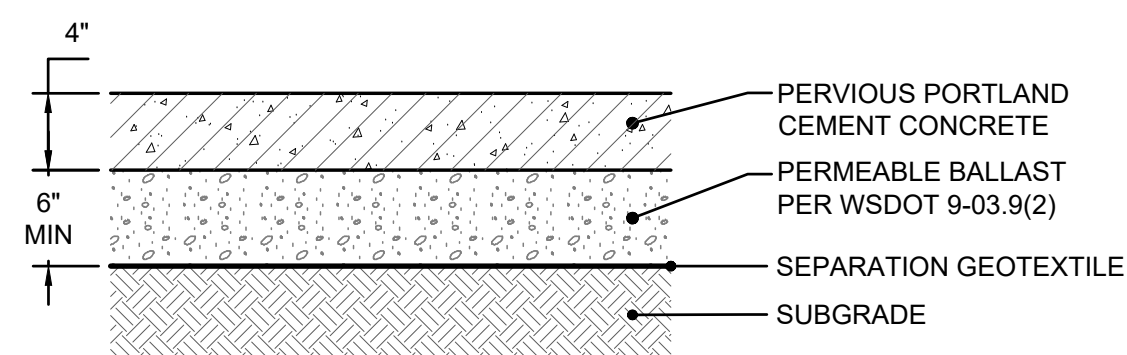

CONCRETE MIX DESIGN


- UNIT WEIGHT: 120 TO 130 POUNDS PER CUBIC FOOT (PERMEABLE CONCRETE IS APPROXIMATELY 70 TO 80 PERCENT OF THE UNIT WEIGHT OF CONVENTIONAL CONCRETE) (FCPA, N.D.)
- VOID SPACE: 15 TO 21 PERCENT ACCORDING TO ASTM C 138.
- WATER CEMENT RATIO: 0.27 TO 0.35.
- AGGREGATE TO CEMENT RATIO: 4:1 TO 4.5:1
- AGGREGATE: USE EITHER:
3/8" - INCH TO NO. 16 WASHED CRUSHED OR ROUND PER ASTM C 35 OR
3/8" - INCH TO NO. 50 WASHED CRUSHED OR ROUND PER ASTM D 448.

PORTLAND CEMENT: TYPE I OR II CONFORMING TO ASTM C 150 OR TYPE IP OR IS CONFORMING TO ASTM C 595.

- ADMIXTURES: CAN BE USED TO INCREASE WORKING TIME AND INCLUDE: WATER REDUCING/RETARDING ADMIXTURE
- IN CONFORMANCE WITH ASTM C 494 TYPE D AND HYDRATION STABILIZER IN CONFORMANCE WITH ASTM C494 TYPE B.
- WATER: USE POTABLE WATER.
- FIBER MESH CAN BE INCORPORATED INTO THE CEMENT MIX FOR ADDED STRENGTH.
- PROVIDE JOINTS AT 15' O.C. - PROVIDE DOWEL BARS 1 1/2" x 18" LONG ON 18" CENTERS ON TRANSVERSE JOINTS AND #5 TIE BARS x 30" LONG ON 36" CENTERS ON LONGITUDINAL JOINTS PER WSDOT A-40.10-04.

3 PERVIOUS CEMENT CONCRETE

NOT TO SCALE

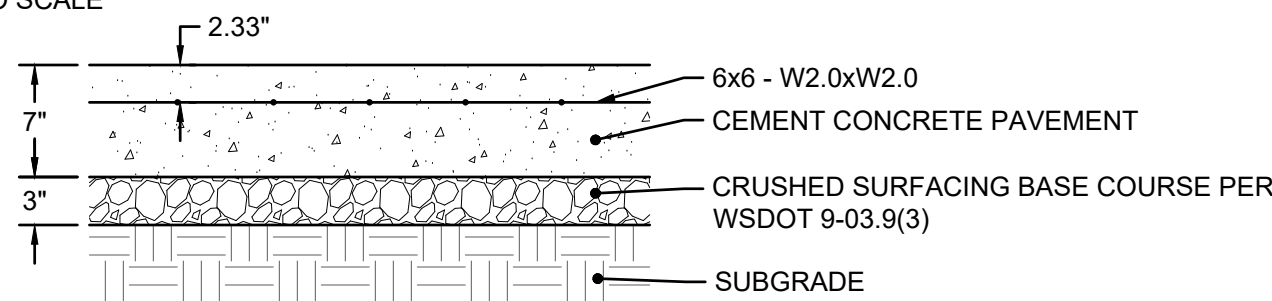


NOTES:

1. DEPTHS INDICATED ARE COMPACTED THICKNESSES.
2. CEMENT CONCRETE PAVEMENT SHALL CONSIST OF PORTLAND CEMENT CONCRETE WITH A MINIMUM COMPRESSIVE STRENGTH OF 4000 PSI AND A MINIMUM RUPTURE MODULUS OF 580 PSI.
3. GRANULAR SUBBASE SHALL CONSIST OF "BALLAST" PER WSDOT 9-03.9(1), "GRAVEL BORROW" PER WSDOT 9-03.14, OR CRUSHED RECYCLED CONCRETE PROVIDED THAT IT MEETS THE SAME TEXTURAL CRITERIA AS "BALLAST" OR "GRAVEL BORROW".
4. ALL BASE MATERIAL SHALL BE COMPACTED TO A MINIMUM DENSITY OF 95% BASED ON THE MODIFIED PROCTOR MAXIMUM DRY DENSITY PER ASTM D-1557.
5. SUBGRADE SHALL BE COMPACTED TO A FIRM AND UNYIELDING CONDITION PRIOR TO PLACEMENT OF ANY PAVEMENT LAYERS. ANY LOCALIZED ZONES OF SOFT, ORGANIC-RICH, OR DEBRIS-LADEN SOILS SHOULD BE OVEREXCAVATED AND REPLACED WITH STRUCTURAL FILL MATERIAL.

4 CEMENT CONCRETE - HEAVY DUTY

NOT TO SCALE

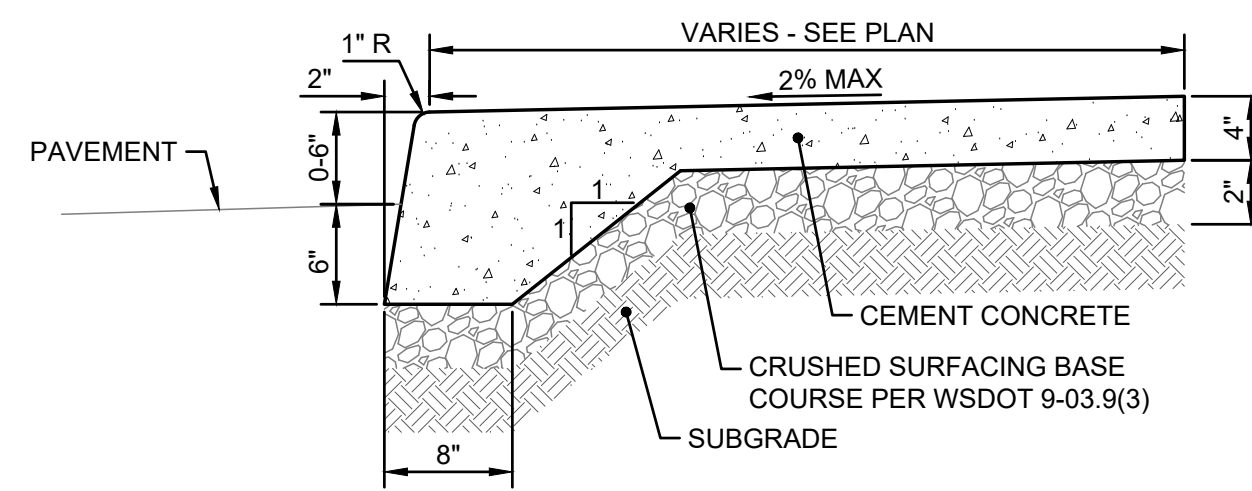


NOTES:

1. DEPTHS INDICATED ARE COMPACTED THICKNESSES.
2. CEMENT CONCRETE PAVEMENT SHALL CONSIST OF PORTLAND CEMENT CONCRETE WITH A MINIMUM COMPRESSIVE STRENGTH OF 4000 PSI AND A MINIMUM RUPTURE MODULUS OF 580 PSI.
3. ALL BASE MATERIAL SHALL BE COMPACTED TO A MINIMUM DENSITY OF 95% BASED ON THE MODIFIED PROCTOR MAXIMUM DRY DENSITY PER ASTM D-1557.
4. SUBGRADE SHALL BE COMPACTED TO A FIRM AND UNYIELDING CONDITION PRIOR TO PLACEMENT OF ANY PAVEMENT LAYERS. ANY LOCALIZED ZONES OF SOFT, ORGANIC-RICH, OR DEBRIS-LADEN SOILS SHOULD BE OVEREXCAVATED AND REPLACED WITH STRUCTURAL FILL MATERIAL.
5. EXPANSION JOINTS SHALL BE AT 10' INTERVALS OR AS SHOWN ON THE ARCHITECTURAL PLANS.
6. RECYCLED CONCRETE IS NOT ACCEPTABLE.


5 INTEGRAL CURB

NOT TO SCALE

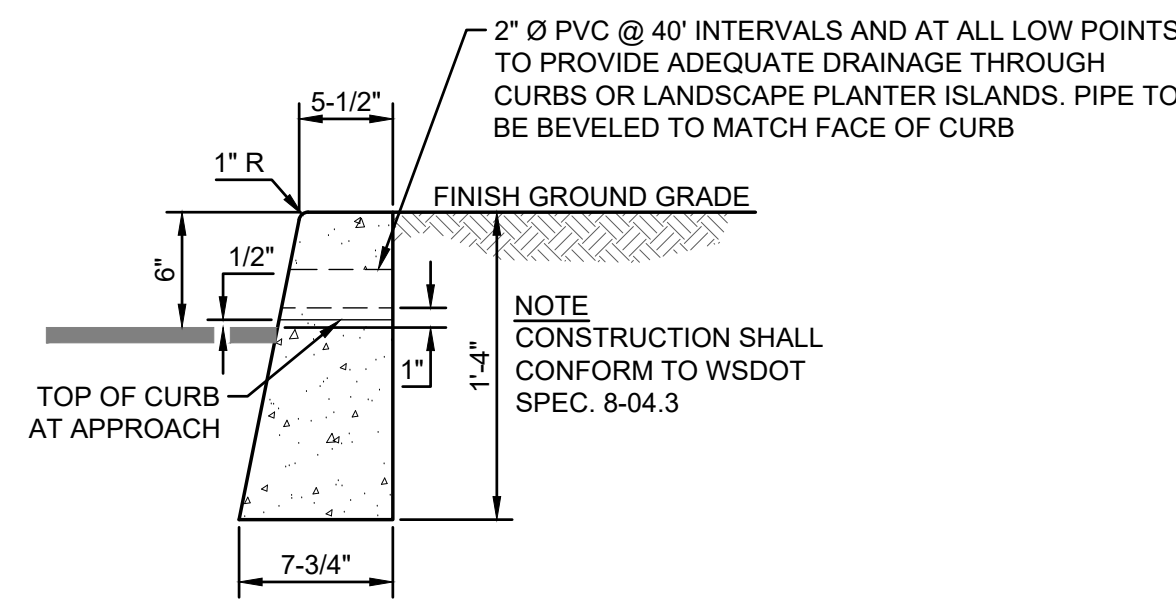


6 VERTICAL CURB

NOT TO SCALE

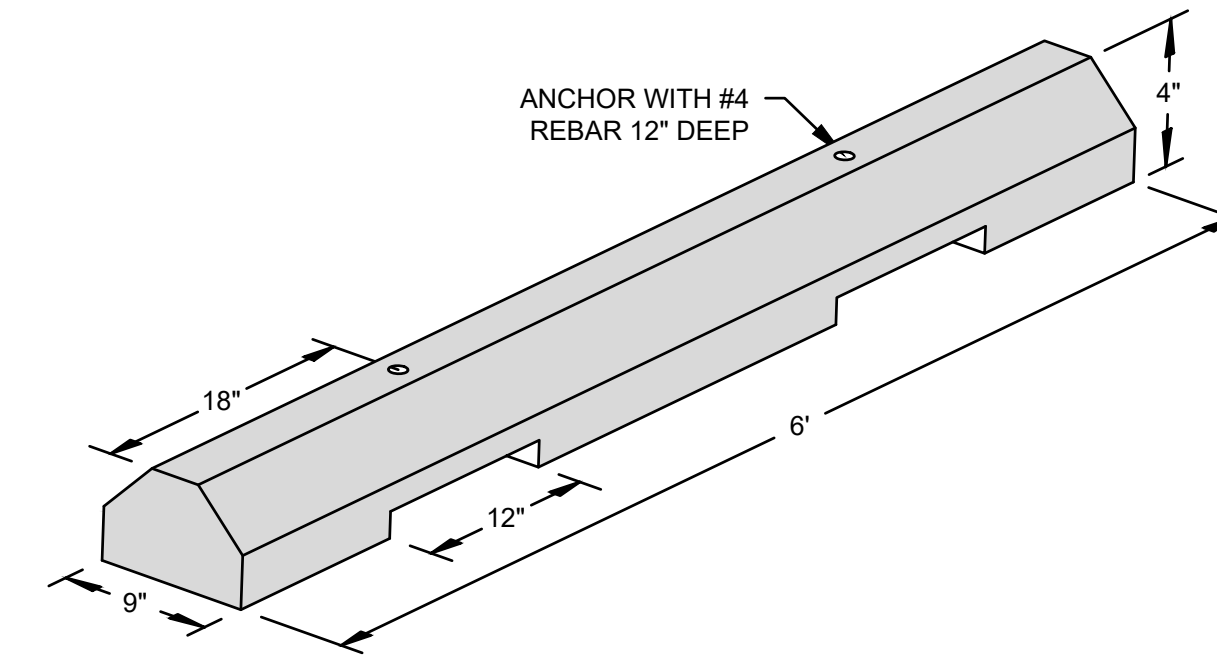

7 CONCRETE WHEEL STOP


NOT TO SCALE

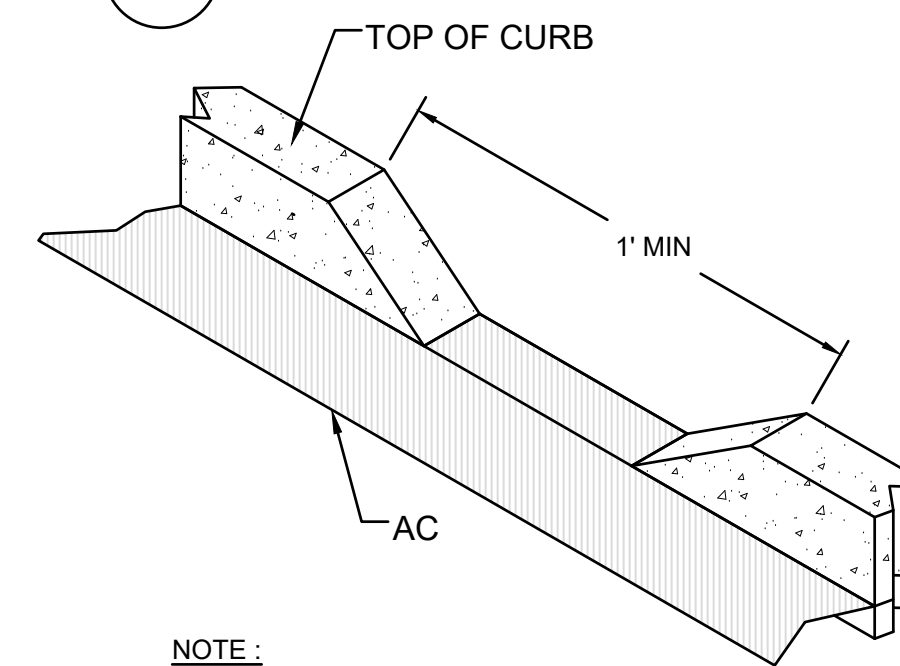

NOTE: INTENT OF CURB CUTS LOCATIONS IS TO BE AT LOW POINTS OF ASPHALT EDGE TO ENSURE PONDING DOES NOT OCCUR. CONTRACTOR SHALL ADJUST LOCATION IN FIELD AS NECESSARY.

8 CURB CUT

NOT TO SCALE

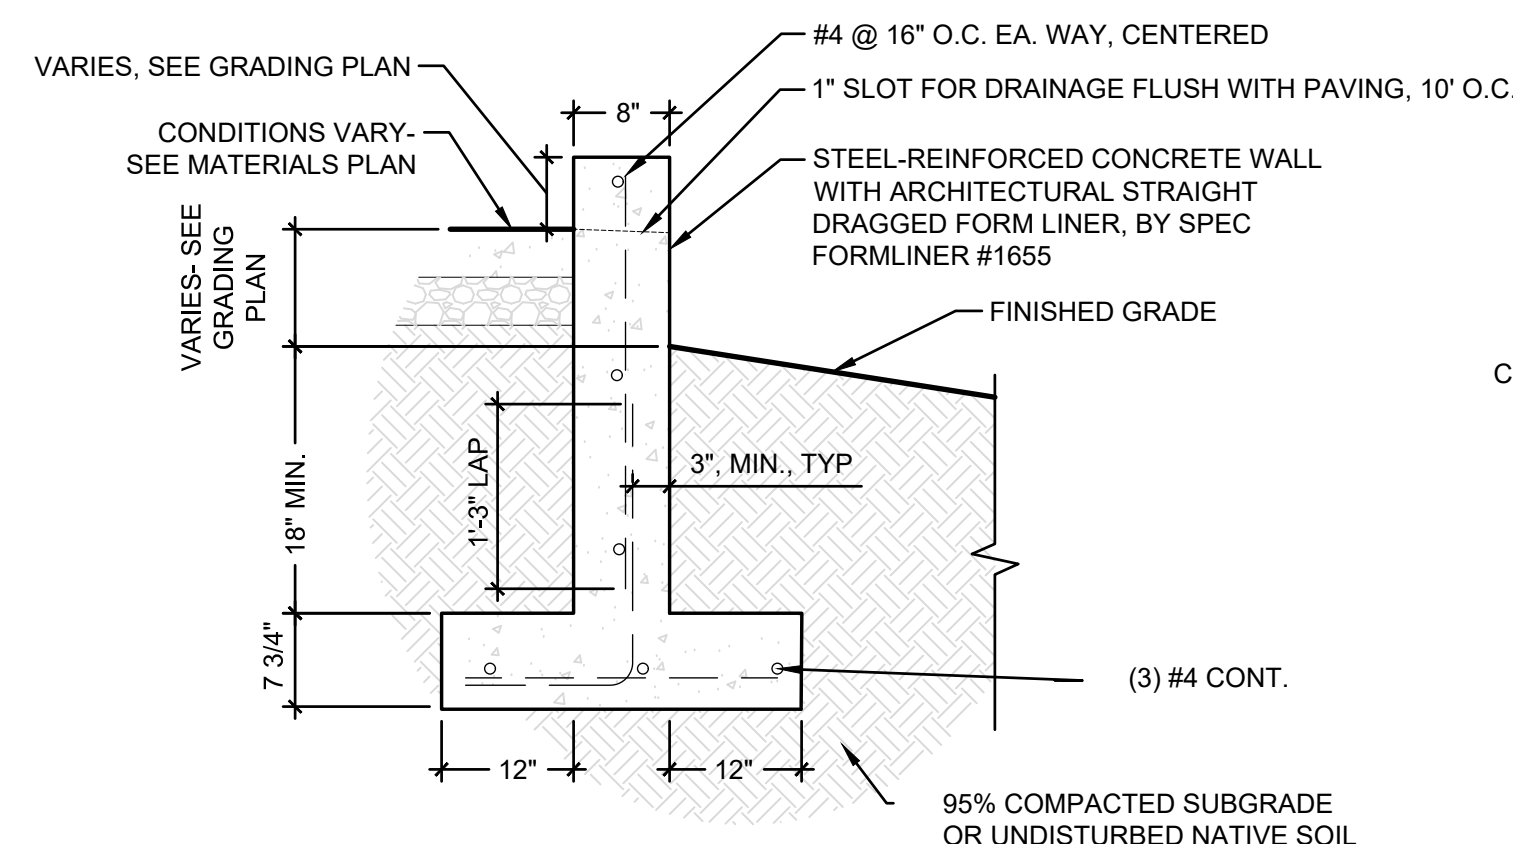


NOTES:

1. KEEP TOP LEVEL
2. MAX WALL HEIGHT 3'-0". SEE STRUCTURAL FOR WALLS ABOVE 3'-0"

9 CONCRETE RETAINING WALL

NOT TO SCALE

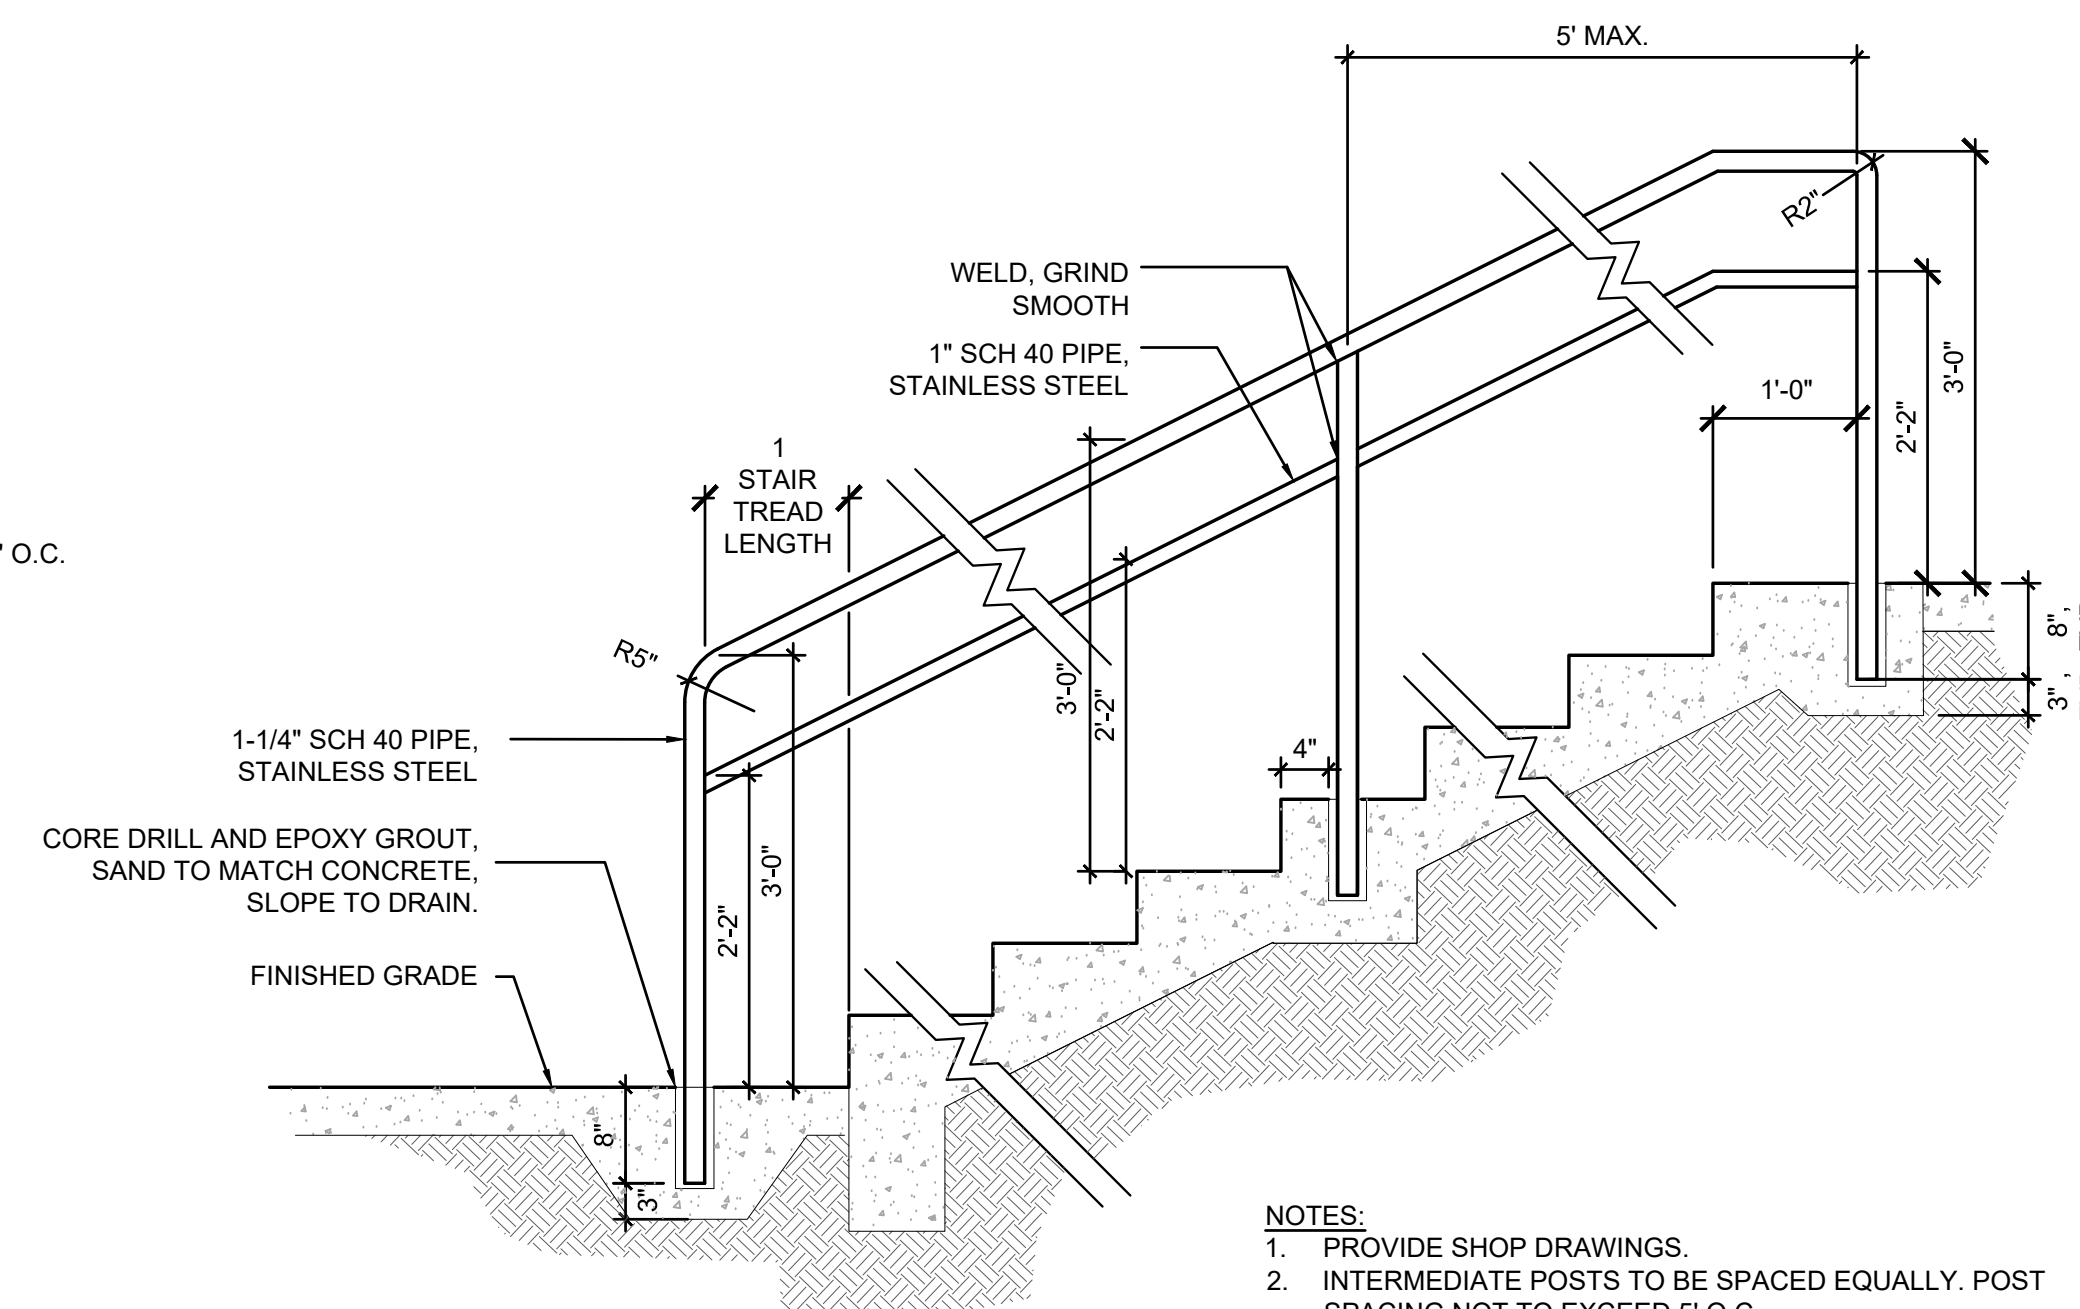

NOTES:

1. PROVIDE SHOP DRAWINGS.
2. INTERMEDIATE POSTS TO BE SPACED EQUALLY. POST SPACING NOT TO EXCEED 5' O.C.

10 CONCRETE STAIRS AND HANDRAILS

NOT TO SCALE



Know what's below.
Call before you dig.

Included note

Add Note: Walls over 4'-0" require separate building permit. (Plans Sht C2.5, Pg 6 of 63)

Revisions:

Sheet Title:

PAVING NOTES AND DETAILS

Designed by: CW Drawn by: SK Checked by: JI

Sheet No.

C2.5

8 of 63 Sheets


EAST TOWN CROSSING PHASE 1

SEC. 26,35/ TWP. 20 N./ RGE. 4 E., W.M.

APPROVED

BY CITY OF PUYALLUP
DEVELOPMENT ENGINEERING
DATE

NOTE: THIS APPROVAL IS VOID AFTER 180 DAYS FROM APPROVAL DATE. THE CITY WILL NOT BE RESPONSIBLE FOR ERRORS AND/OR OMISSIONS ON THESE PLANS. FIELD CONDITIONS MAY DICTATE CHANGES TO THESE PLANS AS DETERMINED BY THE DEVELOPMENT ENGINEERING MANAGER.

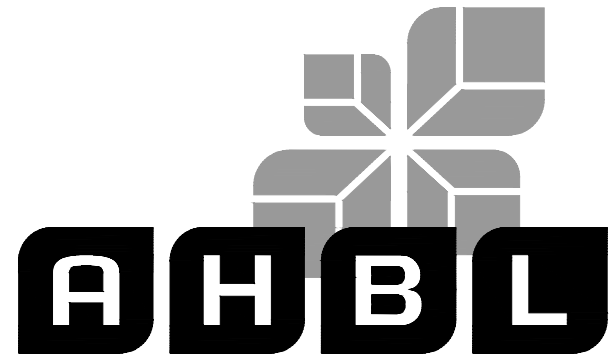

TACOMA · SEATTLE · SPOKANE · TRI-CITIES

2215 North 30th Street, Suite 300, Tacoma, WA 98403
253.383.2422 TEL 253.383.2572 FAX www.ahbl.com WEB

Project Title:

EAST TOWN CROSSING PHASE 1

Client:

ASH DEVELOPMENT

GREG HELLE

GREG.HELLE@ASHNW.COM

Project No.

2230752

Issue Set & Date:

PERMIT SUBMITTAL

11/20/2023







11/21/2023

NOTICE: ALTERATION OF THIS DOCUMENT SHALL INVALIDATE THE PROFESSIONAL SEAL AND SIGNATURE. PUBLICATION OF THIS DOCUMENT DOES NOT CONSTITUTE AN ENDORSEMENT OR GUARANTEE BY THE ENGINEER OR FIRM. THIS DOCUMENT IS FOR THE PROJECT IDENTIFIED IN THE TITLE BLOCK AND IS NOT TO BE USED FOR OTHER PROJECTS OR ACTION TO THAT PROJECT OR FOR ANY OTHER PROJECT.





Added note

IFY if this distance is less than 5ft (between landing and back of curb), then the DWIS is req'd at the bottom of the ramp. [Plans Sht C2.6, Pg 9 of 63]

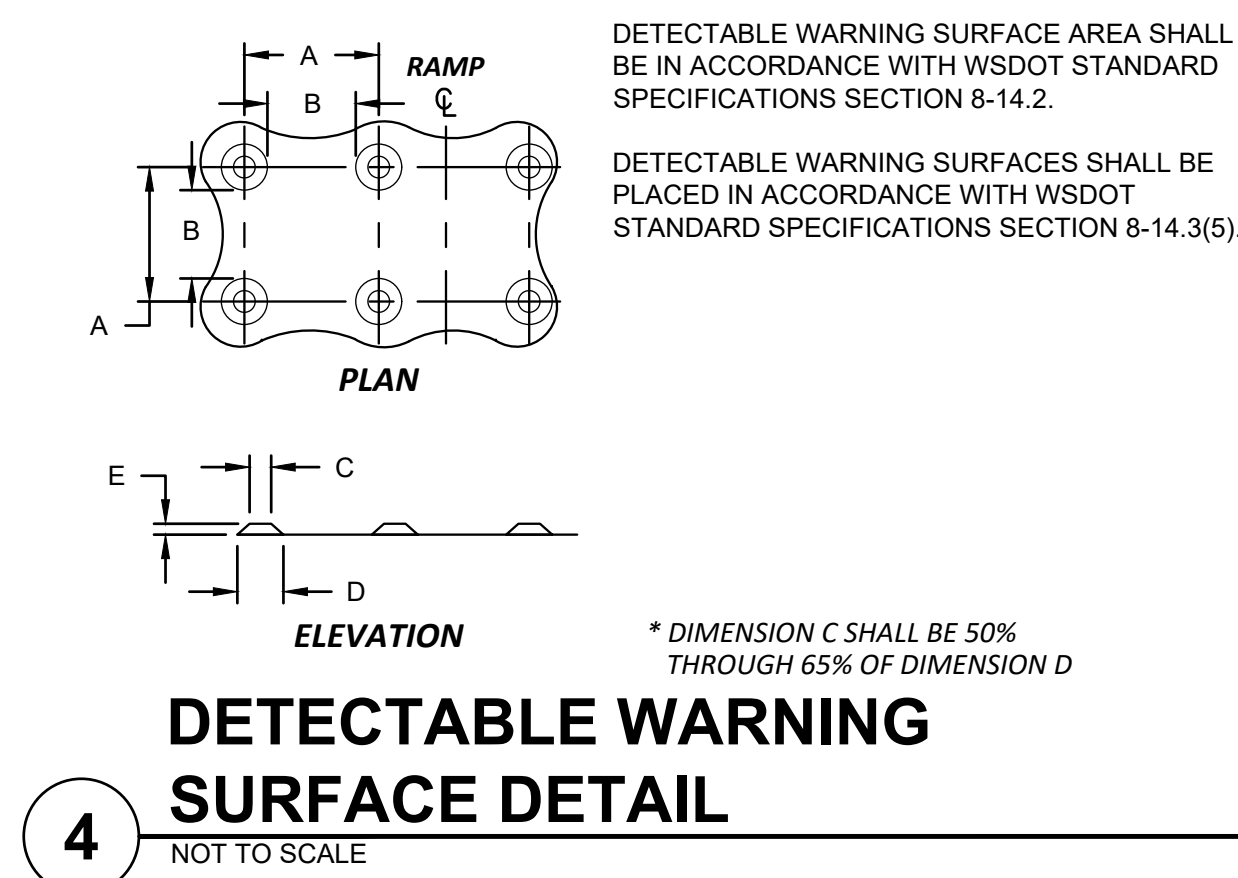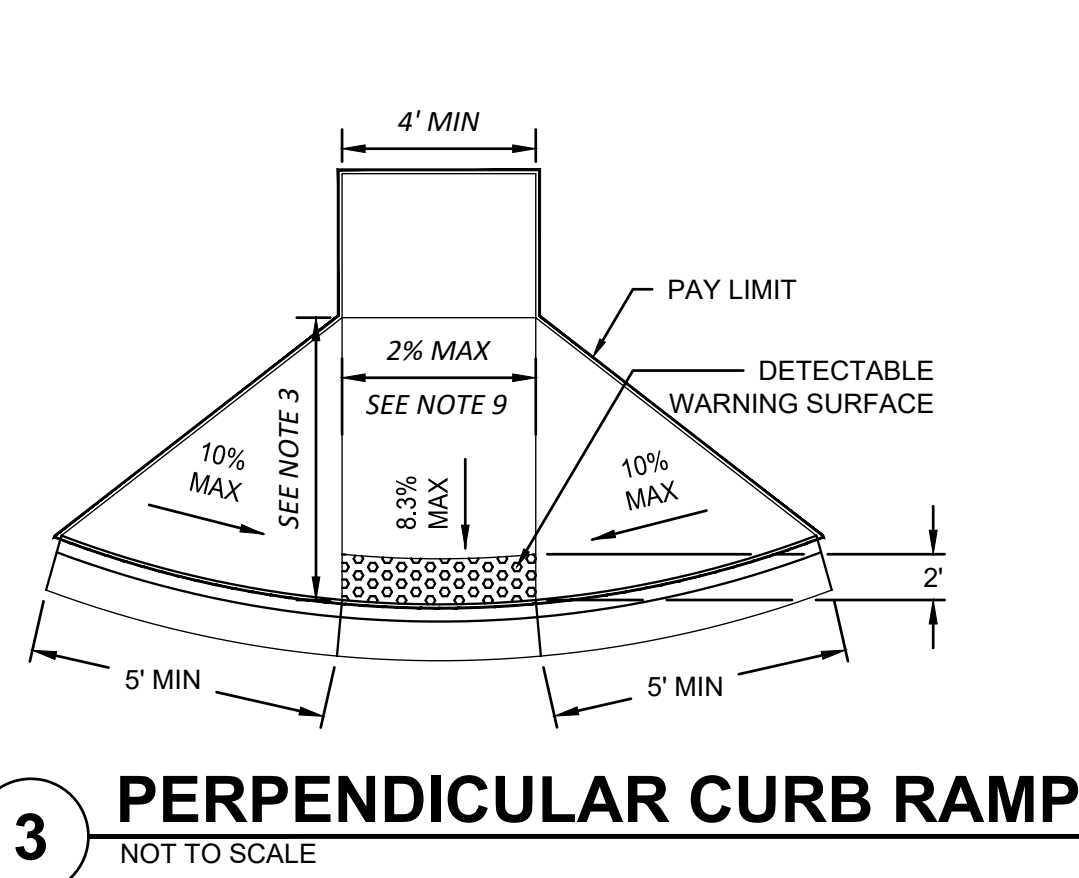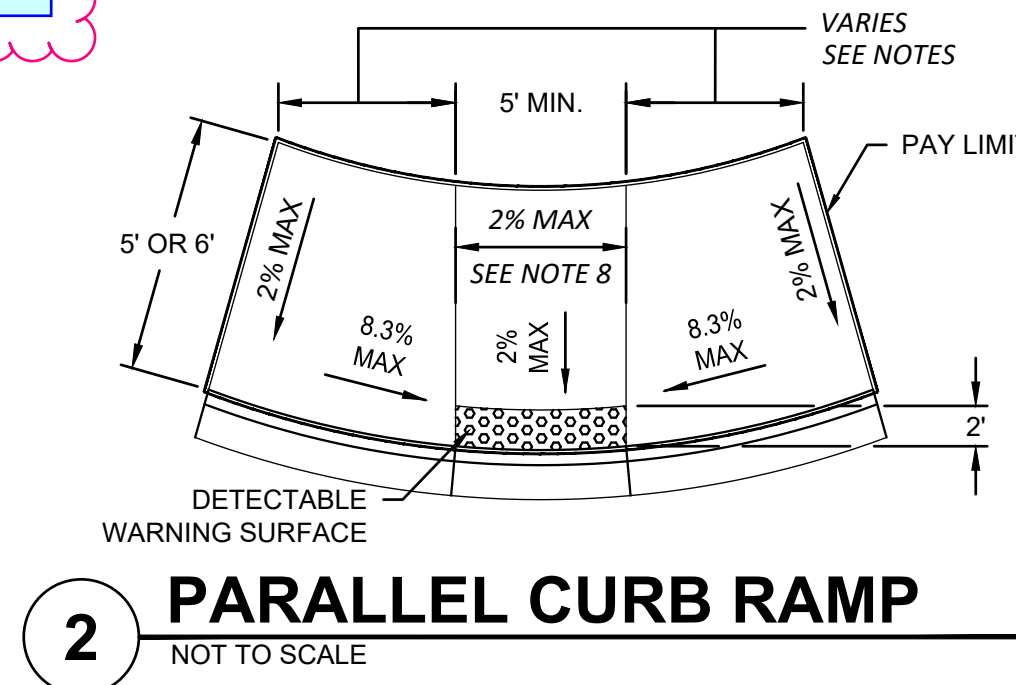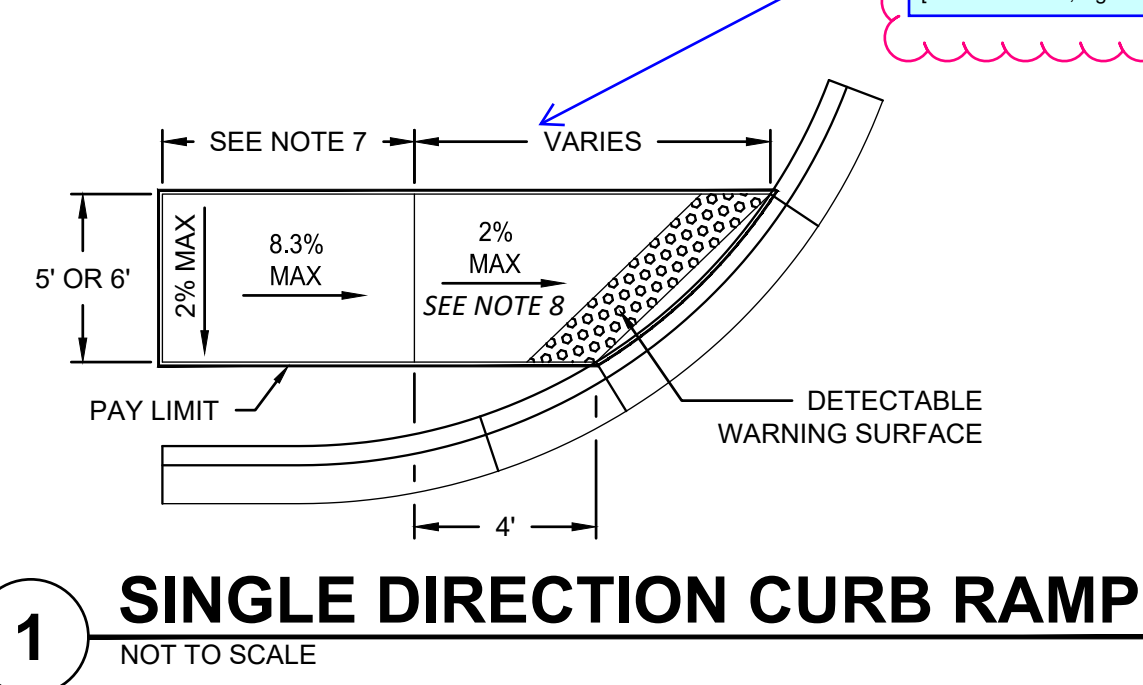

CURB RAMP NOTES:

- CURB RAMP ARE TYPICALLY CENTERED AT THE 1/4 RADIUS POINTS.
- CURB TO BE FLUSH WITH ADJACENT ROADWAY SURFACE. THE BID ITEM DOES NOT INCLUDE THE CURB AND GUTTER.
- PERPENDICULAR RAMP LENGTH IS MEASURED FROM BACK OF CURB.
- PARALLEL RAMP LENGTHS VARY FROM 6' MIN. TO 15' MAX.
- IF SIGNAL POLE EXISTS, PARALLEL CURB RAMP SHALL INCLUDE THE CONCRETE AREA AROUND THE SIGNAL POLE. SIDEWALK DEPTH SHALL BE 6" FROM PC TO PT. SEE STANDARD DRAWING PC.J1.2 FOR ADDITIONAL DETAILS.
- ADJUST RAMP LENGTHS TO MEET ADA REQUIREMENTS 8.3% MAX GRADE, 15' MAX LENGTH.
- SEE WSDOT STANDARD PLAN F-40.16-03 NOTE 8.
- LANDINGS SHALL HAVE A 2% MAX. GRADE IN EACH DIRECTION, EXCEPT AT MIDBLOCK CROSSINGS WHERE THEY MAY MATCH THE GRADE OF THE ROADWAY.
- PERPENDICULAR CURB RAMP SHALL HAVE A 2% MAX. CROSS SLOPE, EXCEPT AT MIDBLOCK CROSSINGS WHERE IT MAY MATCH THE GRADE OF THE ROADWAY.
- THE ROWS OF TRUNCATED DOMES IN DETECTABLE WARNING SURFACES SHALL BE ALIGNED PERPENDICULAR TO THE GRADE BREAK AT THE BACK OF CURB.
- CURB RAMP CANNOT BE PERVIOUS MATERIAL.
- SEE THE CURRENT EDITION OF WSDOT STANDARD PLAN F-10.12 FOR PEDESTRIAN CURB DETAILS.
- FOR RESIDENTIAL DRIVEWAY APPROACHES PARALLEL CURB RAMP SHALL BE 2' MIN. FROM THE DRIVEWAY APPROACH.
- TO AVOID OBSTACLES, CURB RAMP OPPOSITE THE RETURNED CURBS AT "T" INTERSECTIONS MAY BE PLACED AT A SKEW OF 5' MAX FROM AN ALIGNMENT PERPENDICULAR TO THE CENTERLINE

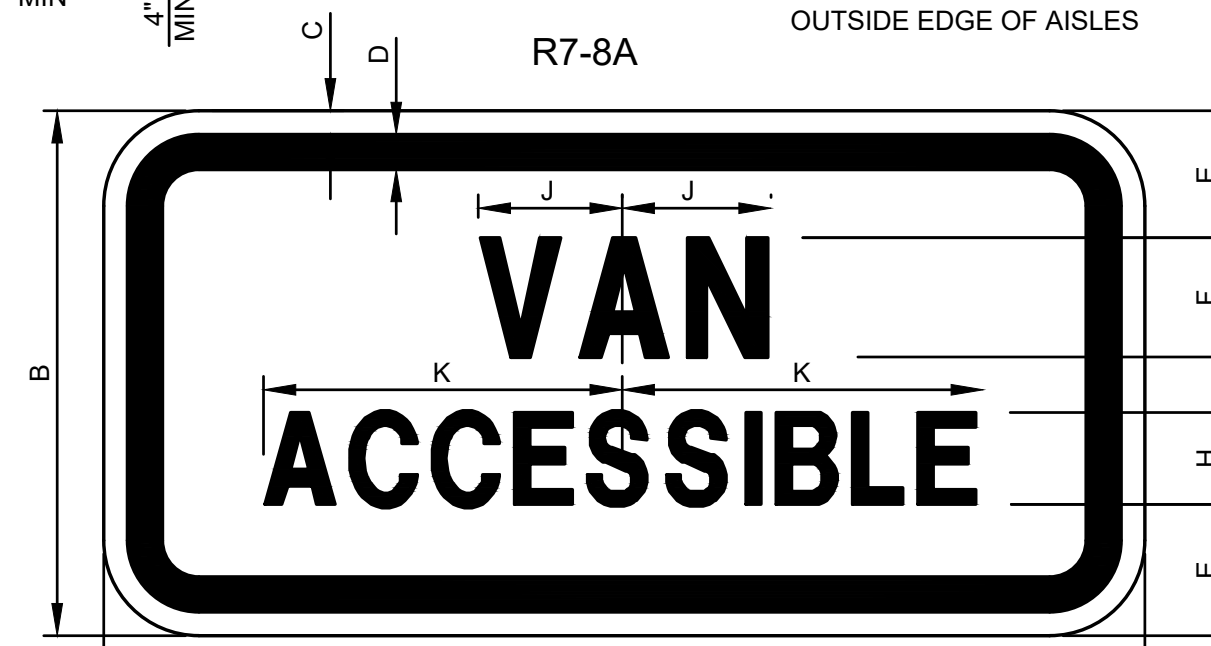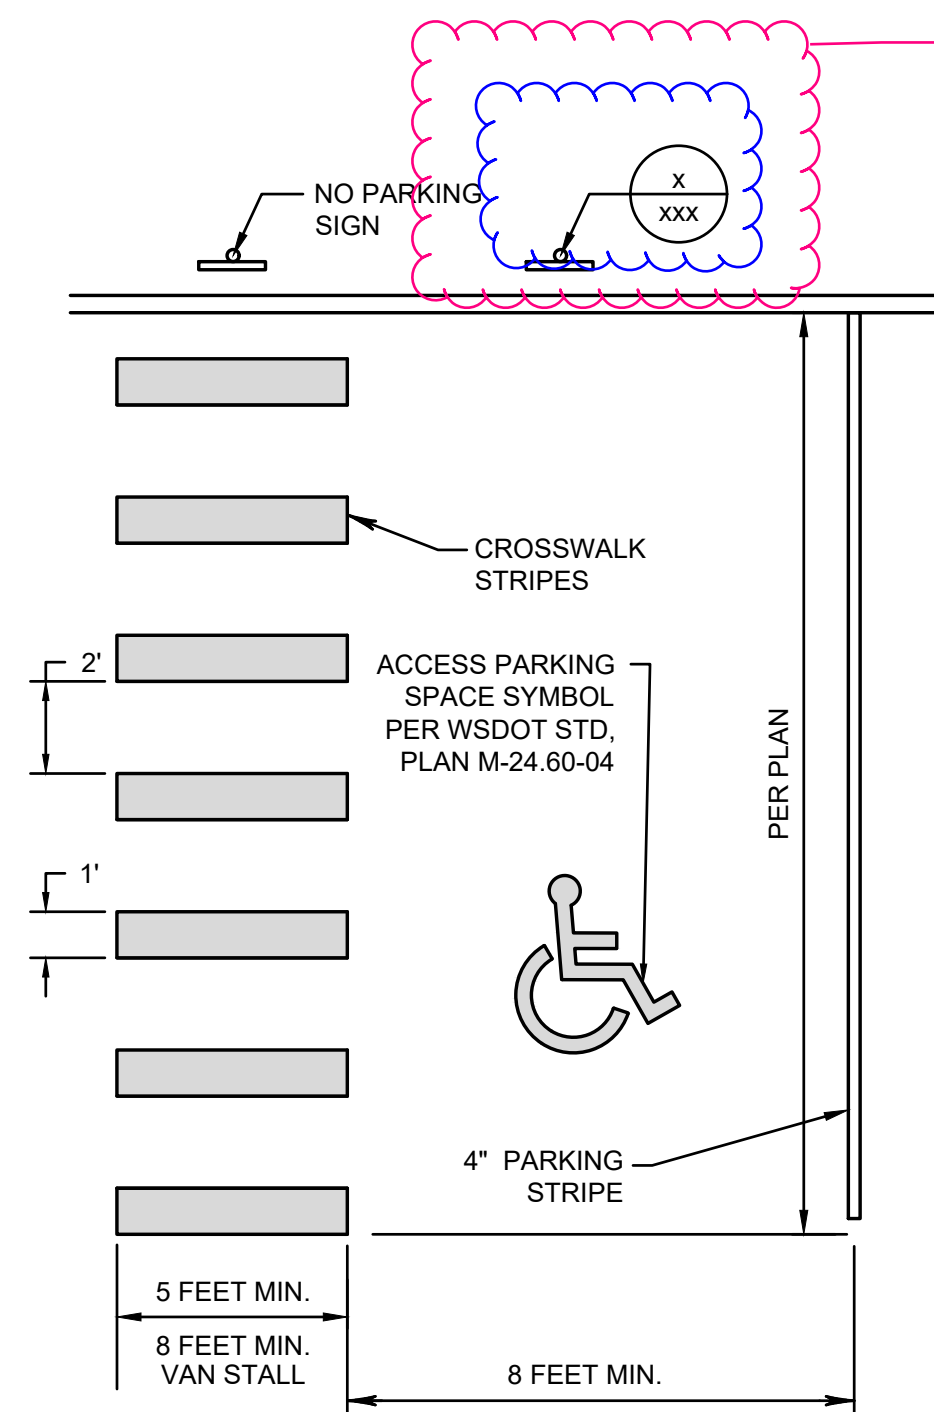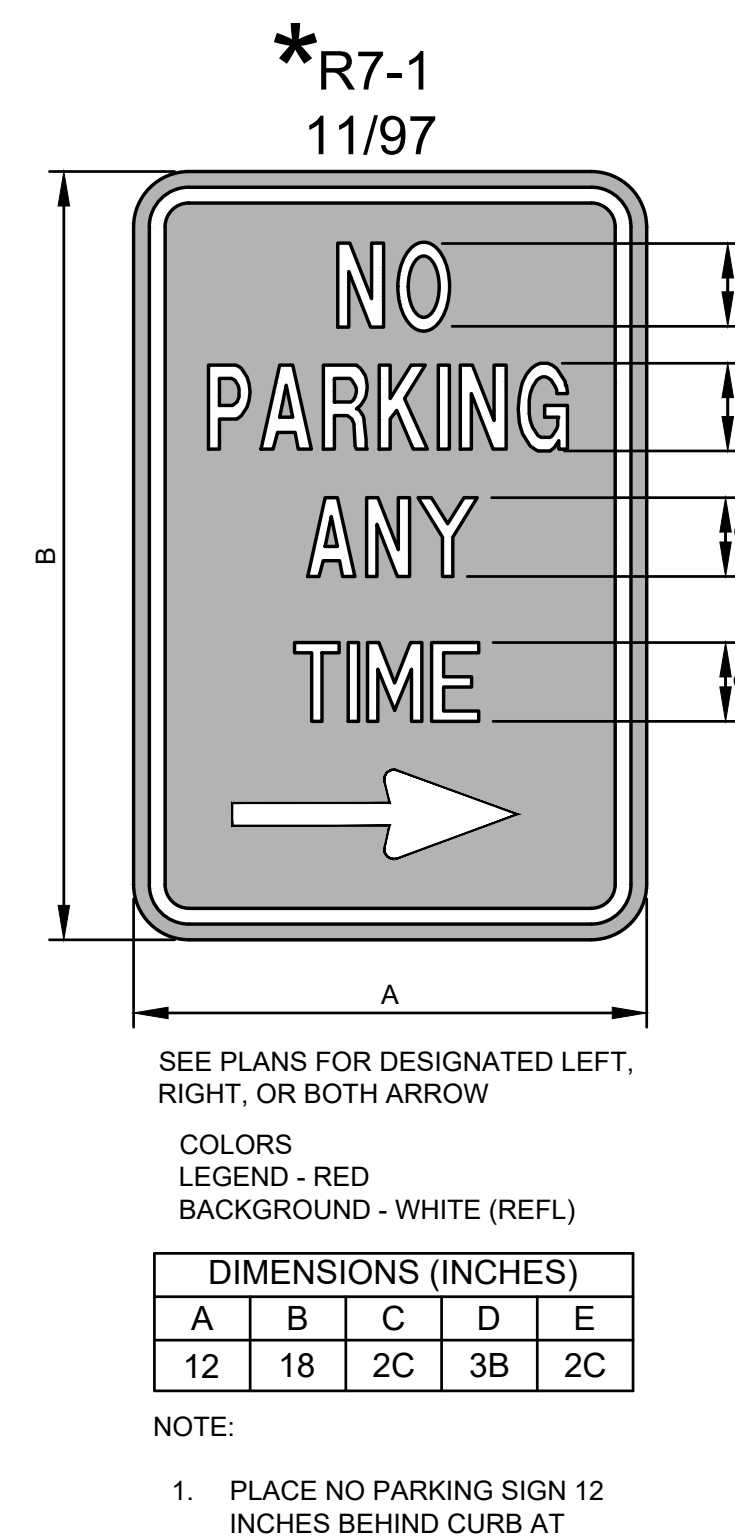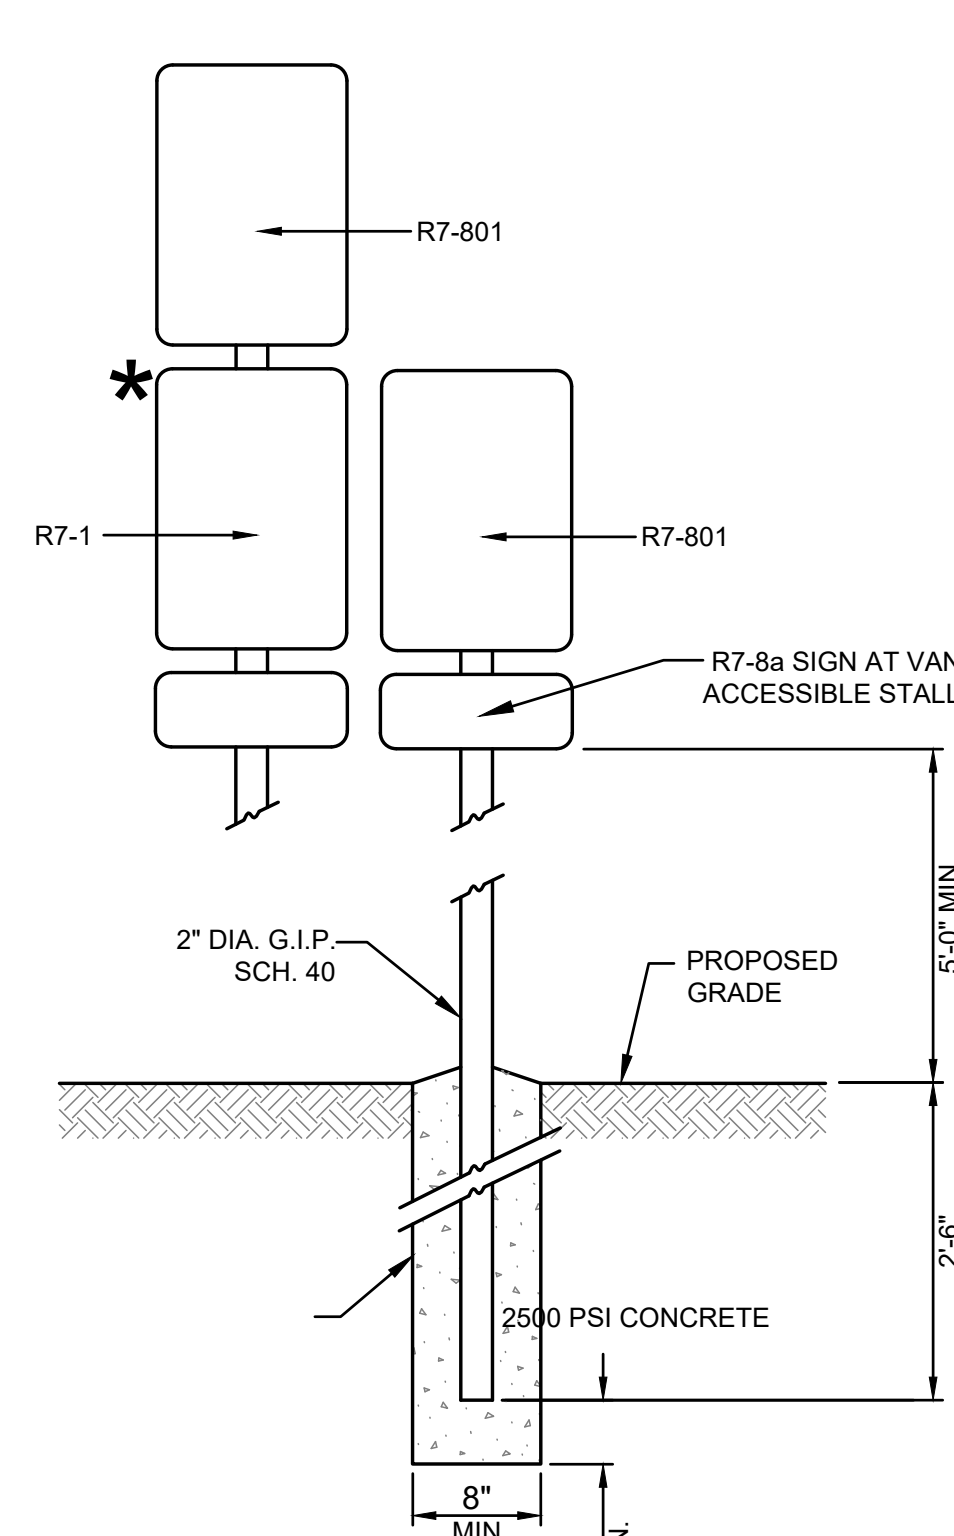

DIMENSIONS (INCHES)								
A	B	C	D	E	F	G	H	J
12	18	3/8	3/8	2 1/2	2C	2	9	1 1/2

- NOTE:
- PROVIDE VAN ACCESSIBLE STALL SIGN ON STALLS IDENTIFIED AS VAN STALLS.
 - PLACE NO PARKING SIGN 12 INCHES BEHIND CURB AT OUTSIDE EDGE OF AISLES
 - PROVIDE NO PARKING SIGN ON STALL POST IF AISLE LEADS TO RAMP

CLARIFY: [Plans Sht C2.6, Pg 9 of 63]

Updated detail label



Know what's below.
Call before you dig.

NOT TO SCALE

Sheet Title:

PAVING NOTES AND DETAILS

Designed by: CW Drawn by: SK Checked by: JI

Sheet No.

C2.6

9 of 63 Sheets



EAST TOWN CROSSING PHASE 1

SEC. 26,35/ TWP. 20 N./ RGE. 4 E., W.M.

APPROVED

BY CITY OF PUYALLUP
DEVELOPMENT ENGINEERING

DATE
NOTE: THIS APPROVAL IS VOID AFTER 180 DAYS FROM APPROVAL DATE. THE CITY WILL NOT BE RESPONSIBLE FOR ERRORS AND/OR OMISSIONS ON THESE PLANS. FIELD CONDITIONS MAY DICTATE CHANGES TO THESE PLANS AS DETERMINED BY THE DEVELOPMENT ENGINEERING MANAGER.

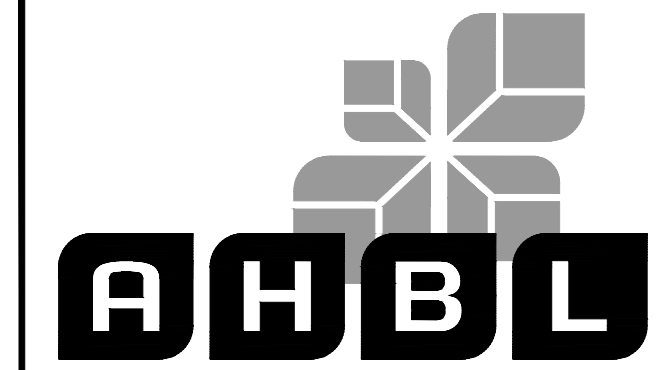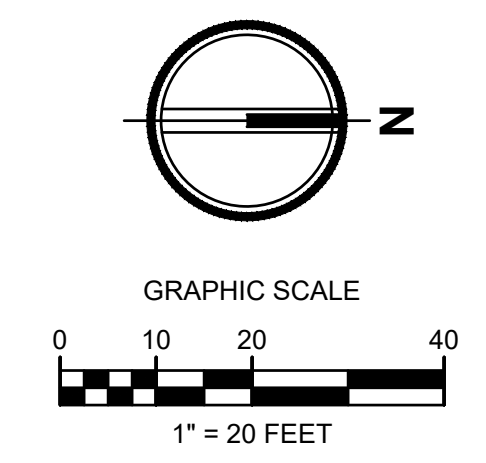

TACOMA • SEATTLE • SPOKANE • TRI-CITIES
2215 North 30th Street, Suite 300, Tacoma, WA 98403
253.383.2422 TEL 253.383.2572 FAX www.ahbl.com WEB

Project Title:
EAST TOWN CROSSING PHASE 1


Client:
ASH DEVELOPMENT
GREG HELLE
GREG.HELLE@ASHNW.COM

Project No.
2230752
Issue Set & Date:
PERMIT SUBMITTAL
11/20/2023



11/21/2023


NOTICE: ALLEGATION OF THIS DOCUMENT SHALL INVALIDATE THE PROFESSIONAL SEAL AND SIGNATURE. PUBLICATION OF THIS DOCUMENT DOES NOT CONSTITUTE A GUARANTEE OR WARRANTY BY THE ENGINEER. THE ENGINEER IS NOT RESPONSIBLE FOR THE PROJECT OR FOR THE PROJECT'S PERFORMANCE. THIS BLOCK SHALL NOT BE USED FOR ANY OTHER PROJECT.

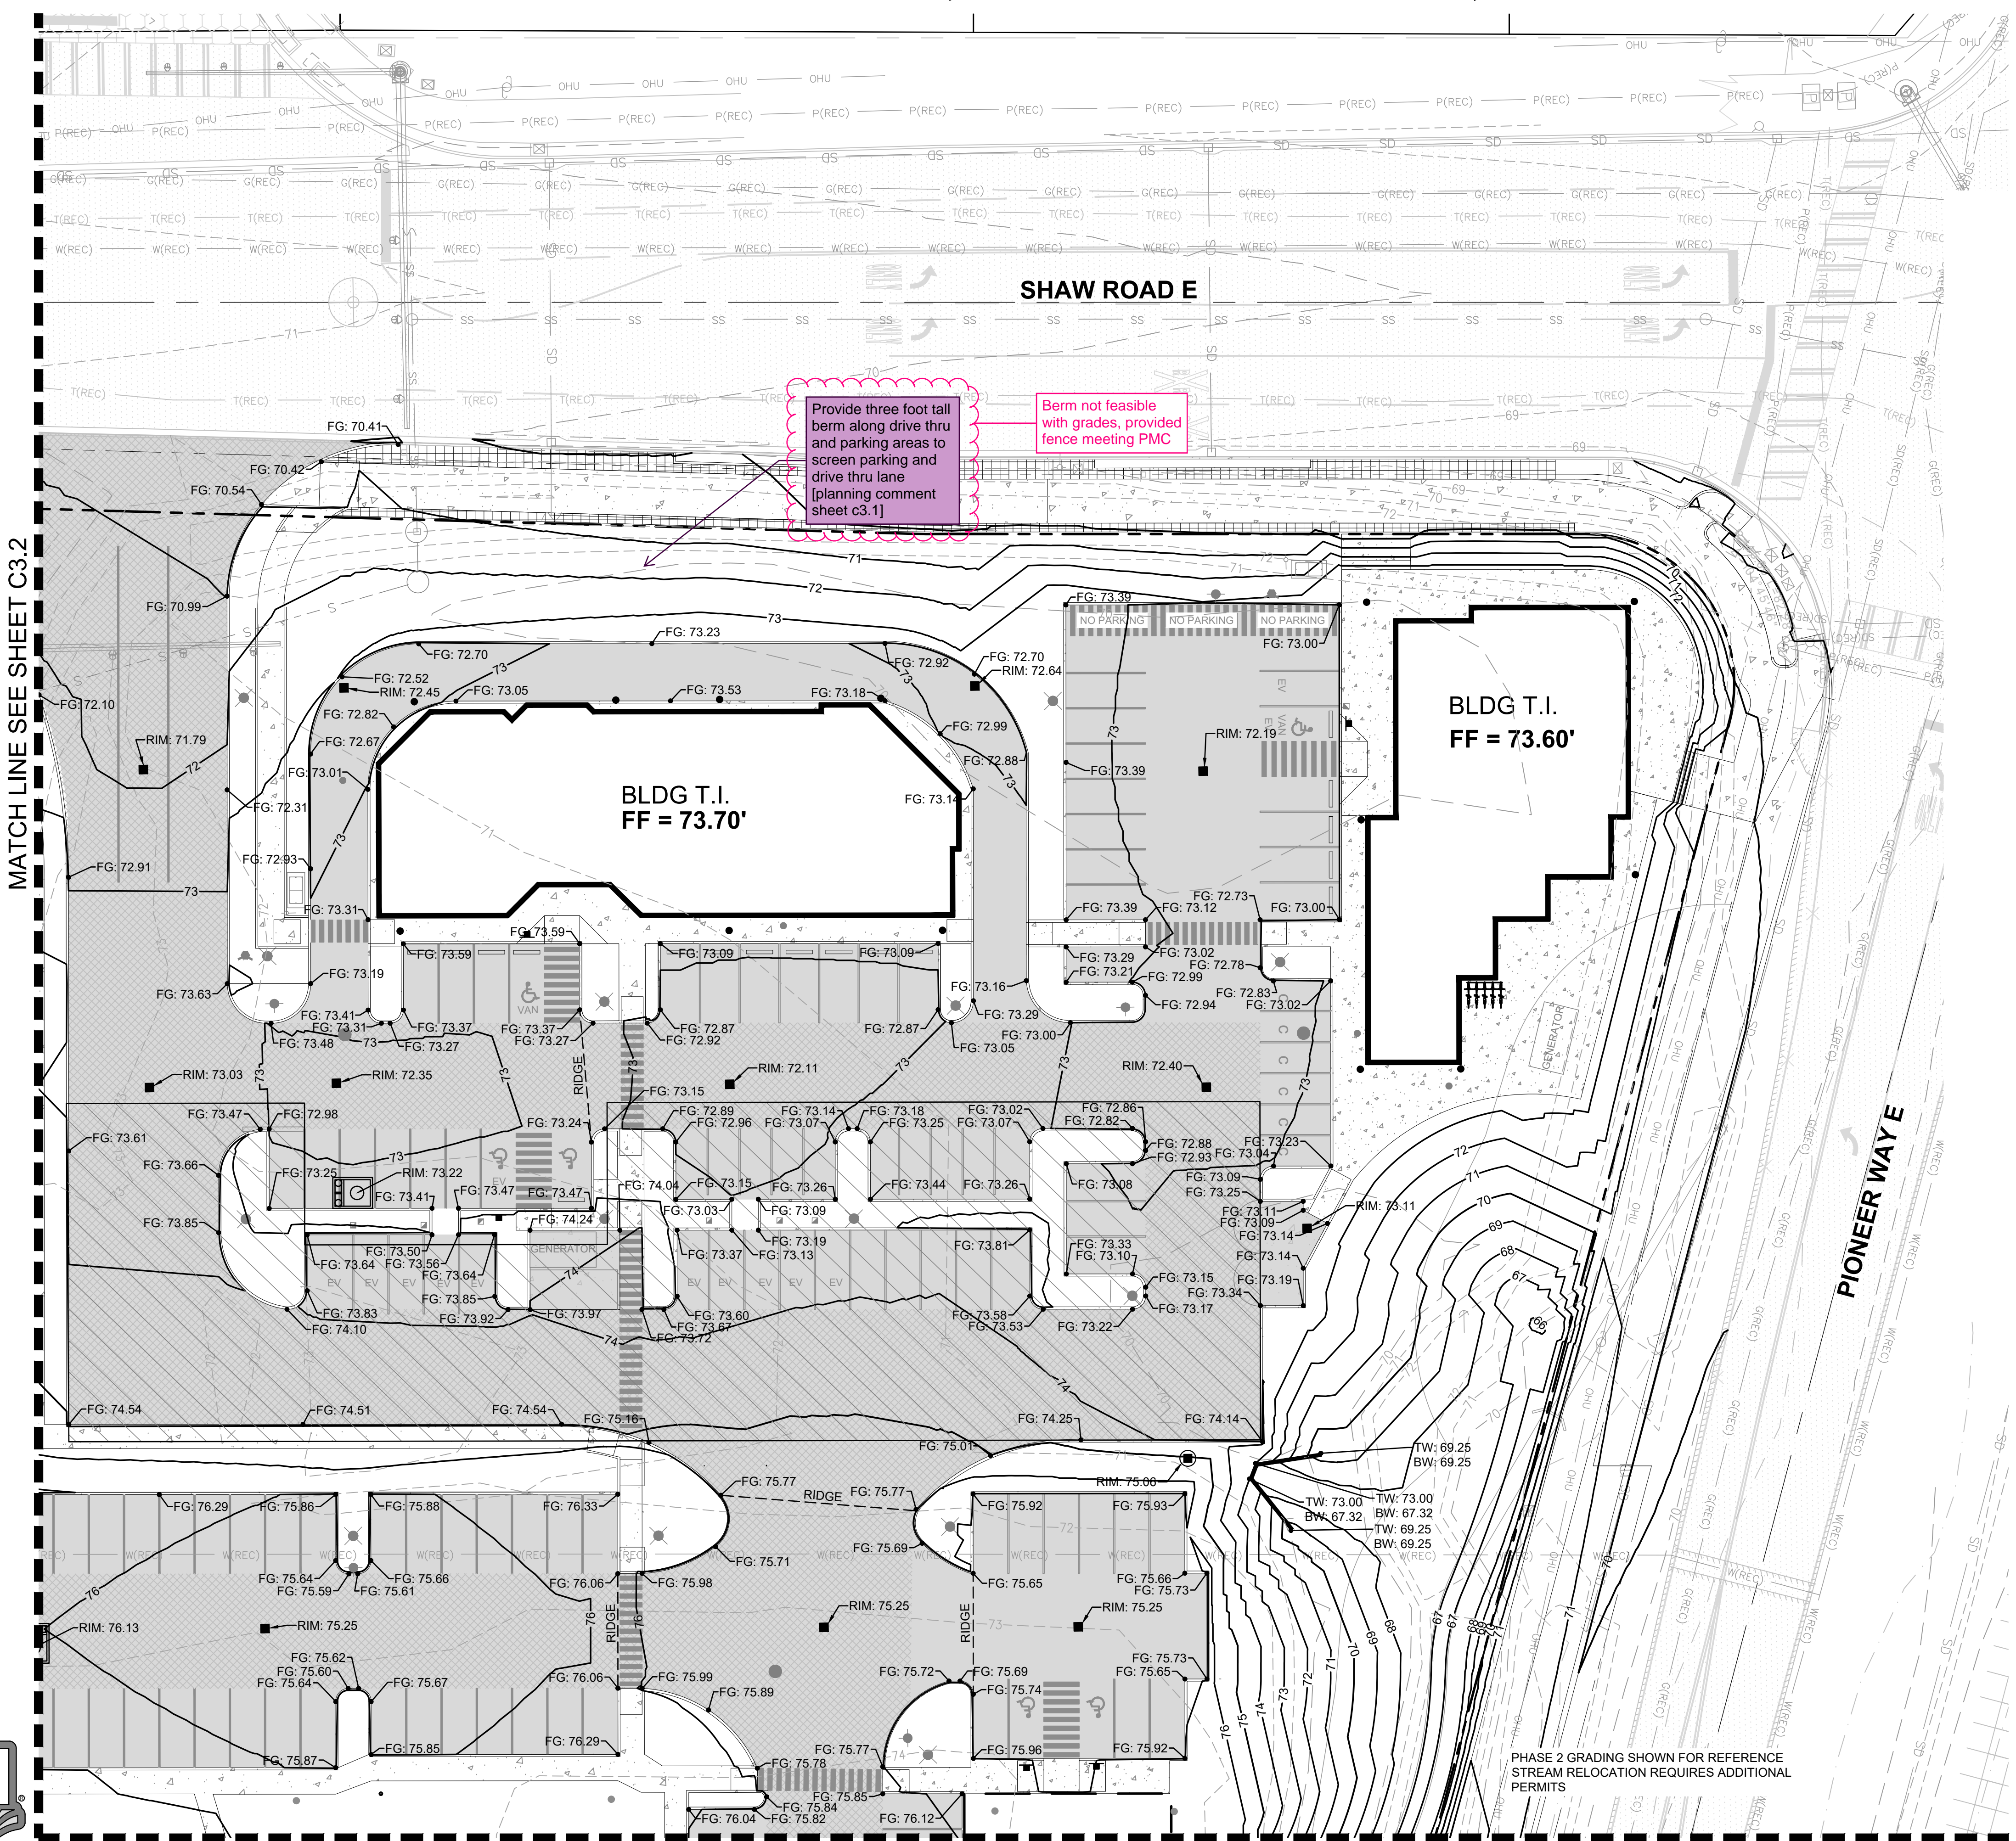

Delineate the regulated floodplain per the LOMR, Effective September 8, 2022. (Plans SH C3.1; Pg 10 of 63)

Called out regulated floodplain

Updated sheet labels

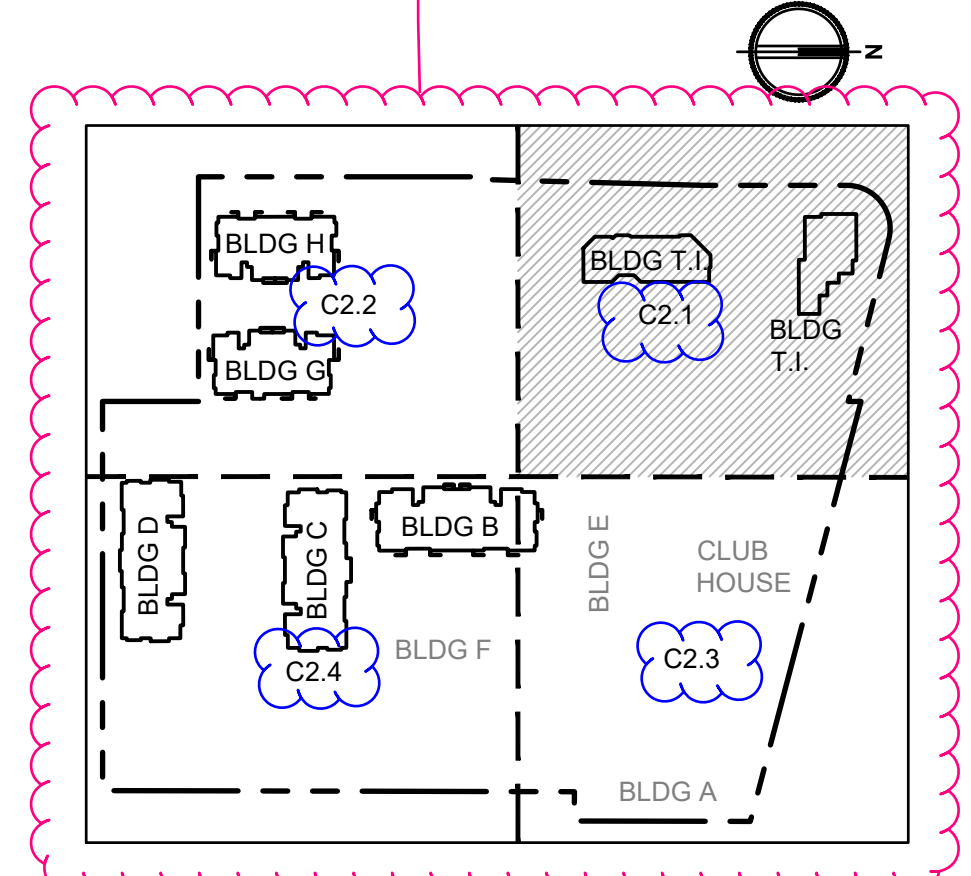

Revisions:

△	
△	
△	
△	

Sheet Title:
GRADING PLAN NW

Designed by: CW
Drawn by: SK
Checked by: JI

Sheet No.
C3.1





Know what's below.
Call before you dig.

MATCH LINE SEE SHEET C3.3

MATCH LINE SEE SHEET C3.2

EAST TOWN CROSSING PHASE 1

SEC. 26,35/ TWP. 20 N./ RGE. 4 E., W.M.

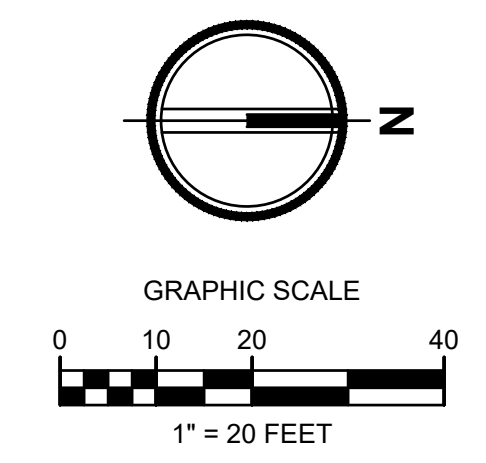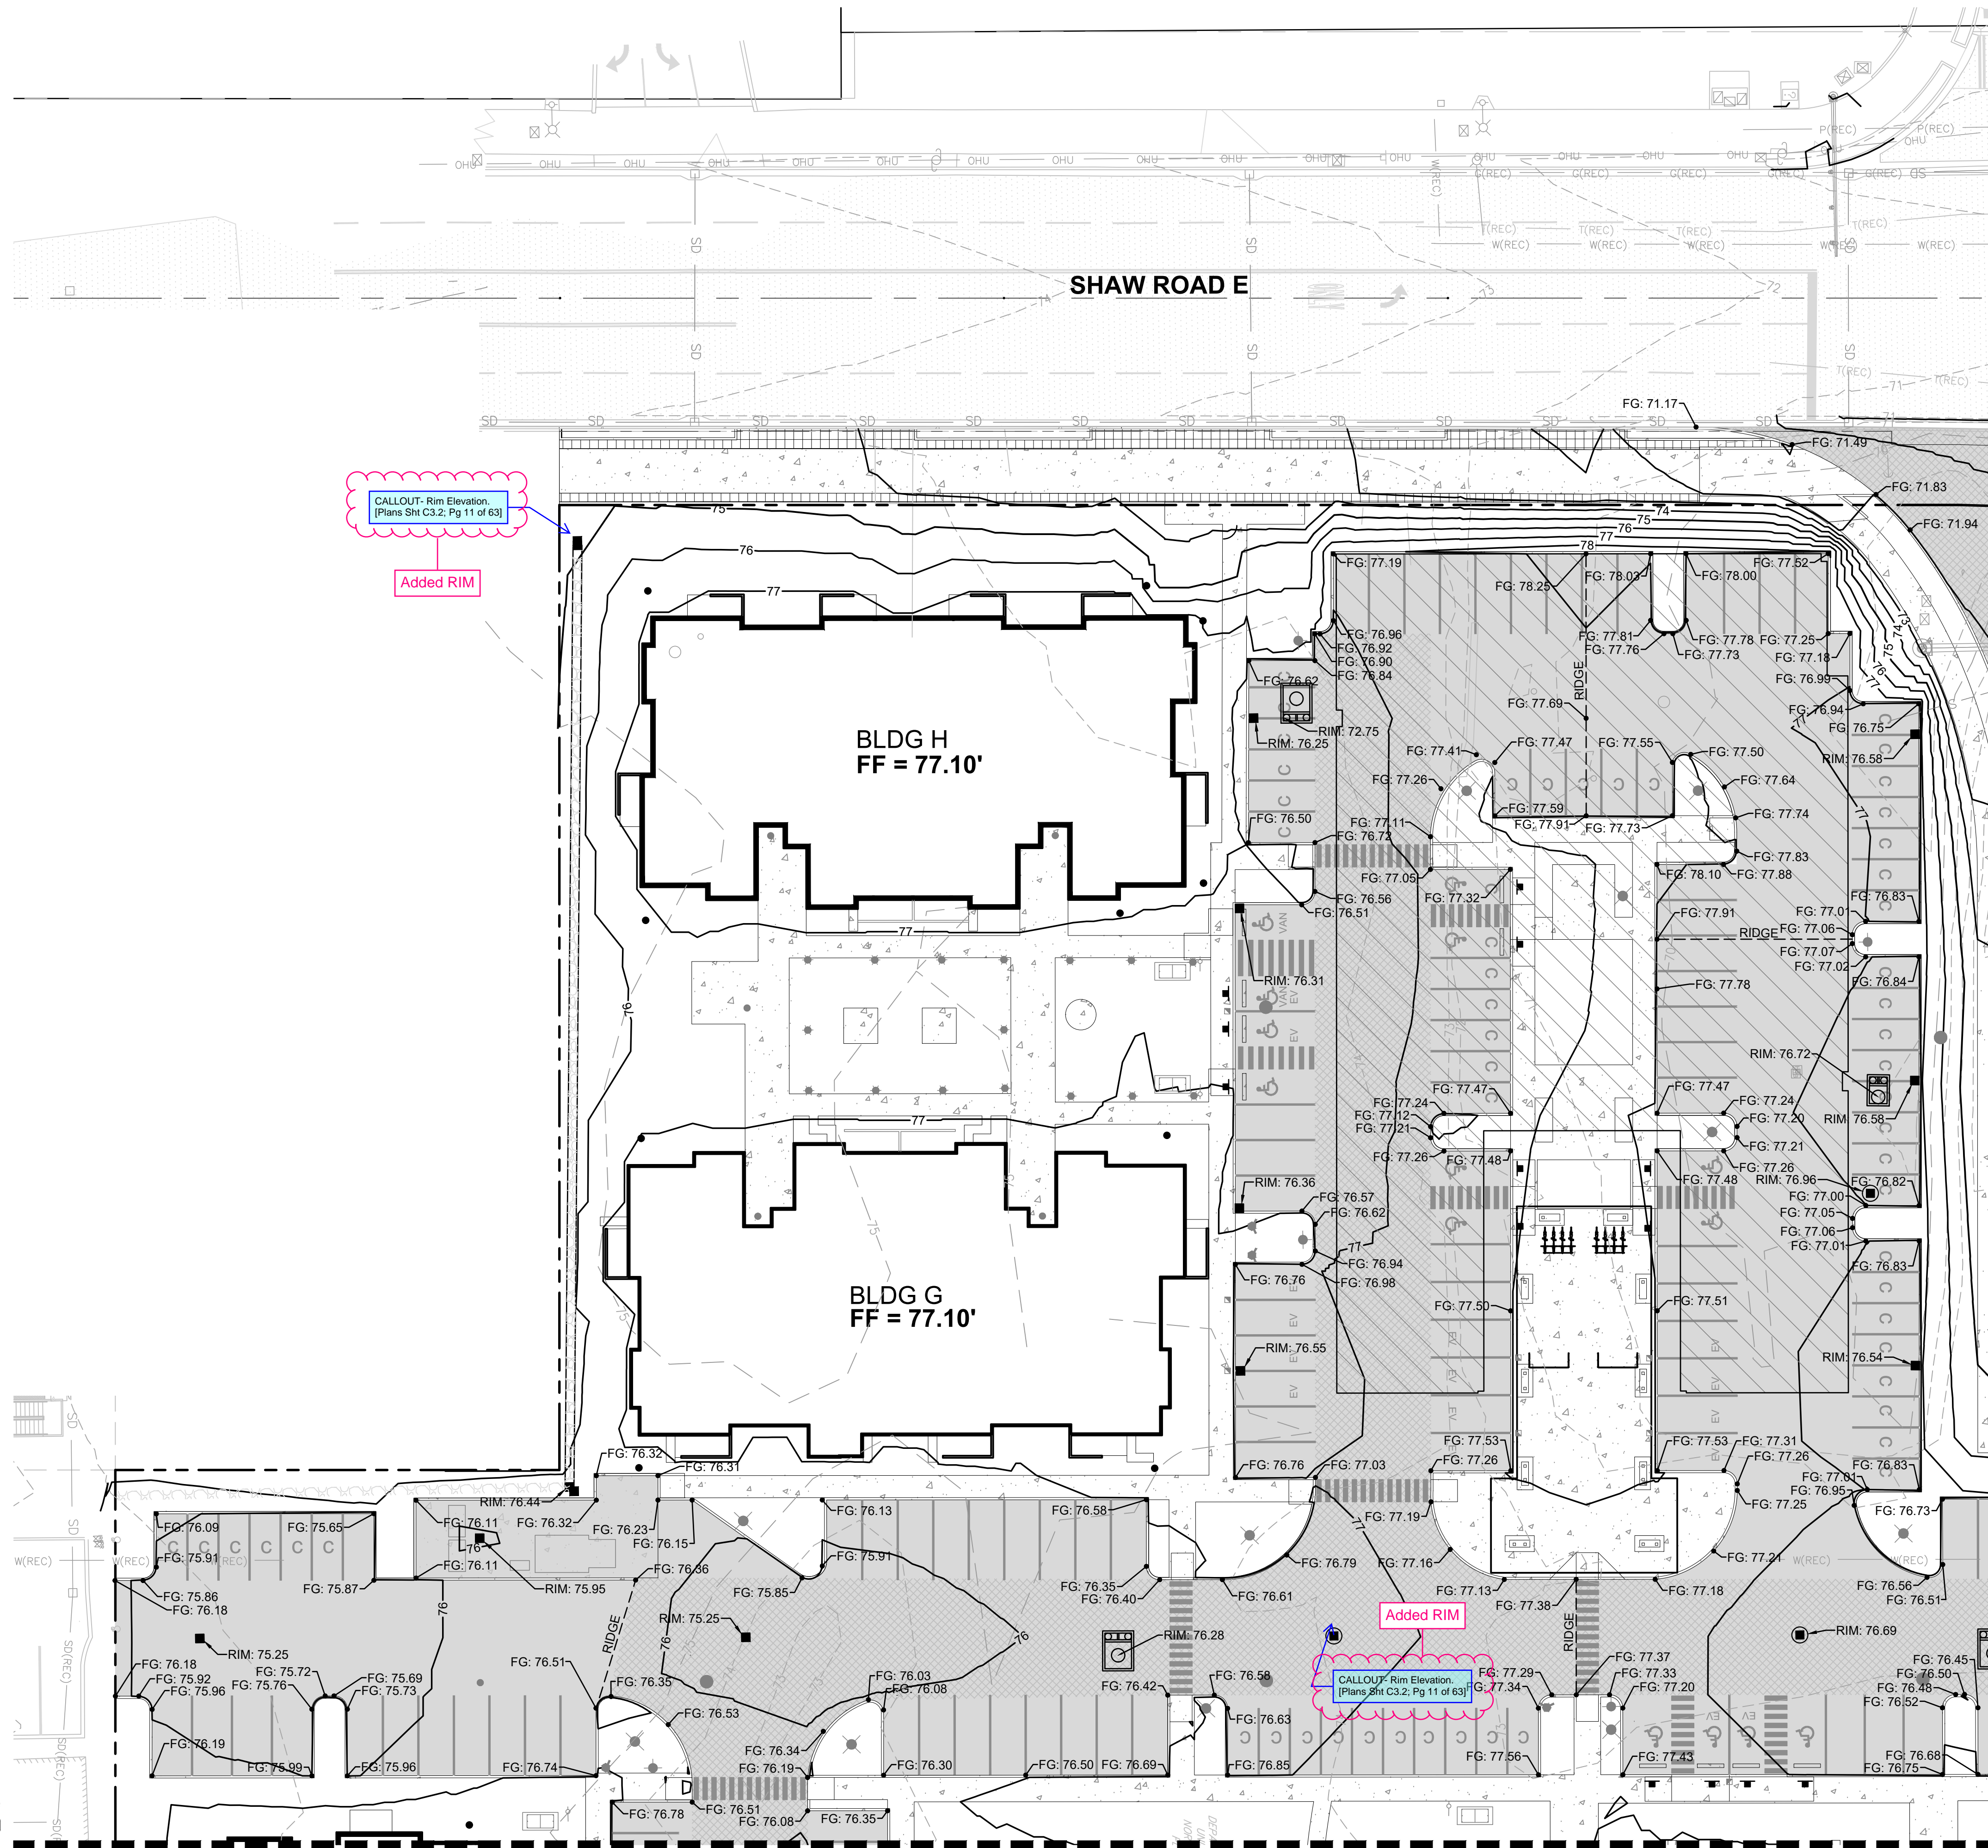

APPROVED
 BY: CITY OF PUYALLUP
 DEVELOPMENT ENGINEERING
 DATE:
 NOTE: THIS APPROVAL IS VOID AFTER 180 DAYS FROM APPROVAL DATE. THE CITY WILL NOT BE RESPONSIBLE FOR ERRORS AND/OR OMISSIONS ON THESE PLANS. FIELD CONDITIONS MAY DICTATE CHANGES TO THESE PLANS AS DETERMINED BY THE DEVELOPMENT ENGINEERING MANAGER.




TACOMA · SEATTLE · SPOKANE · TRI-CITIES
 2215 North 30th Street, Suite 300, Tacoma, WA 98403
 253.383.2422 TEL 253.383.2572 FAX www.ahbl.com WEB

Project Title:
EAST TOWN CROSSING PHASE 1

Client:
 ASH DEVELOPMENT
 GREG HELLE
 GREG.HELLE@ASHNW.COM

Project No.
 2230752

Issue Set & Date:
PERMIT SUBMITTAL
 11/20/2023

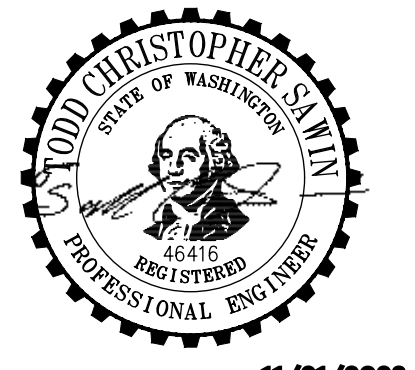


11/21/2023

NOTICE
 A REVISION OF THIS DOCUMENT SHALL INDICATE THE PROFESSIONAL SEAL AND SIGNATURE OF THE REGISTERED PROFESSIONAL ENGINEER. THE REGISTERED PROFESSIONAL ENGINEER'S SEAL AND SIGNATURE SHALL BE USED ONLY FOR THE PROJECT IDENTIFIED IN THE TITLE BLOCK AND IS NOT TO BE USED FOR OTHER PROJECTS OR ADDITION TO THAT PROJECT OR FOR ANY OTHER PROJECT.

MATCH LINE SEE SHEET C3.1

MATCH LINE SEE SHEET C3.4

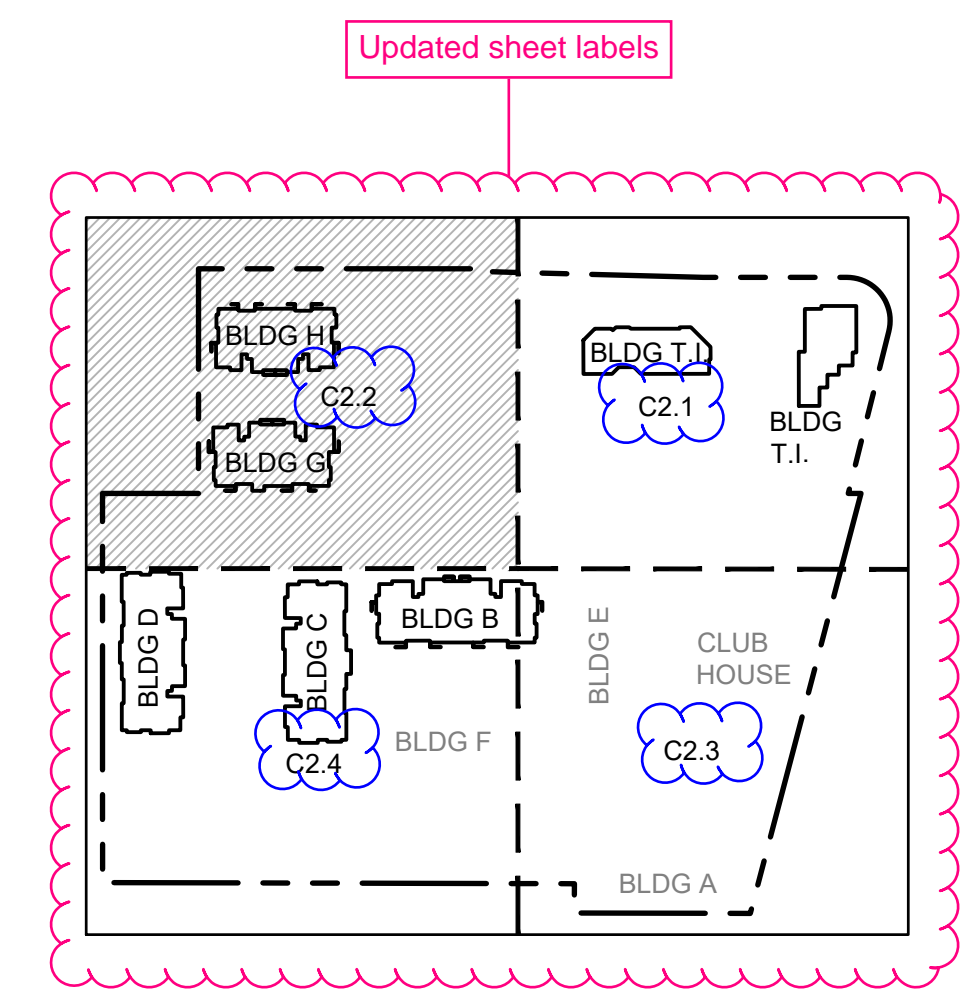

Revisions:

Sheet Title:
GRADING PLAN SW

Designed by: CW
 Drawn by: SK
 Checked by: JI

Sheet No.
C3.2
 11 of 63 Sheets





EAST TOWN CROSSING PHASE 1

SEC. 26,35/ TWP. 20 N./ RGE. 4 E., W.M.

APPROVED

BY: CITY OF PUYALLUP
DEVELOPMENT ENGINEERING
DATE:

NOTE: THIS APPROVAL IS VOID AFTER 180 DAYS FROM APPROVAL DATE. THE CITY WILL NOT BE RESPONSIBLE FOR ERRORS AND/OR OMISSIONS ON THESE PLANS. FIELD CONDITIONS MAY DICTATE CHANGES TO THESE PLANS AS DETERMINED BY THE DEVELOPMENT ENGINEERING MANAGER.

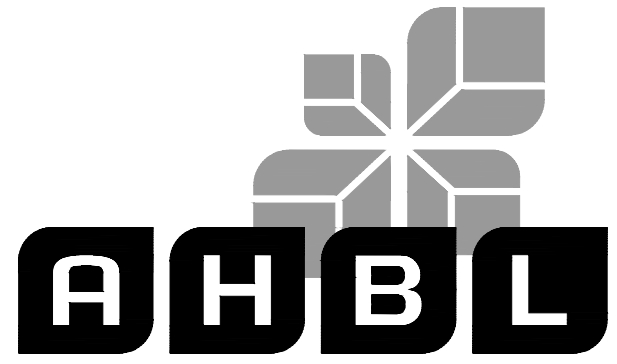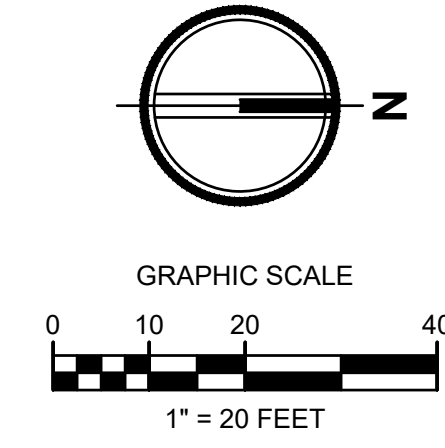

TACOMA · SEATTLE · SPOKANE · TRI-CITIES

2215 North 30th Street, Suite 300, Tacoma, WA 98403
253.383.2422 TEL 253.383.2572 FAX www.ahbl.com WEB

Project Title:

EAST TOWN CROSSING PHASE 1

Client:

ASH DEVELOPMENT

GREG HELLE

GREG.HELLE@ASHNW.COM

Project No.

2230752

Issue Set & Date:

PERMIT SUBMITTAL

11/20/2023




11/21/2023

NOTICE:
A SIGNATURE OF THIS DOCUMENT SHALL VALIDATE THE PROFESSIONAL SEAL AND SIGNATURE PUBLICATION OF THE DOCUMENT DOES NOT CONSTITUTE A PROFESSIONAL ENGINEER'S LIABILITY INSURANCE POLICY. THIS DOCUMENT IS FOR THE USE ONLY FOR THE PROJECT IDENTIFIED IN THE TITLE BLOCK AND IS NOT TO BE USED FOR OTHER, SIMILAR, OR ACTION TO THAT PROJECT OR FOR ANY OTHER PROJECT.

MATCH LINE SEE SHEET C3.1


MATCH LINE SEE SHEET C3.4

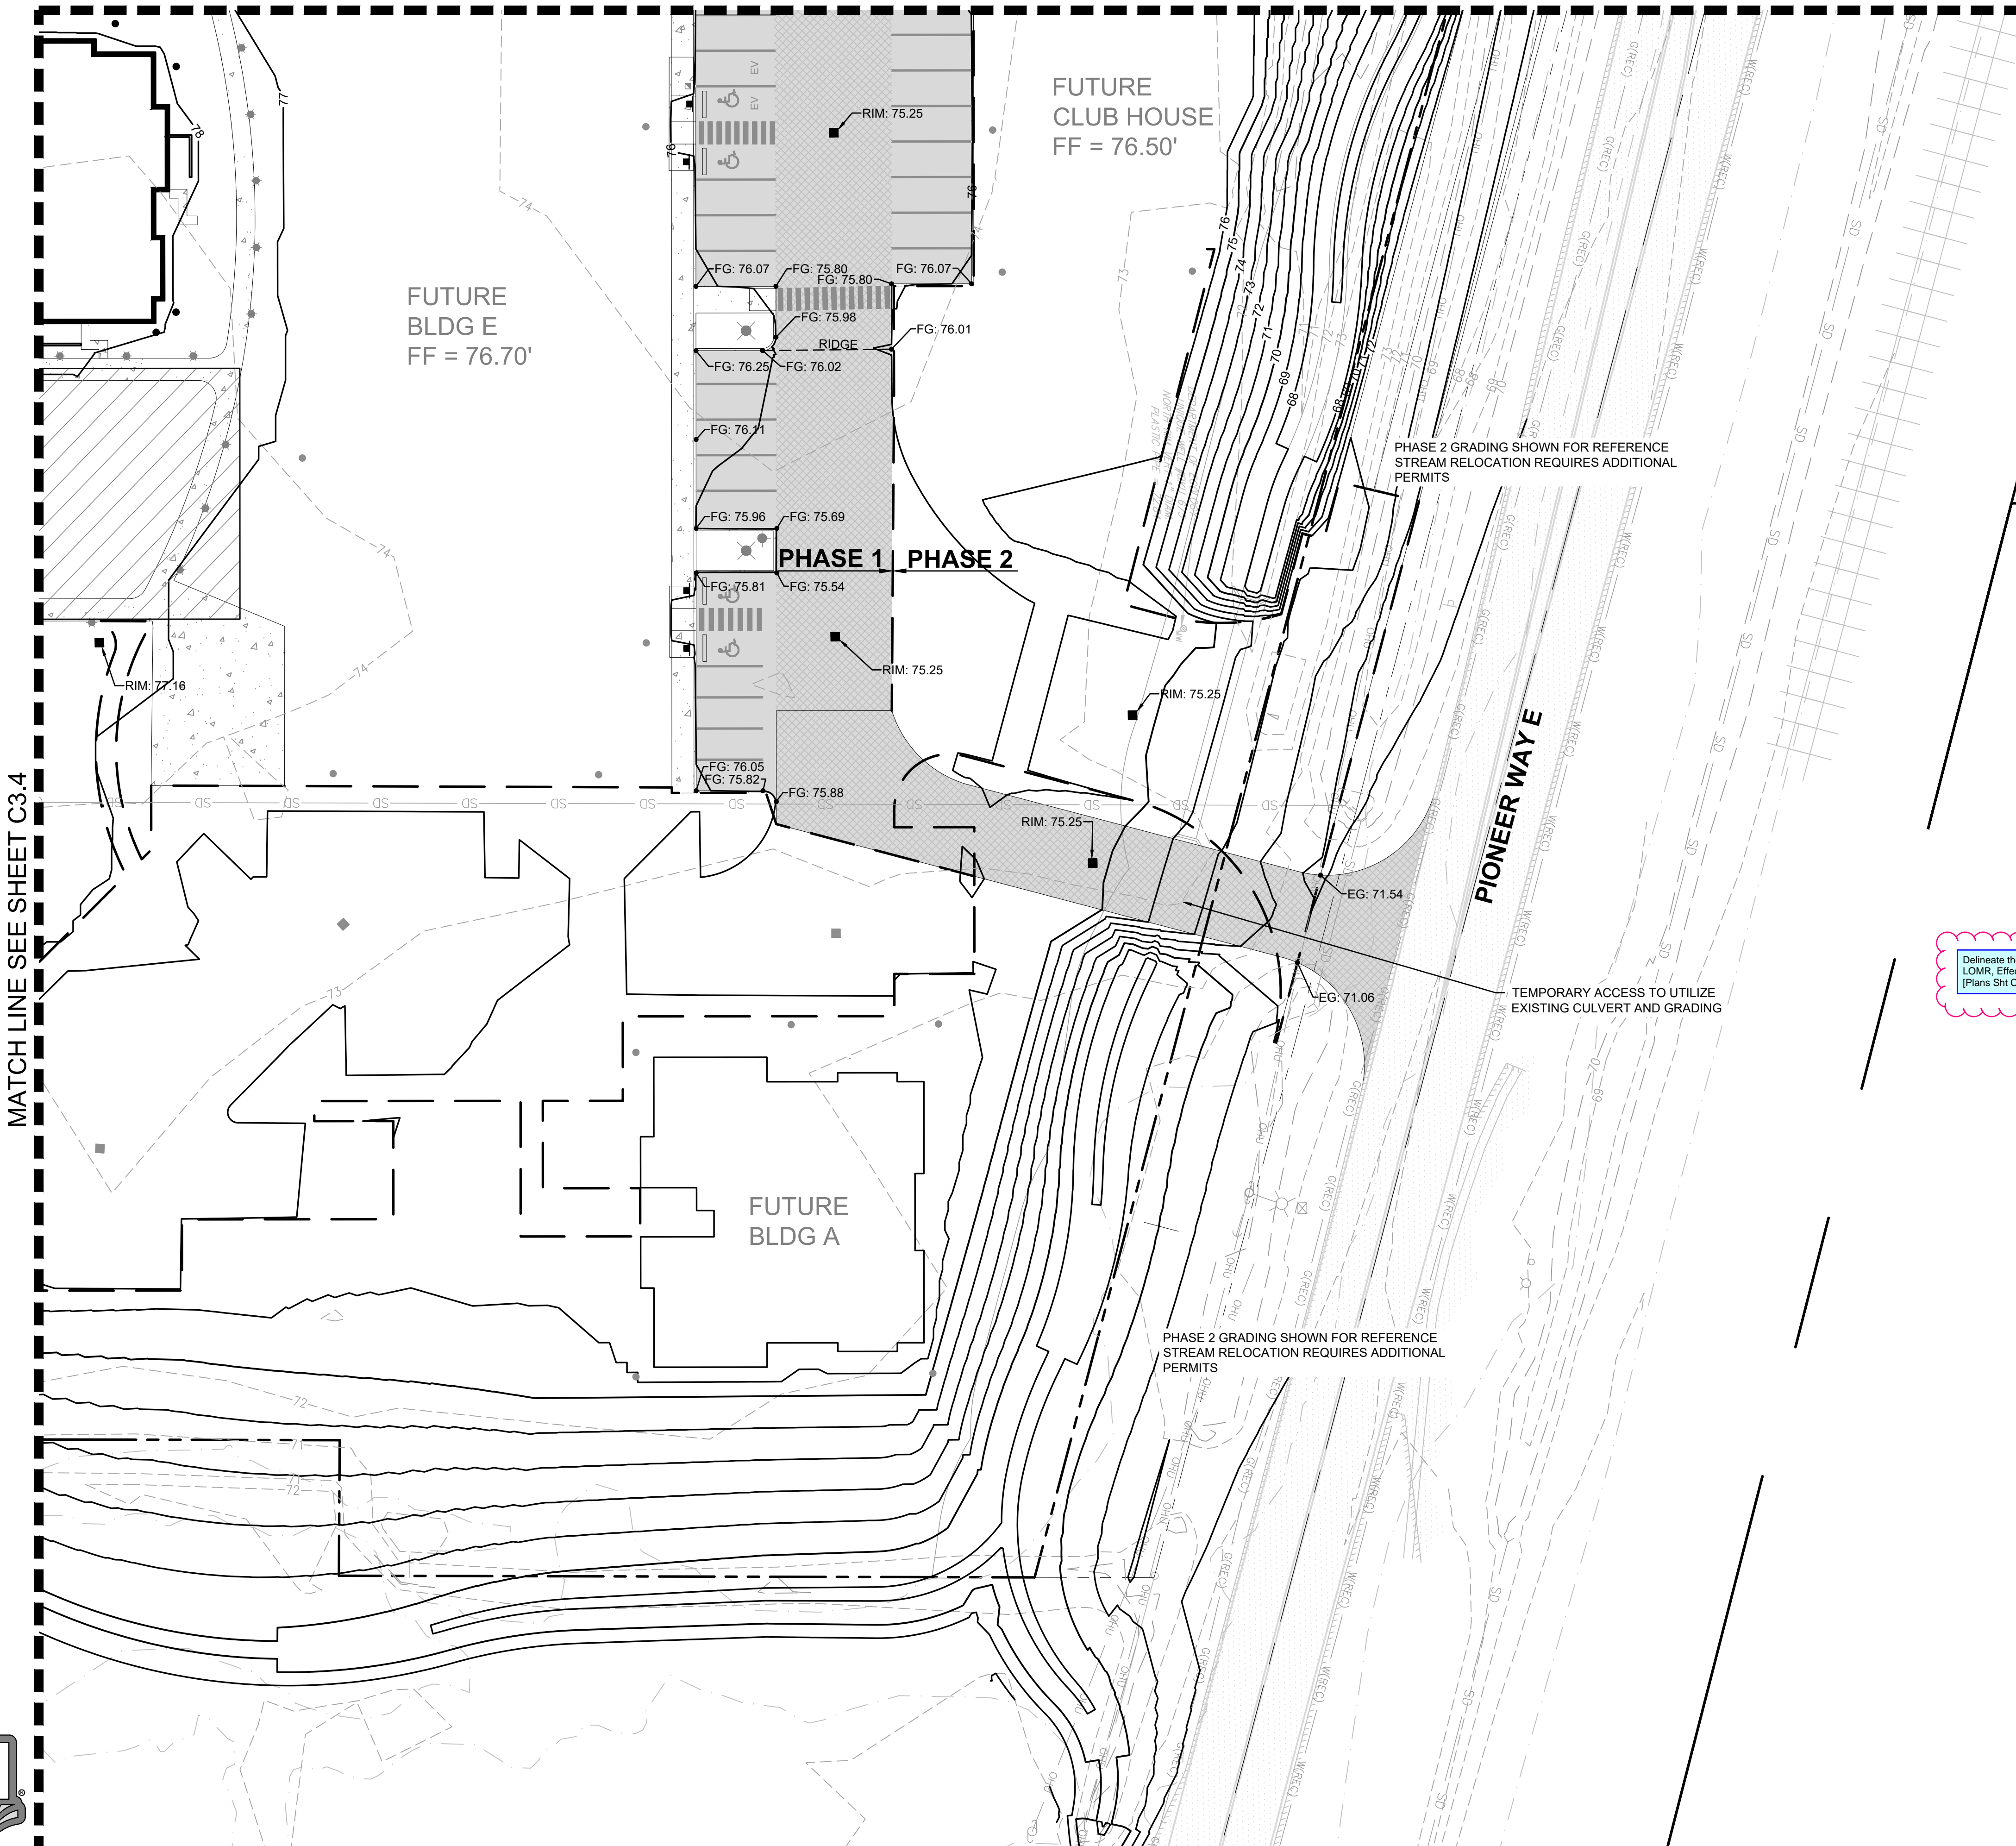

Delineate the regulated floodplain per the LOMR, Effective September 6, 2022. [Plan Sht C3.3, Pg 12 of 63]

Called out

Updated sheet labels

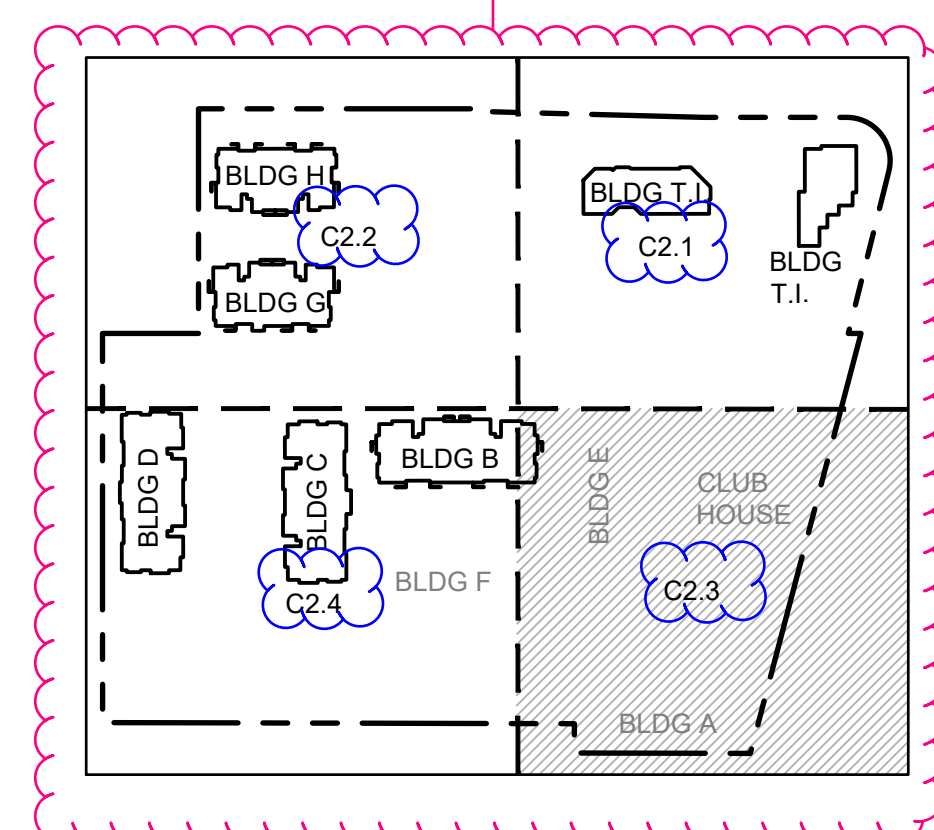

Revisions:

Sheet Title:

GRADING PLAN NE

Designed by: CW Drawn by: SK Checked by: JI

Sheet No.

C3.3

12 of 63 Sheets



Know what's below.
Call before you dig.



EAST TOWN CROSSING PHASE 1

SEC. 26,35/ TWP. 20 N./ RGE. 4 E., W.M.

APPROVED

BY: CITY OF PUYALLUP
DEVELOPMENT ENGINEERING
DATE:

NOTE: THIS APPROVAL IS VOID AFTER 180 DAYS FROM APPROVAL DATE. THE CITY WILL NOT BE RESPONSIBLE FOR ERRORS AND/OR OMISSIONS ON THESE PLANS. FIELD CONDITIONS MAY DICTATE CHANGES TO THESE PLANS AS DETERMINED BY THE DEVELOPMENT ENGINEERING MANAGER.

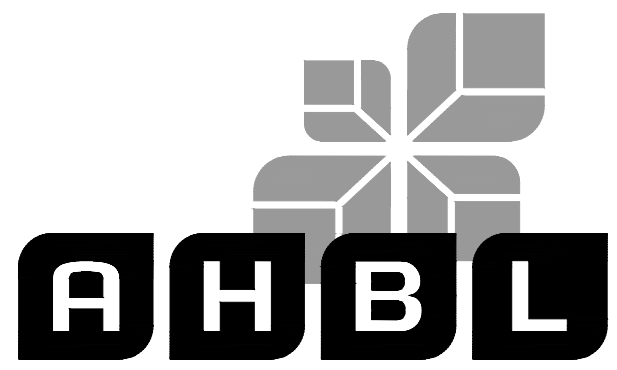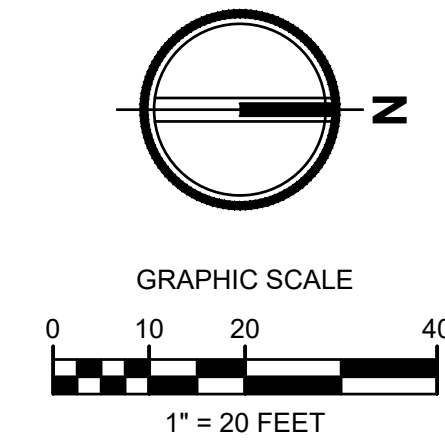

TACOMA · SEATTLE · SPOKANE · TRI-CITIES

2215 North 30th Street, Suite 300, Tacoma, WA 98403
253.383.2422 TEL. 253.383.2572 FAX www.ahbl.com WEB

Project Title:

EAST TOWN CROSSING PHASE 1

Client:

ASH DEVELOPMENT

GREG HELLE

GREG.HELLE@ASHNW.COM

Project No.

2230752

Issue Set & Date:


PERMIT SUBMITTAL

11/20/2023



11/21/2023

NOTICE: ALTERATION OF THIS DOCUMENT SHALL INVALIDATE THE PROFESSIONAL SEAL AND SIGNATURE. PUBLICATION OF THIS DOCUMENT DOES NOT CONSTITUTE AN ENDORSEMENT OR GUARANTEE BY THE ENGINEER OR FIRM. THIS DOCUMENT IS TO BE USED ONLY FOR THE PROJECT DESCRIBED IN THE TITLE BLOCK AND IS NOT TO BE USED FOR OTHER PROJECTS OR IN CONNECTION WITH ANY OTHER PROJECT.

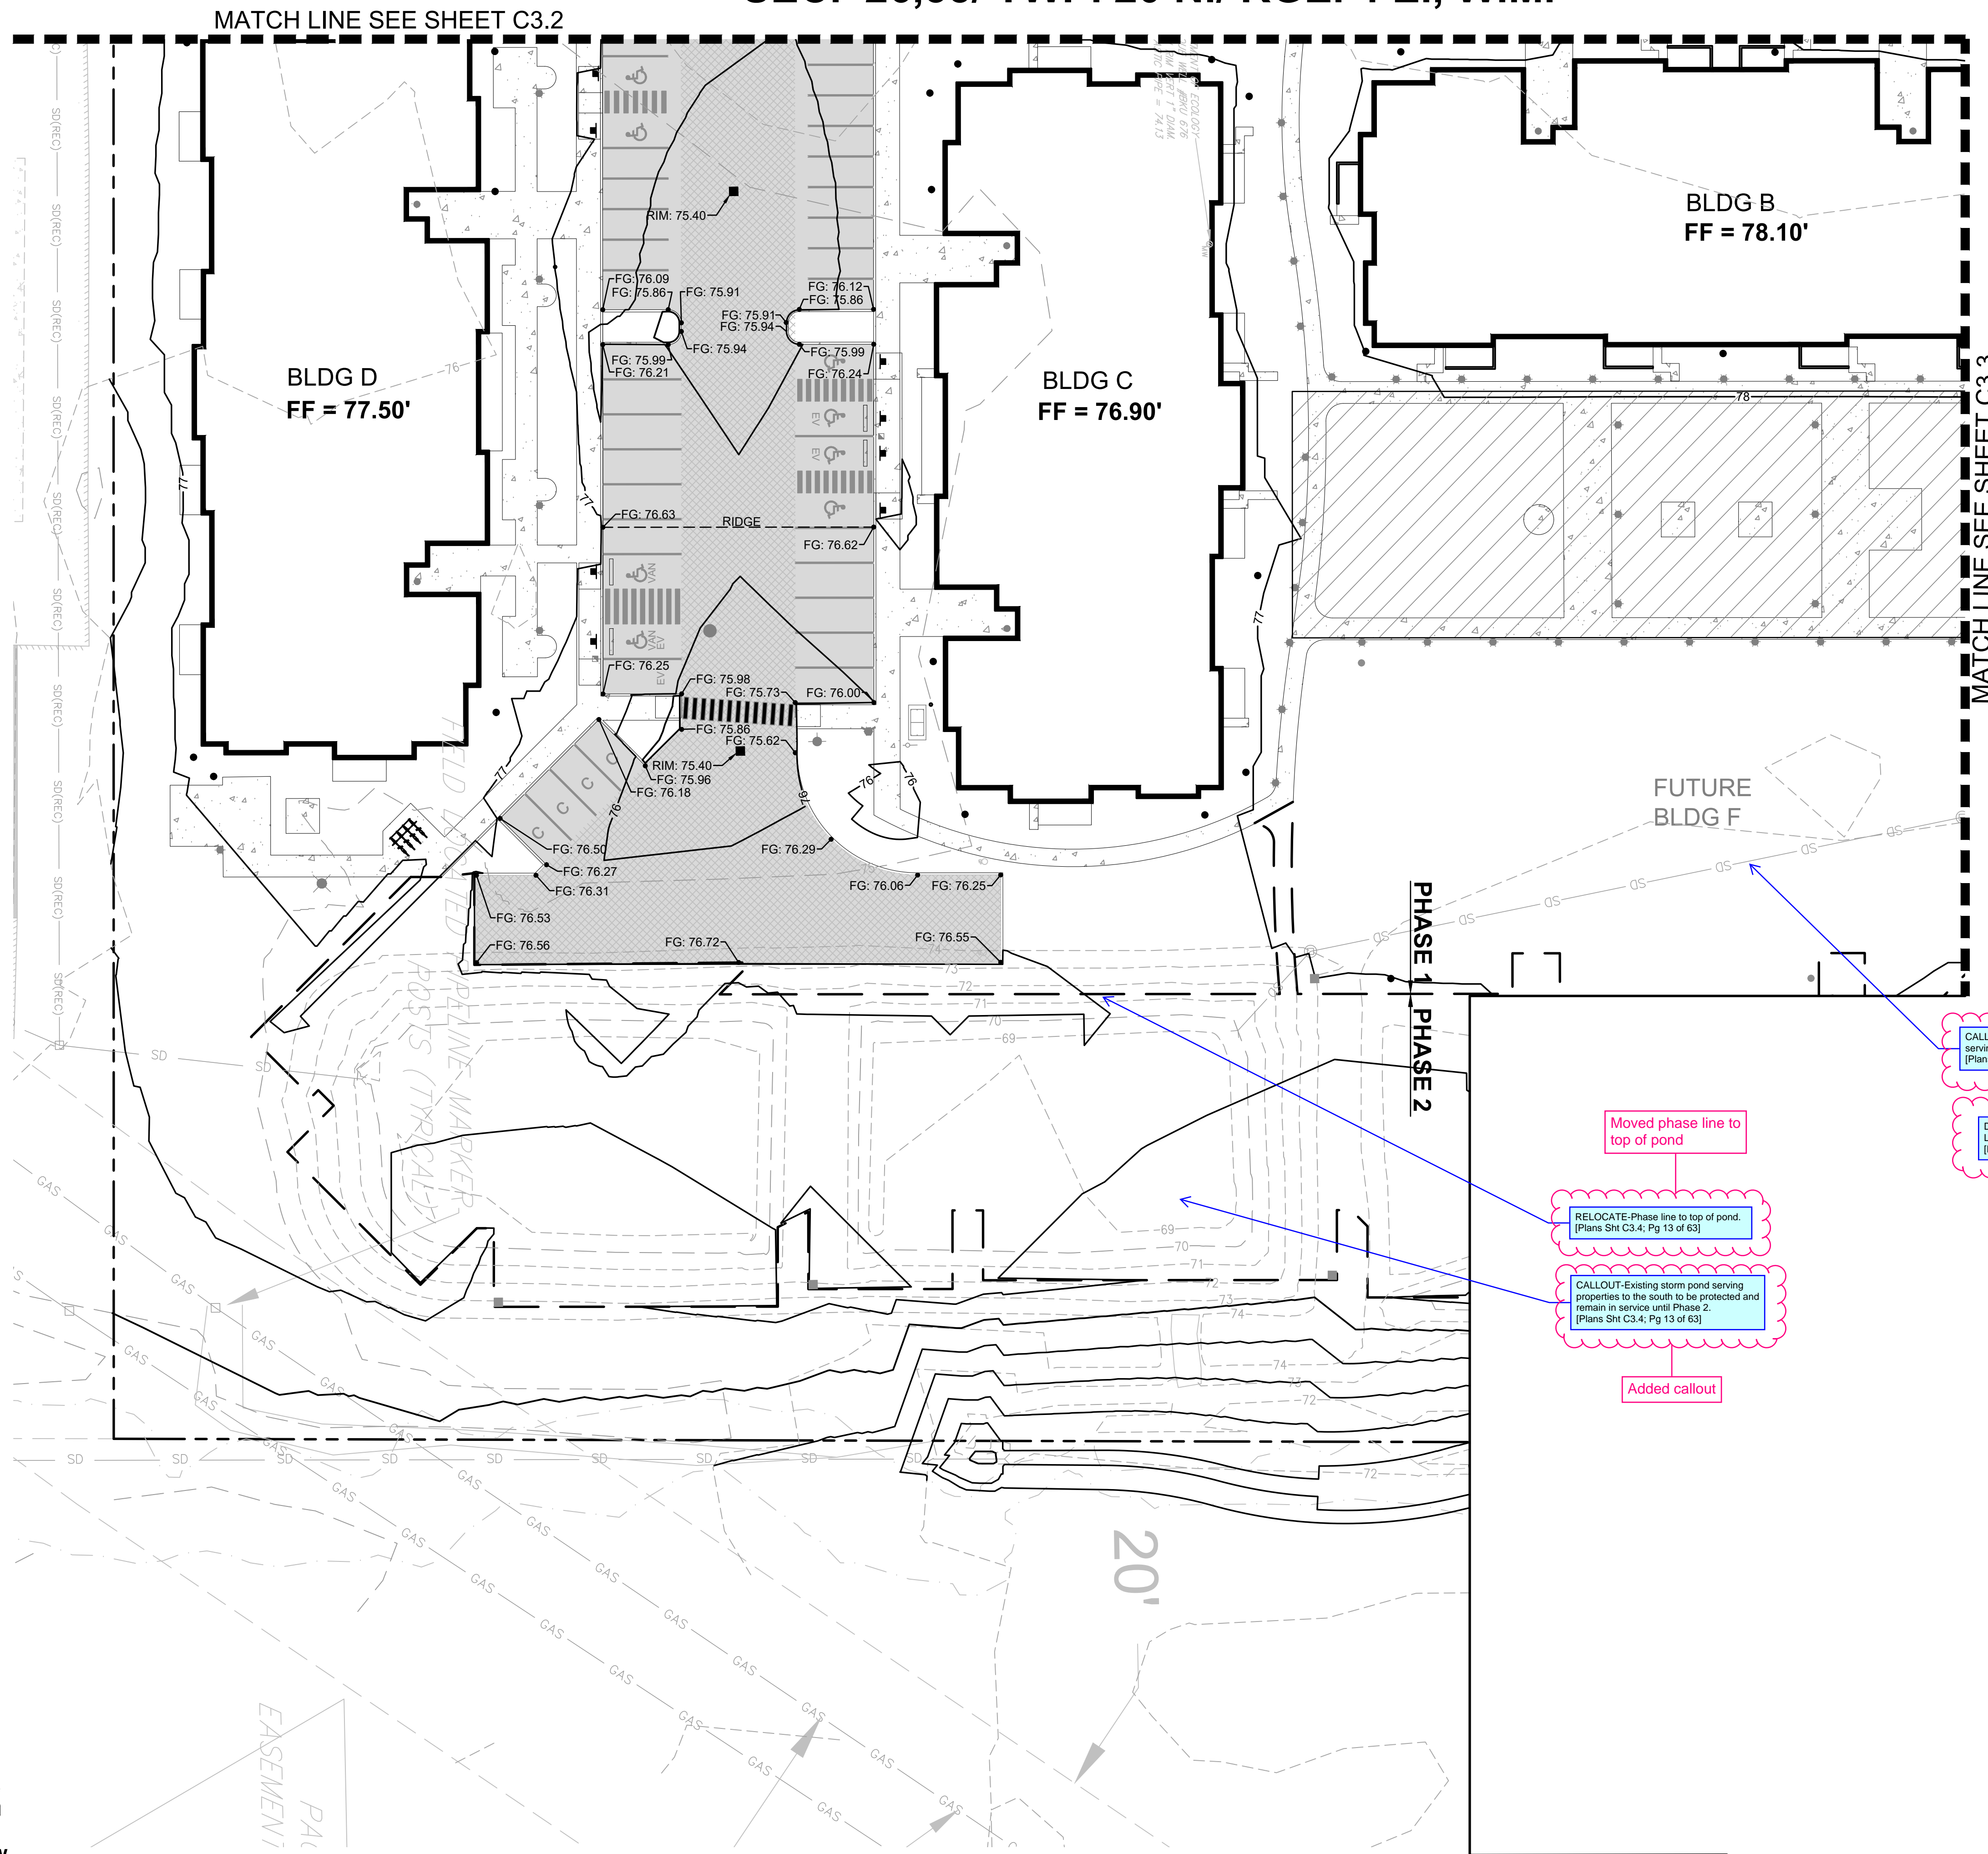

Added callout

CALLOUT to protect existing storm drain serving properties to the south.
[Plans Sht C3.4; Pg 13 of 63]

Called out


Delineate the regulated floodplain per the LOMR, Effective September 8, 2022.
[Plans Sht C3.4; Pg 13 of 63]

Moved phase line to top of pond

RELOCATE-Phase line to top of pond.
[Plans Sht C3.4; Pg 13 of 63]

Added callout

CALLOUT-Existing storm pond serving properties to the south to be protected and remain in service until Phase 2.
[Plans Sht C3.4; Pg 13 of 63]

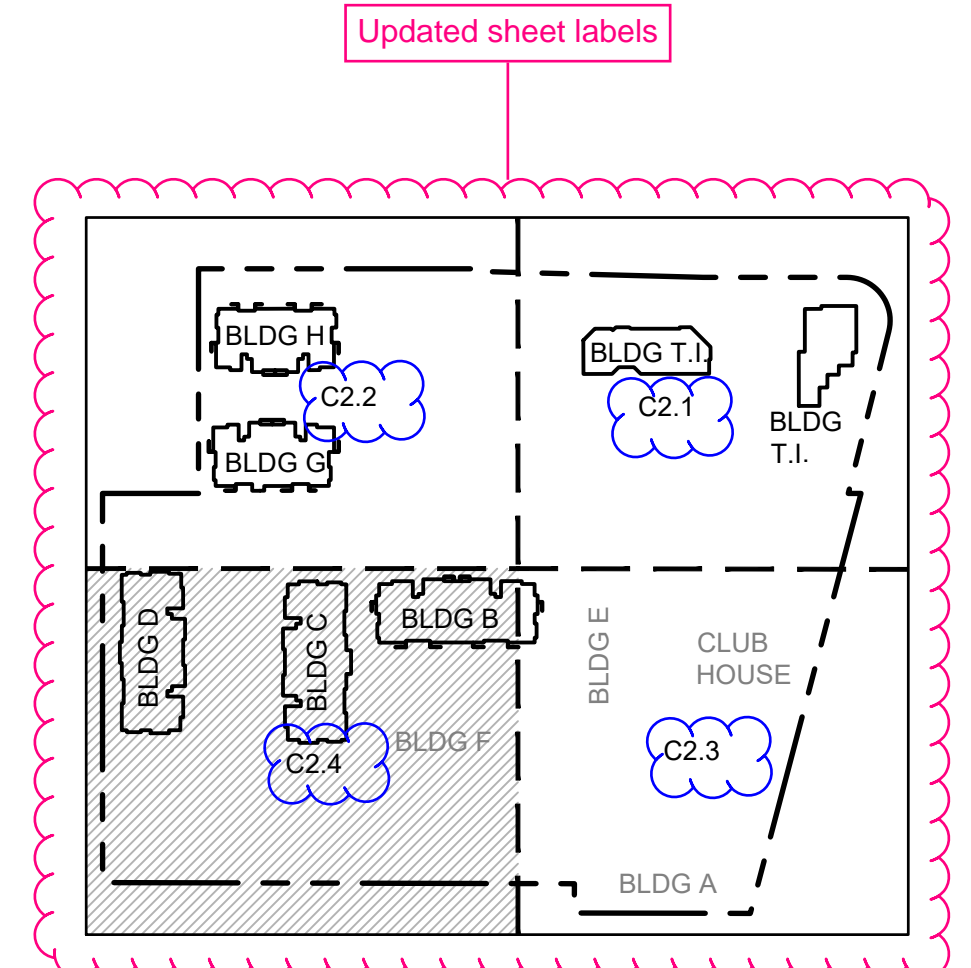

Know what's below.
Call before you dig.

Revisions:

Sheet Title:

GRADING PLAN SE

Designed by: CW Drawn by: SK Checked by: JI

Sheet No.

C3.4

13 of 63 Sheets

EAST TOWN CROSSING PHASE 1


SEC. 26,35/ TWP. 20 N./ RGE. 4 E., W.M.

APPROVED

BY: CITY OF PUYALLUP
DEVELOPMENT ENGINEERING



DATE:

NOTE: THIS APPROVAL IS VOID AFTER 180 DAYS FROM APPROVAL DATE. THE CITY WILL NOT BE RESPONSIBLE FOR ERRORS AND/OR OMISSIONS ON THESE PLANS. FIELD CONDITIONS MAY DICTATE CHANGES TO THESE PLANS AS DETERMINED BY THE DEVELOPMENT ENGINEERING MANAGER.

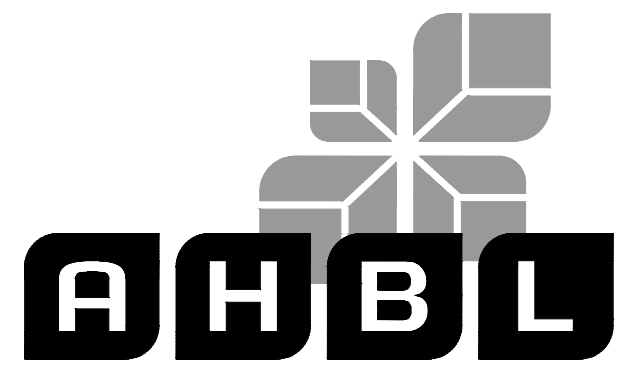

TACOMA • SEATTLE • SPOKANE • TRI-CITIES


2215 North 30th Street, Suite 300, Tacoma, WA 98403
253.383.2422 TEL 253.383.2572 FAX www.ahbl.com WEB

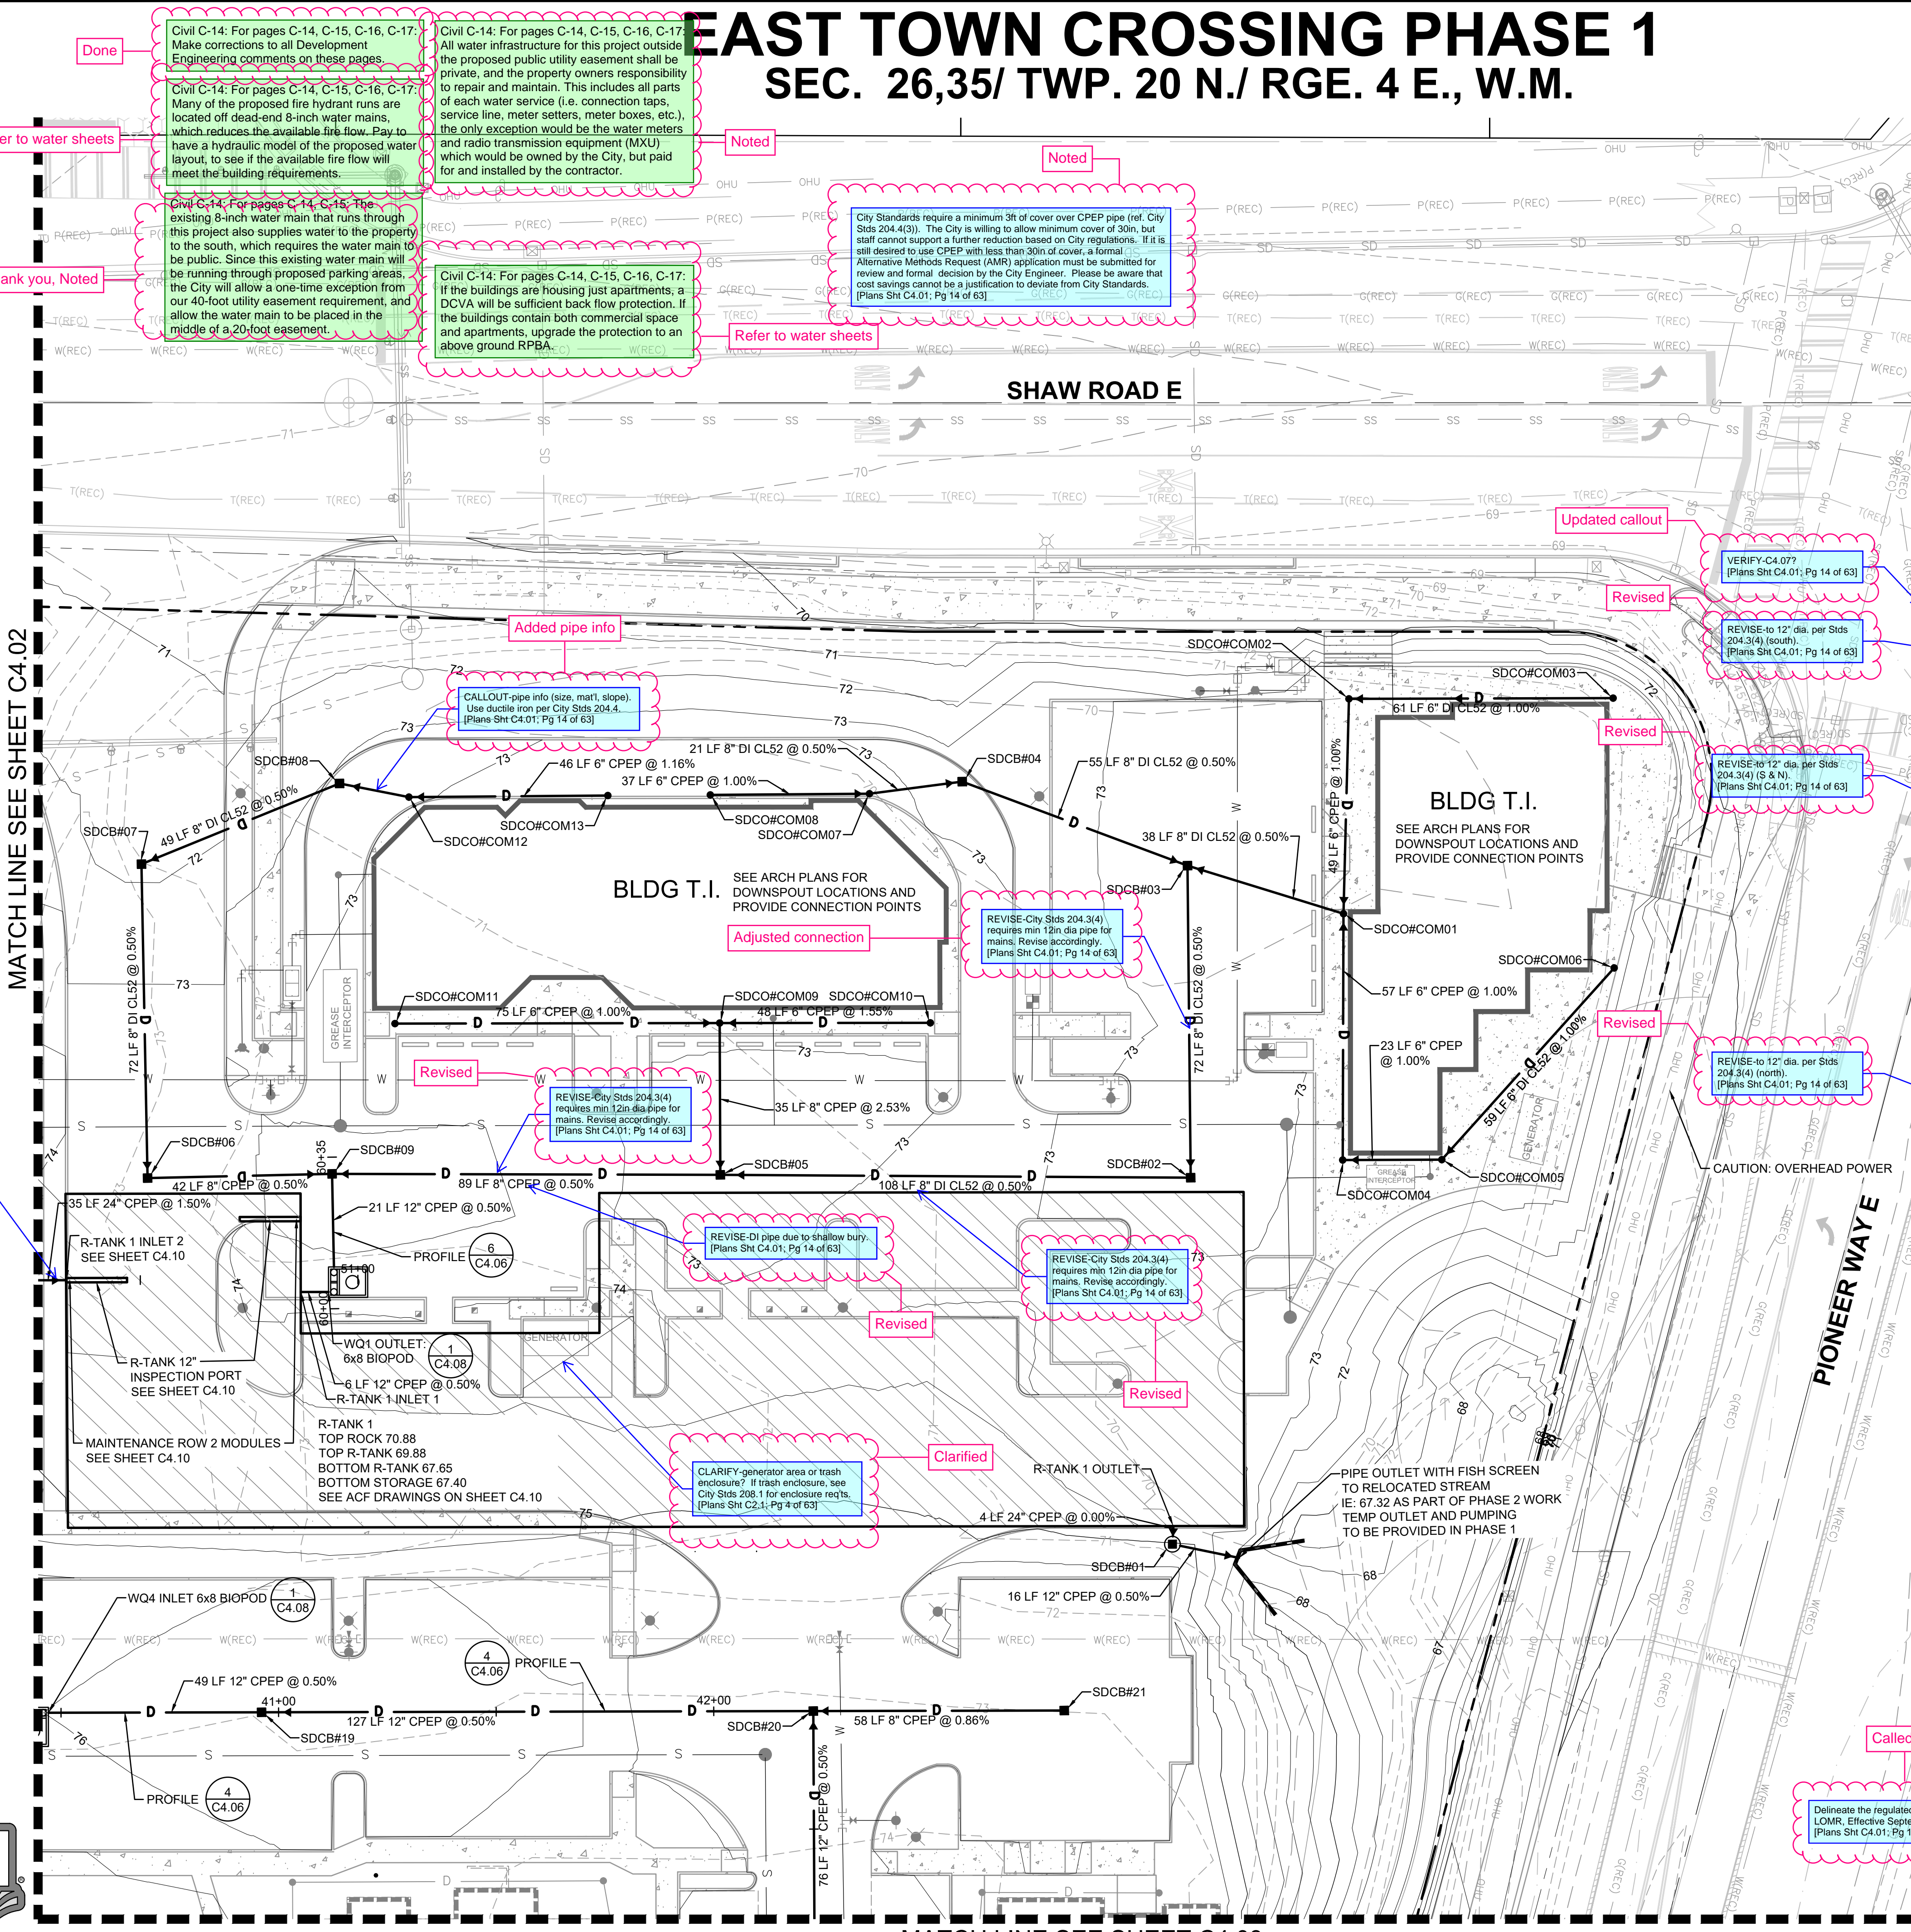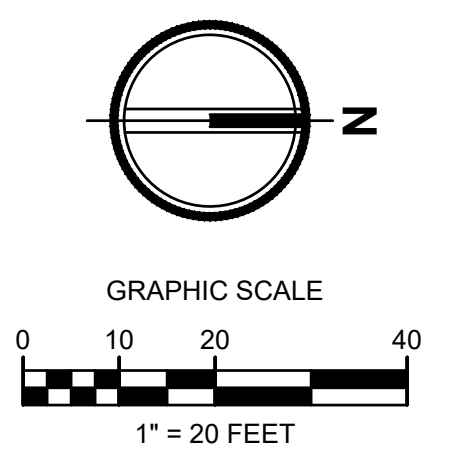

STORM STRUCTURE TABLE		STORM STRUCTURE TABLE	
STRUCTURE NAME	STRUCTURE DETAILS	STRUCTURE NAME	STRUCTURE DETAILS
R-TANK 1 INLET 1 N 679894.35 E 1203965.82	IE = 67.87 (12" N)	SDCO#COM01	RIM = 73.56 IE = 70.38 (8" S) IE = 70.54 (6" E) IE = 70.54 (6" W)
R-TANK 1 INLET 2 N 679840.50 E 1203962.06	IE = 67.87 (24" S)	SDCO#COM02	RIM = 73.51 IE = 71.03 (6" N) IE = 71.03 (6" E)
R-TANK 1 OUTLET N 680093.81 E 1204023.48	IE = 67.40 (24" E)	SDCO#COM03	RIM = 73.53 IE = 71.64 (6" S)
SDCB#01 60" CONTROL STRUCTURE N 680093.51 E 1204027.65	RIM = 75.06 IE = 67.40 (24" W) IE = 67.40 (12" N)	SDCO#COM04	RIM = 73.59 IE = 71.11 (6" N) IE = 71.11 (6" W)
SDCB#02 TYPE 1 N 680099.34 E 1203943.53	RIM = 72.40 IE = 69.83 (8" W) IE = 69.83 (8" S)	SDCO#COM05	RIM = 73.58 IE = 71.34 (6" NW) IE = 71.34 (6" S)
SDCB#03 TYPE 1 N 680100.00 E 1203871.83	RIM = 72.19 IE = 70.19 (8" E) IE = 70.19 (8" N)	SDCO#COM06	RIM = 73.47 IE = 71.93 (6" SE)
SDCB#04 TYPE 1 N 680048.61 E 1203851.51	RIM = 72.64 IE = 70.47 (8" N) IE = 70.47 (8" S)	SDCO#COM07	RIM = 73.18 IE = 70.58 (8" N) IE = 70.74 (6" S)
SDCB#05 TYPE 1 N 679991.28 E 1203940.77	RIM = 72.11 IE = 69.29 (8" S) IE = 69.29 (8" N)	SDCO#COM08	RIM = 73.55 IE = 71.11 (6" N)
SDCB#06 TYPE 1 N 679859.67 E 1203938.96	RIM = 73.03 IE = 69.06 (8" W) IE = 69.06 (8" N)	SDCO#COM09	RIM = 73.63 IE = 70.17 (8" E) IE = 70.34 (6" N) IE = 70.34 (6" S)
SDCB#07 TYPE 1 N 679859.67 E 1203866.80	RIM = 71.79 IE = 69.42 (8" E) IE = 69.42 (8" N)	SDCO#COM10	RIM = 73.63 IE = 71.09 (6" S)
SDCB#08 TYPE 1 N 679905.53 E 1203849.15	RIM = 72.45 IE = 69.67 (8" N) IE = 69.67 (8" S)	SDCO#COM11	RIM = 73.63 IE = 71.09 (6" N)
SDCB#09 TYPE 1 N 679902.08 E 1203938.82	RIM = 72.35 IE = 68.84 (8" S) IE = 68.84 (8" N) IE = 68.51 (12" E)	SDCO#COM12	RIM = 72.88 IE = 70.34 (6" N) IE = 70.17 (8" S)
SDCB#19 TYPE 1 N 679883.48 E 1204062.20	RIM = 75.25 IE = 70.35 (12" S) IE = 70.35 (12" N)	SDCO#COM13	RIM = 73.41 IE = 70.87 (6" S)
SDCB#20 TYPE 1 N 680010.25 E 1204064.38	RIM = 75.25 IE = 71.31 (8" N) IE = 70.98 (12" E)	WQ#4 OUTLET BPU-681B N 679827.49 E 1204061.23	IE = 69.60 (12" S)
SDCB#21 TYPE 1 N 680067.90 E 1204065.38	RIM = 75.25 IE = 71.81 (8" S)	WQ1 OUTLET BPU-681B N 679900.73 E 1203965.93	IE = 67.90 (12" S)

GENERAL NOTE

- SEE DETAILS AS NOTED ON SHEET C4.05
- FOR CATCH BASIN TYPE 1
- AREA DRAIN SEE DETAIL 1
- GUTTER DRAIN SEE DETAIL 2
- FOR CATCH BASIN TYPE II SEE DETAIL 3
- FORM SEWER MANHOLE SEE DETAIL 7

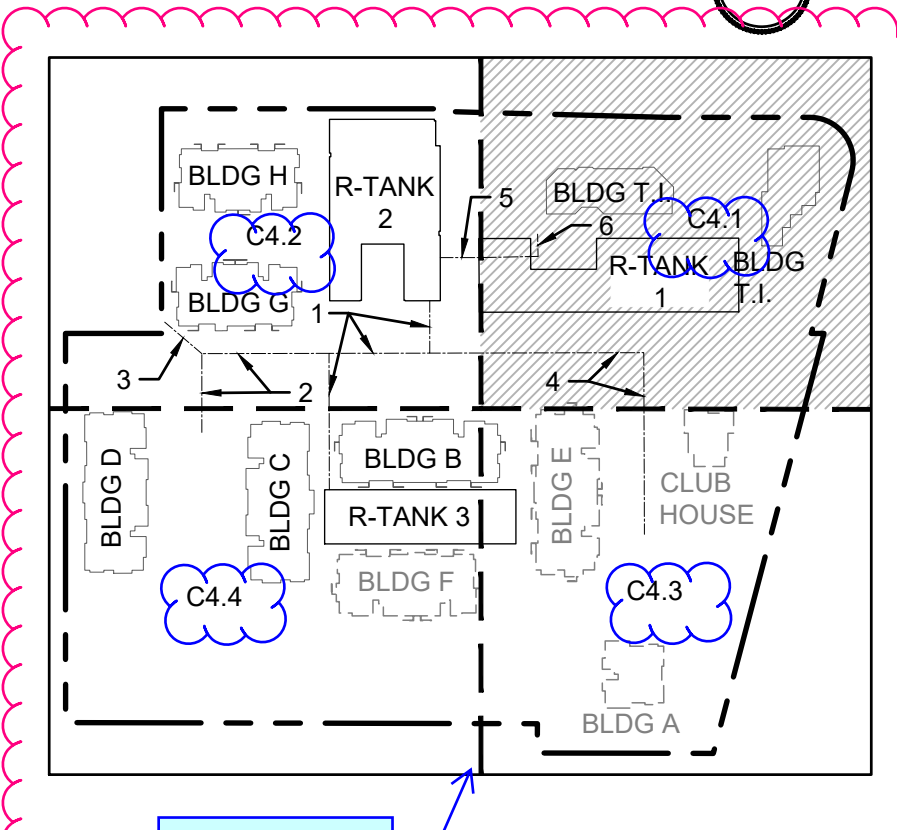

MATCH LINE SEE SHEET C4.02

MATCH LINE SEE SHEET C4.03

Verified
VERIFY-Profile 5/CA.06 (and 6/C4.06)?
[Plans Sht C4.01; Pg 14 of 63]

Done
Civil C-14: For pages C-14, C-15, C-16, C-17. Make corrections to all Development Engineering comments on these pages.
Civil C-14: For pages C-14, C-15, C-16, C-17. Many of the proposed fire hydrant runs are located off dead-end 8-inch water mains, which reduces the available fire flow. Pay to have a hydraulic model of the proposed water layout, to see if the available fire flow will meet the building requirements.
Civil C-14: For pages C-14, C-15. The existing 8-inch water main that runs through this project also supplies water to the property to the south, which requires the water main to be public. Since this existing water main will be running through proposed parking areas, the City will allow a one-time exception from our 40-foot utility easement requirement, and allow the water main to be placed in the middle of a 20-foot easement.

Noted
Civil C-14: For pages C-14, C-15, C-16, C-17. All water infrastructure for this project outside the proposed public utility easement shall be private, and the property owners responsibility to repair and maintain. This includes all parts of each water service (i.e. connection taps, service line, meter setters, meter boxes, etc.), the only exception would be the water meters and radio transmission equipment (MXU) which would be owned by the City, but paid for and installed by the contractor.

Noted
City Standards require a minimum 3ft of cover over CPEP pipe (ref. City Shts 204.4(3)). The City is willing to allow minimum cover of 30in, but still cannot support a further reduction based on City regulations. If it is still desired to use CPEP with less than 30in of cover, a formal Alternative Methods Request (AMR) application must be submitted for review and formal decision by the City Engineer. Please be aware that cost savings cannot be a justification to deviate from City Standards. [Plans Sht C4.01; Pg 14 of 63]

Noted
Civil C-14: For pages C-14, C-15, C-16, C-17. If the buildings are housing just apartments, a DCVA will be sufficient back flow protection. If the buildings contain both commercial space and apartments, upgrade the protection to an above ground RPBA.


Project Title:
EAST TOWN CROSSING PHASE 1

Client:
ASH DEVELOPMENT

GREG HELLE
GREG.HELLE@ASHNW.COM

Project No.
2230752

Issue Set & Date:
PERMIT SUBMITTAL
11/20/2023

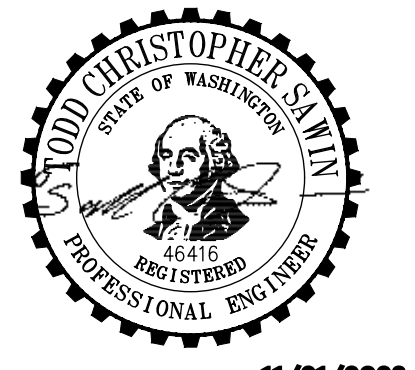

11/21/2023

NOTICE
ALTERNATION OF THIS DOCUMENT SHALL INDICATE THE PROFESSIONAL SEAL AND SIGNATURE PRECEDING THE DOCUMENT TITLE IS THE ORIGINAL AND RESERVED ONLY FOR THE PROJECT ENGINEER IN THE TITLE BLOCK AND IS NOT TO BE USED FOR ANY OTHER PROJECT.

Info on detail sheet, removed from this sheet

ADD-WQ Rim and inlet elevation info.
[Plans Sht C4.01; Pg 14 of 63]

Updated sheet callout
VERIFY-Sheet callout (C4.07)?
[Plans Sht C4.01; Pg 14 of 63]

Called out
Delineate the regulated floodplain per the LOMR, Effective September 8, 2022.
[Plans Sht C4.01; Pg 14 of 63]

Updated sheet labels



Know what's below.
Call before you dig.

Sheet Title:
STORM DRAINAGE PLAN NW

Designed by: CW
Drawn by: SK
Checked by: JI

Sheet No.

C4.01

14 of 63 Sheets


EAST TOWN CROSSING PHASE 1

SEC. 26,35/ TWP. 20 N./ RGE. 4 E., W.M.

APPROVED

BY: CITY OF PUYALLUP
DEVELOPMENT ENGINEERING
DATE:

NOTE: THIS APPROVAL IS VOID AFTER 180 DAYS FROM APPROVAL DATE. THE CITY WILL NOT BE RESPONSIBLE FOR ERRORS AND/OR OMISSIONS ON THESE PLANS. FIELD CONDITIONS MAY DICTATE CHANGES TO THESE PLANS AS DETERMINED BY THE DEVELOPMENT ENGINEERING MANAGER.

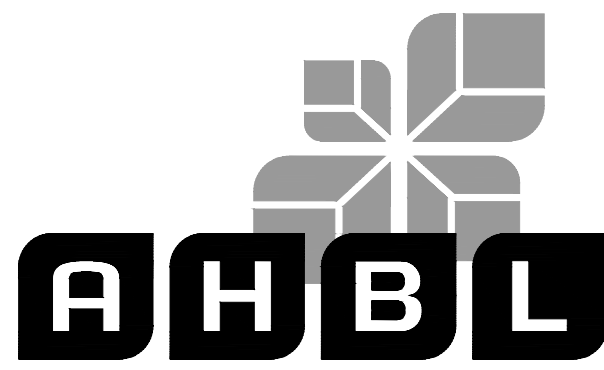

TACOMA • SEATTLE • SPOKANE • TRI-CITIES

2215 North 30th Street, Suite 300, Tacoma, WA 98403
253.383.2422 TEL 253.383.2572 FAX www.ahbl.com WEB

Project Title:

EAST TOWN CROSSING PHASE 1

Client:

ASH DEVELOPMENT

GREG HELLE

GREG.HELLE@ASHNW.COM

Project No.

2230752

Issue Set & Date:


PERMIT SUBMITTAL

11/20/2023



11/21/2023


NOTICE: A SIGNATURE OF THIS DOCUMENT SHALL VALIDATE THE PROFESSIONAL SEAL AND SIGNATURE. PREPARATION OF THIS DOCUMENT DOES NOT GUARANTEE, REPRESENT OR WARRANT ANYTHING. THE DRAWING IS FOR PERMITS ONLY FOR THE PROJECT DESCRIBED IN THE TITLE BLOCK AND IS NOT TO BE USED FOR OTHER PURPOSES OR ADDED TO THAT PROJECT OR FOR ANY OTHER PROJECT.

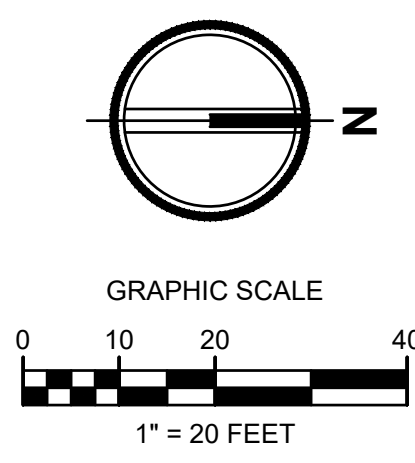

GENERAL NOTE


SEE DETAILS AS NOTED ON SHEET C4.05
-FOR CATCH BASIN TYPE 1
- (AREA DRAIN) SEE DETAIL 1
- (GUTTER DRAIN) SEE DETAIL 2
-FOR CATCH BASIN TYPE II SEE DETAIL 3
-STORM SEWER MANHOLE SEE DETAIL 7

STRUCTURE NAME	STRUCTURE DETAILS	STRUCTURE NAME	STRUCTURE DETAILS
R-TANK 2 INLET 1	N 679799.41 E 1203935.82 IE = 68.87 (12" N)	SDCB#28 TYPE 1 N 679427.04 E 1204054.32	RIM = 75.25 IE = 72.15 (8" N) IE = 72.15 (8" E)
R-TANK 2 INLET 2	N 679698.36 E 1203851.96 IE = 68.87 (12" S)	SDCB#40 TYPE 1 N 679510.96 E 1204021.83	RIM = 76.44 IE = 73.22 (12" NE) IE = 74.00 (6" W)
R-TANK 2 INLET 3	N 679788.42 E 1204006.00 IE = 68.40 (24" E)	SDCO#D6	RIM = 77.33 IE = 74.79 (6" NE)
R-TANK 2 OUTLET	N 679800.23 E 1203961.30 IE = 68.40 (24" N)	SDCO#G1	RIM = 77.07 IE = 73.22 (6" S) IE = 73.29 (6" NE)
SDCB#10 60" CONTROL STRUCTURE	RIM = 76.96 N 679805.23 E 1203961.40 IE = 68.40 (24" S) IE = 68.40 (24" N)	SDCO#G2	RIM = 77.01 IE = 74.47 (6" N)
SDCB#11 TYPE 1	RIM = 76.58 N 679815.72 E 1203936.19 IE = 73.48 (8" W) IE = 73.48 (8" E) IE = 73.48 (8" S)	SDCO#G3	RIM = 77.15 IE = 73.06 (6" S) IE = 72.89 (8" NW)
SDCB#12 TYPE 1	RIM = 76.54 N 679814.62 E 1204000.39 IE = 73.83 (8" W)	SDCO#G4	RIM = 76.85 IE = 74.22 (6" N)
SDCB#13 TYPE 1	RIM = 76.58 N 679817.30 E 1203858.20 IE = 73.87 (8" E)	SDCO#H1	RIM = 77.10 IE = 72.93 (6" S) IE = 72.76 (8" NE)
SDCB#14 TYPE 1	RIM = 76.31 N 679664.39 E 1203894.46 IE = 71.89 (12" W) IE = 72.22 (8" SW) IE = 71.89 (12" E)	SDCO#H2	RIM = 77.02 IE = 73.13 (6" S) IE = 73.13 (6" N)
SDCB#15 TYPE 1	RIM = 76.25 N 679668.39 E 1203851.68 IE = 71.68 (12" E) IE = 72.18 (6" SW) IE = 71.68 (12" N)	SDCO#H3	RIM = 76.74 IE = 74.20 (6" N)
SDCB#16 TYPE 1	RIM = 76.36 N 679663.04 E 1203961.97 IE = 72.57 (8" E) IE = 72.23 (12" W) IE = 72.73 (6" SW)	SDCO#H4	RIM = 77.00 IE = 72.79 (6" SW) IE = 72.79 (6" NE)
SDCB#17 TYPE 1	RIM = 76.55 N 679662.59 E 1203998.62 IE = 72.75 (8" SE)	SDCO#H5	RIM = 75.70 IE = 72.94 (6" S) IE = 72.94 (6" NE)
SDCB#18 48" TYPE 2	RIM = 76.69 N 679787.40 E 1204060.54 IE = 69.40 (12" N) IE = 69.73 (8" E) IE = 68.40 (24" S) IE = 68.40 (24" W)	SDCO#H6	RIM = 76.59 IE = 74.06 (6" N)
SDCB#26 48" TYPE 2	RIM = 76.79 N 679682.46 E 1204058.73 IE = 69.40 (12" S) IE = 68.40 (24" E) IE = 68.40 (24" N)	WQ#2 INLET BPU-461B N 679810.02 E 1203936.05	IE = 72.83 (8" N)
SDCB#27 TYPE 1	RIM = 75.25 N 679550.01 E 1204056.45 IE = 71.54 (8" S) IE = 71.20 (12" SW) IE = 71.20 (12" E)	WQ#3 INLET 6x8 BIOPOD N 679675.06 E 1203851.68	IE = 71.65 (12" S)

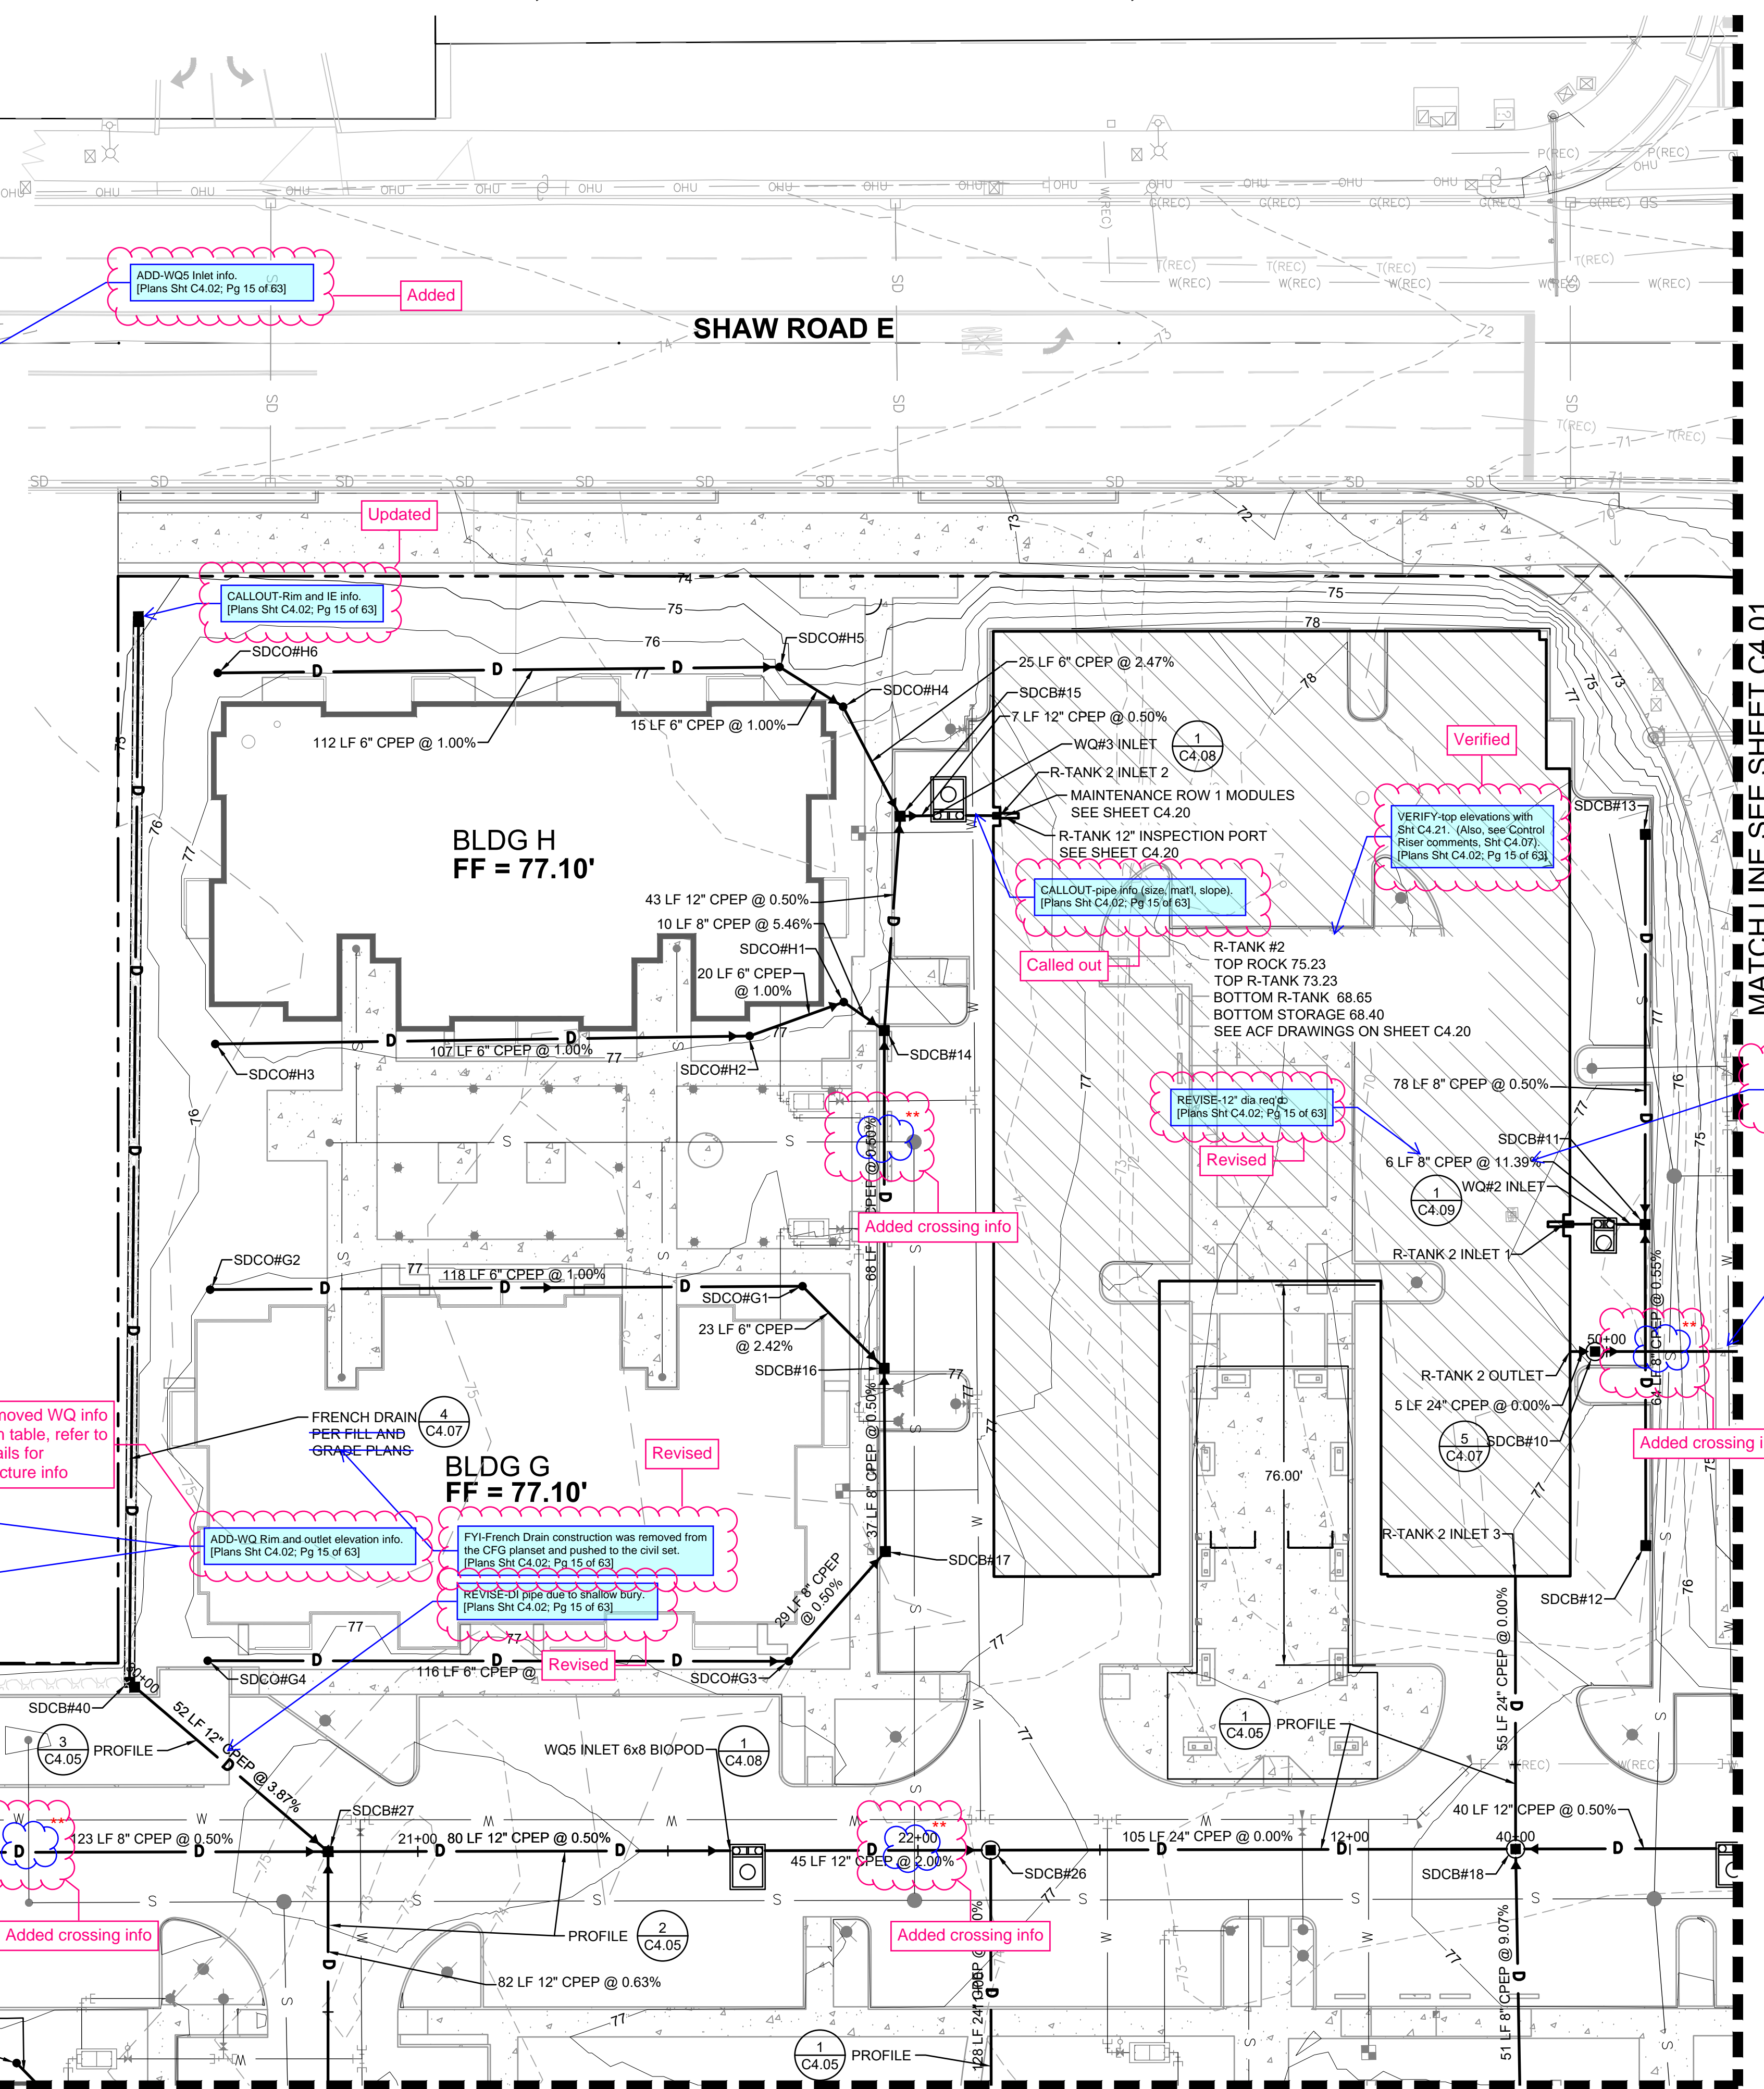

MATCH LINE SEE SHEET C4.01

MATCH LINE SEE SHEET C4.04

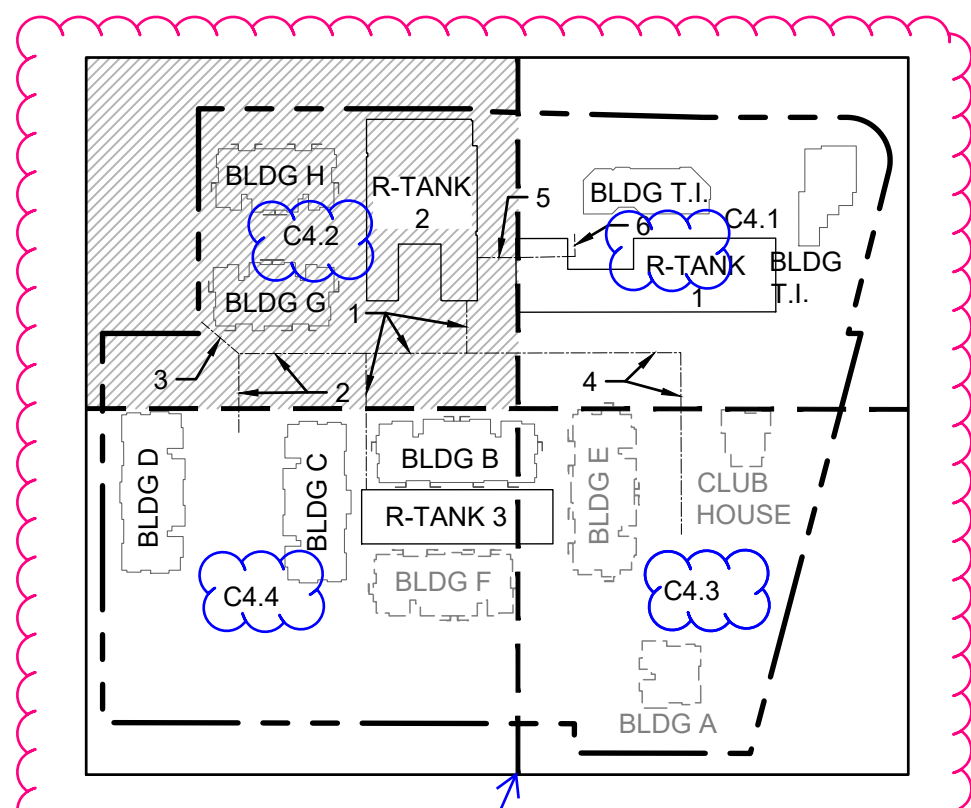

VERIFY-C4.07? [Plans Sht C4.02; Pg 15 of 63]
Updated callout

Updated

VERIFY-Solid locking lid for WQ purposes? [Plans Sht C4.02; Pg 15 of 63]

Removed WQ info from table, refer to details for structure info

ADD-WQ Rim and outlet elevation info. [Plans Sht C4.02; Pg 15 of 63]

FYI-French Drain construction was removed from the CFG planset and pushed to the civil set. [Plans Sht C4.02; Pg 15 of 63]

REVISE-D1 pipe due to shallow bury. [Plans Sht C4.02; Pg 15 of 63]

CALLOUT-pipe info (size, mat'l, slope). [Plans Sht C4.02; Pg 15 of 63]

VERIFY-Top elevations with Sht C4.21. (Also, see Control Riser comments, Sht C4.07). [Plans Sht C4.02; Pg 15 of 63]

VERIFY-pipe slope w/ IEs. [Plans Sht C4.02; Pg 15 of 63]

VERIFY-Profile 5/C4.06 (and 6/C4.06)? [Plans Sht C4.02; Pg 15 of 63]

Updated sheet labels



Know what's below.
Call before you dig.

Revisions:

Sheet Title:

STORM DRAINAGE PLAN SW

Designed by: CW
Drawn by: SK
Checked by: JI

Sheet No.

C4.02



15 of 63 Sheets

EAST TOWN CROSSING PHASE 1

SEC. 26,35/ TWP. 20 N./ RGE. 4 E., W.M.

APPROVED

BY: CITY OF PUYALLUP
DEVELOPMENT ENGINEERING
DATE:

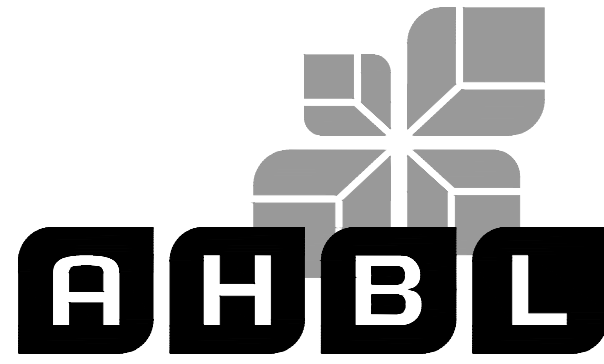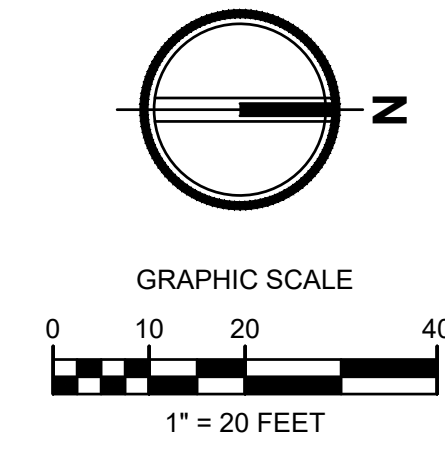

TACOMA • SEATTLE • SPOKANE • TRI-CITIES
2215 North 30th Street, Suite 300, Tacoma, WA 98403
253.383.2422 TEL 253.383.2572 FAX www.ahbl.com WEB

Project Title:

**EAST TOWN
CROSSING PHASE 1**

Client:

ASH DEVELOPMENT

GREG HELLE

GREG.HELLE@ASHNW.COM

Project No.

2230752

Issue Set & Date:

PERMIT SUBMITTAL


11/20/2023



11/21/2023

NOTICE
A REVISION OF THIS DOCUMENT SHALL VALIDATE THE
PROFESSIONAL SEAL AND SIGNATURE PUBLICATION OF
THE DOCUMENT DOES NOT REPRESENT THE REVISED
OR CORRECTED PROJECT. IT IS THE OWNER'S OBLIGATION
ONLY FOR THE PROJECT EXPRESSED IN THE TITLE BLOCK
AND NOT TO BE USED FOR OTHER, PARTIAL, OR
ACTION TO THAT PROJECT OR FOR ANY OTHER PROJECT.

MATCH LINE SEE SHEET C4.01

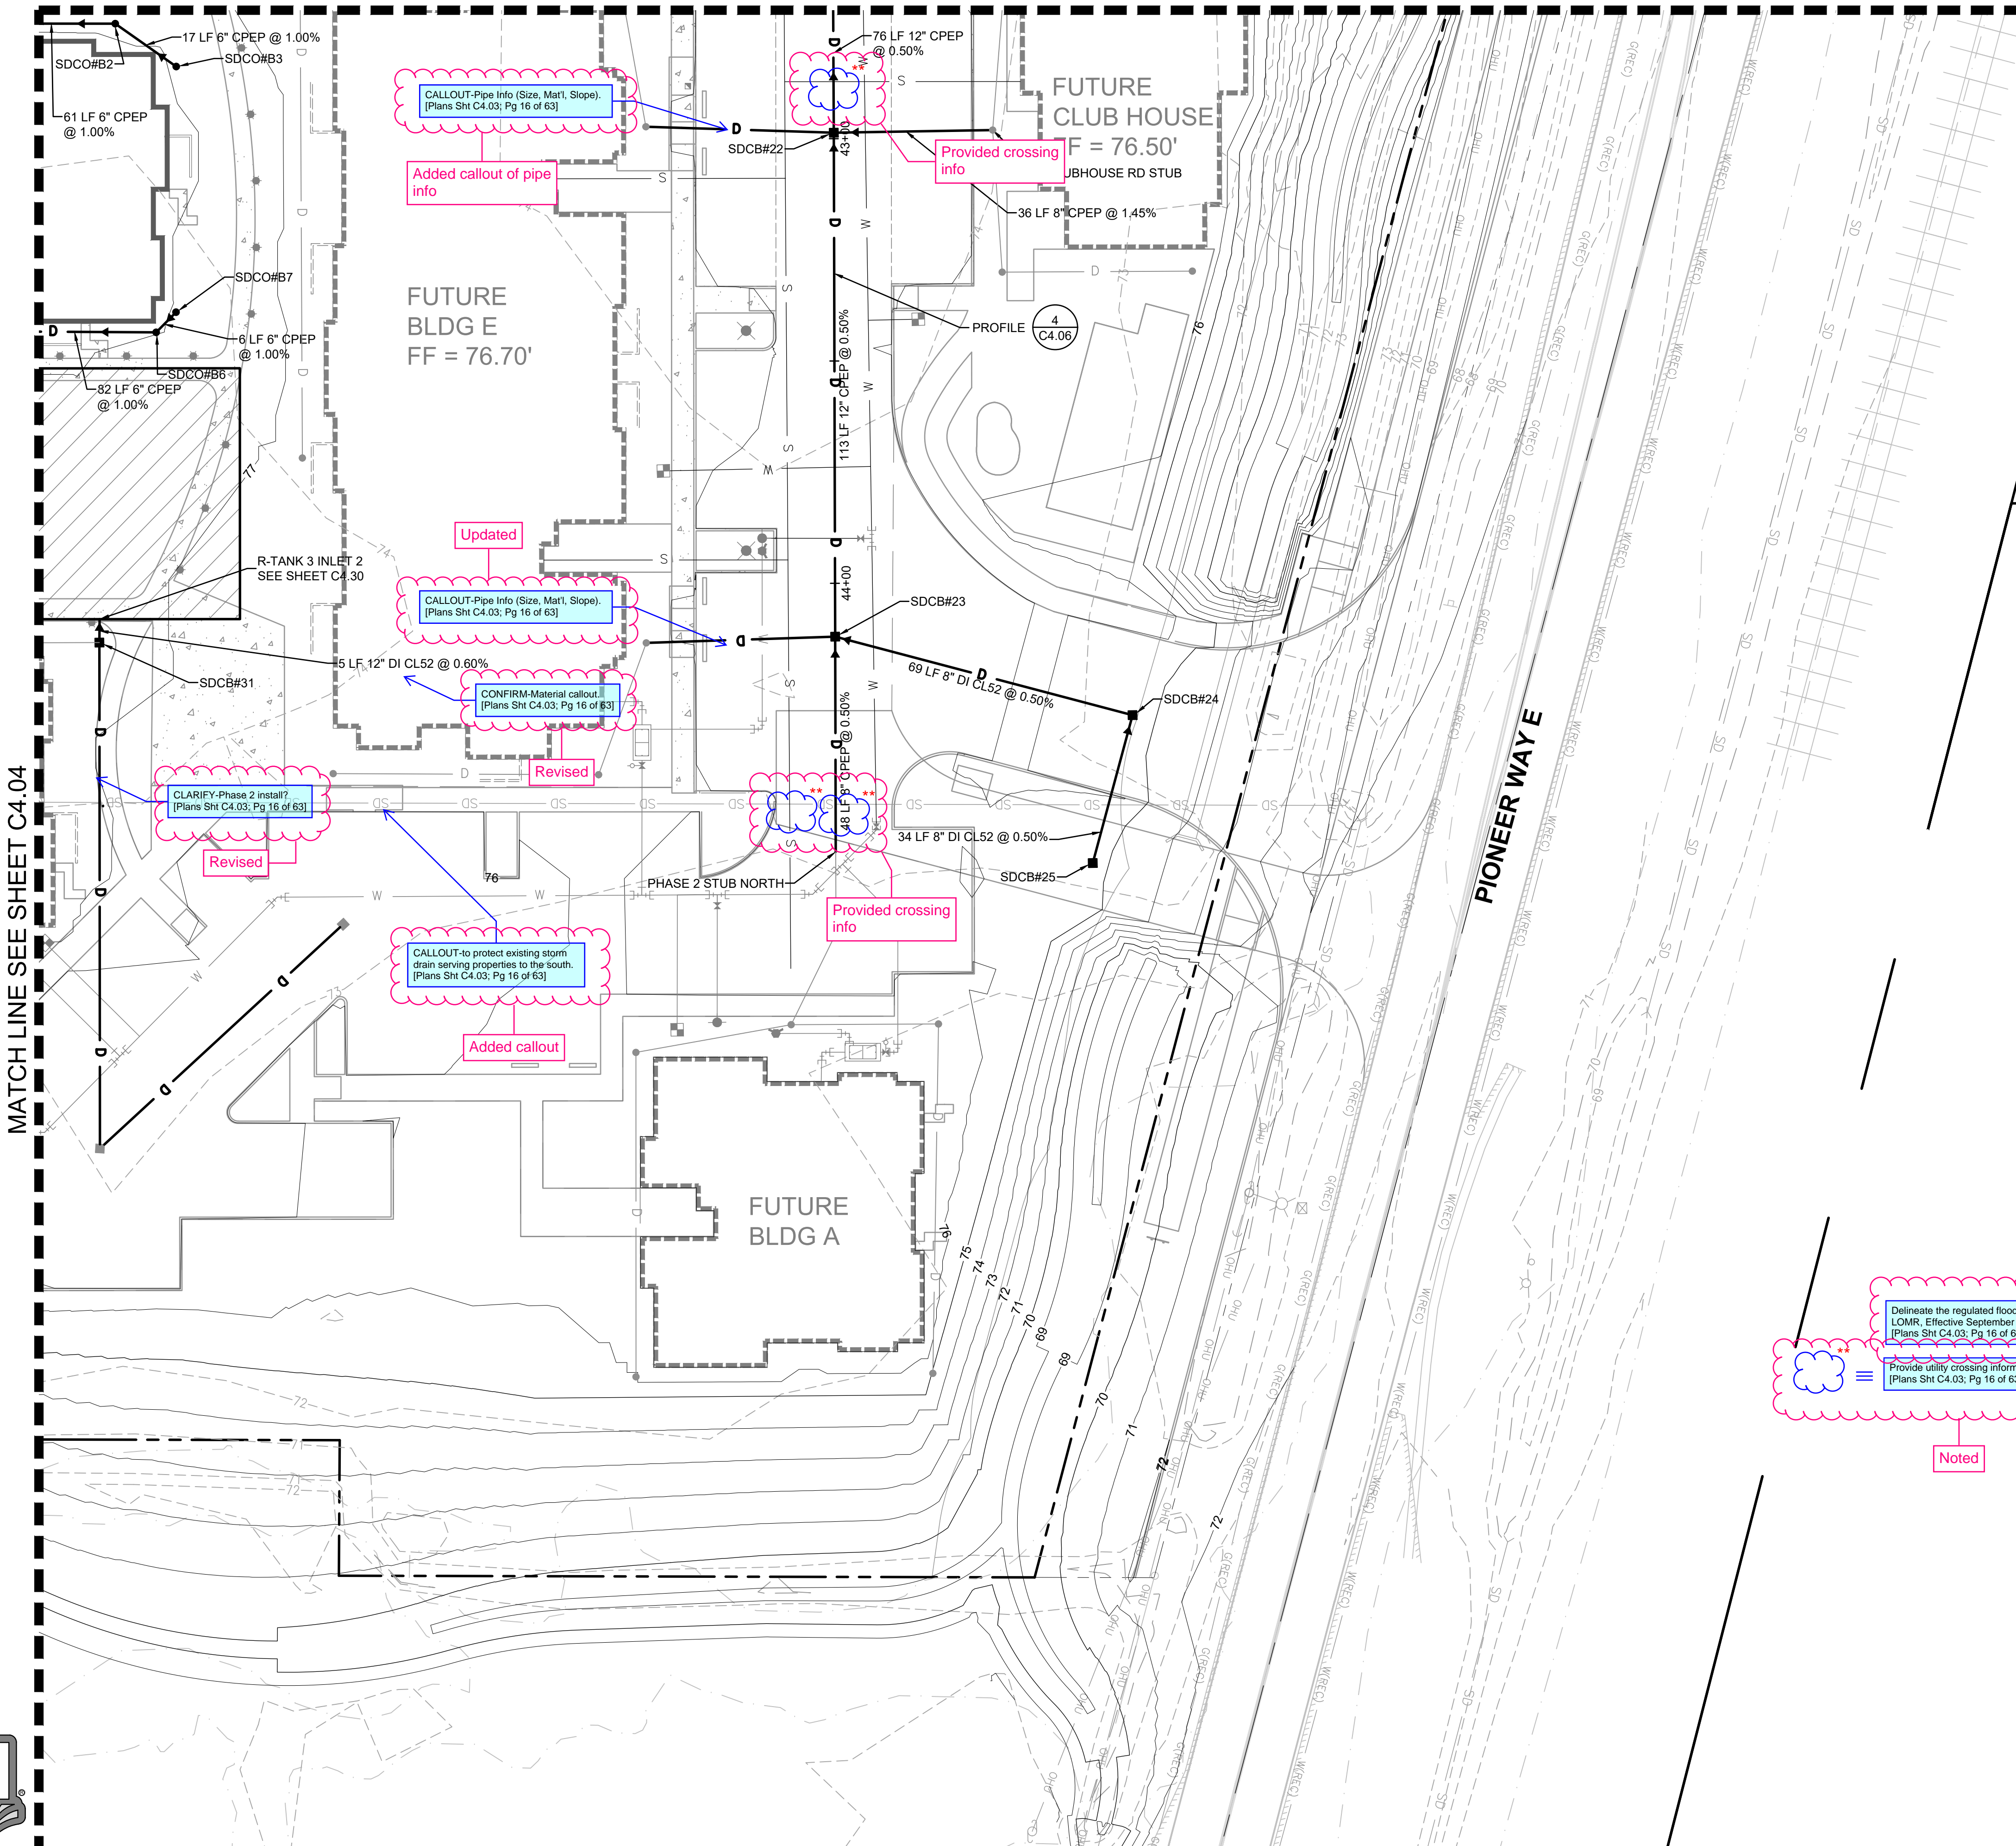

STORM STRUCTURE TABLE	
STRUCTURE NAME	STRUCTURE DETAILS
R-TANK 3 INLET 2 N 679841.90 E 1204246.34	IE = 70.22 (12" E)
SDCB#22 TYPE 1 N 680009.17 E 1204140.15	RIM = 75.25 IE = 71.36 (12" E) IE = 71.36 (12" W) IE = 71.69 (8" N) IE = 71.69 (8" S)
SDCB#23 TYPE 1 N 680007.27 E 1204253.48	RIM = 75.25 IE = 71.93 (12" W) IE = 72.26 (8" N) IE = 72.26 (8" E) IE = 72.26 (8" S)
SDCB#24 TYPE 1 W/ SOLID LOCKING LID N 680073.82 E 1204272.43	RIM = 75.25 IE = 72.61 (8" E) IE = 72.61 (8" S)
SDCB#25 TYPE 1 N 680064.22 E 1204305.52	RIM = 75.25 IE = 72.79 (8" W)
SDCB#31 AREA DRAIN N 679841.75 E 1204251.59	RIM = 77.16 IE = 70.25 (12" W)
SDCO#B2 N 679848.03 E 1204112.49	RIM = 77.80 IE = 75.11 (6" NE) IE = 75.11 (6" S)
SDCO#B3 N 679861.56 E 1204122.40	RIM = 77.92 IE = 75.28 (6" SW)
SDCO#B6 N 679855.88 E 1204182.08	RIM = 78.02 IE = 72.81 (6" S) IE = 72.81 (6" NW)
SDCO#B7 N 679860.43 E 1204177.64	RIM = 77.95 IE = 72.87 (6" SE)

GENERAL NOTE


- SEE DETAILS AS NOTED ON SHEET C4.03
- FOR CATCH BASIN TYPE 1
-(AREA DRAIN) SEE DETAIL 1
-(GUTTER DRAIN) SEE DETAIL 2
- FOR CATCH BASIN TYPE II SEE DETAIL 3
- STORM SEWER MANHOLE SEE DETAIL 7

Delineate the regulated floodplain per the LOMR, Effective September 8, 2022. [Plans Sht C4.03; Pg 16 of 63]

Provide utility crossing information [Plans Sht C4.03; Pg 16 of 63]

Called out

Noted

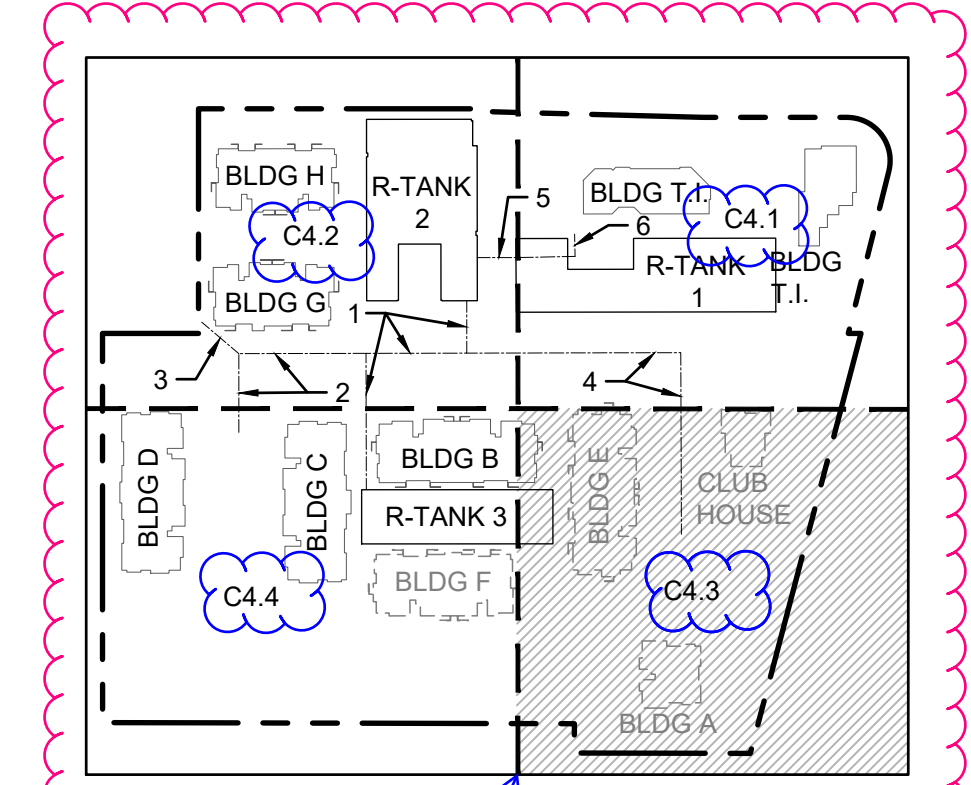

VERIFY-Sheet callout (C4.07). [Plans Sht C4.03; Pg 16 of 63]

Updated sheet callout

CALLOUT-Pipe Info (Size, Mat'l, Slope). [Plans Sht C4.03; Pg 16 of 63]

Added callout of pipe info

Provided crossing info

Updated
CALLOUT-Pipe Info (Size, Mat'l, Slope). [Plans Sht C4.03; Pg 16 of 63]

CONFIRM-Material callout. [Plans Sht C4.03; Pg 16 of 63]

Revised

CLARIFY-Phase 2 install? [Plans Sht C4.03; Pg 16 of 63]

Revised

CALLOUT-to protect existing storm drain serving properties to the south. [Plans Sht C4.03; Pg 16 of 63]

Added callout

Provided crossing info



- Revisions:

Sheet Title:

**STORM
DRAINAGE
PLAN NE**

Designed by: CW Drawn by: SK Checked by: JI

Sheet No.

C4.03

16 of 63 Sheets

Updated sheet labels



EAST TOWN CROSSING PHASE 1

SEC. 26,35/ TWP. 20 N./ RGE. 4 E., W.M.

APPROVED

BY: CITY OF PUYALLUP
DEVELOPMENT ENGINEERING
DATE:

NOTE: THIS APPROVAL IS VOID AFTER 180 DAYS FROM APPROVAL DATE. THE CITY WILL NOT BE RESPONSIBLE FOR ERRORS AND/OR OMISSIONS ON THESE PLANS. FIELD CONDITIONS MAY DICTATE CHANGES TO THESE PLANS AS DETERMINED BY THE DEVELOPMENT ENGINEERING MANAGER.

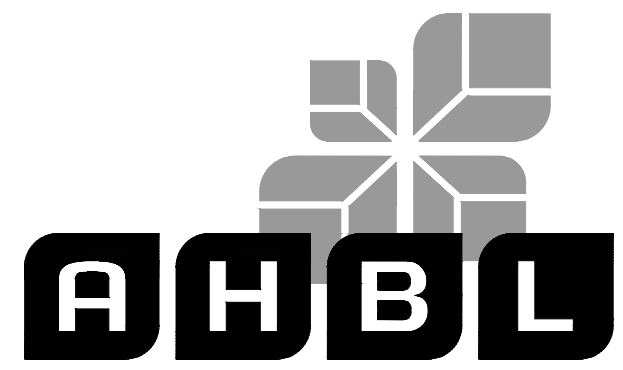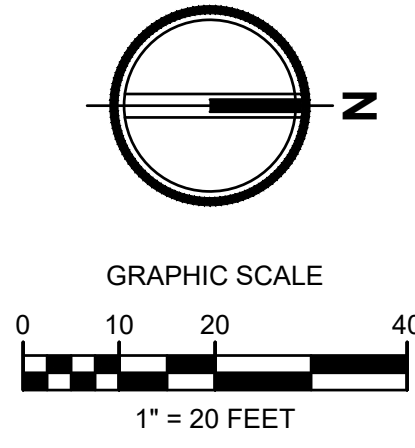


TACOMA • SEATTLE • SPOKANE • TRI-CITIES
2215 North 30th Street, Suite 300, Tacoma, WA 98403
253.383.2422 TEL 253.383.2572 FAX www.ahbl.com WEB

Project Title:
EAST TOWN CROSSING PHASE 1

Client:
ASH DEVELOPMENT
GREG HELLE
GREG.HELLE@ASHNW.COM


Project No.
2230752

Issue Set & Date:
PERMIT SUBMITTAL
11/20/2023

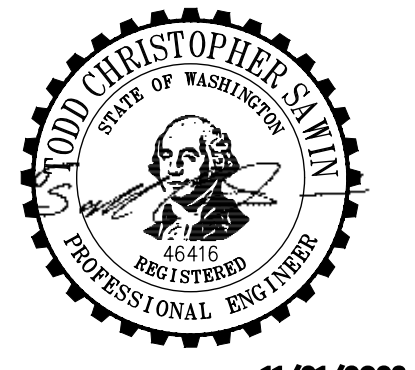

11/21/2023

NOTICE: ALTERATION OF THIS DOCUMENT SHALL INVALIDATE THE PROFESSIONAL SEAL AND SIGNATURE. PUBLICATION OF THIS DOCUMENT DOES NOT CONSTITUTE AN ENDORSEMENT OR GUARANTEE BY THE ENGINEER OR ARCHITECT. THE ENGINEER OR ARCHITECT IS NOT TO BE HELD RESPONSIBLE FOR ANY ERRORS OR OMISSIONS IN THIS BLOCK OR FOR ANY OTHER PROJECT.

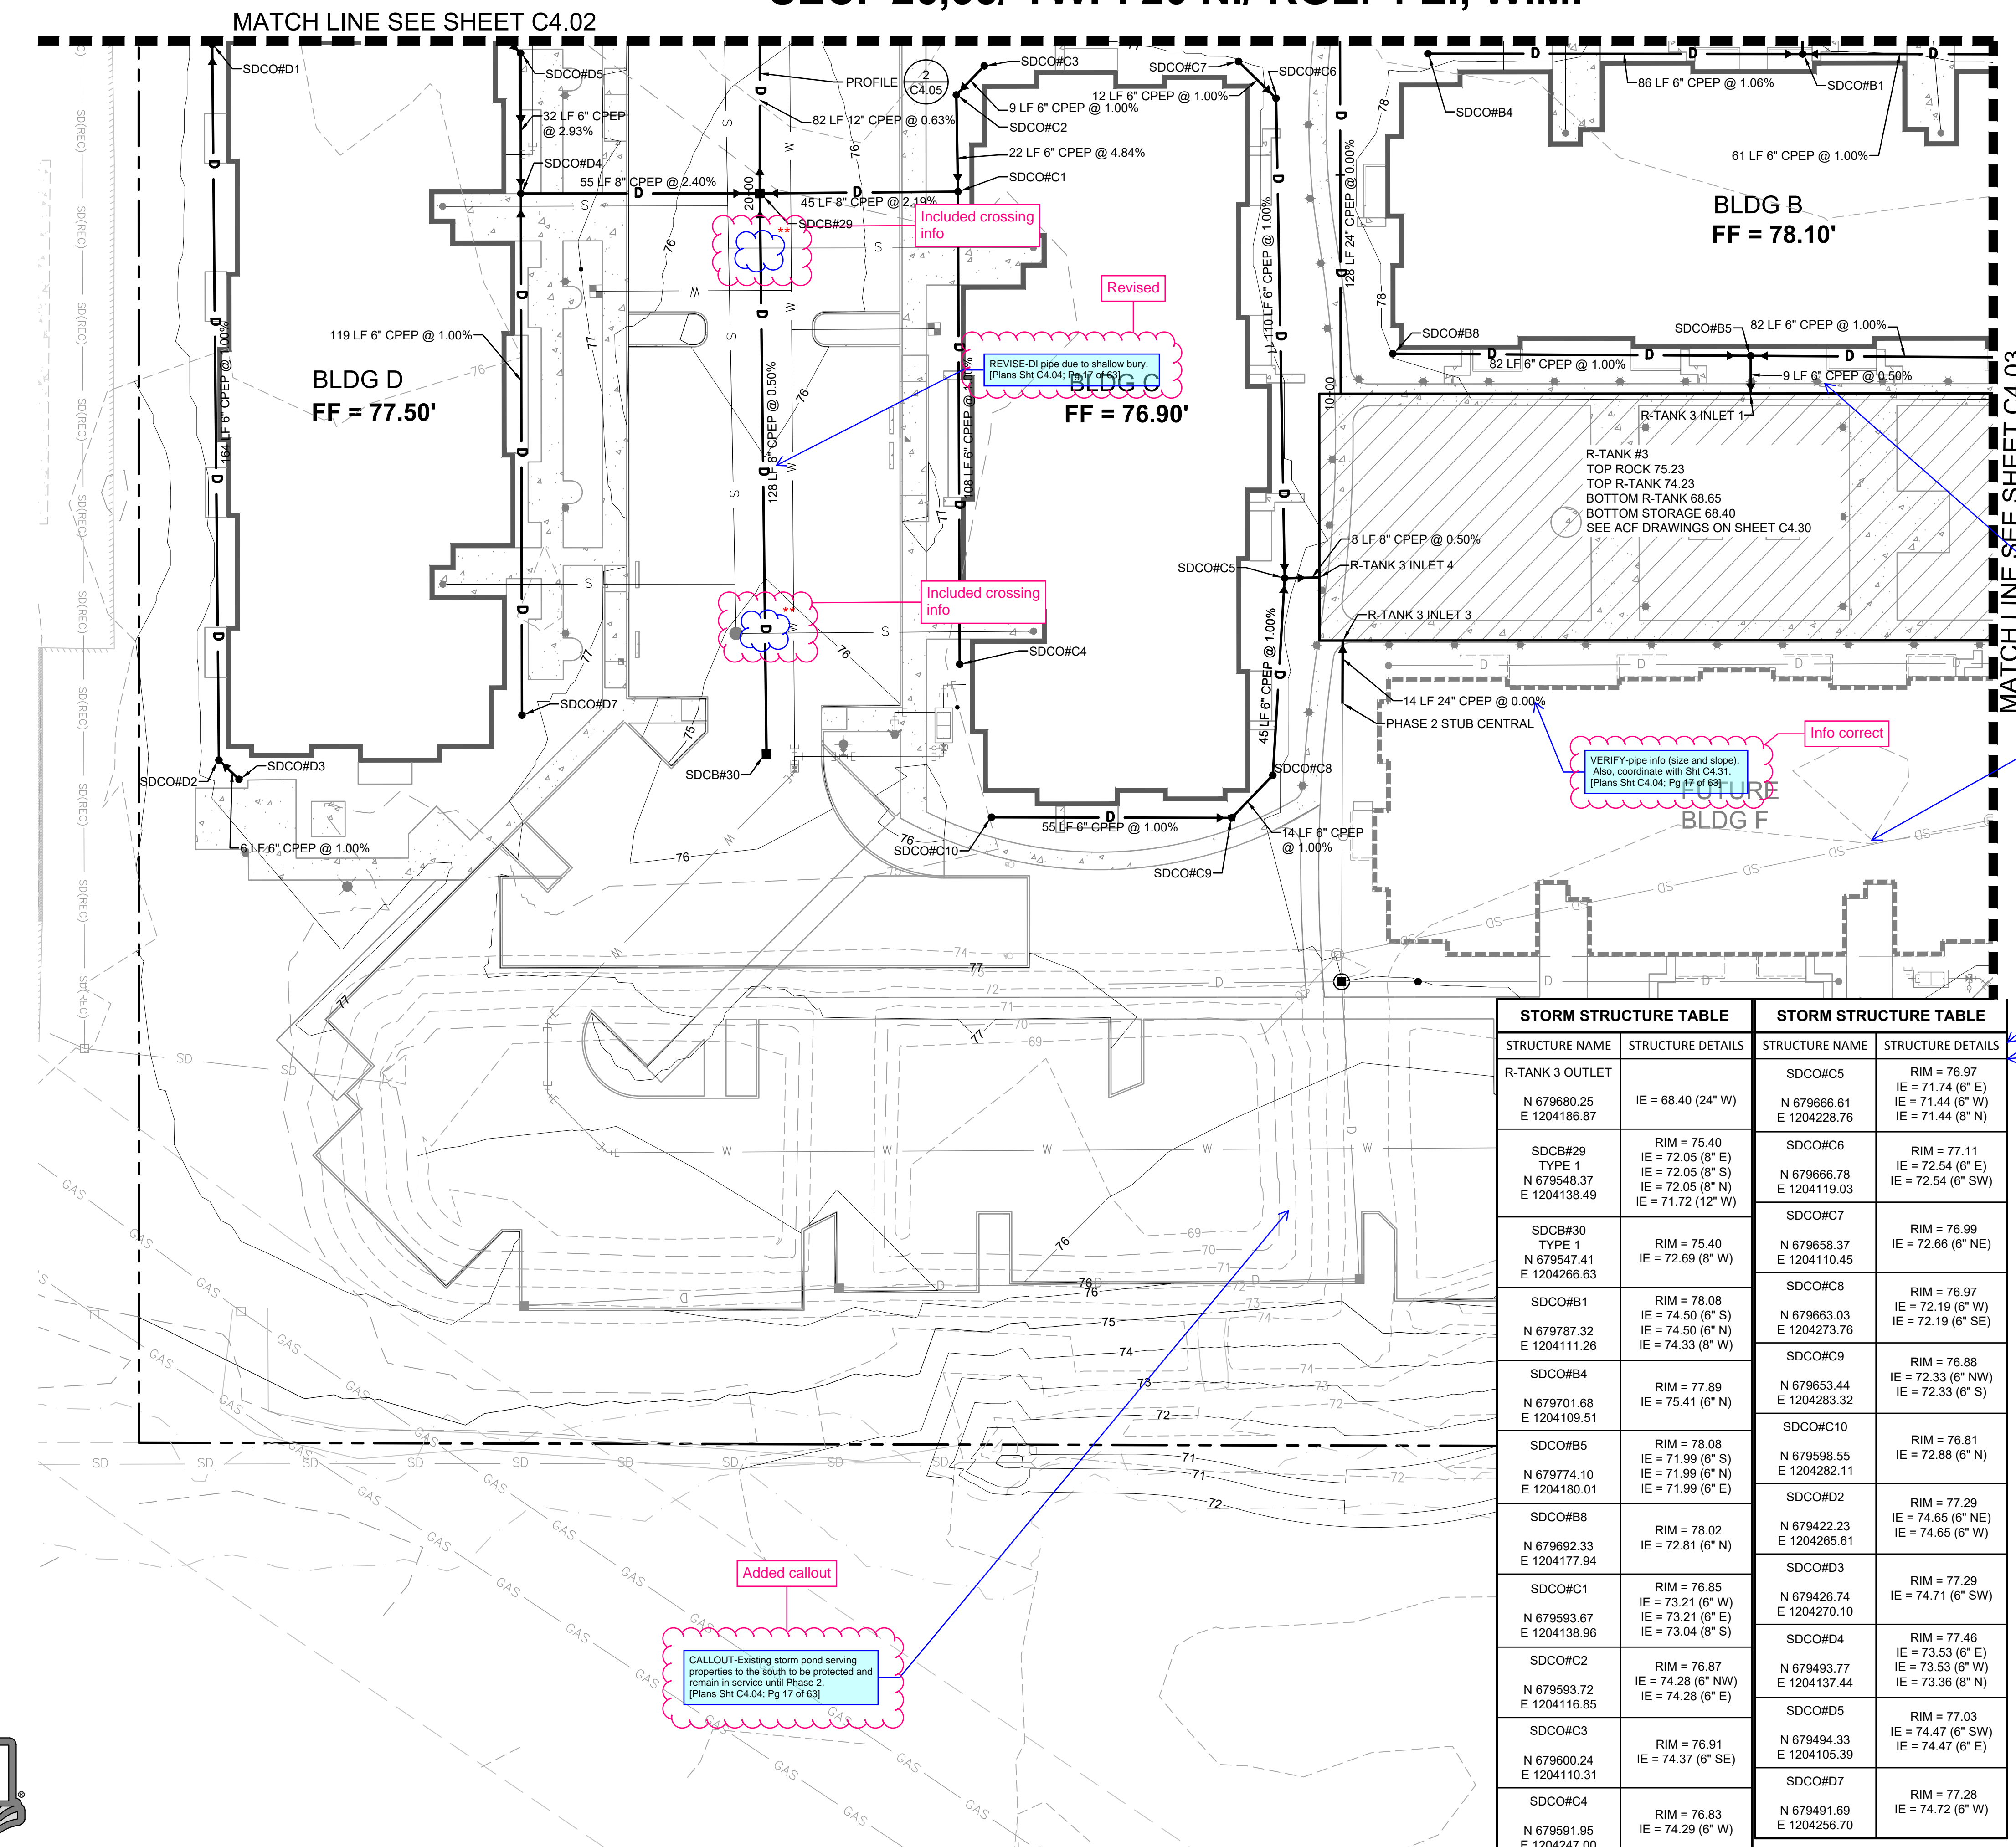

GENERAL NOTE
SEE DETAILS AS NOTED ON SHEET C4.05
-FOR CATCH BASIN TYPE I
-(AREA DRAIN) SEE DETAIL 1
-(GUTTER DRAIN) SEE DETAIL 2
-FOR CATCH BASIN TYPE II SEE DETAIL 3
-STORM SEWER MANHOLE SEE DETAIL 7

Updated callout
Provide utility crossing information.
[Plans Sht C4.04; Pg 17 of 63]


Correct info
VERIFY pipe size.
[Plans Sht C4.04; Pg 17 of 63]

Called out
CALLOUT to protect existing storm drain serving properties to the south.
[Plans Sht C4.04; Pg 17 of 63]

Added
ADD R-Tank 3 inlets #1, 3, and 4 with IEs.
[Plans Sht C4.04; Pg 17 of 63]

Added
ADD SDCO#D1 structure details.
[Plans Sht C4.04; Pg 17 of 63]

Sheet labels?

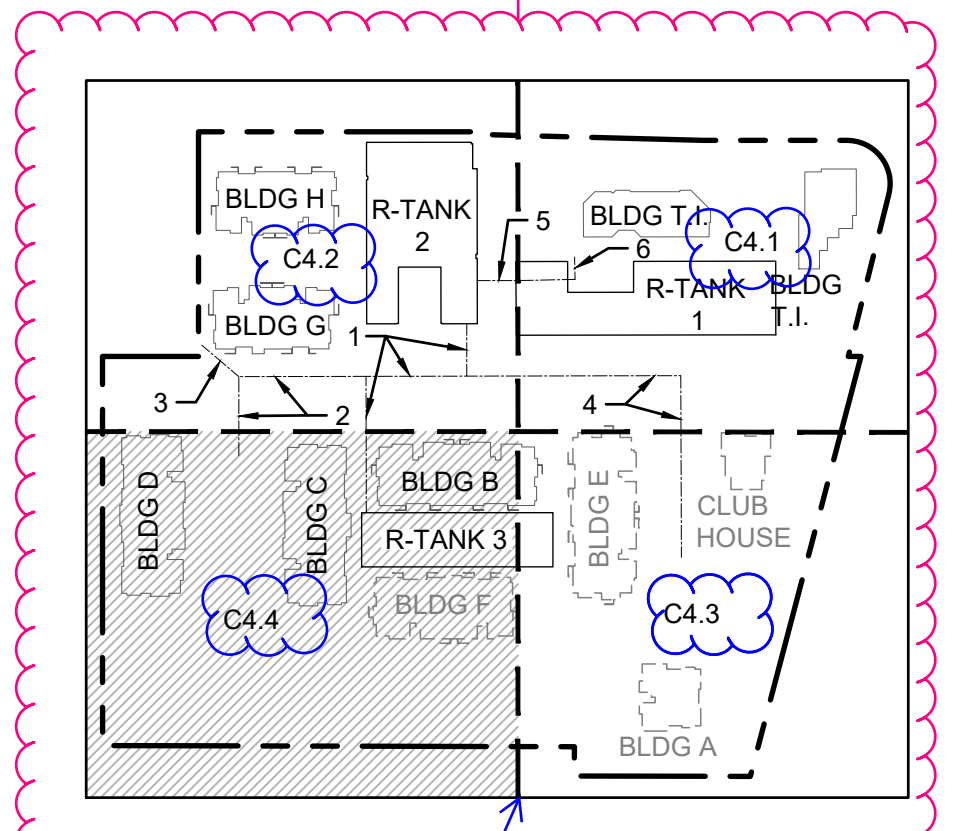

STORM STRUCTURE TABLE		STORM STRUCTURE TABLE	
STRUCTURE NAME	STRUCTURE DETAILS	STRUCTURE NAME	STRUCTURE DETAILS
R-TANK 3 OUTLET N 679680.25 E 1204186.87	IE = 68.40 (24" W)	SDCO#C5	RIM = 76.97 IE = 71.74 (6" E) IE = 71.44 (6" W) IE = 71.44 (8" N)
SDCB#29 TYPE 1 N 679548.37 E 1204138.49	RIM = 75.40 IE = 72.05 (8" E) IE = 72.05 (8" S) IE = 72.05 (8" N) IE = 71.72 (12" W)	SDCO#C6	RIM = 77.11 IE = 72.54 (6" E) IE = 72.54 (6" SW)
SDCB#30 TYPE 1 N 679547.41 E 1204266.63	RIM = 75.40 IE = 72.69 (8" W)	SDCO#C7	RIM = 76.99 IE = 72.66 (6" NE)
SDCO#B1	RIM = 78.08 IE = 74.50 (6" S) IE = 74.50 (6" N) IE = 74.33 (6" W)	SDCO#C8	RIM = 76.97 IE = 72.19 (6" W) IE = 72.19 (6" SE)
SDCO#B4	RIM = 77.89 IE = 75.41 (6" N)	SDCO#C9	RIM = 76.88 IE = 72.33 (6" NW) IE = 72.33 (6" S)
SDCO#B5	RIM = 78.08 IE = 71.99 (6" S) IE = 71.99 (6" N) IE = 71.99 (6" E)	SDCO#C10	RIM = 76.81 IE = 72.88 (6" N)
SDCO#B8	RIM = 78.02 IE = 72.81 (6" N)	SDCO#D2	RIM = 77.29 IE = 74.65 (6" NE) IE = 74.65 (6" W)
SDCO#C1	RIM = 76.85 IE = 73.21 (6" W) IE = 73.21 (6" E) IE = 73.04 (8" S)	SDCO#D3	RIM = 77.29 IE = 74.71 (6" SW)
SDCO#C2	RIM = 76.87 IE = 74.28 (6" NW) IE = 74.28 (6" E)	SDCO#D4	RIM = 77.46 IE = 73.53 (6" E) IE = 73.53 (6" W) IE = 73.36 (8" N)
SDCO#C3	RIM = 76.91 IE = 74.37 (6" SE)	SDCO#D5	RIM = 77.03 IE = 74.47 (6" SW) IE = 74.47 (6" E)
SDCO#C4	RIM = 76.83 IE = 74.29 (6" W)	SDCO#D7	RIM = 77.28 IE = 74.72 (6" W)

Added callout
CALLOUT-Existing storm pond serving properties to the south to be protected and remain in service until Phase 2.
[Plans Sht C4.04; Pg 17 of 63]



Know what's below.
Call before you dig.

C4.04

17 of 63 Sheets

EAST TOWN CROSSING PHASE 1


SEC. 26,35/ TWP. 20 N./ RGE. 4 E., W.M.

APPROVED


BY _____
CITY OF PUYALLUP
DEVELOPMENT ENGINEERING

DATE _____


NOTE: THIS APPROVAL IS VOID AFTER 180 DAYS FROM APPROVAL DATE. THE CITY WILL NOT BE RESPONSIBLE FOR ERRORS AND/OR OMISSIONS ON THESE PLANS. FIELD CONDITIONS MAY DICTATE CHANGES TO THESE PLANS AS DETERMINED BY THE DEVELOPMENT ENGINEERING MANAGER.

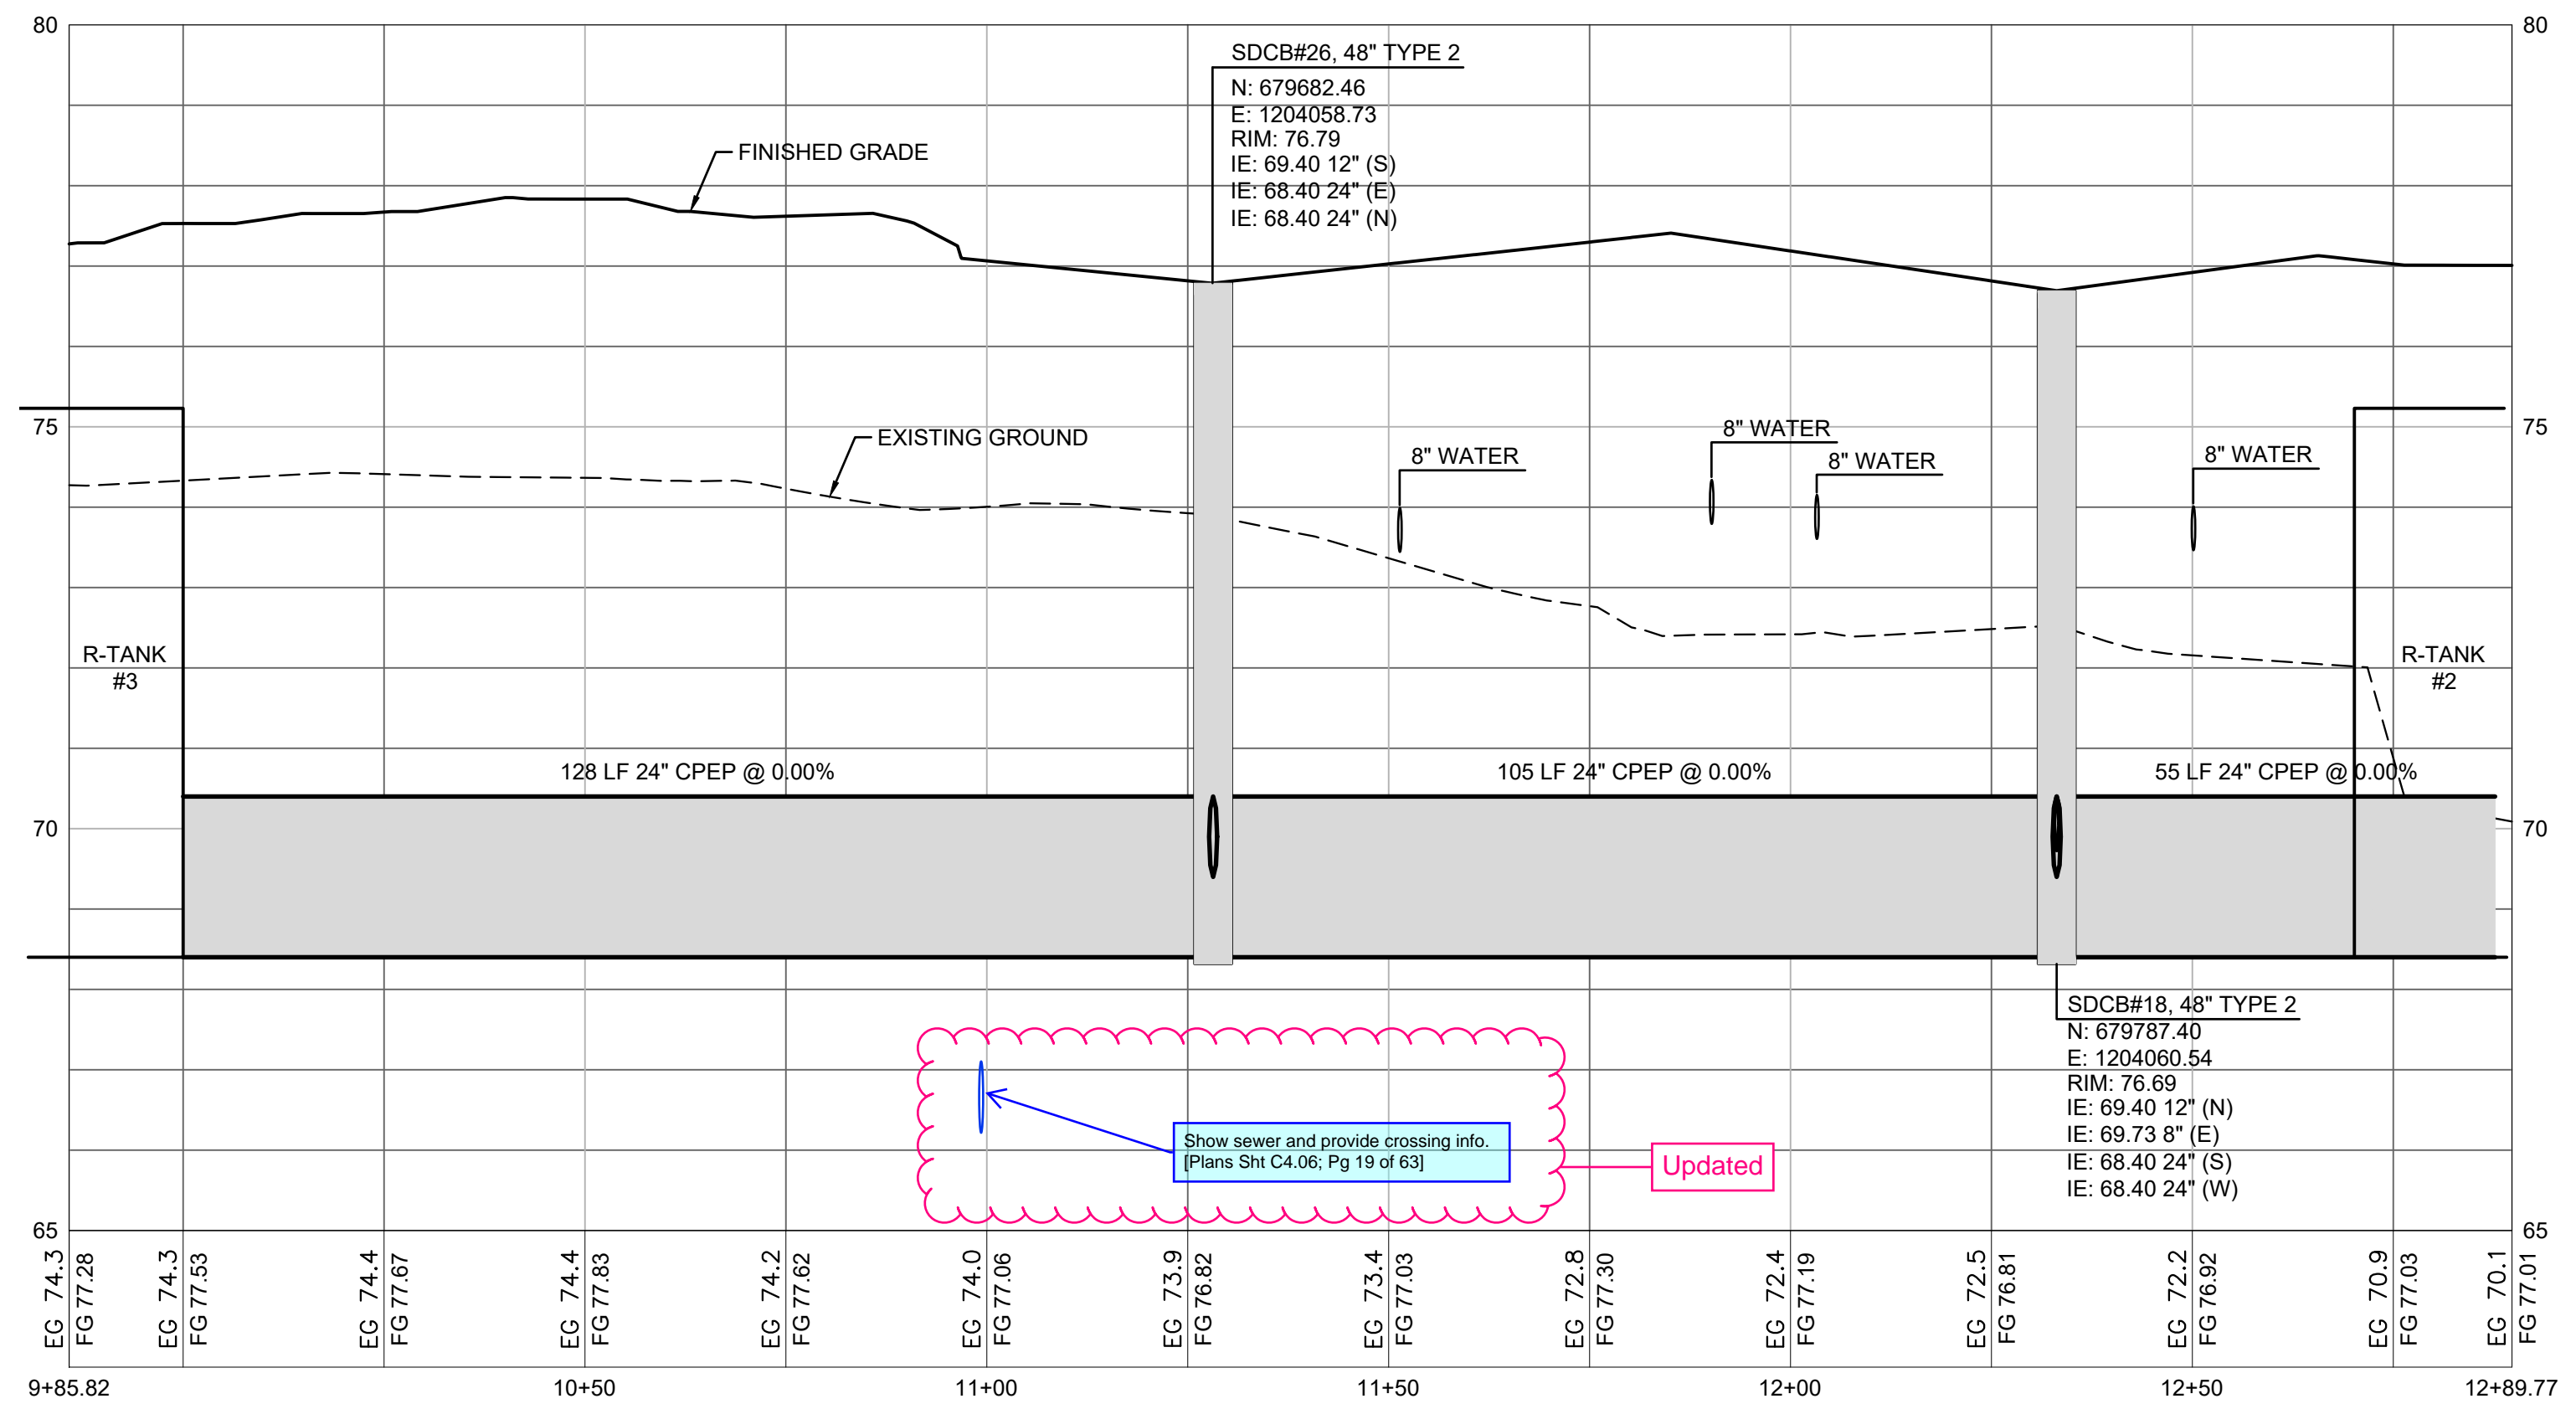


1 STORM PROFILE
SCALE: HORIZ 1"=20'; VERT 1"=2'

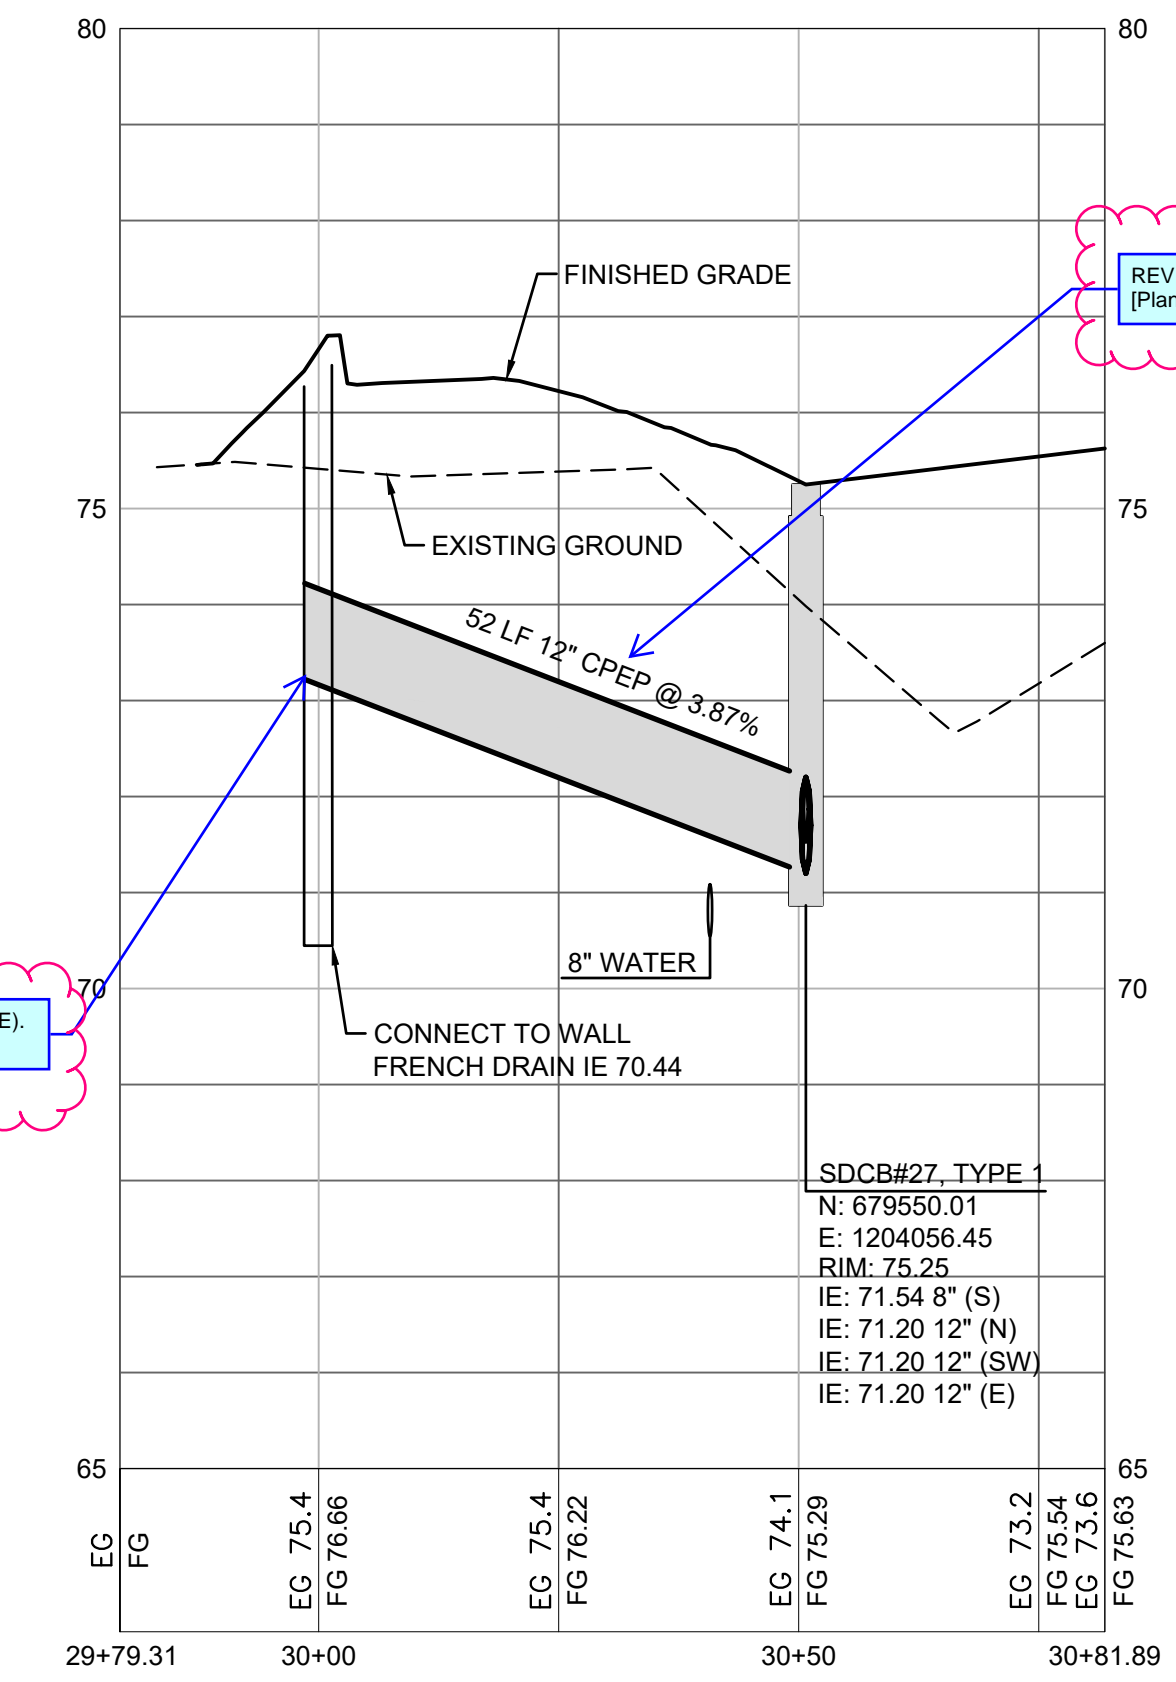

3 STORM PROFILE
SCALE: HORIZ 1"=20'; VERT 1"=2'

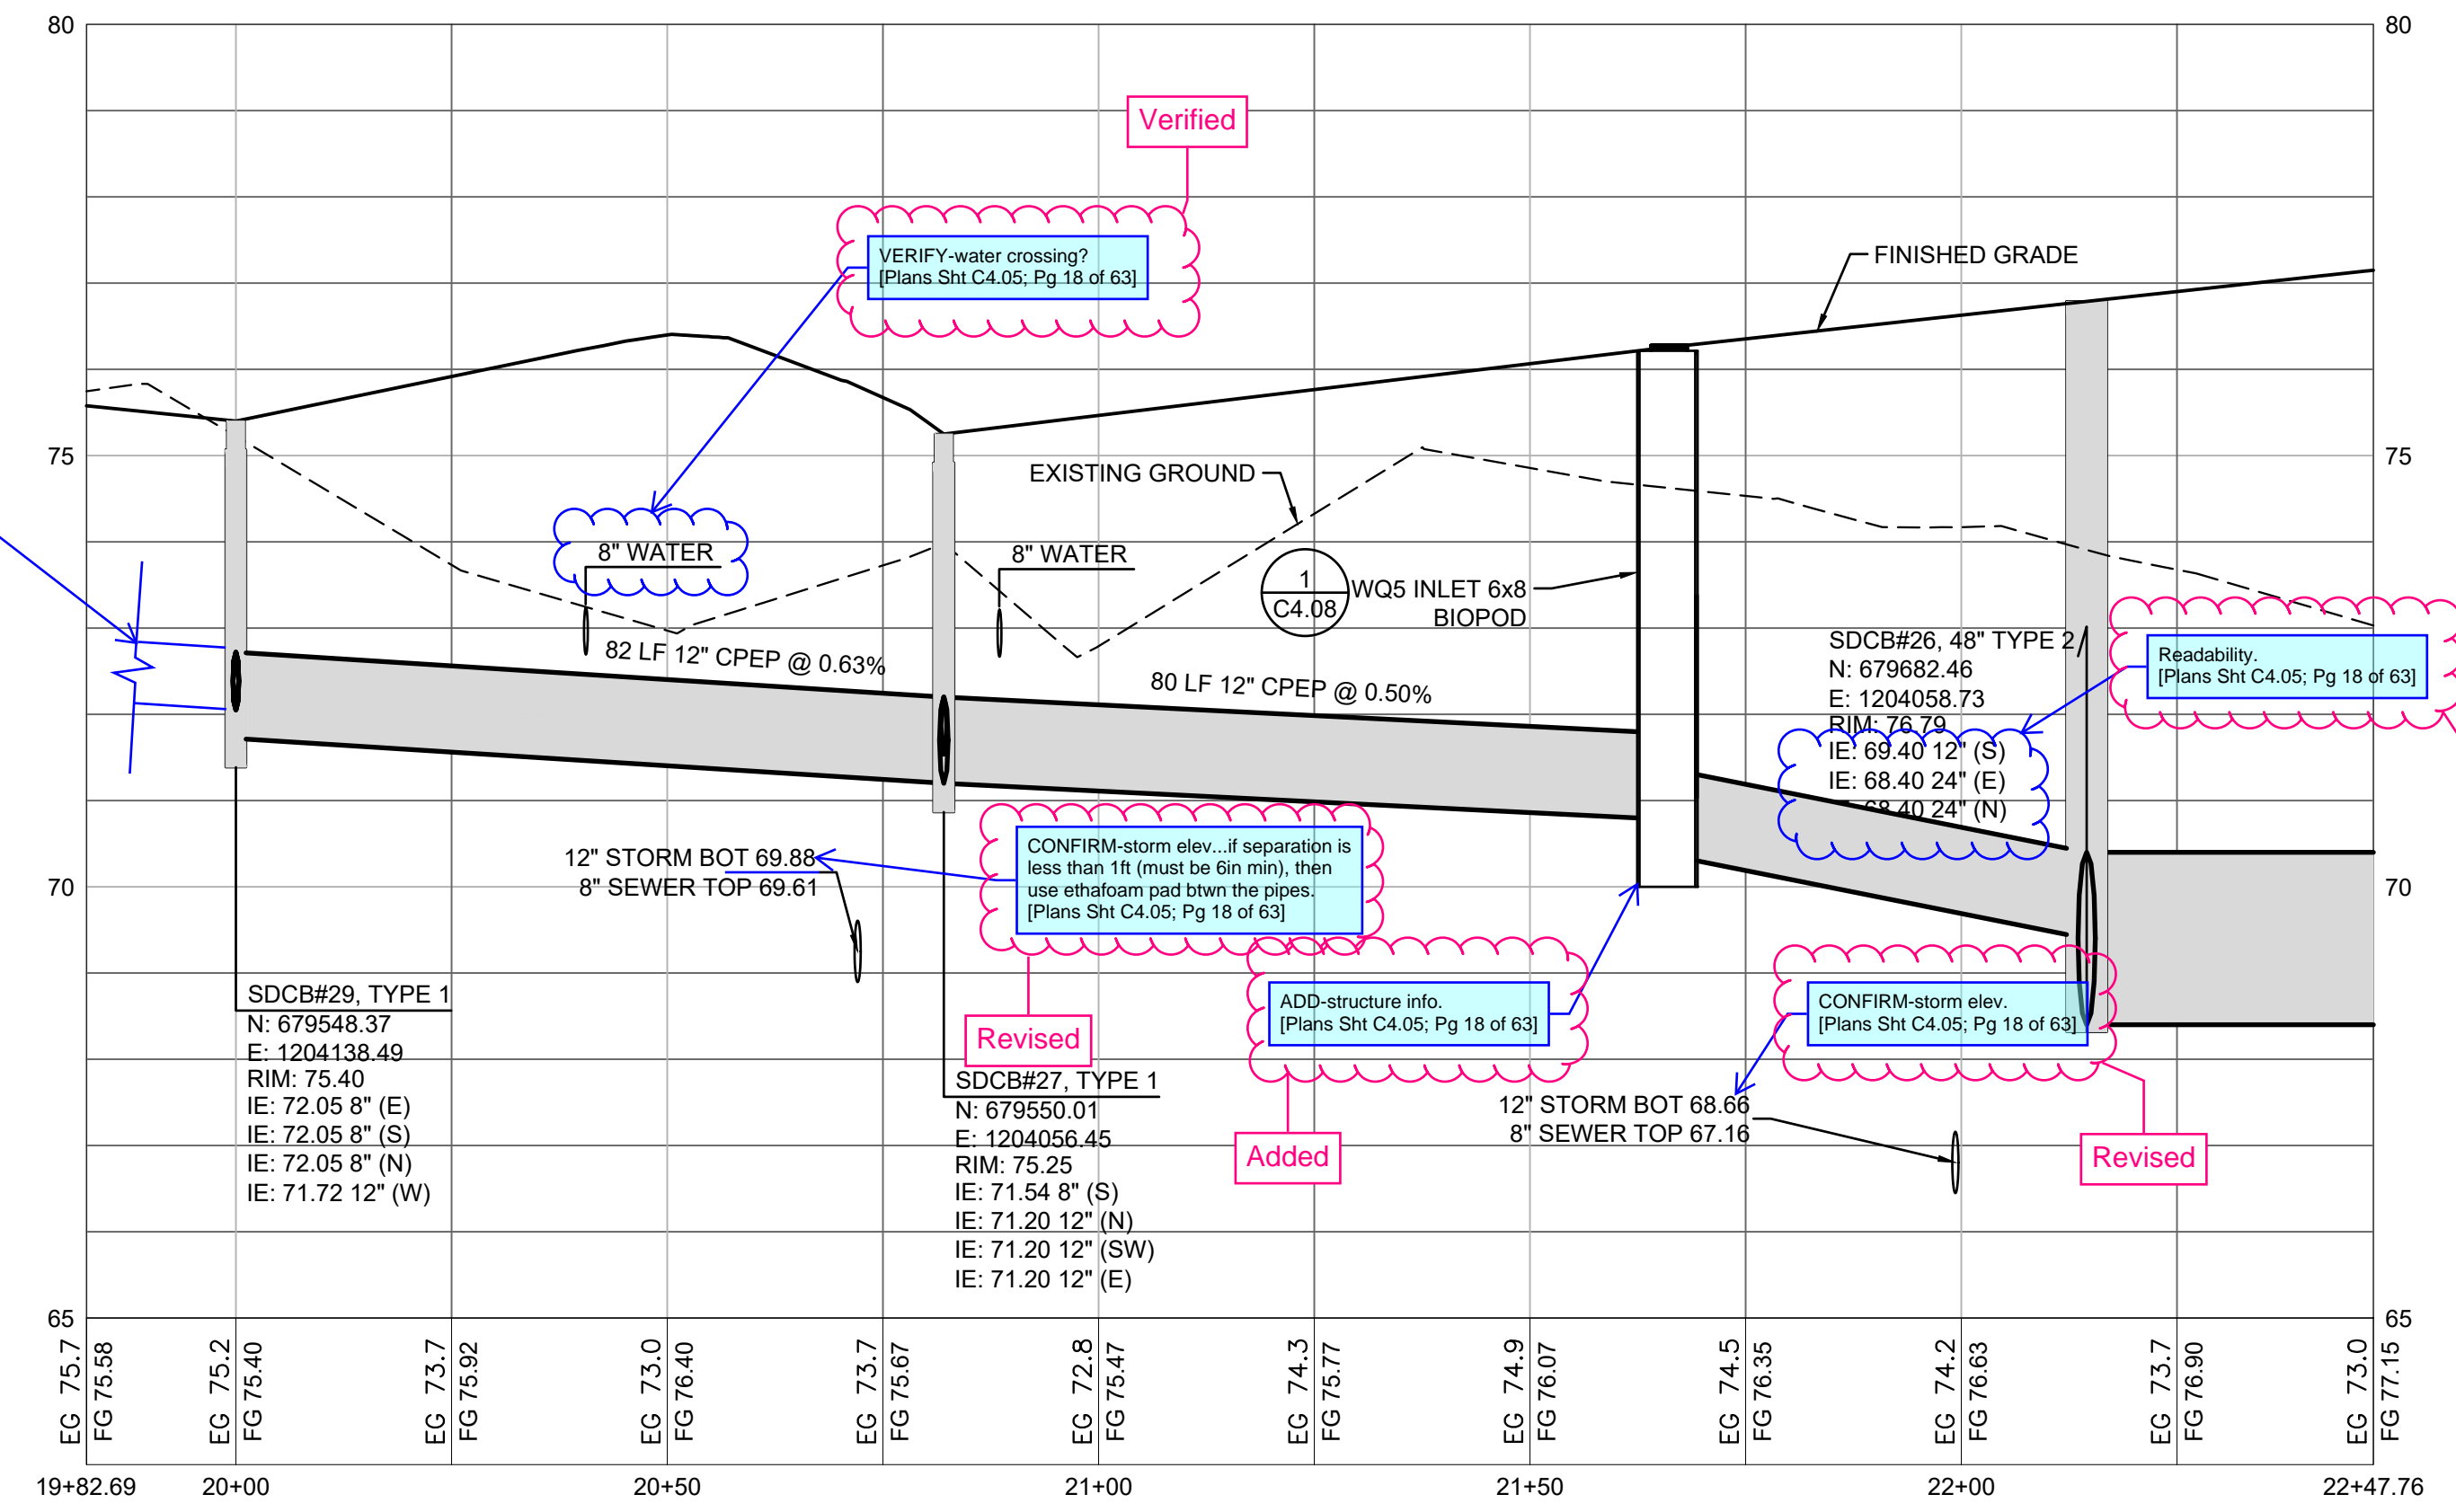

2 STORM PROFILE
SCALE: HORIZ 1"=20'; VERT 1"=2'

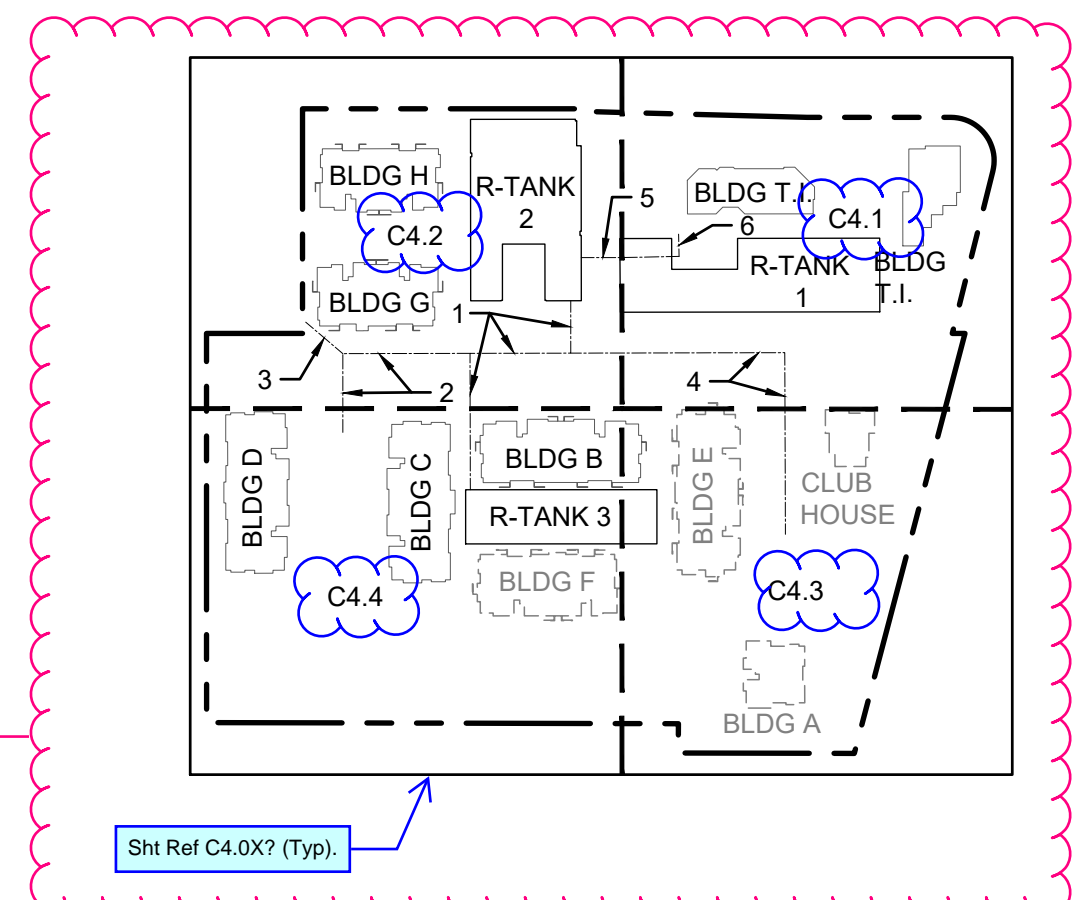


Project Title:
EAST TOWN CROSSING PHASE 1

Client:
ASH DEVELOPMENT

GREG HELLE
GREG.HELLE@ASHNW.COM

Project No.
2230752

Issue Set & Date:
PERMIT SUBMITTAL
11/20/2023

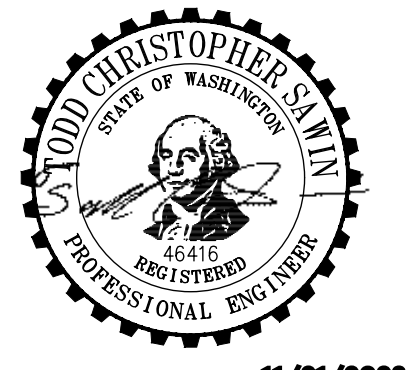

11/21/2023

NOTICE: ALTERATION OF THIS DOCUMENT SHALL INVALIDATE THE PROFESSIONAL SEAL AND SIGNATURE. PUBLICATION OF THIS DOCUMENT DOES NOT CONSTITUTE AN ENDORSEMENT OR GUARANTEE BY THE ENGINEER. THE ENGINEER IS NOT RESPONSIBLE FOR THE PROJECT EXCEPT IN THE TITLE BLOCK AND IS NOT TO BE USED FOR OTHER PROJECTS OR ADDITION TO THAT PROJECT OR FOR ANY OTHER PROJECT.

Revisions:

Sheet Title:
STORM PROFILES

Designed by: CW Drawn by: SK Checked by: JI

Sheet No.
C4.05
18 of 63 Sheets



EAST TOWN CROSSING PHASE 1

SEC. 26,35/ TWP. 20 N./ RGE. 4 E., W.M.

APPROVED
 BY: CITY OF PUYALLUP
 DEVELOPMENT ENGINEERING
 DATE: _____
NOTE: THIS APPROVAL IS VOID AFTER 180 DAYS FROM APPROVAL DATE. THE CITY WILL NOT BE RESPONSIBLE FOR ERRORS AND/OR OMISSIONS ON THESE PLANS. FIELD CONDITIONS MAY DICTATE CHANGES TO THESE PLANS AS DETERMINED BY THE DEVELOPMENT ENGINEERING MANAGER.




Project Title:
EAST TOWN CROSSING PHASE 1

Client:
 ASH DEVELOPMENT

GREG HELLE
 GREG.HELLE@ASHNW.COM


Project No.
 2230752

Issue Set & Date:
PERMIT SUBMITTAL
 11/20/2023

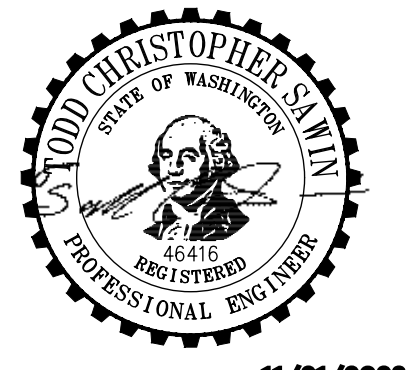


11/21/2023


NOTICE
 ALTERATION OF THIS DOCUMENT SHALL INVALIDATE THE PROFESSIONAL SEAL AND SIGNATURE. PUBLICATION OF THIS DOCUMENT DOES NOT CONSTITUTE A GUARANTEE OR WARRANTY BY THE ENGINEER OR ARCHITECT. THE ENGINEER OR ARCHITECT IS NOT TO BE USED FOR ANY OTHER PROJECT OR ACTION TO THAT PROJECT OR FOR ANY OTHER PROJECT.

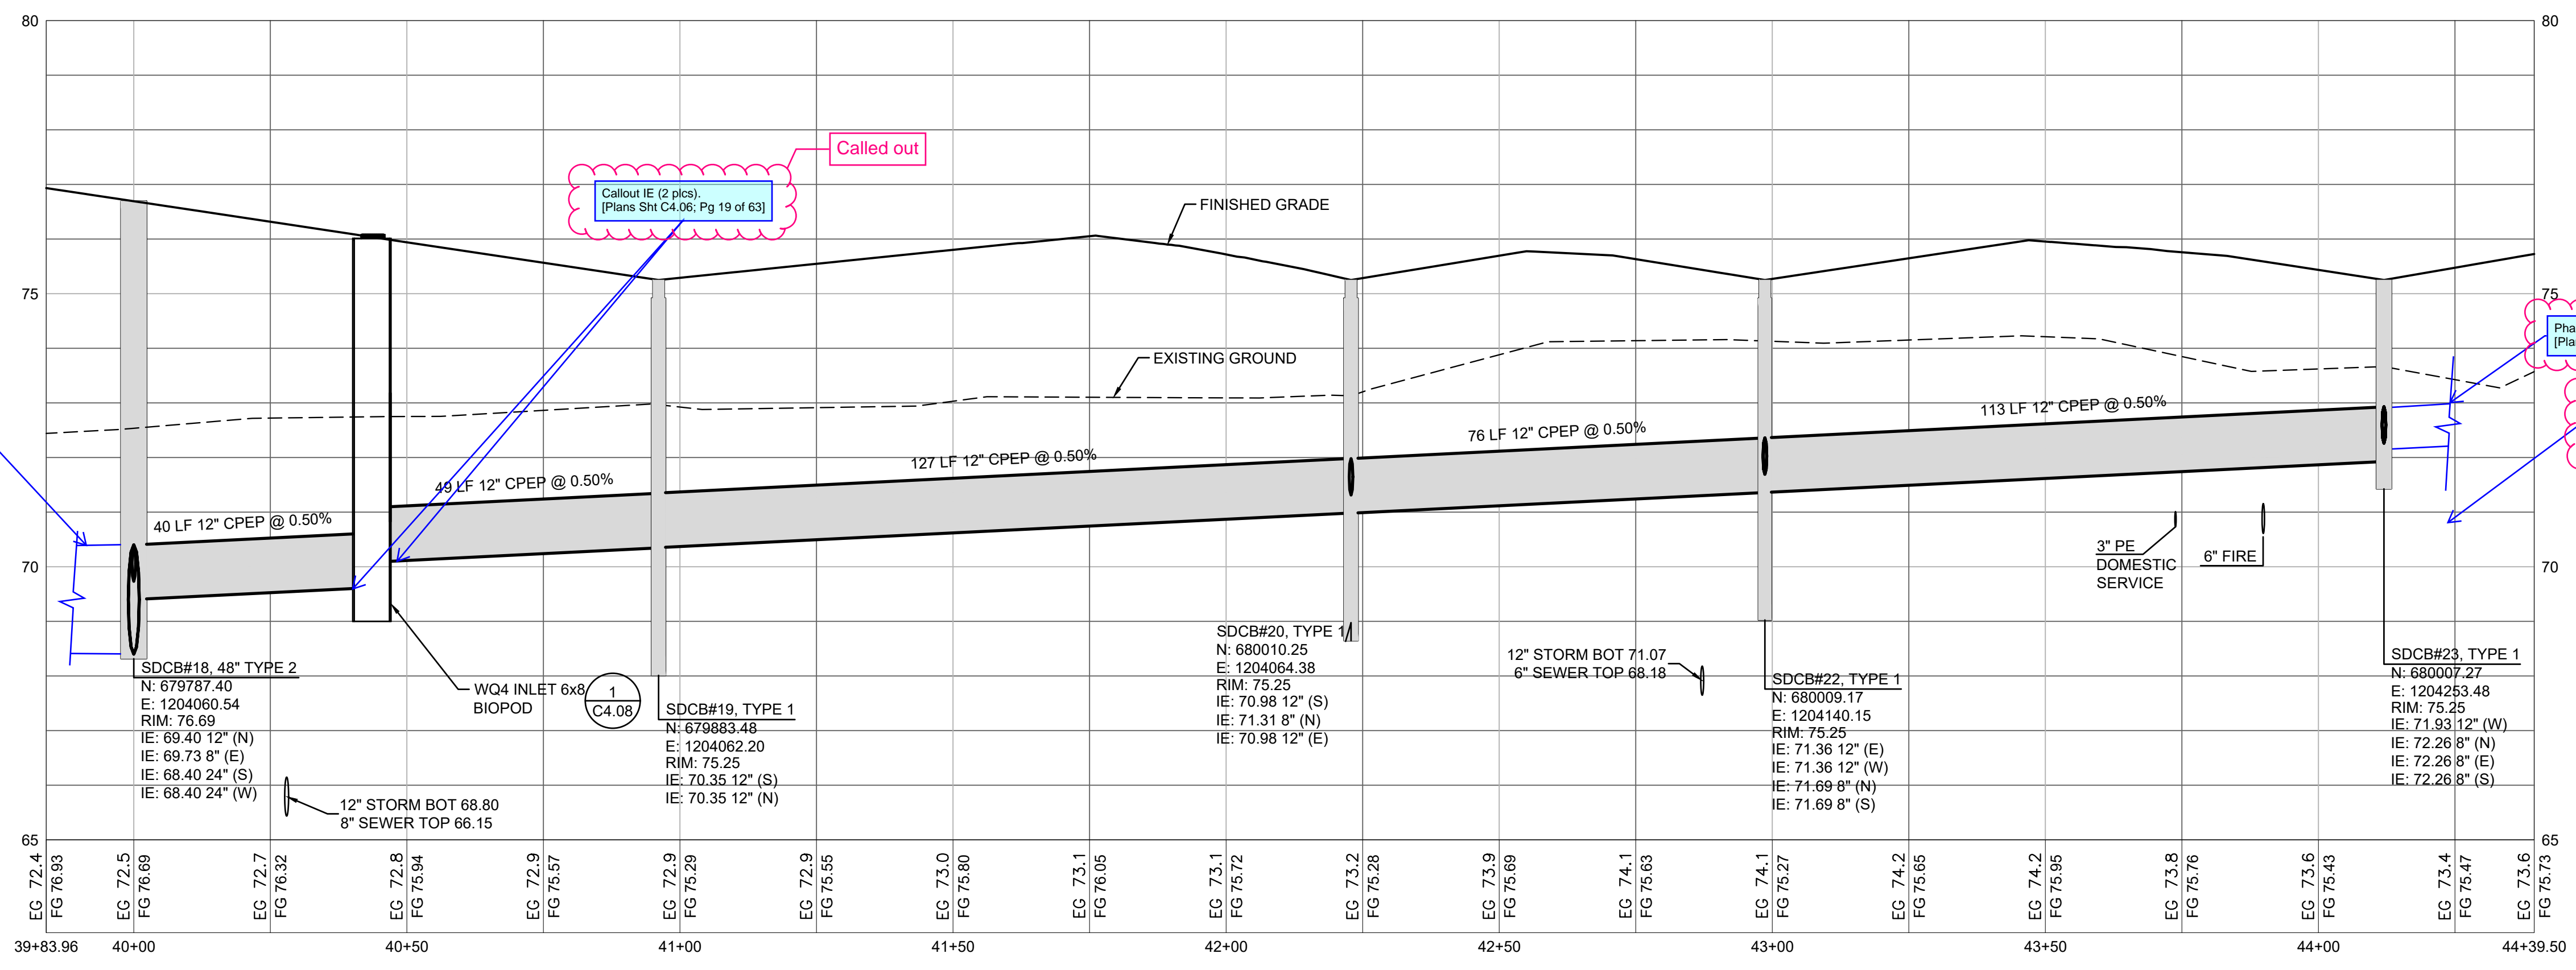


4 STORM PROFILE
 SCALE: HORIZ 1"=20'; VERT 1"=2'

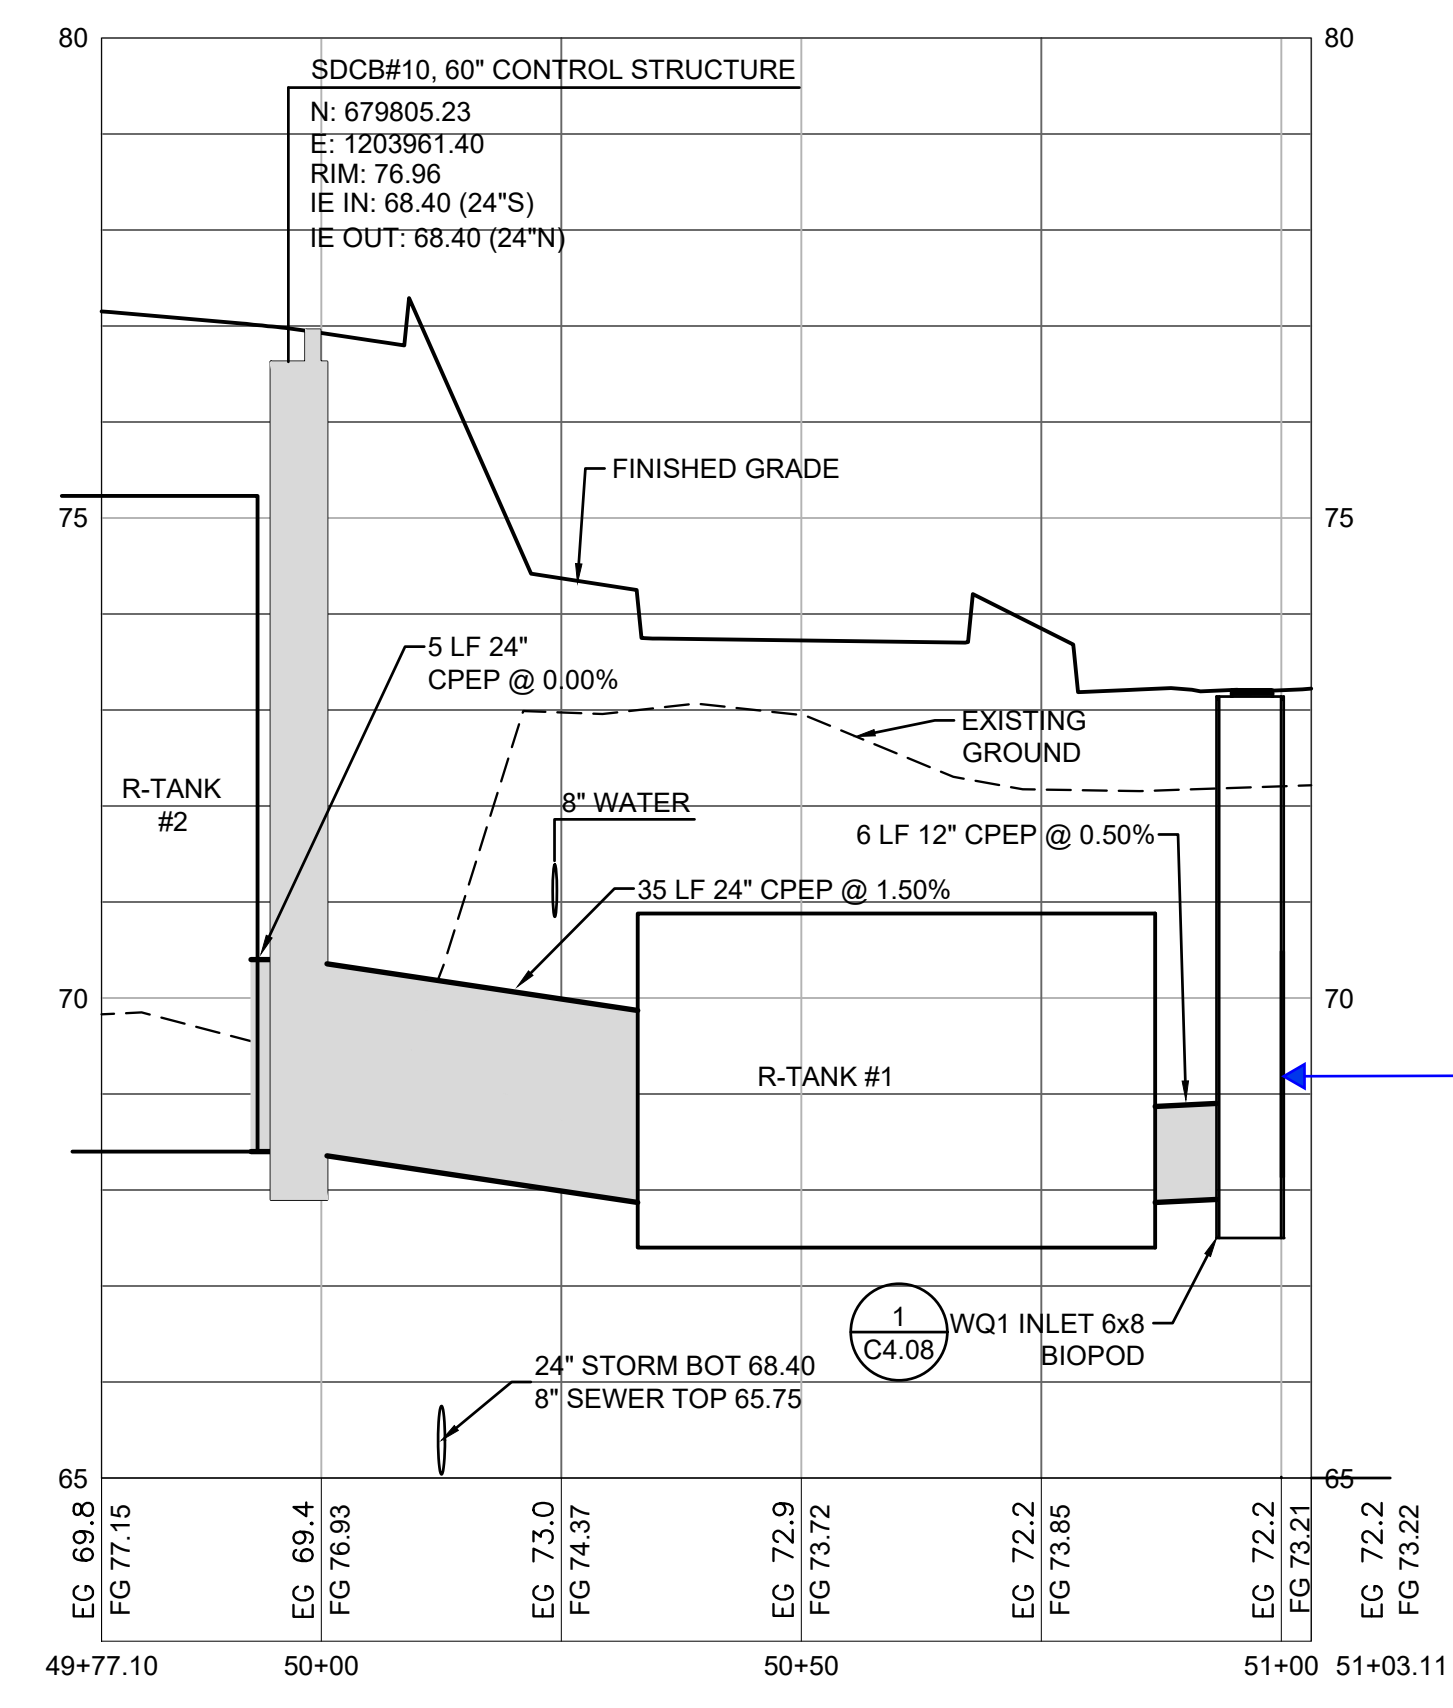

5 STORM PROFILE
 SCALE: HORIZ 1"=20'; VERT 1"=2'

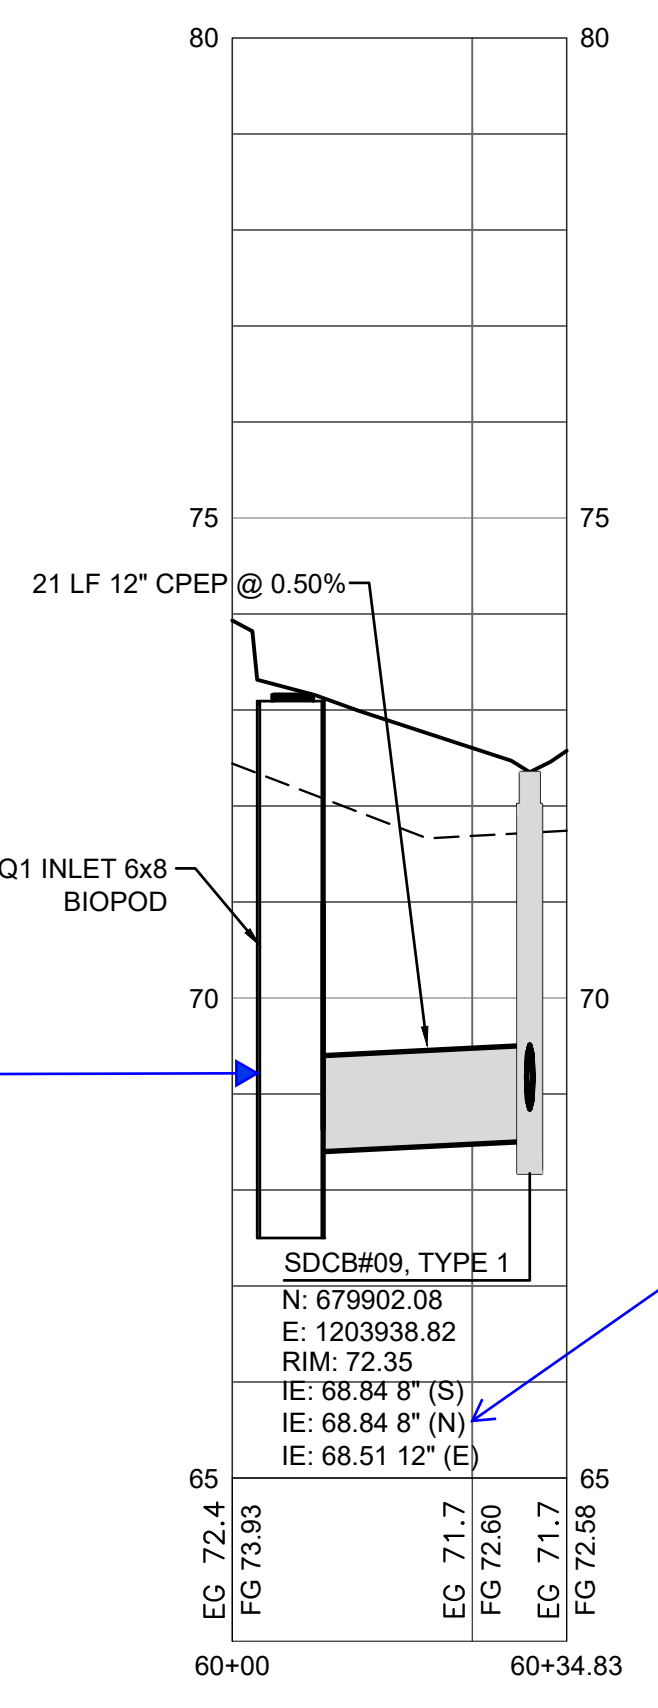

6 STORM PROFILE
 SCALE: HORIZ 1"=20'; VERT 1"=2'

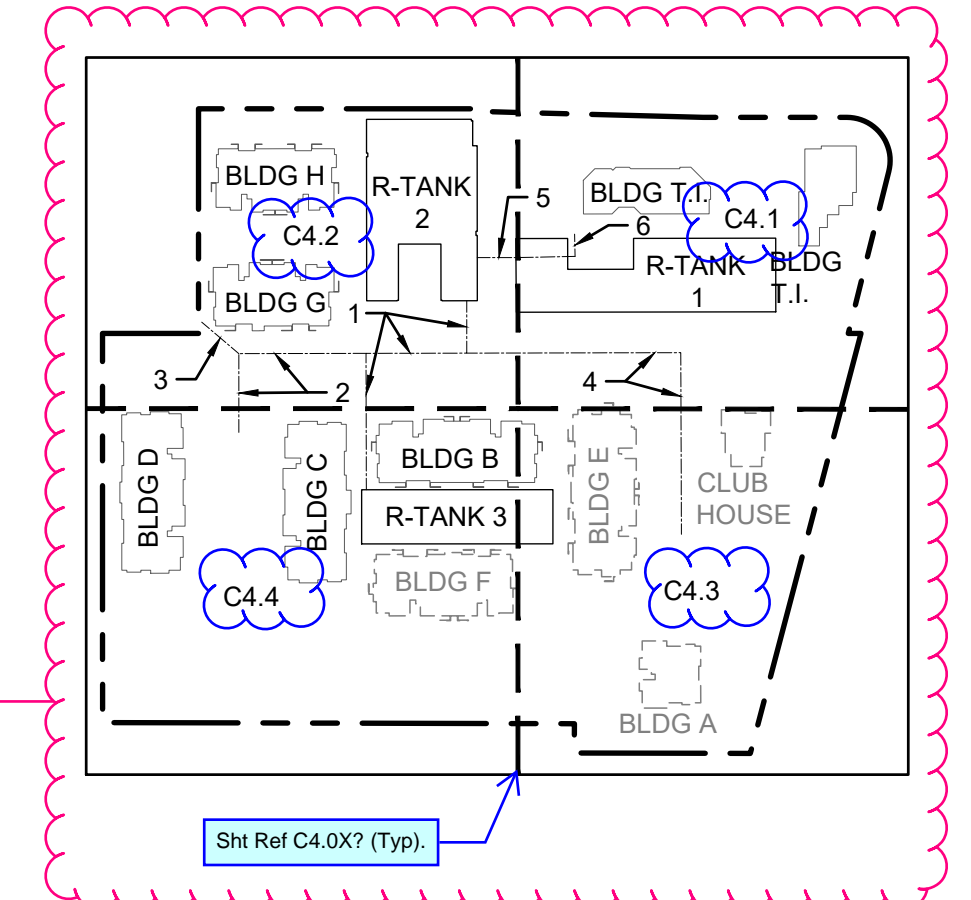

Revised
 Per comments on C4.01, revise to 12" dia. per Shts 204-3/4 (north). [Plans Sht C4.06; Pg 19 of 63]

Correct, they are the same structure

Updated sheet labels

Pipe to south? [Plans Sht C4.06; Pg 19 of 63]
 Updated

Called out
 Callout IE (2 pics). [Plans Sht C4.06; Pg 19 of 63]

Updated
 Phase 2 Stub? [Plans Sht C4.06; Pg 19 of 63]
 Show existing storm main and provide crossing information. [Plans Sht C4.06; Pg 19 of 63]
 Updated



Revisions:

Sheet Title:
STORM PROFILES

Designed by: CW Drawn by: SK Checked by: JI

Sheet No.
C4.06
 19 of 63 Sheets

EAST TOWN CROSSING PHASE 1


SEC. 26,35/ TWP. 20 N./ RGE. 4 E., W.M.

APPROVED

BY CITY OF PUYALLUP
DEVELOPMENT ENGINEERING

DATE

NOTE: THIS APPROVAL IS VOID AFTER 180 DAYS FROM APPROVAL DATE. THE CITY WILL NOT BE RESPONSIBLE FOR ERRORS AND/OR OMISSIONS ON THESE PLANS. FIELD CONDITIONS MAY DICTATE CHANGES TO THESE PLANS AS DETERMINED BY THE DEVELOPMENT ENGINEERING MANAGER.

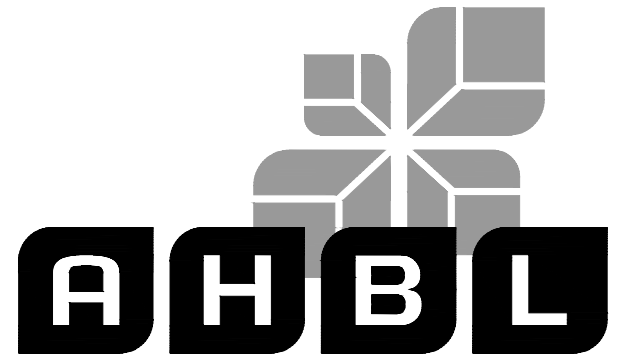

TACOMA • SEATTLE • SPOKANE • TRI-CITIES
2215 North 30th Street, Suite 300, Tacoma, WA 98403
253.383.2422 TEL 253.383.2572 FAX www.ahbl.com

Project Title:

EAST TOWN CROSSING PHASE 1

Client:
ASH DEVELOPMENT

GREG HELLE

GREG.HELLE@ASHNW.COM

Project No.

2230752

Issue Set & Date:


PERMIT SUBMITTAL

11/20/2023




11/21/2023



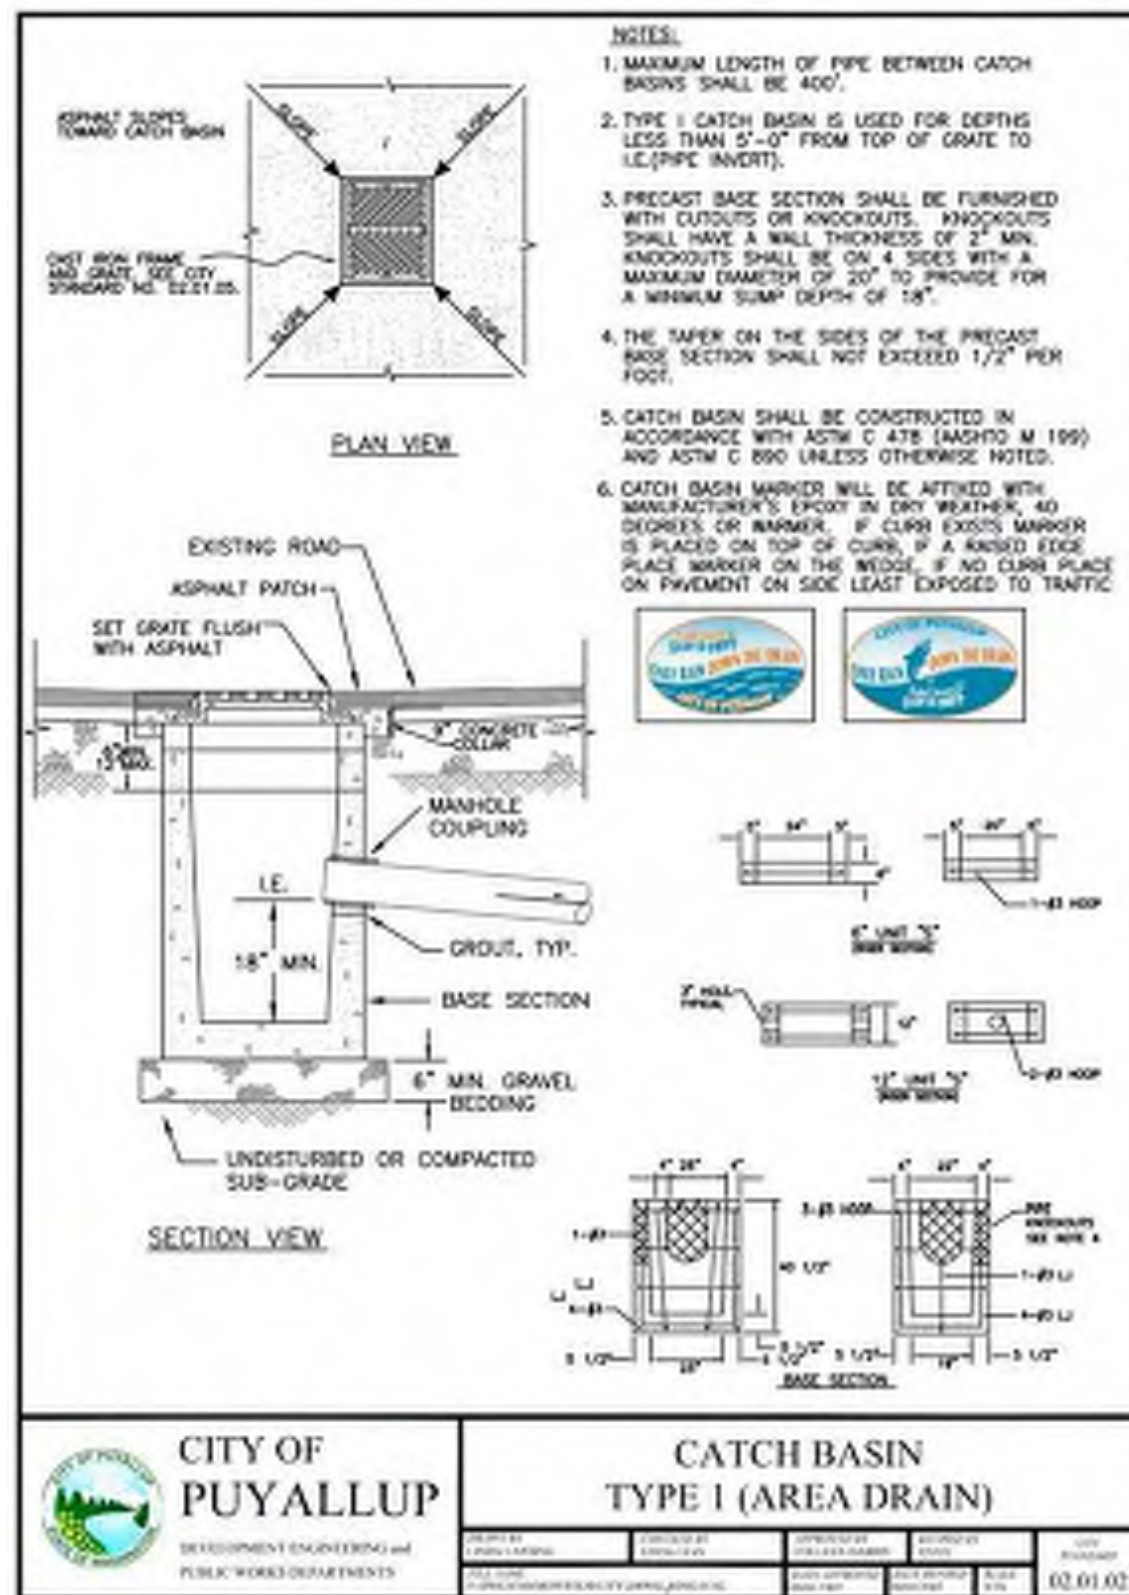


1 CATCH BASIN TYPE 1 (AREA DRAIN)
NOT TO SCALE

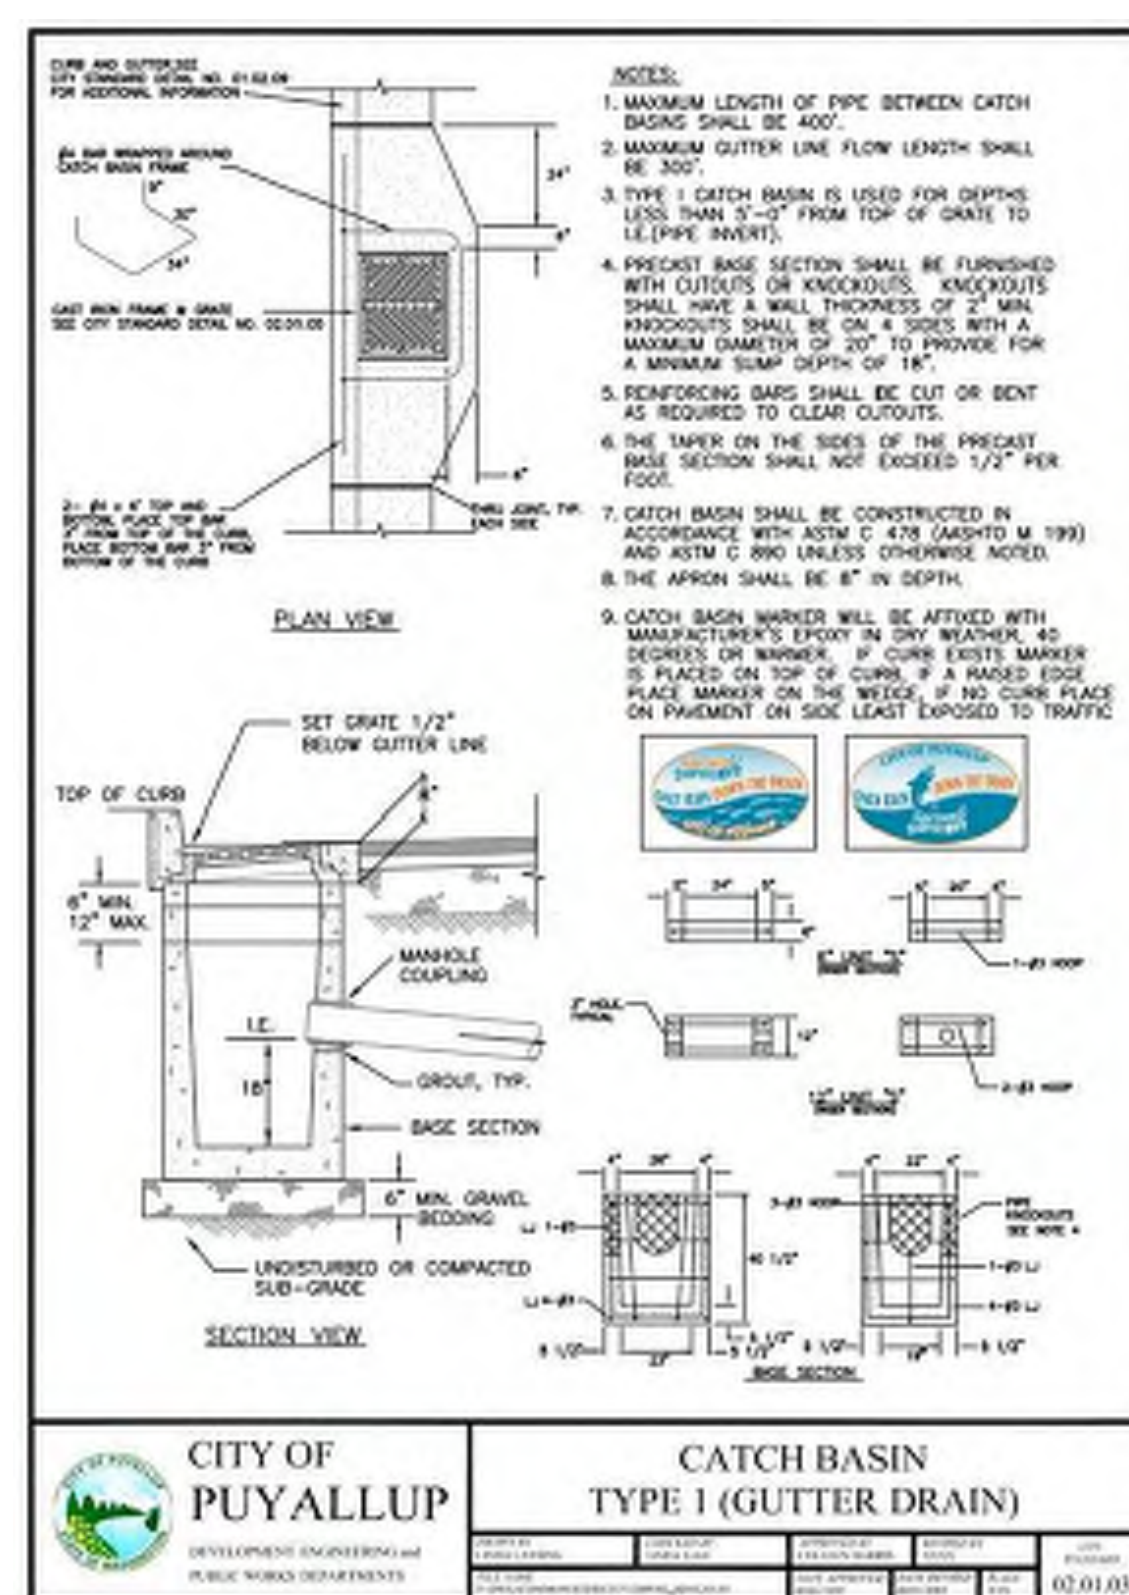


2 CATCH BASIN TYPE 1 (GUTTER DRAIN)
NOT TO SCALE

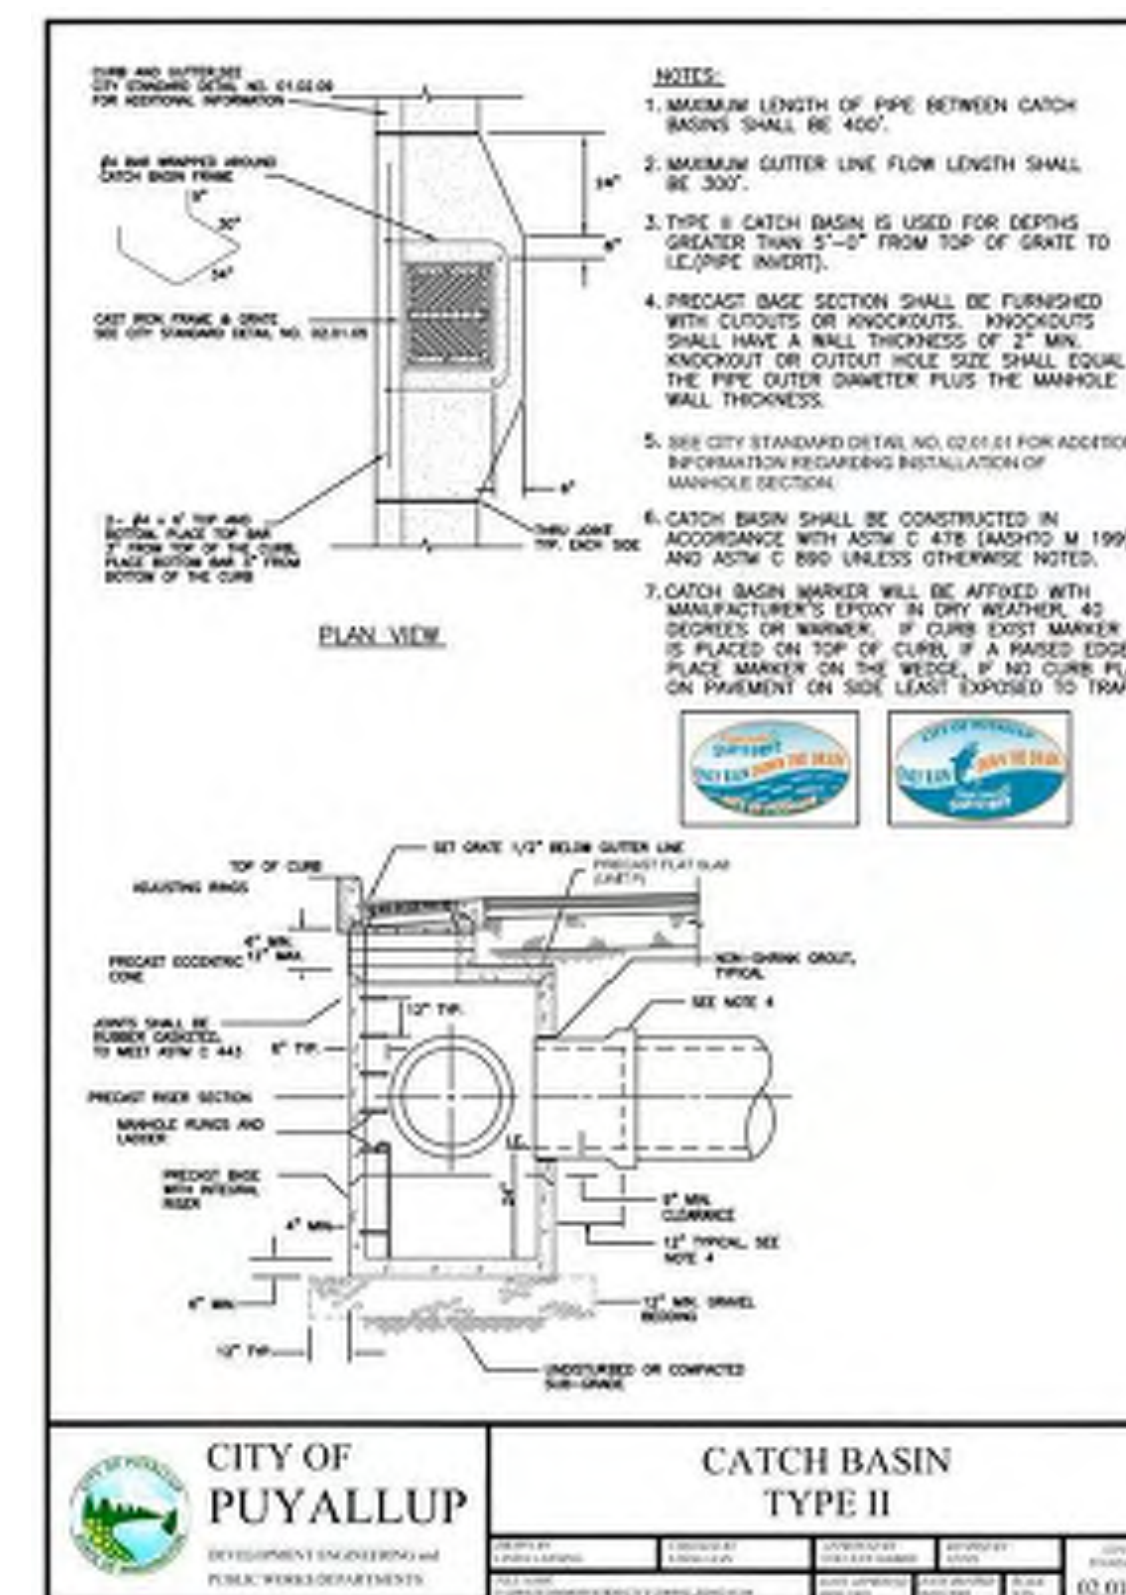

3 CATCH BASIN TYPE II
NOT TO SCALE

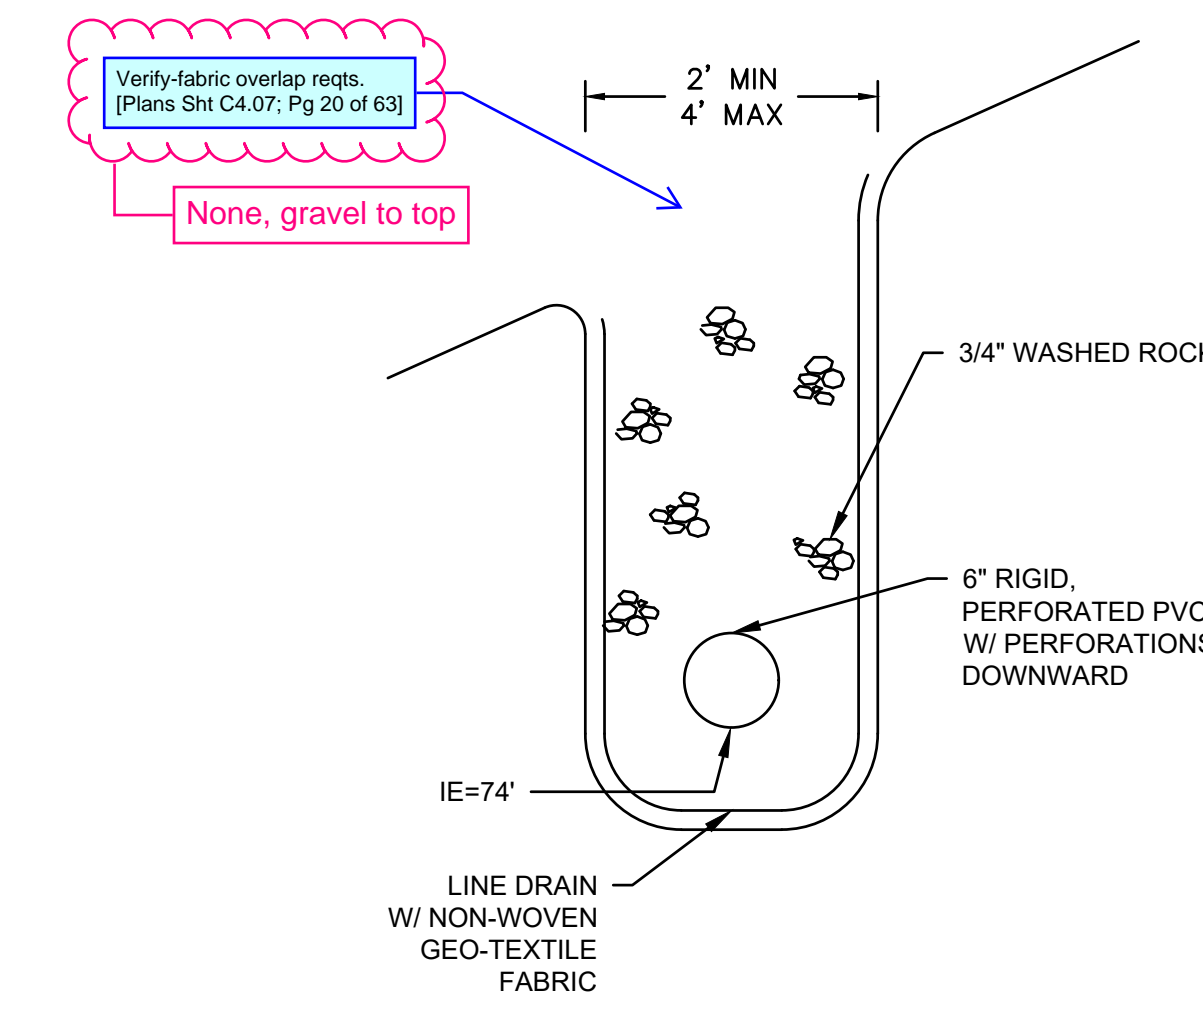


4 FRENCH DRAIN DETAIL
NOT TO SCALE

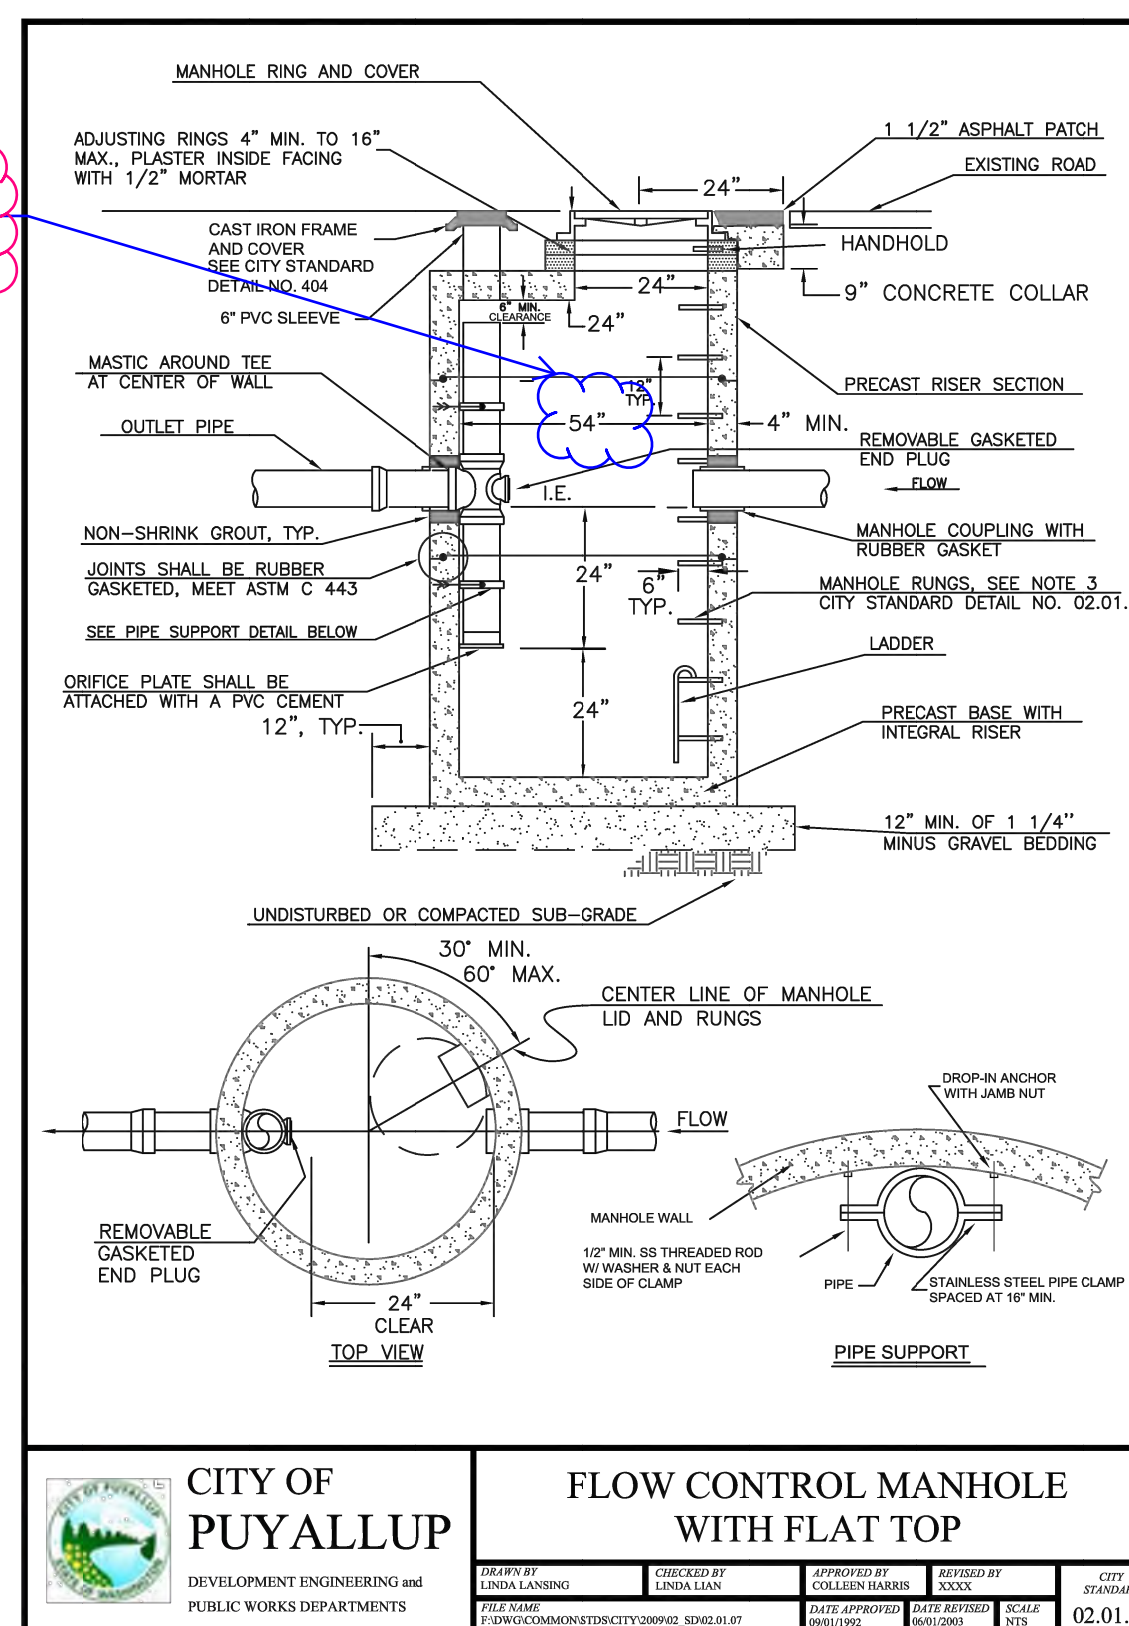


5 FLOW CONTROL MANHOLE WITH FLAT TOP (AND DATA TABLE)
NOT TO SCALE

CONTROL STRUCTURE GEOMETRY

STRUCTURE	PART	INVERT ELEVATION	DIAMETER (IN)	NOTES
5.1	RISER CREST	73.35	12.00	CIRCULAR
	ORIFICE 1	67.40	2.06	CIRCULAR, NO ELBOW
	ORIFICE 2	68.30	3.00	CIRCULAR, WITH ELBOW
5.2	RISER CREST	75.25	18.00	CIRCULAR
	ORIFICE 1	68.40	1.37	CIRCULAR, NO ELBOW
	ORIFICE 2	74.21	2.25	CIRCULAR, WITH ELBOW
	OUTLET PIPE	68.40	24.00	RIM: 76.96

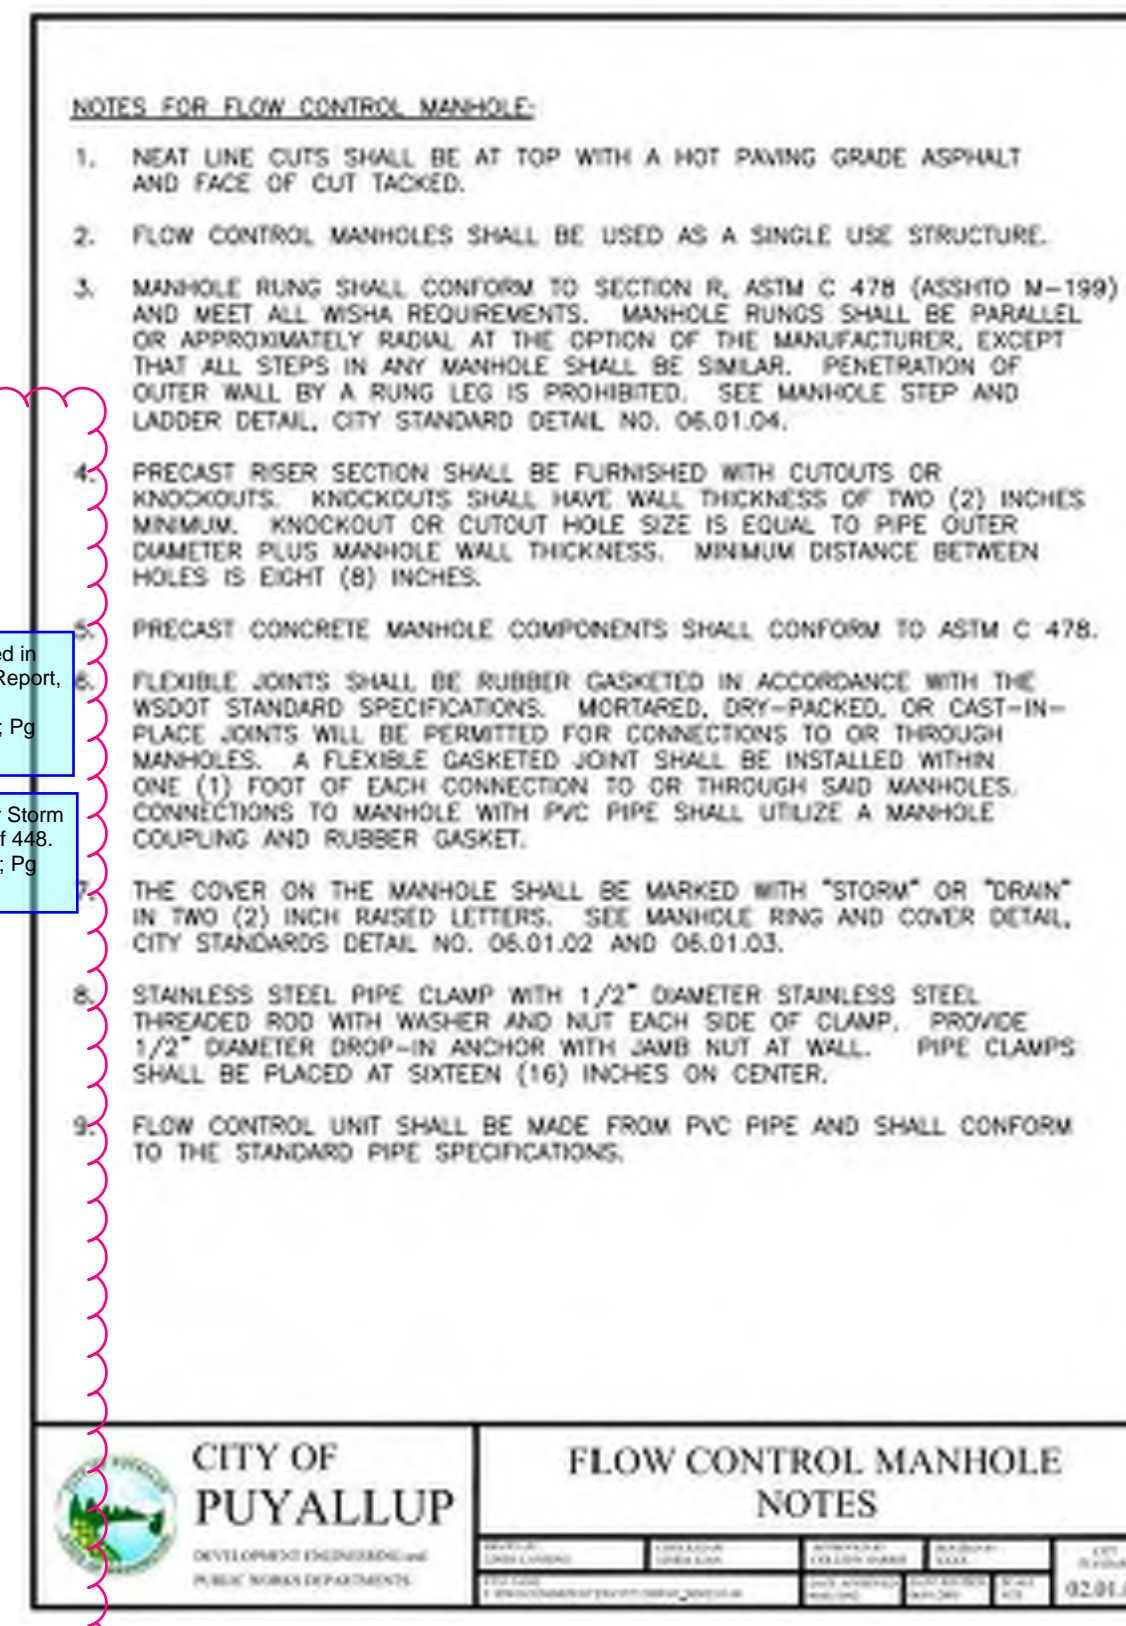

6 FLOW CONTROL MANHOLE NOTES
NOT TO SCALE

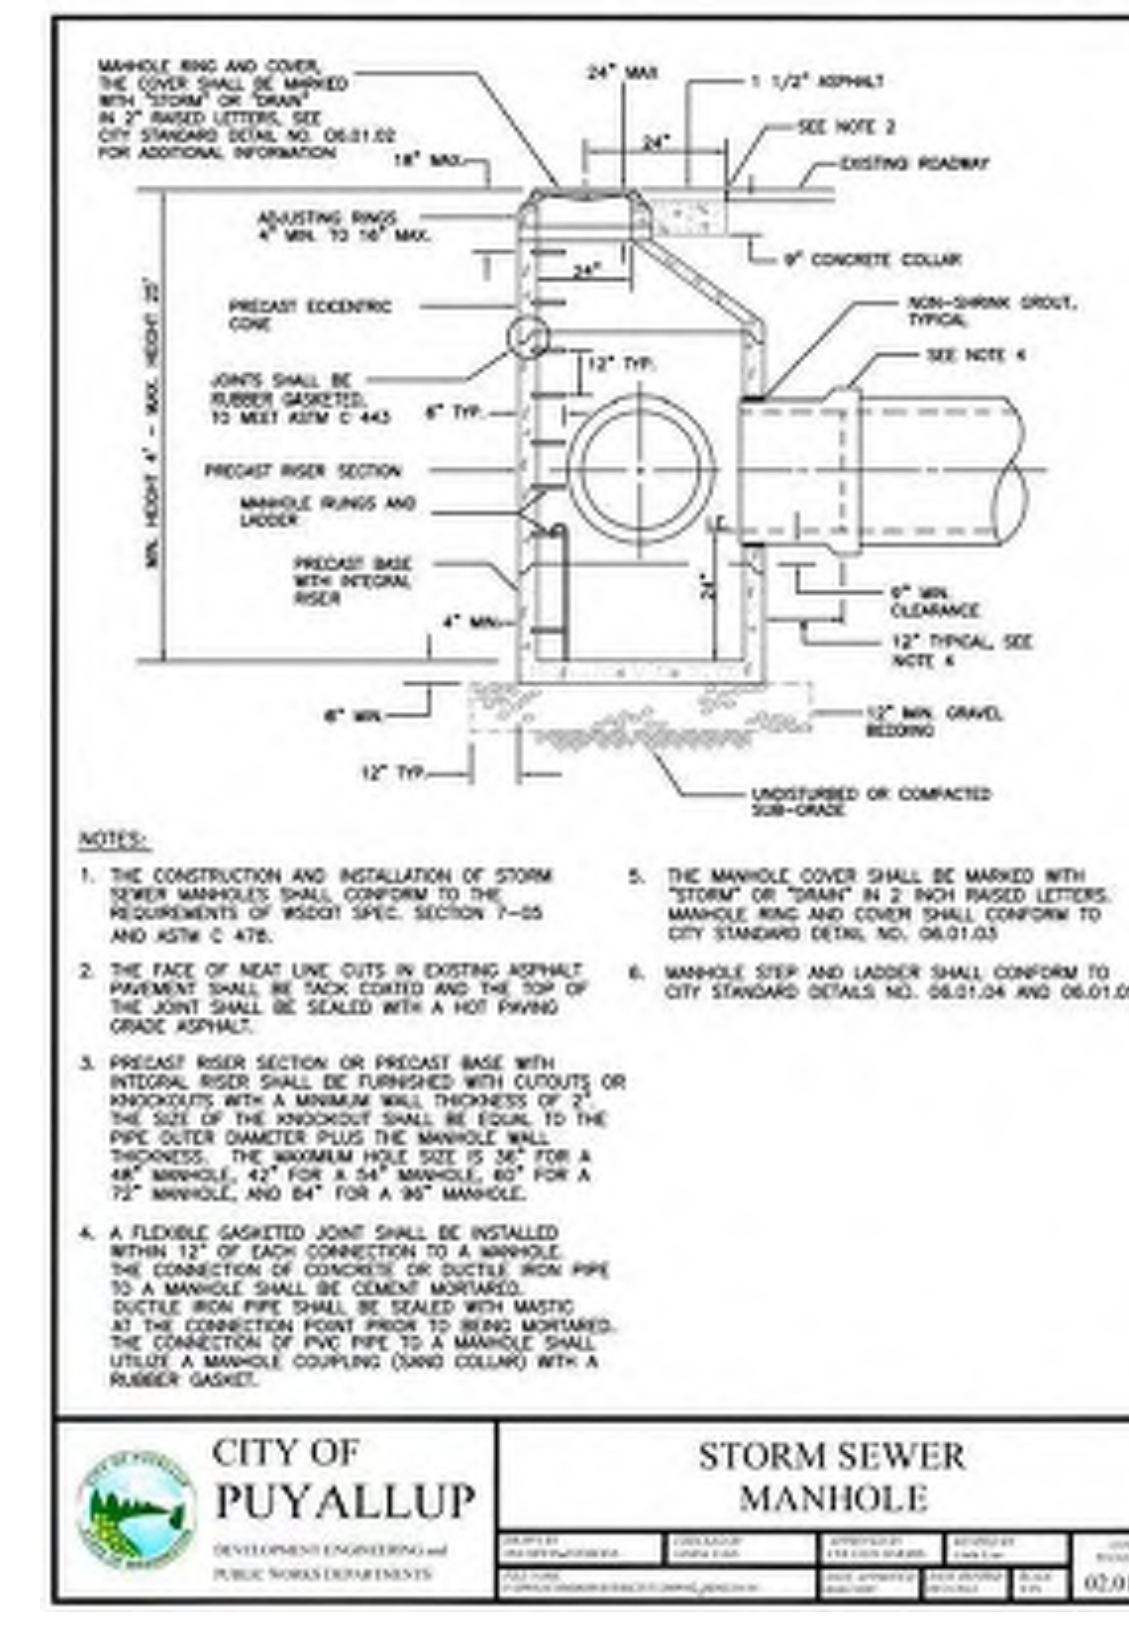

7 STORM SEWER MANHOLE
NOT TO SCALE

60in. [Plans Sh C4.07; Pg 20 of 63]
Revised Plan

VERIFY-1.25ft above IE per calcs in Storm Report, Pg 373 of 448. [Plans Sh C4.07; Pg 20 of 63]

VERIFY-It appears to be EI 70.88 noted on Sh. C4.11 (2ft of live storage per calcs-which places riser top at EI 69.40). Also, there are a number of CB rims below this elevation. [Plans Sh C4.07; Pg 20 of 63]

VERIFY-18in used in calcs per Storm Report, Pg 373 of 448. [Plans Sh C4.07; Pg 20 of 63]

VERIFY-2.25 per Storm Report, Pg 373 of 448. [Plans Sh C4.07; Pg 20 of 63]

VERIFY-It appears to be EI 73.32 noted on Sh. C4.21 (8ft of live storage per calcs-which places riser top at EI 73.40). However, RTank 3 top of storage is EI 75.23. It appears that as RTank 3 fills, RTank 2 will go into overflow before RTank 3 storage is fully utilized. If riser top is intended to be EI 75.25, then RTank 2 appears to be in a surcharged condition. [Plans Sh C4.07; Pg 20 of 63]

VERIFY-24in used in calcs per Storm Report, Pg 373 of 448. [Plans Sh C4.07; Pg 20 of 63]

VERIFY-1.5 per Storm Report, Pg 372 of 448. [Plans Sh C4.07; Pg 20 of 63]

VERIFY-1.25 per Storm Report, Pg 372 of 448. [Plans Sh C4.07; Pg 20 of 63]

ADD-City Standard Details 02.01.05 / 02.01.09. [Plans Sh C4.07; Pg 20 of 63]
Added



Know what's below.
Call before you dig.

Revisions:

Sheet Title:

STORM DRAINAGE NOTES AND DETAILS

Designed by: CW Drawn by: SK Checked by: JI

Sheet No.

C4.07

20 of 63 Sheets


EAST TOWN CROSSING PHASE 1

SEC. 26,35/ TWP. 20 N./ RGE. 4 E., W.M.

APPROVED

BY
CITY OF PUYALLUP
DEVELOPMENT ENGINEERING

DATE
NOTE: THIS APPROVAL IS VOID AFTER 180 DAYS FROM APPROVAL DATE. THE CITY WILL NOT BE RESPONSIBLE FOR ERRORS AND/OR OMISSIONS ON THESE PLANS. UNLESS OTHERWISE NOTED, ALL CONDITIONS MAY DICTATE CHANGES TO THESE PLANS AS DETERMINED BY THE DEVELOPMENT ENGINEERING DEPARTMENT.

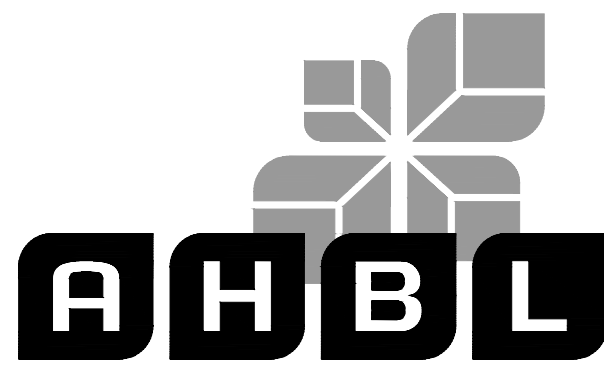

TACOMA · SEATTLE · SPOKANE · TRI-CITIES

2215 North 30th Street, Suite 300, Tacoma, WA 98403
253.383.2422 TEL 253.383.2572 FAX www.ahbl.com WEB

Project Title:

EAST TOWN CROSSING PHASE 1

Client:
ASH DEVELOPMENT

GREG HELLE

GREG.HELLE@ASHNW.COM

Project No.

2230752

Issue Set & Date:

PERMIT SUBMITTAL

11/20/2023




11/21/2023

NOTICE: ALTERATION OF THIS DOCUMENT SHALL INVALIDATE THE PROFESSIONAL SEAL AND SIGNATURE PUBLICATION OF THIS DOCUMENT DOES NOT CONSTITUTE A PROFESSIONAL ENGINEER'S RESPONSIBILITY FOR THE DESIGN OR FOR THE ONLY FOR THE PROJECT EXERCISED IN THE TITLE BLOCK AND IS NOT TO BE USED FOR OTHER PROJECTS OR ACTION TO THAT PROJECT OR FOR ANY OTHER PROJECT.



Fixed
Legibility
[Plans Sht C4.08; Pg 21 of 63]

SITE SPECIFIC DATA	
Structure ID	ID
Treatment Flow Rate (cfs)	0.12 CFS
Peak Flow Rate (cfs)	4 CFS
Rim Elevation	
Top of Vault Elevation	
Pipe Data	Invert Elevation
Inlet	
Outlet	
Notes: SEE TABLE BELOW FOR DATA	
PERFORMANCE SPECIFICATIONS	
Treatment Flow Capacities:*	
NJDEP 80% Removal, 75 micron	0.144 cfs
WA Ecology GULD - Basic, Enhanced & Phosphorus	0.128 cfs
Bypass Capacity	5.0 cfs
*Contact Oldcastle for alternative treatment flow capacities.	

6x8 BIOPOD				
NUMBER	1	3	4	5
RIM	73.16	76.48	76.19	76.23
TOP OF VAULT ELEVATION	72.83	76.15	75.86	75.90
INLET LOCATION	W	S	N	S
PIPE SIZE	8"	12"	12"	12"
PIPE TYPE	CPEP	CPEP	CPEP	CPEP
INLET IE	68.40	71.7	70.10	70.80
OUTLET LOCATION	S	N	S	N
PIPE SIZE	8"	12"	12"	12"
PIPE TYPE	CPEP	CPEP	CPEP	CPEP
OUTLET IE	67.90	68.90	69.60	70.30

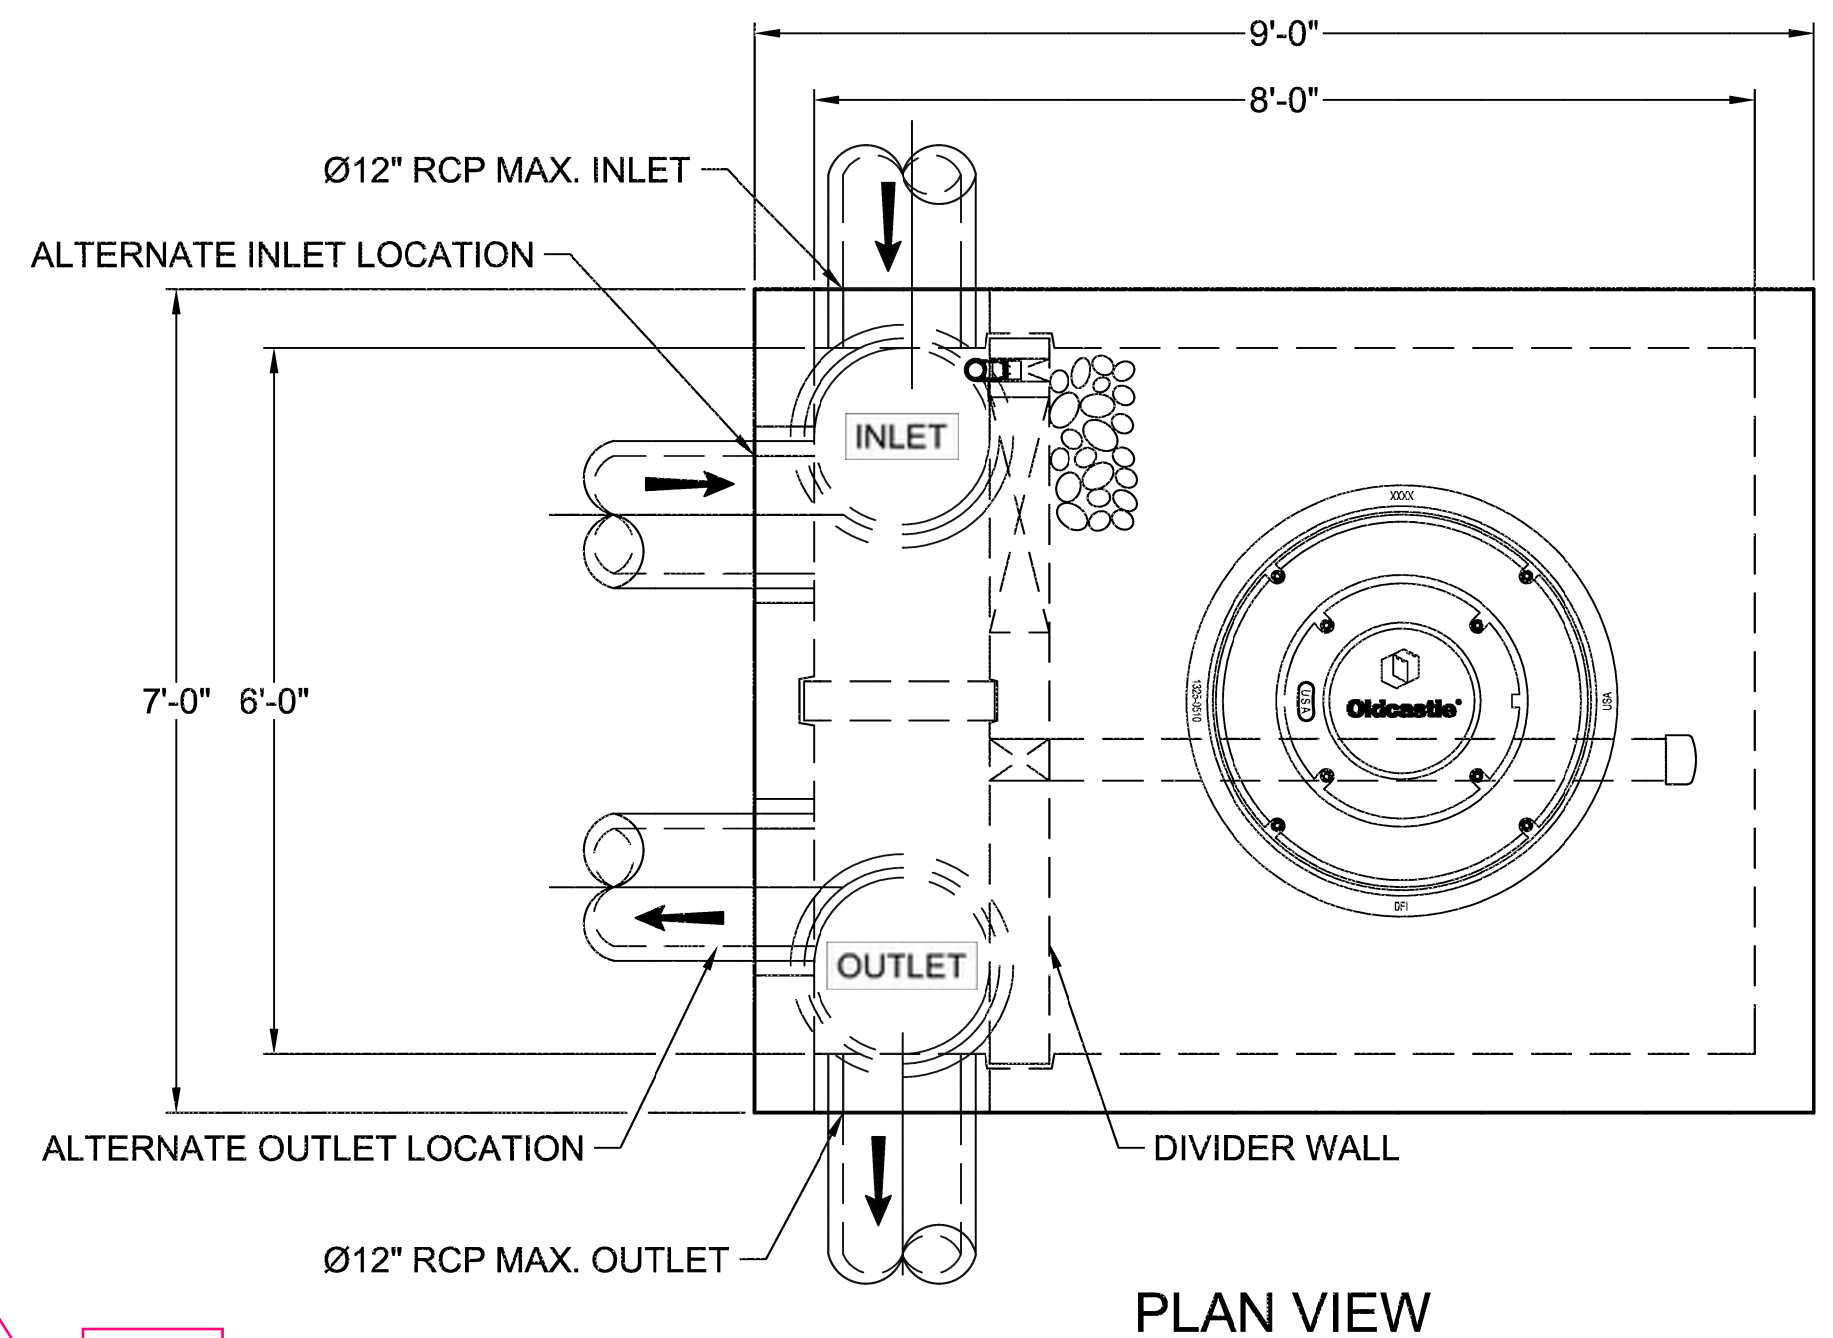

- NOTES:
- DESIGN LOADINGS:
 - AASHTO HS-20-44 (WITH IMPACT)
 - DESIGN SOIL COVER: 5'-0" MAXIMUM
 - ASSUMED WATER TABLE: BELOW BASE OF PRECAST (ENGINEER-OF-RECORD TO CONFIRM SITE WATER TABLE ELEVATION)
 - LATERAL EARTH PRESSURE: 45 PCF (DRAINED)
 - LATERAL LIVE LOAD SURCHARGE: 80 PSF (APPLIED TO 8'-0" BELOW GRADE)
 - NO LATERAL SURCHARGE FROM ADJACENT BUILDINGS, WALLS, PIERS, OR FOUNDATIONS.
 - CONCRETE 28-DAY MINIMUM COMPRESSIVE STRENGTH: 5,000 PSI MINIMUM.
 - REINFORCING: REBAR, ASTM A615/A706, GRADE 60
 - CEMENT: ASTM C150
 - REQUIRED ALLOWABLE SOIL BEARING CAPACITY: 2,500 PSF
 - REFERENCE STANDARD:
 - ASTM C890
 - ASTM C913
 - ACI 318-14
 - THIS STRUCTURE IS DESIGNED TO THE PARAMETERS NOTED HEREIN. ENGINEER-OF-RECORD SHALL VERIFY FY THAT NOTED PARAMETERS MEET OR EXCEED PROJECT REQUIREMENTS. IF DESIGN PARAMETERS ARE INCORRECT, REVIEWING ENGINEER/AUTHORITY SHALL NOTIFY OLDCASTLE INFRASTRUCTURE UPON REVIEW.
 - INLET AND OUTLET HOLES WILL BE FACTORY CORED/CAST PER PLANS AND CUSTOMER REQUIREMENTS. INLET AND OUTLET LOCATIONS CAN BE MIRRORED.
 - CONTRACTOR RESPONSIBLE TO VERIFY ALL SIZES, LOCATIONS, AND ELEVATIONS OF OPENINGS.
 - CONTRACTOR RESPONSIBLE TO ENSURE ADEQUATE BEARING SURFACE IS PROVIDED (I.E. COMPACTED AND LEVEL PER PROJECT SPECIFICATIONS).
 - SECTION HEIGHTS, SLAB/WALL THICKNESSES, AND KEYWAYS ARE SUBJECT TO CHANGE AS REQUIRED FOR SITE REQUIREMENTS AND/OR DUE TO PRODUCT AVAILABILITY AND PRODUCTION FACILITY CONSTRAINTS.
 - MAXIMUM PICK WEIGHTS*:
 - TOP: XX,XXX LBS
 - BASE: XX,XXX LBS*
 - (* COMBINED WEIGHT OF BASE INCLUDES BYPASS WEIR, DIVIDER WALL, ROCK & MEDIA)
 - INTERNALS SHALL CONSIST OF UNDERDRAIN PIPE, ROCK, STORMMIX™ MEDIA, MULCH, DIVIDER WALL, BYPASS WEIR AND OPTIONAL DRAIN DOWN.

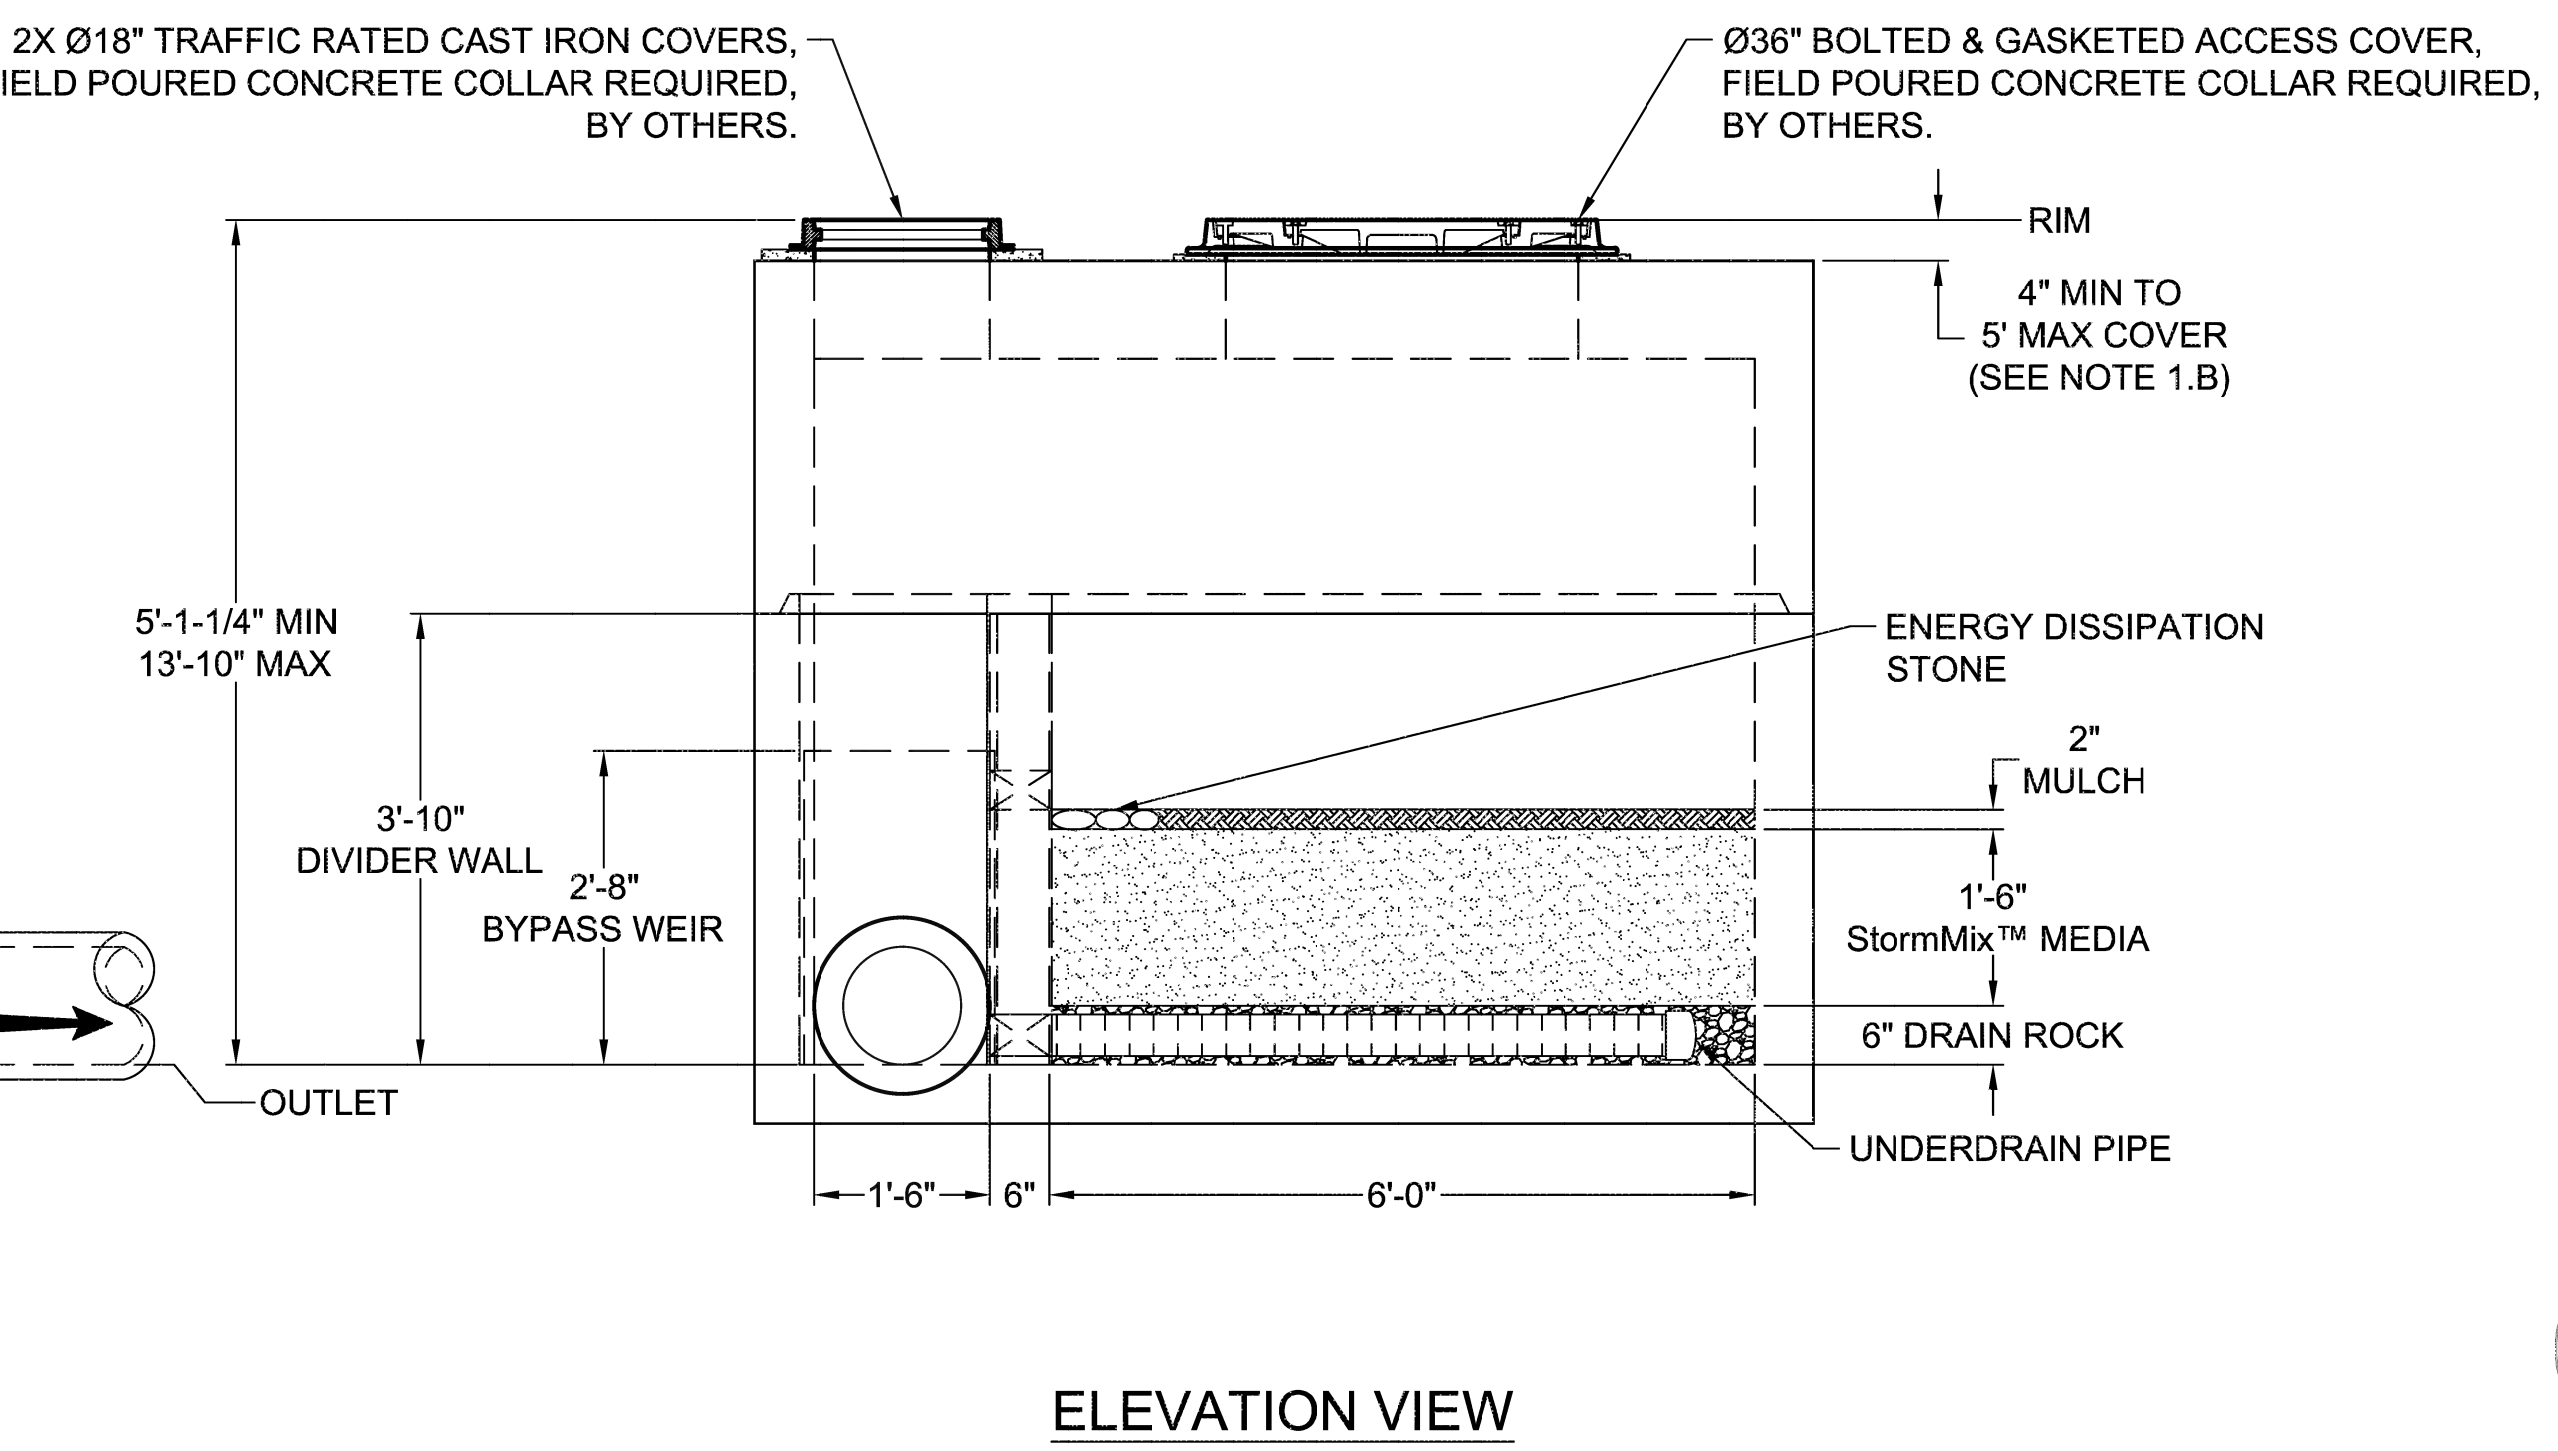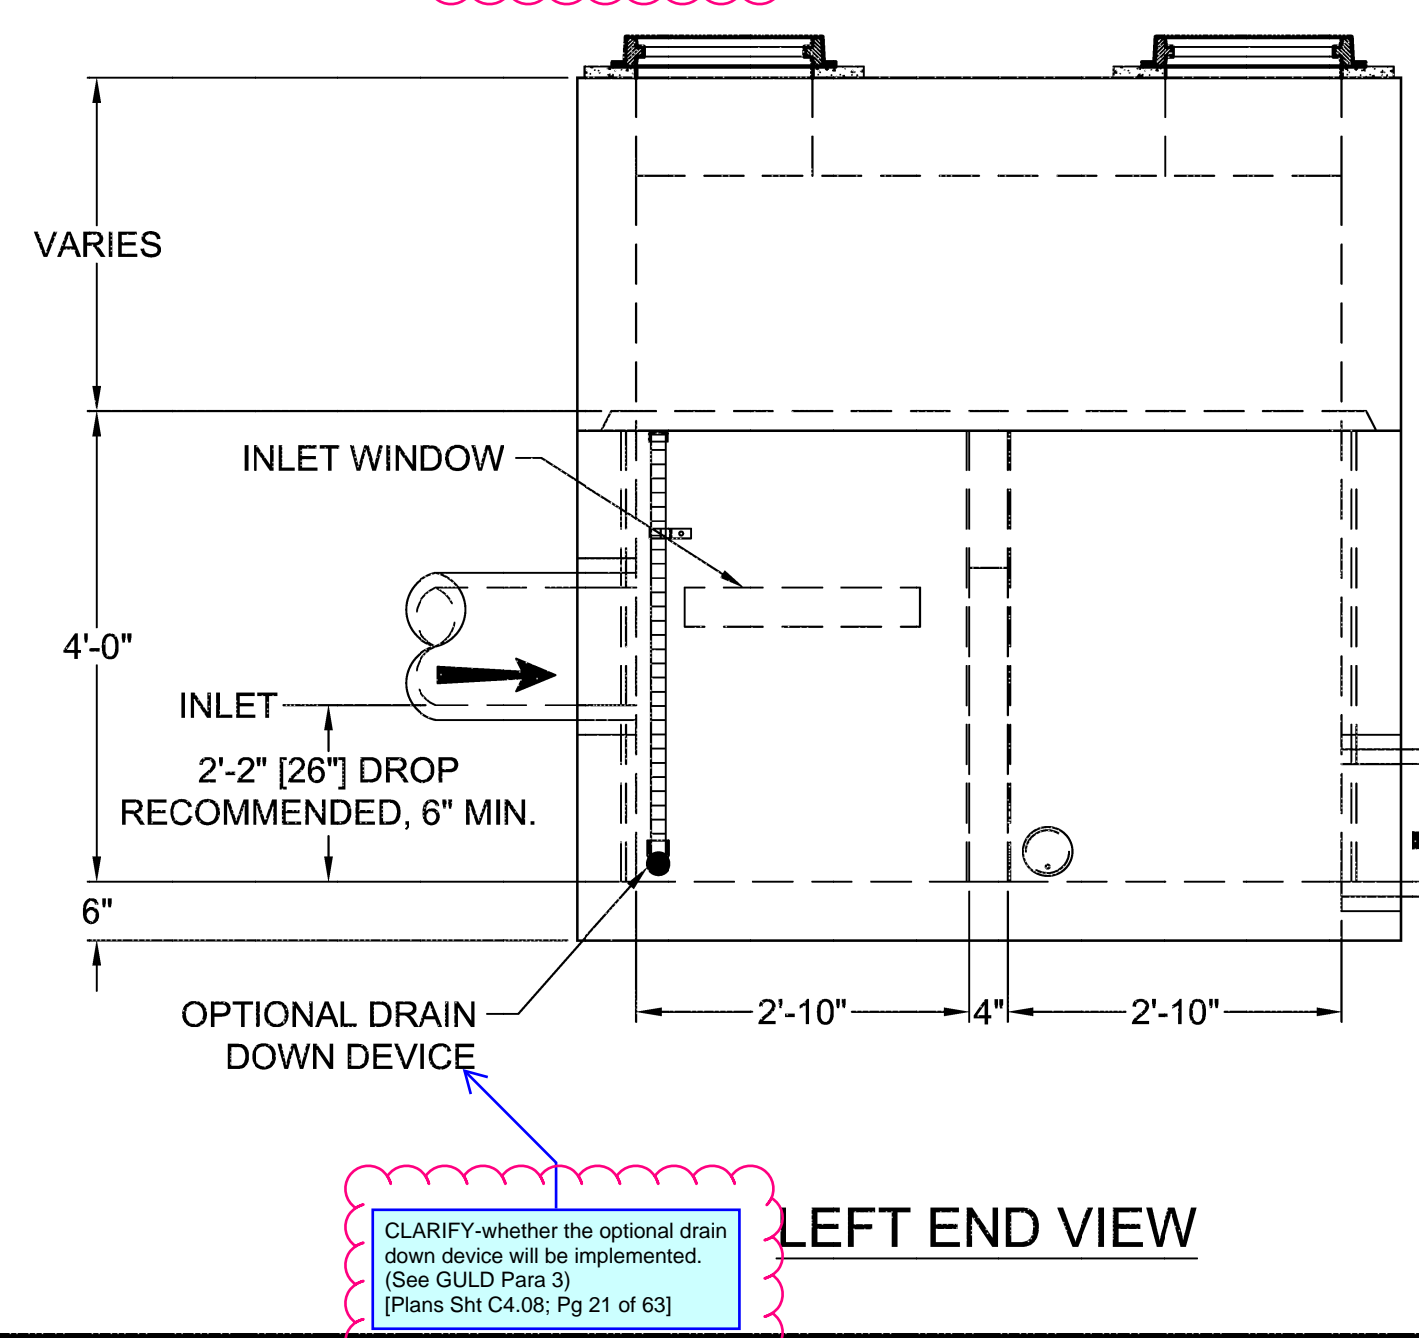

Oldcastle Infrastructure
A CRH COMPANY

Ph: 800.579.8819 | www.oldcastleinfrastructure.com/stormwater

THIS DOCUMENT IS THE PROPERTY OF OLDCASTLE INFRASTRUCTURE, INC. IT IS CONFIDENTIAL, SUBMITTED FOR REFERENCE PURPOSES ONLY AND SHALL NOT BE USED IN ANY WAY INJURIOUS TO THE INTERESTS OF, OR WITHOUT THE WRITTEN PERMISSION OF OLDCASTLE INFRASTRUCTURE, INC. COPYRIGHT © 2021 OLDCASTLE INFRASTRUCTURE, INC. ALL RIGHTS RESERVED.

BioPod™ Biofilter System (STANDARD)
Underground Vault with Internal Bypass

CUSTOMER	
PROJECT NAME	
SHEET NAME	1 OF 1
Specifer Drawing BPU-681B	
REVISION	
REV DATE	

1 6X8 BIOPOD
NOT TO SCALE



Know what's below.
Call before you dig.

Revisions:

Sheet Title:

STORM DRAINAGE NOTES AND DETAILS

Designed by: CW
Drawn by: SK
Checked by: JI

Sheet No.

C4.08

21 of 63 Sheets


EAST TOWN CROSSING PHASE 1

SEC. 26,35/ TWP. 20 N./ RGE. 4 E., W.M.

APPROVED

BY: CITY OF PUYALLUP
DEVELOPMENT ENGINEERING

DATE: _____
NOTE: THIS APPROVAL IS VOID AFTER 180 DAYS FROM APPROVAL DATE. THE CITY WILL NOT BE RESPONSIBLE FOR ERRORS AND/OR OMISSIONS ON THESE PLANS. FIELD CONDITIONS MAY DICTATE CHANGES TO THESE PLANS AS DETERMINED BY THE DEVELOPMENT ENGINEERING NAGLER.

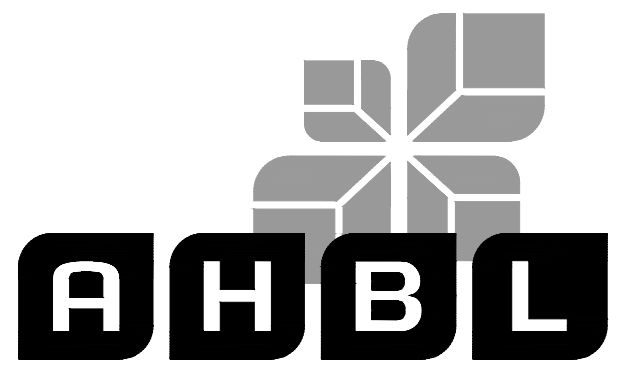

TACOMA · SEATTLE · SPOKANE · TRI-CITIES

2215 North 30th Street, Suite 300, Tacoma, WA 98403
253.383.2422 TEL 253.383.2572 FAX www.ahbl.com WEB

Project Title:

EAST TOWN CROSSING PHASE 1

Client:
ASH DEVELOPMENT

GREG HELLE

GREG.HELLE@ASHNW.COM

Project No.

2230752

Issue Set & Date:

PERMIT SUBMITTAL

11/20/2023




11/21/2023

NOTICE: ALTERATION OF THIS DOCUMENT SHALL INVALIDATE THE PROFESSIONAL SEAL AND SIGNATURE. PUBLICATION OF THIS DOCUMENT DOES NOT CONSTITUTE AN ENDORSEMENT OR GUARANTEE BY THE ENGINEER OR ARCHITECT FOR THE PROJECT DESCRIBED IN THE TITLE BLOCK AND IS NOT TO BE USED FOR OTHER PROJECTS OR ADDITION TO THAT PROJECT OR FOR ANY OTHER PROJECT.

Legibility: [Plans Sht C4.09, Pg 22 of 63]
Fixed


SITE SPECIFIC DATA				
Structure ID	ID			
Treatment Flow Rate (cfs)	0.05 CFS			
Peak Flow Rate (cfs)	1.2 CFS			
Rim Elevation	76.71			
Top of Vault Elevation	76.38			
Pipe Data	Pipe Location	Pipe Size	Pipe Type	Invert Elevation
Inlet	N	8"	CPEP	72.83
Outlet	S	12"	CPEP	70.66
Notes:				
PERFORMANCE SPECIFICATIONS				
Treatment Flow Capacities:*				
NJDEP 80% Removal, 75 micron	0.064 cfs			
WA Ecology GULD - Basic, Enhanced & Phosphorus	0.057 cfs			
Bypass Capacity	5.0 cfs			
*Contact Oldcastle for alternative treatment flow capacities.				

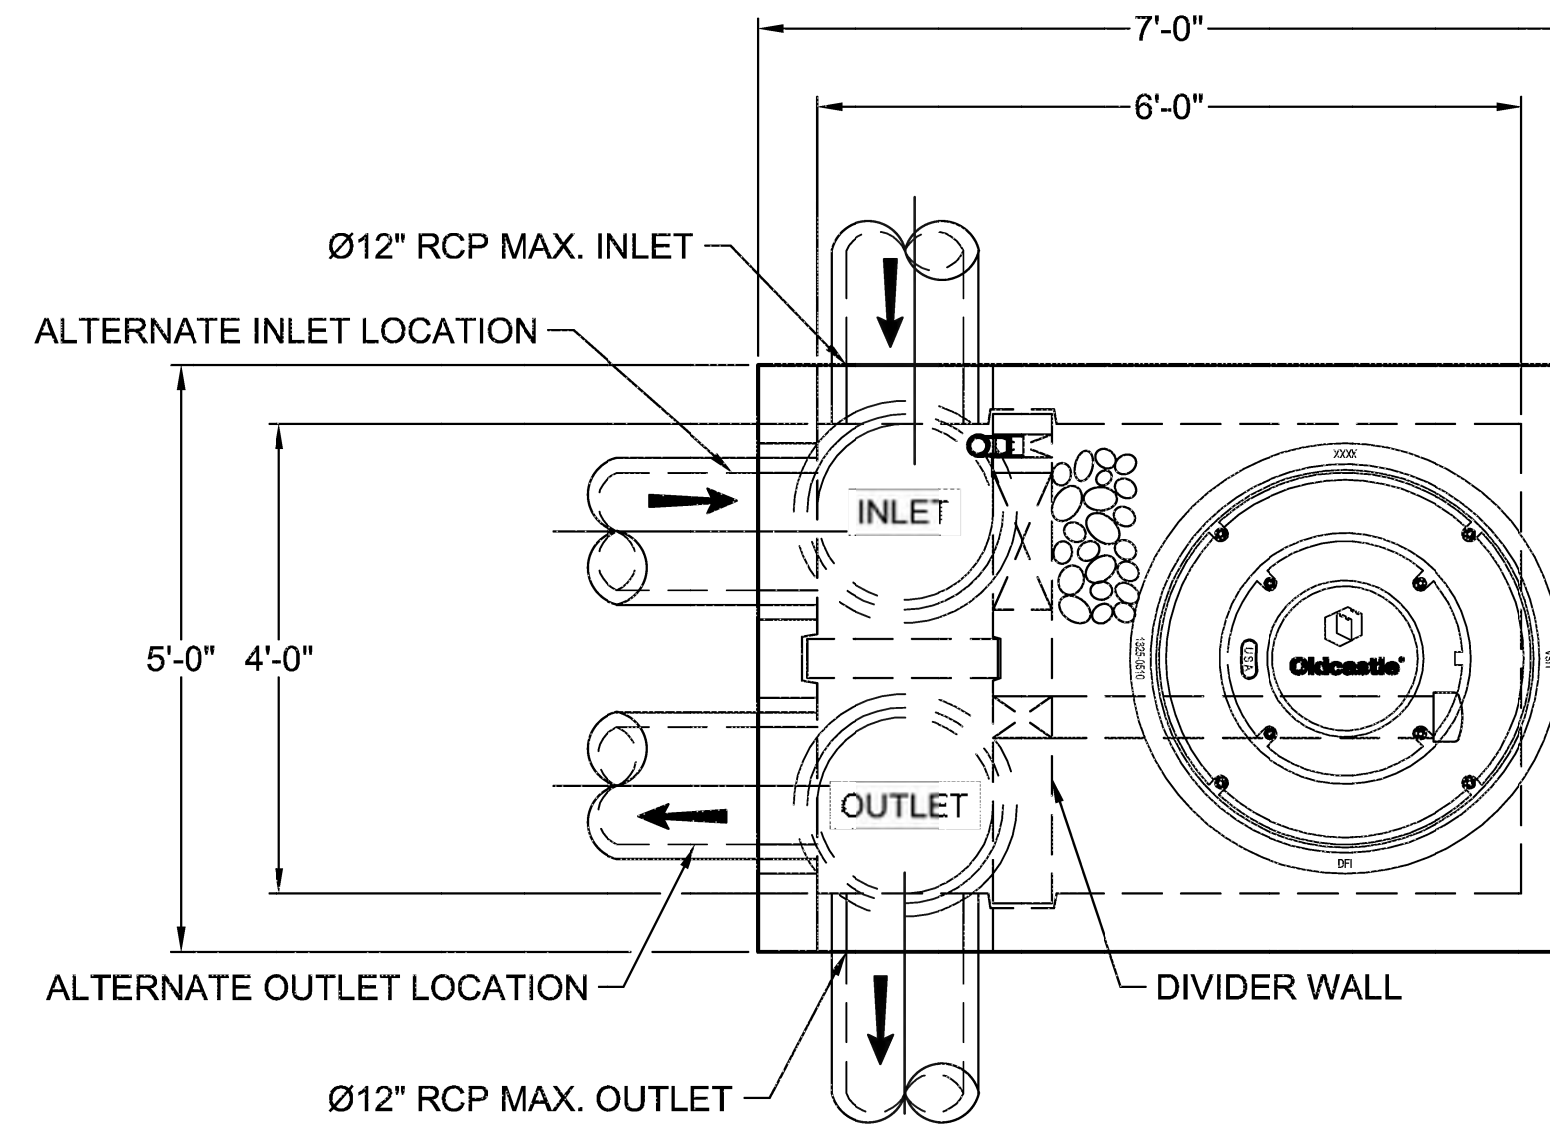


PLAN VIEW

NOTES:

- DESIGN LOADINGS:
 - AASHTO HS-20-44 (WITH IMPACT)
 - DESIGN SOIL COVER: 5'-0" MAXIMUM
 - ASSUMED WATER TABLE: BELOW BASE OF PRECAST (ENGINEER-OF-RECORD TO CONFIRM SITE WATER TABLE ELEVATION)
 - LATERAL EARTH PRESSURE: 45 PCF (DRAINED)
 - LATERAL LIVE LOAD SURCHARGE: 80 PSF (APPLIED TO 8'-0" BELOW GRADE)
 - NO LATERAL SURCHARGE FROM ADJACENT BUILDINGS, WALLS, PIERS, OR FOUNDATIONS.
- CONCRETE 28-DAY MINIMUM COMPRESSIVE STRENGTH: 5,000 PSI MINIMUM.
- REINFORCING: REBAR, ASTM A615/A706, GRADE 60
- CEMENT: ASTM C150
- REQUIRED ALLOWABLE SOIL BEARING CAPACITY: 2,500 PSF
- REFERENCE STANDARD:
 - ASTM C890
 - ASTM C913
 - ACI 318-14
- THIS STRUCTURE IS DESIGNED TO THE PARAMETERS NOTED HEREIN. ENGINEER-OF-RECORD SHALL VERIFY THAT NOTED PARAMETERS MEET OR EXCEED PROJECT REQUIREMENTS. IF DESIGN PARAMETERS ARE INCORRECT, REVIEWING ENGINEER/AUTHORITY SHALL NOTIFY OLDCASTLE INFRASTRUCTURE UPON REVIEW.
- INLET AND OUTLET HOLES WILL BE FACTORY CORED/CAST PER PLANS AND CUSTOMER REQUIREMENTS. INLET AND OUTLET LOCATIONS CAN BE MIRRORRED.
- CONTRACTOR RESPONSIBLE TO VERIFY ALL SIZES, LOCATIONS, AND ELEVATIONS OF OPENINGS.
- CONTRACTOR RESPONSIBLE TO ENSURE ADEQUATE BEARING SURFACE IS PROVIDED (I.E. COMPACTED AND LEVEL PER PROJECT SPECIFICATIONS).
- SECTION HEIGHTS, SLAB/WALL THICKNESSES, AND KEYWAYS ARE SUBJECT TO CHANGE AS REQUIRED FOR SITE REQUIREMENTS AND/OR DUE TO PRODUCT AVAILABILITY AND PRODUCTION FACILITY CONSTRAINTS.
- MAXIMUM PICK WEIGHTS*:
 - TOP: XX,XXX LBS
 - BASE: XX,XXX LBS*
 - (* COMBINED WEIGHT OF BASE INCLUDES BYPASS WEIR, DIVIDER WALL, ROCK & MEDIA)
- INTERNALS SHALL CONSIST OF UNDERDRAIN PIPE, ROCK, STORMMIX™ MEDIA, MULCH, DIVIDER WALL, BYPASS WEIR AND OPTIONAL DRAIN DOWN.

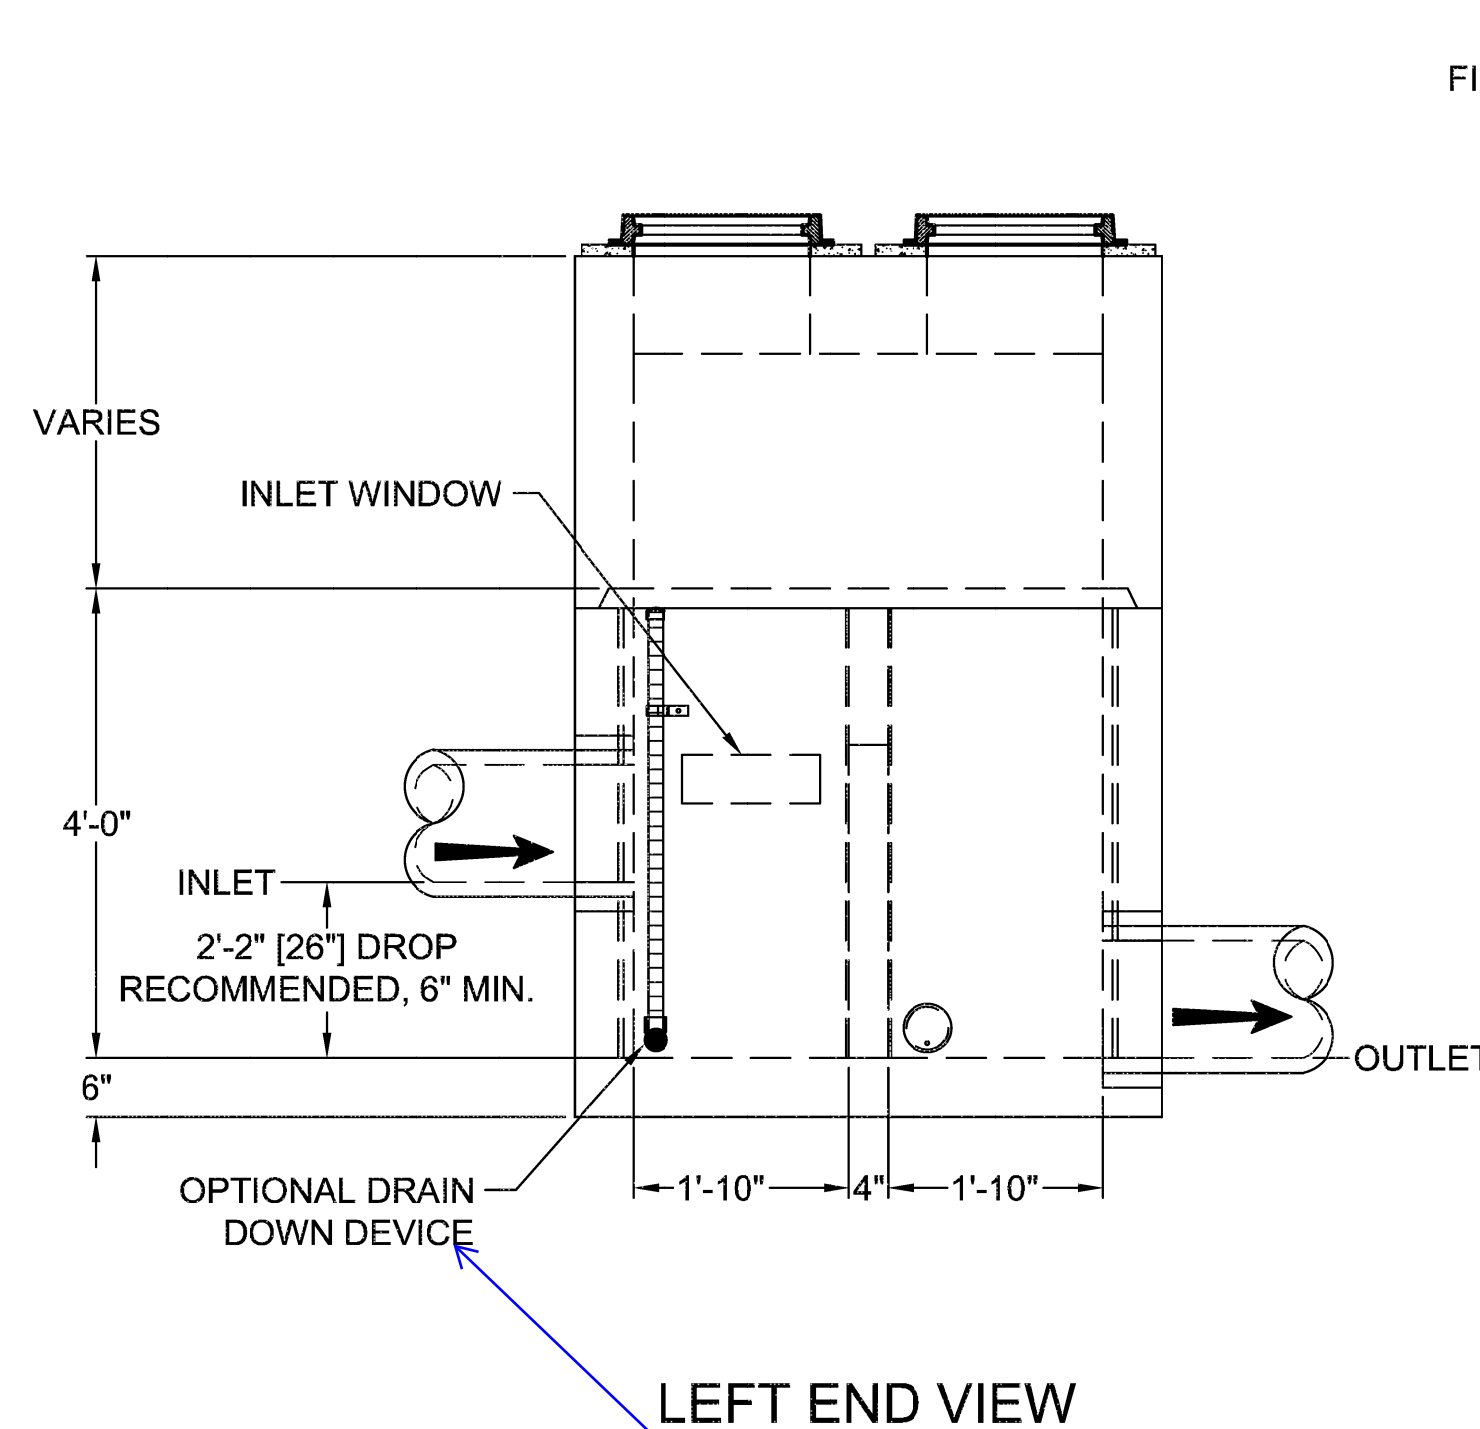

LEFT END VIEW

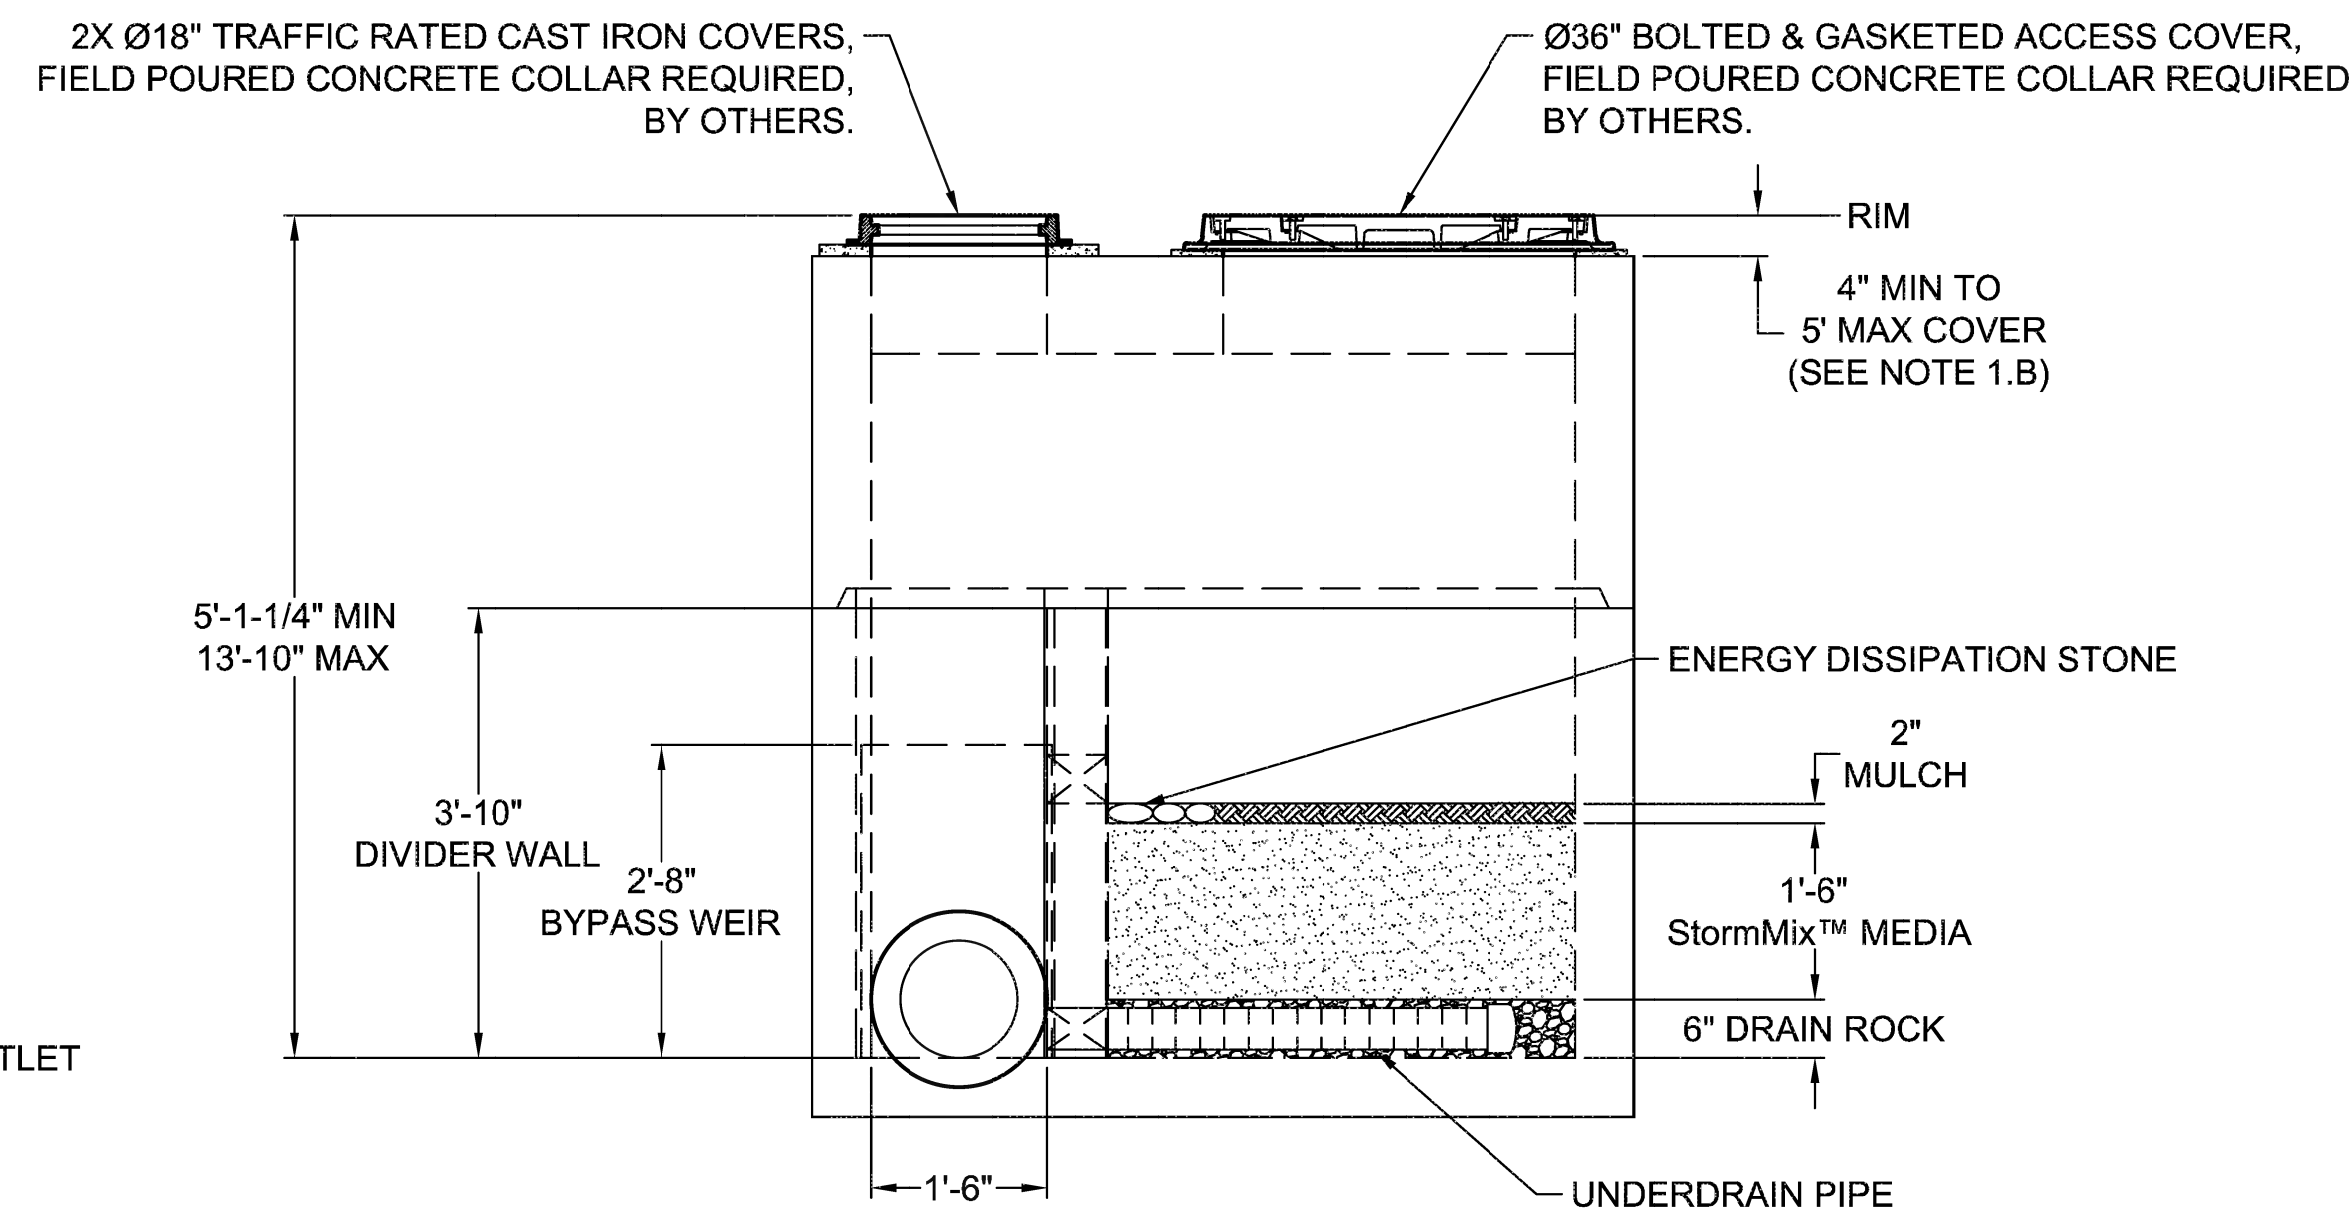

ELEVATION VIEW

CLARIFY-whether the optional drain down device will be implemented. (See GULD Para 3) [Plans Sht C4.09, Pg 22 of 63]
Will not be included


Oldcastle Infrastructure
A CEM COMPANY

Ph: 800.579.8819 | www.oldcastleinfrastructure.com/stormwater

THIS DOCUMENT IS THE PROPERTY OF OLDCASTLE INFRASTRUCTURE, INC. IT IS CONFIDENTIAL, SUBMITTED FOR REFERENCE PURPOSES ONLY AND SHALL NOT BE USED IN ANY WAY INJURIOUS TO THE INTERESTS OF OLDCASTLE INFRASTRUCTURE, INC. WITHOUT THE WRITTEN PERMISSION OF OLDCASTLE INFRASTRUCTURE, INC. COPYRIGHT © 2021 OLDCASTLE INFRASTRUCTURE, INC. ALL RIGHTS RESERVED.

BioPod™ Biofilter System (STANDARD)
Underground Vault with Internal Bypass

CUSTOMER	-		
PROJECT NAME	-		
SHEET NAME	REVISION	REV DATE	SHEET
Specifier Drawing BPU-461B	-	-	1 OF 1

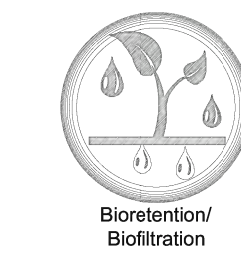

Know what's below.
Call before you dig.

1 4X6 BIPOD
NOT TO SCALE

Revisions:

Sheet Title:

STORM DRAINAGE NOTES AND DETAILS

Designed by: CW Drawn by: SK Checked by: JI

Sheet No.

C4.09

22 of 63 Sheets

EAST TOWN CROSSING PHASE 1

SEC. 26,35/ TWP. 20 N./ RGE. 4 E., W.M.

Legibility:
[Plane SH C4.10, Pg 23 of 63]

Fixed

APPROVED

BY
CITY OF PUYALLUP
DEVELOPMENT ENGINEERING

DATE


NOTE: THIS APPROVAL IS VOID
IF NOT SIGNED AND DATED WITHIN
10 BUSINESS DAYS FROM APPROVAL.
THE CITY WILL NOT BE
RESPONSIBLE FOR ERRORS
OR OMISSIONS ON THESE
PLANS. UNLESS OTHERWISE
STATED, ALL CONDITIONS MAY DICTATE
CHANGES TO THESE PLANS AS
DETERMINED BY THE
DEVELOPMENT ENGINEERING
MANAGER.



ACKNOWLEDGEMENT:
AN APPROVAL OF THE SUBMITTAL PLANS IS REQUIRED PRIOR TO MATERIAL ORDER. AS PART OF THE SUBMITTAL APPROVAL, THE ENGINEER OF RECORD HEREBY ACKNOWLEDGES THAT THE R-TANK SYSTEM IS NOT DESIGNED TO SUPPORT LOADS FROM BUILDINGS OR STRUCTURES. THEREFORE, THE ENGINEER OF RECORD HAS COORDINATED WITH THE PROPER DISCIPLINES TO ENSURE NO STRUCTURAL LOADS ARE IMPARTED UPON THE SYSTEM AND ANY INFILTRATION FROM THE SYSTEM HAS BEEN ACCOUNTED FOR IN THE FOUNDATION DESIGN.

NOTES:

- THE CONTRACTOR SHALL PARTICIPATE IN A PRECONSTRUCTION MEETING AND SIGN THE PRECONSTRUCTION CHECKLIST PRIOR TO MATERIAL INSTALLATION.
- DOCUMENTATION SHALL BE RECORDED BY THE CONTRACTOR OR ENGINEER OF RECORD SHOWING PROPER INSTALLATION OF THE SYSTEM AND ALL CONNECTIONS, IN ACCORDANCE WITH MANUFACTURER SPECIFICATIONS.
- IT IS HEREBY RECOMMENDED THAT THE R-TANK SYSTEM BE INSTALLED AFTER THE FOUNDATIONS HAVE BEEN INSTALLED TO ENSURE PROPER SEPARATION DISTANCES ARE MAINTAINED.

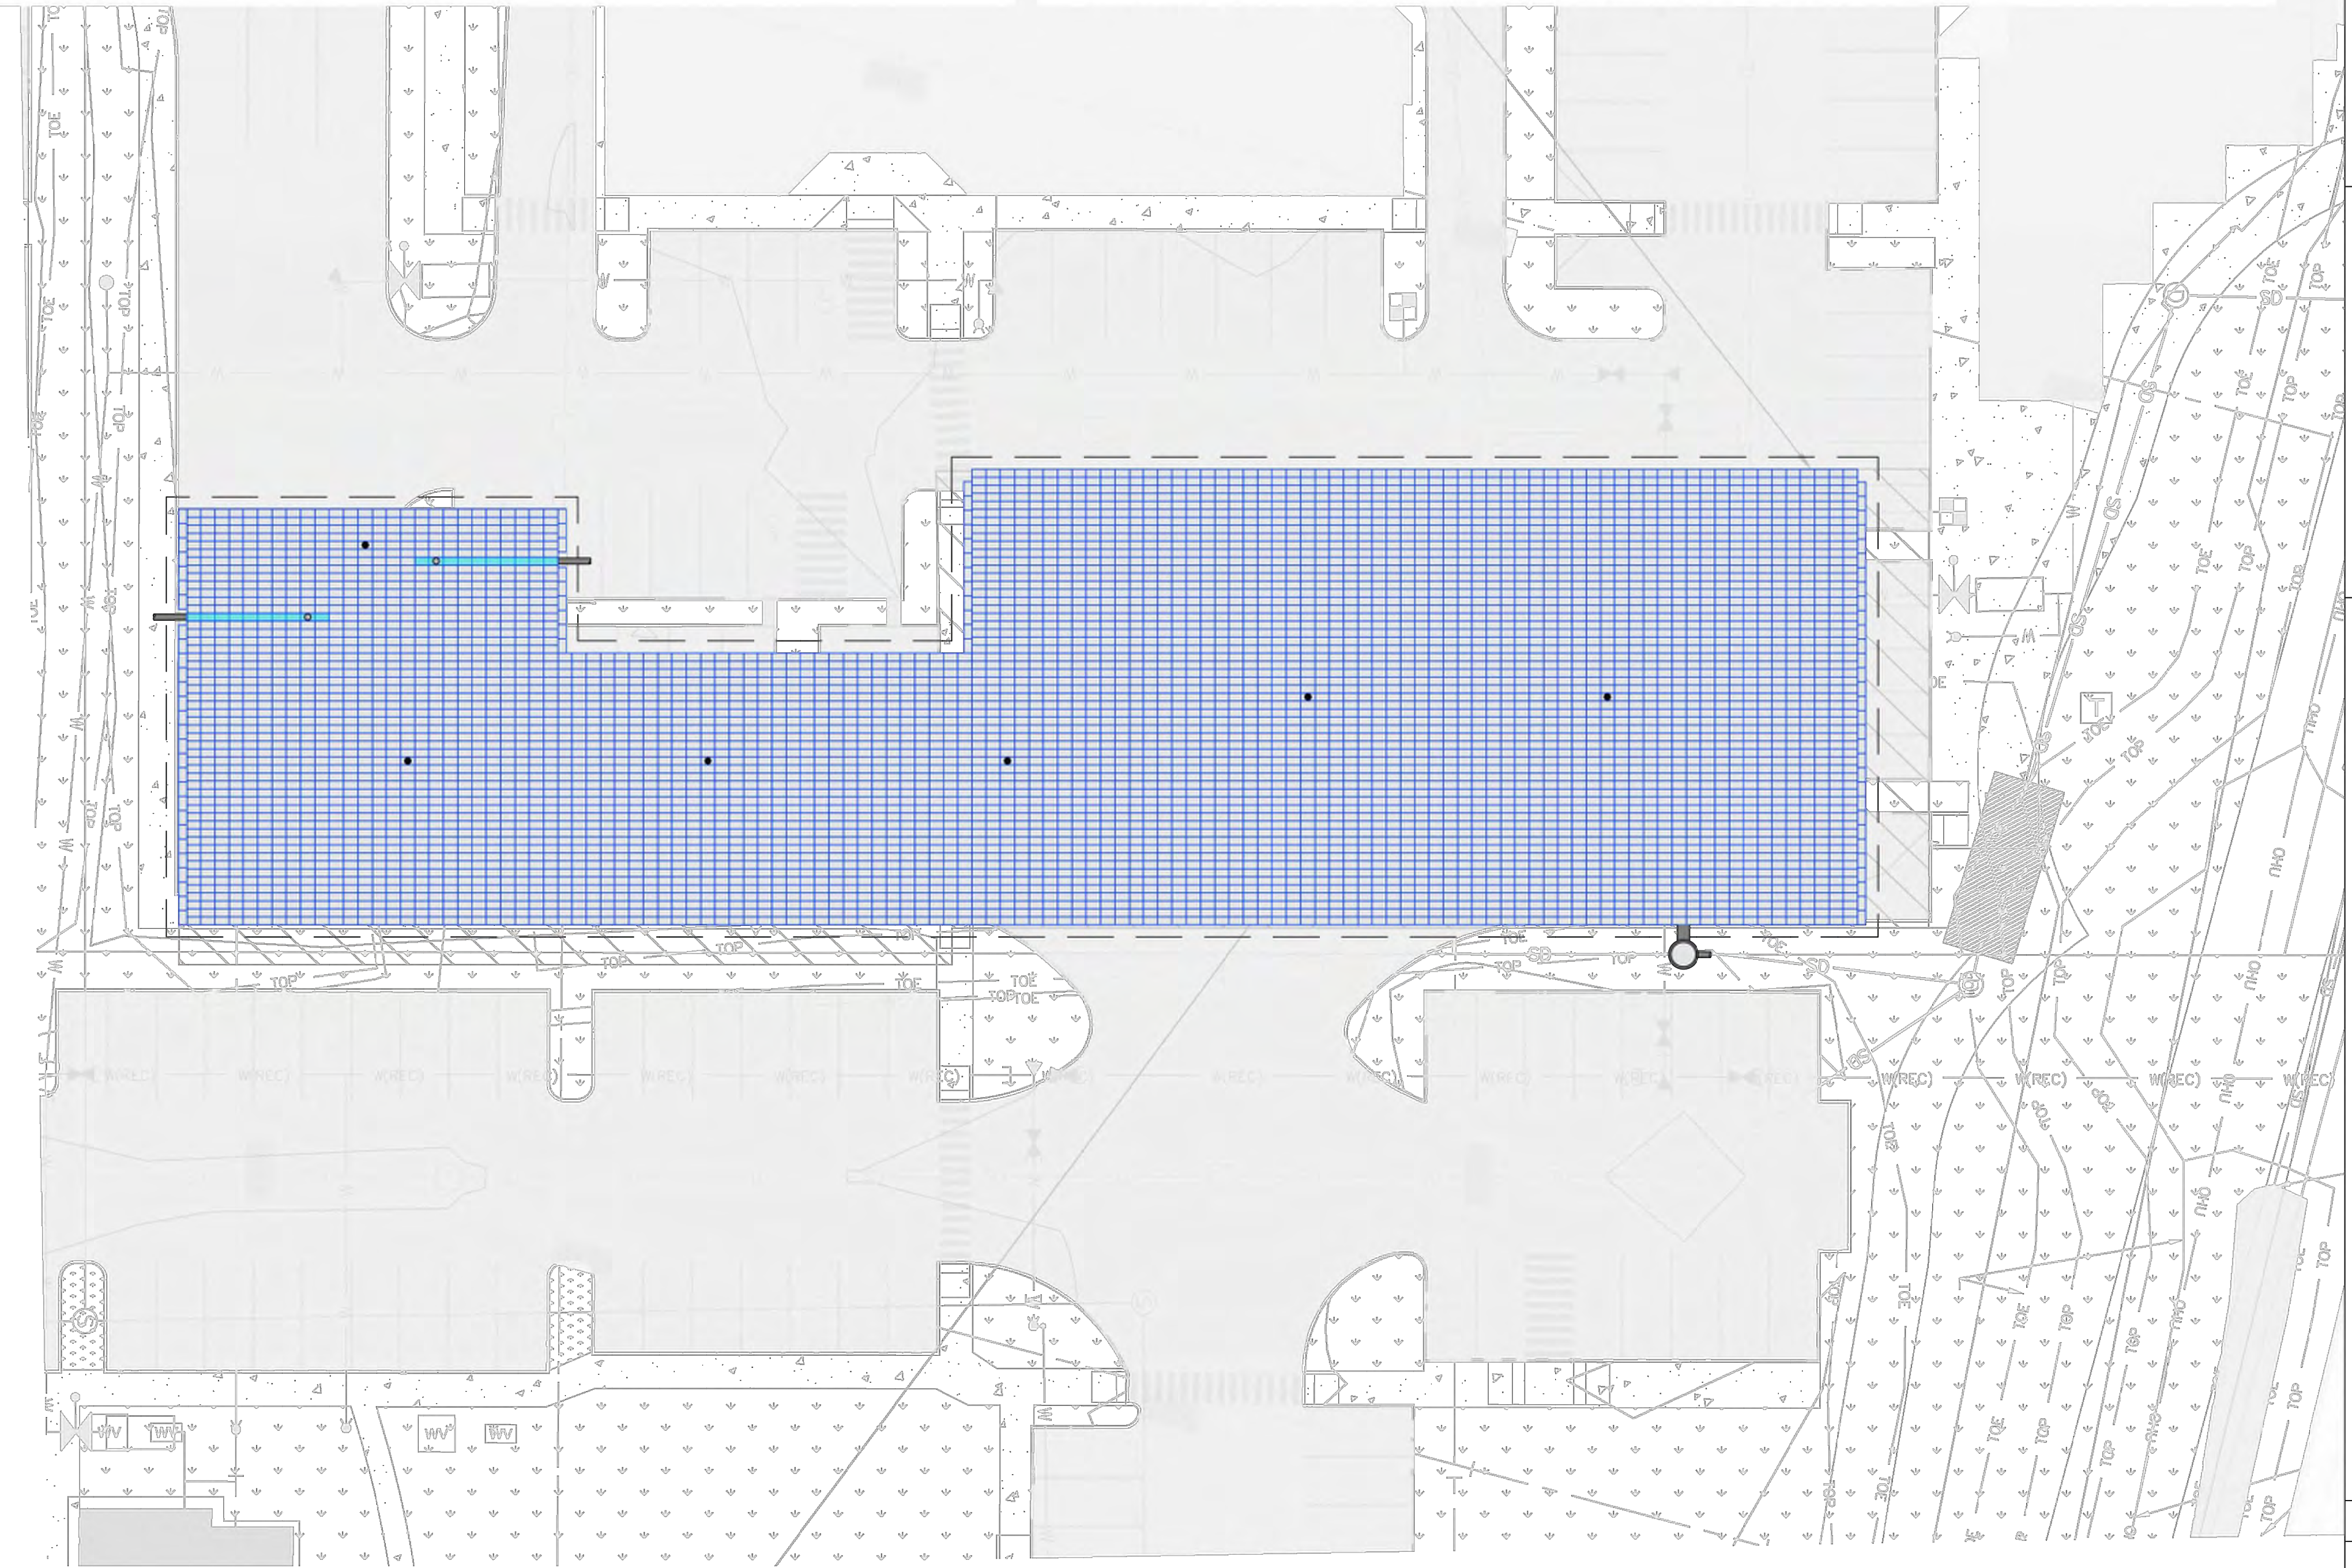

R-TANK^{SD} SYSTEM OVERLAY
EAST TOWN CROSSING
PUYALLUP, WA
SITE DESIGNATION: R-TANK 1


DRAWN BY
EDQ

DATE
11/10/2023

ACF WEST PROJECT NUMBER
23-004WA

SHEET NO.
1 of 8

R-TANK^{SD} SYSTEM OVERLAY
SCALE: 1" = 30'

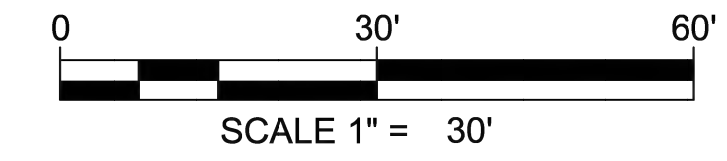


Project Title:
EAST TOWN CROSSING PHASE 1

Client:
ASH DEVELOPMENT

GREG HELLE
GREG.HELLE@ASHNW.COM

Project No.
2230752

Issue Set & Date:
PERMIT SUBMITTAL
11/20/2023

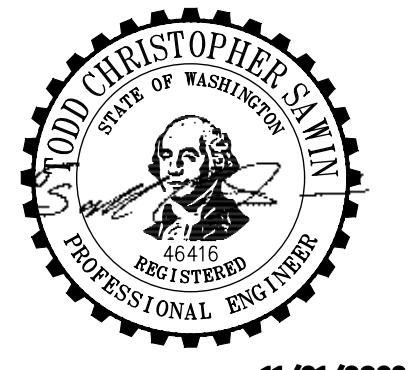

11/21/2023

NOTICE
ALTERNATION OF THIS DOCUMENT SHALL INDICATE THE PROFESSIONAL SEAL AND SIGNATURE PUBLICATION OF THIS DOCUMENT DOES NOT REPRESENT A REVIEWED OR CHECKED STATE BY THE ENGINEER OF RECORD ONLY FOR THE PROJECT ENTITLED IN THE TITLE BLOCK AND IS NOT TO BE USED FOR OTHER PROJECTS OR ADDITION TO THAT PROJECT OR FOR ANY OTHER PROJECT.

Revisions:

△

△

△

△

Sheet Title:
R-TANK 1 NOTES AND DETAILS

Designed by: CW
Drawn by: SK
Checked by: JI

Sheet No.
C4.10
23 of 63 Sheets



EAST TOWN CROSSING PHASE 1


SEC. 26,35/ TWP. 20 N./ RGE. 4 E., W.M.

Legibility:
[Plans Sht C4.11; Pg 24 of 63]
Fixed

APPROVED
BY: CITY OF PUYALLUP
DEVELOPMENT ENGINEERING
DATE: 11/10/2023



NOTE:
MINIMUM COVER FROM TOP OF TANK TO FINISH GRADE MUST BE AT LEAST 30" TO MEET A 45 KIP OUTRIGGER LOAD ON AN 18"X18" PAD.

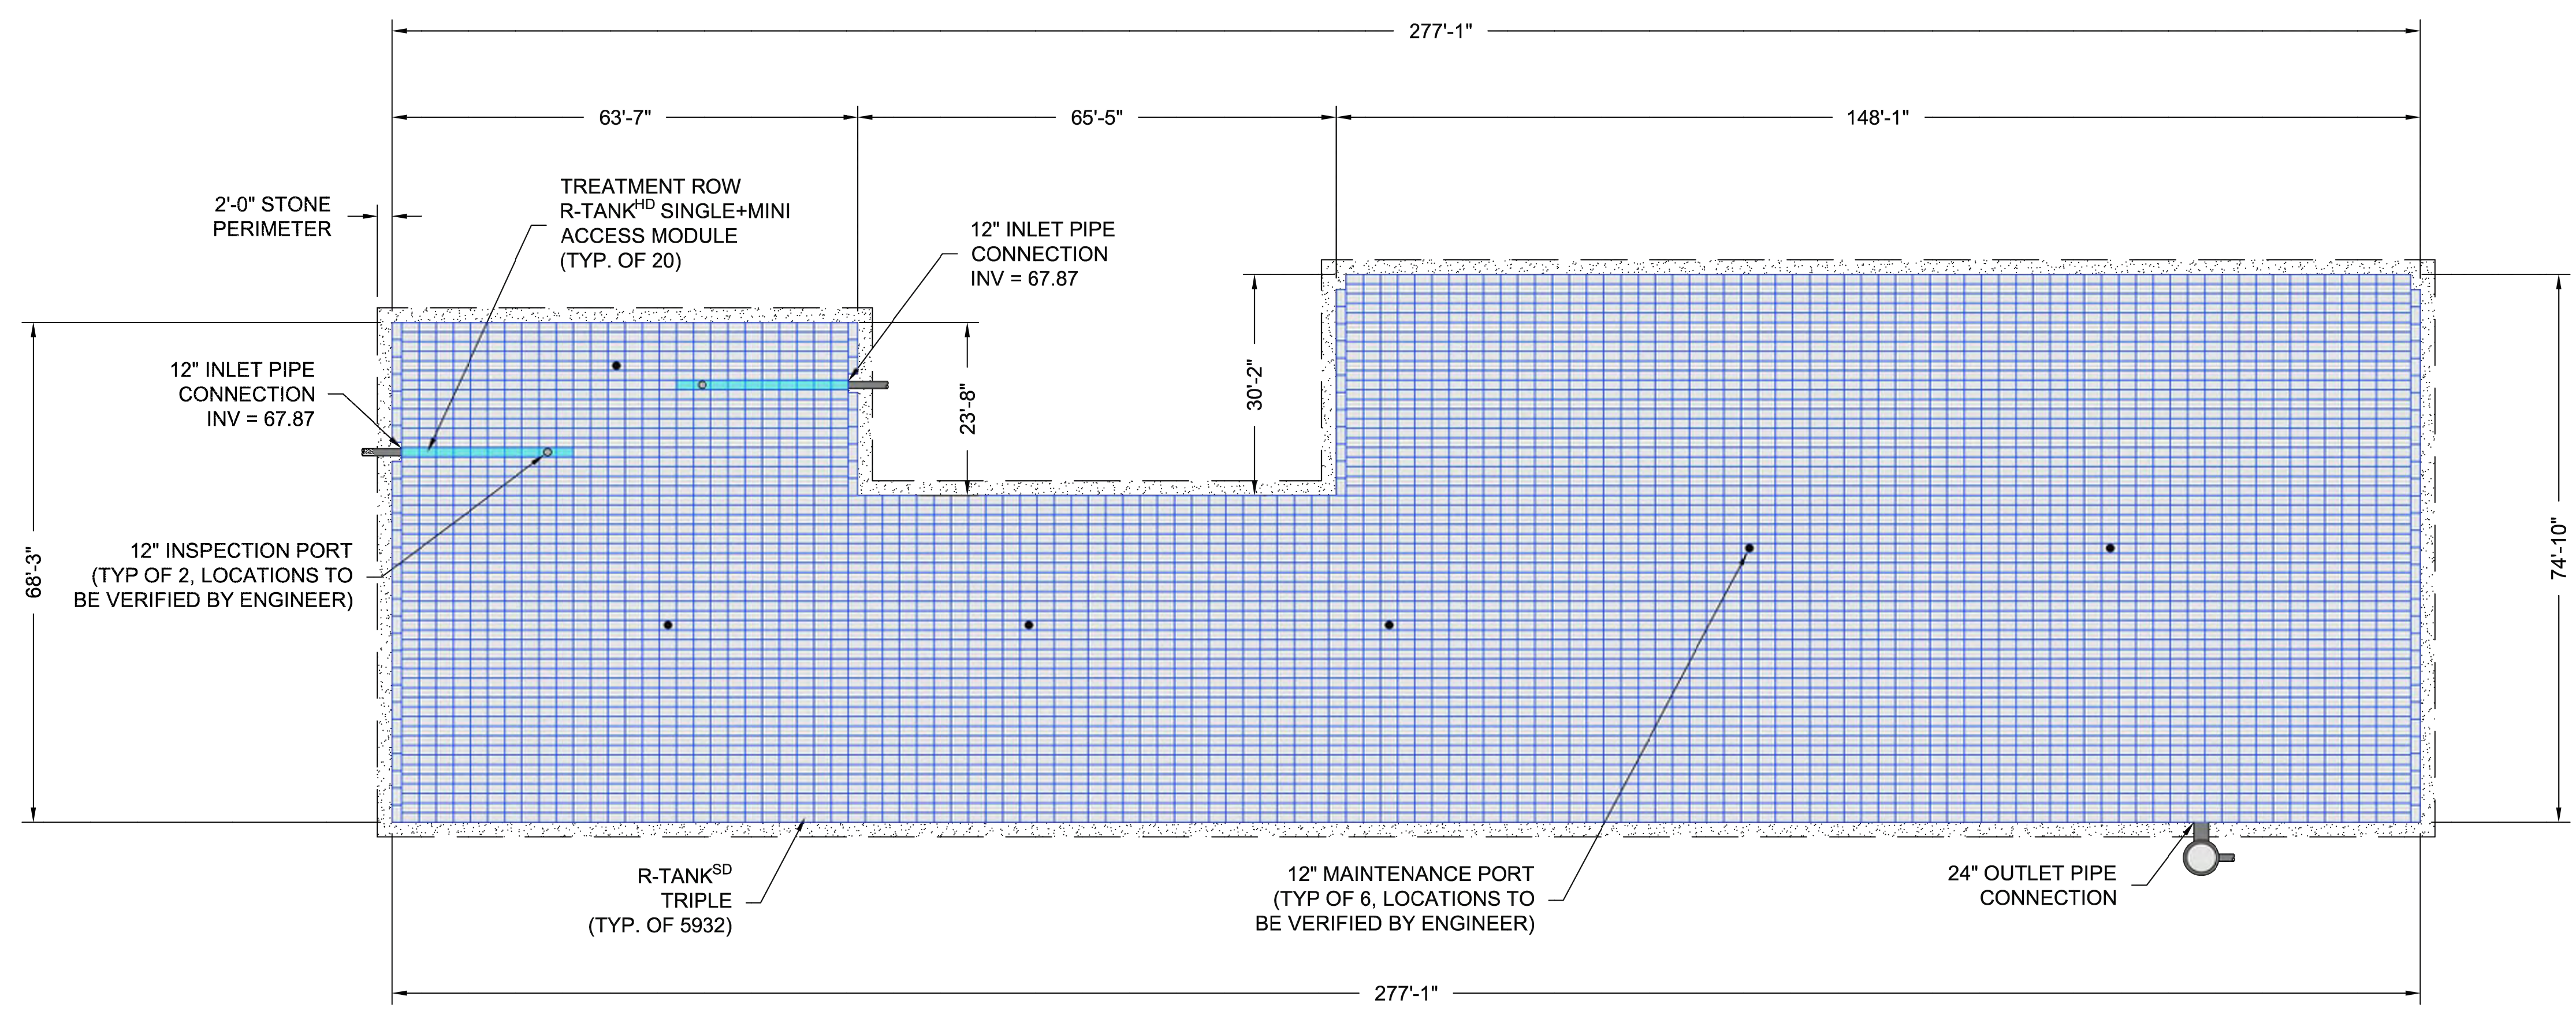

SD R-TANK
ENGINEER OF RECORD TO REVIEW, APPROVE AND ENDORSE FINAL SITE SPECIFIC DESIGN.

ACF WEST INC. GEOSYNTHETICS
Products | Service | Solutions
FOR ADDITIONAL INFORMATION PLEASE CONTACT:
ACF WEST, 1-800-423-4567, www.acfwest.com

R-TANK^{SD} SYSTEM LAYOUT
EAST TOWN CROSSING
PUYALLUP, WA
SITE DESIGNATION: R-TANK 1

Project Title:
EAST TOWN CROSSING PHASE 1

Client:
ASH DEVELOPMENT

GREG HELLE
GREG.HELLE@ASHNW.COM

Project No.
2230752

Issue Set & Date:
PERMIT SUBMITTAL
11/20/2023





NOTICE
ALTERATION OF THIS DOCUMENT SHALL INVALIDATE THE PROFESSIONAL SEAL AND SIGNATURE. PUBLICATION OF THIS DOCUMENT DOES NOT CONSTITUTE A PROFESSIONAL ENGINEER'S OPINION ON THE QUALITY OF THE DESIGN OR THE ACCURACY OF THE INFORMATION PROVIDED IN THE TITLE BLOCK. THIS DOCUMENT IS NOT TO BE USED FOR ANY OTHER PROJECT OR ACTION TO THAT PROJECT OR FOR ANY OTHER PROJECT.

- NOTES:
- DEAD STORAGE VOLUME FROM ELEVATION 66.90 TO 67.40 = 3,971 CF
 - LIVE STORAGE VOLUME FROM ELEVATION 67.40 TO 70.88 = 50,099 CF
 - ONLY 3" OF BASE STONE INCLUDED IN LIVE STORAGE VOLUME.

LAYOUT SCALE	1" = 25'
R-TANK ^{SD} MODULE TYPE	TRIPLE
TRAFFIC LOAD	45 KIP OUTRIGGER (18"X18")
# OF SD TRIPLE R-TANKS	5,932
# OF HD SINGLE+MINI R-TANK ACCESS MODULES	20
TOTAL SYSTEM STORAGE	50,099 CF
R-TANK STORAGE VOLUME	38,803 CF
STONE STORAGE VOLUME (40% VOID RATIO)	11,296 CF
TOP OF COVER STONE ELEV. (12")	70.88
NAUE SECUGRID 30/30 GEOGRID ELEV.	70.88
TOP OF R-TANK ELEV.	69.88
TANK INVERT	67.65
INVERT OF STONE BASE (9")	66.90
MIN. STONE PERIMETER WIDTH	2.0 FT

SEE SHEETS 3 - 8 FOR DETAILS AND ADDITIONAL INFORMATION

PROVIDE-2yr and 10yr water surface elevations on the cross section.
[Plans Sht C4.11; Pg 24 of 63]
Provided

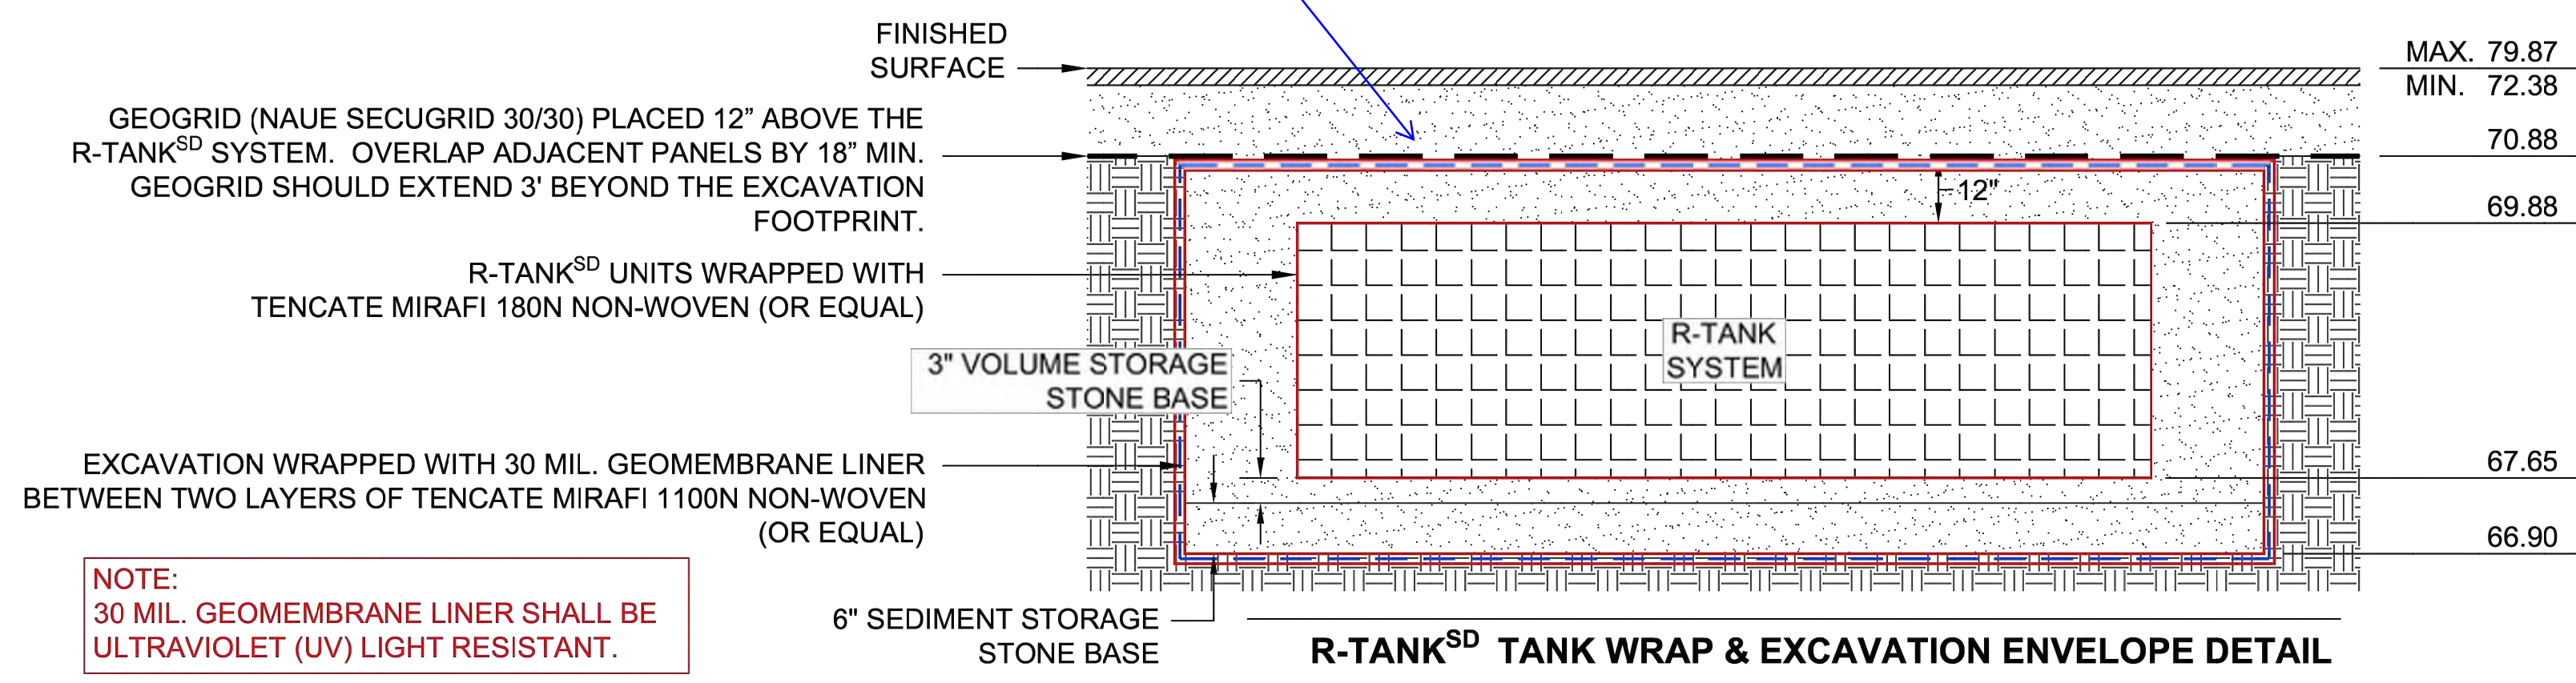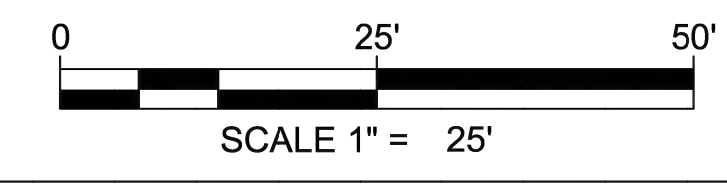

NOTE:
30 MIL. GEOMEMBRANE LINER SHALL BE ULTRAVIOLET (UV) LIGHT RESISTANT.

DRAWN BY: EDQ
DATE: 11/10/2023
ACF WEST PROJECT NUMBER: 23-004WA
SHEET NO.: 2 of 8

Revisions:

R-TANK 1 NOTES AND DETAILS

Designed by: CW
Drawn by: SK
Checked by: JI

Sheet No.
C4.11
24 of 63 Sheets



EAST TOWN CROSSING PHASE 1

SEC. 26,35/ TWP. 20 N./ RGE. 4 E., W.M.

APPROVED

BY: CITY OF PUYALLUP
DEVELOPMENT ENGINEERING

DATE: _____

NOTE: THIS APPROVAL IS VOID AFTER 180 DAYS FROM APPROVAL. THE CITY WILL NOT BE RESPONSIBLE FOR ERRORS OR OMISSIONS ON THESE PLANS. UNFORD CONDITIONS MAY DICTATE CHANGES TO THESE PLANS AS DETERMINED BY THE DEVELOPMENT ENGINEERING MANAGER.




Project Title:
EAST TOWN CROSSING PHASE 1

Client:
ASH DEVELOPMENT

GREG HELLE
GREG.HELLE@ASHNW.COM


Project No.
2230752

Issue Set & Date:
PERMIT SUBMITTAL
11/20/2023

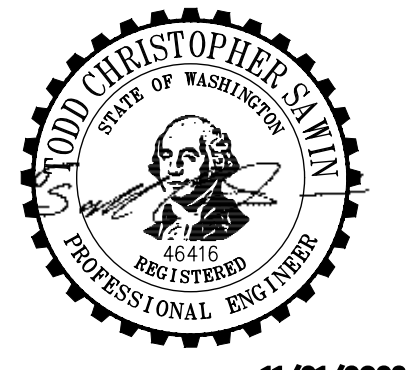


11/21/2023

NOTICE: ALTERATION OF THIS DOCUMENT SHALL INVALIDATE THE PROFESSIONAL SEAL AND SIGNATURE. PUBLICATION OF THIS DOCUMENT DOES NOT CONSTITUTE A GUARANTEE OR WARRANTY. THE DESIGNER IS NOT RESPONSIBLE FOR THE PROJECT EXCEPT IN THE TITLE BLOCK AND IS NOT TO BE USED FOR OTHER PROJECTS OR ACTION TO THAT PROJECT OR FOR ANY OTHER PROJECT.

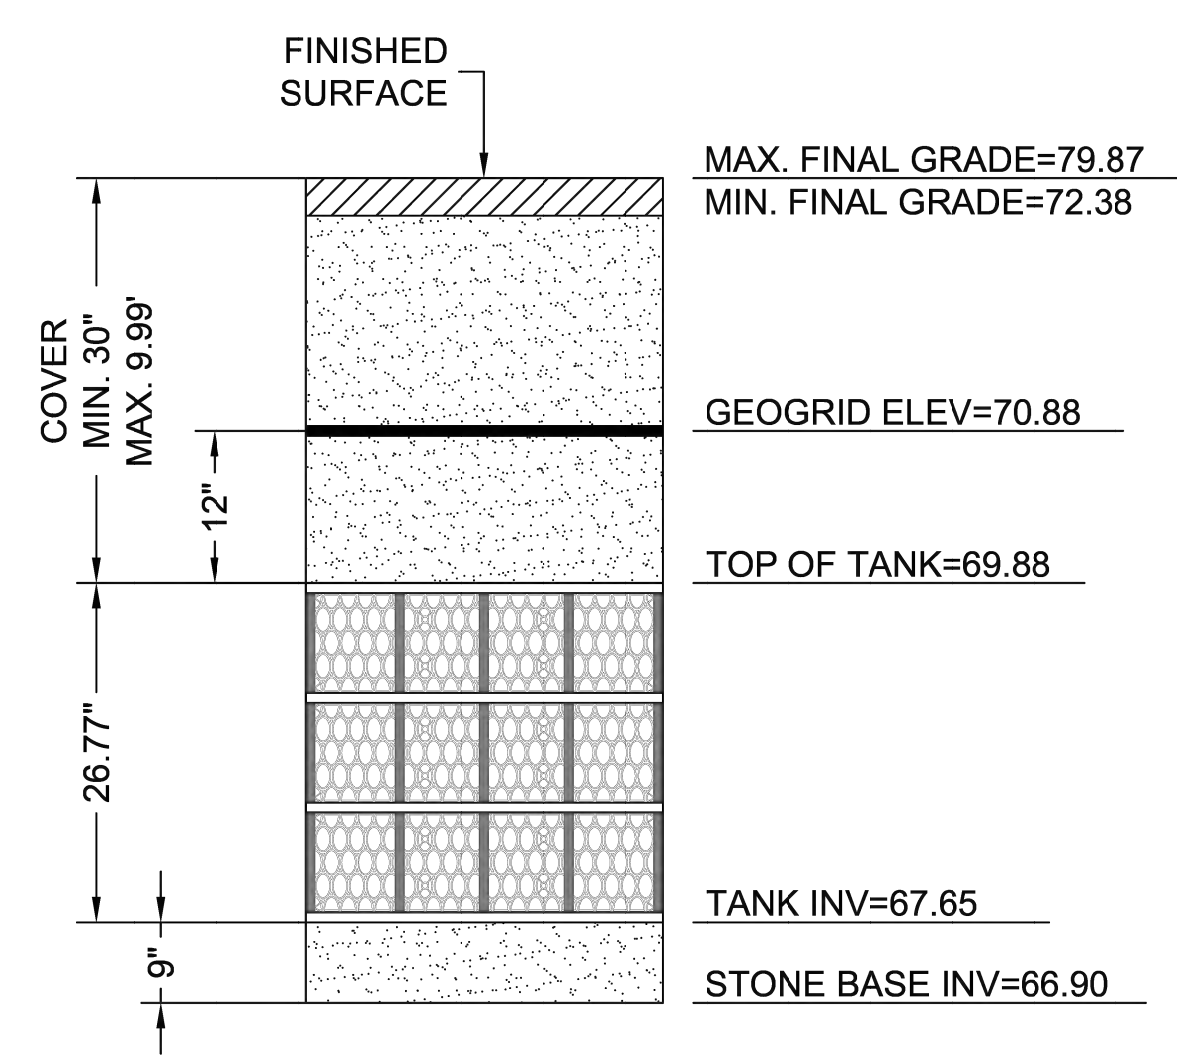

TRIPLE R-TANK^{SD} - ELEVATION

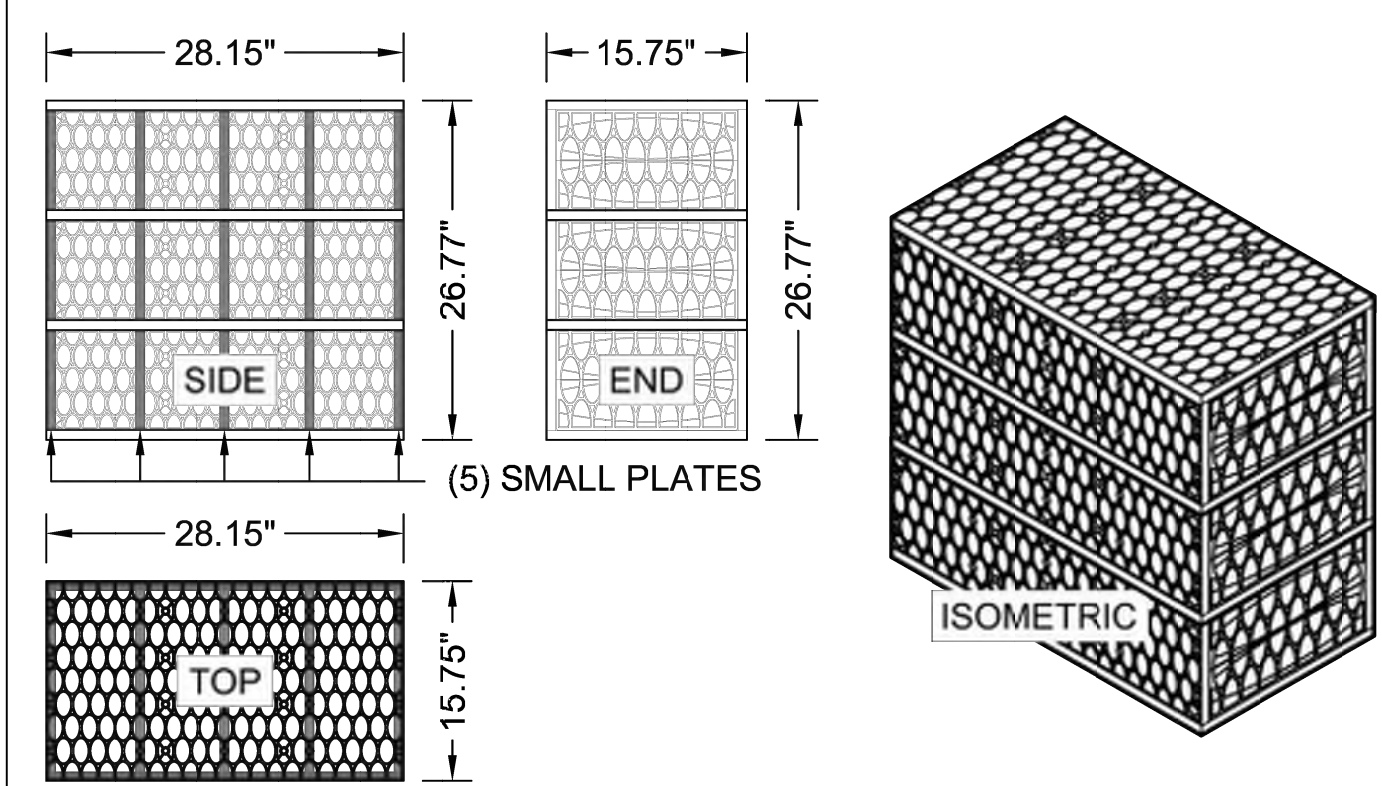

MODULE DATA

GEOMETRY: LENGTH = 28.15 IN. (715 MM) WIDTH = 15.75 IN. (400 MM) HEIGHT = 26.77 IN. (680 MM) TANK VOLUME = 6.87 CF STORAGE VOLUME = 6.52 CF VOID INTERNAL VOLUME: 95% VOID SURFACE AREA: 90%	LOAD RATING: 42.9 PSI, (MODULE ONLY) HS20/HS25 - SEE SPEC FOR COVER REQUIREMENTS MATERIAL: 100% RECYCLED POLYPROPYLENE SMALL PLATES REQUIRED: 5/SEGMENT, 15/MODULE
--	---

TRIPLE R-TANK^{SD} - MODULE DETAIL

R-TANK ^{SD} QUANTITIES	
R-TANK ^{SD} MODULE TYPE	TRIPLE
# OF SD TRIPLE R-TANKS	5,932
# OF HD SINGLE+MINI R-TANK ACCESS MODULES	20
TOTAL SYSTEM STORAGE	50,099 CF
R-TANK STORAGE VOLUME	38,803 CF
STONE STORAGE VOLUME (40% VOID RATIO)	11,296 CF
STONE BED FOOTPRINT	19,856 SF
STONE QUANTITY	1,414 CY
TENCATE MIRAFI 180N NON-WOVEN TANK WRAP	44,091 SF (4,899 SY)
30 MIL. GEOMEMBRANE LINER EXCAVATION WRAP	49,184 SF (5,465 SY)
TENCATE MIRAFI 1100N NON-WOVEN LINER PROTECTION	98,368 SF (10,930 SY)
TENCATE MIRAFI 180N NON-WOVEN TREAT. ROW WRAP	327 SF (36 SY)
TENCATE MIRAFI FW-402 WOVEN TREAT. ROW BASE FABRIC	388 SF (43 SY)
NAUE SECUGRID 30/30 GEOGRID	25,522 SF (2,836 SY)
12" MAINTENANCE PORTS	6
12" INSPECTION PORTS	2
12" PIPE BOOTS	2
24" PIPE BOOTS	1
TRASHGUARD PLUS UNITS (RECOMMENDED)	2

NOTE: STONE QUANTITY INCLUDES 12" OF COVER AND 9" OF BASE.
NOTE: GEOTEXTILE / LINER QUANTITIES INCLUDE A 15% WASTE FACTOR.

NOTE:
30 MIL. GEOMEMBRANE LINER SHALL BE ULTRAVIOLET (UV) LIGHT RESISTANT.


- NOTES:
- DEAD STORAGE VOLUME FROM ELEVATION 66.90 TO 67.40 = 3,971 CF
 - LIVE STORAGE VOLUME FROM ELEVATION 67.40 TO 70.88 = 50,099 CF
 - ONLY 3" OF BASE STONE INCLUDED IN LIVE STORAGE VOLUME.



R-TANK^{SD} SYSTEM DETAILS
EAST TOWN CROSSING
PUYALLUP, WA
SITE DESIGNATION: R-TANK 1


DRAWN BY: EDQ
DATE: 11/10/2023
ACF WEST PROJECT NUMBER: 23-004WA
SHEET NO.: 3 of 8

CUT AN "X" IN THE FABRIC ENVELOPE THAT IS SLIGHTLY LARGER THAN THE PIPE. PULL THE FABRIC FLAPS AROUND THE PIPE, AND SEAL WITH A STAINLESS STEEL BAND.

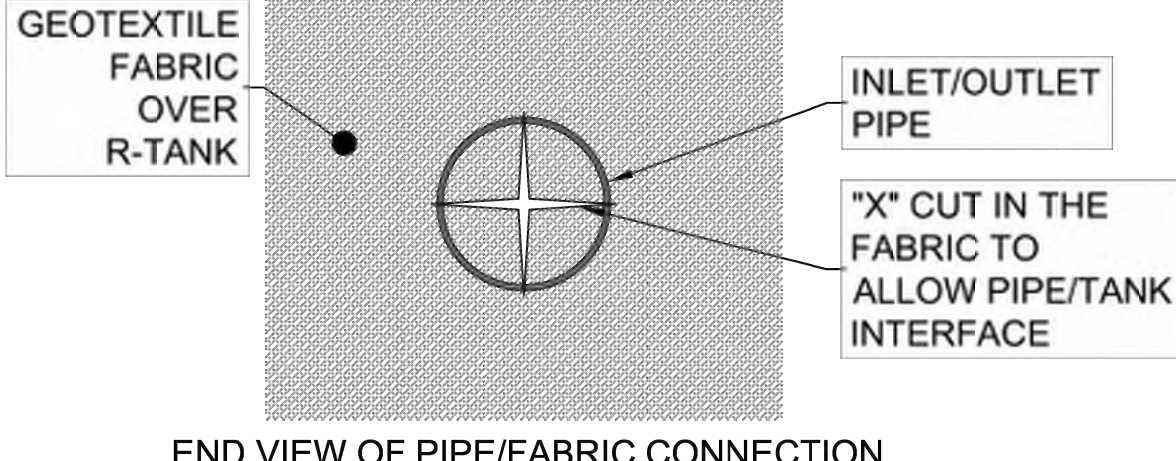


END VIEW OF PIPE/FABRIC CONNECTION


NOTE: PIPE MUST BUTT DIRECTLY AGAINST R-TANK. PIPE EFFLUENT SHALL NOT PASS THROUGH FABRIC ENVELOPE

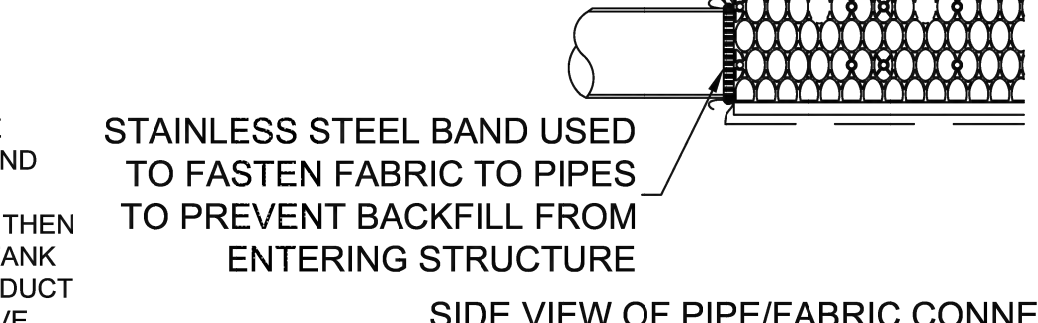


SIDE VIEW OF PIPE/FABRIC CONNECTION

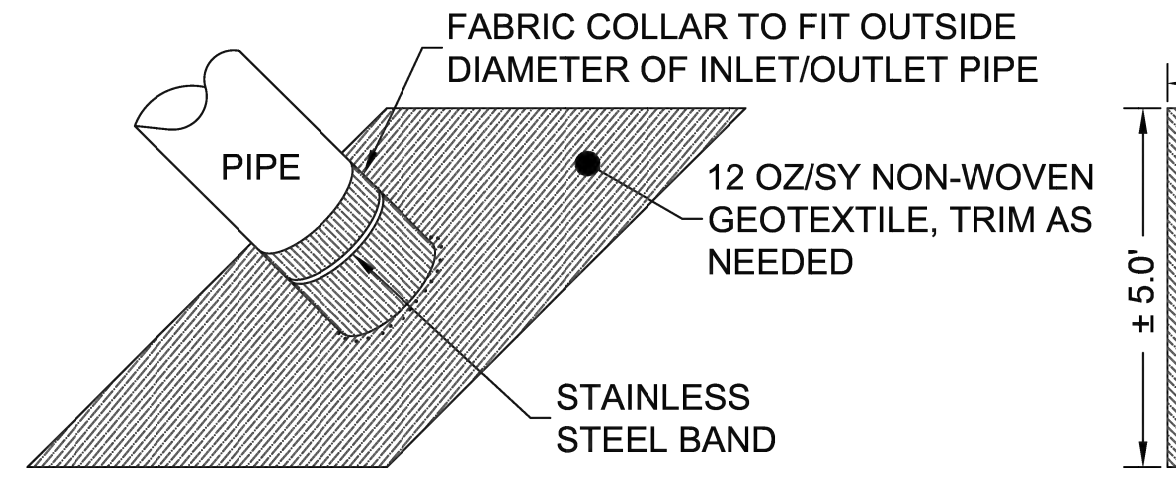

GEOTEXTILE BOOT

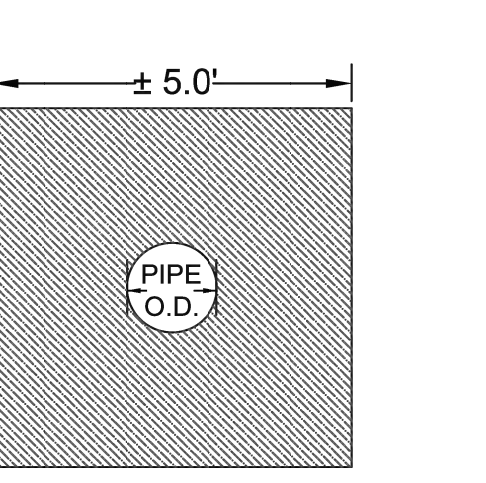

FRONT VIEW OF GEOTEXTILE BOOT

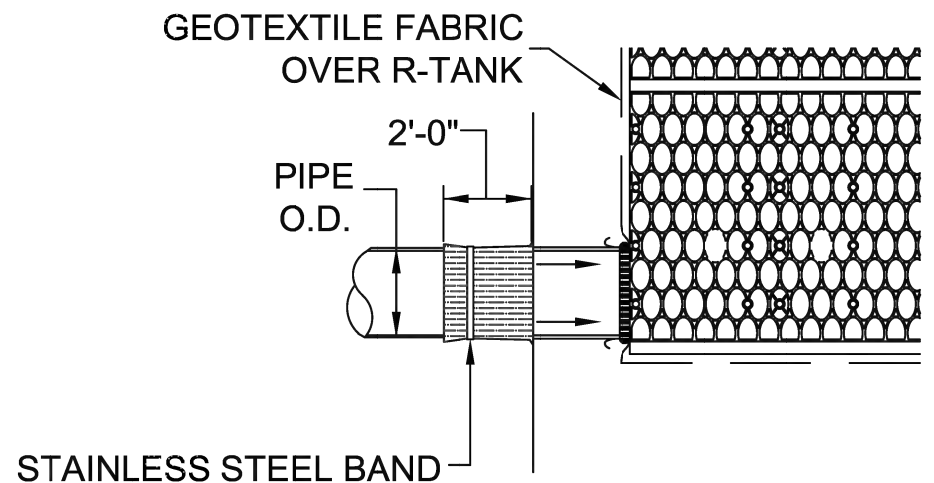

SIDE VIEW OF GEOTEXTILE BOOT

R-TANK^{SD} TYPICAL TANK INLET/OUTLET W/ GEOTEXTILE PIPE BOOT DETAIL



Know what's below.
Call before you dig.

Revisions:

Sheet Title:

R-TANK 1 NOTES AND DETAILS

Designed by: CW Drawn by: SK Checked by: JI

Sheet No.
C4.12
25 of 63 Sheets

EAST TOWN CROSSING PHASE 1

SEC. 26,35/ TWP. 20 N./ RGE. 4 E., W.M.


Legibility:
[Plans Sht C4.13; Pg 26 of 63]

Fixed

APPROVED

BY: CITY OF PUYALLUP
DEVELOPMENT ENGINEERING

DATE: _____
 THIS APPROVAL IS VOID
 AFTER 90 DAYS FROM APPROVAL
 THE CITY WILL NOT BE
 RESPONSIBLE FOR ERRORS
 OR OMISSIONS ON THESE
 PLANS.
 FIELD CONDITIONS MAY DICTATE
 CHANGES TO THESE PLANS AS
 DETERMINED BY THE
 DEVELOPMENT ENGINEERING
 NAGLER.

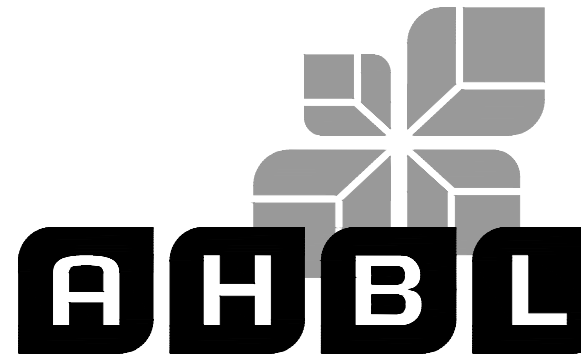

TACOMA • SEATTLE • SPOKANE • TRI-CITIES

2215 North 30th Street, Suite 300, Tacoma, WA 98403
 253.383.2422 TEL. 253.383.2572 FAX www.ahbl.com WEB

Project Title:

**EAST TOWN
CROSSING PHASE 1**

Client:

ASH DEVELOPMENT

GREG HELLE

GREG.HELLE@ASHNW.COM


Project No.

2230752

Issue Set & Date:

PERMIT SUBMITTAL

11/20/2023

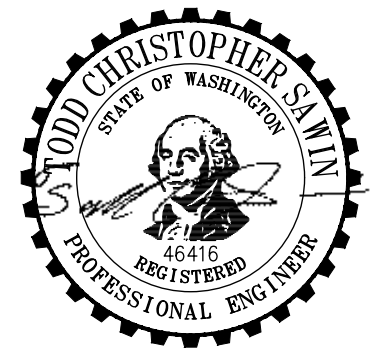


11/21/2023

NOTICE
 ALTERATION OF THIS DOCUMENT SHALL INVALIDATE THE
 PROFESSIONAL SEAL AND SIGNATURE PUBLICATION OF
 THIS DOCUMENT DOES NOT CONSTITUTE A PROFESSIONAL
 ENGINEER'S RESPONSIBILITY. THE DRAWING IS FOR THE
 ONLY FOR THE PROJECT EXHIBITED IN THE TITLE BLOCK
 AND IS NOT TO BE USED FOR OTHER PROJECTS, OR
 ACTION TO THAT PROJECT OR FOR ANY OTHER PROJECT.


TOTAL COVER: 18" MINIMUM AND 120" MAXIMUM. FIRST 12" MUST BE FREE DRAINING BACKFILL (SPEC SECTION 2.03B); STONE <1.5" OR SOIL (USCS CLASS GW, GP, SW OR SP). ADDITIONAL FILL MAY BE STRUCTURAL FILL (SPEC SECTION 2.03C): STONE OR SOIL (USCS CLASS SM, SP, SW, GM, GP OR GW) WITH MAX CLAY CONTENT <10%, MAX 25% PASSING NO. 200 SIEVE, AND MAX PLASTICITY INDEX OF 4. A MIN. 12" COVER MUST BE MAINTAINED BETWEEN BACKFILL EQUIPMENT AND THE TOP OF THE R-TANK™ SYSTEM AT ALL TIMES. TOTAL HEIGHT OF TOP BACKFILL SHOULD NOT EXCEED 10'. CONTACT ACF WEST IF MORE THAN 10' OR LESS THAN 18" OF TOP BACKFILL IS REQUIRED (FROM TOP OF TANK TO TOP OF PAVEMENT).

NOTES:

- FOR COMPLETE MODULE DATA, SEE APPROPRIATE R-TANK^{SD} MODULE SHEET.
- INSTALLATIONS PER THIS DETAIL MEET GUIDELINES OF HL-93 LOADING PER THE AASHTO LRFD BRIDGE DESIGN SPECIFICATIONS, CUSTOMARY U.S. UNITS, 7TH EDITION, 2014 WITH 2015 AND 2016 INTERIM REVISIONS.
- PRE-TREATMENT STRUCTURES NOT SHOWN.
- FOR INFILTRATION APPLICATIONS, GEOTEXTILE ENVELOPING R-TANK SHALL BE TENCATE MIRAFI FW-402 WOVEN (PER SPEC SECTION 2.02A) AND BASE SHALL BE 4" MIN. UNCOMPACTED FREE DRAINING BACKFILL (SPEC SECTION 2.03A) TO PROVIDE A LEVEL BASE. SURFACE MUST BE SMOOTH, FREE OF LUMPS OR DEBRIS, AND EXTEND 2' BEYOND R-TANK^{SD} FOOTPRINT.

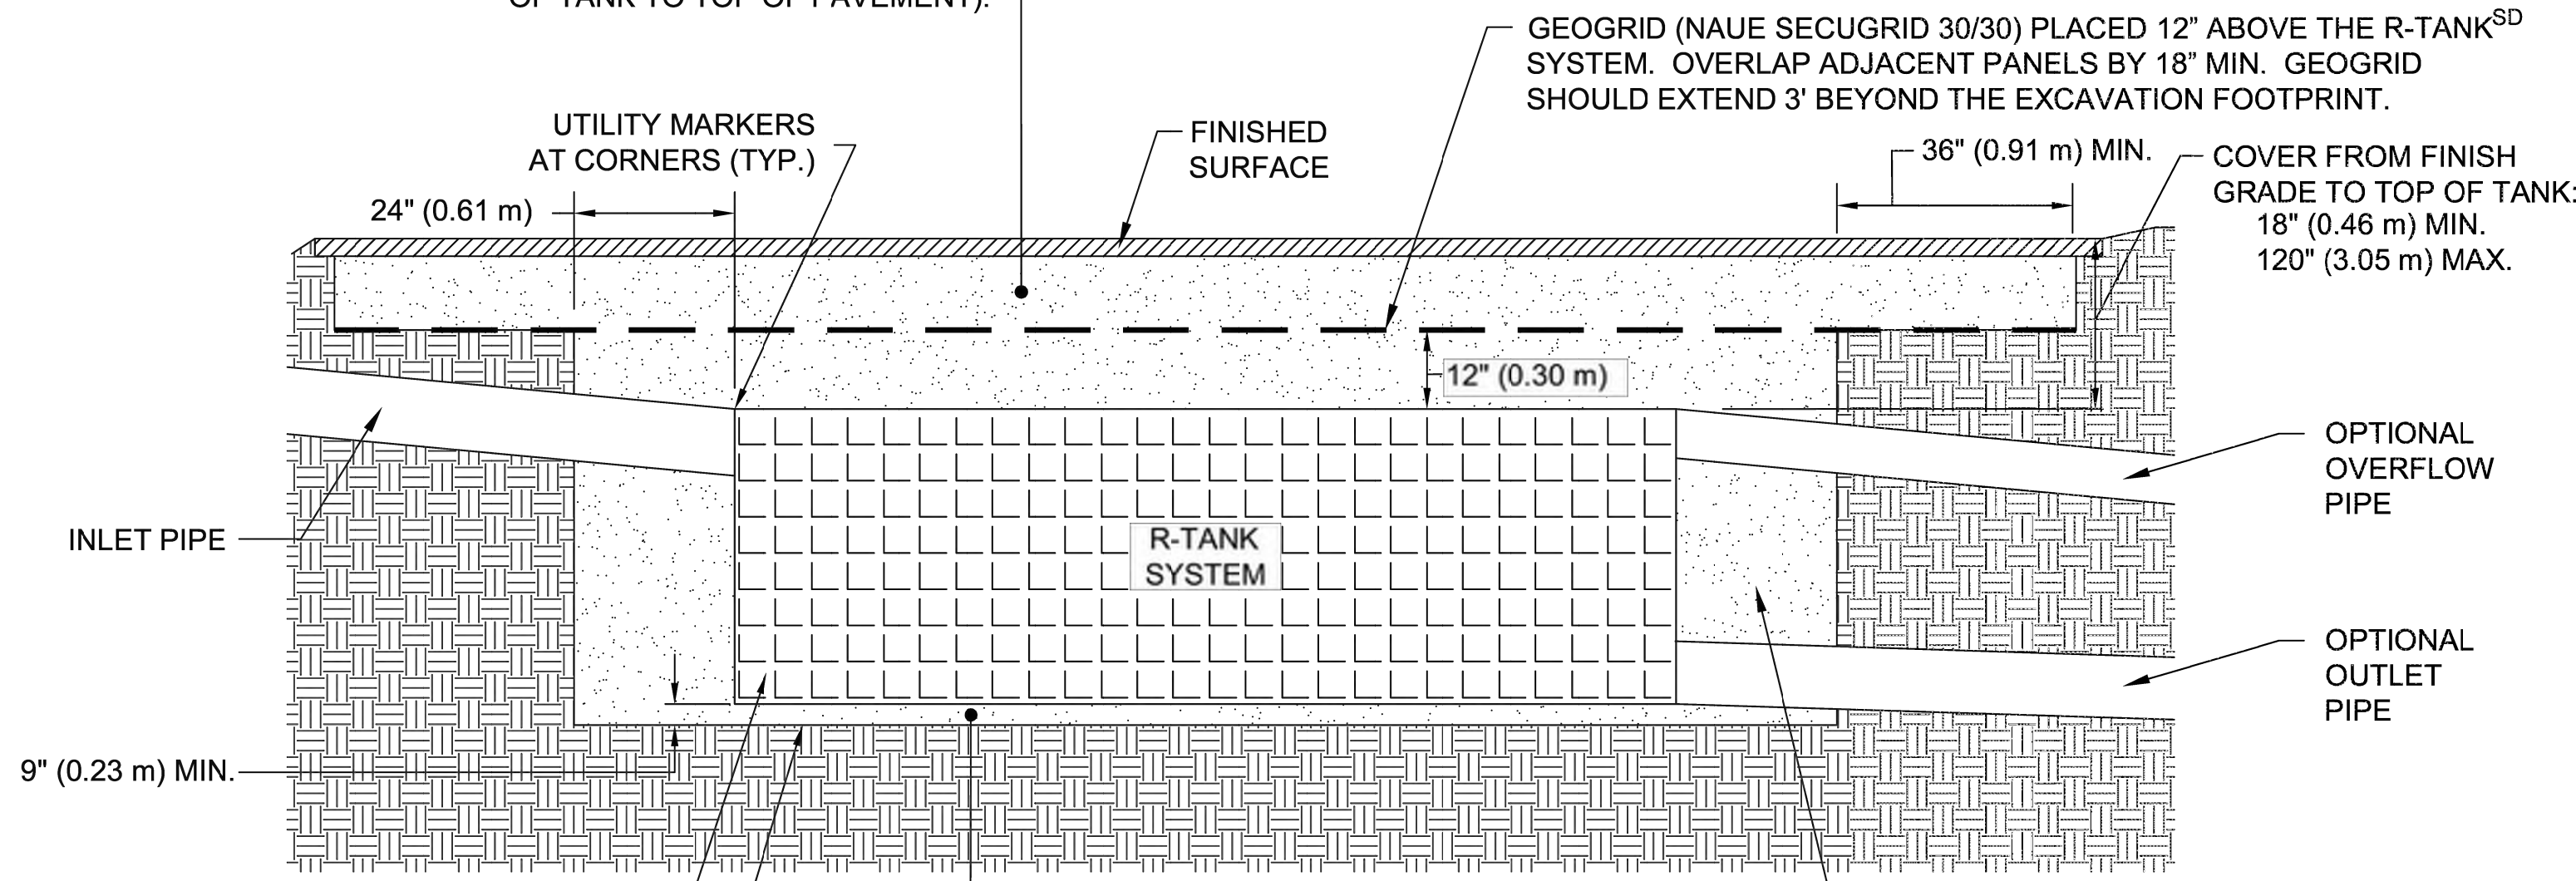

R-TANK^{SD} & HS-20 LOADS - SECTION VIEW

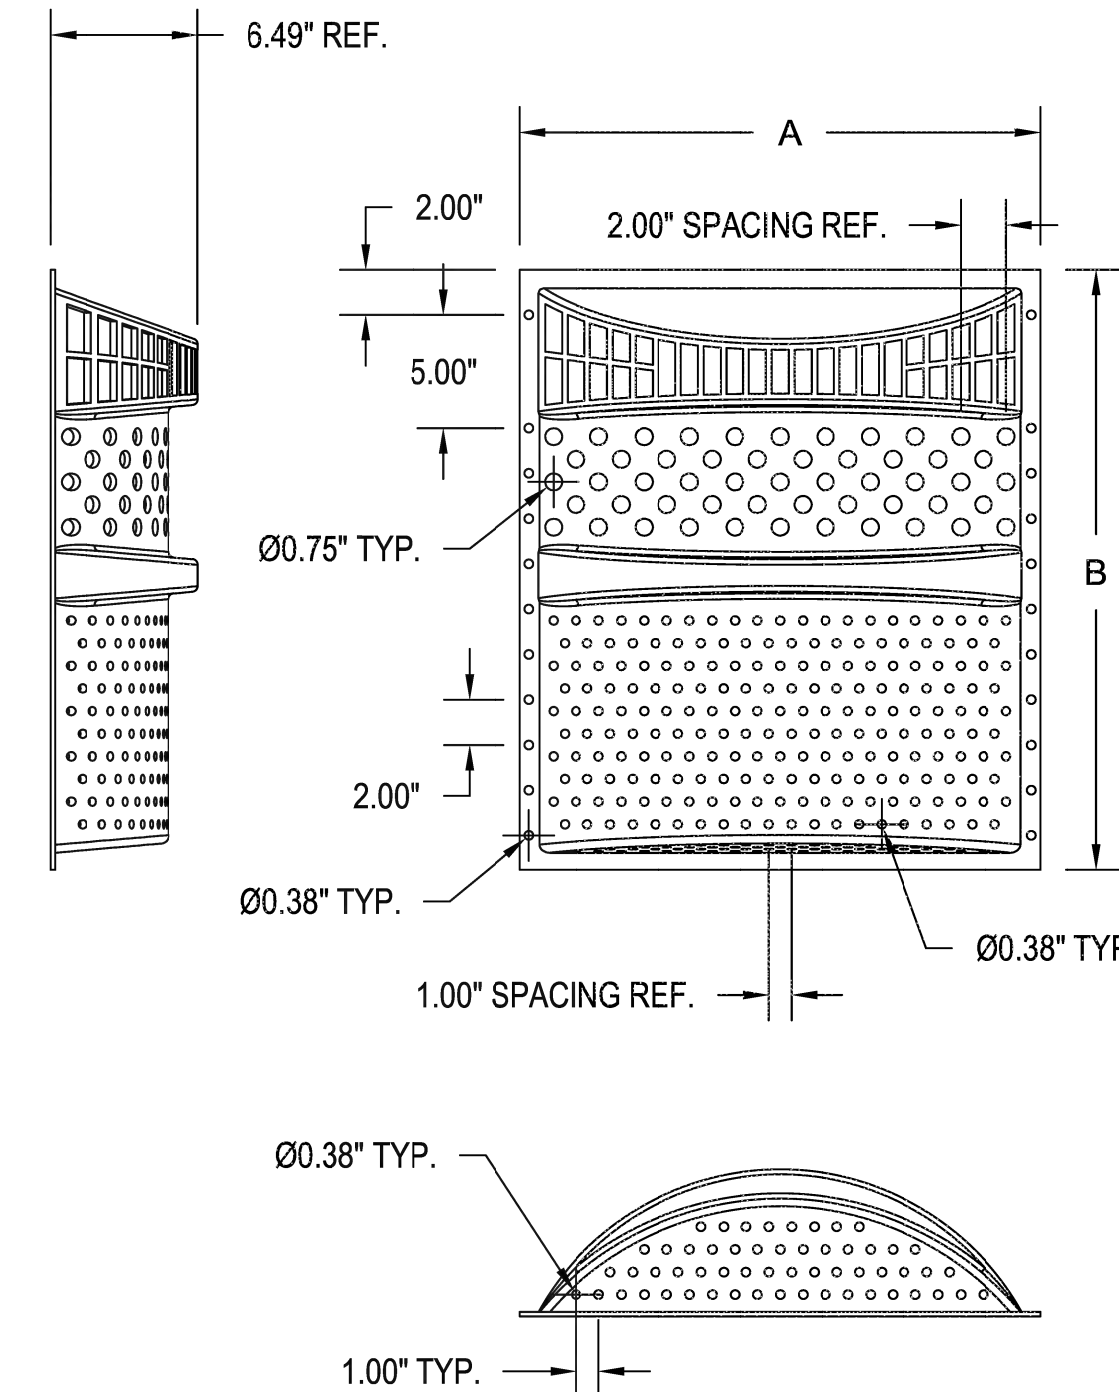

SIZE	A	B
23" x 24"	23"	26.51"
28" x 30"	28"	33.15"
34" x 36"	34"	38.69"

±0.25" TOLERANCE ON DIMENSIONS


NOTE:
 TRASHGUARD PLUS UNITS ARE RECOMMENDED TO BE INSTALLED IN ALL CATCH BASINS DIRECTLY CONNECTED UPSTREAM OF THE R-TANK SYSTEM.

TRASHGUARD PLUS PRETREATMENT DETAIL

NOTE:
 MINIMUM COVER FROM TOP OF TANK TO FINISH GRADE MUST BE AT LEAST 30" TO MEET A 45 KIP OUTRIGGER LOAD ON AN 18"X18" PAD.

NOTES

- THIS PORT IS USED TO PUMP WATER INTO THE SYSTEM AND RE-SUSPEND ACCUMULATED SEDIMENT SO THAT IT MAY BE PUMPED OUT.
- MINIMUM REQUIRED MAINTENANCE INCLUDES A QUARTERLY INSPECTION DURING THE FIRST YEAR OF OPERATION AND A YEARLY INSPECTION THEREAFTER. FLUSH AS NEEDED.
- R-TANK^{HD}, R-TANK^{SD}, R-TANK^{UD} AND R-TANK^{XD} MAY BE USED IN TRAFFIC APPLICATIONS.
- SEE TRAFFIC LOADING DETAIL FOR MINIMUM & MAXIMUM COVER REQUIREMENTS.
- IF MAINTENANCE PORT IS LOCATED IN A NON-TRAFFIC AREA, A PLASTIC CAP CAN BE USED IN LIEU OF A FRAME AND COVER WITH CONCRETE COLLAR.

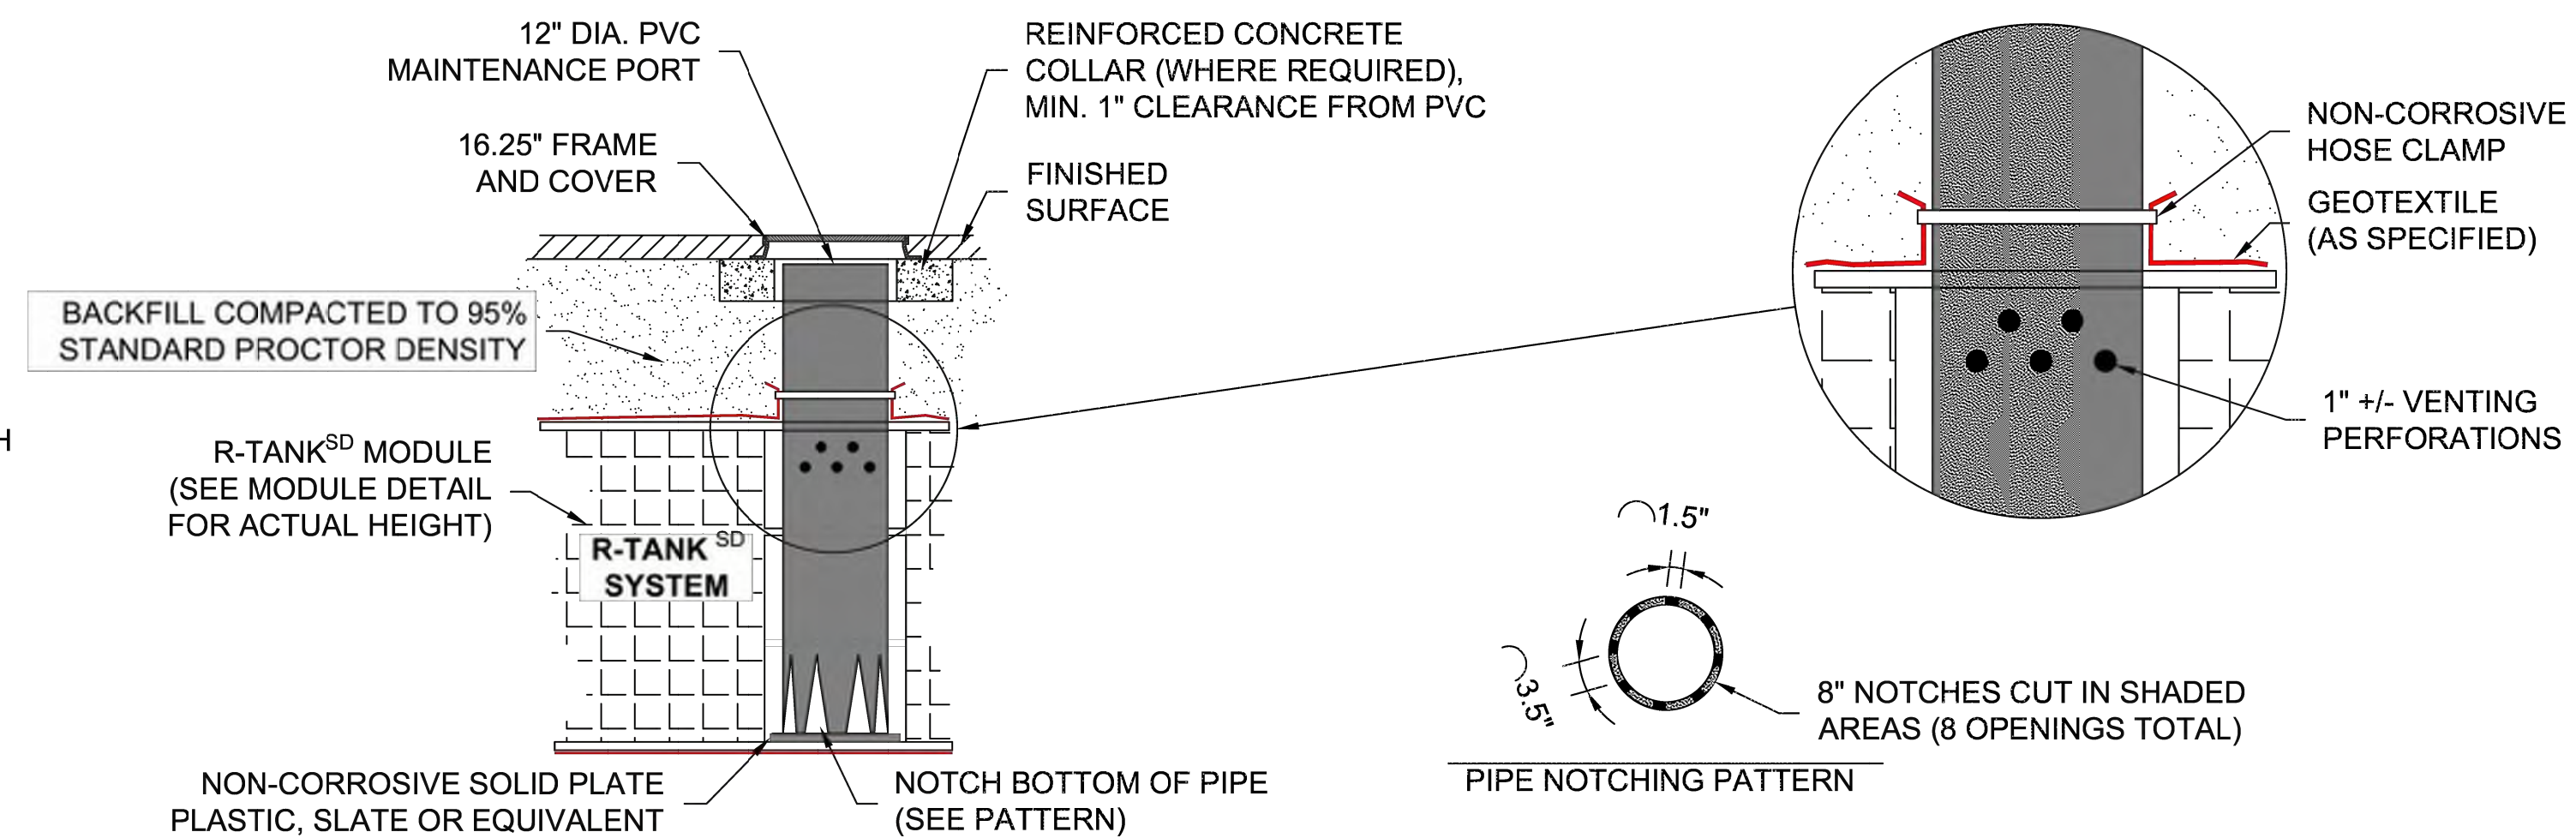

R-TANK^{SD} TYPICAL MAINTENANCE PORT



R-TANK^{SD} SYSTEM DETAILS
 EAST TOWN CROSSING
 PUYALLUP, WA
 SITE DESIGNATION: R-TANK 1

DRAWN BY: EDQ
 DATE: 11/10/2023
 ACF WEST PROJECT NUMBER: 23-004WA
 SHEET NO.: 4 of 8

Revisions:

Sheet Title:

**R-TANK 1 NOTES
AND DETAILS**

Designed by: CW Drawn by: SK Checked by: JI

Sheet No.

C4.13

26 of 63 Sheets



Know what's below.
Call before you dig.

EAST TOWN CROSSING PHASE 1

SEC. 26,35/ TWP. 20 N./ RGE. 4 E., W.M.

APPROVED

BY: CITY OF PUYALLUP
DEVELOPMENT ENGINEERING

DATE: _____

NOTE: THIS APPROVAL IS VOID AFTER 180 DAYS FROM APPROVAL. THE CITY WILL NOT BE RESPONSIBLE FOR ERRORS OR OMISSIONS ON THESE PLANS. FIELD CONDITIONS MAY DICTATE CHANGES TO THESE PLANS AS DETERMINED BY THE DEVELOPMENT ENGINEERING MANAGER.



TACOMA · SEATTLE · SPOKANE · TRI-CITIES

2215 North 30th Street, Suite 300, Tacoma, WA 98403
253.383.2422 TEL 253.383.2572 FAX www.ahbl.com WEB


Project Title:
EAST TOWN CROSSING PHASE 1

Client:
ASH DEVELOPMENT

GREG HELLE
GREG.HELLE@ASHNW.COM

Project No.
2230752

Issue Set & Date:
PERMIT SUBMITTAL
11/20/2023

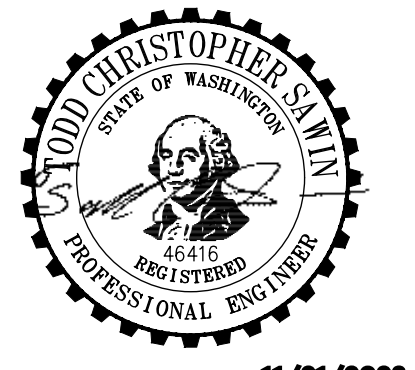


11/21/2023

NOTICE
ALTERATION OF THIS DOCUMENT SHALL INVALIDATE THE PROFESSIONAL SEAL AND SIGNATURE. PUBLICATION OF THIS DOCUMENT DOES NOT CONSTITUTE A PROFESSIONAL ENGINEER'S RESPONSIBILITY TO THE GENERAL PUBLIC. THIS DOCUMENT IS FOR THE PROJECT IDENTIFIED IN THE TITLE BLOCK AND IS NOT TO BE USED FOR OTHER PROJECTS OR ACTION TO THAT PROJECT OR FOR ANY OTHER PROJECT.



TOTAL COVER: 20" MINIMUM AND 84" MAXIMUM. FIRST 12" MUST BE FREE DRAINING BACKFILL (SPEC SECTION 2.03B): STONE <1.5" OR SOIL (USCS CLASS GW, GP, SW OR SP). ADDITIONAL FILL MAY BE STRUCTURAL FILL (SPEC SECTION 2.03C): STONE OR SOIL (USCS CLASS SM, SP, SW, GM, GP OR GW) WITH MAX CLAY CONTENT <10%, MAX 25% PASSING NO. 200 SIEVE, AND MAX PLASTICITY INDEX OF 4. A MIN. 12" COVER MUST BE MAINTAINED BETWEEN BACKFILL EQUIPMENT AND THE TOP OF THE R-TANK™ SYSTEM AT ALL TIMES. TOTAL HEIGHT OF TOP BACKFILL SHOULD NOT EXCEED 7'. CONTACT ACF WEST IF MORE THAN 7' OR LESS THAN 20" OF TOP BACKFILL IS REQUIRED (FROM TOP OF TANK TO TOP OF PAVEMENT).

- NOTES:
- FOR COMPLETE MODULE DATA, SEE APPROPRIATE R-TANK^{HD} MODULE SHEET.
 - INSTALLATIONS PER THIS DETAIL MEET GUIDELINES OF HL-93 LOADING PER THE AASHTO LRFD BRIDGE DESIGN SPECIFICATIONS, CUSTOMARY U.S. UNITS, 7TH EDITION, 2014 WITH 2015 AND 2016 INTERIM REVISIONS.
 - PRE-TREATMENT STRUCTURES NOT SHOWN.
 - FOR INFILTRATION APPLICATIONS, GEOTEXTILE ENVELOPING R-TANK SHALL BE ACF M200 (PER SPEC SECTION 2.02A) AND BASE SHALL BE 4" MIN. UNCOMPACTED FREE DRAINING BACKFILL (SPEC SECTION 2.03A) TO PROVIDE A LEVEL BASE. SURFACE MUST BE SMOOTH, FREE OF LUMPS OR DEBRIS, AND EXTEND 2' BEYOND R-TANK^{HD} FOOTPRINT.

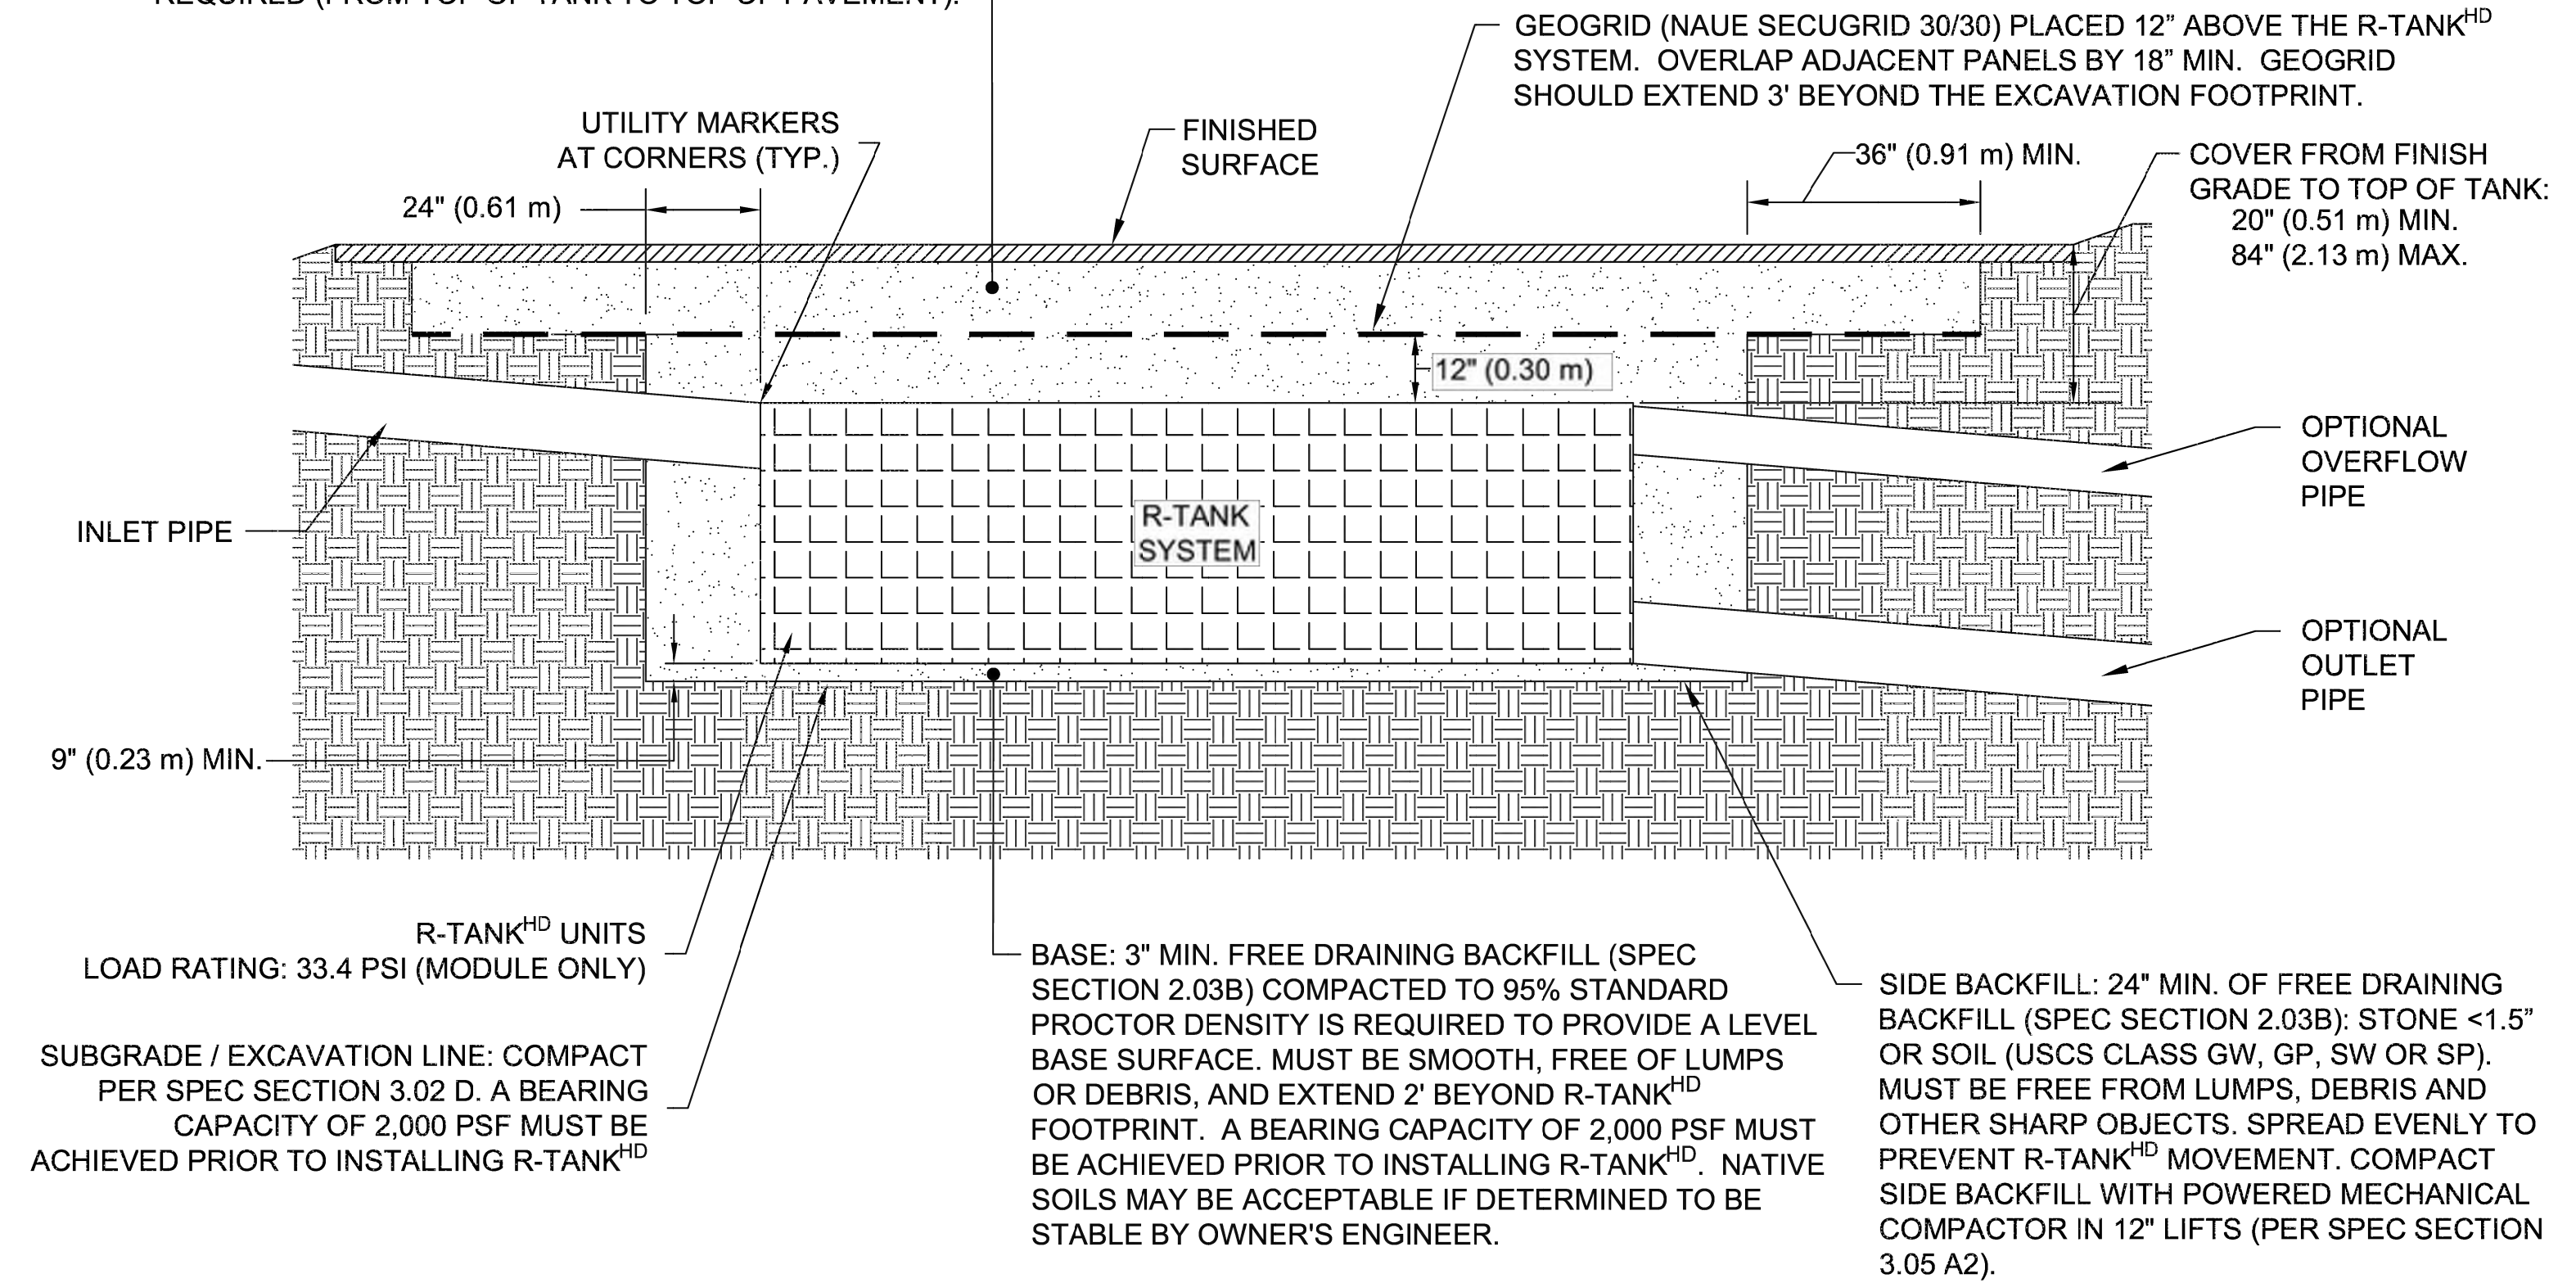

R-TANK^{HD} & HS-20 LOADS - SECTION VIEW

- NOTES
- THE INSPECTION PORT IS USED IN THE ACCESS MODULE TO INSPECT THE LEVEL OF SEDIMENT ACCUMULATION.
 - MINIMUM REQUIRED MAINTENANCE INCLUDES A QUARTERLY INSPECTION DURING THE FIRST YEAR OF OPERATION AND A YEARLY INSPECTION THEREAFTER. FLUSH AS NEEDED.
 - R-TANK^{HD}, R-TANK^{SD}, R-TANK^{LD} AND R-TANK^{MD} MAY BE USED IN TRAFFIC APPLICATIONS.
 - SEE TRAFFIC LOADING DETAIL FOR MINIMUM & MAXIMUM COVER REQUIREMENTS.
 - IF INSPECTION PORT IS LOCATED IN A NON-TRAFFIC AREA, A PLASTIC CAP CAN BE USED IN LIEU OF A FRAME AND COVER WITH CONCRETE COLLAR.

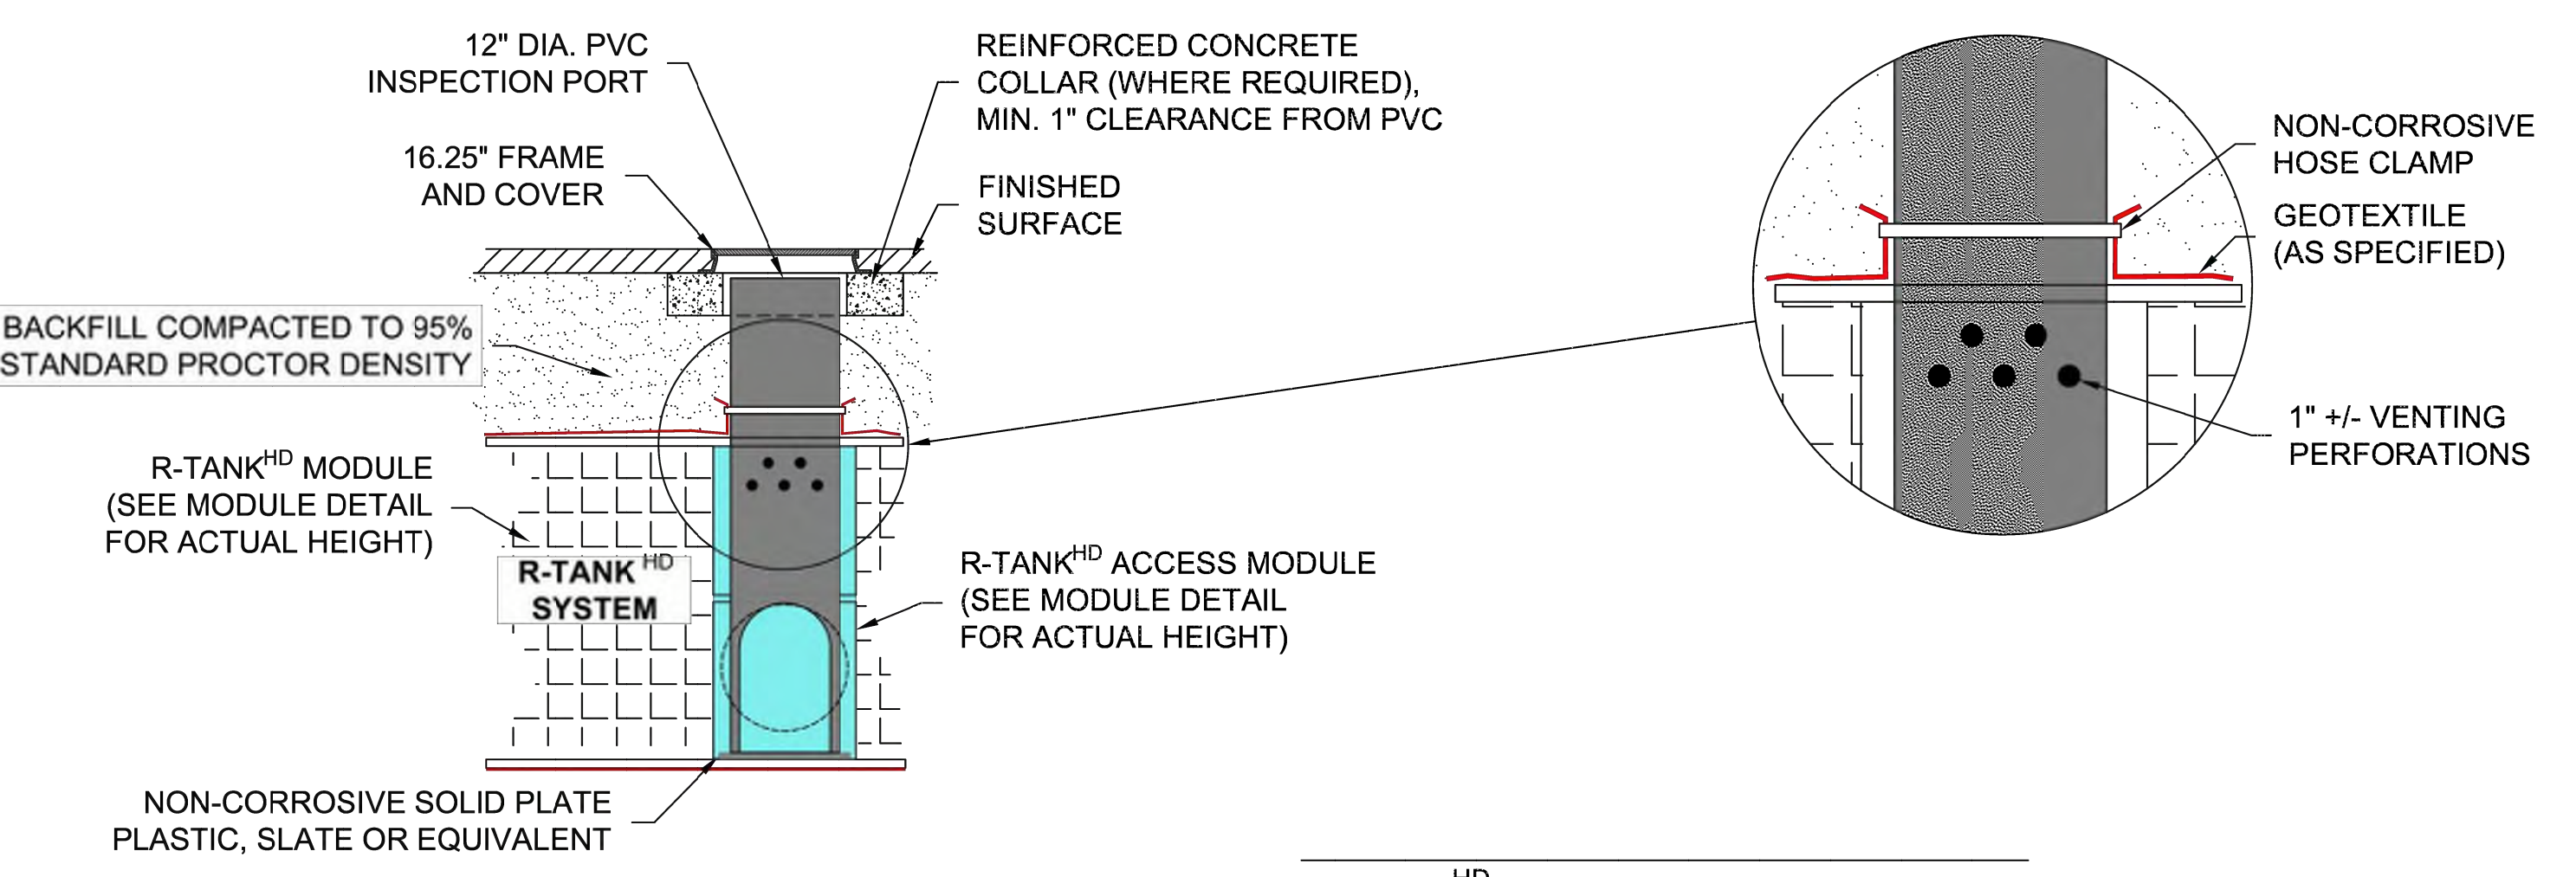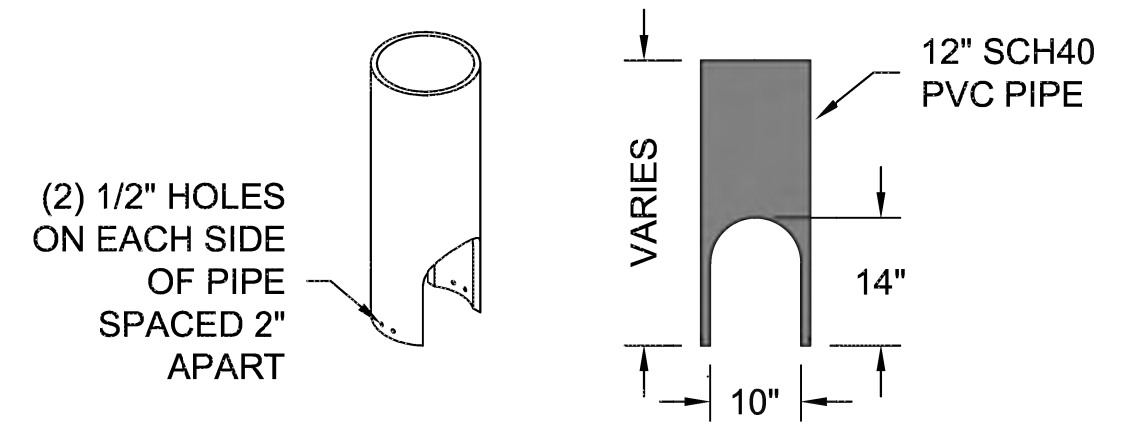

R-TANK^{HD} TYPICAL INSPECTION PORT



ACF WEST INC. GEOSYNTHETICS
Products | Service | Solutions
FOR ADDITIONAL INFORMATION PLEASE CONTACT:

R-TANK^{SD} SYSTEM DETAILS
EAST TOWN CROSSING
PUYALLUP, WA
SITE DESIGNATION: R-TANK 1

DRAWN BY: EDQ
DATE: 11/10/2023
ACF WEST PROJECT NUMBER: 23-004WA
SHEET NO.: 5 of 8

Revisions:

Sheet Title:

R-TANK 1 NOTES AND DETAILS

Designed by: CW Drawn by: SK Checked by: JI

Sheet No.

C4.14

27 of 63 Sheets



EAST TOWN CROSSING PHASE 1

SEC. 26,35/ TWP. 20 N./ RGE. 4 E., W.M.

APPROVED

BY: CITY OF PUYALLUP
DEVELOPMENT ENGINEERING

DATE: _____

NOTE: THIS APPROVAL IS VOID AFTER 180 DAYS FROM APPROVAL. THE CITY WILL NOT BE RESPONSIBLE FOR ERRORS OR OMISSIONS ON THESE PLANS. FIELD CONDITIONS MAY DICTATE CHANGES TO THESE PLANS AS DETERMINED BY THE DEVELOPMENT ENGINEERING MANAGER.

Fixed [Legibility, Plans Sht C4.15, Pg 28 of 63]







Project Title:
EAST TOWN CROSSING PHASE 1

Client:
ASH DEVELOPMENT

GREG HELLE
GREG.HELLE@ASHNW.COM

Project No.
2230752

Issue Set & Date:
PERMIT SUBMITTAL
11/20/2023

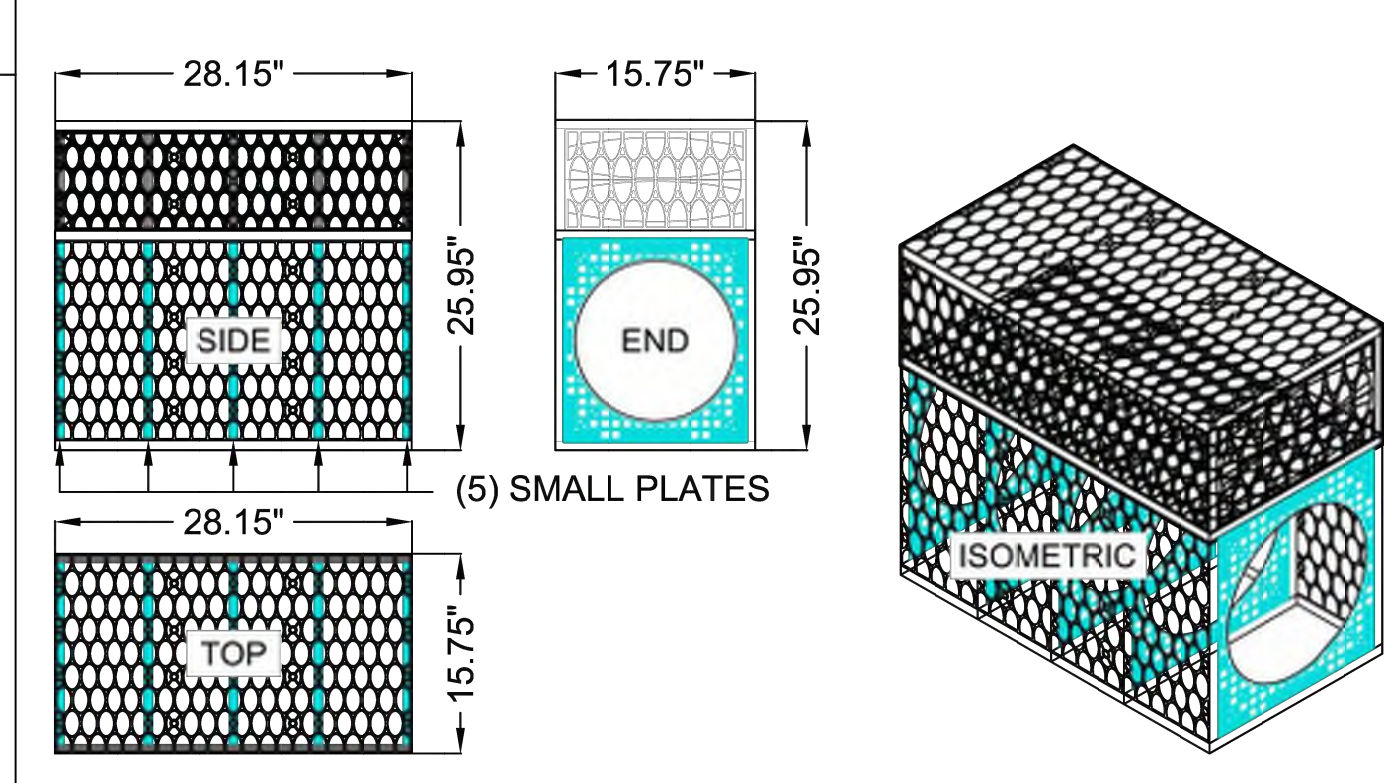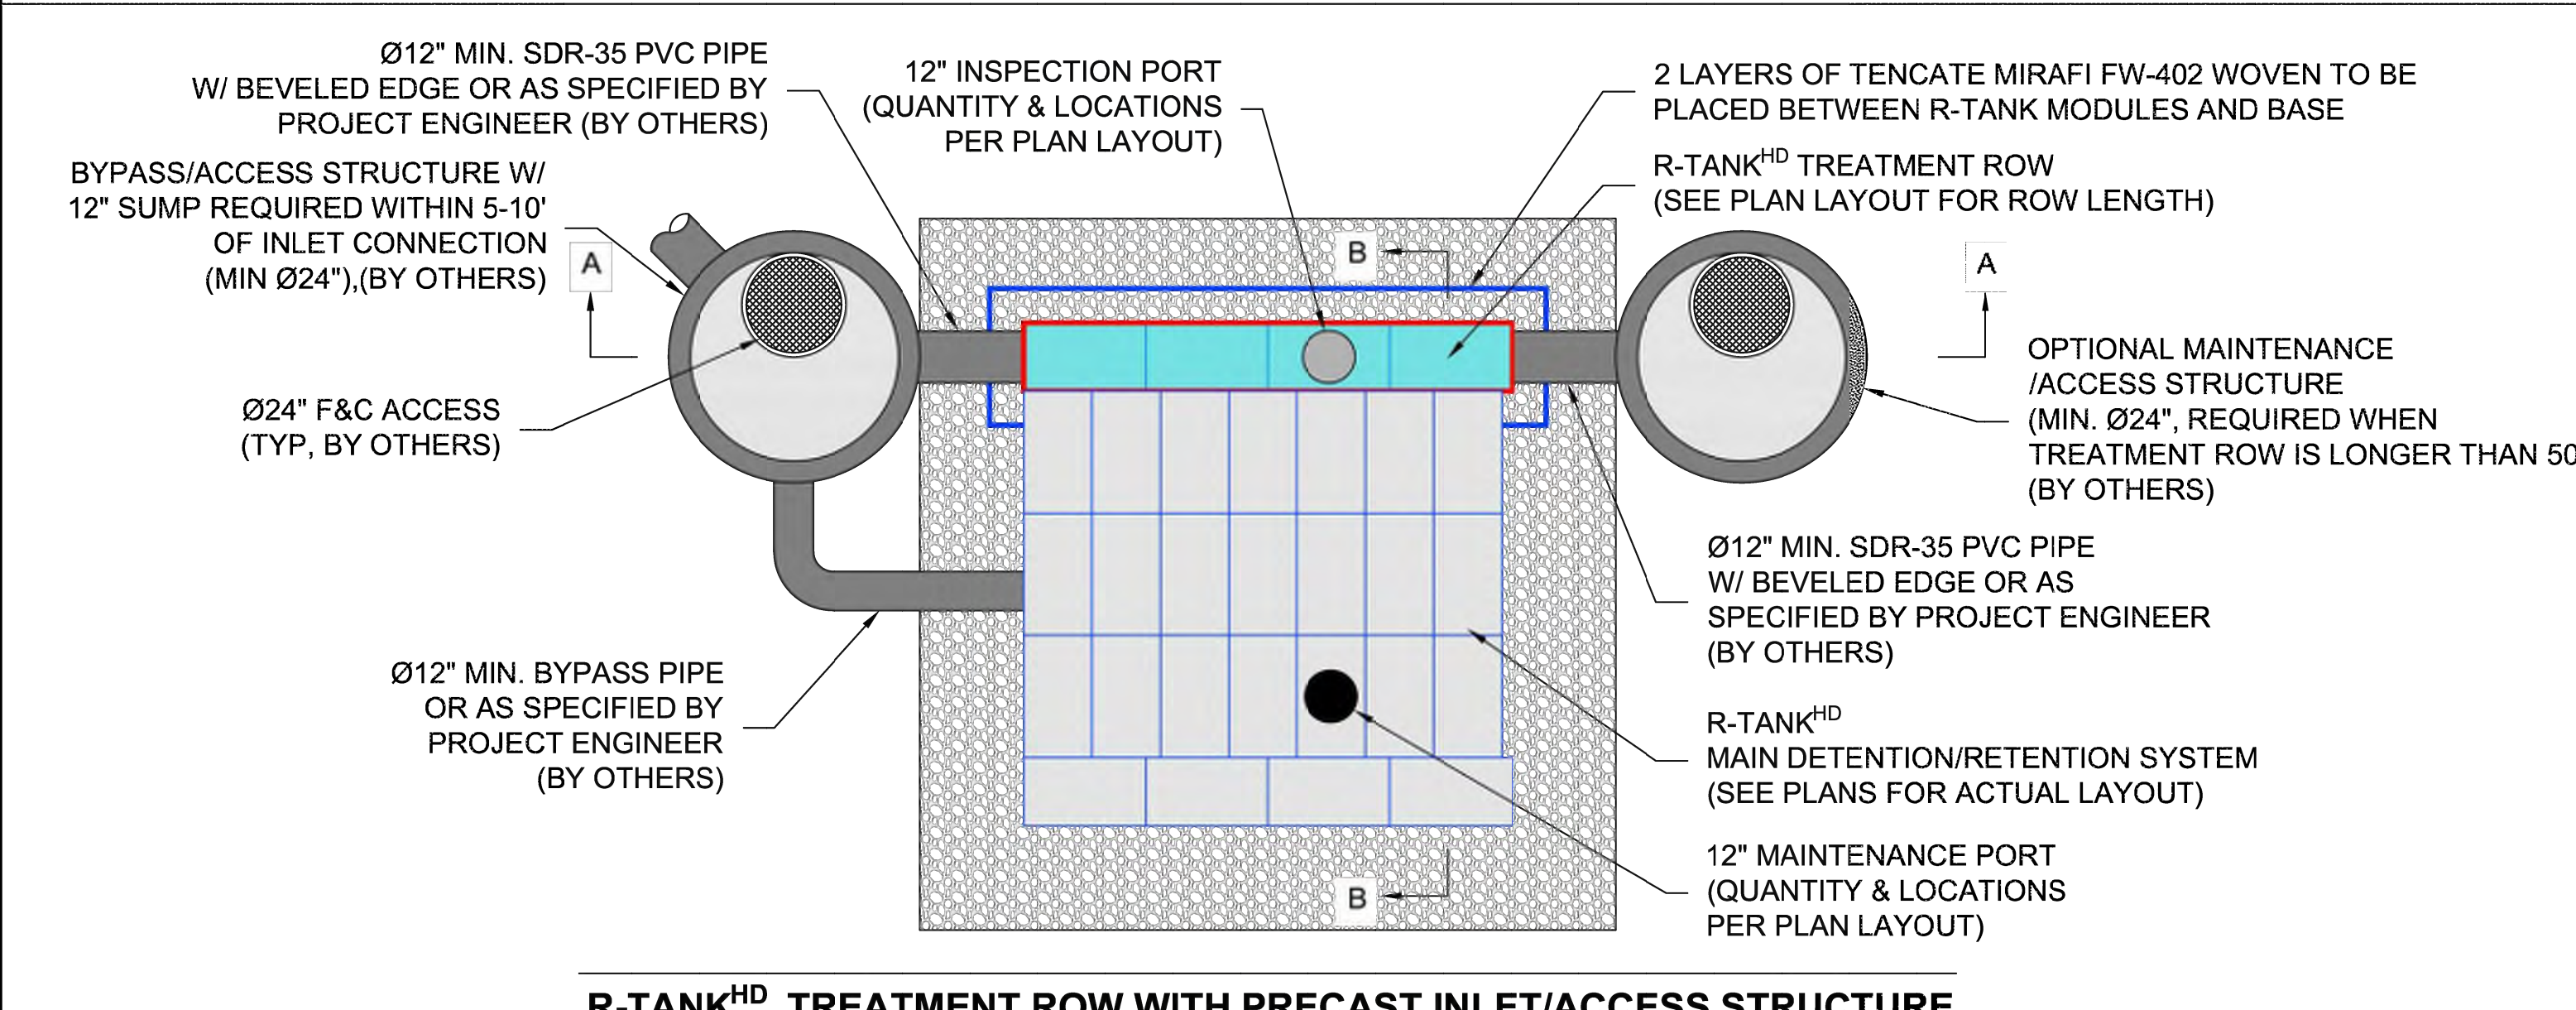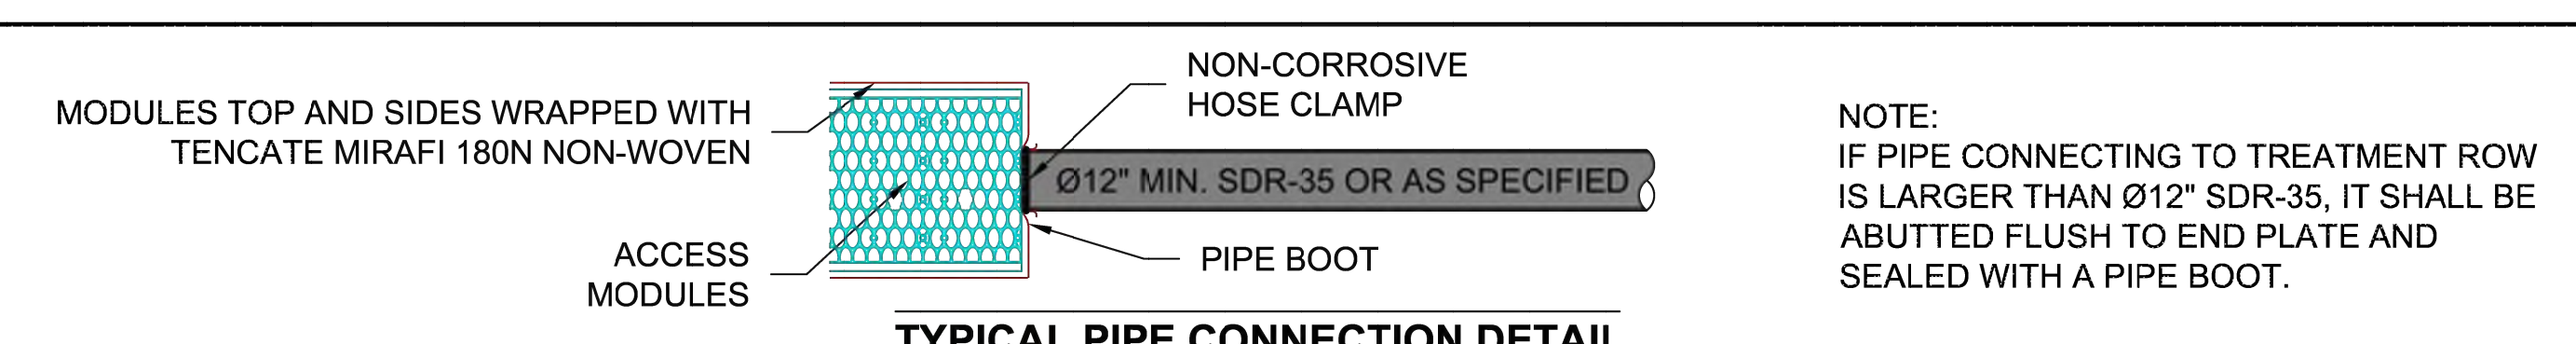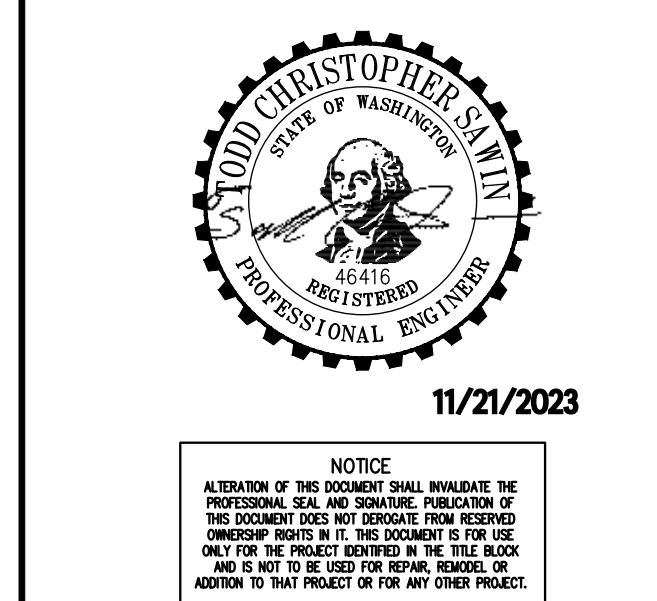



R-TANK

ENGINEER OF RECORD TO REVIEW, APPROVE AND ENDORSE FINAL SITE SPECIFIC DESIGN.

ACF WEST INC. GEOSYNTHETICS

Products | Service | Solutions

FOR ADDITIONAL INFORMATION PLEASE CONTACT:
ACF WEST, 1-800-423-4567, www.acfwest.com

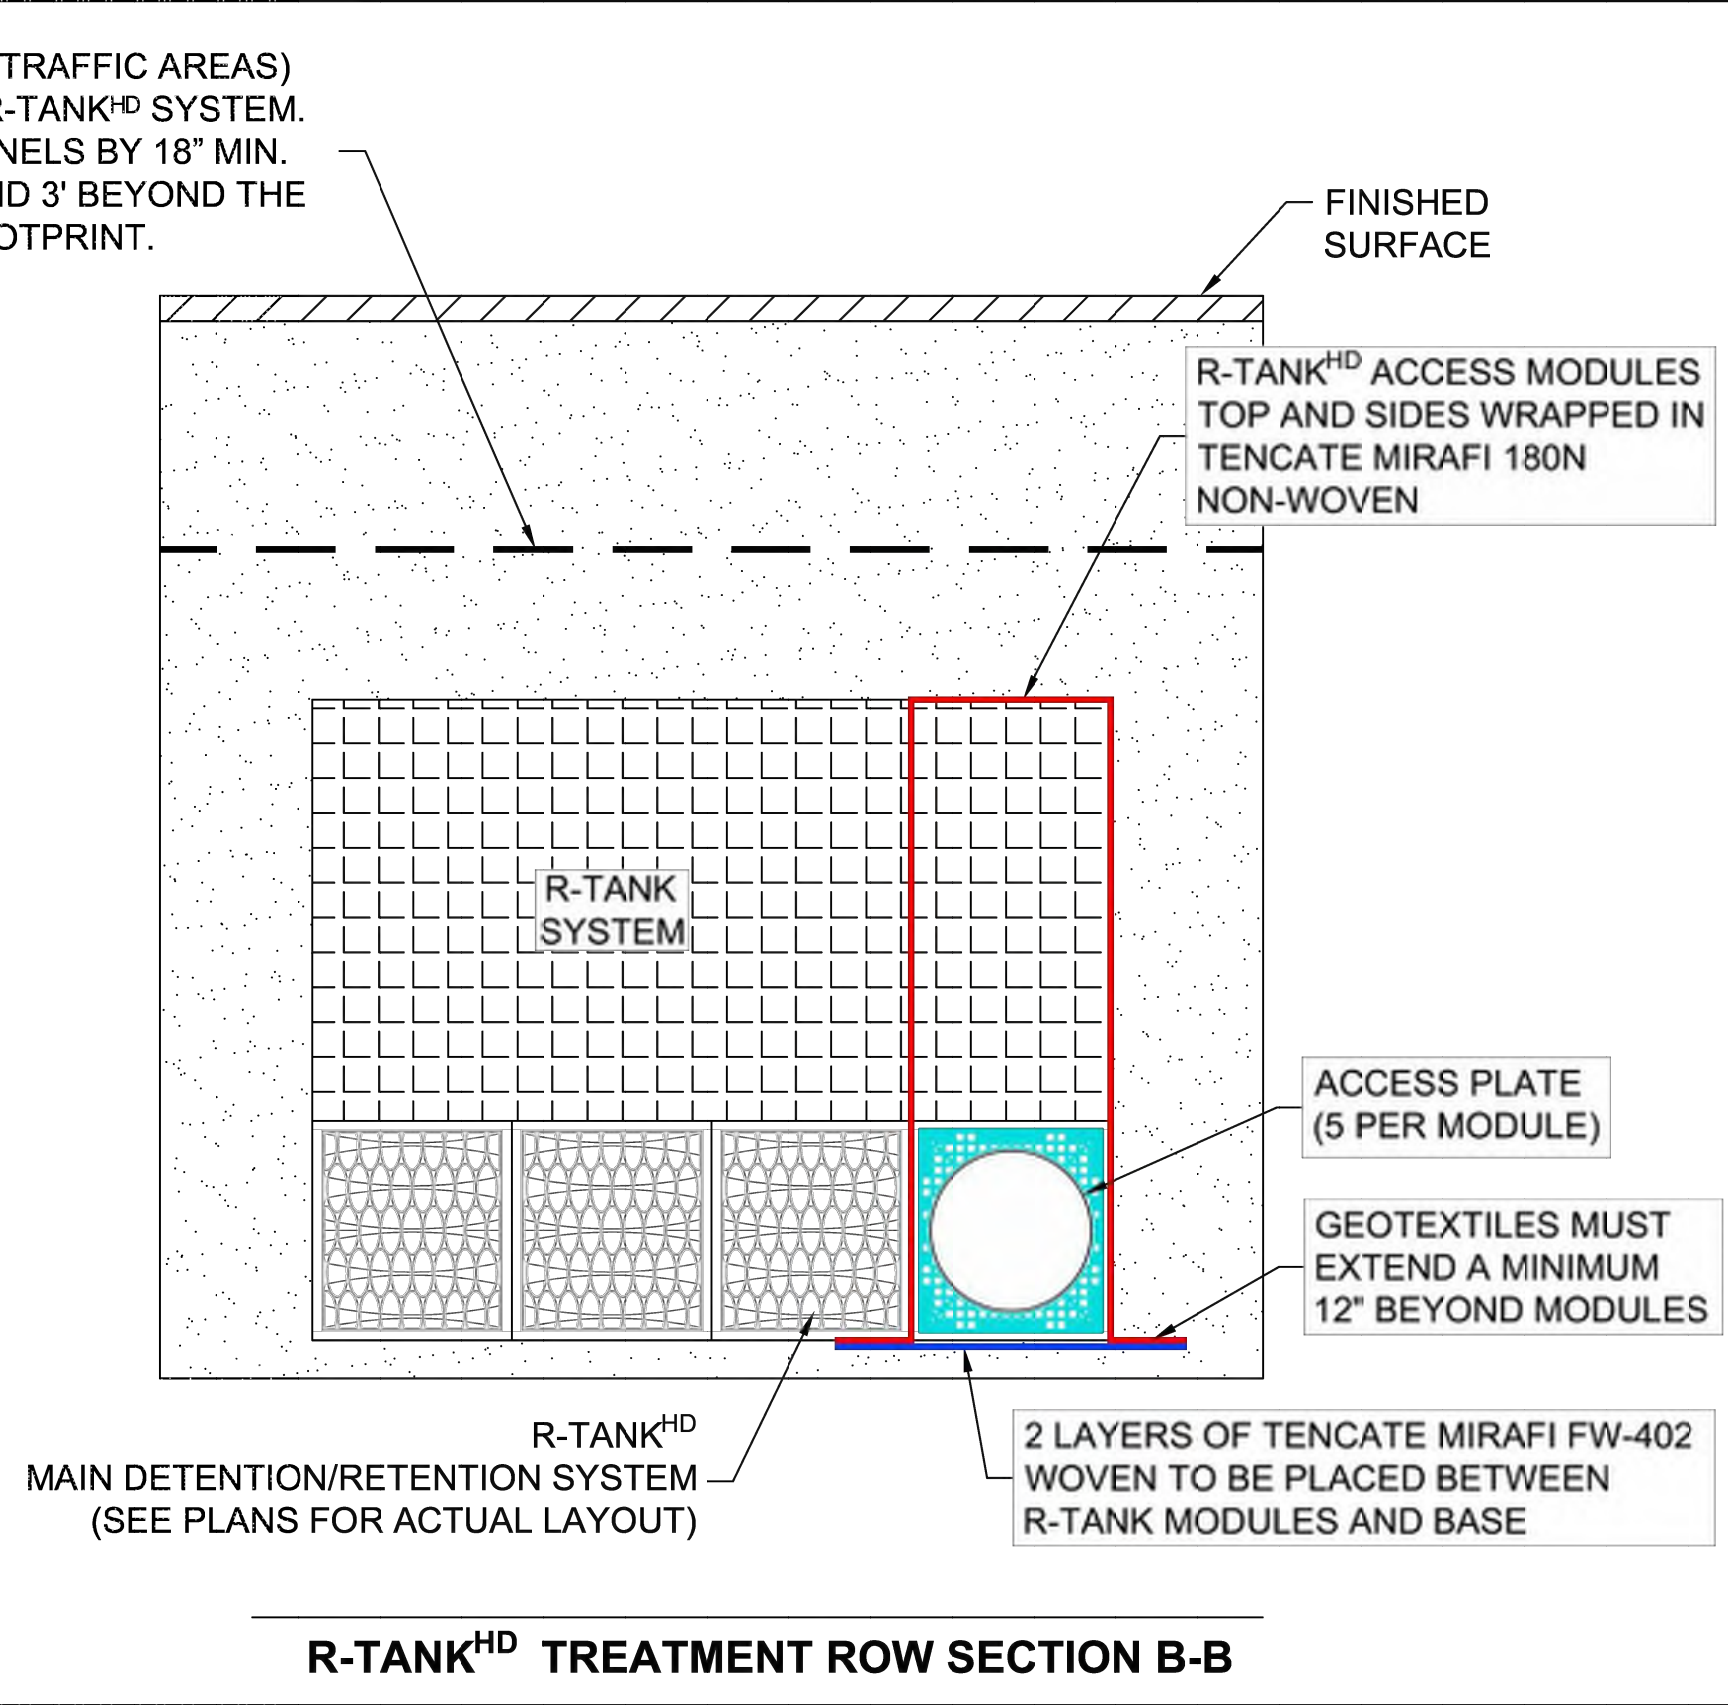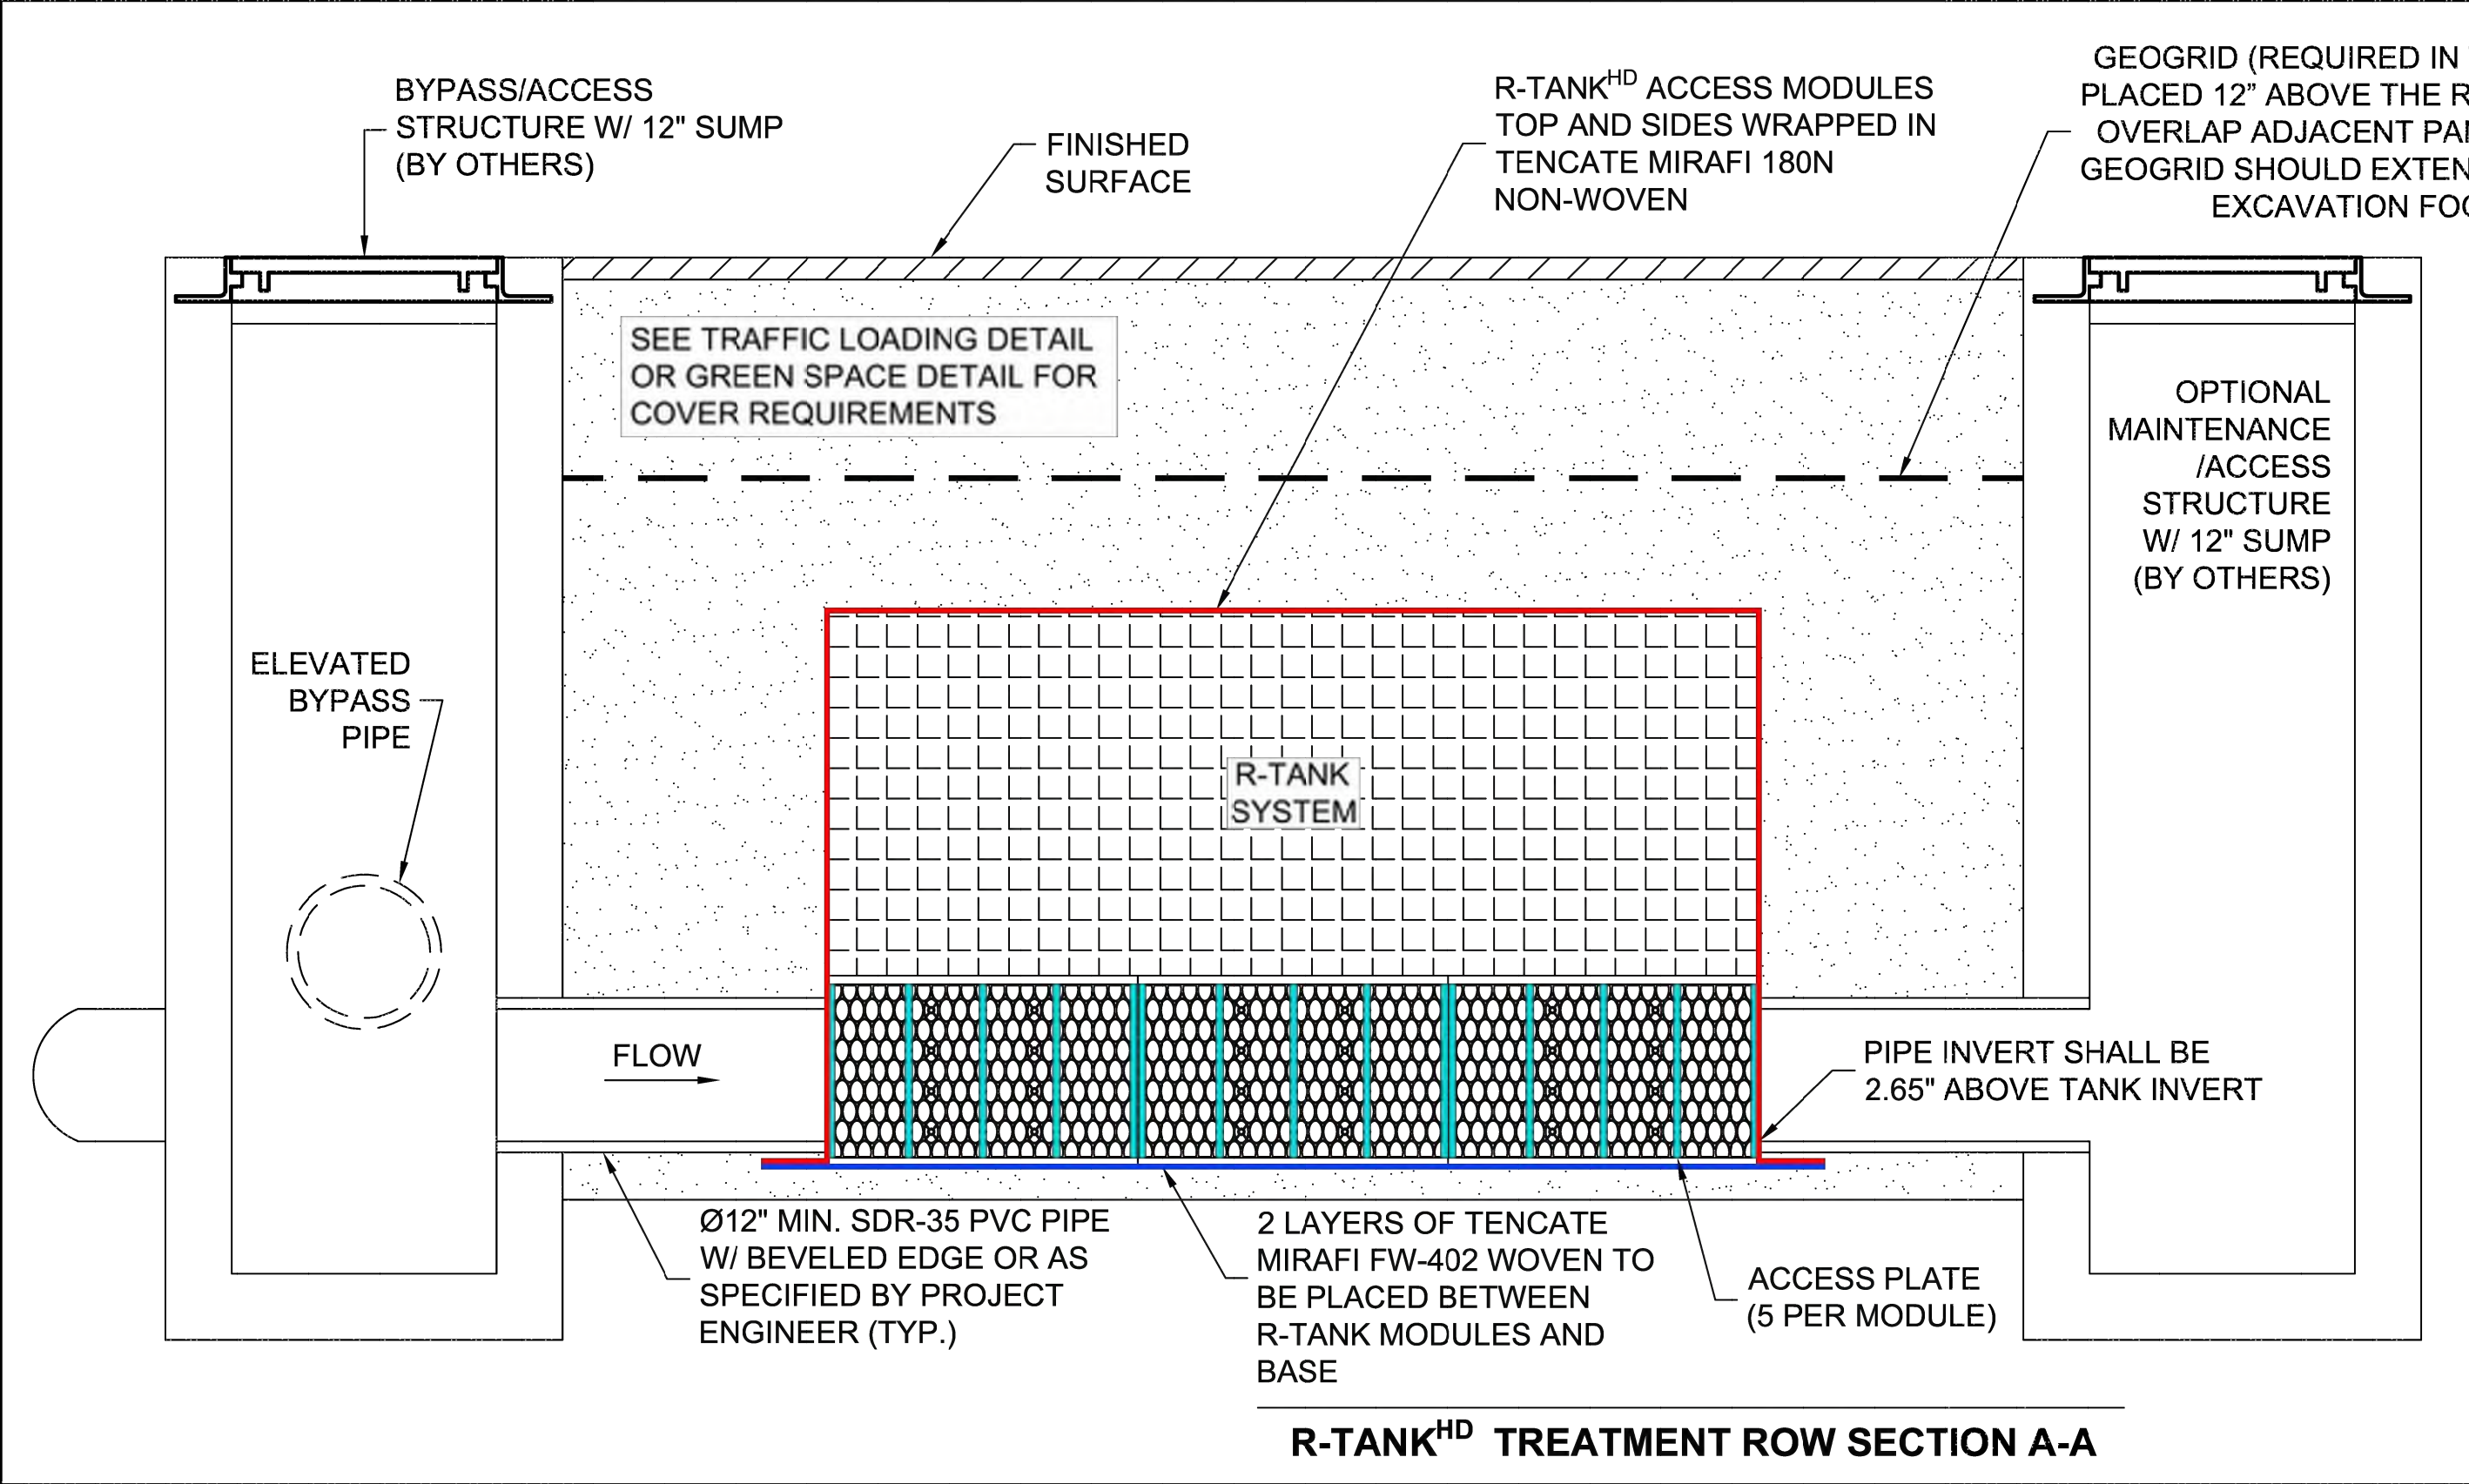

R-TANK^{HD} TREATMENT ROW DETAILS
EAST TOWN CROSSING
PUYALLUP, WA
SITE DESIGNATION: R-TANK 1

DRAWN BY: EDQ
DATE: 11/10/2023
ACF WEST PROJECT NUMBER: 23-004WA
SHEET NO.: 6 of 8

Revisions:

Sheet Title:
R-TANK 1 NOTES AND DETAILS

Designed by: CW Drawn by: SK Checked by: JI

Sheet No.
C4.15
28 of 63 Sheets



EAST TOWN CROSSING PHASE 1

SEC. 26,35/ TWP. 20 N./ RGE. 4 E., W.M.

APPROVED


BY: CITY OF PUYALLUP
DEVELOPMENT ENGINEERING

DATE: _____

NOTE: THIS APPROVAL IS VOID AFTER 180 DAYS FROM APPROVAL. THE CITY WILL NOT BE RESPONSIBLE FOR ERRORS OR OMISSIONS ON THESE PLANS. UNFAVORABLE FIELD CONDITIONS MAY DICTATE CHANGES TO THESE PLANS AS DETERMINED BY THE DEVELOPMENT ENGINEERING MANAGER.



DUMP TRUCKS AND PANS SHALL NOT OPERATE OVER THE SYSTEM EXCAVATION AREA

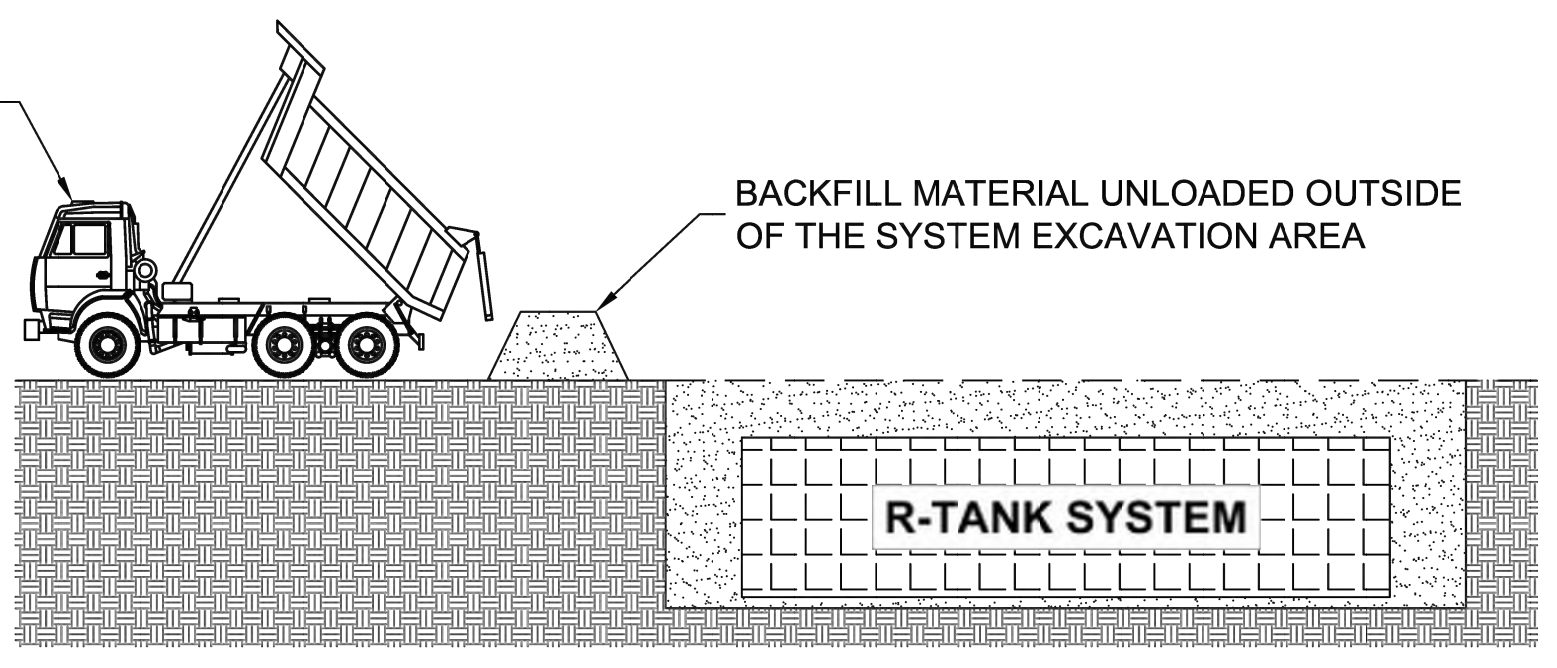


DUMP TRUCK DETAIL (SEE NOTE 3)

- NOTES:
- FOLLOWING PLACEMENT OF SIDE BACKFILL, A UNIFORM 12" LIFT OF THE FREELY DRAINING MATERIAL (SPEC SECTION 2.03 B2) SHALL BE PLACED OVER THE R-TANK AND LIGHTLY COMPACTED USING A WALK-BEHIND TRENCH ROLLER. ALTERNATELY, A ROLLER (MAXIMUM GROSS VEHICLE WEIGHT OF 6 TONS) MAY BE USED. ROLLER MUST REMAIN IN STATIC MODE UNTIL A MINIMUM OF 24" OF COVER HAS BEEN PLACED OVER THE MODULES. SHEEP FOOT ROLLERS SHOULD NOT BE USED. **SPEC SECTION 3.05 A5**
 - ONLY LOW PRESSURE TIRE OR TRACK VEHICLES (LESS THAN 7 PSI AND OPERATING WEIGHT OF LESS THAN 20,000 LBS) SHALL BE OPERATED OVER THE R-TANK SYSTEM DURING CONSTRUCTION. **SPEC SECTION 3.05 A5**
 - DUMP TRUCKS AND PANS SHALL NOT BE OPERATED WITHIN THE R-TANK SYSTEM AT ANY TIME. WHERE NECESSARY, THE HEAVY EQUIPMENT SHOULD UNLOAD IN AN AREA ADJACENT TO THE R-TANK SYSTEM AND THE MATERIAL SHOULD BE MOVED OVER THE SYSTEM WITH TRACKED EQUIPMENT. **SPEC SECTION 3.05 A5**
 - ENSURE THAT ALL UNRELATED CONSTRUCTION TRAFFIC IS KEPT AWAY FROM THE LIMITS OF EXCAVATION UNTIL THE PROJECT IS COMPLETE AND FINAL SURFACE MATERIALS ARE IN PLACE. NO NON-INSTALLATION RELATED LOADING SHOULD BE ALLOWED OVER THE R-TANK SYSTEM UNTIL THE FINAL DESIGN SECTION HAS BEEN CONSTRUCTED (INCLUDING PAVEMENT). **SPEC SECTION 3.05 B**
 - SEE R-TANK INSTALLATION GUIDE OR CONTACT YOUR LOCAL ACF WEST REPRESENTATIVE FOR ADDITIONAL INFORMATION.

SMOOTH DRUM ROLLER
STATIC MODE
(6 TON MAX, SEE NOTE 1)

LOW GROUND PRESSURE DOZER
(10 TON MAX, SEE NOTE 2)


SMOOTH DRUM ROLLER
VIBRATORY MODE
(6 TON MAX, SEE NOTE 1)

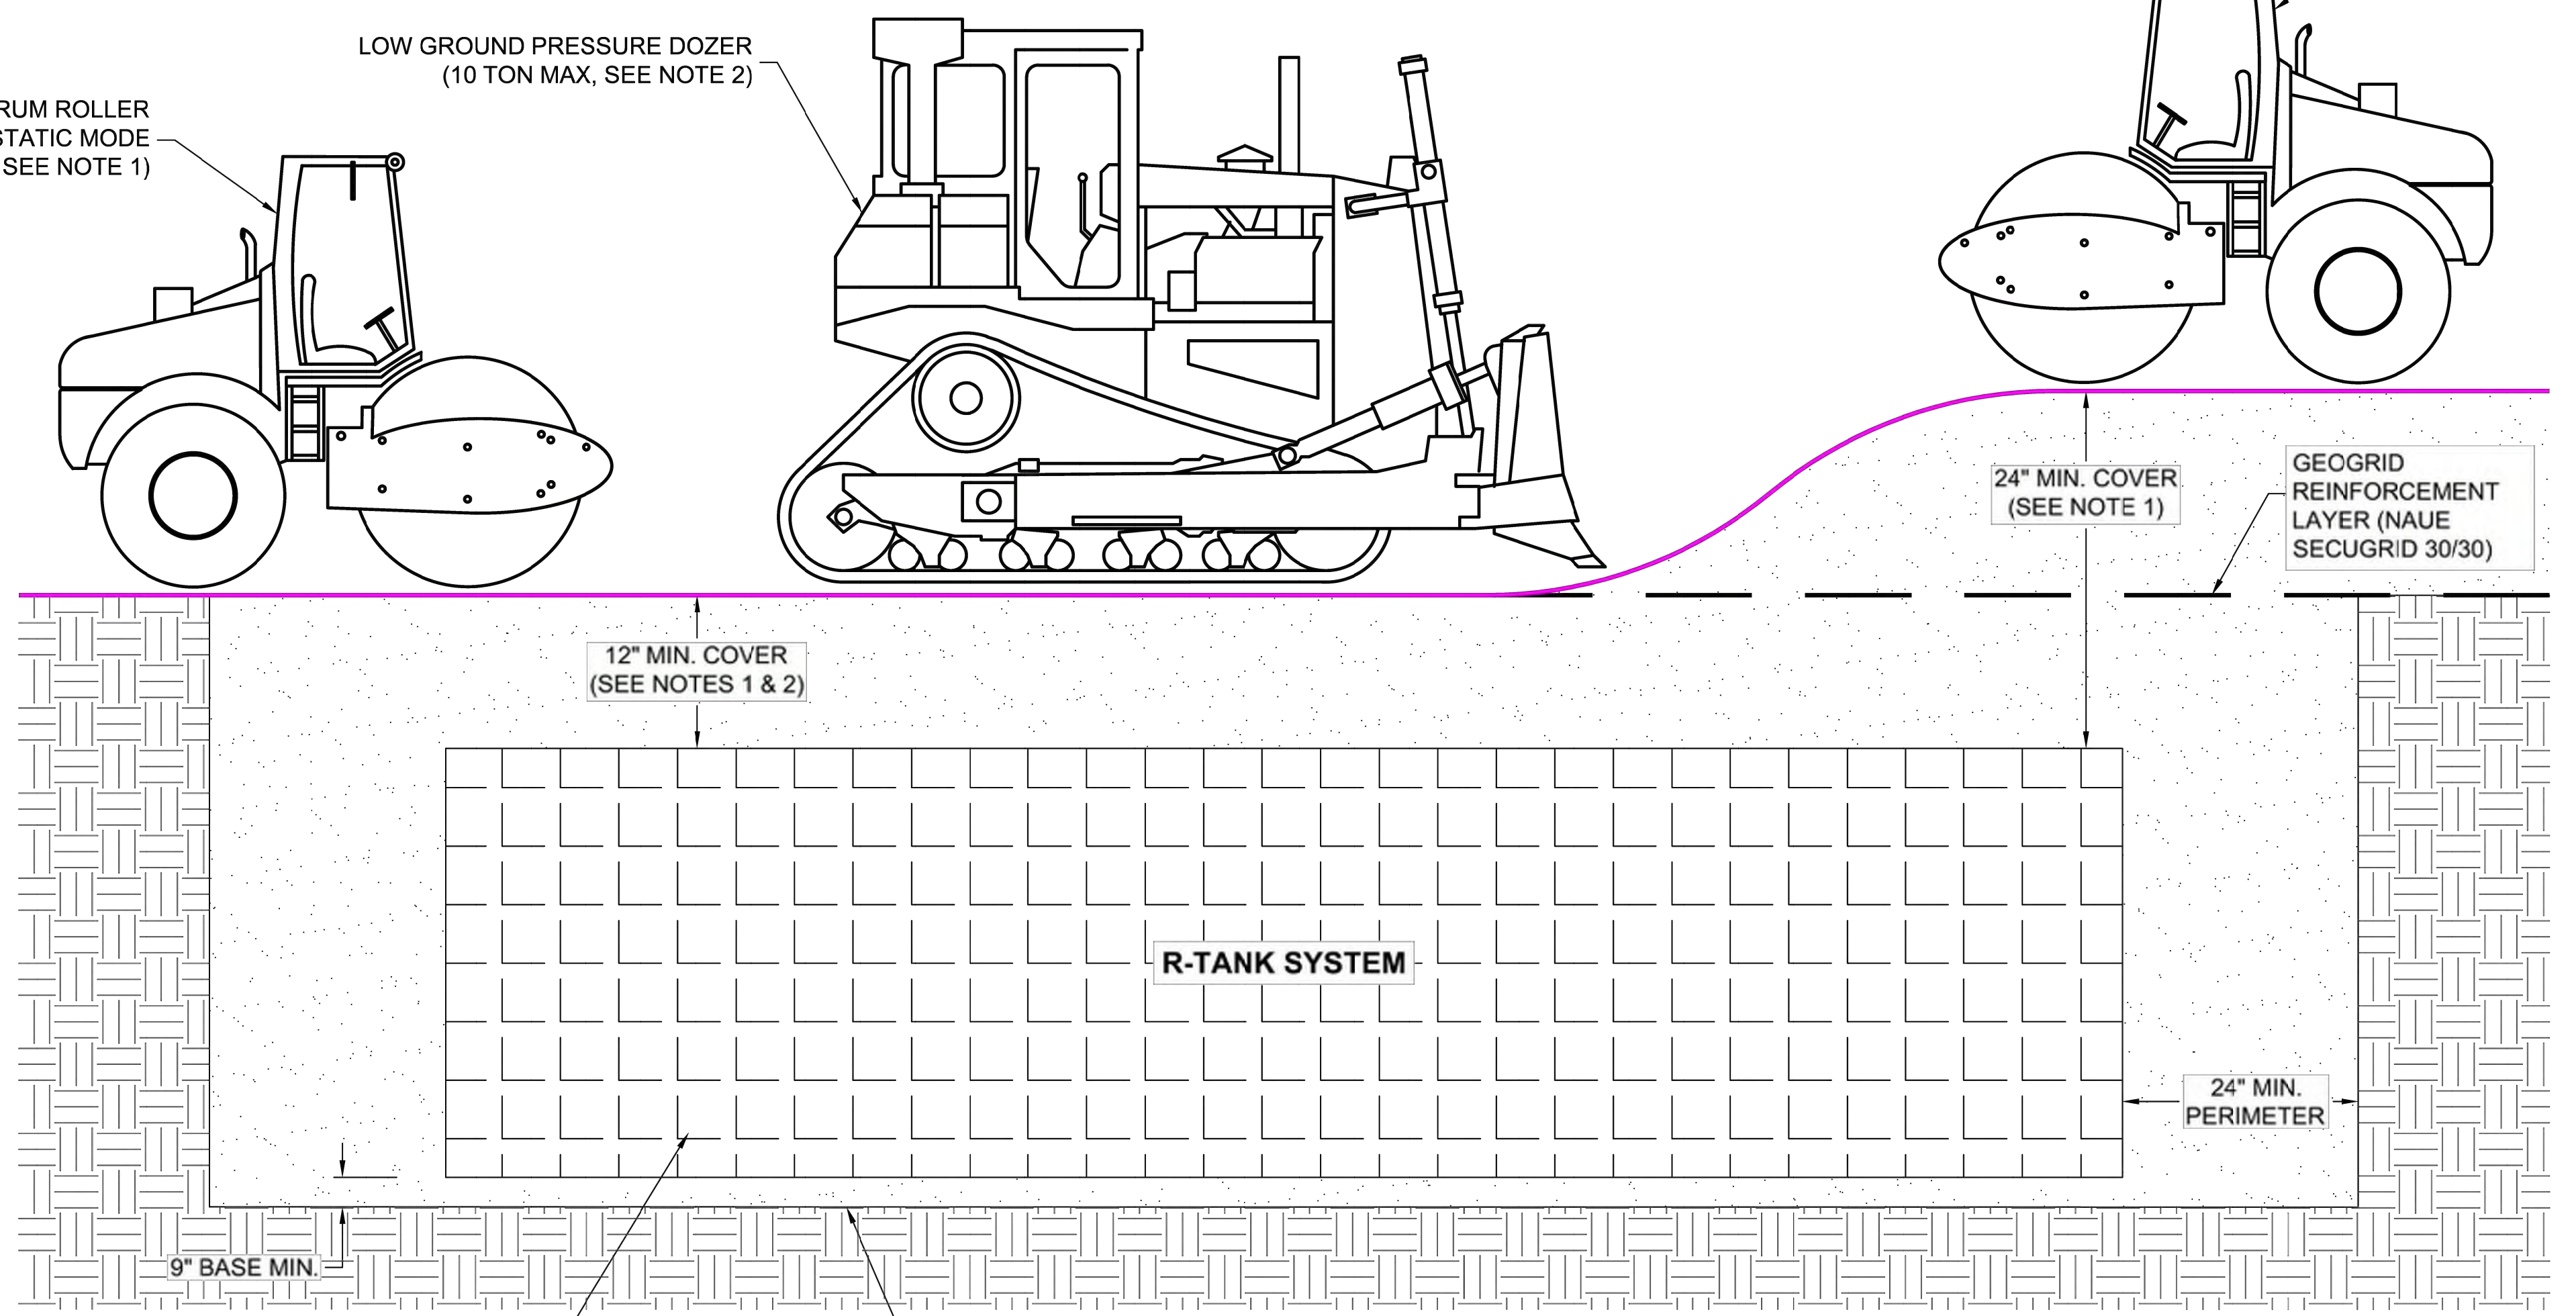

R-TANK^{HD} OR R-TANK^{SD} UNITS
HD: LOAD RATING: 33.4 PSI (MODULE ONLY)
SD: LOAD RATING: 42.9 PSI (MODULE ONLY)

SUBGRADE / EXCAVATION LINE: COMPACT PER SPEC SECTION 3.02 D. A BEARING CAPACITY OF 2,000 PSF MUST BE ACHIEVED PRIOR TO INSTALLING R-TANK^{HD} OR R-TANK^{SD}

CONSTRUCTION EQUIPMENT COVER DETAIL - VEHICULAR TRAFFIC

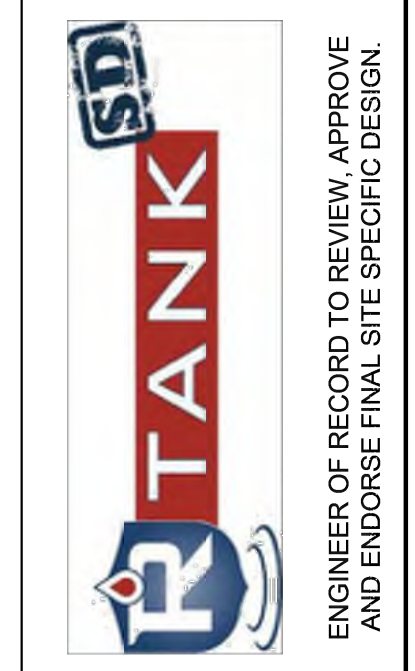

R-TANK^{SD} CONSTRUCTION EQUIPMENT COVER DETAIL
EAST TOWN CROSSING
PUYALLUP, WA
SITE DESIGNATION: R-TANK 1

DRAWN BY: EDQ
DATE: 11/10/2023
ACF WEST PROJECT NUMBER: 23-004WA
SHEET NO: 7 of 8

Project Title:
EAST TOWN CROSSING PHASE 1


Client:
ASH DEVELOPMENT

GREG HELLE
GREG.HELLE@ASHNW.COM

Project No.
2230752

Issue Set & Date:
PERMIT SUBMITTAL

11/20/2023

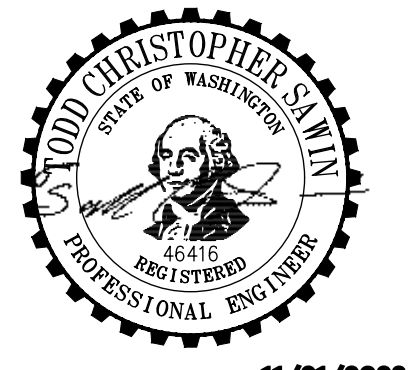

NOTICE
ALTERATION OF THIS DOCUMENT SHALL INVALIDATE THE PROFESSIONAL SEAL AND SIGNATURE. PUBLICATION OF THIS DOCUMENT DOES NOT CONSTITUTE AN ENDORSEMENT OR GUARANTEE BY THE ENGINEER OR FIRM. THIS DOCUMENT IS FOR THE PROJECT IDENTIFIED IN THE TITLE BLOCK AND IS NOT TO BE USED FOR OTHER PROJECTS OR ACTION TO THAT PROJECT OR FOR ANY OTHER PROJECT.

Revisions:

△

△

△

△

Sheet Title:

R-TANK 1 NOTES AND DETAILS

Designed by: CW
Drawn by: SK
Checked by: JI

Sheet No.

C4.16

29 of 63 Sheets



EAST TOWN CROSSING PHASE 1

SEC. 26,35/ TWP. 20 N./ RGE. 4 E., W.M.

Legibility
[Plans Sht C4.17; Pg 30 of 63]

Fixed

APPROVED

BY: CITY OF PUYALLUP
DEVELOPMENT ENGINEERING

DATE:

THIS APPROVAL IS VOID
IF NOT SIGNED AND DATED
WITHIN 180 DAYS FROM APPROVAL
THE CITY WILL NOT BE
RESPONSIBLE FOR ERRORS
OR OMISSIONS ON THESE
PLANS. UNLESS OTHERWISE
NOTED, ALL CONDITIONS MAY DICTATE
CHANGES TO THESE PLANS AS
TERMINATED BY THE
DEVELOPMENT ENGINEERING
DESIGNER.



R-TANK SPECIFICATION

PART 1 - GENERAL

1.01 RELATED DOCUMENTS

A. Drawings, technical specification and general provisions of the Contract as modified herein apply to this section.

1.02 DESCRIPTION OF WORK INCLUDED

A. Provide excavation and base preparation per geotechnical engineer's recommendations and/or as shown on the design drawings, to provide adequate support for project design loads and safety from excavation sidewall collapse. Excavations shall be in accordance with the owner's and OSHA requirements.

B. Provide and install R-TankLD/, R-TankHD/, R-TankSD/, or R-TankUD/ system (hereafter called R-Tank) and all related products including fill materials, geotextiles, geogrids, inlet and outlet pipe with connections per the manufacturer's installation guidelines provided in this section.

C. Provide and construct the cover of the R-Tank system including: stone backfill, structural fill cover, and pavement section as specified.

D. Protect R-Tank system from construction traffic after installation until completion of all construction activity in the installation area.

1.03 QUALITY CONTROL

A. All materials shall be manufactured in ISO certified facilities.

B. Installation Applications shall demonstrate the following experience:

1. A minimum of three R-Tank or equivalent projects completed within 2 years; and,
2. A minimum of 25,000 cubic feet of storage volume completed within 2 years.

C. Contractor experience requirement may be waived if the manufacturer's representative provides on-site training and review during construction.

D. Installation Personnel: Performed only by skilled workers with satisfactory record of performance on bulk earthworks, pipe, chamber, or pond/landfill construction projects of comparable size and quality.

E. Contractor must have manufacturer's representative available for site review if requested by Owner.

1.04 SUBMITTALS

A. Submit proposed R-Tank layout drawings. Drawings shall include typical section details as well as the required base elevation of stone and tanks, minimum cover requirements and tank configuration.

B. Submit manufacturer's product data, including compressive strength and unit weight.

C. Submit manufacturer's installation instructions.

D. Submit R-Tank sample for review. Reviewed and accepted samples will be returned to the Contractor.

E. Submit material certificates for geotextile, geogrid, base course and backfill materials.

F. Submit required experience and personnel requirements as specified in Section 1.03.

G. Any proposed equal alternative product substitution to this specification must be submitted for review and approved prior to bid opening. Review package should include third party reviewed performance data that meets or exceeds criteria in Table 2.01 B.

1.05 DELIVERY, STORAGE, AND HANDLING

A. Protect R-Tank and other materials from damage during delivery, and store UV sensitive materials under tarp to protect from sunlight when time from delivery to installation exceeds two weeks. Storage of materials should be on smooth surfaces, free from dirt, mud and debris.

B. Handling is to be performed with equipment appropriate to the materials and site conditions, and may include hand, handcart, forklifts, extension lifts, etc.

C. Cold weather:

1. Care must be taken when handling plastics when air temperature is 40 degrees or below as plastic becomes brittle.
2. Do not use frozen materials or materials mixed or coated with ice or frost.
3. Do not build on frozen ground or wet, saturated or muddy subgrade.

1.06 PREINSTALLATION CONFERENCE

A. Prior to the start of the installation, a preinstallation conference shall occur with the representatives from the design team, the general contractor, the excavation contractor, the R-Tank installation contractor, and the manufacturer's representative.

1.07 PROJECT CONDITIONS

A. Coordinate installation for the R-Tank system with other on-site activities to eliminate all non-installation related construction traffic over the completed R-Tank system. No loads heavier than the design loads shall be allowed over the system, and in no case shall loads higher than a standard AASHTO HS20 (or HS25, depending on design criteria) load be allowed on the system at any time.

B. Protect adjacent work from damage during R-Tank system installation.

C. All pre-treatment systems to remove debris and heavy sediments must be in place and functional prior to operation of the R-Tank system. Additional pretreatment measures may be needed if unit is operational during construction due to increased sediment loads.

D. Contractor is responsible for any damage to the system during construction.

PART 2 - PRODUCTS

2.01 R-TANK UNITS

A. R-Tank - Injection molded plastic tank plates assembled to form a 95% void modular structure of pre-designed height (custom for each project).

B. R-Tank units shall meet the following Physical & Chemical Characteristics:

PROPERTY	DESCRIPTION	R-Tank SM VALUE	R-Tank ^{HD} VALUE	R-Tank ^{SD} VALUE	R-Tank ^{UD} VALUE
Void Area	Volume available for water storage	95%	95%	95%	95%
Surface Void Area	Percentage of exterior available for infiltration	90%	90%	90%	90%
Vertical Compressive Strength	ASTM D 2412 / ASTM F 2418	30.0 psi	33.4 psi	42.9 psi	134.2 psi
Lateral Compressive Strength	ASTM D 2412 / ASTM F 2418	20.0 psi	22.4 psi	28.9 psi	N/A
HS-20 Minimum Cover	Cover required to support HS-20 loads	N/A	20"	18"	12" (STONE BACKFILL)
HS-25 Minimum Cover	Cover required to support HS-25 loads	N/A	24"	19"	12" (STONE BACKFILL)
Maximum Cover	Maximum allowable cover depth	3 feet	4 feet	4.10 feet	5 feet
Unit Weight	Weight of plastic per cubic foot of tank	3.29 lbs / cf	3.61 Backfill	3.96 lbs / cf	4.33 lbs / cf
Rib Thickness	Thickness of load-bearing members	0.18 inches	0.18 inches	0.18 inches	N/A
Service Temperature	Safe temperature range for use	-14 - 167° F	-14 - 167° F	-14 - 167° F	-14 - 167° F

C. Supplier: ACF West 15540 Woodinville-Redmond Rd., Woodinville, Washington 98072, (425) 415-6115, www.acfwest.com

2.02 GEOSYNTHETICS

A. Geotextile: A geotextile envelope is required to prevent backfill material from entering the R-Tank modules.

1. Standard Application: The standard geotextile shall be an 8 oz per square yard nonwoven geotextile (TenCate Mirafi 180N or equivalent).
2. Infiltration Applications: When water must infiltrate/exfiltrate through the geotextile as a function of the system design, a woven monofilament (TenCate Mirafi FW402 or equivalent) shall be used.

B. Geogrid: For installations subject to traffic loads and/or when required by project plans, install geogrid (Naue Secugrid 30/30 or equivalent) to reinforce backfill above the R-Tank system. Geogrid is not always required for R-TankUD/ installations, and is often not required for non-traffic load applications.

2.03 BACKFILL & COVER MATERIALS

A. Bedding Materials: Stone (angular and smaller than 1.5" in diameter) or soil (GW, GP, SW, or SP as classified by the Unified Soil Classification System) shall be used below the R-Tank system (3" minimum). Material must be free from lumps, debris, and any sharp objects that could cut the geotextile. Material shall be within 3 percent of the optimum moisture content as determined by ASTM D698 at the time of installation. For infiltration applications bedding material shall be free draining.

B. Side and Top Backfill: Material must be free from lumps, debris and any sharp objects that could cut the geotextile. Material shall be within 3 percent of the optimum moisture content as determined by ASTM D698 at the time of installation.

1. Traffic Applications - Free draining material shall be used adjacent to (24" minimum) and above (for the first 12") the R-Tank system.
2. For HD, and SD modules, backfill materials shall be free draining stone (angular and smaller than 1.5" in diameter) or soil (GW, GP, SW, or SP as classified by the Unified Soil Classification System).
3. For UD modules with less than 14" of top cover, backfill materials shall be free draining stone (angular and smaller than 1.5" in diameter). The use of soil backfill on the sides and top of the UD module is not permitted unless the modules are installed outside of traffic areas or with cover depths of 14" or more. Top backfill material (from top of module to bottom of pavement base or 12" maximum) must be consistent with side backfill.

C. Non-Traffic / Green Space Applications - For all R-Tank modules installed in green spaces and not subjected to vehicular loads, backfill materials may either follow the guidelines for Traffic Applications above, or the top backfill layer (12" minimum) may consist of AASHTO #57 stone blended with 30-40% (by volume) topsoil to aid in establishing vegetation.

D. Additional Cover Materials: Structural fill shall consist of granular materials meeting the gradational requirements of SM, SP, SW, GM, GP or GW as classified by the Unified Soil Classification System. Structural fill shall have a maximum of 25 percent passing the No. 200 sieve, shall have a maximum clay content of 10 percent and a maximum Plasticity Index of 4. Material shall be within 3 percent of the optimum moisture content as determined by ASTM D698 at the time of installation.

2.04 OTHER MATERIALS

A. Utility Marker: Install metallic tape at corners of R-Tank system to mark the area for future utility detection.

PART 3 - EXECUTION

3.01 ASSEMBLY OF R-TANK UNITS

A. Assembly of modules shall be performed in accordance with the R-Tank Installation Manual, Section 2.

3.02 LAYOUT AND EXCAVATION

A. Installer shall stake out, excavate, and prepare the subgrade area to the required plan grades and dimensions, ensuring that the excavation is at least 2 feet greater than R-Tank dimensions in each direction allowing for installation of geotextile filter fabric, R-Tank modules, and free draining backfill materials.

B. All excavations must be prepared with OSHA approved excavated sides and sufficient working space.

C. Protect partially completed installation against damage from other construction traffic by establishing a perimeter with high visibility construction tape, fencing, barricades, or other means until construction is complete.

D. Base of the excavation shall be uniform, level, and free of lumps or debris and soft or yielding subgrade areas. A minimum 2,000 pounds per square foot bearing capacity is required.

E. Standard Applications: Compact subgrade to a minimum of 95% of Standard Proctor (ASTM D698) density or as required by the Owner's engineer.

F. Infiltration Applications: Subgrade shall be prepared in accordance with the contract documents. Compaction of subgrade should not be performed in infiltration applications.

G. Unsuitable Soils or Conditions: All questions about the base of the excavation shall be directed to the owner's engineer, who will approve the subgrade conditions prior to placement of stone. The owner's engineer shall determine the required bearing capacity of the R-Tank subgrade; however in no case shall a bearing capacity of less than 2,000 pounds per square foot be provided.

1. If unsuitable soils are encountered at the subgrade, or if the subgrade is pumping or appears excessively soft, repair the area in accordance with contract documents and/or as directed by the owner's engineer.
2. If indications of the water table are observed during excavation, the engineer shall be contacted to provide recommendations.
3. Do not start installation of the R-Tank system until unsatisfactory subgrade conditions are corrected and the subgrade conditions are accepted by the owner's engineer.

3.03 PREPARATION OF BASE

A. Place a thin layer (3" unless otherwise specified) of bedding material (Section 2.03 A), over the subgrade to establish a level working platform for the R-Tank modules. Level to within 1/2" (+/- 1/4") or as shown on the plans. Native subgrade soils or other materials may be used if determined to meet the requirements of 2.03 A and are accepted by the owner's engineer.

1. Standard Applications: Static roll or otherwise compact bedding materials until they are firm and unyielding.
2. Infiltration Applications: Bedding materials shall be prepared in accordance with the contract documents.

B. Outline the footprint of the R-Tank system on the excavation floor using spray paint or chalk line to ensure a 2' perimeter is available around the R-Tank system for proper installation and compaction of backfill.

3.04 INSTALLATION OF THE R-TANKS

A. Where a geotextile wrap is specified on the stone base, cut strips to length and install in excavation, removing wrinkles so material lays flat. Overlap geotextile a minimum 12" or as recommended by manufacturer. Use tape, special adhesives, sandbags or other ballast to secure overlaps. As geotextiles can be damaged by extreme heat, smoking is not permissible on/near the geotextile, and tools using a flame to tack the overlaps, such as propane torches, are prohibited.

B. Where an impervious liner (for containment) is specified, install the liner per manufacturer's recommendations and the contract documents. The R-Tank units shall be separated from impervious liner by a non-woven geotextile fabric installed accordance with Section 3.04A.

C. Install R-Tank modules by placing side by side, in accordance with the design drawings. No lateral connections are required. It is advisable to use a string line to form square corners and straight edges along the perimeter of the R-Tank system. The modules are to be oriented as per the design drawing with required depth as shown on plans.

1. For LD, HD, and SD installations, the large side plate of the tank should be placed on the perimeter of the system. This will typically require that the two ends of the tank area will have a row of tanks placed perpendicular to all other tanks. If this is not shown in the construction drawings, it is a simple field adjustment that will have minimal effect on the overall system footprint. Refer to R-Tank Installation Guide for more details.
2. For UD installations, there is no perpendicular end row required.

D. Wrap the R-Tank top and sides in specified geotextile. Cut strips of geotextile so that it will cover the sides and top, encapsulating the entire system to prevent backfill entry into the system. Overlap geotextile 12" or as recommended by manufacturer. Take great care to avoid damage to geotextile (and, if specified, impervious liner) during placement.

E. Identify locations of inlet, outlet and any other penetrations of the geotextile (and optional liner). These connections should be installed flush (butted up to the R-Tank) and the geotextile fabric shall be cut to enable hydraulic continuity between the connections and the R-Tank units. These connections shall be secured using pipe boots with stainless steel pipe clamps. Support pipe in trenches during backfill operations to prevent pipe from settling and damaging the geotextile, impervious liner (if specified) or pipe. Connecting pipes at 90 degree angles facilitates construction, unless otherwise specified. Ensure end of pipe is installed snug against R-Tank system.

F. Install Inspection and Maintenance Ports in locations noted on plans. At a minimum one maintenance port shall be installed within 10' of each inlet & outlet connection, and with a maximum spacing of one maintenance port for every 2,500 square feet. Install all ports as noted in the R-Tank Installation Guide.

G. If required, install ventilation pipes and vents as specified on drawings to provide ventilation for proper hydraulic performance. The number of pipes and vents will depend on the size of the system. Vents are often installed using a 90 degree elbow with PVC pipe into a landscaped area with "U" bend or venting bollard to inhibit the ingress of debris. A ground level concrete or steel cover can be used.

3.05 BACKFILLING OF THE R-TANK UNITS

A. Backfill and fill with recommended materials as follows:

1. Place freely draining backfill materials (Section 2.03 B) around the perimeter in lifts with a maximum thickness of 12". Each lift shall be placed around the entire perimeter such that each lift is no more than 24" higher than the side backfill along any other location on the perimeter of the R-Tank system. No fill shall be placed over top of tanks until the side backfill has been completed.
2. Each lift shall be compacted at the specified moisture content to a minimum of 95% of the Standard Proctor Density until no further densification is observed (for self-compacting stone materials). The side lifts must be compacted with walk behind compaction equipment. Even when "self-compacting" backfill materials are selected, a walk behind vibratory compactor must be used.
3. Take care to ensure that the compaction process does not allow the machinery to come into contact with the modules due to the potential for damage to the geotextile and R-Tank units.
4. No compaction equipment is permissible to operate directly on the R-Tank modules.
5. Top Backfill: Only low pressure track vehicles shall be operated over the R-Tank system during construction. Dump Trucks and Pans shall not be operated within the R-Tank system footprint at any time. Heavy equipment should unload in an area adjacent to the R-Tank system and the material should be moved over the system using tracked equipment with an operating weight of less than 10 tons.
 - a. Typical Applications: Install a 12" (or as shown on plans) lift of freely draining material (Section 2.03 B) over the R-Tank Units, maintaining 12" between equipment tracks and R-Tank System. Lightly compacted using a walk-behind trench roller. Alternately, a roller (maximum gross vehicle weight of 6 tons) may be used. Roller must remain in static mode until a minimum of 24" of cover has been placed over the modules. Sheep foot rollers should not be used.
 - b. Shallow Applications (< 18" total cover): Install top backfill in accordance with plans.
6. If required, install a geogrid as shown on plans. Geogrid shall extend a minimum of 3 feet beyond the limits of the excavation wall.
7. Following placement and compaction of the initial cover, subsequent lifts of structural fill (Section 2.03 C) shall be placed at the specified moisture content and compacted to a minimum of 95% of the Standard Proctor Density and shall cover the entire footprint of the R-Tank system. During placement of fill above the system, unless otherwise specified, a uniform elevation of fill shall be maintained to within 12" across the footprint of the R-Tank system. Do not exceed maximum cover depths listed in Table 2.01 B.
8. Place additional layers of geotextile and/or geogrid at elevations as specified in the design details. Each layer of geosynthetic reinforcement placed above the R-Tank system shall extend a minimum of 3 feet beyond the limits of the excavation wall.

B. Ensure that all unrelated construction traffic is kept away from the limits of excavation until the project is complete and final surface materials are in place. No non-installation related loading should be allowed over the R-Tank system until the final design section has been constructed (including pavement).

C. Place surfacing materials, such as groundcovers (no large trees), or paving materials over the structure with care to avoid displacement of cover fill and damage to surrounding areas.

D. Backfill depth over R-Tank system must be within the limitations shown in the table in Section 2.01 B. If the total backfill depth does not comply with this table, contact engineer or manufacturer's representative for assistance.

3.06 MAINTENANCE REQUIREMENTS

A. A routine maintenance effort is required to ensure proper performance of the R-Tank system. The Maintenance program should be focused on pretreatment systems. Ensuring these structures are clean and functioning properly will reduce the risk of contamination of the R-Tank system and stormwater released from the site. Pre-treatment systems shall be inspected yearly, or as directed by the regulatory agency and by the manufacturer (for proprietary systems). Maintain as needed using acceptable practices or following manufacturer's guidelines (for proprietary systems).

B. All inlet pipes and inspection and/or Maintenance Ports in the R-Tank system will need to be inspected for accumulation of sediments at least quarterly through the first year of operation and at least yearly thereafter.

C. If sediment has accumulated to the level noted in the R-Tank Maintenance Guide or beyond a level acceptable to the Owner's engineer, the R-Tank system should be flushed.

D. All inspection and maintenance activities should be performed in accordance with the R-Tank Operation, Inspection & Maintenance Manual.

Called out

CALLOUT-manufactured 30mil (min) impermeable liner to prevent groundwater intrusion. [Plans Sht C4.17; Pg 30 of 63]

SDI TANK

ACF WEST INC. GEOSYNTHETICS Products | Service | Solutions

FOR ADDITIONAL INFORMATION PLEASE CONTACT: ACF WEST, 1-800-423-4567, www.acfwest.com

R-TANK SPECIFICATION EAST TOWN CROSSING PUYALLUP, WA SITE DESIGNATION: R-TANK 1

DRAWN BY: EDQ

DATE: 11/10/2023

ACF WEST PROJECT NUMBER: 23-004WA

SHEET NO. 8 of 8

Project Title:

EAST TOWN CROSSING PHASE 1

Client:

ASH DEVELOPMENT

GREG HELLE


GREG.HELLE@ASHNW.COM

Project No. 2230752

Issue Set & Date:

PERMIT SUBMITTAL

11/20/2023

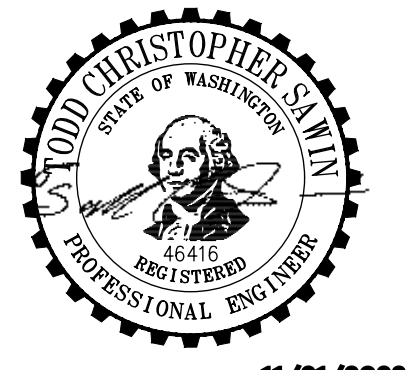

11/21/2023


Revisions:

Sheet Title:

R-TANK 1 NOTES AND DETAILS

Designed by: CW Drawn by: SK Checked by: JI

Sheet No. C4.17

30 of 63 Sheets



EAST TOWN CROSSING PHASE 1

SEC. 26,35/ TWP. 20 N./ RGE. 4 E., W.M.

Legibility:
[Plans Sht C4.20, Pg 31 of 63]

Fixed

APPROVED

BY: CITY OF PUYALLUP
DEVELOPMENT ENGINEERING

DATE:



NOTE: THIS APPROVAL IS VOID
IF NOT RECEIVED WITHIN
180 DAYS FROM APPROVAL
DATE. THE CITY WILL NOT BE
RESPONSIBLE FOR ERRORS
OR OMISSIONS ON THESE
PLANS. UNLESS OTHERWISE
NOTED, ALL CONDITIONS MAY DICTATE
CHANGES TO THESE PLANS AS
TERMINATED BY THE
DEVELOPMENT ENGINEERING
MANAGER.




ACKNOWLEDGEMENT:
AN APPROVAL OF THE SUBMITTAL PLANS IS REQUIRED PRIOR TO MATERIAL ORDER. AS PART OF THE SUBMITTAL APPROVAL, THE ENGINEER OF RECORD HEREBY ACKNOWLEDGES THAT THE R-TANK SYSTEM IS NOT DESIGNED TO SUPPORT LOADS FROM BUILDINGS OR STRUCTURES. THEREFORE, THE ENGINEER OF RECORD HAS COORDINATED WITH THE PROPER DISCIPLINES TO ENSURE NO STRUCTURAL LOADS ARE IMPARTED UPON THE SYSTEM AND ANY INFILTRATION FROM THE SYSTEM HAS BEEN ACCOUNTED FOR IN THE FOUNDATION DESIGN.

NOTES:

- THE CONTRACTOR SHALL PARTICIPATE IN A PRECONSTRUCTION MEETING AND SIGN THE PRECONSTRUCTION CHECKLIST PRIOR TO MATERIAL INSTALLATION.
- DOCUMENTATION SHALL BE RECORDED BY THE CONTRACTOR OR ENGINEER OF RECORD SHOWING PROPER INSTALLATION OF THE SYSTEM AND ALL CONNECTIONS, IN ACCORDANCE WITH MANUFACTURER SPECIFICATIONS.
- IT IS HEREBY RECOMMENDED THAT THE R-TANK SYSTEM BE INSTALLED AFTER THE FOUNDATIONS HAVE BEEN INSTALLED TO ENSURE PROPER SEPARATION DISTANCES ARE MAINTAINED.

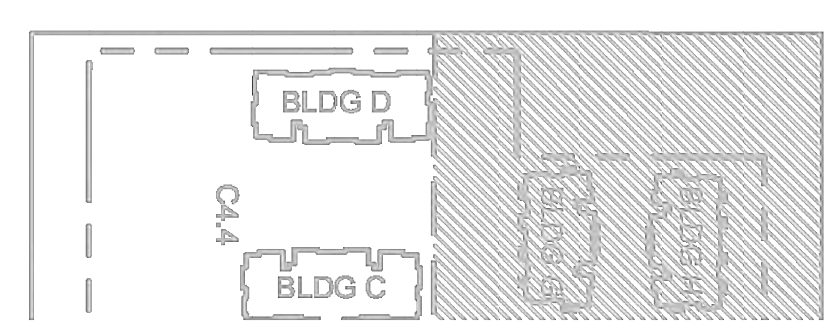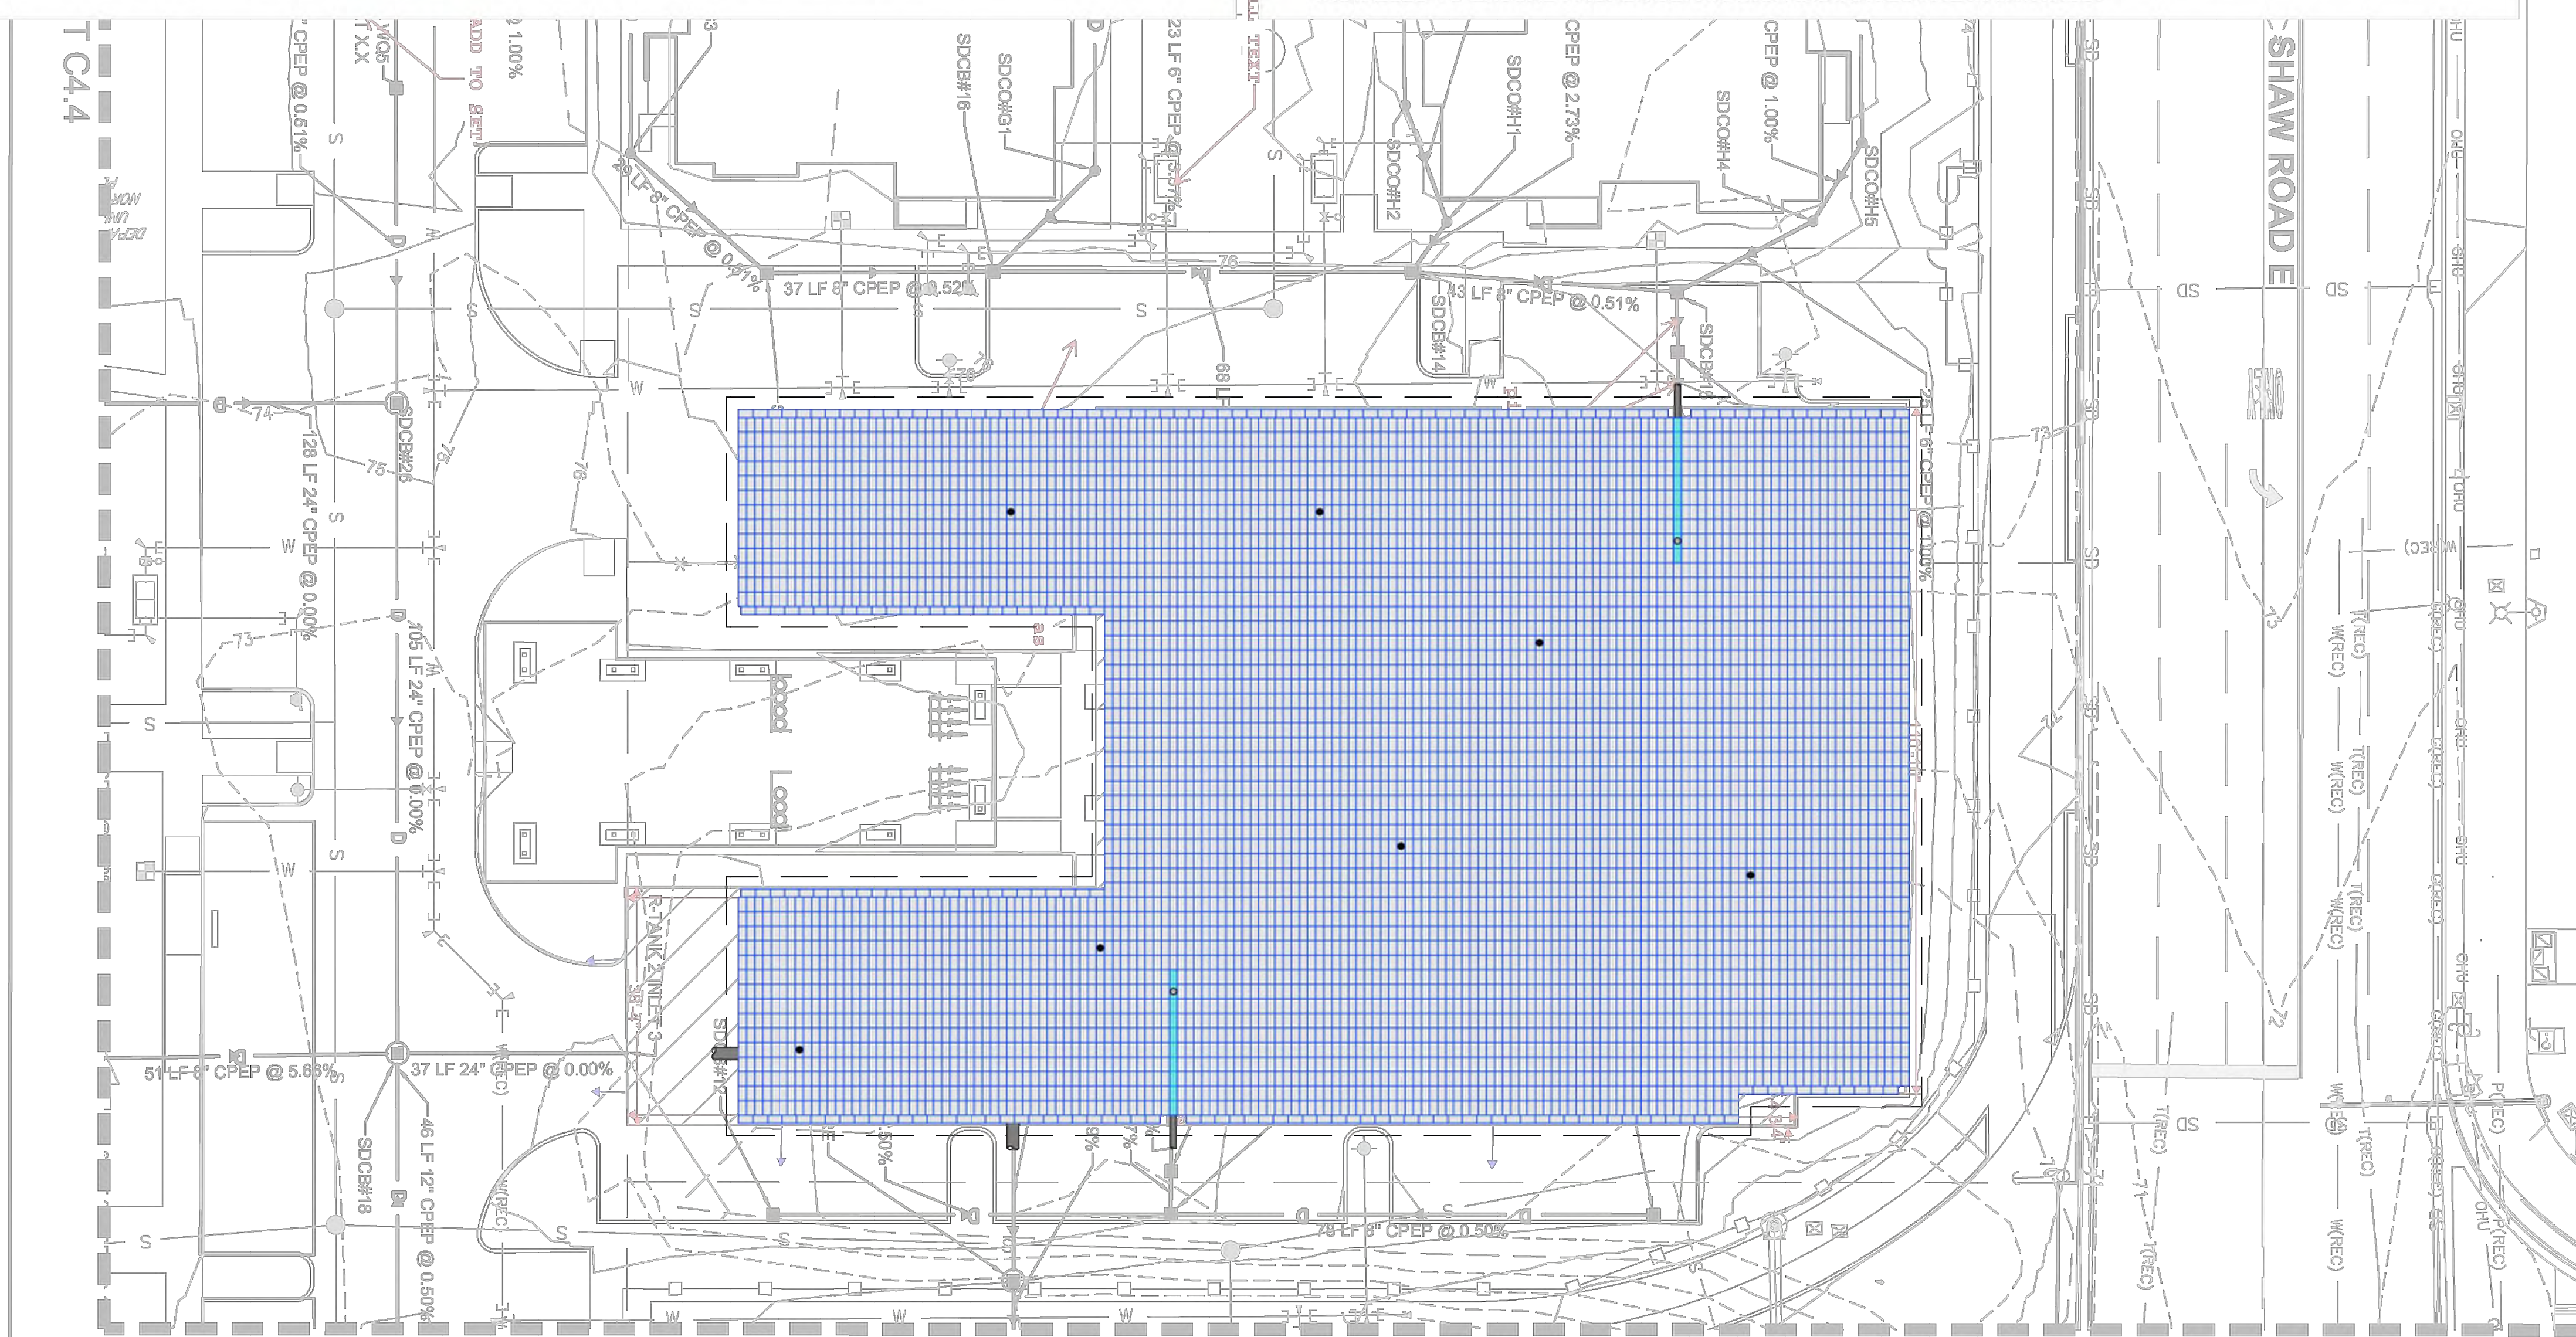

R-TANK^{SD} SYSTEM OVERLAY
SCALE: 1" = 30'

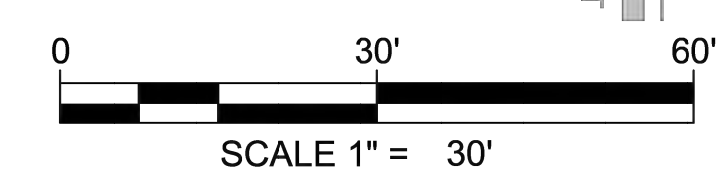

R-TANK^{SD} SYSTEM OVERLAY
EAST TOWN CROSSING
PUYALLUP, WA
SITE DESIGNATION: R-TANK 2

DRAWN BY: EDQ
DATE: 11/10/2023
ACF WEST PROJECT NUMBER: 23-004WA
SHEET NO.: 1 of 8


Project Title:
EAST TOWN CROSSING PHASE 1

Client:
ASH DEVELOPMENT

GREG HELLE
GREG.HELLE@ASHNW.COM

Project No.
2230752

Issue Set & Date:
PERMIT SUBMITTAL
11/20/2023

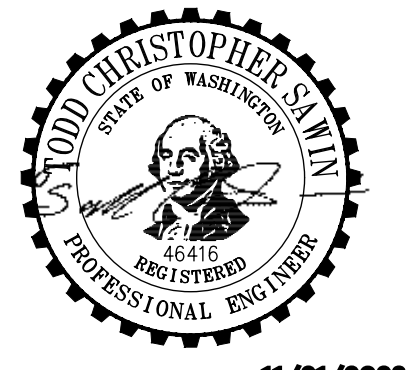

11/21/2023

NOTICE
A REVISION OF THIS DOCUMENT SHALL INDICATE THE PROFESSIONAL SEAL AND SIGNATURE PUBLICATION OF THE DOCUMENT DOES NOT REPRESENT THE REGISTERED ENGINEER'S RESPONSIBILITY FOR THE DOCUMENT OR FOR THE ONLY FOR THE PROJECT ENTERED IN THE TITLE BLOCK AND IS NOT TO BE USED FOR OTHER, SIMILAR, OR ACTION TO THAT PROJECT OR FOR ANY OTHER PROJECT.

Revisions:

Sheet Title:
R-TANK 2 NOTES AND DETAILS

Designed by: CW
Drawn by: SK
Checked by: JI

Sheet No.
C4.20
31 of 63 Sheets



EAST TOWN CROSSING PHASE 1

SEC. 26,35/ TWP. 20 N./ RGE. 4 E., W.M.

Legibility: [Plans Sht C4.21; Pg 32 of 63] Fixed

APPROVED
 BY: CITY OF PUYALLUP
 DEVELOPMENT ENGINEERING
 DATE: _____

THIS APPROVAL IS VOID
 AFTER 180 DAYS FROM APPROVAL.
 THE CITY WILL NOT BE
 RESPONSIBLE FOR ERRORS
 OR OMISSIONS ON THESE
 PLANS. UNDESIRABLE
 FIELD CONDITIONS MAY DICTATE
 CHANGES TO THESE PLANS AS
 DETERMINED BY THE
 DEVELOPMENT ENGINEERING
 MANAGER.



Project Title:
EAST TOWN CROSSING PHASE 1

Client:
 ASH DEVELOPMENT

GREG HELLE
 GREG.HELLE@ASHNW.COM

Project No.
 2230752

Issue Set & Date:
PERMIT SUBMITTAL
 11/20/2023




NOTICE
 ALTERATION OF THIS DOCUMENT SHALL INVALIDATE THE
 PROFESSIONAL SEAL AND SIGNATURE. PUBLICATION OF
 THIS DOCUMENT DOES NOT CONSTITUTE A WARRANTY.
 THE DESIGNER SHALL BE RESPONSIBLE FOR OBTAINING
 ALL NECESSARY PERMITS. THIS DOCUMENT IS FOR THE
 PROJECT ONLY AND IS NOT TO BE USED FOR ANY OTHER
 PROJECT OR FOR ANY OTHER PURPOSE.

SD R-TANK
 ENGINEER OF RECORD TO REVIEW, APPROVE
 AND ENDORSE FINAL SITE SPECIFIC DESIGN.

ACF WEST INC. GEOSYNTHETICS
 Products | Service | Solutions
 FOR ADDITIONAL INFORMATION PLEASE CONTACT:
 ACF WEST, 1-800-423-4567, www.acfwest.com

R-TANK^{SD} SYSTEM LAYOUT
 EAST TOWN CROSSING
 PUYALLUP, WA
 SITE DESIGNATION: R-TANK 2

DRAWN BY:
 EDQ
 DATE:
 11/10/2023
 ACF WEST PROJECT NUMBER:
 23-004WA
 SHEET NO.
2 of 8

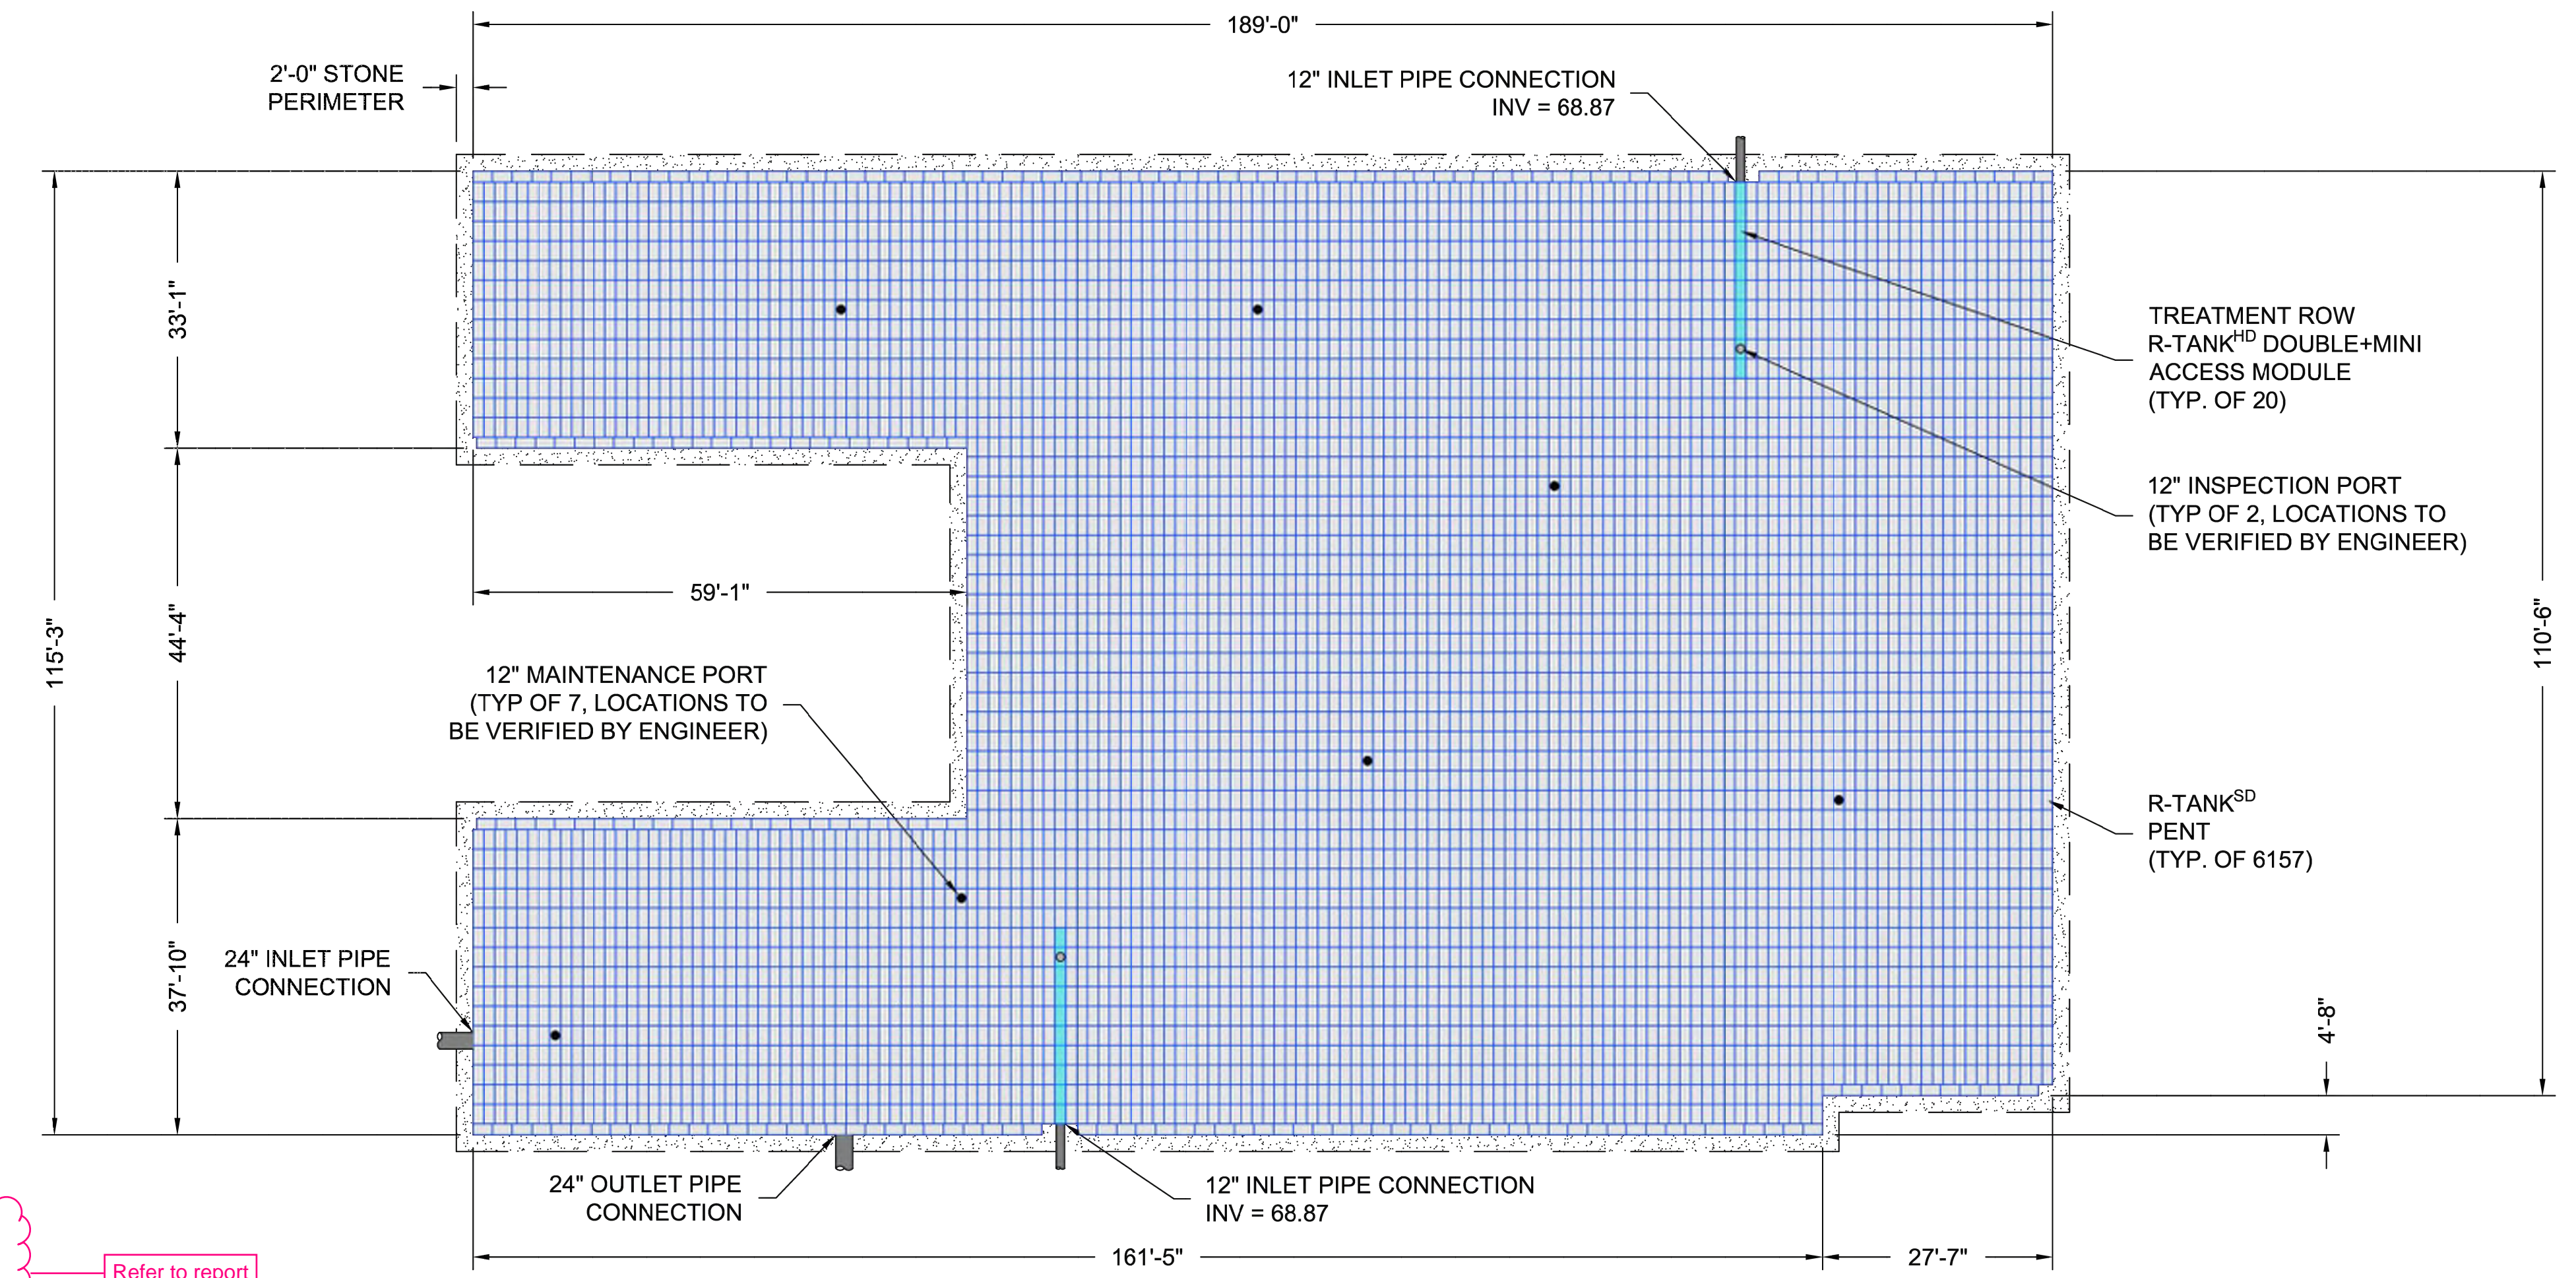


NOTE:
 MINIMUM COVER FROM TOP OF TANK TO FINISH GRADE MUST BE AT
 LEAST 30" TO MEET A 45 KIP OUTRIGGER LOAD ON AN 18'X18" PAD.

CLARIFY: See storage volume required comments in Storm Report, Pg 372 of 448. [Plans Sht C4.21; Pg 32 of 63] Refer to report


- NOTES:
- DEAD STORAGE VOLUME FROM ELEVATION 67.90 TO 68.40 = 4,100 CF
 - LIVE STORAGE VOLUME FROM ELEVATION 68.40 TO 73.32 = 78,829 CF
 - ONLY 3" OF BASE STONE INCLUDED IN LIVE STORAGE VOLUME.

CLARIFY: See Control Structure comments on Sht C4.07, and riser comments in Storm Report, Pg 372 of 448. [Plans Sht C4.21; Pg 32 of 63] Refer to report

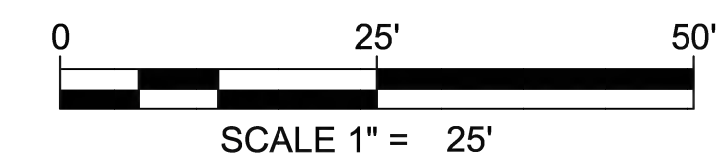

LAYOUT SCALE	1" = 25'
R-TANK ^{SD} MODULE TYPE	PENT
TRAFFIC LOAD	45 KIP OUTRIGGER (18"X18")
# OF SD PENT R-TANKS	6,157
# OF HD DOUBLE+MINI R-TANK ACCESS MODULES	20
TOTAL SYSTEM STORAGE	78,829 CF
R-TANK STORAGE VOLUME	66,395 CF
STONE STORAGE VOLUME (40% VOID RATIO)	12,434 CF
TOP OF COVER STONE ELEV. (12")	73.32
NAUE SECUGRID 30/30 GEOGRID ELEV.	73.32
TOP OF R-TANK ELEV.	72.32
TANK INVERT	68.65
INVERT OF STONE BASE (9")	67.90
MIN. STONE PERIMETER WIDTH	2.0 FT

SEE SHEETS 3 - 8 FOR DETAILS AND ADDITIONAL INFORMATION

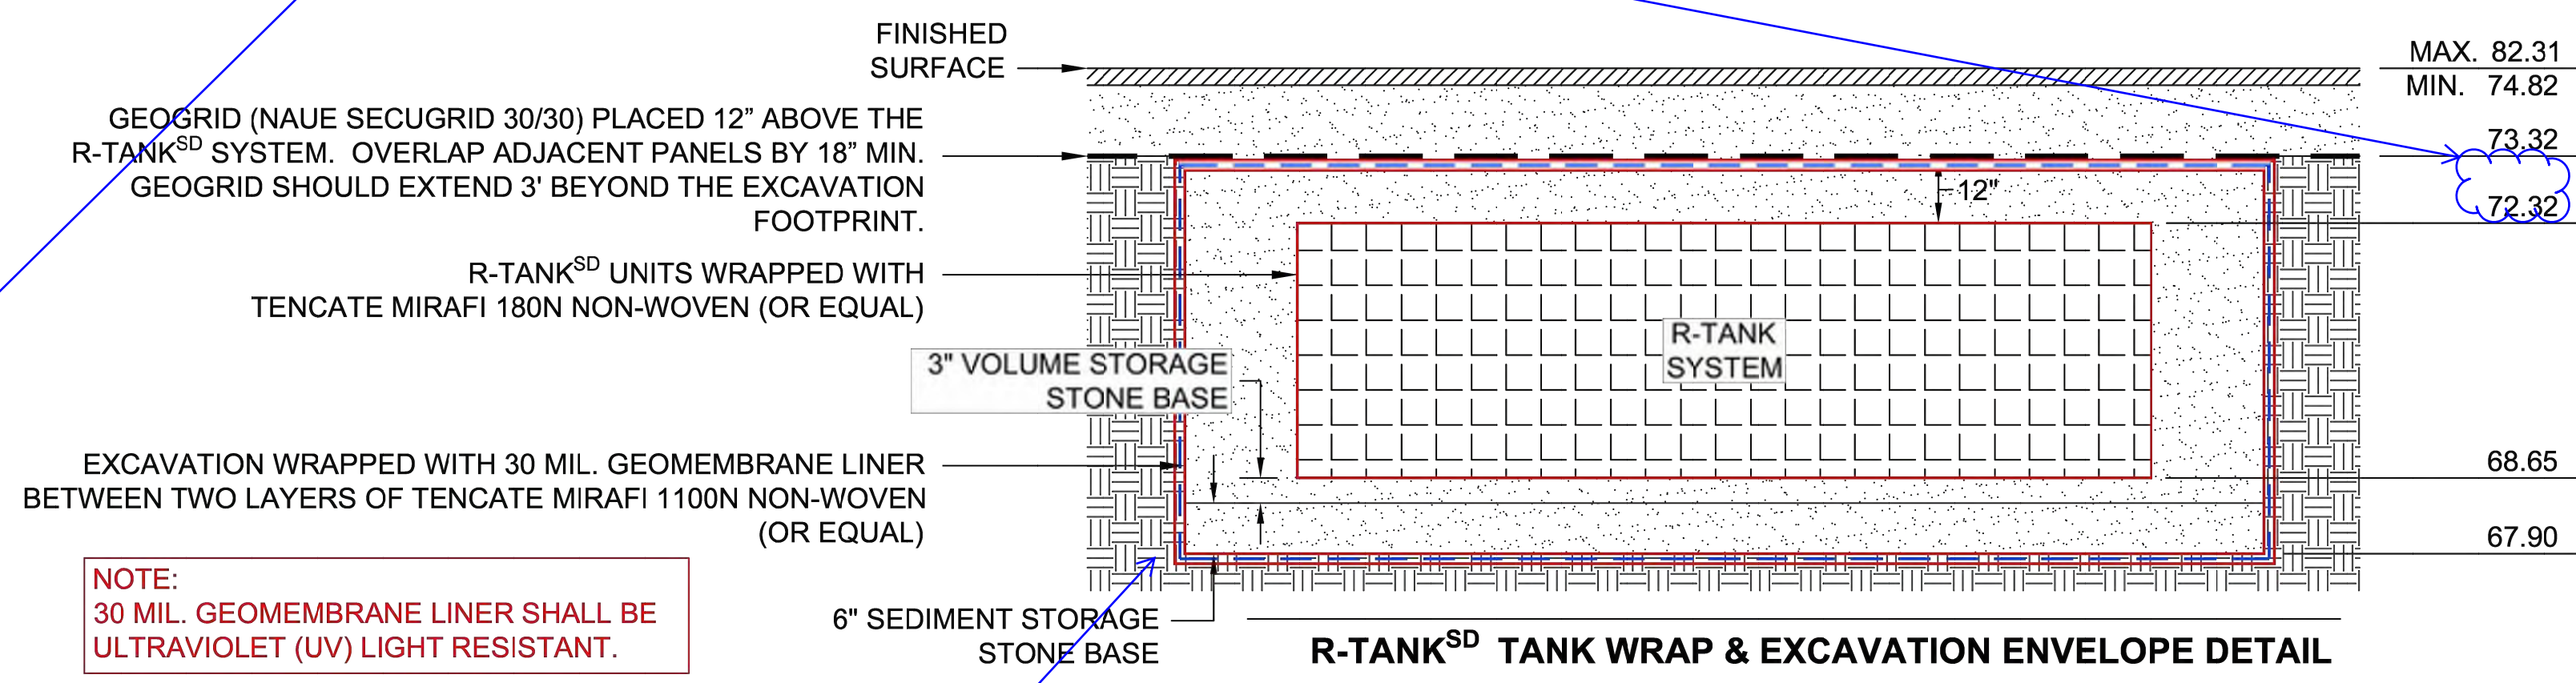

PROVIDE 2yr and 10yr water surface elevations on the cross section. [Plans Sht C4.21; Pg 32 of 63] Provided



R-TANK 2 NOTES AND DETAILS

Designed by: CW Drawn by: SK Checked by: JI

Sheet No.
C4.21
 32 of 63 Sheets

EAST TOWN CROSSING PHASE 1

SEC. 26,35/ TWP. 20 N./ RGE. 4 E., W.M.

Loggility
(Plans Sht C4.22; Pg 33 of 63)



Fixed

APPROVED

BY: CITY OF PUYALLUP
DEVELOPMENT ENGINEERING

DATE:

THIS APPROVAL IS VOID
IF NOT USED WITHIN 90 DAYS FROM APPROVAL
THE CITY WILL NOT BE
RESPONSIBLE FOR ERRORS
OR OMISSIONS ON THESE
PLANS UNLESS OTHERWISE
SPECIFIED BY THE
DEVELOPMENT ENGINEERING
NAGER.

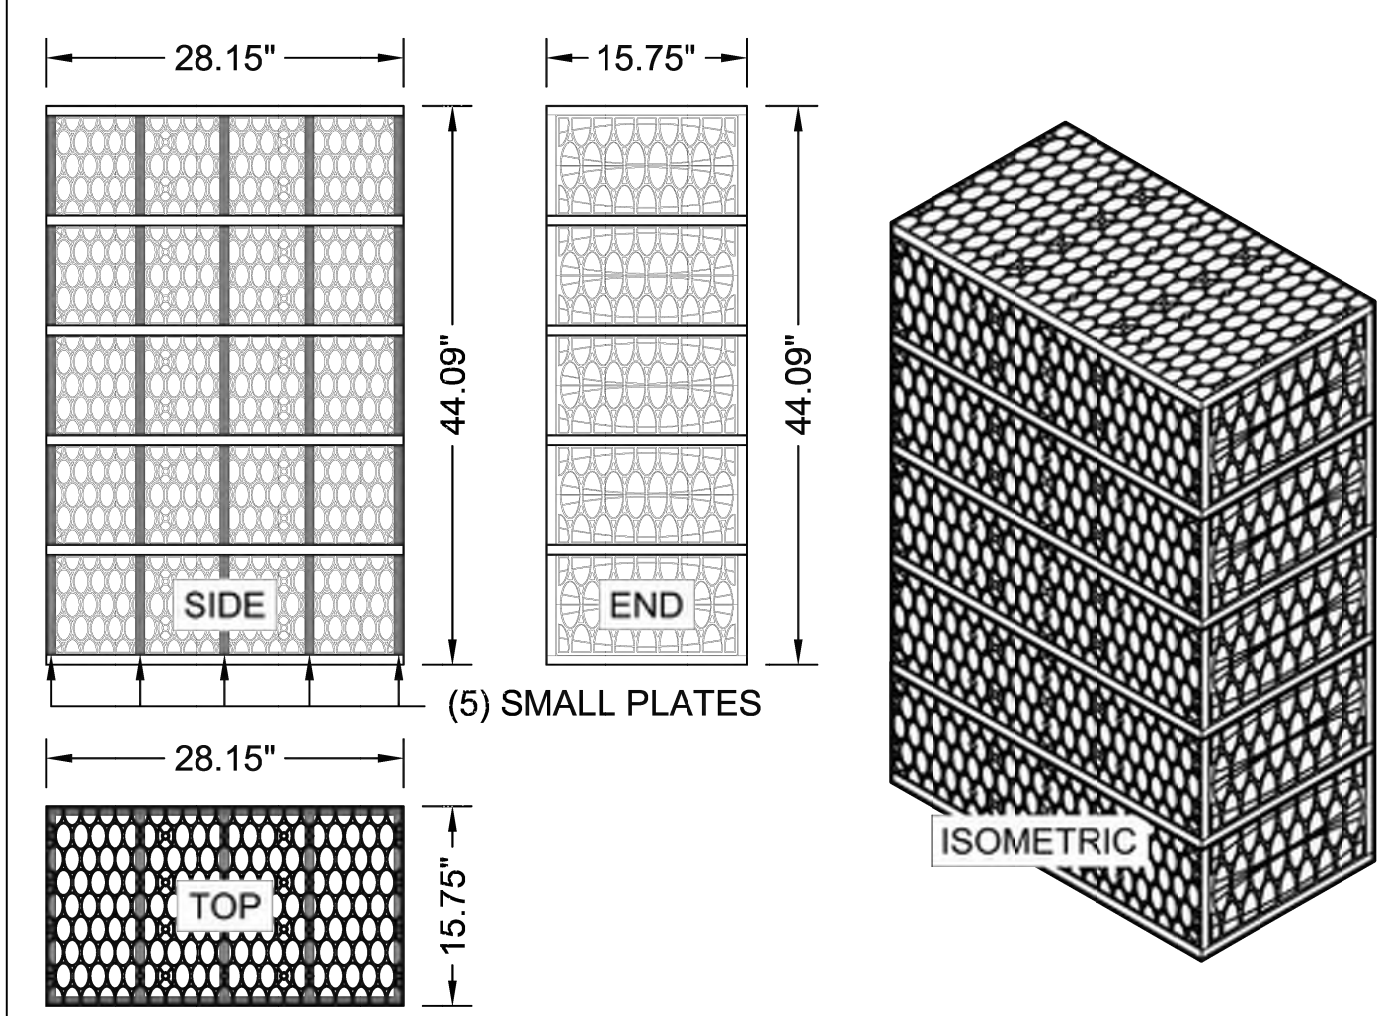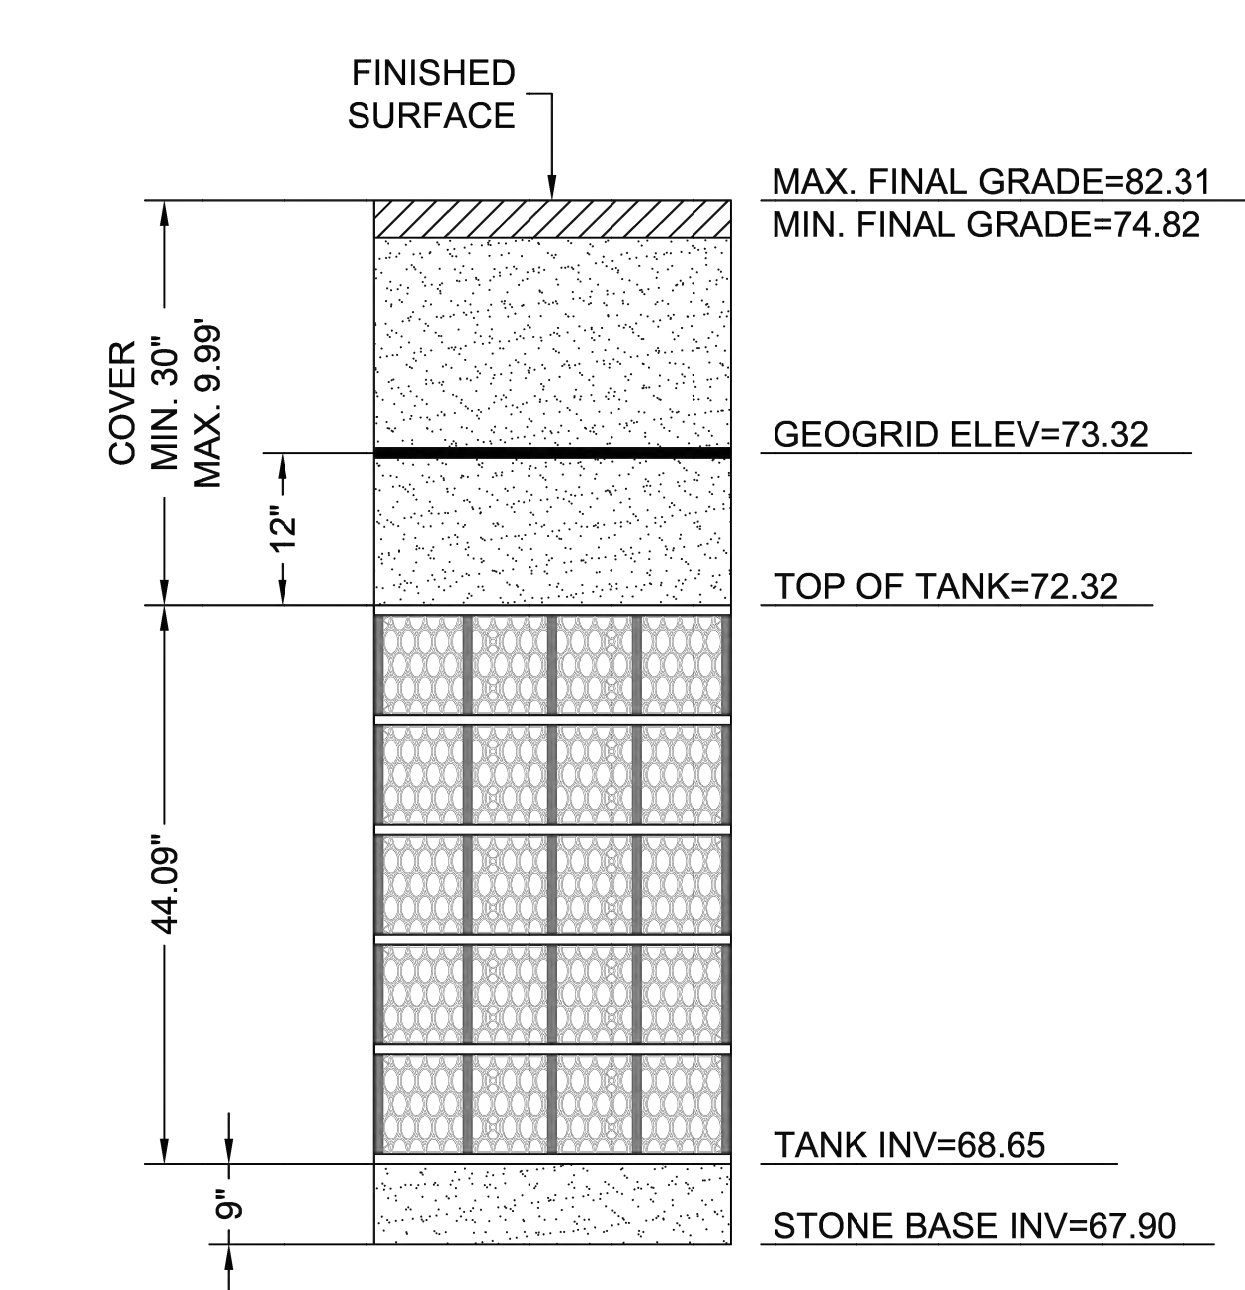

MODULE DATA

GEOMETRY:	LOAD RATING:
LENGTH = 28.15 IN. (715 MM)	42.9 PSI, (MODULE ONLY)
WIDTH = 15.75 IN. (400 MM)	HS20/HS25 - SEE SPEC FOR COVER REQUIREMENTS
HEIGHT = 44.09 IN. (1120 MM)	MATERIAL:
TANK VOLUME = 11.31 CF	100% RECYCLED POLYPROPYLENE
STORAGE VOLUME = 10.75 CF	SMALL PLATES REQUIRED:
VOID INTERNAL VOLUME: 95%	5/SEGMENT, 25/MODULE
VOID SURFACE AREA: 90%	

R-TANK^{SD} QUANTITIES

R-TANK ^{SD} MODULE TYPE	PENT
# OF SD PENT R-TANKS	6,157
# OF HD SINGLE+MINI R-TANK ACCESS MODULES	20
TOTAL SYSTEM STORAGE	78,829 CF
R-TANK STORAGE VOLUME	66,395 CF
STONE STORAGE VOLUME (40% VOID RATIO)	12,434 CF
STONE BED FOOTPRINT	20,501 SF
STONE QUANTITY	1,531 CY
TENCATE MIRAFI 180N NON-WOVEN TANK WRAP	46,835 SF (5,204 SY)
30 MIL. GEOMEMBRANE LINER EXCAVATION WRAP	51,788 SF (5,754 SY)
TENCATE MIRAFI 1100N NON-WOVEN LINER PROTECTION	103,576 SF (11,508 SY)
TENCATE MIRAFI 180N NON-WOVEN TREAT. ROW WRAP	493 SF (55 SY)
TENCATE MIRAFI FW-402 WOVEN TREAT. ROW BASE FABRIC	388 SF (43 SY)
NAUE SECUGRID 30/30 GEOGRID	26,180 SF (2,909 SY)
12" MAINTENANCE PORTS	7
12" INSPECTION PORTS	2
12" PIPE BOOTS	2
24" PIPE BOOTS	2
TRASHGUARD PLUS UNITS (RECOMMENDED)	1

NOTE: STONE QUANTITY INCLUDES 12" OF COVER AND 9" OF BASE.
NOTE: GEOTEXTILE / LINER QUANTITIES INCLUDE A 15% WASTE FACTOR.

NOTE:
30 MIL. GEOMEMBRANE LINER SHALL BE
ULTRAVIOLET (UV) LIGHT RESISTANT.

- NOTES:
- DEAD STORAGE VOLUME FROM ELEVATION 67.90 TO 68.40 = 4,100 CF
 - LIVE STORAGE VOLUME FROM ELEVATION 68.40 TO 73.32 = 78,829 CF
 - ONLY 3" OF BASE STONE INCLUDED IN LIVE STORAGE VOLUME.

SD R-TANK

ENGINEER OF RECORD TO REVIEW, APPROVE AND ENDORSE FINAL SITE SPECIFIC DESIGN.

ACF WEST INC. GEOSYNTHETICS

Products | Service | Solutions

FOR ADDITIONAL INFORMATION PLEASE CONTACT:
ACF WEST, 1-800-423-4567, www.acfwest.com

R-TANK^{SD} SYSTEM DETAILS
EAST TOWN CROSSING
PUYALLUP, WA
SITE DESIGNATION: R-TANK 2

DRAWN BY: EDQ
DATE: 11/10/2023
ACF WEST PROJECT NUMBER: 23-004WA
SHEET NO: 3 of 8


Project Title:
EAST TOWN CROSSING PHASE 1

Client:
ASH DEVELOPMENT

GREG HELLE
GREG.HELLE@ASHNW.COM

Project No.
2230752

Issue Set & Date:
PERMIT SUBMITTAL
11/20/2023

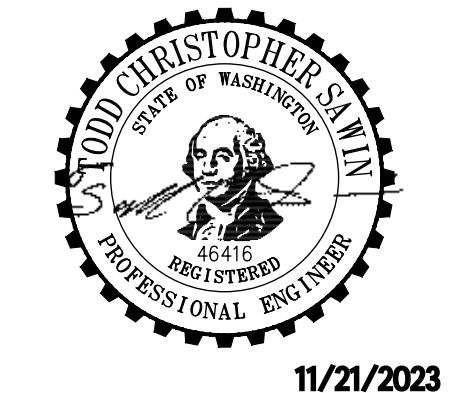


NOTICE
ALLERATION OF THIS DOCUMENT SHALL INDICATE THE PROFESSIONAL SEAL AND SIGNATURE PUBLICATION OF THE DOCUMENT DOES NOT GUARANTEE THE ACCURACY OR COMPLETENESS OF THE INFORMATION PROVIDED HEREIN. THE USER SHALL BE RESPONSIBLE FOR VERIFYING THE INFORMATION PROVIDED IN THIS DOCUMENT IS ACCURATE AND COMPLETE FOR THE PROJECT AND FOR ANY OTHER PROJECT.

Revisions:

Sheet Title:
R-TANK 2 NOTES AND DETAILS

Designed by: CW
Drawn by: SK
Checked by: JI

Sheet No.
C4.22
33 of 63 Sheets

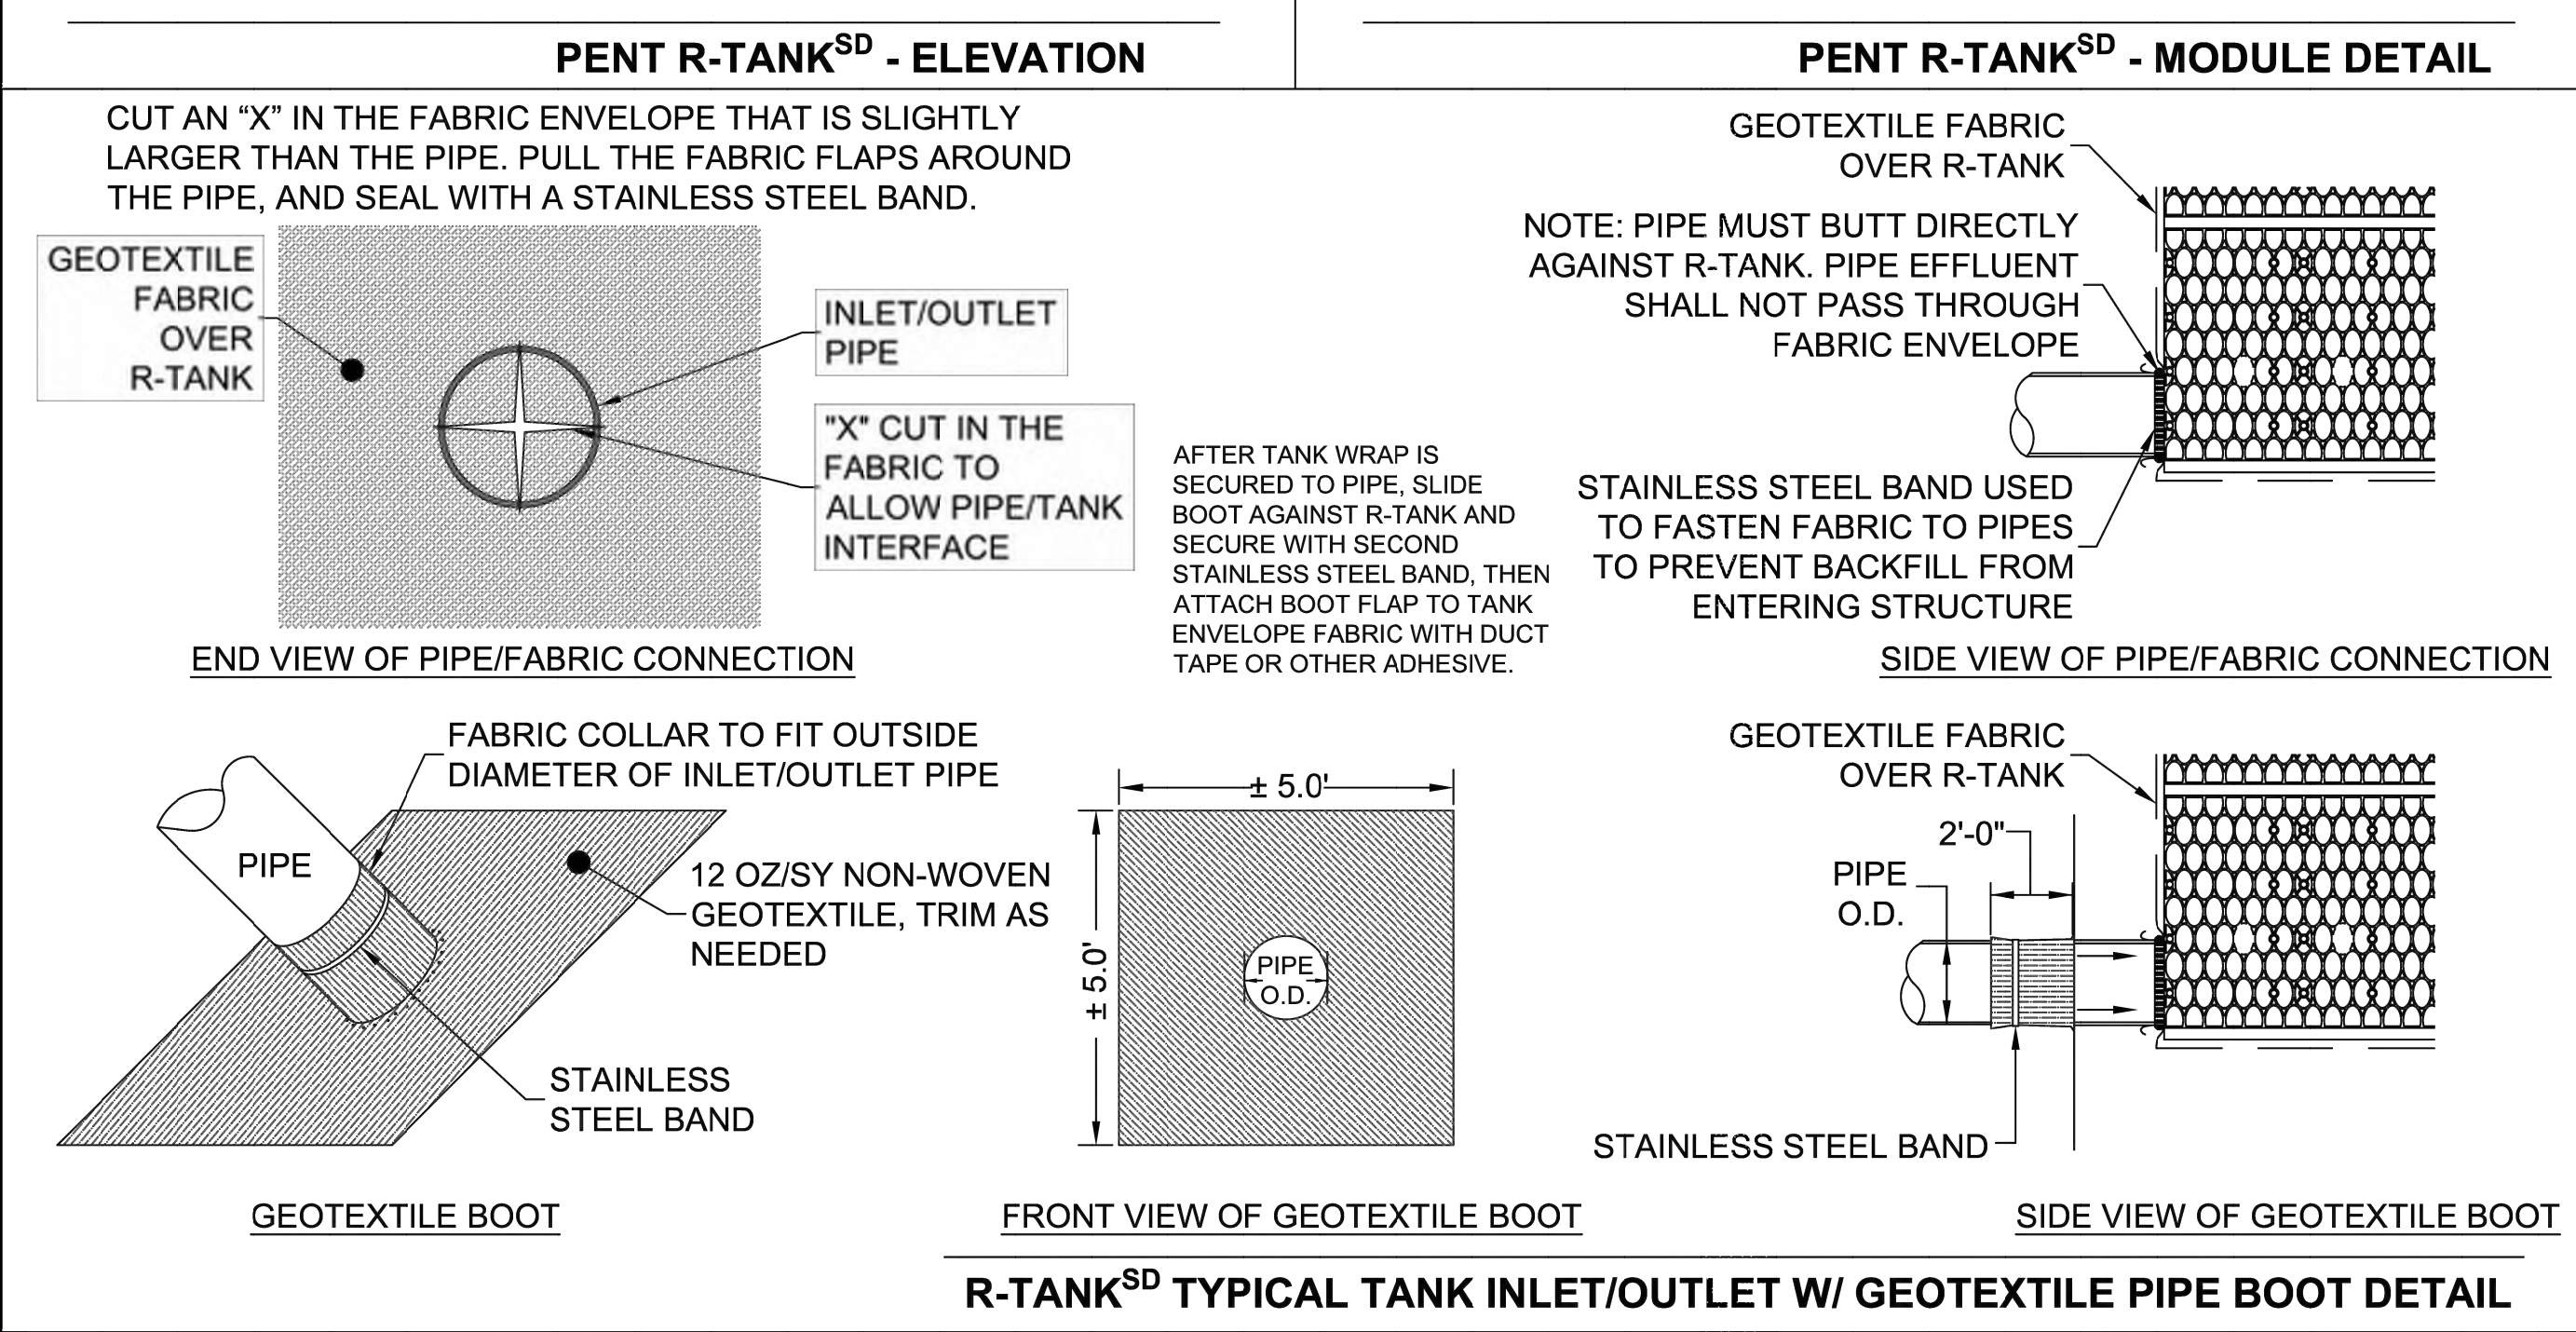

EAST TOWN CROSSING PHASE 1

SEC. 26,35/ TWP. 20 N./ RGE. 4 E., W.M.

APPROVED

BY: CITY OF PUYALLUP
DEVELOPMENT ENGINEERING


DATE: _____

NOTE: THIS APPROVAL IS VOID AFTER 180 DAYS FROM APPROVAL. THE CITY WILL NOT BE RESPONSIBLE FOR ERRORS OR OMISSIONS ON THESE PLANS. UNLESS OTHERWISE NOTED, ALL CONDITIONS MAY DICTATE CHANGES TO THESE PLANS AS DETERMINED BY THE DEVELOPMENT ENGINEERING (NAGER).




TOTAL COVER: 18" MINIMUM AND 120" MAXIMUM. FIRST 12" MUST BE FREE DRAINING BACKFILL (SPEC SECTION 2.03B): STONE <1.5" OR SOIL (USCS CLASS GW, GP, SW OR SP). ADDITIONAL FILL MAY BE STRUCTURAL FILL (SPEC SECTION 2.03C): STONE OR SOIL (USCS CLASS SM, SP, SW, GM, GP OR GW) WITH MAX CLAY CONTENT <10%, MAX 25% PASSING NO. 200 SIEVE, AND MAX PLASTICITY INDEX OF 4. A MIN. 12" COVER MUST BE MAINTAINED BETWEEN BACKFILL EQUIPMENT AND THE TOP OF THE R-TANK™ SYSTEM AT ALL TIMES. TOTAL HEIGHT OF TOP BACKFILL SHOULD NOT EXCEED 10'. CONTACT ACF WEST IF MORE THAN 10' OR LESS THAN 18" OF TOP BACKFILL IS REQUIRED (FROM TOP OF TANK TO TOP OF PAVEMENT).

- NOTES:
- FOR COMPLETE MODULE DATA, SEE APPROPRIATE R-TANK^{SD} MODULE SHEET.
 - INSTALLATIONS PER THIS DETAIL MEET GUIDELINES OF HL-93 LOADING PER THE AASHTO LRFD BRIDGE DESIGN SPECIFICATIONS, CUSTOMARY U.S. UNITS, 7TH EDITION, 2014 WITH 2015 AND 2016 INTERIM REVISIONS.
 - PRE-TREATMENT STRUCTURES NOT SHOWN.
 - FOR INFILTRATION APPLICATIONS, GEOTEXTILE ENVELOPING R-TANK SHALL BE TENCATE MIRAFI FW-402 WOVEN (PER SPEC SECTION 2.02A) AND BASE SHALL BE 4" MIN. UNCOMPACTED FREE DRAINING BACKFILL (SPEC SECTION 2.03A) TO PROVIDE A LEVEL BASE. SURFACE MUST BE SMOOTH, FREE OF LUMPS OR DEBRIS, AND EXTEND 2' BEYOND R-TANK^{SD} FOOTPRINT.

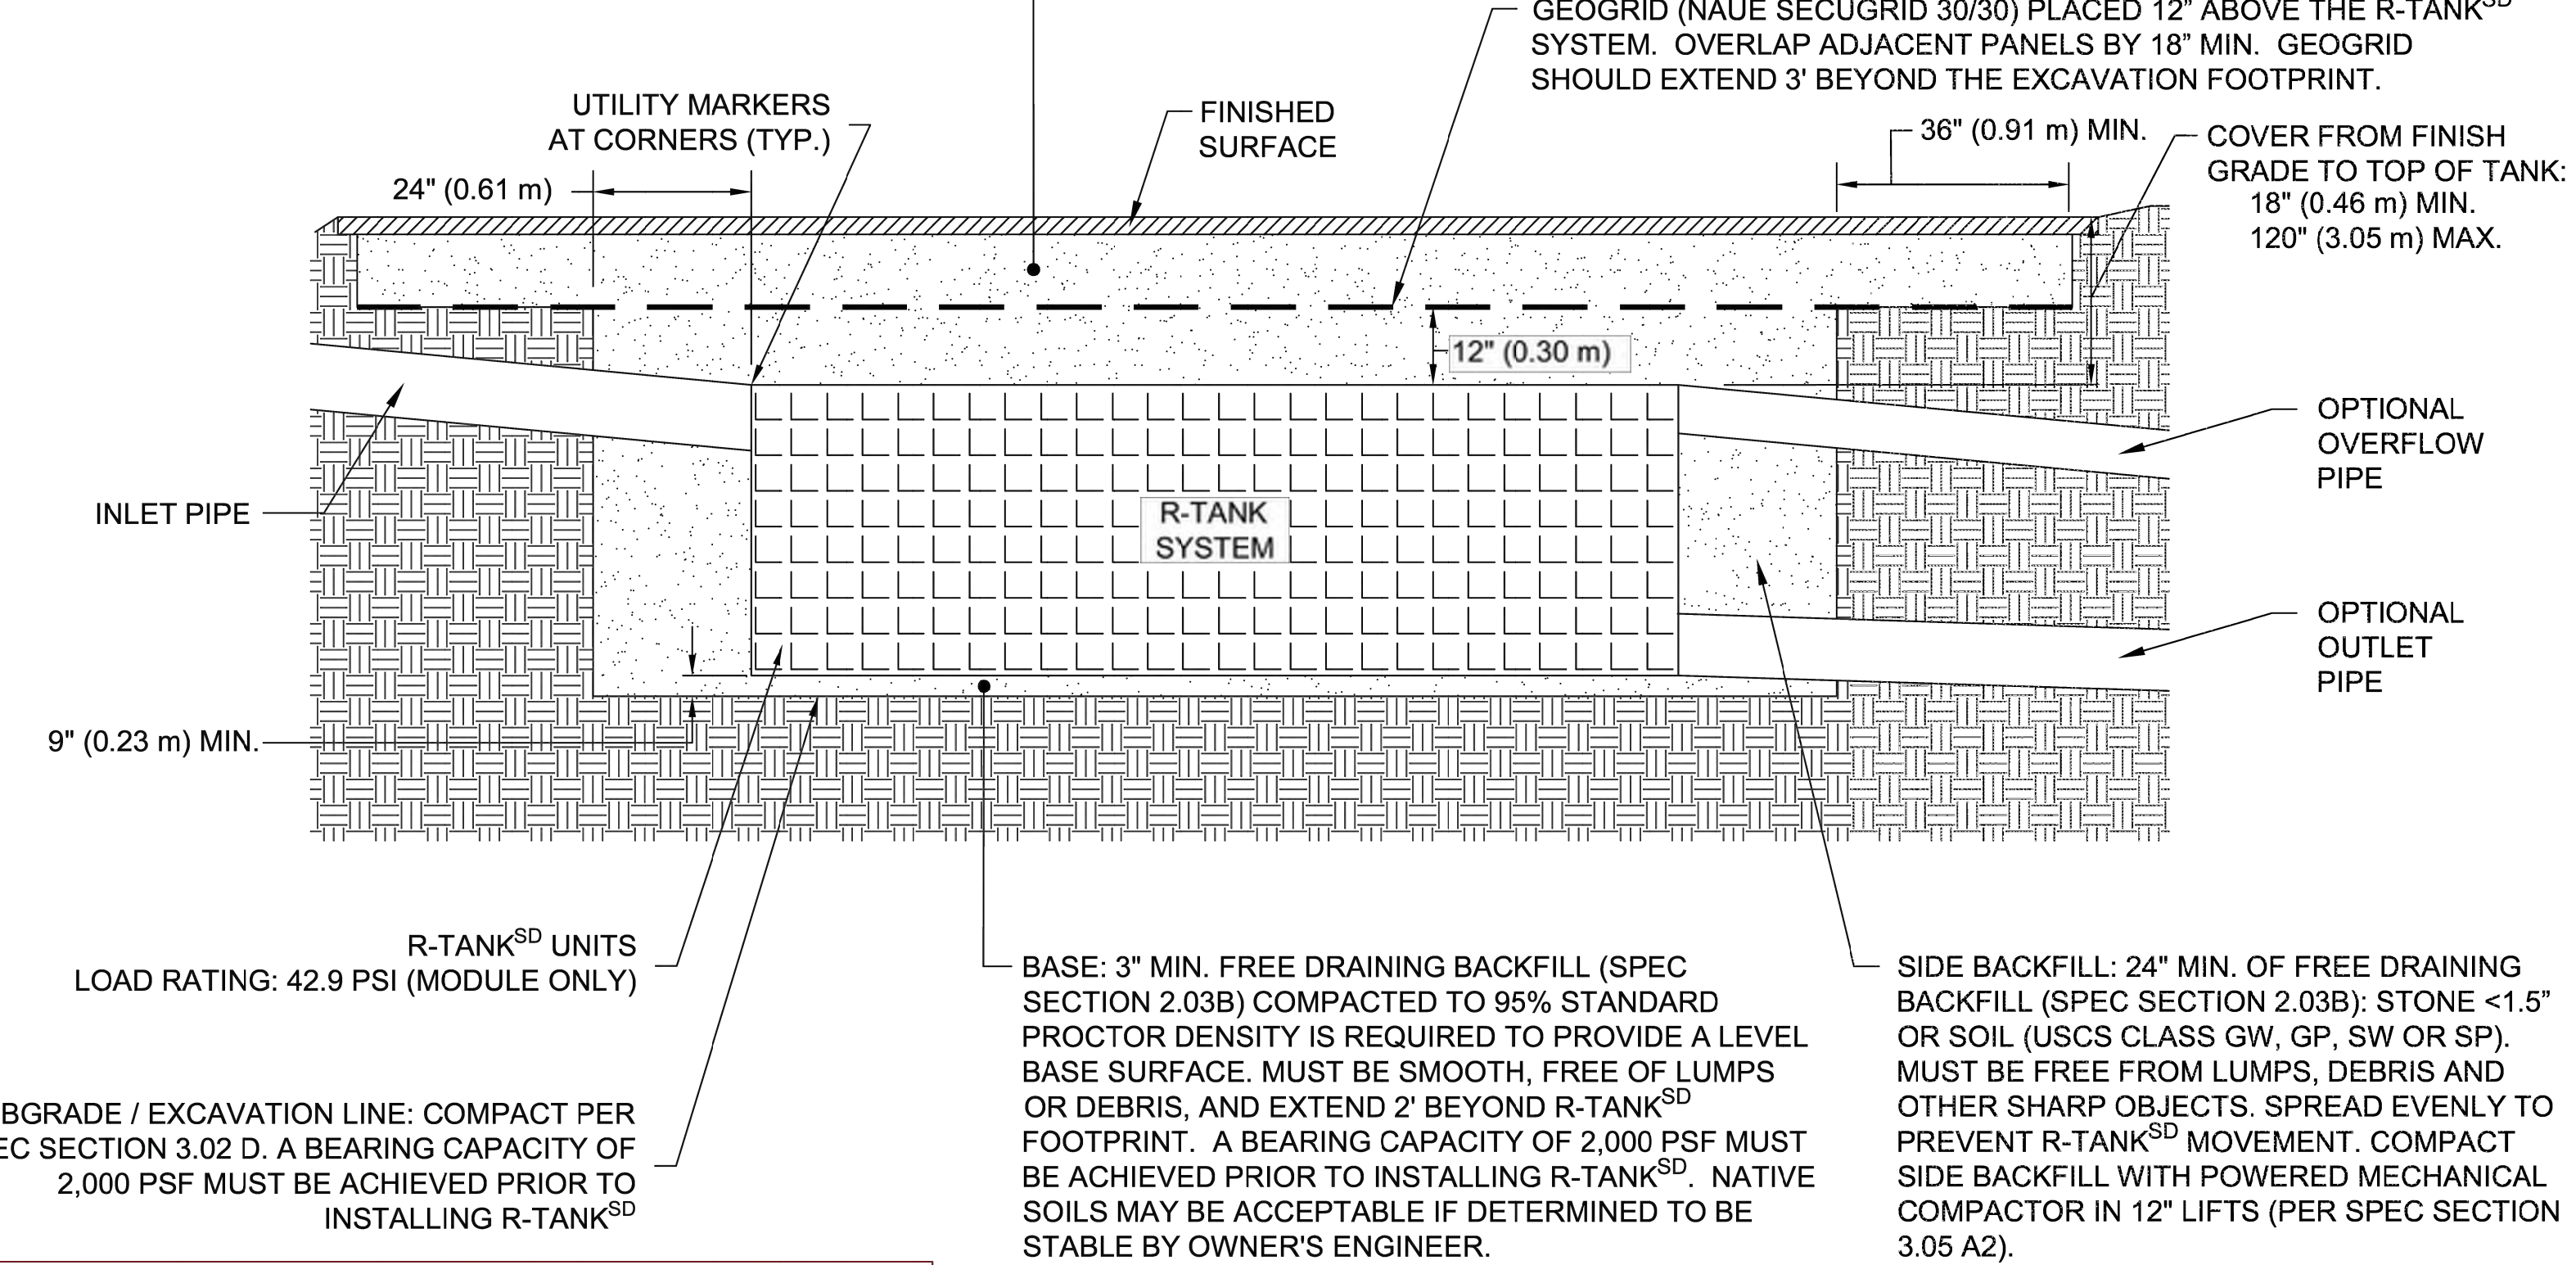

R-TANK^{SD} & HS-20 LOADS - SECTION VIEW

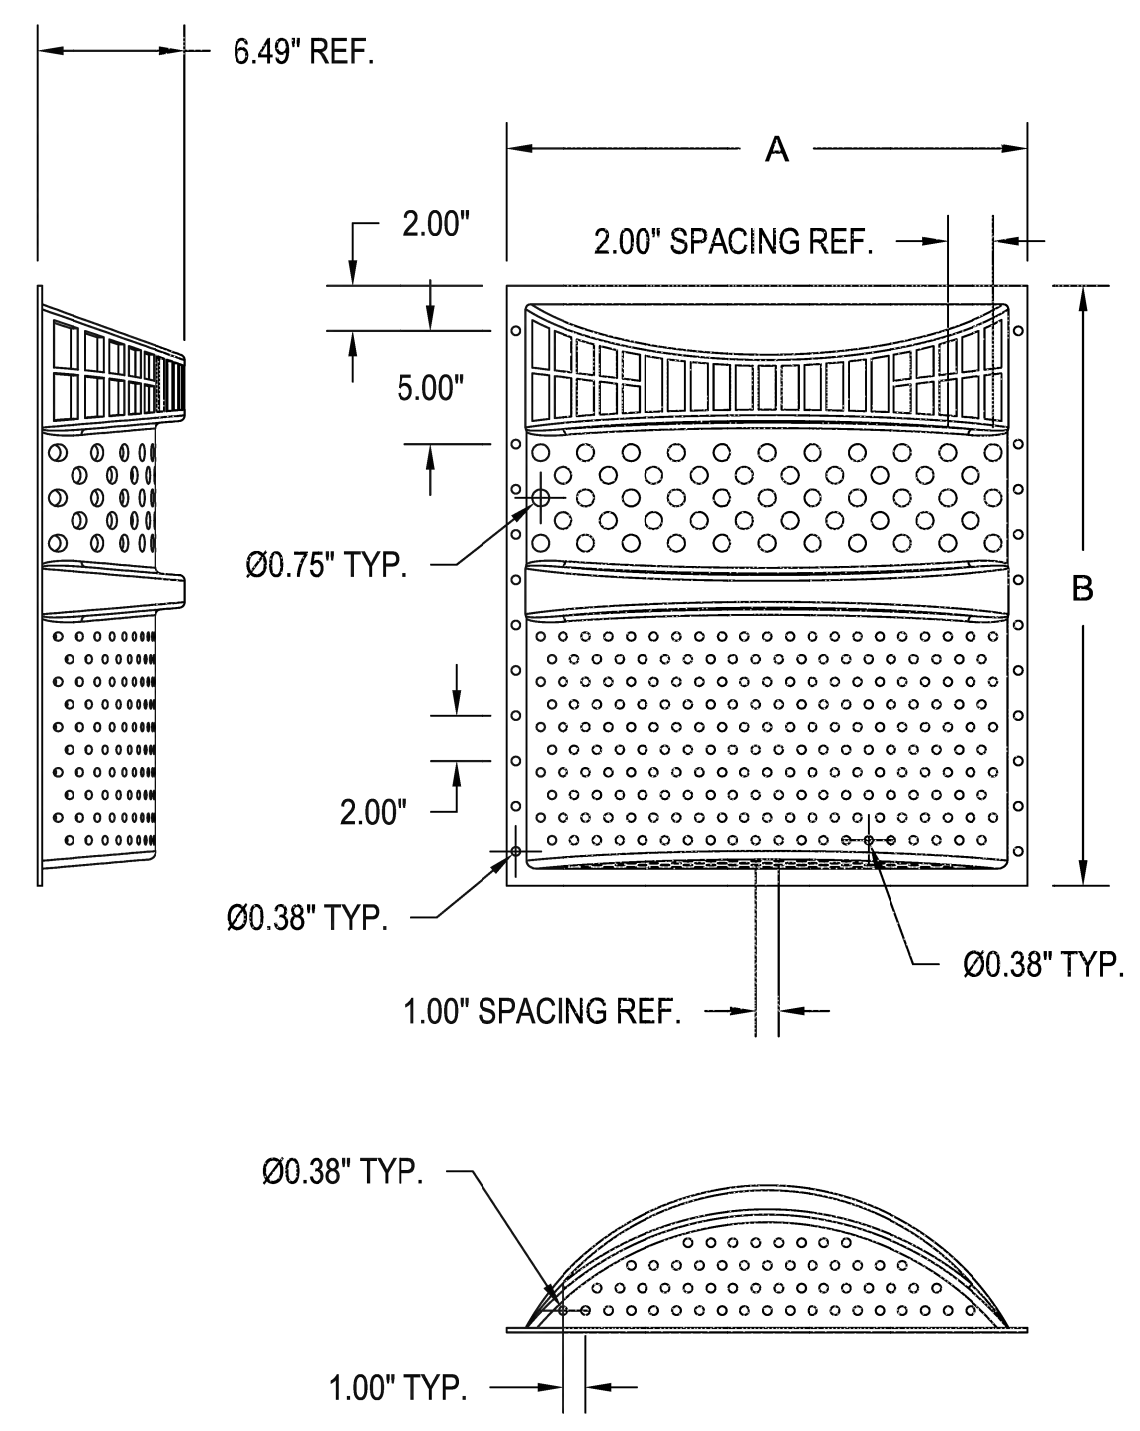

SIZE	A	B
23" x 24"	23"	26.51"
28" x 30"	28"	33.15"
34" x 36"	34"	38.69"


±0.25" TOLERANCE ON DIMENSIONS

NOTE: TRASHGUARD PLUS UNITS ARE RECOMMENDED TO BE INSTALLED IN ALL CATCH BASINS DIRECTLY CONNECTED UPSTREAM OF THE R-TANK SYSTEM.

TRASHGUARD PLUS PRETREATMENT DETAIL

NOTE: MINIMUM COVER FROM TOP OF TANK TO FINISH GRADE MUST BE AT LEAST 30" TO MEET A 45 KIP OUTRIGGER LOAD ON AN 18'X18" PAD.

- NOTES
- THIS PORT IS USED TO PUMP WATER INTO THE SYSTEM AND RE-SUSPEND ACCUMULATED SEDIMENT SO THAT IT MAY BE PUMPED OUT.
 - MINIMUM REQUIRED MAINTENANCE INCLUDES A QUARTERLY INSPECTION DURING THE FIRST YEAR OF OPERATION AND A YEARLY INSPECTION THEREAFTER. FLUSH AS NEEDED.
 - R-TANK^{HD}, R-TANK^{SD}, R-TANK^{UD} AND R-TANK^{XD} MAY BE USED IN TRAFFIC APPLICATIONS.
 - SEE TRAFFIC LOADING DETAIL FOR MINIMUM & MAXIMUM COVER REQUIREMENTS.
 - IF MAINTENANCE PORT IS LOCATED IN A NON-TRAFFIC AREA, A PLASTIC CAP CAN BE USED IN LIEU OF A FRAME AND COVER WITH CONCRETE COLLAR.

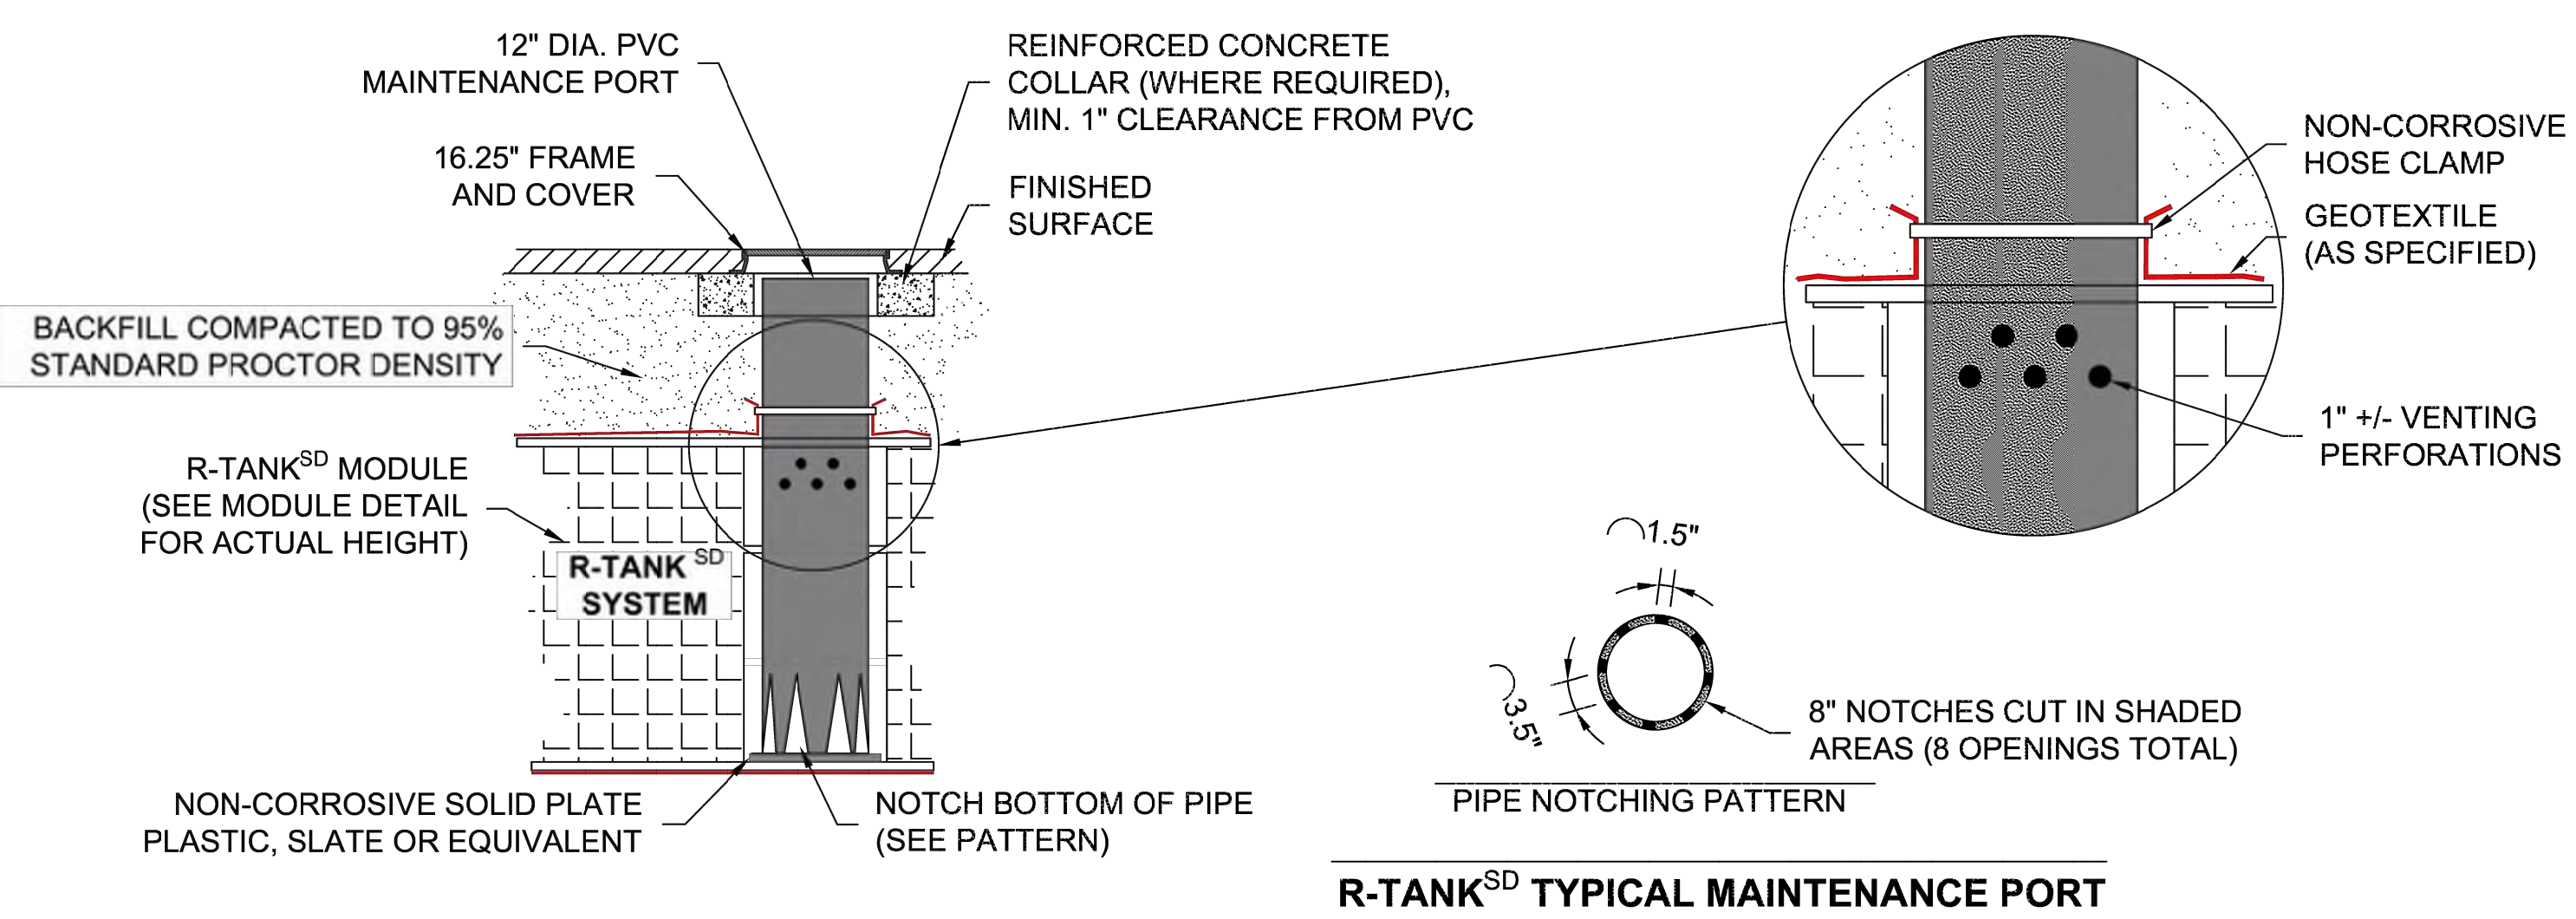

R-TANK^{SD} TYPICAL MAINTENANCE PORT

ACF WEST INC.
GEOSYNTHETICS

Products | Service | Solutions

FOR ADDITIONAL INFORMATION PLEASE CONTACT:
ACF WEST, 1-800-423-4567, www.acfwest.com

ENGINEER OF RECORD TO REVIEW, APPROVE AND ENDORSE FINAL SITE SPECIFIC DESIGN.

R-TANK^{SD} SYSTEM DETAILS
EAST TOWN CROSSING
PUYALLUP, WA
SITE DESIGNATION: R-TANK 2

DRAWN BY: EDQ
DATE: 11/10/2023
ACF WEST PROJECT NUMBER: 23-004WA
SHEET NO.: 4 of 8

Project Title:
EAST TOWN CROSSING PHASE 1


Client:
ASH DEVELOPMENT

GREG HELLE
GREG.HELLE@ASHNW.COM

Project No.
2230752

Issue Set & Date:
PERMIT SUBMITTAL

11/20/2023

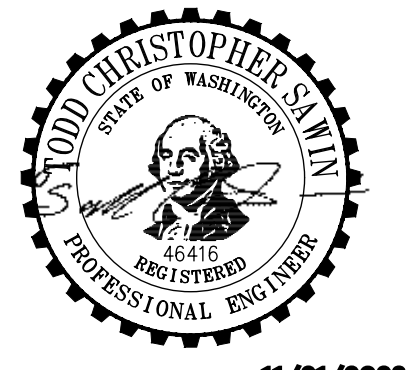

11/21/2023

NOTICE: ALTERATION OF THIS DOCUMENT SHALL INVALIDATE THE PROFESSIONAL SEAL AND SIGNATURE. PUBLICATION OF THIS DOCUMENT DOES NOT CONSTITUTE A PROFESSIONAL ENGINEER'S RESPONSIBILITY. THE ENGINEER'S RESPONSIBILITY IS LIMITED TO THE PROJECT DESCRIBED IN THE TITLE BLOCK AND TO BE USED FOR THE PROJECT, PERMITS, OR ACTION TO THAT PROJECT OR FOR ANY OTHER PROJECT.

Revisions:

Sheet Title:

R-TANK 2 NOTES AND DETAILS

Designed by: CW
Drawn by: SK
Checked by: JI

Sheet No.

C4.23

34 of 63 Sheets



Know what's below.
Call before you dig.

EAST TOWN CROSSING PHASE 1

SEC. 26,35/ TWP. 20 N./ RGE. 4 E., W.M.

APPROVED

BY: CITY OF PUYALLUP
DEVELOPMENT ENGINEERING


DATE: _____

NOTE: THIS APPROVAL IS VOID AFTER 180 DAYS FROM APPROVAL. THE CITY WILL NOT BE RESPONSIBLE FOR ERRORS OR OMISSIONS ON THESE PLANS. FIELD CONDITIONS MAY DICTATE CHANGES TO THESE PLANS AS DETERMINED BY THE DEVELOPMENT ENGINEERING MANAGER.





TOTAL COVER: 20" MINIMUM AND 84" MAXIMUM. FIRST 12" MUST BE FREE DRAINING BACKFILL (SPEC SECTION 2.03B): STONE <1.5" OR SOIL (USCS CLASS GW, GP, SW OR SP). ADDITIONAL FILL MAY BE STRUCTURAL FILL (SPEC SECTION 2.03C): STONE OR SOIL (USCS CLASS SM, SP, SW, GM, GP OR GW) WITH MAX CLAY CONTENT <10%, MAX 25% PASSING NO. 200 SIEVE, AND MAX PLASTICITY INDEX OF 4. A MIN. 12" COVER MUST BE MAINTAINED BETWEEN BACKFILL EQUIPMENT AND THE TOP OF THE R-TANK™ SYSTEM AT ALL TIMES. TOTAL HEIGHT OF TOP BACKFILL SHOULD NOT EXCEED 7'. CONTACT ACF WEST IF MORE THAN 7' OR LESS THAN 20" OF TOP BACKFILL IS REQUIRED (FROM TOP OF TANK TO TOP OF PAVEMENT).

- NOTES:
- FOR COMPLETE MODULE DATA, SEE APPROPRIATE R-TANK^{HD} MODULE SHEET.
 - INSTALLATIONS PER THIS DETAIL MEET GUIDELINES OF HL-93 LOADING PER THE AASHTO LRFD BRIDGE DESIGN SPECIFICATIONS, CUSTOMARY U.S. UNITS, 7TH EDITION, 2014 WITH 2015 AND 2016 INTERIM REVISIONS.
 - PRE-TREATMENT STRUCTURES NOT SHOWN.
 - FOR INFILTRATION APPLICATIONS, GEOTEXTILE ENVELOPING R-TANK SHALL BE ACF M200 (PER SPEC SECTION 2.02A) AND BASE SHALL BE 4" MIN. UNCOMPACTED FREE DRAINING BACKFILL (SPEC SECTION 2.03A) TO PROVIDE A LEVEL BASE. SURFACE MUST BE SMOOTH, FREE OF LUMPS OR DEBRIS, AND EXTEND 2' BEYOND R-TANK^{HD} FOOTPRINT.

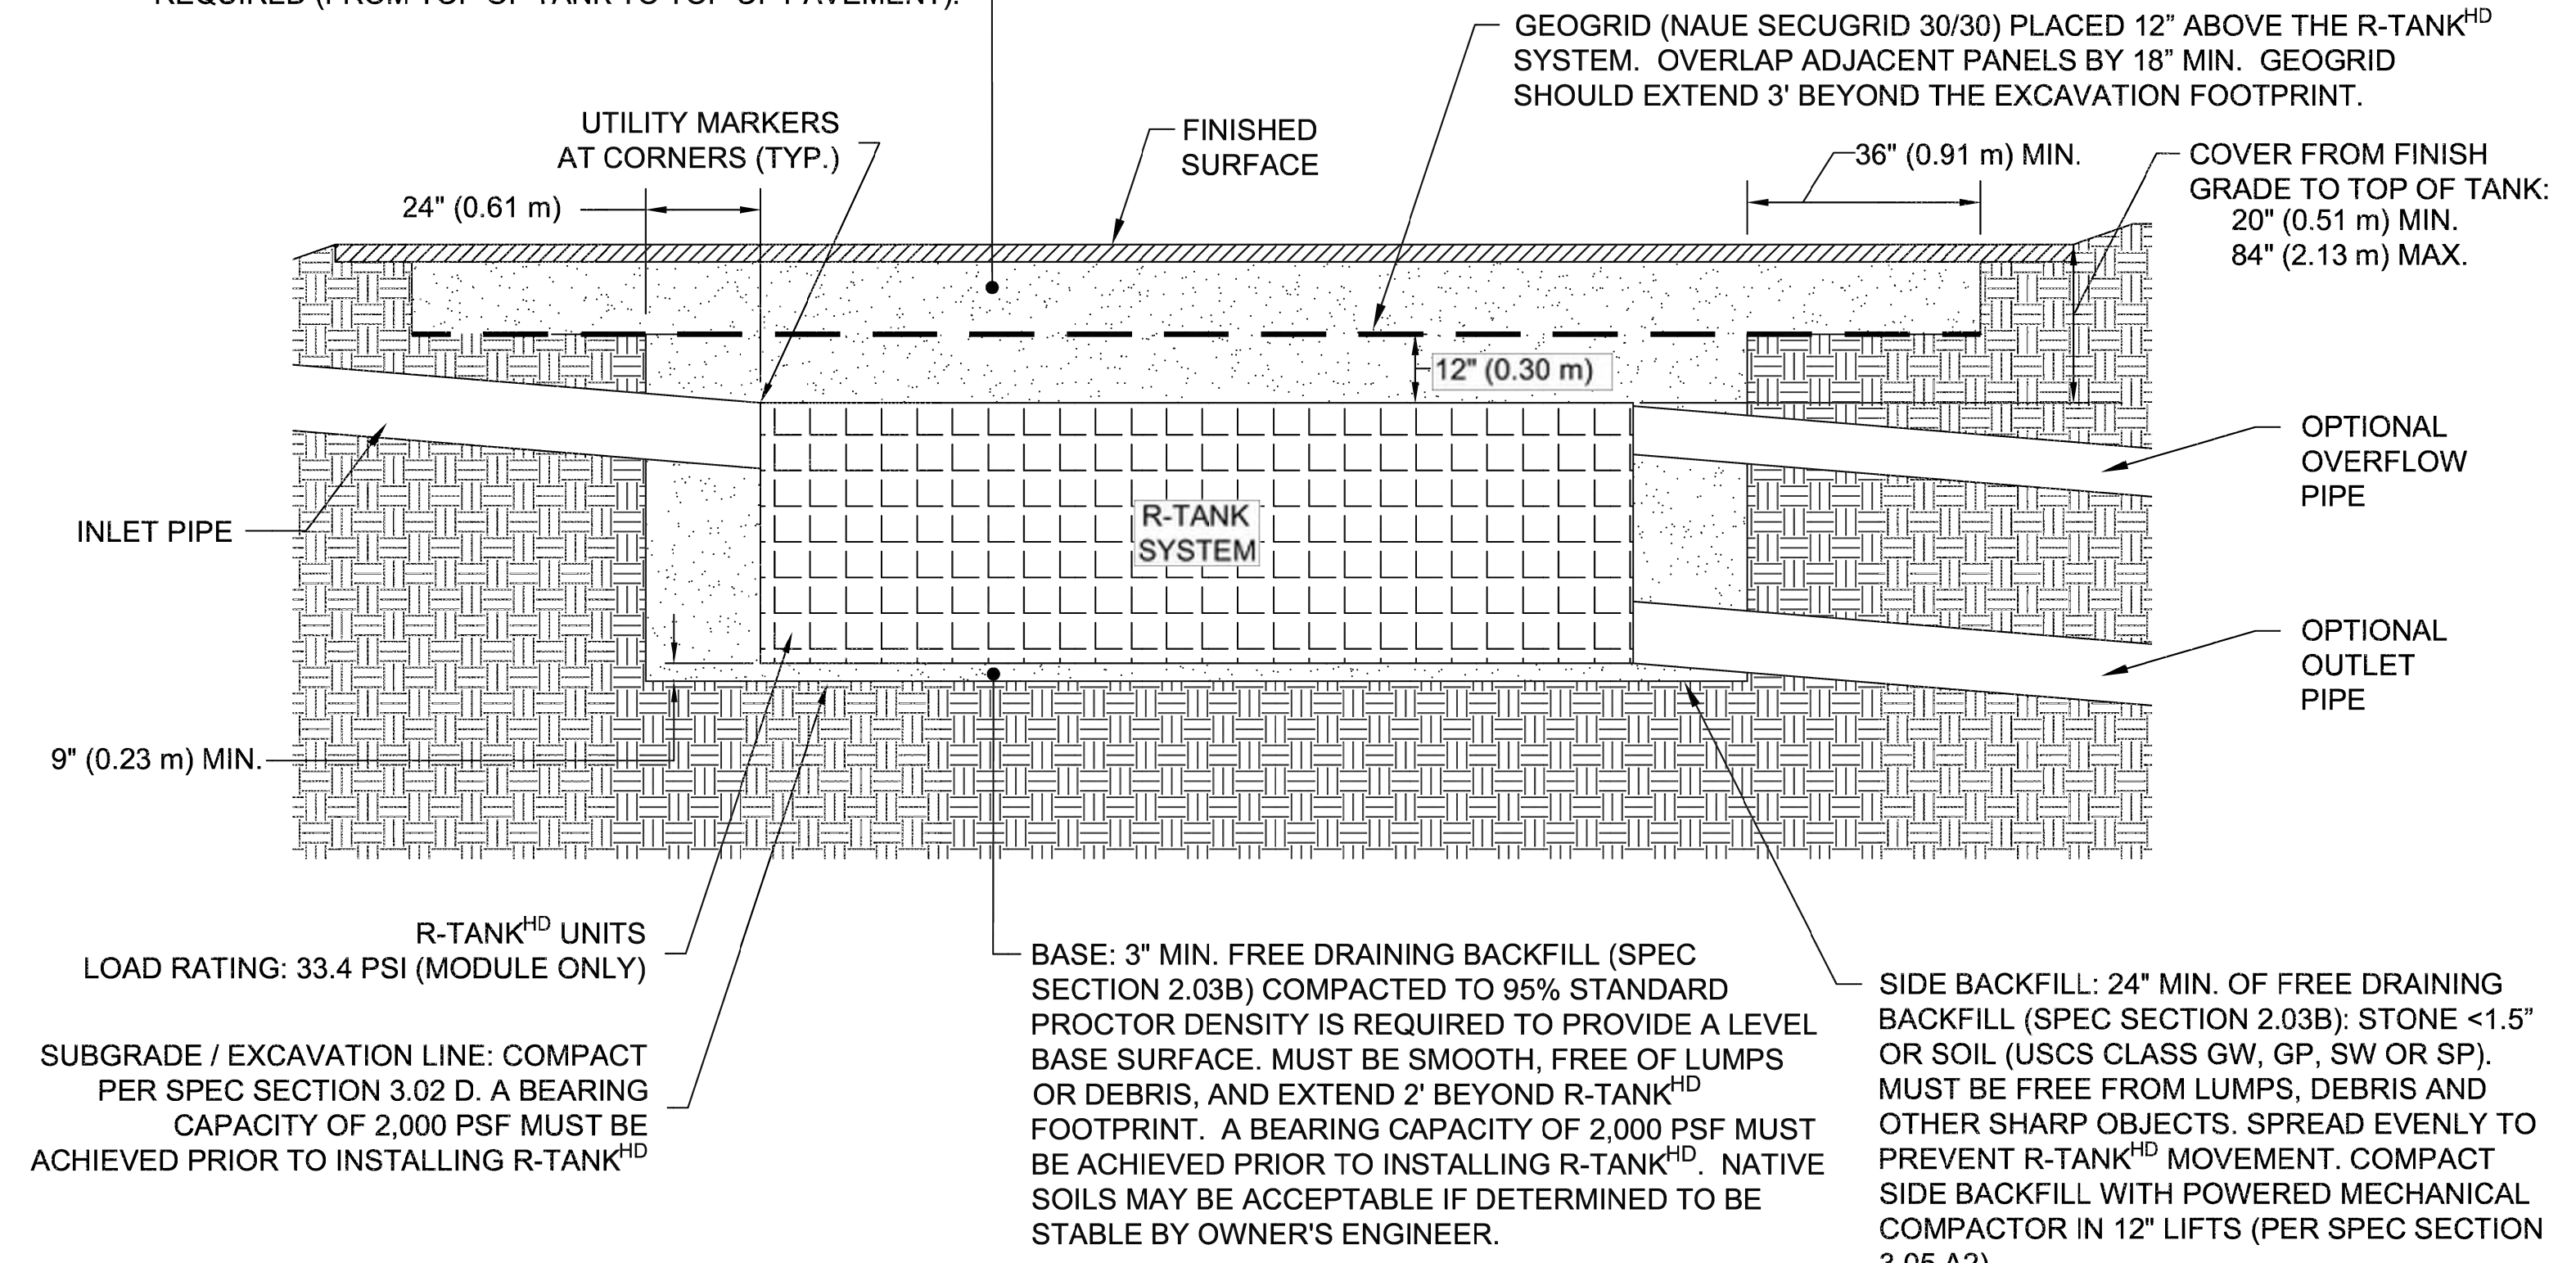

R-TANK^{HD} & HS-20 LOADS - SECTION VIEW

- NOTES
- THE INSPECTION PORT IS USED IN THE ACCESS MODULE TO INSPECT THE LEVEL OF SEDIMENT ACCUMULATION.
 - MINIMUM REQUIRED MAINTENANCE INCLUDES A QUARTERLY INSPECTION DURING THE FIRST YEAR OF OPERATION AND A YEARLY INSPECTION THEREAFTER. FLUSH AS NEEDED.
 - R-TANK^{HD}, R-TANK^{SD}, R-TANK^{LD} AND R-TANK^{MD} MAY BE USED IN TRAFFIC APPLICATIONS.
 - SEE TRAFFIC LOADING DETAIL FOR MINIMUM & MAXIMUM COVER REQUIREMENTS.
 - IF INSPECTION PORT IS LOCATED IN A NON-TRAFFIC AREA, A PLASTIC CAP CAN BE USED IN LIEU OF A FRAME AND COVER WITH CONCRETE COLLAR.

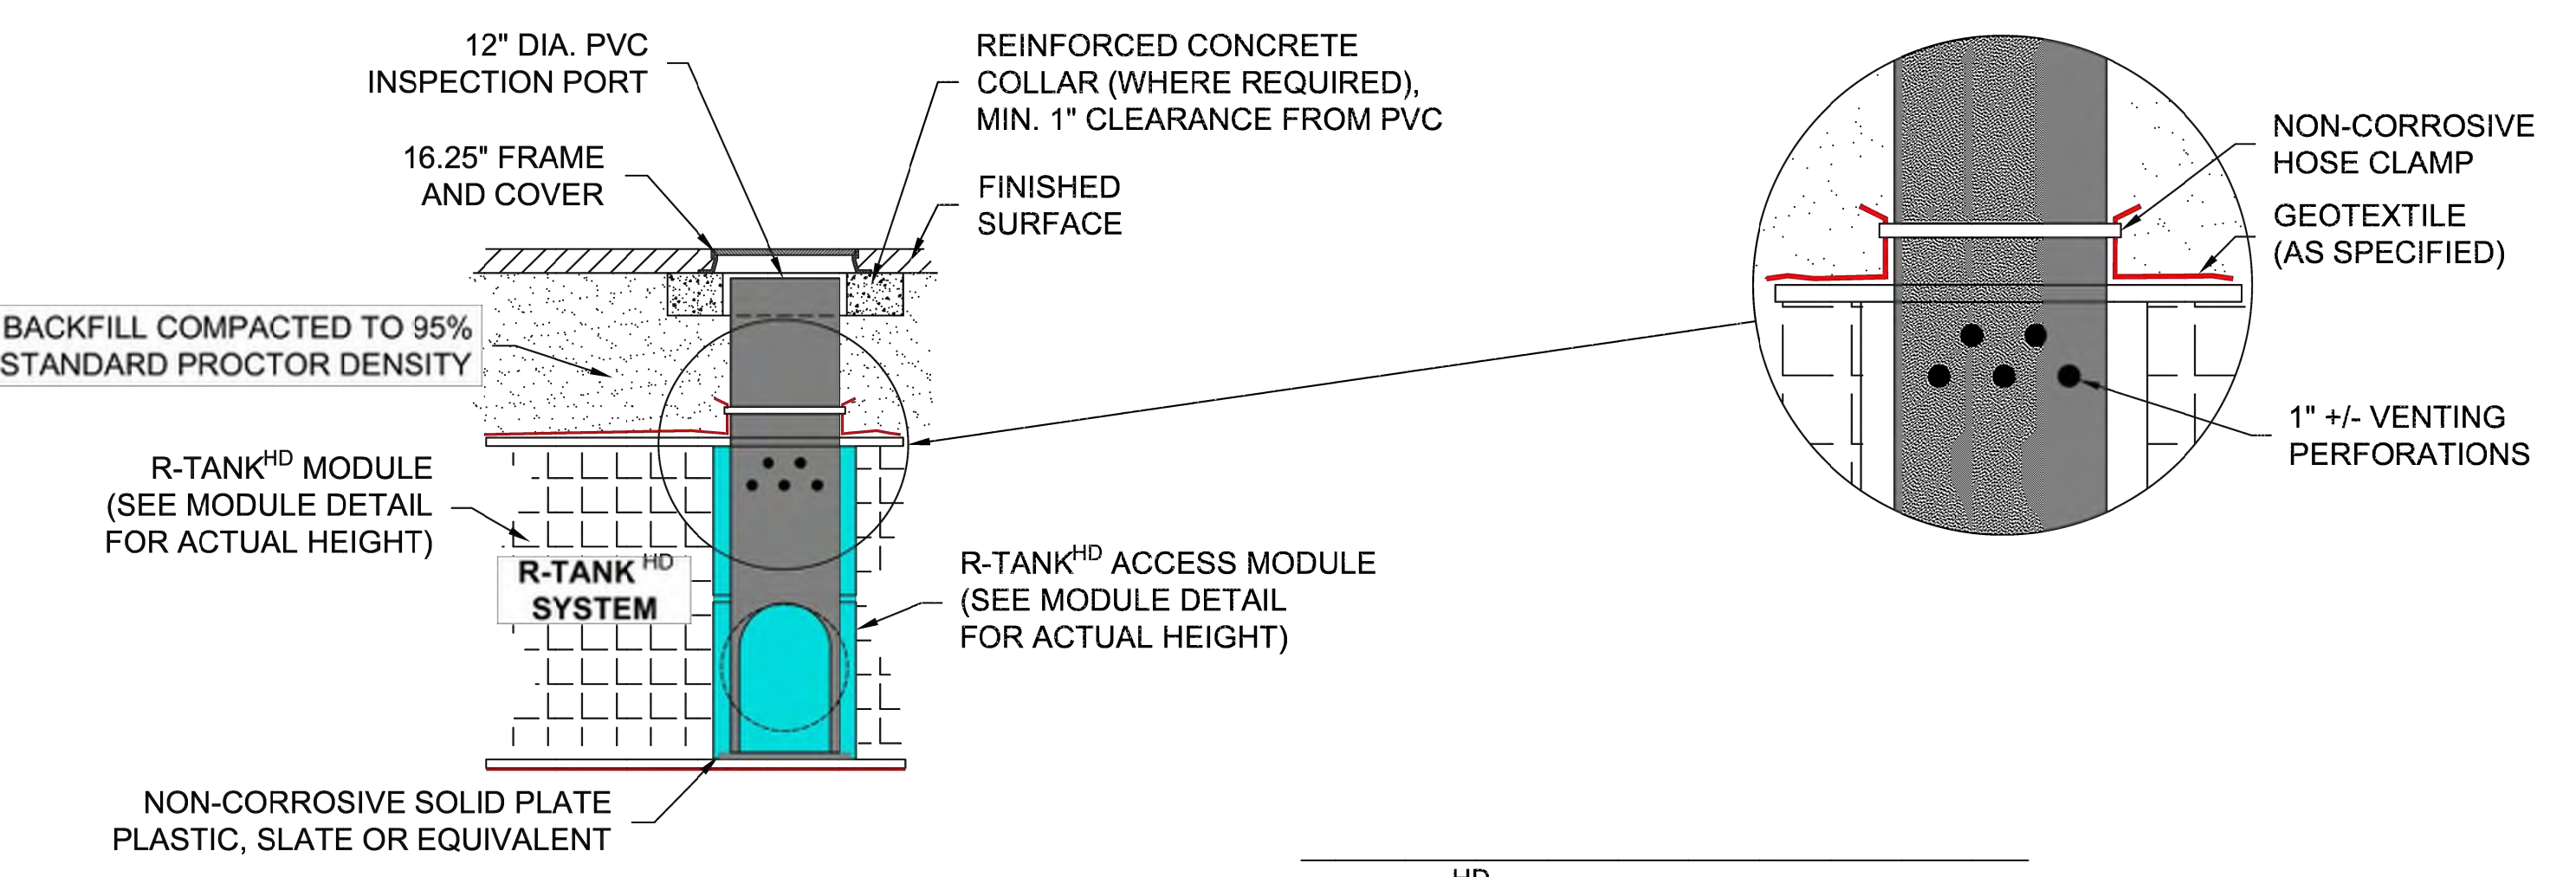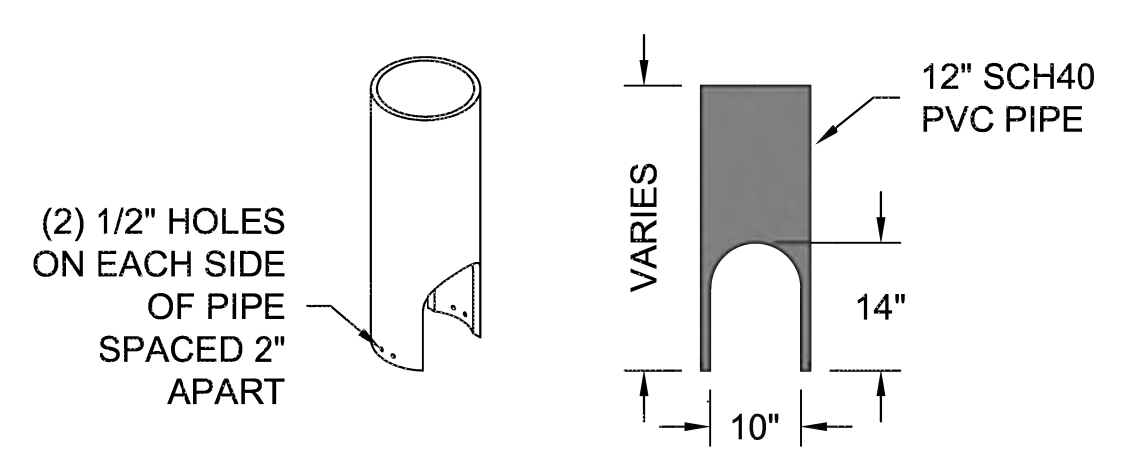

R-TANK^{HD} TYPICAL INSPECTION PORT

R-TANK^{HD}

ENGINEER OF RECORD TO REVIEW, APPROVE AND ENDORSE FINAL SITE SPECIFIC DESIGN.

ACF WEST INC. GEOSYNTHETICS

Products | Service | Solutions

FOR ADDITIONAL INFORMATION PLEASE CONTACT: ACF WEST, 1-800-423-4567, www.acfwest.com

R-TANK^{SD} SYSTEM DETAILS
EAST TOWN CROSSING
PUYALLUP, WA
SITE DESIGNATION: R-TANK 2

DRAWN BY: EDQ
DATE: 11/10/2023
ACF WEST PROJECT NUMBER: 23-004WA
SHEET NO.: 5 of 8


Project Title:
EAST TOWN CROSSING PHASE 1

Client:
ASH DEVELOPMENT

GREG HELLE
GREG.HELLE@ASHNW.COM

Project No.
2230752

Issue Set & Date:
PERMIT SUBMITTAL
11/20/2023

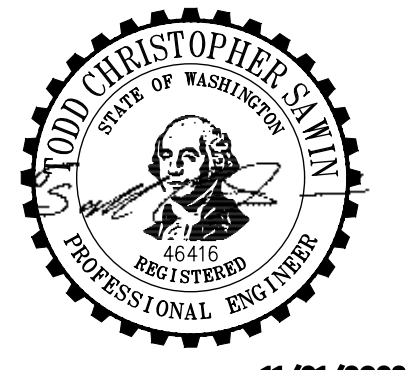

11/21/2023

NOTICE: ALTERATION OF THIS DOCUMENT SHALL INVALIDATE THE PROFESSIONAL SEAL AND SIGNATURE. PUBLICATION OF THIS DOCUMENT DOES NOT CONSTITUTE A PROFESSIONAL ENGINEER'S RESPONSIBILITY TO THE GENERAL PUBLIC. THIS DOCUMENT IS FOR THE PROJECT IDENTIFIED IN THE TITLE BLOCK AND IS NOT TO BE USED FOR OTHER PROJECTS OR ACTION TO THAT PROJECT OR FOR ANY OTHER PROJECT.

Revisions:

Sheet Title:
R-TANK 2 NOTES AND DETAILS

Designed by: CW
Drawn by: SK
Checked by: JI

Sheet No.
C4.24
35 of 63 Sheets



EAST TOWN CROSSING PHASE 1

SEC. 26,35/ TWP. 20 N./ RGE. 4 E., W.M.

Legibility: [Plans Sht C4.25; Pg 36 of 63]

Fixed

APPROVED

BY: CITY OF PUYALLUP
DEVELOPMENT ENGINEERING

DATE:

NOTE: THIS APPROVAL IS VOID AFTER 180 DAYS FROM APPROVAL. THE CITY WILL NOT BE RESPONSIBLE FOR ERRORS OR OMISSIONS ON THESE PLANS. FIELD CONDITIONS MAY DICTATE CHANGES TO THESE PLANS AS DETERMINED BY THE DEVELOPMENT ENGINEERING MANAGER.



Project Title:

EAST TOWN CROSSING PHASE 1

Client:

ASH DEVELOPMENT

GREG HELLE
GREG.HELLE@ASHNW.COM


Project No.

2230752


Issue Set & Date:

PERMIT SUBMITTAL


11/20/2023

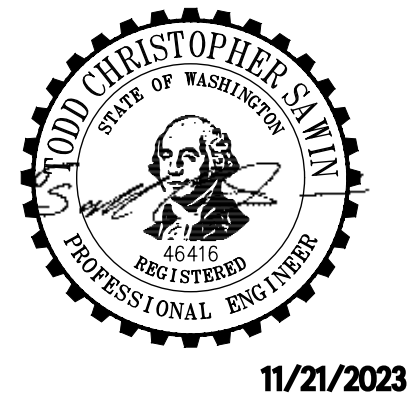


NOTICE: ALTERATION OF THIS DOCUMENT SHALL INVALIDATE THE PROFESSIONAL SEAL AND SIGNATURE. PUBLICATION OF THIS DOCUMENT DOES NOT CONSTITUTE A PROFESSIONAL ENGINEER'S RESPONSIBILITY. THE ENGINEER'S RESPONSIBILITY IS LIMITED TO THE PROJECT DESCRIBED IN THE TITLE BLOCK AND IS NOT TO BE USED FOR OTHER PROJECTS OR ACTION TO THAT PROJECT OR FOR ANY OTHER PROJECT.

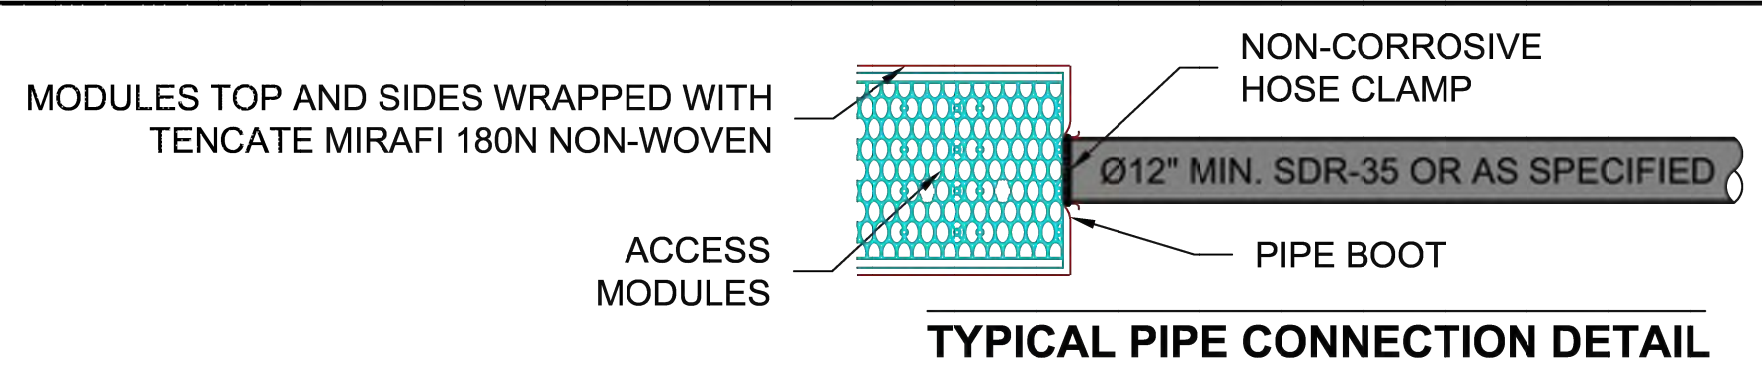


NOTE: IF PIPE CONNECTING TO TREATMENT ROW IS LARGER THAN Ø12" SDR-35, IT SHALL BE ABUTTED FLUSH TO END PLATE AND SEALED WITH A PIPE BOOT.

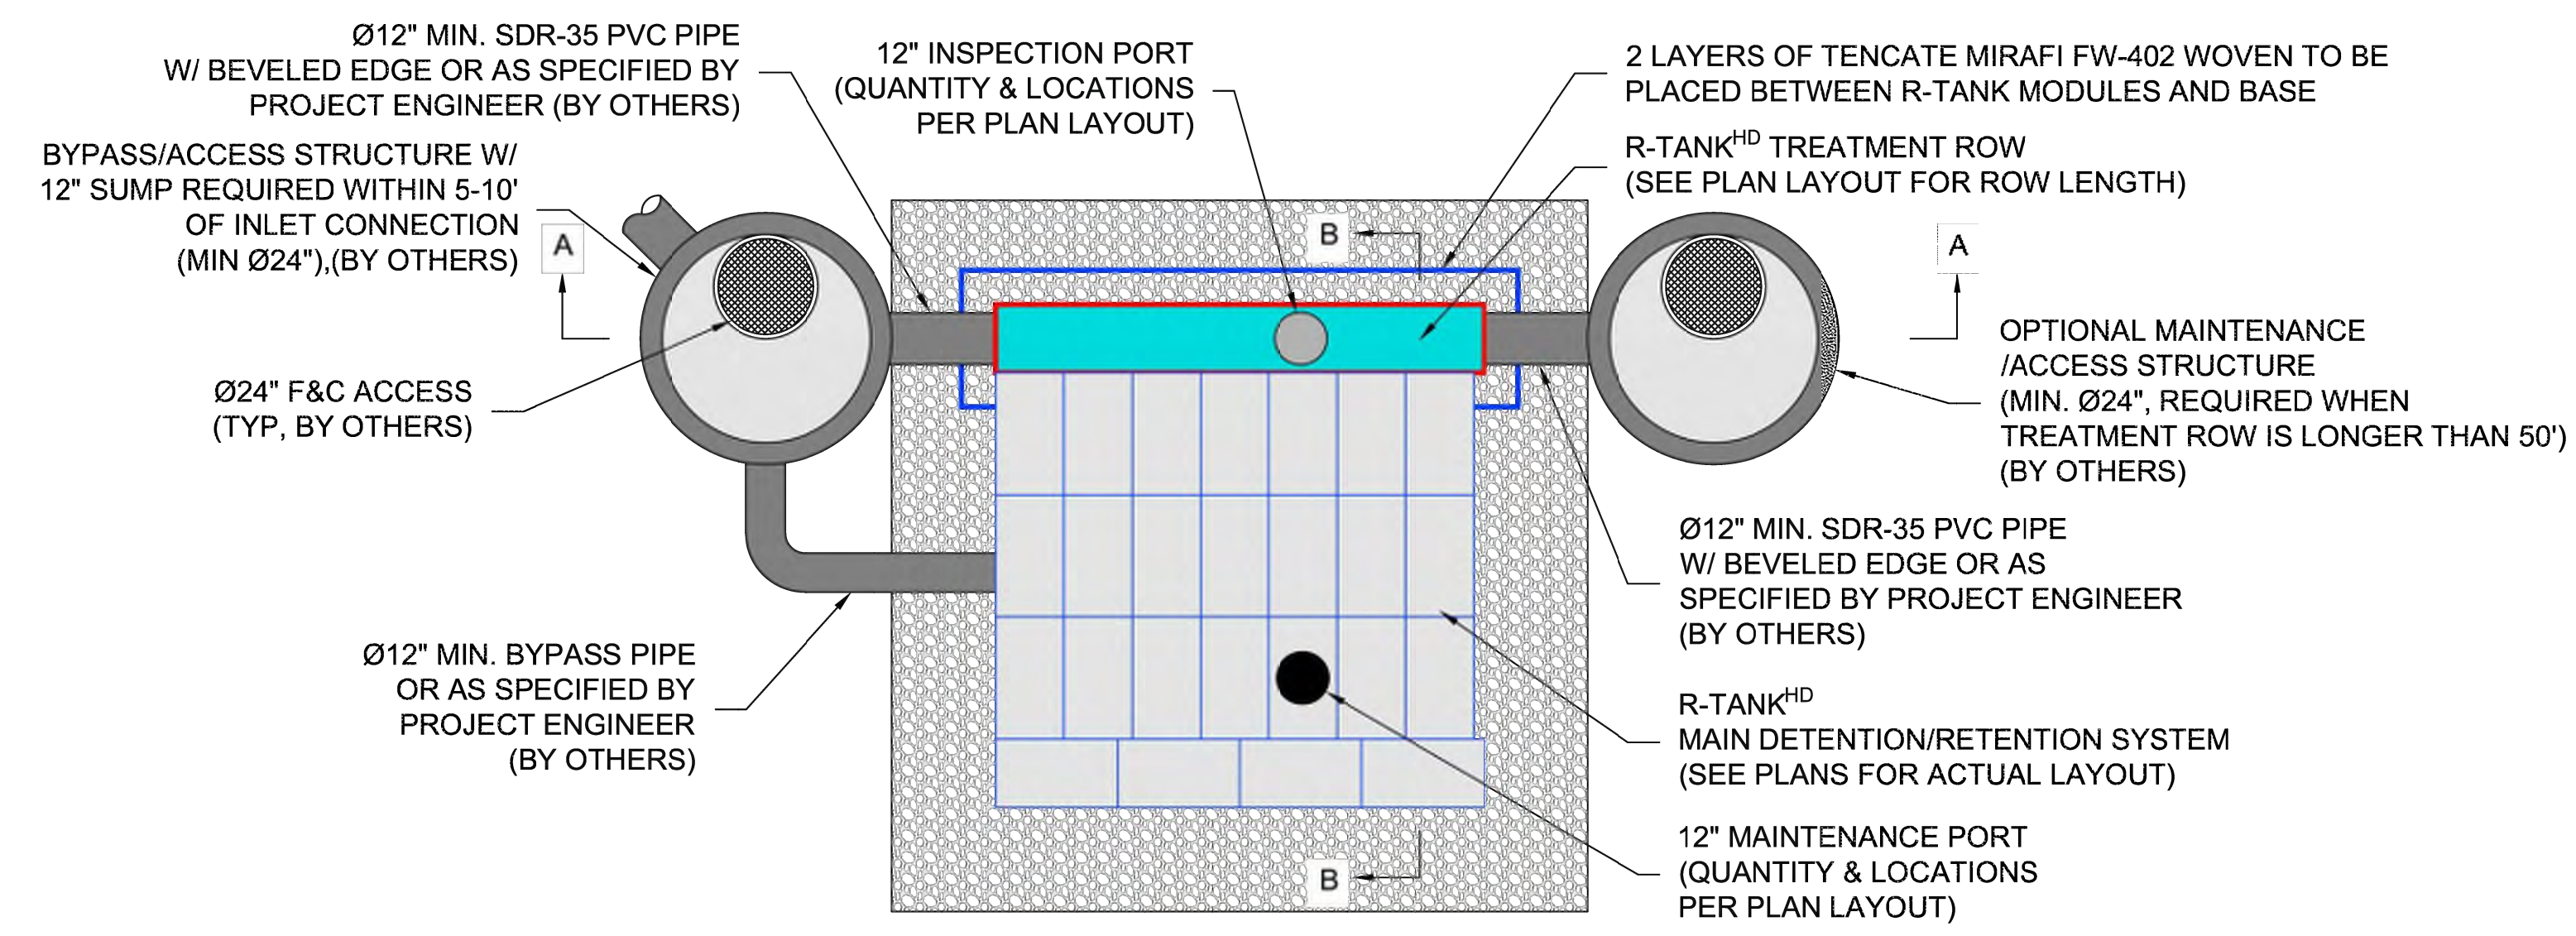


R-TANK^{HD} TREATMENT ROW WITH PRECAST INLET/ACCESS STRUCTURE

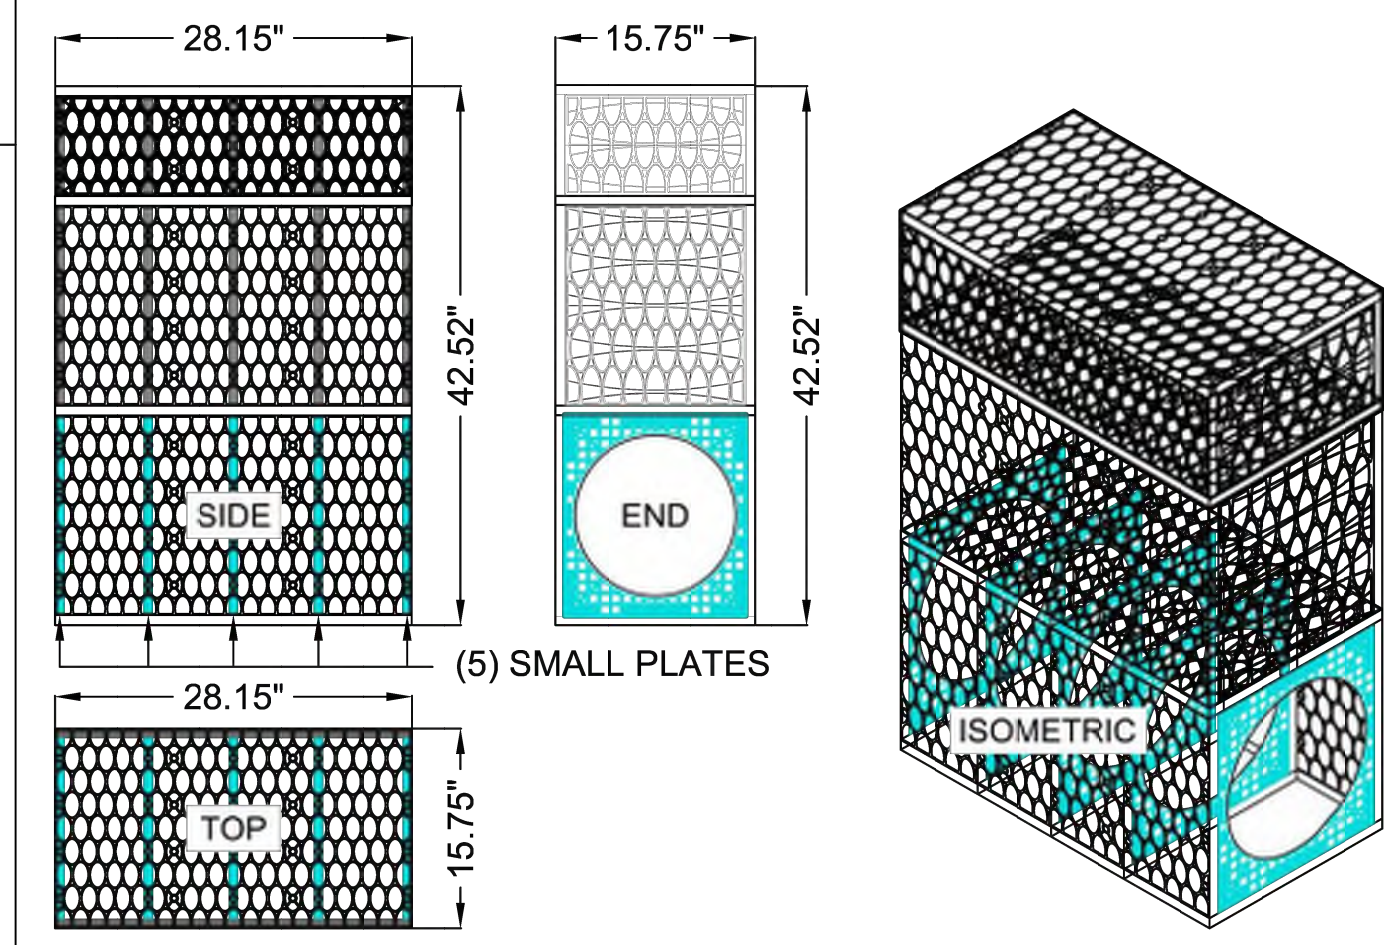

DOUBLE + MINI R-TANK^{HD} - ACCESS MODULE DETAIL (FOR MODULE DATA, SEE STANDARD MODULE DETAIL)

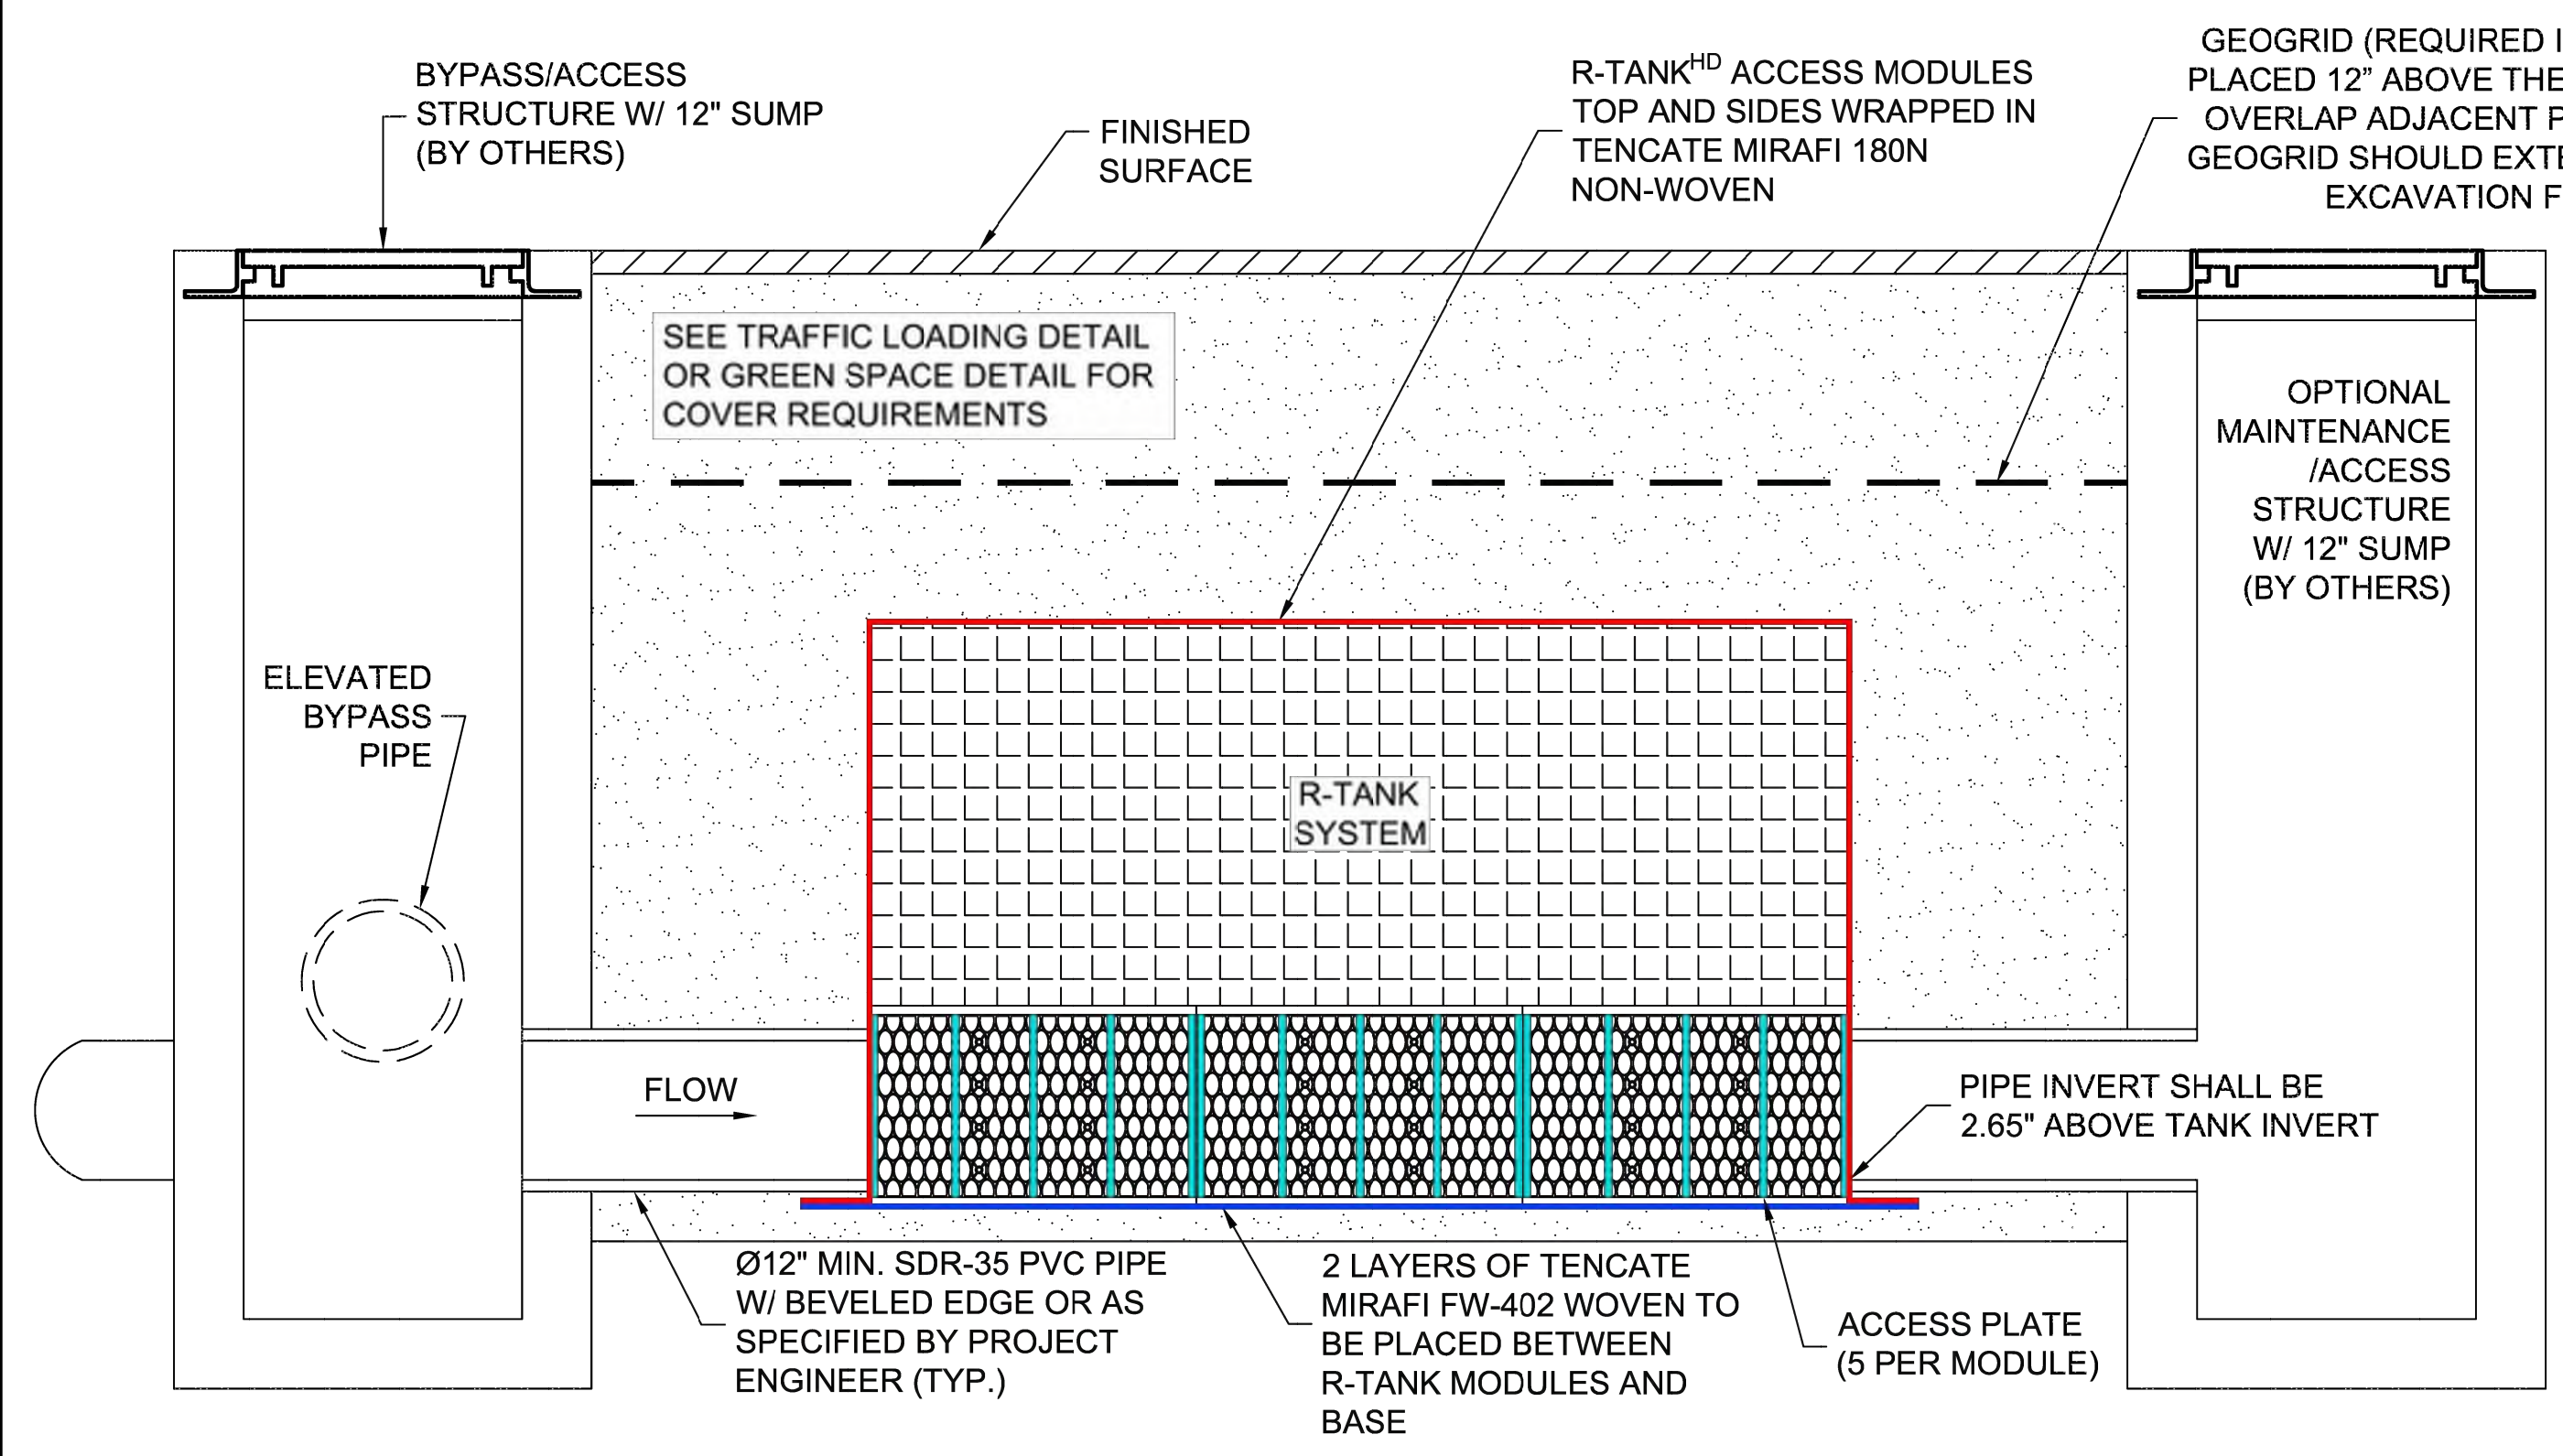

R-TANK^{HD} TREATMENT ROW SECTION A-A

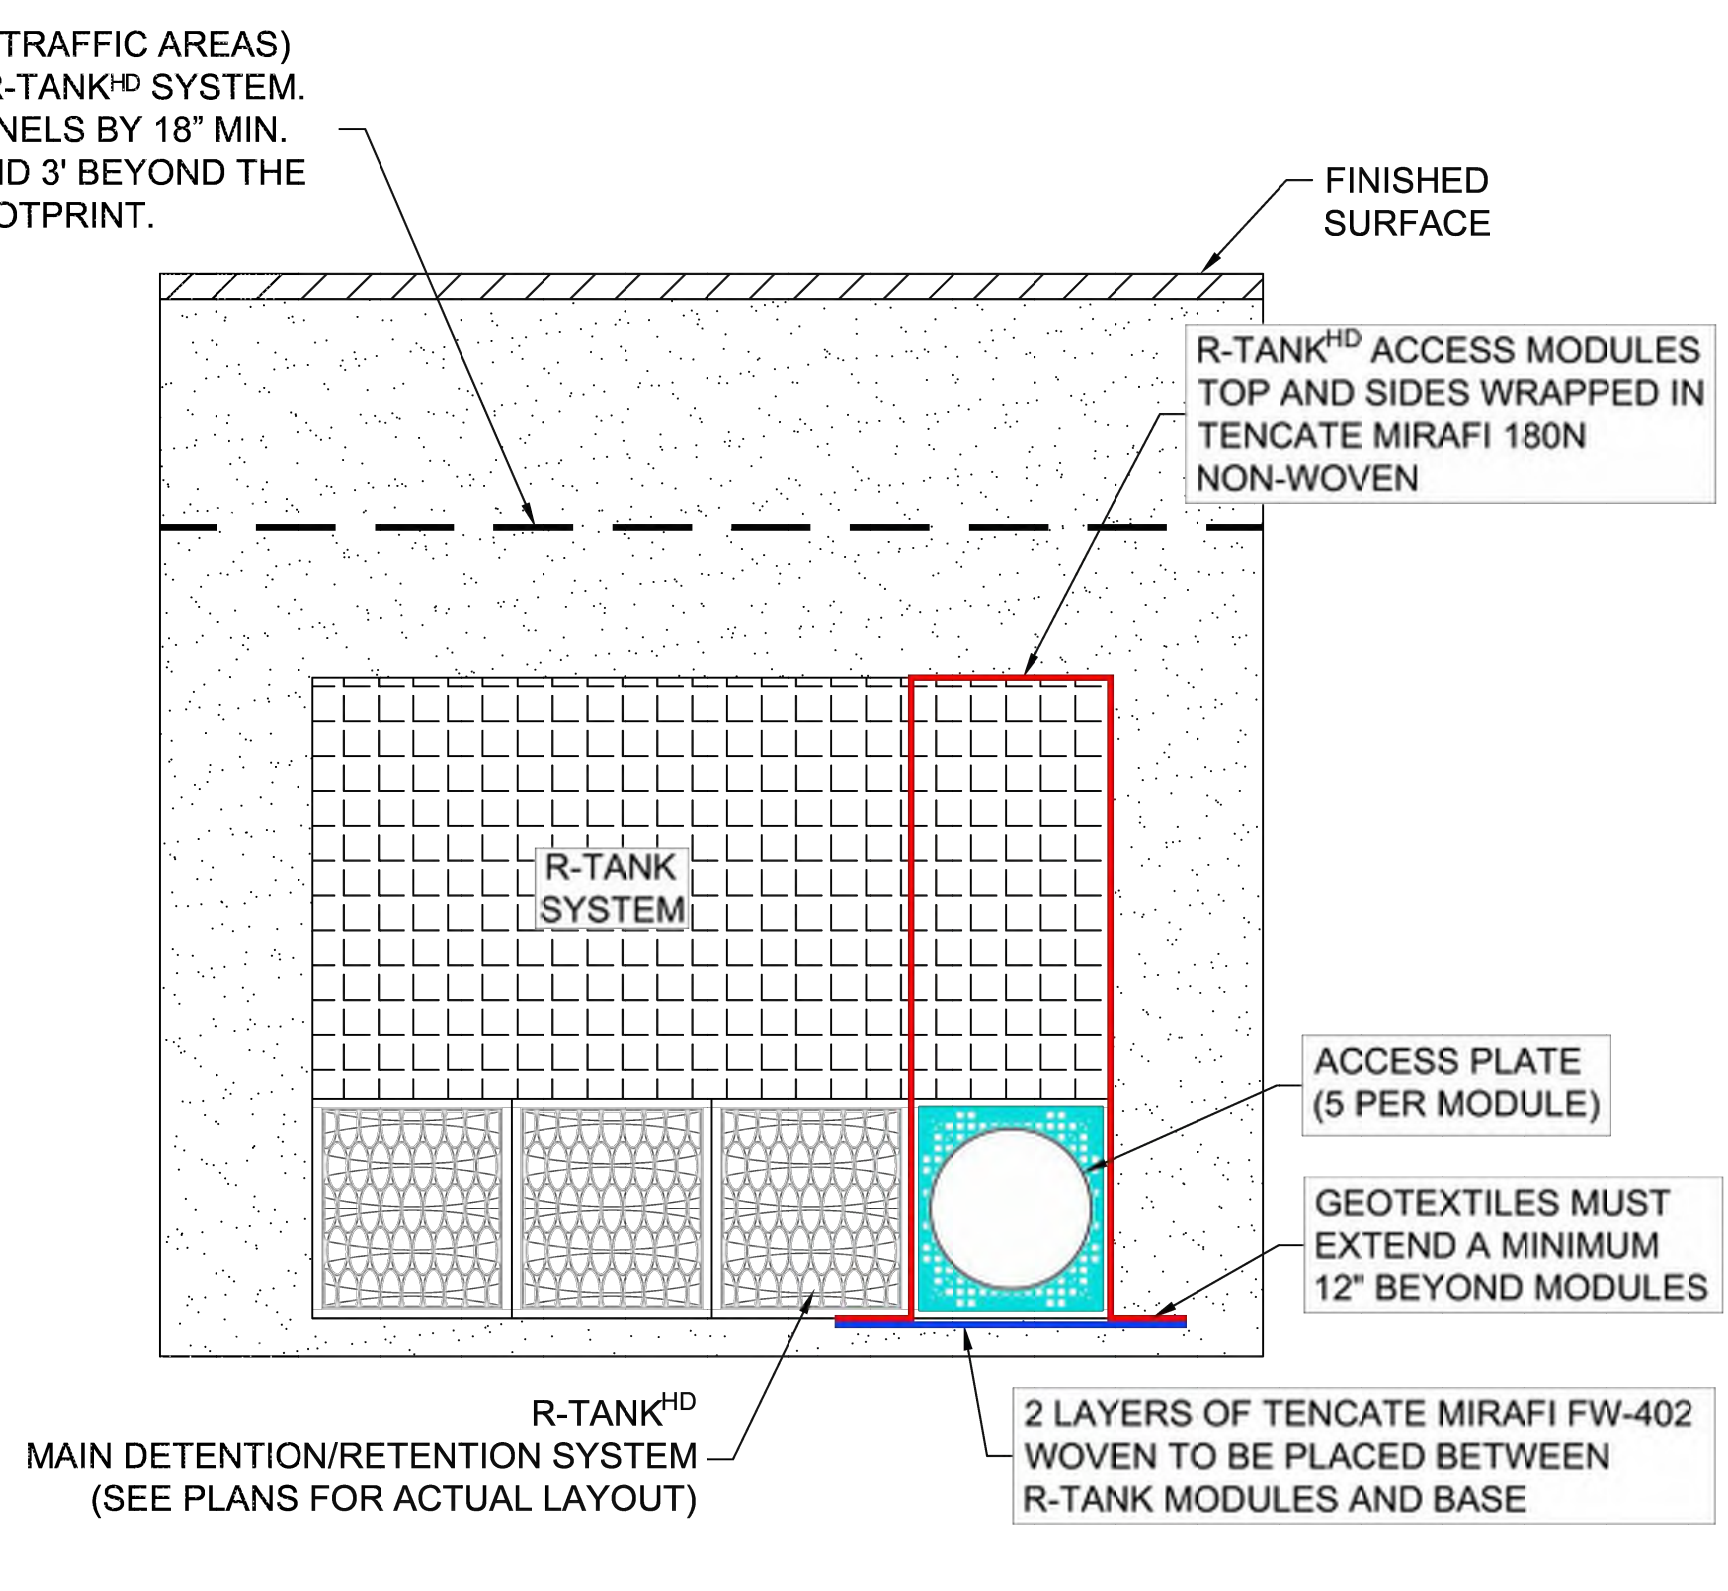

R-TANK^{HD} TREATMENT ROW SECTION B-B

R-TANK^{HD}

ENGINEER OF RECORD TO REVIEW, APPROVE AND ENDORSE FINAL SITE SPECIFIC DESIGN.

ACF WEST INC. GEOSYNTHETICS

Products | Service | Solutions

FOR ADDITIONAL INFORMATION PLEASE CONTACT: ACF WEST, 1-800-423-4567, www.acfwest.com

R-TANK^{HD} TREATMENT ROW DETAILS

EAST TOWN CROSSING

PUYALLUP, WA

SITE DESIGNATION: R-TANK 2

DRAWN BY: EDQ

DATE: 11/10/2023

ACF WEST PROJECT NUMBER: 23-004WA

SHEET NO. 6 of 8

Revisions:

Sheet Title:

R-TANK 2 NOTES AND DETAILS

Designed by: CW Drawn by: SK Checked by: JI

Sheet No.

C4.25

36 of 63 Sheets



EAST TOWN CROSSING PHASE 1

SEC. 26,35/ TWP. 20 N./ RGE. 4 E., W.M.

Legibility: [Plans Shd C4.26; Pg 37 of 63]
 Fixed

APPROVED

BY: CITY OF PUYALLUP
 DEVELOPMENT ENGINEERING


DATE:

NOTE: THIS APPROVAL IS VOID AFTER 180 DAYS FROM APPROVAL. THE CITY WILL NOT BE RESPONSIBLE FOR ERRORS OR OMISSIONS ON THESE PLANS. FIELD CONDITIONS MAY DICTATE CHANGES TO THESE PLANS AS DETERMINED BY THE DEVELOPMENT ENGINEERING MANAGER.




TACOMA • SEATTLE • SPOKANE • TRI-CITIES

2215 North 30th Street, Suite 300, Tacoma, WA 98403
 253.383.2422 TEL 253.383.2572 FAX www.ahbl.com WEB

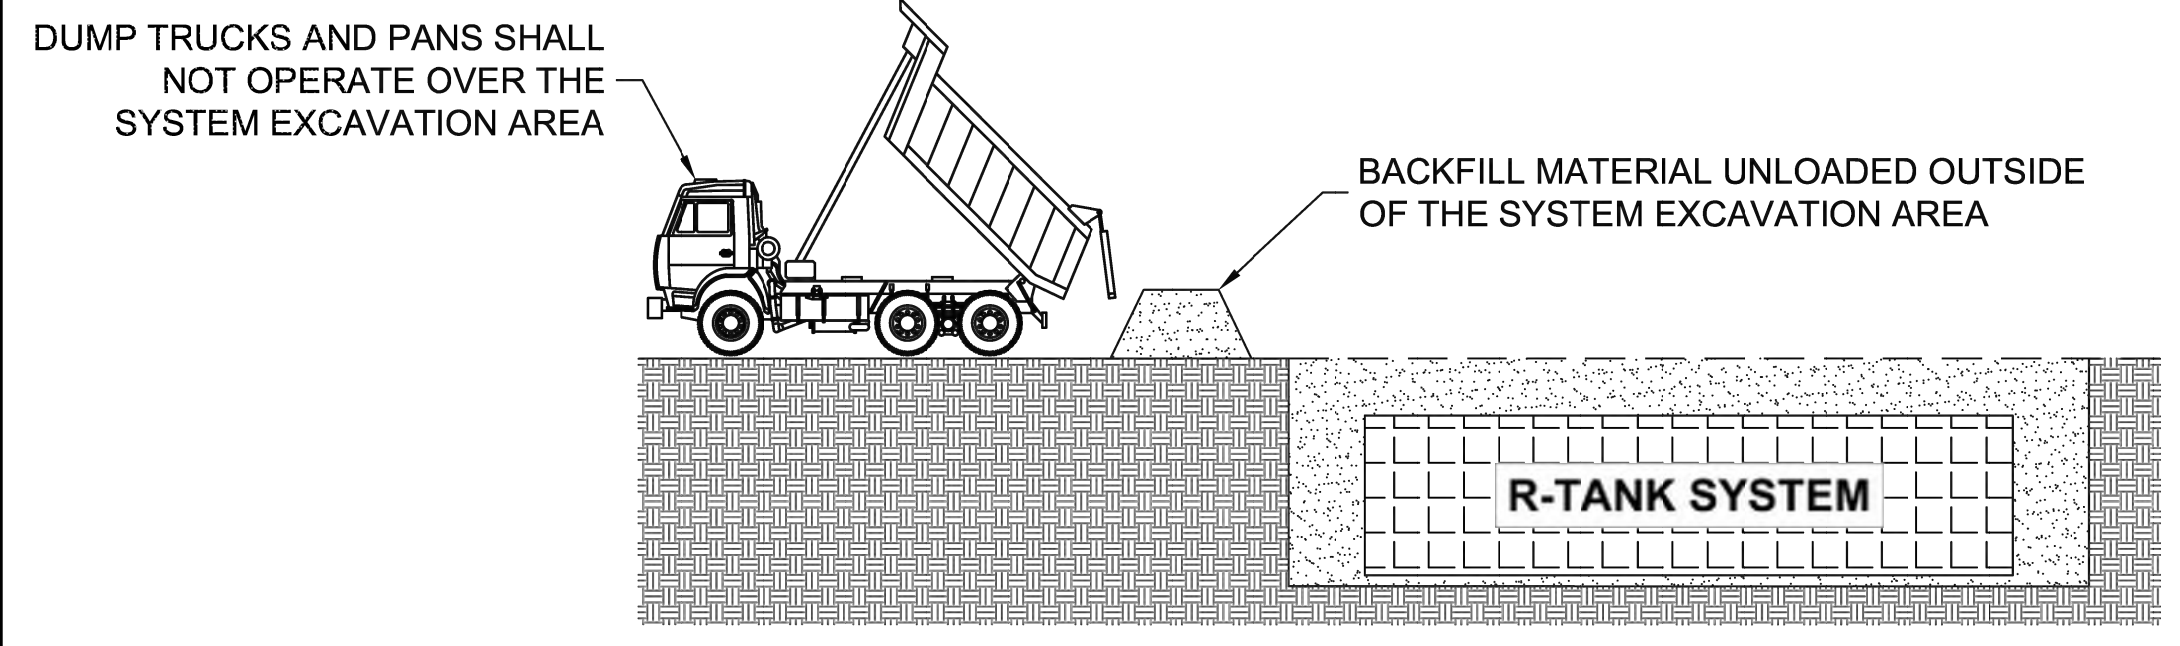


DUMP TRUCK DETAIL (SEE NOTE 3)

- NOTES:
- FOLLOWING PLACEMENT OF SIDE BACKFILL, A UNIFORM 12" LIFT OF THE FREELY DRAINING MATERIAL (SPEC SECTION 2.03 B2) SHALL BE PLACED OVER THE R-TANK AND LIGHTLY COMPACTED USING A WALK-BEHIND TRENCH ROLLER. ALTERNATELY, A ROLLER (MAXIMUM GROSS VEHICLE WEIGHT OF 6 TONS) MAY BE USED. ROLLER MUST REMAIN IN STATIC MODE UNTIL A MINIMUM OF 24" OF COVER HAS BEEN PLACED OVER THE MODULES. SHEEP FOOT ROLLERS SHOULD NOT BE USED. **SPEC SECTION 3.05 A5**
 - ONLY LOW PRESSURE TIRE OR TRACK VEHICLES (LESS THAN 7 PSI AND OPERATING WEIGHT OF LESS THAN 20,000 LBS) SHALL BE OPERATED OVER THE R-TANK SYSTEM DURING CONSTRUCTION. **SPEC SECTION 3.05 A5**
 - DUMP TRUCKS AND PANS SHALL NOT BE OPERATED WITHIN THE R-TANK SYSTEM AT ANY TIME. WHERE NECESSARY, THE HEAVY EQUIPMENT SHOULD UNLOAD IN AN AREA ADJACENT TO THE R-TANK SYSTEM AND THE MATERIAL SHOULD BE MOVED OVER THE SYSTEM WITH TRACKED EQUIPMENT. **SPEC SECTION 3.05 A5**
 - ENSURE THAT ALL UNRELATED CONSTRUCTION TRAFFIC IS KEPT AWAY FROM THE LIMITS OF EXCAVATION UNTIL THE PROJECT IS COMPLETE AND FINAL SURFACE MATERIALS ARE IN PLACE. NO NON-INSTALLATION RELATED LOADING SHOULD BE ALLOWED OVER THE R-TANK SYSTEM UNTIL THE FINAL DESIGN SECTION HAS BEEN CONSTRUCTED (INCLUDING PAVEMENT). **SPEC SECTION 3.05 B**
 - SEE R-TANK INSTALLATION GUIDE OR CONTACT YOUR LOCAL ACF WEST REPRESENTATIVE FOR ADDITIONAL INFORMATION.

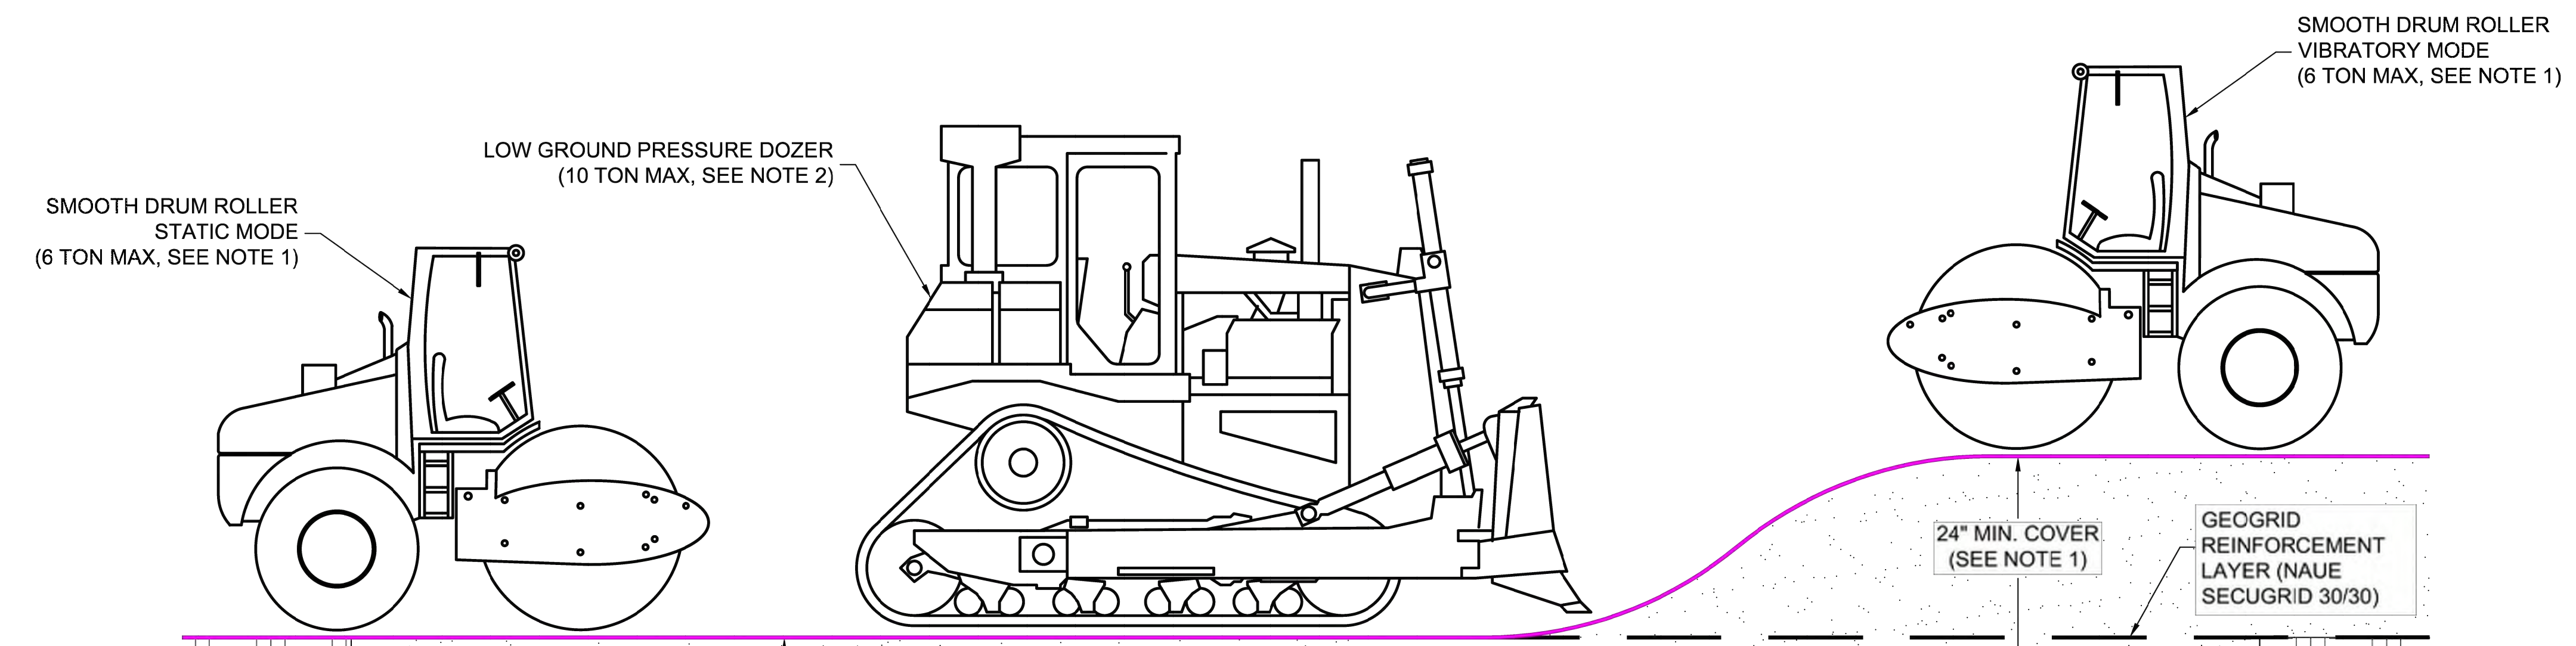


CONSTRUCTION EQUIPMENT COVER DETAIL - VEHICULAR TRAFFIC

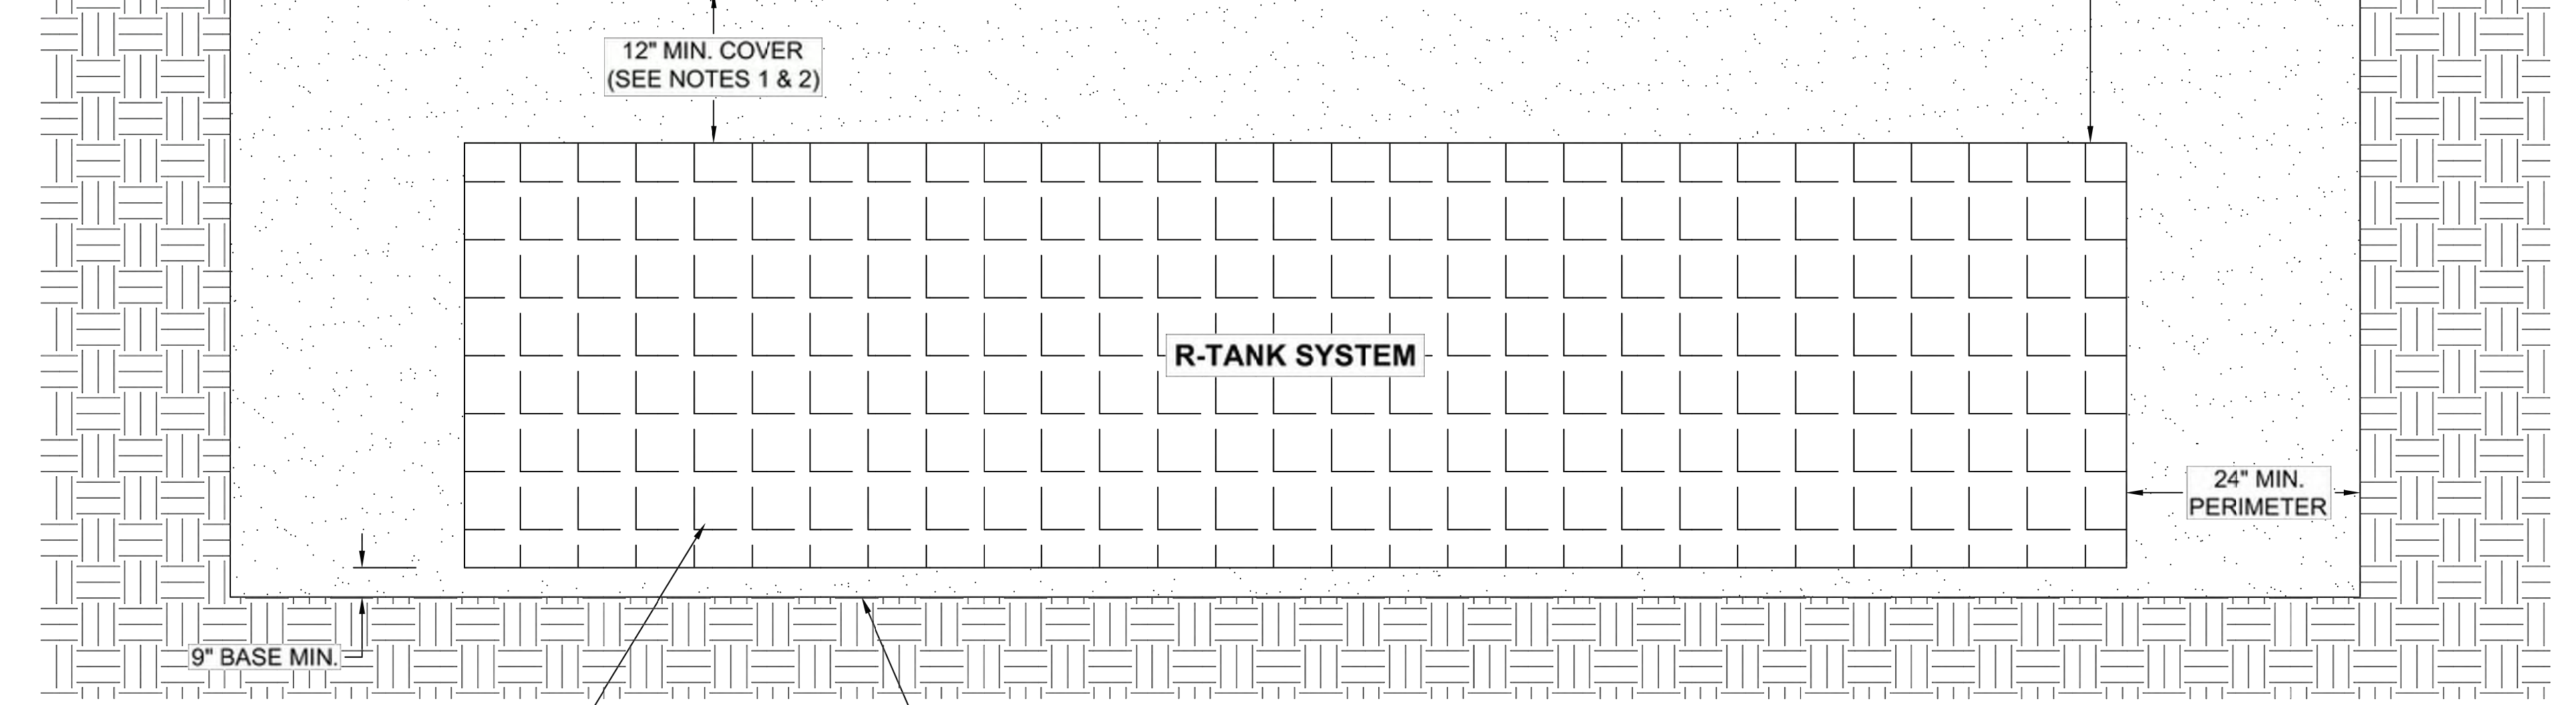

R-TANK^{HD} OR R-TANK^{SD} UNITS
 HD: LOAD RATING: 33.4 PSI (MODULE ONLY)
 SD: LOAD RATING: 42.9 PSI (MODULE ONLY)

SUBGRADE / EXCAVATION LINE: COMPACT PER SPEC SECTION 3.02 D. A BEARING CAPACITY OF 2,000 PSF MUST BE ACHIEVED PRIOR TO INSTALLING R-TANK^{HD} OR R-TANK^{SD}

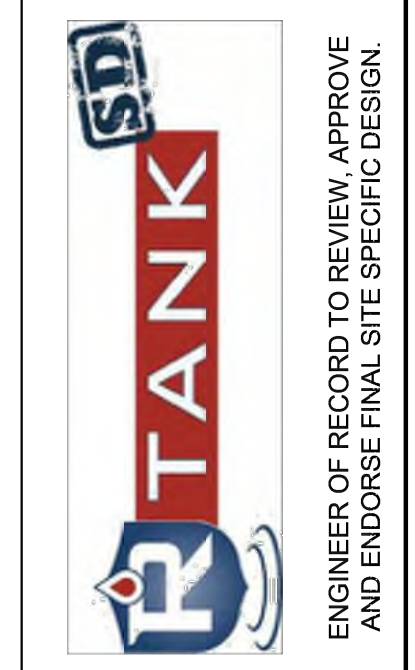

ENGINEER OF RECORD TO REVIEW, APPROVE AND ENDORSE FINAL SITE SPECIFIC DESIGN.



Products | Service | Solutions
 FOR ADDITIONAL INFORMATION PLEASE CONTACT:
 ACF WEST, 1-800-423-4567, www.acfwest.com

R-TANK^{SD} CONSTRUCTION EQUIPMENT COVER DETAIL
 EAST TOWN CROSSING
 PUYALLUP, WA
 SITE DESIGNATION: R-TANK 2

DRAWN BY: EDQ
 DATE: 11/10/2023
 ACF WEST PROJECT NUMBER: 23-004WA
 SHEET NO: 7 of 8


Project Title:
EAST TOWN CROSSING PHASE 1

Client:
 ASH DEVELOPMENT

GREG HELLE
 GREG.HELLE@ASHNW.COM

Project No.
 2230752

Issue Set & Date:
 PERMIT SUBMITTAL
 11/20/2023

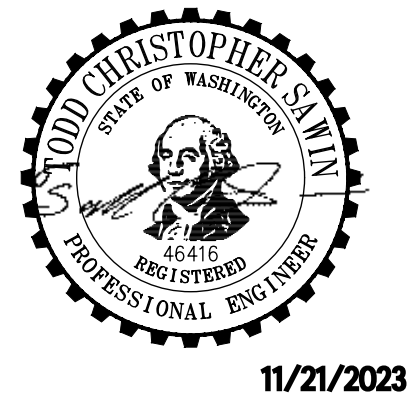

NOTICE
 ALTERATION OF THIS DOCUMENT SHALL INVALIDATE THE PROFESSIONAL SEAL AND SIGNATURE. PUBLICATION OF THIS DOCUMENT DOES NOT CONSTITUTE A PROFESSIONAL ENGINEER'S RESPONSIBILITY TO THE GENERAL PUBLIC. THIS DOCUMENT IS FOR THE PROJECT IDENTIFIED IN THE TITLE BLOCK AND IS NOT TO BE USED FOR OTHER PROJECTS, OR ACTION TO THAT PROJECT OR FOR ANY OTHER PROJECT.

Revisions:

Sheet Title:

R-TANK 2 NOTES AND DETAILS

Designed by: CW
 Drawn by: SK
 Checked by: JI

Sheet No.

C4.26



EAST TOWN CROSSING PHASE 1

SEC. 26,35/ TWP. 20 N./ RGE. 4 E., W.M.

Legibility
[Plans Sht C4.27; Pg 38 of 63]
Fixed

APPROVED
BY
CITY OF PUYALLUP
DEVELOPMENT ENGINEERING
DATE
THIS APPROVAL IS VOID
IF NOT SIGNED AND DATED
WITHIN 180 DAYS FROM APPROVAL
DATE. THE CITY WILL NOT BE
RESPONSIBLE FOR ERRORS
OR OMISSIONS ON THESE
PLANS. UNLESS OTHERWISE
NOTED, ALL CONDITIONS MAY DICTATE
CHANGES TO THESE PLANS AS
DETERMINED BY THE
DEVELOPMENT ENGINEERING
MANAGER.



R-TANK SPECIFICATION

PART 1 - GENERAL
1.01 RELATED DOCUMENTS
A. Drawings, technical specification and general provisions of the Contract as modified herein apply to this section.

1.02 DESCRIPTION OF WORK INCLUDED
A. Provide excavation and base preparation per geotechnical engineer's recommendations and/or as shown on the design drawings, to provide adequate support for project design loads and safety from excavation sidewall collapse. Excavations shall be in accordance with the owner's and OSHA requirements.
B. Provide and install R-TankLD/, R-TankHD/, R-TankSD/, or R-TankUD/ system (hereafter called R-Tank) and all related products including fill materials, geotextiles, geogrids, inlet and outlet pipe with connections per the manufacturer's installation guidelines provided in this section.
C. Provide and construct the cover of the R-Tank system including: stone backfill, structural fill cover, and pavement section as specified.
D. Protect R-Tank system from construction traffic after installation until completion of all construction activity in the installation area.

1.03 QUALITY CONTROL
A. All materials shall be manufactured in ISO certified facilities.
B. Installation Contractor shall demonstrate the following experience:
1. A minimum of three R-Tank or equivalent projects completed within 2 years; and,
2. A minimum of 25,000 cubic feet of storage volume completed within 2 years.
C. Contractor experience requirement may be waived if the manufacturer's representative provides on-site training and review during construction.
D. Installation Personnel: Performed only by skilled workers with satisfactory record of performance on bulk earthworks, pipe, chamber, or pond/landfill construction projects of comparable size and quality.
E. Contractor must have manufacturer's representative available for site review if requested by Owner.

1.04 SUBMITTALS
A. Submit proposed R-Tank layout drawings. Drawings shall include typical section details as well as the required base elevation of stone and tanks, minimum cover requirements and tank configuration.
B. Submit manufacturer's product data, including compressive strength and unit weight.
C. Submit manufacturer's installation instructions.
D. Submit R-Tank sample for review. Reviewed and accepted samples will be returned to the Contractor.
E. Submit material certificates for geotextile, geogrid, base course and backfill materials.
F. Submit required experience and personnel requirements as specified in Section 1.03.
G. Any proposed equal alternative product substitution to this specification must be submitted for review and approved prior to bid opening. Review package should include third party reviewed performance data that meets or exceeds criteria in Table 2.01 B.

1.05 DELIVERY, STORAGE, AND HANDLING
A. Protect R-Tank and other materials from damage during delivery, and store UV sensitive materials under tarp to protect from sunlight when time from delivery to installation exceeds two weeks. Storage of materials should be on smooth surfaces, free from dirt, mud and debris.
B. Handling is to be performed with equipment appropriate to the materials and site conditions, and may include hand, handcart, forklifts, extension lifts, etc.
C. Cold weather:
1. Care must be taken when handling plastics when air temperature is 40 degrees or below as plastic becomes brittle.
2. Do not use frozen materials or materials mixed or coated with ice or frost.
3. Do not build on frozen ground or wet, saturated or muddy subgrade.

2.04 OTHER MATERIALS
A. Utility Marker: Install metallic tape at corners of R-Tank system to mark the area for future utility detection.

3.02 LAYOUT AND EXCAVATION
A. Installer shall stake out, excavate, and prepare the subgrade area to the required plan grades and dimensions, ensuring that the excavation is at least 2 feet greater than R-Tank dimensions in each direction allowing for installation of geotextile filter fabric, R-Tank modules, and free draining backfill materials.
B. All excavations must be prepared with OSHA approved excavated sides and sufficient working space.
C. Protect partially completed installation against damage from other construction traffic by establishing a perimeter with high visibility construction tape, fencing, barricades, or other means until construction is complete.
D. Base of the excavation shall be uniform, level, and free of lumps or debris and soft or yielding subgrade areas. A minimum 2,000 pounds per square foot bearing capacity is required.
E. Standard Applications: Compact subgrade to a minimum of 95% of Standard Proctor (ASTM D698) density or as required by the Owner's engineer.
F. Infiltration Applications: Subgrade shall be prepared in accordance with the contract documents. Compaction of subgrade should not be performed in infiltration applications.
G. Unstable Soils or Conditions: All questions about the base of the excavation shall be directed to the owner's engineer, who will approve the subgrade conditions prior to placement of stone. The owner's engineer shall determine the required bearing capacity of the R-Tank subgrade; however in no case shall a bearing capacity of less than 2,000 pounds per square foot be provided.
1. If unsuitable soils are encountered at the subgrade, or if the subgrade is pumping or appears excessively soft, repair the area in accordance with contract documents and/or as directed by the owner's engineer.
2. If indications of the water table are observed during excavation, the engineer shall be contacted to provide recommendations.
3. Do not start installation of the R-Tank system until unsatisfactory subgrade conditions are corrected and the subgrade conditions are accepted by the owner's engineer.

3.03 PREPARATION OF BASE
A. Place a thin layer (3" unless otherwise specified) of bedding material (Section 2.03 A), over the subgrade to establish a level working platform for the R-Tank modules. Level to within 1/2" (+/- 1/4") or as shown on the plans. Native subgrade soils or other materials may be used if determined to meet the requirements of 2.03 A and are accepted by the owner's engineer.
1. Standard Applications: Static roll or otherwise compact bedding materials until they are firm and unyielding.
2. Infiltration Applications: Bedding materials shall be prepared in accordance with the contract documents.
B. Outline the footprint of the R-Tank system on the excavation floor using spray paint or chalk line to ensure a 2' perimeter is available around the R-Tank system for proper installation and compaction of backfill.

3.04 INSTALLATION OF THE R-TANKS
A. Where a geotextile wrap is specified on the stone base, cut strips to length and install in excavation, removing wrinkles so material lays flat. Overlap geotextile a minimum 12" or as recommended by manufacturer. Use tape, special adhesives, sandbags or other ballast to secure overlaps. As geotextiles can be damaged by extreme heat, smoking is not permissible on/near the geotextile, and tools using a flame to tack the overlaps, such as propane torches, are prohibited.
B. Where an impervious liner (for containment) is specified, install the liner per manufacturer's recommendations and the contract documents. The R-Tank units shall be separated from impervious liner by a non-woven geotextile fabric installed accordance with Section 3.04A.
C. Install R-Tank modules by placing side by side, in accordance with the design drawings. No lateral connections are required. It is advisable to use a string line to form square corners and straight edges along the perimeter of the R-Tank system. The modules are to be oriented as per the design drawing with required depth as shown on plans.
1. For LD, HD, and SD installations, the large side plate of the tank should be placed on the perimeter of the system. This will typically require that the two ends of the tank area will have a row of tanks placed perpendicular to all other tanks. If this is not shown in the construction drawings, it is a simple field adjustment that will have minimal effect on the overall system footprint. Refer to R-Tank Installation Guide for more details.
2. For UD installations, there is no perpendicular end row required.
D. Wrap the R-Tank top and sides in specified geotextile. Cut strips of geotextile so that it will cover the sides and top, encapsulating the entire system to prevent backfill entry into the system. Overlap geotextile 12" or as recommended by manufacturer. Take great care to avoid damage to geotextile (and, if specified, impervious liner) during placement.
E. Identify locations of inlet, outlet and any other penetrations of the geotextile (and optional liner). These connections should be installed flush (butted up to the R-Tank) and the geotextile fabric shall be cut to enable hydraulic continuity between the connections and the R-Tank units. These connections shall be secured using pipe boots with stainless steel pipe clamps. Support pipe in trenches during backfill operations to prevent pipe from settling and damaging the geotextile, impervious liner (if specified) or pipe. Connecting pipes at 90 degree angles facilitates construction, unless otherwise specified. Ensure end of pipe is installed snug against R-Tank system.
F. Install Inspection and Maintenance Ports in locations noted on plans. At a minimum one maintenance port shall be installed within 10' of each inlet & outlet connection, and with a maximum spacing of one maintenance port for every 2,500 square feet. Install all ports as noted in the R-Tank Installation Guide.
G. If required, install ventilation pipes and vents as specified on drawings to provide ventilation for proper hydraulic performance. The number of pipes and vents will depend on the size of the system. Vents are often installed using a 90 degree elbow with PVC pipe into a landscaped area with "U" bend or venting bollard to inhibit the ingress of debris. A ground level concrete or steel cover can be used.

3.05 BACKFILLING OF THE R-TANK UNITS
A. Backfill and fill with recommended materials as follows:
1. Place freely draining backfill materials (Section 2.03 B) around the perimeter in lifts with a maximum thickness of 12". Each lift shall be placed around the entire perimeter such that each lift is no more than 24" higher than the side backfill along any other location on the perimeter of the R-Tank system. No fill shall be placed over top of tanks until the side backfill has been completed.
2. Each lift shall be compacted at the specified moisture content to a minimum of 95% of the Standard Proctor Density until no further densification is observed (for self-compacting stone materials). The side lifts must be compacted with walk behind compaction equipment. Even when "self-compacting" backfill materials are selected, a walk behind vibratory compactor must be used.
3. Take care to ensure that the compaction process does not allow the machinery to come into contact with the modules due to the potential for damage to the geotextile and R-Tank units.
4. No compaction equipment is permissible to operate directly on the R-Tank modules.
5. Top Backfill: Only low pressure track vehicles shall be operated over the R-Tank system during construction. Dump Trucks and Pans shall not be operated within the R-Tank system footprint at any time. Heavy equipment should unload in an area adjacent to the R-Tank system and the material should be moved over the system using tracked equipment with an operating weight of less than 10 tons.
a. Typical Applications: Install a 12" (or as shown on plans) lift of freely draining material (Section 2.03 B) over the R-Tank Units, maintaining 12" between equipment tracks and R-Tank System. Lightly compacted using a walk-behind trench roller. Alternately, a roller (maximum gross vehicle weight of 6 tons) may be used. Roller must remain in static mode until a minimum of 24" of cover has been placed over the modules. Sheep foot rollers should not be used.
b. Shallow Applications (< 18" total cover): Install top backfill in accordance with plans.
6. If required, install a geogrid as shown on plans. Geogrid shall extend a minimum of 3 feet beyond the limits of the excavation wall.
7. Following placement and compaction of the initial cover, subsequent lifts of structural fill (Section 2.03 C) shall be placed at the specified moisture content and compacted to a minimum of 95% of the Standard Proctor Density and shall cover the entire footprint of the R-Tank system. During placement of fill above the system, unless otherwise specified, a uniform elevation of fill shall be maintained to within 12" across the footprint of the R-Tank system. Do not exceed maximum cover depths listed in Table 2.01 B.
8. Place additional layers of geotextile and/or geogrid at elevations as specified in the design details. Each layer of geosynthetic reinforcement placed above the R-Tank system shall extend a minimum of 3 feet beyond the limits of the excavation wall.
B. Ensure that all unrelated construction traffic is kept away from the limits of excavation until the project is complete and final surface materials are in place. No non-installation related loading should be allowed over the R-Tank system until the final design section has been constructed (including pavement).
C. Place surfacing materials, such as groundcovers (no large trees), or paving materials over the structure with care to avoid displacement of cover fill and damage to surrounding areas.
D. Backfill depth over R-Tank system must be within the limitations shown in the table in Section 2.01 B. If the total backfill depth does not comply with this table, contact engineer or manufacturer's representative for assistance.

SDI TANK
ENGINEER OF RECORD TO REVIEW, APPROVE AND ENDORSE FINAL SITE SPECIFIC DESIGN.

ACF WEST INC. GEOSYNTHETICS
Products | Service | Solutions
FOR ADDITIONAL INFORMATION PLEASE CONTACT:
ACF WEST, 1-800-423-4567, www.acfwest.com

**R-TANK SPECIFICATION
EAST TOWN CROSSING
PUYALLUP, WA
SITE DESIGNATION: R-TANK 2**

DRAWN BY
EDQ
DATE
11/10/2023
ACF WEST PROJECT NUMBER
23-004WA
SHEET NO.
8 of 8

1.06 PREINSTALLATION CONFERENCE
A. Prior to the start of the installation, a preinstallation conference shall occur with the representatives from the design team, the general contractor, the excavation contractor, the R-Tank installation contractor, and the manufacturer's representative.

1.07 PROJECT CONDITIONS
A. Coordinate installation for the R-Tank system with other on-site activities to eliminate all non-installation related construction traffic over the completed R-Tank system. No loads heavier than the design loads shall be allowed over the system, and in no case shall loads higher than a standard AASHTO HS20 (or HS25, depending on design criteria) load be allowed on the system at any time.
B. Protect adjacent work from damage during R-Tank system installation.
C. All pre-treatment systems to remove debris and heavy sediments must be in place and functional prior to operation of the R-Tank system. Additional pretreatment measures may be needed if unit is operational during construction due to increased sediment loads.
D. Contractor is responsible for any damage to the system during construction.

PART 2 - PRODUCTS
2.01 R-TANK UNITS
A. R-Tank - Injection molded plastic tank plates assembled to form a 95% void modular structure of predesigned height (custom for each project).
B. R-Tank units shall meet the following Physical & Chemical Characteristics:

PROPERTY	DESCRIPTION	R-Tank ^{LD} VALUE	R-Tank ^{HD} VALUE	R-Tank ^{SD} VALUE	R-Tank ^{UD} VALUE
Void Area	Volume available for water storage	95%	95%	95%	95%
Surface Void Area	Percentage of exterior available for infiltration	90%	90%	90%	90%
Vertical Compressive Strength	ASTM D 2412 / ASTM F 2418	30.0 psi	33.4 psi	42.9 psi	134.2 psi
Lateral Compressive Strength	ASTM D 2412 / ASTM F 2418	20.0 psi	22.4 psi	28.9 psi	N/A
HS-20 Minimum Cover	Cover required to support HS-20 loads	N/A	20"	18"	12" (STONE BACKFILL)
HS-25 Minimum Cover	Cover required to support HS-25 loads	N/A	24"	19"	12" (STONE BACKFILL)
Maximum Cover	Maximum allowable cover depth	3 feet	4 feet	4 to 10 feet	5 feet
Unit Weight	Weight of plastic per cubic foot of tank	3.29 lbs / cf	3.61 Backfill	3.96 lbs / cf	4.33 lbs / cf
Rib Thickness	Thickness of load-bearing members	0.18 inches	0.18 inches	3.18 inches	N/A
Service Temperature	Safe temperature range for use	-14 - 167° F	-14 - 167° F	-14 - 167° F	-14 - 167° F

Called out
CALLOUT-manufactured 30mil (min) impermeable liner to prevent groundwater intrusion. [Plans Sht C4.27; Pg 38 of 63]

2.02 GEOSYNTHETICS
A. Geotextile: A geotextile envelope is required to prevent backfill material from entering the R-Tank modules.
1. Standard Application: The standard geotextile shall be an 8 oz per square yard nonwoven geotextile (TenCate Mirafi 180N or equivalent).
2. Infiltration Applications: When water must infiltrate/exfiltrate through the geotextile as a function of the system design, a woven monofilament (TenCate Mirafi FW402 or equivalent) shall be used.
B. Geogrid: For installations subject to traffic loads and/or when required by project plans, install geogrid (Naue Secugrid 30/30 or equivalent) to reinforce backfill above the R-Tank system. Geogrid is not always required for R-TankUD/ installations, and is often not required for non-traffic load applications.

2.03 BACKFILL & COVER MATERIALS
A. Bedding Materials: Stone (angular and smaller than 1.5" in diameter) or soil (GW, GP, SW, or SP as classified by the Unified Soil Classification System) shall be used below the R-Tank system (3" minimum). Material must be free from lumps, debris, and any sharp objects that could cut the geotextile. Material shall be within 3 percent of the optimum moisture content as determined by ASTM D698 at the time of installation.
B. Side and Top Backfill: Material must be free from lumps, debris and any sharp objects that could cut the geotextile. Material shall be within 3 percent of the optimum moisture content as determined by ASTM D698 at the time of installation.
1. Traffic Applications - Free draining material shall be used adjacent to (24" minimum) and above (for the first 12") the R-Tank system.
For HD, and SD modules, backfill materials shall be free draining stone (angular and smaller than 1.5" in diameter) or soil (GW, GP, SW, or SP as classified by the Unified Soil Classification System).
2. For UD modules with less than 14" of top cover, backfill materials shall be free draining stone (angular and smaller than 1.5" in diameter). The use of soil backfill on the sides and top of the UD module is not permitted unless the modules are installed outside of traffic areas or with cover depths of 14" or more. Top backfill material (from top of module to bottom of pavement base or 12" maximum) must be consistent with side backfill.
3. Non-Traffic / Green Space Applications - For all R-Tank modules installed in green spaces and not subjected to vehicular loads, backfill materials may either follow the guidelines for Traffic Applications above, or the top backfill layer (12" minimum) may consist of AASHTO #57 stone blended with 30-40% (by volume) topsoil to aid in establishing vegetation.
C. Additional Cover Materials: Structural fill shall consist of granular materials meeting the gradational requirements of SM, SP, SW, GM, GP or GW as classified by the Unified Soil Classification System. Structural fill shall have a maximum of 25 percent passing the No. 200 sieve, shall have a maximum clay content of 10 percent and a maximum Plasticity Index of 4. Material shall be within 3 percent of the optimum moisture content as determined by ASTM D698 at the time of installation.

3.06 MAINTENANCE REQUIREMENTS
A. A routine maintenance effort is required to ensure proper performance of the R-Tank system. The Maintenance program should be focused on pretreatment systems. Ensuring these structures are clean and functioning properly will reduce the risk of contamination of the R-Tank system and stormwater released from the site. Pre-treatment systems shall be inspected yearly, or as directed by the regulatory agency and by the manufacturer (for proprietary systems). Maintain as needed using acceptable practices or following manufacturer's guidelines (for proprietary systems).
B. All inlet pipes and inspection and/or Maintenance Ports in the R-Tank system will need to be inspected for accumulation of sediments at least quarterly through the first year of operation and at least yearly thereafter.
C. If sediment has accumulated to the level noted in the R-Tank Maintenance Guide or beyond a level acceptable to the Owner's engineer, the R-Tank system should be flushed.
D. All inspection and maintenance activities should be performed in accordance with the R-Tank Operation, Inspection & Maintenance Manual.

Project Title:
EAST TOWN CROSSING PHASE 1

Client:
ASH DEVELOPMENT


GREG HELLE
GREG.HELLE@ASHNW.COM

Project No.
2230752

Issue Set & Date:
11/20/2023

PERMIT SUBMITTAL

11/20/2023

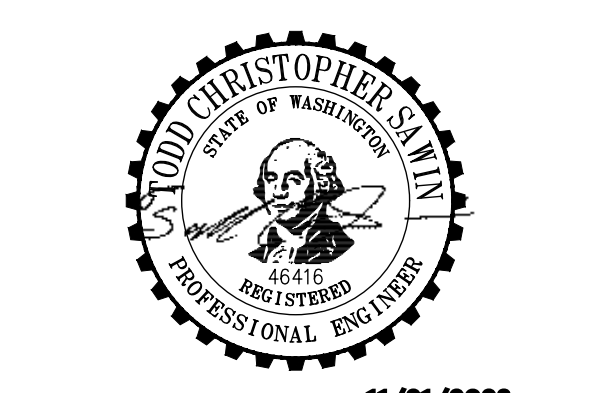

11/21/2023
NOTICE: A SIGNATURE OF THIS DOCUMENT SHALL INDICATE THE PROFESSIONAL SEAL AND SIGNATURE OF THE REGISTERED PROFESSIONAL ENGINEER OR ARCHITECT HAS BEEN REVIEWED AND APPROVED FOR THE PROJECT. THIS DOCUMENT IS NOT VALID FOR ANY OTHER PROJECT.

Revisions:
Sheet Title:
8 of 8

R-TANK 2 NOTES AND DETAILS

Designed by: CW Drawn by: SK Checked by: JI

Sheet No.
C4.27
38 of 63 Sheets



EAST TOWN CROSSING PHASE 1

SEC. 26,35/ TWP. 20 N./ RGE. 4 E., W.M.

APPROVED

BY: CITY OF PUYALLUP
DEVELOPMENT ENGINEERING

DATE: _____
 THIS APPROVAL IS VOID
 AFTER 180 DAYS FROM APPROVAL
 THE CITY WILL NOT BE
 RESPONSIBLE FOR ERRORS
 OR OMISSIONS ON THESE
 PLANS.
 UNLESS AND UNLESS
 AND CONDITIONS MAY DICTATE
 ANGLE TO THESE PLANS AS
 DETERMINED BY THE
 DEVELOPMENT ENGINEERING
 MANAGER.



TACOMA · SEATTLE · SPOKANE · TRI-CITIES

2215 North 30th Street, Suite 300, Tacoma, WA 98403
 253.383.2422 TEL 253.383.2572 FAX www.ahbl.com WEB

Project Title:

**EAST TOWN
CROSSING PHASE 1**

Client:

ASH DEVELOPMENT

GREG HELLE

GREG.HELLE@ASHNW.COM


Project No.

2230752

Issue Set & Date:

PERMIT SUBMITTAL

11/20/2023

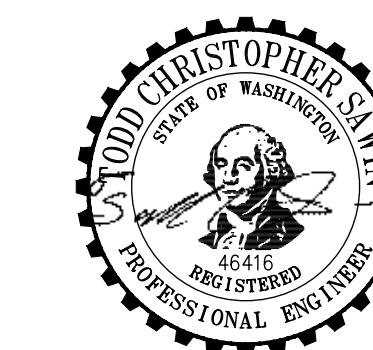


11/21/2023

NOTICE
 A SIGNATURE OF THIS DOCUMENT SHALL INDICATE THE
 PROFESSIONAL SEAL AND SIGNATURE PUBLICATION OF
 THE DOCUMENT DOES NOT CONSTITUTE FROM RESERVING
 OR OTHER RIGHTS IN THE DOCUMENT OR FOR USE
 ONLY FOR THE PROJECT ENTITLED IN THE TITLE BLOCK
 AND IS NOT TO BE USED FOR OTHER PROJECTS OR
 ACTION TO THAT PROJECT OR FOR ANY OTHER PROJECT.

ACKNOWLEDGEMENT:
 AN APPROVAL OF THE SUBMITTAL PLANS IS REQUIRED PRIOR TO MATERIAL ORDER. AS PART OF THE SUBMITTAL
 APPROVAL, THE ENGINEER OF RECORD HEREBY ACKNOWLEDGES THAT THE R-TANK SYSTEM IS NOT DESIGNED TO
 SUPPORT LOADS FROM BUILDINGS OR STRUCTURES. THEREFORE, THE ENGINEER OF RECORD HAS COORDINATED
 WITH THE PROPER DISCIPLINES TO ENSURE NO STRUCTURAL LOADS ARE IMPARTED UPON THE SYSTEM AND ANY
 INFILTRATION FROM THE SYSTEM HAS BEEN ACCOUNTED FOR IN THE FOUNDATION DESIGN.

NOTES:

- THE CONTRACTOR SHALL PARTICIPATE IN A PRECONSTRUCTION MEETING AND SIGN THE PRECONSTRUCTION CHECKLIST PRIOR TO MATERIAL INSTALLATION.
- DOCUMENTATION SHALL BE RECORDED BY THE CONTRACTOR OR ENGINEER OF RECORD SHOWING PROPER INSTALLATION OF THE SYSTEM AND ALL CONNECTIONS, IN ACCORDANCE WITH MANUFACTURER SPECIFICATIONS.
- IT IS HEREBY RECOMMENDED THAT THE R-TANK SYSTEM BE INSTALLED AFTER THE FOUNDATIONS HAVE BEEN INSTALLED TO ENSURE PROPER SEPARATION DISTANCES ARE MAINTAINED.

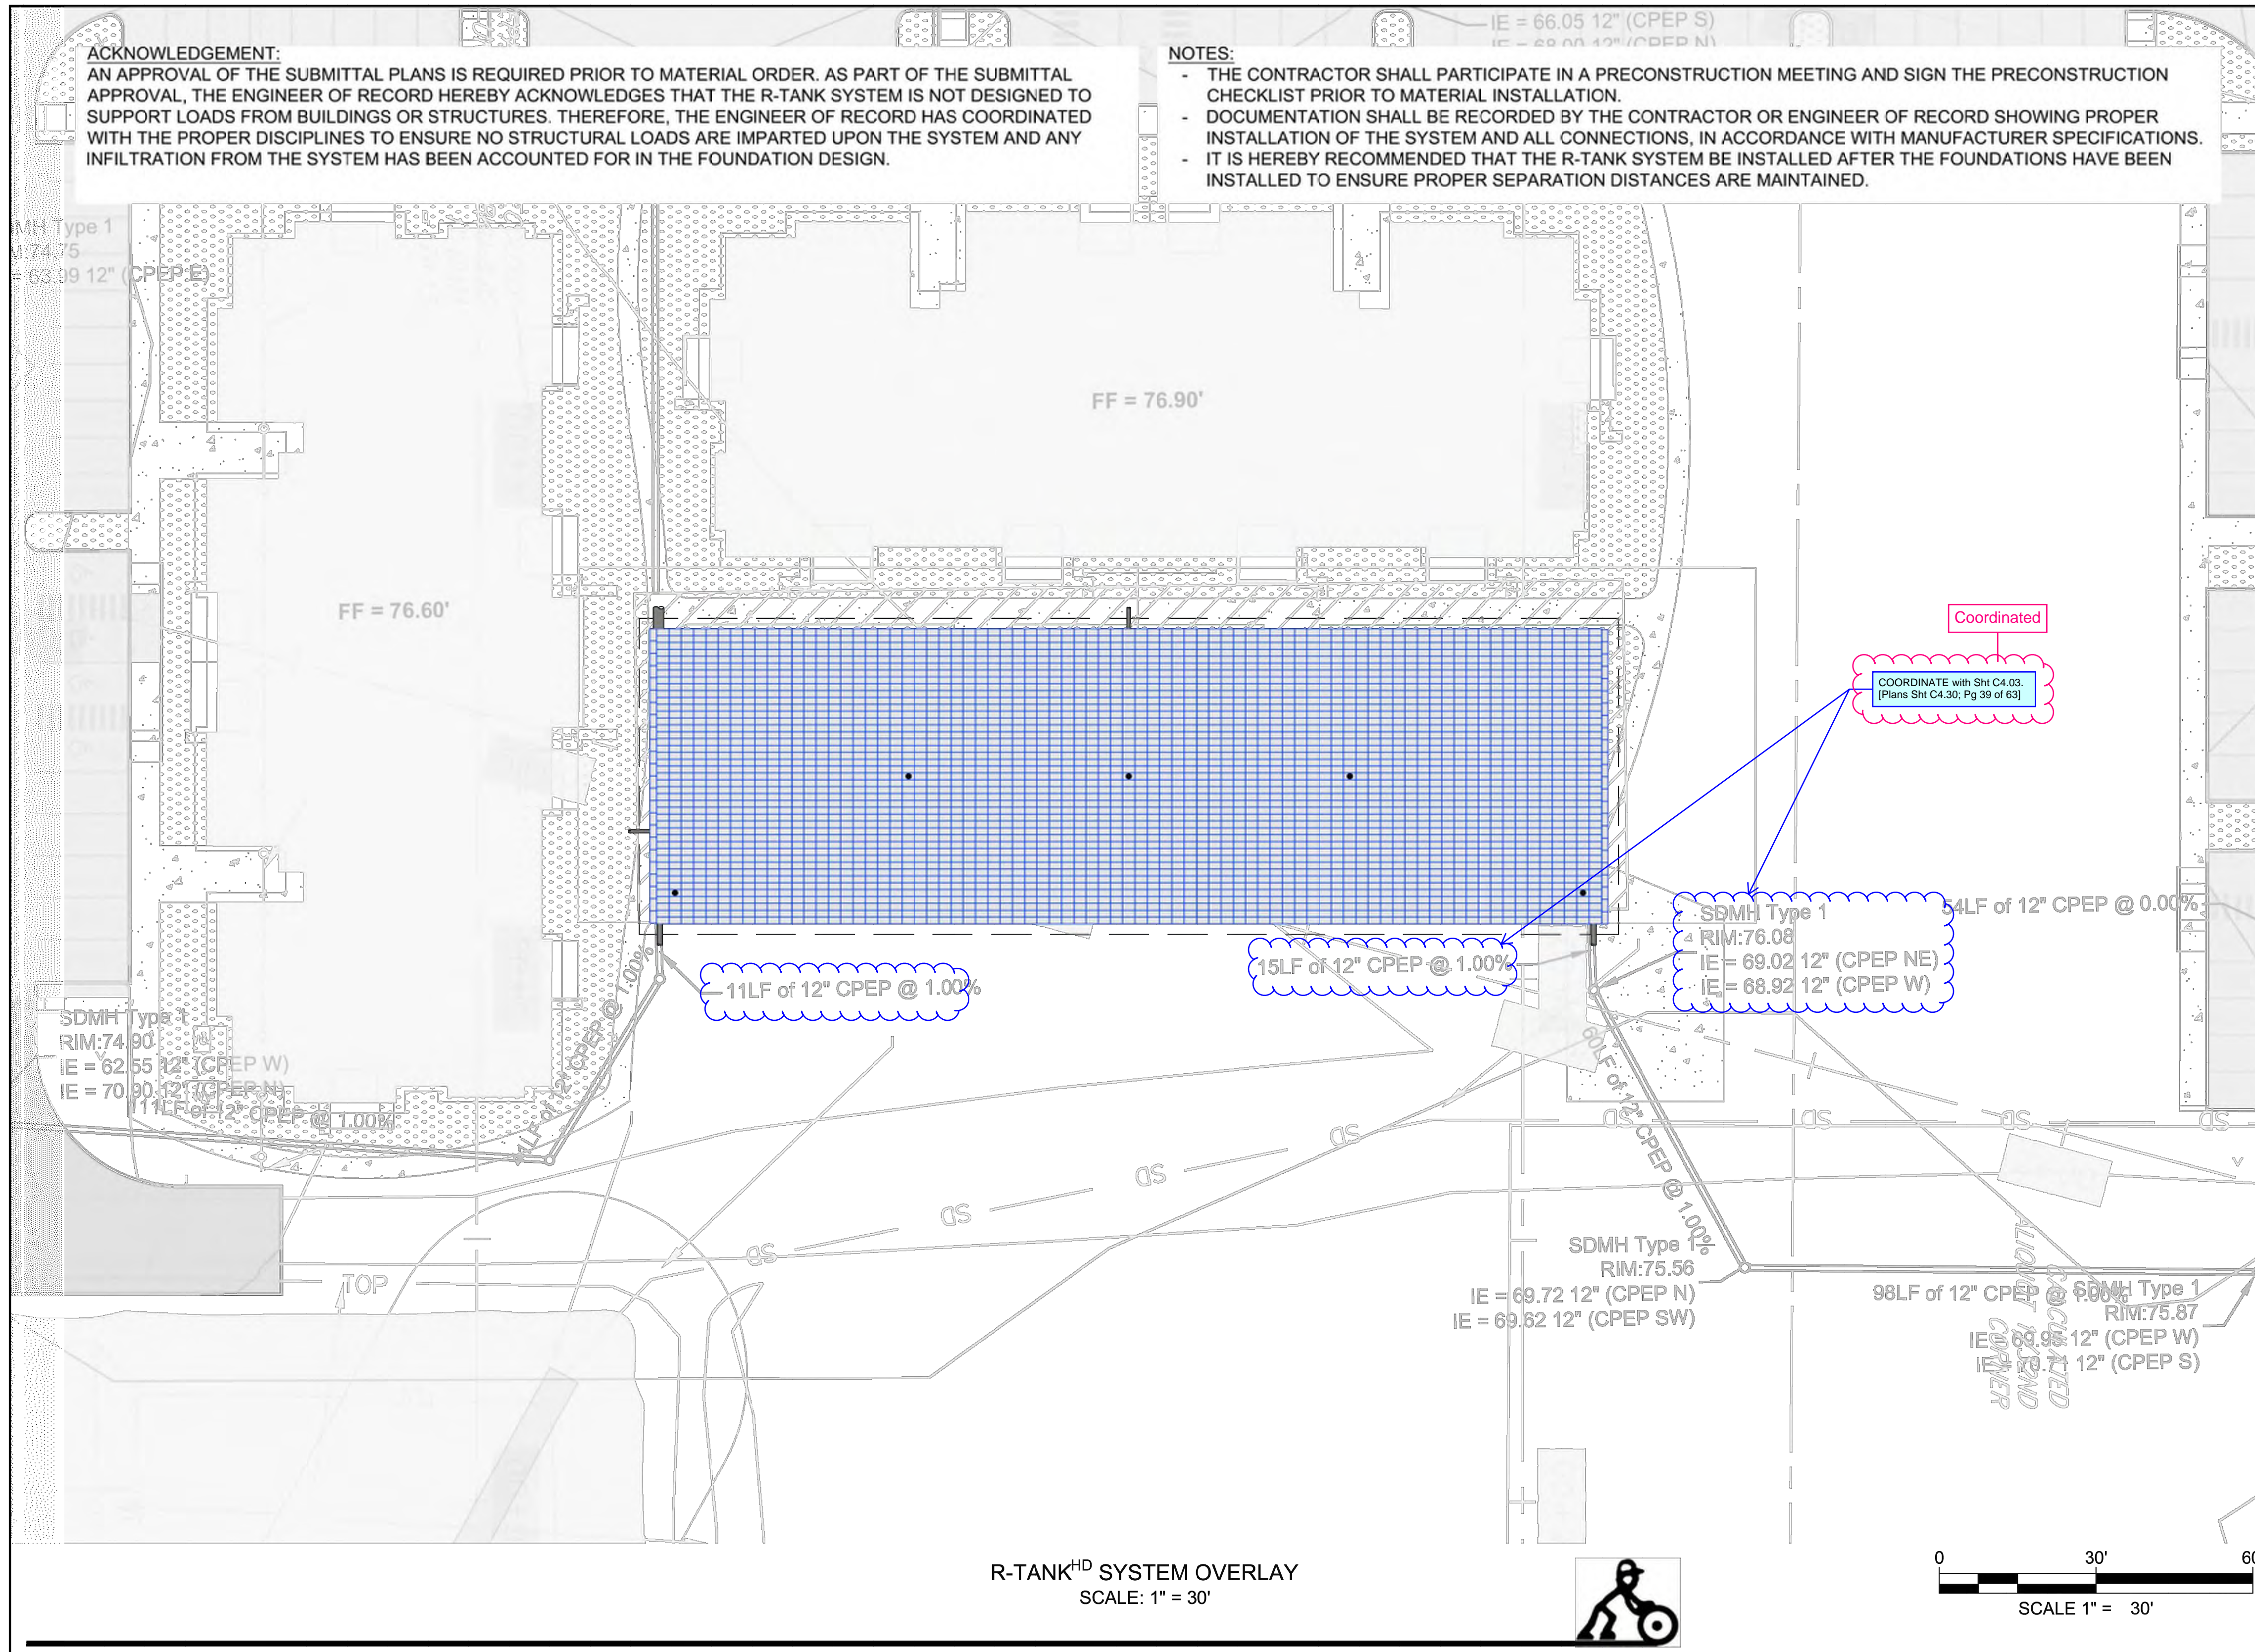

R-TANK^{HD} SYSTEM OVERLAY
 EAST TOWN CROSSING
 PUYALLUP, WA
 SITE DESIGNATION: R-TANK 3

DRAWN BY: EDQ
 DATE: 11/09/2023
 ACF WEST PROJECT NUMBER: 23-004WA
 SHEET NO.: 1 of 6

Revisions:

△	
△	
△	
△	

Sheet Title:
**R-TANK 3 NOTES
AND DETAILS**

Designed by: CW
 Drawn by: SK
 Checked by: JI

Sheet No.
C4.30
 39 of 63 Sheets



EAST TOWN CROSSING PHASE 1

SEC. 26,35/ TWP. 20 N./ RGE. 4 E., W.M.

APPROVED

BY: CITY OF PUYALLUP
DEVELOPMENT ENGINEERING

DATE:

THIS APPROVAL IS VOID
IF NOT USED WITHIN 180 DAYS FROM APPROVAL.
THE CITY WILL NOT BE
RESPONSIBLE FOR ERRORS
OR OMISSIONS ON THESE
PLANS. UNLESS STATED
OTHERWISE, ALL CONDITIONS MAY DICTATE
CHANGES TO THESE PLANS AS
DETERMINED BY THE
DEVELOPMENT ENGINEERING
DEPARTMENT.

Legibility
[Plans Sht C4.31; Pg 40 of 63]
Fixed



Project Title:
EAST TOWN CROSSING PHASE 1

Client:
ASH DEVELOPMENT

GREG HELLE
GREG.HELLE@ASHNW.COM

Project No.
2230752


Issue Set & Date:
PERMIT SUBMITTAL

11/20/2023



11/21/2023

NOTICE
ALTERATION OF THIS DOCUMENT SHALL INVALIDATE THE
PROFESSIONAL SEAL AND SIGNATURE. PUBLICATION OF
THIS DOCUMENT DOES NOT CONSTITUTE A GUARANTEE.
CHECKING ENGINEER: THIS IS THE DRAWING OF THE
ONLY FOR THE PROJECT DESCRIBED IN THE TITLE BLOCK
AND IS NOT TO BE USED FOR OTHER PROJECTS, OR
ACTION TO THAT PROJECT OR FOR ANY OTHER PROJECT.

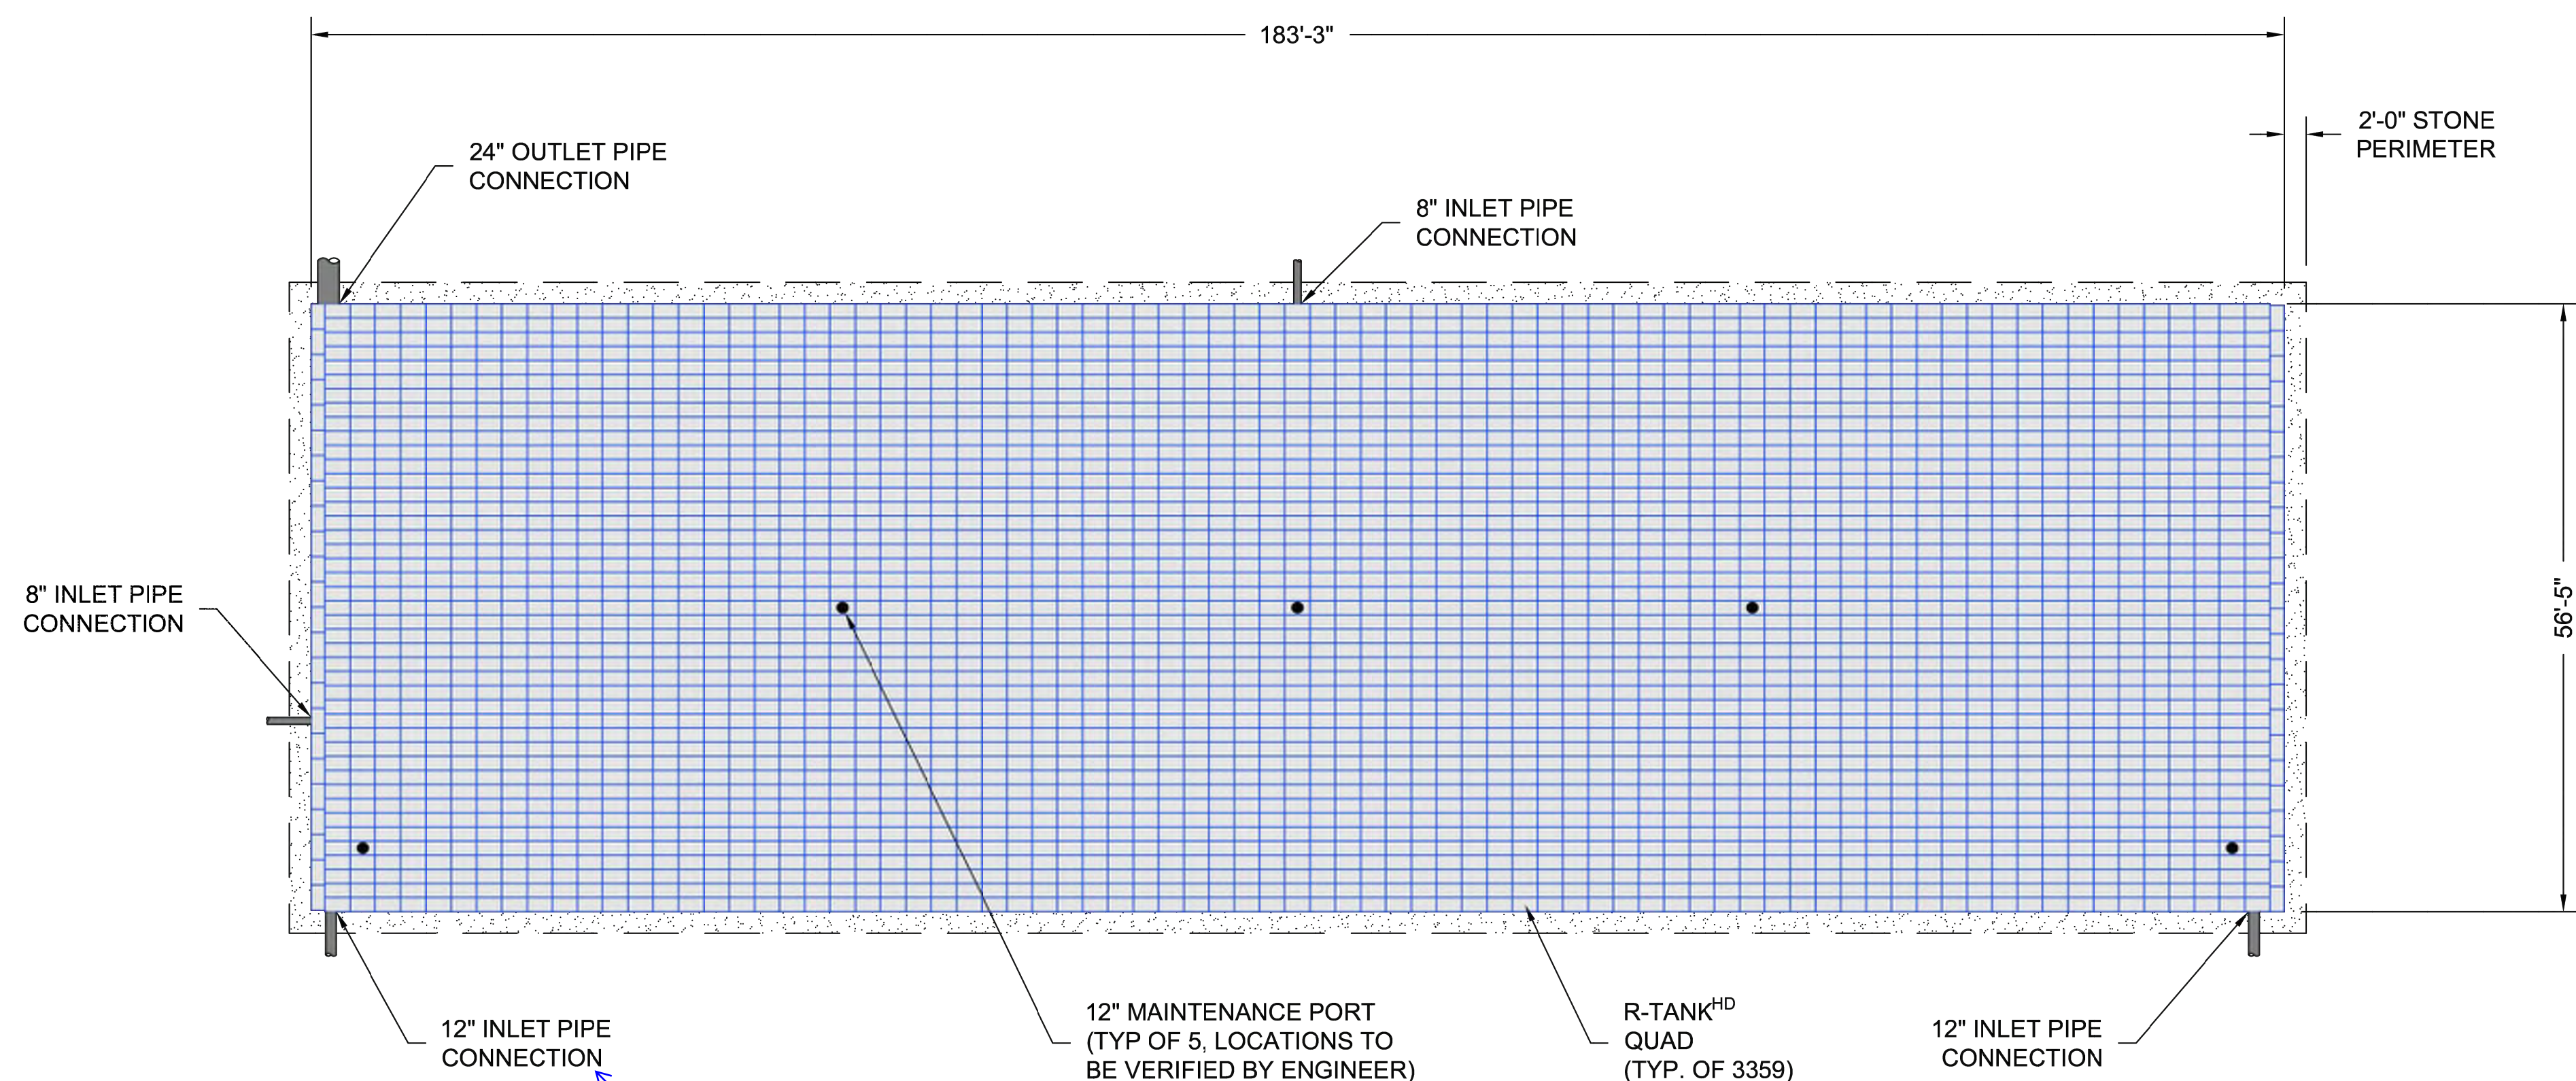

R-TANK
ENGINEER OF RECORD TO REVIEW, APPROVE
AND ENDORSE FINAL SITE SPECIFIC DESIGN.

ACF WEST INC.
GEOSYNTHETICS
Products | Service | Solutions
FOR ADDITIONAL INFORMATION PLEASE CONTACT:
ACF WEST, 1-800-423-4567, www.acfwest.com

R-TANK^{HD} SYSTEM LAYOUT
EAST TOWN CROSSING
PUYALLUP, WA
SITE DESIGNATION: R-TANK 3


DRAWN BY:
EDQ
DATE:
11/09/2023
ACF WEST PROJECT NUMBER:
23-004WA
SHEET NO.
2 of 6

Clarified in report
CLARIFY: See storage volume required
comments in Storm Report, Pg 372 of 448.
[Plans Sht C4.31; Pg 40 of 63]


COORDINATE with Sht C4.04
[Plans Sht C4.31; Pg 40 of 63]
Revised to 24"

Clarified in report
CLARIFY: See Control Structure comments on Sht C4.07,
and riser comments in Storm Report, Pg 372 of 448.
[Plans Sht C4.31; Pg 40 of 63]

- NOTES:
- DEAD STORAGE VOLUME FROM ELEVATION 67.90 TO 68.40 = 2,263 CF
 - LIVE STORAGE VOLUME FROM ELEVATION 68.40 TO 75.23 = 62,623 CF
 - ONLY 3" OF BASE STONE INCLUDED IN LIVE STORAGE VOLUME.

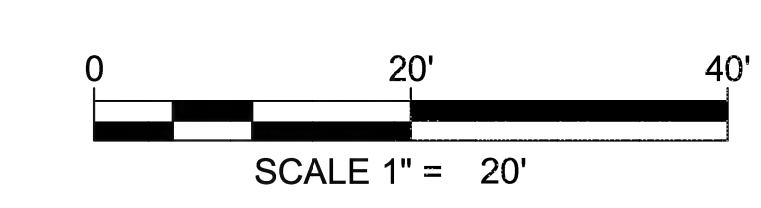

LAYOUT SCALE	1" = 20'
R-TANK ^{HD} MODULE TYPE	QUAD
TRAFFIC LOAD	HS-20
# OF QUAD R-TANKS	3,359
TOTAL SYSTEM STORAGE	62,623 CF
R-TANK STORAGE VOLUME	54,785 CF
STONE STORAGE VOLUME (40% VOID RATIO)	7,838 CF
NAUE SECUGRID 30/30 GEOGRID ELEV.	75.23
TOP OF COVER STONE ELEV. (12")	75.23
TOP OF R-TANK ELEV.	74.23
TANK INVERT	68.65
INVERT OF STONE BASE (9")	67.90
MIN. STONE PERIMETER WIDTH	2.0 FT
SEE SHEETS 3 - 6 FOR DETAILS AND ADDITIONAL INFORMATION	

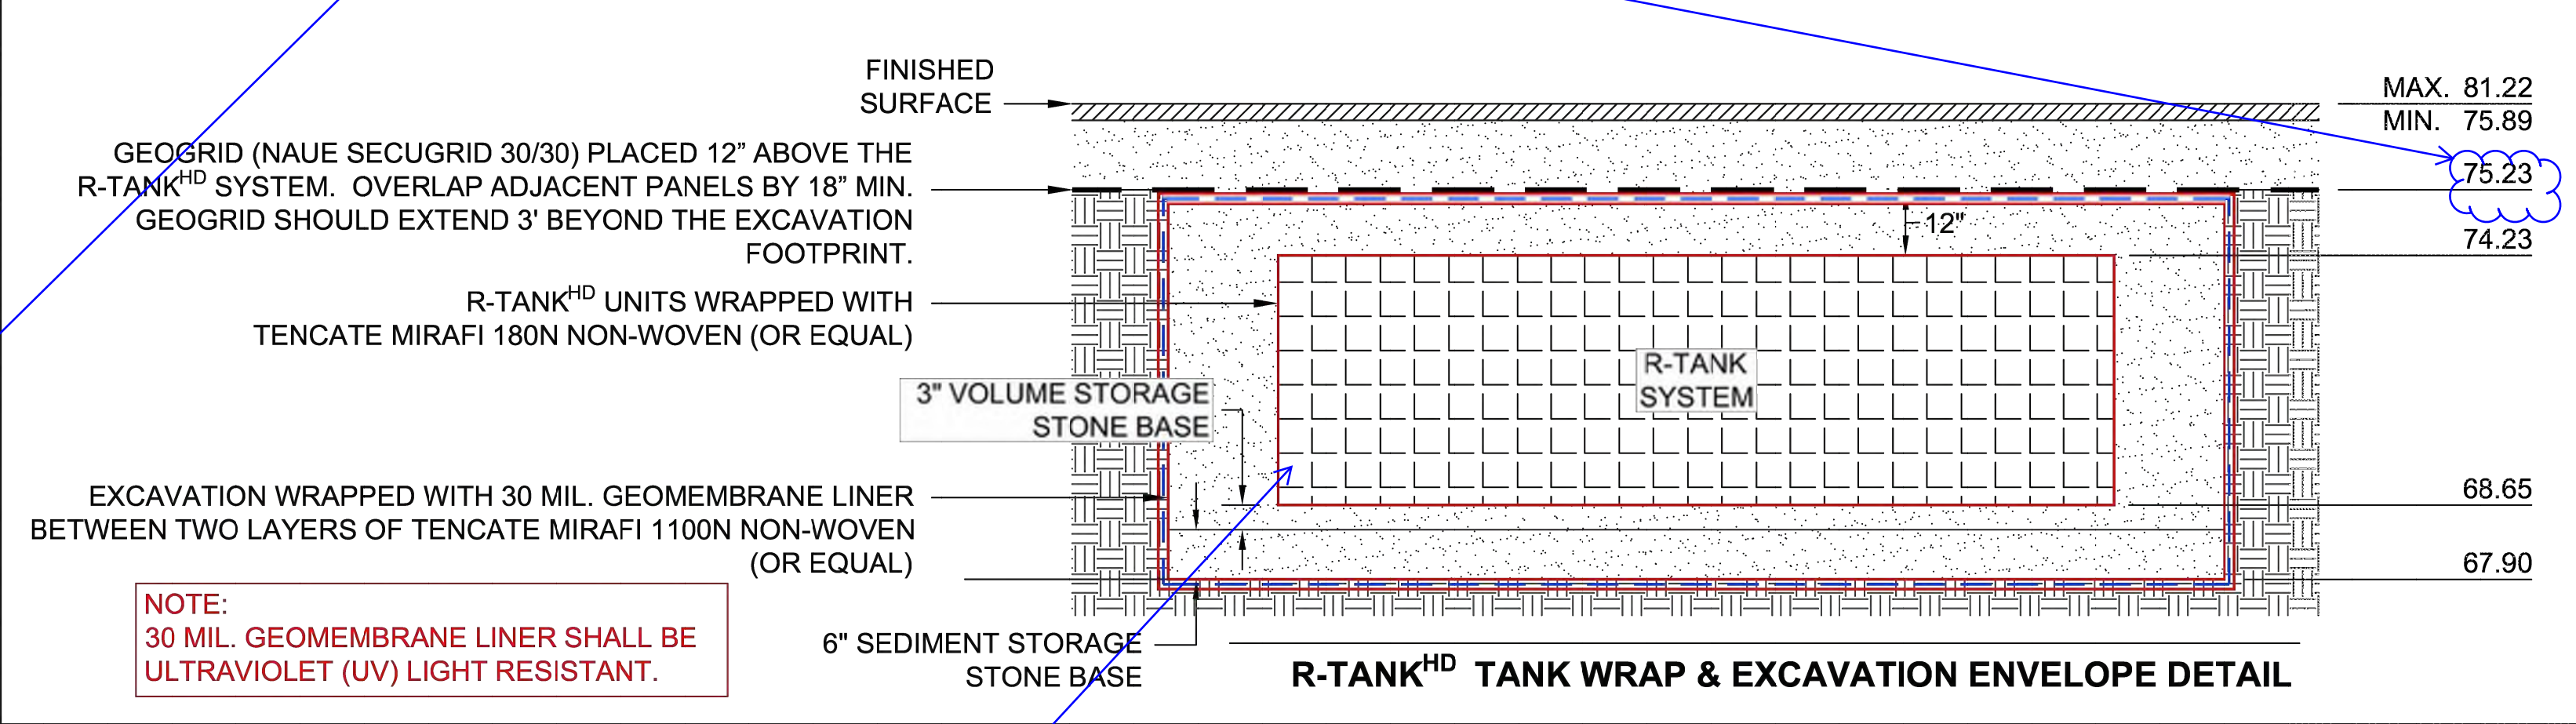

NOTE:
30 MIL. GEOMEMBRANE LINER SHALL BE
ULTRAVIOLET (UV) LIGHT RESISTANT.

Provided
PROVIDE 2-yr and 10-yr water surface
elevations on the cross section.
[Plans Sht C4.31; Pg 40 of 63]



Revisions:

Sheet Title:
R-TANK 3 NOTES AND DETAILS

Designed by: CW
Drawn by: SK
Checked by: JI

Sheet No.
C4.31
40 of 63 Sheets

EAST TOWN CROSSING PHASE 1

SEC. 26,35/ TWP. 20 N./ RGE. 4 E., W.M.

Fixed
 Legibility:
 (Plans Sht C4.32, Pg 41 of 63)

APPROVED

BY: CITY OF PUYALLUP
 DEVELOPMENT ENGINEERING
 DATE:

NOTE: THIS APPROVAL IS VOID
 AFTER 180 DAYS FROM APPROVAL
 IF THE CITY WILL NOT BE
 RESPONSIBLE FOR ERRORS
 OR OMISSIONS ON THESE
 PLANS. UNLESS OTHERWISE
 STATED, CONDITIONS MAY DICTATE
 CHANGES TO THESE PLANS AS
 DETERMINED BY THE
 DEVELOPMENT ENGINEERING
 MANAGER




AHBL
 TACOMA • SEATTLE • SPOKANE • TRI-CITIES
 2215 North 30th Street, Suite 300, Tacoma, WA 98403
 253.383.2422 TEL 253.383.2572 FAX www.ahbl.com WEB

Project Title:
EAST TOWN CROSSING PHASE 1

Client:
 ASH DEVELOPMENT
 GREG HELLE
 GREG.HELLE@ASHNW.COM

Project No.
 2230752

Issue Set & Date:
PERMIT SUBMITTAL
 11/20/2023

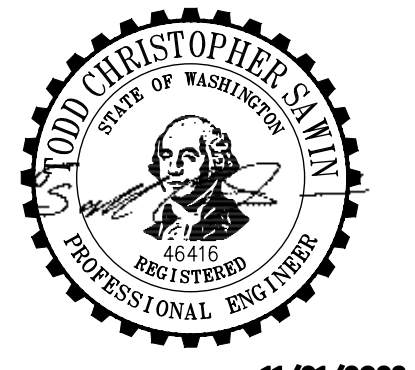

11/21/2023

NOTICE
 ALTERATION OF THIS DOCUMENT SHALL INVALIDATE THE
 PROFESSIONAL SEAL AND SIGNATURE. PUBLICATION OF
 THIS DOCUMENT DOES NOT CONSTITUTE A WARRANTY.
 THE DESIGNER MAKES NO REPRESENTATION OR
 WARRANTY AS TO THE ACCURACY OF THE INFORMATION
 PROVIDED HEREIN. THIS DOCUMENT IS FOR USE
 ONLY FOR THE PROJECT DESCRIBED IN THE TITLE BLOCK
 AND IS NOT TO BE USED FOR OTHER PROJECTS OR
 ACTION TO THAT PROJECT OR FOR ANY OTHER PROJECT.

Revisions:

Sheet Title:


R-TANK 3 NOTES AND DETAILS

Designed by: CW Drawn by: SK Checked by: JI

Sheet No.

C4.32

41 of 63 Sheets

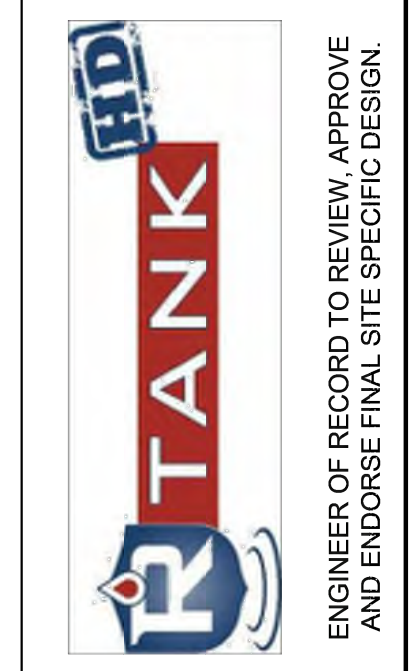

R-TANK^{HD} SYSTEM DETAILS
 EAST TOWN CROSSING
 PUYALLUP, WA
 SITE DESIGNATION: R-TANK 3


DRAWN BY: EDQ
 DATE: 11/09/2023
 ACF WEST PROJECT NUMBER: 23-004WA
 SHEET NO.: **3 of 6**

R-TANK ^{HD} QUANTITIES	
R-TANK ^{HD} MODULE TYPE	QUAD
# OF QUAD R-TANKS	3,359
TOTAL SYSTEM STORAGE	62,623 CF
R-TANK STORAGE VOLUME	54,785 CF
STONE STORAGE VOLUME (40% VOID RATIO)	7,838 CF
STONE BED FOOTPRINT	11,317 SF
STONE QUANTITY	935 CY
TENCATE MIRAFI 180N NON-WOVEN TANK WRAP	26,865 SF (2,985 SY)
30 MIL. GEOMEMBRANE LINER EXCAVATION WRAP	30,209 SF (3,357 SY)
TENCATE MIRAFI 1100N NON-WOVEN LINER PROTECTION	60,418 SF (6,713 SY)
NAUE SECUGRID 30/30 GEOGRID	14,765 SF (1,641 SY)
12" MAINTENANCE PORTS	5
8" PIPE BOOTS	2
12" PIPE BOOTS	2
24" PIPE BOOTS	1
TRASHGUARD PLUS UNITS (RECOMMENDED)	2


NOTE: STONE QUANTITY INCLUDES 12" OF COVER AND 9" OF BASE.
 NOTE: GEOTEXTILE / LINER QUANTITIES INCLUDE A 15% WASTE FACTOR.

NOTE:
 30 MIL. GEOMEMBRANE LINER SHALL BE
 ULTRAVIOLET (UV) LIGHT RESISTANT.

- NOTES:
- DEAD STORAGE VOLUME FROM ELEVATION 67.90 TO 68.40 = 2,263 CF
 - LIVE STORAGE VOLUME FROM ELEVATION 68.40 TO 75.23 = 62,623 CF
 - ONLY 3" OF BASE STONE INCLUDED IN LIVE STORAGE VOLUME.

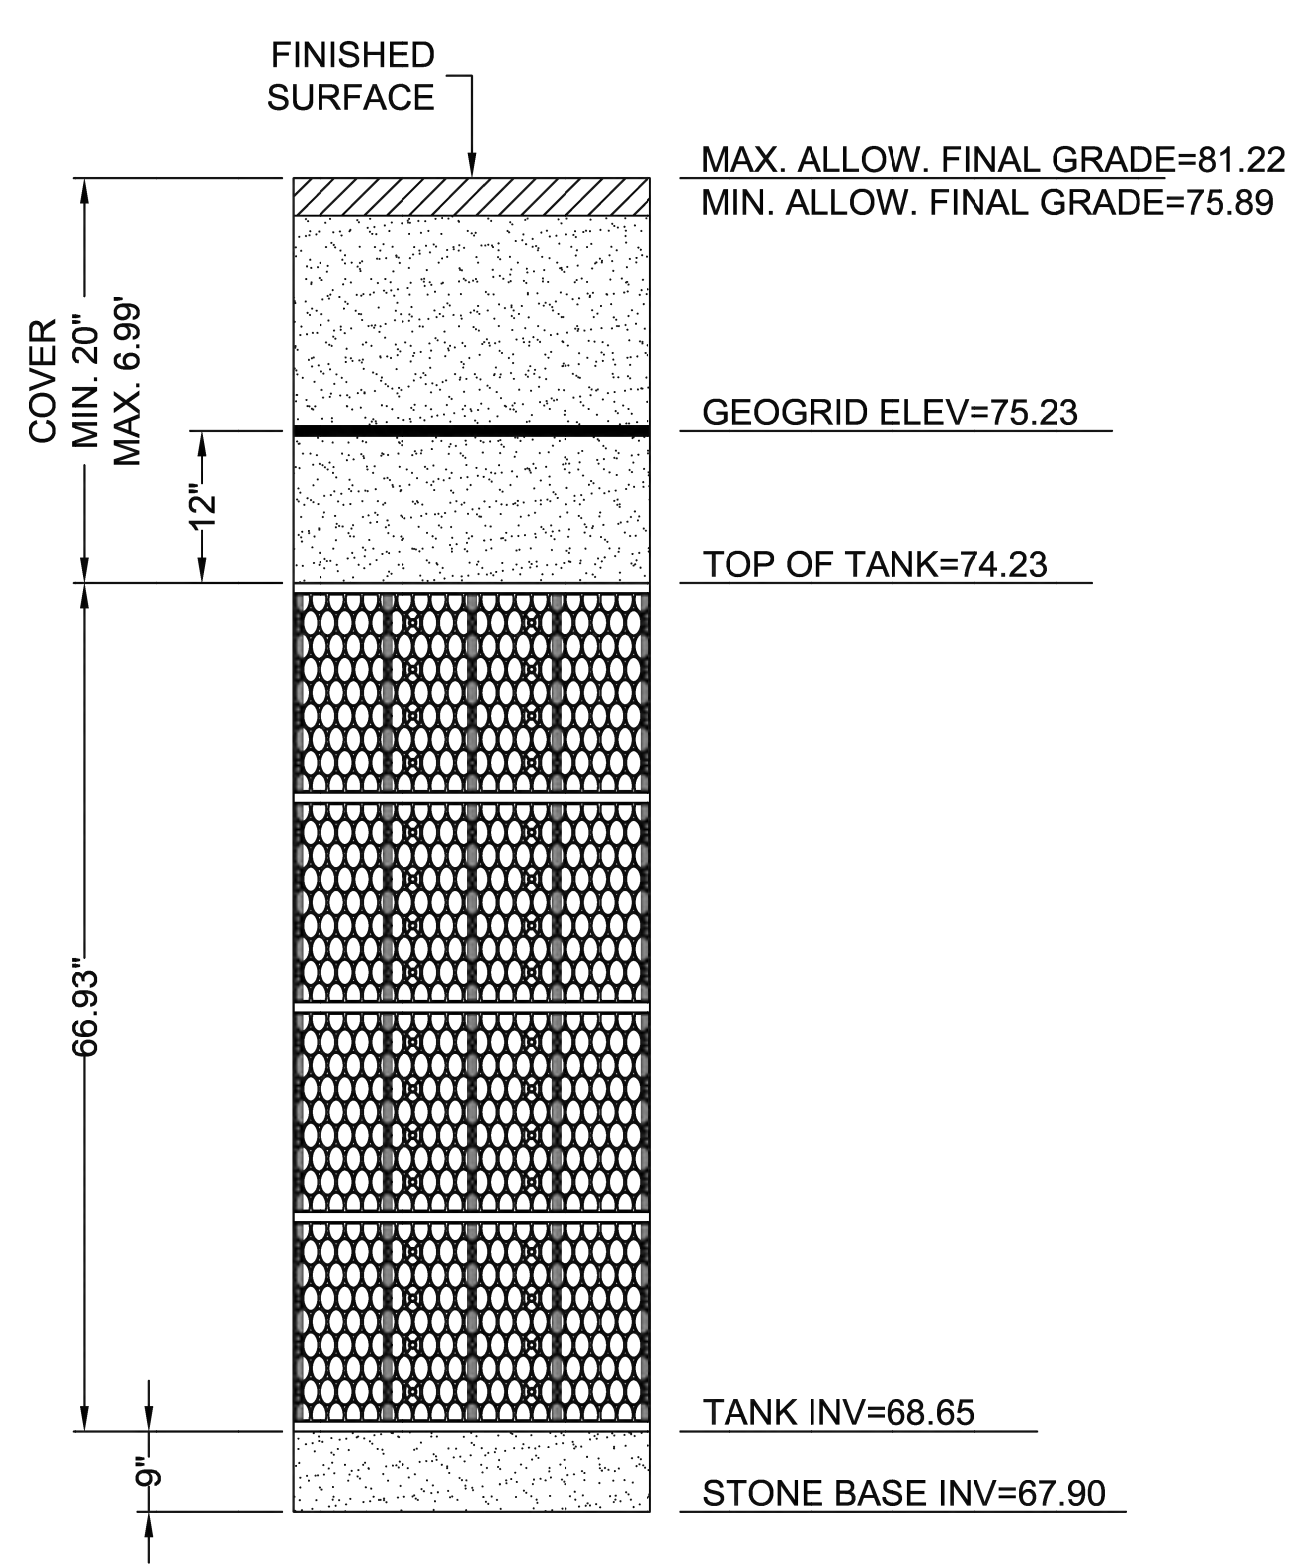


QUAD R-TANK^{HD} - ELEVATION

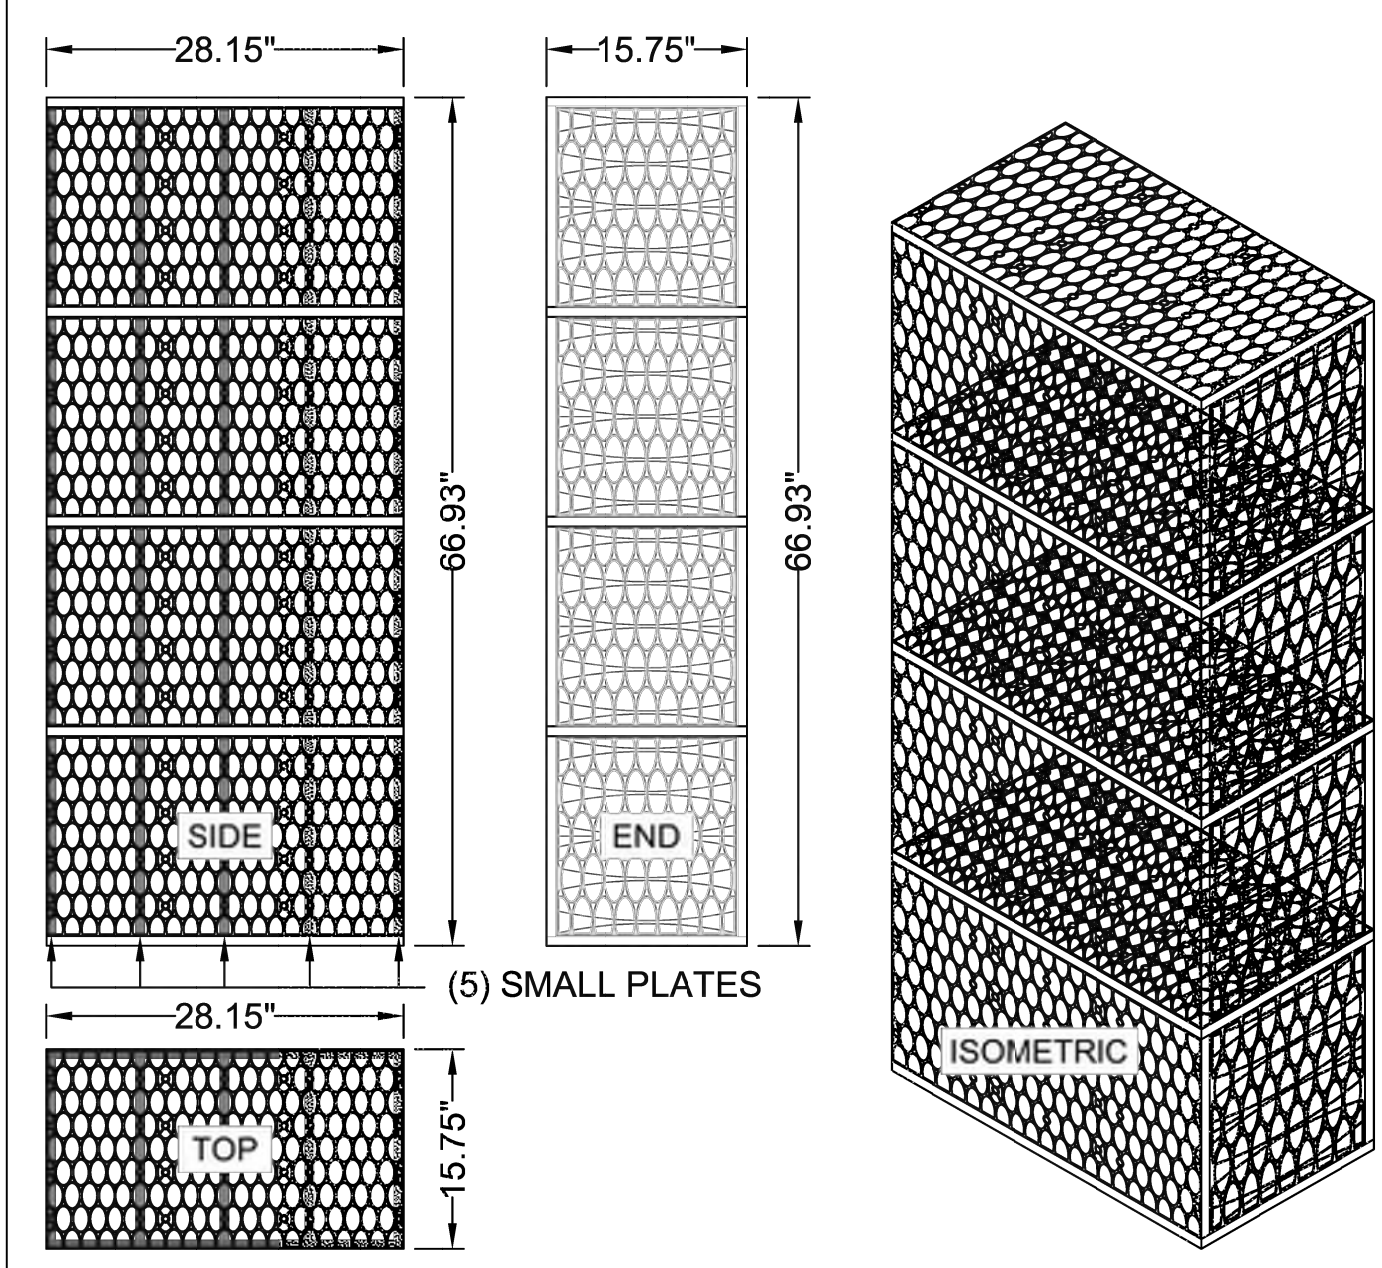

MODULE DATA

GEOMETRY: LENGTH = 28.15 IN. (715 MM) WIDTH = 15.75 IN. (400 MM) HEIGHT = 66.93 IN. (1700 MM) TANK VOLUME = 17.17 CF STORAGE VOLUME = 16.31 CF VOID INTERNAL VOLUME: 95% VOID SURFACE AREA: 90%	LOAD RATING: 33.4 PSI, (MODULE ONLY) HS20/HS25 - SEE SPEC FOR COVER REQUIREMENTS MATERIAL: 100% RECYCLED POLYPROPYLENE SMALL PLATES REQUIRED: 5/SEGMENT, 20/MODULE
---	--

QUAD R-TANK^{HD} - MODULE DETAIL

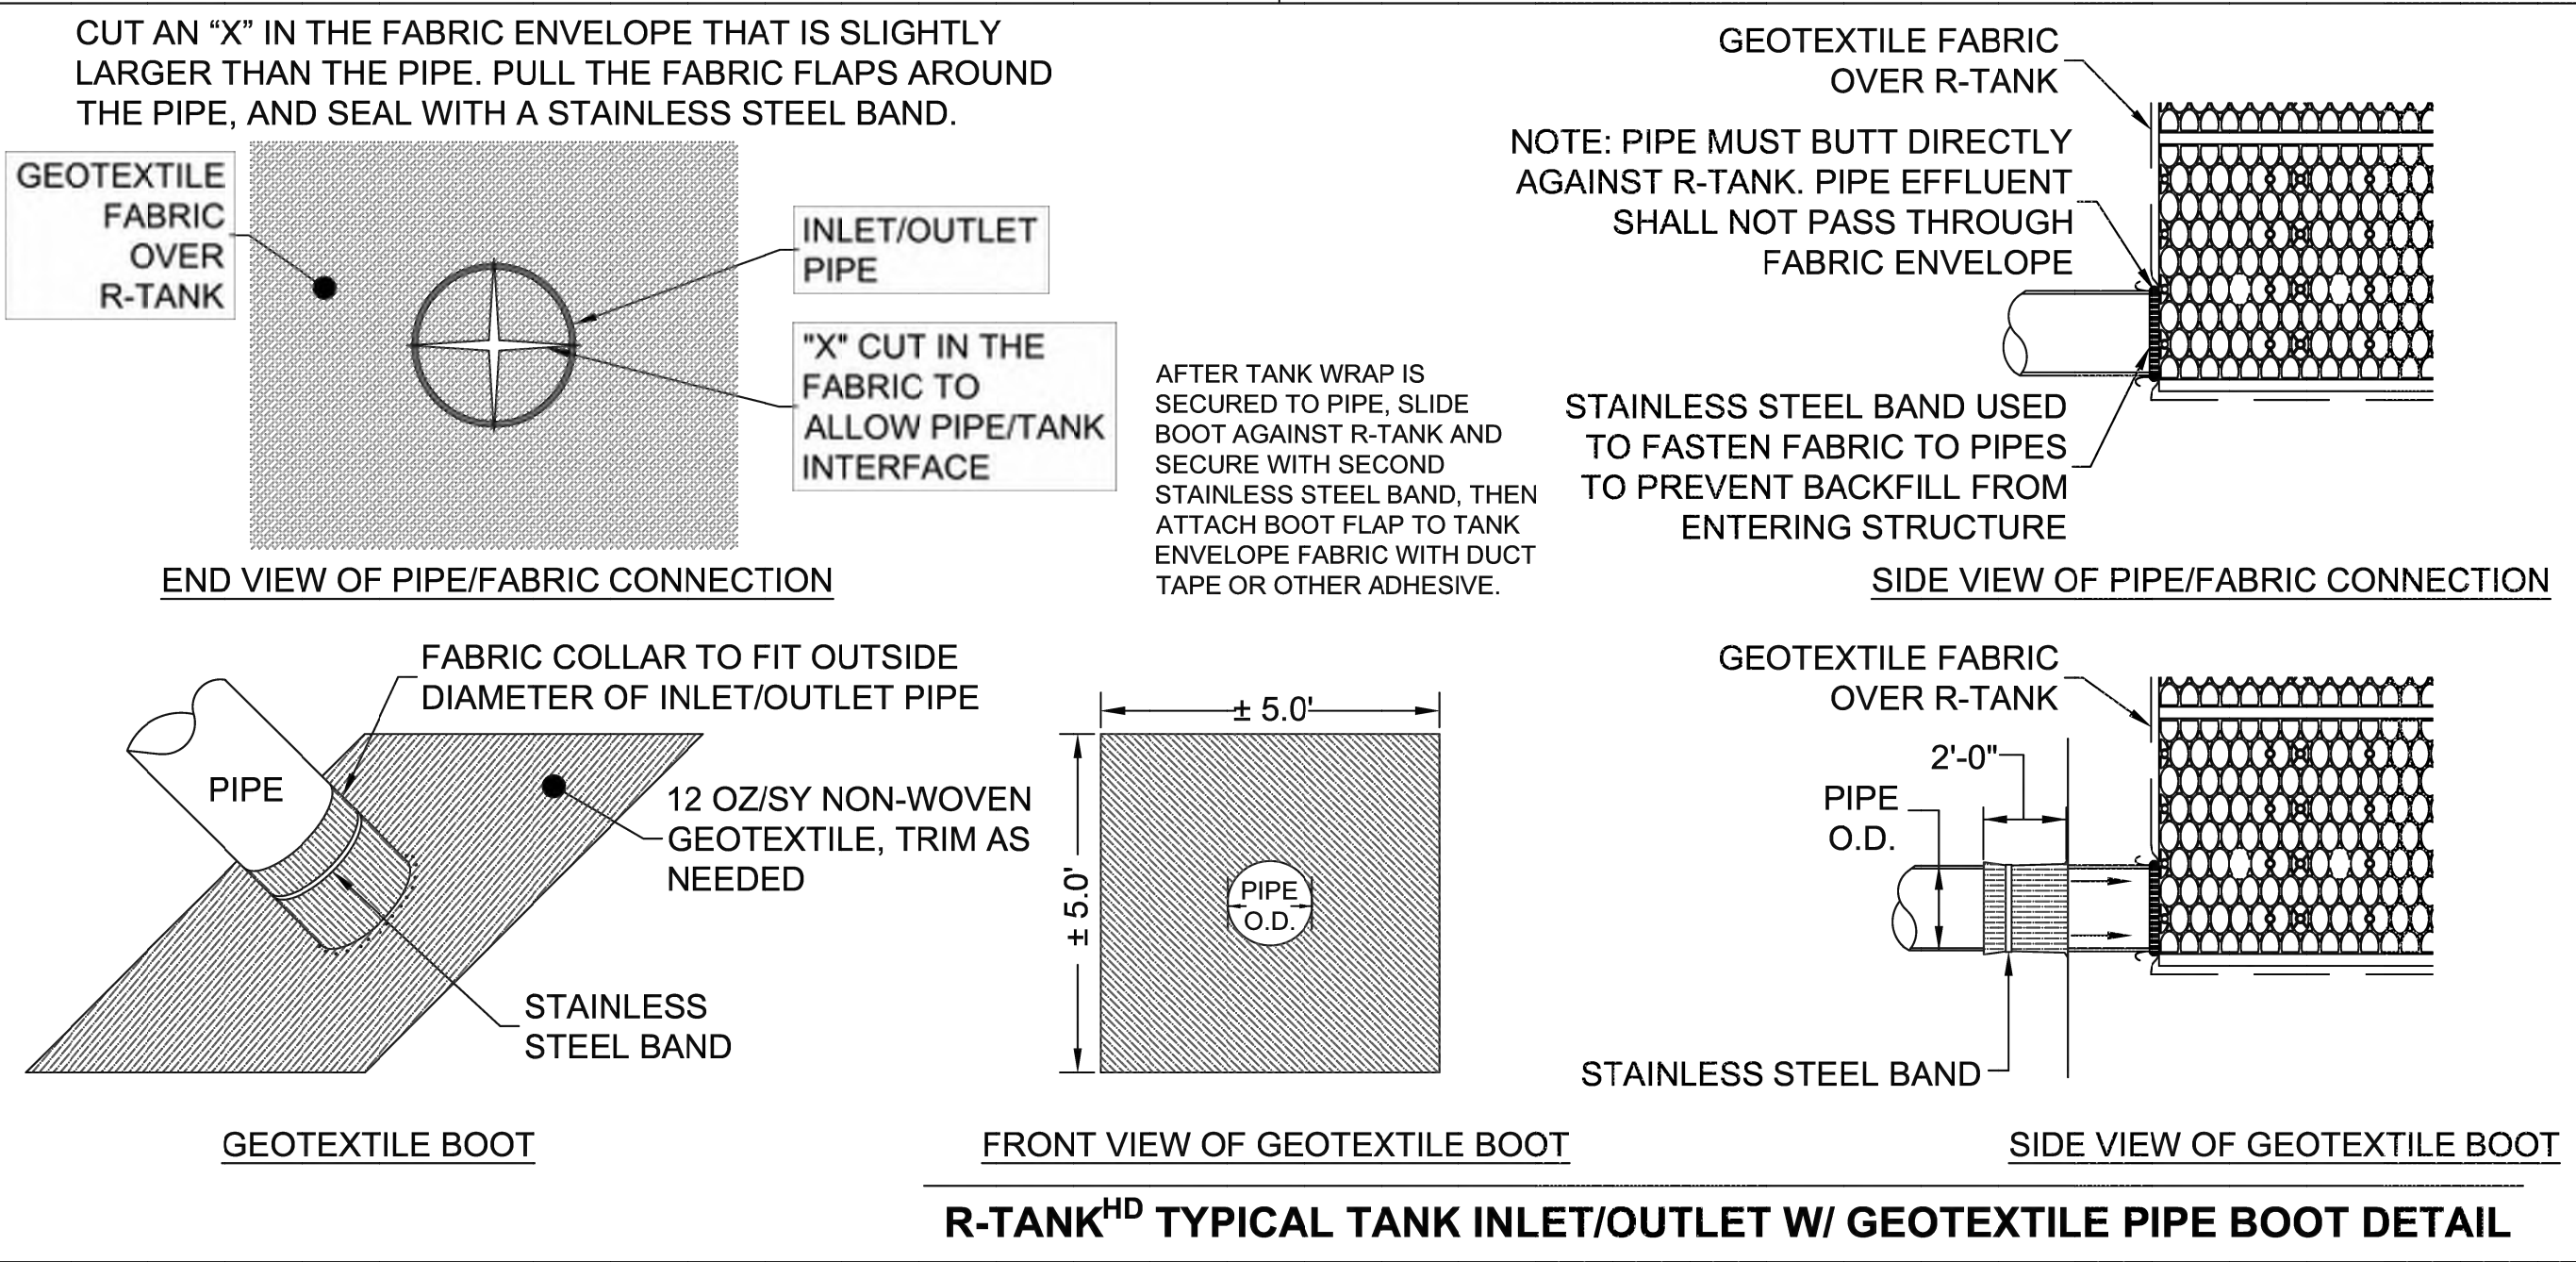

EAST TOWN CROSSING PHASE 1

SEC. 26,35/ TWP. 20 N./ RGE. 4 E., W.M.

APPROVED

BY: CITY OF PUYALLUP
DEVELOPMENT ENGINEERING


DATE: _____

NOTE: THIS APPROVAL IS VOID AFTER 180 DAYS FROM APPROVAL. THE CITY WILL NOT BE RESPONSIBLE FOR ERRORS OR OMISSIONS ON THESE PLANS. FIELD CONDITIONS MAY DICTATE CHANGES TO THESE PLANS AS DETERMINED BY THE DEVELOPMENT ENGINEERING MANAGER.




TOTAL COVER: 20" MINIMUM AND 84" MAXIMUM. FIRST 12" MUST BE FREE DRAINING BACKFILL (SPEC SECTION 2.03B): STONE <1.5" OR SOIL (USCS CLASS GW, GP, SW OR SP). ADDITIONAL FILL MAY BE STRUCTURAL FILL (SPEC SECTION 2.03C): STONE OR SOIL (USCS CLASS SM, SP, SW, GM, GP OR GW) WITH MAX CLAY CONTENT <10%, MAX 25% PASSING NO. 200 SIEVE, AND MAX PLASTICITY INDEX OF 4. A MIN. 12" COVER MUST BE MAINTAINED BETWEEN BACKFILL EQUIPMENT AND THE TOP OF THE R-TANK™ SYSTEM AT ALL TIMES. TOTAL HEIGHT OF TOP BACKFILL SHOULD NOT EXCEED 7'. CONTACT ACF WEST IF MORE THAN 7' OR LESS THAN 20" OF TOP BACKFILL IS REQUIRED (FROM TOP OF TANK TO TOP OF PAVEMENT).

- NOTES:
- FOR COMPLETE MODULE DATA, SEE APPROPRIATE R-TANK^{HD} MODULE SHEET.
 - INSTALLATIONS PER THIS DETAIL MEET GUIDELINES OF HL-93 LOADING PER THE AASHTO LRFD BRIDGE DESIGN SPECIFICATIONS, CUSTOMARY U.S. UNITS, 7TH EDITION, 2014 WITH 2015 AND 2016 INTERIM REVISIONS.
 - PRE-TREATMENT STRUCTURES NOT SHOWN.
 - FOR INFILTRATION APPLICATIONS, GEOTEXTILE ENVELOPING R-TANK SHALL BE ACF M200 (PER SPEC SECTION 2.02A) AND BASE SHALL BE 4" MIN. UNCOMPACTED FREE DRAINING BACKFILL (SPEC SECTION 2.03A) TO PROVIDE A LEVEL BASE. SURFACE MUST BE SMOOTH, FREE OF LUMPS OR DEBRIS, AND EXTEND 2' BEYOND R-TANK^{HD} FOOTPRINT.

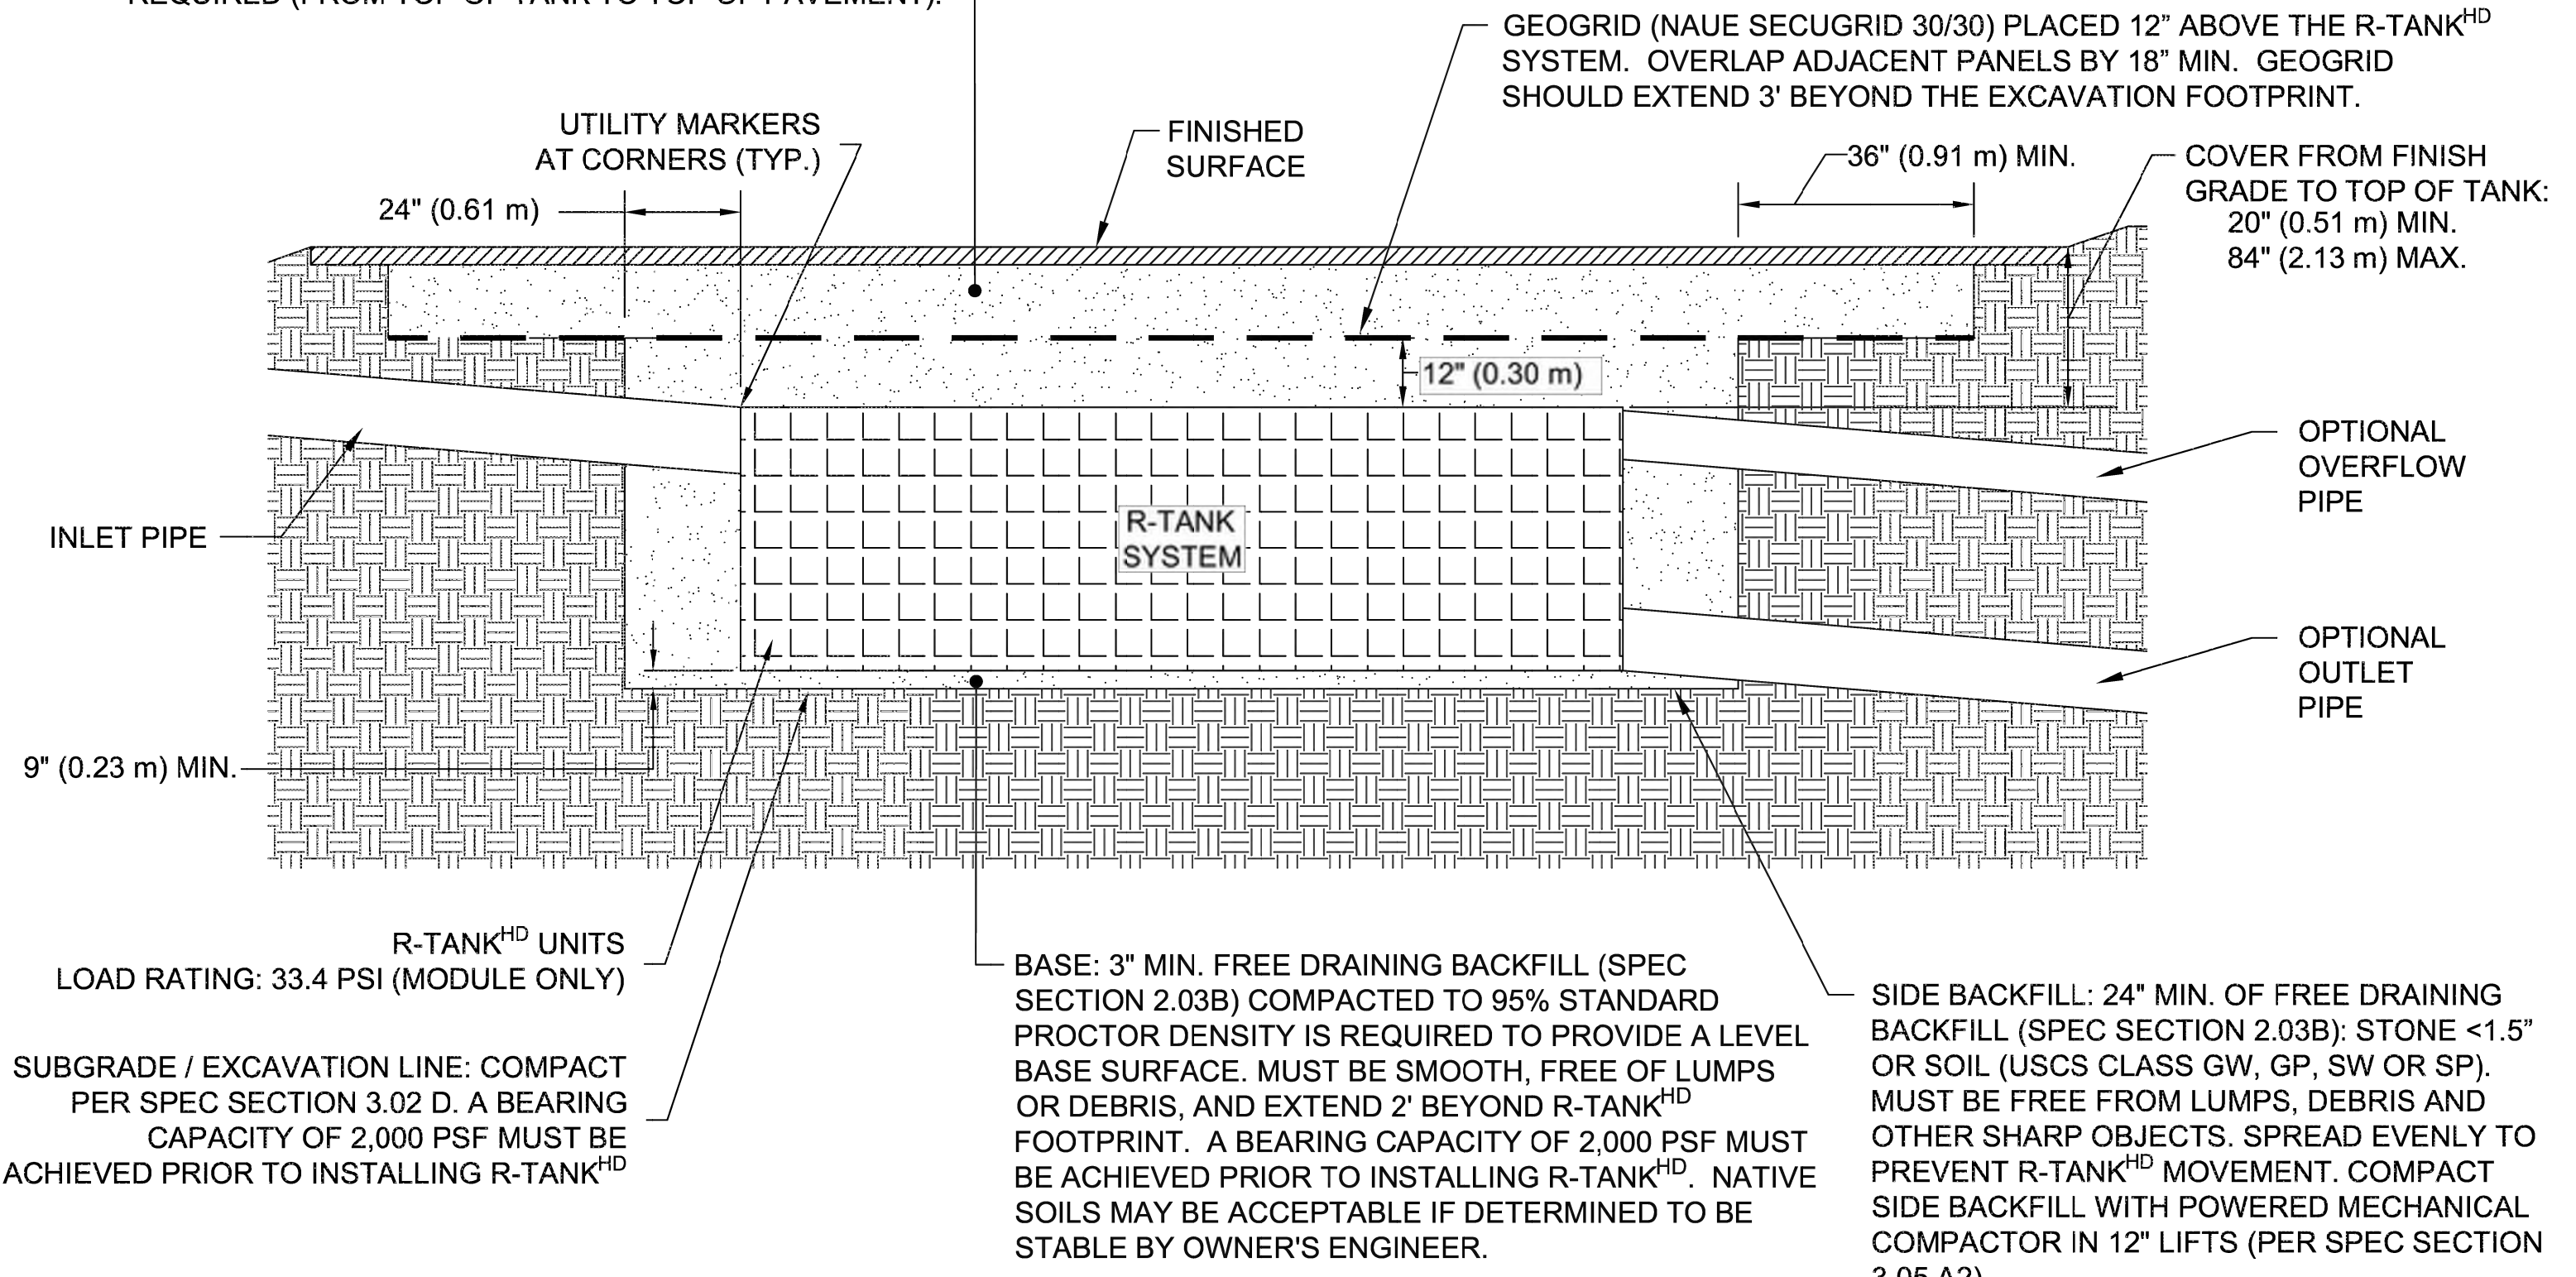

R-TANK^{HD} & HS-20 LOADS - SECTION VIEW

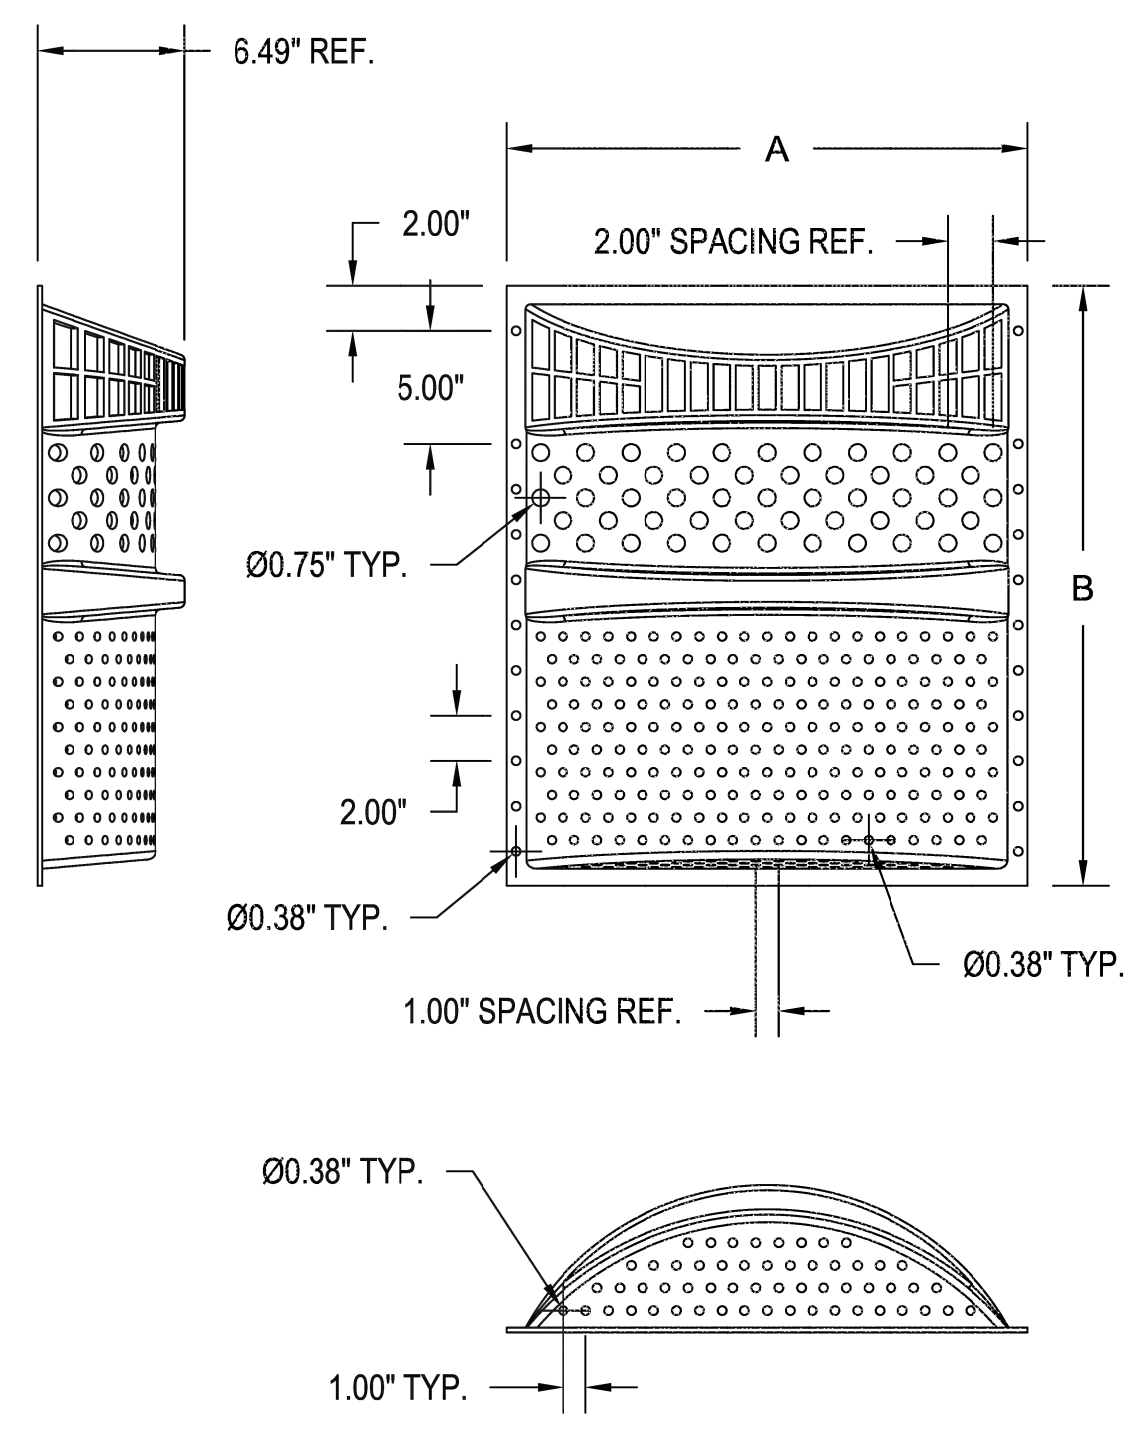


SIZE	A	B
23" x 24"	23"	26.51"
28" x 30"	28"	33.15"
34" x 36"	34"	38.69"

±0.25" TOLERANCE ON DIMENSIONS

NOTE: TRASHGUARD PLUS UNITS ARE RECOMMENDED TO BE INSTALLED IN ALL CATCH BASINS DIRECTLY CONNECTED UPSTREAM OF THE R-TANK SYSTEM.

TRASHGUARD PLUS PRETREATMENT DETAIL

- NOTES
- THIS PORT IS USED TO PUMP WATER INTO THE SYSTEM AND RE-SUSPEND ACCUMULATED SEDIMENT SO THAT IT MAY BE PUMPED OUT.
 - MINIMUM REQUIRED MAINTENANCE INCLUDES A QUARTERLY INSPECTION DURING THE FIRST YEAR OF OPERATION AND A YEARLY INSPECTION THEREAFTER. FLUSH AS NEEDED.
 - R-TANK^{HD}, R-TANK^{SD}, R-TANK^{UD} AND R-TANK^{XD} MAY BE USED IN TRAFFIC APPLICATIONS.
 - SEE TRAFFIC LOADING DETAIL FOR MINIMUM & MAXIMUM COVER REQUIREMENTS.
 - IF MAINTENANCE PORT IS LOCATED IN A NON-TRAFFIC AREA, A PLASTIC CAP CAN BE USED IN LIEU OF A FRAME AND COVER WITH CONCRETE COLLAR.

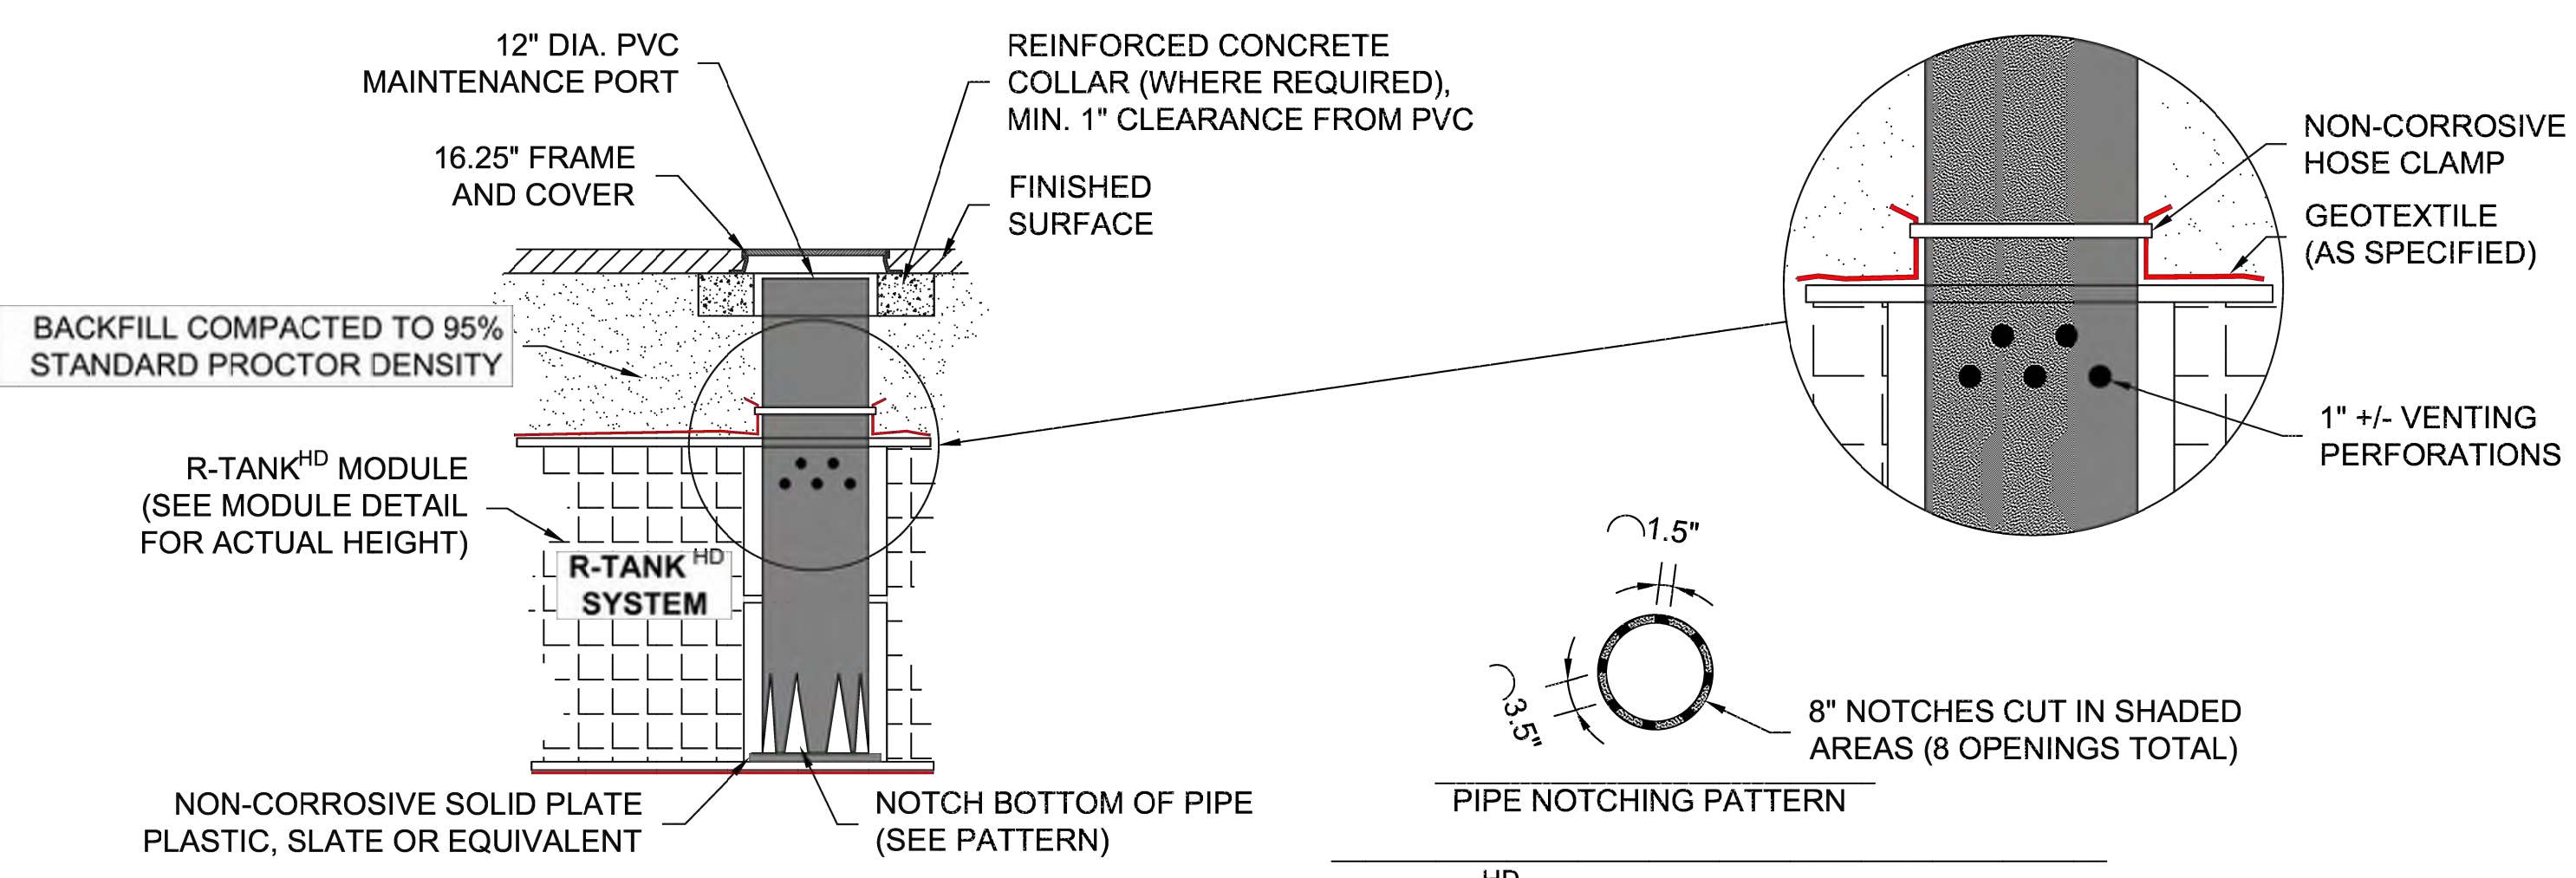

R-TANK^{HD} TYPICAL MAINTENANCE PORT

R-TANK^{HD} SYSTEM DETAILS
EAST TOWN CROSSING
PUYALLUP, WA
SITE DESIGNATION: R-TANK 3

ACF WEST INC.
GEOSYNTHETICS
 Products | Service | Solutions
 FOR ADDITIONAL INFORMATION PLEASE CONTACT:
 ACF WEST, 1-800-423-4567, www.acfwest.com

DRAWN BY: EDQ
 DATE: 11/09/2023
 ACF WEST PROJECT NUMBER: 23-004WA
 SHEET NO.: **4 of 6**

Project Title:
EAST TOWN CROSSING PHASE 1


Client:
ASH DEVELOPMENT

GREG HELLE
GREG.HELLE@ASHNW.COM

Project No.
2230752

Issue Set & Date:
PERMIT SUBMITTAL

11/20/2023

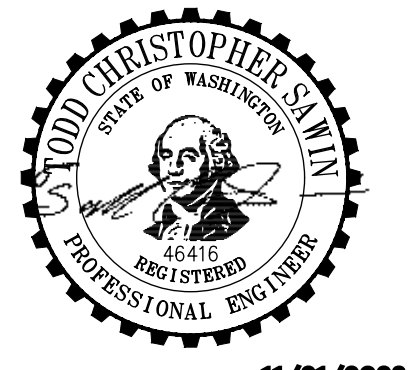

11/21/2023

NOTICE: ALTERATION OF THIS DOCUMENT SHALL INVALIDATE THE PROFESSIONAL SEAL AND SIGNATURE. PUBLICATION OF THIS DOCUMENT DOES NOT CONSTITUTE A PROFESSIONAL ENGINEER'S RESPONSIBILITY. IT IS THE USER'S RESPONSIBILITY TO VERIFY THE ACCURACY OF THE INFORMATION PROVIDED IN THIS BLOCK AND TO TAKE APPROPRIATE ACTION TO THAT PROJECT OR FOR ANY OTHER PROJECT.

Revisions:

Sheet Title:
R-TANK 3 NOTES AND DETAILS

Designed by: CW
Drawn by: SK
Checked by: JI

Sheet No. _____

C4.33

42 of 63 Sheets



Know what's below.
Call before you dig.

EAST TOWN CROSSING PHASE 1

SEC. 26,35/ TWP. 20 N./ RGE. 4 E., W.M.

Legibility:
[Plans Shd C4.34; Pg 43 of 63]


Fixed

APPROVED

BY
CITY OF PUYALLUP
DEVELOPMENT ENGINEERING

DATE

NOTE: THIS APPROVAL IS VOID
IF NOT USED WITHIN 180 DAYS FROM APPROVAL
DATE. THE CITY WILL NOT BE
RESPONSIBLE FOR ERRORS
OR OMISSIONS ON THESE
PLANS. UNDESIRABLE
FIELD CONDITIONS MAY DICTATE
CHANGES TO THESE PLANS AS
TERMINATED BY THE
DEVELOPMENT ENGINEERING
MANAGER.

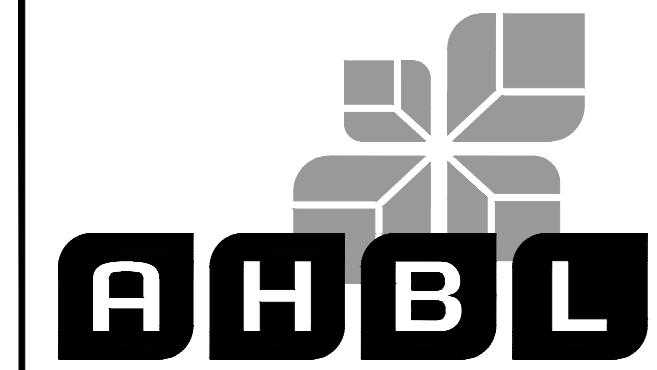

TACOMA · SEATTLE · SPOKANE · TRI-CITIES
2215 North 30th Street, Suite 300, Tacoma, WA 98403
253.383.2422 TEL 253.383.2572 FAX www.ahbl.com WEB


Project Title:
EAST TOWN CROSSING PHASE 1

Client:
ASH DEVELOPMENT

GREG HELLE
GREG.HELLE@ASHNW.COM


Project No.
2230752

Issue Set & Date:
PERMIT SUBMITTAL
11/20/2023

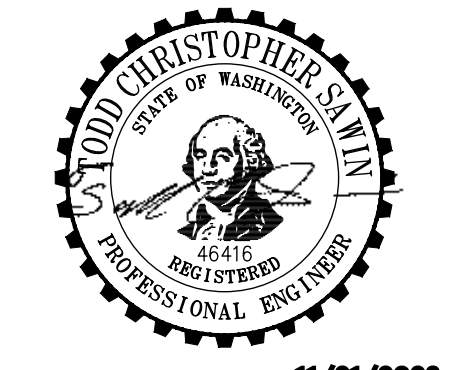


11/21/2023

NOTICE
ALTERATION OF THIS DOCUMENT SHALL INVALIDATE THE
PROFESSIONAL SEAL AND SIGNATURE. PUBLICATION OF
THIS DOCUMENT DOES NOT CONSTITUTE A PROFESSIONAL
ENGINEER'S RESPONSIBILITY. THE ENGINEER IS NOT
RESPONSIBLE FOR THE PROJECT EXCEPT IN THE TITLE BLOCK
AND IS NOT TO BE USED FOR OTHER PROJECTS, OR
ACTION TO THAT PROJECT OR FOR ANY OTHER PROJECT.

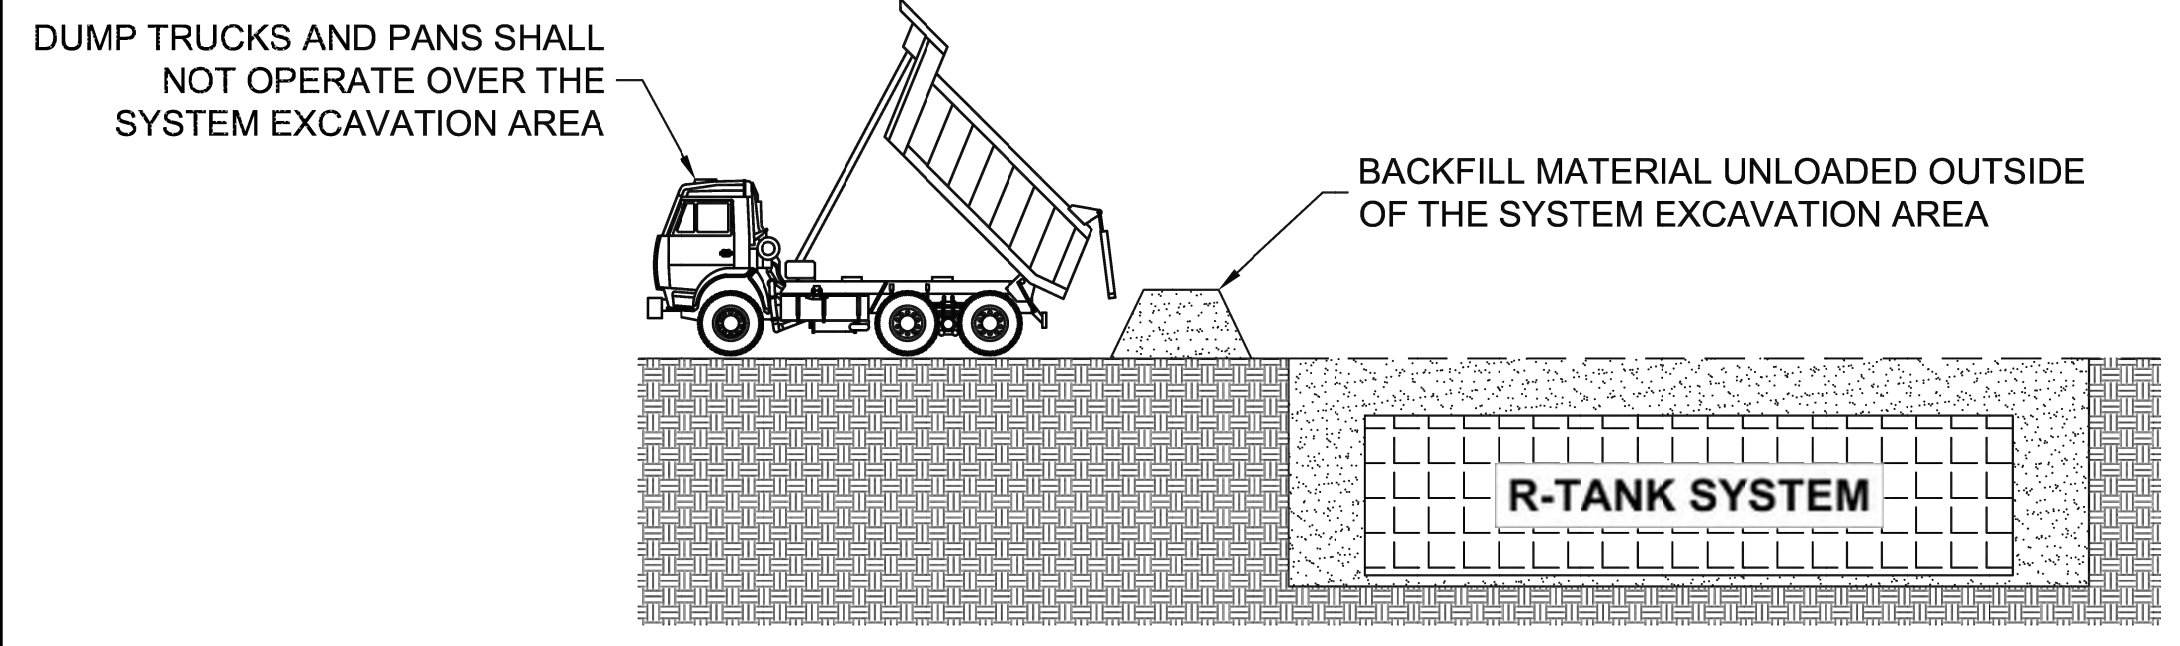

DUMP TRUCK DETAIL (SEE NOTE 3)


- NOTES:
1. FOLLOWING PLACEMENT OF SIDE BACKFILL, A UNIFORM 12" LIFT OF THE FREELY DRAINING MATERIAL (SPEC SECTION 2.03 B2) SHALL BE PLACED OVER THE R-TANK AND LIGHTLY COMPACTED USING A WALK-BEHIND TRENCH ROLLER. ALTERNATELY, A ROLLER (MAXIMUM GROSS VEHICLE WEIGHT OF 6 TONS) MAY BE USED. ROLLER MUST REMAIN IN STATIC MODE UNTIL A MINIMUM OF 24" OF COVER HAS BEEN PLACED OVER THE MODULES. SHEEP FOOT ROLLERS SHOULD NOT BE USED. **SPEC SECTION 3.05 A5**
 2. ONLY LOW PRESSURE TIRE OR TRACK VEHICLES (LESS THAN 7 PSI AND OPERATING WEIGHT OF LESS THAN 20,000 LBS) SHALL BE OPERATED OVER THE R-TANK SYSTEM DURING CONSTRUCTION. **SPEC SECTION 3.05 A5**
 3. DUMP TRUCKS AND PANS SHALL NOT BE OPERATED WITHIN THE R-TANK SYSTEM AT ANY TIME. WHERE NECESSARY, THE HEAVY EQUIPMENT SHOULD UNLOAD IN AN AREA ADJACENT TO THE R-TANK SYSTEM AND THE MATERIAL SHOULD BE MOVED OVER THE SYSTEM WITH TRACKED EQUIPMENT. **SPEC SECTION 3.05 A5**
 4. ENSURE THAT ALL UNRELATED CONSTRUCTION TRAFFIC IS KEPT AWAY FROM THE LIMITS OF EXCAVATION UNTIL THE PROJECT IS COMPLETE AND FINAL SURFACE MATERIALS ARE IN PLACE. NO NON-INSTALLATION RELATED LOADING SHOULD BE ALLOWED OVER THE R-TANK SYSTEM UNTIL THE FINAL DESIGN SECTION HAS BEEN CONSTRUCTED (INCLUDING PAVEMENT). **SPEC SECTION 3.05 B**
 5. SEE R-TANK INSTALLATION GUIDE OR CONTACT YOUR LOCAL ACF WEST REPRESENTATIVE FOR ADDITIONAL INFORMATION.

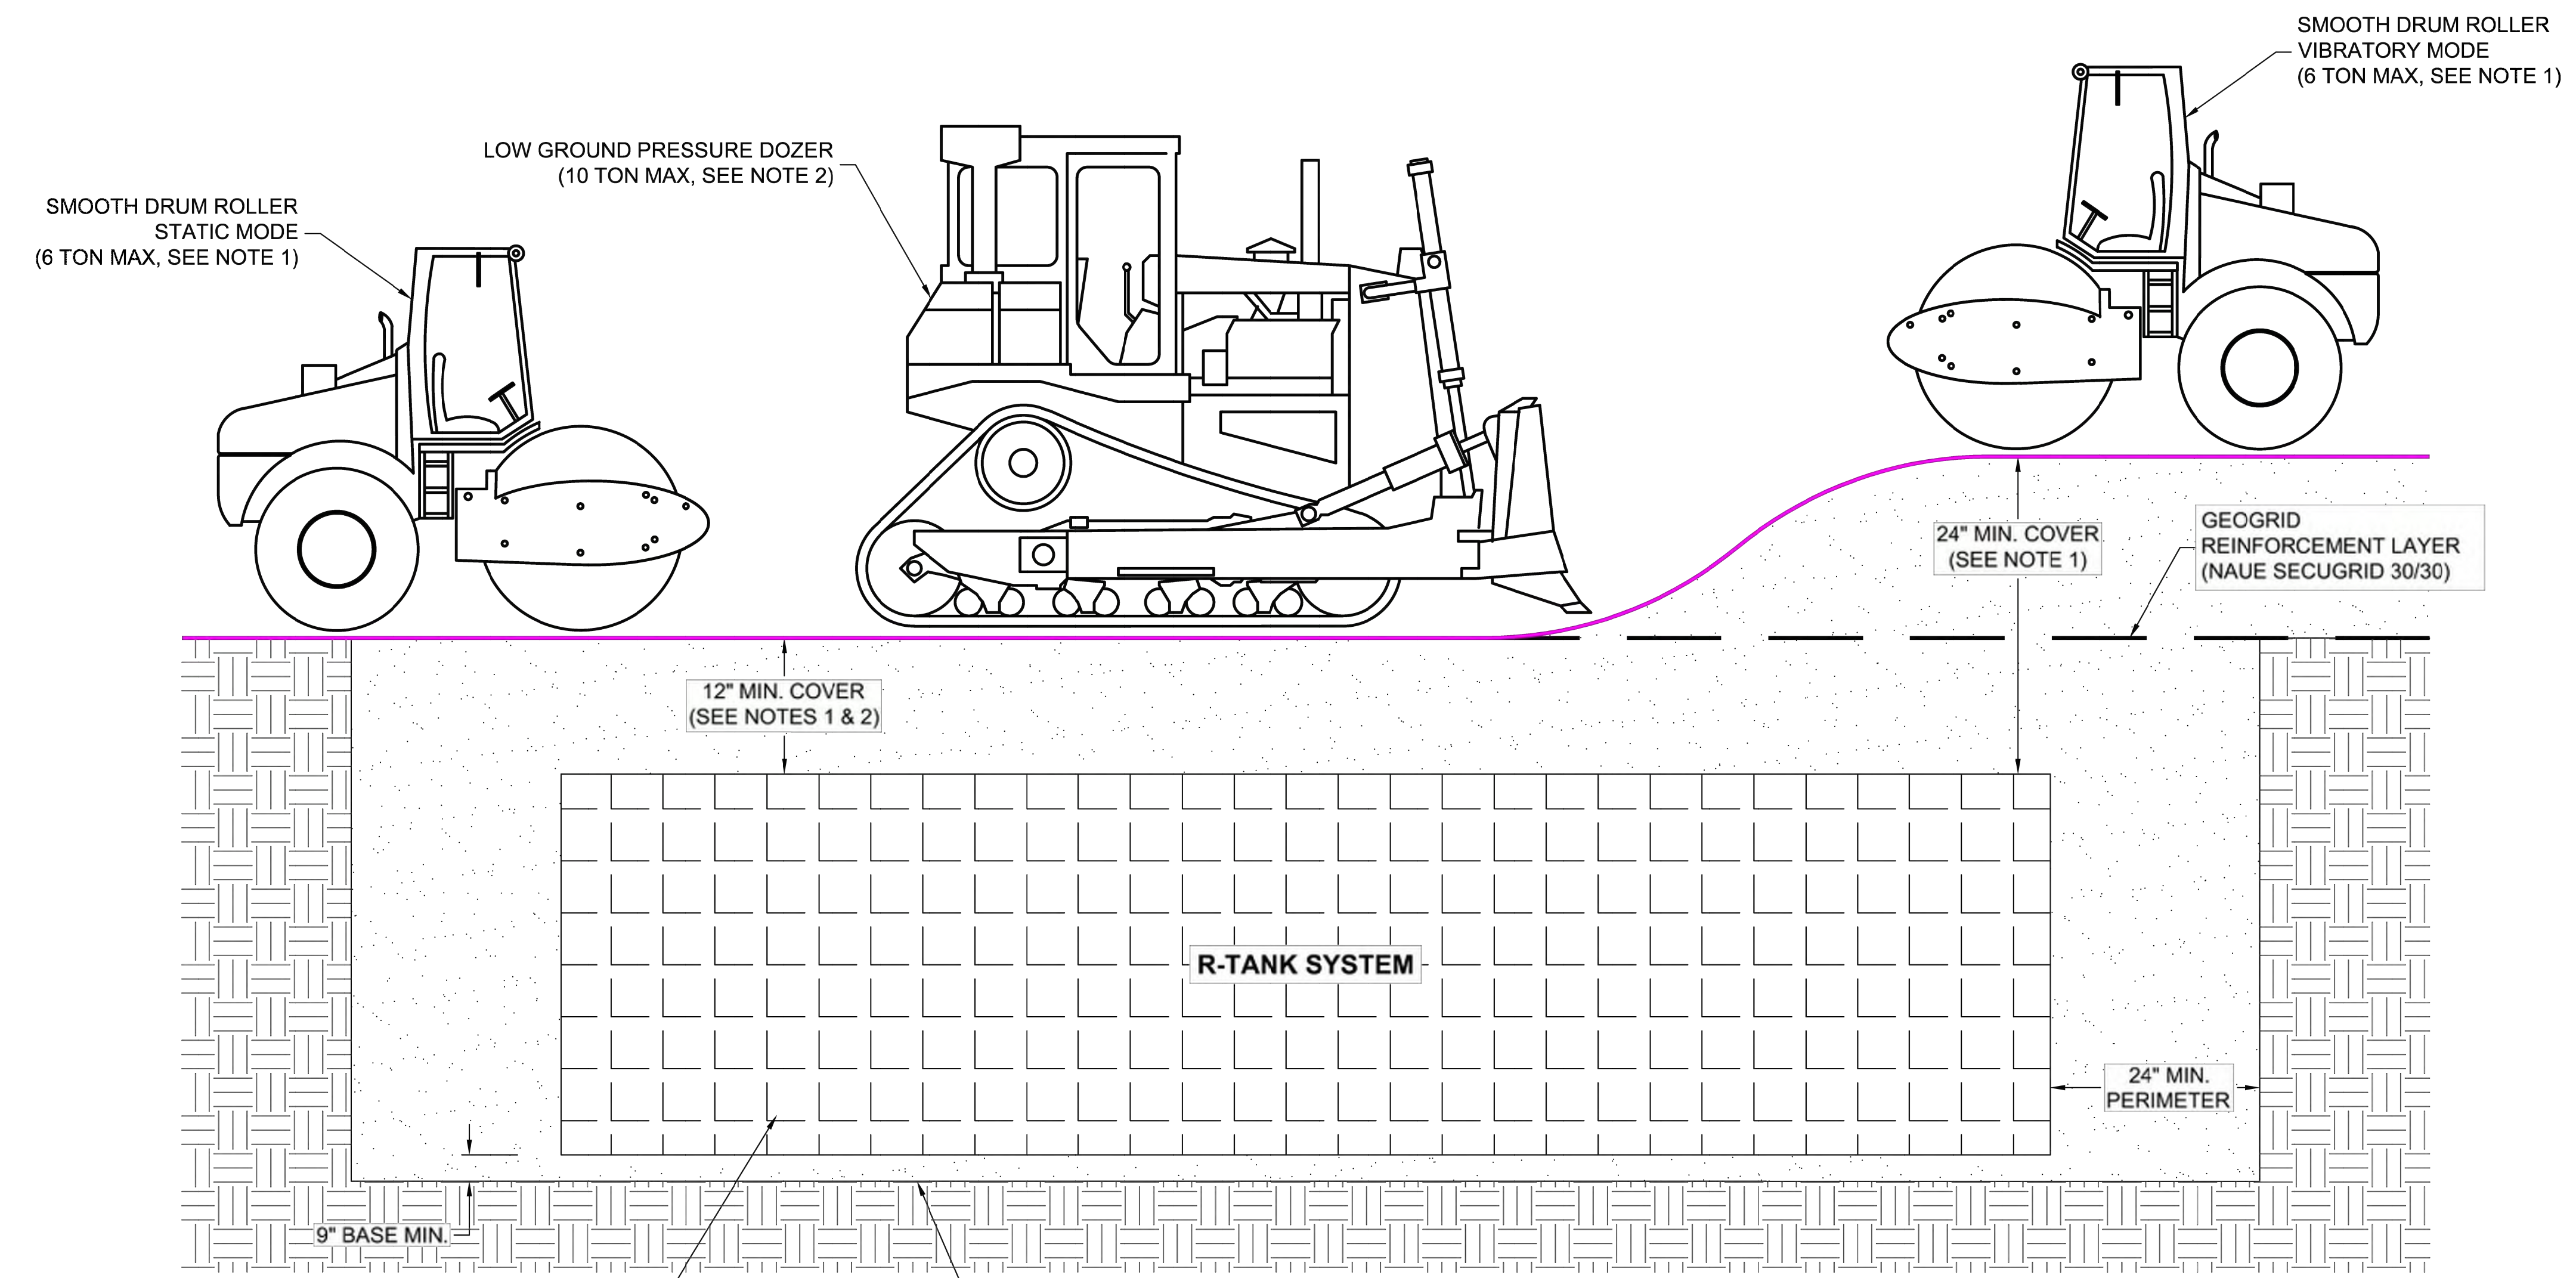

CONSTRUCTION EQUIPMENT COVER DETAIL - VEHICULAR TRAFFIC

R-TANK^{HD} OR R-TANK^{SD} UNITS
HD: LOAD RATING: 33.4 PSI (MODULE ONLY)
SD: LOAD RATING: 42.9 PSI (MODULE ONLY)

SUBGRADE / EXCAVATION LINE: COMPACT PER SPEC SECTION 3.02 D. A BEARING CAPACITY OF 2,000 PSF MUST BE ACHIEVED PRIOR TO INSTALLING R-TANK^{HD} OR R-TANK^{SD}

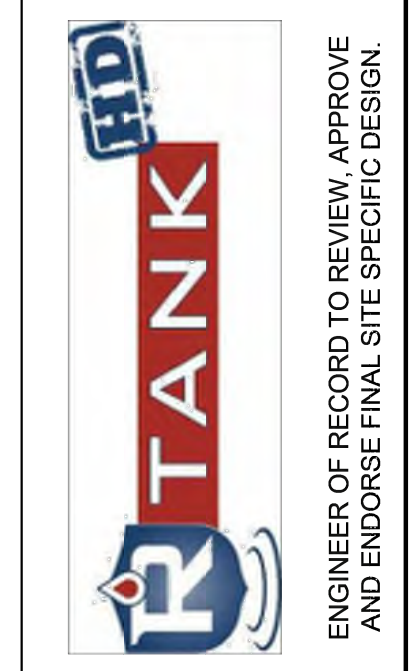

ENGINEER OF RECORD TO REVIEW, APPROVE AND ENDORSE FINAL SITE SPECIFIC DESIGN.



FOR ADDITIONAL INFORMATION PLEASE CONTACT:
ACF WEST, 1-800-423-4567, www.acfwest.com

R-TANK^{HD} CONSTRUCTION EQUIPMENT COVER DETAIL
EAST TOWN CROSSING
PUYALLUP, WA
SITE DESIGNATION: R-TANK 3

DRAWN BY
EDQ
DATE
11/09/2023
ACF WEST PROJECT NUMBER
23-004WA
SHEET NO.
5 of 6

Revisions:

Sheet Title:

R-TANK 3 NOTES AND DETAILS

Designed by: CW Drawn by: SK Checked by: JI

Sheet No.

C4.34

43 of 63 Sheets



EAST TOWN CROSSING PHASE 1

SEC. 26,35/ TWP. 20 N./ RGE. 4 E., W.M.

Fixed
 Legibility
 [Plans Sht C4.35; Pg 44 of 63]

APPROVED

BY
 CITY OF PUYALLUP
 DEVELOPMENT ENGINEERING

DATE
 THIS APPROVAL IS VOID
 AFTER 180 DAYS FROM APPROVAL
 THE CITY WILL NOT BE
 RESPONSIBLE FOR ERRORS
 OR OMISSIONS ON THESE
 PLANS.
 FIELD CONDITIONS MAY DICTATE
 CHANGES TO THESE PLANS AS
 DETERMINED BY THE
 DEVELOPMENT ENGINEERING
 MANAGER.



R-TANK SPECIFICATION

PART 1 - GENERAL

1.01 RELATED DOCUMENTS

A. Drawings, technical specification and general provisions of the Contract as modified herein apply to this section.

1.02 DESCRIPTION OF WORK INCLUDED

A. Provide excavation and base preparation per geotechnical engineer's recommendations and/or as shown on the design drawings, to provide adequate support for project design loads and safety from excavation sidewall collapse. Excavations shall be in accordance with the owner's and OSHA requirements.

B. Provide and install R-TankLD/, R-TankHD/, or R-TankSD/, or R-TankUD/ system (hereafter called R-Tank) and all related products including fill materials, geotextiles, geogrids, inlet and outlet pipe with connections per the manufacturer's installation guidelines provided in this section.

C. Provide and construct the cover of the R-Tank system including: stone backfill, structural fill cover, and pavement section as specified.

D. Protect R-Tank system from construction traffic after installation until completion of all construction activity in the installation area.

1.03 QUALITY CONTROL

A. All materials shall be manufactured in ISO certified facilities.

B. Installation Contractor shall demonstrate the following experience:

1. A minimum of three R-Tank or equivalent projects completed within 2 years; and,
2. A minimum of 25,000 cubic feet of storage volume completed within 2 years.

C. Contractor experience requirement may be waived if the manufacturer's representative provides on-site training and review during construction.

D. Installation Personnel: Performed only by skilled workers with satisfactory record of performance on bulk earthworks, pipe, chamber, or pond/landfill construction projects of comparable size and quality.

E. Contractor must have manufacturer's representative available for site review if requested by Owner.

1.04 SUBMITTALS

A. Submit proposed R-Tank layout drawings. Drawings shall include typical section details as well as the required base elevation of stone and tanks, minimum cover requirements and tank configuration.

B. Submit manufacturer's product data, including compressive strength and unit weight.

C. Submit manufacturer's installation instructions.

D. Submit R-Tank sample for review. Reviewed and accepted samples will be returned to the Contractor.

E. Submit material certificates for geotextile, geogrid, base course and backfill materials.

F. Submit required experience and personnel requirements as specified in Section 1.03.

G. Any proposed equal alternative product substitution to this specification must be submitted for review and approved prior to bid opening. Review package should include third party reviewed performance data that meets or exceeds criteria in Table 2.01 B.

1.05 DELIVERY, STORAGE, AND HANDLING

A. Protect R-Tank and other materials from damage during delivery, and store UV sensitive materials under tarp to protect from sunlight when time from delivery to installation exceeds two weeks. Storage of materials should be on smooth surfaces, free from dirt, mud and debris.

B. Handling is to be performed with equipment appropriate to the materials and site conditions, and may include hand, handcart, forklifts, extension lifts, etc.

C. Cold weather:

1. Care must be taken when handling plastics when air temperature is 40 degrees or below as plastic becomes brittle.
2. Do not use frozen materials or materials mixed or coated with ice or frost.
3. Do not build on frozen ground or wet, saturated or muddy subgrade.

1.06 PREINSTALLATION CONFERENCE

A. Prior to the start of the installation, a preinstallation conference shall occur with the representatives from the design team, the general contractor, the excavation contractor, the R-Tank installation contractor, and the manufacturer's representative.

1.07 PROJECT CONDITIONS

A. Coordinate installation for the R-Tank system with other on-site activities to eliminate all non-installation related construction traffic over the completed R-Tank system. No loads heavier than the design loads shall be allowed over the system, and in no case shall loads higher than a standard AASHTO HS20 (or HS25, depending on design criteria) load be allowed on the system at any time.

B. Protect adjacent work from damage during R-Tank system installation.

C. All pre-treatment systems to remove debris and heavy sediments must be in place and functional prior to operation of the R-Tank system. Additional pretreatment measures may be needed if unit is operational during construction due to increased sediment loads.

D. Contractor is responsible for any damage to the system during construction.

PART 2 - PRODUCTS

2.01 R-TANK UNITS

A. R-Tank - Injection molded plastic tank plates assembled to form a 95% void modular structure of pre-designed height (custom for each project).

B. R-Tank units shall meet the following Physical & Chemical Characteristics:

PROPERTY	DESCRIPTION	R-Tank ^{HD} VALUE	R-Tank ^{LD} VALUE	R-Tank ^{SD} VALUE	R-Tank ^{UD} VALUE
Void Area	Volume available for water storage	95%	95%	95%	95%
Surface Void Area	Percentage of exterior available for infiltration	90%	90%	90%	90%
Vertical Compressive Strength	ASTM D 2412 / ASTM F 2418	30.0 psi	33.4 psi	42.9 psi	134.2 psi
Lateral Compressive Strength	ASTM D 2412 / ASTM F 2418	20.0 psi	22.4 psi	28.9 psi	N/A
HS-20 Minimum Cover	Cover required to support HS-20 loads	N/A	20"	18"	12" (STONE BACKFILL)
HS-25 Minimum Cover	Cover required to support HS-25 loads	N/A	24"	19"	15" (STONE BACKFILL)
Maximum Cover	Maximum allowable cover depth	3 feet	4 feet	4.5 feet	5 feet
Unit Weight	Weight of plastic per cubic foot of tank	3.29 lbs / cf	3.62 lbs / cf	3.96 lbs / cf	4.33 lbs / cf
Rib Thickness	Thickness of load-bearing members	0.18 inches	0.18 inches	0.18 inches	N/A
Service Temperature	Safe temperature range for use	-14 - 167° F	-14 - 167° F	-14 - 167° F	-14 - 167° F

C. Supplier: ACF West 15540 Woodinville-Redmond Rd., Woodinville, Washington 98072, (425) 415-6115, www.acfwest.com

2.02 GEOSYNTHETICS

A. Geotextile: A geotextile envelope is required to prevent backfill material from entering the R-Tank modules.

1. Standard Application: The standard geotextile shall be an 8 oz per square yard nonwoven geotextile (TenCate Mirafi 180N or equivalent).
2. Infiltration Applications: When water must infiltrate/exfiltrate through the geotextile as a function of the system design, a woven monofilament (TenCate Mirafi FW402 or equivalent) shall be used.

B. Geogrid: For installations subject to traffic loads and/or when required by project plans, install geogrid (Naue Secugrid 30/30 or equivalent) to reinforce backfill above the R-Tank system. Geogrid is not always required for R-TankUD/ installations, and is often not required for non-traffic load applications.

2.03 BACKFILL & COVER MATERIALS

A. Bedding Materials: Stone (angular and smaller than 1.5" in diameter) or soil (GW, GP, SW, or SP as classified by the Unified Soil Classification System) shall be used below the R-Tank system (3" minimum). Material must be free from lumps, debris, and any sharp objects that could cut the geotextile. Material shall be within 3 percent of the optimum moisture content as determined by ASTM D698 at the time of installation.

B. Side and Top Backfill: Material must be free from lumps, debris and any sharp objects that could cut the geotextile. Material shall be within 3 percent of the optimum moisture content as determined by ASTM D698 at the time of installation.

1. Traffic Applications - Free draining material shall be used adjacent to (24" minimum) and above (for the first 12") the R-Tank system.
2. For HD, and SD modules, backfill materials shall be free draining stone (angular and smaller than 1.5" in diameter) or soil (GW, GP, SW, or SP as classified by the Unified Soil Classification System).
3. For UD modules with less than 14" of top cover, backfill materials shall be free draining stone (angular and smaller than 1.5" in diameter). The use of soil backfill on the sides and top of the UD module is not permitted unless the modules are installed outside of traffic areas or with cover depths of 14" or more. Top backfill material (from top of module to bottom of pavement base or 12" maximum) must be consistent with side backfill.

C. Non-Traffic / Green Space Applications - For all R-Tank modules installed in green spaces and not subjected to vehicular loads, backfill materials may either follow the guidelines for Traffic Applications above, or the top backfill layer (12" minimum) may consist of AASHTO #57 stone blended with 30-40% (by volume) topsoil to aid in establishing vegetation.

D. Additional Cover Materials: Structural fill shall consist of granular materials meeting the gradational requirements of SM, SP, SW, GM, GP or GW as classified by the Unified Soil Classification System. Structural fill shall have a maximum of 25 percent passing the No. 200 sieve, shall have a maximum clay content of 10 percent and a maximum Plasticity Index of 4. Material shall be within 3 percent of the optimum moisture content as determined by ASTM D698 at the time of installation.

2.04 OTHER MATERIALS

A. Utility Marker: Install metallic tape at corners of R-Tank system to mark the area for future utility detection.

PART 3 - EXECUTION

3.01 ASSEMBLY OF R-TANK UNITS

A. Assembly of modules shall be performed in accordance with the R-Tank Installation Manual, Section 2.

3.02 LAYOUT AND EXCAVATION

A. Installer shall stake out, excavate, and prepare the subgrade area to the required plan grades and dimensions, ensuring that the excavation is at least 2 feet greater than R-Tank dimensions in each direction allowing for installation of geotextile filter fabric, R-Tank modules, and free draining backfill materials.

B. All excavations must be prepared with OSHA approved excavated sides and sufficient working space.

C. Protect partially completed installation against damage from other construction traffic by establishing a perimeter with high visibility construction tape, fencing, barricades, or other means until construction is complete.

D. Base of the excavation shall be uniform, level, and free of lumps or debris and soft or yielding subgrade areas. A minimum 2,000 pounds per square foot bearing capacity is required.

E. Infiltration Applications: Subgrade shall be prepared in accordance with the contract documents. Compaction of subgrade should not be performed in infiltration applications.

F. Unstable Soils or Conditions: All questions about the base of the excavation shall be directed to the owner's engineer, who will approve the subgrade conditions prior to placement of stone. The owner's engineer shall determine the required bearing capacity of the R-Tank subgrade; however in no case shall a bearing capacity of less than 2,000 pounds per square foot be provided.

1. If unsuitable soils are encountered at the subgrade, or if the subgrade is pumping or appears excessively soft, repair the area in accordance with contract documents and/or as directed by the owner's engineer.
2. If indications of the water table are observed during excavation, the engineer shall be contacted to provide recommendations.
3. Do not start installation of the R-Tank system until unsatisfactory subgrade conditions are corrected and the subgrade conditions are accepted by the owner's engineer.

3.03 PREPARATION OF BASE

A. Place a thin layer (3" unless otherwise specified) of bedding material (Section 2.03 A), over the subgrade to establish a level working platform for the R-Tank modules. Level to within 1/2" (+/- 1/4") or as shown on the plans. Native subgrade soils or other materials may be used if determined to meet the requirements of 2.03 A and are accepted by the owner's engineer.

1. Standard Applications: Static roll or otherwise compact bedding materials until they are firm and unyielding.
2. Infiltration Applications: Bedding materials shall be prepared in accordance with the contract documents.

B. Outline the footprint of the R-Tank system on the excavation floor using spray paint or chalk line to ensure a 2' perimeter is available around the R-Tank system for proper installation and compaction of backfill.

3.04 INSTALLATION OF THE R-TANKS

A. Where a geotextile wrap is specified on the stone base, cut strips to length and install in excavation, removing wrinkles so material lays flat. Overlap geotextile a minimum 12" or as recommended by manufacturer. Use tape, special adhesives, sandbags or other ballast to secure overlaps. As geotextiles can be damaged by extreme heat, smoking is not permissible on/near the geotextile, and tools using a flame to tack the overlaps, such as propane torches, are prohibited.

B. Where an impervious liner (for containment) is specified, install the liner per manufacturer's recommendations and the contract documents. The R-Tank units shall be separated from impervious liner by a non-woven geotextile fabric installed accordance with Section 3.04A.

C. Install R-Tank modules by placing side by side, in accordance with the design drawings. No lateral connections are required. It is advisable to use a string line to form square corners and straight edges along the perimeter of the R-Tank system. The modules are to be oriented as per the design drawing with required depth as shown on plans.

1. For LD, HD, and SD installations, the large side plate of the tank should be placed on the perimeter of the system. This will typically require that the two ends of the tank area will have a row of tanks placed perpendicular to all other tanks. If this is not shown in the construction drawings, it is a simple field adjustment that will have minimal effect on the overall system footprint. Refer to R-Tank Installation Guide for more details.
2. For UD installations, there is no perpendicular end row required.

D. Wrap the R-Tank top and sides in specified geotextile. Cut strips of geotextile so that it will cover the sides and top, encapsulating the entire system to prevent backfill entry into the system. Overlap geotextile 12" or as recommended by manufacturer. Take great care to avoid damage to geotextile (and, if specified, impervious liner) during placement.

E. Identify locations of inlet, outlet and any other penetrations of the geotextile (and optional liner). These connections should be installed flush (butted up to the R-Tank) and the geotextile fabric shall be cut to enable hydraulic continuity between the connections and the R-Tank units. These connections shall be secured using pipe boots with stainless steel pipe clamps. Support pipe in trenches during backfill operations to prevent pipe from settling and damaging the geotextile, impervious liner (if specified) or pipe. Connecting pipes at 90 degree angles facilitates construction, unless otherwise specified. Ensure end of pipe is installed snug against R-Tank system.

F. Install Inspection and Maintenance Ports in locations noted on plans. At a minimum one maintenance port shall be installed within 10' of each inlet & outlet connection, and with a maximum spacing of one maintenance port for every 2,500 square feet. Install all ports as noted in the R-Tank Installation Guide.

G. If required, install ventilation pipes and vents as specified on drawings to provide ventilation for proper hydraulic performance. The number of pipes and vents will depend on the size of the system. Vents are often installed using a 90 degree elbow with PVC pipe into a landscaped area with "U" bend or venting bollard to inhibit the ingress of debris. A ground level concrete or steel cover can be used.

3.05 BACKFILLING OF THE R-TANK UNITS

A. Backfill and lift with recommended materials as follows:

1. Place freely draining backfill materials (Section 2.03 B) around the perimeter in lifts with a maximum thickness of 12". Each lift shall be placed around the entire perimeter such that each lift is no more than 24" higher than the side backfill along any other location on the perimeter of the R-Tank system. No fill shall be placed over top of tanks until the side backfill has been completed.
2. Each lift shall be compacted at the specified moisture content to a minimum of 95% of the Standard Proctor Density until no further densification is observed (for self-compacting stone materials). The side lifts must be compacted with walk behind compaction equipment. Even when "self-compacting" backfill materials are selected, a walk behind vibratory compactor must be used.
3. Take care to ensure that the compaction process does not allow the machinery to come into contact with the modules due to the potential for damage to the geotextile and R-Tank units.
4. No compaction equipment is permissible to operate directly on the R-Tank modules.
5. Top Backfill: Only low pressure track vehicles shall be operated over the R-Tank system during construction. Dump Trucks and Pans shall not be operated within the R-Tank system footprint at any time. Heavy equipment should unload in an area adjacent to the R-Tank system and the material should be moved over the system using tracked equipment with an operating weight of less than 10 tons.
 - a. Typical Applications: Install a 12" (or as shown on plans) lift of freely draining material (Section 2.03 B) over the R-Tank Units, maintaining 12" between equipment tracks and R-Tank System. Lightly compacted using a walk-behind trench roller. Alternately, a roller (maximum gross vehicle weight of 6 tons) may be used. Roller must remain in static mode until a minimum of 24" of cover has been placed over the modules. Sheep foot rollers should not be used.
 - b. Shallow Applications (< 18" total cover): Install top backfill in accordance with plans.
6. If required, install a geogrid as shown on plans. Geogrid shall extend a minimum of 3 feet beyond the limits of the excavation wall.
7. Following placement and compaction of the initial cover, subsequent lifts of structural fill (Section 2.03 C) shall be placed at the specified moisture content and compacted to a minimum of 95% of the Standard Proctor Density and shall cover the entire footprint of the R-Tank system. During placement of fill above the system, unless otherwise specified, a uniform elevation of fill shall be maintained to within 12" across the footprint of the R-Tank system. Do not exceed maximum cover depths listed in Table 2.01 B.
8. Place additional layers of geotextile and/or geogrid at elevations as specified in the design details. Each layer of geosynthetic reinforcement placed above the R-Tank system shall extend a minimum of 3 feet beyond the limits of the excavation wall.

B. Ensure that all unrelated construction traffic is kept away from the limits of excavation until the project is complete and final surface materials are in place. No non-installation related loading should be allowed over the R-Tank system until the final design section has been constructed (including pavement).

C. Place surfacing materials, such as groundcovers (no large trees), or paving materials over the structure with care to avoid displacement of cover fill and damage to surrounding areas.

D. Backfill depth over R-Tank system must be within the limitations shown in the table in Section 2.01 B. If the total backfill depth does not comply with this table, contact engineer or manufacturer's representative for assistance.

3.06 MAINTENANCE REQUIREMENTS

A. A routine maintenance effort is required to ensure proper performance of the R-Tank system. The Maintenance program should be focused on pretreatment systems. Ensuring these structures are clean and functioning properly will reduce the risk of contamination of the R-Tank system and stormwater released from the site. Pre-treatment systems shall be inspected yearly, or as directed by the regulatory agency and by the manufacturer (for proprietary systems). Maintain as needed using acceptable practices or following manufacturer's guidelines (for proprietary systems).

B. All inlet pipes and inspection and/or Maintenance Ports in the R-Tank system will need to be inspected for accumulation of sediments at least quarterly through the first year of operation and at least yearly thereafter.

C. If sediment has accumulated to the level noted in the R-Tank Maintenance Guide or beyond a level acceptable to the Owner's engineer, the R-Tank system should be flushed.

D. All inspection and maintenance activities should be performed in accordance with the R-Tank Operation, Inspection & Maintenance Manual.



R-TANK SPECIFICATION
 EAST TOWN CROSSING
 PUYALLUP, WA
 SITE DESIGNATION: R-TANK 3

DRAWN BY
 EDQ

DATE
 11/09/2023

ACF WEST PROJECT NUMBER
 23-004WA

SHEET NO.
 6 of 6

Called out
 CALLOUT-manufactured 30mil (min) impermeable liner to prevent groundwater intrusion.
 [Plans Sht C4.35; Pg 44 of 63]

EAST TOWN CROSSING PHASE 1

Client:
 ASH DEVELOPMENT


GREG HELLE
 GREG.HELLE@ASHNW.COM

Project No.
 2230752

Issue Set & Date:

PERMIT SUBMITTAL

11/20/2023

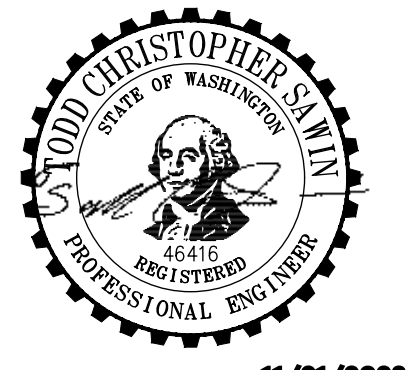

11/21/2023

NOTICE

Revisions:

Sheet Title:
 R-TANK 3

R-TANK 3 NOTES AND DETAILS

Designed by: CW
 Drawn by: SK
 Checked by: JI

Sheet No.

C4.35

44 of 63 Sheets



Know what's below.
 Call before you dig.

EAST TOWN CROSSING PHASE 1



SEC. 26,35/ TWP. 20 N./ RGE. 4 E., W.M.

APPROVED

BY: CITY OF PUYALLUP
DEVELOPMENT ENGINEERING

DATE:

NOTE: THIS APPROVAL IS VOID AFTER 180 DAYS FROM APPROVAL DATE. THE CITY WILL NOT BE RESPONSIBLE FOR ERRORS AND/OR OMISSIONS ON THESE PLANS. FIELD CONDITIONS MAY DICTATE CHANGES TO THESE PLANS AS DETERMINED BY THE DEVELOPMENT ENGINEERING MANAGER.

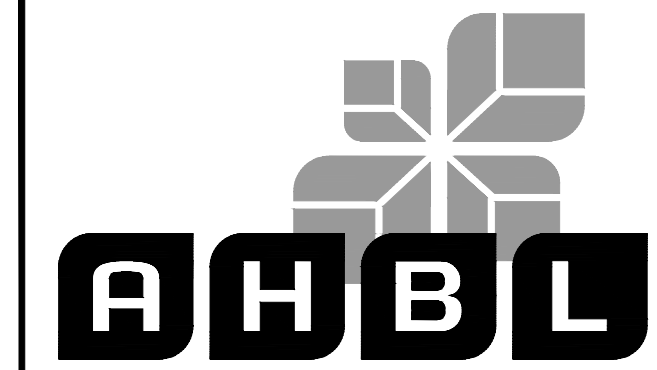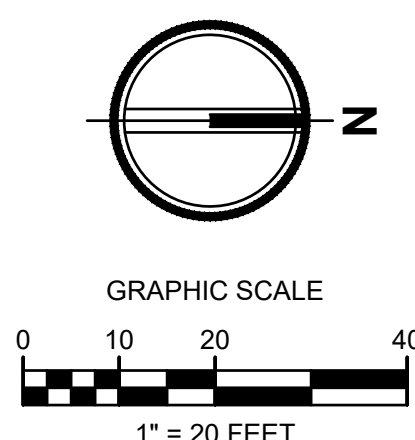

TACOMA • SEATTLE • SPOKANE • TRI-CITIES
2215 North 30th Street, Suite 300, Tacoma, WA 98403
253.383.2422 TEL 253.383.2572 FAX www.ahbl.com WEB


Project Title:
EAST TOWN CROSSING PHASE 1

Client:
ASH DEVELOPMENT

GREG HELLE
GREG.HELLE@ASHNW.COM

Project No.
2230752

Issue Set & Date:
PERMIT SUBMITTAL
11/20/2023

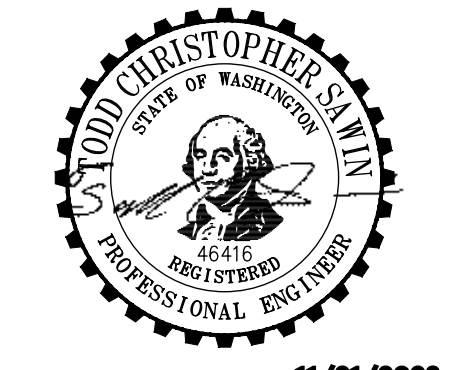

11/21/2023
NOTICE: ALTERNATE OF THIS DOCUMENT SHALL MAINTAIN THE PROFESSIONAL SEAL AND SIGNATURE PUBLICATION OF THE DOCUMENT DOES NOT GUARANTEE FROM DEFECTS ONLY FOR THE PROJECT EXHIBIT IN THE TITLE BLOCK THIS IS NOT TO BE USED FOR OTHER PROJECTS OR ADDITION TO THAT PROJECT OR FOR ANY OTHER PROJECT.

Service lateral exceeds max. grade (8% max). Revise accordingly. [Plans Sht C5.01; Pg 45 of 63] **Noted**



PROVIDE grease interceptor sizing calculations (750 gal min) for both GIs. [Plans Sht C5.01; Pg 45 of 63] **Provided as memo**

LEGEND

- RIGHT-OF-WAY / PROPERTY LINE
- CENTERLINE
- - - EASEMENT
- BUILDING OUTLINE
- S — SANITARY SIDE SEWER
- S — SANITARY SEWER MAIN
- FM — SANITARY SEWER FORCE MAIN
- — SANITARY SEWER CLEANOUT
- — SANITARY SEWER MANHOLE
- 123 — PROPOSED MAJOR CONTOUR
- 123 — PROPOSED MINOR CONTOUR

STRUCTURE NAME	STRUCTURE DETAILS
EXISTING SSMH 15 N 679922.81 E 1203825.42	RIM = 72.18 IE = 50.82 (8" W) IE = 62.37 (8" S)
EXISTING SSMH 16 N 679922.81 E 1203814.05	RIM = 71.33 IE = 50.70 (8" E)
SSCB 11 TYPE 1 CB N 680121.57 E 1203976.02	RIM = 73.11 IE = 69.76 (6" W)
SSCO 10 N 680154.37 E 1203944.34	RIM = 73.57 IE = 69.76 (6" S) IE = 69.76 (6" W)
SSCO 17 N 679904.86 E 1203870.14	RIM = 72.88 IE = 70.62 (6" E) IE = 70.62 (6" N)
SSMH 1 48" SSMH N 679999.02 E 1204074.16	RIM = 75.54 IE = 66.34 (8" S) IE = 66.44 (8" E)
SSMH 12 48" SSMH N 680121.64 E 1203931.70	RIM = 72.95 IE = 66.22 (8" S) IE = 69.32 (6" E) IE = 66.32 (6" N)
SSMH 13 48" SSMH N 679904.20 E 1203927.82	RIM = 73.05 IE = 65.25 (8" S) IE = 65.35 (8" W)

GENERAL NOTE
SEE DETAILS AS NOTED ON SHEET C5.5
-SIDE SEWER CLEANOUT PLACED IN DRIVEWAY SEE DETAIL 1
-INSIDE DROP FOR SANITARY SEWER MANHOLE SEE DETAIL 2 AND 3
-SANITARY SEWER MANHOLE SEE DETAIL 4

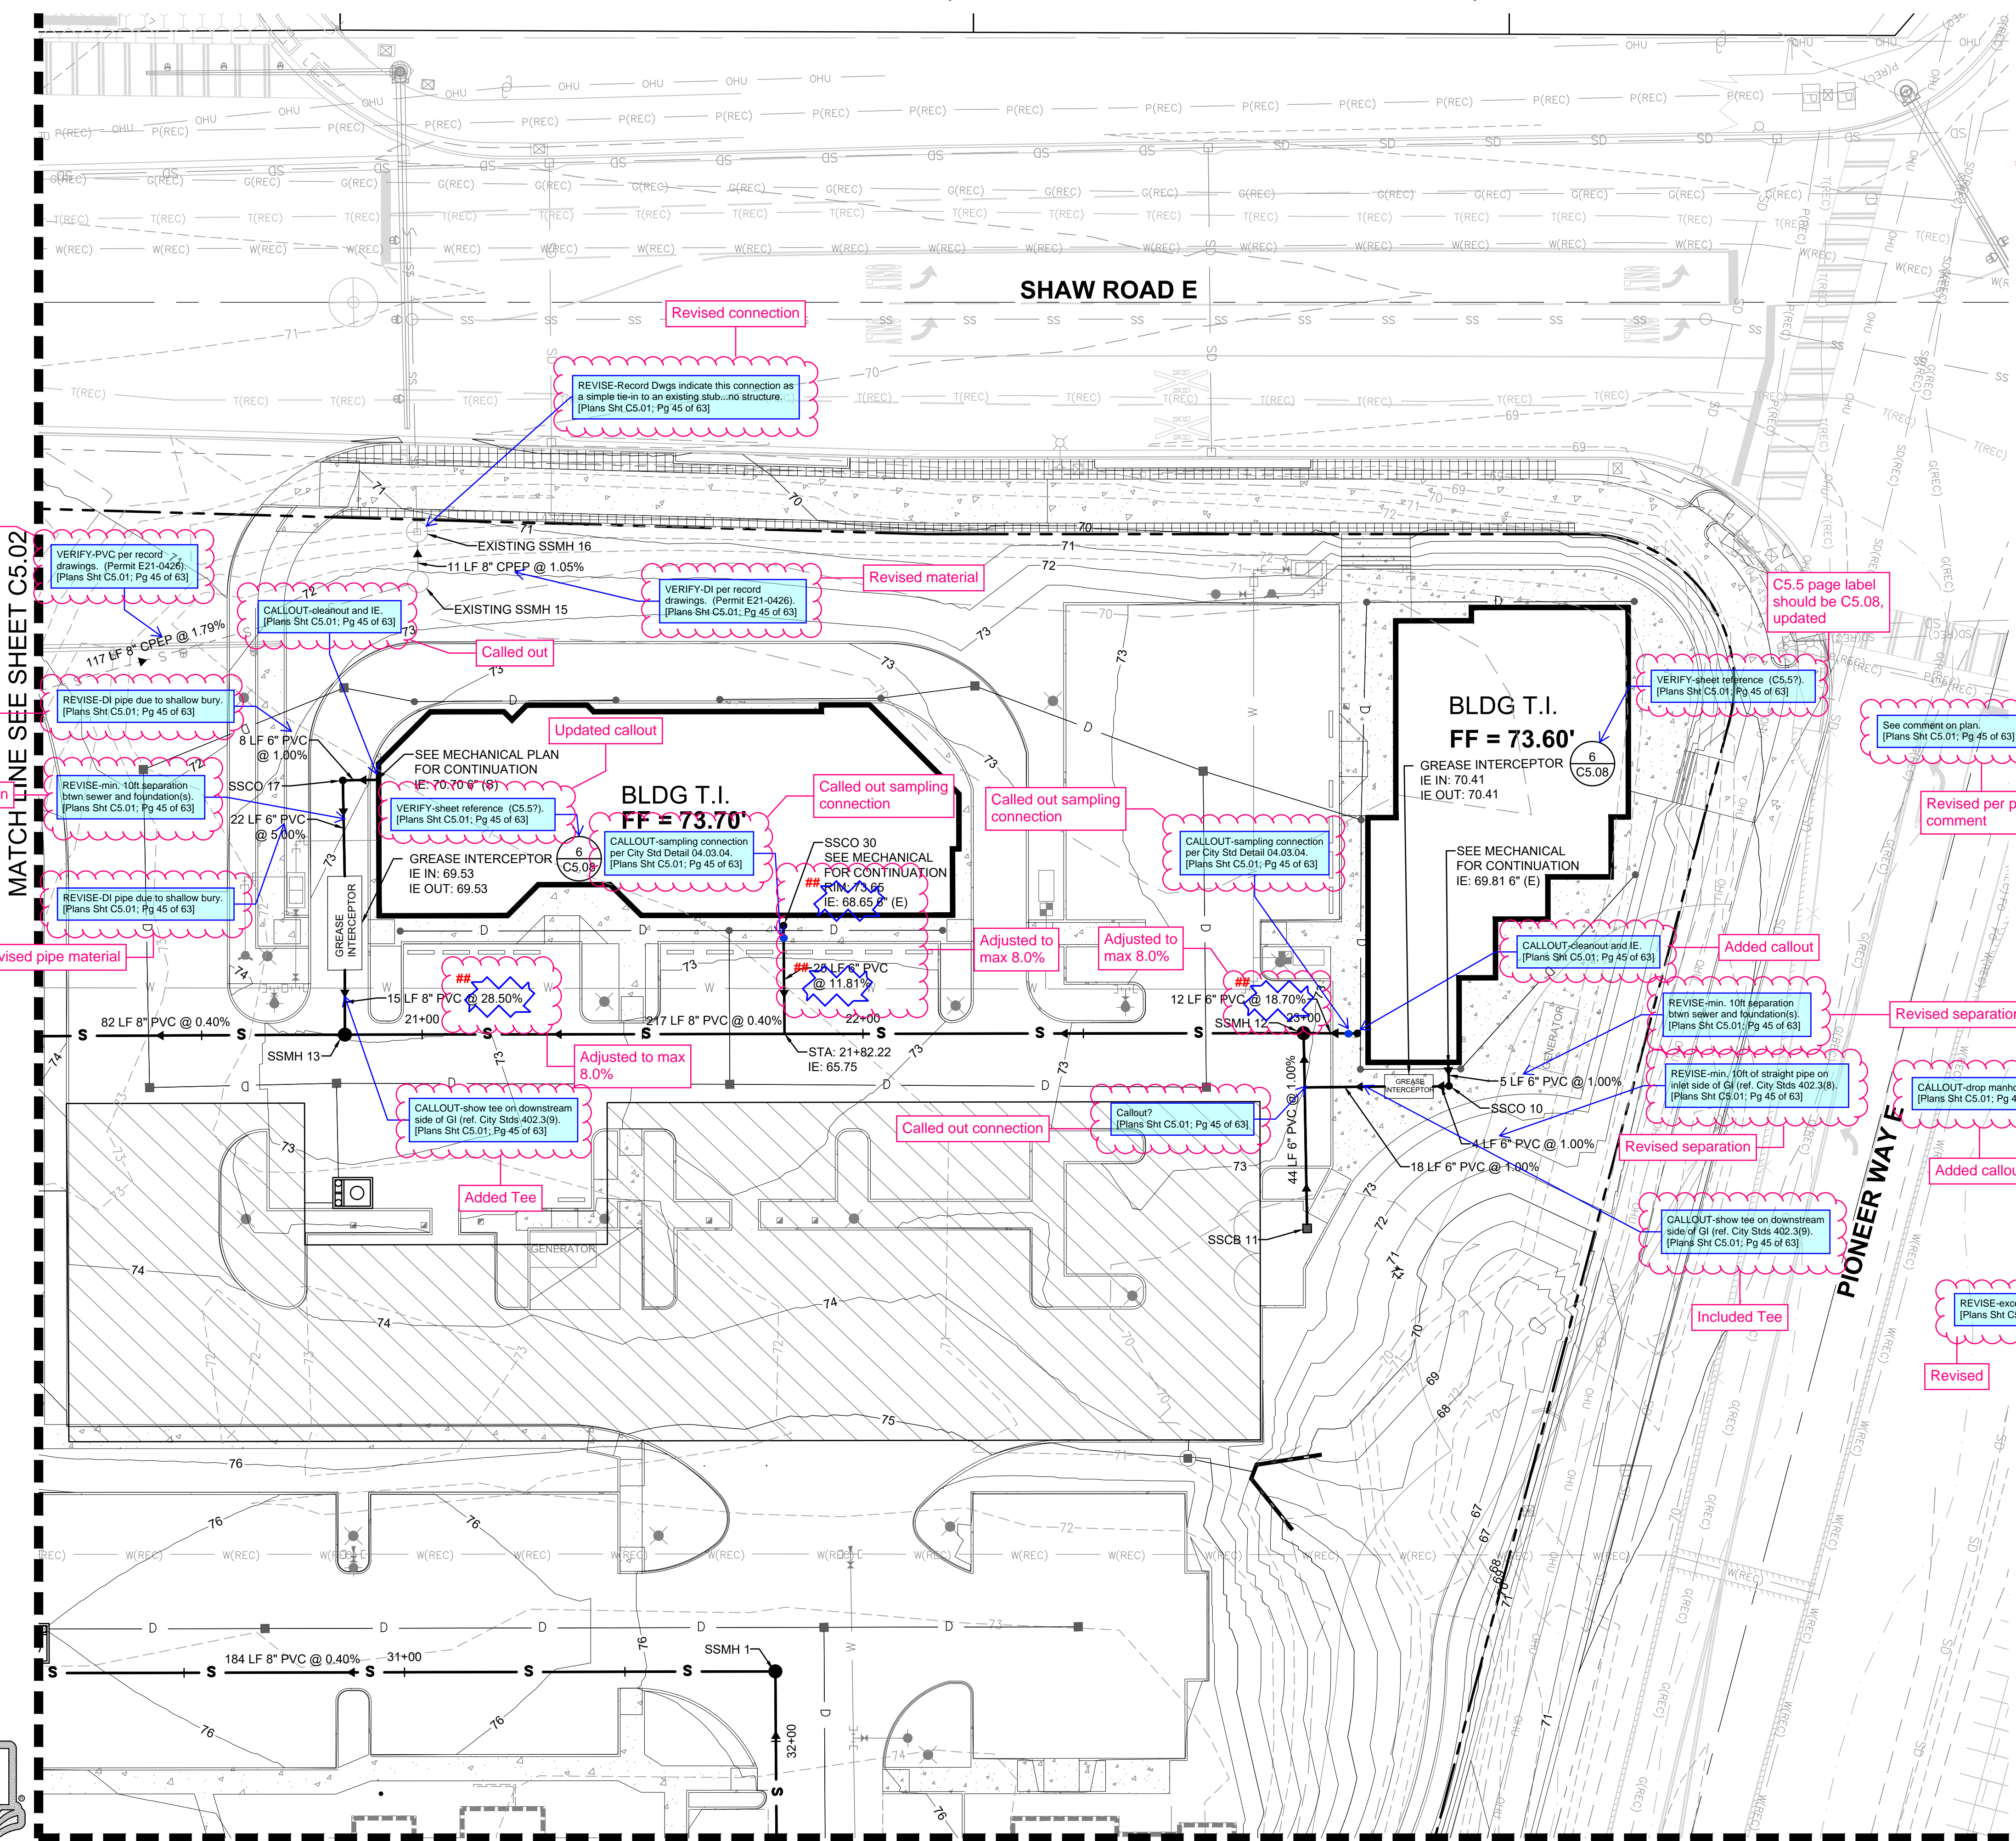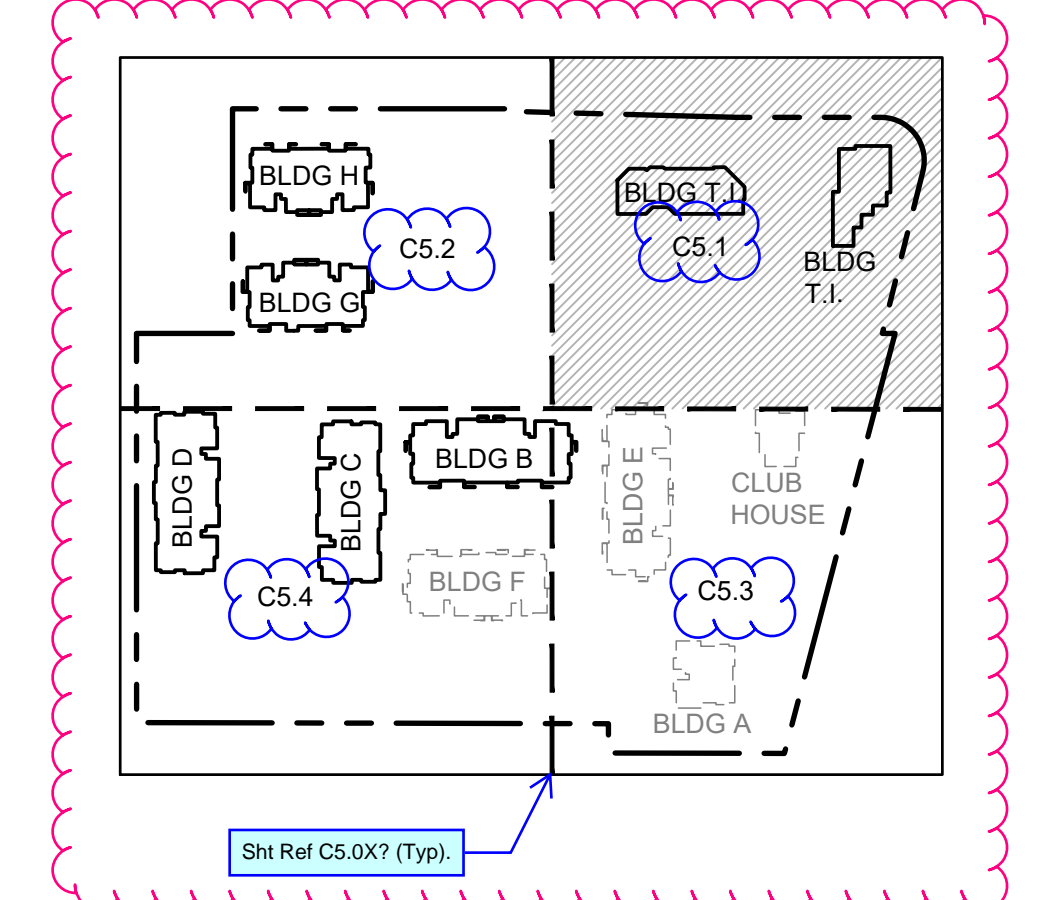

Match line SEE SHEET C5.02

Revised material

Revised pipe material

Revised separation

Revised pipe material

Match line SEE SHEET C5.03



Revisions:

Sheet Title:
SEWER PLAN NW

Designed by: CW
Drawn by: SK
Checked by: JI

Sheet No.
C5.01
45 of 63 Sheets

EAST TOWN CROSSING PHASE 1



SEC. 26,35/ TWP. 20 N./ RGE. 4 E., W.M.

APPROVED

BY: CITY OF PUYALLUP
DEVELOPMENT ENGINEERING

DATE:

NOTE: THIS APPROVAL IS VOID AFTER 180 DAYS FROM APPROVAL DATE.
THE CITY WILL NOT BE RESPONSIBLE FOR ERRORS AND/OR OMISSIONS ON THESE PLANS.
FIELD CONDITIONS MAY DICTATE CHANGES TO THESE PLANS AS DETERMINED BY THE DEVELOPMENT ENGINEERING MANAGER.

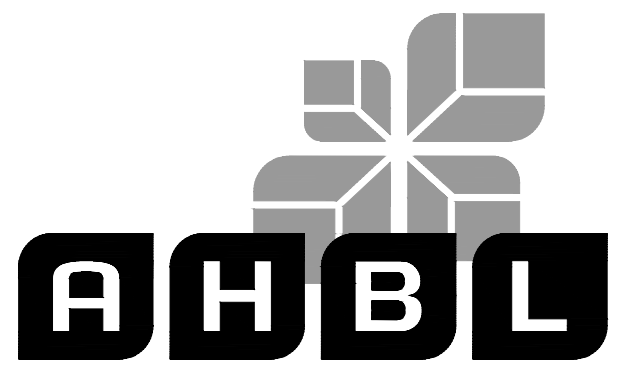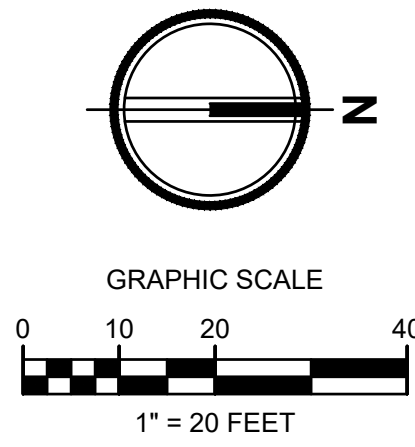

TACOMA • SEATTLE • SPOKANE • TRI-CITIES

2215 North 30th Street, Suite 300, Tacoma, WA 98403
253.383.2422 TEL 253.383.2572 FAX www.ahbl.com WEB

Project Title:

EAST TOWN CROSSING PHASE 1

Client:

ASH DEVELOPMENT

GREG HELLE

GREG.HELLE@ASHNW.COM

Project No.

2230752

Issue Set & Date:

PERMIT SUBMITTAL

11/20/2023



11/21/2023

NOTICE
A SIGNATURE OF THIS DOCUMENT SHALL VALIDATE THE PROFESSIONAL SEAL AND SIGNATURE. PUBLICATION OF THIS DOCUMENT DOES NOT CONSTITUTE A REVIEWED OR APPROVED PROJECT. THE DRAWING OR REVISED DRAWING MUST BE USED FOR THE PROJECT. THIS BLOCK MAY NOT BE USED FOR ANY OTHER PROJECT, OR ADDED TO THAT PROJECT FOR ANY OTHER PROJECT.

REVISE: side sewer IE. [Plans Sht C5.02; Pg 46 of 63]

Revised connection



LEGEND

- RIGHT-OF-WAY / PROPERTY LINE
- CENTERLINE
- EASEMENT
- BUILDING OUTLINE
- S --- SANITARY SIDE SEWER
- S --- SANITARY SEWER MAIN
- FM --- SANITARY SEWER FORCE MAIN
- --- SANITARY SEWER CLEANOUT
- --- SANITARY SEWER MANHOLE
- 123 --- PROPOSED MINOR CONTOUR
- 123 --- PROPOSED MAJOR CONTOUR

SEWER STRUCTURE TABLE	
STRUCTURE NAME	STRUCTURE DETAILS
EXISTING SSMH 14	RIM = 76.75
EXISTING SSMH 48"	IE = 64.46 (8" N)
N 679809.71	IE = 64.53 (8" E)
E 1203855.61	
SSCB 5	RIM = 75.95
N 679490.51	IE = 70.04 (6" E)
E 1204032.97	
SSCO 7	RIM = 76.72
N 679553.05	IE = 67.46 (8" N)
E 1203914.74	
SSCO 18	RIM = 76.15
N 679490.00	IE = 69.71 (6" N)
E 1204065.50	IE = 69.71 (6" W)
SSMH 2	RIM = 76.47
48" TYPE 1	IE = 65.50 (8" W)
N 679814.92	IE = 65.60 (8" N)
E 1204071.02	IE = 65.60 (8" S)
	IE = 65.50 (6" E)
SSMH 3	RIM = 76.13
48" TYPE 1	IE = 64.82 (8" W)
N 679821.72	IE = 64.92 (8" E)
E 1203926.62	IE = 64.92 (8" N)
SSMH 6	RIM = 75.88
48" SSMH	IE = 69.10 (8" N)
N 679540.98	IE = 69.20 (8" E)
E 1204066.28	IE = 69.20 (6" S)
SSMH 8	RIM = 76.55
48" TYPE 1	IE = 66.90 (8" E)
N 679669.89	IE = 67.00 (8" S)
E 1203916.63	
SSMH 9	RIM = 76.69
48" TYPE 1	IE = 66.34 (8" N)
N 679667.05	IE = 66.44 (8" S)
E 1204068.46	IE = 66.44 (8" W)

GENERAL NOTE

- SEE DETAILS AS NOTED ON SHEET C5.5
- SIDE SEWER CLEANOUT PLACED IN DRIVEWAY SEE DETAIL 1
- INSIDE DROP FOR SANITARY SEWER MANHOLE SEE DETAIL 2 AND 3
- SANITARY SEWER MANHOLE SEE DETAIL 4

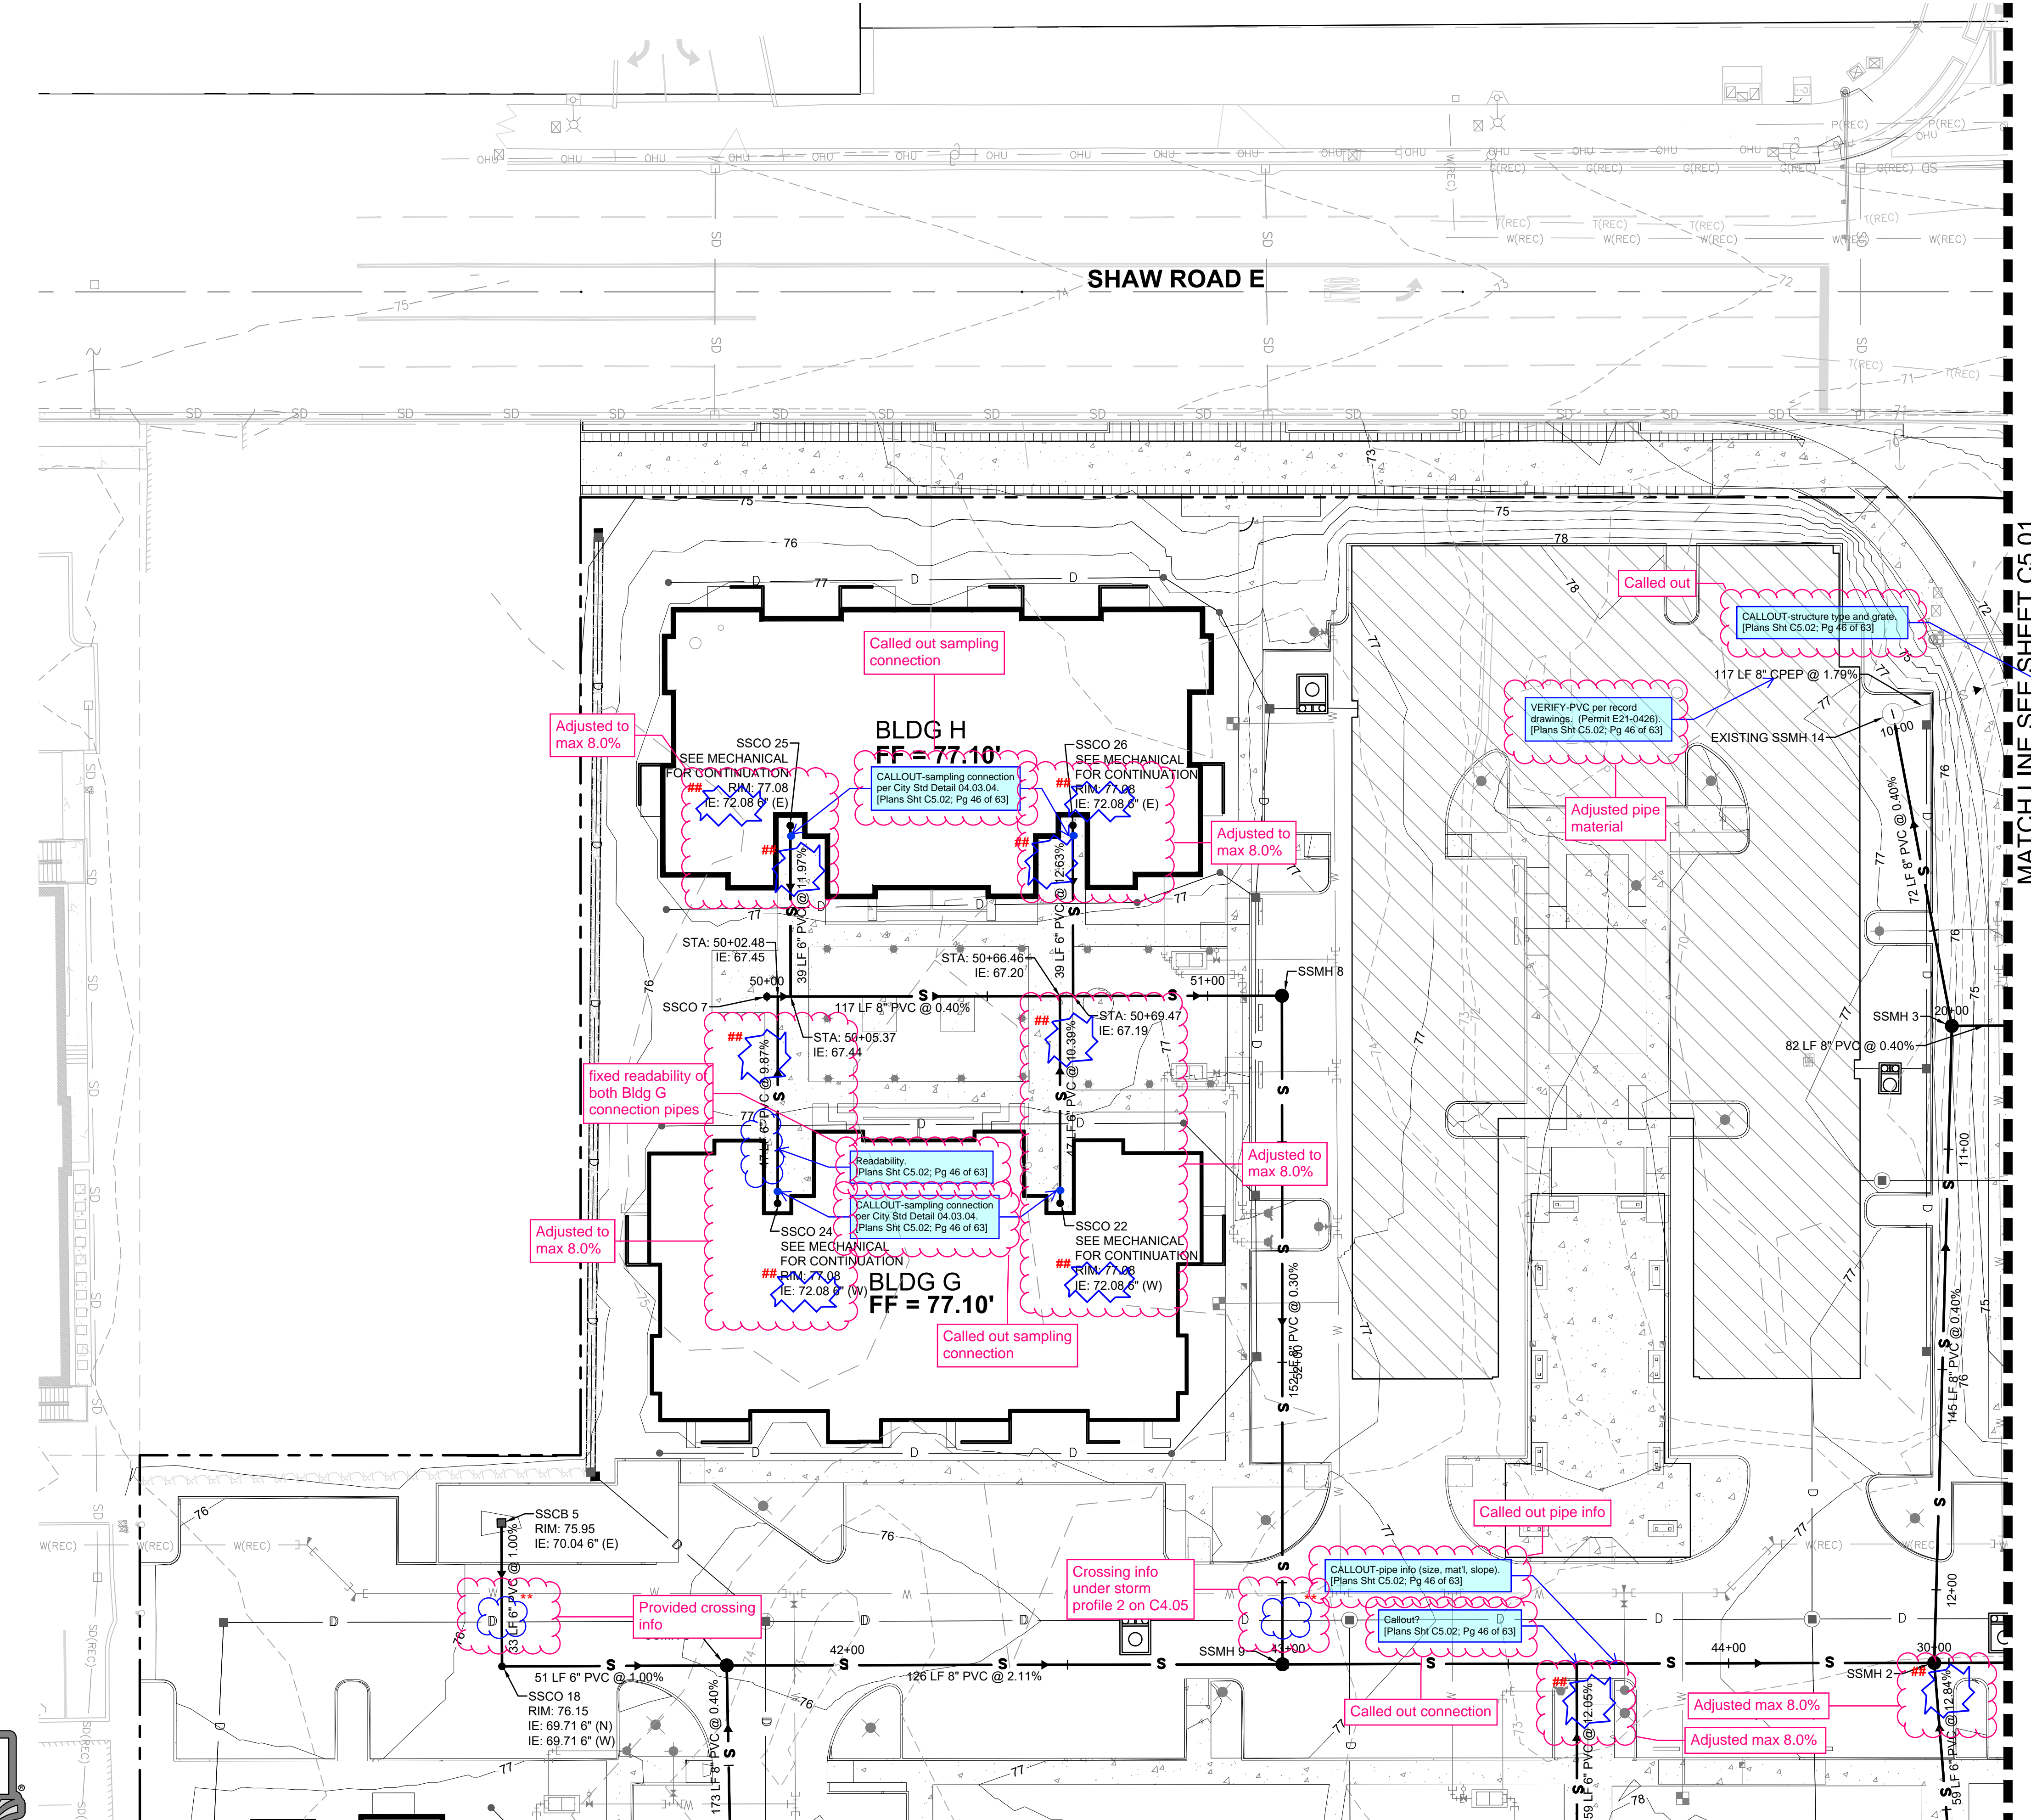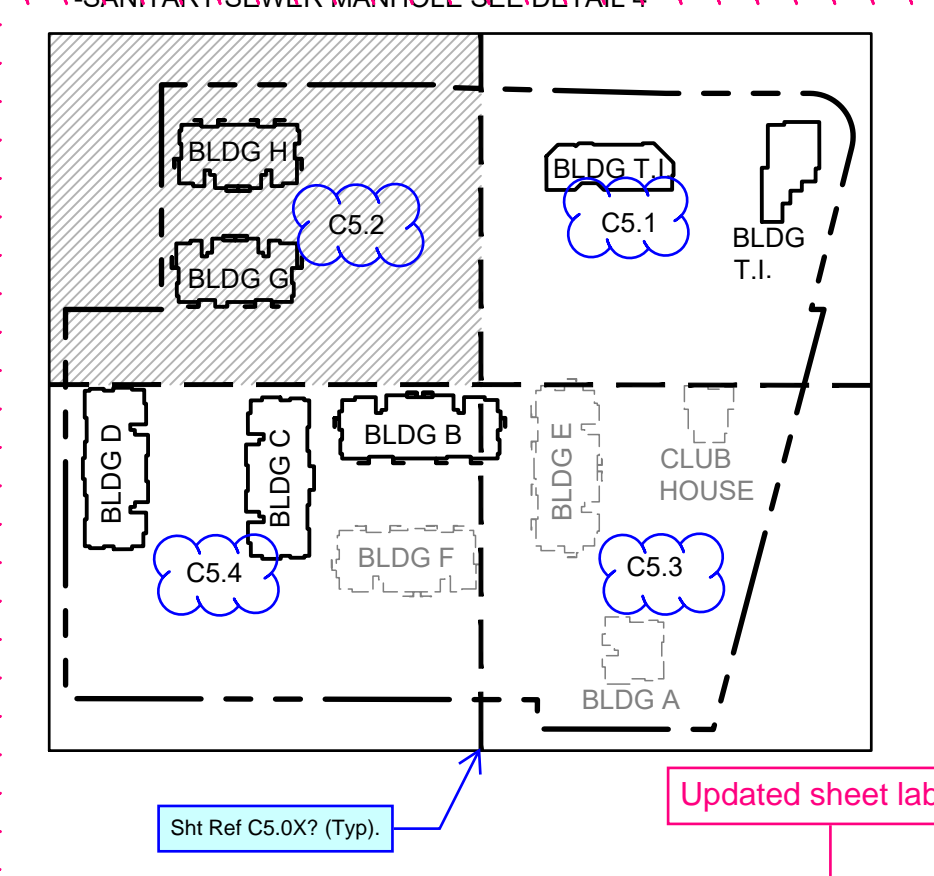

MATCH LINE SEE SHEET C5.01

MATCH LINE SEE SHEET C5.04



Know what's below.
Call before you dig.

Sheet Title:

SEWER PLAN SW

Designed by: CW
Drawn by: SK
Checked by: JI

Sheet No.

C5.02

46 of 63 Sheets



EAST TOWN CROSSING PHASE 1

SEC. 26,35/ TWP. 20 N./ RGE. 4 E., W.M.

APPROVED

BY: CITY OF PUYALLUP
DEVELOPMENT ENGINEERING
DATE:

NOTE: THIS APPROVAL IS VOID AFTER 180 DAYS FROM APPROVAL DATE. THE CITY WILL NOT BE RESPONSIBLE FOR ERRORS AND/OR OMISSIONS ON THESE PLANS. FIELD CONDITIONS MAY DICTATE CHANGES TO THESE PLANS AS DETERMINED BY THE DEVELOPMENT ENGINEERING MANAGER.

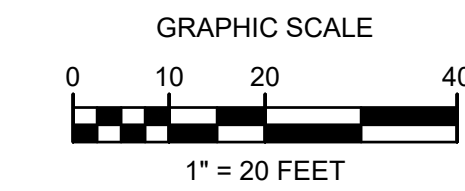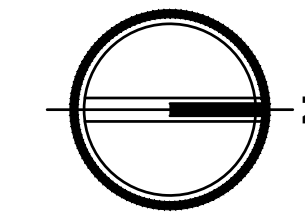

Service lateral exceeds max. grade (8% max). Revise accordingly. [Plans Sht C5.03, Pg 47 of 63]


Provide utility crossing information. [Plans Sht C5.03, Pg 47 of 63]

LEGEND

- RIGHT-OF-WAY / PROPERTY LINE
- CENTERLINE
- - - EASEMENT
- BUILDING OUTLINE
- S — SANITARY SIDE SEWER
- S — SANITARY SEWER MAIN
- FM — SANITARY SEWER FORCE MAIN
- — SANITARY SEWER CLEANOUT
- — SANITARY SEWER MANHOLE
- 123 — PROPOSED MINOR CONTOUR
- 123 — PROPOSED MAJOR CONTOUR

GENERAL NOTE

- SEE DETAILS AS NOTED ON SHEET C5.5
- SIDE SEWER CLEANOUT PLACED IN DRIVEWAY SEE DETAIL 1
- INSIDE DROP FOR SANITARY SEWER MANHOLE SEE DETAIL 2 AND 3
- SANITARY SEWER MANHOLE SEE DETAIL 4

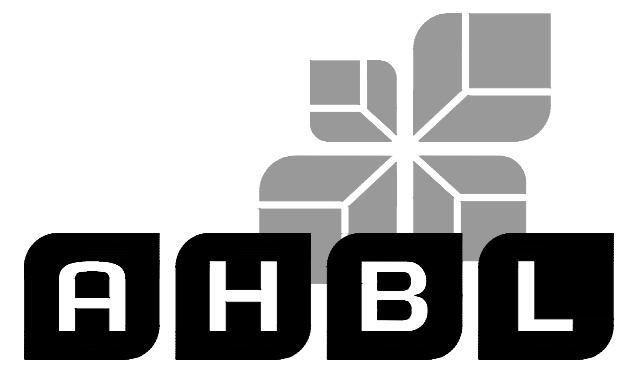

TACOMA • SEATTLE • SPOKANE • TRI-CITIES
2215 North 30th Street, Suite 300, Tacoma, WA 98403
253.383.2422 TEL 253.383.2572 FAX www.ahbl.com WEB


Project Title:
EAST TOWN CROSSING PHASE 1

Client:
ASH DEVELOPMENT

GREG HELLE
GREG.HELLE@ASHNW.COM


Project No.
2230752

Issue Set & Date:
PERMIT SUBMITTAL
11/20/2023

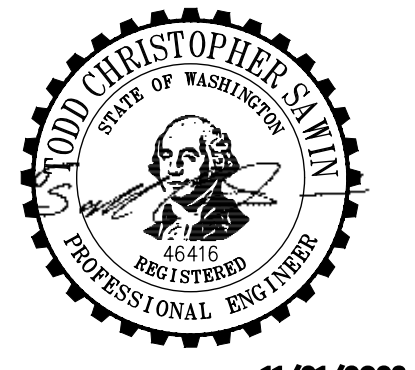


11/21/2023

NOTICE

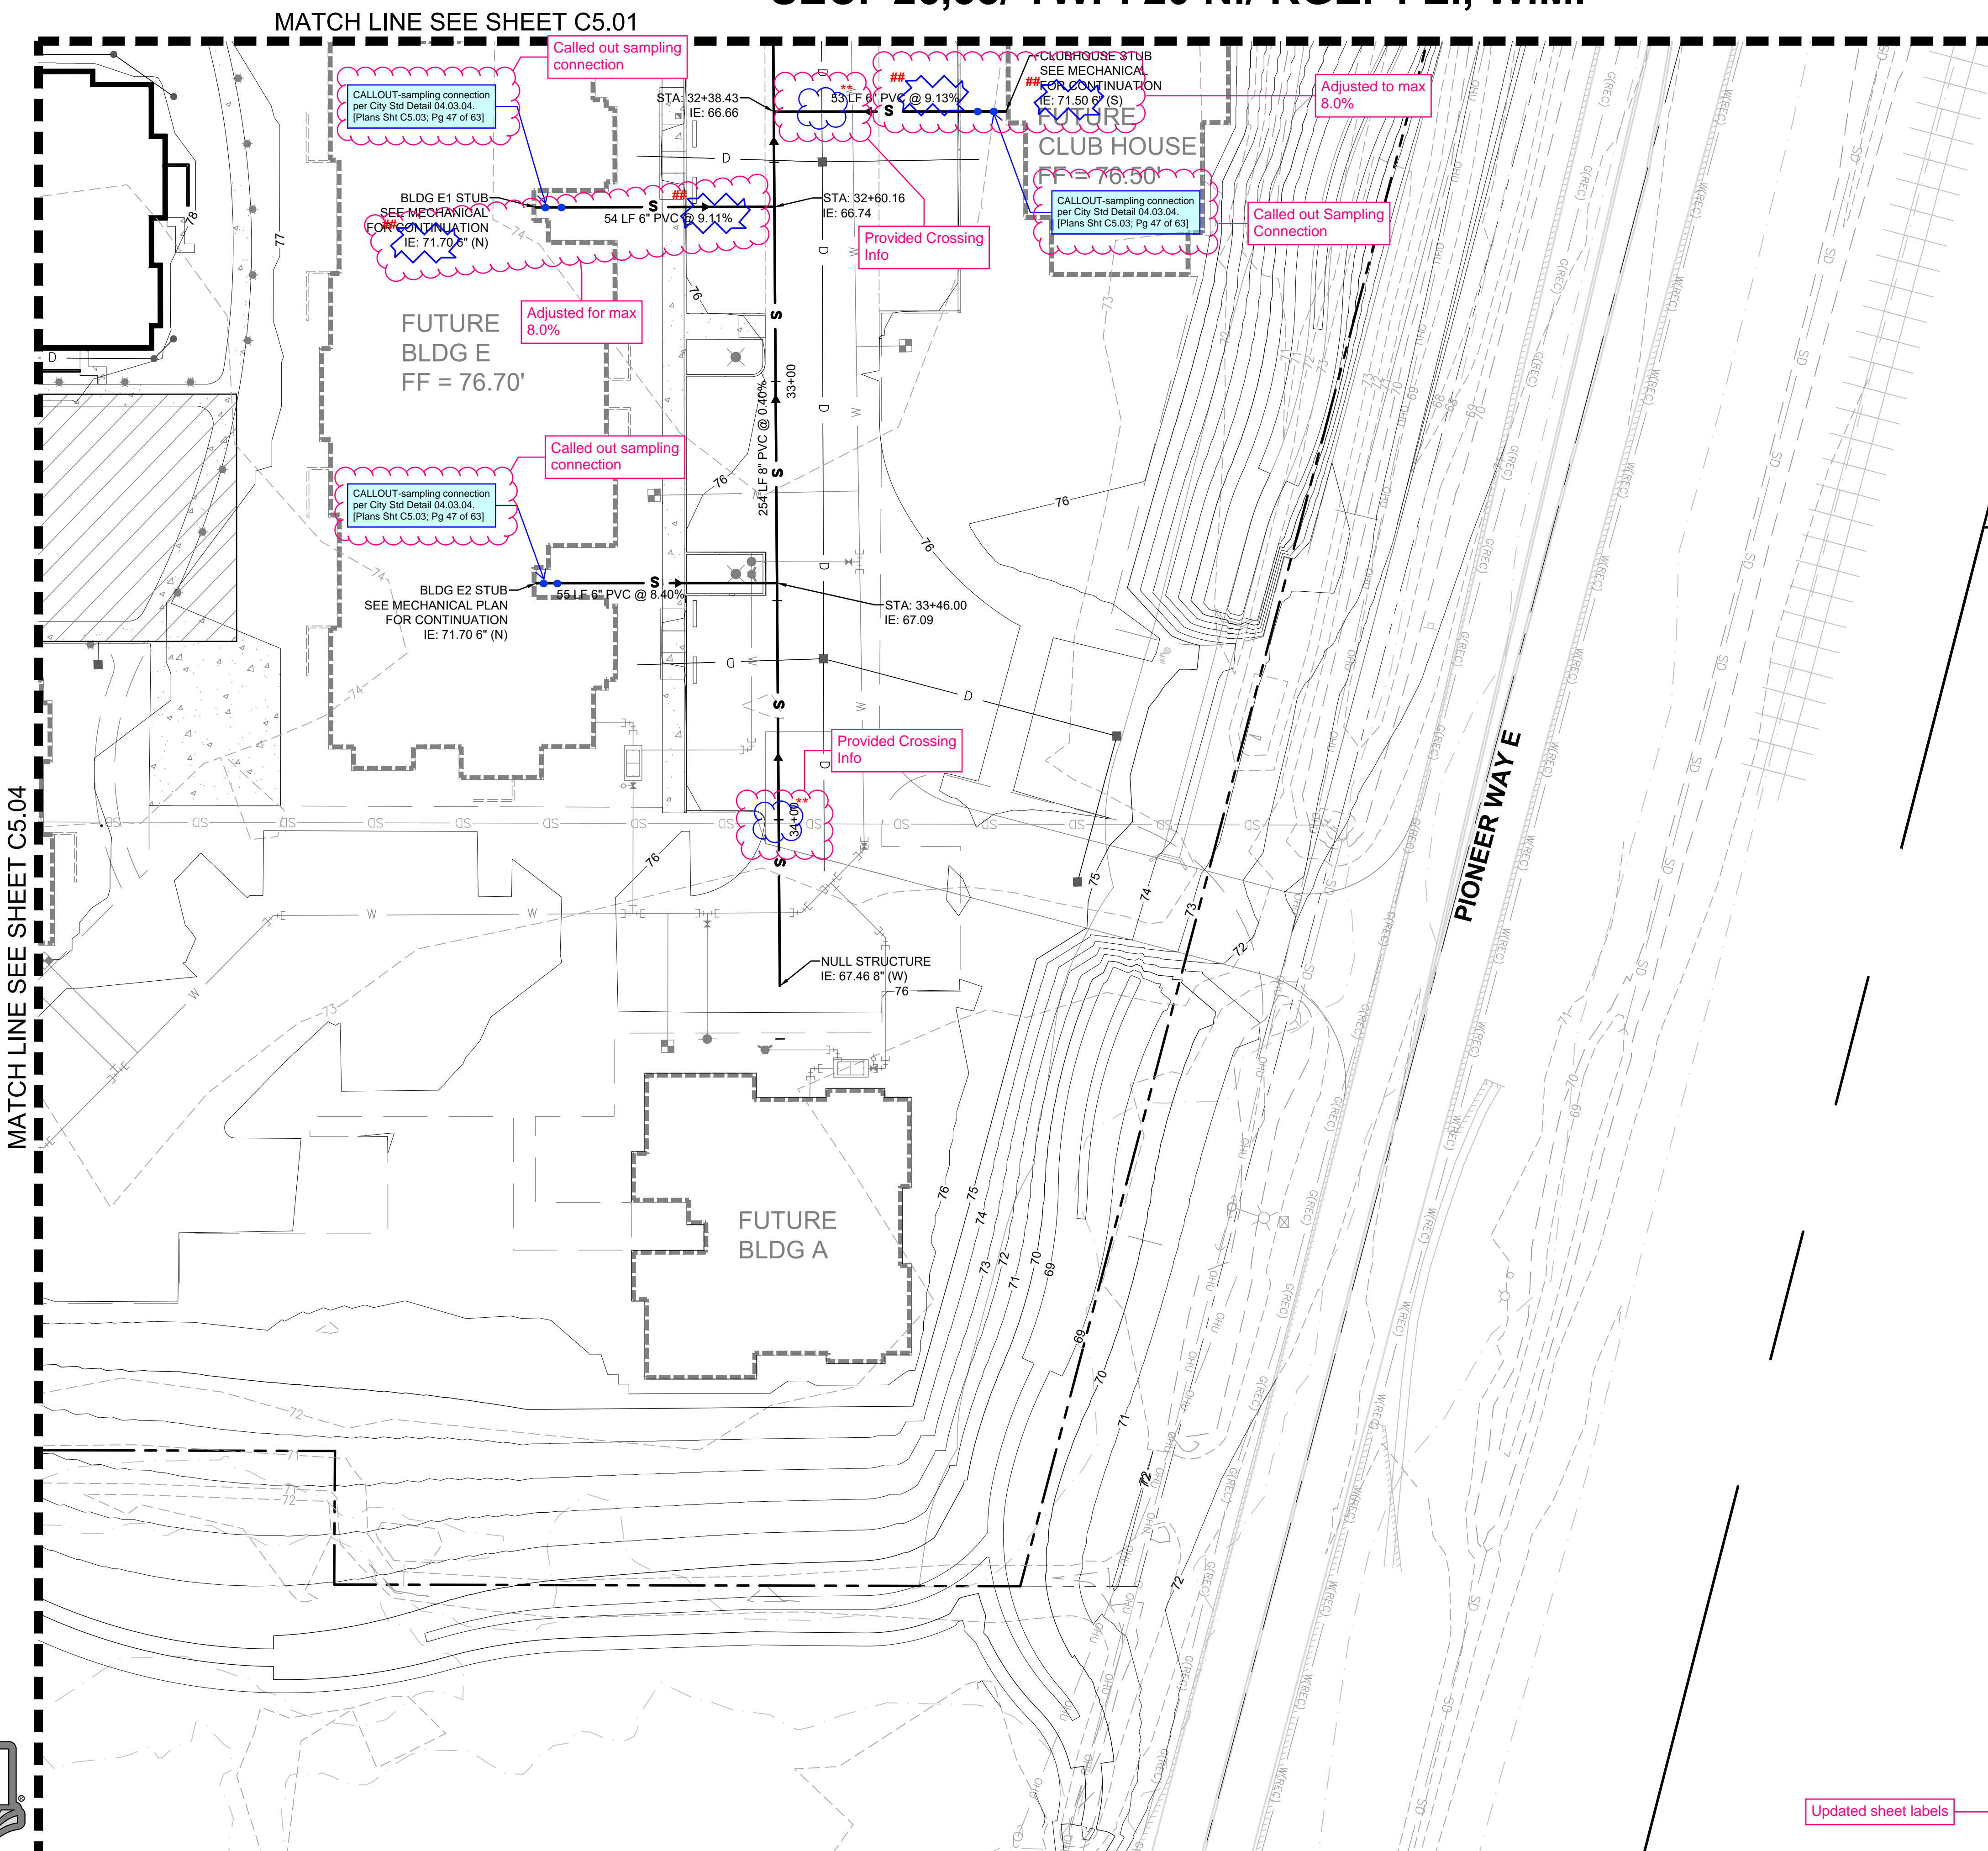

MATCH LINE SEE SHEET C5.04

MATCH LINE SEE SHEET C5.01

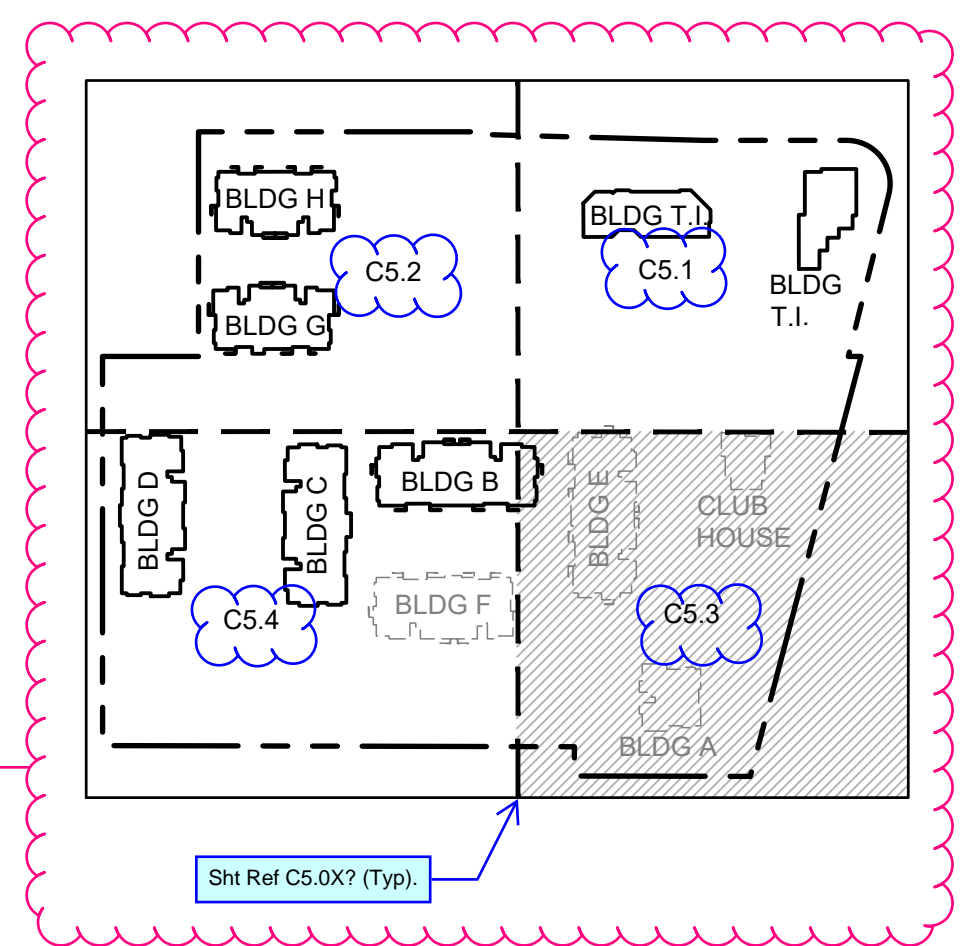

Updated sheet labels

Revisions:

Sheet Title:
SEWER PLAN NE

Designed by: CW
Drawn by: SK
Checked by: JI

Sheet No.
C5.03
47 of 63 Sheets


EAST TOWN CROSSING PHASE 1

SEC. 26,35/ TWP. 20 N./ RGE. 4 E., W.M.

APPROVED

BY: CITY OF PUYALLUP
DEVELOPMENT ENGINEERING
DATE:

NOTE: THIS APPROVAL IS VOID AFTER 180 DAYS FROM APPROVAL DATE. THE CITY WILL NOT BE RESPONSIBLE FOR ERRORS AND/OR OMISSIONS ON THESE PLANS. FIELD CONDITIONS MAY DICTATE CHANGES TO THESE PLANS AS DETERMINED BY THE DEVELOPMENT ENGINEERING MANAGER.

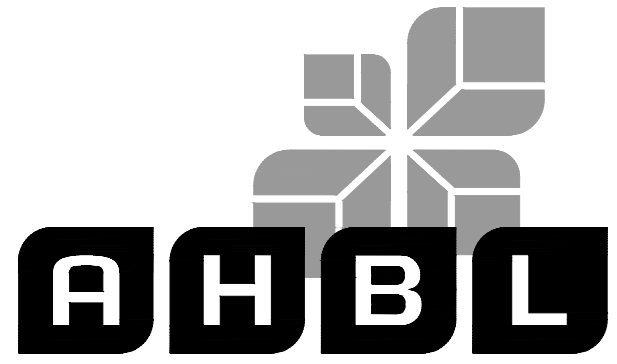

TACOMA · SEATTLE · SPOKANE · TRI-CITIES
2215 North 30th Street, Suite 300, Tacoma, WA 98403
253.383.2422 TEL 253.383.2572 FAX www.ahbl.com WEB

Project Title:
EAST TOWN CROSSING PHASE 1

Client:
ASH DEVELOPMENT

GREG HELLE
GREG.HELLE@ASHNW.COM

Project No.
2230752


Issue Set & Date:
PERMIT SUBMITTAL
11/20/2023





11/21/2023


MATCH LINE SEE SHEET C5.02

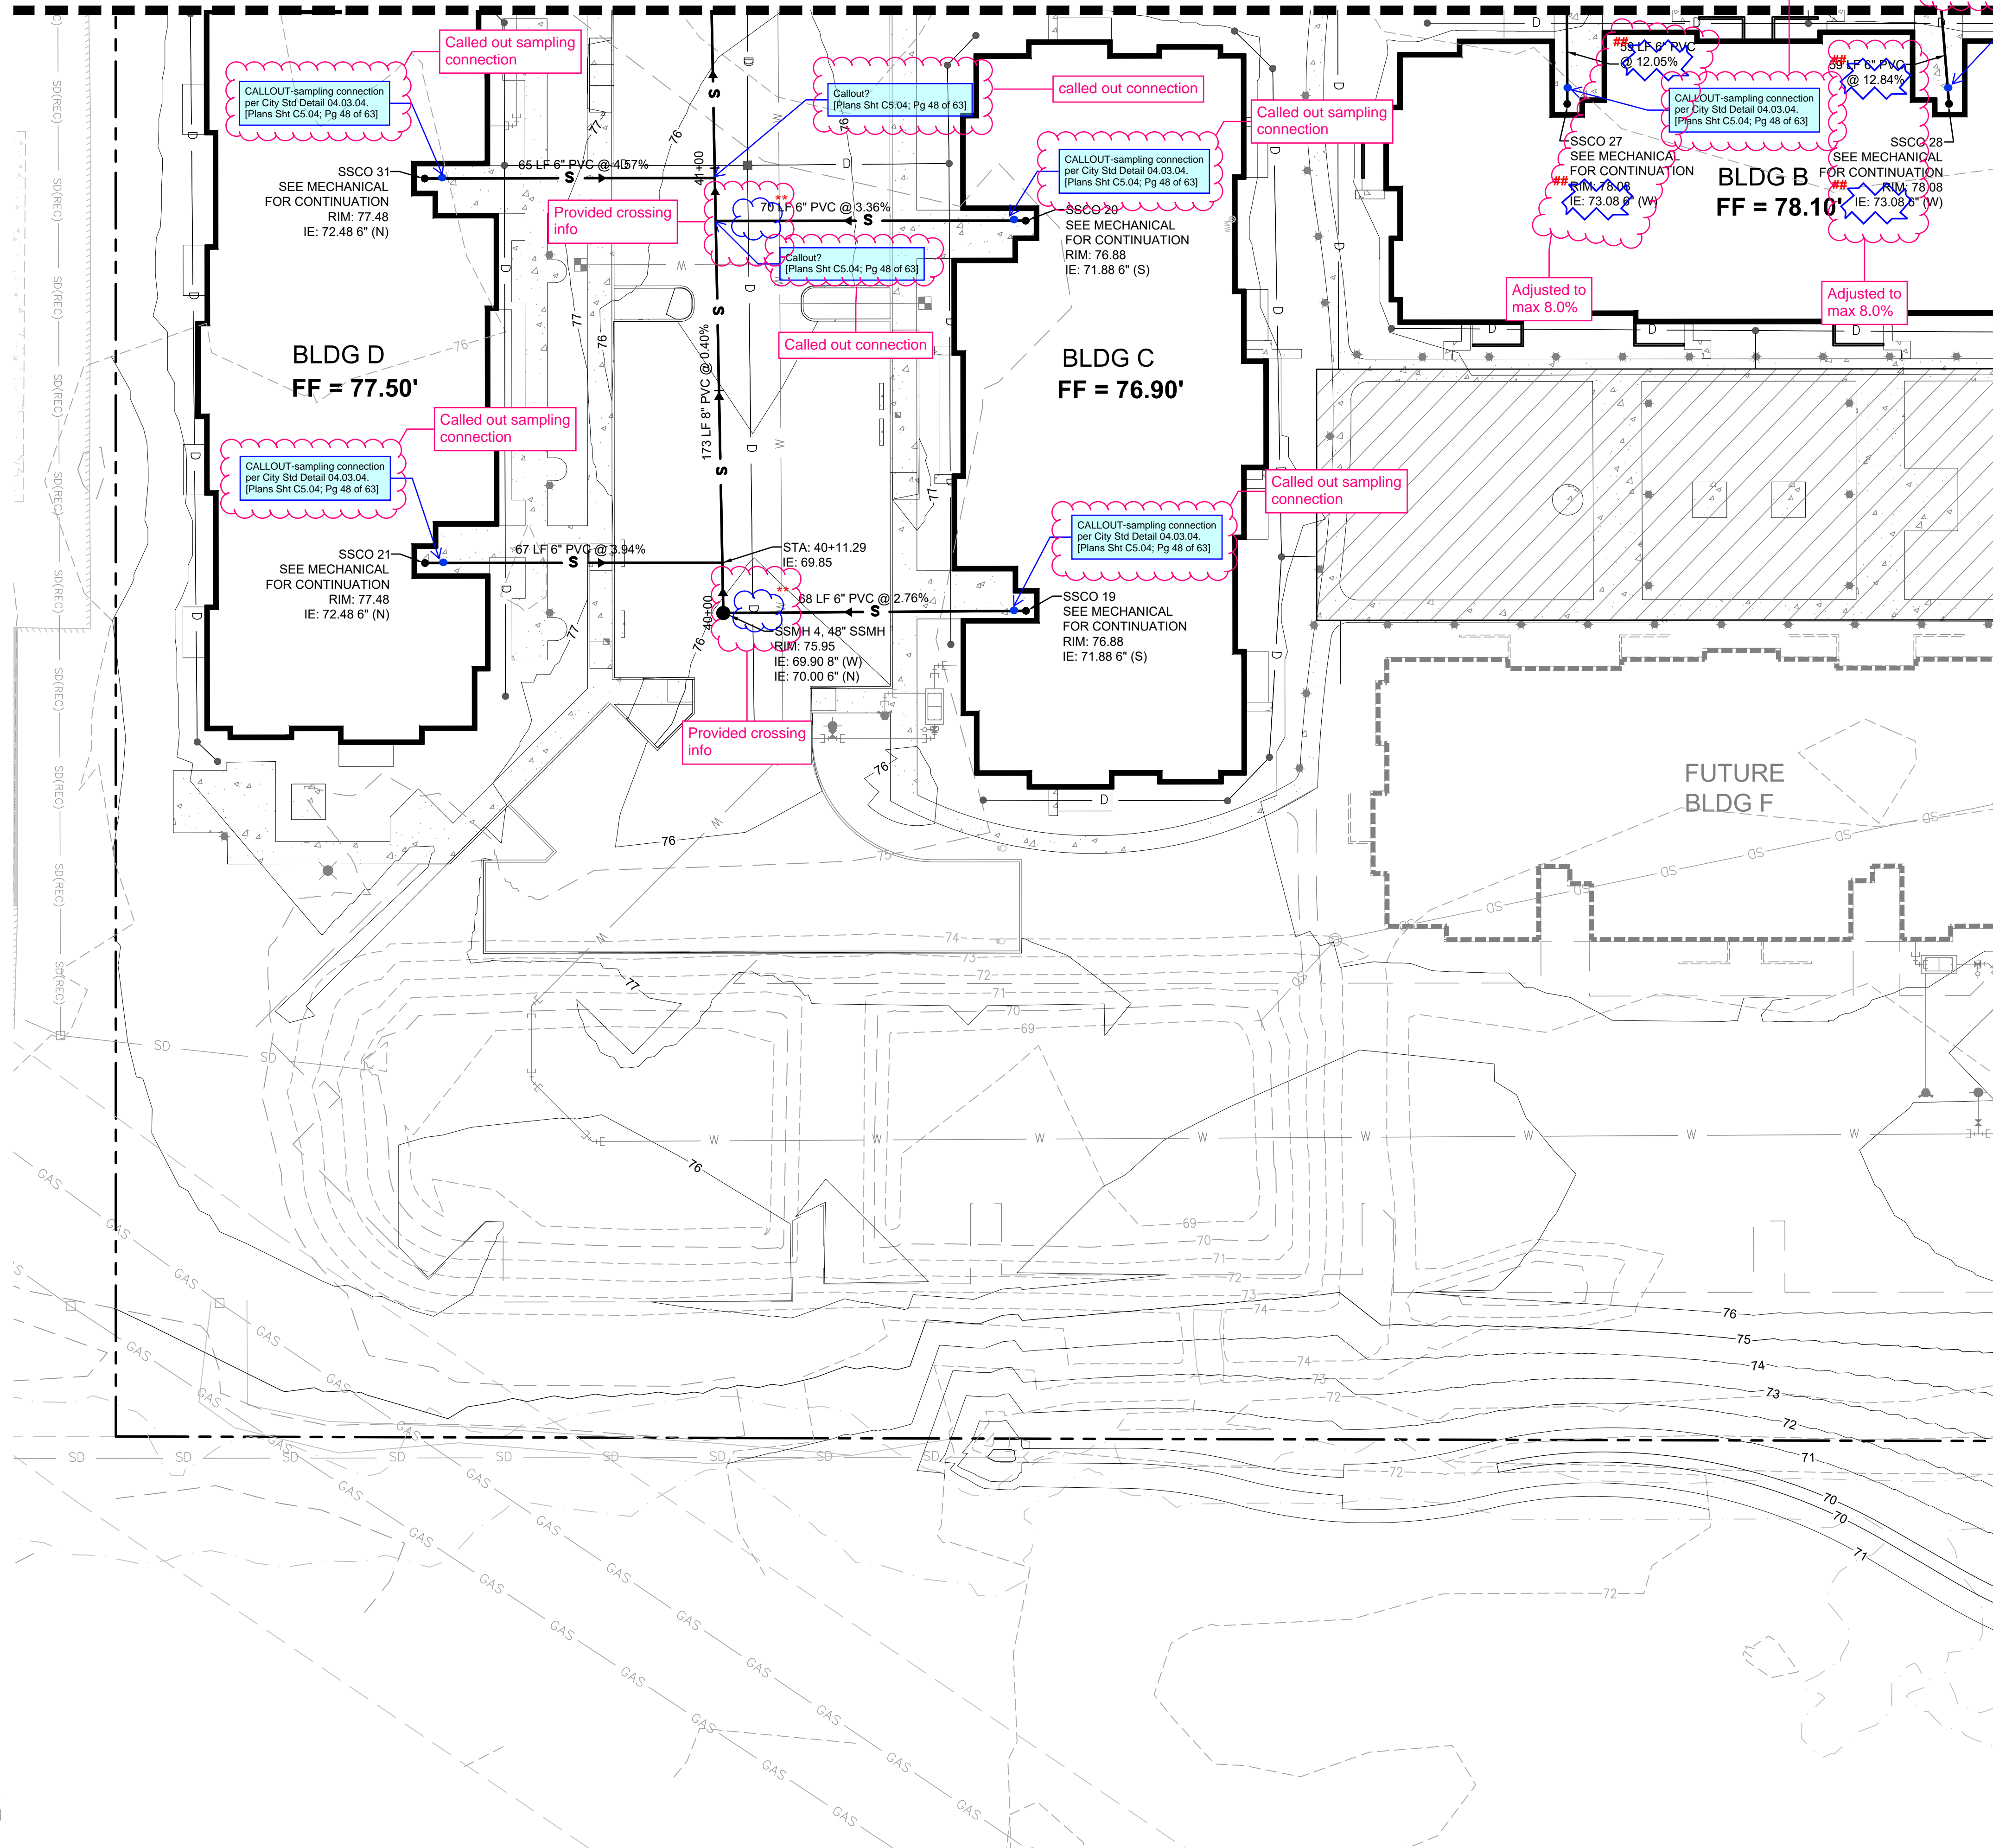


MATCH LINE SEE SHEET C5.03

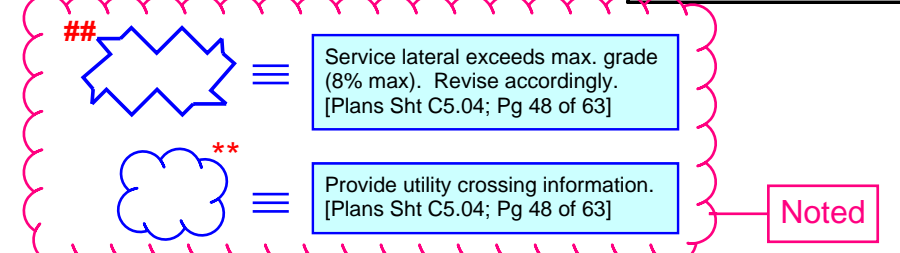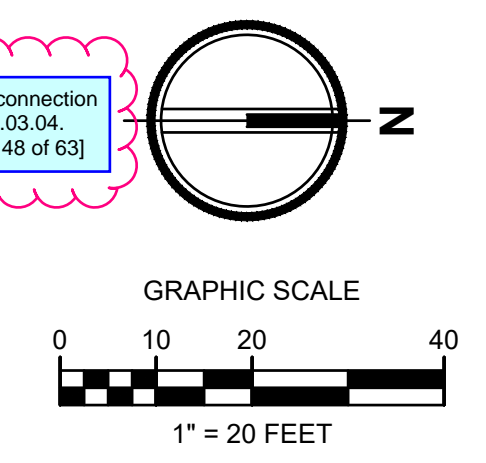

- LEGEND**
- RIGHT-OF-WAY / PROPERTY LINE
 - - - CENTERLINE
 - - - EASEMENT
 - BUILDING OUTLINE
 - S SANITARY SIDE SEWER
 - S SANITARY SEWER MAIN
 - FM SANITARY SEWER FORCE MAIN
 - SANITARY SEWER CLEANOUT
 - SANITARY SEWER MANHOLE
 - 123 PROPOSED MINOR CONTOUR
 - 123 PROPOSED MAJOR CONTOUR

GENERAL NOTE
SEE DETAILS AS NOTED ON SHEET C5.5
-SIDE SEWER CLEANOUT PLACED IN DRIVEWAY SEE DETAIL 1
-INSIDE DROP FOR SANITARY SEWER MANHOLE SEE DETAIL 2 AND 3
-SANITARY SEWER MANHOLE SEE DETAIL 4

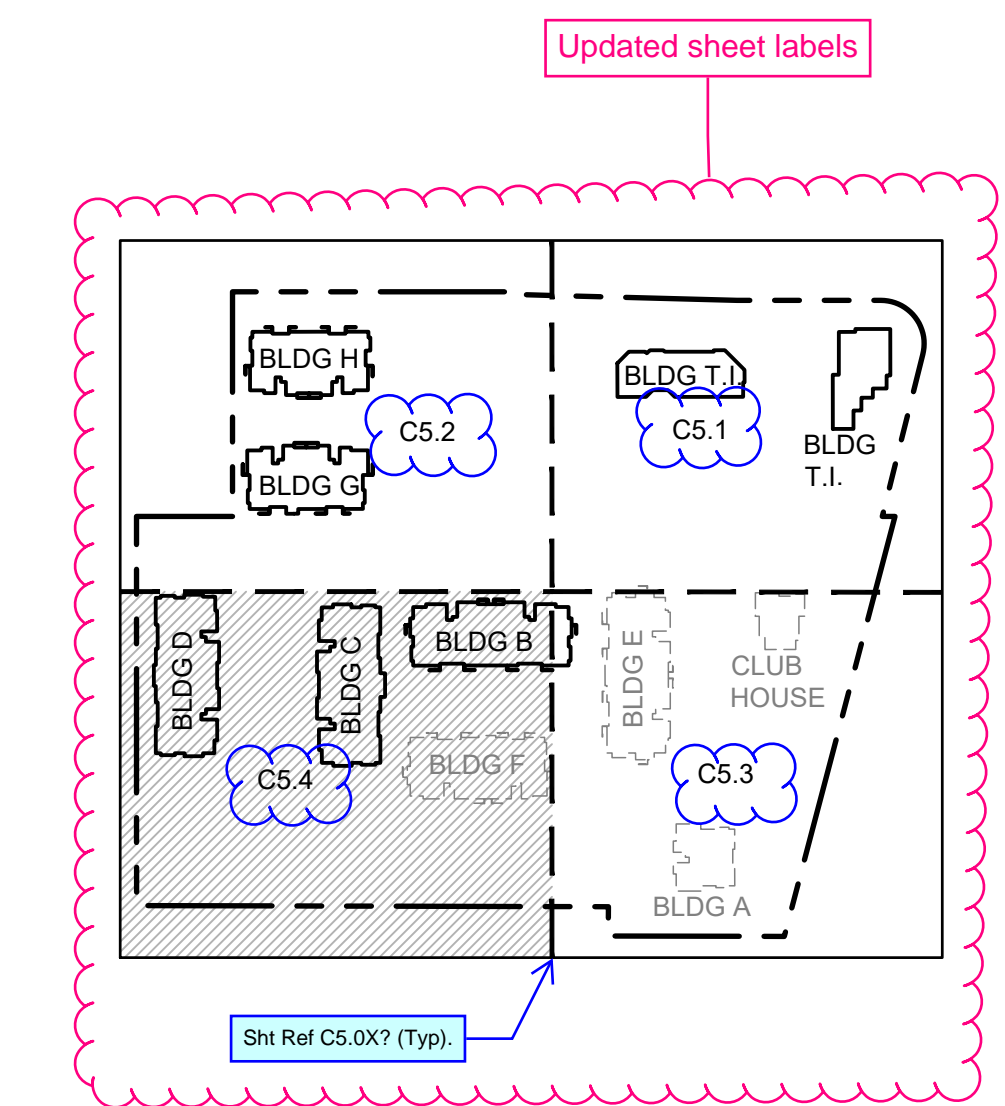

Revisions:

Sheet Title:

SEWER PLAN SE

Designed by: CW Drawn by: SK Checked by: JI

Sheet No.

C5.04

48 of 63 Sheets



EAST TOWN CROSSING PHASE 1



SEC. 26,35/ TWP. 20 N./ RGE. 4 E., W.M.

APPROVED

BY _____
CITY OF PUYALLUP
DEVELOPMENT ENGINEERING

DATE _____

NOTE: THIS APPROVAL IS VOID AFTER 180 DAYS FROM APPROVAL DATE. THE CITY WILL NOT BE RESPONSIBLE FOR ERRORS AND/OR OMISSIONS ON THESE PLANS. FIELD CONDITIONS MAY DICTATE CHANGES TO THESE PLANS AS DETERMINED BY THE DEVELOPMENT ENGINEERING MANAGER.

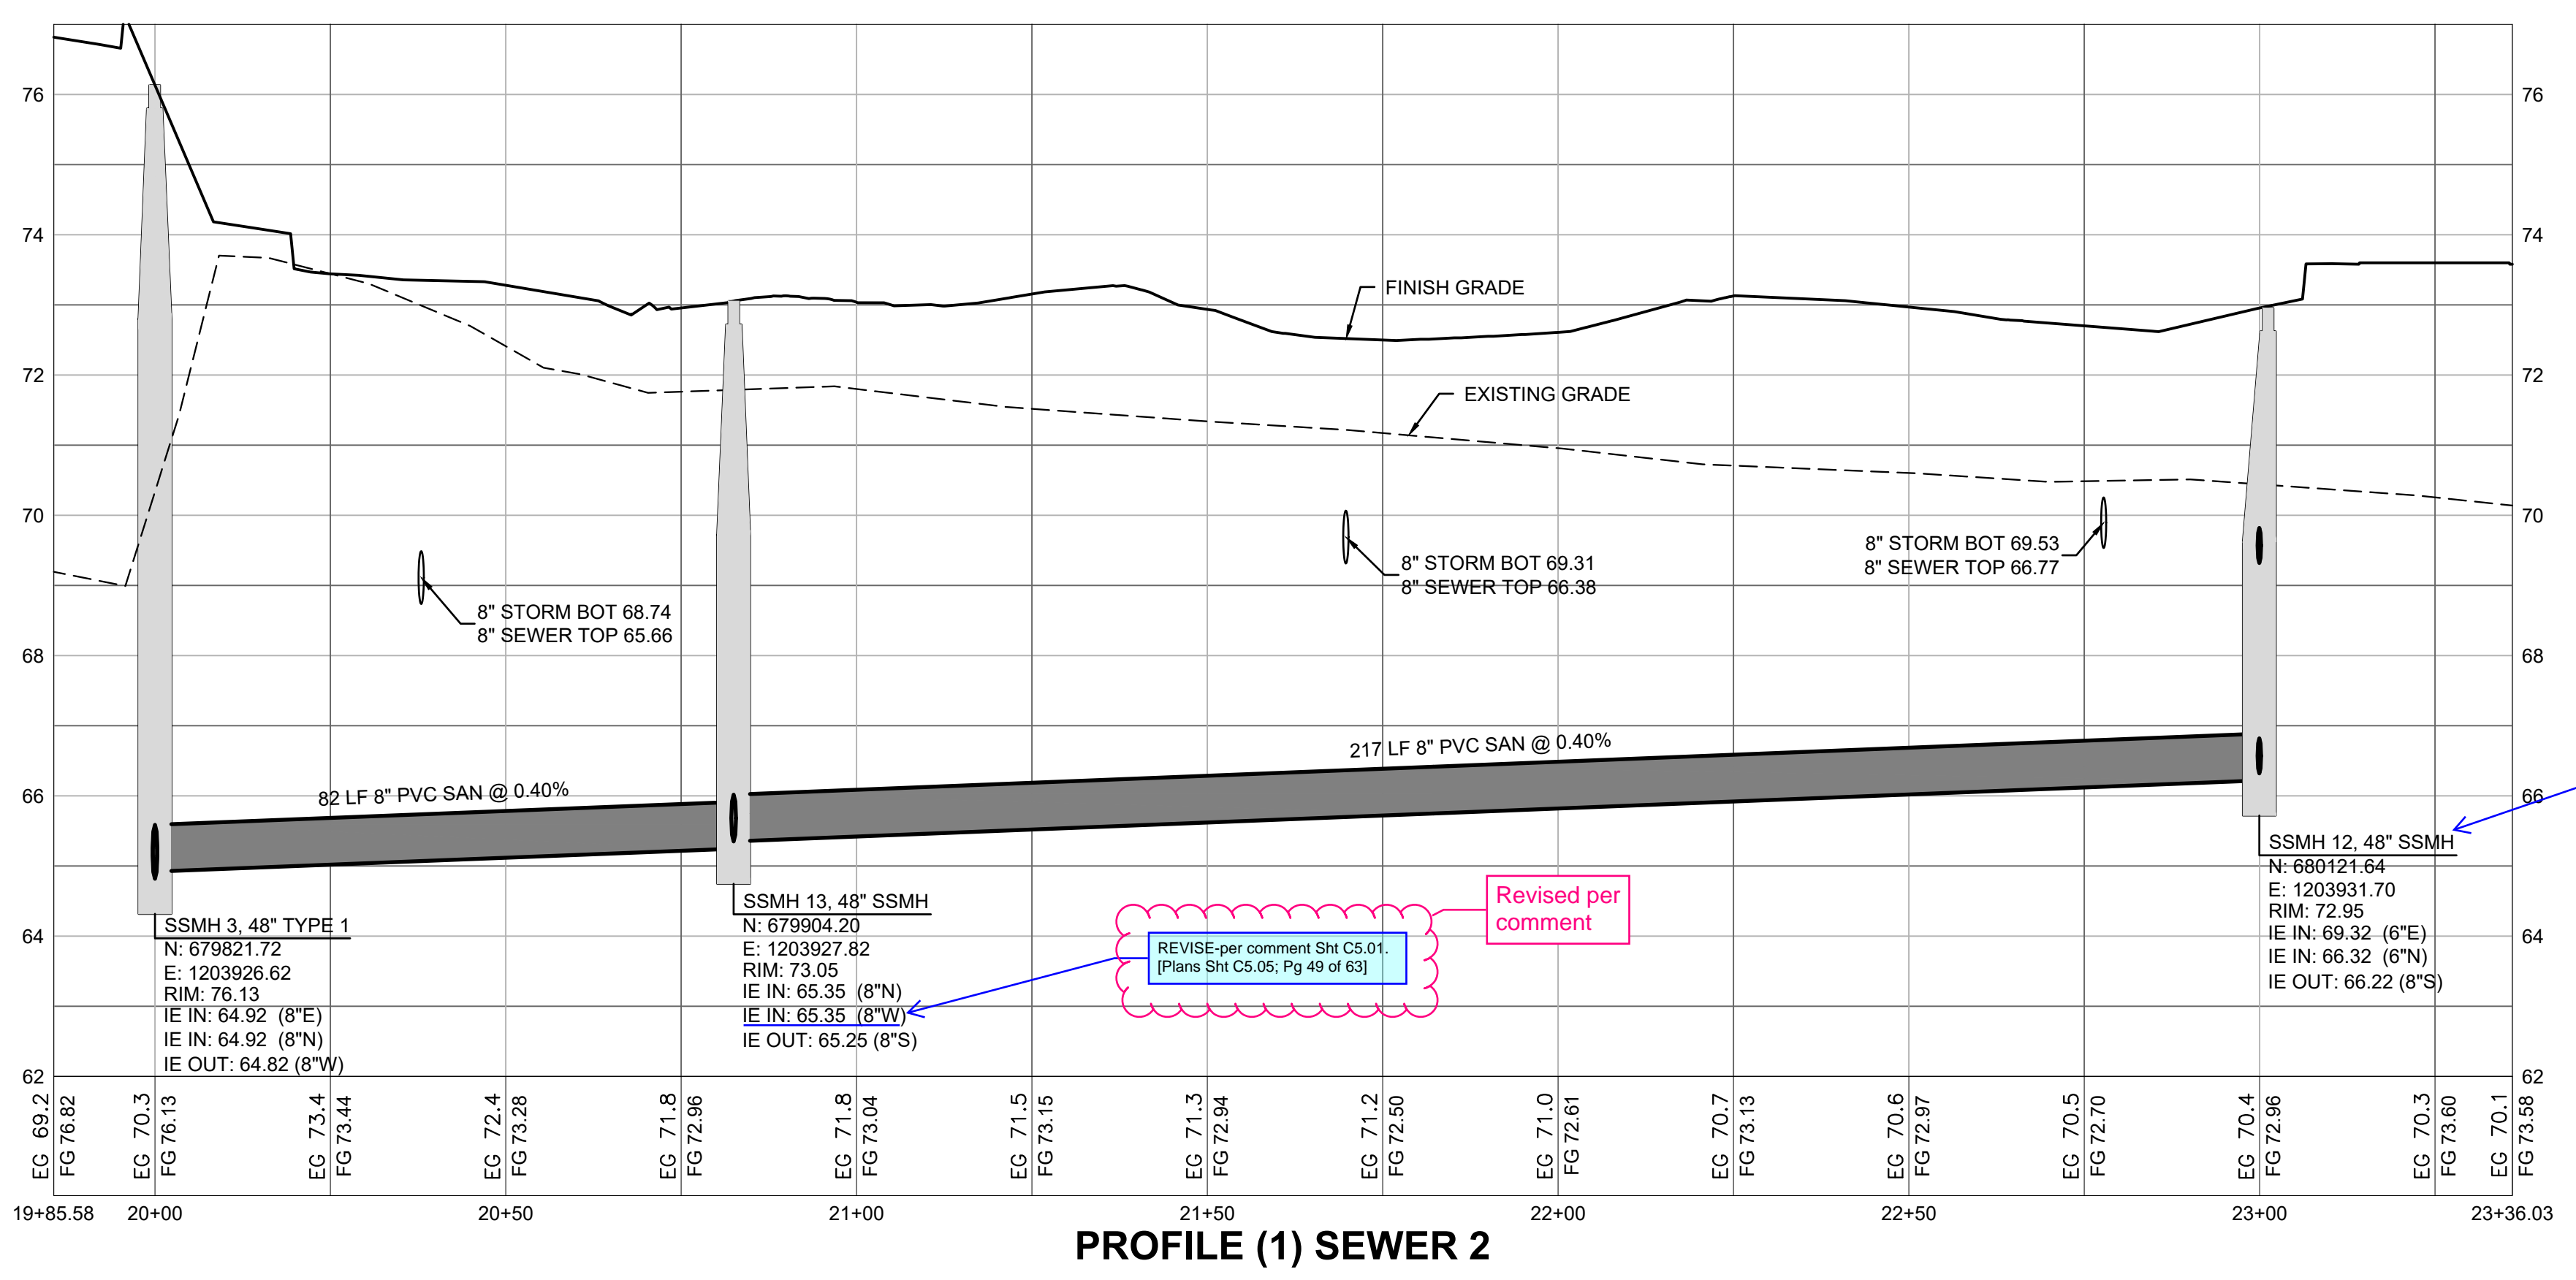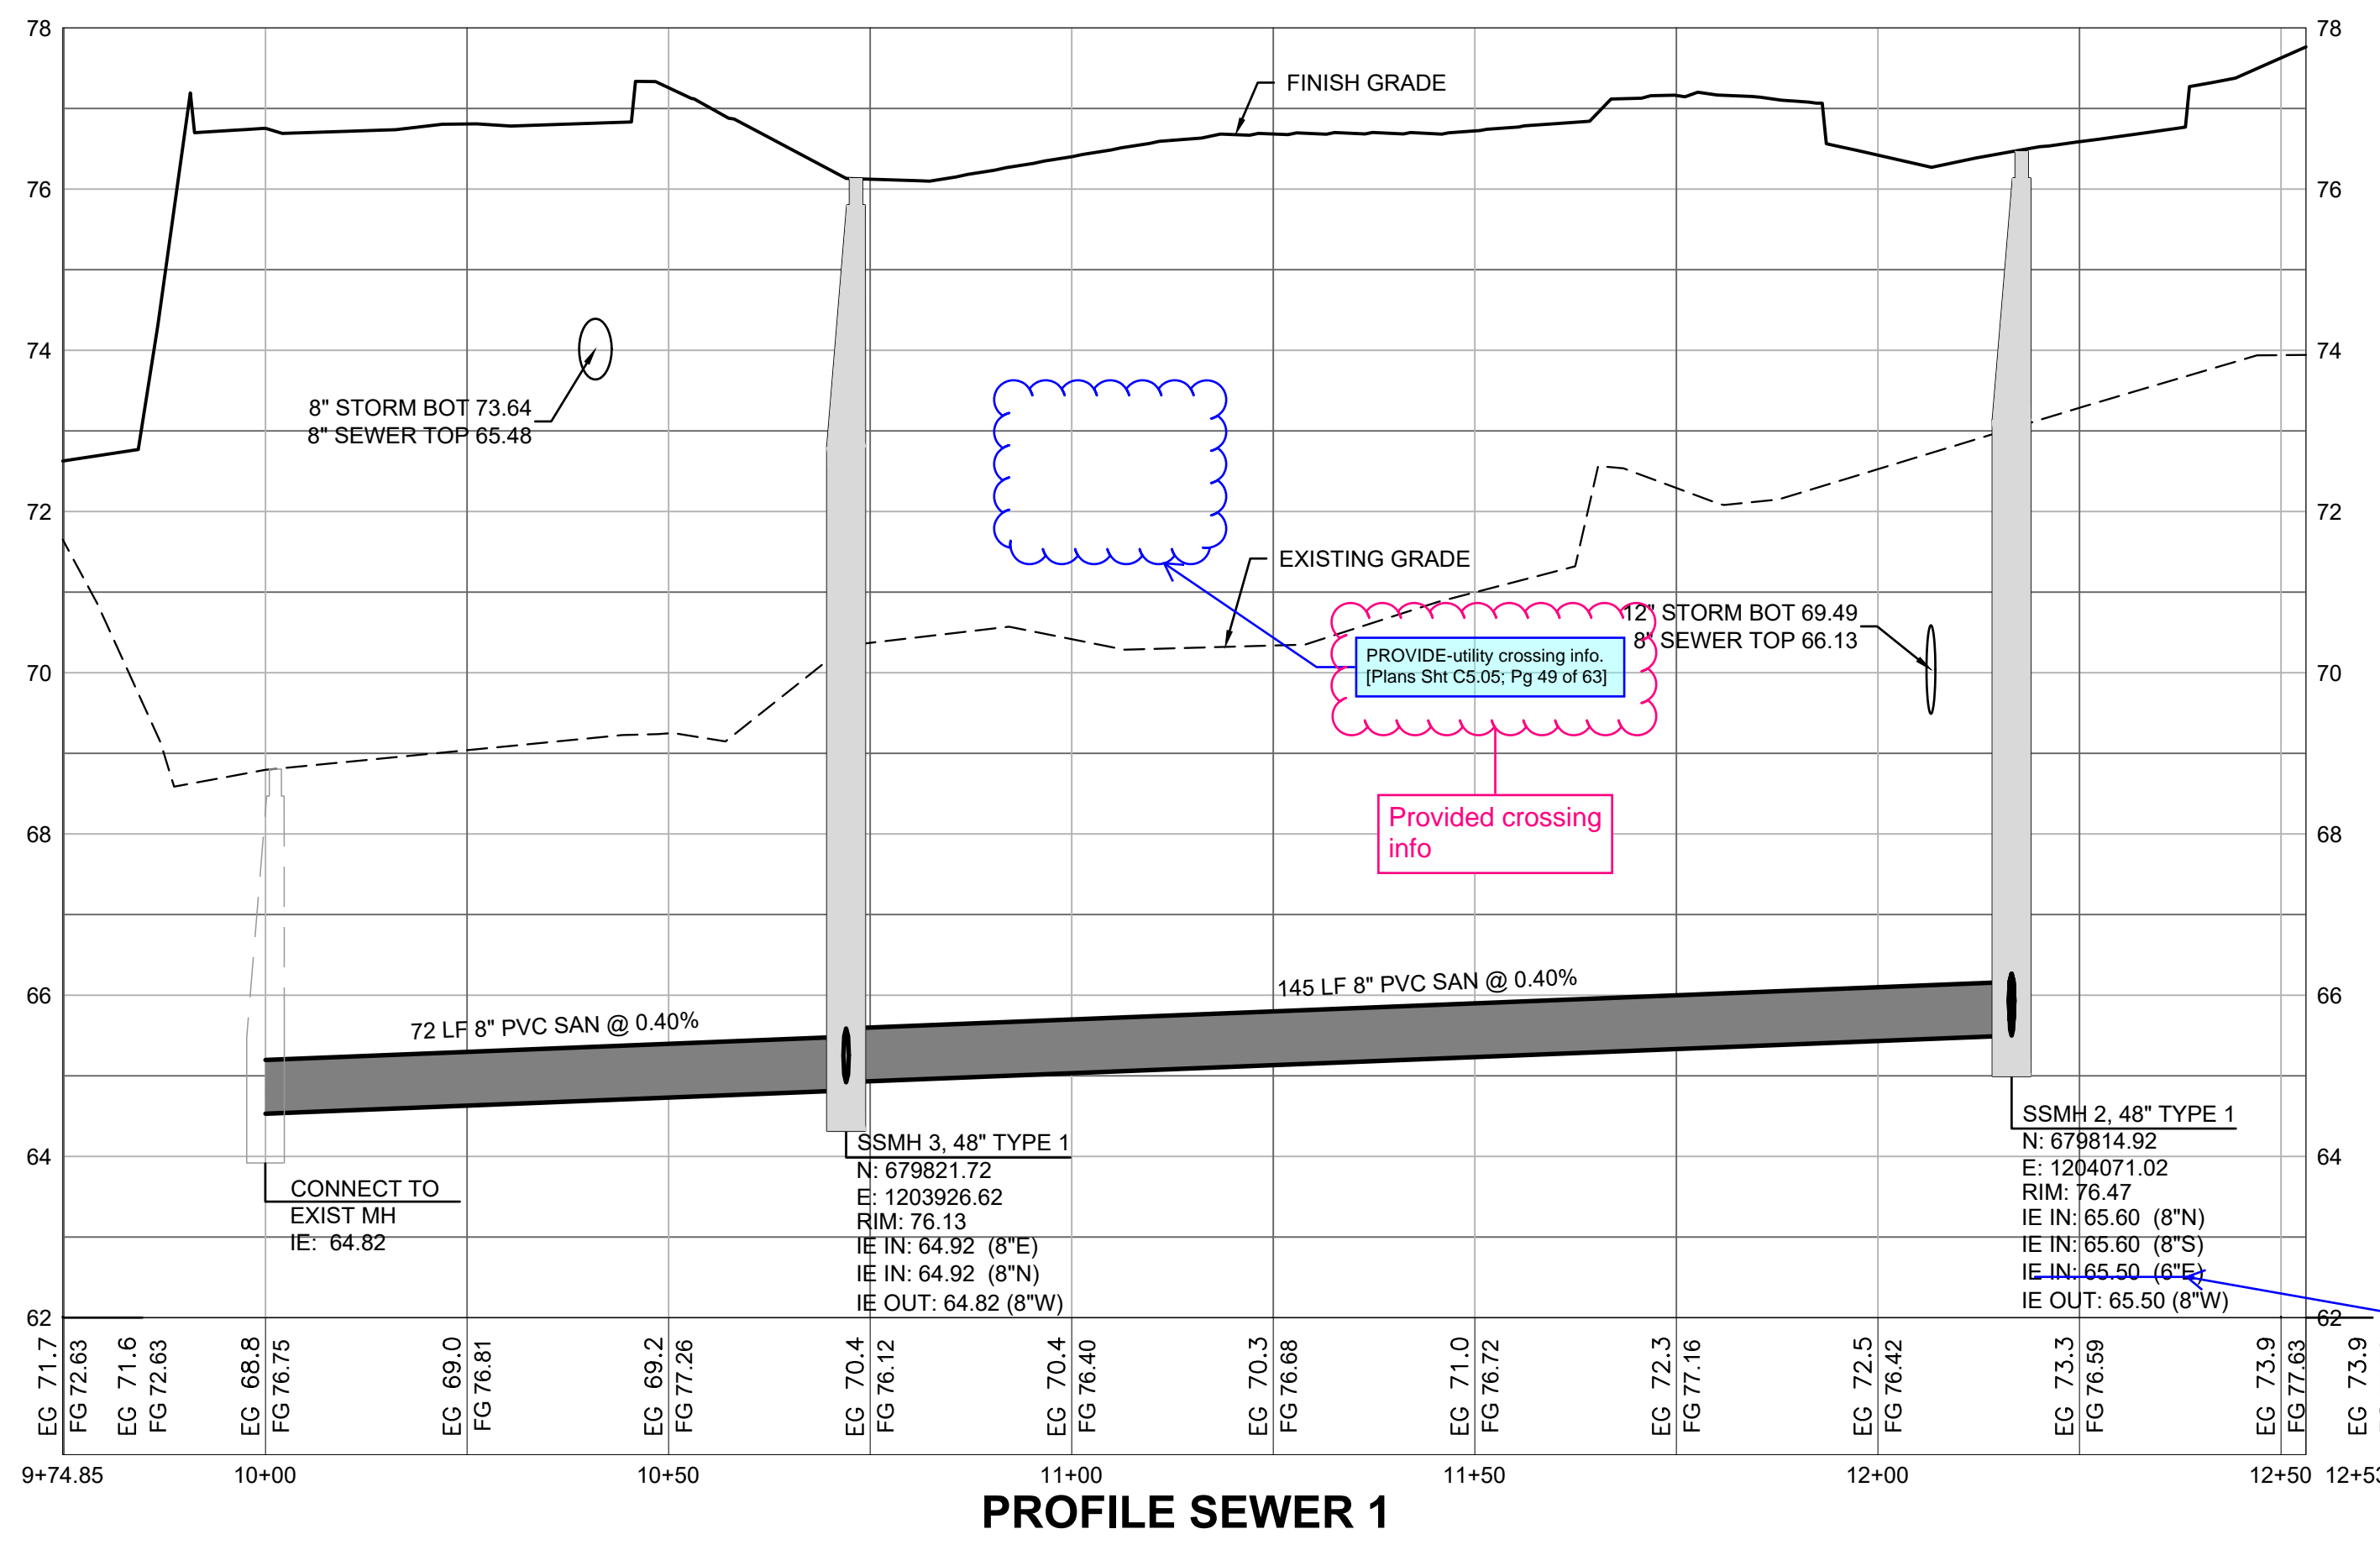

Revised per comment

REVISE-per comment Sht C5.02. [Plans Sht C5.05; Pg 49 of 63]

Removed drop

CALLOUT-drop manhole per City Sht Detail 04.01.02 [Plans Sht C5.05; Pg 49 of 63]


Project Title:
EAST TOWN CROSSING PHASE 1

Client:
ASH DEVELOPMENT

GREG HELLE
GREG.HELLE@ASHNW.COM

Project No.
2230752

Issue Set & Date:
PERMIT SUBMITTAL
11/20/2023

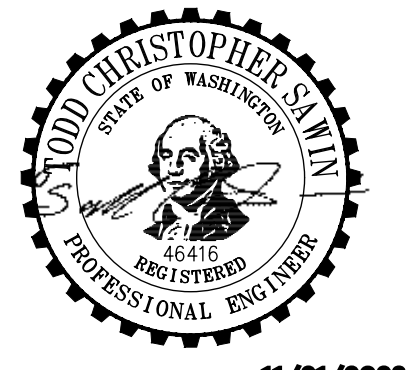

11/21/2023

NOTICE: ALTERATION OF THIS DOCUMENT SHALL INVALIDATE THE PROFESSIONAL SEAL AND SIGNATURE. PUBLICATION OF THIS DOCUMENT DOES NOT REPRESENT AWA'S ENDORSEMENT OF THE PROJECT OR THE DESIGNER'S LIABILITY. THIS DOCUMENT IS FOR THE USE ONLY FOR THE PROJECT IDENTIFIED IN THE TITLE BLOCK AND IS NOT TO BE USED FOR ANY OTHER PROJECT, OR ACTION TO THAT PROJECT OR FOR ANY OTHER PROJECT.

Revisions:

Sheet Title:
SEWER PROFILES

Designed by: CW
Drawn by: SK
Checked by: JI

Sheet No.
C5.05
49 of 63 Sheets




EAST TOWN CROSSING PHASE 1

SEC. 26,35/ TWP. 20 N./ RGE. 4 E., W.M.

APPROVED

BY _____
CITY OF PUYALLUP
DEVELOPMENT ENGINEERING
DATE _____

NOTE: THIS APPROVAL IS VOID AFTER 180 DAYS FROM APPROVAL DATE. THE CITY WILL NOT BE RESPONSIBLE FOR ERRORS AND/OR OMISSIONS ON THESE PLANS. FIELD CONDITIONS MAY DICTATE CHANGES TO THESE PLANS AS DETERMINED BY THE DEVELOPMENT ENGINEERING MANAGER.

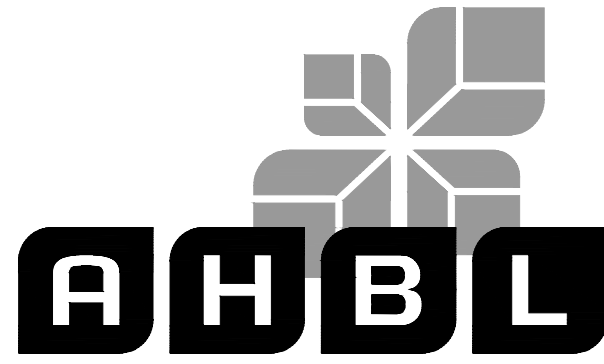

TACOMA · SEATTLE · SPOKANE · TRI-CITIES

2215 North 30th Street, Suite 300, Tacoma, WA 98403
253.383.2422 TEL 253.383.2572 FAX www.ahbl.com WEB

Project Title:

EAST TOWN CROSSING PHASE 1

Client:
ASH DEVELOPMENT

GREG HELLE
GREG.HELLE@ASHNW.COM

Project No.
2230752

Issue Set & Date:


PERMIT SUBMITTAL

11/20/2023




11/21/2023

NOTICE
ALTERATION OF THIS DOCUMENT SHALL INVALIDATE THE PROFESSIONAL SEAL AND SIGNATURE. PUBLICATION OF THIS DOCUMENT DOES NOT CONSTITUTE A GUARANTEE OR WARRANTY BY THE ENGINEER OR ARCHITECT. THE ENGINEER OR ARCHITECT IS NOT TO BE HELD RESPONSIBLE FOR ANY DAMAGE, LOSS, OR ACTION TO THAT PROJECT OR FOR ANY OTHER PROJECT.

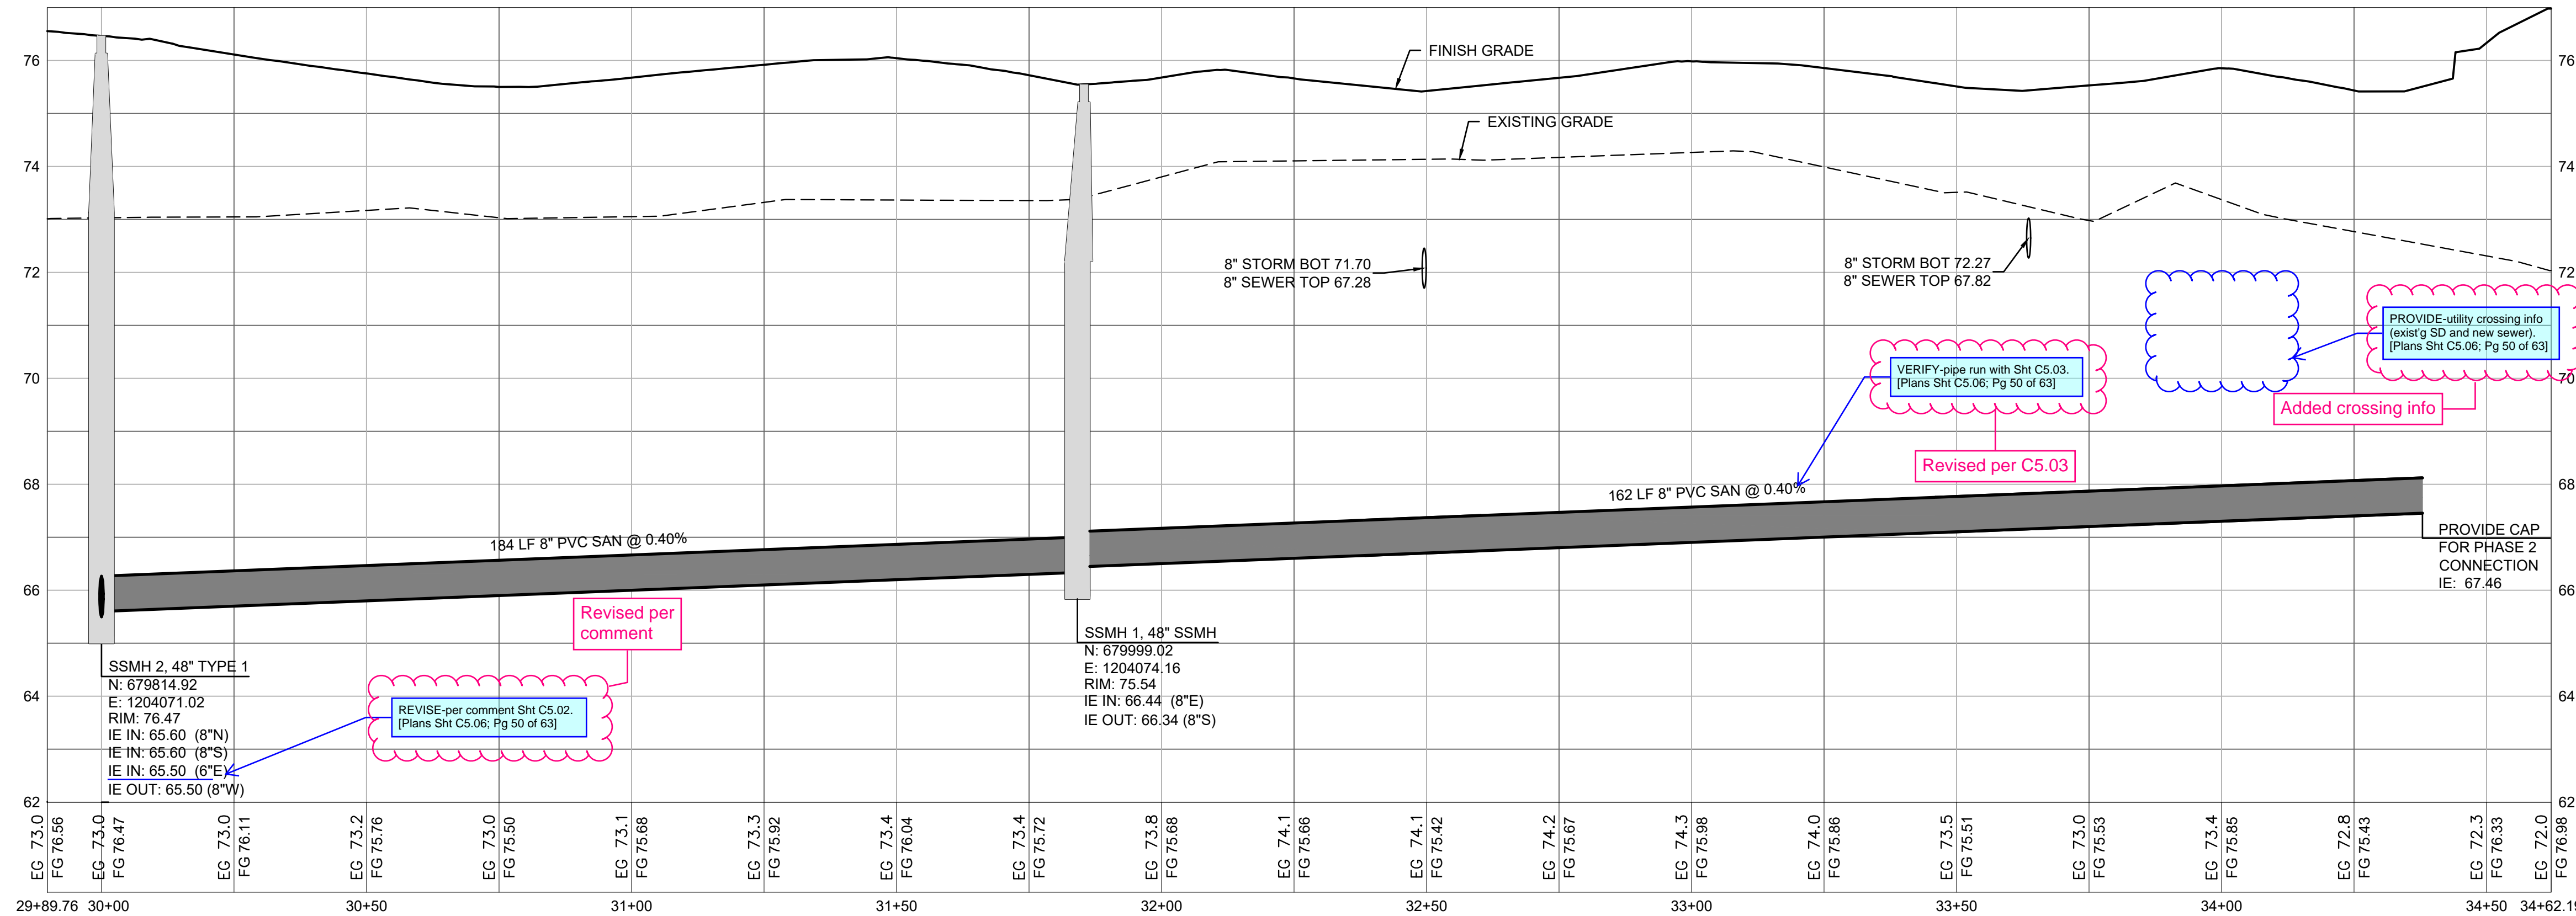

PROFILE (2) SEWER 3

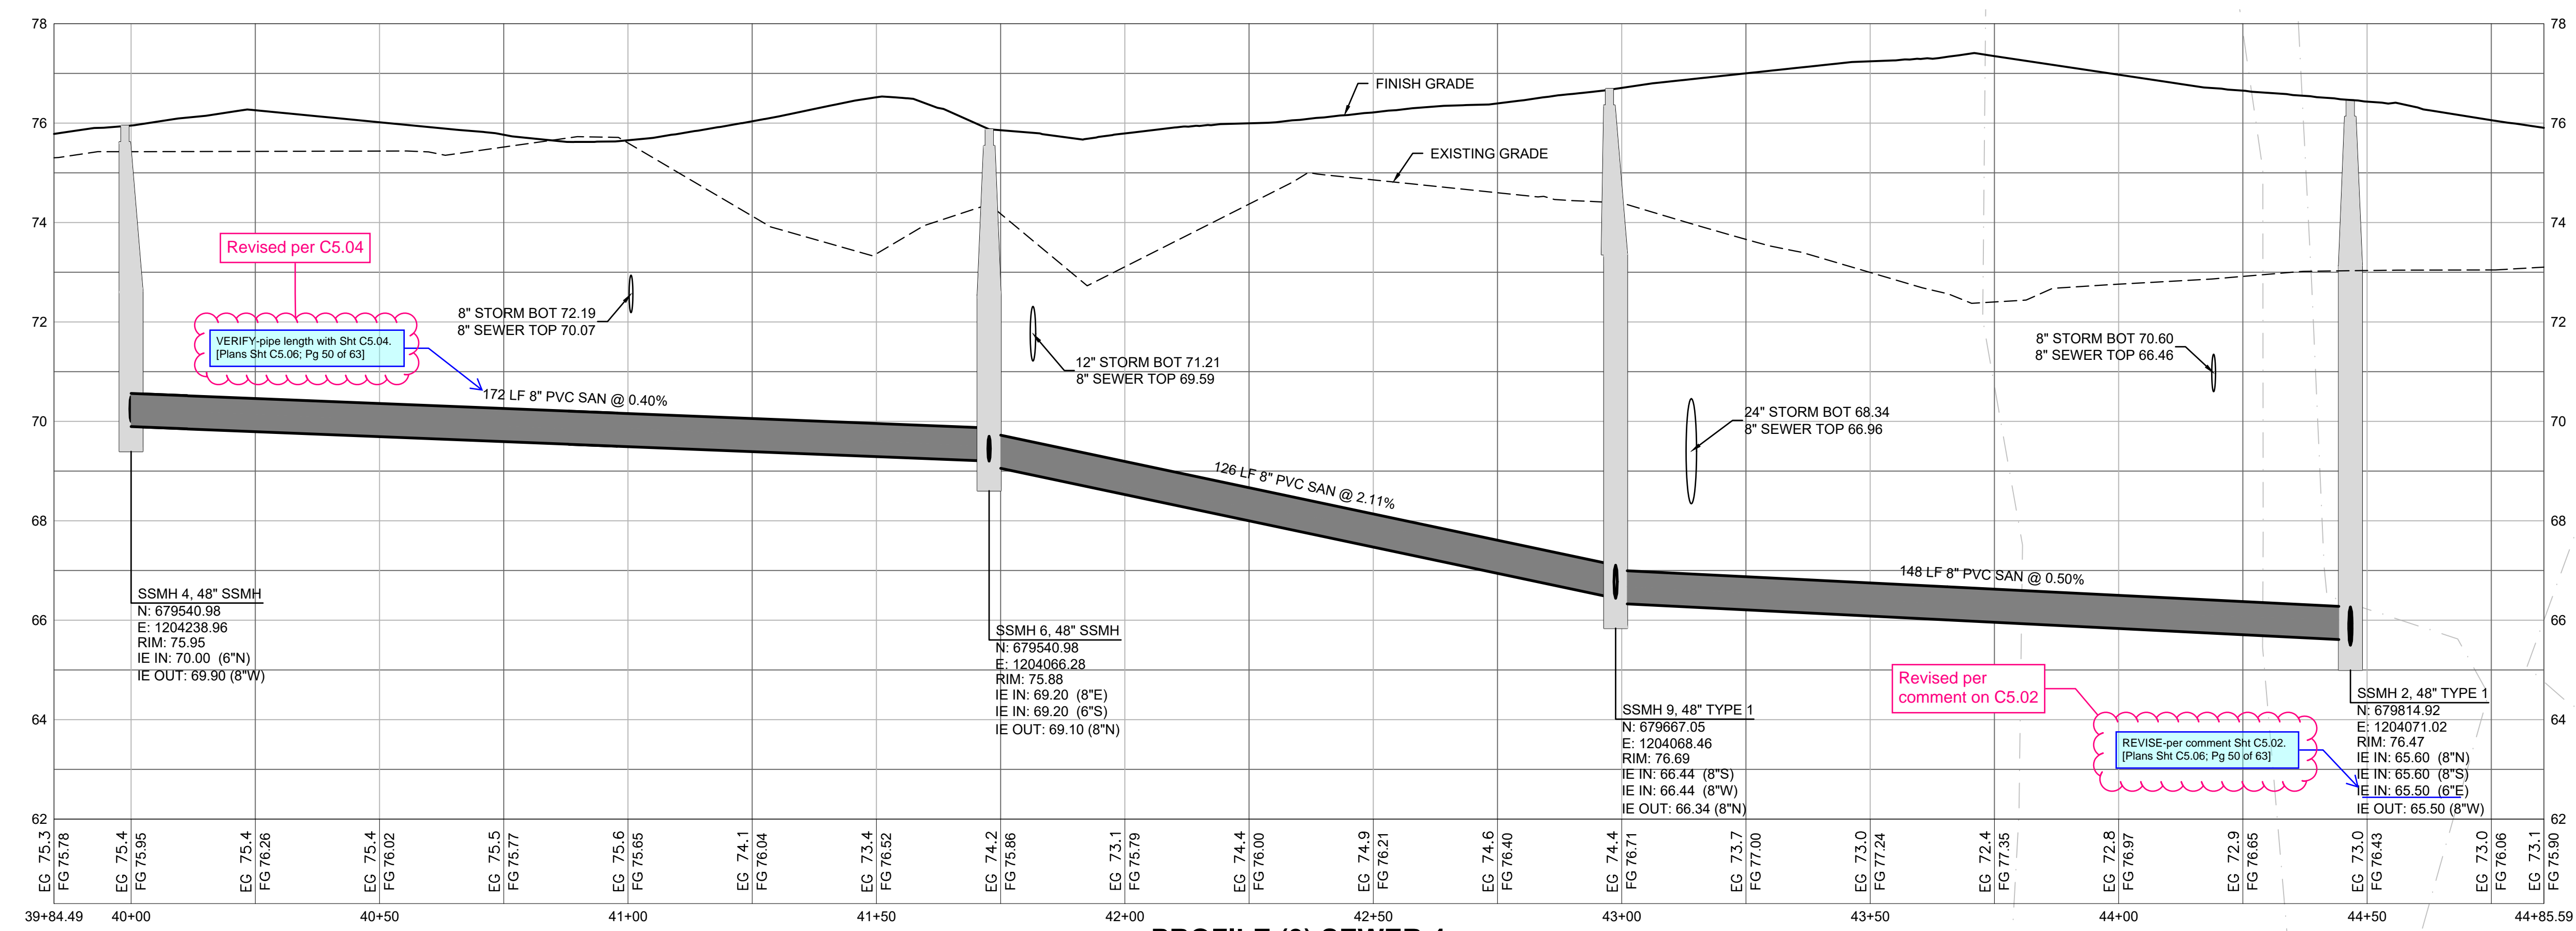

PROFILE (3) SEWER 4



Know what's below.
Call before you dig.

- △
- △
- △
- △

Revisions:

Sheet Title:

SEWER PROFILES

Designed by: CW Drawn by: SK Checked by: JI

Sheet No.

C5.06

50 of 63 Sheets

EAST TOWN CROSSING PHASE 1

SEC. 26,35/ TWP. 20 N./ RGE. 4 E., W.M.

APPROVED
 BY _____
 CITY OF PUYALLUP
 DEVELOPMENT ENGINEERING
 DATE _____

NOTE: THIS APPROVAL IS VOID AFTER 180 DAYS FROM APPROVAL DATE. THE CITY WILL NOT BE RESPONSIBLE FOR ERRORS AND/OR OMISSIONS ON THESE PLANS. FIELD CONDITIONS MAY DICTATE CHANGES TO THESE PLANS AS DETERMINED BY THE DEVELOPMENT ENGINEERING MANAGER.




Project Title:
EAST TOWN CROSSING PHASE 1

Client:
 ASH DEVELOPMENT
 GREG HELLE
 GREG.HELLE@ASHNW.COM


Project No.
 2230752

Issue Set & Date:
PERMIT SUBMITTAL
 11/20/2023

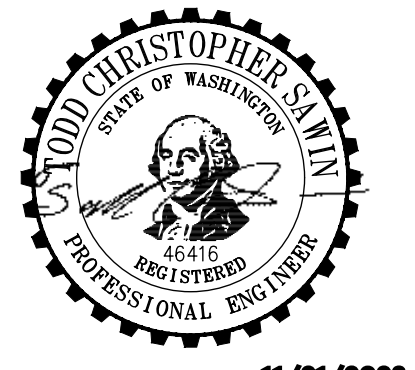

11/21/2023

NOTICE
 A SIGNATURE OF THIS DOCUMENT SHALL VALIDATE THE PROFESSIONAL SEAL AND SIGNATURE PUBLICATION OF THE DOCUMENT DOES NOT CONSTITUTE A PROFESSIONAL ENGINEER'S LIABILITY INSURANCE POLICY. THIS DOCUMENT IS FOR USE ONLY FOR THE PROJECT IDENTIFIED IN THE TITLE BLOCK AND IS NOT TO BE USED FOR OTHER PROJECTS, OR ADDED TO THAT PROJECT OR FOR ANY OTHER PROJECT.

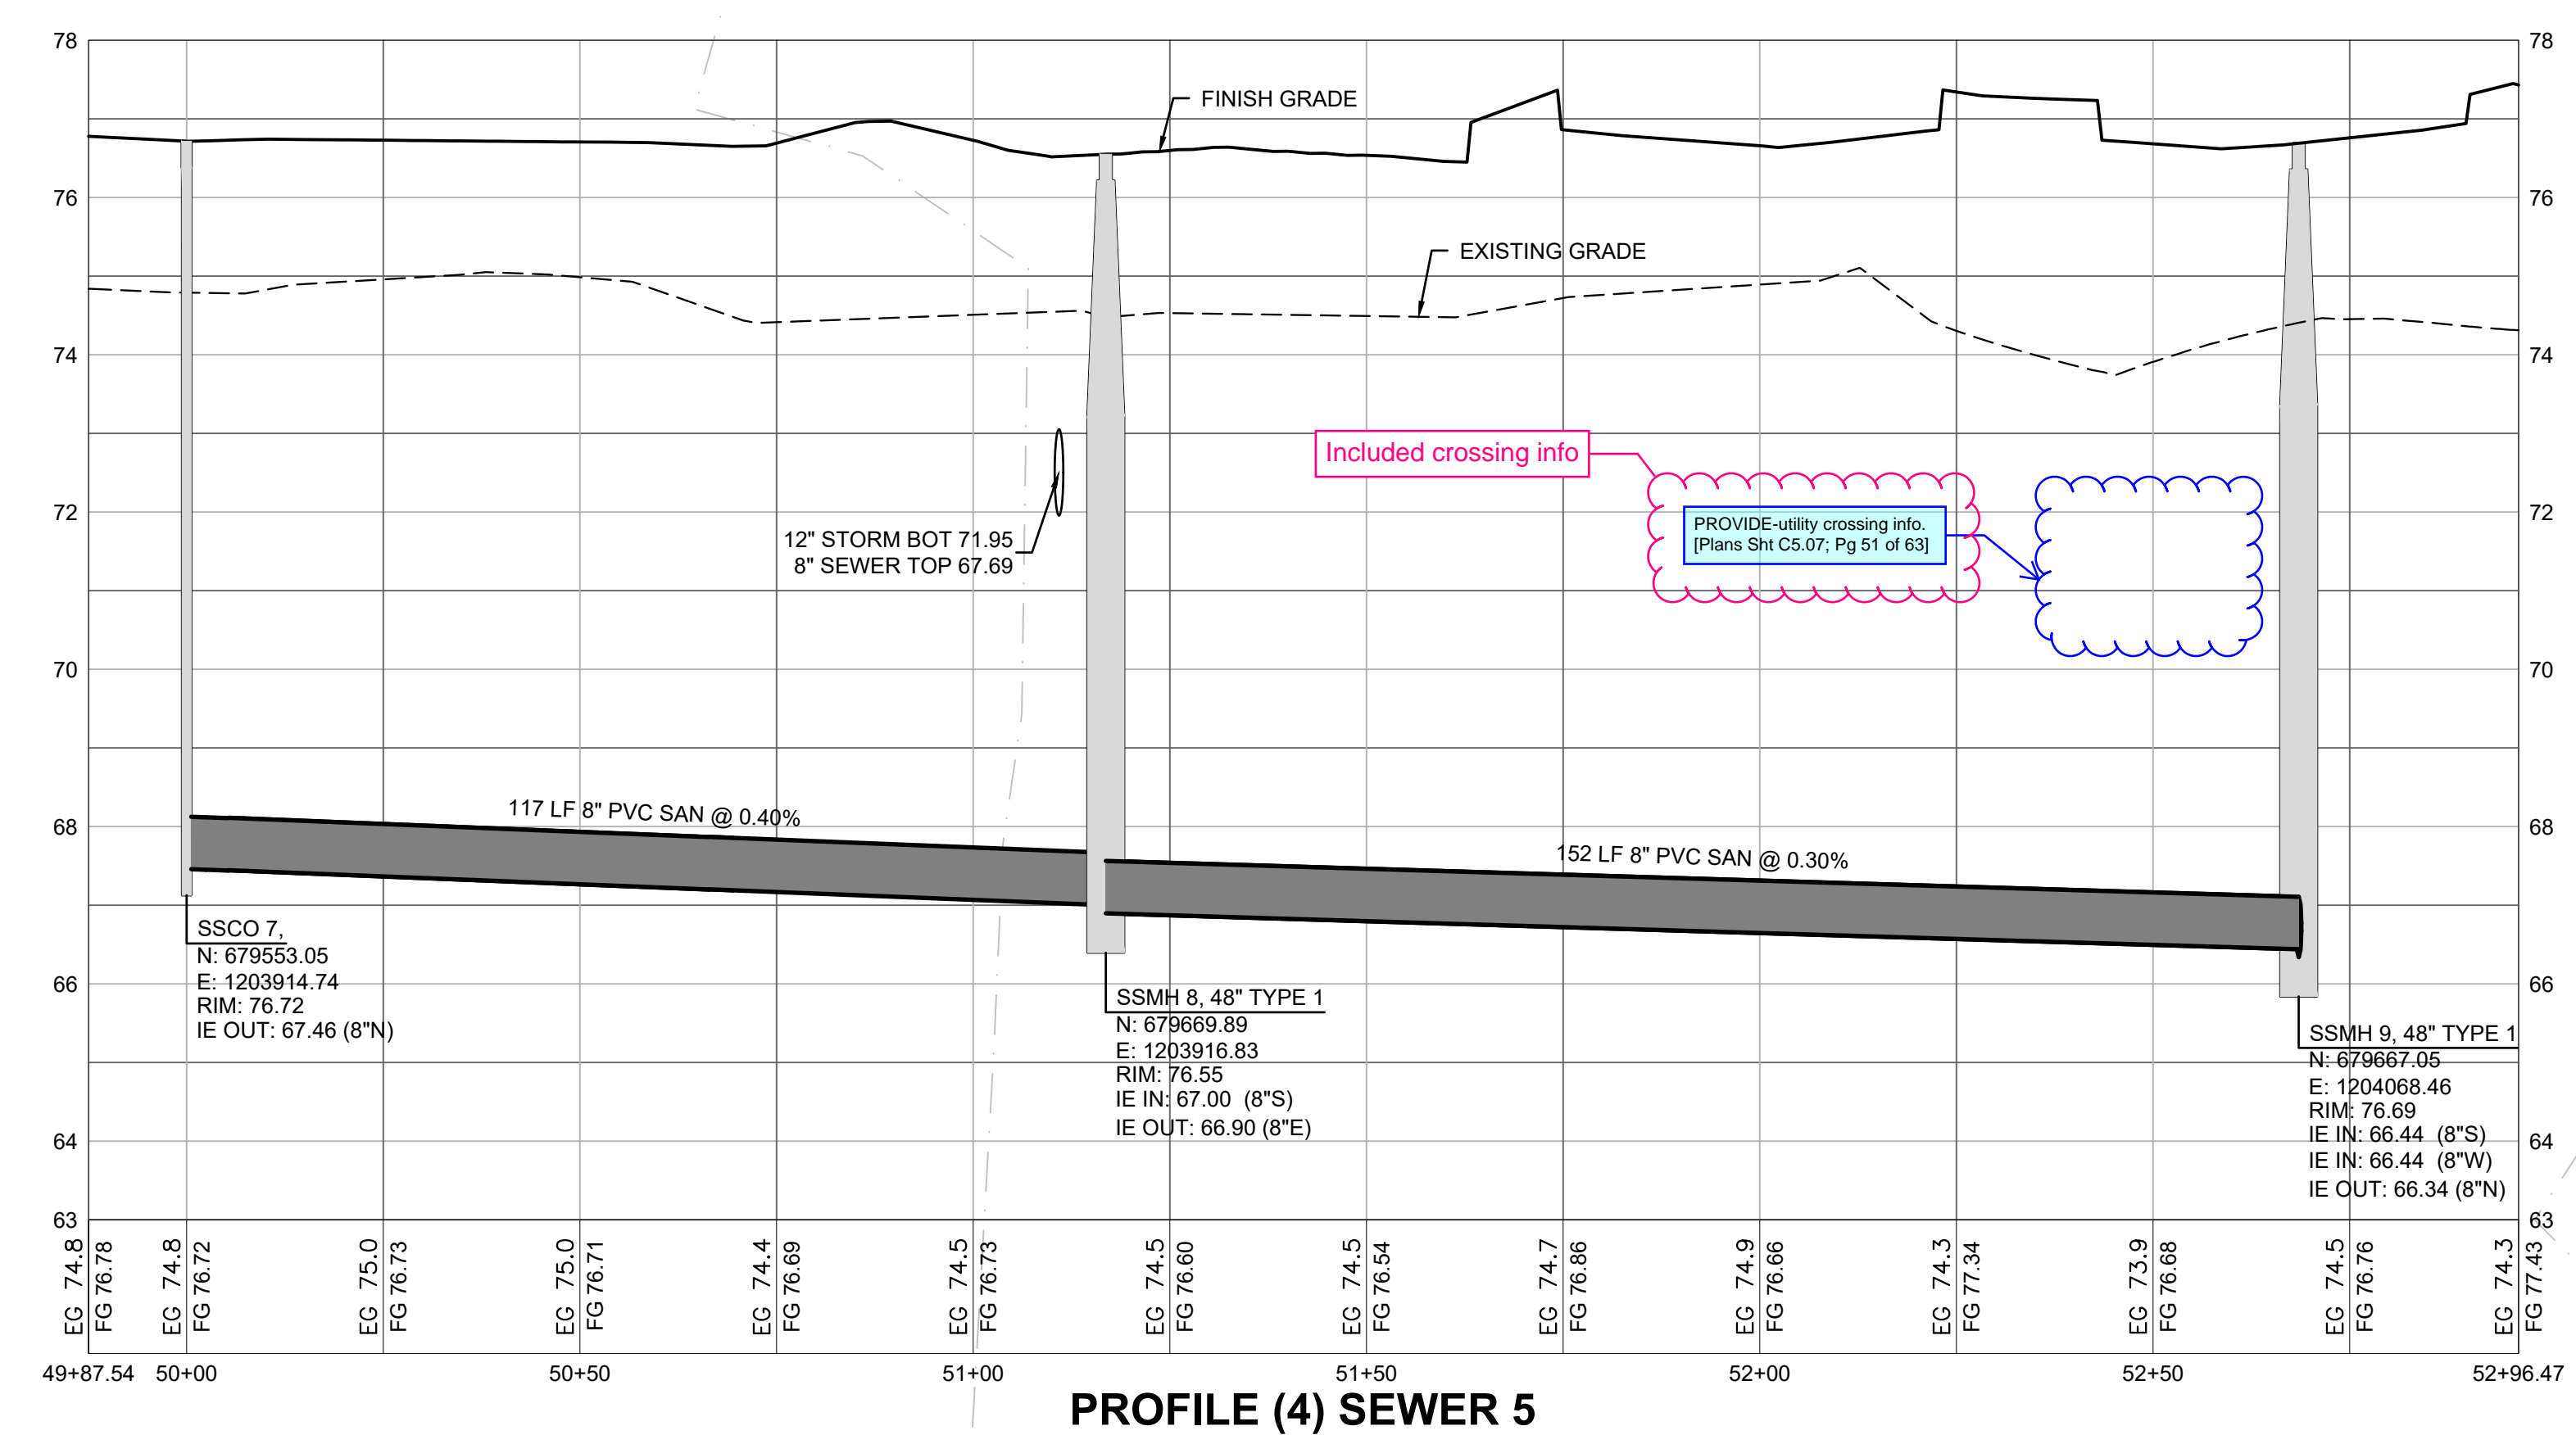

△ _____
 △ _____
 △ _____
 △ _____

Revisions:
 Sheet Title:

SEWER PROFILES

Designed by: CW Drawn by: SK Checked by: JI

Sheet No.
C5.07
 51 of 63 Sheets



EAST TOWN CROSSING PHASE 1


SEC. 26,35/ TWP. 20 N./ RGE. 4 E., W.M.

APPROVED

BY CITY OF PUYALLUP
DEVELOPMENT ENGINEERING

DATE

NOTE: THIS APPROVAL IS VOID AFTER 180 DAYS FROM APPROVAL DATE. THE CITY WILL NOT BE RESPONSIBLE FOR ERRORS AND/OR OMISSIONS ON THESE PLANS. FIELD CONDITIONS MAY DICTATE CHANGES TO THESE PLANS AS DETERMINED BY THE DEVELOPMENT ENGINEERING MANAGER.

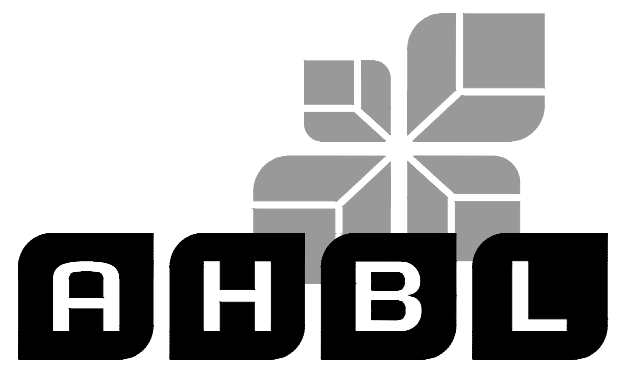

TACOMA · SEATTLE · SPOKANE · TRI-CITIES

2215 North 30th Street, Suite 300, Tacoma, WA 98403
253.383.2422 TEL 253.383.2572 FAX www.ahbl.com WEB

Project Title:

EAST TOWN CROSSING PHASE 1

Client:

ASH DEVELOPMENT

GREG HELLE

GREG.HELLE@ASHNW.COM

Project No.

2230752

Issue Set & Date:






PERMIT SUBMITTAL

11/20/2023




11/21/2023

NOTICE: ALTERNATION OF THIS DOCUMENT SHALL INVALIDATE THE PROFESSIONAL SEAL AND SIGNATURE PUBLICATION OF THE ORIGINAL SET OF PLANS. ANY CHANGES TO THE ORIGINAL SET OF PLANS SHALL BE MADE ONLY FOR THE PROJECT IDENTIFIED IN THE TITLE BLOCK AND NOT TO BE USED FOR OTHER PROJECTS OR ADDITION TO THAT PROJECT OR FOR ANY OTHER PROJECT.

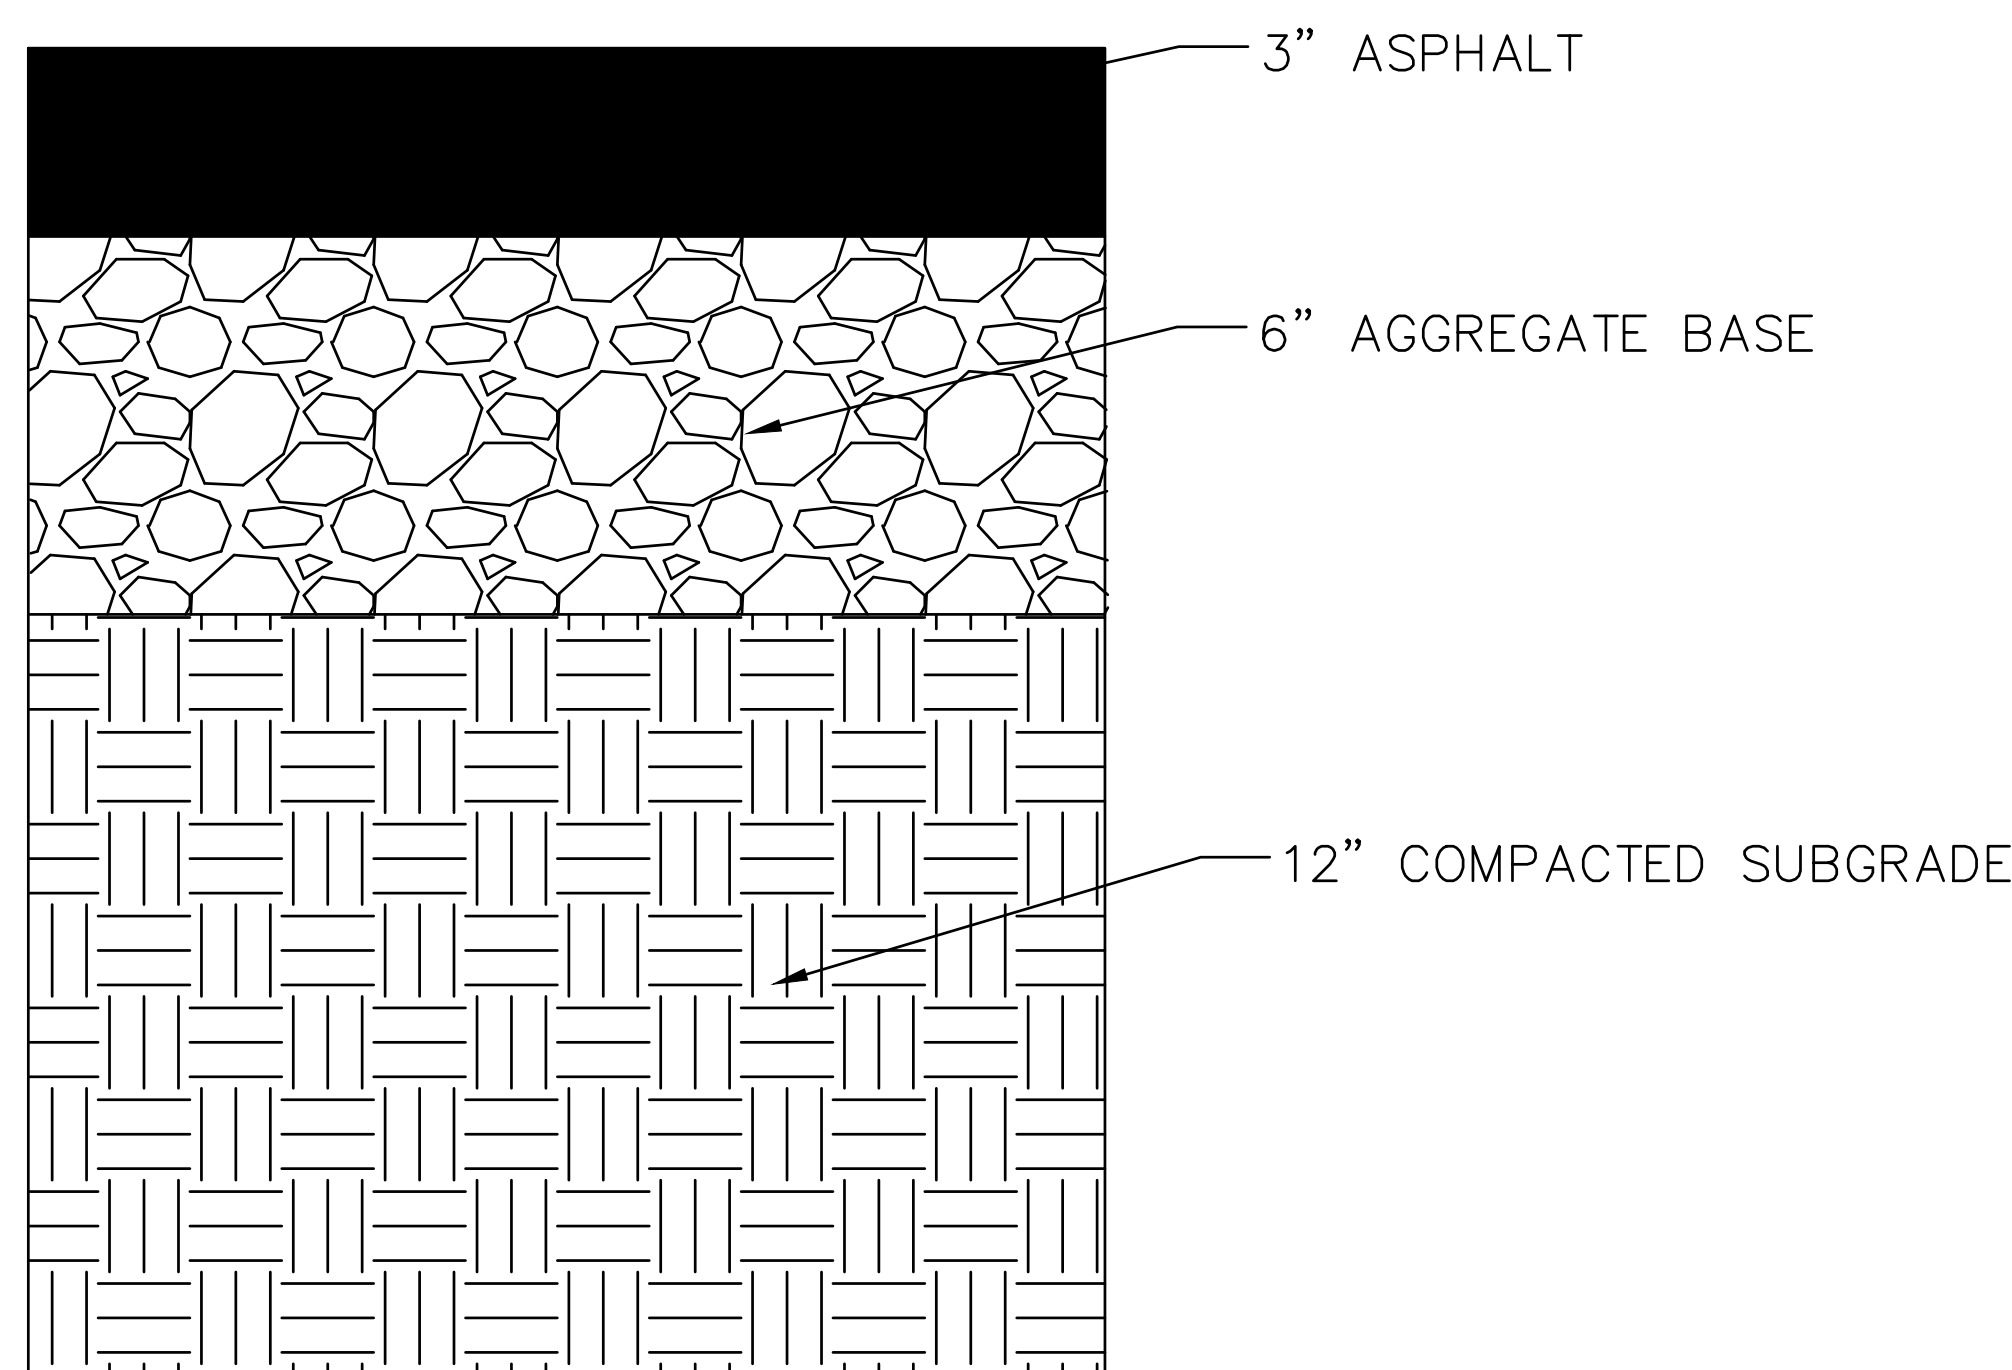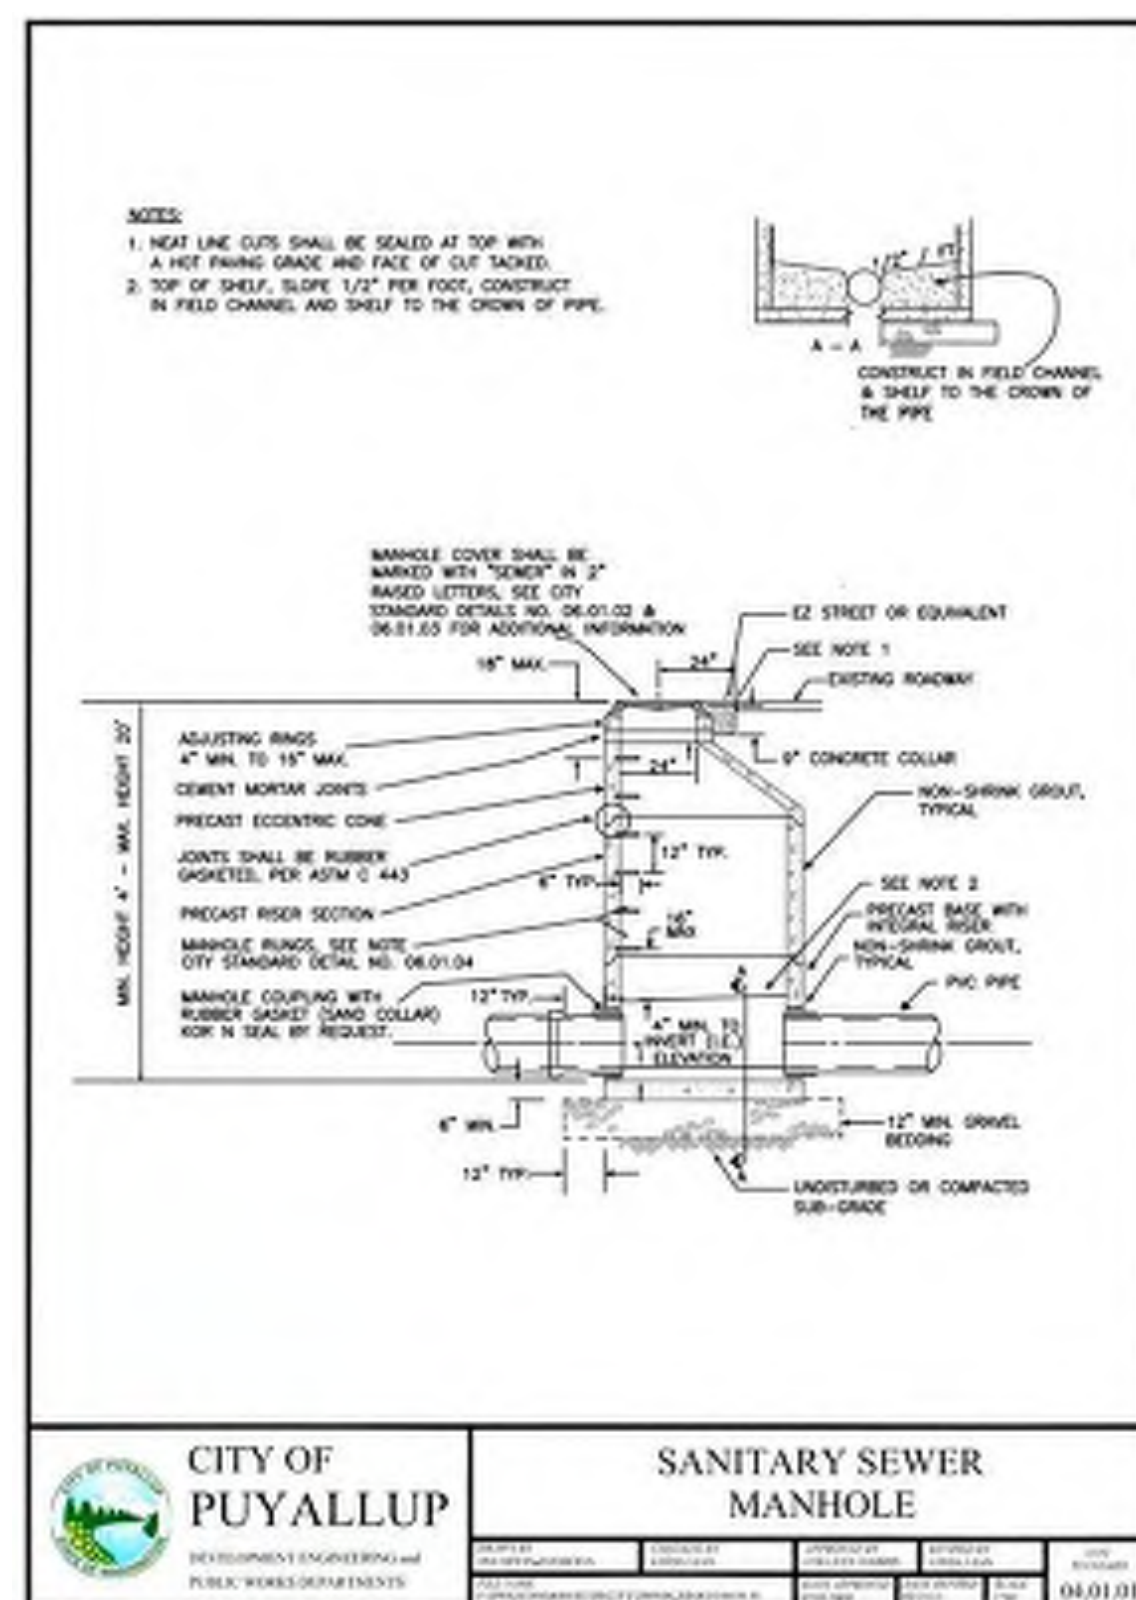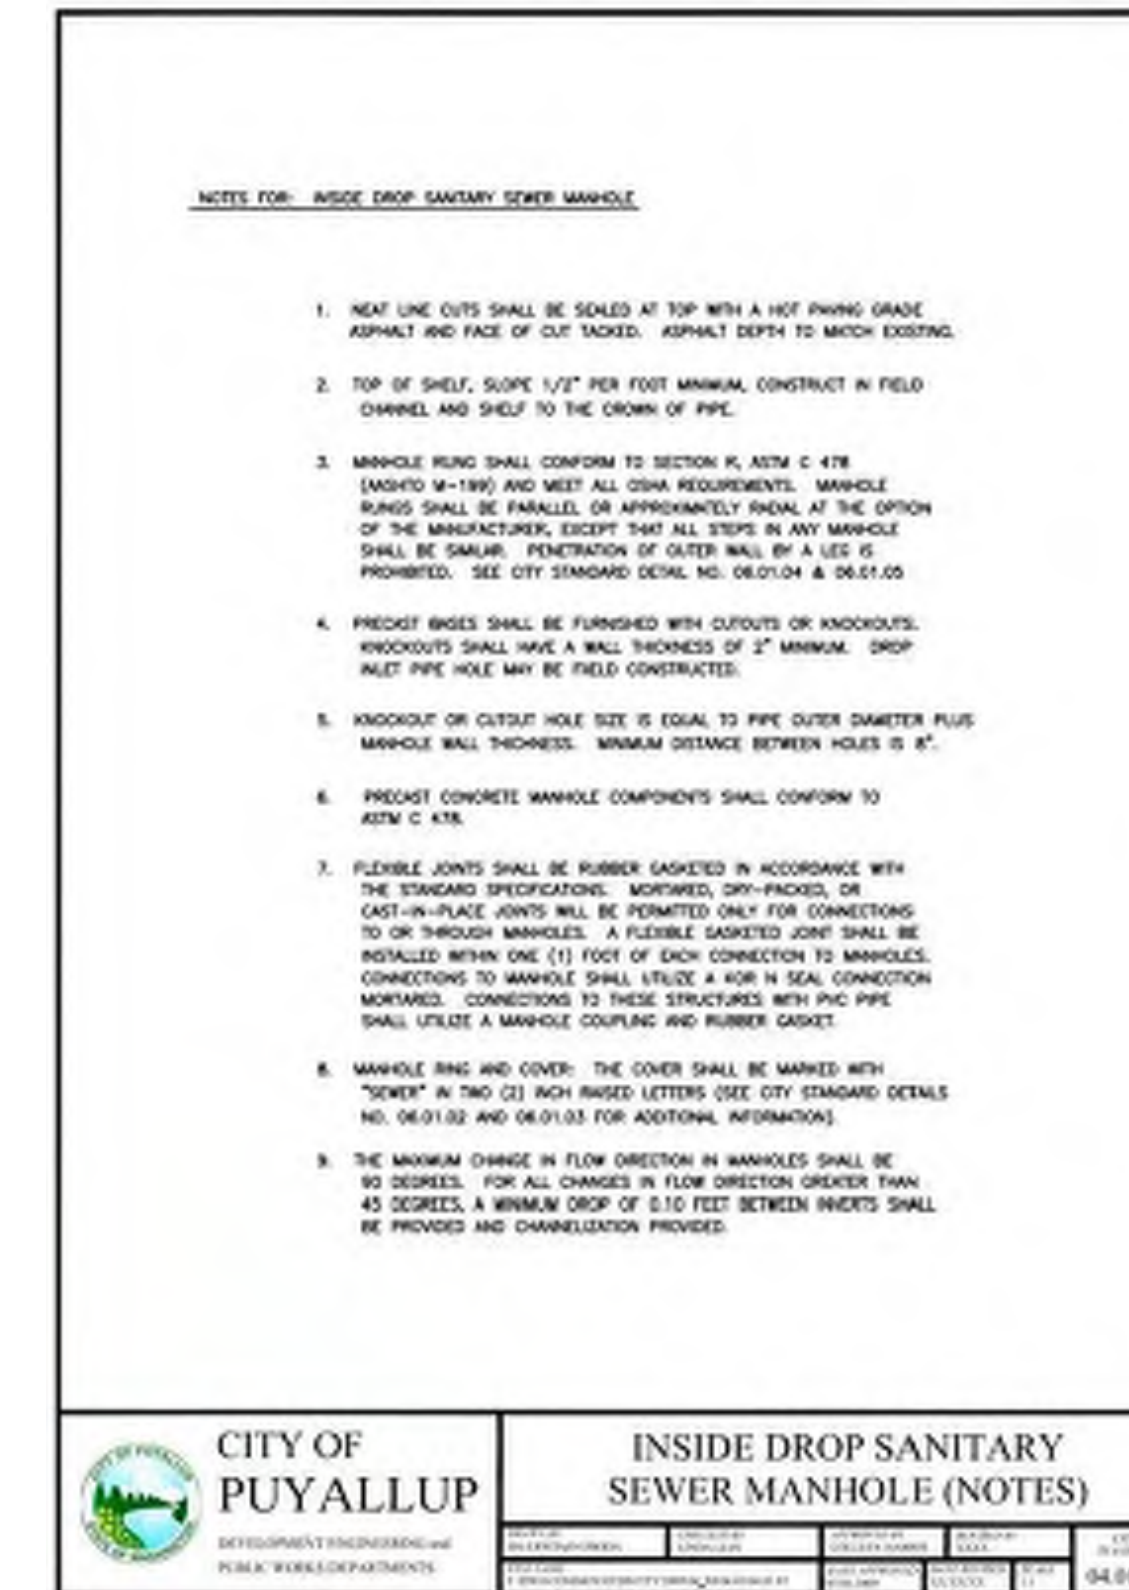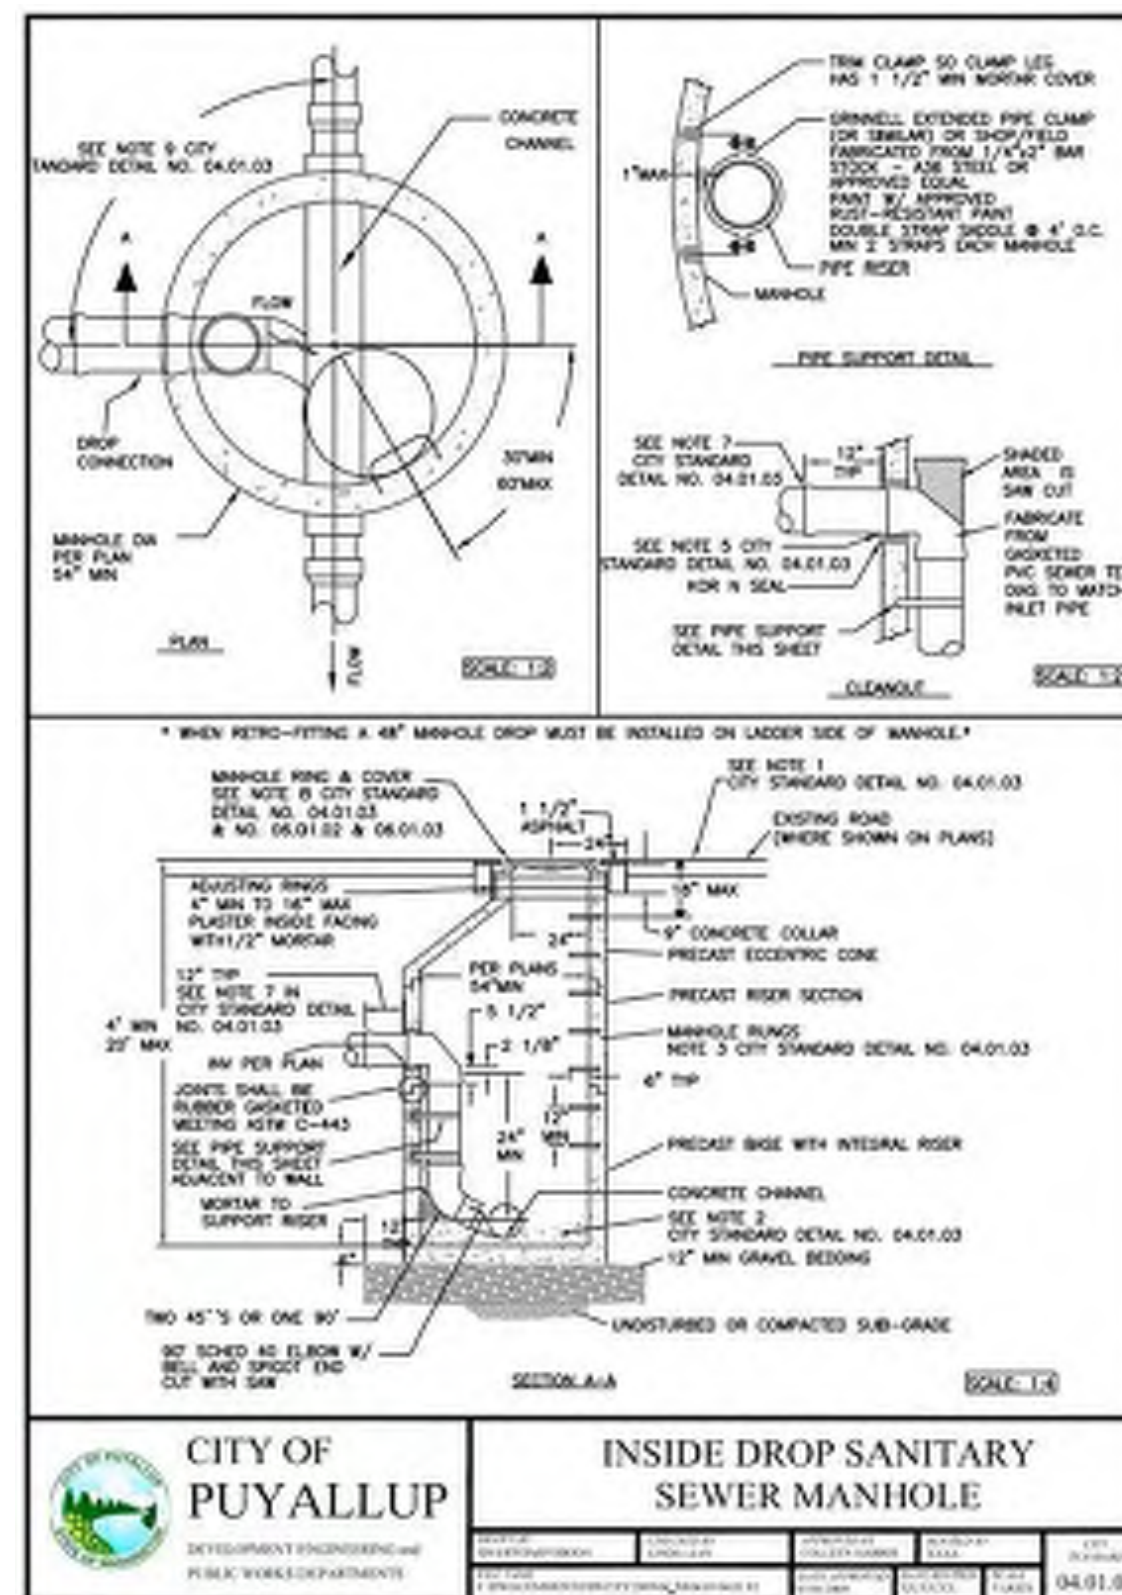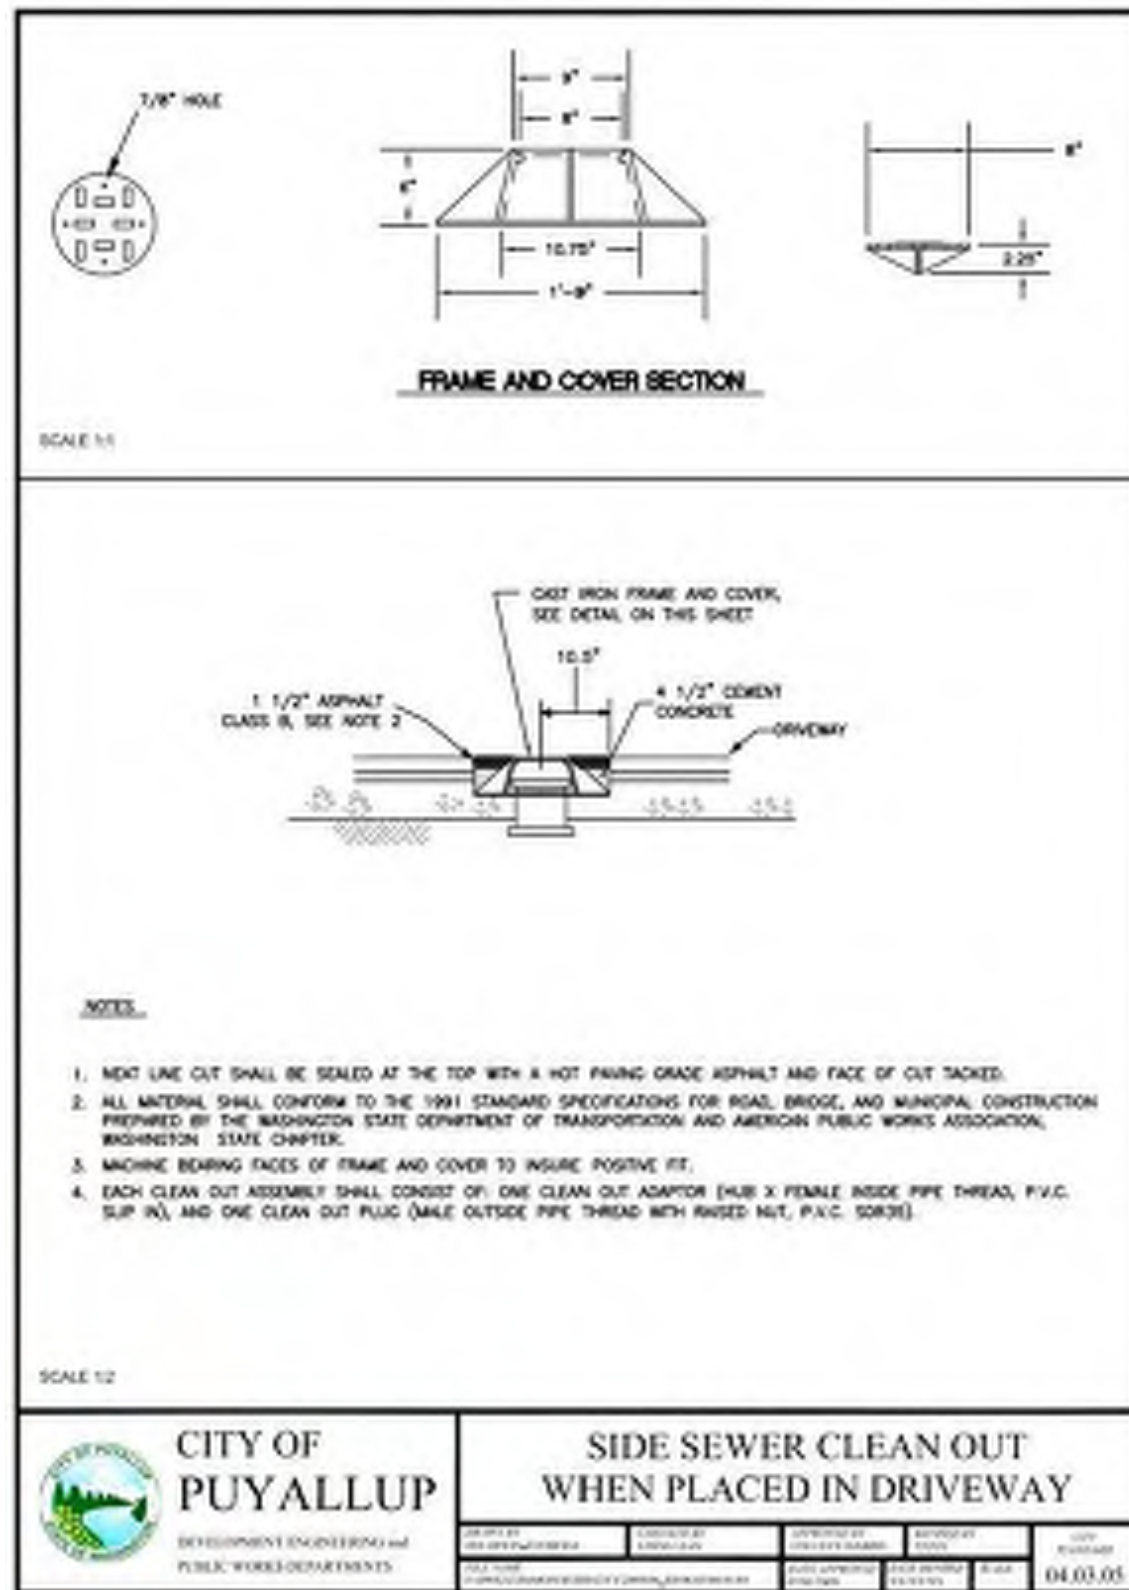

ADD-City Std Detail 04.03.04 // 04.06.02
[Plans SH C5.5, Pg 52 of 63]

Added city details

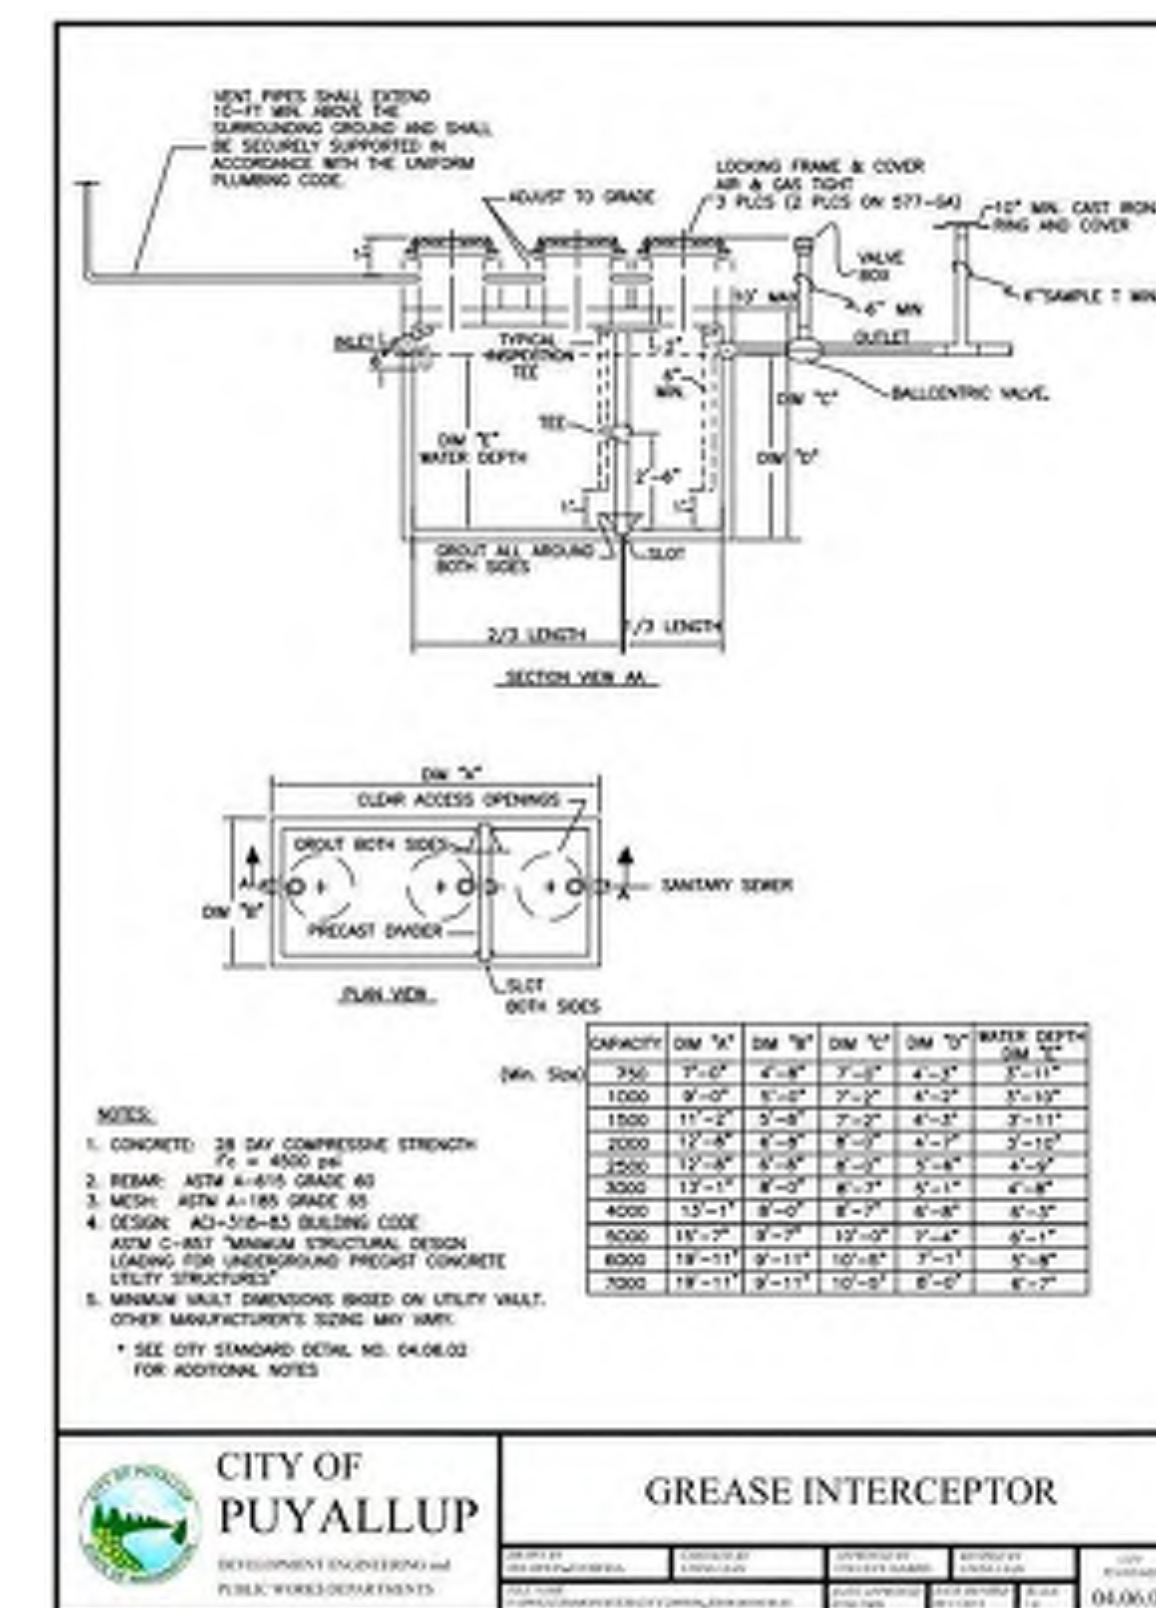

Know what's below.
Call before you dig.

Revisions:

Sheet Title:

SEWER NOTES AND DETAILS

Updated Sheet callout

Designed by: CW
Drawn by: SK
Checked by: JI

Sheet No.

VERIFY sheet callout (C5.087) [Plans SH C5.5, Pg 52 of 63]

C5.5

52 of 63 Sheets

EAST TOWN CROSSING PHASE 1



SEC. 26,35/ TWP. 20 N./ RGE. 4 E., W.M.

APPROVED

BY: CITY OF PUYALLUP
DEVELOPMENT ENGINEERING

DATE:

NOTE: THIS APPROVAL IS VOID AFTER 180 DAYS FROM APPROVAL DATE. THE CITY WILL NOT BE RESPONSIBLE FOR ERRORS AND/OR OMISSIONS ON THESE PLANS. FIELD CONDITIONS MAY DICTATE CHANGES TO THESE PLANS AS DETERMINED BY THE DEVELOPMENT ENGINEERING MANAGER.

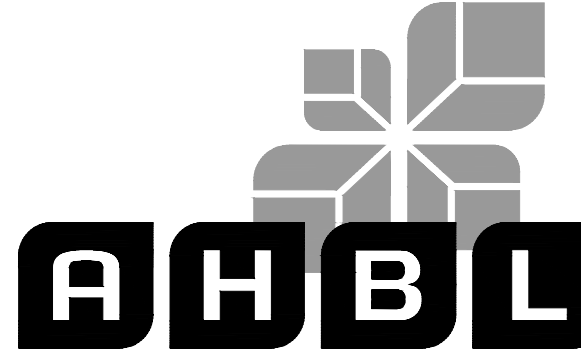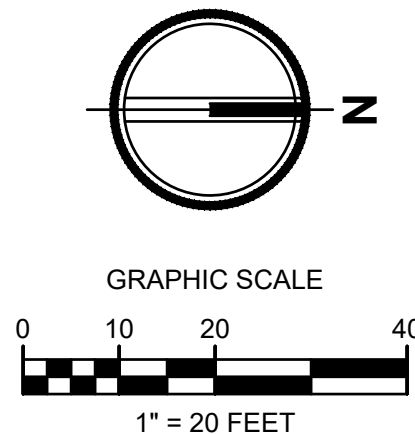

TACOMA • SEATTLE • SPOKANE • TRI-CITIES
2215 North 30th Street, Suite 300, Tacoma, WA 98403
253.383.2422 TEL 253.383.2572 FAX www.ahbl.com WEB

Project Title:

EAST TOWN CROSSING PHASE 1

Client:

ASH DEVELOPMENT

GREG HELLE

GREG.HELLE@ASHNW.COM

Project No.:

Updated callouts

2230752


Issue Set & Date:

VERIFY-sheet callout (C6.087) (4 pics)
[Plans Sht C6.01; Pg 53 of 63]

PERMIT SUBMITTAL

11/20/2023

VERIFY-sheet callout (C6.097) (5 pics)
[Plans Sht C6.01; Pg 53 of 63]

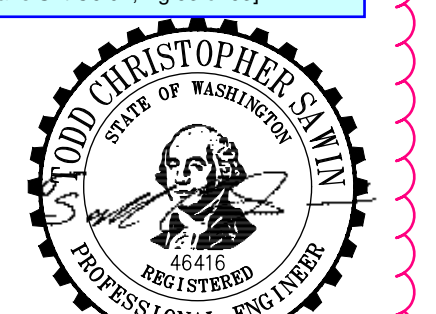

VERIFY-sheet callout (C6.107) (4 pics)
[Plans Sht C6.01; Pg 53 of 63]

11/21/2023

NOTICE: A REVIEW OF THIS DOCUMENT SHALL VALIDATE THE PROFESSIONAL SEAL AND SIGNATURE. PUBLICATION OF THIS DOCUMENT DOES NOT GUARANTEE THE ACCURACY OF THE INFORMATION OR THE QUALITY OF THE WORK. THE USER SHALL BE RESPONSIBLE FOR THE DESIGN AND CONSTRUCTION OF THE PROJECT. THE CITY SHALL NOT BE HELD RESPONSIBLE FOR ANY DAMAGE OR INJURY TO THE PROJECT OR FOR ANY OTHER PROJECT.

FIRE PROTECTION NOTES

THE FIRE PROTECTION SYSTEM INCLUDING MATERIALS, SIZING, AND CONFIGURATION IS SUBJECT TO A CONTRACTOR PROVIDED DESIGN BY A FIRE PROTECTION ENGINEER, AND AS SUCH, THE FINAL DESIGN OF THE FIRE PROTECTION SYSTEM MAY DEVIATE FROM THE SYSTEM SHOWN. THE FIRE PROTECTION SYSTEM AS SHOWN FROM THE MAIN LINE TO THE CONNECTION AT THE BUILDING SPRINKLER IS INTENDED FOR LOCATION OF THE FIRE HYDRANTS AND FIRE DEPARTMENT CONNECTION ONLY. CONTRACTOR'S BID SHALL REFLECT THE CONDITIONS OF THE FIRE PROTECTION ENGINEER'S DESIGN. CONTRACTOR SHALL COMPLY WITH ALL NATIONAL FIRE PROTECTION ASSOCIATION REQUIREMENTS AS SET FORTH BY "NFPA 13", ITS AMENDMENTS, AND LOCAL REQUIREMENTS, INCLUDING BUT NOT LIMITED TO ACQUISITION OF ALL PERMITS.

FIRE SPRINKLER NOTE



WHERE THE UNDERGROUND WATER SUPPLY TEES OFF TO SERVE ONLY A FIRE SPRINKLER SYSTEM AND/OR FIRE HYDRANTS, A SEPARATE DETAILED PLAN MUST BE SUBMITTED AND APPROVED BY THE FIRE MARSHAL PRIOR TO INSTALLATION.

GENERAL NOTE

- SEE DETAILS AS NOTED
- VERTICAL THRUST BLOCKING SEE DETAILS 1 AND 2 SHEET C6.5
- WATER SERVICE CONNECTIONS SEE DETAILS 3 AND 4 SHEET C6.5
- PRIVATE WATER SERVICE LINE SEE DETAIL 5 SHEET C6.5
- FIRE HYDRANT ASSEMBLY SEE DETAIL 6 SHEET C6.5
- AIR/VACUUM VALVE SEE DETAIL 1 SHEET C6.6
- DOUBLE DETECTOR CHECK VALVE ASSEMBLY INSTALLATION SEE DETAIL 2 AND 3 SHEET C6.6
- FIRE DEPARTMENT CONNECTION (FDC) SEE DETAIL 4 SHEET C6.6
- POST INDICATOR VALVE SEE DETAIL 5 ON SHEET C6.6
- HORIZONTAL THRUST BLOCKING SEE DETAIL 6 SHEET C6.6
- WATER VALVES AND MAINS SEE DETAIL 1 ON SHEET C6.7
- VALVE MARKER POST SEE DETAIL 2 SHEET C6.7
- WATER MAIN CROSSING OTHER UTILITIES SEE DETAILS 3 AND 4 SHEET C6.7

- Civil Resub Sheet C6.01: The hydrant tee should be called out as 8-inch by 8-inch by 6-inch FI tee. An 8-inch FI by MJ adapter to the east. An 8-inch by 6-inch FI reducer to the west. A 6-inch gate valve FI by MJ west of reducer. Call out PIV by fire vault.
- Civil Resub Sheet C6.01: 1-inch PE for 1-inch water service.
- Civil Resub Sheet C6.01: Fire flow will be reduced by not looping in the dead-end 8-inch water main runs.
- Added note: Wet taps to existing water mains shall be accomplished through a tapping tee and tapping valve and shall be made by a city approved contractor. The tapping sleeve shall be Romac SST all stainless steel tapping sleeve or approved equal. A two-piece epoxy coated or ductile iron tapping sleeve may be used on ductile iron pipe, when the tap is smaller than the water main size i.e. 6-inch tap on 8-inch pipe. The City shall approve the time and location for these connections. [Plans Sht C6.01; Pg 53 of 63]
- Added note: If the project is utilizing a fire booster pump, the FDC must connect to the sprinkler system on the discharge side of the pump in accordance with NFPA regulations. [Plans Sht C6.01; Pg 53 of 63]

- **** = CALLOUT-and show thrust block [Plans Sht C6.01; Pg 53 of 63]
- Civil Resub Sheet C6.01: Follow City standards. Call out 2-inch PE with 2-inch gate valves shown on plan set.
- Civil Resub Sheet C6.01: This tee will be an 8-inch by 8-inch wet tap with a stainless steel tapping sleeve and an 8-inch gate valve. Not 8-inch by 6-inch as called out.
- Civil Resub Sheet C6.01: The existing 8-inch water main through this project will be public and all other water lines will be private. Show and call out the public water easement on this plan set.

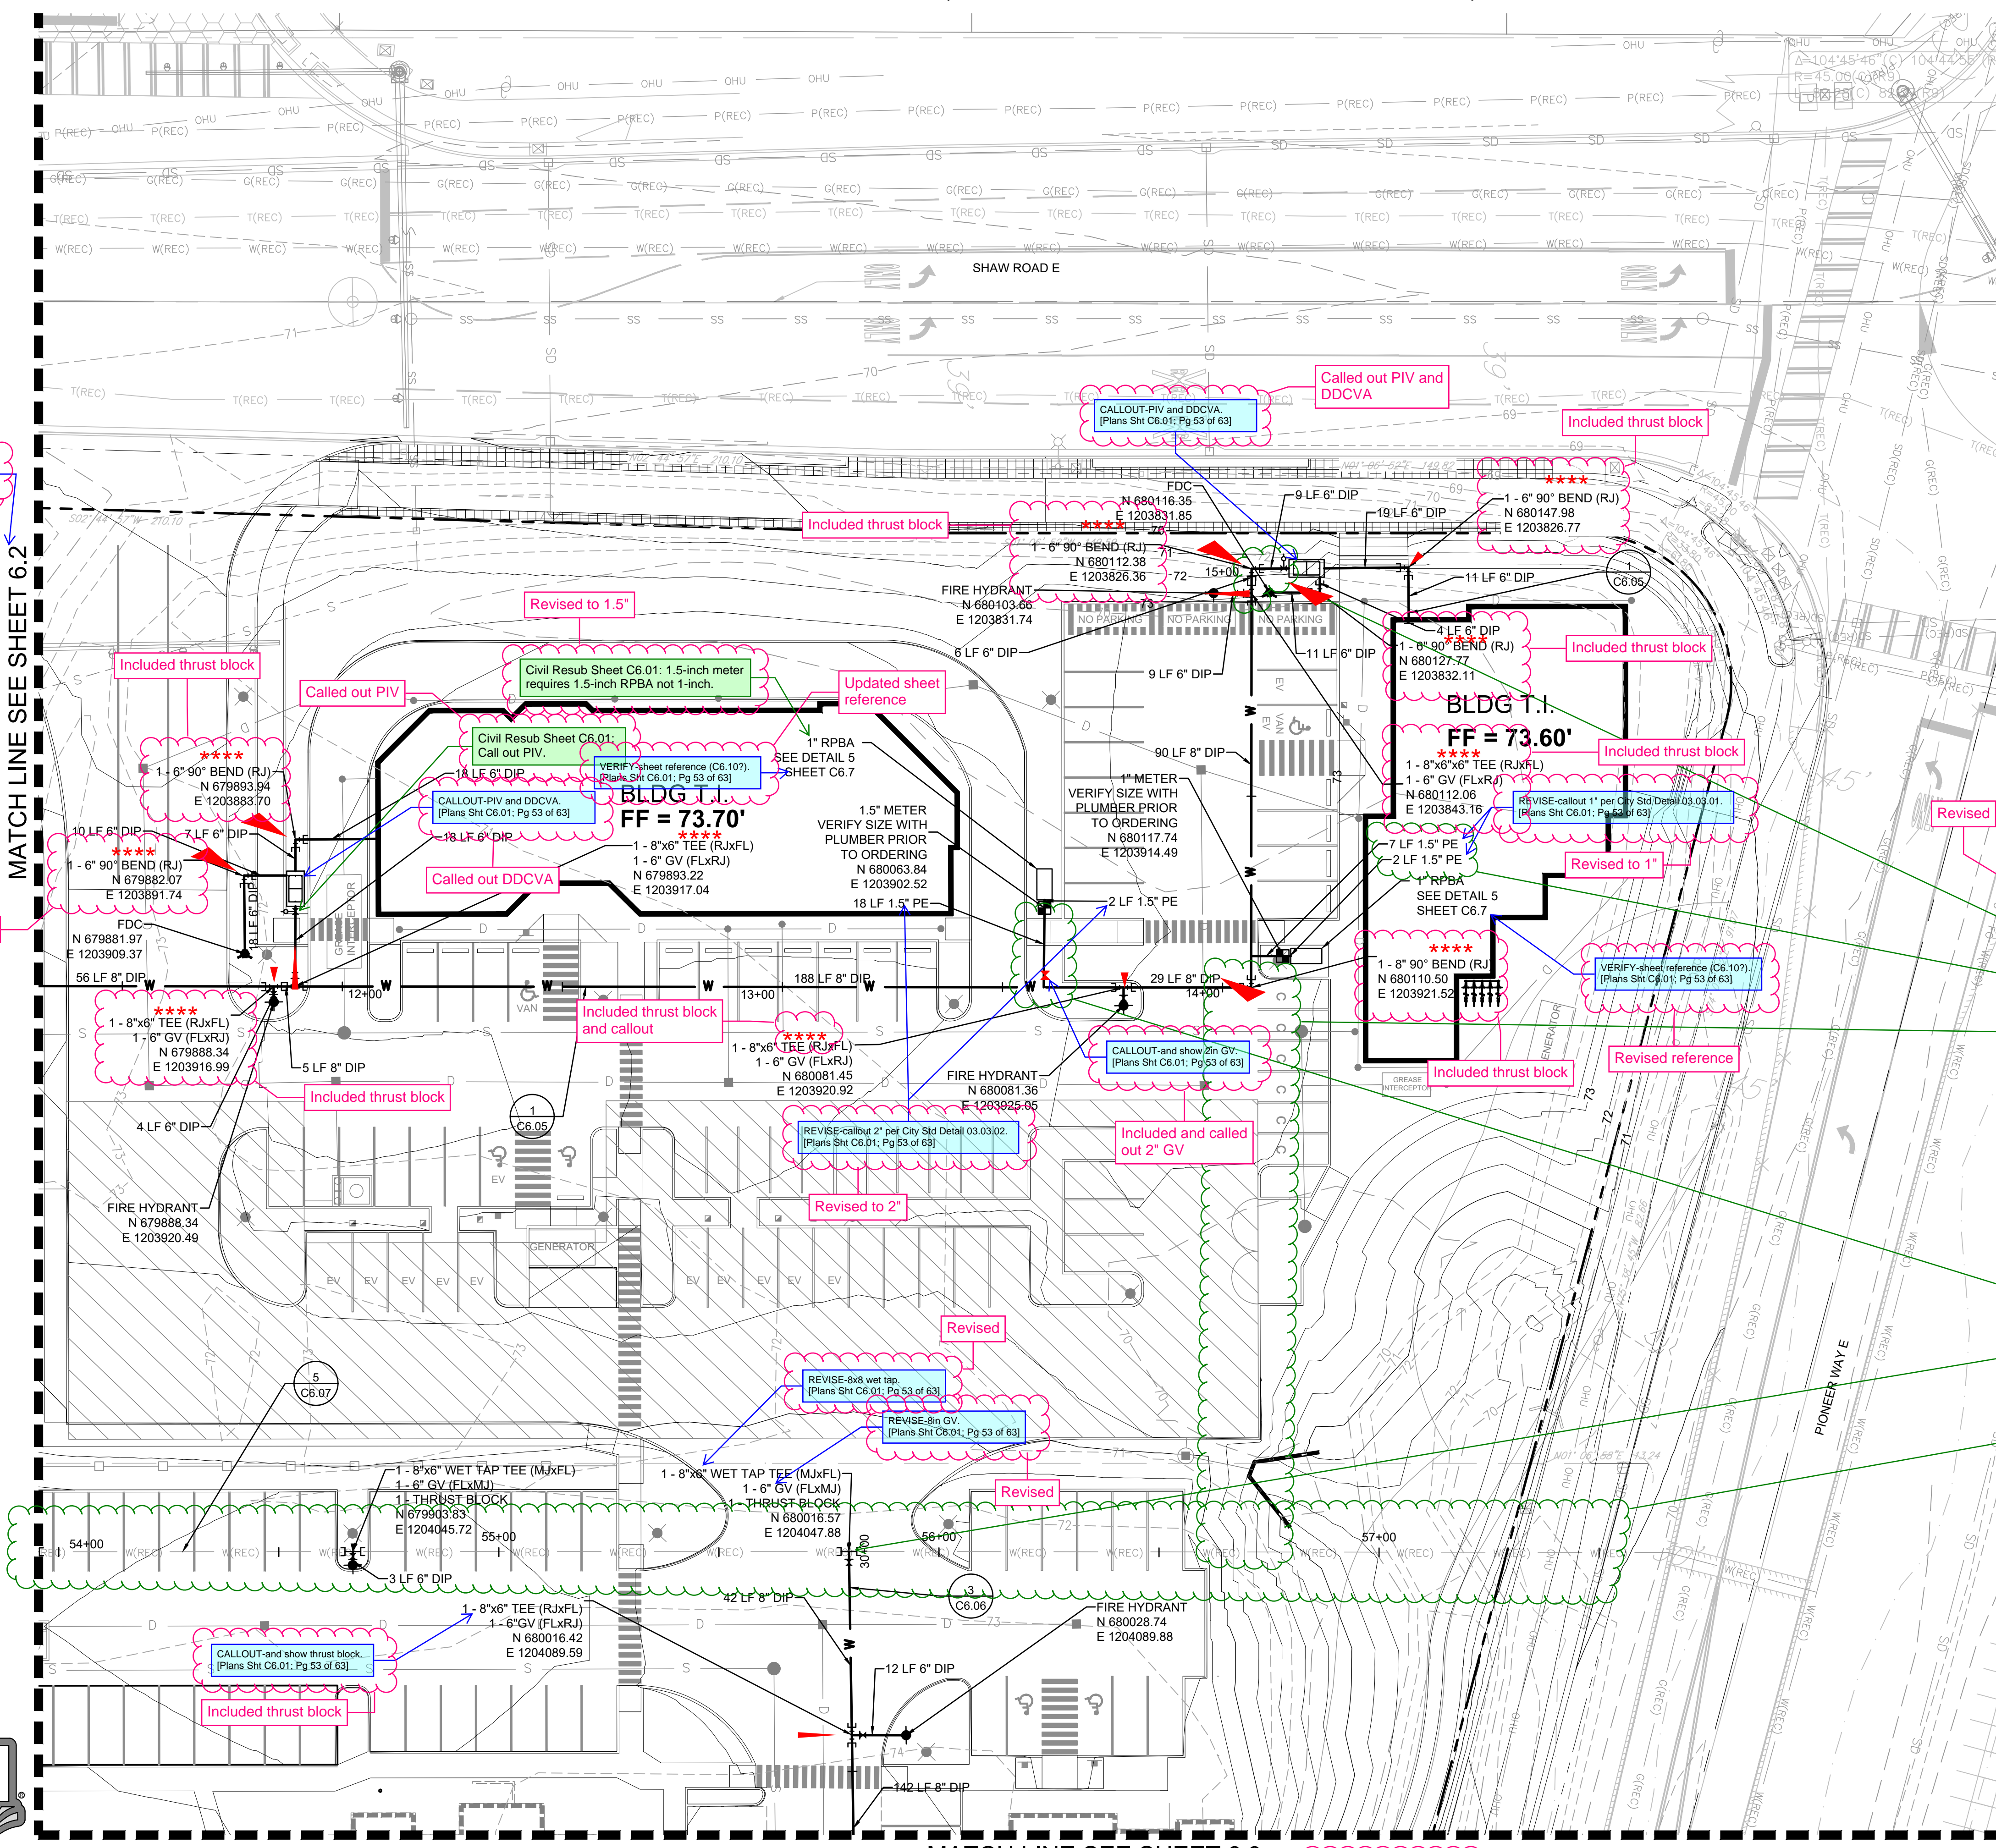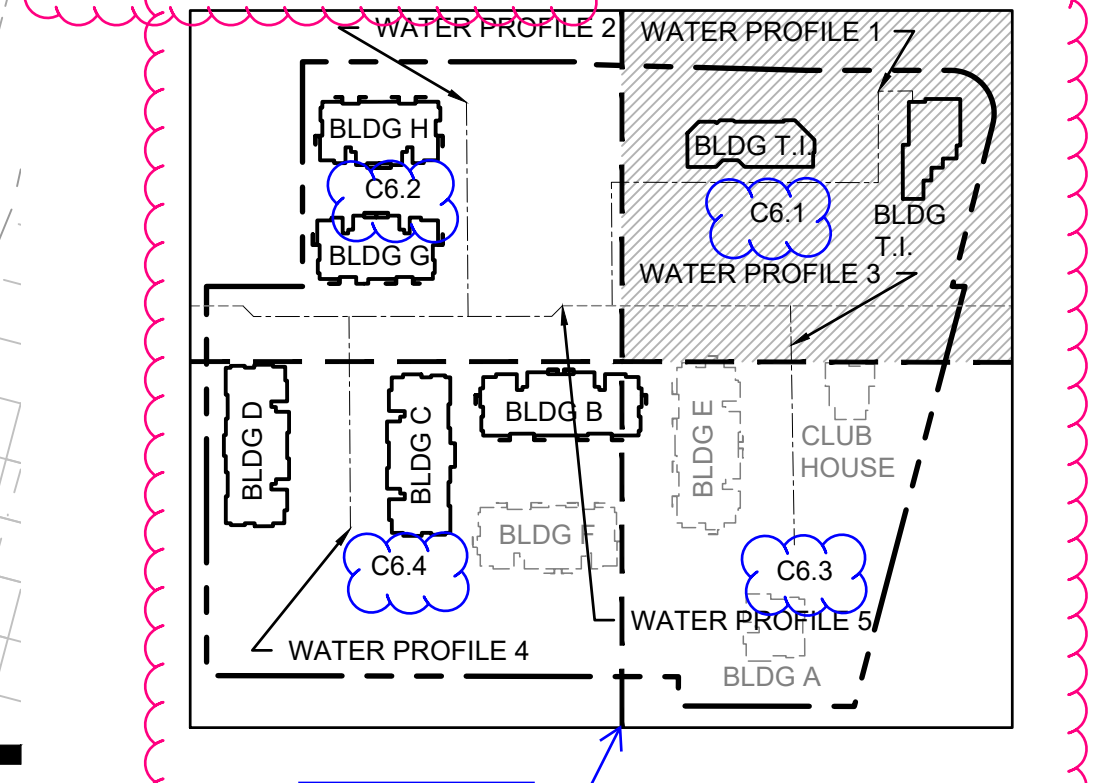

Updated
VERIFY-sheet Ref (C6.02)
[Plans Sht C6.01; Pg 53 of 63]

Updated
Civil Resub Sheet C6.01: 1.5-inch meter requires 1.5-inch RPBA not 1-inch.
Updated sheet reference
1" RPBA
SEE DETAIL 5
SHEET C6.7

Updated
Civil Resub Sheet C6.01: Call out PIV.
Callout PIV and DDCVA
[Plans Sht C6.01; Pg 53 of 63]

Updated
Civil Resub Sheet C6.01: Call out PIV and DDCVA.
[Plans Sht C6.01; Pg 53 of 63]

Updated
Civil Resub Sheet C6.01: Call out PIV and DDCVA.
[Plans Sht C6.01; Pg 53 of 63]

Updated
VERIFY-sheet Ref (C6.03)
[Plans Sht C6.01; Pg 53 of 63]

Revised to 2"

Revised

Included 20' easement

Revised

Revised

Revised

Revised

Revised

Revised

Revised



Know what's below.
Call before you dig.

Sheet Title:
WATER PLAN NW

Designed by: CW
Drawn by: SK
Checked by: JI

Sheet No.
C6.01

53 of 63 Sheets

EAST TOWN CROSSING PHASE 1


SEC. 26,35/ TWP. 20 N./ RGE. 4 E., W.M.

APPROVED

BY: CITY OF PUYALLUP
DEVELOPMENT ENGINEERING


DATE:

NOTE: THIS APPROVAL IS VOID AFTER 180 DAYS FROM APPROVAL DATE. THE CITY WILL NOT BE RESPONSIBLE FOR ERRORS AND/OR OMISSIONS ON THESE PLANS. FIELD CONDITIONS MAY DICTATE CHANGES TO THESE PLANS AS DETERMINED BY THE DEVELOPMENT ENGINEERING MANAGER.

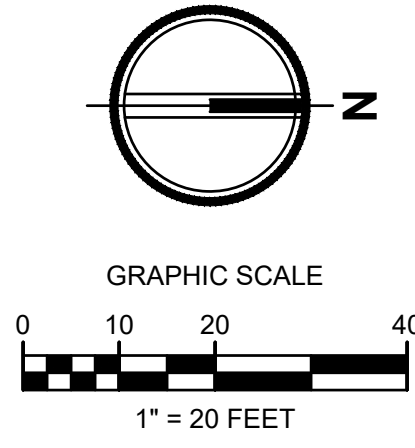

GENERAL NOTE

- SEE DETAILS AS NOTED
- VERTICAL THRUST BLOCKING SEE DETAILS 1 AND 2 SHEET C6.5
- WATER SERVICE CONNECTIONS SEE DETAILS 3 AND 4 SHEET C6.5
- PRIVATE WATER SERVICE LINE SEE DETAIL 5 SHEET C6.5
- FIRE HYDRANT ASSEMBLY SEE DETAIL 6 SHEET C6.5
- AIR/VACUUM VALVE SEE DETAIL 1 SHEET C6.6
- DOUBLE DETECTOR CHECK VALVE ASSEMBLY INSTALLATION SEE DETAIL 2 AND 3 SHEET C6.6
- FIRE DEPARTMENT CONNECTION (FDC) SEE DETAIL 4 SHEET C6.6
- POST INDICATOR VALVE SEE DETAIL 5 ON SHEET C6.6
- HORIZONTAL THRUST BLOCKING SEE DETAIL 6 SHEET C6.6
- WATER VALVES AND MAINS SEE DETAIL 1 ON SHEET C6.7
- VALVE MARKER POST SEE DETAIL 2 SHEET C6.7
- WATER MAIN CROSSING OTHER UTILITIES SEE DETAILS 3 AND 4 SHEET C6.7

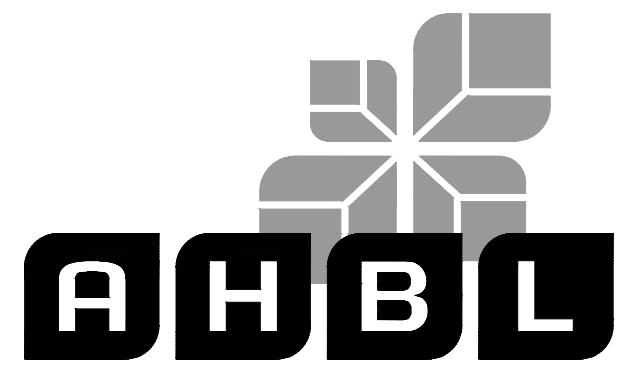

TACOMA • SEATTLE • SPOKANE • TRI-CITIES

2215 North 30th Street, Suite 300, Tacoma, WA 98403
253.383.2422 TEL 253.383.2572 FAX www.ahbl.com WEB

Project Title:
EAST TOWN CROSSING PHASE 1


Client:
ASH DEVELOPMENT

GREG HELLE
GREG.HELLE@ASHNW.COM

Project No.
2230752


Issue Set & Date:
PERMIT SUBMITTAL

11/20/2023

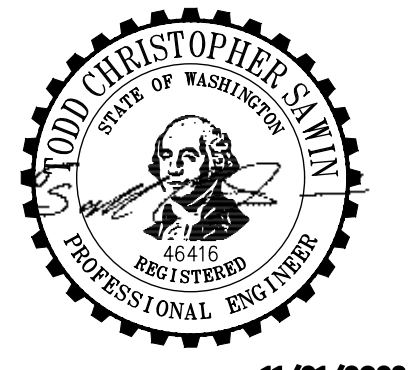

11/21/2023

NOTICE: A REVIEW OF THIS DOCUMENT SHALL INDICATE THE PROFESSIONAL SEAL AND SIGNATURE PRESENTATION OF THIS DOCUMENT DOES NOT GUARANTEE THAT THE DESIGN OR THE PROJECT DESCRIBED IN THE TITLE BLOCK WILL BE CONSTRUCTED AS SHOWN, NOR DOES IT ADDITION TO THAT PROJECT OR FOR ANY OTHER PROJECT.

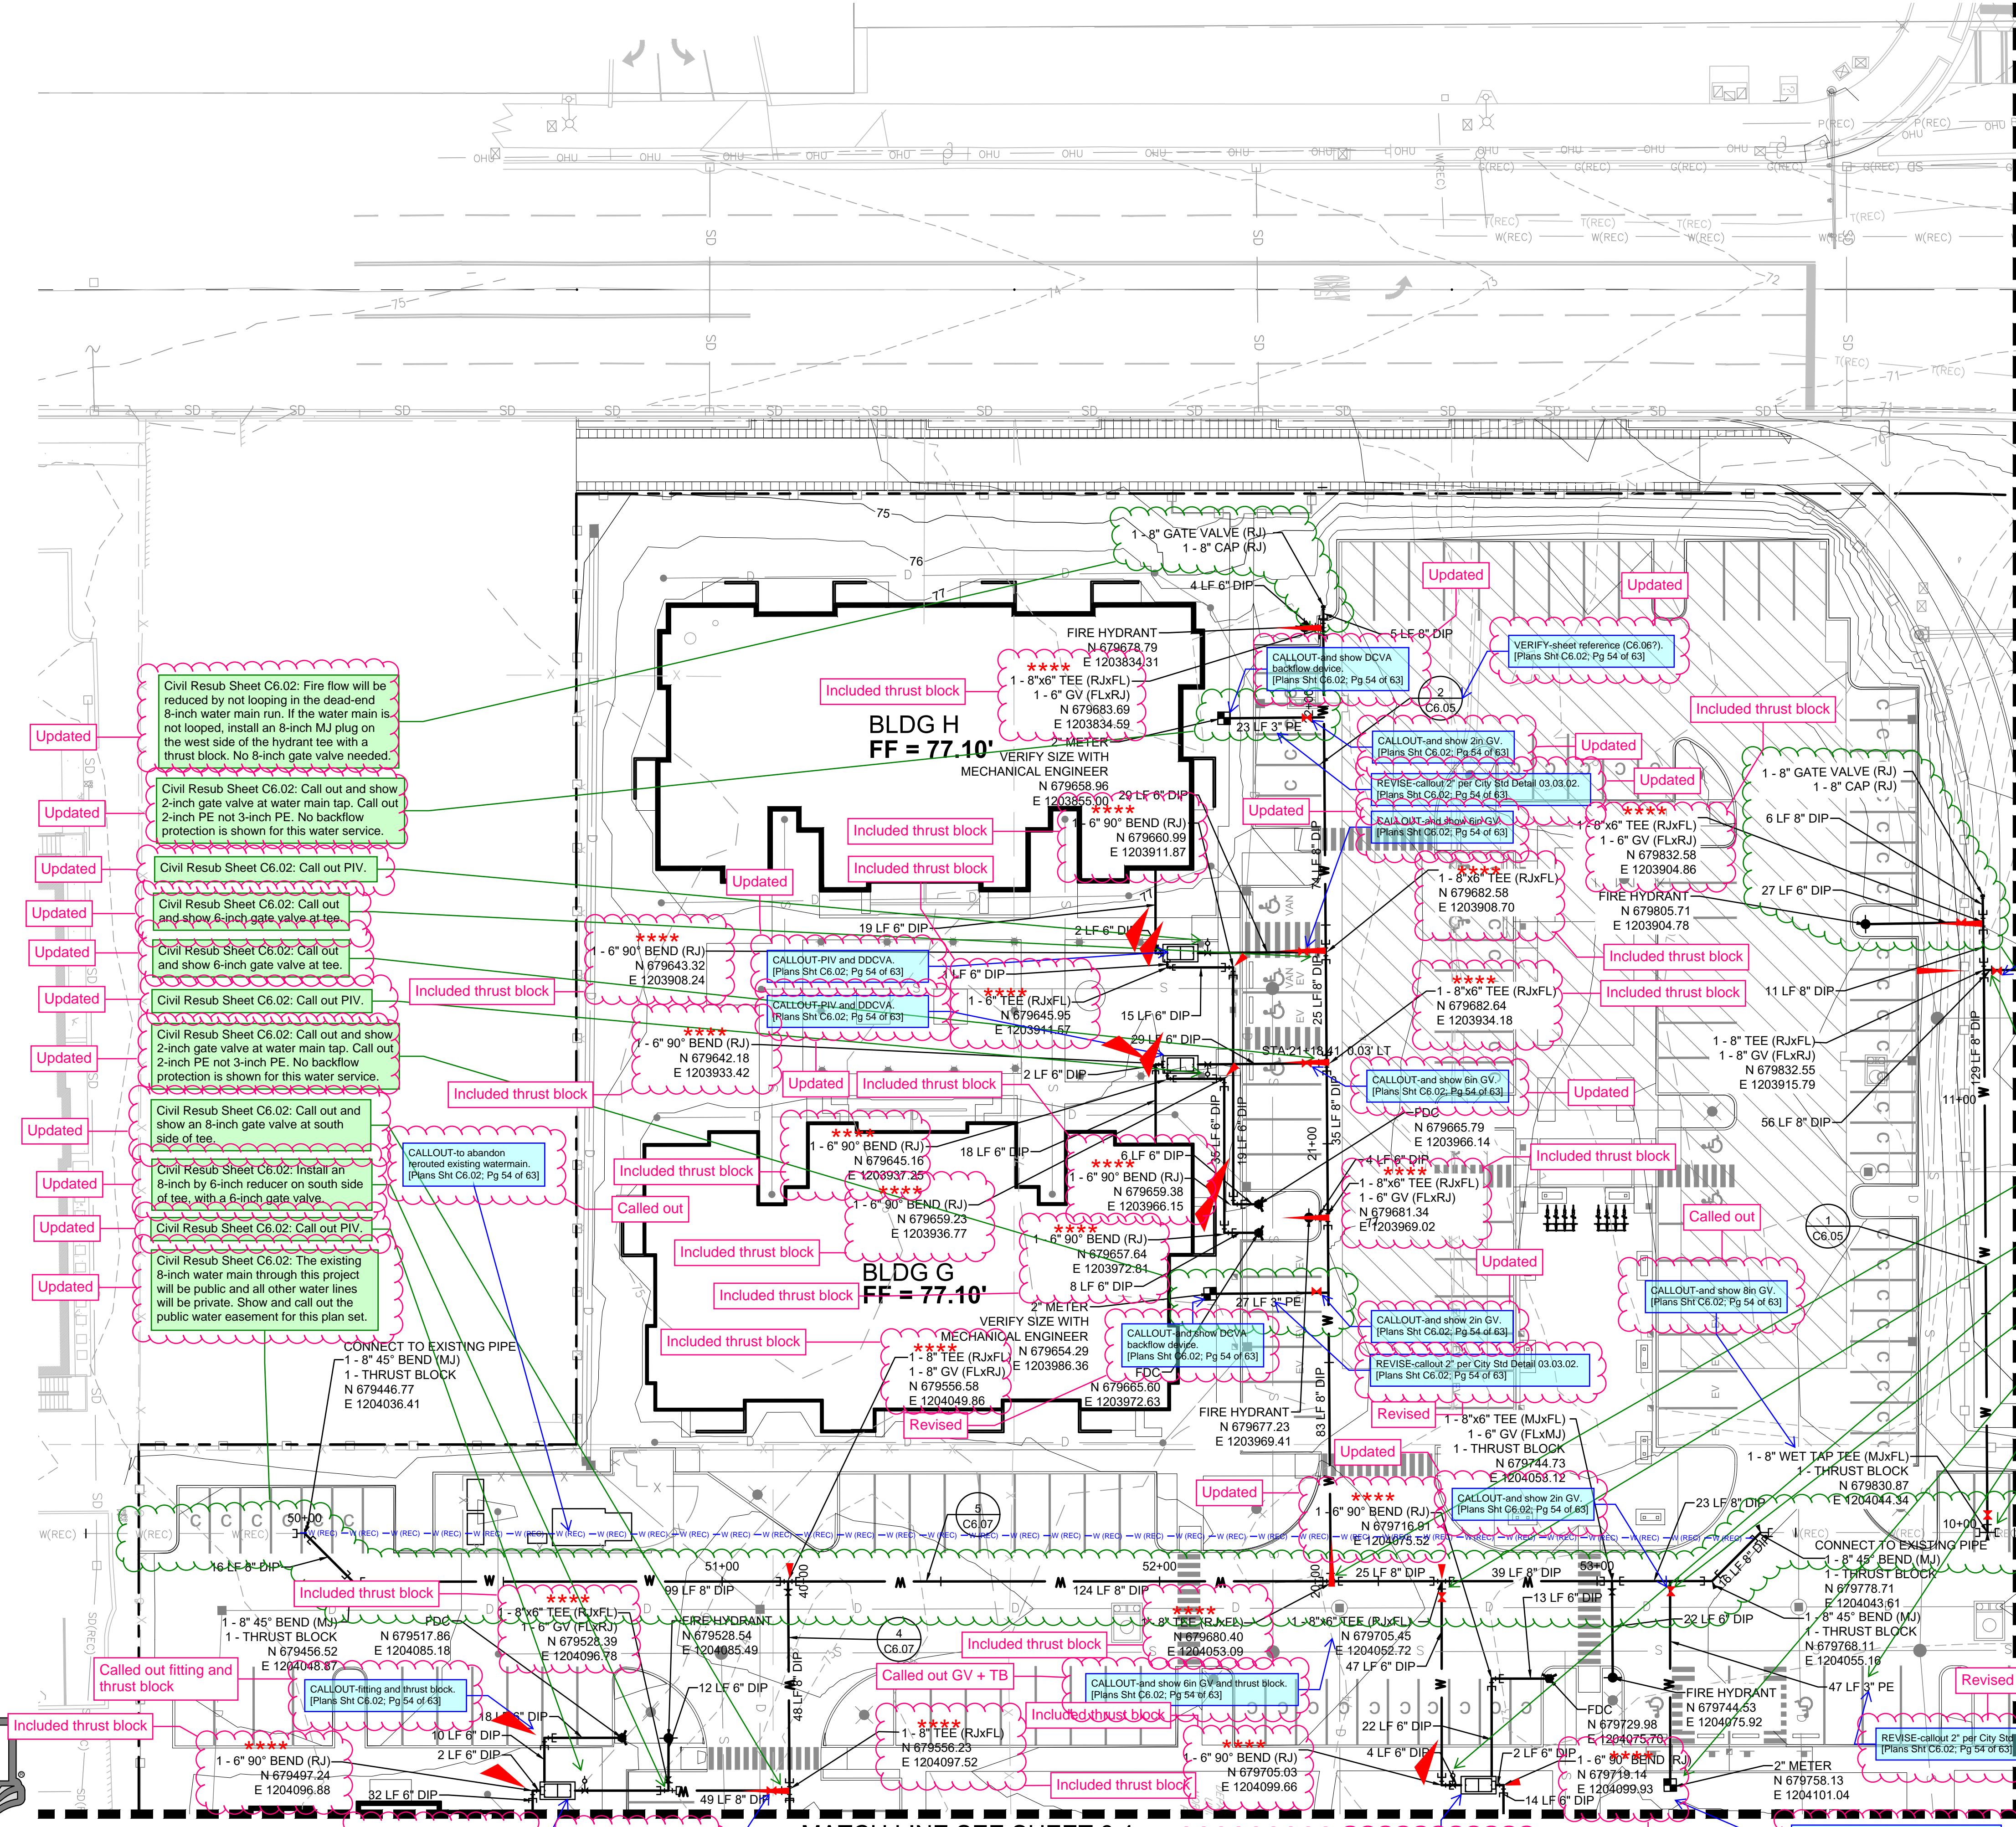

MATCH LINE SEE SHEET 6.1

MATCH LINE SEE SHEET 6.4

- Updated Civil Resub Sheet C6.02: Fire flow will be reduced by not looping in the dead-end 8-inch water main run. If the water main is not looped, install an 8-inch MJ plug on the west side of the hydrant tee with a thrust block. No 8-inch gate valve needed.
- Updated Civil Resub Sheet C6.02: Call out and show 2-inch gate valve at water main tap. Call out 2-inch PE not 3-inch PE. No backflow protection is shown for this water service.
- Updated Civil Resub Sheet C6.02: Call out PIV.
- Updated Civil Resub Sheet C6.02: Call out and show 6-inch gate valve at tee.
- Updated Civil Resub Sheet C6.02: Call out PIV.
- Updated Civil Resub Sheet C6.02: Call out and show 2-inch gate valve at water main tap. Call out 2-inch PE not 3-inch PE. No backflow protection is shown for this water service.
- Updated Civil Resub Sheet C6.02: Call out and show an 8-inch gate valve at south side of tee.
- Updated Civil Resub Sheet C6.02: Install an 8-inch by 6-inch reducer on south side of tee, with a 6-inch gate valve.
- Updated Civil Resub Sheet C6.02: Call out PIV.
- Updated Civil Resub Sheet C6.02: The existing 8-inch water main through this project will be public and all other water lines will be private. Show and call out the public water easement for this plan set.

ADD NOTE: Wet taps to existing water mains shall be accomplished through a tapping tee and tapping valve and shall be made by a city approved contractor. The tapping sleeve shall be Romex SST all stainless steel tapping sleeve or approved equal. A two-piece epoxy coated or ductile iron tapping sleeve may be used on ductile iron pipe, when the tap is smaller than the water main size i.e. 6-inch tap on 8-inch pipe. The City shall approve the time and location for these connections. [Plans Sht C6.02; Pg 54 of 63]

Civil Resub Sheet C6.02: Fire flow will be reduced by not looping in the dead-end 8-inch water main run. If the water main is not looped, install an 8-inch MJ plug on the west side of the hydrant tee with a thrust block. No 8-inch gate valve needed. Show the 6-inch gate valve for the hydrant. A fire hydrant run should be 20-feet or less in length. Move hydrant back in parking bump-out.

Civil Resub Sheet C6.02: Show 8-inch gate valve at tee.

Civil Resub Sheet C6.02: No line valves are called out on the public water main through this project. If any work needs to be done on this public main, all water to this complex will be off until work is completed. At a minimum, consider installing three 8-inch gate valves at this tee for better control. One 8-inch gate valve is required on the east side of this tee.

Civil Resub Sheet C6.02: Call out and show a 6-inch gate valve at this tee.

Civil Resub Sheet C6.02: Call out PIV.

Civil Resub Sheet C6.02: Call out and show 2-inch gate valve at water main tap.

Civil Resub Sheet C6.02: No backflow protection is shown for this water service.

Civil Resub Sheet C6.02: Call out 8-inch stainless steel tapping sleeve with gate valve. Show valve.

Civil Resub Sheet C6.02: Call out 2-inch PE, not 3-inch PE.

Civil Resub Sheet C6.02: Call out 8-inch stainless steel tapping sleeve with gate valve. Show valve.

Civil Resub Sheet C6.02: Call out 2-inch PE, not 3-inch PE.

Civil Resub Sheet C6.02: Call out 8-inch stainless steel tapping sleeve with gate valve. Show valve.

Civil Resub Sheet C6.02: Call out 2-inch PE, not 3-inch PE.



Know what's below.
Call before you dig.

Revisions:

Sheet Title:
WATER PLAN SW

Designed by: CW
Drawn by: SK
Checked by: JI

Sheet No.
C6.02
54 of 63 Sheets

EAST TOWN CROSSING PHASE 1



SEC. 26,35/ TWP. 20 N./ RGE. 4 E., W.M.

APPROVED

BY: CITY OF PUYALLUP
DEVELOPMENT ENGINEERING

DATE:

NOTE: THIS APPROVAL IS VOID AFTER 180 DAYS FROM APPROVAL DATE. THE CITY WILL NOT BE RESPONSIBLE FOR ERRORS AND/OR OMISSIONS ON THESE PLANS. FIELD CONDITIONS MAY DICTATE CHANGES TO THESE PLANS AS DETERMINED BY THE DEVELOPMENT ENGINEERING MANAGER.

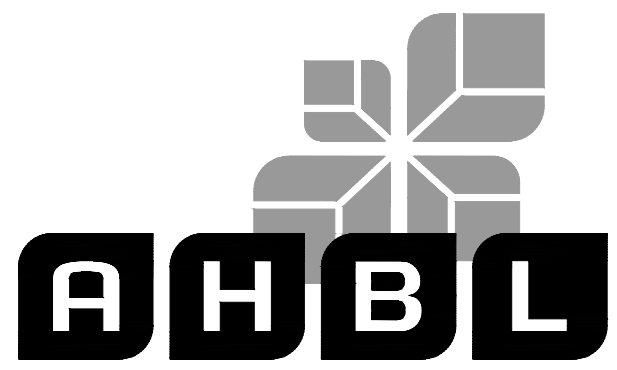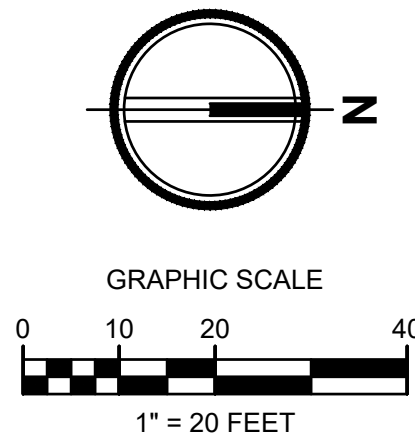

TACOMA • SEATTLE • SPOKANE • TRI-CITIES

2215 North 30th Street, Suite 300, Tacoma, WA 98403
253.383.2422 TEL 253.383.2572 FAX www.ahbl.com WEB

Project Title:

EAST TOWN CROSSING PHASE 1

Client:

ASH DEVELOPMENT

GREG HELLE

GREG.HELLE@ASHNW.COM

Project No.

2230752

Issue Set & Date:

PERMIT SUBMITTAL

11/20/2023




11/21/2023

NOTICE: A REVISION OF THIS DOCUMENT SHALL INVALIDATE THE PROFESSIONAL SEAL AND SIGNATURE. PUBLICATION OF THIS DOCUMENT DOES NOT CONSTITUTE AN ENDORSEMENT OR GUARANTEE BY THE ENGINEER OR THE CITY. THIS DOCUMENT IS FOR THE PROJECT AND SITE SPECIFIC AND IS NOT TO BE USED FOR ANY OTHER PROJECT OR ACTION TO THAT PROJECT OR FOR ANY OTHER PROJECT.

MATCH LINE SEE SHEET 6.1



MATCH LINE SEE SHEET 6.4

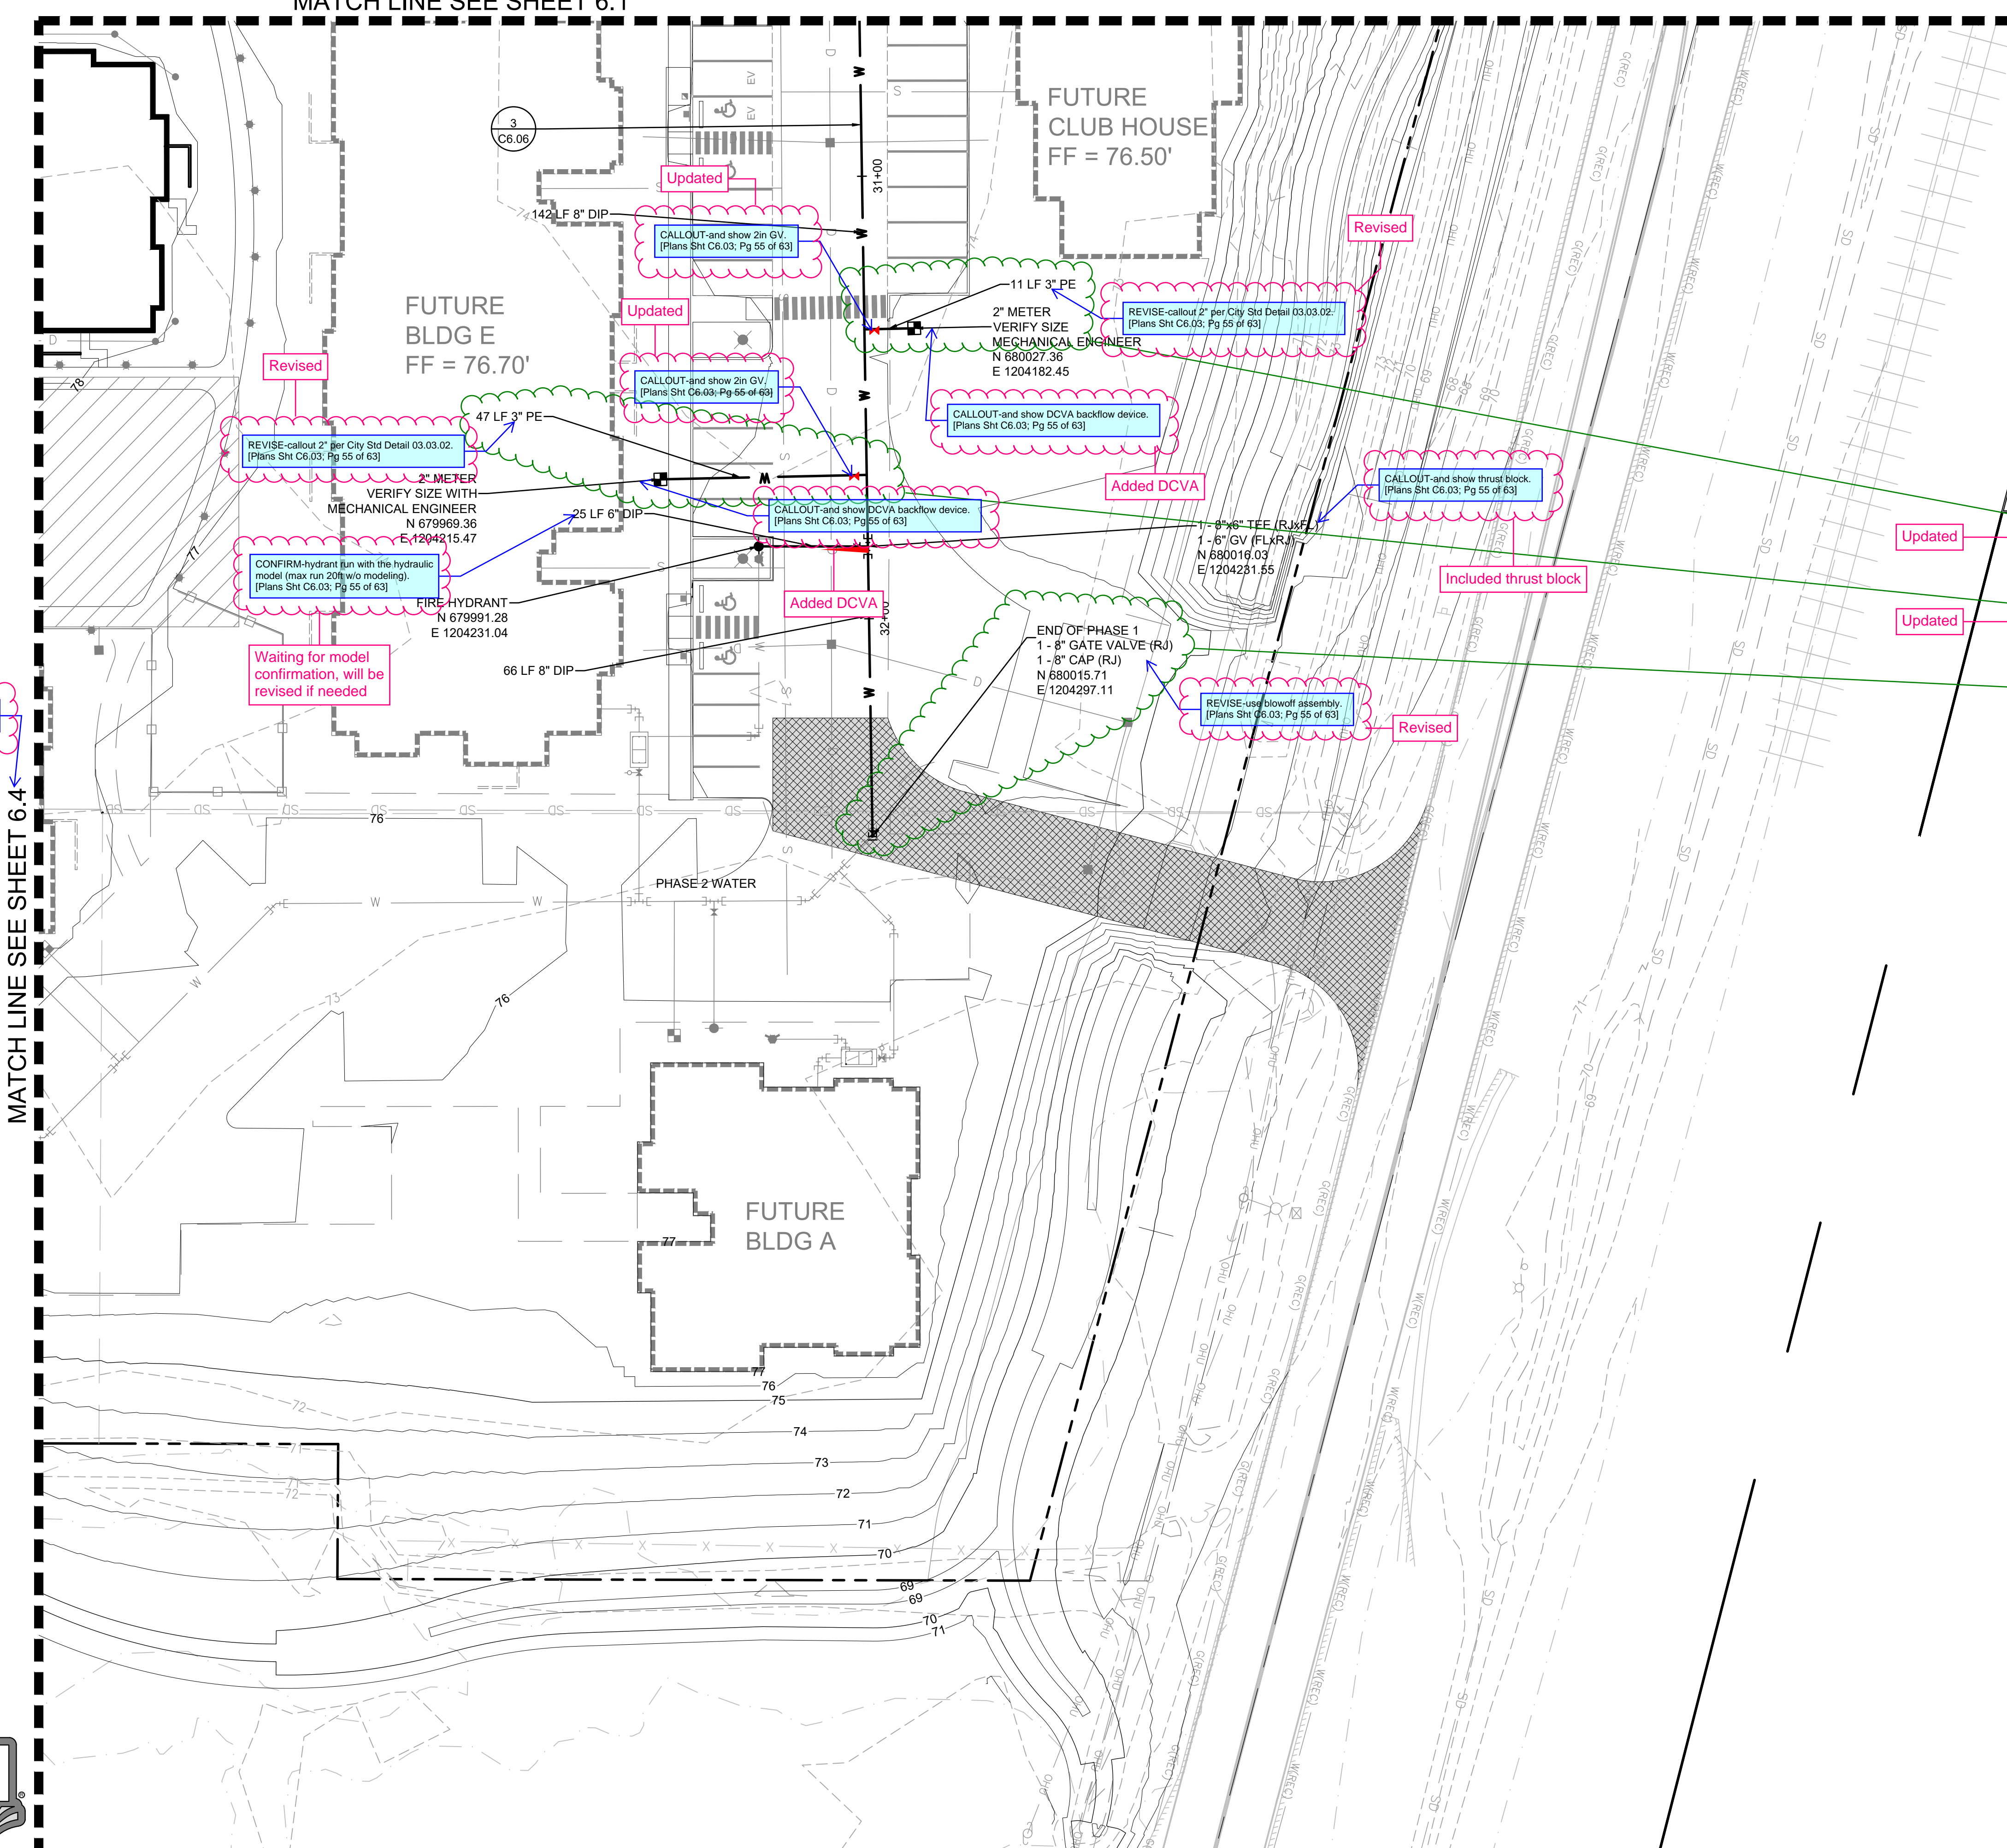

GENERAL NOTE

- SEE DETAILS AS NOTED
- VERTICAL THRUST BLOCKING SEE DETAILS 1 AND 2 SHEET C6.5
- WATER SERVICE CONNECTIONS SEE DETAILS 3 AND 4 SHEET C6.5
- PRIVATE WATER SERVICE LINE SEE DETAIL 5 SHEET C6.5
- FIRE HYDRANT ASSEMBLY SEE DETAIL 6 SHEET C6.5
- AIR/VACUUM VALVE SEE DETAIL 1 SHEET C6.6
- DOUBLE DETECTOR CHECK VALVE ASSEMBLY INSTALLATION SEE DETAIL 2 AND 3 SHEET C6.6
- FIRE DEPARTMENT CONNECTION (FDC) SEE DETAIL 4 SHEET C6.6
- POST INDICATOR VALVE SEE DETAIL 5 ON SHEET C6.6
- HORIZONTAL THRUST BLOCKING SEE DETAIL 6 SHEET C6.6
- VALVE MARKER POST SEE DETAIL 2 SHEET C6.7
- WATER MAIN CROSSING OTHER UTILITIES SEE DETAILS 3 AND 4 SHEET C6.7

- Civil Resub Sheet C6.03: Call out and show 2-inch gate valve at water main tap. Call out 2-inch PE not 3-inch PE. No backflow protection is shown for this water service.
- Civil Resub Sheet C6.03: Call out and show 2-inch gate valve at water main tap. Call out 2-inch PE not 3-inch PE. No backflow protection is shown for this water service.
- Civil Resub Sheet C6.03: Do not install 8-inch gate valve until the phase 2 tie-in. Install a 2-inch blow-off assembly per City Standard detail 03.06.01.

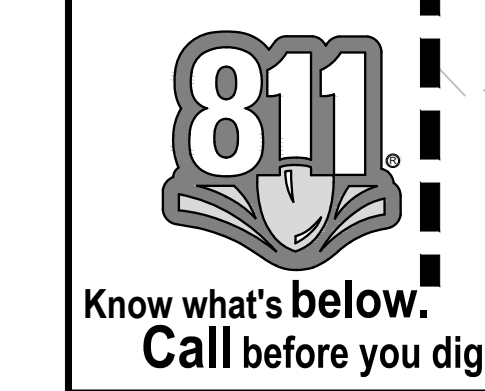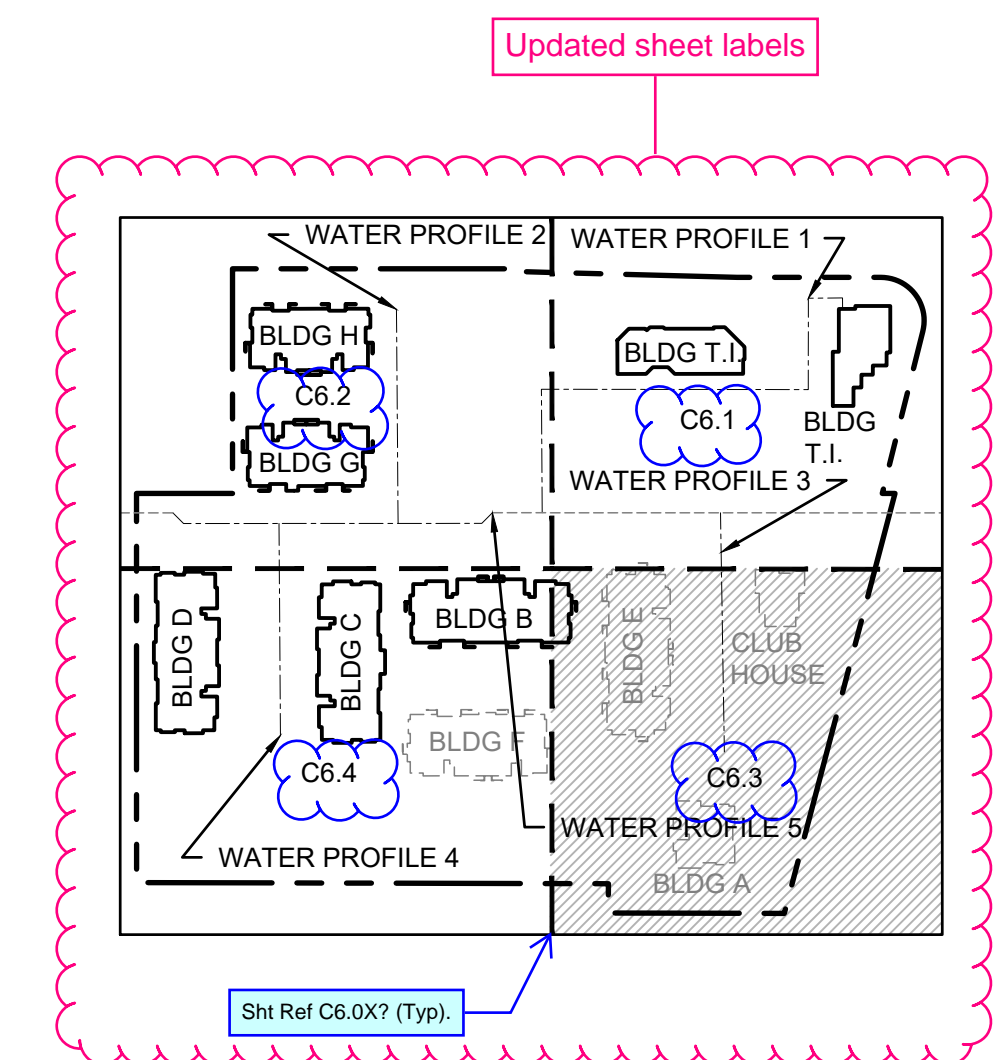

Revisions:	
Sheet Title:	WATER PLAN NE
Designed by:	CW
Drawn by:	SK
Checked by:	JJ
Sheet No.:	C6.03
	55 of 63 Sheets



EAST TOWN CROSSING PHASE 1

SEC. 26,35/ TWP. 20 N./ RGE. 4 E., W.M.

APPROVED

BY: CITY OF PUYALLUP
DEVELOPMENT ENGINEERING
DATE:

NOTE: THIS APPROVAL IS VOID AFTER 180 DAYS FROM APPROVAL DATE. THE CITY WILL NOT BE RESPONSIBLE FOR ERRORS AND/OR OMISSIONS ON THESE PLANS. FIELD CONDITIONS MAY DICTATE CHANGES TO THESE PLANS AS DETERMINED BY THE DEVELOPMENT ENGINEERING MANAGER.

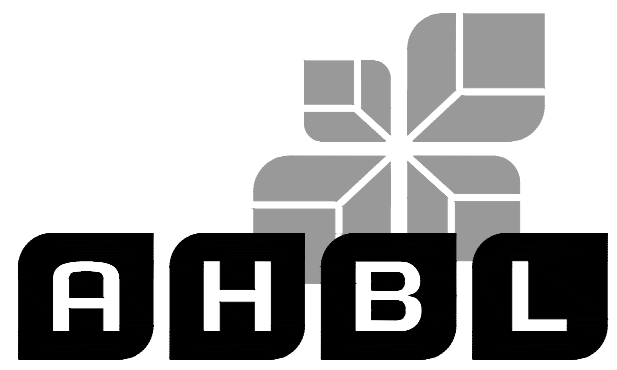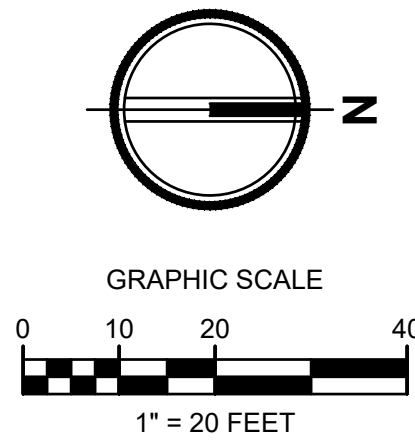

TACOMA · SEATTLE · SPOKANE · TRI-CITIES

2215 North 30th Street, Suite 300, Tacoma, WA 98403
253.383.2422 TEL 253.383.2572 FAX www.ahbl.com WEB

Project Title:

EAST TOWN CROSSING PHASE 1

Client:
ASH DEVELOPMENT

GREG HELLE

GREG.HELLE@ASHNW.COM

Project No.

2230752

Issue Set & Date:


PERMIT SUBMITTAL

11/20/2023



11/21/2023


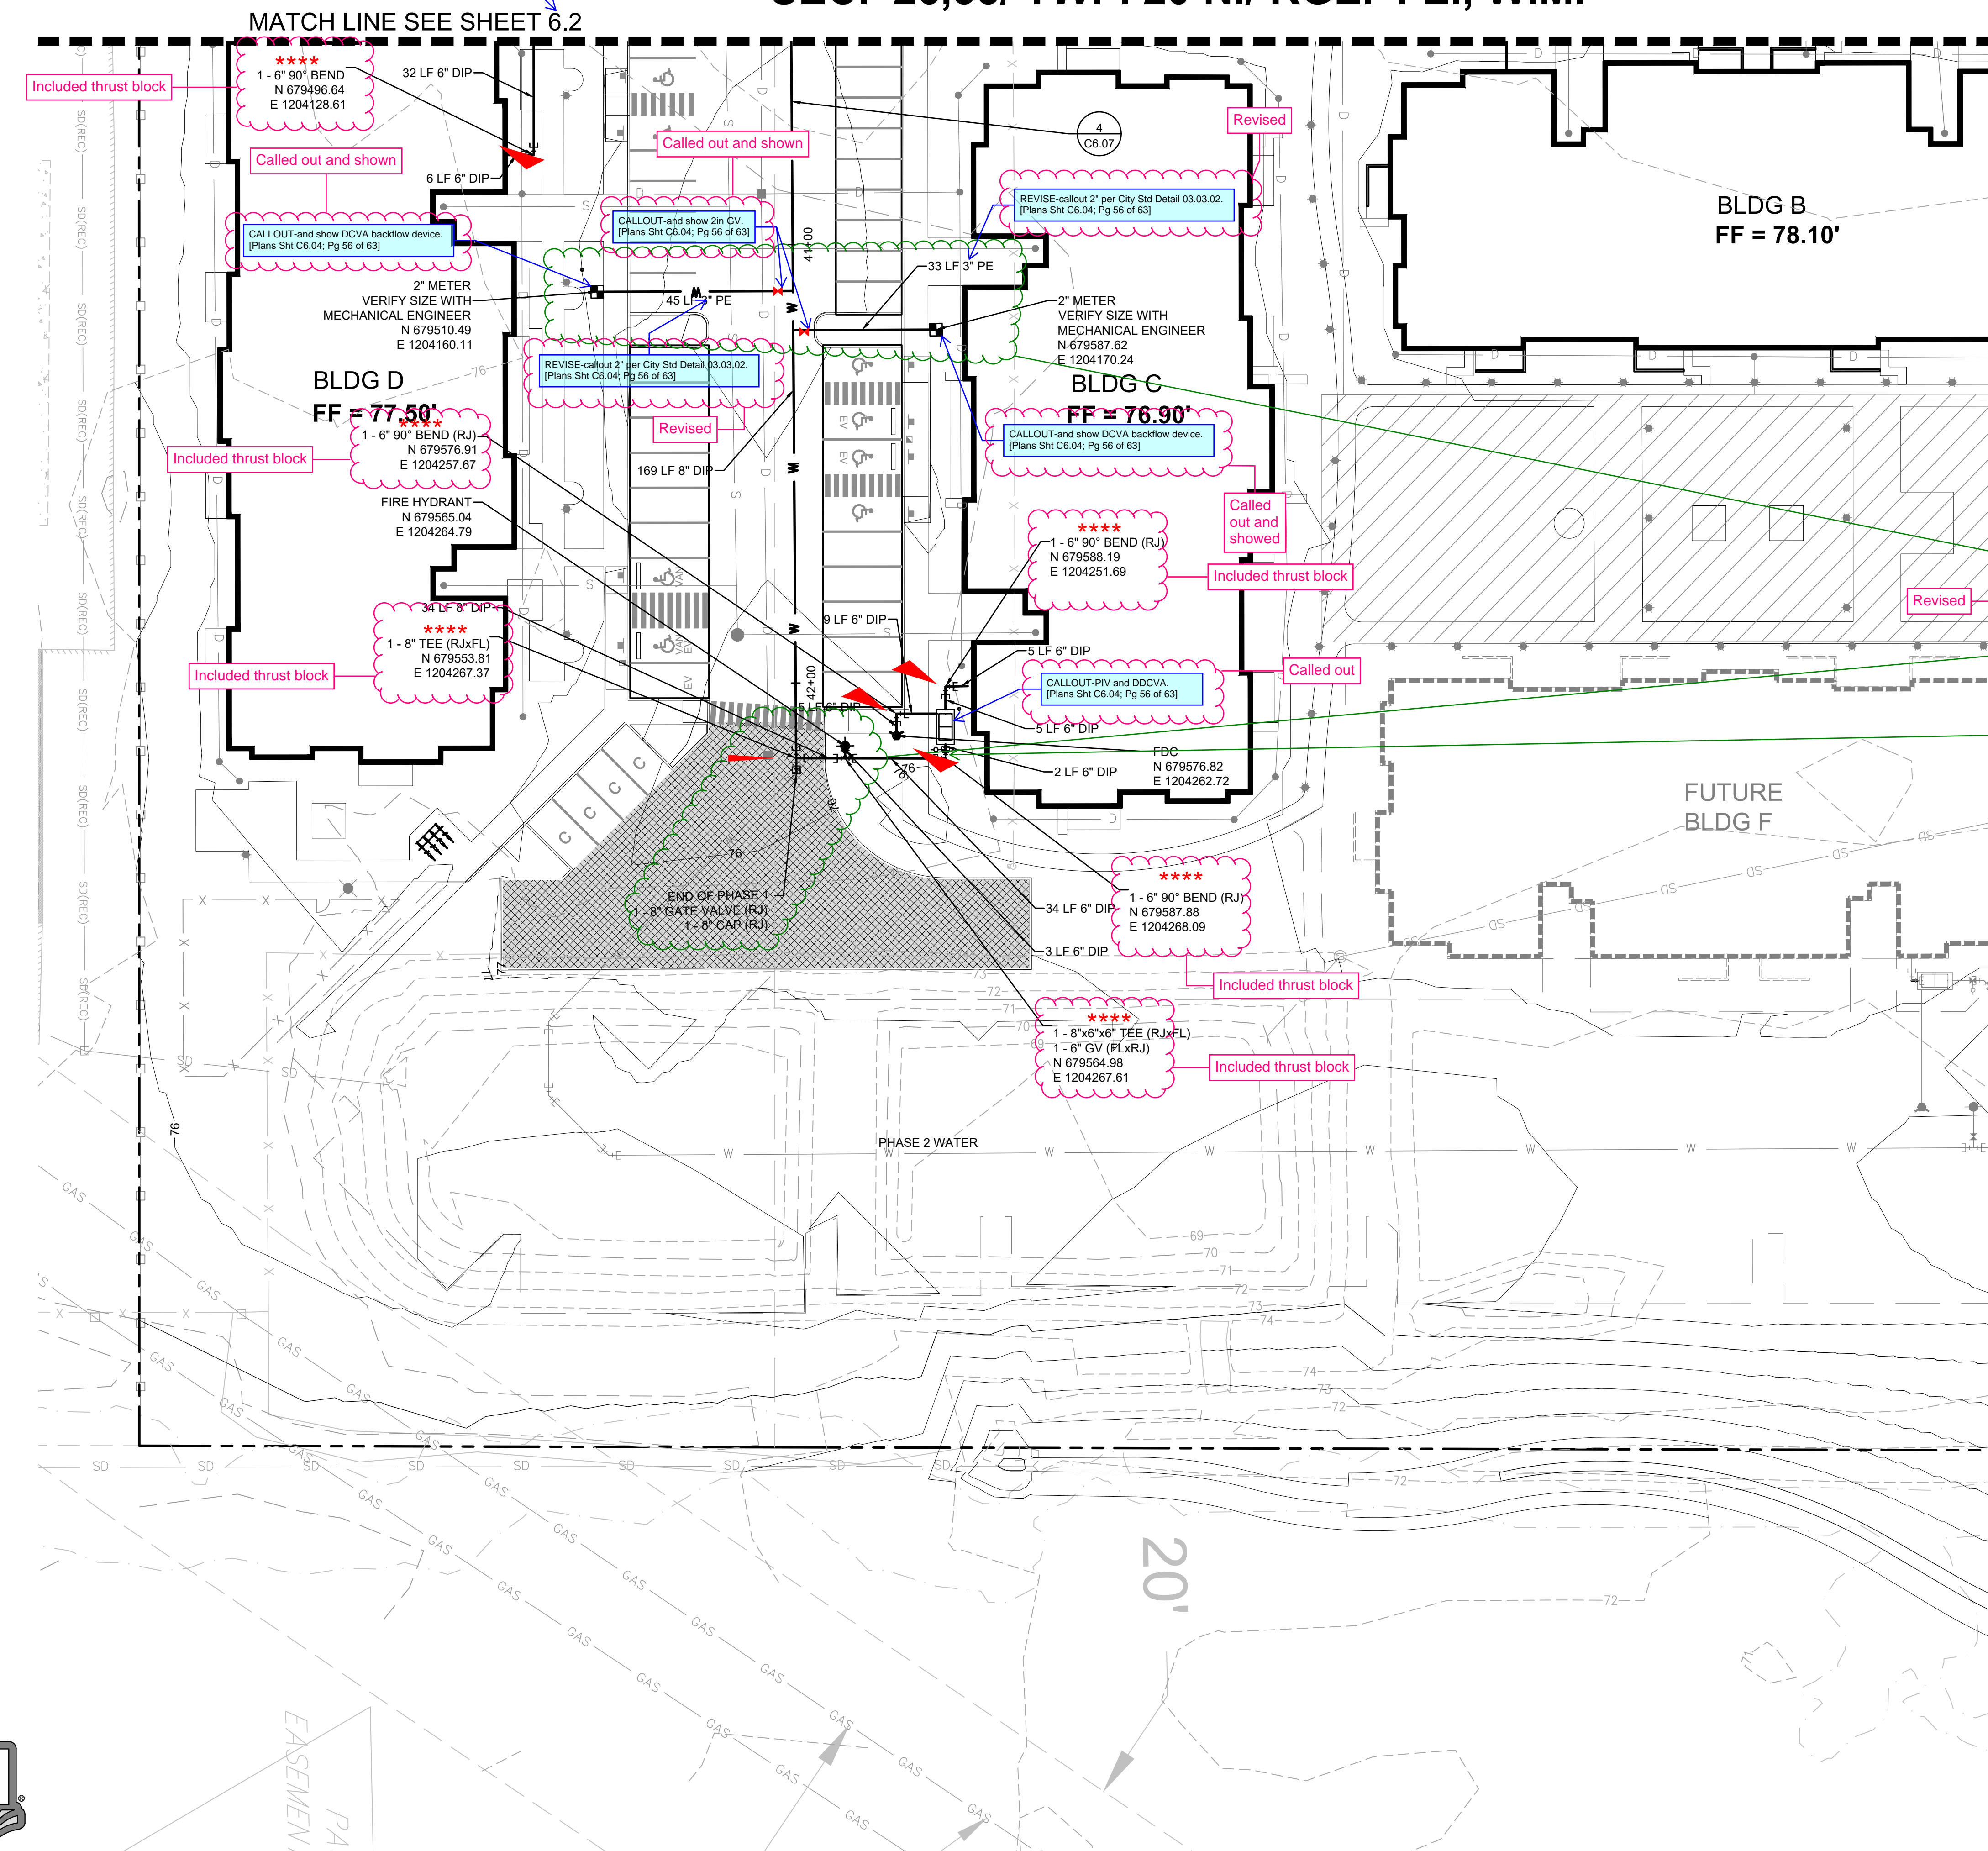

GENERAL NOTE

- SEE DETAILS AS NOTED
- VERTICAL THRUST BLOCKING SEE DETAILS 1 AND 2 SHEET C6.5
- WATER SERVICE CONNECTIONS SEE DETAILS 3 AND 4 SHEET C6.5
- PRIVATE WATER SERVICE LINE SEE DETAIL 5 SHEET C6.5
- FIRE HYDRANT ASSEMBLY SEE DETAIL 6 SHEET C6.5
- AIR/VACUUM VALVE SEE DETAIL 1 SHEET C6.6
- DOUBLE DETECTOR CHECK VALVE ASSEMBLY INSTALLATION SEE DETAIL 2 AND 3 SHEET C6.6
- FIRE DEPARTMENT CONNECTION (FDC) SEE DETAIL 4 SHEET C6.6
- POST INDICATOR VALVE SEE DETAIL 5 ON SHEET C6.6
- HORIZONTAL THRUST BLOCKING SEE DETAIL 6 SHEET C6.6
- WATER VALVES AND MAINS SEE DETAIL 1 ON SHEET C6.7
- VALVE MARKER POST SEE DETAIL 2 SHEET C6.7
- WATER MAIN CROSSING OTHER UTILITIES SEE DETAILS 3 AND 4 SHEET C6.7

Civil Resub Sheet C6.04: Call out and show 2-inch gate valves at water main taps. Call out 2-inch PE not 3-inch PE. No backflow protection is shown for these water services.

See comments Sht C6.01. [Plans Sht C6.04; Pg 56 of 63]


Civil Resub Sheet C6.04: When phase 2 is installed the 8-inch water main will be looped for better fire flow. Install an 8-inch by 6-inch fire hydrant tee west of the fire line tee to provide better future fire flow for the hydrant. The fire line tee can now be 8-inch by 6-inch with a 6-inch gate valve. The 8-inch gate valve to the east will be installed at the phase 2 tie-in. For now install an 8-inch MJ plug in the east end of the fire line tee with thrust blocking.

Civil Resub Sheet C6.04: Call out PIV. [Plans Sht C6.04; Pg 56 of 63]

VERIFY Sheet Ref (C6.03). [Plans Sht C6.04; Pg 56 of 63]

CALLOUT-and show thrust block. [Plans Sht C6.02; Pg 54 of 63]

MATCH LINE SEE SHEET 6.3

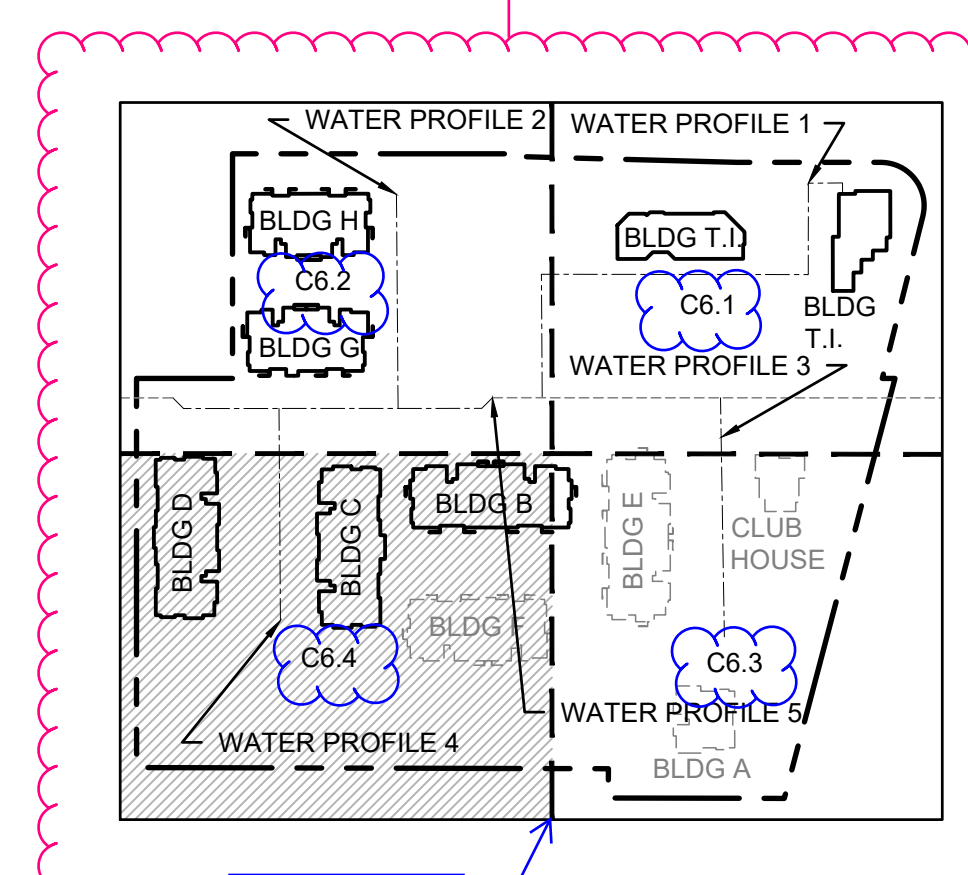

Revisions:

Sheet Title:
WATER PLAN SE

Designed by: CW
Drawn by: SK
Checked by: JI

Sheet No.
C6.04
56 of 63 Sheets

EAST TOWN CROSSING PHASE 1

SEC. 26,35/ TWP. 20 N./ RGE. 4 E., W.M.

APPROVED

BY: CITY OF PUYALLUP
DEVELOPMENT ENGINEERING
DATE:

NOTE: THIS APPROVAL IS VOID AFTER 180 DAYS FROM APPROVAL DATE. THE CITY WILL NOT BE RESPONSIBLE FOR ERRORS AND/OR OMISSIONS ON THESE PLANS. FIELD CONDITIONS MAY DICTATE CHANGES TO THESE PLANS AS DETERMINED BY THE DEVELOPMENT ENGINEERING MANAGER.



TACOMA · SEATTLE · SPOKANE · TRI-CITIES

2215 North 30th Street, Suite 300, Tacoma, WA 98403
253.383.2422 TEL 253.383.2572 FAX www.ahbl.com WEB

Project Title:


EAST TOWN CROSSING PHASE 1

Client:
ASH DEVELOPMENT

GREG HELLE
GREG.HELLE@ASHNW.COM

Project No.
2230752

Issue Set & Date:
PERMIT SUBMITTAL
11/20/2023

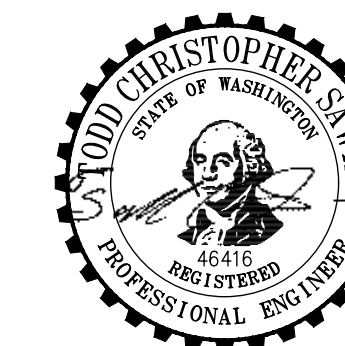

11/21/2023


NOTICE: A SIGNATURE OF THIS DOCUMENT SHALL INDICATE THE PROFESSIONAL SEAL AND SIGNATURE PUBLICATION OF THE DOCUMENT DOES NOT CONSTITUTE A PROFESSIONAL ENGINEER'S RESPONSIBILITY FOR THE DESIGN OR FOR THE ONLY FOR THE PROJECT EXHIBITED IN THE TITLE BLOCK AND IS NOT TO BE USED FOR ANY OTHER PROJECT OR ADDITION TO THAT PROJECT OR FOR ANY OTHER PROJECT.

ADD ethafoam detail to plan set.
[Plans Sht C6.05, Pg 57 of 63]

Added detail

ADD NOTE: "See Ethafoam Detail and City Std Detail 03.01.03-1 & 2 for utility crossing reqts."
[Plans Sht C6.05, Pg 57 of 63]

Added note

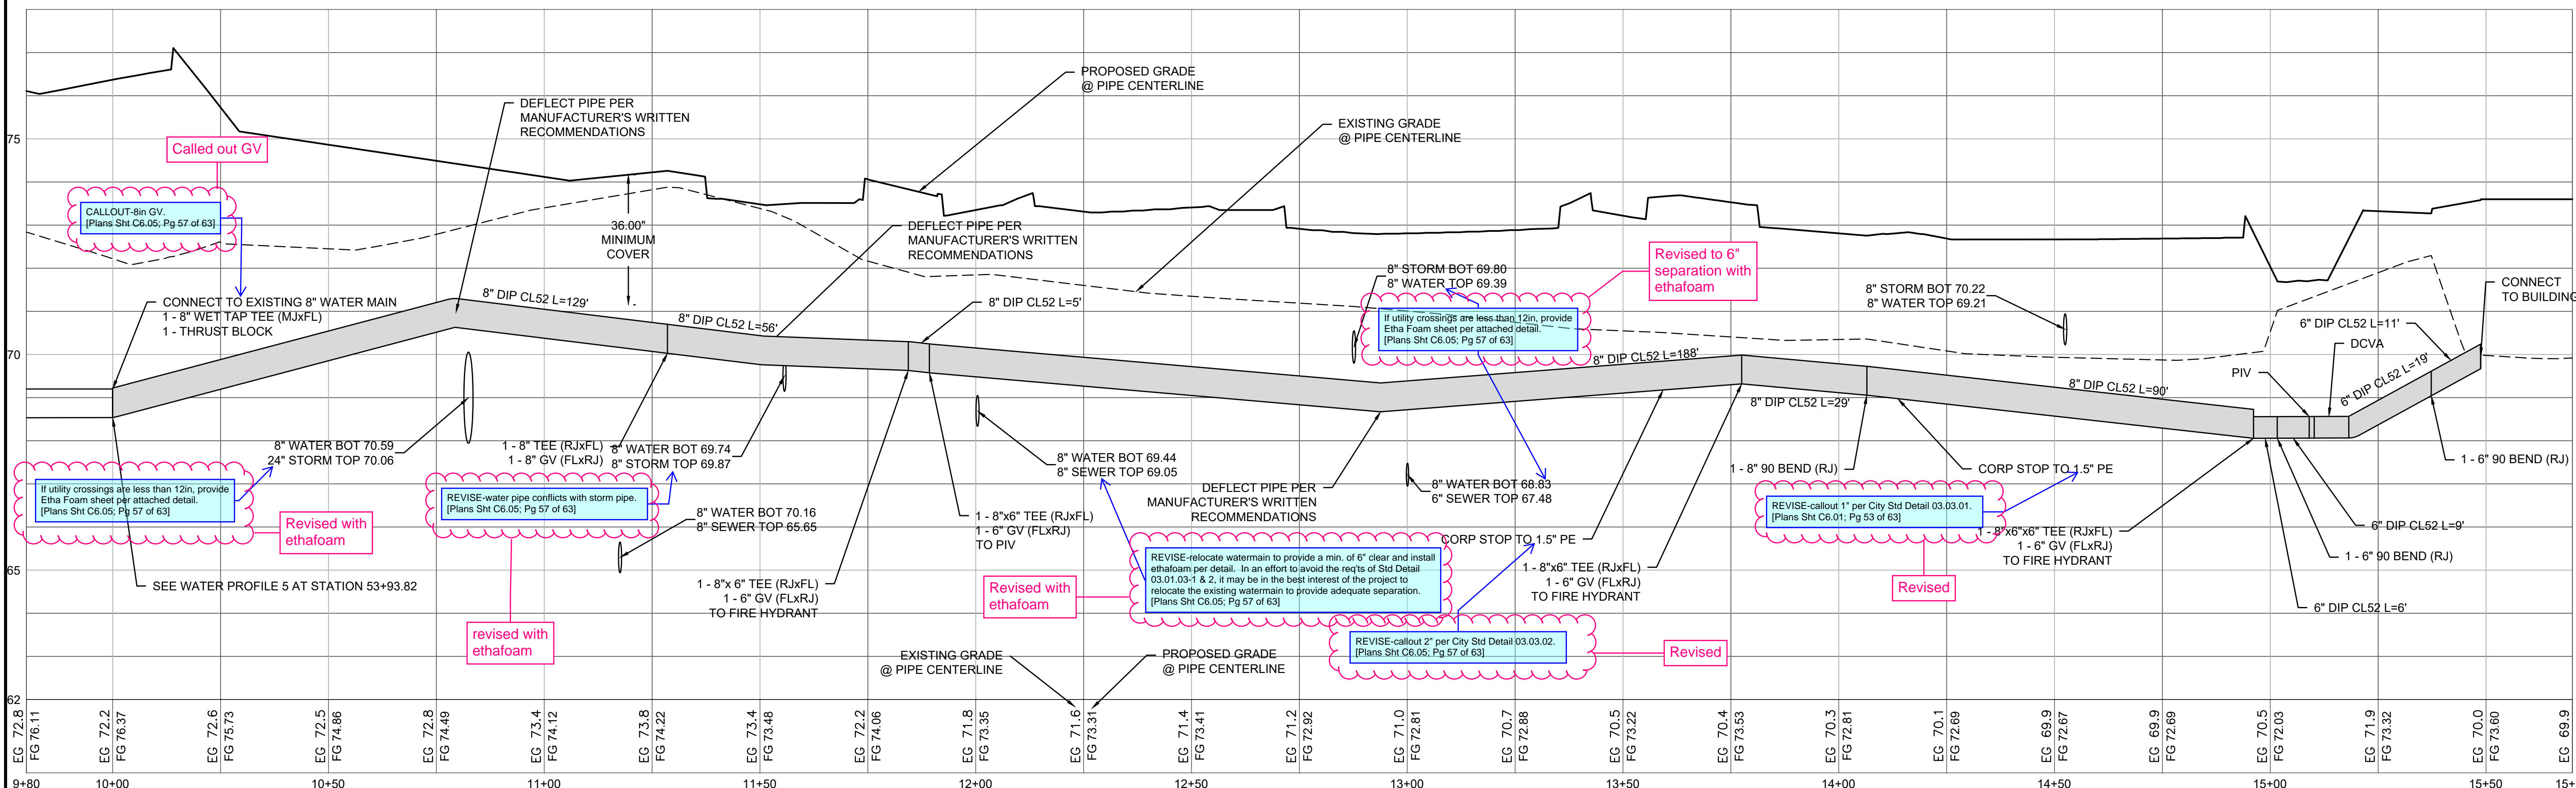

1 WATER PROFILE 1
1"=2' VERTICAL, 1"=20' HORIZONTAL

Revisions:

Sheet Title:
WATER PROFILES

Designed by: CW
Drawn by: SK
Checked by: JI

Sheet No.
C6.05
57 of 63 Sheets



EAST TOWN CROSSING PHASE 1


SEC. 26,35/ TWP. 20 N./ RGE. 4 E., W.M.

APPROVED


BY _____
CITY OF PUYALLUP
DEVELOPMENT ENGINEERING

DATE _____

NOTE: THIS APPROVAL IS VOID AFTER 180 DAYS FROM APPROVAL DATE. THE CITY WILL NOT BE RESPONSIBLE FOR ERRORS AND/OR OMISSIONS ON THESE PLANS. FIELD CONDITIONS MAY DICTATE CHANGES TO THESE PLANS AS DETERMINED BY THE DEVELOPMENT ENGINEERING MANAGER.

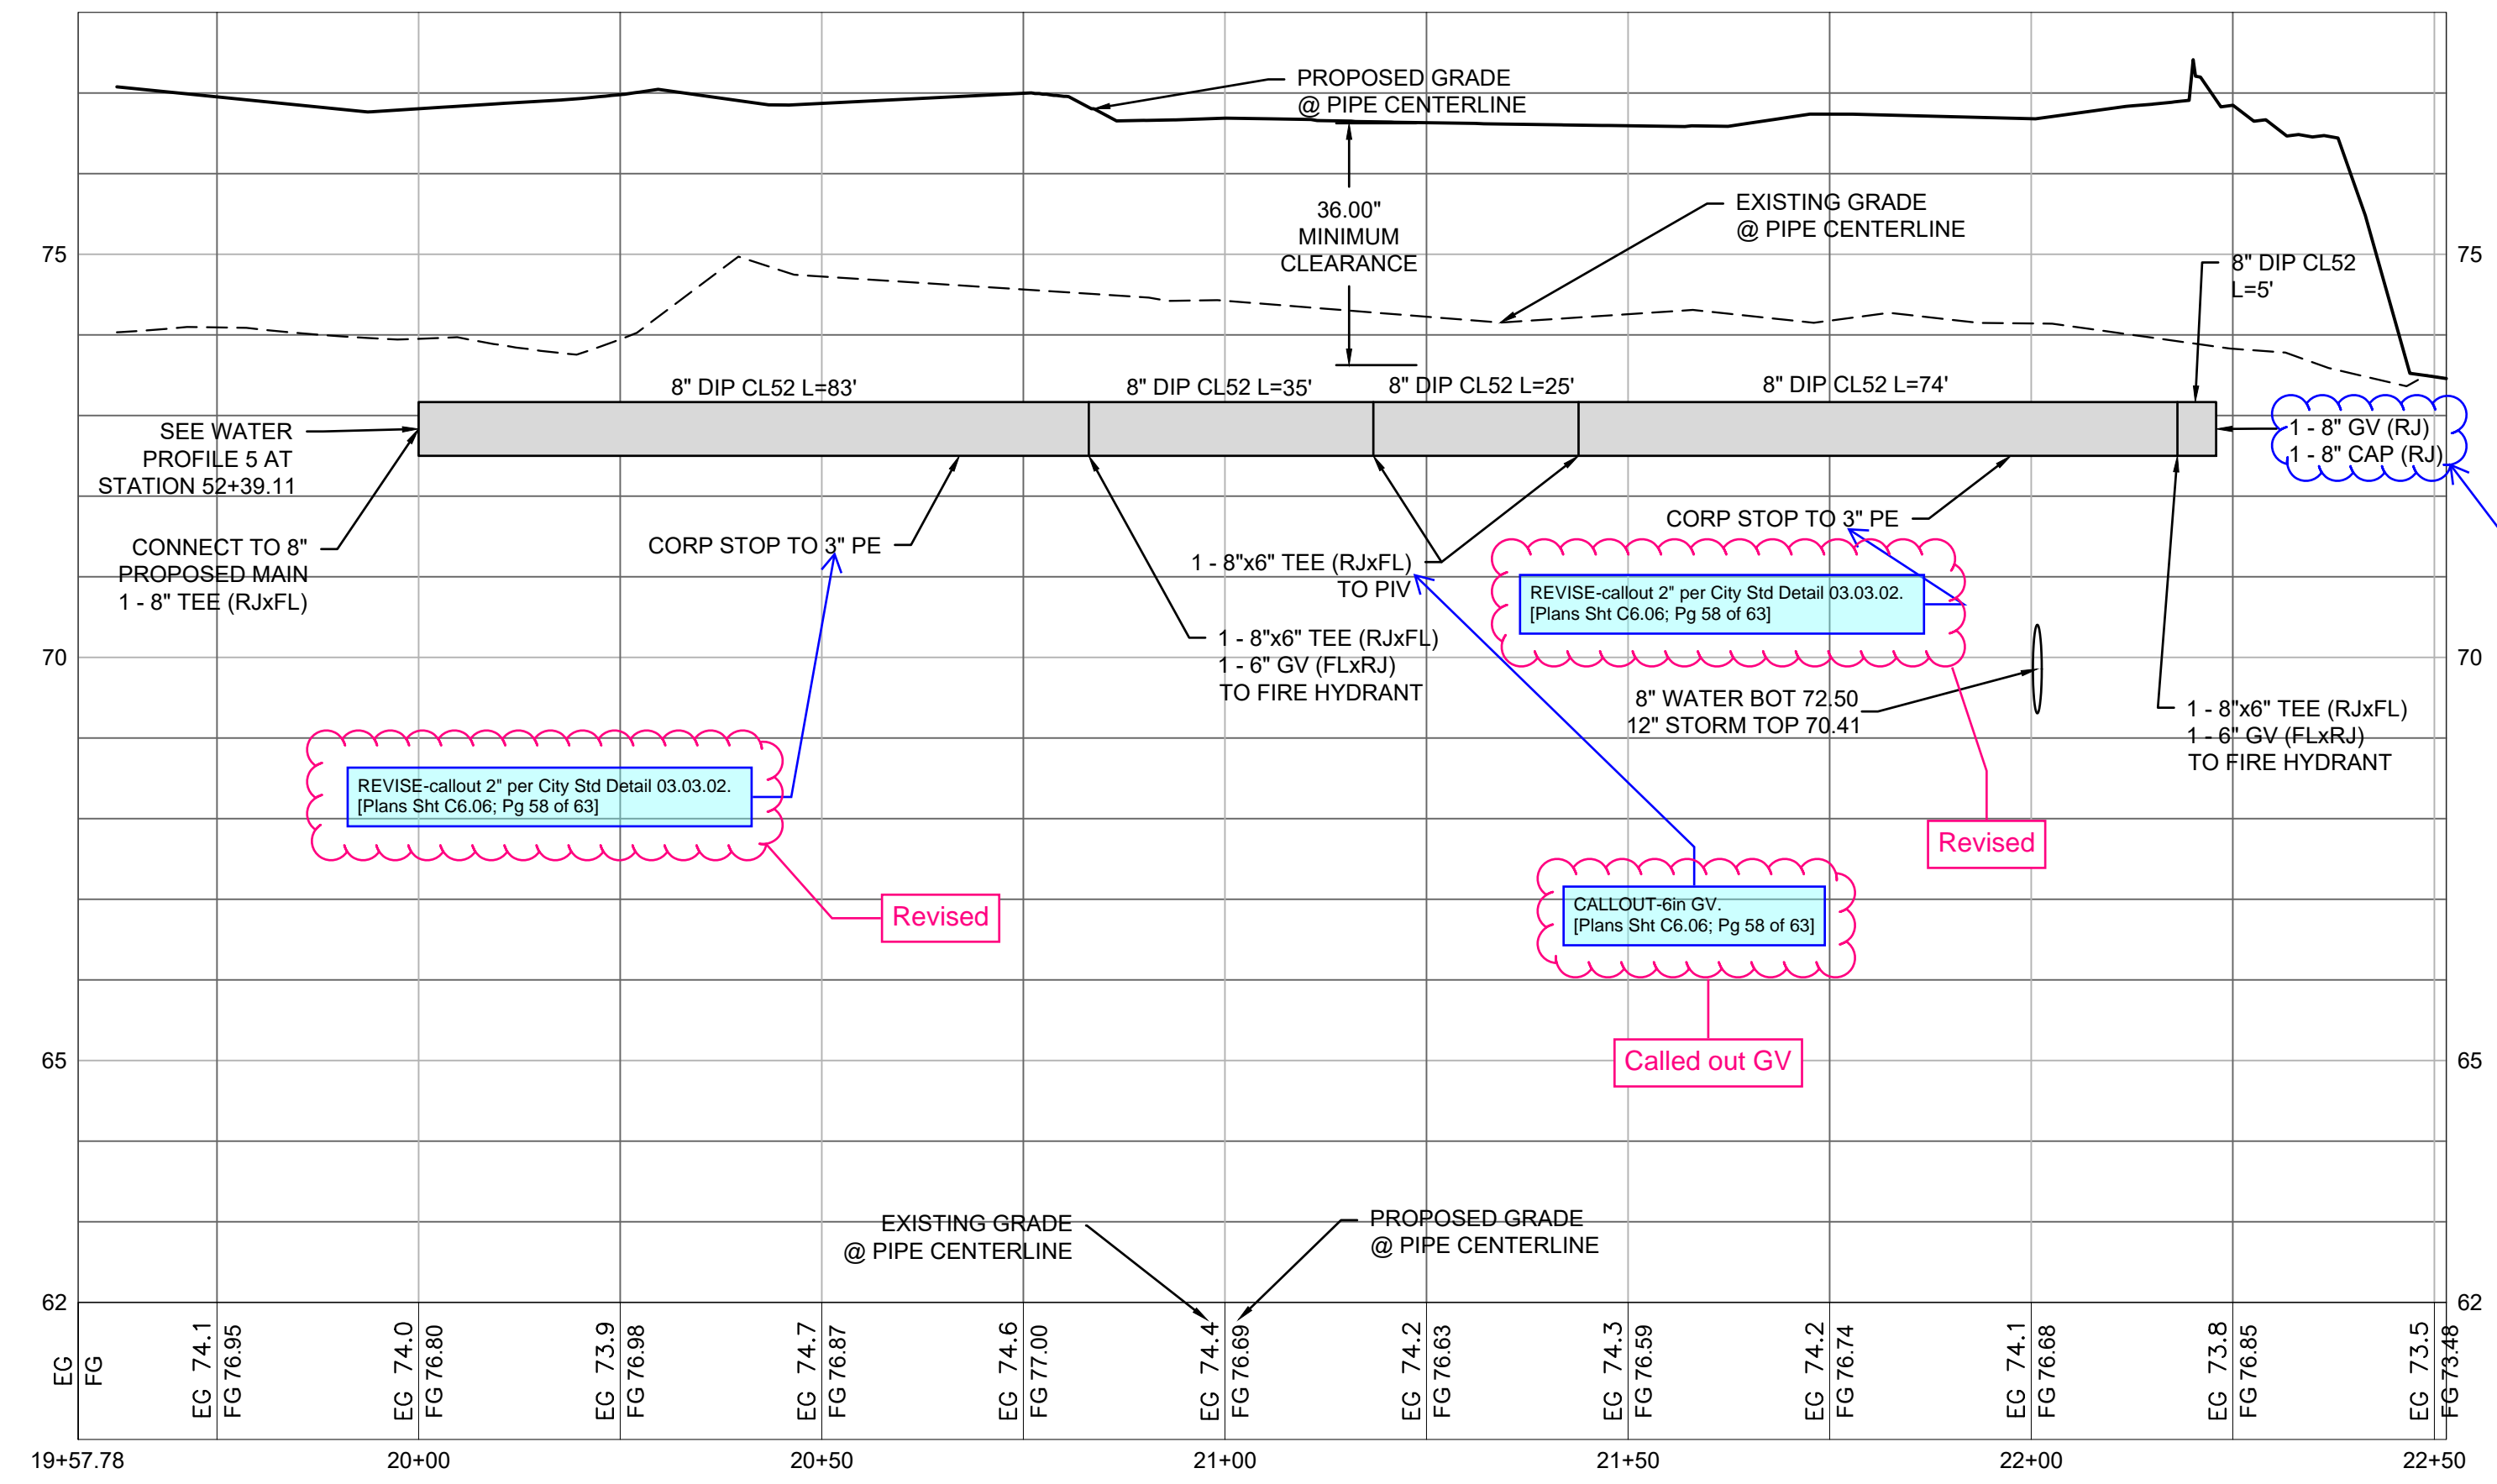

2 WATER PROFILE 2
1"=2' VERTICAL, 1"=20' HORIZONTAL

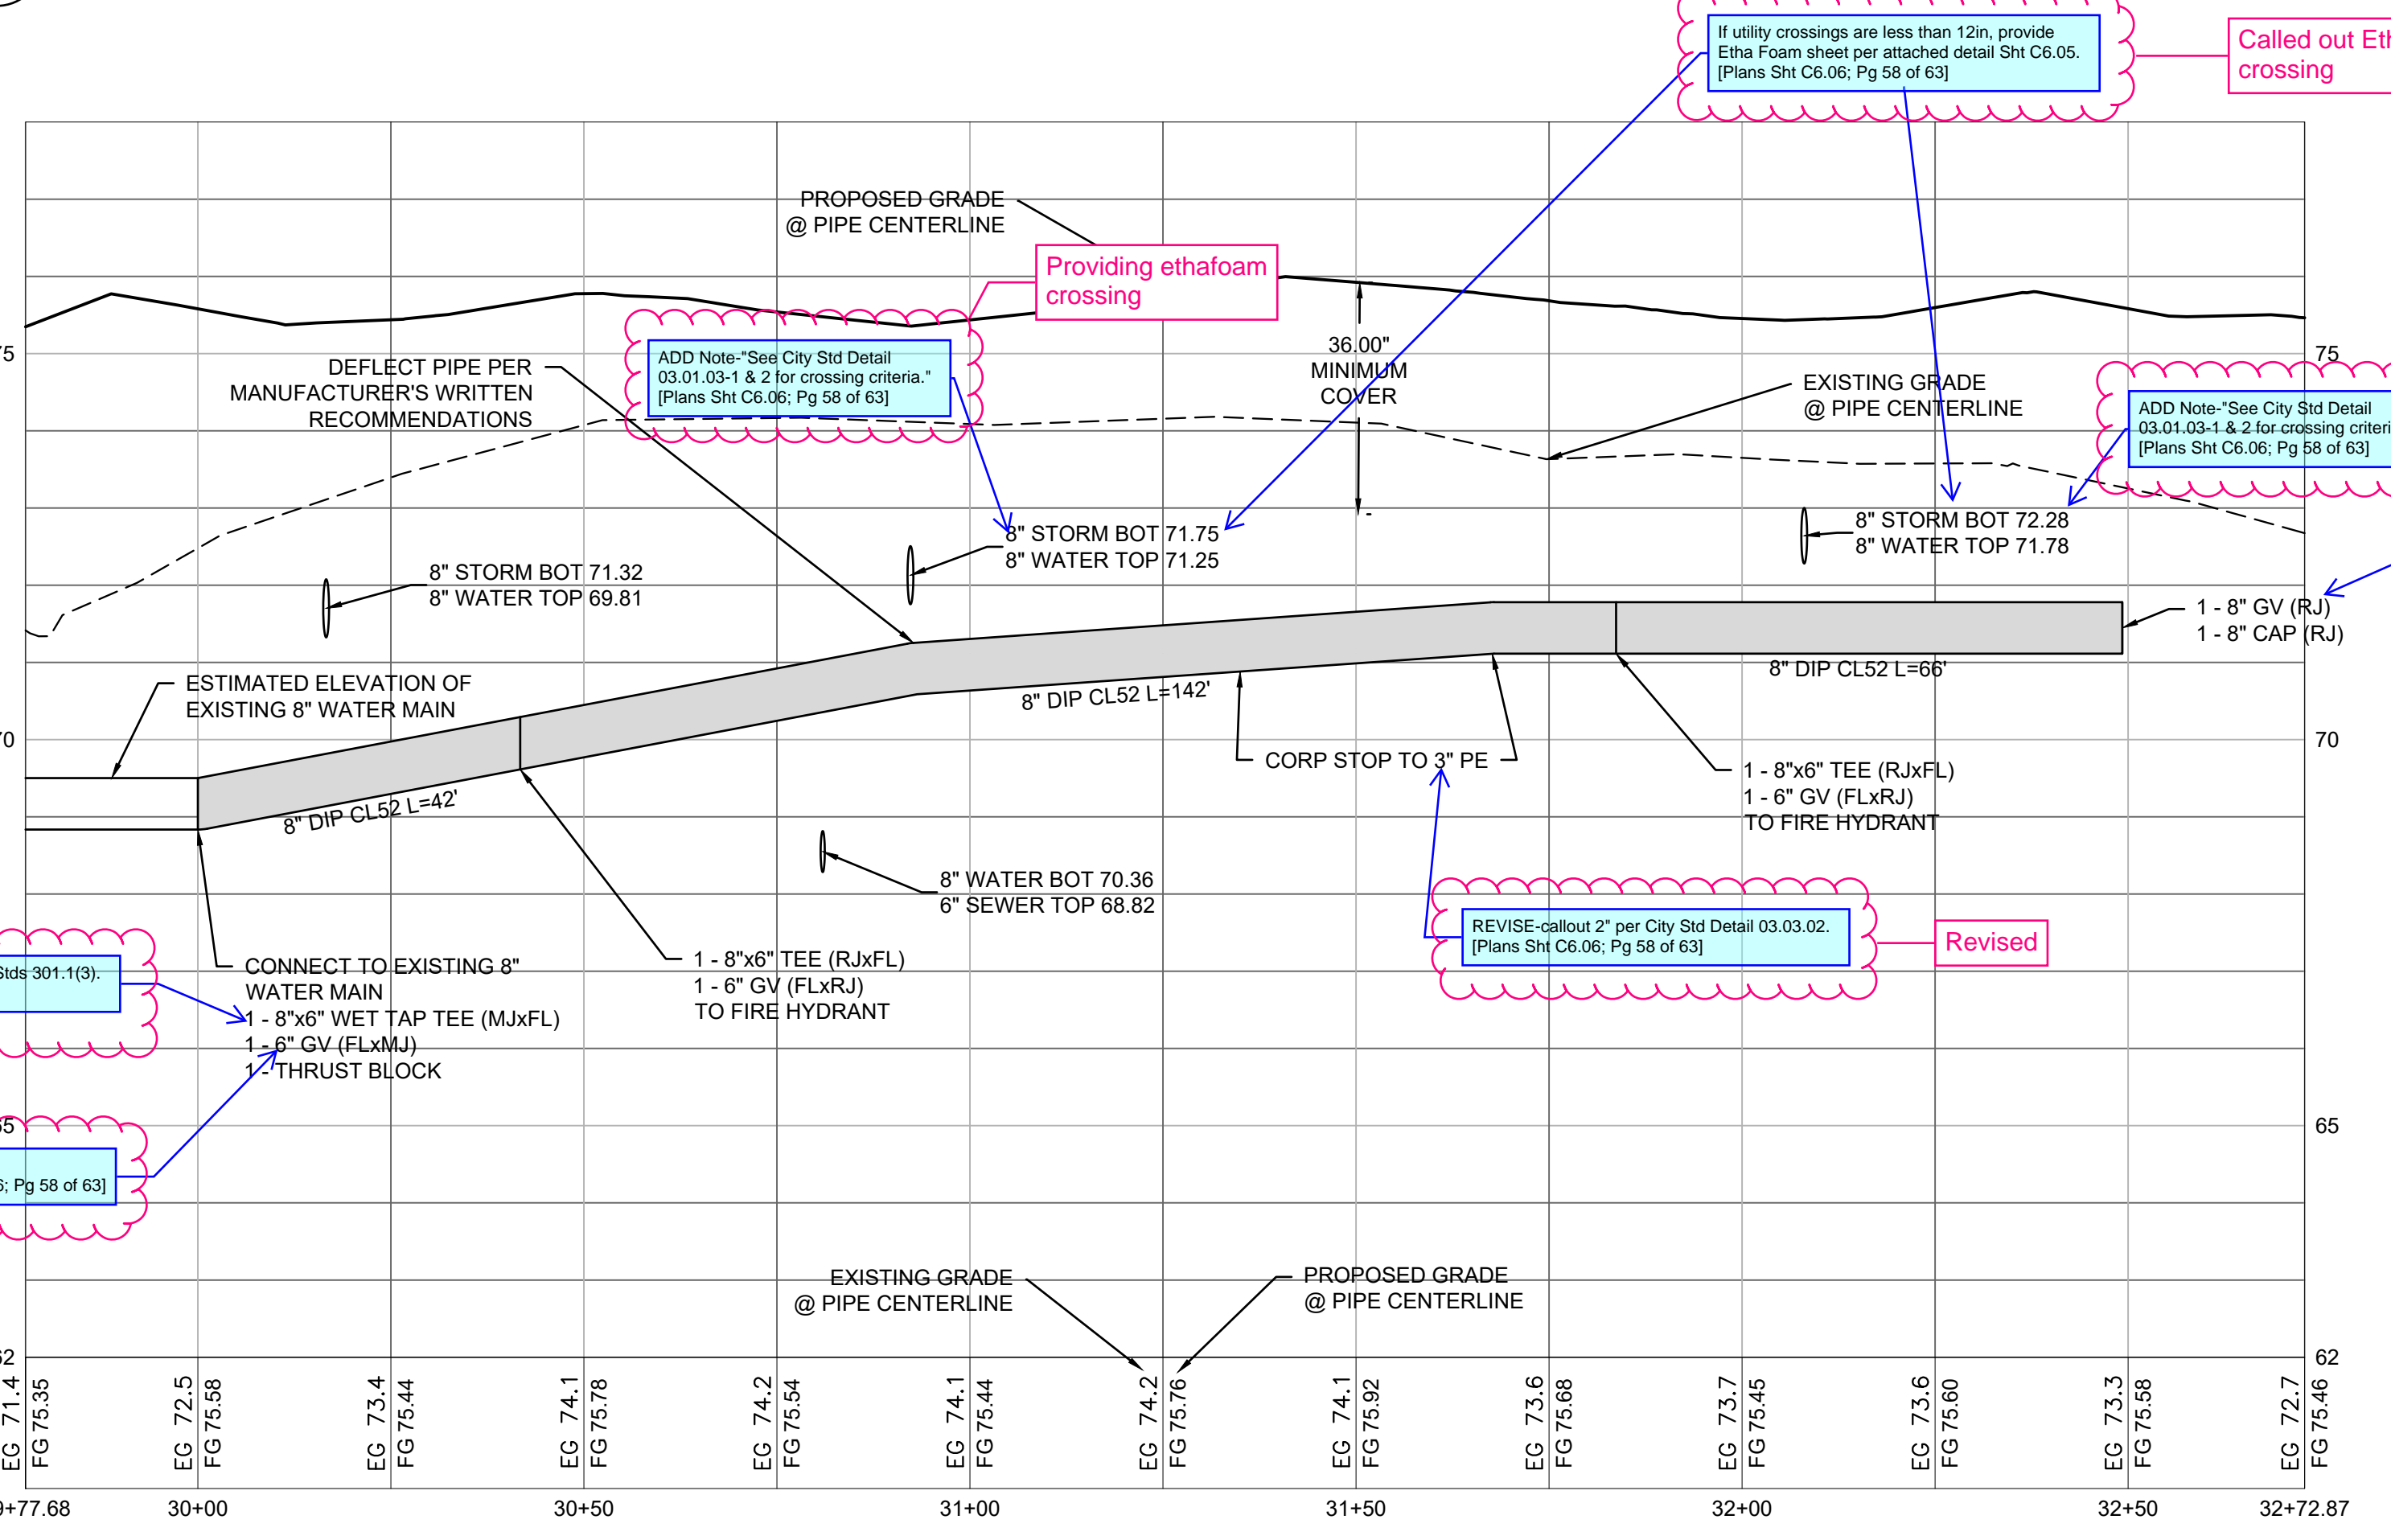

3 WATER PROFILE 3
1"=2' VERTICAL, 1"=20' HORIZONTAL

ADD NOTE-"See Ethafoam Detail and City Std Detail 03.01.03-1 & 2 for utility crossing reqts." [Plans Sht C6.06, Pg 58 of 63]

REVISÉ-per Sht C6.02 comment [Plans Sht C6.06, Pg 58 of 63]

REVISÉ-6in wet tap per City Std: 301.1(3): [Plans Sht C6.06, Pg 58 of 63]

REVISÉ-8in GV. [Plans Sht C6.06, Pg 58 of 63]


REVISÉ-callout 2" per City Std Detail 03.03.02. [Plans Sht C6.06, Pg 58 of 63]

If utility crossings are less than 12in, provide Etha Foam sheet per attached detail Sht C6.05. [Plans Sht C6.06, Pg 58 of 63]

ADD Note-"See City Std Detail 03.01.03-1 & 2 for crossing criteria." [Plans Sht C6.06, Pg 58 of 63]

ADD Note-"See City Std Detail 03.01.03-1 & 2 for crossing criteria." [Plans Sht C6.06, Pg 58 of 63]

REVISÉ-use blowoff assembly. [Plans Sht C6.06, Pg 58 of 63]

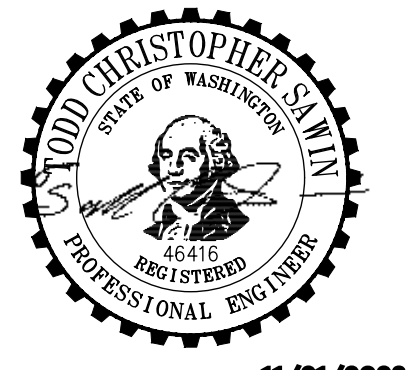

11/21/2023

NOTICE: ALTERATION OF THIS DOCUMENT SHALL INVALIDATE THE PROFESSIONAL SEAL AND SIGNATURE. PUBLICATION OF THIS DOCUMENT DOES NOT CONSTITUTE A GUARANTEE OR WARRANTY BY THE ENGINEER OR ARCHITECT. THE ENGINEER OR ARCHITECT IS NOT TO BE HELD RESPONSIBLE FOR ANY ERRORS OR OMISSIONS IN THIS DOCUMENT OR FOR ANY OTHER PROJECT.

Project Title:
EAST TOWN CROSSING PHASE 1

Client:
ASH DEVELOPMENT

GREG HELLE
GREG.HELLE@ASHNW.COM

Project No.
2230752

Issue Set & Date:
PERMIT SUBMITTAL
11/20/2023

Revisions:

Sheet Title:
WATER PROFILES

Designed by: CW
Drawn by: SK
Checked by: JI

Sheet No.
C6.06
58 of 63 Sheets



EAST TOWN CROSSING PHASE 1


SEC. 26,35/ TWP. 20 N./ RGE. 4 E., W.M.

APPROVED

BY
CITY OF PUYALLUP
DEVELOPMENT ENGINEERING

DATE

NOTE: THIS APPROVAL IS VOID AFTER 180 DAYS FROM APPROVAL DATE. THE CITY WILL NOT BE RESPONSIBLE FOR ERRORS AND/OR OMISSIONS ON THESE PLANS. FIELD CONDITIONS MAY DICTATE CHANGES TO THESE PLANS AS DETERMINED BY THE DEVELOPMENT ENGINEERING MANAGER.

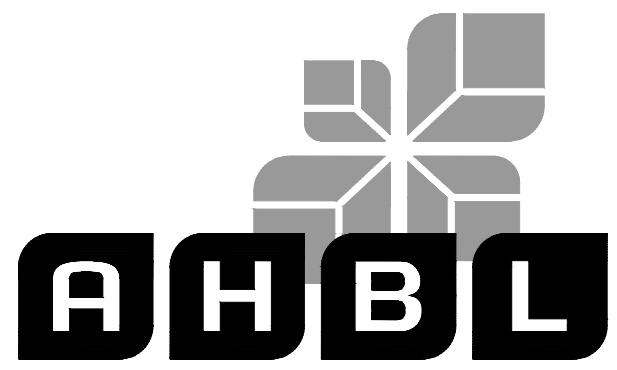

TACOMA · SEATTLE · SPOKANE · TRI-CITIES

2215 North 30th Street, Suite 300, Tacoma, WA 98403
253.383.2422 TEL 253.383.2572 FAX www.ahbl.com WEB

Project Title:

EAST TOWN CROSSING PHASE 1

Client:

ASH DEVELOPMENT

GREG HELLE

GREG.HELLE@ASHNW.COM


Project No.

2230752

Issue Set & Date:


PERMIT SUBMITTAL

11/20/2023

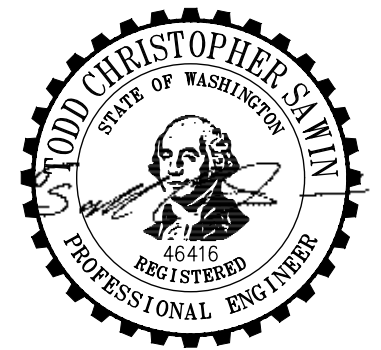

11/21/2023

NOTICE


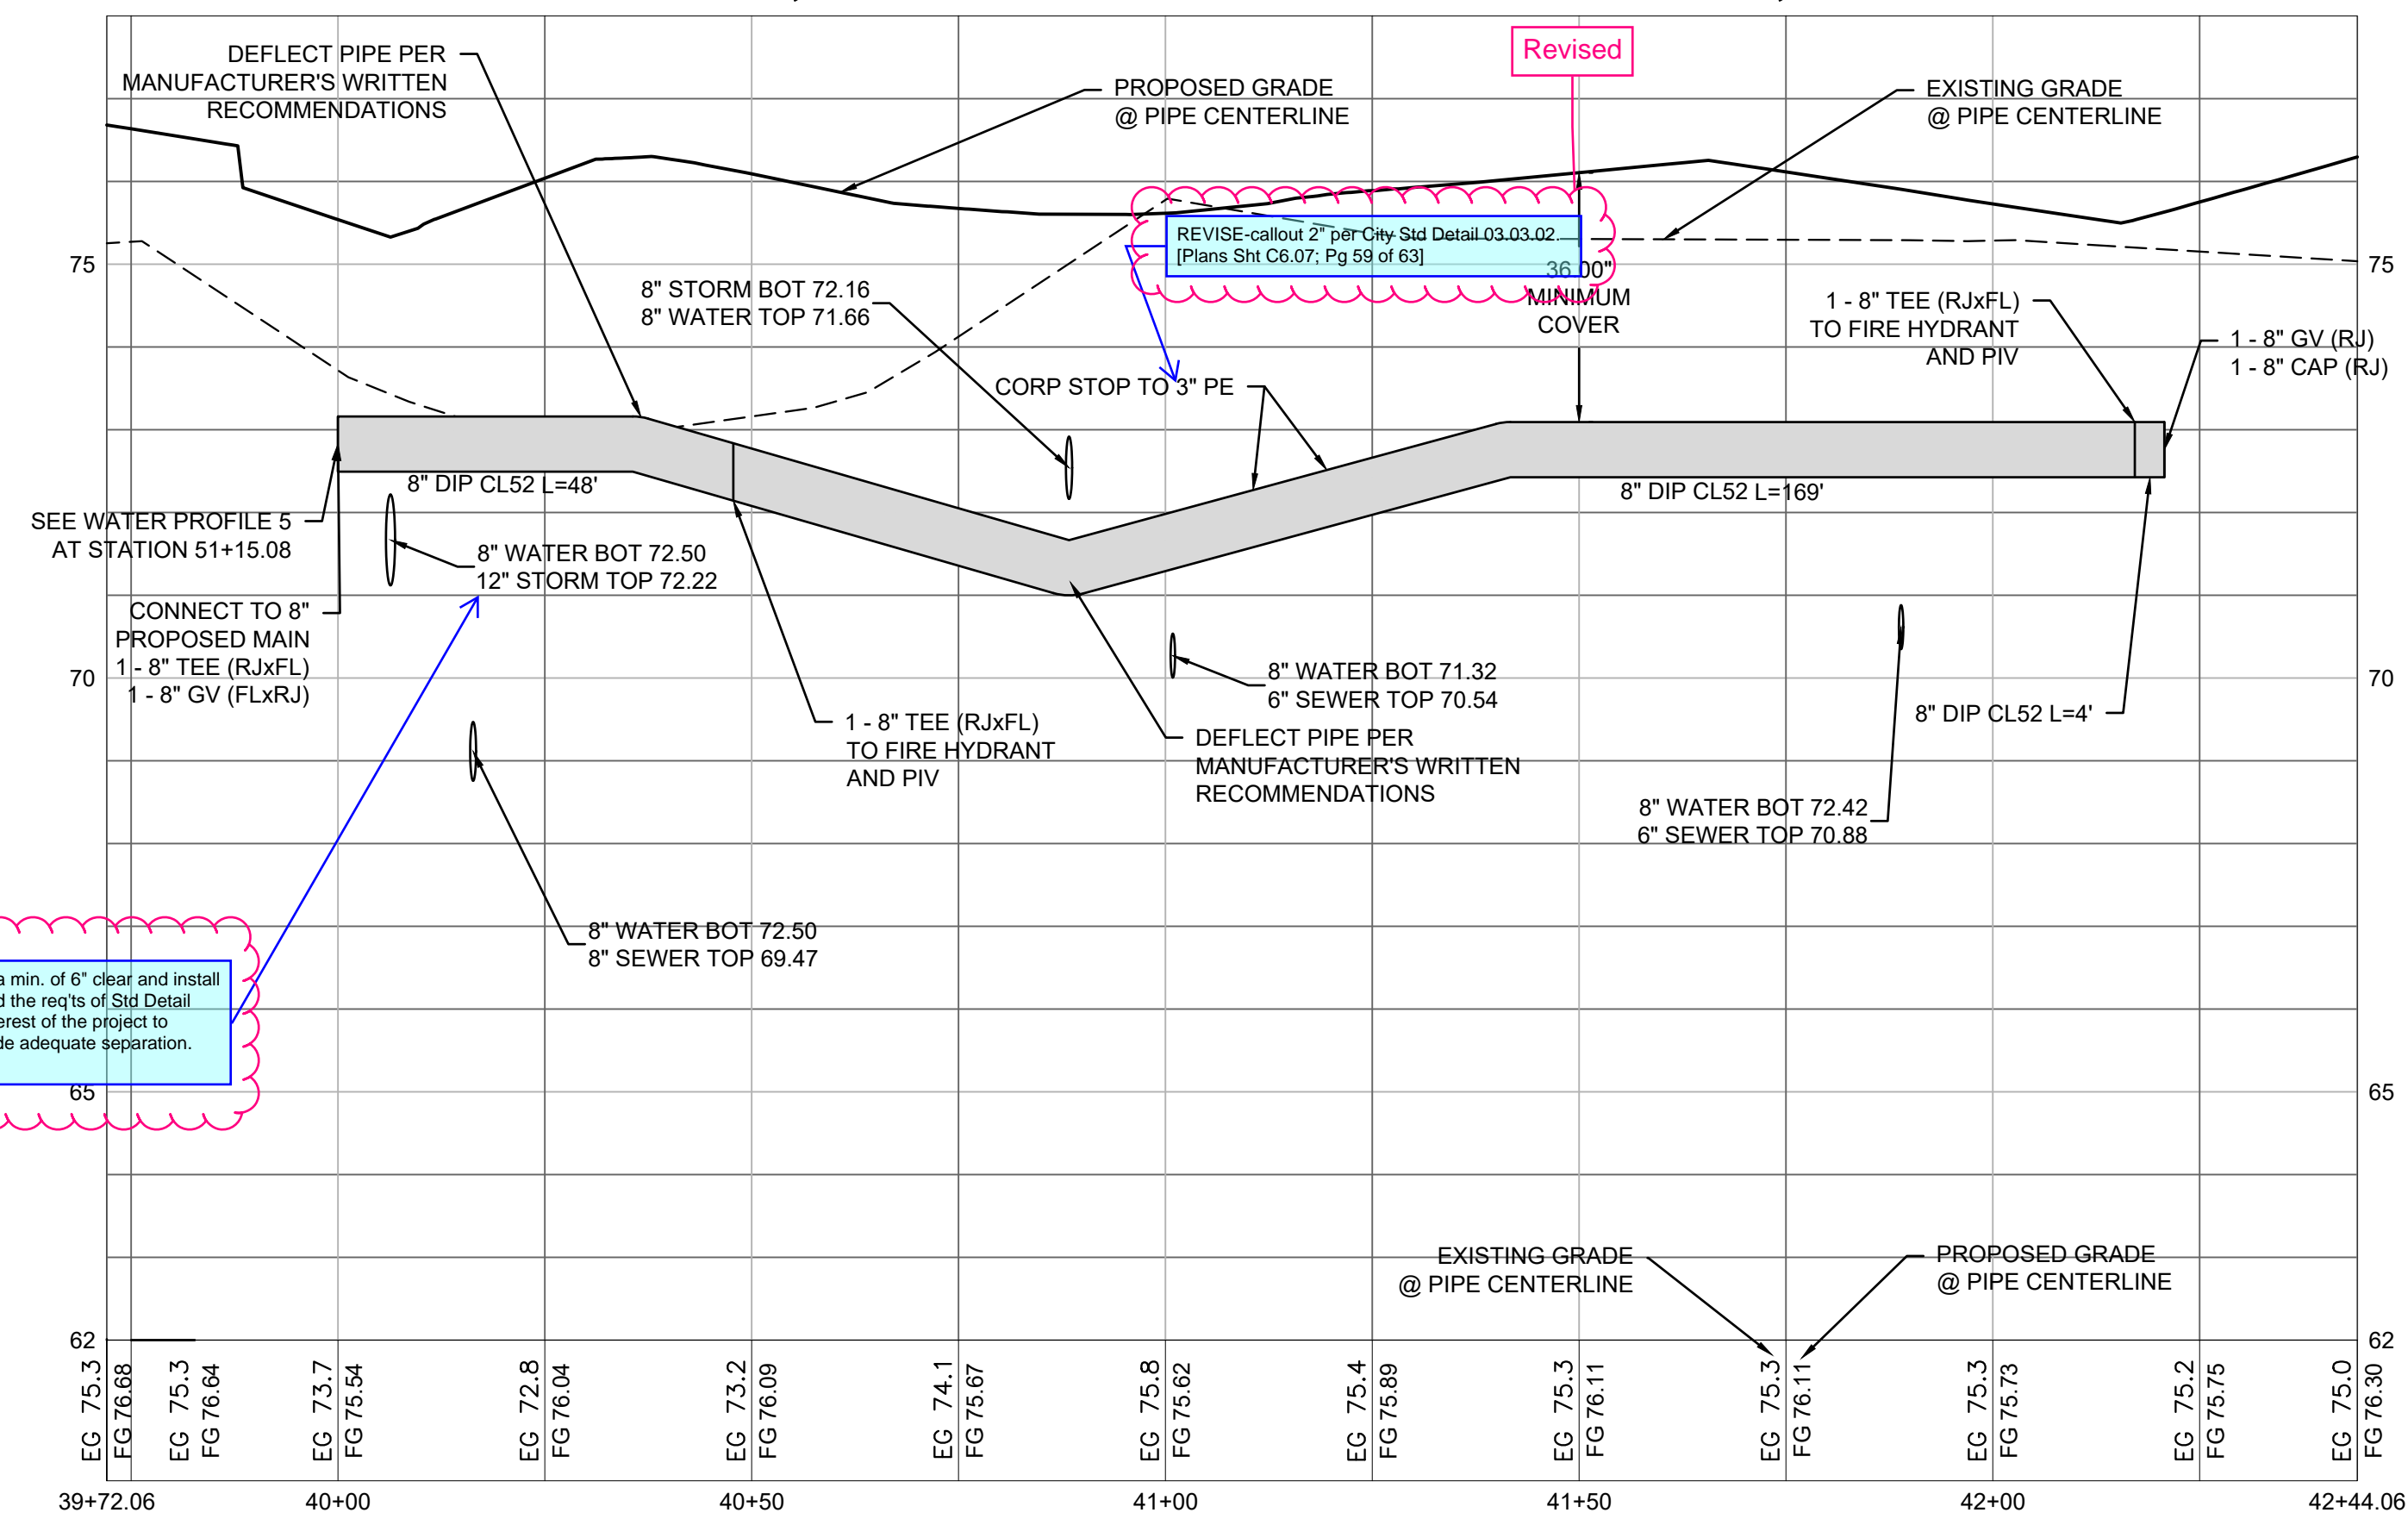

Revised

REVISE-relocate watermain to provide a min. of 6" clear and install ethafoam per detail. In an effort to avoid the reqs of Sid Detail 03.01.03-1 & 2, it may be in the best interest of the project to relocate the existing watermain to provide adequate separation. [Plans Sht C6.07, Pg 59 of 63]

Revised


REVISE-callout 2" per City Std Detail 03.03.02 [Plans Sht C6.07, Pg 59 of 63]

Added note

ADD NOTE-See Ethafoam Detail and City Std Detail 03.01.03-1 & 2 for utility crossing reqs. [Plans Sht C6.07, Pg 59 of 63]

Civil Resub Sheet C6.07. In a perfect world it would be great to keep our water main at 36-inches of cover. To eliminate trapped air high points, it would be best to run the relocated 8-inch water main under the 12-inch storm line at STA 51+00. Run the 8-inch relatively flat and transition with 45-degree bends to the low tie-in.

4 WATER PROFILE 4
1"=2' VERTICAL, 1"=20' HORIZONTAL

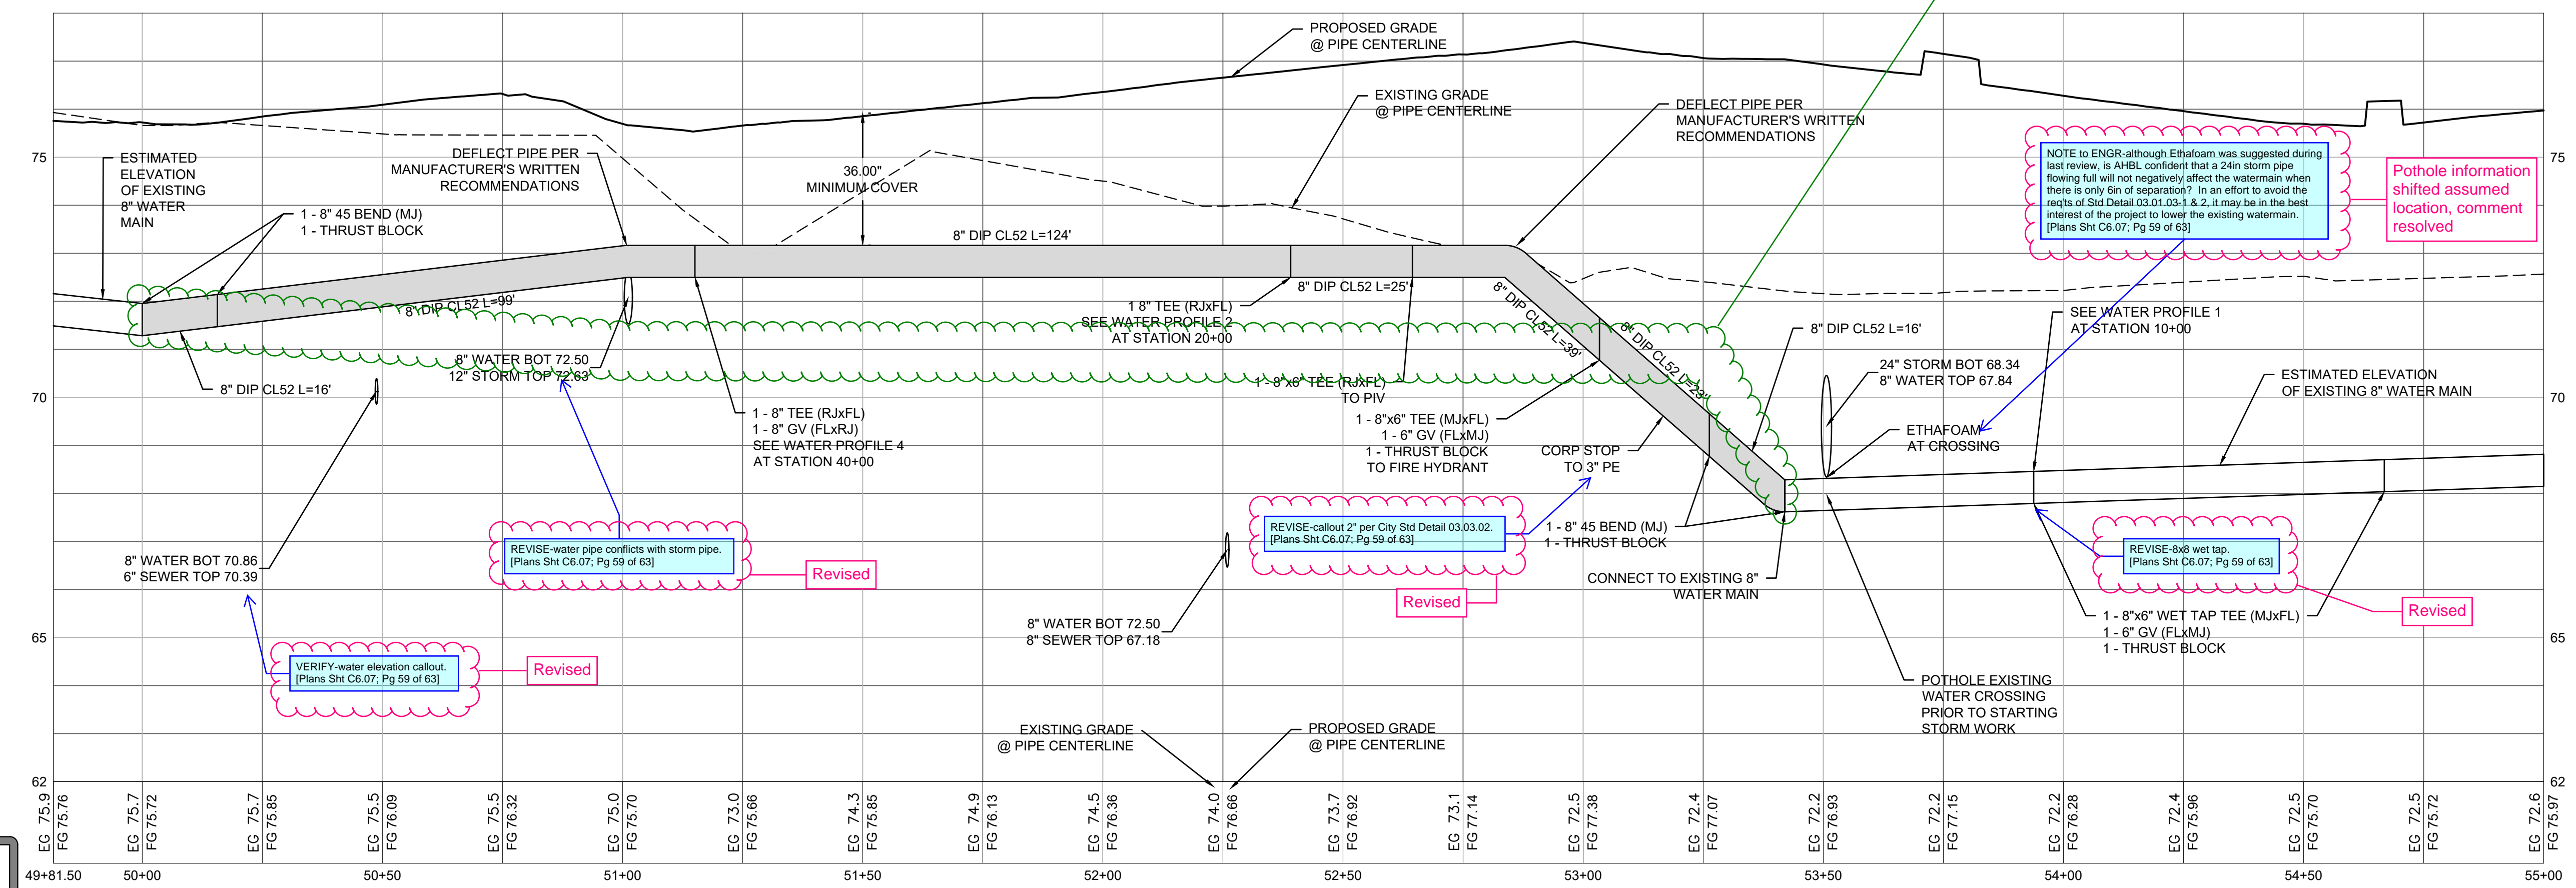

5 WATER PROFILE 5
1"=2' VERTICAL, 1"=20' HORIZONTAL



Know what's below.
Call before you dig.

Revisions:

Sheet Title:
WATER PROFILES

Designed by: CW
Drawn by: SK
Checked by: JI

Sheet No.

C6.07

59 of 63 Sheets

EAST TOWN CROSSING PHASE 1


SEC. 26,35/ TWP. 20 N./ RGE. 4 E., W.M.

APPROVED

BY CITY OF PUYALLUP
DEVELOPMENT ENGINEERING

DATE

NOTE: THIS APPROVAL IS VOID AFTER 180 DAYS FROM APPROVAL DATE. THE CITY WILL NOT BE RESPONSIBLE FOR ERRORS AND/OR OMISSIONS ON THESE PLANS. FIELD CONDITIONS MAY DICTATE CHANGES TO THESE PLANS AS DETERMINED BY THE DEVELOPMENT ENGINEERING MANAGER.

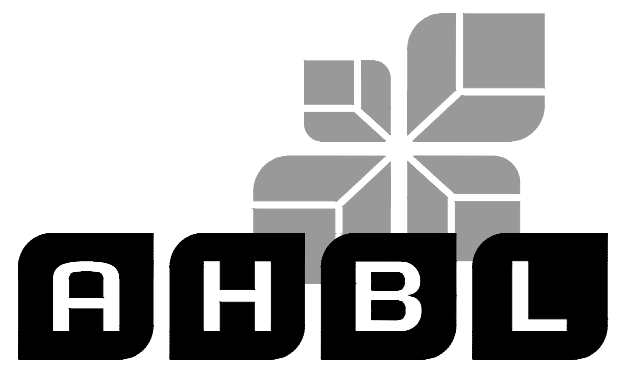

TACOMA • SEATTLE • SPOKANE • TRI-CITIES
2215 North 30th Street, Suite 300, Tacoma, WA 98403
253.383.2422 TEL 253.383.2572 FAX www.ahbl.com WEB

Project Title:

EAST TOWN CROSSING PHASE 1

Client:
ASH DEVELOPMENT

GREG HELLE

GREG.HELLE@ASHNW.COM

Project No.

2230752

Issue Set & Date:

PERMIT SUBMITTAL

11/20/2023



11/21/2023

NOTICE
ABANDON OF THIS DOCUMENT SHALL IMPLICATE THE PROFESSIONAL SEAL AND SIGNATURE OF THE ENGINEER SHALL BE DEEMED AS ABANDONING THE PROJECT AND THE ENGINEER CANNOT BE HELD RESPONSIBLE FOR THE PROJECT. THIS NOTICE IS THE PROPERTY OF THE ENGINEER AND IS NOT TO BE REPRODUCED OR USED FOR ANY OTHER PROJECT.

△

△

△

△

Revisions:

Sheet Title:

WATER NOTES AND DETAILS

Designed by: CW Drawn by: SK Checked by: JI

Sheet No.

C6.08

60 of 63 Sheets

TABLE 1: CONCRETE BLOCKING FOR VERTICAL BENDS


VERTICAL THRUST BLOCKING

CITY OF PUYALLUP OFFICE OF THE CITY ENGINEER

03.02.01-2

1 VERTICAL THRUST BLOCKING NOT TO SCALE

TABLE 2: THRUST AT FITTINGS AT 200 PSI

SIZE	PIPE PRESSURE (PSI)	T	B	C	D	E
4"	200	3,140	4,490	2,408	1,220	618
6"	200	7,070	9,890	5,410	2,790	1,380
8"	200	12,860	17,790	9,300	4,800	2,440
10"	200	18,650	27,720	15,030	7,680	3,850
12"	200	28,270	38,860	21,840	11,230	5,540
14"	200	38,490	54,410	28,490	15,010	7,540
16"	200	50,890	71,080	38,470	19,810	9,910

TABLE 3: BEARING VALUE OF SOIL

SOIL TYPE	SAFE BEARING LOAD (LB/FT ²)
WOOD, PEAT, ETC.	0
SOFT CLAY/ALLUVIAL SOIL	1,000
SAND	2,000
SAND AND GRAVEL	3,800
SAND AND GRAVEL, COMPACTED WITH CLAY	4,500
HARD SHALE	16,000

THRUST BLOCKING TABLE

CITY OF PUYALLUP OFFICE OF THE CITY ENGINEER

03.02.01-3

2 THRUST BLOCKING TABLE NOT TO SCALE

3/4" OR 1" WATER SERVICE CONNECTION

CITY OF PUYALLUP OFFICE OF THE CITY ENGINEER

03.03.01

3 0.75IN OR 1IN WATER SERVICE CONNECTION NOT TO SCALE

1-1/2" AND 2" WATER SERVICE CONNECTION

CITY OF PUYALLUP OFFICE OF THE CITY ENGINEER

03.03.02

4 1.5IN OR 2" WATER SERVICE CONNECTION NOT TO SCALE

PRIVATE WATER SERVICE LINES

CITY OF PUYALLUP OFFICE OF THE CITY ENGINEER

03.03.04

5 PRIVATE WATER SERVICE LINES NOT TO SCALE

FIRE HYDRANT ASSEMBLY

CITY OF PUYALLUP OFFICE OF THE CITY ENGINEER

03.05.01

6 FIRE HYDRANT ASSEMBLY NOT TO SCALE



Know what's below. Call before you dig.

EAST TOWN CROSSING PHASE 1


SEC. 26,35/ TWP. 20 N./ RGE. 4 E., W.M.

APPROVED

BY: CITY OF PUYALLUP
DEVELOPMENT ENGINEERING

DATE:

NOTE: THIS APPROVAL IS VOID AFTER 180 DAYS FROM APPROVAL DATE. THE CITY WILL NOT BE RESPONSIBLE FOR ERRORS AND/OR OMISSIONS ON THESE PLANS. FIELD CONDITIONS MAY DICTATE CHANGES TO THESE PLANS AS DETERMINED BY THE DEVELOPMENT ENGINEERING MANAGER.

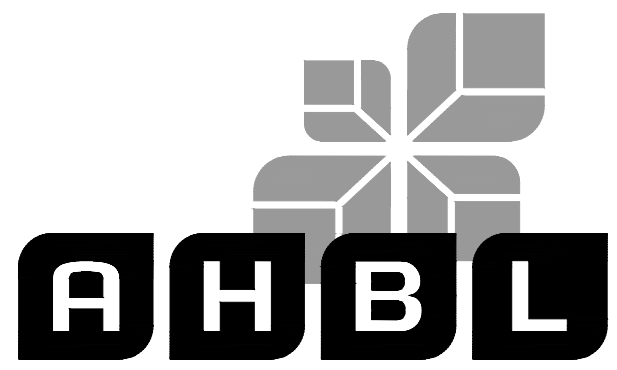

TACOMA · SEATTLE · SPOKANE · TRI-CITIES

2215 North 30th Street, Suite 300, Tacoma, WA 98403
253.383.2422 TEL 253.383.2572 FAX www.ahbl.com WEB

Project Title:

EAST TOWN CROSSING PHASE 1

Client:

ASH DEVELOPMENT

GREG HELLE

GREG.HELLE@ASHNW.COM

Project No.

2230752

Issue Set & Date:


PERMIT SUBMITTAL

11/20/2023



11/21/2023


NOTICE: ALTERATION OF THIS DOCUMENT SHALL VIOLATE THE PROFESSIONAL SEAL AND SIGNATURE PUBLICATION OF THE DOCUMENT DOES NOT CONSTITUTE FROM RESERVING OR CONFIRMING THE QUALITY OF THE WORK OR THE ONLY FOR THE PROJECT ENTERED IN THE TITLE BLOCK AND IS NOT TO BE USED FOR OTHER PROJECTS OR ADDITION TO THAT PROJECT OR FOR ANY OTHER PROJECT.

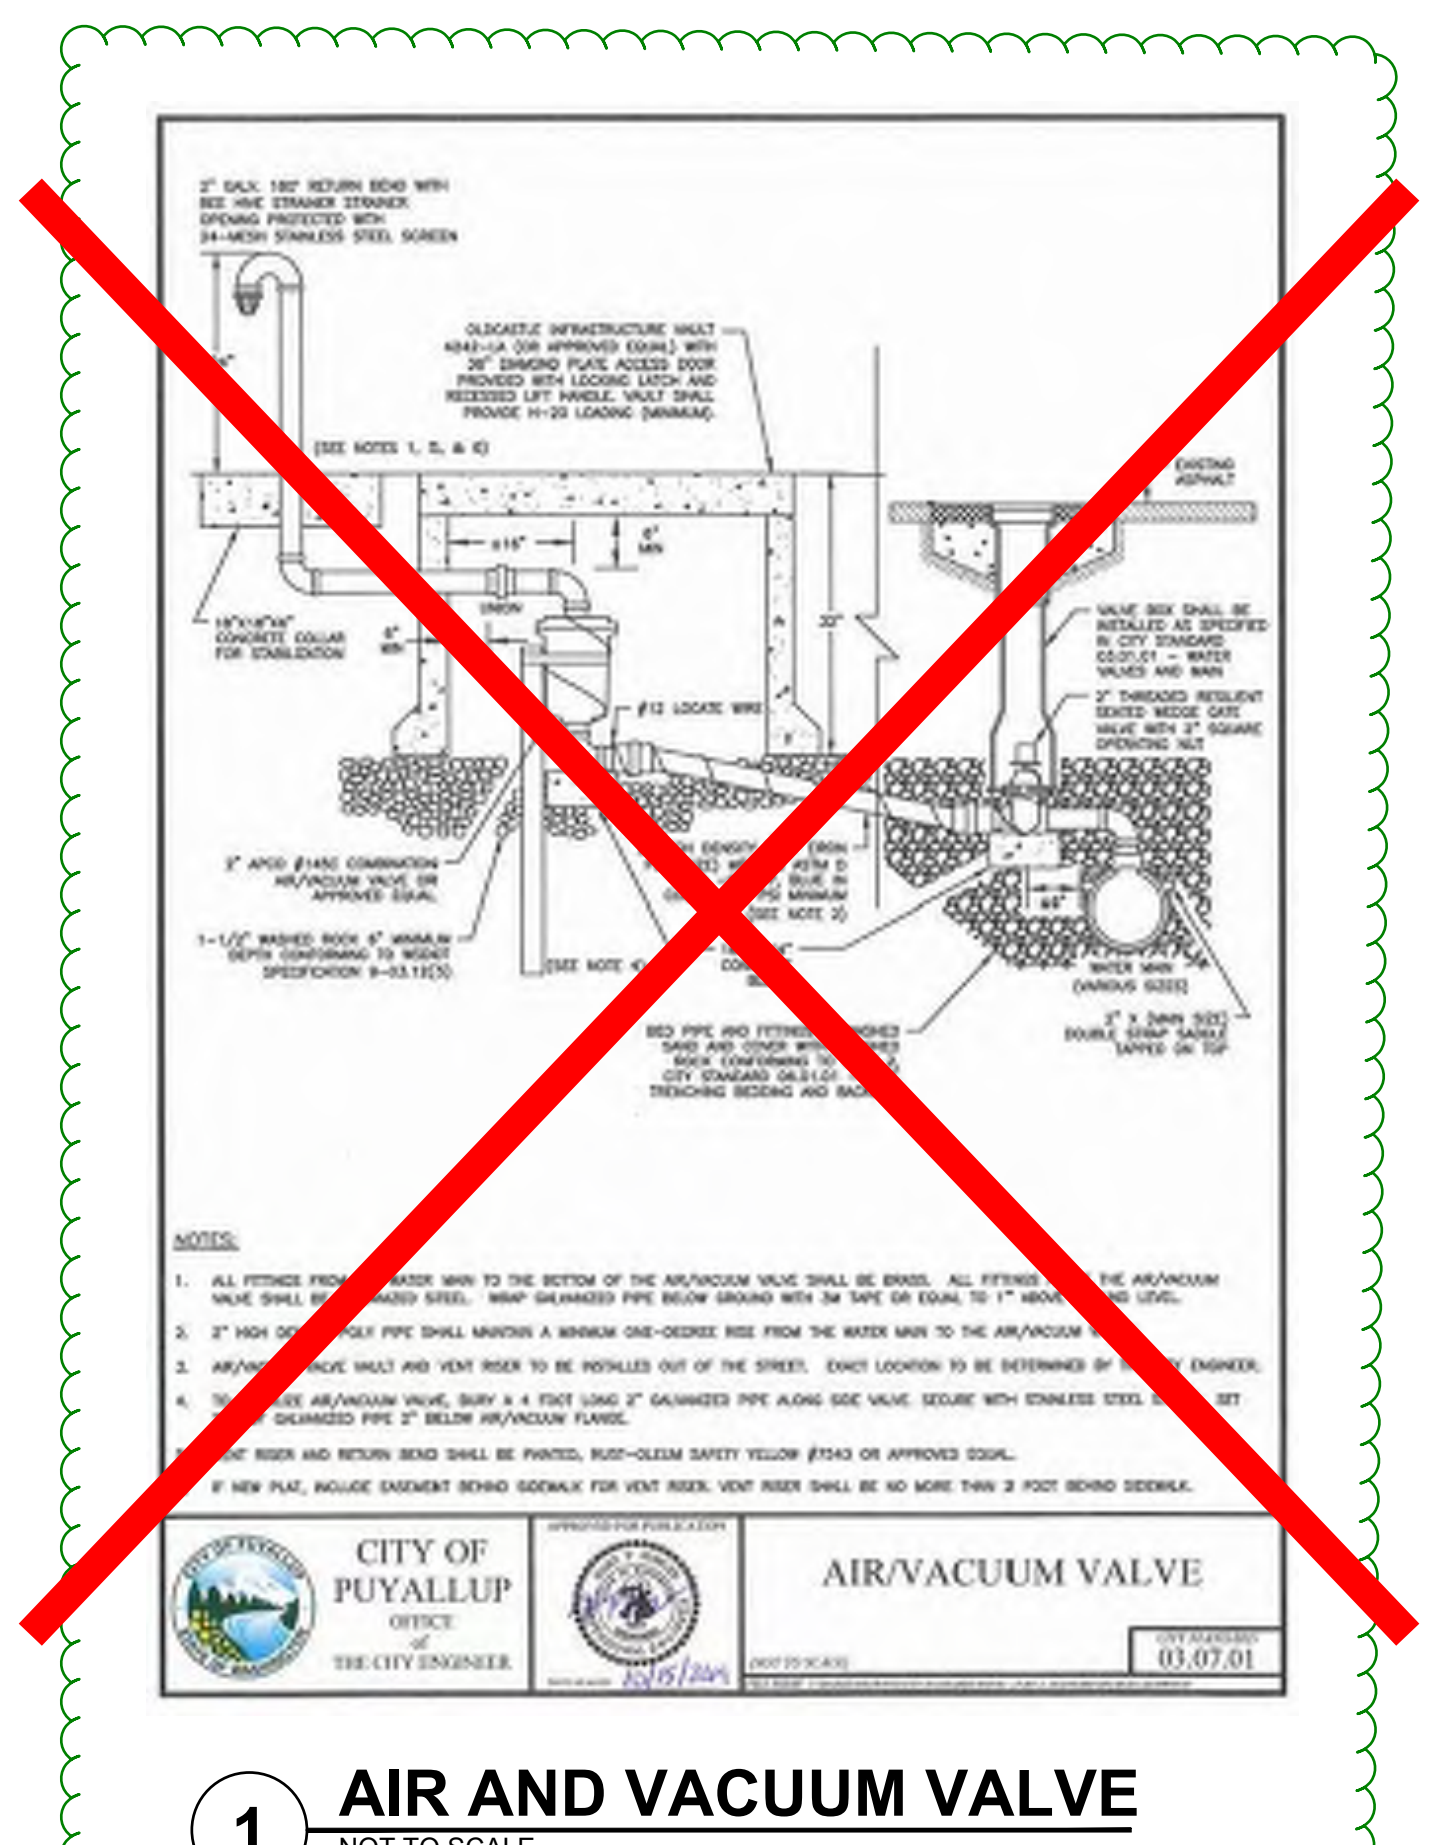

1 AIR AND VACUUM VALVE
NOT TO SCALE

Civil Resub Sheet C6.09: Remove this Standard detail and replace with 03.06.01 2-inch blow-off assembly.


Replaced

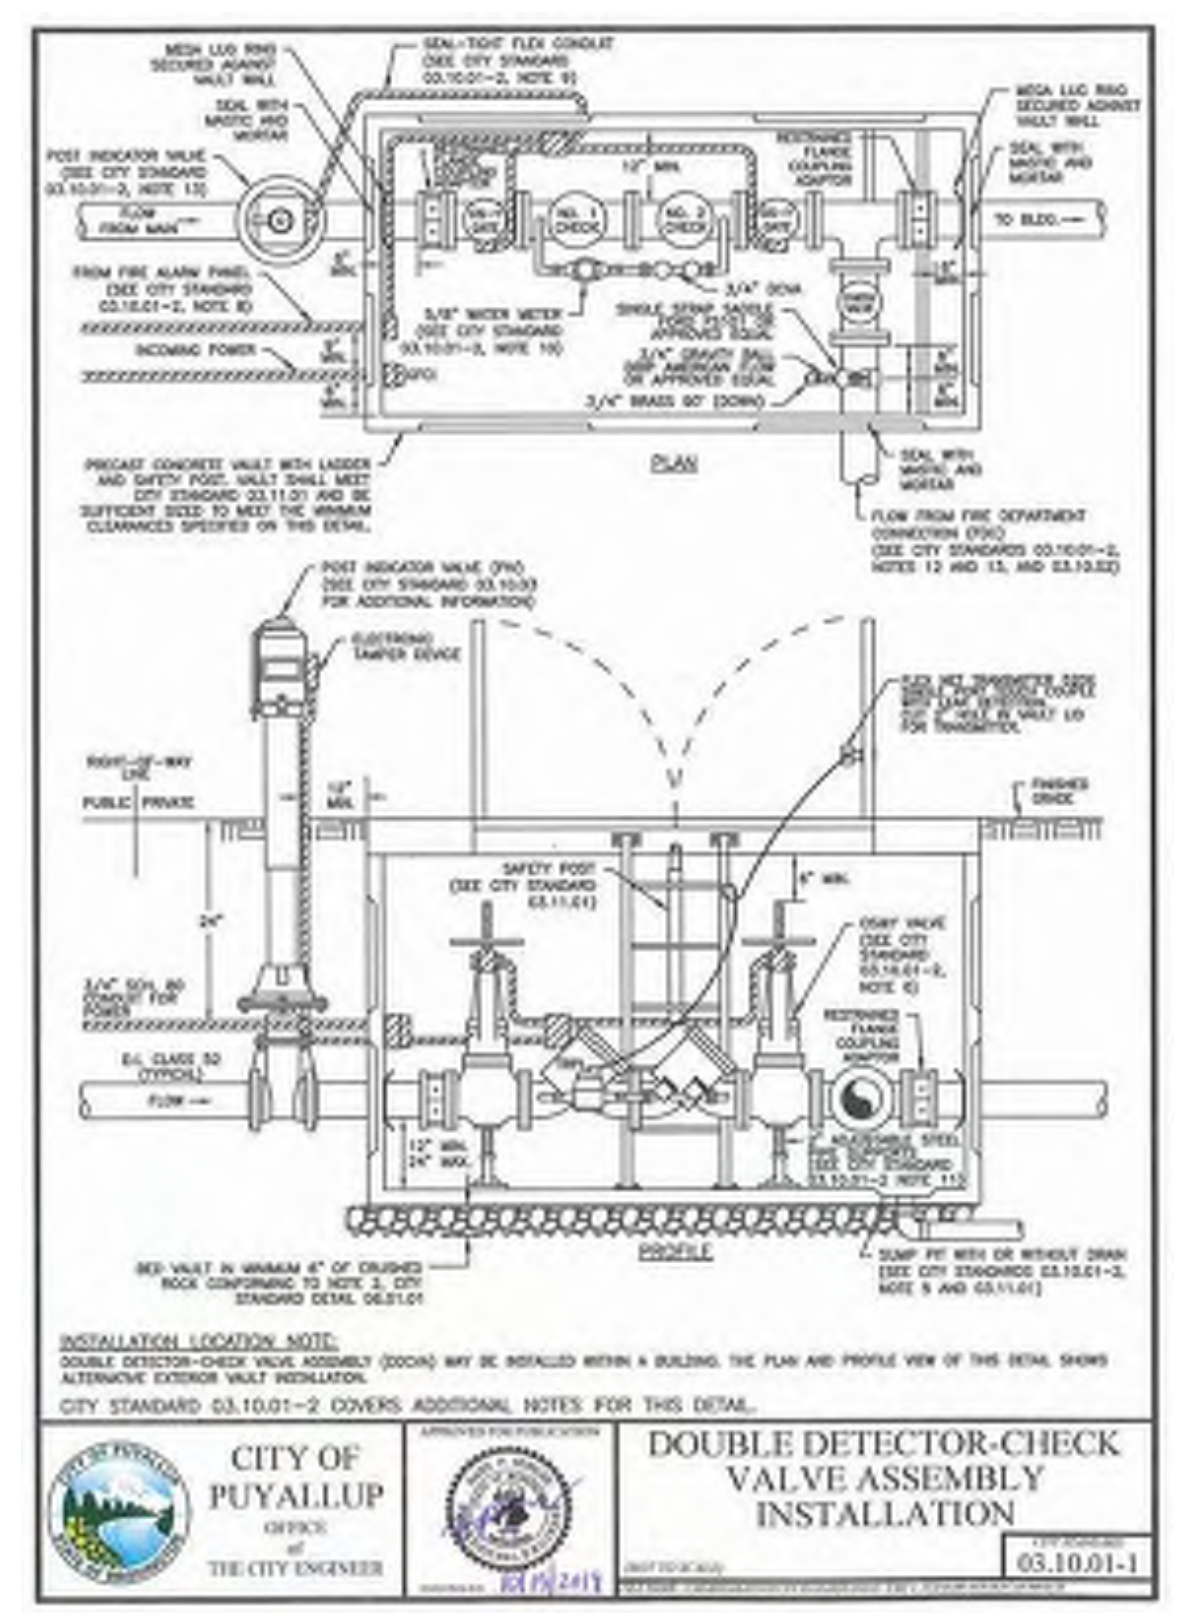


2 DOUBLE DETECTOR CHECK VALVE ASSEMBLY INSTALLATION
NOT TO SCALE



3 DOUBLE DETECTOR CHECK VALVE ASSEMBLY INSTALLATION (NOTES)
NOT TO SCALE

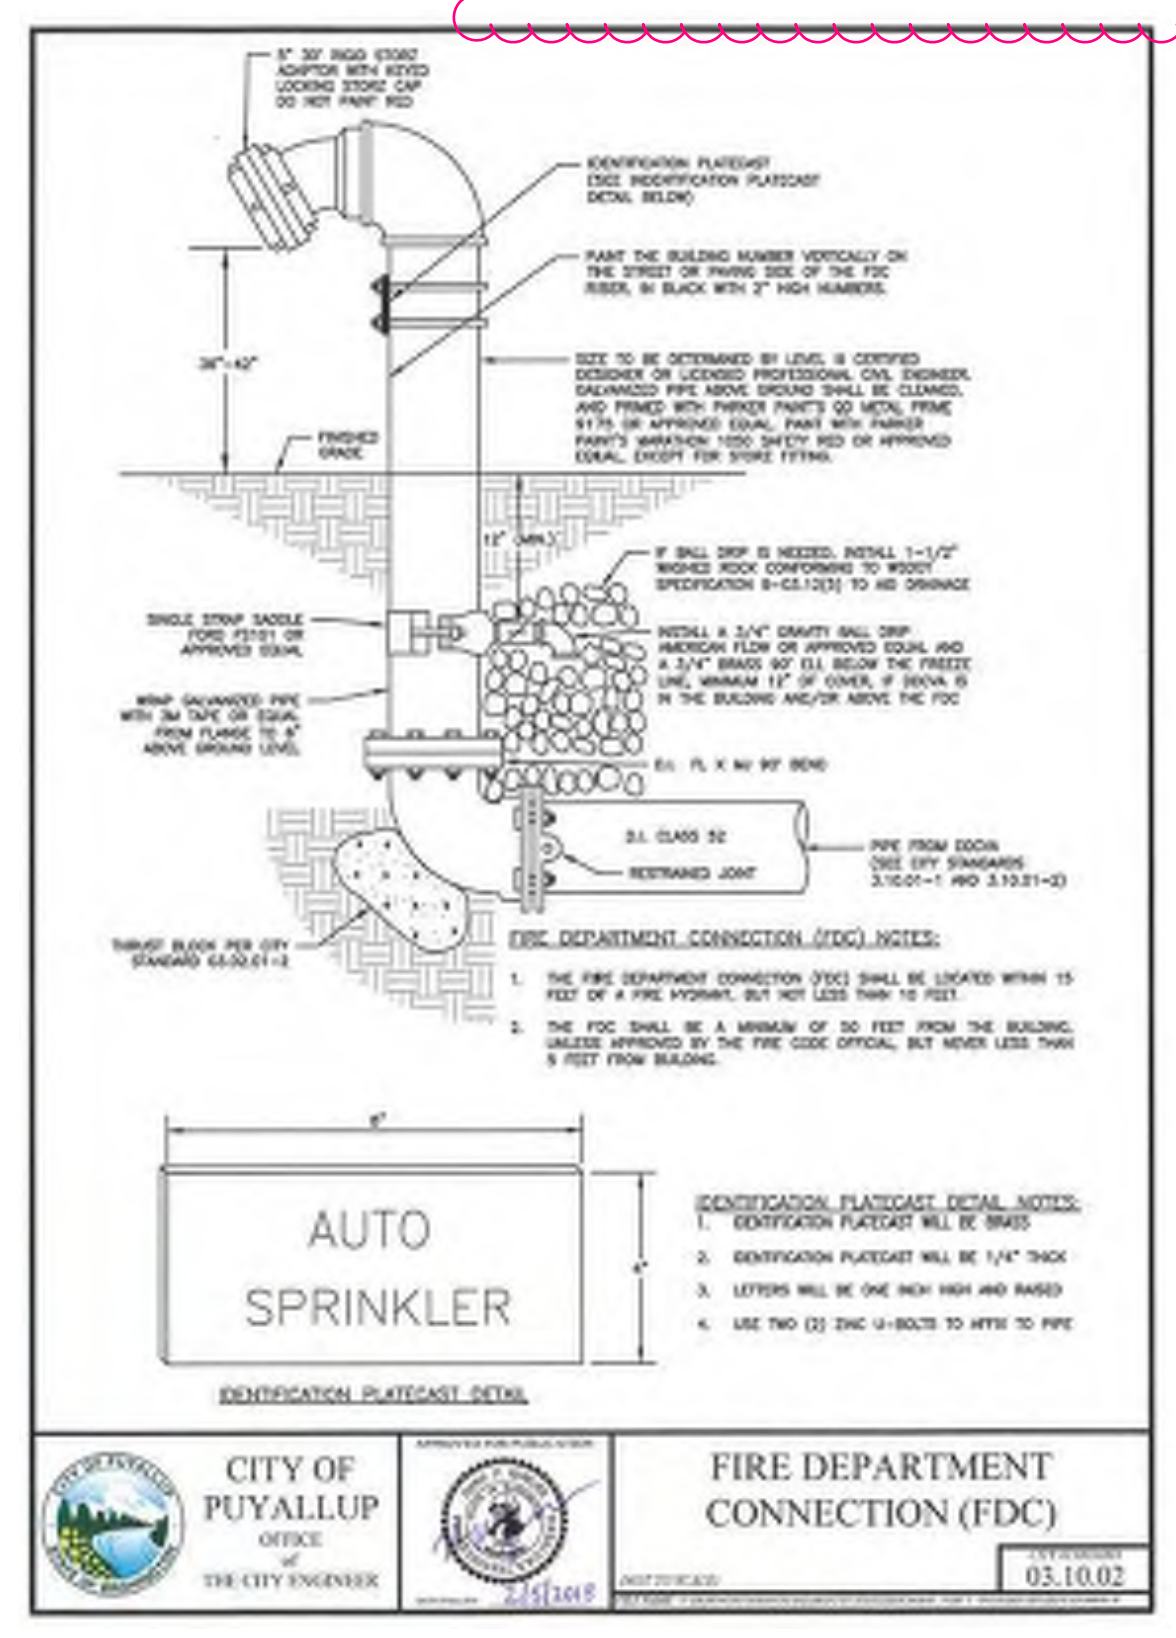


4 FIRE DEPARTMENT CONNECTION (FDC)
NOT TO SCALE

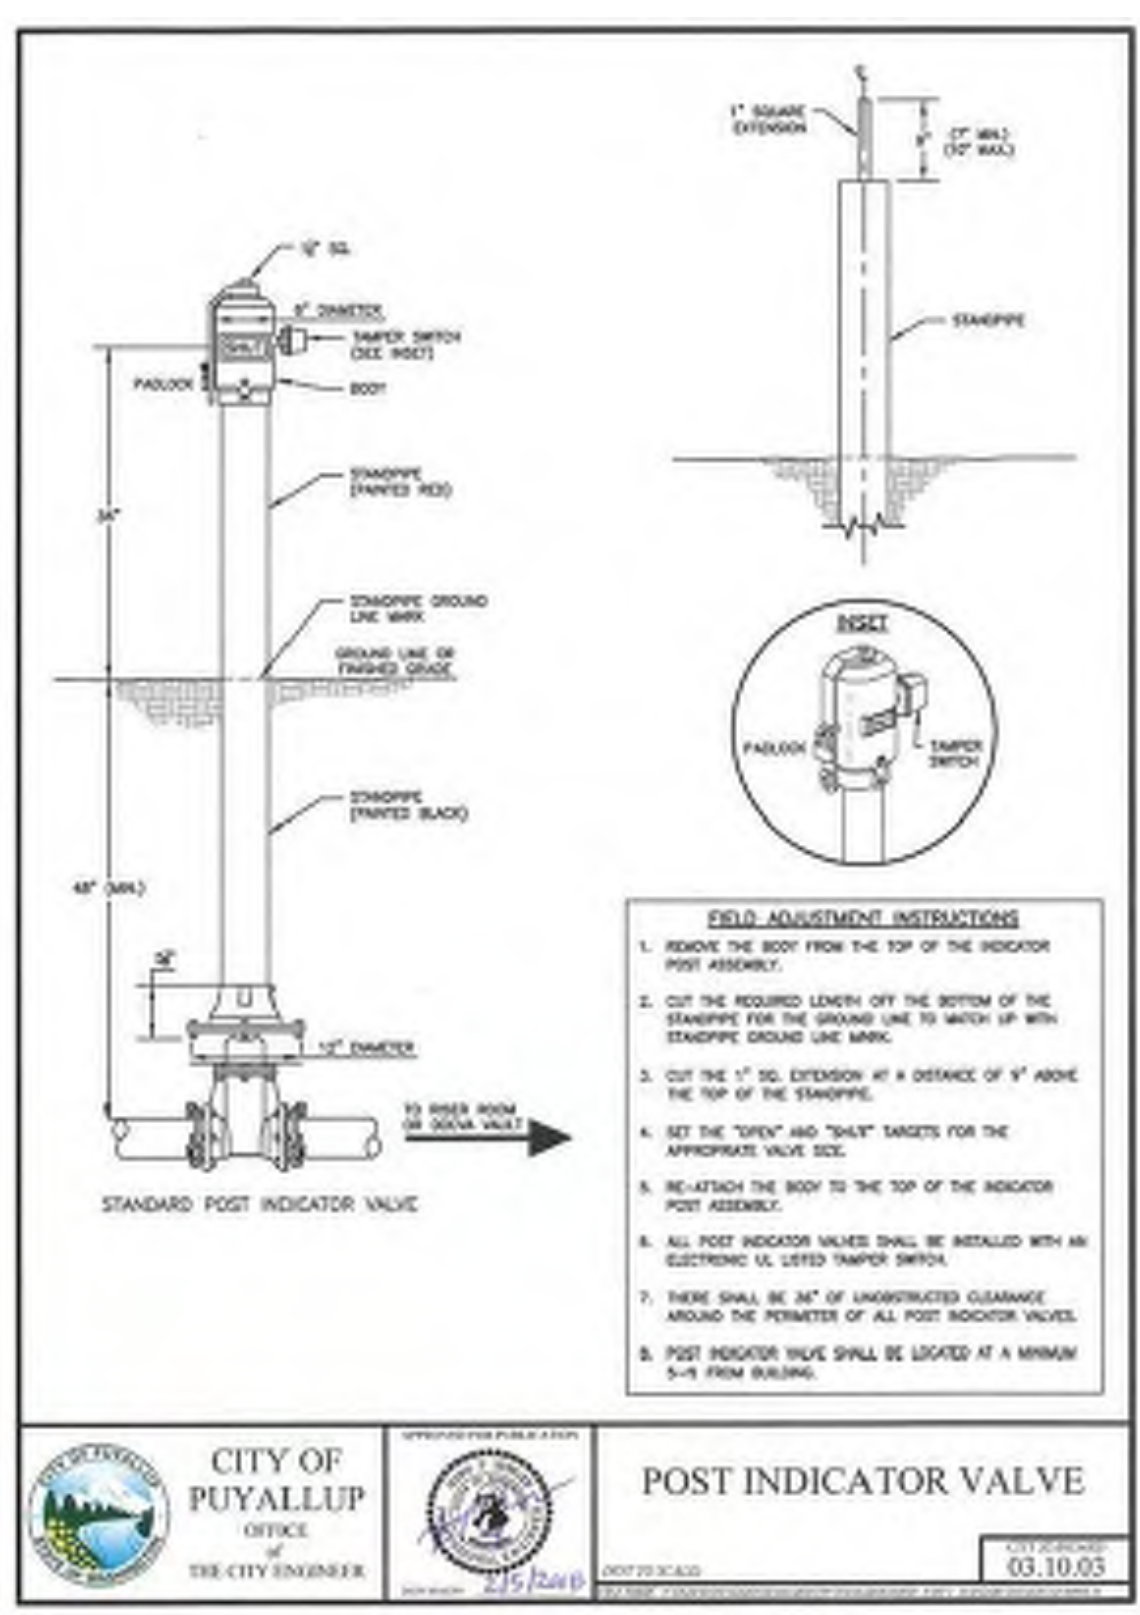

5 POST INDICATOR VALVE
NOT TO SCALE

Combine with thrust block details on SH C6.08. [Plans SH C6.09, Pg 61 of 63]

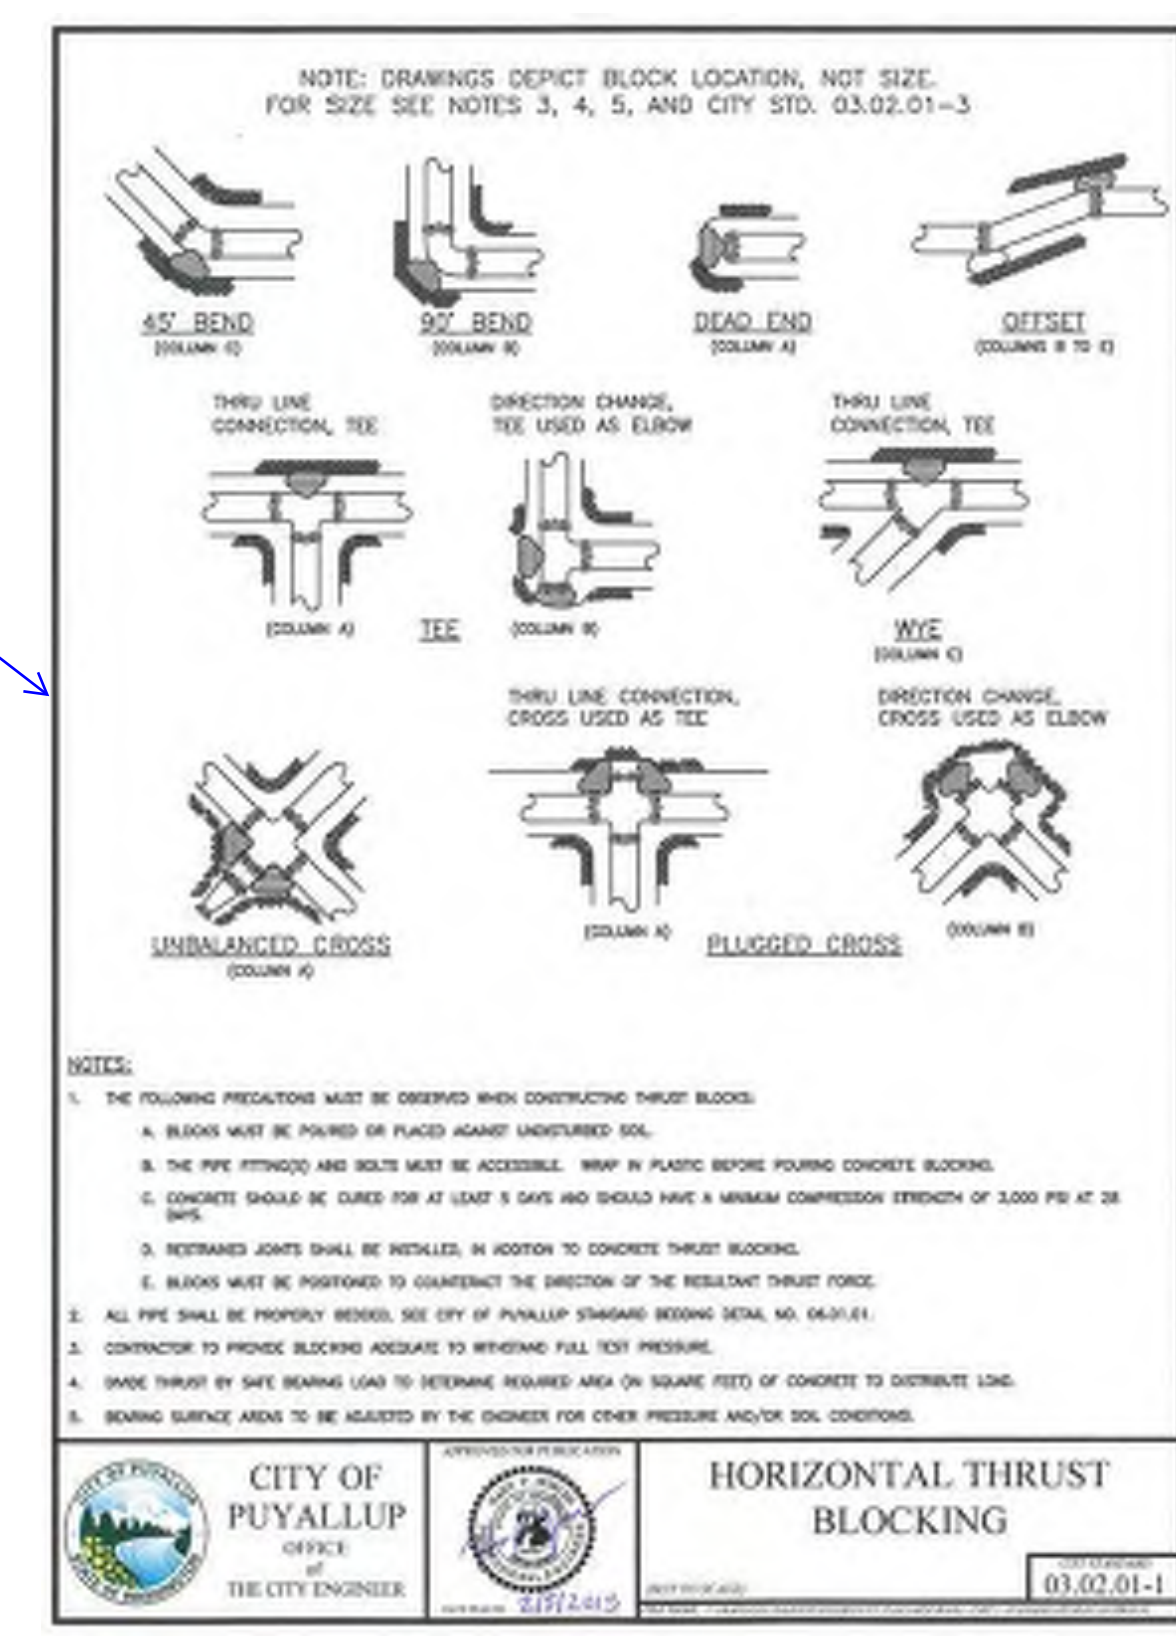

6 HORIZONTAL THRUST BLOCKING
NOT TO SCALE

Civil Resub Sheet C6.09: Move the standard detail to Sheet C6.08.

Moved to C6.08



Know what's below.
Call before you dig.

Revisions:

Sheet Title:
WATER NOTES AND DETAILS

Designed by: CW Drawn by: SK Checked by: JI

Sheet No.

C6.09
61 of 63 Sheets

EAST TOWN CROSSING PHASE 1


SEC. 26,35/ TWP. 20 N./ RGE. 4 E., W.M.

APPROVED

BY: CITY OF PUYALLUP
DEVELOPMENT ENGINEERING

DATE:

NOTE: THIS APPROVAL IS VOID AFTER 180 DAYS FROM APPROVAL DATE. THE CITY WILL NOT BE RESPONSIBLE FOR ERRORS AND/OR OMISSIONS ON THESE PLANS. FIELD CONDITIONS MAY DICTATE CHANGES TO THESE PLANS AS DETERMINED BY THE DEVELOPMENT ENGINEERING MANAGER.

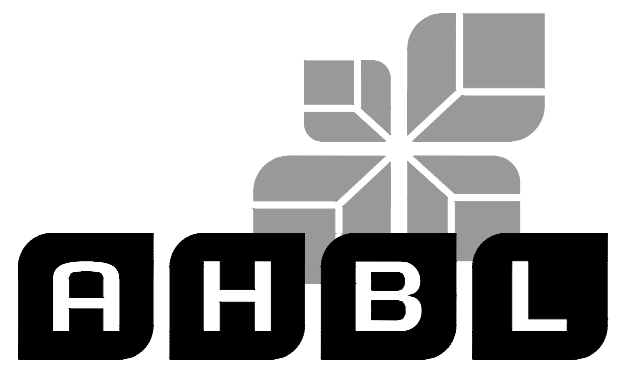

TACOMA • SEATTLE • SPOKANE • TRI-CITIES

2215 North 30th Street, Suite 300, Tacoma, WA 98403
253.383.2422 TEL 253.383.2572 FAX www.ahbl.com WEB

Project Title:

EAST TOWN CROSSING PHASE 1

Client:

ASH DEVELOPMENT

GREG HELLE

GREG.HELLE@ASHNW.COM

Project No.

2230752

Issue Set & Date:

PERMIT SUBMITTAL


11/20/2023




11/21/2023

NOTICE: ALTERATION OF THIS DOCUMENT SHALL INVALIDATE THE PROFESSIONAL SEAL AND SIGNATURE. PUBLICATION OF THIS DOCUMENT DOES NOT CONSTITUTE A WARRANTY OR GUARANTEE BY THE ENGINEER OR ARCHITECT. THE ENGINEER OR ARCHITECT IS NOT RESPONSIBLE FOR ANY ERRORS OR OMISSIONS IN THIS BLOCK AND IS NOT TO BE USED FOR ANY OTHER PROJECT.


Civil Resub Sheet C6.10: Remove this unneeded Standard detail. Removed

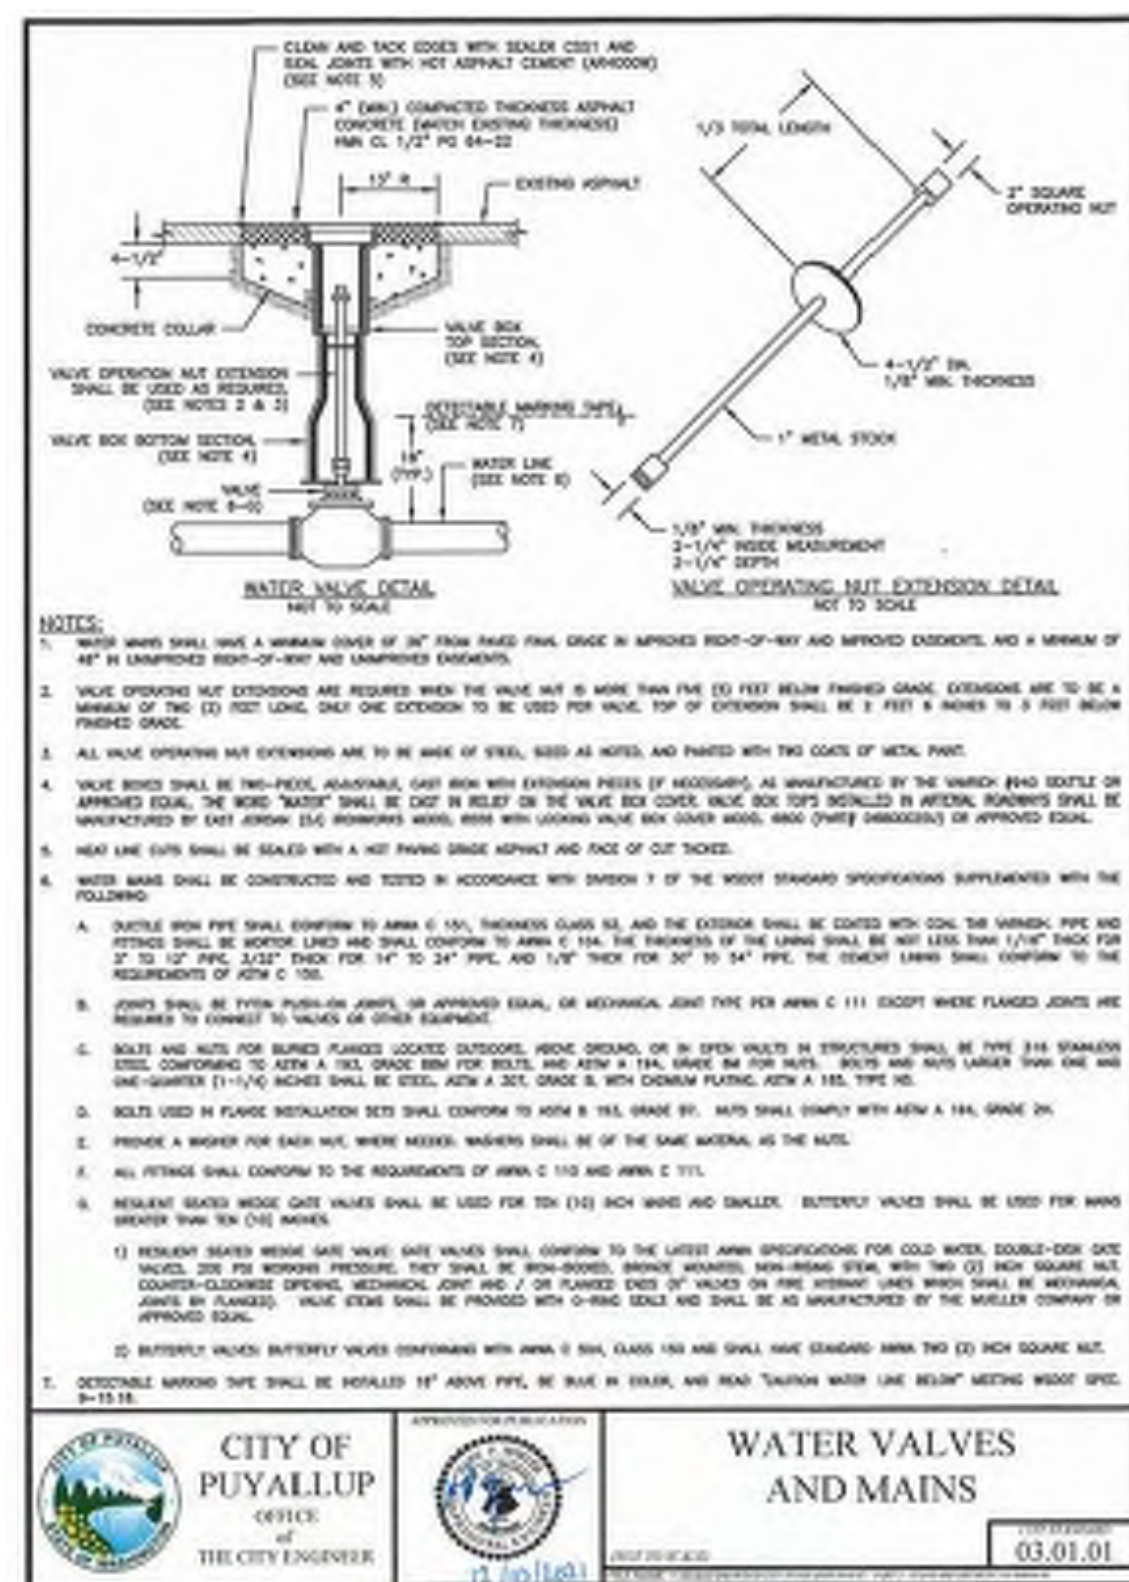

1 WATER VALVES AND MAINS
NOT TO SCALE

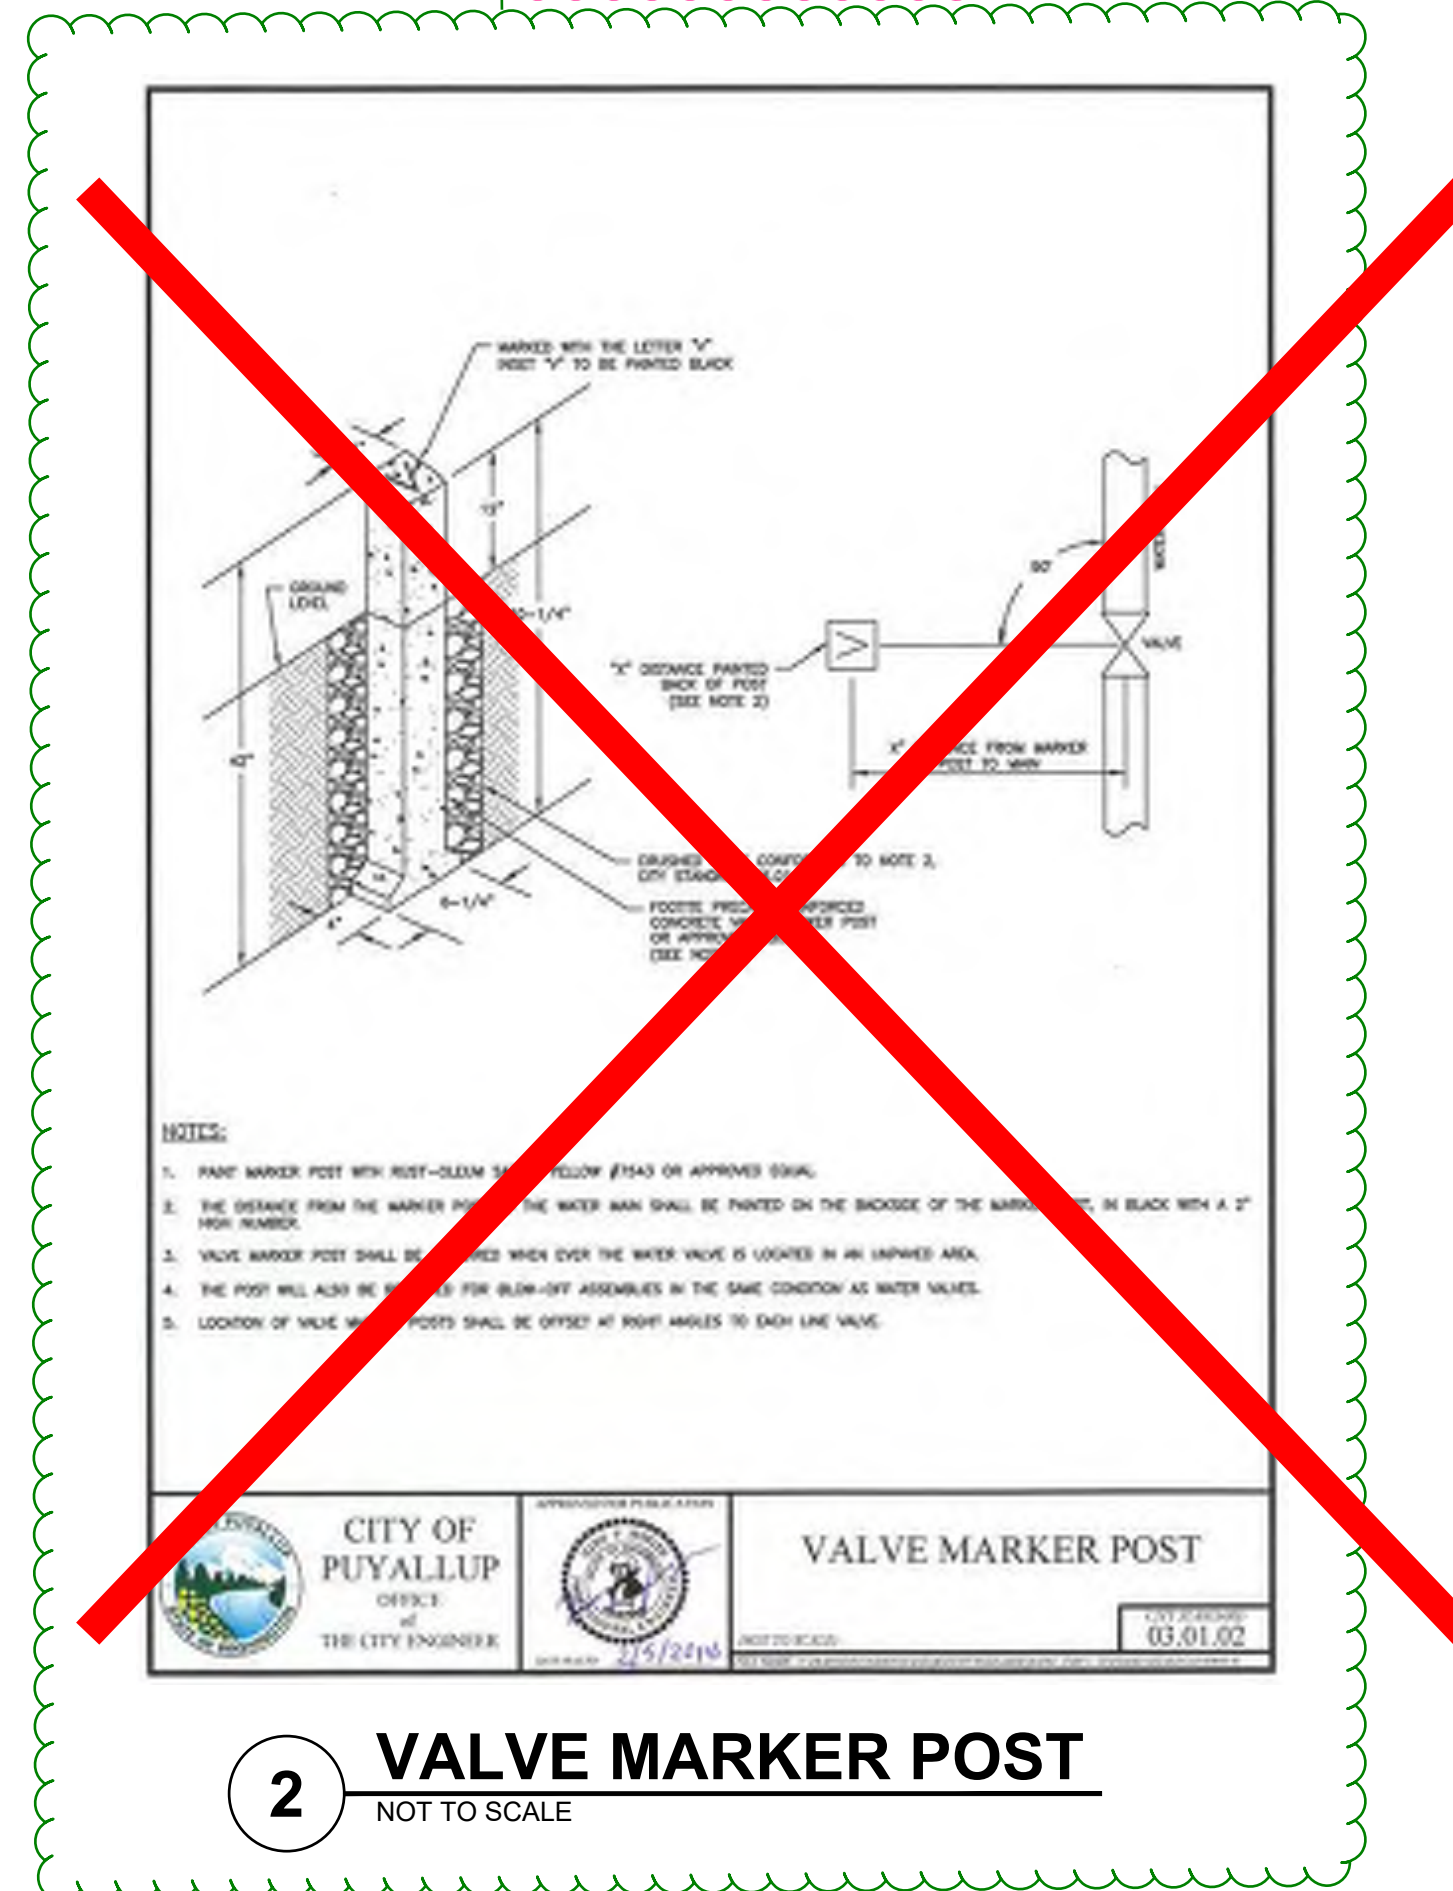


2 VALVE MARKER POST
NOT TO SCALE

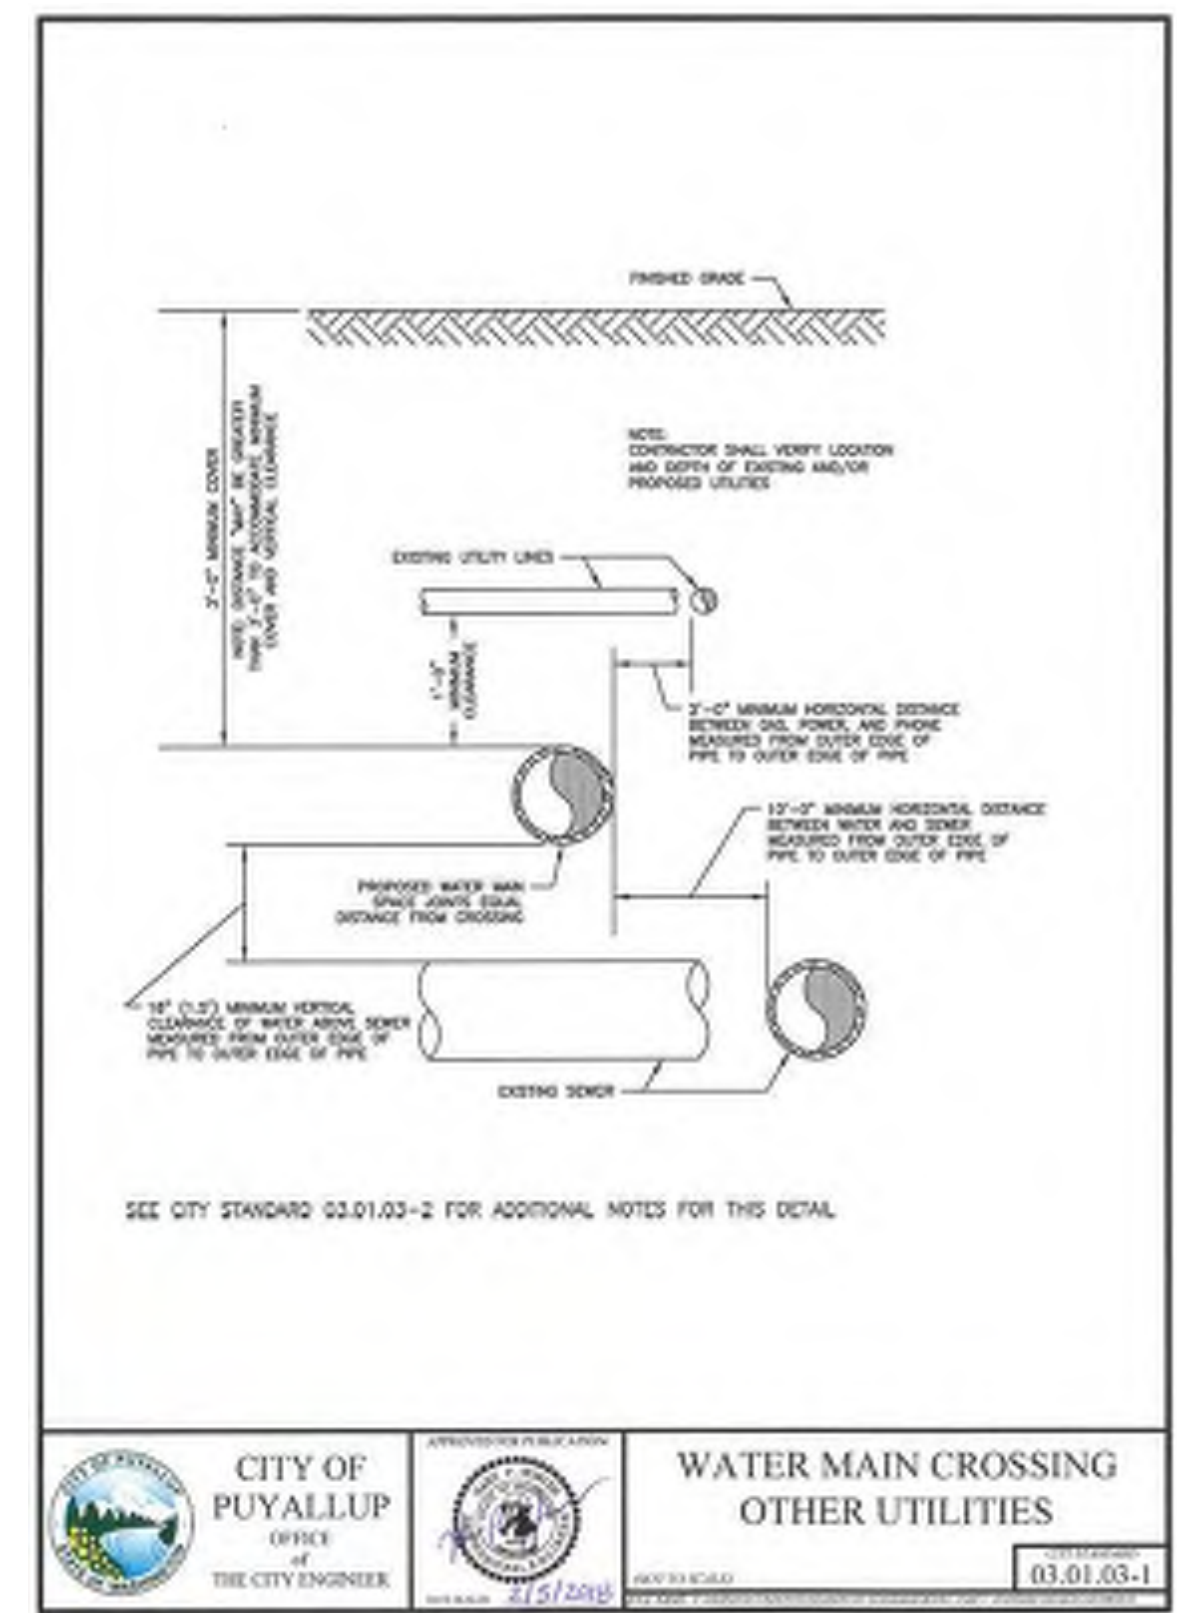

3 WATER MAIN CROSSING OTHER UTILITIES
NOT TO SCALE



4 WATER MAIN CROSSING OTHER UTILITIES (NOTES)
NOT TO SCALE

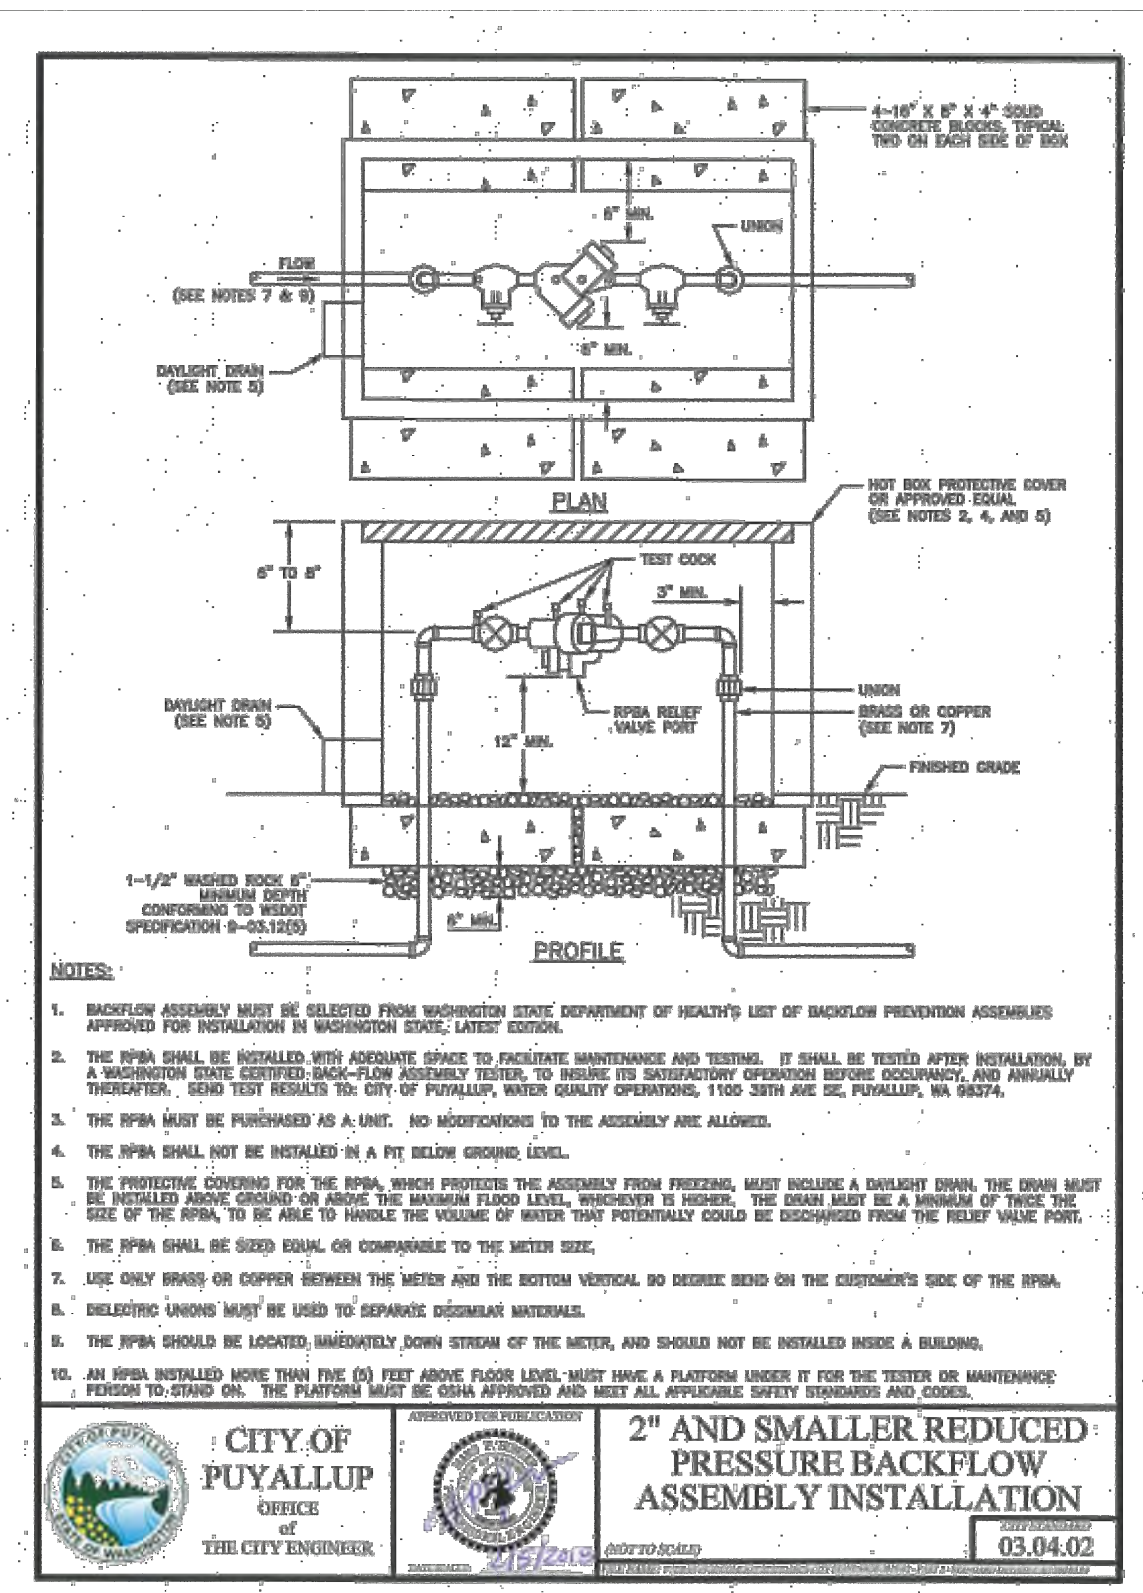

5 2IN AND SMALLER REDUCED PRESSURE BACKFLOW ASSEMBLY INSTALLATION
NOT TO SCALE

Included relevant details
ADD-City Std Details 03.04.01 // 03.04.03 (if 3" water service(s) are anticipated) // 03.06.01 // 03.11.01. [Plans Sht C6.10; Pg 62 of 63]

Revisions:

Sheet Title:

WATER NOTES AND DETAILS

Designed by: CW Drawn by: SK Checked by: JI

Sheet No.

C6.10


62 of 63 Sheets



Know what's below. Call before you dig.

EAST TOWN CROSSING PHASE 1

SEC. 26,35/ TWP. 20 N./ RGE. 4 E., W.M.

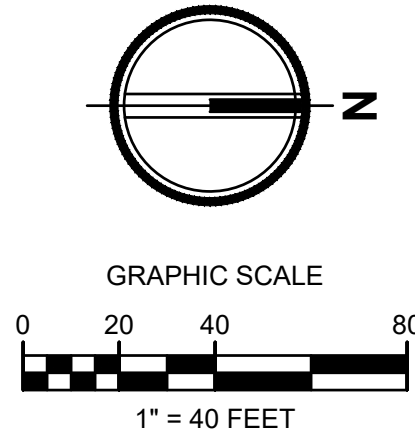

APPROVED

BY: CITY OF PUYALLUP
DEVELOPMENT ENGINEERING

DATE:

NOTE: THIS APPROVAL IS VOID AFTER 180 DAYS FROM APPROVAL DATE. THE CITY WILL NOT BE RESPONSIBLE FOR ERRORS AND/OR OMISSIONS ON THESE PLANS. FIELD CONDITIONS MAY DICTATE CHANGES TO THESE PLANS AS DETERMINED BY THE DEVELOPMENT ENGINEERING MANAGER.

TACOMA • SEATTLE • SPOKANE • TRI-CITIES

2215 North 30th Street, Suite 300, Tacoma, WA 98403
253.383.2422 TEL 253.383.2572 FAX www.ahbl.com WEB

Project Title:

EAST TOWN CROSSING PHASE 1

Client:

ASH DEVELOPMENT

GREG HELLE

GREG.HELLE@ASHNW.COM


Project No.

2230752

Issue Set & Date:



PERMIT SUBMITTAL

11/20/2023

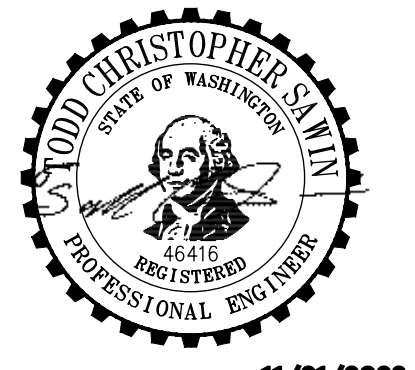

11/21/2023


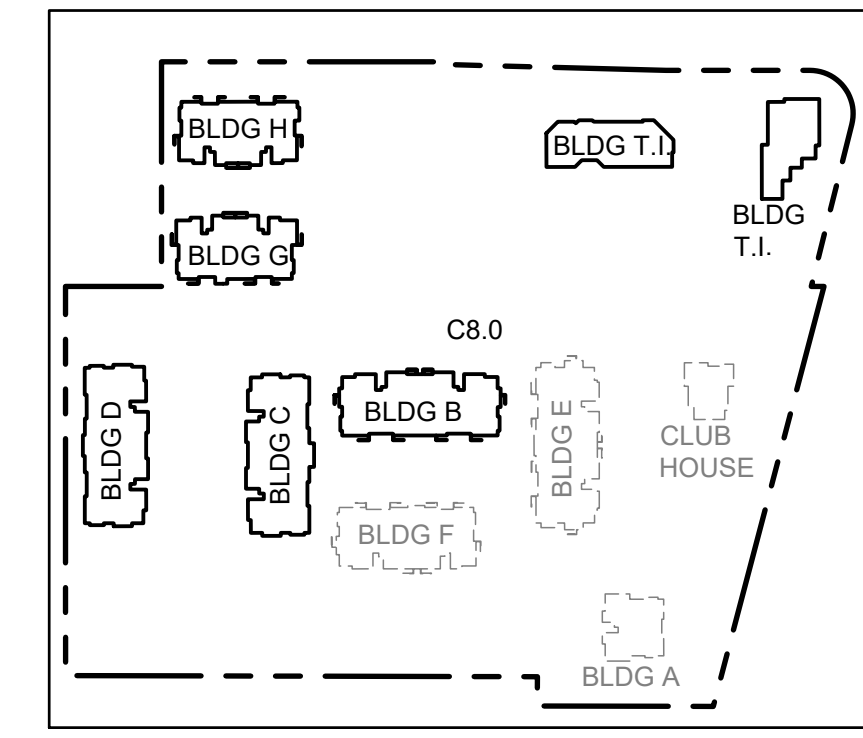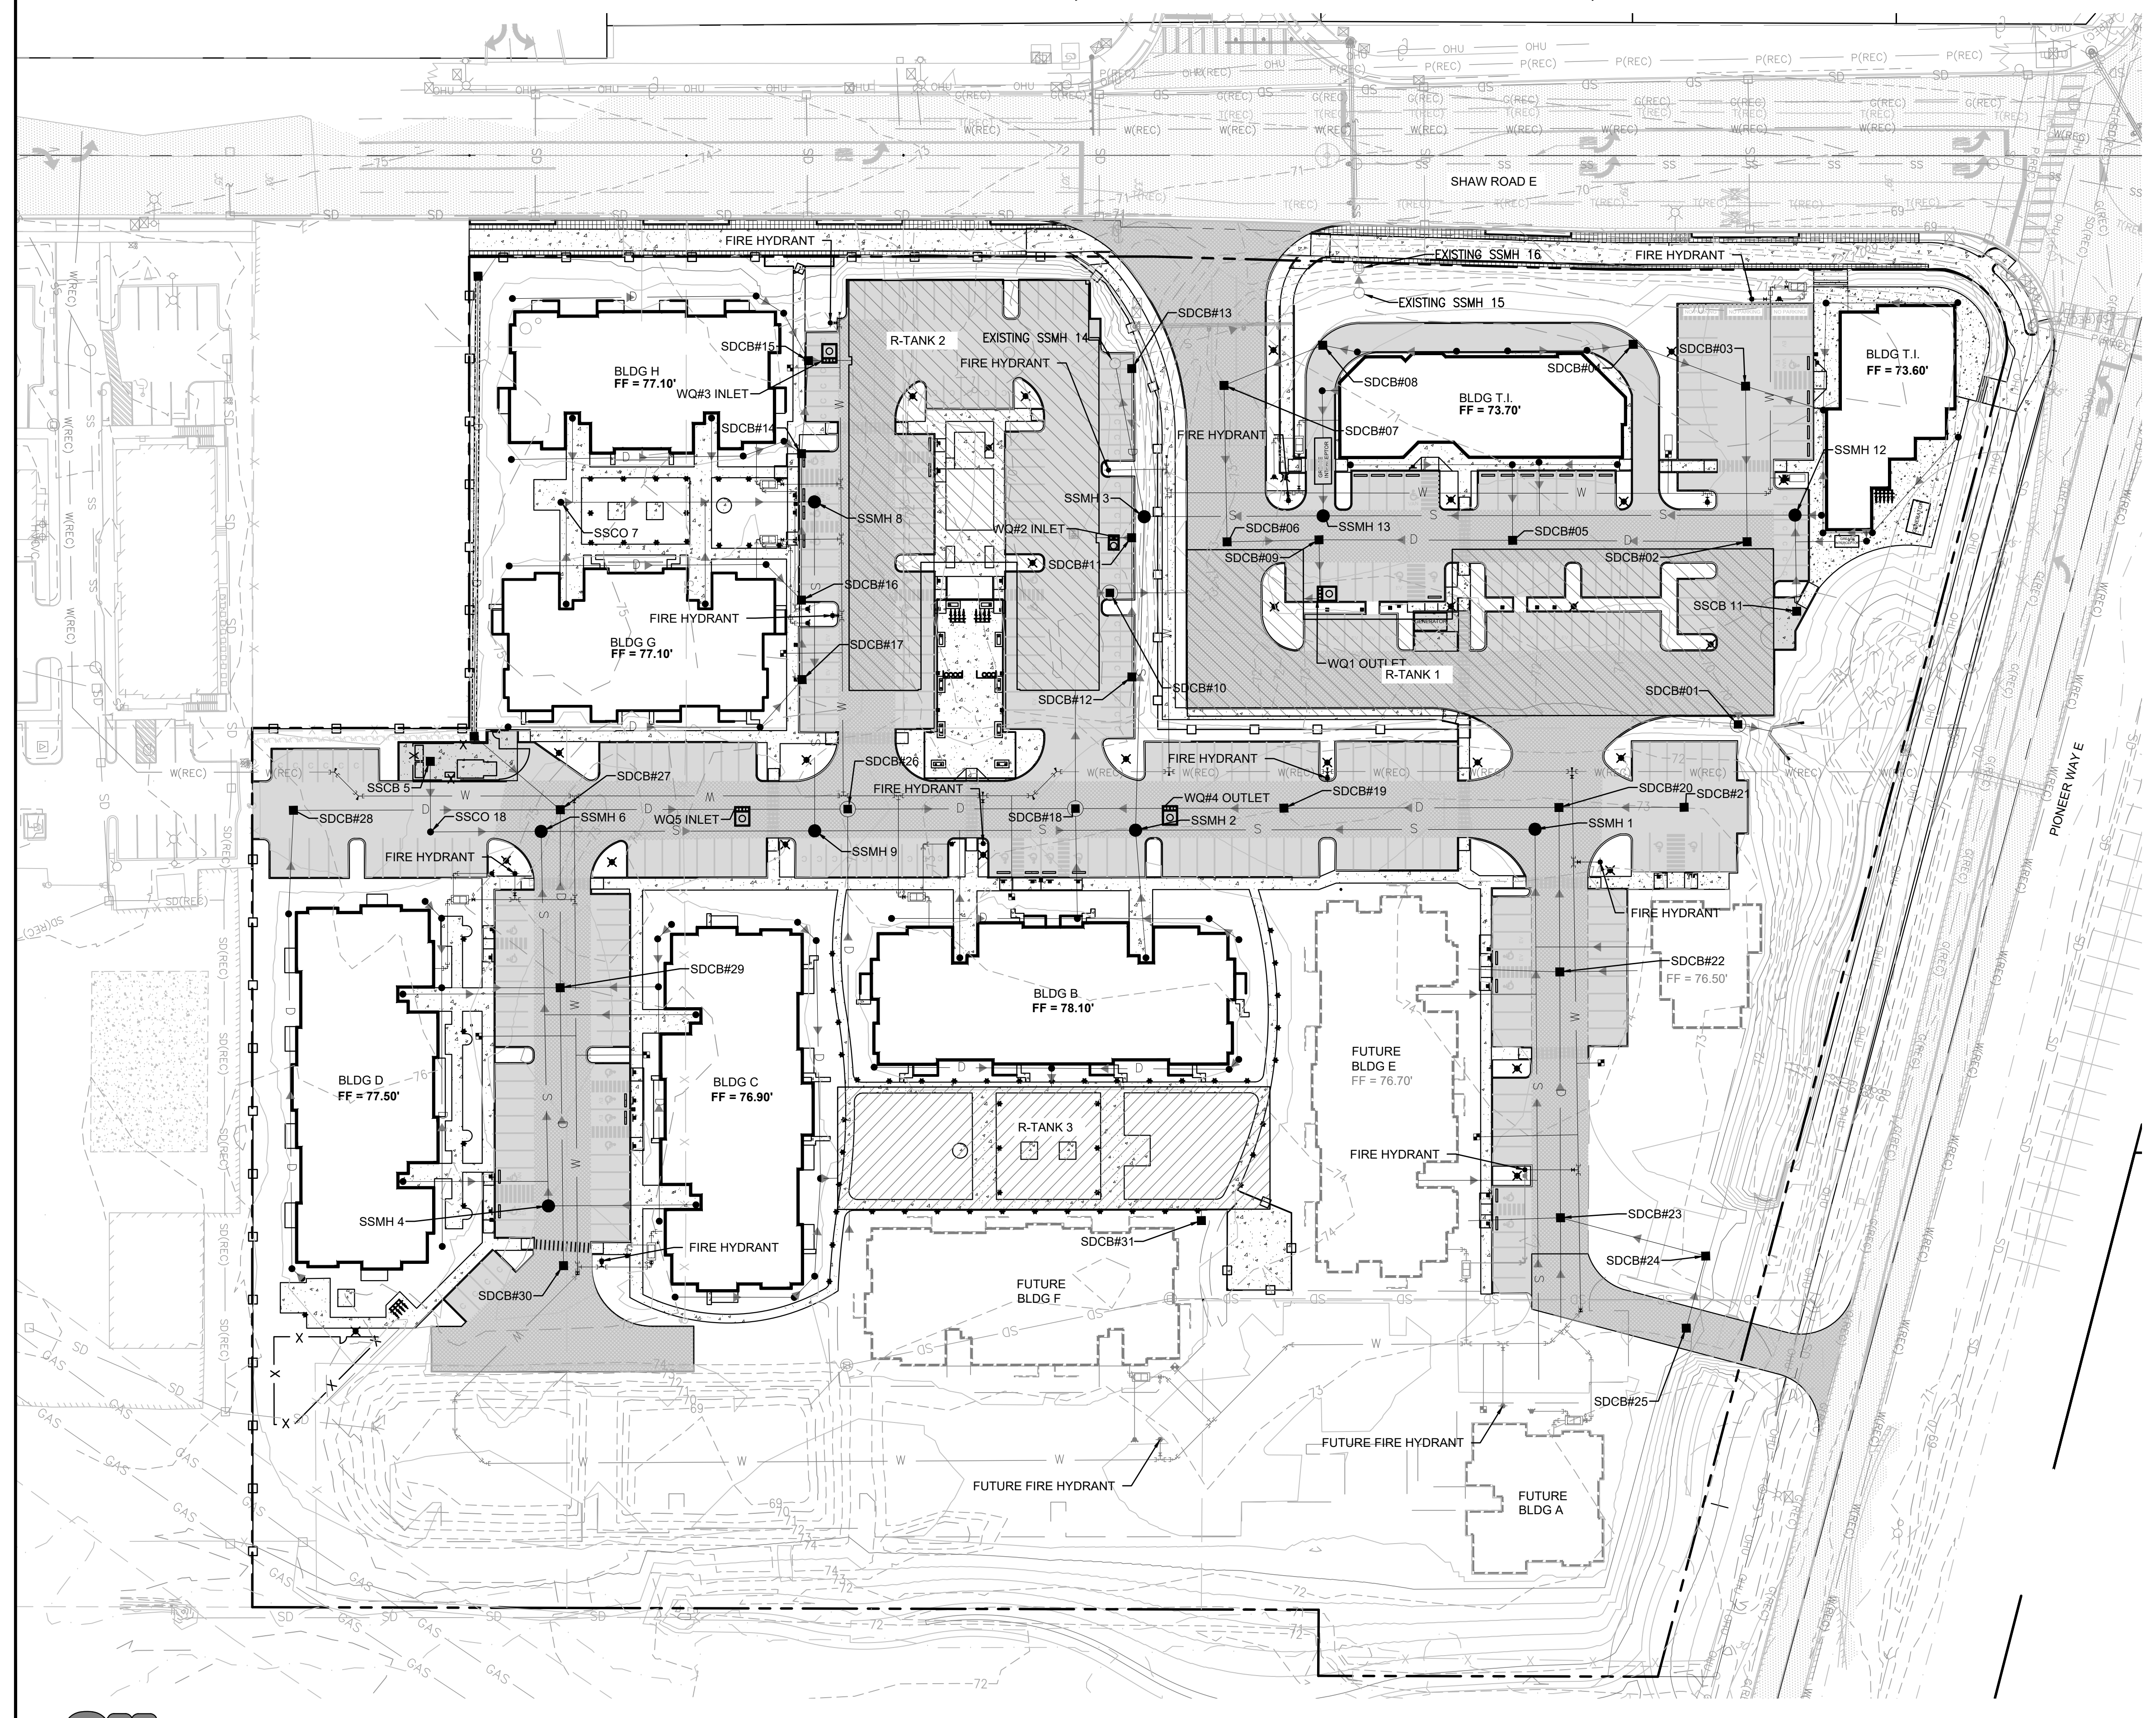

Revisions:

Sheet Title:

OVERALL UTILITY PLAN

Designed by: CW Drawn by: SK Checked by: JI

Sheet No.

C8.0

