

SURVEYOR

ABBEY ROAD GROUP
CONTACT: LARRY WALKER
PO BOX 1224
PUYALLUP, WA 98371
OFFICE: 253-435-3699

ARCHITECT

SYNTHESIS 9, LLC
CONTACT: BRETT LINDSAY
223 N. D. ST
TACOMA, WA 98403
OFFICE: 253-468-4117

CIVIL ENGINEER

AHBL INC.
2215 NORTH 30TH STREET, SUITE 300
TACOMA, WA 98403
PHONE: (253) 383-2422
CONTACT: TODD SAWIN
EMAIL: TSAWIN@AHBL.COM

SITE INFORMATION

PARCEL: 0420264021, 0420264054, 0420264053
0420351066, 0420351030, 0420351029, 0420351026
ADDRESS: 2902 E PIONEER
PUYALLUP, WA 98372
ZONING: CG AND RM-20

SURVEYOR'S NOTES

- 1. HORIZONTAL DATUM: BASIS OF BEARING AND SURVEY DATA PER WASHINGTON STATE PLANE COORDINATE SYSTEM, SOUTH ZONE.
2. BASIS OF BEARING: HELD S 01° 21' 28" W OBSERVED ALONG THE EAST LINE OF THE NORTHEAST QUARTER OF SEC. 35, T. 20 N. R. 4 E. BETWEEN THE NORTHEAST CORNER OF THE NORTHEAST QUARTER MONUMENT AND THE SOUTHEAST CORNER OF THE NORTHEAST QUARTER MONUMENT OF THE SAID SECTION AS SHOWN HEREON.
3. VERTICAL DATUM: NAVD88
AS DEFINED BY THE NATIONAL GEODETIC SURVEY (NGS)
PROJECT BENCHMARK: DESIGNATION: 21 010 PID: DL2774
PUBLISHED ELEVATION: 75.70 FEET (NAVD 88)
DESCRIPTION: ENCASED STEEL ROD LOCATED IN EASTERLY GRAVEL SHOULDER AT THE INTERSECTION OF PIONEER WAY AND 134TH AVE. E.
4. ALL UTILITY LOCATES HAVE BEEN DETERMINED BY SURFACE LOCATION ONLY EITHER BY PHYSICAL STRUCTURES OR PAINT MARKINGS AS DETERMINED BY UNDERGROUND - UTILITY LOCATE, INC. AND/OR UTILITY COMPANY. GAS PIPE LOCATION WITHIN THE PROPERTY DETERMINED BY MAP PROVIDED BY PUGET SOUND ENERGY, INC. ACTUAL UNDERGROUND LOCATION MAY VARY. EXISTING UTILITIES AS SHOWN MAY NOT BE THE SAME AFTER THIS DATE AS MAJOR CONSTRUCTION IS IN PROGRESS.
5. REFERENCE SURVEYS: 1. 200303315001 2. SP 9303315001 3. ROS 8210040207
6. METHOD OF SURVEYING WAS: 1. CONVENTIONAL TRAVERSE USING A TOPCON 800A TOTAL STATION. 2. MONUMENTS FOUND MARCH 2008

TOPOGRAPHIC NOTE

THE EXISTING CULTURAL AND TOPOGRAPHICAL DATA SHOWN ON THESE DRAWINGS HAS BEEN PREPARED, IN PART, BASED UPON INFORMATION FURNISHED BY OTHERS. WHILE THIS INFORMATION IS BELIEVED TO BE RELIABLE, AHBL ENGINEERING CANNOT ENSURE ACCURACY AND THIS IS NOT RESPONSIBLE FOR THE ACCURACY OF THAT INFORMATION OR FOR ANY ERRORS OR OMISSIONS WHICH MAY HAVE BEEN INCORPORATED INTO THESE DRAWINGS AS A RESULT.

FILL SPECIFICATIONS

FILL MATERIAL SHALL NOT CONTAIN PETROLEUM PRODUCTS, OR SUBSTANCES WHICH ARE HAZARDOUS, DANGEROUS, TOXIC, OR WHICH OTHERWISE VIOLATE ANY STATE, FEDERAL, OR LOCAL LAW, ORDINANCE, CODE, REGULATION, RULE, ORDER, OR STANDARD.

FIRE SPRINKLER NOTE

FIRE LINE SHALL BE SIZED BY A LICENSED FIRE PROTECTION ENGINEER, A SEPARATE, DETAILED PLAN SHALL BE APPROVED BY THE FIRE MARSHALL AND INSTALLED BY A WASHINGTON CERTIFIED LEVEL "U" CONTRACTOR IN ACCORDANCE WITH WAC 216-09-010. A POST INDICATOR VALVE SHALL BE INSTALLED ON THE SPRINKLER LINE TO ISOLATE THE FIRE SYSTEM FROM THE WATER SYSTEM WHEN REQUIRED.

VERIFICATION NOTE

ALL EXISTING UTILITIES IN THE CONSTRUCTION AREA SHALL BE IDENTIFIED AND VERIFIED FOR DEPTH AND LOCATION PRIOR TO ANY CONSTRUCTION ACTIVITIES SO TO IDENTIFY ANY POTENTIAL CONFLICTS WITH PROPOSED CONSTRUCTION. CONTACT PROJECT ENGINEER IMMEDIATELY IF ANY CONFLICTS ARE IDENTIFIED.

PRIOR TO ANY CONSTRUCTION ACTIVITIES, VERIFY EXISTING TOPOGRAPHY IS CONSISTENT WITH WHAT IS SHOWN ON PLANS AND IF THERE ARE ANY POTENTIAL CONFLICTS WITH PROPOSED CONSTRUCTION ACTIVITIES, CONTACT PROJECT ENGINEER IMMEDIATELY IF ANY CONFLICTS ARE IDENTIFIED.

TRENCH NOTES

IF WORKERS ENTER ANY TRENCH OR OTHER EXCAVATION FOUR OR MORE FEET IN DEPTH THAT DOES NOT MEET THE OPEN PIT REQUIREMENTS OF WSDOT SECTION 2-09.30(3), IT SHALL BE SHORED AND CRIBBED. THE CONTRACTOR IS ALONE RESPONSIBLE FOR WORKER SAFETY. ALL TRENCH SAFETY SYSTEMS SHALL MEET THE REQUIREMENTS OF THE WASHINGTON INDUSTRIAL SAFETY AND HEALTH ACT, CHAPTER 49.17 RCW.

CONSTRUCTION SEQUENCE

- 1. OBTAIN REQUIRED PERMITS AND HOLD A PRE-CONSTRUCTION MEETING WITH THE CITY
2. FLAG CLEARING LIMITS
3. INSTALL OR REPLACE SILT FENCE
4. INSTALL CONSTRUCTION ENTRANCE
5. POT-HOLE ANY EXISTING UTILITIES FOR VERIFICATION OF DEPTH AND LOCATION. SEE VERIFICATION NOTE.
6. SCHEDULE EROSION CONTROL INSPECTION W/ CITY
7. GRADE SITE
8. MAINTAIN EROSION CONTROL, MEASURE AND RELOCATE SURFACEWATER CONTROLS AS NEEDED IN ACCORDANCE WITH CITY OF PUYALLUP REQUIREMENTS AND NPDES CONSTRUCTION STORMWATER GENERAL PERMIT
9. COVER ALL AREAS THAT WILL BE UNWORKED FOR MORE THAN FIVE DAYS DURING THE DRY SEASON OR TWO DAYS DURING THE WET SEASON
10. STABILIZE ALL AREAS WITHIN SEVEN DAYS OF REACHING FINAL GRADE
11. INSTALL ETPANS
12. STABILIZE ALL DISTURBED AREAS AND REMOVE BMPs AND EROSION CONTROL MEASURES AS APPROPRIATE
13. ARRANGE FINAL INSPECTION WITH THE CITY



CUT AND FILL ESTIMATES

CUT: 2,500 CY
FILL: 45,600 CY
NET IMPORT: 43,100 CY

CONDITIONS:

- 1. PRIOR TO PERMIT ISSUANCE, RIGHT-OF-WAY DEDICATION ALONG SHAW ROAD SHALL BE APPROVED AND RECORDED. RIGHT-OF-WAY ALONG EAST PIONEER SHALL BE APPROVED AND RECORDED PRIOR TO ISSUANCE OF PHASE 2 CIVIL PERMIT.
2. PRIOR TO PERMIT ISSUANCE, THE APPLICANT SHALL CLARIFY WHETHER IT IS THE PROJECT'S INTENT TO DEDICATE RIGHT-OF-WAY OR GRANT AN EASEMENT FOR MAINTENANCE AND OPERATION OF THE SHAW ROAD TRAFFIC SIGNAL AND EQUIPMENT.
3. ALL PRIVATE STORM DRAINAGE FACILITIES SHALL BE COVERED BY A MAINTENANCE AGREEMENT PROVIDED BY THE CITY AND RECORDED WITH PIERCE COUNTY. UNDER THIS AGREEMENT, IF THE OWNER FAILS TO PROPERLY MAINTAIN THE FACILITIES, THE CITY, AFTER GIVING THE OWNER NOTICE, MAY PERFORM NECESSARY MAINTENANCE AT THE OWNER'S EXPENSE. PRIOR TO OCCUPANCY, THE AGREEMENT SHALL BE APPROVED AND RECORDED.
4. PRIOR TO OCCUPANCY, A STREET MAINTENANCE COVENANT WILL BE REQUIRED TO ENSURE THAT PAVEMENT MARKINGS LOCATED ON PRIVATE PROPERTY AT THE DRIVE ENTRANCES WILL BE MAINTAINED.
5. AS MENTIONED DURING THE LAND USE APPLICATION (P-21-0034), THE EXISTING STORMWATER FACILITY SERVING THE OFFSITE LOCATED SOUTH OF THE PROJECT IS CURRENTLY IN VIOLATION OF NPDES REGULATIONS AND THE PUYALLUP MUNICIPAL CODE DUE TO LACK OF MAINTENANCE, BREACHING OF THE POND BERM, AND PASS-THROUGH OF A REGULATED STREAM THROUGH THE CONTROL STRUCTURE. HOWEVER, THE CITY IS WILLING TO ALLOW THE POND REMEDIATION TO OCCUR DURING PHASE 2, PROVIDED THE REMEDIATION IS ACCOMPLISHED PRIOR TO ANY OCCUPANCY OF PHASE 1 STRUCTURES.

EAST TOWN CROSSING PHASE 1
SEC. 26,35/ TWP. 20 N./ RGE. 4 E., W.M.

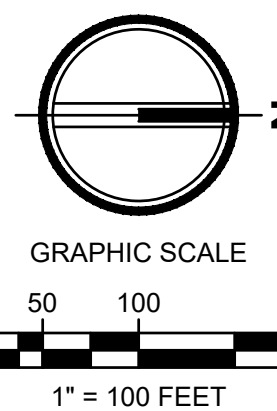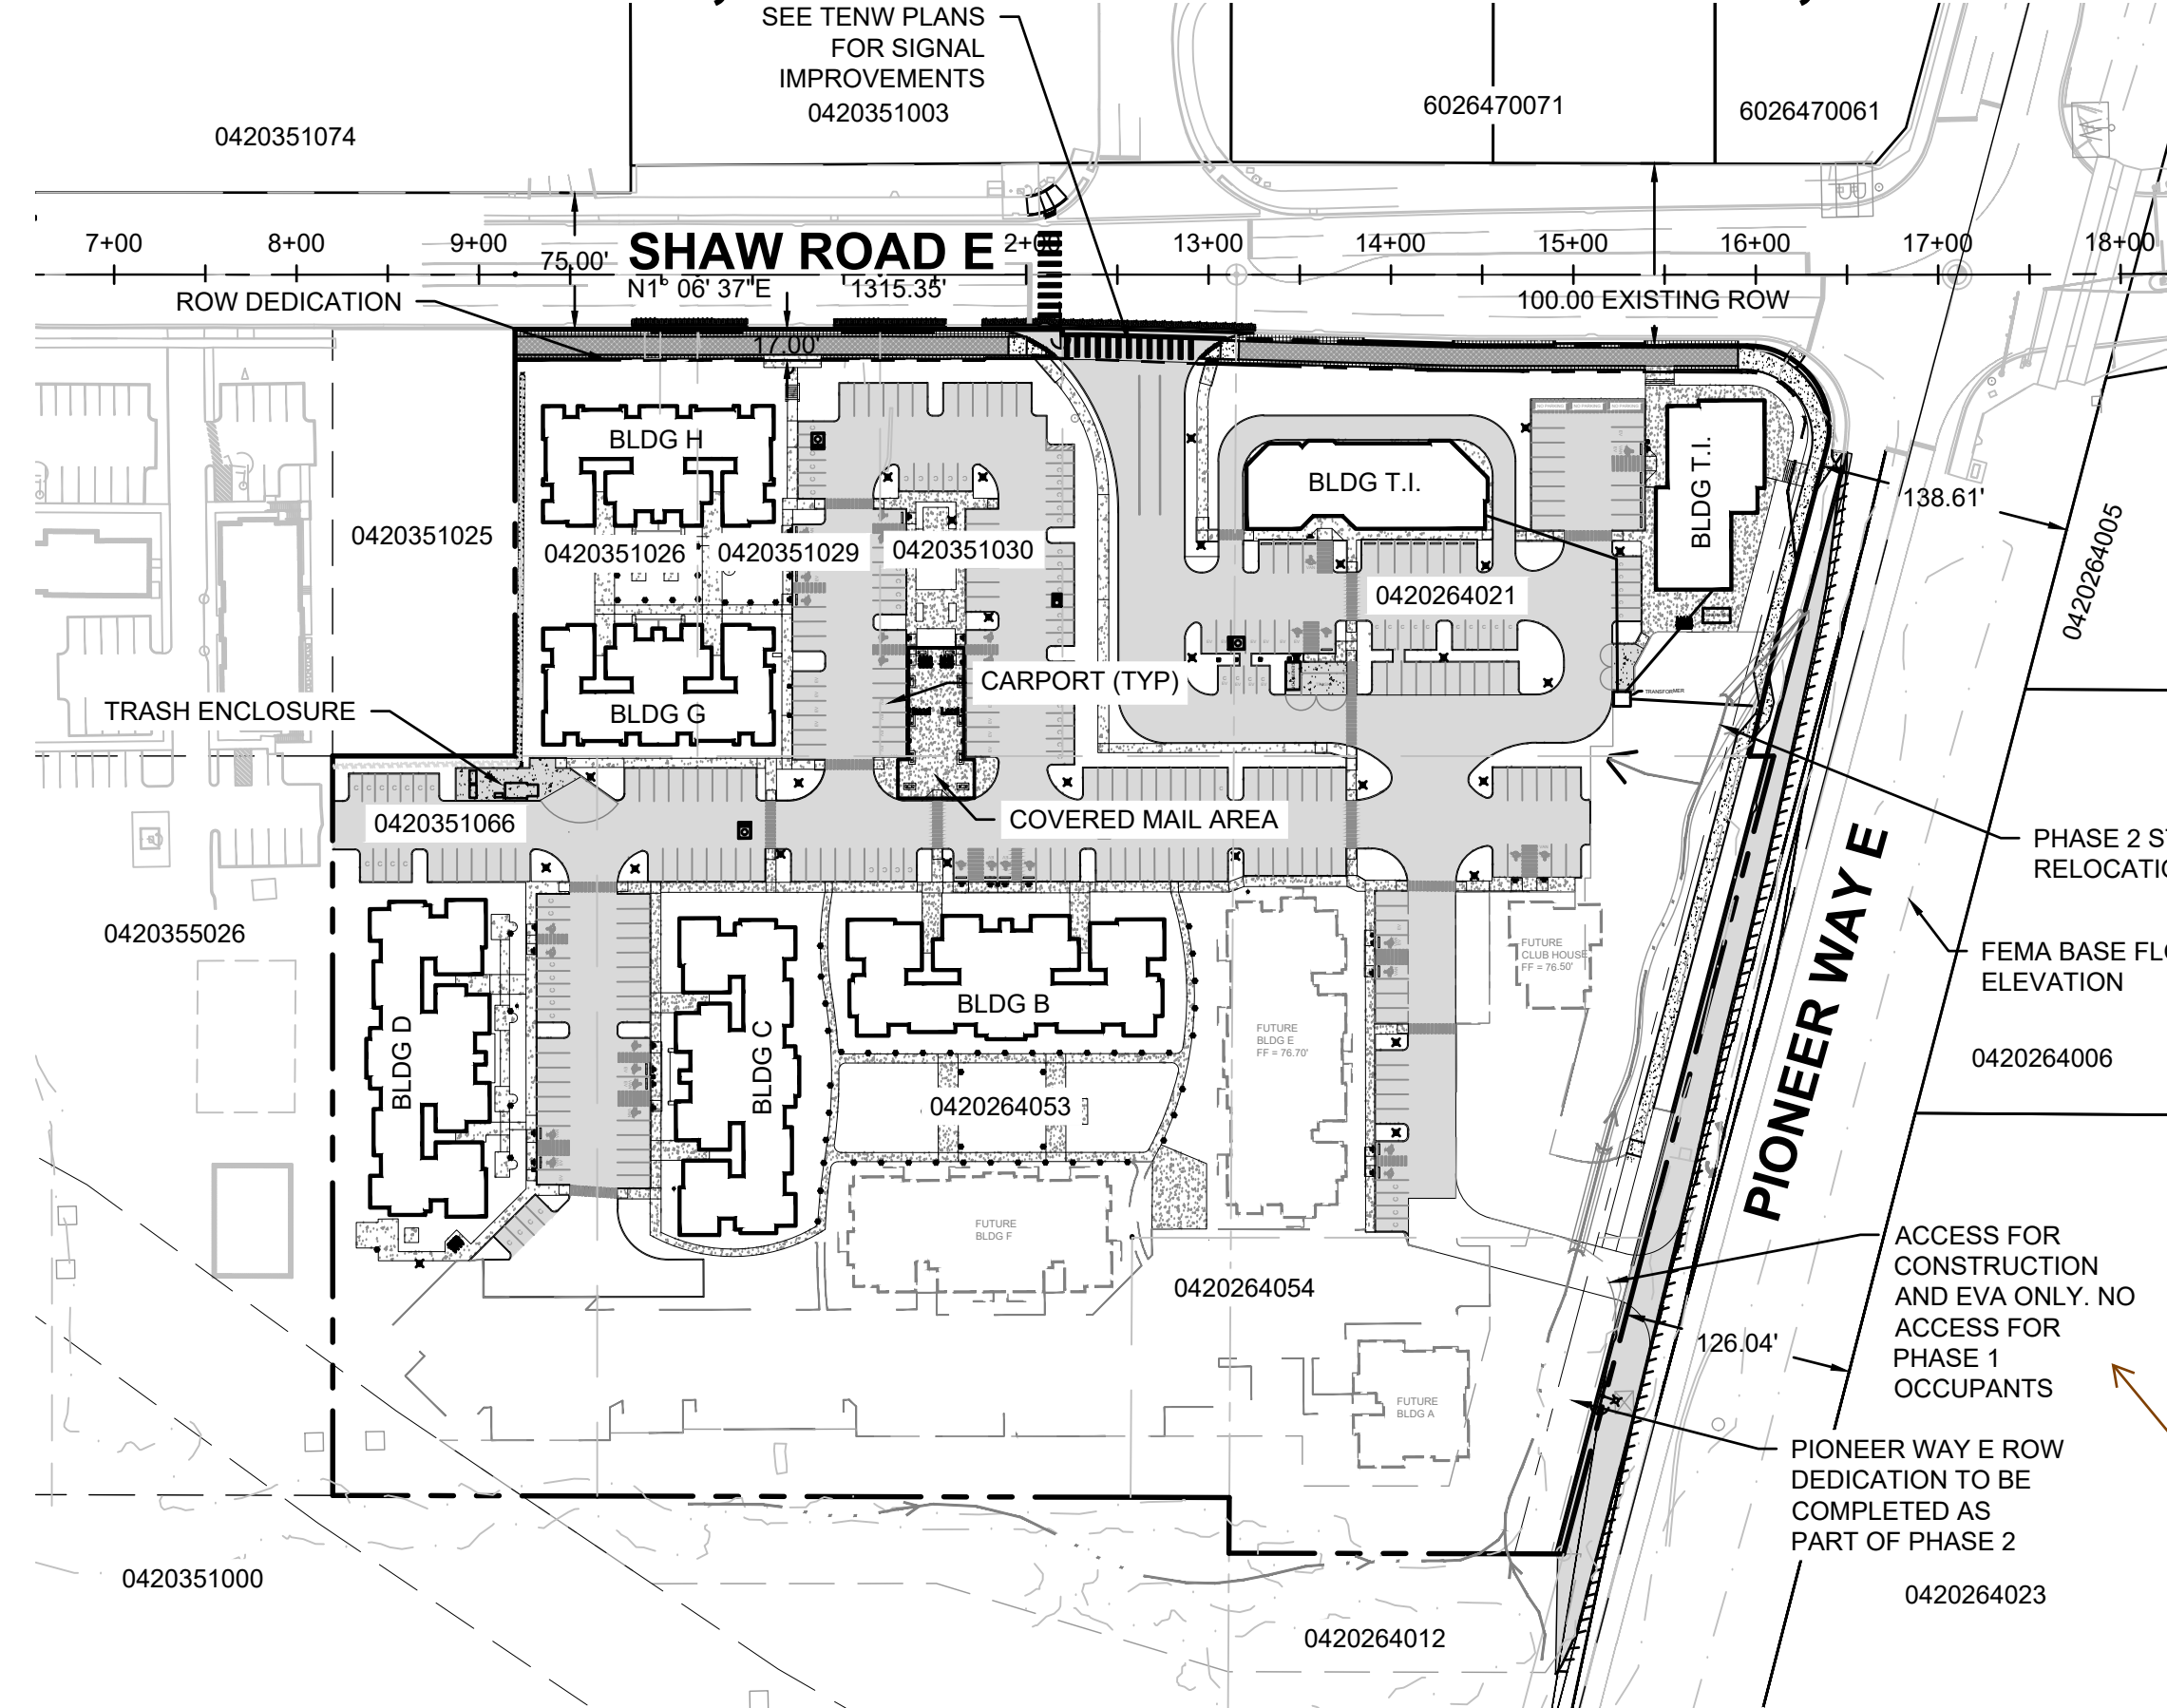

FLOOD PLAIN NOTE

THE FLOOD PLAIN INFORMATION SHOWN IN THE PLAN SET IS BASED ON THE REVISED PANEL 342 OF 1375 OF MAP 5303303042E THAT WAS PART OF THE 09/08/22 LOMR. THE FLOOD ZONES AND BE'S SHOWN IN THE PLAN SET ARE DRAWN FROM A COMBINATION OF THE PDF MAP PANEL AND GIS DATA. THE INFORMATION SHOWN IN THE REVISED PANEL IS BASED ON AN ASSUMED RELOCATED STREAM LOCATION. ACTUAL FLOOD ZONE AND BE'S WILL BE BASED FINAL LOCATION AND ELEVATION OF RELOCATED STREAM.

3rd Review
PRCC20230970
Mar 2024

SHEET LIST TABLE

Table with 2 columns: SHEET # and SHEET TITLE. Lists sheets C0.0 through C7.0 including titles like COVER SHEET, TESC PLAN, GRADING PLANS, STORM DRAINAGE PLANS, etc.

Table with 2 columns: SHEET # and SHEET TITLE. Lists sheets C4.12 through C7.0 including titles like R-TANK 1 NOTES AND DETAILS, SEWER PLAN SW, WATER PLAN NW, etc.

Occupancy (for all buildings) will not be allowed until phase 2 frontage improvements are completed. There will be no phase 1 occupants. Please update note [Civil 0,0]

Note updated to exclude part about access for phase 1 occupants.

LEGAL DESCRIPTION

TAX PARCEL NO. 0420264021; PER CW TITLE TITLE RESOURCES GUARANTY COMPANY SUBDIVISION GUARANTEE ORDER NO. 40249905-T35 DATED JANUARY 22, 2021 AT 8:00 A.M.
BEGINNING AT THE INTERSECTION OF THE SOUTH LINE OF SECTION 26, TOWNSHIP 20 NORTH, RANGE 4 EAST, W.M., IN PIERCE COUNTY, WASHINGTON, WITH THE EAST 1/16TH LINE OF SAID SECTION;
THENCE SOUTH ALONG THE 1/16TH LINE OF SECTION 35, TOWNSHIP 20 NORTH, RANGE 4 EAST, W.M., A DISTANCE OF 95.4 FEET;
THENCE EAST 258.26 FEET;
THENCE NORTH TO THE SOUTHERLY LINE OF THE COUNTY ROAD;
THENCE NORTHWESTERLY ALONG SAID SOUTHERLY LINE OF COUNTY ROAD TO THE EAST 1/16TH LINE OF SECTION 26;
THENCE SOUTH ALONG SAID 1/16TH LINE TO THE POINT OF BEGINNING;
EXCEPT THE WEST 30 FEET THEREOF CONVEYED TO PIERCE COUNTY BY DEED RECORDED UNDER RECORDING NO. 1618885 FOR SHAW COUNTY ROAD.
ALSO EXCEPT THEREFROM THAT PORTION CONVEYED TO THE CITY PUYALLUP BY INSTRUMENT RECORDED UNDER AUDITOR'S FILE NO. 9408290215, BEING A RE-RECORD OF INSTRUMENT RECORDED UNDER AUDITOR'S FILE NO. 9308310400;
AND ALSO EXCEPT ANY PORTION THEREOF LYING SOUTHERLY AND WESTERLY OF A LINE DESCRIBED AS BEGINNING AT THE NORTHWEST CORNER OF THE NORTHEAST QUARTER OF THE NORTHEAST QUARTER OF SAID SECTION 35, HEREINAFTER CALLED "POINT A";
THENCE SOUTH ALONG THE 1/16TH LINE 95.4 FEET TO THE TRUE POINT OF BEGINNING OF THE LINE TO BE DESCRIBED;
THENCE EAST 258.35 FEET;
THENCE SOUTH TO A POINT 495.4 FEET SOUTH OF AND 258.35 FEET EAST OF "POINT A";
THENCE EAST TO THE EAST LINE OF SAID PREMISES AND THE TERMINUS OF SAID LINE, SAID POINT ALSO BEING DESCRIBED AS THE SOUTHWEST CORNER OF LOT 3 OF BOUNDARY LINE ADJUSTMENT RECORDED UNDER AUDITOR'S FILE NO. 200303315001;
SITUATE IN THE CITY OF PUYALLUP, COUNTY OF PIERCE STATE OF WASHINGTON.
TAX PARCEL NO. 0420264053; PER CW TITLE TITLE RESOURCES GUARANTY COMPANY SUBDIVISION GUARANTEE ORDER NO. 40249905-T35 DATED JANUARY 22, 2021 AT 8:00 A.M.
THAT PORTION OF THE NORTHEAST QUARTER OF THE NORTHEAST QUARTER OF SECTION 35 AND THE SOUTHWEST QUARTER OF THE SOUTHWEST QUARTER OF SECTION 26, TOWNSHIP 20 NORTH, RANGE 4 EAST, W.M., IN PIERCE COUNTY, WASHINGTON, DESCRIBED AS FOLLOWS:
COMMENCING AT THE NORTHEAST CORNER OF THE WEST HALF OF THE NORTHEAST QUARTER OF THE NORTHEAST QUARTER OF SAID SECTION 35 WHICH POINT BEARS NORTH 88°32'51" WEST, 640.11 FEET FROM A BRASS IN CONCRETE MONUMENT MARKING THE NORTHEAST CORNER OF SAID SECTION 35;
THENCE ALONG THE EAST LINE OF SAID WEST HALF, SOUTH 01°15'04" WEST, 491.43 FEET TO A POINT LYING SOUTH 88°53'30" EAST, 405.26 FEET TO THE EASTERLY EXTENSION OF THE NORTH LINE OF LOT 2 OF THE PIERCE COUNTY SHORT PLAT NO. 9303010321 AND THE TRUE POINT OF BEGINNING;
THENCE ALONG SAID NORTH LINE, NORTH 88°53'30" WEST, 405.26 TO THE NORTHEAST CORNER OF SAID LOT 2;
THENCE ALONG THE NORTHERLY EXTENSION OF THE EAST LINE OF SAID LOT 2, NORTH 01°06'30" EAST, 145.00 FEET;
THENCE SOUTH 88°53'30" EAST, 405.62 FEET TO THE EAST LINE OF THE WEST HALF OF THE NORTHEAST QUARTER OF THE NORTHEAST QUARTER OF SAID SECTION 35;
THENCE ALONG SAID EAST LINE SOUTH 01°15'04" WEST, 145.00 FEET TO THE TRUE POINT OF BEGINNING
(ALSO KNOWN AS LOT 3 OF RECORD OF SURVEY FOR BOUNDARY LINE ADJUSTMENT RECORDED MARCH 31, 2003 UNDER RECORDING NO. 200303315001);
SITUATE IN THE CITY OF PUYALLUP, COUNTY OF PIERCE, STATE OF WASHINGTON.

TAX PARCEL NO. 0420264054; PER CW TITLE TITLE RESOURCES GUARANTY COMPANY SUBDIVISION GUARANTEE ORDER NO. 40249905-T35 DATED JANUARY 22, 2021 AT 8:00 A.M.
THAT PORTION OF THE NORTHEAST QUARTER OF THE NORTHEAST QUARTER OF SECTION 35, AND THE SOUTHWEST QUARTER OF THE SOUTHWEST QUARTER OF SECTION 26, TOWNSHIP 20 NORTH, RANGE 4 EAST, W.M., IN PIERCE COUNTY, WASHINGTON, DESCRIBED AS FOLLOWS:
BEGINNING AT THE NORTHEAST CORNER OF THE WEST HALF OF THE NORTHEAST QUARTER OF THE NORTHEAST QUARTER OF SECTION 35 WHICH POINT BEARS NORTH 88°32'51" WEST, 640.11 FEET FROM A BRASS IN CONCRETE MONUMENT MARKING THE NORTHEAST CORNER OF SAID SECTION 35;
THENCE ALONG SAID SOUTHERLY MARGIN, SOUTH 74°08'09" EAST, 179.36 FEET TO A LINE LYING 30.48 FEET EAST OF AND PARALLEL WITH EAST LINE OF THE WEST HALF OF THE NORTH EAST QUARTER OF THE NORTHEAST QUARTER OF SAID SECTION 35;
THENCE ALONG SAID PARALLEL LINE, SOUTH 01°15'04" WEST, 183.43 FEET TO THE NORTH LINE OF SAID SECTION 35;
THENCE ALONG SAID NORTH LINE, NORTH 88°32'51" WEST, 30.48 FEET TO THE POINT OF BEGINNING;
(ALSO KNOWN AS LOT 5 OF RECORD OF SURVEY FOR BOUNDARY LINE ADJUSTMENT RECORDED MARCH 31, 2003 UNDER RECORDING NO. 200303315001);
SITUATE IN THE CITY OF PUYALLUP, COUNTY OF PIERCE, STATE OF WASHINGTON.
TAX PARCEL NO. 0420351066; PER CW TITLE TITLE RESOURCES GUARANTY COMPANY SUBDIVISION GUARANTEE ORDER NO. 40249905-T35 DATED JANUARY 22, 2021 AT 8:00 A.M.
COMMENCING AT THE NORTHEAST CORNER OF THE WEST HALF OF THE NORTHEAST QUARTER OF THE NORTHEAST QUARTER OF SAID SECTION 35 WHICH POINT BEARS NORTH 88°32'51" WEST, 640.11 FEET FROM A BRASS IN CONCRETE MONUMENT MARKING THE NORTHEAST CORNER OF SAID SECTION 35;
THENCE ALONG THE EAST LINE OF SAID WEST HALF, SOUTH 01°15'04" WEST, 491.43 FEET TO A POINT LYING SOUTH 88°53'30" EAST, 405.26 FEET TO THE EASTERLY EXTENSION OF THE NORTH LINE OF LOT 2 OF THE PIERCE COUNTY SHORT PLAT NO. 9303010321 AND THE TRUE POINT OF BEGINNING;
THENCE ALONG SAID NORTH LINE, NORTH 88°53'30" WEST, 405.26 TO THE NORTHEAST CORNER OF SAID LOT 2;
THENCE ALONG THE NORTHERLY EXTENSION OF THE EAST LINE OF SAID LOT 2, NORTH 01°06'30" EAST, 145.00 FEET;
THENCE SOUTH 88°53'30" EAST, 405.62 FEET TO THE EAST LINE OF THE WEST HALF OF THE NORTHEAST QUARTER OF THE NORTHEAST QUARTER OF SAID SECTION 35;
THENCE ALONG SAID EAST LINE SOUTH 01°15'04" WEST, 145.00 FEET TO THE TRUE POINT OF BEGINNING
(ALSO KNOWN AS LOT 3 OF RECORD OF SURVEY FOR BOUNDARY LINE ADJUSTMENT RECORDED MARCH 31, 2003 UNDER RECORDING NO. 200303315001);
SITUATE IN THE CITY OF PUYALLUP, COUNTY OF PIERCE, STATE OF WASHINGTON.


TAX PARCEL NO. 0420351030; PER CW TITLE TITLE RESOURCES GUARANTY COMPANY SUBDIVISION GUARANTEE ORDER NO. 40249905-T35 DATED JANUARY 22, 2021 AT 8:00 A.M.
BEGINNING AT THE SIXTEENTH SECTION CORNER OF SECTION 35, TOWNSHIP 20 NORTH, RANGE 4 EAST OF THE WILLAMETTE MERIDIAN, 1321.48 FEET WEST OF THE CORNER COMMON TO SECTIONS 25, 26, 35 AND 36;
THENCE SOUTH ALONG THE SIXTEENTH SECTION 95.4 FEET TO THE TRUE POINT OF BEGINNING;
THENCE EAST 258.26 FEET;
THENCE SOUTH 100 FEET;
THENCE WEST 258.26 FEET;
THENCE NORTH 100 FEET TO THE TRUE POINT OF BEGINNING, IN PIERCE COUNTY, WASHINGTON.
EXCEPT SHAW COUNTY ROAD.
SITUATE IN THE CITY OF PUYALLUP, COUNTY OF PIERCE, STATE OF WASHINGTON.
TAX PARCEL NO. 0420351026; PER CW TITLE TITLE RESOURCES GUARANTY COMPANY SUBDIVISION GUARANTEE ORDER NO. 40249905-T35 DATED JANUARY 22, 2021 AT 8:00 A.M.
BEGINNING AT THE 1/16 SECTION CORNER, 1321.48 FEET WEST OF CORNER MONUMENT COMMON TO SECTIONS 25, 26, 35 AND 36 IN TOWNSHIP 20 NORTH, RANGE 4 EAST, WILLAMETTE MERIDIAN, IN PIERCE COUNTY, WASHINGTON;
THENCE SOUTH ALONG THE 1/16 SECTION LINE 195.4 FEET TO THE TRUE POINT OF BEGINNING;
THENCE EAST 258.26 FEET;
THENCE SOUTH 100 FEET;
THENCE WEST 258.26 FEET;
THENCE NORTH 100 FEET TO TRUE POINT OF BEGINNING.
EXCEPT SHAW COUNTY ROAD.
SITUATE IN THE COUNTY OF PIERCE, STATE OF WASHINGTON.
TAX PARCEL NO. 0420264006; PER CW TITLE TITLE RESOURCES GUARANTY COMPANY SUBDIVISION GUARANTEE ORDER NO. 40249905-T35 DATED JANUARY 22, 2021 AT 8:00 A.M.
BEGINNING AT THE 1/16 SECTION CORNER 1321.48 FEET WEST OF THE CORNER MONUMENT COMMON TO SECTIONS 25, 26, 35 AND 36 IN TOWNSHIP 20 NORTH, RANGE 4 EAST, WILLAMETTE MERIDIAN, IN PIERCE COUNTY, WASHINGTON;
THENCE SOUTH ALONG THE 1/16 SECTION LINE 294.5 FEET TO THE TRUE POINT OF BEGINNING;
THENCE EAST 258.26 FEET;
THENCE SOUTH 100 FEET;
THENCE WEST 258.26 FEET;
THENCE NORTH 100 FEET TO THE TRUE POINT OF BEGINNING, IN PIERCE COUNTY, WASHINGTON.
EXCEPT SHAW COUNTY ROAD.
SITUATE IN THE CITY OF PUYALLUP, COUNTY OF PIERCE, STATE OF WASHINGTON.



VICINITY MAP

1" = 1000'
2902 E PIONEER WAY

APPROVED
BY: CITY OF PUYALLUP
DEVELOPMENT ENGINEERING
DATE:
NOTE: THIS APPROVAL IS VOID AFTER 180 DAYS FROM APPROVAL DATE. THE CITY WILL NOT BE RESPONSIBLE FOR ERRORS AND/OR OMISSIONS ON THESE PLANS. FIELD CONDITIONS MAY DICTATE CHANGES TO THESE PLANS AS DETERMINED BY THE DEVELOPMENT ENGINEERING MANAGER.

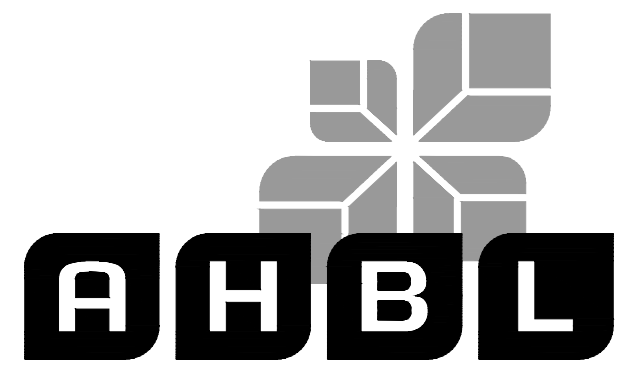

TACOMA • SEATTLE • SPOKANE • TRI-CITIES
2215 North 30th Street, Suite 300, Tacoma, WA 98403
253.383.2422 TEL 253.383.2572 FAX www.ahbl.com WEB


EAST TOWN CROSSING PHASE 1

Client:
ASH DEVELOPMENT
GREG HELLE
GREG.HELLE@ASHNW.COM

Project No:
2230752

PERMIT SUBMITTAL

02/20/2024

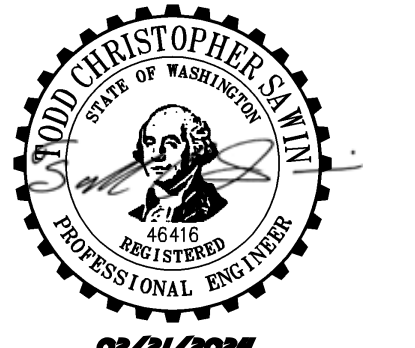


Revisions:
01/29/24 CITY COMMENTS

Designed by: CW
Drawn by: SK / RS
Checked by: JI

COVER SHEET
C0.0
1 of 53 Sheets



EAST TOWN CROSSING PHASE 1



SEC. 26,35/ TWP. 20 N./ RGE. 4 E., W.M.

APPROVED

BY _____
 CITY OF PUYALLUP
 DEVELOPMENT ENGINEERING

DATE _____

NOTE: THIS APPROVAL IS VOID AFTER 180 DAYS FROM APPROVAL DATE. THE CITY WILL NOT BE RESPONSIBLE FOR ERRORS AND/OR OMISSIONS ON THESE PLANS. FIELD CONDITIONS MAY DICTATE CHANGES TO THESE PLANS AS DETERMINED BY THE DEVELOPMENT ENGINEERING MANAGER.

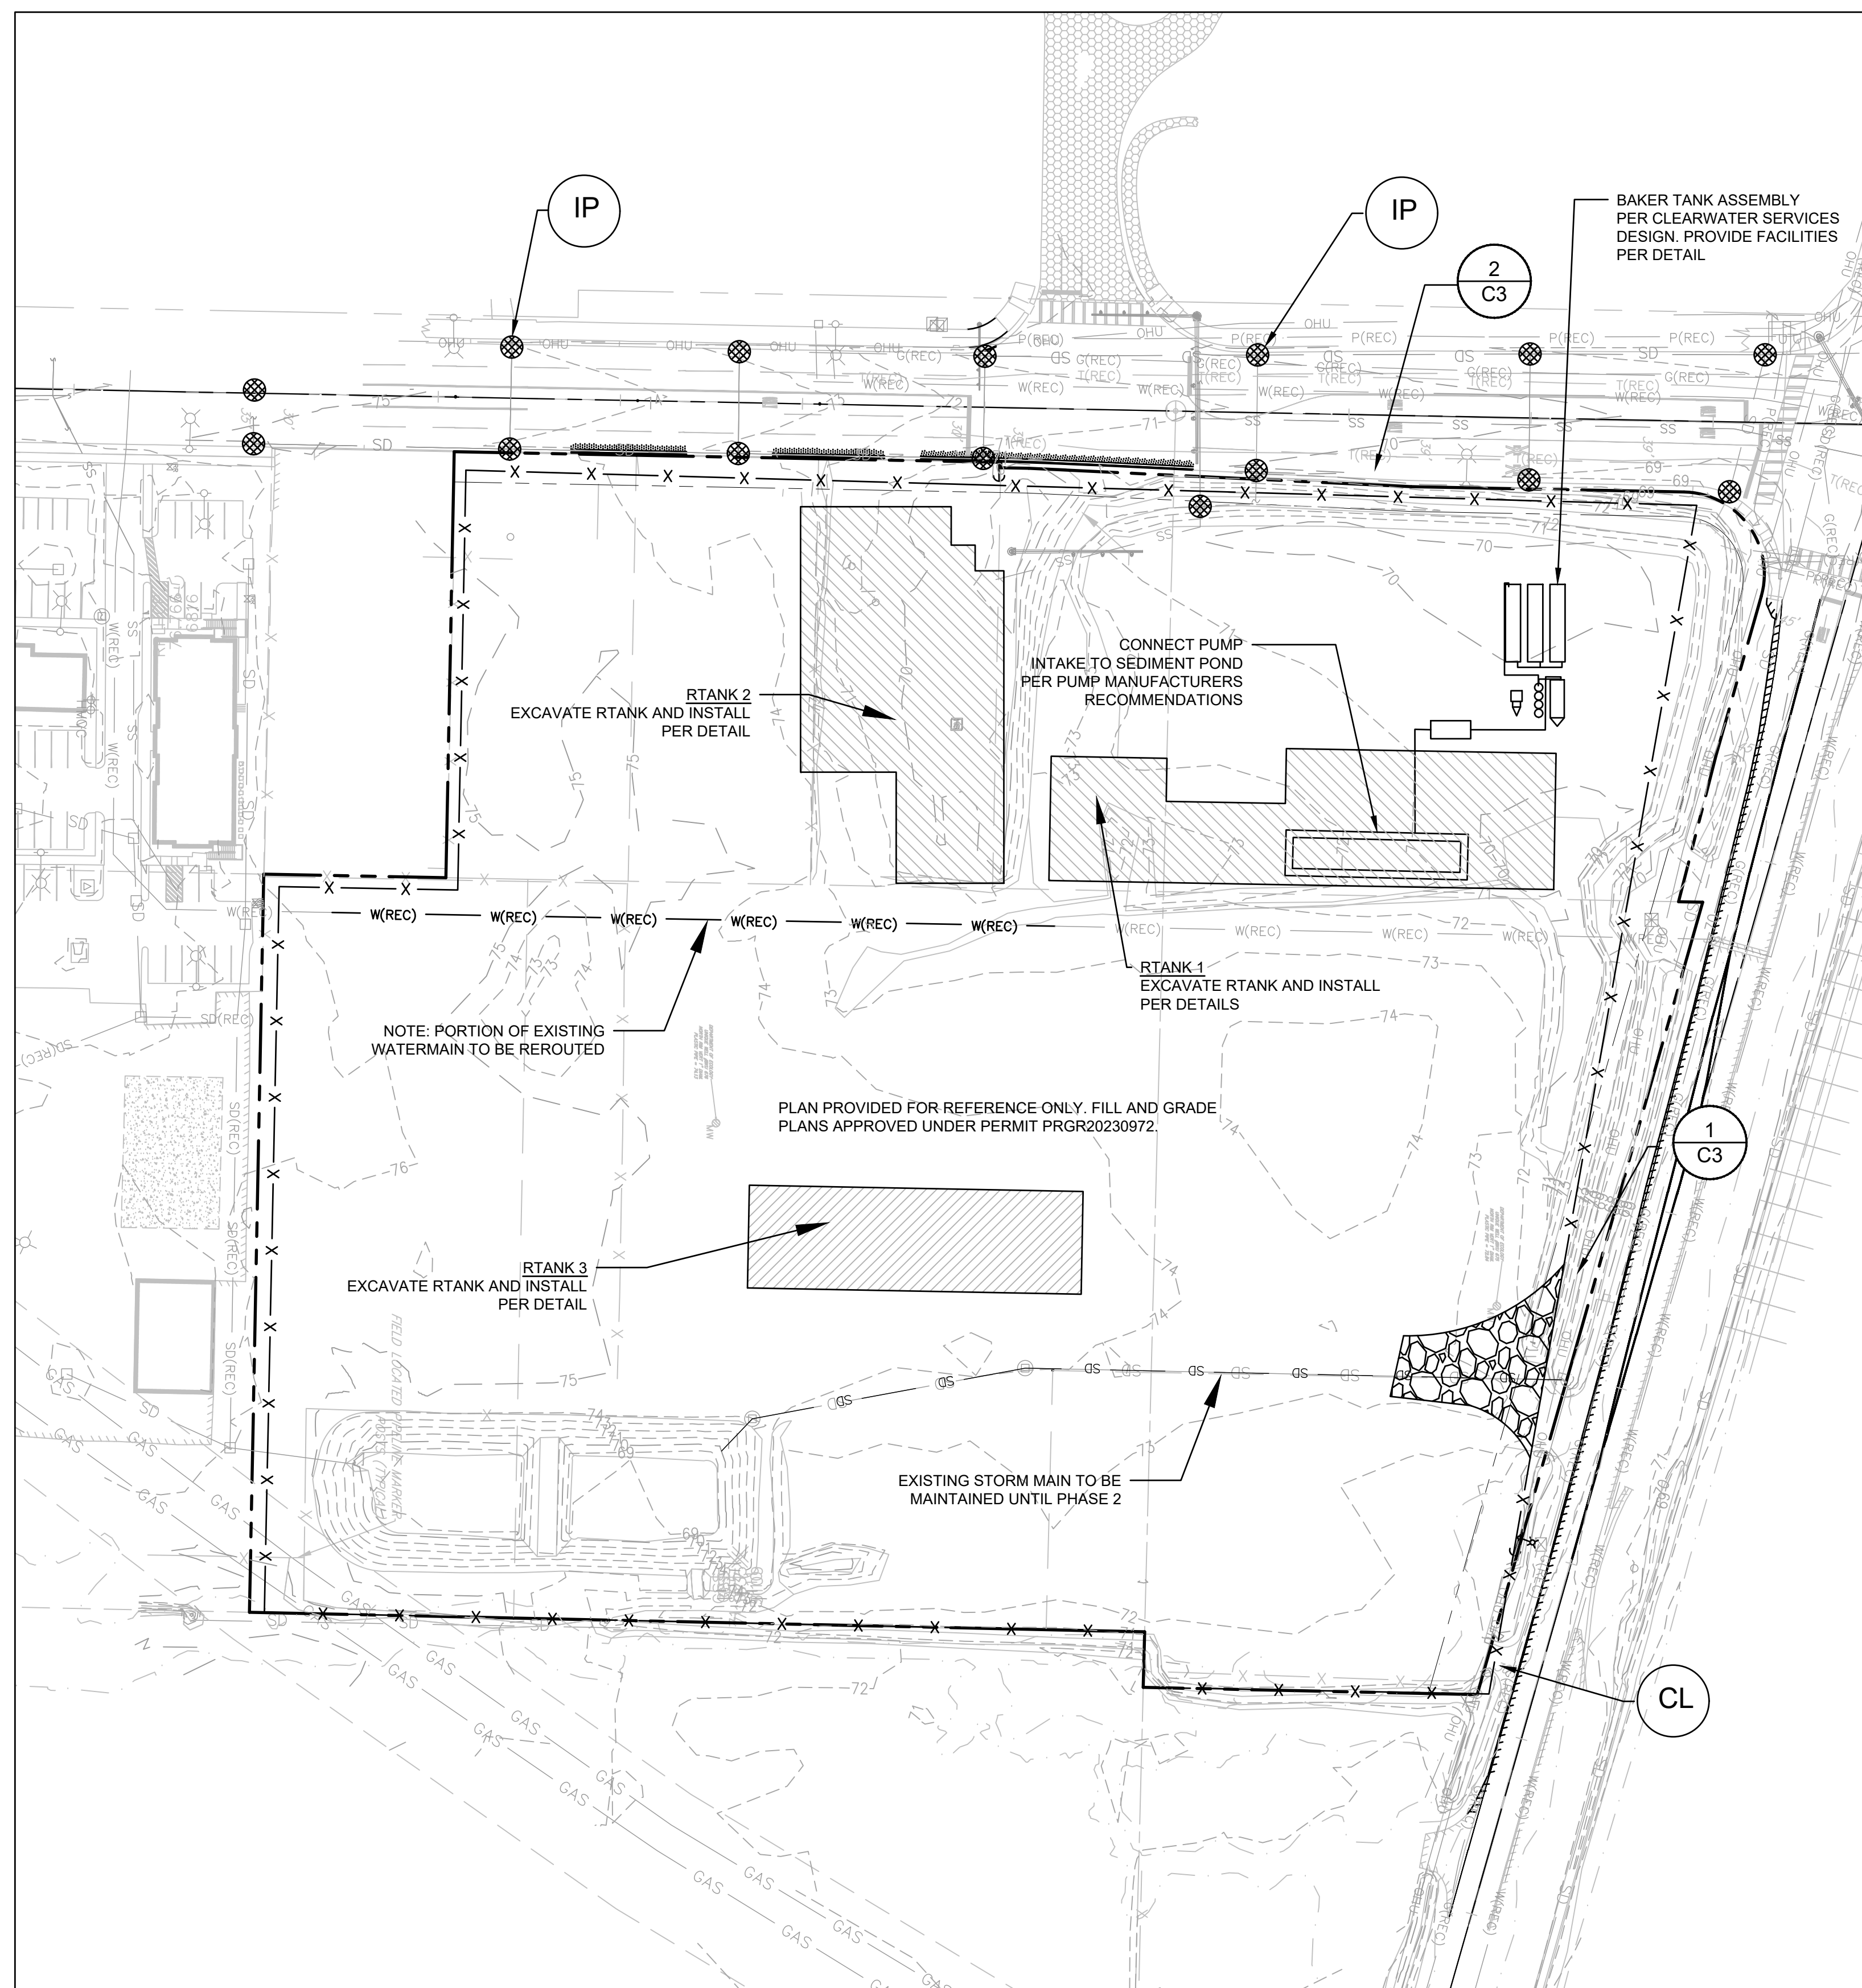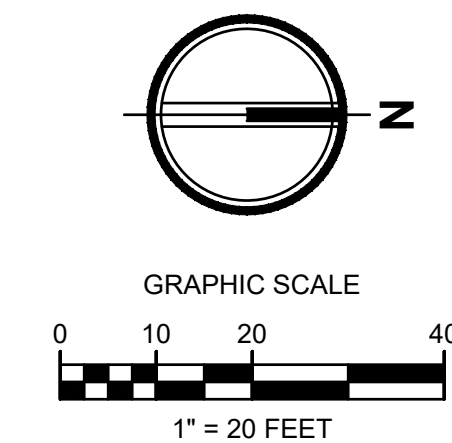

NOTE:

MAINTAIN SEDIMENT POND AND BAKER TANKS AS DESIGNED IN CLEAR. FILL AND GRADE PLANS PER CFG APPLICATION NUMBER PRGR20230972

TESC LEGEND:

- CL ----- CLEARING/ GRADING/ DISTURBED LIMITS
- X ----- X ----- X ----- FF ----- FILTER FABRIC FENCE SEE DETAIL
- CE ----- CONSTRUCTION ENTRANCE
- IP ----- INLET PROTECTION


Project Title:
EAST TOWN CROSSING PHASE 1

Client:
ASH DEVELOPMENT

GREG HELLE
 GREG.HELLE@ASHNW.COM

Project No.
 2230752

Issue Set & Date:
PERMIT SUBMITTAL
 02/20/2024

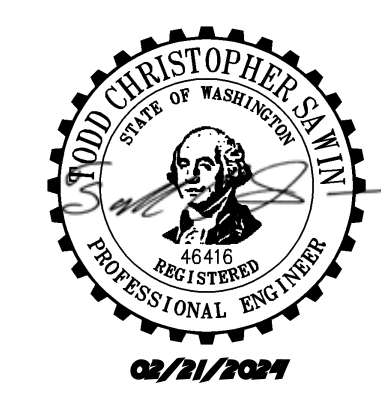

NOTICE: ALTERATION OF THIS DOCUMENT SHALL INVALIDATE THE PROFESSIONAL SEAL AND SIGNATURE. PUBLICATION OF THIS DOCUMENT DOES NOT REPRESENT ANY ENDORSEMENT OR GUARANTEE BY THE ENGINEER OR FOR THE ONLY FOR THE PROJECT DESCRIBED IN THE TITLE BLOCK AND IS NOT TO BE USED FOR OTHER PROJECTS OR ACTION TO THAT PROJECT OR FOR ANY OTHER PROJECT.

△ _____

△ _____

△ _____

△ 01/29/24 CITY COMMENTS

Revisions:

Sheet Title:
TESC PLAN

Designed by: CW Drawn by: SK/RS Checked by: JI

Sheet No.
C1.0
 2 of 53 Sheets



TESC INSPECTION NOTES:


- INSPECT ALL INLET PROTECTION ON CATCH BASINS. CLEAN OR REPLACE IF FULL OF SEDIMENT /DEBRIS AND REPAIR/REPLACE AS NEEDED IF DAMAGED TO MAINTAIN PROTECTION.
- INSPECT ALL PERMANENT AND TEMPORARY STABILIZED SLOPES. REPAIR ANY DAMAGED SECTIONS AND RE-VEGETATE AS NEEDED TO ENSURE THE ESTABLISHMENT OF VEGETATION AND THAT NO EROSION OF THE SLOPES OCCUR.
- INSPECT ALL FILTER FABRIC FENCING FOR SIGNS OF EROSION, DAMAGE OR FAILURES. REPAIR AND/OR REPLACE AS NEEDED. SEE FILTER FABRIC NOTES. SEDIMENT BUILD-UP ALONG FENCE SHALL BE REMOVED WHEN REACHES 1/3 THE FENCE HEIGHT. IF EROSION IS OCCURRING, CONTRACTOR SHALL INSTALL ADDITIONAL EROSION CONTROL MEASURES AS NEEDED TO PREVENT EROSION.
- ANY FILL/CUT SLOPES SHALL BE INSPECTED FOR EROSION. IF SIGNS OF EROSION ARE PRESENT, INSTALL APPROPRIATE BMPS AS NEEDED TO STOP EROSION AND STABILIZE SLOPES.
- TESC LEAD RESPONSIBLE FOR NOTIFYING ENGINEER IF ADDITIONAL MEASURES ARE WARRANTED.

PERMANENT STABILIZATION NOTES:

- ALL EXPOSED SOILS AND SLOPES SHALL BE SEEDED OR OTHERWISE STABILIZED IMMEDIATELY AFTER CONSTRUCTION AND GRADING ACTIVITIES HAVE BEEN COMPLETED.
- SILT FENCE, IF DEEMED APPROPRIATE, SHALL REMAIN FOR A MINIMUM OF 30 DAYS AFTER THE FINAL STABILIZATION OF THE SLOPES HAS OCCURRED.
- ALL TEMPORARY EROSION CONTROL BMP'S SHALL BE REMOVED 30 DAYS AFTER FINAL STABILIZATION HAS OCCURRED AS DIRECTED BY CITY OR COUNTY INSPECTOR.
- CONTRACTOR SHALL REFER TO THE CONSTRUCTION SWPPP FOR APPLICABLE BMP'S.

CONSTRUCTION ENTRANCE NOTES:


- MATERIAL SHALL BE 4" TO 8" QUARRY SPALLS (4 TO 6 INCH FOR RESIDENTIAL SINGLE FAMILY LOTS) AND MAY BE TOP-DRESSED WITH 1 TO 3 INCH ROCK.
- THE ROCK PAD SHALL BE AT LEAST 12" THICK AND 100' LONG (REDUCED TO 20 FEET FOR SITES LESS THAN 1 ACRE OF DISTURBED SOIL) WIDTH SHALL BE FULL WIDTH OF INGRESS AND EGRESS AREA. SMALLER PADS MAY BE APPROVED FOR SINGLE-FAMILY RESIDENTIAL AND COMMERCIAL SITES.
- ADDITIONAL ROCK SHALL BE ADDED PERIODICALLY TO MAINTAIN FUNCTION OF THE PAD.
- IF THE PAD DOES NOT ADEQUATELY REMOVE MUD FROM THE VEHICLE WHEELS, THE WHEELS SHALL BE HOSED OFF BEFORE THE VEHICLE ENTERS A PAVED STREET. THE WASHING SHALL BE DONE ON AN AREA COVERED WITH CRUSHED ROCK AND WASH WATER SHALL DRAIN TO A SEDIMENT RETENTION FACILITY OR THROUGH A SILT FENCE.
- CONSTRUCTION ACCESS IS FORBIDDEN ALONG SHAW ROAD FOR THE DURATION OF CONSTRUCTION.

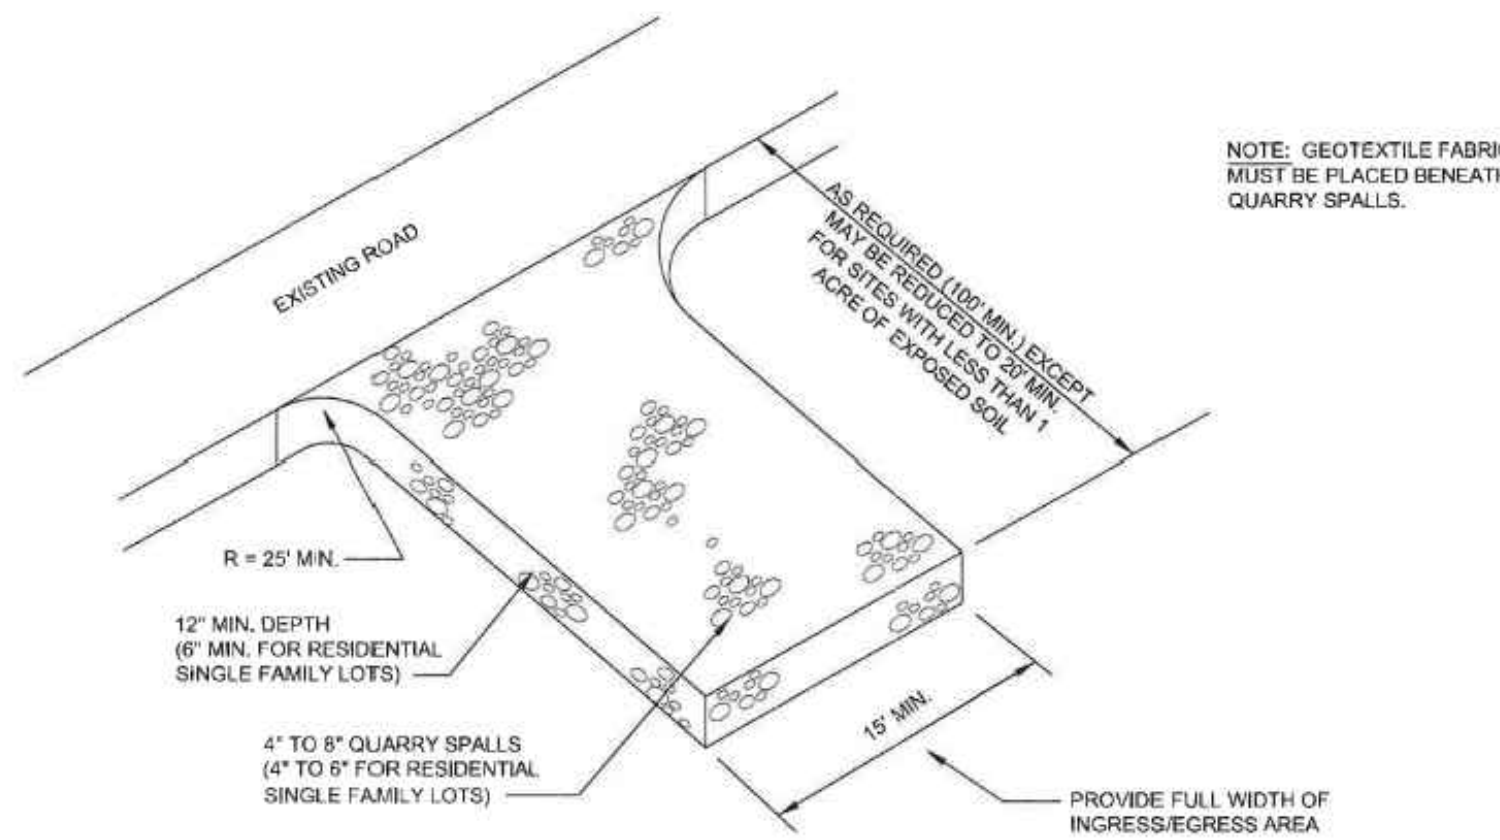

1 CONSTRUCTION ENTRANCE SCALE:NTS

FILTER FABRIC FENCE NOTES:

- SUPPORT POST, WITH A MINIMUM 6-INCH OVERLAP, AND SECURELY FASTENED AT BOTH ENDS TO POSTS.
- POSTS SHALL BE SPACED A MAXIMUM OF 6 FEET APART AND DRIVEN SECURELY INTO THE GROUND (MINIMUM OF 30 INCHES).
- A TRENCH SHALL BE EXCAVATED APPROXIMATELY 8 INCHES WIDE AND 12 INCHES DEEP ALONG THE LINE OF POSTS AND UPSLOPE FROM THE BARRIER. THIS TRENCH SHALL BE BACKFILLED WITH WASHED GRAVEL.
- WHEN STANDARD STRENGTH FILTER FABRIC IS USED, A WIRE MESH SUPPORT FENCE SHALL BE FASTENED SECURELY TO THE UPSLOPE SIDE OF THE POSTS USING HEAVY-DUTY WIRE STAPLES AT LEAST 1 INCH LONG. THE WIRES OR HOG RINGS, THE WIRE SHALL EXTEND INTO THE TRENCH A MINIMUM OF 4 INCHES AND SHALL NOT EXTEND MORE THAN 24 INCHES ABOVE THE ORIGINAL GROUND SURFACE.
- THE STANDARD STRENGTH FILTER FABRIC SHALL BE STAPLED OR WIRED TO THE FENCE, AND 20 INCHES OF THE FABRIC SHALL BE EXTENDED INTO THE TRENCH. THE FABRIC SHALL NOT EXTEND MORE THAN 24 INCHES ABOVE THE ORIGINAL GROUND SURFACE. FILTER FABRIC SHALL NOT BE STAPLED TO EXISTING TREES.
- WHEN EXTRA-STRENGTH FILTER FABRIC AND CLOSER POST SPACING IS USED, THE WIRE MESH SUPPORT FENCE MAY BE ELIMINATED. IN SUCH A CASE, THE FILTER FABRIC IS STAPLED OR WIRED DIRECTLY TO THE POSTS WITH ALL OTHER PROVISIONS OF ABOVE NOTES APPLYING.
- FILTER FABRIC FENCES SHALL NOT BE REMOVED BEFORE THE UPSLOPE AREA HAS BEEN PERMANENTLY STABILIZED.
- FILTER FABRIC FENCES SHALL BE INSPECTED IMMEDIATELY AFTER EACH RAINFALL AND AT LEAST DAILY DURING PROLONGED RAINFALL. ANY REQUIRED REPAIRS SHALL BE MADE IMMEDIATELY.
- SILT FENCES WILL BE INSTALLED PARALLEL TO ANY SLOPE CONTOURS.
- CONTRIBUTING LENGTH TO FENCE WILL NOT BE GREATER THAN 100 FEET.
- DO NOT INSTALL BELOW AN OUTLET PIPE OR WEIR.
- INSTALL DOWNSLOPE OF EXPOSED AREAS.
- DO NOT DRIVE OVER OR FILL OVER SILT FENCES.

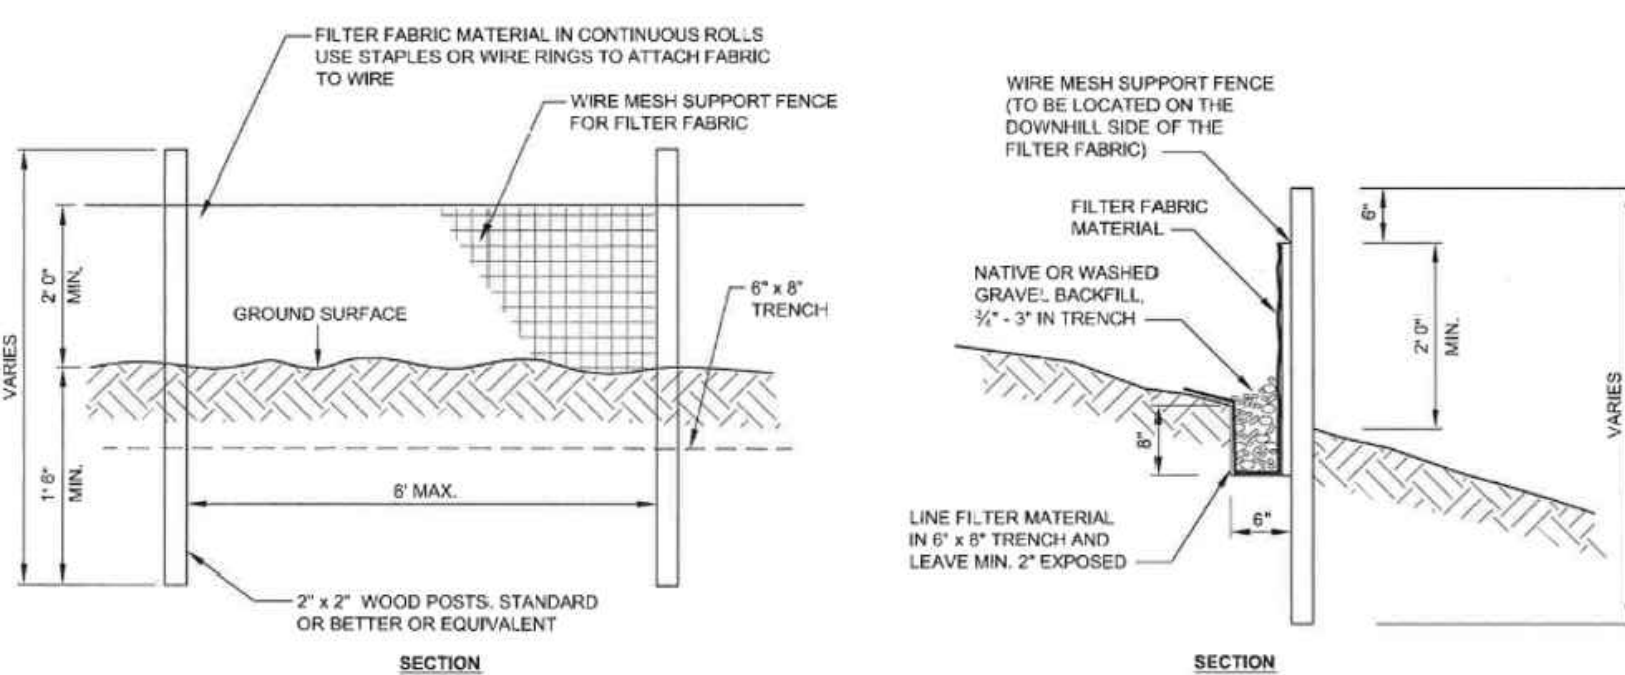

2 FILTER FABRIC FENCE SCALE:NTS



Know what's below.
Call before you dig.

EAST TOWN CROSSING PHASE 1

SEC. 26,35/ TWP. 20 N./ RGE. 4 E., W.M.

AMENDED SOILS NOTES:

- SOIL AMENDMENTS ARE REQUIRED FOR ALL DISTURBED AREAS IN ACCORDANCE WITH BMP L613: POST-CONSTRUCTION SOIL QUALITY AND DEPTH OF THE 2021 SURFACE WATER MANAGEMENT MANUAL.
- AMENDED SOILS SHALL BE A MINIMUM OF 8" (NON-COMPACTED) WITH SUBSOILS SCARIFIED AT LEAST 4" WITH INCORPORATION OF THE UPPER MATERIAL TO AVOID STRATIFIED LAYERS, WHERE FEASIBLE.
- QUALITY OF COMPOST AND OTHER MATERIALS USED TO MEET THE ORGANIC CONTENT REQUIREMENTS ARE AS FOLLOWS:
 - THE ORGANIC CONTENT FOR "PRE-APPROVED" AMENDMENT RATES CAN BE MET ONLY USING COMPOST THAT MEETS THE DEFINITION OF "COMPOSTED MATERIALS" IN WAC 173-350-220. THE WAC IS AVAILABLE ONLINE AT: [HTTP://WWW.ECY.WA.GOV/PROGRAMS/SWFA/FACILITIES/350.HTML](http://www.ecy.wa.gov/PROGRAMS/SWFA/FACILITIES/350.HTML). THE COMPOST MUST ALSO HAVE AN ORGANIC MATTER CONTENT OF 35% TO 65%, AND A CARBON TO NITROGEN RATIO BELOW 25:1. THE CARBON TO NITROGEN RATIO MAY BE AS HIGH AS 35:1 FOR PLANTINGS COMPOSED ENTIRELY OF PLANTS NATIVE TO THE PUGET SOUND LOWLANDS REGION.
 - CALCULATED AMENDMENT RATES MAY BE MET THROUGH USE OF COMPOSTED MATERIALS AS DEFINED ABOVE, OR OTHER ORGANIC MATERIALS AMENDED TO MEET THE CARBON TO NITROGEN RATIO REQUIREMENTS, AND MEETING THE CONTAMINANT STANDARDS OF GRADE A COMPOST.
- USE ONE OF THE FOLLOWING OPTIONS TO MEET THE POST CONSTRUCTION SOIL QUALITY AND DEPTH REQUIREMENTS. USE THE MOST RECENT VERSION OF "GUIDELINES FOR RESOURCES FOR IMPLEMENTING SOIL QUALITY AND DEPTH BMP 15.13" TO MEET THE REQUIREMENTS OF THIS BMP. THIS GUIDANCE CAN BE FOUND ONLINE AT WWW.SOILFORALMON.ORG
 - LEAVE NATIVE VEGETATION AND SOIL UNDISTURBED, AND PROTECT FROM COMPACTION DURING CONSTRUCTION.
 - AMEND EXISTING SITE TOPSOIL OR SUBSOIL EITHER AT DEFAULT "PRE-APPROVED" RATES, OR AT CUSTOM CALCULATED RATES BASED ON SPECIFIC TESTS OF THE SOIL AND AMENDMENT.
 - STOCKPILE EXISTING TOPSOIL DURING GRADING, AND REPLACE IT PRIOR TO PLANTING. STOCKPILED TOPSOIL MUST ALSO BE AMENDED IF NEEDED TO MEET THE ORGANIC MATTER OR DEPTH REQUIREMENTS, EITHER AT A DEFAULT "PRE-APPROVED" RATE OR AT A CUSTOM CALCULATED RATE.
 - IMPORT TOPSOIL WITH SUFFICIENT ORGANIC CONTENT AND DEPTH TO MEET THE REQUIREMENTS. MORE THAN ONE METHOD MAY BE USED ON DIFFERENT PORTIONS OF THE SAME SITE. SOIL THAT ALREADY MEETS THE DEPTH AND ORGANIC MATTER QUALITY STANDARDS, AND IS NOT COMPACTED, DOES NOT NEED TO BE AMENDED.
- AMENDED SOILS SHALL BE MAINTAINED AS FOLLOWS:
 - SOIL QUALITY AND DEPTH SHOULD BE ESTABLISHED TOWARD THE END OF CONSTRUCTION AND ONCE ESTABLISHED, SHOULD BE PROTECTED FROM COMPACTION, SUCH AS FROM LARGE MACHINERY USE, AND FROM EROSION.
 - SOIL SHOULD BE PLANTED AND MULCHED AFTER INSTALLATION.
 - PLANT DEBRIS OR ITS EQUIVALENT SHOULD BE LEFT ON THE SOIL SURFACE TO REPLENISH ORGANIC MATTER.
 - IT SHOULD BE POSSIBLE TO REDUCE USE OF IRRIGATION, FERTILIZERS, HERBICIDES AND PESTICIDES. THESE ACTIVITIES SHOULD BE ADJUSTED WHERE POSSIBLE, RATHER THAN CONTINUING TO IMPLEMENT FORMERLY ESTABLISHED PRACTICES.
- SEE PROJECT CONSTRUCTION SWPPP FOR ADDITIONAL INFORMATION OR SECTION 2.2.1.4 OF CHAPTER 2 OF VOLUME 6 OF THE 2021 SURFACE WATER MANAGEMENT MANUAL.

MULCHING NOTES:

- MULCH MATERIALS USED SHALL BE STRAW OR HAY, AND SHALL BE APPLIED AT THE RATE OF 75-100 POUNDS PER 1000 SQ. FT. (APPX 2" THICK).
- MULCH SHALL BE APPLIED IN ALL AREAS WITH EXPOSED SLOPES GREATER THAN 2: 1.
- MULCHING SHALL BE USED IMMEDIATELY AFTER SEEDING OR IN AREAS WHICH CANNOT BE SEEDED BECAUSE OF THE SEASON.
- ALL AREAS NEEDING MULCH SHALL BE COVERED BY NOVEMBER 1.

CONTRACTOR NOTES:



- INLET PROTECTION SHALL BE INSTALLED IN ALL NEWLY CONSTRUCTED CATCH BASINS AND ALONG ALL IMPACTED FRONTAGE AND OFFSITE AREAS PER THE REQUIREMENTS OF THE COUNTY INSPECTOR PER DETAIL 5 ON THIS SHEET 5.
- CONSTRUCTION FENCE CAN BE UTILIZED IN PLACE OF FILTER FABRIC FENCE ONLY IN AREAS WHERE THE GRADES DO NOT ALLOW THE POTENTIAL FOR ANY STORMWATER TO LEAVE THE SITE.
- ALL DEMOLISHED MATERIALS SHALL BE REMOVED FROM THE SITE AND DISPOSED OF AT A CITY APPROVED LOCATION AND IN A MANNER CONSISTENT WITH CURRENT REGULATIONS AND REQUIREMENTS.
- ALL AREAS THAT WILL BE UNWORKED FOR MORE THAN SEVEN (7) DAYS DURING THE DRY SEASON OR TWO (2) DAYS DURING THE WET SEASON, SHALL BE COVERED WITH STRAW, WOOD FIBER MULCH, COMPOST, PLASTIC SHEETING, OR OTHER EQUIVALENT PER CURRENT CITY OR COUNTY STANDARDS. SEE SEEDING NOTES AND MULCHING NOTES ON THIS SHEET.
- CONTRACTOR SHALL DESIGNATE A WASHINGTON DEPT OF ECOLOGY CERTIFIED EROSION CONTROL LEAD PERSON, AND SHALL COMPLY WITH THE CONSTRUCTION STORMWATER POLLUTION PREVENTION PLAN (SWPPP) PREPARED FOR THE PROJECT.
- AT ANY TIME DURING CONSTRUCTION IT IS DETERMINED BY THE CITY OR COUNTY THAT MUD AND DEBRIS ARE BEING TRACKED ONTO PUBLIC STREETS WITH INSUFFICIENT CLEANUP, ALL WORK SHALL CEASE ON THE PROJECT UNTIL THIS CONDITION IS CORRECTED. THE CONTRACTOR AND/OR THE OWNER SHALL IMMEDIATELY TAKE ALL STEPS NECESSARY TO PREVENT FUTURE TRACKING OF MUD AND DEBRIS INTO THE PUBLIC ROW, WHICH MAY INCLUDE THE INSTALLATION OF A WHEEL WASH FACILITY ON-SITE.
- SEDIMENT LADEN RUNOFF SHALL NOT BE ALLOWED TO DISCHARGE BEYOND THE LIMITS OF THE IMPROVEMENTS. ADDITIONAL MEASURES SHALL BE INSTALLED AS NEEDED.
- SAND BAGS SHALL BE SECURELY PLACED AROUND INSTALLED CATCH BASINS WITH INLET PROTECTION AS FIELD AND WEATHER CONDITIONS WARRANT SO TO PROTECT ALL DISPERSION AND INFILTRATION TRENCHES SEDIMENT LADEN RUNOFF.
- TREES WITHIN WORKING LIMITS TO BE SAVED, SHALL BE MARKED AS SUCH ON SITE AND PROTECTION FENCE PLACED AROUND EACH TREE.

SEEDING NOTES:


- THE FOLLOWING SEED MIXTURE SHALL BE AS BELOW AND SHALL BE APPLIED AT THE RATE RECOMMENDED BY THE SUPPLIER.

TABLE D.3.2.B TEMPORARY EROSION CONTROL SEED MIX			
	% WEIGHT	% PURITY	% GERMINATION
CHEWINGS OR RED FESCUE FESTUCA FESTUCA VAR. COMMUTATA OR FESTUCA RUBRA	40	98	90
ANNUAL OR PERENNIAL RYE LOLIUM MULTIFLORUM OR LOLIUM PERENNE	40	98	90
REDDTOP OR COLONIAL BENTGRASS AGROSTIS ALBA OR AGROSTIS TENUIS	10	92	85
WHITE DUTCH CLOVER TRIFOLIUM REPENS	10	98	90

- SEED BEDS PLANTED BETWEEN MAY 1 AND OCTOBER 31 WILL REQUIRE IRRIGATION AND OTHER MAINTENANCE AS NECESSARY TO FOSTER AND PROTECT THE ROOT STRUCTURE.
- FOR SEED BEDS PLANTED BETWEEN OCTOBER 31 AND APRIL 30, ARMORING OF THE SEED BED WILL BE NECESSARY. (E.G., GEOTEXTILES, JUTE MAT, CLEAR PLASTIC COVERING).
- BEFORE SEEDING, INSTALL NEEDED SURFACE RUNOFF CONTROL MEASURES SUCH AS GRADIENT TERRACES, INTERCEPTOR DIKES, SWALES, LEVEL SPREADERS AND SEDIMENT BASINS.
- THE SEEDBED SHALL BE FIRM WITH A FAIRLY FINE SURFACE, FOLLOWING SURFACE ROUGHENING. PERFORM ALL OPERATIONS ACROSS OR AT RIGHT ANGLES TO THE SLOPE.
- FERTILIZERS ARE TO BE USED ACCORDING TO SUPPLIER'S RECOMMENDATIONS. AMOUNTS USED SHOULD BE MINIMIZED, ESPECIALLY ADJACENT TO WATER BODIES AND WETLANDS.

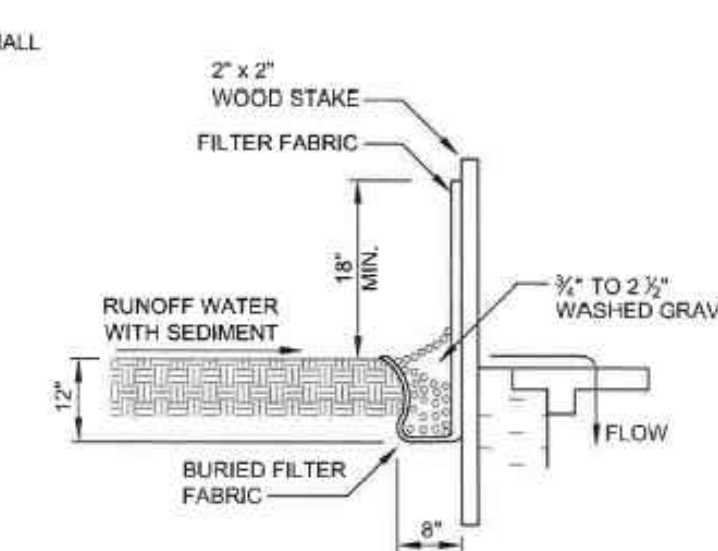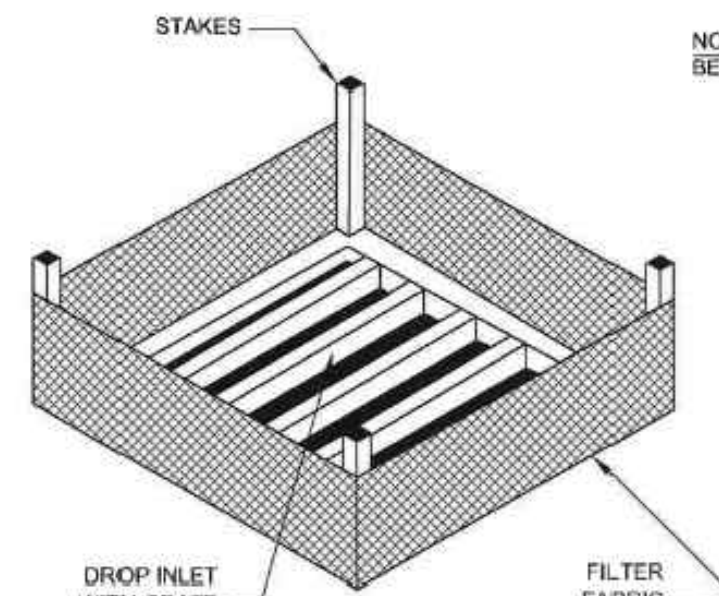

3 INLET PROTECTION WITH FABRIC FENCE SCALE:NTS

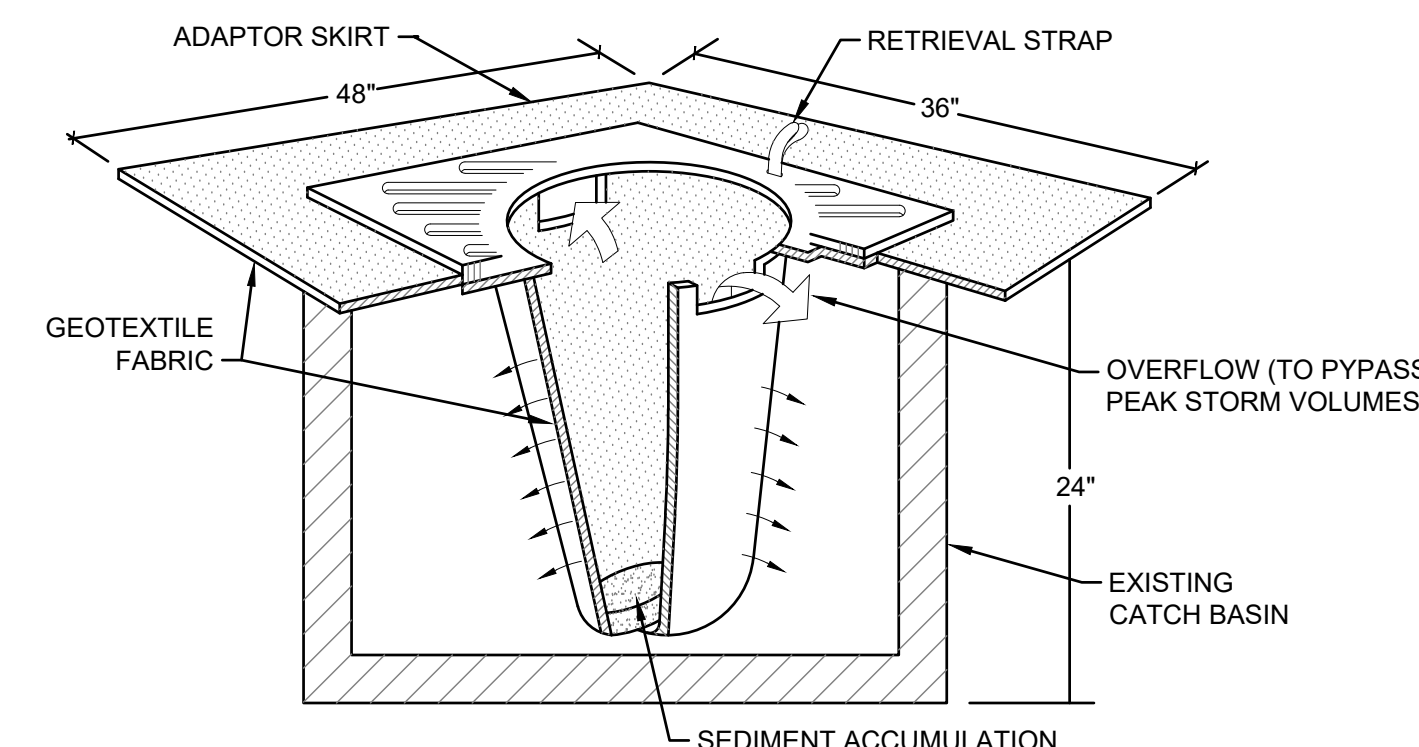

- NOTES:
- FILTERS SHALL BE INSPECTED AFTER EACH STORM EVENT AND CLEANED OR REPLACED WHEN 1/3 FULL.
 - INSTALL INLET PROTECTION IN ALL NEW STORM STRUCTURES THAT WILL COLLECT STORMWATER AS THEY ARE INSTALLED.

4 INLET PROTECTION W/ FILTER SOCK SCALE:NTS

APPROVED

BY: CITY OF PUYALLUP DEVELOPMENT ENGINEERING

DATE:

NOTE: THIS APPROVAL IS VOID AFTER 180 DAYS FROM APPROVAL DATE. THE CITY WILL NOT BE RESPONSIBLE FOR ERRORS AND/OR OMISSIONS ON THESE PLANS. FIELD CONDITIONS MAY DICTATE CHANGES TO THESE PLANS AS DETERMINED BY THE DEVELOPMENT ENGINEERING MANAGER.

TACOMA · SEATTLE · SPOKANE · TRI-CITIES

2215 North 30th Street, Suite 300, Tacoma, WA 98403
253.383.2422 TEL 253.383.2572 FAX www.ahbl.com WEB

Project Title:

EAST TOWN CROSSING PHASE 1

Client:

ASH DEVELOPMENT

GREG HELLE

GREG.HELLE@ASHNW.COM

Project No.

2230752

Issue Set & Date:

PERMIT SUBMITTAL

02/20/2024



NOTICE: A SIGNATURE OF THIS DOCUMENT SHALL VALIDATE THE PROFESSIONAL SEAL AND SIGNATURE. PUBLICATION OF THIS DOCUMENT DOES NOT GUARANTEE THAT THE INFORMATION IS CORRECT OR THAT THE ENGINEER IS NOT BEING USED FOR ANY OTHER PROJECT. ACCORDING TO THAT PROJECT OR FOR ANY OTHER PROJECT.

Revisions:

01/29/24 CITY COMMENTS

Sheet Title:

TESC NOTES AND DETAILS

Designed by: CW Drawn by: SK/RS Checked by: JI

Sheet No.

C1.1

3 of 53 Sheets

EAST TOWN CROSSING PHASE 1

SEC. 26,35/ TWP. 20 N./ RGE. 4 E., W.M.

APPROVED

BY CITY OF PUYALLUP
DEVELOPMENT ENGINEERING



DATE

NOTE: THIS APPROVAL IS VOID AFTER 180 DAYS FROM APPROVAL DATE. THE CITY WILL NOT BE RESPONSIBLE FOR ERRORS AND/OR OMISSIONS ON THESE PLANS. FIELD CONDITIONS MAY DICTATE CHANGES TO THESE PLANS AS DETERMINED BY THE DEVELOPMENT ENGINEERING MANAGER.



TACOMA · SEATTLE · SPOKANE · TRI-CITIES

2215 North 30th Street, Suite 300, Tacoma, WA 98403
253.383.2422 TEL 253.383.2572 FAX www.ahbl.com WEB

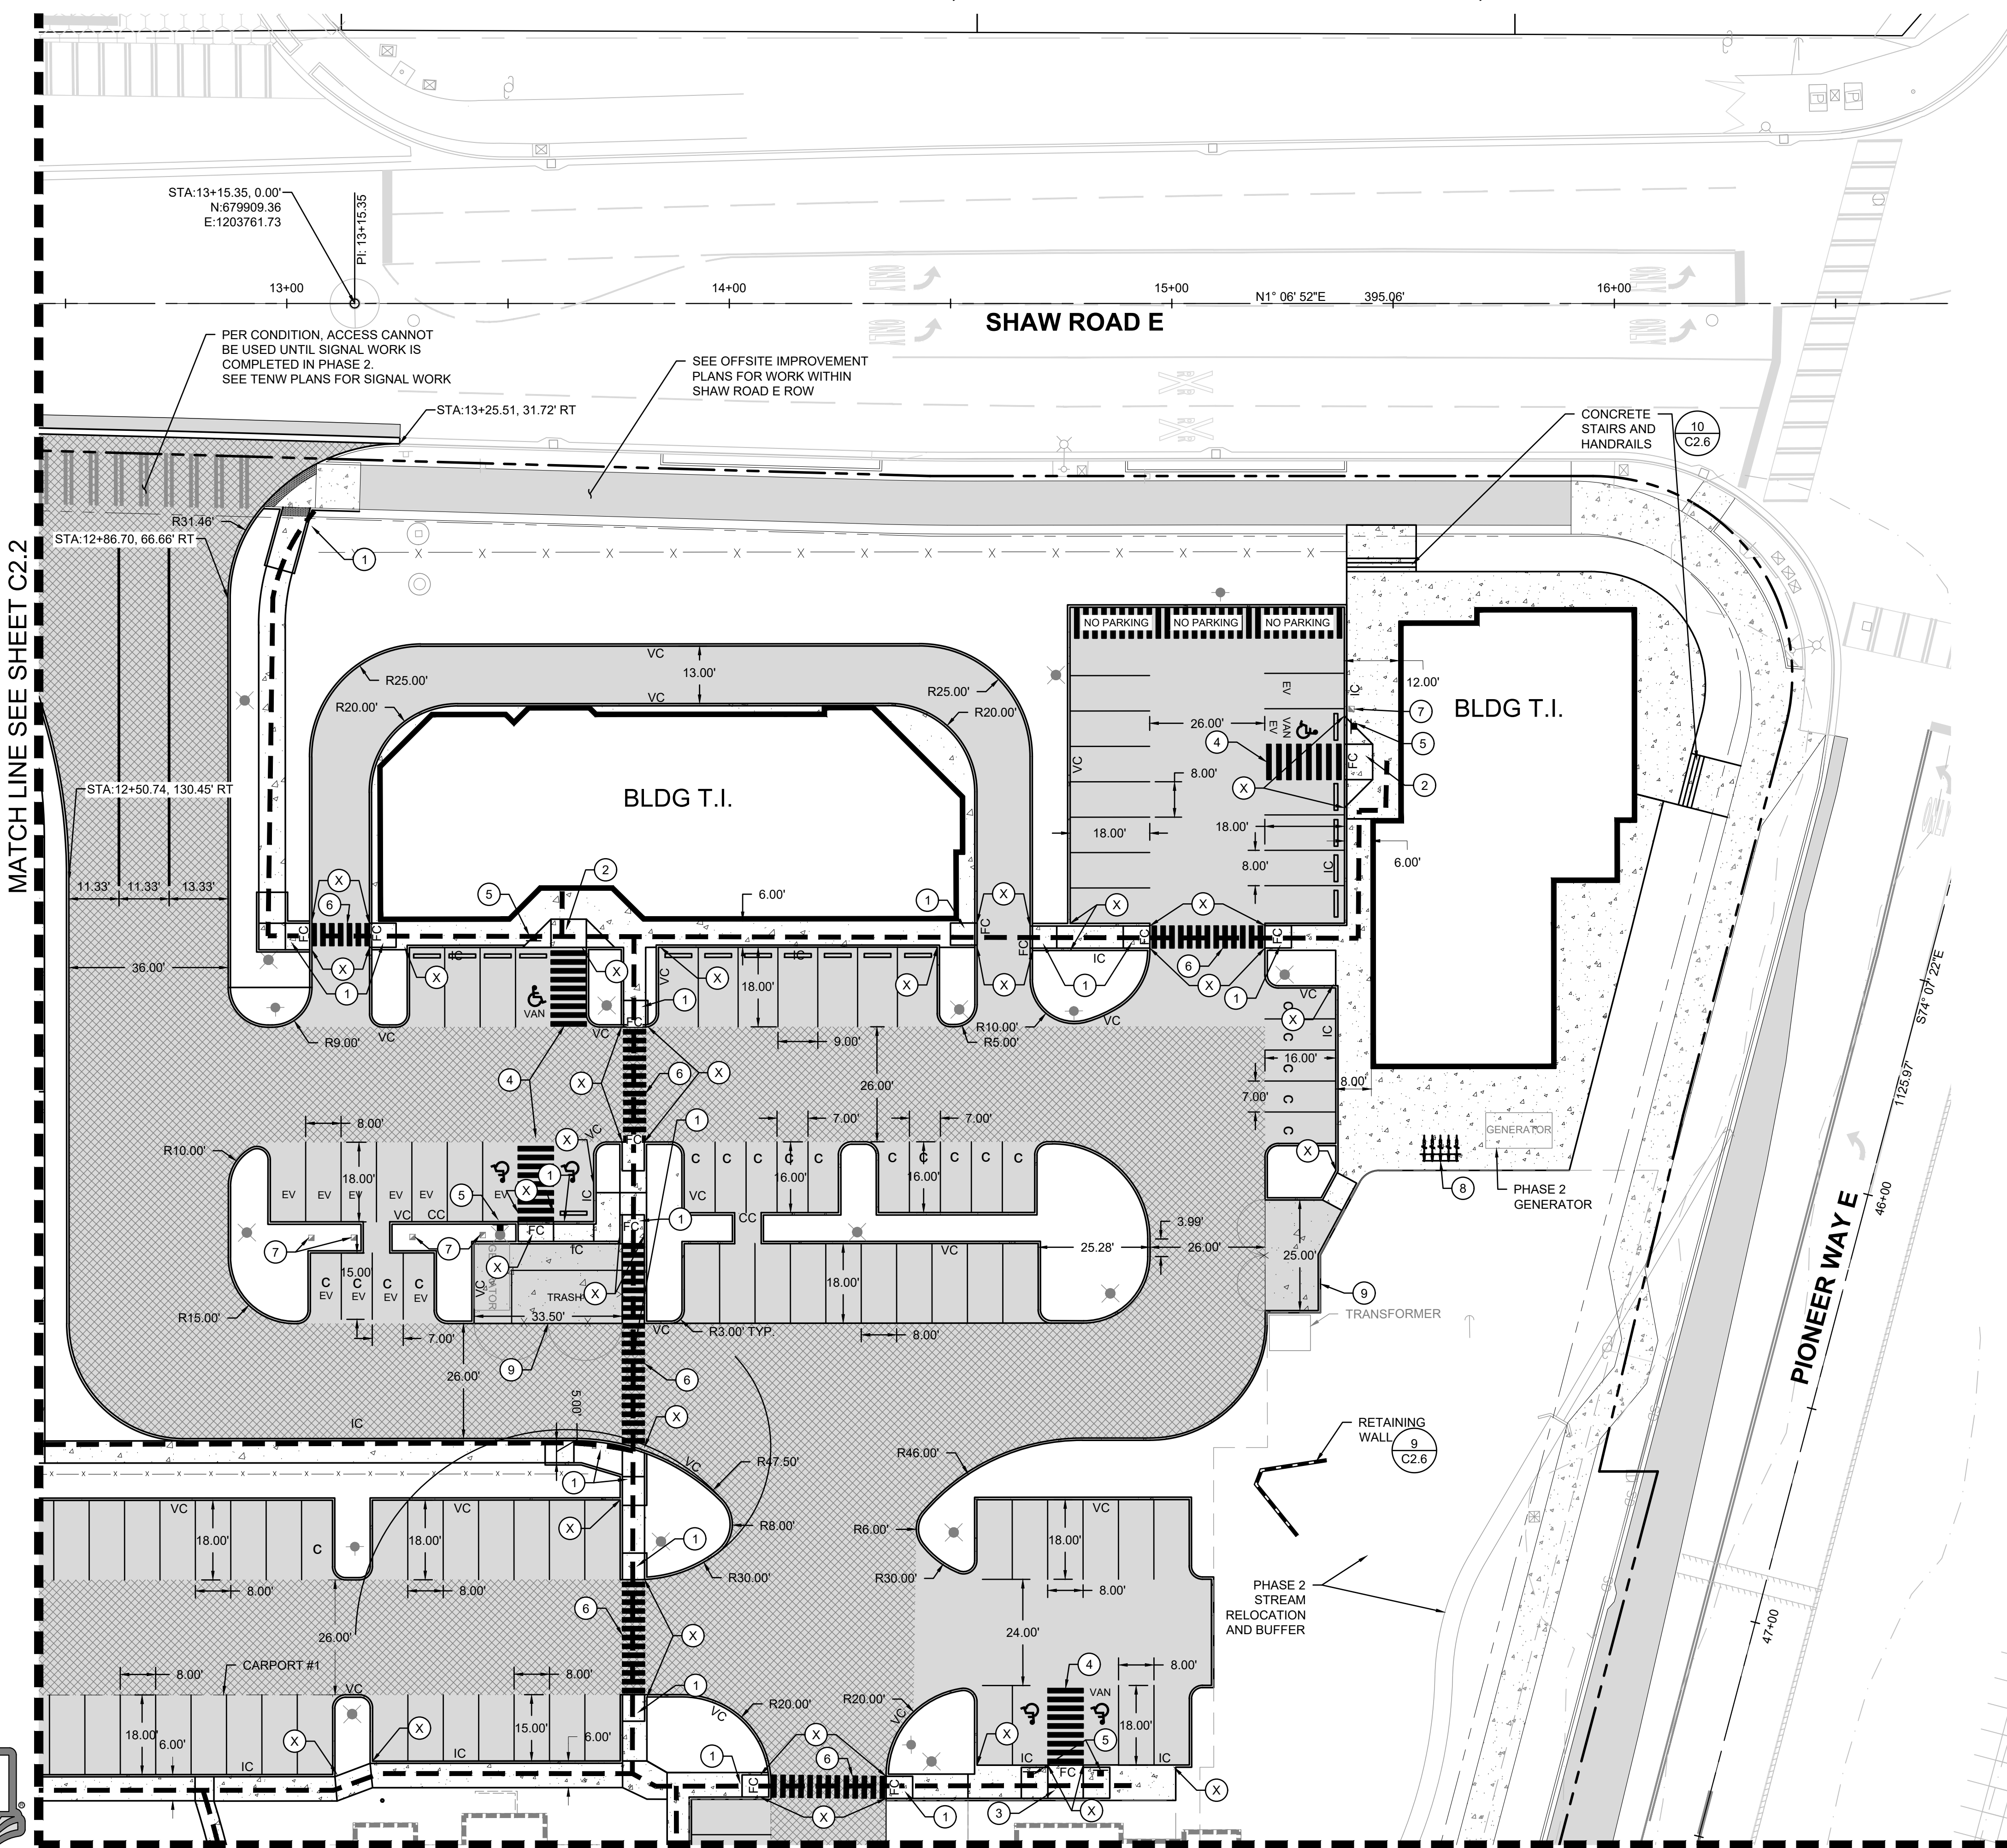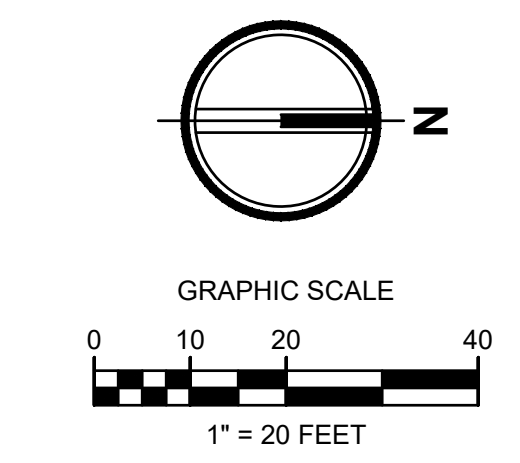


LEGEND:

- RIGHT-OF-WAY/PROPERTY LINE
- CENTERLINE
- PROPOSED BUILDING OUTLINE
- - - FENCING - REFER TO LANDSCAPE ARCHITECTS DRAWINGS.
- - - ACCESSIBLE PATH
- ASPHALT PAVEMENT - STANDARD DUTY (1) C2.6
- ASPHALT PAVEMENT - ATB (2) C2.6
- PERVIOUS CONCRETE SIDEWALK (3) C2.6
- CEMENT CONCRETE - HEAVY DUTY (4) C2.6
- BOLLARD PROTECTION
- CEMENT CONCRETE WHEEL STOP (7) C2.6
- ☼ LIGHTING - REFER TO ELECTRICAL PLANS
- ♿ ADA ACCESSIBLE PARKING STALL (5) C2.7
- ⊗ CHANGE IN CURB TYPE / END CURB
- EC CONCRETE EXTRUDED CURB
- IC INTEGRAL CURB AND SIDEWALK (5) C2.6
- NC NO CURB
- CC CURB CUT (8) C2.6
- VC VERTICAL CURB (6) C2.6
- CG CONCRETE CURB AND GUTTER
- FC FLUSH CURB

KEYNOTES

- 1 ADA RAMP - SINGLE DIRECTIONAL (1) C2.7
- 2 ADA RAMP - PERPENDICULAR (3) C2.7
- 3 ADA RAMP - DEPRESSED SIDEWALK (2) C2.7
- 4 ADA STALL (5) C2.7
- 5 ADA SIGN (5) C2.7
- 6 CROSSWALK STRIPING
- 7 EV CHARGING - SEE ARCHITECTURAL PLANS
- 8 BIKE RACK, SEE ARCHITECTURAL PLANS
- 9 DUMPSTER ENCLOSURE, SEE ARCHITECTURAL PLANS

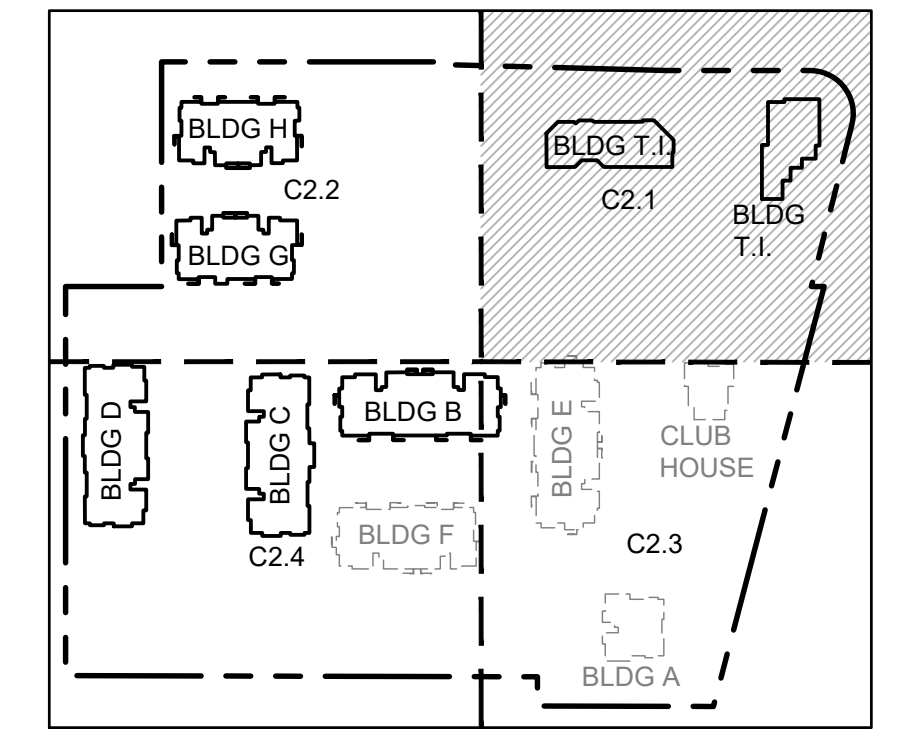

Project Title:

EAST TOWN CROSSING PHASE 1

Client:
ASH DEVELOPMENT

GREG HELLE
GREG.HELLE@ASHNW.COM

Project No.
2230752

Issue Set & Date:
PERMIT SUBMITTAL
02/20/2024



NOTICE: ALTERATION OF THIS DOCUMENT SHALL INVALIDATE THE PROFESSIONAL SEAL AND SIGNATURE. PUBLICATION OF THIS DOCUMENT DOES NOT CONSTITUTE AN ENDORSEMENT OF THE DESIGN OR THE DESIGNER'S LIABILITY FOR THE ONLY FOR THE PROJECT DESCRIBED IN THE TITLE BLOCK AND IS NOT TO BE USED FOR OTHER PROJECTS OR IN ADDITION TO THAT PROJECT OR FOR ANY OTHER PROJECT.

- △
- △
- △
- △ 01/29/24 CITY COMMENTS

Revisions:

HORIZONTAL CONTROL AND PAVING PLAN NW

Designed by: CW
Drawn by: SK / RS
Checked by: JI

Sheet No.

C2.1





MATCH LINE SEE SHEET C2.3

MATCH LINE SEE SHEET C2.2

EAST TOWN CROSSING PHASE 1

SEC. 26,35/ TWP. 20 N./ RGE. 4 E., W.M.

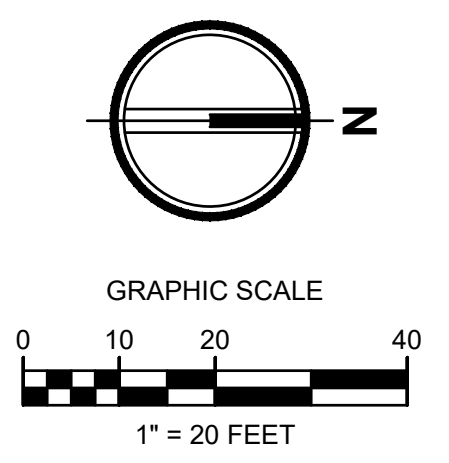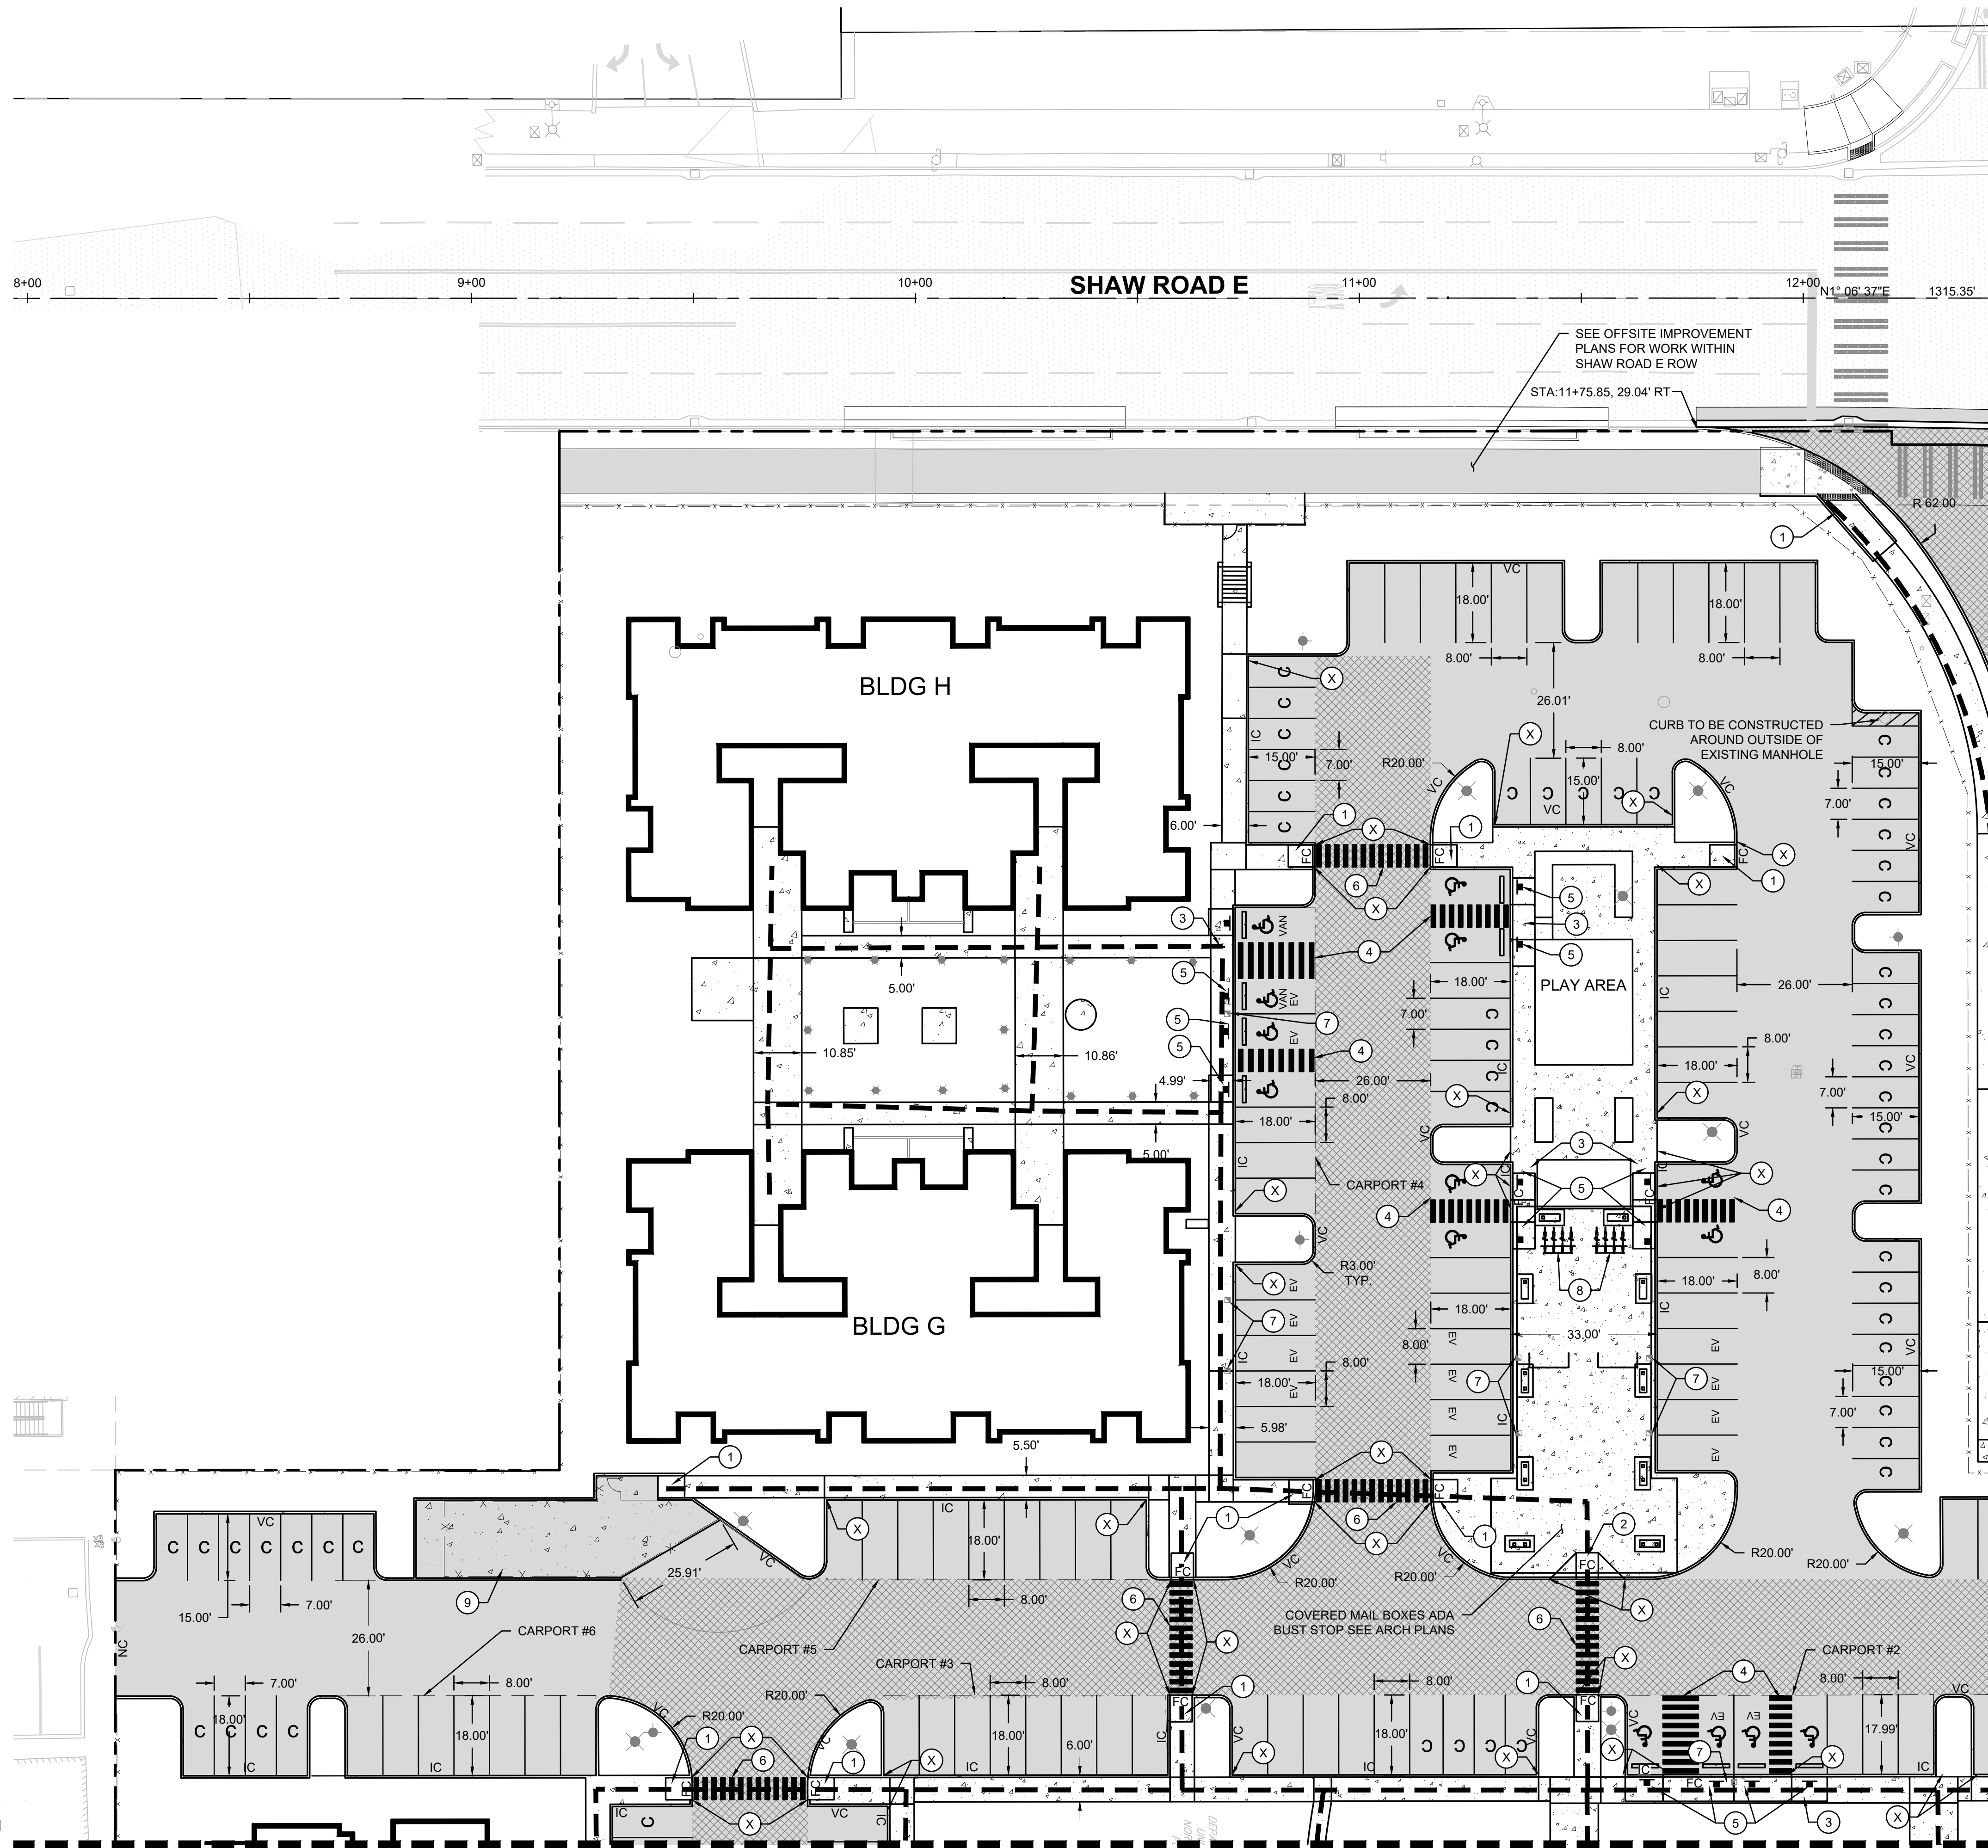

APPROVED

BY: CITY OF PUYALLUP
DEVELOPMENT ENGINEERING


DATE:

NOTE: THIS APPROVAL IS VOID AFTER 180 DAYS FROM APPROVAL DATE. THE CITY WILL NOT BE RESPONSIBLE FOR ERRORS AND/OR OMISSIONS ON THESE PLANS. FIELD CONDITIONS MAY DICTATE CHANGES TO THESE PLANS AS DETERMINED BY THE DEVELOPMENT ENGINEERING MANAGER.



- LEGEND:**
- RIGHT-OF-WAY/PROPERTY LINE
 - CENTERLINE
 - PROPOSED BUILDING OUTLINE
 - - - - - FENCING - REFER TO LANDSCAPE ARCHITECTS DRAWINGS.
 - - - - - ACCESSIBLE PATH
 - ASPHALT PAVEMENT - STANDARD DUTY (1) C2.6
 - ASPHALT PAVEMENT - ATB (2) C2.6
 - PERVIOUS CONCRETE SIDEWALK (3) C2.6
 - CEMENT CONCRETE - HEAVY DUTY (4) C2.6
 - BOLLARD PROTECTION
 - CEMENT CONCRETE WHEEL STOP (7) C2.6
 - ☼ LIGHTING - REFER TO ELECTRICAL PLANS
 - ♿ ADA ACCESSIBLE PARKING STALL (5) C2.7
 - (X) CHANGE IN CURB TYPE / END CURB
 - EC CONCRETE EXTRUDED CURB (5) C2.6
 - IC INTEGRAL CURB AND SIDEWALK (5) C2.6
 - NC NO CURB (8) C2.6
 - CC CURB CUT (6) C2.6
 - VC VERTICAL CURB (6) C2.6
 - CG CONCRETE CURB AND GUTTER
 - FC FLUSH CURB

- KEYNOTES**
- (1) ADA RAMP - SINGLE DIRECTIONAL (1) C2.7
 - (2) ADA RAMP - PERPENDICULAR (3) C2.7
 - (3) ADA RAMP - DEPRESSED SIDEWALK (2) C2.7
 - (4) ADA STALL (5) C2.7
 - (5) ADA SIGN (5) C2.7
 - (6) CROSSWALK STRIPING
 - (7) EV CHARGING - SEE ARCHITECTURAL PLANS
 - (8) BIKE RACK, SEE ARCHITECTURAL PLANS
 - (9) DUMPSTER ENCLOSURE, SEE ARCHITECTURAL PLANS

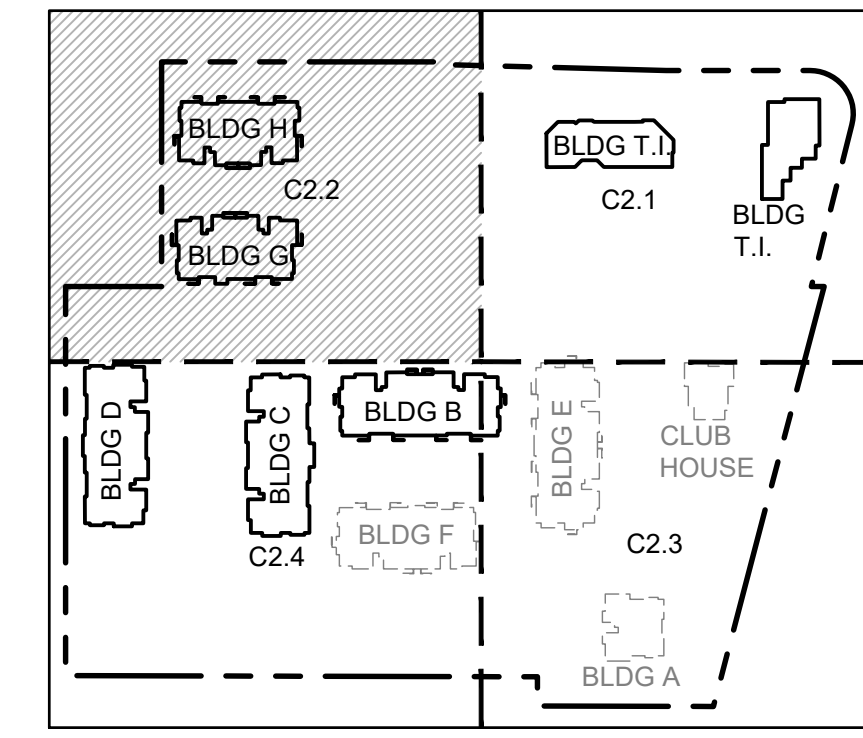

Project Title:

EAST TOWN CROSSING PHASE 1

Client:

ASH DEVELOPMENT

GREG HELLE

GREG.HELLE@ASHNW.COM


Project No.

2230752

Issue Set & Date:

PERMIT SUBMITTAL

02/20/2024

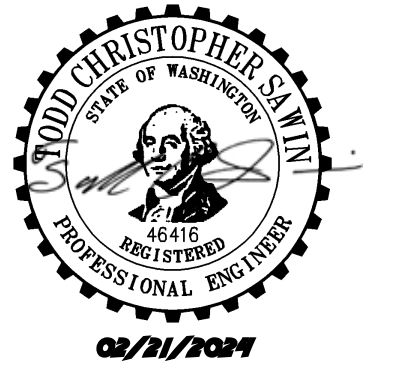

NOTICE

ALTERATION OF THIS DOCUMENT SHALL INVALIDATE THE PROFESSIONAL SEAL AND SIGNATURE. PUBLICATION OF THIS DOCUMENT DOES NOT CONSTITUTE A GUARANTEE OR WARRANTY BY THE ENGINEER OR ARCHITECT. THE ENGINEER OR ARCHITECT SHALL NOT BE HELD RESPONSIBLE FOR ANY ERRORS OR OMISSIONS IN THE DESIGN OR CONSTRUCTION OF THE PROJECT EXCEPT IN THE TITLE BLOCK AND TO THE EXTENT OF THE ORIGINAL DESIGN OR CONSTRUCTION OF THE PROJECT OR FOR ANY OTHER PROJECT.

Revisions:

01/29/24 CITY COMMENTS

Sheet Title:

HORIZONTAL CONTROL AND PAVING PLAN SW

Designed by: CW
Drawn by: SK/RS
Checked by: JI

Sheet No.

C2.2

5 of 53 Sheets




EAST TOWN CROSSING PHASE 1

SEC. 26,35/ TWP. 20 N./ RGE. 4 E., W.M.

APPROVED

BY _____
CITY OF PUYALLUP
DEVELOPMENT ENGINEERING
DATE _____

NOTE: THIS APPROVAL IS VOID AFTER 180 DAYS FROM APPROVAL DATE. THE CITY WILL NOT BE RESPONSIBLE FOR ERRORS AND/OR OMISSIONS ON THESE PLANS. FIELD CONDITIONS MAY DICTATE CHANGES TO THESE PLANS AS DETERMINED BY THE DEVELOPMENT ENGINEERING MANAGER.

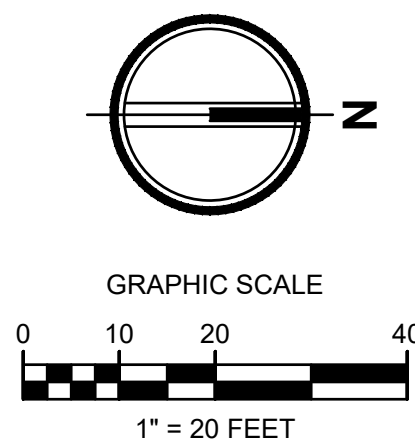

AHBL

TACOMA · SEATTLE · SPOKANE · TRI-CITIES

2215 North 30th Street, Suite 300, Tacoma, WA 98403
253.383.2422 TEL. 253.383.2572 FAX www.ahbl.com WEB


Project Title:
EAST TOWN CROSSING PHASE 1

Client:
ASH DEVELOPMENT

GREG HELLE
GREG.HELLE@ASHNW.COM

Project No.
2230752

Issue Set & Date:
PERMIT SUBMITTAL
02/20/2024

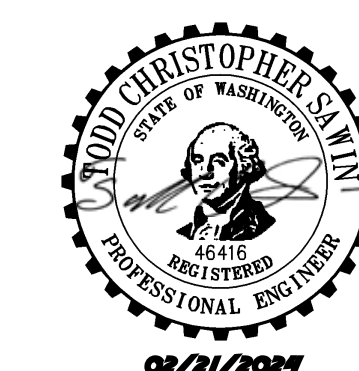


NOTICE
ALTERATION OF THIS DOCUMENT SHALL INVALIDATE THE PROFESSIONAL SEAL AND SIGNATURE. PUBLICATION OF THIS DOCUMENT DOES NOT CONSTITUTE A GUARANTEE OR ENDORSEMENT BY THE ENGINEER OR ARCHITECT. THE ENGINEER OR ARCHITECT IS NOT TO BE USED FOR OTHER PROJECTS OR ACTION TO THAT PROJECT OR FOR ANY OTHER PROJECT.

LEGEND:


- RIGHT-OF-WAY/PROPERTY LINE
- CENTERLINE
- PROPOSED BUILDING OUTLINE
- - - - FENCING - REFER TO LANDSCAPE ARCHITECTS DRAWINGS.
- ACCESSIBLE PATH
- ASPHALT PAVEMENT - STANDARD DUTY (1) C2.6
- ASPHALT PAVEMENT - ATB (2) C2.6
- PERVIOUS CONCRETE SIDEWALK (3) C2.6
- CEMENT CONCRETE - HEAVY DUTY (4) C2.6
- BOLLARD PROTECTION
- CEMENT CONCRETE WHEEL STOP (7) C2.6
- ☼ LIGHTING - REFER TO ELECTRICAL PLANS
- ♿ ADA ACCESSIBLE PARKING STALL (5) C2.7
- (X) CHANGE IN CURB TYPE / END CURB
- EC CONCRETE EXTRUDED CURB
- IC INTEGRAL CURB AND SIDEWALK (5) C2.6
- NC NO CURB
- CC CURB CUT (8) C2.6
- VC VERTICAL CURB (6) C2.6
- CG CONCRETE CURB AND GUTTER
- FC FLUSH CURB

KEYNOTES

- (1) ADA RAMP - SINGLE DIRECTIONAL (1) C2.7
- (2) ADA RAMP - PERPENDICULAR (3) C2.7
- (3) ADA RAMP - DEPRESSED SIDEWALK (2) C2.7
- (4) ADA STALL (5) C2.7
- (5) ADA SIGN (5) C2.7
- (6) CROSSWALK STRIPING
- (7) EV CHARGING - SEE ARCHITECTURAL PLANS
- (8) BIKE RACK, SEE ARCHITECTURAL PLANS
- (9) DUMPSTER ENCLOSURE, SEE ARCHITECTURAL PLANS

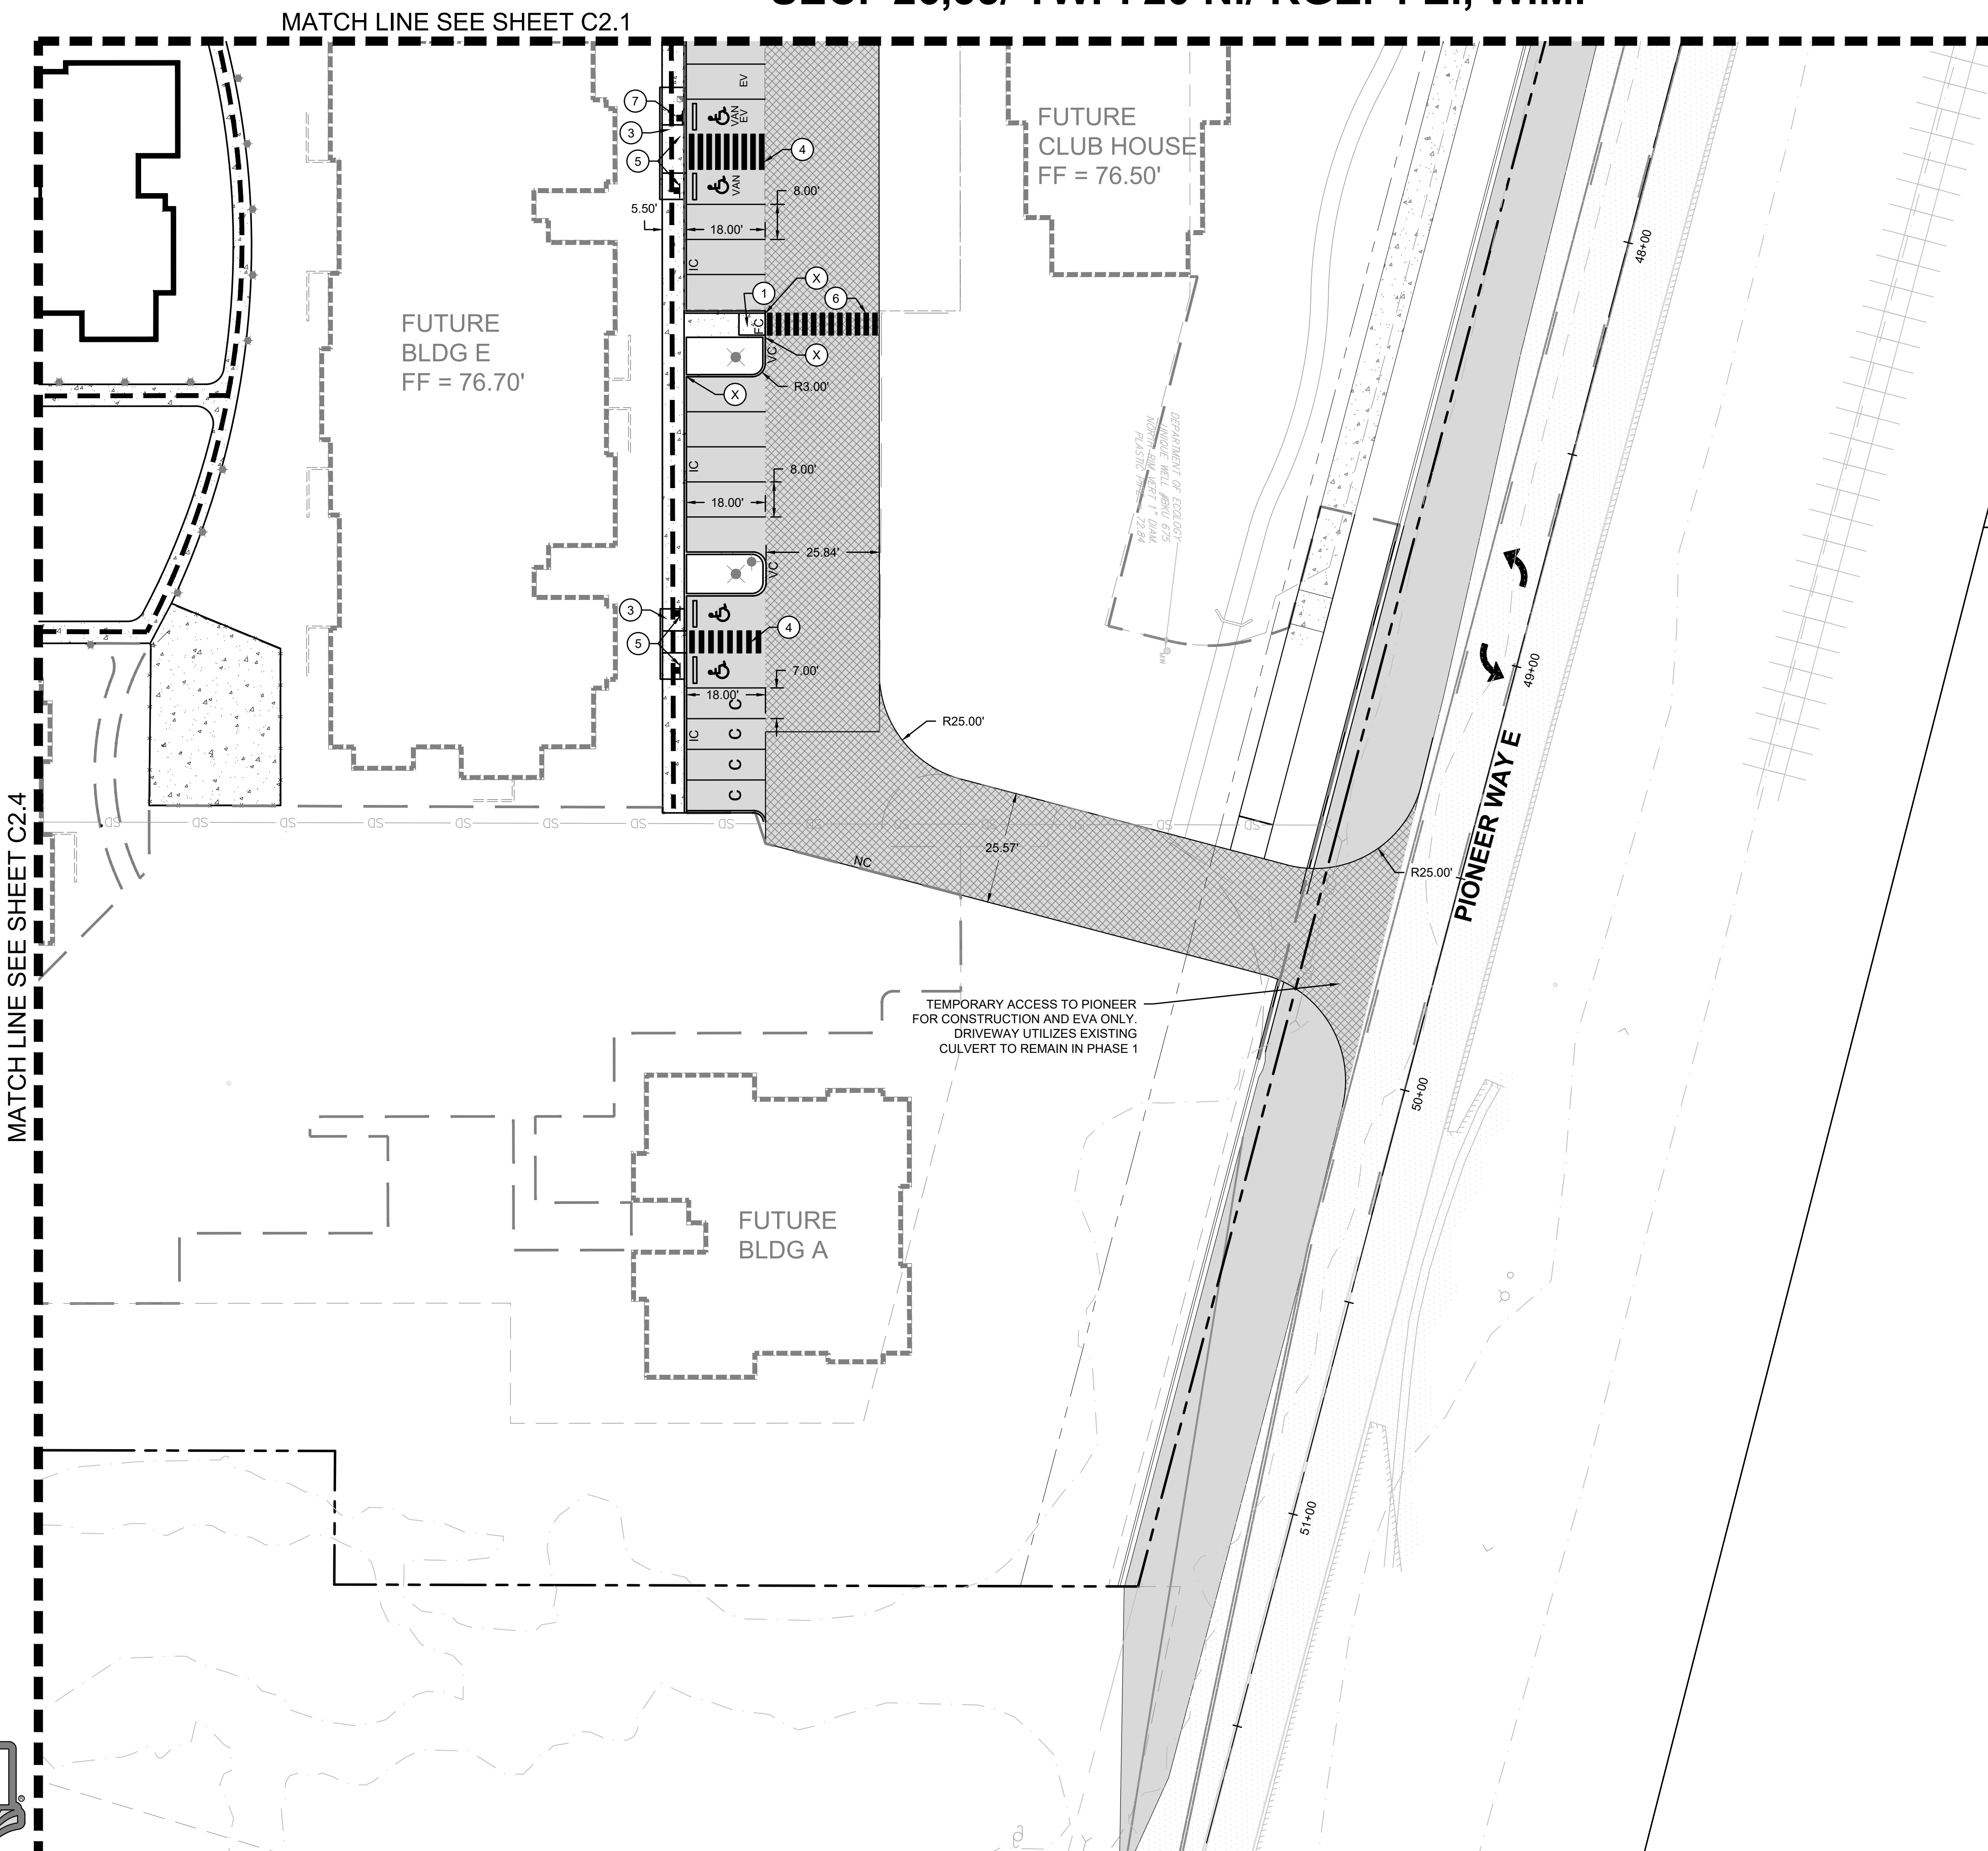

MATCH LINE SEE SHEET C2.4

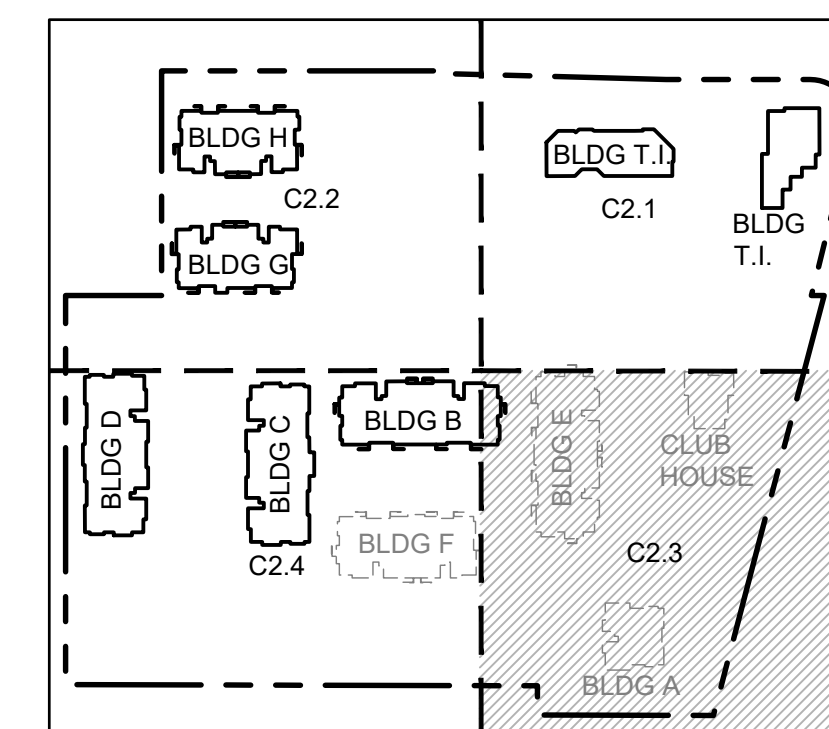

A	
A	
A	
A	01/29/24 CITY COMMENTS
Revisions:	

Sheet Title:
HORIZONTAL CONTROL AND PAVING PLAN NE

Designed by: CW Drawn by: SK/RS Checked by: JI

Sheet No.
C2.3
6 of 53 Sheets



Know what's below.
Call before you dig.



EAST TOWN CROSSING PHASE 1

SEC. 26,35/ TWP. 20 N./ RGE. 4 E., W.M.

APPROVED

BY CITY OF PUYALLUP
DEVELOPMENT ENGINEERING
DATE

NOTE: THIS APPROVAL IS VOID AFTER 180 DAYS FROM APPROVAL DATE. THE CITY WILL NOT BE RESPONSIBLE FOR ERRORS AND/OR OMISSIONS ON THESE PLANS. FIELD CONDITIONS MAY DICTATE CHANGES TO THESE PLANS AS DETERMINED BY THE DEVELOPMENT ENGINEERING MANAGER.

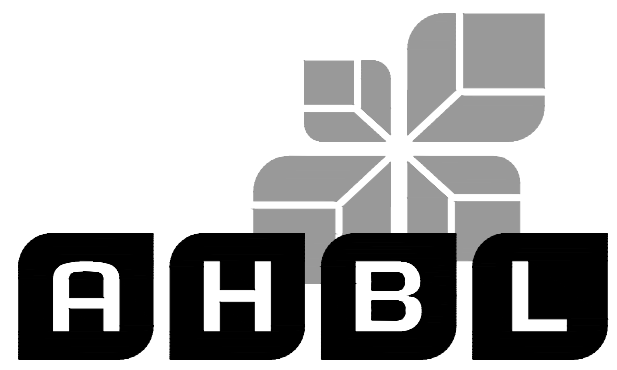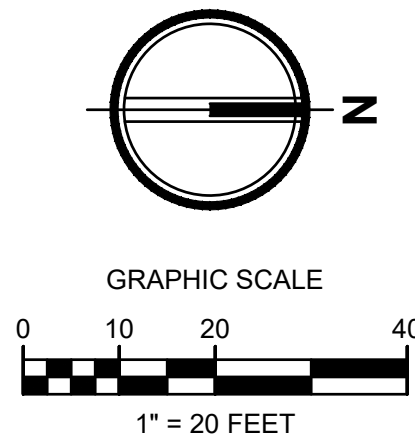

TACOMA · SEATTLE · SPOKANE · TRI-CITIES
2215 North 30th Street, Suite 300, Tacoma, WA 98403
253.383.2422 TEL 253.383.2572 FAX www.ahbl.com WEB

Project Title:
EAST TOWN CROSSING PHASE 1

Client:
ASH DEVELOPMENT


GREG HELLE
GREG.HELLE@ASHNW.COM

Project No.
2230752

Issue Set & Date:
PERMIT SUBMITTAL
02/20/2024




NOTICE
A REVISION OF THIS DOCUMENT SHALL VALIDATE THE PROFESSIONAL SEAL AND SIGNATURE PUBLICATION OF THE DOCUMENT DOES NOT CONSTITUTE A REVISED CHECKED PRINT OR IT IS THE DUTY OF THE USER ONLY FOR THE PROJECT ENCLOSED IN THE TITLE BLOCK AND IS NOT TO BE USED FOR OTHER PROJECTS OR ACTION TO THAT PROJECT OR FOR ANY OTHER PROJECT.

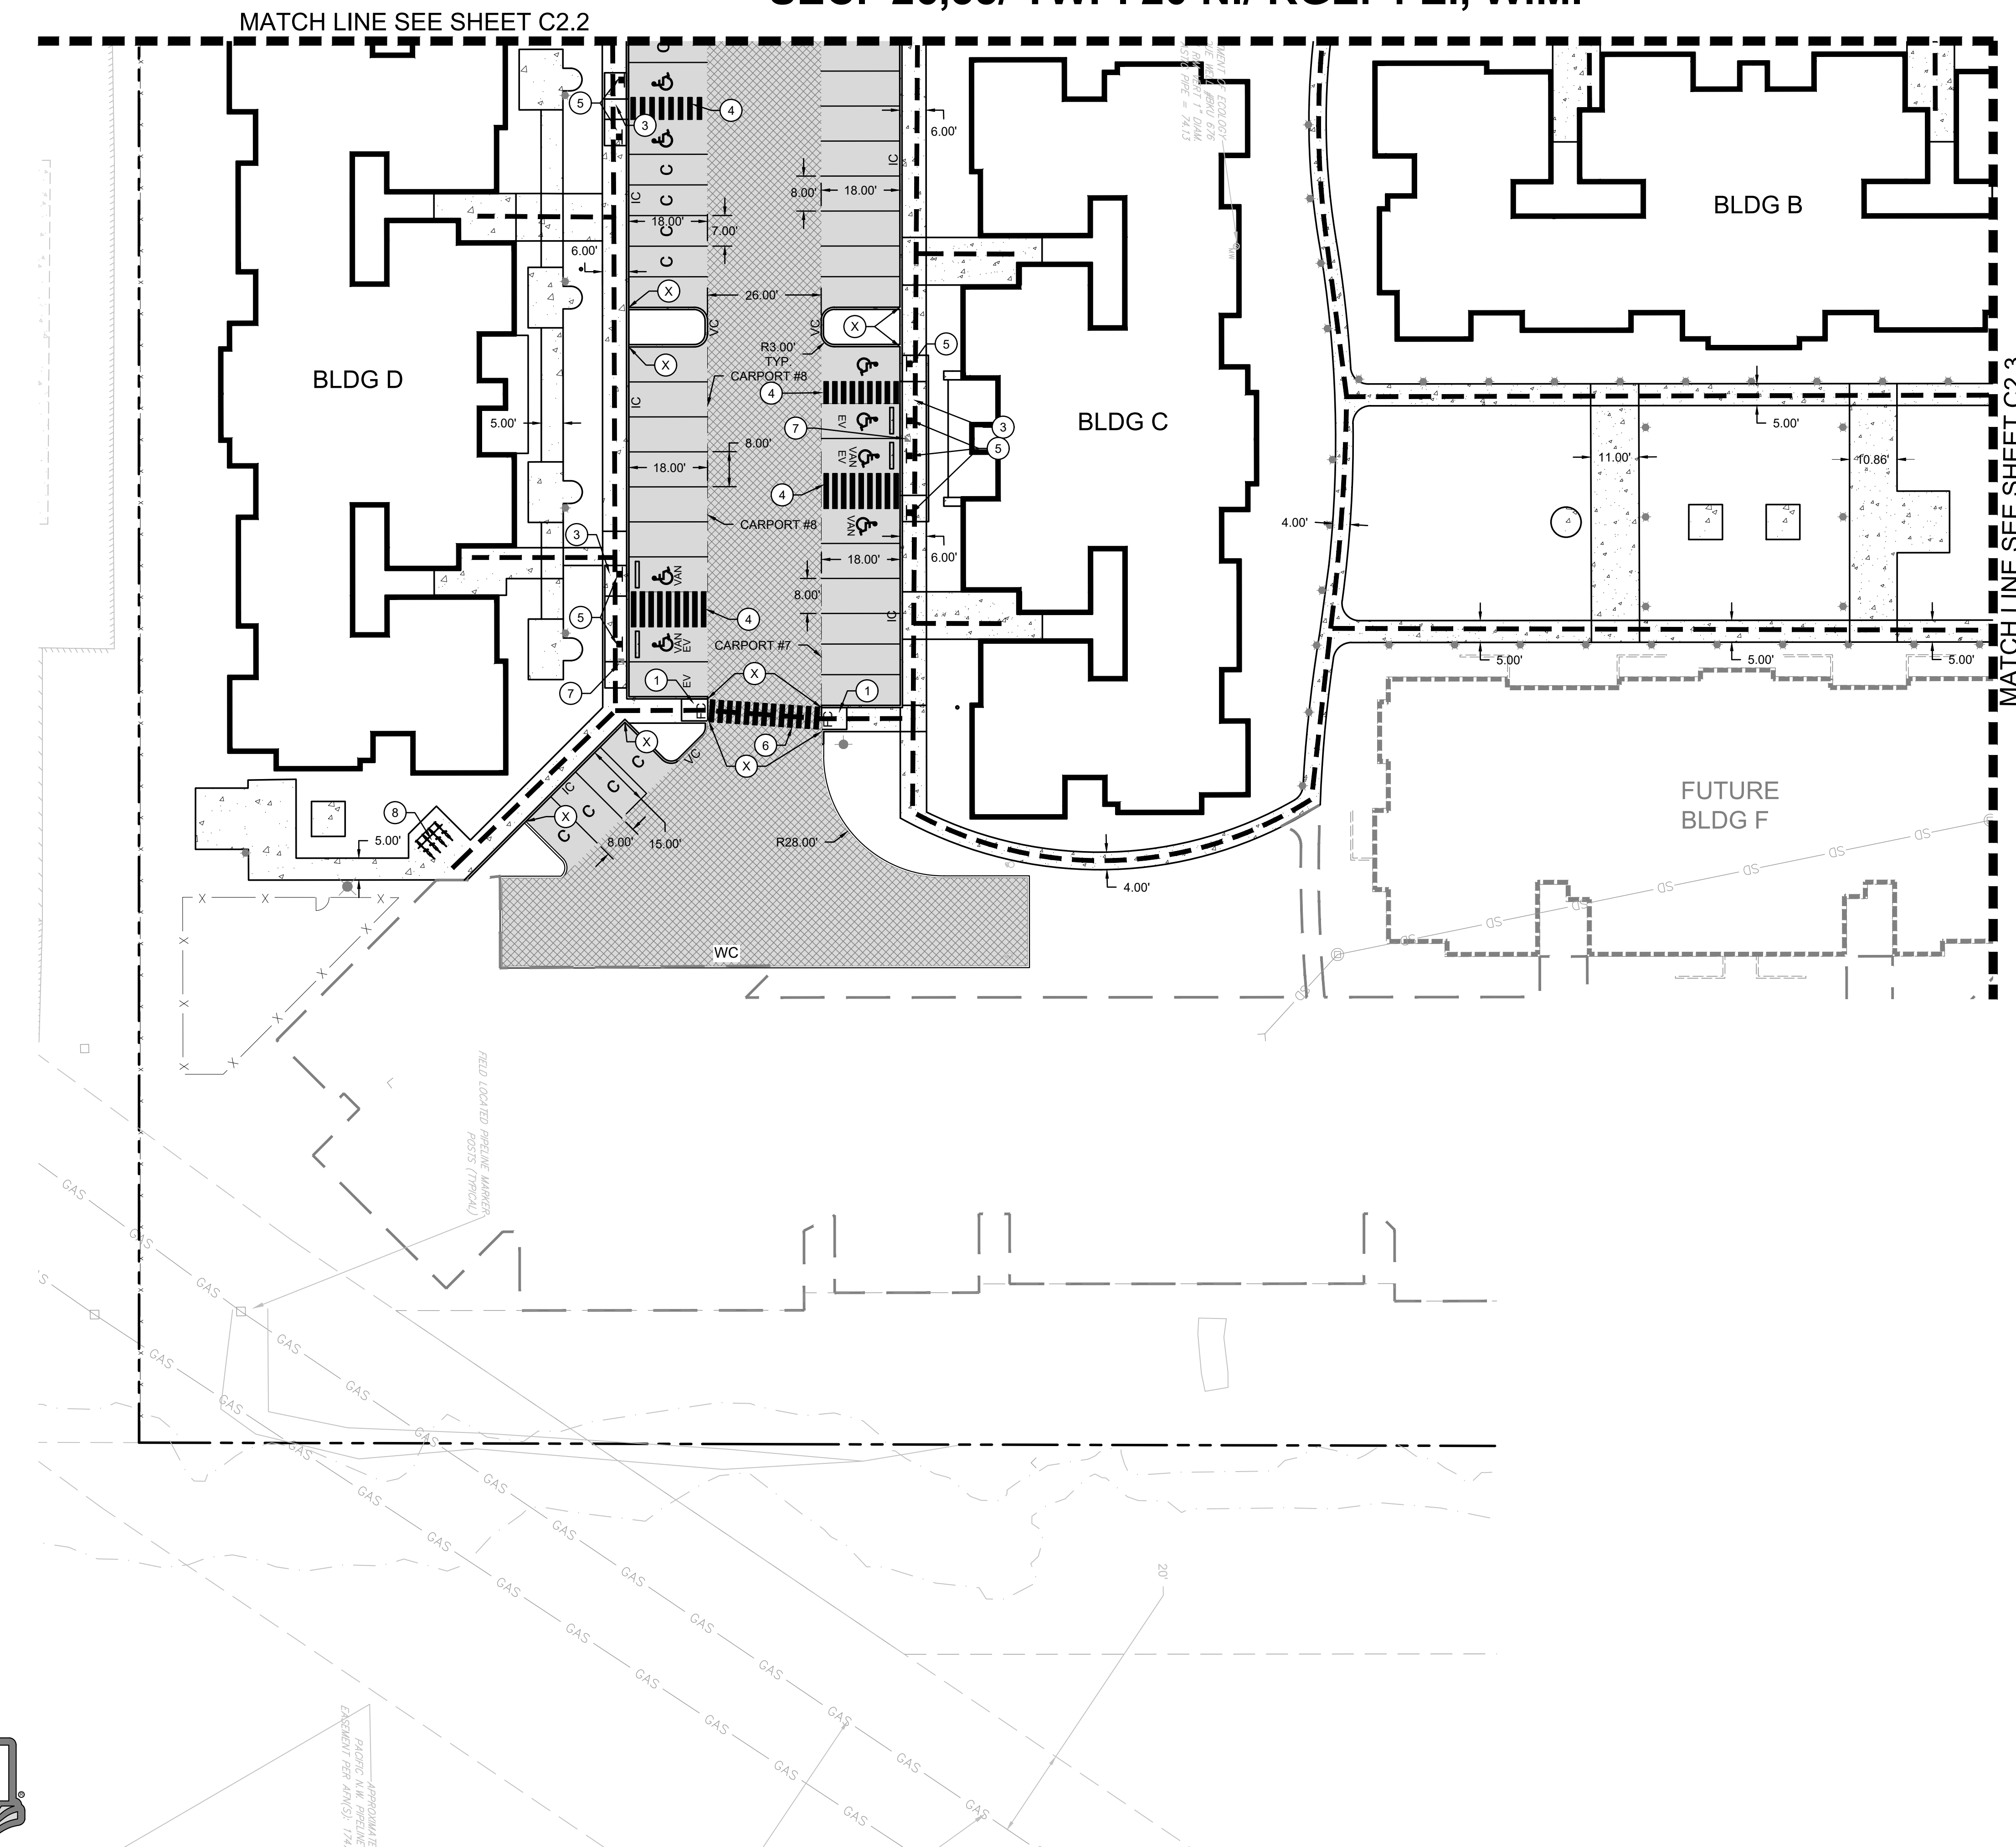

- LEGEND:**
- RIGHT-OF-WAY/PROPERTY LINE
 - - - CENTERLINE
 - PROPOSED BUILDING OUTLINE
 - x - x - x FENCING - REFER TO LANDSCAPE ARCHITECTS DRAWINGS.
 - - - ACCESSIBLE PATH
 - ASPHALT PAVEMENT - STANDARD DUTY (1 C2.6)
 - ASPHALT PAVEMENT - ATB (2 C2.6)
 - PERVIOUS CONCRETE SIDEWALK (3 C2.6)
 - CEMENT CONCRETE - HEAVY DUTY (4 C2.6)
 - BOLLARD PROTECTION
 - CEMENT CONCRETE WHEEL STOP (7 C2.6)
 - ☼ LIGHTING - REFER TO ELECTRICAL PLANS
 - ♿ ADA ACCESSIBLE PARKING STALL (5 C2.7)
 - (X) CHANGE IN CURB TYPE / END CURB
 - EC CONCRETE EXTRUDED CURB
 - IC INTEGRAL CURB AND SIDEWALK (5 C2.6)
 - NC NO CURB
 - CC CURB CUT (8 C2.6)
 - VC VERTICAL CURB (6 C2.6)
 - CG CONCRETE CURB AND GUTTER
 - FC FLUSH CURB

- KEYNOTES**
- ① ADA RAMP - SINGLE DIRECTIONAL (1 C2.7)
 - ② ADA RAMP - PERPENDICULAR (3 C2.7)
 - ③ ADA RAMP - DEPRESSED SIDEWALK (2 C2.7)
 - ④ ADA STALL (5 C2.7)
 - ⑤ ADA SIGN (5 C2.7)
 - ⑥ CROSSWALK STRIPING
 - ⑦ EV CHARGING - SEE ARCHITECTURAL PLANS
 - ⑧ BIKE RACK, SEE ARCHITECTURAL PLANS
 - ⑨ DUMPSTER ENCLOSURE, SEE ARCHITECTURAL PLANS

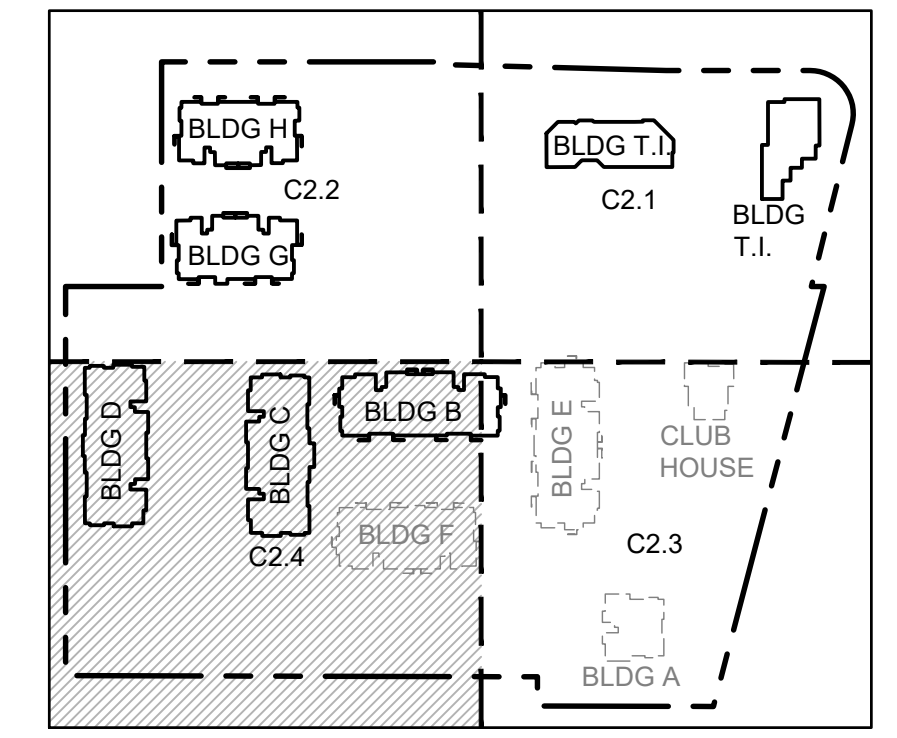

Revisions:
01/29/24 CITY COMMENTS

Sheet Title:
HORIZONTAL CONTROL AND PAVING PLAN SE

Designed by: CW
Drawn by: SK / RS
Checked by: JI

Sheet No.
C2.4



APPROXIMATE

EAST TOWN CROSSING PHASE 1

SEC. 26,35/ TWP. 20 N./ RGE. 4 E., W.M.

APPROVED

BY CITY OF PUYALLUP
DEVELOPMENT ENGINEERING

DATE

NOTE: THIS APPROVAL IS VOID AFTER 180 DAYS FROM APPROVAL DATE. THE CITY WILL NOT BE RESPONSIBLE FOR ERRORS AND/OR OMISSIONS ON THESE PLANS. FIELD CONDITIONS MAY DICTATE CHANGES TO THESE PLANS AS DETERMINED BY THE DEVELOPMENT ENGINEERING MANAGER.



TACOMA · SEATTLE · SPOKANE · TRI-CITIES

2215 North 30th Street, Suite 300, Tacoma, WA 98403
253.383.2422 TEL 253.383.2572 FAX www.ahbl.com WEB

Project Title:

EAST TOWN CROSSING PHASE 1

Client:

ASH DEVELOPMENT

GREG HELLE

GREG.HELLE@ASHNW.COM


Project No.

2230752

Issue Set & Date:


PERMIT SUBMITTAL

02/20/2024


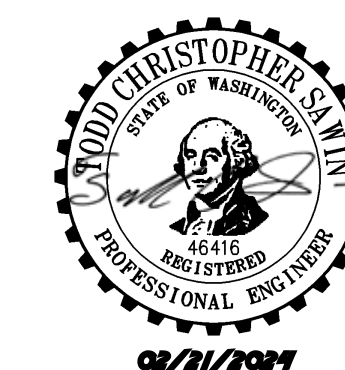


NOTICE: ALTERATION OF THIS DOCUMENT SHALL INVALIDATE THE PROFESSIONAL SEAL AND SIGNATURE. PUBLICATION OF THIS DOCUMENT DOES NOT CONSTITUTE AN ENDORSEMENT OR GUARANTEE BY THE ENGINEER OR ARCHITECT. THIS DOCUMENT IS NOT TO BE USED FOR OTHER PROJECTS OR ACTION TO THAT PROJECT OR FOR ANY OTHER PROJECT.

SHAW ROAD EAST

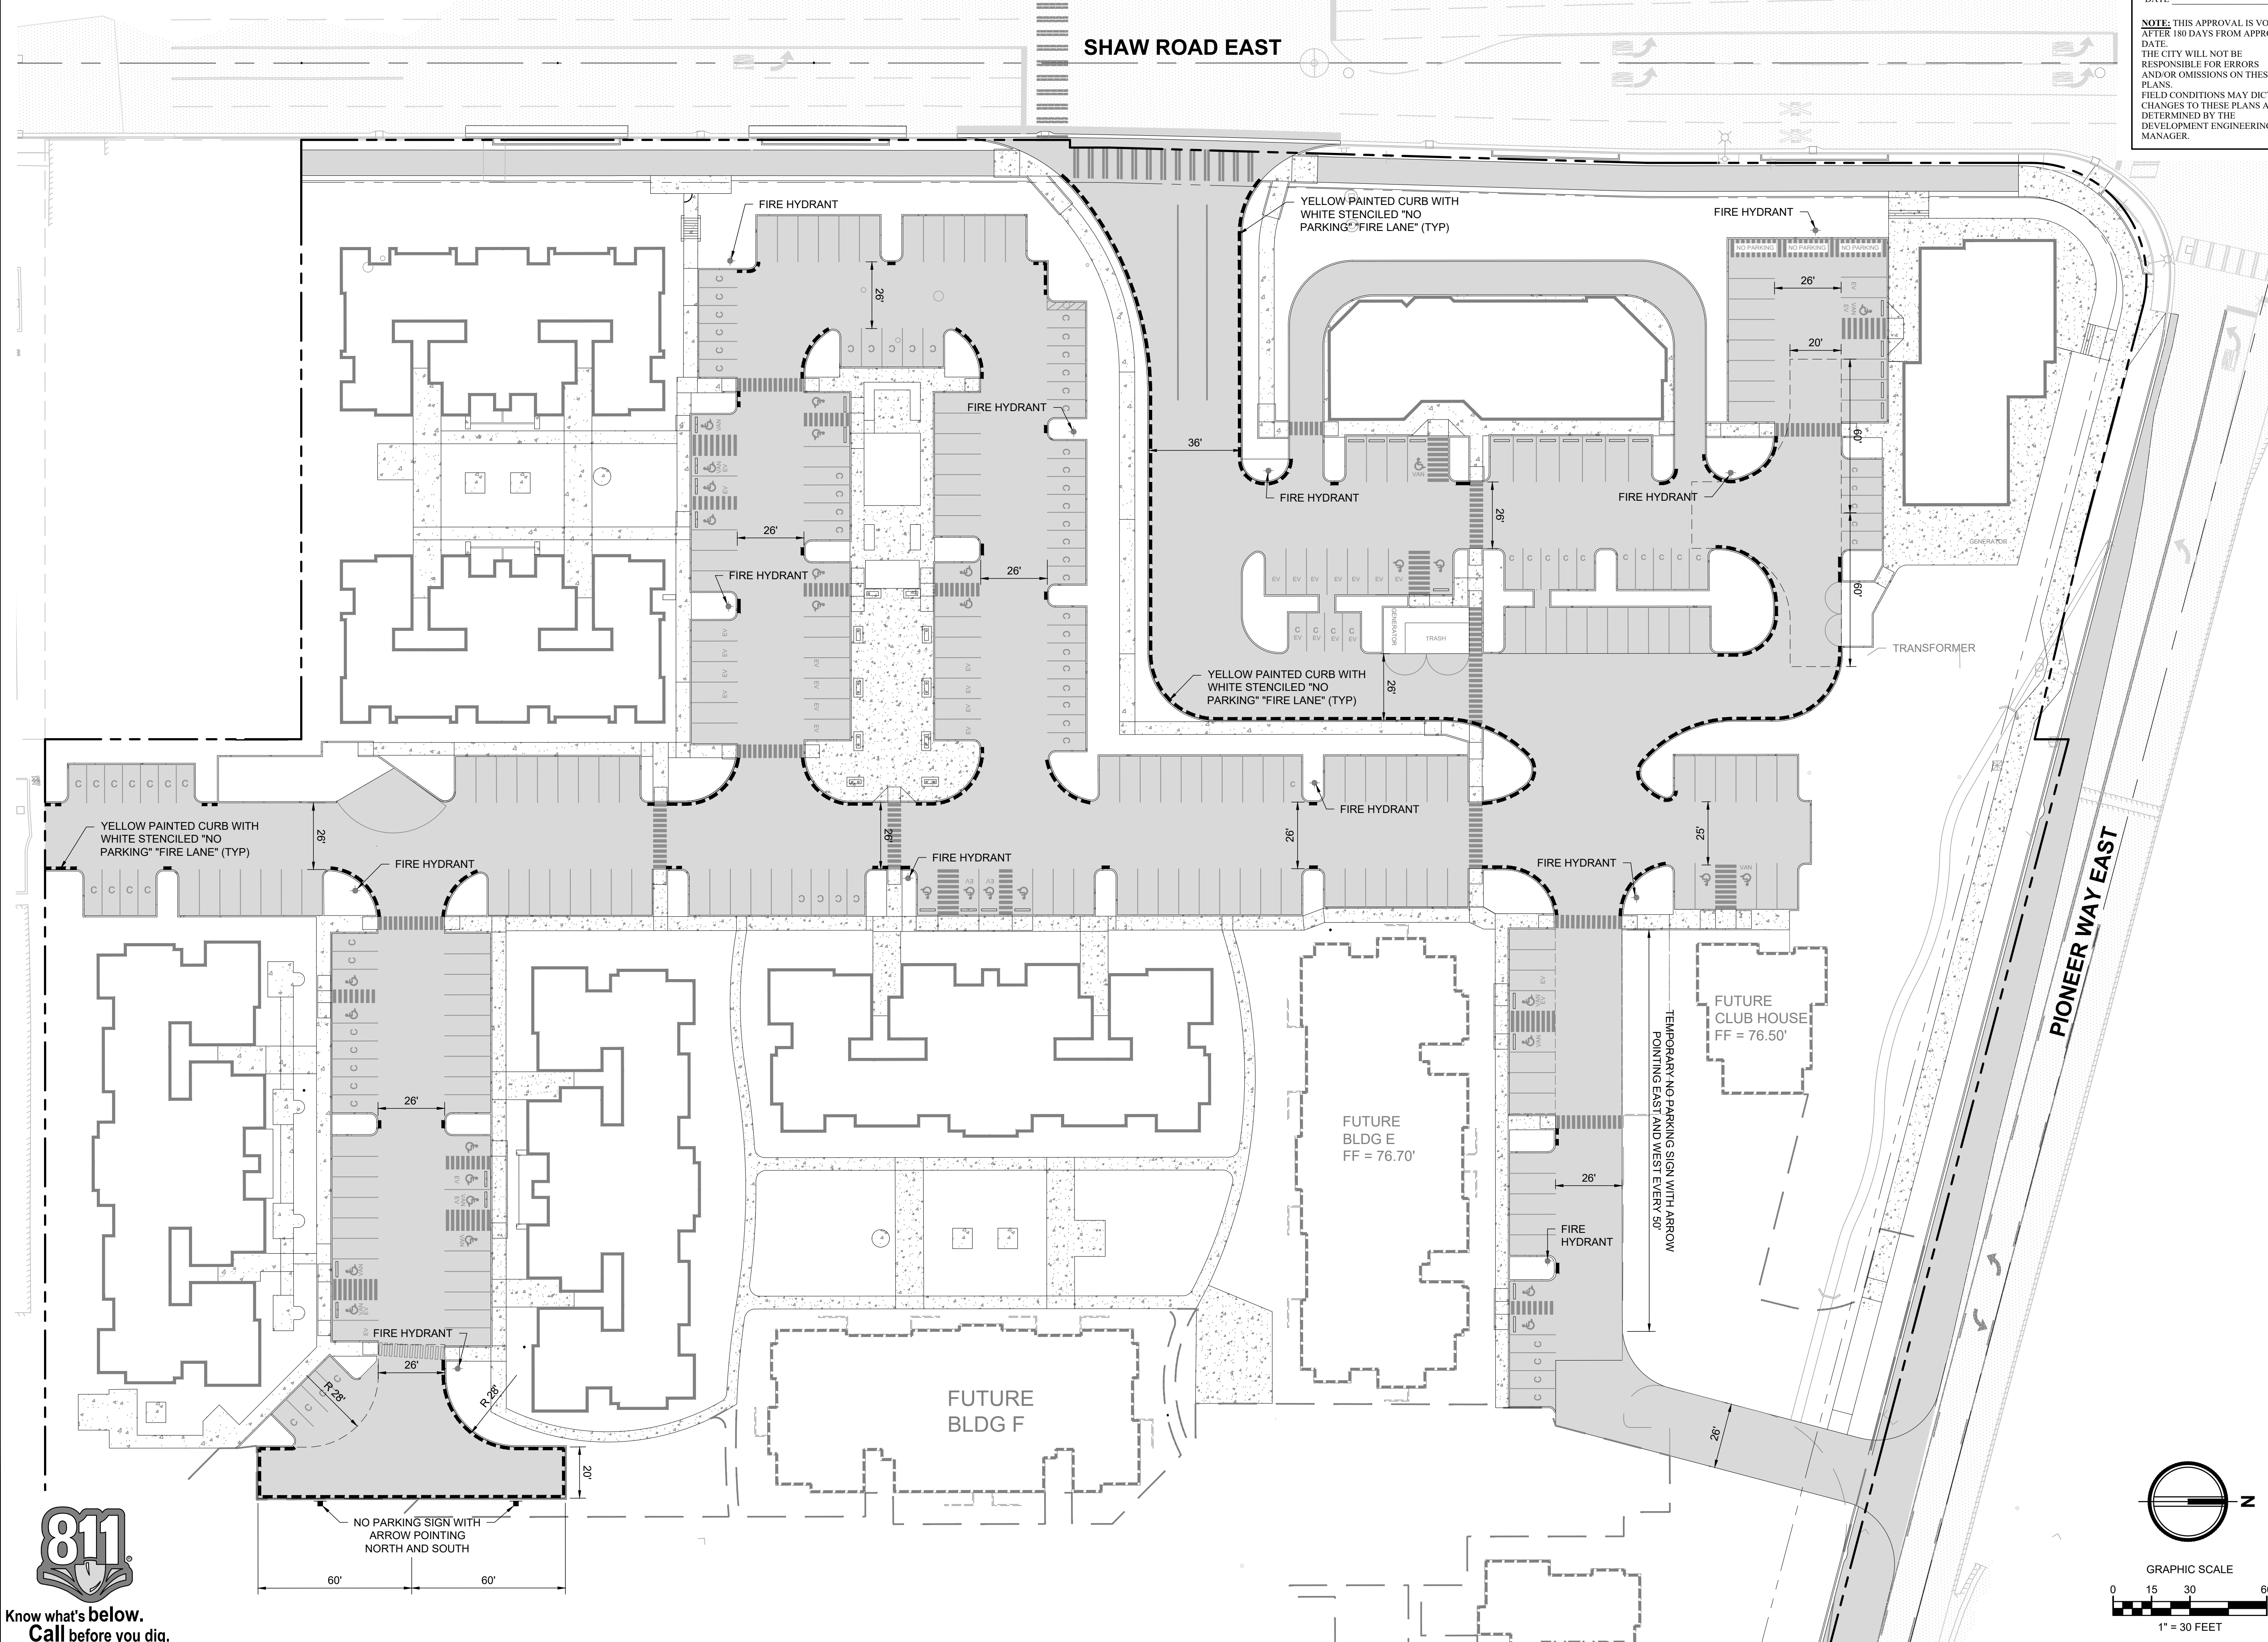

Know what's below.
Call before you dig.

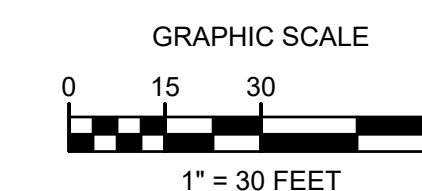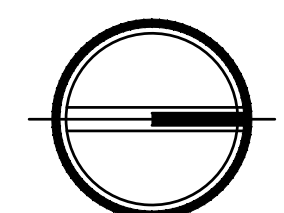

- △
- △
- △

01/29/24 CITY COMMENTS

Revisions:

Sheet Title:

FIRE LANE AND SIGNAGE PLAN

Designed by: CW Drawn by: SK / RS Checked by: JI

Sheet No.

C2.5

8 of 53 Sheets


EAST TOWN CROSSING PHASE 1

SEC. 26,35/ TWP. 20 N./ RGE. 4 E., W.M.

APPROVED

BY: CITY OF PUYALLUP
DEVELOPMENT ENGINEERING

DATE: _____
NOTE: THIS APPROVAL IS VOID AFTER 180 DAYS FROM APPROVAL DATE. THE CITY WILL NOT BE RESPONSIBLE FOR ERRORS AND/OR OMISSIONS ON THESE PLANS. FIELD CONDITIONS MAY DICTATE CHANGES TO THESE PLANS AS DETERMINED BY THE DEVELOPMENT ENGINEERING MANAGER.

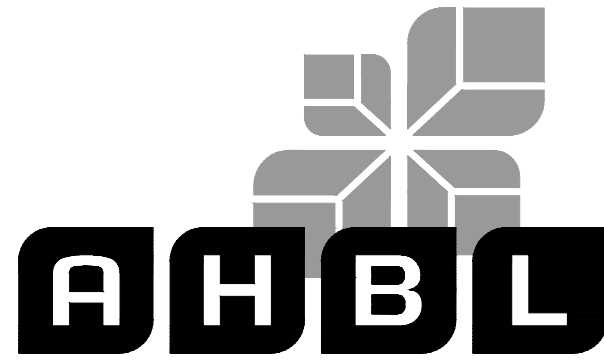

TACOMA · SEATTLE · SPOKANE · TRI-CITIES

2215 North 30th Street, Suite 300, Tacoma, WA 98403
253.383.2422 TEL 253.383.2572 FAX www.ahbl.com WEB

Project Title:

EAST TOWN CROSSING PHASE 1

Client:
ASH DEVELOPMENT

GREG HELLE

GREG.HELLE@ASHNW.COM


Project No.

2230752

Issue Set & Date:

PERMIT SUBMITTAL

02/20/2024

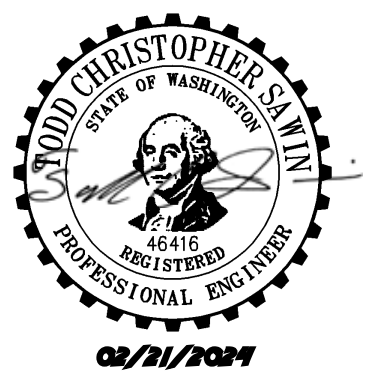

NOTICE: ALTERATION OF THIS DOCUMENT SHALL INVALIDATE THE PROFESSIONAL SEAL AND SIGNATURE. PUBLICATION OF THIS DOCUMENT DOES NOT CONSTITUTE AN ENDORSEMENT OF THE PROJECT OR THE QUALITY OF THE WORK. THIS DOCUMENT IS NOT TO BE USED FOR OTHER PROJECTS OR IN ADDITION TO THAT PROJECT OR FOR ANY OTHER PROJECT.

01/29/24 CITY COMMENTS

Revisions:

Sheet Title:


PAVING NOTES AND DETAILS

Designed by: CW Drawn by: SK/RS Checked by: JI

Sheet No.

C2.6


9 of 53 Sheets

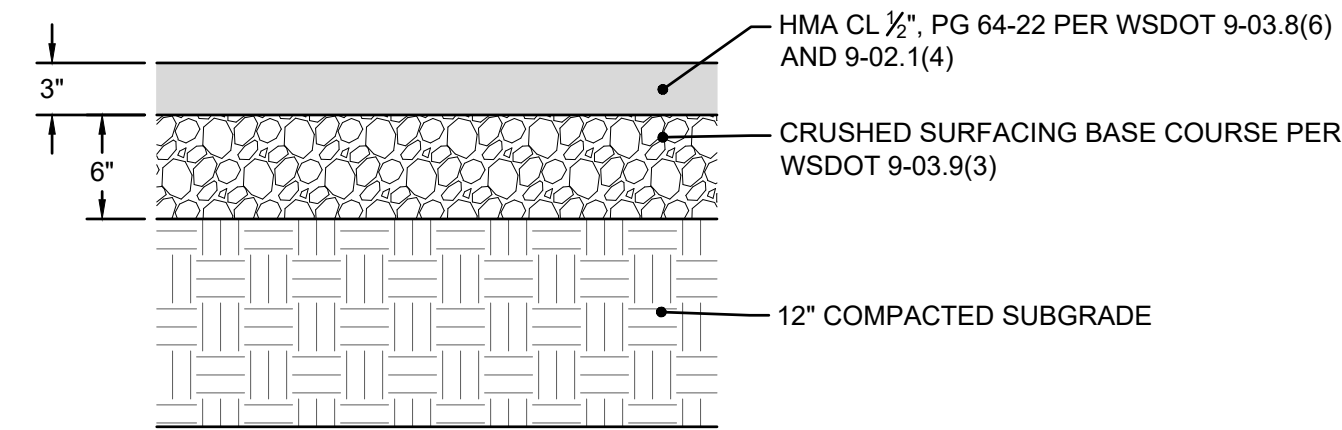

- NOTES:
1. DEPTHS INDICATED ARE COMPACTED THICKNESS.
 2. HMA SHALL BE COMPACTED TO A TARGET AVERAGE DENSITY OF 92% BASED ON THE RICE THEORETICAL MAXIMUM DENSITY PER ASTM D-2041. INDIVIDUAL LOCATIONS SHALL BE COMPACTED NOT LESS THAN 90% NOR MORE THAN 96%.
 3. ALL ASPHALT BASE MATERIAL SHALL BE COMPACTED TO A MINIMUM DENSITY OF 95% BASED ON THE MODIFIED PROCTOR MAXIMUM DRY DENSITY PER ASTM D-1557.
 4. SUBGRADE SHALL BE COMPACTED TO A FIRM AND UNYIELDING CONDITION PRIOR TO PLACEMENT OF ANY PAVEMENT LAYERS. ANY LOCALIZED ZONES OF SOFT, ORGANIC-RICH, OR DEBRIS-LADEN SOILS SHOULD BE OVEREXCAVATED AND REPLACED WITH STRUCTURAL FILL MATERIAL.
 5. SEAL JOINTS WITH EMULSIFIED ASPHALT PER PROJECT SPECIFICATIONS.

1 ASPHALT PAVEMENT - STANDARD DUTY


NOT TO SCALE

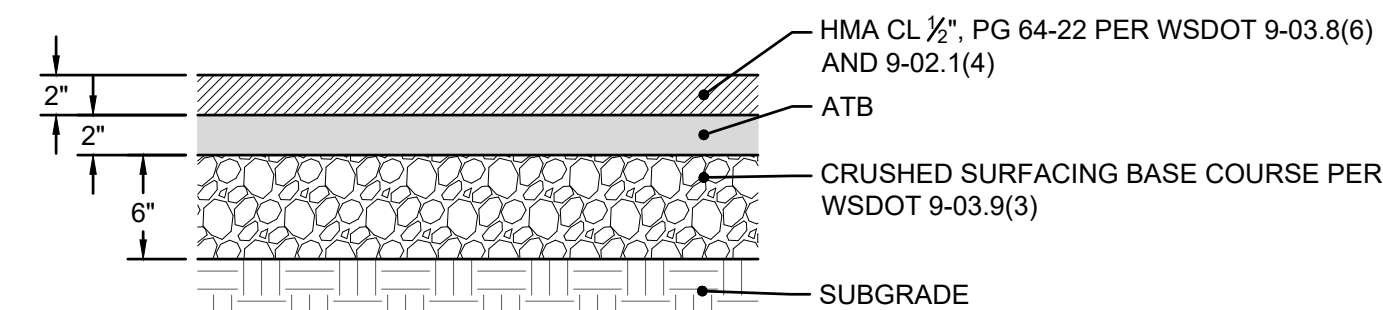

- NOTES:
1. DEPTHS INDICATED ARE COMPACTED THICKNESS.
 2. HMA SHALL BE COMPACTED TO A TARGET AVERAGE DENSITY OF 92% BASED ON THE RICE THEORETICAL MAXIMUM DENSITY PER ASTM D-2041. INDIVIDUAL LOCATIONS SHALL BE COMPACTED NOT LESS THAN 90% NOR MORE THAN 96%.
 3. ALL ASPHALT BASE MATERIAL SHALL BE COMPACTED TO A MINIMUM DENSITY OF 95% BASED ON THE MODIFIED PROCTOR MAXIMUM DRY DENSITY PER ASTM D-1557.
 4. SUBGRADE SHALL BE COMPACTED TO A FIRM AND UNYIELDING CONDITION PRIOR TO PLACEMENT OF ANY PAVEMENT LAYERS. ANY LOCALIZED ZONES OF SOFT, ORGANIC-RICH, OR DEBRIS-LADEN SOILS SHOULD BE OVEREXCAVATED AND REPLACED WITH STRUCTURAL FILL MATERIAL.
 5. SEAL JOINTS WITH EMULSIFIED ASPHALT PER PROJECT SPECIFICATIONS.

2 ASPHALT PAVEMENT - ATB

NOT TO SCALE

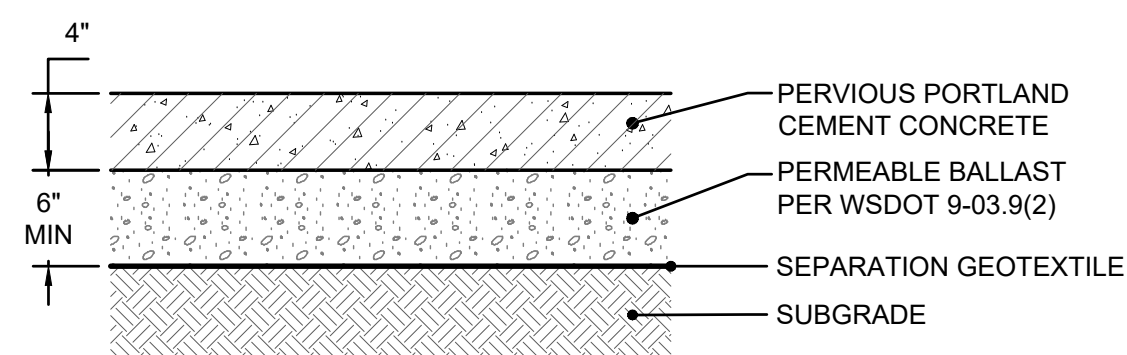


CONCRETE MIX DESIGN

- UNIT WEIGHT: 120 TO 130 POUNDS PER CUBIC FOOT (PERMEABLE CONCRETE IS APPROXIMATELY 70 TO 80 PERCENT OF THE UNIT WEIGHT OF CONVENTIONAL CONCRETE) (FCPA, N.D.)
- VOID SPACE: 15 TO 21 PERCENT ACCORDING TO ASTM C 138.
- WATER CEMENT RATIO: 0.27 TO 0.35.
- AGGREGATE TO CEMENT RATIO: 4:1 TO 4.5:1
- AGGREGATE: USE EITHER:
3/8" - INCH TO NO. 16 WASHED CRUSHED OR ROUND PER ASTM C 35 OR
3/8" - INCH TO NO. 50 WASHED CRUSHED OR ROUND PER ASTM D 448.

- PORTLAND CEMENT: TYPE I OR II CONFORMING TO ASTM C 150 OR TYPE IP OR IS CONFORMING TO ASTM C 595.
- ADMIXTURES: CAN BE USED TO INCREASE WORKING TIME AND INCLUDE: WATER REDUCING/RETARDING ADMIXTURE
 - IN CONFORMANCE WITH ASTM C 494 TYPE D AND HYDRATION STABILIZER IN CONFORMANCE WITH ASTM C494 TYPE B.
 - WATER: USE POTABLE WATER.
 - FIBER MESH CAN BE INCORPORATED INTO THE CEMENT MIX FOR ADDED STRENGTH.
 - PROVIDE JOINTS AT 15' O.C. - PROVIDE DOWEL BARS 1 1/2" x 18" LONG ON 18" CENTERS ON TRANSVERSE JOINTS AND #5 TIE BARS x 30" LONG ON 36" CENTERS ON LONGITUDINAL JOINTS PER WSDOT A-40.10-04.

3 PERVIOUS CEMENT CONCRETE


NOT TO SCALE

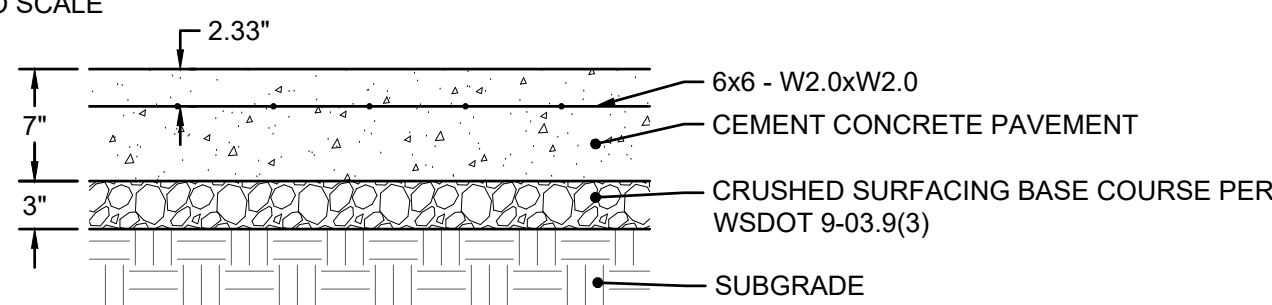

- NOTES:
1. DEPTHS INDICATED ARE COMPACTED THICKNESSES.
 2. CEMENT CONCRETE PAVEMENT SHALL CONSIST OF PORTLAND CEMENT CONCRETE WITH A MINIMUM COMPRESSIVE STRENGTH OF 4000 PSI AND A MINIMUM RUPTURE MODULUS OF 580 PSI.
 3. GRANULAR SUBBASE SHALL CONSIST OF "BALLAST" PER WSDOT 9-03.9(1), "GRAVEL BORROW" PER WSDOT 9-03.14, OR CRUSHED RECYCLED CONCRETE PROVIDED THAT IT MEETS THE SAME TEXTURAL CRITERIA AS "BALLAST" OR "GRAVEL BORROW".
 4. ALL BASE MATERIAL SHALL BE COMPACTED TO A MINIMUM DENSITY OF 95% BASED ON THE MODIFIED PROCTOR MAXIMUM DRY DENSITY PER ASTM D-1557.
 5. SUBGRADE SHALL BE COMPACTED TO A FIRM AND UNYIELDING CONDITION PRIOR TO PLACEMENT OF ANY PAVEMENT LAYERS. ANY LOCALIZED ZONES OF SOFT, ORGANIC-RICH, OR DEBRIS-LADEN SOILS SHOULD BE OVEREXCAVATED AND REPLACED WITH STRUCTURAL FILL MATERIAL.

4 CEMENT CONCRETE - HEAVY DUTY


NOT TO SCALE

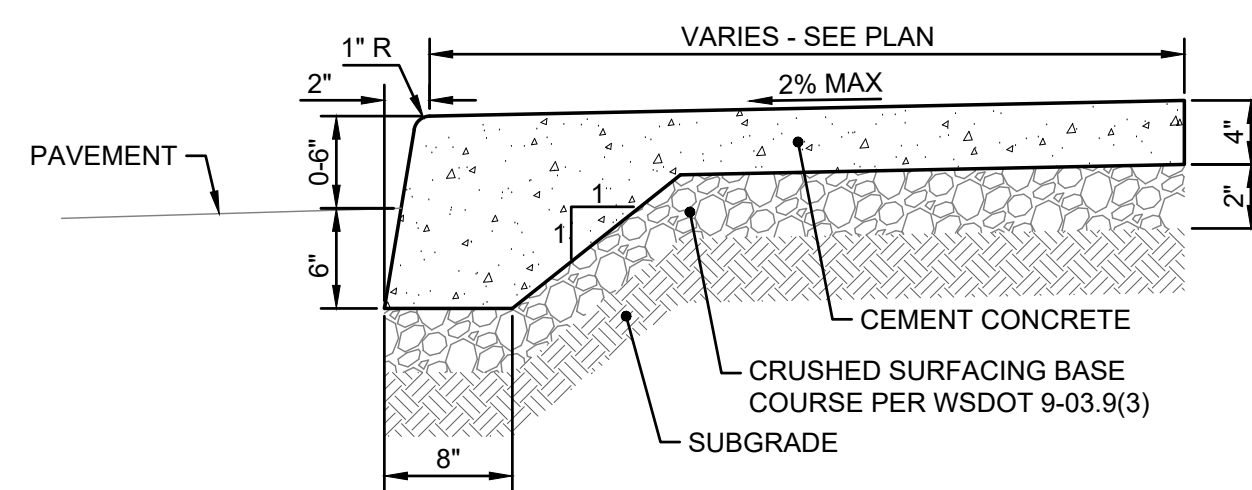

- NOTES:
1. DEPTHS INDICATED ARE COMPACTED THICKNESSES.
 2. CEMENT CONCRETE PAVEMENT SHALL CONSIST OF PORTLAND CEMENT CONCRETE WITH A MINIMUM COMPRESSIVE STRENGTH OF 4000 PSI AND A MINIMUM RUPTURE MODULUS OF 580 PSI.
 3. ALL BASE MATERIAL SHALL BE COMPACTED TO A MINIMUM DENSITY OF 95% BASED ON THE MODIFIED PROCTOR MAXIMUM DRY DENSITY PER ASTM D-1557.
 4. SUBGRADE SHALL BE COMPACTED TO A FIRM AND UNYIELDING CONDITION PRIOR TO PLACEMENT OF ANY PAVEMENT LAYERS. ANY LOCALIZED ZONES OF SOFT, ORGANIC-RICH, OR DEBRIS-LADEN SOILS SHOULD BE OVEREXCAVATED AND REPLACED WITH STRUCTURAL FILL MATERIAL.
 5. EXPANSION JOINTS SHALL BE AT 10' INTERVALS OR AS SHOWN ON THE ARCHITECTURAL PLANS.
 6. RECYCLED CONCRETE IS NOT ACCEPTABLE.


5 INTEGRAL CURB

NOT TO SCALE

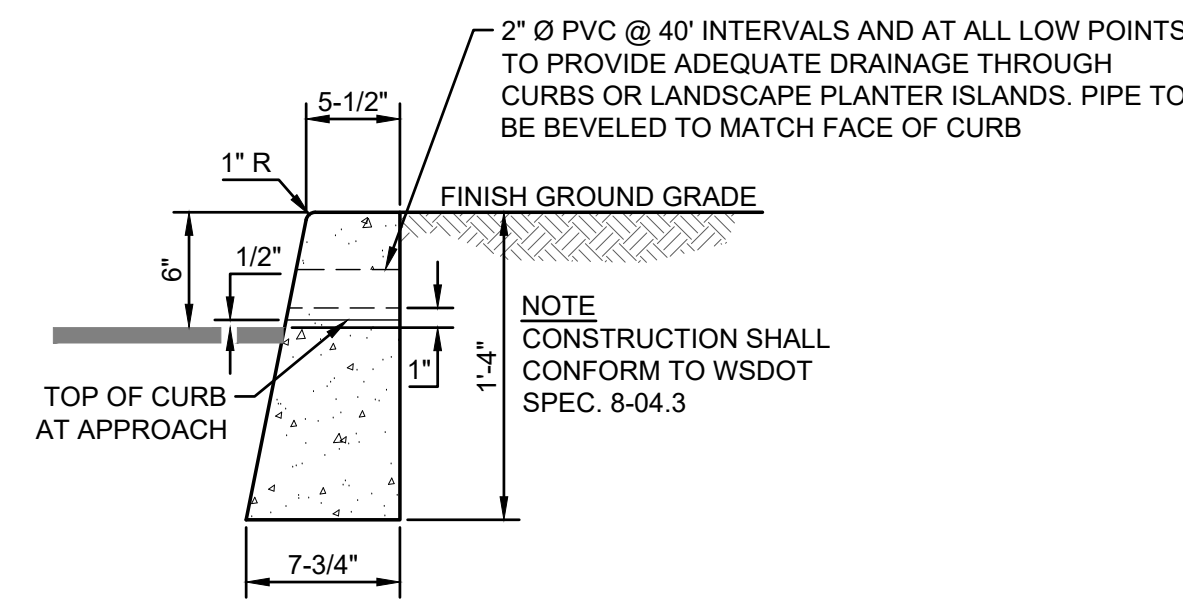


6 VERTICAL CURB

NOT TO SCALE

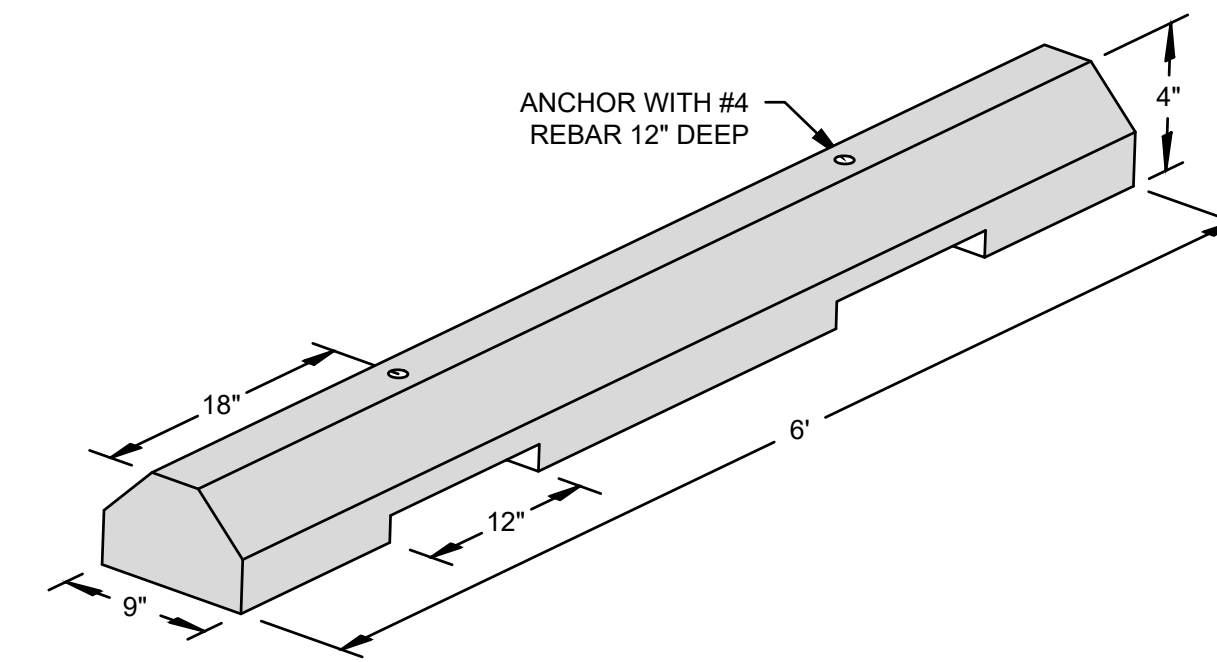

7 CONCRETE WHEEL STOP


NOT TO SCALE

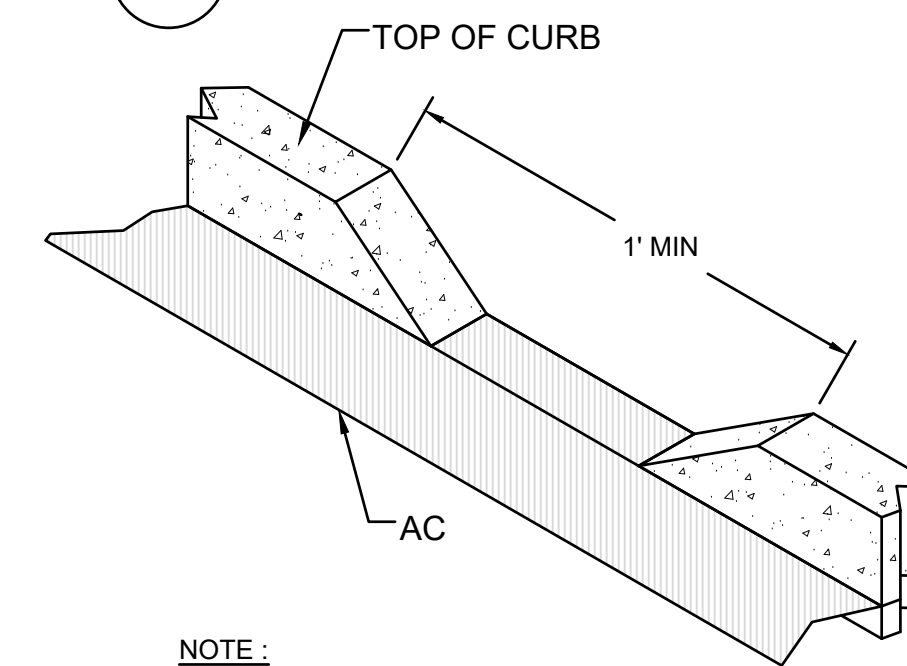

- NOTE:
INTENT OF CURB CUTS LOCATIONS IS TO BE AT LOW POINTS OF ASPHALT EDGE TO ENSURE PONDING DOES NOT OCCUR. CONTRACTOR SHALL ADJUST LOCATION IN FIELD AS NECESSARY.

8 CURB CUT


NOT TO SCALE

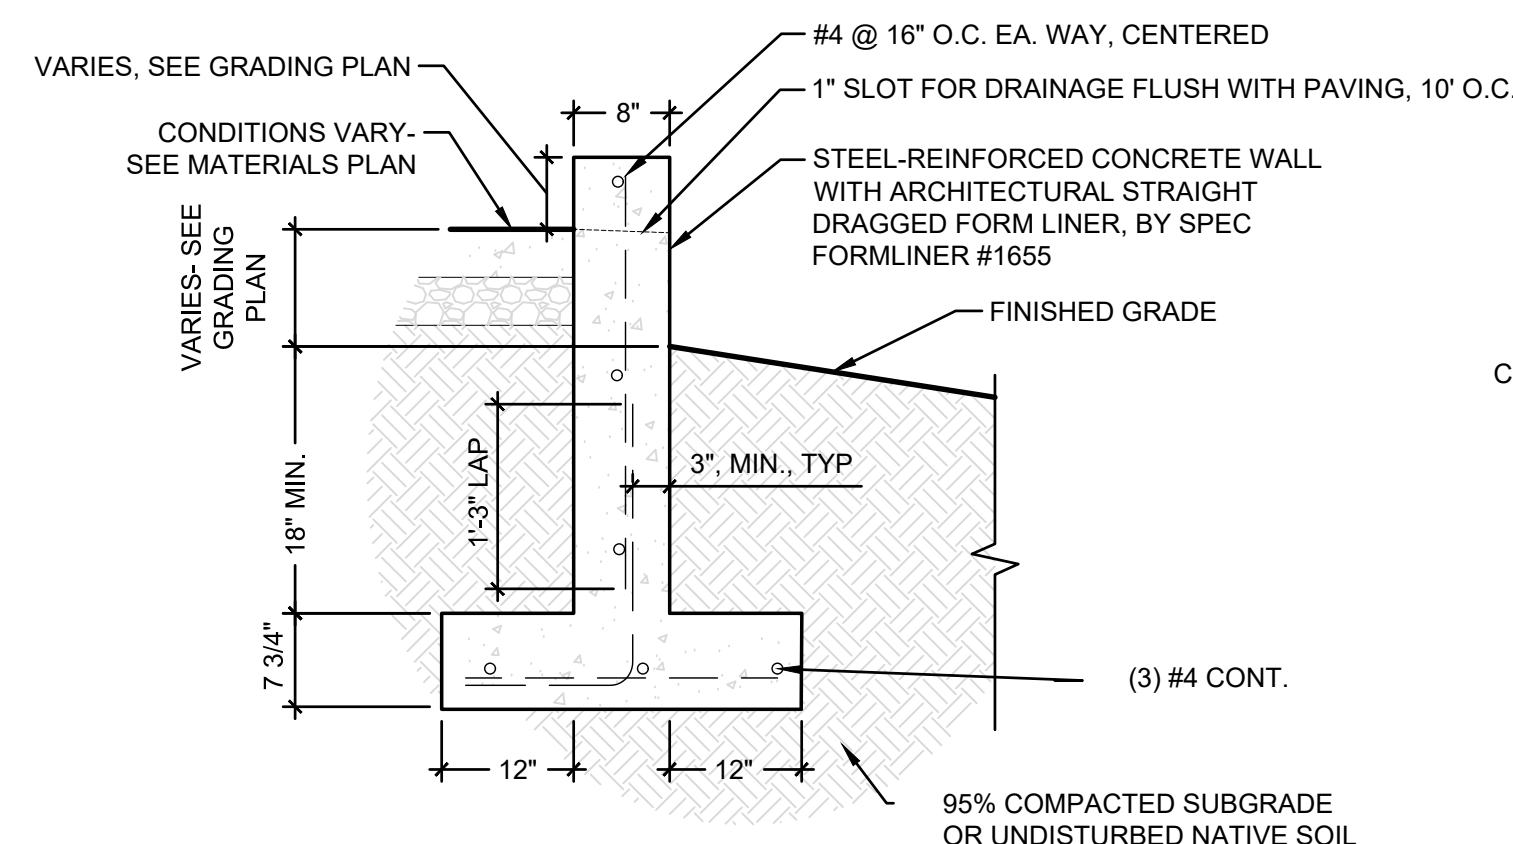

- NOTES:
1. KEEP TOP LEVEL
 2. MAX WALL HEIGHT 3'-0". SEE STRUCTURAL FOR WALLS ABOVE 3'-0"
 3. WALLS OVER 4'-0" REQUIRE SEPARATE BUILDING PERMIT.

9 CONCRETE RETAINING WALL

NOT TO SCALE

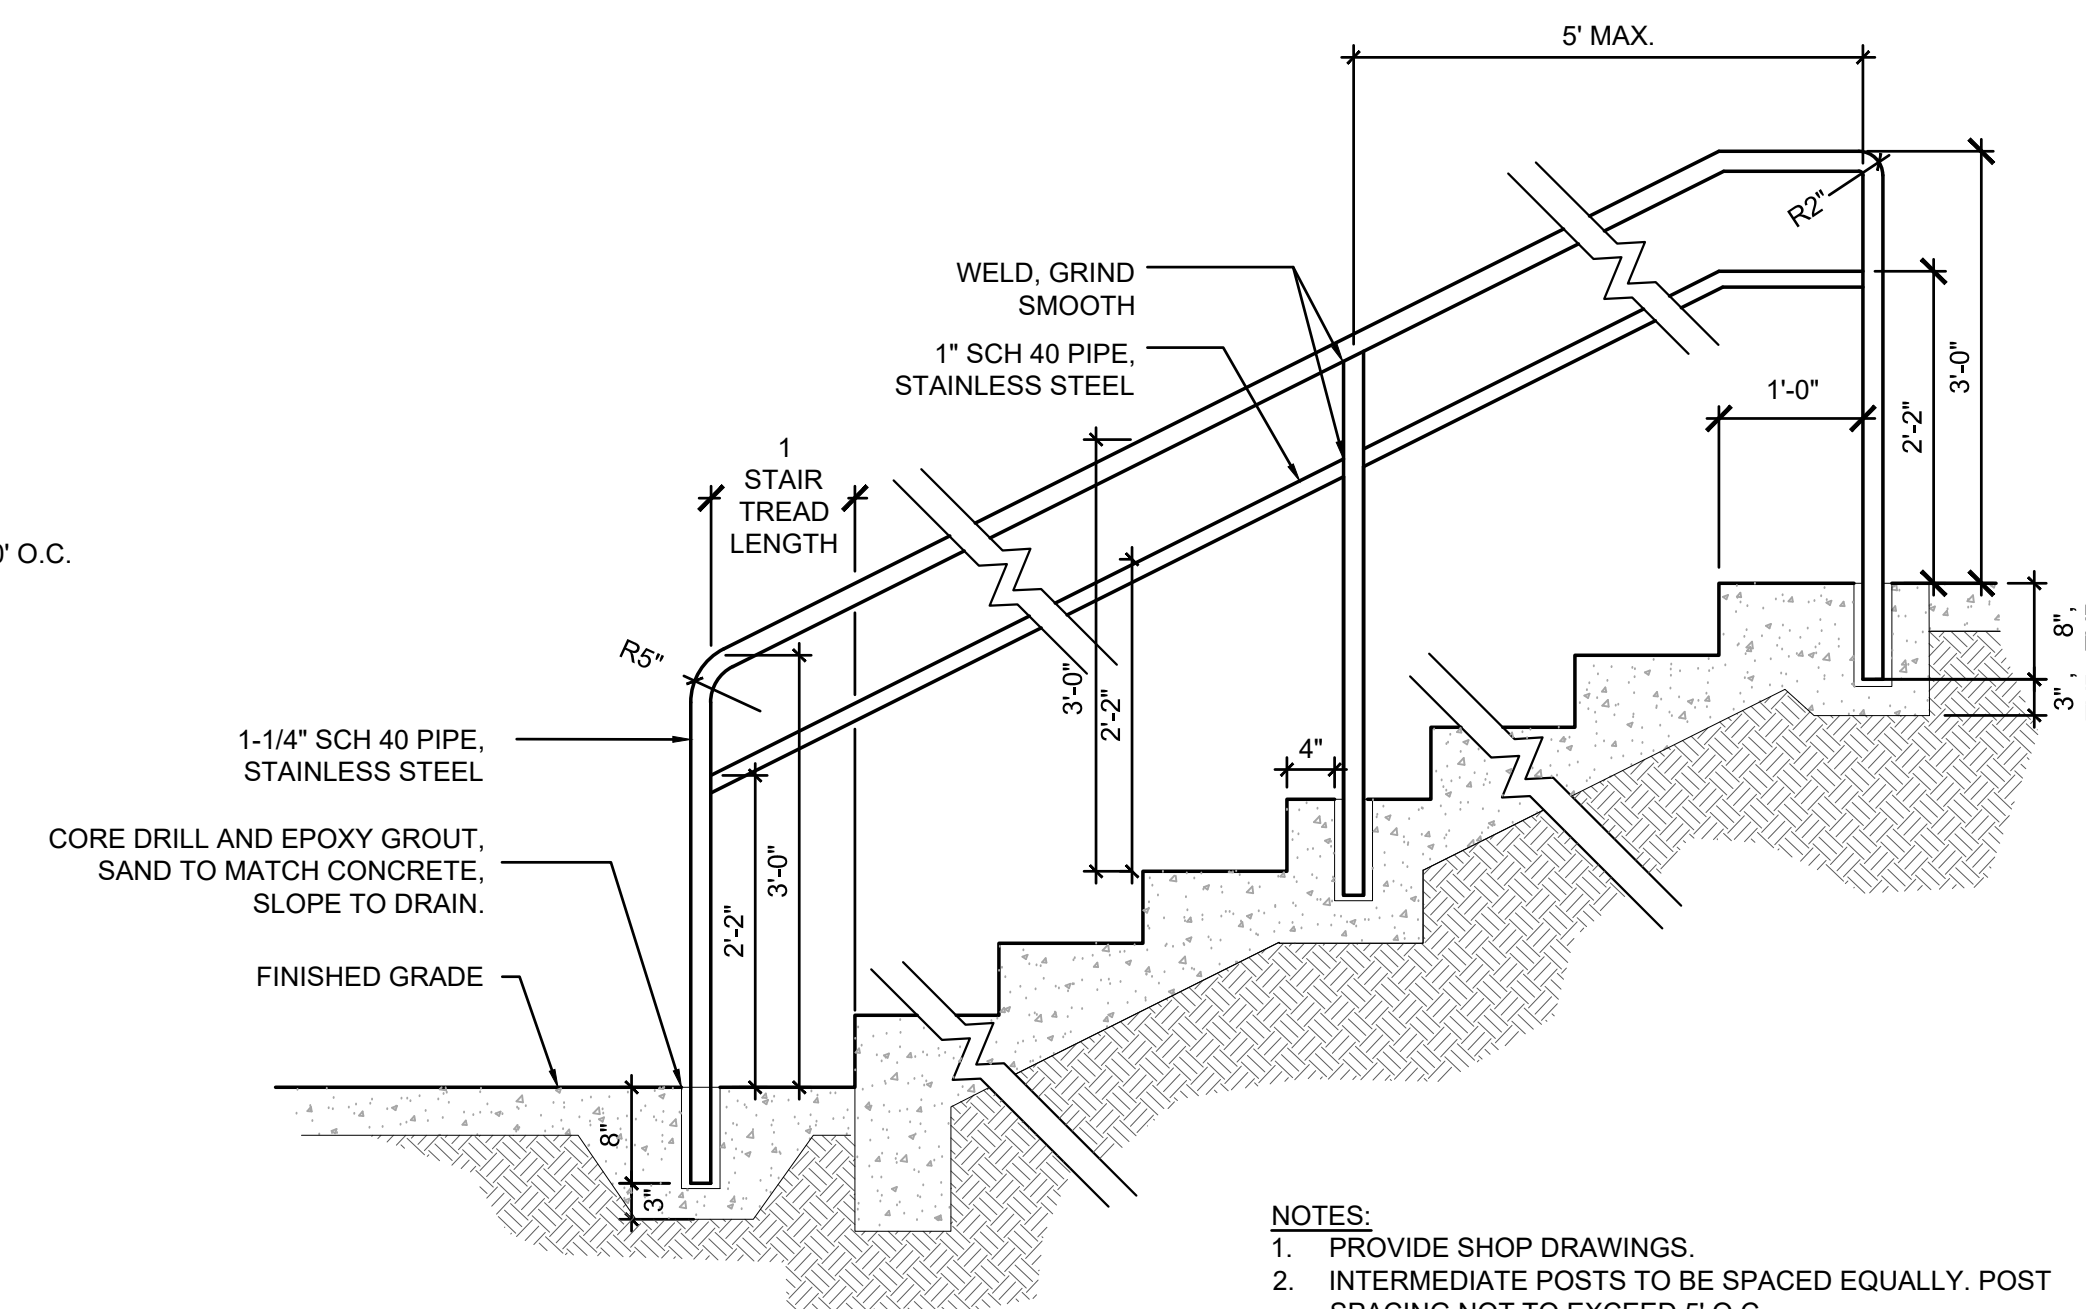

- NOTES:
1. PROVIDE SHOP DRAWINGS.
 2. INTERMEDIATE POSTS TO BE SPACED EQUALLY. POST SPACING NOT TO EXCEED 5' O.C.

10 CONCRETE STAIRS AND HANDRAILS

NOT TO SCALE



Know what's below.
Call before you dig.


EAST TOWN CROSSING PHASE 1

SEC. 26,35/ TWP. 20 N./ RGE. 4 E., W.M.

APPROVED

BY: CITY OF PUYALLUP
DEVELOPMENT ENGINEERING
DATE:

NOTE: THIS APPROVAL IS VOID AFTER 180 DAYS FROM APPROVAL DATE. THE CITY WILL NOT BE RESPONSIBLE FOR ERRORS AND/OR OMISSIONS ON THESE PLANS. FIELD CONDITIONS MAY DICTATE CHANGES TO THESE PLANS AS DETERMINED BY THE DEVELOPMENT ENGINEERING MANAGER.

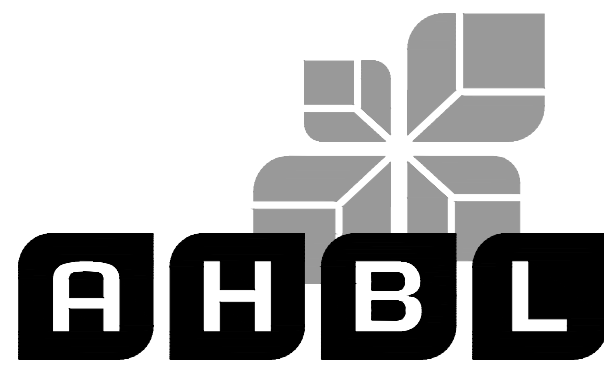

TACOMA · SEATTLE · SPOKANE · TRI-CITIES

2215 North 30th Street, Suite 300, Tacoma, WA 98403
253.383.2422 TEL. 253.383.2572 FAX www.ahbl.com WEB

Project Title:

EAST TOWN CROSSING PHASE 1

Client:

ASH DEVELOPMENT

GREG HELLE

GREG.HELLE@ASHNW.COM


Project No.

2230752

Issue Set & Date:

PERMIT SUBMITTAL

02/20/2024

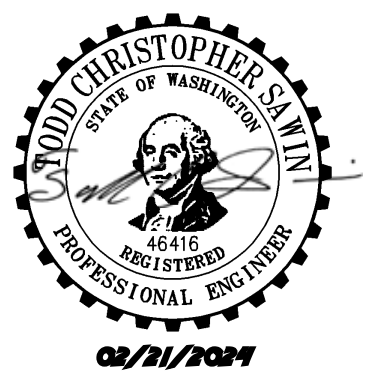

NOTICE: ALTERATION OF THIS DOCUMENT SHALL INVALIDATE THE PROFESSIONAL SEAL AND SIGNATURE PUBLICATION OF THIS DOCUMENT DOES NOT CONSTITUTE A REVIEW. CHECKING ENGINEER'S SEAL AND SIGNATURE IS FOR USE ONLY FOR THE PROJECT ENTITLED IN THE TITLE BLOCK AND IS NOT TO BE USED FOR OTHER PROJECTS OR ACTION TO THAT PROJECT OR FOR ANY OTHER PROJECT.

△

△

△

△ 01/29/24 CITY COMMENTS

Revisions:

Sheet Title:





PAVING NOTES AND DETAILS

Designed by: CW Drawn by: SK / RS Checked by: JI

Sheet No.

C2.7

10 of 53 Sheets

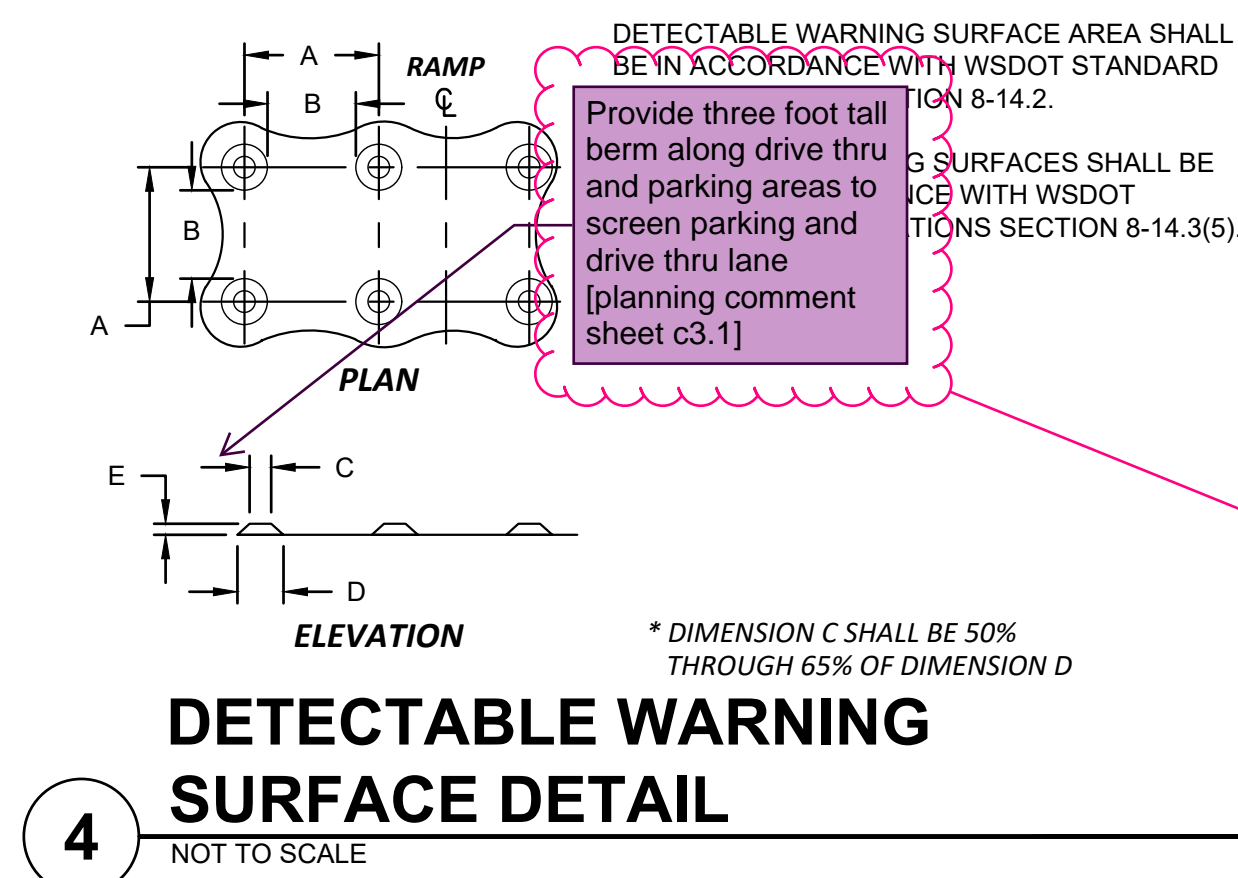
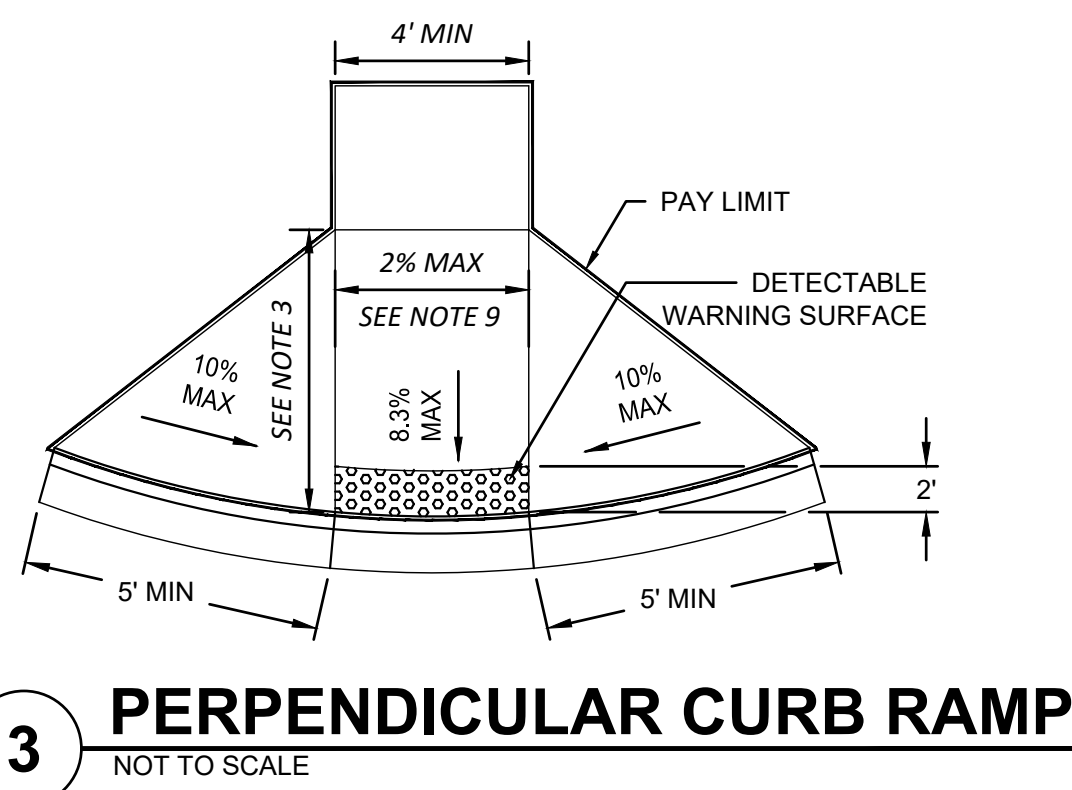
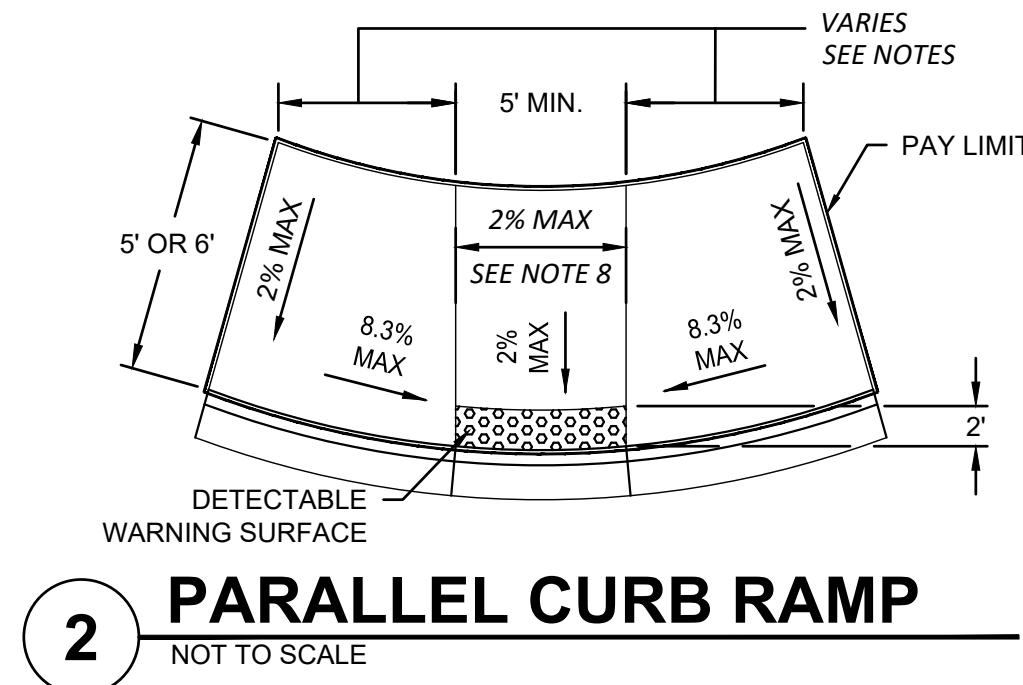
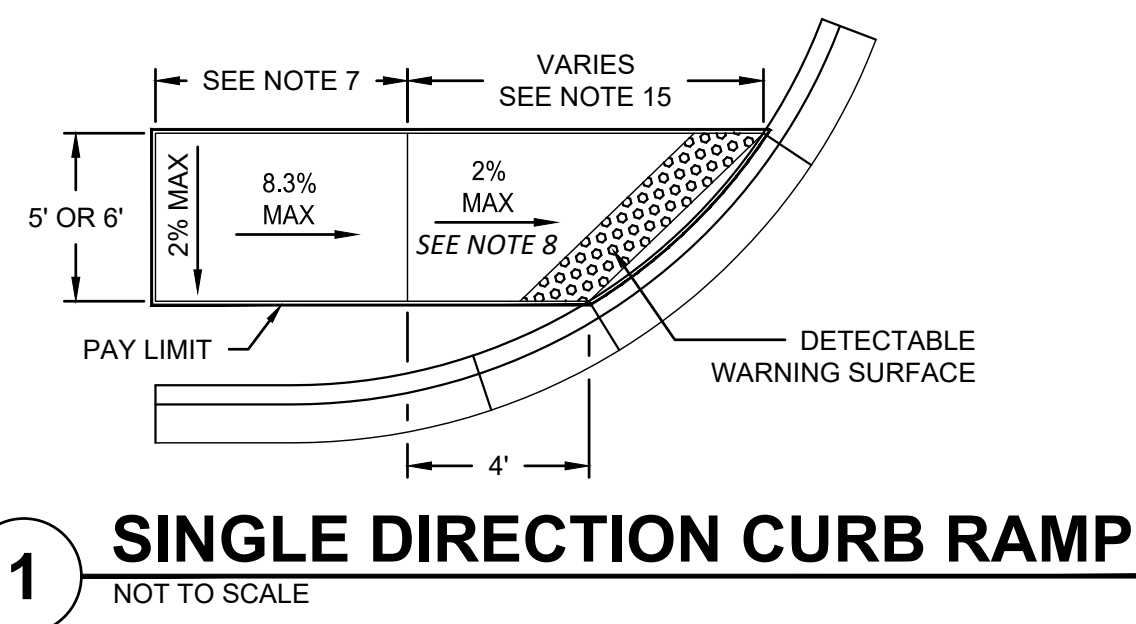


CURB RAMP NOTES:

- CURB RAMP ARE TYPICALLY CENTERED AT THE 1/4 RADIUS POINTS.
- CURB TO BE FLUSH WITH ADJACENT ROADWAY SURFACE. THE BID ITEM DOES NOT INCLUDE THE CURB AND GUTTER.
- PERPENDICULAR RAMP LENGTH IS MEASURED FROM BACK OF CURB.
- PARALLEL RAMP LENGTHS VARY FROM 6' MIN. TO 15' MAX.
- IF SIGNAL POLE EXISTS, PARALLEL CURB RAMP SHALL INCLUDE THE CONCRETE AREA AROUND THE SIGNAL POLE. SIDEWALK DEPTH SHALL BE 6" FROM PC TO PT. SEE STANDARD DRAWING PC.J1.2 FOR ADDITIONAL DETAILS.
- ADJUST RAMP LENGTHS TO MEET ADA REQUIREMENTS 8.3% MAX GRADE, 15' MAX LENGTH.
- SEE WSDOT STANDARD PLAN F-40.16-03 NOTE 8.
- LANDINGS SHALL HAVE A 2% MAX. GRADE IN EACH DIRECTION, EXCEPT AT MIDBLOCK CROSSINGS WHERE THEY MAY MATCH THE GRADE OF THE ROADWAY.
- PERPENDICULAR CURB RAMP SHALL HAVE A 2% MAX. CROSS SLOPE, EXCEPT AT MIDBLOCK CROSSINGS WHERE IT MAY MATCH THE GRADE OF THE ROADWAY.
- THE ROWS OF TRUNCATED DOMES IN DETECTABLE WARNING SURFACES SHALL BE ALIGNED PERPENDICULAR TO THE GRADE BREAK AT THE BACK OF CURB.
- CURB RAMP CANNOT BE PERVIOUS MATERIAL.
- SEE THE CURRENT EDITION OF WSDOT STANDARD PLAN F-10.12 FOR PEDESTRIAN CURB DETAILS.
- FOR RESIDENTIAL DRIVEWAY APPROACHES PARALLEL CURB RAMP SHALL BE 2' MIN. FROM THE DRIVEWAY APPROACH.
- TO AVOID OBSTACLES, CURB RAMP OPPOSITE THE RETURNED CURBS AT "T" INTERSECTIONS MAY BE PLACED AT A SKEW OF 5° MAX FROM AN ALIGNMENT PERPENDICULAR TO THE CENTERLINE
- IF DISTANCE IS LESS THAN 5 FT BETWEEN LANDING AND BACK OF CURB, THE DETECTABLE WARNING STRIP SHALL BE PLACED AT THE BOTTOM OF THE RAMP.

Added berm in front of drive thru area. Due to space limitations, a solid fence is proposed in front of the parking areas. This meets the requirements for Ch 20.30 C Commercial Zones acceptable screening materials of PMC. Landscaping will also be provided

Drive-through window lanes and facilities shall be oriented away from residential zones, and shall be screened from residential zones and public streets to obscure vehicle headlight from shining directly into public streets or residential zones. Required screening shall be a minimum height of three feet above the grade of the drive, and shall be sufficiently dense to obscure at least 80 percent of vehicle headlights prior to occupancy and use, and 100 percent of vehicle headlights within one year of occupancy and use. Acceptable screening materials shall include the use of building walls, berms, landscaping and/or solid fencing. (Ord. 3073 § 18, 2014; Ord. 2866 § 3, 2006; Ord. 2826 § 6, 2005; Ord. 2694 § 5, 2001; Ord. 2615 § 1, 1999; Ord. 2563 § 1, 1998; Ord. 2454 § 1, 1995; Ord. 2393 § 1, 1994; Ord. 2316 § 1, 1992; Ord. 2196 § 4, 1989; Ord. 2147 Exh. A, 1987).

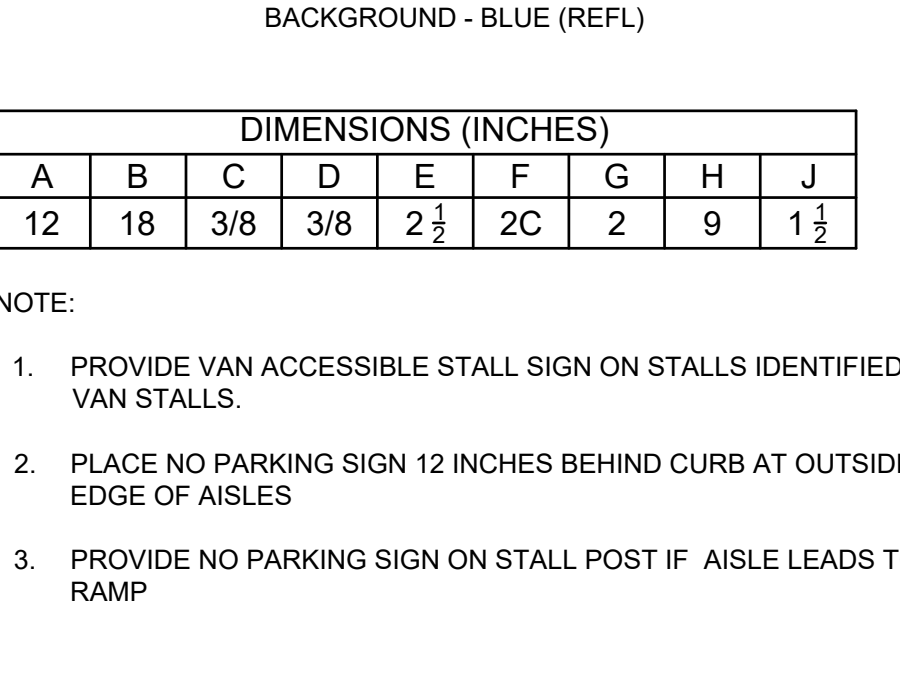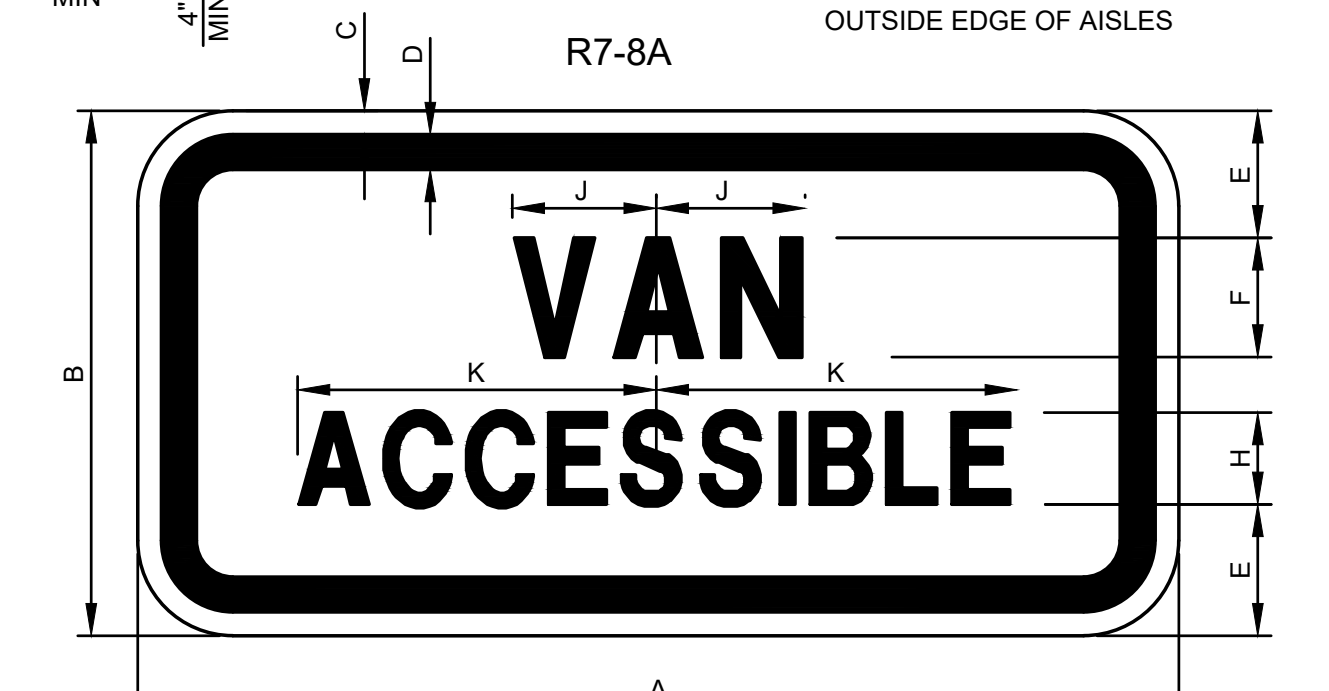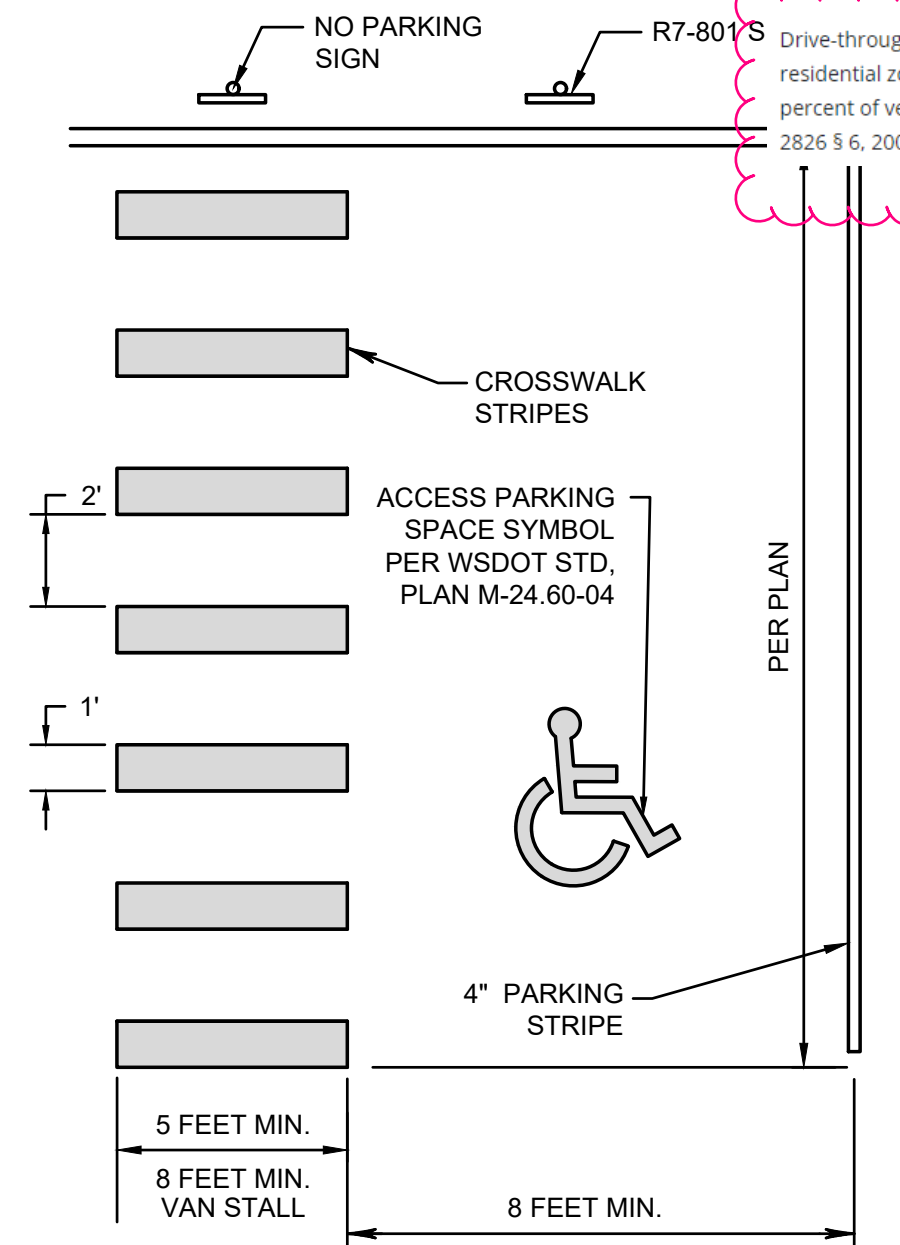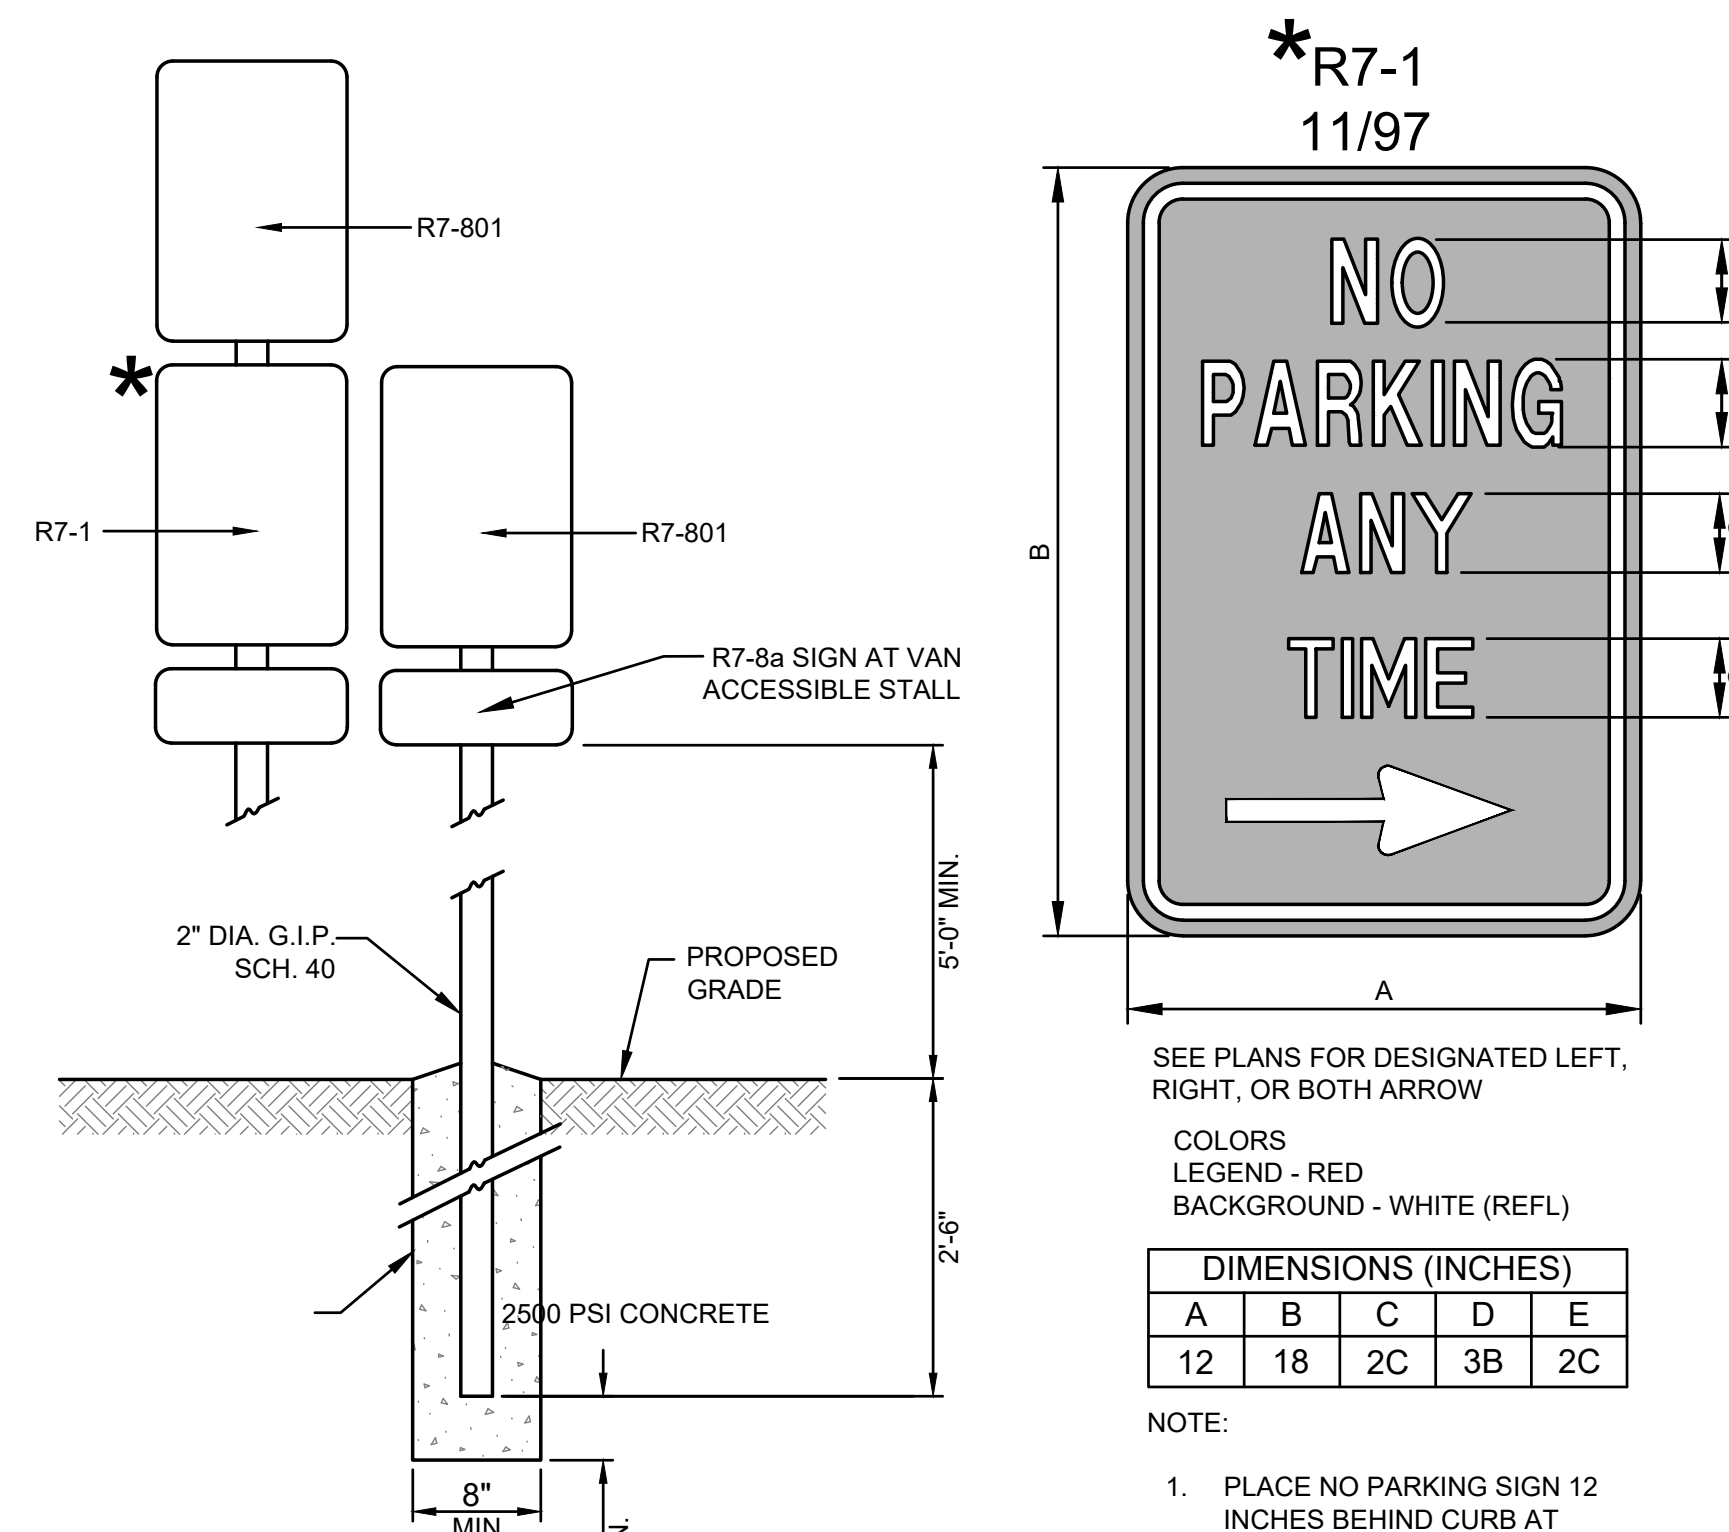

811
Know what's below.
Call before you dig.

5 ACCESSIBLE PARKING STALL AND SIGNAGE
NOT TO SCALE

EAST TOWN CROSSING PHASE 1



SEC. 26,35/ TWP. 20 N./ RGE. 4 E., W.M.

APPROVED

BY: CITY OF PUYALLUP
DEVELOPMENT ENGINEERING

DATE:

NOTE: THIS APPROVAL IS VOID AFTER 180 DAYS FROM APPROVAL DATE. THE CITY WILL NOT BE RESPONSIBLE FOR ERRORS AND/OR OMISSIONS ON THESE PLANS. FIELD CONDITIONS MAY DICTATE CHANGES TO THESE PLANS AS DETERMINED BY THE DEVELOPMENT ENGINEERING MANAGER.

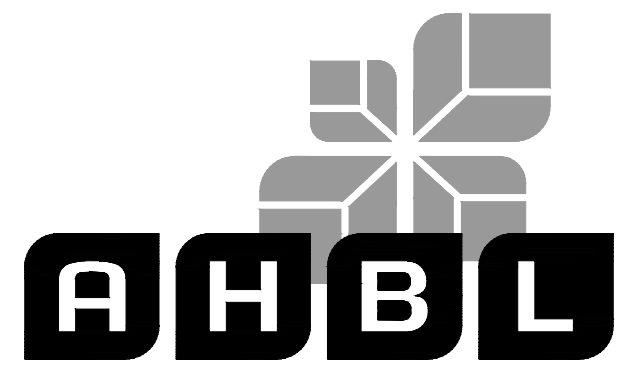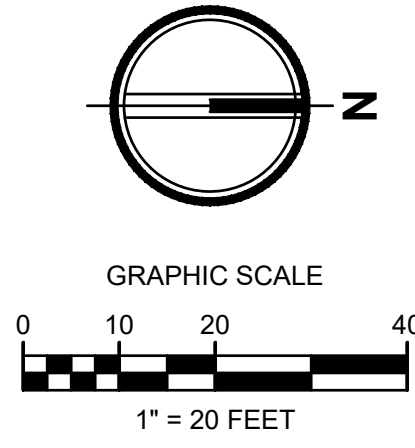

TACOMA · SEATTLE · SPOKANE · TRI-CITIES

2215 North 30th Street, Suite 300, Tacoma, WA 98403
253.383.2422 TEL 253.383.2572 FAX www.ahbl.com WEB

Project Title:

EAST TOWN CROSSING PHASE 1

Client:

ASH DEVELOPMENT


GREG HELLE
GREG.HELLE@ASHNW.COM

Project No.:


2230752

Issue Set & Date:

PERMIT SUBMITTAL
02/20/2024

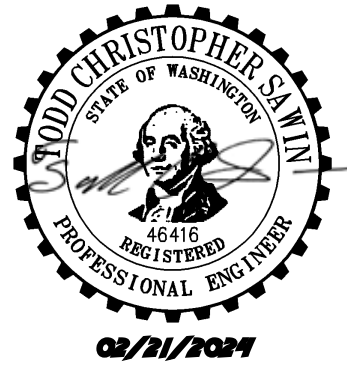

NOTICE:
ALTERNATION OF THIS DOCUMENT SHALL INDICATE THE PROFESSIONAL SEAL AND SIGNATURE PUBLICATION OF THE DOCUMENT DOES NOT REMOVE FROM REGISTERED ENGINEER PROJECTS IN THE ORIGINAL OR REVISED ONLY FOR THE PROJECT EXERCISED IN THE TITLE BLOCK AND IS NOT TO BE USED FOR OTHER, RELATED, OR ACTION TO THAT PROJECT OR FOR ANY OTHER PROJECT.

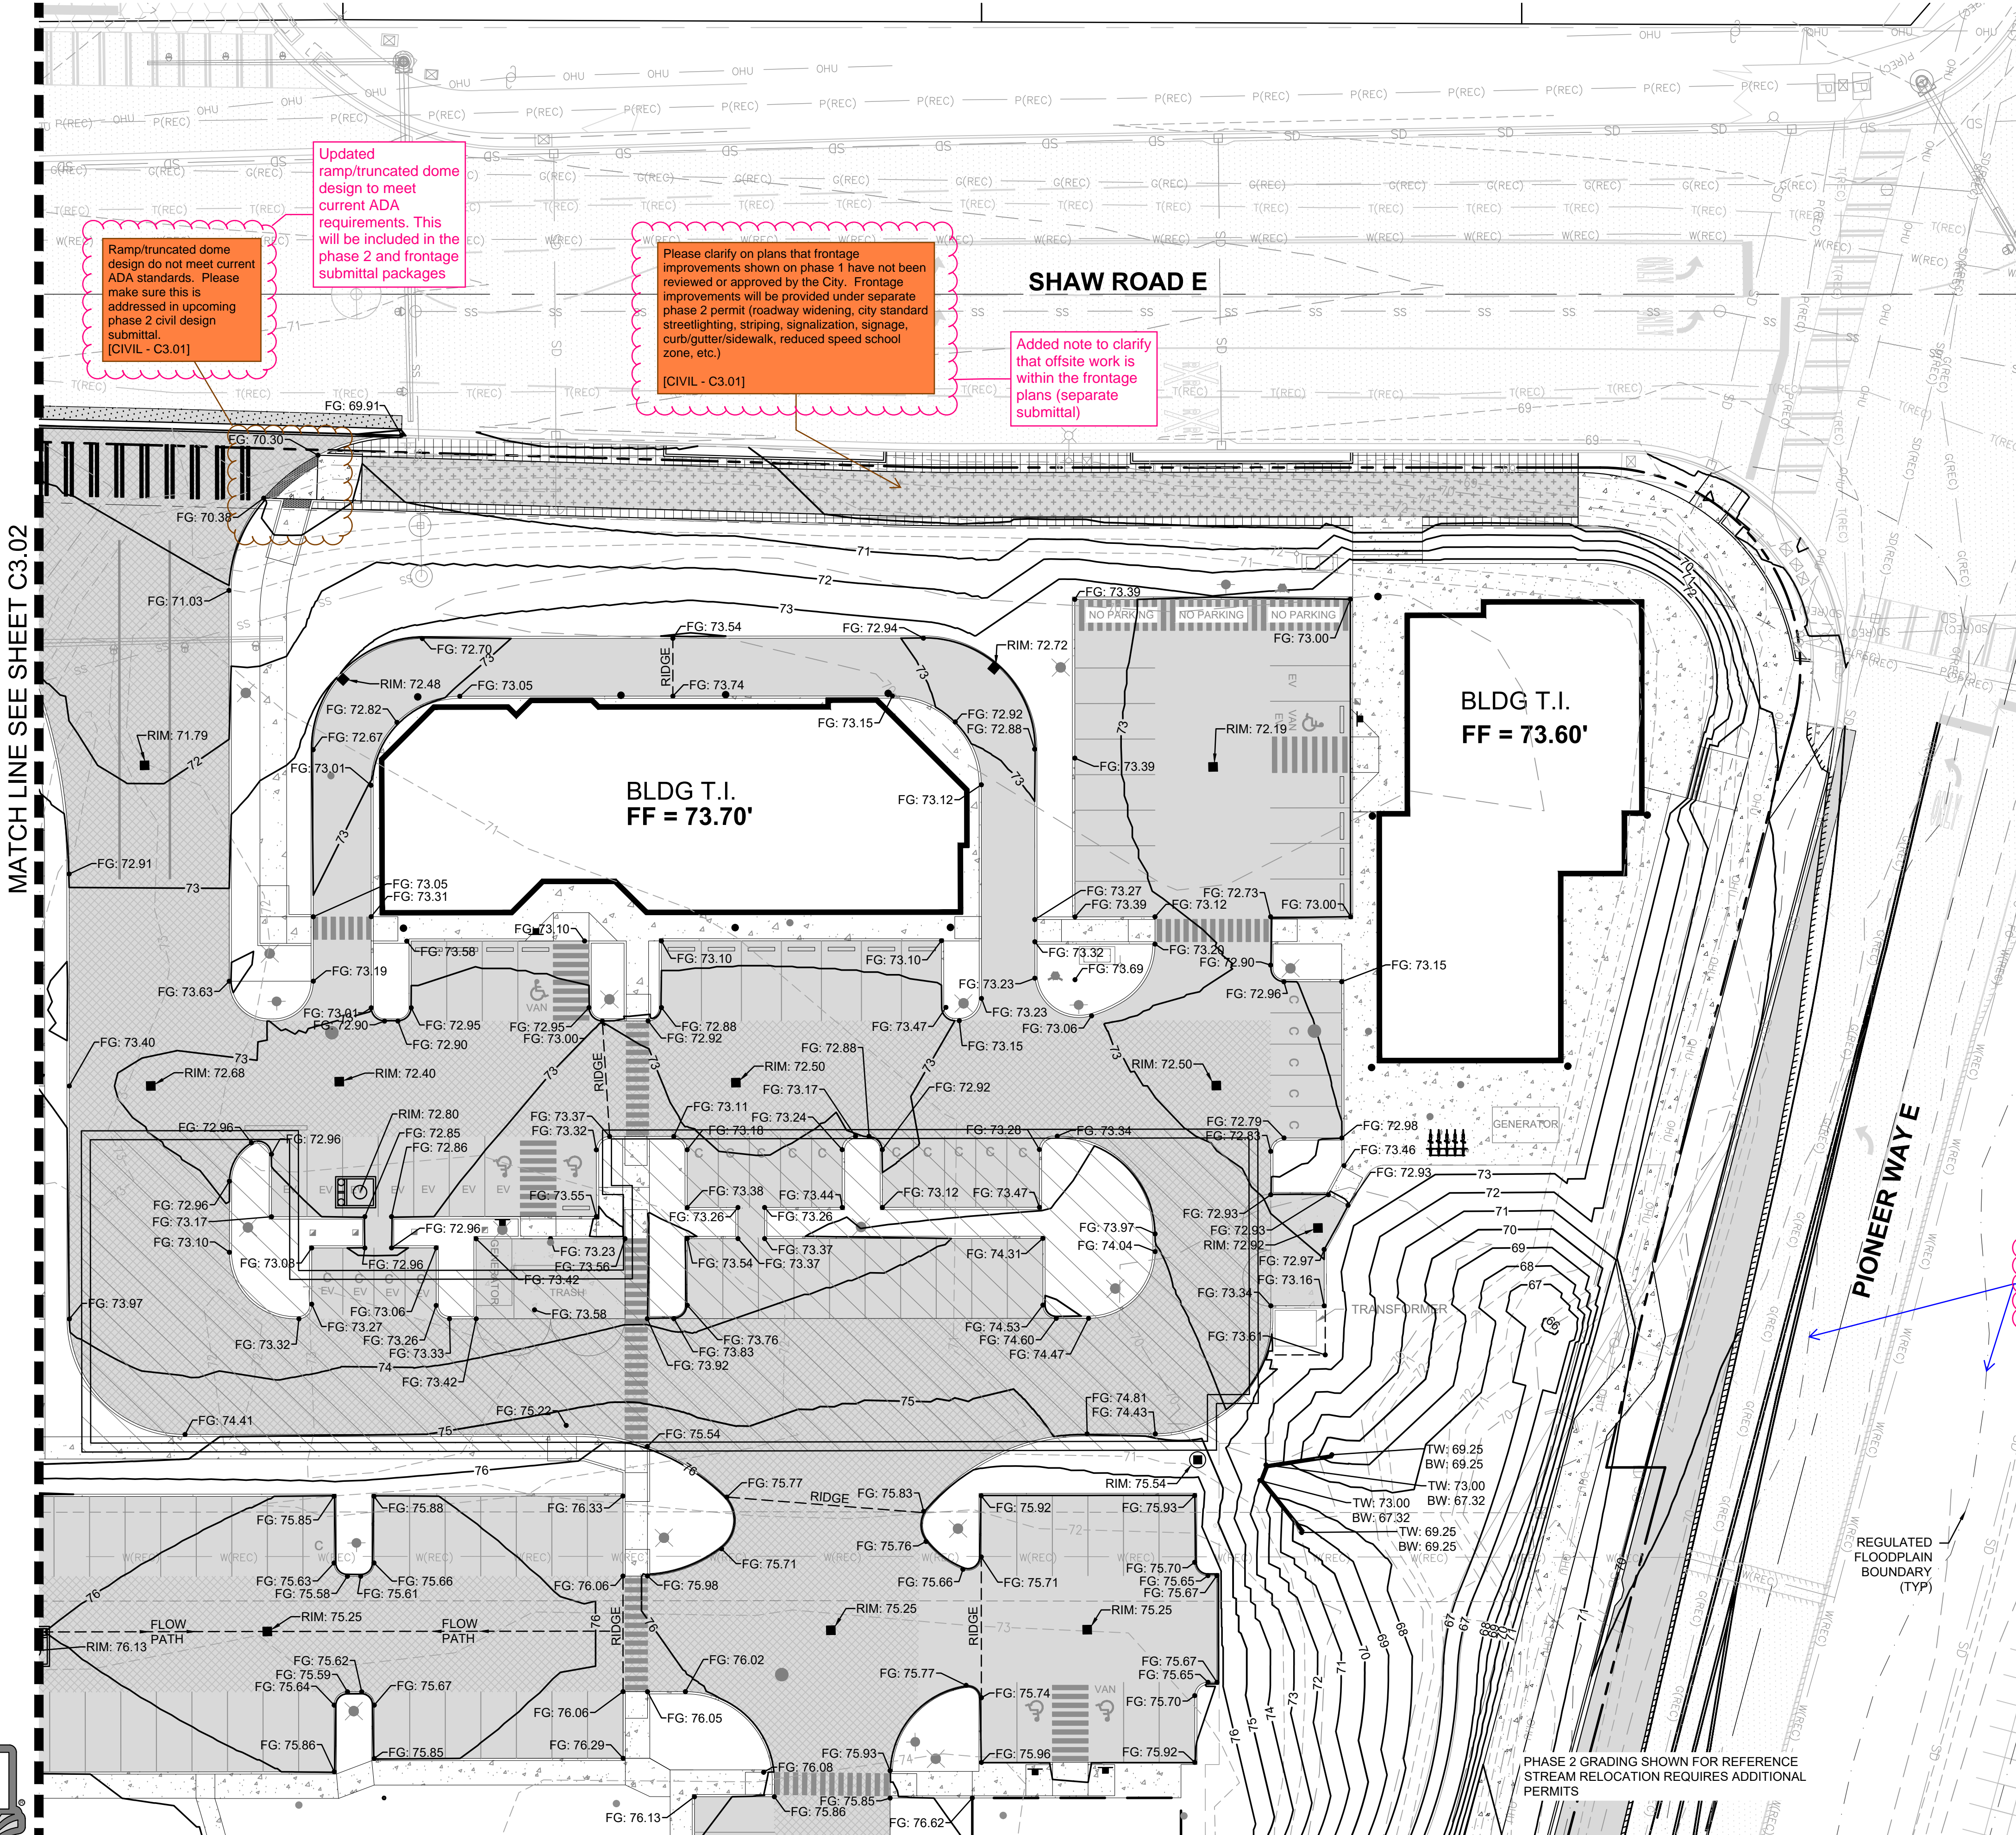


MATCH LINE SEE SHEET C3.02

MATCH LINE SEE SHEET C3.03

Please emphasize the limits of the regulated floodplain for clarity (per the LOMR, Effective September 8, 2022). [Plans Sht C3.01, Pg 11 of 53]

darkened the limits of the floodplain for emphasis

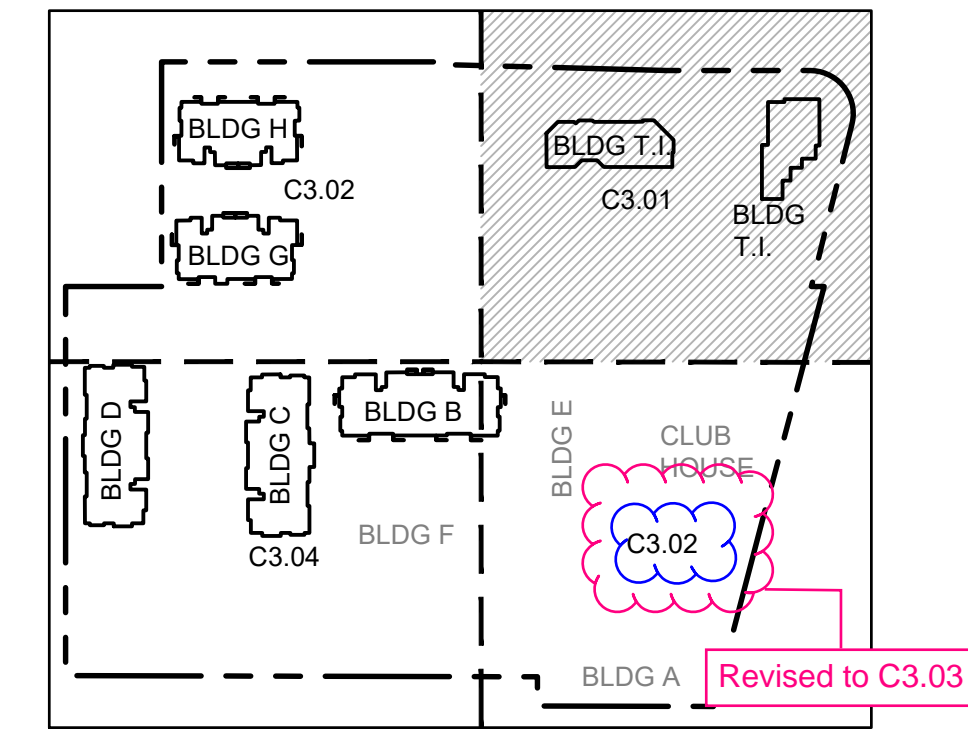

Know what's below.
Call before you dig.

- ▲
 - ▲
 - ▲
 - ▲ 01/29/24 CITY COMMENTS
- Revisions:**

Sheet Title:

GRADING PLAN NW

Designed by: CW
Drawn by: SK / RS
Checked by: JI


Sheet No.:

C3.01

11 of 53 Sheets

EAST TOWN CROSSING PHASE 1

SEC. 26,35/ TWP. 20 N./ RGE. 4 E., W.M.

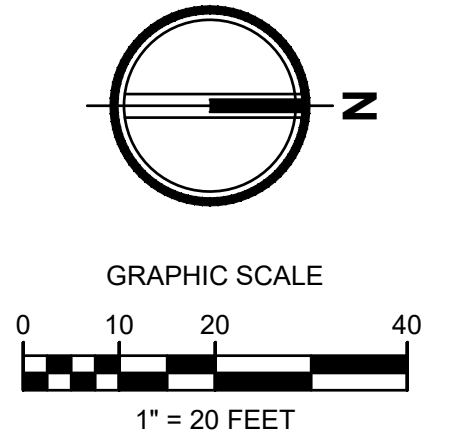

APPROVED

BY _____
CITY OF PUYALLUP
DEVELOPMENT ENGINEERING

DATE _____

NOTE: THIS APPROVAL IS VOID AFTER 180 DAYS FROM APPROVAL DATE. THE CITY WILL NOT BE RESPONSIBLE FOR ERRORS AND/OR OMISSIONS ON THESE PLANS. FIELD CONDITIONS MAY DICTATE CHANGES TO THESE PLANS AS DETERMINED BY THE DEVELOPMENT ENGINEERING MANAGER.



2215 North 30th Street, Suite 300, Tacoma, WA 98403
253.383.2422 TEL 253.383.2572 FAX www.ahbl.com WEB

Project Title:
EAST TOWN CROSSING PHASE 1

Client:
ASH DEVELOPMENT

GREG HELLE
GREG.HELLE@ASHNW.COM


Project No.
2230752

Issue Set & Date:
PERMIT SUBMITTAL

02/20/2024



NOTICE
ALTAIRION OF THIS DOCUMENT SHALL INDICATE THE PROFESSIONAL SEAL AND SIGNATURE PUBLICATION OF THE DOCUMENT DOES NOT CONSTITUTE A GUARANTEE OR WARRANTY BY THE ENGINEER OR ARCHITECT. THE ENGINEER OR ARCHITECT IS NOT TO BE USED FOR ANY OTHER PROJECT OR ACTION TO THAT PROJECT OR FOR ANY OTHER PROJECT.

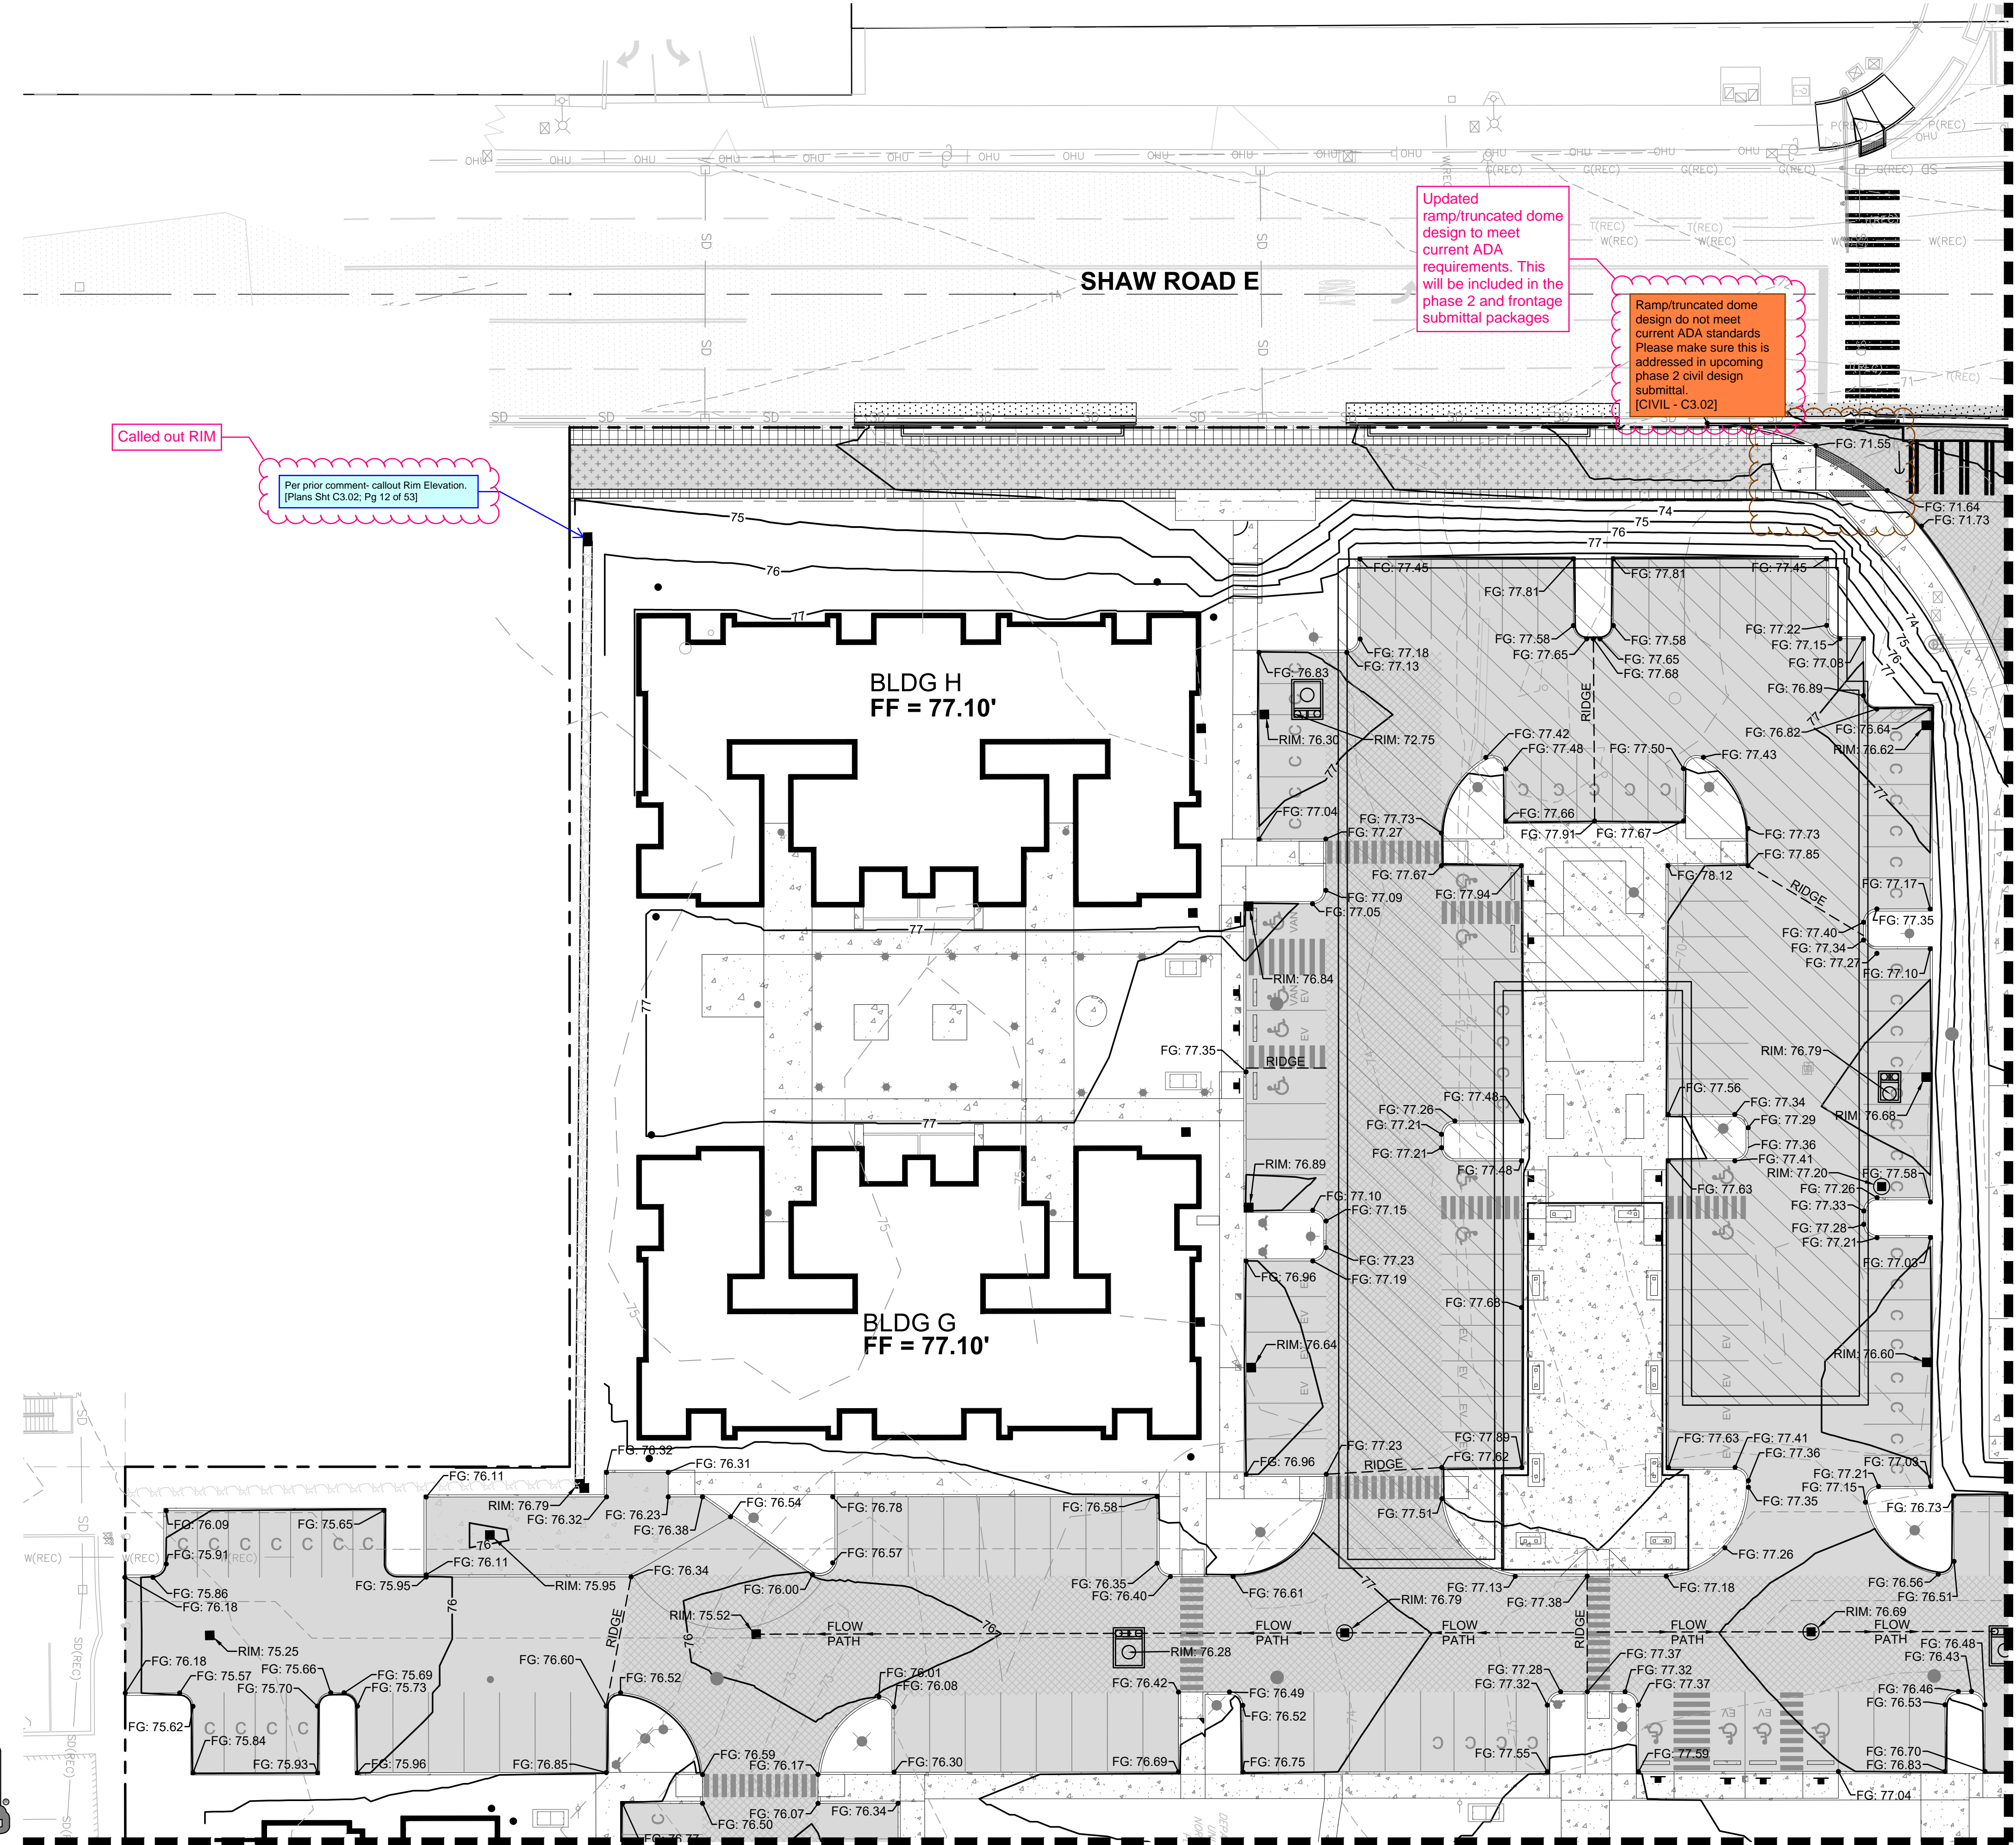

Called out RIM


Per prior comment- callout Rim Elevation. (Plans SH C3.02, Pg 12 of 53)

Updated ramp/truncated dome design to meet current ADA requirements. This will be included in the phase 2 and frontage submittal packages

Ramp/truncated dome design do not meet current ADA standards. Please make sure this is addressed in upcoming phase 2 civil design submittal. [CIVIL - C3.02]

MATCH LINE SEE SHEET C3.01

MATCH LINE SEE SHEET C3.04

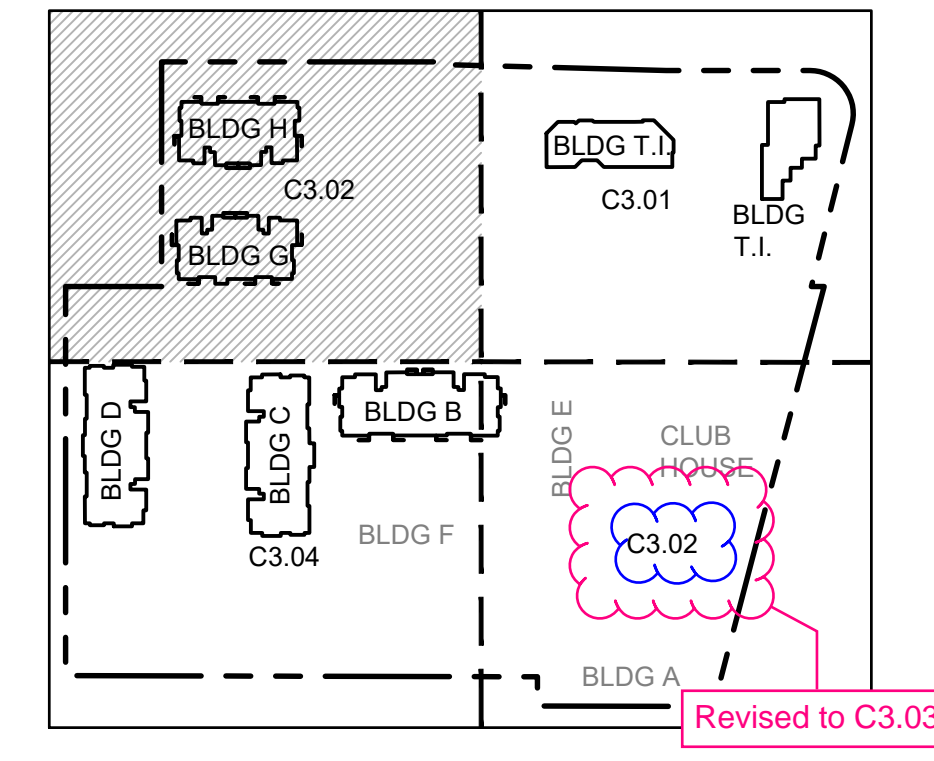

Know what's below.
Call before you dig.

- △
 - △
 - △
 - △ 01/29/24 CITY COMMENTS
- Revisions:

Sheet Title:
GRADING PLAN SW

Designed by: CW
Drawn by: SK / RS
Checked by: JI


Sheet No.
C3.02

EAST TOWN CROSSING PHASE 1


SEC. 26,35/ TWP. 20 N./ RGE. 4 E., W.M.

APPROVED

BY: CITY OF PUYALLUP
DEVELOPMENT ENGINEERING
DATE:

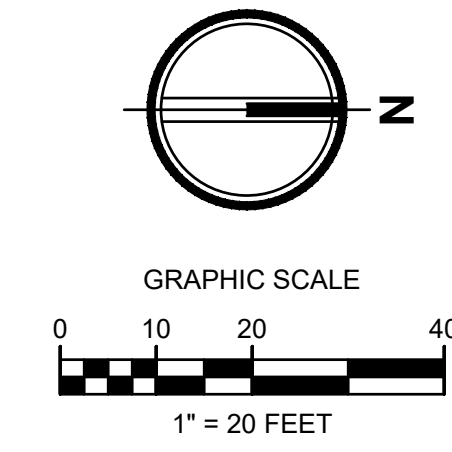

NOTE: THIS APPROVAL IS VOID AFTER 180 DAYS FROM APPROVAL DATE. THE CITY WILL NOT BE RESPONSIBLE FOR ERRORS AND/OR OMISSIONS ON THESE PLANS. FIELD CONDITIONS MAY DICTATE CHANGES TO THESE PLANS AS DETERMINED BY THE DEVELOPMENT ENGINEERING MANAGER.

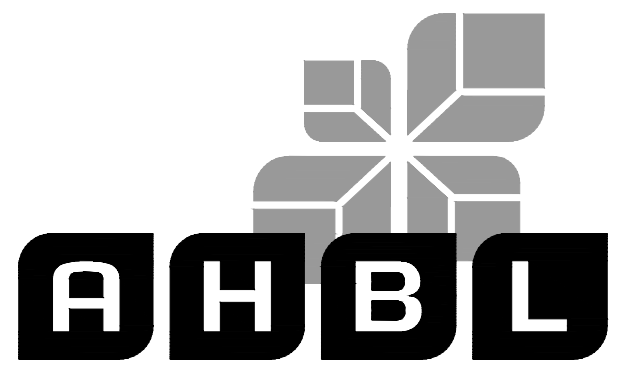

TACOMA · SEATTLE · SPOKANE · TRI-CITIES
2215 North 30th Street, Suite 300, Tacoma, WA 98403
253.383.2422 TEL. 253.383.2572 FAX www.ahbl.com WEB

Project Title:
EAST TOWN CROSSING PHASE 1

Client:
ASH DEVELOPMENT

GREG HELLE
GREG.HELLE@ASHNW.COM


Project No.
2230752

Issue Set & Date:
PERMIT SUBMITTAL

02/20/2024



NOTICE:
ALLEGATION OF THIS DOCUMENT SHALL VALIDATE THE PROFESSIONAL SEAL AND SIGNATURE PUBLICATION OF THIS DOCUMENT DOES NOT REPRESENT FROM RESIGNED OR REVOKED RIGHTS IN IT. THE DRAWING IS FOR USE ONLY FOR THE PROJECT EXHIBITED IN THE TITLE BLOCK AND IS NOT TO BE USED FOR OTHER, SIMILAR, OR ACTION TO THAT PROJECT OR FOR ANY OTHER PROJECT.

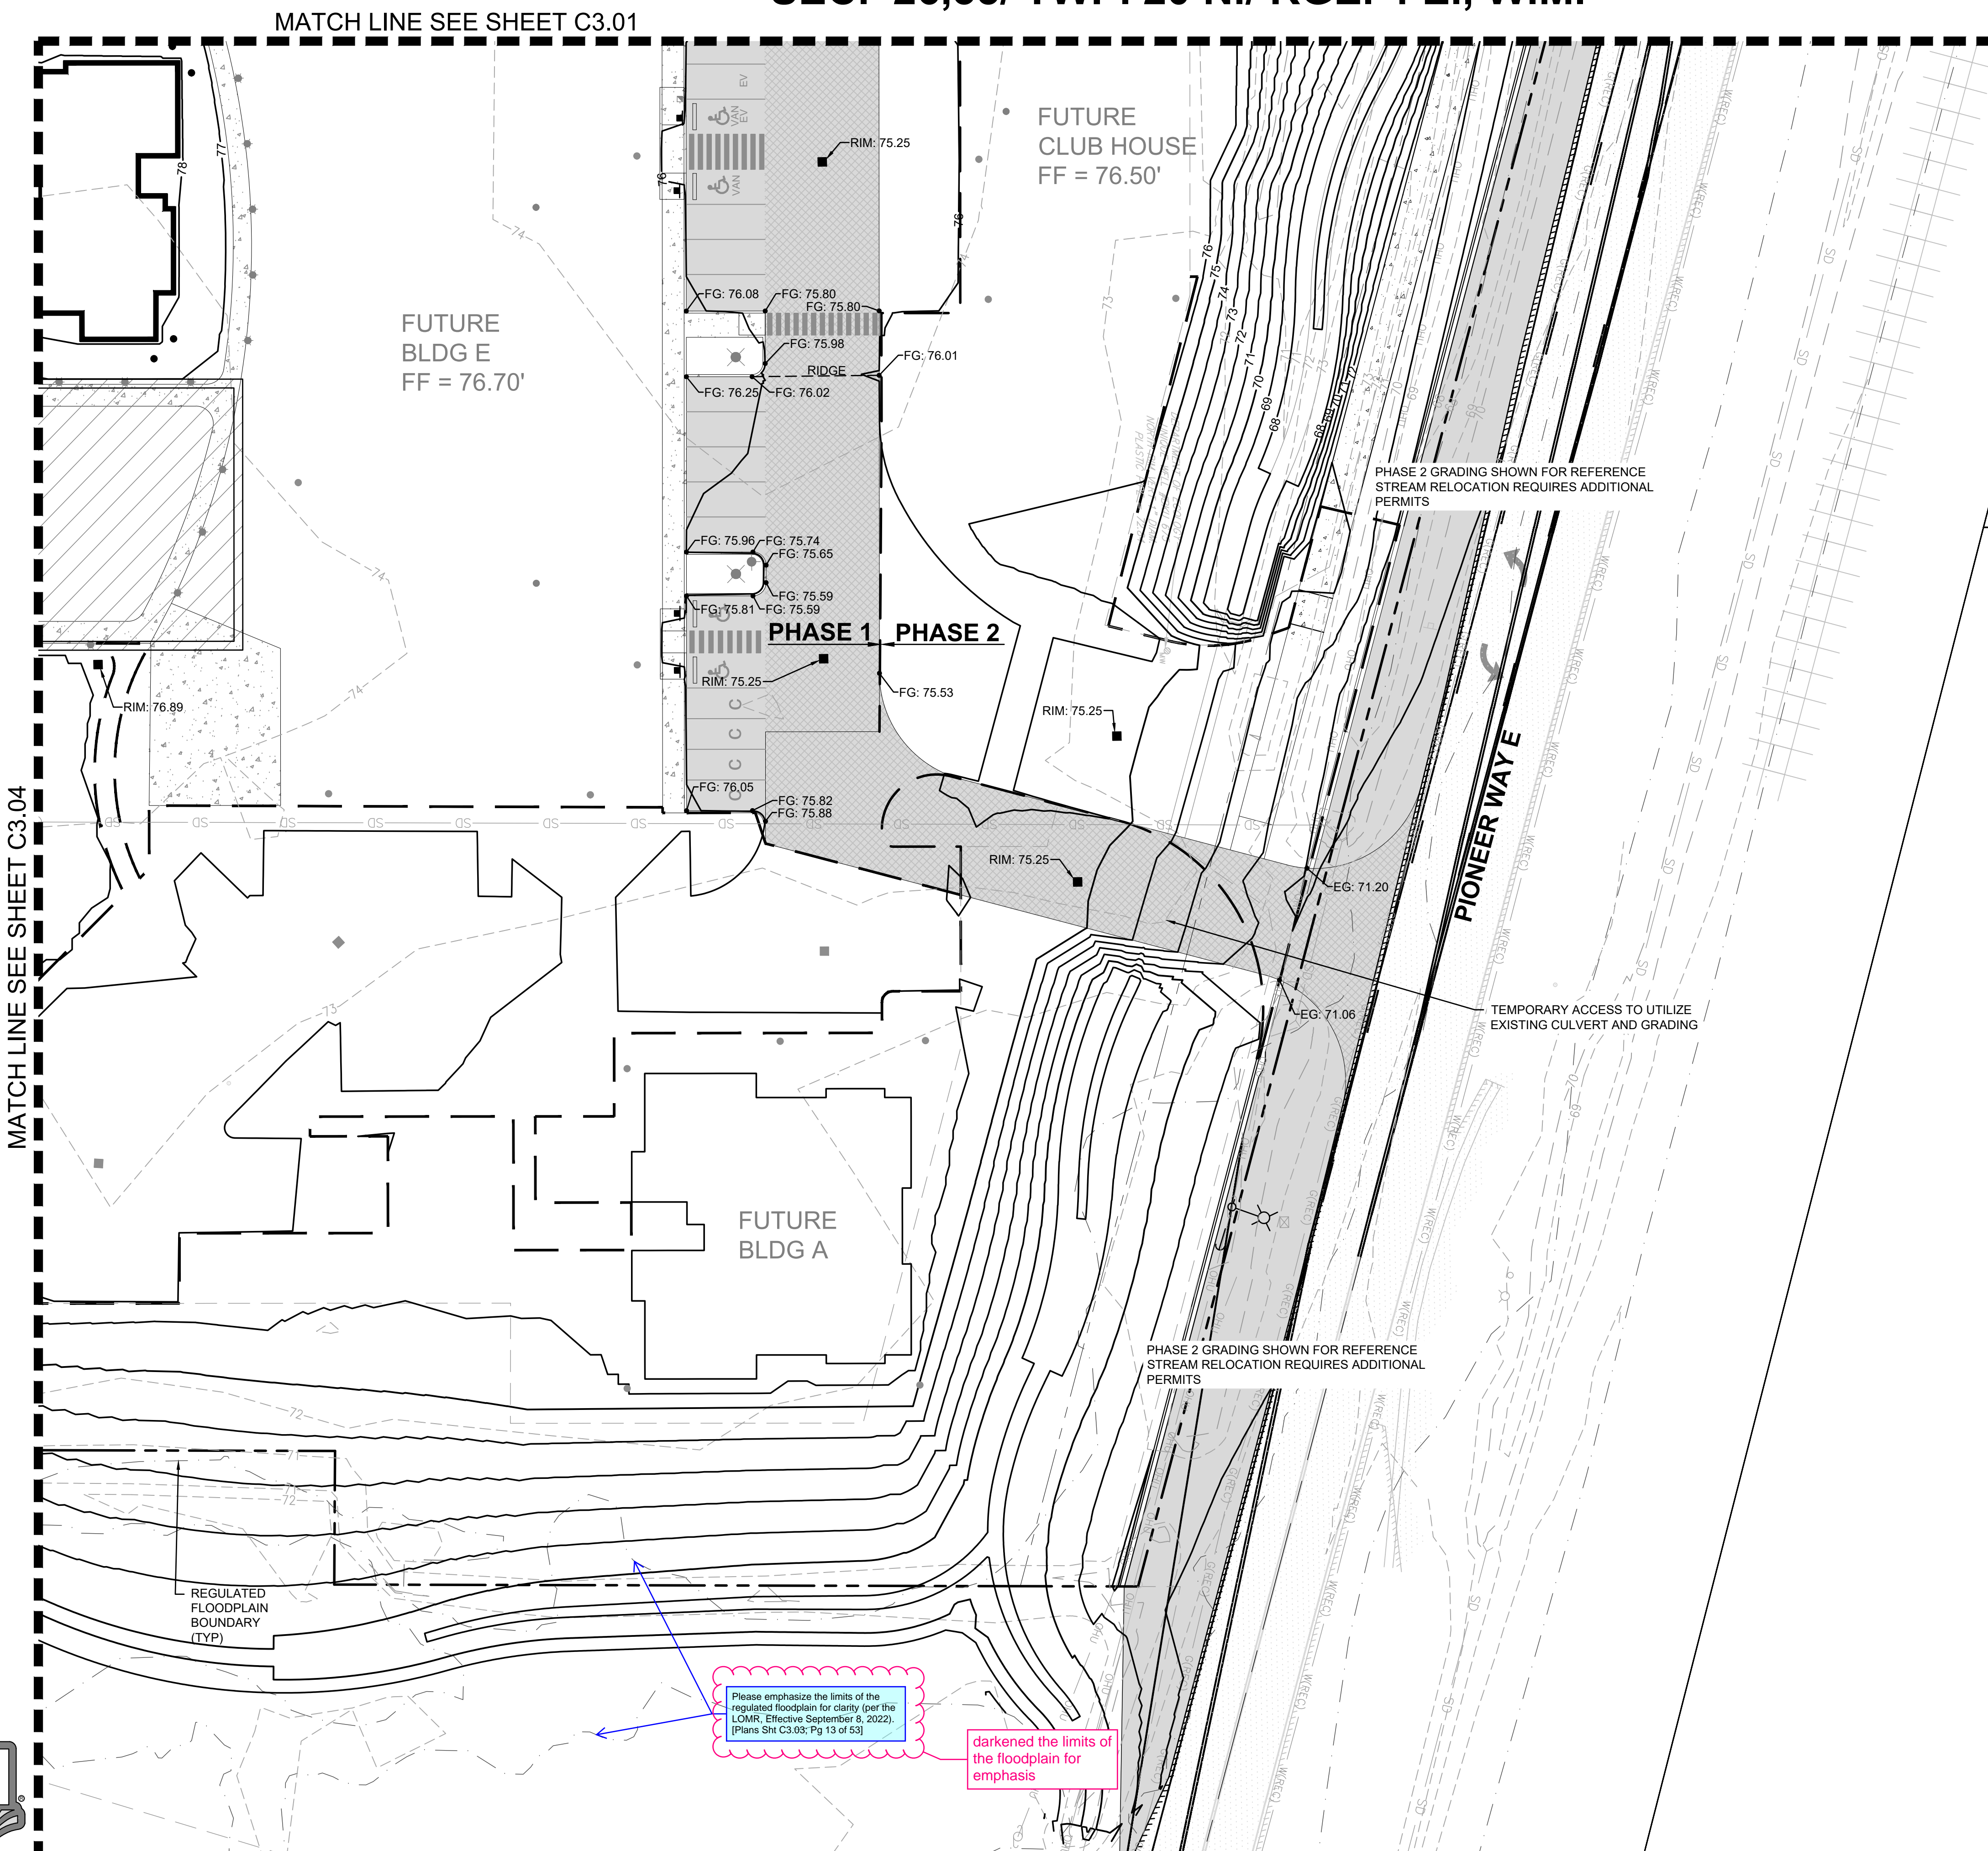

MATCH LINE SEE SHEET C3.04

MATCH LINE SEE SHEET C3.01

FUTURE BLDG E
FF = 76.70'

FUTURE CLUB HOUSE
FF = 76.50'

PHASE 1 PHASE 2

PHASE 2 GRADING SHOWN FOR REFERENCE
STREAM RELOCATION REQUIRES ADDITIONAL PERMITS

PIONEER WAY E


TEMPORARY ACCESS TO UTILIZE
EXISTING CULVERT AND GRADING

PHASE 2 GRADING SHOWN FOR REFERENCE
STREAM RELOCATION REQUIRES ADDITIONAL PERMITS

REGULATED FLOODPLAIN
BOUNDARY (TYP)

Please emphasize the limits of the regulated floodplain for clarity per the LOMR, Effective September 8, 2022. (Plans Sht C3.03; Pg 13 of 53)

darkened the limits of the floodplain for emphasis

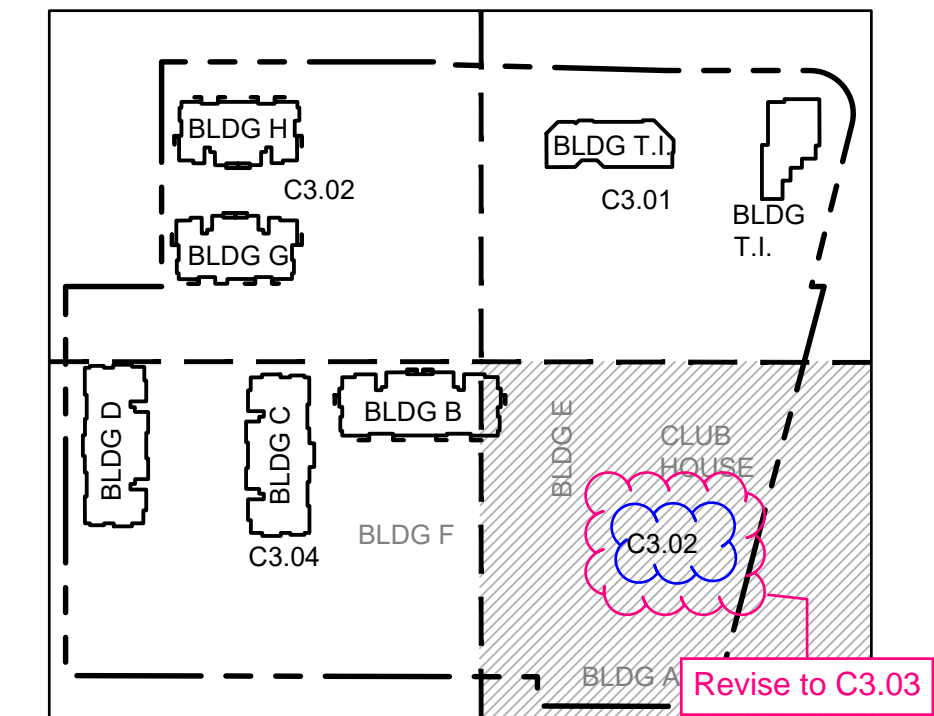

Revise to C3.03



Know what's below.
Call before you dig.

△
△
△

△ 01/29/24 CITY COMMENTS

Revisions:

Sheet Title:

GRADING PLAN NE

Designed by: CW Drawn by: SK / RS Checked by: JI

Sheet No.

C3.03

13 of 53 Sheets



EAST TOWN CROSSING PHASE 1

SEC. 26,35/ TWP. 20 N./ RGE. 4 E., W.M.

APPROVED

BY: CITY OF PUYALLUP
DEVELOPMENT ENGINEERING
DATE:

NOTE: THIS APPROVAL IS VOID AFTER 180 DAYS FROM APPROVAL DATE. THE CITY WILL NOT BE RESPONSIBLE FOR ERRORS AND/OR OMISSIONS ON THESE PLANS. FIELD CONDITIONS MAY DICTATE CHANGES TO THESE PLANS AS DETERMINED BY THE DEVELOPMENT ENGINEERING MANAGER.

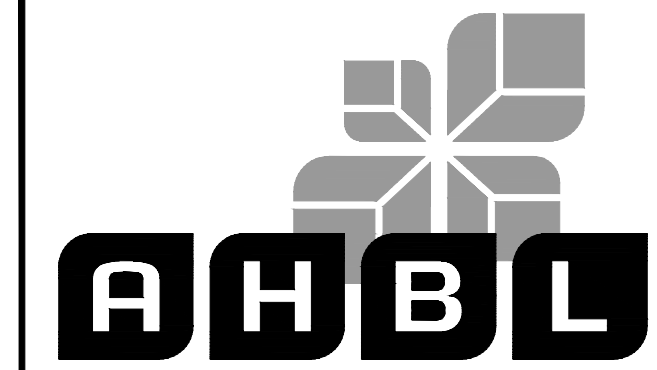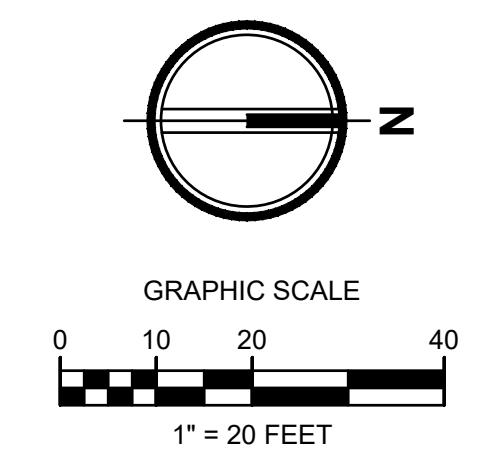

TACOMA • SEATTLE • SPOKANE • TRI-CITIES
2215 North 30th Street, Suite 300, Tacoma, WA 98403
253.383.2422 TEL. 253.383.2572 FAX www.ahbl.com WEB


Project Title:
EAST TOWN CROSSING PHASE 1

Client:
ASH DEVELOPMENT


GREG HELLE
GREG.HELLE@ASHNW.COM

Project No.
2230752

Issue Set & Date:
PERMIT SUBMITTAL
02/20/2024

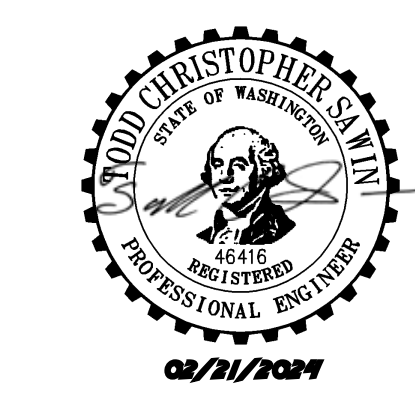

NOTICE: ALTERATION OF THIS DOCUMENT SHALL INVALIDATE THE PROFESSIONAL SEAL AND SIGNATURE. PUBLICATION OF THIS DOCUMENT DOES NOT CONSTITUTE AN ENDORSEMENT OR GUARANTEE BY THE ENGINEER OR FOR THE ONLY FOR THE PROJECT EXERCISED IN THE TITLE BLOCK AND IS NOT TO BE USED FOR OTHER PURPOSES OR ADDITION TO THAT PROJECT OR FOR ANY OTHER PROJECT.

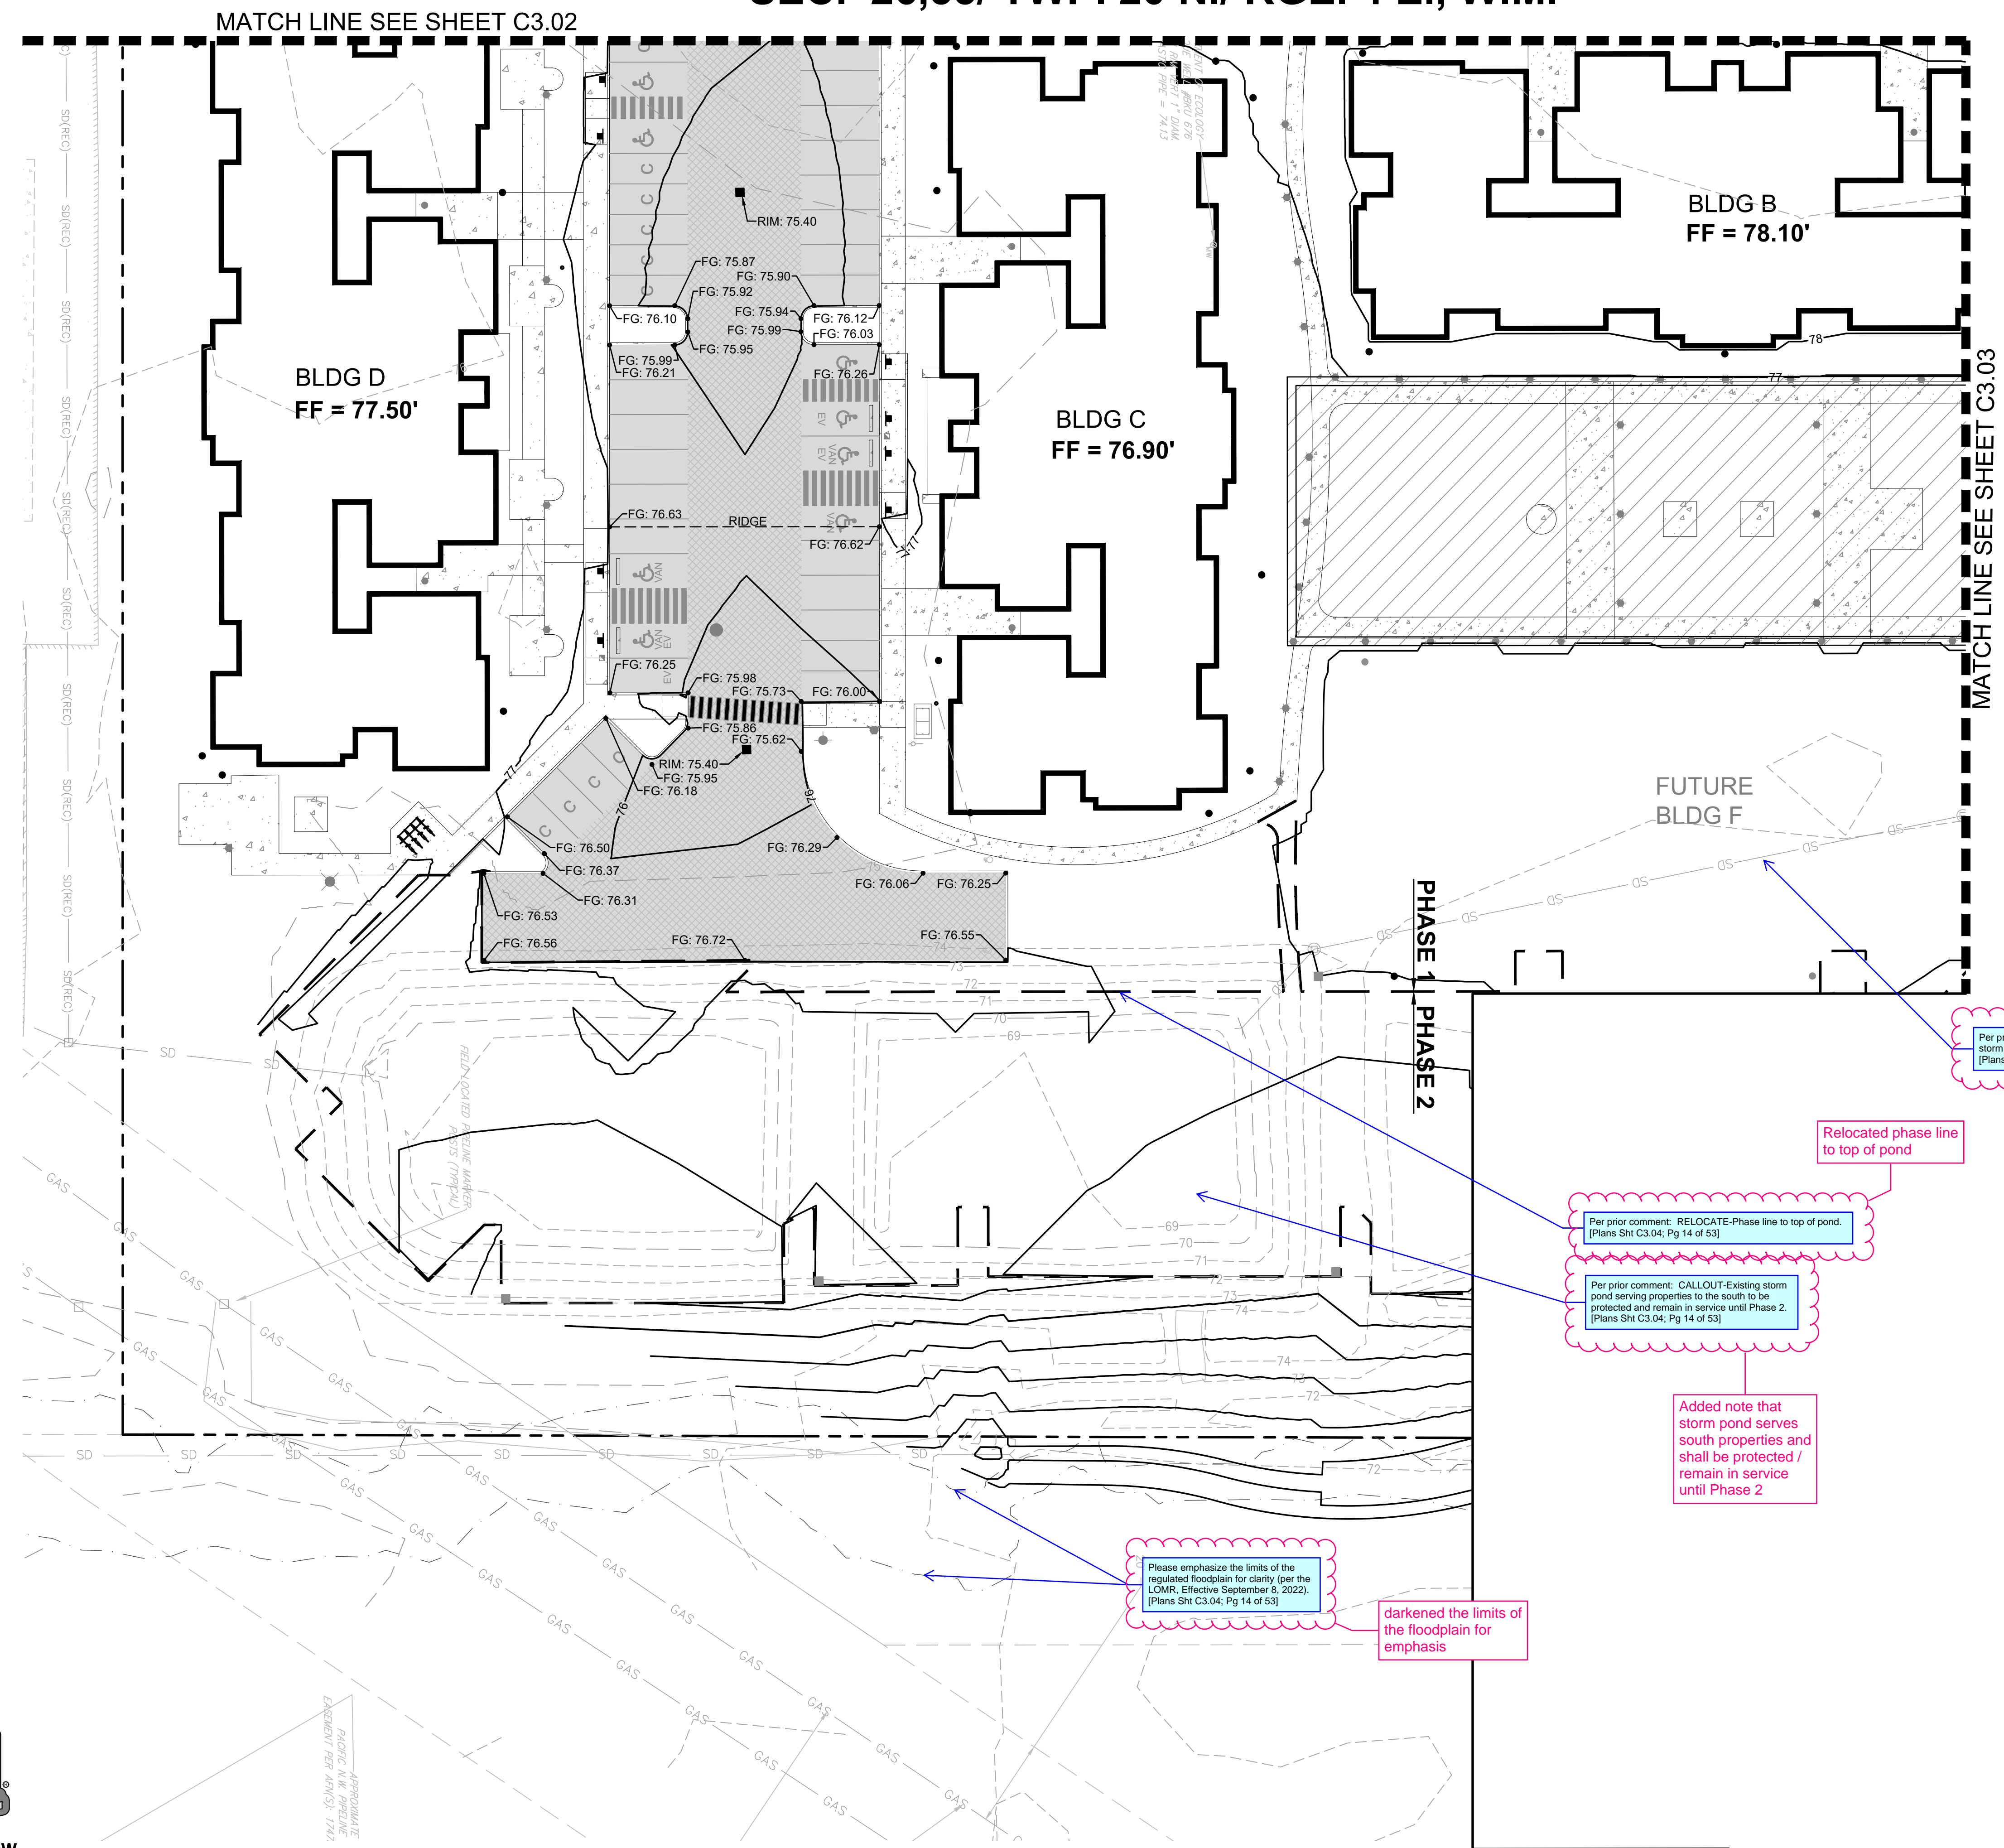

Per prior comment: CALLOUT-to protect existing storm drain serving properties to the south. [Plans Sht C3.04; Pg 14 of 53]

Per prior comment: RELOCATE-Phase line to top of pond. [Plans Sht C3.04; Pg 14 of 53]

Per prior comment: CALLOUT-Existing storm pond serving properties to the south to be protected and remain in service until Phase 2. [Plans Sht C3.04; Pg 14 of 53]


Added note that storm pond serves south properties and shall be protected / remain in service until Phase 2

Please emphasize the limits of the regulated floodplain for clarity (per the LOMR, Effective September 8, 2022). [Plans Sht C3.04; Pg 14 of 53]

darkened the limits of the floodplain for emphasis

Relocated phase line to top of pond

Added note to protect existing pipe

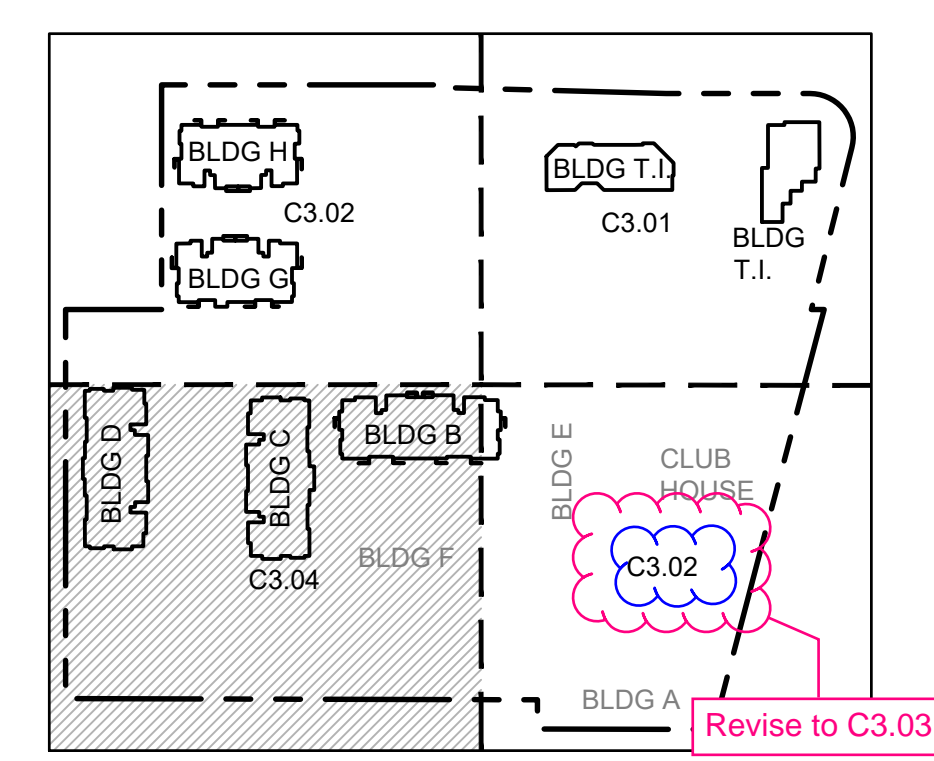

01/29/24 CITY COMMENTS

Revisions:

Sheet Title:
GRADING PLAN SE

Designed by: CW Drawn by: SK / RS Checked by: JI

Sheet No.
C3.04
14 of 53 Sheets



EAST TOWN CROSSING PHASE 1

SEC. 26,35/ TWP. 20 N./ RGE. 4 E., W.M.

APPROVED

BY: CITY OF PUYALLUP
DEVELOPMENT ENGINEERING
DATE:

NOTE: THIS APPROVAL IS VOID AFTER 180 DAYS FROM APPROVAL DATE. THE CITY WILL NOT BE RESPONSIBLE FOR ERRORS AND/OR OMISSIONS ON THESE PLANS. FIELD CONDITIONS MAY DICTATE CHANGES TO THESE PLANS AS DETERMINED BY THE DEVELOPMENT ENGINEERING MANAGER.

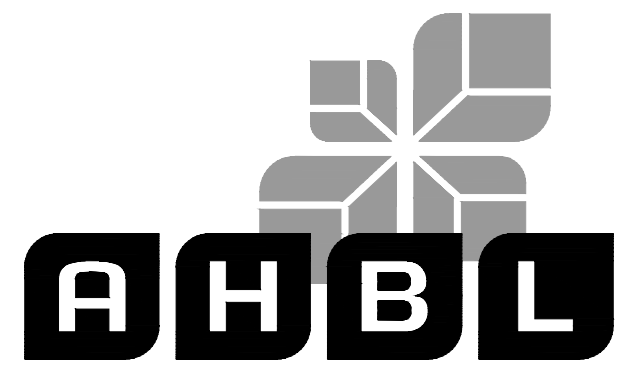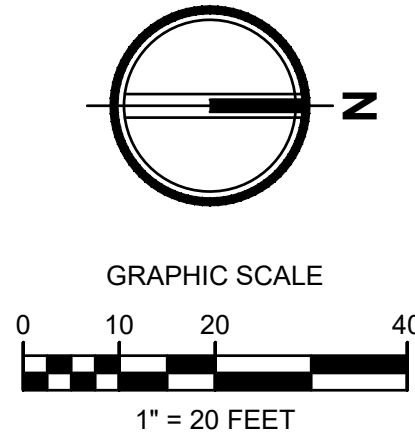

TACOMA · SEATTLE · SPOKANE · TRI-CITIES
2215 North 30th Street, Suite 300, Tacoma, WA 98403
253.383.2422 TEL 253.383.2572 FAX www.ahbl.com WEB

Project Title:
EAST TOWN CROSSING PHASE 1

Client:
ASH DEVELOPMENT

GREG HELLE
GREG.HELLE@ASHNW.COM

Project No.
2230752

Issue Set & Date:
PERMIT SUBMITTAL
02/20/2024





NOTICE: ALTERATION OF THIS DOCUMENT SHALL INVALIDATE THE PROFESSIONAL SEAL AND SIGNATURE. PREPARATION OF THIS DOCUMENT DOES NOT CONSTITUTE AN ENDORSEMENT OR GUARANTEE BY THE ENGINEER. THE ENGINEER IS NOT TO BE USED FOR OTHER PROJECTS, OR ADDITION TO THAT PROJECT OR FOR ANY OTHER PROJECT.

STORM STRUCTURE TABLE		STORM STRUCTURE TABLE	
STRUCTURE NAME	STRUCTURE DETAILS	STRUCTURE NAME	STRUCTURE DETAILS
R-TANK 1 INLET 1 N 679890.39 E 1203965.82	IE = 67.85 (12" N)	SDCB#21 TYPE 1 N 680067.90 E 1204065.38	RIM = 75.25 IE = 71.60 (8" S)
R-TANK 1 INLET 2 N 679845.57 E 1203961.30	IE = 67.79 (24" S)	SDCO#COM01 N 680135.62 E 1203883.57	RIM = 73.56 IE = 70.80 (6" E) IE = 70.80 (6" W)
R-TANK 1 OUTLET N 680093.81 E 1204023.48	IE = 67.40 (24" E)	SDCO#COM02 N 680137.83 E 1203834.23	RIM = 73.51 IE = 71.29 (6" E)
SDCB#01 54" CONTROL STRUCTURE N 680093.51 E 1204027.65	RIM = 75.54 IE = 67.40 (24" W) IE = 67.40 (12" N)	SDCO#COM04 N 680134.35 E 1203940.15	RIM = 73.57 IE = 70.23 (6" N) IE = 70.23 (6" W) IE = 70.06 (8" S)
SDCB#02 TYPE 1 N 680099.34 E 1203943.53	RIM = 72.50 IE = 69.88 (8" W) IE = 69.88 (8" N) IE = 69.50 (12" S)	SDCO#COM05 N 680178.49 E 1203940.71	RIM = 73.56 IE = 70.67 (6" W) IE = 70.67 (6" S)
SDCB#03 TYPE 1 N 680100.00 E 1203871.83	RIM = 72.19 IE = 70.52 (8" E) IE = 70.52 (8" SW)	SDCO#COM06 N 680197.46 E 1203884.56	RIM = 73.56 IE = 71.26 (6" E)
SDCB#04 TYPE 1 N 680051.13 E 1203848.63	RIM = 72.72 IE = 70.79 (8" NE) IE = 70.79 (8" S)	SDCO#COM07 N 680027.25 E 1203853.88	RIM = 73.15 IE = 70.91 (8" N) IE = 71.08 (6" S)
SDCB#05 TYPE 1 N 679991.28 E 1203940.77	RIM = 72.50 IE = 69.29 (8" W) IE = 69.29 (8" N) IE = 68.96 (12" N)	SDCO#COM08 N 679990.68 E 1203853.44	RIM = 73.68 IE = 71.45 (6" N)
SDCB#06 TYPE 1 N 679859.67 E 1203938.96	RIM = 72.68 IE = 69.06 (8" W) IE = 69.06 (8" N)	SDCO#COM09 N 679991.81 E 1203905.90	RIM = 73.64 IE = 70.17 (8" E) IE = 70.34 (6" N) IE = 70.34 (6" S)
SDCB#07 TYPE 1 N 679859.67 E 1203866.80	RIM = 71.79 IE = 69.42 (8" E) IE = 69.42 (8" N)	SDCO#COM10 N 680040.22 E 1203906.79	RIM = 73.64 IE = 71.09 (6" S)
SDCB#08 TYPE 1 N 679904.68 E 1203848.32	RIM = 72.48 IE = 69.67 (8" N) IE = 69.67 (8" S)	SDCO#COM11 N 679917.20 E 1203904.57	RIM = 73.61 IE = 71.09 (6" N)
SDCB#09 TYPE 1 N 679902.08 E 1203938.82	RIM = 72.40 IE = 68.84 (8" S) IE = 68.51 (12" N) IE = 68.51 (12" E)	SDCO#COM12 N 679921.42 E 1203852.60	RIM = 72.88 IE = 69.93 (6" N) IE = 69.76 (8" S)
SDCB#19 TYPE 1 N 679883.48 E 1204062.20	RIM = 75.25 IE = 70.35 (12" S) IE = 70.35 (12" N)	SDCO#COM13 N 679967.13 E 1203853.13	RIM = 73.57 IE = 70.39 (6" S)
SDCB#20 TYPE 1 N 680010.25 E 1204064.38	RIM = 75.25 IE = 70.98 (12" S) IE = 71.31 (8" N) IE = 70.98 (12" E)		

DETAIL REFERENCES

- CATCH BASIN TYPE 1 (AREA DRAIN) 1 C4.07
- CATCH BASIN TYPE 1 (GUTTER DRAIN) 2 C4.07
- FOR CATCH BASIN TYPE II 3 C4.07
- FRENCH DRAIN 5 C4.07
- STORM SEWER MANHOLE 8 C4.07

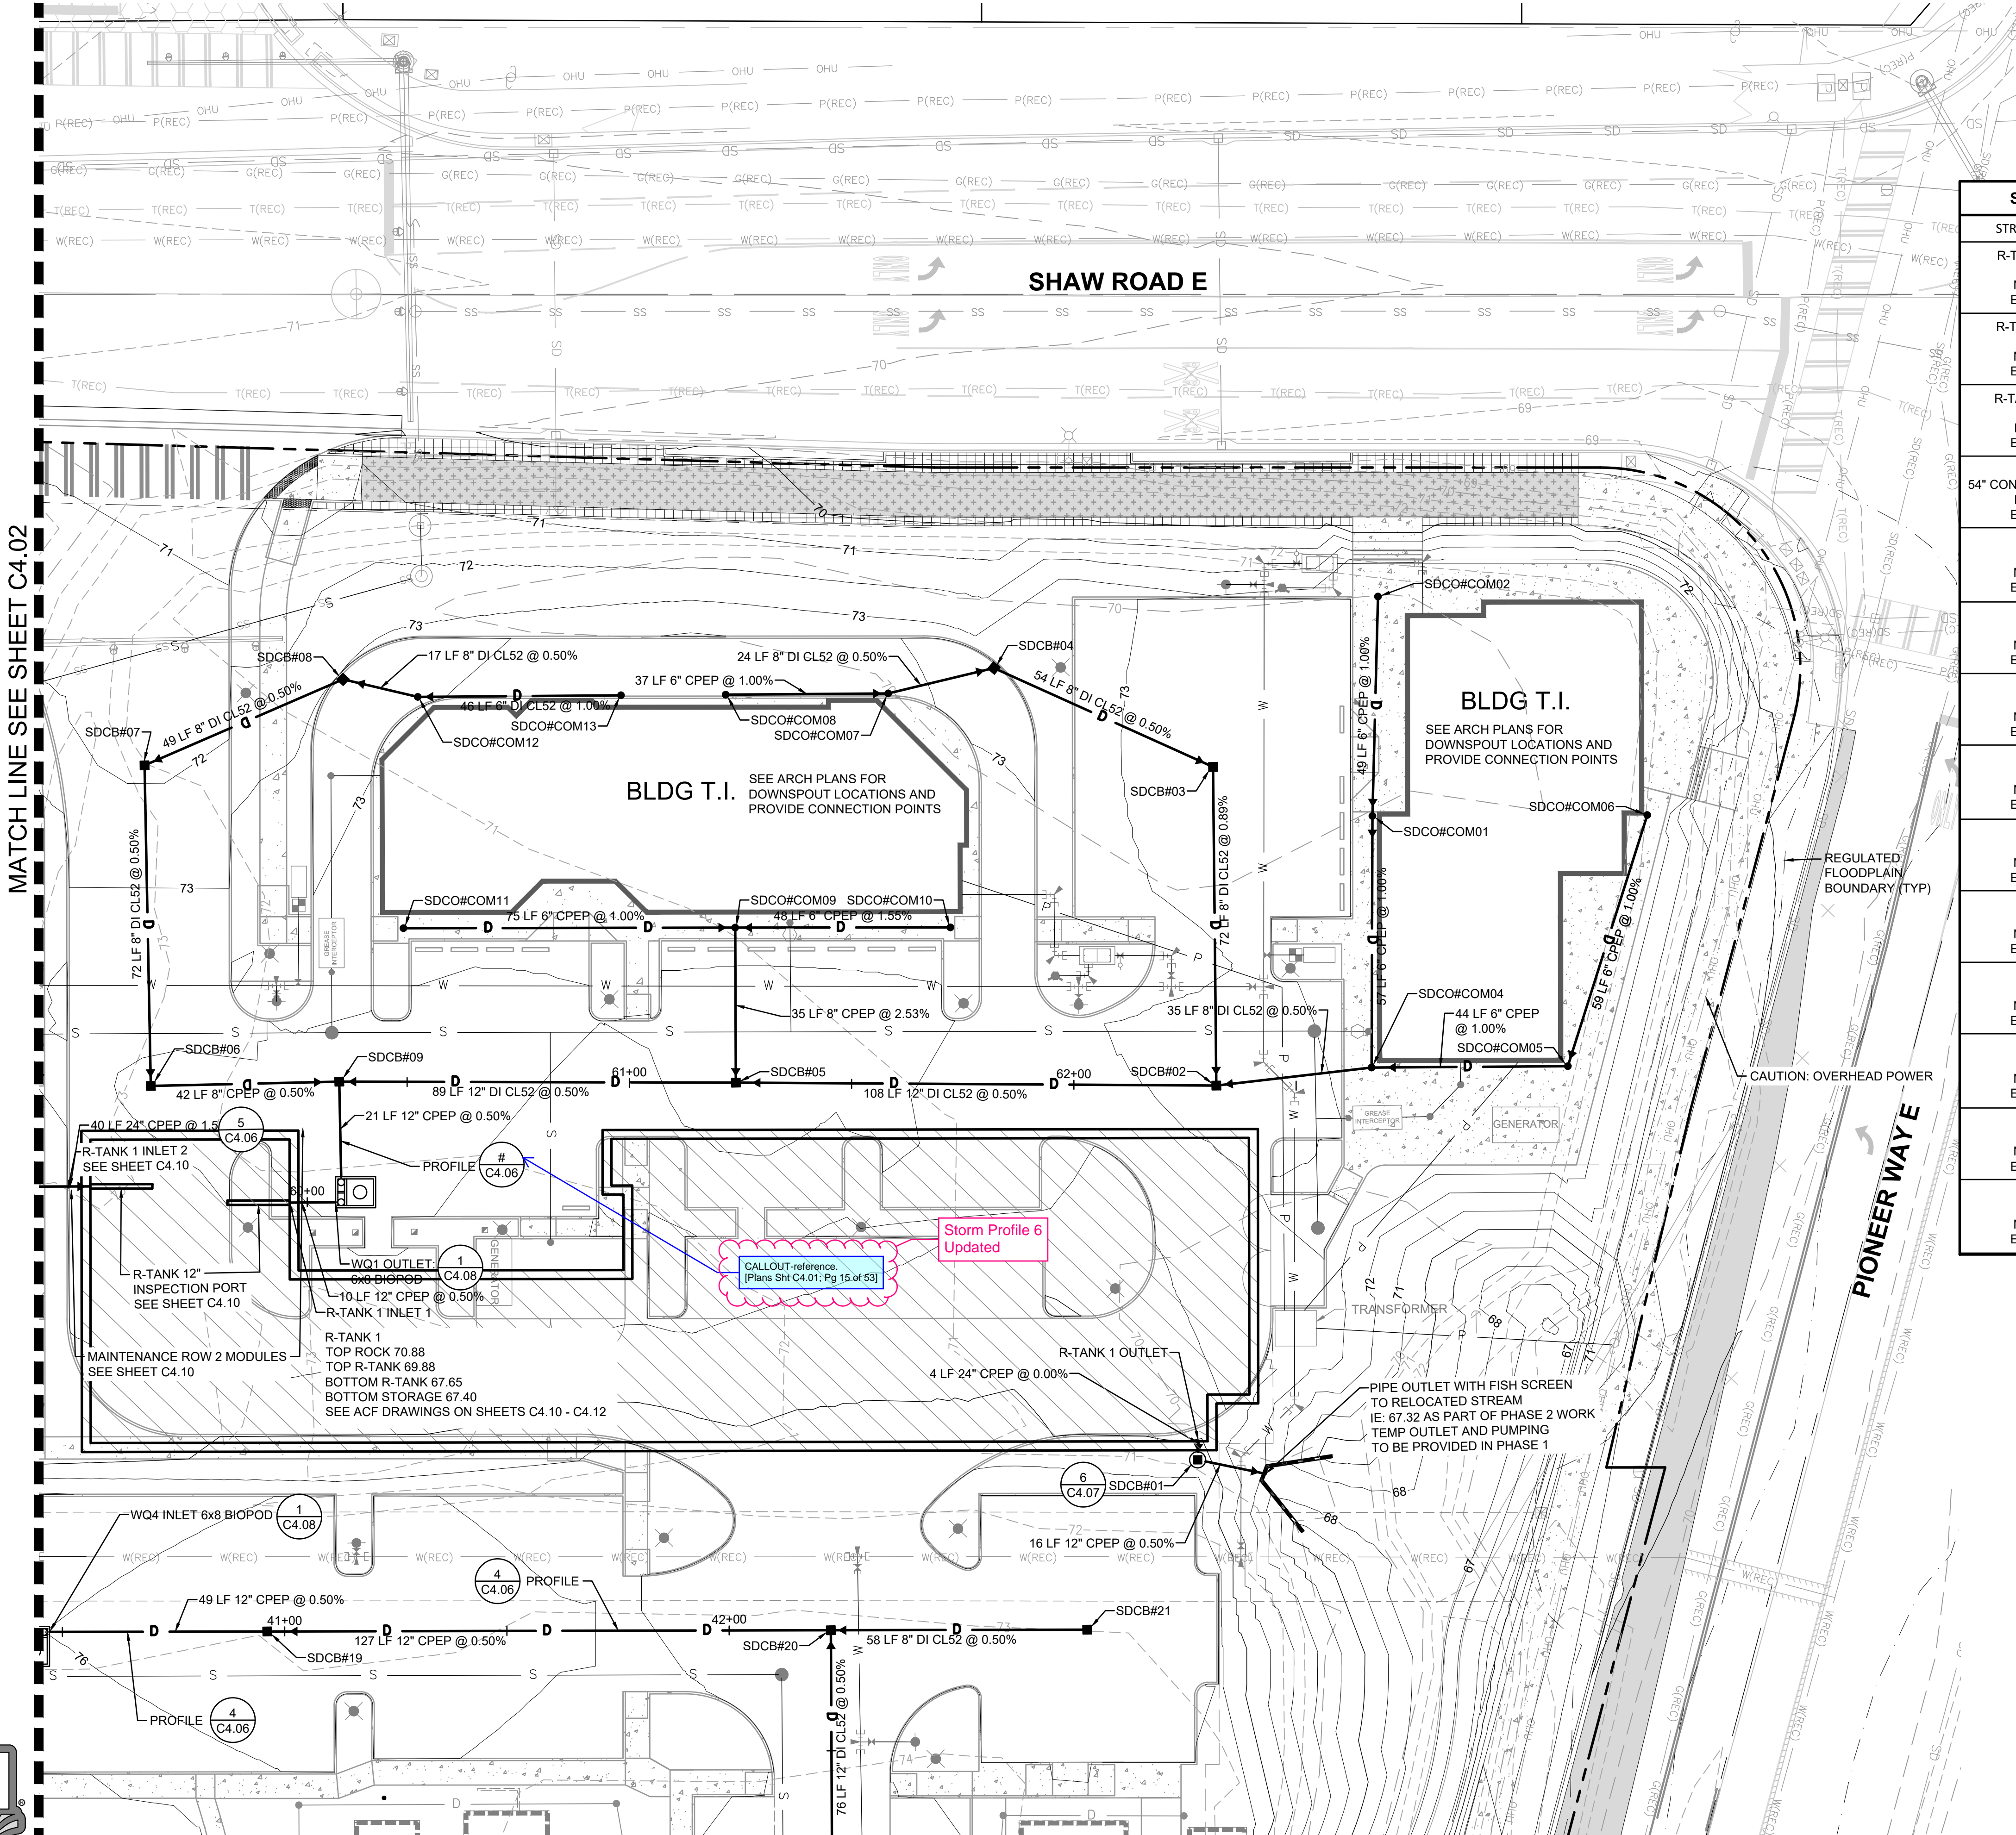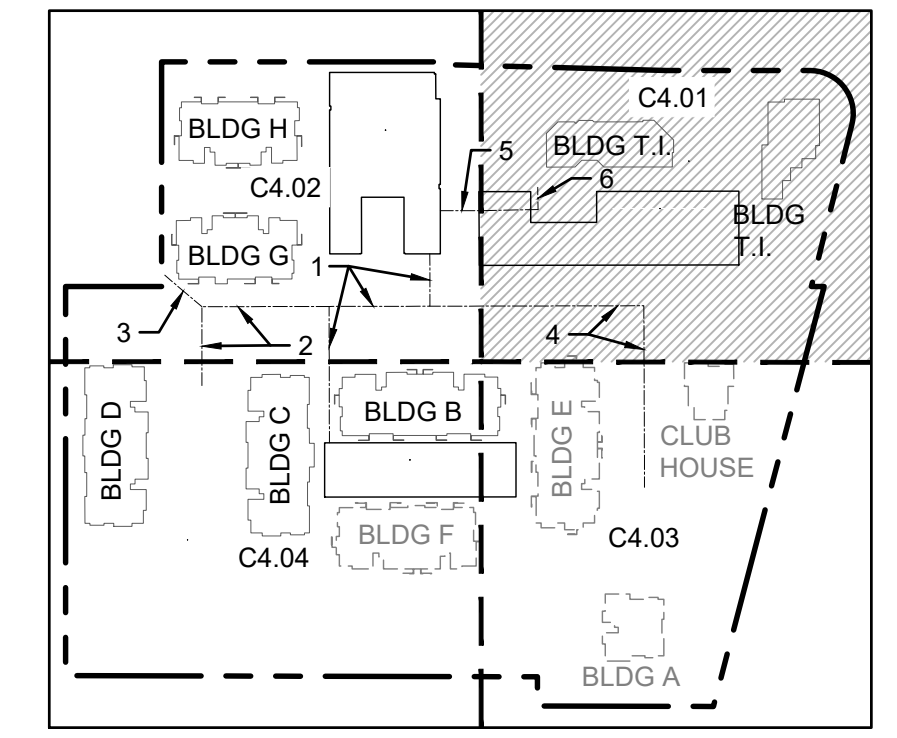

MATCH LINE SEE SHEET C4.02

MATCH LINE SEE SHEET C4.03



Know what's below.
Call before you dig.

01/29/24 CITY COMMENTS

Revisions:


Sheet Title:
STORM DRAINAGE PLAN NW

Designed by: CW
Drawn by: SK/RS
Checked by: JI

Sheet No.
C4.01
15 of 53 Sheets

EAST TOWN CROSSING PHASE 1

SEC. 26,35/ TWP. 20 N./ RGE. 4 E., W.M.

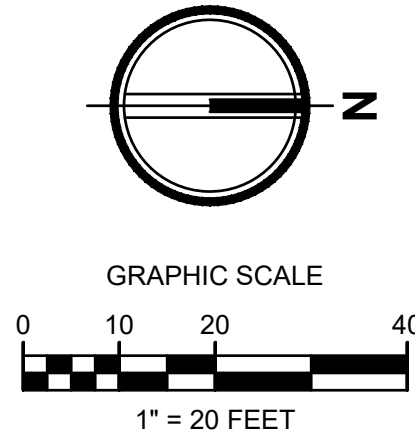

APPROVED

BY: CITY OF PUYALLUP
DEVELOPMENT ENGINEERING

DATE:

NOTE: THIS APPROVAL IS VOID AFTER 180 DAYS FROM APPROVAL DATE. THE CITY WILL NOT BE RESPONSIBLE FOR ERRORS AND/OR OMISSIONS ON THESE PLANS. FIELD CONDITIONS MAY DICTATE CHANGES TO THESE PLANS AS DETERMINED BY THE DEVELOPMENT ENGINEERING MANAGER.

TACOMA · SEATTLE · SPOKANE · TRI-CITIES

2215 North 30th Street, Suite 300, Tacoma, WA 98403
253.383.2422 TEL 253.383.2572 FAX www.ahbl.com WEB


Project Title:
EAST TOWN CROSSING PHASE 1

Client:
ASH DEVELOPMENT

GREG HELLE
GREG.HELLE@ASHNW.COM


Project No.
2230752

Issue Set & Date:
PERMIT SUBMITTAL
02/20/2024

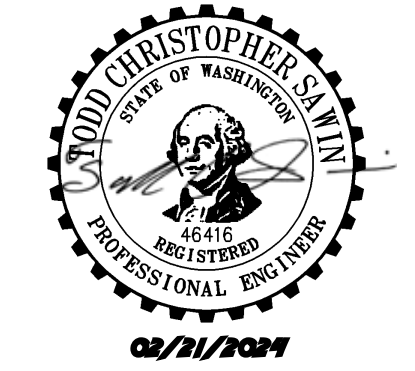

NOTICE: ALTERATION OF THIS DOCUMENT SHALL INVALIDATE THE PROFESSIONAL SEAL AND SIGNATURE. PREPARATION OF THIS DOCUMENT DOES NOT CONSTITUTE AN ENDORSEMENT OR GUARANTEE OF THE ACCURACY OR COMPLETENESS OF THE INFORMATION PROVIDED OR FOR THE PROJECT EXCEPT IN THE TITLE BLOCK AND IT IS NOT TO BE USED FOR OTHER PURPOSES OR IN ADDITION TO THAT PROJECT OR FOR ANY OTHER PROJECT.


STORM STRUCTURE TABLE		STORM STRUCTURE TABLE	
STRUCTURE NAME	STRUCTURE DETAILS	STRUCTURE NAME	STRUCTURE DETAILS
AREA DRAIN G1 TYPE 1 N 679651.27 E 1203988.13	RIM = 77.13 IE = 73.07 (6" NE)	SDCB#17 TYPE 1 N 679662.59 E 1203998.62	RIM = 76.64 IE = 72.75 (8" W) IE = 72.92 (6" SE) IE = 72.92 (6" SW)
AREA DRAIN G2 TYPE 1 N 679648.92 E 1203945.32	RIM = 77.43 IE = 72.78 (6" S) IE = 72.78 (8" NE)	SDCB#18 48" TYPE 2 SOLID LOCKING LID N 679787.40 E 1204060.54	RIM = 76.69 IE = 69.40 (12" N) IE = 69.73 (6" E) IE = 68.40 (24" S) IE = 68.40 (24" W)
AREA DRAIN H1 TYPE 1 N 679654.11 E 1203854.54	RIM = 77.10 IE = 72.33 (6" N)	SDCB#26 48" TYPE 2 SOLID LOCKING LID N 679682.46 E 1204058.73	RIM = 76.79 IE = 69.40 (12" S) IE = 68.40 (24" E) IE = 68.40 (24" N)
AREA DRAIN H2 TYPE 1 N 679651.43 E 1203896.03	RIM = 77.04 IE = 72.58 (6" S) IE = 72.58 (8" N)	SDCB#27 TYPE 1 N 679550.01 E 1204056.45	RIM = 75.52 IE = 71.54 (8" S) IE = 71.20 (12" N) IE = 71.20 (12" SW) IE = 71.20 (12" E)
R-TANK 2 INLET 1 N 679799.41 E 1203935.82	IE = 68.87 (12" N)	SDCB#28 TYPE 1 N 679427.04 E 1204054.32	RIM = 75.25 IE = 72.15 (8" N) IE = 72.15 (8" E)
R-TANK 2 INLET 2 N 679687.01 E 1203851.93	IE = 68.87 (12" S)	SDCB#40 TYPE 1 N 679510.96 E 1204021.83	RIM = 76.79 IE = 72.24 (12" NE)
R-TANK 2 INLET 3 N 679788.39 E 1204007.57	IE = 68.40 (24" E)	SDCO#D6 N 679489.70 E 1204094.51	RIM = 77.38 IE = 73.89 (6" NE)
R-TANK 2 OUTLET N 679800.24 E 1203960.54	IE = 68.40 (24" N)	SDCO#G2 N 679528.62 E 1203943.63	RIM = 76.99 IE = 73.98 (6" N)
54" CONTROL STRUCTURE N 679005.24 E 1203960.64	RIM = 77.20 IE = 68.40 (24" S) IE = 68.40 (24" N)	SDCO#G3 N 679648.60 E 1204018.45	RIM = 77.18 IE = 73.16 (6" S) IE = 73.16 (6" NW)
SDCB#11 TYPE 1 N 679815.72 E 1203936.19	RIM = 76.68 IE = 71.81 (8" W) IE = 71.81 (8" E) IE = 71.48 (12" S)	SDCO#G4 N 679526.72 E 1204016.45	RIM = 76.92 IE = 74.38 (6" N)
SDCB#12 TYPE 1 N 679814.62 E 1204000.39	RIM = 76.60 IE = 72.45 (8" W)	SDCO#H3 N 679530.60 E 1203894.55	RIM = 76.96 IE = 73.73 (6" N)
SDCB#13 TYPE 1 N 679817.31 E 1203857.02	RIM = 76.62 IE = 72.60 (8" E)	SDCO#H4 N 679657.42 E 1203829.56	RIM = 77.17 IE = 72.79 (6" SW) IE = 72.79 (6" NE)
SDCB#14 TYPE 1 N 679664.01 E 1203894.81	RIM = 76.84 IE = 71.89 (12" W) IE = 72.22 (8" S) IE = 71.89 (12" E)	SDCO#H5 N 679644.87 E 1203821.38	RIM = 75.92 IE = 72.94 (6" S) IE = 72.94 (6" NE)
SDCB#15 TYPE 1 N 679668.39 E 1203851.68	RIM = 76.30 IE = 71.69 (12" E) IE = 72.18 (6" SW) IE = 71.68 (12" N) IE = 72.18 (6" S)	SDCO#H6 N 679532.54 E 1203820.38	RIM = 76.55 IE = 74.06 (6" N)
SDCB#16 TYPE 1 N 679662.74 E 1203962.56	RIM = 76.89 IE = 72.57 (8" E) IE = 72.23 (12" W) IE = 72.56 (8" SW)		

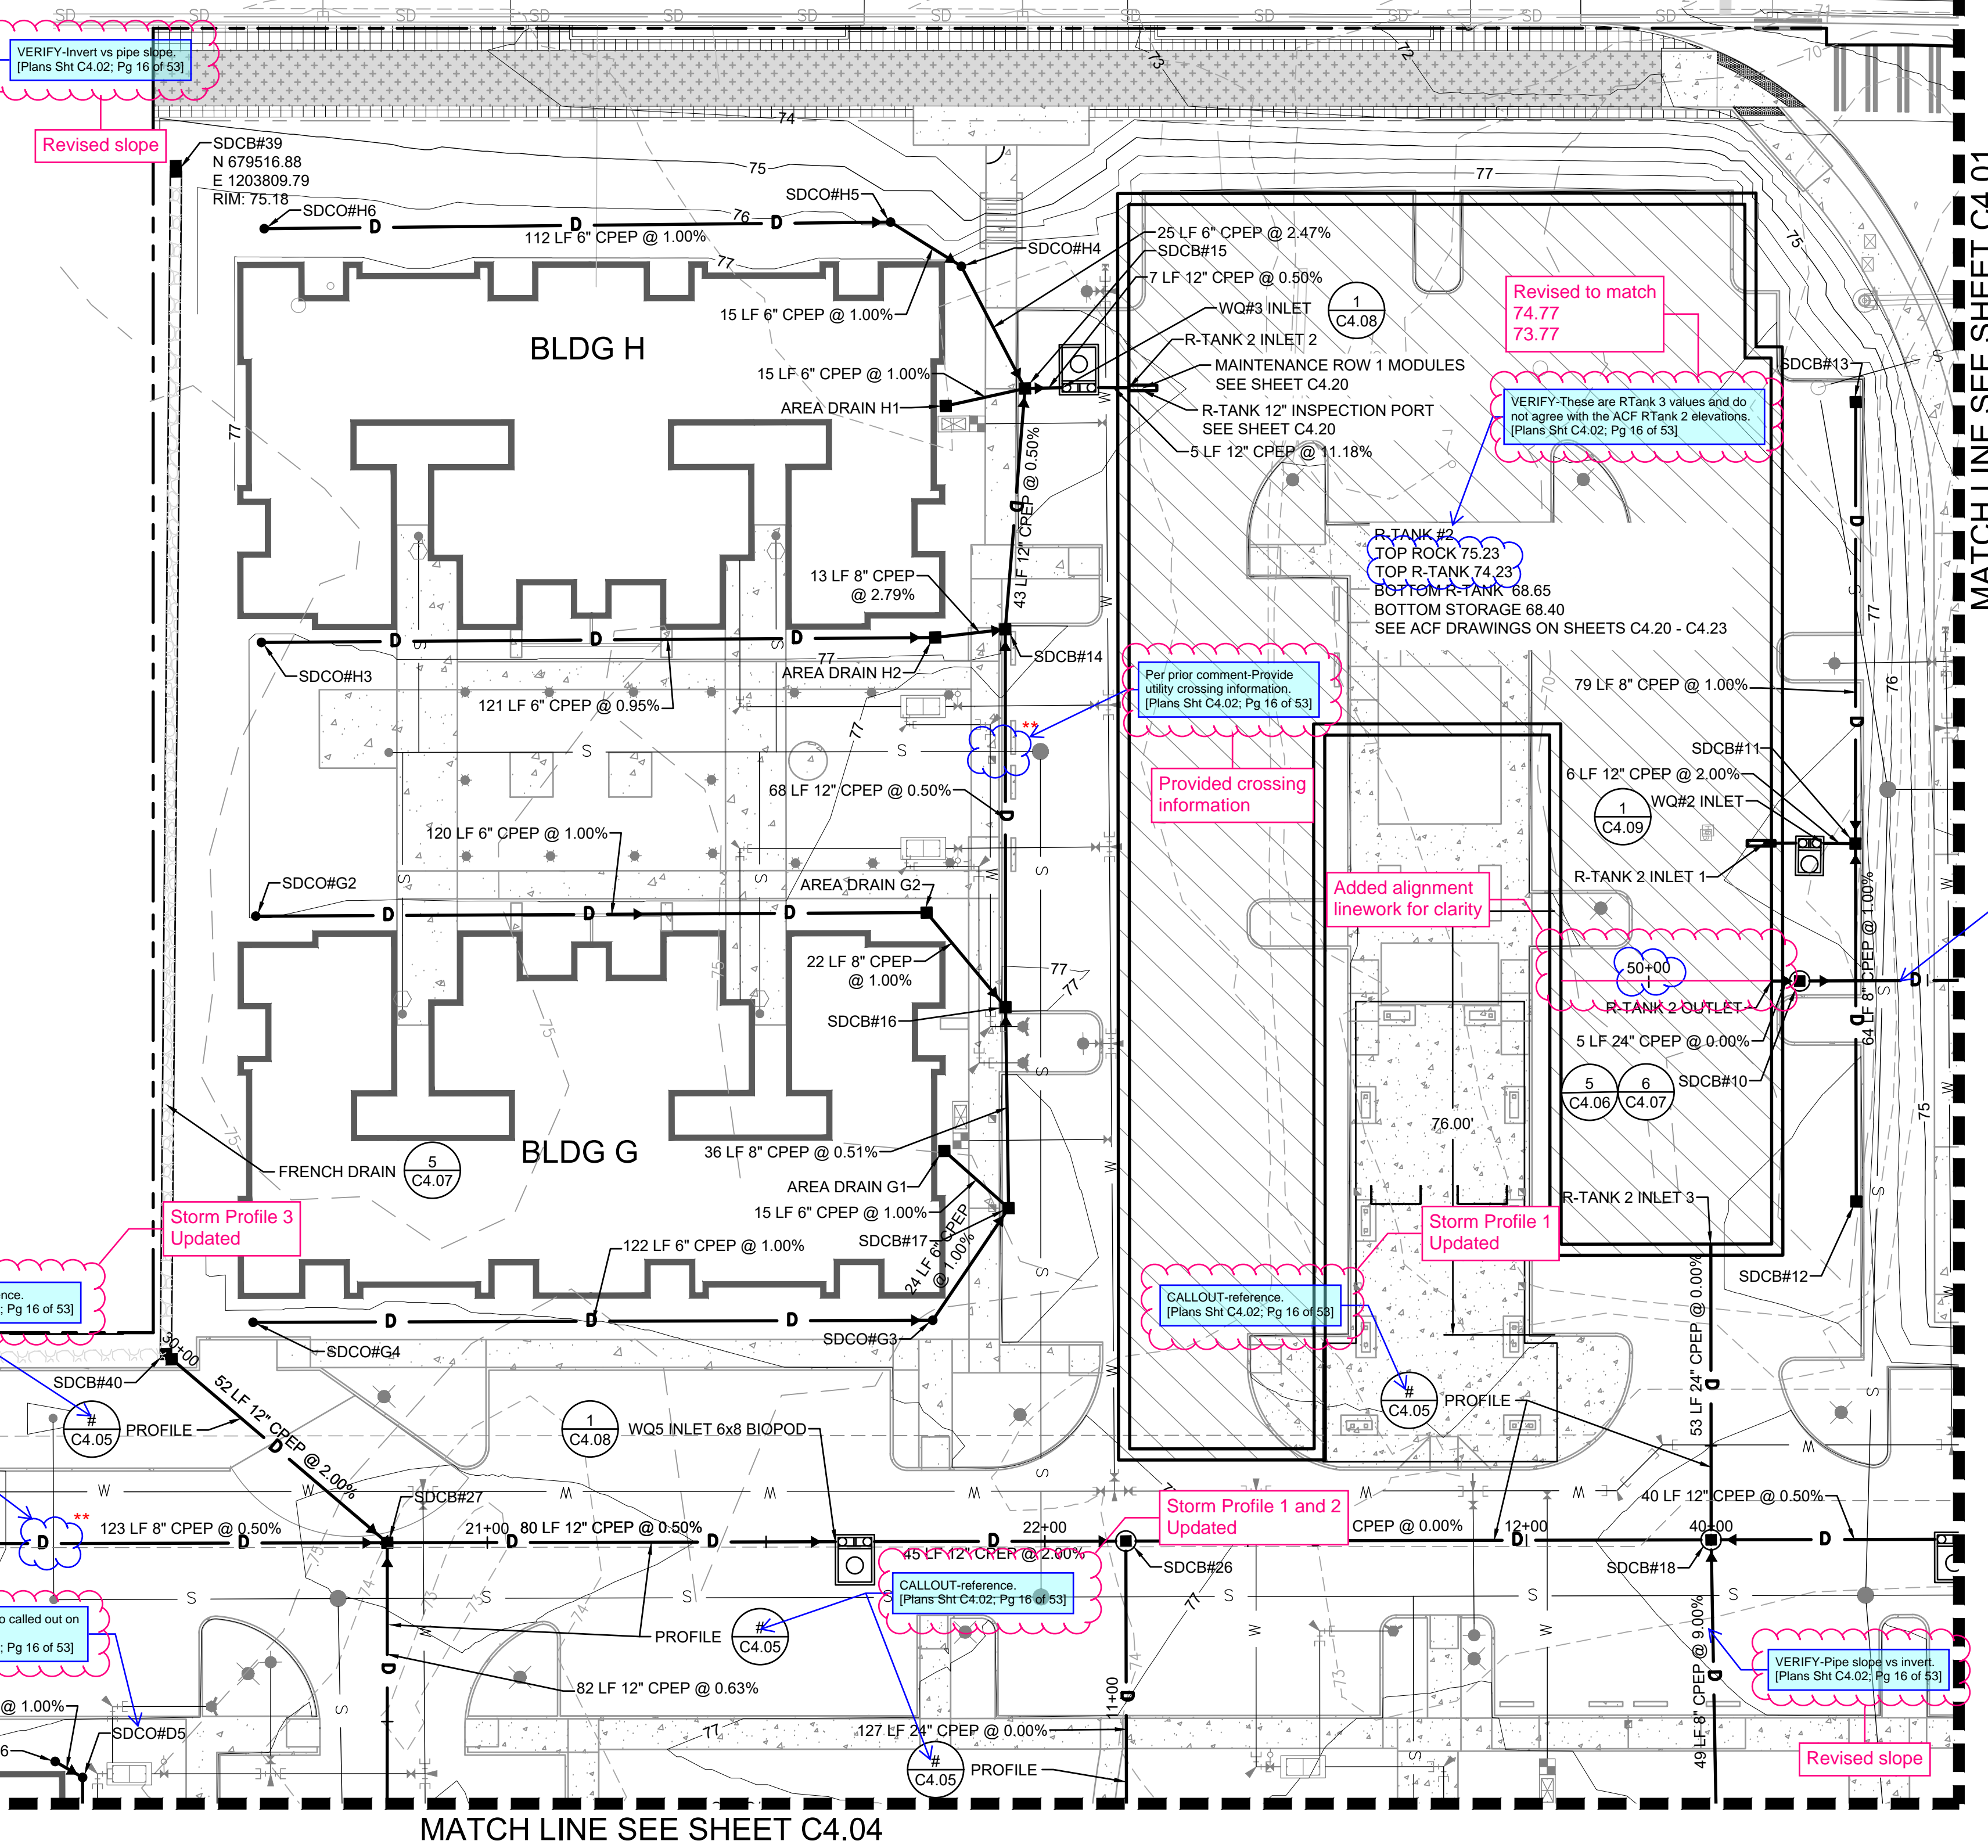

Large pipe is for overflow events (storms above those designed for) to allow water to leave the system without damaging the R-Tanks

VERIFY-Is it necessary to have such a large pipe into and out of the control structure? [Plans Sht C4.02; Pg 16 of 53]

- ### DETAIL REFERENCES
- CATCH BASIN TYPE 1 (AREA DRAIN)
 - CATCH BASIN TYPE 1 (GUTTER DRAIN)
 - FOR CATCH BASIN TYPE II
 - FRENCH DRAIN
 - STORM SEWER MANHOLE

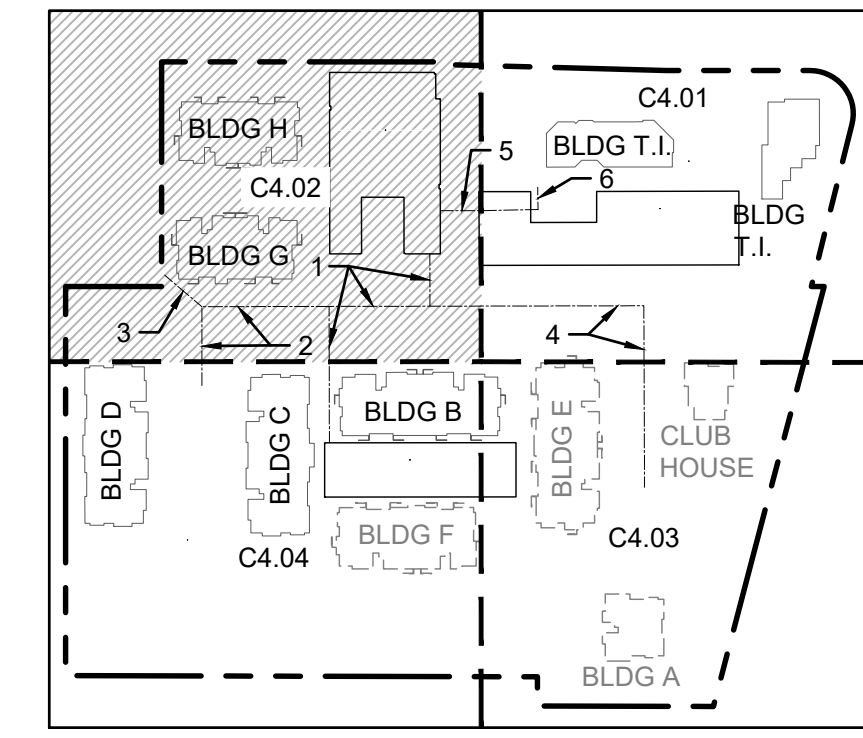

Know what's below.
Call before you dig.

MATCH LINE SEE SHEET C4.04

Revisions:

Sheet Title:
STORM DRAINAGE PLAN SW

Designed by: CW Drawn by: SK/RS Checked by: JI


Sheet No.
C4.02
16 of 53 Sheets

EAST TOWN CROSSING PHASE 1


SEC. 26,35/ TWP. 20 N./ RGE. 4 E., W.M.

APPROVED

BY: CITY OF PUYALLUP
DEVELOPMENT ENGINEERING
DATE:

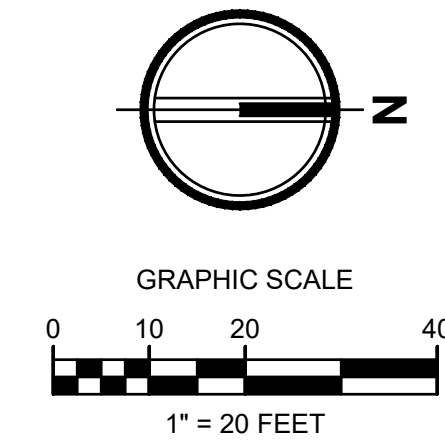

NOTE: THIS APPROVAL IS VOID AFTER 180 DAYS FROM APPROVAL DATE. THE CITY WILL NOT BE RESPONSIBLE FOR ERRORS AND/OR OMISSIONS ON THESE PLANS. FIELD CONDITIONS MAY DICTATE CHANGES TO THESE PLANS AS DETERMINED BY THE DEVELOPMENT ENGINEERING MANAGER.

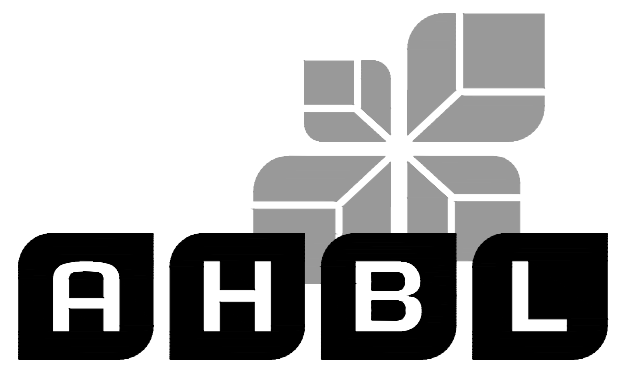

TACOMA • SEATTLE • SPOKANE • TRI-CITIES

2215 North 30th Street, Suite 300, Tacoma, WA 98403
253.383.2422 TEL 253.383.2572 FAX www.ahbl.com WEB

Project Title:

EAST TOWN CROSSING PHASE 1

Client:

ASH DEVELOPMENT

GREG HELLE

GREG.HELLE@ASHNW.COM


Project No.

2230752

Issue Set & Date:

PERMIT SUBMITTAL

02/20/2024

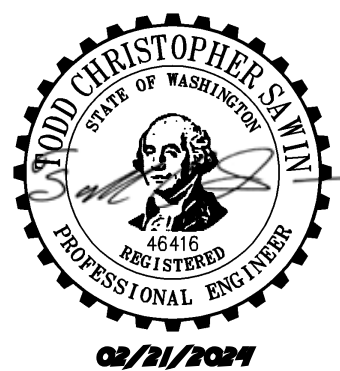
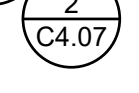

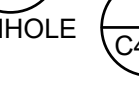



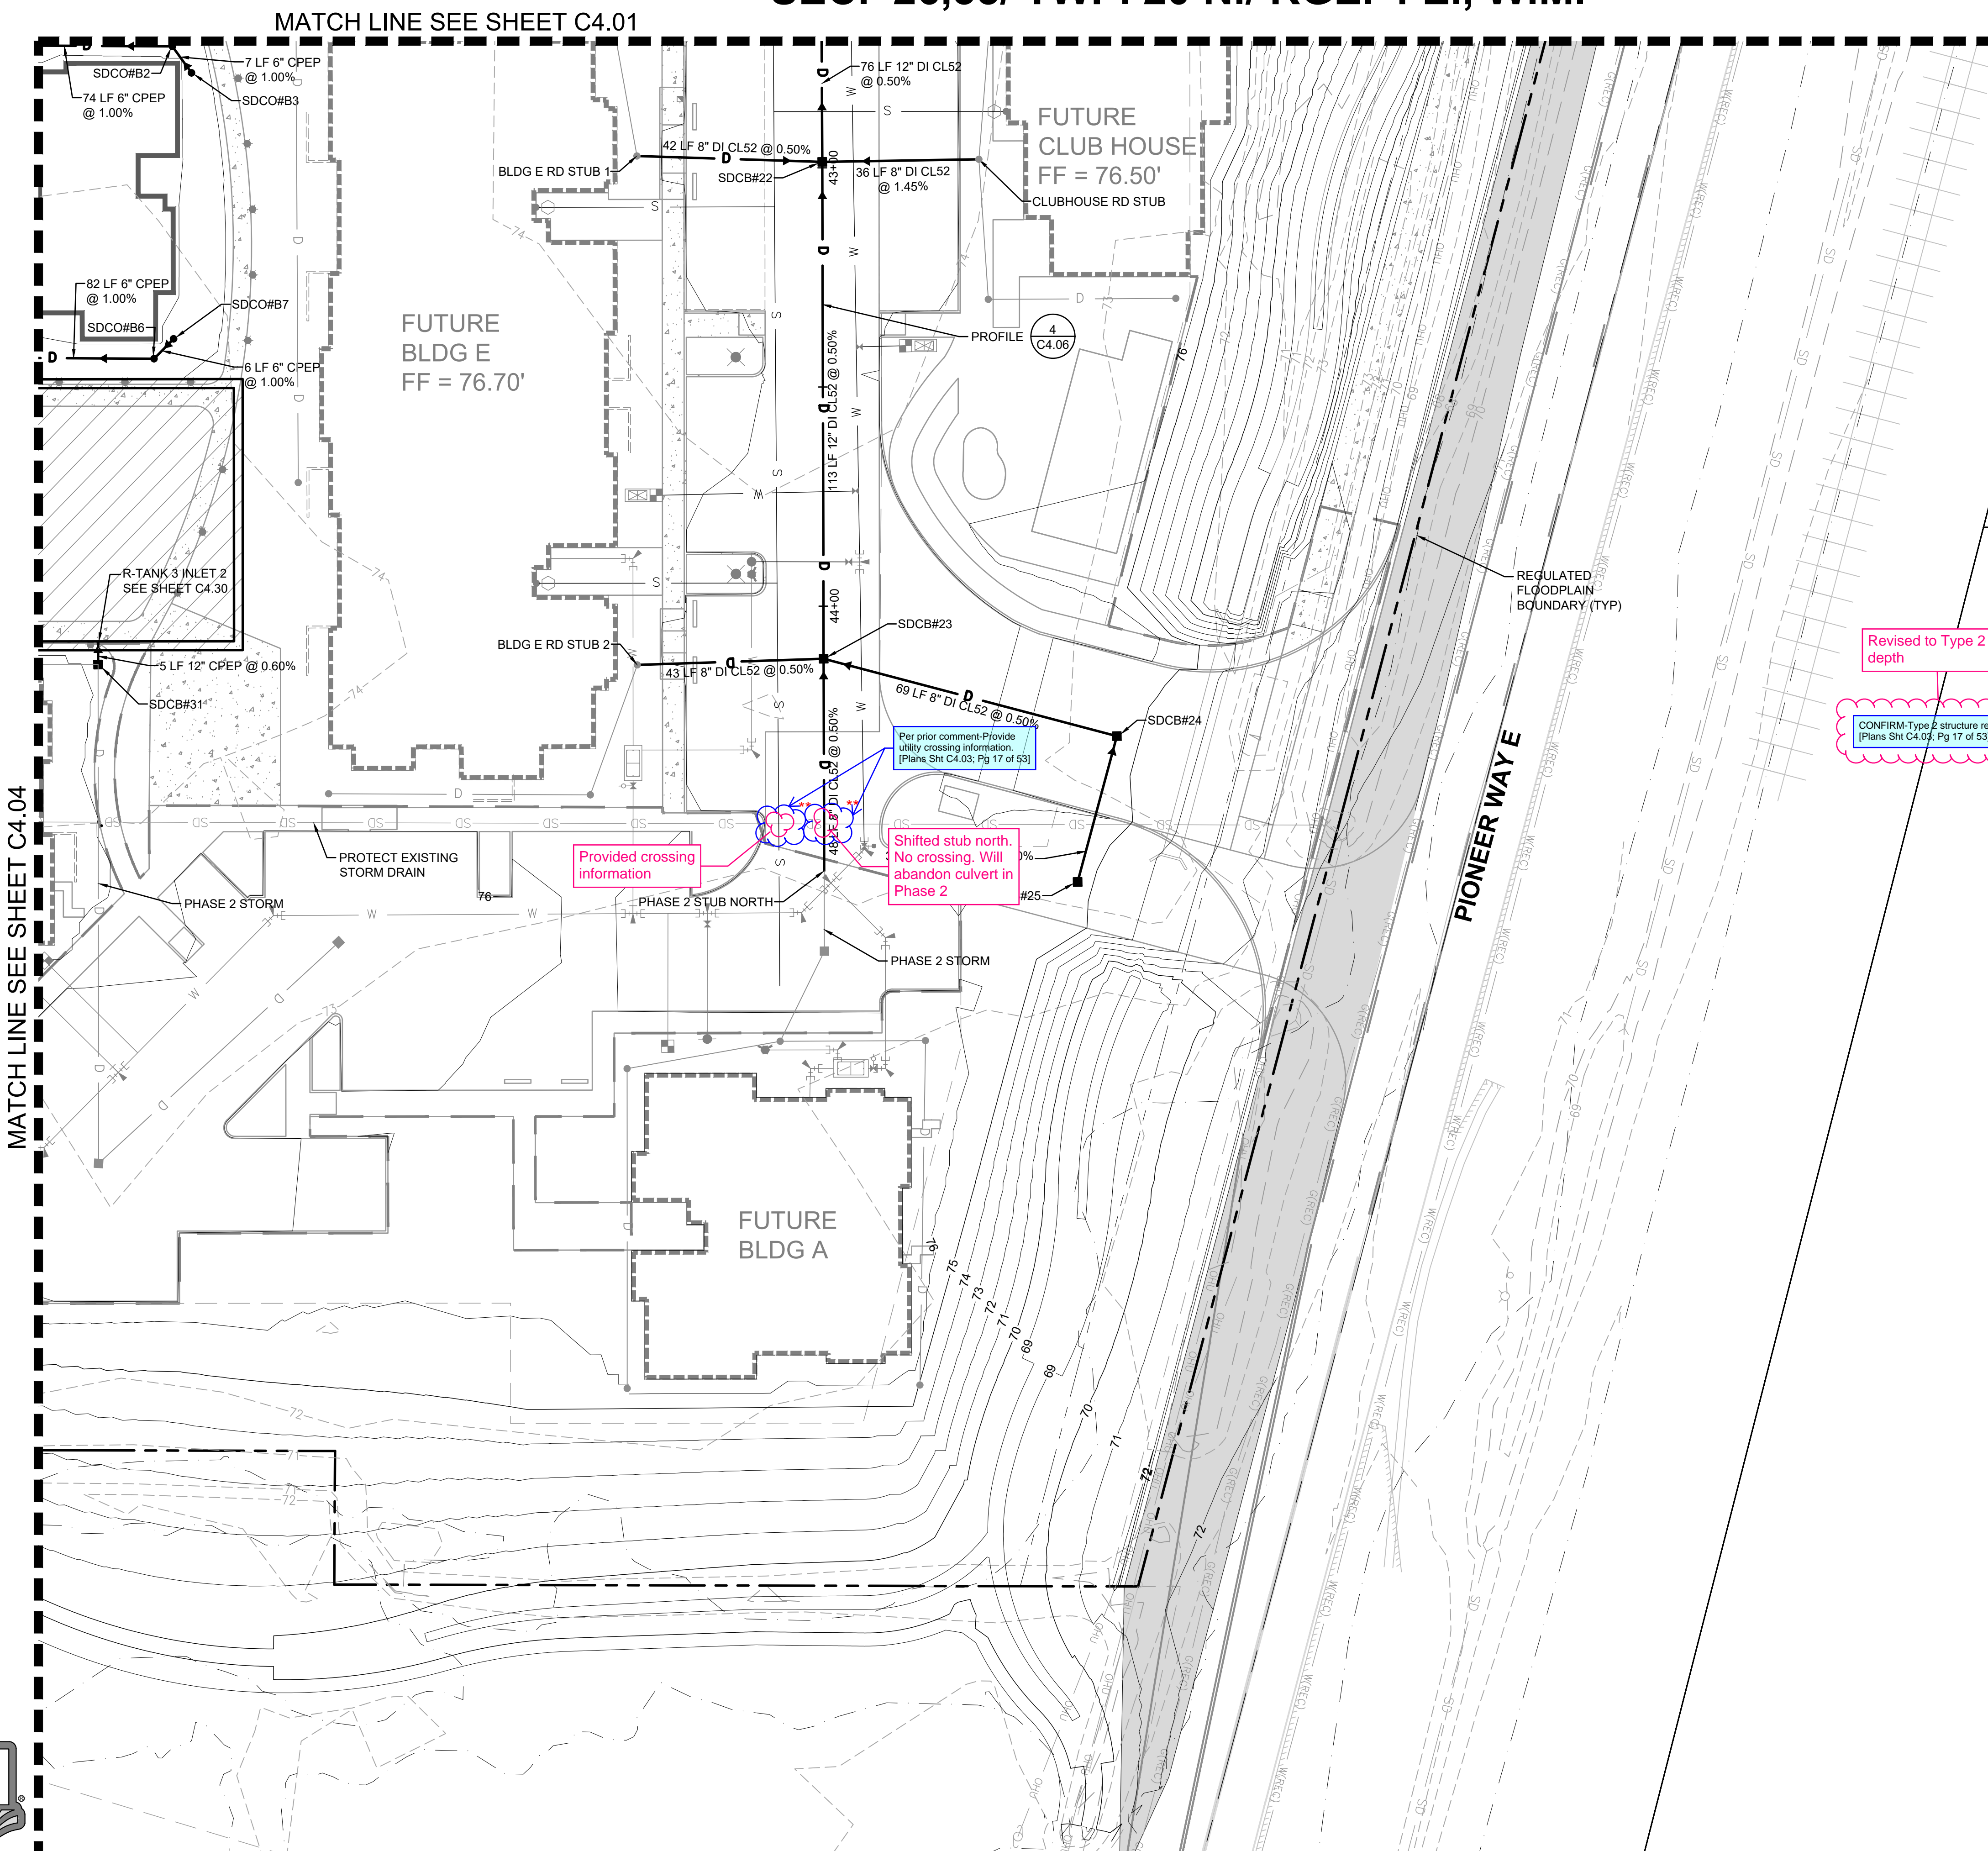
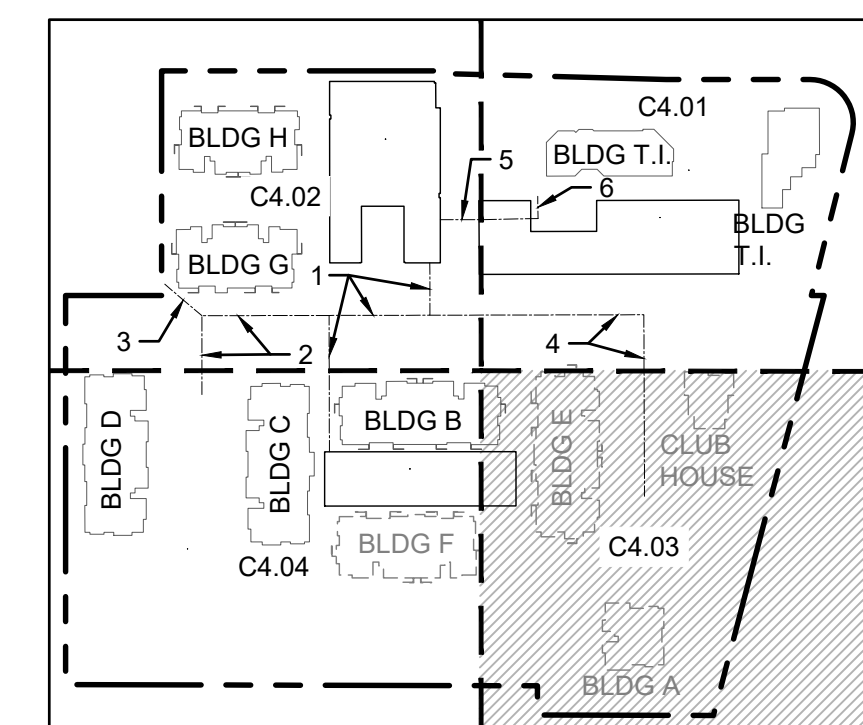
NOTICE
A SIGNATURE OF THIS DOCUMENT SHALL VALIDATE THE PROFESSIONAL SEAL AND SIGNATURE. PUBLICATION OF THIS DOCUMENT DOES NOT REPRESENT ANY RESERVE OR OTHER RIGHTS IN THE DOCUMENT OR THE USE ONLY FOR THE PROJECT ENTITLED IN THE TITLE BLOCK AND IS NOT TO BE USED FOR OTHER, SIMILAR, OR ACTION TO THAT PROJECT OR FOR ANY OTHER PROJECT.

STORM STRUCTURE TABLE	
STRUCTURE NAME	STRUCTURE DETAILS
R-TANK 3 INLET 2 N 679841.90 E 1204246.34	IE = 70.22 (12" E)
SDCB#22 TYPE 1 N 680009.17 E 1204140.15	RIM = 75.25 IE = 71.36 (12" E) IE = 71.36 (12" W) IE = 71.69 (8" N) IE = 71.69 (8" S)
SDCB#23 TYPE 1 N 680007.27 E 1204253.48	RIM = 75.25 IE = 71.93 (12" W) IE = 72.26 (8" N) IE = 72.26 (8" E) IE = 72.26 (8" S)
SDCB#24 TYPE 1 W/ SOLID LOCKING LID N 680073.82 E 1204272.43	RIM = 75.25 IE = 72.61 (8" E) IE = 72.61 (8" S)
SDCB#25 TYPE 1 N 680064.22 E 1204305.52	RIM = 75.25 IE = 72.79 (8" W)
SDCB#31 AREA DRAIN N 679841.75 E 1204251.59	RIM = 76.89 IE = 70.25 (12" W)
SDCO#B2 N 679861.46 E 1204110.92	RIM = 77.68 IE = 75.01 (6" NE) IE = 75.01 (6" S)
SDCO#B3 N 679865.69 E 1204117.04	RIM = 77.64 IE = 75.08 (6" SW)
SDCO#B6 N 679855.88 E 1204182.08	RIM = 77.58 IE = 72.81 (6" S) IE = 72.81 (6" NW)
SDCO#B7 N 679860.43 E 1204177.64	RIM = 77.80 IE = 72.87 (6" SE)

Revised to Type 2 for depth
CONFIRM Type 2 structure req'd. [Plans Sht C4.03, Pg 17 of 53]

DETAIL REFERENCES





- CATCH BASIN TYPE 1 (AREA DRAIN) 
- CATCH BASIN TYPE 1 (GUTTER DRAIN) 
- FOR CATCH BASIN TYPE II 
- FRENCH DRAIN 
- STORM SEWER MANHOLE 



MATCH LINE SEE SHEET C4.04

MATCH LINE SEE SHEET C4.01



- 
- 
- 
-  01/29/24 CITY COMMENTS

Revisions:

Sheet Title:

STORM DRAINAGE PLAN NE

Designed by: CW Drawn by: SK / RS Checked by: JI

Sheet No.

C4.03

17 of 53 Sheets



EAST TOWN CROSSING PHASE 1

SEC. 26,35/ TWP. 20 N./ RGE. 4 E., W.M.

APPROVED

BY: CITY OF PUYALLUP
DEVELOPMENT ENGINEERING
DATE:

NOTE: THIS APPROVAL IS VOID AFTER 180 DAYS FROM APPROVAL DATE. THE CITY WILL NOT BE RESPONSIBLE FOR ERRORS AND/OR OMISSIONS ON THESE PLANS. FIELD CONDITIONS MAY DICTATE CHANGES TO THESE PLANS AS DETERMINED BY THE DEVELOPMENT ENGINEERING MANAGER.

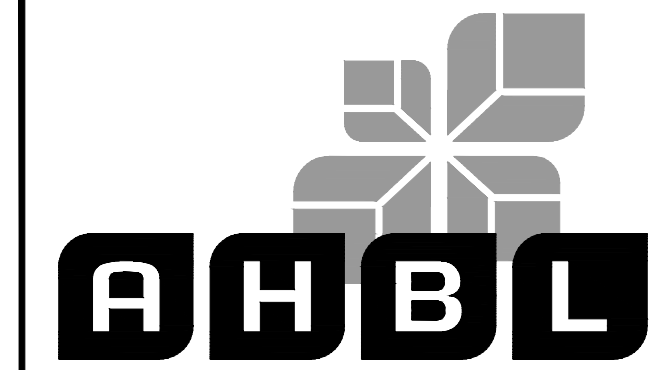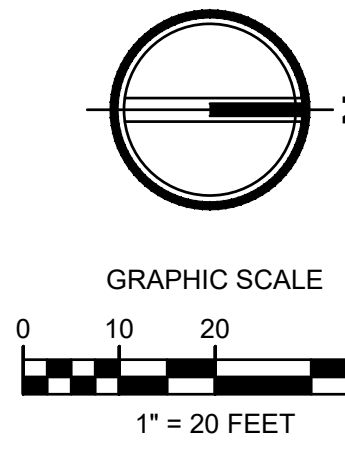

TACOMA • SEATTLE • SPOKANE • TRI-CITIES
2215 North 30th Street, Suite 300, Tacoma, WA 98403
253.383.2422 TEL 253.383.2572 FAX www.ahbl.com WEB


Project Title:
EAST TOWN CROSSING PHASE 1

Client:
ASH DEVELOPMENT

GREG HELLE
GREG.HELLE@ASHNW.COM

Project No.
2230752

Issue Set & Date:
PERMIT SUBMITTAL
02/20/2024

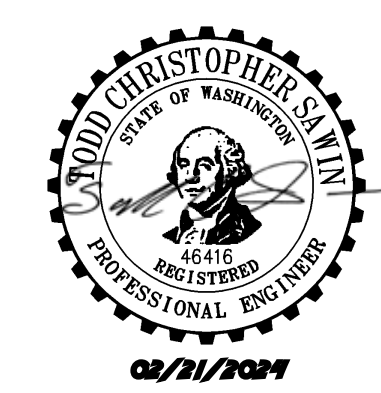

NOTICE: ALTERATION OF THIS DOCUMENT SHALL INVALIDATE THE PROFESSIONAL SEAL AND SIGNATURE. PUBLICATION OF THIS DOCUMENT DOES NOT CONSTITUTE AN ENDORSEMENT OR GUARANTEE BY THE ENGINEER OR ARCHITECT FOR THE PROJECT EXCEPT IN THE BLOCK SHOWN. IT IS NOT TO BE USED FOR OTHER PURPOSES OR IN CONNECTION TO THAT PROJECT OR FOR ANY OTHER PROJECT.

PVI: structure not shown on this sheet. Callout on Sht C4.02. (Plans Sht C4.04, Pg 18 of 53)

Updated structure tables

01/29/24 CITY COMMENTS

Revisions:

Sheet Title:
STORM DRAINAGE PLAN SE



Designed by: CW Drawn by: SK / RS Checked by: JI

Sheet No.
C4.04
18 of 53 Sheets

STORM STRUCTURE TABLE		STORM STRUCTURE TABLE	
STRUCTURE NAME	STRUCTURE DETAILS	STRUCTURE NAME	STRUCTURE DETAILS
R-TANK 3 INLET 1 N 679773.94 E 1204187.21	IE = 71.95 (6" W)	SDCO#C4 N 679591.95 E 1204247.00	RIM = 76.81 IE = 74.29 (6" W)
R-TANK 3 INLET 3 N 679679.59 E 1204243.29	RIM = 70.56 IE = 68.40 (24" E)	SDCO#C5 N 679666.61 E 1204228.76	RIM = 76.86 IE = 71.74 (6" E) IE = 71.44 (6" W) IE = 71.44 (6" N)
R-TANK 3 INLET 4 N 679674.54 E 1204228.76	RIM = 72.15 IE = 71.40 (8" S)	SDCO#C6 N 679666.78 E 1204119.03	RIM = 77.04 IE = 72.54 (6" E) IE = 72.54 (6" SW)
R-TANK 3 OUTLET N 679680.28 E 1204185.47	RIM = 70.56 IE = 68.40 (24" W)	SDCO#C7 N 679658.37 E 1204110.45	RIM = 77.00 IE = 72.66 (6" NE)
SDCB#29 TYPE 1 N 679548.37 E 1204138.49	RIM = 75.40 IE = 72.05 (8" E) IE = 72.05 (8" S) IE = 72.05 (8" N) IE = 71.72 (12" W)	SDCO#C8 N 679663.03 E 1204273.76	RIM = 76.87 IE = 72.19 (6" W) IE = 72.19 (6" SE)
SDCB#30 TYPE 1 N 679547.41 E 1204266.63	RIM = 75.40 IE = 72.69 (8" W)	SDCO#C9 N 679653.44 E 1204283.32	RIM = 76.86 IE = 72.33 (6" NW) IE = 72.33 (6" S)
SDCO#B1 N 679787.35 E 1204109.08	RIM = 78.02 IE = 74.27 (6" S) IE = 74.27 (6" N) IE = 74.10 (8" W)	SDCO#C10 N 679598.55 E 1204282.11	RIM = 76.90 IE = 72.88 (6" N)
SDCO#B4 N 679692.17 E 1204109.27	RIM = 78.03 IE = 75.22 (6" N)	SDCO#D1 N 679423.88 E 1204102.02	RIM = 77.25 IE = 73.01 (6" E) IE = 72.84 (6" W)
SDCO#B5 N 679774.10 E 1204180.01	RIM = 77.85 IE = 71.99 (6" S) IE = 71.99 (6" N) IE = 71.99 (6" E)	SDCO#D2 N 679422.23 E 1204265.61	RIM = 77.29 IE = 74.65 (6" NE) IE = 74.65 (6" W)
SDCO#B8 N 679692.33 E 1204177.94	RIM = 77.71 IE = 72.81 (6" N)	SDCO#D3 N 679426.74 E 1204270.10	RIM = 77.43 IE = 74.71 (6" SW)
SDCO#C1 N 679593.67 E 1204139.96	RIM = 76.84 IE = 73.21 (6" W) IE = 73.21 (6" E) IE = 73.04 (8" S)	SDCO#D4 N 679493.77 E 1204137.44	RIM = 77.45 IE = 73.43 (6" E) IE = 73.43 (6" W) IE = 73.43 (8" N)
SDCO#C2 N 679593.50 E 1204110.27	RIM = 76.86 IE = 73.50 (6" NW) IE = 73.50 (6" E)	SDCO#D5 N 679494.55 E 1204097.47	RIM = 77.41 IE = 73.83 (6" SW) IE = 73.83 (6" E)
SDCO#C3 N 679598.79 E 1204105.90	RIM = 76.90 IE = 73.57 (6" SE)	SDCO#D7 N 679491.69 E 1204256.70	RIM = 77.38 IE = 74.62 (6" W)

DETAIL REFERENCES

- CATCH BASIN TYPE 1 (AREA DRAIN)
- CATCH BASIN TYPE 1 (GUTTER DRAIN)
- FOR CATCH BASIN TYPE II
- FRENCH DRAIN
- STORM SEWER MANHOLE

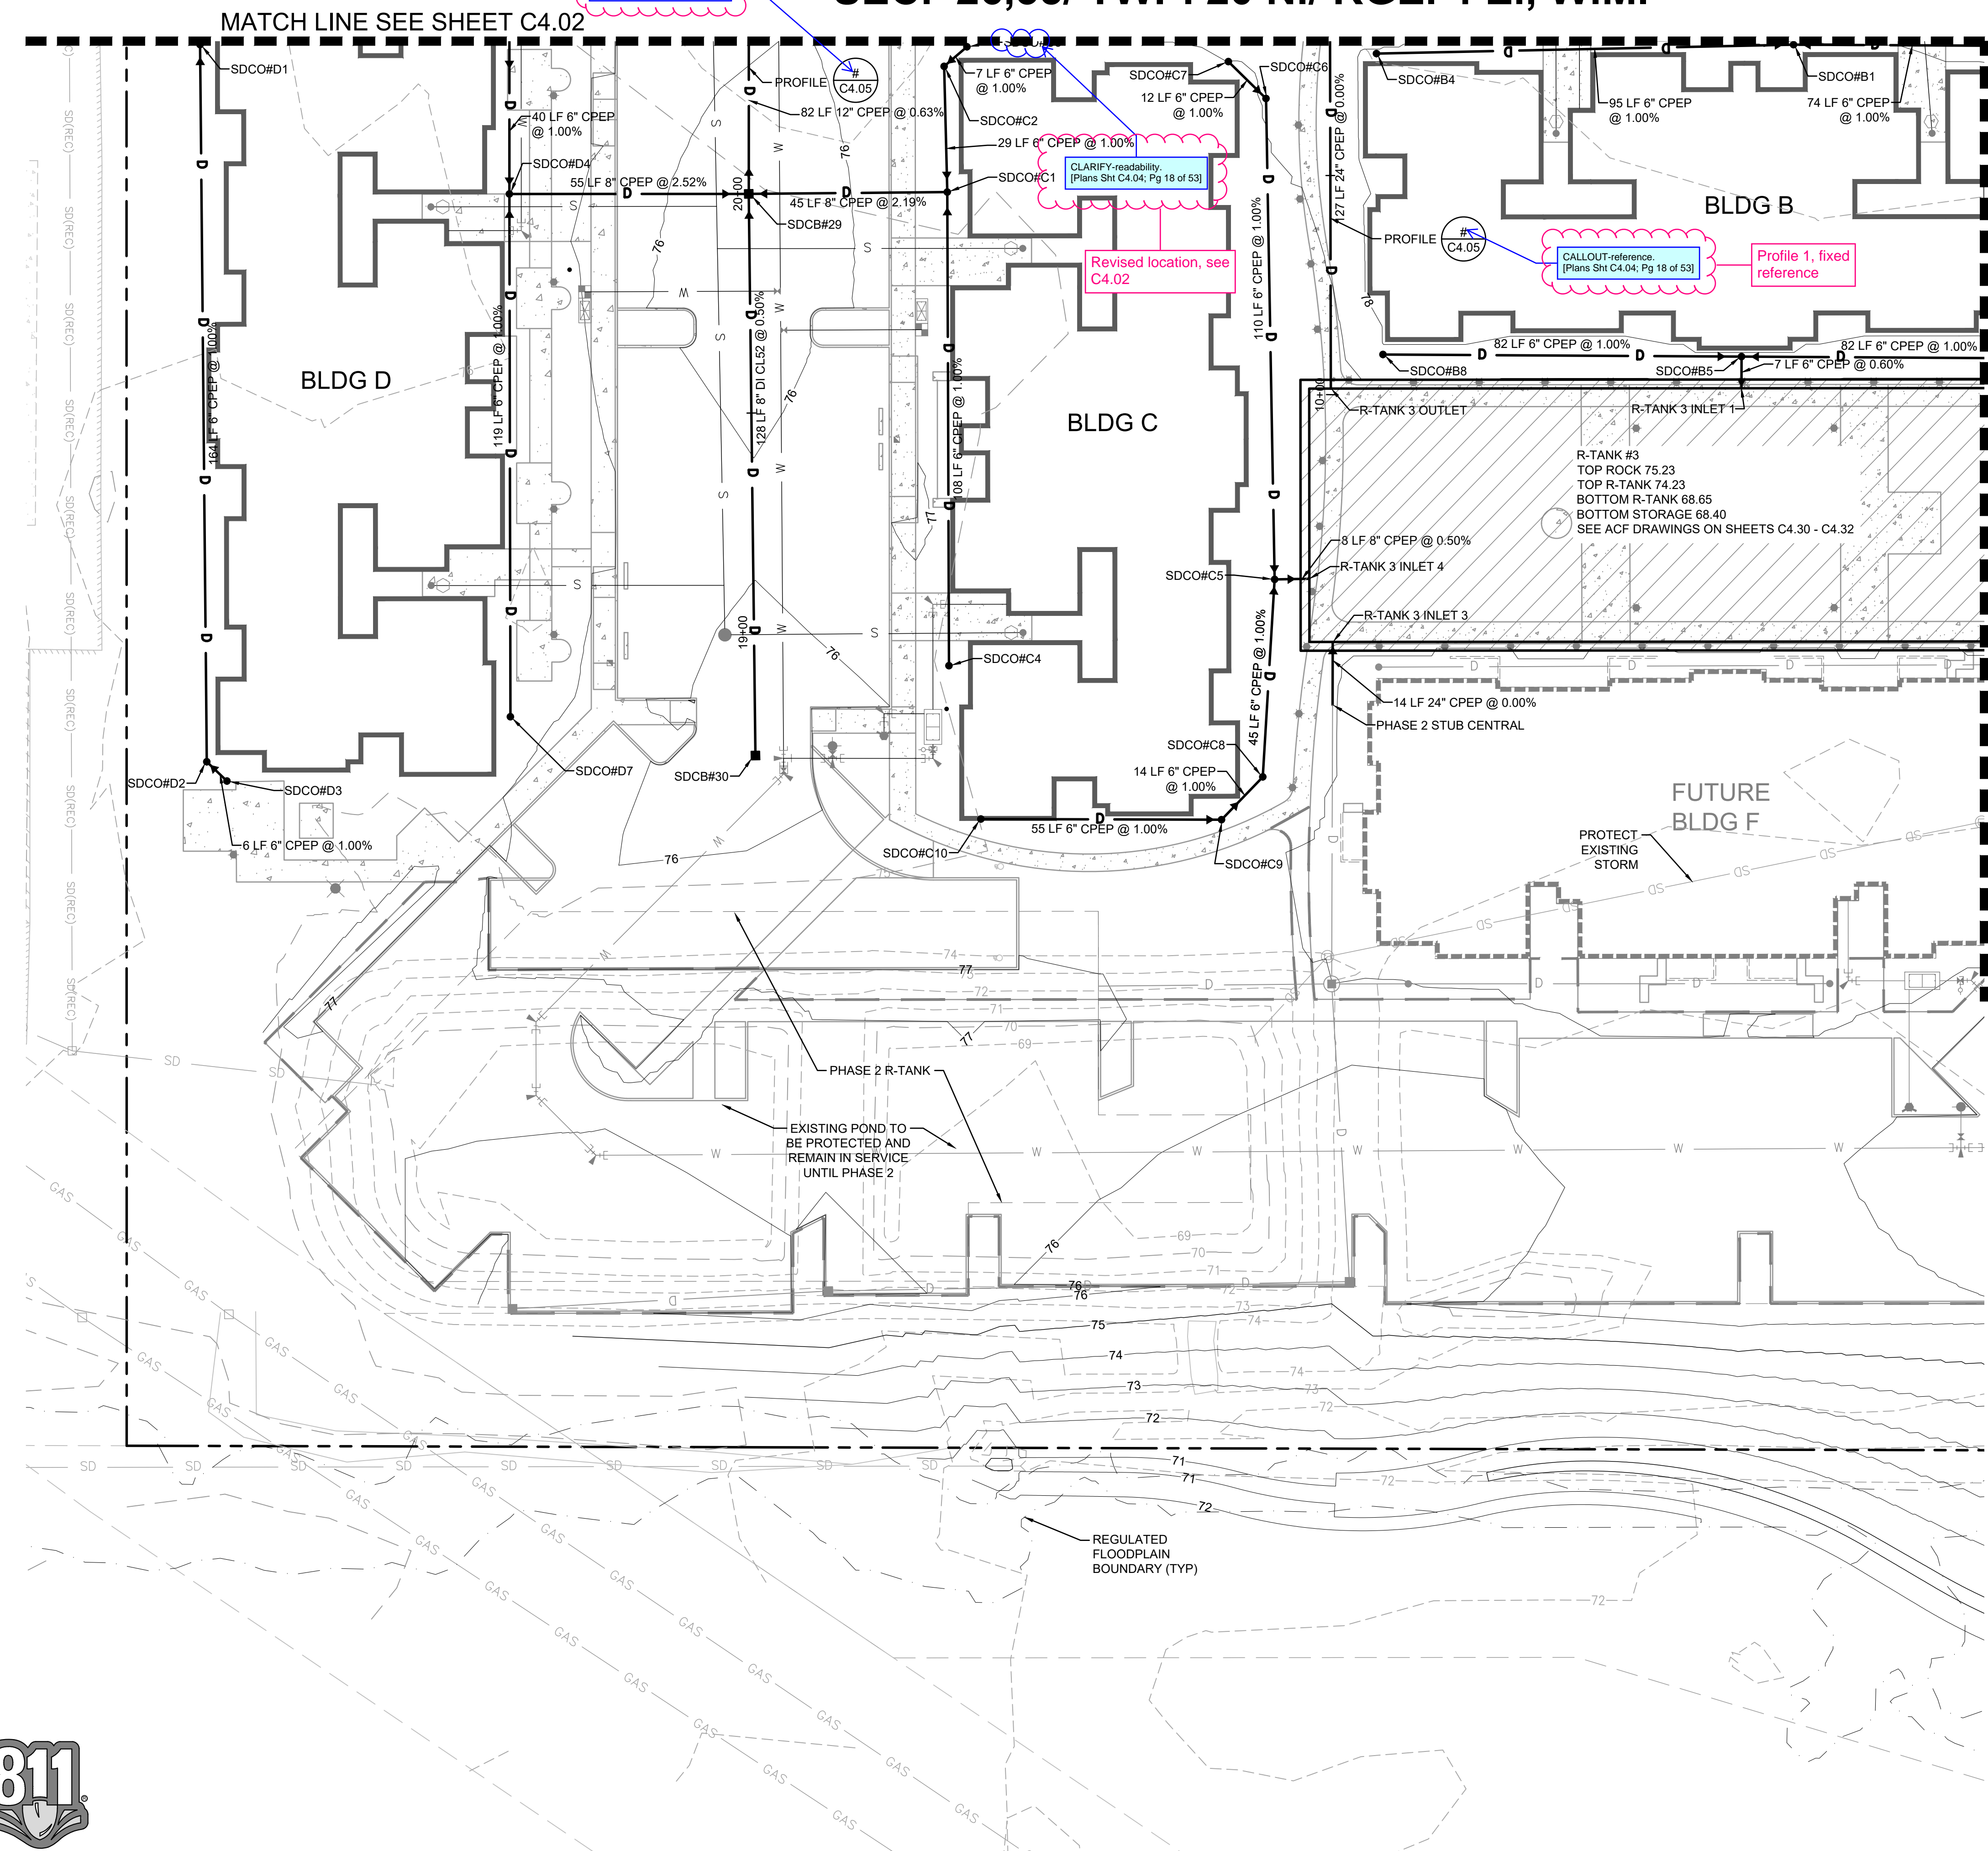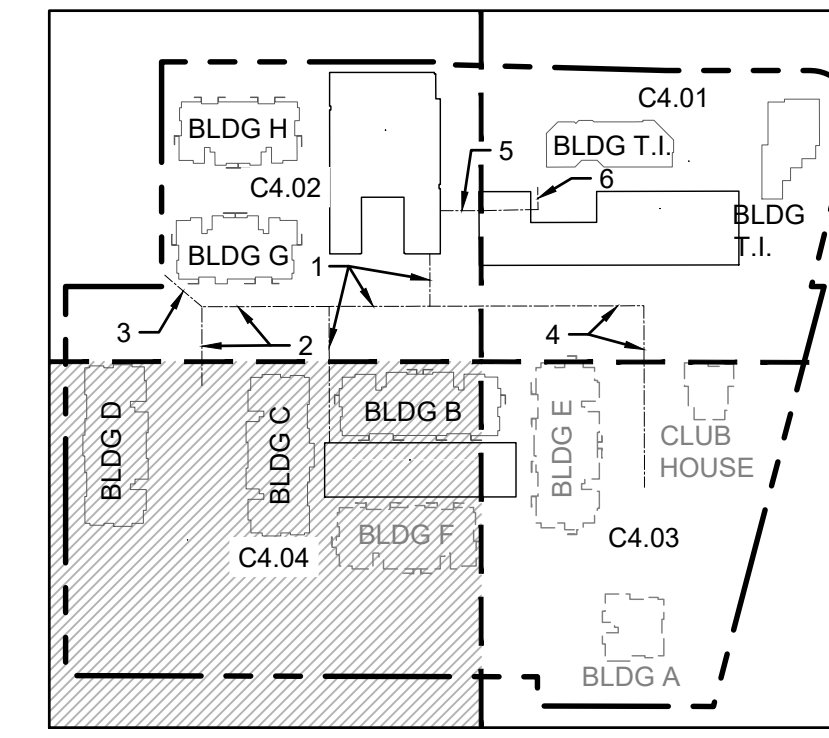

Profile 2, fixed reference

CALLOUT-reference. (Plans Sht C4.04; Pg 18 of 53)

CLARIFY-readability. (Plans Sht C4.04; Pg 18 of 53)

Revised location, see C4.02

CALLOUT-reference. (Plans Sht C4.04; Pg 18 of 53)

Profile 1, fixed reference

MATCH LINE SEE SHEET C4.03

MATCH LINE SEE SHEET C4.02



EAST TOWN CROSSING PHASE 1


SEC. 26,35/ TWP. 20 N./ RGE. 4 E., W.M.

APPROVED

BY: CITY OF PUYALLUP
DEVELOPMENT ENGINEERING

DATE:

NOTE: THIS APPROVAL IS VOID AFTER 180 DAYS FROM APPROVAL DATE. THE CITY WILL NOT BE RESPONSIBLE FOR ERRORS AND/OR OMISSIONS ON THESE PLANS. FIELD CONDITIONS MAY DICTATE CHANGES TO THESE PLANS AS DETERMINED BY THE DEVELOPMENT ENGINEERING MANAGER.

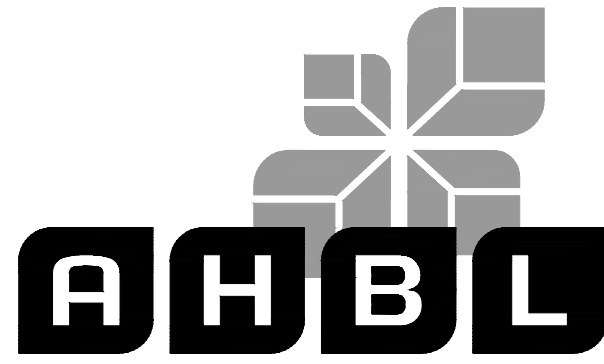

TACOMA • SEATTLE • SPOKANE • TRI-CITIES

2215 North 30th Street, Suite 300, Tacoma, WA 98403
253.383.2422 TEL 253.383.2572 FAX www.ahbl.com WEB

Project Title:

EAST TOWN CROSSING PHASE 1

Client:
ASH DEVELOPMENT

GREG HELLE

GREG.HELLE@ASHNW.COM

Project No.

2230752


Issue Set & Date:

PERMIT SUBMITTAL


02/20/2024




NOTICE: ALTERATION OF THIS DOCUMENT SHALL INVALIDATE THE PROFESSIONAL SEAL AND SIGNATURE. PUBLICATION OF THIS DOCUMENT DOES NOT CONSTITUTE AN ENDORSEMENT OR GUARANTEE BY THE ENGINEER OR ARCHITECT FOR THE PROJECT DESCRIBED IN THE TITLE BLOCK AND IS NOT TO BE USED FOR OTHER PROJECTS IN ADDITION TO THAT PROJECT OR FOR ANY OTHER PROJECT.

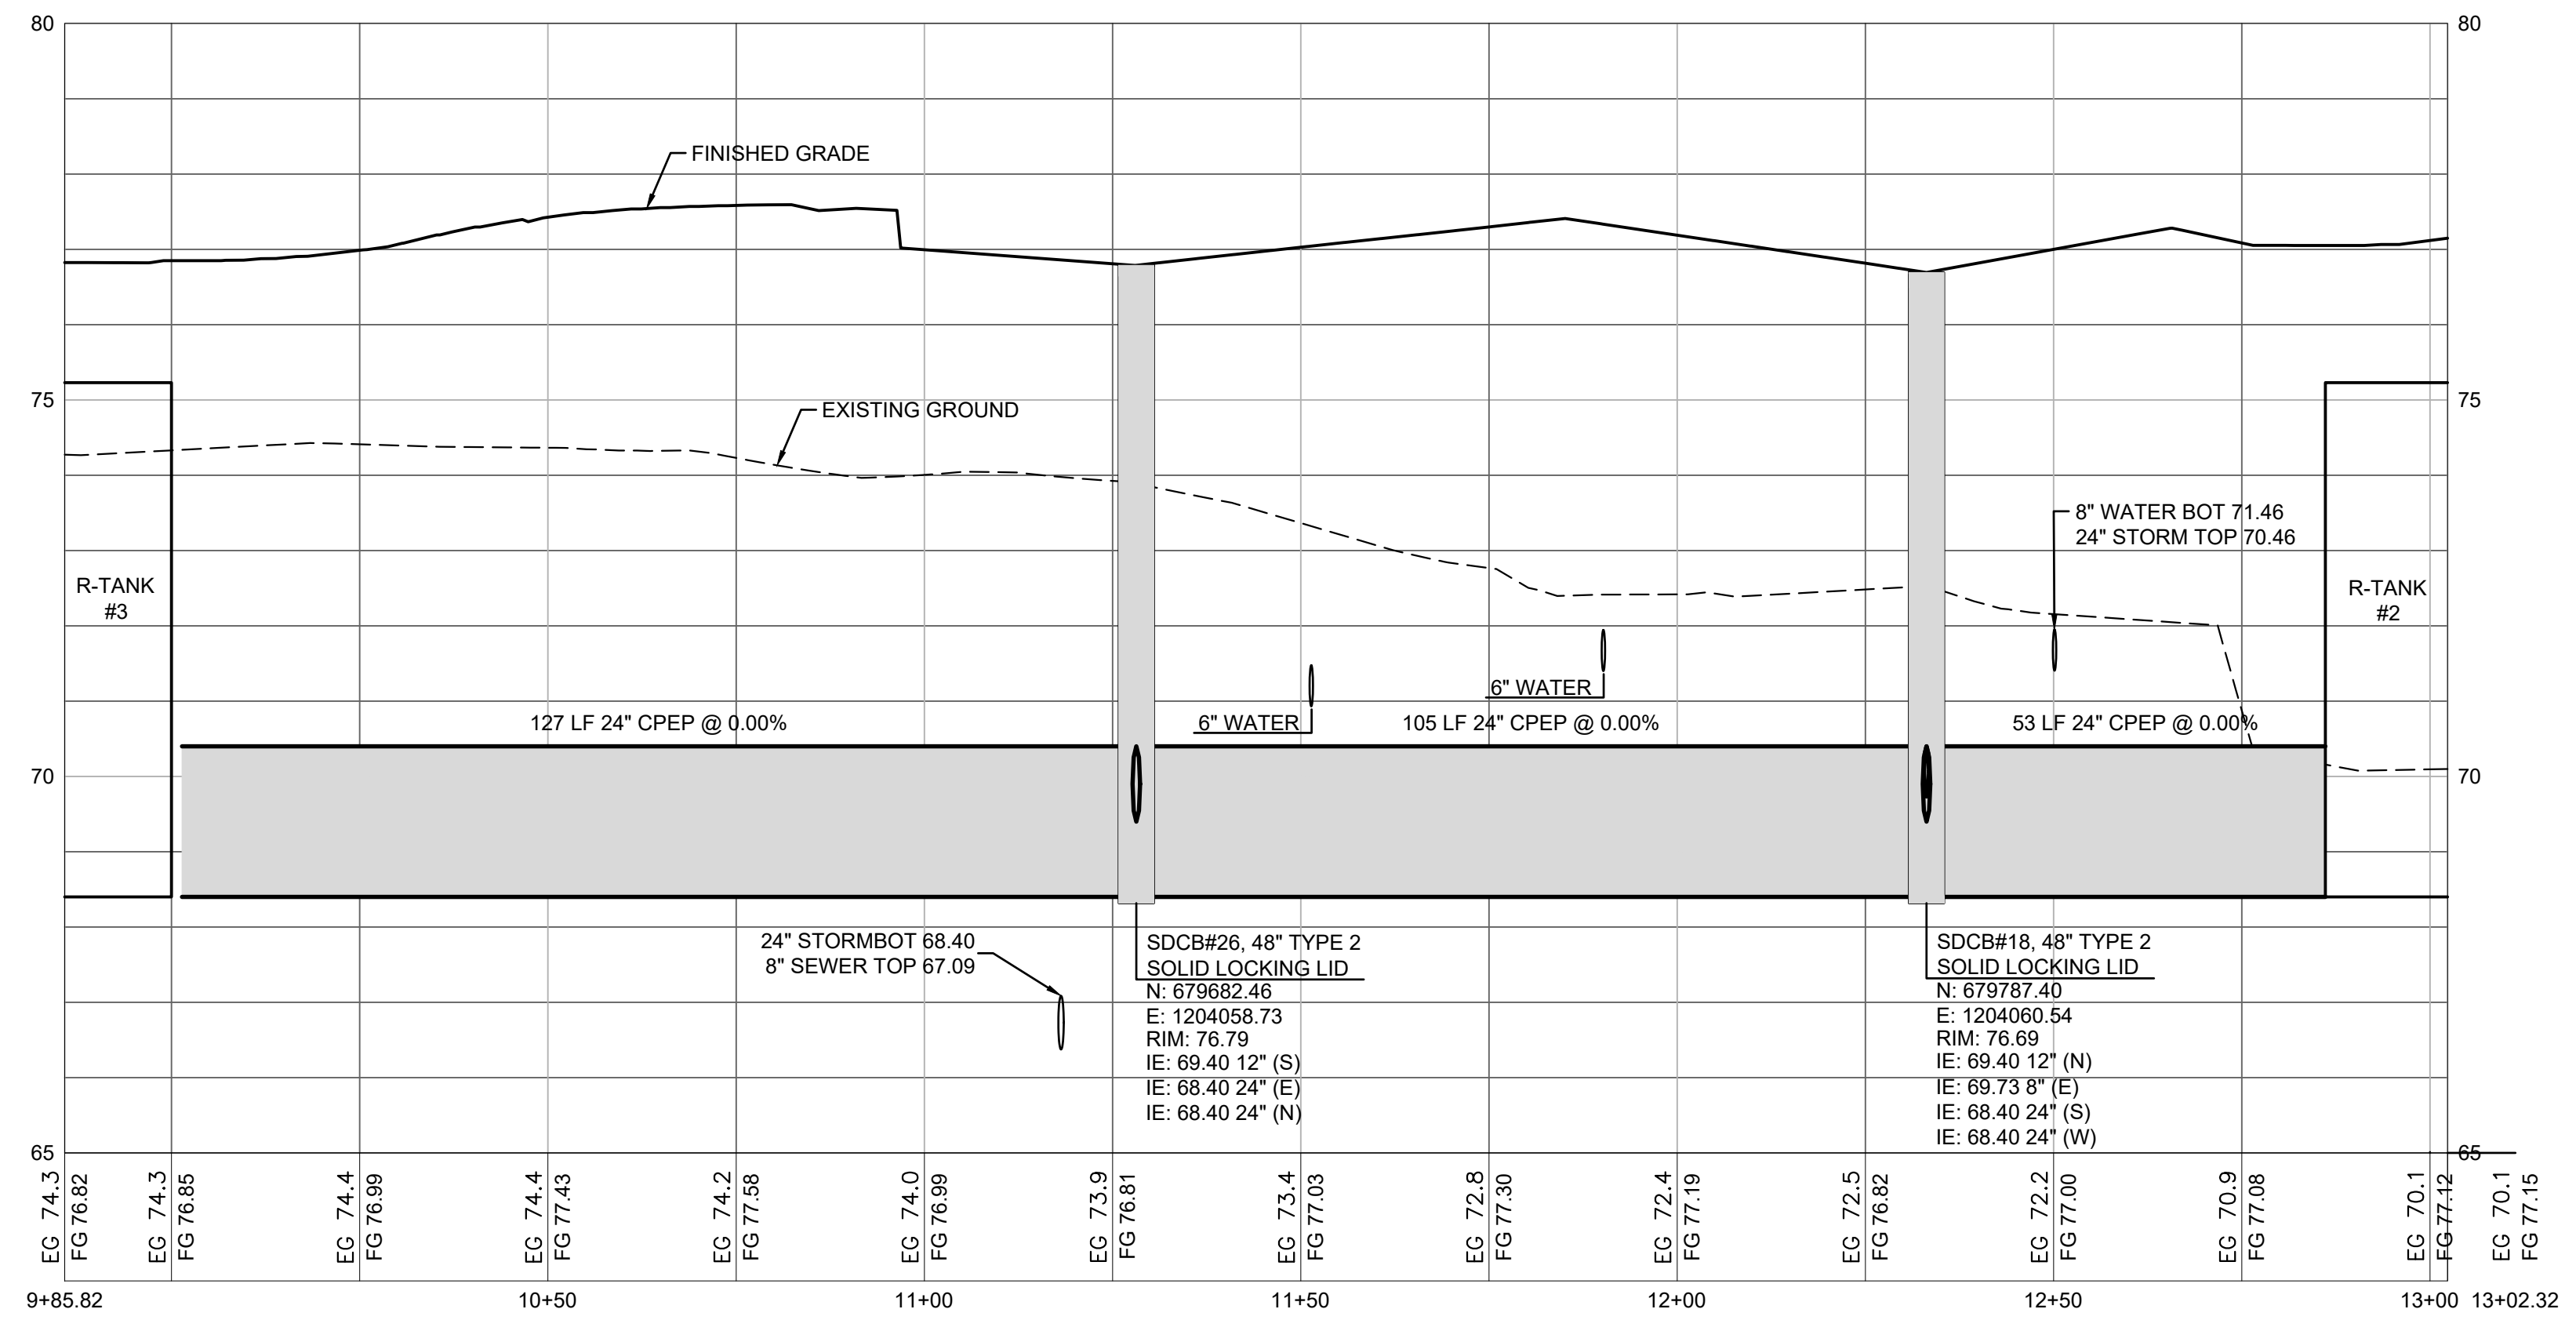


1 STORM PROFILE
SCALE: HORIZ 1"=20'; VERT 1"=2'

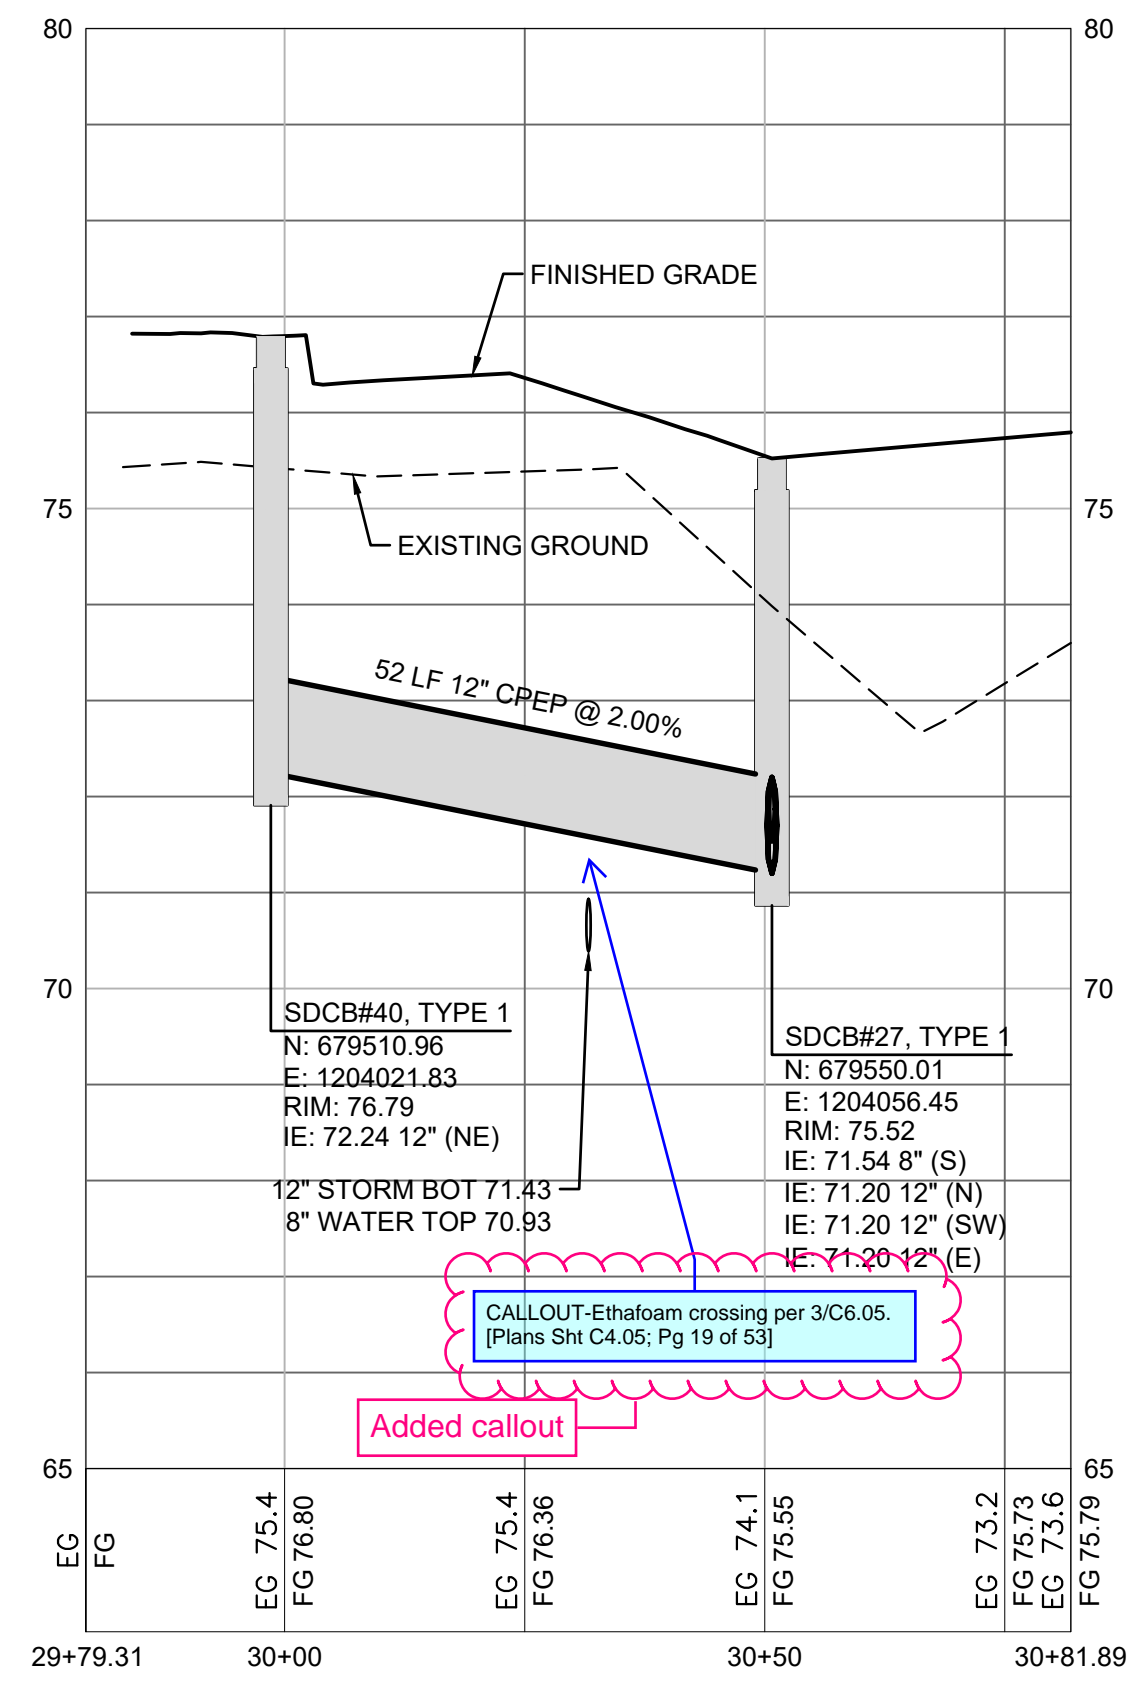

2 STORM PROFILE
SCALE: HORIZ 1"=20'; VERT 1"=2'

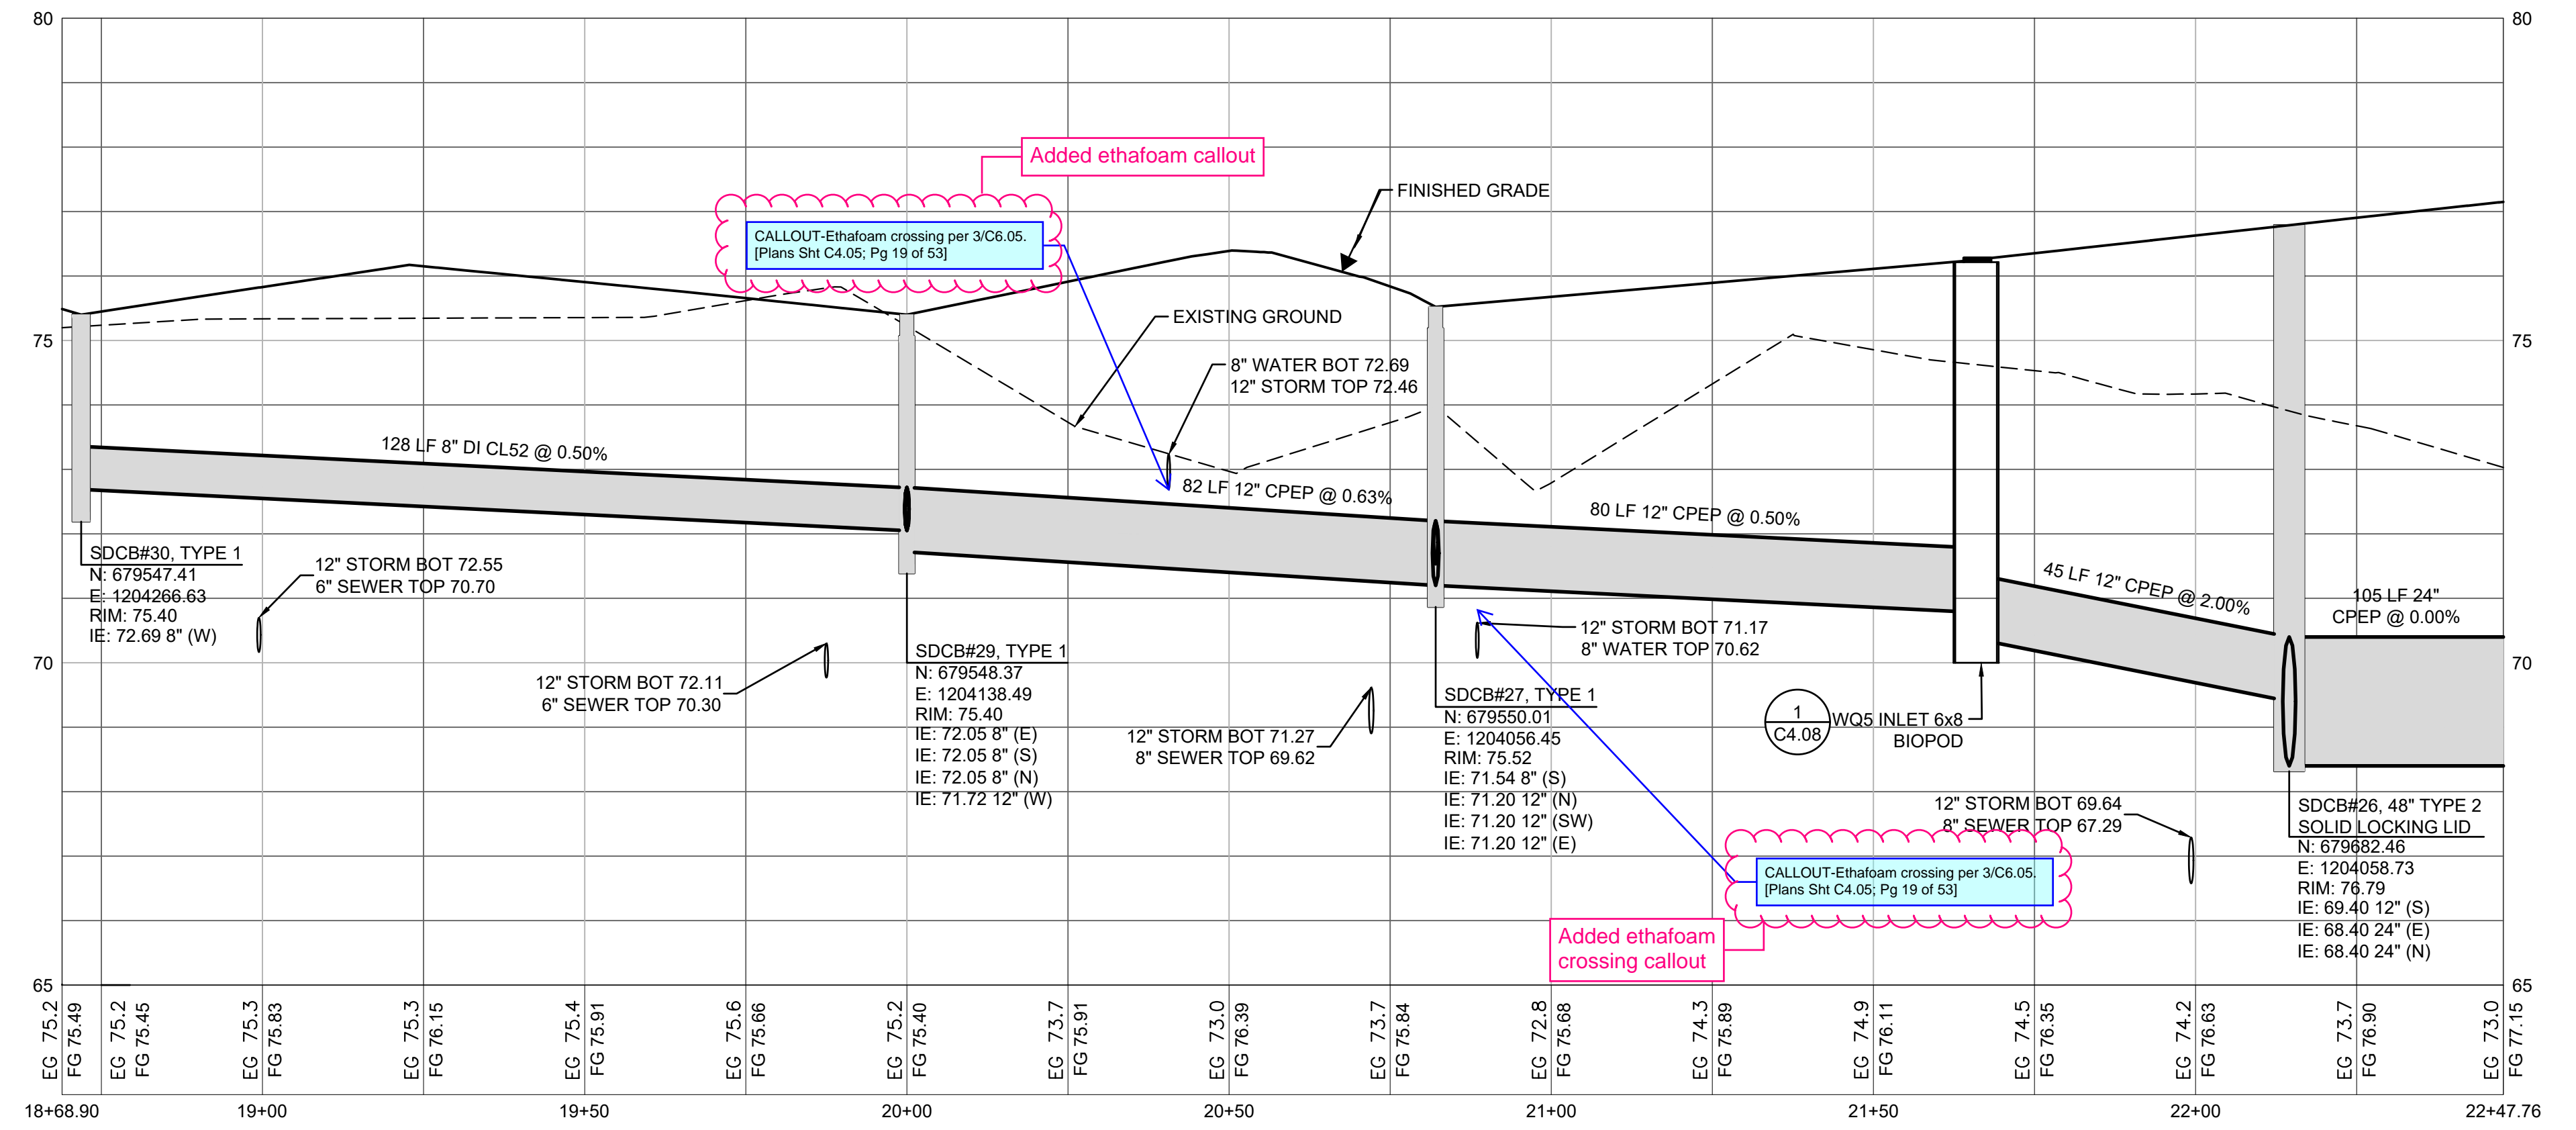

3 STORM PROFILE
SCALE: HORIZ 1"=20'; VERT 1"=2'

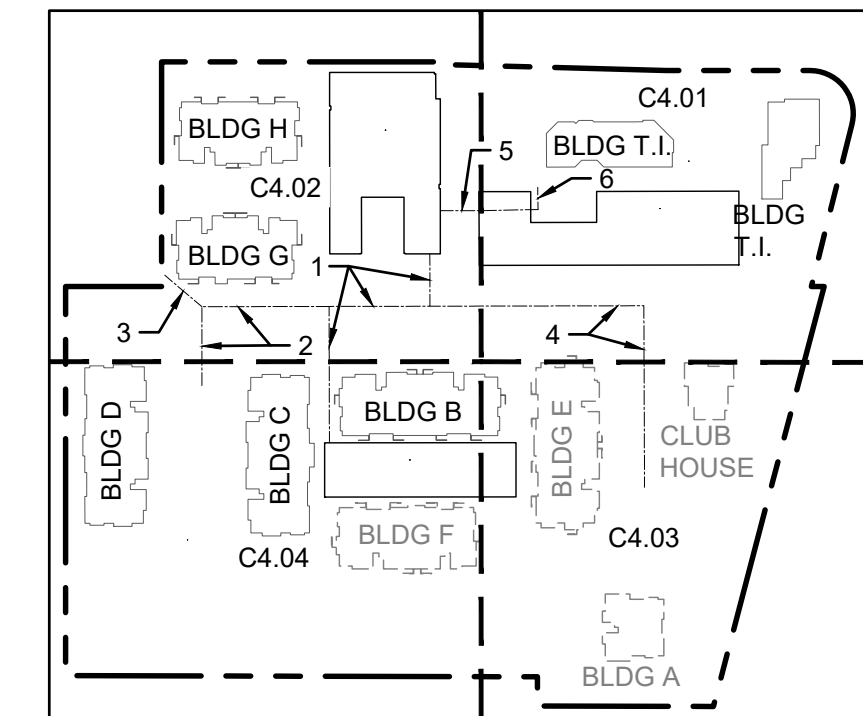

Know what's below.
Call before you dig.

- △
- △
- △
- △ 01/29/24 CITY COMMENTS

Revisions:

Sheet Title:

STORM PROFILES

Designed by: CW
Drawn by: SK/RS
Checked by: JI

Sheet No.

C4.05

19 of 53 Sheets

EAST TOWN CROSSING PHASE 1


SEC. 26,35/ TWP. 20 N./ RGE. 4 E., W.M.

APPROVED

BY: CITY OF PUYALLUP
DEVELOPMENT ENGINEERING

DATE:

NOTE: THIS APPROVAL IS VOID AFTER 180 DAYS FROM APPROVAL DATE. THE CITY WILL NOT BE RESPONSIBLE FOR ERRORS AND/OR OMISSIONS ON THESE PLANS. FIELD CONDITIONS MAY DICTATE CHANGES TO THESE PLANS AS DETERMINED BY THE DEVELOPMENT ENGINEERING MANAGER.

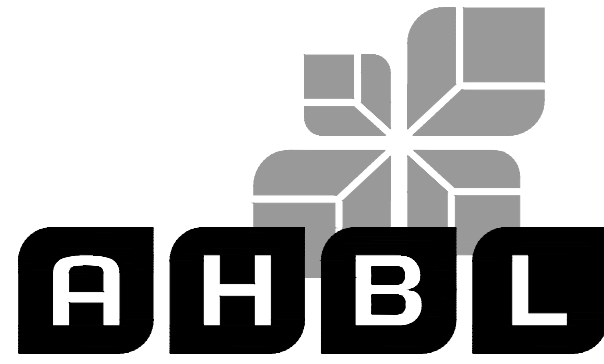

TACOMA · SEATTLE · SPOKANE · TRI-CITIES

2215 North 30th Street, Suite 300, Tacoma, WA 98403
253.383.2422 TEL 253.383.2572 FAX www.ahbl.com WEB

Project Title:

EAST TOWN CROSSING PHASE 1

Client:

ASH DEVELOPMENT

GREG HELLE

GREG.HELLE@ASHNW.COM


Project No.

2230752


Issue Set & Date:

PERMIT SUBMITTAL


02/20/2024

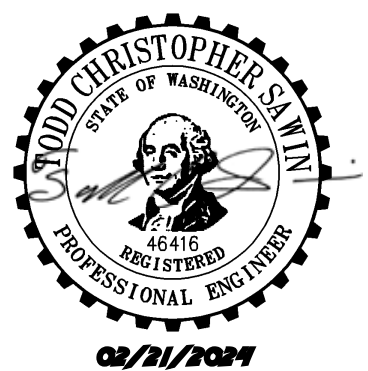


NOTICE: ALTERATION OF THIS DOCUMENT SHALL INVALIDATE THE PROFESSIONAL SEAL AND SIGNATURE. PUBLICATION OF THIS DOCUMENT DOES NOT CONSTITUTE AN ENDORSEMENT OR GUARANTEE BY THE ENGINEER OR ARCHITECT. THE ENGINEER OR ARCHITECT IS NOT TO BE HELD RESPONSIBLE FOR ANY ERRORS OR OMISSIONS IN THIS DOCUMENT OR FOR ANY OTHER PROJECT.

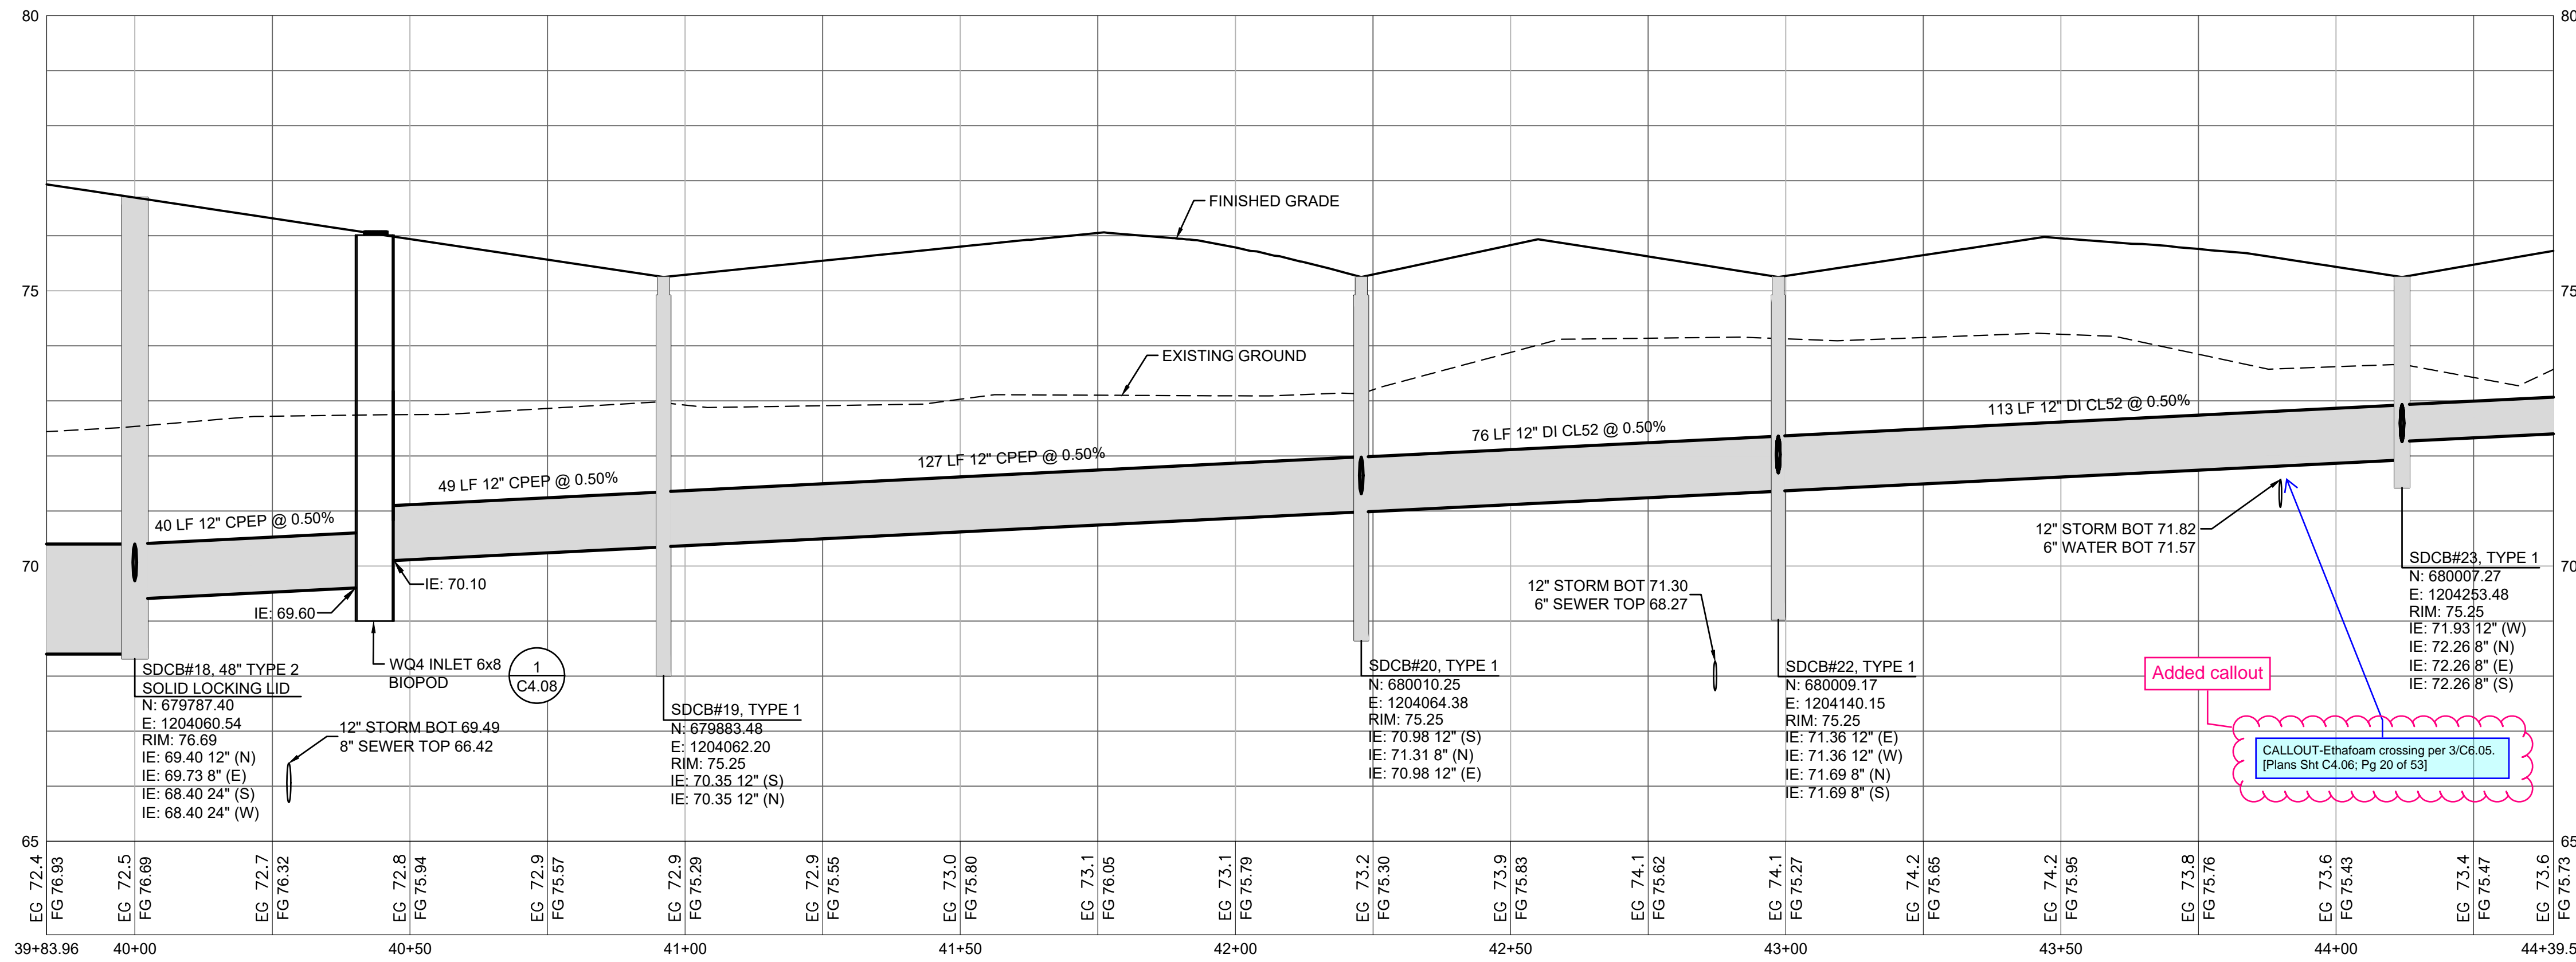


4 STORM PROFILE
SCALE: HORIZ 1"=20'; VERT 1"=2'

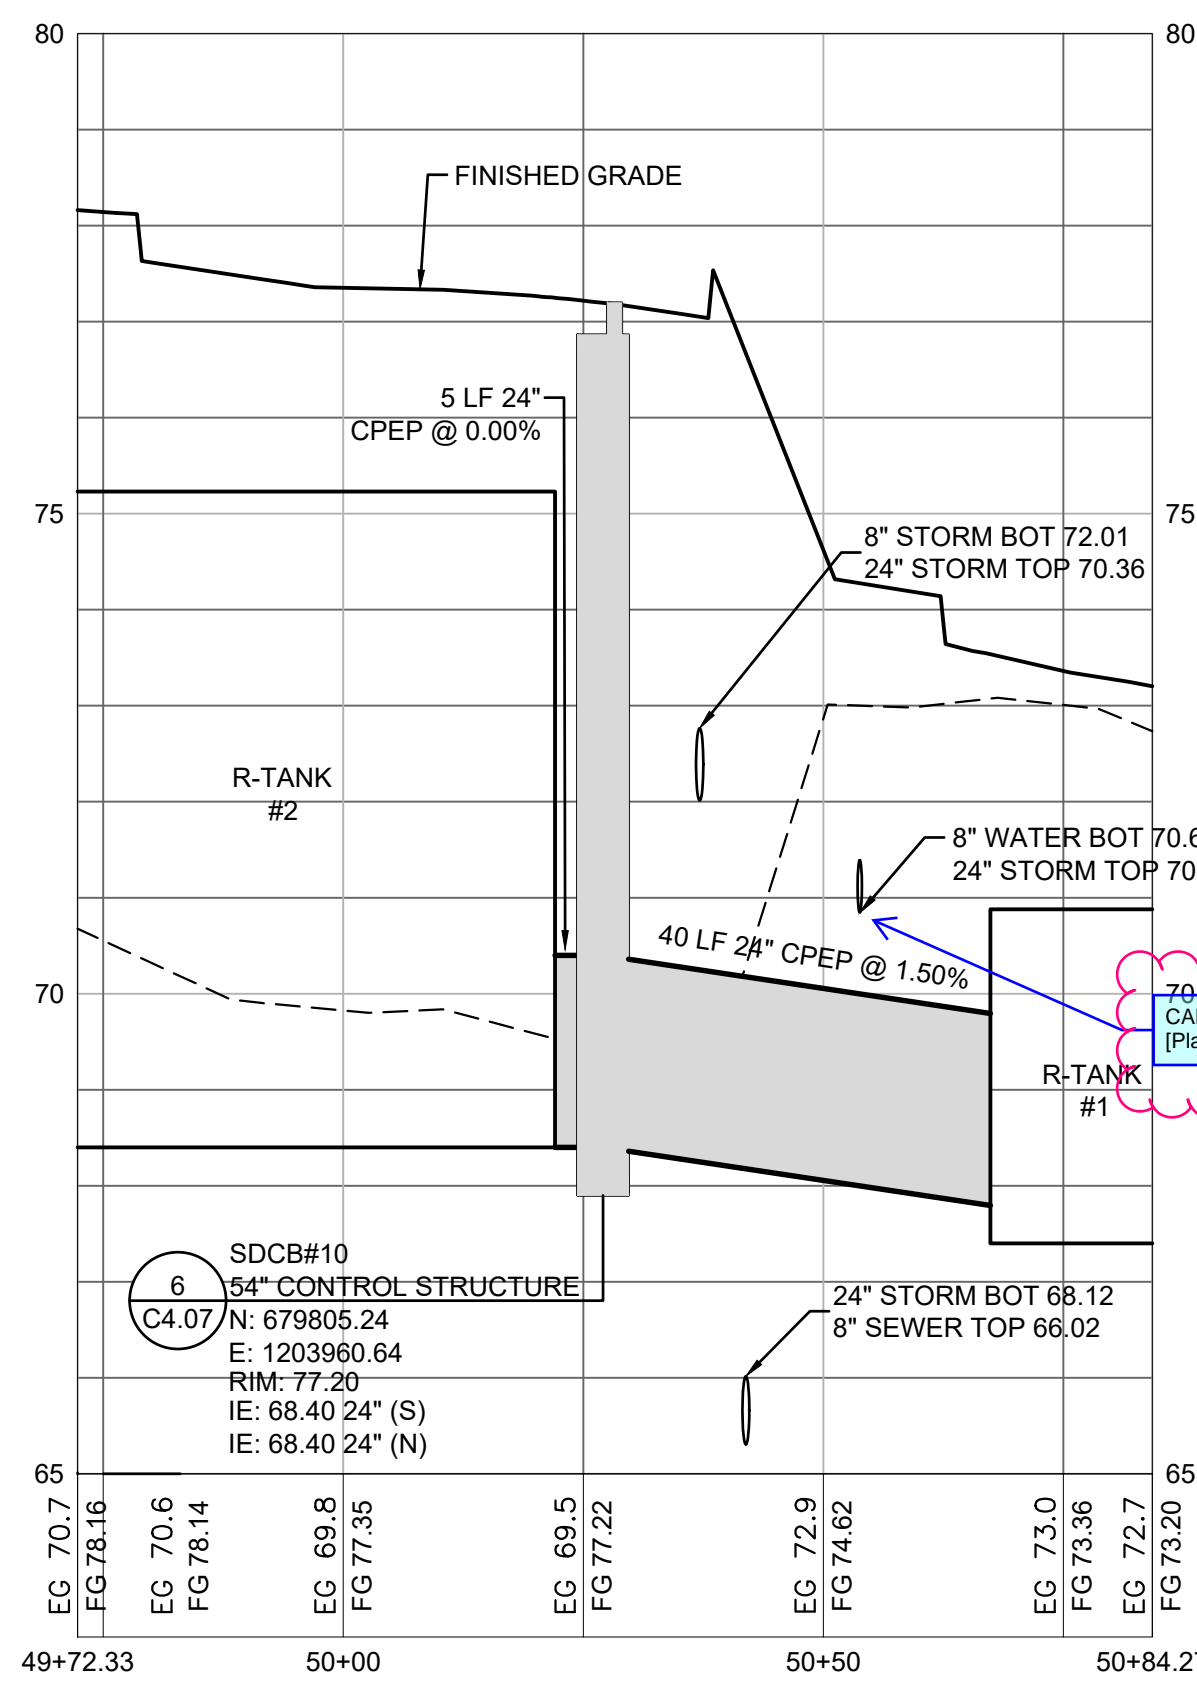

5 STORM PROFILE
SCALE: HORIZ 1"=20'; VERT 1"=2'

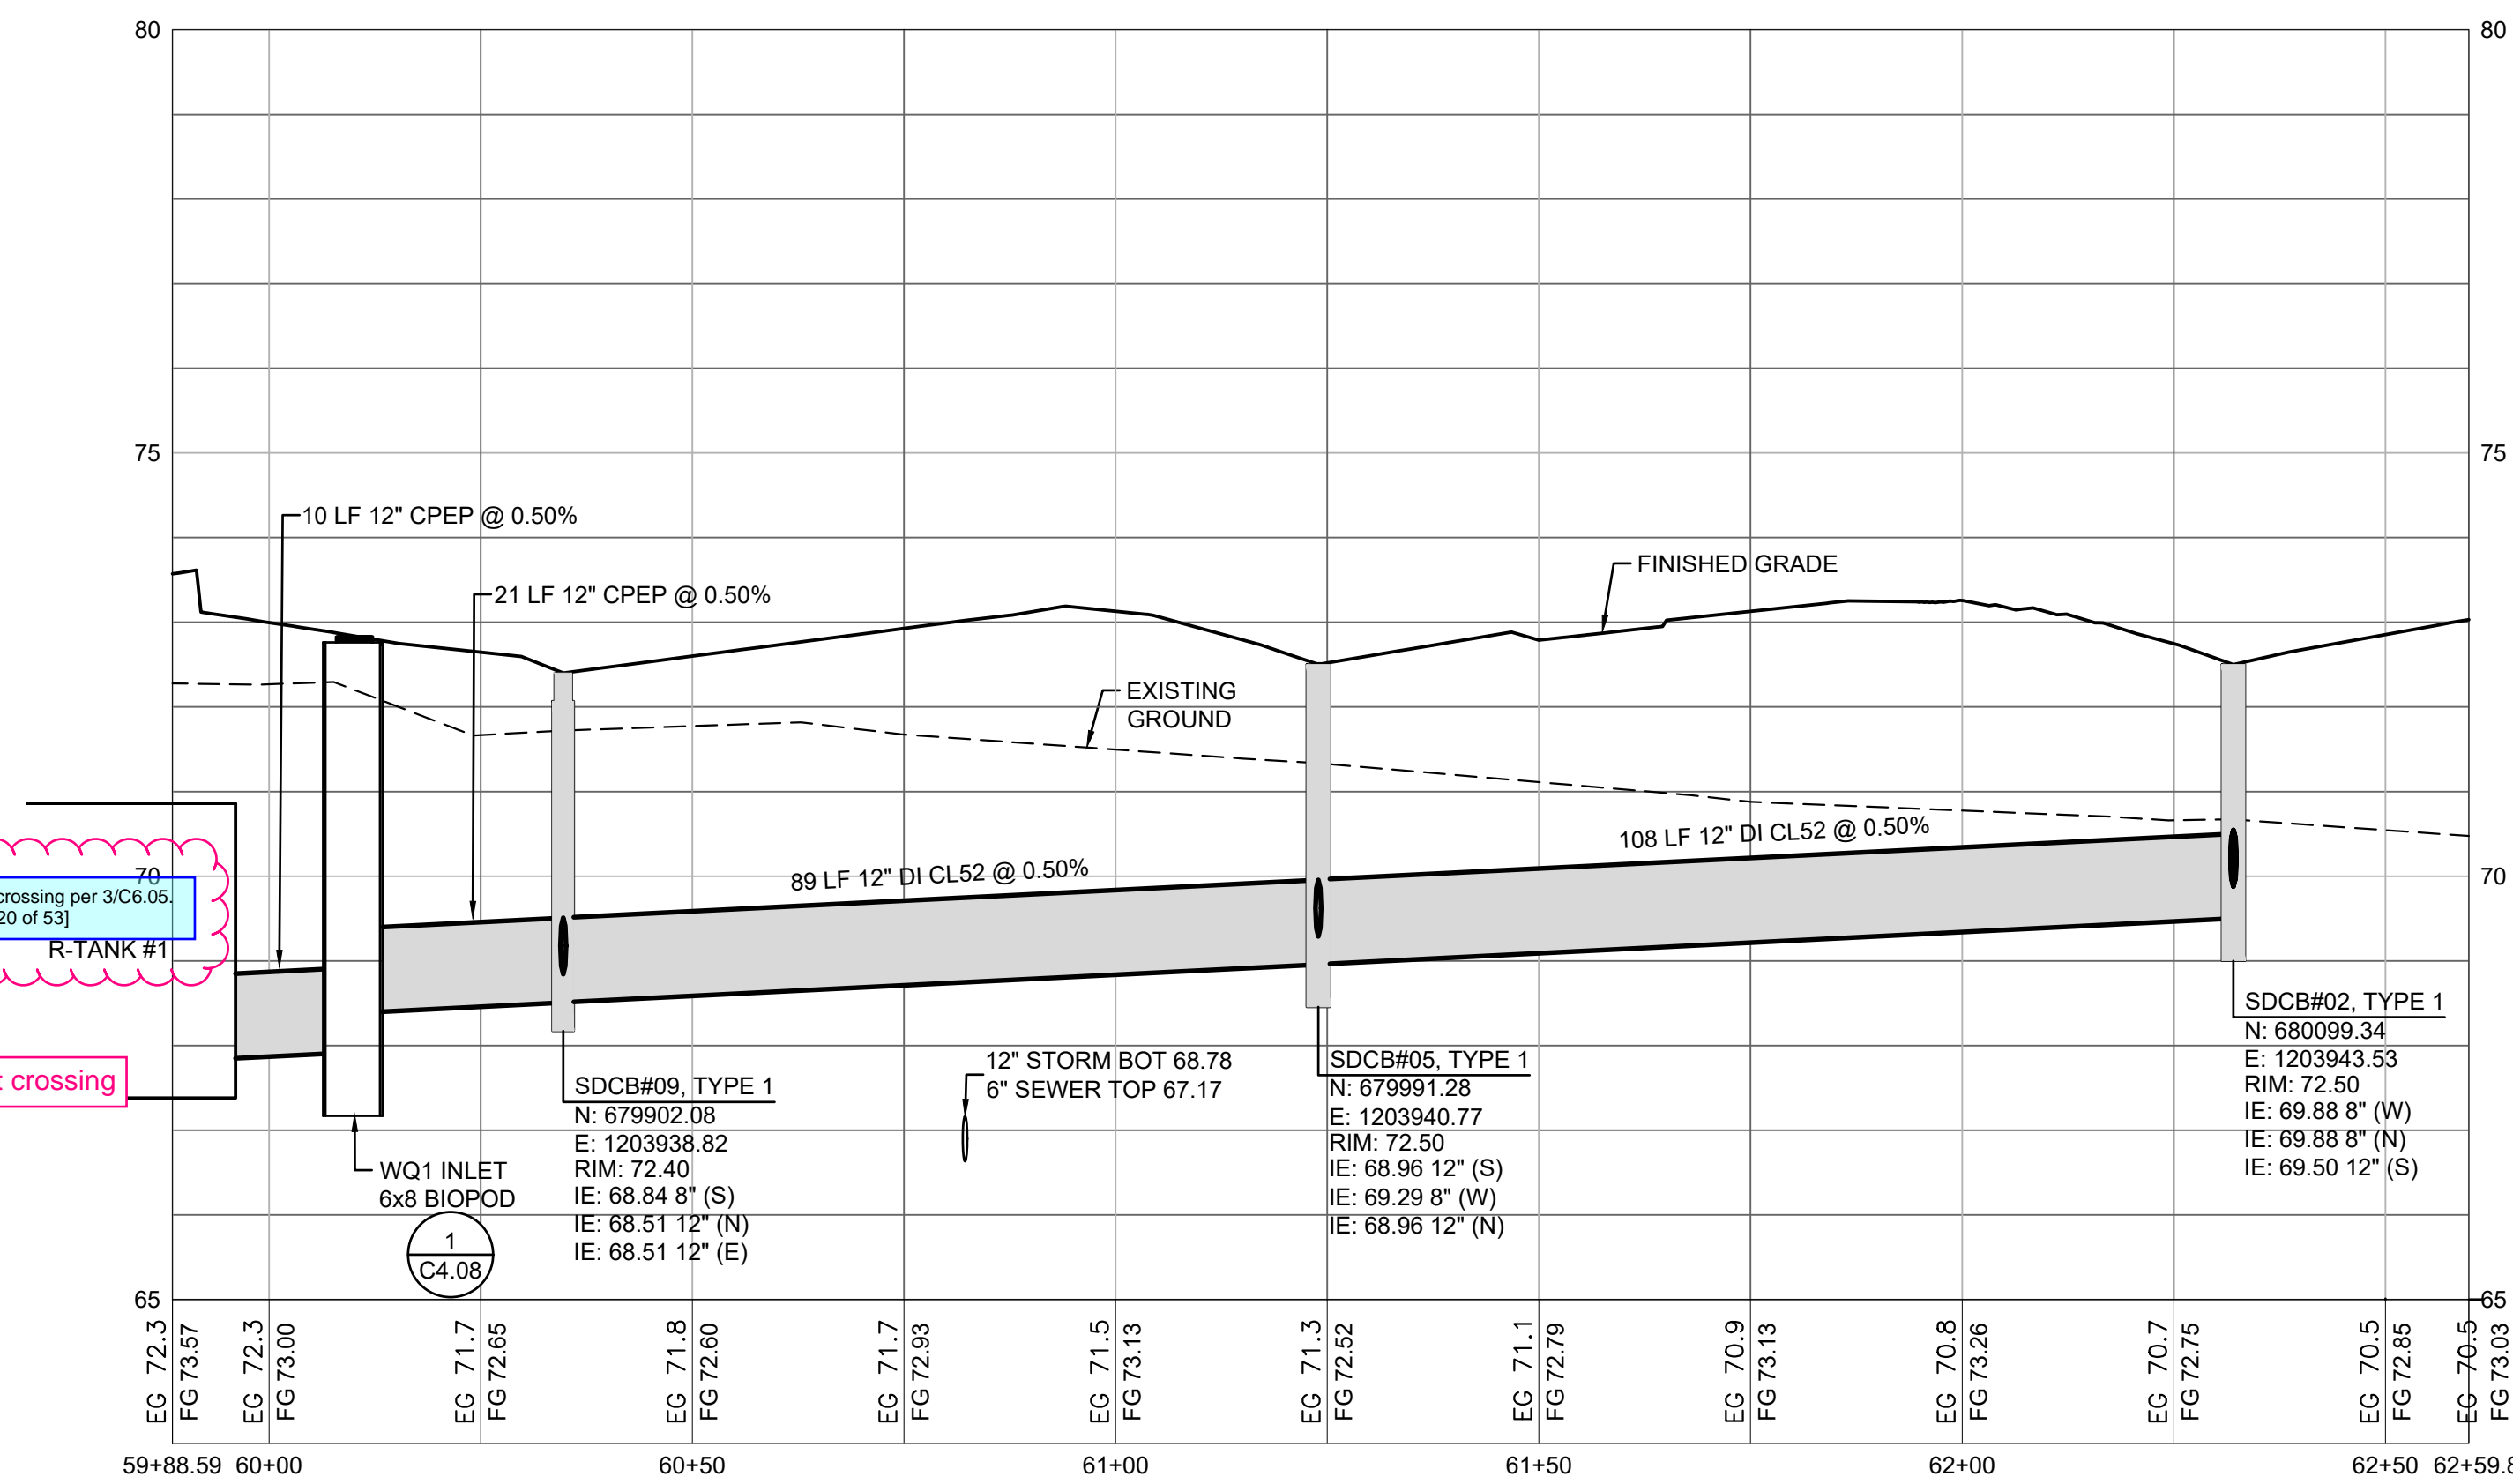

STORM PROFILE
SCALE: HORIZ 1"=20'; VERT 1"=2'

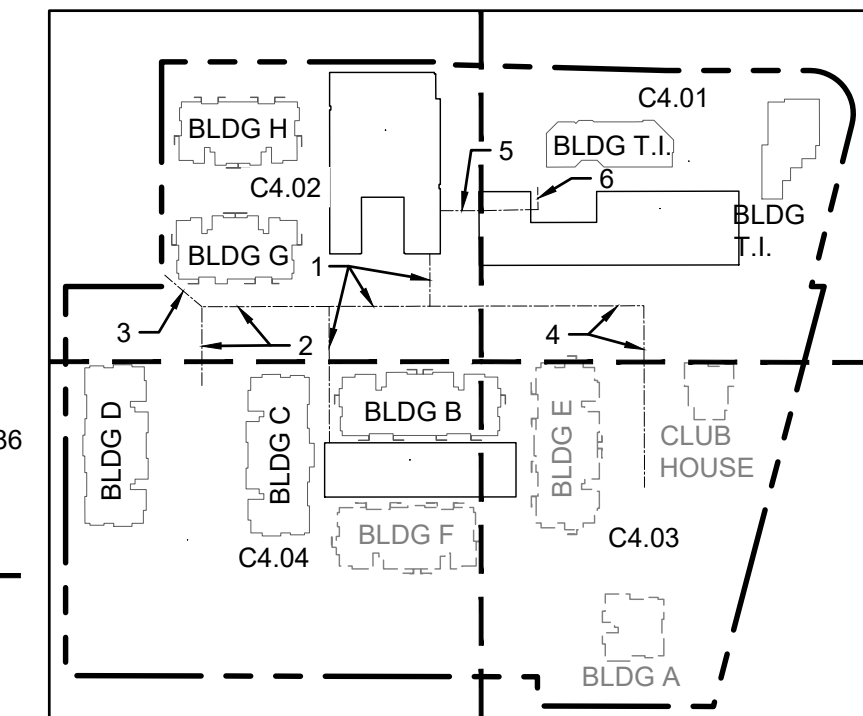

Added callout

CALLOUT: Ethafoam crossing per 3/C6.05, [Plans Sht C4.06; Pg 20 of 53]

Called out crossing

CALLOUT-reference, [Plans Sht C4.06; Pg 20 of 53]

6 fixed broken reference



Know what's below.
Call before you dig.

△

01/29/24 CITY COMMENTS

Revisions:

Sheet Title:

STORM PROFILES

Designed by: CW
Drawn by: SK/RS
Checked by: JI

Sheet No.

C4.06

20 of 53 Sheets

EAST TOWN CROSSING PHASE 1


SEC. 26,35/ TWP. 20 N./ RGE. 4 E., W.M.

APPROVED

BY CITY OF PUYALLUP
DEVELOPMENT ENGINEERING

DATE

NOTE: THIS APPROVAL IS VOID AFTER 180 DAYS FROM APPROVAL DATE. THE CITY WILL NOT BE RESPONSIBLE FOR ERRORS AND/OR OMISSIONS ON THESE PLANS. FIELD CONDITIONS MAY DICTATE CHANGES TO THESE PLANS AS DETERMINED BY THE DEVELOPMENT ENGINEERING MANAGER.

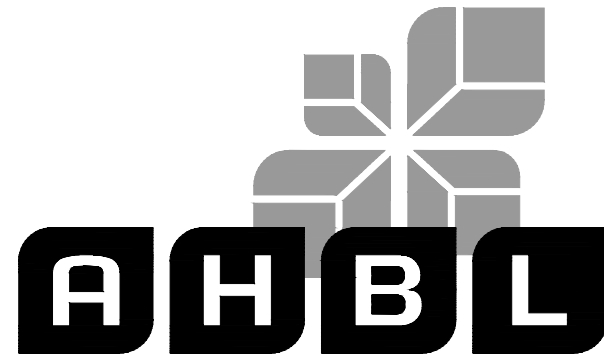

TACOMA • SEATTLE • SPOKANE • TRI-CITIES

2215 North 30th Street, Suite 300, Tacoma, WA 98403
253.383.2422 TEL 253.383.2572 FAX www.ahbl.com WEB

Project Title:

EAST TOWN CROSSING PHASE 1

Client: ASH DEVELOPMENT

GREG HELLE

GREG.HELLE@ASHNW.COM


Project No.

2230752

Issue Set & Date:

PERMIT SUBMITTAL

02/20/2024

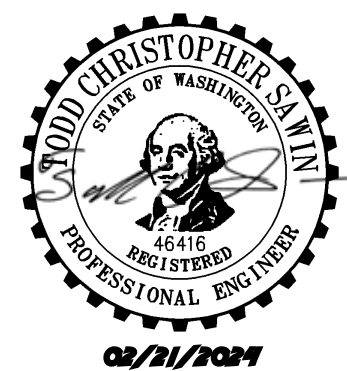

NOTICE: ALTERATION OF THIS DOCUMENT SHALL VIOLATE THE PROFESSIONAL SEAL AND SIGNATURE PROVISIONS OF THE COMPASS RULES OF REGULATION FOR REGISTERED ENGINEERS IN THE STATE OF WASHINGTON. THIS DOCUMENT IS FOR PERMIT SUBMITTAL ONLY FOR THE PROJECT ENTITLED IN THE TITLE BLOCK AND IS NOT TO BE USED FOR OTHER BIDDING OR ACTION ON THAT PROJECT OR FOR ANY OTHER PROJECT.

01/29/24 CITY COMMENTS

Revisions:

Sheet Title:






STORM DRAINAGE NOTES AND DETAILS

Designed by: CW Drawn by: SK/RS Checked by: JI

Sheet No.

C4.07

21 of 53 Sheets

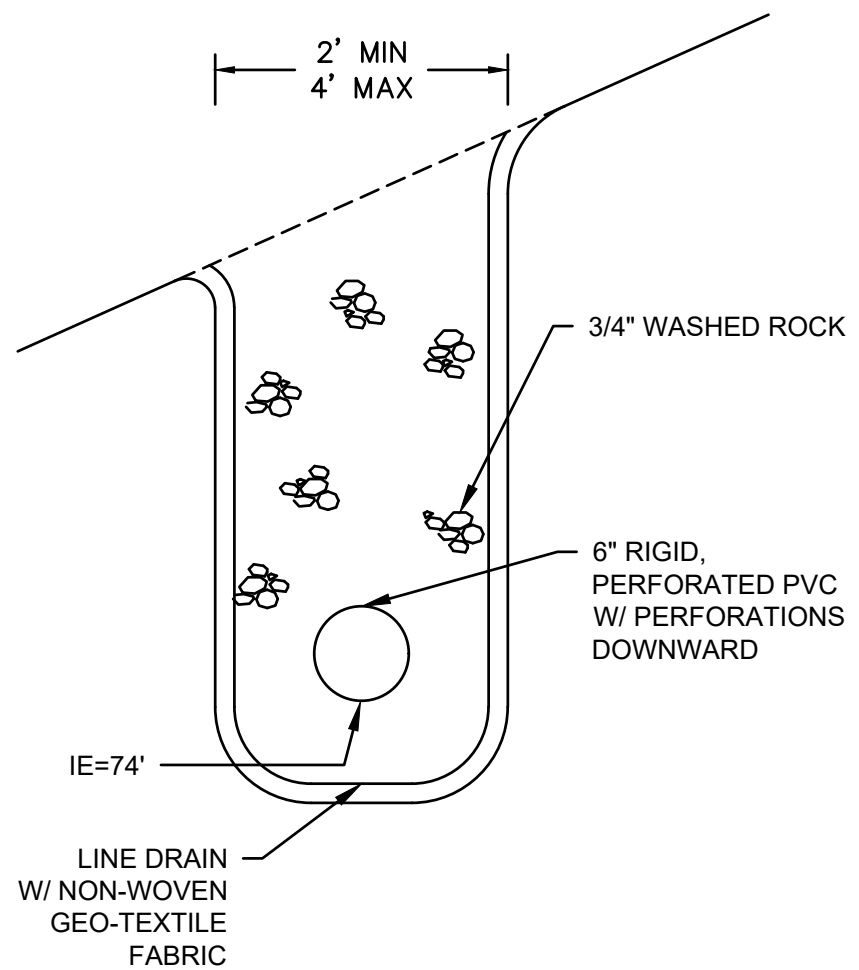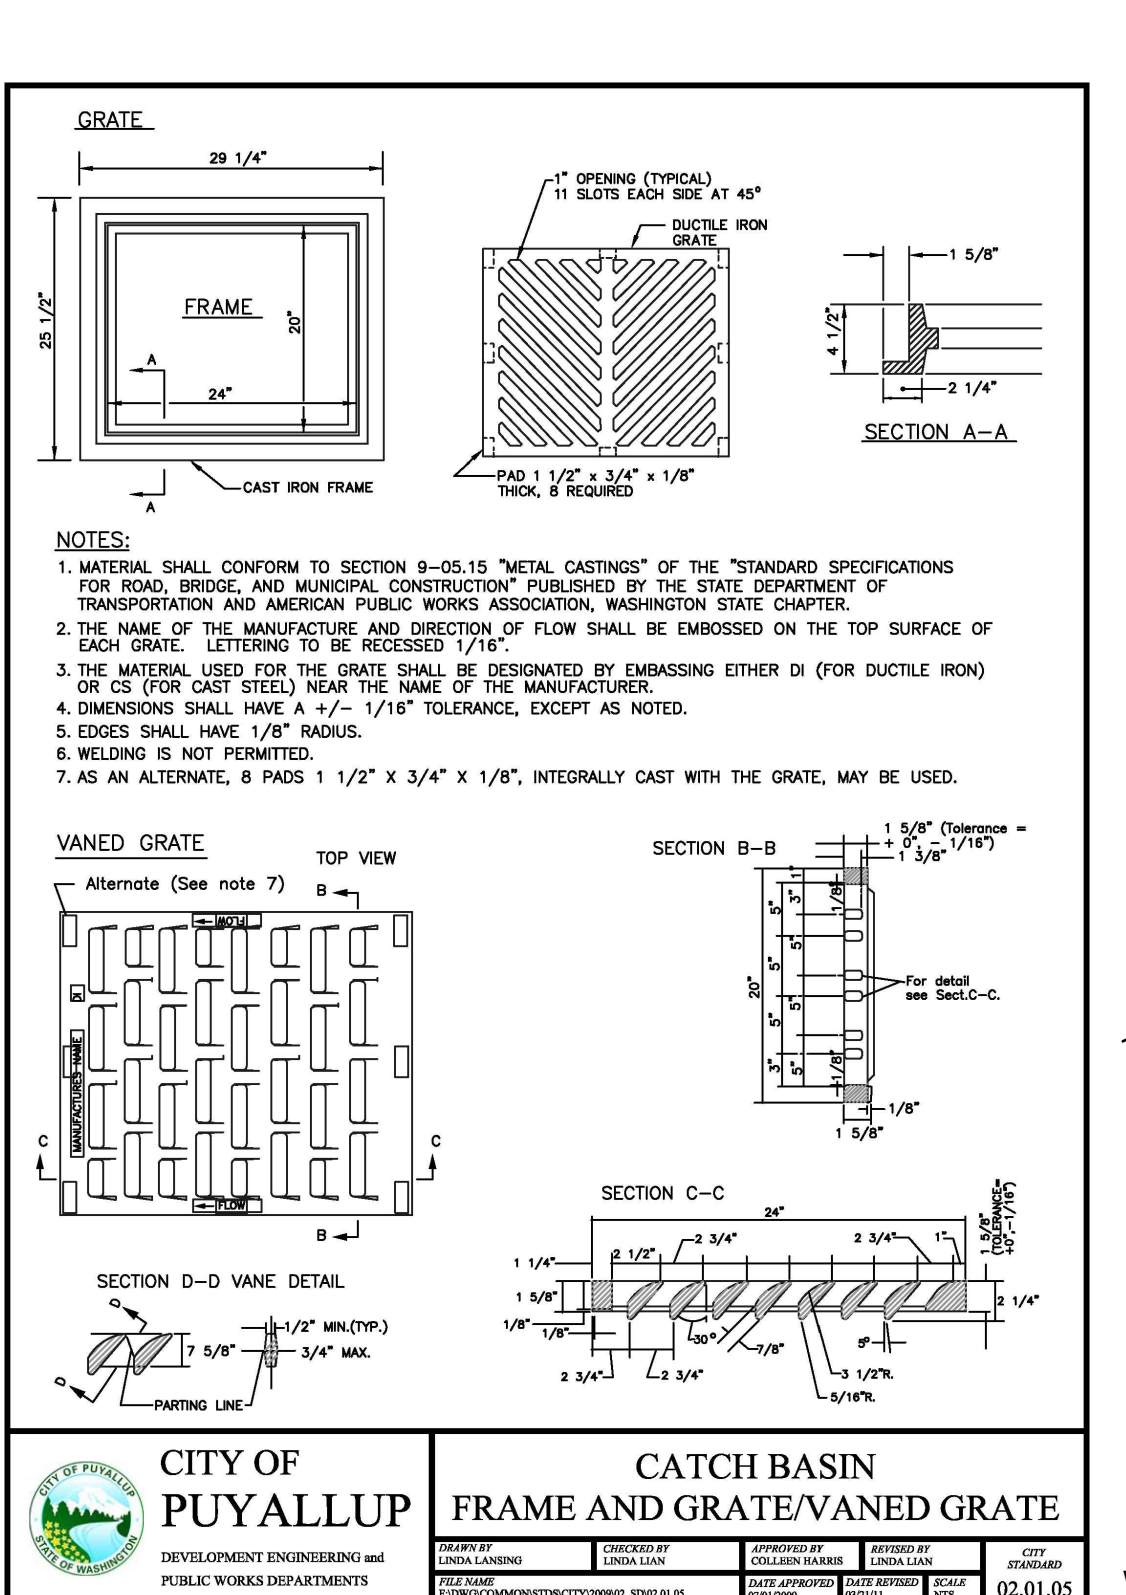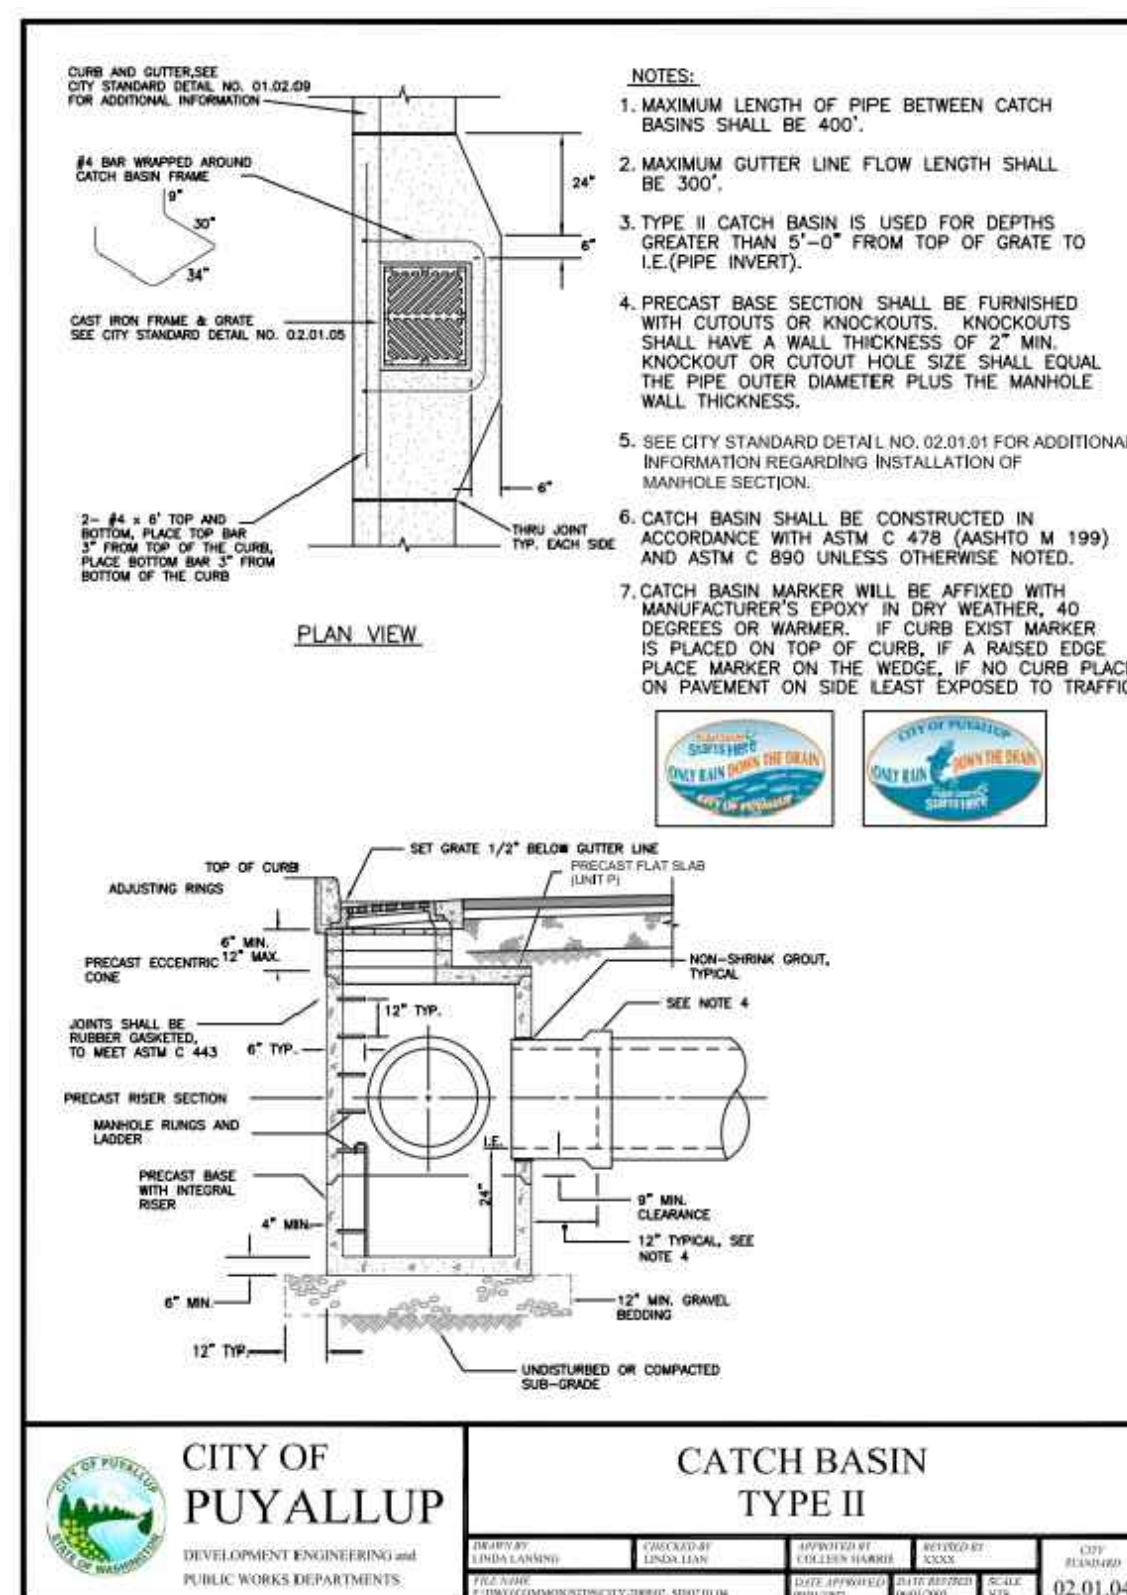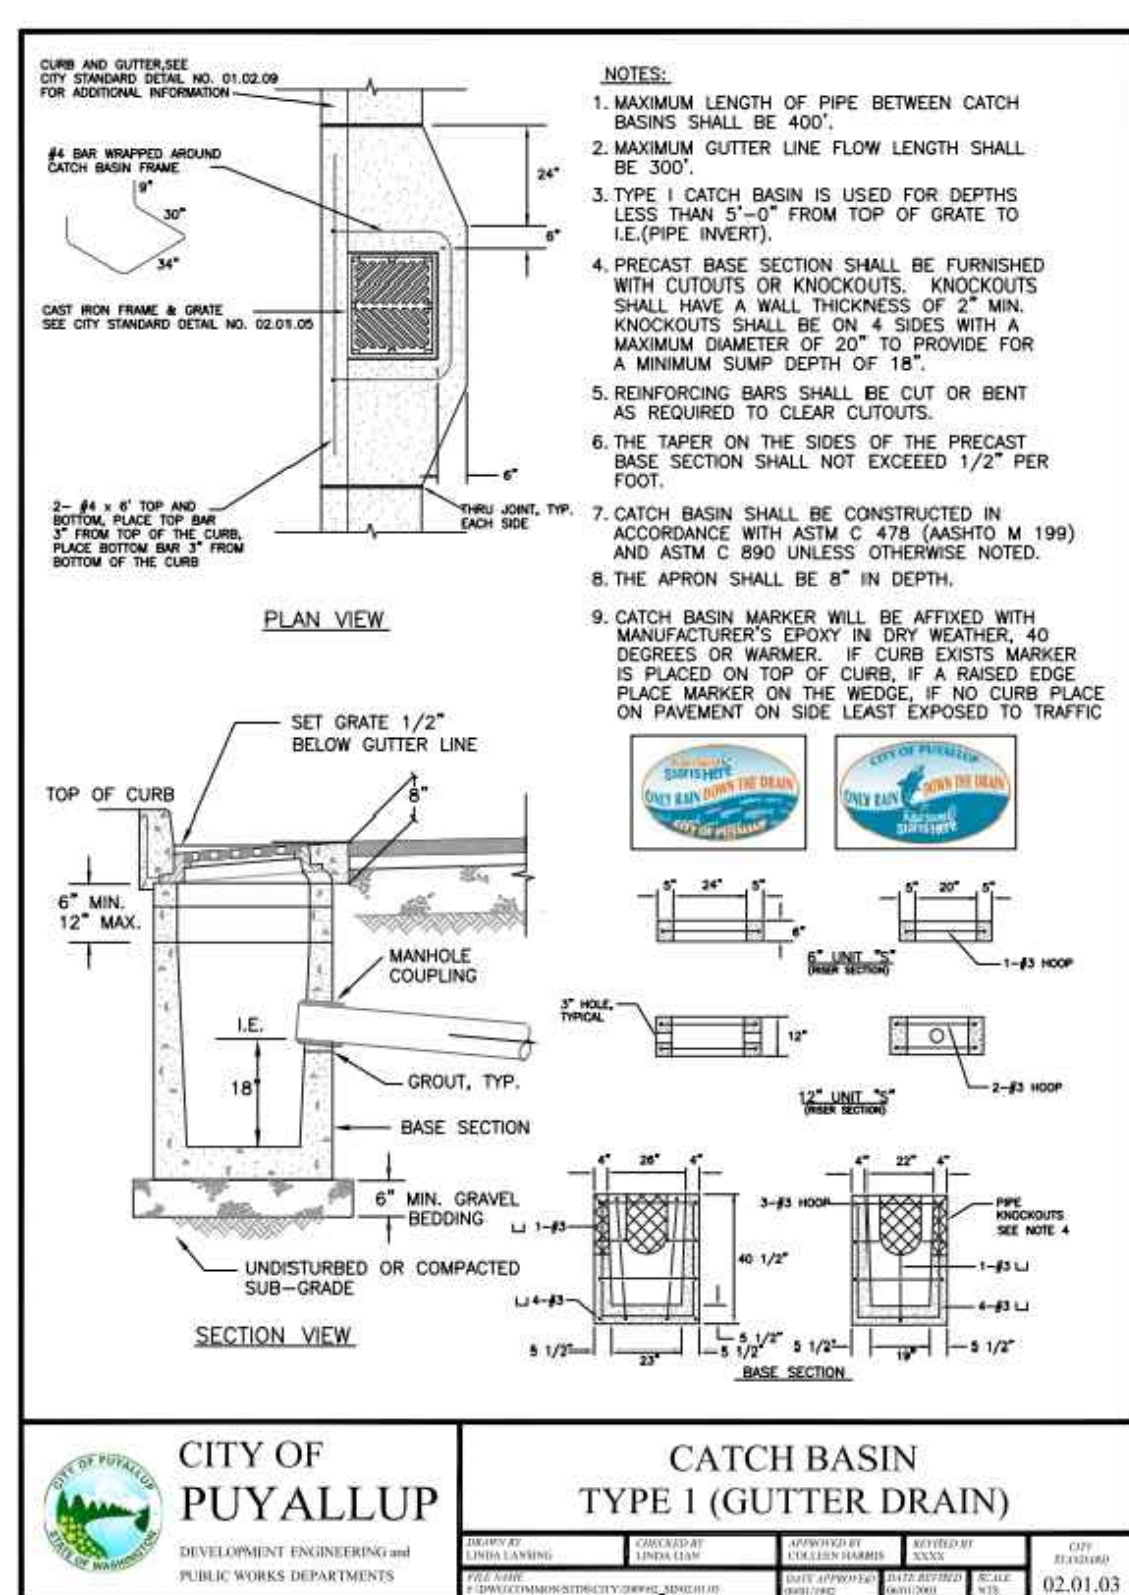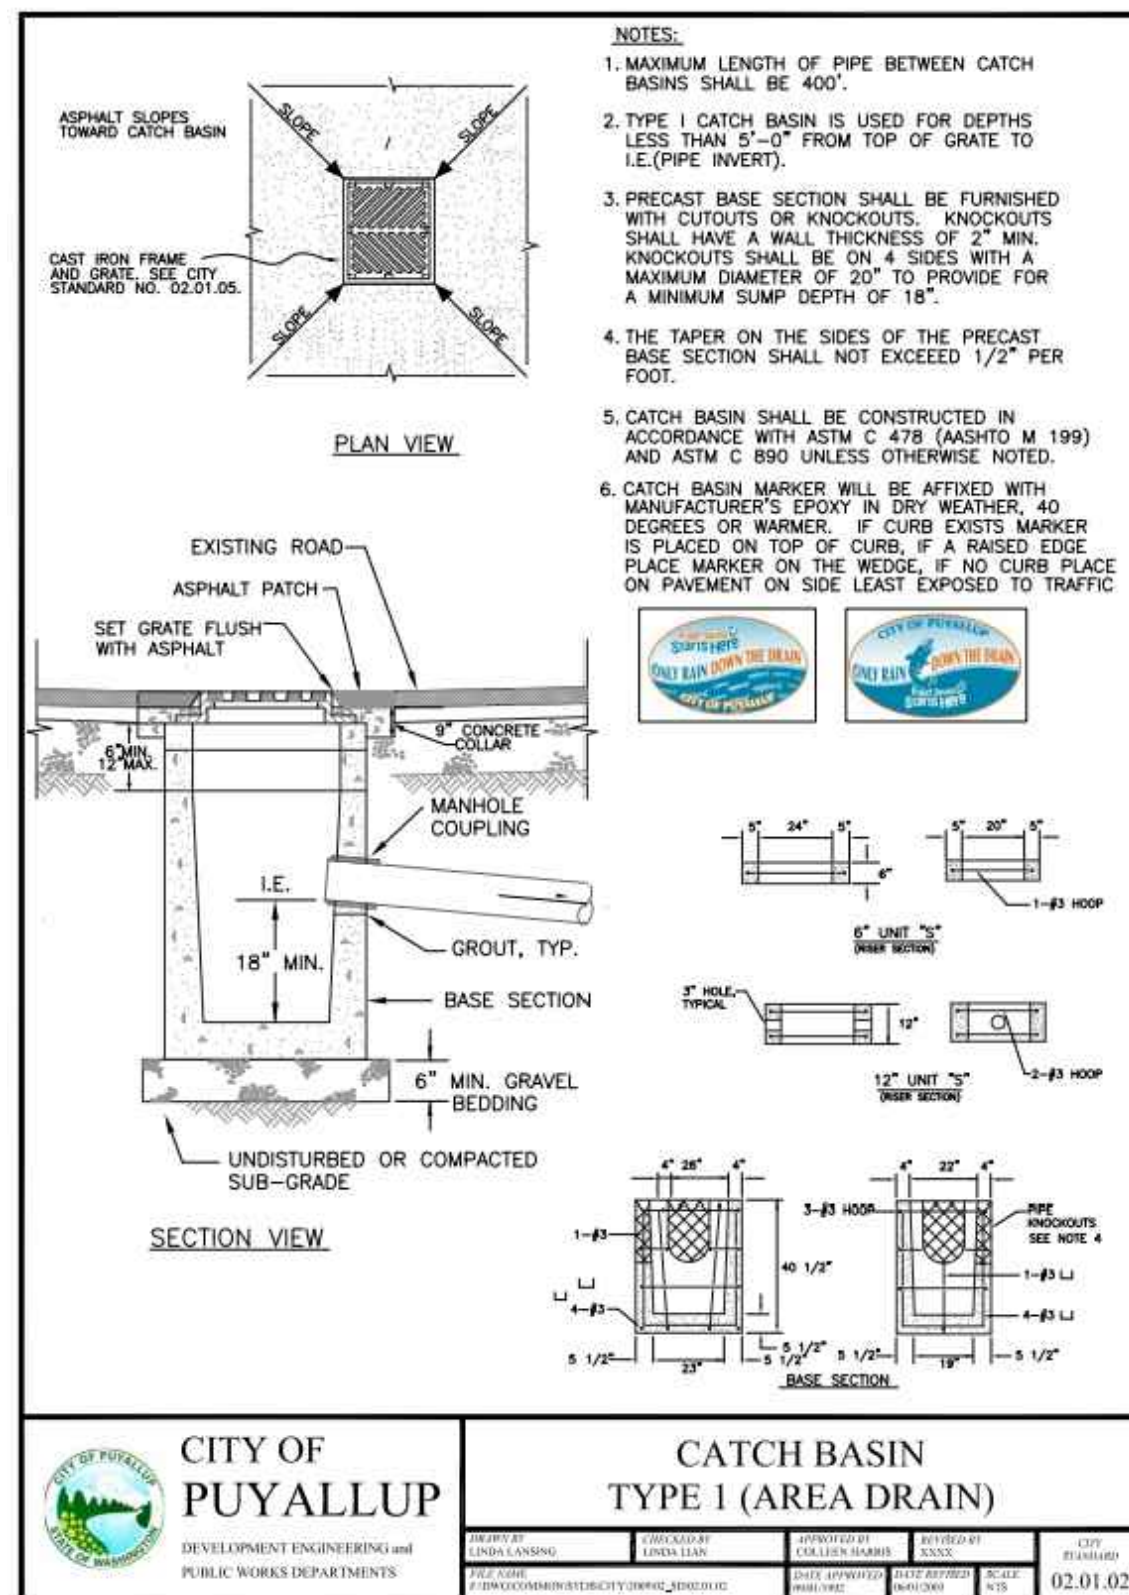


1 CATCH BASIN TYPE 1 (AREA DRAIN)
NOT TO SCALE

2 CATCH BASIN TYPE 1 (GUTTER DRAIN)
NOT TO SCALE




3 CATCH BASIN TYPE II
NOT TO SCALE

4 CATCH BASIN FRAME AND GRATE/FRAMED/VANED GRATE
NOT TO SCALE

5 FRENCH DRAIN DETAIL
NOT TO SCALE

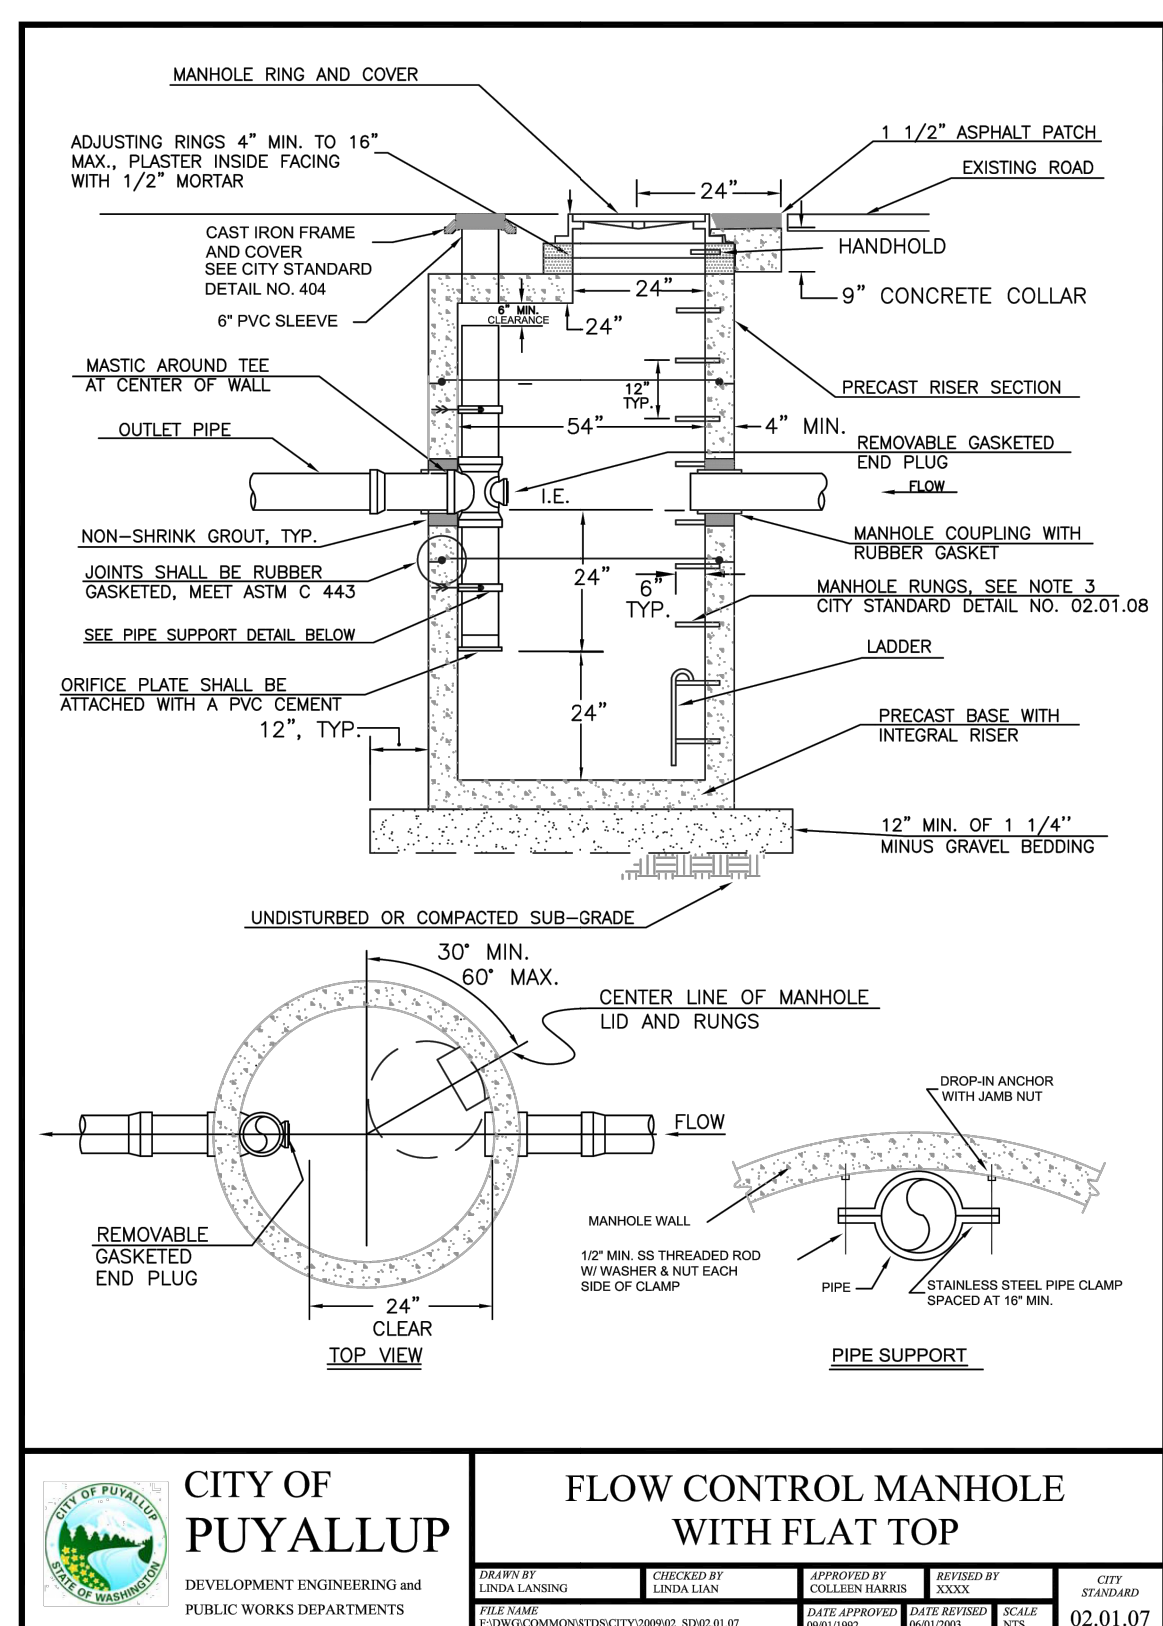

STRUCTURE	PART	INVERT ELEVATION	DIAMETER (IN)	NOTES
SDCB#1	RISER CREST	69.40	18.00	CIRCULAR
	ORIFICE 1	67.65	2.25	CIRCULAR, NO ELBOW
	ORIFICE 2	68.65	3.00	CIRCULAR, NO ELBOW
SDCB#10	ORIFICE 3	69.15	3.50	CIRCULAR, WITH ELBOW
	OUTLET PIPE	67.40	12.00	RIM: 75.54
	RISER CREST	74.77	24.00	CIRCULAR
	ORIFICE 1	68.40	1.375	CIRCULAR, NO ELBOW
	ORIFICE 2	72.40	1.25	CIRCULAR, NO ELBOW
	OUTLET PIPE	68.40	24.00	RIM: 77.21

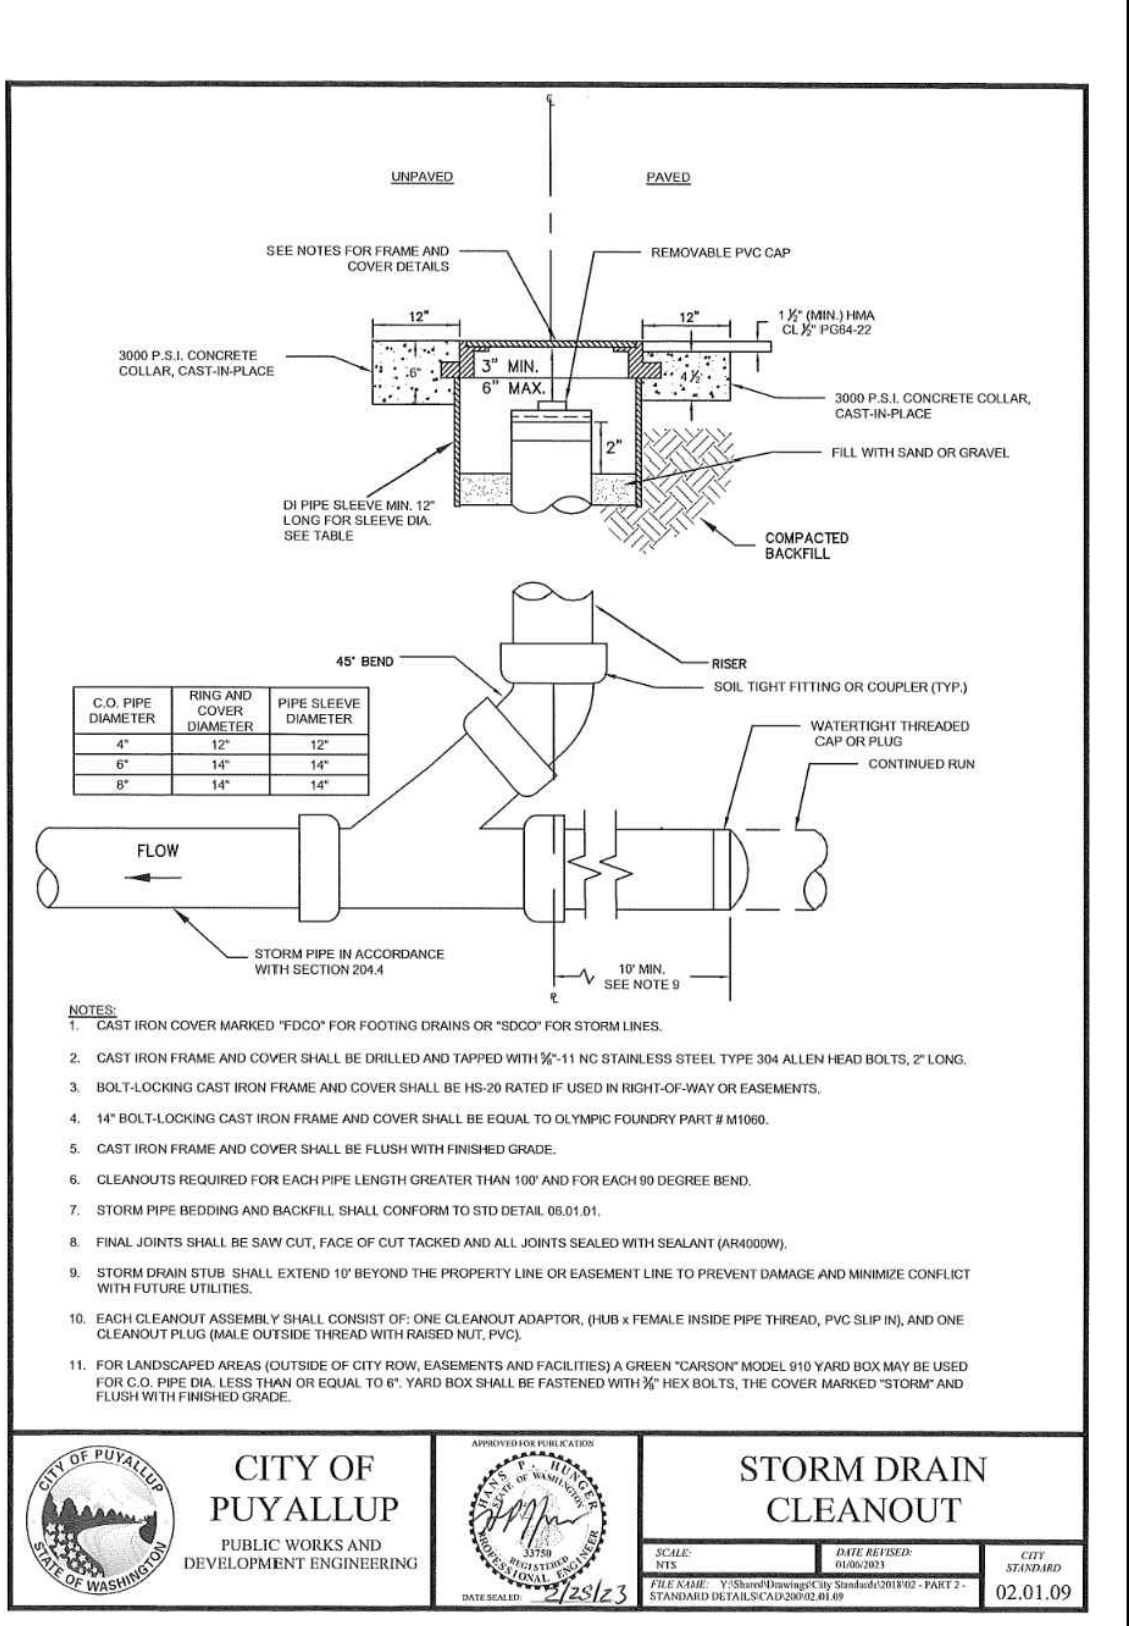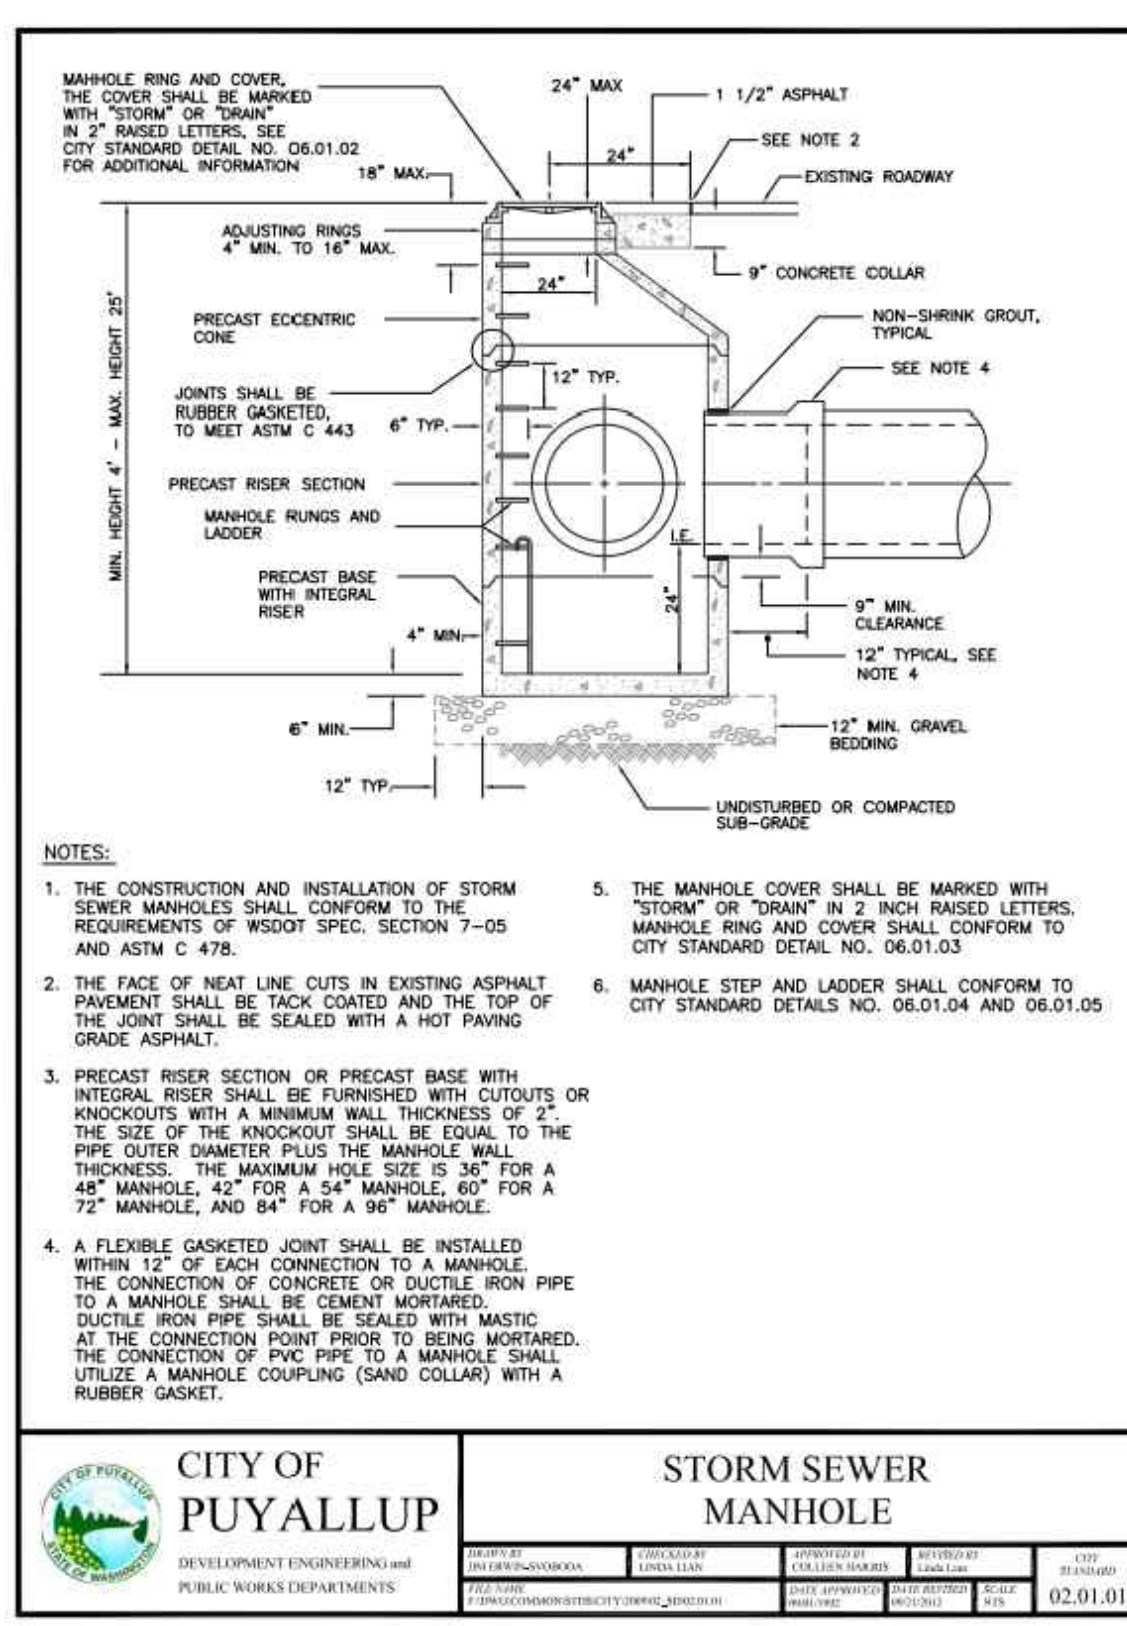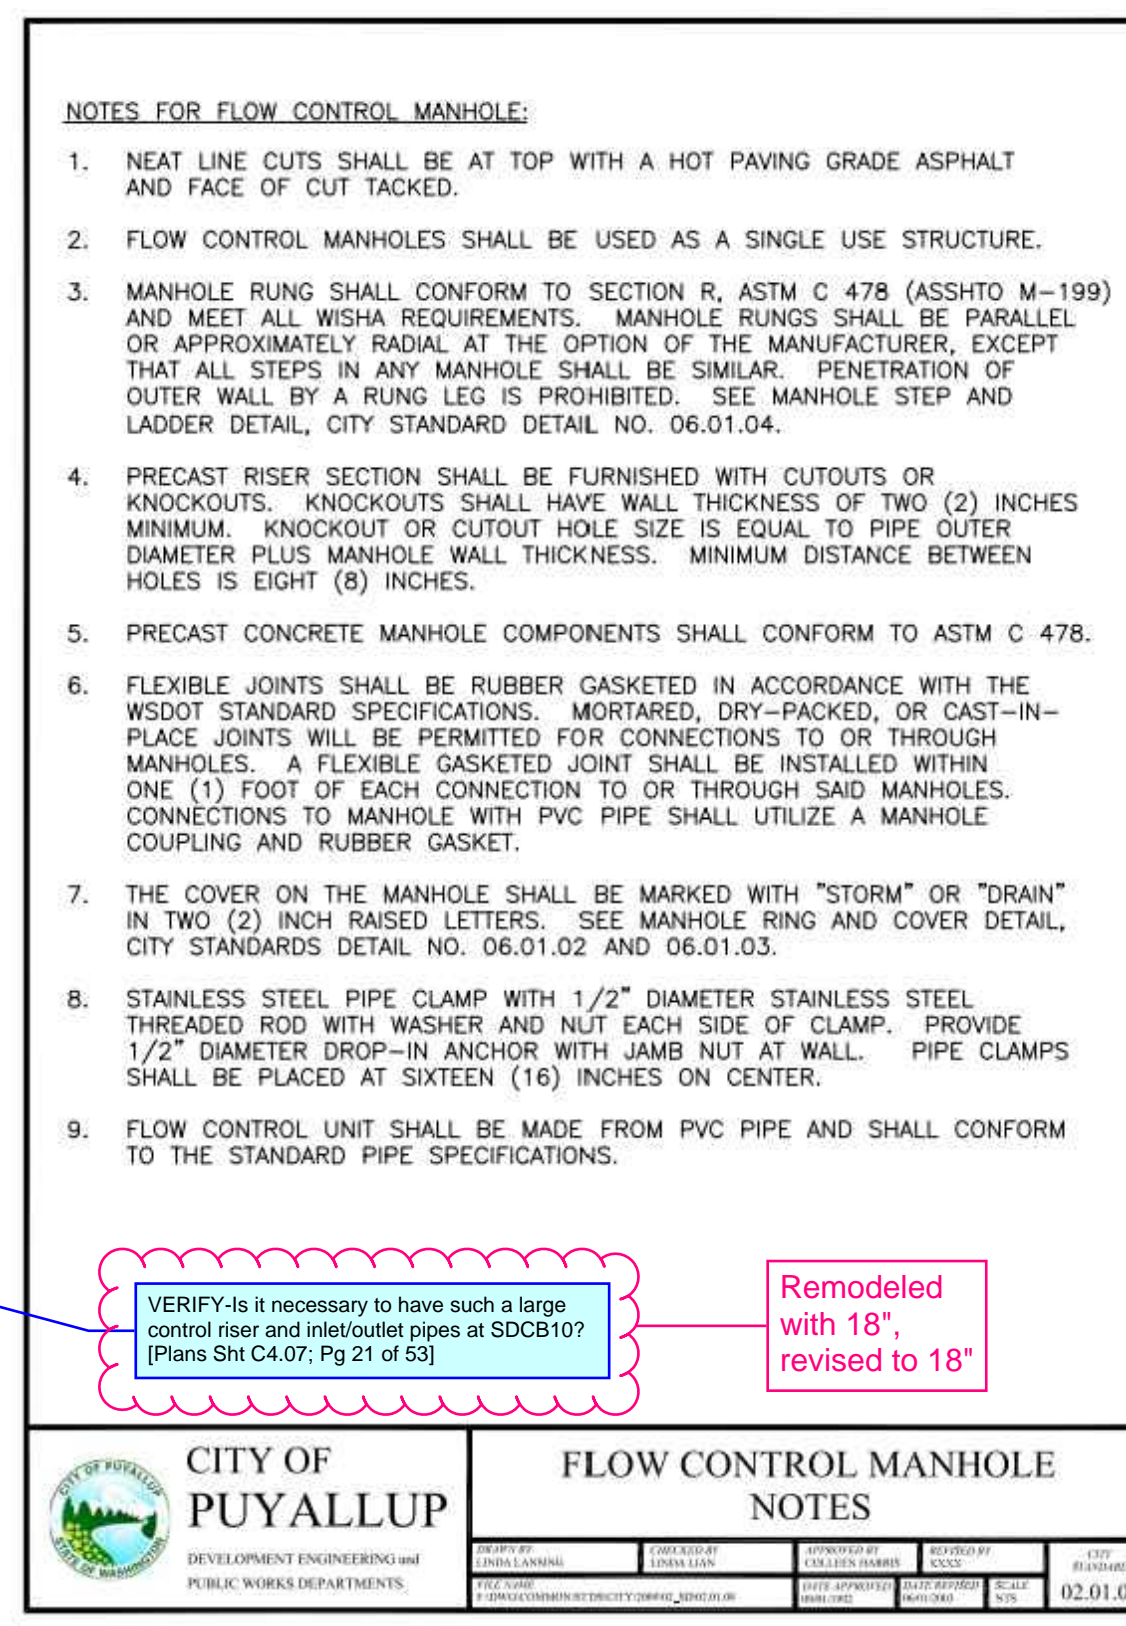

6 FLOW CONTROL MANHOLE WITH FLAT TOP (AND DATA TABLE)
NOT TO SCALE

7 FLOW CONTROL MANHOLE NOTES
NOT TO SCALE

8 STORM SEWER MANHOLE
NOT TO SCALE

9 STORM DRAIN CLEANOUT
NOT TO SCALE

Updated to match revised MGSFlood model

Revised

VERIFY-SDCB91 [Plans Sht C4.07; Pg 21 of 53]

Per prior comment, shouldn't this be EI. 67.40 which is the bottom of storage and the invert of the outlet pipe? EI. 67.65 would place the orifice on the toe of the control riser. [Plans Sht C4.07; Pg 21 of 53]

VERIFY-Is it necessary to have such a large control riser and inlet/outlet pipes at SDCB10? [Plans Sht C4.07; Pg 21 of 53]

Remodeled with 18", revised to 18"

VERIFY-per calcs the orifice is located at 4.22R (EI. 72.65). [Plans Sht C4.07; Pg 21 of 53]

Revised

VERIFY-Per prior comment, per calcs there is 5.87ft of storage which places the riser crest at EI. 74.21 (Bottom of Storage EI. 68.40 + storage depth of 5.87). [Plans Sht C4.07; Pg 21 of 53]

Revised



EAST TOWN CROSSING PHASE 1

SEC. 26,35/ TWP. 20 N./ RGE. 4 E., W.M.

APPROVED

BY _____
CITY OF PUYALLUP
DEVELOPMENT ENGINEERING

DATE _____

NOTE: THIS APPROVAL IS VOID AFTER 180 DAYS FROM APPROVAL DATE. THE CITY WILL NOT BE RESPONSIBLE FOR ERRORS AND/OR OMISSIONS ON THESE PLANS. FIELD CONDITIONS MAY DICTATE CHANGES TO THESE PLANS AS DETERMINED BY THE DEVELOPMENT ENGINEERING MANAGER.



TACOMA · SEATTLE · SPOKANE · TRI-CITIES

2215 North 30th Street, Suite 300, Tacoma, WA 98403
253.383.2422 TEL 253.383.2572 FAX www.ahbl.com WEB

Project Title:

**EAST TOWN
CROSSING PHASE 1**

Client:
ASH DEVELOPMENT

GREG HELLE

GREG.HELLE@ASHNW.COM

Project No.

2230752

Issue Set & Date:

PERMIT SUBMITTAL

02/20/2024




NOTICE
A SIGNATURE OF THIS DOCUMENT SHALL VALIDATE THE PROFESSIONAL SEAL AND SIGNATURE PUBLICATION OF THIS DOCUMENT DOES NOT GUARANTEE THE ACCURACY OR COMPLETENESS OF THE INFORMATION PROVIDED HEREIN. THE USER SHALL BE RESPONSIBLE FOR VERIFYING THE INFORMATION AND FOR THE PROPER USE OF THIS DOCUMENT FOR ANY OTHER PROJECT.

SITE SPECIFIC DATA				
Structure ID	ID			
Treatment Flow Rate (cfs)	0.12 CFS			
Peak Flow Rate (cfs)	4 CFS			
Rim Elevation				
Top of Vault Elevation				
Pipe Data	Pipe Location	Pipe Size	Pipe Type	Invert Elevation
Inlet				
Outlet				
Notes: SEE TABLE BELOW FOR DATA				
PERFORMANCE SPECIFICATIONS				
Treatment Flow Capacities:*				
NJDEP 80% Removal, 75 micron	0.144 cfs			
WA Ecology GULD - Basic, Enhanced & Phosphorus	0.128 cfs			
Bypass Capacity	5.0 cfs			
<small>*Contact Oldcastle for alternative treatment flow capacities.</small>				

6x8 BIOPOD				
NUMBER	1	3	4	5
RIM	73.16	76.48	76.19	76.23
TOP OF VAULT ELEVATION	72.83	76.15	75.86	75.90
INLET LOCATION	W	S	N	S
PIPE SIZE	12"	12"	12"	12"
PIPE TYPE	CPEP	CPEP	CPEP	CPEP
INLET IE	68.40	71.65	70.10	70.80
OUTLET LOCATION	S	N	S	N
PIPE SIZE	12"	12"	12"	12"
PIPE TYPE	CPEP	CPEP	CPEP	CPEP
OUTLET IE	67.90	68.90	69.60	70.30


WQ DEVICE #2 IS A 4x6 BIOPOD. REFER TO SHEET C4.09 FOR SIZING.

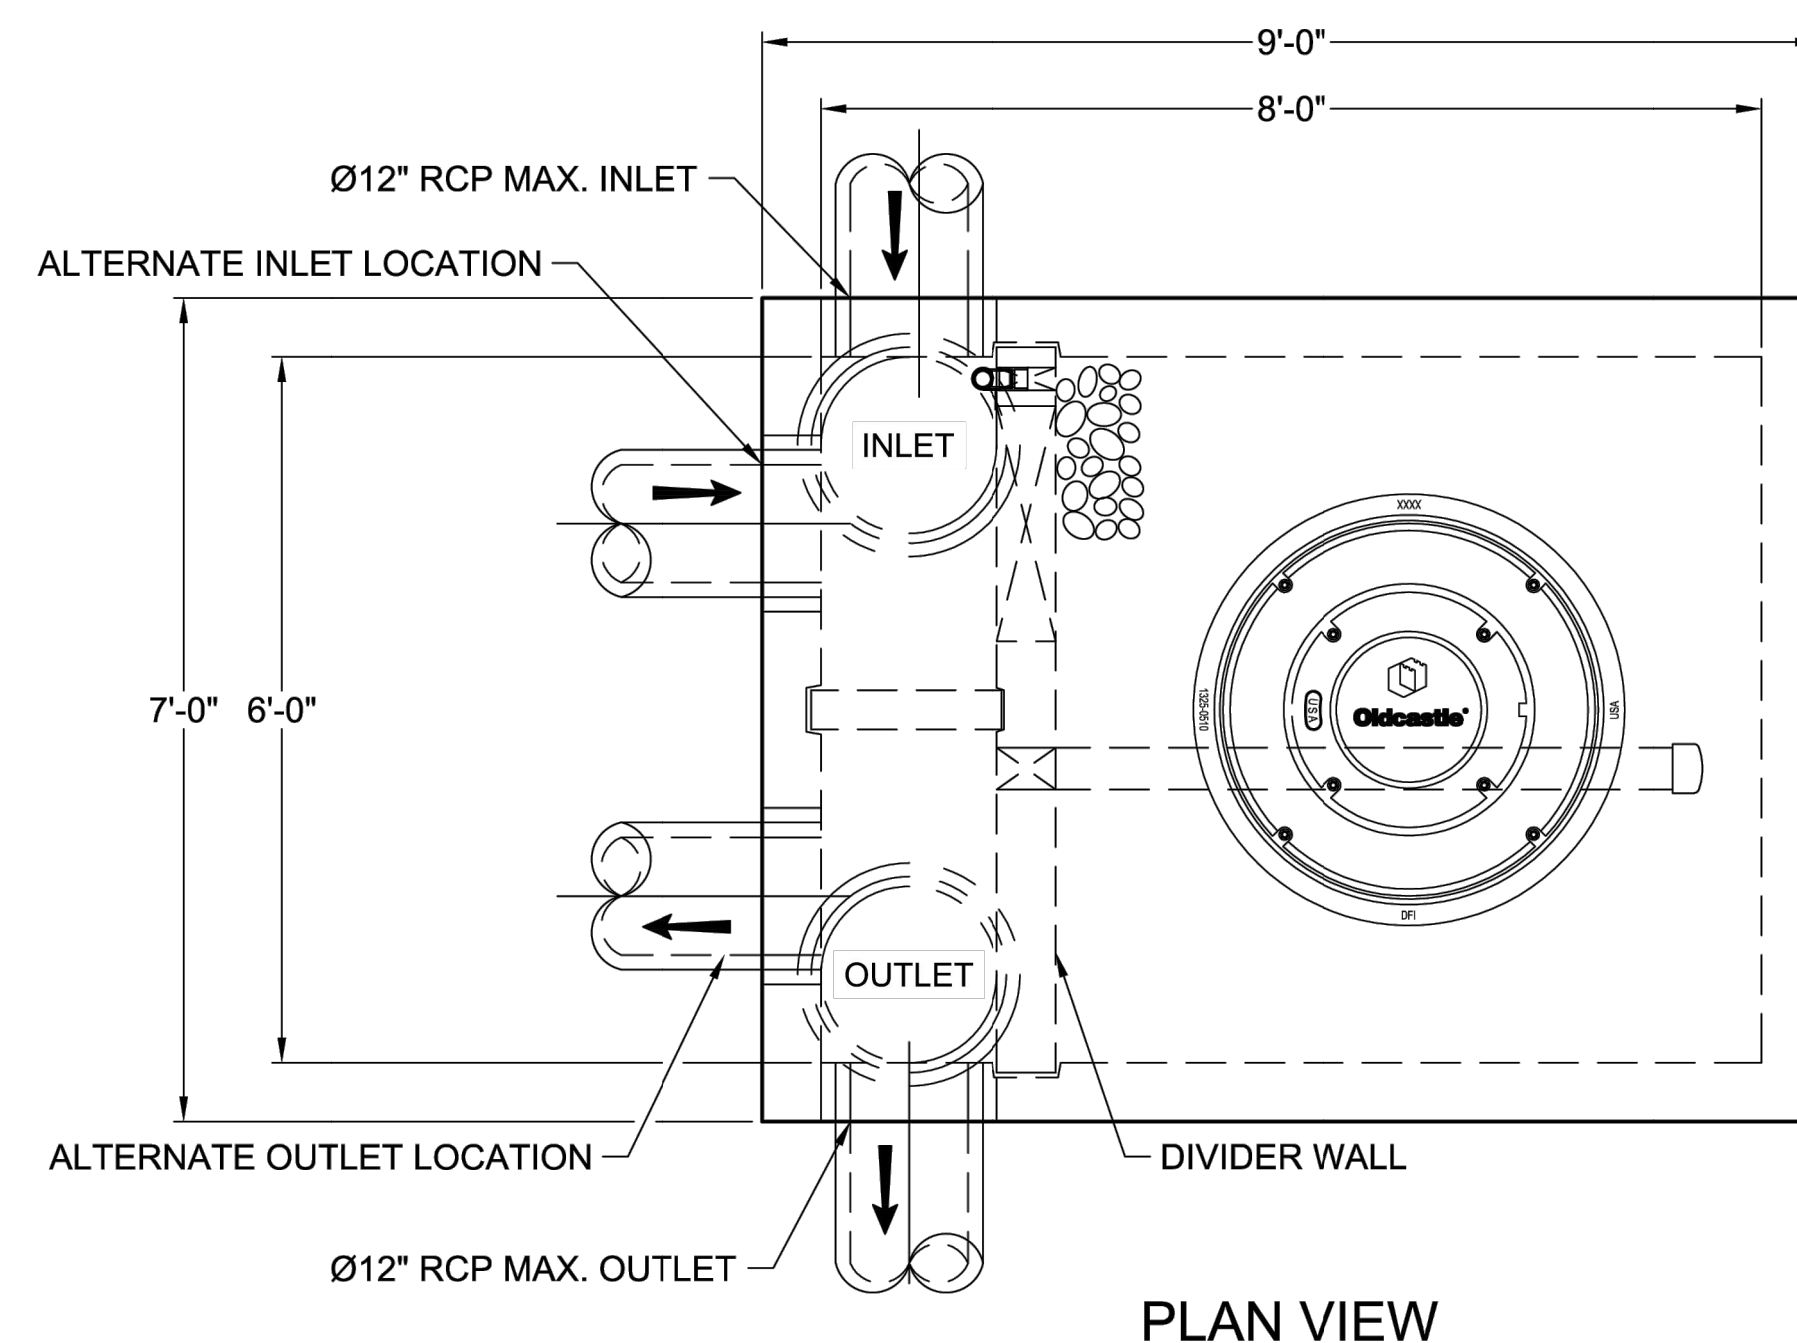

PLAN VIEW

NOTES:

1. DESIGN LOADINGS:
 - A. AASHTO HS-20-44 (WITH IMPACT)
 - B. DESIGN SOIL COVER: 5'-0" MAXIMUM
 - C. ASSUMED WATER TABLE: BELOW BASE OF PRECAST (ENGINEER-OF-RECORD TO CONFIRM SITE WATER TABLE ELEVATION)
 - D. LATERAL EARTH PRESSURE: 45 PCF (DRAINED)
 - E. LATERAL LIVE LOAD SURCHARGE: 80 PSF (APPLIED TO 8'-0" BELOW GRADE)
 - F. NO LATERAL SURCHARGE FROM ADJACENT BUILDINGS, WALLS, PIERS, OR FOUNDATIONS.
2. CONCRETE 28-DAY MINIMUM COMPRESSIVE STRENGTH: 5,000 PSI MINIMUM.
3. REINFORCING: REBAR, ASTM A615/A706, GRADE 60
4. CEMENT: ASTM C150
5. REQUIRED ALLOWABLE SOIL BEARING CAPACITY: 2,500 PSF
6. REFERENCE STANDARD:
 - A. ASTM C890
 - B. ASTM C913
 - C. ACI 318-14
7. THIS STRUCTURE IS DESIGNED TO THE PARAMETERS NOTED HEREIN. ENGINEER-OF-RECORD SHALL VERIFY THAT NOTED PARAMETERS MEET OR EXCEED PROJECT REQUIREMENTS. IF DESIGN PARAMETERS ARE INCORRECT, REVIEWING ENGINEER/AUTHORITY SHALL NOTIFY OLDCASTLE INFRASTRUCTURE UPON REVIEW.
8. INLET AND OUTLET HOLES WILL BE FACTORY CORED/CAST PER PLANS AND CUSTOMER REQUIREMENTS. INLET AND OUTLET LOCATIONS CAN BE MIRRORRED.
9. CONTRACTOR RESPONSIBLE TO VERIFY ALL SIZES, LOCATIONS, AND ELEVATIONS OF OPENINGS.
10. CONTRACTOR RESPONSIBLE TO ENSURE ADEQUATE BEARING SURFACE IS PROVIDED (I.E. COMPACTED AND LEVEL PER PROJECT SPECIFICATIONS).
11. SECTION HEIGHTS, SLAB/WALL THICKNESSES, AND KEYWAYS ARE SUBJECT TO CHANGE AS REQUIRED FOR SITE REQUIREMENTS AND/OR DUE TO PRODUCT AVAILABILITY AND PRODUCTION FACILITY CONSTRAINTS.
12. MAXIMUM PICK WEIGHTS*:
 - A. TOP: XX,XXX LBS
 - B. BASE: XX,XXX LBS*
 - (* COMBINED WEIGHT OF BASE INCLUDES BYPASS WEIR, DIVIDER WALL, ROCK & MEDIA)
13. INTERNALS SHALL CONSIST OF UNDERDRAIN PIPE, ROCK, STORMMIX™ MEDIA, MULCH, DIVIDER WALL, BYPASS WEIR AND OPTIONAL DRAIN DOWN.

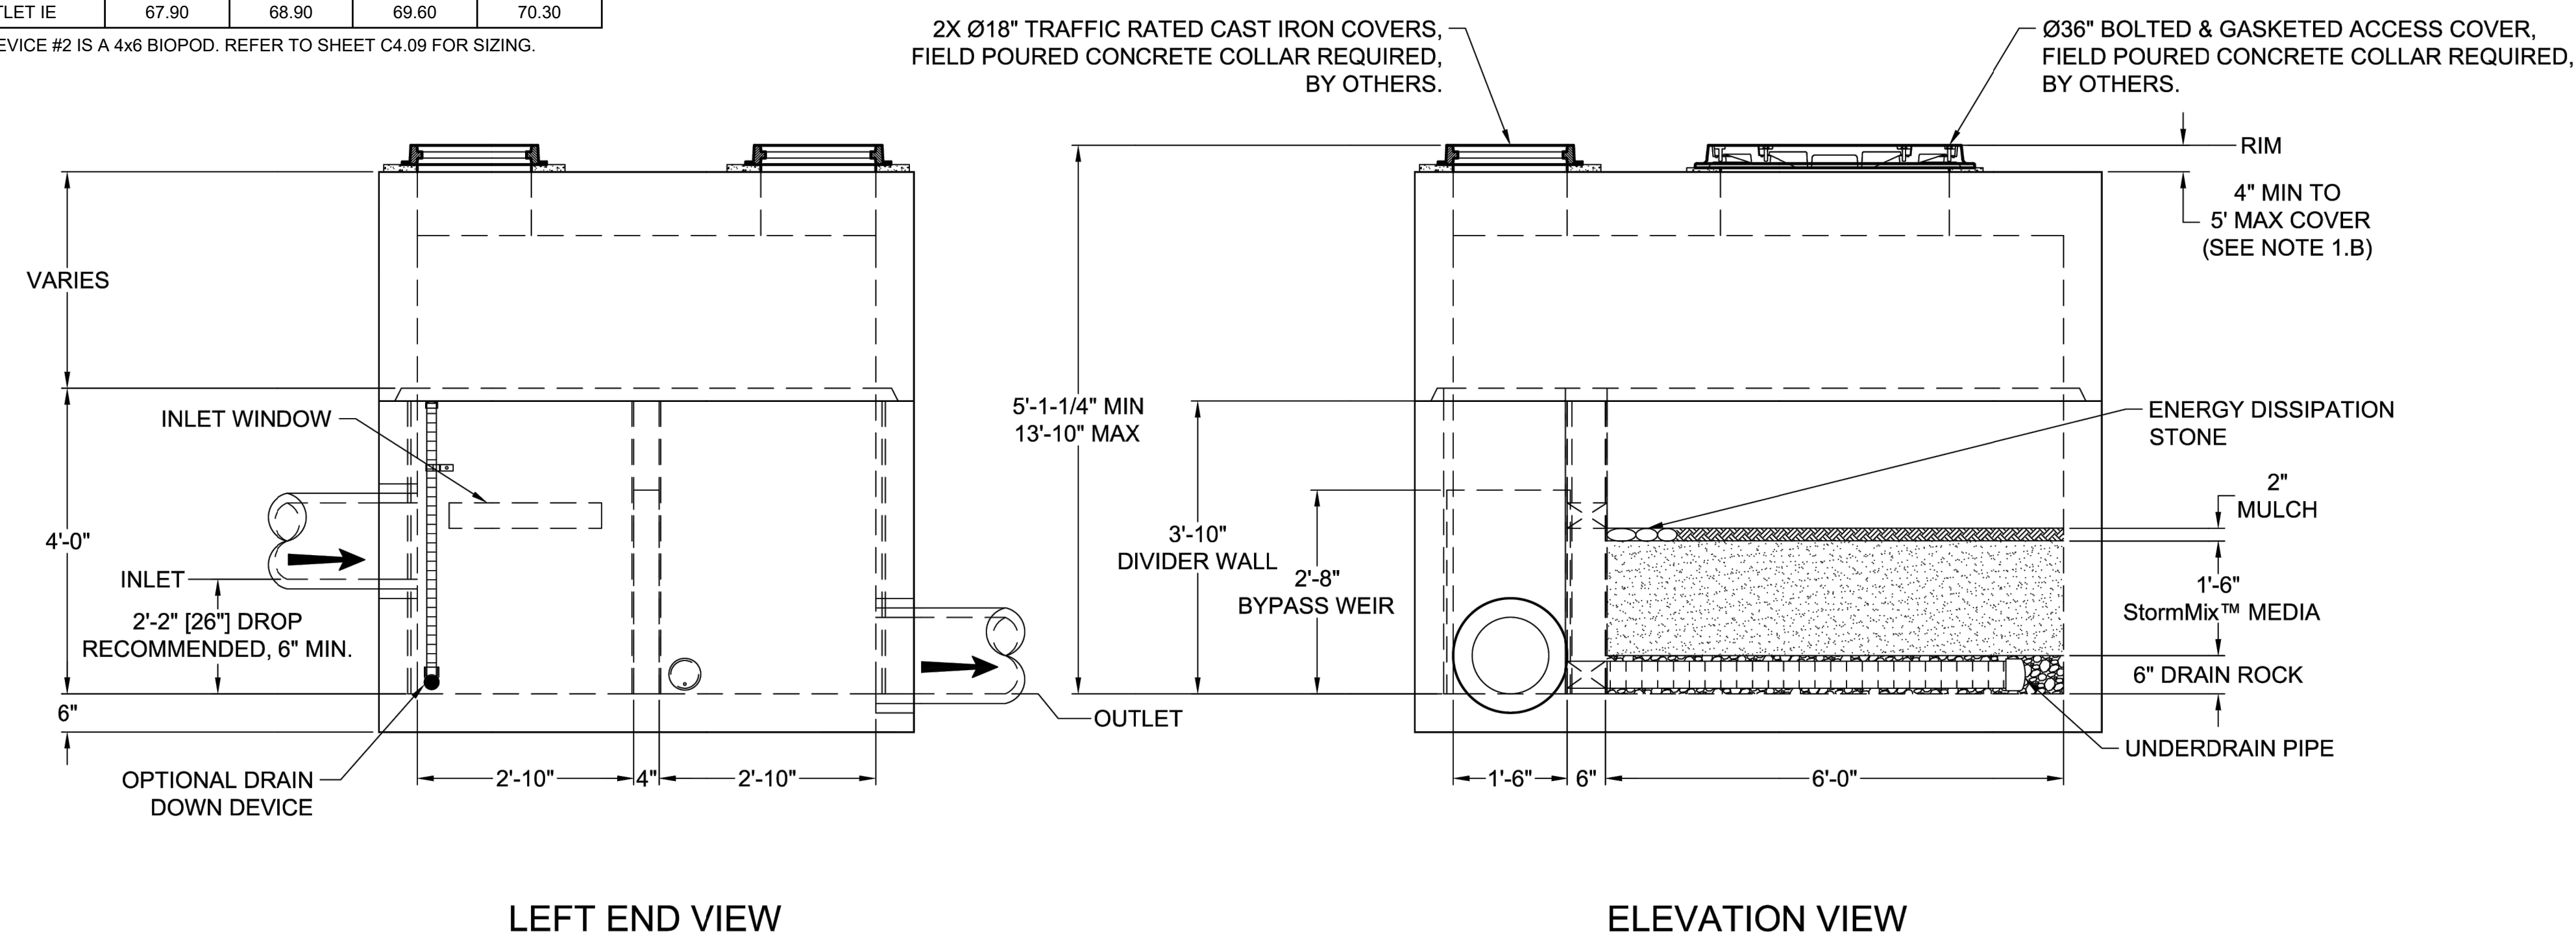

LEFT END VIEW


ELEVATION VIEW

Ph: 800.579.8819 | www.oldcastleinfrastructure.com/stormwater

THIS DOCUMENT IS THE PROPERTY OF OLDCASTLE INFRASTRUCTURE, INC. IT IS CONFIDENTIAL, SUBMITTED FOR REFERENCE PURPOSES ONLY AND SHALL NOT BE USED IN ANY WAY INJURIOUS TO THE INTERESTS OF, OR WITHOUT THE WRITTEN PERMISSION OF OLDCASTLE INFRASTRUCTURE, INC. COPYRIGHT © 2021 OLDCASTLE INFRASTRUCTURE, INC. ALL RIGHTS RESERVED.

BioPod™ Biofilter System (STANDARD)
Underground Vault with Internal Bypass

CUSTOMER			
PROJECT NAME			
SHEET NAME	REVISION	SHEET	
Specifier Drawing		1 OF 1	
BPU-68IB	REV DATE		

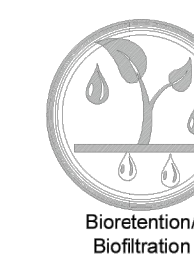

1 6X8 BIOPOD
NOT TO SCALE



Know what's below.
Call before you dig.

A
A
A

01/29/24 CITY COMMENTS

Revisions:

Sheet Title:

**STORM DRAINAGE
NOTES AND
DETAILS**

Designed by: CW Drawn by: SK / RS Checked by: JI

Sheet No.

C4.08

22 of 53 Sheets


EAST TOWN CROSSING PHASE 1

SEC. 26,35/ TWP. 20 N./ RGE. 4 E., W.M.

APPROVED

BY: CITY OF PUYALLUP
DEVELOPMENT ENGINEERING

DATE: _____
NOTE: THIS APPROVAL IS VOID AFTER 180 DAYS FROM APPROVAL DATE. THE CITY WILL NOT BE RESPONSIBLE FOR ERRORS AND/OR OMISSIONS ON THESE PLANS. FIELD CONDITIONS MAY DICTATE CHANGES TO THESE PLANS AS DETERMINED BY THE DEVELOPMENT ENGINEERING MANAGER.

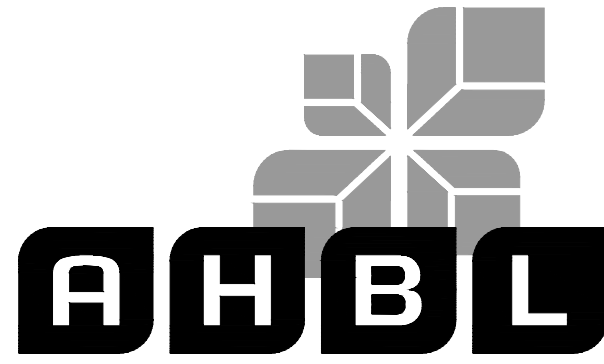

TACOMA · SEATTLE · SPOKANE · TRI-CITIES

2215 North 30th Street, Suite 300, Tacoma, WA 98403
253.383.2422 TEL 253.383.2572 FAX www.ahbl.com WEB

Project Title:

EAST TOWN CROSSING PHASE 1

Client: ASH DEVELOPMENT

GREG HELLE

GREG.HELLE@ASHNW.COM


Project No.

2230752

Issue Set & Date:


PERMIT SUBMITTAL

02/20/2024

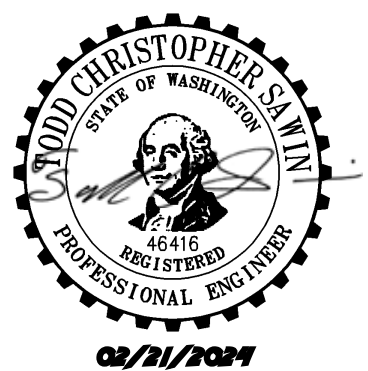


NOTICE
ALTERATION OF THIS DOCUMENT SHALL INVALIDATE THE PROFESSIONAL SEAL AND SIGNATURE PUBLICATION OF THIS DOCUMENT DOES NOT CONSTITUTE A PROFESSIONAL ENGINEER'S RESPONSIBILITY TO THE USER. THIS DOCUMENT IS FOR THE ONLY FOR THE PROJECT IDENTIFIED IN THE TITLE BLOCK AND IS NOT TO BE USED FOR OTHER, SIMILAR, OR ADDITION TO THAT PROJECT OR FOR ANY OTHER PROJECT.


SITE SPECIFIC DATA				
Structure ID	ID			
Treatment Flow Rate (cfs)	0.05 CFS			
Peak Flow Rate (cfs)	1.2 CFS			
Rim Elevation	76.71			
Top of Vault Elevation	76.38			
Pipe Data	Pipe Location	Pipe Size	Pipe Type	Invert Elevation
Inlet	N	8"	CPEP	72.83
Outlet	S	12"	CPEP	70.66
Notes:				
PERFORMANCE SPECIFICATIONS				
Treatment Flow Capacities:*				
NJDEP 80% Removal, 75 micron	0.064 cfs			
WA Ecology GULD - Basic, Enhanced & Phosphorus	0.057 cfs			
Bypass Capacity	5.0 cfs			
*Contact Oldcastle for alternative treatment flow capacities.				

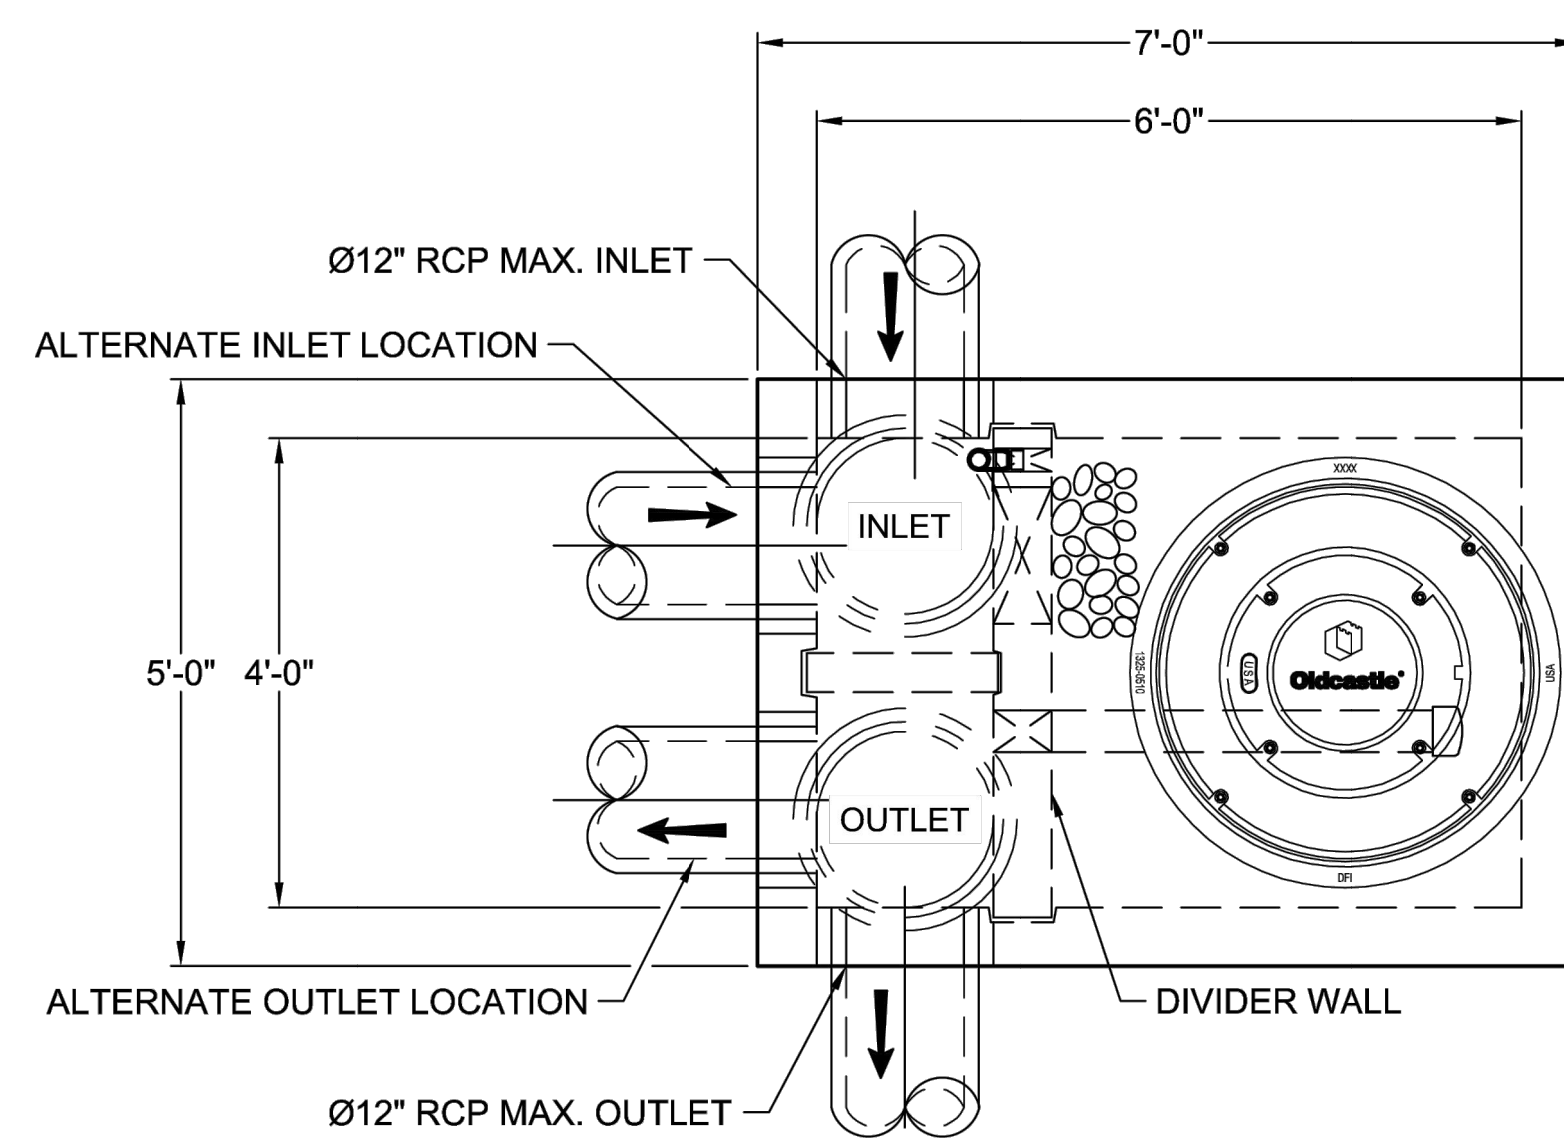

PLAN VIEW

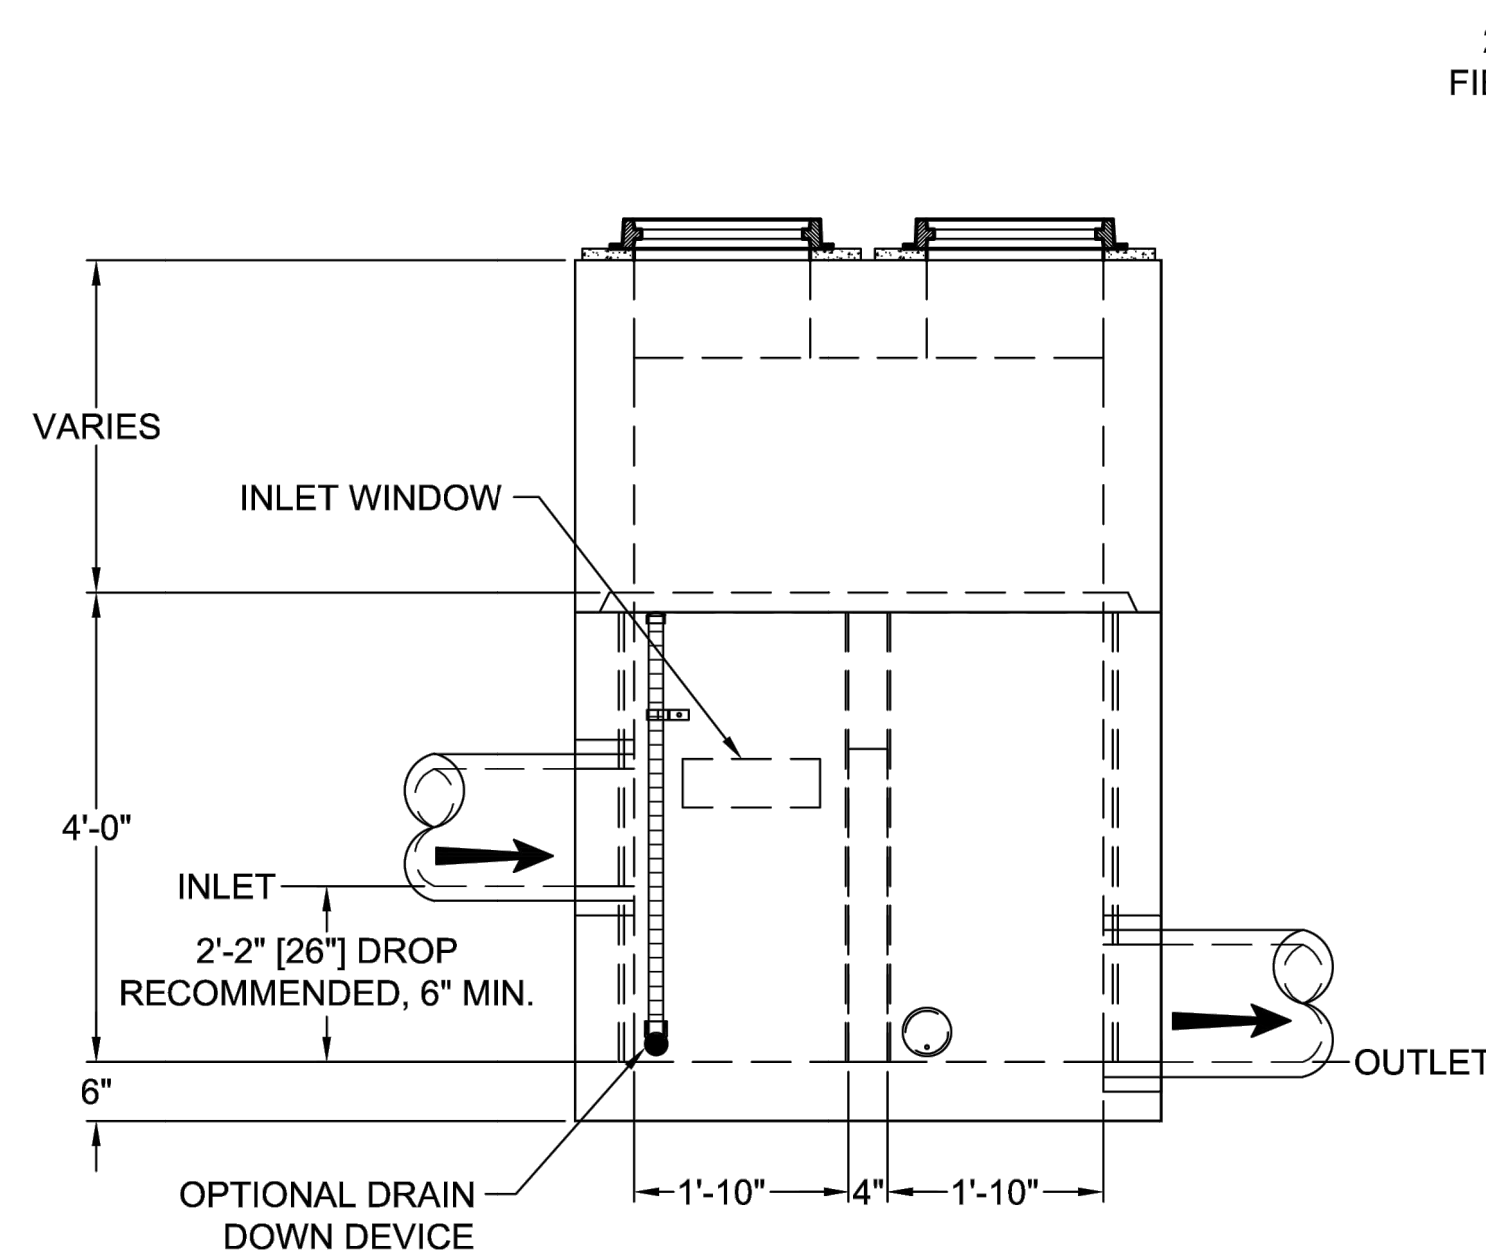

LEFT END VIEW

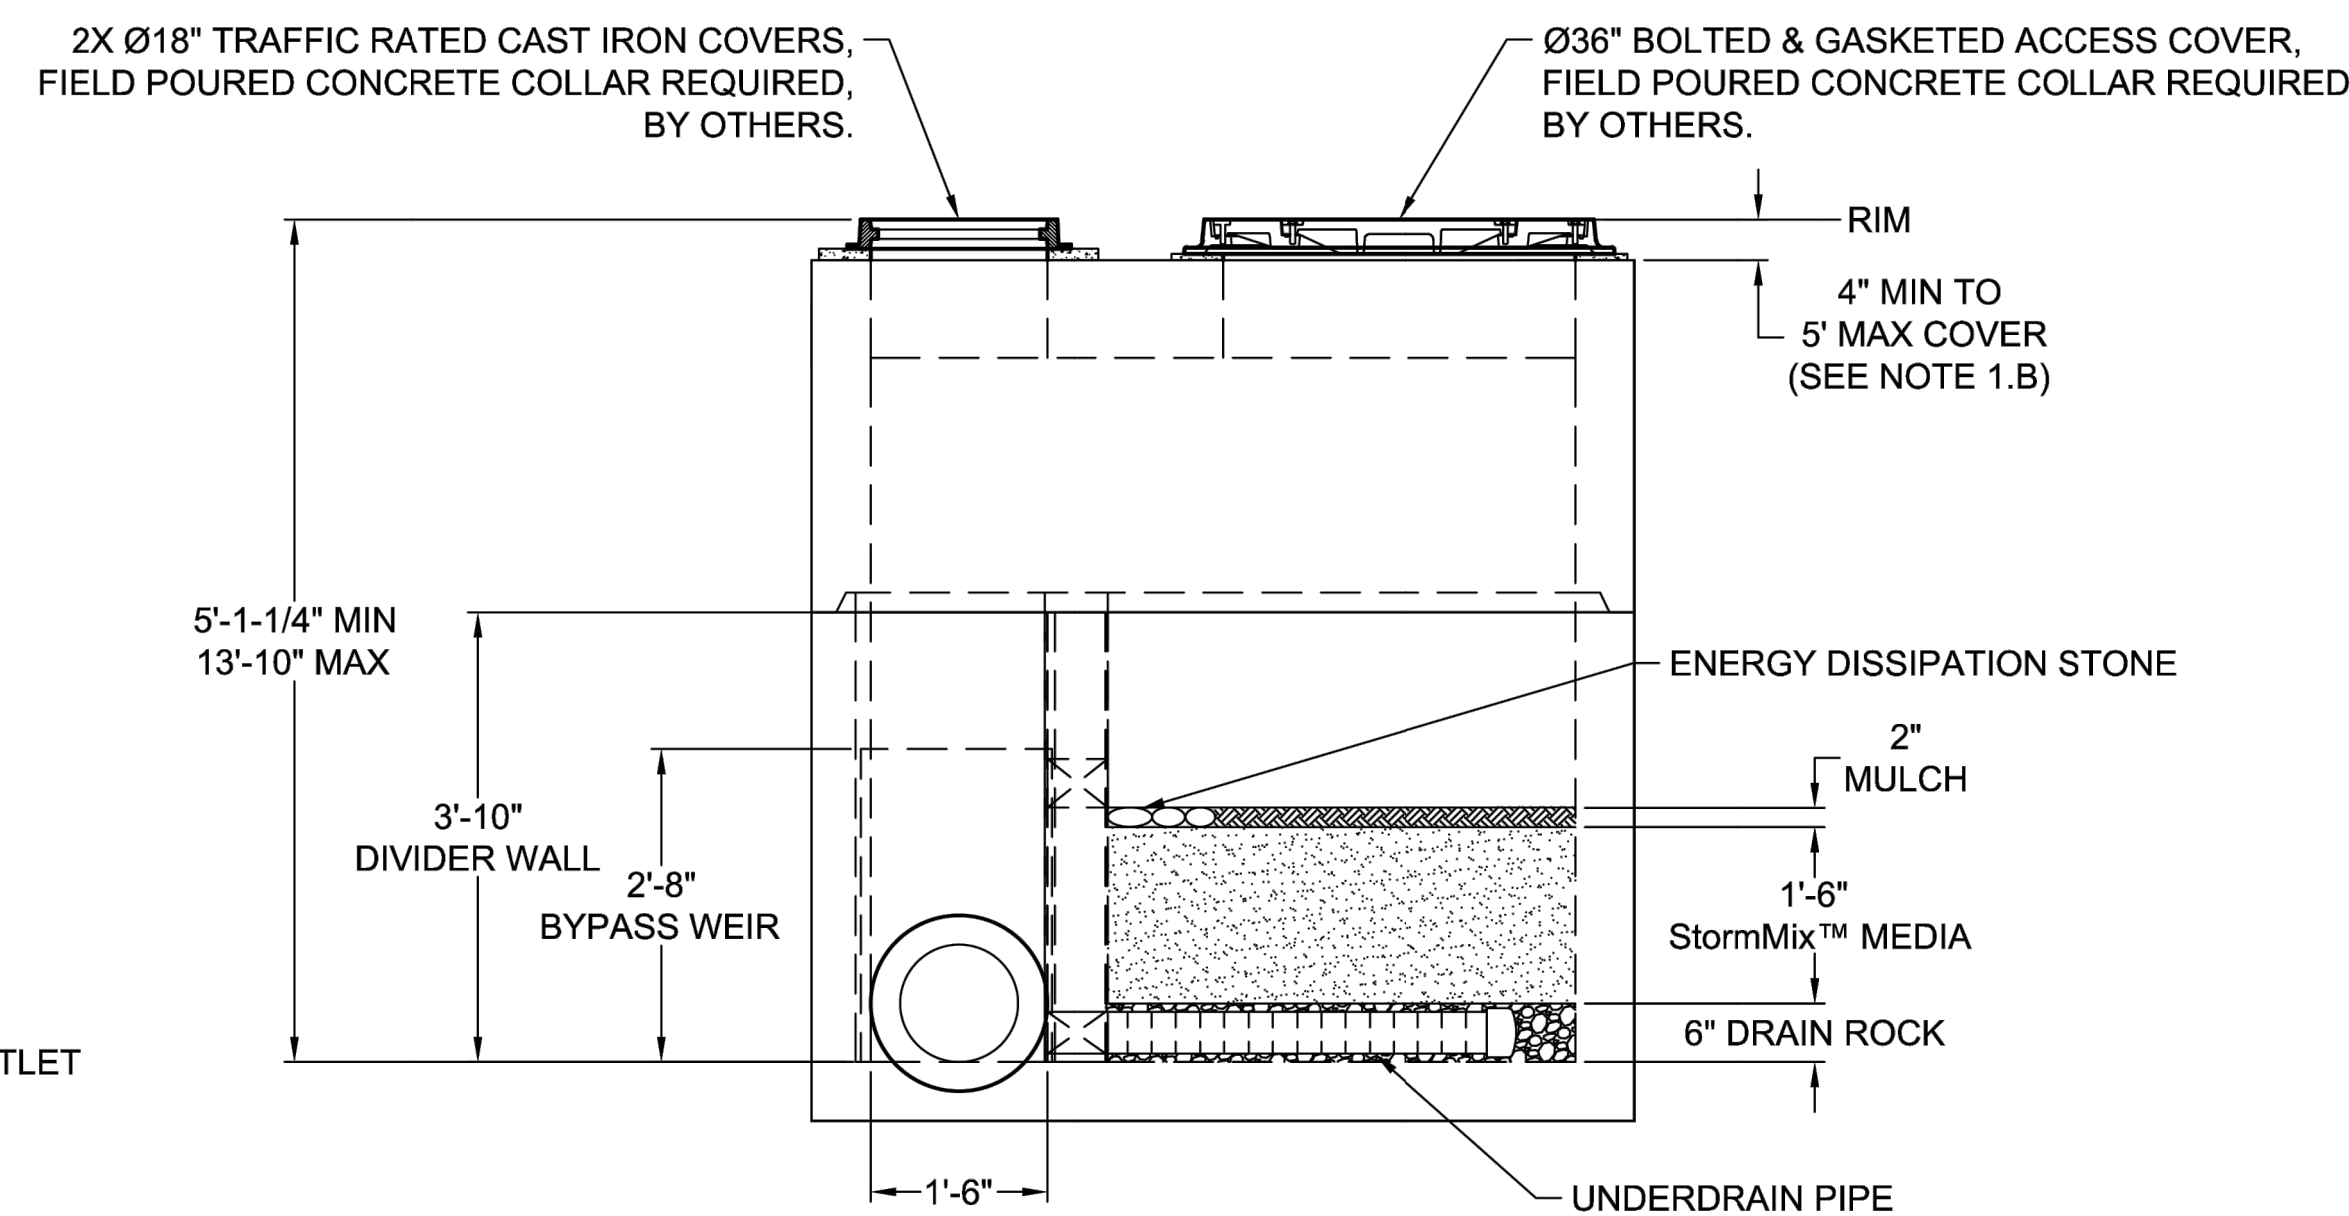

ELEVATION VIEW


NOTES:

- DESIGN LOADINGS:
 - AASHTO HS-20-44 (WITH IMPACT)
 - DESIGN SOIL COVER: 5'-0" MAXIMUM
 - ASSUMED WATER TABLE: BELOW BASE OF PRECAST (ENGINEER-OF-RECORD TO CONFIRM SITE WATER TABLE ELEVATION)
 - LATERAL EARTH PRESSURE: 45 PCF (DRAINED)
 - LATERAL LIVE LOAD SURCHARGE: 80 PSF (APPLIED TO 8'-0" BELOW GRADE)
 - NO LATERAL SURCHARGE FROM ADJACENT BUILDINGS, WALLS, PIERS, OR FOUNDATIONS.
- CONCRETE 28-DAY MINIMUM COMPRESSIVE STRENGTH: 5,000 PSI MINIMUM.
- REINFORCING: REBAR, ASTM A615/A706, GRADE 60
- CEMENT: ASTM C150
- REQUIRED ALLOWABLE SOIL BEARING CAPACITY: 2,500 PSF
- REFERENCE STANDARD:
 - ASTM C890
 - ASTM C913
 - ACI 318-14
- THIS STRUCTURE IS DESIGNED TO THE PARAMETERS NOTED HEREIN. ENGINEER-OF-RECORD SHALL VERIFY THAT NOTED PARAMETERS MEET OR EXCEED PROJECT REQUIREMENTS. IF DESIGN PARAMETERS ARE INCORRECT, REVIEWING ENGINEER/AUTHORITY SHALL NOTIFY OLDCASTLE INFRASTRUCTURE UPON REVIEW.
- INLET AND OUTLET HOLES WILL BE FACTORY CORED/CAST PER PLANS AND CUSTOMER REQUIREMENTS. INLET AND OUTLET LOCATIONS CAN BE MIRRORED.
- CONTRACTOR RESPONSIBLE TO VERIFY ALL SIZES, LOCATIONS, AND ELEVATIONS OF OPENINGS.
- CONTRACTOR RESPONSIBLE TO ENSURE ADEQUATE BEARING SURFACE IS PROVIDED (I.E. COMPACTED AND LEVEL PER PROJECT SPECIFICATIONS).
- SECTION HEIGHTS, SLAB/WALL THICKNESSES, AND KEYWAYS ARE SUBJECT TO CHANGE AS REQUIRED FOR SITE REQUIREMENTS AND/OR DUE TO PRODUCT AVAILABILITY AND PRODUCTION FACILITY CONSTRAINTS.
- MAXIMUM PICK WEIGHTS*:
 - TOP: XX,XXX LBS
 - BASE: XX,XXX LBS*
 - (* COMBINED WEIGHT OF BASE INCLUDES BYPASS WEIR, DIVIDER WALL, ROCK & MEDIA)
- INTERNALS SHALL CONSIST OF UNDERDRAIN PIPE, ROCK, STORMMIX™ MEDIA, MULCH, DIVIDER WALL, BYPASS WEIR AND OPTIONAL DRAIN DOWN.



Ph: 800.579.8819 | www.oldcastleinfrastructure.com/stormwater
THIS DOCUMENT IS THE PROPERTY OF OLDCASTLE INFRASTRUCTURE, INC. IT IS CONFIDENTIAL, SUBMITTED FOR REFERENCE PURPOSES ONLY AND SHALL NOT BE USED IN ANY WAY INJURIOUS TO THE INTERESTS OF OLDCASTLE INFRASTRUCTURE, INC. WITHOUT THE WRITTEN PERMISSION OF OLDCASTLE INFRASTRUCTURE, INC. COPYRIGHT © 2021 OLDCASTLE INFRASTRUCTURE, INC. ALL RIGHTS RESERVED.

BioPod™ Biofilter System (STANDARD)			
Underground Vault with Internal Bypass			
CUSTOMER	-		
PROJECT NAME	-		
SHEET NAME	REVISION	SHEET	
Specifier Drawing	-	1 OF 1	
BPU-461B	REV DATE	-	

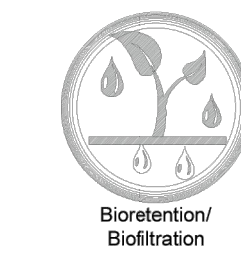

Know what's below.
Call before you dig.

1 4X6 BIPOD
NOT TO SCALE

△
△
△
△ 01/29/24 CITY COMMENTS

Revisions:

Sheet Title:

STORM DRAINAGE NOTES AND DETAILS

Designed by: CW Drawn by: SK / RS Checked by: JI

Sheet No.

C4.09

23 of 53 Sheets

EAST TOWN CROSSING PHASE 1


SEC. 26,35/ TWP. 20 N./ RGE. 4 E., W.M.

APPROVED

BY
CITY OF PUYALLUP
DEVELOPMENT ENGINEERING

DATE

NOTE: THIS APPROVAL IS VOID AFTER 180 DAYS FROM APPROVAL DATE.
THE CITY WILL NOT BE RESPONSIBLE FOR ERRORS AND/OR OMISSIONS ON THESE PLANS.
FIELD CONDITIONS MAY DICTATE CHANGES TO THESE PLANS AS DETERMINED BY THE DEVELOPMENT ENGINEERING MANAGER.

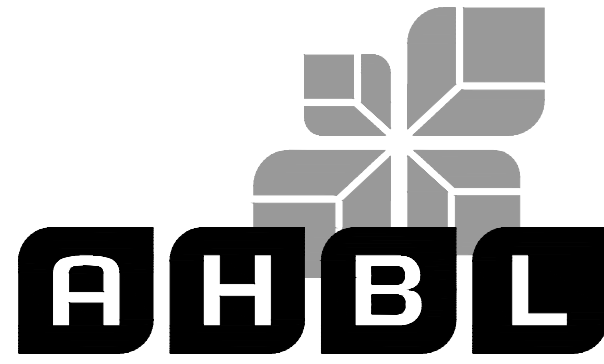

TACOMA • SEATTLE • SPOKANE • TRI-CITIES

2215 North 30th Street, Suite 300, Tacoma, WA 98403
253.383.2422 TEL 253.383.2572 FAX www.ahbl.com WEB

Project Title:

EAST TOWN CROSSING PHASE 1

Client:

ASH DEVELOPMENT

GREG HELLE

GREG.HELLE@ASHNW.COM

Project No.

2230752

Issue Set & Date:

PERMIT SUBMITTAL

02/20/2024



NOTE:
A SIGNATURE OF THE REGISTERED PROFESSIONAL SEAL AND SIGNATURE PUBLICATION OF THE DOCUMENT DOES NOT CONSTITUTE A GUARANTEE OR ENDORSEMENT OF THE DESIGN OR CONSTRUCTION OF THE PROJECT. THE DESIGNER IS NOT TO BE HELD RESPONSIBLE FOR ANY ACTION TO THAT PROJECT OR FOR ANY OTHER PROJECT.

Revisions:

01/29/24 CITY COMMENTS

Revisions:

Sheet Title:



R-TANK 1 NOTES AND DETAILS

Designed by: CW
Drawn by: SK / RS
Checked by: JI

Sheet No.

C4.10

24 of 53 Sheets

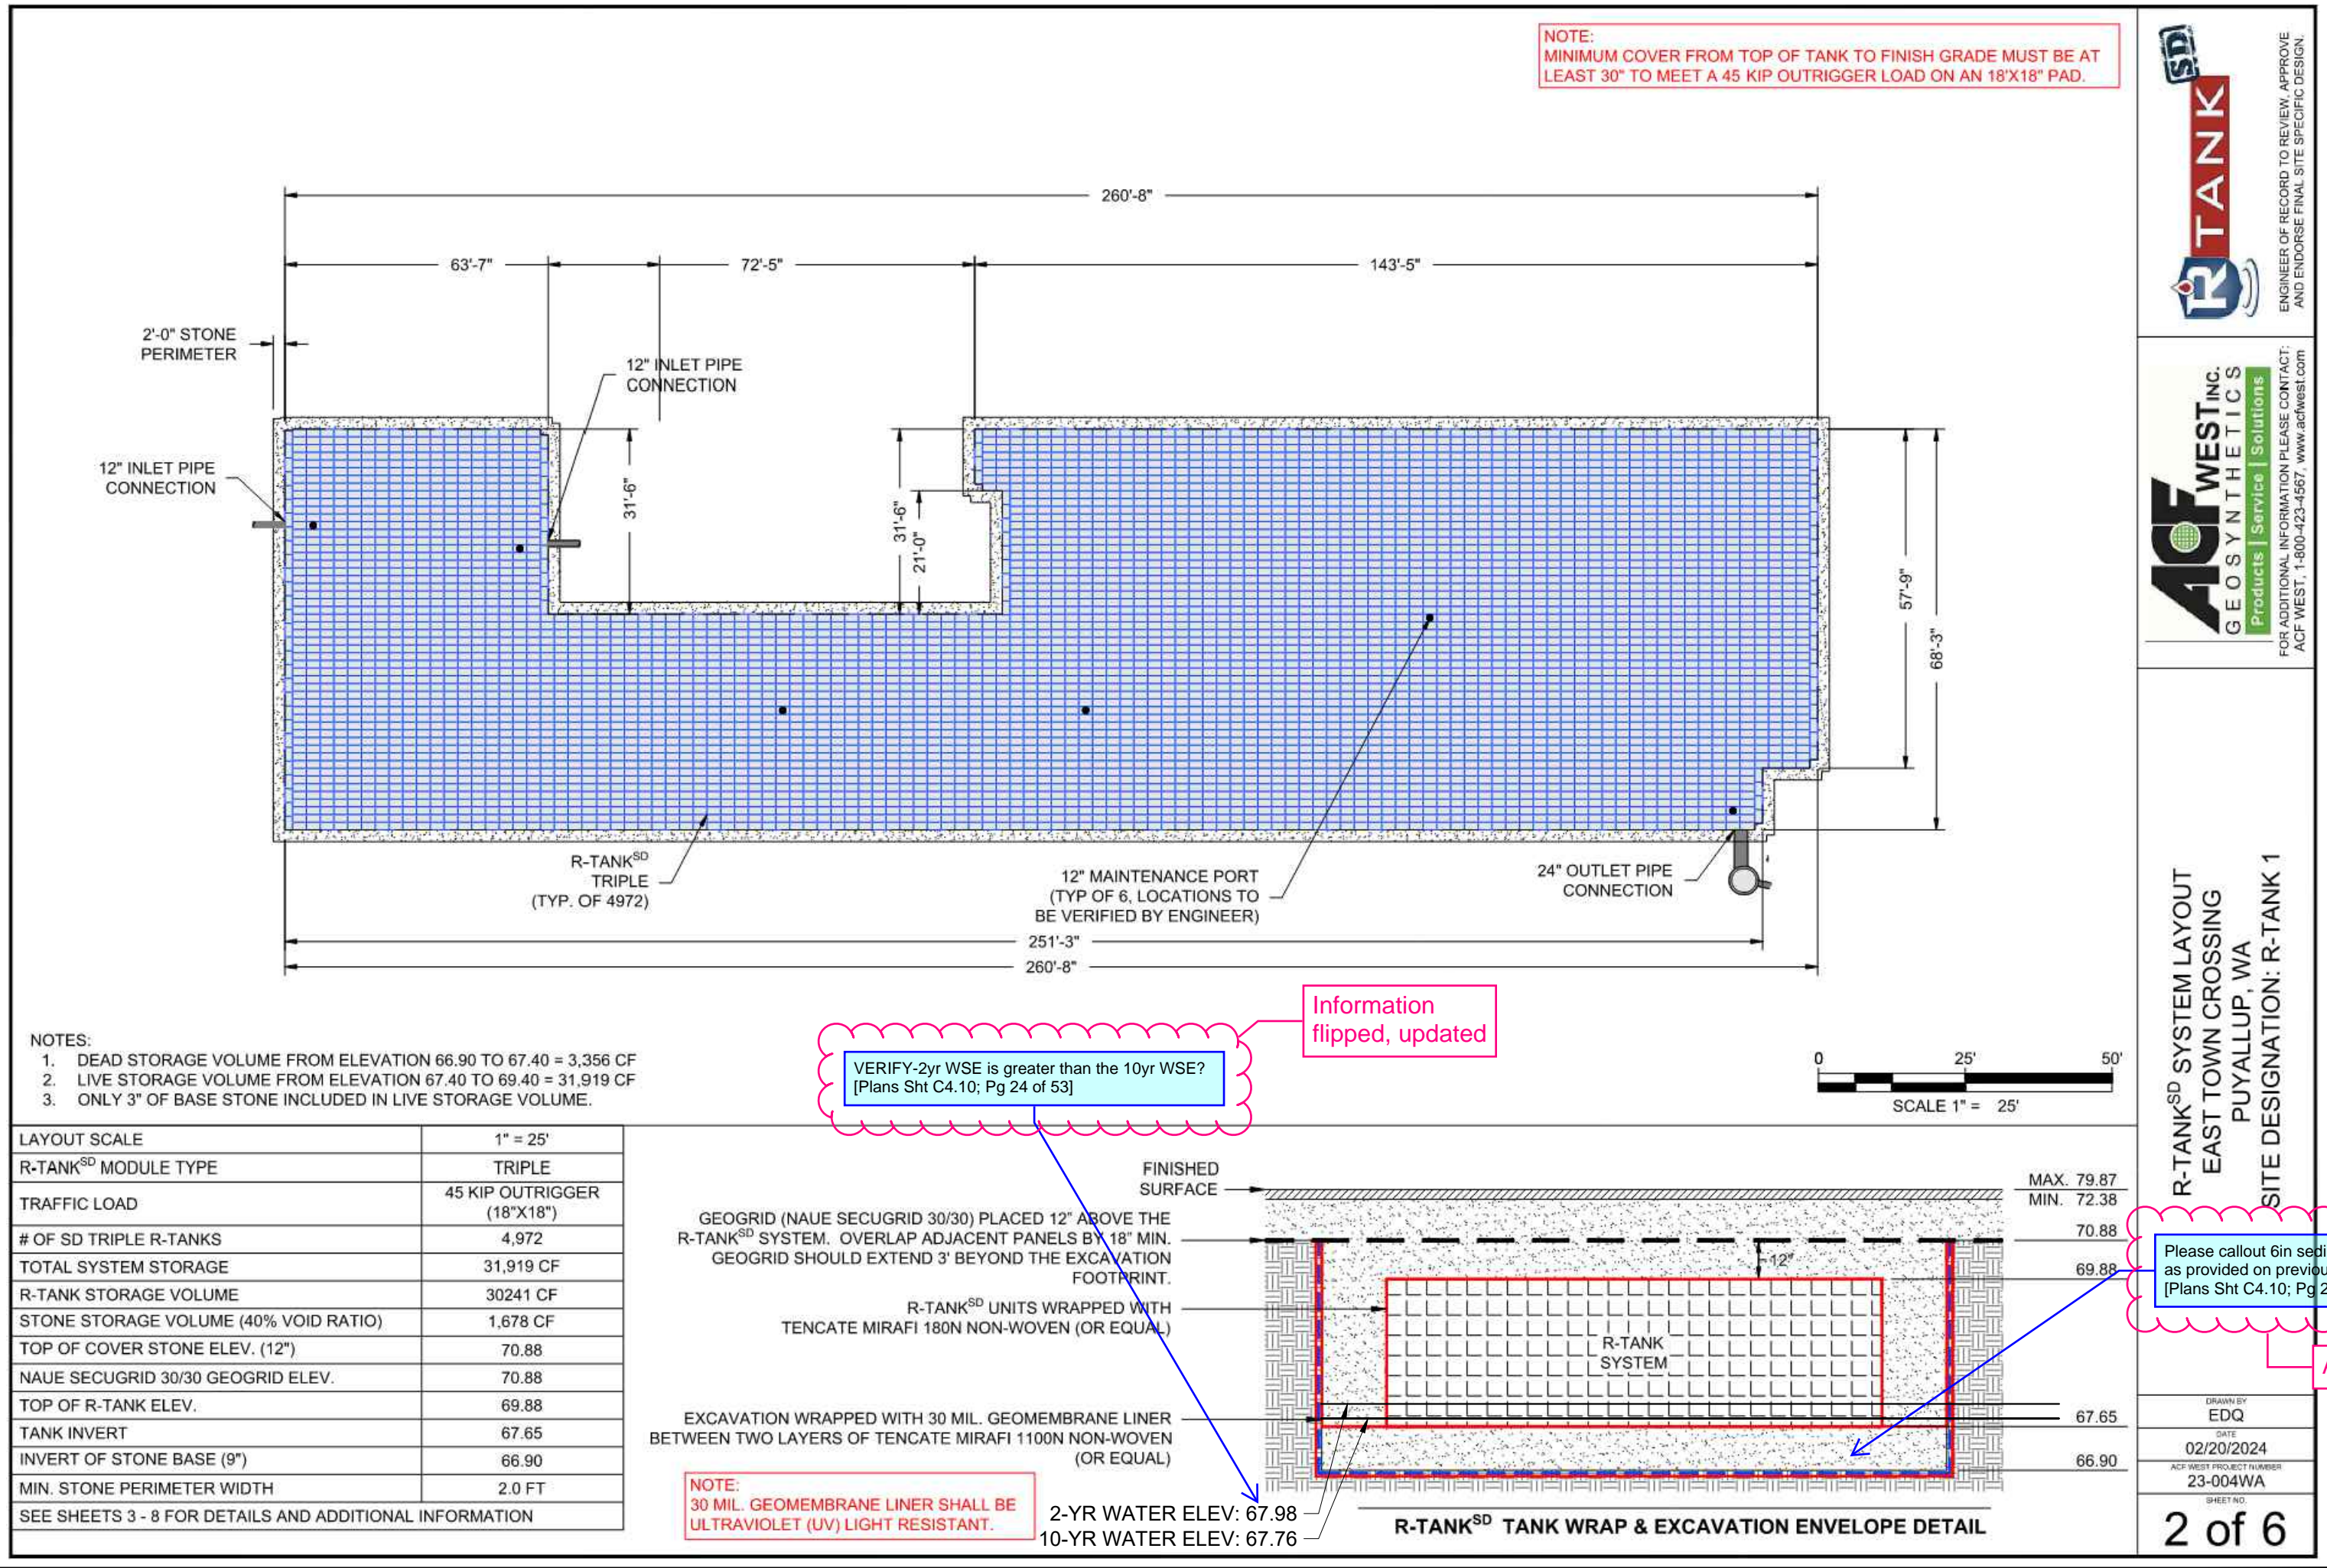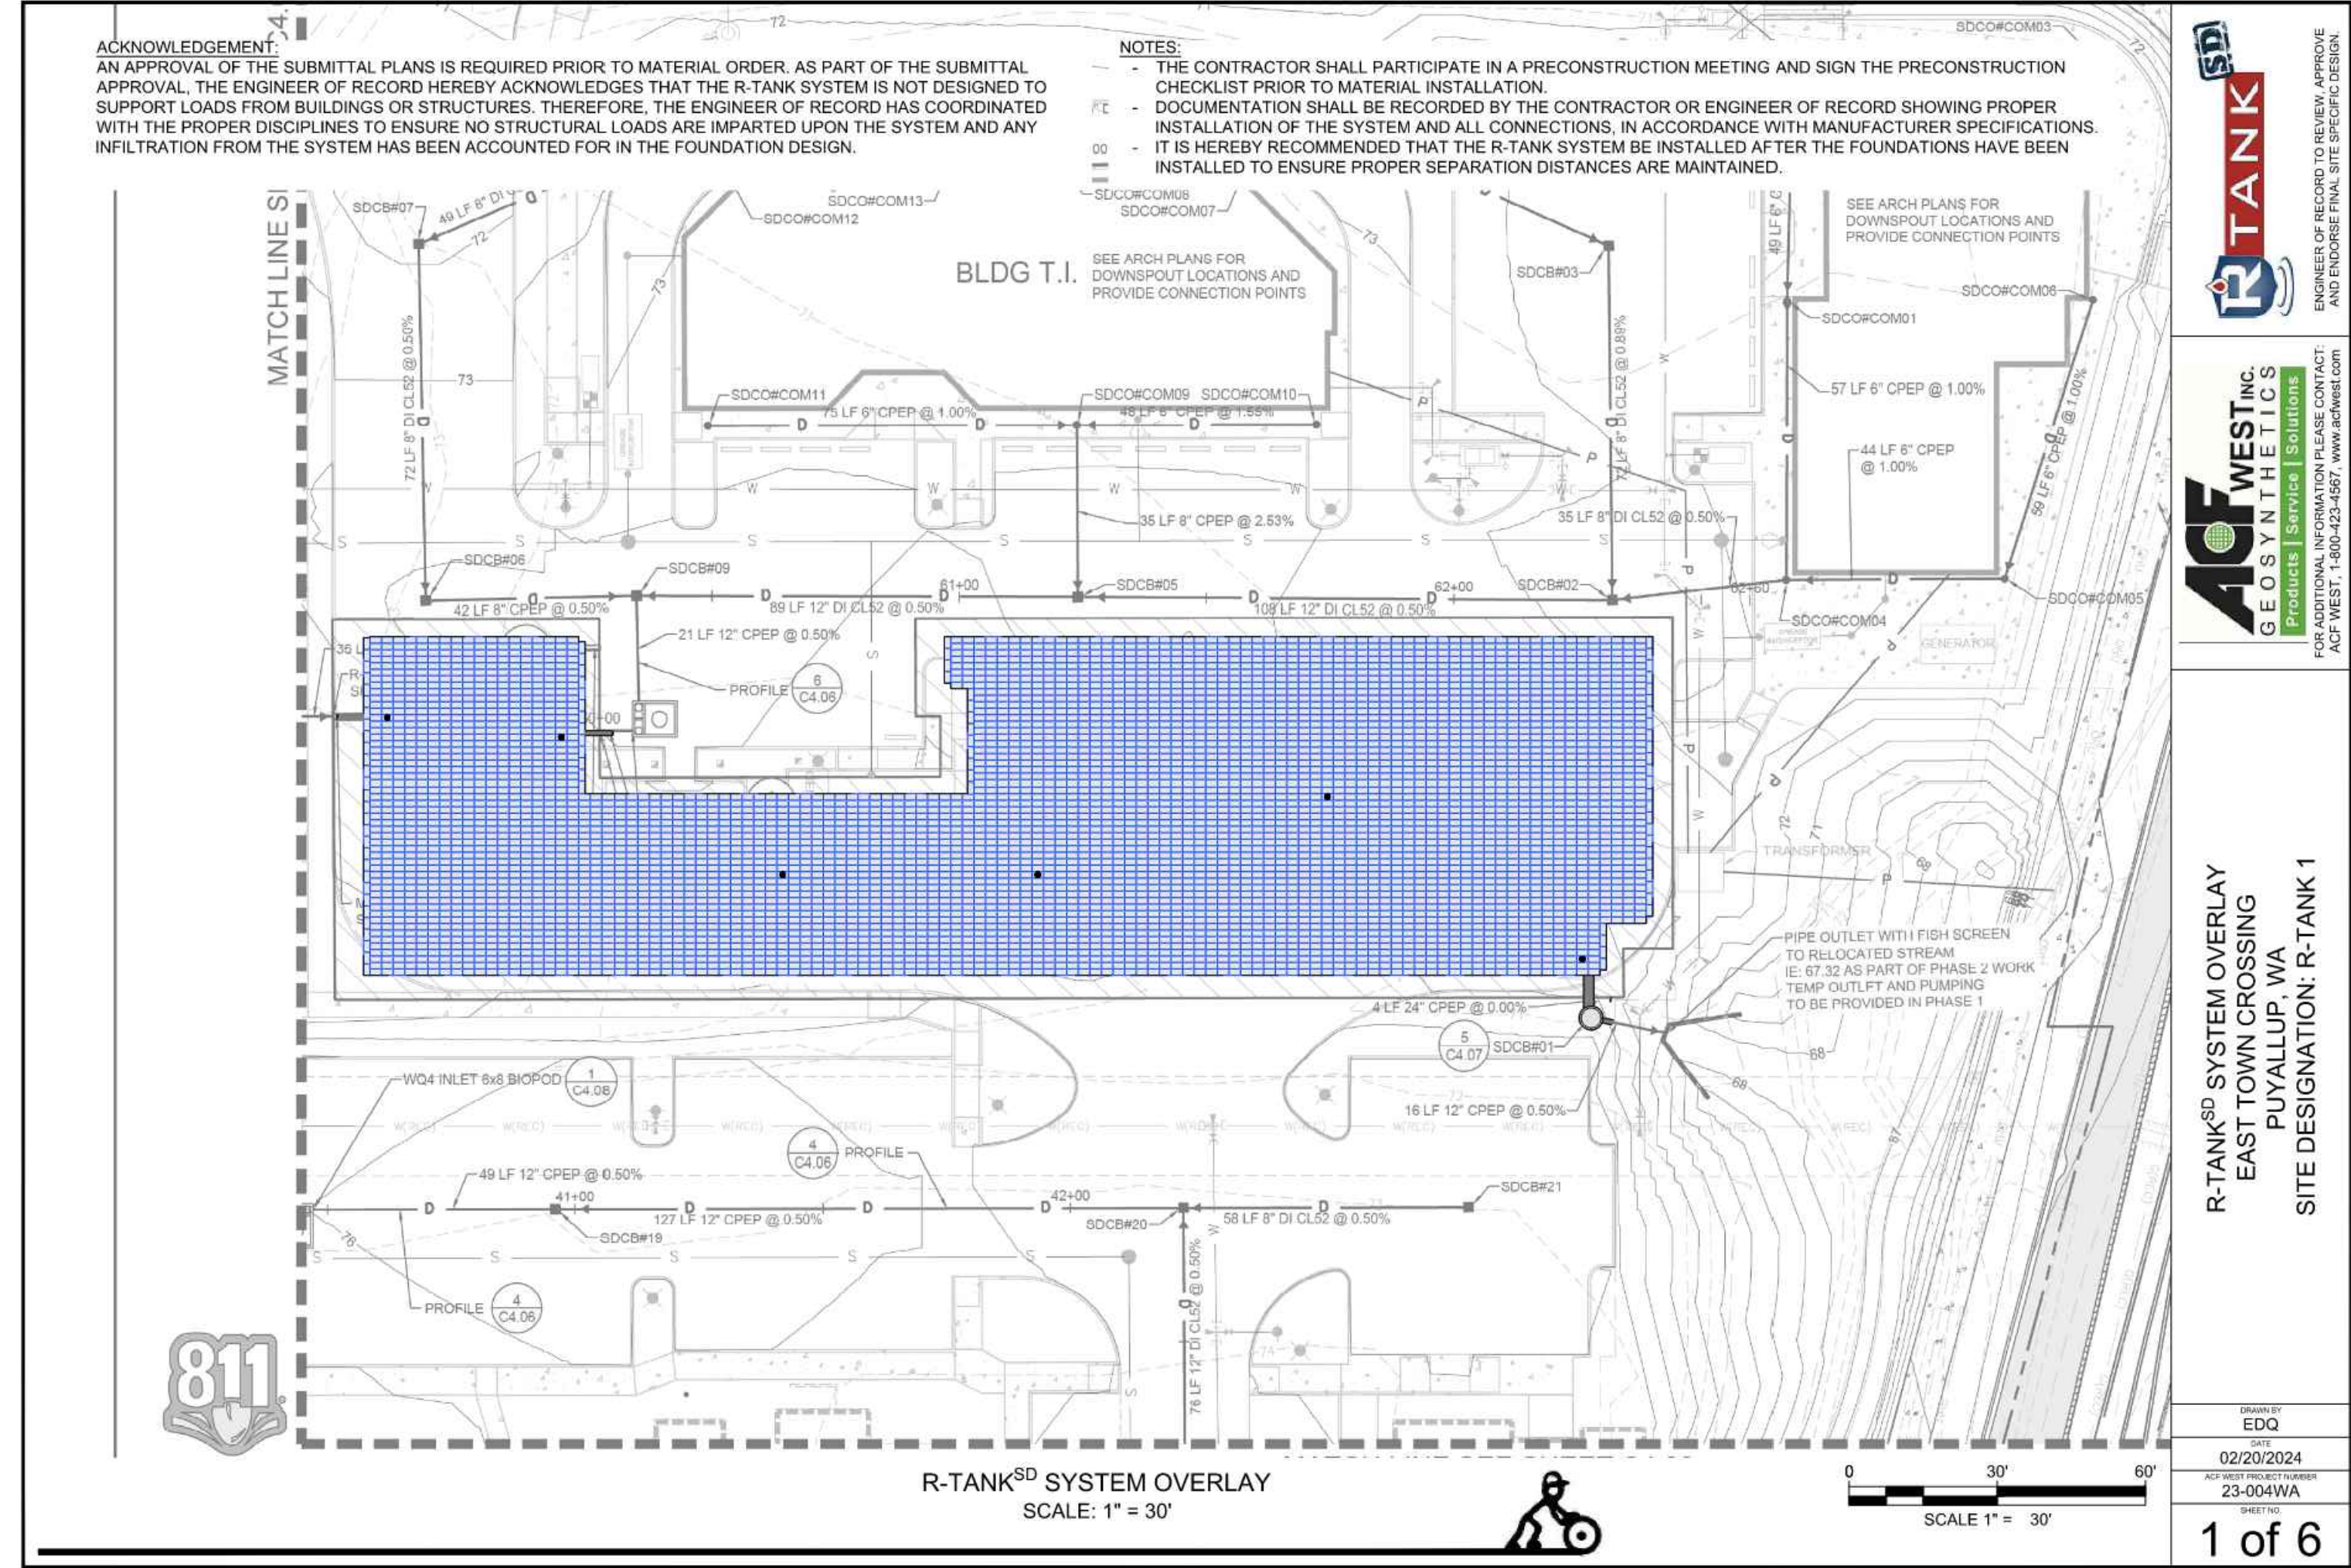

811
Know what's below.
Call before you dig.

EAST TOWN CROSSING PHASE 1


SEC. 26,35/ TWP. 20 N./ RGE. 4 E., W.M.

APPROVED

BY CITY OF PUYALLUP
DEVELOPMENT ENGINEERING

DATE

NOTE: THIS APPROVAL IS VOID AFTER 180 DAYS FROM APPROVAL DATE. THE CITY WILL NOT BE RESPONSIBLE FOR ERRORS AND/OR OMISSIONS ON THESE PLANS. FIELD CONDITIONS MAY DICTATE CHANGES TO THESE PLANS AS DETERMINED BY THE DEVELOPMENT ENGINEERING MANAGER.

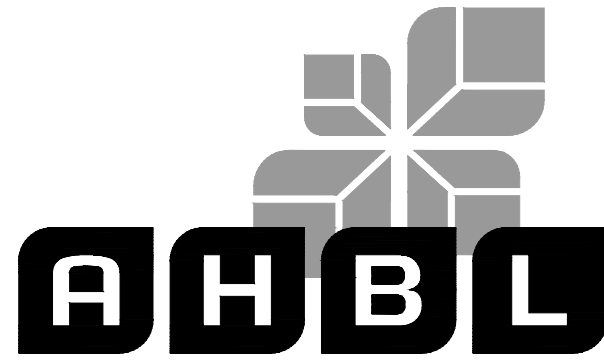

TACOMA · SEATTLE · SPOKANE · TRI-CITIES

2215 North 30th Street, Suite 300, Tacoma, WA 98403
253.383.2422 TEL 253.383.2572 FAX www.ahbl.com WEB

Project Title:

EAST TOWN CROSSING PHASE 1

Client:

ASH DEVELOPMENT

GREG HELLE

GREG.HELLE@ASHNW.COM


Project No.

2230752

Issue Set & Date:

PERMIT SUBMITTAL

02/20/2024

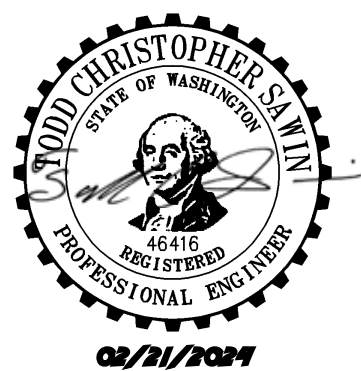

NOTICE: ALTERATION OF THIS DOCUMENT SHALL INDICATE THE PROFESSIONAL SEAL AND SIGNATURE PUBLICATION OF THE DOCUMENT DOES NOT GUARANTEE FROM FUTURE CHANGES TO THE DESIGN OR FROM THE DESIGNER'S LIABILITY FOR THE PROJECT. REVISED IN THE TITLE BLOCK AND NOT BE USED FOR THE DESIGN OR CONSTRUCTION OF THAT PROJECT OR FOR ANY OTHER PROJECT.

A

A

A

A 01/29/24 CITY COMMENTS

Revisions:

Sheet Title:


R-TANK 1 NOTES AND DETAILS

Designed by: CW Drawn by: SK/RS Checked by: JI

Sheet No.

C4.11

25 of 53 Sheets

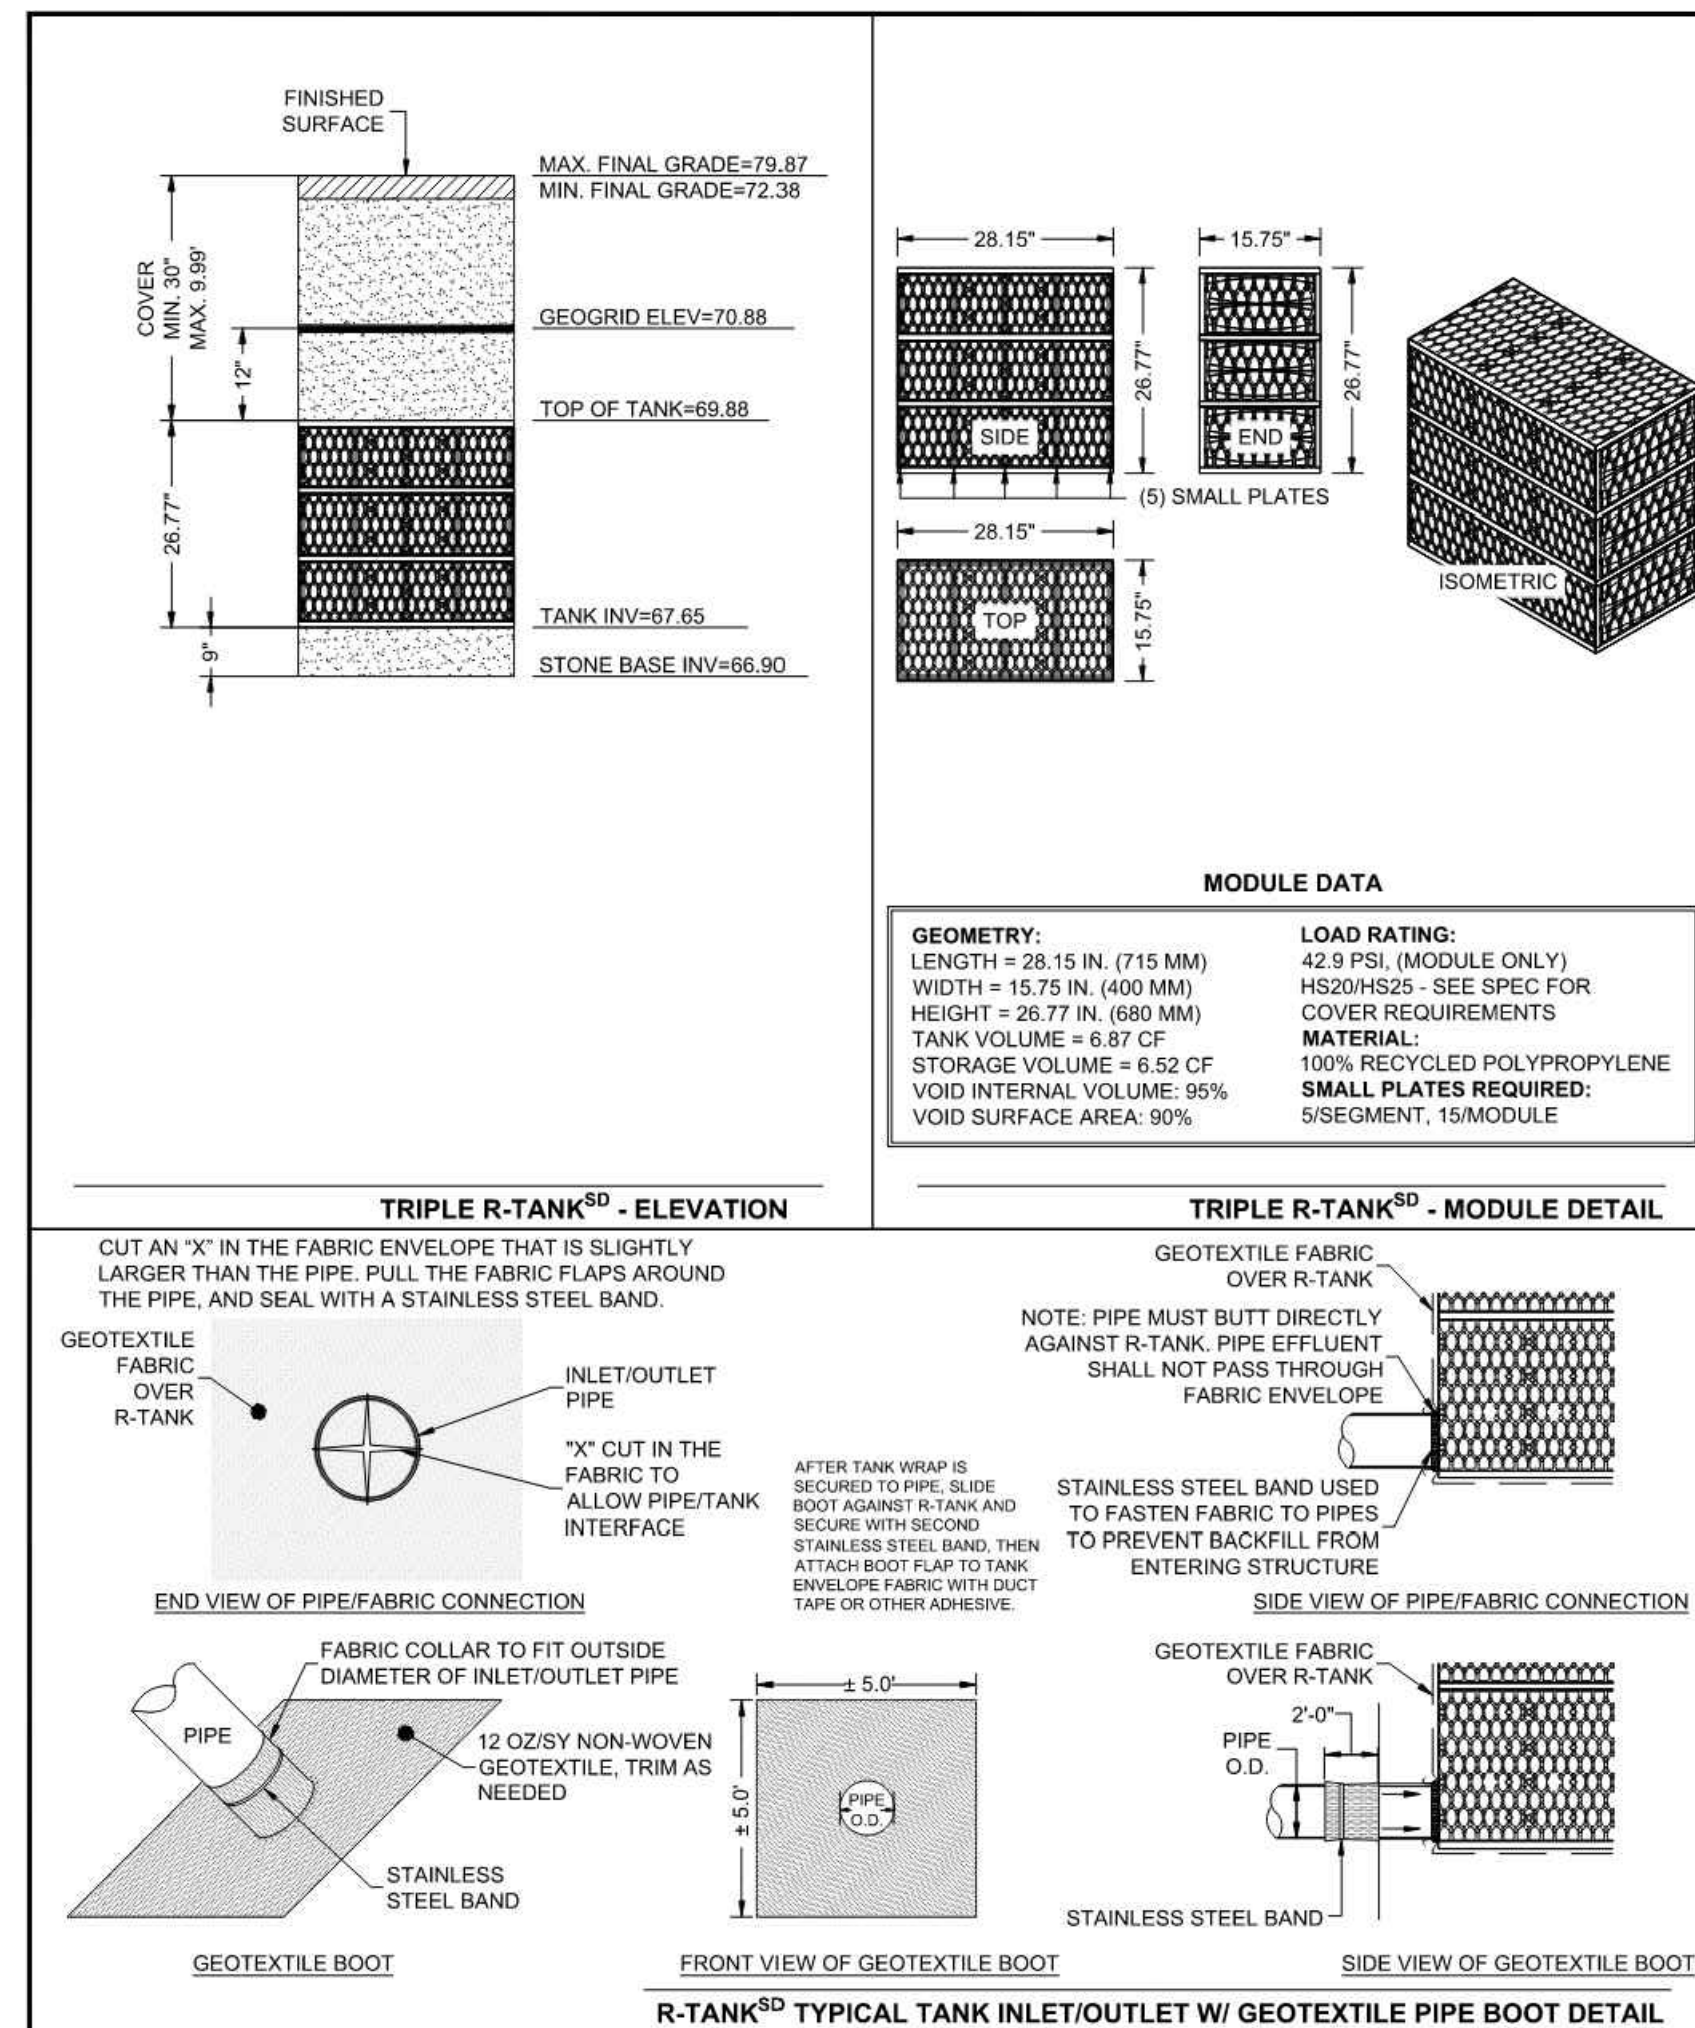





R-TANK ^{SD} QUANTITIES	
R-TANK ^{SD} MODULE TYPE	TRIPLE
# OF SD TRIPLE R-TANKS	4,972
TOTAL SYSTEM STORAGE	31919
R-TANK STORAGE VOLUME	30241
STONE STORAGE VOLUME (40% VOID RATIO)	1678
STONE BED FOOTPRINT	1,209 CY
TENCATE MIRAFI 160N NON-WOVEN TANK WRAP	37,082 SF (4,120 SY)
30 MIL. GEOMEMBRANE LINER EXCAVATION WRAP	22,713 SF (2,524 SY)
TENCATE MIRAFI 1100N NON-WOVEN LINER PROTECTION	45,427 SF (5,047 SY)
NAUE SECUGRID 30/30 GEOGRID	20,162 SF (2,240 SY)
12" MAINTENANCE PORTS	6
12" PIPE BOOTS	2
24" PIPE BOOTS	1
TRASHGUARD PLUS UNITS (RECOMMENDED)	2

- NOTE: 30 MIL. GEOMEMBRANE LINER SHALL BE ULTRAVIOLET (UV) LIGHT RESISTANT.
- NOTES:
- DEAD STORAGE VOLUME FROM ELEVATION 66.90 TO 67.40 = 3,356 CF
 - LIVE STORAGE VOLUME FROM ELEVATION 67.40 TO 69.40 = 31,919 CF
 - ONLY 3" OF BASE STONE INCLUDED IN LIVE STORAGE VOLUME.

ACF WEST INC.
GEOSYNTHETICS
PRODUCTS | INSTALLATION | SOLUTIONS
FOR ADDITIONAL INFORMATION PLEASE CONTACT:
ACF WEST, 1-800-823-4567, www.acfwest.com

R-TANK^{SD} SYSTEM DETAILS
EAST TOWN CROSSING
PUYALLUP, WA
SITE DESIGNATION: R-TANK 1

EDG
02/20/2024
23-004WA
3 of 6

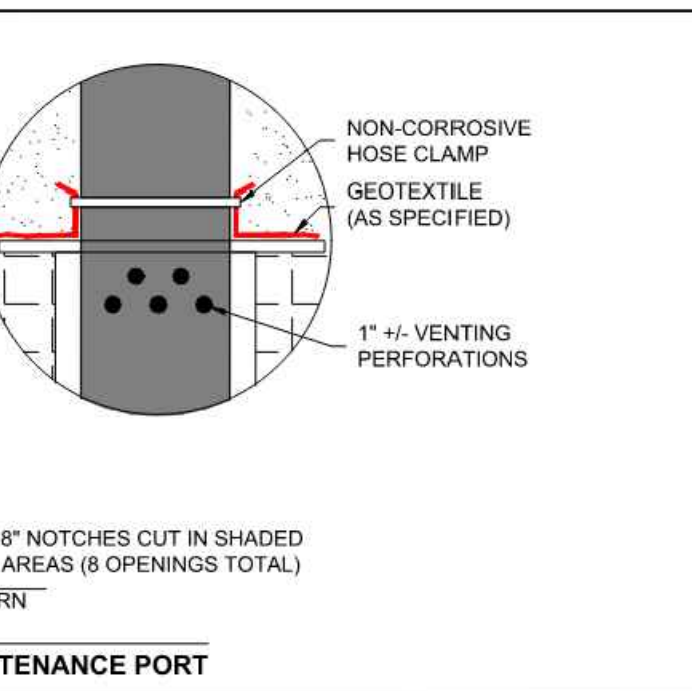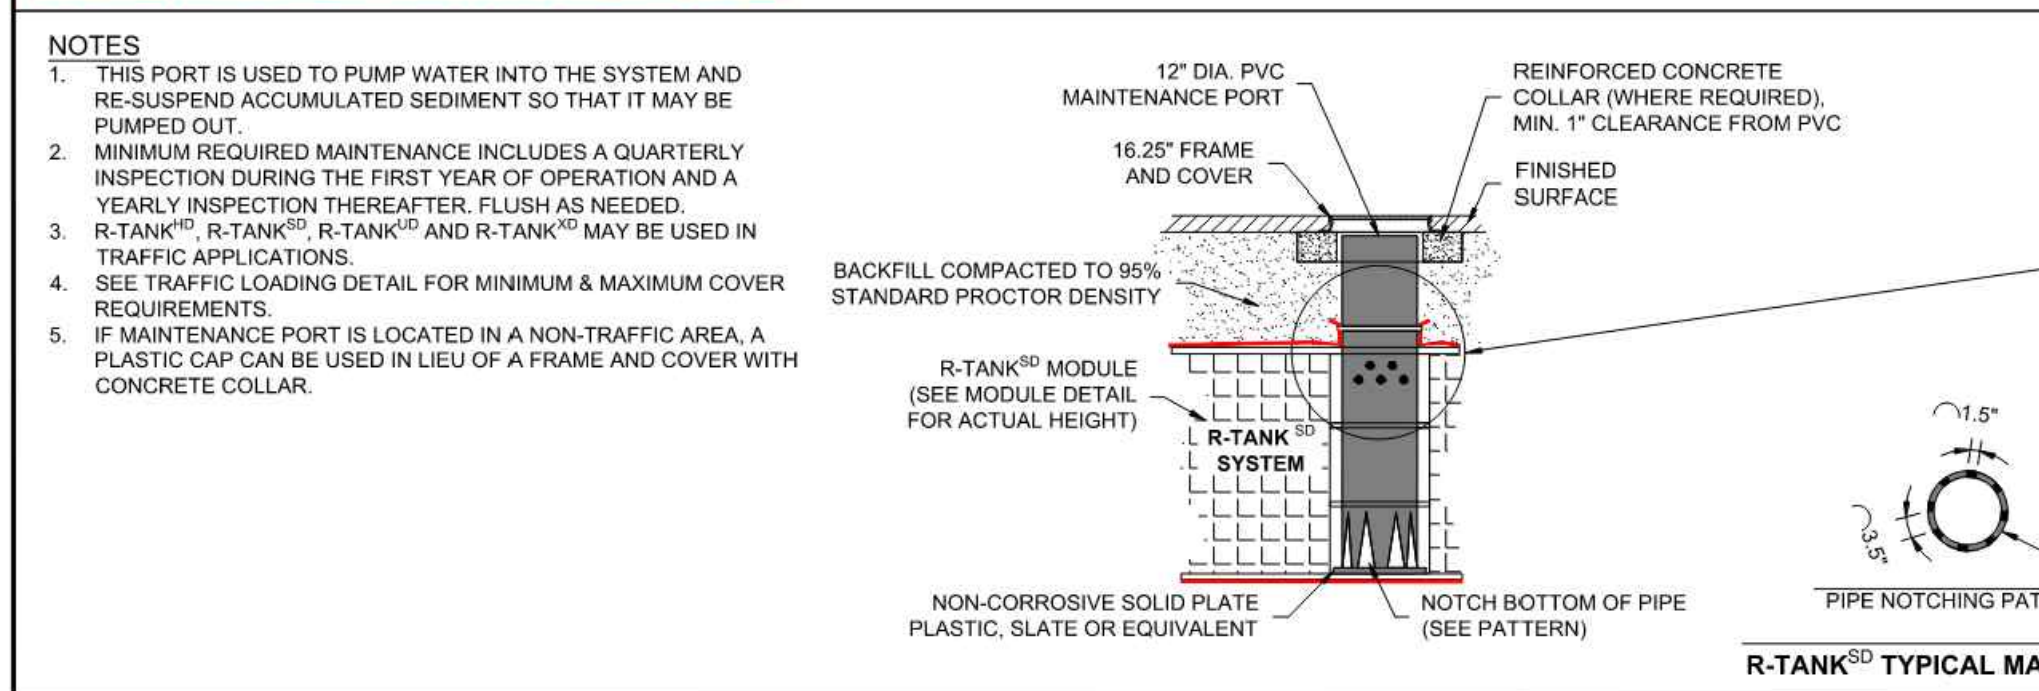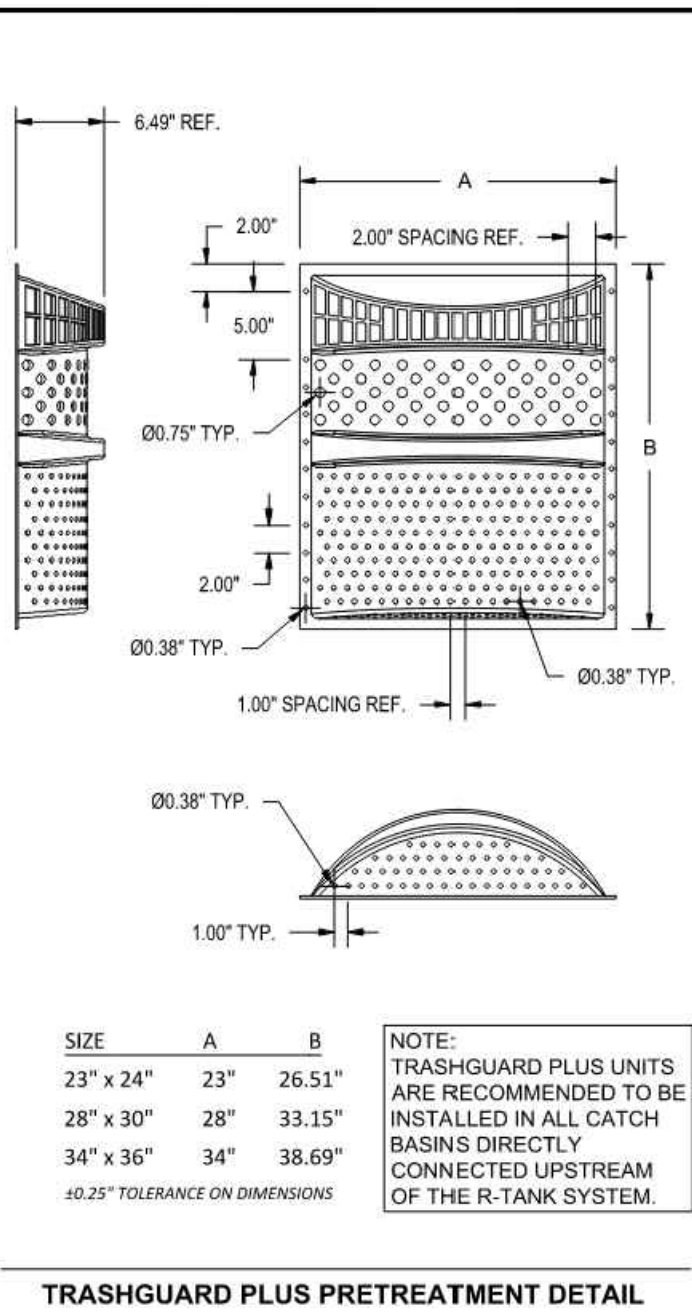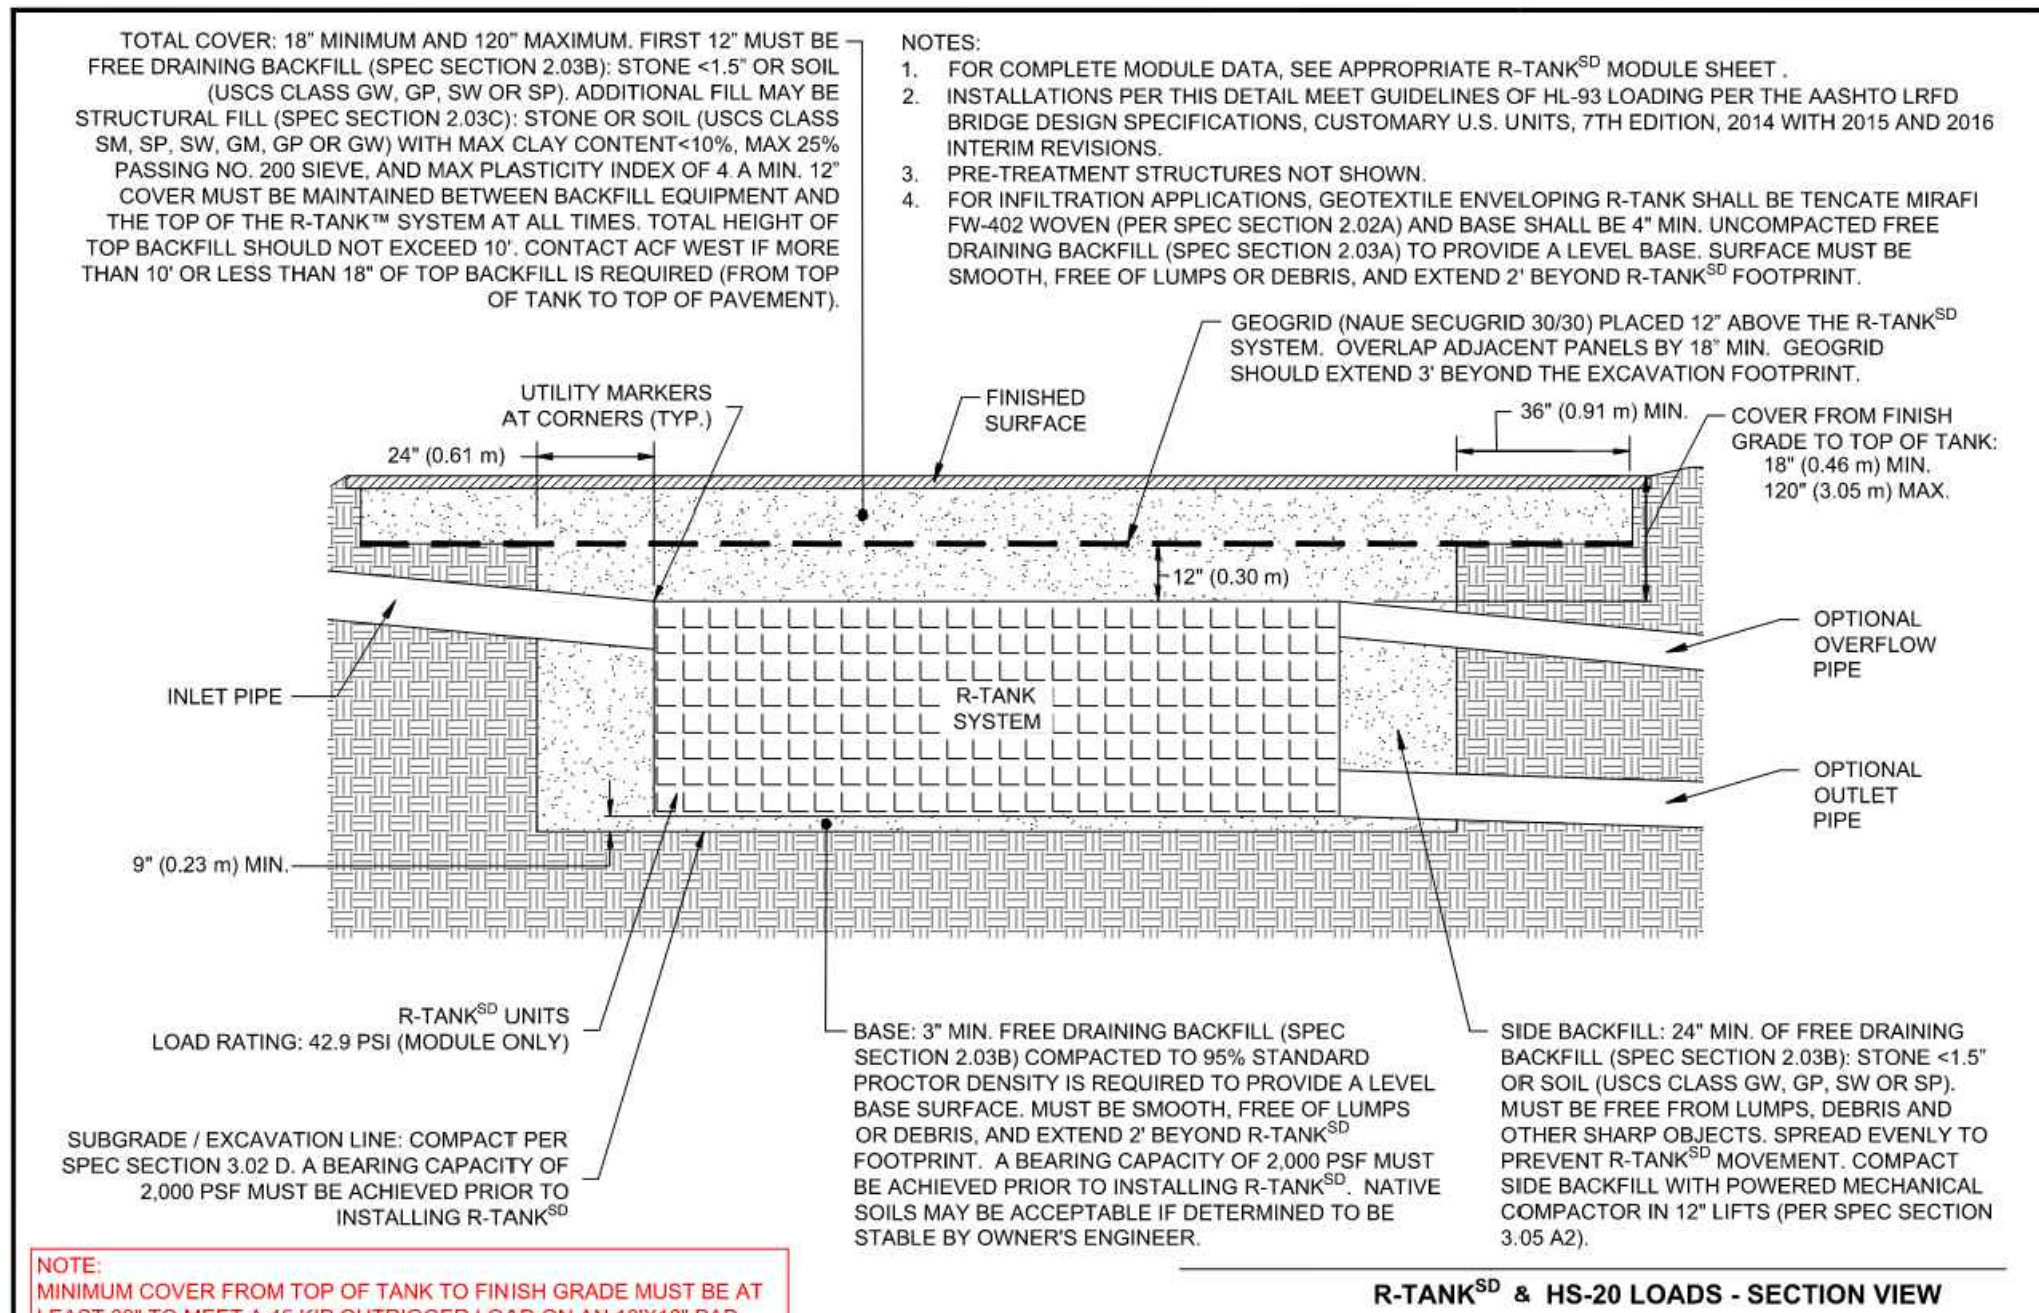

Know what's below.
Call before you dig.

ACF WEST INC.
GEOSYNTHETICS
PRODUCTS | INSTALLATION | SOLUTIONS
FOR ADDITIONAL INFORMATION PLEASE CONTACT:
ACF WEST, 1-800-823-4567, www.acfwest.com

R-TANK^{SD} SYSTEM DETAILS
EAST TOWN CROSSING
PUYALLUP, WA
SITE DESIGNATION: R-TANK 1

EDG
02/20/2024
23-004WA
4 of 6

EAST TOWN CROSSING PHASE 1

SEC. 26,35/ TWP. 20 N./ RGE. 4 E., W.M.

APPROVED

BY: CITY OF PUYALLUP
DEVELOPMENT ENGINEERING

DATE:

NOTE: THIS APPROVAL IS VOID AFTER 180 DAYS FROM APPROVAL DATE. THE CITY WILL NOT BE RESPONSIBLE FOR ERRORS AND/OR OMISSIONS ON THESE PLANS. FIELD CONDITIONS MAY DICTATE CHANGES TO THESE PLANS AS DETERMINED BY THE DEVELOPMENT ENGINEERING MANAGER.




Project Title:
EAST TOWN CROSSING PHASE 1

Client:
ASH DEVELOPMENT


GREG HELLE
GREG.HELLE@ASHNW.COM

Project No.
2230752

Issue Set & Date:
PERMIT SUBMITTAL
02/20/2024

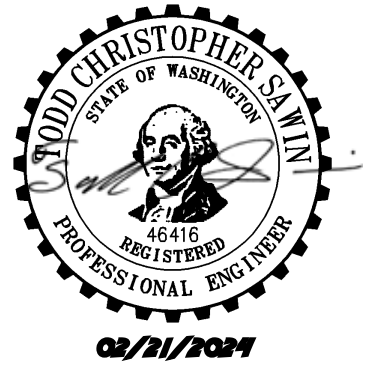

NOTICE: ALTERATION OF THIS DOCUMENT SHALL INVALIDATE THE PROFESSIONAL SEAL AND SIGNATURE. PUBLICATION OF THIS DOCUMENT DOES NOT CONSTITUTE A GUARANTEE OR WARRANTY. THE ENGINEER SHALL BE RESPONSIBLE FOR THE DESIGN OF THE PROJECT EXCEPT IN THE TITLE BLOCK WHERE HE OR SHE HAS MADE A SIGNATURE OR ADDITION TO THIS PROJECT OR FOR ANY OTHER PROJECT.

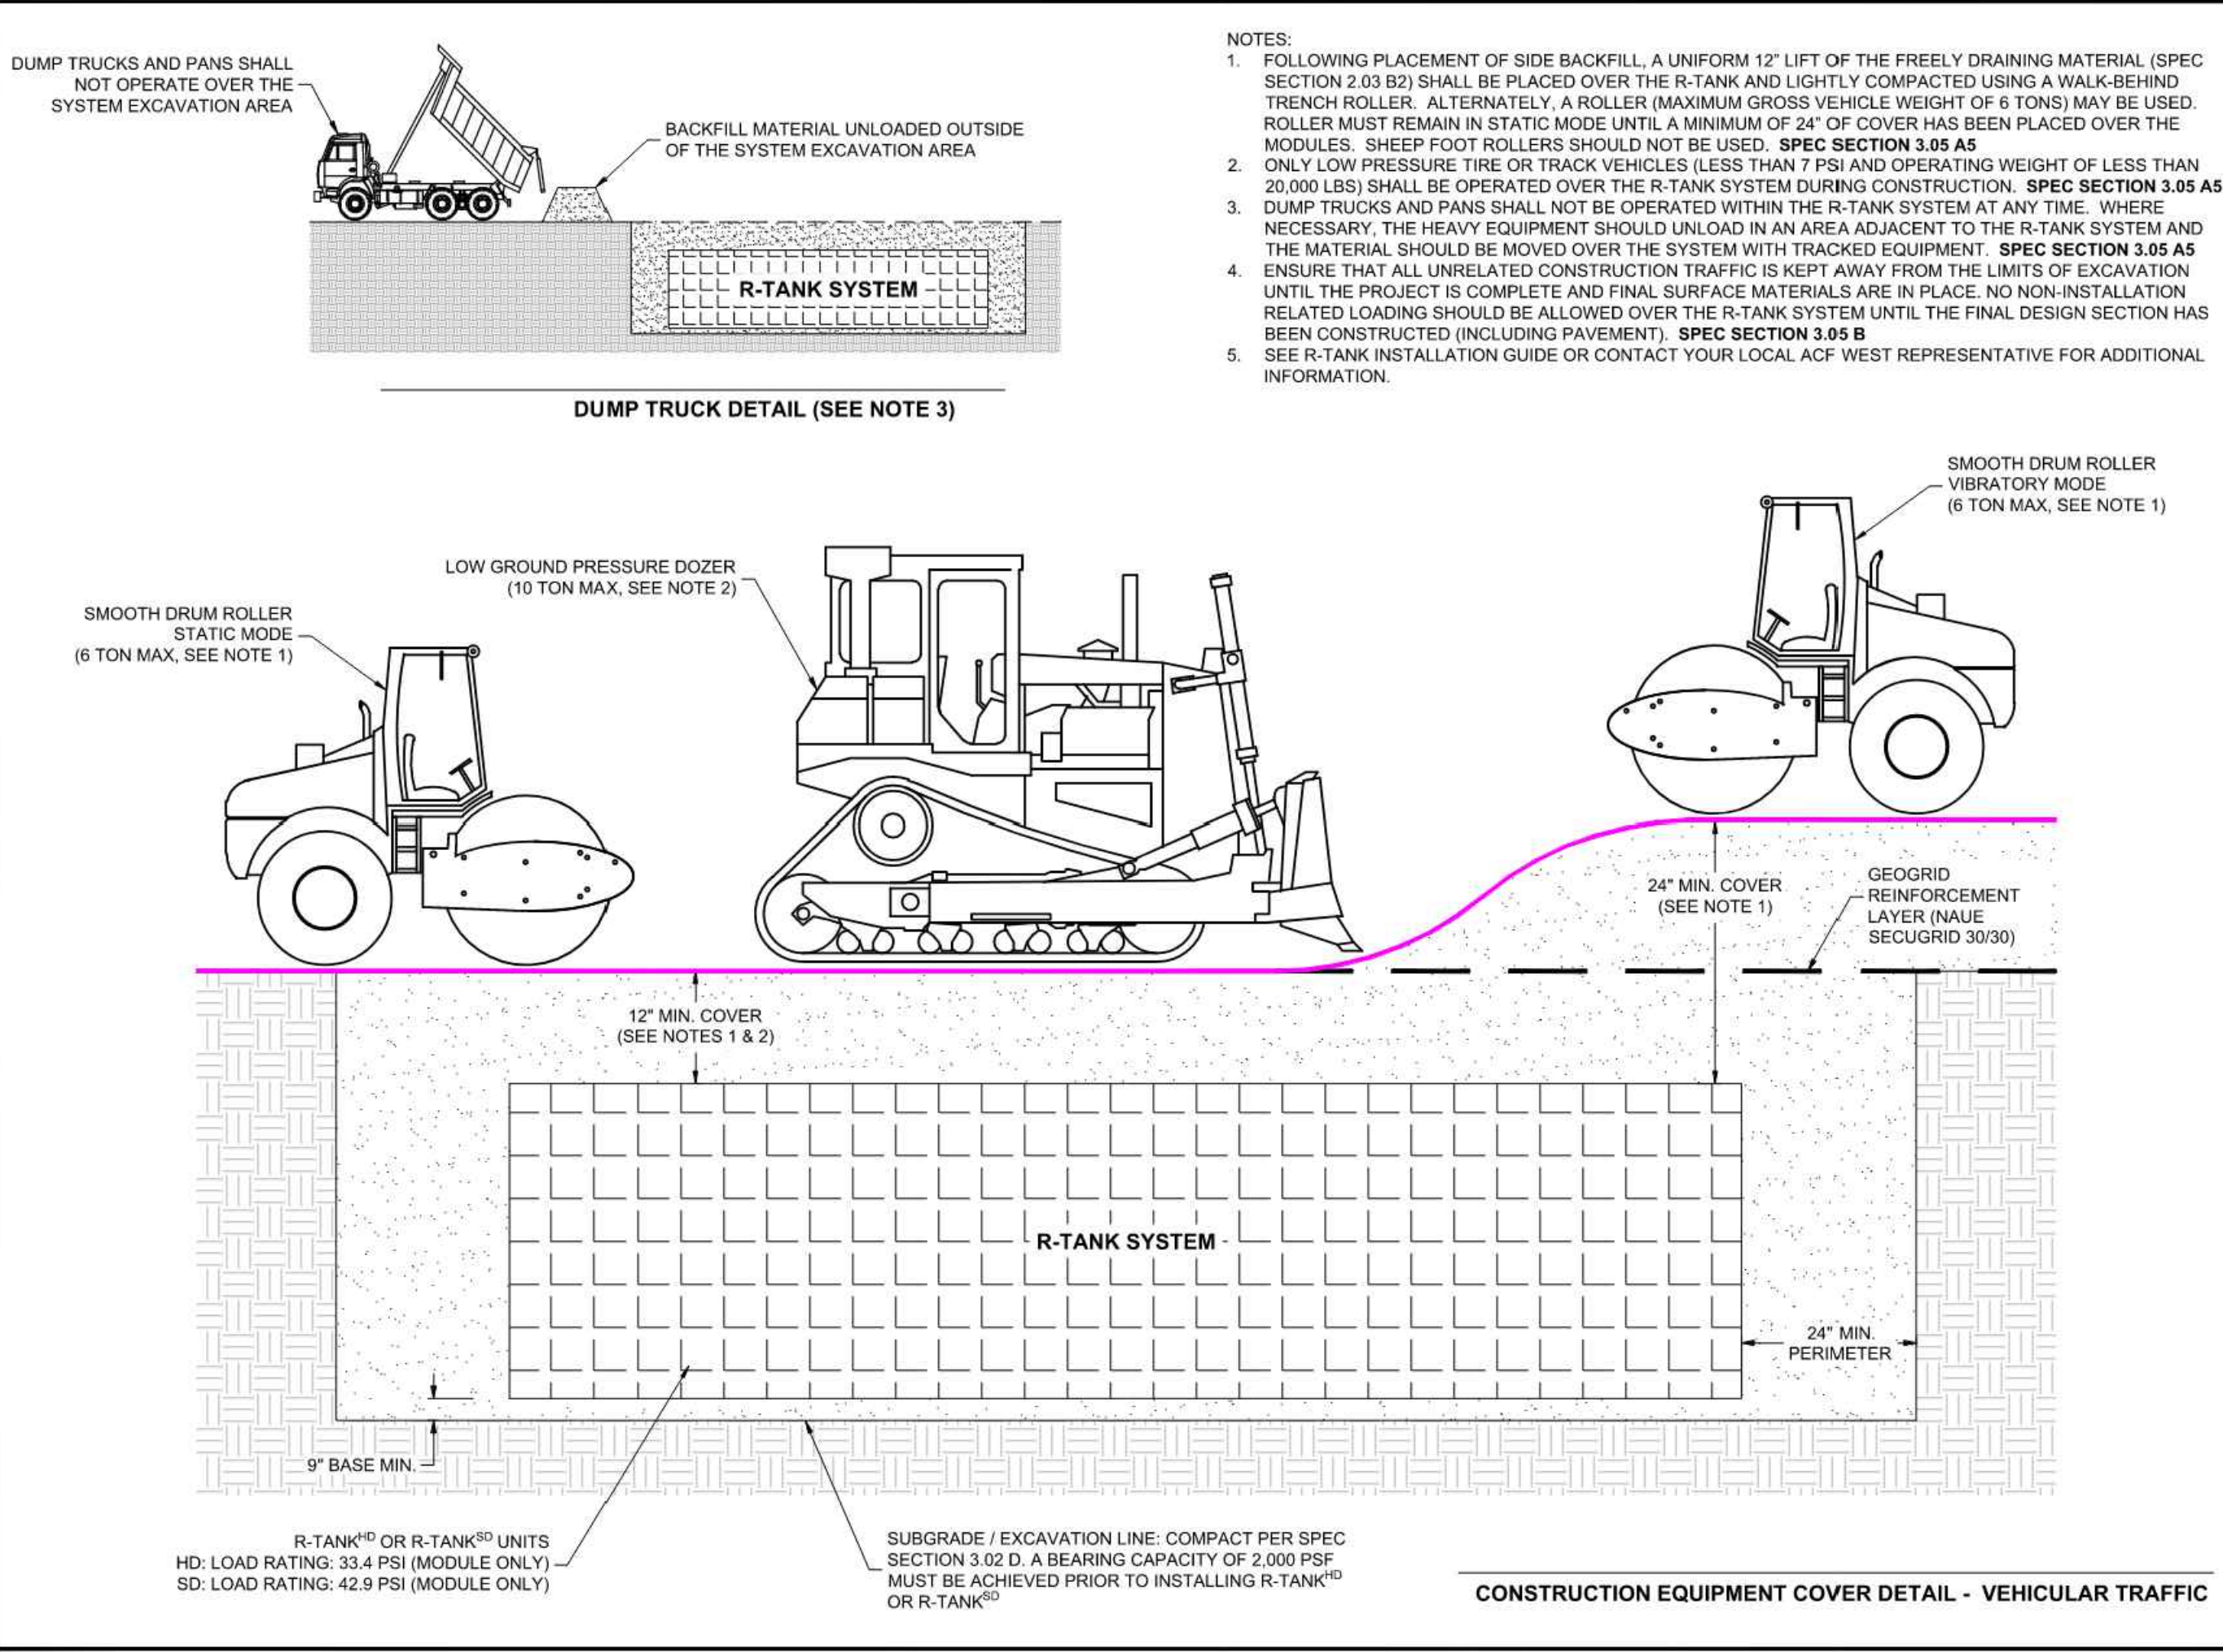

ACF WEST INC.
GEOTECHNICAL SOLUTIONS
FOR ADDITIONAL INFORMATION PLEASE CONTACT:
ACF WEST, 1400-425-4507, www.acfwest.com

R-TANK
ENGINEER OF RECORD TO REVIEW, APPROVE AND ENDORSE FINAL SITE SPECIFIC DESIGN

R-TANK^{SD} CONSTRUCTION EQUIPMENT COVER DETAIL
EAST TOWN CROSSING
PUYALLUP, WA
SITE DESIGNATION: R-TANK 1

EDD
02/20/2024
23-0044VA
5 of 6

R-TANK SPECIFICATION

PART 1 - GENERAL

1.01 RELATED DOCUMENTS

A. Drawings, technical specification and general provisions of the Contract as modified herein apply to this section.

1.02 DESCRIPTION OF WORK INCLUDED

A. Provide excavation and base preparation per geotechnical engineer's recommendations and/or as shown on the design drawings, to provide adequate support for project design loads and safety from excavation related collapse. Excavations shall be in accordance with the owner's and OSHA requirements.

B. Provide and install R-Tank^{SD}, R-Tank^{SD}, R-Tank^{SD}, or R-Tank^{SD} system (hereafter called R-Tank) and all related products including fill materials, geotextiles, geogrids, inlets and outlet pipes with connections per the manufacturer's installation guidelines provided in this section.

C. Provide and construct the cover of the R-Tank system including: stone backfill, structural fill cover, and pavement section as specified.

D. Protect R-Tank system from construction traffic after installation until completion of all construction activity in the installation area.

1.03 QUALITY CONTROL

A. All materials shall be manufactured in ISO certified facilities.

B. Installation Contractor shall demonstrate the following experience:

1. A minimum of three R-Tank or equivalent projects completed within 2 years; and
2. A minimum of 25,000 cubic feet of storage volume completed within 2 years;
3. Contractor experience requirement may be waived if the manufacturer's representative provides on-site training and review during construction.

C. Installation Personnel: Performed only by skilled workers with satisfactory record of performance on bulk earthworks, pipe, chamber, or postdrift construction projects of comparable size and quality.

D. Contractor must have manufacturer's representative available for site review if requested by Owner.

1.04 SUBMITTALS

A. Submit proposed R-Tank layout drawings. Drawings shall include typical section details as well as the required base elevation of stone and tanks, minimum cover requirements and tank configuration.

B. Submit manufacturer's product data, including compressive strength and unit weight.

C. Submit manufacturer's installation instructions.

D. Submit R-Tank samples for review. Retained and accepted samples will be returned to the Contractor.

E. Submit material certificates for geotextile, geogrid, base course and backfill materials.

F. Submit required experience and personnel requirements as specified in Section 1.03.

G. Any proposed equal alternative product substitution to this specification must be submitted for review and approved prior to bid opening. Review package should include third party reviewed performance data that meets or exceeds criteria in Table 2.01 B.

1.05 DELIVERY, STORAGE, AND HANDLING

A. Protect R-Tank and other materials from damage during delivery, and store UV sensitive materials under tarp to protect from sunlight when time from delivery to installation exceeds two weeks. Storage of materials should be on smooth surfaces, free from dirt, mud and debris.

B. Handling is to be performed with equipment appropriate to the materials and site conditions, and may include hand, handcart, forklifts, extension lifts, etc.

C. Cold weather:

1. Cans must be taken when handling plastics when air temperature is 40 degrees or below as plastic becomes brittle.
2. Do not use frozen materials or materials moist or coated with ice or frost.
3. Do not build up frozen ground, or vent, or installation of muddy subgrade.

1.06 PREINSTALLATION CONFERENCE

A. Prior to the start of the installation, a preinstallation conference shall occur with the representatives from the design team, the general contractor, the excavation contractor, the R-Tank installation contractor, and the manufacturer's representative.

1.07 PROJECT CONDITIONS

A. Coordinate installation for the R-Tank system with other on-site activities to eliminate all non-installation related construction traffic over the completed R-Tank system. No loads heavier than the design loads shall be allowed over the system, and in no case shall loads higher than a standard ASHRAE H320 or H525, depending on design criteria) load be imposed on the system at any time.

B. Protect adjacent work from damage during R-Tank system installation.

C. All pre-treatment systems to remove debris and heavy sediments must be in place and functional prior to operation of the R-Tank system. Additional pretreatment measures may be needed if unit is operational during construction due to increased sediment loads.

D. Contractor is responsible for any damage to the system during construction.

PART 2 - PRODUCTS

2.01 R-TANK UNITS

A. R-Tank - injection molded plastic tank assembly to form a 95% void modular structure of pre-designed height (custom for each project).

B. R-Tank units shall meet the following Physical & Chemical Characteristics:


C. Supplier: ACF WEST 15540 Woodville-Redmond Rd., Woodville, Washington 98072, (425) 415-6115, www.acfwest.com

2.02 GEOSYNTHETICS

A. Geotextile: A geotextile envelope is required to prevent backfill material from entering the R-Tank modules.

B. Standard Applications: 1.02 oz per square yard nonwoven geotextile (TerCair M800 or equivalent).

C. Infiltration Applications: When water must infiltrate/effluent through the geotextile as a function of the system design, a woven monofilament (TerCair M800 or equivalent) shall be used.

D. Geogrid: For installations subject to traffic loads and/or when required by project plans, install geogrid (Naue Secugrid 30/30 or equivalent) to reinforce backfill above the R-Tank system. Geogrid is not always required by R-Tank^{SD} installations, but is often required for non-traffic load applications.

E. MANUFACTURED TO MEET ANY IMPERMEABLE LINER TO PREVENT GROUNDWATER INTRUSION.

2.03 BACKFILL & COVER MATERIALS

A. Backfill Materials: Stone (angular and smaller than 1.5" in diameter) or soil (GW, GP, SW, or SP as classified by the Unified Soil Classification System) shall be used below the R-Tank system (12" minimum). Material must be free from lumps, debris, and any sharp objects that could cut the geotextile. Material shall be within 3 percent of the optimum moisture content as determined by ASTM D698 at the time of installation. For infiltration applications bedding material shall be free draining.

B. Side and Top Backfill: Material must be free from lumps, debris and any sharp objects that could cut the geotextile. Material shall be within 3 percent of the optimum moisture content as determined by ASTM D698 at the time of installation.

C. Traffic Applications: Free draining material shall be used adjacent to (24" minimum) and above (for the first 12" the R-Tank system).

D. For HD, and SD modules, bedding materials shall be free draining stone (angular and smaller than 1.5" in diameter) or soil (GW, GP, SW, or SP as classified by the Unified Soil Classification System).

E. For LD modules, bedding materials shall be free draining stone (angular and smaller than 1.5" in diameter). The use of soil backfill on the sides and top of the LD module is not permitted unless the modules are installed outside of traffic areas or with cover depths of 14" or more. Top backfill material (from top of module to bottom of pavement base or 12" maximum) must be consistent with side backfill.

F. Non-Traffic / Green Space Applications: For all R-Tank modules installed in green spaces and not subjected to vehicular loads, backfill materials may either follow the guidelines for Traffic Applications above, or the top backfill layer (12" minimum) may consist of AS-4070 #57 stone blended with 30-40% (by volume) based on soil and in stabilizing vegetation.

G. Additional Cover Materials: Structural fill shall consist of granular materials meeting the geotechnical requirements of SM, SP, SW, GM, GP or GW as classified by the Unified Soil Classification System. Structural fill shall have a maximum of 25 percent passing the No. 200 sieve, shall have a maximum dry content of 10 percent and a maximum Plasticity Index of 4. Material shall be within 3 percent of the optimum moisture content as determined by ASTM D698 at the time of installation.

2.04 OTHER MATERIALS

A. Utility Marker: Install metallic tape at corners of R-Tank system to mark the area for future utility detection.

3.01 ASSEMBLY OF R-TANK UNITS

A. Assembly of modules shall be performed in accordance with the R-Tank Installation Manual, Section 2.

3.02 LAYOUT AND EXCAVATION

A. Installation shall start and excavate, and prepare the subgrade area to the required plan grades and dimensions, ensuring that the excavation is at least 2 feet greater than R-Tank dimensions in each direction allowing for installation of geotextile filter fabric, R-Tank modules, and free draining backfill materials.

B. All excavations must be prepared with OSHA approved excavated sides and sufficient working space.

C. Protect partially completed installation against damage from other construction traffic by establishing a perimeter with high visibility construction tape, fencing, barricades, or other means until construction is complete.

D. Base of the excavation shall be uniform, level, and free of lumps or debris and soft or yielding subgrade areas. A minimum 2,000 pounds per square foot bearing capacity is required.

E. Infiltration Applications: Subgrade shall be prepared in accordance with the contract documents. Compaction of subgrade should not be performed in infiltration applications.

F. Unstable Soils or Conditions: All conditions about the base of the excavation shall be directed to the owner's engineer, who will approve the subgrade conditions prior to placement of stone. The owner's engineer shall determine the required bearing capacity of the R-Tank subgrade; however in no case shall a bearing capacity of less than 2,000 pounds per square foot be provided.

G. If unstable soils are encountered at the subgrade, or if the subgrade is pumping or appears excessively soft, repair the area in accordance with contract documents and/or as directed by the owner's engineer.

H. If indications of the water table are observed during excavation, the engineer shall be contacted to provide recommendations.

I. Do not start installation of the R-Tank system until satisfactory subgrade conditions are corrected and the subgrade conditions are accepted by the owner's engineer.

3.03 PREPARATION OF BASE

A. Place a thin layer (1" unless otherwise specified) of bedding material (Section 2.03 A), over the subgrade to establish a level working platform for the R-Tank modules. Level to within 1/8" (+/- 1/8") or as shown on the plans. Native subgrade soils or other materials may be used if determined to meet the requirements of 2.03 A and are accepted by the owner's engineer.

B. Standard Applications: Static roll or otherwise compact bedding materials until they are firm and unyielding.

C. Infiltration Applications: Bedding materials shall be prepared in accordance with the contract documents.

D. Outline the footprint of the R-Tank system on the excavation floor using spray paint or chalk line to ensure a 2" perimeter is available around the R-Tank system for proper installation and compaction of backfill.

3.04 INSTALLATION OF THE R-TANKS

A. Where a geotextile wrap is specified on the stone base, cut strips to length and install in excavation, removing wrinkles so material lays flat. Overlap geotextile a minimum 12" or as recommended by manufacturer. Use tape, special adhesives, sandbags or other ballast to secure overlaps. As geotextiles can be damaged by extreme heat, smoking is not permissible within the site of the work, and any other operations of the geotextile and optional liner. 

B. Install R-Tank modules by placing side by side, in accordance with the design drawings. No lateral connections are required. It is advisable to use a string line to form square corners and straight edges along the length of the R-Tank system. The modules are to be oriented as per the design drawing with required depth as shown on plans.

C. For LD, HD, and SD installations, the large side plate of the tank should be placed on the perimeter of the system. This will typically require that the two ends of the tank area will have a row of tanks placed perpendicular to all other tanks. If this is not shown in the construction drawings, it is a simple field adjustment that will have minimal effect on the overall system footprint. Refer to R-Tank Installation Guide for more details.

D. For UD installations, there is no perpendicular and no required.

E. Prep the R-Tank top and sides in specified geotextile. Cut strips of geotextile so that it will cover the sides and top, encapsulating the entire system to prevent backfill entry into the system. Overlap geotextile 12" or as recommended by manufacturer. Take great care to avoid damage to geotextile (and, if specified, impervious liner) during placement.

F. Identify locations of inlet, outlet and any other operations of the geotextile and optional liner. These connections should be installed flush (flush to the R-Tank) and the geotextile fabric shall be cut to enable hydraulic continuity between the connections and the R-Tank units. These connections shall be secured using pipe boots with stainless steel clip clamps. Support pipe through the geotextile and bedding materials to prevent pipe from settling and causing the geotextile, impervious liner if specified, or pipe. Connect pipes at 90 degree angles, facilitate installation, unless otherwise specified. Ensure end of pipe is installed snug against R-Tank system.

G. Install Inlet and Maintenance Ports in locations noted on plans. At a minimum one maintenance port shall be installed within 12" of each inlet & outlet connection, and with a maximum spacing of one maintenance port for every 2,500 square feet. Install all ports as noted in the R-Tank Installation Guide.

H. If required, install venting pipes and vents as specified on drawings to provide ventilation for proper hydraulic performance. The number of pipes and vents will depend on the size of the system. Vents are often installed using a 90 degree elbow with PVC pipe into a landscaped area with 'U' bend or venting bollard to inhibit the ingress of debris. A ground level concrete or steel cover can be used.

3.05 BACKFILLING OF THE R-TANK SYSTEMS

A. Place freely draining backfill materials (Section 2.03 B) around the perimeter in lifts with a maximum thickness of 12". Each lift shall be placed around the entire perimeter such that each lift is no more than 24" higher than the side backfill along any other location on the perimeter of the R-Tank system. No lift shall be placed over top of tanks until the side backfill has been completed.

B. Each lift shall be compacted at the specified moisture content to a minimum of 95% of the Standard Proctor Density until no further densification is observed (for self-compacting stone materials) the side lifts must be compacted with walk behind compaction equipment. Even when "self-compacting" backfill materials are selected, a walk behind vibratory compactor must be used.

C. Take care to ensure that the compaction process does not allow the machinery to come into contact with the modules for the potential for damage to the geotextile and R-Tank units.

D. No compaction equipment is permissible to operate directly on the R-Tank modules.

E. Top Backfill: Only low pressure track vehicles shall be operated over the R-Tank system during construction. Dump Trucks and Pans shall not be operated within the R-Tank system footprint at any time. Heavy equipment should unload in an area adjacent to the R-Tank system and the material should be moved over the system using tracked equipment with an operating weight of less than 10 tons.

F. Typical Applications: Install a 12" of free draining material (Section 2.03 B) over the R-Tank Units, maintaining 12" between equipment tracks and R-Tank System. Lightly compact using an walk-behind trench roller. Alternatively, a roller (maximum gross vehicle weight of 6 tons) may be used. Roller must remain in static mode with a minimum wheel 24" of cover has been placed over the modules. Sheep foot rollers should not be used.

G. Snow Applications: (4" lift total cover) install top backfill in accordance with plans.

H. Following placement and compaction of the initial cover, subsequent lifts of structural fill (Section 2.03 C) shall be placed at the specified moisture content and compacted to a minimum of 90% of the Standard Proctor Density and shall cover the entire footprint of the R-Tank system. During placement of fill above the system, unless otherwise specified, a uniform elevation of fill shall be maintained to within 12" across the footprint of the R-Tank system. Do not exceed maximum cover depths listed in Table 2.01 B.

I. Place additional layers of geotextile and/or geogrid as specified in the design details. Each layer of geosynthetic reinforcement placed above the R-Tank system shall extend a minimum of 3 feet beyond the limits of the excavation wall.

J. Ensure that all unrelated construction fill is kept away from the limits of excavation and the project construction area. If surface materials are in place, no non-installation related backfill should be allowed over the R-Tank system until the final design section has been constructed (including pavement). Final design section has been constructed (including pavement).

K. Place surfacing materials, such as groundcover (no large trees), or paving materials over the structure with care to avoid displacement of cover fill and damage to surrounding areas.

L. Backfill depth over R-Tank system shall be within the limitations shown in the table in Section 2.01 B. If the total backfill depth does not comply with this table, contact engineer or manufacturer's representative for assistance.

3.06 MAINTENANCE REQUIREMENTS

A. Routine maintenance effort is required to ensure proper performance of the R-Tank system. The Maintenance program should be focused on preventative systems. Ensuring these structures are clean and functioning properly will reduce the risk of contamination of the R-Tank system and stormwater released from the site. The treatment systems shall be inspected yearly, or as directed by the regulatory agency and by the manufacturer (for proprietary systems). Maintain an as needed using acceptable practices or following manufacturer's guidelines (for proprietary systems).

B. All inlet pipes and inspection and/or Maintenance Ports in the R-Tank system will need to be inspected for accumulation of sediments at least quarterly through the first year of operation and at least yearly thereafter.

C. If sediment has accumulated to the level noted in the R-Tank Maintenance Guide or beyond a level acceptable to the Owner's engineer, the R-Tank system should be flushed.

D. All inspection and maintenance activities should be performed in accordance with the R-Tank Operation, Inspection & Maintenance Manual.

ACF WEST INC.
GEOTECHNICAL SOLUTIONS
FOR ADDITIONAL INFORMATION PLEASE CONTACT:
ACF WEST, 1400-425-4507, www.acfwest.com

R-TANK
ENGINEER OF RECORD TO REVIEW, APPROVE AND ENDORSE FINAL SITE SPECIFIC DESIGN

R-TANK SPECIFICATION
EAST TOWN CROSSING
PUYALLUP, WA
SITE DESIGNATION: R-TANK 1

EDD
02/20/2024
23-0044VA
6 of 6

01/29/24 CITY COMMENTS

Revisions:

Sheet Title:
R-TANK 1 NOTES AND DETAILS

Designed by: CW Drawn by: SK/RS Checked by: JI

Sheet No.
C4.12

26 of 53 Sheets



EAST TOWN CROSSING PHASE 1


SEC. 26,35/ TWP. 20 N./ RGE. 4 E., W.M.

APPROVED

BY CITY OF PUYALLUP
DEVELOPMENT ENGINEERING

DATE

NOTE: THIS APPROVAL IS VOID AFTER 180 DAYS FROM APPROVAL DATE. THE CITY WILL NOT BE RESPONSIBLE FOR ERRORS AND/OR OMISSIONS ON THESE PLANS. FIELD CONDITIONS MAY DICTATE CHANGES TO THESE PLANS AS DETERMINED BY THE DEVELOPMENT ENGINEERING MANAGER.

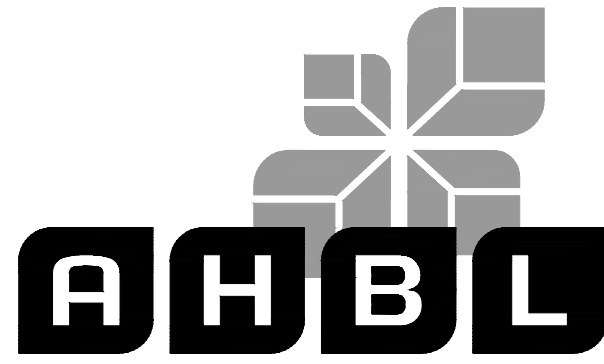

TACOMA · SEATTLE · SPOKANE · TRI-CITIES

2215 North 30th Street, Suite 300, Tacoma, WA 98403
253.383.2422 TEL 253.383.2572 FAX www.ahbl.com WEB

Project Title:

EAST TOWN CROSSING PHASE 1

Client:

ASH DEVELOPMENT

GREG HELLE

GREG.HELLE@ASHNW.COM


Project No.

2230752

Issue Set & Date:

PERMIT SUBMITTAL

02/20/2024

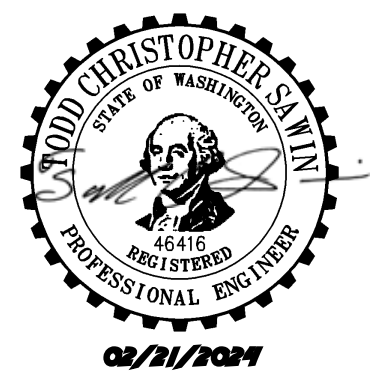

NOTE: ALTERATION OF THIS DOCUMENT SHALL INVALIDATE THE PROFESSIONAL SEAL AND SIGNATURE. PUBLICATION OF THIS DOCUMENT DOES NOT CONSTITUTE A PROFESSIONAL ENGINEER'S OPINION ON THE DESIGN OR CONSTRUCTION OF THE PROJECT EXCEPT IN THE TITLE BLOCK AND IS NOT TO BE USED FOR OTHER PURPOSES OR ACTION TO THAT PROJECT OR FOR ANY OTHER PROJECT.

△

△

△

△ 01/29/24 CITY COMMENTS

Revisions:

Sheet Title:


R-TANK 2 NOTES AND DETAILS

Designed by: CW Drawn by: SK / RS Checked by: JI

Sheet No.

C4.20


27 of 53 Sheets

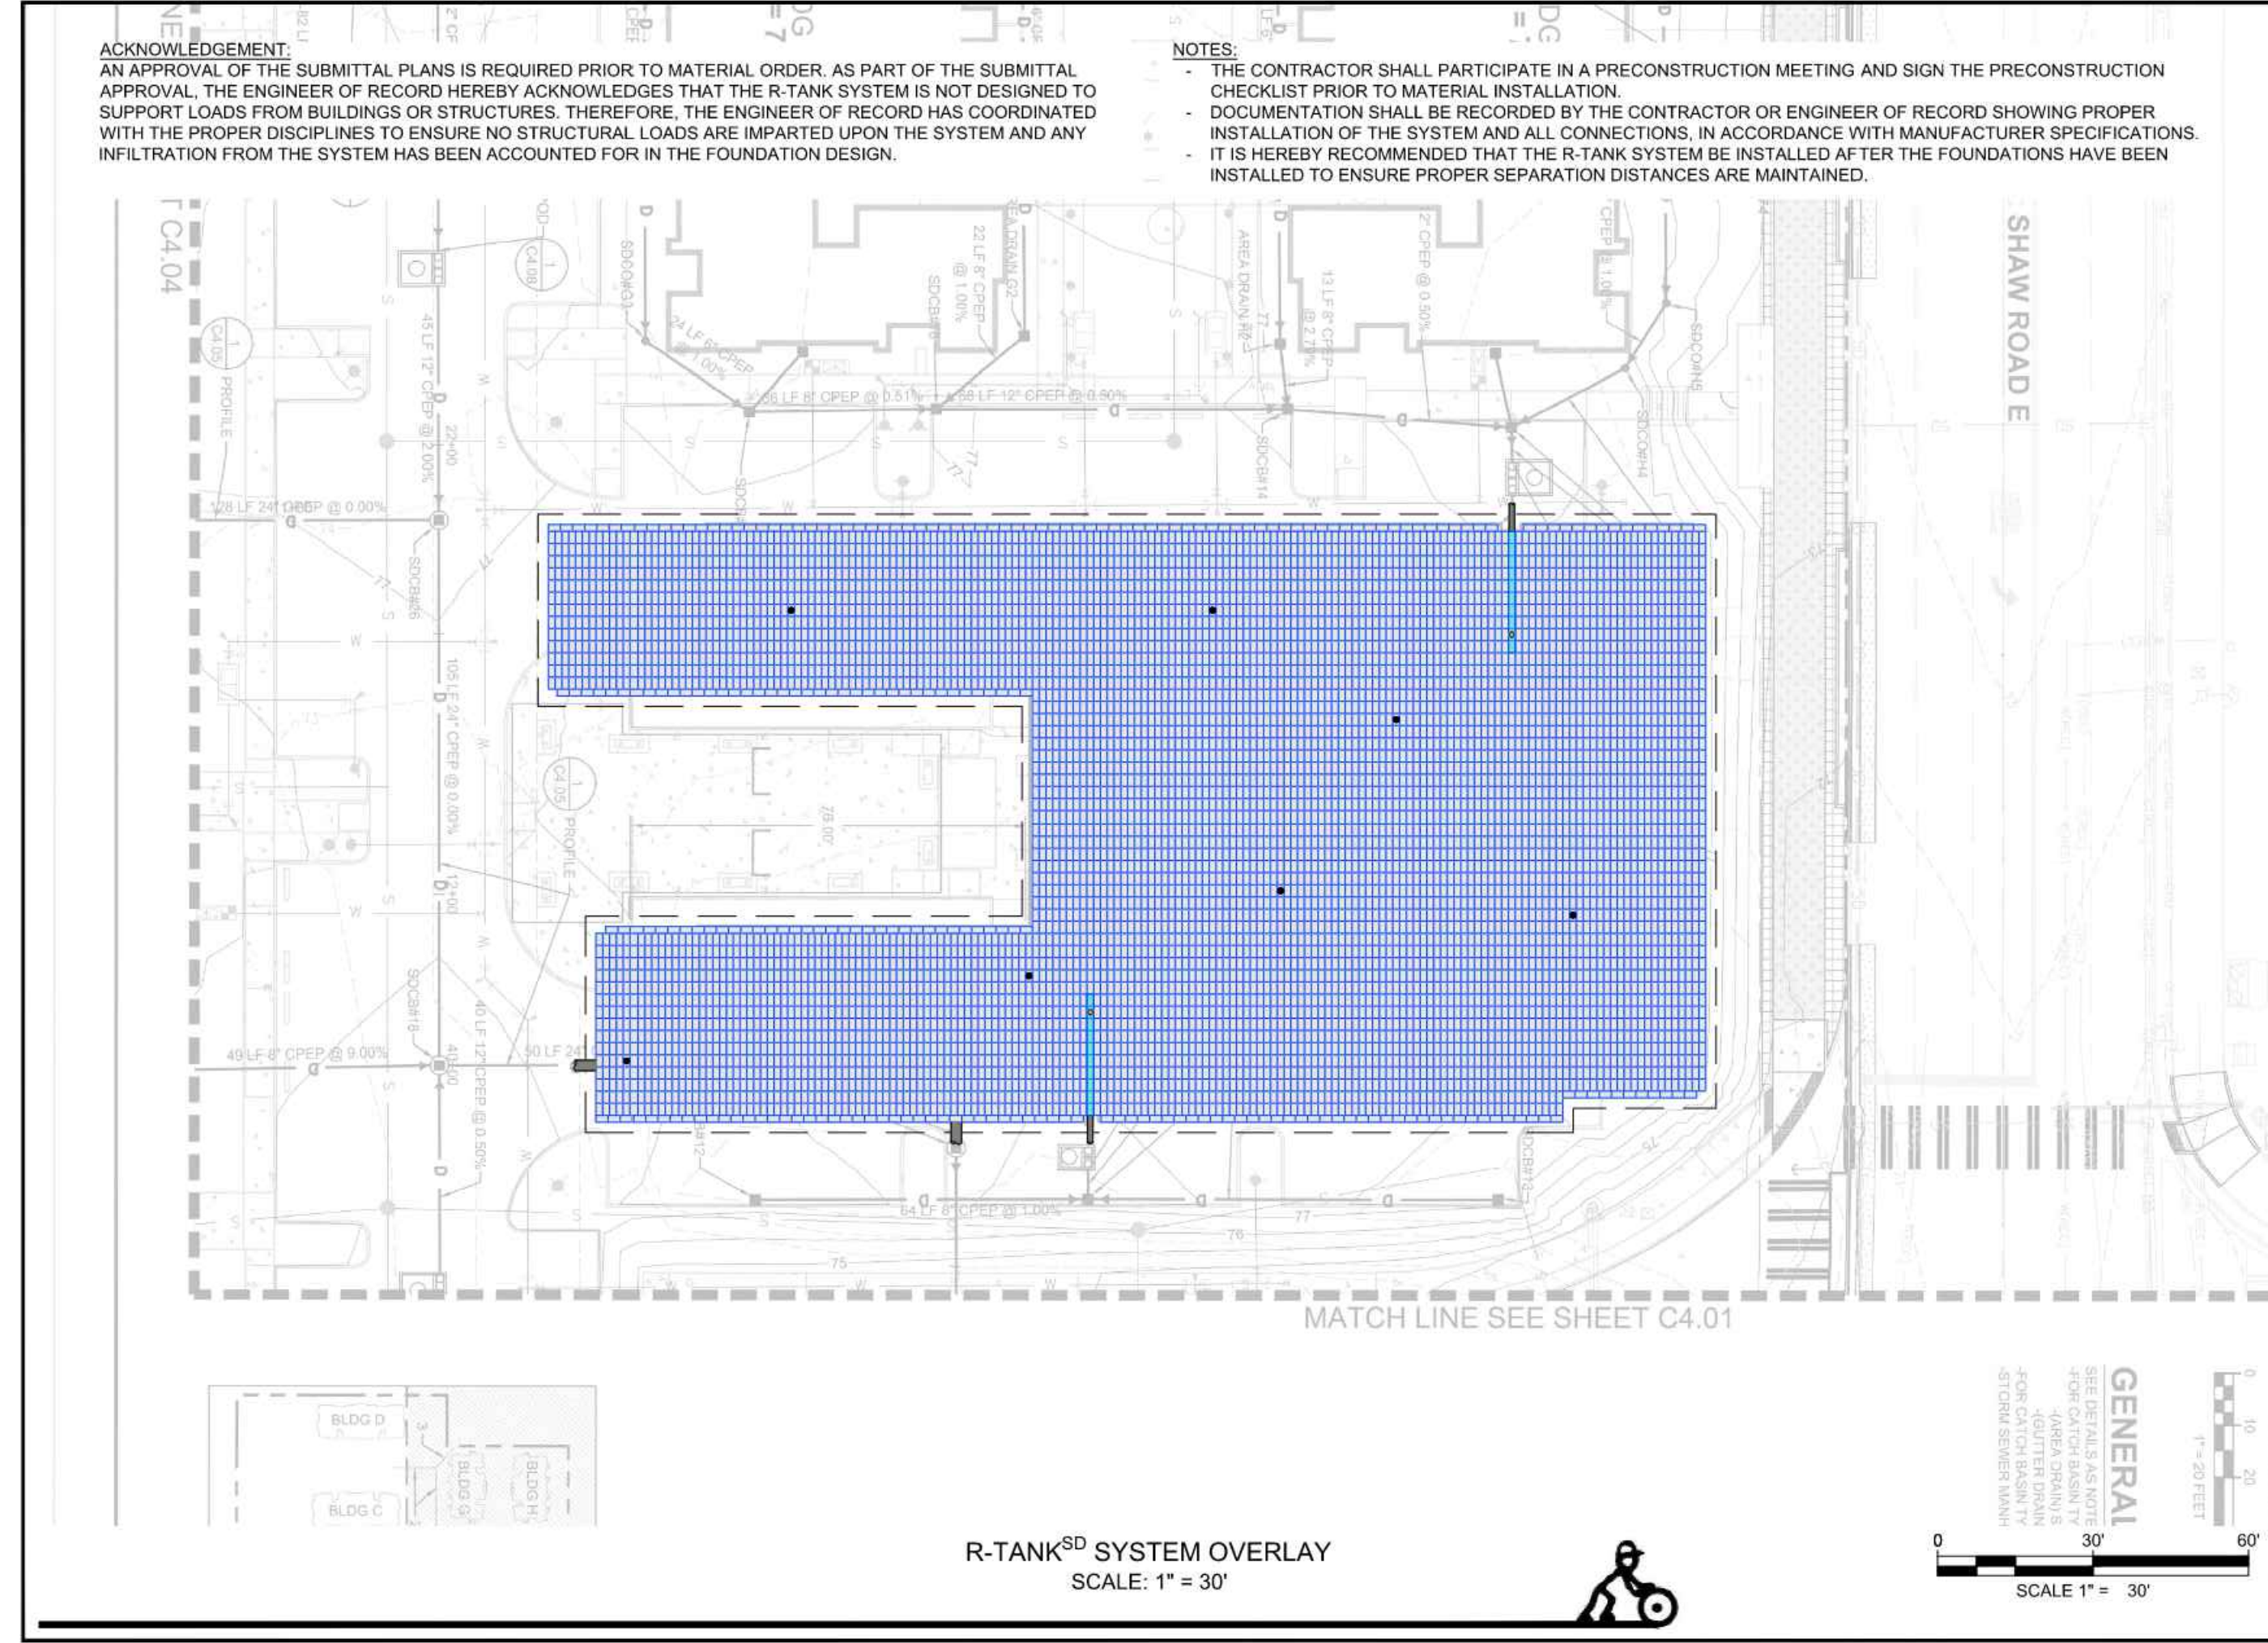


R-TANK^{SD}
ENGINEER OF RECORD TO REVIEW, APPROVE AND ENDORSE FINAL SITE SPECIFIC DESIGN

ACF WEST, Inc.
GEOTECHNICAL CONSULTING
FOR ADDITIONAL INFORMATION PLEASE CONTACT:
ACF WEST, 1-800-423-4667, www.acfwest.com

EDG
02/21/2024
23-004WA

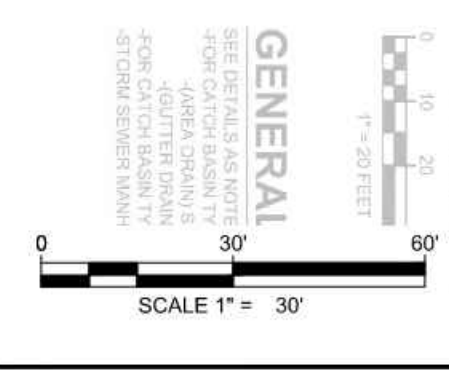


GENERAL

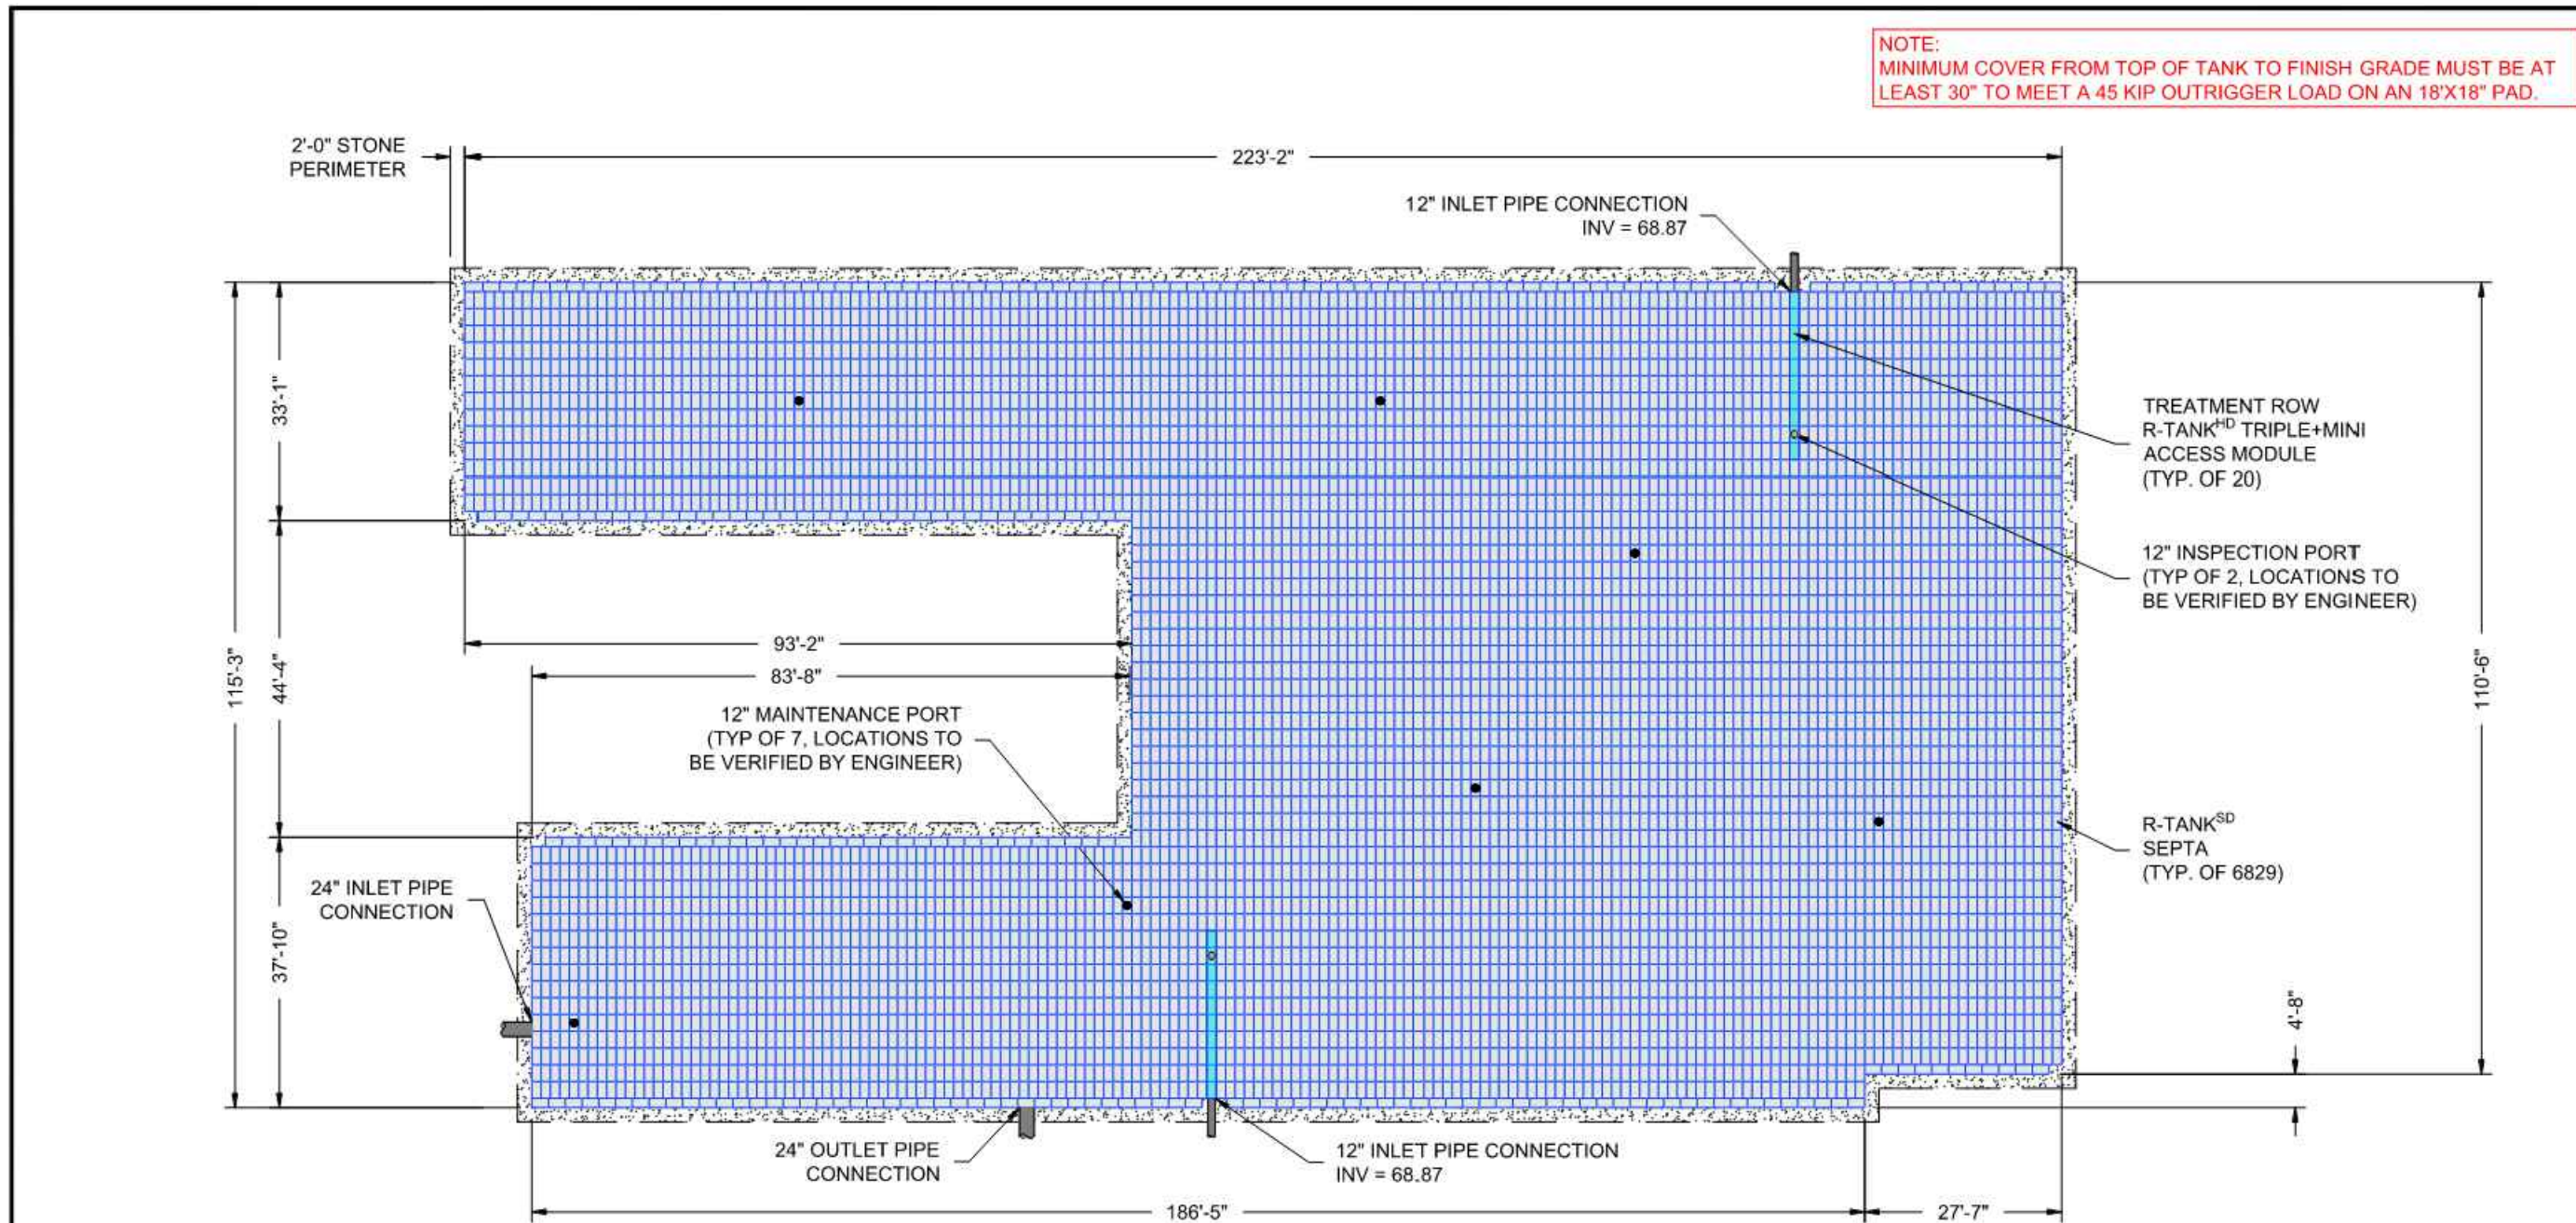

- NOTES:**
- DEAD STORAGE VOLUME FROM ELEVATION 67.90 TO 68.40 = 4,562 CF
 - LIVE STORAGE VOLUME FROM ELEVATION 68.40 TO 74.27 = 112,902 CF
 - ONLY 3" OF BASE STONE INCLUDED IN LIVE STORAGE VOLUME.

LAYOUT SCALE	1" = 25'
R-TANK ^{SD} MODULE TYPE	SEPTA
TRAFFIC LOAD	45 KIP OUTRIGGER (18"x18")
# OF SD SEPTA R-TANKS	6,829
# OF HD DOUBLE+MINI R-TANK ACCESS MODULES	20
TOTAL SYSTEM STORAGE	112,902 CF
R-TANK STORAGE VOLUME	102,518 CF
STONE STORAGE VOLUME (40% VOID RATIO)	10,384 CF
TOP OF COVER STONE ELEV. (12")	74.77
NAUE SECUGRID 30/30 GEOGRID ELEV.	74.77
TOP OF R-TANK ELEV.	73.77
TANK INVERT	68.65
INVERT OF STONE BASE (6")	67.90
MIN. STONE PERIMETER WIDTH	2.0 FT

SEE SHEETS 3 - 8 FOR DETAILS AND ADDITIONAL INFORMATION

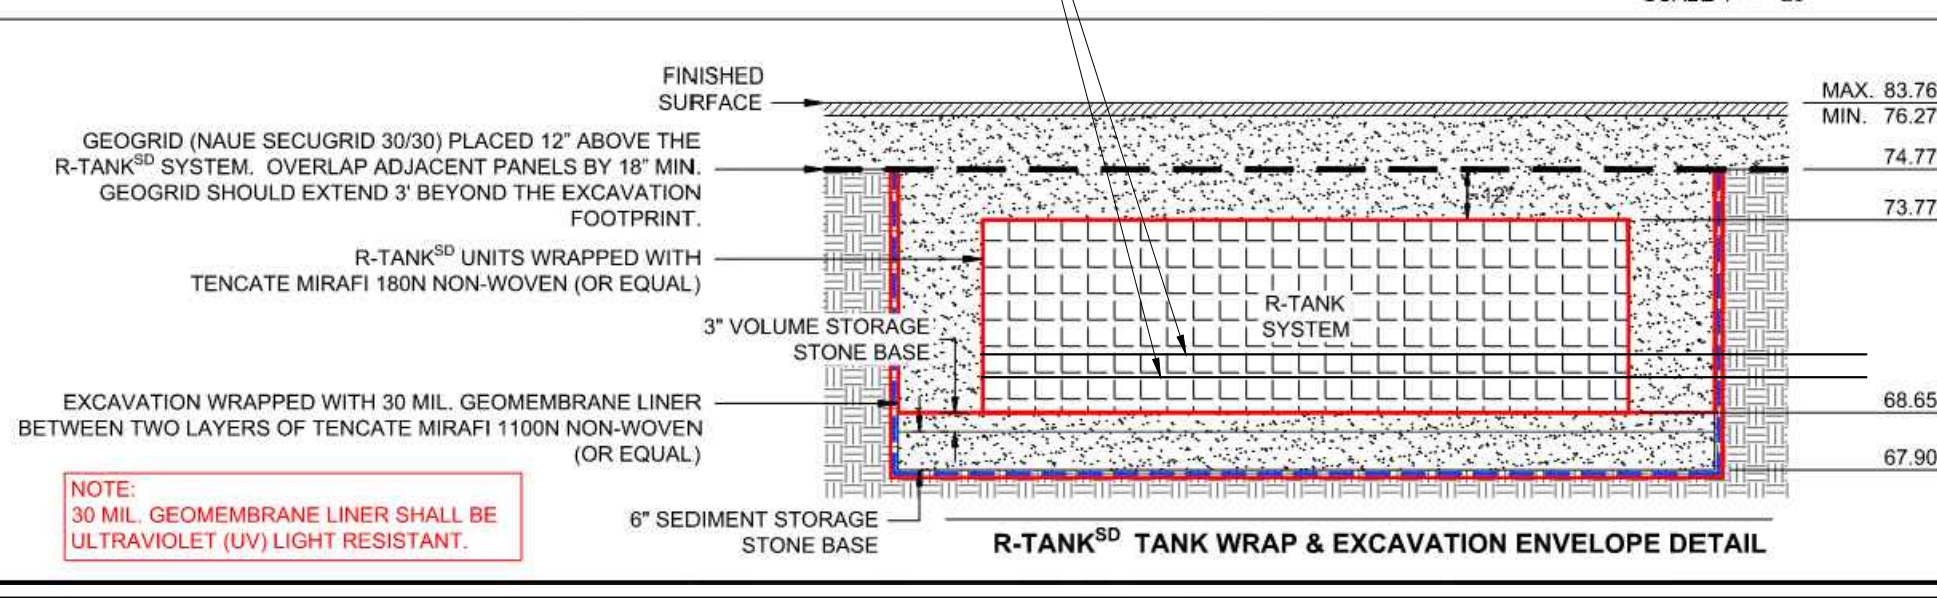

Know what's below.
Call before you dig.

R-TANK^{SD}
ENGINEER OF RECORD TO REVIEW, APPROVE AND ENDORSE FINAL SITE SPECIFIC DESIGN

ACF WEST, Inc.
GEOTECHNICAL CONSULTING
FOR ADDITIONAL INFORMATION PLEASE CONTACT:
ACF WEST, 1-800-423-4667, www.acfwest.com

EDG
02/21/2024
23-004WA

2 of 8

EAST TOWN CROSSING PHASE 1


SEC. 26,35/ TWP. 20 N./ RGE. 4 E., W.M.

APPROVED

BY CITY OF PUYALLUP
DEVELOPMENT ENGINEERING

DATE

NOTE: THIS APPROVAL IS VOID AFTER 180 DAYS FROM APPROVAL DATE. THE CITY WILL NOT BE RESPONSIBLE FOR ERRORS AND/OR OMISSIONS ON THESE PLANS. FIELD CONDITIONS MAY DICTATE CHANGES TO THESE PLANS AS DETERMINED BY THE DEVELOPMENT ENGINEERING MANAGER.

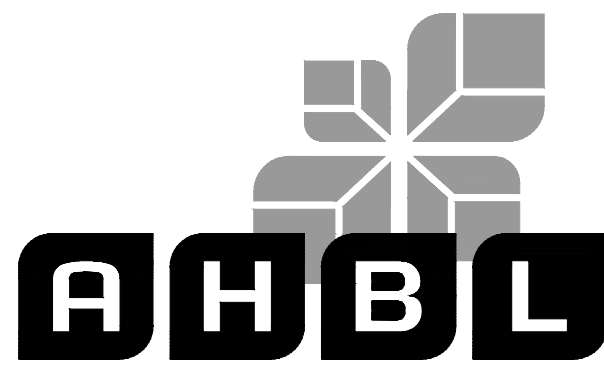

TACOMA • SEATTLE • SPOKANE • TRI-CITIES

2215 North 30th Street, Suite 300, Tacoma, WA 98403
253.383.2422 TEL 253.383.2572 FAX www.ahbl.com WEB

Project Title:

EAST TOWN CROSSING PHASE 1

Client:

ASH DEVELOPMENT

GREG HELLE

GREG.HELLE@ASHNW.COM

Project No.

2230752

Issue Set & Date:

PERMIT SUBMITTAL

02/20/2024



NOTICE: ALTERATION OF THIS DOCUMENT SHALL INVALIDATE THE PROFESSIONAL SEAL AND SIGNATURE. PUBLICATION OF THIS DOCUMENT DOES NOT CONSTITUTE A PROFESSIONAL ENGINEER'S OPINION ON THE DESIGN OR THE ONLY FOR THE PROJECT. ENGINEER IN THE TITLE BLOCK AND NOT TO BE USED FOR ANY OTHER PROJECT OR ACTION TO THAT PROJECT OR FOR ANY OTHER PROJECT.

▲

▲

▲

▲ 01/29/24 CITY COMMENTS

Revisions:

Sheet Title:


R-TANK 2 NOTES AND DETAILS

Designed by: CW Drawn by: SK/RS Checked by: JI

Sheet No.

C4.21

28 of 53 Sheets

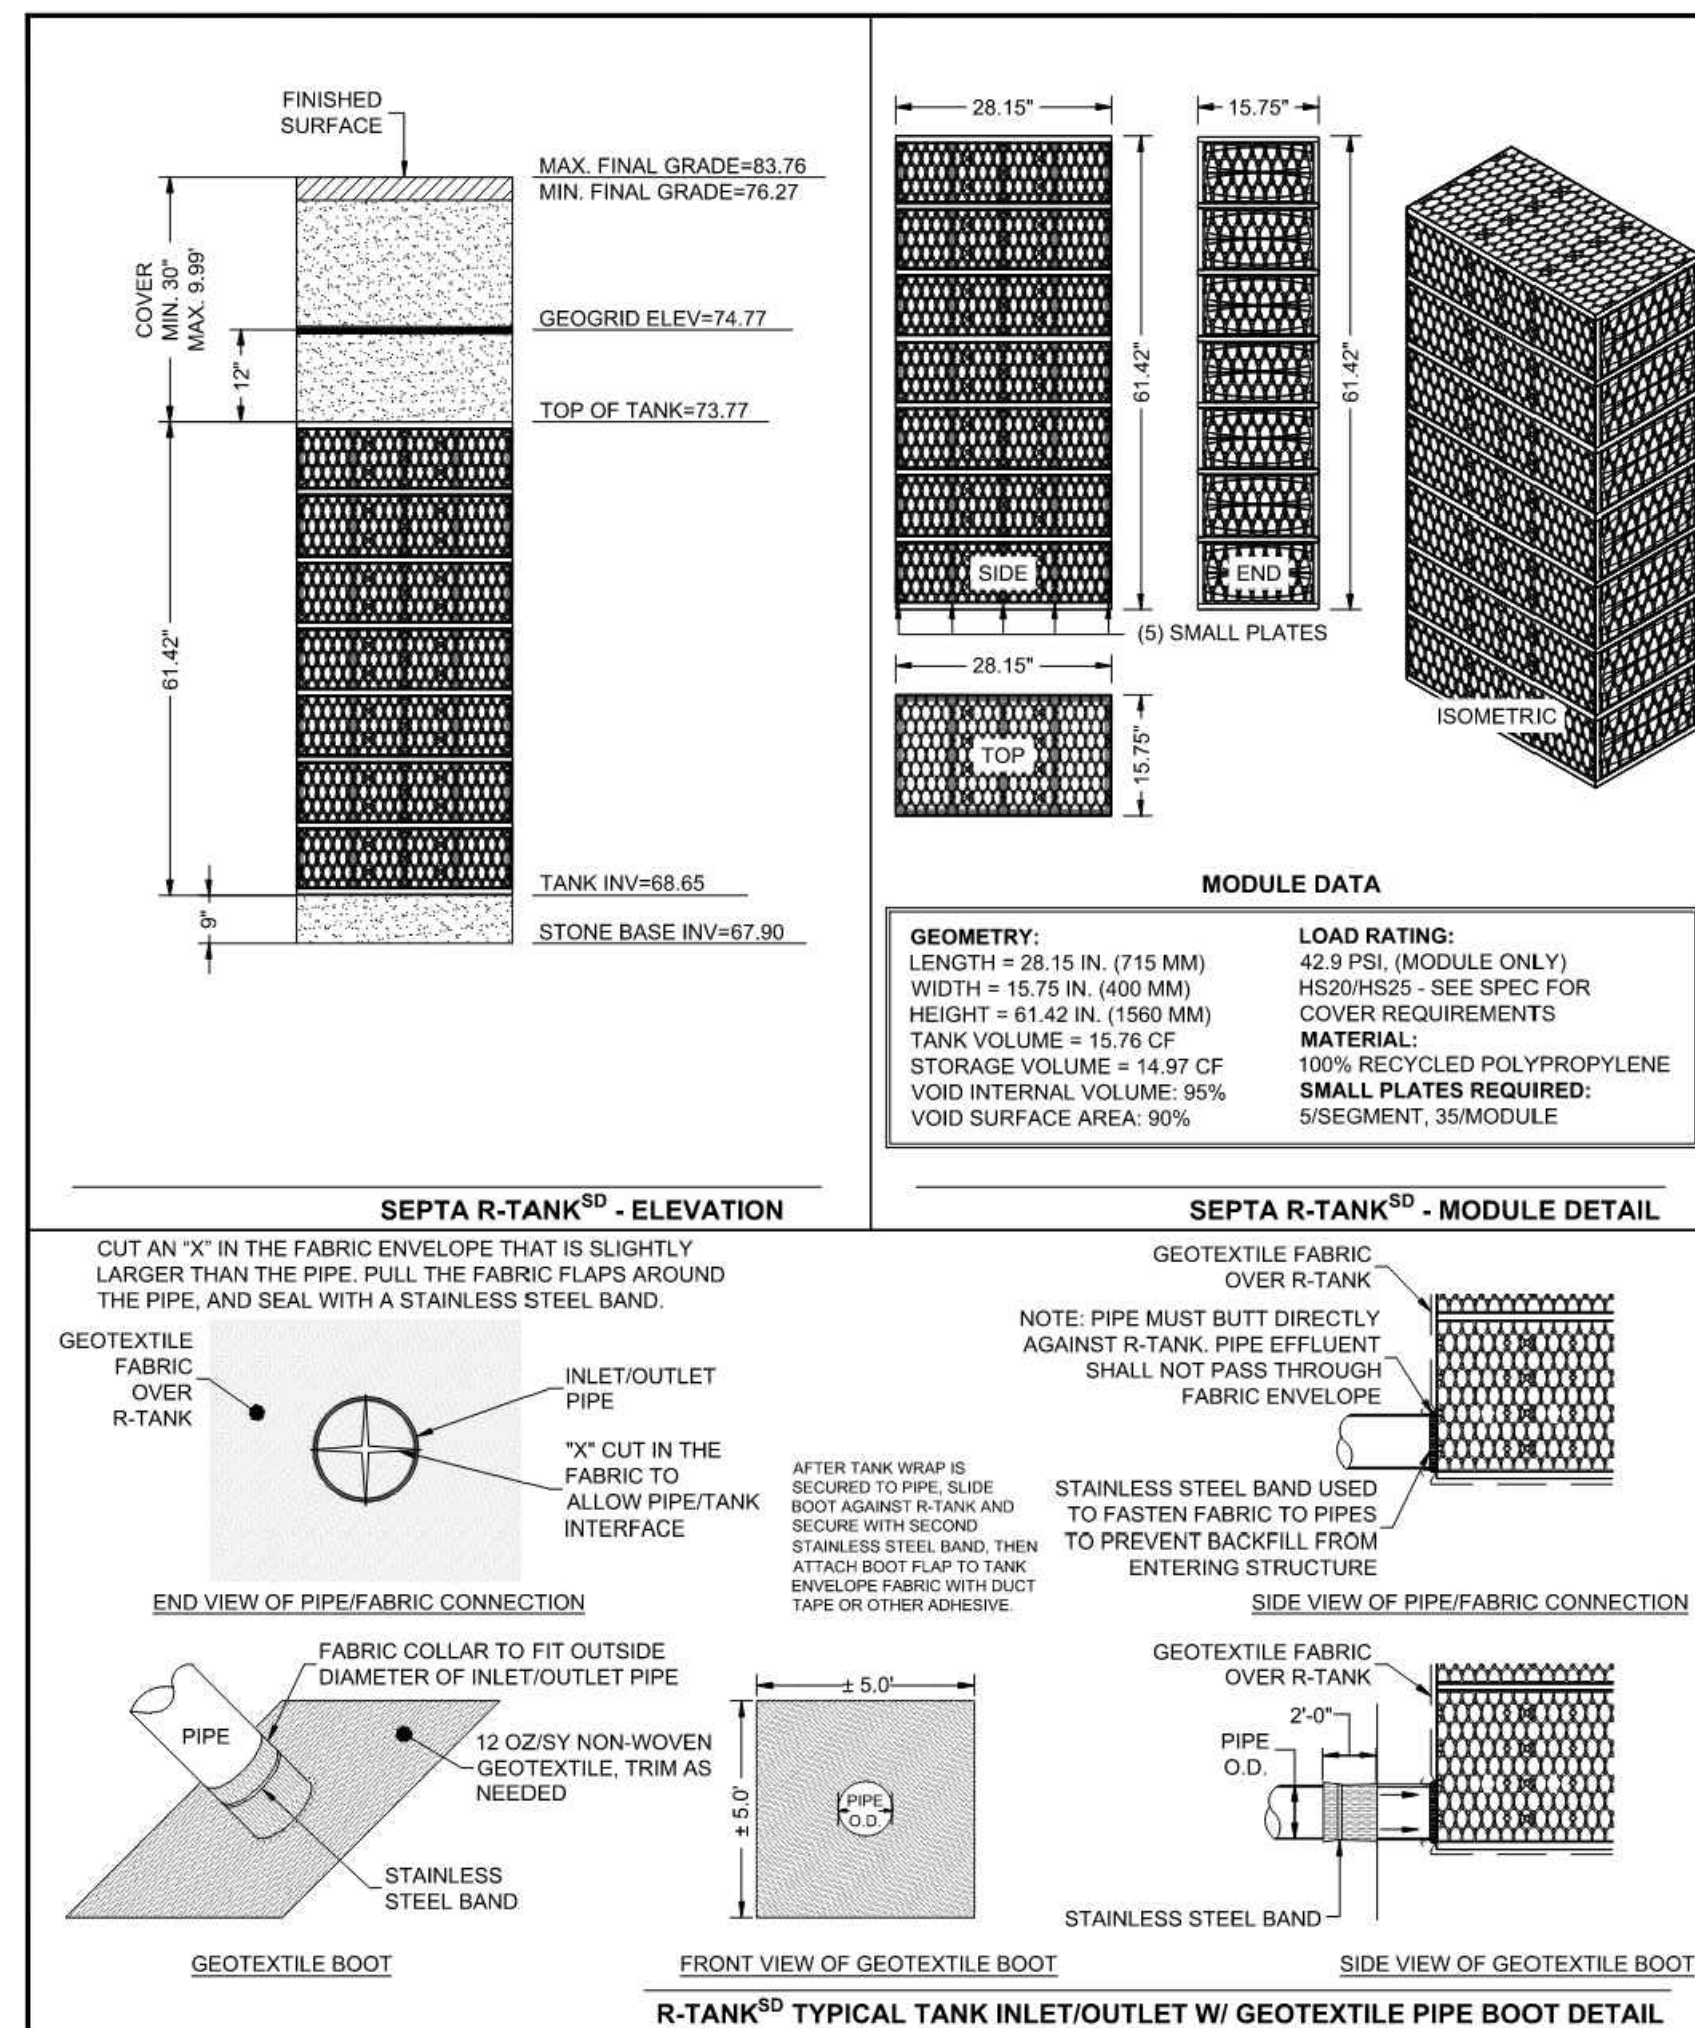

R-TANK[®] QUANTITIES

R-TANK [®] MODULE TYPE	SEPTA
# OF SD SEPTA R-TANKS	6,829
# OF HD TRIPLE-MINI R-TANK ACCESS MODULES	20
TOTAL SYSTEM STORAGE	112,902 CF
R-TANK STORAGE VOLUME	102,518 CF
STONE STORAGE VOLUME (40% VOID RATIO)	10,384 CF
STONE BED FOOTPRINT	22,811 SF
STONE QUANTITY	1,806 CY
TENCATE MIRAFI 180N NON-WOVEN TANK WRAP	53,504 SF (5,945 SY)
30 MIL. GEOMEMBRANE LINER EXCAVATION WRAP	33,030 SF (3,670 SY)
TENCATE MIRAFI 1100N NON-WOVEN LINER PROTECTION	66,060 SF (7,340 SY)
TENCATE MIRAFI 180N NON-WOVEN TREAT. ROW WRAP	659 SF (73 SY)
TENCATE MIRAFI FW-402 WOVEN TREAT. ROW BASE FABRIC	388 SF (43 SY)
NAUE SECUGRID 30/30 GEOGRID	30,265 SF (3,363 SY)
12" MAINTENANCE PORTS	7
12" INSPECTION PORTS	2
12" PIPE BOOTS	2
24" PIPE BOOTS	2
TRASHGUARD PLUS UNITS (RECOMMENDED)	1
NOTE: STONE QUANTITY INCLUDES 12" OF COVER AND 9" OF BASE.	
NOTE: GEOTEXTILE / LINER QUANTITIES INCLUDE A 15% WASTE FACTOR.	




NOTE: 30 MIL. GEOMEMBRANE LINER SHALL BE ULTRAVIOLET (UV) LIGHT RESISTANT.

- NOTES:
- DEAD STORAGE VOLUME FROM ELEVATION 67.90 TO 68.40 = 4,562 CF
 - LIVE STORAGE VOLUME FROM ELEVATION 68.40 TO 74.77 = 112,902 CF
 - ONLY 3" OF BASE STONE INCLUDED IN LIVE STORAGE VOLUME.



R-TANK[®] SYSTEM DETAILS
EAST TOWN CROSSING
PUYALLUP, WA
SITE DESIGNATION: R-TANK 2

DATE: 02/21/2024
PROJECT NUMBER: 23-004WA
SHEET: 3 of 8

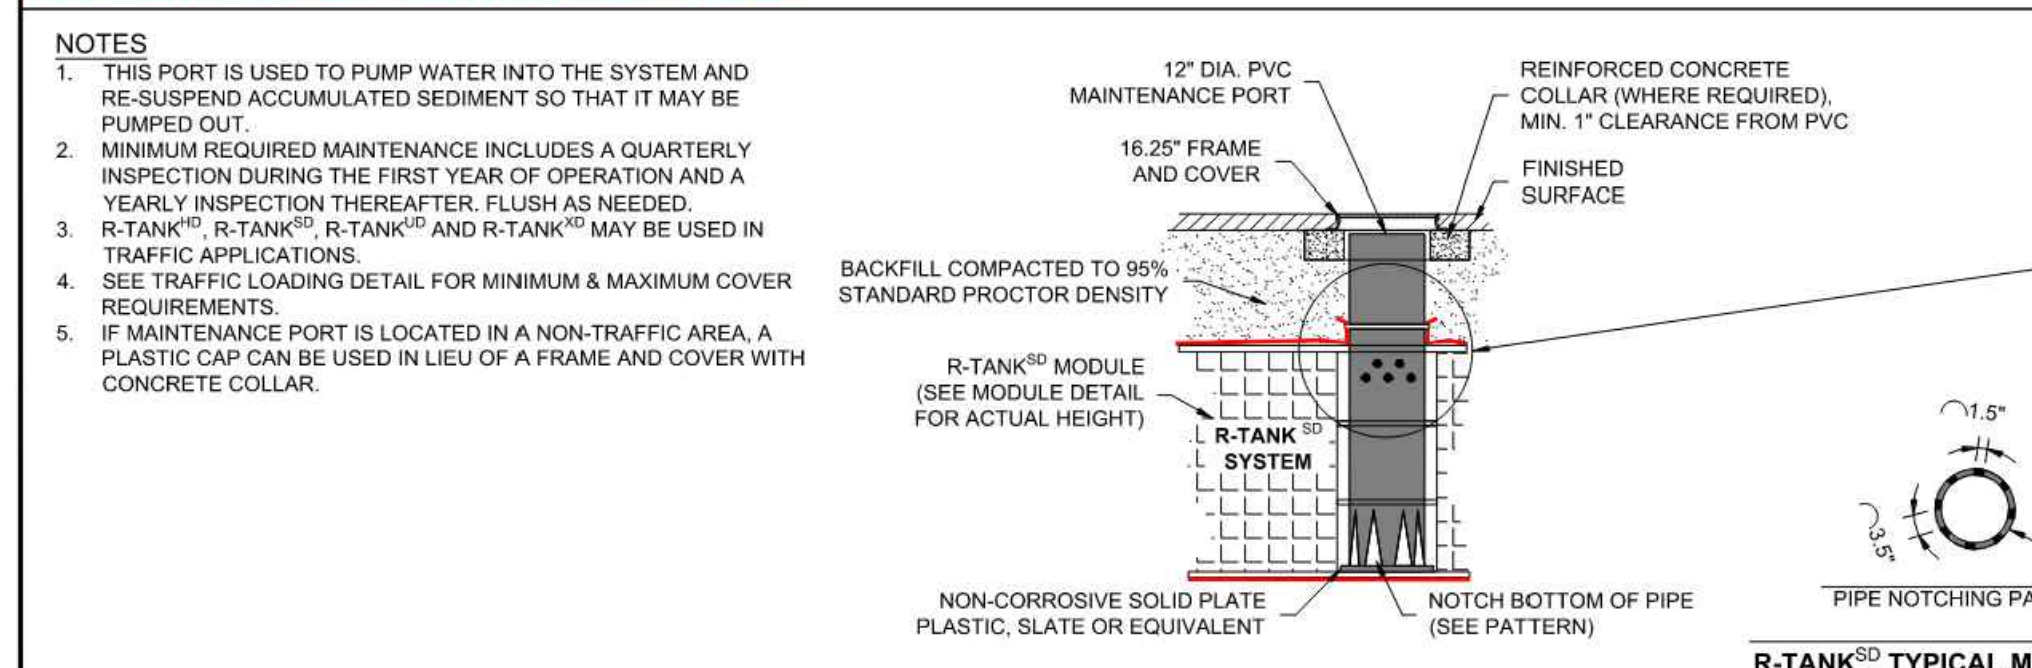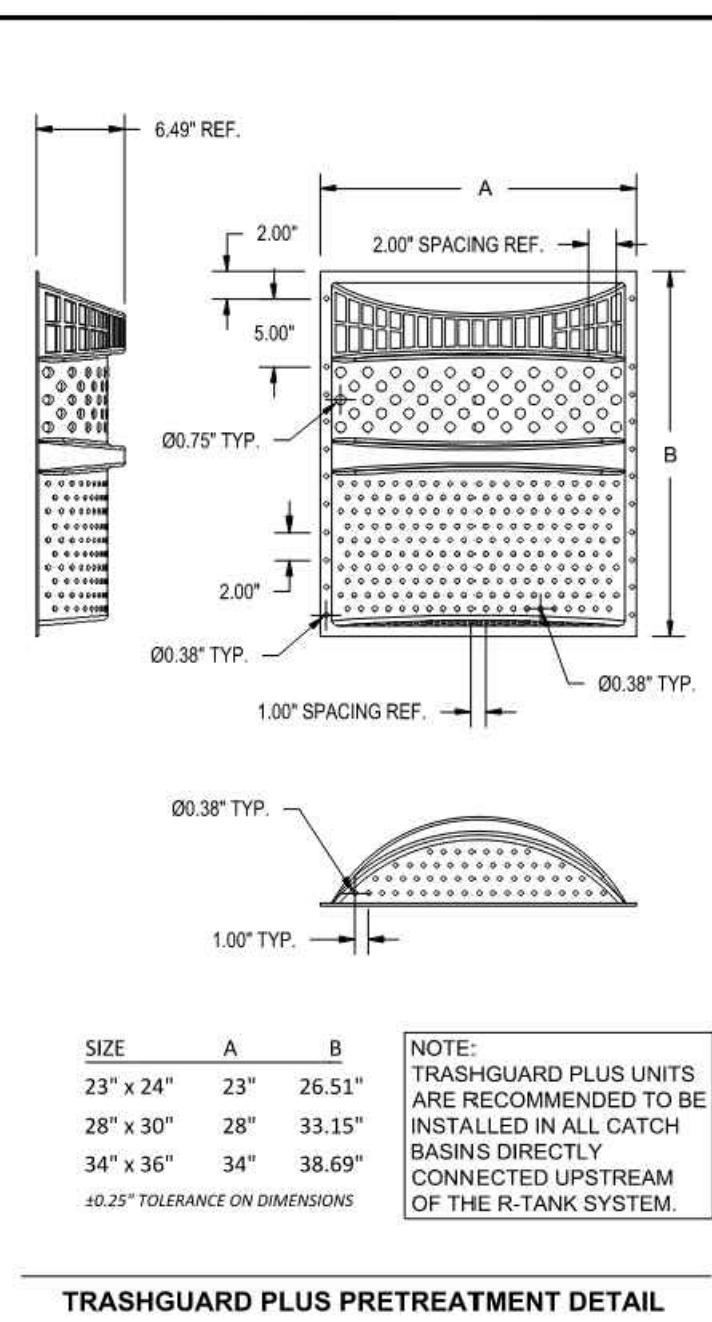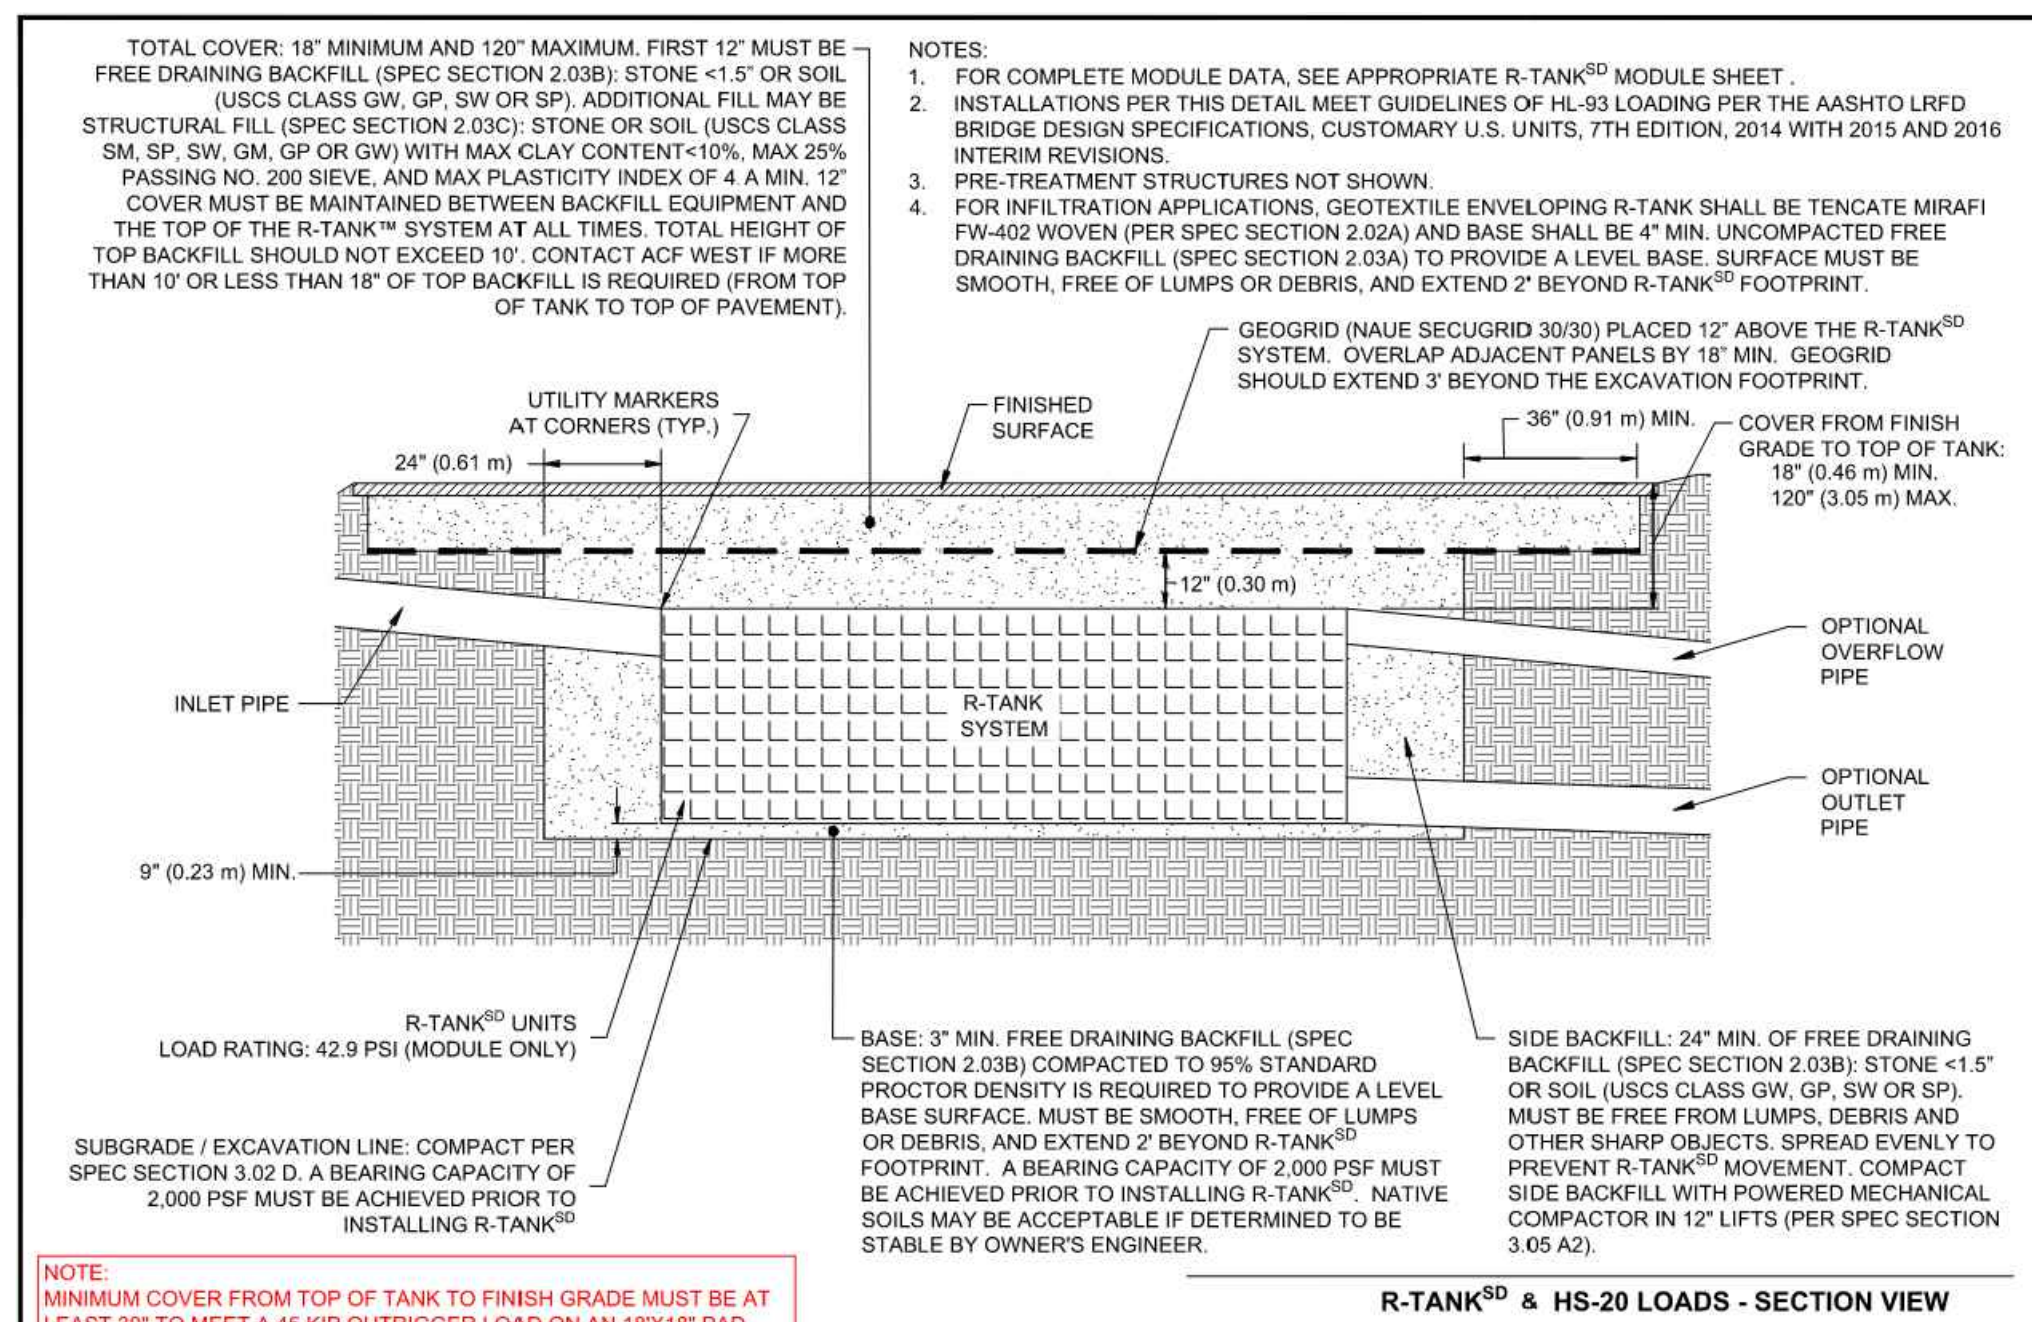

R-TANK[®] SYSTEM DETAILS
EAST TOWN CROSSING
PUYALLUP, WA
SITE DESIGNATION: R-TANK 2

DATE: 02/21/2024
PROJECT NUMBER: 23-004WA
SHEET: 4 of 8



Know what's below.
Call before you dig.

EAST TOWN CROSSING PHASE 1


SEC. 26,35/ TWP. 20 N./ RGE. 4 E., W.M.

APPROVED

BY CITY OF PUYALLUP
DEVELOPMENT ENGINEERING

DATE

NOTE: THIS APPROVAL IS VOID AFTER 180 DAYS FROM APPROVAL DATE. THE CITY WILL NOT BE RESPONSIBLE FOR ERRORS AND/OR OMISSIONS ON THESE PLANS. FIELD CONDITIONS MAY DICTATE CHANGES TO THESE PLANS AS DETERMINED BY THE DEVELOPMENT ENGINEERING MANAGER.

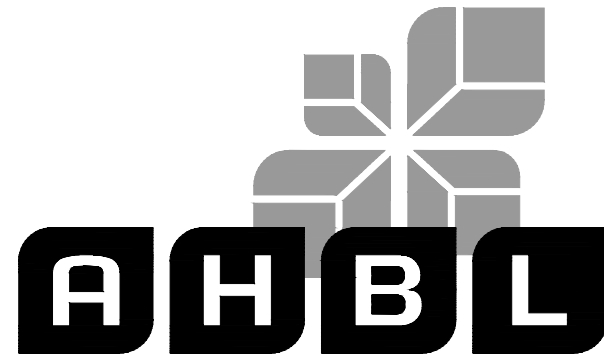

TACOMA · SEATTLE · SPOKANE · TRI-CITIES

2215 North 30th Street, Suite 300, Tacoma, WA 98403
253.383.2422 TEL 253.383.2572 FAX www.ahbl.com WEB

Project Title:

EAST TOWN CROSSING PHASE 1

Client:

ASH DEVELOPMENT

GREG HELLE

GREG.HELLE@ASHNW.COM


Project No.

2230752


Issue Set & Date:

PERMIT SUBMITTAL


02/20/2024

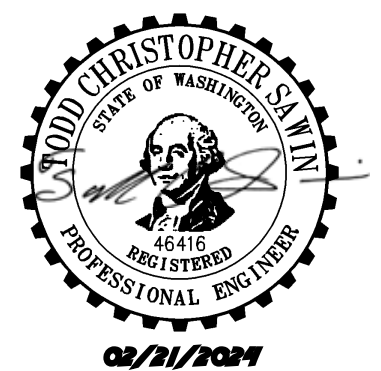

NOTICE: ALTERATION OF THIS DOCUMENT SHALL INVALIDATE THE PROFESSIONAL SEAL AND SIGNATURE. PUBLICATION OF THIS DOCUMENT DOES NOT CONSTITUTE A GUARANTEE OF ACCURACY OR A WARRANTY. THE USER SHALL BE RESPONSIBLE FOR VERIFYING THE ACCURACY OF THE INFORMATION PROVIDED IN THIS BLOCK AND FOR OBTAINING ANY NECESSARY PERMITS OR APPROVALS FOR ANY OTHER PROJECT.

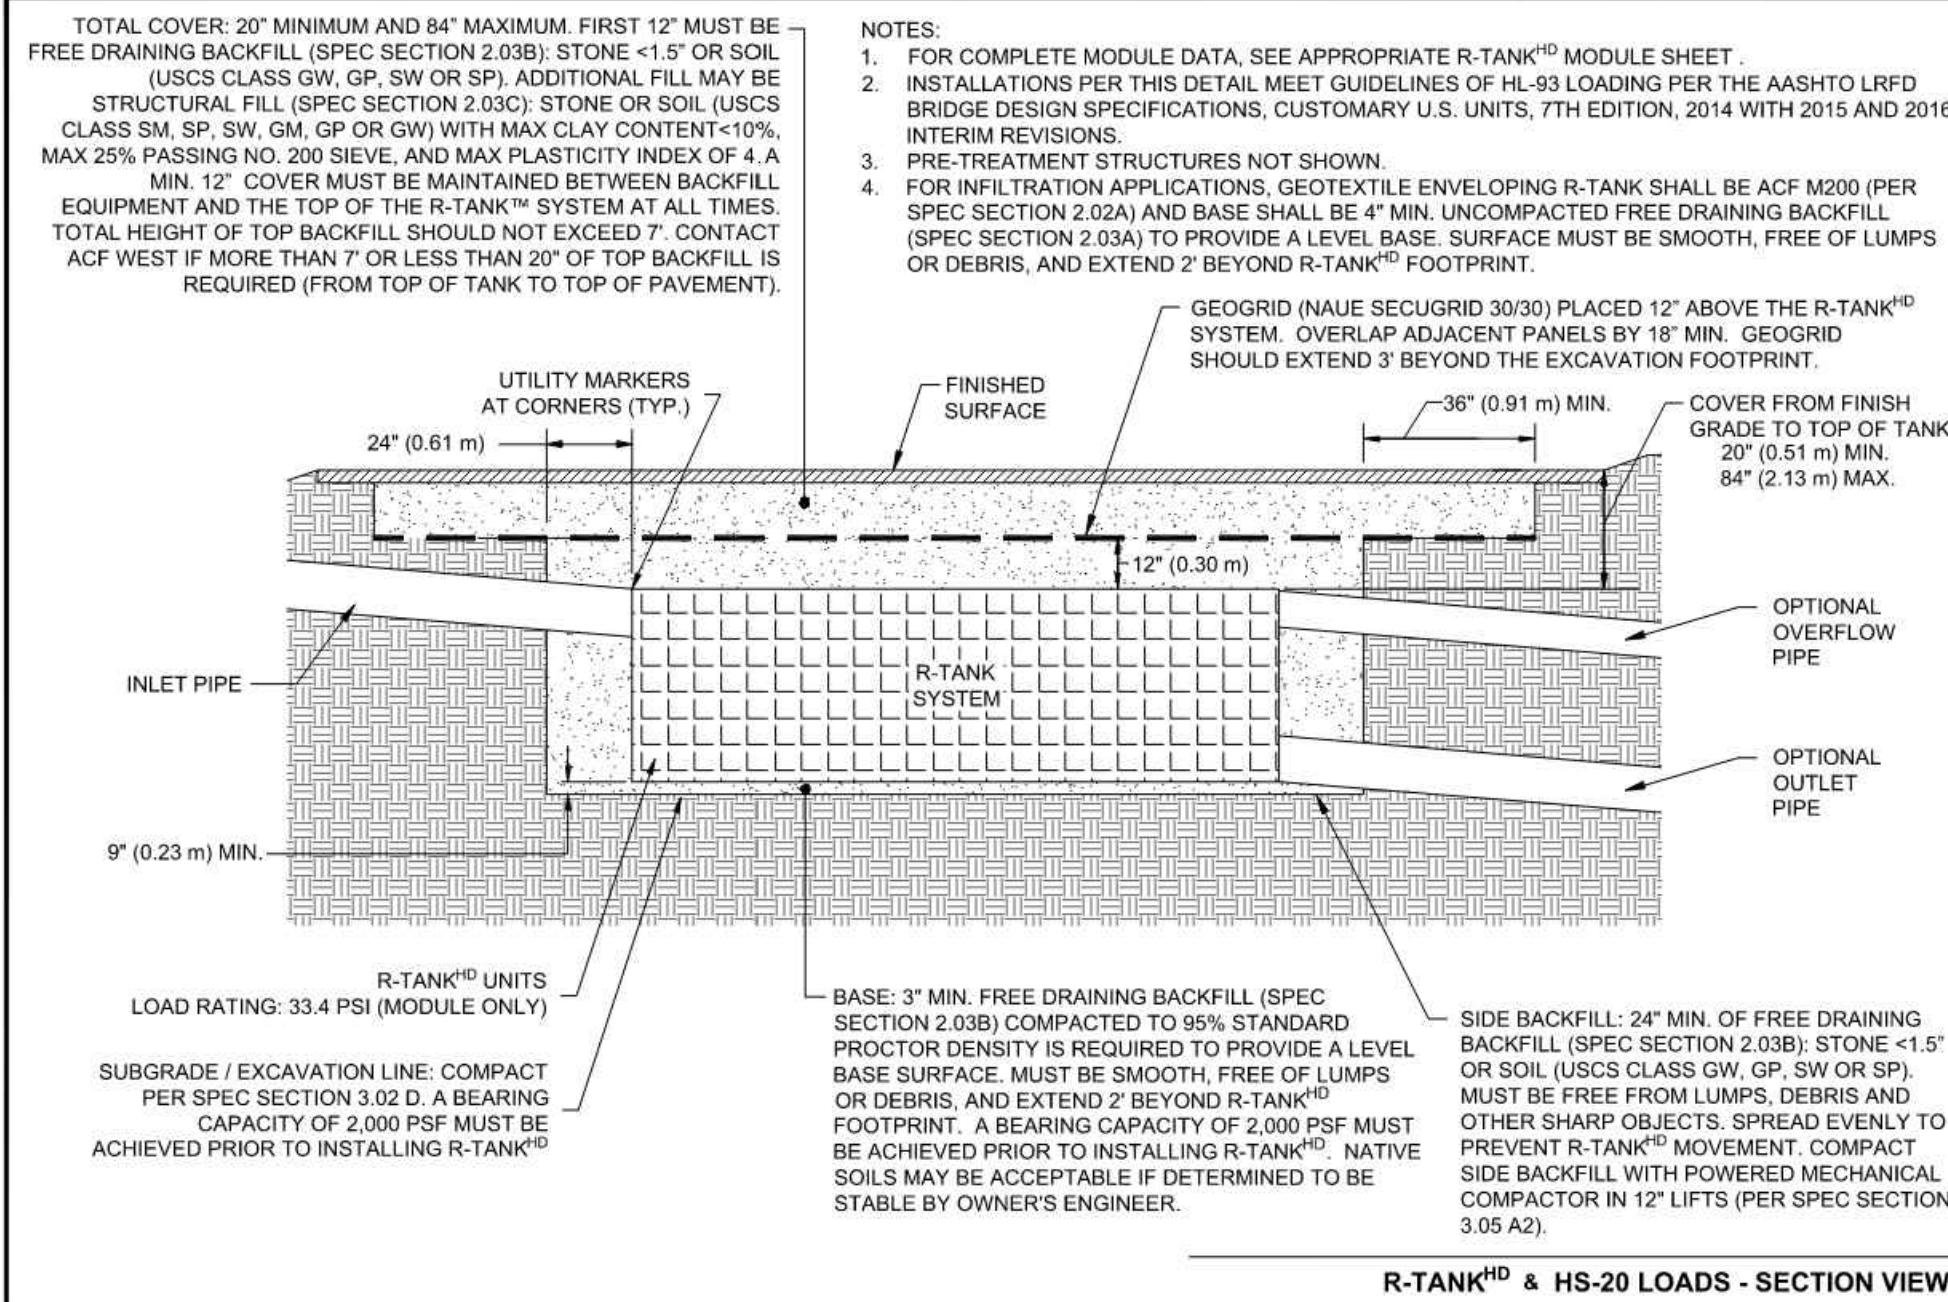



R-TANK® & HS-20 LOADS - SECTION VIEW

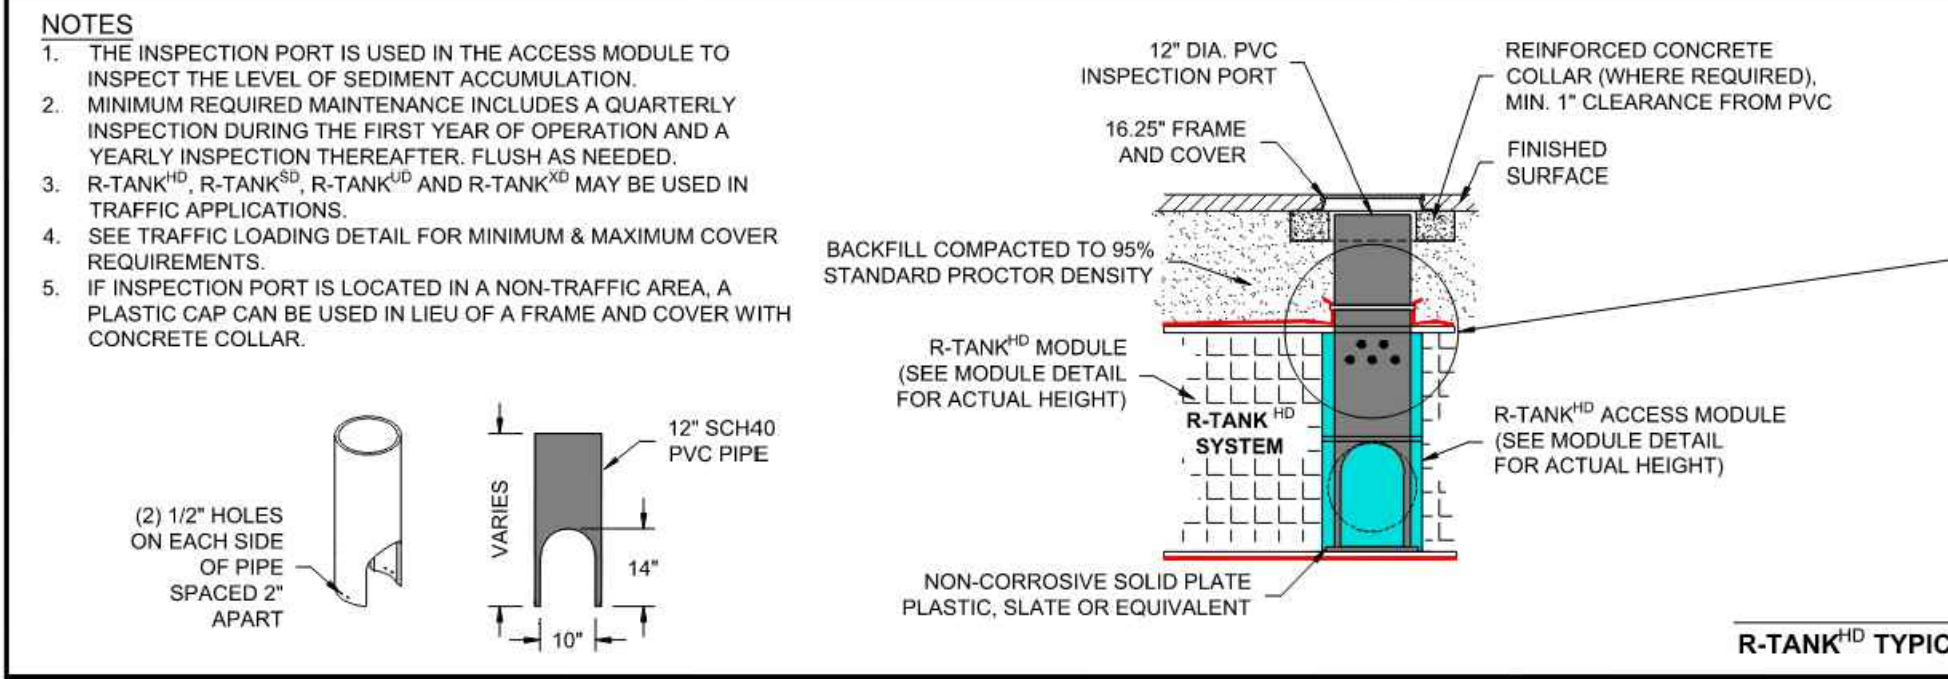

R-TANK® TYPICAL INSPECTION PORT

R-TANK® SYSTEM DETAILS
EAST TOWN CROSSING
PUYALLUP, WA
SITE DESIGNATION: R-TANK 2

REVISED BY EDQ
DATE 02/21/2024
ACF WEST, INC. 23-004WA
5 of 8

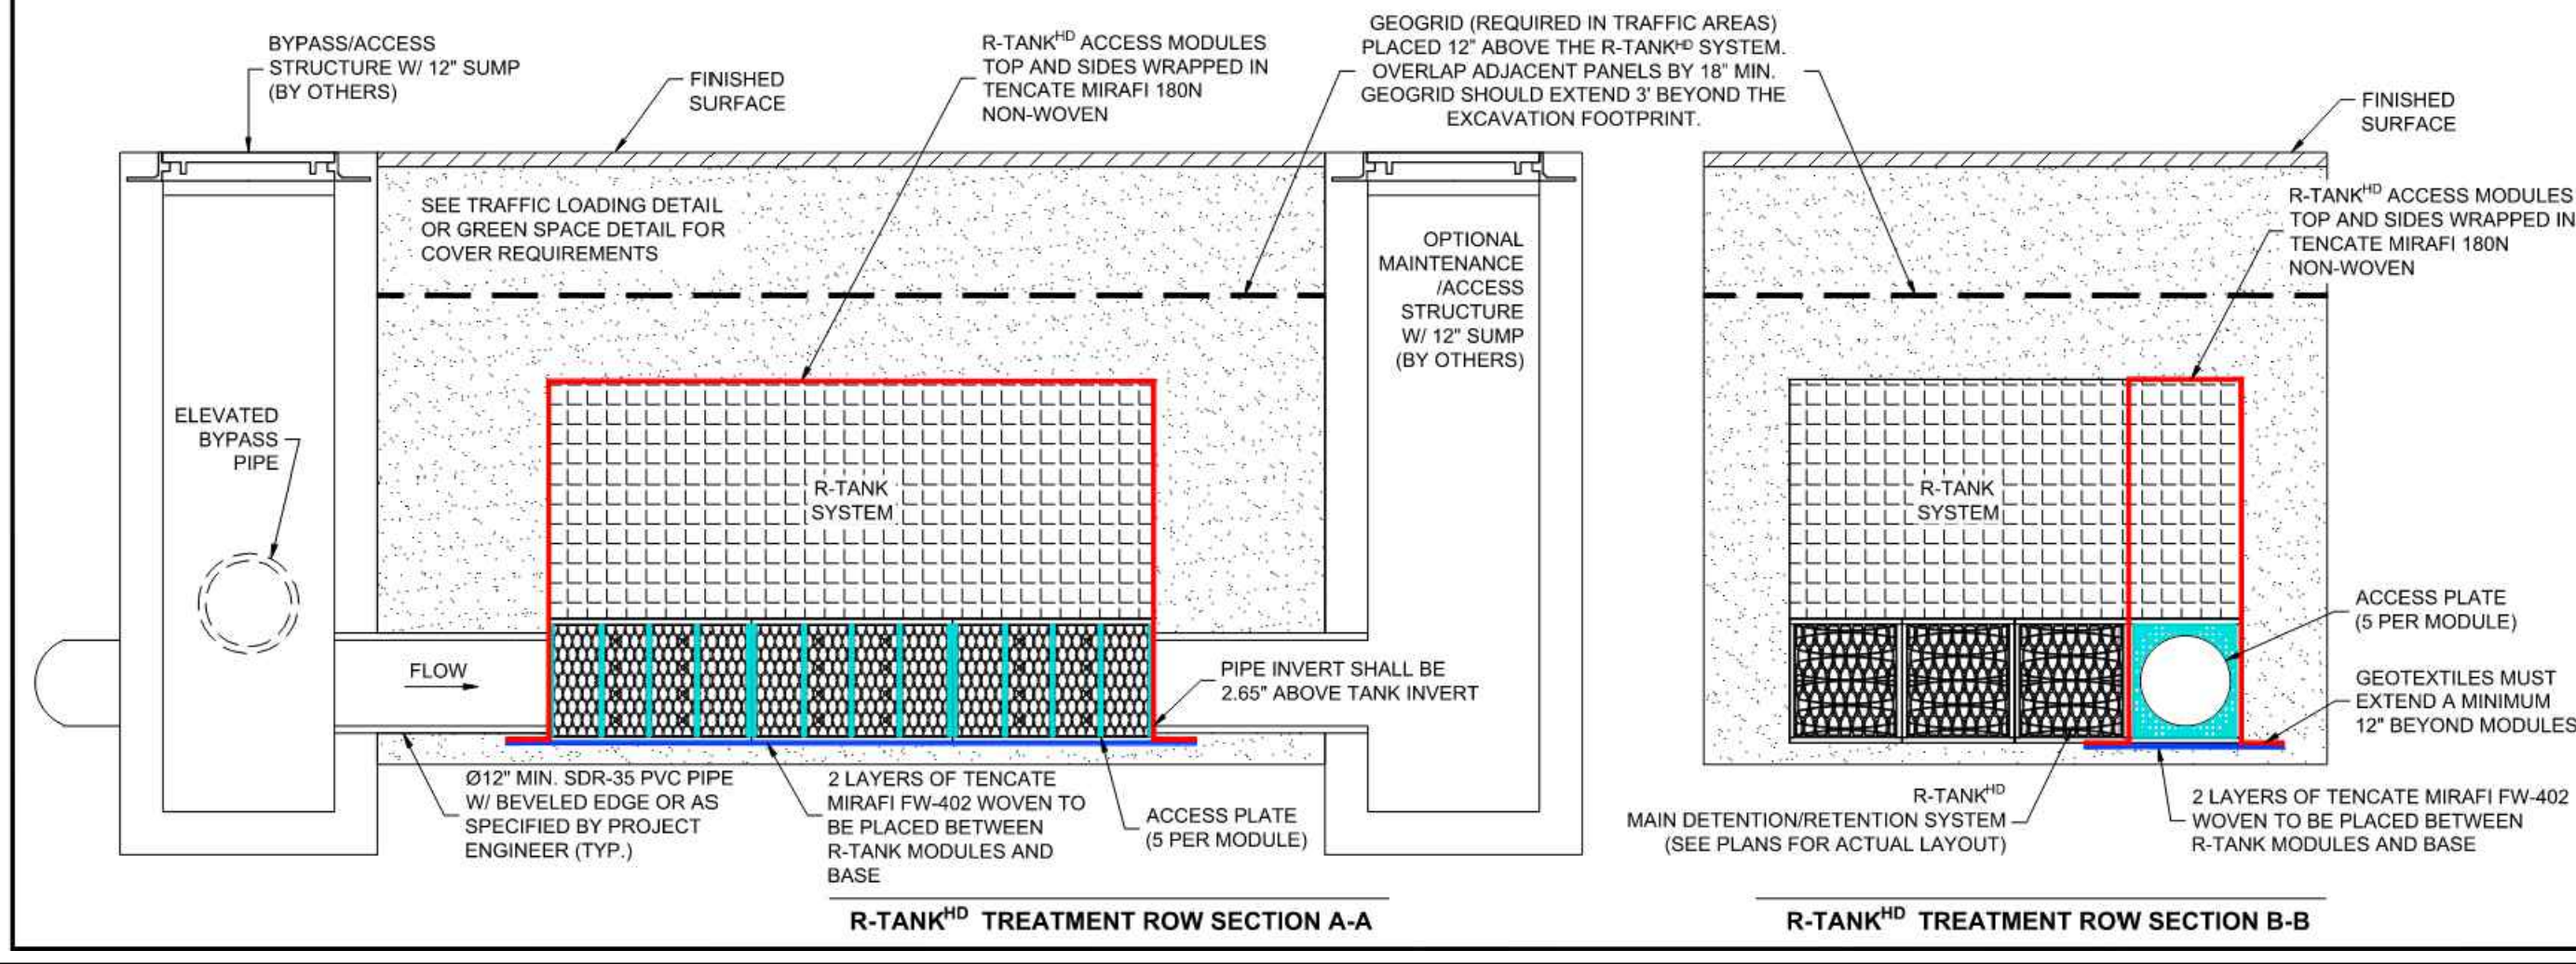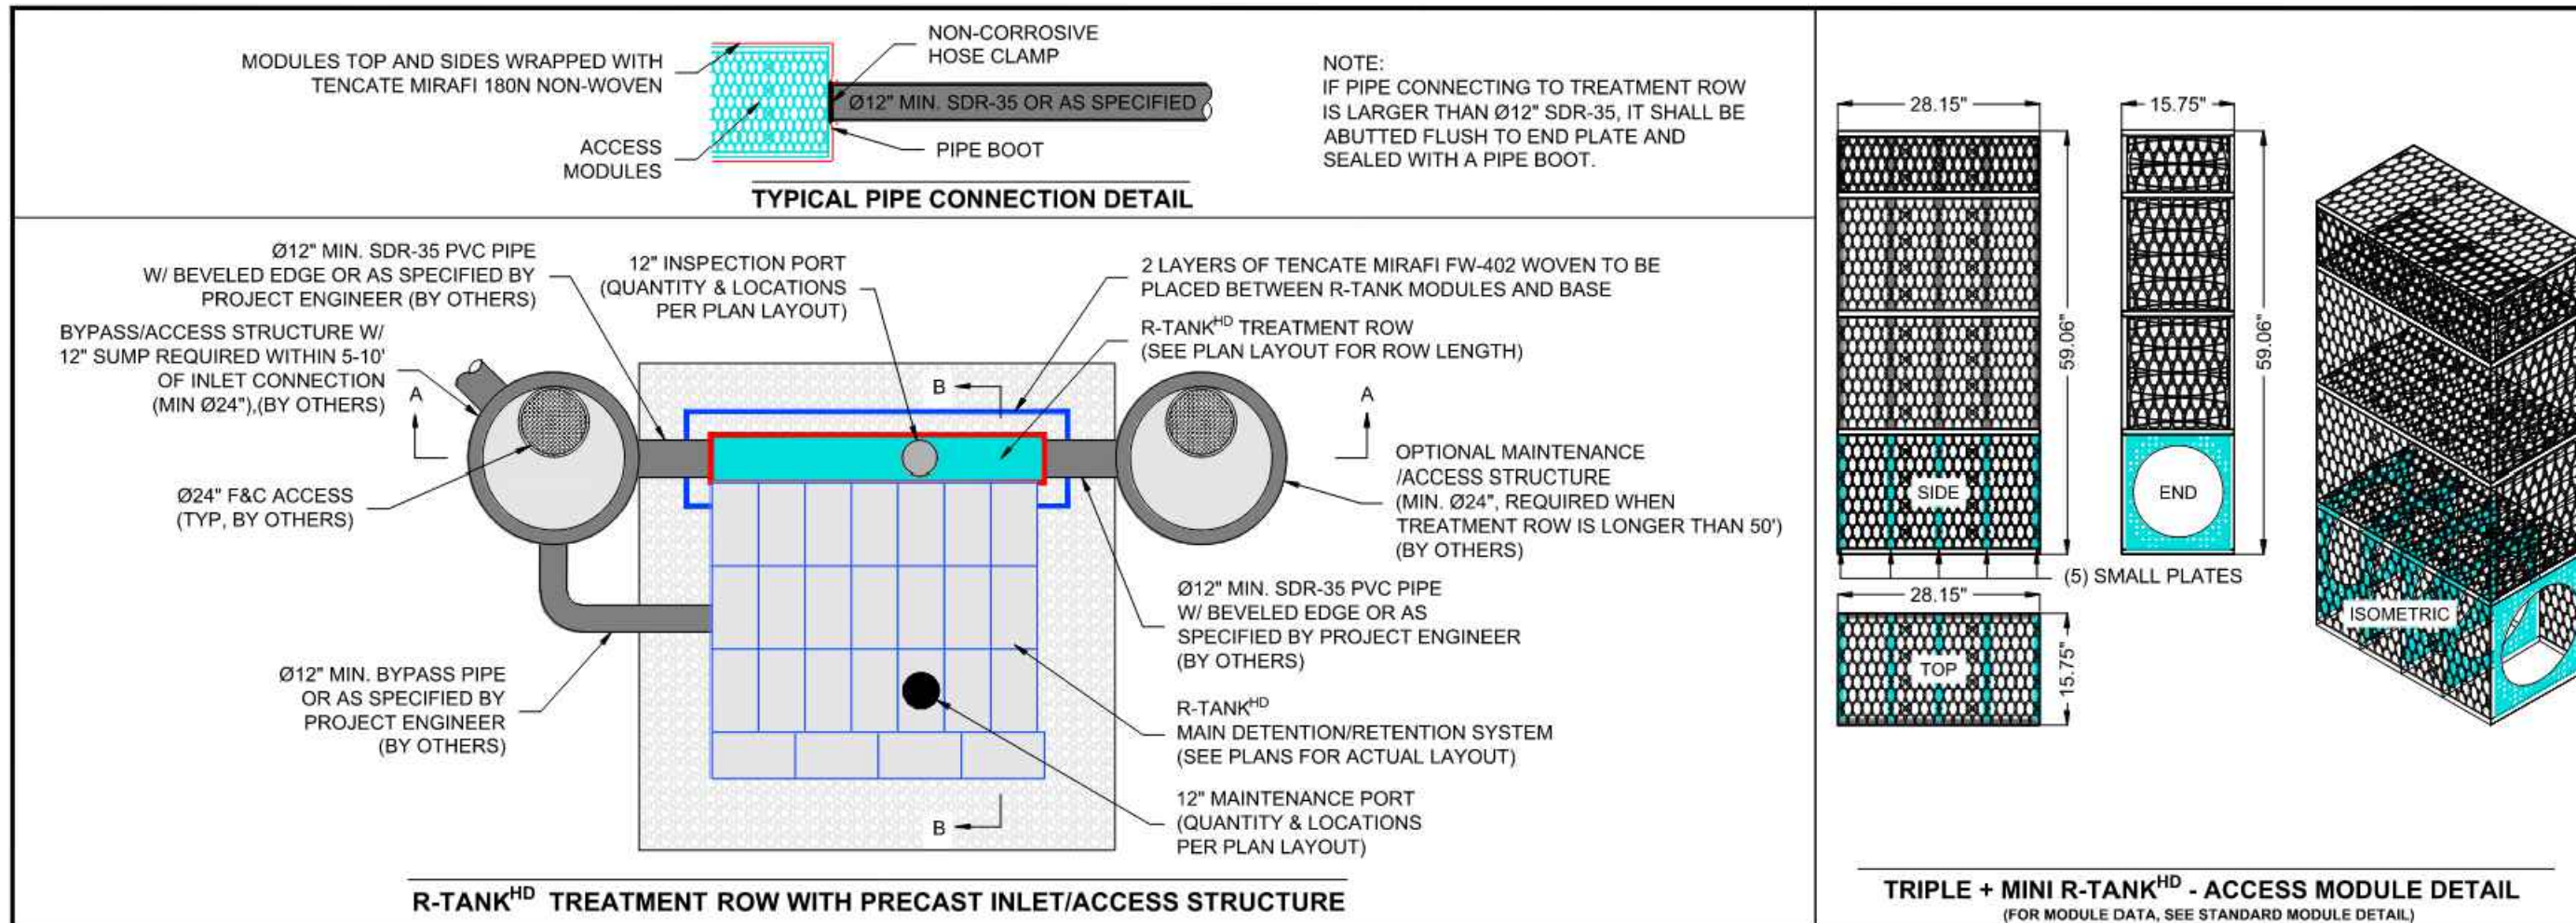

R-TANK® SYSTEM DETAILS
EAST TOWN CROSSING
PUYALLUP, WA
SITE DESIGNATION: R-TANK 2

REVISED BY EDQ
DATE 02/21/2024
ACF WEST, INC. 23-004WA
6 of 8



Revisions:

01/29/24 CITY COMMENTS

Sheet Title:

R-TANK 2 NOTES AND DETAILS

Designed by: CW
Drawn by: SK / RS
Checked by: JI

Sheet No.

C4.22

29 of 53 Sheets

EAST TOWN CROSSING PHASE 1


SEC. 26,35/ TWP. 20 N./ RGE. 4 E., W.M.

APPROVED

BY
CITY OF PUYALLUP
DEVELOPMENT ENGINEERING

DATE

NOTE: THIS APPROVAL IS VOID AFTER 180 DAYS FROM APPROVAL DATE.
THE CITY WILL NOT BE RESPONSIBLE FOR ERRORS AND/OR OMISSIONS ON THESE PLANS.
FIELD CONDITIONS MAY DICTATE CHANGES TO THESE PLANS AS DETERMINED BY THE DEVELOPMENT ENGINEERING MANAGER.

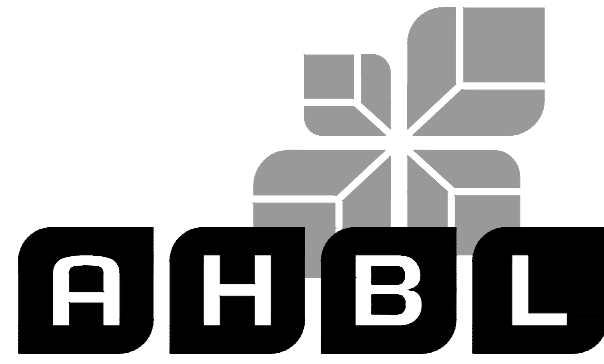

TACOMA · SEATTLE · SPOKANE · TRI-CITIES

2215 North 30th Street, Suite 300, Tacoma, WA 98403
253.383.2422 TEL 253.383.2572 FAX www.ahbl.com WEB

Project Title:

EAST TOWN CROSSING PHASE 1

Client:

ASH DEVELOPMENT

GREG HELLE

GREG.HELLE@ASHNW.COM


Project No.

2230752

Issue Set & Date:

PERMIT SUBMITTAL


02/20/2024

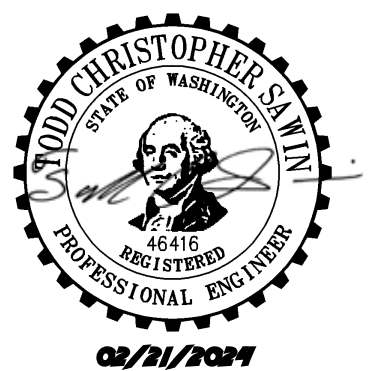

NOTICE
ALTERATION OF THIS DOCUMENT SHALL INVALIDATE THE PROFESSIONAL SEAL AND SIGNATURE. PUBLICATION OF THIS DOCUMENT DOES NOT CONSTITUTE AN ENDORSEMENT OR GUARANTEE BY THE ENGINEER OR ARCHITECT. THE ENGINEER OR ARCHITECT IS NOT TO BE HELD RESPONSIBLE FOR ANY ERRORS OR OMISSIONS IN THIS DOCUMENT OR FOR ANY OTHER PROJECT.

ACKNOWLEDGEMENT:
AN APPROVAL OF THE SUBMITTAL PLANS IS REQUIRED PRIOR TO MATERIAL ORDER. AS PART OF THE SUBMITTAL APPROVAL, THE ENGINEER OF RECORD HEREBY ACKNOWLEDGES THAT THE R-TANK SYSTEM IS NOT DESIGNED TO SUPPORT LOADS FROM BUILDINGS OR STRUCTURES. THEREFORE, THE ENGINEER OF RECORD HAS COORDINATED WITH THE PROPER DISCIPLINES TO ENSURE NO STRUCTURAL LOADS ARE IMPARTED UPON THE SYSTEM AND ANY INFILTRATION FROM THE SYSTEM HAS BEEN ACCOUNTED FOR IN THE FOUNDATION DESIGN.

NOTES:
- THE CONTRACTOR SHALL PARTICIPATE IN A PRECONSTRUCTION MEETING AND SIGN THE PRECONSTRUCTION CHECKLIST PRIOR TO MATERIAL INSTALLATION.
- DOCUMENTATION SHALL BE RECORDED BY THE CONTRACTOR OR ENGINEER OF RECORD SHOWING PROPER INSTALLATION OF THE SYSTEM AND ALL CONNECTIONS, IN ACCORDANCE WITH MANUFACTURER SPECIFICATIONS.
- IT IS HEREBY RECOMMENDED THAT THE R-TANK SYSTEM BE INSTALLED AFTER THE FOUNDATIONS HAVE BEEN INSTALLED TO ENSURE PROPER SEPARATION DISTANCES ARE MAINTAINED.

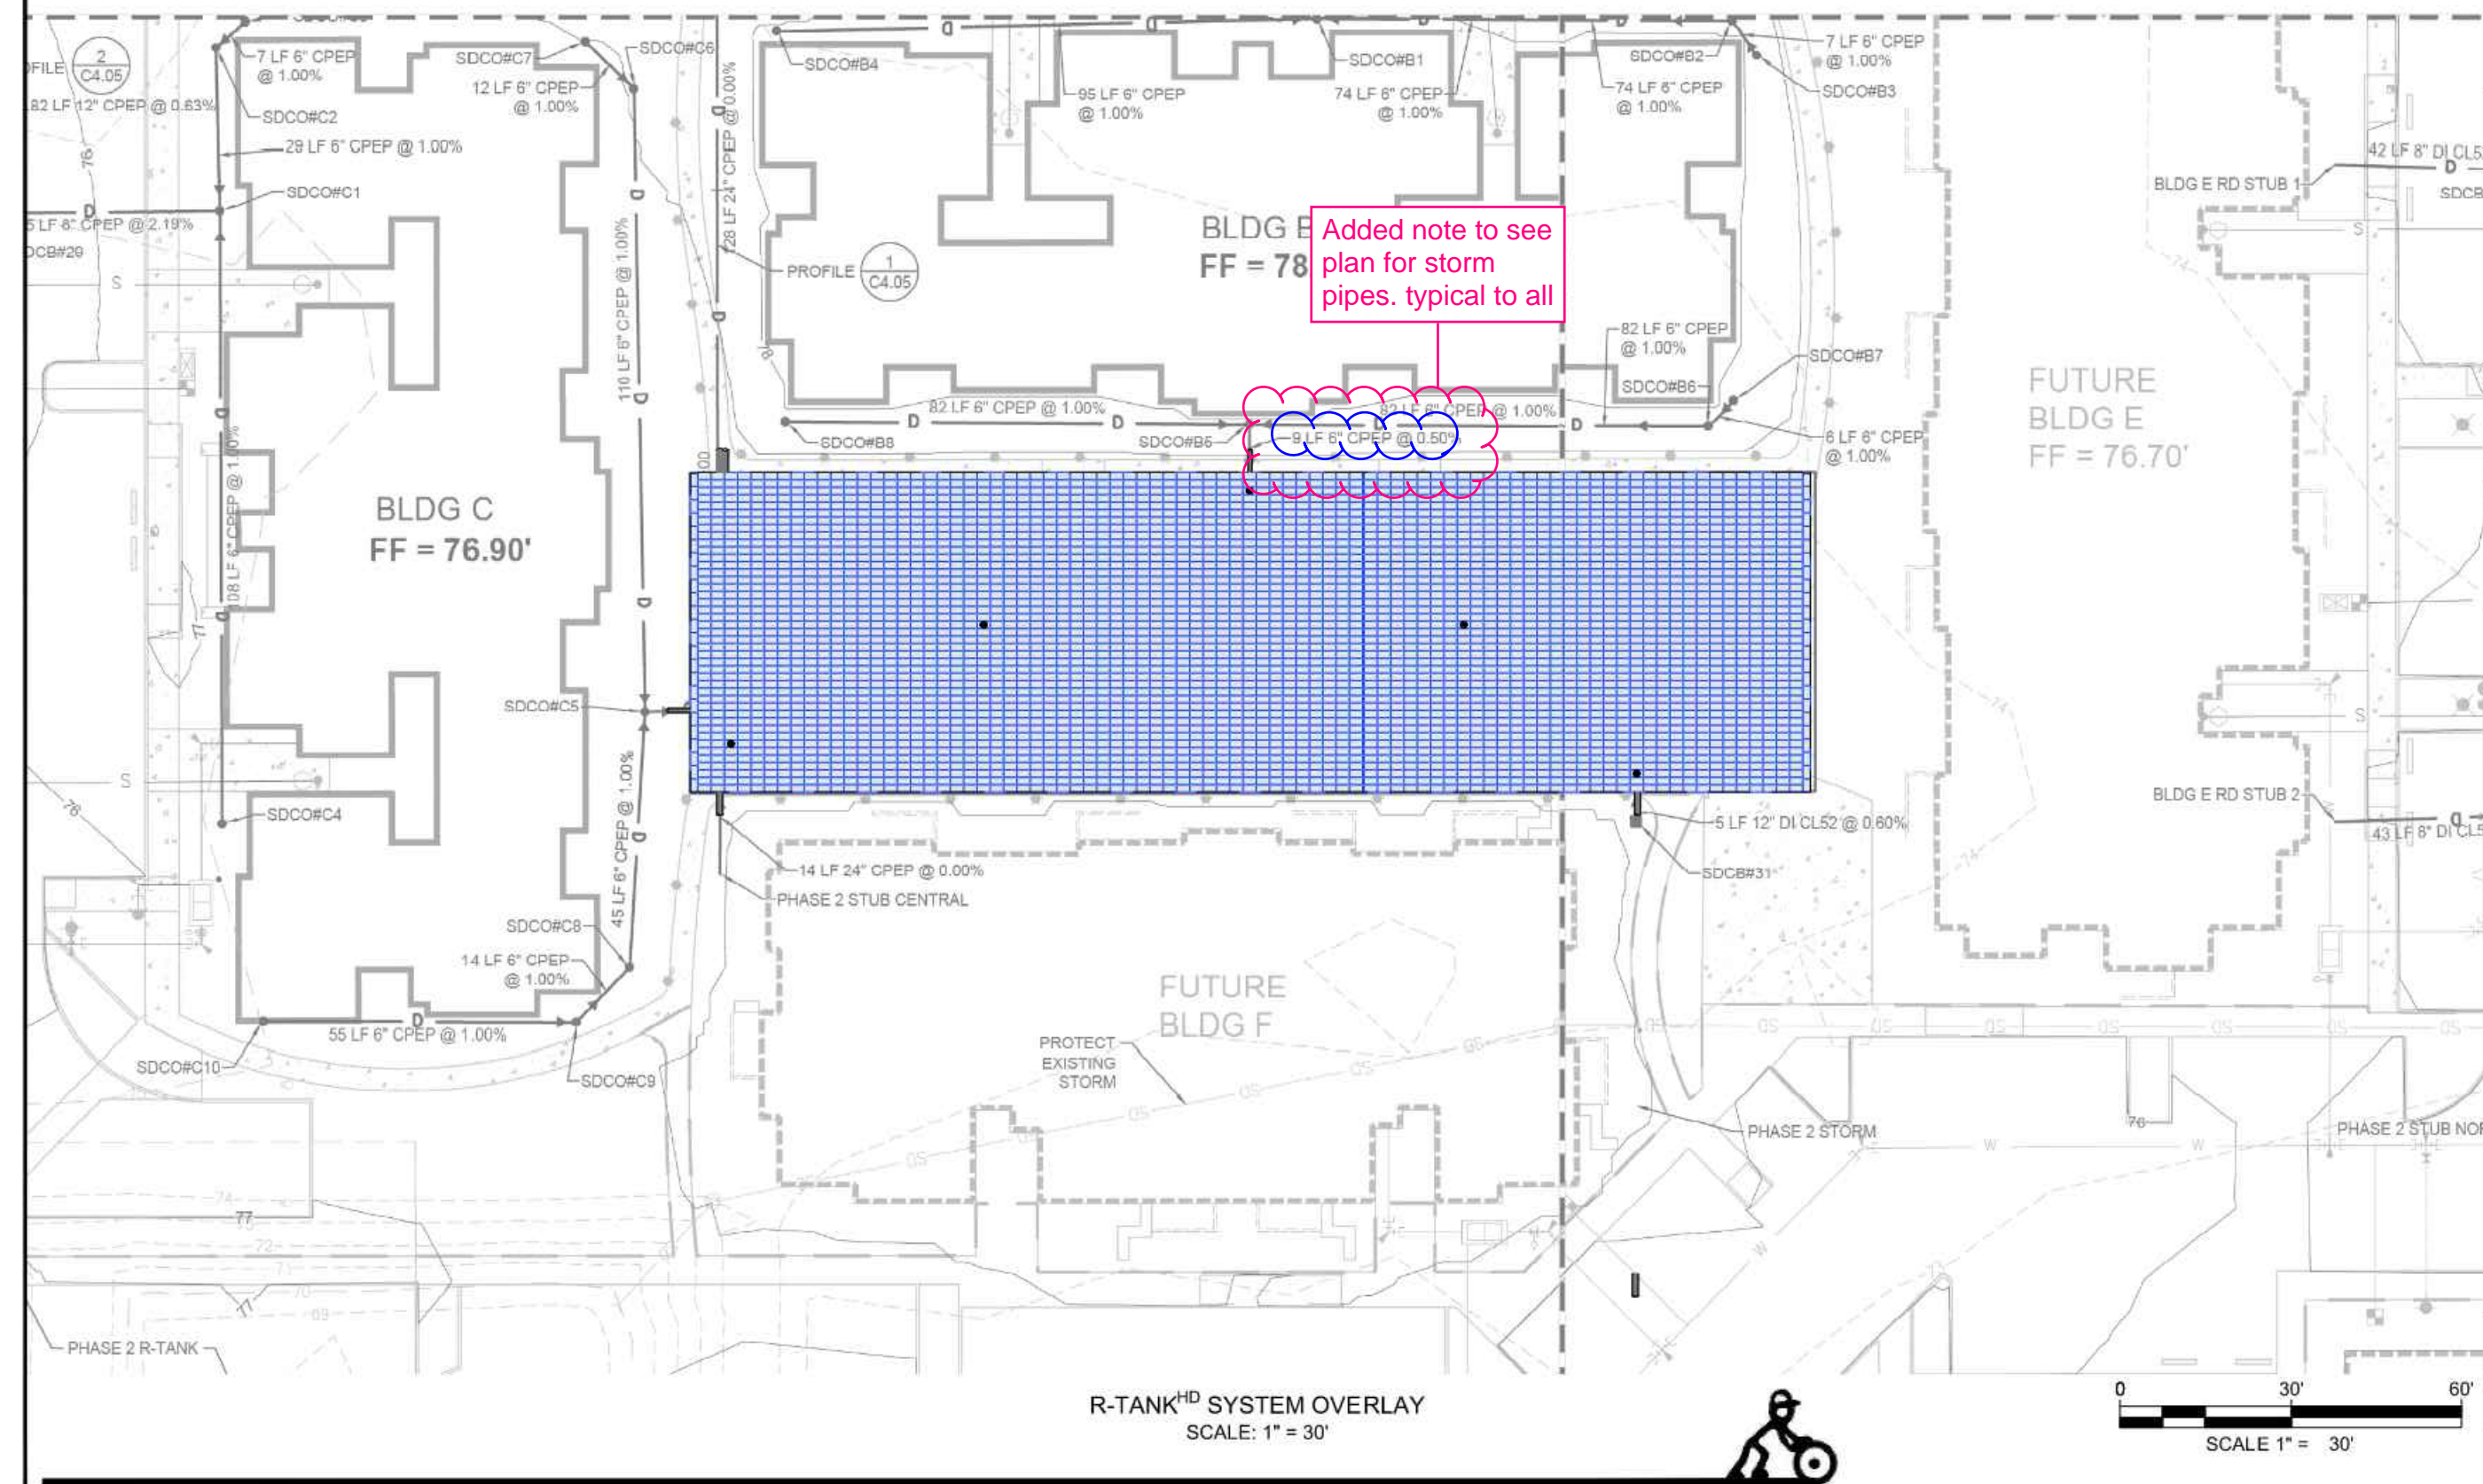


R-TANK
ENGINEER OF RECORD TO REVIEW, APPROVE AND ENDORSE FINAL SITE SPECIFIC DESIGN.

ACF WEST, Inc.
GEO SYNTHETICS
PRODUCTS | SERVICES | SOLUTIONS
FOR ADDITIONAL INFORMATION PLEASE CONTACT:
ACF WEST, 1-800-423-4467, www.acfwest.com

**R-TANK[®] SYSTEM OVERLAY
EAST TOWN CROSSING
PUYALLUP, WA
SITE DESIGNATION: R-TANK 3**

EDQ
02/20/2024
23-004WA


1 of 6

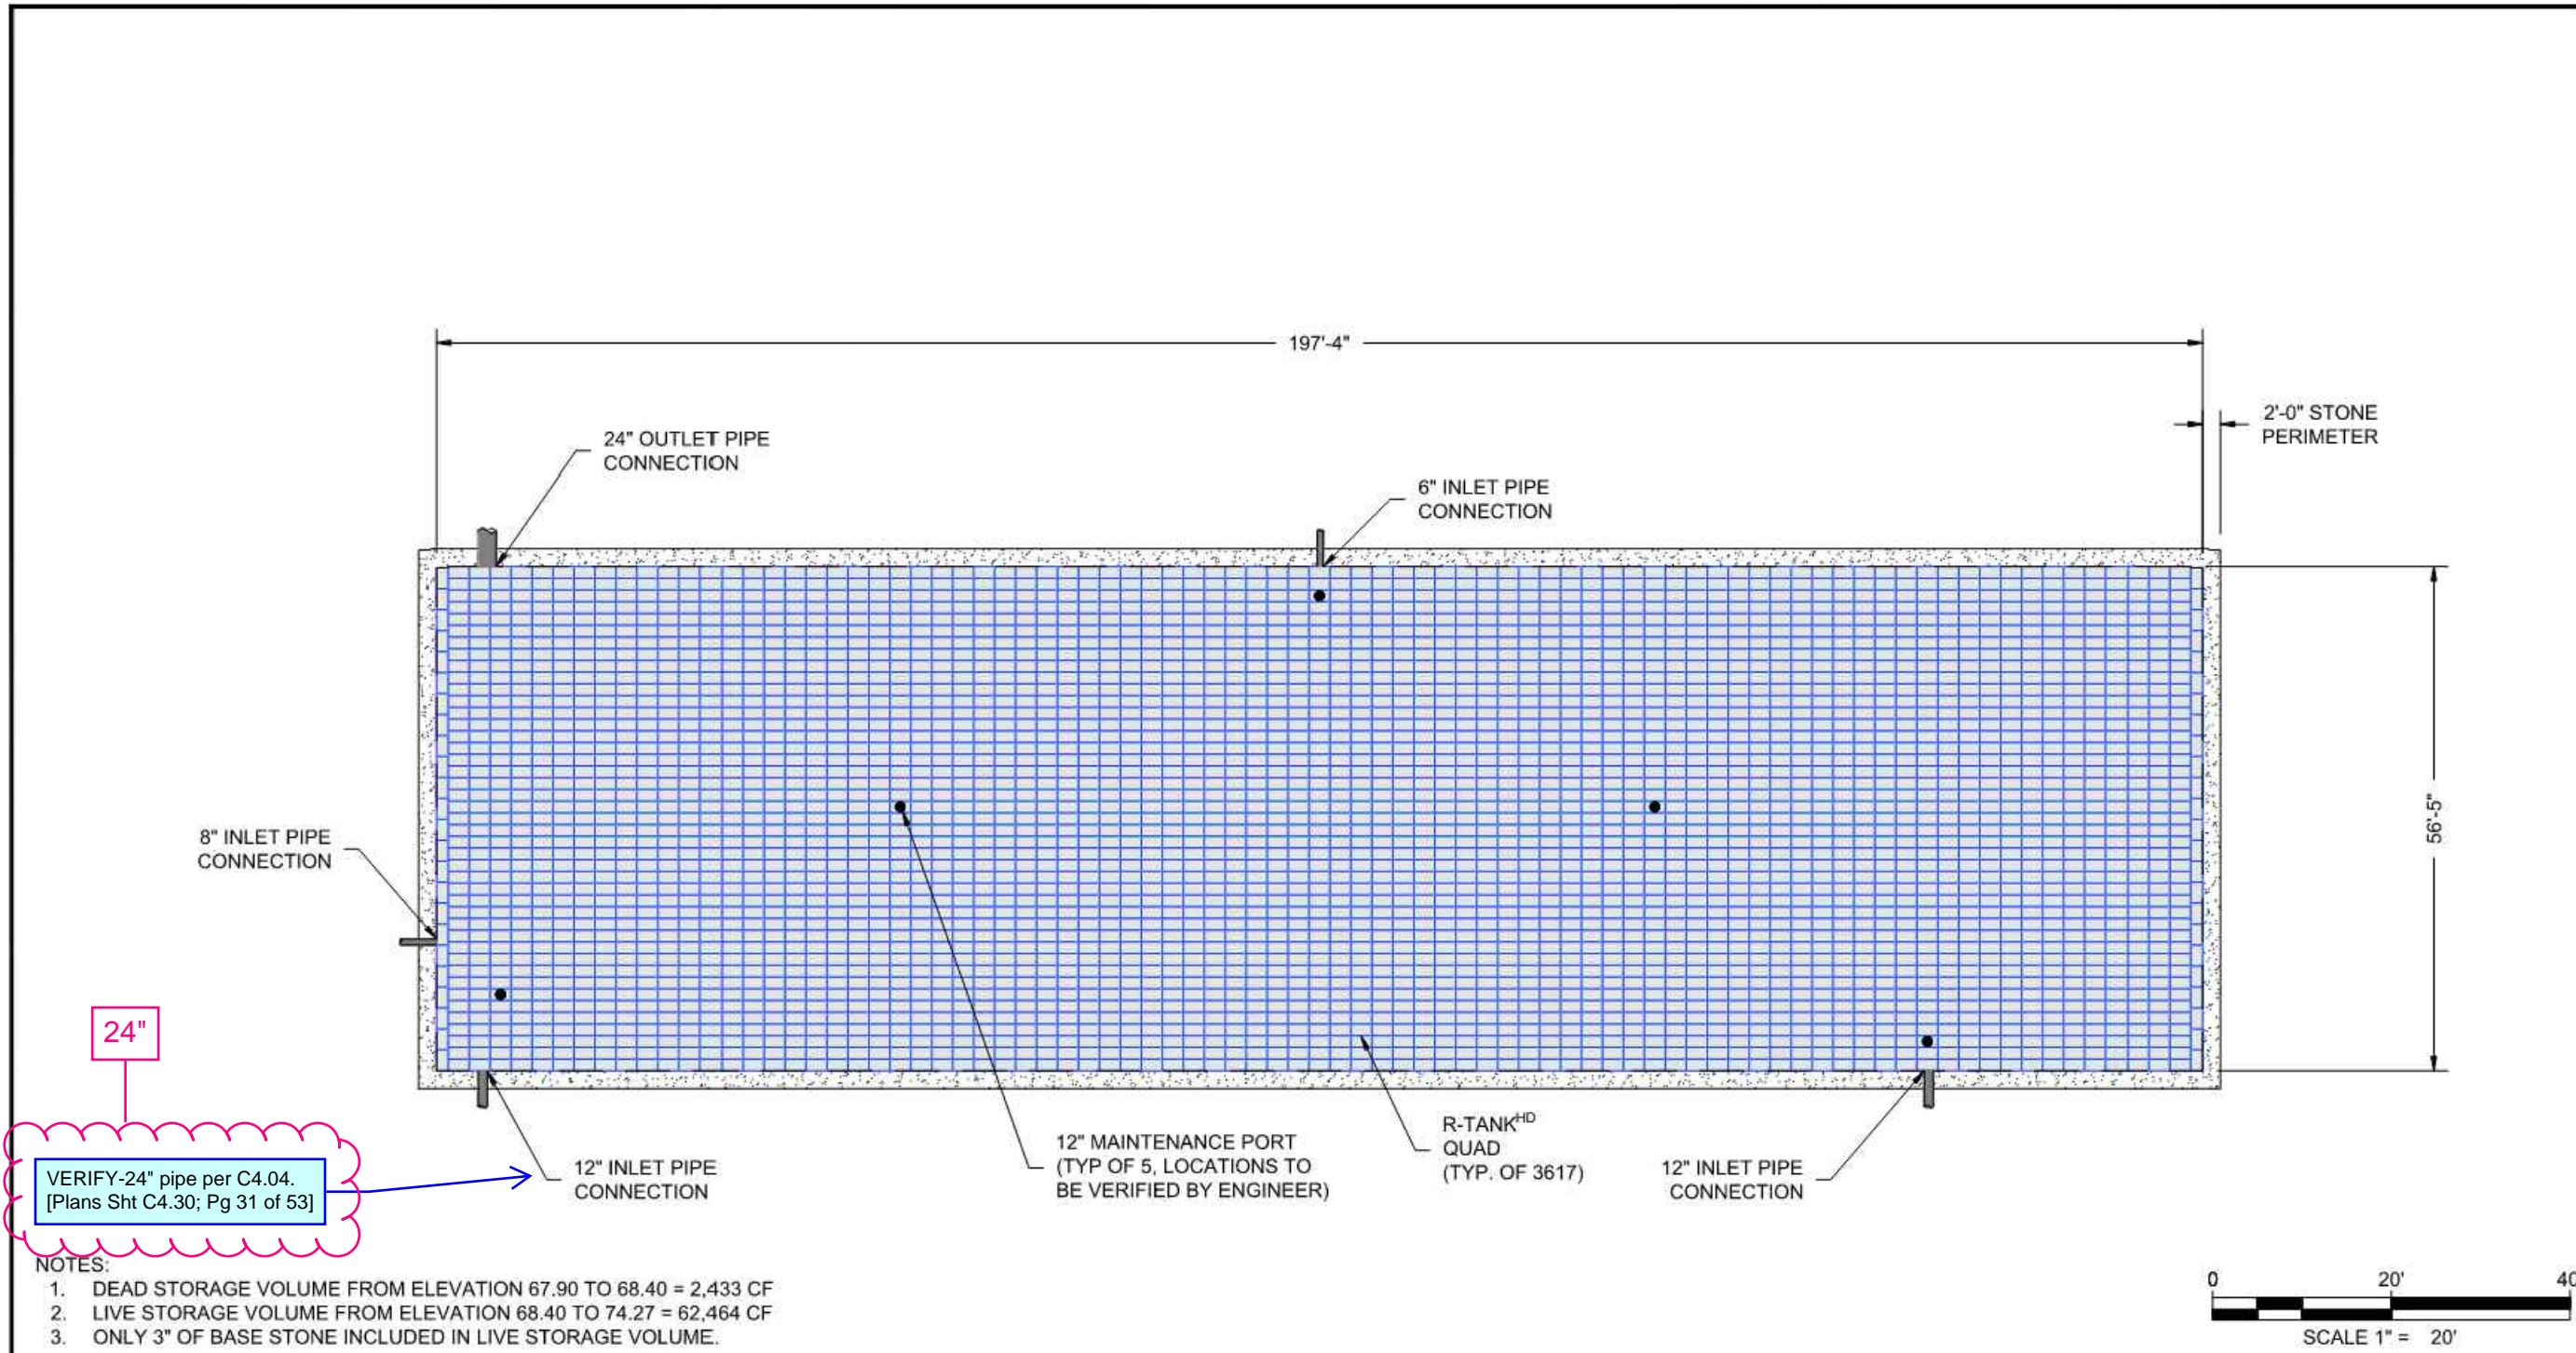

NOTES:
1. DEAD STORAGE VOLUME FROM ELEVATION 67.90 TO 68.40 = 2,433 CF
2. LIVE STORAGE VOLUME FROM ELEVATION 68.40 TO 74.27 = 62,464 CF
3. ONLY 3" OF BASE STONE INCLUDED IN LIVE STORAGE VOLUME.

LAYOUT SCALE	1" = 20'
R-TANK [®] MODULE TYPE	QUAD
TRAFFIC LOAD	HS-20
# OF QUAD R-TANKS	3,727
TOTAL SYSTEM STORAGE	62,464 CF
R-TANK STORAGE VOLUME	60,787 CF
STONE STORAGE VOLUME (40% VOID RATIO)	1,677 CF
NAUE SECUGRID 30/30 GEOGRID ELEV.	75.23
TOP OF COVER STONE ELEV. (12")	75.23
TOP OF R-TANK ELEV.	74.23
TANK INVERT	68.85
INVERT OF STONE BASE (6")	67.90
MIN. STONE PERIMETER WIDTH	2.0 FT

SEE SHEETS 3 - 6 FOR DETAILS AND ADDITIONAL INFORMATION

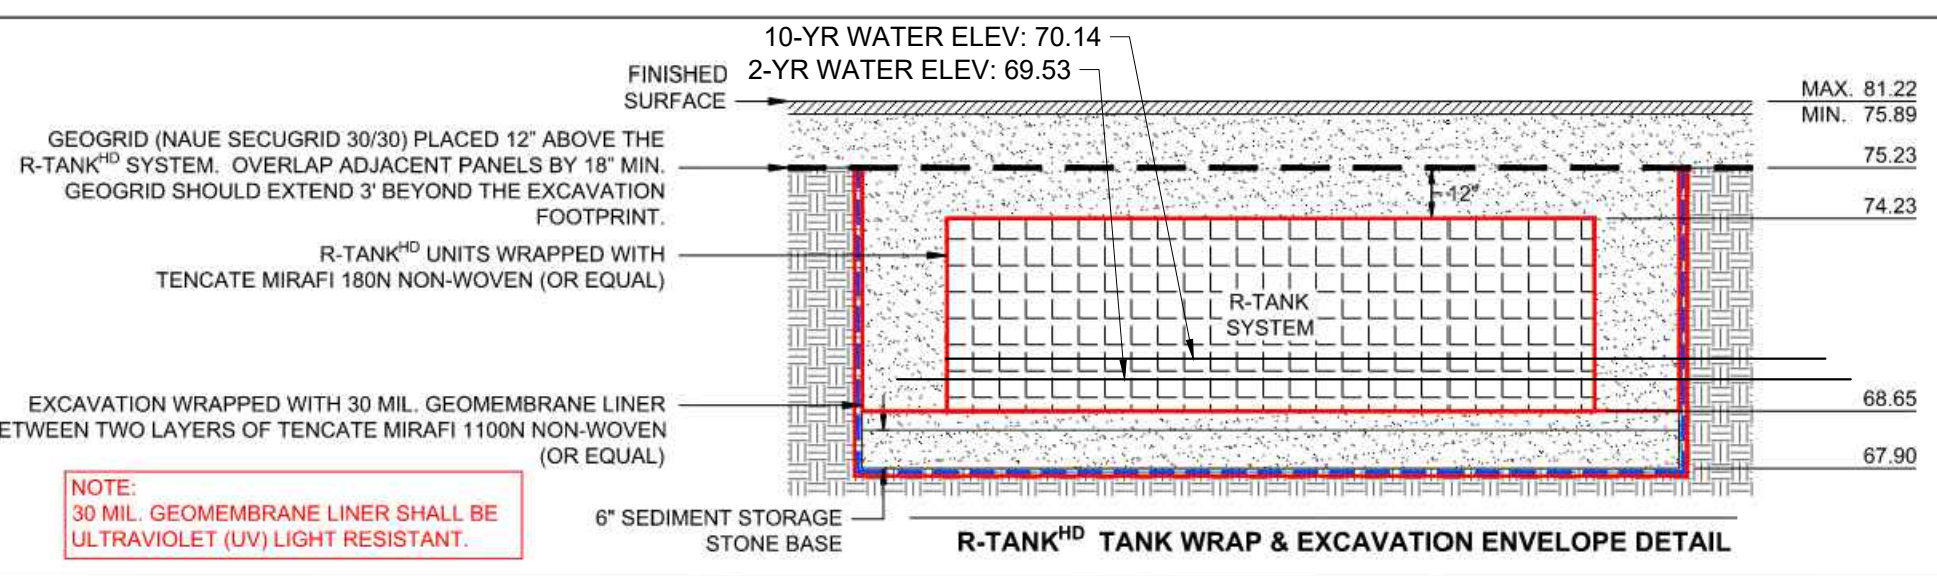

NOTE:
30 MIL. GEOMEMBRANE LINER SHALL BE ULTRAVIOLET (UV) LIGHT RESISTANT.

R-TANK
ENGINEER OF RECORD TO REVIEW, APPROVE AND ENDORSE FINAL SITE SPECIFIC DESIGN.

ACF WEST, Inc.
GEO SYNTHETICS
PRODUCTS | SERVICES | SOLUTIONS
FOR ADDITIONAL INFORMATION PLEASE CONTACT:
ACF WEST, 1-800-423-4467, www.acfwest.com

**R-TANK[®] SYSTEM LAYOUT
EAST TOWN CROSSING
PUYALLUP, WA
SITE DESIGNATION: R-TANK 3**

EDQ
02/20/2024
23-004WA

2 of 6

Revisions:

01/29/24 CITY COMMENTS

Sheet Title:
R-TANK 3 NOTES AND DETAILS

Designed by: CW
Drawn by: SK / RS
Checked by: JI

Sheet No.
C4.30
31 of 53 Sheets



EAST TOWN CROSSING PHASE 1


SEC. 26,35/ TWP. 20 N./ RGE. 4 E., W.M.

APPROVED

BY CITY OF PUYALLUP
DEVELOPMENT ENGINEERING

DATE

NOTE: THIS APPROVAL IS VOID AFTER 180 DAYS FROM APPROVAL DATE. THE CITY WILL NOT BE RESPONSIBLE FOR ERRORS AND/OR OMISSIONS ON THESE PLANS. FIELD CONDITIONS MAY DICTATE CHANGES TO THESE PLANS AS DETERMINED BY THE DEVELOPMENT ENGINEERING MANAGER.

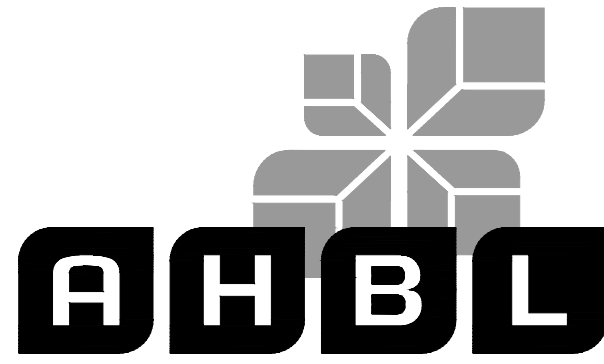

TACOMA · SEATTLE · SPOKANE · TRI-CITIES

2215 North 30th Street, Suite 300, Tacoma, WA 98403
253.383.2422 TEL 253.383.2572 FAX www.ahbl.com WEB

Project Title:

EAST TOWN CROSSING PHASE 1

Client:

ASH DEVELOPMENT

GREG HELLE

GREG.HELLE@ASHNW.COM

Project No.

2230752


Issue Set & Date:

PERMIT SUBMITTAL

02/20/2024



NOTICE: A REVIEWER OF THIS DOCUMENT SHALL INDICATE THE PROFESSIONAL SEAL AND SIGNATURE PUBLICATION OF THE ENGINEER DOES NOT CONSTITUTE A GUARANTEE OR WARRANTY FOR THE PROJECT. THE ENGINEER IS NOT TO BE HELD RESPONSIBLE FOR ANY ACTION TO THAT PROJECT OR FOR ANY OTHER PROJECT.

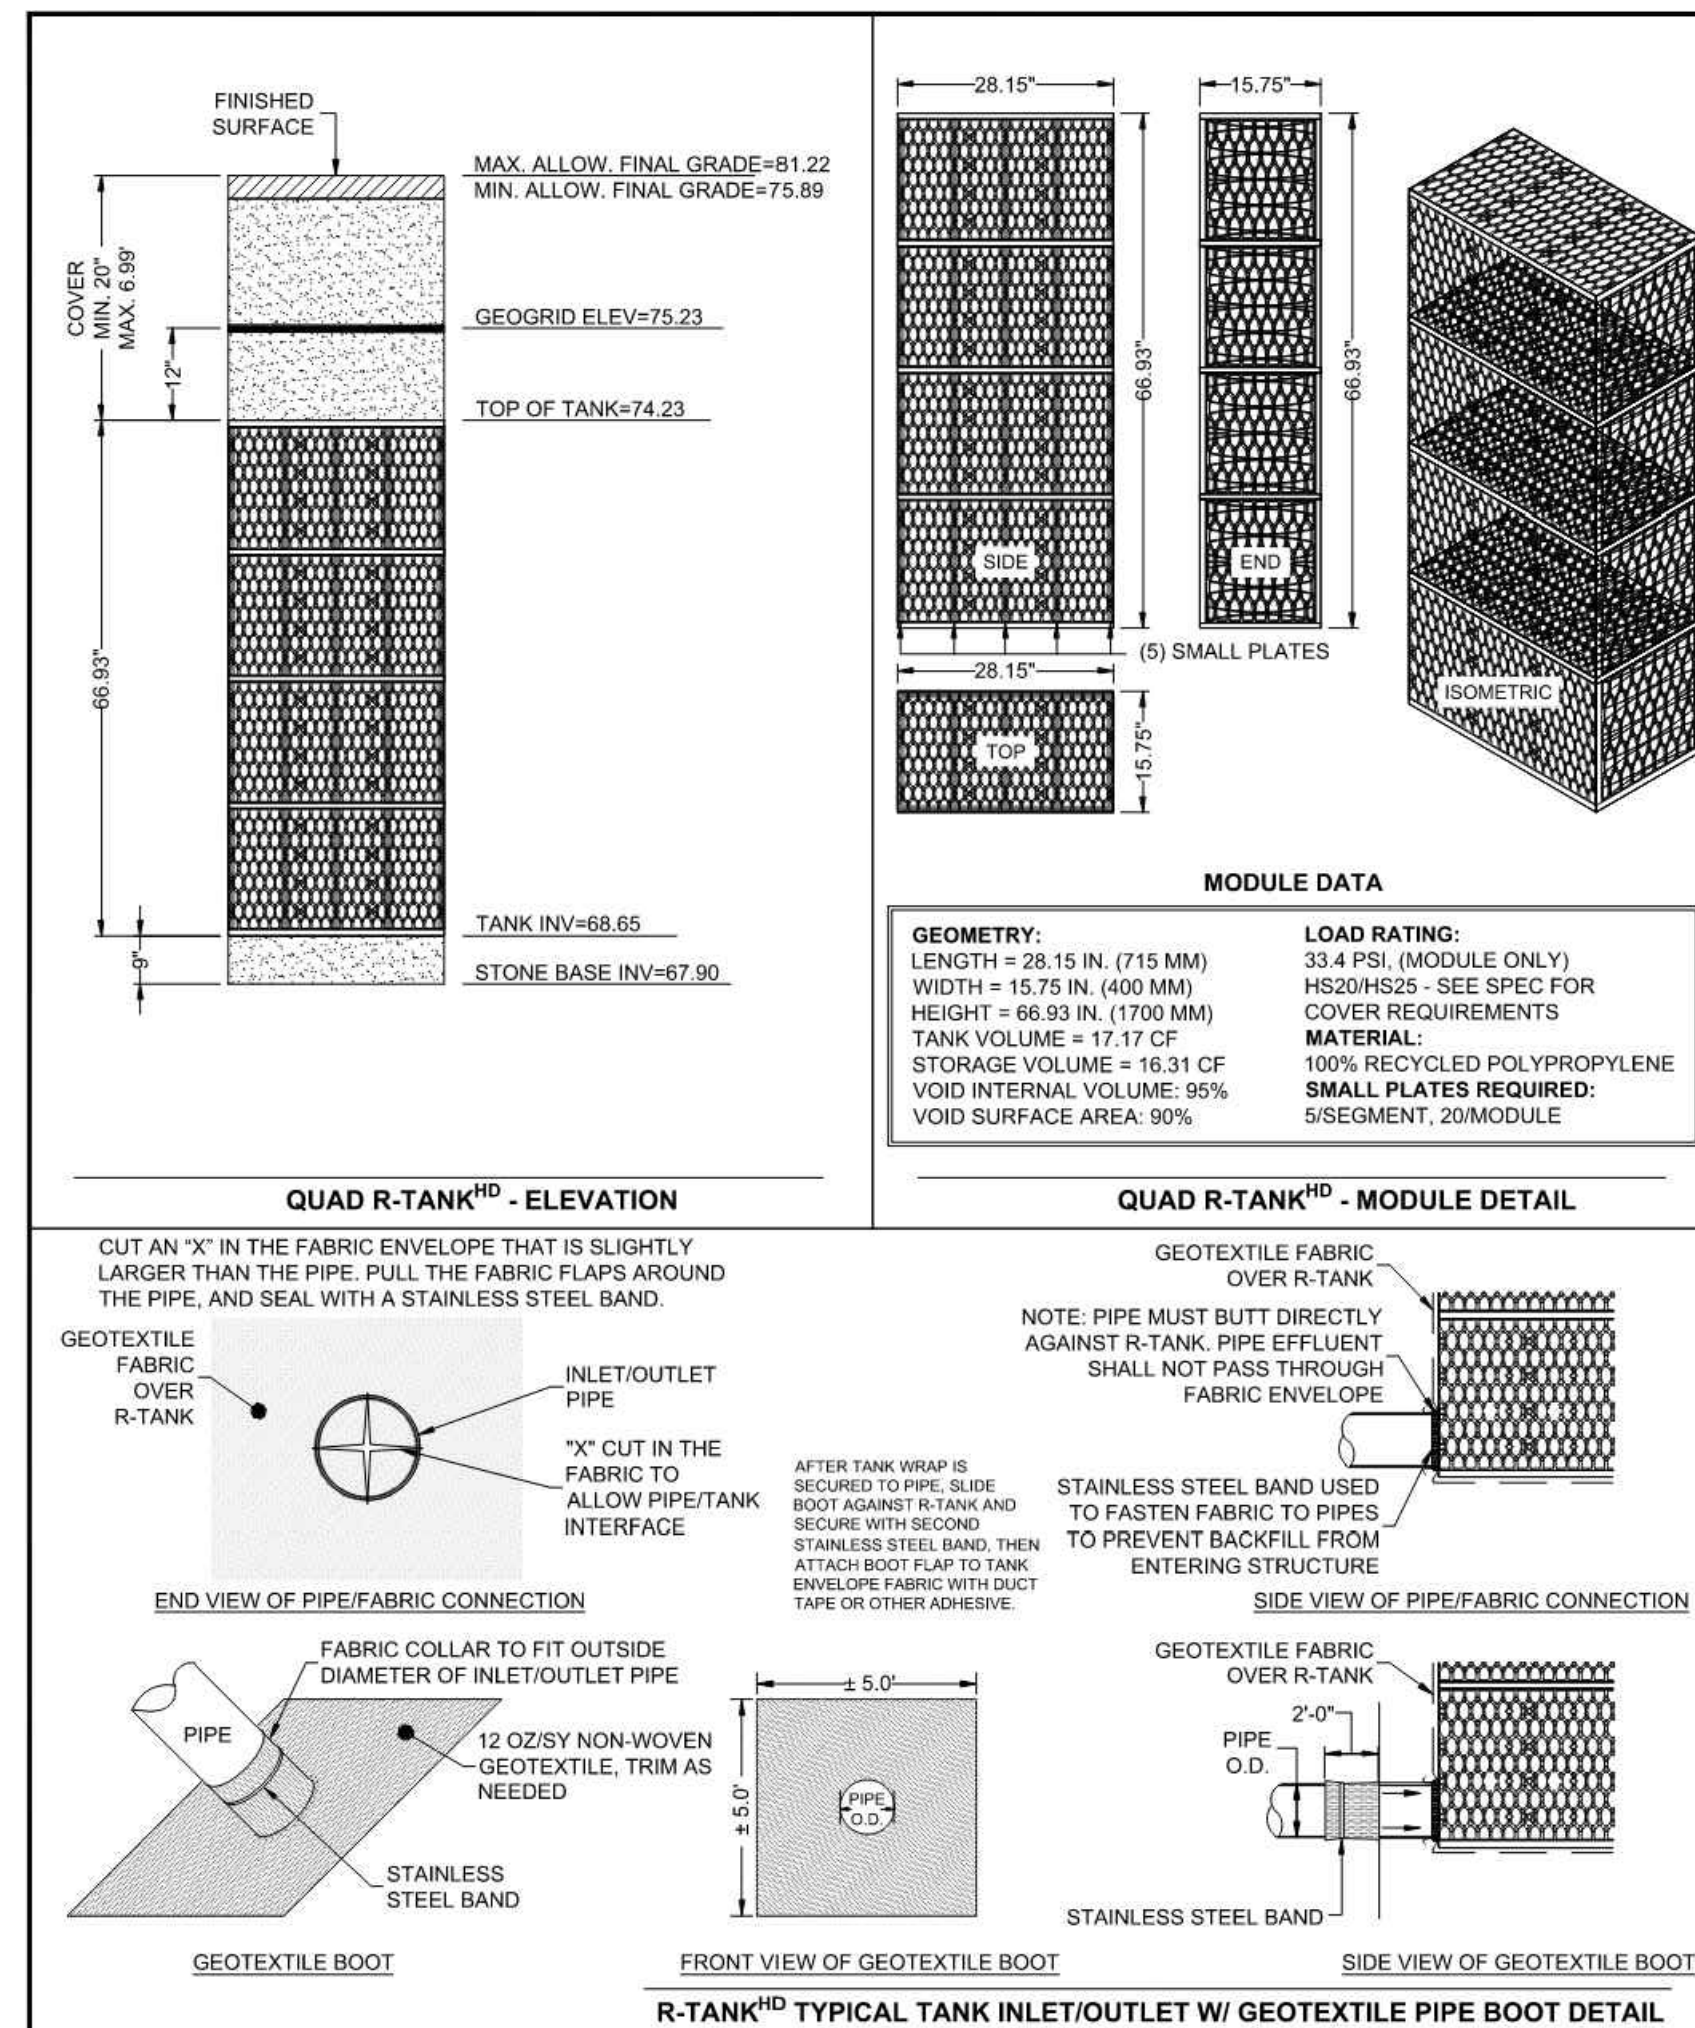




R-TANK [®] QUANTITIES	
R-TANK [®] MODULE TYPE	QUAD
# OF QUAD R-TANKS	3,617
TOTAL SYSTEM STORAGE	67,380 CF
R-TANK STORAGE VOLUME	58,993 CF
STONE STORAGE VOLUME (40% VOID RATIO)	8,387 CF
STONE BED FOOTPRINT	12,167 SF
STONE QUANTITY	1,002 CY
TENCATE MIRAFI 180N NON-WOVEN TANK WRAP	26,872 SF (3,208 SY)
30 MIL. GEOMEMBRANE LINER EXCAVATION WRAP	18,403 SF (2,045 SY)
TENCATE MIRAFI 1100N NON-WOVEN LINER PROTECTION	36,807 SF (4,090 SY)
NAUE SECUGRID 30/30 GEOGRID	14,599 SF (1,622 SY)
12" MAINTENANCE PORTS	5
8" PIPE BOOTS	2
12" PIPE BOOTS	2
24" PIPE BOOTS	1
TRASHGUARD PLUS UNITS (RECOMMENDED)	2

NOTE: STONE QUANTITY INCLUDES 12" OF COVER AND 9" OF BASE.
NOTE: GEOTEXTILE / LINER QUANTITIES INCLUDE A 15% WASTE FACTOR.

- NOTES:
- DEAD STORAGE VOLUME FROM ELEVATION 67.90 TO 68.40 = 2,433 CF
 - LIVE STORAGE VOLUME FROM ELEVATION 68.40 TO 75.23 = 67,380 CF
 - ONLY 3" OF BASE STONE INCLUDED IN LIVE STORAGE VOLUME.

R-TANK[®] SYSTEM DETAILS
EAST TOWN CROSSING
PUYALLUP, WA
SITE DESIGNATION: R-TANK 3

DATE: 02/20/2024
PROJECT NUMBER: 23-004WA
SHEET: 3 of 6

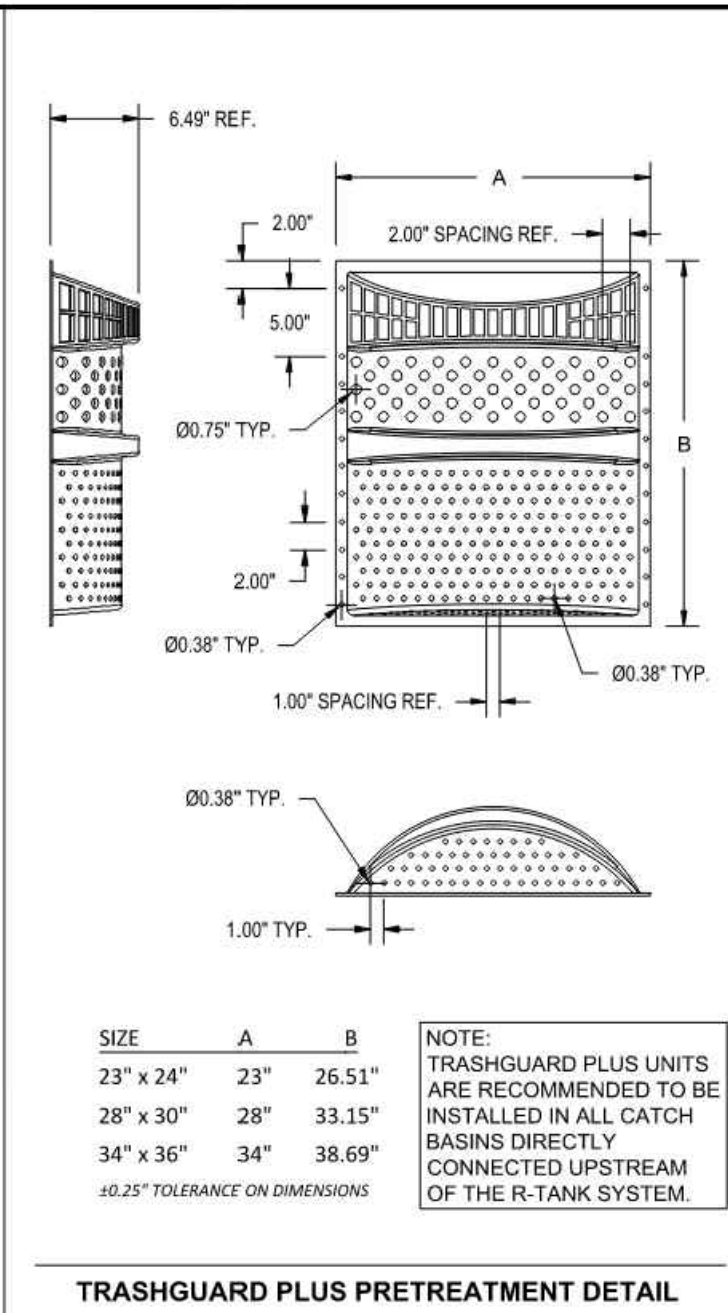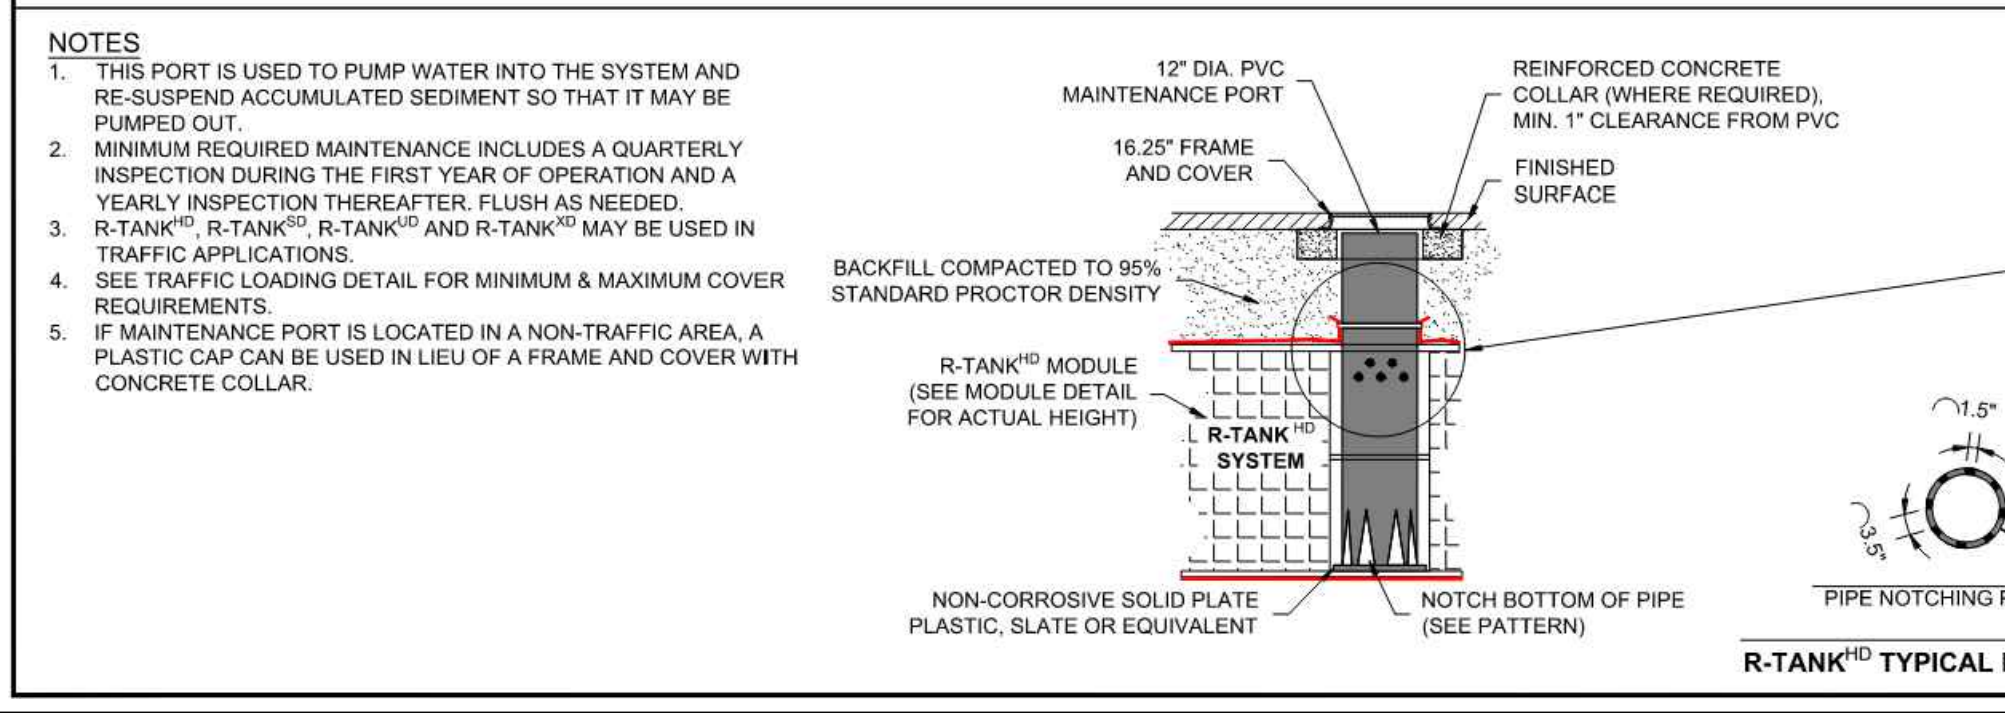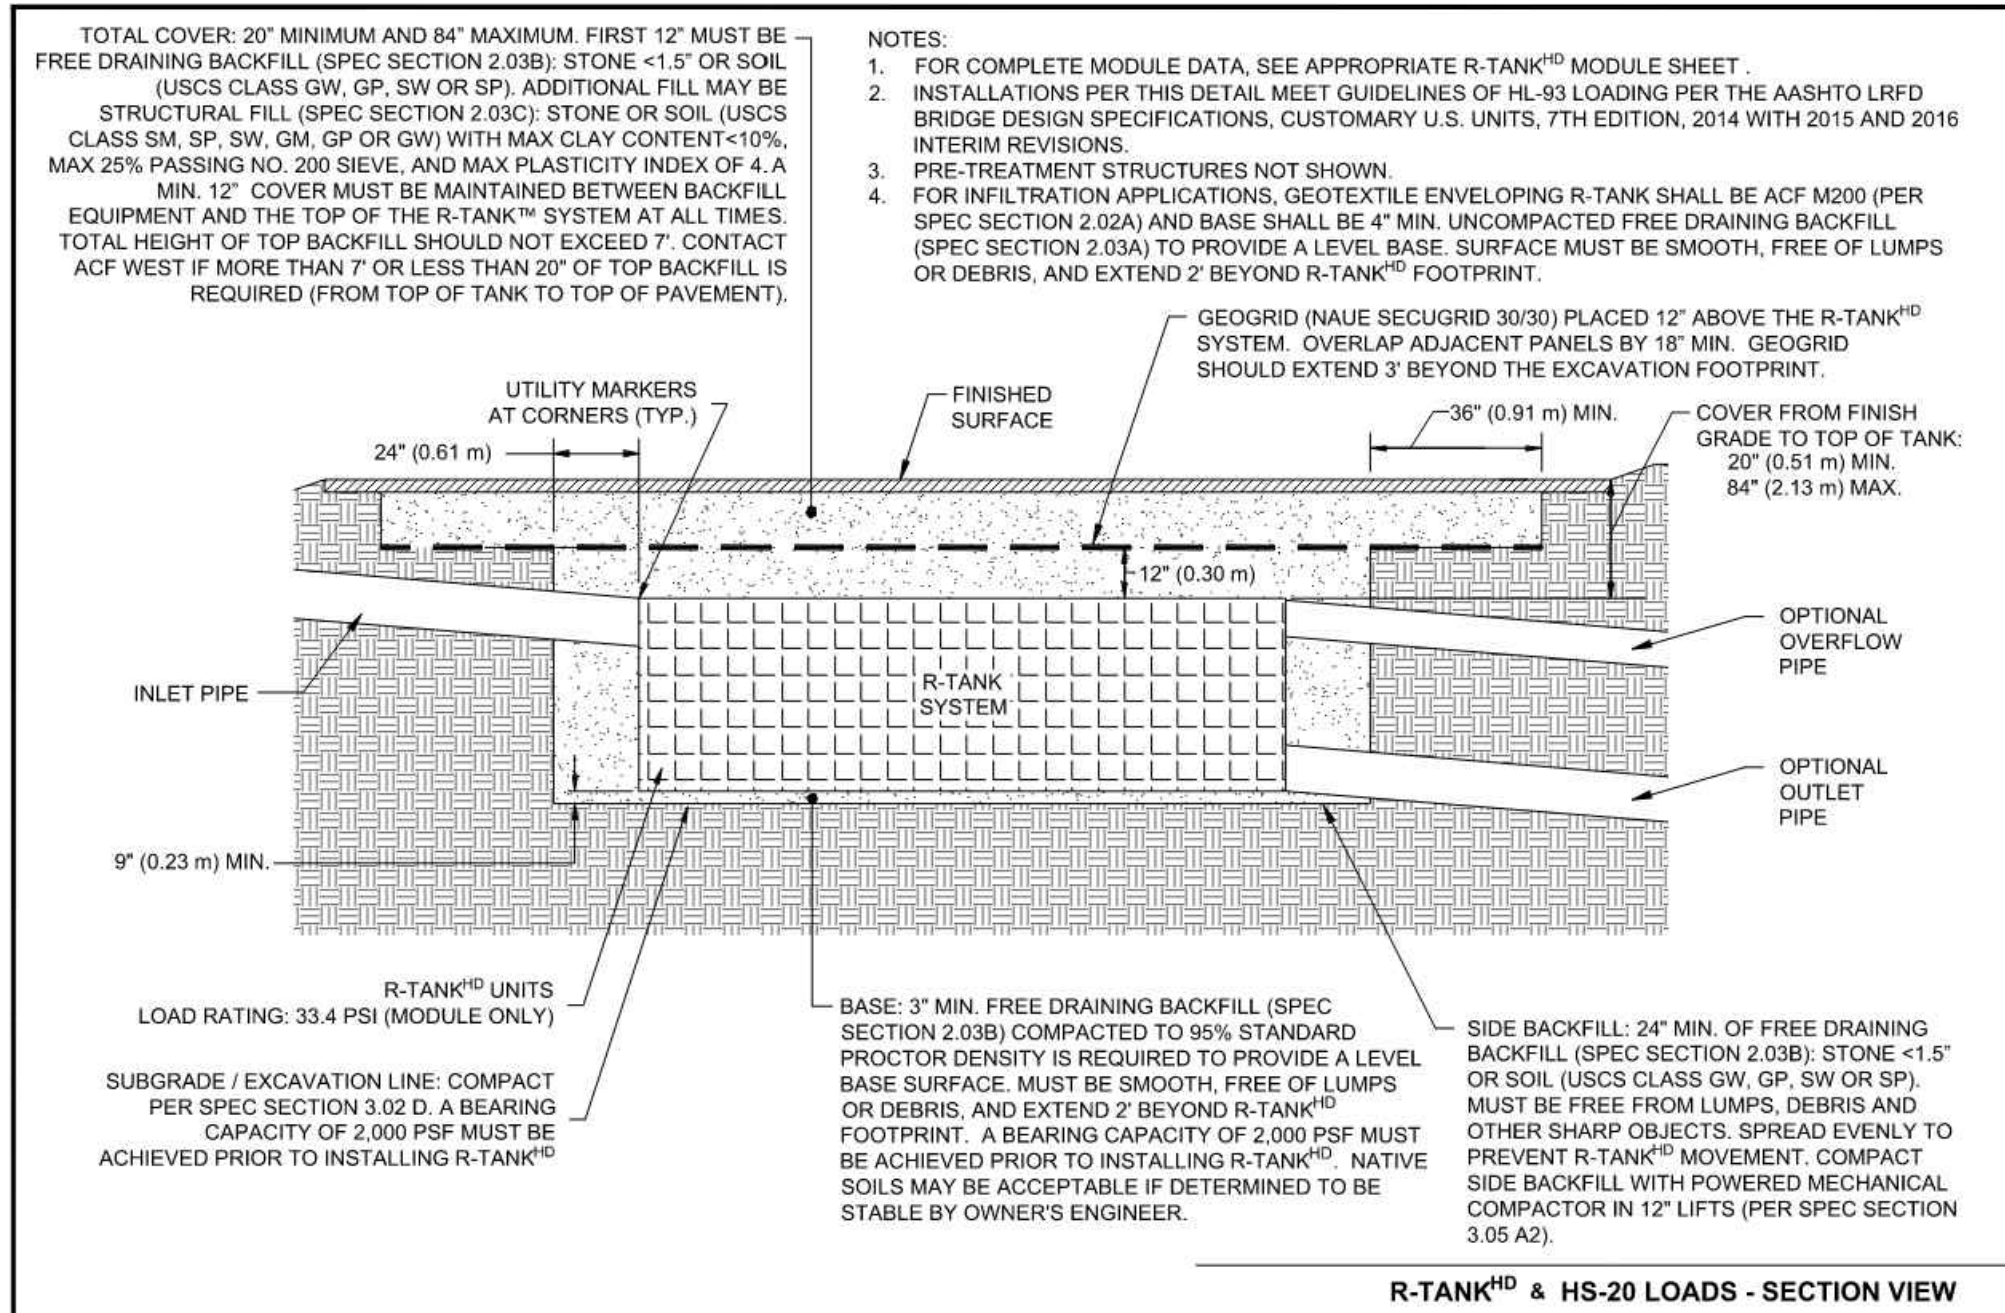

TRASHGUARD PLUS PRETREATMENT DETAIL

SIZE	A	B
23" x 24"	23"	26.51"
28" x 30"	28"	33.15"
34" x 36"	34"	38.69"

NOTE: TRASHGUARD PLUS UNITS ARE RECOMMENDED TO BE INSTALLED IN ALL CATCH BASINS DIRECTLY CONNECTED UPSTREAM OF THE R-TANK SYSTEM.

R-TANK[®] SYSTEM DETAILS
EAST TOWN CROSSING
PUYALLUP, WA
SITE DESIGNATION: R-TANK 3

DATE: 02/20/2024
PROJECT NUMBER: 23-004WA
SHEET: 4 of 6

811
Know what's below.
Call before you dig.

Revisions:

01/29/24 CITY COMMENTS

Sheet Title:

R-TANK 3 NOTES AND DETAILS

Designed by: CW
Drawn by: SK/RS
Checked by: JI

Sheet No.

C4.31

32 of 53 Sheets

EAST TOWN CROSSING PHASE 1


SEC. 26,35/ TWP. 20 N./ RGE. 4 E., W.M.

APPROVED

BY CITY OF PUYALLUP
DEVELOPMENT ENGINEERING

DATE

NOTE: THIS APPROVAL IS VOID AFTER 180 DAYS FROM APPROVAL DATE. THE CITY WILL NOT BE RESPONSIBLE FOR ERRORS AND/OR OMISSIONS ON THESE PLANS. FIELD CONDITIONS MAY DICTATE CHANGES TO THESE PLANS AS DETERMINED BY THE DEVELOPMENT ENGINEERING MANAGER.

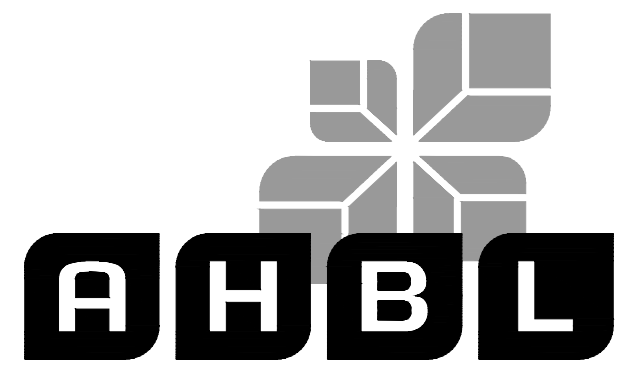

TACOMA · SEATTLE · SPOKANE · TRI-CITIES

2215 North 30th Street, Suite 300, Tacoma, WA 98403
253.383.2422 TEL 253.383.2572 FAX www.ahbl.com WEB


Project Title:
EAST TOWN CROSSING PHASE 1

Client:
ASH DEVELOPMENT


GREG HELLE
GREG.HELLE@ASHNW.COM

Project No.
2230752

Issue Set & Date:
PERMIT SUBMITTAL
02/20/2024

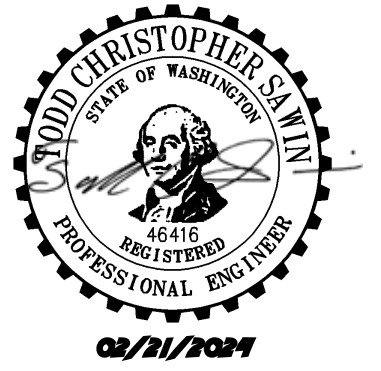

NOTICE

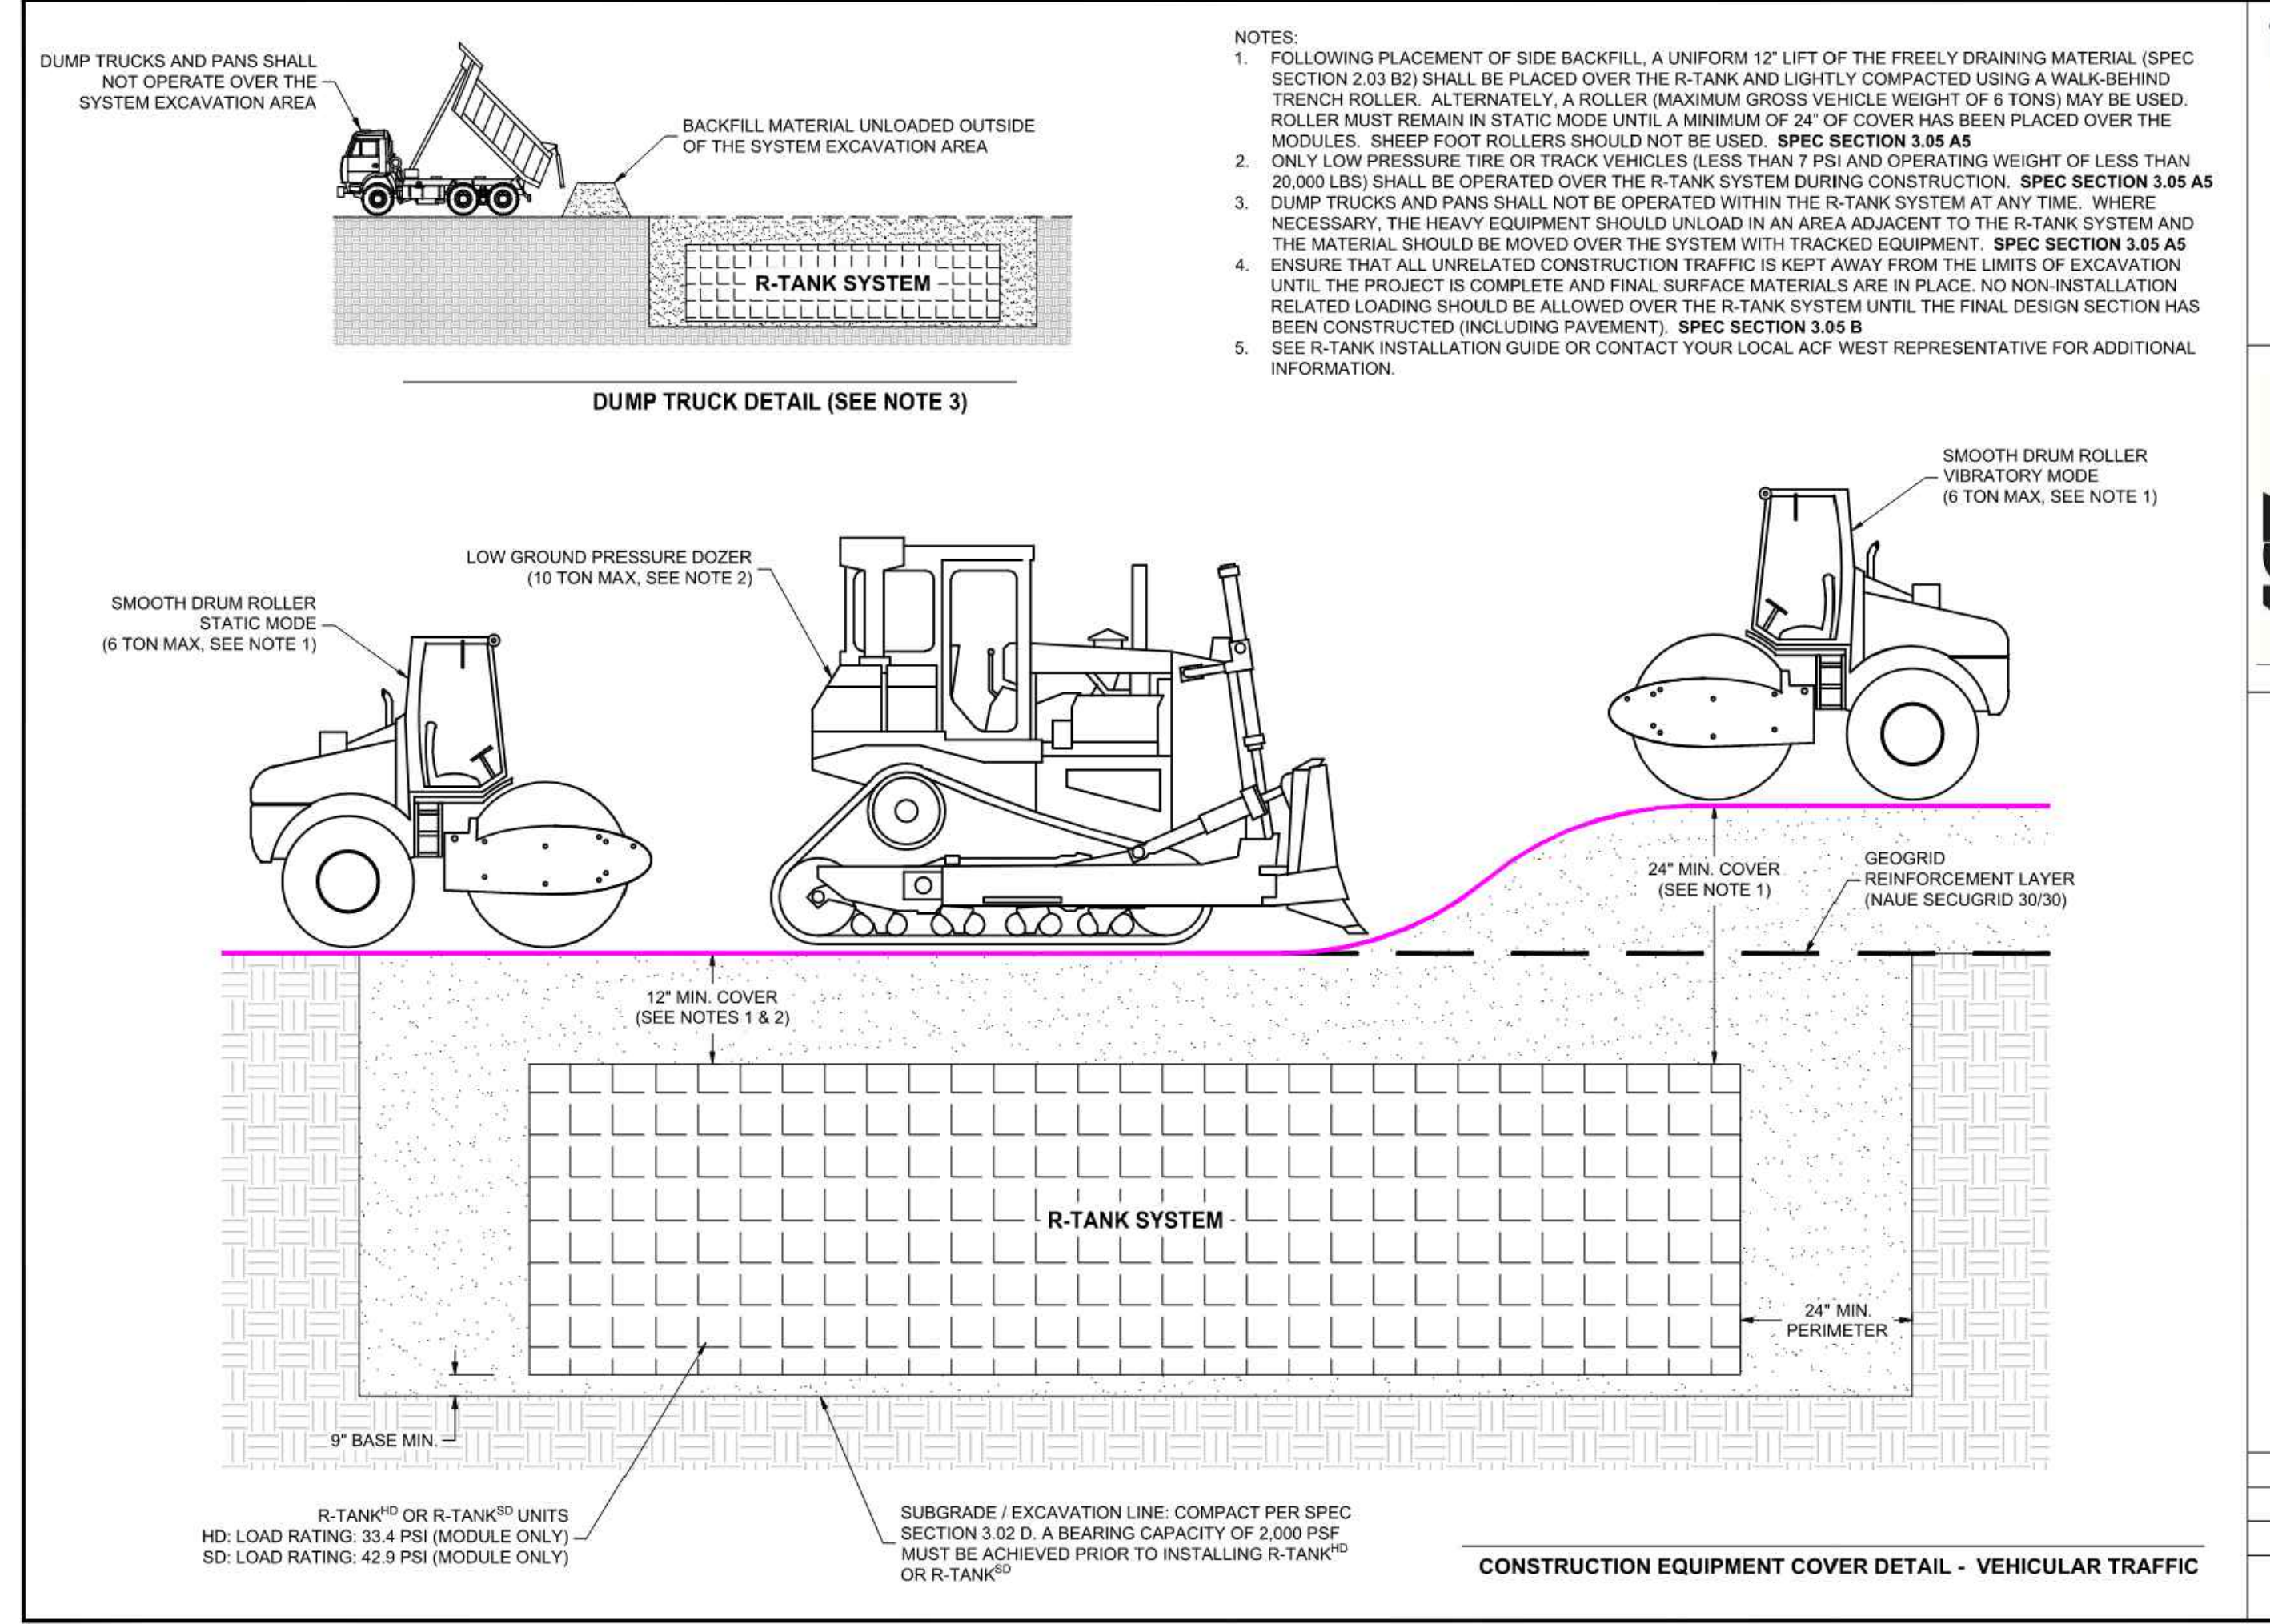

NOTES:

- FOLLOWING PLACEMENT OF SIDE BACKFILL, A UNIFORM 12" LIFT OF THE FREELY DRAINING MATERIAL (SPEC SECTION 2.03 B2) SHALL BE PLACED OVER THE R-TANK AND LIGHTLY COMPACTED USING A WALK-BEHIND TRENCH ROLLER. ALTERNATIVELY, A ROLLER (MAXIMUM GROSS VEHICLE WEIGHT OF 6 TONS) MAY BE USED. ROLLER MUST REMAIN IN STATIC MODE UNTIL A MINIMUM OF 24" OF COVER HAS BEEN PLACED OVER THE MODULES. SHEEP FOOT ROLLERS SHOULD NOT BE USED. SPEC SECTION 3.05 A5
- ONLY LOW PRESSURE TIRE OR TRACK VEHICLES (LESS THAN 7 PSI AND OPERATING WEIGHT OF LESS THAN 20,000 LBS) SHALL BE OPERATED OVER THE R-TANK SYSTEM DURING CONSTRUCTION. SPEC SECTION 3.05 A5
- DUMP TRUCKS AND PANS SHALL NOT BE OPERATED WITHIN THE R-TANK SYSTEM AT ANY TIME. WHERE NECESSARY, THE HEAVY EQUIPMENT SHOULD UNLOAD IN AN AREA ADJACENT TO THE R-TANK SYSTEM AND THE MATERIAL SHOULD BE MOVED OVER THE SYSTEM WITH TRACKED EQUIPMENT. SPEC SECTION 3.05 A5
- ENSURE THAT ALL UNRELATED CONSTRUCTION TRAFFIC IS KEPT AWAY FROM THE LIMITS OF EXCAVATION UNTIL THE PROJECT IS COMPLETE AND FINAL SURFACE MATERIALS ARE IN PLACE. NO NON-INSTALLATION RELATED LOADING SHOULD BE ALLOWED OVER THE R-TANK SYSTEM UNTIL THE FINAL DESIGN SECTION HAS BEEN CONSTRUCTED (INCLUDING PAVEMENT). SPEC SECTION 3.05 B
- SEE R-TANK INSTALLATION GUIDE OR CONTACT YOUR LOCAL ACF WEST REPRESENTATIVE FOR ADDITIONAL INFORMATION.

ACF WEST INC. GEOSYNTHETICS
Products | Estimating | Solutions
FOR ADDITIONAL INFORMATION PLEASE CONTACT:
ACF WEST: 1-800-423-4567 www.acfwest.com

EDITION: 02/20/2024
ACF WEST PROJECT NUMBER: 23-004VA
SHEET NUMBER: 5 of 6
R-TANK[®] CONSTRUCTION EQUIPMENT COVER DETAIL
EAST TOWN CROSSING
PUYALLUP, WA
SITE DESIGNATION: R-TANK 3

R-TANK SPECIFICATION

1.01 GENERAL

1.02 RELATED DOCUMENTS

1.03 DESCRIPTION OF WORK INCLUDED

1.04 QUALITY CONTROL

1.05 SUBMITTALS

1.06 DELIVERY, STORAGE, AND HANDLING

1.07 PREINSTALLATION CONFERENCE

1.08 PROJECT CONDITIONS

2.00 PRODUCTS

2.01 R-TANK UNITS


2.02 GEOSYNTHETICS

2.03 BACKFILL & COVER MATERIALS

2.04 MANTENANCE REQUIREMENTS

ACF WEST INC. GEOSYNTHETICS
Products | Estimating | Solutions
FOR ADDITIONAL INFORMATION PLEASE CONTACT:
ACF WEST: 1-800-423-4567 www.acfwest.com

R-TANK SPECIFICATION
EAST TOWN CROSSING
PUYALLUP, WA
SITE DESIGNATION: R-TANK 3

EDITION: 02/20/2024
ACF WEST PROJECT NUMBER: 23-004VA
SHEET NUMBER: 6 of 6



01/29/24 CITY COMMENTS

Revisions:
Sheet Title:

R-TANK 3 NOTES AND DETAILS

Designed by: CW
Drawn by: SK / RS
Checked by: JI

Sheet No.
C4.32
33 of 53 Sheets

EAST TOWN CROSSING PHASE 1



SEC. 26,35/ TWP. 20 N./ RGE. 4 E., W.M.

APPROVED

BY: CITY OF PUYALLUP
DEVELOPMENT ENGINEERING

DATE:

NOTE: THIS APPROVAL IS VOID AFTER 180 DAYS FROM APPROVAL DATE. THE CITY WILL NOT BE RESPONSIBLE FOR ERRORS AND/OR OMISSIONS ON THESE PLANS. FIELD CONDITIONS MAY DICTATE CHANGES TO THESE PLANS AS DETERMINED BY THE DEVELOPMENT ENGINEERING MANAGER.

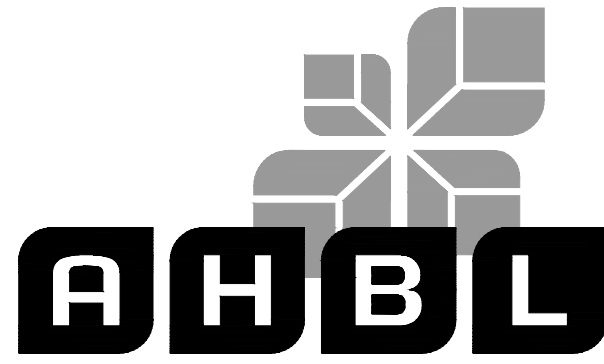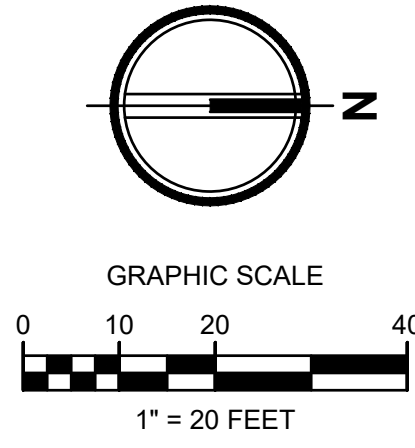

TACOMA · SEATTLE · SPOKANE · TRI-CITIES

2215 North 30th Street, Suite 300, Tacoma, WA 98403
253.383.2422 TEL 253.383.2572 FAX www.ahbl.com WEB

Project Title:

EAST TOWN CROSSING PHASE 1

Client:

ASH DEVELOPMENT

GREG HELLE

GREG.HELLE@ASHNW.COM

Project No.

2230752

Issue Set & Date:

PERMIT SUBMITTAL

02/20/2024



NOTICE: ALTERATION OF THIS DOCUMENT SHALL INVALIDATE THE PROFESSIONAL SEAL AND SIGNATURE. PUBLICATION OF THIS DOCUMENT DOES NOT CONSTITUTE A GUARANTEE OR WARRANTY BY THE ENGINEER OR ARCHITECT. THE ENGINEER OR ARCHITECT IS NOT TO BE USED FOR ANY OTHER PROJECT.


LEGEND

- RIGHT-OF-WAY / PROPERTY LINE
- CENTERLINE
- EASEMENT
- BUILDING OUTLINE
- S — SANITARY SIDE SEWER
- S — SANITARY SEWER MAIN
- FM — SANITARY SEWER FORCE MAIN
- — SANITARY SEWER CLEANOUT
- — SAMPLING CONNECTION
- — SANITARY SEWER MANHOLE
- 123 — PROPOSED MINOR CONTOUR
- 123 — PROPOSED MAJOR CONTOUR


SEWER STRUCTURE TABLE

STRUCTURE NAME	STRUCTURE DETAILS
EXISTING SSMH 15 ADJUST RIM TO FINISH GRADE N 679922.81 E 1203825.42	RIM = 72.18 IE = 50.82 (8" W) IE = 62.37 (8" S)
SSCB 4 TYPE 1 CB N 679948.91 E 1203975.91	RIM = 73.25 IE = 69.31 (6" W)
SSCB 11 TYPE 1 CB N 680121.57 E 1203976.02	RIM = 72.92 IE = 68.37 (6" W)
SSCO 10 N 680154.32 E 1203944.40	RIM = 73.56 IE = 68.65 (6" SE) IE = 68.65 (6" W)
SSCO 11 SSCO N 680147.26 E 1203951.45	RIM = 73.55 IE = 68.15 (6" S) IE = 68.15 (6" NW)
SSCO 17 N 679901.55 E 1203869.97	RIM = 72.81 IE = 69.17 (6" E) IE = 69.17 (6" N)
SSMH 12 48" SSMH N 680121.64 E 1203931.70	RIM = 72.99 IE = 66.50 (8" S) IE = 66.50 (6" E) IE = 66.50 (6" N)
SSMH 13 48" SSMH N 679900.63 E 1203927.77	RIM = 72.87 IE = 65.51 (8" S) IE = 65.51 (8" N) IE = 65.51 (8" W)

MATCH LINE SEE SHEET C5.02

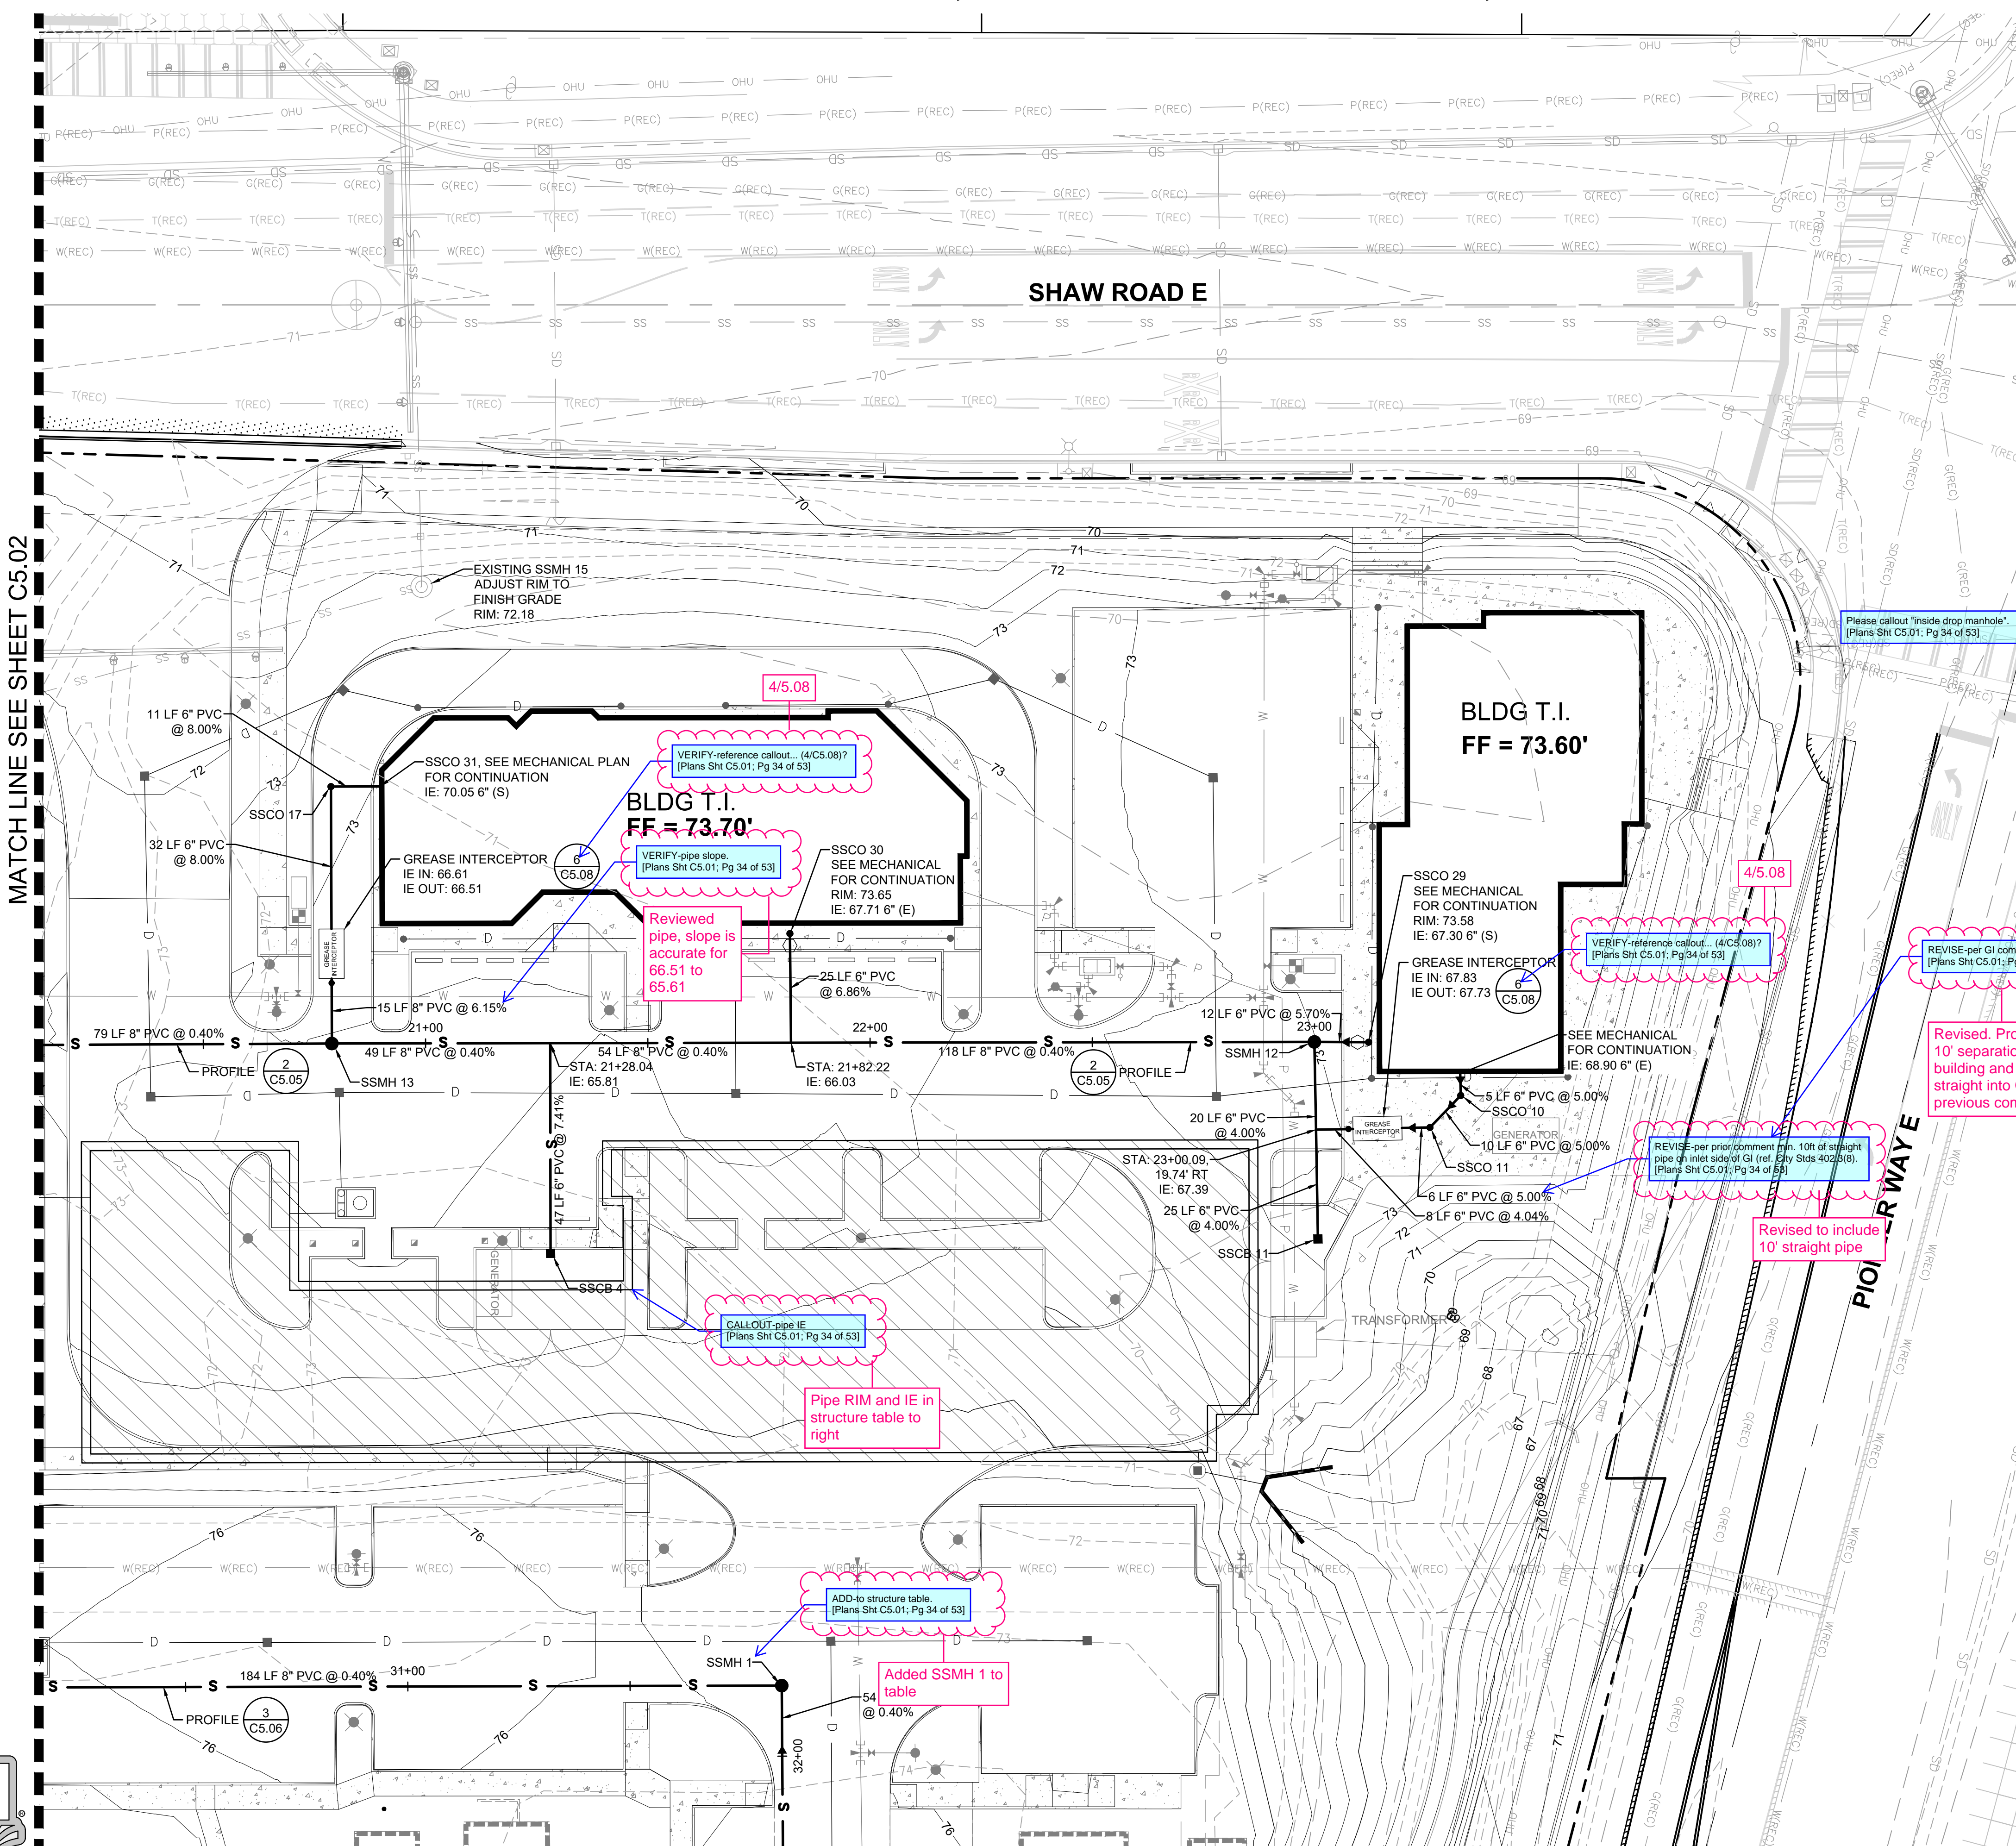

MATCH LINE SEE SHEET C5.03

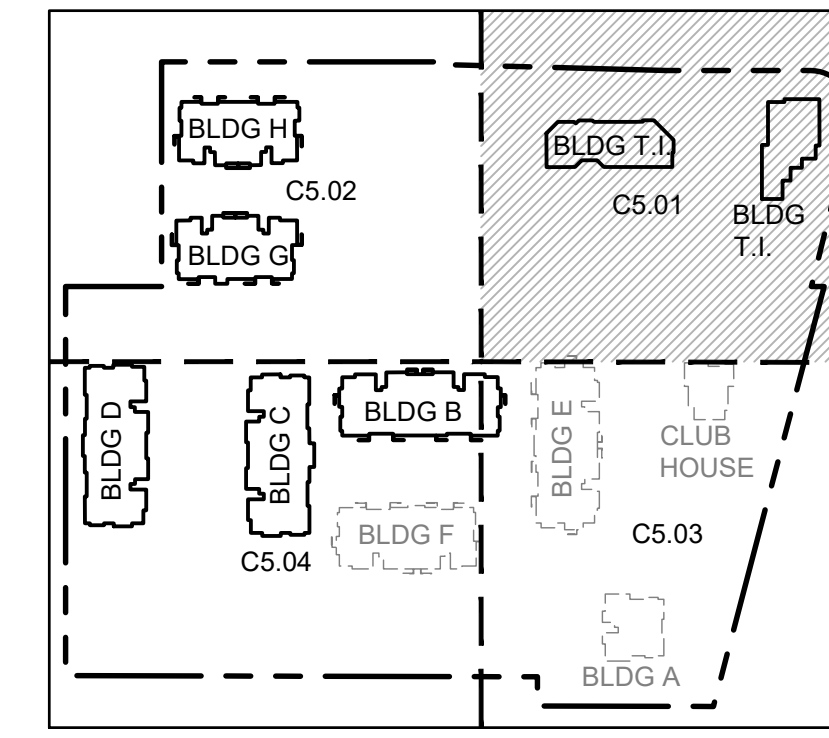

Know what's below.
Call before you dig.

▲

▲

▲

01/29/24 CITY COMMENTS

Revisions:

Sheet Title:

SEWER PLAN NW

Designed by: CW Drawn by: SK/RS Checked by: JI

Sheet No.

C5.01

34 of 53 Sheets

EAST TOWN CROSSING PHASE 1



SEC. 26,35/ TWP. 20 N./ RGE. 4 E., W.M.

APPROVED

BY: CITY OF PUYALLUP
DEVELOPMENT ENGINEERING

DATE:

NOTE: THIS APPROVAL IS VOID AFTER 180 DAYS FROM APPROVAL DATE. THE CITY WILL NOT BE RESPONSIBLE FOR ERRORS AND/OR OMISSIONS ON THESE PLANS. FIELD CONDITIONS MAY DICTATE CHANGES TO THESE PLANS AS DETERMINED BY THE DEVELOPMENT ENGINEERING MANAGER.

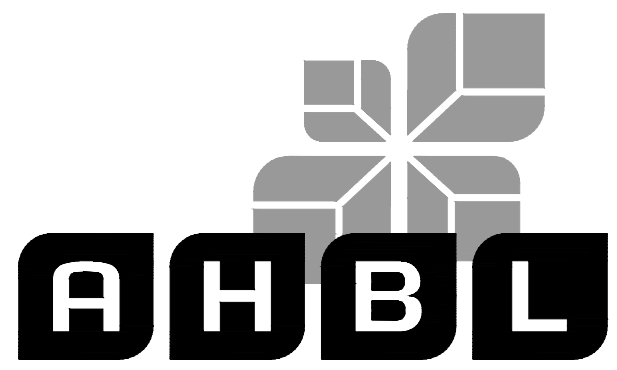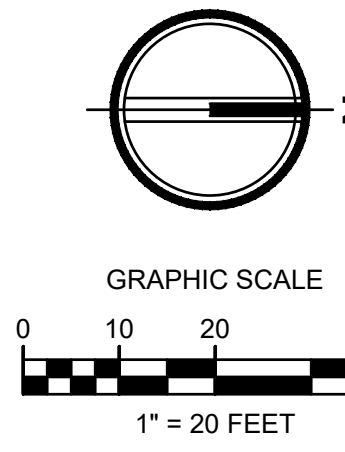

TACOMA · SEATTLE · SPOKANE · TRI-CITIES
2215 North 30th Street, Suite 300, Tacoma, WA 98403
253.383.2422 TEL 253.383.2572 FAX www.ahbl.com WEB

Project Title:

EAST TOWN CROSSING PHASE 1

Client:
ASH DEVELOPMENT

GREG HELLE
GREG.HELLE@ASHNW.COM

Project No.
2230752

Issue Set & Date:
PERMIT SUBMITTAL
02/20/2024




NOTICE: ALTERATION OF THIS DOCUMENT SHALL INVALIDATE THE PROFESSIONAL SEAL AND SIGNATURE. PUBLICATION OF THIS DOCUMENT DOES NOT CONSTITUTE A PROFESSIONAL ENGINEER'S OPINION ON THE DESIGN OR CONSTRUCTION OF THE PROJECT EXCEPT AS SHOWN IN THIS BLOCK AND IS NOT TO BE USED FOR OTHER PURPOSES OR ADDITION TO THAT PROJECT OR FOR ANY OTHER PROJECT.

LEGEND


- RIGHT-OF-WAY / PROPERTY LINE
- - - CENTERLINE
- - - EASEMENT
- ▭ BUILDING OUTLINE
- S SANITARY SIDE SEWER
- S SANITARY SEWER MAIN
- FM SANITARY SEWER FORCE MAIN
- SANITARY SEWER CLEANOUT
- SAMPLING CONNECTION
- SANITARY SEWER MANHOLE
- 123 PROPOSED MINOR CONTOUR
- 123 PROPOSED MAJOR CONTOUR

STRUCTURE NAME	STRUCTURE DETAILS
EXISTING SSMH 14 ADJUST RIM TO FINISH GRADE N 679810.64 E 1203854.27	RIM = 76.74 IE = 64.46 (8" N) IE = 64.80 (8" E)
SSCO 5 TYPE 1 CB N 679490.51 E 1204032.97	RIM = 75.95 IE = 71.01 (6" E)
SSCO 7 N 679553.05 E 1203914.74	RIM = 76.68 IE = 67.73 (8" N)
SSCO 18 N 679490.00 E 1204065.50	RIM = 76.18 IE = 69.71 (8" N) IE = 69.71 (6" W)
SSMH 2 48" TYPE 1 N 679814.92 E 1204071.02	RIM = 76.46 IE = 65.77 (8" W) IE = 65.87 (8" N) IE = 65.87 (8" S) IE = 65.87 (6" E)
SSMH 3 48" TYPE 1 N 679821.72 E 1203926.62	RIM = 76.14 IE = 65.09 (8" W) IE = 65.19 (8" E) IE = 65.19 (8" N)
SSMH 6 48" SSMH N 679540.98 E 1204066.28	RIM = 76.03 IE = 69.10 (8" N) IE = 69.20 (8" E) IE = 69.20 (6" S)
SSMH 8 48" TYPE 1 N 679669.99 E 1203916.83	RIM = 77.24 IE = 67.17 (8" E) IE = 67.27 (8" S)
SSMH 9 48" TYPE 1 N 679667.05 E 1204068.46	RIM = 76.63 IE = 66.46 (8" N) IE = 66.56 (8" S) IE = 66.56 (8" W)

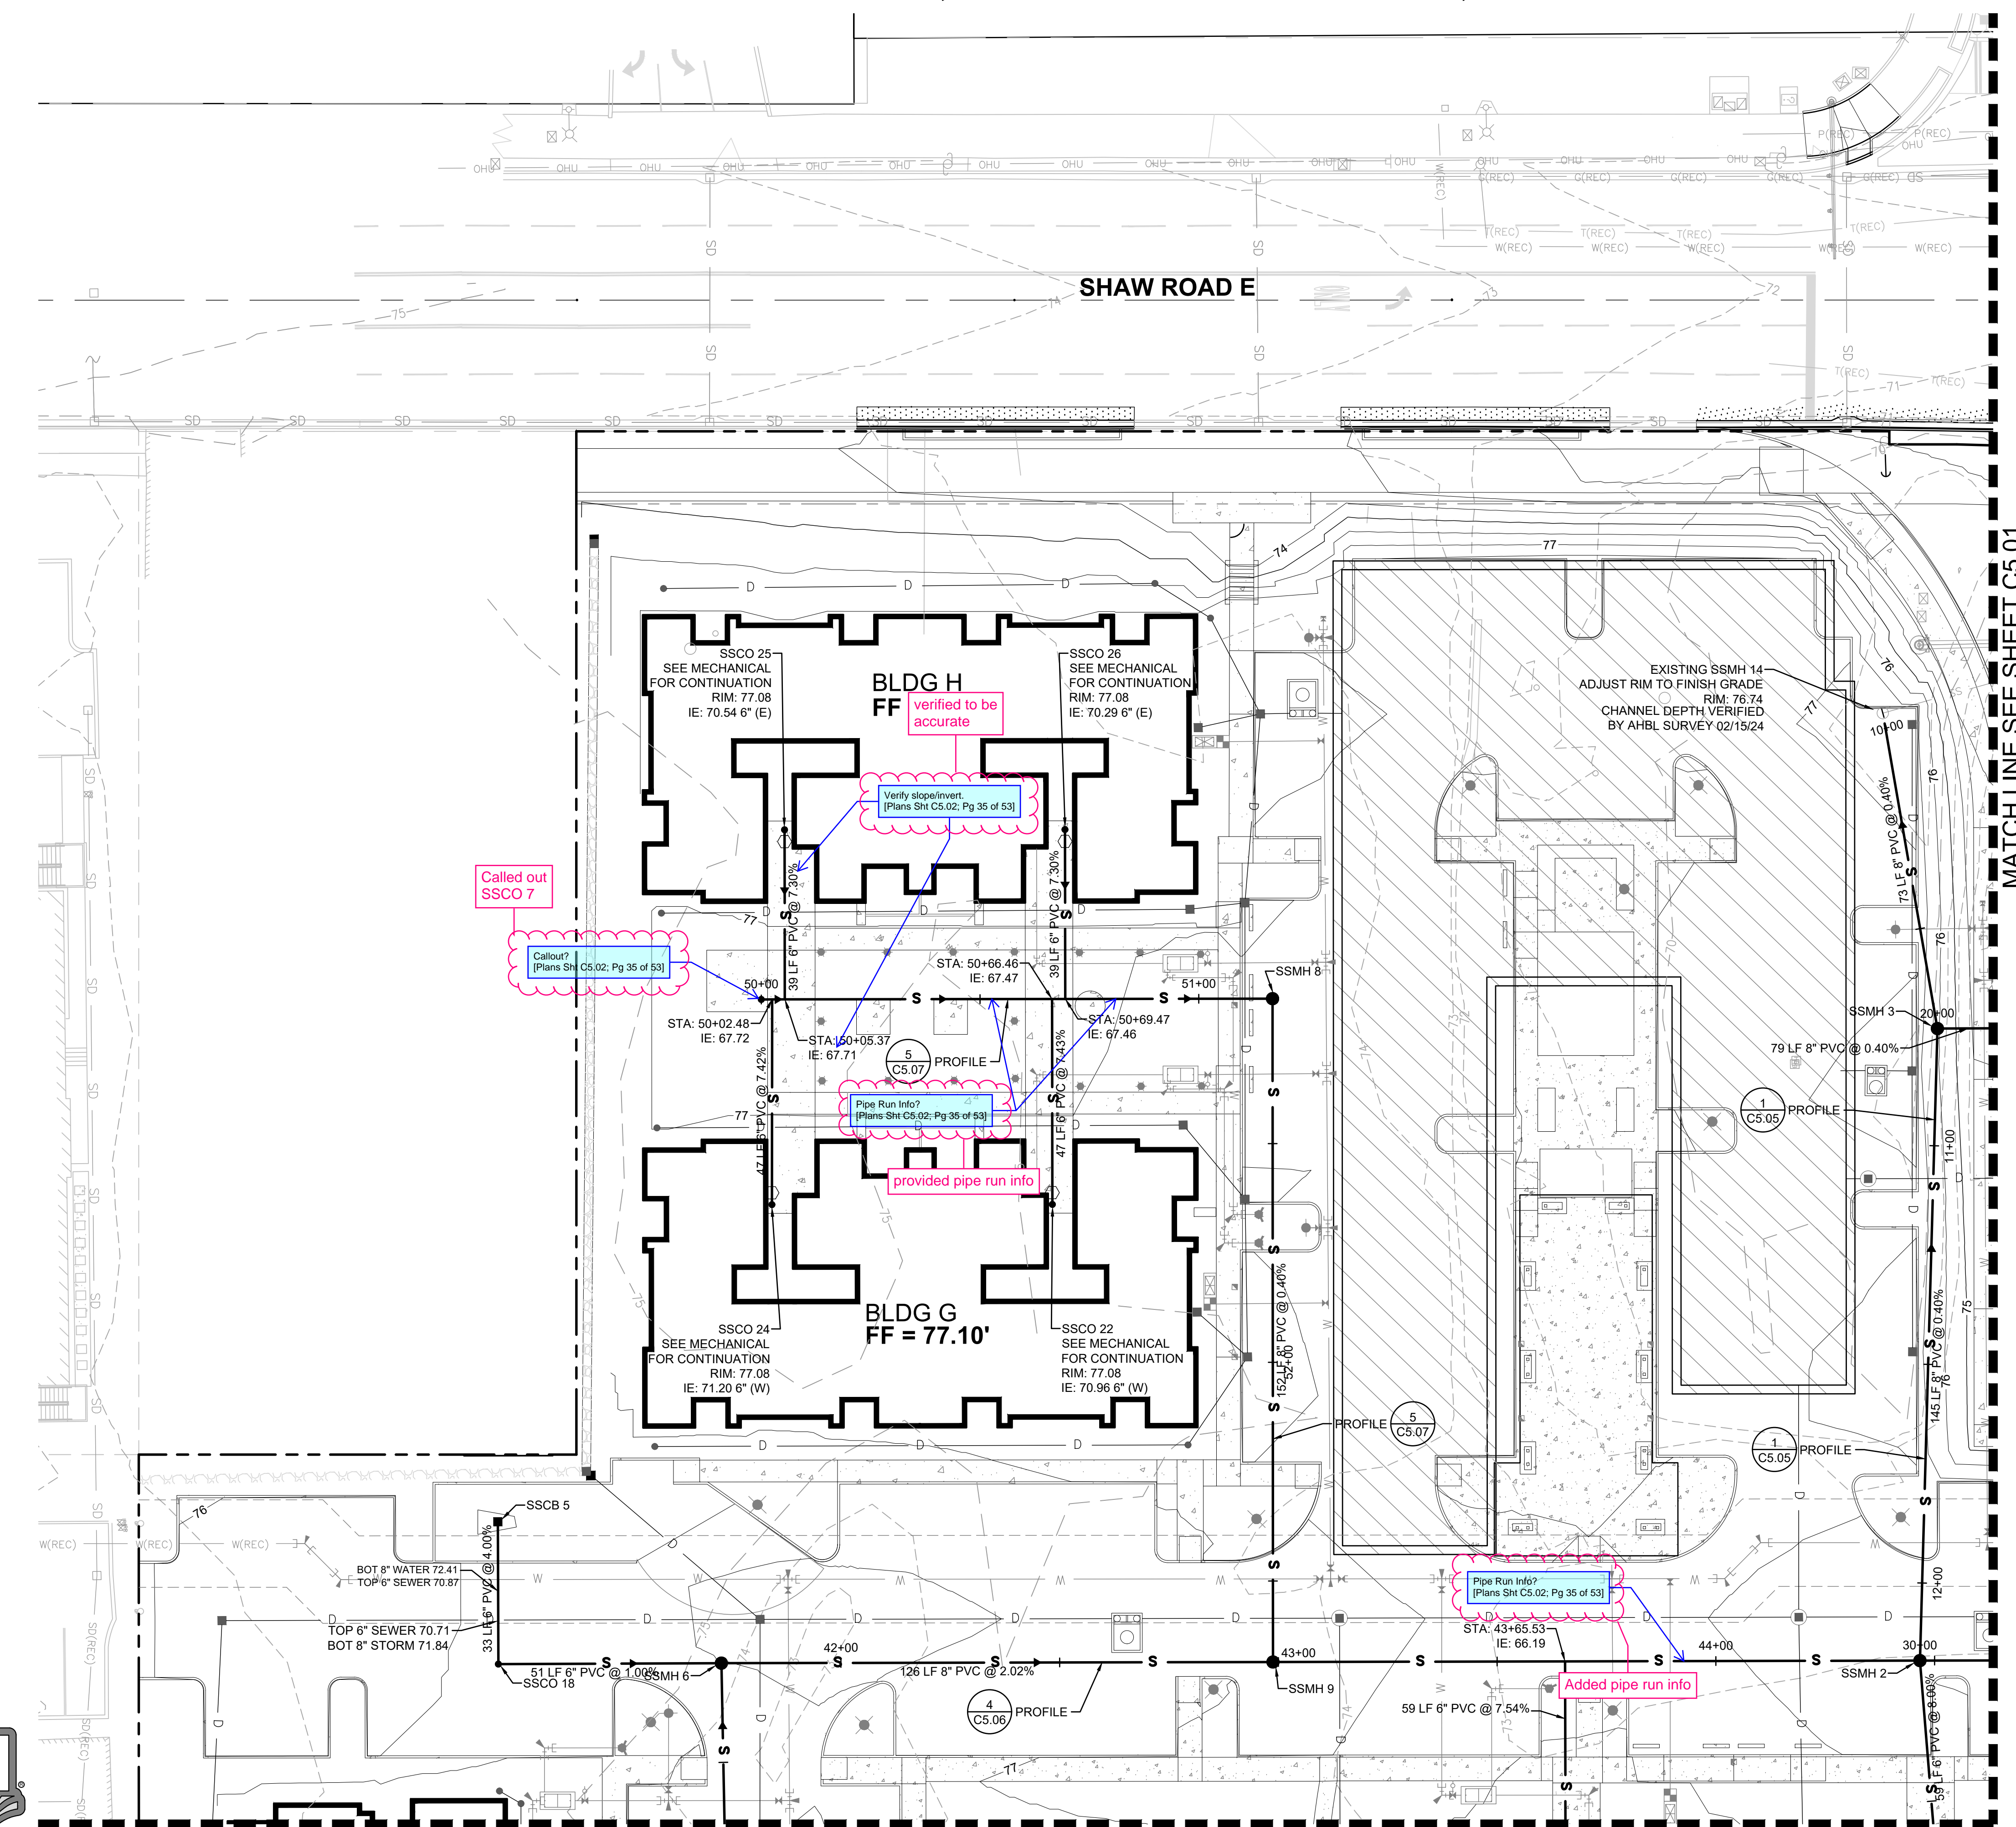

MATCH LINE SEE SHEET C5.01

MATCH LINE SEE SHEET C5.04

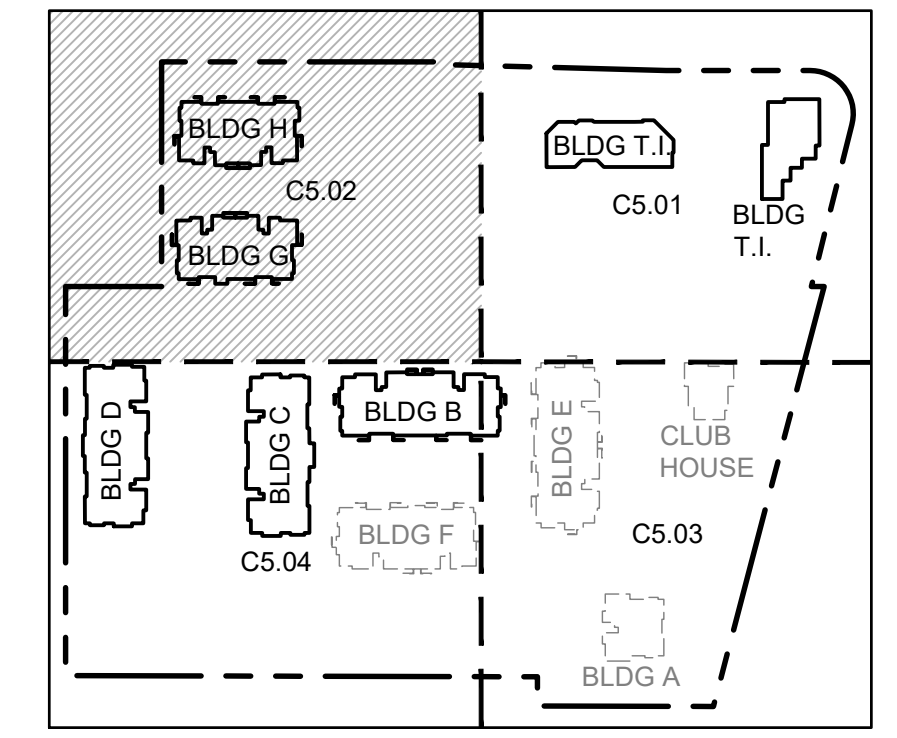

Called out SSCO 7

Callout? [Plans Sht C5.02; Pg 35 of 53]

Verify slope/invert [Plans Sht C5.02; Pg 35 of 53]

Pipe Run Info? [Plans Sht C5.02; Pg 35 of 53]

provided pipe run info

Pipe Run Info? [Plans Sht C5.02; Pg 35 of 53]

Added pipe run info



Know what's below.
Call before you dig.

- △
- △
- △
- △ 01/29/24 CITY COMMENTS

Revisions:

Sheet Title:

SEWER PLAN SW

Designed by: CW
Drawn by: SK/RS
Checked by: JI

Sheet No.

C5.02

35 of 53 Sheets



EAST TOWN CROSSING PHASE 1

SEC. 26,35/ TWP. 20 N./ RGE. 4 E., W.M.

APPROVED

BY: CITY OF PUYALLUP
DEVELOPMENT ENGINEERING
DATE:

NOTE: THIS APPROVAL IS VOID AFTER 180 DAYS FROM APPROVAL DATE. THE CITY WILL NOT BE RESPONSIBLE FOR ERRORS AND/OR OMISSIONS ON THESE PLANS. FIELD CONDITIONS MAY DICTATE CHANGES TO THESE PLANS AS DETERMINED BY THE DEVELOPMENT ENGINEERING MANAGER.

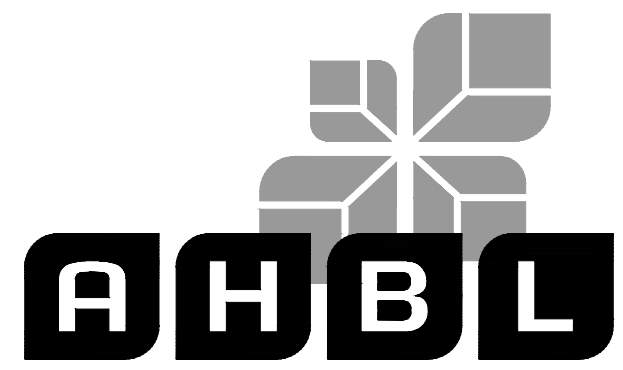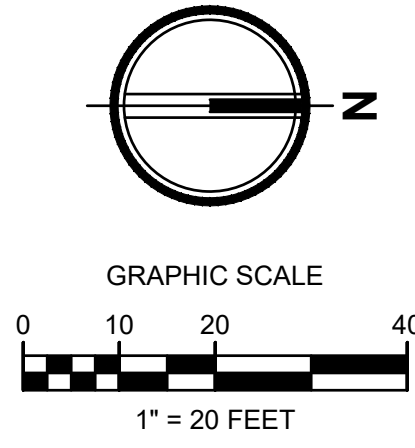

TACOMA • SEATTLE • SPOKANE • TRI-CITIES
2215 North 30th Street, Suite 300, Tacoma, WA 98403
253.383.2422 TEL. 253.383.2572 FAX www.ahbl.com WEB


Project Title:
EAST TOWN CROSSING PHASE 1

Client:
ASH DEVELOPMENT

GREG HELLE
GREG.HELLE@ASHNW.COM

Project No.
2230752


Issue Set & Date:
PERMIT SUBMITTAL
02/20/2024

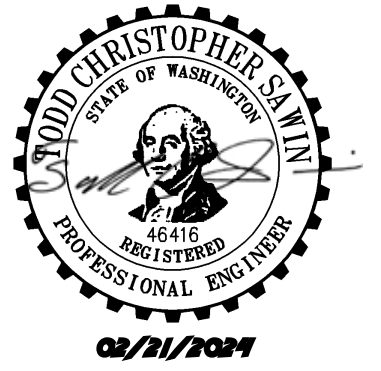

NOTICE: ALTERATION OF THIS DOCUMENT SHALL INVALIDATE THE PROFESSIONAL SEAL AND SIGNATURE. PUBLICATION OF THIS DOCUMENT DOES NOT CONSTITUTE AN ENDORSEMENT OR GUARANTEE BY THE ENGINEER OR ARCHITECT. THIS DOCUMENT IS FOR THE PROJECT IDENTIFIED IN THE TITLE BLOCK AND IS NOT TO BE USED FOR OTHER PROJECTS OR ACTION TO THAT PROJECT OR FOR ANY OTHER PROJECT.

LEGEND

---	RIGHT-OF-WAY / PROPERTY LINE
---	CENTERLINE
---	EASEMENT
---	BUILDING OUTLINE
S	SANITARY SIDE SEWER
S	SANITARY SEWER MAIN
FM	SANITARY SEWER FORCE MAIN
•	SANITARY SEWER CLEANOUT
○	SAMPLING CONNECTION
●	SANITARY SEWER MANHOLE
123	PROPOSED MINOR CONTOUR
123	PROPOSED MAJOR CONTOUR

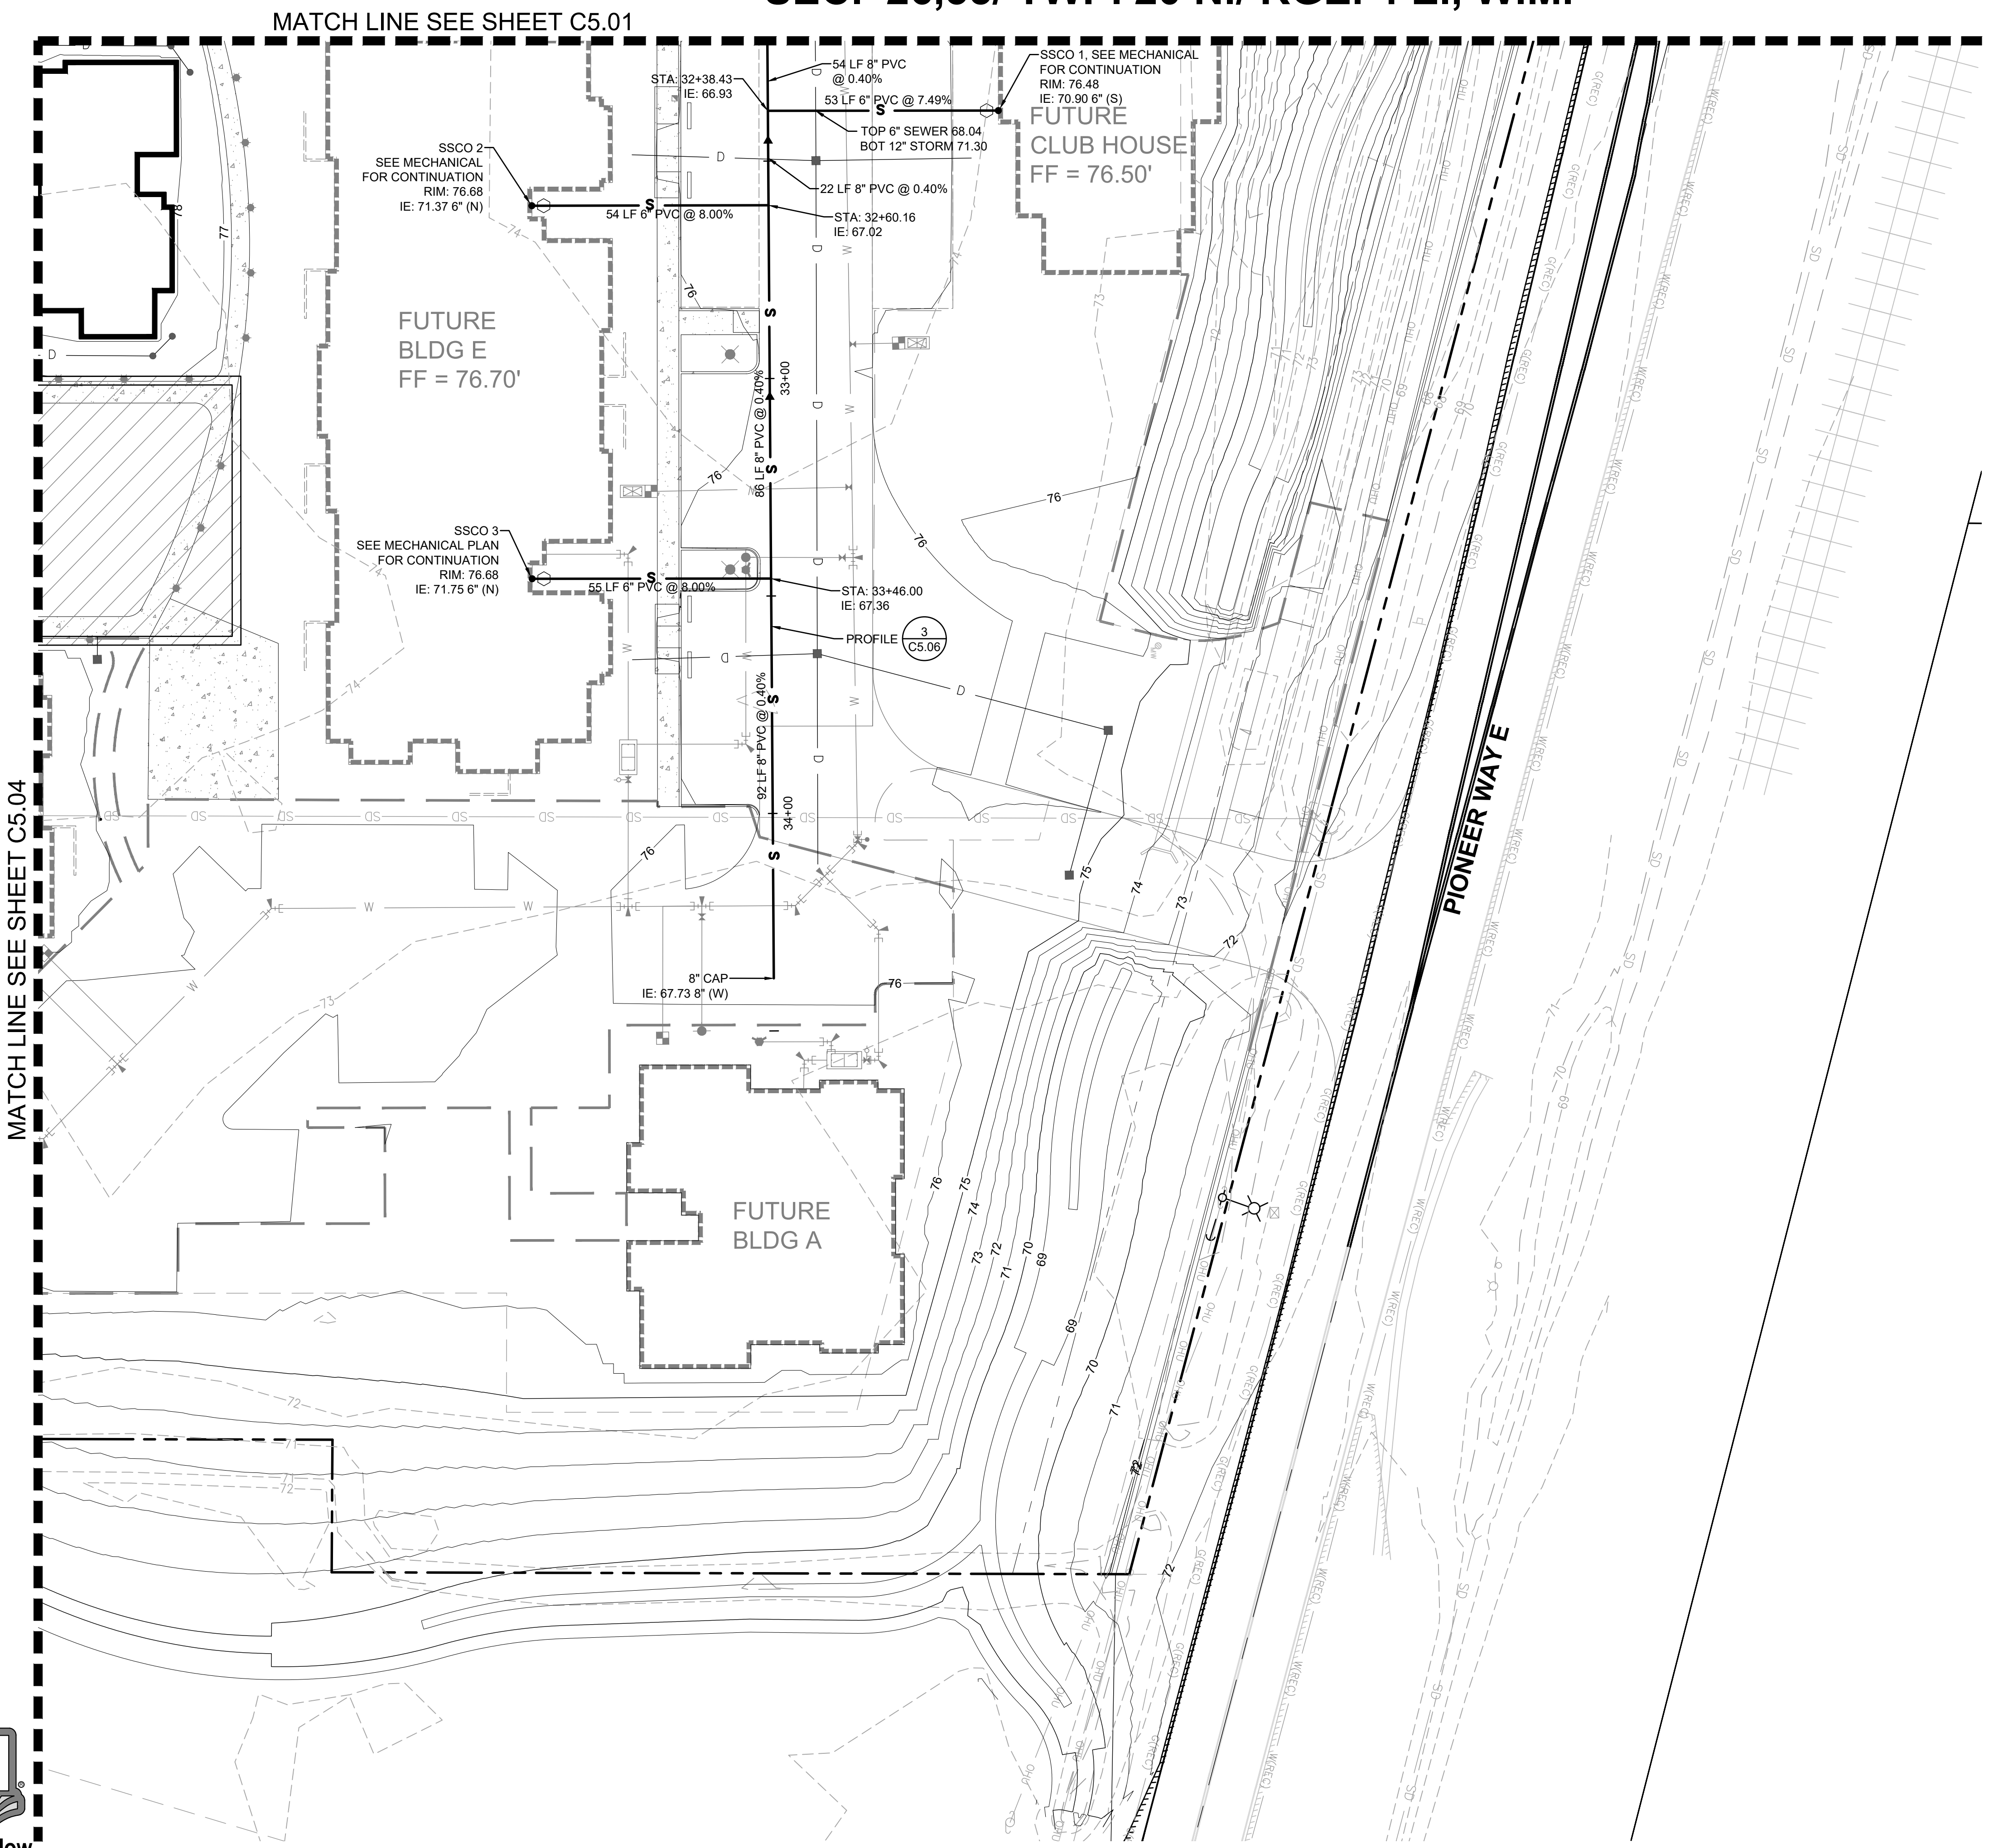

MATCH LINE SEE SHEET C5.04


MATCH LINE SEE SHEET C5.01

SSCO 2
SEE MECHANICAL FOR CONTINUATION
RIM: 76.68
IE: 71.37 6" (N)

SSCO 3
SEE MECHANICAL PLAN FOR CONTINUATION
RIM: 76.68
IE: 71.75 6" (N)

SSCO 1, SEE MECHANICAL FOR CONTINUATION
RIM: 76.48
IE: 70.90 6" (S)
FF = 76.50'

PROFILE
C5.06

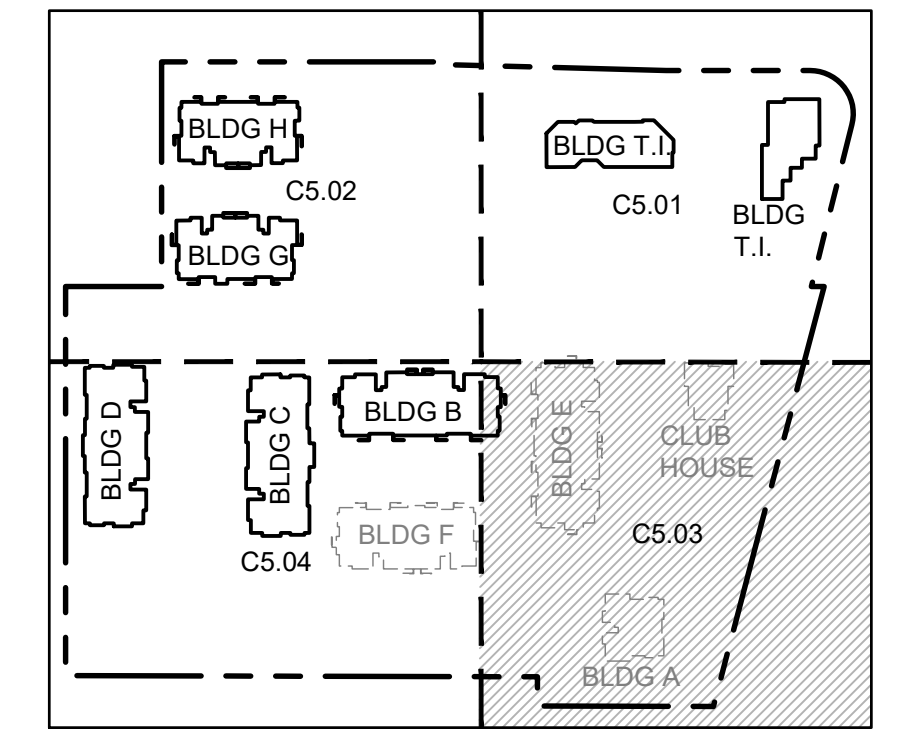

Revisions:
01/29/24 CITY COMMENTS

Sheet Title:
SEWER PLAN NE

Designed by: CW
Drawn by: SK / RS
Checked by: JI


Sheet No.
C5.03
36 of 53 Sheets

EAST TOWN CROSSING PHASE 1

SEC. 26,35/ TWP. 20 N./ RGE. 4 E., W.M.

APPROVED

BY: CITY OF PUYALLUP
DEVELOPMENT ENGINEERING
DATE:

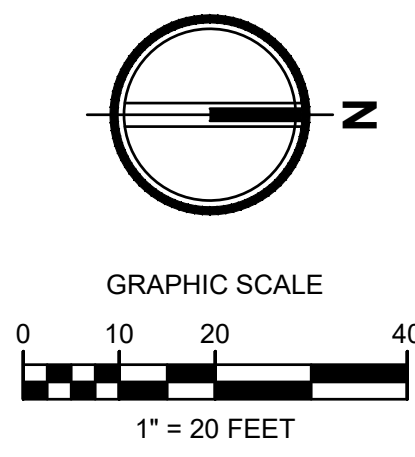

NOTE: THIS APPROVAL IS VOID AFTER 180 DAYS FROM APPROVAL DATE. THE CITY WILL NOT BE RESPONSIBLE FOR ERRORS AND/OR OMISSIONS ON THESE PLANS. FIELD CONDITIONS MAY DICTATE CHANGES TO THESE PLANS AS DETERMINED BY THE DEVELOPMENT ENGINEERING MANAGER.

AHBL
TACOMA • SEATTLE • SPOKANE • TRI-CITIES
2215 North 30th Street, Suite 300, Tacoma, WA 98403
253.383.2422 TEL 253.383.2572 FAX www.ahbl.com WEB


Project Title:
EAST TOWN CROSSING PHASE 1

Client:
ASH DEVELOPMENT


GREG HELLE
GREG.HELLE@ASHNW.COM

Project No.
2230752

Issue Set & Date:
PERMIT SUBMITTAL
02/20/2024

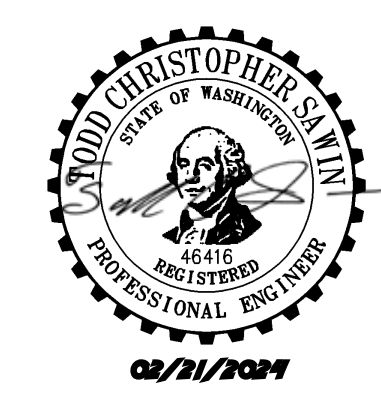


NOTICE:

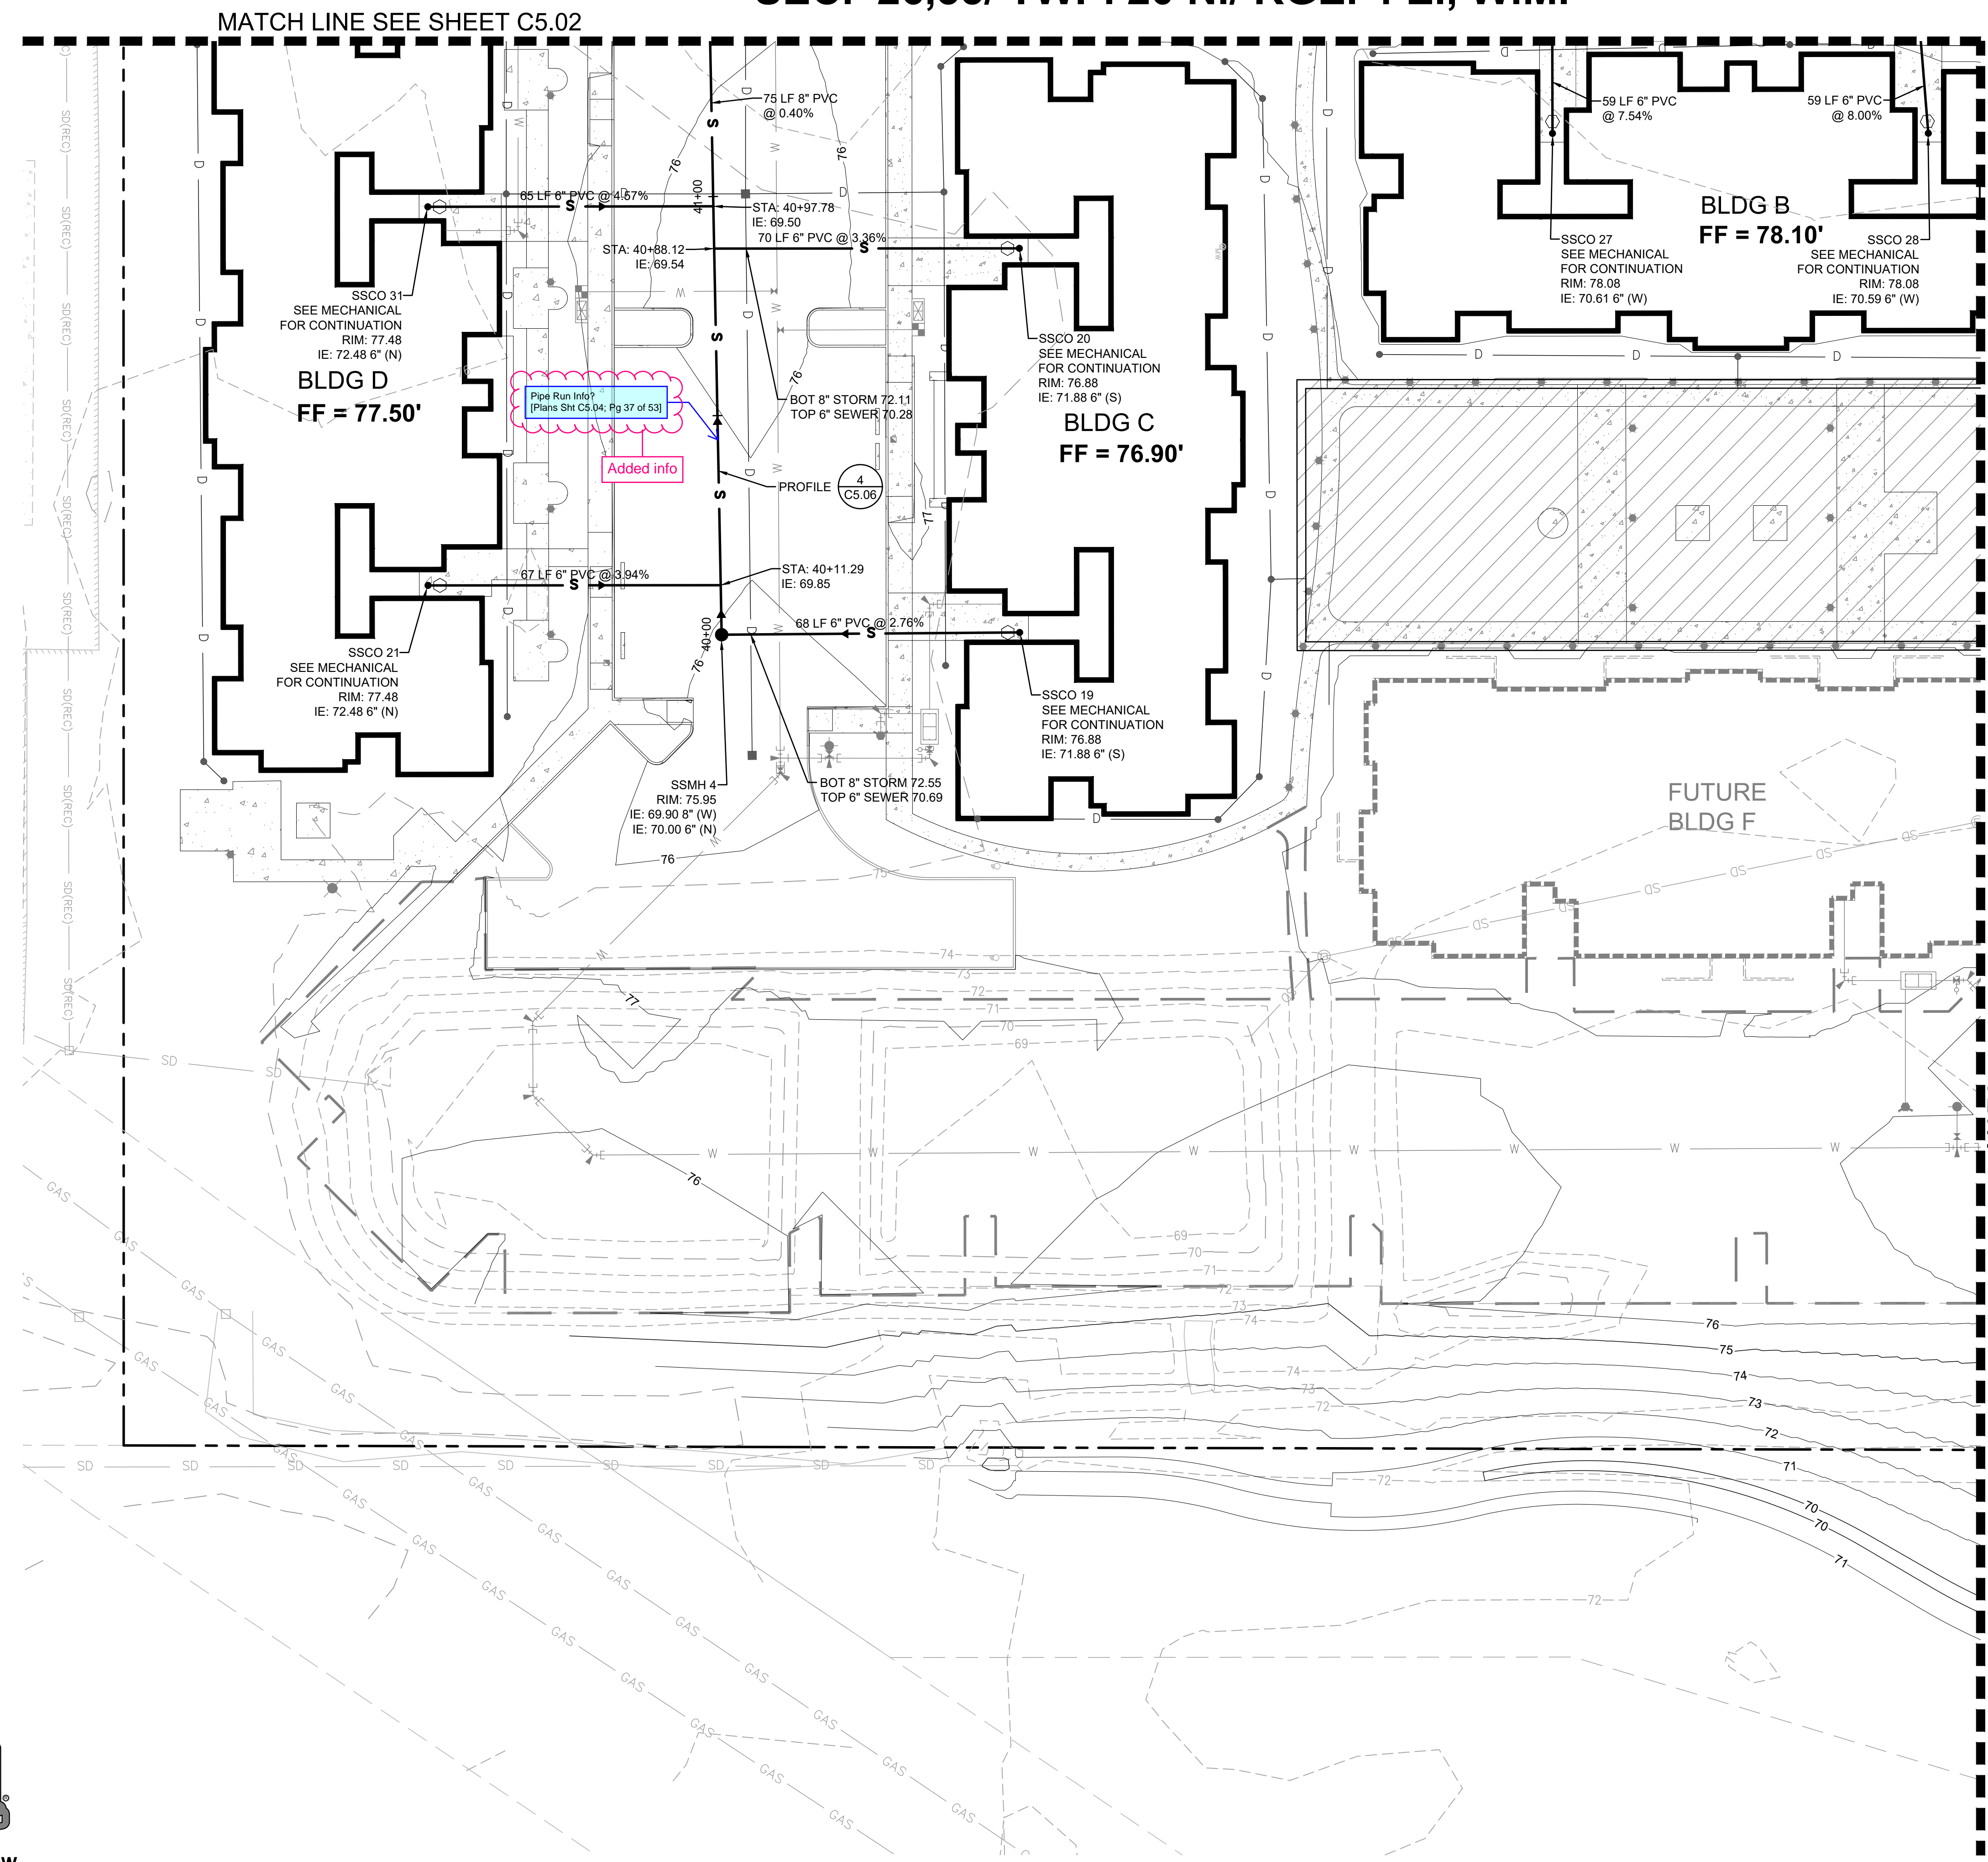

LEGEND

—	RIGHT-OF-WAY / PROPERTY LINE
—	CENTERLINE
---	EASEMENT
—	BUILDING OUTLINE
S	SANITARY SIDE SEWER
S	SANITARY SEWER MAIN
FM	SANITARY SEWER FORCE MAIN
•	SANITARY SEWER CLEANOUT
○	SAMPLING CONNECTION
●	SANITARY SEWER MANHOLE
123	PROPOSED MINOR CONTOUR
123	PROPOSED MAJOR CONTOUR

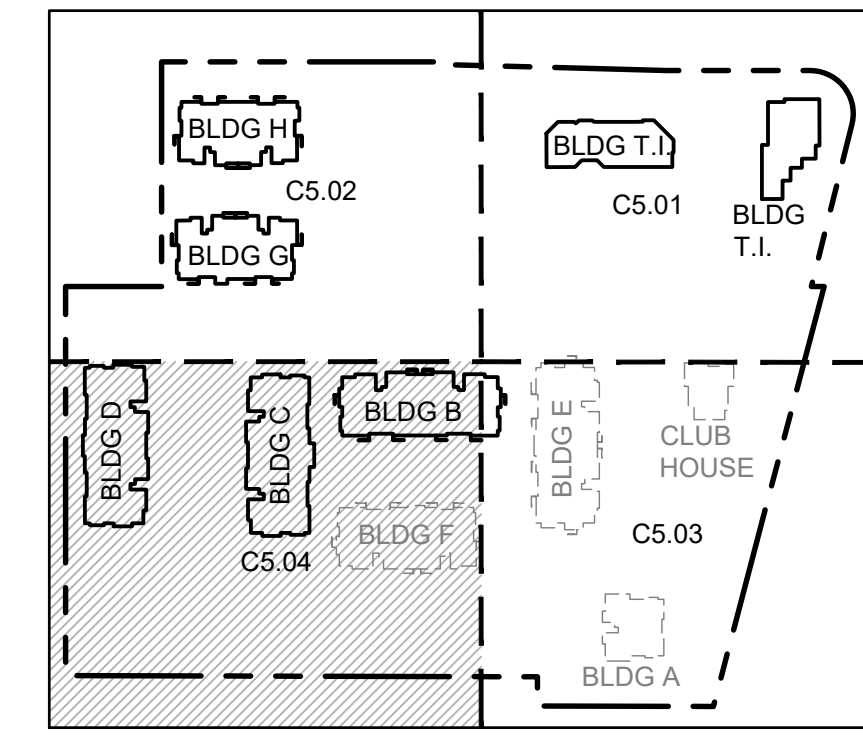

MATCH LINE SEE SHEET C5.03

MATCH LINE SEE SHEET C5.02



Revisions:

01/29/24 CITY COMMENTS

Sheet Title:
SEWER PLAN SE

Designed by: CW Drawn by: SK / RS Checked by: JI

Sheet No.
C5.04
37 of 53 Sheets


EAST TOWN CROSSING PHASE 1

SEC. 26,35/ TWP. 20 N./ RGE. 4 E., W.M.

APPROVED

BY CITY OF PUYALLUP
DEVELOPMENT ENGINEERING
DATE

NOTE: THIS APPROVAL IS VOID AFTER 180 DAYS FROM APPROVAL DATE. THE CITY WILL NOT BE RESPONSIBLE FOR ERRORS AND/OR OMISSIONS ON THESE PLANS. FIELD CONDITIONS MAY DICTATE CHANGES TO THESE PLANS AS DETERMINED BY THE DEVELOPMENT ENGINEERING MANAGER.

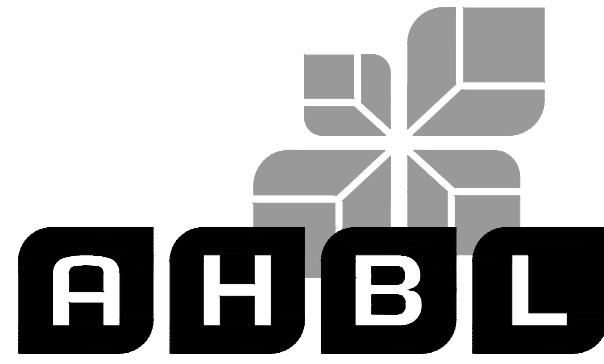

TACOMA · SEATTLE · SPOKANE · TRI-CITIES

2215 North 30th Street, Suite 300, Tacoma, WA 98403
253.383.2422 TEL 253.383.2572 FAX www.ahbl.com WEB

Project Title:

EAST TOWN CROSSING PHASE 1

Client:
ASH DEVELOPMENT

GREG HELLE
GREG.HELLE@ASHNW.COM

Project No.
2230752


Issue Set & Date:

PERMIT SUBMITTAL


02/20/2024



NOTICE: ALTERATION OF THIS DOCUMENT SHALL INVALIDATE THE PROFESSIONAL SEAL AND SIGNATURE PUBLICATION OF THE DOCUMENT DOES NOT CONSTITUTE A REVIEW. DESIGNER'S RESPONSIBILITY IS TO THE OWNER. IT IS THE USER'S RESPONSIBILITY TO VERIFY THE INFORMATION IN THIS BLOCK AND NOT TO BE USED FOR ANY OTHER PROJECT OR ACTION TO THAT PROJECT OR FOR ANY OTHER PROJECT.

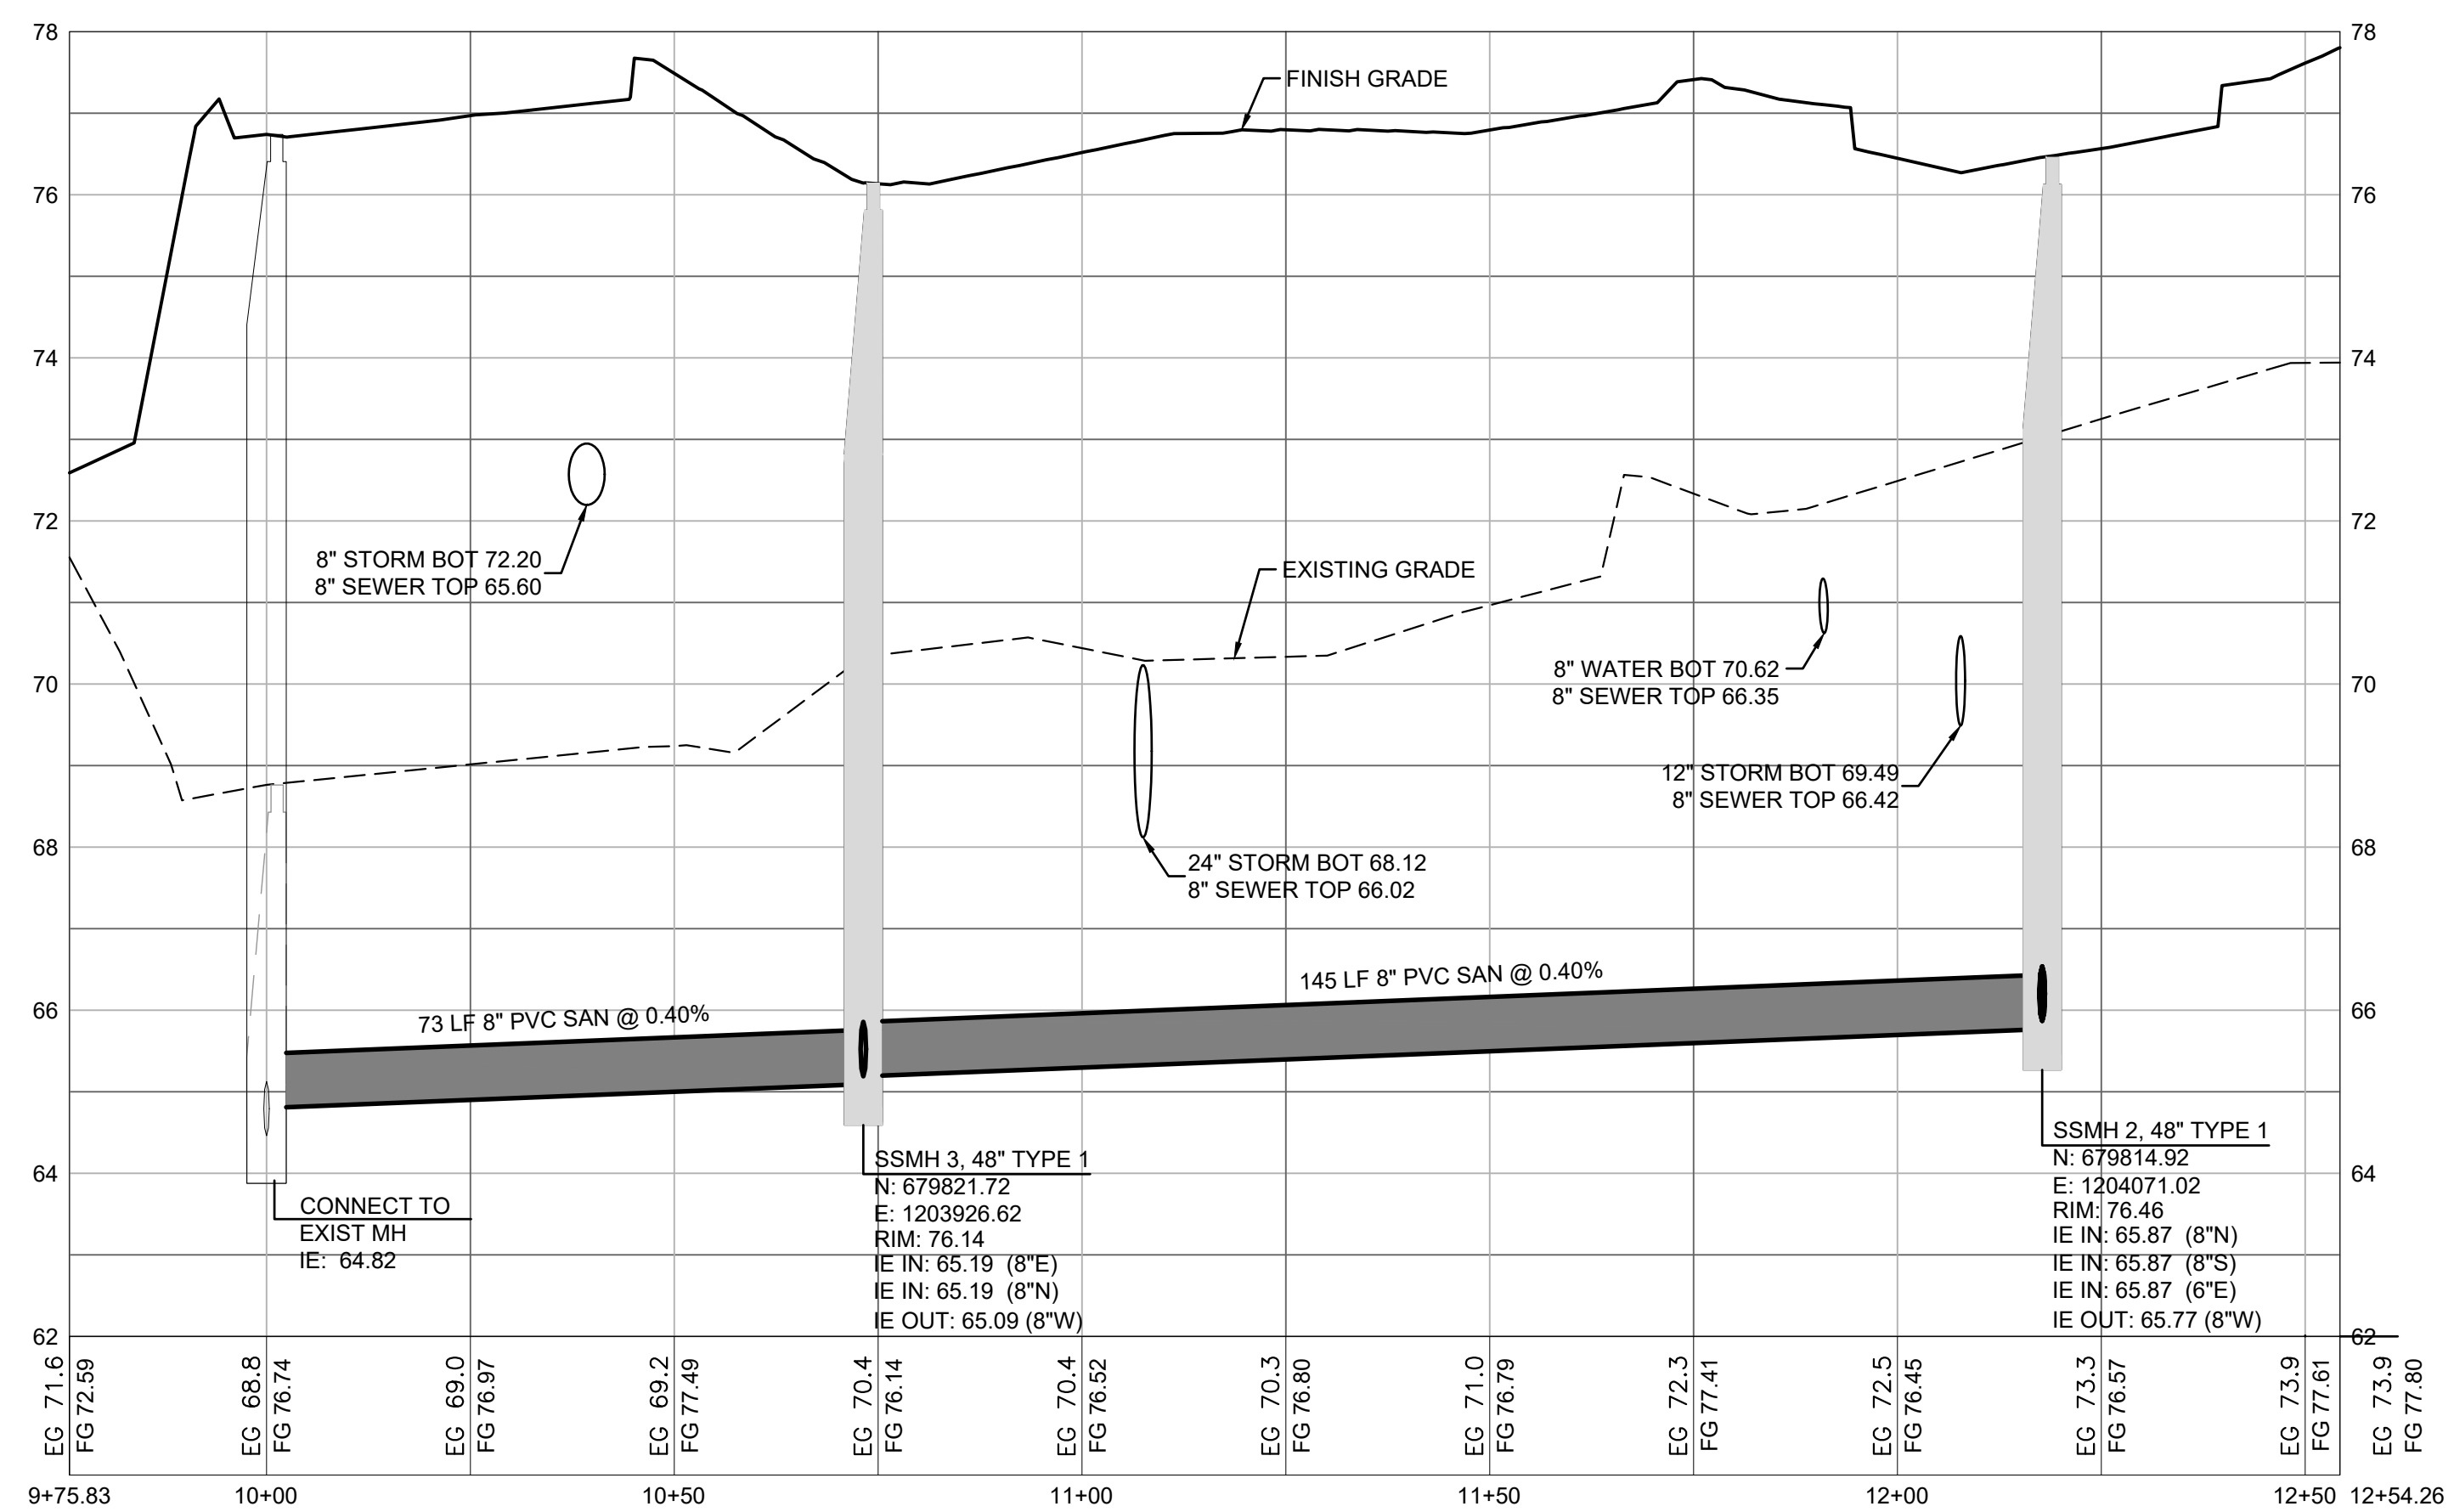

1 SEWER PROFILE
SCALE: HORIZ 1"=20'; VERT 1"=2'

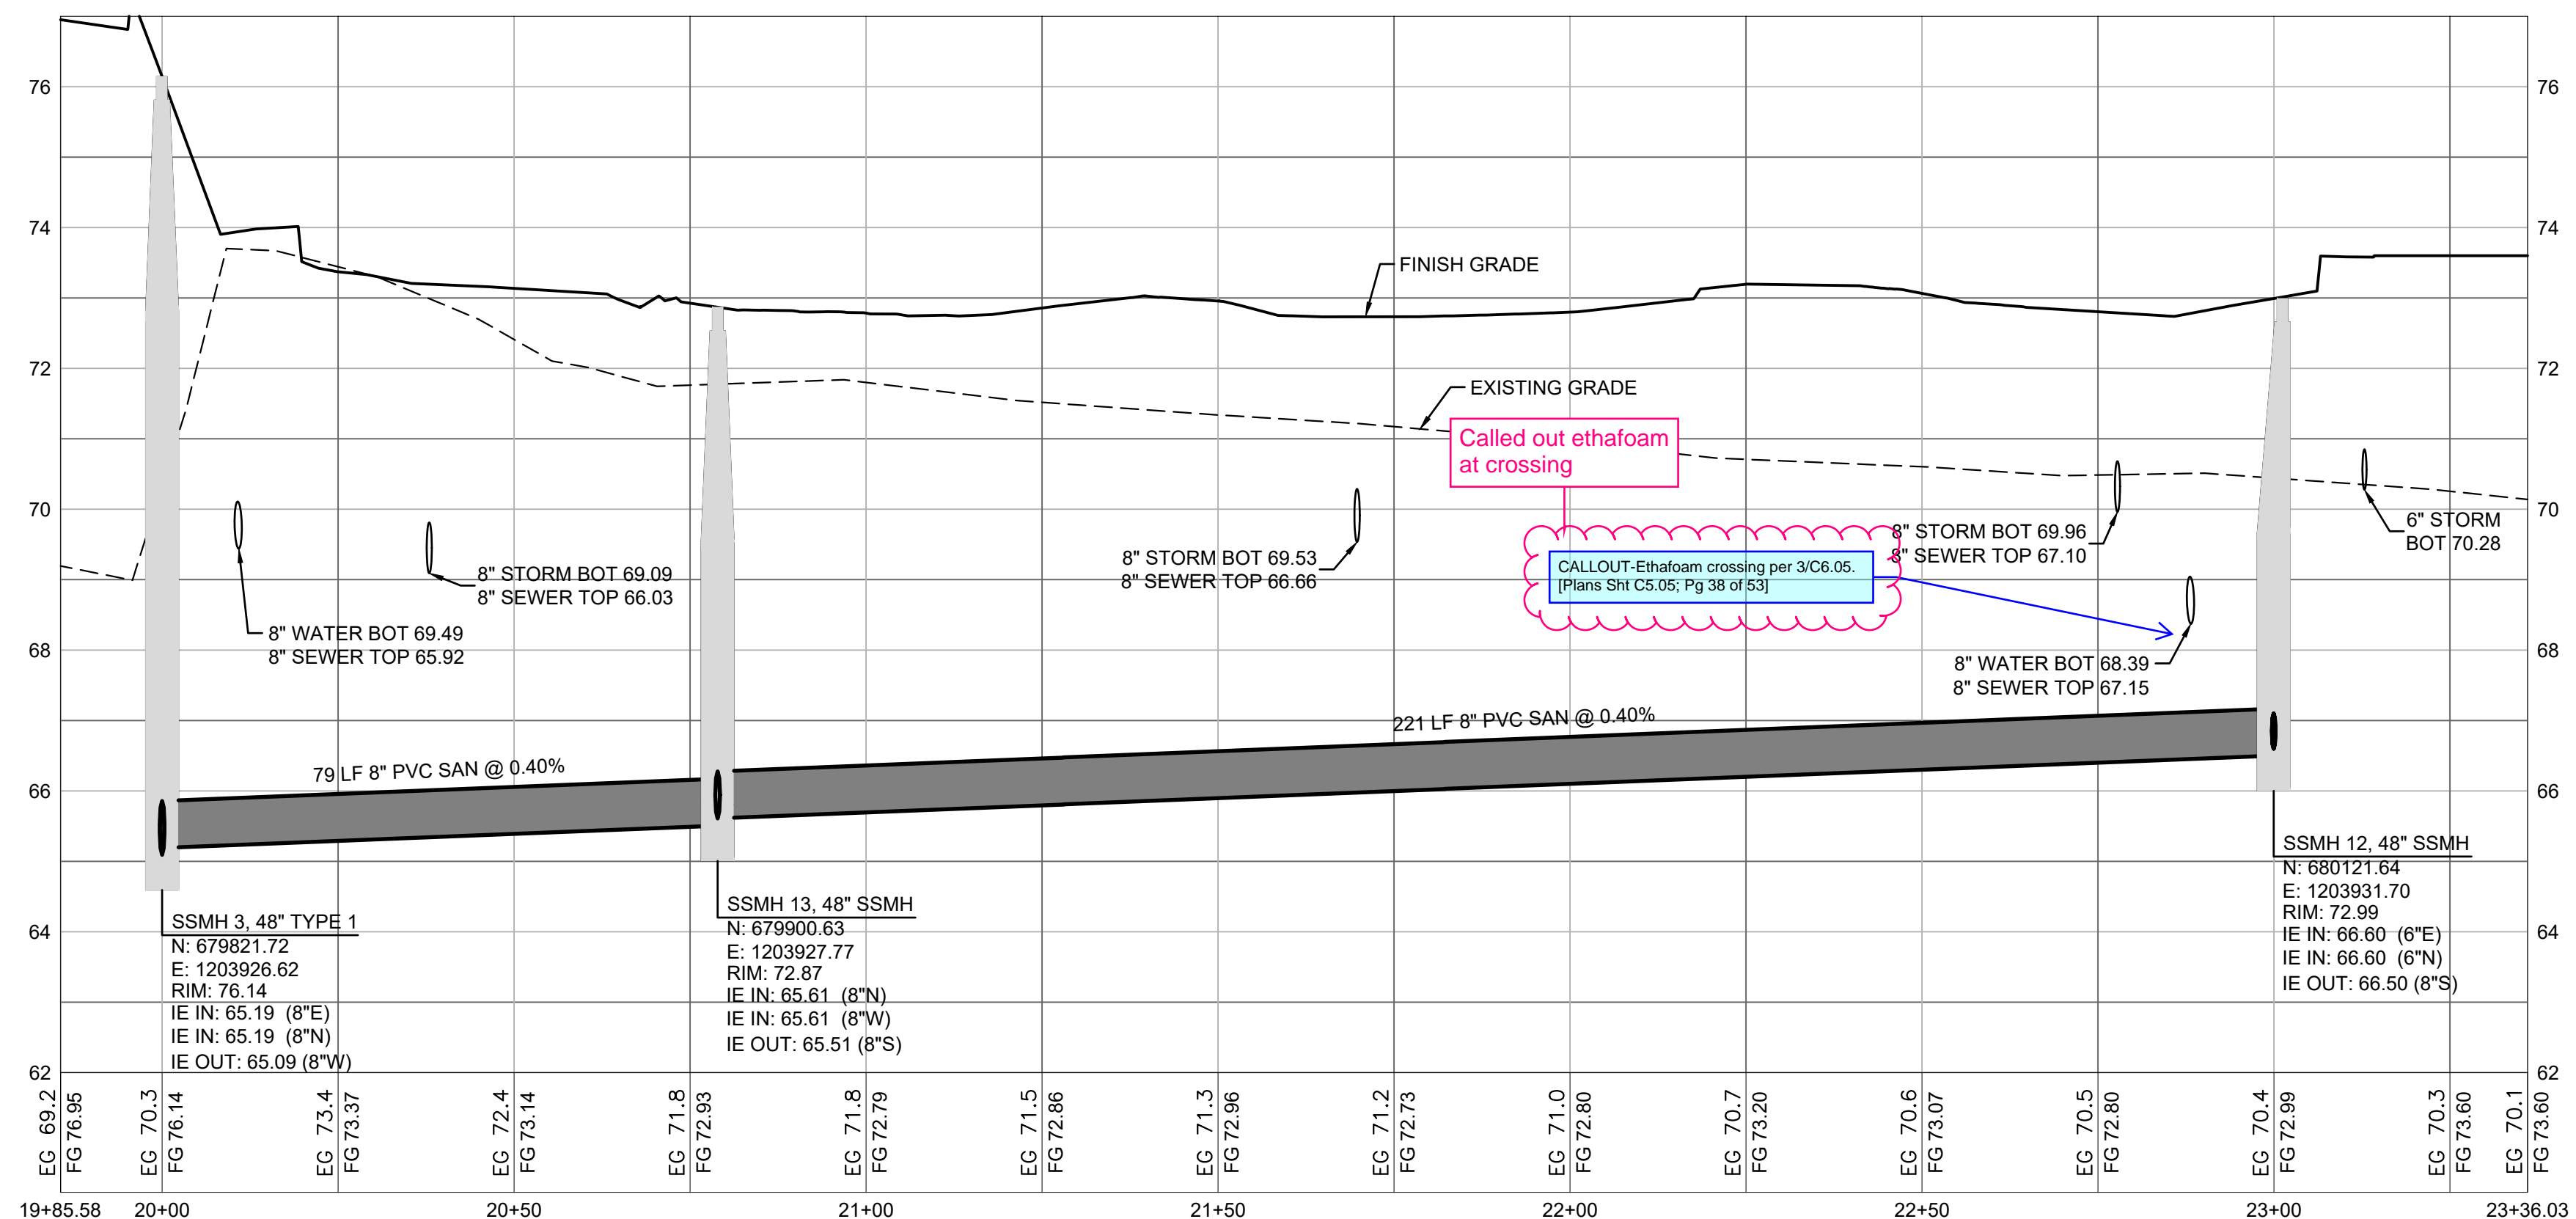

2 SEWER PROFILE
SCALE: HORIZ 1"=20'; VERT 1"=2'



Know what's below.
Call before you dig.

- △
- △
- △
- △ 01/29/24 CITY COMMENTS

Revisions:

Sheet Title:

SEWER PROFILES

Designed by: CW Drawn by: SK/RS Checked by: JI

Sheet No.

C5.05

38 of 53 Sheets


EAST TOWN CROSSING PHASE 1

SEC. 26,35/ TWP. 20 N./ RGE. 4 E., W.M.

APPROVED

BY _____
CITY OF PUYALLUP
DEVELOPMENT ENGINEERING
DATE _____

NOTE: THIS APPROVAL IS VOID AFTER 180 DAYS FROM APPROVAL DATE. THE CITY WILL NOT BE RESPONSIBLE FOR ERRORS AND/OR OMISSIONS ON THESE PLANS. FIELD CONDITIONS MAY DICTATE CHANGES TO THESE PLANS AS DETERMINED BY THE DEVELOPMENT ENGINEERING MANAGER.

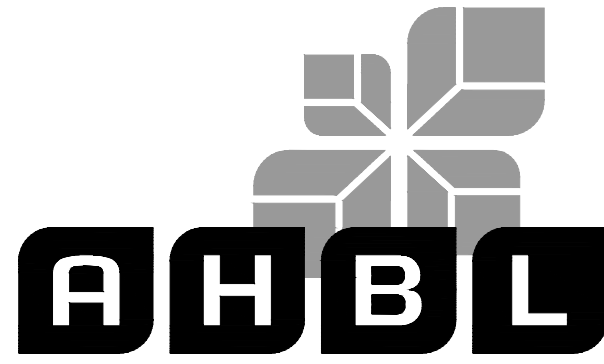

TACOMA · SEATTLE · SPOKANE · TRI-CITIES

2215 North 30th Street, Suite 300, Tacoma, WA 98403
253.383.2422 TEL 253.383.2572 FAX www.ahbl.com WEB

Project Title:

EAST TOWN CROSSING PHASE 1

Client:
ASH DEVELOPMENT

GREG HELLE

GREG.HELLE@ASHNW.COM


Project No.

2230752


Issue Set & Date:

PERMIT SUBMITTAL


02/20/2024

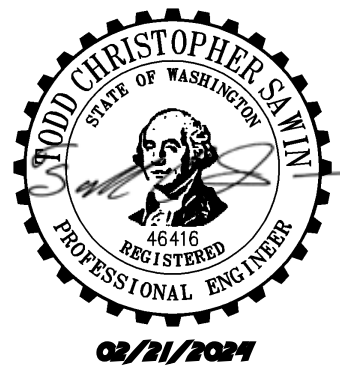

NOTICE
ALTERATION OF THIS DOCUMENT SHALL INVALIDATE THE PROFESSIONAL SEAL AND SIGNATURE. PUBLICATION OF THIS DOCUMENT DOES NOT CONSTITUTE A GUARANTEE OR ENDORSEMENT BY THE ENGINEER OF THE ACCURACY OF THE INFORMATION PROVIDED HEREIN. THE ENGINEER IS NOT TO BE HELD RESPONSIBLE FOR ANY ERRORS OR OMISSIONS IN THIS DOCUMENT OR FOR ANY OTHER PROJECT.

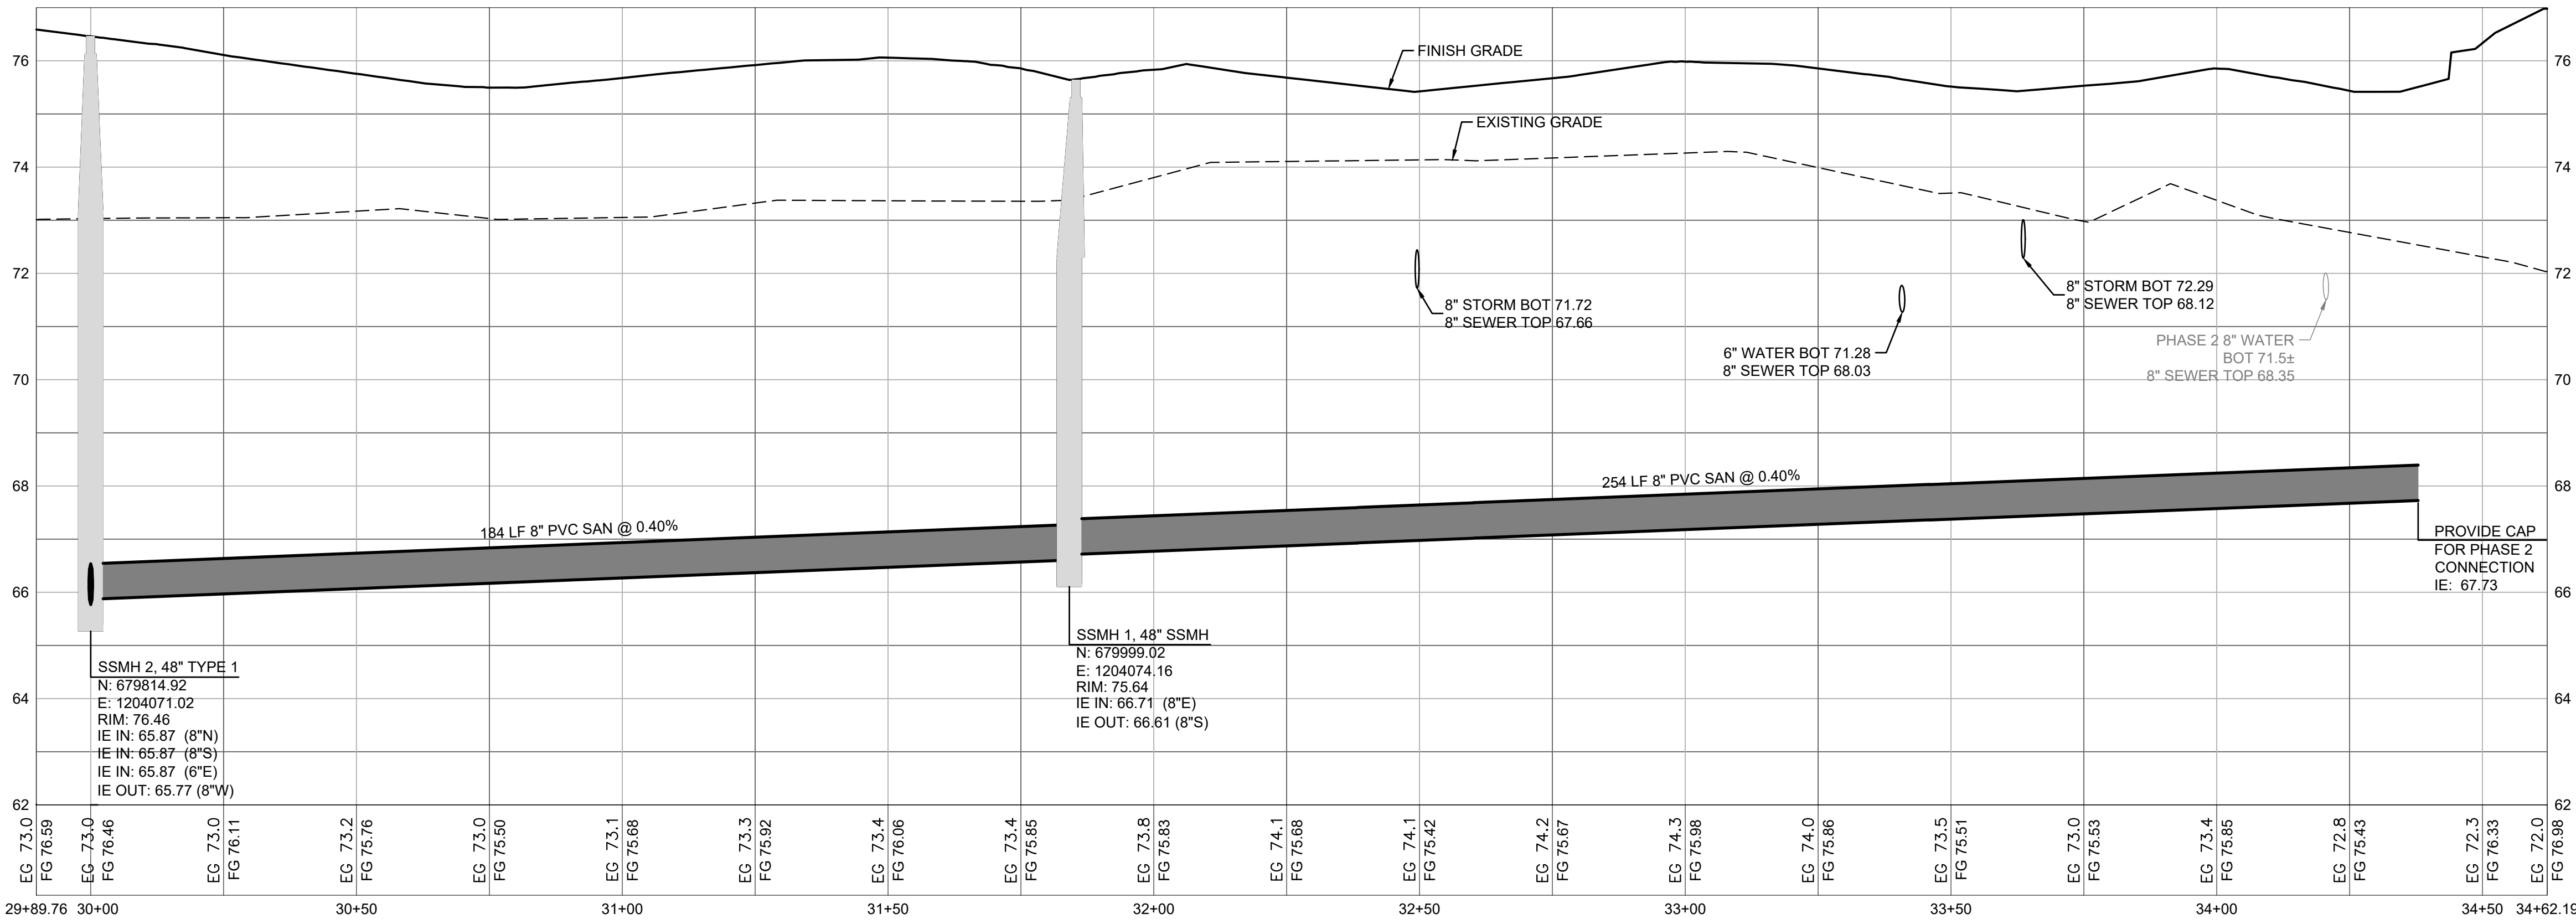

3 SEWER PROFILE
SCALE: HORIZ 1"=20'; VERT 1"=2'

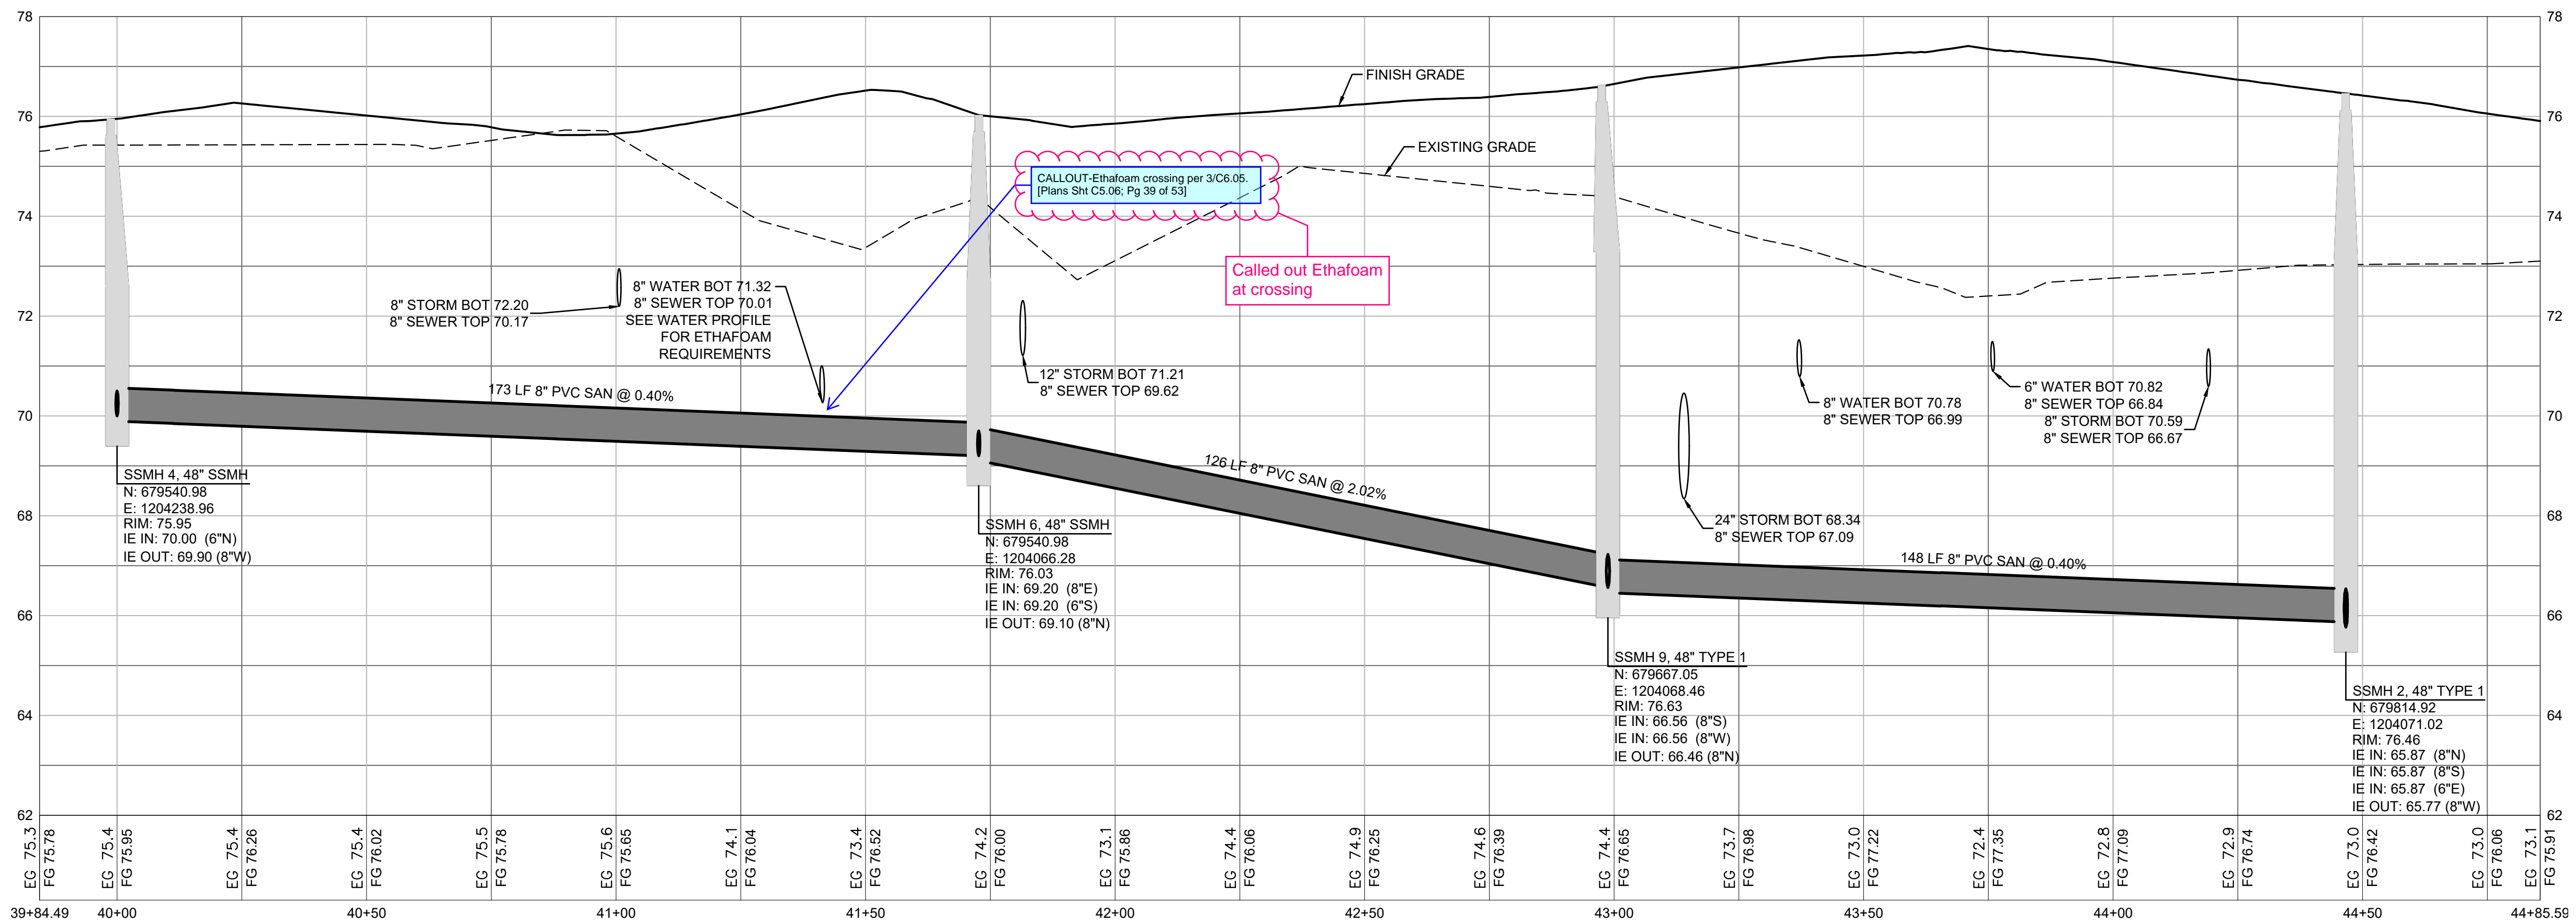

4 SEWER PROFILE
SCALE: HORIZ 1"=20'; VERT 1"=2'



Know what's below.
Call before you dig.

△
△
△

01/29/24 CITY COMMENTS

Revisions:

Sheet Title:

SEWER PROFILES

Designed by: CW Drawn by: SK / RS Checked by: JI

Sheet No.

C5.06

39 of 53 Sheets

EAST TOWN CROSSING PHASE 1


SEC. 26,35/ TWP. 20 N./ RGE. 4 E., W.M.

APPROVED

BY _____
CITY OF PUYALLUP
DEVELOPMENT ENGINEERING

DATE _____

NOTE: THIS APPROVAL IS VOID AFTER 180 DAYS FROM APPROVAL DATE. THE CITY WILL NOT BE RESPONSIBLE FOR ERRORS AND/OR OMISSIONS ON THESE PLANS. FIELD CONDITIONS MAY DICTATE CHANGES TO THESE PLANS AS DETERMINED BY THE DEVELOPMENT ENGINEERING MANAGER.

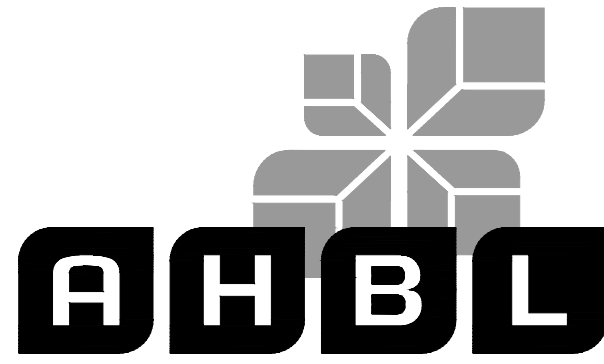

TACOMA · SEATTLE · SPOKANE · TRI-CITIES

2215 North 30th Street, Suite 300, Tacoma, WA 98403
253.383.2422 TEL 253.383.2572 FAX www.ahbl.com WEB

Project Title:

**EAST TOWN
CROSSING PHASE 1**

Client:
ASH DEVELOPMENT

GREG HELLE

GREG.HELLE@ASHNW.COM


Project No.

2230752


Issue Set & Date:

PERMIT SUBMITTAL

02/20/2024

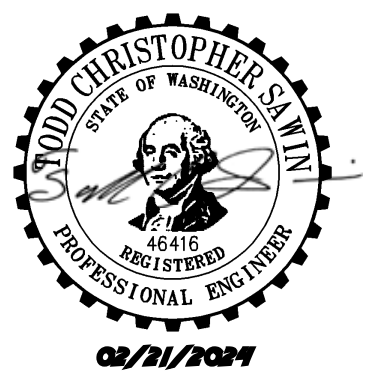

NOTICE
A REVISION OF THIS DOCUMENT SHALL INVALIDATE THE PROFESSIONAL SEAL AND SIGNATURE PUBLICATION OF THE DOCUMENT DOES NOT CONSTITUTE A REVISED DESIGN OR PLAN. THE DESIGNER IS NOT RESPONSIBLE FOR THE PROJECT EXCEPT IN THE TITLE BLOCK AND IS NOT TO BE USED FOR OTHER PROJECTS OR ACTION TO THAT PROJECT OR FOR ANY OTHER PROJECT.

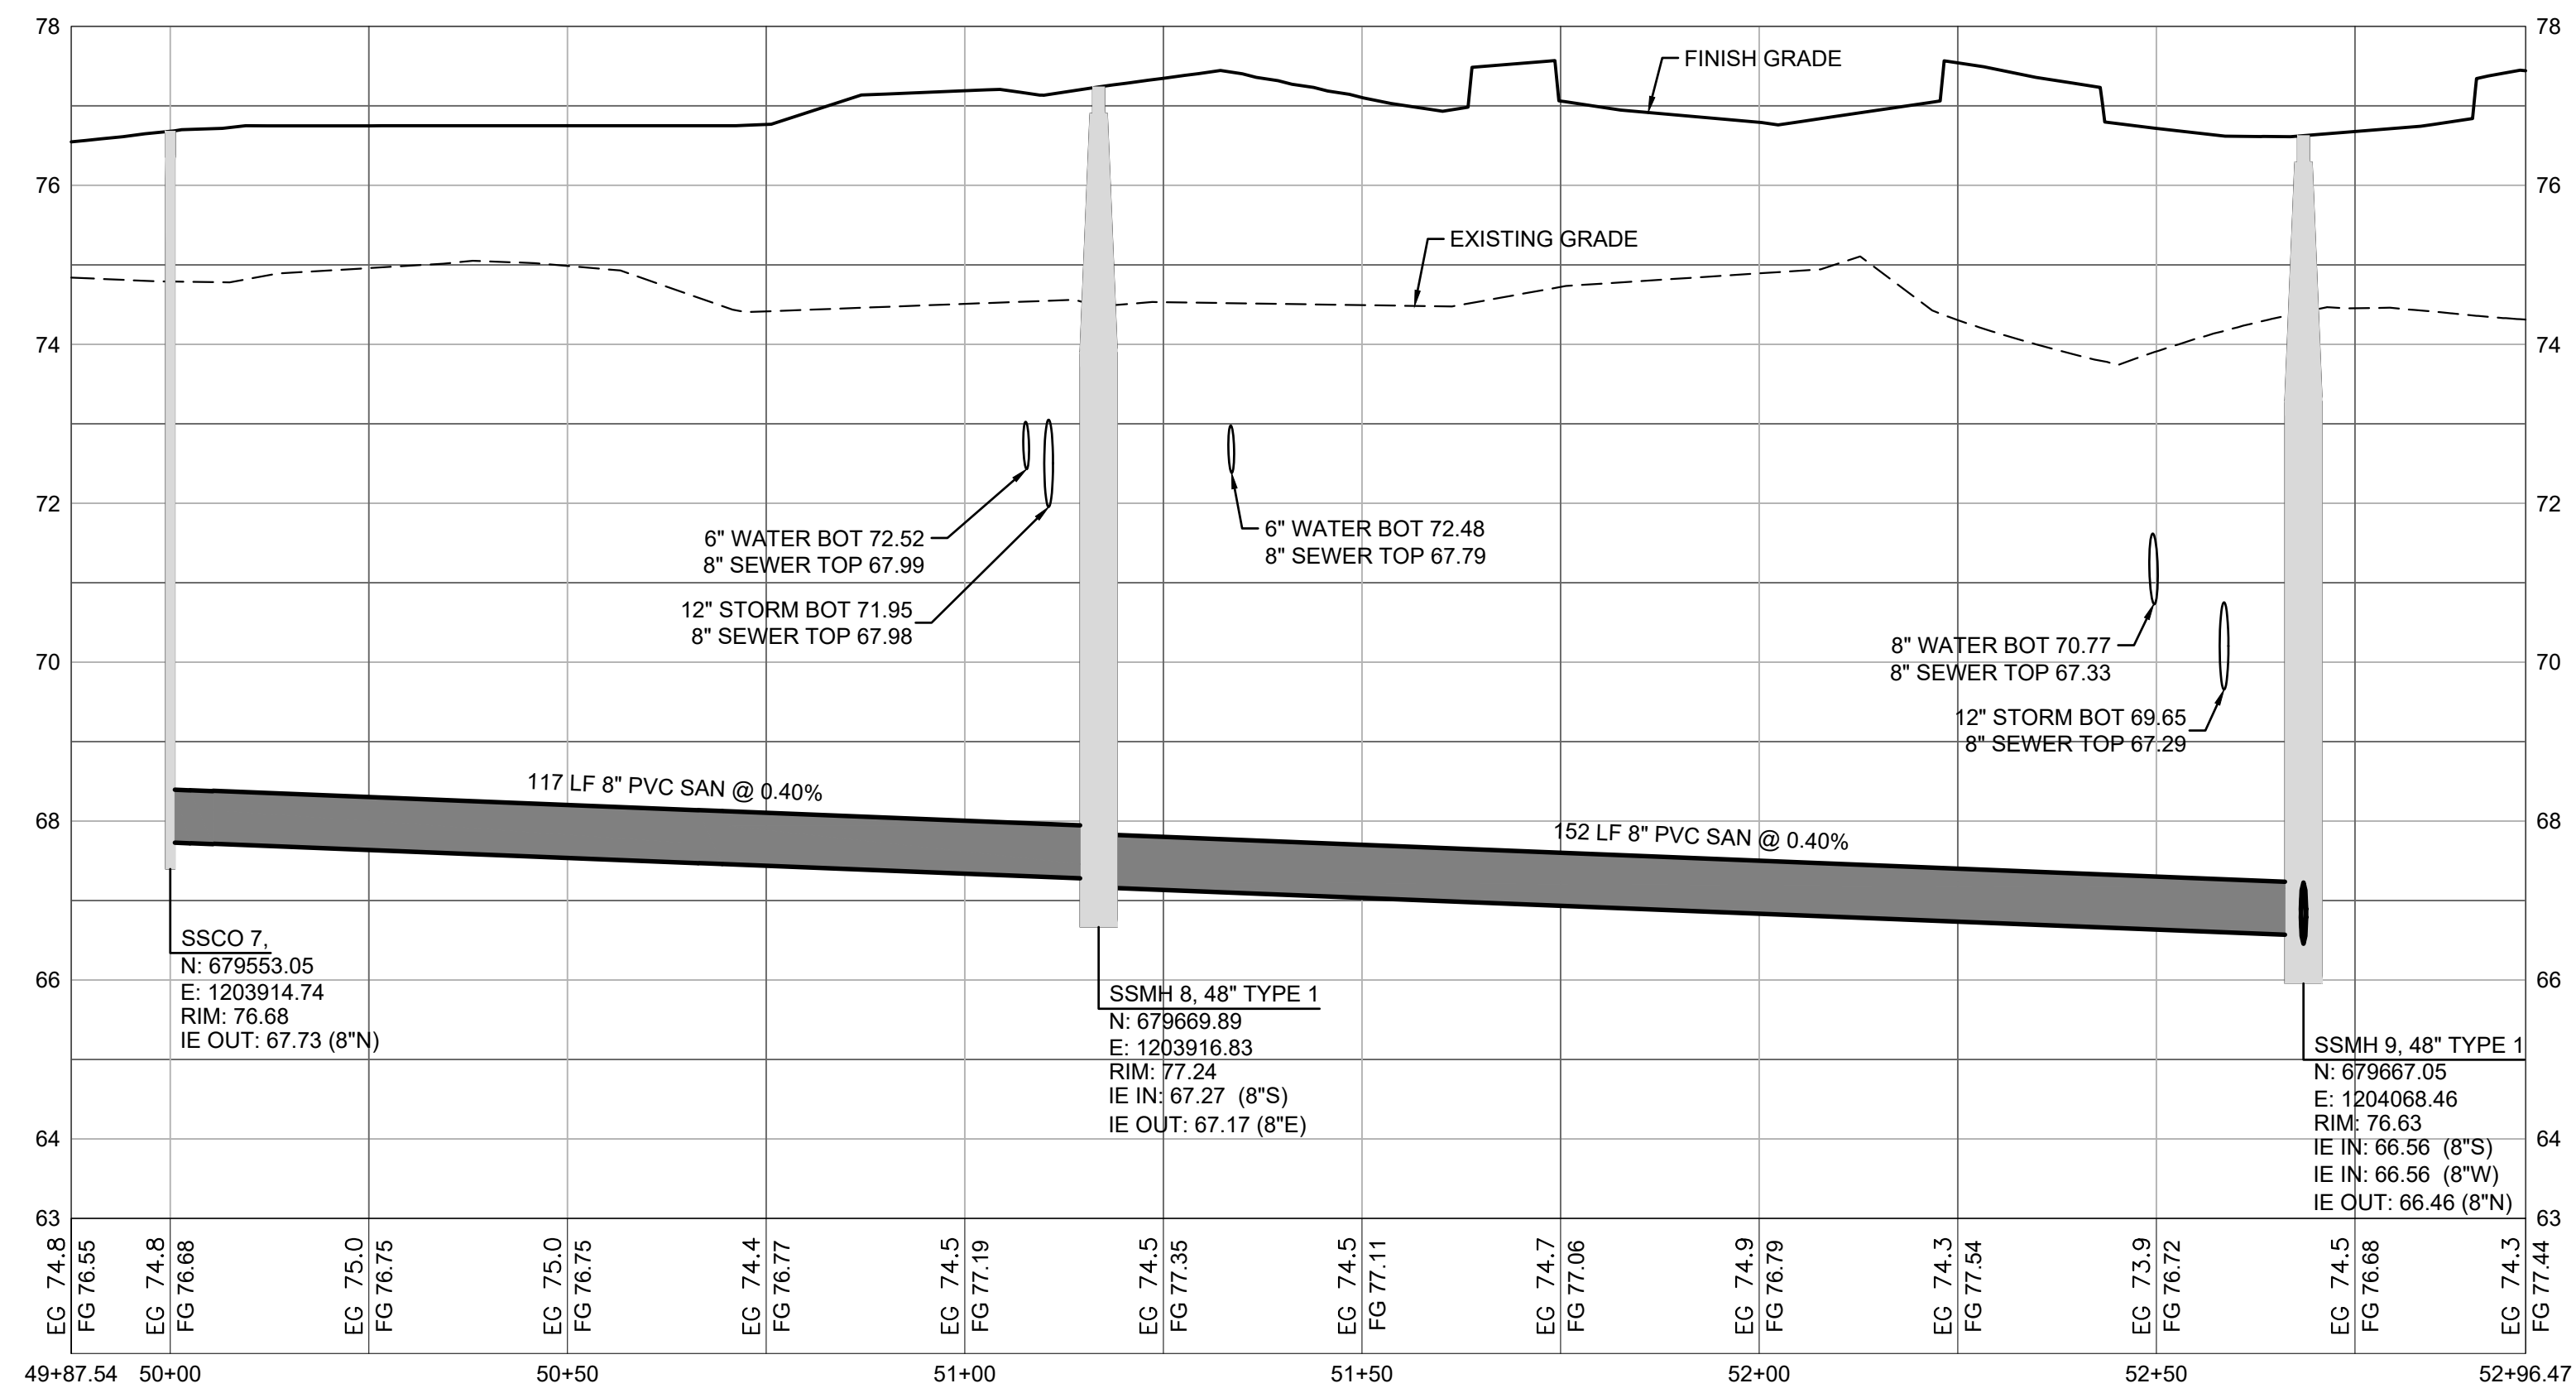

5 SEWER PROFILE
SCALE: HORIZ 1"=20'; VERT 1"=2'

△ _____
△ _____
△ _____

△ 01/29/24 CITY COMMENTS

Revisions:

Sheet Title:

SEWER PROFILES

Designed by: CW Drawn by: SK / RS Checked by: JI

Sheet No.

C5.07

40 of 53 Sheets



Know what's below.
Call before you dig.

EAST TOWN CROSSING PHASE 1


SEC. 26,35/ TWP. 20 N./ RGE. 4 E., W.M.

APPROVED

BY CITY OF PUYALLUP
DEVELOPMENT ENGINEERING

DATE

NOTE: THIS APPROVAL IS VOID AFTER 180 DAYS FROM APPROVAL DATE. THE CITY WILL NOT BE RESPONSIBLE FOR ERRORS AND/OR OMISSIONS ON THESE PLANS. FIELD CONDITIONS MAY DICTATE CHANGES TO THESE PLANS AS DETERMINED BY THE DEVELOPMENT ENGINEERING MANAGER.

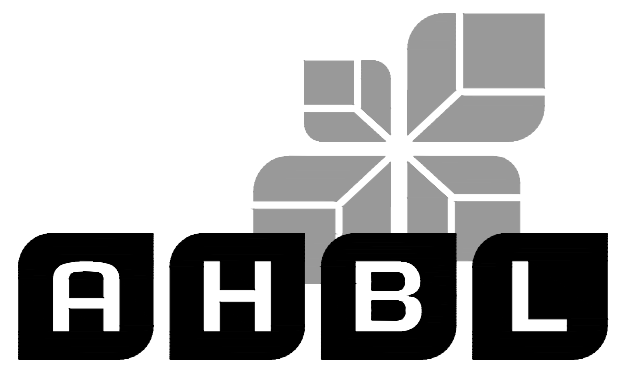

TACOMA · SEATTLE · SPOKANE · TRI-CITIES

2215 North 30th Street, Suite 300, Tacoma, WA 98403
253.383.2422 TEL 253.383.2572 FAX www.ahbl.com WEB

Project Title:

EAST TOWN CROSSING PHASE 1

Client:

ASH DEVELOPMENT

GREG HELLE

GREG.HELLE@ASHNW.COM


Project No.

2230752


Issue Set & Date:

PERMIT SUBMITTAL

02/20/2024

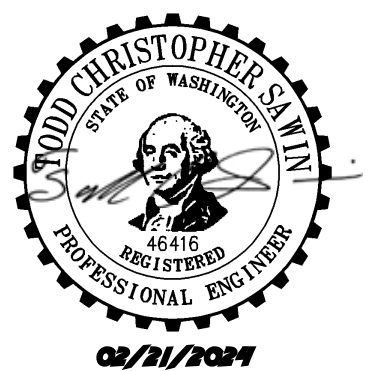


NOTICE: ALTERATION OF THIS DOCUMENT SHALL INVALIDATE THE PROFESSIONAL SEAL AND SIGNATURE. PUBLICATION OF THIS DOCUMENT DOES NOT CONSTITUTE AN ENDORSEMENT OR GUARANTEE BY THE ENGINEER OR FIRM. THIS DOCUMENT IS FOR THE PROJECT IDENTIFIED IN THE TITLE BLOCK AND IS NOT TO BE USED FOR OTHER PROJECTS OR ADDITION TO THAT PROJECT OR FOR ANY OTHER PROJECT.

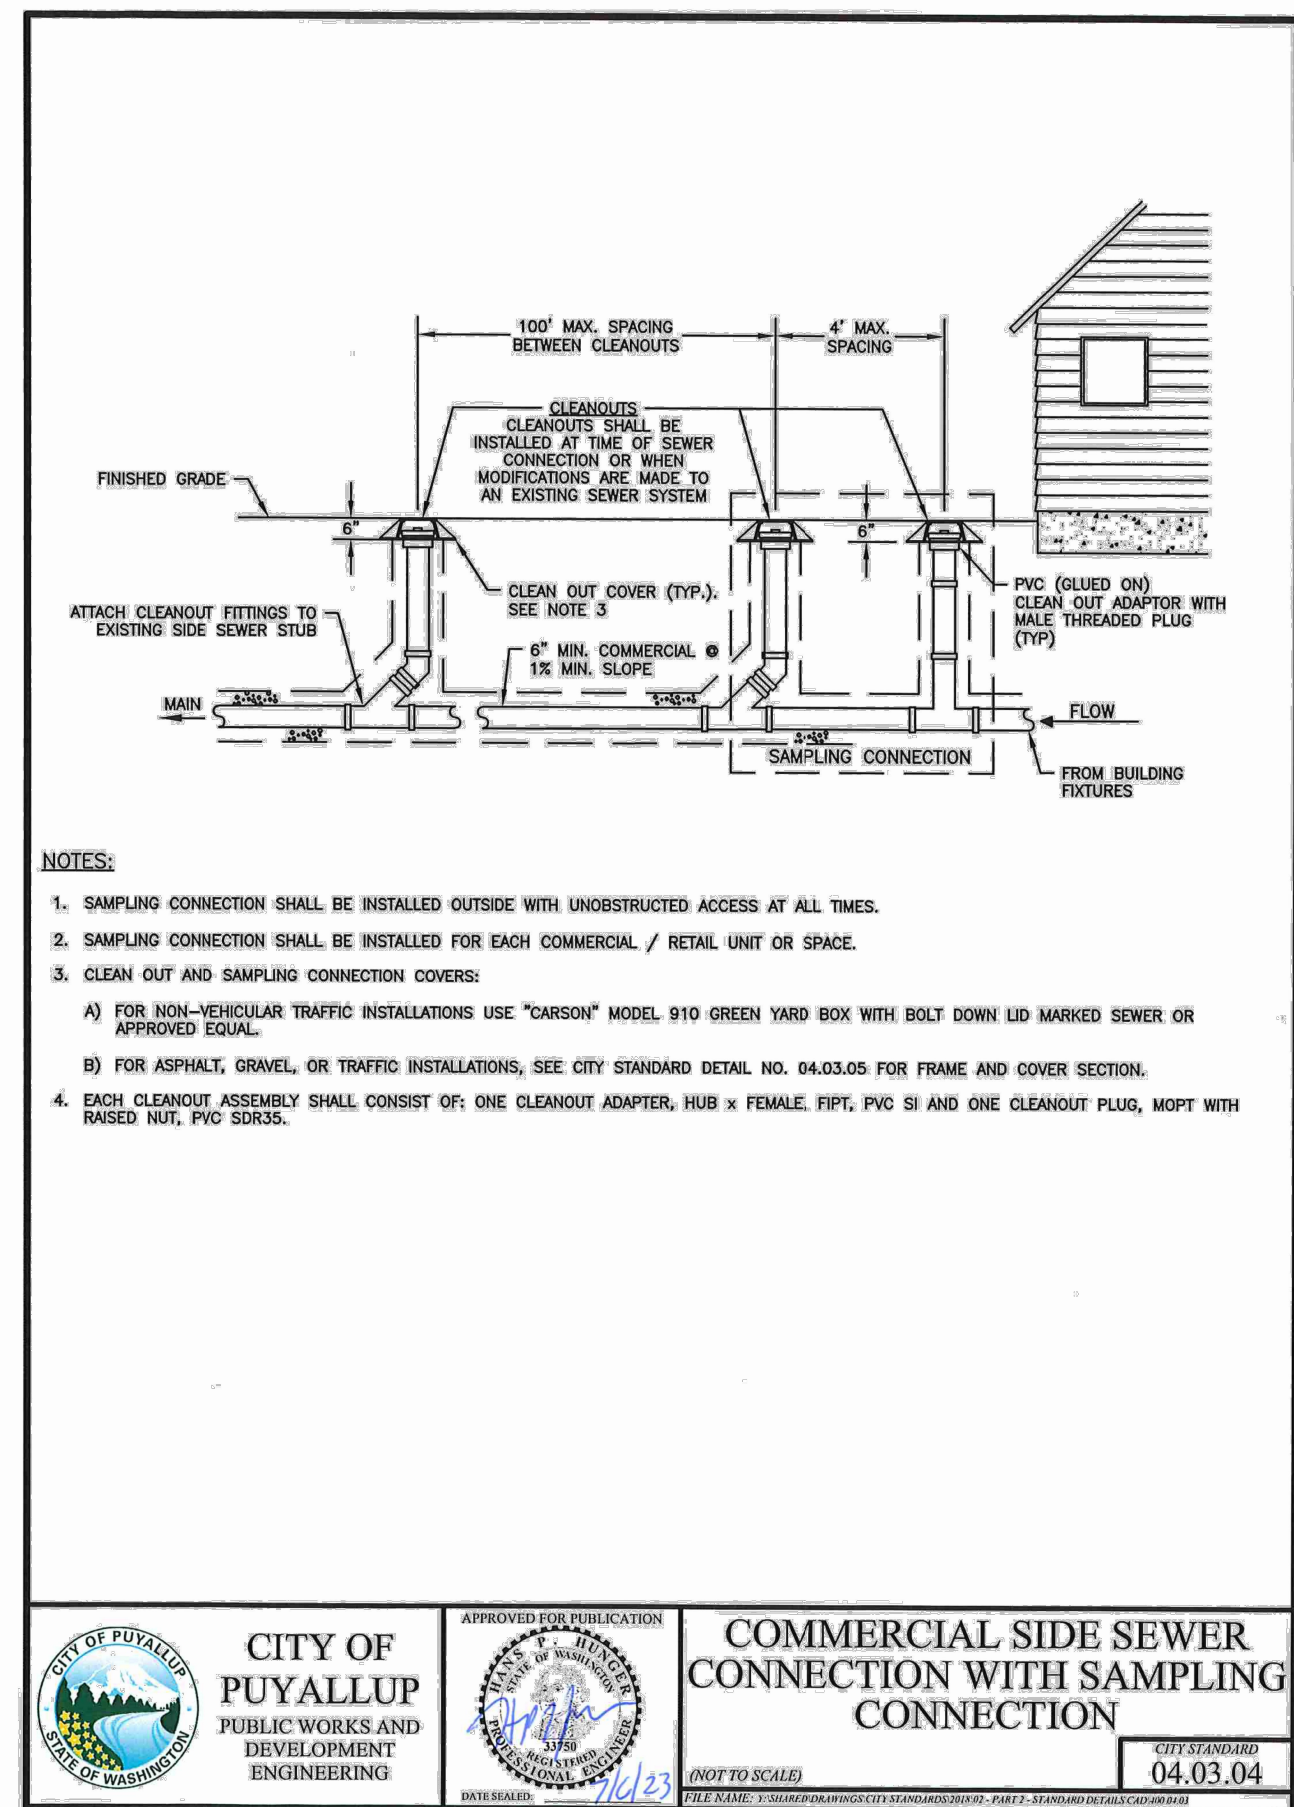


1 COMMERCIAL SIDE SEWER CONNECTION WITH SAMPLING CONNECTION

NOT TO SCALE

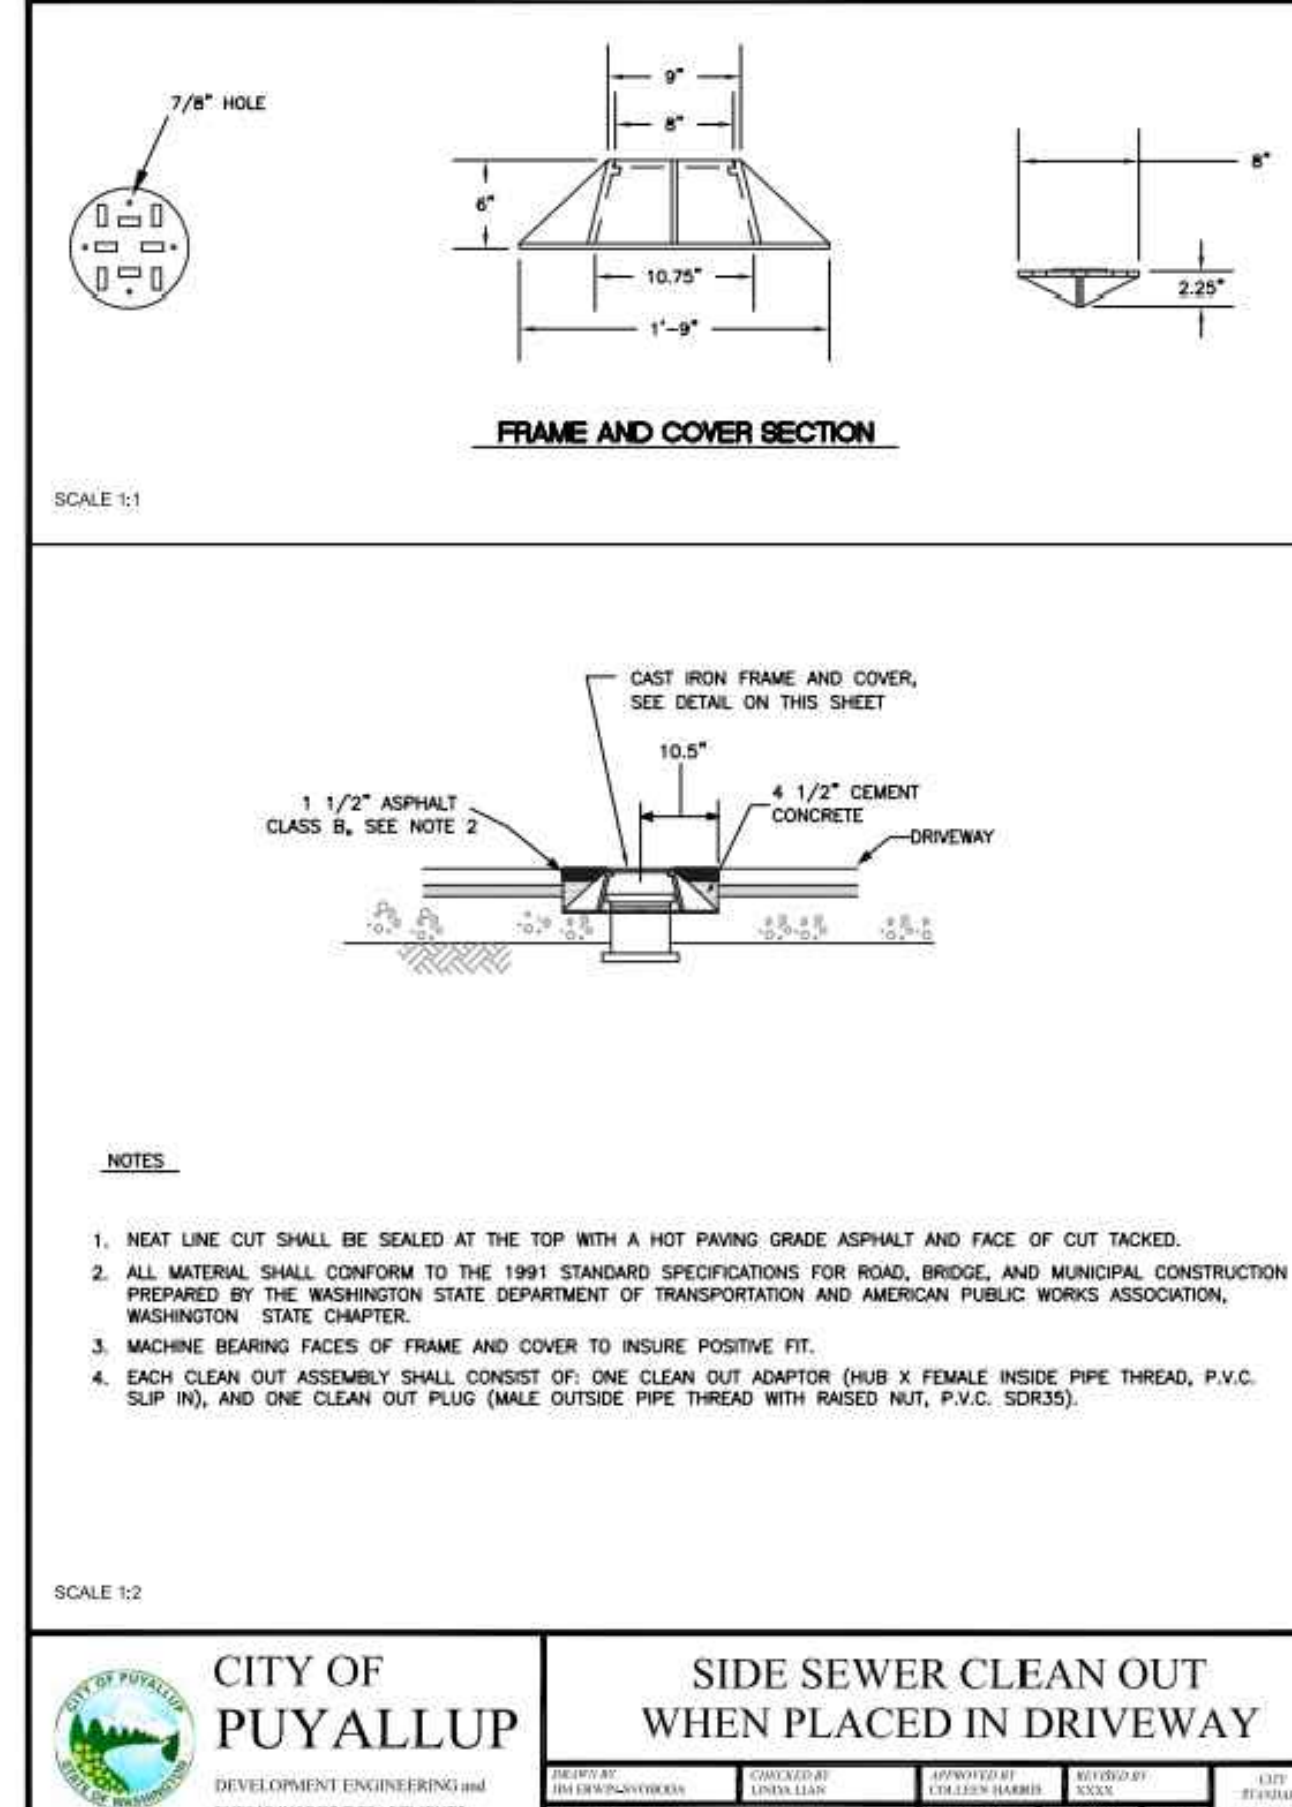


2 SIDE SEWER CLEAN OUT WHEN PLACED IN DRIVEWAY

NOT TO SCALE

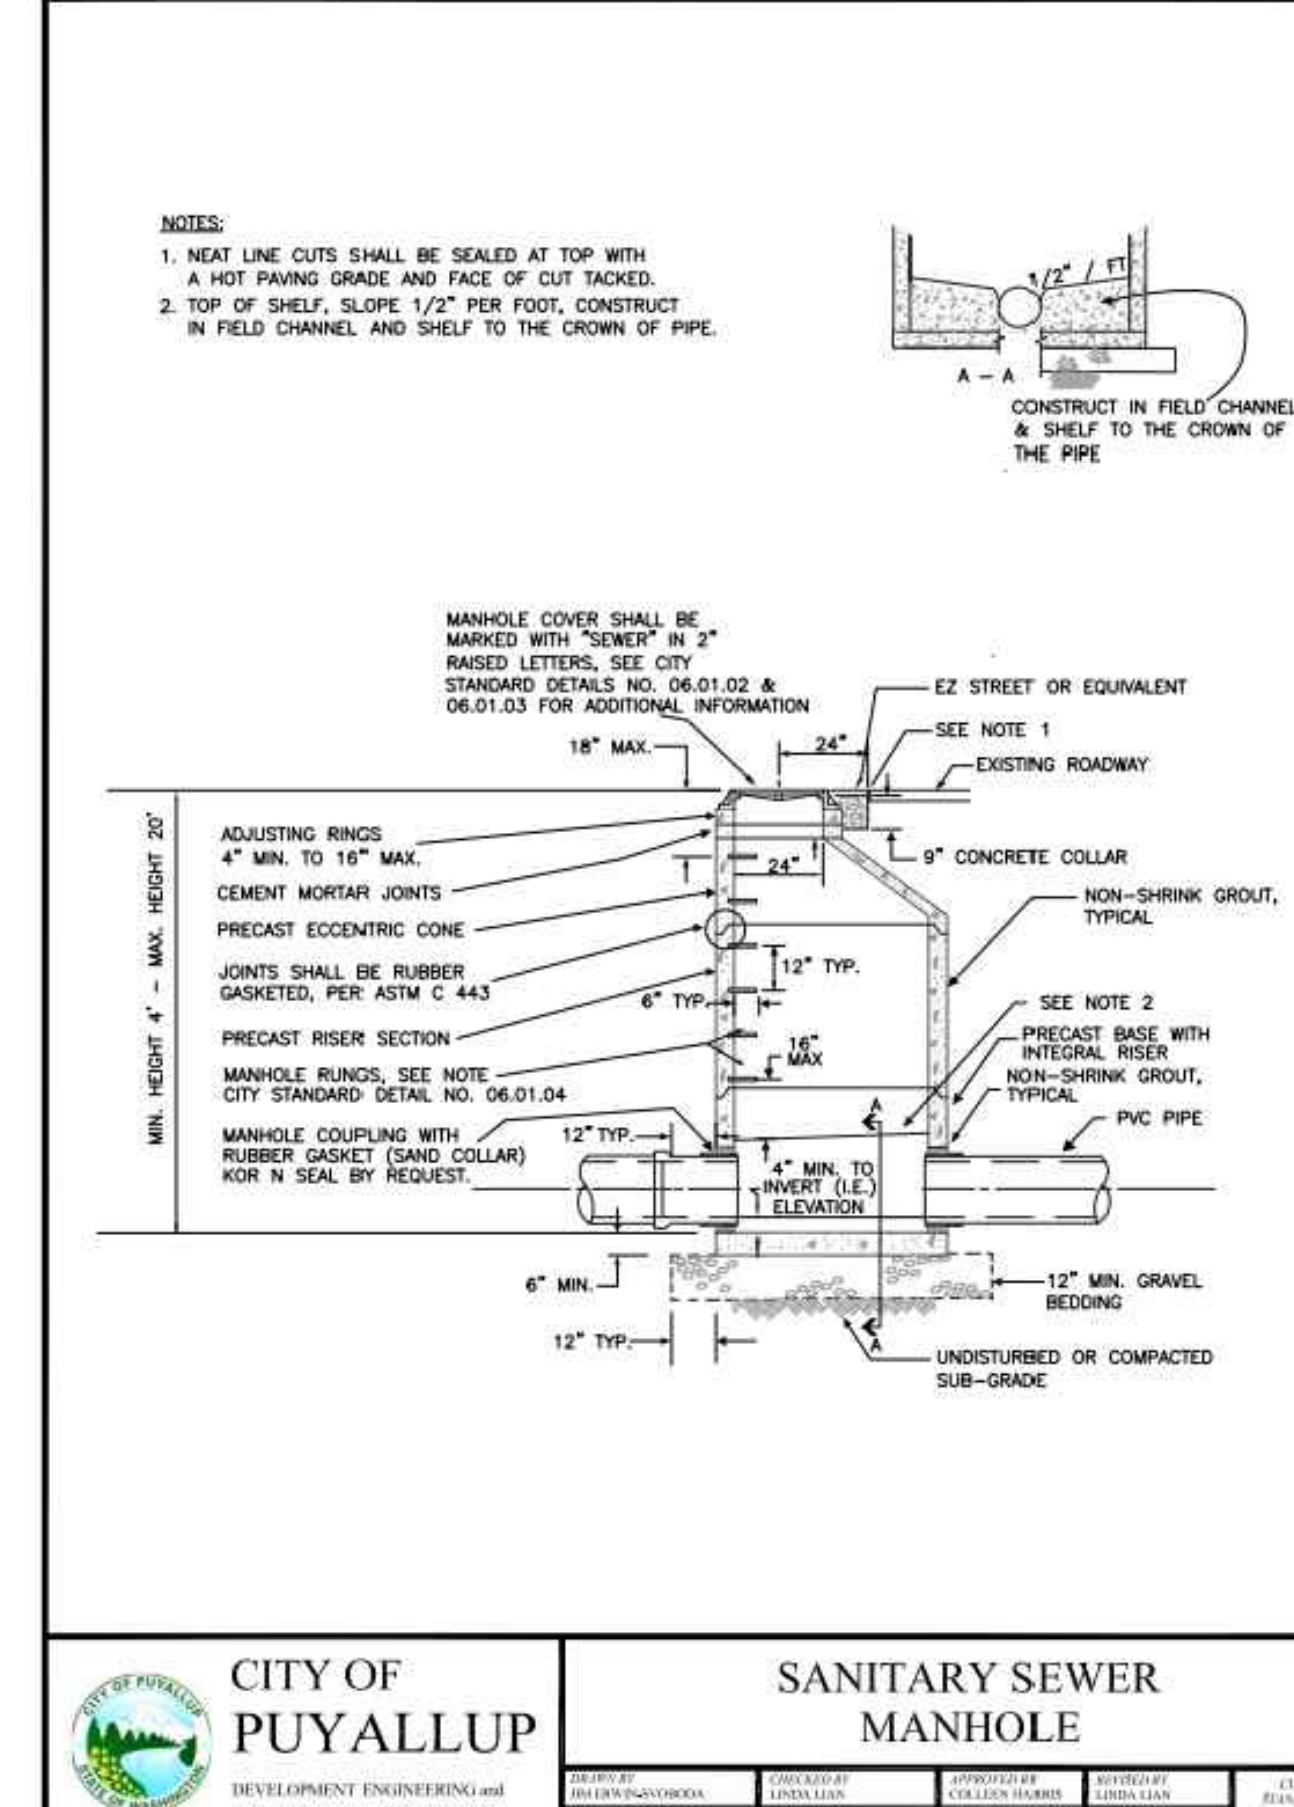


3 SANITARY SEWER MANHOLE

NOT TO SCALE

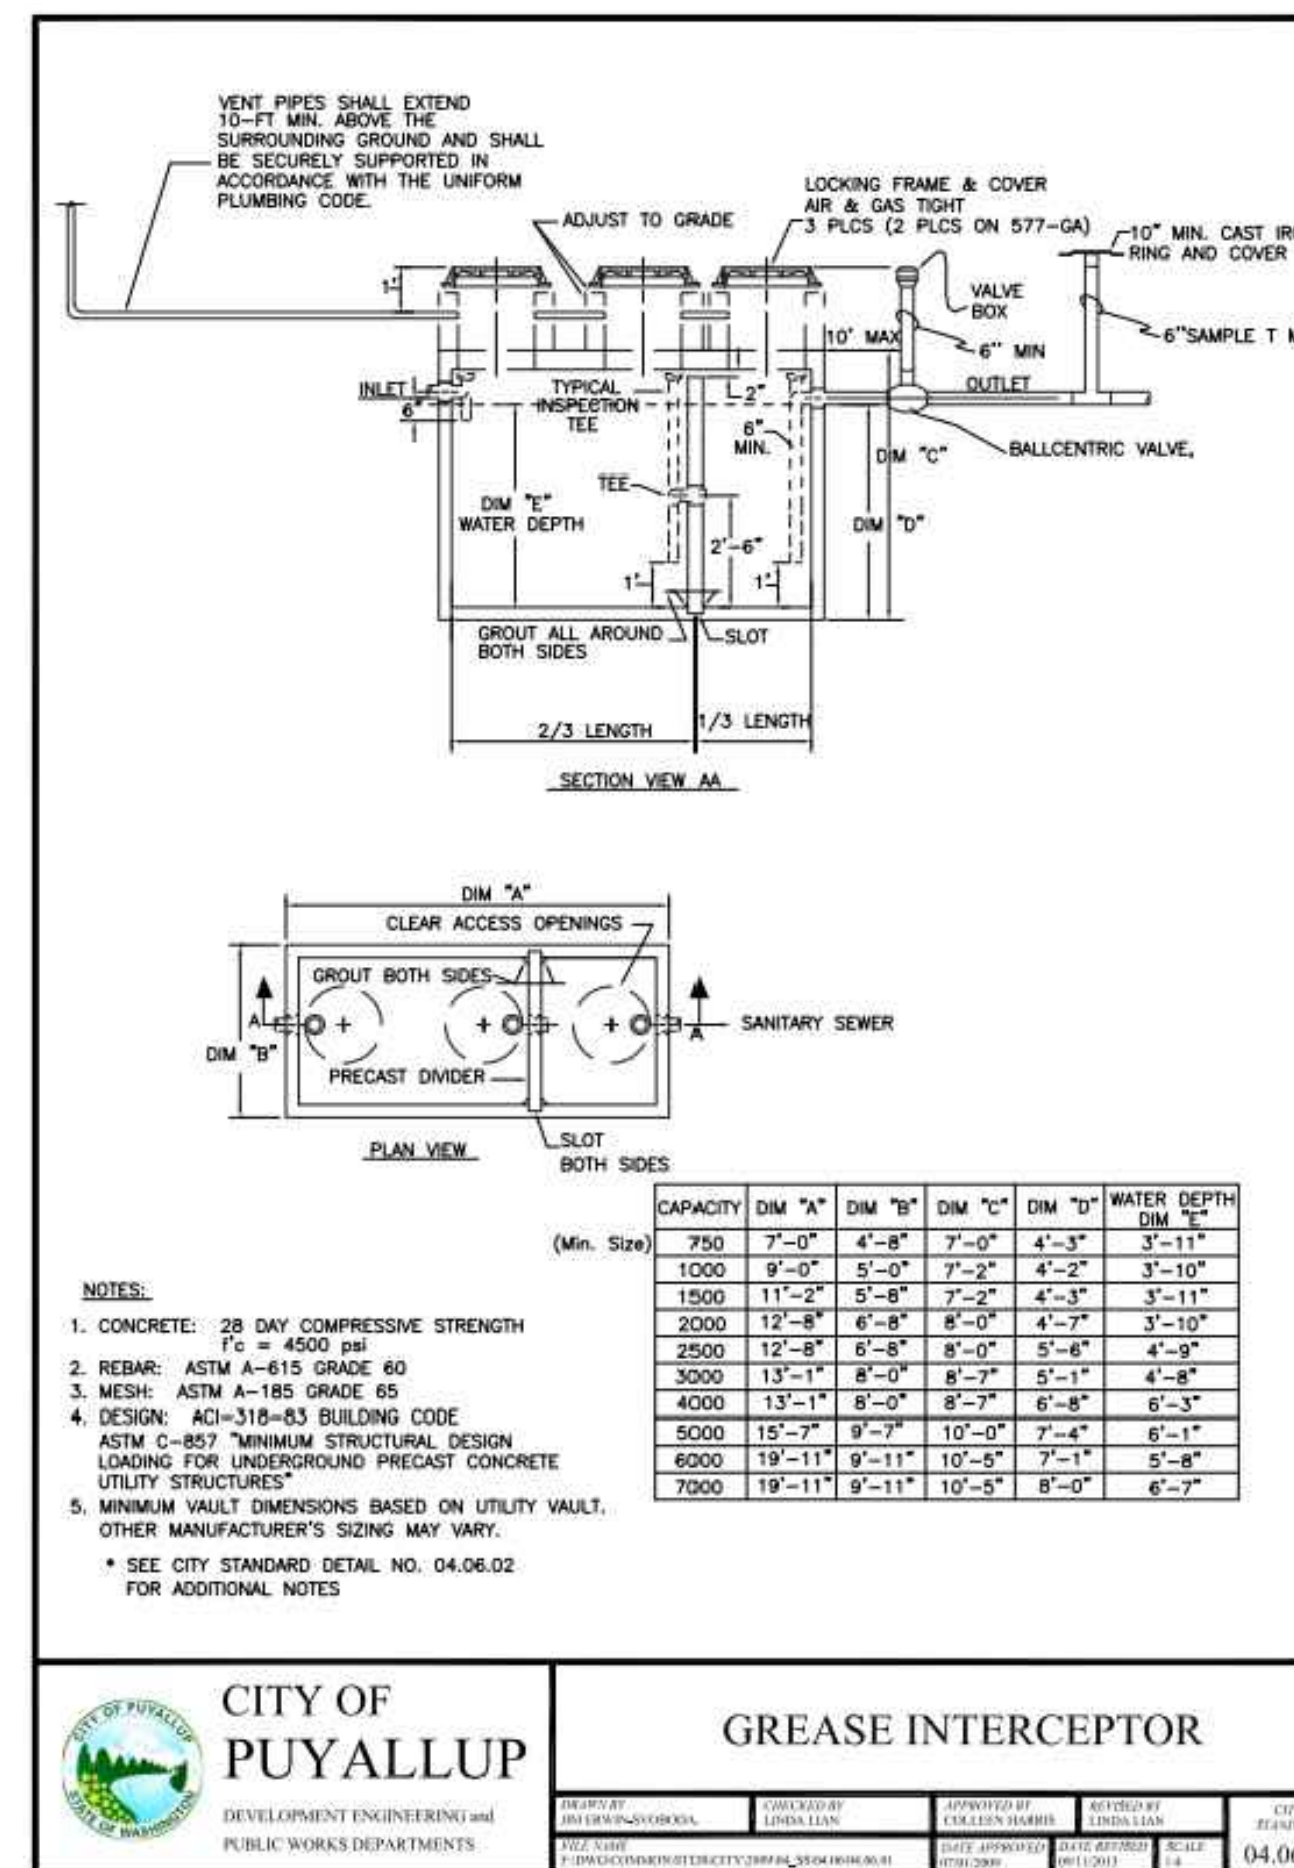

4 GREASE INTERCEPTOR AND NOTES

NOT TO SCALE

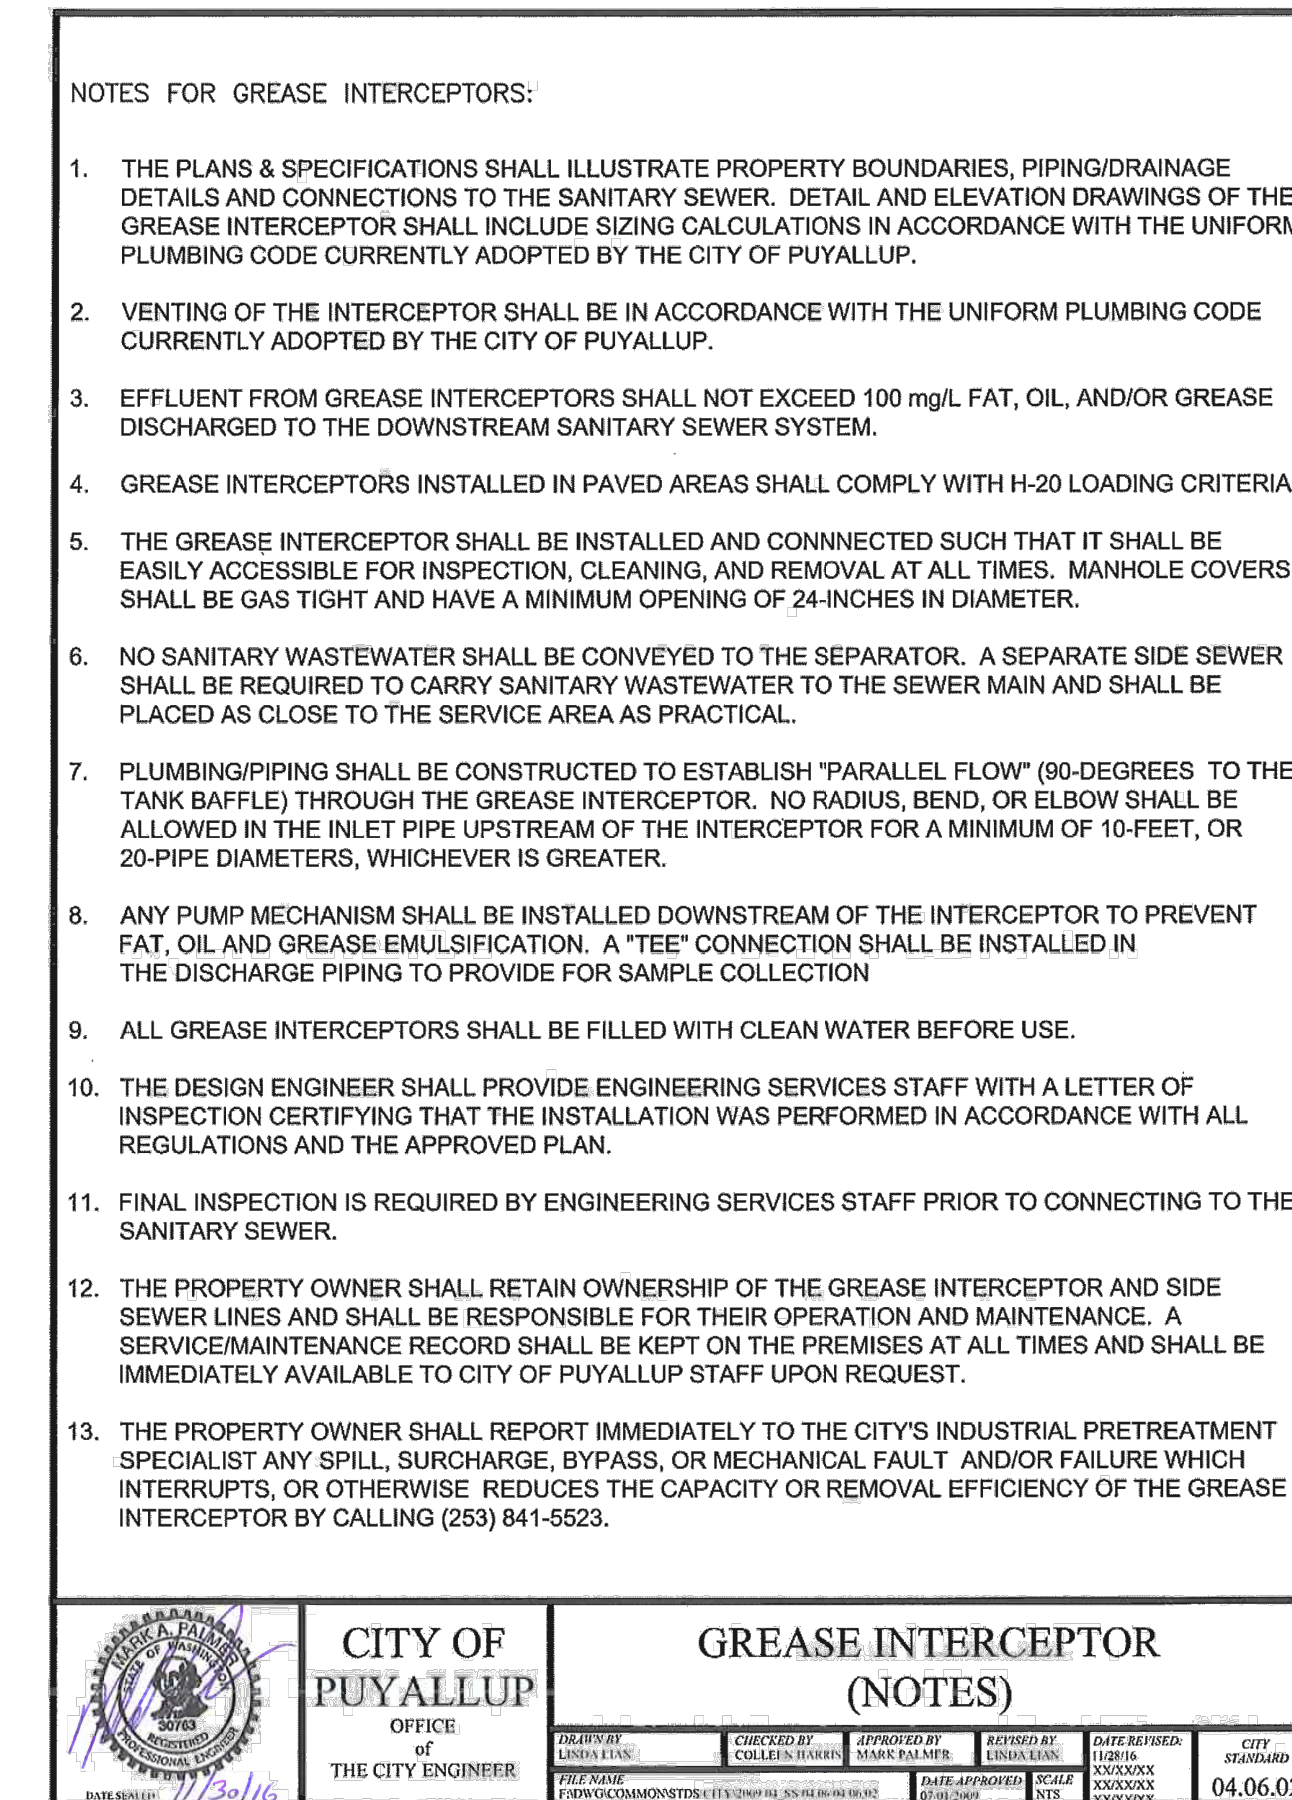

5 PAVING DETAIL

NOT TO SCALE



Know what's below.
Call before you dig.

Revisions:

01/29/24 CITY COMMENTS

Revisions:

Sheet Title:

SEWER NOTES AND DETAILS

Designed by: CW Drawn by: SK/RS Checked by: JI


Sheet No.

C5.08

41 of 53 Sheets

EAST TOWN CROSSING PHASE 1

SEC. 26,35/ TWP. 20 N./ RGE. 4 E., W.M.

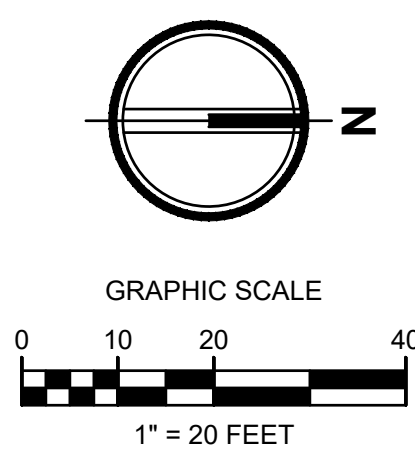

FIRE HYDRANT/FDC LOCATION/ACCESS APPROVED

BY: CITY OF PUYALLUP
FIRE CODE OFFICIAL

DATE: _____

NOTE: THIS APPROVAL IS VOID AFTER 1 YEAR FROM APPROVAL DATE.

THE CITY WILL NOT BE RESPONSIBLE FOR ERRORS AND/OR OMISSIONS ON THESE PLANS.

FIELD CONDITIONS MAY DICTATE CHANGES TO THESE PLANS AS DETERMINED BY THE DEVELOPMENT ENGINEERING MANAGER.

APPROVED


BY: CITY OF PUYALLUP
DEVELOPMENT ENGINEERING

DATE: _____

NOTE: THIS APPROVAL IS VOID AFTER 180 DAYS FROM APPROVAL DATE.

THE CITY WILL NOT BE RESPONSIBLE FOR ERRORS AND/OR OMISSIONS ON THESE PLANS.

FIELD CONDITIONS MAY DICTATE CHANGES TO THESE PLANS AS DETERMINED BY THE DEVELOPMENT ENGINEERING MANAGER.

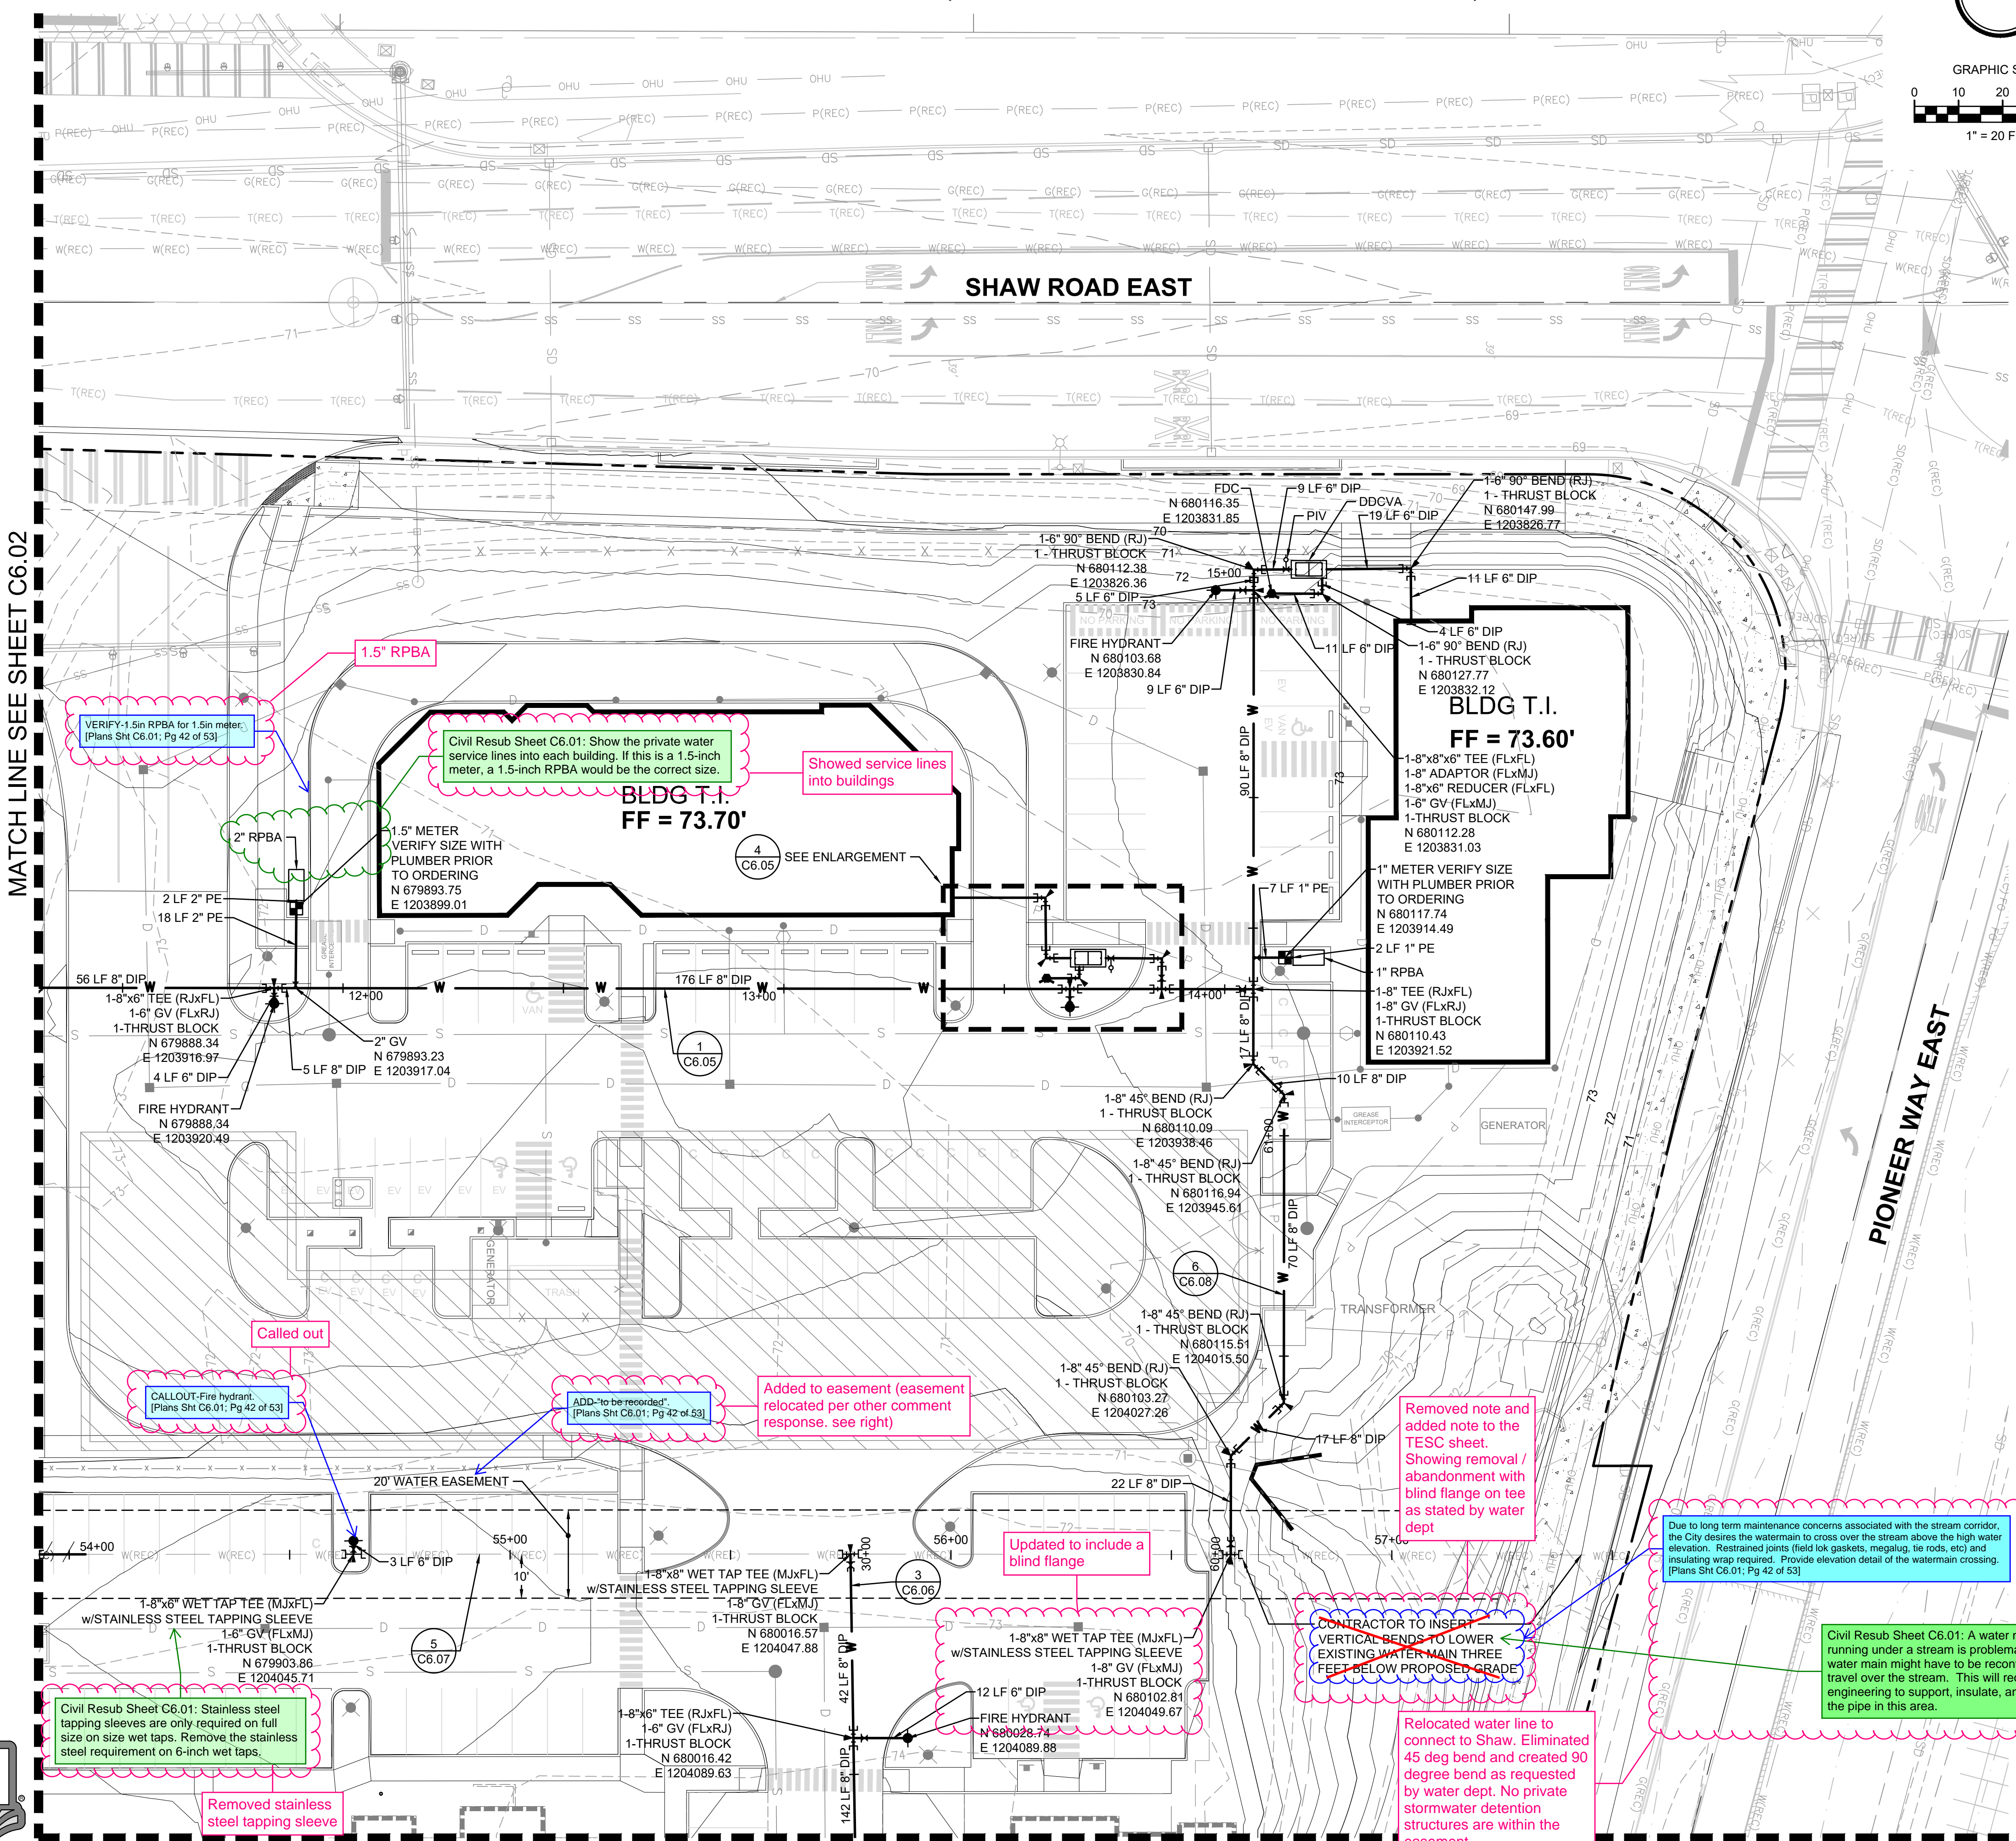

- ### GENERAL NOTES
- WET TAPS TO EXISTING WATER MAINS SHALL BE ACCOMPLISHED THROUGH A TAPPING TEE AND TAPPING VALVE, AND SHALL BE MADE BY A CITY APPROVED CONTRACTOR. THE TAPPING SLEEVE SHALL BE ROMAC SST ALL STAINLESS STEEL TAPPING SLEEVE OR APPROVED EQUAL. A TWO-PIECE EPOXY COATED OR DUCTILE IRON TAPPING SLEEVE MAY BE USED ON DUCTILE IRON PIPE, WHEN THE TAP IS SMALLER THAN THE WATER MAIN, I.E. 6" TAP ON 8" PIPE. THE CITY SHALL APPROVE THE TIME AND LOCATION FOR THESE CONNECTIONS.
 - IF THE PROJECT IS UTILIZING A FIRE BOOSTER PUMP, THE FDC MUST CONNECT TO THE SPRINKLER SYSTEM ON THE DISCHARGE SIDE OF THE PUMP IN ACCORDANCE WITH NFPA REGULATIONS.


- ### DETAIL REFERENCES
- HORIZONTAL THRUST BLOCKING 1 C6.09
 - VERTICAL THRUST BLOCKING 2 C6.09
 - THRUST BLOCKING TABLE 3 C6.09
 - 3/4" OR 1" WATER SERVICE CONNECTION 4 C6.09
 - 1-1/2" OR 2" WATER SERVICE CONNECTION 5 C6.09
 - PRIVATE WATER SERVICE LINES 6 C6.09
 - 2" AND SMALLER DCVA INSTALLATION 7 C6.09
 - FIRE HYDRANT ASSEMBLY 8 C6.09
 - 2" BLOW-OFF ASSEMBLY 1 C6.10
 - DDCVA ASSEMBLY AND NOTES 2 C6.10 3 C6.10
 - FIRE DEPARTMENT CONNECTION 4 C6.10
 - POST INDICATOR VALVE 5 C6.10
 - WATER VALVES AND MAINS 1 C6.11
 - WATER MAIN CROSSING OTHER UTILITIES AND NOTES 2 C6.11 3 C6.11
 - 2" AND SMALLER RPBA ASSEMBLY INSTALLATION 4 C6.11
 - WATER VAULT DETAILS 5 C6.11

FIRE PROTECTION NOTES

THE FIRE PROTECTION SYSTEM INCLUDING MATERIALS, SIZING, AND CONFIGURATION IS SUBJECT TO A CONTRACTOR PROVIDED DESIGN BY A FIRE PROTECTION ENGINEER, AND AS SUCH, THE FINAL DESIGN OF THE FIRE PROTECTION SYSTEM MAY DEVIATE FROM THE SYSTEM SHOWN. THE FIRE PROTECTION SYSTEM AS SHOWN FROM THE MAIN LINE TO THE CONNECTION AT THE BUILDING SPRINKLER IS INTENDED FOR LOCATION OF THE FIRE HYDRANTS AND FIRE DEPARTMENT CONNECTION ONLY. CONTRACTOR'S BID SHALL REFLECT THE CONDITIONS OF THE FIRE PROTECTION ENGINEER'S DESIGN. CONTRACTOR SHALL COMPLY WITH ALL NATIONAL FIRE PROTECTION ASSOCIATION REQUIREMENTS AS SET FORTH BY "NFPA 13", ITS AMENDMENTS, AND LOCAL REQUIREMENTS, INCLUDING BUT NOT LIMITED TO ACQUISITION OF ALL PERMITS.

FIRE SPRINKLER NOTE

WHERE THE UNDERGROUND WATER SUPPLY TEES OFF TO SERVE ONLY A FIRE SPRINKLER SYSTEM AND/OR FIRE HYDRANTS, A SEPARATE DETAILED PLAN MUST BE SUBMITTED AND APPROVED BY THE FIRE MARSHAL PRIOR TO INSTALLATION.

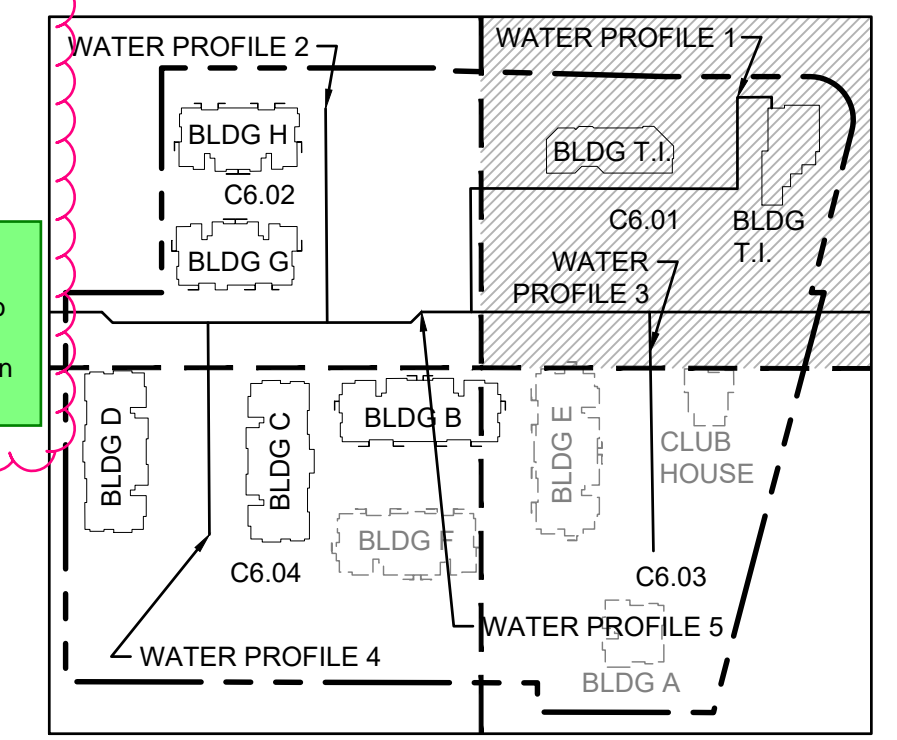

Project Title:

EAST TOWN CROSSING PHASE 1

Client:

ASH DEVELOPMENT

GREG HELLE
GREG.HELLE@ASHNW.COM

Project No.

2230752

Issue Set & Date:

PERMIT SUBMITTAL

02/20/2024




NOTICE: ALTERATION OF THIS DOCUMENT SHALL INVALIDATE THE PROFESSIONAL SEAL AND SIGNATURE. PRODUCTION OF THIS DOCUMENT DOES NOT CONSTITUTE A PROFESSIONAL ENGINEER'S DESIGN OR A PROFESSIONAL ENGINEER'S SEAL OR SIGNATURE. THIS DOCUMENT IS FOR THE PROJECT IDENTIFIED IN THE TITLE BLOCK AND IS NOT TO BE USED FOR ANY OTHER PROJECT, OR ADDITION TO THAT PROJECT OR FOR ANY OTHER PROJECT.



EAST TOWN CROSSING PHASE 1

SEC. 26,35/ TWP. 20 N./ RGE. 4 E., W.M.

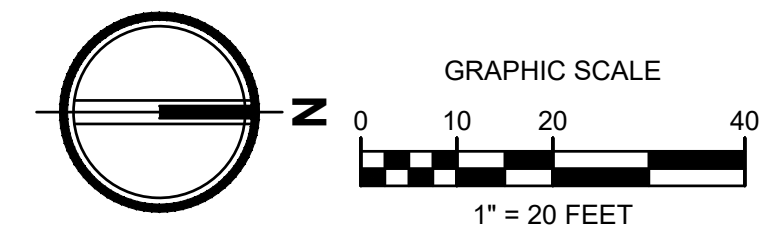

FIRE HYDRANT/FDC LOCATION/ACCESS APPROVED

BY: CITY OF PUYALLUP
FIRE CODE OFFICIAL

DATE: _____

NOTE: THIS APPROVAL IS VOID AFTER 1 YEAR FROM APPROVAL DATE.

THE CITY WILL NOT BE RESPONSIBLE FOR ERRORS AND/OR OMISSIONS ON THESE PLANS.

FIELD CONDITIONS MAY DICTATE CHANGES TO THESE PLANS AS DETERMINED BY THE DEVELOPMENT ENGINEERING MANAGER.

APPROVED


BY: CITY OF PUYALLUP
DEVELOPMENT ENGINEERING

DATE: _____

NOTE: THIS APPROVAL IS VOID AFTER 180 DAYS FROM APPROVAL DATE.

THE CITY WILL NOT BE RESPONSIBLE FOR ERRORS AND/OR OMISSIONS ON THESE PLANS.

FIELD CONDITIONS MAY DICTATE CHANGES TO THESE PLANS AS DETERMINED BY THE DEVELOPMENT ENGINEERING MANAGER.

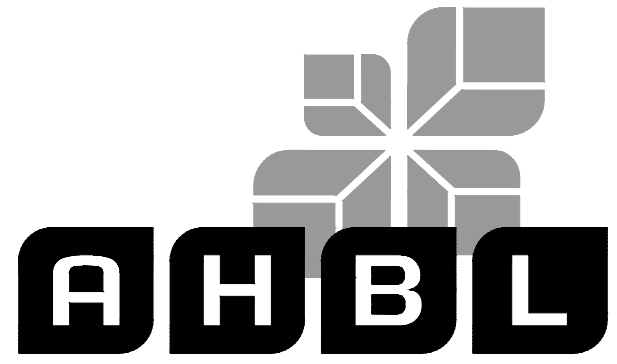

TACOMA · SEATTLE · SPOKANE · TRI-CITIES

2215 North 30th Street, Suite 300, Tacoma, WA 98403
253.383.2422 TEL 253.383.2572 FAX www.ahbl.com WEB

Project Title:

EAST TOWN CROSSING PHASE 1

Client:
ASH DEVELOPMENT

GREG HELLE
GREG.HELLE@ASHNW.COM

Project No.
2230752

Issue Set & Date:

PERMIT SUBMITTAL

02/20/2024



NOTICE
ALTERATION OF THIS DOCUMENT SHALL INVALIDATE THE PROFESSIONAL SEAL AND SIGNATURE. PUBLICATION OF THIS DOCUMENT DOES NOT CONSTITUTE A GUARANTEE OR WARRANTY OF ANY KIND. THE ENGINEER IS NOT RESPONSIBLE FOR THE PROJECT EXCEPT IN THE FIELD WORK AND NOT TO BE USED FOR OTHER PURPOSES OR IN CONNECTION WITH ANY OTHER PROJECT.

01/29/24 CITY COMMENTS

Revisions:

Sheet Title: WATER PLAN SW

Designed by: CW
Drawn by: SK/RS
Checked by: JI

Sheet No.

C6.02

43 of 53 Sheets

Civil Resub Sheet C6.02: There are two old water services on Shaw Road that need to be removed as part of this project. A water main shutdown will need to be scheduled with the Water Division, and the corporation stops will need to be removed off the water main and replaced with brass plugs.

Included on frontage plans submitted 04/04/2024

Civil Resub Sheet C6.02: Remove the 5 LF of 8-inch DIP and install 8-inch MJ plug in west side of hydrant tee.

Removed 5LF and called plug directly on tee

Wet tap tee per water dept connection comment

called out two 90 degree bends without callouts

Fitting callout. [Plans Sht C6.02; Pg 43 of 53]

Pipe run correct. Added additional labels

VERIFY pipe run. [Plans Sht C6.02; Pg 43 of 53]

Added note

ADD: to be recorded. [Plans Sht C6.02; Pg 43 of 53]


Revised to 90 degree as required by water dept

Civil Resub Sheet C6.02: Remove the 6 LF of 8-inch DIP and install 8-inch MJ plug in west side of hydrant tee.

Water line connects through to Shaw now


VERIFY pipe run. [Plans Sht C6.02; Pg 43 of 53]

Pipe run revised for new run

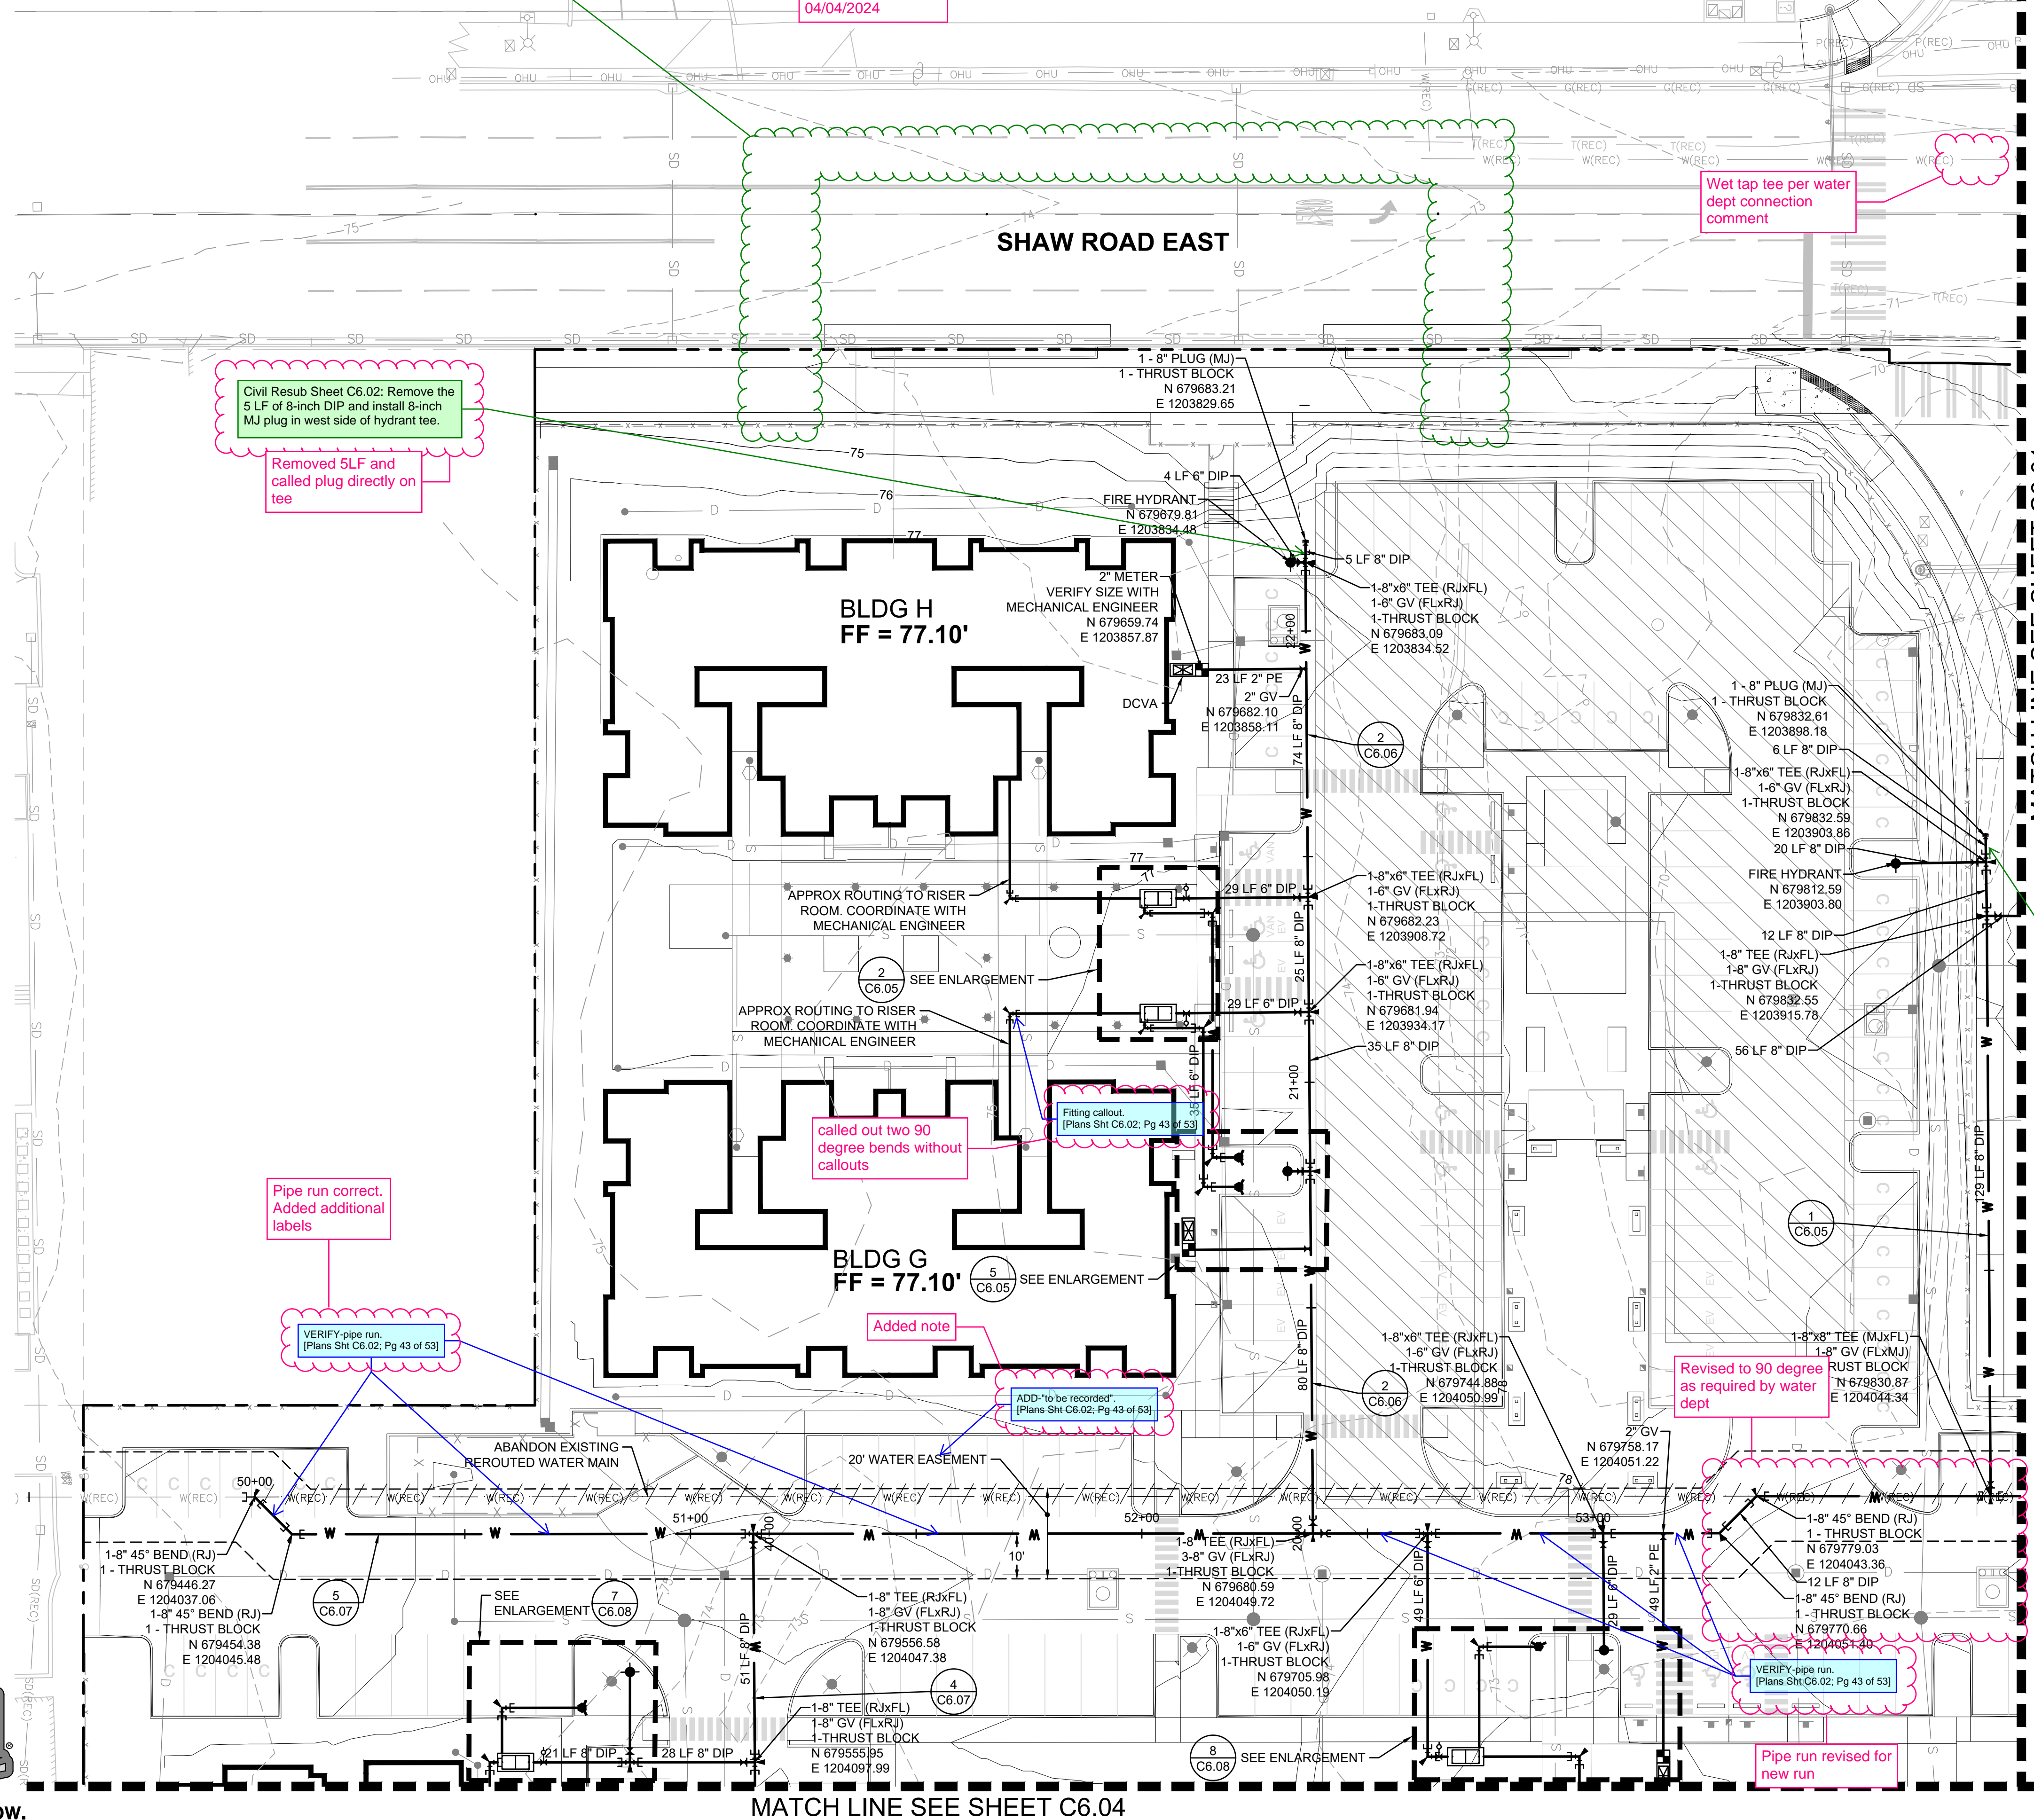

MATCH LINE SEE SHEET C6.01


MATCH LINE SEE SHEET C6.04

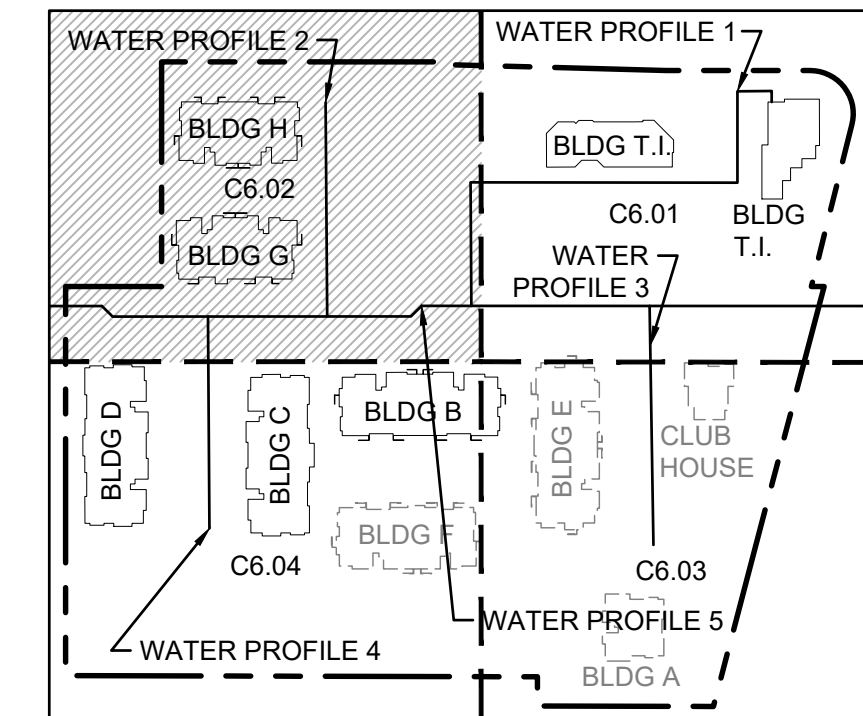

Know what's below.
Call before you dig.

EAST TOWN CROSSING PHASE 1

SEC. 26,35/ TWP. 20 N./ RGE. 4 E., W.M.

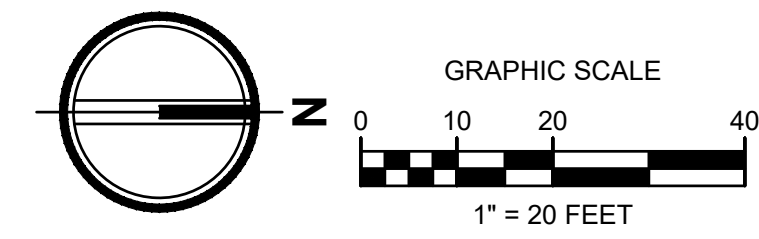

FIRE HYDRANT/FDC LOCATION/ACCESS APPROVED

APPROVED

BY: CITY OF PUYALLUP
FIRE CODE OFFICIAL

DATE:

NOTE: THIS APPROVAL IS VOID AFTER 1 YEAR FROM APPROVAL DATE.

THE CITY WILL NOT BE RESPONSIBLE FOR ERRORS AND/OR OMISSIONS ON THESE PLANS.

FIELD CONDITIONS MAY DICTATE CHANGES TO THESE PLANS AS DETERMINED BY THE FIRE CODE OFFICIAL.


NOTE: THIS APPROVAL IS VOID AFTER 180 DAYS FROM APPROVAL DATE.

THE CITY WILL NOT BE RESPONSIBLE FOR ERRORS AND/OR OMISSIONS ON THESE PLANS.

FIELD CONDITIONS MAY DICTATE CHANGES TO THESE PLANS AS DETERMINED BY THE DEVELOPMENT ENGINEERING MANAGER.



MATCH LINE SEE SHEET C6.01

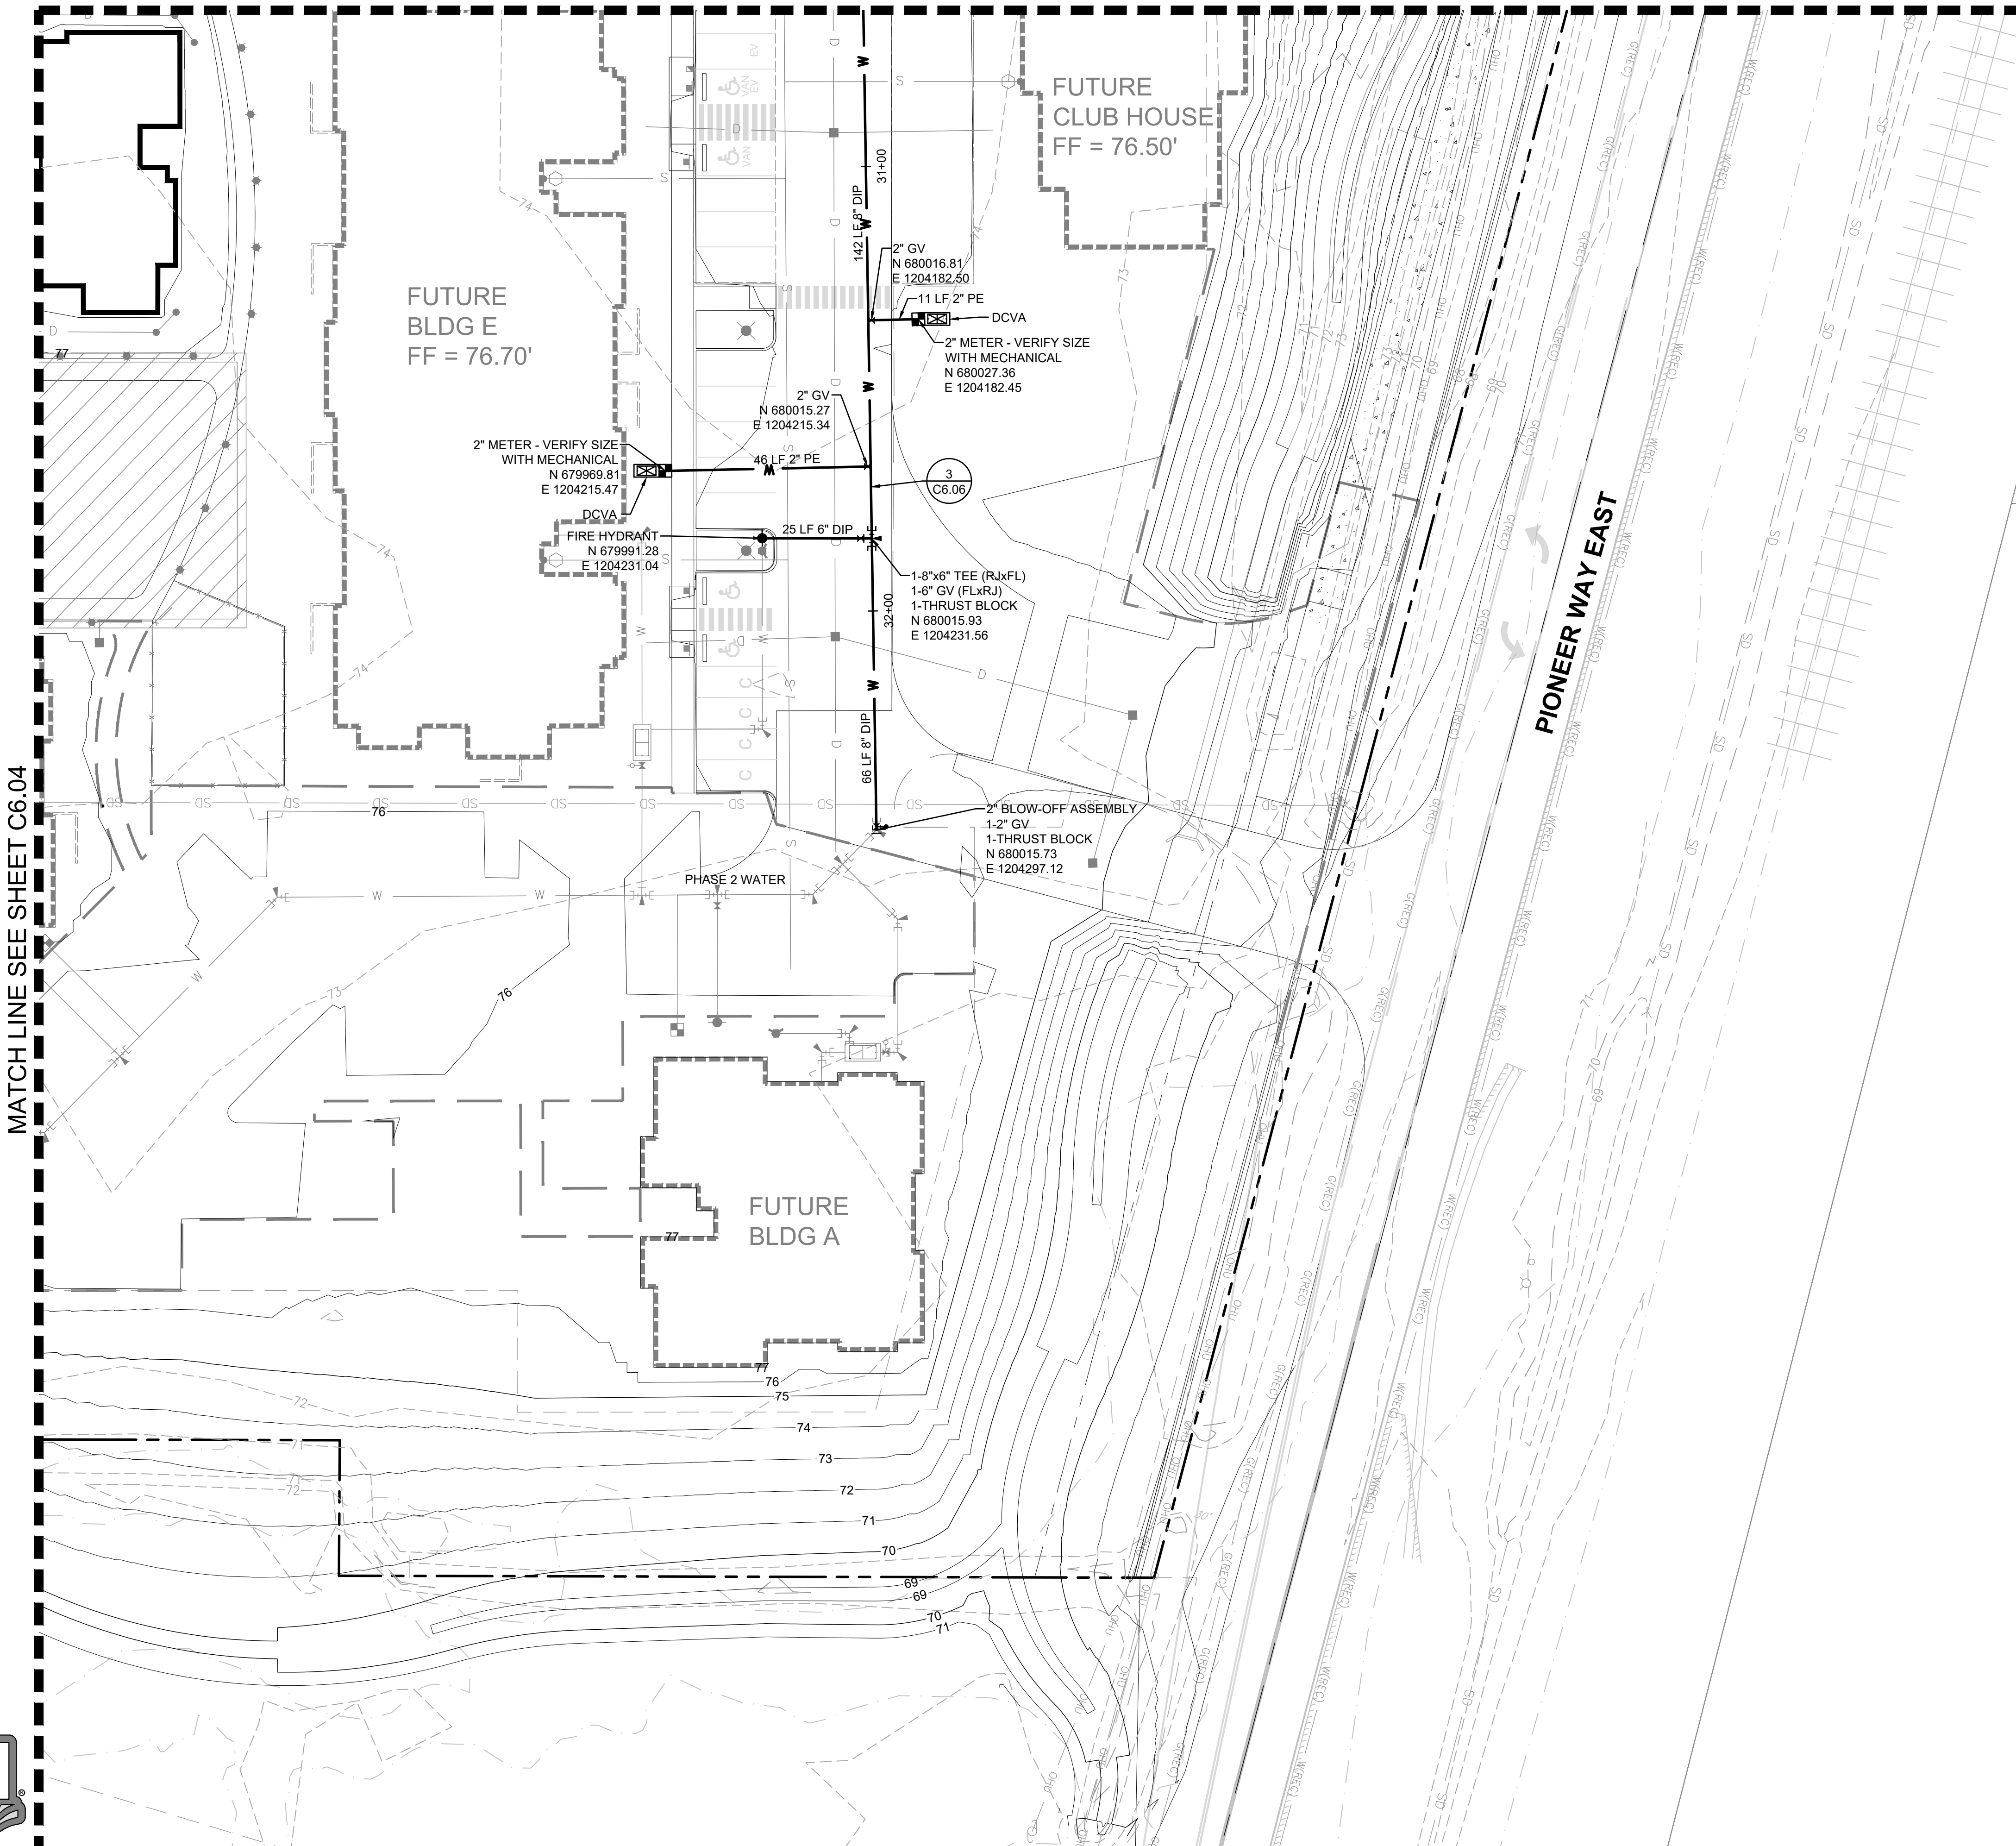


GENERAL NOTES

- WET TAPS TO EXISTING WATER MAINS SHALL BE ACCOMPLISHED THROUGH A TAPPING TEE AND TAPPING VALVE, AND SHALL BE MADE BY A CITY APPROVED CONTRACTOR. THE TAPPING SLEEVE SHALL BE ROMAC SST ALL STAINLESS STEEL TAPPING SLEEVE OR APPROVED EQUAL. A TWO-PIECE EPOXY COATED OR DUCTILE IRON TAPPING SLEEVE MAY BE USED ON DUCTILE IRON PIPE, WHEN THE TAP IS SMALLER THAN THE WATER MAIN, I.E. 6" TAP ON 8" PIPE. THE CITY SHALL APPROVE THE TIME AND LOCATION FOR THESE CONNECTIONS.
- IF THE PROJECT IS UTILIZING A FIRE BOOSTER PUMP, THE FDC MUST CONNECT TO THE SPRINKLER SYSTEM ON THE DISCHARGE SIDE OF THE PUMP IN ACCORDANCE WITH NFPA REGULATIONS.

DETAIL REFERENCES

- HORIZONTAL THRUST BLOCKING (1) C6.09
- VERTICAL THRUST BLOCKING (2) C6.09
- THRUST BLOCKING TABLE (3) C6.09
- 3/4" OR 1" WATER SERVICE CONNECTION (4) C6.09
- 1-1/2" OR 2" WATER SERVICE CONNECTION (5) C6.09
- PRIVATE WATER SERVICE LINES (6) C6.09
- 2" AND SMALLER DCVA INSTALLATION (7) C6.09
- FIRE HYDRANT ASSEMBLY (8) C6.09
- 2" BLOW-OFF ASSEMBLY (1) C6.10
- DCVA ASSEMBLY AND NOTES (2) C6.10 (3) C6.10
- FIRE DEPARTMENT CONNECTION (4) C6.10
- POST INDICATOR VALVE (5) C6.10
- WATER VALVES AND MAINS (1) C6.11
- WATER MAIN CROSSING OTHER UTILITIES AND NOTES (2) C6.11 (3) C6.11
- 2" AND SMALLER RPBA ASSEMBLY INSTALLATION (4) C6.11
- WATER VAULT DETAILS (5) C6.11

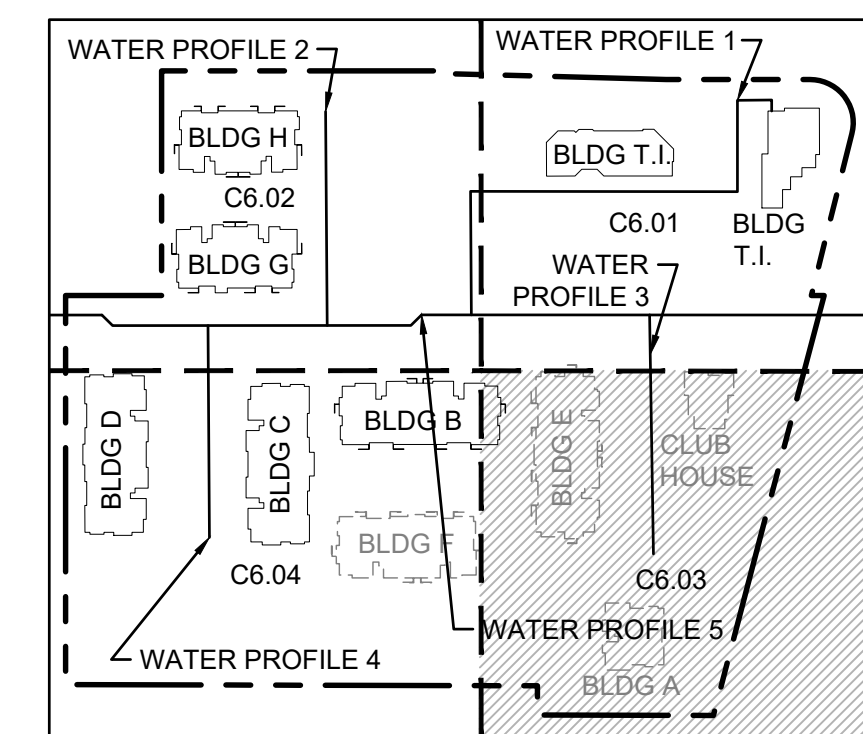

Project Title:

EAST TOWN CROSSING PHASE 1

Client:

ASH DEVELOPMENT

GREG HELLE

GREG.HELLE@ASHNW.COM

Project No.

2230752

Issue Set & Date:

PERMIT SUBMITTAL

02/20/2024



NOTICE: ALTERATION OF THIS DOCUMENT SHALL INVALIDATE THE PROFESSIONAL SEAL AND SIGNATURE. PUBLICATION OF THIS DOCUMENT DOES NOT CONSTITUTE A GUARANTEE OR ASSURANCE OF ACCURACY. THE ENGINEER IS NOT RESPONSIBLE FOR THE DESIGN OR CONSTRUCTION OF THE PROJECT EXCEPT IN THE FIELD OF HIS PROFESSIONAL ENGINEERING. THIS DOCUMENT IS NOT TO BE USED FOR ANY OTHER PROJECT.

△

△

△

△ 01/29/24 CITY COMMENTS

Revisions:

Sheet Title:

WATER PLAN NE

Designed by: CW
Drawn by: SK / RS
Checked by: JI

Sheet No.

C6.03


44 of 53 Sheets



Know what's below.
Call before you dig.

EAST TOWN CROSSING PHASE 1

SEC. 26,35/ TWP. 20 N./ RGE. 4 E., W.M.

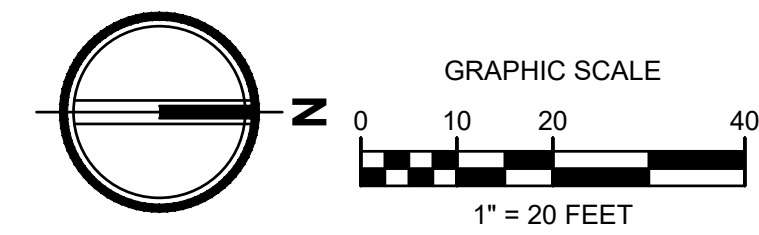

FIRE HYDRANT/FDC LOCATION/ACCESS APPROVED

BY: CITY OF PUYALLUP
FIRE CODE OFFICIAL

DATE: _____

NOTE: THIS APPROVAL IS VOID AFTER 1 YEAR FROM APPROVAL DATE.

THE CITY WILL NOT BE RESPONSIBLE FOR ERRORS AND/OR OMISSIONS ON THESE PLANS.

FIELD CONDITIONS MAY DICTATE CHANGES TO THESE PLANS AS DETERMINED BY THE FIRE CODE OFFICIAL.

APPROVED


BY: CITY OF PUYALLUP
DEVELOPMENT ENGINEERING

DATE: _____

NOTE: THIS APPROVAL IS VOID AFTER 180 DAYS FROM APPROVAL DATE.


THE CITY WILL NOT BE RESPONSIBLE FOR ERRORS AND/OR OMISSIONS ON THESE PLANS.

FIELD CONDITIONS MAY DICTATE CHANGES TO THESE PLANS AS DETERMINED BY THE DEVELOPMENT ENGINEERING MANAGER.

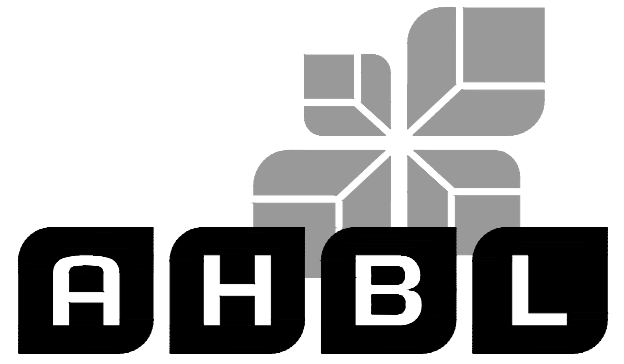

TACOMA · SEATTLE · SPOKANE · TRI-CITIES

2215 North 30th Street, Suite 300, Tacoma, WA 98403
253.383.2422 TEL 253.383.2572 FAX www.ahbl.com WEB

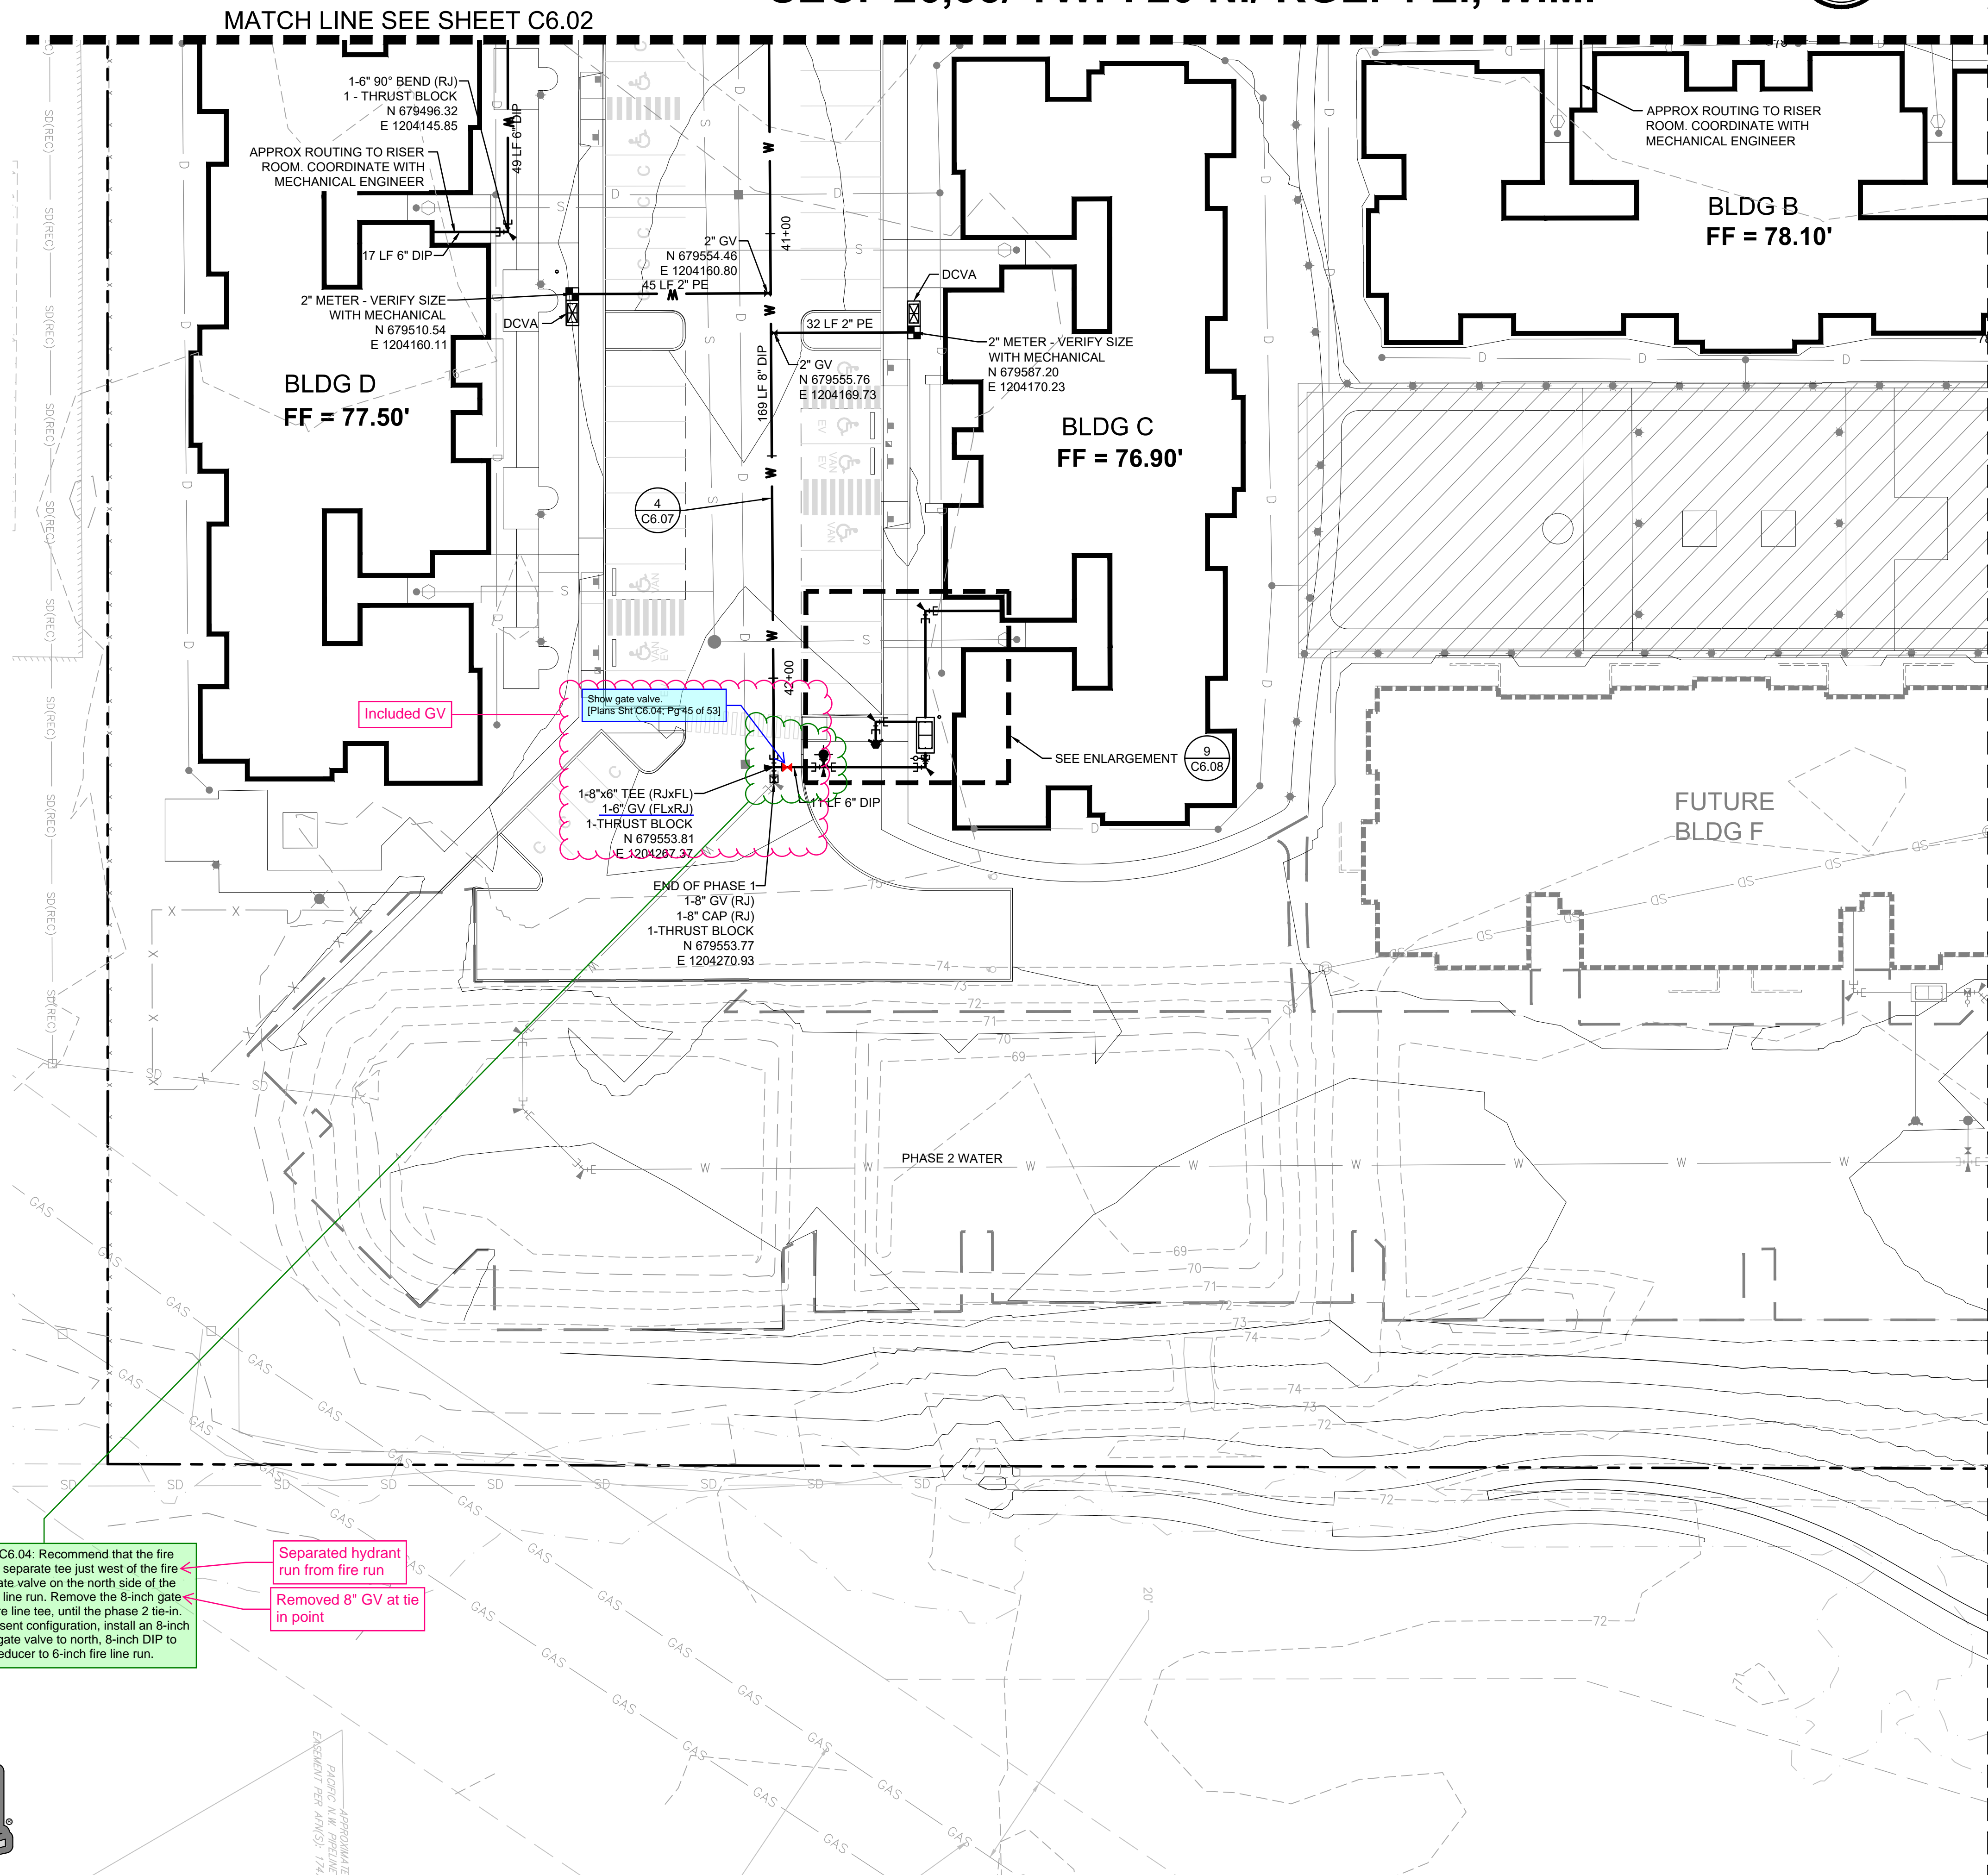


GENERAL NOTES

- WET TAPS TO EXISTING WATER MAINS SHALL BE ACCOMPLISHED THROUGH A TAPPING TEE AND TAPPING VALVE, AND SHALL BE MADE BY A CITY APPROVED CONTRACTOR. THE TAPPING SLEEVE SHALL BE ROMAC SST ALL STAINLESS STEEL TAPPING SLEEVE OR APPROVED EQUAL. A TWO-PIECE EPOXY COATED OR DUCTILE IRON TAPPING SLEEVE MAY BE USED ON DUCTILE IRON PIPE, WHEN THE TAP IS SMALLER THAN THE WATER MAIN, I.E. 6" TAP ON 8" PIPE. THE CITY SHALL APPROVE THE TIME AND LOCATION FOR THESE CONNECTIONS.
- IF THE PROJECT IS UTILIZING A FIRE BOOSTER PUMP, THE FDC MUST CONNECT TO THE SPRINKLER SYSTEM ON THE DISCHARGE SIDE OF THE PUMP IN ACCORDANCE WITH NFPA REGULATIONS.

DETAIL REFERENCES

- HORIZONTAL THRUST BLOCKING (1) C6.09
- VERTICAL THRUST BLOCKING (2) C6.09
- THRUST BLOCKING TABLE (3) C6.09
- 3/4" OR 1" WATER SERVICE CONNECTION (4) C6.09
- 1-1/2" OR 2" WATER SERVICE CONNECTION (5) C6.09
- PRIVATE WATER SERVICE LINES (6) C6.09
- 2" AND SMALLER DCVA INSTALLATION (7) C6.09
- FIRE HYDRANT ASSEMBLY (8) C6.09
- 2" BLOW-OFF ASSEMBLY (1) C6.10
- DCVA ASSEMBLY AND NOTES (2) C6.10 (3) C6.10
- FIRE DEPARTMENT CONNECTION (4) C6.10
- POST INDICATOR VALVE (5) C6.10
- WATER VALVES AND MAINS (1) C6.11
- WATER MAIN CROSSING OTHER UTILITIES AND NOTES (2) C6.11 (3) C6.11
- 2" AND SMALLER RPBA ASSEMBLY INSTALLATION (4) C6.11
- WATER VAULT DETAILS (5) C6.11

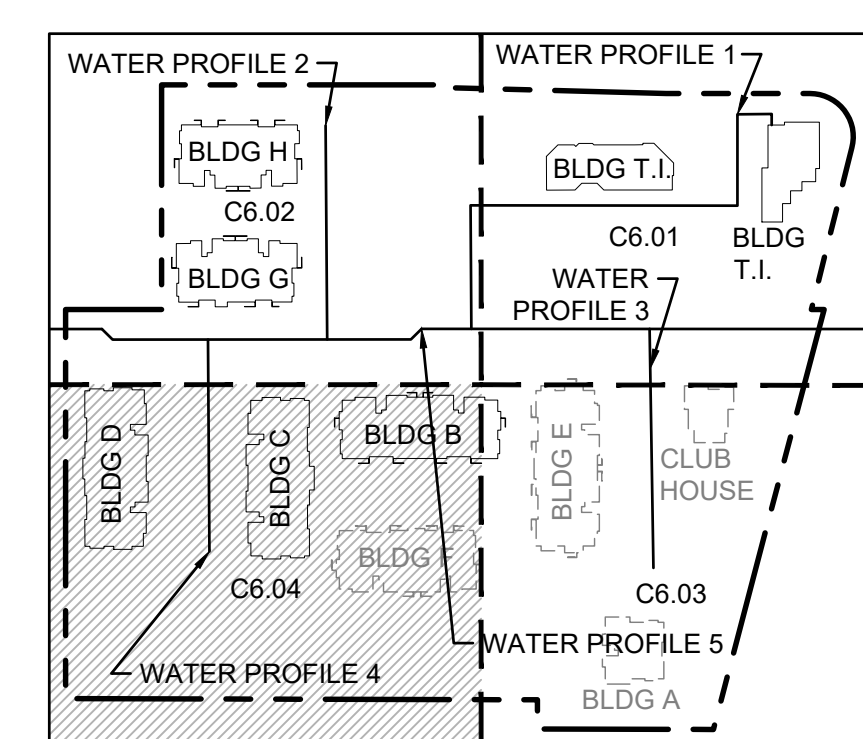

Civil Resub Sheet C6.04: Recommend that the fire hydrant run is off a separate tee just west of the fire line tee. Install a gate valve on the north side of the tee for the solo fire line run. Remove the 8-inch gate valve east of the fire line tee, until the phase 2 tie-in. If you keep the present configuration, install an 8-inch by 8-inch tee with gate valve to north, 8-inch DIP to hydrant tee, then reducer to 6-inch fire line run.

Separated hydrant run from fire run

Removed 8" GV at tie in point



Know what's below.
Call before you dig.

Project Title:
EAST TOWN CROSSING PHASE 1

Client:
ASH DEVELOPMENT


GREG HELLE
GREG.HELLE@ASHNW.COM

Project No.
2230752

Issue Set & Date:

PERMIT SUBMITTAL

02/20/2024

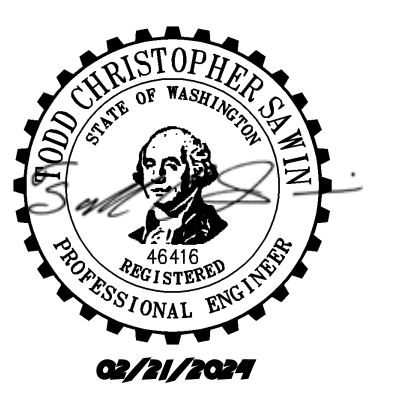

NOTICE: ALTERATION OF THIS DOCUMENT SHALL INVALIDATE THE PROFESSIONAL SEAL AND SIGNATURE PUBLICATION OF THIS DOCUMENT DOES NOT CONSTITUTE A PROFESSIONAL ENGINEER'S RESPONSIBILITY FOR THE PROJECT. THIS BLOCK SHALL NOT BE USED FOR SIGNATURE, SEAL, OR ACTION TO THAT PROJECT OR FOR ANY OTHER PROJECT.

Revisions:

01/29/24 CITY COMMENTS

Sheet Title:
WATER PLAN SE

Designed by: CW
Drawn by: SK / RS
Checked by: JI

Sheet No.

C6.04

45 of 53 Sheets

EAST TOWN CROSSING PHASE 1

SEC. 26,35/ TWP. 20 N./ RGE. 4 E., W.M.

FIRE HYDRANT/FDC LOCATION/ACCESS APPROVED

BY: CITY OF PUYALLUP
FIRE CODE OFFICIAL

DATE: _____

NOTE: THIS APPROVAL IS VOID AFTER 1 YEAR FROM APPROVAL DATE.

THE CITY WILL NOT BE RESPONSIBLE FOR ERRORS AND/OR OMISSIONS ON THESE PLANS.

FIELD CONDITIONS MAY DICTATE CHANGES TO THESE PLANS AS DETERMINED BY THE FIRE CODE OFFICIAL.

APPROVED


BY: CITY OF PUYALLUP
DEVELOPMENT ENGINEERING

DATE: _____

NOTE: THIS APPROVAL IS VOID AFTER 180 DAYS FROM APPROVAL DATE.

THE CITY WILL NOT BE RESPONSIBLE FOR ERRORS AND/OR OMISSIONS ON THESE PLANS.

FIELD CONDITIONS MAY DICTATE CHANGES TO THESE PLANS AS DETERMINED BY THE DEVELOPMENT ENGINEERING MANAGER.

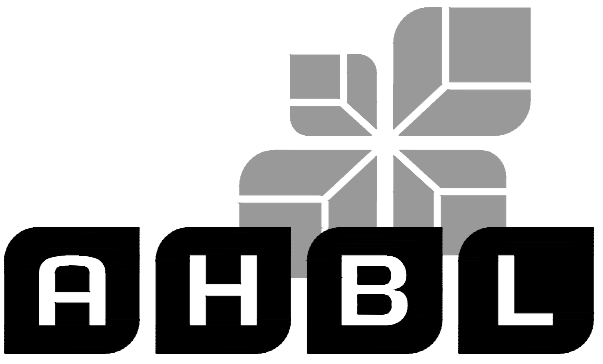

TACOMA · SEATTLE · SPOKANE · TRI-CITIES

2215 North 30th Street, Suite 300, Tacoma, WA 98403
253.383.2422 TEL 253.383.2572 FAX www.ahbl.com WEB

Project Title:

EAST TOWN CROSSING PHASE 1

Client:

ASH DEVELOPMENT

GREG HELLE
GREG.HELLE@ASHNW.COM


Project No:

2230752


Issue Set & Date:

PERMIT SUBMITTAL


02/20/2024

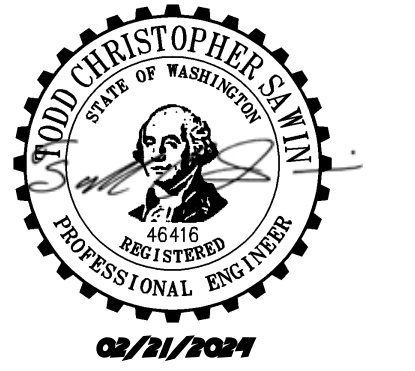


NOTICE: ALTERATION OF THIS DOCUMENT SHALL INVALIDATE THE PROFESSIONAL SEAL AND SIGNATURE PUBLICATION OF THIS DOCUMENT DOES NOT REMOVE FROM REPRODUCED OR TRANSMITTED IN ANY FORM OR BY ANY MEANS, OR FOR ANY PURPOSE, WITHOUT THE WRITTEN PERMISSION OF THE ORIGINAL AUTHOR. THIS DOCUMENT IS FOR THE PROJECT IDENTIFIED IN THE TITLE BLOCK AND IS NOT TO BE USED FOR OTHER PROJECTS, OR ADDITION TO THAT PROJECT OR FOR ANY OTHER PROJECT.

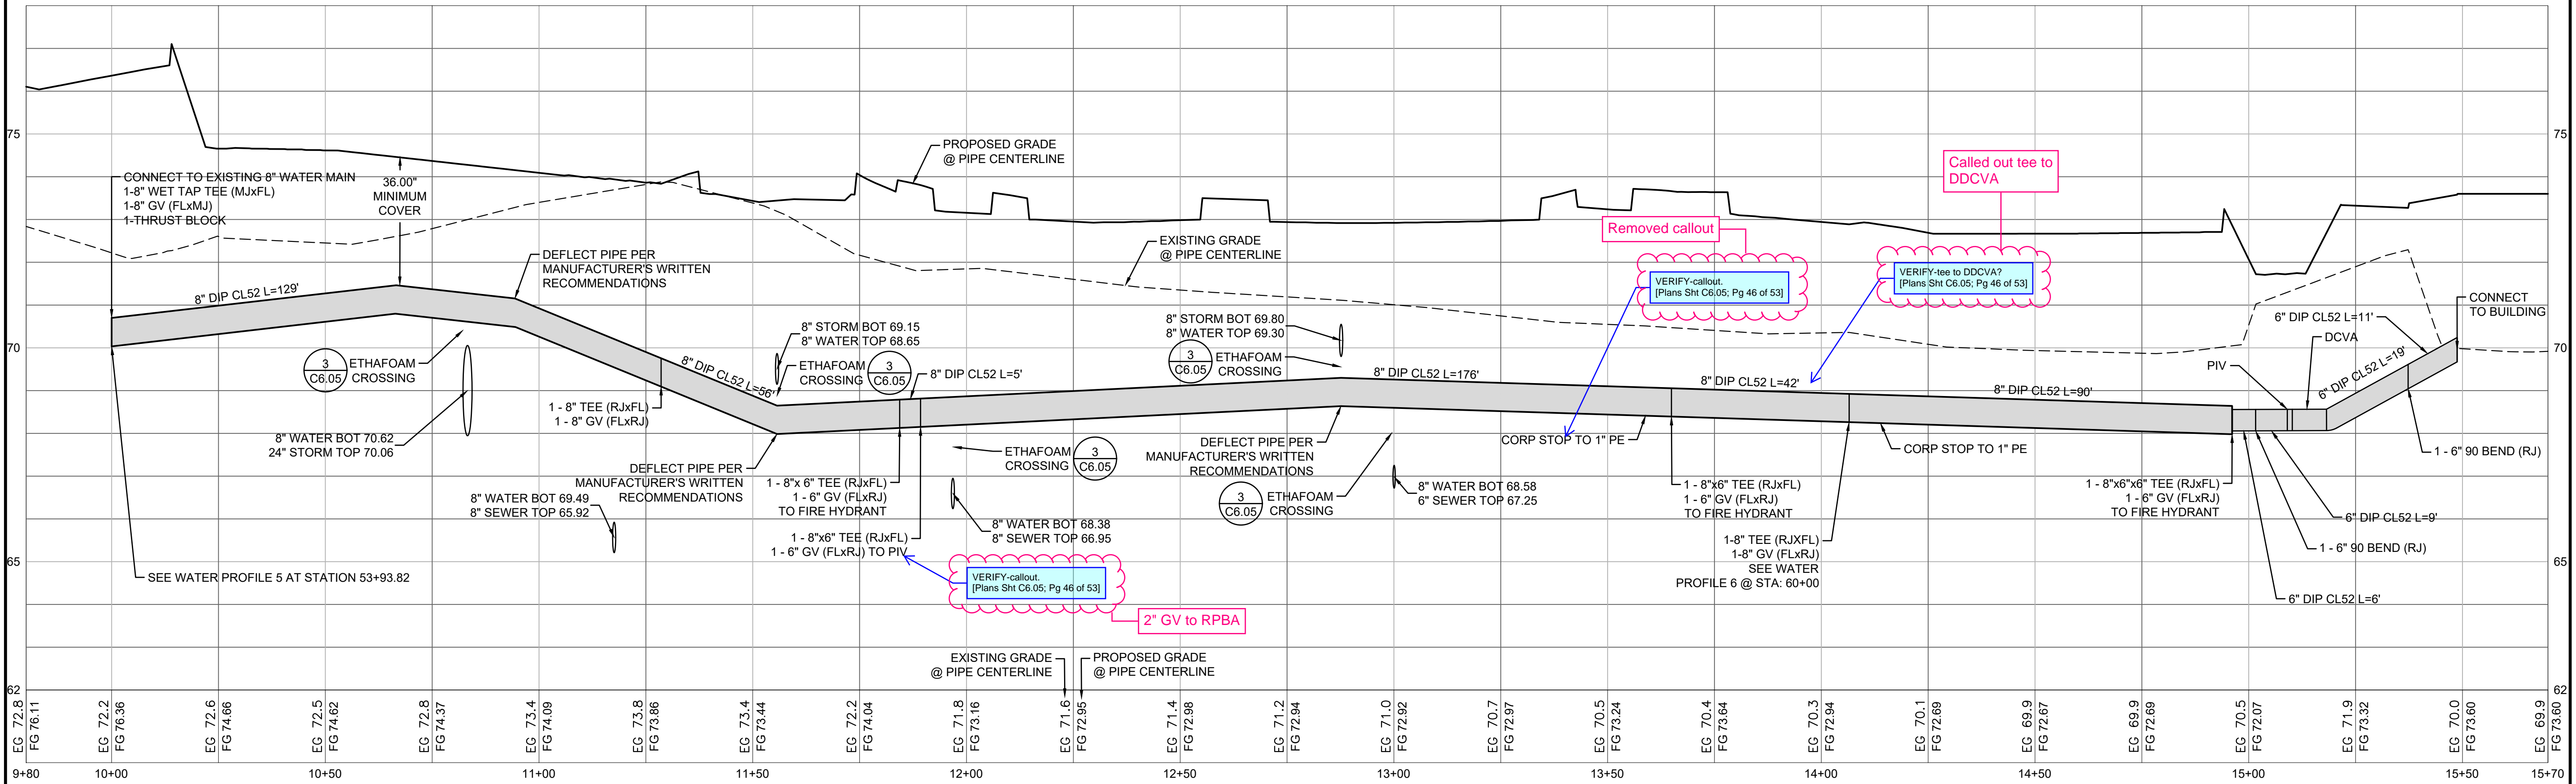


1 WATER PROFILE 1
1"=2" VERTICAL, 1"=20' HORIZONTAL

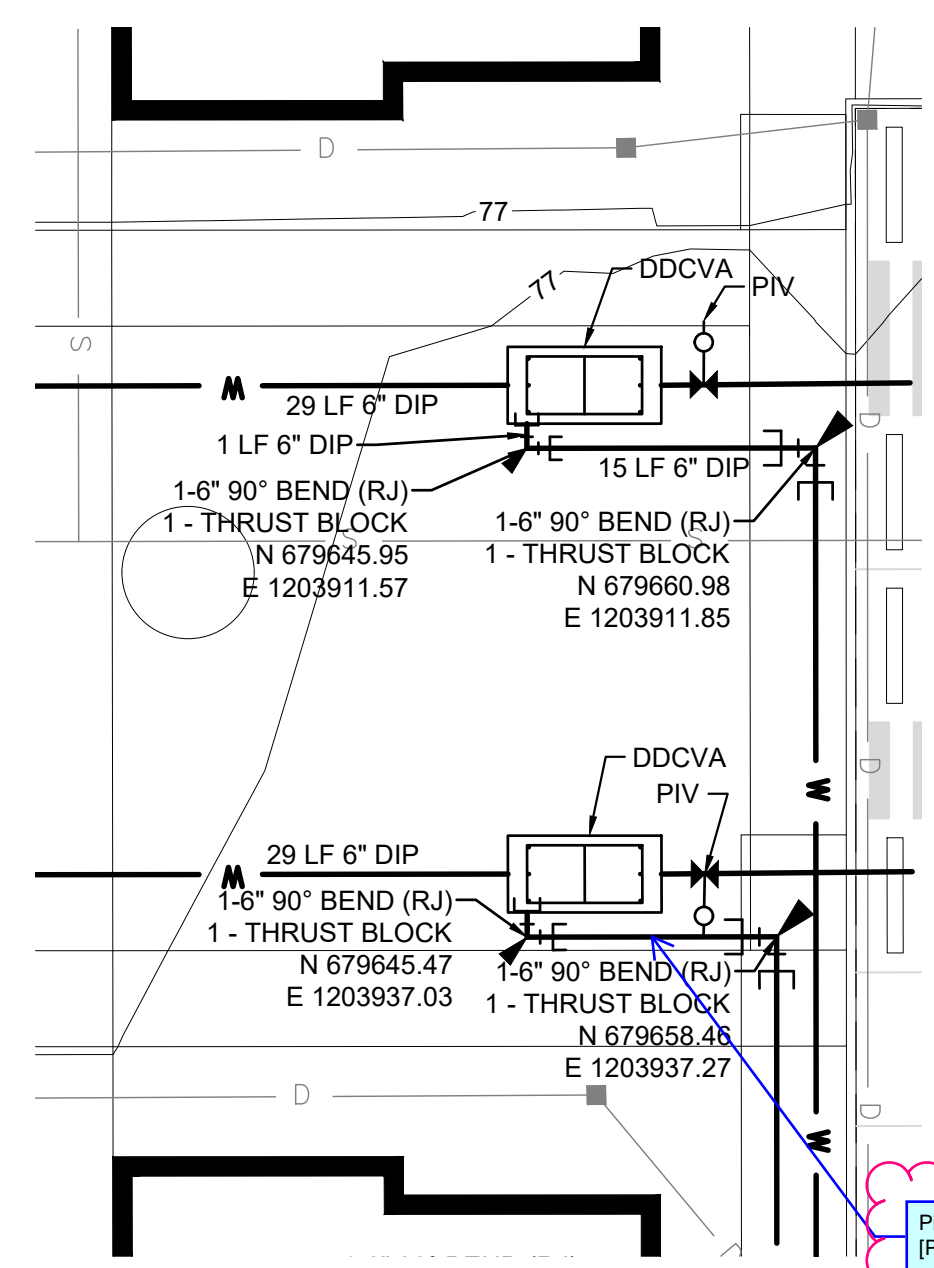


2 ENLARGEMENT
SCALE: 1"=10'

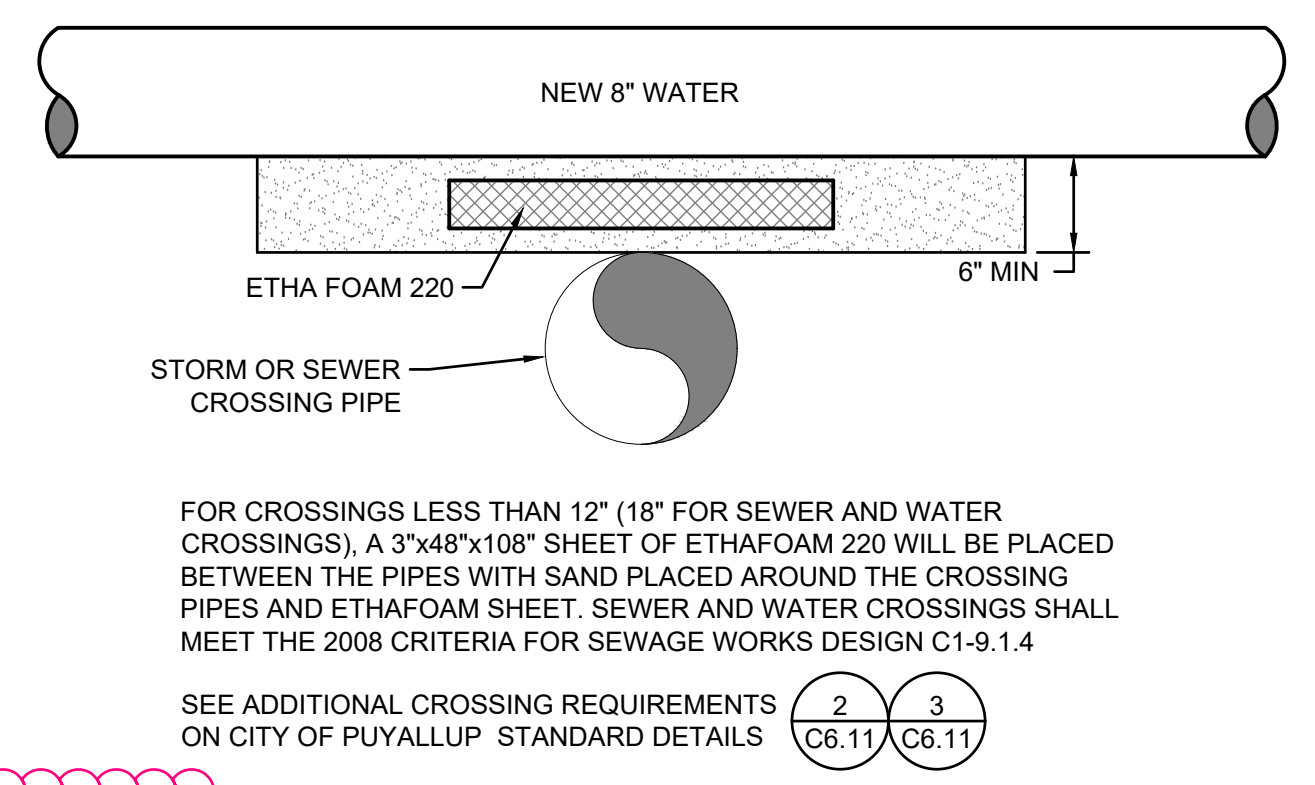

3 ETHAFOAM DETAIL
NOT TO SCALE

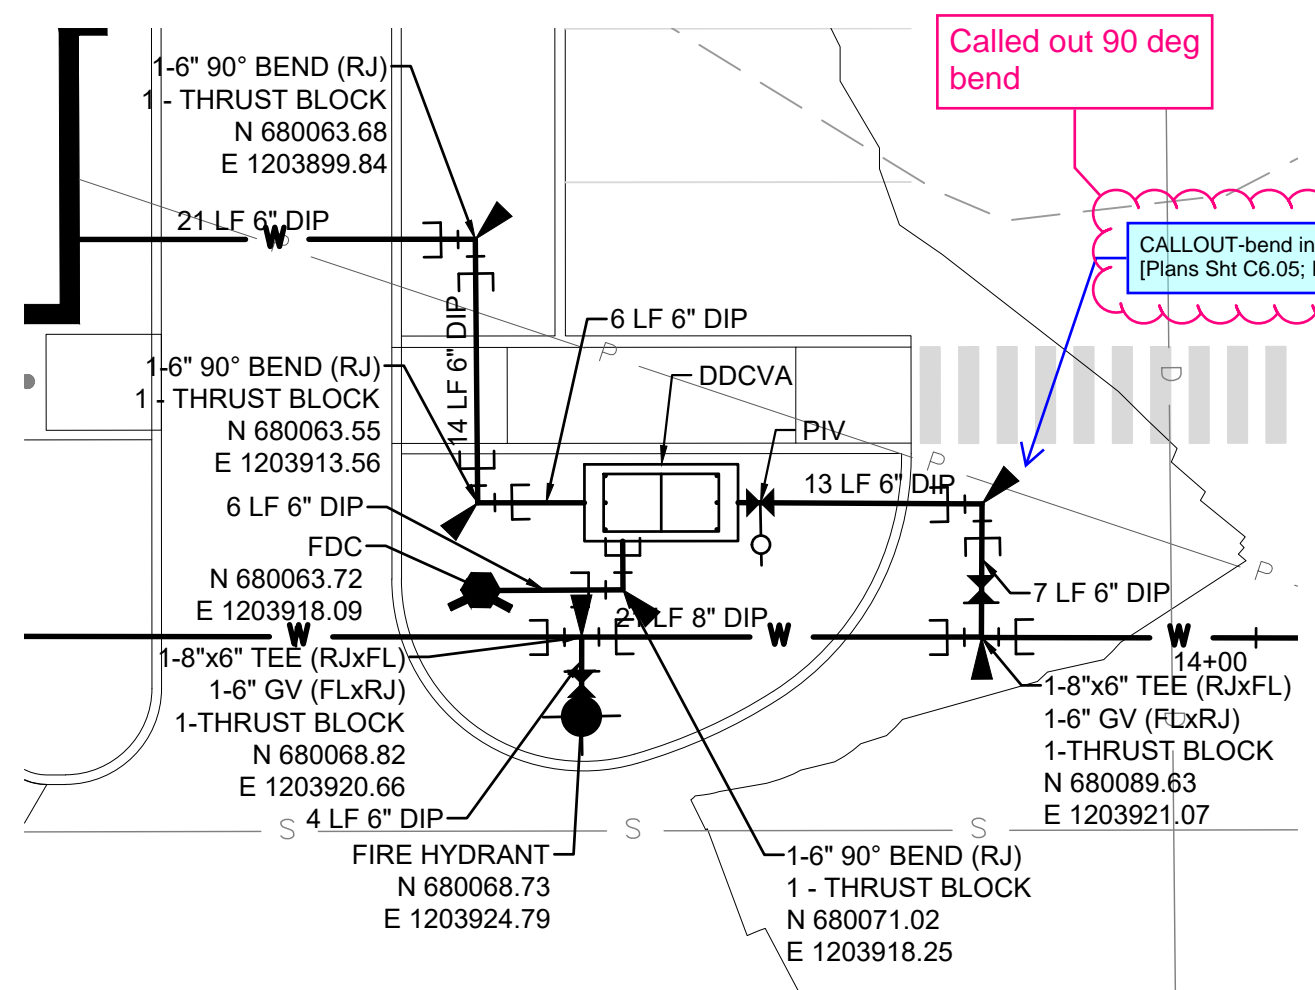

4 ENLARGEMENT
SCALE: 1"=10'

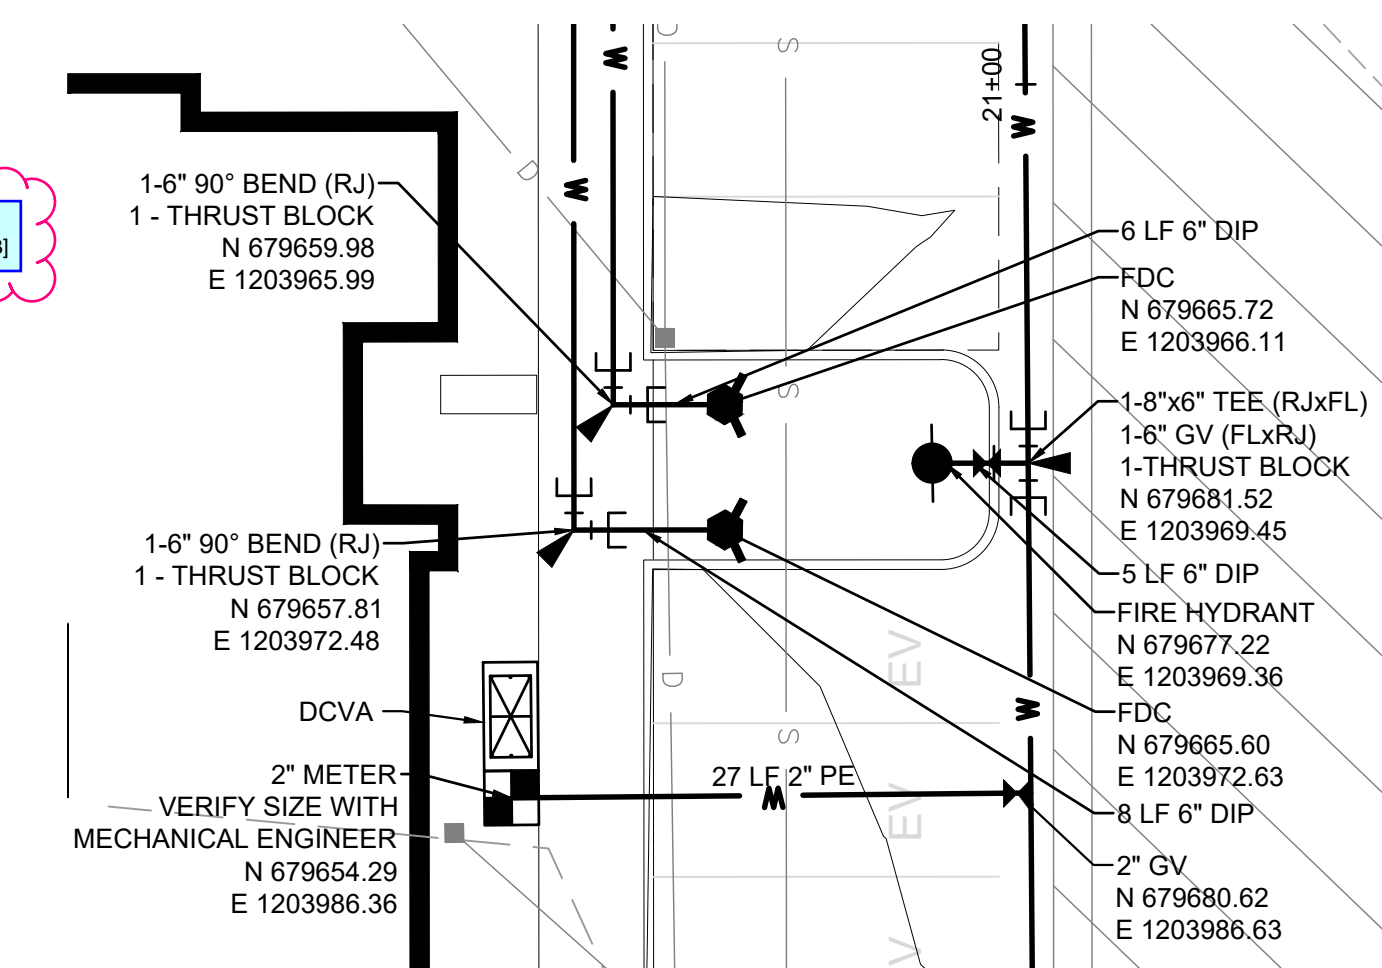

5 ENLARGEMENT
SCALE: 1"=10'



Know what's below.
Call before you dig.

Revisions:

01/29/24 CITY COMMENTS

Sheet Title:

WATER PROFILES

Designed by: CW
Drawn by: SK/RS
Checked by: JI

Sheet No.

C6.05

46 of 53 Sheets

EAST TOWN CROSSING PHASE 1

SEC. 26,35/ TWP. 20 N./ RGE. 4 E., W.M.

FIRE HYDRANT/FDC
LOCATION/ACCESS APPROVED

BY _____
CITY OF PUYALLUP
FIRE CODE OFFICIAL

DATE _____

NOTE:
THIS APPROVAL IS VOID AFTER 1
YEAR FROM APPROVAL DATE.

THE CITY WILL NOT BE
RESPONSIBLE FOR ERRORS
AND/OR OMISSIONS ON THESE
PLANS.

FIELD CONDITIONS MAY DICTATE
CHANGES TO THESE PLANS AS
DETERMINED BY THE FIRE CODE
OFFICIAL.

APPROVED


BY _____
CITY OF PUYALLUP
DEVELOPMENT ENGINEERING

DATE _____

NOTE: THIS APPROVAL IS VOID
AFTER 180 DAYS FROM APPROVAL
DATE.

THE CITY WILL NOT BE
RESPONSIBLE FOR ERRORS
AND/OR OMISSIONS ON THESE
PLANS.

FIELD CONDITIONS MAY DICTATE
CHANGES TO THESE PLANS AS
DETERMINED BY THE
DEVELOPMENT ENGINEERING
MANAGER.

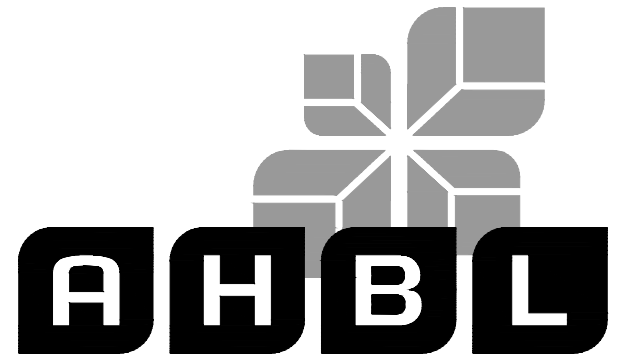

TACOMA · SEATTLE · SPOKANE · TRI-CITIES

2215 North 30th Street, Suite 300, Tacoma, WA 98403
253.383.2422 TEL 253.383.2572 FAX www.ahbl.com WEB

Project Title:

EAST TOWN CROSSING PHASE 1

Client:

ASH DEVELOPMENT

GREG HELLE

GREG.HELLE@ASHNW.COM

Project No.

2230752


Issue Set & Date:

PERMIT SUBMITTAL


02/20/2024



NOTICE
ALTERATION OF THIS DOCUMENT SHALL INVALIDATE THE
PROFESSIONAL SEAL AND SIGNATURE. PUBLICATION OF
THIS DOCUMENT DOES NOT CONSTITUTE A GUARANTEE.
CHECKING ENGINEER SHALL BE RESPONSIBLE FOR THE
ONLY FOR THE PROJECT DESCRIBED IN THE TITLE BLOCK
AND NOT TO BE USED FOR OTHER PROJECTS, OR
ACTION TO THAT PROJECT OR FOR ANY OTHER PROJECT.

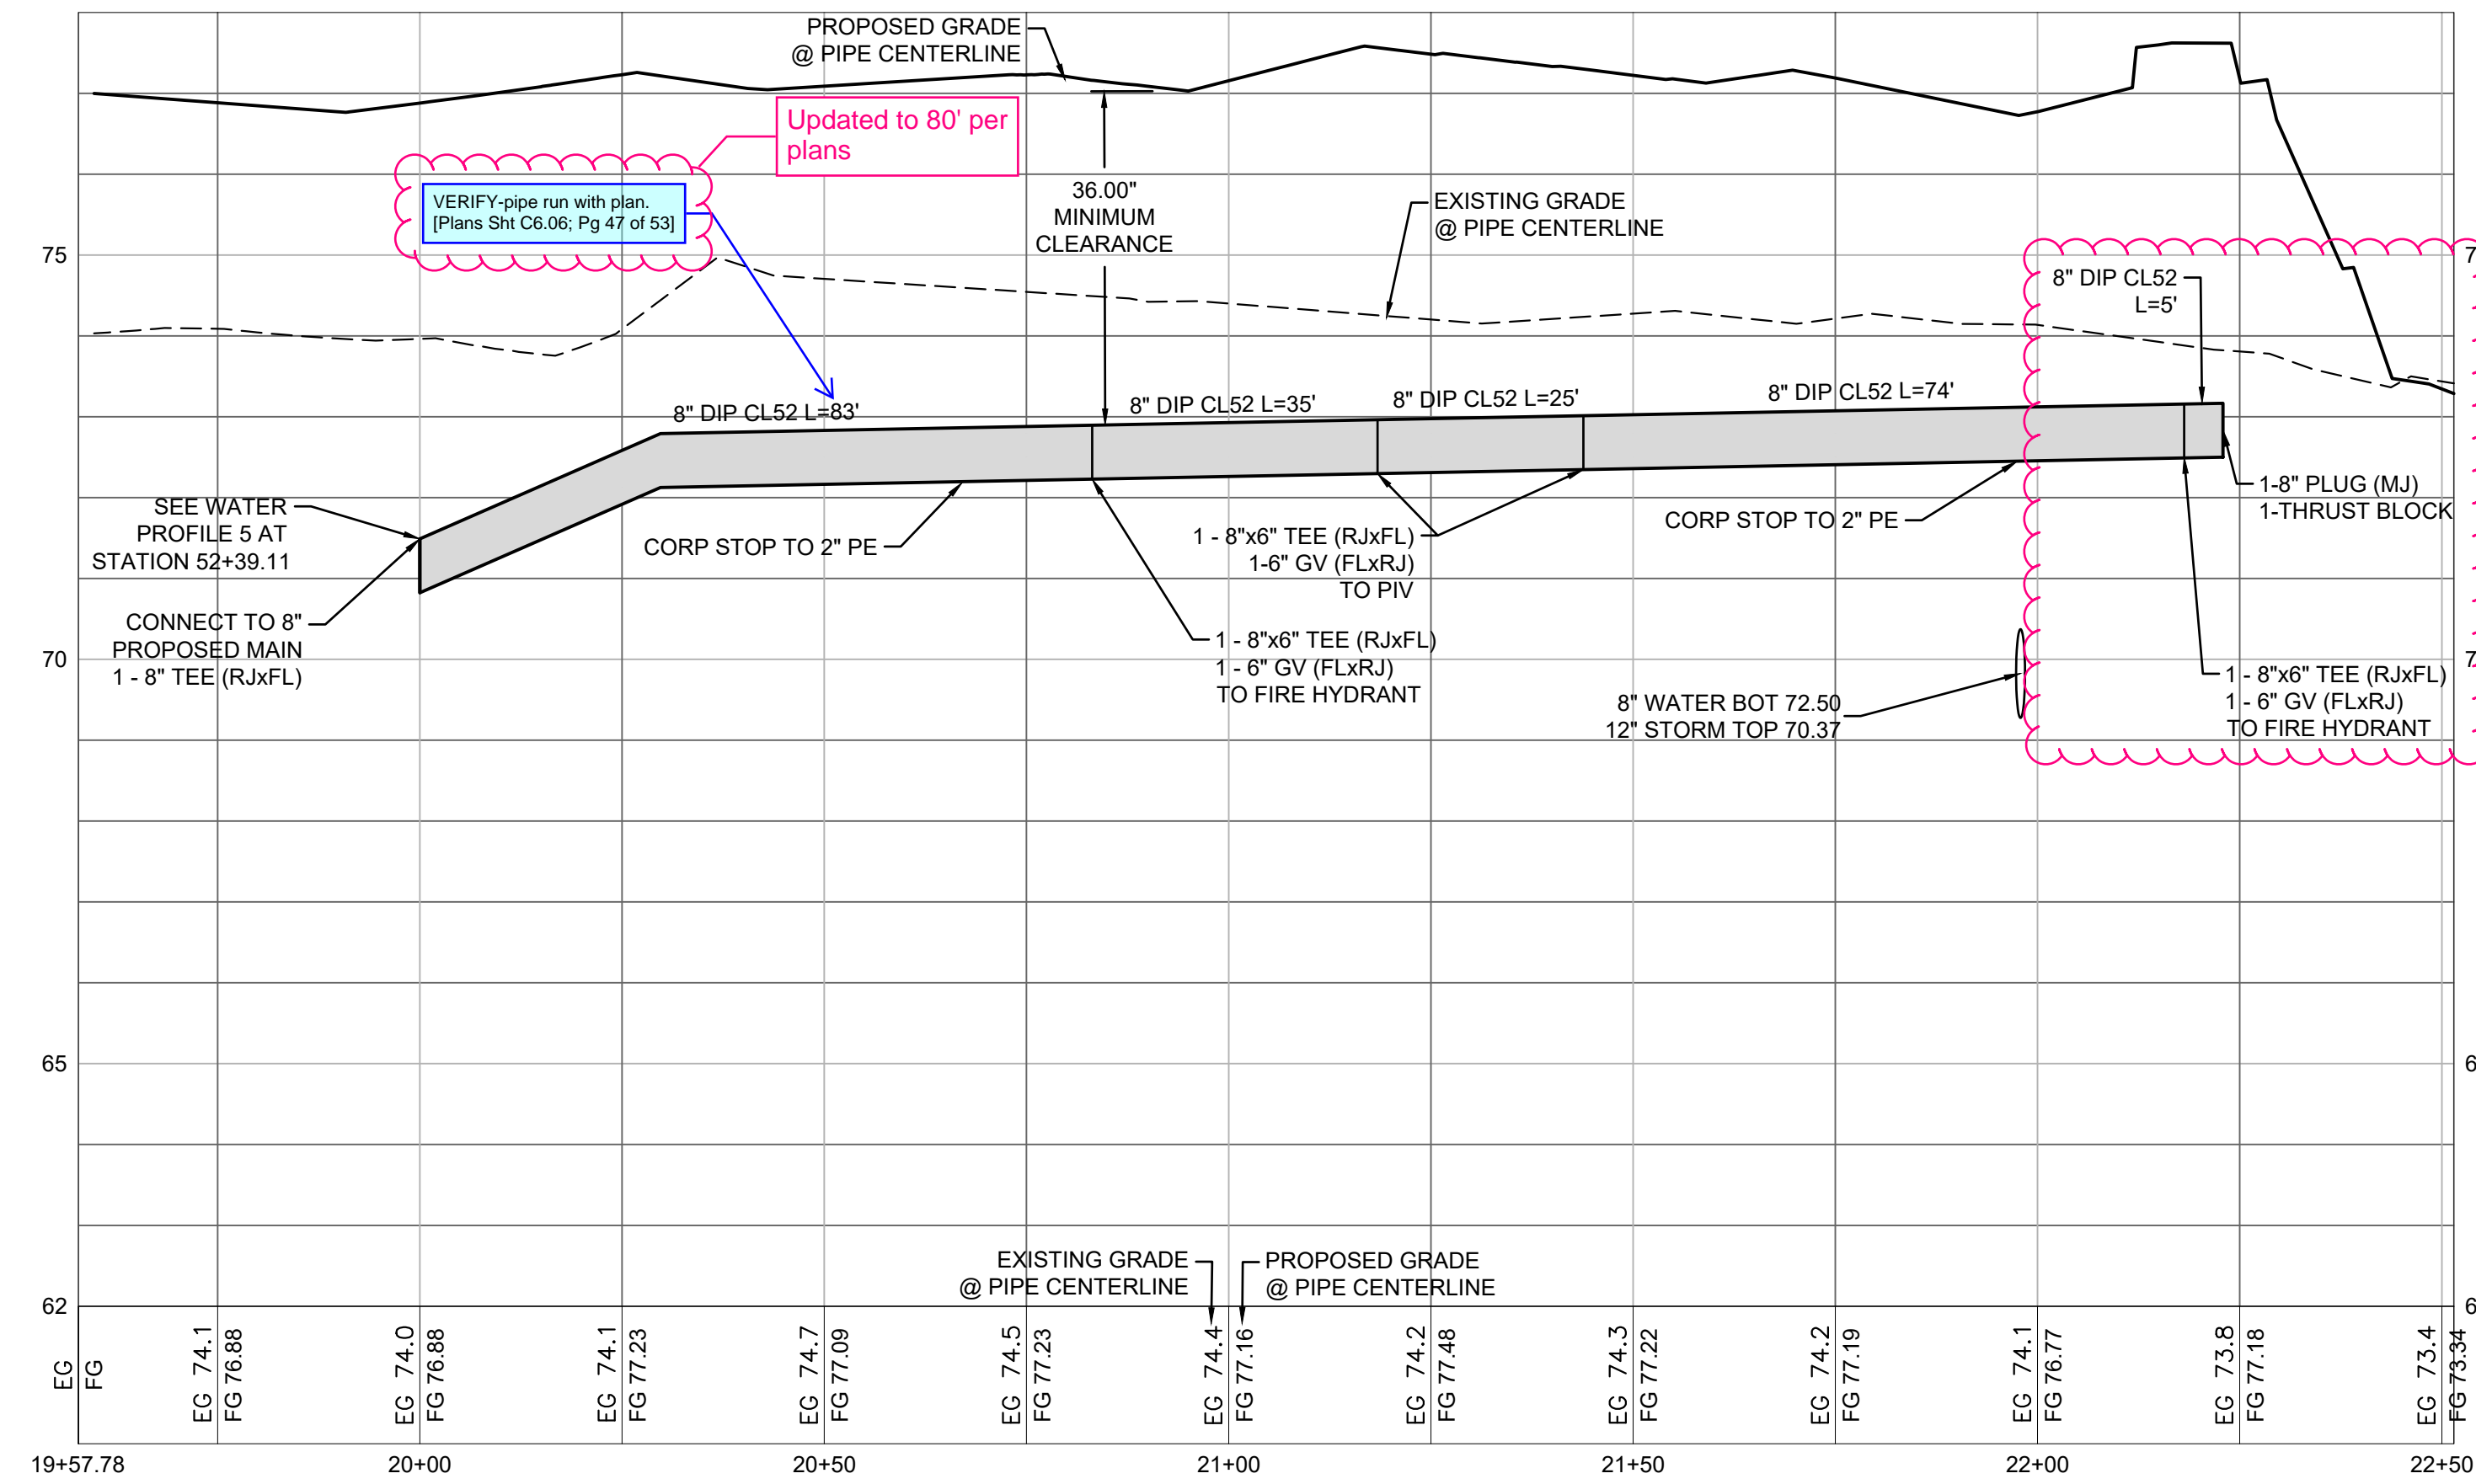

2 WATER PROFILE 2
1"=2' VERTICAL, 1"=20' HORIZONTAL

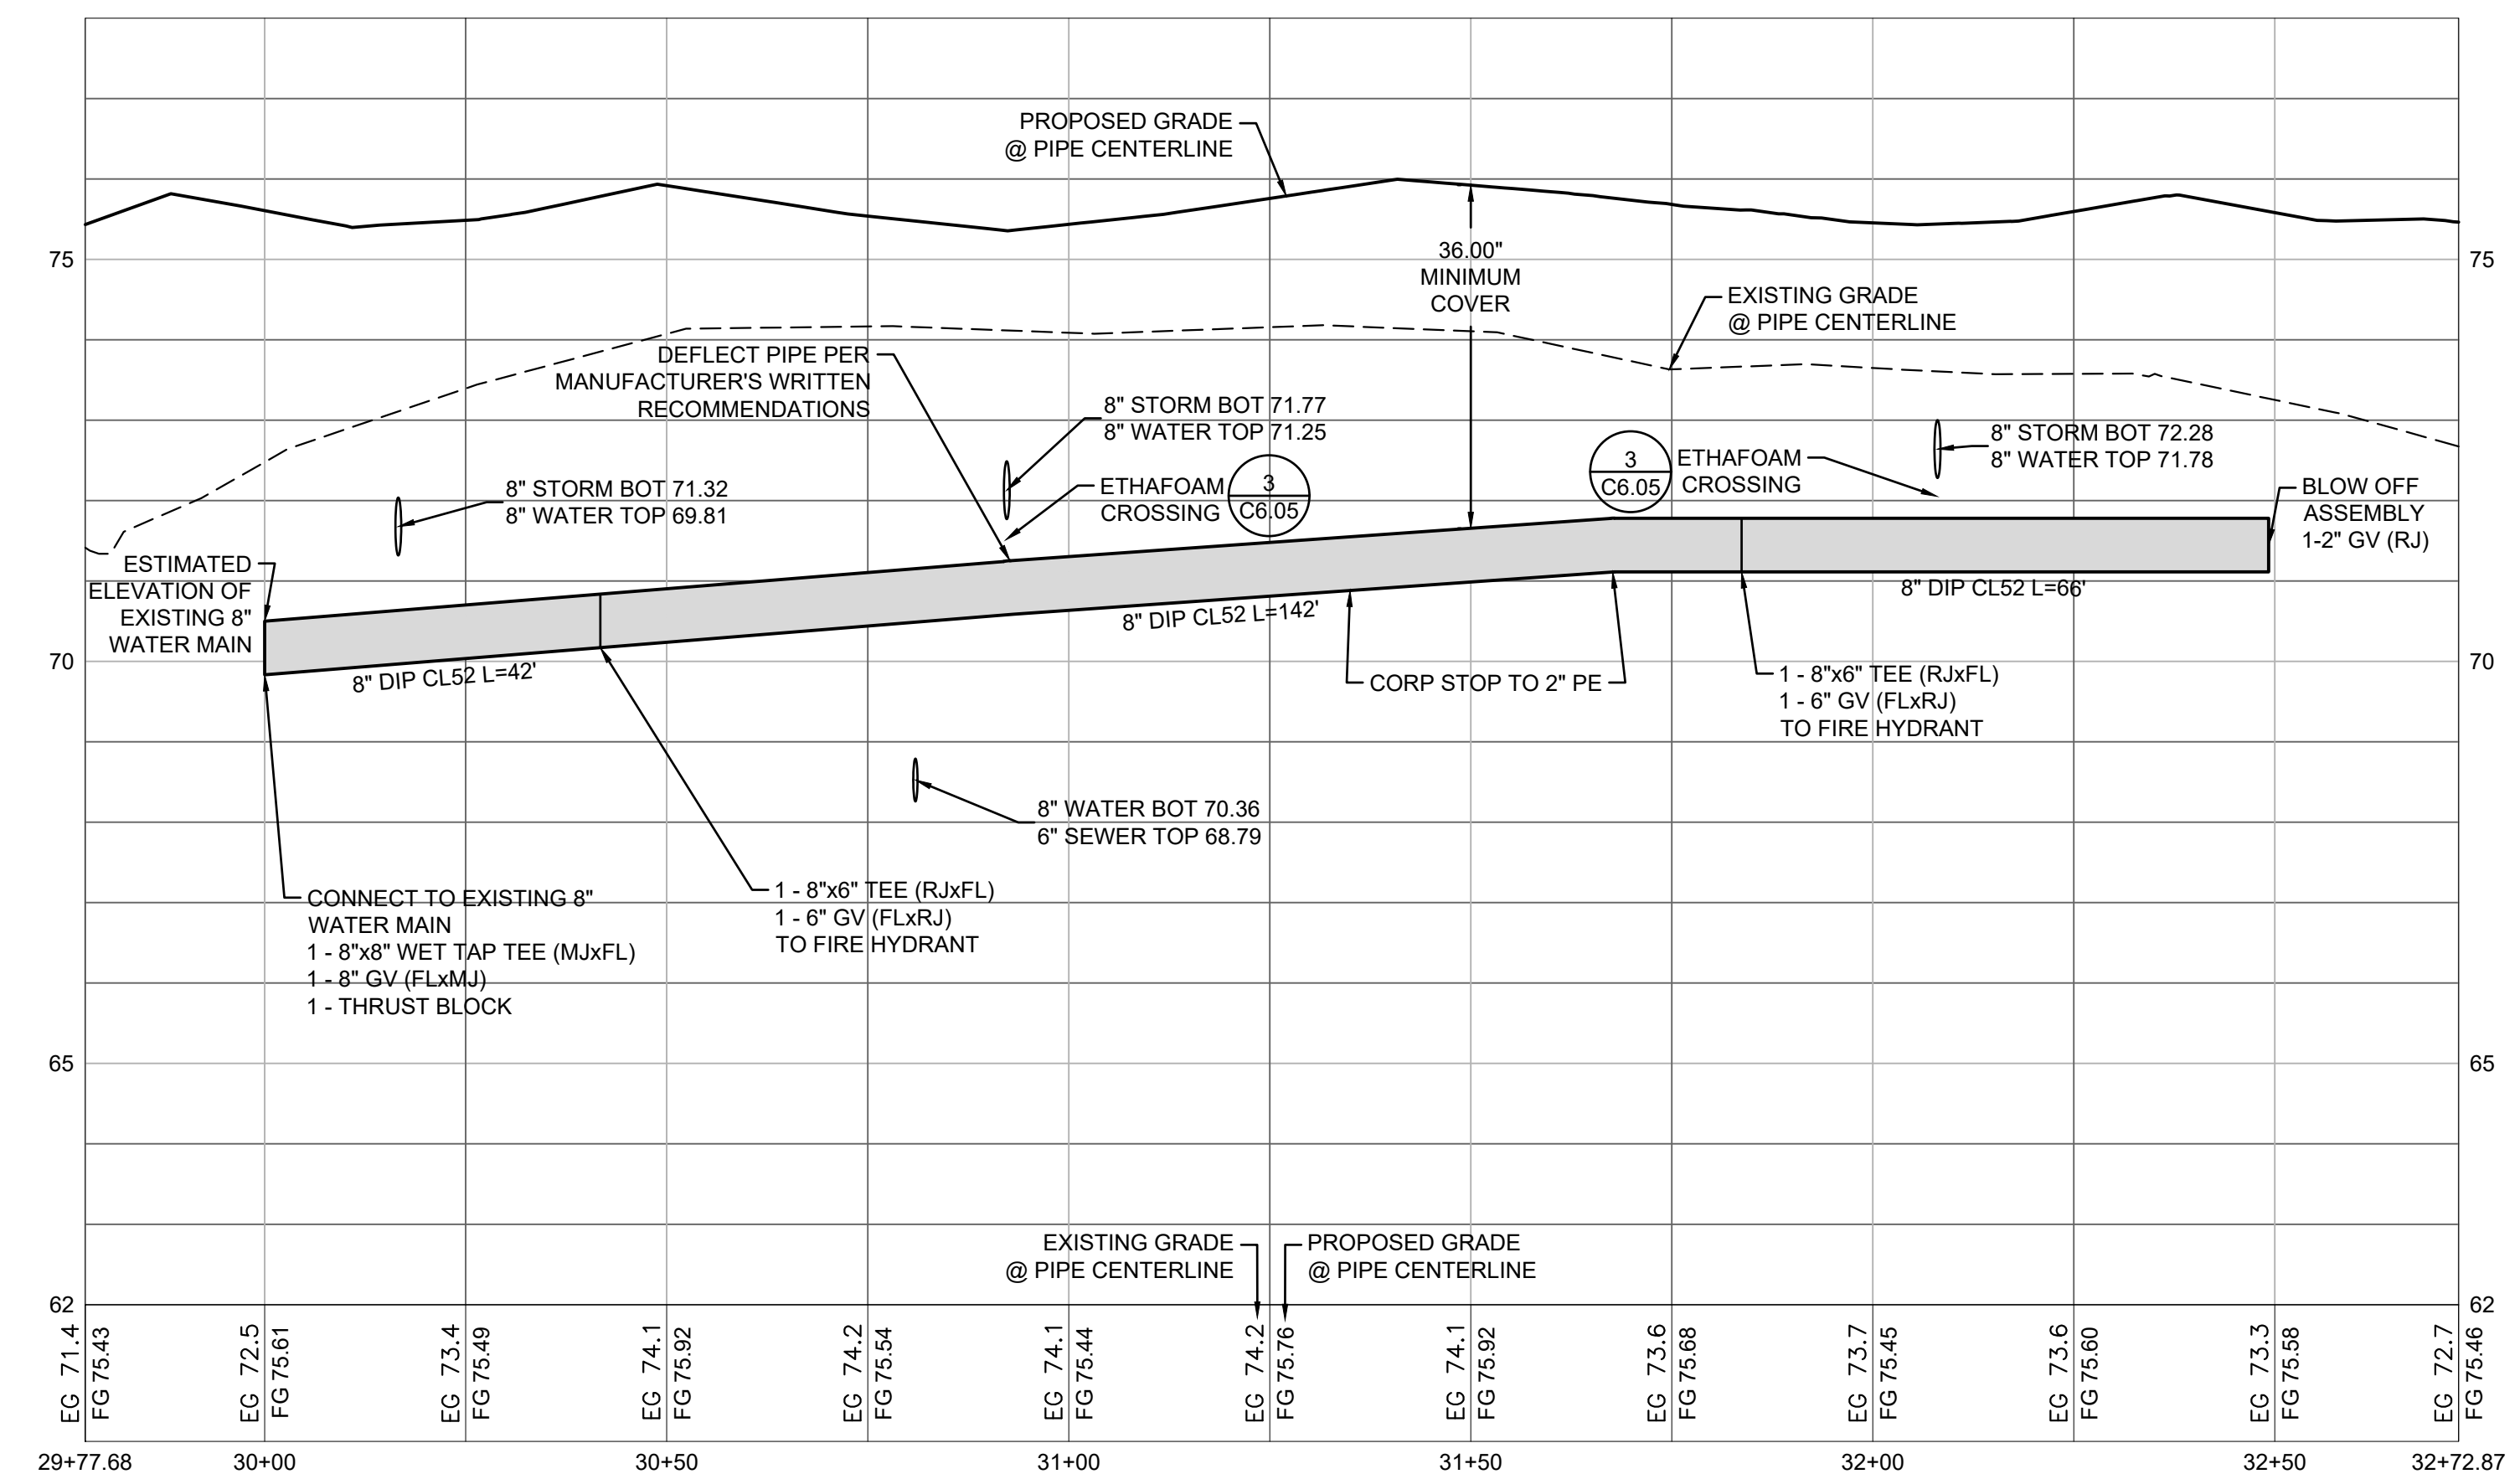

3 WATER PROFILE 3
1"=2' VERTICAL, 1"=20' HORIZONTAL



Know what's below.
Call before you dig.

△

△

△

01/29/24 CITY COMMENTS

Revisions:

Sheet Title:

WATER PROFILES

Designed by: CW Drawn by: SK / RS Checked by: JI

Sheet No.

C6.06

47 of 53 Sheets

EAST TOWN CROSSING PHASE 1

SEC. 26,35/ TWP. 20 N./ RGE. 4 E., W.M.

FIRE HYDRANT/FDC LOCATION/ACCESS APPROVED

BY: _____
CITY OF PUYALLUP
FIRE CODE OFFICIAL

DATE: _____

NOTE: THIS APPROVAL IS VOID AFTER 1 YEAR FROM APPROVAL DATE.

THE CITY WILL NOT BE RESPONSIBLE FOR ERRORS AND/OR OMISSIONS ON THESE PLANS.

FIELD CONDITIONS MAY DICTATE CHANGES TO THESE PLANS AS DETERMINED BY THE DEVELOPMENT ENGINEERING MANAGER.

APPROVED


BY: _____
CITY OF PUYALLUP
DEVELOPMENT ENGINEERING

DATE: _____


NOTE: THIS APPROVAL IS VOID AFTER 180 DAYS FROM APPROVAL DATE.

THE CITY WILL NOT BE RESPONSIBLE FOR ERRORS AND/OR OMISSIONS ON THESE PLANS.

FIELD CONDITIONS MAY DICTATE CHANGES TO THESE PLANS AS DETERMINED BY THE DEVELOPMENT ENGINEERING MANAGER.

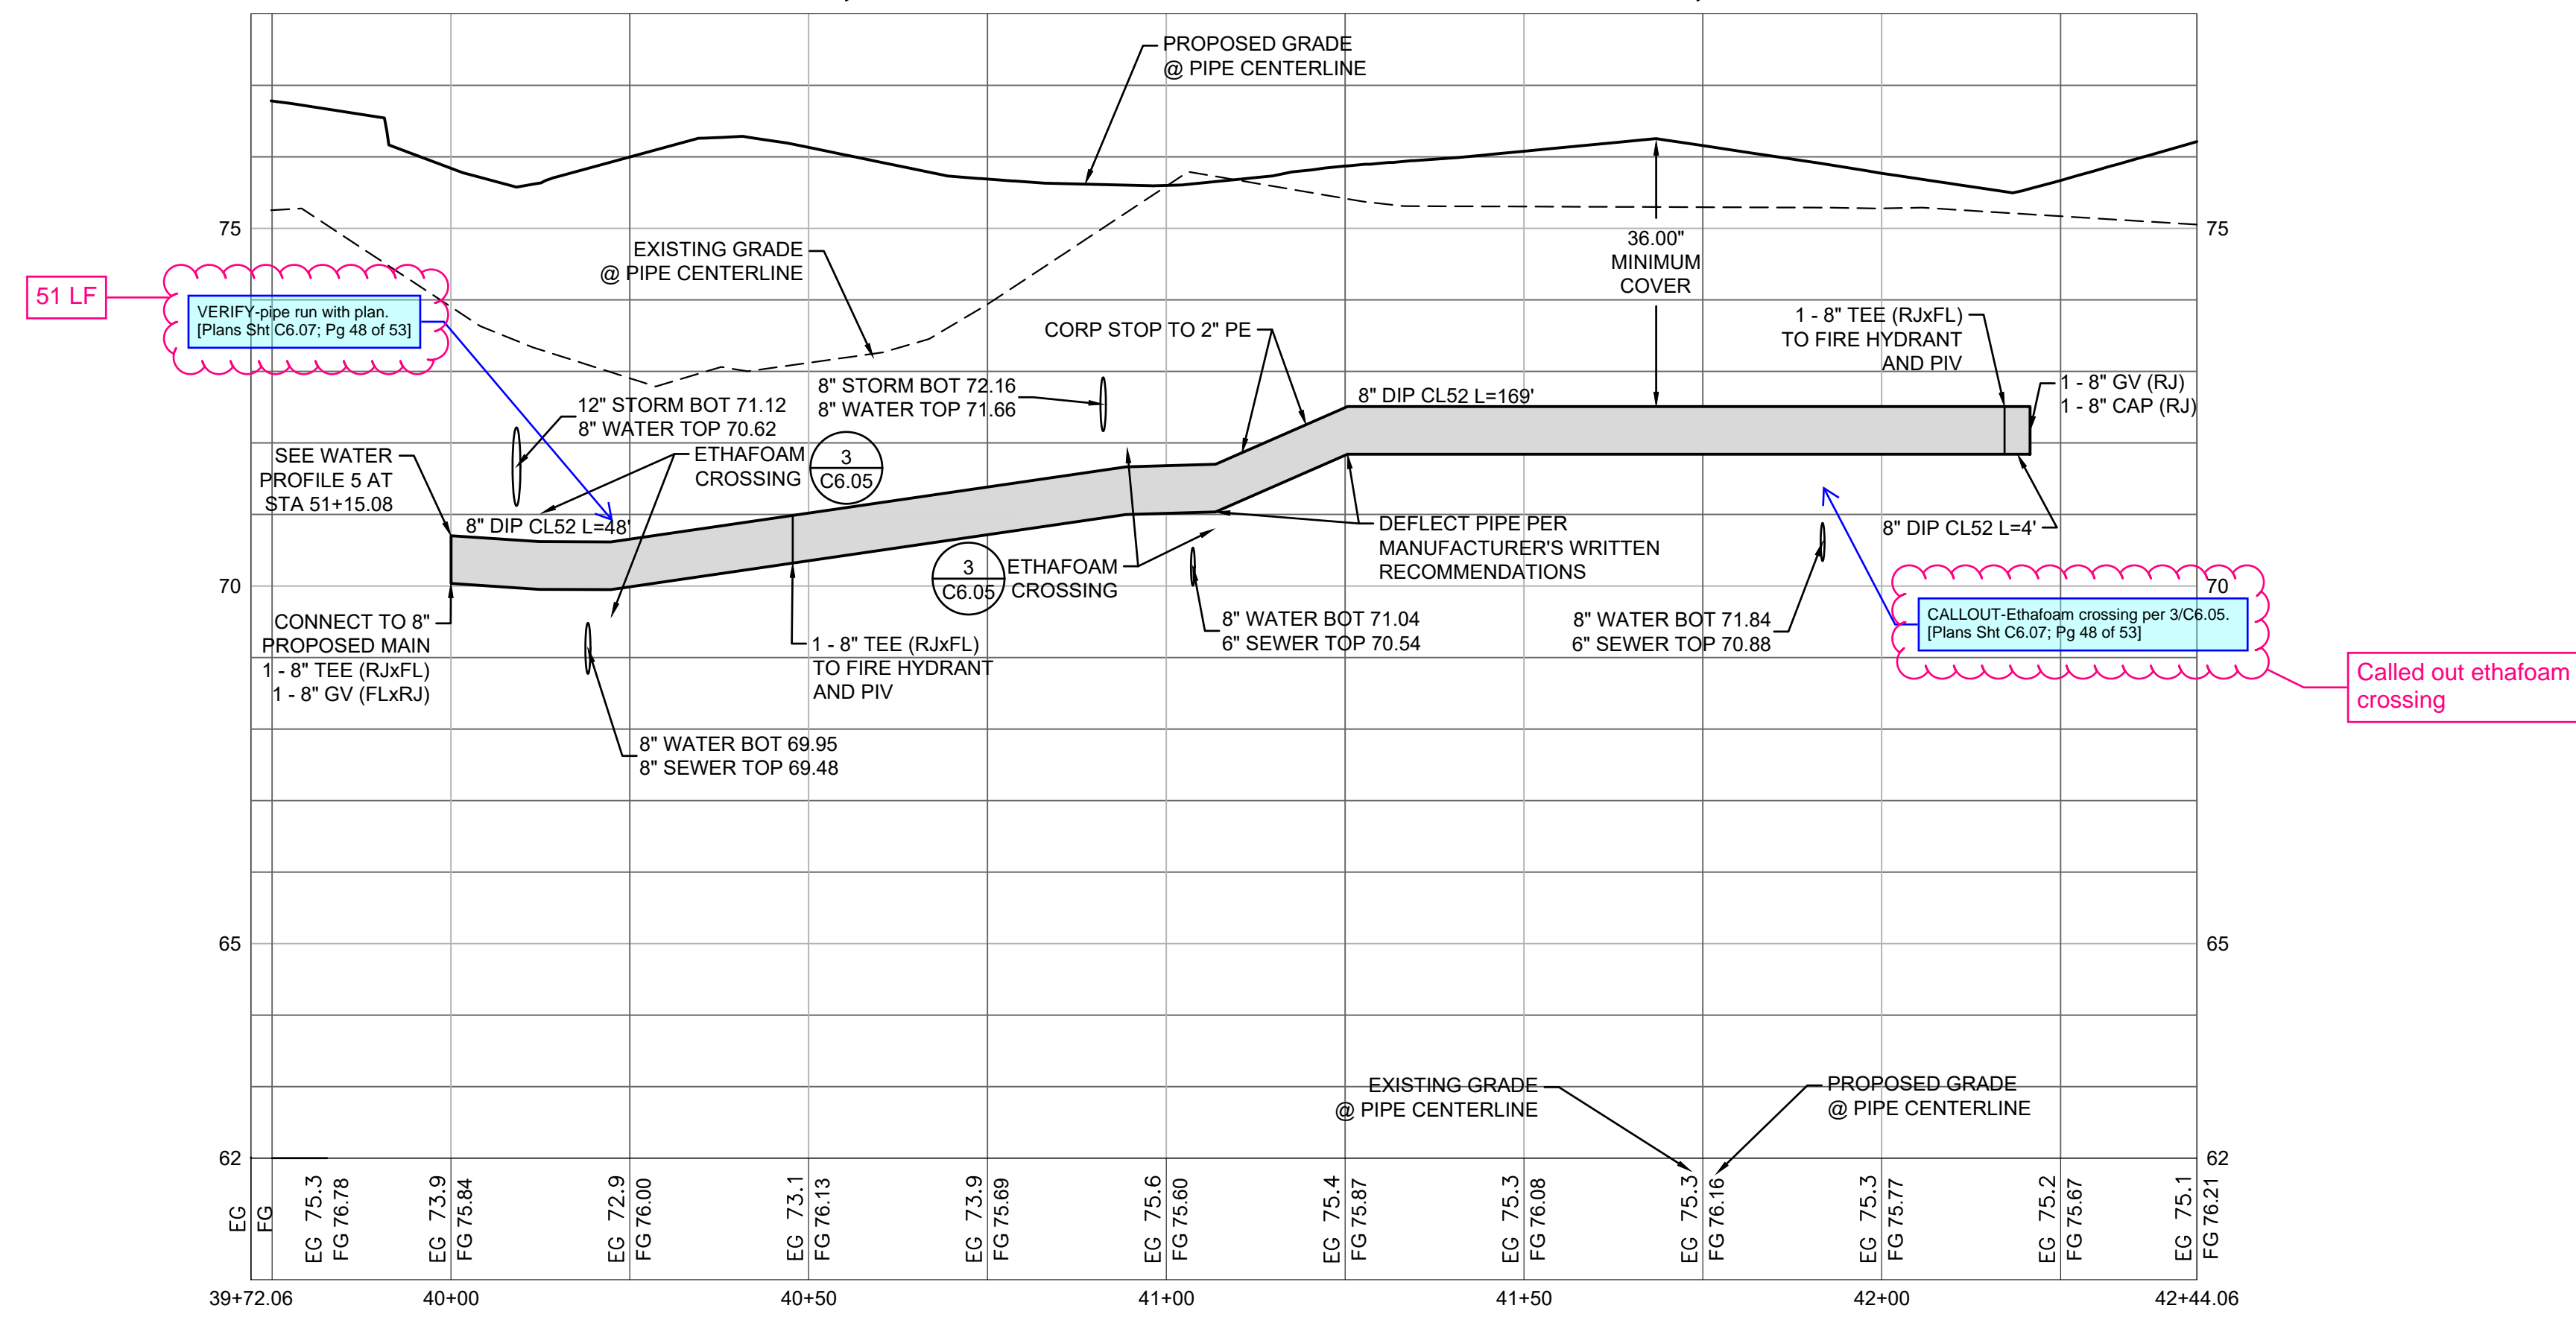

4 WATER PROFILE 4
1"=2' VERTICAL, 1"=20' HORIZONTAL

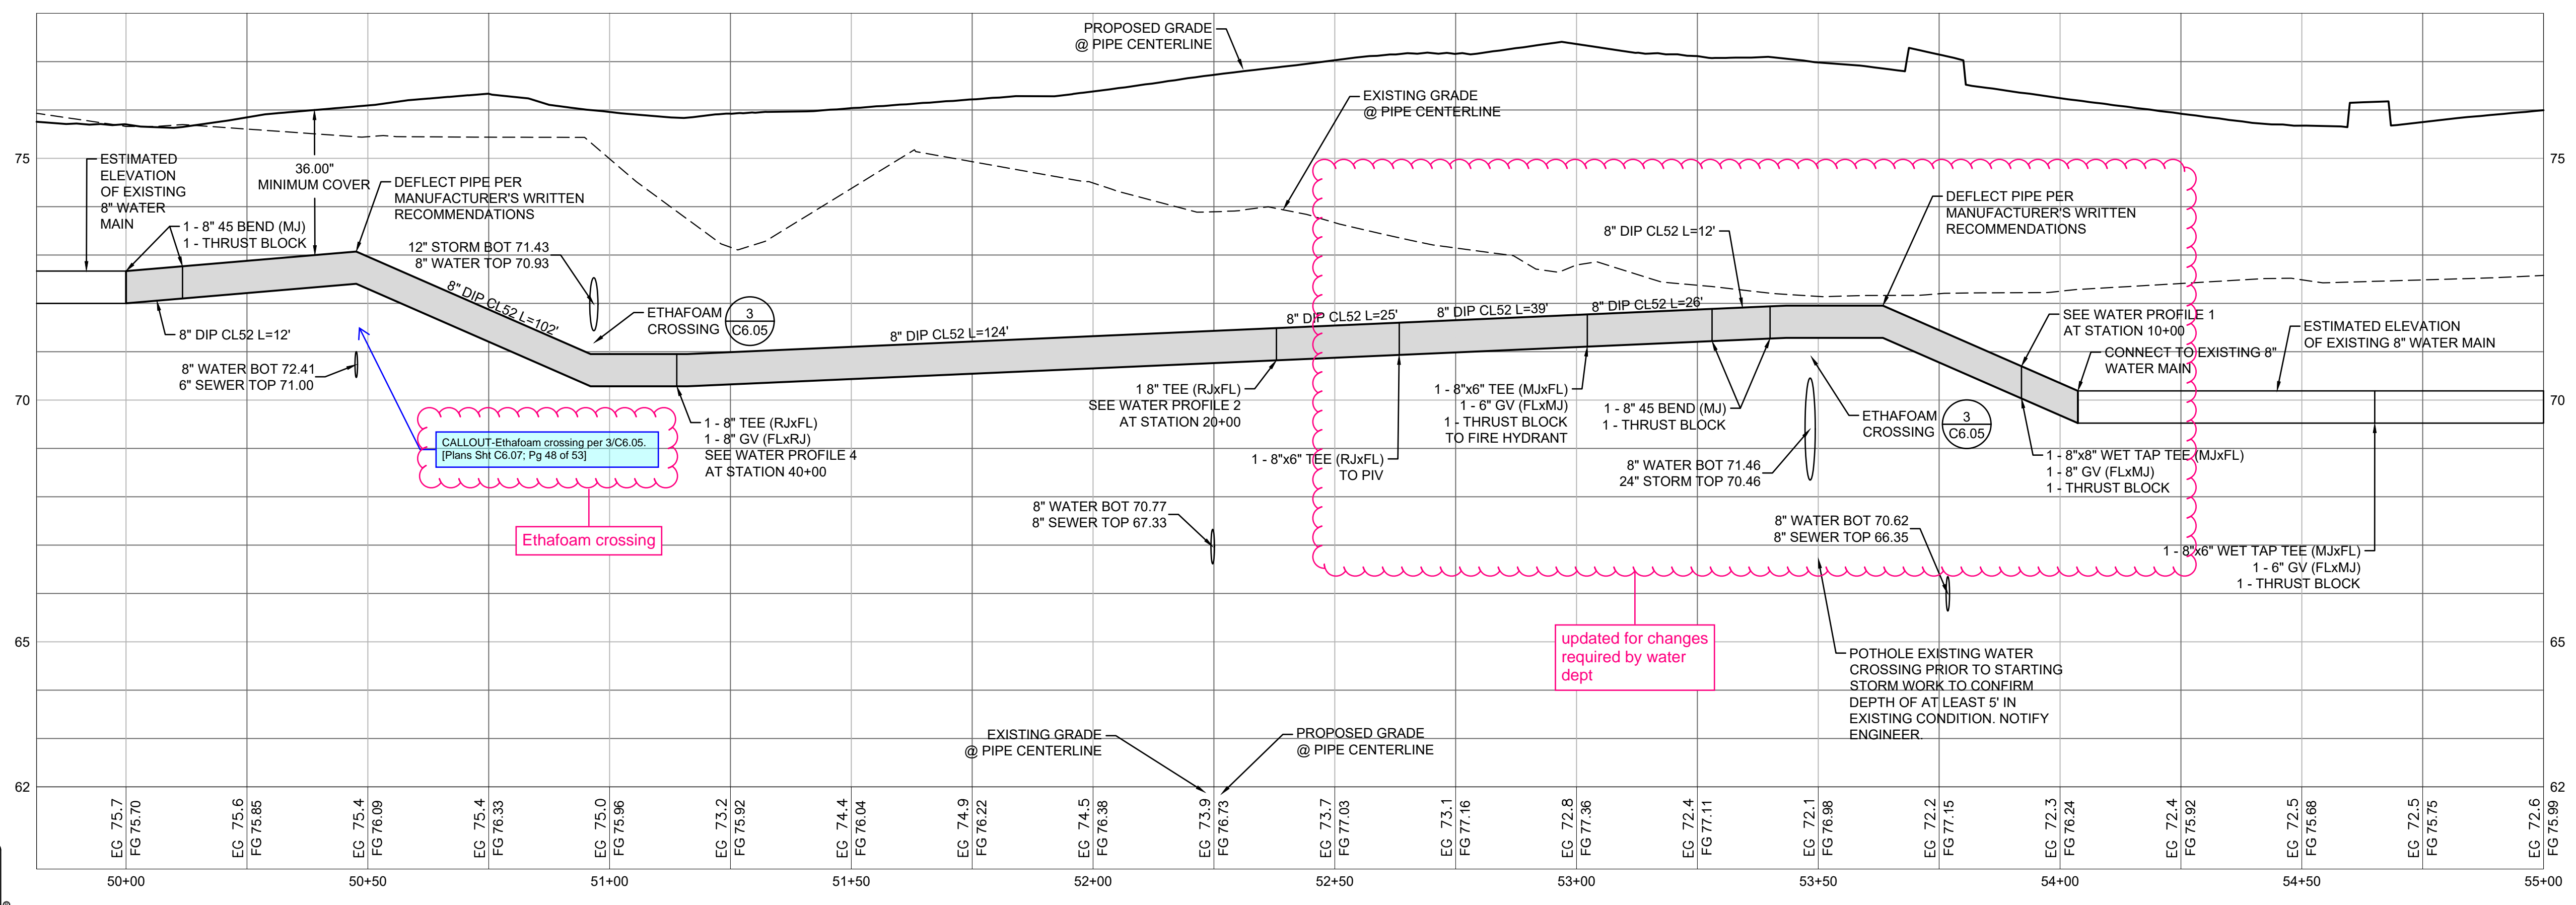

5 WATER PROFILE 5
1"=2' VERTICAL, 1"=20' HORIZONTAL




Project Title:
EAST TOWN CROSSING PHASE 1

Client:
ASH DEVELOPMENT

GREG HELLE
GREG.HELLE@ASHNW.COM

Project No.
2230752

Issue Set & Date:
PERMIT SUBMITTAL
02/20/2024

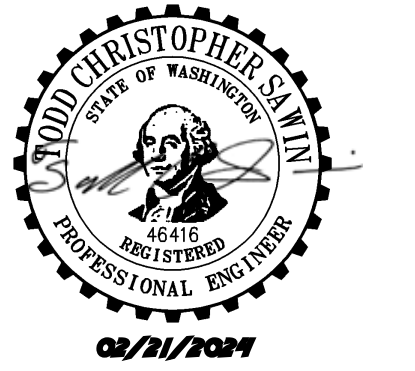

NOTICE: ALTERATION OF THIS DOCUMENT SHALL INVALIDATE THE PROFESSIONAL SEAL AND SIGNATURE PUBLICATION OF THIS DOCUMENT DOES NOT CONSTITUTE A PROFESSIONAL ENGINEER'S RESPONSIBILITY FOR THE DESIGN OR FOR THE ONLY FOR THE PROJECT EXHIBIT IN THE TITLE BLOCK AND IS NOT TO BE USED FOR OTHER PROJECTS OR ACTION TO THAT PROJECT OR FOR ANY OTHER PROJECT.

01/29/24 CITY COMMENTS

Revisions:

Sheet Title:
WATER PROFILES

Designed by: CW
Drawn by: SK / RS
Checked by: JI

Sheet No.
C6.07
48 of 53 Sheets

EAST TOWN CROSSING PHASE 1

SEC. 26,35/ TWP. 20 N./ RGE. 4 E., W.M.

FIRE HYDRANT/FDC LOCATION/ACCESS APPROVED

BY: CITY OF PUYALLUP
FIRE CODE OFFICIAL

DATE: _____

NOTE: THIS APPROVAL IS VOID AFTER 1 YEAR FROM APPROVAL DATE.

THE CITY WILL NOT BE RESPONSIBLE FOR ERRORS AND/OR OMISSIONS ON THESE PLANS.

FIELD CONDITIONS MAY DICTATE CHANGES TO THESE PLANS AS DETERMINED BY THE FIRE CODE OFFICIAL.

APPROVED


BY: CITY OF PUYALLUP
DEVELOPMENT ENGINEERING

DATE: _____

NOTE: THIS APPROVAL IS VOID AFTER 180 DAYS FROM APPROVAL DATE.

THE CITY WILL NOT BE RESPONSIBLE FOR ERRORS AND/OR OMISSIONS ON THESE PLANS.

FIELD CONDITIONS MAY DICTATE CHANGES TO THESE PLANS AS DETERMINED BY THE DEVELOPMENT ENGINEERING MANAGER.

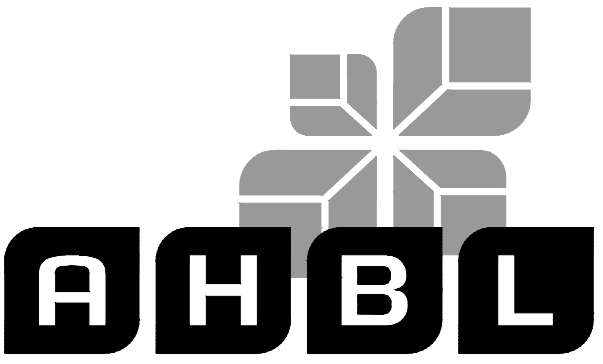

TACOMA · SEATTLE · SPOKANE · TRI-CITIES

2215 North 30th Street, Suite 300, Tacoma, WA 98403
253.383.2422 TEL 253.383.2572 FAX www.ahbl.com WEB

Project Title:

EAST TOWN CROSSING PHASE 1

Client:
ASH DEVELOPMENT


GREG HELLE
GREG.HELLE@ASHNW.COM

Project No.
2230752


Issue Set & Date:

PERMIT SUBMITTAL


02/20/2024

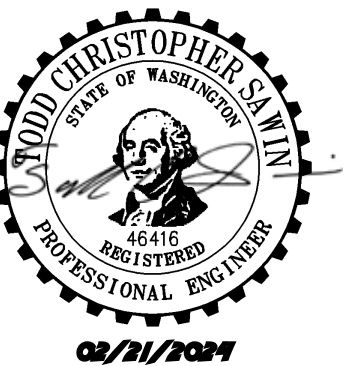



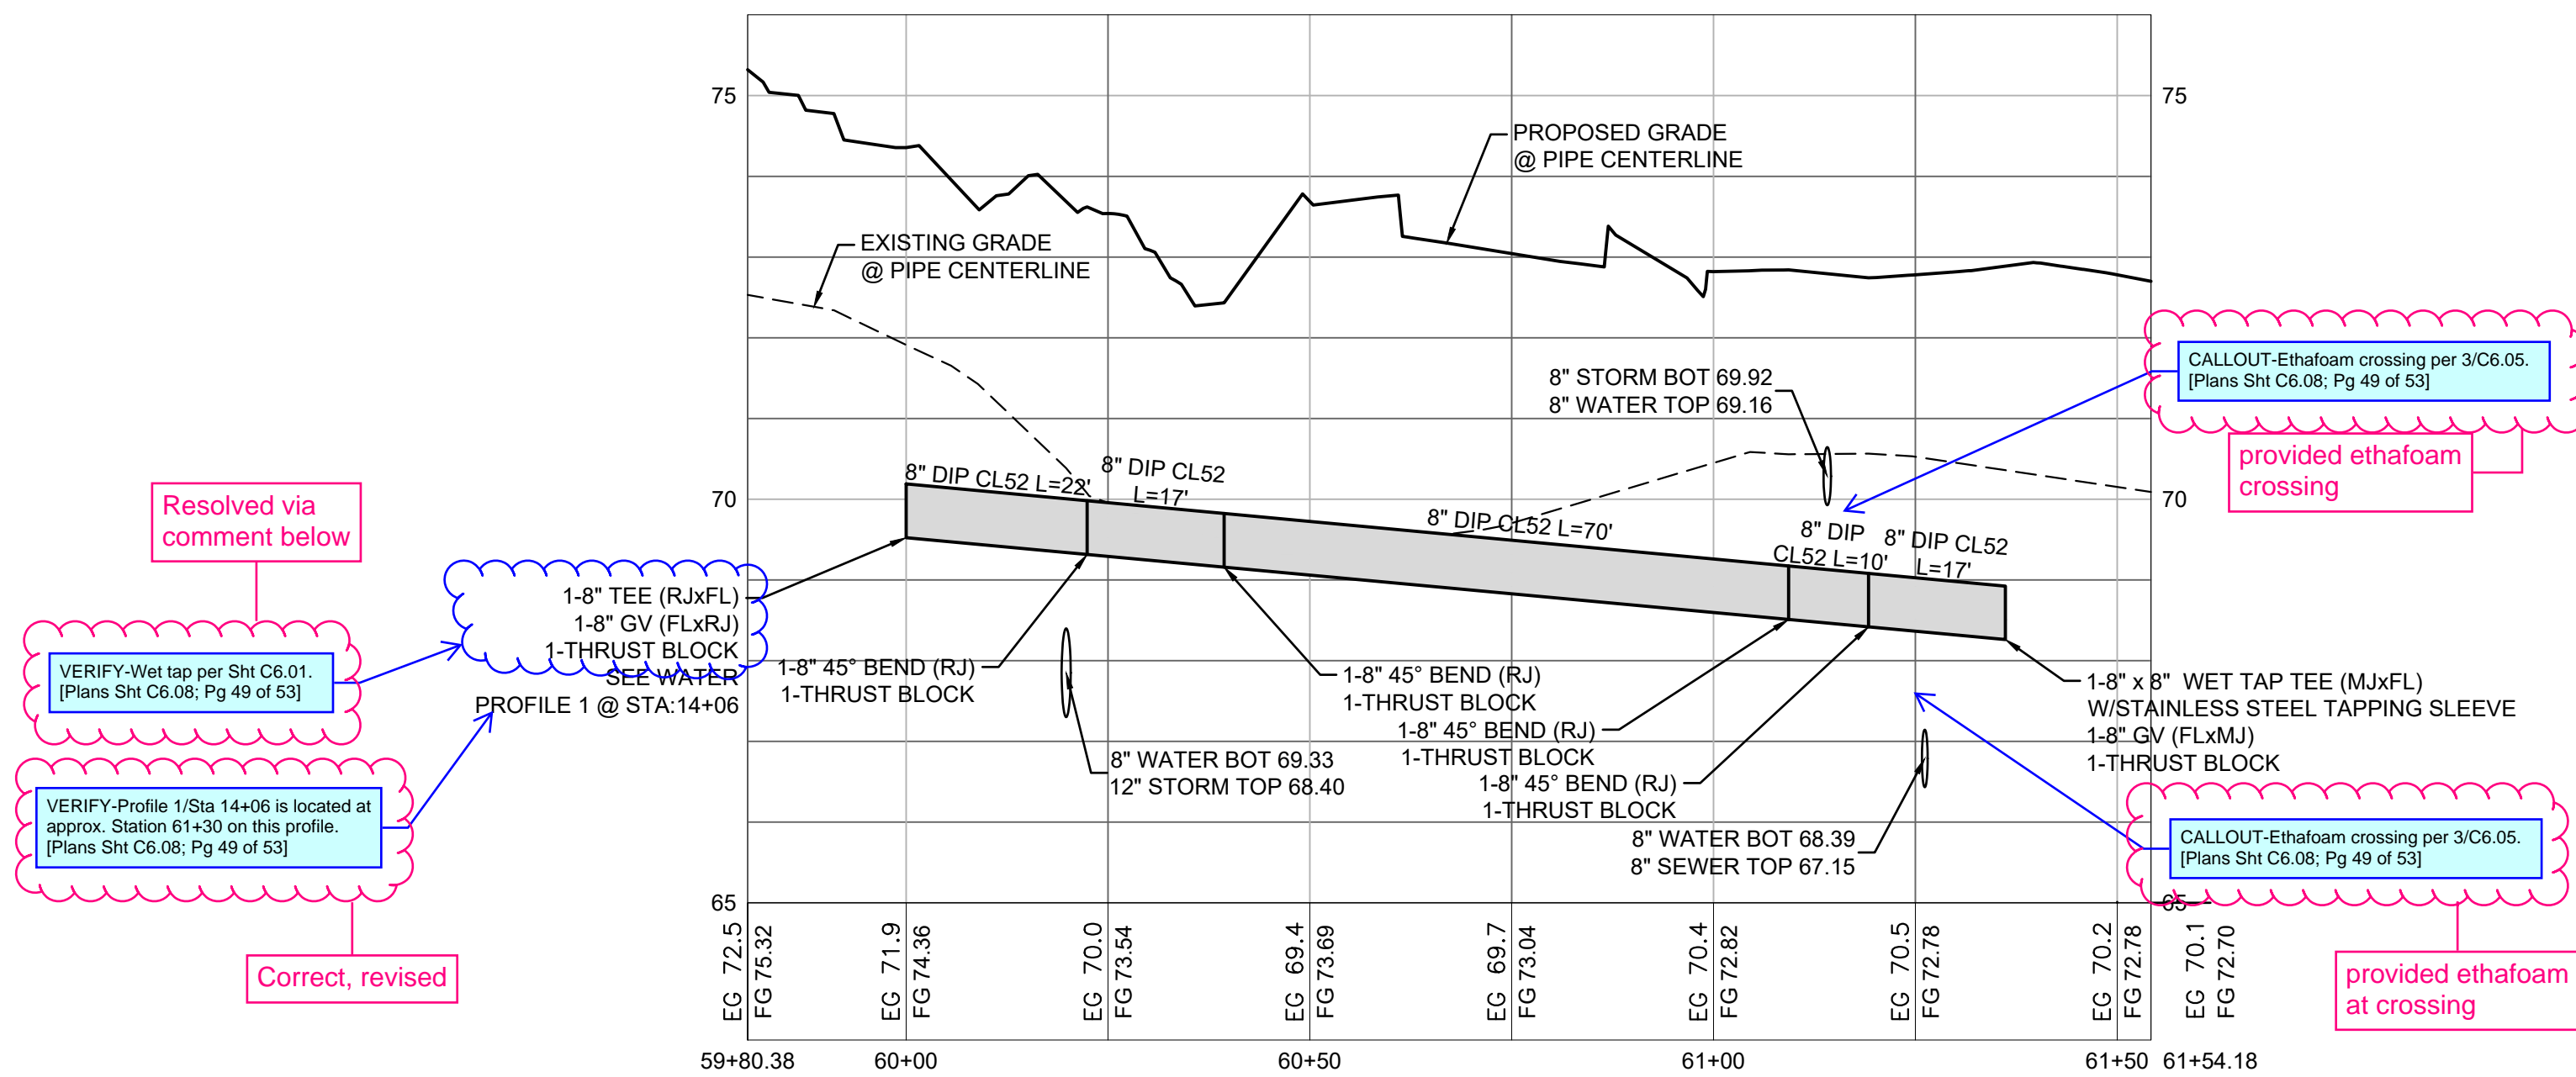


6 WATER PROFILE 6
1"=2' VERTICAL, 1"=20' HORIZONTAL

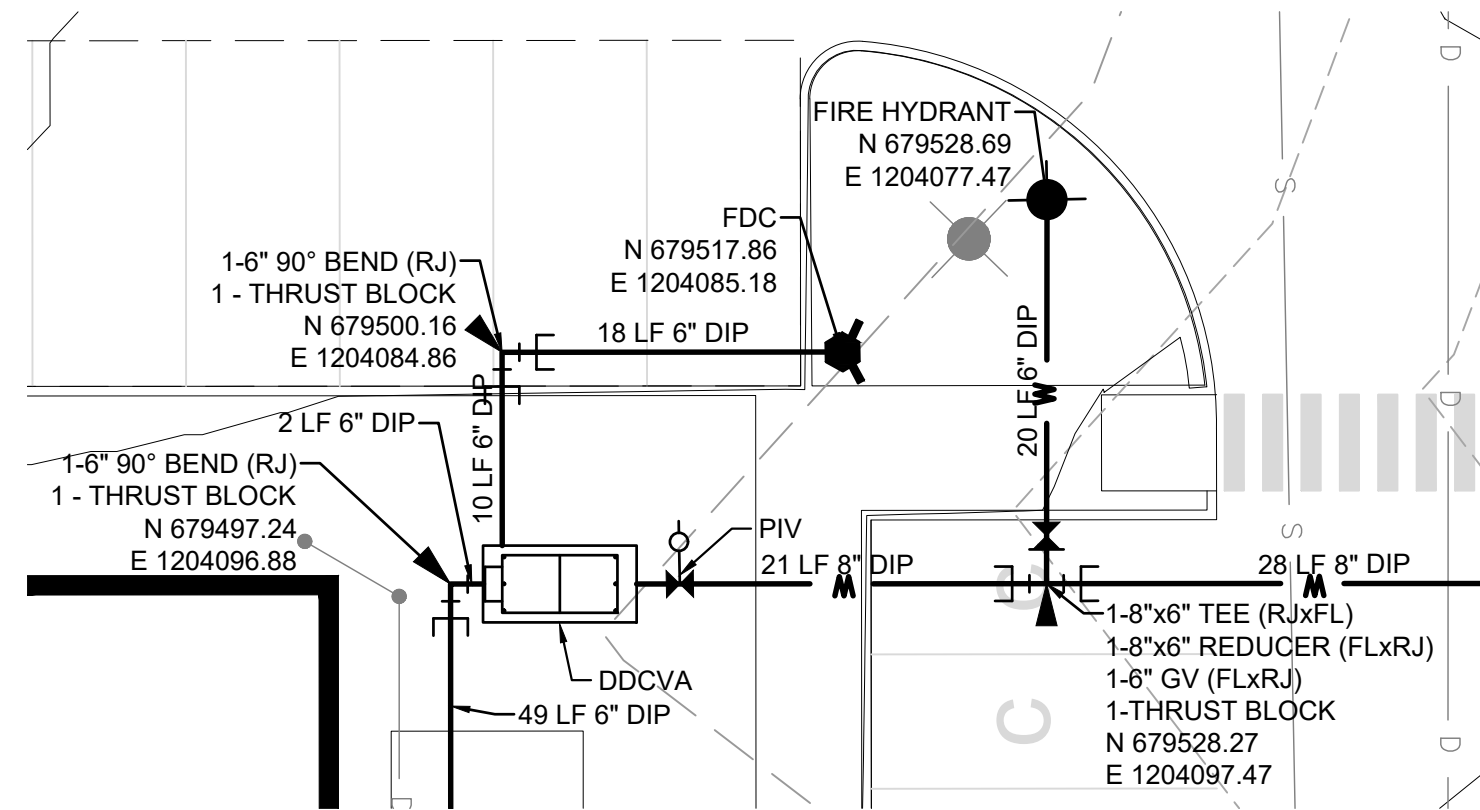

7 ENLARGEMENT
SCALE: 1"=10'

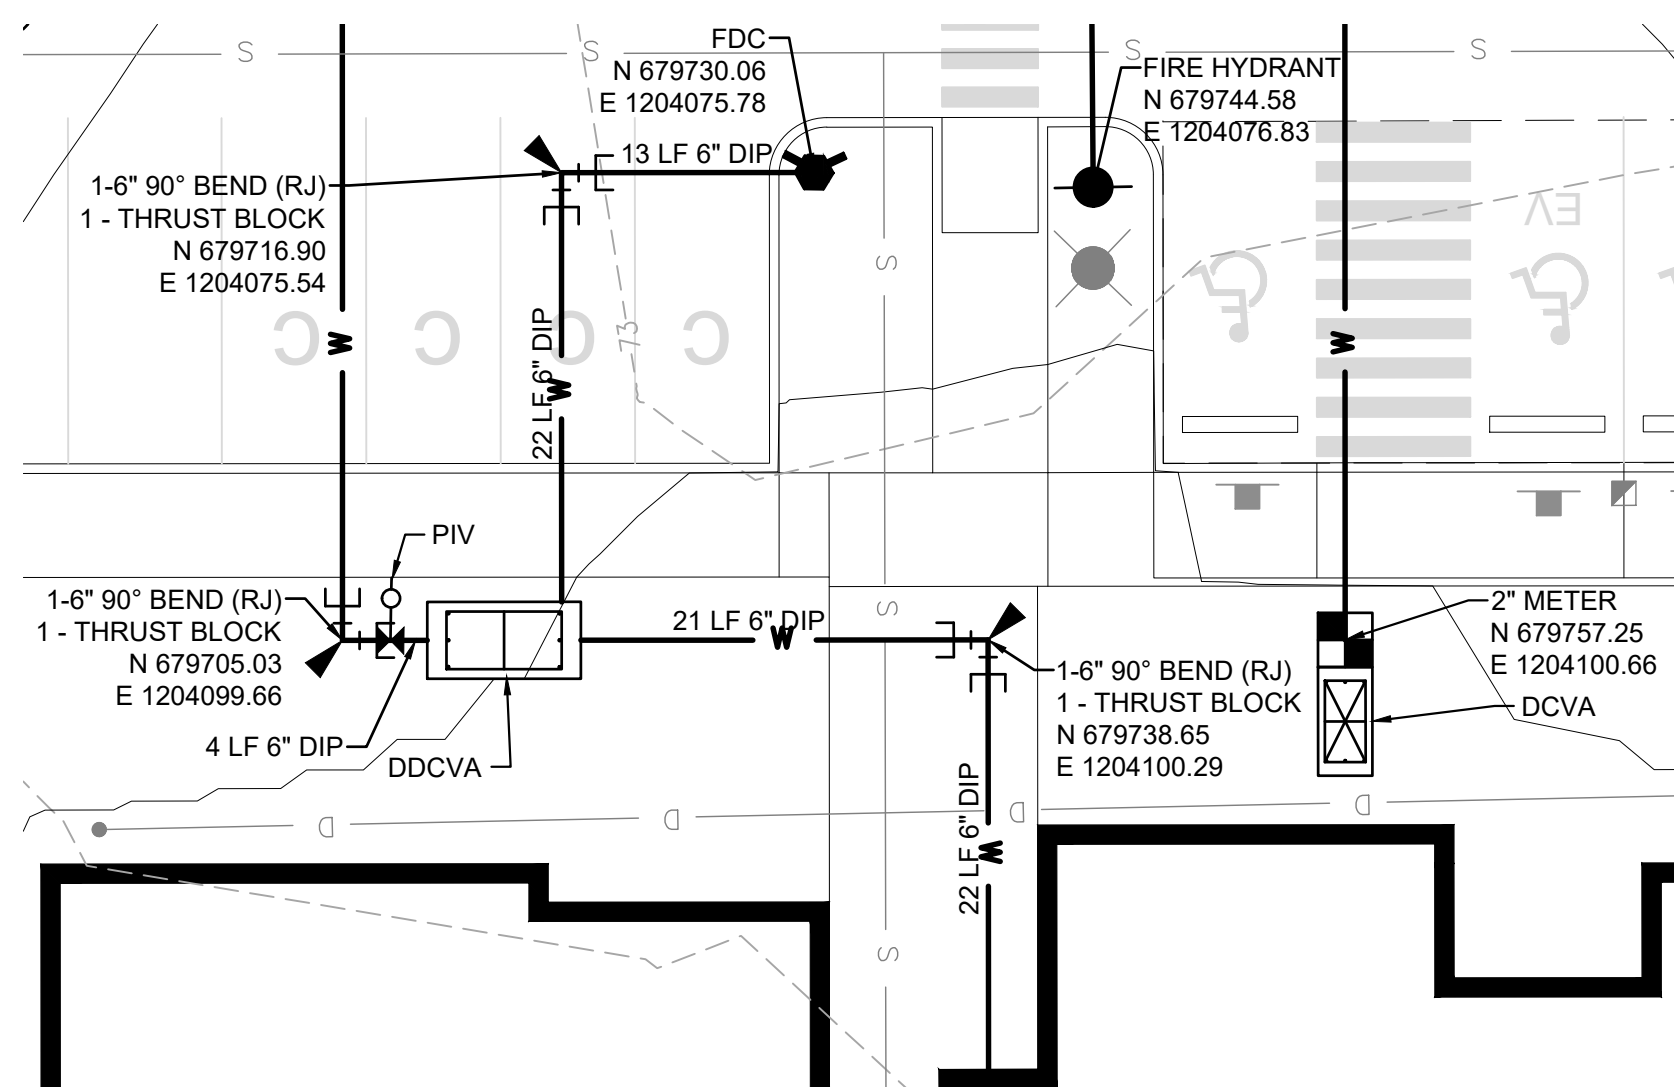

8 ENLARGEMENT
SCALE: 1"=10'

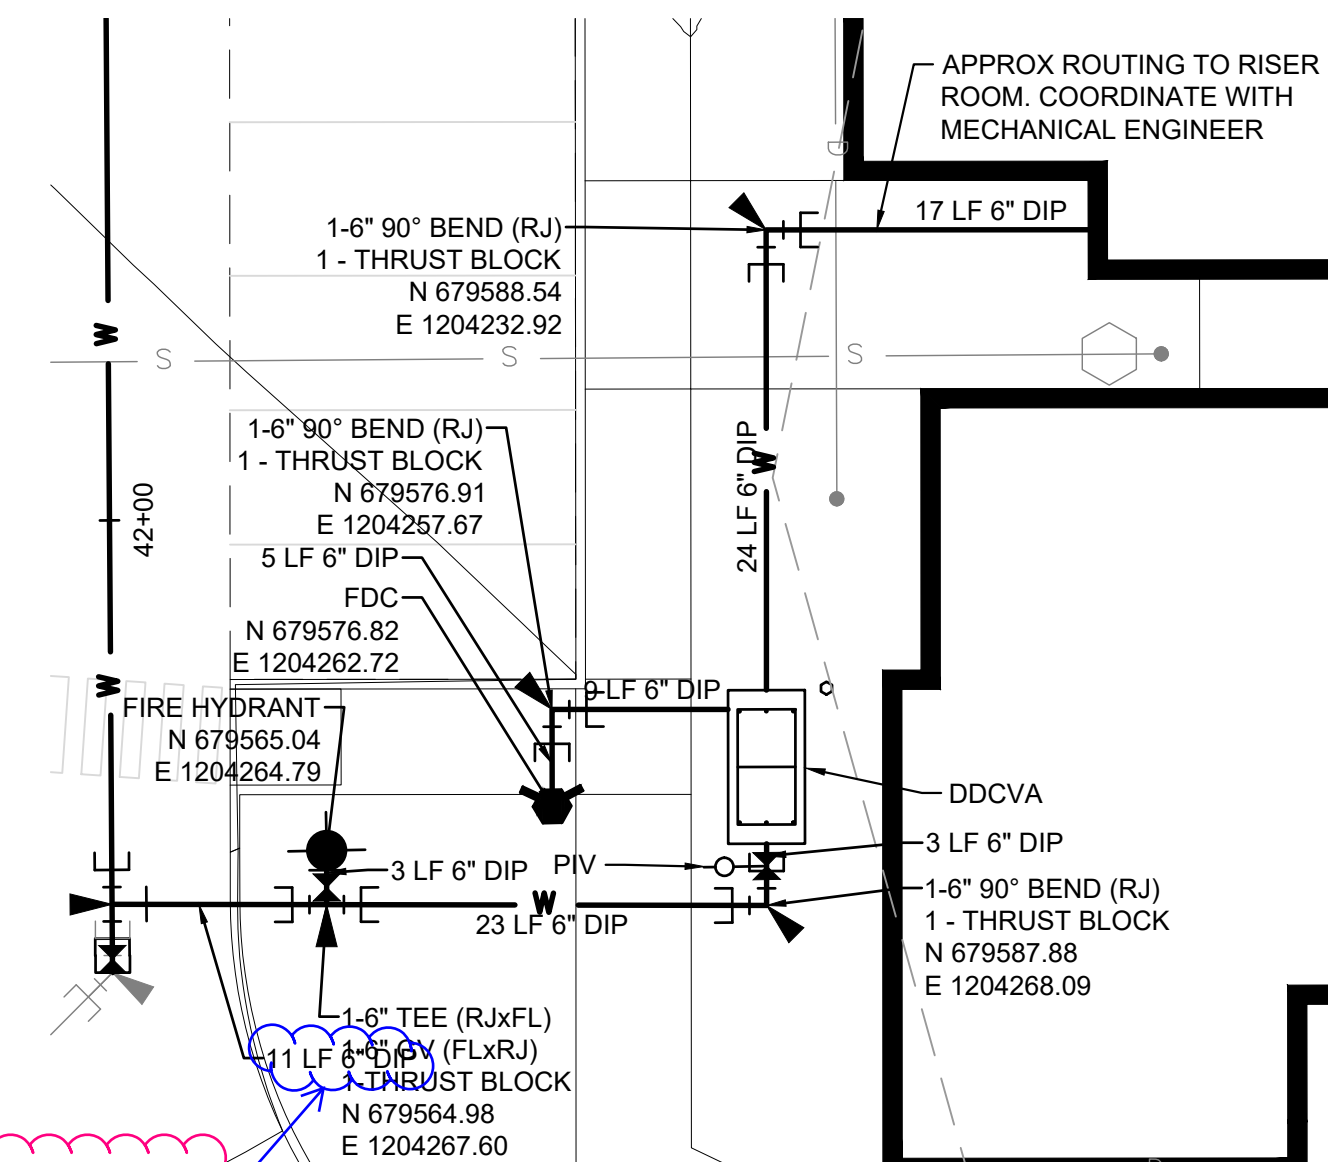

Readability. [Plans Sht C6.08; Pg 49 of 53]

revised

9 ENLARGEMENT
SCALE: 1"=10'



Know what's below.
Call before you dig.

Revisions:

01/29/24 CITY COMMENTS

Sheet Title: WATER PROFILES

Designed by: CW
Drawn by: SK / RS
Checked by: JI

Sheet No.
C6.08

EAST TOWN CROSSING PHASE 1

SEC. 26,35/ TWP. 20 N./ RGE. 4 E., W.M.

FIRE HYDRANT/FDC LOCATION/ACCESS APPROVED

BY: CITY OF PUYALLUP
FIRE CODE OFFICIAL

DATE: _____

NOTE: THIS APPROVAL IS VOID AFTER 1 YEAR FROM APPROVAL DATE.

THE CITY WILL NOT BE RESPONSIBLE FOR ERRORS AND/OR OMISSIONS ON THESE PLANS.

FIELD CONDITIONS MAY DICTATE CHANGES TO THESE PLANS AS DETERMINED BY THE FIRE CODE OFFICIAL.

APPROVED


BY: CITY OF PUYALLUP
DEVELOPMENT ENGINEERING

DATE: _____

NOTE: THIS APPROVAL IS VOID AFTER 180 DAYS FROM APPROVAL DATE.

THE CITY WILL NOT BE RESPONSIBLE FOR ERRORS AND/OR OMISSIONS ON THESE PLANS.

FIELD CONDITIONS MAY DICTATE CHANGES TO THESE PLANS AS DETERMINED BY THE DEVELOPMENT ENGINEERING MANAGER.

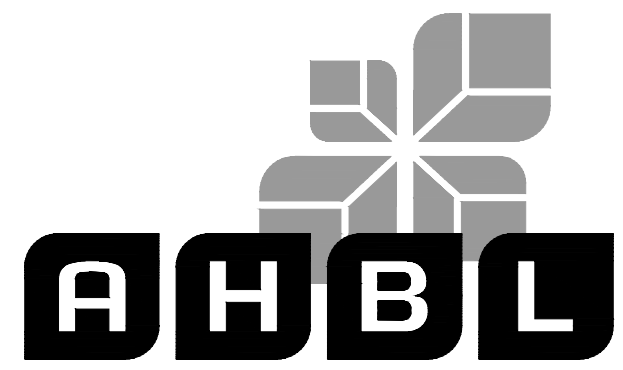

TACOMA • SEATTLE • SPOKANE • TRI-CITIES

2215 North 30th Street, Suite 300, Tacoma, WA 98403
253.383.2422 TEL 253.383.2572 FAX www.ahbl.com WEB

Project Title:

EAST TOWN CROSSING PHASE 1

Client:

ASH DEVELOPMENT

GREG HELLE

GREG.HELLE@ASHNW.COM

Project No.

2230752

Issue Set & Date:


PERMIT SUBMITTAL

02/20/2024




NOTICE


ALTERATION OF THIS DOCUMENT SHALL INVALIDATE THE PROFESSIONAL SEAL AND SIGNATURE. PUBLICATION OF THIS DOCUMENT DOES NOT CONSTITUTE A GUARANTEE OR ENDORSEMENT BY THE ENGINEER OF THE DESIGN OR THE ONLY FOR THE PROJECT EXCEPT IN THE TITLE BLOCK AND IS NOT TO BE USED FOR OTHER PURPOSES OR ADDITION TO THAT PROJECT OR FOR ANY OTHER PROJECT.

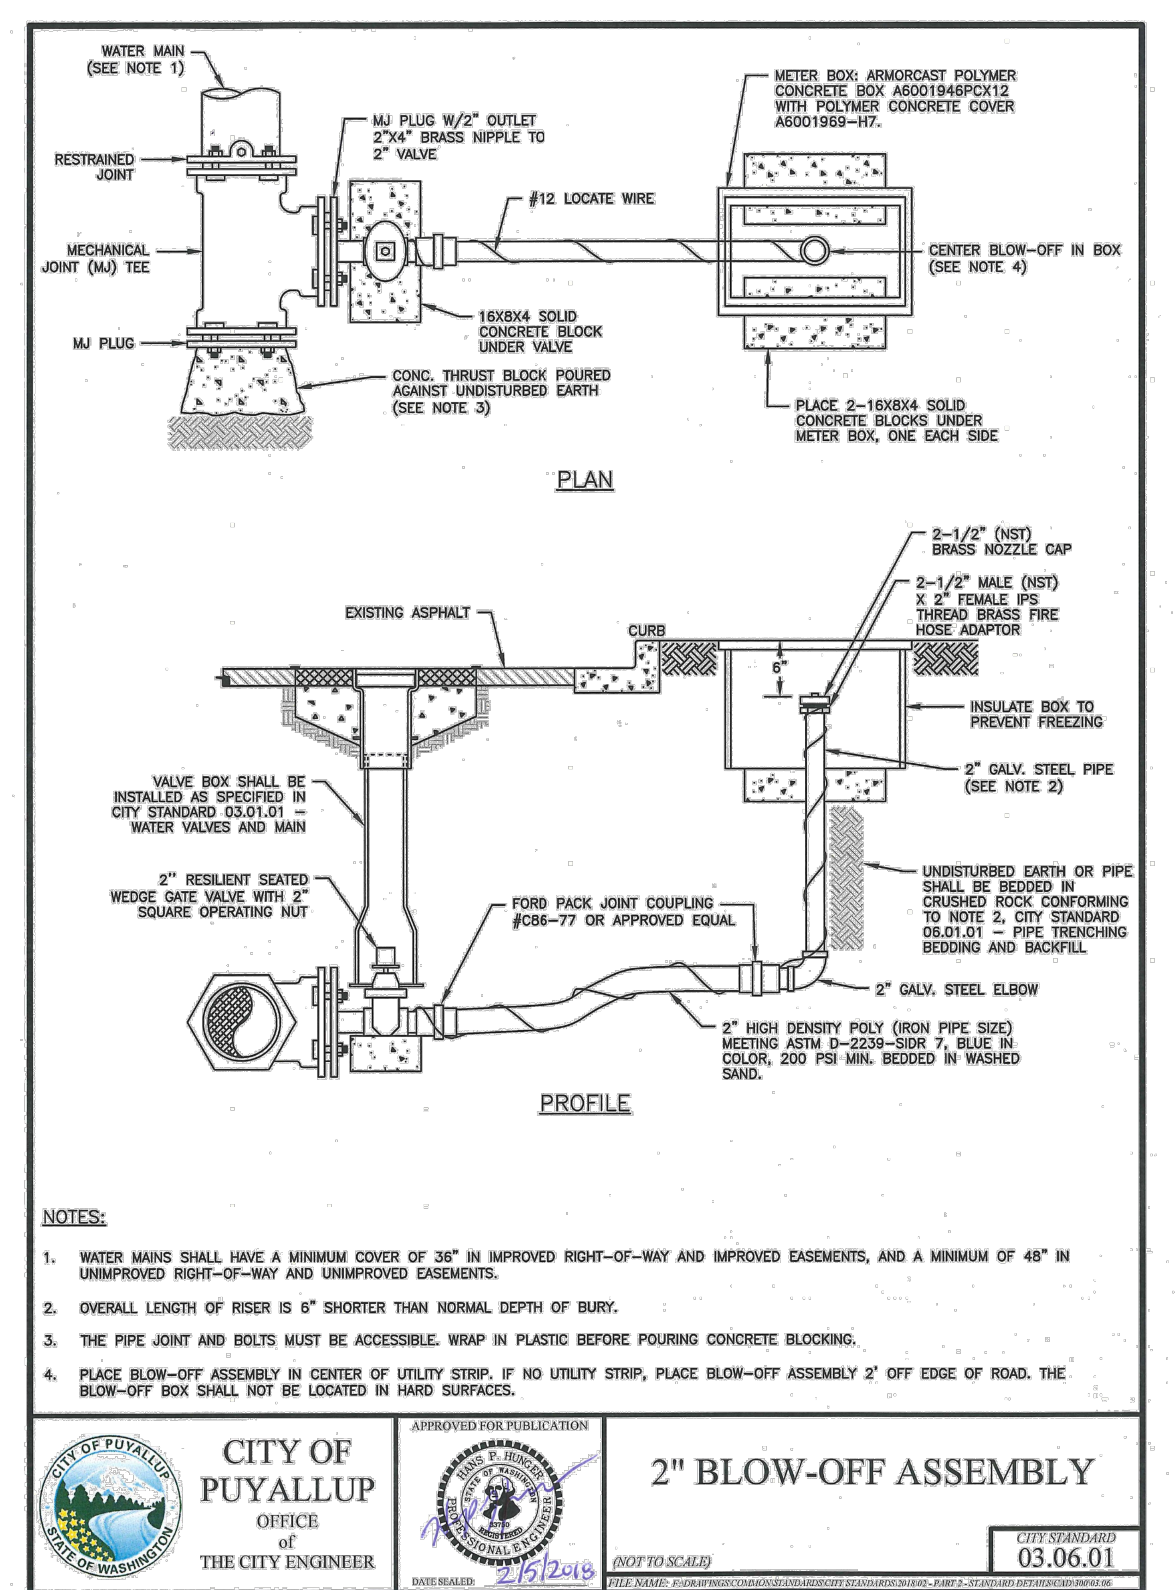


1 **2 IN BLOW-OFF ASSEMBLY**
NOT TO SCALE

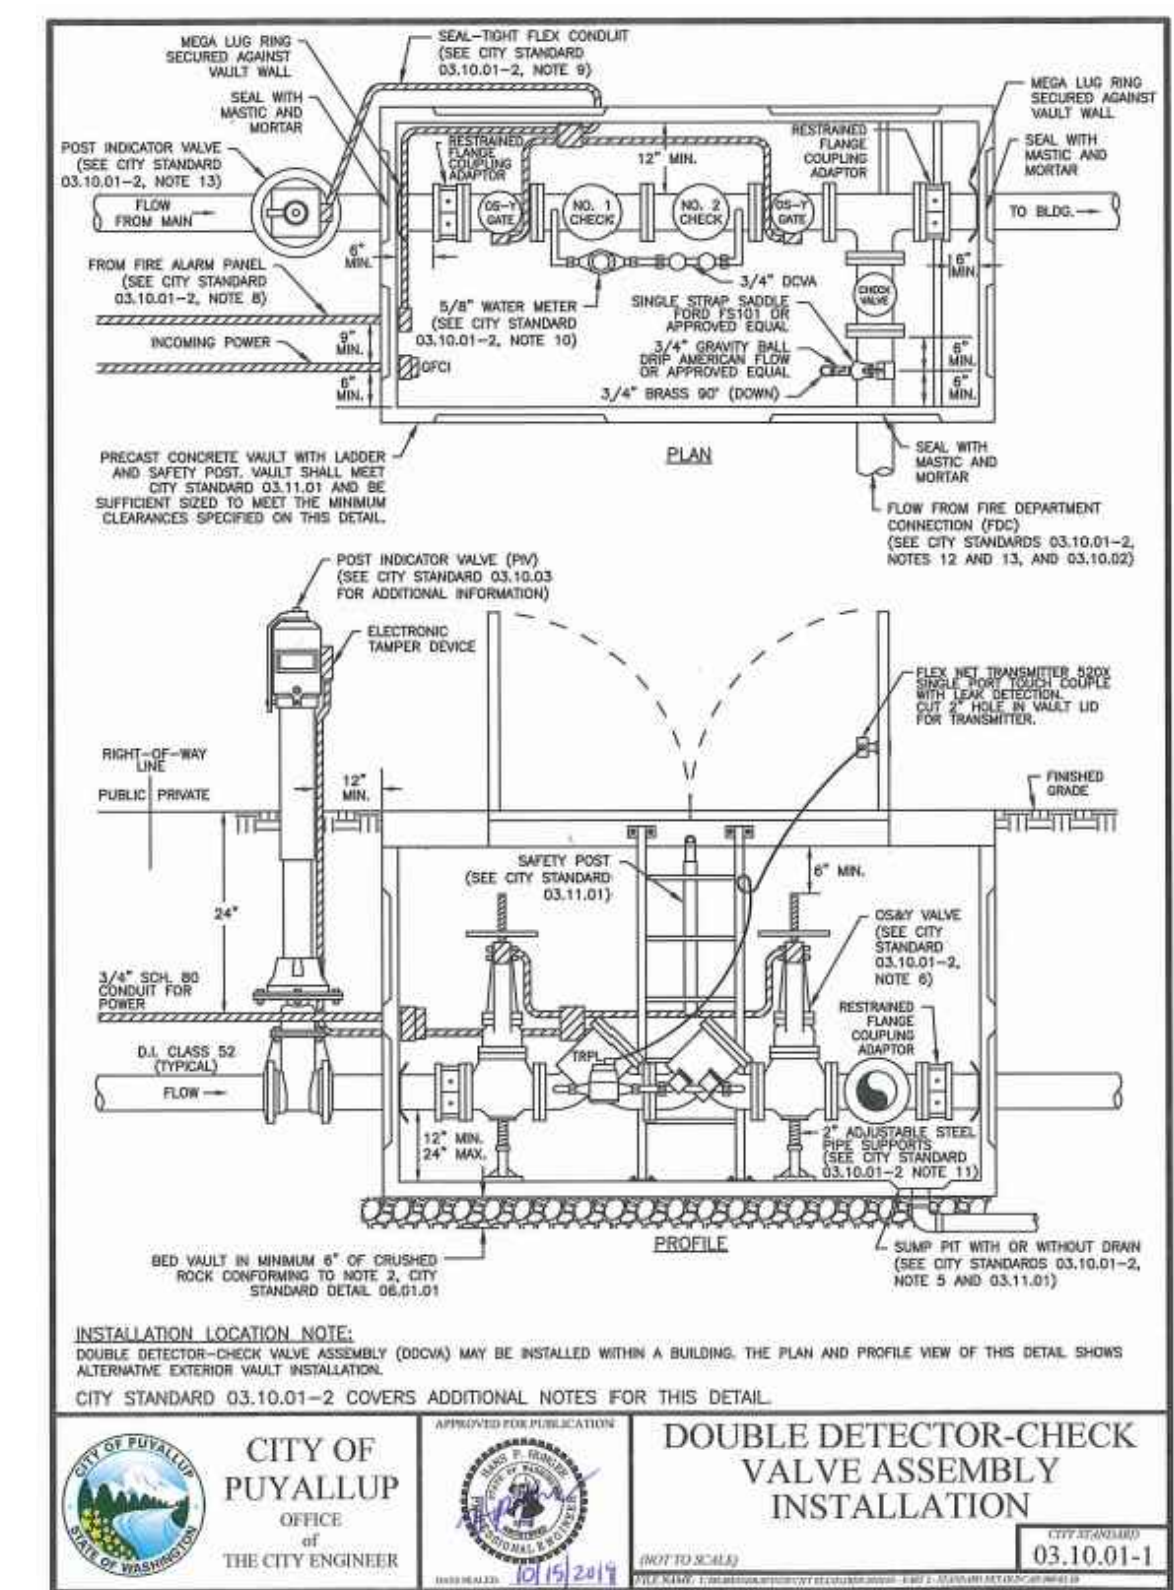


2 **DOUBLE DETECTOR CHECK VALVE ASSEMBLY INSTALLATION**
NOT TO SCALE

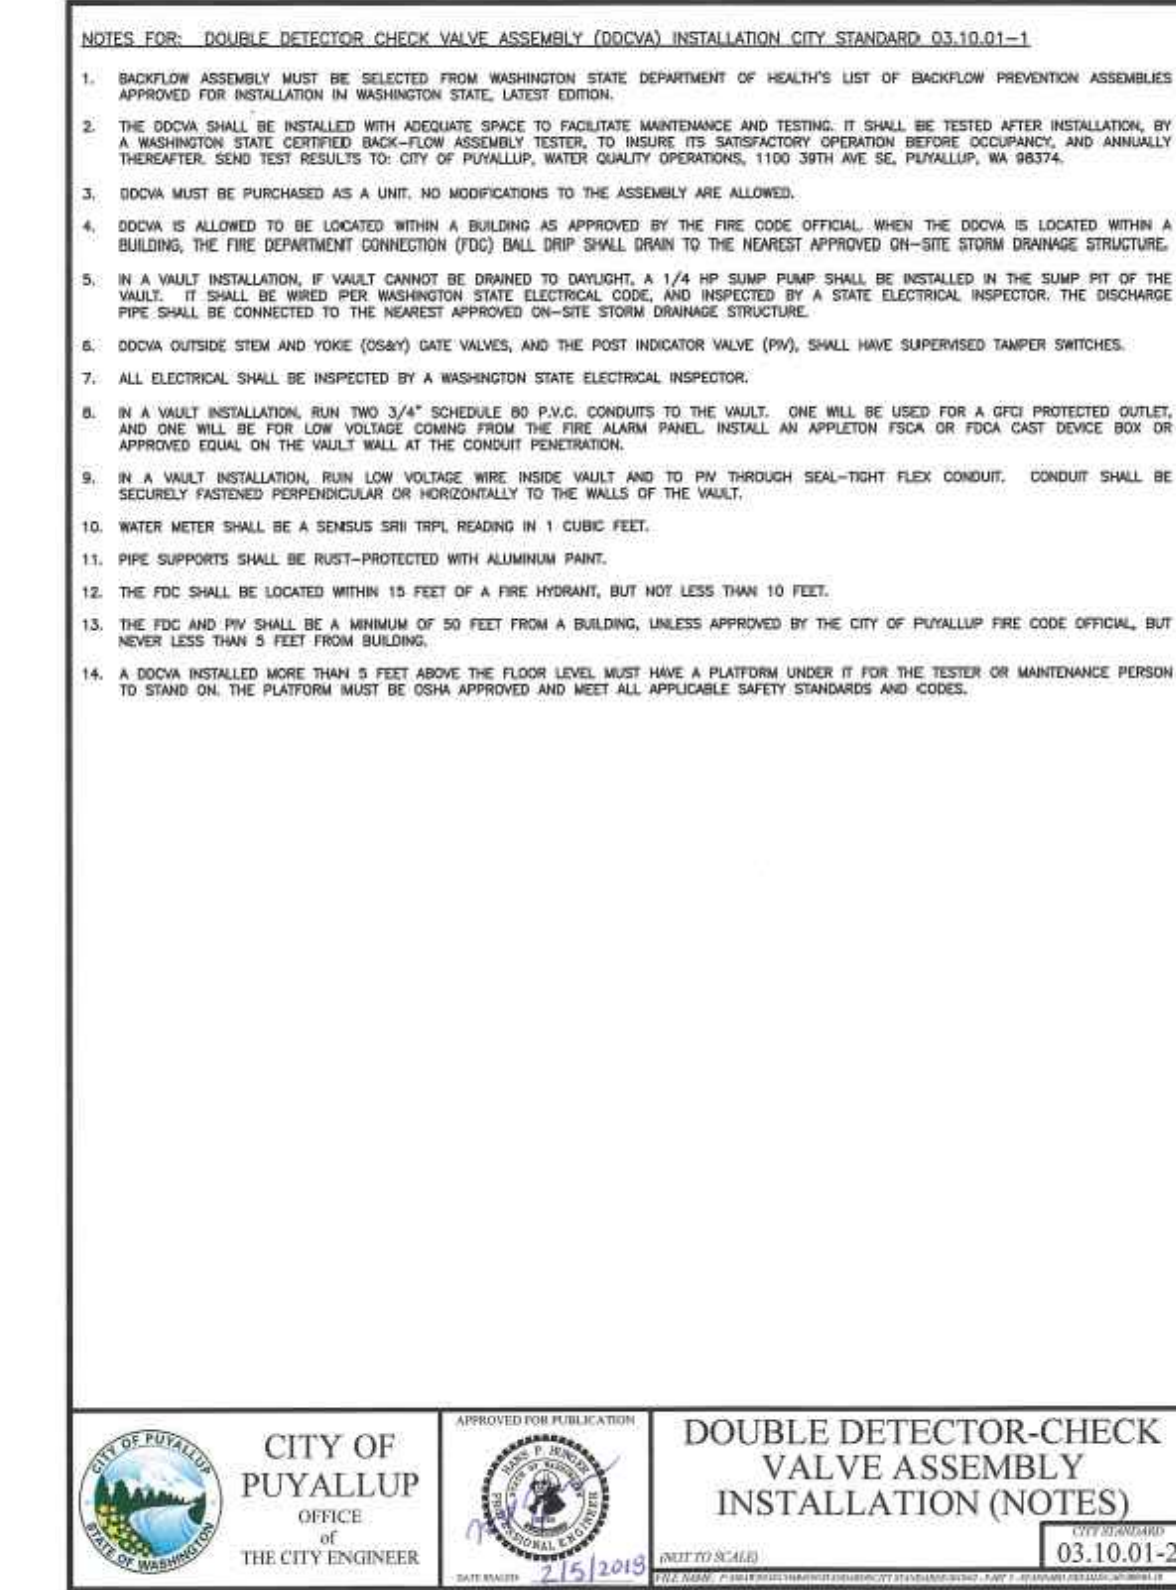

3 **DOUBLE DETECTOR CHECK VALVE ASSEMBLY INSTALLATION (NOTES)**
NOT TO SCALE

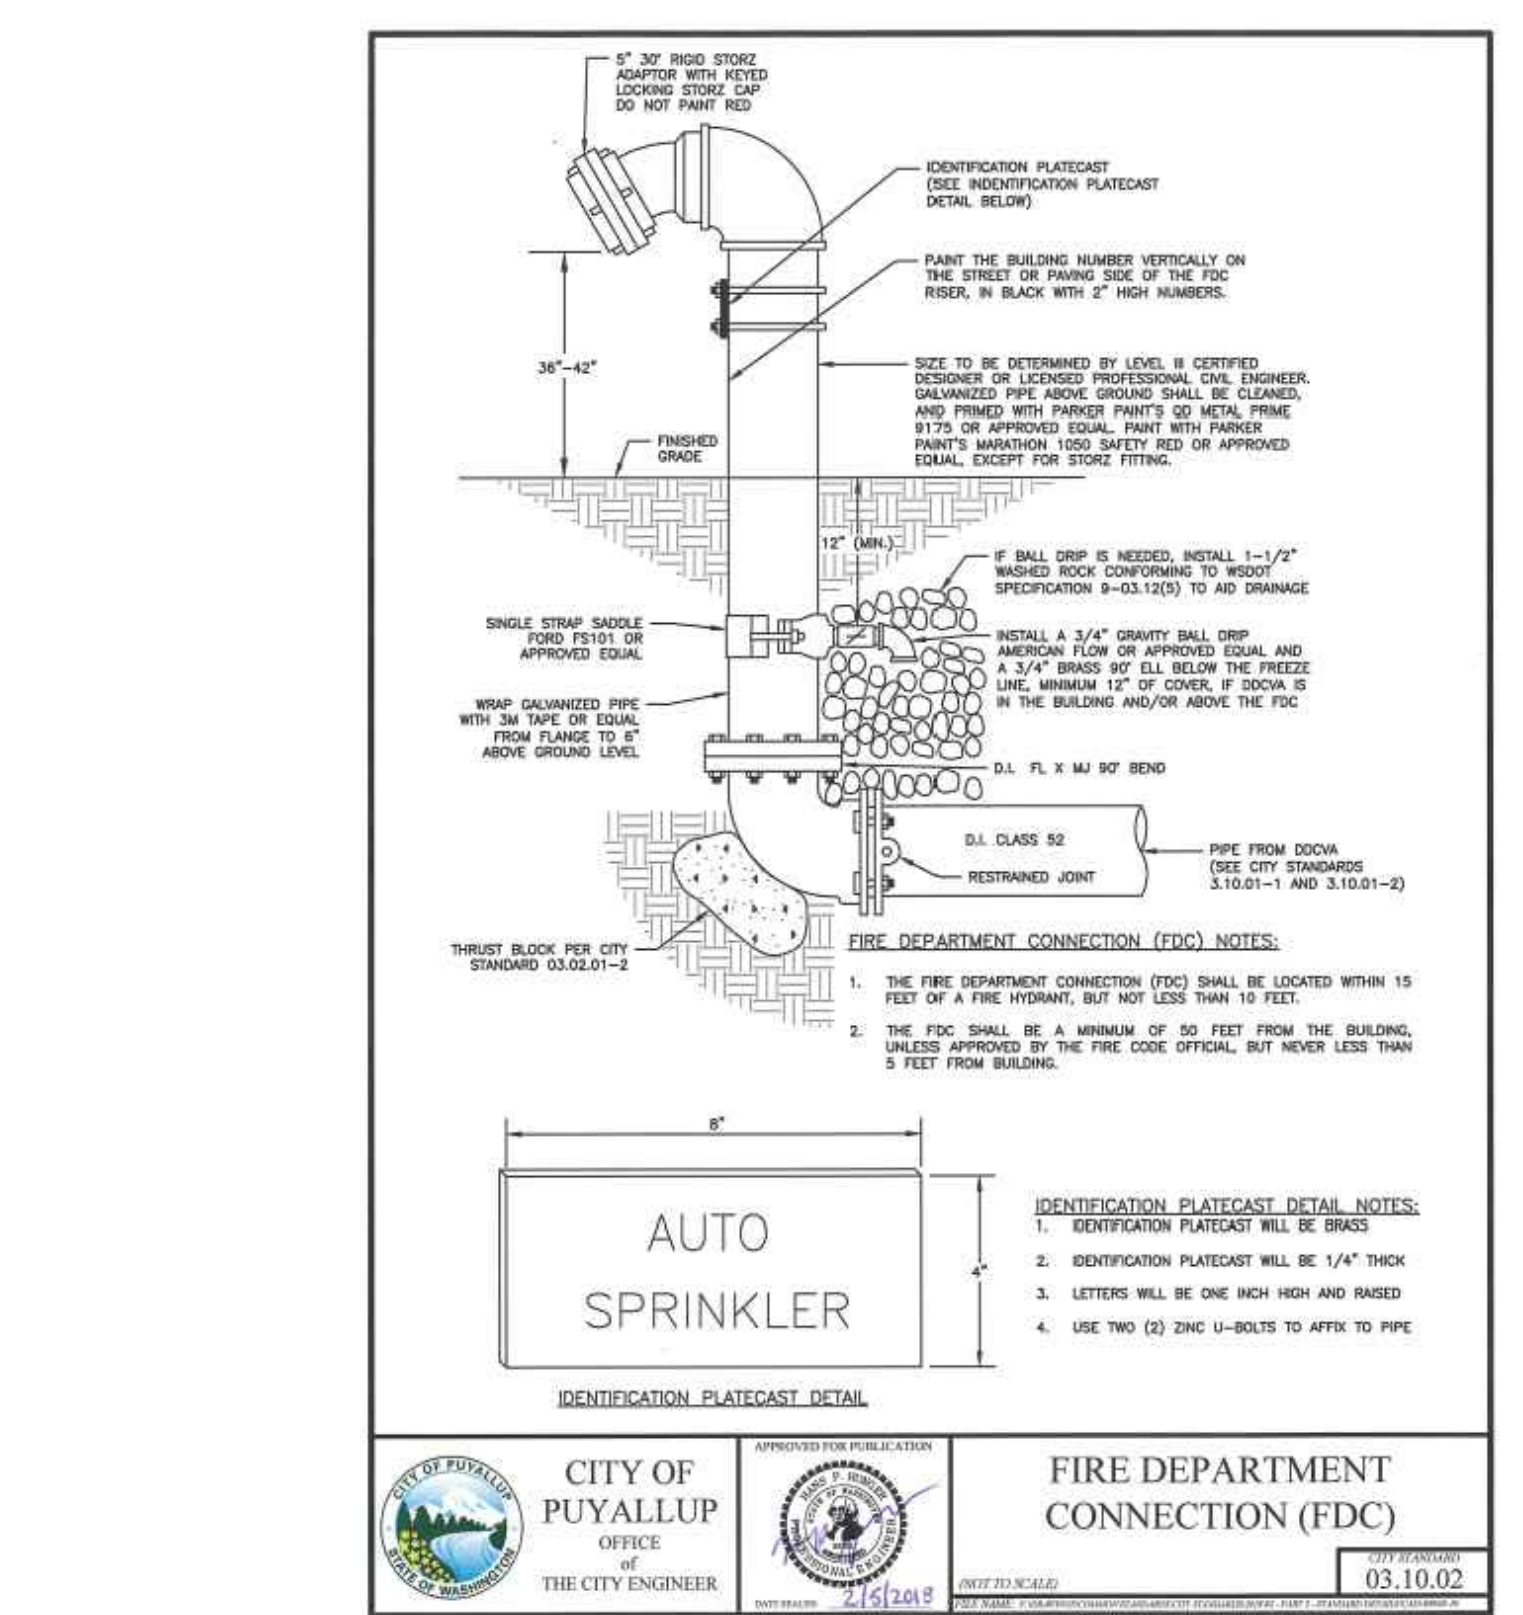

4 **FIRE DEPARTMENT CONNECTION (FDC)**
NOT TO SCALE

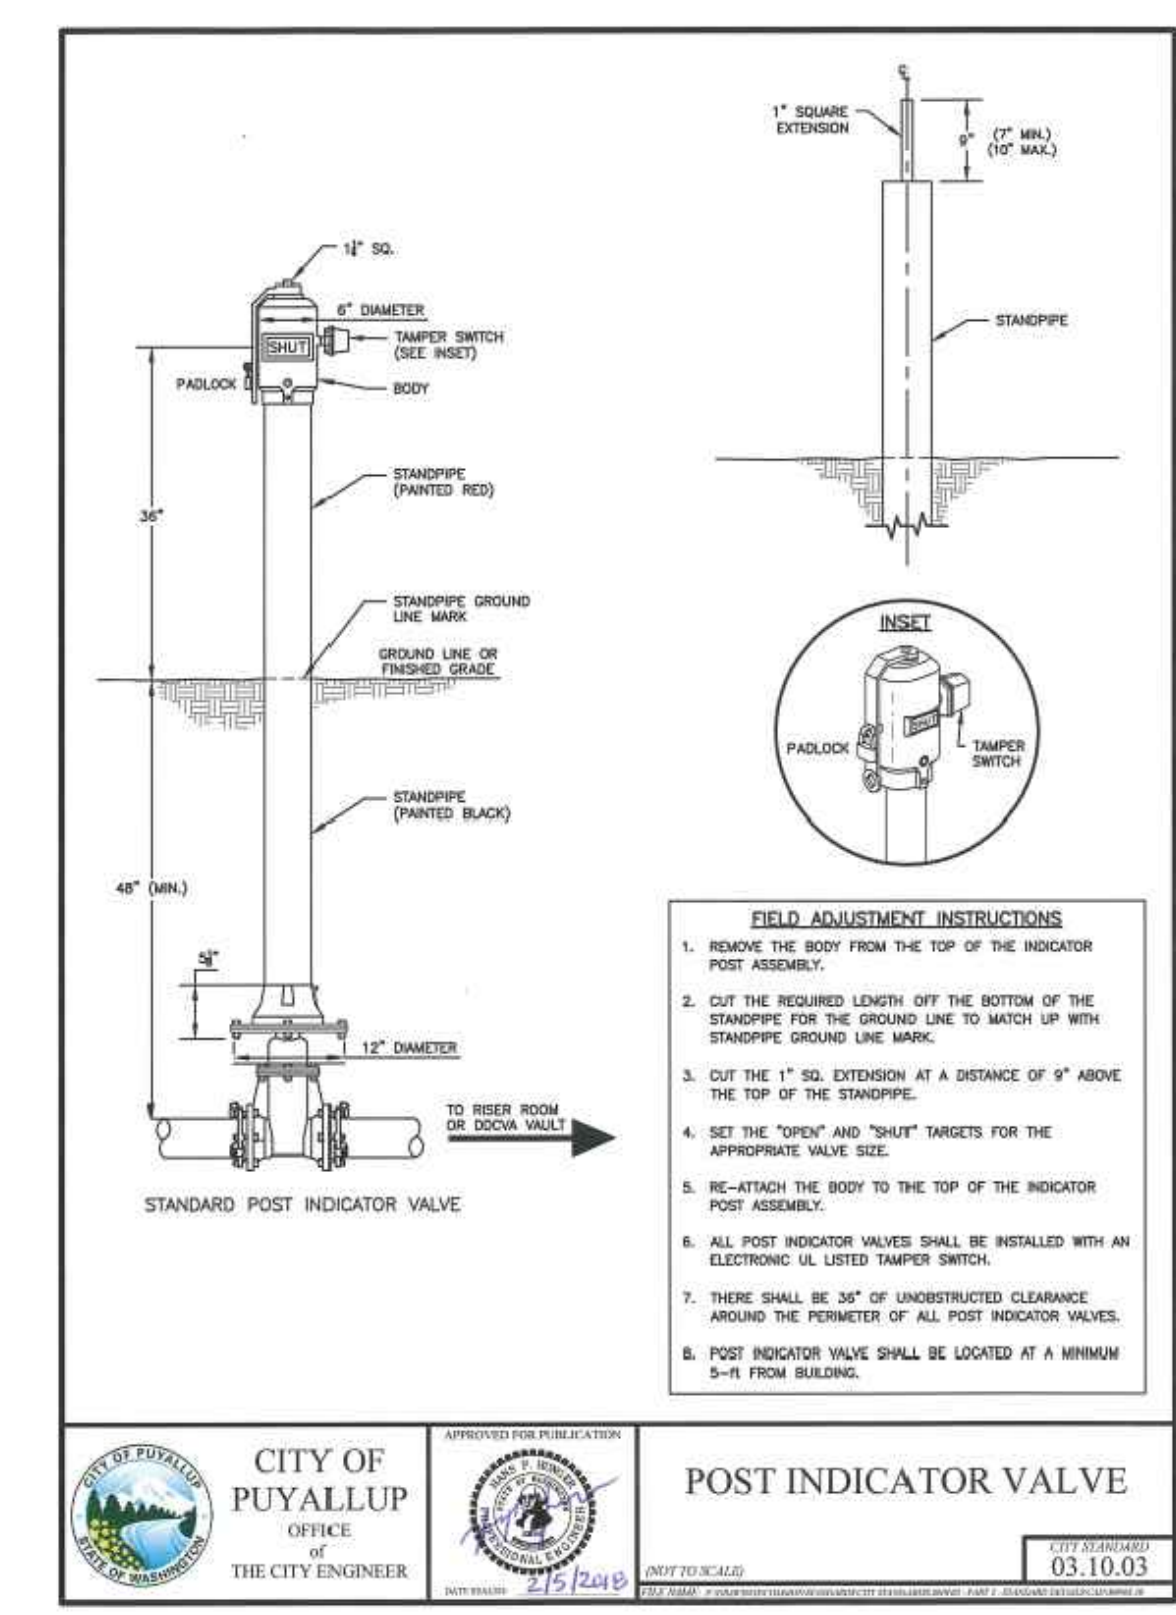

5 **POST INDICATOR VALVE**
NOT TO SCALE



Know what's below.
Call before you dig.

Revisions:

01/29/24 CITY COMMENTS

Sheet Title:

WATER NOTES AND DETAILS

Designed by: CW
Drawn by: SK / RS
Checked by: JI

Sheet No.

C6.10


51 of 53 Sheets

EAST TOWN CROSSING PHASE 1

SEC. 26,35/ TWP. 20 N./ RGE. 4 E., W.M.

FIRE HYDRANT/FDC LOCATION/ACCESS APPROVED
 BY CITY OF PUYALLUP
 FIRE CODE OFFICIAL
 DATE
 NOTE: THIS APPROVAL IS VOID AFTER 1 YEAR FROM APPROVAL DATE.
 THE CITY WILL NOT BE RESPONSIBLE FOR ERRORS AND/OR OMISSIONS ON THESE PLANS.
 FIELD CONDITIONS MAY DICTATE CHANGES TO THESE PLANS AS DETERMINED BY THE FIRE CODE OFFICIAL.

APPROVED
 BY CITY OF PUYALLUP
 DEVELOPMENT ENGINEERING
 DATE
 NOTE: THIS APPROVAL IS VOID AFTER 180 DAYS FROM APPROVAL DATE.
 THE CITY WILL NOT BE RESPONSIBLE FOR ERRORS AND/OR OMISSIONS ON THESE PLANS.
 FIELD CONDITIONS MAY DICTATE CHANGES TO THESE PLANS AS DETERMINED BY THE DEVELOPMENT ENGINEERING MANAGER.

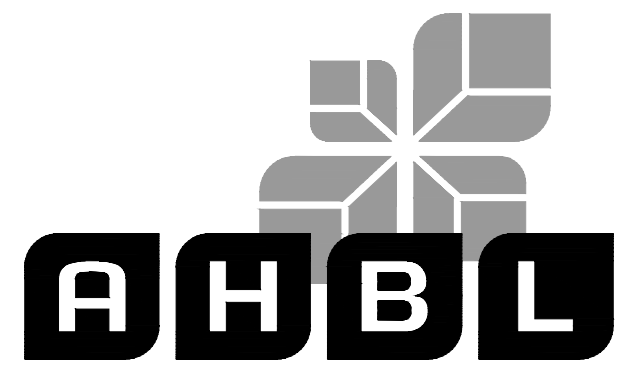

TACOMA · SEATTLE · SPOKANE · TRI-CITIES
 2215 North 30th Street, Suite 300, Tacoma, WA 98403
 253.383.2422 TEL 253.383.2572 FAX www.ahbl.com WEB

Project Title:
EAST TOWN CROSSING PHASE 1


Client:
 ASH DEVELOPMENT

GREG HELLE
 GREG.HELLE@ASHNW.COM


Project No.
 2230752

Issue Set & Date:
 PERMIT SUBMITTAL


02/20/2024

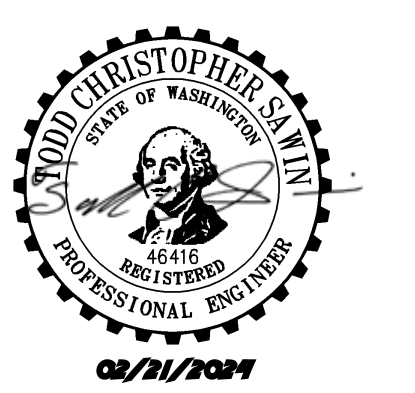


NOTICE
 ALTERATION OF THIS DOCUMENT SHALL INVALIDATE THE PROFESSIONAL SEAL AND SIGNATURE. PUBLICATION OF THIS DOCUMENT DOES NOT GUARANTEE THE ACCURACY OF THE INFORMATION OR THE QUALITY OF THE WORK. THE USER SHALL BE RESPONSIBLE FOR VERIFYING THE INFORMATION AND THE QUALITY OF THE WORK. THIS DOCUMENT IS NOT TO BE USED FOR ANY OTHER PROJECT.

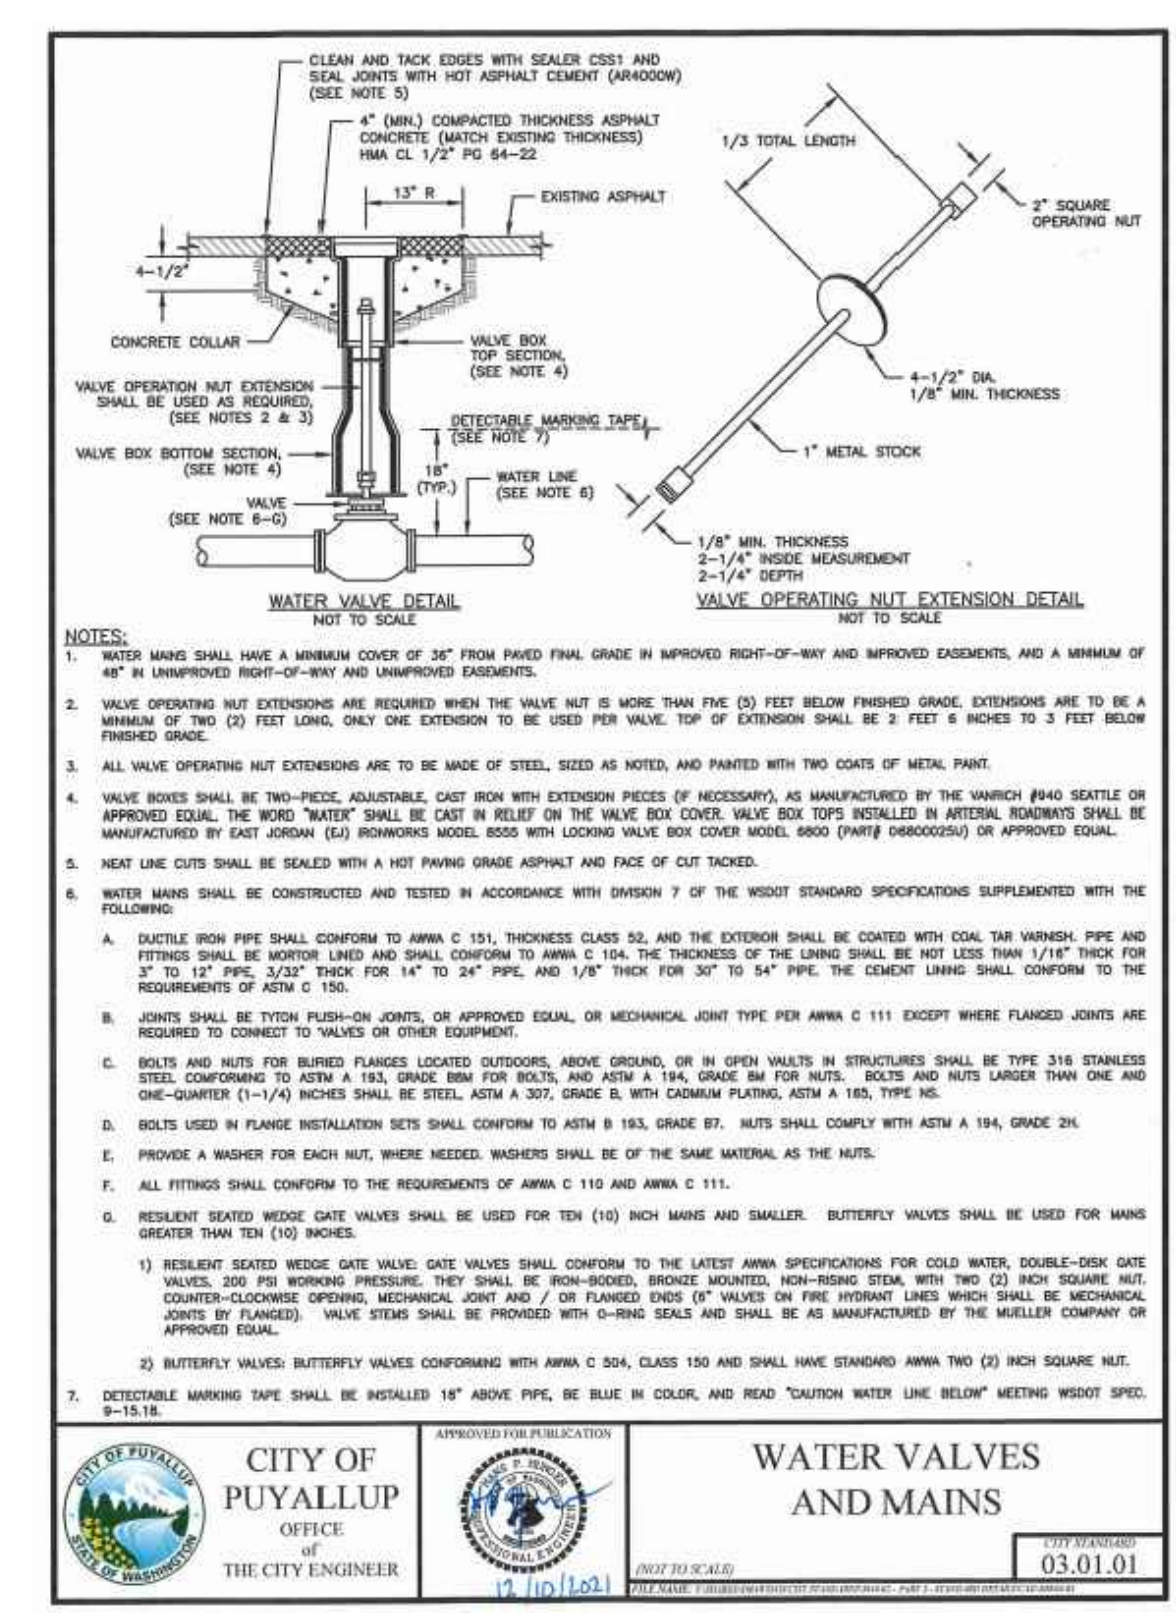


1 WATER VALVES AND MAINS
 NOT TO SCALE

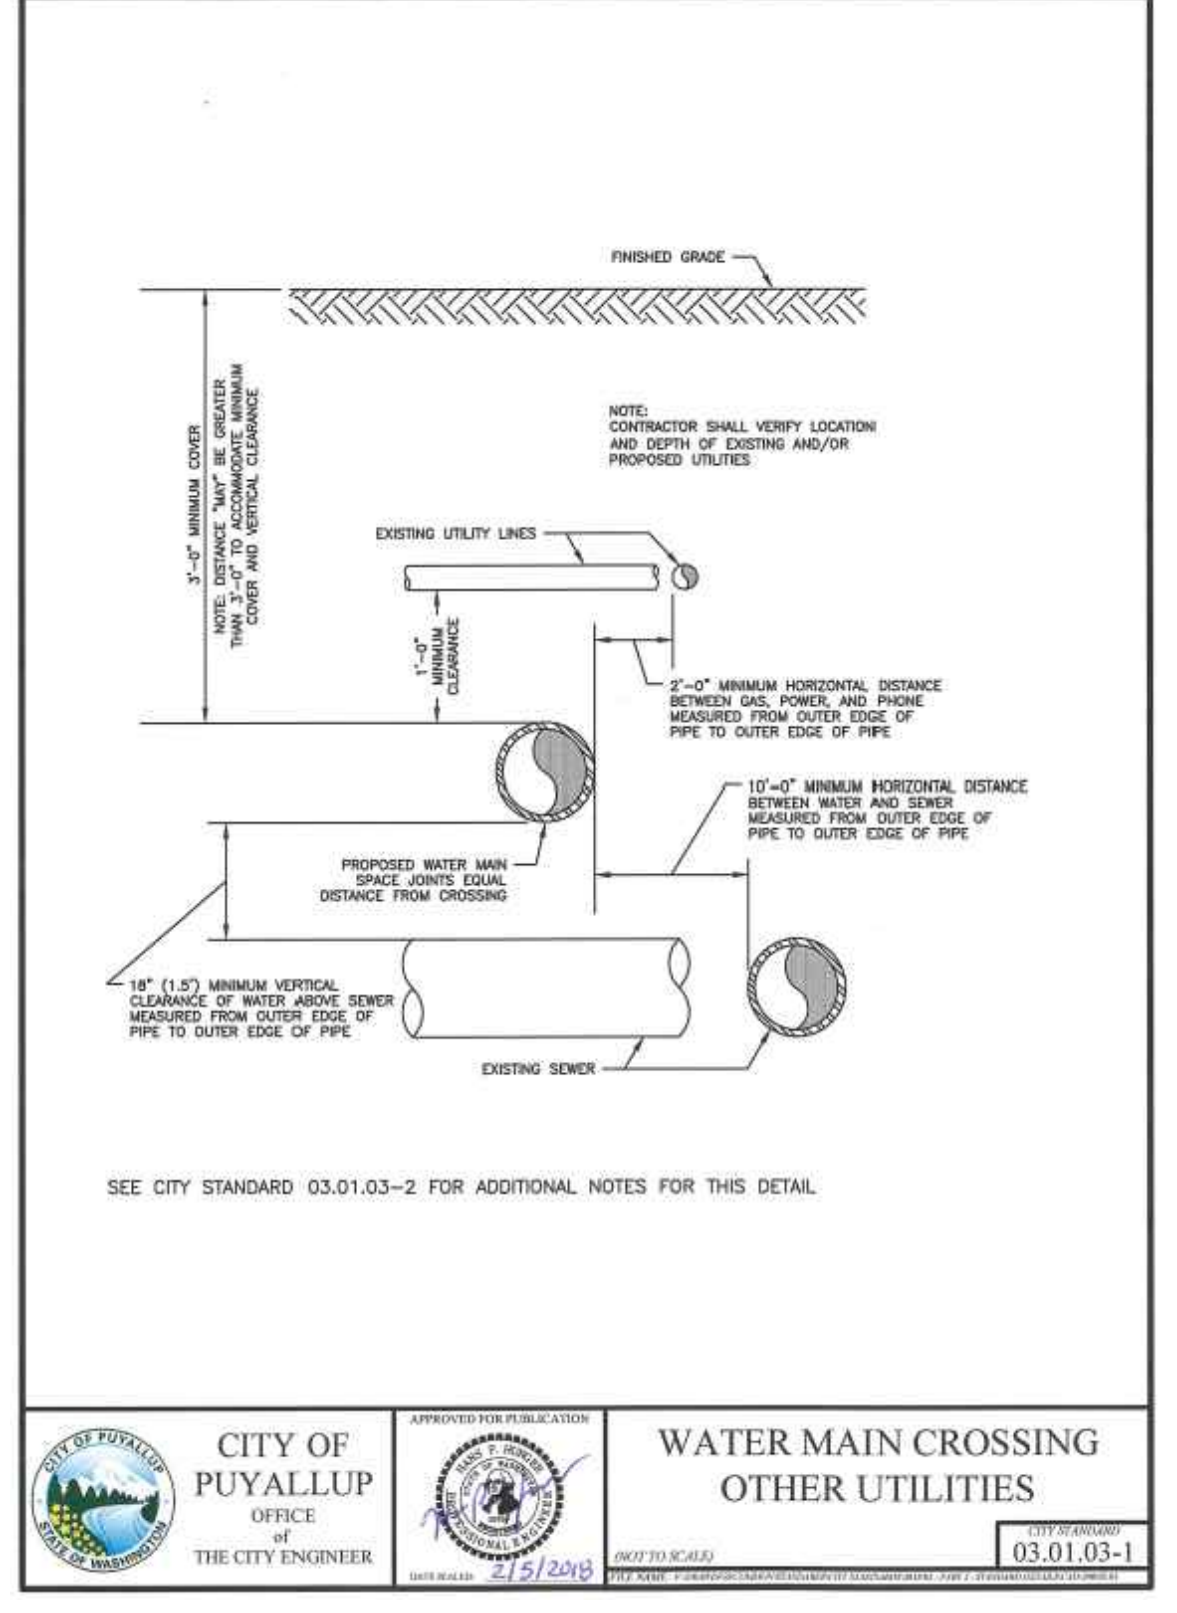


2 WATER MAIN CROSSING OTHER UTILITIES
 NOT TO SCALE

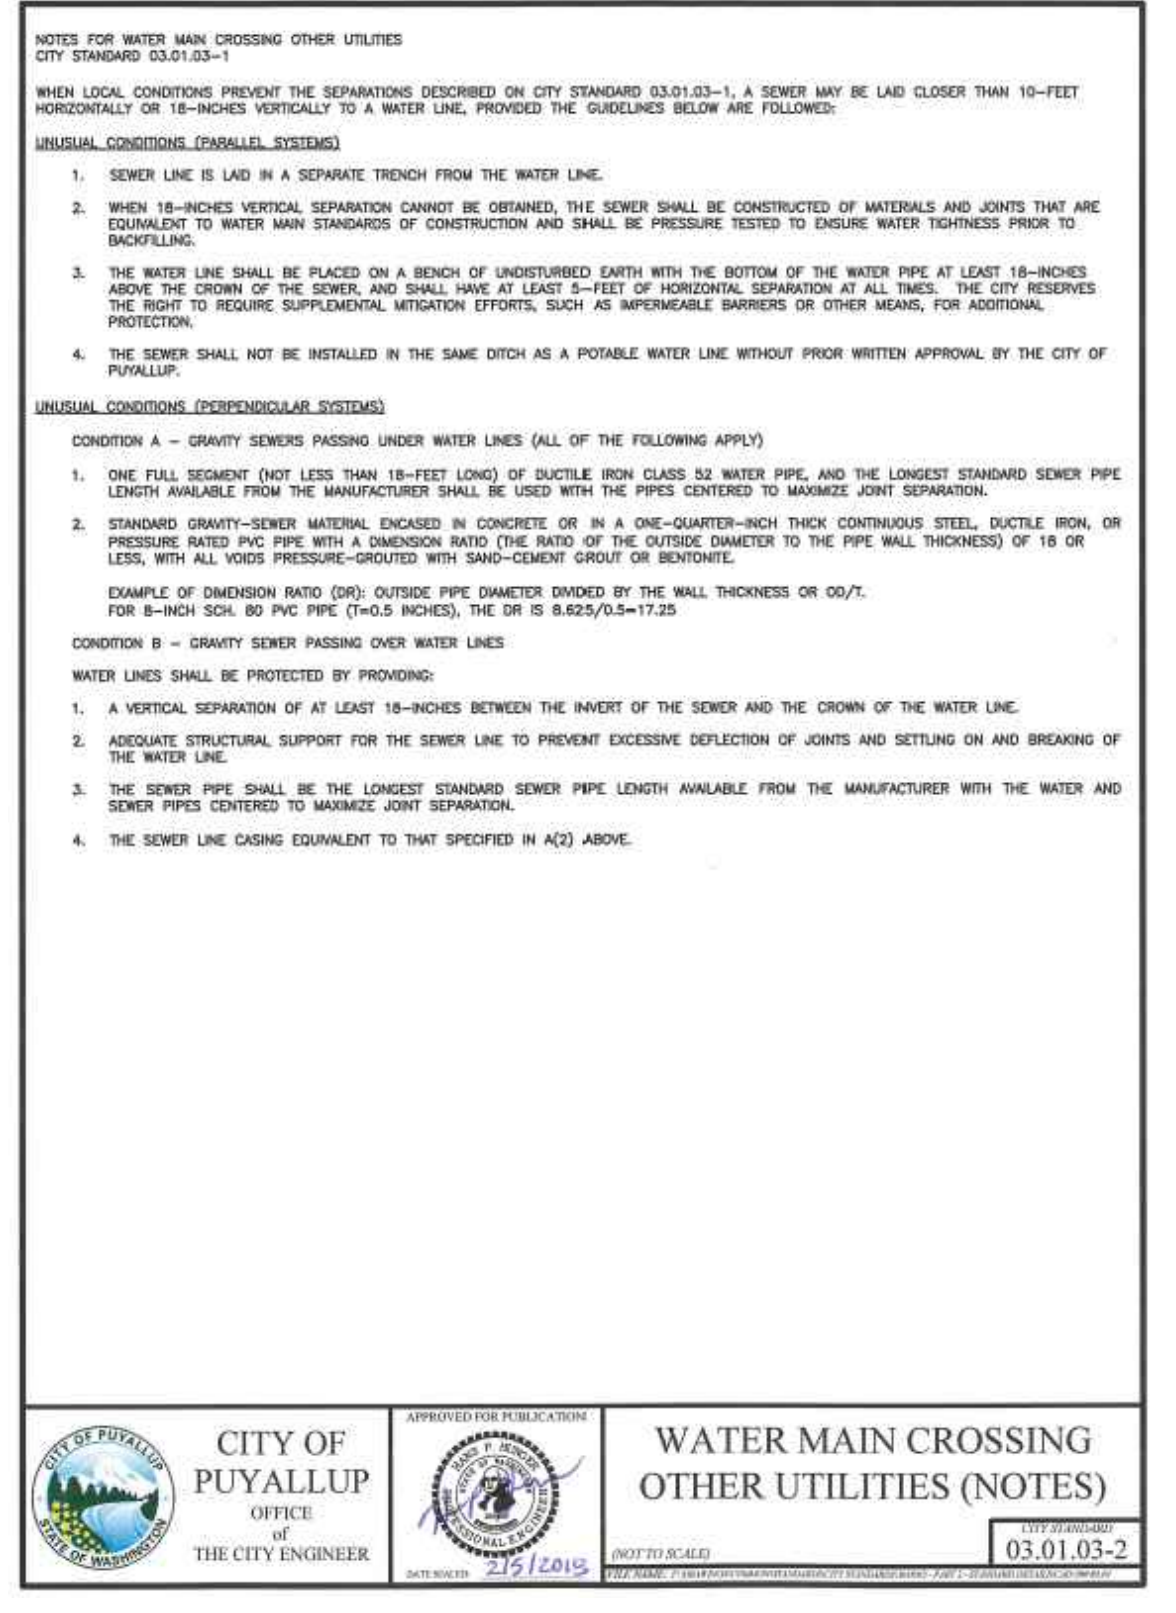

3 WATER MAIN CROSSING OTHER UTILITIES (NOTES)
 NOT TO SCALE

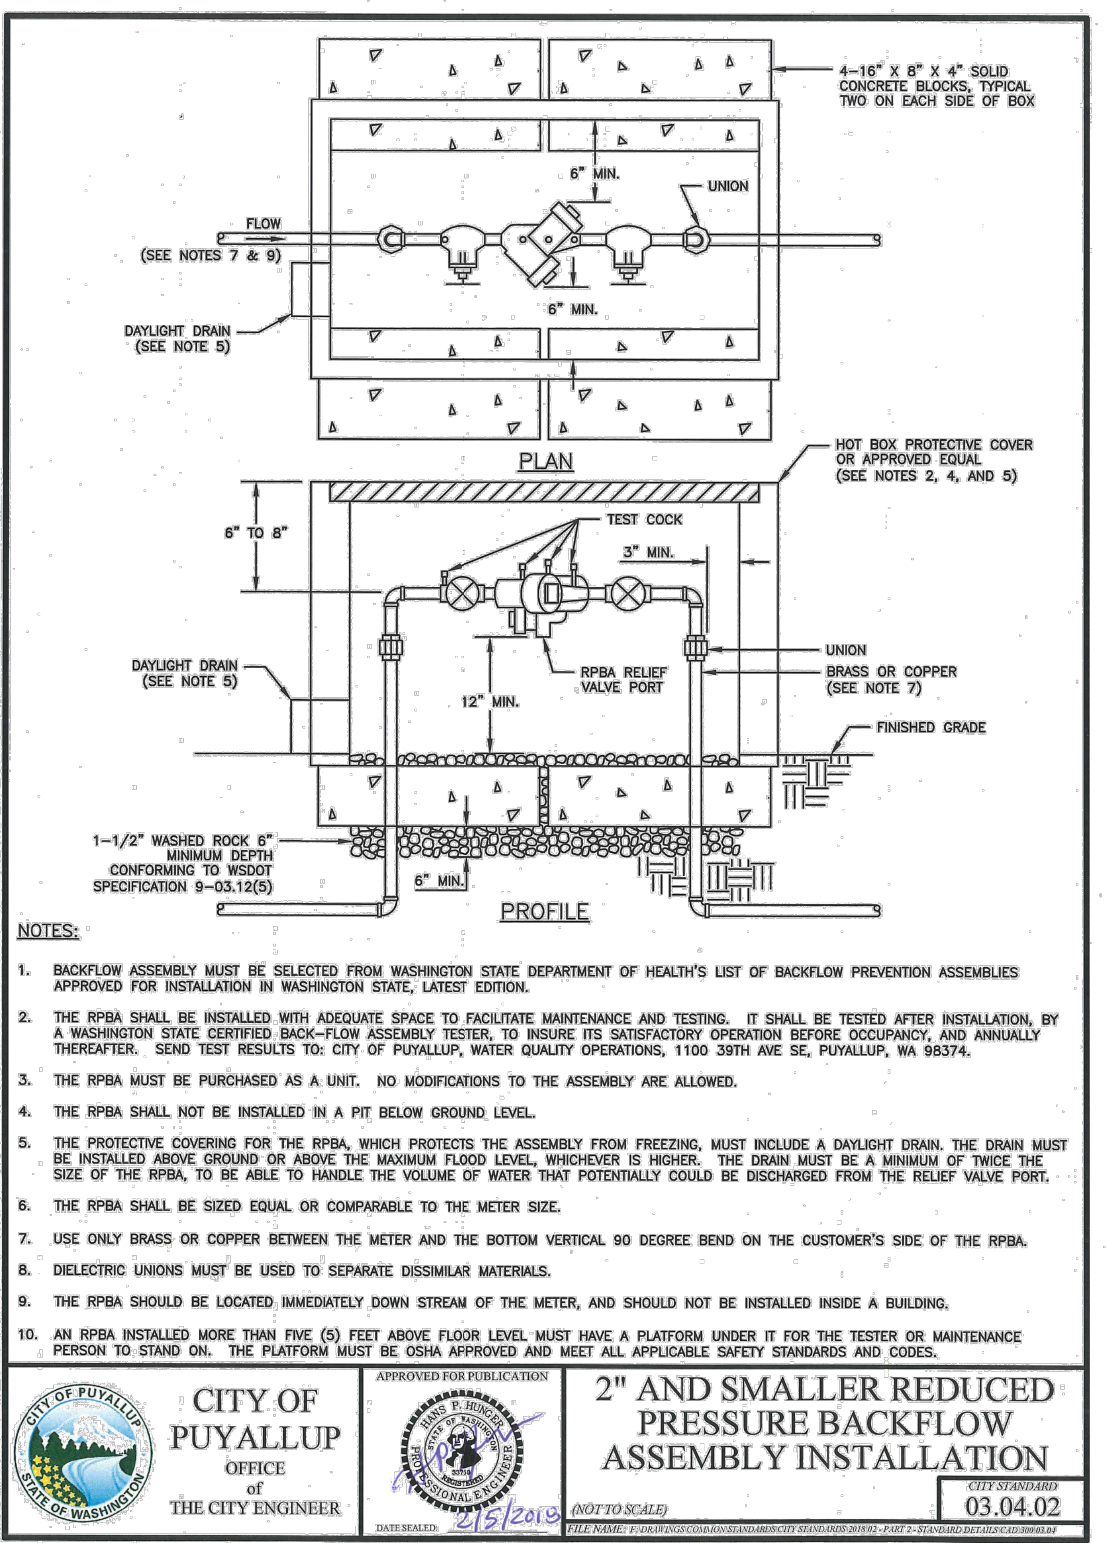

4 2IN AND SMALLER REDUCED PRESSURE BACKFLOW ASSEMBLY INSTALLATION
 NOT TO SCALE

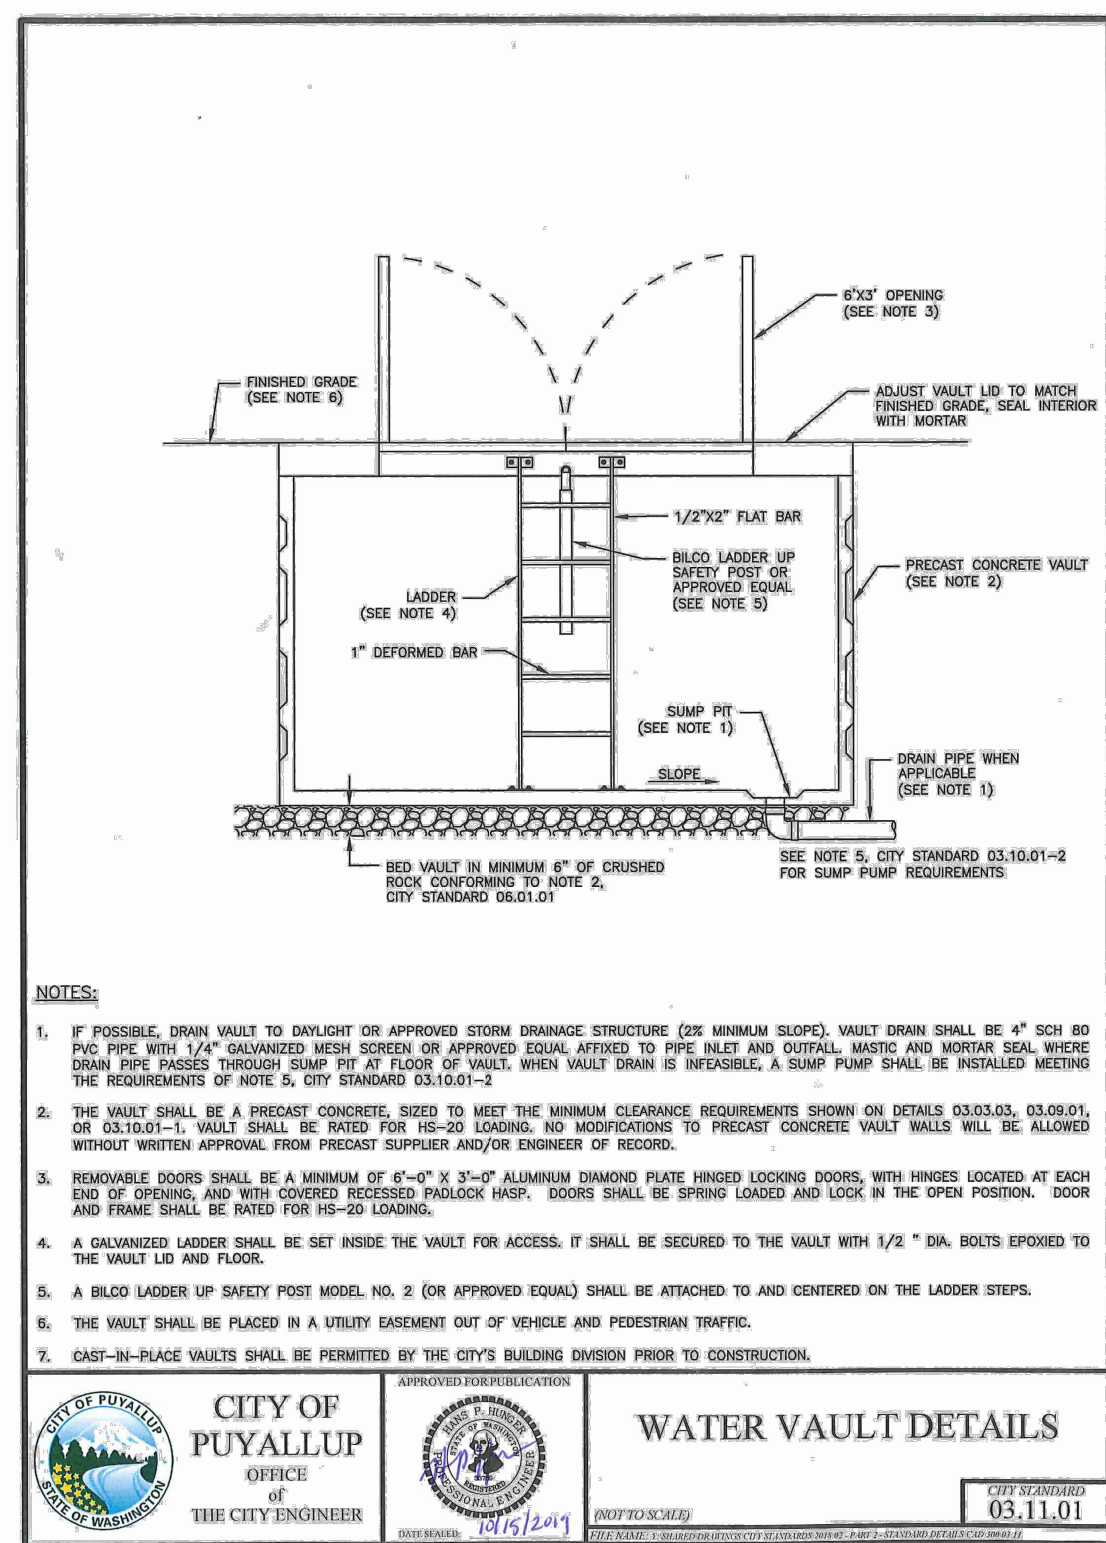

5 WATER VAULT DETAILS
 NOT TO SCALE



Know what's below.
 Call before you dig.

Revisions:
 01/29/24 CITY COMMENTS


Sheet Title:
WATER NOTES AND DETAILS

Designed by: CW
 Drawn by: SK/RS
 Checked by: JI

Sheet No.
C6.11
 52 of 53 Sheets

EAST TOWN CROSSING PHASE 1

SEC. 26,35/ TWP. 20 N./ RGE. 4 E., W.M.

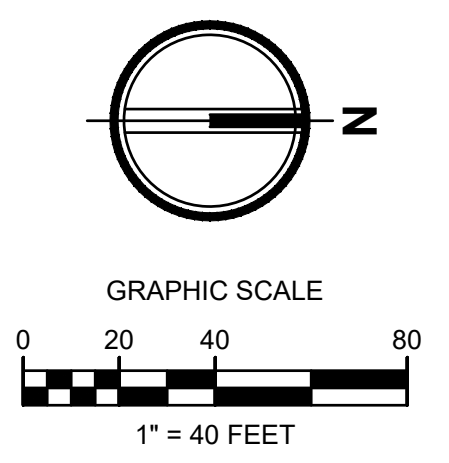

APPROVED

BY: CITY OF PUYALLUP
DEVELOPMENT ENGINEERING

DATE:

NOTE: THIS APPROVAL IS VOID AFTER 180 DAYS FROM APPROVAL DATE. THE CITY WILL NOT BE RESPONSIBLE FOR ERRORS AND/OR OMISSIONS ON THESE PLANS. FIELD CONDITIONS MAY DICTATE CHANGES TO THESE PLANS AS DETERMINED BY THE DEVELOPMENT ENGINEERING MANAGER.



2215 North 30th Street, Suite 300, Tacoma, WA 98403
253.383.2422 TEL 253.383.2572 FAX www.ahbl.com WEB

Project Title:
EAST TOWN CROSSING PHASE 1

Client:
ASH DEVELOPMENT

GREG HELLE
GREG.HELLE@ASHNW.COM


Project No.:
2230752

Issue Set & Date:
PERMIT SUBMITTAL

02/20/2024



NOTICE: ALTERATION OF THIS DOCUMENT SHALL INVALIDATE THE PROFESSIONAL SEAL AND SIGNATURE. PUBLICATION OF THIS DOCUMENT DOES NOT CONSTITUTE AN ENDORSEMENT OR GUARANTEE BY THE ENGINEER OR THE FIRM. THIS DOCUMENT IS FOR THE PROJECT IDENTIFIED IN THE TITLE BLOCK ONLY AND IS NOT TO BE USED FOR OTHER PROJECTS OR ACTION TO THAT PROJECT OR FOR ANY OTHER PROJECT.

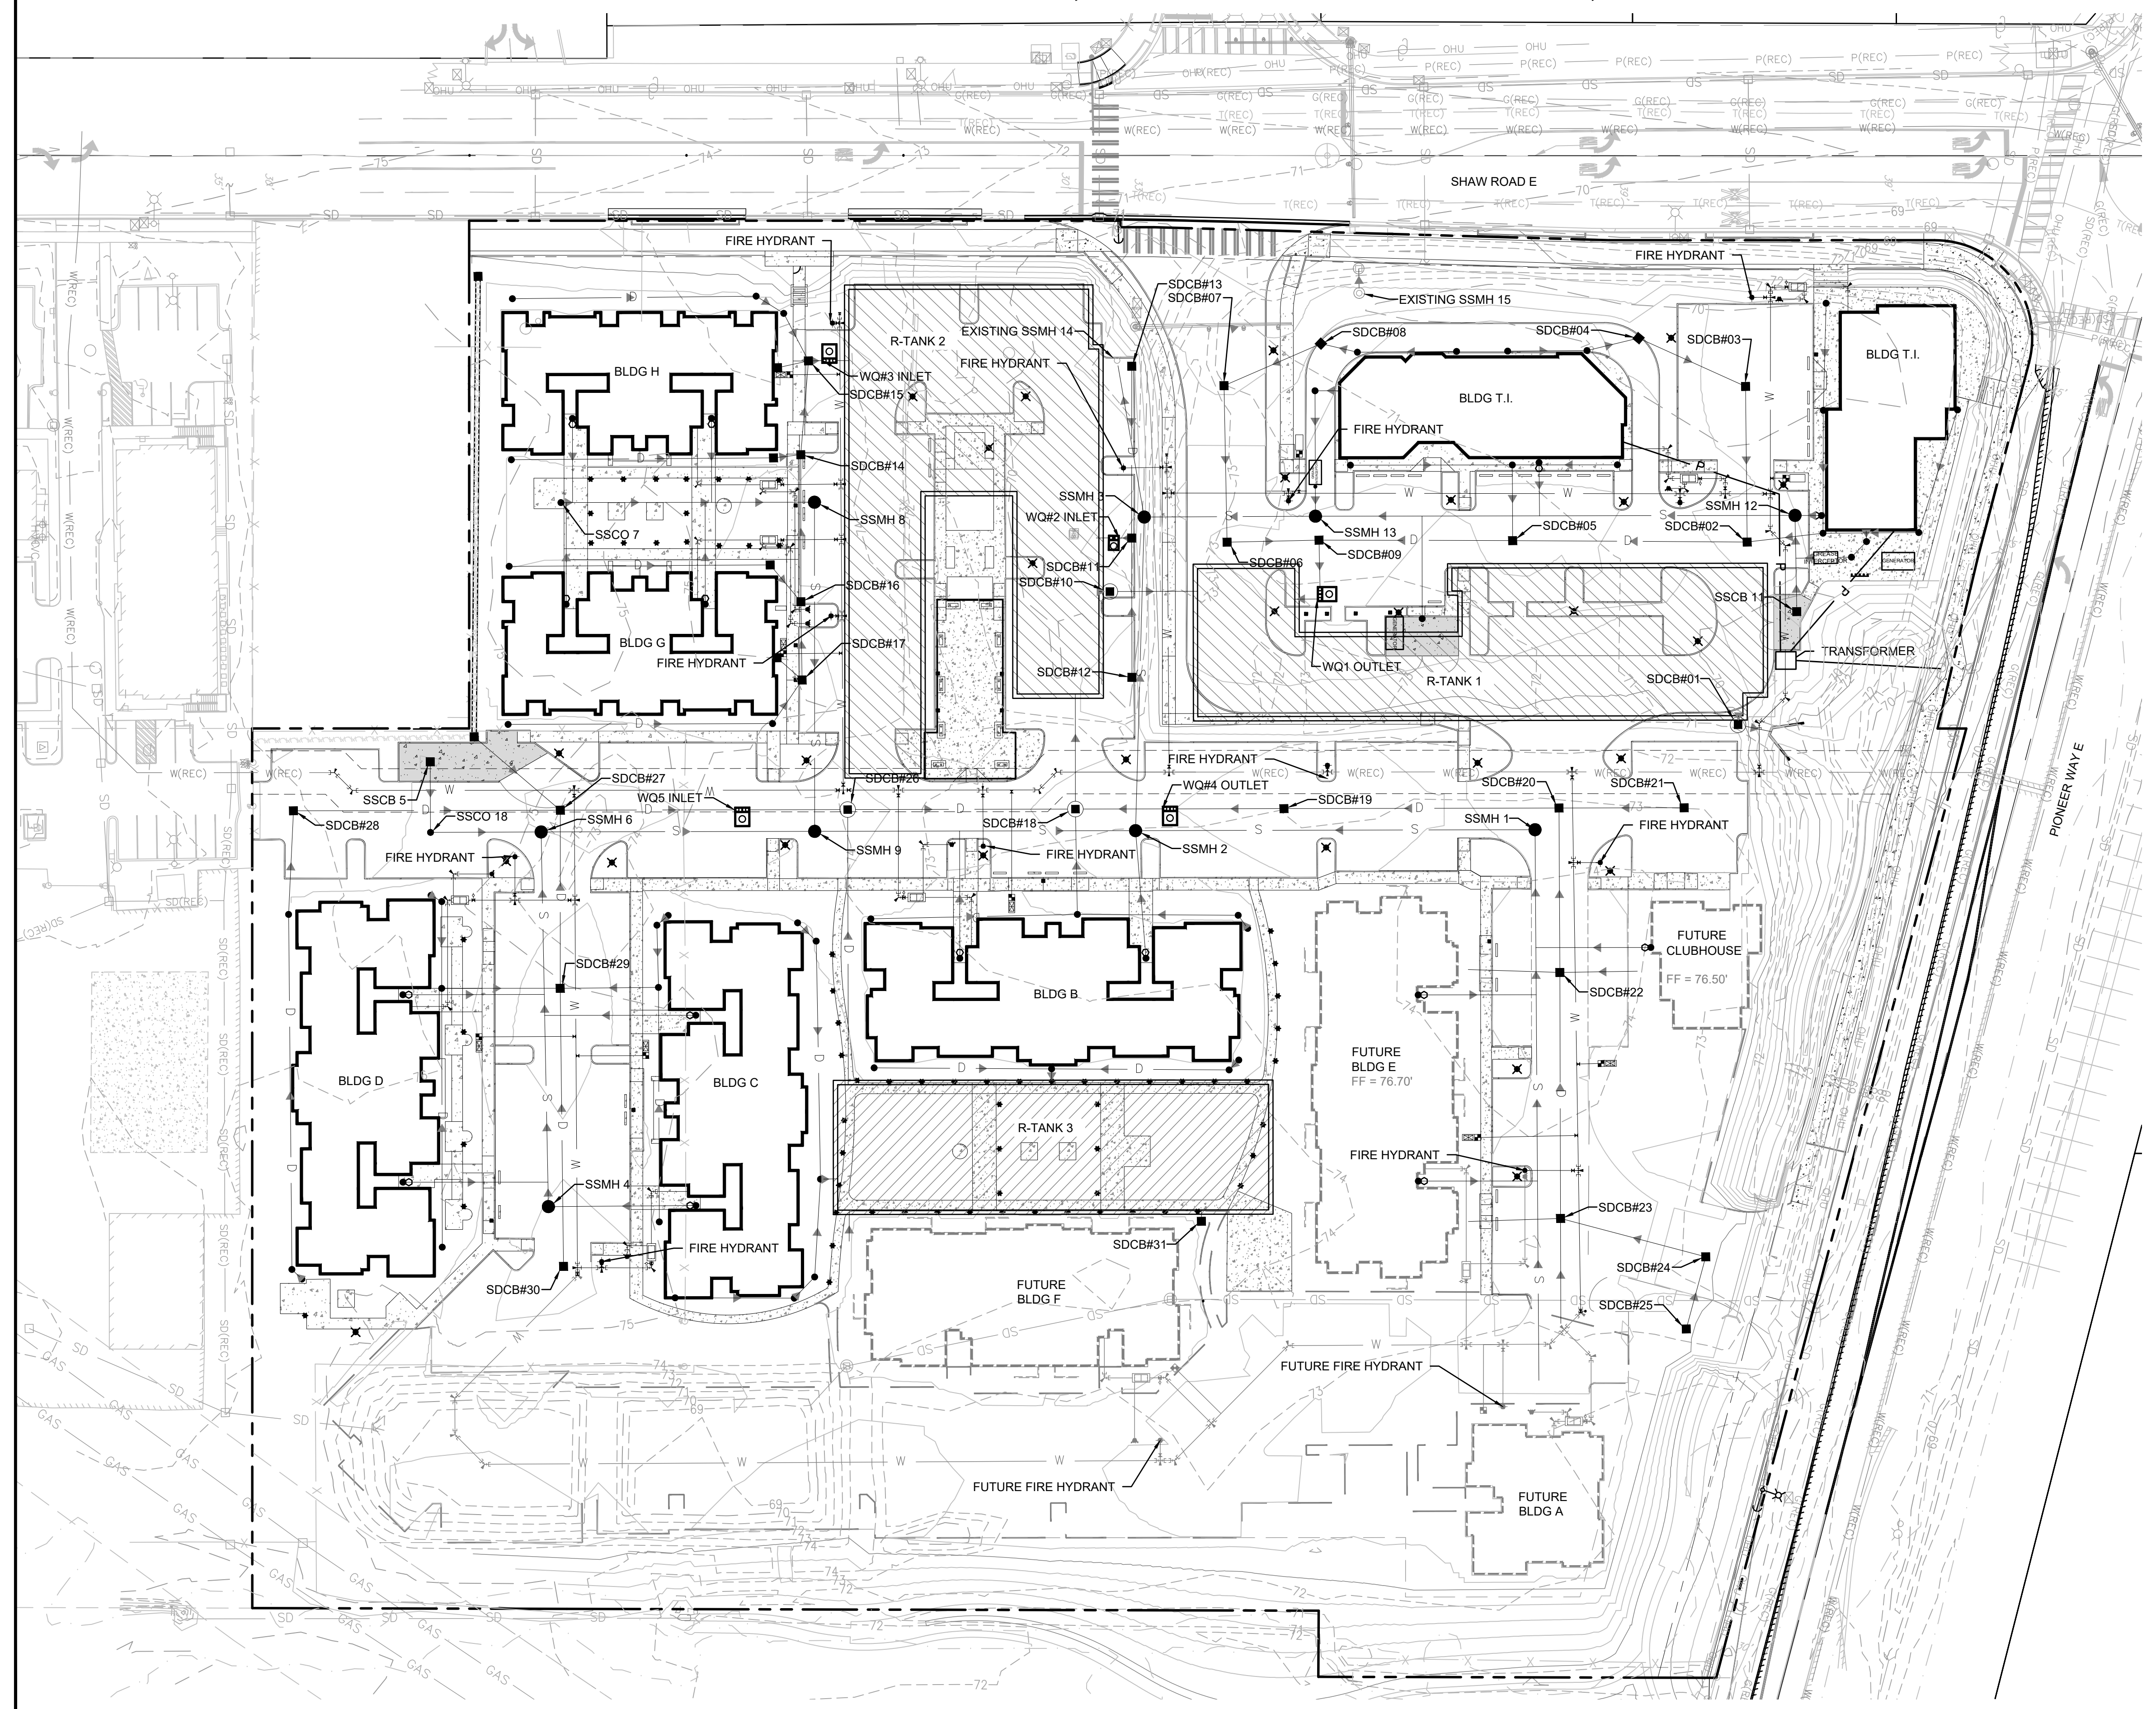

△

△

△

△ 01/29/24 CITY COMMENTS

Revisions:

Sheet Title:

OVERALL UTILITY PLAN

Designed by: CW Drawn by: SK / RS Checked by: JI

Sheet No.:

C7.0