Development Services 333 S. Meridian Puyallup, WA 98371 Phone: 253-864-4165 www.cityofpuyallup.org



Plan Change Request

A plan change request is necessary for civil projects that propose substantial changes to the approved civil plans and requires additional review by City of Puyallup review staff. This application should be filled out completely and sent directly to the City Review Engineer assigned to the civil permit application via email.

Project Information	
Site Address/ Parcel #: 707 39th Ave SE	Permit #: PRCCP20231028 PCR 002
Owner: Wesley Homes -Kevin Anderson	Email: kanderson@wesleyhomes.com
Design Engineer: Dan Balmelli	Email: dbalmelli@barghausen.com
Contractor: Walsh Construction Company - Anthony Mizi	n Email: amizin@walshconstruction.com
Originator of the Request: ■ Owner □ Design	n Engineer □ Contractor □ City of Puyallup
Does this request require a <u>deviation</u> from city so	andards? ☐ Yes
If yes, submit an <u>Alternative Method's Request</u> vis	the <u>CityView Portal</u> instead of this form
Indicate the development infrastructure being affected	d
☐ Road ☐ Storm ☐ Water	■ Sanitary □ Grading □ Erosion Control
Specify the approved civil plans affected: C2, C5-C1	3
Describe the change(s) being requested: Building footprint revision to the New Care Center and revisions to associated grade	
In addition, some minor adjustments to water and sewer utilities for the Brownst	
be made by the City Review Engineer. All changes me	nless initiated by the City of Puyallup. Final approval/denial will ust be fully approved/denied prior to any work on the proval is at the risk of the developer/contractor and may not be
	esign Engineer Contractor
May 1 Throng 1	
City Inspector Ci	Approved w/ Conditions. ty Reviewer Approved/ Denied
CONDITIONS (Prior to Occupancy): 1) See markups on Civil and Landscape plans.	
2) Provide confirmation that an approved oil/water separator the Brownstone parking garage under the Building Permit. S	

2) Provide confirmation that an approved oil/water separator was installed in the Brownstone parking garage under the Building Permit. Separator installation shall be certified by the Engineer-of-Record associated with the O/W design in accordance with City Standards 402.2.

3) Provide fully executed landscape easement between Wesley Homes and Lowes Corporation.

LEGAL DESCRIPTION

(PER FIRST AMERICAN TITLE INSURANCE COMPANY'S FILE NO. NCS-811513-WA1, DATED AUGUST 30,

REVISED PARCEL 2 OF CITY OF PUYALLUP BOUNDARY LINE ADJUSTMENT NO. 06-84-007, RECORDED AUGUST 18, 2006 UNDER RECORDING NO. 200608185003 AND AFFIDAVIT OF MINOR CORRECTION OF SURVEY RECORDED NOVEMBER 30, 2006 UNDER RECORDING NO. 200611300893, RECORDS OF PIERCE

A NON-EXCLUSIVE EASEMENT FOR INGRESS AND EGRESS CREATED BY INSTRUMENT RECORDED APRIL 26, 2007 UNDER RECORDING NO. 200704260812, IN PIERCE COUNTY, WASHINGTON.

HORIZONTAL DATUM (NAD 83/91)- BASIS OF BEARINGS SOUTH 05°28'09" EAST, AS MEASURED BETWEEN W.S.D.O.T. MONUMENT ID 244 AND 4208.

VERTICAL DATUM - (NAVD 1988)

BENCHMARK: W.S.D.O.T. MONUMENT ID 244 (GP27512-17), BEING THE TOP OF A FOUND 3" BRASS DISK "1991 GP27512-17" ON NORTH SIDE OF MERIDIAN AVE., 30' EAST OF N.E. CORNER OF SR-512 OVERPASS ELEV. = 409.93 US FEET

PROCEDURE / NARRATIVE

A FIELD TRAVERSE USING A "TOPCON QS" AND SPECTRA "FOCUS 30" TOTAL STATION. "TOPCON GR5" AND "TDS RANGER" DATA COLLECTOR SUPPLEMENTED WITH GPS AND FIELD NOTES WAS PERFORMED, ESTABLISHING THE ANGULAR, DISTANCE, BETWEEN THE MONUMENTS, PROPERTY LINES. AND TOPOGRAPHIC FEATURES AS SHOWN HEREON. THE RESULTING DATA MEETS OR OR EXCEEDS THE STANDARDS FOR LAND BOUNDARY SURVEYS AS SET FORTH IN WAC 332-130-090.

DATES OF SURVEYS:

FIELD SURVEY BY BARGHAUSEN CONSULTING ENGINEERS, INC. CONDUCTED IN MAY 2015 AND SEPTEMBER 2016. ALL MONUMENTS SHOWN AS FOUND WERE VISITED IN 2015.

TAX ACCOUNT NUMBERS: 0419037014

CALCULATED AREA:

PROPERTY ADDRESS:

625,733.52± SQ. FT. (14.36± ACRES)

707 39TH AVE. S.E. PUYALLUP, WA 98374

SURVEYORS NOTES:

. UNDERGROUND UTILITIES AND FEATURES DEPICTED HEREON ARE BASED ON FIELD OBSERVATION, MARKINGS, DEVELOPMENT PLANS, AND/OR AVAILABLE RECORD DOCUMENTS ONLY. THE TRUE LOCATION, NATURE AND/OR EXISTENCE OF BELOW GROUND FEATURES, DETECTED OR UNDETECTED, SHOULD BE

- 2. ALL DISTANCES ARE IN US FEET
- 3. NO BUILDINGS ARE WITHIN THE SURVEYED AREA
- 4. THERE WAS NO EVIDENCE OF CURRENT EARTH MOVING WORK, BUILDING CONSTRUCTION OR BUILDING ADDITIONS OBSERVED AT THE TIME OF THE
- 5. THERE WAS NO EVIDENCE OF SITE USE AS A SOLID WASTE DUMP, SUMP OR SANITARY LANDFILL WAS OBSERVED AT THE TIME OF THE FIELD
- 6. NO PARKING OR STRIPING WAS FOUND ON SITE.
- 7. FLAGGED WETLANDS SHOWN AS LOCATED IN THE FIELD IN 2015.
- 8. NO ZONING INFORMATION HAS BEEN PROVIDED AS OF OCTOBER 13, 2016

LEGEND

CURB AND GUTTER

BARRIER CURB

PAINT STRIPING

DIRECTIONAL ARROW

CONCRETE

ASPHALT

SAWCUT

BOLLARD

BUILDING LINE

CONTOURS

WATER LINE

WATER METER

WATER VALVE

FIRE DEPARTMENT CONN.

SIGN

REFERENCE SURVEYS:

- . R.O.S., REC. NO. 8410300247 2. R.O.S., REC. NO. 8603170340
- 3. R.O.S., REC. NO. 8604080409 4. PUYALLUP BLA, REC. NO. 200608185003

ZONING: "CB" COMMUNITY BUSINESS.

GEOTECHNICAL NOTE:

1. DURING SITE GRADING AND BUILDING CONSTRUCTION THE GEOTECHNICAL ENGINEER OF RECORD OR HIS/HER REPRESENTATIVE WILL PERFORM BI-WEEKLY RECONNAISSANCE OF THE SLOPE AND ISSUE A FIELD REPORT REGARDING SITE CONDITIONS. THESE BI-WEEKLY SLOPE RECONS WILL CONTINUE UNTIL BUILDING SHELL CONSTRUCTION AND STORMWATER FACILITIES ARE COMPLETED AND FUNCTIONAL. POST BUILDING CONSTRUCTION SLOPE RECONS SHALL OCCUR ON A QUARTERLY BASIS FOR A PERIOD OF NO LESS THAN TWO YEARS. IF NO INSTABILITY OR EROSION ISSUES ARE PRESENT AT THAT TIME, MONITORING CAN BE TERMINATED.

POST INDICATOR VALVE

———T(UG)———

——P (OH)———P(OH)—

——P (UG)———P(UG)——

CATCH BASIN TYPE

CATCH BASIN TYPE 2

SANITARY SEWER LINE

CLEANOUT (AS NOTED)

POWER UNDERGROUND

JUNCTION BOX (TYPE 1,2,3)

POWER OVERHEAD

POWER METER

UTILITY POLE

LUMINAIRE

YARD LIGHT

TELEPHONE

GAS METER

GAS VALVE

SANITARY SEWER MANHOLE

CONSTRUCTION SEQUENCE:

SCHEDULE AND ATTEND PRE-CONSTRUCTION MEETING WITH CITY OF PUYALLUP OFFICIALS.

FLAG ALL TREES TO REMAIN, CLEARING AND GRADING LIMITS FOR PROJECT AS SHOWN ON THE PLANS.

- CONSTRUCT TEMPORARY CONSTRUCTION ENTRANCE.
- INSTALL TEMPORARY FILTER FABRIC FENCE AND CB PROTECTION AS SHOWN ON PLANS.
- REMOVE EXISTING SITE IMPROVEMENTS AS INDICATED ON
- 6. CONSTRUCT INTERCEPTOR DITCHES WHERE SHOWN.
- TIME LIMIT APPLIES TO ANY WORK PERFORMED IN THE CITY OF PUYALLUP. CONTRACTOR TO COORDINATE WITH CITY OFFICIAL FOR TIMING OF ANY CONSTRUCTION WITHIN ROW.
- PROTECT ALL PROPERTIES ADJACENT TO THE PROJECT FROM SEDIMENT DEPOSITION.
- 9. NO RUNOFF IS TO LEAVE SITE WITHOUT TREATMENT.
- 10. CLEAR AND GRADE SITE AMEND E.S.C. FACILITIES AS REQUIRED.

THE ROAD SHALL BE CLEANED IMMEDIATELY.

- 11. WHEREVER CONSTRUCTION VEHICLES ACCESS ROUTE CROSSES PAVED ROADS, CARE MUST BE MADE TO MINIMIZE THE TRANSPORT OF SEDIMENT (MUD) ONTO THE PAVED ROAD. IF SEDIMENT IS TRANSPORTED ONTO PAVED SURFACE,
- 12. WITH EACH LAYER OF FILL MATERIAL, INTERCEPTOR DITCHES AND T.E.S.C. FACILITIES MUST BE GRADED AND MAINTAINED TO PROVIDE POSITIVE SLOPE FOR DRAINAGE TO DISCHARGE
- 13. INSTALL SANITARY SEWER, WATER, AND STORM SYSTEMS.
- 14. CONSTRUCT BUILDING.
- 15. CONSTRUCT RIGHT-OF-WAY IMPROVEMENTS.
- 16. ONCE THE INSTALLED SYSTEMS ARE TESTED AND APPROVED, COMMENCE SITE PAVING.
- 17. MAINTAIN T.E.S.C. FACILITIES UNTIL ALL RISK OF EROSION/SEDIMENTATION DRAINAGE HAS PASSED AND PERMANENT STORM DRAINAGE SYSTEM IS INSTALLED AND FUNCTIONAL. DO NOT CONVEY SEDIMENT-LADEN WATER INTO STORM DRAINAGE SYSTEM. REMOVE TEMPORARY EROSION & SEDIMENTATION CONTROL MEASURES UPON FINAL SITE STABILIZATION AND APPROVAL FROM THE CITY INSPECTOR.
- 18. COMPLETE INSPECTION/ PUNCHLIST

	SHEET INDEX
Sheet Number	Sheet Title
C1	COVER SHEET
C2	EXISTING SITE AND TESC PLAN NORTH
C3	EXISTING SITE AND TESC PLAN SOUTH
C4	TESC NOTES AND DETAILS
C5	GRADING PLAN NORTH
C6	GRADING PLAN SOUTH
C7	GRADING PLAN — CARE CENTER SOUTH
C8	GRADING PLAN - CARE CENTER ENTRANCE PAVING
C9	GRADING PLAN - BROWNSTONE NORTHEAST SIDEWALK
C10	DRAINAGE PLAN NORTH
C11	DRAINAGE PLAN SOUTH
C12	WATER AND SEWER PLAN NORTH
C13	WATER AND SEWER PLAN SOUTH
C14	CONSTRUCTION NOTES
C15	CONSTRUCTION NOTES & DETAILS
C16	CONSTRUCTION NOTES & DETAILS
C17	WATER DETAILS
C18	WATER DETAILS
C19	SEWER DETAILS
C20	ENTERING SIGHT DISTANCE

CONTRACTOR SHALL BE FULLY RESPONSIBLE FOR OBTAINING PERMITS FROM THE

REPLACING ALL SURVEY MONUMENTATION THAT MAY BE AFFECTED BY CONSTRUCTION

REGISTERED LAND SURVEYOR. APPLICATIONS FOR PERMITS TO REMOVE MONUMENTS

RESOURCES, OR BY CONTACTING THEIR OFFICE BY TELEPHONE AT (206) 902-1190.

UPON COMPLETION OF CONSTRUCTION, ALL MONUMENTS DISPLACED, REMOVED, OR

AT THE DIRECTION OF THE CONTRACTOR, PURSUANT TO THESE REGULATIONS. THE

DESTROYED SHALL BE REPLACED BY A REGISTERED LAND SURVEYOR. AT THE COST AND

APPROPRIATE FORMS FOR REPLACEMENT OF SAID MONUMENTATION SHALL ALSO BE THE

ACTIVITY, PURSUANT TO WAC 332-120. APPLICATIONS MUST BE COMPLETED BY A

WASHINGTON STATE DEPARTMENT OF NATURAL RESOURCES FOR REMOVING AND

MAY BE OBTAINED FROM THE WASHINGTON STATE DEPARTMENT OF NATURAL

WASHINGTON STATE DEPARTMENT OF NATURAL RESOURCES

PUBLIC LAND SURVEY OFFICE

RESPONSIBILITY OF THE CONTRACTOR.

P.O. BOX 47060

1111 WASHINGTON STREET S.E.

OLYMPIA, WASHINGTON 98504-7060

COVER SHEET

PHASE 2 - WESLEY BRADLEY PARK


A PORTION OF THE SE1/4 OF THE SW1/4 OF SEC. 3, TWP. 19 NORTH, RGE. 4 EAST, W.M.

SCALE: 1"=80'

WETLAND A

UTILITY CONFLICT NOTE:

THE CONTRACTOR SHALL BE RESPONSIBLE FOR VERIFYING THE LOCATION, DIMENSION, AND DEPTH OF ALL EXISTING UTILITIES WHETHER SHOWN ON THESE PLANS OR NOT BY POTHOLING THE UTILITIES AND SURVEYING THE HORIZONTAL AND VERTICAL LOCATION PRIOR TO CONSTRUCTION. THIS SHALL INCLUDE CALLING UTILITY LOCATE © 1-800-424-5555 AND THEN POTHOLING ALL OF THE EXISTING UTILITIES AT LOCATIONS OF NEW UTILITY CROSSINGS TO PHYSICALLY VERIFY WHETHER OR NOT CONFLICTS EXIST. LOCATIONS OF SAID UTILITIES AS SHOWN ON THESE PLANS ARE BASED UPON THE UNVERIFIED PUBLIC INFORMATION AND ARE SUBJECT TO VARIATION. IF CONFLICTS SHOULD OCCUR, THE CONTRACTOR SHALL CONSULT BARGHAUSEN CONSULTING ENGINEERS, INC. TO RESOLVE ALL PROBLEMS PRIOR TO PROCEEDING WITH

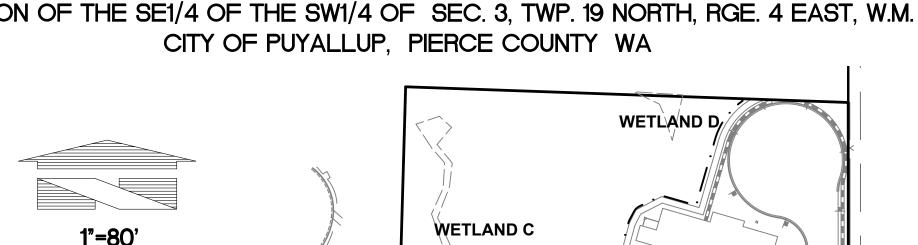

CARE

CENTER

LEVEL 1

FF=468.0

LEVEL 0

FF=457.0

LEVEL POOL

FF=454.0

EX LODGE

FF=468.0

39TH AVENUE S.E.

OWNER/DEVELOPER

WESLEY HOMES 815 SOUTH 216TH STREET DES MOINES, WA 98190 (206) 870-1209

ARCHITECT:

— EX DRIVE &

ESTIMATED CUT AND FILL QUANTITIES:

(QTYS. ARE FOR PERMITTING PURPOSES ONLY.

CONTRACTOR SHALL VERIFY EXACT QTYS. BEFORE

CUT: 13,807 CY

FILL: 2,366 CY

CONSTRUCTION.)

CALL BEFORE YOU DIG:

1-800-424-5555

PARKING

CONTACT: KEVIN ANDERSON

2324 UNIVERSITY AVE. WEST, SUITE 105 ST. PAUL, MN 55114 (612) 252-4822 CONTACT: JILL KRANCE

ENGINEER/SURVEYORS

BARGHAUSEN CONSULTING ENGINEERS, INC. 18215 72ND AVENUE SOUTH KENT, WA. 98032 (425) 251-6222

IN-SITE ARCHITECTS

CONTACT: DAN BALMELLI, P.E. (ENGINEERING) CONTACT: BRIAN GILLOOLY, P.L.S. (SURVEY) NOTE: THIS APPROVAL IS VOID

AFTER 1 YEAR FROM APPROVAL THE CITY WILL NOT BE RESPONSIBLE FOR ERRORS AND/OR OMISSIONS ON THESE PLANS. FIELD CONDITIONS MAY DICTATE CHANGES TO THESE PLANS AS DETERMINED BY THE ENGINEERING SERVICES MANAGER.

CITY OF PUYALLUP

ENGINEERING SERVICES


PRCCP20231028

BCE GENERAL SITE NOTES:

- 1. THE CONTRACTOR SHALL OBTAIN AND HAVE AVAILABLE COPIES OF THE APPLICABLE GOVERNING AGENCY STANDARDS AT THE JOB SITE DURING THE RELATED CONSTRUCTION OPERATIONS.
- 2. CONTRACTOR SHALL ASSURE THAT ALL NECESSARY PERMITS HAVE BEEN OBTAINED PRIOR TO COMMENCING
- 3. THE CONTRACTOR SHALL BE RESPONSIBLE FOR VERIFYING THE LOCATION, DIMENSION AND DEPTH OF ALL EXISTING UTILITIES PRIOR TO CONSTRUCTION WHETHER SHOWN ON THESE PLANS OR NOT. UTILITIES OTHER THAN THOSE SHOWN MAY EXIST ON THIS SITE. ONLY THOSE UTILITIES WITH EVIDENCE OF THEIR INSTALLATION VISIBLE AT GROUND SURFACE OR SHOWN ON RECORD DRAWING PROVIDED BY OTHERS ARE SHOWN HEREON. EXISTING UNDERGROUND UTILITY LOCATIONS SHOWN ARE APPROXIMATE ONLY AND ARE SUBJECT TO A DEGREE OF UNKNOWN VARIATION. SOME UNDERGROUND LOCATIONS SHOWN HEREON MAY HAVE BEEN TAKEN FROM PUBLIC RECORDS. BARGHAUSEN CONSULTING ENGINEERS, INC. ASSUMES NO LIABILITY FOR THE ACCURACY OF PUBLIC RECORDS OR RECORDS OF OTHERS. IF CONFLICTS SHOULD OCCUR, THE CONTRACTOR SHALL CONSULT BARGHAUSEN CONSULTING ENGINEERS. INC. TO RESOLVE ALL PROBLEMS PRIOR TO PROCEEDING
- 4. IT IS THE RESPONSIBILITY OF THE CONTRACTOR TO REVIEW ALL OF THE DRAWINGS AND SPECIFICATIONS ASSOCIATED WITH THE PROJECT WORK SCOPE PRIOR TO THE INITIATION OF CONSTRUCTION. SHOULD THE CONTRACTOR FIND A CONFLICT WITH THE DOCUMENTS RELATIVE TO THE SPECIFICATIONS OR THE RELATIVE CODES. IT IS THE CONTRACTOR'S RESPONSIBILITY TO NOTIFY THE PROJECT ENGINEER OF RECORD IN WRITING PRIOR TO THE START OF CONSTRUCTION. FAILURE BY THE CONTRACTOR TO NOTIFY THE PROJECT ENGINEER SHALL CONSTITUTE ACCEPTANCE OF FULL RESPONSIBILITY BY THE CONTRACTOR TO COMPLETE THE SCOPE OF WORK AS DEFINED BY THE DRAWINGS AND IN FULL COMPLIANCE WITH LOCAL REGULATIONS AND CODES.
- IT SHALL BE THE CONTRACTOR'S RESPONSIBILITY TO NOTIFY THE APPROPRIATE UTILITIES INVOLVED PRIOR TO CONSTRUCTION.
- 6. INSPECTION OF SITE WORK WILL BE ACCOMPLISHED BY A REPRESENTATIVE OF THE GOVERNING JURISDICTION. INSPECTION OF PRIVATE FACILITIES WILL BE ACCOMPLISHED BY A REPRESENTATIVE OF THE OWNER. IT SHALL BE THE CONTRACTOR'S RESPONSIBILITY TO NOTIFY THE INSPECTOR 24 HOURS IN ADVANCE OF BACKFILLING
- PRIOR TO ANY CONSTRUCTION OR DEVELOPMENT ACTIVITY THE CONTRACTOR SHALL CONTACT THE AGENCY AND/OR UTILITY INSPECTION PERSONNEL AND ARRANGE ANY REQUIRED PRE-CONSTRUCTION MEETING(S). CONTRACTOR SHALL PROVIDE ONE WEEK MINIMUM ADVANCE NOTIFICATION TO OWNER, FIELD ENGINEER AND ENGINEER OF PRE-CONSTRUCTION MEETINGS.
- 8. THE CONTRACTOR IS RESPONSIBLE FOR WORKER AND SITE SAFETY AND SHALL COMPLY WITH THE LATEST OSHA STANDARDS AND REGULATIONS, OR ANY OTHER AGENCY HAVING JURISDICTION FOR EXCAVATION AND TRENCHING PROCEDURES. THE CONTRACTOR IS RESPONSIBLE FOR DETERMINING THE "MEANS AND METHODS" REQUIRED TO MEET THE INTENT AND PERFORMANCE CRITERIA OF OSHA. AS WELL AS ANY OTHER ENTITY THAT HAS JURISDICTION FOR EXCAVATION AND/OR TRENCHING PROCEDURES.
- PROTECTIVE EQUIPMENT, FLAGGERS, AND ANY OTHER NEEDED ACTIONS TO PROTECT THE LIFE, HEALTH, AND SAFETY OF THE PUBLIC. AND TO PROTECT PROPERTY IN CONNECTION WITH THE PERFORMANCE OF WORI COVERED BY THE CONTRACTOR. ANY WORK WITHIN THE TRAVELED RIGHT-OF-WAY THAT MAY INTERRUPT NORMAL TRAFFIC FLOW SHALL REQUIRE AT LEAST ONE FLAGGER FOR EACH LANE OF TRAFFIC AFFECTED. 10. PROTECTIVE MEASURES SHALL BE TAKEN BY THE CONTRACTOR TO PROTECT ALL ADJACENT PUBLIC AND

THE CONTRACTOR SHALL BE RESPONSIBLE FOR PROVIDING ADEQUATE SAFEGUARDS. SAFETY DEVICES.

- PRIVATE PROPERTIES AT ALL TIMES DURING CONSTRUCTION. THE CONTRACTOR SHALL BE RESPONSIBLE FOR PROTECTION OF ALL EXISTING UTILITY SERVICES THAT ARE TO REMAIN OPERATIONAL WITHIN THE CONSTRUCTION AREA WHETHER SHOWN OR NOT SHOWN ON THE PLANS.
- 11. TWO (2) COPIES OF THESE APPROVED PLANS MUST BE ON THE JOB SITE WHENEVER CONSTRUCTION IS IN PROGRESS. ONE (1) SET WITH RECORDS OF AS-BUILT INFORMATION SHALL BE SUBMITTED TO BARGHAUSEN CONSULTING ENGINEERS, INC. AT COMPLETION OF PROJECT.
- 12. CONTRACTOR SHALL OBTAIN SERVICES OF A LICENSED LAND SURVEYOR TO STAKE HORIZONTAL CONTROL FOR ALL NEW IMPROVEMENTS. STAKING CONTROL SHALL BE TAKEN FROM ELECTRONIC PLAN FILES PROVIDED BY BARGHAUSEN CONSULTING ENGINEERS, INC.
- 13. CONTRACTOR SHALL REQUEST FROM BARGHAUSEN CONSULTING ENGINEERS, INC., PRIOR TO ANY CONSTRUCTION STAKING OR CONSTRUCTION WORK, A FORMAL CONSTRUCTION RELEASE PLAN SET OR SPECIFIC RELEASE IN WRITING. THE APPROVED AGENCY PERMIT DRAWINGS WILL NOT BE CONSIDERED CONSTRUCTION RELEASE PLANS BY BARGHAUSEN CONSULTING ENGINEERS, INC. UNLESS BARGHAUSEN CONSULTING ENGINEERS, INC. HAS GIVEN A FORMAL WRITTEN RELEASE OR ISSUED A CONSTRUCTION RELEASE PLAN SET.

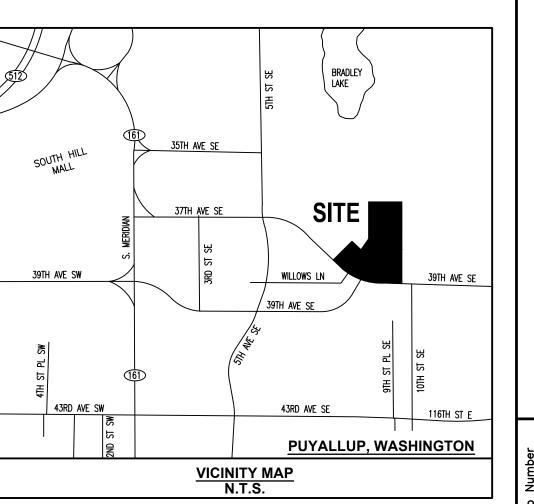


PROPERTY ADDRESS: 707 39TH AVE. S.E. PUYALLUP, WA 98374

LANS BRADLEY SHE CIVII **∑** 2 S


PARK


STRI 981 HOMES 6TH STR **~** O

SLE JTH OIN (90)

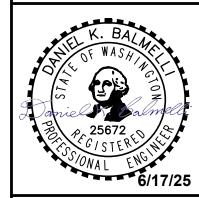

irghauser insulting

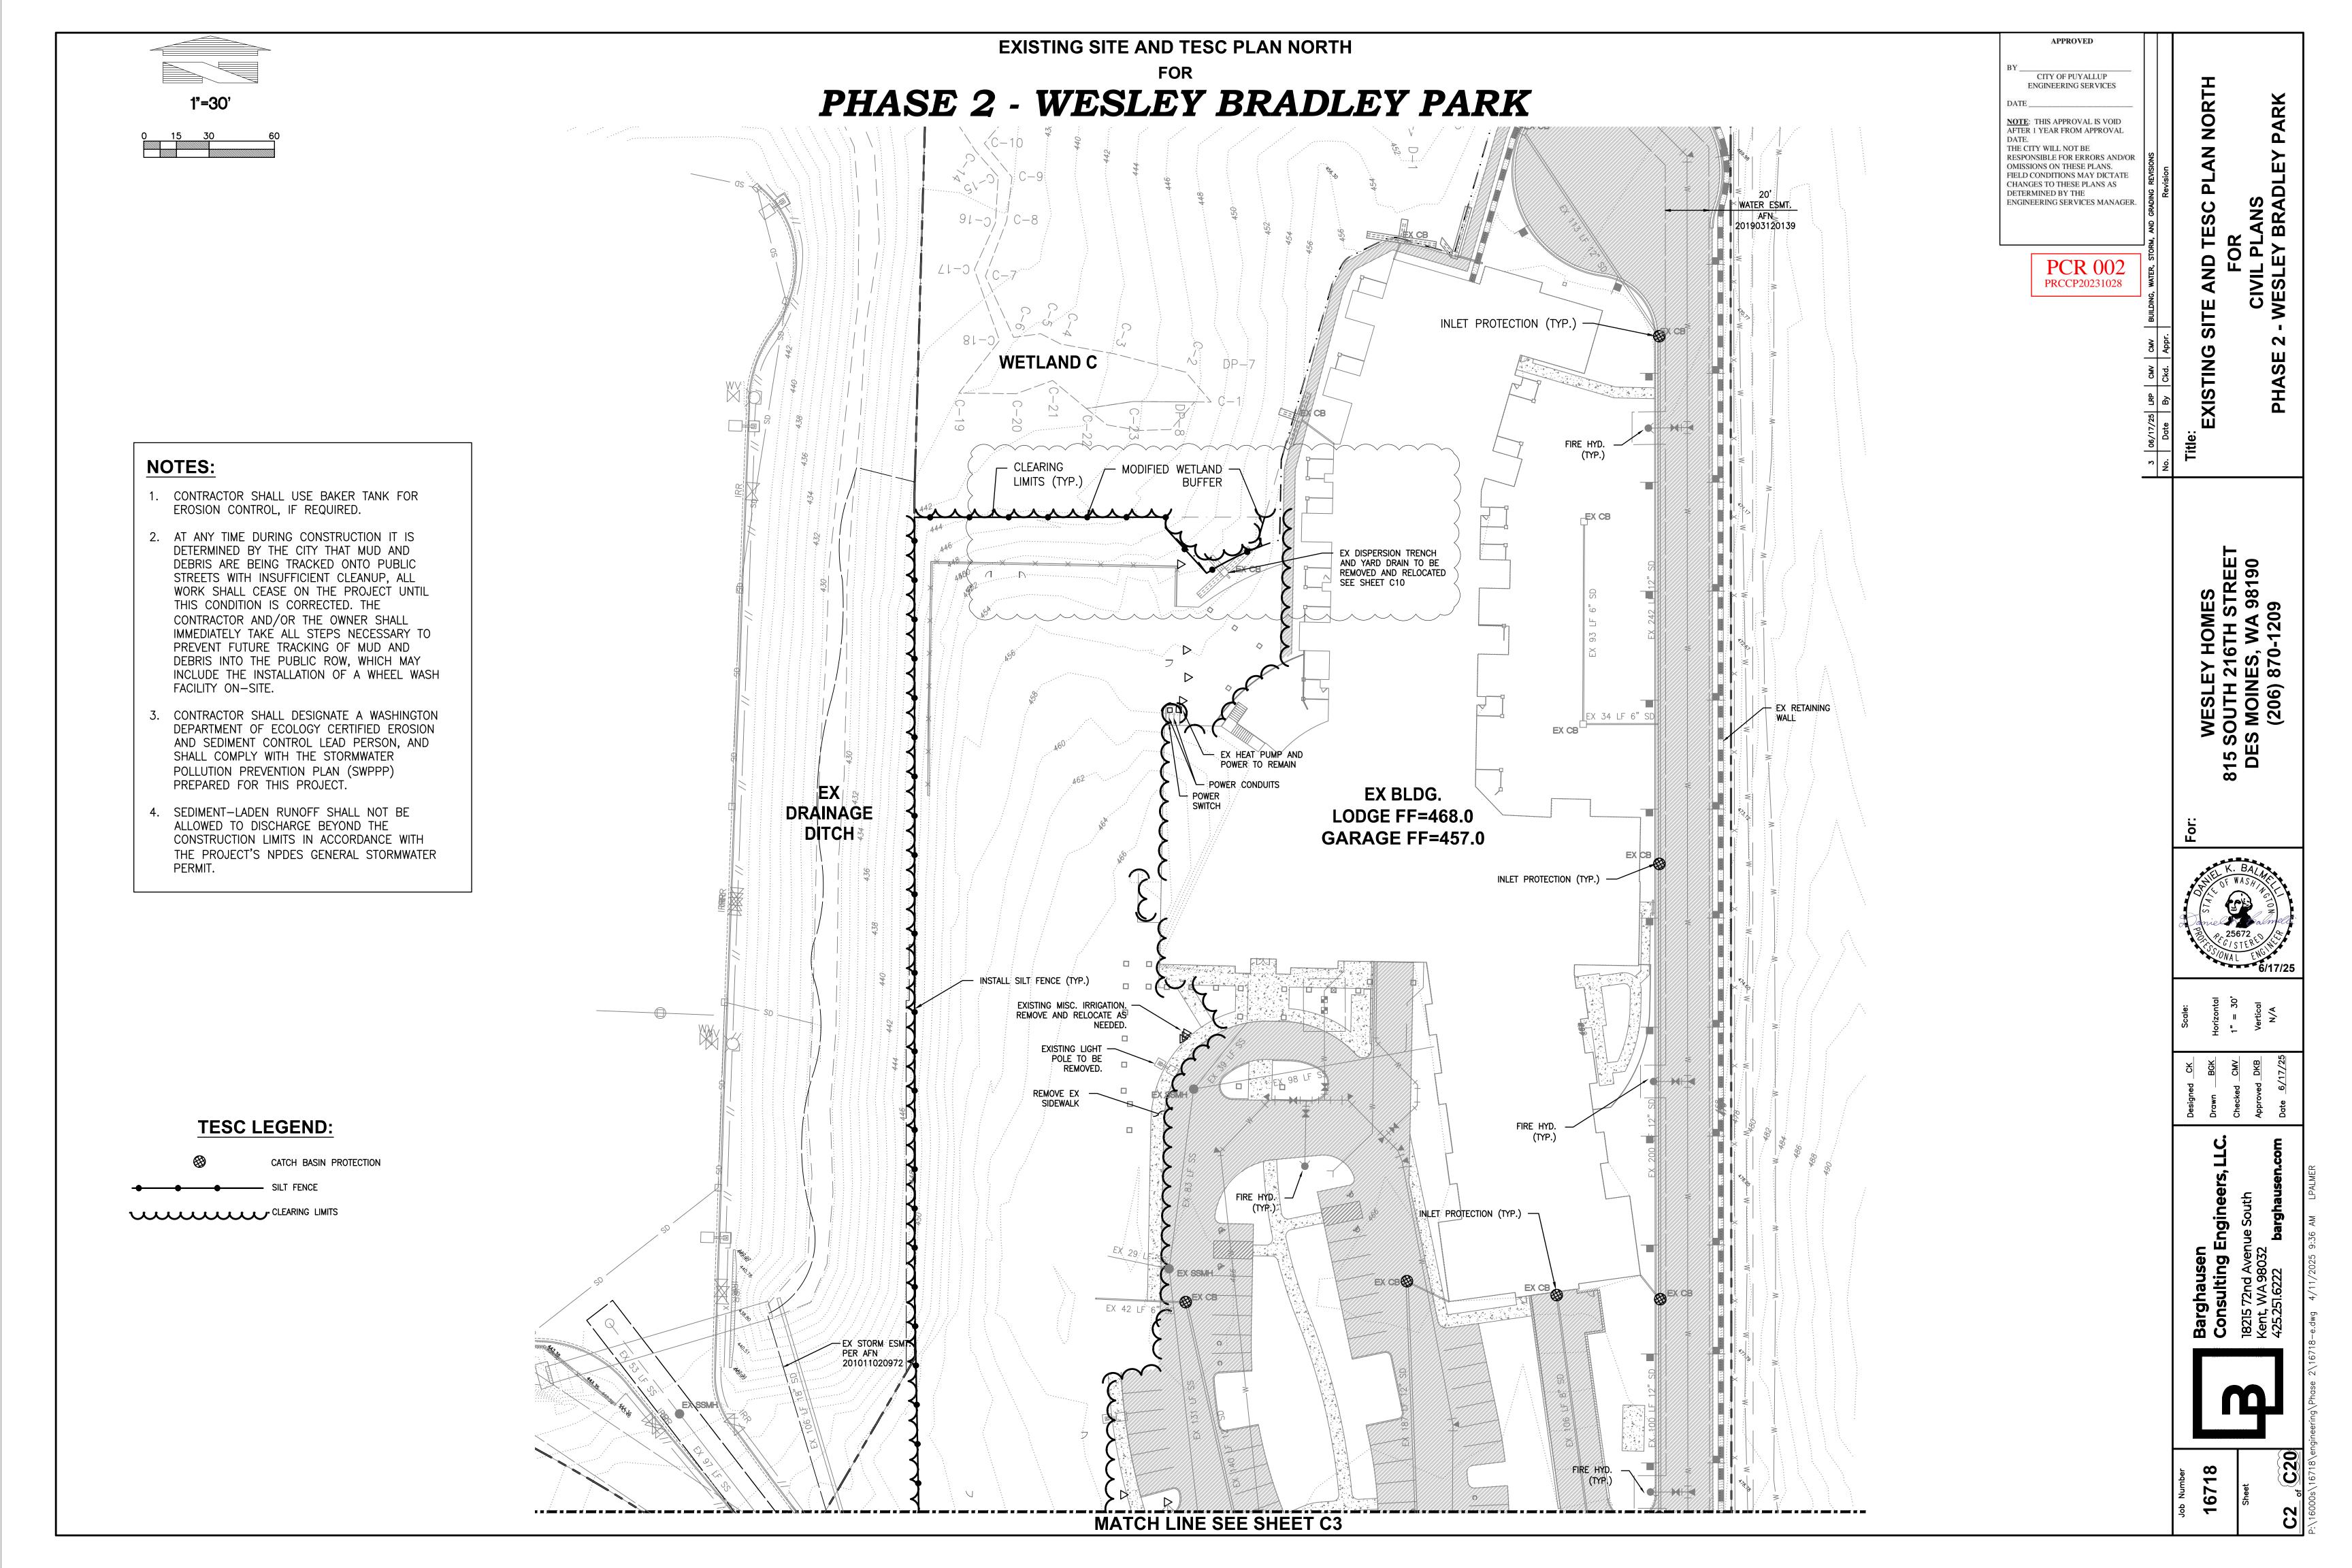

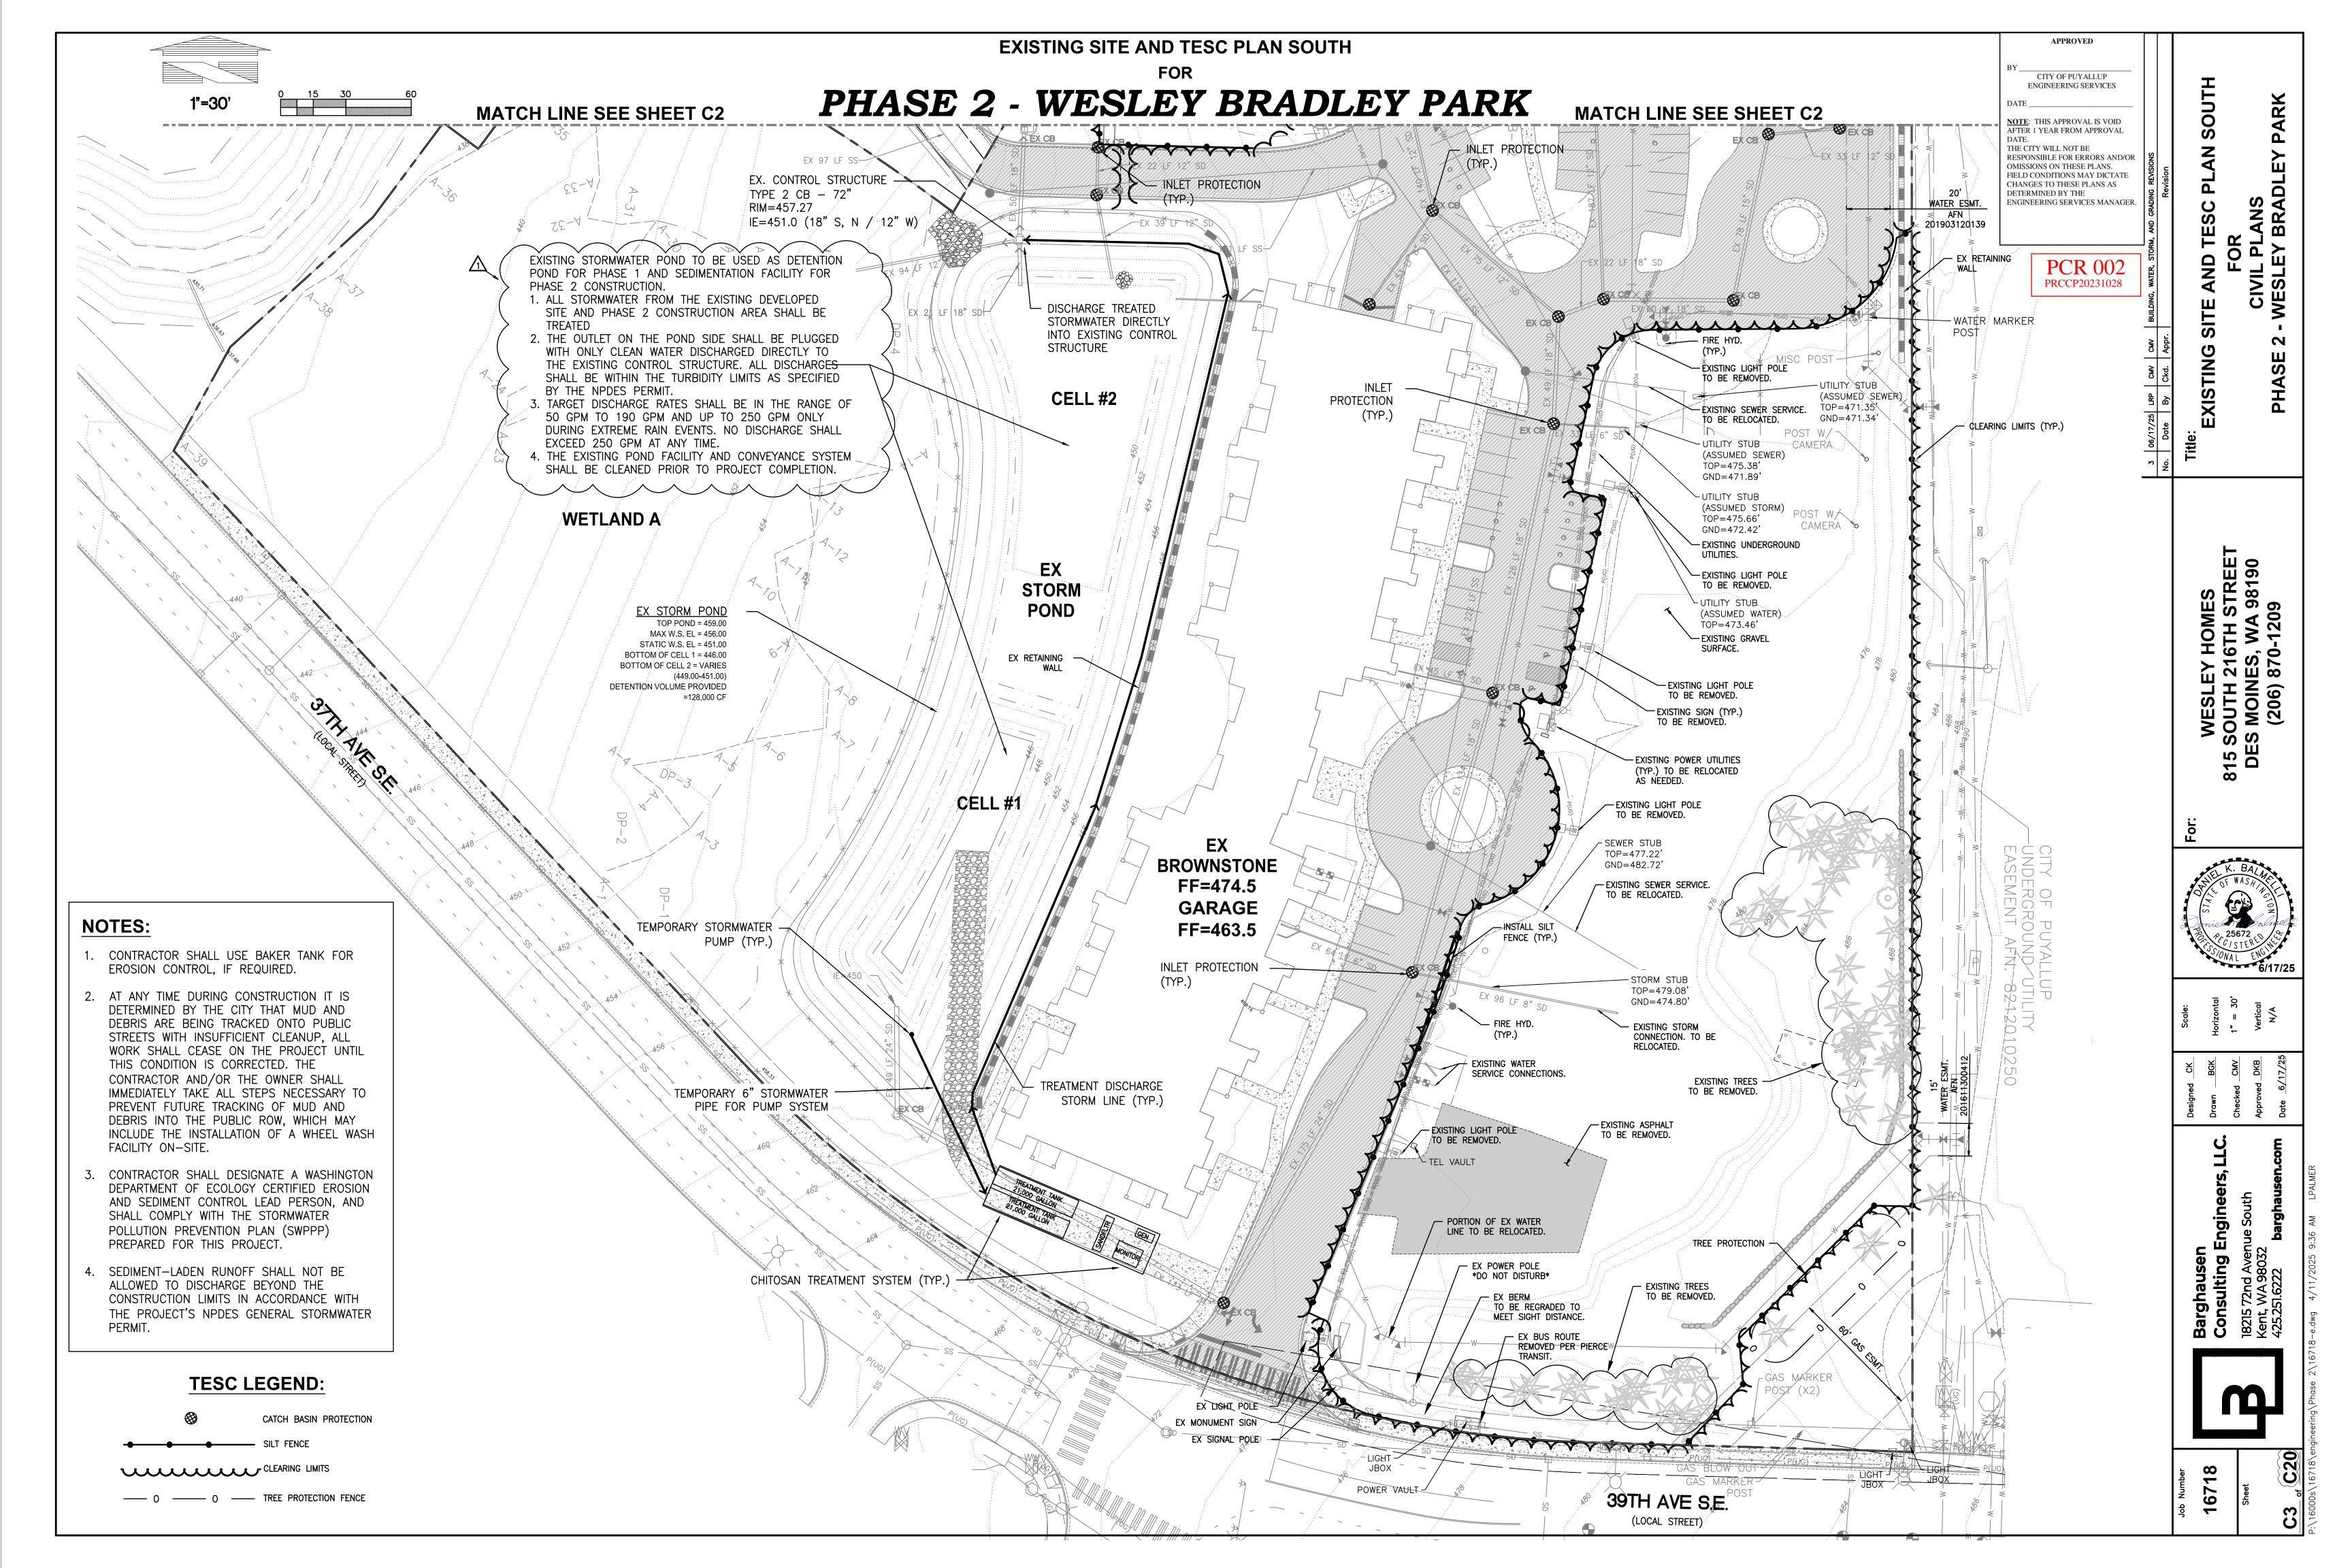

1. PERFORM MAINTENANCE IN ACCORDANCE WITH WSDOT STANDARD

3. THE BGID SHALL HAVE A BUILT-IN HIGH-FLOW RELIEF SYSTEM

ISOMETRIC VIEW

NOT TO SCALE

- FILTERED WATER

CROSS SECTION

NOT TO SCALE

STORM DRAIN

INLET DEVICE DETAILS

WSDOT STANDARD PLAN I-7

PREFABRICATED BELOW GRATE

2. SIZE THE BELOW GRATE INLET DEVICE (BGID) FOR THE STORM WATER

4. THE RETRIEVAL SYSTEM MUST ALLOW REMOVAL OF THE BGID WITHOUT

NOTES

GEOTEXTILE

SPECIFICATION 8-01.3(15).

(OVERFLOW BYPASS).

STRUCTURE IT WILL SERVICE.

SPILLING THE COLLECTED MATERIAL.

CITY OF PUYALLUP ENGINEERING SERVICES NOTE: THIS APPROVAL IS VOID

AFTER 1 YEAR FROM APPROVAL THE CITY WILL NOT BE RESPONSIBLE FOR ERRORS AND/OR OMISSIONS ON THESE PLANS. FIELD CONDITIONS MAY DICTATE CHANGES TO THESE PLANS AS DETERMINED BY THE ENGINEERING SERVICES MANAGER.

- RETRIEVAL SYSTEM

---- OVERFLOW BYPASS

- OVERFLOW BYPASS

- SEDIMENT AND DEBRIS

5" MAX. TRIM GEOTEXTILE

PRCCP20231028

7

PHASE


HOMES 16TH STRE 5, WA 9819 70-1209


Barghausen Consulting Engine


SOIL STABILIZATION AND REVEGETATION


EXPOSED AREAS AND SOIL STOCKPILES MUST BE STABILIZED ACCORDING TO THE FOLLOWING

- 1. FROM APRIL 1 TO OCTOBER 31 ALL DISTURBED AREAS AT FINAL GRADE AND ALL EXPOSED AREAS THAT ARE SCHEDULED TO REMAIN UNWORKED FOR MORE THAN 30 DAYS SHALL BE STABILIZED
- 2. FROM NOVEMBER 1 TO MARCH 31 ALL EXPOSED SOILS AT FINAL GRADE SHALL BE STABILIZED IMMEDIATELY USING PERMANENT OR TEMPORARY MEASURES. EXPOSED SOILS WITH AN AREA GREATER THAN 5,000 SQUARE FEET THAT ARE SCHEDULED TO REMAIN UNWORKED FOR MORE THAN 24 HOURS AND EXPOSED AREAS OF LESS THAN 5,000 SQUARE FEET THAT WILL REMAIN UNWORKED FOR MORE THAN SEVEN (7) DAYS SHALL BE STABILIZED IMMEDIATELY.
- ALL DISTURBED AREAS WHICH ARE NOT PLANNED TO BE CONSTRUCTED ON WITHIN 90 DAYS FROM TIME OF CLEARING AND GRADING SHALL BE REVEGETATED WITH THE NATIVE VEGETATION.

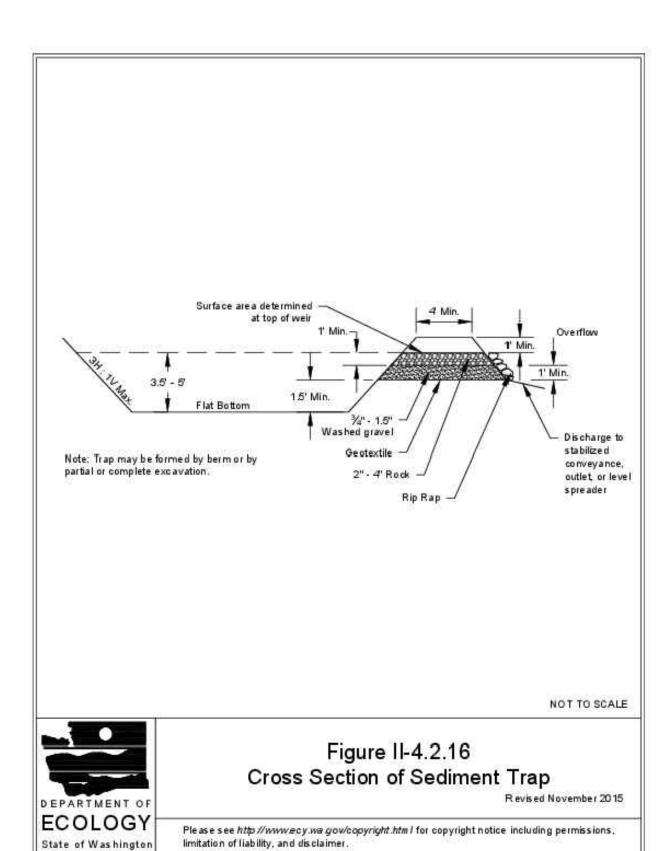

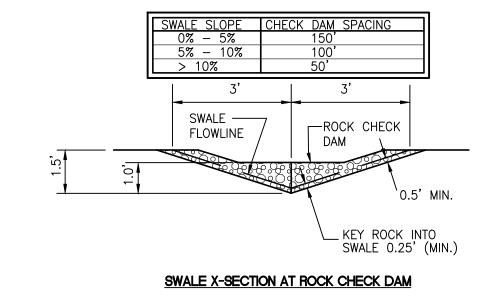


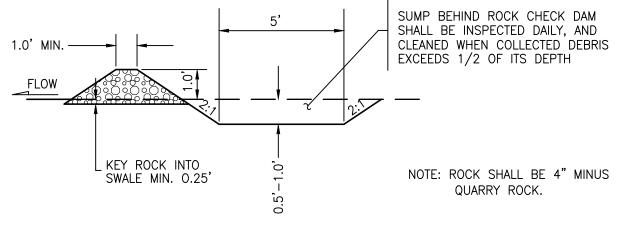


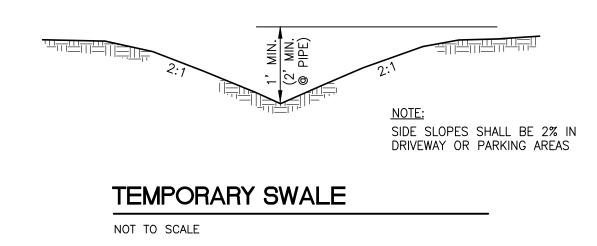






NOT TO SCALE

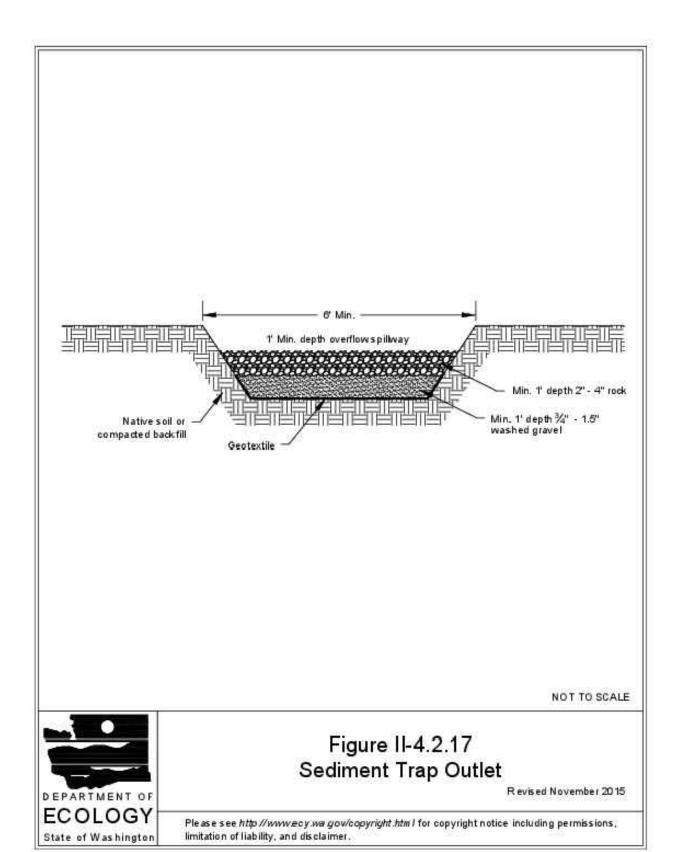


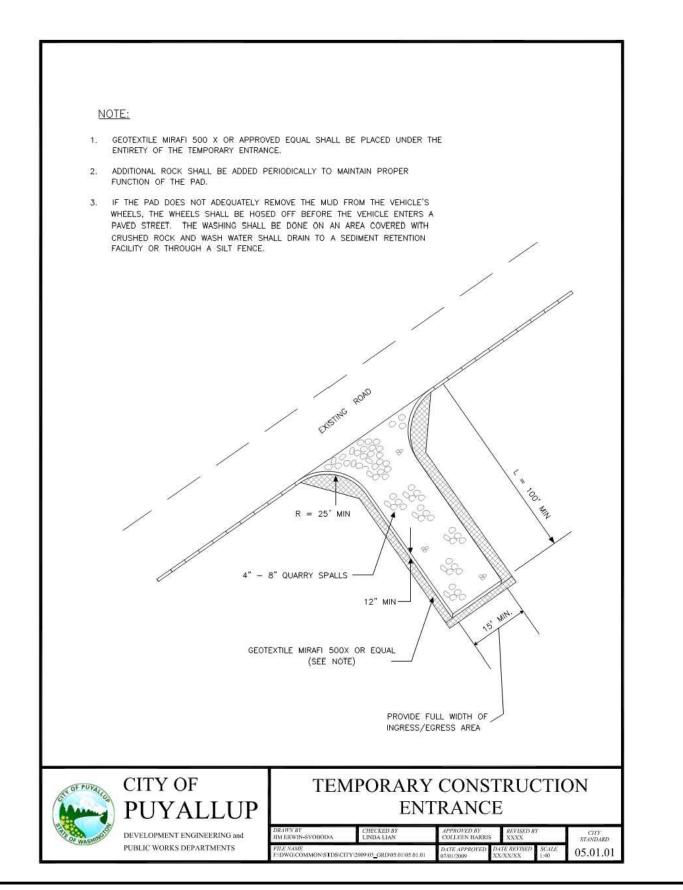


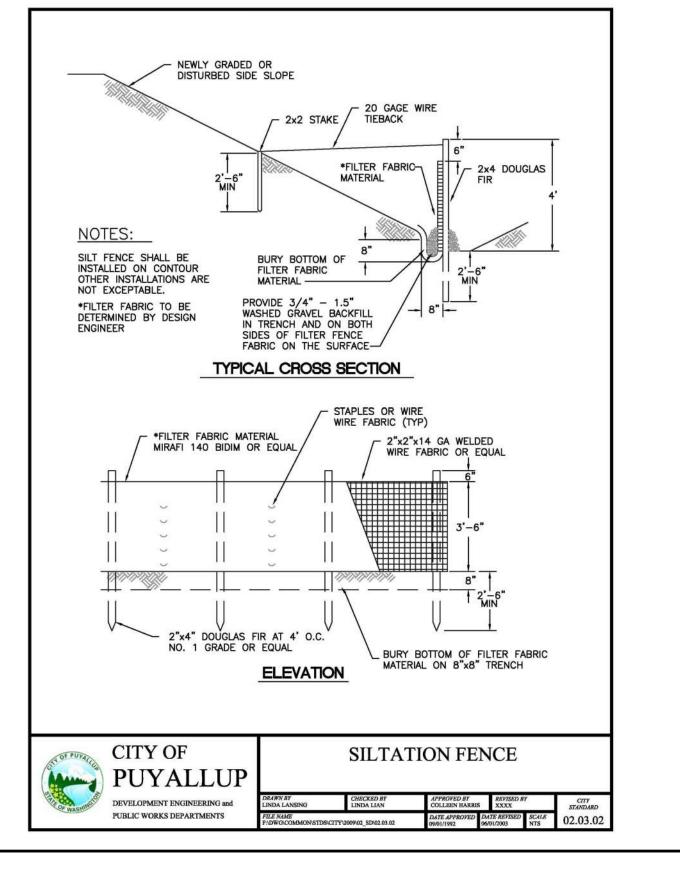

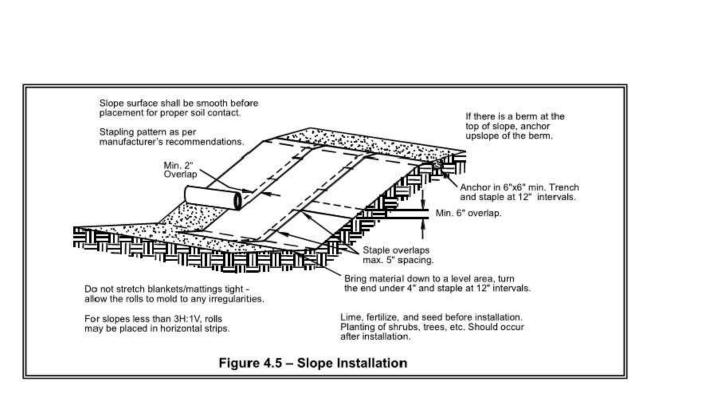

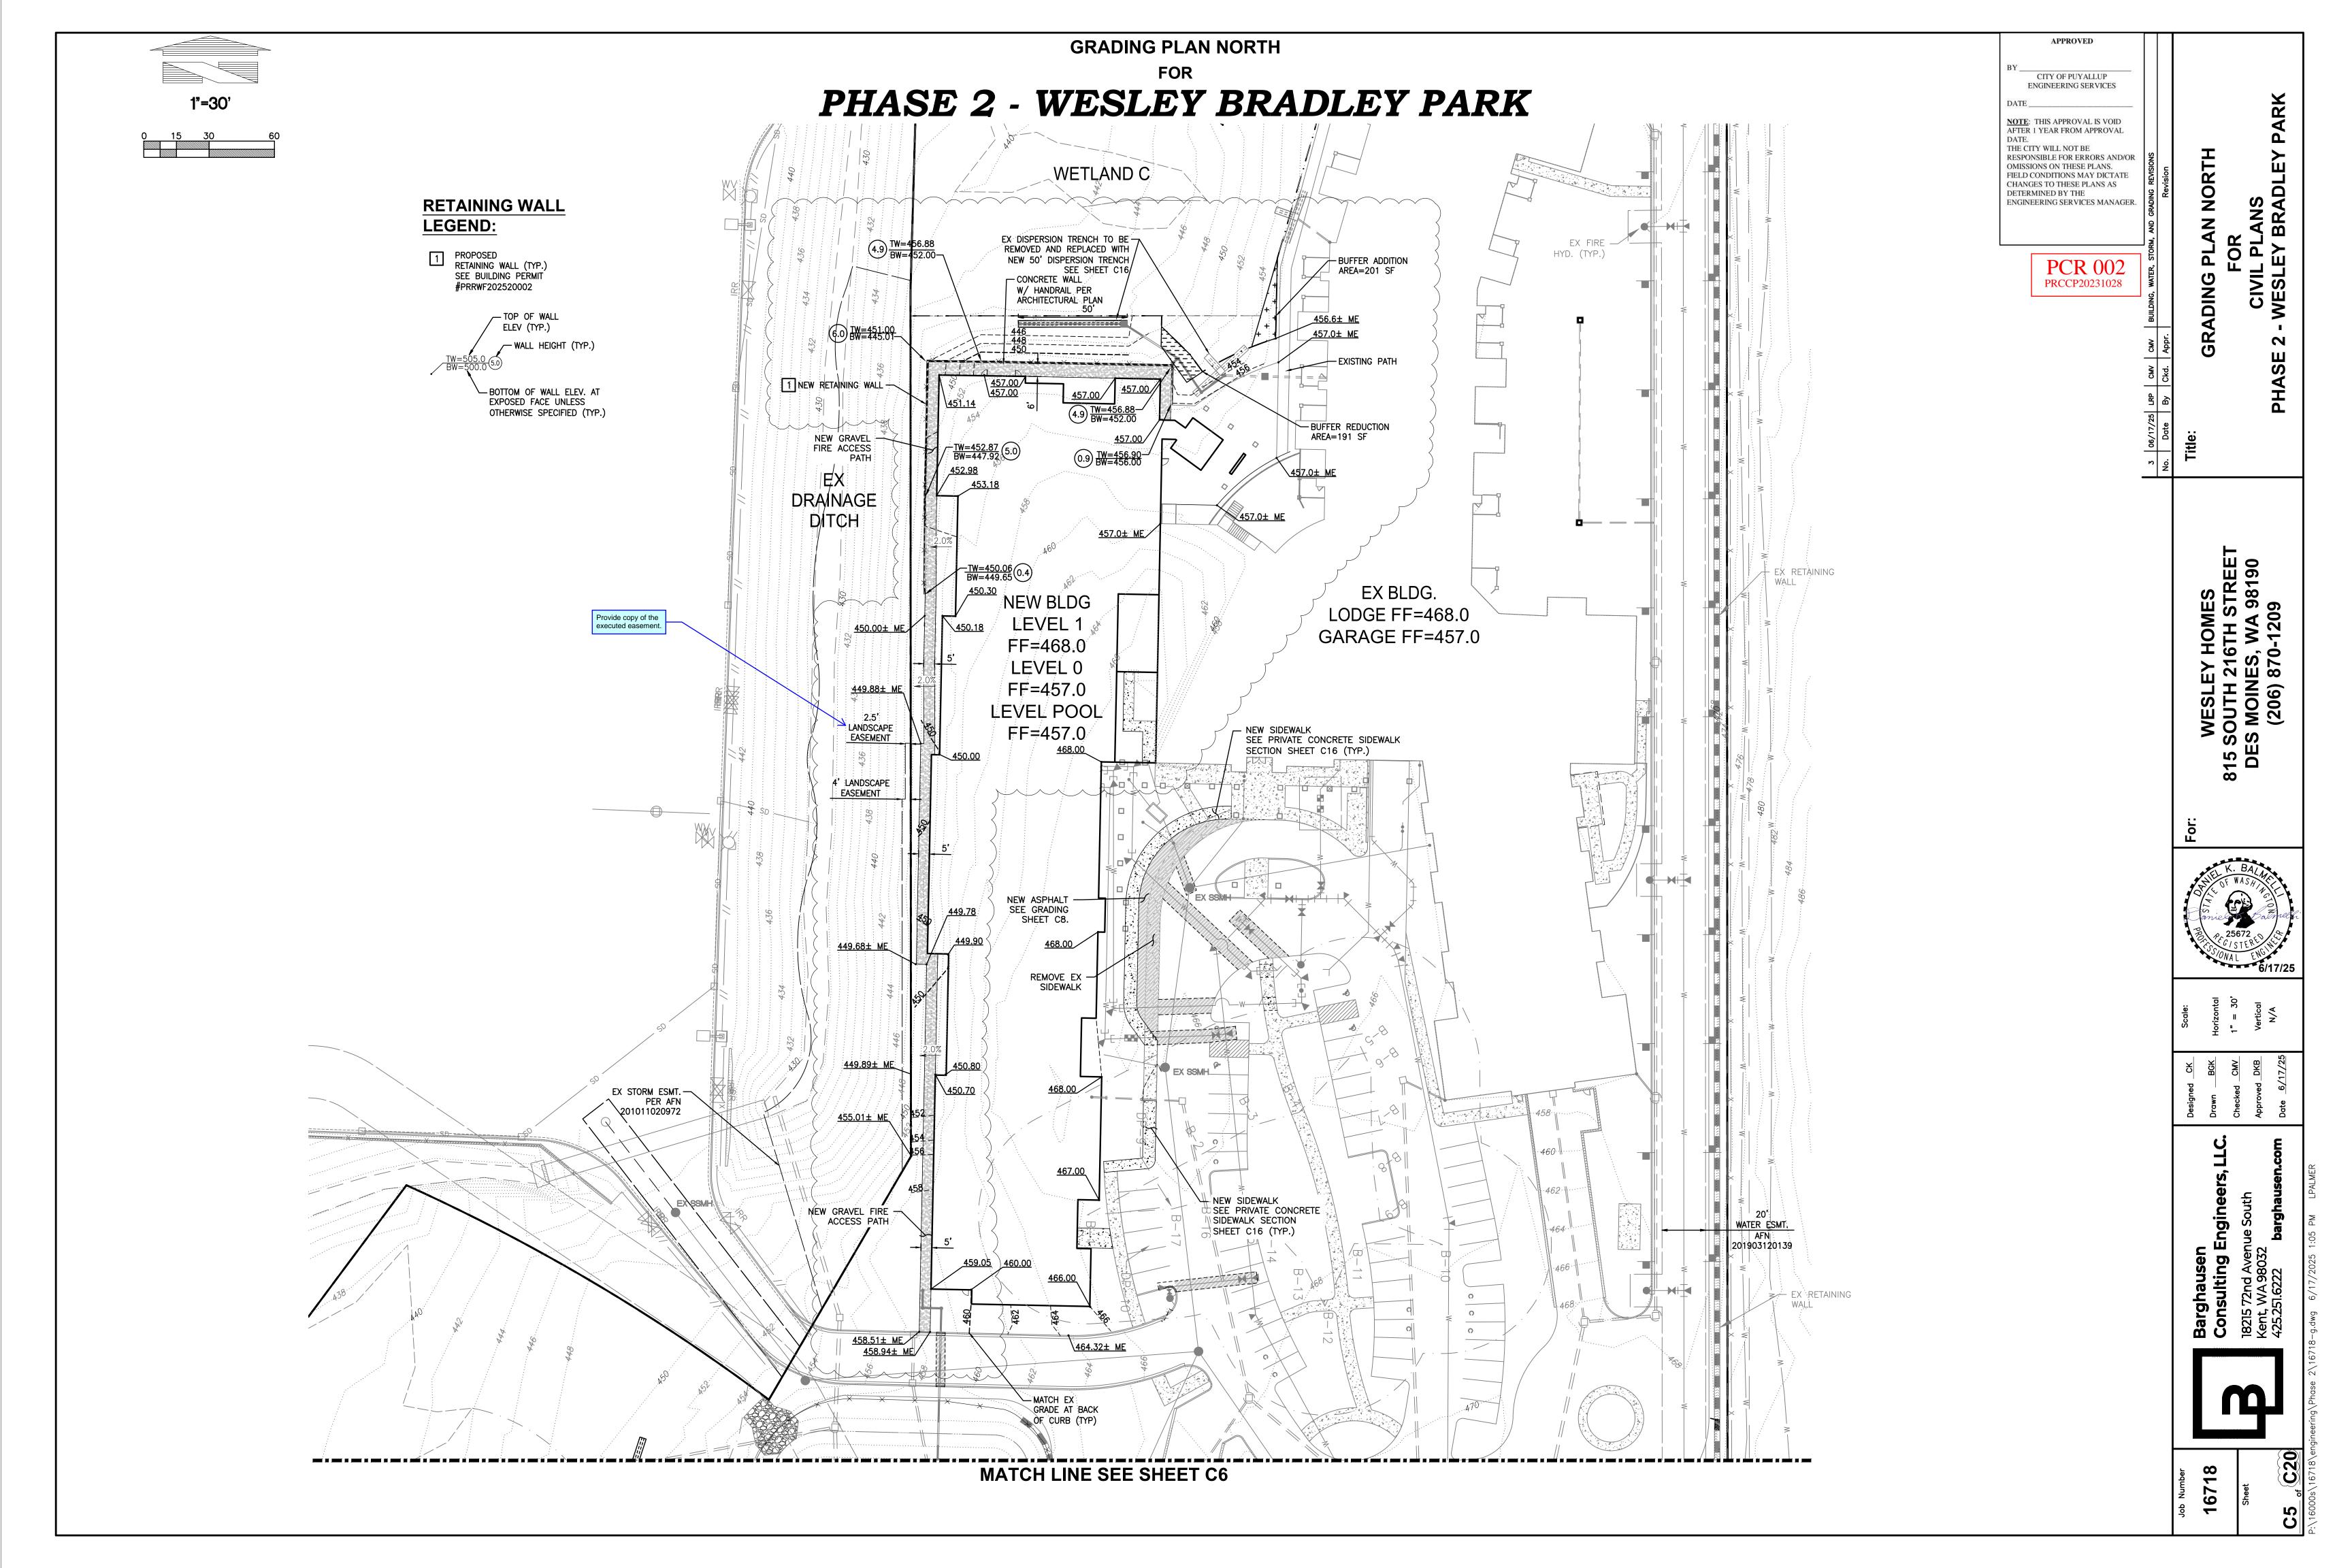

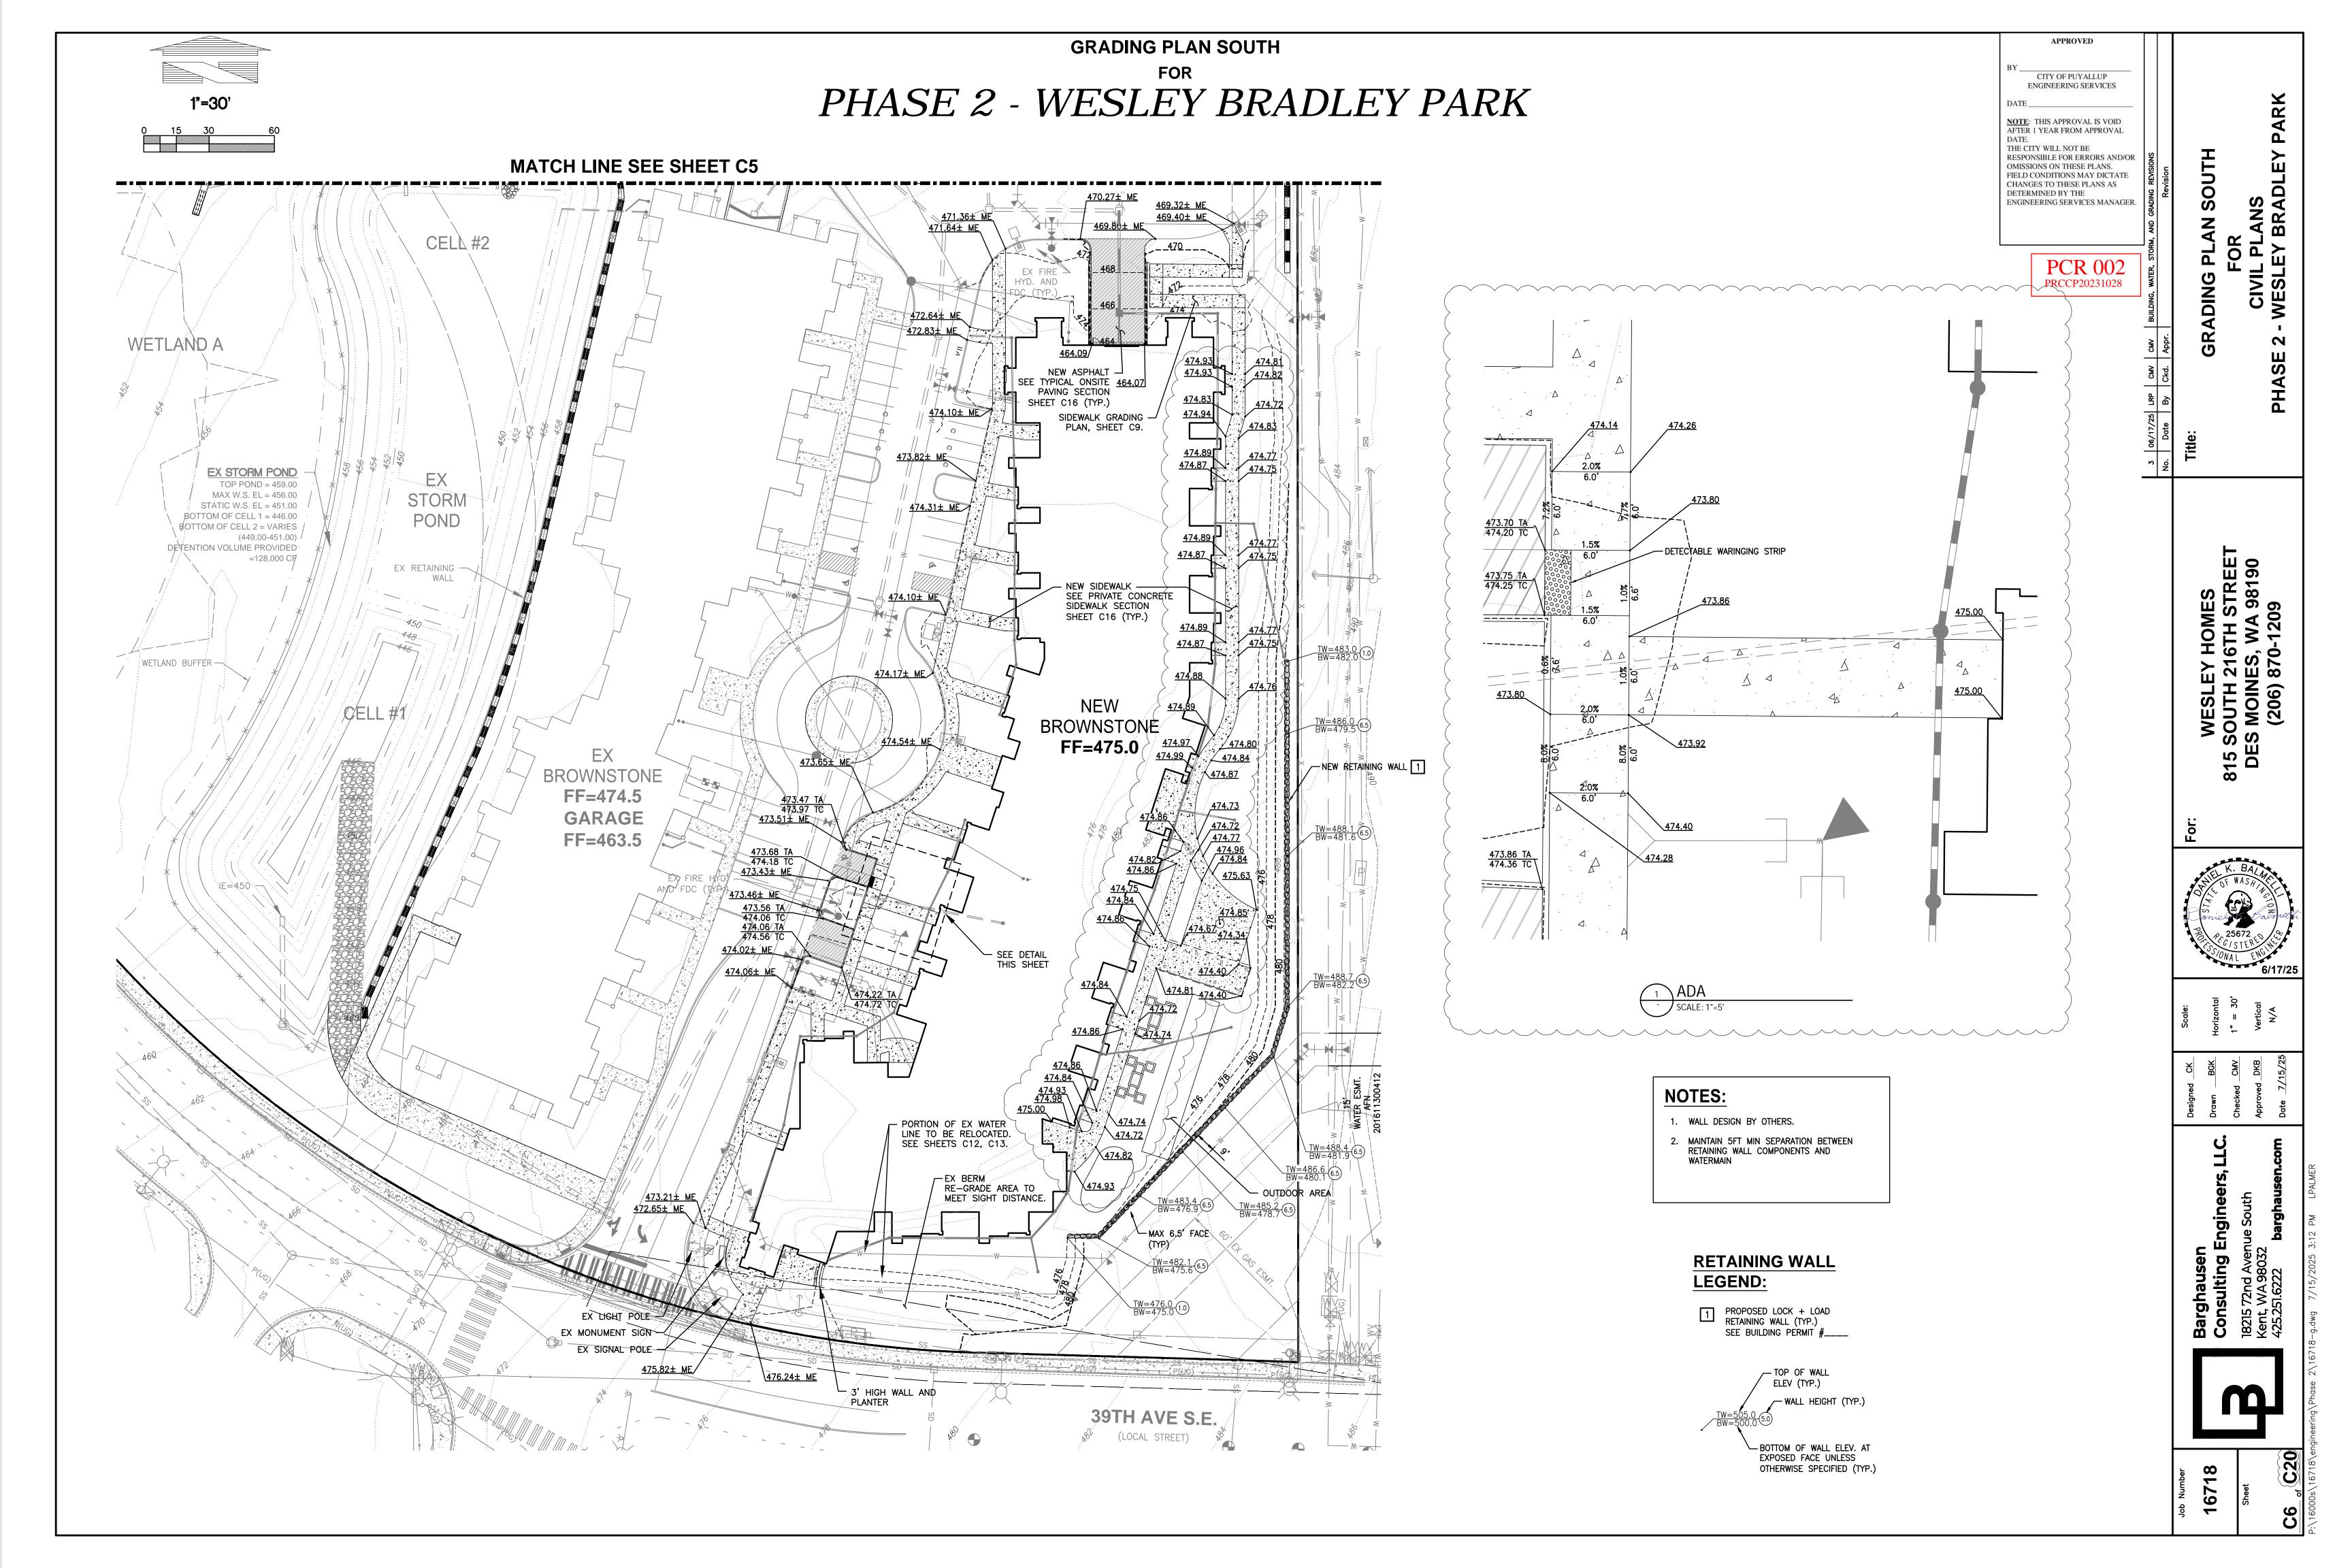

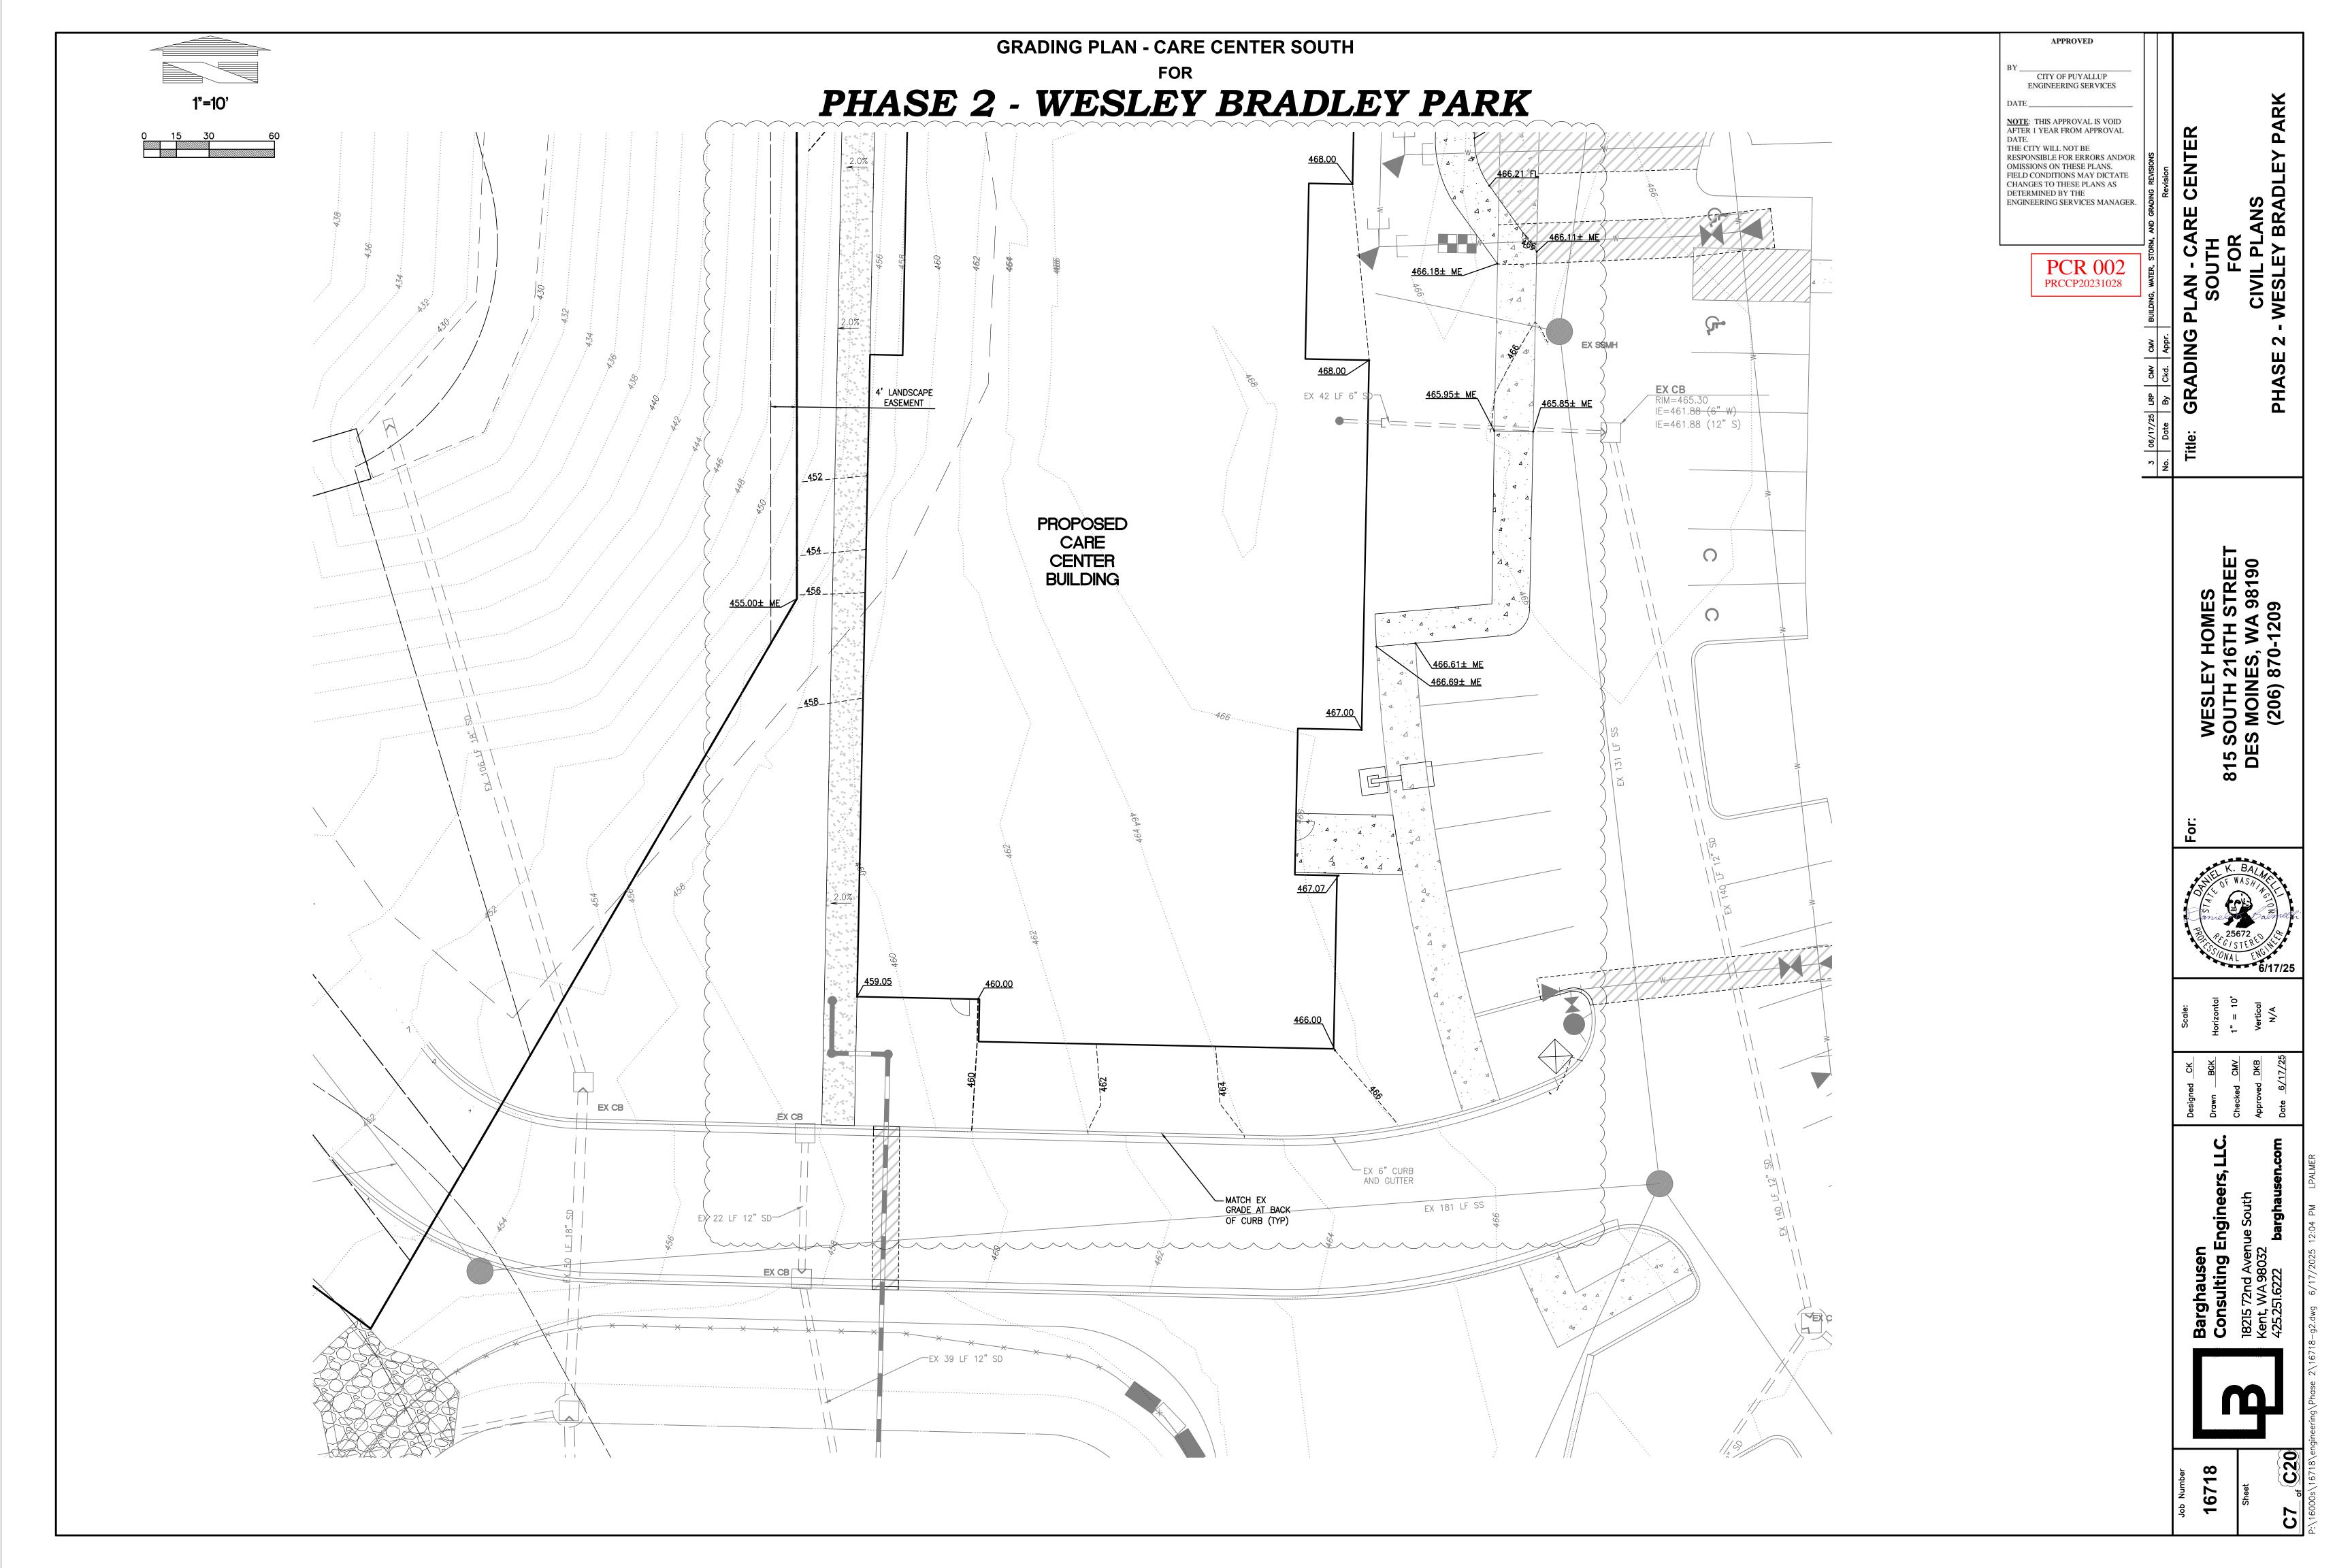


CITY OF PUYALLUP ENGINEERING SERVICES NOTE: THIS APPROVAL IS VOID AFTER 1 YEAR FROM APPROVAL DATE.
THE CITY WILL NOT BE
RESPONSIBLE FOR ERRORS AND/OR
OMISSIONS ON THESE PLANS.
FIELD CONDITIONS MAY DICTATE
CHANGES TO THESE PLANS AS DETERMINED BY THE

PRCCP20231028



Barghausen
Consulting Engineers, L
18215 72nd Avenue South
Kent, WA 98032
425.251.6222 barghausen.c

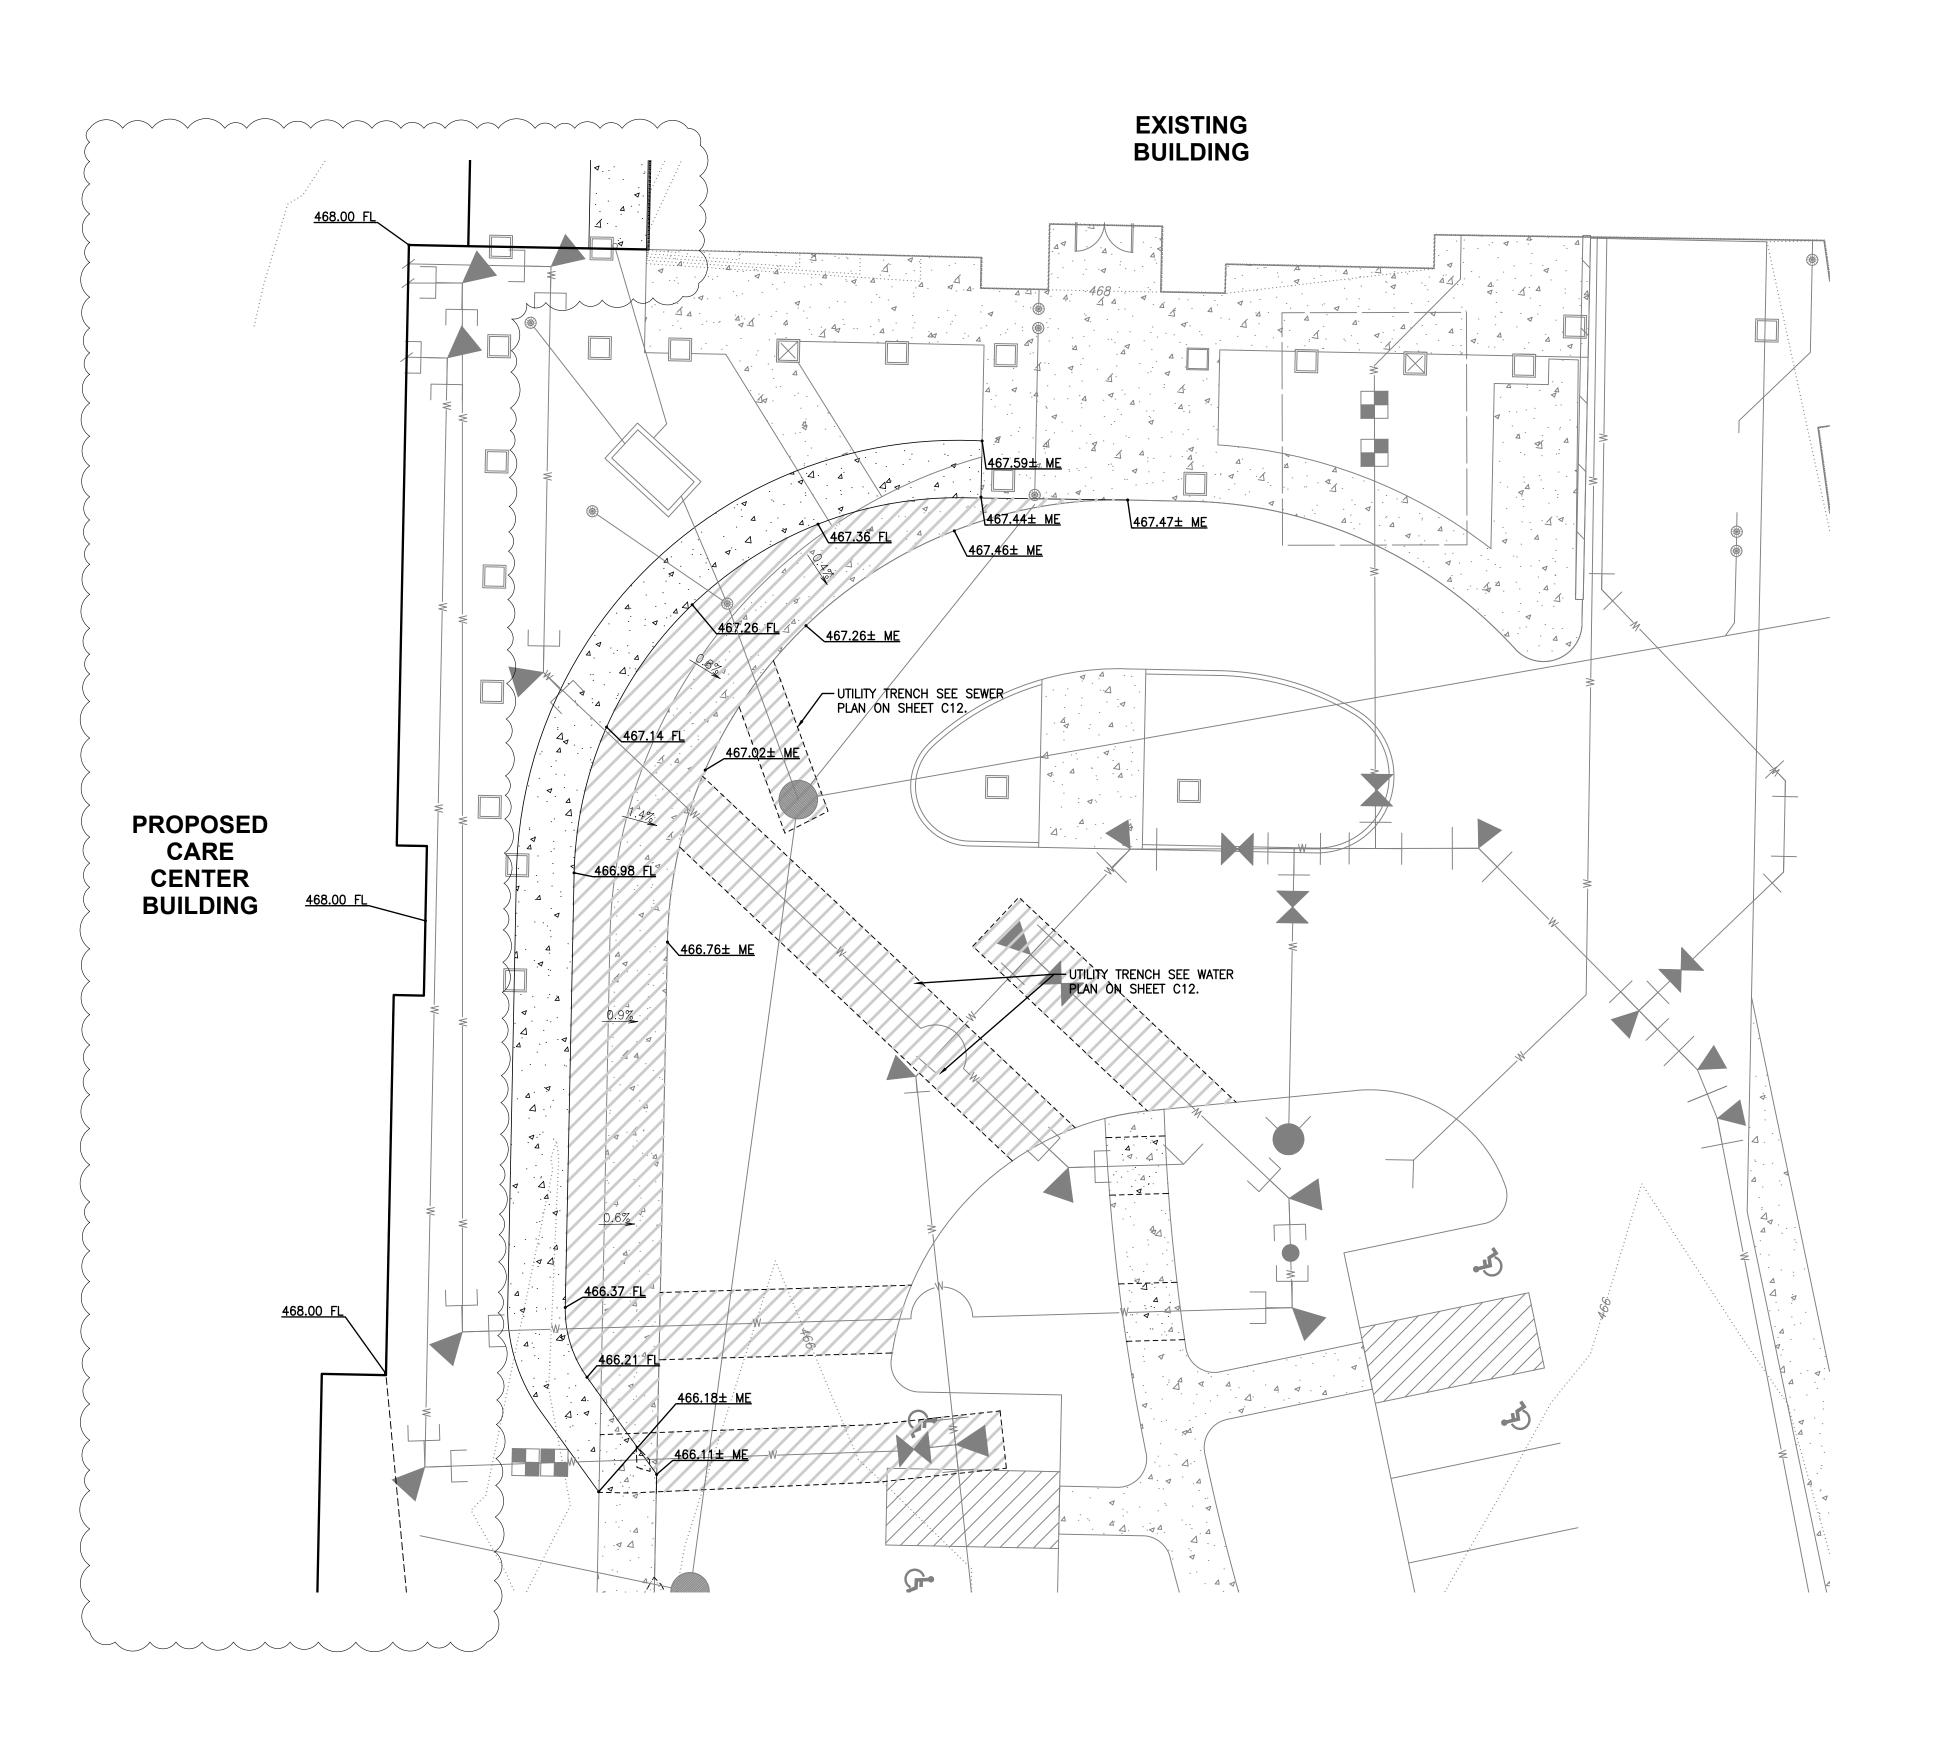

OR

PHASE 2 - WESLEY BRADLEY PARK

PCR 002
PRCCP20231028

| Date | By | Ckd. | Appr. |

Title: GRADING PLAN - BRONN - BR

EY HOMES 1 216TH STREET NES, WA 98190

For:



Scale:
Horizontal

1" = 10'

Designed CK

Drawn BGK Ho

Checked CMV 1'

Approved DKB

ing Engineers, LLC.

Avenue South


8032


barghausen.com


Consulting Engine
18215 72nd Avenue South
Kent, WA 98032

16718 Sheet

Sheet C20 of C20

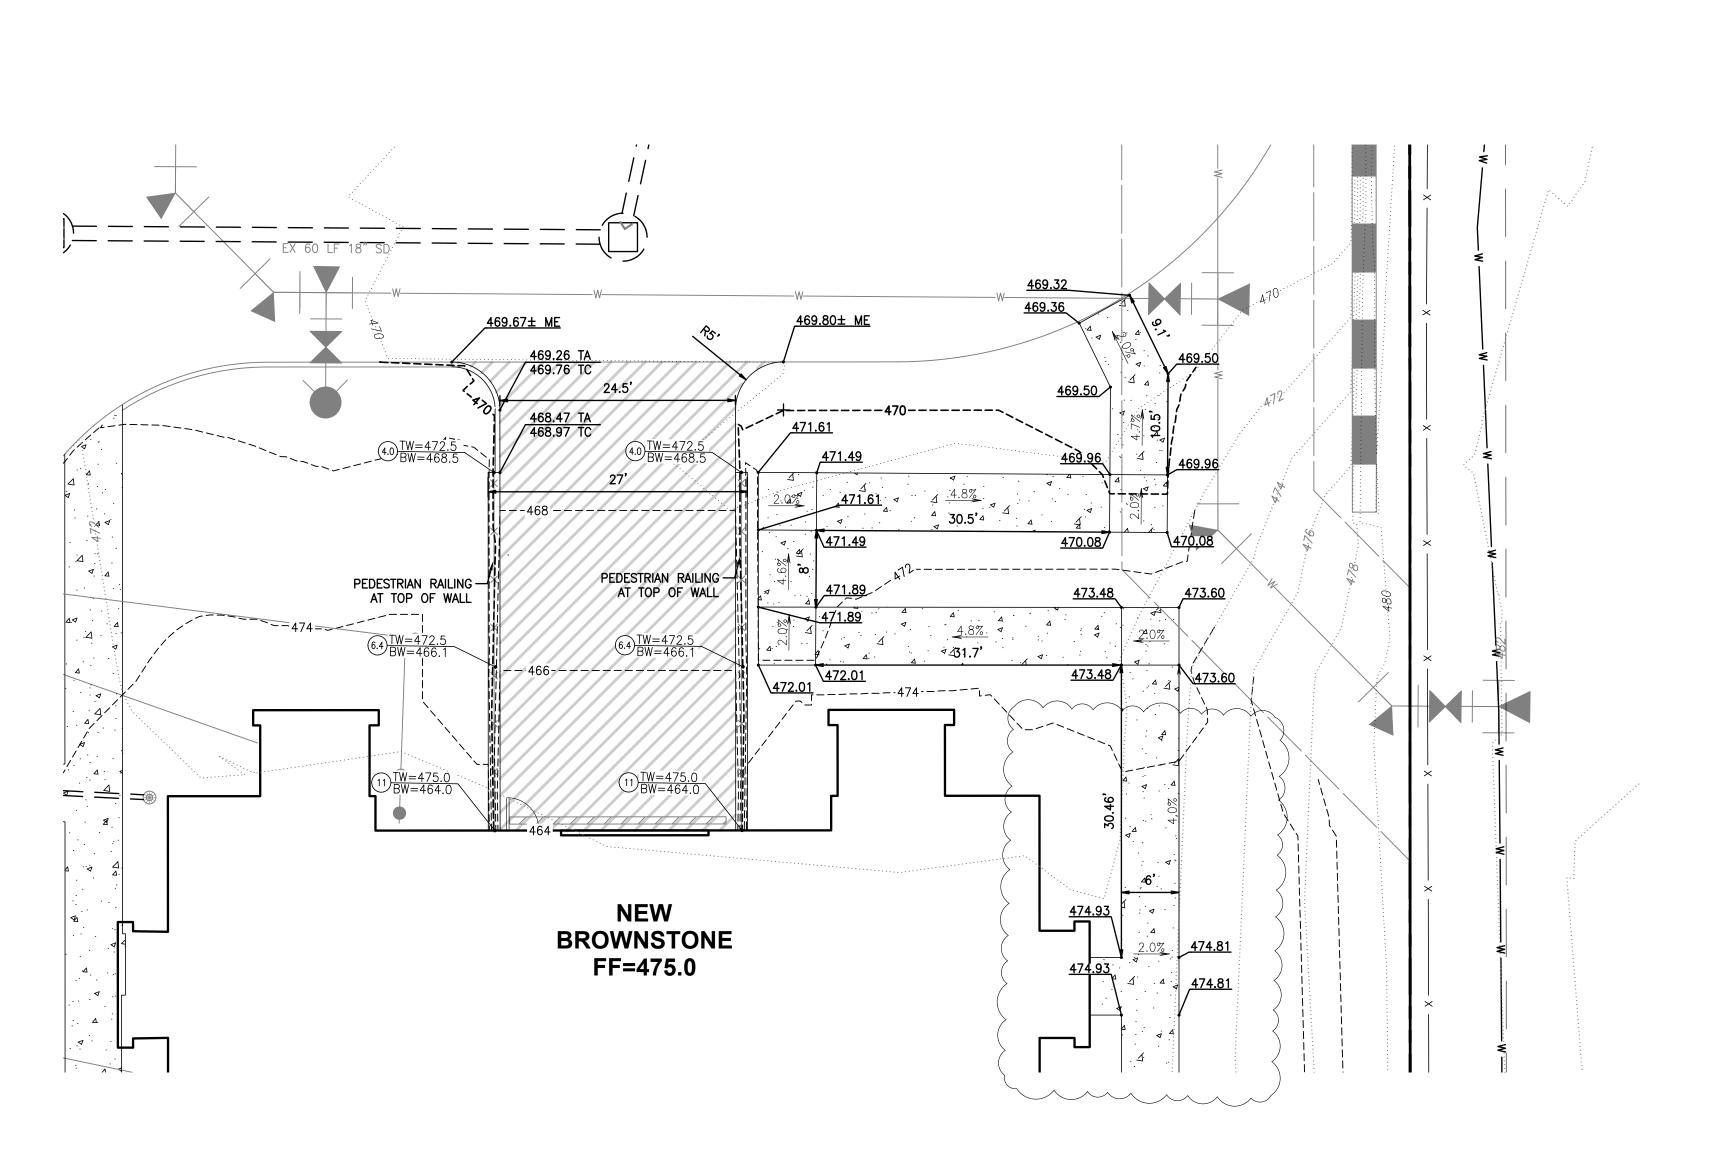

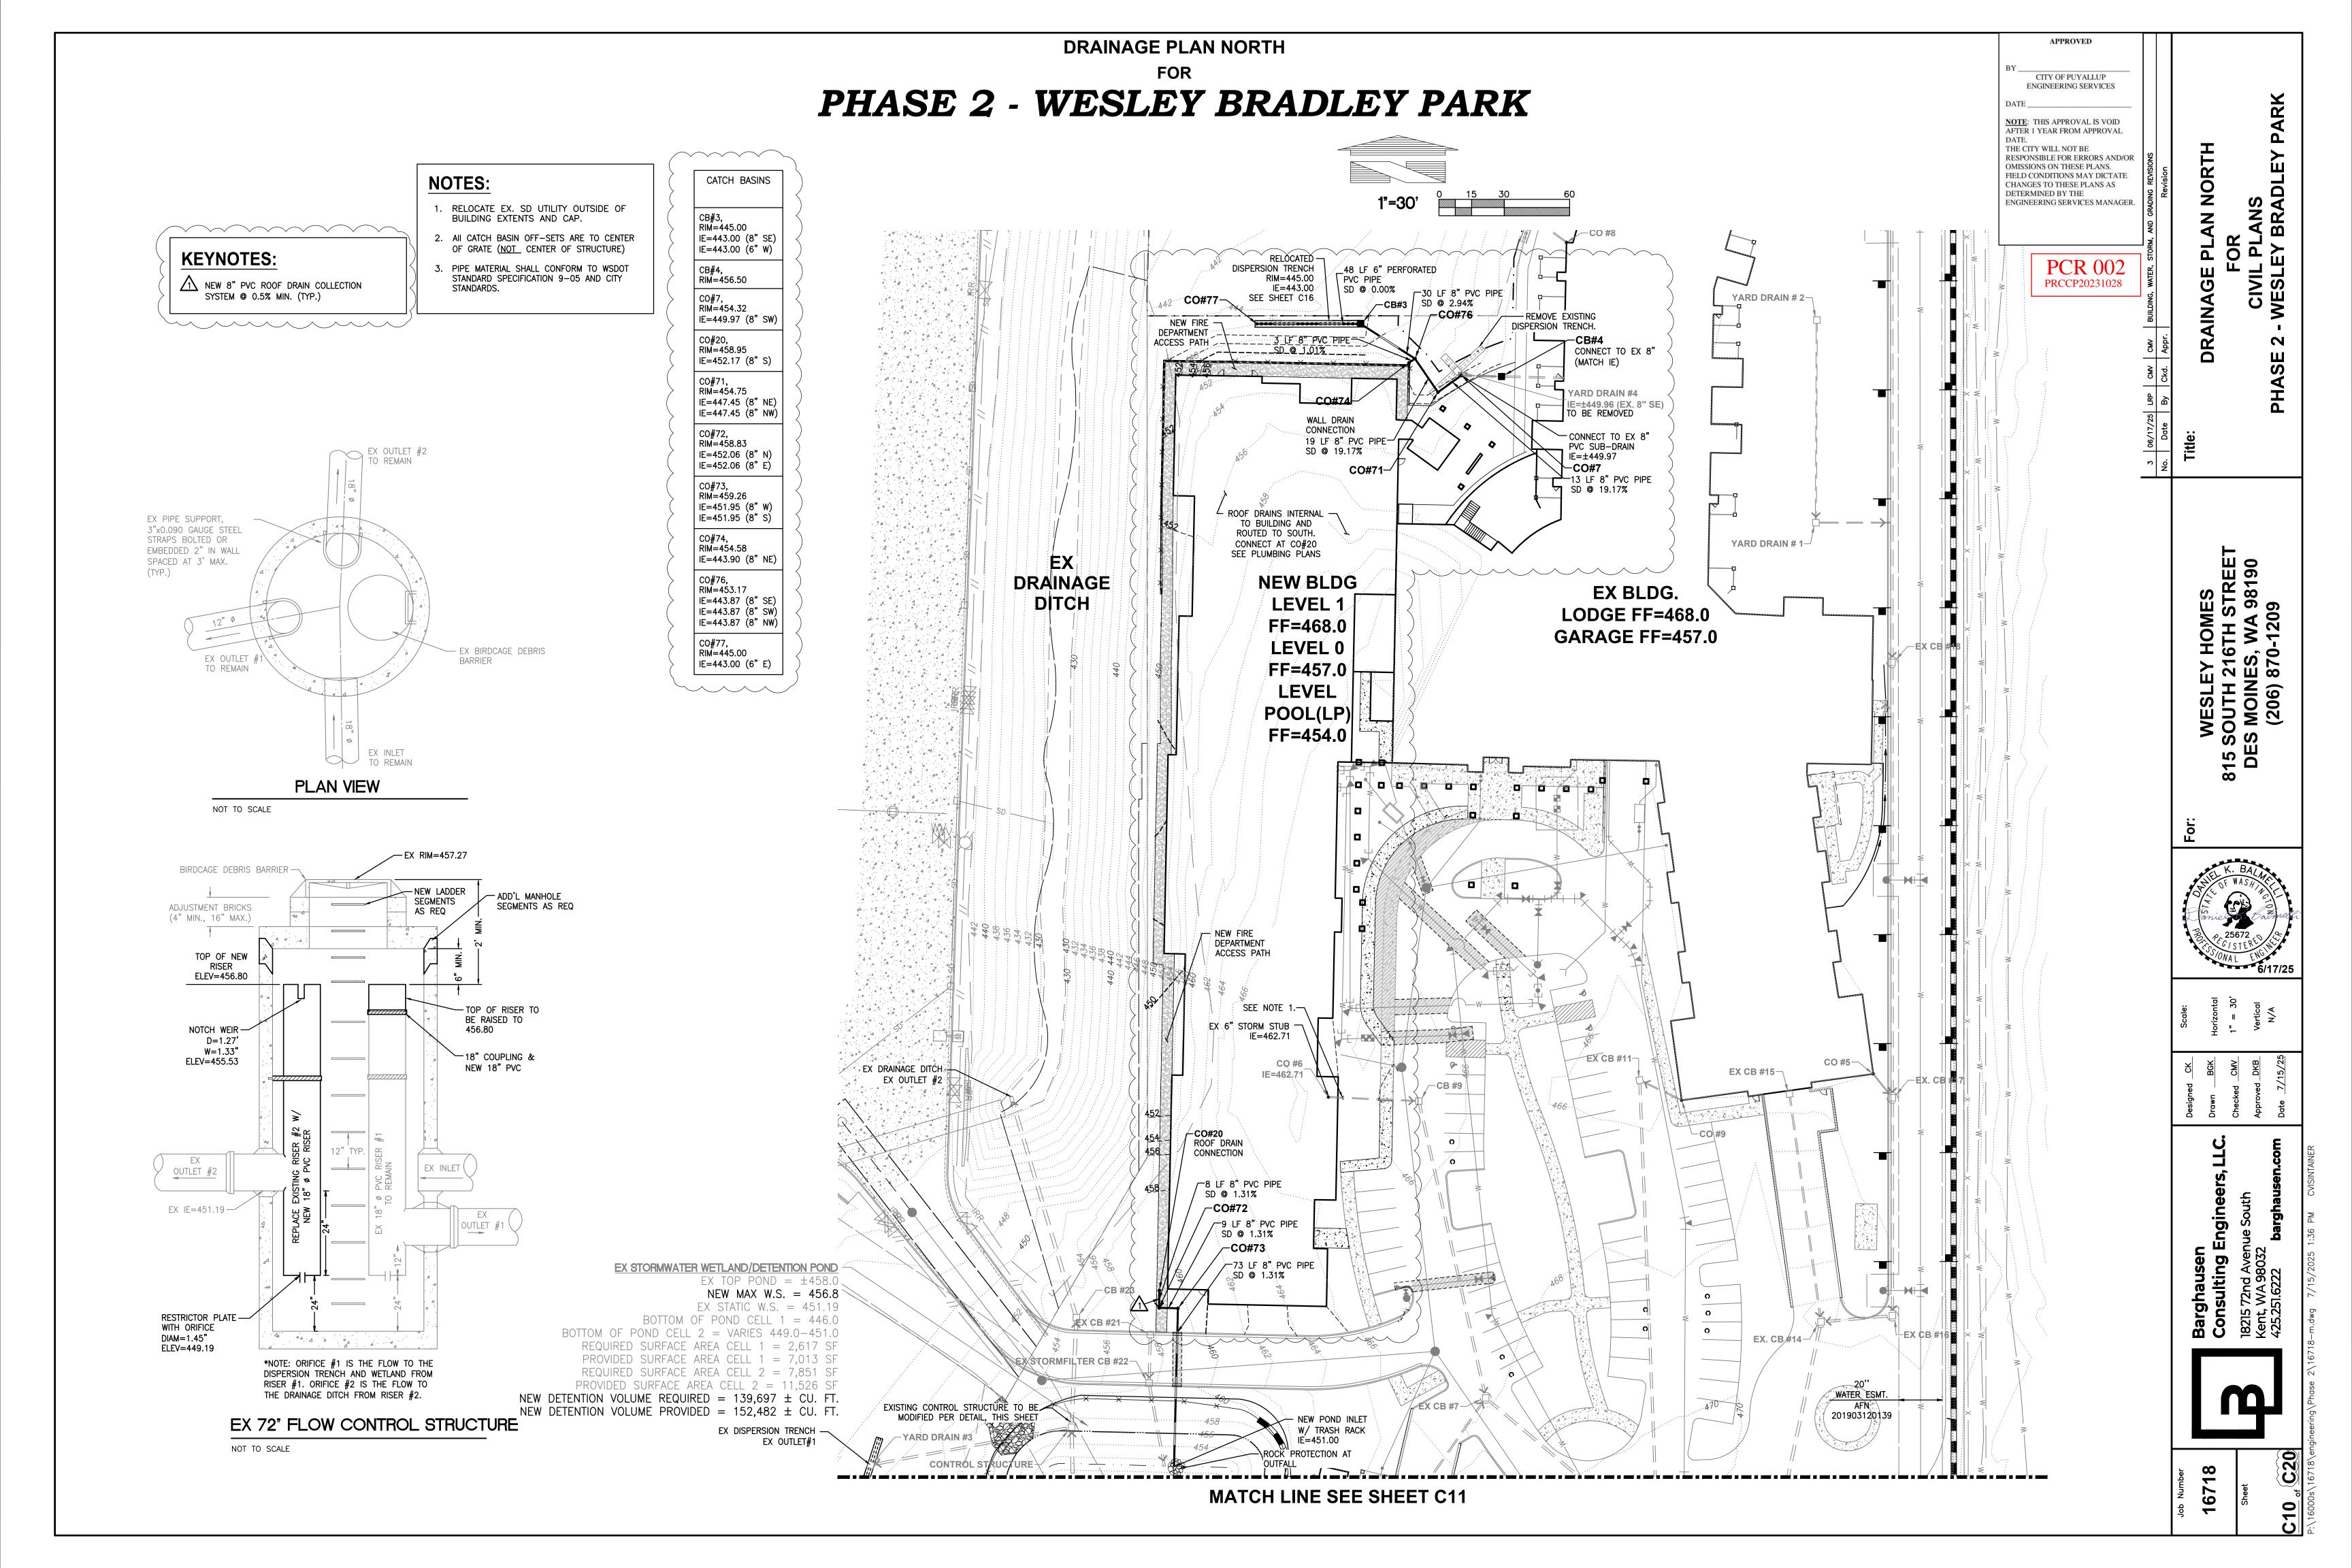

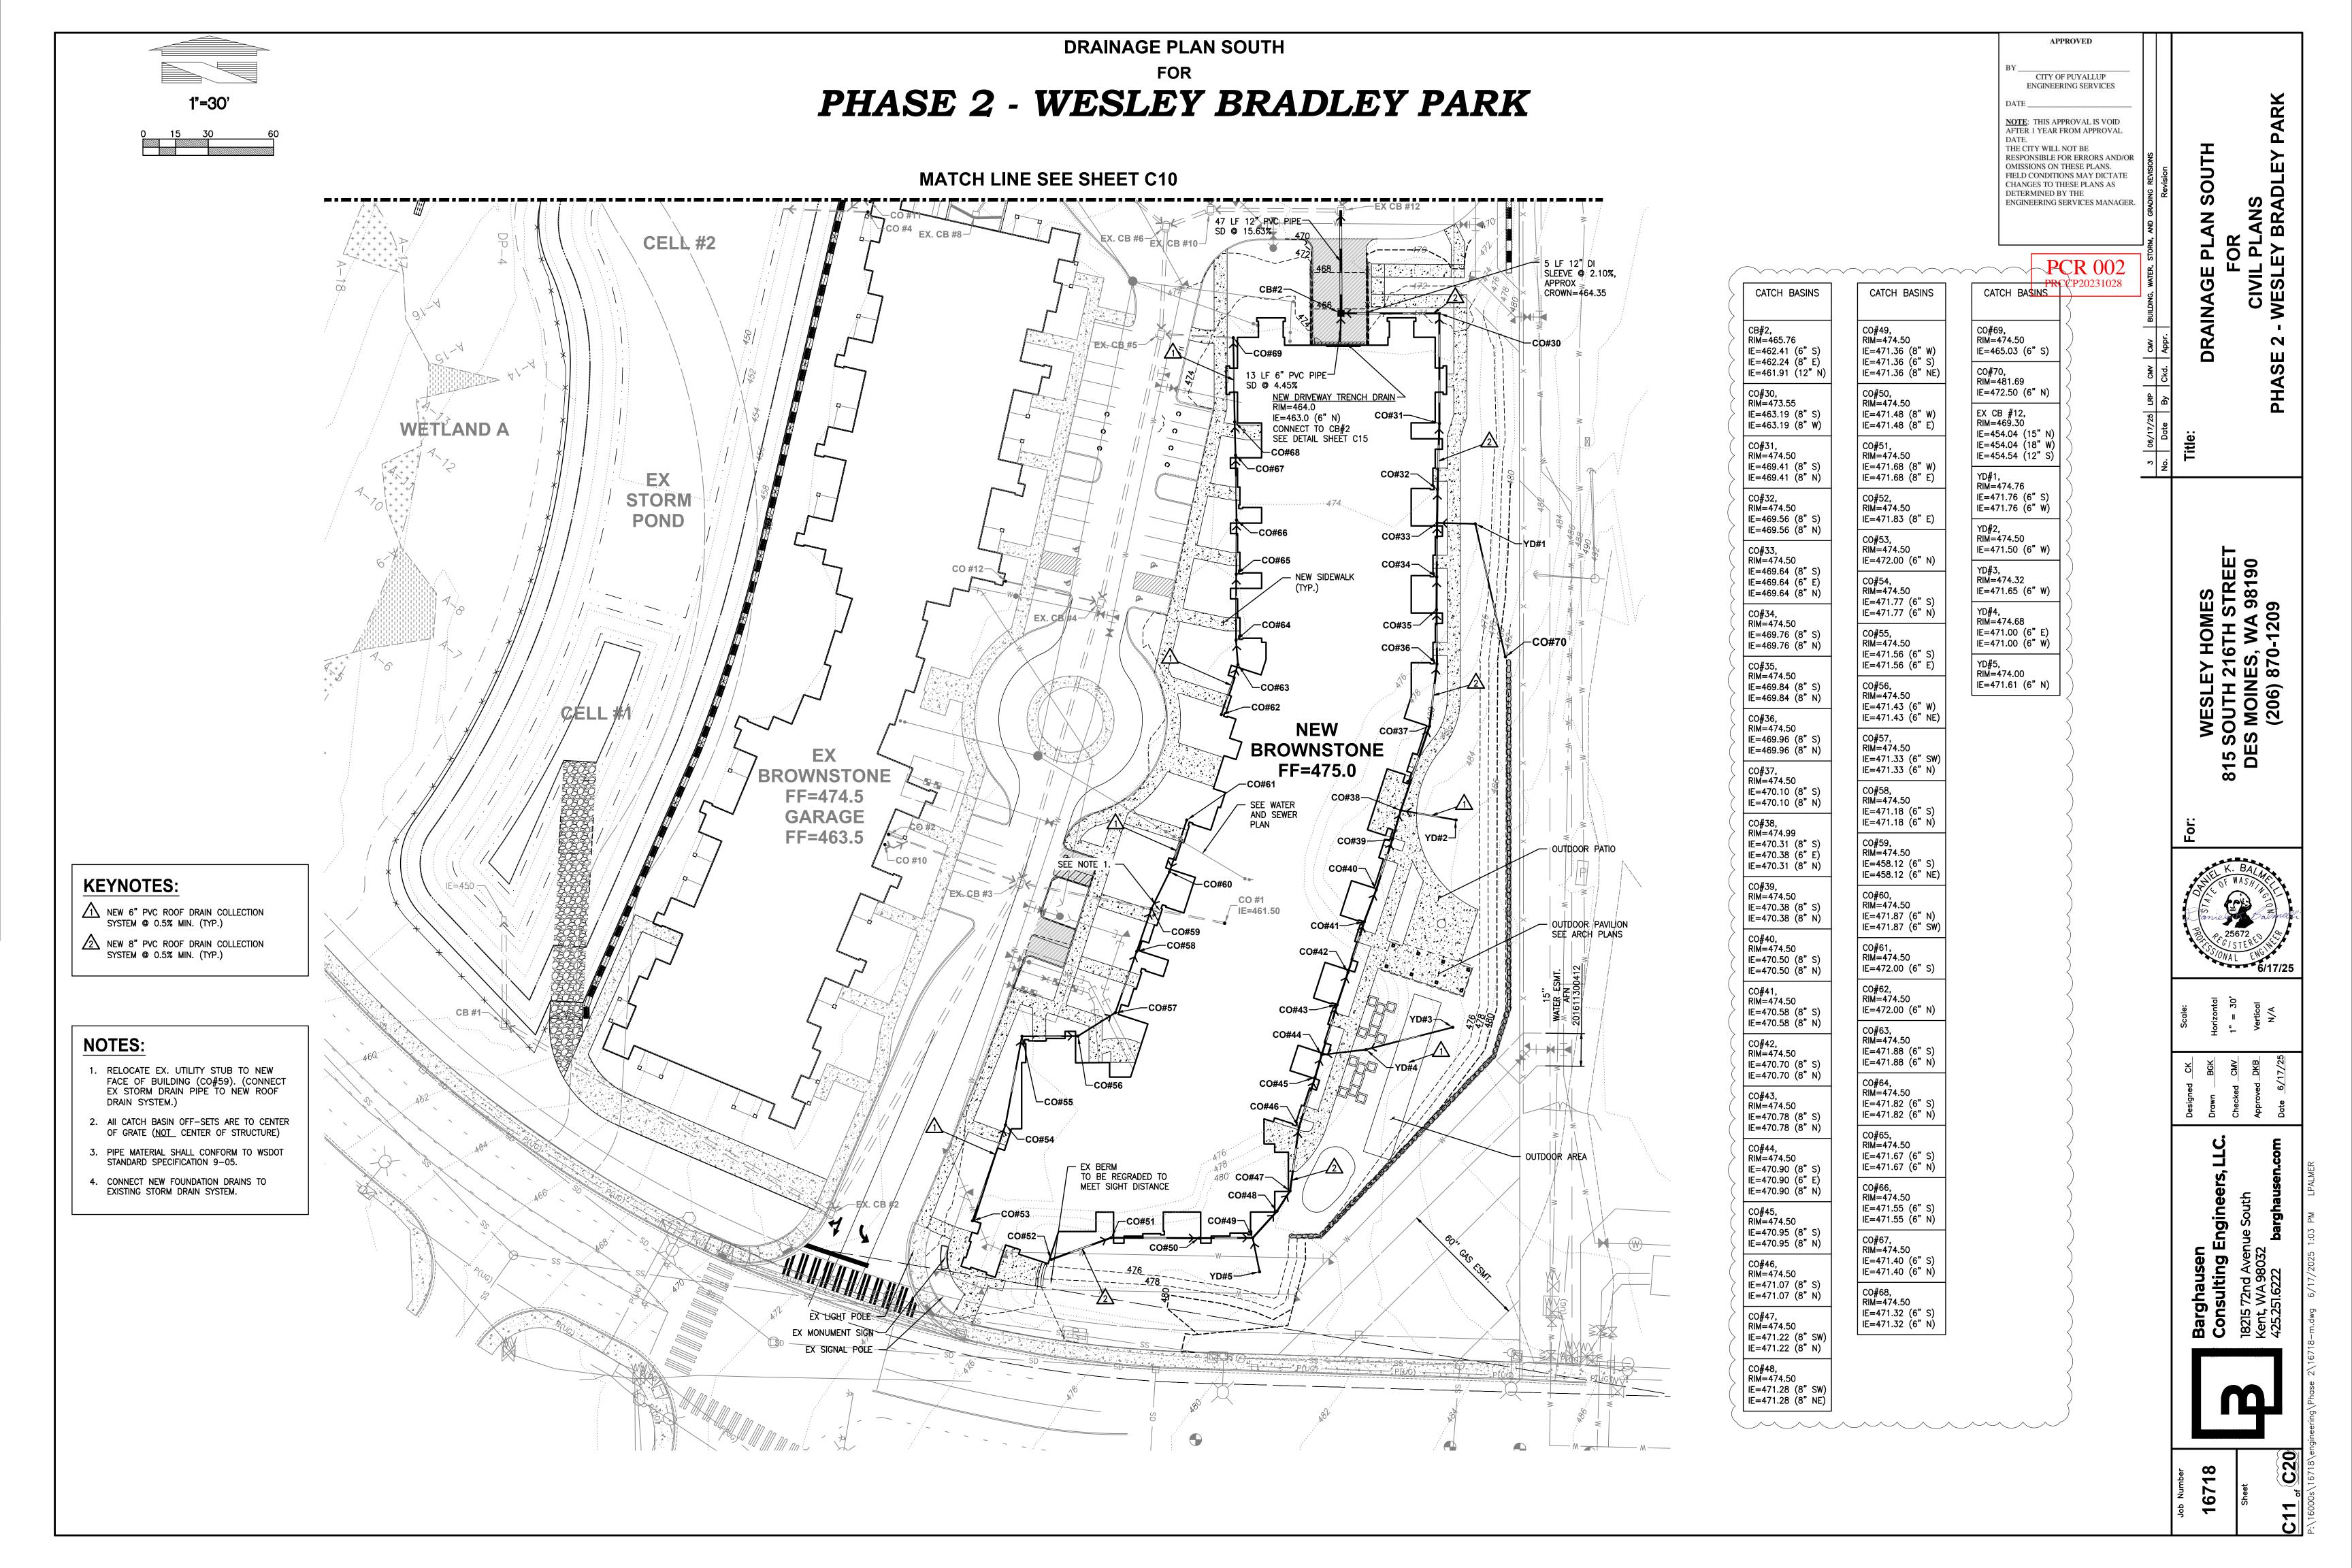

CITY OF PUYALLUP ENGINEERING SERVICES

NOTE: THIS APPROVAL IS VOID AFTER 1 YEAR FROM APPROVAL THE CITY WILL NOT BE RESPONSIBLE FOR ERRORS AND/OR OMISSIONS ON THESE PLANS. FIELD CONDITIONS MAY DICTATE CHANGES TO THESE PLANS AS

DETERMINED BY THE

ENGINEERING SERVICES MANAGER.

PRCCP20231028

SEWER AND

7

PHASE



7

NOTES:


1. ALL 12" VALVES TO BE BUTTERFLY VALVES PER CITY STANDARDS.

- 2. NO TREES TO BE PLANTED WITHIN 5 FEET OF THE WATER MAIN.
- 3. ALL FDCs SHALL BE LOCATED WITHIN 15 FEET OF THE ADJACENT FIRE HYDRANT, BUT NOT LESS THAN 10 FEET.
- 4. MINIMUM 3FT CLEARANCE BETWEEN FH, FDC, AND PIV.

UTILITY CONFLICT NOTE: CAUTION:

THE CONTRACTOR SHALL BE RESPONSIBLE FOR OF ALL EXISTING UTILITIES WHETHER SHOWN ON THESE PLANS OR NOT BY POTHOLING THE UTILITIES AND SURVEYING THE HORIZONTAL AND VERTICAL LOCATION PRIOR TO CONSTRUCTION. THIS SHALL INCLUDE CALLING UTILITY LOCATE @

1-800-424-5555 AND THEN POTHOLING ALL OF THE EXISTING UTILITIES AT LOCATIONS OF NEW UTILITY CROSSINGS TO PHYSICALLY VERIFY WHETHER OR NOT CONFLICTS EXIST. LOCATIONS OF SAID UTILITIES AS SHOWN ON THESE PLANS ARE BASED UPON THE UNVERIFIED PUBLIC INFORMATION AND ARE SUBJECT TO VARIATION. IF CONFLICTS SHOULD OCCUR, THE CONTRACTOR SHALL CONSULT BARGHAUSEN CONSULTING ENGINEERS, INC. TO RESOLVE ALL PROBLEMS PRIOR TO PROCEEDING WITH CONSTRUCTION.

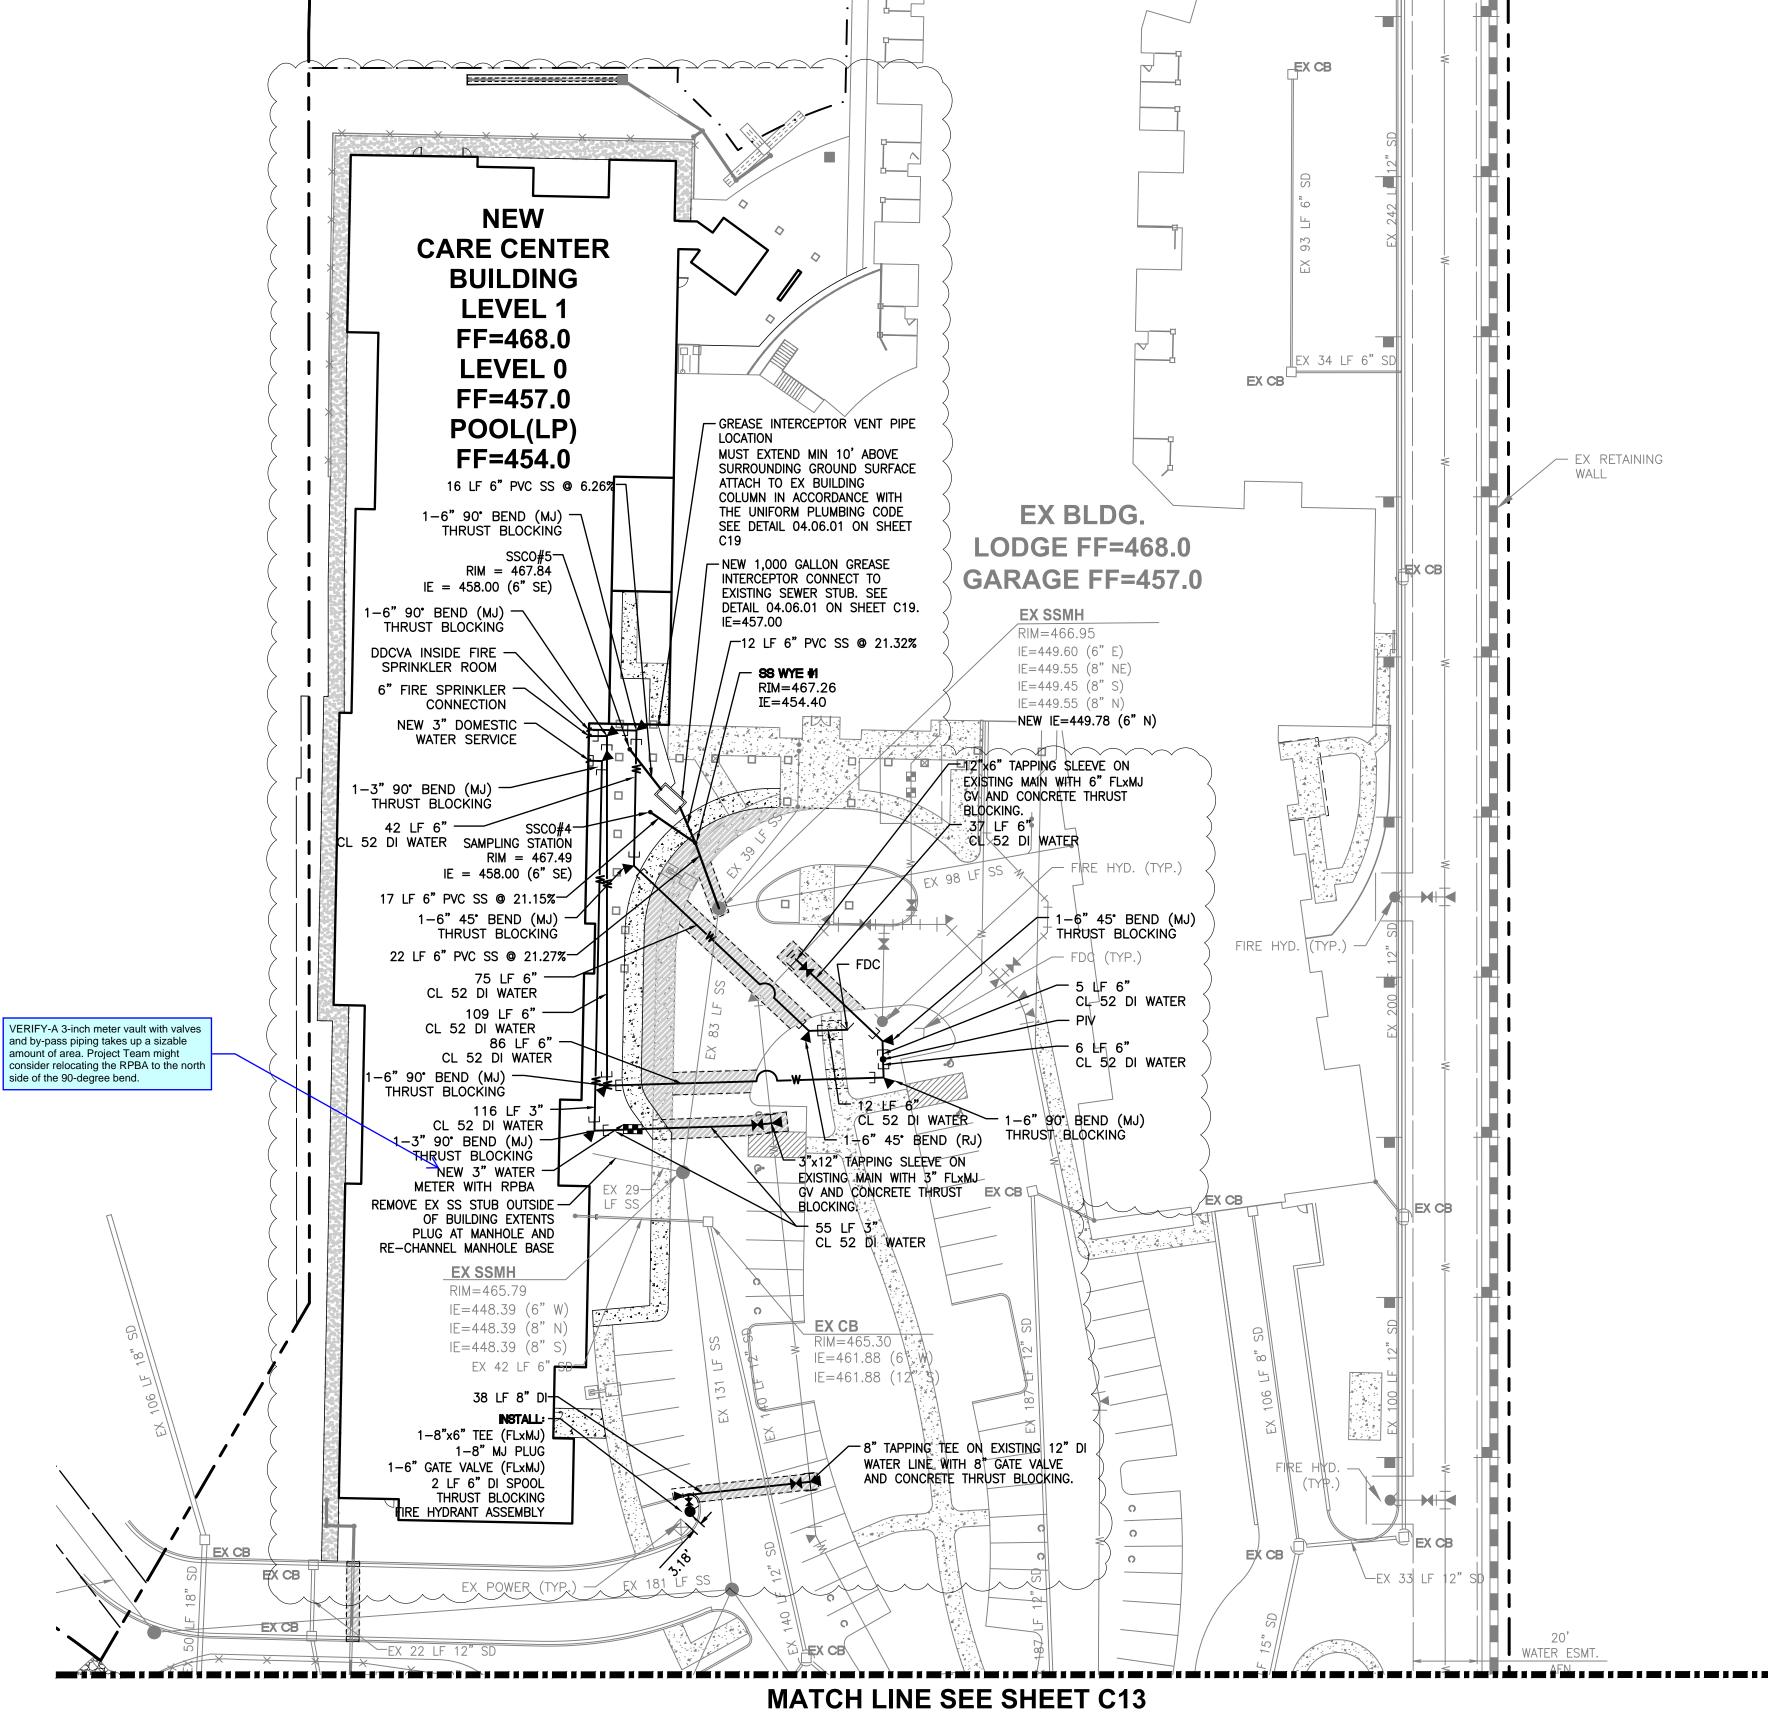

2. AFTER COMPLETION OF ALL ITEMS SHOWN ON THESE PLANS AND BEFORE ACCEPTANCE OF THE PROJECT THE CONTRACTOR SHALL OBTAIN A "PUNCH LIST" PREPARED BY THE CITY'S INSPECTOR DETAILING REMAINING ITEMS OF WORK TO BE COMPLETED. ALL ITEMS OF WORK SHOWN ON THESE PLANS SHALL BE COMPLETED TO THE SATISFACTION OF THE CITY PRIOR TO ACCEPTANCE OF THE WATER SYSTEM AND PROVISION OF SANITARY SEWER

3. ALL MATERIALS AND WORKMANSHIP SHALL CONFORM TO THE STANDARD SPECIFICATIONS FOR ROAD, BRIDGE, AND MUNICIPAL CONSTRUCTION (HEREINAFTER REFERRED TO AS THE "STANDARD SPECIFICATIONS"), WASHINGTON STATE DEPARTMENT OF TRANSPORTATION AND AMERICAN PUBLIC WORKS ASSOCIATION. WASHINGTON STATE CHAPTER, LATEST EDITION, UNLESS SUPERSEDED OR AMENDED BY THE CITY OF PUYALLUP CITY STANDARDS FOR PUBLIC WORKS ENGINEERING AND CONSTRUCTION (HEREINAFTER REFERRED TO AS THE "CITY STANDARDS").

4. A COPY OF THESE APPROVED PLANS AND APPLICABLE CITY DEVELOPER SPECIFICATIONS AND DETAILS SHALL BE ON SITE DURING CONSTRUCTION.

5. ANY REVISIONS MADE TO THESE PLANS MUST BE REVIEWED AND APPROVED BY THE DEVELOPER'S ENGINEER AND THE CITY PRIOR TO ANY IMPLEMENTATION IN THE FIELD. THE CITY SHALL NOT BE RESPONSIBLE FOR ANY ERRORS AND/OR OMISSIONS ON THESE PLANS.

6. THE CONTRACTOR SHALL HAVE ALL UTILITIES VERIFIED ON THE GROUND PRIOR TO ANY CONSTRUCTION. CALL (811) AT LEAST TWO WORKING DAYS IN ADVANCE. THE OWNER AND HIS/HER ENGINEER SHALL BE CONTACTED IMMEDIATELY IF A CONFLICT EXISTS.

7. ANY STRUCTURE AND/OR OBSTRUCTION THAT REQUIRES REMOVAL OR RELOCATION RELATING TO THIS PROJECT WASHINGTON STATE DEPARTMENT OF TRANSPORTATION AND AMERICAN PUBLIC WORKS ASSOCIATION, SHALL BE DONE SO AT THE DEVELOPER'S EXPENSE.

8. LOCATIONS OF EXISTING UTILITIES ARE APPROXIMATE. IT SHALL BE THE CONTRACTOR'S RESPONSIBILITY TO DETERMINE THE TRUE ELEVATIONS AND LOCATIONS OF HIDDEN UTILITIES. ALL VISIBLE ITEMS SHALL BE THE ENGINEER'S RESPONSIBILITY.

9. THE CONTRACTOR SHALL INSTALL, REPLACE, OR RELOCATE ALL SIGNS, AS SHOWN ON THE PLANS OR AS AFFECTED BY CONSTRUCTION, PER CITY STANDARDS.

10. POWER, STREET LIGHT, CABLE, AND TELEPHONE LINES SHALL BE IN A TRENCH LOCATED WITHIN A 10-FOOT UTILITY EASEMENT ADJACENT TO PUBLIC RIGHT-OF-WAY. RIGHT-OF-WAY CROSSINGS SHALL HAVE A MINIMUM HORIZONTAL SEPARATION FROM OTHER UTILITIES (SEWER, WATER, AND STORM) OF 5 FEET.

11. ALL CONSTRUCTION SURVEYING FOR EXTENSIONS OF PUBLIC FACILITIES SHALL BE DONE UNDER THE DIRECTION OF A WASHINGTON STATE LICENSED LAND SURVEYOR OR A WASHINGTON STATE LICENSED PROFESSIONAL CIVIL ENGINEER.

12. DURING CONSTRUCTION, ALL PUBLIC STREETS ADJACENT TO THIS PROJECT SHALL BE KEPT CLEAN OF ALL MATERIAL DEPOSITS RESULTING FROM ON-SITE CONSTRUCTION, AND EXISTING STRUCTURES SHALL BE PROTECTED AS DIRECTED BY THE CITY.

13. CERTIFIED RECORD DRAWINGS ARE REQUIRED PRIOR TO PROJECT ACCEPTANCE.

14. A NPDES STORMWATER GENERAL PERMIT MAY BE REQUIRED BY THE DEPARTMENT OF ECOLOGY FOR THIS PROJECT. FOR INFORMATION CONTACT THE DEPARTMENT OF ECOLOGY, SOUTHWEST REGION OFFICE AT (360)407-6300.

15. ANY DISTURBANCE OR DAMAGE TO CRITICAL AREAS AND ASSOCIATED BUFFERS, OR SIGNIFICANT TREES DESIGNATED FOR PRESERVATION AND PROTECTION SHALL BE MITIGATED IN ACCORDANCE WITH A MITIGATION PLAN REVIEWED AND APPROVED BY THE CITY'S PLANNING DIVISION. PREPARATION AND IMPLEMENTATION OF THE MITIGATION PLAN SHALL BE AT THE DEVELOPER'S EXPENSE.

STORMWATER NOTES

. ALL WORK IN CITY RIGHT-OF-WAY REQUIRES A PERMIT FROM THE CITY OF PUYALLUP. PRIOR TO ANY WORK COMMENCING. THE GENERAL CONTRACTOR SHALL ARRANGE FOR A PRECONSTRUCTION MEETING AT THE DEVELOPMENT SERVICES CENTER TO BE ATTENDED BY ALL CONTRACTORS THAT WILL PERFORM WORK SHOWN ON THE ENGINEERING PLANS, REPRESENTATIVES FROM ALL APPLICABLE UTILITY COMPANIES, THE PROJECT OWNER AND APPROPRIATE CITY STAFF. CONTACT ENGINEERING SERVICES TO SCHEDULE THE MEETING (253) 841-5568. THE CONTRACTOR IS RESPONSIBLE TO HAVE THEIR OWN APPROVED SET OF PLANS AT THE

2. AFTER COMPLETION OF ALL ITEMS SHOWN ON THESE PLANS AND BEFORE ACCEPTANCE OF THE PROJECT, THE Contractor shall obtain a "punch list" prepared by the city's inspector detailing remaining ITEMS OF WORK TO BE COMPLETED. ALL ITEMS OF WORK SHOWN ON THESE PLANS SHALL BE COMPLETED TO THE SATISFACTION OF THE CITY PRIOR TO ACCEPTANCE OF THE WATER SYSTEM AND PROVISION OF SANITARY

3. ALL MATERIALS AND WORKMANSHIP SHALL CONFORM TO THE STANDARD SPECIFICATIONS FOR ROAD, BRIDGE, AND MUNICIPAL CONSTRUCTION (HEREINAFTER REFERRED TO AS THE "STANDARD SPECIFICATIONS"). WASHINGTON STATE DEPARTMENT OF TRANSPORTATION AND AMERICAN PUBLIC WORKS ASSOCIATION, WASHINGTON STATE CHAPTER, LATEST EDITION, UNLESS SUPERSEDED OR AMENDED BY THE CITY OF PUYALLUP CITY STANDARDS FOR PUBLIC WORKS ENGINEERING AND CONSTRUCTION (HEREINAFTER REFERRED TO AS THE "CITY STANDARDS").

4. A COPY OF THESE APPROVED PLANS AND APPLICABLE CITY DEVELOPER SPECIFICATIONS AND DETAILS SHALL BE ON SITE DURING CONSTRUCTION.

5. ANY REVISIONS MADE TO THESE PLANS MUST BE REVIEWED AND APPROVED BY THE DEVELOPER'S ENGINEER AND THE ENGINEERING SERVICES STAFF PRIOR TO ANY IMPLEMENTATION IN THE FIELD. THE CITY SHALL NOT BE RESPONSIBLE FOR ANY ERRORS AND/OR OMISSIONS ON THESE PLANS.

6. THE CONTRACTOR SHALL HAVE ALL UTILITIES VERIFIED ON THE GROUND PRIOR TO ANY CONSTRUCTION. CALL (811) AT LEAST TWO WORKING DAYS IN ADVANCE. THE OWNER AND HIS/HER ENGINEER SHALL BE CONTACTED IMMEDIATELY IF A CONFLICT EXISTS.

7. ANY STRUCTURE AND/OR OBSTRUCTION WHICH REQUIRE REMOVAL OR RELOCATION RELATING TO THIS PROJECT, SHALL BE DONE SO AT THE DEVELOPER'S EXPENSE.

8. DURING CONSTRUCTION, ALL EXISTING AND NEWLY INSTALLED DRAINAGE STRUCTURES SHALL BE PROTECTED FROM SEDIMENTS.

9. ALL STORM MANHOLES SHALL CONFORM TO CITY STANDARD DETAIL NO. 02.01.01. FLOW CONTROL MANHOLE/OIL WATER SEPARATOR SHALL CONFORM TO CITY STANDARD DETAIL NO. 02.01.06 AND 02.01.07.

MANHOLE RING AND COVER SHALL CONFORM TO CITY STANDARD DETAIL 06.01.02.

1. CATCH BASINS TYPE I SHALL CONFORM TO CITY STANDARD DETAIL NO.02.01.02 AND 02.01.03 AND SHALL BE USED ONLY FOR DEPTHS LESS THAN 5 FEET FROM TOP OF THE GRATE TO THE INVERT OF THE STORM

12. CATCH BASINS TYPE II SHALL CONFORM TO CITY STANDARD DETAIL NO.02.01.04 AND SHALL BE USED FOR DEPTHS GREATER THAN 5 FEET FROM TOP OF THE GRATE TO THE INVERT OF THE STORM PIPE. CITY OF PUYALLUP - CITY STANDARDS STORM REVISED 08/2024

13. CAST IRON OR DUCTILE IRON FRAME AND GRATE SHALL CONFORM TO CITY STANDARD DETAIL NO.02.01.05. GRATE SHALL BE MARKED WITH "DRAINS TO STREAM". SOLID CATCH BASIN LIDS (SQUARE UNLESS NOTED AS ROUND) SHALL CONFORM TO WSDOT STANDARD PLAN B-30.20-04 (OLYMPIC FOUNDRY NO. SM60 OR EQUAL). VANED GRATES SHALL CONFORM TO WSDOT STANDARD PLAN B-30.30-03 (OLYMPIC FOUNDRY NO. SM60V OR EQUAL).

14. STORMWATER PIPE SHALL BE ONLY PVC, CONCRETE, DUCTILE IRON, OR DUAL WALLED POLYPROPYLENE PIPE.

A. THE USE OF ANY OTHER TYPE SHALL BE REVIEWED AND APPROVED BY THE ENGINEERING SERVICES STAFF PRIOR TO INSTALLATION.

B. PVC PIPE SHALL BE PER ASTM D3034, SDR 35 FOR PIPE SIZE 15-INCH AND SMALLER AND F679 FOR PIPE SIZES 18 TO 27 INCH. MINIMUM COVER ON PVC PIPE SHALL BE 3.0 FEET.

C. CONCRETE PIPE SHALL CONFORM TO THE WSDOT STANDARD SPECIFICATIONS FOR CONCRETE UNDERDRAIN PIPE. MINIMUM COVER ON CONCRETE PIPE SHALL NOT LESS THAN 3.0 FEET.

D. DUCTILE IRON PIPE SHALL BE CLASS 50, CONFORMING TO AWWA C151. MINIMUM COVER ON

DUCTILE IRON PIPE SHALL BE 1.0 FOOT.

E. POLYPROPYLENE PIPE (PP) SHALL BE DUAL WALLED, HAVE A SMOOTH INTERIOR AND EXTERIOR CORRUGATIONS AND MEET WSDOT 9-05.24(1), 12-INCH THROUGH 30-INCH PIPE SHALL MEET OR EXCEED ASTM F2736 AND AASHTO M330, TYPE S, OR TYPE D. 36-INCH THROUGH 60-INCH PIPE SHALL MEET OR EXCEED ASTM F2881 AND AASHTO M330. TYPE S. OR TYPE D. TESTING SHALL BE PER ASTM F1417. MINIMUM COVER OVER POLYPROPYLENE PIPE SHALL BE 3-FEET.

15. TRENCHING, BEDDING, AND BACKFILL FOR PIPE SHALL CONFORM TO CITY STANDARD DETAIL NO. 06.01.01.

16. STORM PIPE SHALL BE A MINIMUM OF 10 FEET AWAY FROM BUILDING FOUNDATIONS AND/OR ROOF LINES.

17. ALL STORM PIPE SHALL BE TESTED AND INSPECTED FOR ACCEPTANCE AS OUTLINED IN SECTION 209 OF THE CITY OF PUYALLUP STORMWATER MANAGEMENT STANDARDS.

18. ALL TEMPORARY SEDIMENTATION AND EROSION CONTROL MEASURES. AND PROTECTIVE MEASURES FOR

CRITICAL AREAS AND SIGNIFICANT TREES SHALL BE INSTALLED PRIOR TO INITIATING ANY CONSTRUCTION

REGISTRATION SHALL BE SUBMITTED TO THE CITY PRIOR TO CONSTRUCTION.

19. REGISTRATION IS REQUIRED FOR ALL CLASS V UIC WELLS WITHIN PUBLIC DRAINAGE TRACTS OR PUBLIC RIGHTOF-WAY AND MUST BE SUBMITTED SIXTY (60) DAYS PRIOR TO WELL CONSTRUCTION. A COPY OF THE ONLINE 26. NEW WATER MAIN INSTALLATION:

WATER SYSTEM NOTES:

1. ALL WORK IN CITY RIGHT-OF-WAY REQUIRES A PERMIT FROM THE CITY OF PUYALLUP. PRIOR TO ANY WORK COMMENCING, THE GENERAL CONTRACTOR SHALL ARRANGE FOR A PRECONSTRUCTION MEETING AT THE DEVELOPMENT SERVICES CENTER TO BE ATTENDED BY ALL CONTRACTORS THAT WILL PERFORM WORK SHOWN ON THE ENGINEERING PLANS, REPRESENTATIVES FROM ALL APPLICABLE UTILITY COMPANIES, THE PROJECT OWNER AND APPROPRIATE CITY STAFF. CONTACT ENGINEERING SERVICES TO SCHEDULE THE MEETING (253) 841-5568. THE CONTRACTOR IS RESPONSIBLE TO HAVE THEIR OWN APPROVED SET OF PLANS AT THE

2. AFTER COMPLETION OF ALL ITEMS SHOWN ON THESE PLANS AND BEFORE ACCEPTANCE OF THE PROJECT, THE CONTRACTOR SHALL OBTAIN A "PUNCH LIST" PREPARED BY THE CITY'S INSPECTOR DETAILING REMAINING ITEMS OF WORK TO BE COMPLETED. ALL ITEMS OF WORK SHOWN ON THESE PLANS SHALL BE COMPLETED TO THE SATISFACTION OF THE CITY PRIOR TO ACCEPTANCE OF THE WATER SYSTEM AND PROVISION OF SANITARY

3. ALL MATERIALS AND WORKMANSHIP SHALL CONFORM TO THE STANDARD SPECIFICATIONS FOR ROAD, BRIDGE, AND MUNICIPAL CONSTRUCTION (HEREINAFTER REFERRED TO AS THE "STANDARD SPECIFICATIONS"), WASHINGTON STATE CHAPTER, LATEST EDITION, UNLESS SUPERSEDED OR AMENDED BY THE CITY OF PUYALLUP CITY STANDARDS FOR PUBLIC WORKS ENGINEERING AND CONSTRUCTION (HEREINAFTER REFERRED TO AS THE "CITY STANDARDS"). OR AS DIRECTED BY FRUITLAND MUTUAL WATER COMPANY (FMWC), VALLEY WATER (VW), OR TACOMA CITY WATER (TCW) IS THE PURVEYOR.

4. A COPY OF THESE APPROVED PLANS AND APPLICABLE CITY DEVELOPER SPECIFICATIONS AND DETAILS SHALL BE ON SITE DURING CONSTRUCTION.

5. ANY REVISIONS MADE TO THESE PLANS MUST BE REVIEWED AND APPROVED BY THE DEVELOPER'S ENGINEER, THE ENGINEERING SERVICES STAFF, AND THE FMWC, VW OR TCW WHEN SERVED BY THAT PURVEYOR, PRIOR TO ANY IMPLEMENTATION IN THE FIELD. THE CITY SHALL NOT BE RESPONSIBLE FOR ANY ERRORS AND/OR OMISSIONS ON THESE PLANS.

6. THE CONTRACTOR SHALL HAVE ALL UTILITIES VERIFIED ON THE GROUND PRIOR TO ANY CONSTRUCTION. CALL (811) AT LEAST TWO WORKING DAYS IN ADVANCE. THE OWNER AND HIS/HER ENGINEER SHALL BE CONTACTED IMMEDIATELY IF A CONFLICT EXISTS.

7. ANY STRUCTURE AND/OR OBSTRUCTION WHICH REQUIRES REMOVAL OR RELOCATION RELATING TO THIS PROJECT SHALL BE DONE SO AT THE DEVELOPER'S EXPENSE.

8. BACTERIOLOGICAL (COLIFORM AND IRON BACTERIA) TEST SAMPLES WILL BE TAKEN BY THE CITY (OR FMWC, VW OR TCW WHEN SERVED BY THAT PURVEYOR) AND PAID FOR BY THE CONTRACTOR, EXCEPT FOR CAPITAL IMPROVEMENT PROJECTS (CIP) WHICH SHALL BE PAID FOR BY THE CITY.

9. WATER MAINS SHALL HAVE A MINIMUM COVER OF 36 INCHES FROM PAVED FINAL GRADE IN IMPROVED RIGHT-OF-WAY AND IMPROVED EASEMENTS, AND A MINIMUM OF 48 INCHES IN UNIMPROVED RIGHT-OFWAY AND UNIMPROVED EASEMENTS.

10. PIPE FOR WATER MAINS SHALL BE DUCTILE IRON CONFORMING TO SECTION 7-09 OF THE STANDARD SPECIFICATIONS, CLASS 52 WITH TYTON OR APPROVED EQUAL JOINTS. PIPE SHALL BE CEMENT LINED IN ACCORDANCE WITH A.S.A. SPECIFICATION A 21.4-1964.

11. CONNECTIONS TO EXISTING WATER MAINS TYPICALLY SHALL BE WET TAPS THROUGH A TAPPING TEE AND TAPPING VALVE AND SHALL BE MADE BY A CITY APPROVED CONTRACTOR. THE TAPPING SLEEVE SHALL BE ROMAC SST ALL STAINLESS STEEL TAPPING SLEEVE OR APPROVED EQUAL. A TWO-PIECE EPOXY COATED OR DUCTILE IRON TAPPING SLEEVE MAY BE USED ON DUCTILE IRON PIPE, WHEN THE TAP IS SMALLER THAN THE WATER MAIN SIZE I.E. 6-INCH TAP ON 8-INCH PIPE. THE CITY (OR FMWC, VW OR TCW WHEN SERVED BY THAT PURVEYOR) SHALL APPROVE THE TIME AND LOCATION FOR THESE CONNECTIONS

12. ALL WATER MAINS AND APPURTENANCES SHALL BE HYDROSTATICALLY TESTED AT 200 PSI IN ACCORDANCE WITH STANDARD SPECIFICATION 7-09.3(23), PRESSURE TESTING SHALL NOT BE PERFORMED UNTIL SATISFACTORY PURITY SAMPLES HAVE BEEN RECEIVED, EXCEPT WHEN NEW WATER MAINS ARE INSTALLEI INDEPENDENTLY FROM THE WATER SYSTEM PIPING.

13. FIRE HYDRANTS SHALL BE INSTALLED IN ACCORDANCE WITH CITY STANDARD DETAIL 03.05.01 AND AS DIRECTED BY THE CITY OF PUYALLUP FIRE CODE OFFICIAL.

14. VALVE MARKER POSTS SHALL BE INSTALLED WHERE VALVE BOXES ARE HIDDEN FROM VIEW OR IN UNPAVED AREAS THE INSTALLATION SHALL BE IN ACCORDANCE WITH CITY STANDARD DETAIL 03.01.02.

15. RESILIENT SEATED WEDGE GATE VALVES SHALL BE USED FOR 10-INCH MAINS AND SMALLER. BUTTERFLY VALVES SHALL BE USED FOR MAINS GREATER THAN 10 INCHES.

AWWA SPECIFICATION C111-72. 17. WATER MAIN PIPE AND SERVICE CONNECTIONS SHALL BE A MINIMUM OF 10 FEET AWAY FROM BUILDING

16. PIPE FITTING FOR WATER MAINS SHALL BE DUCTILE IRON AND SHALL BE MECHANICAL JOINT CONFORMING TO

FOUNDATIONS AND/OR ROOF LINES. 18. WHERE A WATER MAIN CROSSES THE NORTHWEST GAS PIPELINE, THE WATER LINE SHALL BE CASED WITH PVC PIPE A MINIMUM OF 10 FEET BEYOND EACH SIDE OF THE GAS LINE EASEMENT. CONTACT WILLIAMS

19. TRENCHING, BEDDING, AND BACKFILL FOR WATER MAINS SHALL BE INSTALLED IN ACCORDANCE WITH CITY

NORTHWEST PIPELINE BEFORE THE CROSSING IS MADE.

DIVISION SUPERVISOR PRIOR TO COMMENCING WORK.)

STANDARD DETAIL 06.01.01.

20. ALL COMMERCIAL AND INDUSTRIAL DEVELOPMENTS, IRRIGATION SYSTEMS, AND MULTI-FAMILY WATER SERVICE CONNECTIONS SHALL BE PROTECTED BY A DOUBLE CHECK VALVE ASSEMBLY OR A REDUCED PRESSURE BACKFLOW ASSEMBLY AS DIRECTED BY THE CITY (OR FMWC, VW OR TCW WHEN SERVED BY THAT PURVEYOR) CONFORMING TO CITY STANDARD DETAILS 03.04.01, 03.04.02, AND 03.04.03.

21. ANY LEAD JOINT FITTING DISTURBED DURING CONSTRUCTION SHALL BE REPLACED WITH A MECHANICAL JOINT FITTING AT THE CONTRACTOR'S EXPENSE.

22. HYDRAULIC FIRE FLOW MODELING SHALL BE REQUIRED FOR FORMAL PLATS WITHIN OR TO BE ANNEXED INTO THE CITY OF PUYALLUP'S WATER SERVICE AREA. THE DEVELOPER SHALL BE RESPONSIBLE TO APPLY FOR A HYDRAULIC MODEL PERMIT PRIOR TO PLAT REVIEW. THE HYDRAULIC MODELING CRITERIA IS BASED ON THE PROJECTED WATER DEMAND WHILE MAINTAINING A MINIMUM SYSTEM PRESSURE OF 20 POUNDS PER SQUARE INCH (PSI) AND A MAXIMUM VELOCITY OF 10 FEET PER SECOND.

23. WHEN USING A FIRE HYDRANT FOR NON-FIREFIGHTING PURPOSES, A CITY HYDRANT METER MUST BE USED. COORDINATE THE ACQUISITION OF THE HYDRANT METER WITH THE CITY'S UTILITY BILLING DIVISION AT PUYALLUP CITY HALL. A CITY APPROVED BACKFLOW PROTECTION ASSEMBLY SHALL BE INSTALLED BY THE PERSON REQUESTING USE OF A FIRE HYDRANT. THE ASSEMBLY SHALL BE ACCOMPANIED BY A CURRENT BACKFLOW ASSEMBLY TEST REPORT. THE TEST REPORT SHALL BE AVAILABLE AT THE SITE FOR THE DURATION OF THE HYDRANT USE.

24. SHOULD A BREAK OCCUR ON ANY CITY WATER MAIN, THE CONTRACTOR SHALL FOLLOW THE CITY'S ADOPTED "WATER MAIN BREAK PROCEDURE" ISSUED TO THEM AT THE PRE-CONSTRUCTION MEETING AND NOTIFY THOSE CONNECTED TO THE SYSTEM IN THE IMPACTED AREA AS OUTLINED IN THE PROCEDURE.

25. WATER MAIN REPAIRS (REFERENCES: AWWA C651-14 AND WSDOT STANDARD SPECIFICATION SECTION 7-09) (NOTE: A PLANNED WATER MAIN REPAIR SHALL BE APPROVED BY THE CITY INSPECTOR AND/OR WATER

a. REPAIR WITHOUT DEPRESSURIZATION - SMALL LEAKS SHALL BE REPAIRED USING REPAIR BANDS WHILE MAINTAINING POSITIVE PRESSURE IN THE WATER MAIN. VALVES SURROUNDING THE LEAK WILL BE PARTIALLY SHUT BY THE CITY WATER DEPARTMENT TO REDUCE THE FLOW AND PRESSURE TO THE AREA. BLOWOFFS AND HYDRANTS IN THE REDUCED PRESSURE AREA MAY BE OPENED AS NEEDED TO FURTHER REDUCE THE PRESSURE. THE WATER MAIN TRENCH SHALL BE OVER-EXCAVATED TO ALLOW WATER IN THE TRENCH TO BE PUMPED OUT AND MAINTAINED BELOW THE LEVEL OF THE WATER MAIN. THE REPAIR SHALL BE COMPLETED WITH THE WATER MAIN PRESSURE REMAINING POSITIVE. AFTER THE REPAIR IS MADE, THE SYSTEM SHALL BE FULLY PRESSURIZED AND A VISUAL LEAK INSPECTION WILL BE COMPLETED. THE WATER MAIN IN THE AFFECTED AREA SHALL BE FLUSHED TO ACHIEVE THREE PIPE VOLUMES PULLED FROM THE PIPE (DISTANCE MEASURED FROM VALVE OPENED FOR FLUSHING TO THE EXIT HYDRANT OR BLOWOFF).

CONSTRUCTION NOTES

REPAIR/CUT-IN WITH DEPRESSURIZATION -TRENCH SHALL BE OVER EXCAVATED AND DEWATERED BELOW THE WATER MAIN. FLUSH WATER FROM PIPE FROM EACH DIRECTION UNTIL IT RUNS CLEAR. IMMEDIATELY PRIOR TO INSTALLATION OF A NEW PIPE SECTION FOR REPAIR OR CUT IN TEE, ALL NEW FITTINGS AND PIPE SPOOLS SHALL BE SWABBED WITH A FIVE PERCENT (5%) CHLORINE SOLUTION (MINIMUM). THE INTERIOR OF THE EXISTING PIPE SHALL BE SWABBED WITH A FIVE PERCENT (5%) CHLORINE SOLUTION AT LEAST 6 FEET IN EACH DIRECTION FROM EXPOSED CUT ENDS. THE WATER MAIN IN THE AFFECTED AREA SHALL BE FLUSHED TO ACHIEVE THREE PIPE VOLUMES PULLED FROM THE PIPE (DISTANCE MEASURED FROM THE VALVE OPENED FOR FLUSHING TO THE EXIT HYDRANT OR BLOWOFF). CUSTOMERS SHALL BE NOTIFIED AFTER THE WATER MAIN IS FLUSHED AND REPAIRS HAVE BEEN COMPLETED, AS OUTLINED IN THE "WATER MAIN BREAK PROCEDURE."

a. EACH NEW WATER MAIN SECTION SHALL BE DELIVERED, STACKED AND STORED ONSITE WITH ENDS PLUGGED. THE PLUGS SHALL REMAIN IN THE PIPE UNTIL EACH PARTICULAR SECTION IS INSTALLED. NATIONAL SANITATION FOUNDATION (NSF) APPROVED SIXTY-FIVE PERCENT (65%) CALCIUM HYPOCHLORITE SHALL BE ADDED TO THE UPSTREAM END OF EACH PIPE SECTION, AND AT EACH HYDRANT TEE IN THE AMOUNT GIVEN IN THE TABLE BELOW (OR PER APPROVED MANUFACTURER SPECIFICATIONS). THE MINIMUM AMOUNT OF CALCIUM HYPOCHLORITE ADDED SHOULD BE SUFFICIENT TO ACHIEVE A 50 MG/L CONCENTRATION WITHIN THE IMPACTED AREA.

65% Calcium Hypochlorite Addition per Pipe Section

	Pipe Volume	5-gram	Hypochlori	te Granules	Maximum
Pipe Diameter	per 18 feet	tablets per	Ounces per	Teaspoons	Fill Rate
(Inches)	(gal)	pipe section	500 feet	per 18 feet	(gpm)_
4	35	1	1.7	0.2	40
6	53	1	3.8	0.4	90
8	70	2	6.7	0.7	150
12	106	4	15.1	1.4	350
16	141	6	27	2.5	600

b. NEW WATER MAINS SHALL BE FILLED USING AN APPROVED BACKFLOW PREVENTION ASSEMBLY. THE WATER MAIN SHALL BE FILLED FROM THE LOWER ELEVATION END SO THAT AS THE WATER MAIN IS FILLED. THE CHORINE IS CONTACTED. DISSOLVED AND SPREAD RELATIVELY UNIFORM THROUGH THE LENGTH OF THE NEW WATER MAIN. THE FILL RATE SHALL BE MINIMIZED SO THAT THE VELOCITY OF THE WATER IS LESS THAN 1 FT/SEC (SEE TABLE ABOVE). SUCCESSFUL PRESSURE TEST AND BACTERIOLOGICAL TESTS SHALL BE COMPLETED AND PROVIDED TO THE CITY PRIOR TO ANY NEW MATER MAIN CONNECTION TO THE EXISTING WATER SYSTEM.

THE CHLORINATED WATER WILL BE ALLOWED TO REMAIN IN CONTACT WITH THE NEW WATER MAIN SYSTEM FOR 24 TO 72 HOURS. AFTER 24 HOURS, WATER MAY BE ADDED TO THE WATER MAIN FOR THE PURPOSES OF PRESSURE TESTING. THE WATER IN THE MAIN USED FOR PRESSURE TESTING MUST REMAIN IN THE WATER MAIN UNTIL PRESSURE TEST IS COMPLETED. IF NECESSARY, LIQUID CHLORINE SHALL BE INJECTED INTO THE WATER MAIN WITH FILL WATER TO MAINTAIN A CONCENTRATION IN THE WATER MAIN ABOVE 50 MG/L. UNDER NO CIRCUMSTANCE SHALL "SUPER" CHLORINATED WATER BE ALLOWED TO SIT WITHIN A NEW WATER MAIN FOR MORE THAN 5 DAYS.

d. PRESSURE TESTING INCLUDES TESTING AGAINST NEW VALVES AND HYDRANTS. EACH VALVE SHALL BE TESTED BY CLOSING EACH IN TURN AND REDUCING THE PRESSURE BEYOND THE VALVE. THE PRESSURE ON THE BACK SIDE OF THE VALVE SHOULD NOT BE ELIMINATED. CARE MUST BE TAKEN THAT. DURING THIS PROCESS, POSITIVE PRESSURE REMAINS THROUGHOUT THE SYSTEM BEING TESTED AT ALL TIMES. ALL HYDRANT FOOT VALVES SHALL BE OPEN DURING PRESSURE TESTING SO THAT THE PRESSURE TEST IS AGAINST THE HYDRANT VALVE. PRESSURE TESTING WILL NOT BE ALLOWED AGAINST ANY EXISTING VALVES.

e. AFTER SUCCESSFUL PRESSURE TESTING, THE WATER MAIN SHALL BE THOROUGHLY FLUSHED TO REMOVE ALL "SUPER" CHLORINATED WATER FROM THE NEW WATER MAIN. FLUSHING OF NEW OR EXTENDED WATER MAINS SHALL BE CONDUCTED PER WSDOT SPECIFICATION 7-09.3(24)A WITH A MINIMUM VELOCITY DEVELOPED WITHIN THE PIPE WHILE FLUSHING OF 2.5 FEET PER SECOND (FPS). ALL FLUSHED WATER SHALL BE DECHLORINATED PRIOR TO DISPOSAL. THE CONTRACTOR SHALL BE RESPONSIBLE FOR DISPOSAL OF ALL CHLORINATED WATER FLUSHED FROM MAINS. THE CITY SHALL APPROVE THE DISPOSAL METHOD PRIOR TO IMPLEMENTATION IN THE FIELD. THE CONTRACTOR SHALL UTILIZE ONSITE DISPOSAL METHODS, IF AVAILABLE. DISPOSAL OF FLUSH WATER TO THE SANITARY SEWER SYSTEM SHALL NOT BE ALLOWED WITHOUT WRITTEN PERMISSION FROM THE WATER POLLUTION CONTROL PLANT (WPCP) SUPERVISOR. ANY PLANNED DISCHARGE TO A STORMWATER SYSTEM SHALL BE DECHLORINATED TO A CONCENTRATION OF 0.1 PPM OR LESS, PH ADJUSTED (IF NECESSARY) TO BE BETWEEN 6.5 AND 8.5, AND VOLUMETRICALLY AND VELOCITY CONTROLLED TO PREVENT ANY RESUSPENSION OF SEDIMENTS. THE CITY WILL REQUIRE INDEPENDENT TESTING THROUGHOUT THE WATER DISCHARGE PROCESS TO ENSURE COMPLIANCE OF THESE STANDARDS ARE MET.

f. SAMPLES FOR BACTERIOLOGICAL ANALYSIS SHALL BE COLLECTED AFTER FLUSHING AND AGAIN 24 HOURS AFTER THE FIRST SET OF SAMPLES.

ALL CLOSURE/FINAL CONNECTION FITTINGS SHALL BE SPRAYED CLEAN AND THEN SWABBED WITH A FIVE PERCENT (5%) CHLORINE SOLUTION IMMEDIATELY PRIOR TO INSTALLATION PER AWWA STANDARD C651. ADDITIONAL SAMPLES FOR BACTERIOLOGICAL ANALYSIS SHALL BE COLLECTED FROM THE IMMEDIATE VICINITY OF THE NEW OR REPLACED WATER MAIN AND ANALYZED AFTER THE FINAL CONNECTIONS ARE MADE. IF NECESSARY, ADDITIONAL FLUSHING SHALL BE CONDUCTED AND ADDITIONAL SAMPLES SHALL BE COLLECTED UNTIL SATISFACTORY RESULTS ARE OBTAINED.

SANITARY SEWER NOTES:

WITHIN CITY RIGHT-OF-WAY.

WASHINGTON INDUSTRIAL SAFETY AND HEALTH ACT (WISHA).

1. ALL WORK IN CITY RIGHT-OF-WAY REQUIRES A PERMIT FROM THE CITY OF PUYALLUP. PRIOR TO ANY WORK COMMENCING. THE GENERAL CONTRACTOR SHALL ARRANGE FOR A PRECONSTRUCTION MEETING AT THE DEVELOPMENT SERVICES CENTER TO BE ATTENDED BY ALL CONTRACTORS THAT WILL PERFORM WORK SHOWN ON THE ENGINEERING PLANS, REPRESENTATIVES FROM ALL APPLICABLE UTILITY COMPANIES, THE PROJECT OWNER AND APPROPRIATE CITY STAFF. CONTACT ENGINEERING SERVICES TO SCHEDULE THE MEETING (253) 841-5568. THE CONTRACTOR IS RESPONSIBLE TO HAVE THEIR OWN APPROVED SET OF PLANS AT THE

2. AFTER COMPLETION OF ALL ITEMS SHOWN ON THESE PLANS AND BEFORE ACCEPTANCE OF THE PROJECT, THE CONTRACTOR SHALL OBTAIN A "PUNCH LIST" PREPARED BY THE CITY'S INSPECTOR DETAILING REMAINING ITEMS OF WORK TO BE COMPLETED. ALL ITEMS OF WORK SHOWN ON THESE PLANS SHALL BE COMPLETED TO THE SATISFACTION OF THE CITY PRIOR TO ACCEPTANCE OF THE SEWER SYSTEM AND PROVISION OF SANITARY SEWER SERVICE.

3. ALL MATERIALS AND WORKMANSHIP SHALL CONFORM TO THE STANDARD SPECIFICATIONS FOR ROAD, BRIDGE, AND MUNICIPAL CONSTRUCTION (HEREINAFTER REFERRED TO AS THE "STANDARD SPECIFICATIONS"). WASHINGTON STATE DEPARTMENT OF TRANSPORTATION AND AMERICAN PUBLIC WORKS ASSOCIATION, WASHINGTON STATE CHAPTER, LATEST EDITION, UNLESS SUPERSEDED OR AMENDED BY THE CITY OF PUYALLUP CITY STANDARDS FOR PUBLIC WORKS ENGINEERING AND CONSTRUCTION (HEREINAFTER REFERRED TO AS THE "CITY STANDARDS").

4. A COPY OF THESE APPROVED PLANS AND APPLICABLE CITY DEVELOPER SPECIFICATIONS AND DETAILS SHALL BE ON SITE DURING CONSTRUCTION.

5. ANY REVISIONS MADE TO THESE PLANS MUST BE REVIEWED AND APPROVED BY THE DEVELOPER'S ENGINEER AND THE ENGINEERING SERVICES STAFF PRIOR TO ANY IMPLEMENTATION IN THE FIELD. THE CITY SHALL NOT BE RESPONSIBLE FOR ANY ERRORS AND/OR OMISSIONS ON THESE PLANS.

6. THE CONTRACTOR SHALL HAVE ALL UTILITIES VERIFIED ON THE GROUND PRIOR TO ANY CONSTRUCTION. CALL (811) AT LEAST TWO WORKING DAYS IN ADVANCE. THE OWNER AND HIS/HER ENGINEER SHALL BE CONTACTED IMMEDIATELY IF A CONFLICT EXISTS.

7. ANY STRUCTURE AND/OR OBSTRUCTION WHICH REQUIRE REMOVAL OR RELOCATION RELATING TO THIS PROJECT SHALL BE DONE SO AT THE DEVELOPER'S EXPENSE. 8. MINIMUM GRADE ON ALL 4 INCH RESIDENTIAL SIDE SEWERS SHALL BE 2 PERCENT AND 6 INCH COMMERCIAL

SIDE SEWERS SHALL BE 1 PERCENT; MAXIMUM SHALL BE 8 PERCENT. ALL SIDE SEWERS SHALL BE 6 INCHES

9. SIDE SEWERS SHALL BE INSTALLED IN ACCORDANCE WITH CITY STANDARD NOS. 04.03.01, 04.03.02, 04.03.03 AND 04.03.04. SIDE SEWER INSTALLATION WORK SHALL BE DONE IN ACCORDANCE WITH THE

10. ALL SEWER PIPE SHALL BE PVC, POLYPROPYLENE, OR DUCTILE IRON. PVC SEWER PIPE SHALL CONFORM TO ASTM D-3034, SDR35 FOR PIPE SIZES 15-INCH AND SMALLER AND ASTM F679 FOR PIPE SIZES 18- TO 27-INCH, DUCTILE IRON PIPE SHALL BE CLASS 51 OR GREATER, LINED WITH PROTECTO 401TM EPOXY LINING OR EQUIVALENT, UNLESS OTHERWISE NOTED. 12-INCH THROUGH 30-INCH POLYPROPYLENE PIPE (PP) SHALL BE DUAL WALLED, HAVE A SMOOTH INTERIOR AND EXTERIOR CORRUGATIONS AND MEET WSDOT 9-05.24(2). IT SHALL MEET OR EXCEED ASTM F2764. 36-INCH THROUGH 60-INCH PP PIPE SHALL BE TRIPLE WALLED AND MEET WSDOT 9-05.24(2). IT SHALL MEET OR EXCEED ASTM F2764. PP SHALL HAVE A MINIMUM PIPE STIFFNESS OF 46 PÌI WHEN TESTED IN ACCORDANCE WITH ASTM D2412. TESTING SHALL BE PER ASTM F1417. TRENCHING, BEDDING, AND BACKFILL SHALL BE IN ACCORDANCE WITH CITY STANDARD NO. 06.01.01. MINIMUM COVER ON PVC AND PP PIPE SHALL BE 3.0 FEET. MINIMUM COVER ON DUCTILE IRON PIPE SHALL BE 1.0 FOOT.

11. SANITARY SEWER MANHOLE FRAMES AND COVERS SHALL CONFORM TO CITY STANDARD NO. 06.01.02. 12. SANITARY SEWER MANHOLES SHALL CONFORM TO CITY STANDARD NOS. 04.01.01, 04.01.02. 04.01.03 AND 04.01.04. ALL MANHOLES SHALL BE CHANNELED FOR FUTURE LINES AS SPECIFIED ON THESE PLANS. MANHOLE STEPS AND LADDER SHALL CONFORM TO STANDARD NO. 06.01.03.

13. SANITARY SEWER PIPE AND SIDE SEWERS SHALL BE 10 FEET AWAY FROM BUILDING FOUNDATIONS AND/OR ROOF LINES WITH THE EXCEPTION OF SIDE SEWERS THAT PROVIDE SERVICE TO A SINGLE-FAMILY RESIDENCE. AT THE DISCRETION OF THE REVIEW ENGINEER, A LICENSED PROFESSIONAL ENGINEER WILL BE REQUIRED TO STAMP THE DESIGN TO ACCOUNT FOR DEPTH OR PROXIMITY TO FOUNDATION, STEEP SLOPES, OR OTHER

14. NO SIDE SEWERS SHALL BE CONNECTED TO ANY HOUSE OR BUILDING UNTIL ALL MANHOLES ARE ADJUSTED THE FINISHED GRADE OF THE COMPLETED ASPHALT ROADWAY AND THE ASPHALT PATCH AND SEAL AROUND THE

15. FOR COMMERCIAL DEVELOPMENTS IN WHICH SOURCES OF GREASE AND/OR OILS MAY BE INTRODUCED TO THE CITY SANITARY SEWER SYSTEM, A CITY APPROVED GREASE INTERCEPTOR SHALL BE INSTALLED DOWNSTREAM FROM THE SOURCE.

16. ONCE SEWER AND ALL OTHER UTILITY CONSTRUCTION IS COMPLETED, ALL SANITARY SEWER MAINS AND SIDE SEWERS SHALL BE TESTED PER SECTION 406 OF THE CITY STANDARDS. ROADWAY NOTES:

1. ALL WORK IN CITY RIGHT-OF-WAY REQUIRES A PERMIT FROM THE CITY OF PUYALLUP. PRIOR TO ANY WORK COMMENCING, THE GENERAL CONTRACTOR SHALL ARRANGE FOR A PRECONSTRUCTION MEETING AT THE DEVELOPMENT SERVICES CENTER TO BE ATTENDED BY ALL CONTRACTORS THAT WILL PERFORM WORK SHOWN ON THE ENGINEERING PLANS, REPRESENTATIVES FROM ALL APPLICABLE UTILITY COMPANIES, THE PROJECT OWNER AND APPROPRIATE CITY STAFF. CONTACT ENGINEERING SERVICES TO SCHEDULE THE MEETING (253) 841-5568. THE CONTRACTOR IS RESPONSIBLE TO HAVE THEIR OWN APPROVED SET OF PLANS AT THE MEETING.

2. AFTER COMPLETION OF ALL ITEMS SHOWN ON THESE PLANS AND BEFORE ACCEPTANCE OF THE PROJECT, THE CONTRACTOR SHALL OBTAIN A "PUNCH LIST" PREPARED BY THE CITY'S INSPECTOR DETAILING REMAINING ITEMS OF WORK TO BE COMPLETED, ALL ITEMS OF WORK SHOWN ON THESE PLANS SHALL BE COMPLETED TO THE SATISFACTION OF THE CITY PRIOR TO ACCEPTANCE OF THE WATER SYSTEM AND PROVISION OF SANITARY SEWER

3. ALL MATERIALS AND WORKMANSHIP SHALL CONFORM TO THE STANDARD SPECIFICATIONS FOR ROAD, BRIDGE, AND MUNICIPAL CONSTRUCTION (HEREINAFTER REFERRED TO AS THE "STANDARD SPECIFICATIONS"), WASHINGTON STATE DEPARTMENT OF TRANSPORTATION AND AMERICAN PUBLIC WORKS ASSOCIATION WASHINGTON STATE CHAPTER, LATEST EDITION, UNLESS SUPERSEDED OR AMENDED BY THE CITY OF PUYALLUP CITY STANDARDS FOR PUBLIC WORKS ENGINEERING AND CONSTRUCTION (HEREINAFTER REFERRED TO AS THE

4. A COPY OF THESE APPROVED PLANS AND APPLICABLE CITY DEVELOPER SPECIFICATIONS AND DETAILS SHALL BE ON SITE DURING CONSTRUCTION.

5. ANY REVISIONS MADE TO THESE PLANS MUST BE REVIEWED AND APPROVED BY THE DEVELOPER'S ENGINEER AND THE ENGINEERING SERVICES STAFF PRIOR TO ANY IMPLEMENTATION IN THE FIELD. THE CITY SHALL NOT BE RESPONSIBLE FOR ANY ERRORS AND/OR OMISSIONS ON THESE PLANS.

6. THE CONTRACTOR SHALL HAVE ALL UTILITIES VERIFIED ON THE GROUND PRIOR TO ANY CONSTRUCTION. CALL (811) AT LEAST TWO WORKING DAYS IN ADVANCE. THE OWNER AND HIS/HER ENGINEER SHALL BE CONTACTED MMEDIATELY IF A CONFLICT EXISTS.

7. ANY STRUCTURE AND/OR OBSTRUCTION WHICH REQUIRES REMOVAL OR RELOCATION RELATING TO THIS PROJECT, SHALL BE DONE SO AT THE DEVELOPER'S EXPENSE.

B. MONUMENTS SHALL BE INSTALLED AT ALL STREET INTERSECTIONS, AT ANGLE POINTS, AND POINTS OF CURVATURE IN EACH STREET. ALL BOUNDARY MONUMENTS MUST BE INSTALLED ACCORDING TO THE WASHINGTON STATE

10. SIDEWALKS AND DRIVEWAYS SHALL BE INSTALLED AS LOTS ARE BUILT ON. SIDEWALKS AND DRIVEWAYS SHALL CONFORM TO CITY STANDARD DETAIL 01.02.01, 01.02.02 AND 01.02.12. IF ASPHALT IS DAMAGED DURING REPLACEMENT OF CURB AND GUTTER, THE REPAIR SHALL CONFORM TO CITY STANDARD DETAIL 01.02.10.

9. CURB AND GUTTER INSTALLATION SHALL CONFORM TO CITY STANDARD DETAIL 01.02.09.

11. THE SURROUNDING GROUND (5 FEET BEYOND THE BASE) FOR ALL POWER TRANSFORMERS, TELEPHONE/TV PEDESTALS, AND STREET LIGHT MAIN DISCONNECTS SHALL BÉ GRADED TO A POSITIVE 2 PERCENT SLOPE FROM

12. SIGNAGE AND TRAFFIC CONTROL DEVICES ARE SAFETY ITEMS AND SHALL BE INSTALLED PRIOR TO ISSUANCE OF ANY CERTIFICATE OF OCCUPANCY OR PLAT APPROVAL. HOWEVER, IN LARGER DEVELOPMENTS, EXACT LOCATIONS OF STOP AND YIELD SIGNS MAY NEED TO BE DETERMINED AFTER FULL BUILDOUT WHEN TRAFFIC PATTERNS HAVE BEEN ESTABLISHED. IN THIS CASE, CONTRACTOR SHALL PROVIDE INDICATED "CITY—PLACED" SIGNS, SIGNPOSTS, AND BRACKETS TO THE CITY SIGN SPECIALIST (253) 841–5471 FOR LATER INSTALLATION BY THE CITY. ALL SIGNAGE SHALL BE IN ACCORDANCE WITH THE MANUAL ON UNIFORM TRAFFIC CONTROL DEVICES (MUTCD). 13. PRIOR TO ANY SIGN OR STRIPING INSTALLATION OR REMOVAL THE CONTRACTOR SHALL CONTACT THE CITY SIGN SPECIALIST (253) 841-5471 TO ARRANGE FOR AN ON-SITE MEETING TO DISCUSS PLACEMENT AND UNIFORMITY. 14. NEW OR REVISED STOP SIGNS OR YIELD SIGNS SHALL BE ADVANCE WARNED USING THE PROCEDURE OUTLINED IN

MUICD, ADVANCE WARNING SIGNS AND FLAGS SHALL BE MAINTAINED BY INSTALLER FOR 30 DAYS AND

GRADING, EROSION AND SEDIMENTATION CONTROL NOTES:

THEN REMOVED.

1. ALL WORK IN CITY RIGHT-OF-WAY REQUIRES A PERMIT FROM THE CITY OF PUYALLUP. PRIOR TO ANY WORK COMMENCING, THE GENERAL CONTRACTOR SHALL ARRANGE FOR A PRECONSTRUCTION MEETING AT THE DEVELOPMENT SERVICES CENTER TO BE ATTENDED BY ALL CONTRACTORS THAT WILL PERFORM WORK SHOWN ON THE ENGINEERING PLANS, REPRESENTATIVES FROM ALL APPLICABLE UTILITY COMPANIES, THE PROJECT OWNER AND APPROPRIATE CITY STAFF. CONTACT ENGINEERING SERVICES TO SCHEDULE THE MEETING (253) 841-5568. THE CONTRACTOR IS RESPONSIBLE TO HAVE THEIR OWN APPROVED SET OF PLANS AT THE MEETING.

. AFTER COMPLETION OF ALL ITEMS SHOWN ON THESE PLANS AND BEFORE ACCEPTANCE OF THE PROJECT, THE CONTRACTOR SHALL OBTAIN A "PUNCH LIST" PREPARED BY THE CITY'S INSPECTOR DETAILING REMAINING ITEMS OF WORK TO BE COMPLETED. ALL ITEMS OF WORK SHOWN ON THESE PLANS SHALL BE COMPLETED TO THE SATISFACTION OF THE CITY PRIOR TO ACCEPTANCE OF THE WATER SYSTEM AND PROVISION OF SANITARY SEWER SERVICE.

3. ALL MATERIALS AND WORKMANSHIP SHALL CONFORM TO THE STANDARD SPECIFICATIONS FOR ROAD, BRIDGE, AND MUNICIPAL CONSTRUCTION (HEREINAFTER REFERRED TO AS THE "STANDARD SPECIFICATIONS"), WASHINGTON STATE DEPARTMENT OF TRANSPORTATION AND AMERICAN PUBLIC WORKS ASSOCIATION, WASHINGTON STATE CHAPTER, LATEST EDITION, UNLESS SUPERSEDED OR AMENDED BY THE CITY OF PUYALLUP CITY STANDARDS FOR PUBLIC WORKS ENGINEERING AND CONSTRUCTION (HERINAFTER REFERRED TO AS THE "CITY STANDARDS").

4. A COPY OF THESE APPROVED PLANS AND APPLICABLE CITY DEVELOPER SPECIFICATIONS AND DETAILS SHALL BE ON SITE DURING CONSTRUCTION. 5. ANY REVISIONS MADE TO THESE PLANS MUST BE REVIEWED AND APPROVED BY THE DEVELOPER'S ENGINEER AND THE CITY ENGINEER PRIOR TO ANY IMPLEMENTATION IN THE FIELD. THE CITY SHALL NOT BE

RESPONSIBLE FOR ANY ERRORS AND/OR OMISSIONS ON THESE PLANS. 6. THE CONTRACTOR SHALL HAVE ALL UTILITIES VERIFIED ON THE GROUND PRIOR TO ANY CONSTRUCTION. CALL (811) AT LEAST TWO WORKING DAYS HOURS IN ADVANCE. THE OWNER AND HIS/HER ENGINEER SHALL BE

CONTACTED IMMEDIATELY IF A CONFLICT EXISTS. 7. ALL LIMITS OF CLEARING AND AREAS OF VEGETATION PRESERVATION AS PRESCRIBED ON THE PLANS SHALL BE CLEARLY FLAGGED IN THE FIELD AND OBSERVED DURING CONSTRUCTION.

8. ALL REQUIRED SEDIMENTATION AND EROSION CONTROL FACILITIES MUST BE CONSTRUCTED AND IN OPERATION PRIOR TO ANY LAND CLEARING AND/OR OTHER CONSTRUCTION TO ENSURE THAT SEDIMENT LADEN NATER DOES NOT ENTER THE NATURAL DRAINAGE SYSTEM. THE CONTRACTOR SHALL SCHEDULE AN INSPECTION OF THE EROSION CONTROL FACILITIES PRIOR TO ANY LAND CLEARING AND/OR OTHER CONSTRUCTION. ALL EROSION AND SEDIMENT FACILITIES SHALL BE MAINTAINED IN A SATISFACTÓRY CONDITION AS DETERMINED BY THE CITY, UNTIL SUCH TIME THAT CLEARING AND/OR CONSTRUCTION IS COMPLETED AND THE POTENTIAL FOR ON-SITÉ EROSION HAS PASSED. THE IMPLEMENTATION, MAINTENANCE, REPLACEMENT, AND additions to the erosion and sedimentation control systems shall be the responsibility of the PERMITTEE. CITY OF PUYALLUP - CITY STANDARDS GESC REVISED 06/06/12500-6

THE EROSION AND SEDIMENTATION CONTROL SYSTEM FACILITIES DEPICTED ON THESE PLANS ARE INTENDED TO BE MINIMUM REQUIREMENTS TO MEET ANTICIPATED SITE CONDITIONS. AS CONSTRUCTION PROGRESSES AND UNEXPECTED OR SEASONAL CONDITIONS DICTATE, FACILITIES WILL BE NECESSARY TO ENSURE COMPLETE SILTATION CONTROL ON THE SITE. DURING THE COURSE OF CONSTRUCTION, IT SHALL BE THE OBLIGATION AND RESPONSIBILITY OF THE PERMITTEE TO ADDRESS ANY NEW CONDITIONS THAT MAY BE CREATED BY HIS ACTIVITIES AND TO PROVIDE ADDITIONAL FACILITIES, OVER AND ABOVE THE MINIMUM REQUIREMENTS, AS MAY BE NEEDED TO PROTECT ADJACENT PROPERTIES, SENSITIVE AREAS, NATURAL WATER COURSES, AND/OR STORM DRAINAGE SYSTEMS.

10. APPROVAL OF THESE PLANS IS FOR GRADING, TEMPORARY DRAINAGE, EROSION AND SEDIMENTATION CONTROL ONLY. IT DOES NOT CONSTITUTE AN APPROVAL OF PERMANENT STORM DRAINAGE DESIGN, SIZE OR LOCATION OF PIPES, RESTRICTORS, CHANNELS, OR RETENTION FACILITIES.

11. ANY DISTURBED AREA WHICH HAS BEEN STRIPPED OF VEGETATION AND WHERE NO FURTHER WORK IS ANTICIPATED FOR A PERIOD OF 30 DAYS OR MORE, MUST BE IMMEDIATELY STABILIZED WITH MULCHING, GRASS PLANTING. OR OTHER APPROVED EROSION CONTROL TREATMENT APPLICABLE TO THE TIME OF YEAR IN QUESTION. GRASS SEEDING ALONE WILL BE ACCEPTABLE ONLY DURING THE MONTHS OF APRIL THROUGH SEPTEMBER INCLUSIVE. SEEDING MAY PROCEED OUTSIDE THE SPECIFIED TIME PERIOD WHENEVER IT IS IN THE INTEREST OF THE PERMITTEE BUT MUST BE AUGMENTED WITH MULCHING, NETTING, OR OTHER TREATMENT APPROVED BY THE CITY.

12. IN CASE EROSION OR SEDIMENTATION OCCURS TO ADJACENT PROPERTIES, ALL CONSTRUCTION WORK WITHIN THE DEVELOPMENT THAT WILL FURTHER AGGRAVATE THE SITUATION MUST CEASE, AND THE OWNER/CONTRACTOR WILL IMMEDIATELY COMMENCE RESTORATION METHODS. RESTORATION ACTIVITY WILL CONTINUE UNTIL SUCH TIME AS THE AFFECTED PROPERTY OWNER IS SATISFIED.

13. NO TEMPORARY OR PERMANENT STOCKPILING OF MATERIALS OR EQUIPMENT SHALL OCCUR WITHIN CRITICAL AREAS OR ASSOCIATED BUFFERS, OR THE CRITICAL ROOT ZONE FOR VEGETATION PROPOSED FOR RETENTION.

CITY OF PUYALLUP ENGINEERING SERVICES

NOTE: THIS APPROVAL IS VOID

AFTER 1 YEAR FROM APPROVAL THE CITY WILL NOT BE RESPONSIBLE FOR ERRORS AND/OR OMISSIONS ON THESE PLANS. FIELD CONDITIONS MAY DICTATE CHANGES TO THESE PLANS AS DETERMINED BY THE

ENGINEERING SERVICES MANAGER.

PRCCP20231028

 $\mathbf{\omega}$


> \(\mathcal{S} \)


2

S

. 96 9 0 **—** 6 · - O SLE JTH OIN 06)

25672

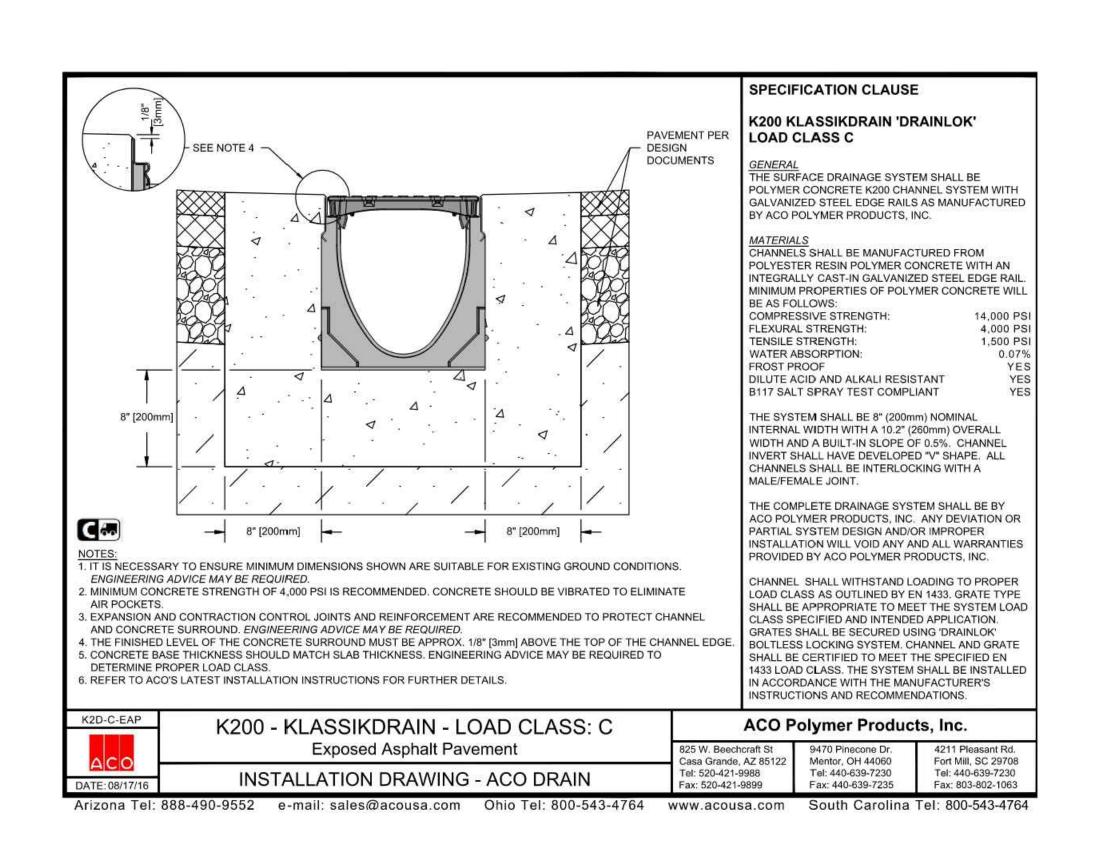

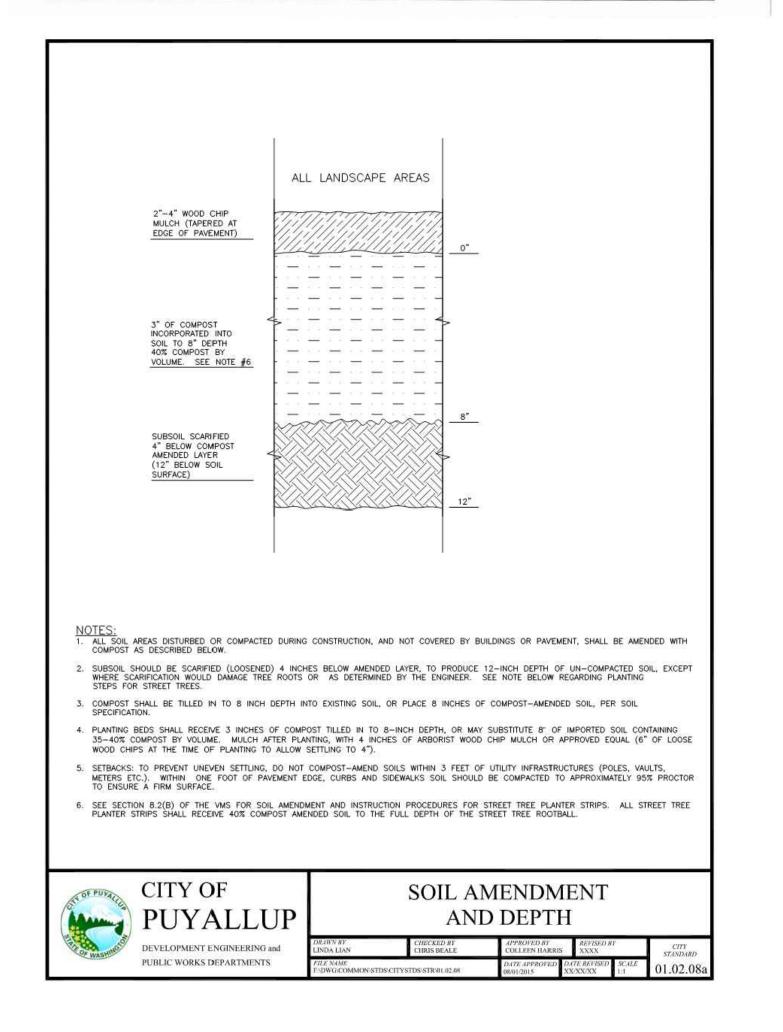

TIED AT ALL JOINTS

STRUCTURE PROFILE VIEW

TRAFFIC APPLICATIONS SHALL BE HS-20 RATED, NOT FOR USE IN PUBLIC RIGHT-OF-WAY, PUBLIC EASEMENTS, OR TRACTS.

ALL BOLT HOLES DRILLED IN THE STRUCTURE SHALL BE WATERTIGHT WITH RUBBER SEALING WASHERS OR APPROVED EQUAL.

DUCTILE IRON FRAME AND COVER SHALL BE DRILLED AND TAPPED WITH 1/6"- 8 ZINC-PLATED HEX BOLT 1 1/6" LONG.

A CONCRETE FOOTING SHALL BE PROVIDED AT THE BASE OF THE STRUCTURE WHEN THE BOTTOM ELEVATION OF THE

18" SOLID LOCKING DUCTILE IRON FRAME AND COVER BY NYLOPLAST - TYPE C OR APPROVED EQUAL.

STORM PIPE AND STRUCTURE BEDDING AND BACKFILL SHALL CONFORM TO STD DETAIL 06.01.01.

DUCTILE IRON FRAME AND COVER SHALL BE FLUSH WITH FINISHED GRADE.

THE MAXIMUM DEPTH FROM FINISHED GRADE TO THE PIPE INVERT IS 5'-0".

STRUCTURE PLAN VIEW

PVC TIEE TO MATCH -

OUTLET PIPE DIAMETER

4" Ø MIN. SDR 35 PVC PIPE -

½" FINE MESH SCREEN

STEEL HOSE CLAMP

STAINLESS STEEL PIPE CLAMP

ATTACHED WITH STAINLESS

(SEE PLAN VIEW THIS DETAIL)

STRUCTURE IS WITHIN 6" OF HIGH GROUNDWATER.

CITY OF

PUBLIC WORKS AND

SECURELY FASTENED TO STRUCTURE WALL

REBAR PENETRATION 3" ABOVE BASE OF STRUCTURE (4 PLACES)

- 1/6" x 1 1/8" LONG HEX BOLT, ZINC PLATED

GRAVEL BACKFILL (SEE NOTE 5)

- 18" DUCTILE IRON SOLID COVER

- PIPE INVETS PER PLAN

- 4" Ø MIN. SDR 35 PVC PIPE

18" Ø PVC DRAIN BASIN

AS MANUFACTURE BY

YARD DRAIN

NYLOPLAST OR APPROVED

3000 PSI CONCRETE


ANTI-FLOTATION FOOTING


(SEE NOTE 5)


- 18" DUCTILE IRON FRAME


(SEE NOTE 1-4)


(3 SPACED EQUALLY)

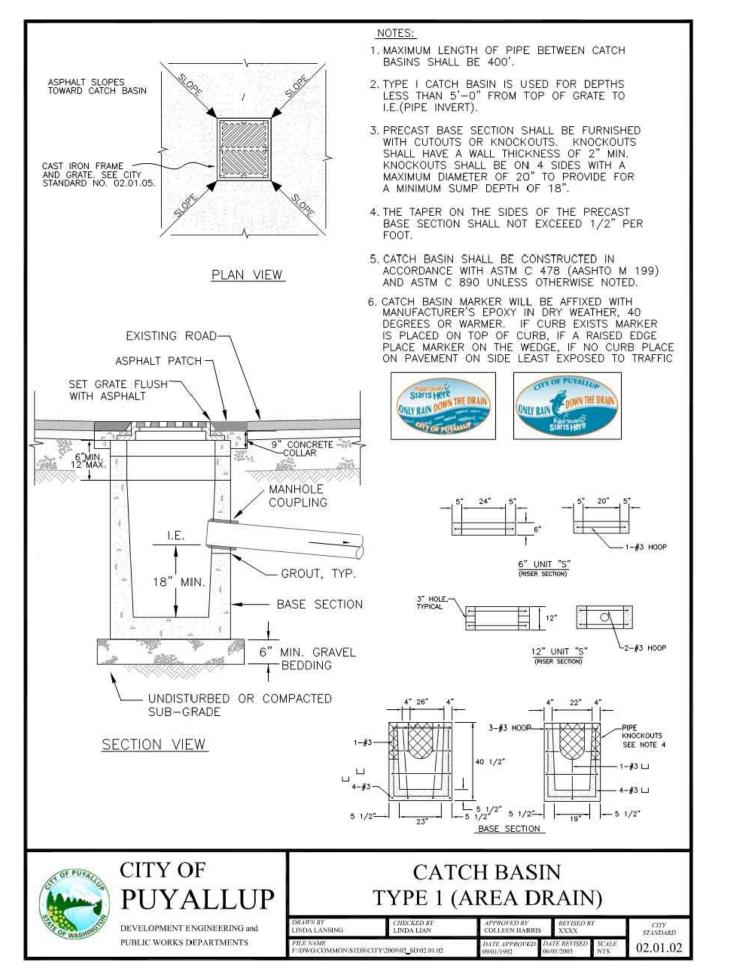


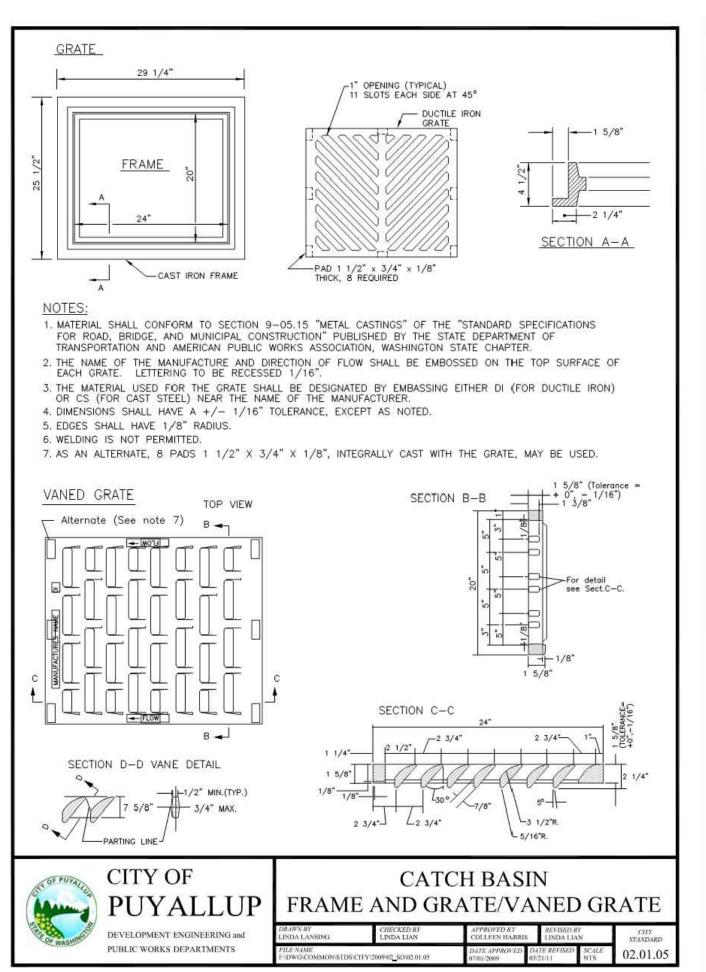


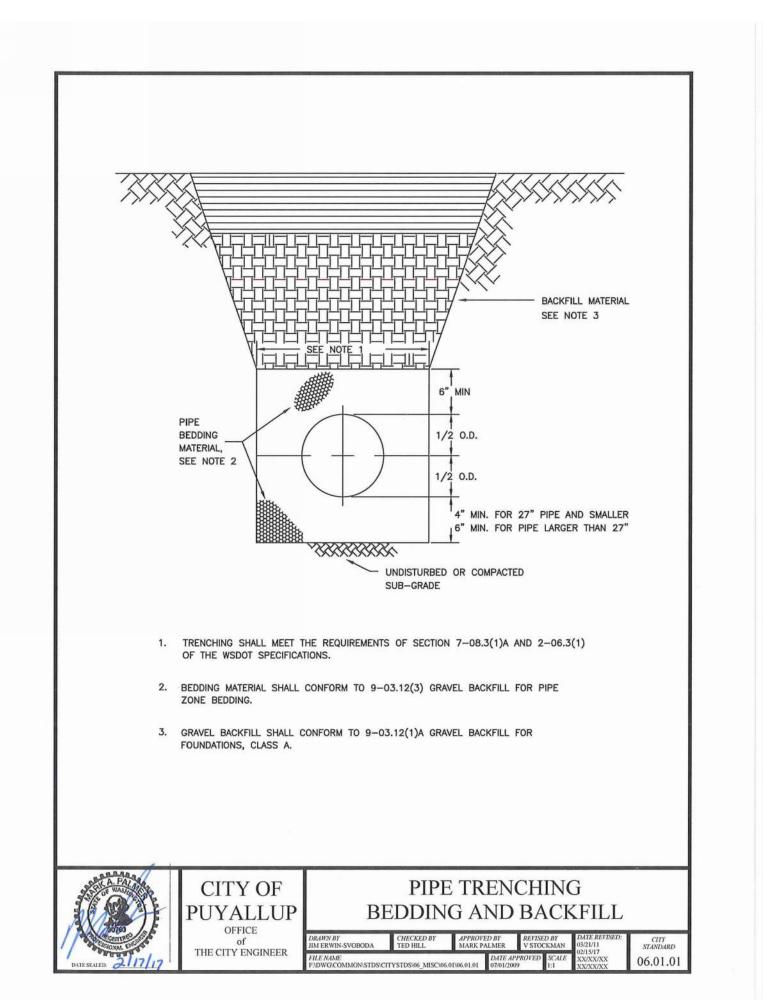


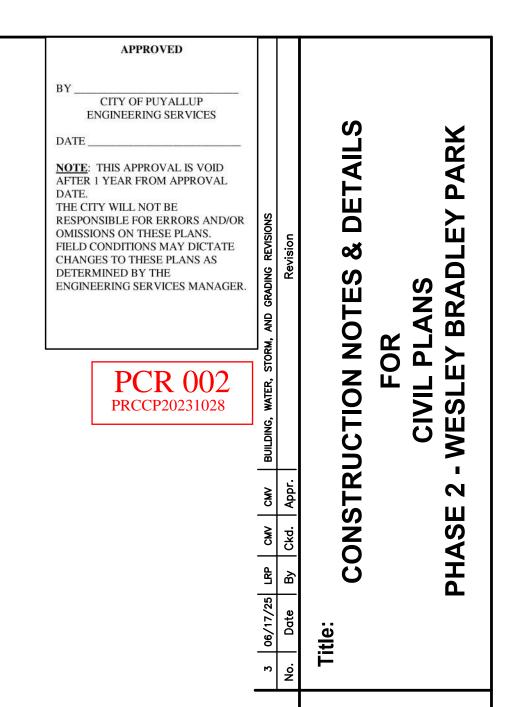


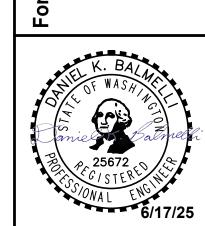


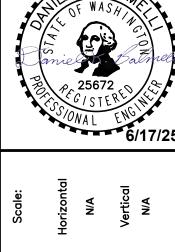


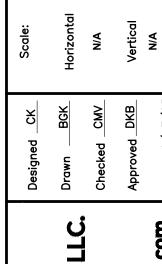


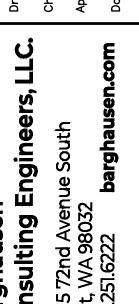

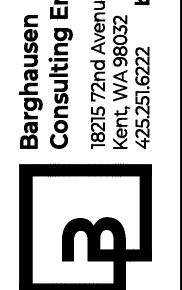

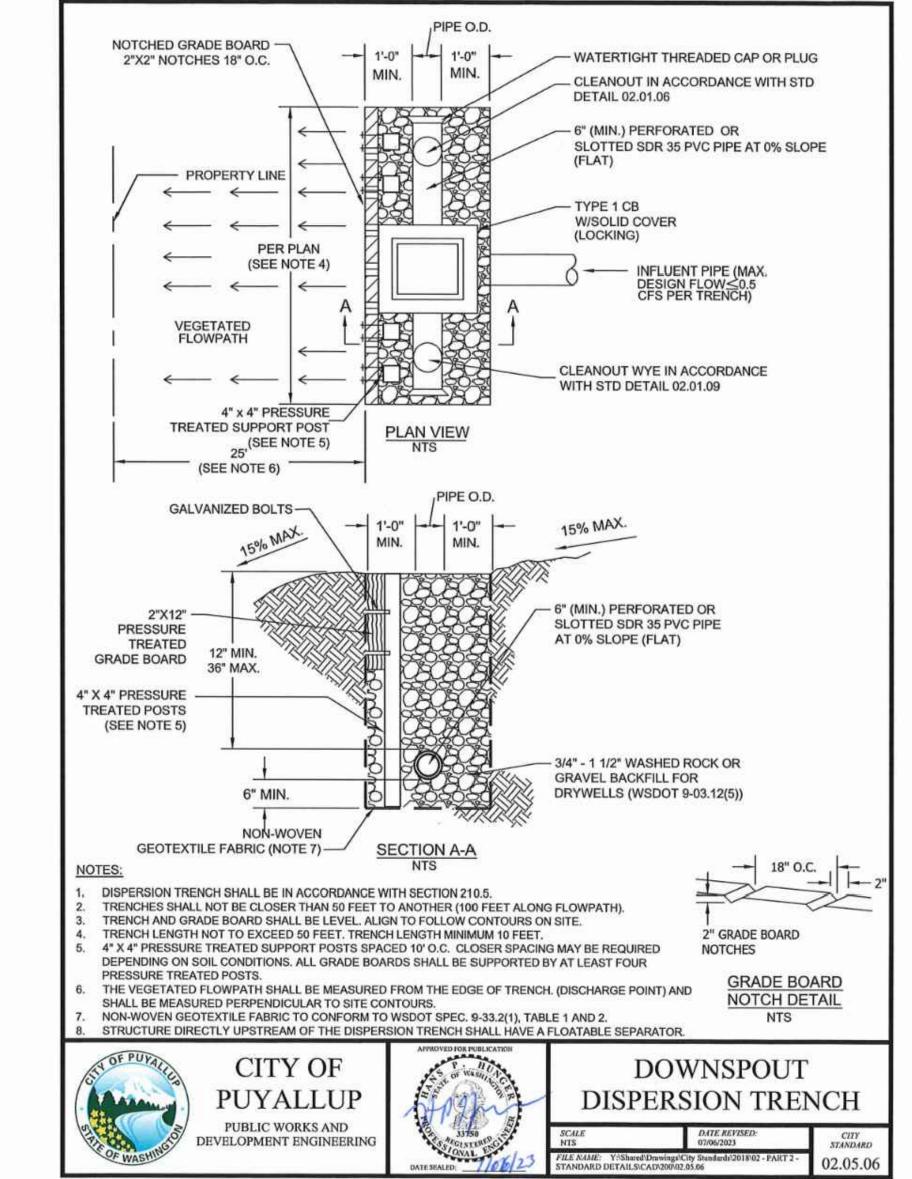

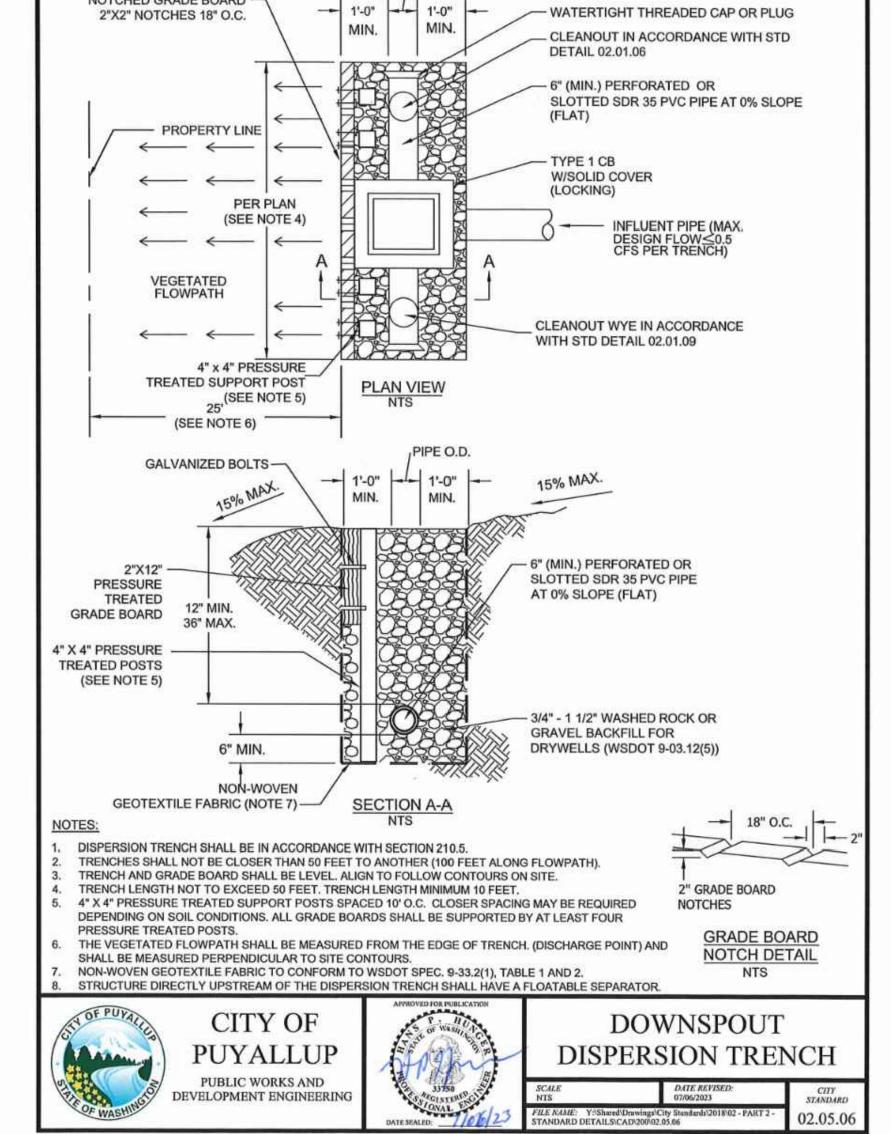

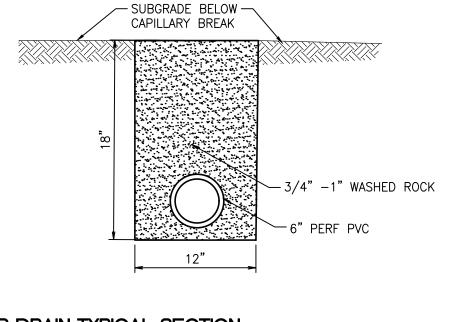



SUB DRAIN TYPICAL SECTION NOT TO SCALE

NOT TO SCALE

2" COMPACTED DEPTH —

12" STRUCTURAL FILL COMPACTED TO 95% MAX. DRY DENSITY PER ASTM D-698 (STANDARD PROCTOR)

ALTERNATE PAVING SECTION 2" COMPACTED DEPTH

3" ASPHALT TREATED BASE (ATB)

TYPICAL PAVING SECTION (ONSITE ONLY)

4" COMPACTED DEPTH ——

CRUSHED ROCK

GRAVEL WALKING PATH (ONSITE ONLY)

4" PORTLAND CEMENT CONCRETE

4" COMPACTED DEPTH CRUSHED

PRIVATE CONCRETE SIDEWALKS (ONSITE ONLY)

EXTRUDED CONCRETE CURB DETAIL (ONSITE ONLY)

CLASS "B" A.C. PAVEMENT

NOT TO SCALE

NOT TO SCALE

NOT TO SCALE

12" STRUCTURAL FILL COMPACTED TO 95% MAX. —— DRY DENSITY PER ASTM D-698 (STANDARD PROCTOR)

6" COMPACTED DEPTH CRUSHED

CITY OF PUYALLUP ENGINEERING SERVICES

NOTE: THIS APPROVAL IS VOID AFTER 1 YEAR FROM APPROVAL

RESPONSIBLE FOR ERRORS AND/OR OMISSIONS ON THESE PLANS. FIELD CONDITIONS MAY DICTATE CHANGES TO THESE PLANS AS

ENGINEERING SERVICES MANAGER.

PRCCP20231028

ONSTRUCTION

2

PHASE

THE CITY WILL NOT BE


DETERMINED BY THE

CITY OF PUYALLUP ENGINEERING SERVICES

NOTE: THIS APPROVAL IS VOID AFTER 1 YEAR FROM APPROVAL THE CITY WILL NOT BE

RESPONSIBLE FOR ERRORS AND/OR OMISSIONS ON THESE PLANS. FIELD CONDITIONS MAY DICTATE CHANGES TO THESE PLANS AS DETERMINED BY THE ENGINEERING SERVICES MANAGER.


PRCCP20231028

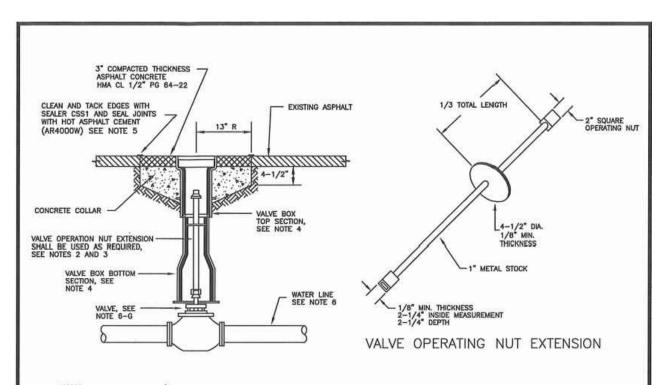

- WATER MAINS SHALL HAVE A MINIMUM COVER OF 35" FROM PAVED FINAL GRADE IN IMPROVED RIGHT-OF-WAY AND IMPROVED EASEMENTS, AND A MINIMUM OF 48" IN UNIMPROVED RIGHT-OF-WAY AND UNIMPROVED EASEMENTS,
- 3. ALL VALVE OPERATING NUT EXTENSIONS ARE TO BE MADE OF STEEL, SIZED AS NOTED, AND PAINTED WITH TWO COATS OF METAL PAINT.
- 5. NEAT LINE CUTS SHALL BE SEALED WITH A HOT PAVING GRADE ASPHALT AND FACE OF CUT TACKED.
- 6. WATER MAINS SHALL BE CONSTRUCTED AND TESTED IN ACCORDANCE WITH DIVISION 7 OF THE WSDOT STANDARD SPECIFICATIONS SUPPLEMENTED WITH THE
- B. JOINTS SHALL BE TYTON PUSH-ON JOINTS, OR APPROVED EQUAL, OR MECHANICAL JOINT TYPE PER AWWA C 111 EXCEPT WHERE FLANGED JOINTS ARE REQUIRED TO CONNECT TO VALVES OR OTHER EQUIPMENT.
- D. BOLTS USED IN FLANGE INSTALLATION SETS SHALL CONFORM TO ASTM B 193, GRADE B7. NUTS SHALL COMPLY WITH ASTM A 194, GRADE 2H.
- E. PROVIDE A WASHER FOR EACH NUT, WHERE NEEDED. WASHERS SHALL BE OF THE SAME MATERIAL AS THE NUTS.
- F. ALL FITTINGS SHALL CONFORM TO THE REQUIREMENTS OF AWWA C 110 AND AWWA C 111. G. RESILIENT SEATED WEDGE GATE VALVES SHALL BE USED FOR TEN (10) INCH MAINS AND SMALLER. BUTTERFLY VALVES SHALL BE USED FOR MAINS GREATER THAN TEN (10) INCHES.
- RESILIENT SEATED WEDGE GATE VALVE: GATE VALVES SHALL CONFORM TO THE LATEST AWWA SPECIFICATIONS FOR COLD WATER, DOUBLE-DISK SATE VALVES, 200 PSI WORKING PRESSURE. THEY SHALL BE IRON-BODIED, BRONZE MOUNTED, NON-RISING STEM, WITH TWO (2) INCH SQUARE WIT. COUNTER-CLOCKWINGS OPENING, MECHANICAL JOINT AND / OR FLANGED BY GO VALVES ON FIRE HYDRANT LINES WHICH SHALL BE MECHANICAL JOINTS BY FLANGED). VALVE STEMS SHALL BE PROVIDED WITH O-RING SEALS AND SHALL BE AS MANUFACTURED BY THE MUELLER ZOMPANY OR APPROVED EQUAL.
- 2) BUTTERFLY VALVES: BUTTERFLY VALVES CONFORMING WITH AWWA C 504, CLASS 150 AND SHALL HAVE STANDARD AWWA TWO (2) INCH SQUARE




PUYALLU OFFICE THE CITY ENGINEER WATER VALVES AND MAINS

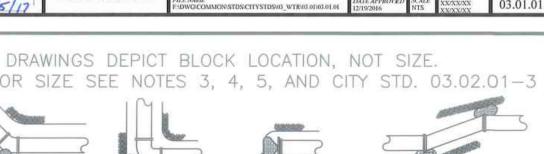

DEAD END



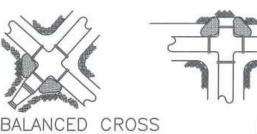


PLUGGED CROSS


1. THE FOLLOWING PRECAUTIONS MUST BE OBSERVED WHEN CONSTRUCTING THRUST


- BLOCKS MUST BE POURED AGAINST UNDISTURBED SOIL.
 THE PIPE FITTING(S) AND BOLTS MUST BE ACCESSIBLE. WRAP IN PLASTIC BEFORE POURING CONCRETE BLOCKING.
- CONCRETE SHOULD BE CURED FOR AT LEAST 5 DAYS AND SHOULD HAVE A MINIMUM COMPRESSION STRENGTH OF 2,000 PSI AT 28 DAYS.
- D. RESTRAINED JOINTS SHALL BE INSTALLED, IN ADDITION TO CONCRETE THRUST
- E. BLOCKS MUST BE POSITIONED TO COUNTERACT THE DIRECTION OF THE RESULTANT THRUST FORCE.
- 2. ALL PIPE SHALL BE PROPERLY BEDDED, SEE CITY OF PUYALLUP STANDARD BEDDING DETAIL NO. 06.01.01
- 3. CONTRACTOR TO PROVIDE BLOCKING ADEQUATE TO WITHSTAND FULL TEST PRESSURE. 4. DIVIDE THRUST BY SAFE BEARING LOAD TO DETERMINE REQUIRED AREA (IN SQUARE FEET)
- BEARING SURFACE AREAS TO BE ADJUSTED BY THE ENGINEER FOR OTHER PRESSURE AND/OR SOIL CONDITIONS.

	CITY OF PUYALLUP		HOR	IZONTA BLOC		RUST	
OSIONAL V	OFFICE of	DRAWN BY BRIAN JOHNSON	CHECKED BY TED HILL	APPROVED BY MARK PAEMER	REFISED BY BRIAN JOHNSON	DATE REFISED: 12/27/16	CITY STANDARD
DATE SEALED 2/10/17	THE CITY ENGINEER	FILE NAME FEDWG/COMMONISTD	SCHYSTDS/03_WTR/03	02/03/02/01+1 DATE A 09/10/20	PPROVED SCALE 00 NTS	02/10/17 XX/XX/XX XX/XX/XX	03.02.01-

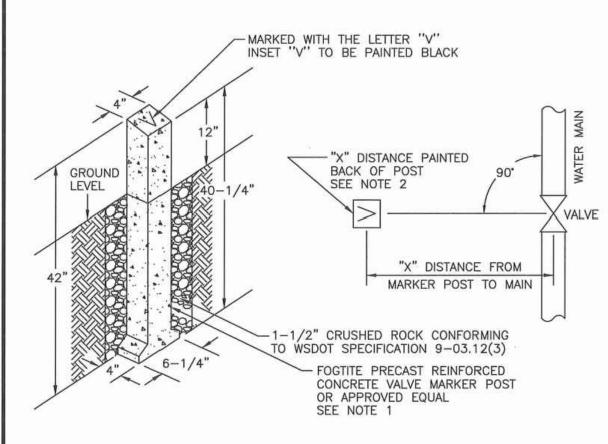

- 1. PAINT MARKER POST WITH RUST-OLEUM SAFETY YELLOW #7543 OR APPROVED EQUAL.
- 2. THE DISTANCE FROM THE MARKER POST TO THE WATER MAIN SHALL BE PAINTED ON THE BACKSIDE OF THE MARKER POST, IN BLACK WITH A 2" HIGH NUMBER.
- 3. VALVE MARKER POST SHALL BE REQUIRED WHEN EVER THE WATER VALVE IS LOCATED IN AN UNPAVED AREA.
- 4. THE POST WILL ALSO BE REQUIRED FOR BLOW-OFF ASSEMBLIES IN THE SAME CONDITION AS WATER VALVES.
- 5. LOCATION OF VALVE MARKER POSTS SHALL BE OFFSET AT RIGHT ANGLES TO EACH LINE

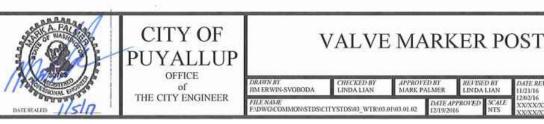


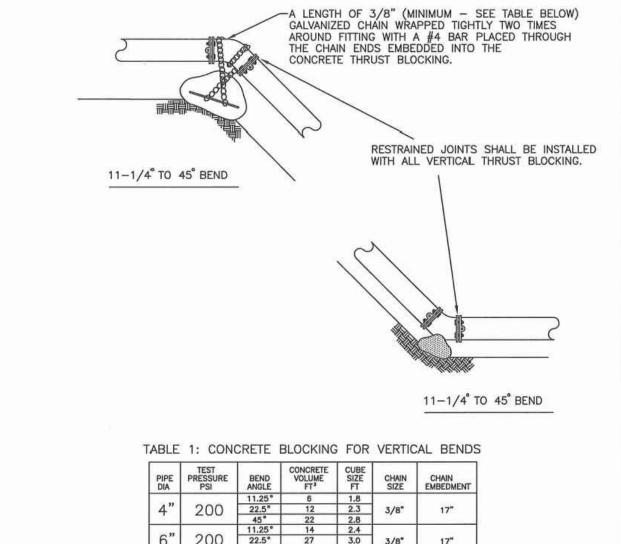


PIPE DIA	TEST PRESSURE PSI	BEND ANGLE	CONCRETE VOLUME FT ³	CUBE SIZE FT	CHAIN SIZE	CHAIN EMBEDMENT
	11.25°	6	1.8			
4"	200	22.5°	12	2.3	3/8"	17"
	200	45°	22	2.8	7/6	
6" 200	11.25°	14	2.4	560		
	200	22.5°	27	3.0	3/8"	17"
	45°	50	3.7	202	Win	
8" 20		11.25°	25	2.9		
	200	22.5*	48	3.6	3/8"	17"
	restable:	45°	89	4.5	(2:5 / 075)	A-4702
		11.25°	38	3.4	3/8"	17"
0"	200	22.5°	75	4.2		
٠	200	45°	139	5.2	1000	(4,160)
- "		11.25°	55	3.8	3/8"	17"
2"	200	22.5°	108	4.8	3/6	17
		45°	200	5.8	1/2"	24"
	5000 0000	11.25"	75	4.2	3/8"	17"
4"	200	22.5°	147	5.3	1/2"	20"
	200	45°	272	6.5	1/2"	27"
- 11	202	11.25°	98	4.6	3/8"	17"
6"	200	22.5*	192	5.8	1/2"	24"
11053	10000000	45°	355	7.1	3/4"	30"

ALL NOTES ON CITY STANDARD 03.02.01-1 SHALL APPLY TO THIS DETAIL. SEE CITY STANDARD 03.02.01-3 FOR ADDITIONAL INFORMATION.



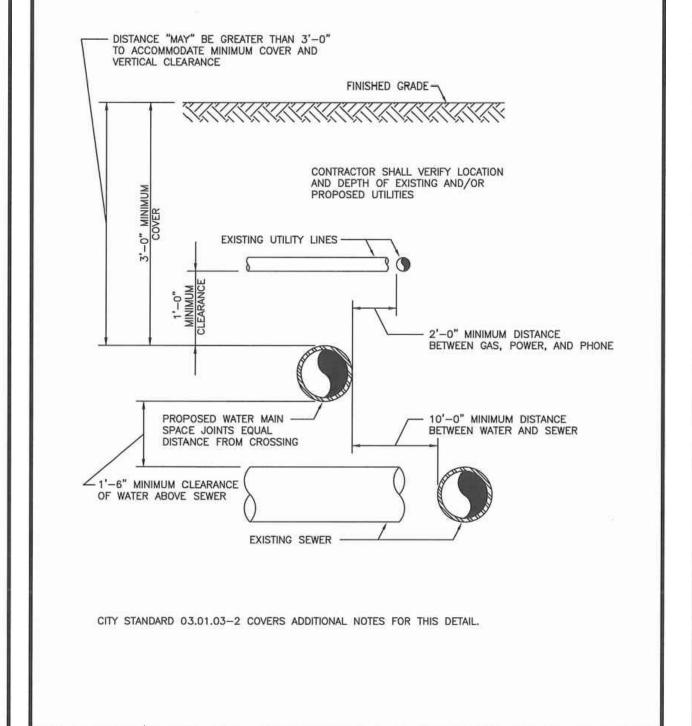

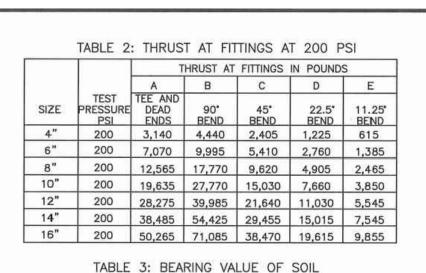

WATER MAIN CROSSING

SOIL TYPE	SAFE BEARING LOAD LBS/SF
MUCK, PEAT, ETC.	0
SOFT CLAY / ALLUVIAL SOIL	1,000
SAND	2,000
SAND AND GRAVEL	3,000
SAND AND GRAVEL CEMENTED WITH CLAY	4,000
HARD SHALE	10,000

SEE CITY STANDARDS 03.02.01-1 AND 03.02.01-2 FOR ADDITIONAL INFORMATION.

① TO DETERMINE THRUST AT PRESSURES OTHER THAN PSI SHOWN, MULTIPLY THE THRUST OBTAINED IN TABLE 2 BY THE RATIO OF THE PRESSURE TO 200 PSI. EXAMPLE, THE THRUST ON A 12 INCH, 90° BEND AT 300 PSI.


② TO DETERMINE THE VOLUME OF THE THRUST BLOCK: 59,978 LBS + 150 LB/CF = 399.9 CF

 $39,985 \times \frac{300 \text{ PSI}}{200 \text{ PSI}} = 59,978 \text{ LBS}$

399.9 CF+27 CF/CY = 14.81 CY OF CONCRETE ③ TO DETERMINE THE BEARING AREA OF THE THRUST BLOCK IN SQUARE FEET (SF) SEE TABLE 3, BEARING VALUE OF SOIL: EXAMPLE, FOR SAND AND GRAVEL BEARING VALUE FROM TABLE 3 IS 3,000 LBS/SF

- 59,978 LBS + 3000 LB/SF = 20 SF OF AREA
- ① CONTRACTOR TO PROVIDE BLOCKING ADEQUATE TO WITHSTAND FULL TEST PRESSURE.
- 5 AREAS TO BE ADJUSTED FOR OTHER PRESSURE CONDITIONS ® NO WATER MAIN SHALL DEAD END AGAINST A MAIN LINE VALVE. DEAD END WATER MAINS SHALL BE BLOCKED AGAINST A RESTRAINED MECHANICAL—JOINT (M.J.) PLUG OR CAP.

THRUST BLOCKING TABLE

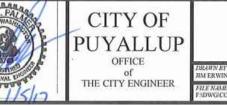

NOTES FOR WATER MAIN CROSSING OTHER UTILITIES CITY STANDARD 03.01.03-1

WHEN LOCAL CONDITIONS PREVENT THE SEPARATIONS DESCRIBED ON CITY STANDARD 03.01.03-1, A SEWER MAY BE LAID CLOSER THAN 10-FEET HORIZONTALLY OR 18-INCHES VERTICALLY TO A WATER LINE, PROVIDED THE GUIDELINES BELOW ARE FOLLOWED:

UNUSUAL CONDITIONS (PARALLEL SYSTEMS)

- 1. SEWER LINE IS LAID IN A SEPARATE TRENCH FROM THE WATER LINE.
- WHEN 18-INCHES VERTICAL SEPARATION CANNOT BE OBTAINED, THE SEWER SHALL BE CONSTRUCTED OF MATERIALS AND JOINTS THAT ARE EQUIVALENT TO WATER MAIN STANDARDS OF CONSTRUCTION AND SHALL BE PRESSURE TESTED TO ENSURE WATER TIGHTNESS PRIOR TO
- 3. THE WATER LINE SHALL BE PLACED ON A BENCH OF UNDISTURBED EARTH WITH THE BOTTOM OF THE WATER PIPE AT LEAST 18-INCHES ABOVE THE CROWN OF THE SEWER, AND SHALL HAVE AT LEAST 5-FEET OF HORIZONTAL SEPARATION AT ALL TIMES. THE CITY RESERVES THE RIGHT TO REQUIRE SUPPLEMENTAL MITIGATION EFFORTS, SUCH AS IMPERMEABLE BARRIERS OR OTHER MEANS, FOR ADDITIONAL PROTECTION.
- 4. THE SEWER SHALL NOT BE INSTALLED IN THE SAME DITCH AS A POTABLE WATER LINE WITHOUT PRIOR APPROVAL OF THE CITY OF PUYALLUP.

UNUSUAL CONDITIONS (PERPENDICULAR SYSTEMS) A. GRAVITY SEWERS PASSING UNDER WATER LINES (ALL OF THE FOLLOWING APPLY)

- ONE FULL SEGMENT (NOT LESS THAN 18—FEET LONG) OF DUCTILE IRON CLASS 52 WATER PIPE, AND THE LONGEST STANDARD SEWER PIPE LENGTH AVAILABLE FROM THE
- MANUFACTURER SHALL BE USED WITH THE PIPES CENTERED TO MAXIMIZE JOINT SEPARATION. STANDARD GRAVITY-SEWER MATERIAL ENCASED IN CONCRETE OR IN A ONE-QUARTER-INCH HICK CONTINUOUS STEEL, DUCTILE IRON, OR PRESSURE RATED PVC PIPE WITH A DIMENSION RATIO (THE RATIO OF THE OUTSIDE DIAMETER TO THE PIPE WALL THICKNESS) OF 18 OR


LESS, WITH ALL VOIDS PRESSURE-GROUTED WITH SAND-CEMENT GROUT OR BENTONITE.


EXAMPLE OF DIMENSION RATIO (DR): OUTSIDE PIPE DIAMETER DIVIDED BY THE WALL THICKNESS OR OD/T. FOR 8-INCH SCH. 80 PVC PIPE (T=0.5 INCHES) THE DR IS 8.625/0.5=17.25

B. GRAVITY SEWER PASSING OVER WATER LINES


- WATER LINES SHALL BE PROTECTED BY PROVIDING: 1. A VERTICAL SEPARATION OF AT LEAST 18-INCHES BETWEEN THE INVERT OF THE SEWER AND THE
- 2. ADEQUATE STRUCTURAL SUPPORT FOR THE SEWER LINE TO PREVENT EXCESSIVE DEFLECTION OF
- 3. THE SEWER PIPE SHALL BE THE LONGEST STANDARD SEWER PIPE LENGTH AVAILABLE FROM THE
- MANUFACTURER WITH THE WATER AND SEWER PIPES CENTERED TO MAXIMIZE JOINT SEPARATION. 4. THE SEWER LINE CASING EQUIVALENT TO THAT SPECIFIED IN A(2) ABOVE.

JOINTS AND SETTLING ON AND BREAKING OF THE WATER LINE.

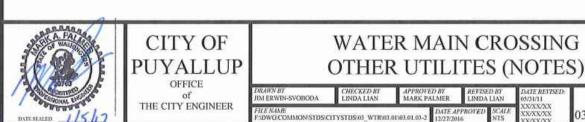

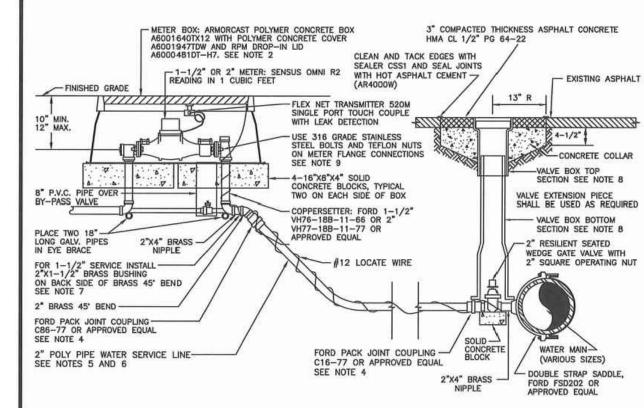

- ALL MATERIALS AND FITTINGS SHALL BE AS SPECIFIED OR AN APPROVED EQUAL.
- NORMALLY THE WATER METER BOX SHOULD BE LOCATED IN THE PLANTING STRIP. IF SIDEWALK IS AGAINST THE CURB, PLACE METER BOX DIRECTLY BEHIND THE SIDEWALK. THE WATER METER BOX SHALL NOT BE LOCATED IN HARD SURFACES. WHEN UNAVOIDABLE, EXCEPTIONS CAN BE MADE AT END OF CUL—DE—SACS
- WATER MAINS SHALL HAVE A MINIMUM COVER OF 36" IN IMPROVED RIGHT-OF-WAY AND IMPROVED EASEMENTS, AND A MINIMUM OF 48" IN UNIMPROVED RIGHT-OF-WAY AND UNIMPROVED EASEMENTS. ALL POLY PIPE COUPLINGS SHALL USE PIPE INSERT STIFFENERS.
- THE WATER SERVICE LINE SHALL HAVE 36" OF COVER BELOW FINISHED GRADE WITHIN THE RIGHT-OF-WAY. THE WATER SERVICE LINE SHALL BE ONE CONTINUOUS PIECE WITH NO SPLICES.
- ALL POLY PIPE SHALL BE HIGH DENSITY POLY (IRON PIPE SIZE) MEETING ASTM D-2239-SIDR 7 (PE 3408),
- FOR A 1-1/2" WATER SERVICE, ALL MATERIAL SHALL BE 2" FROM THE WATER MAIN TO THE COPPERSETTER. REDUCE FROM 2" TO 1-1/2" IMMEDIATELY BEFORE COPPERSETTER.
- VALVE BOXES SHALL BE TWO-PIECE, ADJUSTABLE, CAST IRON WITH EXTENSION PIECE (IF NECESSARY), AS MANUFACTURED BY THE VANRICH # 940 SEATTLE OR APPROVED EQUAL. THE WORD "WATER" SHALL BE CAST IN RELIEF ON THE VALVE BOX COVER. VALVE BOX TOPS INSTALLED IN ARTERIAL ROADWAYS SHALL BE MANUFACTURED BY EAST JORDAN (EJ) IRONWORKS MODEL 8555 WITH VALVE BOX COVER MODEL 6800 OR
- THE STAINLESS STEEL METER FLANGE BOLTS SHALL BE 5/8" DIAMETER FOR THE 1-1/2" METER, AND 3/4" DIAMETER FOR THE 2" METER.

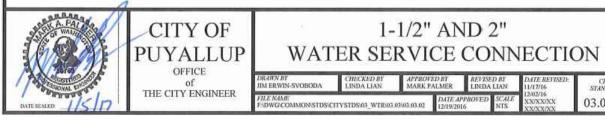


JTRI 9819 HOMES 6TH ST


LANS BRADLEY


2

S

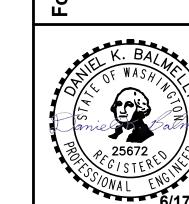



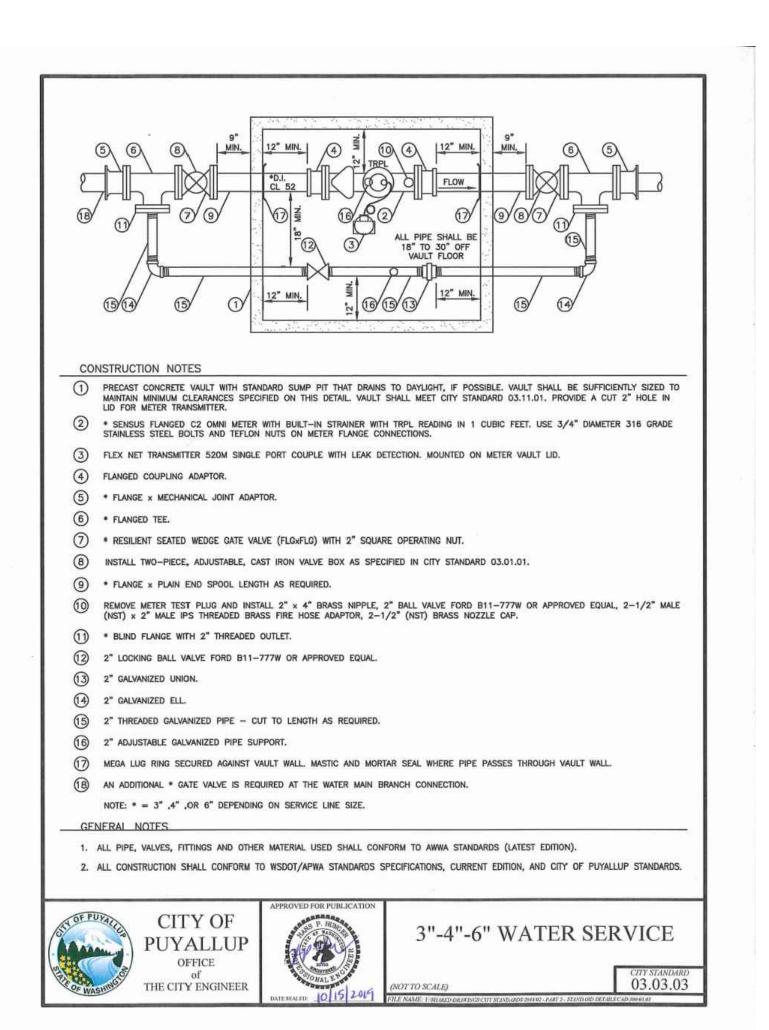

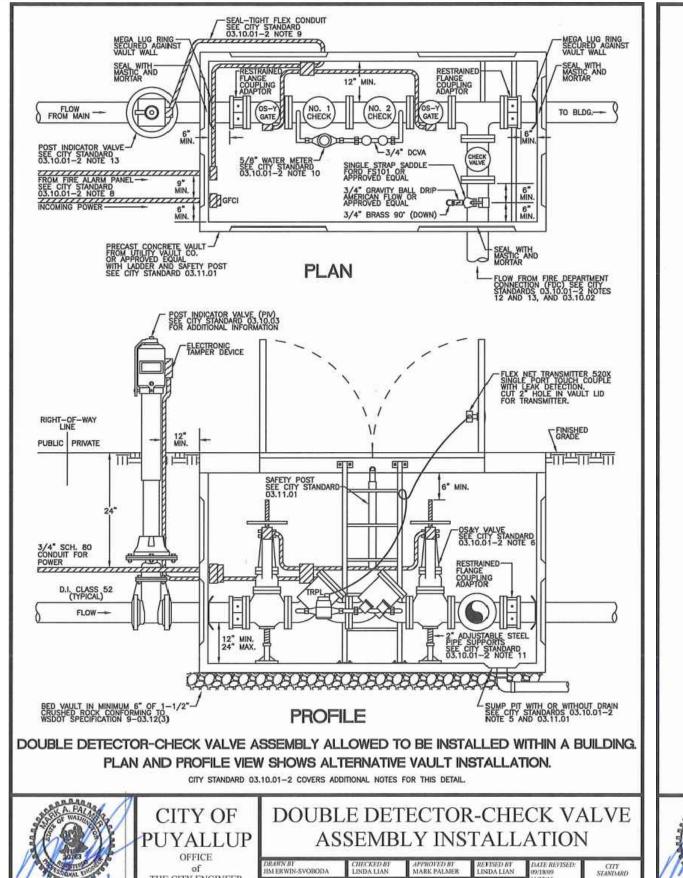

NOTES FOR: DOUBLE DETECTOR CHECK VALVE ASSEMBLY (DDCVA) INSTALLATION CITY STANDARD 03.10.01-1

BACKFLOW ASSEMBLY MUST BE SELECTED FROM WASHINGTON STATE DEPARTMENT OF HEALTH'S LIST OF BACKFLOW PREVENTION ASSEMBLIES APPROVED FOR INSTALLATION

THE DDCVA SHALL BE INSTALLED WITH ADEQUATE SPACE TO FACILITATE MAINTENANCE AND TESTING. IT SHALL BE TESTED AFTER INSTALLATION, BY A WASHINGTON STATE

CERTIFIED BACK-FLOW ASSEMBLY TESTER, TO INSURE ITS SATISFACTORY OPERATION BEFORE OCCUPANCY, AND ANNUALLY THEREAFTER. SEND TEST RESULTS TO: CITY OF PUYALLUP, WATER QUALITY OPERATIONS, 1100 39TH AVE SE, PUYALLUP, WA 98374.

3. DDCVA MUST BE PURCHASED AS A UNIT. NO MODIFICATIONS TO THE ASSEMBLY ARE

DDCVA IS ALLOWED TO BE LOCATED WITHIN A BUILDING AS APPROVED BY THE FIRE CODE OFFICIAL. WHEN THE DDCVA IS LOCATED WITHIN A BUILDING, THE FIRE DEPARTMENT CONNECTION (FDC) BALL DRIP SHALL DRAIN TO THE NEAREST APPROVED ON—SITE STORM DRAINAGE STRUCTURE.

ELECTRICAL INSPECTOR. THE DISCHARGE PIPE SHALL BE CONNECTED TO THE NEAREST

IN A VAULT INSTALLATION, IF VAULT CANNOT BE DRAINED TO DAYLIGHT, A 1/4 HP SUMP PUMP SHALL BE INSTALLED IN THE SUMP PIT OF THE VAULT. IT SHALL BE WIRED PER WASHINGTON STATE ELECTRICAL CODE, AND INSPECTED BY A STATE

6. DDCVA OUTSIDE STEM AND YOKE (OS&Y) GATE VALVES, AND THE POST INDICATOR VALVE (PIV), SHALL HAVE SUPERVISED TAMPER SWITCHES.

8. IN A VAULT INSTALLATION, RUN TWO 3/4" SCHEDULE 80 P.V.C. CONDUITS TO THE VAULT. ONE WILL BE USED FOR A GFCI PROTECTED OUTLET, AND ONE WILL BE FOR LOW VOLTAGE COMING FROM THE FIRE ALARM PANEL. INSTALL AN APPLETON FSCA OR FDCA CAST DEVICE BOX OR APPROVED EQUAL ON THE VAULT WALL AT THE CONDUIT

9. IN A VAULT INSTALLATION, RUN LOW VOLTAGE WIRE INSIDE VAULT AND TO PIV THROUGH SEAL—TIGHT FLEX CONDUIT. CONDUIT SHALL BE SECURELY FASTENED PERPENDICULAR OR HORIZONTALLY TO THE WALLS OF THE VAULT.

7. ALL ELECTRICAL SHALL BE INSPECTED BY A WASHINGTON STATE ELECTRICAL

10. WATER METER SHALL BE A SENSUS SRII TRPL READING IN 1 CUBIC FEET.

12. THE FDC SHALL BE LOCATED WITHIN 15 FEET OF A FIRE HYDRANT, BUT NOT LESS

14. A DDCVA INSTALLED MORE THAN 5 FEET ABOVE THE FLOOR LEVEL MUST HAVE A

THE FDC AND PIV SHALL BE A MINIMUM OF 50 FEET FROM A BUILDING, UNLESS APPROVED BY THE CITY OF PUYALLUP FIRE CODE OFFICIAL, BUT NEVER LESS THAN 5

PLATFORM UNDER IT FOR THE TESTER OR MAINTENANCE PERSON TO STAND ON. THE

PLATFORM MUST BE OSHA APPROVED AND MEET ALL APPLICABLE SAFETY STANDARDS

DOUBLE DETECTOR-CHECK VALVI


11. PIPE SUPPORTS SHALL BE RUST-PROTECTED WITH ALUMINUM PAINT.


APPROVED ON-SITE STORM DRAINAGE STRUCTURE.


ALLOWED.


AND CODES.


OFFICE HE CITY ENGINEER

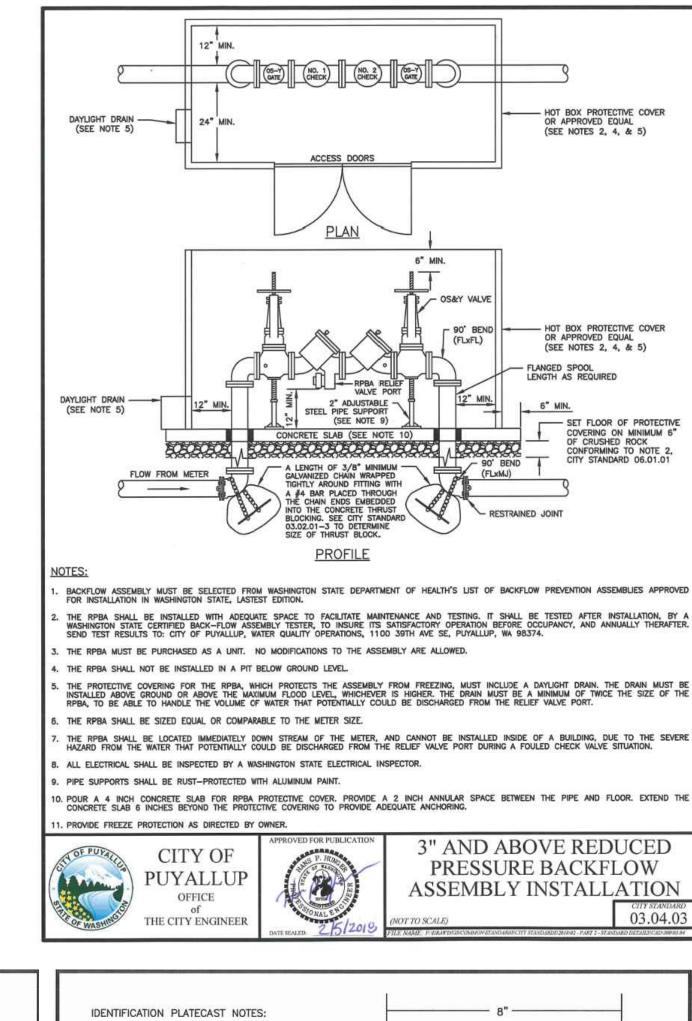

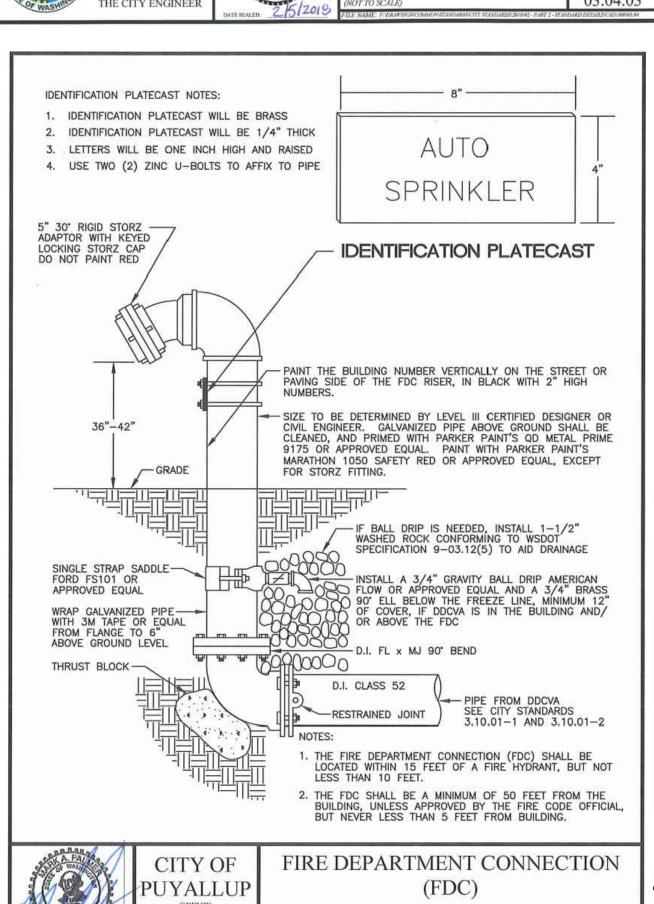

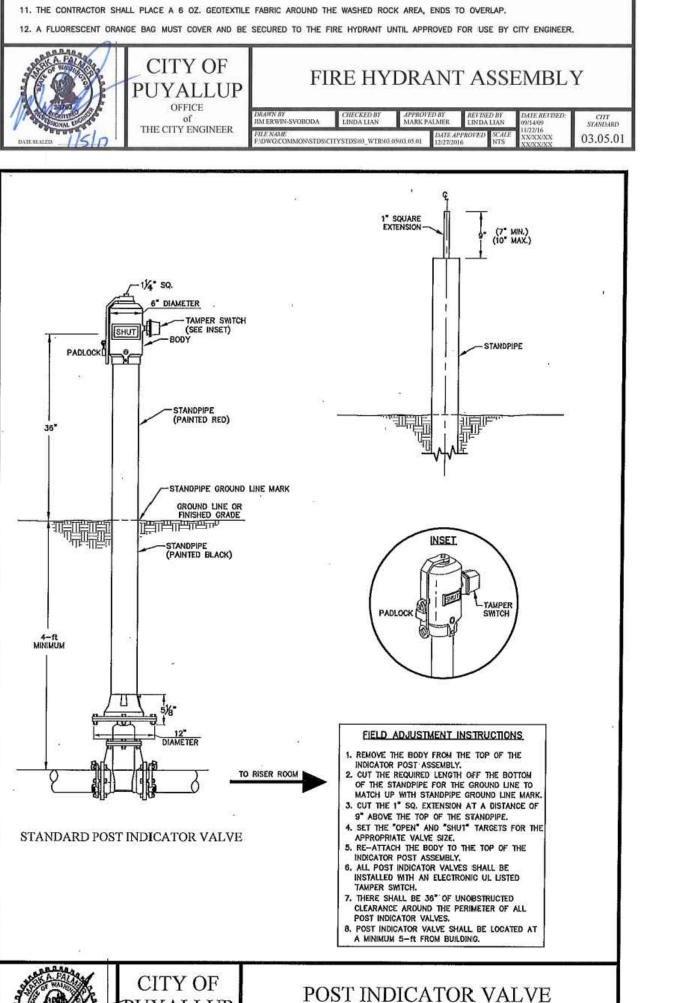

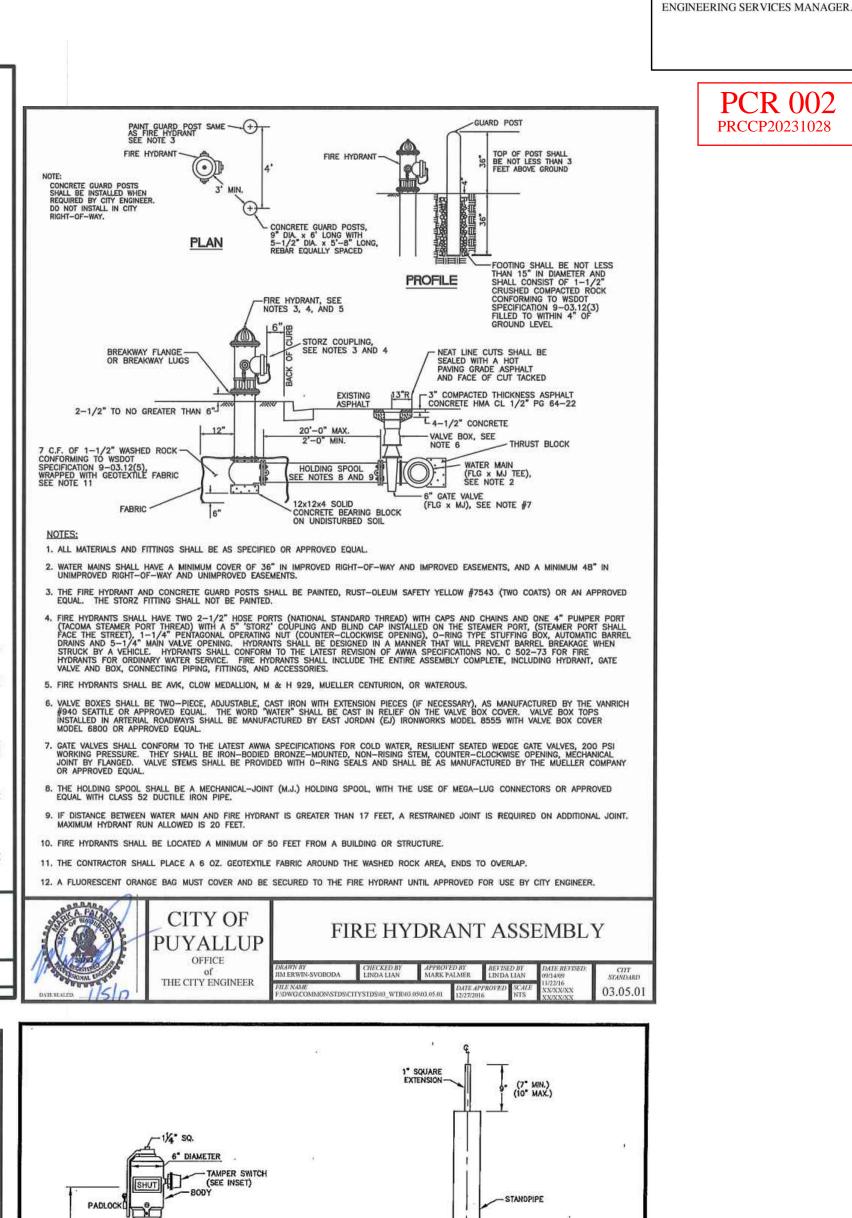

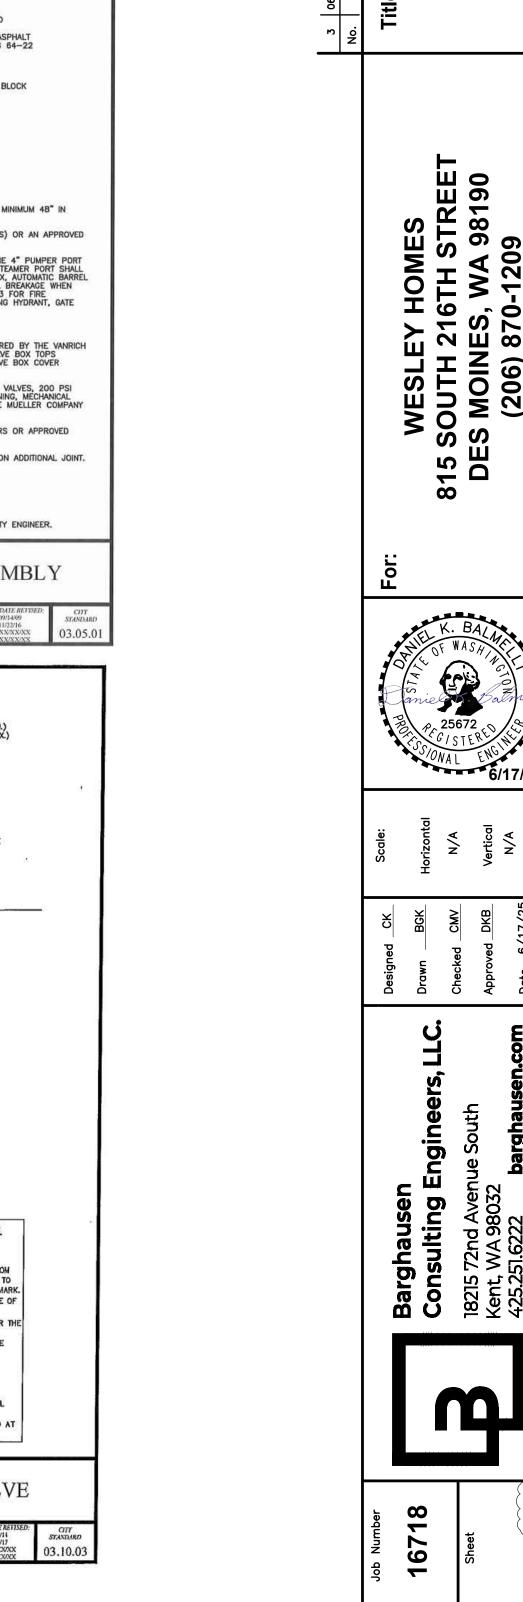

CITY OF PUYALLUP ENGINEERING SERVICES

NOTE: THIS APPROVAL IS VOID AFTER 1 YEAR FROM APPROVAL

RESPONSIBLE FOR ERRORS AND/OR OMISSIONS ON THESE PLANS. FIELD CONDITIONS MAY DICTATE CHANGES TO THESE PLANS AS


PRCCP20231028

2

S

THE CITY WILL NOT BE


DETERMINED BY THE

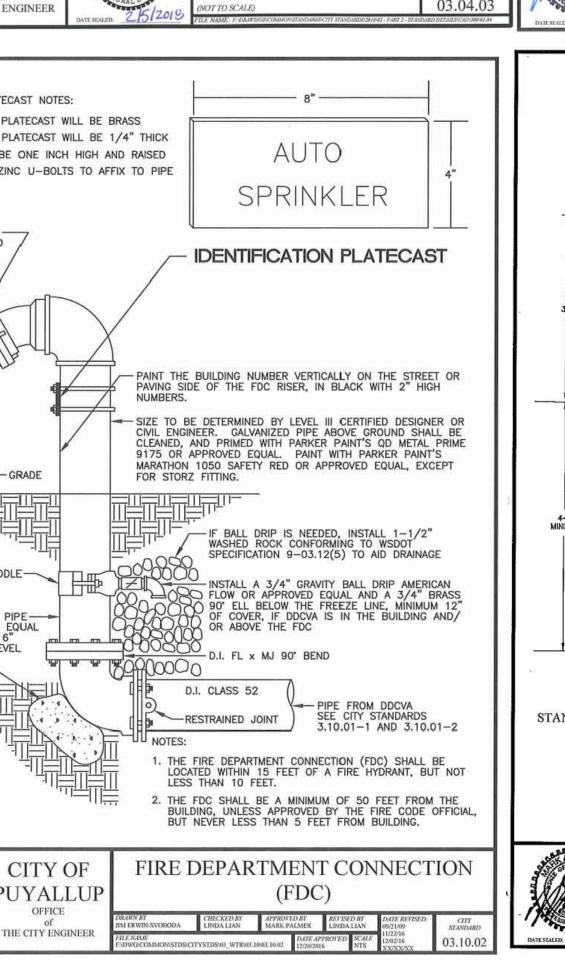





SEWER DETAILS


PHASE 2 - WESLEY BRADLEY PARK

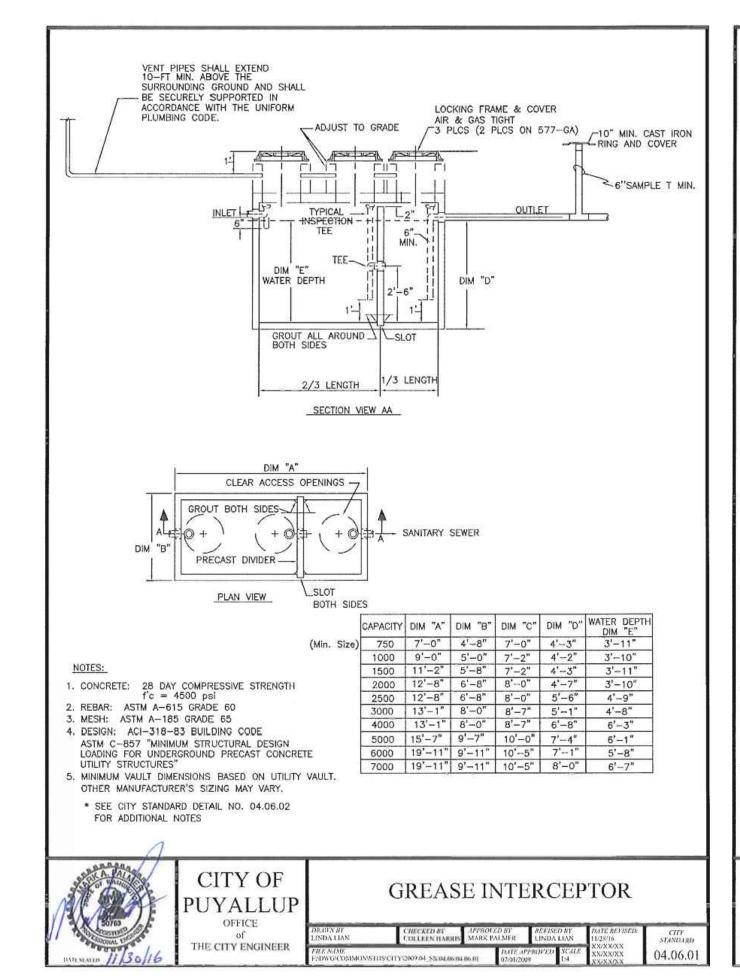


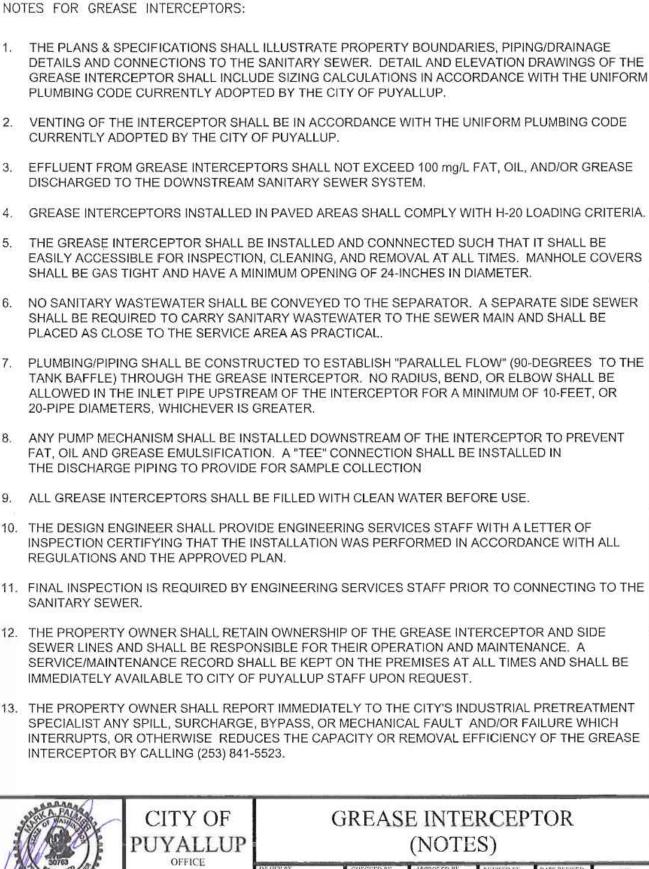


THE CITY ENGINEER

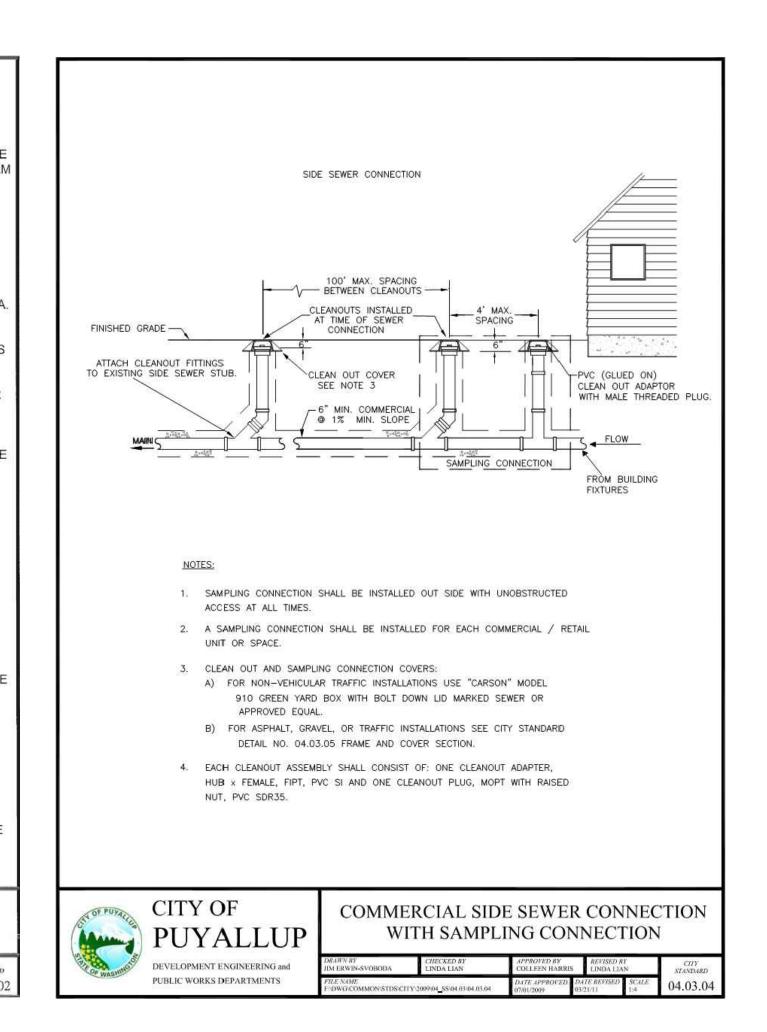

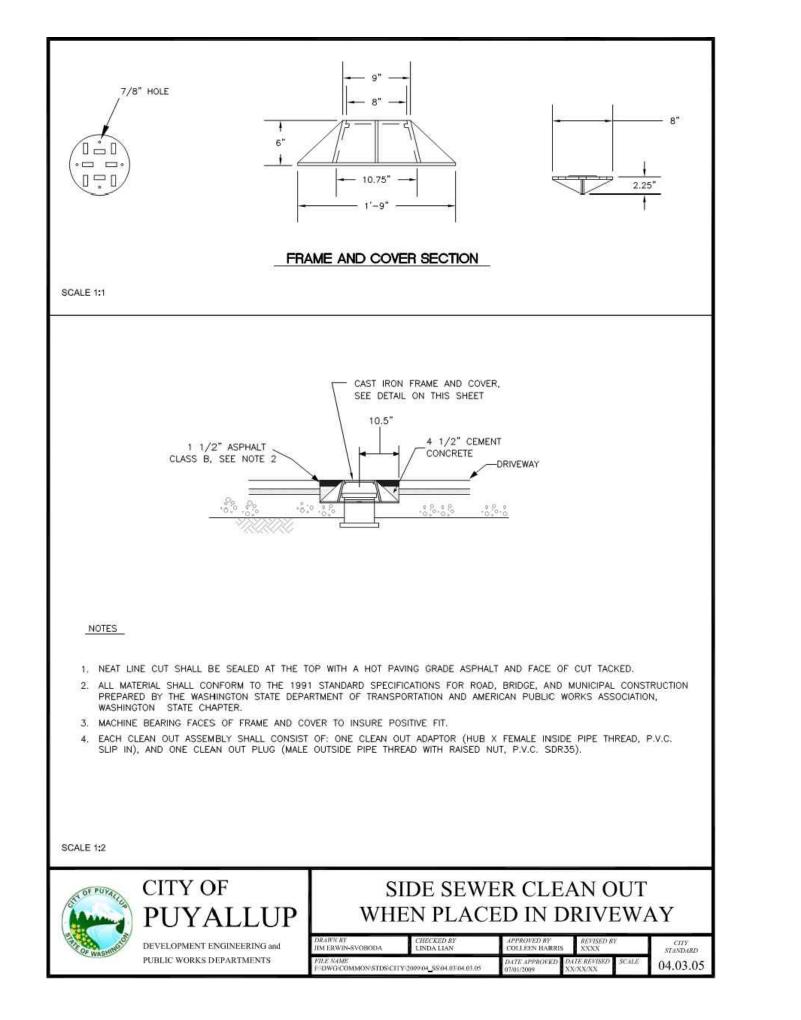


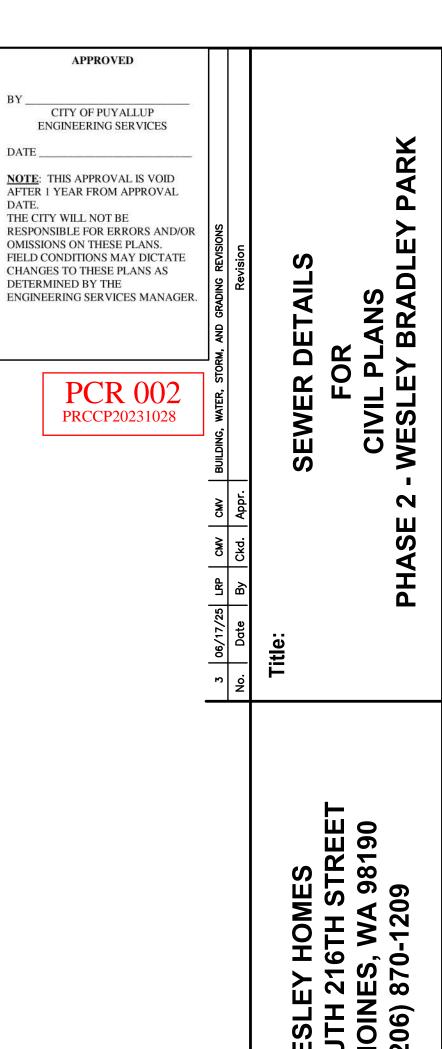


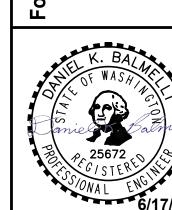

Barghausen Consulting Engineer


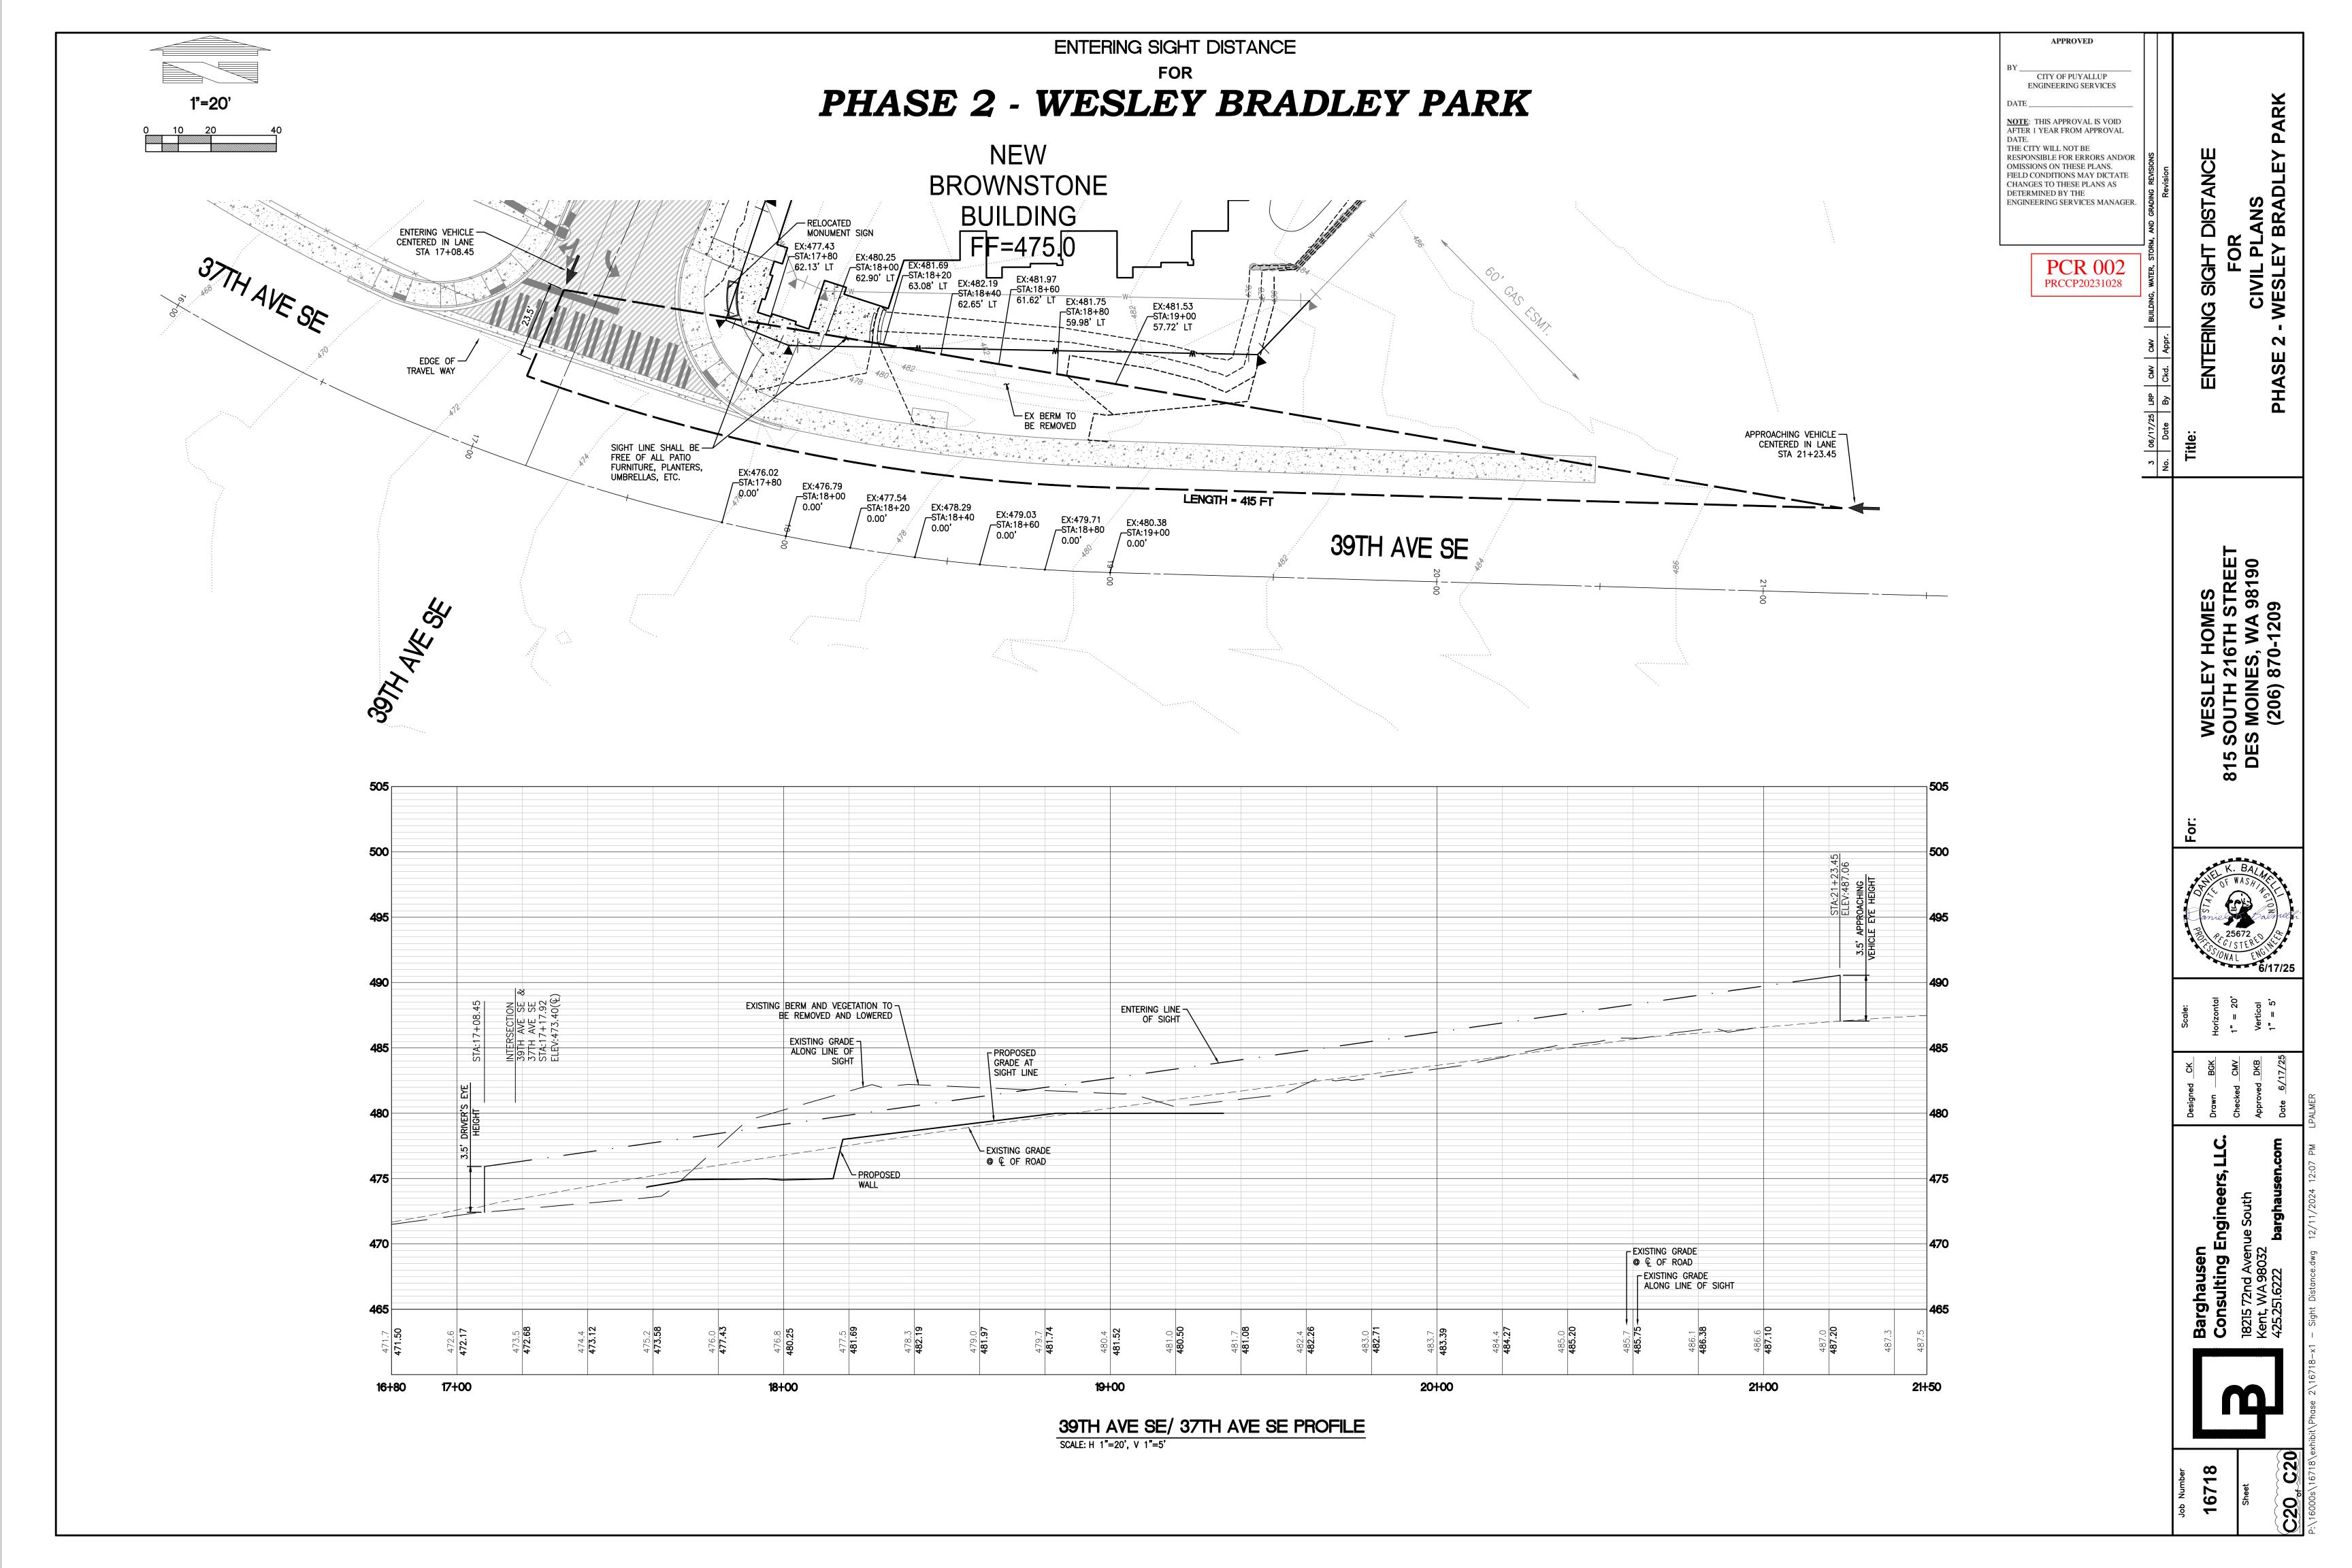

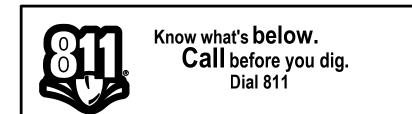

LANDSCAPE PLAN NORTH

LANDSCAPE SHEET INDEX


LANDSCAPE PLAN NORTH

2

PHASE

ENGINEERING SERVICES MANAGER.


PHASE 2 - WESLEY BRADLEY PARK

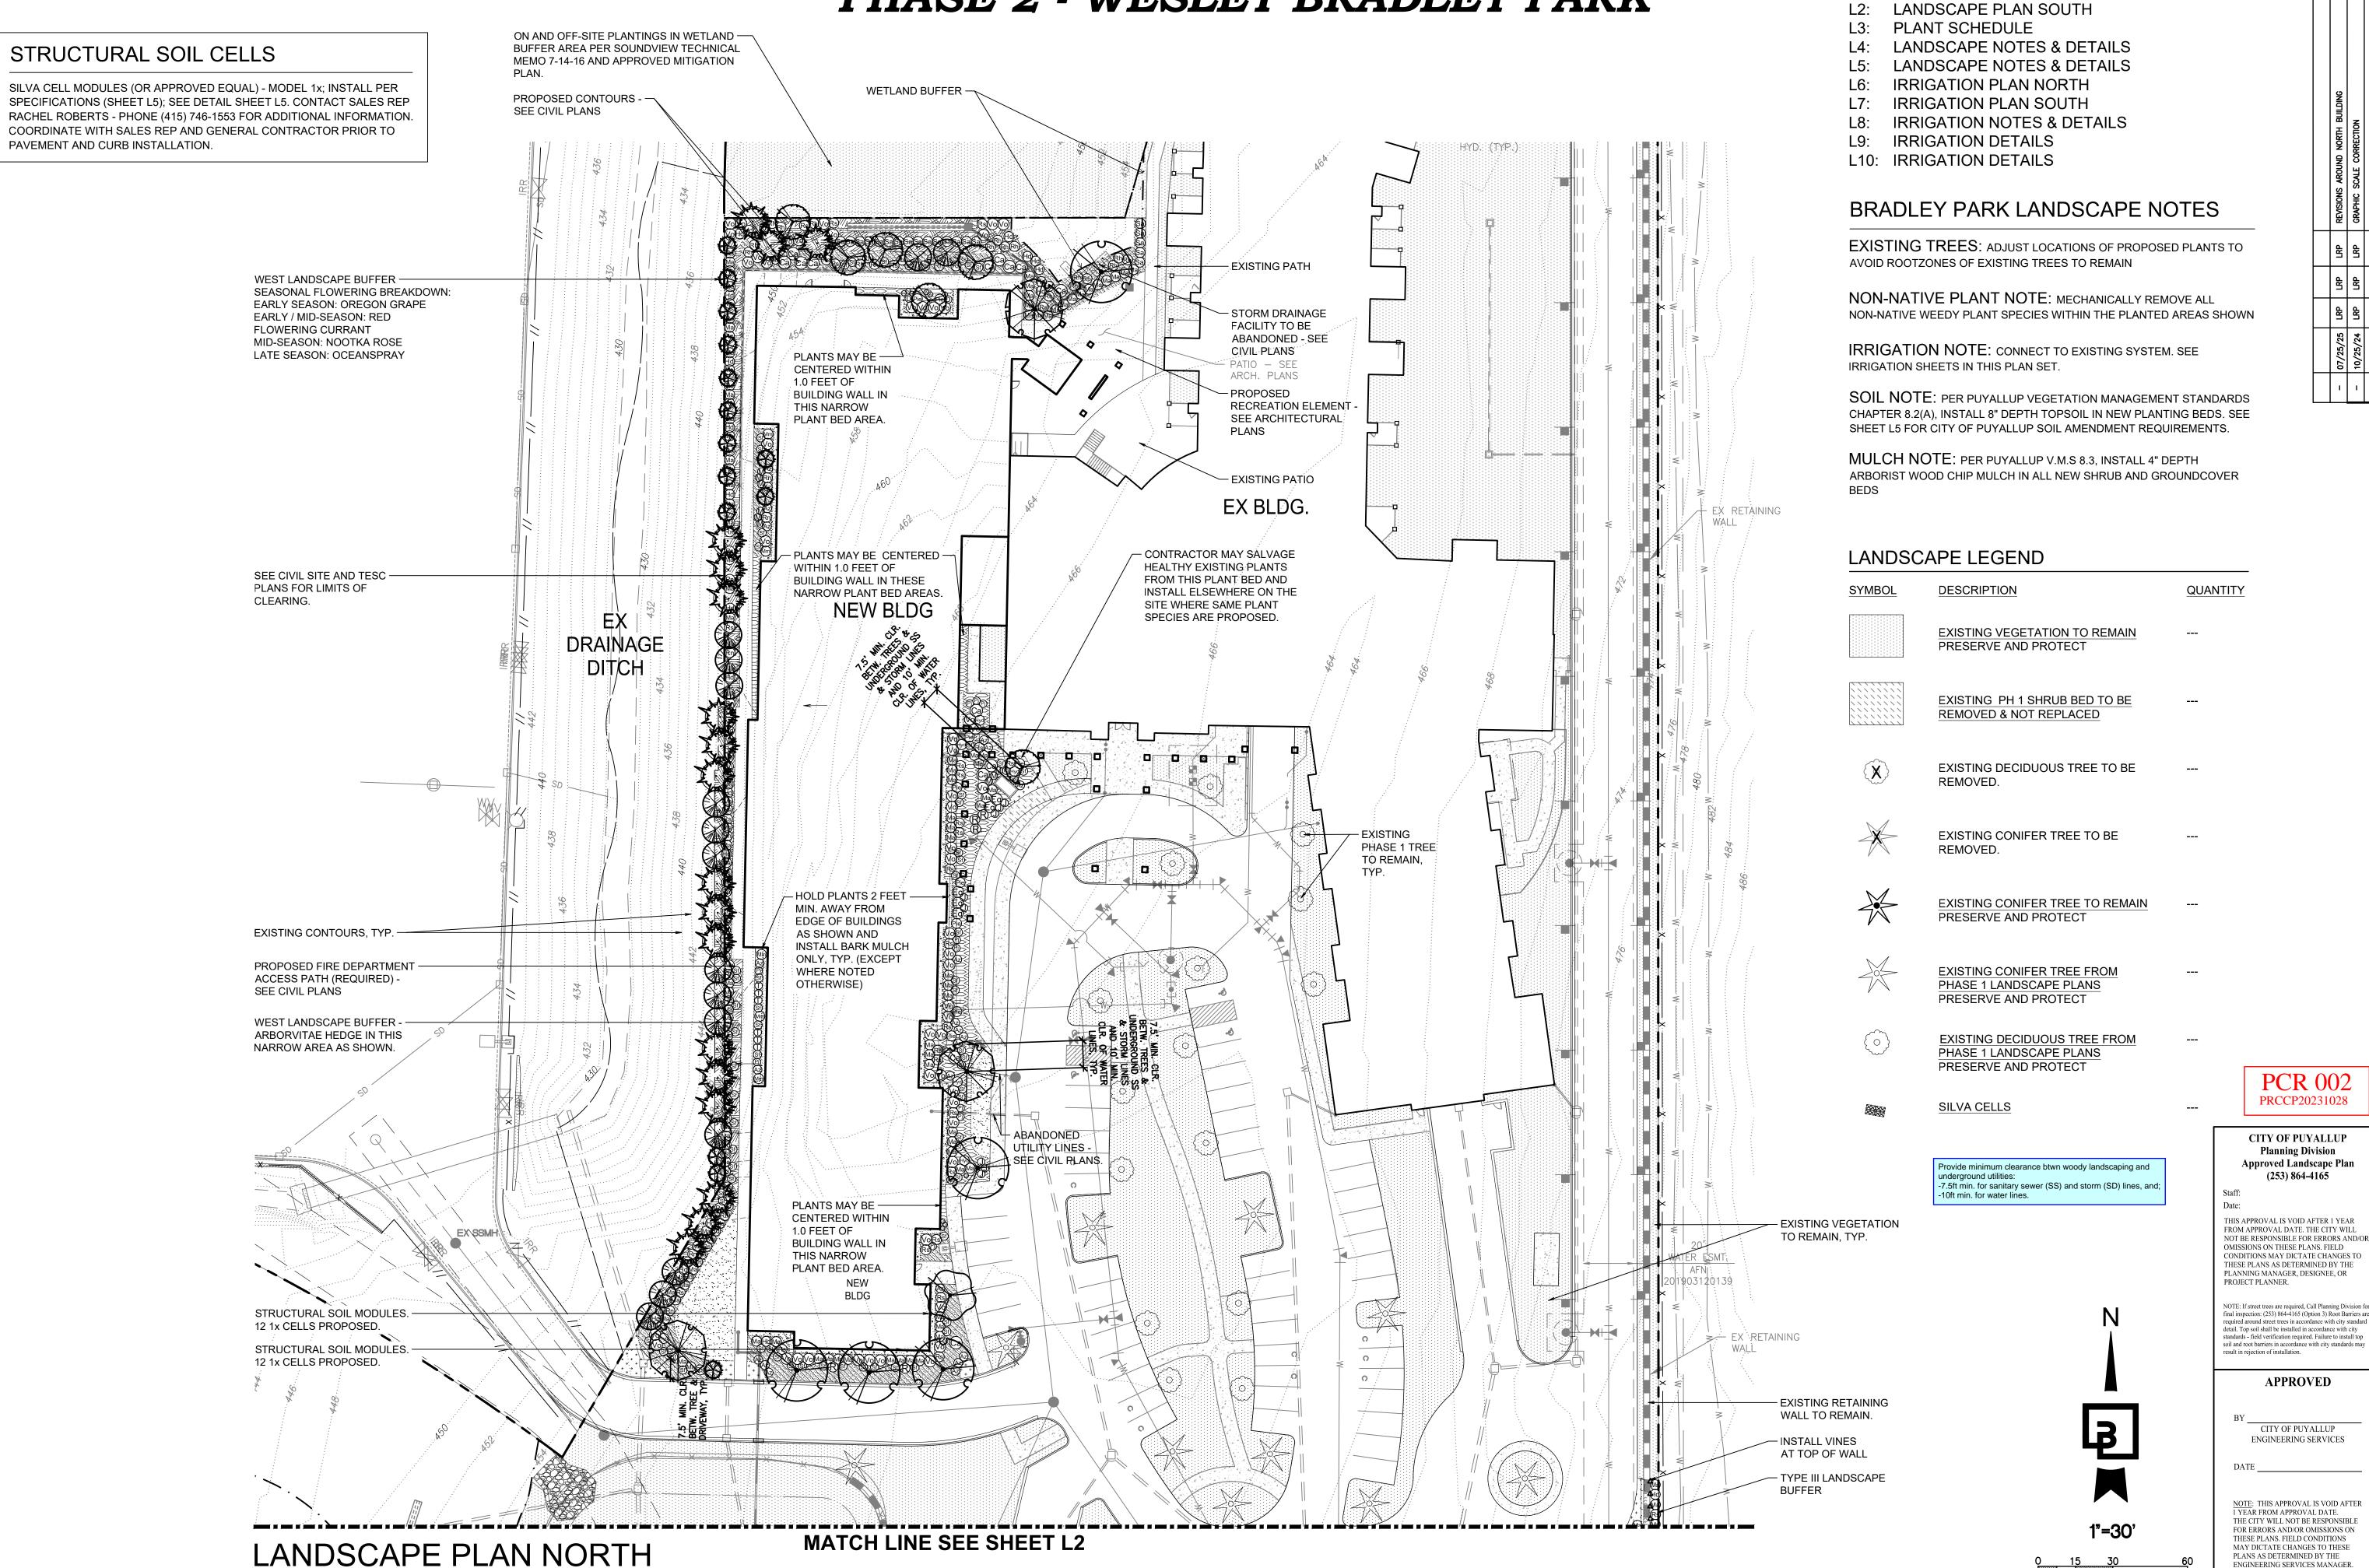


Know what's below. Call before you dig.

LANDSCAPE PLAN SOUTH

PHASE 2 - WESLEY BRADLEY PARK

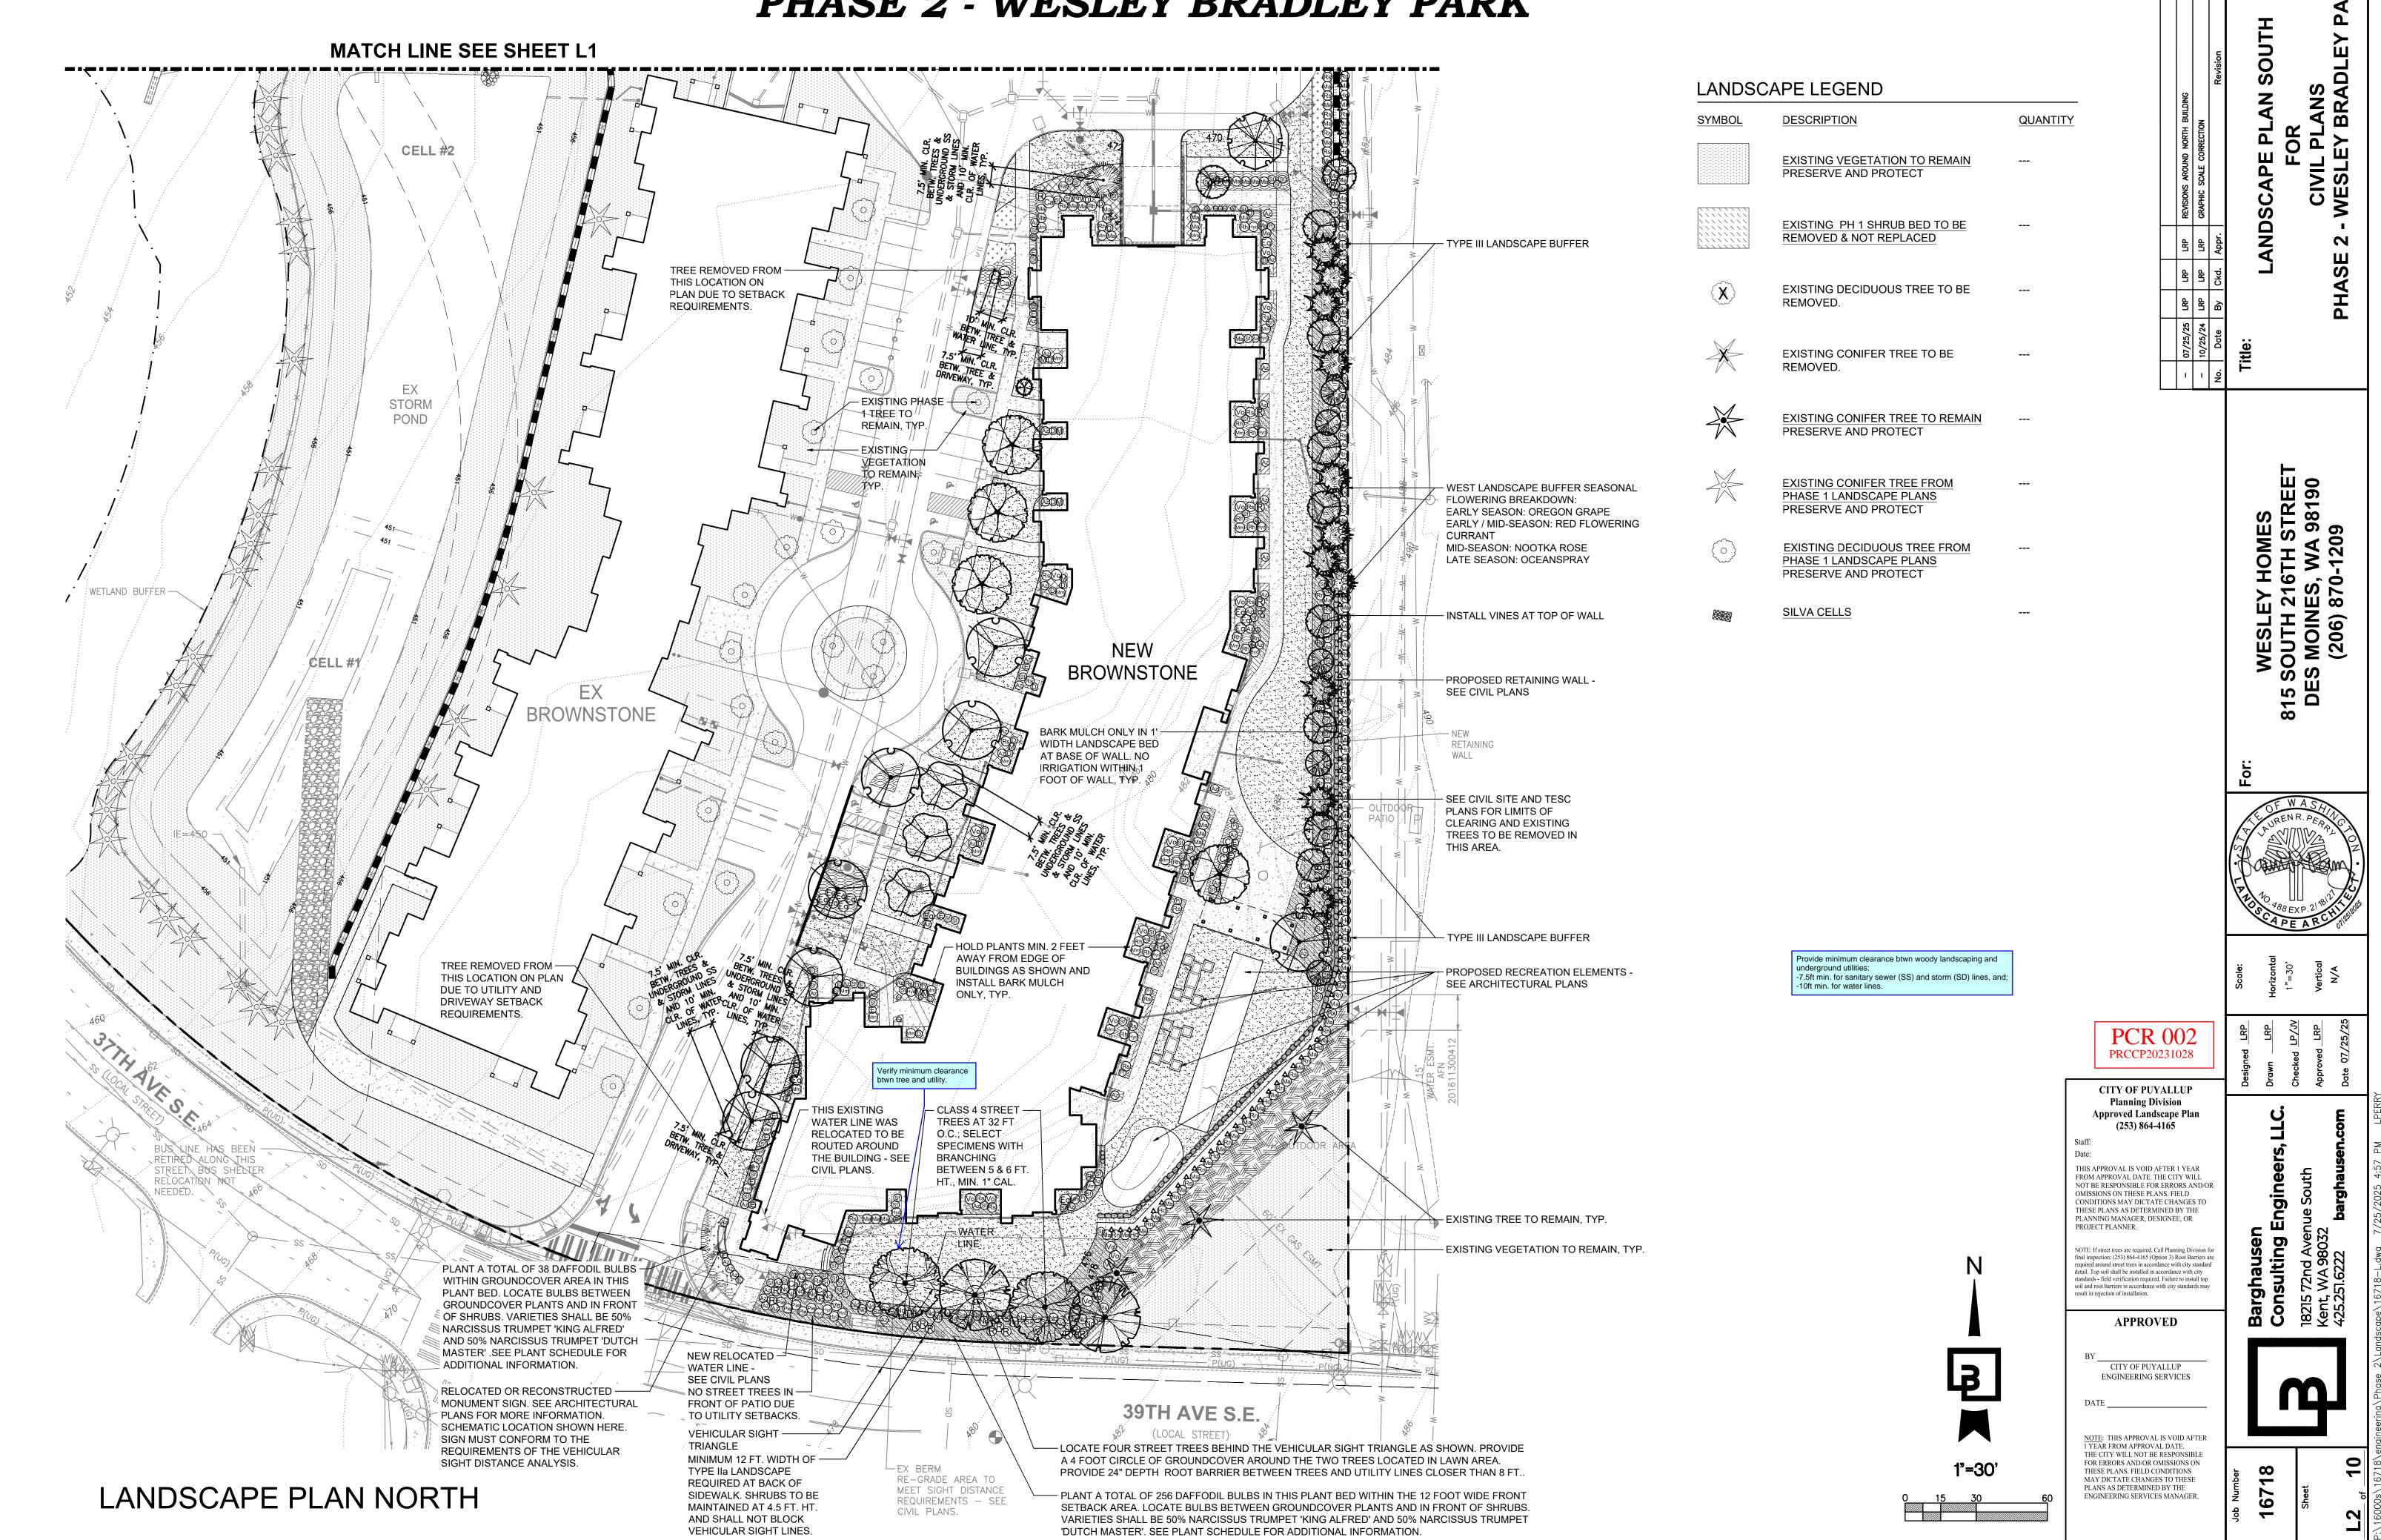

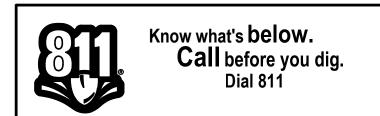

PLANT SCHEDULE

PHASE 2 - WESLEY BRADLEY PARK

SYMBOL	QTY	BOTANICAL / COMMON NAME	CONT.	SIZE	ORIGIN
DECIDUOUS		BOTANICAL / COMMON NAME	<u>00111.</u>	<u> </u>	ORIOIN
MA .	16	ACER CIRCINATUM / VINE MAPLE	B & B	1" CAL	NATIVE
E C	4	GINKGO BILOBA `AUTUMN GOLD` / AUTUMN GOLD MAIDENHAIR TREE	B & B	1" CAL	ADAPTIVE
	4	GLEDITSIA TRIACANTHOS INERMIS `SUNCOLE` / SUNBURST® HONEY LOCUST	B & B	1" CAL	ADAPTIVE
	4	LIRIODENDRON TULIPIFERA `JFS-OZ` / EMERALD CITY® TULIP POPLAR	B & B	1" CAL	ADAPTIVI
	13	MAGNOLIA GRANDIFLORA 'VICTORIA' / VICTORIA SOUTHERN MAGNOLIA	B & B	1" CAL	ADAPTIVI
EVERGREEN	N TREES				
The state of the s	29	PSEUDOTSUGA MENZIESII / DOUGLAS FIR	В&В	5`-6` MIN. HT.	NATIVE
	1	SEQUOIADENDRON GIGANTEUM / GIANT SEQUOIA	B & B	5`-6` MIN. HT.	ADAPTIVI
	20	THUJA PLICATA / WESTERN RED CEDAR	B & B	5`-6` MIN. HT.	NATIVE
\otimes	15	X CUPRESSOCYPARIS LEYLANDII 'MONCAL' TM / EMERALD ISLE LEYLAND CYPRESS	B & B	5`-6` MIN. HT.	ADAPTIVI
A TOP	2	FAGUS SYLVATICA 'RIVERSII' / RIVERS EUROPEAN BEECH BRANCHED TO BETWEEN 5 & 6 FT. HT.	B & B	1" CAL	ADAPTIV
E TO THE STATE OF	2	QUERCUS COCCINEA / SCARLET OAK BRANCHED TO BETWEEN 5 & 6 FT. HT.	B & B	1" CAL	ADAPTIV
SYMBOL	QTY	BOTANICAL / COMMON NAME	CONT.	ORIGIN	SPACING
SHRUBS ®	81	AZALEA X 'HINO-CRIMSON' / HINO-CRIMSON KURUME AZALEA	#2	ADAPTIVE	42" o.c.
©a)	24	CORNUS ALBA 'ELEGANTISSIMA' / SILVEREDGE TATARIAN DOGWOOD	#2	ADAPTIVE	60" o.c.
6	18	EUONYMUS ALATUS 'COMPACTUS' / COMPACT BURNING BUSH	#2	ADAPTIVE	54" o.c.
	20	EUONYMUS FORTUNEI 'EMERALD GAIETY' / EMERALD GAIETY WINTERCREEPER	#2	ADAPTIVE	36" o.c.
Hd	52	HOLODISCUS DISCOLOR / OCEAN-SPRAY	#2	NATIVE	48" o.c.
Hyd	24	HYDRANGEA QUERCIFOLIA 'MUNCHKIN' / MUNCHKIN OAKLEAF HYDRANGEA	#2	ADAPTIVE	48" o.c.
0	8	JUNIPERUS SQUAMATA 'BLUE STAR' / BLUE STAR JUNIPER	#2	ADAPTIVE	36" o.c.
Ma	234	MAHONIA AQUIFOLIUM 'COMPACTA' / COMPACT OREGON GRAPE	#2	NATIVE	48" o.c.
M	18	MAHONIA NERVOSA / OREGON GRAPE	#2	NATIVE	36" o.c.
Mm	28	MAHONIA X MEDIA 'WINTER SUN' / WINTER SUN MAHONIA	#2	ADAPTIVE	48" o.c.
Ng	27	NANDINA DOMESTICA 'GULF STREAM' / GULF STREAM HEAVENLY BAMBOO	#2	ADAPTIVE	48" o.c.
(P)	18	PIERIS JAPONICA 'CAVATINE' / CAVATINE JAPANESE PIERIS	#2	ADAPTIVE	36" o.c.
(Pie)	14	PIERIS X 'FOREST FLAME' / FOREST FLAME PIERIS	#2	ADAPTIVE	48" o.c.
(Rh)	50	RHODODENDRON MACROPHYLLUM / PACIFIC RHODODENDRON	#2	NATIVE	48" o.c.
Rs)	93	RIBES SANGUINEUM 'KING EDWARD VII' / RED FLOWERING CURRANT	#2	NATIVE	48" o.c.
®	60	ROSA NUTKANA / NOOTKA ROSE	#2	NATIVE	48" o.c.
®	20	ROSA RUGOSA 'FRU DAGMAR HASTRUP' / FRU DAGMAR HASTRUP ROSE	#2	ADAPTIVE	48" o.c.
(a)	33	SYMPHORICARPOS ALBUS / COMMON WHITE SNOWBERRY	#2	NATIVE	48" o.c.
0	6	THUJA OCCIDENTALIS `EMERALD GREEN` / EMERALD GREEN ARBORVITAE	5`-6` HT	ADAPTIVE	36" o.c.
(i)	72	VACCINIUM OVATUM / EVERGREEN HUCKLEBERRY	#2	NATIVE	54" o.c.
FERNS ©	22	DRYOPTERIS FILIX-MAS 'ROBUSTA' / ROBUST MALE FERN	#2	ADAPTIVE	36" o.c.
(3)	166	POLYSTICHUM MUNITUM / WESTERN SWORD FERN	#2	NATIVE	40" o.c.
GRASSES ©	3	CHIONOCHLOA RUBRA / RED TUSSOCK	#2	ADAPTIVE	48" o.c.
PERENNIALS ⊗	<u>5</u>	ARUNCUS DIOICUS / GOATSBEARD	#2	NATIVE	36" o.c.
⊗ ⊗	3 7	ASTILBE X ARENDSII 'BEAUTY OF ERNST' / COLOR FLASH® ASTILBE	#2 #2	ADAPTIVE	36 o.c. 24" o.c.
©	, 18	CAMPANULA PERSICIFOLIA / PEACH-LEAF BELLFLOWER	#2	ADAPTIVE	22" o.c.
•	8	HELLEBORUS FOETIDUS / BEARSFOOT HELLEBORE	#2	ADAPTIVE	24" o.c.

HELLEBORUS FOETIDUS / BEARSFOOT HELLEBORE

SYMBOL	QTY	BOTANICAL / COMMON NAME	CONT.	ORIGIN	SPACING
<u>VINES</u>	76	LONICERA JAPONICA 'HALLIANA' / HALLS HONEYSUCKLE FLOWERING VINE	#1	ADAPTIVE	24" o.c.
GROUND COV	ERS				
	1,740	ARCTOSTAPHYLOS UVA-URSI / KINNIKINNICK	#1	NATIVE	24" o.c.
* * * * * * * * * * * * * * * * * * *	239	ERICA X DARLEYENSIS 'WHITE PERFECTION' / WHITE PERFECTION DARLEY HEATH	#1	ADAPTIVE	24" o.c.
	693	GAULTHERIA SHALLON / SALAL	#1	NATIVE	36" o.c.
	79	LAVANDULA ANGUSTIFOLIA 'HIDCOTE SUPERIOR' / HIDCOTE SUPERIOR ENGLISH LAVENDER	#1	ADAPTIVE	18" o.c.
	914	LIRIOPE MUSCARI `SILVERY SUNPROOF` / SILVERY SUNPROOF LILYTURF	#1	ADAPTIVE	24" o.c.
	196	LIRIOPE SPICATA / CREEPING LILYTURF	#1	ADAPTIVE	24" o.c.
		NARCISSUS X 'DUTCH MASTER' / DUTCH MASTER DAFFODIL			Г

TOP SIZE BULBS; PLANT ALONG FRONTAGE BETWEEN GROUNDCOVER PLANTS AS NOTED

ON LANDSCAPE PLAN. PLANT BULBS SEPTEMBER - NOVEMBER, OR DURING ALTERNATE

TIME OF YEAR AS APPROVED BY LANDSCAPE ARCHITECT.

TIME OF YEAR AS APPROVED BY LANDSCAPE ARCHITECT.

NARCISSUS X 'KING ALFRED' / KING ALFRED DAFFODIL

LANDSCAPE LEGEND

EXISTING CONIFER TREE FROM

EXISTING DECIDUOUS TREE FROM

PHASE 1 LANDSCAPE PLANS PRESERVE AND PROTECT

PHASE 1 LANDSCAPE PLANS

PRESERVE AND PROTECT

SILVA CELLS

ADAPTIVE 24" o.c.

SYMBOL	DESCRIPTION	QUANTITY	SYMBOL	DESCRIPTION	QUANTITY
	EXISTING VEGETATION TO REMAIN PRESERVE AND PROTECT			EROSION CONTROL HYDROSEED SUNMARK SEEDS NATIVE EC MIX, OAE. INSTALL PER MANUFACTURER'S RECOMMENDATIONS.	194 SF
	EXISTING PH 1 SHRUB BED TO BE REMOVED & NOT REPLACED			LAWN SOD OR SEED LAWN. SEE LANDSCAPE	13,385 SF
(X)	EXISTING DECIDUOUS TREE TO BE REMOVED.			NOTES.	
	EXISTING CONIFER TREE TO BE REMOVED.			FOUR (4) INCHES ARBORIST CHIP MULCH SEE SOILS AND LANDSCAPE NOTES. (MULCH QUANTITY SHOWN IN THIS LEGEND ONLY INCLUDES AREAS OF MULCH SHOWN ON THE PLANS. THE	7,188 SF
	EXISTING CONIFER TREE TO REMAIN PRESERVE AND PROTECT			QUANTITY DOES NOT INCLUDE THE 4" DEPTH OF MULCH REQUIRED WITHIN SHRUB AND GROUNDCOVER BEDS.)	

PLANT SCHEDULE NOTES

- ALL TREES SHALL BE FULL, WELL BRANCHED AND SYMMETRICAL WITH STRONG, STRAIGHT, UNCUT
- TREES OF SAME SPECIES GROUPED TOGETHER SHALL BE MATCHED SPECIMENS.
- PRESERVE AND PROTECT ALL EXISTING TREES TO REMAIN PER CITY OF PUYALLUP TREE PROTECTION STANDARDS.
- STAKE AND GUY ALL TREES FOR ONE GROWING
- REMOVE ALL WEEDS FROM PLANT ROOT BALLS AND CONTAINERS PRIOR TO PLANTING.
- ALL GROUNDCOVERS SHALL BE WELL ROOTED WITH FULL TOP GROWTH, AND BE PLANTED WITH TRIANGULAR SPACING. VINE TYPE GROUNDCOVERS
- SHALL HAVE MINIMUM 3 RUNNERS. SEE DETAIL ON L4. ALL SHRUBS SHALL BE WELL ROOTED, SYMMETRICAL, AND BE FULL AND BUSHY.
- 8. ALL FERNS AND GRASSES SHALL BE WELL ROOTED, SYMMETRICAL, WITH FULL TOP GROWTH. ALL FERNS SHALL HAVE A MINIMUM OF 3 FRONDS.
- ALL PLANTS SHALL BE NURSERY GROWN, NOT COLLECTED.
- 10. APPLY 4" ARBORISTS WOOD CHIP MULCH TO THE SURFACES OF ALL SHRUB AND GROUNDCOVER BEDS AND AREAS ADJACENT TO BUILDINGS AND WALLS AS NOTED ON THE PLANS.
- 11. ALL PROPOSED NEW PLANTS SHALL BE IRRIGATED WITH A WATER-WISE AUTOMATIC IRRIGATION
- 12. MAINTAIN ALL NEW PLANTS IN A HEALTHY CONDITION THROUGH THE ONE YEAR GUARANTEE PERIOD.
- 13. PLANTS SHALL BE NO CLOSER TO THE FACE OF A BUILDING THAN HALF OF THE PLANT SPACING INDICATED IN THE PLANT SCHEDULE PLUS 2 FEET.

Provide minimum clearance btwn woody landscaping and -7.5ft min. for sanitary sewer (SS) and storm (SD) lines, and; -10ft min. for water lines.





THIS APPROVAL IS VOID AFTER 1 YEAR FROM APPROVAL DATE. THE CITY WILL NOT BE RESPONSIBLE FOR ERRORS AND/OR OMISSIONS ON THESE PLANS, FIELD CONDITIONS MAY DICTATE CHANGES TO THESE PLANS AS DETERMINED BY THE PLANNING MANAGER, DESIGNEE, OR PROJECT PLANNER.

NOTE: If street trees are required, Call Planning Division for final inspection: (253) 864-4165 (Option 3) Root Barriers are required around street trees in accordance with city standard detail. Top soil shall be installed in accordance with city standards - field verification required. Failure to install top soil and root barriers in accordance with city standards may result in rejection of installation.

APPROVED

CITY OF PUYALLUP ENGINEERING SERVICES

NOTE: THIS APPROVAL IS VOID AFTER 1 YEAR FROM APPROVAL DATE. THE CITY WILL NOT BE RESPONSIBLE FOR ERRORS AND/OR OMISSIONS ON THESE PLANS. FIELD CONDITIONS MAY DICTATE CHANGES TO THESE PLANS AS DETERMINED BY THE ENGINEERING SERVICES MANAGER.

Barghausen Consulting I 18215 72nd Aver Kent, WA 98032 425.251.6222

2

PHASE

WESLEY HOMES 5 SOUTH 216TH STREET ES MOINES, WA 98190 (206) 870-1209

15 S

SUBJECT TO APPROVAL BY THE OWNER.

REPAIR OF EXISTING PLANTINGS:

CONDITIONS PRIOR TO THE DAMAGE.

C) TREE STAKING AND GUYING MATERIALS.

D) ONE (1) QUART SIZE OF TOPSOIL AND MULCH. E) PLANTING SCHEDULE INCLUDING DATES AND TIMES.

F) MAINTENANCE INSTRUCTIONS FOR ONE (1) FULL YEAR.

30-DAY MAINTENANCE:

START OF ANY WORK:

MATERIALS:

SCOPE OF WORK

LANDSCAPE PLANTING NOTES AND MATERIALS

FERTILIZER, STAKING, MULCH, CLEAN-UP, DEBRIS REMOVAL, AND 30-DAY MAINTENANCE.

PERFORM THE WORK SPECIFIED WITHIN THE PRESIDING JURISDICTION

FURNISH ALL MATERIALS, LABOR, EQUIPMENT AND RELATED ITEMS NECESSARY TO ACCOMPLISH TOPSOIL,

TREATMENT AND PREPARATION OF SOIL, FINISH GRADING, PLACEMENT OF SPECIFIED PLANT MATERIALS,

LANDSCAPE CONTRACTOR TO BE SKILLED AND KNOWLEDGEABLE IN THE FIELD OF WORK AND HAVE A

IT IS THE CONTRACTOR'S RESPONSIBILITY TO REVIEW THE SITE AND REPORT ANY DISCREPANCIES TO

THE OWNER OR THE OWNER'S REPRESENTATIVES. ALL PLANT MATERIAL AND FINISH GRADES ARE

SAVE AND PROTECT ALL EXISTING PLANTINGS SHOWN TO REMAIN. DO NOT PLANT UNTIL OTHER

CONSTRUCTION OPERATIONS WHICH CONFLICT HAVE BEEN COMPLETED. IF AN IRRIGATION SYSTEM IS TO

BE INSTALLED DO NOT PLANT UNTIL THE SYSTEM HAS BEEN INSTALLED, TESTED, AND APPROVED BY THE OWNER. HANDLE PLANTS WITH CARE - DO NOT DAMAGE OR BREAK ROOT SYSTEM, BARK, OR

BRANCHES. REPAIR AND/OR REPLACE ITEMS DAMAGED AS A RESULT OF WORK, OR WORK NOT IN

DURING THE COURSE OF WORK, REPAIR ALL EXISTING PLANTING AREAS BY PRUNING DEAD

DURING THE COURSE OF WORK, REPAIR ANY DAMAGE TO THE IRRIGATION SYSTEM TO MATCH

GUARANTEE ALL PLANT MATERIAL FOR A PERIOD OF ONE YEAR FROM DATE OF FINAL ACCEPTANCE OF

PROVIDE LANDSCAPE AND IRRIGATION MAINTENANCE FOR 30 DAYS FOLLOWING STORE OPENING. WORK

SUBMIT THE FOLLOWING TO THE LANDSCAPE ARCHITECT FOR REVIEW AND APPROVAL PRIOR TO THE

B) TOPSOIL ANALYSIS AND RECOMMENDED AMENDMENTS; SEE SOIL AMENDMENT NOTES ON SHEET

CONTRACTOR TO PROVIDE OWNER WITH A SCOPE OF WORK AT TIME OF INITIAL PROJECT BID TO

TO INCLUDE MAINTENANCE AS DESCRIBED BELOW, IN PLANTING AND IRRIGATION MAINTENANCE.

A) DOCUMENTATION THAT ALL PLANT MATERIAL HAS BEEN ORDERED.

PLANT MATERIALS TO BE GRADE NO. 1, SIZED IN ACCORDANCE WITH (AAN) AMERICAN

STANDARDS FOR NURSERY STOCK (ANSI Z60.1-2004). PRUNE PLANTS RECEIVED FROM THE

A) SPECIFIED PLANT CANOPY SIZE OR CALIPER IS THE MINIMUM ACCEPTABLE CONTAINER

OR BALL SIZE AND ESTABLISHES MINIMUM PLANT CONDITION TO BE PROVIDED.

DEVELOPED FIBROUS ROOT SYSTEMS. ROOT BALLS OF PLANTS TO BE SOLID

AND FIRMLY HELD TOGETHER, SECURELY CONTAINED AND PROTECTED FROM INJURY AND DESICCATION. PLANTS DETERMINED BY LANDSCAPE ARCHITECT TO HAVE BEEN

DAMAGED; HAVE DEFORMITIES OF STEM, BRANCHES, OR ROOTS; LACK SYMMETRY, HAVE MULTIPLE LEADERS OR "Y" CROTCHES LESS THAN 30 DEGREES IN TREES, OR DO NOT MEET SIZE OR ANSI STANDARDS WILL BE REJECTED. PLANT MATERIAL TO BE

NO SUBSTITUTION OF PLANT MATERIAL, SPECIES OR VARIETY, WILL BE PERMITTED

BROKERAGE OFFICES. SUBSTITUTIONS WHICH ARE PERMITTED TO BE IN WRITING

FROM THE OWNER AND LANDSCAPE ARCHITECT. THE SPECIFIED SIZE, SPECIES AND NEAREST VARIETY, AS APPROVED, TO BE FURNISHED. SUBSTITUTIONS MAY REQUIRE

D) LABEL AT LEAST ONE (1) TREE, SHRUB, AND GROUNDCOVER OF EACH VARIETY WITH A

24 INCH DEPTH ROOT BARRIER AS MANUFACTURED BY DEEP ROOT OR APPROVED EQUAL

SECURELY ATTACHED WATERPROOF TAG BEARING LEGIBLE DESIGNATION OF BOTANICAL

FROM A SINGLE NURSERY SOURCE FOR EACH SPECIFIED SPECIES/HYBRID. NURSERY

UNLESS WRITTEN EVIDENCE IS SUBMITTED TO THE OWNER FROM TWO QUALIFIED PLANT

PLANT MATERIAL TO COMPLY WITH STATE AND FEDERAL LAWS FOR DISEASE INSPECTION. PLANTS TO BE FULLY LIVE. VIGOROUS. WELL FORMED. WITH WELL

SOURCES TO BE THOSE LOCATED IN THE SAME REGION AS THE JOB SITE.

SUBMITTAL TO REVISED LANDSCAPE PLAN TO CITY FOR APPROVAL.

AND COMMON NAMES.

PRUNE DAMAGED TWIGS AFTER PLANTING —

PROTECT TRUNK AND LIMBS FROM INJURY.

OF MATERIAL.

MULCH LAYER

UNDER BALL

KEEP ROOTBALL MOIST AND PROTECTED AT ALL TIMES.

REMOVE ALL WRAP, TIES & CONTAINERS, REGARDLESS

RUBBER GUYS TIED IN FIGURE EIGHT; REMOVE AFTER ONE

PROTECTIVE WRAPPING DURING SHIPMENT TO SITE AND -

PREPARE PLANTING BED PER SPEC'S; AT MIN., LOSSEN -

SET BALL ON UNDISTURBED BASE OR COMPACTED MOUND—

DECIDUOUS TREE PLANTING/STAKING DETAIL

AND MIX SOIL TO 18" OR DEPTH OF ROOTBALL AND 2

REMOVE ALL WRAP, TIES, AND CONTAINERS SCORE ROOTBALL AND WORK NURSERY SOIL

AWAY FROM PERIMETER ROOTS

PENETRATION TO SUBBASE (+) 24" ——

INSTALLATION REMOVE AT COMPLETION OF PLANTING

PLACE IN VERT. POSITION: DOUBLE LEADERS WILL BE REJECTED —

HOLD CROWN OF ROOTBALL AT OR JUST ABOVE FINISH GRADE.

BACKFILL TO BE SETTLED USING WATER ONLY - NO MECHANICAL

(2) LODGEPOLE STAKES, PLUMB WITH ELASTIC CHAIN-LOCK TYPE OR-

BALLED AND BURLAPPED; "CONT." INDICATES CONTAINER; "BR" INDICATES BARE ROOT; "GAL" INDICATES

NURSERY ONLY UPON AUTHORIZATION BY THE LANDSCAPE ARCHITECT. "B & B" INDICATES

GROWTH, RE-ESTABLISHING FINISH GRADE AND RE-MULCHING TO SPECIFIED DEPTH.

COMPLIANCE WITH PLANS AND SPECIFICATIONS. AS DIRECTED BY OWNER AT NO ADDITIONAL COST TO

MINIMUM OF FIVE (5) YEAR'S EXPERIENCE INSTALLING SIMILAR WORK. CONTRACTOR TO BE LICENSED TO

LANDSCAPE NOTES + DETAILS

Provide minimum clearance btwn woody landscaping and

-10ft min. for water lines.

-7.5ft min. for sanitary sewer (SS) and storm (SD) lines, and;

PHASE 2 - WESLEY BRADLEY PARK

FINISH GRADE AT

4:1 SLOPE MAXIMUM

2% SLOPE MINIMUM

CURB PER CIVIL

SIMILAR)

DRAWINGS (WALK

PLANTER SECTION DETAIL

3x THE ROOTBALL

APPLY ADDITIONAL 4 OZ. 8-32-16 FERTILIZER INTO TOP

FROM ROOTBALL. ROUGHEN ALL SURFACES OF PIT.

CUT AND REMOVE BURLAP FROM ROOT BALL

SHRUB PLANTING DETAIL

PLANT SHRUB HIGH ENOUGH TO ALLOW POSITIVE DRAINAGE AWAY

DIAMETER

2" OF PLANTING MIX.

NOT TO SCALE

D) LABEL AT LEAST ONE (1) TREE, SHRUB, AND GROUNDCOVER OF EACH VARIETY WITH A SECURELY ATTACHED WATERPROOF TAG BEARING LEGIBLE DESIGNATION OF BOTANICAL

AND COMMON NAMES. E) DELIVER PLANT MATERIAL AFTER PREPARATION OF PLANTING AREAS HAVE BEEN COMPLETED AND PLANT IMMEDIATELY. IF PLANTING IS DELAYED MORE THAN SIX (6) HOURS AFTER DELIVERY, SET MATERIAL IN SHADE, PROTECT FOR WEATHER AND MECHANICAL DAMAGE, AND KEEP ROOT BALLS MOIST BY COVERING WITH MULCH, BURLAP OR OTHER ACCEPTABLE MEANS OF RETAINING MOISTURE.

SOIL PREPARATION: SEE SOIL AMENDMENT AND DEPTH NOTES ON SHEET L5.

THE CITY OF PUYALLUP REQUIRES:

A MINIMUM OF 4 INCHES OF MULCH AND 8 INCHES OF COMPOST AMENDED SOIL ARE REQUIRED IN ALL PLANTED AREAS PER CITY VMS. INSTALL PER CITY VMS SECTION 8, 2A.

ARBORISTS WOOD CHIP MULCH, COARSE BARK MULCH MAY BE USED ONLY AS APPROVED.

2-INCH DIAMETER BY 8-FOOT MINIMUM LODGEPOLE PINE STAKES.

1-INCH WIDE POLYETHYLENE CHAIN LOCK TYPE TIES; OR, 3/8" DIAMETER RUBBER. NO WIRE.

DROUGHT TOLERANT COMMERCIAL SEED AS NOTED ON PLANS.

"WILT-PROOF," 48 HOURS PRIOR TO SHIPMENT TO SITE FROM JUNE 1 THROUGH SEPTEMBER. THOROUGHLY ROOT WATER PLANTS PRIOR TO DELIVERY. PLANT MATERIAL DELIVERED TO SITE TO BE KEPT CONTINUALLY MOIST THROUGH INSTALLATION.

VERIFY THAT ALL SOIL CONTAMINANTS (E.G., PAINT, SEALANTS, SOLVENTS, OILS, GREASES,

FINE GRADE AND REMOVE ROCKS, DEBRIS, AND FOREIGN OBJECTS OVER 2 INCHES DIAMETER FROM TOP SURFACE OF PREPARED LANDSCAPE AREAS. FINISH ELEVATIONS TO BE DEFINED AS 3 INCHES BELOW CURBS, WALKS AND/OR OTHER ADJACENT HARDSCAPE FOR ALL PLANTING BED AREAS AND 1-INCH BELOW CURBS, WALKS AND/OR OTHER ADJACENT HARDSCAPE FOR ALL LAWN AREAS. 'FINISH GRADE' REFERS TO GRADES PRIOR TO INSTALLATION OF MULCH OR LAWN. ALL FINISH GRADES TO BE SMOOTH EVEN GRADES, LIGHTLY COMPACTED, AS SHOWN ON THE PLAN AND DETAILED. PROVIDE POSITIVE DRAINAGE AWAY FROM BUILDINGS AND STRUCTURES. SITE CIVIL DRAWINGS IDENTIFY FINAL ELEVATIONS. MOISTEN PREPARED AREAS BEFORE PLANTING IF SOIL IS DRY. WATER THOROUGHLY AND ALLOW

ARRANGE TREES AND SHRUBS ON SITE IN PROPOSED LOCATIONS PER DRAWINGS. EXCAVATE PIT, PLANT AND STAKE OR GUY, AS CALLED OUT AND DETAILED. ALL TREES, SHRUBS, AND SUPPORTS TO STAND VERTICAL. BACKFILL SHALL BE PIT SPOILS. SETTLE BACKFILL USING WATER ONLY. NO MECHANICAL

INSTALL ROOT BARRIER ADJACENT TO CURB OR PAVEMENT EDGE WHERE TREES ARE LESS THAN 5 FEET FROM CURBS AND PAVEMENTS. SEE DETAIL ON SHEET L5.

PROVIDE A 3 TO 4-INCH MINIMUM DEPTH AFTER SETTLEMENT.

FIELD ADJUST PLANT LOCATIONS FOR 8-FOOT SEPARATION OF TREES/SHRUBS AND 2-FOOT SEPARATION FOR GROUNDCOVER FROM FIRE HYDRANTS AND UTILITY VAULTS.

DURING LANDSCAPE WORK, KEEP ALL PAVEMENT CLEAN AND WORK AREAS IN AN ORDERLY CONDITION.

HERBICIDE IS NOT RECOMMENDED FOR THE FIRST YEAR AFTER INSTALLATION.

EXECUTION:

CONTAMINANTS:

CONCRETE/ASPHALT SPOILS, ETC.) HAVE BEEN SATISFACTORILY REMOVED FROM ALL PLANTING AREAS. DO NOT BEGIN WORK UNTIL UNSATISFACTORY CONDITIONS HAVE BEEN CORRECTED.

SURFACE TO DRY BEFORE PLANTING. DO NOT CREATE MUDDY SOIL.

EXCAVATE PITS TO A MINIMUM OF 3 INCHES BELOW, AND TWICE THE ROOT BALL DIAMETER. WATER THOROUGHLY AND TAKE CARE TO ENSURE THAT ROOT CROWN IS AT

MULCH ALL LANDSCAPE AREAS NOT COVERED BY LAWN AND/OR SEED. APPLY SUFFICIENT QUANTITY TO

PROTECT LANDSCAPE WORK AND MATERIALS FROM DAMAGE DUE TO LANDSCAPE OPERATIONS AND TRESPASSERS. MAINTAIN PROTECTION DURING INSTALLATION AND MAINTENANCE PERIOD. TREAT, REPAIR, OR REPLACE DAMAGE LANDSCAPE WORK AS DIRECTED BY THE OWNER.

TOPSOIL SETTLED (COMPACTED CONDITION) OVER ALL TOPSOIL DEPTH OF 3 FEET - 1-1/2" DRAIN AT LOW POINTS & BERM HEIGHT 6" MIN. 10' SPACING MAXIMUM IN MULCH, 1" IN LAWN - PAVING (SEE CIVIL PLANS) REMOVE EXCESS GRAVEL AND PAVING COARSE TRANSITION FROM TOPSOIL TO SUBSOIL


TO LOOSEN COMPACTED SUBBASE

OVER EXCAVATE PARKING LOT PLANTERS

DEDUCT ALT #1: IF LANDSCAPE CONTRACTOR CAN DEMONSTRATE WITH A SOIL ANALYSIS (OR SIMILAR) THAT PARKING LOT ISLAND PLANTERS HAVE EXISTING SOIL THAT HAS SIMILAR QUALITIES AS THE IMPORTED TOPSOIL, 6" OF ORGANIC COMPOST CAN BE INSTALLED IN THE PLANTERS AND CULTIVATED INTO THE TOP 12"-18" OF EXISTING SOIL


SOIL DEPTH FOR PARKING LOT PLANTER DETAIL

CITY OF PUYALLUP MINIMUM SOIL REQUIREMENTS: SOIL PREPARATION IN ALL DISTURBED AREAS WITH NEW LANDSCAPING SHALL CONFORM TO SPECIFICATIONS PROVIDED IN BMP T5.13 - THE "STORM WATER MANAGEMENT MANUAL OF WESTERN WASHINGTON", DEPARTMENT OF ECOLOGY, DATED AUGUST 2012, OR AS SUBSEQUENTLY AMENDED. COMPACTION OF LANDSCAPED AREAS FROM VEHICLES AND HEAVY EQUIPMENT SHALL BE AVOIDED AFTER TILLING.

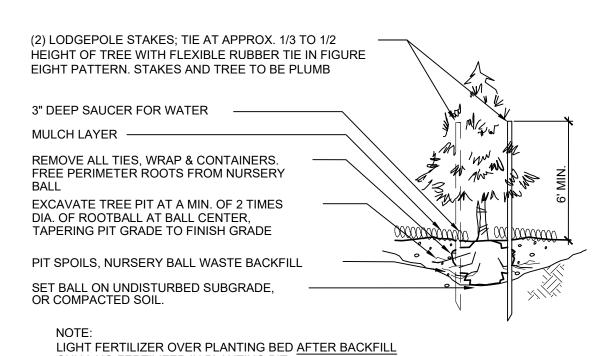

ONLY; NO FERTILIZER IN PLANTING PIT WORK PERIMETER ROOTS FREE OF NURSERY BALL. BALL & PIT TO BE COURSELY SCARIFIED.

EVERGREEN TREE PLANTING/STAKING DETAIL

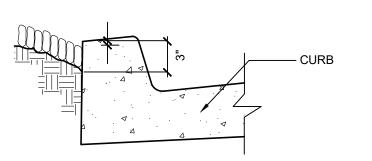

MULCH AT CURB DETAIL

NOT TO SCALE

- MULCH LAYER

TOPSOIL AS SPECIFIED

FINISH GRADE AT

CLEAR

SHRUB - PRUNE AS DIRECTED

MULCH LAYER. HOLD MULCH BACK

BACKFILL TO BE A MIX OF TOPSOIL,

SCARIFY ROOTBALL ON CONTAINER

FERTILIZER, AND PEAT MOSS

MATERIAL. REMOVE TOP 1/3 OF

BURLAP ON B&B MATERIAL

DUST ROOT BALL WITH ROOT GROWTH HORMONE

BY LANDSCAPE ARCHITECT

4" SAUCER FOR WATERING


FROM STEM

MULCH CONDITION (CURB SIMILAR)

3:1 SLOPE MAXIMUM

10:1 SLOPE MINIMUM

PREPARED SUBGRADE

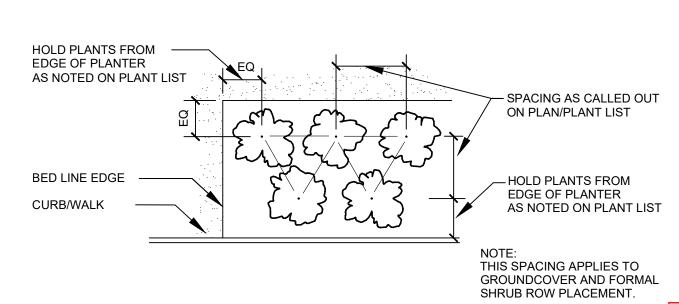

(VINE PLANTING SHALL BE SIMILAR TO THIS

DETAIL. SEE DETAIL ON SHEET L7 AS WELL)

" MULCH AT CROWN -

1 GAL. CONTAINER and LARGER

(PLANTED BEFORE MULCH)

PLANT MATERIAL SPACING DETAIL

BACKFILL TO BE SETTLED USING WATER ONLY

GROUNDCOVER PLANTING DETAIL

SEE PLANT LIST FOR PLANT SPACING



CITY OF PUYALLUP Planning Division



ΓHIS APPROVAL IS VOID AFTER 1 YEAR FROM APPROVAL DATE. THE CITY WILL NOT BE RESPONSIBLE FOR ERRORS AND/OF OMISSIONS ON THESE PLANS. FIELD CONDITIONS MAY DICTATE CHANGES TO THESE PLANS AS DETERMINED BY THE PLANNING MANAGER, DESIGNEE, OR PROJECT PLANNER.

NOTE: If street trees are required, Call Planning Division for final inspection: (253) 864-4165 (Option 3) Root Barriers are quired around street trees in accordance with city standar tandards - field verification required. Failure to install top oil and root barriers in accordance with city standards may esult in rejection of installation.

APPROVED

CITY OF PUYALLUP ENGINEERING SERVICES

YEAR FROM APPROVAL DATE. THE CITY WILL NOT BE RESPONSIBLE FOR ERRORS AND/OR OMISSIONS ON THESE PLANS. FIELD CONDITIONS MAY DICTATE CHANGES TO THESE PLANS AS DETERMINED BY THE ENGINEERING SERVICES MANAGER.

ANS BRAI

2

SE

1.Rl 981

SLE JTH OIN (90)


15 DE

~ O

HOME 6TH ST

LANDSCAPE NOTES + DETAILS

PHASE 2 - WESLEY BRADLEY PARK

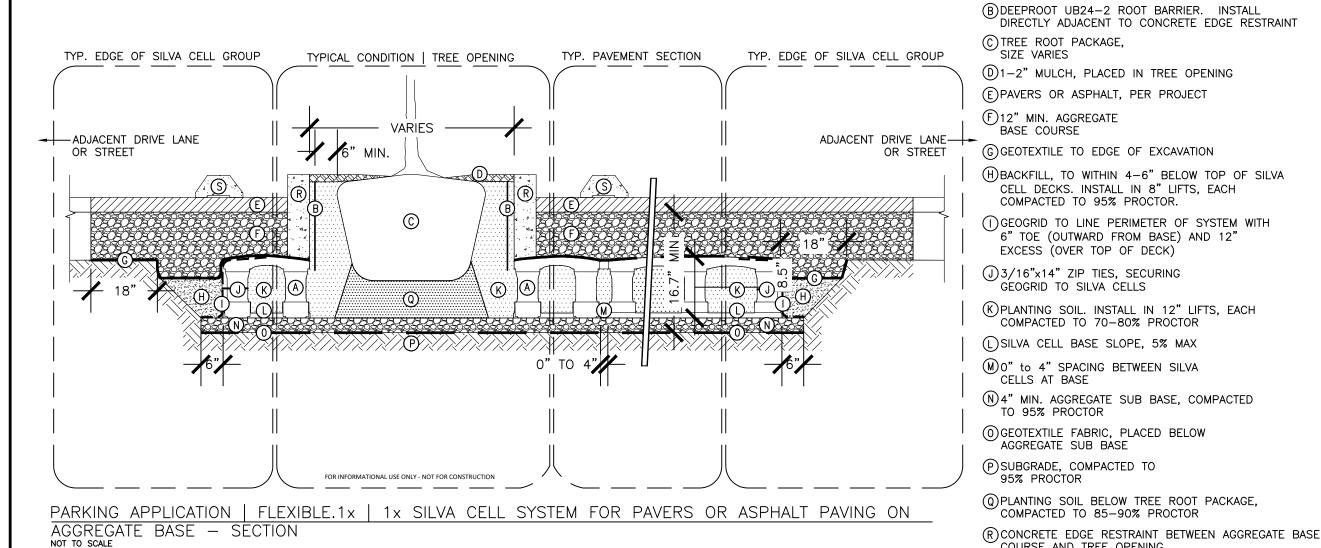

K E Y P L A N

(A) SILVA CELL SYSTEM (DECK,

COURSE AND TREE OPENING

MANUFACTURER'S SPECIFICATIONS

NOTE: SILVA CELL OR

INFORMATION TO BE

APPROVED EQUAL

ALTERNATIVE

(\$)OPTIONAL WHEEL STOP, PER PROJECT. PROTECT SILVA

INSTALLATION TO BE COMPLETED IN ACCORDANCE WITH

STRUCTURAL SOIL PRODUCT

MANUFACTURER PRODUCT

SUBMITTED TO LANDSCAPE

ARCHITECT WITH OTHER

REQUIRED SUBMITTALS

PROVIDE SUPPLEMENTAL IRRIGATION FOR SEASONAL DROUGHT

CELLS FROM DAMAGE WHEN ANCHORING TO PAVEMENT

BASE, AND POSTS)

SILVA CELL SPECIFICATIONS, ADDTIONAL

3.14 INSTALLATION OF GEOTEXTILE AND AGGREGATE BASE COURSE OVER THE DECK

- A. Place geotextile over the top of the deck and extend to the edge of the excavation. Overlap joints a minimum of 18 inches (450 mm). Leave enough slack in the geotextile for the aggregate base course to push the geotextile down in the gaps in between the decks.
- B. Install the aggregate base course (including aggregate setting bed if installing unit pavers) over the geotextile immediately after completing the installation of the fabrics. Work the aggregate from one side of the layout to the other so that the fabric and aggregate conform to the Silva Cell deck contours.
- C. Maintain equipment used to place aggregate base course completely outside the limits of the Silva Cell excavation area to prevent damage to the installed system.
- D. For large or confined areas, where aggregate cannot easily be placed from the edges of the excavated area, obtain approval for the installation procedure and types of equipment to be used in the installation from the Silva Cell
- E. Compact aggregate base course(s) to 95 percent of maximum dry density in accordance with ASTM D698, Standard Proctor Method. Utilize a vibration or plate compactor with a maximum weight of 800 lbs (362.87 kg).
- F. Do not drive vehicles or operate equipment over the completed aggregate base course.

3.15 INSTALLATION OF CONCRETE CURBS AT TREE OPENINGS, AGGREGATE SUBBASE AND PAVEMENT ABOVE THE SILVA CELL SYSTEM

- A. Place concrete curbs along planting areas and tree openings as shown on the Drawings to retain the aggregate base course from migrating
- B. When staking concrete forms (e.g. curbs around the tree openings), prevent stakes from penetrating the Silva Cell decks.
- C. Turn down edge of concrete paving to the Silva Cell deck along the edges of tree openings or planting areas to retain the aggregate base course material.
- D. When paving type is a unit paver or other flexible material, provide a concrete curb under the paving at the edge of the Silva Cell deck to retain the aggregate base course material at the tree opening.
- E. Place paving material over Silva Cell system in accordance with the Drawings.
- 1. The Silva Cell system does not fully meet loading strength until the final paving is installed. Do not operate construction equipment on top of the Silva Cell system until paving installation has been completed.
- F. Use care when placing paving or other backfill on top of Silva Cell system to prevent damage to the Silva Cell system or its components.

3.16 INSTALLATION OF ROOT BARRIERS

A. Install root barrier in accordance with manufacturer's installation instructions.

3.17 INSTALLATION OF PLANTING SOIL WITHIN THE TREE PLANTING AREA

- A. Remove rubble, debris, dust and silt from the top of the planting soil within the tree opening that may have accumulated after the initial installation of the planting soil within the Silva Cells.
- B. Install additional planting soil within the tree openings, to the depths indicated on the Drawings.
- 1. Use the same soil used within the Silva Cells for planting soil within the tree openings.
- C. Compact planting soil under the tree root ball to between 85 and 90 percent of maximum dry density in accordance with ASTM D698. Standard Proctor Method, to prevent settlement of the root ball.
- D. Place trees in accordance with the Drawings.

3.18 PROTECTION

- A. Keep construction traffic away from the limits of the Silva Cells until the final pavement profile is in place. The Silva Cell system does not fully meet loading strength until the final paving is installed
- 1. Do not operate equipment directly on top of the Silva Cell system until paving installation has been completed.
- 2. Provide fencing and other barriers to prevent vehicles from entering into the Silva Cell area.
- B. When the Silva Cell installation is completed and the permanent pavement is in place, limit traffic and construction related activities to only loads less than the design loads.

3.19 CLEAN UP

- A. Perform clean up during installation and upon completion of the Work. Maintain the site free of soil, sediment, trash and debris. Remove excess soil materials, debris, and equipment from the site following completion of the Work of this Section.
- B. Repair damage to adjacent materials and surfaces resulting from installation of this Work using mechanics skilled in remedial work of the construction type and trades affected.

Provide minimum clearance btwn woody landscaping and -7.5ft min. for sanitary sewer (SS) and storm (SD) lines, and

SOIL AMENDMENT NOTES

ALL SOILS IN ALL LANDSCAPE INSTALLATIONS SHALL CONFORM TO THE FOLLOWING SOIL DEPTH AND QUALITY REQUIREMENTS. PLEASE REFER TO APPENDIX 20.9 FOR FURTHER INSTALLATION GUIDANCE

- A. A MINIMUM OF EIGHT (8) INCHES OF TOP SOIL, CONTAINING TEN PERCENT DRY WEIGHT IN PLANTING BEDS, AND 5% ORGANIC MATTER CONTENT IN TURF AREAS, AND A pH FROM 6.0 TO 8.0 OR MATCHING THE pH OF THE ORIGINAL UNDISTURBED SOIL. THE TOPSOIL LAYER SHALL HAVE A MINIMUM DEPTH OF EIGHT INCHES (8") EXCEPT WHERE TREE ROOTS LIMIT THE DEPTH OF INCORPORATION OF AMENDMENTS NEEDED TO MEET THE CRITERIA. SUBSOILS BELOW THE TOPSOIL LAYER SHOULD BE SCARIFIED AT LEAST 6 INCHES WITH SOME INCORPORATION OF THE UPPER MATERIAL TO AVOID STRATIFIED LAYERS, WHERE FEASIBLE. INSTALLATION OF THE EIGHT INCHES (8") OF TOPSOIL, AS DESCRIBED ABOVE, SHALL GENERALLY BE ACHIEVED BY PLACING FIVE INCHES (5") OF IMPORTED SANDY-LOAM SOIL INTO PLANNED LANDSCAPE AREAS (SUB-BASE SCARIFIED FOUF INCHES (4") WITH A THREE INCH (3") LAYER OF COMPOST TILLED INTO THE ENTIRE DEPTH.
- FOR STREET TREES IN THE RIGHT OF WAY PLANTER STRIP, THE FOLLOWING STANDARDS SHALL APPLY IN RELATION TO SOIL DEPTH, SOIL AMENDMENTS AND INSTALLATION OF NEW STREET TREES. THE FOLLOWING NOTES SHALL BE SHOWN ON THE FACE OF THE PRELIMINARY AND FINAL LANDSCAPE PLAN SHEETS (1) FOR NEW CONSTRUCTION: IN AREAS WHERE A NEW PLANTER STRIP AND STREET TREE SHALL BE ESTABLISHED

EXCAVATED TO A DEPTH OF 24" AND BACKFILLED FOLLOWING THE STANDARD ABOVE TO ACHIEVE A TOPSOIL MIX

WITH 40 PERCENT COMPOST BY VOLUME. THE CONTRACTOR OR INSTALLER SHALL (1)1) REVIEW THE CITY STANDARD PLANTING DETAIL - ALL CONTRACTORS/INSTALLERS AREA REQUIRED TO FOLLOW CITY STANDARD #01.02.07 (STREET TREE PLANTING) AND #01.02.03 (ROOT BARRIER INSTALLATION). THE CONTRACTOR/INSTALLER SHALL REVIEW THE PLANTING STANDARD DETAIL PRIOR TO INSTALLATION TO UNDERSTAND THE CITY'S REQUIREMENTS. FAILURE TO FOLLOW THE STANDARD MAY RESULT IN REJECTION OF THE WORK BY THE INSPECTOR AND/OR PLANNING DEPARTMENT

OR RECONSTRUCTED DUE TO A STREET CONSTRUCTION PROJECT, THE PLANTER STRIP AREA SHALL BE

- (1)2) SCHEDULE A FIELD PRE-CONSTRUCTION MEETING THE CONTRACTOR/INSTALLER SHALL CONTACT THE SITE INSPECTOR AND PLANNING DEPARTMENT 48 HOURS IN ADVANCE OF THE INSTALLATION OF STREET TREE(S) FOR A FIELD PRE-CONSTRUCTION MEETING ON-SITE TO REVIEW THE APPROVED PLAN SET AND CITY STANDARD DETAILS. IF STREET TREES ARE TO BE INSTALLED OVER A LONGER TIMELINE (SUCH AS A RESIDENTIAL PLAT WHERE TREES MAY BE INSTALLED OVER A MULTI-MONTH PERIOD OF TIME), THE CONTRACTOR/INSTALLER SHALL HOLD ONE CONSOLIDATED PRE-CON TO REVIEW PLANS. ALL STREET TREES SHALL BE INSPECTED AFTER PLANTING BY THE PLANNING DEPARTMENT.
- (1)3) EXCAVATE ALL CONSTRUCTION MATERIALS EXCAVATE ALL CONSTRUCTION MATERIALS, REMNANT SOIL, GRAVEL, PIT RUN, CONSTRUCTION DEBRIS, ETC. FROM THE PLANTER STRIP AREA TO A DEPTH OF 24' PRIOR TO PLANTING. DISCARD THIS MATERIAL AS THE PLACEMENT OF NEW COMPOST AMENDED TOP SOIL IS
- (1)4) PREPARE THE PLANTING STRIP AFTER EXCAVATING ALL MATERIALS FROM THE PLANTER STRIP, SCARIF AND RIP THE SUB-BASE WITH THE TEETH OF A BACKHOE BUCKET (OR OTHER MECHANICAL MEANS OR HAND TOOLS) TO A DEPTH OF 6" WITH MULTIPLE PASSES, 90-DEGREES TO EACH OTHER. PRIOR TO PLANTING THE TREE, RE-COMPACT THE TREE BASE WHERE THE STREET TREE WILL BE PLANTED TO AVOID SETTING OF THE ROOT BALL. AT THIS STAGE, IF THE TREE IS TO BE PLANTED WHEN THE PLANTER STRIP IS BACKFILLED WITH AMENDED TOPSOIL, THE CONTRACTOR/INSTALLER SHOULD MEASURE THE DEPTH OF THE ROOT BALL TO DETERMINE WHEN TO PLACE THE TREE IN THE PIT DURING THE BACKFILLING PROCESS. I THE ROOTBALL OR ROOT MASS (IN THE CASE OF BARE ROOT TREES) IS LESS THAN 24", THE STREET TREE SHALL BE PLANTED IN A MANNER IN WHICH THE ROOT FLARE IS LEVEL WITH OR AT LEAST 1" ABOVE GRADE AT THE TIME OF FINISHED PLANTING. THE MAY REQUIRE THE ROOTBALL BE PLACED ON A COMPACTED SUB-BASE OF THE COMPOST AMENDED TOPSOIL AS BACKFILLING IS OCCURRING
- (1)5) INSTALL ROOT BARRIER PANELS AT THIS STAGE THE CONTRACTOR/INSTALLER SHALL PLACE 24" DEEF ROOT BARRIER PANELS (UB—24) ALONG THE EDGE OF THE SIDEWALK AND CURB LINE FOR A TOTAL OF EIGHT FEET (8') OF LINEAL PROTECTION ALONG EITHER SIDE OF THE PLANTING AREA. THE PANELS SHAL BE INSTALLED PERPENDICULAR TO THE EDGE OF THE PLANTING AREA. THE PANELS SHALL BE INSTALLED PERPENDICULAR TO THE DGE OF PAVED SURFACE IN ACCORDANCE WITH THE MANUFACTURER'S STSANDARDS FOR A 'LINEAR' APPLICATION; THE ROOT BARRIER PANELS SHALL NOT BE INSTALLED IN THE PLANTING PIT AS A 'SURROUND' APPLICATION, UNLESS SPECIFIED ON THE FINAL LANDSCAPE PLANS. THE TOP OF THE ROOT BARRIER PANEL SHALL BE INSTALLED SUCH THAT 1 OF THE ROOT BARRIER IS ABOVE THE FINISHED
- (1)6) COMPOST AMENDED TOP SOILS REQUIRED TOPSOIL SOURCE SHALL BE REVIEWED AND APPROVED DURING THE PRE-CONSTRUCTION MEETING; ALL TOPSOIL SHALL BE A TOP QUALITY SANDY-LOAM MIX, OR EQUIVALENT AS APPROVED BY THE PLANNING DEPARTMENT. THE TOPSOIL SHALL BE AMENDED ON SITE DURING INSTALLATION WITH COMPOST TO ACHIEVE A 40 PERCENT BY VOLUME TOPSOIL MIX IN THE RIGHT-OF-WAY PLANTER STRIP. IMPORTED TOPSOIL MAY BE USED BY THE CONTRACTOR IF DATA 'CUT SHEETS' ARE AVAILABLE FROM THE SUPPLIER CERTIFYING COMPOST AMENDMENT EQUALING 40 PERCENT BY VOLUME USING ONE OF THE APPROVED COMPOST SOURCES BELOW. COMPOST SHALL ONLY BE SOURCED
 - -CASCADE COMPOST (ALSO KNOWN AS PREP/LRI) (AVAILABLE THROUGH PIERCE COUNTY RECYCLING, COMPOSTING & DISPOSAL, 10308 SALES ROAD, TACOMA, WASHINGTON 98499, OR RETAIL/WHOLESALE LANDSCAPE MATERIAL SUPPLIERS) -TAGRO COMPOST MIX (AVAILABLE THROUGH CITY OF TACOMA, 2201 EAST
 - PORTLAND AVENUE, GATE 6, TACOMA, WA 98421, OR RETAIL/WHOLESALE LANDSCAPE MATERIAL SUPPLIERS) -CEDAR GROVE COMPOST (AVAILABLE THROUGH CEDAR GROVE COMPOST, 17825 CEDAR GROVE ROAD SE. MAPLE VALLEY. 98038. OR RETAIL/WHOLESALE LANDSCAPE MATERIAL SUPPLIERS)
- (1)7) INSTALL AND AMEND TOPSOILS TO AVOID STRATIFIED LAYERS, FIRST PLACE SEVEN INCHES (7") OF APPROVED TOPSOIL IN THE PREPARED/SCARIFIED PLANTING STRIP AREA AND MECHANICALLY TILL IN FIVE INCHES (5") OF APPROVED COMPOST; FOLLOW THIS PROCEDURE TWICE TO ACHIEVE THE TOTAL 24" TOPSOIL DEPTH. FINISHED GRADE OF TOPSOIL SHOULD BE 1" BELOW THE EDGE OF SIDEWALK TO ALLOW THE ROOT BARRIER PANEL TO BE PROPERLY INSTALLED ABOVE FINISHED GRADE.
- (1)8) INSTALL TREE STAKES AND FINISH MULCH PLACEMENT OF FOUR INCHES (4") OF WOOD CHIP MULCH, WATER BASIN RINGS, TREE STAKING AND TEMPORARY IRRIGATION BAGS (WHERE REQUIRED) SHALL FOLLOW CITY STANDARD #01.02.07


SEE SHEET L4 FOR ADDITIONAL PLANTING SPECIFICATIONS. CONFORM TO THE SPECIFICATIONS AND DRAWINGS IN THESE LANDSCAPE PLANS AND THE REQUIREMENTS OF CITY OF PUYALLUP VEGETATION MANAGEMENT STANDARDS (VMS). WHERE THERE IS A CONFLICT CONFORM TO THE MORE STRINGENT REQUIREMENTS.

CITY OF PUYALLUP MINIMUM SOIL REQUIREMENTS: SOIL PREPARATION IN ALL DISTURBED AREAS WITH NEW LANDSCAPING SHALL CONFORM TO SPECIFICATIONS PROVIDED IN BMP T5.13 - THE "STORM WATER MANAGEMENT MANUAL OF WESTERN WASHINGTON", DEPARTMENT OF ECOLOGY, DATED AUGUST 2012, OR AS SUBSEQUENTLY AMENDED. COMPACTION OF LANDSCAPED AREAS FROM VEHICLES AND HEAVY EQUIPMENT SHALL BE AVOIDED AFTER TILLING.

SOIL AMENDMENT AND DEPTH

- NEW OR EXISTING TREE CONCRETE SIDEWALK **NSTALL MINIMUM 8 LF OF ROOT BARRIER PANELS** ALONG THE EDGE OF UB 24-2 ROOT BARRIER THE PAVEMENT / CURB IN LOCATIONS WHERE TREE TRUNKS ARE CLOSER THAN 7 FEET FROM A CURB OR PAVED AREA. DO NOT INSTALL BETWEEN TREE AND SILVA CELLS. — UB 24-2 ROOT BARRIER 1. ROOT BARRIERS SHALL BE REQUIRED IN ALL STREET TREE PLANTING INSTALLATIONS WHETHER NEW OR EXISTING, WHEN STREET TREES ARE INSTALLED IN RIGHT-OF-WAY OR IN A PLANTING EASEMENT*. 2. ROOT BARRIERS USED SHALL BE DeepRoot ROOT BARRIERS OR EQUIVALENT 3. UB - 24 SHALL BE USED 4. ROOT BARRIERS SHALL BE INSTALLED IF REQUIRED BY THE CITY. 5. INSTALLATION OF ROOT BARRIERS TO BE IN ACCORDANCE WITH THE MANUFACTURER'S SPECIFICATIONS 6. THE PANEL SHALL BE INSTALLED SO THE VERTICAL RIBS FACE THE ROOTS OF THE TREE. A MINIMUM OF 7. FOR PRODUCT INFORMATION VISIT: "PLANTING EASEMENT" SHALL MEAN THAT PORTION OF LAND MADE AVAILABLE AS A PUBLIC EASEMENT FOR THE PURPOSE OF PLANTING AND MAINTAINING CITY STREET TREES. ALL STREET TREES PLANTED WITHIN A PLANTING EASEMENT SHALL BE PLANTED WITHIN THREE FEET OF RIGHT-OF-WAY. ROOT BARRIER DETAIL PUYALLUI

ROOT BARRIER

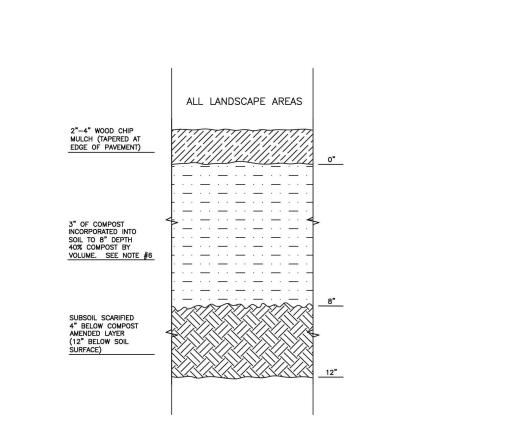

- ALL SOIL AREAS DISTURBED OR COMPACTED DURING CONSTRUCTION, AND NOT COVERED BY BUILDINGS OR PAVEMENT, SHALL BE AMENDED WITH COMPOST AS DESCRIBED BELOW.
- . COMPOST SHALL BE TILLED IN TO 8 INCH DEPTH INTO EXISTING SOIL, OR PLACE 8 INCHES OF COMPOST—AMENDED SOIL, PER SOIL SPECIFICATION
- 4. PLANTING BEDS SHALL RECEIVE 3 INCHES OF COMPOST TILLED IN TO 8-INCH DEPTH, OR MAY SUBSTITUTE 8" OF IMPORTED SOIL CONTAINING 35-40% COMPOST BY VOLUME. MULCH AFTER PLANTING, WITH 4 INCHES OF ARBORIST WOOD CHIP MULCH OR APPROVED EQUAL (6" OF LOOSE WOOD CHIPS AT THE TIME OF PLANTING TO ALLOW SETTLING TO 4").
- 5. SETBACKS: TO PREVENT UNEVEN SETTLING, DO NOT COMPOST-AMEND SOILS WITHIN 3 FEET OF UTILITY INFRASTRUCTURES (POLES, VAULTS, METERS ETC.). WITHIN ONE FOOT OF PAVEMENT EDGE, CURBS AND SIDEWALKS SOIL SHOULD BE COMPACTED TO APPROXIMATELY 95% PROCTO TO ENSURE A FIRM SURFACE. 5. SEE SECTION 8.2(B) OF THE VMS FOR SOIL AMENDMENT AND INSTRUCTION PROCEDURES FOR STREET TREE PLANTER STRIPS. ALL STREET TREE PLANTER STRIPS SHALL RECEIVE 40% COMPOST AMENDED SOIL TO THE FULL DEPTH OF THE STREET TREE ROOTBALL.

		N OF PUYALITY	CITY OF PUYALLUP		SOIL AM AND	ENDME DEPTH	ENT	
DEVELOPMENT ENGINEERING and UNDALIAN CHECKED BY COLLEEN HARRIS XXXX STANDARD PUBLIC WORKS DEPARTMENTS FILE NAME.	STATI	THO WASHINGTON		LINDA LIAN	CHRIS BEALE	COLLEEN HARRIS	XXXX	CITY STANDARD

2

SE

98

HOI 6TH

CITY OF PUYALLUP **Planning Division** Approved Landscape Plan (253) 864-4165

PCR 002

PRCCP20231028

THIS APPROVAL IS VOID AFTER 1 YEAR FROM APPROVAL DATE. THE CITY WILL NOT BE RESPONSIBLE FOR ERRORS AND/O OMISSIONS ON THESE PLANS FIELD CONDITIONS MAY DICTATE CHANGES TO THESE PLANS AS DETERMINED BY THE PLANNING MANAGER, DESIGNEE, OR PROJECT PLANNER.

NOTE: If street trees are required, Call Planning Division inal inspection: (253) 864-4165 (Option 3) Root Barriers are equired around street trees in accordance with city standar tandards - field verification required. Failure to install top

APPROVED

esult in rejection of installation.


CITY OF PUYALLUP ENGINEERING SERVICES


NOTE: THIS APPROVAL IS VOID AFTER TYEAR FROM APPROVAL DATE. THE CITY WILL NOT BE RESPONSIBLE FOR ERRORS AND/OR OMISSIONS OF MAY DICTATE CHANGES TO THESE PLANS AS DETERMINED BY THE ENGINEERING SERVICES MANAGER.

Barghausen Consulting

IRRIGATION PLAN NORTH

PHASE 2 - WESLEY BRADLEY PARK

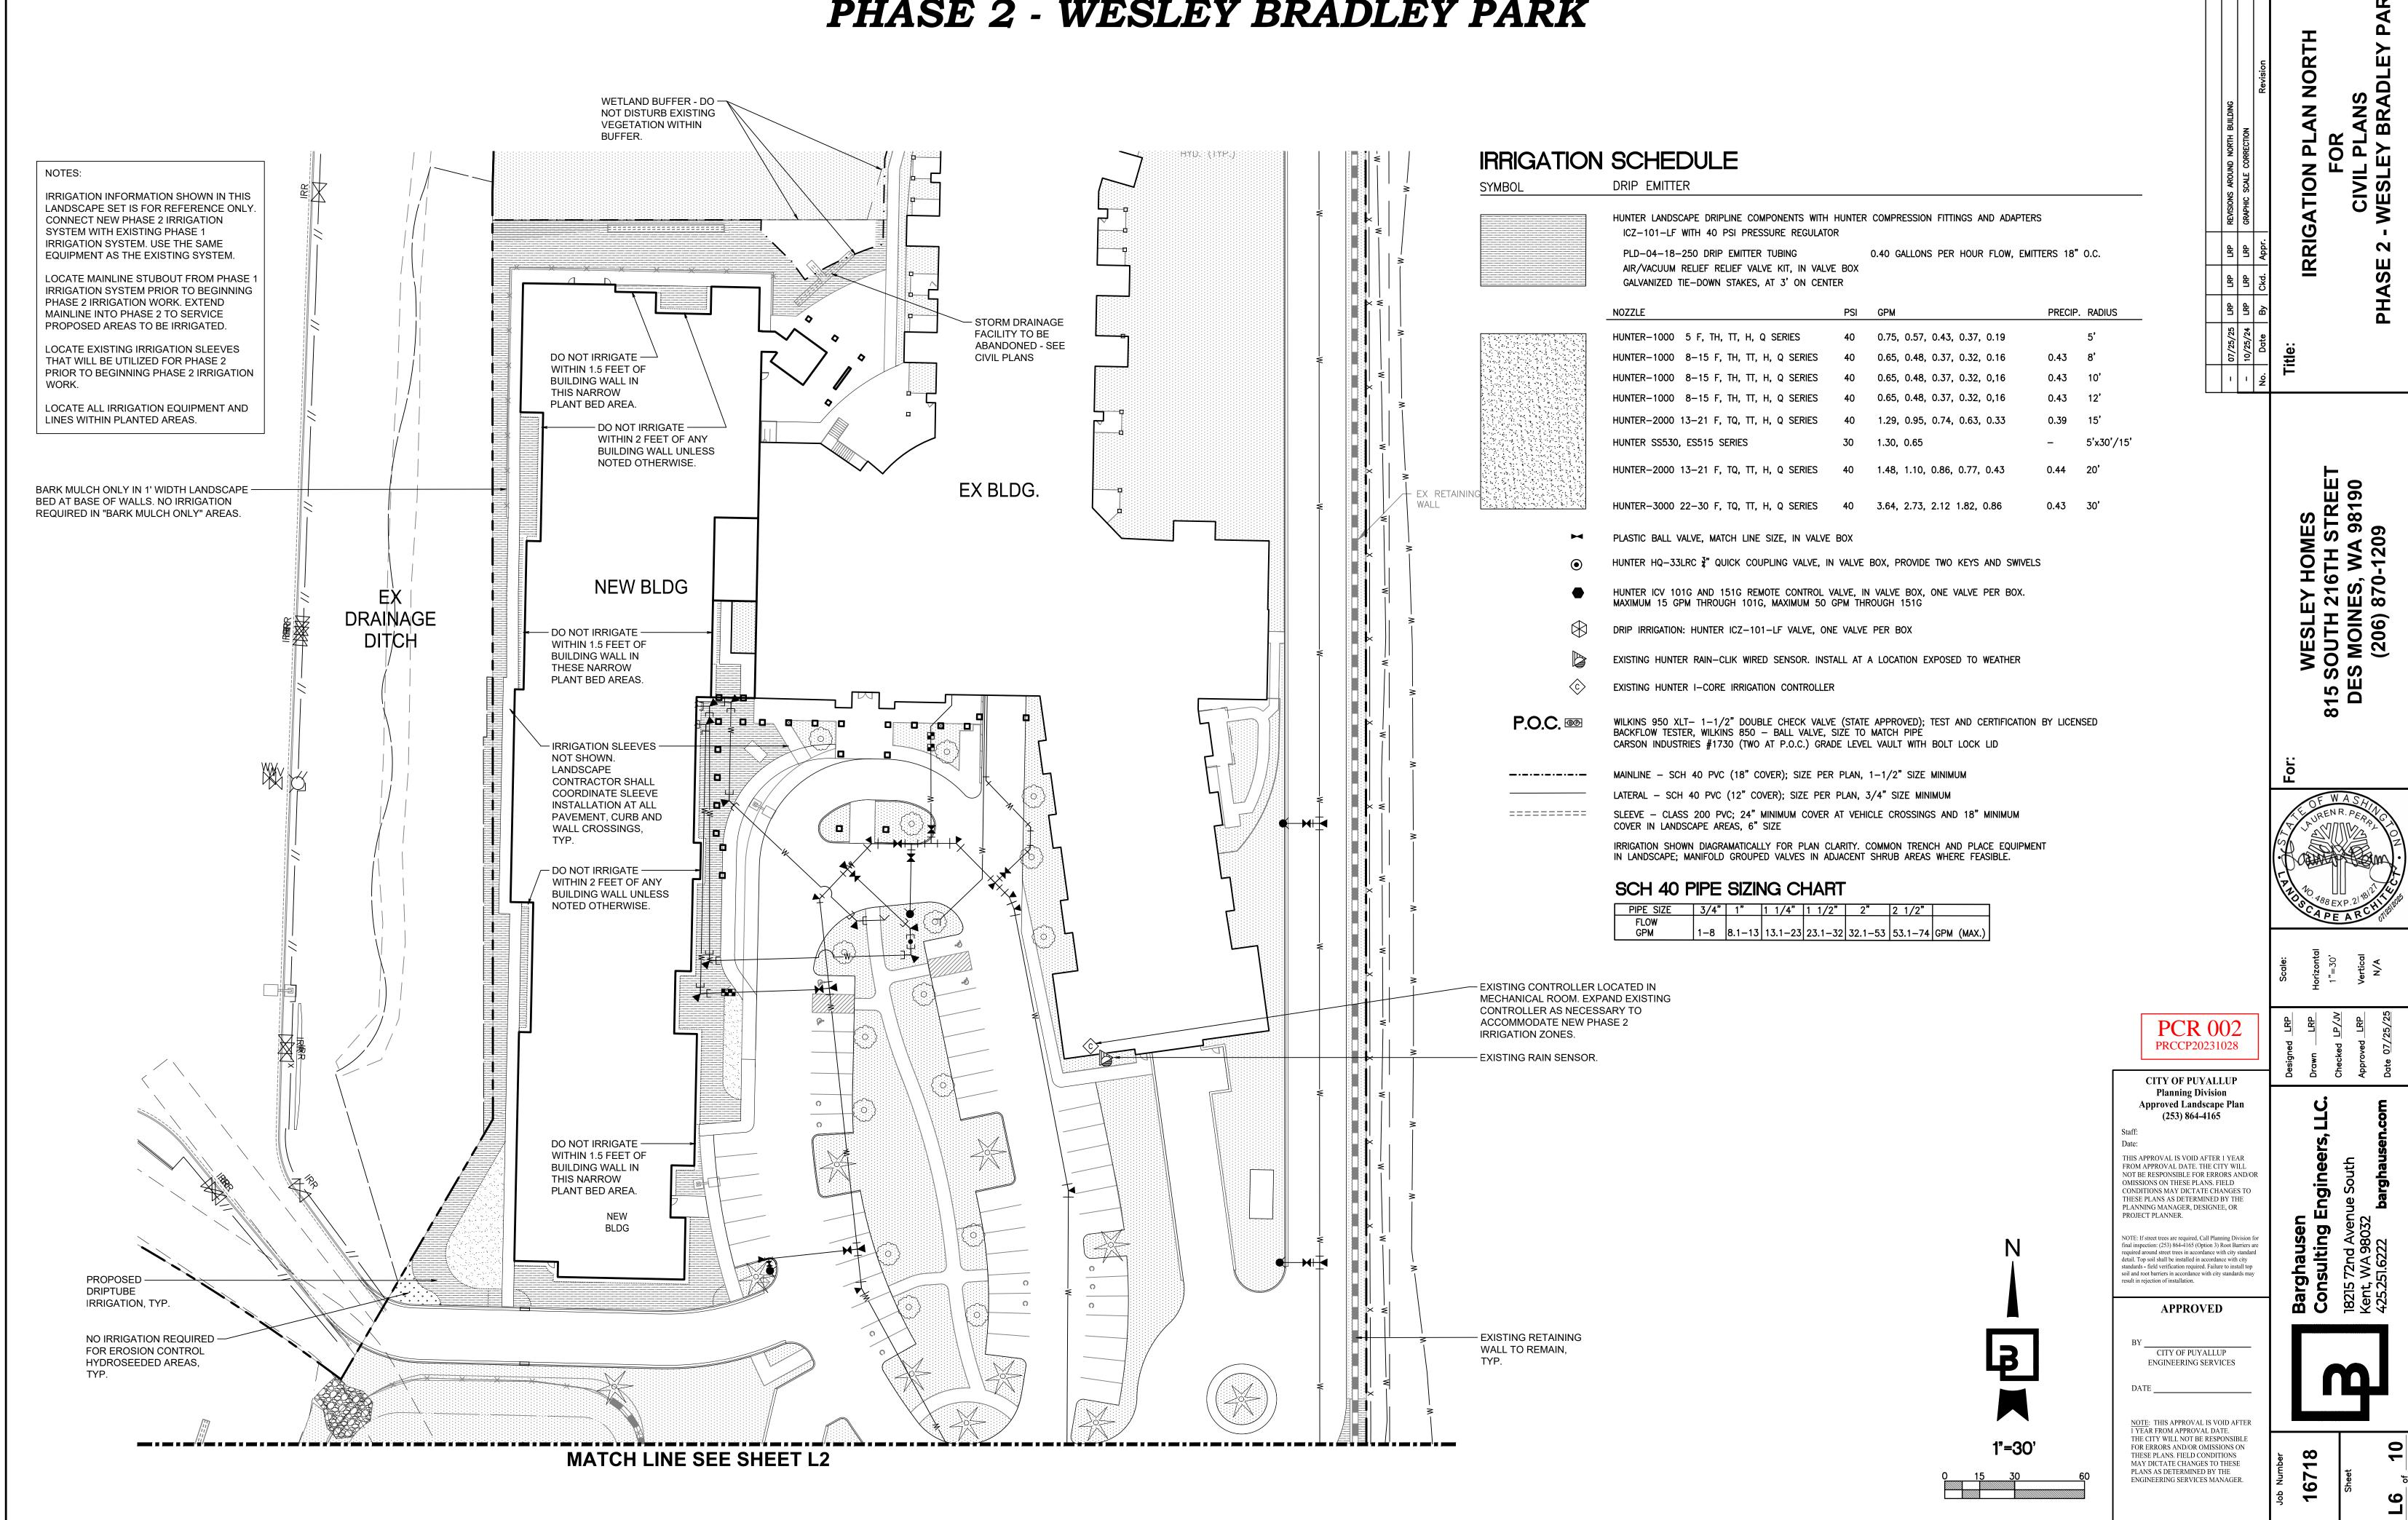

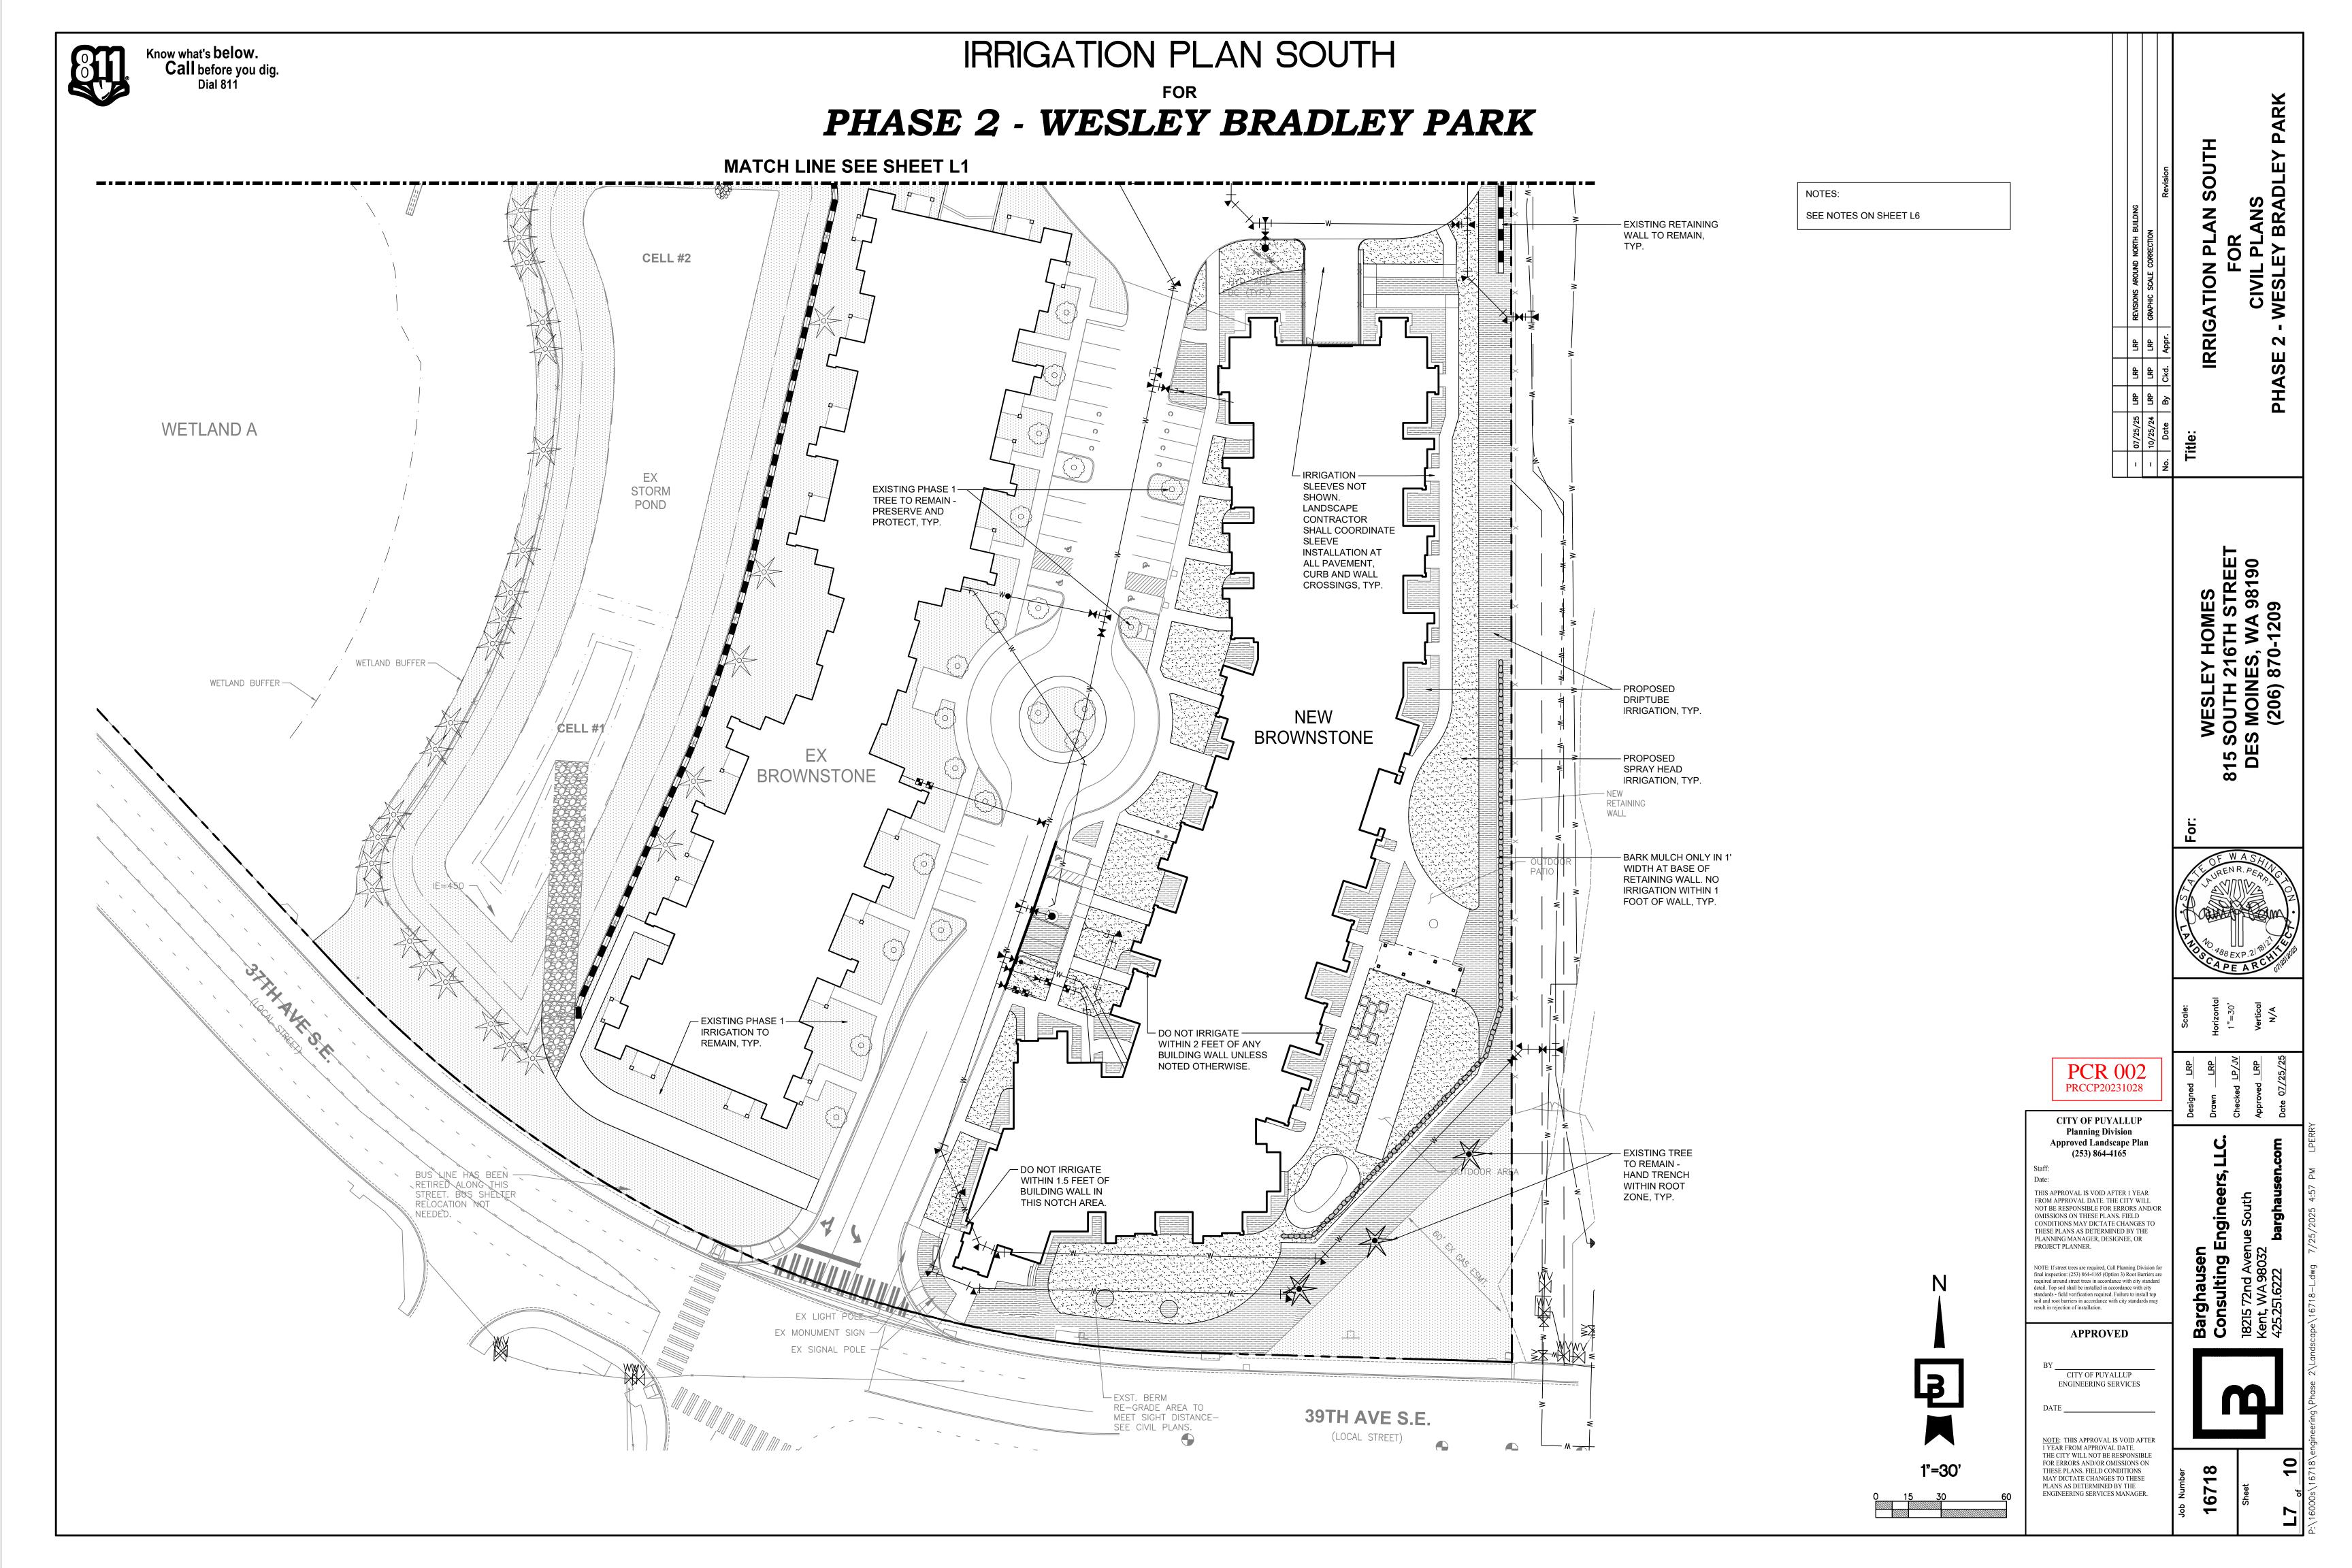

IRRIGATION NOTES + DETAILS

FOR

PHASE 2 - WESLEY BRADLEY PARK

IRRIGATION NOTES

- 1. GENERAL CONTRACTOR AND LANDSCAPE CONTRACTOR TO COORDINATE:
 - A) INSTALLATION OF 110V ELECTRICAL SERVICE FROM ELECTRICAL SOURCE TO AUTOMATIC CONTROLLER, INCLUDING WIRE HOOK—UP INTO MOUNTED CONTROLLER. IRRIGATION CONTRACTOR WILL MOUNT CONTROLLER PER DESIGN AND COORDINATE WITH GENERAL CONTRACTOR.
 - INSTALLATION OF IRRIGATION/SERVICE METER AND STUB TO IRRIGATION POINT OF CONNECTION, PER UTILITY PLAN(S).

 PROVIDE STANDARD THREADED STUB—OUT WITH THREADED CAP ON DISCHARGE SIDE OF METER. STUB—OUT TO BE INSTALLED APPROXIMATELY 18 INCHES BELOW FINISH CRADE
 - VERIFICATION OF STATIC WATER PRESSURE AT POINT—OF—CONNECTION (P.O.C.)
 CONTRACTOR SHALL NOTIFY OWNER AND BARGHAUSEN CONSULTING ENGINEERS,
 INC., OF ANY VARIATION IN STATIC PRESSURE OVER 5 PSI GREATER/LESS THAN
 DESIGN PRESSURE.
 - D) INSTALLATION OF SLEEVING.
- 2. PROVIDE ALL LABOR, MATERIALS, TRANSPORTATION, AND SERVICES NECESSARY TO FURNISH AND INSTALL A COMPLETE IRRIGATION SYSTEM AS INDICATED ON THE DRAWINGS AND/OR NOTES. PROVIDE A ONE (1) YEAR WARRANTY/GUARANTEE FROM FINAL ACCEPTANCE AGAINST ALL DEFECTS IN MATERIALS, EQUIPMENT, AND WORKMANSHIP.
- 3. COORDINATE IRRIGATION INSTALLATION WITH GENERAL CONTRACTOR, ELECTRICAL CONTRACTOR, LANDSCAPE CONTRACTOR, OWNER, ARCHITECT, AND LANDSCAPE ARCHITECT.
- 4. LANDSCAPE CONTRACTOR TO TEST AVAILABLE WATER PRESSURE PRIOR TO BEGINNING ANY
- WORK. PROVIDE WRITTEN TEST RESULTS TO LANDSCAPE ARCHITECT.

 5. ALL WORK PER LOCAL CODE. INSTALLATION PER MANUFACTURER'S WRITTEN SPECIFICATIONS.
- 6. CONTRACTOR TO OBTAIN AND PAY FOR ALL PERMITS, FEES, AND REQUIRED CITY INSPECTIONS.
- A) SUBMIT EACH ITEM LISTED BELOW FOR LANDSCAPE ARCHITECT'S REVIEW AND APPROVAL,
 - B) PRODUCT DATA: FOR EACH TYPE OF PRODUCT INDICATED,
 - C) CONTROL WIRING PATH DIAGRAM,
 - D) "AS-BUILT" DRAWINGS.

SUBMITTALS:

- E) OPERATION AND MAINTENANCE MANUALS.
- PROVIDE AND KEEP UP TO DATE A COMPLETE "AS-BUILT" RECORD SET OF PRINTS WHICH ARE TO BE CORRECTED DAILY AND SHOW EVERY CHANGE FROM THE ORIGINAL DRAWINGS AND NOTES AND EXACT "AS-BUILT" LOCATIONS, SIZES AND KIND OF EQUIPMENT. THIS SET OF DRAWINGS. ARE TO BE KEPT ON SITE AND ARE TO BE USED ONLY AS THE RECORD SET. ALL WORK IS TO BE NEAT AND LEGIBLE ANNOTATIONS THEREON DAILY AS THE WORK PROCEEDS, SHOWING WORK AS ACTUALLY INSTALLED. DIMENSION FORM TWO (2) PERMANENT POINTS OF REFERENCE, BUILDING CORNERS, WALKS, OR ROAD INTERSECTIONS, ETC., THE LOCATION OF THE FOLLOWING:
 - A) CONNECTION TO WATER LINES (P.O.C.),
 - B) CONNECTIONS TO ELECTRICAL POWER,
- C) GATE VALVE, QUICK COUPLERS, AND REMOTE CONTROL VALVE,
- D) ROUTING OF MAINLINE (DIMENSION MAXIMUM 100' ALONG ROUTING),
- E) ROUTING OF CONTROL WIRING,
- F) OTHER RELATED EQUIPMENT AS DIRECTED BY THE LANDSCAPE ARCHITECT.
- 9. PREPARE AND PROVIDE PRIOR TO COMPLETION OF CONSTRUCTION, A THREE RING BINDER CONTAINING THE FOLLOWING INFORMATION:
 - A) INDEX SHEET STATING CONTRACTOR'S ADDRESS, TELEPHONE NUMBER, FAX, E-MAIL AND A,
 - LIST OF EQUIPMENT WITH NAME AND ADDRESS OF LOCAL MANUFACTURER'S REPRESENTATIVES,
- B) CATALOG AND PARTS SHEETS ON EVERY MATERIAL AND EQUIPMENT INSTALLED UNDER THIS, CONTRACT,
- C) GUARANTEE STATEMENT,
- D) COMPLETE OPERATING AND MAINTENANCE INSTRUCTIONS ON ALL MAJOR EQUIPMENT.
- E) CONSTRUCTION DETAILS FROM THE PROJECT,
- F) COMPLETE TROUBLE—SHOOTING GUIDE TO COMMON IRRIGATION PROBLEMS,
- G) WINTERIZATION AND SPRING START-UP PROCEDURES,
- H) CHART OF APPROXIMATE WATERING TIMES FOR SPRING, SUMMER, AND FALL,
- I) A COPY OF THE "AS-BUILT" DRAWINGS AND CONTROLLER CHART
- 10. ALL VALVES TO BE PLACED IN "CARSON" GRADE LEVEL BOXES WITH BOLT-LOCK LIDS (OR APPROVED EQUIVALENT). SET BOXES 2 INCHES HIGHER THAN FINISH GRADE IN MULCH AREAS AND FLUSH WITH FINISH GRADE IN LAWN AREAS. JUMBO BOX FOR CHECK VALVE, 10" ROUND BOX FOR GATE/QUICK COUPLER/WIRE SPLICES, AND 12" STANDARD FOR CONTROL VALVES. PROVIDE BOX EXTENSIONS AS REQUIRED.
- 11. MAINLINE PIPE TO BE BURIED 18 INCHES, LATERALS 12 INCHES, AND SLEEVES 24" INCHES BELOW FINISH GRADE. NO ROCK OR DEBRIS TO BE BACKFILLED OVER PIPE.
- 12. HEAD AND LINE POSITIONING IS DIAGRAMMATIC ON PLAN. ADJUST IN FIELD AS NECESSARY FOR 100 PERCENT COVERAGE. VALVES TO BE POSITIONED ADJACENT TO PAVEMENT/CURBS IN SHRUB BEDS WHERE POSSIBLE.
- 13. FAMILIARIZE OWNERS FACILITY OPERATOR WITH IRRIGATION SYSTEM FUNCTION, CONTROLLER PROGRAMMING, SYSTEM OPERATION AND MAINTENANCE REQUIREMENTS.

RADIUS REDUCTION TO BE MADE BY USE OF PRESSURE ADJUSTMENT, SCREENS, AND/OR

- 14. SPRINKLERS ON RISERS WILL NOT BE ALLOWED UNLESS NOTED ON PLANS.
- ALTERNATE NOZZLES. IN-NOZZLE ADJUSTMENT IS LIMITED TO 10 PERCENT FOR SPRAY
 HEADS AND PER MANUFACTURER'S LIMITS FOR OTHER SPRINKLERS. SPRINKLER SPACING
 NOT EXCEED 60% OF THE DIAMETER OF THE PUBLISHED DATA.

 16 ALL CONTROL WIRE SPLICES TO BE MADE AT VALVE BOXES WITH WATER TIGHT FLECTRICAL
- 16. ALL CONTROL WIRE SPLICES TO BE MADE AT VALVE BOXES WITH WATER TIGHT ELECTRICAL SPLICES, 3M, SCOTT'S LOCK SEAL TACK 3576-78, OR EQUIVALENT.
- 7. EACH VALVE BOX TO CONTAIN A MINIMUM OF 1 DECODER, CONNECTED TO JACKETED HUNTER IDWIRE1 (14 GUAGE), RECOMMENDED FOR WIRE PATH LENGTH UP TO 10,000 FT OR HUNTER IDWIRE (12 GUAGE) FOR WIRE PATH LENGTH BEYONE 10,000 FT UP TO 15,000 FEET. THESE MAXIMUM WIRE PATH LENGTHS ARE FOR ACTIVATING UP TO 225 HUNTER DECODERS, 6 P/MV AND UP TO 6 SENSOR DECODERS. AVOID RUNNING POWER CABLES AND DECODER PATH IN PARALLEL. ALL WIRE PATHS AND ITS BRANCHES SHOULD BE ENDED WITH PROPER GROUNDING. NEW CONSTRUCTION CAN RELY ON EXISTING WIRE PATH BY TIEING ON AND EXTENDING OUT TO SERVICE NEW CONSTRUCTION, UP TO A MAXIMUM 225 VALVES.
- 18. ALL ELECTRICAL EQUIPMENT TO BE U.L. TESTED AND APPROVED, AND BEAR THE U.L. LABEL.
- 19. CROSS CONNECTION PROTECTION INSPECTION REQUIRED. THE BACKFLOW DEVICE TO BE TESTED UPON THE ORIGINAL INSTALLATION. THE TESTING TO BE PERFORMED BY A PERSON HOLDING A CURRENT CERTIFICATE AS A BACKFLOW TESTER. THE TEST REPORT TO BE SUBMITTED TO THE LOCAL WATER DISTRICT, OR PURVEYOR, AND OWNER WITH A COPY TO BARGHAUSEN CONSULTING ENGINEERS, INC. CONTRACTOR TO INCLUDE TESTING IN THE SCOPE OF WORK. OWNER IS RESPONSIBLE FOR ANNUAL INSPECTIONS AFTER THE INTIAL INSPECTION.
- 20. CONTRACTOR TO PROVIDE SYSTEM WINTERIZATION/SPRING SERVICE WHEN INSTALLATION HAS BEEN COMPLETED WITHIN 90 DAYS OF NOVEMBER 1 FOR WINTERIZATION, OR MAY 15 FOR SPRING SERVICE. SERVICE TO BE PERFORMED AS NEAR AS PRACTICAL TO THE ABOVE DATES, OR AS FREEZE/PRECIPITATION CONDITIONS DETERMINE SERVICE NEED.

- THE IRRIGATION CONTROLLER CONTAINS A WATER BUDGET FEATURE. PERIODIC

 (WEEKLY) ADJUSTMENT OF THE WATER SCHEDULE IS INTENDED TO BE MADE VIA

 BUDGET ADJUSTMENT. RE—ADJUST WATERING DAYS AT 100 PERCENT BUDGET WHEN

 ADJUSTMENT EXCEEDS 30%. SET CONTROLLER FOR HIGHEST ETO WATER SCHEDULE,

 BASED ON PUBLISHED LOCAL EVAPOTRANSPIRATION DATA. SYSTEM HAS BEEN DESIGNED

 FOR 50 TO 80 PERCENT DISTRIBUTION UNIFORMITY. LAWN ZONES SHOULD BE SCHEDULED

 FOR 100 PERCENT REPLACEMENT FACTOR ON A TYPICAL MINIMUM 3—DAY CYCLE. SHRUB

 ZONES SHOULD BE PROGRAMMED AT 40 TO 70 PERCENT OF THE MONTHLY LAWN WATER


 REQUIREMENT ON A ONCE PER WEEK CYCLE. ALL WATERING IN EXCESS OF THE LOCAL

 ETO ("FIELD RECHARGE") TO BE COMPLETED DURING THE CONSTRUCTION PHASE WHILE

 THE CONTRACTOR IS ON THE JOB SITE. OVER WATERING OF LANDSCAPE DUE TO


 CONTROLLER SCHEDULING TO BE GROUNDS FOR CONTRACTOR TO REPAIR ANY RESULTANT

 DAMAGES AT CONTRACTOR'S OWN EXPENSE.
- 22. SUBSTITUTION OF IRRIGATION MATERIAL/EQUIPMENT TO BE MADE ONLY UPON WRITTEN APPROVAL OF OWNER'S REPRESENTATIVE.
- 23. ALL ZONES TO PASS A MINIMUM DISTRIBUTION UNIFORMITY OF 62 PERCENT, AS TESTED THROUGH AN IRRIGATION ASSOCIATION CERTIFIED WATER AUDIT.
- 24. CLEANUP AND PROTECTION: DURING IRRIGATION WORK, KEEP ALL PAVEMENT CLEAN AND WORK AREAS IN AN ORDERLY CONDITION. PROTECT IRRIGATION WORK AND MATERIALS FROM DAMAGE DUE TO LANDSCAPE AND IRRIGATION OPERATIONS AND TRESPASSERS. MAINTAIN PROTECTION DURING INSTALLATION AND MAINTENANCE PERIOD. TREAT, REPAIR, OR REPLACE DAMAGE LANDSCAPE AND IRRIGATION WORK AS DIRECTED BY THE OWNER.
- 25. PRIOR TO BACKFILLING IRRIGATION TRENCHES, LANDSCAPE CONTRACTOR SHALL CONDUCT A WATER PRESSURE AND COVERAGE TEST IN THE PRESENCE OF THE LANDSCAPE ARCHITECT. LANDSCAPE CONTRACTOR TO GIVE 3 (THREE) WORKING DAYS NOTICE PRIOR TO TEST.

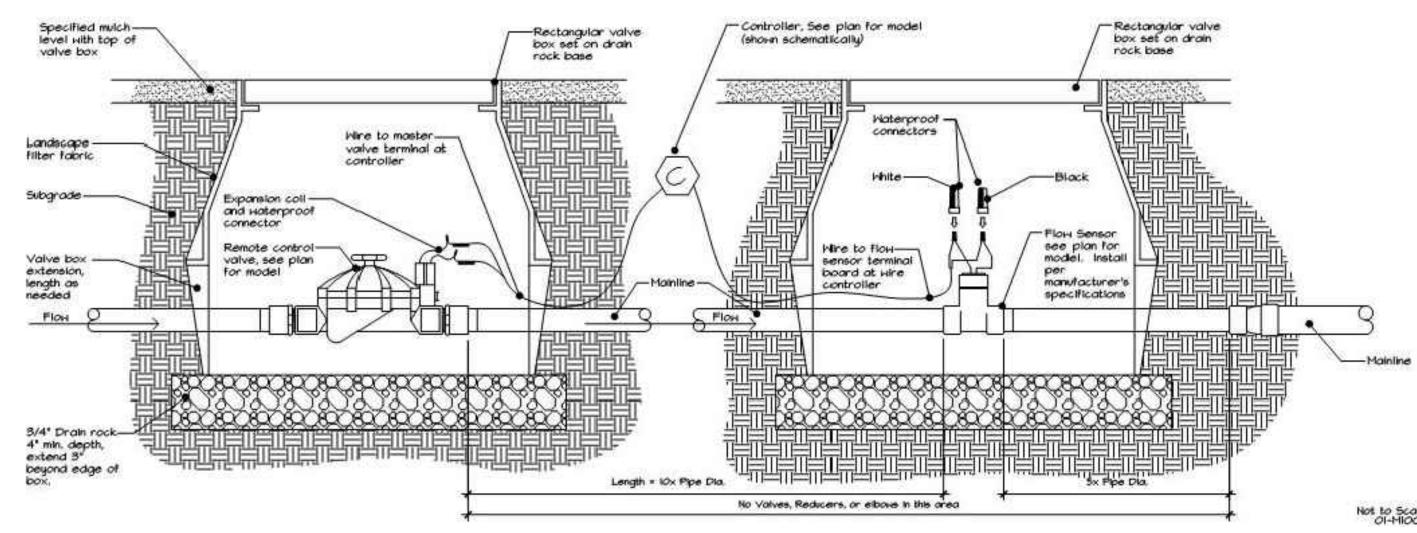


MASTER VALVE and FLOW SENSOR

NOT TO SCALE

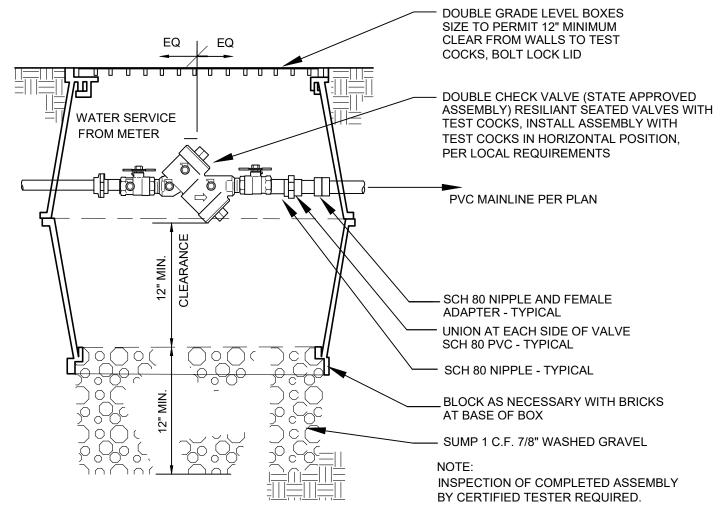

CHECK VALVE ASSEMBLY DETAIL

NOT TO SCALE

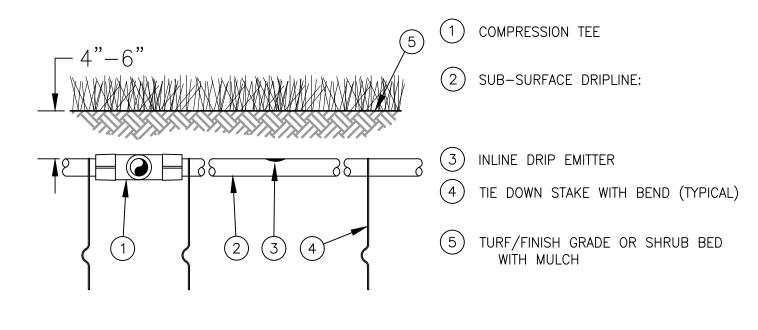


- S:

 ACE THE DOWN STAKES EVERY THREE FEET IN (
- 1. PLACE TIE DOWN STAKES EVERY THREE FEET IN SAND, FOUR FEET IN LOAM, AND
- AT FITTINGS WHERE THERE IS A CHANGE OF DIRECTION SUCH AS TEES OR ELBOWS, USE TIE—DOWN STAKES ON EACH LEG OF THE CHANGE OF DIRECTION.
 INSERTION PLOW AND TRENCHED INSTALLATIONS DO NOT REQUIRE TIE DOWN STAKES.


DRIPLINE BURIAL

NOT TO SCALE

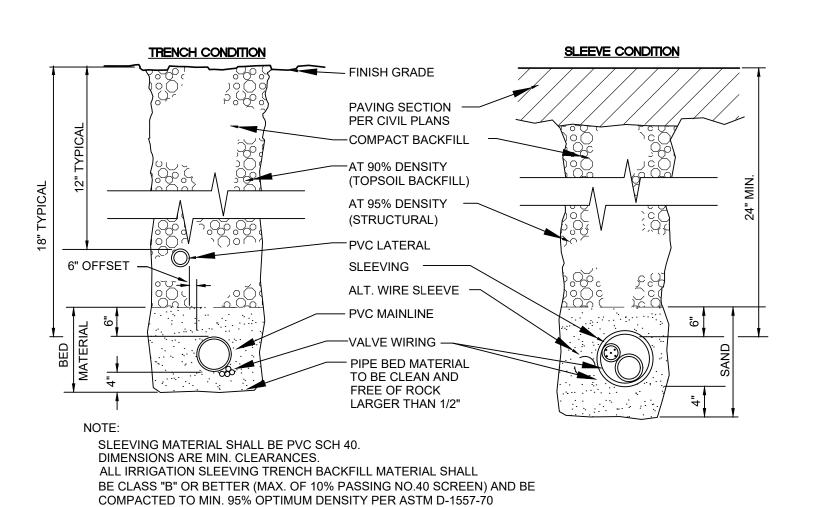


SLEEVE/TRENCHING DETAIL

(MODIFIED PROCTOR)

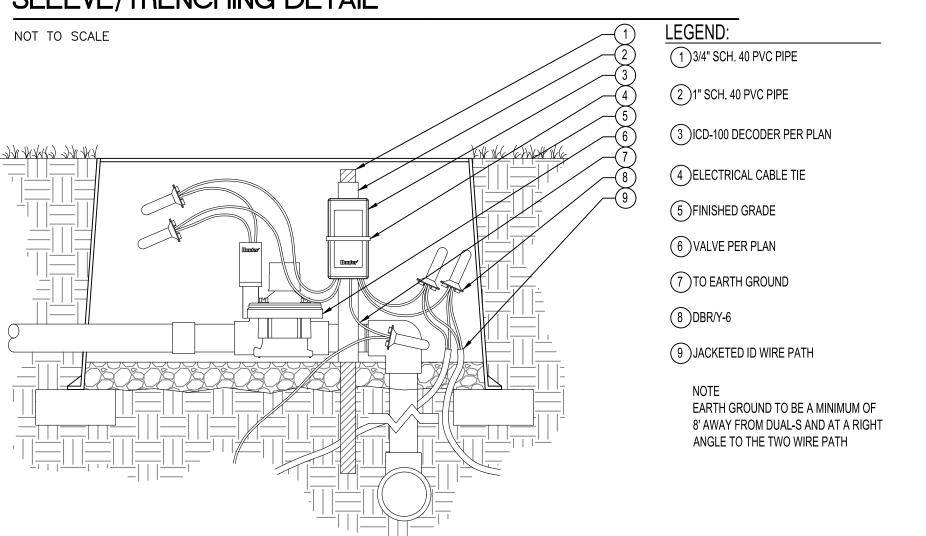

ICD-100 DECODER ON STAKE

NOT TO SCALE

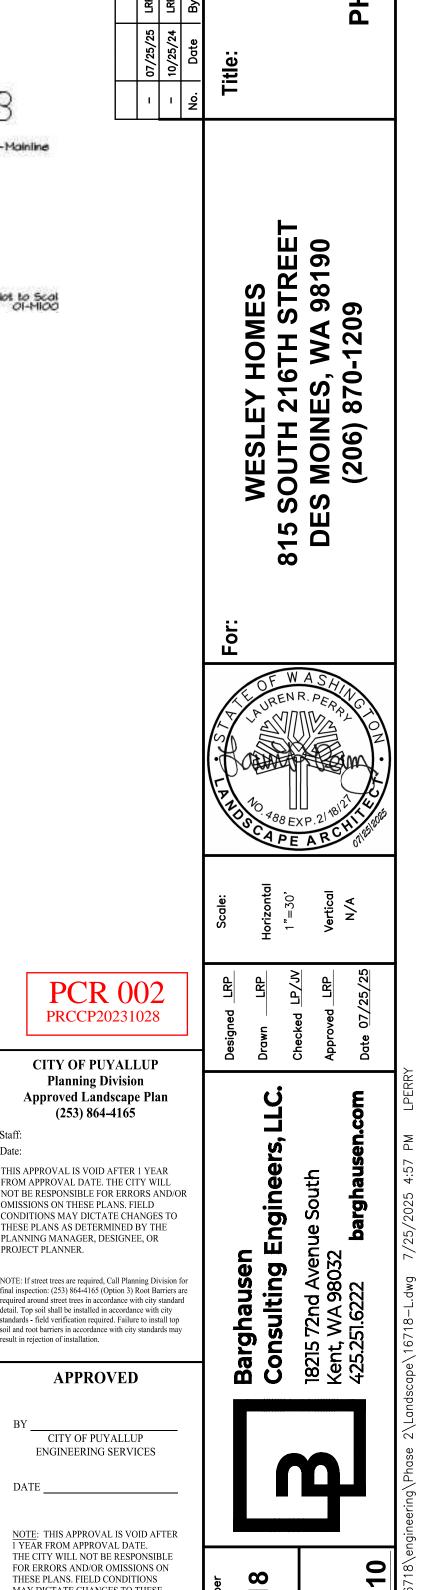

PLANS AS DETERMINED BY THE

ENGINEERING SERVICES MANAGER.


2

S

Know what's **below**. Call before you dig.

IRRIGATION DETAILS


PHASE 2 - WESLEY BRADLEY PARK

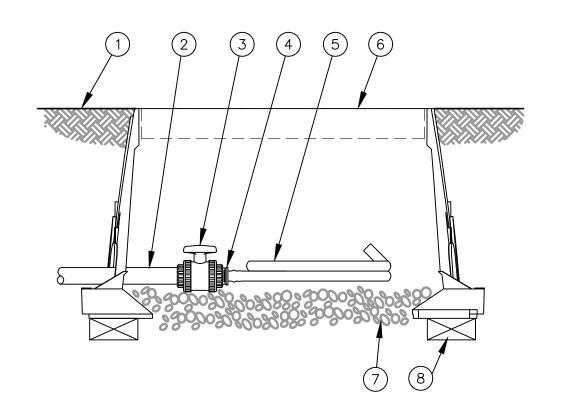

- FINISH GRADE
- PVC DRIP MANIFOLD PIPE PVC 1" X 3/4" TRUE UNION
- BALL VALVE EASY FIT MALE X BARB RAIN BIRD XFF-MA-075
- (5) SUB-SURFACE DRIPLINE: (6) 12-INCH VALVE BOX WITH
- RAIN BIRD VB-STD 7) 3-INCH MINIMUM DEPTH OF 3/4" WASHED GRAVEL 8 BRICK (1 OF 2)

FLUSH POINT WITH BALL VALVE

NOT TO SCALE

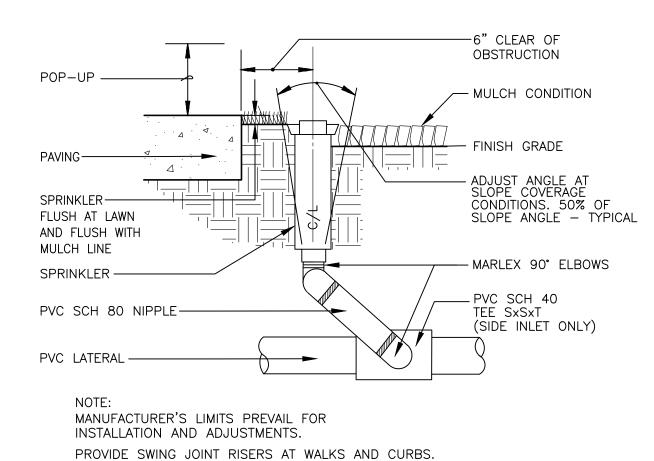


POP-UP RISER ASSEMBLY

24" FLEXIBLE RISERS ACCEPTABLE ELSEWHERE.

NOT TO SCALE


NOT TO SCALE

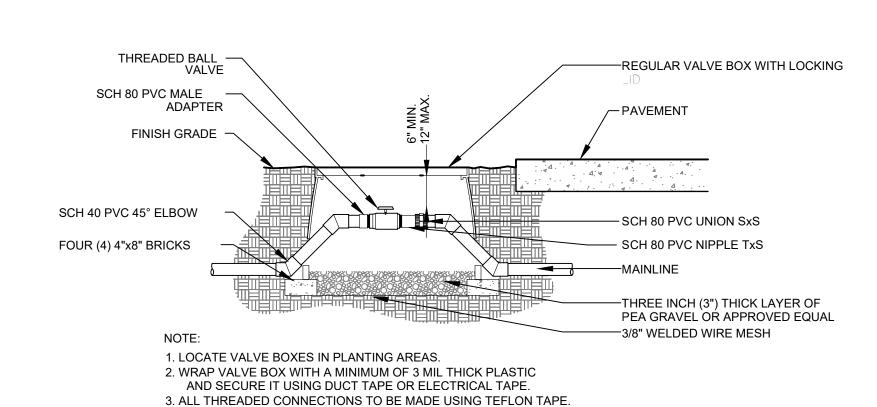

BALL VALVE DETAIL


4. ALL CHANGES IN ELEVATION SHALL BE MADE USING SCH 40 PVC 45° ELBOWS.

NOT TO SCALE

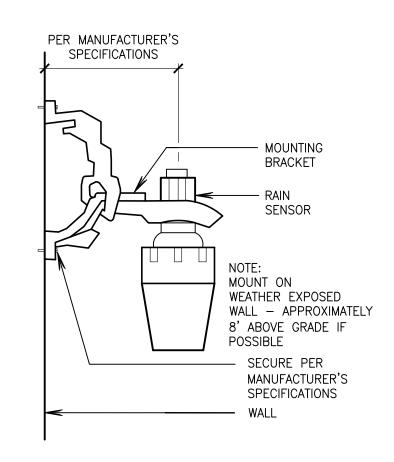

RAIN SENSOR DETAIL


NOT TO SCALE

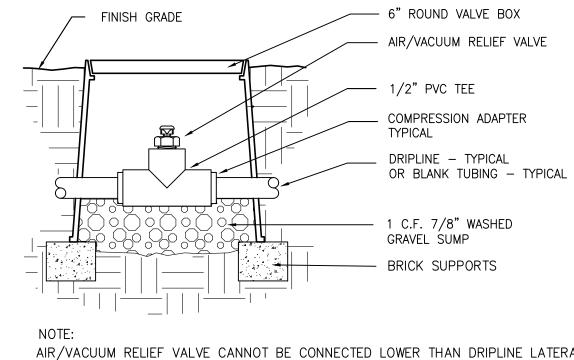

AIR/VACUUM RELIEF VALVE CANNOT BE CONNECTED LOWER THAN DRIPLINE LATERALS. FOR USE ON ZONES OF 7 GPM OR LESS ONLY (PLUMBED TO TUBING)

1/2" AIR/VACUUM RELIEF VALVE DETAIL

NOT TO SCALE

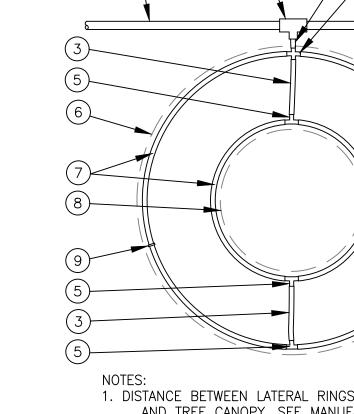


- (1) PVC DRIP MANIFOLD PIPE
- 2 PVC SCH 40 TEE OR EL
- (3) BLANK TUBING
- (4) BARB CROSS INSERT FITTING
- (5) BARB TEE INSERT FITTING
- (7) SUB-SURFACE DRIPLINE:
- SEE IRRIGATION SCHEDULE

(6) PROJECTED CANOPY LINE OF TREE


- (8) PLACE AS SHOWN (LENGTH AS REQUIRED) ROOT BALL
- (9) TIE DOWN STAKE: QUANTITY AS REQUIRED, SEE NOTES 2-3
- 1. DISTANCE BETWEEN LATERAL RINGS AND EMITTER SPACING TO BE BASED ON SOIL TYPE AND TREE CANOPY. SEE MANUFACTURER DRIPLINE INSTALLATION GUIDE FOR SUGGESTED
- 2. PLACE TIE DOWN STAKES EVERY THREE FEET IN SAND, FOUR FEET IN LOAM, AND FIVE
- 3. AT FITTINGS WHERE THERE IS A CHANGE OF DIRECTION SUCH AS TEES OR ELBOWS, USE TIE-DOWN STAKES ON EACH LEG OF THE CHANGE OF DIRECTION.

DRIPLINE AROUND TREE

NOT TO SCALE

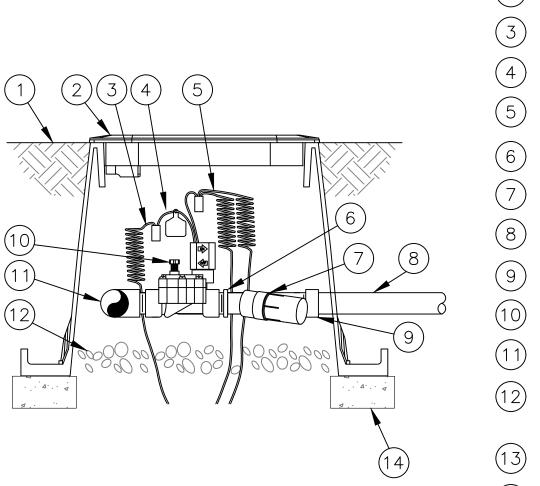

- (1) FINISH GRADE
- (2) STANDARD VALVE BOX WITH COVER:
- WATERPROOF CONNECTION:
- (4) VALVE ID TAG
- 30-INCH LINEAR LENGTH OF WIRE, COILED
- 1" X 34" REDUCING COUPLING
- (7) PRESSURE REGULATING FILTER:
- (8) LATERAL PIPE
- (9) PVC SCH 40 FEMALE ADAPTOR OR REDUCER
- (10) REMOTE CONTROL VALVE
- (11) PVC SCH 40 TEE OR ELL TO MANIFOLD
- (12) 3-INCH MINIMUM DEPTH OF 3/4-INCH WASHED GRAVEL
- (13) MANIFOLD PIPE AND FITTINGS
- (14) MINIMUM FOUR (4) 4"x8" BRICKS

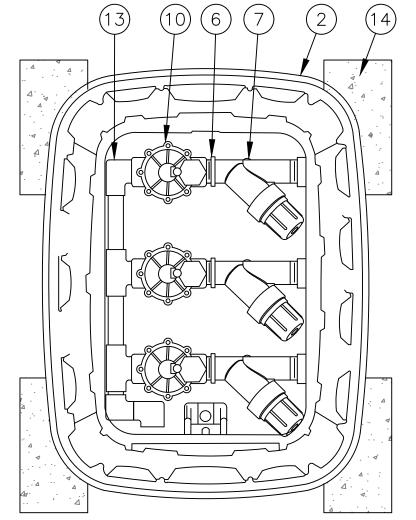


TOP VIEW

DRIP IRRIGATION VALVE

NOT TO SCALE


SIDE VIEW

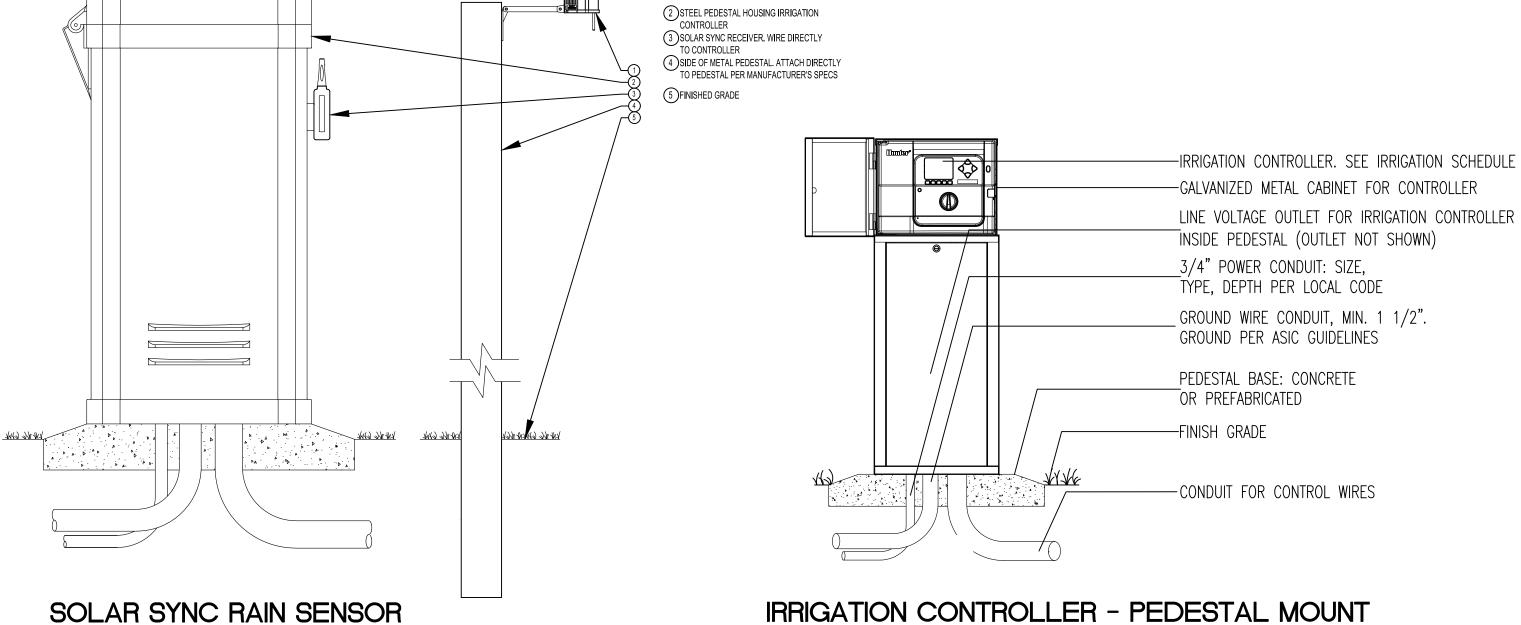


NOT TO SCALE

LEGEND:

1) SOLAR SYNC WIRELESS SENSOR

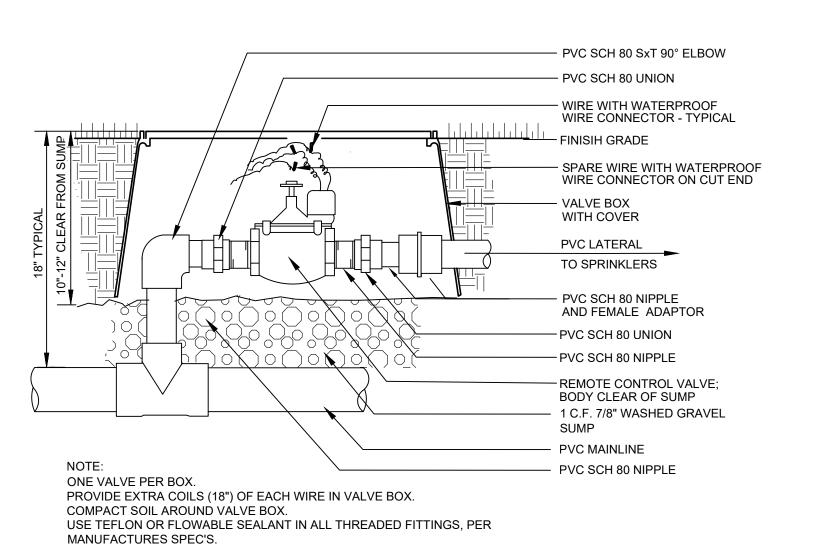

REMOTE CONTROL VALVE ASSEMBLY NOT TO SCALE

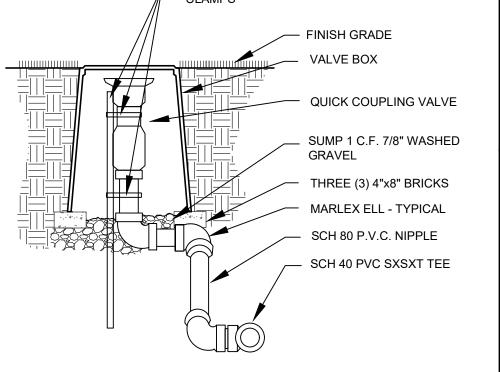

SUPPORT STAKES AND

QUICK COUPLING VALVE DETAIL NOT TO SCALE

PCR 002 PRCCP20231028



FROM APPROVAL DATE. THE CITY WILL NOT BE RESPONSIBLE FOR ERRORS AND/OF OMISSIONS ON THESE PLANS, FIELD CONDITIONS MAY DICTATE CHANGES TO THESE PLANS AS DETERMINED BY THE PLANNING MANAGER, DESIGNEE, OR PROJECT PLANNER.

NOTE: If street trees are required, Call Planning Division for final inspection: (253) 864-4165 (Option 3) Root Barriers ar equired around street trees in accordance with city standar etail. Top soil shall be installed in accordance with city tandards - field verification required. Failure to install top soil and root barriers in accordance with city standards magnetic in rejection of installation.

APPROVED

CITY OF PUYALLUP ENGINEERING SERVICES

NOTE: THIS APPROVAL IS VOID AFTER 1 YEAR FROM APPROVAL DATE. THE CITY WILL NOT BE RESPONSIBLE FOR ERRORS AND/OR OMISSIONS ON THESE PLANS. FIELD CONDITIONS MAY DICTATE CHANGES TO THESE PLANS AS DETERMINED BY THE

ENGINEERING SERVICES MANAGER.


2

PHASE

HOMES 6TH STR

IRRIGATION DETAILS

PHASE 2 - WESLEY BRADLEY PARK

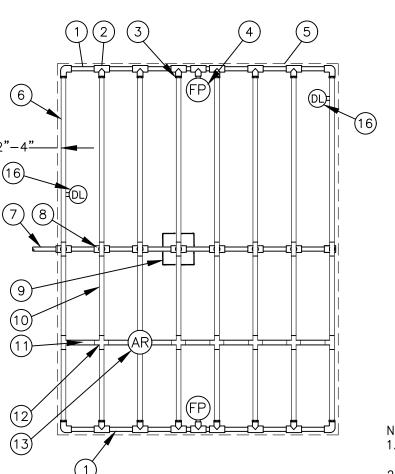

1) PVC EXHAUST HEADER (2) PVC SCH 40 TEE OR EL (TYPICAL)

(3) BARB X MALE FITTING: (4) FLUSH POINT (TYPICAL)

(5) PERIMETER OF AREA

(8) PVC SUPPLY MANIFOLD

(6) PERIMETER DRIPLINE PIPE TO BE INSTALLED 2"-4" FROM PVC SUPPLY PIPE FROM CONTROL ZONE KIT (SIZED TO MEET LATERAL FLOW DEMAND)

(9) CONNECTION FROM SUPPLY MANIFOLD TO DRIPLINE (TYPICAL) - SEE INSET A

(10) SUB-SURFACE DRIPLINE: (11) RAIN BIRD XF SERIES BLANK TUBING (12) BARB X BARB INSERT TEE OR CROSS

(13) 1/2" AIR RELIEF VALVE: RAIN BIRD MODEL: ARVO50 (14) BARB X FEMALE FITTING:

(15) 34" PVC NIPPLE, LENGTH AS NECESSARY (16) DRIPLINE INDICATOR. SEE DETAIL FOR ADDITIONAL INFORMATION

XFS [Oripline I	Maximun	n Latera	Length	s (Feet)	
Inlet Pressure	Nomin	pacing al Flow ph)	Nomina	pacing al Flow oh)	Nomin	pacing al Flow ph)
P 5,	0.6	0.9	0.6	0.9	0.6	0.9
15	273	155	314	250	424	322
20	318	169	353	294	508	368
30	360	230	413	350	586	414
40	395	255	465	402	652	474
50	417	285	528	420	720	488

1. DISTANCE BETWEEN LATERAL ROWS AND EMITTER SPACING TO BE BASED ON SOIL TYPE, PLANT MATERIALS AND CHANGES IN ELEVATION. SEE MANUFACTURER'S INSTALLATION GUIDE FOR SUGGESTED SPACINGS. . LENGTH OF LONGEST DRIPLINE LATERAL SHOULD NOT EXCEED THE MAXIMUM LENGTH SHOWN IN THE ACCOMPANYING TABLE.

3. AIR RELIEF VALVE TO BE INSTALLED AT HIGH POINT OF AREA. 4. WHEN USING 17MM INSERT FITTINGS WITH DESIGN PRESSURE OVER 50PSI, IT IS RECOMMENDED THAT STAINLESS STEEL CLAMPS BE INSTALLED ON EACH FITTING.


DRIPLINE CENTER FEED LAYOUT

OF SLOPE

 DISTANCE BETWEEN LATERAL ROWS AND EMITTER SPACING TO BE BASED ON SOIL TYPE, PLANT MATERIALS AND CHANGES IN ELEVATION. DISTANCE BETWEEN LATERAL ROWS FOR BOTTOM 1/3 OF SLOPE TO BE SPACED GREATER THAN OPTIMAL ROW DISTANCE. SEE RAIN BIRD XFD DRIPLINE INSTALLATION GUIDE FOR SUGGESTED

 LENGTH OF LONGEST DRIPLINE LATERAL SHOULD NOT EXCEED THE MAXIMUM LENGTH SHOWN IN THE WHEN ELEVATION CHANGE EXCEEDS 8 FEET IT IS RECOMMENDED THAT A NEW DRIPLINE ZONE BE CREATED

• INSTALL AIR RELIEF VALVE AT HIGH POINTS IN DRIP LATERAL. WHEN USING 17MM INSERT FITTINGS WITH DESIGN PRESSURE OVER 50PSI, IT IS RECOMMENDED THAT

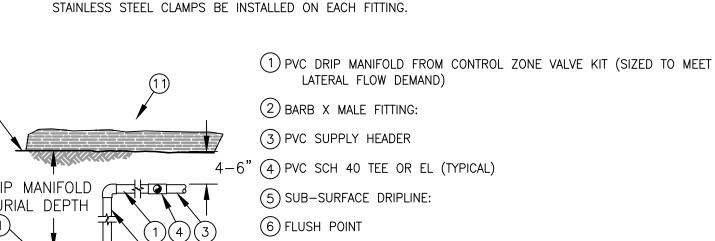


(8) ½" AIR RELIEF VALVE

(7) PVC FLUSH HEADER

(9) DRIPLINE INDICATOR. SEE DETAIL FOR ADDITIONAL INFORMATION

(10) PVC RISER PIPE (11) TURF OR MULCH

(12) FINISH GRADE

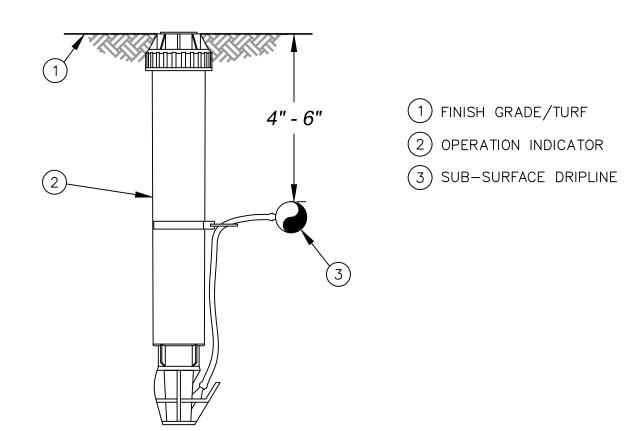

1. INSERT BARB TRANSFER FITTING DIRECTLY INTO DRIPLINE TUBING. 2. VAN NOZZLE MAY BE SET TO CLOSED, OR IF IT IS DESIRED TO SEE SPRAY FROM THE NOZZLE, SET THE ARC TO 1/4 PATTERN. THE FLOW FROM THE NOZZLE, 0.3 GPM, SHOULD BE ACCOUNTED FOR IN THE SYSTEM DESIGN.

DRIP IRRIGATION DRIPLINE INDICATOR


 DISTANCE BETWEEN LATERAL ROWS AND EMITTER SPACING TO BE BASED ON SOIL TYPE, PLANT MATERIALS AND CHANGES IN ELEVATION. SEE

NOT TO SCALE

MANUFACTURER'S INSTALLATION GUIDE FOR SUGGESTED SPACINGS. LENGTH OF LONGEST DRIPLINE LATERAL SHOULD NOT EXCEED THE MAXIMUM LENGTH SHOWN IN

THE ACCOMPANYING TABLE. AIR RELIEF VALVE TO BE INSTALLED AT HIGH POINT OF AREA.

 WHEN USING 17MM INSERT FITTINGS WITH DESIGN PRESSURE OVER 50PSI, IT IS RECOMMENDED THAT STAINLESS STEEL CLAMPS BE INSTALLED ON EACH FITTING.

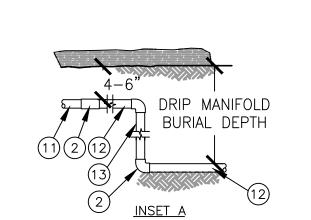

(1) PVC EXHAUST HEADER (2)PVC SCH 40 TEE OR EL (TYPICAL) (3) BARB X MALE FITTING:

(4) FLUSH POINT (TYPICAL) (5) PERIMETER OF AREA

(6) PERIMETER DRIPLINE PIPE TO BE INSTALLED 2"-4" FROM PERIMETER OF AREA

(7) SUB-SURFACE DRIPLINE: (8) BLANK TUBING

(9) BARB X BARB INSERT TEE OR CROSS:

(10) 1/2" AIR RELIEF VALVE (11) PVC SUPPLY HEADER

(12) PVC DRIP MANIFOLD FROM CONTROL ZONE VALVE KIT (SIZED TO MEET LATERAL FLOW DEMAND) (13) PVC SCH 40 RISER PIPE

(14) DRIPLINE INDICATOR. SEE DETAIL FOR ADDT'L INFO

XFS [Oripline M	1aximum	Lateral L	engths (Feet)	
	12" S	pacing	18" S	pacing	24" Spacing	
Inlet Pressure psi	Nominal F	low (gph)	Nominal Flow (gph)		Nominal Flow (gp	
	0.6	0.9	0.6	0.9	0.6	0
15	273	1 55	314	250	424	3.
20	318	169	353	294	508	36
30	360	230	413	350	586	4
40	395	255	465	402	652	4
50	417	285	528	420	720	48
60	460	290	596	455	780	5

DRIPLINE SLOPED LAYOUT

DRIPLINE ODD CURVES LAYOUT

NOT TO SCALE

1. DISTANCE BETWEEN LATERAL ROWS AND EMITTER SPACING TO BE BASED ON SOIL TYPE, PLANT MATERIALS AND CHANGES IN ELEVATION. SEE INSTALLATION SPECIFICATIONS ON MANUFACTURER'S WEB SITE FOR SUGGESTED SPACING. 2. LENGTH OF LONGEST DRIPLINE LATERAL SHOULD NOT EXCEED THE MAXIMUM SPACING SHOWN IN THE ACCOMPANYING

3. INSTALL AIR RELIEF VALVE AT HIGH POINTS IN DRIP LATERAL. 4. WHEN USING 17MM INSERT FITTINGS WITH DESIGN PRESSURE OVER 50PSI, IT IS RECOMMENDED THAT STAINLESS STEEL CLAMPS BE INSTALLED ON EACH FITTING.

DRIP MANIFOLD BURIAL DEPTH

<u>INSET A</u>

(1) PVC SUPPLY PIPE FROM RAIN BIRD CONTROL ZONE KIT (SIZED TO MEET LATERAL FLOW DEMAND)

(2) PERIMETER OF AREA

(3) PERIMETER DRIPLINE PIPE TO BE INSTALLED 2"-4" FROM PERIMETER OF AREA

(4) PVC SUPPLY MANIFOLD (5) PVC SCH 40 TEE OR EL (TYPICAL) (6) BARB X MALE FITTING

(7) SUB-SURFACE DRIPLINE:

(8) ARB X BARB INSERT TEE:

(9) TOTAL LENGTH OF SELECTED DRIPLINE SHOULD NOT EXCEED LENGTH SHOWN IN TABLE

(10) PVC FLUSH HEADER (11) FLUSH POINT:

(12) PVC RISER PIPE (13) TURF OR MULCH

(14) FINISH GRADE (15) 1/2" AIR RELIEF VALVE

(16) DRIPLINE INDICATOR. SEE DETAIL FOR ADDT'L INFO

<u>INSET A</u>

DRIPLINE END FEED LAYOUT

NOT TO SCALE

DRIPLINE IRREGULAR SHAPED LAYOUT

NOT TO SCALE

(1) PVC EXHAUST HEADER (2)PVC SCH 40 TEE OR EL (TYPICAL) (3) FLUSH POINT (TYPICAL)

(4)BARB X MALE FITTING: (5) PERIMETER OF AREA

(6) BARB X BARB INSERT TEE OR CROSS: (7) PERIMETER DRIPLINE PIPE TO BE INSTALLED 2"-4" FROM PERIMETER OF AREA

(8) SUB-SURFACE DRIPLINE:

(10)½" AIR RELIEF VALVE (11) PVC SUPPLY MANIFOLD (12) PVC SUPPLY PIPE FROM CONTROL ZONE KIT (SIZED

TO MEET LATERAL FLOW DEMAND) 13) TOTAL LENGTH OF SELECTED DRIPLINE SHOULD NO EXCEED LENGTH SHOWN IN TABLE (14) PVC SCH 40 RISER PIPE

(15) dripline indicator. See detail for addt'l info

 DISTANCE BETWEEN LATERAL ROWS AND EMITTER SPACING TO BE BASED ON SOIL TYPE, PLANT MATERIALS AND CHANGES IN ELEVATION. SEE INSTALLATION GUIDE FOR SUGGESTED SPACINGS. LENGTH OF LONGEST DRIPLINE LATERAL SHOULD NOT EXCEED THE MAXIMUM LENGTH SHOWN IN THE ACCOMPANYING TABLE. AIR RELIEF VALVE TO BE INSTALLED

AT HIGH POINT OF AREA. WHEN USING 17MM INSERT FITTINGS WITH DESIGN PRESSURE OVER 50PSI, IT IS RECOMMENDED THAT STAINLESS STEEL CLAMPS BE INSTALLED ON

DRIP MANIFOLD

BURIAL DEPTH

NOTE: If street trees are required, Call Planning Division for final inspection: (253) 864-4165 (Option 3) Root Barriers are equired around street trees in accordance with city standar etail. Top soil shall be installed in accordance with city tandards - field verification required. Failure to install top oil and root barriers in accordance with city standards ma result in rejection of installation.

PROJECT PLANNER.

APPROVED

PRCCP20231028

CITY OF PUYALLUP

Planning Division

Approved Landscape Plan

(253) 864-4165

THIS APPROVAL IS VOID AFTER 1 YEAR

FROM APPROVAL DATE. THE CITY WILL

OMISSIONS ON THESE PLANS, FIELD

PLANNING MANAGER, DESIGNEE, OR

NOT BE RESPONSIBLE FOR ERRORS AND/OF

CONDITIONS MAY DICTATE CHANGES TO

THESE PLANS AS DETERMINED BY THE

CITY OF PUYALLUP ENGINEERING SERVICES

NOTE: THIS APPROVAL IS VOID AFTER 1 YEAR FROM APPROVAL DATE. THE CITY WILL NOT BE RESPONSIBLE FOR ERRORS AND/OR OMISSIONS ON THESE PLANS. FIELD CONDITIONS MAY DICTATE CHANGES TO THESE PLANS AS DETERMINED BY THE

ENGINEERING SERVICES MANAGER.

2

HOMES 6TH STR