DO NOT CUT, DRILL, NOTCH OR MODIFY TRUSS MEMBERS WITHOUT PRIOR APPROVAL FROM Builders FirstSource Truss

*****ATTENTION******
TRIANGLE SHAPE ▲= LEFT SIDE INDICATOR
RED MARK ON TRUSS IS LEFT SIDE
TRIANGLE SHAPE ▲ = INDICADOR DE LADO IZQUIERDO
MARCA ROJA EN ARMADURA ES LADO IZQUIERDO

MKM LEGACY
EAST TOWN CROSSING LOT 1# REV 1#
5' & 8' PARAPET FROM BOTTOM CHORD MAX

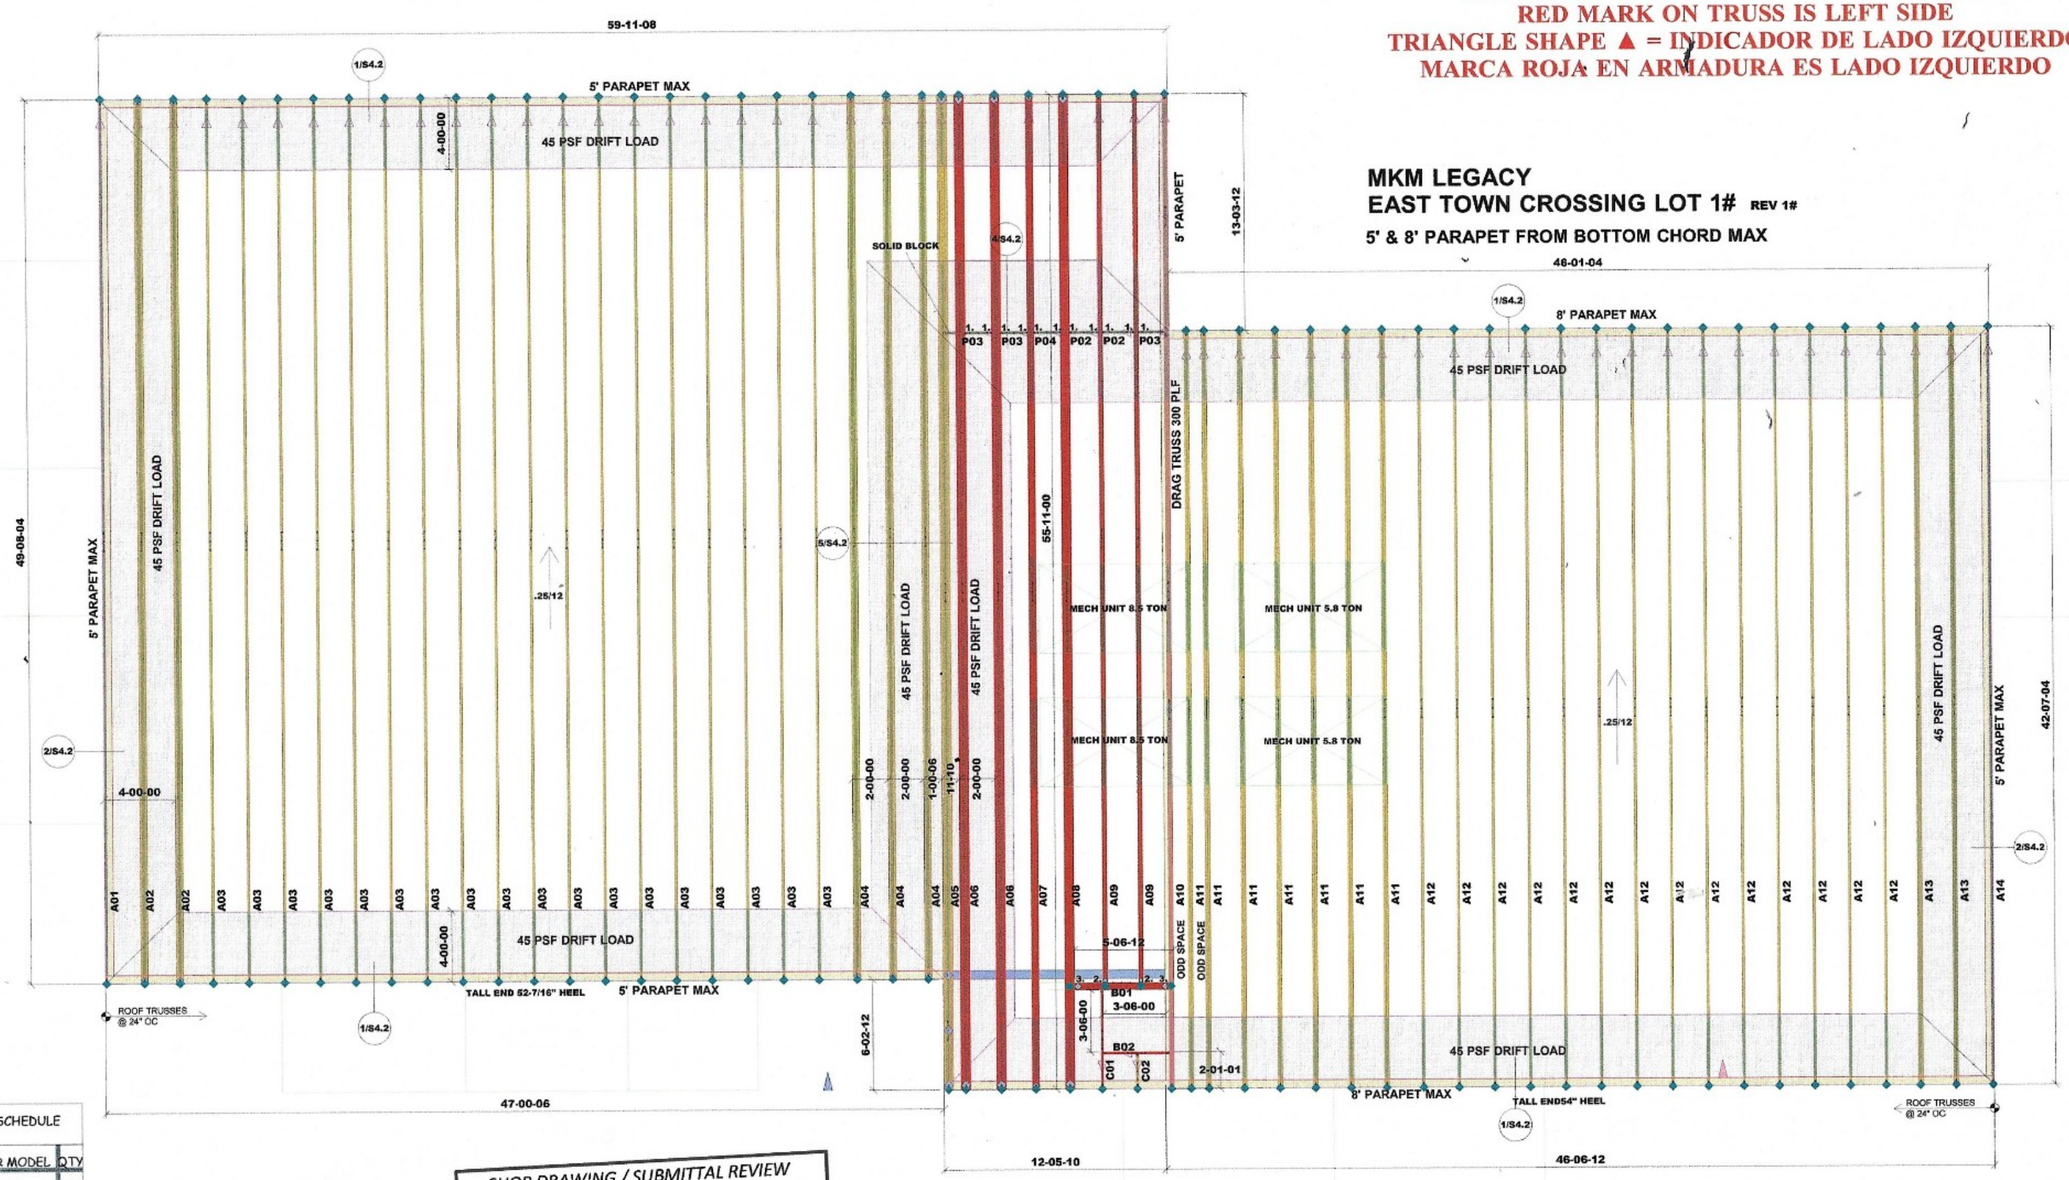

HANGER SCHEDULE		
ID	HANGER MODEL	QTY
1.	LUS24	11
2.	HGUS28-2	2
3.	HGUS210-3	2

BLOCKING SCHEDULE	
TYPE	QTY
2x8 SOLIDS	216

SHOP DRAWING / SUBMITTAL REVIEW

☒ APPROVED ☐ APPROVED AS NOTED
☐ REVISE & RESUBMIT ☐ REJECTED

SUBMITTAL WAS REVIEWED FOR DESIGN CONFORMITY AND GENERAL CONFORMANCE TO CONTRACT DOCUMENTS ONLY. THE CONTRACTOR IS RESPONSIBLE FOR CONFIRMING AND CORRELATING DIMENSIONS AT JOBSITE FOR TOLERANCE, CLEARANCE, QUANTITIES, FABRICATION PROCESSES AND TECHNIQUES OF CONSTRUCTION, COORDINATION OF HIS WORK WITH OTHER TRADES AND FULL COMPLIANCE WITH CONTRACT DOCUMENTS

BY: Chon Pieruccioni DATE: 5/23/25

PIERUCCIONI E&C, LLC

PRCTI20251445

City of Puyallup
Development & Permitting Services
ISSUED PERMIT
Building | Planning
Engineering | Public Works
Fire | Traffic

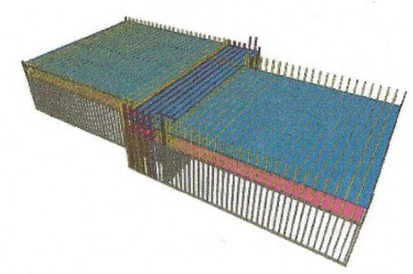

THIS IS A TRUSS PLACEMENT DIAGRAM ONLY. These trusses are designed as individual building components to be incorporated into the building design at the discretion of the building designer. See the individual design sheets for each truss design identified on the placement drawing. The building designer is responsible for temporary and permanent bracing of the roof and floor system and for the overall structure. The design of the truss support structure including headers, beams, walls, and columns is the responsibility of the building designer. For general guidance regarding bracing, consult "Bracing of wood trusses" available from the Truss Plate Institute, 583 D'Onofrio Drive; Madison, WI 53179

ROOF TRUSS PLACEMENT LAYOUT

Puget Sound Market Trusses

Builders FirstSource

BUILDER : MKM LEGACY
PLAN : EAST TOWN CROSSING LOT 1# REV 1#
ADDRESS : EAST TOWN CROSSING LOT 1# REV 1#
PLAT & LOT : EAST TOWN CROSSING LOT 1# REV 1#
DATE :
SCALE: NTS
SALES : DOUG F.
DESIGNER : JEFF C.
APPWRIGHT/ MBA #: 4623747
CITY, STATE:

ARLINGTON 360-925-4155 SPANAWAY 253-846-3005 ISSAQUAH 425-391-8000 KINGSTON 425-961-6778