Commercial GI Sewer Service As-built

Service Address: 3500 S. Meridian

~~Subdivision:~~ Round 1 Bowling & Amusement Lot #: South Hill mall

Permit No.: E-21-0068

Contractor: A Advanced & Cafaro NW Partnership

Pipe Type: PVC SDR 35 Pipe Size: 4" & 6" No. of cleanouts: 5

" of sample tees 3

Approved by: ~~Marcus Sedlickas,~~ Engineering Inspector Date: 1-28-2022

Jason Little
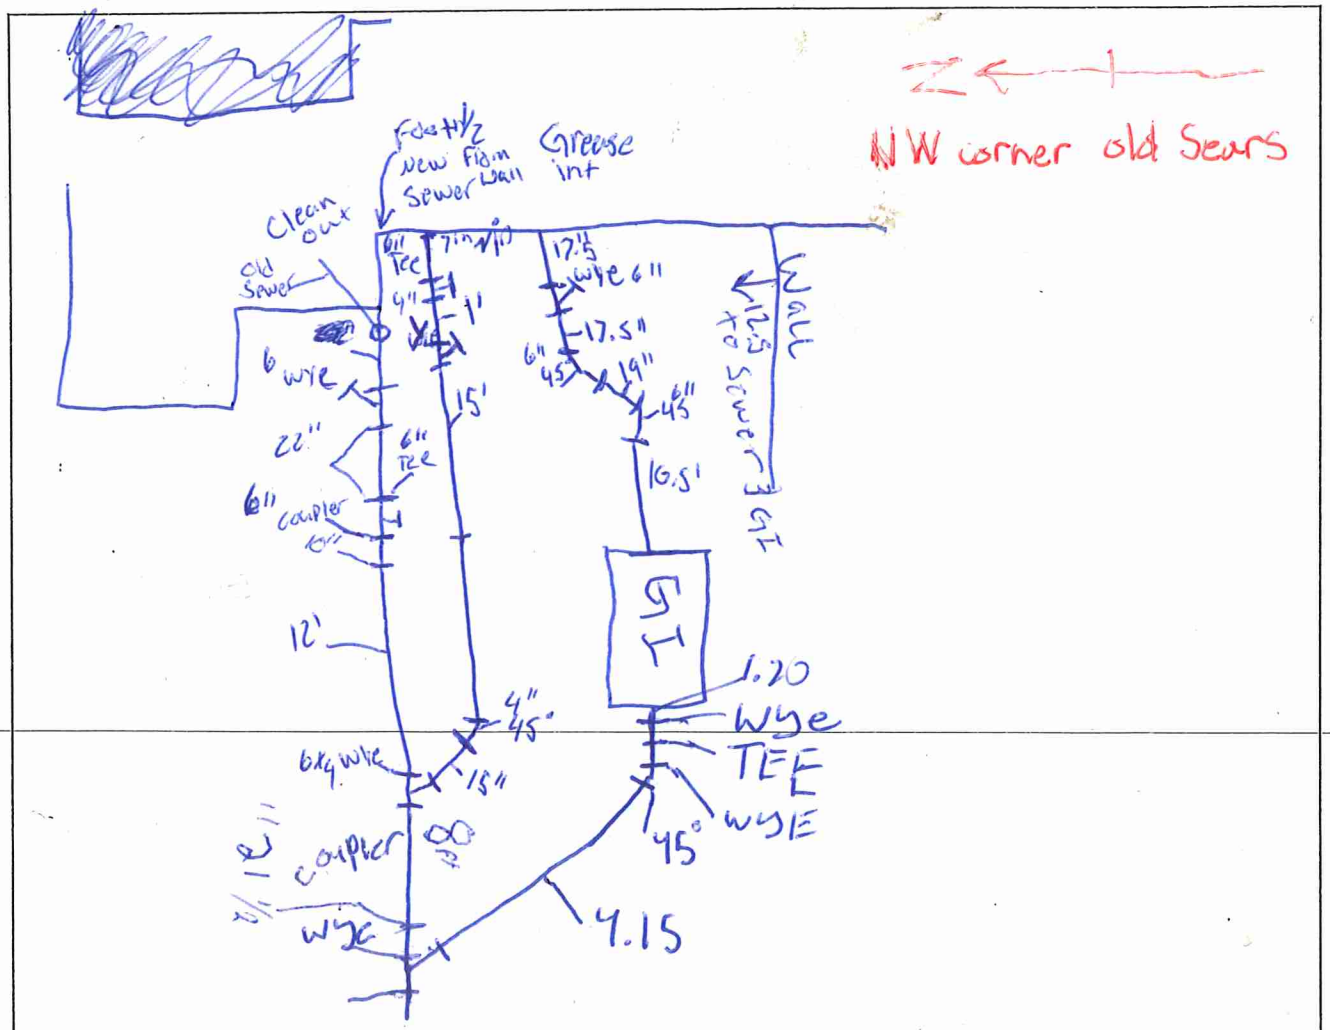
Inspector comments: