



PROJECT:
BASS PRO SHOP
1106 Valley Ave NW, PUYALLUP, WA 98371
1042 Valley Ave NW, PUYALLUP, WA 98371
PARCEL #: 04220163042

REVISIONS:
B. REVISED SITE PLAN BASED ON AGENCY REVIEW

DRAWING ISSUED FOR:
AGENCY REVIEW
DATE: JANUARY 5, 2026



PROJECT NO: 25083
FILE NAME: 25083LSB
DRAWN BY: KLO
CHECKED BY: KLO
X-REFS: CIVIL
PLOT SCALE: 1:1
DRAWING SCALES: 1:30

DRAWING CONTENTS:
PLANTING PLAN
DRAWING NO.:
L1
1 OF 2
ORIG. SHEET SIZE 22X34

PLANT LEGEND				
TREES				
SYMBOL	QTY THIS PROJECT	EXISTING NEWLY PLANTED VEG	DESCRIPTION	SIZE
	1	5	Picea omorika Serbian Spruce	6' Ht. Min. Full / Compact
		9	Cornus x Starlight' Starlight Dogwood	2" Cal. Min. Well Formed
		9	Amelanchier g. 'Autumn Brilliance' Autumn Brilliance Serviceberry (multi stem allowed on site)	2" Cal. Min. Well Formed
	1	6	Pinus contorta Shore Pine	6' Ht. Min. Full / Compact
		4	Thuja plicata Western Red Cedar	6' Ht. Min. Full / Compact
	1		Pinus ponderosa Ponderosa Pine	6' Ht. Min. Full / Compact
		1	Ulmus americana 'ACCOLADE' Accolade Elm	2" Cal. Min. Well Formed
SHRUBS & GROUND COVERS				
SYMBOL	QTY		DESCRIPTION	SIZE
	1	41	Myrica californica Pacific Wax Myrtle	5 Gal. Min.
		12	Spirea douglasii Douglas Spirea	2 Gal. Min.
	12	65	Berberis aquifolium Tall Oregon Grape	2 Gal. Min.
		14	Vaccinium ovatum Evergreen Huckleberry	2 Gal. Min.
	6	33	Ribes sanguineum Flowering Red Currant	2 Gal. Min.
	1	44	Symphoricarpos alba Snowberry	2 Gal. Min.
	45	49	Rosa rugosa Wild Rose	2 Gal. Min.
	2	13	Holodiscus discolor Oceanspray	2 Gal. Min.

SUNMARK SEEDS INTERNATIONAL, INC.
PO Box 1210
Fairview OR 97024
503-241-7333
888-214-7333

Acres: 1
Quantity: 43.43 lbs.


Botanical Name	Common Name	% by Weight	Seeds per lb. of Mix	Seeds per lb.	Actual % by Seed Size	Lbs. Needed	Requested %
<i>Hordium brachyanthemum</i>	Meadow Barley	40.00%	34000	85,000	10.51%	17.45	10%
<i>Bromus ciliaris</i>	California Brome	35.00%	38800	110,000	11.90%	15.27	10%
<i>Poa trivialis</i>	Native Red Fescue	25.00%	100000	500,000	30.91%	8.73	30%
<i>Deschampsia cespitosa</i>	Tufted Hairgrass	3.00%	75000	2,500,000	23.18%	1.31	25%
<i>Agrostis exarata</i>	Spike Bentgrass	1.00%	75000	3,800,000	13.49%	0.87	15%
TOTALS:		100.00%	323500		100.00%	43.43	100%

Seeding Rate:
1 PLS lbs. per 1000 sq. ft.
43.43 PLS lbs. per acre

Site Price Per Project: 5 17.15
Total Site Price: 5 748.12

Native EC is a native erosion control grass mix that is quick to establish, low-growing and has superior root masses for reduced erosion of soils. This mix should be used with the addition of EcoLive™ organics with mycorrhizae. It will stay under 24 inches in height and has excellent drought tolerance. Will work on wet and dry sites, has some shade tolerance.

NOTE: THE FOLLOWING SUBSTITUTIONS FOR TREES ARE APPROVED BY RACHEL BROWN (CITY OF PUYALLUP) AS FOLLOWS:
Ulmus x 'Accolade'
Cornus x 'Starlight'
Amelanchier g. 'Autumn Brilliance'; MULTI-STEM ALLOWED FOR ONSITE LANDSCAPE, SINGLE-STEM ONLY FOR STREET TREES
Amelanchier laevis

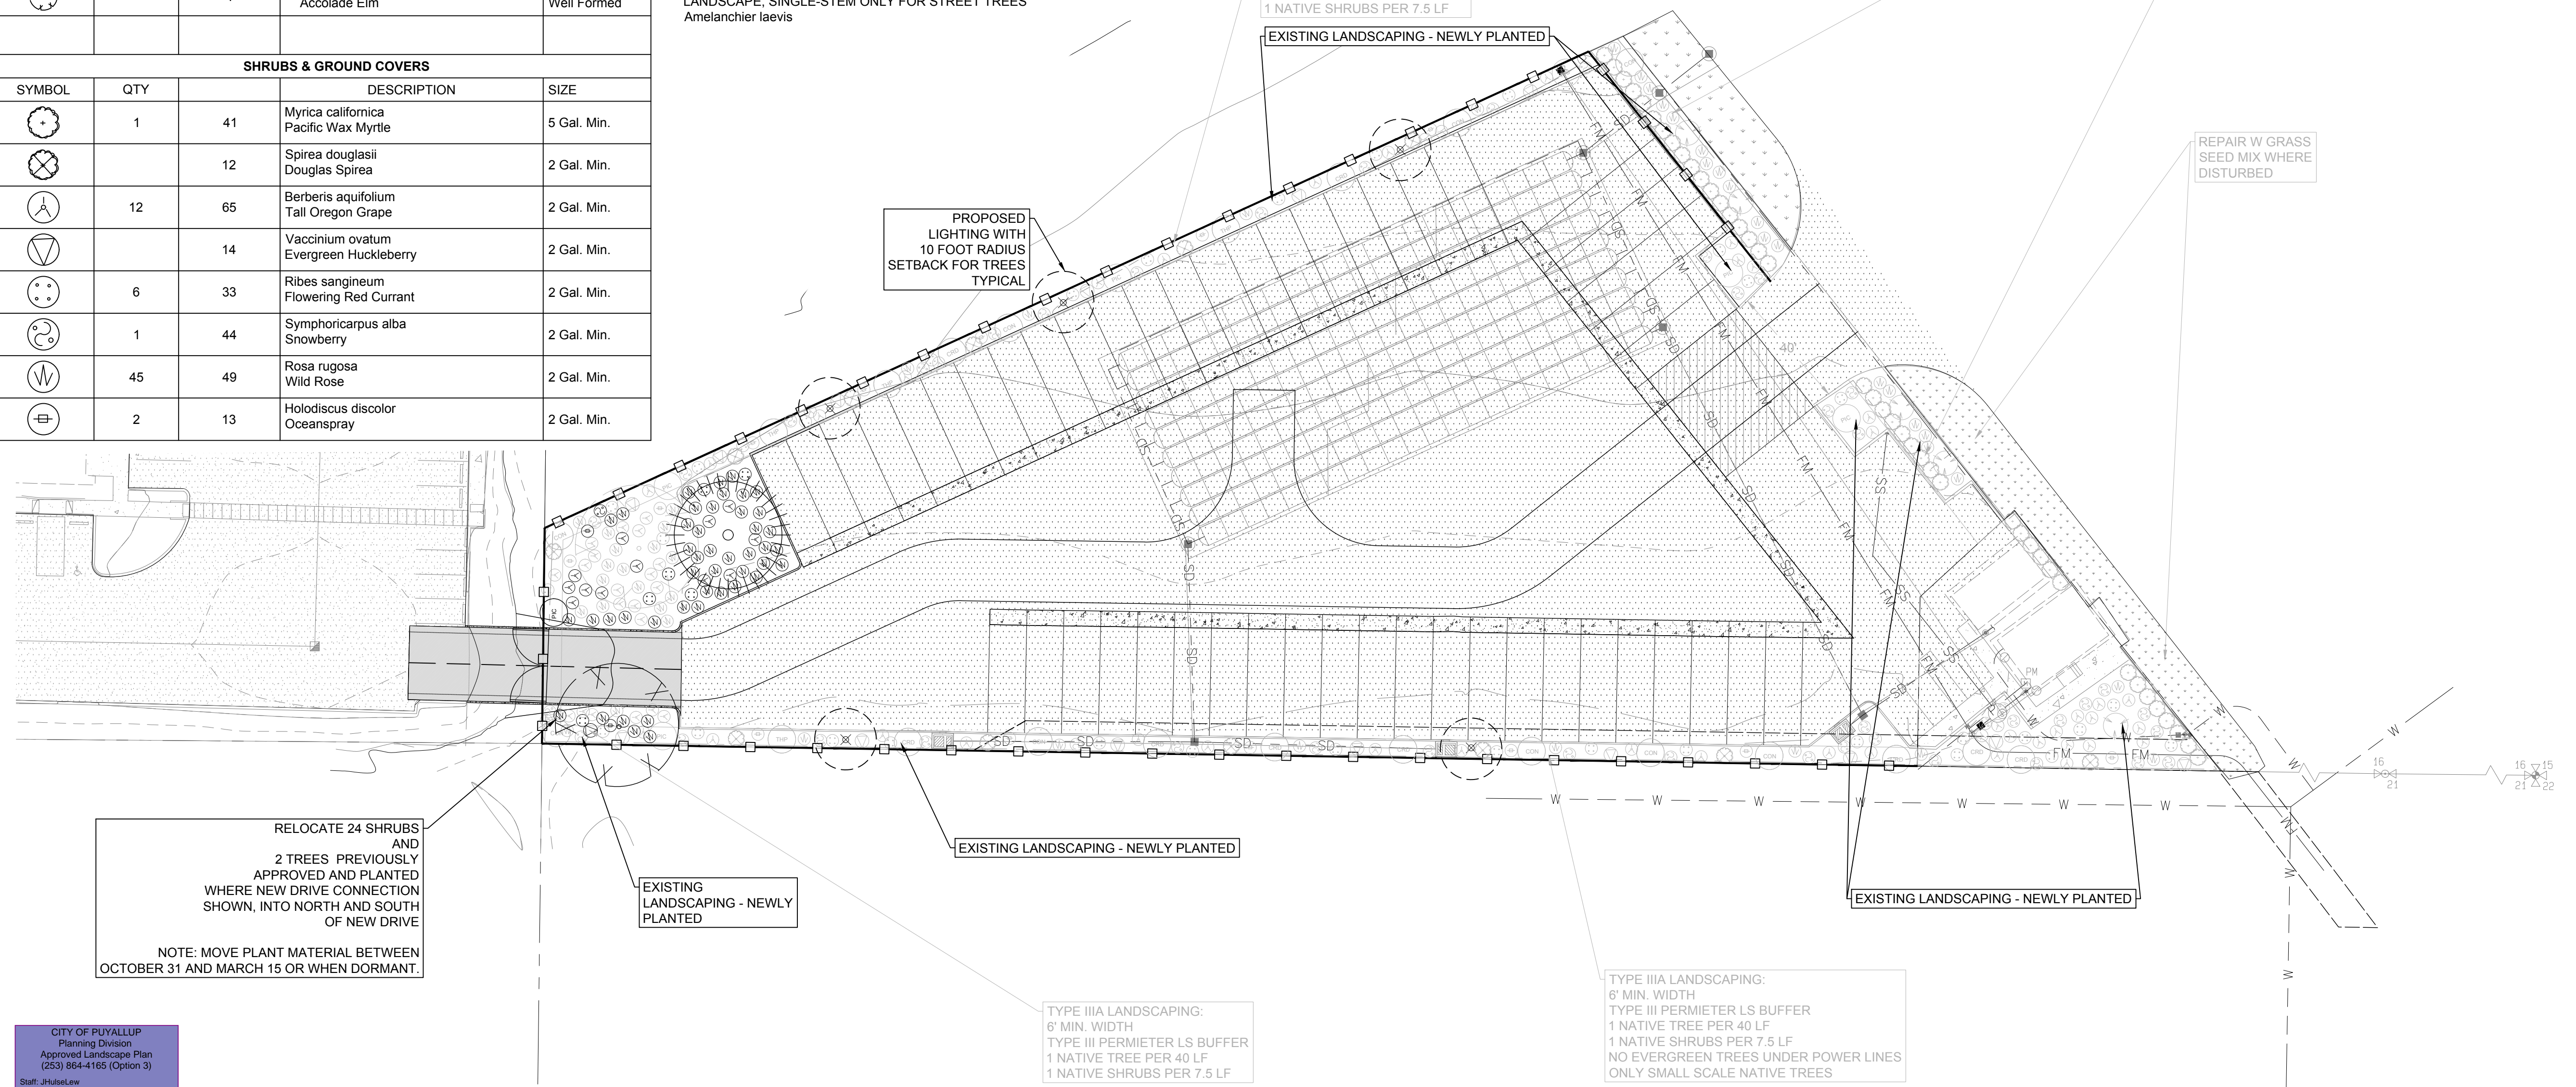

NOTE: PREVIOUSLY APPROVED AND INSTALLED LANDSCAPING. THIS PROJECT IS MOVING 2 TREES AND 24 SHRUBS TO ALLOW FOR ACCESS DRIVE TO WEST. PREVIOUSLY APPROVED NOTES AND SHRUB / TREE SYMBOLS ARE FADED FOR REFERENCE ONLY. NO NEW PLANT MATERIAL IS PROPOSED. ONLY RELOCATION OF NEWLY PLANTED MATERIAL AS SHOWN.

TOPSOIL REQUIREMENTS PER CITY OF PUYALLUP CODE:

1374 SF DISTURBED NEWLY LANDSCAPED AREAS:
1374 X .666 (8 INCHES) = 1220 / 27= 45 CY OF TOPSOIL REQUIRED FOR LANDSCAPE REPLACEMENT AREA -

NOTE: CONTRACTOR TO SUBMIT DELIVERY SHEETS AND DEMONSTRATE COMPLIANCE WITH TOPSOIL REQUIRED AND SPECIFIED ON PLANS AT TIME OF FINAL INSPECTION.

CITY OF PUYALLUP
Planning Division
Approved Landscape Plan
(253) 864-4165 (Option 3)
Staff: JHulsedLaw
Date: 03/26/2026

THIS APPROVAL IS VOID AFTER 180 DAYS FROM APPROVAL DATE. THE CITY IS NOT RESPONSIBLE FOR ERRORS OR OMISSIONS ON THESE PLANS. FIELD CONDITIONS MAY REQUIRE CHANGES TO THESE PLANS AS DETERMINED BY THE PLANNING DIRECTOR, DESIGNEE, OR PROJECT PLANNER.

NOTE: Request final landscape inspection via the City's online permit portal at www.puyallup.gov/portal. Root barriers are required around street trees in accordance with city standards. Top soil shall be installed in accordance with city standards. Final verification required. Failure to install top soil and root barriers in accordance with the city standards may result in rejection of installation.



8.2 Soil Quantity and Quality Standards
Purpose and Definition

Naturally occurring (undisturbed) soil and vegetation provide important stormwater functions including: water infiltration; nutrient, sediment, and pollutant adsorption; sediment and pollutant biofiltration; water interflow storage and transmission; and pollutant decomposition. These functions are largely lost when development strips away native soil and vegetation and replaces it with minimal topsoil and sod. Not only are these important stormwater functions lost, but such landscapes themselves become pollution-generating pervious surfaces due to increased use of pesticides, fertilizers and other landscaping and household/industrial chemicals, the concentration of pet wastes, and pollutants that accompany roadside litter. Establishing soil quality and depth regains greater stormwater functions in the post development landscape, provides increased treatment of pollutants and sediments that result from development and habitation, and minimizes the need for some landscaping chemicals, thus reducing pollution through prevention.

All soils in all landscape installations shall conform to the following soil depth and quality requirements. Please refer to appendix 20.9 for further installation guidance:

A. A minimum of eight (8) inches of top soil, containing ten percent dry weight in planting beds, and 5% organic matter content in turf areas, and a pH from 6.0 to 8.0 or matching the pH of the original undisturbed soil. The topsoil layer shall have a minimum depth of eight inches (8") except where tree roots limit the depth of incorporation of amendments needed to meet the criteria. Subsoils below the topsoil layer should be scarified at least 6 inches with some incorporation of the upper material to avoid stratified layers, where feasible. Installation of the eight inches (8") of top soil, as described above, shall generally be achieved by placing five inches (5") of imported sandy-loam top soil into planned landscape areas (sub-base scarified four inches (4") with a three inch (3") layer of compost tilled into the entire depth.

B. For street trees in the right of way planter strip, the following standards shall apply in relation to soil depth, soil amendments and installation of new street trees. The following notes shall be shown on the face of the preliminary and final landscape plan sheets:

(1) For new construction: In areas where a new planter strip and street tree shall be established or reconstructed due to a street construction project, the planter strip area shall be excavated to a depth of 24" and backfilled following the standard above to achieve a top soil mix with 40 percent compost by volume. The contractor or installer shall:

- Review the city standard planting detail – All contractors/installers are required to following city standard #01.02.07 (street tree planting) and #01.02.03 (root barrier installation). The contractor/installer shall review the planting standard detail prior to installation to understand the city's requirements. Failure to follow the standard may result in rejection of the work by the inspector and/or Planning Department.
- Schedule a field pre-construction meeting - The contractor/installer shall contact the site inspector and Planning Department 48 hours in advance of the installation of street tree(s) for a field pre-construction meeting on-site to review the approved plan set and city standard details. If street trees are to be installed over a longer timeline (such as a residential plat where trees may be installed over a multi-month period of time), the contractor/installer shall hold one consolidated pre-con to review plans. All street trees shall be inspected after planting by the Planning Department.
- Excavate all construction materials - Excavate all construction materials, remnant soil, gravel, pit run, construction debris, etc. from the planter strip area to a depth of 24" prior to planting. Discard this material as the placement of new compost amended top soil is required.
- Prepare the planting strip - After excavating all materials from the planter strip, scarify and rip the sub-base with the teeth of a backhoe bucket (or other mechanical means or hand tools) to a depth of 6" with multiple passes, 90 degrees to each other. Prior to planting the tree, re-compact the tree base where the street tree will be planted to avoid setting of the root ball.

At this stage, if the tree is to be planted when the planter strip is backfilled with amended top soil, the contractor/installer should measure the depth of the root ball to determine when to place the tree in the pit during the backfilling process. If the root ball or root mass (in the case of bare root trees) is less than 24", the street tree shall be planted in a manner in which the root flare is level with or at least 1" above grade at the time of finished planting. This may require the root ball be placed on a compacted sub-base of the compost amended top soil as backfilling is occurring.

- Install root barrier panels - At this stage the contractor/installer shall place 24" deep root barrier panels (UB-24) along the edge of the sidewalk and curb line for a total of eight feet (8') of linear protection along either side of the planting area. The panels shall be installed perpendicular to the edge of paved surface in accordance with the manufacturer's standards for a 'linear' application; the root barrier panels shall not be installed in the planting pit as a 'surround' application, unless specified on the final landscape plans. The top of the root barrier panel shall be installed such that 1/2" of the root barrier is above the finished grade.
- Compost amended top soils required – Top soil source shall be reviewed and approved during the pre-construction meeting; all top soil shall be a top quality sandy-loam mix, or equivalent as approved by the Planning Department. The top soil shall be amended on site during installation with compost to achieve a 40 percent by volume top soil mix in the right-of-way planter strip. Imported top soil may be used by the contractor if data 'cut sheets' are available from the supplier certifying compost amendment equaling 40 percent by volume using one of the approved compost sources below. Compost shall only be sourced from:
 - Cascade Compost (also known as PREP/LRI) (available through Pierce County Recycling, Composting & Disposal, 10308 Sales Road, Tacoma, Washington 98499, or retail/wholesale landscape material suppliers)
 - TAGRO Compost Mix (available through City of Tacoma, 2201 E. Portland Avenue, Gate 6, Tacoma, WA, 98421, or retail/wholesale landscape material suppliers)
 - Cedar Grove Compost (available through Cedar Grove Compost, 17825 Cedar Grove Road S.E., Maple Valley, 98038, or retail/wholesale landscape material suppliers)
- Install and amend top soils - To avoid stratified layers, first place seven inches (7") of approved top soil in the prepared/scarified planting strip area and mechanically till in five inches (5") of approved compost; follow this procedure twice to achieve the total 24" top soil depth. Finished grade of top soil should be 1/2" below the edge of sidewalk to allow the root barrier panel to be properly installed above finished grade.
- Install tree stakes and finish mulch - Placement of four inches (4") of wood chip mulch, water basin rings, tree staking and temporary irrigation bags (where required) shall follow city standard #01.02.07.

For street trees to be planted in existing right-of-way planter strips: In a planter strip which already exists and a new street tree shall be installed, the following procedures shall be followed to achieve a top soil mix with 40 percent compost by volume:

- Excavate soil - Excavate existing soil to a depth of 24" (or equal to the root ball depth, whichever is greater) and width of 8" (or three times (3X) wider than the root ball or root mass, whichever is greater). Stockpile excavated soil on a tarp away from the street and storm water catch basins.
- Prepare the planting strip - After excavating all materials from the planter strip, scarify and rip the sub-base (by mechanical means or hand tools) to a depth of 6" with multiple passes, 90 degrees to each other. Prior to planting the tree, re-compact the tree base where the street tree will be planted to avoid setting of the root ball.

At this stage, if the tree is to be planted when the planter strip is backfilled with amended top soil, the contractor/installer should measure the depth of the root ball to determine when to place the tree in the pit during the backfilling process. If the root ball or root mass (in the case of bare root trees) is less than 24", the street tree shall be planted in a manner in which the root flare is level with or at least 1" above grade at the time of finished planting. This may require the root ball be placed on a compacted sub-base of the compost amended top soil as backfilling is occurring.

- Install root barrier panels - At this stage the contractor/installer shall place 24" deep root barrier panels (UB-24) along the edge of the sidewalk and curb line for a total of eight feet (8') of linear protection along either side of the planting area. The panels shall be installed perpendicular to the edge of paved surface in accordance with the manufacturer's standards for a 'linear' application; the root barrier panels shall not be installed in the planting pit as a 'surround' application, unless specified on the final landscape plans. The top of the root barrier panel shall be installed such that 1/2" of the root barrier is above the finished grade.
- Compost amended top soils required – The top soil shall be amended on site during installation with compost to achieve a 40 percent by volume top soil mix in the right-of-way planter strip. Imported top soil may be used by the contractor/installer if data 'cut sheets' are available from the supplier certifying compost amendment equaling 40 percent by volume using one of the approved compost sources below. Compost shall only be sourced from:
 - Cascade Compost (also known as PREP/LRI) (available through Pierce County Recycling, Composting & Disposal, 10308 Sales Road, Tacoma, Washington 98499, or retail/wholesale landscape material suppliers)
 - TAGRO Compost Mix (available through City of Tacoma, 2201 E. Portland Avenue, Gate 6, Tacoma, WA, 98421, or retail/wholesale landscape material suppliers)
 - Cedar Grove Compost (available through Cedar Grove Compost, 17825 Cedar Grove Road S.E., Maple Valley, 98038, or retail/wholesale landscape material suppliers)
- Install and amend top soils - To avoid stratified layers, first place seven inches (7") of approved top soil in the prepared/scarified planting strip area and mechanically till in five inches (5") of approved compost; follow this procedure twice to achieve the total 24" top soil depth. Finished grade of top soil should be 1/2" below the edge

of sidewalk to allow the root barrier panel to be properly installed above finished grade.

- Install tree stakes and finish mulch - Placement of four inches (4") of wood chip mulch, water basin rings, tree staking and temporary irrigation bags (where required) shall follow city standard #01.02.07.

B. The project landscape architect shall utilize one of the design methods outlined in appendix 20.9 in incorporating this standard. The landscape architect shall estimate total top soil and compost import volumes and specify the top soil and compost source during the final landscape plan review. A top soil delivery ticket(s), invoice(s) or other physical proof that the correct quantity and quality of top soil was delivered shall be provided at the time of final inspection.

8.3 Mulching

In an effort to minimize water use, reduce costs and use of chemicals for maintenance, all planting areas shall be mulched with a uniform four (4") inch layer of organic compost mulch material or wood chips over a properly cleaned, amended and graded subsurface. Four inches of mulch in planting areas shall be maintained through the life of the project. Herbicides shall not be used in the mulch ring area for street trees; see city standard #01.02.07 for street tree mulch application and dimensions.

9.0 GUARDING AGAINST DAMAGE:

9.1 Vegetation Protection

Any person, firm or corporation engaged in the construction, alteration or repair of any street, sidewalk, parking area, building or portion thereof, prior to starting of any such activity, shall place proper guards or temporary fences to ensure the protection of adjacent existing vegetation from all damage or injury. This shall include restriction on stacking, stockpiling, or the accumulation of goods or material in the area defined as the Critical Root Zone. See appendix 20.10 for tree protection on construction and development sites best management practices. See appendix 20.5 for standard detail for protection of all trees (public, private)

In developing a tree protection plan, the applicant shall consult a certified arborist, with a certification in Tree Risk Assessment (TRAQ). All vegetation scheduled or conditioned to be retained during development or construction actions shall be assessed by a certified arborist in accordance with industry accepted arboricultural standards as well as the standards contained in appendix 20.10. The project arborist shall integrate any and all applicable protection and pre-conditioning measures outlined in appendix 20.10.

9.2 Excavation in Root Zone

To avoid damaging the health and stability of any existing tree which is to be retained, all root structures one (1) inch in diameter or greater found within the upper 24 inches of soil, should not be cut. All roots over two inches in diameter should be tunneled under. Use of pneumatic air tools to remove soil around existing root system is preferred. As last resort, if roots are to be cut, they should be cut cleanly. All exposed/cut roots shall be immediately covered with wet burlap, wet hog fuel/wood chips/sawdust or damp soil or compost to prevent desiccation. No ripping or tearing of the root structure shall be allowed. At no time shall the amount of root disturbance pose a danger to the general health or stability of the tree.

9.3 Violation - Penalty for Damage

Penalties for damage to vegetation covered by this document shall follow the appropriate PMC Section(s) including 11.28 or 20.95.

SLD-02 – Landscaping in storm water control facilities (Implementing standards - PMC 20.58.005 (3) code requirement).

Landscaping of storm water ponds and other storm water control or treatment facilities (e.g. rain gardens, bio-swales, bio-filtration cells, etc.) shall be designed to use native and/or climate adaptable plant materials to provide 100% ground coverage and 75% visual coverage within five (5) years of installation. In order to reduce maintenance requirements, the use of turf lawn is prohibited in these areas, unless part of a water treatment structure (e.g. bio-swale) where grass is required by the project engineer for water quality treatment purposes.

Ground covers shall be spaced at 18" intervals and shrubs at 3-5' intervals, or as specified by the project landscape architect, to meet the 100% ground coverage and 75% visual coverage requirement within five (5) years. Groupings or clusters of native evergreen and native deciduous trees shall be integrated into the overall design. NW native shrubs and ground cover plant species that provide a native, wildflower-rich landscape area that utilizes native plant species that bloom in successive timeframes throughout the growing season shall be used in all storm pond areas.

This is intended to promote local biological diversity and provide pockets of landscape area to benefit pollinator species. Selections from the following shrub species, in addition to other acceptable native plants the meet the criteria of providing blooming plants throughout the growing season, may be utilized to meet the SLD-02 requirements:

- Early season (April/May):
 - Osobery (Oemleria cerasiformis)
 - Oregon grape (Mahonia aquifolium)
 - Evergreen Huckleberry (Vaccinium ovatum)
 - Red elderberry (Sambucus racemosa)
 - Early/Mid-season (May/June):
 - Ninebark (Physocarpus capitatus)
 - Twinberry (Lonicera involucrate)
 - Red Flowering Currant (Ribes sanguineum)
 - Snowberry (Symphoricarpos albus)
 - Mid-season (June/July):
 - Nootka rose (Rosa nutkana)
 - Mocckorange (Philadelphus lewisii)
 - Rugosa rose (Rosa rugosa)
 - Late-season (August+):
 - Douglas spirea (Spiraea douglassii)
 - Oceanspray (Holodiscus discolor)

7.0 MATERIAL STANDARDS:

7.1 Plant Material - General Standards

At the time of installation, landscape plants required by the Puyallup Municipal Code or this document shall be healthy, vigorous, disease free specimens that meet or exceed the minimum standards presented below.

- All planting material shall meet or exceed the most recent standards established in the publication 'American Standards for Nursery Stock', ANSI Z60.1-2004 or current successor, of the American Association of Nurserymen (AAN).
- Specific size, location, spacing, installation, maintenance and/or removal techniques not specifically stated herein shall conform to prevailing arboricultural and horticultural best management practices and/or the most recent standards as set forth by the American Association of Nurserymen, International Society of Arboriculture or applicable equivalent.
- All plants installed shall be of the type, size and condition shown on the project's approved final landscape plan. Plants shall exhibit normal habits of growth for the species, shall be free of scars, bruises, breaks to major branches and weed roots and seeds. Trees shall be pruned to correct any structural defects in the branch architecture (e.g. co-dominant stems, crossing branches, branch spacing, etc.) as well as correct circling/girdling roots in the root ball.
- Plants shall be spaced appropriately for their type, function and intent within the landscape design (massing, screening, specimen). For example, plants used for screening need to be spaced more closely than those for individual display.
- No artificial lawn or plant material shall be accepted as satisfying landscape requirements.

7.2 Plant Material - Required Sizes

All non-street tree landscape material shall meet or exceed the following size standards at time of installation. Required sizes for street tree material is described in section 12.3. In some instances, additional or larger sized material may be required to mitigate the loss of on-site vegetation, to provide more immediate vegetation re-establishment, screening or buffering of the project site, or as other mitigation as determined appropriate by the Director. The following standards shall not apply in voluntary restoration of natural or critical areas.

- All small deciduous trees, those less than 25 feet tall at maturity, shall be at least 1" caliper, preferably 1.5" or larger, and branched with a strong, central single leader.
- Medium or large deciduous trees shall be at least one (1") inch in caliper, preferably 1.5" or larger, and branched with a strong, central single leader.
- All shrubs required by this document and/or Title 20 of the Puyallup Municipal Code shall be no smaller than two (2) gallon in size at the time of planting, unless otherwise specified.
- All groundcover materials required by this document and/or Title 20 of the Puyallup Municipal Code shall be no smaller than one (1) gallon in size, unless otherwise specified.
- Coniferous evergreen trees shall be a minimum of 5 to 6 feet in height.
- Any material not specifically listed shall meet current AAN standards and be of appropriate size to satisfy the intent of this document and/or the PMC.
- 7.3 Native plant materials
- A minimum of 25 percent of the shrubs and ground covers used in projects under the requirements of the PMC and the VMS shall be native to the Puget Sound region.
- 7.4 Non-vegetative Landscape Material
 - Bark, mulch, gravel or other non-vegetative material shall only be used in conjunction with ground cover plantings to assist growth and maintenance or to visually complement plant material. Non-vegetative material is not a substitute for and should not appear to be visually dominate over plant material.
 - All non-vegetative ground cover material shall be generally free of foreign material and not detract from the overall design intent of the plan or these policies.
 - All non-vegetative material, site furnishings and built structures shall meet all applicable codes and be installed in a safe and professional manner.

CITY OF PUYALLUP
Planning Division
Approved Landscape Plan
(253) 864-4165 (Option 3)

Staff: JHJ&LEW
Date: 03/26/2026

THIS APPROVAL IS VOID AFTER 180 DAYS FROM APPROVAL DATE. THE CITY IS NOT RESPONSIBLE FOR ERRORS OR OMISSIONS ON THESE PLANS. FIELD CONDITIONS MAY DICTATE CHANGES TO THESE PLANS AS DETERMINED BY THE PLANNING DIRECTOR, DESIGNER, OR PROJECT PLANNER.

NOTE: Request final landscape inspection via the City's online permit portal at [permits.puyallup.gov/permits](https://puyallup.gov/permits). Root barriers are required around street trees in accordance with city standard detail. Top soil shall be installed in accordance with city standards. Field verification required. Failure to install top soil and root barriers in accordance with the city standards may result in rejection of installation.

Nature By Design
Landscape Architecture

1320 Alameda Avenue, Suite B, Everett, WA 98206
www.naturebydesigninc.com
253.460.6067

PROJECT: **BASS PRO SHOP**

1106 Valley Ave NW, PUYALLUP, WA 98371
1042 Valley Ave NW, PUYALLUP, WA 98371

FARCEL #: 04220163042

REVISIONS:

B. REVISED SITE PLAN BASED ON AGENCY REVIEW

DRAWING ISSUED FOR: **AGENCY REVIEW**

DATE: JANUARY 5, 2026

STATE OF WASHINGTON
KATHARINE OWENS
LICENSED LANDSCAPE ARCHITECT

PROJECT NO: 25083
FILE NAME: 25083LSB
DRAWN BY: KLO
CHECKED BY: KLO
X-REFS: NONE
PLOT SCALE: 1:1
DRAWING SCALES: N.T.S.

DRAWING CONTENTS

LANDSCAPE DETAILS & NOTES

DRAWING NO.: **L2**

2 OF 2

CITY OF PUYALLUP
DEVELOPMENT ENGINEERING and PUBLIC WORKS DEPARTMENTS

ROOT BARRIER DETAIL

1. ROOT BARRIERS SHALL BE REQUIRED IN ALL STREET TREE PLANTING INSTALLATIONS WHETHER NEW OR EXISTING, WHEN STREET TREES ARE INSTALLED IN RIGHT-OF-WAY OR IN A PLANTING EASEMENT.
2. ROOT BARRIERS USED SHALL BE DOWROCK ROOT BARRIERS OR EQUIVALENT.
3. UB - 24 SHALL BE USED.
4. ROOT BARRIERS SHALL BE INSTALLED IF REQUIRED BY THE CITY.
5. INSTALLATION OF ROOT BARRIERS TO BE IN ACCORDANCE WITH THE MANUFACTURER'S SPECIFICATIONS.
6. THE PANEL SHALL BE INSTALLED SO THE VERTICAL RIBS FACE THE ROOTS OF THE TREE. A MINIMUM OF FOUR (4) PANELS SHALL BE INSTALLED ON EACH SIDE OF ROOT BALL FOR 6" OF PROTECTION.
7. FOR PRODUCT INFORMATION VISIT: https://www.dowrock.com/?media=347&tree=products&media=tree&rootbarrier&content=ub_24&tab=3&id=1
*PLANTING EASEMENT SHALL MEAN THAT PORTION OF LAND MADE AVAILABLE AS A PUBLIC EASEMENT FOR THE PURPOSE OF PLANTING AND MAINTAINING CITY STREET TREES. ALL STREET TREES PLANTED WITHIN A PLANTING EASEMENT SHALL BE PLANTED WITHIN THREE FEET OF ROOT-OF-WAY.

01.02.03

CITY OF PUYALLUP
DEVELOPMENT ENGINEERING and PUBLIC WORKS DEPARTMENTS

GROUND COVER PLANTING DETAIL


01.02.05

CITY OF PUYALLUP
DEVELOPMENT ENGINEERING and PUBLIC WORKS DEPARTMENTS

BALL AND BURLAP PLANTING DETAIL


01.02.07

CITY OF PUYALLUP
DEVELOPMENT ENGINEERING and PUBLIC WORKS DEPARTMENTS

STREET TREE PLANTING IN PLANTING STRIP

