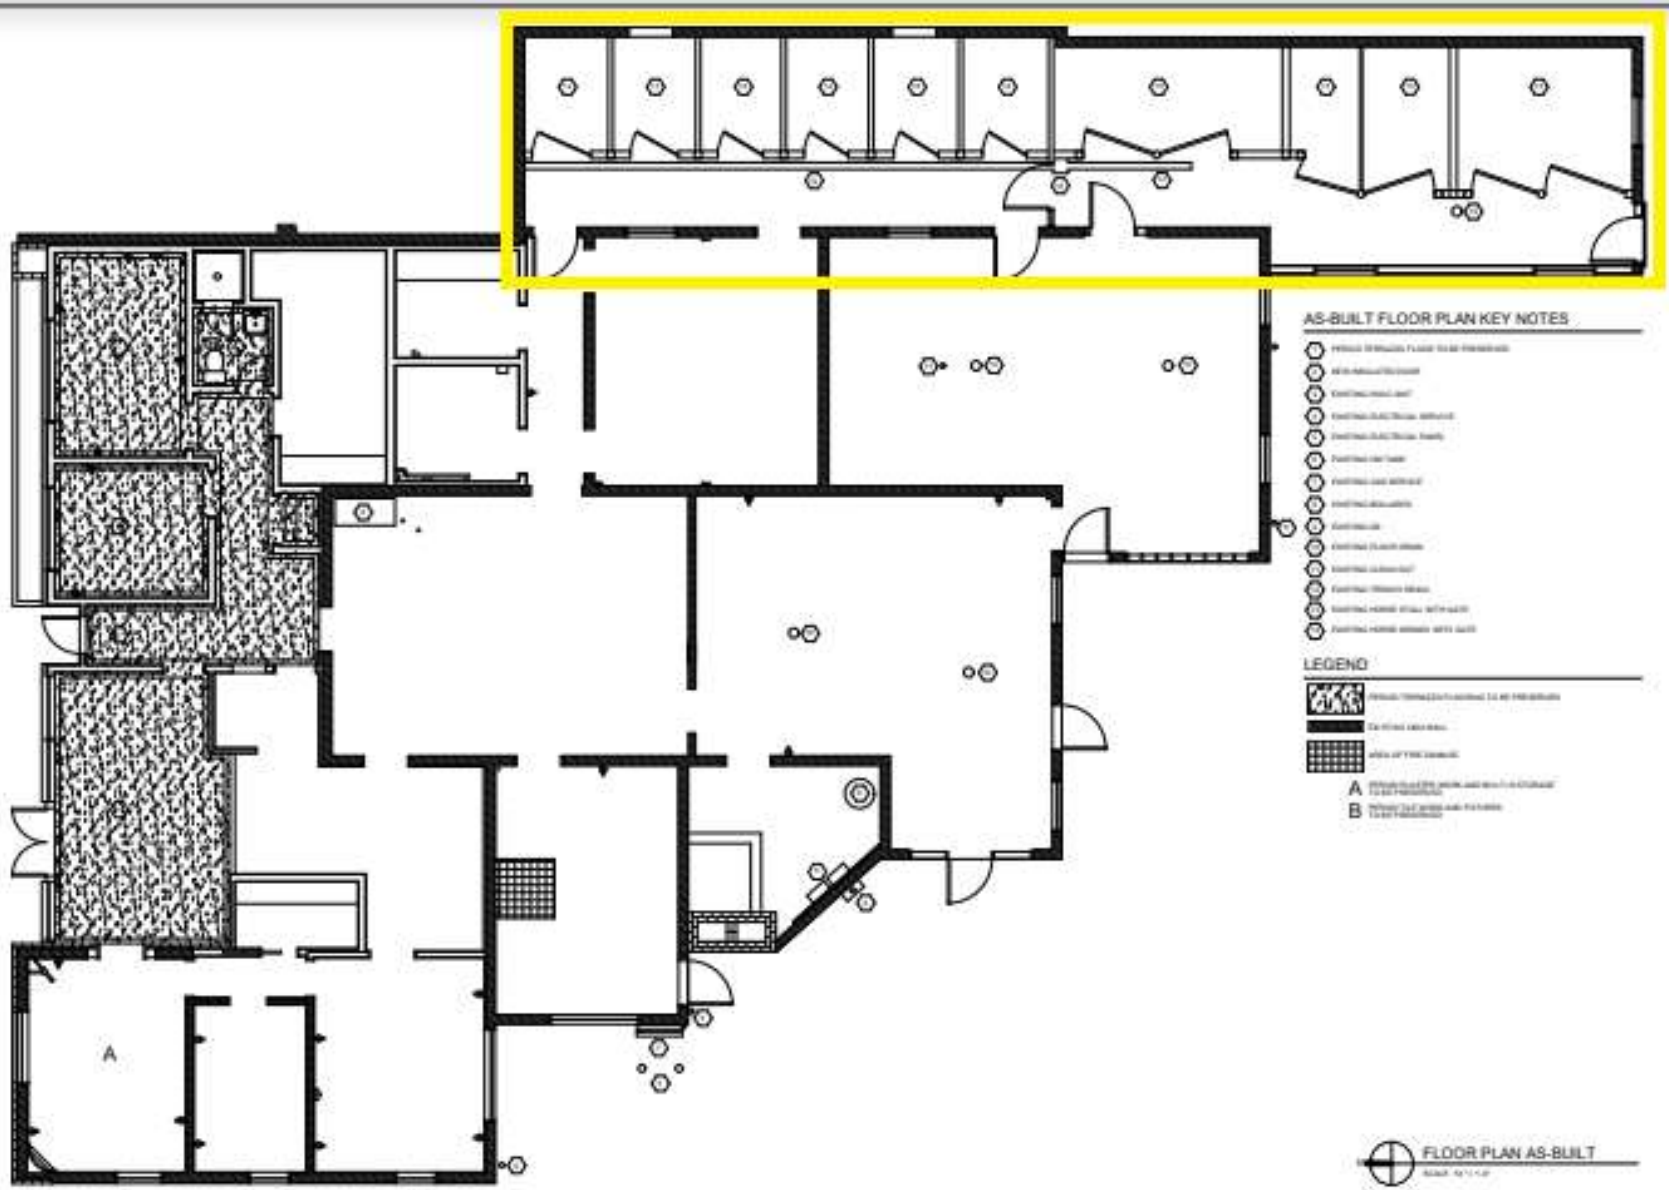

CHECK SET
NOT FOR CONSTRUCTION

BENTON | ARCHITECTS

FIRE DAMAGE REPAIR
MR. JOHN HOPKINS
192 E. MAIN

AS-BUILT FLOOR PLAN

A.1